

Tests to Determine the Behavior of #11 Bars with Lap Splices

Bowen Laboratory
 Purdue University
 Spring 2012

Test Procedure

1. Fabrication

1.1 Formwork

The formwork shall be made using non-absorbent plywood. Its interior shall be caulked to prevent water leakage and it shall be covered with a thin layer of oil before casting. The dimensions of the formwork shall be checked and recorded using Form 1.

1.2 Reinforcement Cages

The steel reinforcement cages shall be built following the drawings attached. Reinforcing bars shall be supported by steel chairs placed away from lap splices. To ensure alignment, the bars shall be tied to chairs and to one another using gage-16 steel wire. The location of the reinforcement shall be recorded using Form 1. The locations of wire ties and rebar markings shall be recorded using Form 2.

Tolerances (within the test region) are:

- 3/16" for horizontal cover and horizontal spacing measured to the surface of the bar (excluding ribs)
- 1/4" for vertical distances shown in Form 1

1.3 Casting

Fresh concrete properties to be measured include:

- Unit Weight
- Slump
- Air Content

These measurements shall be made following the Specifications and recorded using Form 3.

Summary										
BECHTEL POWER CORPORATION										
SUPPLIER DOCUMENT REVIEW CLASSIFICATION & STATUS										
<input type="checkbox"/> Nuclear Safety-Related			<input type="checkbox"/> Augmented Quality			<input checked="" type="checkbox"/> Non-Safety-Related				
STATUS CODE:										
1	<input checked="" type="checkbox"/> Work may proceed			3	<input type="checkbox"/> Rejected. Revise and Resubmit.					
1C	<input type="checkbox"/> Work may proceed. Editorial comments need only be incorporated if revised for other purposes.			4	<input type="checkbox"/> Review not required. Work may proceed.					
2	<input type="checkbox"/> Revise and resubmit. Work may proceed subject to incorporation of changes indicated.									
Permission to proceed does not constitute acceptance or approval of design details, calculations, analysis, test methods, or materials developed or selected by the Supplier and does not relieve the Supplier from full compliance with contractual obligations.										
Reviewed by	Arch	Civil	CS	Elect	Mech	MET	PD	Constr	Startup	STE
	N/A	R	N/A	N/A	N/A	N/A	N/A	N/A	N/A	N/A
Checked by:	P. ...						Date:	6/13/12		

Slump shall be measured before any other activity related to casting takes place to make sure that the delivered mix has satisfactory workability. The mixing truck shall deliver a ticket with the batched mix weights. These weights shall be examined to corroborate that the delivered mix has the specified proportions. Concrete shall not be accepted if it arrives more than 45 min. after leaving the batching plant. No water shall be added to the mix after the truck leaves the plant.

Specimens and cylinders shall be cast and vibrated in two lifts following the Specifications. The vibrators to be used shall have the following cross-sectional dimensions:

For cylinders: 3/4" - 7/8"
For Larger Specimens: 1-3/4"

Their frequencies shall be between 50 and 200 Hz.

Excess concrete shall be removed off the formwork. The exposed surfaces of the specimens shall be finished using cast magnesium floats. Lifting inserts shall be inserted in the fresh concrete as soon as the finishing is completed.

Each test beam shall be cast using concrete from a single mixing truck. A complete set of concrete samples (cylinders) shall be obtained from each truck. Test beams and samples shall be marked with a number referring to the truck from which they were cast and the date of casting. In each casting day, trucks shall be numbered sequentially starting at 1. The number assigned to a truck shall be written clearly on the mix ticket describing the mix proportions for the batch. Test beams shall be cast and tested oriented in the North-South axis of the laboratory. During finishing, the north end of each beam shall be marked with the letter N.

These activities shall be documented using Form 3

1.4 Curing

As soon as casting is completed all specimens shall be covered with impermeable sheets. When the concrete surface sets, wet burlap shall be inserted between these sheets and the exposed concrete. All formwork and molds shall be struck no later than three days after the cast.

All exposed concrete surfaces shall be covered by wet burlap and impermeable sheets for a total of at least seven days after casting.

Burlap shall be doused with water at least every other day during the curing period.

Curing activities shall be logged using Form 4.

Test cylinders shall be stored and cured next to the test specimens and under similar conditions of temperature and humidity.

The variation of concrete strength with time shall be monitored as specified in the Specifications. The results of cylinder tests shall be recorded using Form 5.

2. Calibration

Three types of measurements will be made: displacement, force, air content.

The apparatuses to be used to calibrate sensors to measure these quantities are:

Displacement Sensors: INSTRON Universal Testing Machine (S.N.:)

Load Sensors: INSTRON Universal Testing Machine (S.N.:)

Air Content: Calibrated Cylinder (S.N.)

Load and displacement sensors will be calibrated following steps listed below:

- 1) Connect the sensor to the data-acquisition system that is going to be used in the test
- 2) Set and record the excitation voltage to the maximum possible value (not exceeding the maxima specified for the data-acquisition system and the sensor)
- 3) Set the data-acquisition equipment to record voltage
- 4) Set the gain of the data-acquisition system to the first available level lower than the ratio of the maximum range of the system to the maximum expected output from the sensor.
- 5) Mount the sensor on the universal testing machine
- 6) Apply a series of known displacement or force increments to the sensor ranging between 10% and 90% of the rated capacity of the sensor
- 7) Record the voltage read on the data-acquisition system at each known displacement or force increment
- 8) Create a plot of change in output voltage vs. change in force or displacement
- 9) Fit a line to the plot from 7) using "least squares"
- 10) Record the slope of the line from 8) (sensor sensitivity)
- 11) Label the cable used in the calibration with the serial number of the sensor

Sensors shall be calibrated before the first test and after the final test.

The apparatus used to measure air content of the fresh concrete shall be calibrated following the procedure described in ASTM standard 231. Form 6B shall be used to document the calibration.

All calibrations shall be performed by at least two persons: one leading each step and the other checking the work of the first independently. A log of each calibration shall be made using Form 6 and it shall include an estimate of the accuracy of the sensor.

Sensors for which the sensitivity obtained in 9) above deviates by more than 10% from the nominal sensitivity (as reported by the manufacturer) shall not be used in any of the tests.

3. Setup

Each test beam shall be placed on two roller supports as described in the attached proposal. The final location of the supports shall be measured (to the nearest 1/16 in.) with maximum deviation of 1/4 in and reported using Form 7. As-built external dimensions of each test beam shall be recorded using the same form. The maximum deviation from nominal dimensions in the test region shall be 1/4 in.

The test beam shall be placed with the reinforcement facing up as shown in the attached proposal.

The shear spans shall be reinforced with external stirrups (pairs of 5/8-in threaded rods) installed at a spacing not exceeding 12 in. The locations of the stirrups shall be measured. The measurements shall be recorded using Form 7.

The loading rigs (consisting of a loading tube, two hydraulic rams, two threaded rods, plates and nuts, and one load cell per rig) shall be placed on the test specimen and connected to "the strong floor" of the laboratory (without applying load to the specimen other than the weight of the rigs) as described in the attached proposal. The rams in each rig shall be connected to a single manifold and pump using 10,000-psi hydraulic hoses. All hoses and other hydraulic hardware shall be inspected visually and replaced -if defective- before testing.

4. Instrumentation

Displacement sensors shall be installed at midspan, at each support, and at each load point. They shall be secured to the strong floor of the laboratory directly below the point where displacement is to be measured.

All sensors (displacement and force) shall be connected to the data acquisition system using the same cables used during calibration. The excitation voltage and gain shall also be set to the value used in calibration. The data acquisition system shall be set to record voltage changes caused by loading. Before applying load with the hydraulic rams, all sensors shall be set to read a voltage value between 10% and 90% of the voltage output of the sensor at its rated capacity. These voltages shall be referred to as the "zero offsets" of the sensors. If a sensor is set to have an initial

voltage exceeding 20% of its output at rated capacity, the sign of the initial “zero offset” shall be opposite to the sign of the expected change in its signal.

Set the data acquisition system to scan all sensors and save at least one record per sensor every 1 sec.

Record a file of “zero offsets” capturing at least 10 min. of data before any load is applied with the hydraulic system.

Means of initial voltages for all sensors (mean “zero offsets”), sensor serial numbers, the most recent sensitivity constants, excitation voltages, and the channels of the data-acquisition system used for each sensor shall be recorded using Form 8. The pairing of channels and sensors shall be checked by a second person working independently from the person making the initial connections.

Infrared targets to be used to measure displacements as described in the attached proposal shall be glued to one face of the test beam using epoxy adhesive. The numbering sequence of these targets shall be recorded using Form 9.

Video cameras (one for long-time lapse video and one for high-speed video) will be positioned to capture the response of the mid third of each specimen. To the extent possible, the location of the cameras shall be the same in all tests.

5. Testing

The following actions shall take place during each test:

At the end of each loading increment:

Mark Cracks: all visible cracks shall be marked using black permanent markers. Cracks shall be marked by drawing lines parallel to them and with an offset of approximately 0.25 in.

Measure Crack Widths: Crack widths shall be measured using crack comparators or graduated handheld microscopes.

Measure coordinates of infrared coordinates: A set of coordinates shall be obtained using an OptoTrack System 600 Pro. A set of four targets shall be attached to the strong floor. They shall be located at approximately the same distance to the OptoTrack cameras as targets attached to the test beam. Coordinates for these reference targets shall be obtained at each loading increment. They are to be used to monitor the stability of the Optotrack system by computing the variation in the distances between reference targets.

In-Test Data Backup: At every loading increment the data being produced by the data-acquisition system shall be copied to an external hard drive.

Photographs: a set of high-resolution photographs shall be obtained after cracks are marked at each loading increment. The photographs shall include views of both elevations of the test beam and the top concrete surface above lap splices.

The following data shall be recorded throughout each test:

Sensor readings: to be recorded on a hard drive in volts. Conversion to engineering units shall be done after the test as follows:

- Subtract zero offsets
- Divide the result by the sensitivity obtained in the most recent calibration

Lapse video photographs: to be obtained every 5 min.

Actions to be taken at failure

Trigger high-speed camera to record breaking away of the concrete cover and relative movement of the bars.

Actions to be taken after test

Generate a record of sensors that may have malfunctioned or been accidentally moved during the test


Remove from all files recordings from sensors for which the results of the after-test calibration differ by more than 5% from the before-test calibration.

6. Reporting and Backup


Produce all the captured data in two ways:

- By uploading data, photos, and video to a private project at nees.org.
- By recording all data, photos, and video on a magnetic hard drive

Reports shall be produced as described in the Specifications.

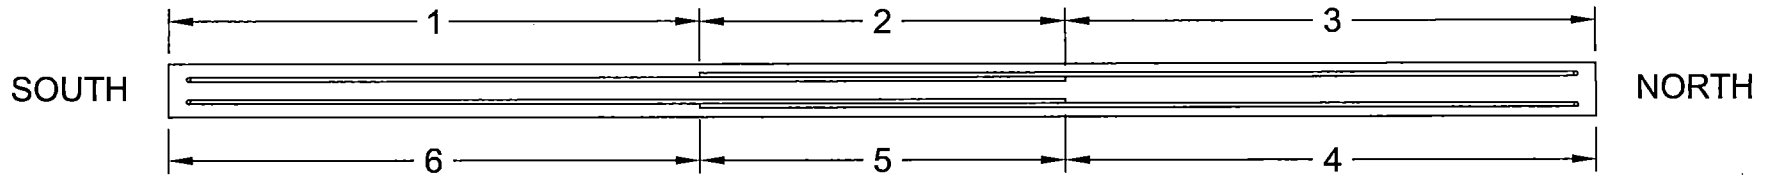

Section A-A


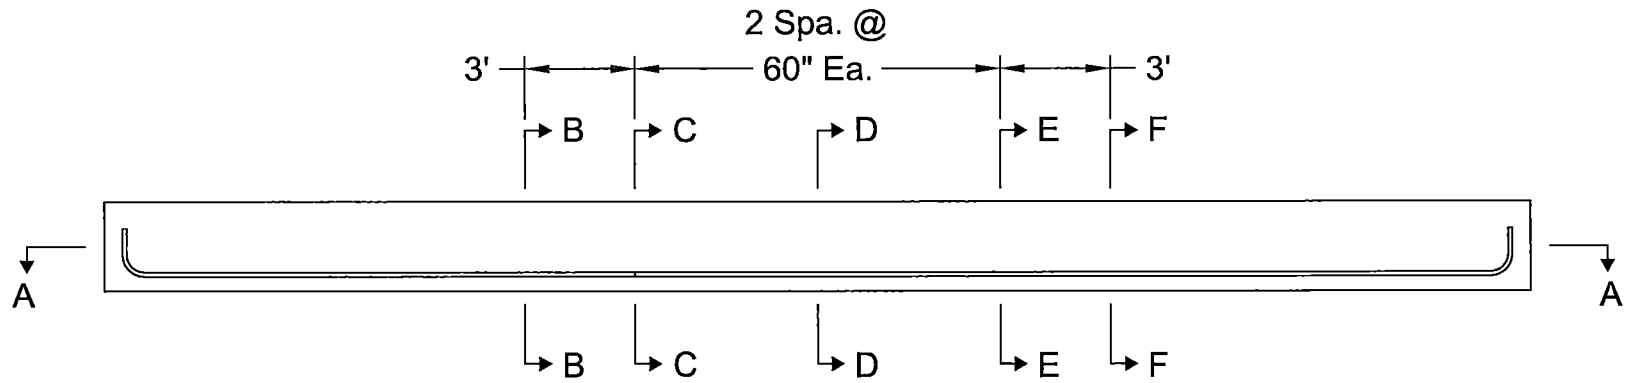


*For section B-B through F-F see Sheet 3 of 3

Series A



Drawing:	Series A Formwork As-builts	Sheet:	1	of	3
Project:	Experimental Investigation of Capacity of Lap Splices of No. 11 Reinforcing Bars	Drawn by:	BPR	Checked by:	SP
		Date:	04/04/2012		

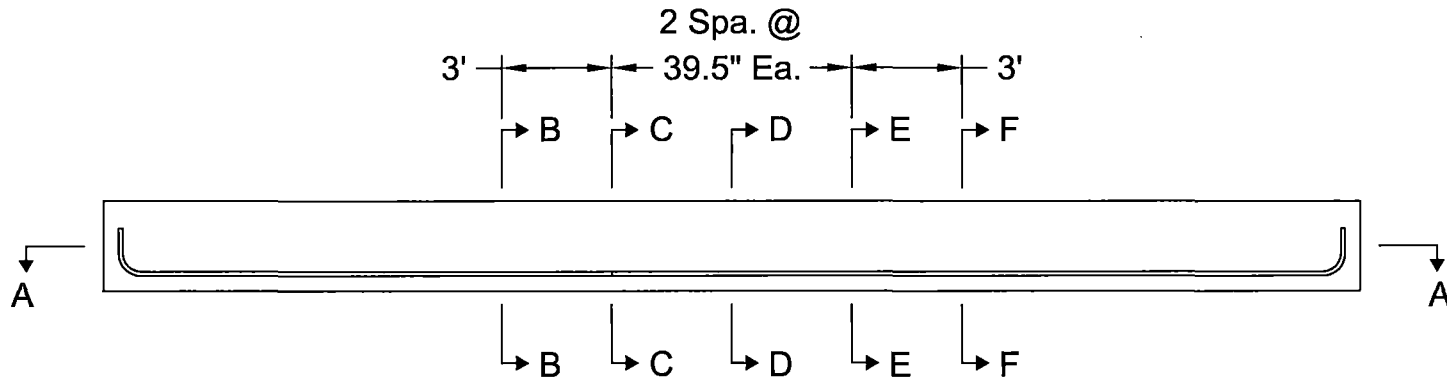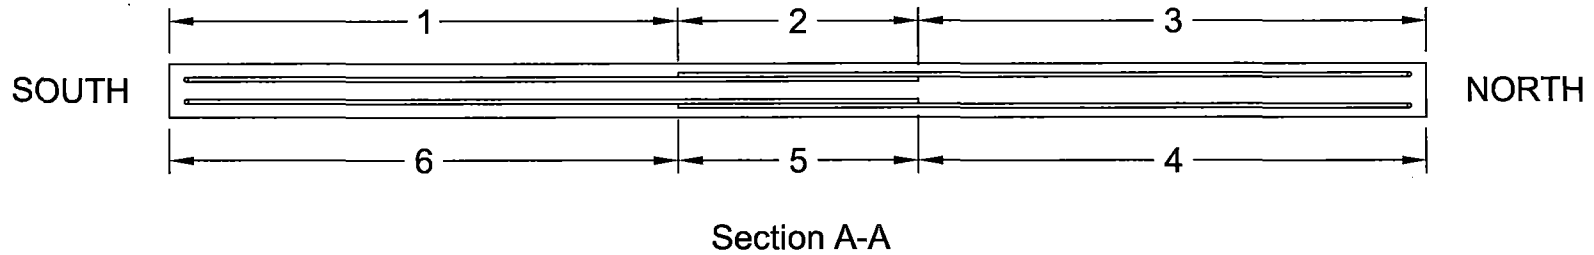

*For section B-B through F-F see Sheet 3 of 3

Series B



Drawing:

Series B Formwork As-builts

Sheet:

2

of

3

Project:

Experimental Investigation of
Capacity of Lap Splices of No.
11 Reinforcing Bars

Drawn by:


BPR

Checked by:


SP

Date:

04/04/2012

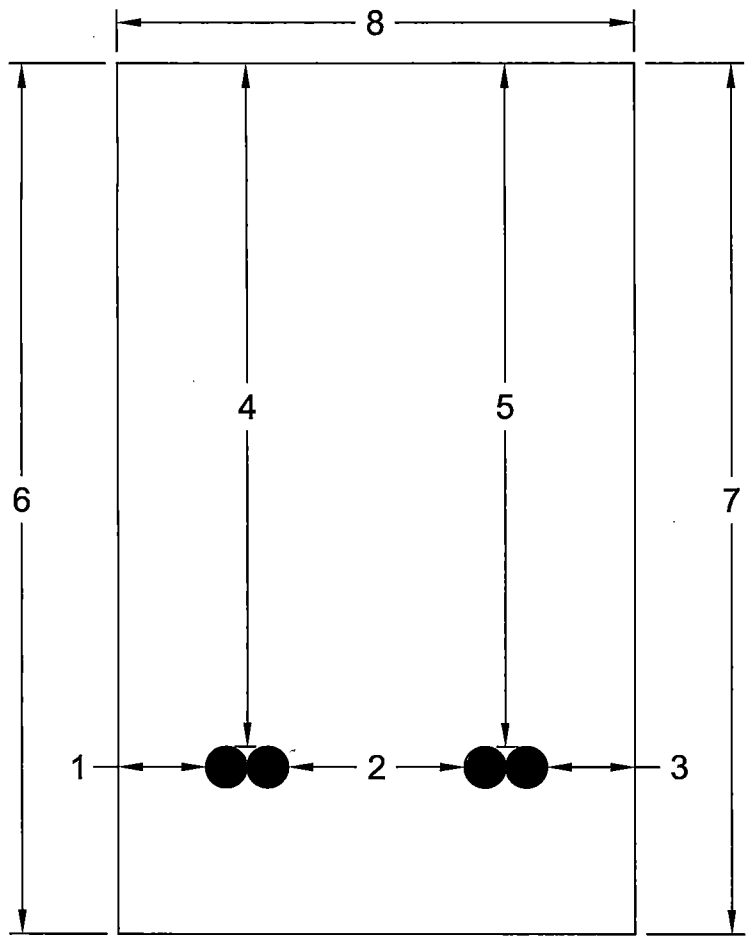

Section C-C, D-D, & E-E
*Facing North

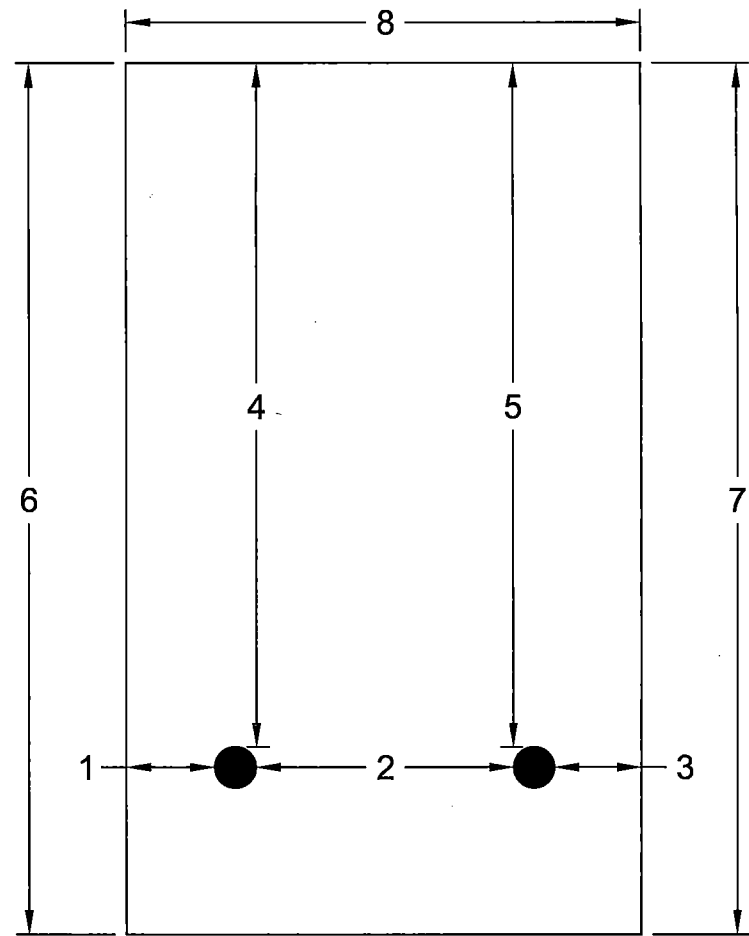

Section B-B & F-F
*Facing North



Drawing:	Formwork As-built Sections	Sheet:	3	of	3
Project:	Experimental Investigation of Capacity of Lap Splices of No. 11 Reinforcing Bars	Drawn by:	BPR	Checked by:	SP
		Date:	04/04/2012		

Project: Tests to Determine the Behavior of Spliced #11 Bars

As-built Dimensions v.1
(Rev. 04/04/2012)

Specimen: _____


Section	Formwork As-built Dimensions							
	1	2	3	4	5	6	7	8
A-A								
B-B								
C-C								
D-D								
E-E								
F-F								
Recorded by:			Signature				Date	Time
Checked by:			Signature				Date	Time
Checked by:			Signature				Date	Time

Comments:

*See formwork as-built drawings for dimension locations


Section	Formwork As-built Dimensions Key - Series A							
	1	2	3	4	5	6	7	8
A-A	14'-6"	10'-0"	14'-6"	14'-6"	10'-0"	14'-6"	N/A	N/A
B-B	4-3/8"	6"	4-3/8"	23-5/8"	23-5/8"	30"	30"	17-5/8"
C-C	3"	6"	3"	23-5/8"	23-5/8"	30"	30"	17-5/8"
D-D	3"	6"	3"	23-5/8"	23-5/8"	30"	30"	17-5/8"
E-E	3"	6"	3"	23-5/8"	23-5/8"	30"	30"	17-5/8"
F-F	3"	8-3/4"	3"	23-5/8"	23-5/8"	30"	30"	17-5/8"
Section	Formwork As-built Dimensions Key - Series B							
	1	2	3	4	5	6	7	8
A-A	13'-10.5"	6'-7"	13'-10.5"	13'-10.5"	6'-7"	13'-10.5"	N/A	N/A
B-B	4-3/8"	6"	4-3/8"	23-5/8"	23-5/8"	30"	30"	17-5/8"
C-C	3"	6"	3"	23-5/8"	23-5/8"	30"	30"	17-5/8"
D-D	3"	6"	3"	23-5/8"	23-5/8"	30"	30"	17-5/8"
E-E	3"	6"	3"	23-5/8"	23-5/8"	30"	30"	17-5/8"
F-F	3"	8-3/4"	3"	23-5/8"	23-5/8"	30"	30"	17-5/8"

Wire Ties

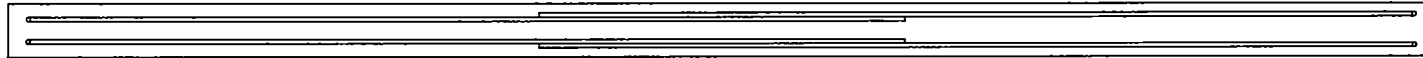

NORTH

Bar Marks

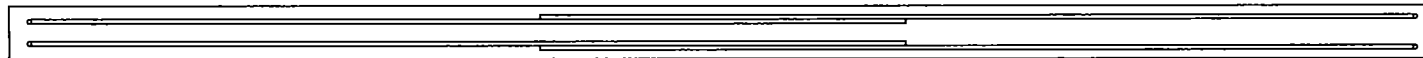

NORTH



Specimen:					
Project:	Behavior of Lap Splices of No. 11 Reinforcing Bars	Drawn by:		Checked by:	
		Date:			

Project: Tests to Determine the Behavior of Spliced #11 Bars

Casting Documentation v.1
(Rev. 03/30/2012)

Specimen: _____

Sheet 1 of 1

General Information					
Date	Disp Ticket Num	Truck No.	Time on Ticket	Time of Arrival	Temp. in Lab
Measurements made upon arrival of concrete					
Slump (ASTM C143 - 10a)		Air Content (ASTM C231 - 10)			
Time ₁	Result ₁	Time ₁	Result ₁	S/N of Air Meter	
Time ₂	Result ₂	Time ₂	Result ₂	S/N of Scale	
Unit Weight (ASTM C138 - 10b)					
Time ₁	Wt. of Cont. ₁	Total Wt. ₁	Wt. of Conc. ₁	Result ₁ = Wt. of Conc./Vol. of Cont.	
Time ₂	Wt. of Cont. ₂	Total Wt. ₂	Wt. of Conc. ₂	Result ₂ = Wt. of Conc./Vol. of Cont.	
Times of actions during and after casting					
Layer 1 placed	Layer 1 vibration complete	Layer 2 placed	Layer 2 vibration complete	Top surface struck off	Truck Departing Lab
Lifting Inserts Placed	Covered with plastic	Plastic removed	Covered with burlap	Burlap doused with water	Covered with plastic
Recorded by		Signature		Date	Time
Checked by		Signature		Date	Time
Checked by		Signature		Date	Time
Comments:					
*The following ASTM standards and specifications will be followed during casting: C172-10, C192-07, C470-09					

Project: Tests to Determine the Behavior of Spliced #11 Bars

Curing Documentation v.1 (Rev. 03/30/2012)

Purdue University - Bowen Laboratory Sheet 1 of 1

General Information			
Specimen(s)	Date	Specimen Age	
	Time Beginning	Time Ending	
	Temperature inside Lab (deg. F)		
Description of Work Performed			
Recorded by	Signature	Date	Time
Checked by	Signature	Date	Time
Checked by	Signature	Date	Time
Comments:			
*Test specimens and associated cylinders are to be cured under wet burlap for seven days			

Project: Tests to Determine the Behavior of Spliced #11 Bars

Cylinder Compression Tests Documentation v.2
(Rev. 04/01/2012)

Specimen: _____

Specimen	Date	Time of Test	Wet/Dry	Diameter [nearest 0.01 in.]		Length [nearest 0.05 in.]			P _{max} [lb _f]	Fracture Type (1-6)
				1	2	1	2	3		
1										
2										
3										
4										
5										
6										

S/N of Testing Machine:					
Recorded by:	Signature			Date	Time
Checked by:	Signature			Date	Time
Checked by:	Signature			Date	Time

Comments:

*Cylinders to be test per ASTM C-39-12 and C-1231-10a with a loading rate of 60,000lb_f/min at concrete ages of 3, 7, 14, 28 days, and on same day that test of corresponding specimen is conducted. Specimens and caps free of defects unless otherwise noted in comments. Average cylinder diameter and area and unit compressive stress (f'_c) calculated on sheet 2 of 2.

Project: Tests to Determine the Behavior of Spliced #11 Bars

Cylinder Compression Tests Documentation v.2
(Rev. 04/01/2012)

Specimen: _____

Specimen	Date	Age	Time of Test	Wet/Dry	Average Measured Dia. [in.]	Cross-sectional Area [in ²]	P _{max} [lbf]	f' _c [psi]	Fracture Type (1-6)
1	0-Jan		12:00 AM	0	#DIV/0!	#DIV/0!	0	#DIV/0!	0
2	0-Jan		12:00 AM	0	#DIV/0!	#DIV/0!	0	#DIV/0!	0
3	0-Jan		12:00 AM	0	#DIV/0!	#DIV/0!	0	#DIV/0!	0
4									
5									
6									

S/N of Testing Machine:							
Recorded by:		Signature			Date		Time
0					0		0
Checked by:		Signature			Date		Time
0					0		0
Checked by:		Signature			Date		Time

Comments:

*Cylinders to be test per ASTM C-39-12 and C-1231-10a with a loading rate of 60,000lbf/min at concrete ages of 3, 7, 14, 28 days, and on same day that test of corresponding specimen is conducted. Specimens and caps free of defects unless otherwise noted in comments. Recorded data is shown on sheet 1 of 2.

Project: Tests to Determine the Behavior of Spliced #11 Bars

Calibration Documentation v.1
(Rev. 04/02/2012)

Bowen Lab - Purdue University
Sheet 1 of 1


Calibration Instrument Name and S.N.:					
Data Acquisition System:					
Gain:					
Excitation Voltage:					
Channel:					
Sensor:					
Sensor S.N.:					
Measurand	Voltage	Measurand	Voltage	Measurand	Voltage
Operator		Signature		Date	Time
Checked by		Signature		Date	Time
Checked by		Signature		Date	Time
Results	Sensitivity		Accuracy		
Notes:					

Project: Tests to Determine the Behavior of Spliced #11 Bars

Form 05
Calibration Documentation v.1
(Rev. 04/06/2012)

Bowen Lab - Purdue University
Sheet 1 of 1

Meter S.N.			
Type of Meter			
Meter Brand Name			
Ambient Temperature			
	Target Air Content	Measured Air Content	
Operator	Signature	Date	Time
Checked by	Signature	Date	Time
Checked by	Signature	Date	Time
Notes:			

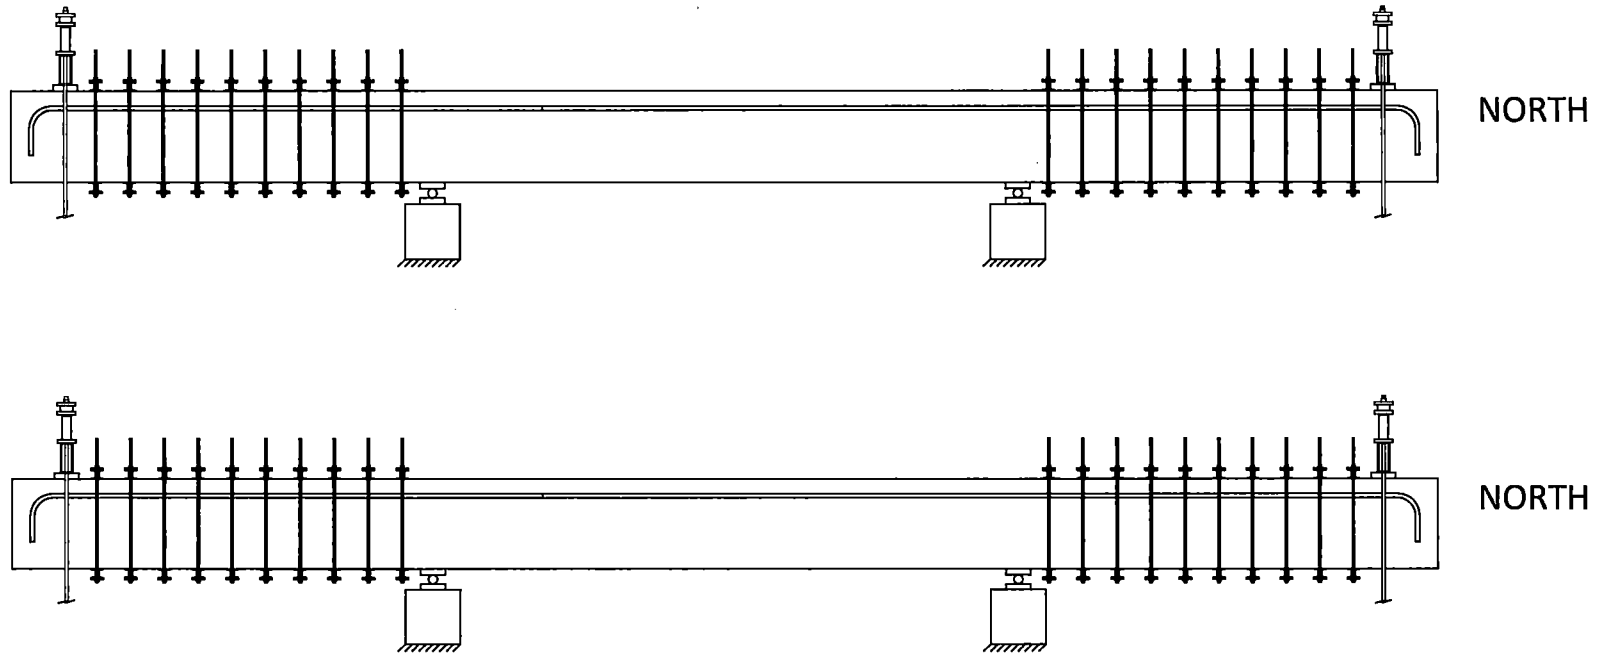

Specimen

Behavior of Lap Splices of No. 11
Reinforcing Bars

Sheet:

1


of

4

Drawn by:



Checked by:

Date:

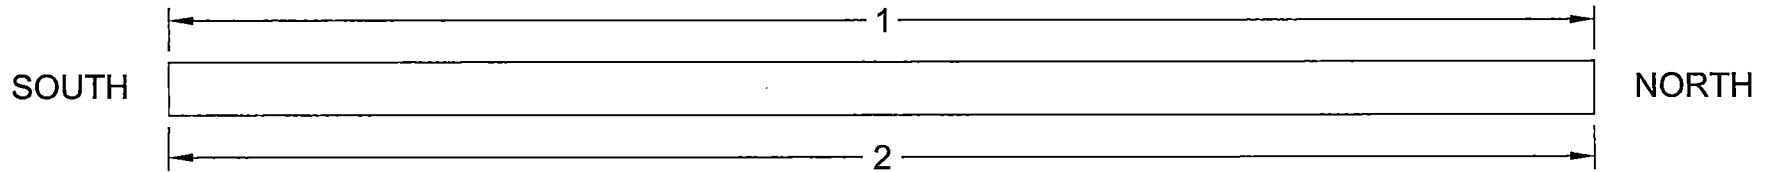


Top Plan

2 Spa. @

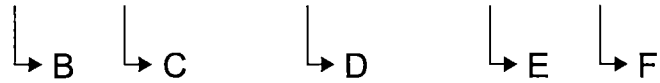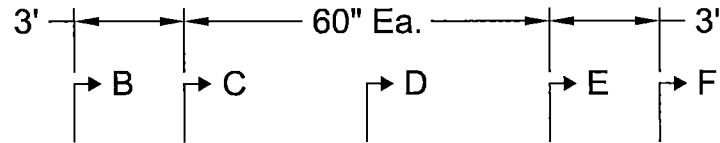

Profile


*For section B-B through F-F see Sheet 3 of 3

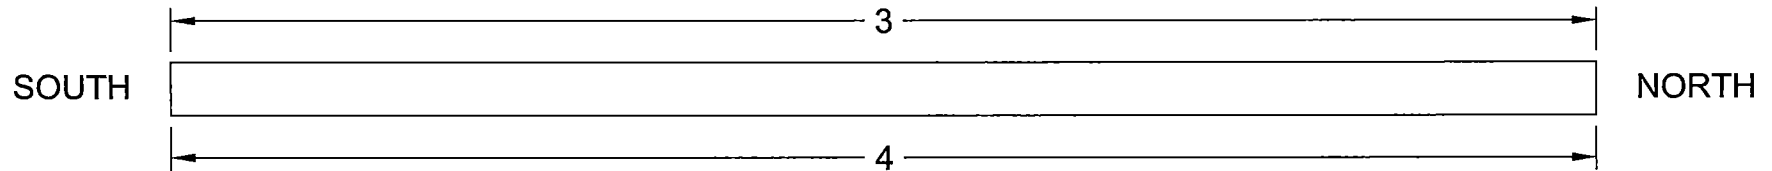



Bottom Plan



Drawing:	Series A Concrete As-builts	Sheet:	2	of	4
Project:	Experimental Investigation of Capacity of Lap Splices of No. 11 Reinforcing Bars	Drawn by:	BPR	Checked by:	SP
		Date:	04/04/2012		

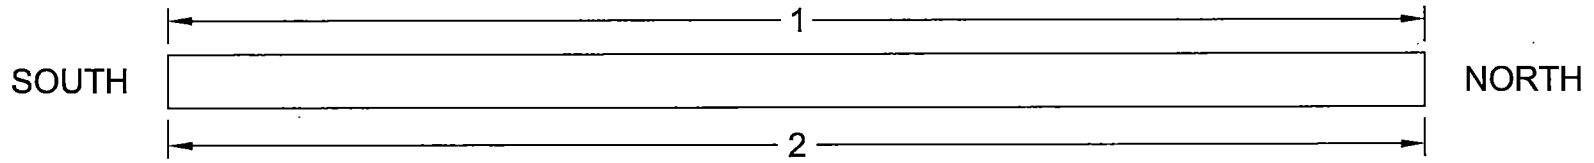


Top Plan

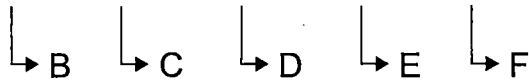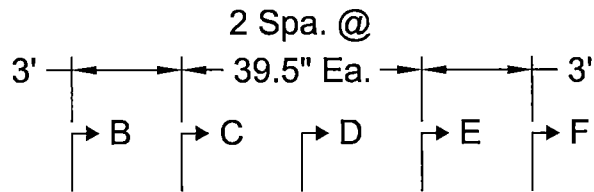

Profile


*For section B-B through F-F see Sheet 3 of 3

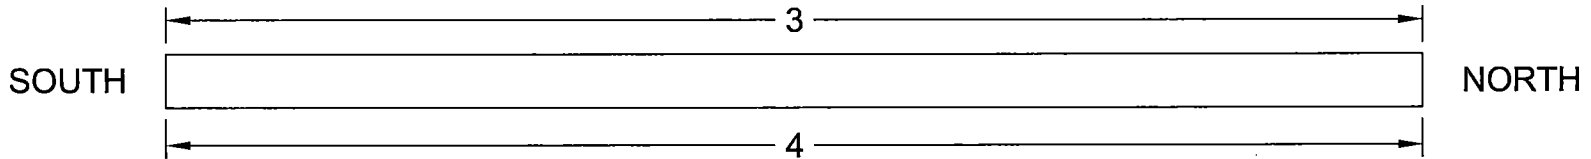

Bottom Plan



Drawing:	Series B Concrete As-builts	Sheet:	3	of	4
Project:	Experimental Investigation of Capacity of Lap Splices of No. 11 Reinforcing Bars	Drawn by:	BPR	Checked by:	SP
		Date:	04/04/2012		

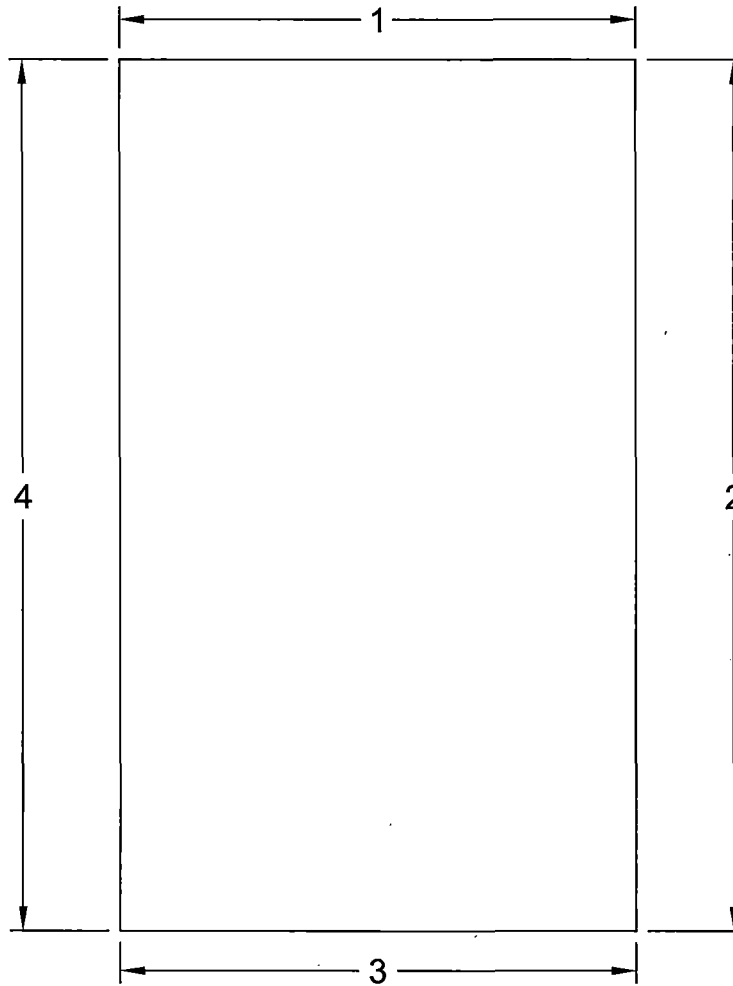

Section B-B, C-C, D-D, E-E & F-F
*Facing North



Drawing:	Concrete As-built Sections	Sheet:	4	of	4
Project:	Experimental Investigation of Capacity of Lap Splices of No. 11 Reinforcing Bars	Drawn by:	BPR	Checked by:	SP
		Date:	04/04/2012		

Section	Concrete As-built Dimensions							
	1	2	3	4	5	6	7	8
Plan								
B-B								
C-C								
D-D								
E-E								
F-F								
Recorded by:			Signature				Date	Time
Checked by:			Signature				Date	Time
Checked by:			Signature				Date	Time
Comments:								

*See concrete as-built drawings for dimension locations

Section	Concrete As-built Dimensions Key - Series A							
	1	2	3	4	5	6	7	8
Plan	39'-0"	39'-0"	39'-0"	39'-0"	N/A	N/A	N/A	N/A
B-B	17-5/8"	30"	17-5/8"	30"	N/A	N/A	N/A	N/A
C-C	17-5/8"	30"	17-5/8"	30"	N/A	N/A	N/A	N/A
D-D	17-5/8"	30"	17-5/8"	30"	N/A	N/A	N/A	N/A
E-E	17-5/8"	30"	17-5/8"	30"	N/A	N/A	N/A	N/A
F-F	17-5/8"	30"	17-5/8"	30"	N/A	N/A	N/A	N/A
Section	Concrete As-built Dimensions Key - Series B							
	1	2	3	4	5	6	7	8
Plan	34'-4"	34'-4"	34'-4"	34'-4"	N/A	N/A	N/A	N/A
B-B	17-5/8"	30"	17-5/8"	30"	N/A	N/A	N/A	N/A
C-C	17-5/8"	30"	17-5/8"	30"	N/A	N/A	N/A	N/A
D-D	17-5/8"	30"	17-5/8"	30"	N/A	N/A	N/A	N/A
E-E	17-5/8"	30"	17-5/8"	30"	N/A	N/A	N/A	N/A
F-F	17-5/8"	30"	17-5/8"	30"	N/A	N/A	N/A	N/A


Form 8

Project: Tests to Determine the Behavior of Spliced #11 Bars

Instrumentation Documentation v.1
(Rev. 04/01/2012)

Specimen: _____
Sheet _____ of _____

Data Acquisition System:								
Channel #	Gain	Excitation V.	Sensor	S.N.	Sensitivity	Zero Offset	Location	Comments
Operator		Signature			Date		Time	
Checked by		Signature			Date		Time	
Checked by		Signature			Date		Time	
Notes:								

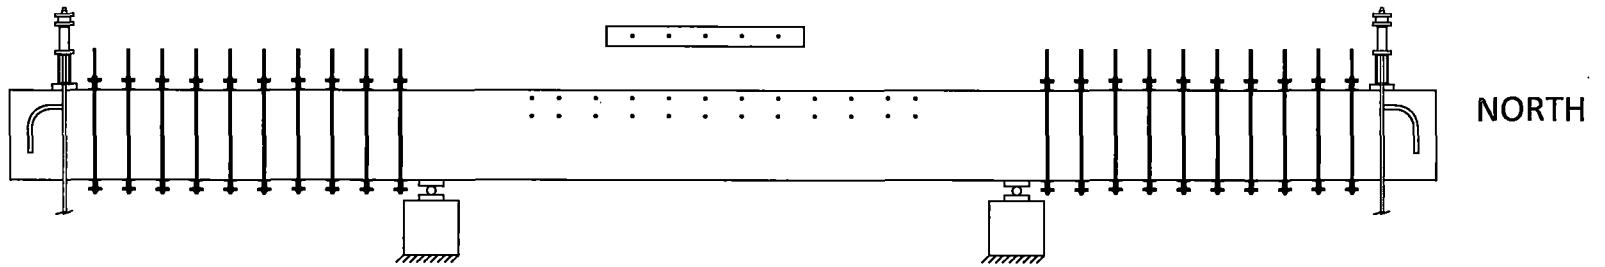

Specimen

Behavior of Lap Splices of No. 11
Reinforcing Bars

Drawn by:

Checked by:

Date:

	Average Load (lb) K	North Overhang (in)	South Overhang (in)	North Splice End (in)	Midspan (in)	South Splice End (in)	LVDT North Support	LVDT South Support	North Load Cell (lb) K	South Load Cell (lb) K	DG North Overhang (in)	DG South Overhang (in)	Time
1	0.2	0.01	0.01	0.00	-0.00	-0.00	0.000	-0.000	0.2 0.2	0.2 0.2	0.300 0.100	0.000	7:44A
2	3.6	first crack											
3	6	0.20	0.19	0.03	0.04	0.02	0.000	-0.000	6	6	0.294	0.171	8:16A
4	12	0.52	0.51	0.08	0.11	0.07	-0.000	-0.000	12	12	0.614	0.500	8:38A
5	18	0.87	0.90	0.13	0.19	0.13	-0.000	0.000	18	18	0.960	0.897	9:01A
6	24	1.23	1.27	0.18	0.28	0.19	-0.001	-0.001	24	24	1.329	1.268	9:35A
7	30	1.64	1.67	0.24	0.36	0.25	-0.002	-0.001	30	30	1.738	1.668	10:00A
8	N+S	DG reset									0.800	0.900	10:26A
9	36	2.05	2.09	0.31	0.46	0.31	-0.002	-0.001	36	36	1.236	1.338	10:28A
10	37.3	yield											
11	38	2.36	2.51	0.35	0.53	0.38	-0.003	-0.001			1.554	1.755	10:54A
12	40.5	3.87	4.14	0.65	0.90	0.68	-0.005	-0.004	40.7	40.3			11:33A
13	20.2	3.03	3.20	0.52	0.70	0.55	-0.005	-0.005	20.2	20.2			11:58A
14	0.2	1.91	2.14	0.32	0.43	0.36	-0.005	-0.004	0.2	0.2			12:05P
15	12	2.42	2.68	0.42	0.55	0.44	-0.005	-0.004	12.0	12.0			12:20P
16	24	3.05	3.34	0.52	0.70	0.55	-0.005	-0.004	24.0	24.0			12:37P
17	36	3.70	3.99	0.62	0.86	0.65	-0.004	-0.004	36.0	36.0			12:54P
18	40.7	4.33	4.67	0.73	1.01	0.77	-0.005	-0.005	40.1	40.0			1:22p
19	41.9	5.34	5.67	0.90	1.23	0.95	-0.006	-0.004	41.4	41.2			1:36p
20	43	6.34	6.67	1.09	1.48	1.13	-0.010	-0.010	42.2	42.1			1:44p

Purdue University

Specimen: A-2

Date: 6/1/12

	Average Load (lbf)	North Overhang (in)	South Overhang (in)	North Splice End (in)	Midspan (in)	South Splice End (in)	LVDT North Support	LVDT South Support	North Load Cell (lbf)	South Load Cell (lbf)	DG North Overhang (in)	DG South Overhang (in)	Time
1	0.28	0	0	-0.01	0	-0.01	-0.001	-0.001	0.3	0.3	0.2	0.2	8:01A
2	1st crack at 2.7k								6 ^{DL}	6 ^{DL}			8:01A ^{DL}
3	6	0.14	0.11	0.01	0.03	0.01	-0.001	-0.001	6	6	0.340	0.312	8:07A
4	12	0.44	0.44	0.06	0.10	0.06	-0.000	-0.001	12	12	0.638	0.632	8:35A
5	18	0.79	0.78	0.11	0.18	0.11	-0.001	-0.001	18	18	0.985	0.968	8:54A
6	24	1.16	1.17	0.17	0.26	0.17	-0.001	-0.001	24	24	1.355	1.367	9:21A
7	30	1.56	1.53	0.22	0.34	0.22	-0.002	-0.001	30	30	1.765	1.720	9:55A
8	N + S DG reset										0.800 ^{DL}	0.800	
9	36	1.93	1.89	0.27	0.42	0.28	-0.002	-0.001	36	36	1.274	1.165	10:29A
10	38.4	2.29	2.22	0.33	0.48	0.32	-0.001	-0.000			1.499 ^{DL} 635	1.499	10:59A
11	40.8	3.63	3.39	0.55	0.72	0.53	-0.002	-0.001	10.6	41			11:32A
12	Max. Load ~44.5k.												
13													
14													
15													
16													
17													
18													
19													
20													

Purdue University

Specimen: A-3

Date: 5/30/12

	Average Load (lb) K	North Overhang (in)	South Overhang (in)	North Splice End (in)	Midspan (in)	South Splice End (in)	LVDT North Support	LVDT South Support	North Load Cell (lb) K	South Load Cell (lb) K	DG North Overhang (in)	DG South Overhang (in)	Time
1	0.16	0.00	0.00	0.00	0.00	0.00	-0.002	-0.002	0.2	0.1	0.1	0.1	8:06
2	6.2	0.13	0.15	0.02	0.03	0.02	-0.002	-0.002	6.2	6.2	6.2 ^{0.234}	0.218	8:13
3	12	0.44	0.47	0.07	0.1	0.07	-0.002	-0.001	12	12	0.538	0.57	8:33
4	18	0.80	0.83	0.12	0.18	0.12	-0.003	0.000	17.9	18	0.894	0.932	9:03
5	24	1.19	1.19	0.18	0.26	0.17	-0.003	0.001	24	24	1.289	1.284	9:32
6	30	1.55	1.57	0.23	0.33	0.23	-0.003	0.002	30	30	1.657	1.657	10:11
7	36	1.93	1.96	0.29	0.42	0.29	-0.004	0.004	36	36	/	/	10:40
8													
9													
Purdue University

Specimen : A-4

Date: 6/8/12

	Average Load (lbf)	North Overhang (in)	South Overhang (in)	North Splice End (in)	Midspan (in)	South Splice End (in)	LVDT North Support	LVDT South Support	North Load Cell (lbf)	South Load Cell (lbf)	DG North Overhang (in)	DG South Overhang (in)	Time
1	0.3	-0.01	-0.01	-0.00	-0.00	0.00	-0.001	-0.001	0.3	0.3	0.000	0.000	7:43A
2	2.2	first crack											
3	6.0	0.17	0.16	0.02	0.04	0.03	-0.001	-0.001	6.0	6.0	0.169	0.171	7:52A
4	12.0	0.49	0.51	0.07	0.11	0.07	-0.001	-0.002	12.0	12.0	0.494	0.519	8:11A
5	18.0	0.96	0.92	0.14	0.21	0.14	-0.001	-0.001	18.0	18.0	0.963	0.929	8:36A
6	24.1	1.33	1.29	0.19	0.29	0.19	-0.001	-0.001	24.1	24.1	1.338	1.299	9:04A
7	29.9	1.73	1.69	0.25	0.38	0.26	-0.000	-0.001	29.9	29.9	1.740	1.706	9:24A
8	N+S	DG reset									0.000	0.000	
9	36.0	2.15	2.13	0.32	0.48	0.32	-0.000	0.001	36.0	36.0	0.428	0.439	9:51A
10	N+S	DG reset									0.000	0.000	
11	36.8	yield							36.8	36.7			
12	37.8	2.66	2.67	0.40	0.58	0.42	-0.001	0.002	37.8	37.8	0.520	0.538	10:20A
13	40.0	3.97	4.04	0.61	0.85	0.66	-0.003	0.003	39.9	40.1	1.825	2.922	10:54A
14	20.2	3.13	3.25	0.49	0.66	0.54	-0.003	0.003	20.2	20.2	0.983	1.110	11:25A
15	0.3	1.97	2.09	0.31	0.40	0.35	-0.003	0.001	0.3	0.3			11:30A
16	12.0	2.49	2.60	0.39	0.51	0.43	-0.003	0.001	12.0	12.0			11:46A
17	24.0	3.16	3.26	0.49	0.66	0.54	-0.003	0.002	24.1	24.0			11:59A
18	36.0	3.83	3.93	0.59	0.82	0.64	-0.003	0.003	36.0	36.0			12:16P
19	40.4	4.44	4.56	0.69	0.96	0.75	-0.003	0.005	40.5	40.4			12:35P
20	41.7	5.17	5.55	0.86	1.17	0.93	-0.003	0.005	41.6	41.9			12:53P

Purdue University

Specimen: A-5Date: 6/7/12

	Average Load (lbf)	North Overhang (in)	South Overhang (in)	North Splice End (in)	Midspan (in)	South Splice End (in)	LVDT North Support	LVDT South Support	North Load Cell (lbf)	South Load Cell (lbf)	DG North Overhang (in)	DG South Overhang (in)	Time
1	0.22	0.03	0.00	0.01	0.01	0.00	-0.002	-0.002	0.3	0.2	0.000	0.000	7:35A
2	3.2	first crack											
3	6.0	0.17	0.15	0.03	0.05	0.03	-0.002	-0.002	5.9	6.1	0.169	0.151	8:00A
4	12.0	0.49	0.49	0.07	0.11	0.07	-0.002	-0.001	12.0	12.0	0.488	0.488	8:21A
5	18.0	0.86	0.84	0.13	0.20	0.13	-0.002	-0.001	18.0	18.0	0.860	0.846	8:45A
6	24.0	1.23	1.25	0.18	0.28	0.18	-0.001	0.000	24.0	24.0	1.231	1.257	9:11A
7	30.0	1.61	1.63	0.25	0.37	0.24	-0.001	0.001	30.0	20.0	1.623	1.645	9:38A
8	N+S	DG reset									0.000	0.000	
9	36.0	2.07	2.10	0.31	0.47	0.32	-0.000	0.001	36.0	36.0	0.450	0.464	10:06A
10	37.5	yield											
11	37.38	2.44	2.61	0.37	0.55	0.39	-0.000	0.001	37.7	37.5	0.875	0.987	10:32A
12	N+S	DG reset									0.000	0.000	
13	40.2	3.90	4.12	0.63	0.85	0.66	-0.000	-0.001	40.2	40.2	1.540	1.531	10:58A
14	20.3	3.08	3.29	0.50	0.66	0.52	-0.000	-0.001	20.3	20.2	0.622	0.767	11:32A
15	0.2	1.95	2.12	0.32	0.40	0.34	-0.002	-0.001	0.2	0.2			11:38A
16	12.0	2.47	2.67	0.40	0.51	0.42	-0.002	-0.001	11.9	12.0			11:51A
17	24.0	3.11	3.34	0.50	0.67	0.53	-0.001	-0.001	24.1	24.0			12:04P
18	36.0	3.77	4.01	0.61	0.82	0.64	-0.000	-0.001	36.0	36.0			12:19P
19	40.7	4.38	4.62	0.71	0.97	0.75	0.000	-0.001	40.8	40.6			12:41P
20	42.2	5.39	5.63	0.88	1.20	0.94	0.000	-0.003	42.3	42.0			12:58P

Purdue University

Specimen : A-6

Date: 6/5/12

	Average Load (k)	North Overhang (in)	South Overhang (in)	North Splice End (in)	Midspan (in)	South Splice End (in)	LVDT North Support	LVDT South Support	North Load Cell (k)	South Load Cell (k)	DG North Overhang (in)	DG South Overhang (in)	Time
1	0.23	0.00	0.00	0.00	-0.00	0.00	-0.000	-0.000	0.3	0.2	0.000	0.000	1:04 P
2	3.14	first crack											
3	6	0.15	0.15	0.02	0.03	0.03	0.001	-0.000	6.0	6.0	0.144	0.154	1:12 P
4	12	0.45	0.45	0.07	0.09	0.07	0.004	0.000	12.0	12.1	0.447	0.450	1:30 P
5	18	0.86	0.86	0.13	0.18	0.13	0.007	-0.001	18.0	17.9	0.851	0.845	1:55 P
6	24	1.27	1.23	0.18	0.27	0.18	0.008	-0.001	24.0	24.0	1.268	1.219	2:25 P
7	30	1.64	1.64	0.24	0.36	0.25	0.009	-0.002	30.0	30.0	1.639	1.651	2:48 P
8	N+S	DG reset									0.000	0.000	2:56 P
9	36	2.09	2.12	0.31	0.47	0.33	0.009	-0.003	36	36	0.458	0.475	3:51 P
10	37	Yield											
11	38	2.63	2.79	0.41	0.59	0.44	0.009	-0.004	37	37	1.003	1.163	3:55 P
12	N+S	DG reset									1.021	1.181	
13											0.000	0.000	4:26 P
14	39.8	3.84	4.19	0.62	0.86	0.68	0.009	-0.007	39.9	39.7	1.173	1.400	4:31 P
15	20.2	3.00	3.37	0.49	0.66	0.54	0.008	-0.007	20.1	20.3	0.333	0.556	4:57 P
16	0.22	1.86	2.20	0.31	0.40	0.35	0.007	-0.007	0.2	0.2			5:06 P
17	12	2.39	2.74	0.39	0.52	0.44	0.007	-0.007	12.0	12.0			5:22 P
18	24	3.04	3.40	0.50	0.67	0.55	0.008	-0.007	24.0	24.0			5:36 P
19	36	3.71	4.07	0.60	0.83	0.66	0.009	-0.007	36.0	36.0			5:49 P
20	10.3	4.32	4.70	0.70	0.97	0.77	0.009	-0.009	10.7	39.9			6:13 P

Purdue University

Specimen : A-6

Date: 6.5.12

	Average Load (lbf)	North Overhang (in)	South Overhang (in)	North Splice End (in)	Midspan (in)	South Splice End (in)	LVDT North Support	LVDT South Support	North Load Cell (lbf)	South Load Cell (lbf)	DG North Overhang (in)	DG South Overhang (in)	Time
21	41.1	5.07	5.44	0.83	1.15	0.93	0.008	-0.011	41.1	41.2			6:23P
22	Max Load: ~42.k												
23													
24													
Purdue University

Specimen: B-1

Date: 5/10/12

	Average Load (kip)	North Overhang (in)	South Overhang (in)	North Splice End (in)	Midspan (in)	South Splice End (in)	LVDT North Support	LVDT South Support	North Load Cell (lbf)	South Load Cell (lbf)	TIME
1	0.2	0.01	-0.01	0	0	0	-0.001	-0.000	0.2	0.2	12:10
2	DGs	0	0								
3	3.5	0.05	0.04	0.01	0	0	0	0	3.5	3.5	
4	DGs	0.035	0.045								
5	2.3	0.04	0.04	0.01	0	0	-0.001	0	2.2	2.3	2 PM
6	DGs	0.033	0.044								
7	6	0.13	0.14	0.02	0.02	0.02	0.001	0.001	6	6	2:04
8	DGs	0.122	0.146								
9	12	0.44	0.42	0.05	0.07	0.06	0.003	0.001	12	12	2:21
10	DGs	0.414	0.429								
11	18	0.79	0.76	0.1	0.13	0.1	0.004	0.002	18	18	2:53
12	DGs	0.762	0.770								
13	24	1.1	1.07	0.15	0.18	0.14	0.007	0.002	24	24	3:16
14	DGs	1.069	1.079								
15	30	1.43	1.42	0.19	0.24	0.19	0.008	0.003	30	30	3:43
16	DGs	1.401	1.432	→ REMOVED							
17	36	1.82	1.81	0.25	0.31	0.25	0.009	0.003	36	36	4:16
18	~40	Failure.									
19											
20											

Purdue University

Specimen: B-2

Date: 5/23/12

	Average Load (lb) K	North Overhang (in)	South Overhang (in)	North Splice End (in)	Midspan (in)	South Splice End (in)	LVDT North Support	LVDT South Support	North Load Cell (lb) kip	South Load Cell (lb) kip	DG North Overhang (in)	DG South Overhang (in)	Time
1	0.2	0	0.01	0	0	-0.01	-0.005	0.001	0.3	0.2	+ 0.100	0.100	7:57A
2	3.4	1 st CRACK											
3	6.0	0.14	0.16	0.02	0.02	0.01	-0.005	0.001	6	6	0.238	0.244	8:30 A
4	12	0.47	0.42	0.06	0.07	0.05	-0.004	0.002	12	12	0.571	0.510	8:54A
5	18	0.81	0.78	0.11	0.13	0.10	-0.003	0.002	18	18	0.897	0.871	9:11 A
6	24	1.14	1.11	0.15	0.19	0.15	-0.002	0.003	24	24	1.217	1.206	9:35A
7	30	1.48	1.46	0.2	0.25	0.2	-0.001	0.004	30	30	1.558	1.548	10:00A
8	36	1.88	1.85	0.26	0.33	0.26	-0.001	0.004	36	36	N.A.	1.945	10:26 A
9											Reset: @ 1.9	RELATIVE MEASUREMENTS	
10	18	1.27	1.23	0.18	0.22	0.17	-0.002	0.005	18	18	1.296	1.320	11:10 A
11	0.2	0.48	0.48	0.07	0.08	0.06	-0.004	0.001	0.2	0.2	0.500	0.550	11:15 A
12	12	0.89	0.87	0.12	0.15	0.11	-0.002	0.002	12	12	0.914	0.960	11:30 A
13	24	1.43	1.39	0.2	0.24	0.19	-0.001	0.004	24	24	1.444	1.480	11:45A
14	36	1.96	1.91	0.28	0.34	0.27	-0.001	0.006	36	36	—	2.009	12:00 N.
15	DG's Removed @ 36 k												
16	Max Load = 39k												
17													
18													
19													
20													

	Average Load <u>lb/k</u>	North Overhang (in)	South Overhang (in)	North Splice End (in)	Midspan (in)	South Splice End (in)	LVDT North Support	LVDT South Support	North Load Cell <u>lb/k</u>	South Load Cell <u>lb/k</u>	DG North Overhang (in)	DG South Overhang (in)	Time
1	0.2	0	0	0	0	0	-0.001	-0.003	0.2	0.2	0	0	8A
2	3k	: 1st crack											
3	6.2	0.14	0.14	0.02	0.03	0.02	-0.001	-0.002	6.2	6.2	0.143	0.132	8:10A
4	12	0.42	0.40	0.05	0.07	0.05	-0.003	-0.002	12	12	0.429	0.407	8:35A
5	18	0.78	0.74	0.10	0.13	0.10	-0.004	-0.002	18	18	0.780	0.747	9:04A
6	24	1.09	1.07	0.14	0.19	0.15	-0.004	-0.002	24	24	1.087	1.080	9:27A
7	30	1.43	1.41	0.19	0.25	0.2	-0.004	-0.001	30	30	1.420	1.423	9:57A
8	36	1.79	1.78	0.25	0.32	0.25	-0.004	0.000	36	36	1.780	1.795	10:28A
9	0.2	0.44	0.44	0.06	0.09	0.06	-0.004	-0.006	0.2	0.2	0.435	0.436	11:05A
10	12	0.86	0.84	0.12	0.15	0.12	-0.004	-0.004	12.1	11.9	0.854	0.840	11:14A
11	24	1.36	1.34	0.18	0.24	0.19	-0.004	-0.002	24	24	1.352	1.352	11:25A
12	36	1.87	1.84 ⁵	0.26	0.34	0.26	-0.004	-0.001	36	36	1.855	1.864	11:47A
13	MAX LOAD: 39.8k												
14													
15													
16													
17													
18													
19													
20													

Purdue University

Specimen : B-4

Date: 5/14/12

	Average Load (lbf)	North Overhang (in)	South Overhang (in)	North Splice End (in)	Midspan (in)	South Splice End (in)	LVDT North Support	LVDT South Support	North Load Cell (lbf)	South Load Cell (lbf)	DG North Overhang (in)	DG South Overhang (in)	Time
21	0.2	0	0	0	0	0	0	0	0.2	0.2	0.2	0.2	4:10 P
22	3.5	0.02	0.03	0	0	0	0	0.001	3.5	3.5	0.225	0.228	4:17 P
23	0.2	0	0	0	0	0	0	0.001	0.2	0.2	0.202	0.202	4:27 P
24													
25													
Purdue University

Specimen : B-4

Date: 5/14

	Average Load (lbf)	North Overhang (in)	South Overhang (in)	North Splice End (in)	Midspan (in)	South Splice End (in)	LVDT North Support	LVDT South Support	North Load Cell (lbf)	South Load Cell (lbf)	DG North Overhang (in)	DG South Overhang (in)	Time
1	0.2	0	0	0	0	0	-0.002	-0.001	0.2	0.2	0.203	+0.205	1:26
2	5.2	0.04	0.05	0	0	0	-0.001	0	5.2	5.2	0.245	0.255	~1:35
3	L	1ST CRACK											
4	12	0.31	0.33	0.04	0.05	0.05	0	0.001	12	12	0.514	0.535	1:58
5	18	0.62	0.63	0.08	0.11	0.08	0.003	0.002	18	18	0.811	0.833	2:20
6	L	1ST SPLIT. CRACK											
7	24	0.95	0.94	0.13	0.16	0.13	0.004	0.003	24	24	1.131 ✓	1.148 ✓	2:57
8	30	1.26	1.25	0.17	0.21	0.17	0.006	0.004	30	30	1.439 ✓	1.459 ✓	3:33
9	36	1.62	1.61	0.21	0.27	0.22	0.006	0.004	36	36	1.898	1.824	4:07
10	DGs Removed.												
11	38	1.77	1.76	0.23	0.3	0.24	.008	.005	38	38	—	—	4:56
12													
13													
14													
15													
16													
17													
18													
19													
20													

Purdue University

Specimen : B-5

Date: 5/17/12

	Average Load (lbf)	North Overhang (in)	South Overhang (in)	North Splice End (in)	Midspan (in)	South Splice End (in)	LVDT North Support	LVDT South Support	North Load Cell (lbf) \swarrow	South Load Cell (lbf) \swarrow	DG North Overhang (in)	DG South Overhang (in)	Time
1	0.2	0	0	0	0	0	0	0	0.2	0.2	0	0.300	12:20 PM
2	0.2	0	0	0	0	0	0.001	0.001	0.2	0.2	0	0.300	1:25 PM
3	6	0.08	0.08	0	0.02	0.01	0.002	0.002	6	6	0.076	0.380	1:37 PM
4	↳ 1 ST CRACK OBSERVED												
5	12	0.33	0.36	0.04	0.06	0.05	0.004	0.002	11.9	12	—	0.660	1:56 PM
6	18	0.70	0.65	0.08	0.11	0.09	0.004	0.003	18	18	0.691	0.948	2:20 PM
7	24	1.01	0.98	0.12	0.17	0.13	0.004	0.003	24	24	0.997	1.275	2:48 PM
8	30	1.33	1.30	0.17	0.22	0.17	0.005	0.003	30	30	1.303	1.593	3:16 PM
9	RESET DGS:										1.000	1.000	
10	36	1.68	1.63	0.22	0.28	0.22	0.005	0.004	36	36	1.343	1.342	3:44 PM
11	0	0.39	0.39	0.05	0.07	0.05	0.003	0.002	0	0	0.082	0.085	4:14 PM
12	12	0.76	0.74	0.09	0.13	0.10	0.004	0.002	12	12	0.444	0.441	4:42 PM
13	24	1.25	1.21	0.15	0.21	0.16	0.004	0.003	24	24	0.918	0.915	4:49 PM
14	32	1.56	1.53	0.2	0.27	0.21	0.005	0.004	32	32	—	—	5:30 PM
15													
16													
17													
18													
19													
20													

	Average Load <u>kip</u>	North Overhang (in)	South Overhang (in)	North Splice End (in)	Midspan (in)	South Splice End (in)	LVDT North Support	LVDT South Support	North Load Cell <u>kip</u>	South Load Cell <u>kip</u>	DG North Overhang (in)	DG South Overhang (in)	Time
1	0.18	0	0.02	0	0	0	-0.006	0	0.2	0.2	0	0.100	8:22 A
2	3.9 k:	1st crack											
3	6	0.1	0.12	0.01	0.01	0.01	-0.005	0.002	6	6	0.105	0.207	8:29 A
4	12	0.37	0.39	0.05	0.06	0.04	-0.004	0.003	12	12	0.368	0.470	8:57 A
5	18	0.73	0.71	0.09	0.11	0.08	-0.003	0.003	18	18	0.718	0.805	9:06 A
6	24	1.09	1.04	0.14	0.17	0.13	-0.002	0.004	24	23.9	1.068	1.130	9:30 A
7									30 ↘	30 ↘			
8	30	1.42	1.36	0.19	0.22	0.17	-0.001	0.005	30 ↘	30 ↘	1.392	1.457	9:54 A
9	36	1.76	1.70	0.24 0.24	0.29	0.23	0.001	0.006	36	36	1.734	1.795	10:14 A
10	18.5	1.18	1.16	0.16	0.19	0.15	-0.001	0.005	18.5	18.5	1.169	1.256	10:39 A
11	0	0.43	0.43	0.06	0.07	0.05	-0.004	0.004	0.2	0.2	0.404	0.505	10:50 A
12	12	0.81	0.80	0.11	0.13	0.10	-0.002	0.004	12	12	0.805	0.892	11:06 A
13	24	1.33	1.29	0.18	0.21	0.17	-0.000	0.005	24	24	1.303	1.381	11:18 A
14	36	1.85	1.78	0.25	0.30	0.24	0.001	0.006	36	36.1	1.820	1.876	11:34 A
15	38	2.02	1.93								NO DGs		
16	MAX	LOAD:	~41.6										
17													
18													
19													
20													

TAKING ACCURATE THERMOMETER READINGS

COMMON TYPES OF THERMOMETERS AND FACTORS AFFECTING THEIR USE

TOTAL IMMERSION thermometers are designed with scales calibrated to indicate the true temperature when the bulb and the portion of the thermometer that contains the mercury column are exposed to the temperature to be measured (practically, less than an inch is permitted to extend above the surface, to permit the reading to be made). Most total immersion thermometers can also be used in a condition of complete immersion, in which case the entire thermometer is exposed to the temperature being measured, such as in a freezer.

PARTIAL IMMERSION thermometers are designed with scales calibrated to indicate the true temperature when the thermometers are immersed to specified depths. The portion that should be immersed is indicated on the back of each thermometer.

COMPUTATION OF EMERGENT STEM CORRECTION

When total immersion thermometers are used only partially immersed, a stem correction may be calculated and applied to the reading for precision results. To compute an emergent stem correction, the following variables must be defined:

T = the reading of the thermometer in situ.

N = the number of degrees on the thermometer scale between the liquid surface and the top of the mercury column.

A = the average temperature of the emergent mercury column. To find value A, suspend alongside the subject thermometer a secondary or auxiliary thermometer with its bulb centered between the liquid level and the temperature indicated on the subject thermometer.

The temperature indicated on this auxiliary thermometer will be value A.

Find the stem correction (SC) by computation from the following formula:

$SC = 0.00016 \times (N \times (T-A))$ for Celsius temperatures, or

$SC = 0.00009 \times (N \times (T-A))$ for Fahrenheit temperatures.

Example: A thermometer graduated from -1° to 101°C ., immersed to 20°C on its scale, reading 90°C . The auxiliary thermometer reads 42°C . Hence, $T=90$, $N=70$ ($90-20$). $A=42$

Working the formula, $SC = 0.00016 \times (70 \times (90 - 42))$ yields a value for SC of $+0.537$. This value must be added to the observed indication of the subject thermometer to determine the true temperature of the liquid. Hence, the true temperature of the liquid is $90^{\circ} + .54^{\circ}$ (rounded result) = 90.54°

GENERAL CONSIDERATIONS FOR MAKING AN ACCURATE READING

The error due to parallax may be eliminated by taking care that the reflection of the scale can be seen in the mercury thread, and by adjusting the line of sight so that the graduation of the scale nearest the meniscus exactly hides its own image: the line of sight will then be normal to the stem at that point. In reading thermometers, account must be taken of the fact that the lines are of appreciable width. The best practice is to consider the position of the lines as defined by their middle parts.

PERFORMING A CALIBRATION AT THE ICE POINT (0 DEGREES CELSIUS OR 32 DEGREES FAHRENHEIT)

Select clear pieces of ice, preferably made from relatively pure water. Discard any cloudy or unsound portions. Rinse the ice with distilled water and shave or crush into small pieces, avoiding direct contact with the hands or any chemically unclean objects. Fill a Dewar or other insulated vessel with the crushed ice and add sufficient distilled (and preferably precooled) water to form a slush, but not enough to float the ice. Insert the thermometer, packing the ice gently about the stem, to a depth sufficient to cover the 0°C (32°F) graduation. As the ice melts, drain off some of the water and add more crushed ice.

Raise the thermometer a few millimeters after at least 3 minutes have elapsed, tap the stem gently and observe the reading. Successive readings taken at least one minute apart should agree within one tenth of one graduation.

APPLYING THE CORRECTION AT ICE POINT

Record readings and compare with previous readings. If the readings are found to be higher or lower than the reading corresponding to a previous calibration, readings at all other temperatures will be correspondingly increased or decreased.

Reproduced in part from ASTM E77.


KESSLER
KESSLER THERMOMETER CORP.

Precision and Reliability . . . from a name you can trust.

REDACTED VERSION

CALSER CORPORATION 302 N. BELT EAST SWANSEA, IL 62226 (618)277-0329

TESTING MACHINE CERTIFICATE OF CALIBRATION

Owner : Purdue University
Location : 1040 South River Rd. - Bowen Lab
 West Lafayette, IN 47907
Machine : Forney 600,000lbf Model F-600-DFM/1
Serial No. : 99058
 w/ Forney DFM/1 Digital R/O #9902182
 w/ Dynisco P/T #02-23-990747

Report # : VN# 6560

Page : 2 of 2

Date of Service: 06/06/11

This is to certify that the testing machine listed above has been calibrated by Calser Corporation personnel.
 The method of verification and listed data are in accordance with ASTM E 4-09.
 Accuracy of all calibration devices is traceable to the National Institute of Standards and Testing (NIST)
 and all calculations have been corrected for temperature where applicable.

Capacity Range	Loading Range	Max. Error
Run 1 600,000lbf Range	5,000 - 600,000	1.20 %
Run 2 600,000lbf Range	5,000 - 600,000	0.10 %
Run 3 600,000lbf Range	5,000 - 600,000	0.08 %

Verification Equipment Used:

(400,000 Load Cell Set)

Admet Gage Buster Digital Readout, Serial # GB-9911092,
 and Load Cell(s) Listed Below:

<u>Serial #</u>	<u>Range</u>	<u>Calib. Date</u>	<u>Uncertainty</u>
901120B	716.99 -10,000 lbf	08/19/2009	1.792 lbf
090716C (LO)	5,572.38 - 100,000 lbf	08/10/2010	13.931 lbf
090716C (HI)	39,281.95 - 400,000 lbf	08/10/2010	98.205 lbf

This certificate is issued as a statement of the fact that on the above date the listed testing machine has an accuracy as indicated. It should not be construed or regarded as a Guarantee or Warranty of any kind (in favor of the client, the client's customers, or the public at large) that the testing machine will continue to retain the same percentage (%) of accuracy or efficiency as determined on the date when the calibration, and adjustments if required, was performed and reported by "Calser Corporation" since the calibrator has absolutely no control over the future operation, damage, maintenance, repairs, and overall condition of the testing machine and hereby expressly disclaims any and all liability for damage or loss sustained by all parties arising or resulting from the deterioration, obsolescence, malfunction or substandard performance of said testing machine; which shall remain the sole responsibility of the machine's regular custodian, owner, and/or user. This certificate shall not be reproduced except in full, without the written approval of Calser Corporation.

CALSER CORPORATION

Quality Control Director


 Thomas R. Gagen

Form # 104-01-Rev 3

CALSER CORPORATION

302 N. Belt East, Swansea, IL 62226

(618) 277-0329

TESTING MACHINE CALIBRATION DATA AND REPORT

Report #: **VN# 6560**

Customer: Purdue University
 Location: 1040 South River Rd. - Bowen Lab
West Lafayette, IN 47907
 Machine: Fomey 600,000lbf Model F-600-DFM/1
 Serial No.: 99058
 Auxiliary Equipment: w/ Fomey DFM/1 Digital R/O #9902182
w/ Dymisco P/T #02-23-990747

Date of Service: 06/06/11
 Cust Order No.: Verbal
 Order Date: 06/02/11
 Temp.: 74° F
 Date Last Done: 05/19/10

Page 1 of 2

Applied Force	*	Indicated Force	Error	%	*	Indicated Force	Error	%	*	Indicated Force	Error	%
Run #1		Run #1	"As Found" Condition			Run #2	"As Left" Condition			Run #3	"As Left" Condition	
600,000lbf Range	*	10lbf / DIV			*				*			
0	6C	0	0	0.00	6C	0	0	0.00	6C	0	0	0.00
5,000	6C	4,940	-60	1.20	6C	5,000	0	0.00	6C	5,000	0	0.00
10,000	7	9,880	-120	1.20	7	9,990	-10	0.10	7	10,000	0	0.00
20,000	7	19,790	-210	1.05	7	19,990	-10	0.05	7	19,990	-10	0.05
40,000	8	39,530	-470	1.18	8	40,000	0	0.00	8	40,000	0	0.00
60,000	8	59,340	-660	1.10	8	60,010	10	0.02	8	60,000	0	0.00
80,000	8	79,150	-950	1.06	8	80,050	50	0.06	8	80,030	30	0.04
100,000	8	98,940	-1,060	1.06	8	100,060	60	0.06	8	100,070	70	0.07
125,000	8	123,600	-1,400	1.12	8	125,090	90	0.07	8	125,100	100	0.08
150,000	8	148,330	-1,670	1.11	8	150,150	150	0.10	8	150,120	120	0.08
200,000	8	197,650	-2,350	1.18	8	199,980	-20	0.01	8	200,010	10	0.01
300,000	8	296,650	-3,350	1.12	8	300,060	60	0.02	8	300,040	40	0.01
400,000	8	395,880	-4,120	1.03	8	400,120	120	0.03	8	400,090	90	0.02
500,000	8	495,110	-4,890	0.98	8	500,260	260	0.05	8	500,210	210	0.04
600,000	8	593,770	-6,230	1.04	8	600,310	310	0.05	8	600,290	290	0.05
0	8	0	20	0.00	8	0	-10	0.00	8	0	-30	0.00

***CALIBRATION EQUIPMENT**

All verification equipment-including dead weights, proving rings, load cells, etc, is calibrated and traceable to the latest procedures stipulated by the National Institute of Standards and Testing (NIST) and ASTM E74-06. All equipment is traceable under guidelines set forth in ISO/IEC 17025. All instrument readings have been corrected for temperature where necessary.

Notes:

Calibration in accordance with ASTM E4-09, and Calser Corporation Procedure # 1-01, Rev 1.

ACCURACY SUMMARY

Capacity Range	Loading Range	Max. Error
Run 1		
600,000lbf Range	5,000 - 600,000	1.20 %
Run 2		
600,000lbf Range	5,000 - 600,000	0.10 %
Run 3		
600,000lbf Range	5,000 - 600,000	0.08 %

VERIFICATION EQUIPMENT

Manufacturer & Serial #	* L/C	Class A Range (in LBs) and Uncertainty (LBF)	Agency & Date
Strainsense 901120B	6C	716.99 - 10,000 lbf 1.792 lbf	Morehouse 08/19/09
Strainsense 090716C (LO)	7	5,572.38 - 100,000lbf 13.931 lbf	Morehouse 08/10/10
Strainsense 090716C (HI)	8	39,281.95 - 400,000 lbf 98.205 lbf	Morehouse 08/10/10

Calibration Technician Jerry Parker

This report shall not be copied except in its entirety without express written approval of Calser Corp.

Form# 103-01-Rev 3

CERTIFICATE OF CALIBRATION

ISSUED BY: INSTRON CALIBRATION LABORATORY

DATE OF ISSUE: 30-Jan-12

CERTIFICATE NUMBER: 340013012113643



Lab code: 200301-0



Instron
 825 University Avenue
 Norwood, MA 02062-2643
 Telephone: (800) 473-7838
 Fax: (781) 575-5750
 Email: service_requests@instron.com

Page 1 of 3 pages

APPROVED SIGNATORY

**Richard
 Binford**

Digitally signed by Richard
 Binford
 DN: cn=Richard Binford,
 c=US, l=Norwood, st=MA,
 ou=OVR
 Date: 2012.01.30 12:01:16
 -05'00'

Type of Calibration: Strain
Relevant Standard: ASTM E83-10
Date of Calibration: 30-Jan-12

Customer

Name: PURDUE UNIVERSITY
Address: 550 STADIUM MALL DR.
 WEST LAFAYETTE, IN 47907
 KBROWER@PURDUE.EDU
P.O./Contract No.:
Contact: KEVIN BROWER

Machine

Manufacturer: BALDWIN
Serial Number: 120BTEC502040
System ID: 120BTEC502040
Range Type: Single

Transducer

Manufacturer: INSTRON
Transducer ID: 2630-115/590
Extensometer Type: Type 1
Travel (Tension): 1 in
Travel (Compression): 0.1 in
Gauge Length: 2 in
Mode: Static (Tension/Compression)

Classification

The following indicators of the extensometer system were verified and classed:

Indicator Type	Description	Indicator Units	Range Full Scale (%)	System Class
1. Digital Readout		strain	100	B-1

Certification Statement

All indicators listed above were verified on-site at customer location by Instron in accordance with ASTM E83.

The verification and equipment used conform to a controlled Quality Assurance program which meets the specifications outlined in ANSI/NCSL Z540-1, ISO 10012, ISO 9001:2008 and ISO/IEC 17025:2005.

The testing machine was verified in the 'as found' condition.

Instron Calpro Version 3.23

The results indicated on this certificate and the following report relate only to the items verified. If there are methods or data included that are not covered by the NVLAP accreditation it will be identified in the comments. Any limitations of use as a result of this verification will be indicated in the comments. This report must not be used to claim product endorsement by NVLAP or the United States government. This report shall not be reproduced, except in full, without the approval of the issuing laboratory.

REDACTED VERSION

CERTIFICATE OF CALIBRATION

NVLAP ACCREDITED CALIBRATION LABORATORY No. 200301-0

CERTIFICATE NUMBER:

340013012113643

Page 3 of 3 pages

Data**Indicator 1. - Digital Readout (strain)**

% of Range	Run 1		Run 2	
	Indicated (strain)	Applied (in)	Indicated (strain)	Applied (in)
100% Range (Full Scale: 1.00016 in)				
Run Temperature: 70.0 °F			Run Temperature: 70.1 °F	
40	0.19991	0.400580	0.1995	0.400013
70	0.34995	0.700010	0.349987	0.700023
100	0.49985	1.000162	0.49899	1.000050

Verification Equipment and Usage:**Verification Equipment:**

Make/Model	Serial Number	Description	Calibration Agency	Measurement Range	Cal Date	Cal Due
Exttech 445580	1003552	temp. indicator	Tektronix	NA	12-Feb-11	12-Feb-13
Epsilon 3590VHR	A5010 (ASTM)	disp. indicator	Instron Ltd	2.00 in	14-Feb-11	14-Feb-12
* Instron US Gauge Bar	I902	gauge bar	AA Jansson	NA	11-May-10	11-May-12
* HBM ML38	90630412	force indicator	Instron	NA	21-Jan-11	21-Jan-13
* Epsilon 3590VHR	A5010 (ASTM)	(Note: Also used for displacement measurements and listed above.)				

* Equipment used for gauge length measurements.

Verification Equipment Usage:

Measurement Type	Serial Number	Range (% Full Scale)	Percent(s) of Range
Displacement	A5010 (ASTM)	100	0/10/20/40/70/100

Instron standards are traceable to NIST and/or other National standards.

Comments

Verified by: Rich Binford
Field Service Engineer

NOTE: Clause 9 of ASTM E-83 states; It is recommended that extensometer systems be verified annually or more frequently if required. In no case shall the time interval between verifications exceed 18 months (unless an extensometer is being used in a long-time test running beyond the 18 month period). An extensometer system shall not be used after an adjustment or repair that could affect its accuracy without first verifying its accuracy utilizing the procedure described in this practice.

Instron Calpro Version 3.23



INSTRON®

CEAST/Dynatup / IST / SATEC / Wilson / WOLPERT

Instron® Service

825 University Avenue ■ Norwood, MA 02062-2643

Tel: +1-800-473-7838 ■ Fax: +1-781-575-5755

www.Instron.com

Field Service Report

Company: Purdue University
 Address: 550 Stadium Mall Drive
 Civil Room G151
 West Lafayette, IN 47907
 USA

Contact: Brower Kevin
 Service Order #: SV1201120017@@@1

Field Engineer: Richard Binford

Service Notes: Contract Total Amount: \$2330.

PO #: Credit Card

Reference #:

Verified force, displacement and the extensometer. Keep a regular check on the pressure transducer oil capsule gap regularly to insure the .030" gap for accurate force readings.

Labor Activities

Work Date	Product/SN	Tag Number	Work Hours	Charge Code	Description
01/30/2012		120BTEC502040	0.02	S1400-003-A	Zone 3 For Tensile Service
01/30/2012		120BTEC502040	1.00	S1460-011-A	Crosshead Displacement Verification
01/30/2012		120BTEC502040	2.00	S1481-017-C-A	Force Verification, 68K lb- 300K lb Compression
01/30/2012	2630-115/590	120BTEC502040	1.00	S1490-003-A	Strain Verification, Static Ext or Deflectometer

Materials

Part Number	Part Number Description	Qty	Serial #

CERTIFICATE OF CALIBRATION

ISSUED BY : INSTRON CALIBRATION LABORATORY

DATE OF ISSUE : 30-Jan-2012

CERTIFICATE NUMBER: 340013012110833

NVLAP

Lab code: 200301-0

Page 1 of 3



Instron
 825 University Avenue
 Norwood, MA 02062-2643
 Telephone: (800) 473 - 7838
 Fax: (781) 575 - 5755
 Email: service_requests@instron.com

APPROVED SIGNATORY

**Richard
Binford**

Digitally signed by Richard
 Binford
 DN: cn=Richard Binford, c=US,
 l=Norwood, st=MA, ou=OVR
 Date: 2012.01.30 11:36:28
 -05'00'

Type of Calibration: **Displacement**Relevant Standard: **astm e2309**Date of Calibration: **30-Jan-2012**Customer Requested Due Date: **30-Jan-2013**

Customer
 PURDUE UNIVERSITY
 550 STADIUM MALL DR.
 WEST LAFAYETTE, IN 47907

Machine
 Serial No : C502040
 Make : BALDWIN
 Model : 120BTE

P.O. Number :

Contact : HARRY TIDRICK

Readout Verified

1. Digital Readout (in)

Certification Statement

This certifies that the displacements verified with machine indicator 1 (listed above) were verified by Instron in accordance with ASTM E2309-05 (Follow-the-Displacement Method) and Instron work instruction ICA-8-07.

The testing machine was verified on-site at customer location. Adjustments are noted in the comments section of this report with a reference to the "As Found" data.

The verification and equipment used conform to a controlled Quality Assurance program which meets the specifications outlined in ANSI/NCSS Z540-1, ISO 10012, ISO 9001:2000, and ISO/IEC 17025:2005. The Instron measurement equipment used for verification is traceable to NIST.

Summary of Results

Indicator 1- Digital Readout (in)

Verified Range (in)	Max Error (in)	Max Error (%)	Max Repeat Error (in)	Max Repeat Error (%)	System Class*	Resolution (in)	Resolution Class	ASTM Lower Limit (in)
0.2 - 1	-0.00268	-0.355	0.00112	0.257	B	.001	B	0.2

*System Class is derived from assessment of the following: error, repeatability, resolution, and standard device classification.

The results indicated on this certificate and report relate only to the items verified. If there are methods or data included that are not covered by the NVLAP accreditation it will be identified in the comments. Any limitations of use as a result of this verification will be indicated in the comments. This report must not be used to claim product endorsement by NVLAP or the United States government. This report shall not be reproduced, except in full, without the approval of Instron.

CalproSDS version 3.3

REDACTED VERSION

CERTIFICATE OF CALIBRATION

ISSUED BY : INSTRON CALIBRATION LABORATORY

DATE OF ISSUE : 30-Jan-2012

CERTIFICATE NUMBER: 340013012110833

Page 2 of 3

Direction of Displacement : Ascending

Datapoint Summary - Indicator 1 - Digital Readout (in)

Suggested Value (in)	Run 1 Error (in)	Run 1 Error (%)	Run 2 Error (in)	Run 2 Error (%)	Run 3 Error (in)	Run 3 Error (%)	Repeat Error (in)	Uncertainty (in)*	Coverage Factor = k
0.2	0.00007	0.035	-0.00045	-0.222	-0.00026	-0.129	0.00052	0.00081	2.26
0.4	-0.00110	-0.276	-0.00086	-0.213	-0.00091	-0.227	0.00024	0.00070	2.26
0.6	-0.00105	-0.153	-0.00214	-0.355	-0.00176	-0.292	0.00109	0.00150	2.78
0.8	-0.00268	-0.331	-0.00156	-0.189	-0.00162	-0.203	0.00112	0.00165	2.78
1	-0.00168	-0.164	-0.00142	-0.142	-0.00198	-0.196	0.00056	0.00086	2.26

*The reported expanded uncertainty of measurement is based on a combined uncertainty multiplied by a coverage factor k to provide a level of confidence of approximately 95 %.

Runs 1 and 2 are performed to comply with the requirements of ASTM E2309, run 3 is performed to calculate the uncertainty of measurement.

Data - Indicator 1 - Digital Readout (in)

Temperature at start of verification : 67.9 °F

Suggested Value	Run 1			Run 2			Run 3	
	Applied	Indicated	Error Class	Applied	Indicated	Error Class	Applied	Indicated
0.2	0.19993	0.200	A	0.20245	0.202	A	0.20126	0.201
0.4	0.39810	0.397	A	0.40286	0.402	A	0.40091	0.400
0.6	0.68605	0.685	A	0.60314	0.601	A	0.60176	0.600
0.8	0.80968	0.807	A	0.82356	0.822	A	0.79962	0.798
1	1.02568	1.024	A	1.00142	1.000	A	1.00798	1.006

For runs 1 and 2: the worst Resolution Class is B and the worst Repeatability Class is A.

Temperature at end of verification : 70 °F

Starting Point of crosshead : 0 in

Verification Equipment

Make/Model	Serial No.	Description	Cal Agency	Uncertainty of Calibration	Resolution	Cal Date	Due Date
Instron LDS-10	06105014	Linear Gage	AA JANSSON	.000013 in	.00001 in	3-Aug-10	3-Aug-12
EXTECH 445580	1003552	Thermometer	TEKTRONIX	1 °F	.1 °F	12-Feb-11	12-Feb-13

The standards used for this verification are traceable to NIST.

CERTIFICATE OF CALIBRATION

ISSUED BY : INSTRON CALIBRATION LABORATORY

DATE OF ISSUE : 30-Jan-2012

CERTIFICATE NUMBER: 340013012110833

Page 3 of 3

Comments

Verified By: RICHARD BINFORD
SNR.SERV.ENGR,

CERTIFICATE OF CALIBRATION

ISSUED BY: INSTRON CALIBRATION LABORATORY

DATE OF ISSUE: 30-Jan-12

CERTIFICATE NUMBER: 340013012095410



Lab code: 200301-0



Instron
 825 University Avenue
 Norwood, MA 02062-2643
 Telephone: (800) 473-7838
 Fax: (781) 575-5750
 Email: service_requests@instron.com

Page 1 of 4 pages

APPROVED SIGNATORY

**Richard
 Binford**

Digitally signed by Richard Binford
 DN: cn=Richard Binford, c=US, l=Norwood, st=MA, ou=QVR
 Date: 2012.01.30 11:08:19 -05'00'

Type of Calibration: ~~Force~~
 Relevant Standard: **ASTM E4-10**
 Date of Calibration: ~~30-Jan-12~~

Customer Requested Due Date: **30-Jan-13**

Customer

Name: PURDUE UNIVERSITY
 Address: 550 STADIUM MALL DR.
 WEST LAFAYETTE, IN 47907
 KBROWER@PURDUE.EDU

P.O./Contract No.:

Contact: KEVIN BROWER

Machine

Manufacturer: BALDWIN
 Serial Number: 120BTEC502040
 System ID: 120BTEC502040
 Range Type: Single

Transducer

Manufacturer: BALDWIN
 Transducer ID: 120BTEC502040
 Capacity: 120000 lbf
 Type: Compression

Classification

1. Digital Readout - PASSED

Certification Statement

This certifies that the forces verified with machine indicator(s) (listed above) that passed are WITHIN $\pm 1\%$ accuracy, 1% repeatability, and zero return tolerance.
 All machine indicators were verified on-site at customer location by Instron in accordance with ASTM E4.
 The certification is based on runs 1 and 2 only. A third run is taken to satisfy uncertainty requirements according to ISO 17025 specifications.
 The verification and equipment used conform to a controlled Quality Assurance program which meets the specifications outlined in ANSI/NCSL Z540-1, ISO 10012, ISO 9001:2008 and ISO/IEC 17025:2005.

Method

The testing machine was verified in the 'as found' condition with no adjustments carried out.

Instron CalproCR Version 3.23

The results indicated on this certificate and the following report relate only to the items verified. If there are methods or data included that are not covered by the NVLAP accreditation it will be identified in the comments. Any limitations of use as a result of this verification will be indicated in the comments. This report must not be used to claim product endorsement by NVLAP or the United States government. This report shall not be reproduced, except in full, without the approval of the issuing laboratory.

CERTIFICATE OF CALIBRATION

NVLAP ACCREDITED CALIBRATION LABORATORY No. 200301-0

CERTIFICATE NUMBER:
340013012095410

Page 2 of 4 pages

Summary of Results

Temperature at start of verification: 67.00 °F.

Indicator 1. - Digital Readout (lbf)

Range	ASTM E4	ASTM E4	Zero	Resolution	ASTM E4
Full Scale (%)	Max Error (%)	Max Repeat Error (%)	Return	(lbf)	Lower Limit (lbf)
100	0.88	0.11	Pass	1	200

Temperature at end of verification: 67.80 °F.

Data Point Summary - Indicator 1. - Digital Readout (lbf)

COMPRESSION

% of Range	Run 1 Error (%)	Run 2 Error (%)	Run 3 Error (%)	ASTM E4 Repeat Error (%)	Relative Uncertainty* (%)	Uncertainty of Measurement* (± lbf)
100% Range (Full Scale: -119044.9 lbf)						
1	0.47	0.43	0.43	0.04	0.14	1.661
2	0.41	0.48	0.49	0.07	0.14	3.321
4	0.42	0.46	0.45	0.04	0.13	6.213
7	0.77	0.76	0.77	0.01	0.14	11.254
10	0.82	0.75	0.76	0.07	0.14	16.908
20	0.88	0.77	0.78	0.11	0.15	36.187
40	0.81	0.81	0.80	0.00	0.14	64.283
70	0.81	0.80	0.81	0.01	0.14	112.494
100	0.80	0.81	0.81	0.01	0.14	160.702

* The reported expanded uncertainty is based on a standard uncertainty multiplied by a coverage factor $k = 2$, providing a level of confidence of approximately 95%.

Data - Indicator 1. - Digital Readout (lbf)

COMPRESSION

% of Range	Run 1		Run 2		Run 3	
	Indicated (lbf)	Applied (lbf)	Indicated (lbf)	Applied (lbf)	Indicated (lbf)	Applied (lbf)
100% Range (Full Scale: -119044.9 lbf)						
0 Return	1		0		-1	
1	-1200	-1194.4	-1200	-1194.9	-1200	-1194.85
2	-2400	-2390.3	-2400	-2388.5	-2400	-2388.2
4	-4800	-4780.1	-4800	-4777.95	-4800	-4778.5
7	-8400	-8335.52	-8400	-8336.7	-8400	-8336.11
10	-12000	-11902.07	-12000	-11910.33	-12000	-11909.74
20	-24000	-23789.98	-24000	-23815.94	-24000	-23815.35
40	-48000	-47615.95	-48000	-47615.36	-48000	-47618.9
70	-84000	-83326.29	-84000	-83333.37	-84000	-83327.47
100	-120000	-119044.89	-120000	-119034.86	-120000	-119034.86

CERTIFICATE OF CALIBRATION


NVLAP ACCREDITED CALIBRATION LABORATORY No. 200301-0

CERTIFICATE NUMBER:
340013012095410

Page 3 of 4 pages

The Return to Zero tolerance is \pm the indicator resolution, 0.1 % of the maximum force verified in the range, or 1% of the lowest force verified in the range, whichever is greater.

Graphical Data - Indicator 1 - Digital Readout (lbf)

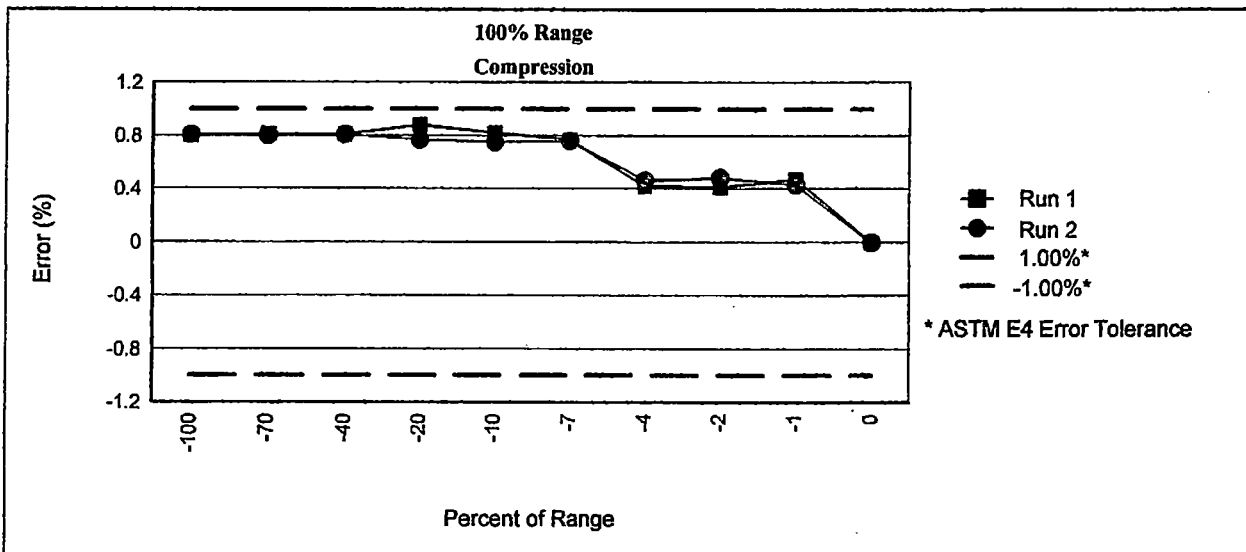

Verification Equipment

Make/Model	Serial Number	Description	Calibration Agency	Capacity	Cal Date	Cal Due
Extech 445580	1003552	temp. indicator	Tektronix	NA	12-Feb-11	12-Feb-13
HBM ML38	90630412	force indicator	Instron	NA	21-Jan-11	21-Jan-13
Strainsense 050530	050530	load cell	Instron	120000 lbf	10-Dec-10	10-Dec-12
HBM 10KFRR	688077	load cell	Instron	12000 lbf	24-Apr-10	24-Apr-12

Verification Equipment Usage

Range	Full Scale (%)	Standard Serial Number	Mode	Percent(s) of Range	Lower Limit for Standard Class A / A1 (lbf)
100	100	050530	C	7/10/20/40/70/100	5000 / 5000
100	100	688077	C	1/2/4	200 / 200

Instron standards are traceable to NIST.

The standard Class A lower limit is used for systems with an accuracy of \pm 1.0% and the standard Class A1 lower limit is used for systems with an accuracy of \pm 0.5%.

Standard forces have been temperature compensated as necessary.

Comments

CERTIFICATE OF CALIBRATION

ISSUED BY: INSTRON CALIBRATION LABORATORY

DATE OF ISSUE: 12-Apr-12

CERTIFICATE NUMBER: 516041212091759



Lab code: 200301-0

**Instron**

825 University Avenue
Norwood, MA 02062-2643
Telephone: (800) 473-7838
Fax: (781) 575-5750
Email: service_requests@instron.com

Page 1 of 3 pages

APPROVED SIGNATORY

Jimmy Warner

Digitally signed by Jimmy Warner
DN: cn=Jimmy Warner, c=US,
l=Norwood, st=MA, ou=OVR
Reason: I attest to the accuracy
and integrity of this document
Date: 2012.04.12 09:51:28 -04'00'

Type of Calibration: Strain
Relevant Standard: ASTM E83-10
Date of Calibration: 12-Apr-12

Customer Requested Due Date: 23-Mar-13**Customer**

Name: Purdue University
Address: 550 Stadium Mall Drive
Civil Room G151
West Lafayette IN 47907
sarahh@purdue.edu
P.O./Contract No.:
Contact: Kevin Brower

Machine

Manufacturer: BALDWIN
Serial Number: 120BTEC502040
System ID: 120BTEC502040
Range Type: Single

Transducer

Manufacturer: EPSILON
Transducer ID: 3543-0800-200T-ST/E89895
Extensometer Type: Type 1
Travel (Tension): 2 in
Gauge Length: 8 in
Mode: Static (Tension)

Classification

The following indicators of the extensometer system were verified and classed:

Indicator Type	Description	Indicator Units	Range Full Scale (%)	System Class
1. Digital Readout		strain	100	B-1

Certification Statement

All indicators listed above were verified on-site at customer location by Instron in accordance with ASTM E83.

The verification and equipment used conform to a controlled Quality Assurance program which meets the specifications outlined in ANSI/NCSS Z540-1, ISO 10012, ISO 9001:2008 and ISO/IEC 17025:2005.

The testing machine was verified in the 'as found' condition.

Instron Calpro Version 3.23

The results indicated on this certificate and the following report relate only to the items verified. If there are methods or data included that are not covered by the NVLAP accreditation it will be identified in the comments. Any limitations of use as a result of this verification will be indicated in the comments. This report must not be used to claim product endorsement by NVLAP or the United States government. This report shall not be reproduced, except in full, without the approval of the issuing laboratory.

REDACTED VERSION

CERTIFICATE OF CALIBRATION

NVLAP ACCREDITED CALIBRATION LABORATORY No. 200301-0

CERTIFICATE NUMBER:

516041212091759

Page 2 of 3 pages

Summary of Results**Indicator 1. - Digital Readout (strain)**

Range	Tested Range	Mode	System Class*	Resolution (strain)	Resolution Class	ASTM E83 Lower Limit (in)
100	0.2 to 2	Tension	B-1	0.000001	A	0.0008

* System Class for a range is the worst of the following classes: gauge length class, resolution class, individual point error class, repeatability class and is also based on the measurement capability of the laboratory.

Gauge Length Measurement and Classification

Nominal Gauge Length (in)	Actual Gauge Length (in)	Measurement Type	Error in Gauge Length (%)	ASTM E83 Gauge Length Class	Uncertainty of Measurement* (in)
8	7.9897	Direct	-0.13	B-1	0.0062

* The reported expanded uncertainty is based on a standard uncertainty multiplied by a coverage factor $k = 2$, providing a level of confidence of approximately 95%.

Data Summary and Classification**Indicator 1. - Digital Readout (strain)**

% of Range	Run 1 Error		Run 2 Error		Repeat Error (strain)	Worst Class	Uncertainty of Measurement* (strain)
	Fixed (strain)	Relative (% of strain)	Fixed (strain)	Relative (% of strain)			
100% Range (Full Scale: 2 in)							
10	0.00000	0.012	-0.00001	-0.037	0.00001	A	0.000025
20	-0.00003	-0.054	0.00000	-0.004	0.00003	A	0.000042
40	0.00003	0.028	0.00003	0.034	0.00000	A	0.000079
70	0.00001	0.005	0.00005	0.028	0.00004	A	0.000137
100	-0.00016	-0.064	-0.00019	-0.074	0.00003	A	0.000195

* The reported expanded uncertainty is based on a standard uncertainty multiplied by a coverage factor $k = 2$, providing a level of confidence of approximately 95%.

Data**Indicator 1. - Digital Readout (strain)**

% of Range	Run 1		Run 2	
	Indicated (strain)	Applied (in)	Indicated (strain)	Applied (in)
100% Range (Full Scale: 2 in)				
Run Temperature: 73.0 °F				
0	0.000001	0.000000	0.000006	0.000000
10	0.025004	0.200000	0.024998	0.200010
20	0.049975	0.400010	0.050004	0.400000
Run Temperature: 73.3 °F				

Instron Calpro Version 3.23

CERTIFICATE OF CALIBRATION

NVLAP ACCREDITED CALIBRATION LABORATORY No. 200301-0

CERTIFICATE NUMBER:

516041212091759

Page 3 of 3 pages

Data**Indicator 1. - Digital Readout (strain)**

% of Range	Run 1		Run 2	
	Indicated (strain)	Applied (in)	Indicated (strain)	Applied (in)
100% Range (Full Scale: 2 in)				
	Run Temperature: 73.0 °F		Run Temperature: 73.3 °F	
40	0.100030	0.800010	0.100040	0.800000
70	0.175010	1.400000	0.175060	1.400040
100	0.249840	2.000000	0.249820	2.000000

Verification Equipment and Usage**Verification Equipment:**

Make/Model	Serial Number	Description	Calibration Agency	Measurement Range	Cal Date	Cal Due
Extech 445580	984437	temp. indicator	Tektronix	NA	28-Dec-11	28-Dec-13
Boeckeler Micrometer 1398	20641 (ASTM)	disp. indicator	A.A. Jansson	2.00 in	07-Oct-11	07-Oct-12
* Fowler Economy Electronic	SH9J2879982	disp. indicator	AA Jansson	NA	20-Apr-10	20-Apr-12

* *Equipment used for gauge length measurements.***Verification Equipment Usage:**

Measurement Type	Serial Number	Range (% Full Scale)	Percent(s) of Range
Displacement	20641 (ASTM)	100	0/10/20/40/70/100

*Instron standards are traceable to NIST and/or other National standards.***Comments**

none

Verified by: James Warner
Field Service Engineer

NOTE: Clause 9 of ASTM E-83 states; It is recommended that extensometer systems be verified annually or more frequently if required. In no case shall the time interval between verifications exceed 18 months (unless an extensometer is being used in a long-time test running beyond the 18 month period). An extensometer system shall not be used after an adjustment or repair that could affect its accuracy without first verifying its accuracy utilizing the procedure described in this practice.

Instron Calpro Version 3.23

REDACTED VERSION

CALIBRATION CERTIFICATE

Address
86 Seabro Avenue
Amityville, NY 11701
Website
www.kesslerusa.com



KESSLER THERMOMETER CORPORATION

Telephone
631-841-5500
Facsimile
631-841-5553
E-mail
KesslerUSA@aol.com

CALIBRATION REPORT FOR THERMOMETER

THIS REPORT OF CALIBRATION SHALL DOCUMENT THAT THE INSTRUMENT DESCRIBED HEREIN WAS EXAMINED AND TESTED IN KESSLER'S CALIBRATION LABORATORY AGAINST NIST TRACEABLE STANDARDS, IN ACCORDANCE TO KESSLER'S PROCEDURE T-2008, WHICH IS BASED ON ASTM E-77-98 (2003) AND NIST PUBLICATION 250-23. THIS CALIBRATION MEETS THE REQUIREMENTS OF ISO/IEC 17025, ANSI/NCL Z2540-1-1994 AND THE ISO 9000 AND QS 9000 SERIES OF QUALITY STANDARDS.

CUSTOMER INFORMATION: GILSON COMPANY, INC.

Purchase Order Number: PO00096475

Date Calibrated: September 20, 2011

Next Recommended Due Date: October 20, 2012

INSTRUMENT DESCRIPTION:

Serial No.: 689373 Marked: KESSLER USA Catalog No.: 6340-FC
Scale Range: 30/124°F Divisions: 0.2°F Immersion: 3"

RESULTS OF PHYSICAL EXAMINATION:

This instrument was examined under a polarized lens and strains in the glass, if any, were judged to be minimal and of no detriment to the function of the instrument. The capillary was examined under magnification and no irregularities or foreign material was discovered. It was determined that this instrument was suitable for calibration.

RESULTS OF CALIBRATION:

TEST TEMP	READING	CORRECTION	UNCERTAINTY
32.00	32.04	-0.04	+/-0.06
60.00	60.00	0.00	+/-0.06
80.00	80.20	-0.20	+/-0.06
100.00	100.20	-0.20	+/-0.06
120.00	120.20	-0.20	+/-0.06

- The above readings were made under magnification and resolved to one tenth of one scale division.
- The indications of this instrument cannot be adjusted or modified by ordinary means: accordingly, the readings given in the table above should be considered, in effect to be both "As Found" and "As Left" readings
- Laboratory Environment Conditions: Temperature: 25°C ± 5°C / Relative Humidity: Between 40% and 60%
- All temperatures given in this report are based on the International Scale of 1990 (ITS-90)

TRACEABILITY INFORMATION:

NIST Primary Standard: Rosemount Model 162CE Serial No. 5058
Transfer Standard: Hart Scientific 1502A Serial No. A14422 / 547027

Calibration Performed By: Barbara Plaza

Approved By: 

John Lewis

Calibration Report Prepared By: RP

Report No.: 092011-03



CALIBRATION REPORT

PI TAPE®

Report Number:	02221223040412
Date Issued:	Apr-04-12
Pi Tape Corporation Serial Number:	02221223
Tape Size:	2" - 12" O.D.

About this Calibration

Temperature	68 Degrees F \pm 2 Degrees	
Relative Humidity	45% \pm 15%	
Tension	Five Pounds	
Tape Tolerance	Within .001"	Within Mfg Tolerance of .001"
Uncertainty of Measurement	\pm .00025 Inches	

Calibration Performed by: Jerry Mathis

Actual Findings and Procedure Numbers

Tape Reads	4.9000	Over 4.9000"	Procedure 1
------------	--------	--------------	-------------

Remarks: New Gage

Calibration Equipment Used

Gage	Serial Number	Test Date	Due Date	NIST Traceable Report Number
4.9"	102098	May-12-11	May-12-12	86903-1

This tape has been checked at one or more points over a calibrated measuring standard. Calibration performed in accordance with ANSI/NCSS Z540-1-1994, ISO/IEC 17025 and the former MIL-STD 45662A.

All standards are traceable to the National Institute of Standards and Technology

Jerry Mathis, Quality Assurance Manager

This calibration report shall not be reproduced, except in full, without the written approval of the issuing laboratory. Results listed relate only to the item being calibrated.

Pi Tape Corporation

344 N. Vinewood St. Escondido, CA 92029 USA
 Phone (760) 746-9830 Fax (760) 746-9196
 www.pitape.com



CERTIFICAT D'ETALONNAGE
KALIBRIER-ZERTIFIKAT
CALIBRATION CERTIFICATE

N° 26594

Date

Datum

Date

13.10.2009

Objet Instrument vertical
 Gegenstand Vertikal- Messgerät
 Object Vertical instrument

Type
 Typ V1004+
 Model

Numéro de série
 Serien-Nummer 10473 / A
 Serial number

Date d'émission du certificat
 Ausgabedatum des Zertifikates 13.10.2009
 Certificate issue date

Déclaration de conformité

L'instrument de mesure
 auquel se réfère ce certificat
 a été réalisé conformément
 aux données techniques de
 TRIMOS contenues dans
 les documents de vente
 (prospectus, manuels
 d'utilisation).

Konformitätserklärung

Das Messgerät, auf
 welches sich dieses
 Zertifikat bezieht, wurde
 entsprechend den von
 TRIMOS in den Verkaufs-
 unterlagen (Prospekte,
 Gebrauchsanleitung)
 angegebenen technischen
 Daten hergestellt.

Conformity declaration

The measuring instrument
 to which this certificate
 refers to has been
 manufactured in
 accordance with the given
 TRIMOS specifications
 stated in sale documents
 (leaflets, instructions for
 use).

Responsable département qualité:
 Leiter der Qualitätsabteilung:
 Manager of quality department:

Gilbert Villard

Contrôleur:

Prüfer:

Inspector:

Philippe Desponds

La publication ou la reproduction de ce document n'est autorisée que dans sa forme intégrale.

Der Inhalt dieses Dokumentes darf nur in vollständiger Form veröffentlicht oder weitergegeben werden.

This document may not be published or forwarded other than in its entire form.

Page

Seite

Page

1 / 8



CERTIFICAT D'ETALONNAGE
KALIBRIER-ZERTIFIKAT
CALIBRATION CERTIFICATE

N° 26594

Date

Datum

Date

13.10.2009

Caractéristique de l'objet mesuré
Merkmale des Gegenstandes der Kalibrierung
Features of the calibrated object

Nombre d'axes de mesures

Anzahl der Messachsen

Number of measuring axis

1

Etendue de mesure

Messbereich

Measuring range

0 - 990 mm

0 - 38.976 in

Coefficient de dilatation linéaire

Linearer Ausdehnungskoeffizient

Linear expansion coefficient

11.5 µm/m

Etalonnage**Kalibrierung****Calibration**

Accessoire(s) utilisé(s)

Verwendete Zubehöre

Used accessories

V-1

Pas de mesure

Messstufen

Measuring steps

20 mm

(0.787 in)

Nombre de série de mesures

Anzahl von Messreihen

Number of measurement series

3

Principe de mesure

Messprinzip

Principle of measurement

En montant

Antastung aufwärts

Upwards direction

Condition de référence**Referenzbedingungen****Reference conditions**

Températures / Temperatur / Temperature

20°C +/- 0.5°C

Humidité relative / Relative Luftfeuchtigkeit / Relativ humidity

50% +/- 5%

Pression d'air / Luftdruck / Air pressure

722 mm Hg

La publication ou la reproduction de ce document n'est autorisée que dans sa forme intégrale.

Der Inhalt dieses Dokumentes darf nur in vollständiger Form veröffentlicht oder weitergegeben werden.

This document may not be published or forwarded other than in its entire form.

Page

Seite

Page

2 / 8



CERTIFICAT D'ETALONNAGE
KALIBRIER-ZERTIFIKAT
CALIBRATION CERTIFICATE

N° 26594

Date

Datum

Date

13.10.2009

Etalon de référence et traçabilité
Bezugsnormal und Rückverfolgbarkeit
Reference standard and tracability

Les résultats de mesure contenus dans ce certificat d'étalonnage se réfèrent, par une traçabilité documentée, aux étalons reconnus sur le plan national et dont la conformité avec le système international d'unité (SI) est démontrée. L'étalon de référence est composé des éléments suivants :

Die in diesem Kalibrierzertifikat erhaltenen Ergebnisse von Messungen sind über Bezugsnormale bsw. Einrichtungen auf national Normale rückverfolgbar. Deren Übereinstimmung ist durch das Internationale Einheitensystem (SI) nachgewiesen. Das Bezugsnormal besteht aus folgenden Elementen :

All measurement results contained in this calibration certificate maintain a link of tracability recognized by national standards. Their accordance with the international unity system (SI) is proved. The reference standard is composed of the following components:

Etalon de référence Bezugsnormal Reference standard	N° de série Serien-Nr. Serial no.	N° du certificat Zertifikat-Nr. Certificate no.	Etalonné par Kalibriert durch Calibrated by
--	--	--	--

Check-Master	800002	81228	Fabricant
Equerre	215-904	E310Z106	Kunz SCS
Marbre 2000x1800	1644	R402B028	Kunz SCS

* Métrologie et accréditation suisse

La publication ou la reproduction de ce document n'est autorisée que dans sa forme intégrale.

Der Inhalt dieses Dokumentes darf nur in vollständiger Form veröffentlicht oder weitergegeben werden.

This document may not be published or forwarded other than in its entire form.

Page

Seite

Page

3 / 8




CERTIFICAT D'ETALONNAGE
KALIBRIER-ZERTIFIKAT
CALIBRATION CERTIFICATE

N° 26594

Date
Datum 13.10.2009
Date

Justesse
 Richtigkeit
 Freedom from bias

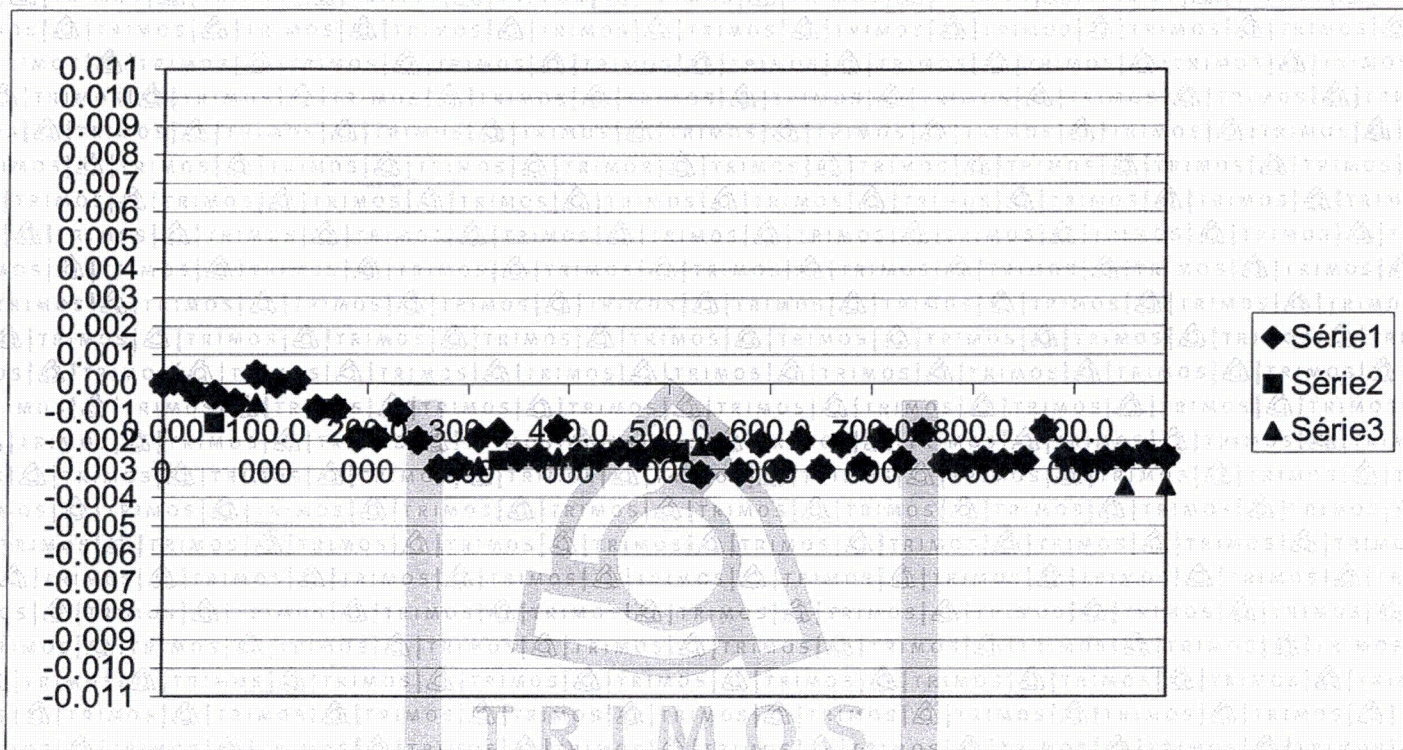

Valeur réelle Wahrer Wert True value mm	Série 1 Serie 1 Series 1 mm	Série 2 Serie 2 Series 2 mm	Série 3 Serie 3 Series 3 mm	Moyenne Mittenswert Average mm	Ecart moyen Mittenabweichung Average deviation µm
0.0000	0.000	0.000	0.000	0.000	0.0
9.9999	10.000	10.000	10.000	10.000	0.1
30.0003	30.000	30.000	30.000	30.000	-0.3
50.0004	50.000	49.999	49.999	49.999	-1.1
70.0007	70.000	70.000	70.000	70.000	-0.7
90.0007	90.001	90.001	90.000	90.001	0.0
110.001	110.001	110.001	110.001	110.001	0.0
130.0009	130.001	130.001	130.001	130.001	0.1
150.0009	150.000	150.000	150.000	150.000	-0.9
170.0009	170.000	170.000	170.000	170.000	-0.9
190.0009	189.999	189.999	189.999	189.999	-1.9

La publication ou la reproduction de ce document n'est autorisée que dans sa forme intégrale.

Der Inhalt dieses Dokumentes darf nur in vollständiger Form veröffentlicht oder weitergegeben werden.

This document may not be published or forwarded other than in its entire form.

Page

Seite

Page

4 / 8



CERTIFICAT D'ETALONNAGE
KALIBRIER-ZERTIFIKAT
CALIBRATION CERTIFICATE

N° 26594

Date

Datum

Date

13.10.2009

Valeur vraie Wahrer Wert True value mm	Série 1 Serie 1 Series 1 mm	Série 2 Serie 2 Series 2 mm	Série 3 Serie 3 Series 3 mm	Moyenne Mittenswert Average mm	Ecart moyen Mittenabweichung Average deviation µm
210.0009	209.999	209.999	209.999	209.999	-1.90
230.001	230.000	230.000	230.000	230.000	-1.00
250.001	249.999	249.999	249.999	249.999	-2.00
270.001	269.998	269.998	269.998	269.998	-3.00
290.0009	289.998	289.998	289.998	289.998	-2.90
310.0009	309.999	309.999	309.998	309.999	-2.23
330.0007	329.999	329.998	329.998	329.998	-2.37
350.0006	349.998	349.998	349.998	349.998	-2.60
370.0006	369.998	369.998	369.998	369.998	-2.60
390.0006	389.999	389.999	389.998	389.999	-1.93
410.0006	409.998	409.998	409.998	409.998	-2.60
430.0006	429.998	429.998	429.998	429.998	-2.60
450.0004	449.998	449.998	449.998	449.998	-2.40
470.0006	469.998	469.998	469.998	469.998	-2.60
490.0003	489.998	489.998	489.998	489.998	-2.30
510.0004	509.998	509.998	509.998	509.998	-2.40
530.0002	529.997	529.997	529.998	529.997	-2.87
550.0002	549.998	549.998	549.998	549.998	-2.20
570.0001	569.997	569.997	569.997	569.997	-3.10
590.0001	589.998	589.998	589.998	589.998	-2.10
610	609.997	609.997	609.997	609.997	-3.00
630	629.998	629.998	629.998	629.998	-2.00
650	649.997	649.997	649.997	649.997	-3.00
670.0001	669.998	669.998	669.998	669.998	-2.10
689.9999	689.997	689.997	689.997	689.997	-2.90
709.9999	709.998	709.998	709.998	709.998	-1.90
729.9997	729.997	729.997	729.997	729.997	-2.70
749.9997	749.998	749.998	749.998	749.998	-1.70
769.9998	769.997	769.997	769.997	769.997	-2.80
789.9998	789.997	789.997	789.997	789.997	-2.80
809.9997	809.997	809.997	809.997	809.997	-2.70
829.9998	829.997	829.997	829.997	829.997	-2.80
849.9997	849.997	849.997	849.997	849.997	-2.70
869.9996	869.998	869.998	869.998	869.998	-1.60
889.9996	889.997	889.997	889.997	889.997	-2.60
909.9998	909.997	909.997	909.997	909.997	-2.80
929.9997	929.997	929.997	929.997	929.997	-2.70
949.9996	949.997	949.997	949.996	949.997	-2.93
969.9995	969.997	969.997	969.997	969.997	-2.50
989.9996	989.997	989.997	989.996	989.997	-2.93

La publication ou la reproduction de ce document n'est autorisée que dans sa forme intégrale.

Der Inhalt dieses Dokumentes darf nur in vollständiger Form veröffentlicht oder weitergegeben werden.

This document may not be published or forwarded other than in its entire form.

Page

Seite

Page

5 / 8



CERTIFICAT D'ETALONNAGE
KALIBRIER-ZERTIFIKAT
CALIBRATION CERTIFICATE

N° 26594

Date

Datum

Date

13.10.2009

Résultats de mesure

Messergebnisse

Measurement results

Erreur maximale autorisée

Max. Fehlergrenze

Maximum permissible error

5.8 µm

Erreur maximale mesurée

Grösste gemessene Abweichung

Maximum error measured

3.2 µm

Fidélité

Wiederholpräzision

Repeatability

+/- 2s < 2 µm

Incertitude de mesure

Messunsicherheit

Uncertainty of measurement

L'incertitude de mesure "U" indiquée ci-après pour la détermination des erreurs de mesures englobe :
 l'objet étalonné, l'étalon de référence, l'étendue de mesure et les conditions de référence.

Die nachstehend angegebene Messunsicherheit "U" für die Ermittlung der Messabweichungen umfasst
 folgende Komponente: das kalibrierte Objekt, das Bezugsnormale, den Messbereich und
 die Referenzbedingungen.

The uncertainty of measurement "U" for the determination of the errors of measurement given hereafter
 includes the calibrated object, the reference standard, the measuring range and the reference conditions.

le niveau de confiance est de 95%

Das Vertrauensniveau beträgt 95%

Confidence probability is 95%

K = 2

Incertitude de mesure

Messunsicherheit

Uncertainty of measurement

U 95 = 2.5µm + (L(mm) / 300)

La publication ou la reproduction de ce document n'est autorisée que dans sa forme intégrale.

Der Inhalt dieses Dokumentes darf nur in vollständiger Form veröffentlicht oder weitergegeben werden.

This document may not be published or forwarded other than in its entire form.

Page

Seite

Page

6 / 8




CERTIFICAT D'ETALONNAGE
KALIBRIER-ZERTIFIKAT
CALIBRATION CERTIFICATE

N° 26594

Date
Datum 13.10.2009
Date

Côntrole de la perpendicularité (direction de mesure)
 Kontrolle der Rechtwinkligkeit (Messrichtung)
 Checking of the squareness (measuring direction)

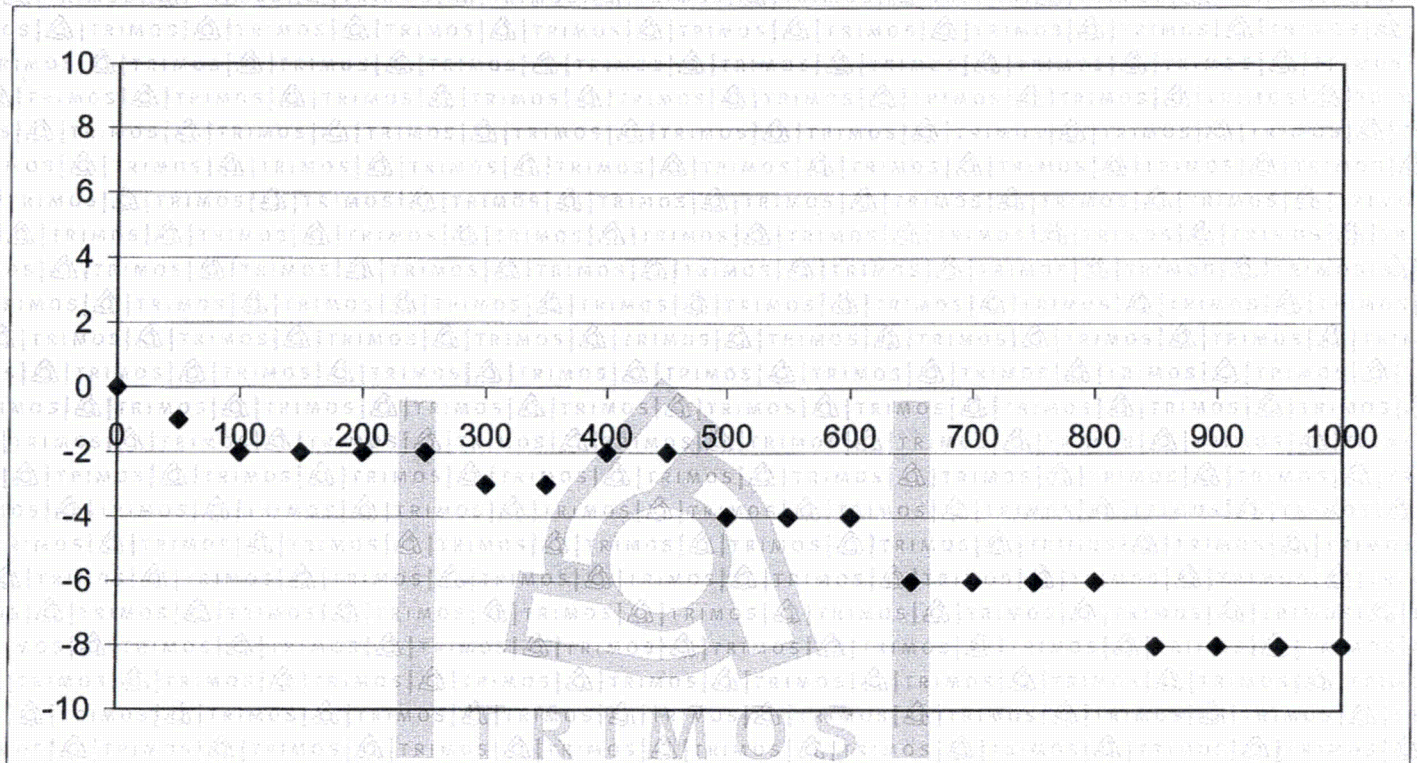

Hauteur Höhe Height mm	Ecart Abweichung Deviation µm
0	0.0
50	-1.0
100	-2.0
150	-2.0
200	-2.0
250	-2.0
300	-3.0
350	-3.0
400	-2.0
450	-2.0
500	-4.0

La publication ou la reproduction de ce document n'est autorisée que dans sa forme intégrale.

Der Inhalt dieses Dokumentes darf nur in vollständiger Form veröffentlicht oder weitergegeben werden.

This document may not be published or forwarded other than in its entire form.

Page

Seite 7 / 8

Page



CERTIFICAT D'ETALONNAGE
KALIBRIER-ZERTIFIKAT
CALIBRATION CERTIFICATE

N° 26594

Date
Datum 13.10.2009
Date

Hauteur Höhe Height mm	Ecart Abweichung Deviation µm
550	-4.0
600	-4.0
650	-6.0
700	-6.0
750	-6.0
800	-6.0
850	-8.0
900	-8.0
950	-8.0
1000	-8.0

Resultats du contrôle de la perpendicularité (dans la direction de mesure) :

Ergebnisse der Rechtwinkligkeitsprüfung (in Messrichtung) :

Results of squareness checking (in measuring direction) :

Erreur maximale autorisée

Max. angegebene Fehlergrenze

Maximum permissible error

12.0 µm

Erreur de la perpendicularité mesurée

Gemessene Rechtwinkligkeitsabweichung

Squareness error measured

8.0 µm

La publication ou la reproduction de ce document n'est autorisée que dans sa forme intégrale.

Der Inhalt dieses Dokumentes darf nur in vollständiger Form veröffentlicht oder weitergegeben werden.


This document may not be published or forwarded other than in its entire form.

Page

Seite

Page

8 / 8

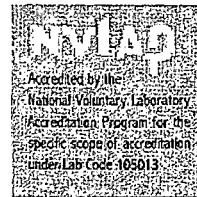

Calibration Certificate

201 Wolf Drive • P.O. Box 87 • Thorofare, NJ 08086-0087 • Phone: 856-686-1600 • Fax: 856-686-1601 • www.troemner.com • e-mail: troemner@troemner.com

Page 1 of 7 Pages
Weight


Certificate Number 663364-1
 Date of Calibration 30-APR-2012

SECTION 1: NAME AND ADDRESS OF CUSTOMER

End user
 Purdue University
 1040 S. River Road
 Bowen Laboratory
 West Lafayette IN 47907

Client
 Precision Weighing Balances
 30 South Cross Road
 Bradford MA 01835-8232

SECTION 2: APPROVED SIGNATORY

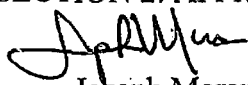
 Joseph Moran, Metrology Manager

SECTION 3: PERSON PERFORMING WORK

Daniel Foglio

SECTION 4: CERTIFICATE INFORMATION

Description of Masses: Grip Handle

Accuracy Class	: NIST 105-1 Class F	Date Received	: 30-APR-2012
Order Number	: 100001369	Date of Calibration	: 30-APR-2012
Construction	: Two Piece	Date of Issue	: 30-APR-2012
Material	: Cast Iron	Weight Range	: 100 lb

SECTION 5: ENVIRONMENTAL CONDITIONS DURING TEST

Temperature: 21.84°C Pressure: 769.06 mm Hg Relative Humidity: 48%

SECTION 6: PERTINENT INFORMATION

The Weights listed on this calibration report have been compared to reference mass standards that are directly traceable to the National Institute of Standards and Technology under Test No. 822-275872-11.


Reference standards and balances used to perform the calibration are listed in Section 10.

The weights calibrated for this report have been calibrated in accordance with Troemner's calibration process. The calibration performed meets Level III criteria as described in the NIST/NVLAP Technical Guide 150-2.

This calibration also meets specifications as outlined in ISO 9001, ISO/IEC 17025, ANSI/NCSL Z540-1-1994, NRC Document 10CFR50 Appendix B, and applicable documents.



Henry Troemner LLC

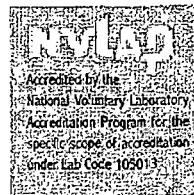

Calibration Certificate

201 Wolf Drive • P.O. Box 87 • Thorofare, NJ 08086-0087 • Phone: 856-686-1600 • Fax: 856-686-1601 • www.troemner.com • e-mail: troemner@troemner.com

Page 2 of 7 Pages
Weight

Certificate Number 663364-1
 Date of Calibration 30-APR-2012

NAME AND ADDRESS OF CUSTOMER

End user
 Purdue University
 1040 S. River Road
 Bowen Laboratory
 West Lafayette IN 47907

Client
 Precision Weighing Balances
 30 South Cross Road
 Bradford MA 01835-8232


SECTION 7: TRUE MASS (MASS IN VACUUM) CALIBRATION DATA

Nominal Mass Value	Serial Number	True Mass	Density ¹ of Weight	Uncertainty (+ or -)
100 lb		45362.709 g	7.2000 g/cm ³	450 mg

¹ Density is assumed unless otherwise stated



Henry Troemner LLC

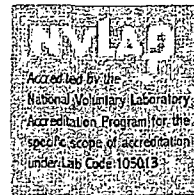

Calibration Certificate

201 Wolf Drive • P.O. Box 87 • Thorofare, NJ 08086-0087 • Phone: 856-686-1600 • Fax: 856-686-1601 • www.troemner.com • e-mail: troemner@troemner.com

Page 3 of 7 Pages
Weight

Certificate Number 663364-1
 Date of Calibration 30-APR-2012


NAME AND ADDRESS OF CUSTOMER

End user
 Purdue University
 1040 S. River Road
 Bowen Laboratory
 West Lafayette IN 47907

Client
 Precision Weighing Balances
 30 South Cross Road
 Bradford MA 01835-8232


SECTION 8: MASS IN AIR CALIBRATION VALUE VS. REFERENCE DENSITY 8000 kg m⁻³

Nominal Mass Value	Serial Number	Conventional Mass Value	Uncertainty (+ or -)	Tolerance (+ or -)
100 lb		45361.953 g	450 mg	4.5000 g

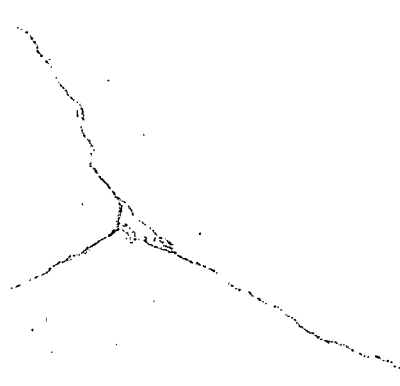



Henry Troemner LLC

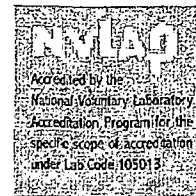

Calibration Certificate

201 Wolf Drive • P.O. Box 87 • Thorofare, NJ 08086-0087 • Phone: 856-686-1600 • Fax: 856-686-1601 • www.troemner.com • e-mail: troemner@troemner.com

Page 4 of 7 Pages
Weight

Certificate Number 663364-1
 Date of Calibration 30-APR-2012


NAME AND ADDRESS OF CUSTOMER

End user
 Purdue University
 1040 S. River Road
 Bowen Laboratory
 West Lafayette IN 47907

Client
 Precision Weighing Balances
 30 South Cross Road
 Bradford MA 01835-8232


SECTION 9: MASS IN AIR CALIBRATION DATA VS. REFERENCE DENSITY 8000 kg m⁻³

Nominal Mass Value	Serial Number	Conventional Mass Correction	Uncertainty (+ or -)	Tolerance (+ or -)
100 lb		2716 mg	450 mg	4.5000 g

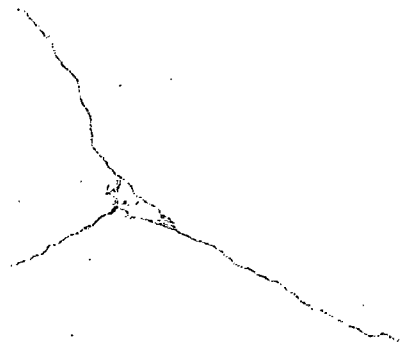



Henry Troemner LLC

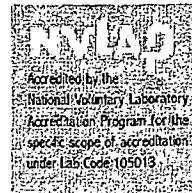

Calibration Certificate

201 Wolf Drive • P.O. Box 87 • Thorofare, NJ 08086-0087 • Phone: 856-686-1600 • Fax: 856-686-1601 • www.troemner.com • e-mail: troemner@troemner.com

Page 5 of 7 Pages
Weight

Certificate Number 663364-1
Date of Calibration 30-APR-2012

NAME AND ADDRESS OF CUSTOMER


End user
Purdue University
1040 S. River Road
Bowen Laboratory
West Lafayette IN 47907

Client
Precision Weighing Balances
30 South Cross Road
Bradford MA 01835-8232

SECTION 10: CALIBRATION PROCEDURE DATA

Nominal Mass Value	Serial Number	Standard Set No.	Cal Due	Balance Used	Cal Due	Procedure Used
100 lb		S1104	05/31/12	XP64003L-A01	11/30/12	Multi A-B



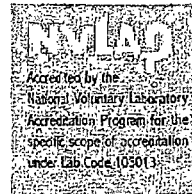

Calibration Certificate

201 Wolf Drive • P.O. Box 87 • Thorofare, NJ 08086-0087 • Phone: 856-686-1600 • Fax: 856-686-1601 • www.troemner.com • e-mail: troemner@troemner.com

Page 6 of 7 Pages

Weight

Certificate Number 663364-1

Date Of Calibration 30-APR-2012

NAME AND ADDRESS OF CUSTOMER

End user

Purdue University
1040 S. River Road
Bowen Laboratory
West Lafayette IN 47907

Client

Precision Weighing Balances
30 South Cross Road
Bradford MA 01835-8232

SECTION 11: GENERAL INFORMATION

This calibration was performed in Troemner's High Precision Level I Mass Metrology Laboratory at 201 Wolf Drive, Thorofare, New Jersey 08086 unless otherwise noted on page one. The internal procedures used are CAL-CLASSI and NIST HB145.

SECTION 12: DEFINITIONS AND TERMS

MASS IN A VACUUM - The mass of a weight as if it were measured in a vacuum. Also known as True Mass.

MASS IN AIR - The conventional value of the result of weighing in air, in accordance to International Recommendation OIML D 28. For a weight taken at 20° C, the conventional mass is the mass of a reference weight of a density of 8000 kg·m⁻³ which it balances in air of a density of 1.2 kg·m⁻³.

AS FOUND MASS IN A VACUUM - The measured value of the mass(es) as they were received by Troemner.

AS LEFT MASS IN A VACUUM - The measured value of the mass(es) after they were adjusted, repaired or replaced when necessary. The As Found Mass in a Vacuum will equal the As Left Mass in a Vacuum if the mass(es) did not require adjustment, repair or replacement.

NOMINAL MASS - The mass value as marked on the weight.

CORRECTION - The difference between the mass value of a weight and its nominal value. A positive correction indicates that the mass value is greater than the nominal value by the amount of the correction.


AS FOUND CONVENTIONAL MASS CORRECTION - The conventional correction of the result, as it was received by Troemner, of weighing in air in accordance to International Recommendation D 28. For a weight taken at 20° C, the conventional mass is the mass of a reference weight of density 8000 kg·m⁻³ which it balances in air density of 1.2 kg·m⁻³. If the customer requires cleaning prior to calibration, the after cleaning correction would be reported.

AS LEFT CONVENTIONAL MASS CORRECTION - The conventional correction of the result, after adjustment, repair, or replacement of weighing in air in accordance to International Recommendation D 28. For a weight taken at 20° C, the conventional mass is the mass of a reference weight of density 8000 kg·m⁻³ which it balances in air density of 1.2 kg·m⁻³. The As Found will equal the As Left Conventional Mass Correction if the mass(es) did not require adjustment, repair or replacement.

(continued on next page)



Henry Troemner LLC

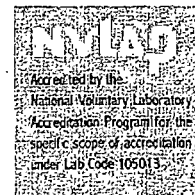

Calibration Certificate

201 Wolf Drive • P.O. Box 87 • Thorofare, NJ 08086-0087 • Phone: 856-686-1600 • Fax: 856-686-1601 • www.troemner.com • e-mail: troemner@troemner.com

Page 7 of 7 Pages

Weight

Certificate Number 663364-1

Date of Calibration 30-APR-2012

NAME AND ADDRESS OF CUSTOMER

End user

Purdue University
1040 S. River Road
Bowen Laboratory
West Lafayette IN 47907

Client

Precision Weighing Balances
30 South Cross Road
Bradford MA 01835-8232

SECTION 12: DEFINITIONS AND TERMS (continued)

UNCERTAINTY - The standard deviation associated with the result of the measurement that characterizes the dispersion of the values that could reasonably be attributed to the measurand. The uncertainty is calculated in accordance with NIST TechNote 1297 / UKAS M3003 using a coverage factor of $k = 2$ ($k = 2$ defines an interval having a level of confidence of approximately 95 percent). The uncertainty does not include possible effects of magnetism.

TOLERANCE - Defines the limits in which the correction value and the uncertainty must fall to meet the tolerance specification for the given Class.

AS FOUND CONVENTIONAL MASS VALUE - The measured value of the mass(es) as they were received by Troemner, of weighing in air in accordance to International Recommendation OIML D 28. For a weight taken at 20° C, the conventional mass is the mass of a reference weight of density 8000 kg·m⁻³ which it balances in air density of 1.2 kg·m⁻³. If the customer requires cleaning prior to calibration, the after cleaning value would be reported. F denotes Out of Tolerance Weight.

AS LEFT CONVENTIONAL MASS VALUE - The measured value of the mass(es) after they were adjusted, repaired or replaced when necessary of weighing in air in accordance to International Recommendation OIML D 28. For a weight taken at 20° C, the Conventional Mass is the mass of a reference weight of density 8000 kg·m⁻³ which it balances in air density of 1.2 kg·m⁻³. The As Found will equal the As Left Conventional Mass Value if the mass(es) did not require adjustment, repair or replacement.

ASTM E617-97 - Weights meet the tolerance specification for ASTM E617-97. Weights 2kg - 1g screened for magnetism using a Gaussmeter.

Project: Tests to Determine the Behavior of Spliced #11 Bars

Calibration Documentation v.1
(Rev. 04/02/2012)

Bowen Lab - Purdue University
Sheet 1 of 2

Calibration Instrument Name and S.N.:			Instron 1044172		
Data Acquisition System:			OptroTrack Pro Series 600		
Gain:			NA		
Excitation Voltage:			NA		
Channel:			NA		
Sensor:			OptroTrack Pro Series 600		
Sensor S.N.:			OptroTrack Pro Series 600		
Input [in.]	Output [in.]		Input [in.]	Output [in.]	
0	0		6.5	6.507	
0	0		6.5	6.507	
1	1.001		4	3.999	
1	1.001		4	3.999	
4	3.998		1.5	1.499	
4	3.997		1.5	1.498	
6.5	6.502				
6.5	6.502				
9	9.007				
9	9.007				
Operator		Signature		Date	Time
S.P.				6/13/12	10AM
Checked by		Signature		Date	Time
BPR				6/13/12	10:15AM
Checked by		Signature		Date	Time
Results		Sensitivity		Accuracy	
		1		0.007 in.	

Project: Tests to Determine the
Behavior of Spliced #11 Bars

Calibration Documentation v.1
(Rev. 04/02/2012)

Bowen Lab - Purdue University
Sheet 2 of 2

Notes: The accuracy of the INSTRON sensor is 0.003 in.

Project: Tests to Determine the Behavior of Spliced #11 Bars

Calibration Documentation v.1
(Rev. 04/02/2012)


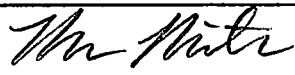
Bowen Lab - Purdue University
Sheet 1 of 1

Calibration Instrument Name and S.N.:		INSTRON 1044172			
Data Acquisition System:		NI-SCXI-1000 PCI 6289			
Gain:		1			
Excitation Voltage:		3.333			
Channel:		MI-0			
Sensor:		PA-20-NJC-DS-L3M			
Sensor S.N.:		37100980			
Measurand	Voltage	Measurand	Voltage	Measurand	Voltage
0.611	1.498				
0.611	0.038				
2.602	0.362				
4.553	0.675				
6.560	1.001				
8.630	1.332				
Operator		Signature		Date	Time
S.P.				5/9/12	
Checked by		Signature		Date	Time
BPR				5/9/12	
Checked by		Signature		Date	Time
Results	Sensitivity			Accuracy	
	6.197 in/v			0.1%	
Notes:					

Project: Tests to Determine the Behavior of Spliced #11 Bars

Calibration Documentation v.1
(Rev. 04/02/2012)

Bowen Lab - Purdue University
Sheet 1 of 1

Calibration Instrument Name and S.N.:		INSTRON 1044172			
Data Acquisition System:		NI-SOXI-1000 PCI 6289			
Gain:		1			
Excitation Voltage:		3.333			
Channel:		M1-1			
Sensor:		PA-20-NJC-DS-L3M			
Sensor S.N.:		37100981			
Measurand	Voltage	Measurand	Voltage	Measurand	Voltage
8.630	1.335				
6.618	1.011				
4.640	0.691				
2.655	0.369				
0.651	0.041				
Operator		Signature		Date	Time
S.P.				5/9/12	
Checked by		Signature		Date	Time
BPR				5/9/12	
Checked by		Signature		Date	Time
Results		Sensitivity		Accuracy	
		6.167 in/V		0.1%	
Notes:					



Project: Tests to Determine the Behavior of Spliced #11 Bars

Calibration Documentation v.1
(Rev. 04/02/2012)

Bowen Lab - Purdue University
Sheet 1 of 1

Calibration Instrument Name and S.N.:	INSTRON 1044172
Data Acquisition System:	NI SCXI-1000 PCI 6289
Gain:	1
Excitation Voltage:	3.333
Channel:	M1-02
Sensor:	PA-10-DS
Sensor S.N.:	40010980

Measurand	Voltage	Measurand	Voltage	Measurand	Voltage
8.594	2.578				
6.647	1.965				
4.600	1.323				
2.603	0.696				
0.642	0.071				

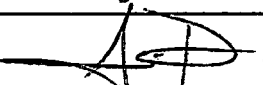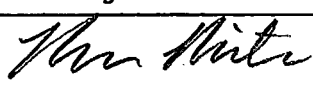Operator	Signature	Date	Time
S.P.		5/9/12	
Checked by	Signature	Date	Time
BPR		5/9/12	
Checked by	Signature	Date	Time



Results	Sensitivity	Accuracy
	3.175 in/v	0.2%

Notes:

Project: Tests to Determine the Behavior of Spliced #11 Bars

Calibration Documentation v.1
(Rev. 04/02/2012)


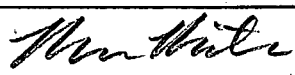
Bowen Lab - Purdue University
Sheet 1 of 1

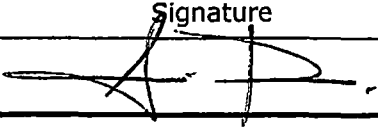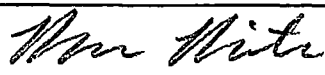Calibration Instrument Name and S.N.:		INSTRON 1044172			
Data Acquisition System:		NI SCXI-1000 PCI 6289			
Gain:		1			
Excitation Voltage:		3.333			
Channel:		M1-03			
Sensor:		PA-10-DS			
Sensor S.N.:		40010985			
Measurand	Voltage	Measurand	Voltage	Measurand	Voltage
0.610	0.056				
2.578	0.682				
4.625	1.328				
6.566	1.939				
8.620	2.584				
Operator	Signature		Date	Time	
S. P.			5/9/12		
Checked by	Signature		Date	Time	
BPR			5/9/12		
Checked by	Signature		Date	Time	
Results	Sensitivity		Accuracy		
	3.169 in/v		0.2%		
Notes:					

Project: Tests to Determine the Behavior of Spliced #11 Bars

Calibration Documentation v.1
(Rev. 04/02/2012)


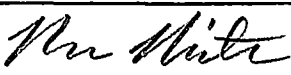
Bowen Lab - Purdue University
Sheet 1 of 1

Calibration Instrument Name and S.N.:		INSTRON 1044172			
Data Acquisition System:		NI SCXI-1000 PCI 6289			
Gain:		1			
Excitation Voltage:		3.333			
Channel:		M2-0			
Sensor:		PA-10-DS			
Sensor S.N.:		40010977			
Measurand	Voltage	Measurand	Voltage	Measurand	Voltage
8.620	2.590				
6.602	1.957				
4.607	1.331				
2.604	0.699				
0.611	0.065				
Operator		Signature		Date	Time
S.P.				5/9/12	
Checked by		Signature		Date	Time
BPR				5/9/12	
Checked by		Signature		Date	Time
Results		Sensitivity		Accuracy	
		3.173 in/V		0.2%	
Notes: M2-0					

Project: Tests to Determine the
Behavior of Spliced #11 Bars

Calibration Documentation v.1
(Rev. 04/02/2012)


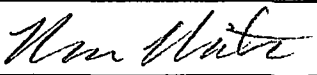
Bowen Lab - Purdue University
Sheet 1 of 1

Calibration Instrument Name and S.N.:		Instron 1094172			
Data Acquisition System:		NI-SCXI-1000 PCI 6289			
Gain:		100			
Excitation Voltage:		10V			
Channel:		M2-02			
Sensor:		3175-50K			
Sensor S.N.:		443			
Measurand	Voltage	Measurand	Voltage	Measurand	Voltage
- 0	0				
6.1	-0.00240				
11.9	-0.00466				
15.3	-0.00600				
20.2	-0.00790				
25.3	-0.00990				
30.4	-0.01190				
Operator		Signature		Date	Time
S.P.				5/9/12	
Checked by		Signature		Date	Time
BPR				5/9/12	
Checked by		Signature		Date	Time
Results		Sensitivity		Accuracy	
		- 2556 K/V		0.1%	
Notes:					

Project: Tests to Determine the
Behavior of Spliced #11 Bars

Calibration Documentation v.1
(Rev. 04/02/2012)


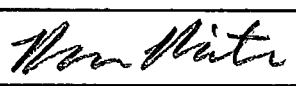
Bowen Lab - Purdue University
Sheet 1 of 1

Calibration Instrument Name and S.N.:		Instron 1044172			
Data Acquisition System:		NI-SCXI-1000 PCI 6289			
Gain:		100			
Excitation Voltage:		10V			
Channel:		M2-3			
Sensor:		3175-50K			
Sensor S.N.:		442			
Measurand	Voltage	Measurand	Voltage	Measurand	Voltage
0	0				
5.5	-0.00215				
10.4	-0.00407				
15.5	-0.00605				
20.5	-0.00799				
25.5	-0.00996				
30.5	-0.01190				
0	+0.000010				
Operator		Signature		Date	Time
S.P.				5/9/12	
Checked by		Signature		Date	Time
BPR				5/9/12	
Checked by		Signature		Date	Time
Results	Sensitivity		Accuracy		
	- 2563 K/V		0.1%		
Notes:					

Project: Tests to Determine the Behavior of Spliced #11 Bars

Calibration Documentation v.1
(Rev. 04/02/2012)



Bowen Lab - Purdue University
Sheet 1 of 1

Calibration Instrument Name and S.N.:		INSTRON 1044172			
Data Acquisition System:		NI SCXI-1000 PCI 6289			
Gain:		1			
Excitation Voltage:		30			
Channel:		M3-0			
Sensor:		LUCAS DCEC-2000			
Sensor S.N.:		J7250			
Measurand	Voltage	Measurand	Voltage	Measurand	Voltage
1.835	-4.272				
1.500	-2.655				
1.000	-0.253				
0.500	2.133				
0.125	3.953				
Operator		Signature		Date	Time
S.P.				5/9/12	
Checked by		Signature		Date	Time
BPR				5/9/12	
Checked by		Signature		Date	Time
Results		Sensitivity		Accuracy	
		- 0.208 in/V		0.1%	
Notes:					

Project: Tests to Determine the
Behavior of Spliced #11 Bars

Calibration Documentation v.1
(Rev. 04/02/2012)

Bowen Lab - Purdue University
Sheet 1 of 1

Calibration Instrument Name and S.N.:		INSTRON 1044172			
Data Acquisition System:		NI SCXI-1000 PCI 6289			
Gain:		1			
Excitation Voltage:		30			
Channel:		M3-1			
Sensor:		LUCAS DCEC-2000			
Sensor S.N.:		J7251			
Measurand	Voltage	Measurand	Voltage	Measurand	Voltage
0.125	4.150				
0.507	2.318				
0.999	-0.020				
1.500	-2.414				
1.835	-4.025				
Operator		Signature		Date	Time
S.P.				5/9/12	
Checked by		Signature		Date	Time
BPR				5/9/12	
Checked by		Signature		Date	Time
Results		Sensitivity		Accuracy	
		-0.209 in/V		0.1%	
Notes:					

Project: Tests to Determine the Behavior of Spliced #11 Bars

Calibration Documentation v.1
(Rev. 04/02/2012)

Bowen Lab - Purdue University
Sheet 1 of :

Calibration Instrument Name and S.N.:	INSTRON PUID 1044172
Data Acquisition System:	NI SCXI 1000 SN 1188607
Gain:	1
Excitation Voltage:	3.333V
Channel:	M1-0
Sensor:	PA-20
Sensor S.N.:	37100980

Measurand	Voltage	Measurand	Voltage	Measurand	Voltage
0.5"	0.307				
2.5"	0.627				
4.5"	0.952				
6.5"	1.271				
8.5"	1.594				

Operator	Signature	Date	Time
----------	-----------	------	------

S.P.		6/13/12	3 PM
------	--	---------	------

Checked by	Signature	Date	Time
------------	-----------	------	------

BPR		6/13	3:10PM
-----	--	------	--------

Checked by	Signature	Date	Time
------------	-----------	------	------

--	--	--	--



Results	Sensitivity	Accuracy
	0.0483 V/V/in	0.1%

Notes: Deviation from sensitivity computed before test*: 0.3% OK
*0.0484 V/V/in.

Project: Tests to Determine the Behavior of Spliced #11 Bars

Calibration Documentation v.1
(Rev. 04/02/2012)

Bowen Lab - Purdue University
Sheet 1 of 1

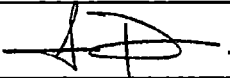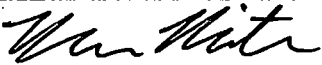Calibration Instrument Name and S.N.:		INSTRON 1044172			
Data Acquisition System:		NI SCXI 1000 SN 1188607			
Gain:		1			
Excitation Voltage:		3.333V			
Channel:		M1-1			
Sensor:		PA-20			
Sensor S.N.:		37100981			
Measurand	Voltage	Measurand	Voltage	Measurand	Voltage
8.5"	1.612				
6.5	1.291				
4.5	0.968				
2.5	0.646				
0.5	0.320				
Operator		Signature		Date	Time
S.P.				6/13/12	3:20 P.
Checked by		Signature		Date	Time
BPR				6/13	3:30PM
Checked by		Signature		Date	Time
Results		Sensitivity		Accuracy	
		0.0484		0.1%	
Notes: Deviation = 0.4%					

Project: Tests to Determine the Behavior of Spliced #11 Bars

Calibration Documentation v.1
(Rev. 04/02/2012)

Bowen Lab - Purdue University
Sheet 1 of 1

Calibration Instrument Name and S.N.:	INSTRON 1044172
Data Acquisition System:	NI SCXI 1000 1188607
Gain:	1
Excitation Voltage:	3.333V
Channel:	M1-2
Sensor:	PA-10
Sensor S.N.:	40010980

Measurand	Voltage	Measurand	Voltage	Measurand	Voltage
0.5"	0.584				
2.5	1.212				
4.5	1.839				
6.5	2.467				
8.0	2.942				

Operator	Signature	Date	Time
----------	-----------	------	------

S.P.		6/13/12	3:30 P.
------	---	---------	---------

Checked by	Signature	Date	Time
------------	-----------	------	------

BPR		6/13	3:40 PM
-----	--	------	---------

Checked by	Signature	Date	Time
------------	-----------	------	------

--	--	--	--



Results	Sensitivity	Accuracy
---------	-------------	----------

	0.0943 v/v/in	0.1%
--	---------------	------

Notes: Deviation : 0.2%

Calibration Instrument Name and S.N.:	INSTRON 1044172
Data Acquisition System:	SCXI 1000 1188607
Gain:	1
Excitation Voltage:	3.333 V
Channel:	M1-3
Sensor:	PA-10
Sensor S.N.:	40010985

Measurand	Voltage	Measurand	Voltage	Measurand	Voltage
8 "	2.934				
6.5	2.462				
4.5	1.835				
2.5	1.207				
0.5	0.577				

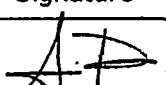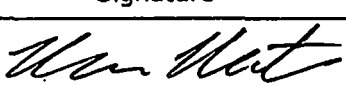Operator	Signature	Date	Time
S.P.		6/13/12	3:40 P.
Checked by	Signature	Date	Time
BPR		6/13	3:50 PM
Checked by	Signature	Date	Time

Results	Sensitivity	Accuracy
	0.0943 v/v/in	0.03%

Notes:
Deviation: 0.4%

Project: Tests to Determine the Behavior of Spliced #11 Bars

Calibration Documentation v.1
(Rev. 04/02/2012)

Bowen Lab - Purdue University
Sheet 1 of 1

Calibration Instrument Name and S.N.:	INSTRON 1044172
Data Acquisition System:	NI SCXI 1000 1188607
Gain:	1
Excitation Voltage:	3.333V
Channel:	M2-0
Sensor:	PA-10
Sensor S.N.:	40010977

Measurand	Voltage	Measurand	Voltage	Measurand	Voltage
0.5"	0.584				
2.5"	1.215				
4.5"	1.841				
6.5"	2.469				
8.0"	2.939				

Operator	Signature	Date	Time
S.P.	<i>A. Dwyer</i>	6/13/12	3:55 P.

Checked by	Signature	Date	Time
BPR	<i>W. Hart</i>	6/13/12	4:00PM

Checked by	Signature	Date	Time



Results	Sensitivity	Accuracy
	0.0942 v/v/in	0.1%


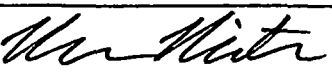
Notes: Deviation = 0.4%

Project: Tests to Determine the
Behavior of Spliced #11 Bars

Calibration Documentation v.1
(Rev. 04/02/2012)

Bowen Lab - Purdue University
Sheet 1 of 1


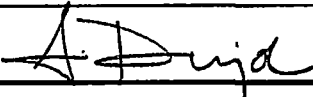
Calibration Instrument Name and S.N.:		INSTRON 1044172			
Data Acquisition System:		NI SCXI 1000 1188607			
Gain:		100			
Excitation Voltage:		10V			
Channel:		M2-2			
Sensor:		LEBOW 50K -443			
Sensor S.N.:		443			
Measurand	Voltage	Measurand	Voltage	Measurand	Voltage
-0.4±0.4=0	0				
5k +0.4	-0.00211				
10k +0.4	-0.00410				
14.6k +0.4	-0.00588				
19.7k +0.4	-0.00787				
24.7k +0.4	-0.00984				
29.7k +0.4	-0.01178				
Operator		Signature		Date	Time
S.P.				6/13/12	4:45 P
Checked by		Signature		Date	Time
BPR				6/13	4:50 PM
Checked by		Signature		Date	Time
Results		Sensitivity		Accuracy	
		-1.957 mV/V @ FSV		0.1%	
Notes: DEVIATION from prev. cal (5/4/12): 0.1%					

Calibration Instrument Name and S.N.:		INSTRON 1044172			
Data Acquisition System:		NISCXI 1000 1188607			
Gain:		100			
Excitation Voltage:		10V			
Channel:		M2-3			
Sensor:		LEBOW 50k - 442			
Sensor S.N.:		442			
Measurand	Voltage	Measurand	Voltage	Measurand	Voltage
-0.4 + 0.4k	0.00001				
4.65 ^k + 0.4	-0.00196				
9.67 ^k + 0.4	-0.00392				
14.6 ^k + 0.4	-0.00584				
19.7 ^k + 0.4	-0.00785				
25.25 ^k + 0.4	-0.01001				
29.6 ^k + 0.4	-0.01172				
Operator		Signature		Date	Time
S.P.				6/13/12	5:05 P.
Checked by		Signature		Date	Time
BPR				6/13	5:10 PM
Checked by		Signature		Date	Time
Results	Sensitivity			Accuracy	
	-1.955 mV/V @ 50k			0.1%	
Notes: Deviation : 0.2%					

Project: Tests to Determine the
Behavior of Spliced #11 Bars

Calibration Documentation v.1
(Rev. 04/02/2012)

Bowen Lab - Purdue University
Sheet 1 of 1

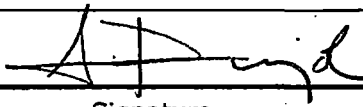
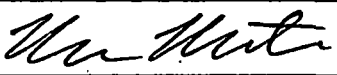
Calibration Instrument Name and S.N.:		INSTRON 1044172			
Data Acquisition System:		NI SCXI 1000 1188607			
Gain:		1			
Excitation Voltage:		30V			
Channel:		M3-0			
Sensor:		LUCAS DCDT $\pm 2''$			
Sensor S.N.:		J7250			
Measurand	Voltage	Measurand	Voltage	Measurand	Voltage
0.125"	4.288				
0.5"	2.477				
1.0"	0.106 ✓				
1.5'	-2.271 ✓				
2.0"	-4.663				
1.0	0.112				
0.5'	2.480				
0.125"	4.289				
Operator		Signature		Date	Time
S.P.				6/13/12	5:50 P
Checked by		Signature		Date	Time
BPR				6/13	6:00PM
Checked by		Signature		Date	Time
Results		Sensitivity		Accuracy	
		-4.769 v/in		0.2%	
Notes: Deviation from 5/4/12 cal. = 0.7%					

Project: Tests to Determine the Behavior of Spliced #11 Bars


Calibration Documentation v.1
(Rev. 04/02/2012)

Bowen Lab - Purdue University
Sheet 1 of 1


Calibration Instrument Name and S.N.:		INSTRON 1044172			
Data Acquisition System:		NISCXI 1000 1188607			
Gain:		1			
Excitation Voltage:		30V			
Channel:		M3-1			
Sensor:		LUCAS DOT ±2"			
Sensor S.N.:		J 7251			
Measurand	Voltage	Measurand	Voltage	Measurand	Voltage
0.125"	4.293				
0.500"	2.496				
1.0"	0.140				
1.5"	-2.232				
2.0"	-4.606				
Operator		Signature		Date	Time
S.P.		<i>A. Dwyer</i>		6/13/12	6 PM
Checked by		Signature		Date	Time
BPR		<i>Wm. Hite</i>		6/13	6:10PM
Checked by		Signature		Date	Time
Results		Sensitivity		Accuracy	
		-4.742 V/in		0.2%	
Notes: Deviation = 0.7%.					

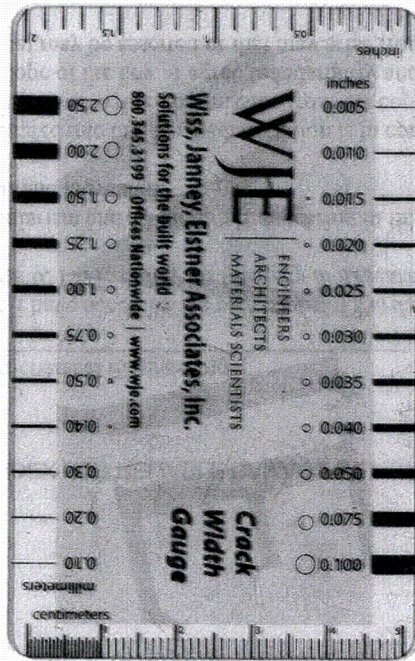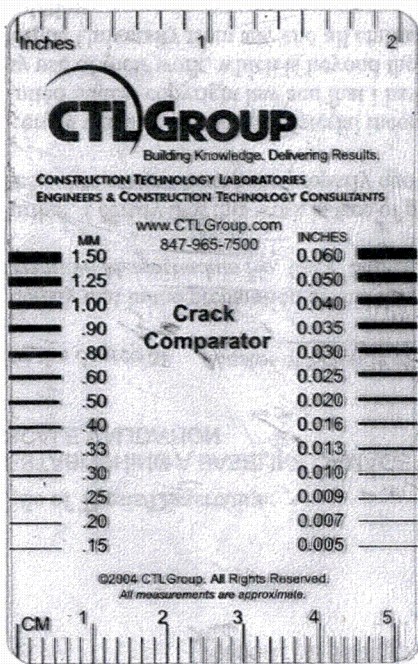

FIRST LOADING

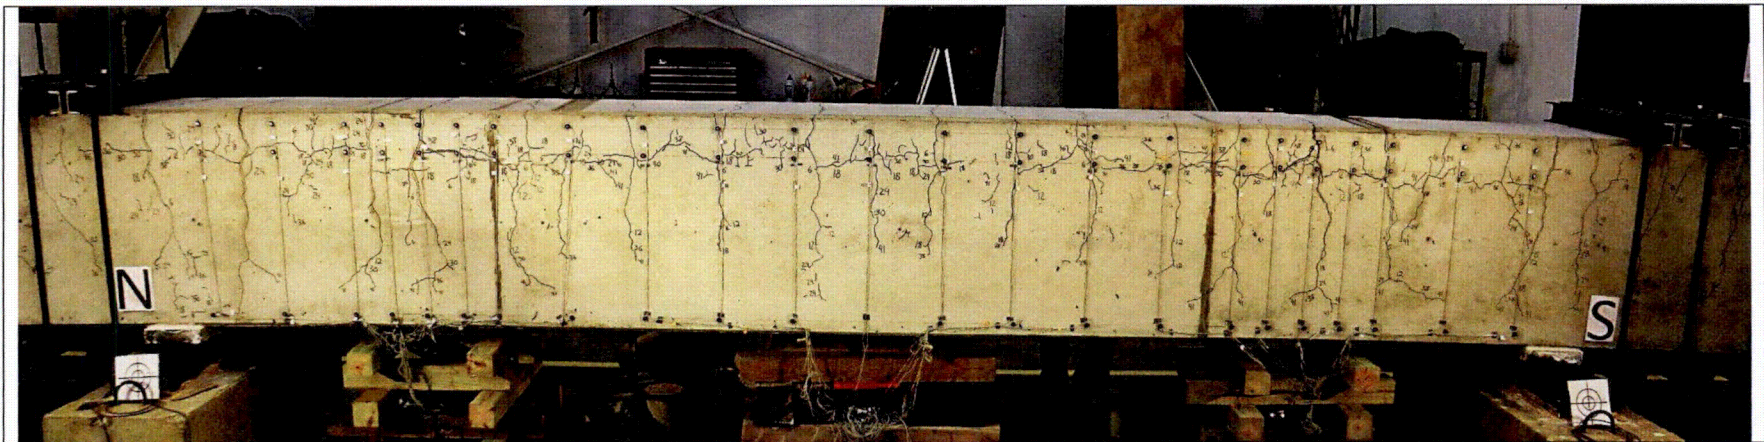

GIRDER A1 – 41 kip

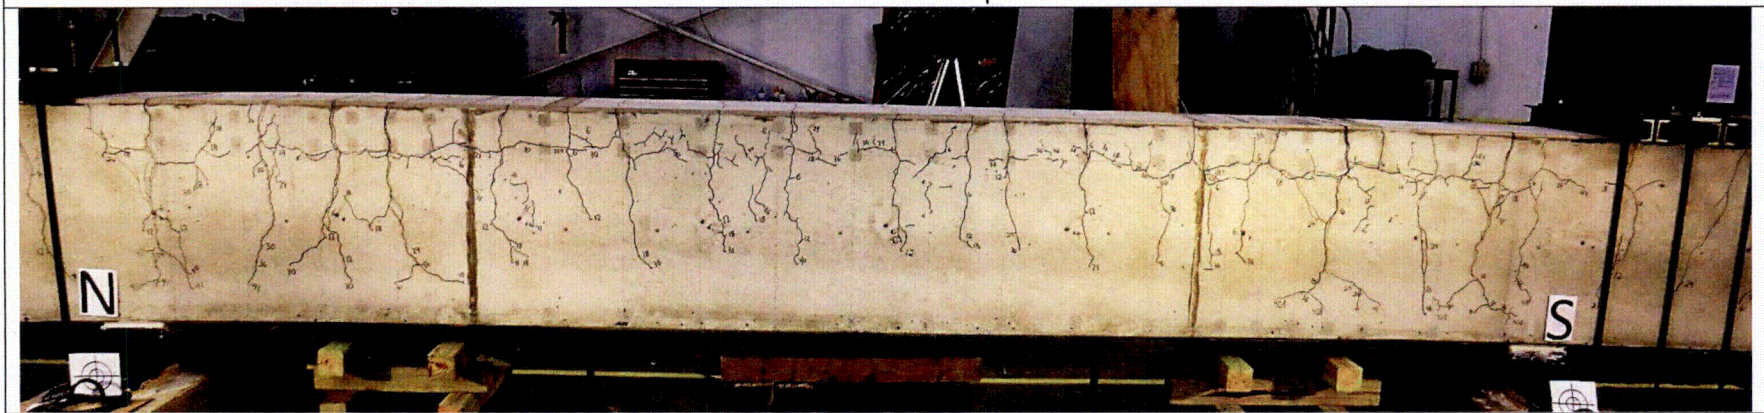

GIRDER A2 – 41 kip

FIRST LOADING



GIRDER A3 – 36 kip



GIRDER A4 – 40 kip

FIRST LOADING




GIRDER A5 – 40 kip



GIRDER A6 – 40 kip

RELOADING

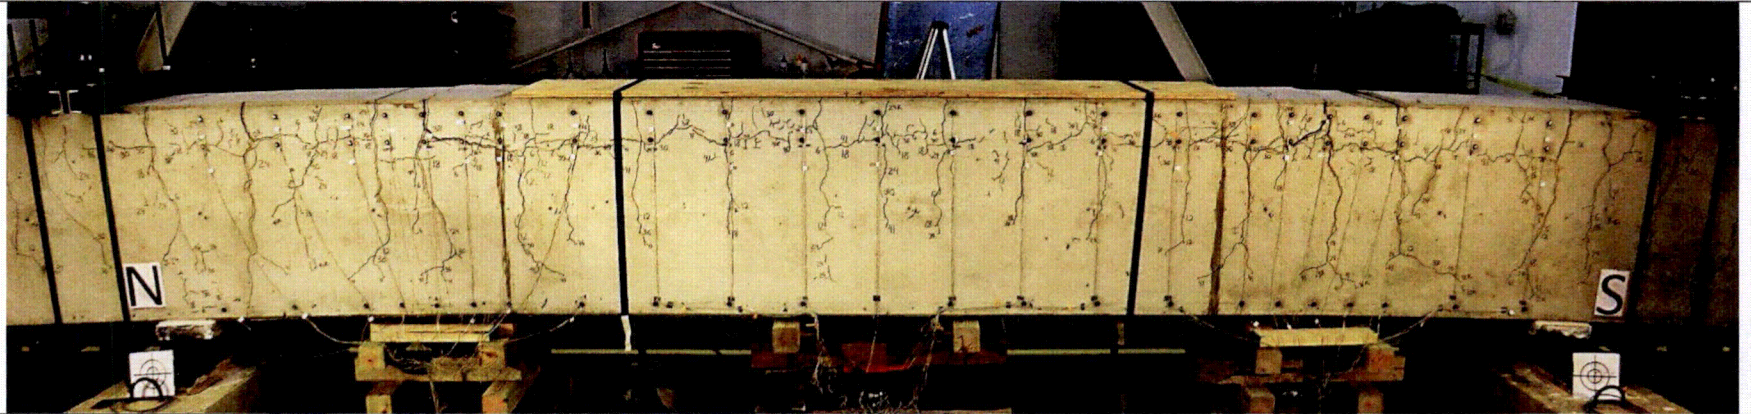

GIRDER A1 – 42 kip

No reload

GIRDER A2

RELOADING


No reload

GIRDER A3




GIRDER A4 - 42 kip

RELOADING

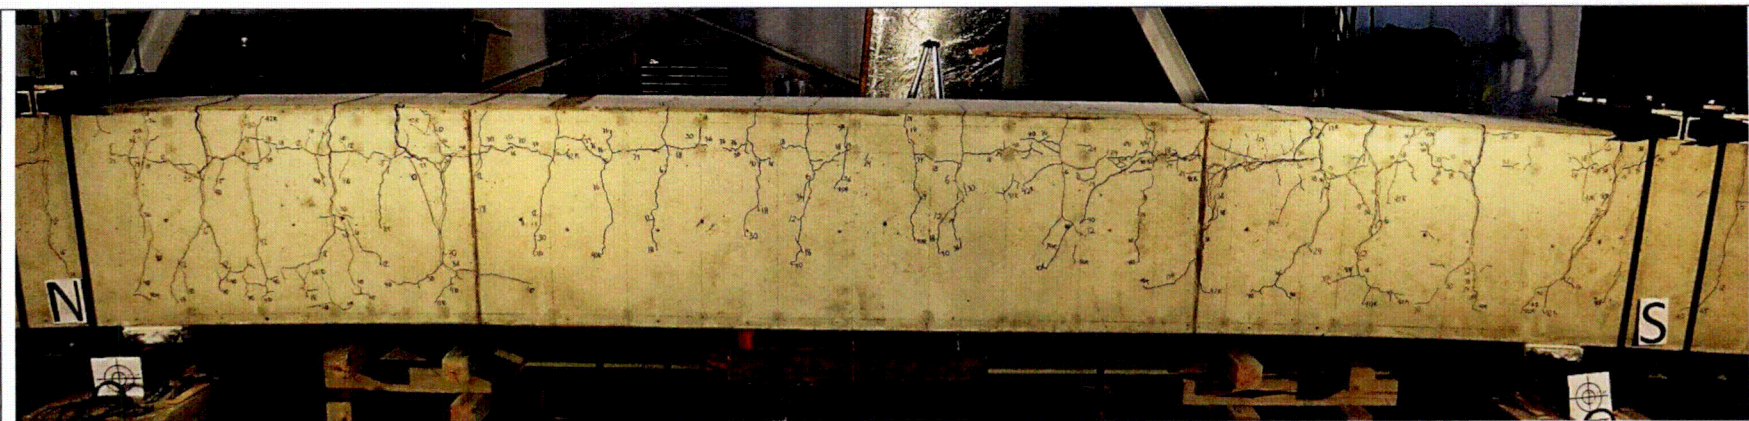

GIRDER A5 - 42 kip

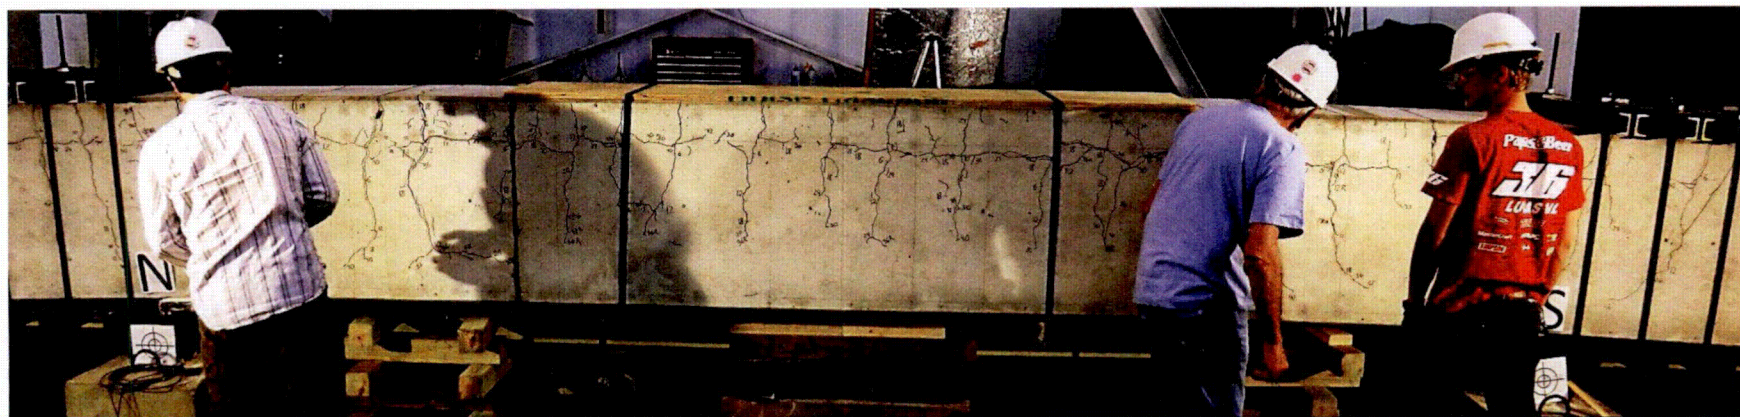

GIRDER A6 - 41 kip

FIRST LOADING




GIRDER B1 – 36 kip




GIRDER B2 – 36 kip

FIRST LOADING

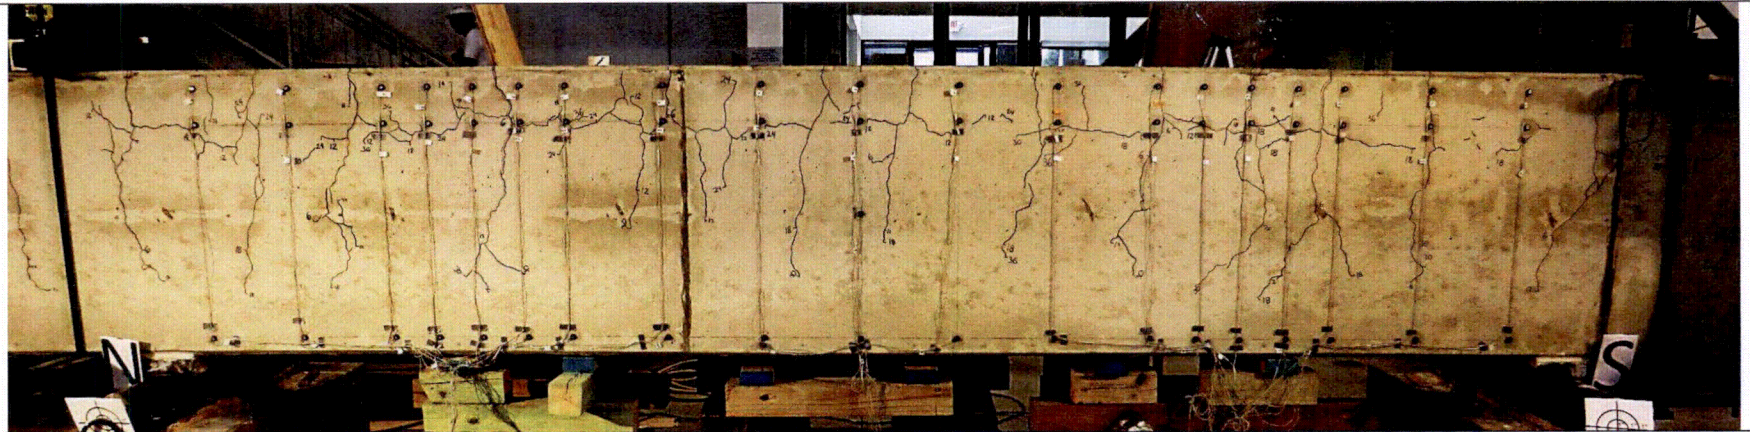


GIRDER B3 – 36 kip

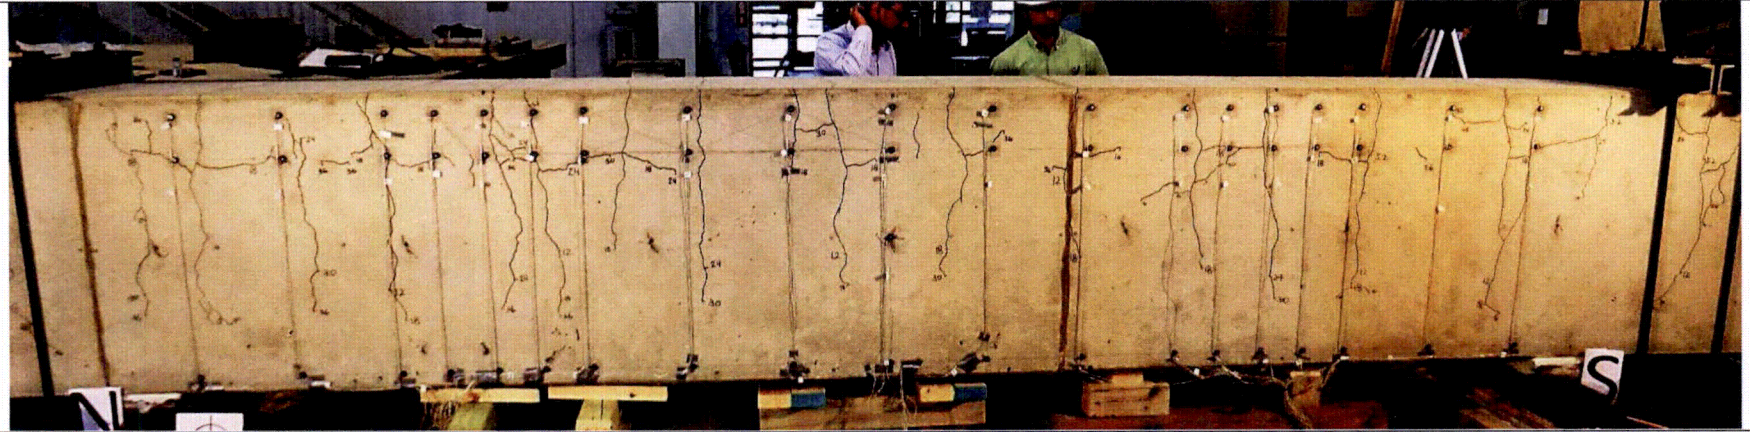


GIRDER B4 – 36 kip

FIRST LOADING

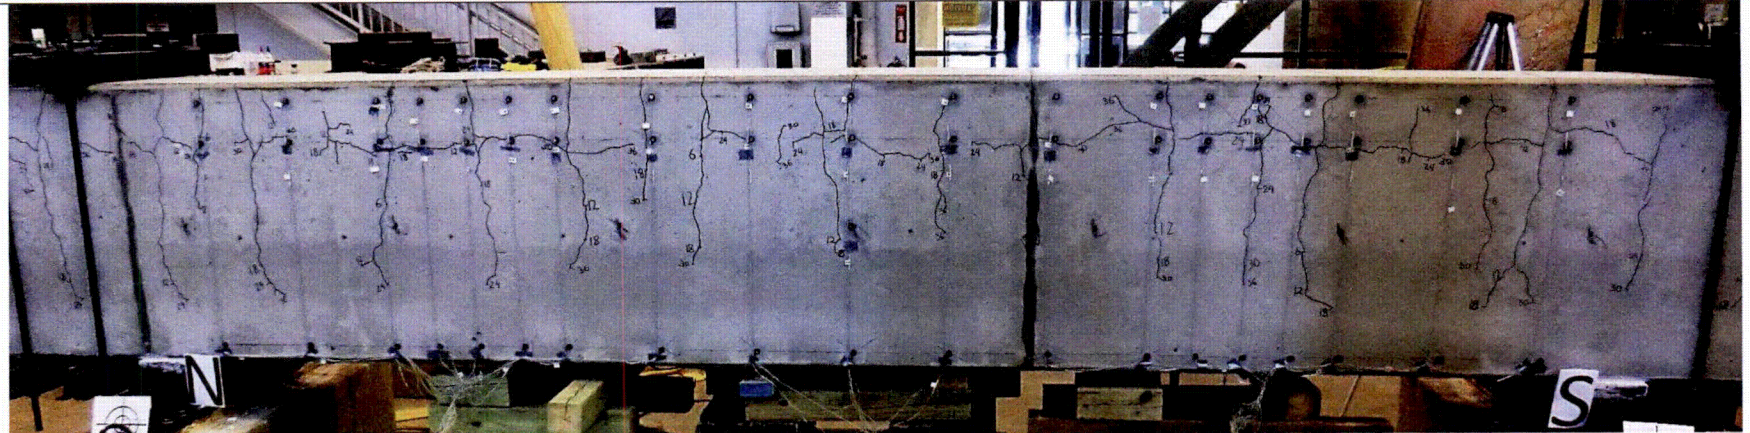

GIRDER B5 – 36 kip

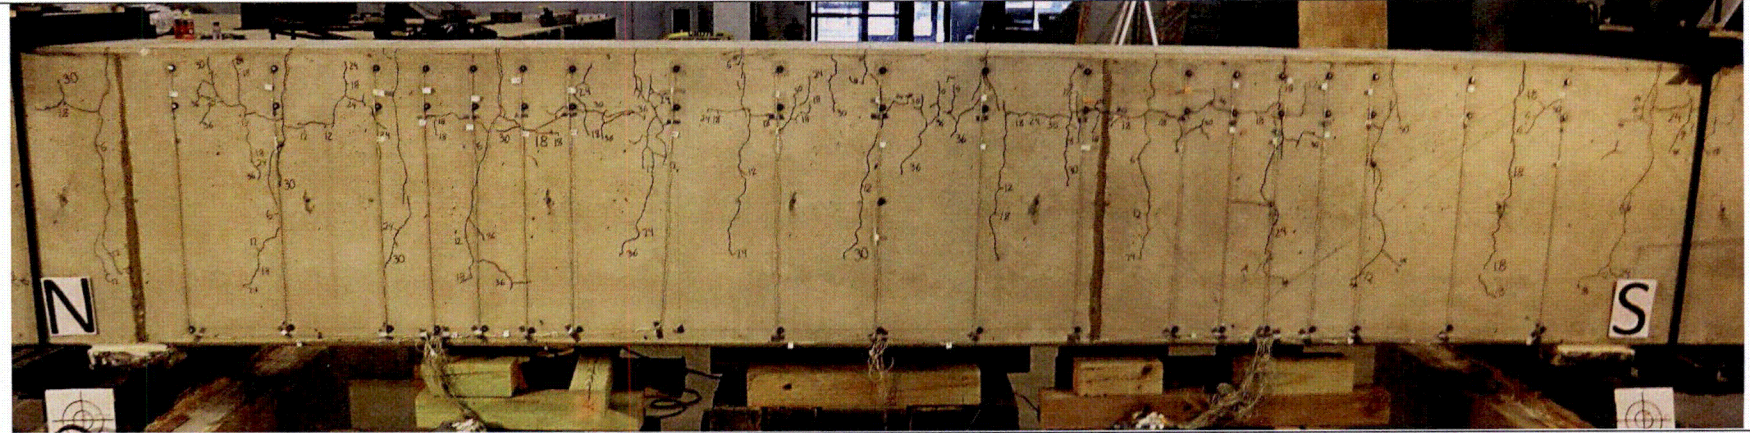

GIRDER B6 – 1 kip

RELOADING


No reload

GIRDER B1 – kip



GIRDER B2 – Load = 36 kip.

RELOADING

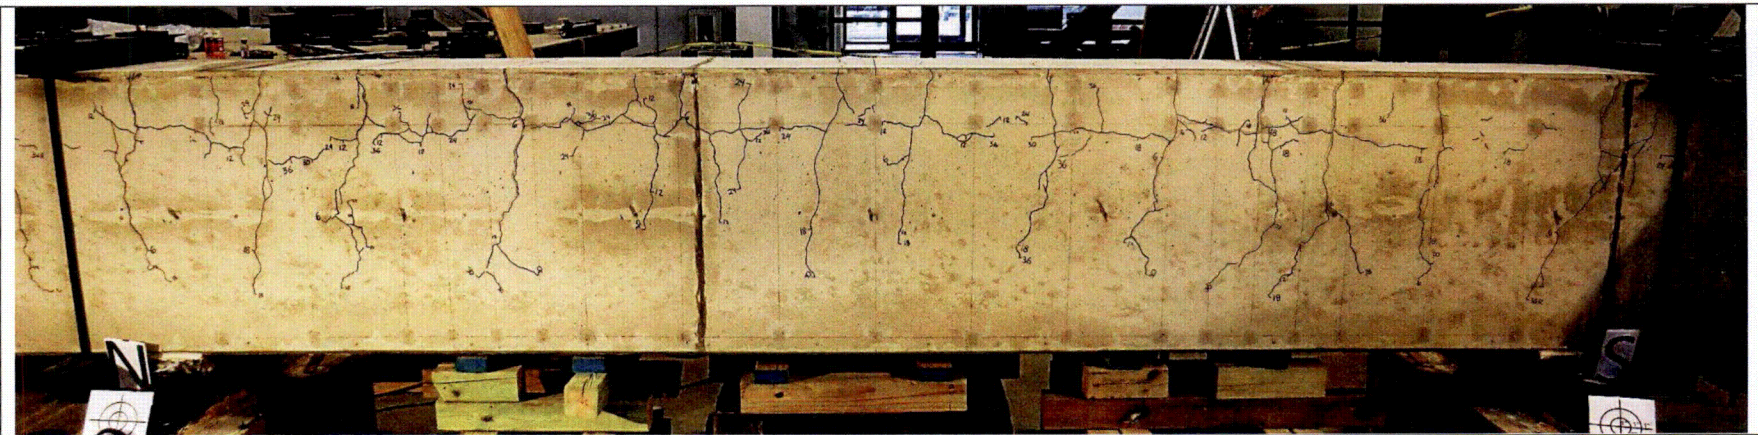


GIRDER B3 – Load = 36 kip


No reload

GIRDER B4

RELOADING

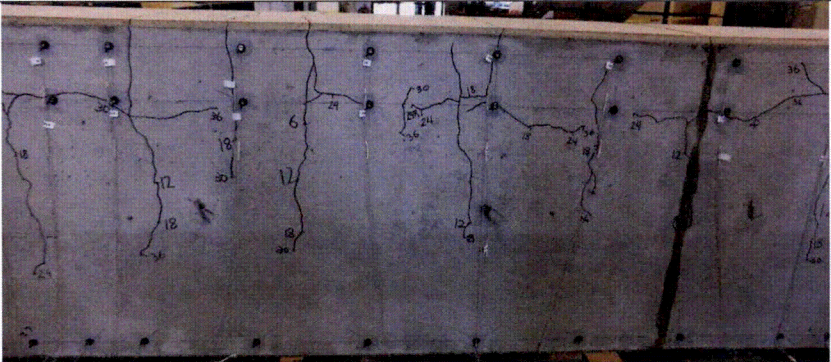


GIRDER B5 – 24 kip.

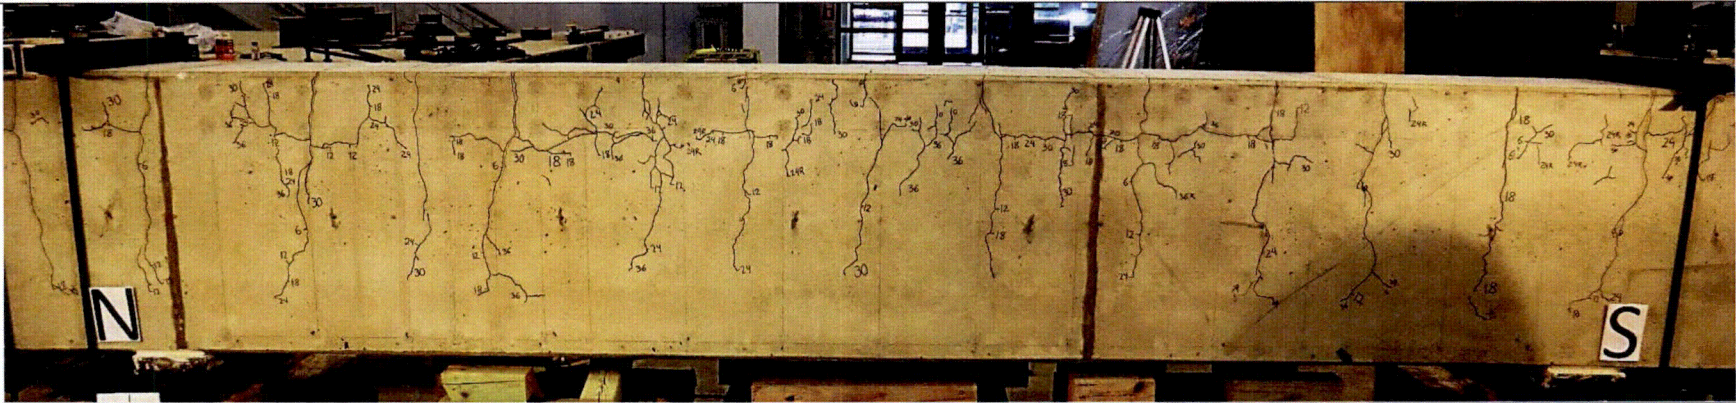

GIRDER B6 – 36 kip.

Data Acquisition System:								
Channel #	Gain	Excitation V.	Sensor	S.N.	[in/V] Sensitivity	[in] Zero Offset	Location	Zeros [V] Comments
0 M1-0	1	3.333	PA-20	37100980	-6.197	-17.26	N. Overhang	2.785
1 M1-1	1	"	"	37100981	-6.167	-17.02	S. "	2.759
2 M1-2	1	"	PA-10	40010986	3.175	1.18	N. Splice End	0.372
3 M1-3	1	"	"	40010991	3.169	0.87	Midspan	0.274
4 M2-0	1	"	"	40010988	3.173	1.08	S. Splice End	0.339
5 M2-2	100	10	Lebow 50K	443	-2556	0.2 [K]	N. End	-0.000044
6 M2-3	100	10	"	442	-2563	0.2 [K]	S. "	-0.000033
7 M3-0	1	30	Lucas 2	J7250	0.208	0.005	N. Support	0.027
8 M3-1	1	30	"	J7251	0.209	0.000	S. "	0.000
Operator		Signature			Date		Time	
BPR		<i>[Signature]</i>			6/2/12		2:40 PM	
Checked by		Signature			Date		Time	
KAN		<i>[Signature]</i>			6-2-12		2:40 pm	
Checked by		Signature			Date		Time	

Notes:

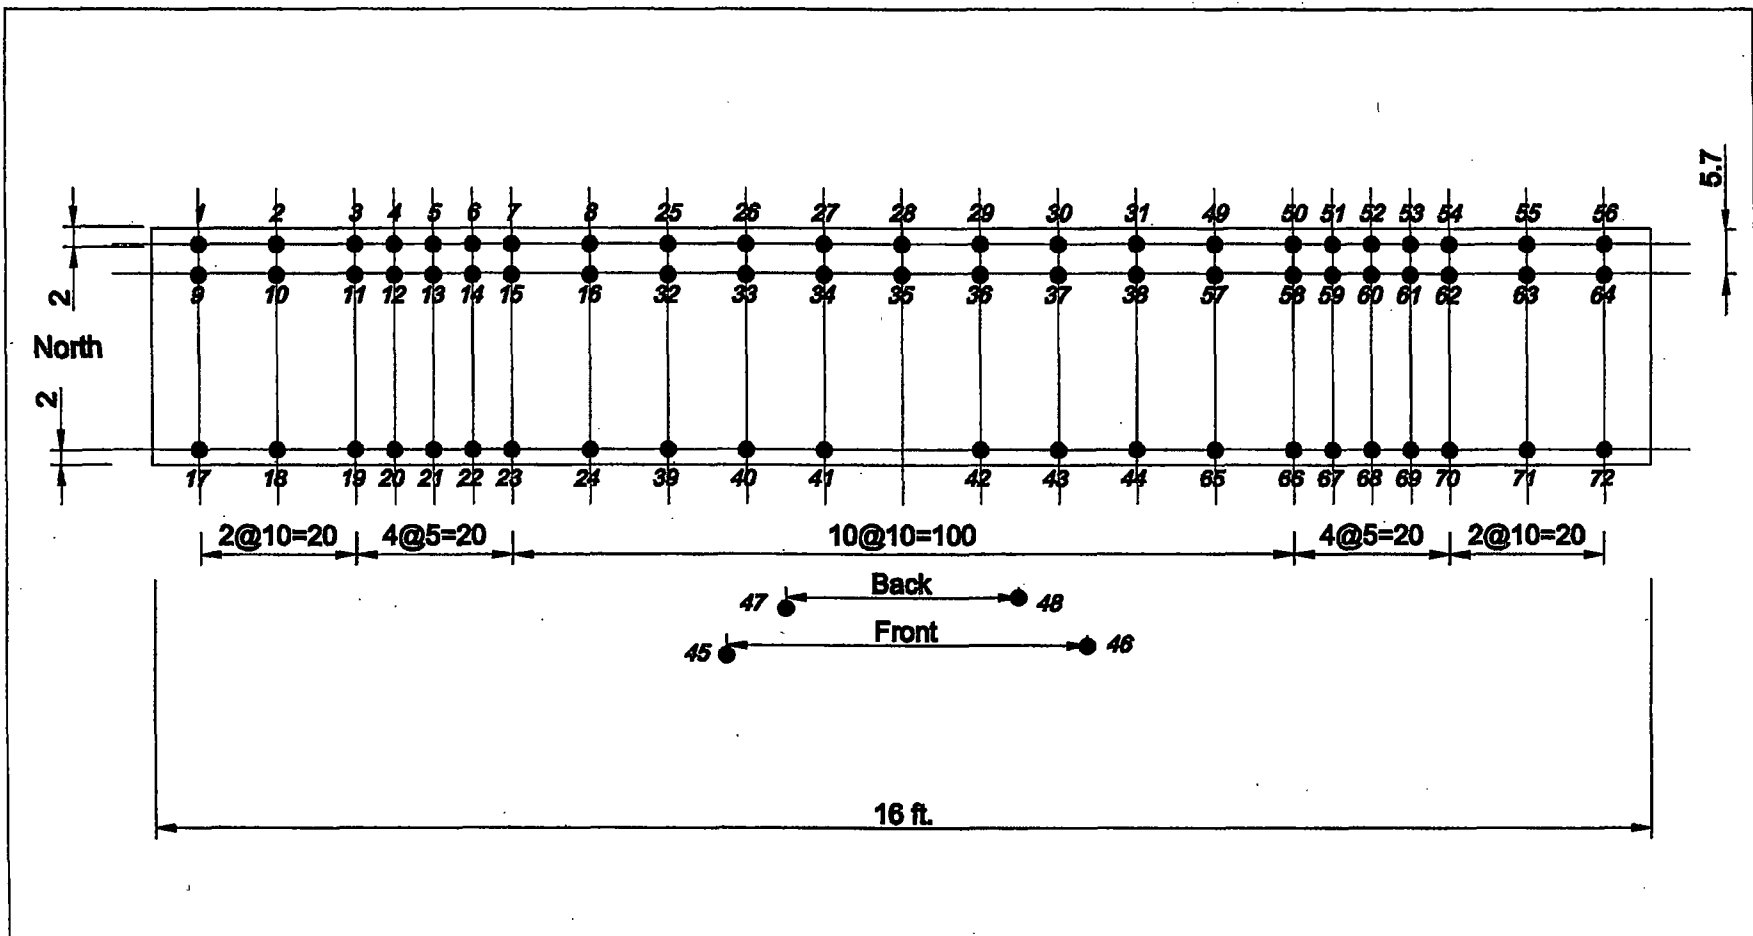


Specimen A-1			
	Behavior of Lap Splices of No. 11 Reinforcing Bars	Drawn by: BPR	Checked by: KAM
		Date: 6/2/12	

Data Acquisition System:								
Channel #	Gain	Excitation V.	Sensor	S.N.	(in/v) Sensitivity	(in) Zero Offset	Location	Zeros (v) Comments
0 M1-0	1	3.333	PA-20	37100980	-6.197	-17.04	N. Overhang	2.750
1 M1-1	1	"	"	37100981	-6.167	-17.31	S. "	2.807
2 M1-2	1	"	PA-10	40010986	3.175	1.26	N. Splice End	0.396
3 M1-3	1	"	"	40010991	3.169	0.82	Midspan	0.260
4 M2-0	1	"	"	40010988	3.173	0.99	S. Splice End	0.311
5 M2-2	100	10	Lebow 50K	443	-2556	0.3 [K]	N. End	-0.000060
6 M2-3	100	10	"	442	-2563	0.2 [K]	S. "	-0.000036
7 M3-0	1	30	Lucas 2	J7250	0.208	0.004	N. Support	0.013
8 M3-1	1	30	"	J7251	0.209	-0.004	S. "	-0.025

Operator	Signature	Date	Time
BPR	<i>[Signature]</i>	5/31/12	5:10 PM
Checked by	Signature	Date	Time
KAM	<i>[Signature]</i>	5-31-12	5:30 pm
Checked by	Signature	Date	Time


Notes:

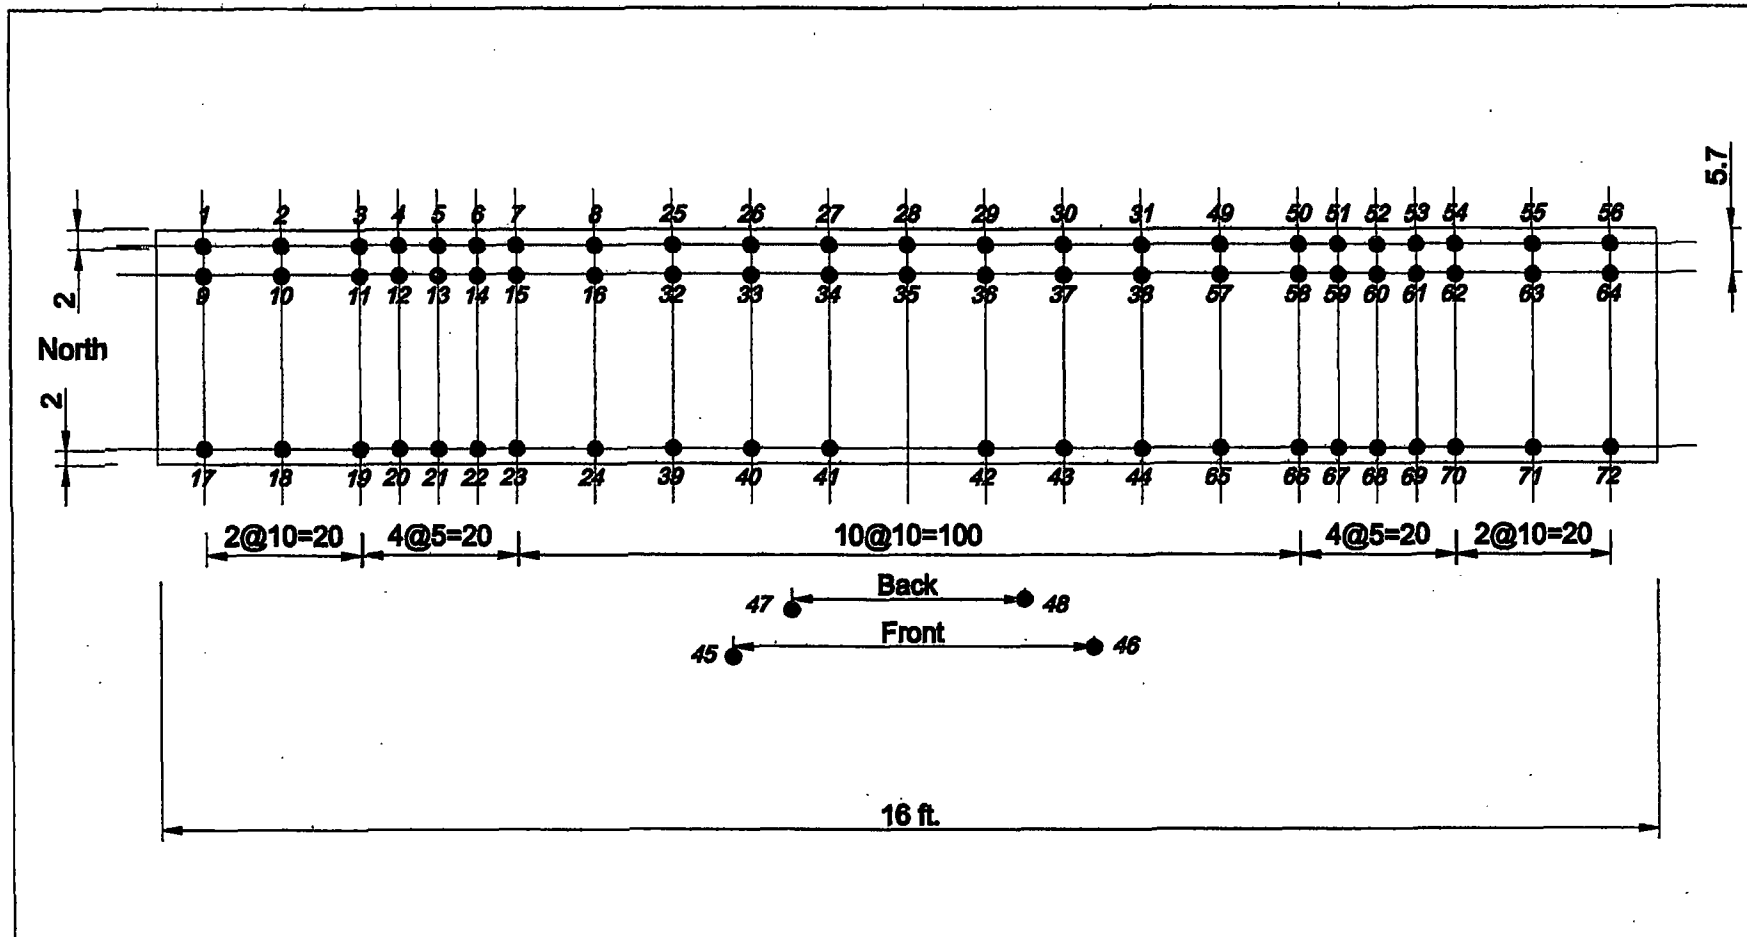

Specimen A-2			
Behavior of Lap Splices of No. 11 Reinforcing Bars	Drawn by: BPR	Checked by: KAM	
	Date: 5/31/12		

Data Acquisition System:		BPR 5/29/12						
Channel #	Gain	Excitation V.	Sensor	S.N.	[in/V] Sensitivity	[in] Zero Offset	Location	Zeros [V] Comments
0 M1-0	1	3.333	PA-20	37100980	-6.197	18. 17.43	N. Overhang	2.813
1 M1-1	1	"	"	37100981	-6.167	-17.13	S. "	2.777
2 M1-2	1	"	PA-10	40010986	3.175	1.19	N. Splice End	0.376
3 M1-3	1	"	"	40010991	3.169	0.90	Midspan	0.283
4 M2-0	1	"	"	40010988	3.173	1.15	S. Splice End	0.362
5 M2-2	100	10	Lebow 50K	443	-2556	0.2 [K]	N. End	-0.000034
6 M2-3	100	10	"	442	-2563	0.2 [K]	S. "	-0.000031
7 M3-0	1	30	Lucas 2	J7250	0.208	-0.003	N. Support	-0.016
8 M3-1	1	30	"	J7251	0.209	-0.001	S. "	-0.007
Operator		Signature			Date		Time	
BPR		<i>[Signature]</i>			5/29/12		9:20 PM	
Checked by		Signature			Date		Time	
J.N.H.		<i>[Signature]</i>			5.29.12		9:20	
Checked by		Signature			Date		Time	

Notes:

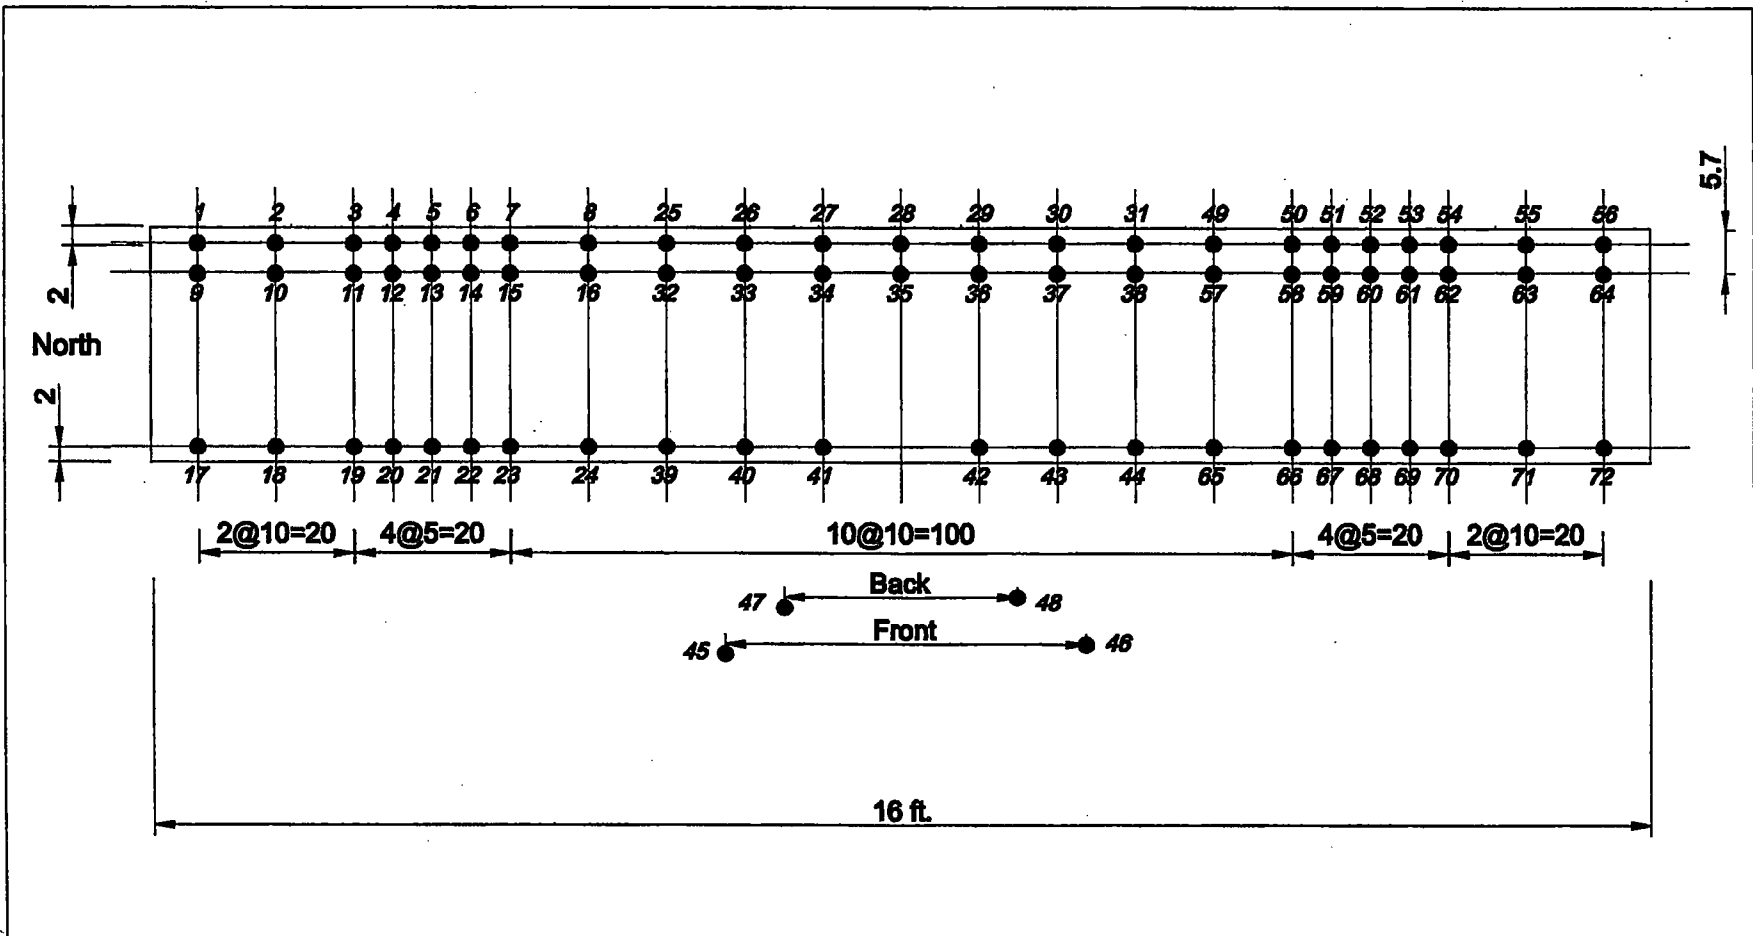

Specimen **A-3**



Behavior of Lap Splices of No. 11 Reinforcing Bars

Drawn by:	BPR	Checked by:	WAM
Date:	5/29/12		


Project: Tests to Determine the Behavior of Spliced #11 Bars

Instrumentation Documentation v.1
(Rev. 04/01/2012)

Specimen: A-4
Sheet 1 of 1

Data Acquisition System:								
Channel #	Gain	Excitation V.	Sensor	S.N.	(in/v) Sensitivity	[in] Zero Offset	Location	Zeros [v] Comments
0 M1-0	1	3.333	PA-20	37100980	-6.197	-17.08	N. Overhang	2.757
1 M1-1	1	"	"	37100981	-6.167	-17.45	S. "	2.830
2 M1-2	1	"	PA-10	40010986	3.175	1.22	N. Splice E.	0.383
3 M1-3	1	"	"	40010991	3.169	0.86	Midspan	0.271
4 M2-0	1	"	"	40010988	3.173	1.05	S. Splice E.	0.332
5 M2-2	100	10	Lebow 50K	443	-2556	^{BPR 6/7} 0.007 0.3	N. End	-0.000056
6 M2-3	100	10	"	442	-2563	0.3 [K]	S. End	-0.000055
7 M3-0	1	30	Lucas 2	J7250	0.208	0.007	N. Support	0.035
8 M3-1	1	30	"	J7251	0.209	-0.007	S. "	-0.034
Operator			Signature		Date		Time	
BPR					6/7/12		10:30 PM	
Checked by			Signature		Date		Time	
KAM					6-7-12		10:30 pm	
Checked by			Signature		Date		Time	

Notes:

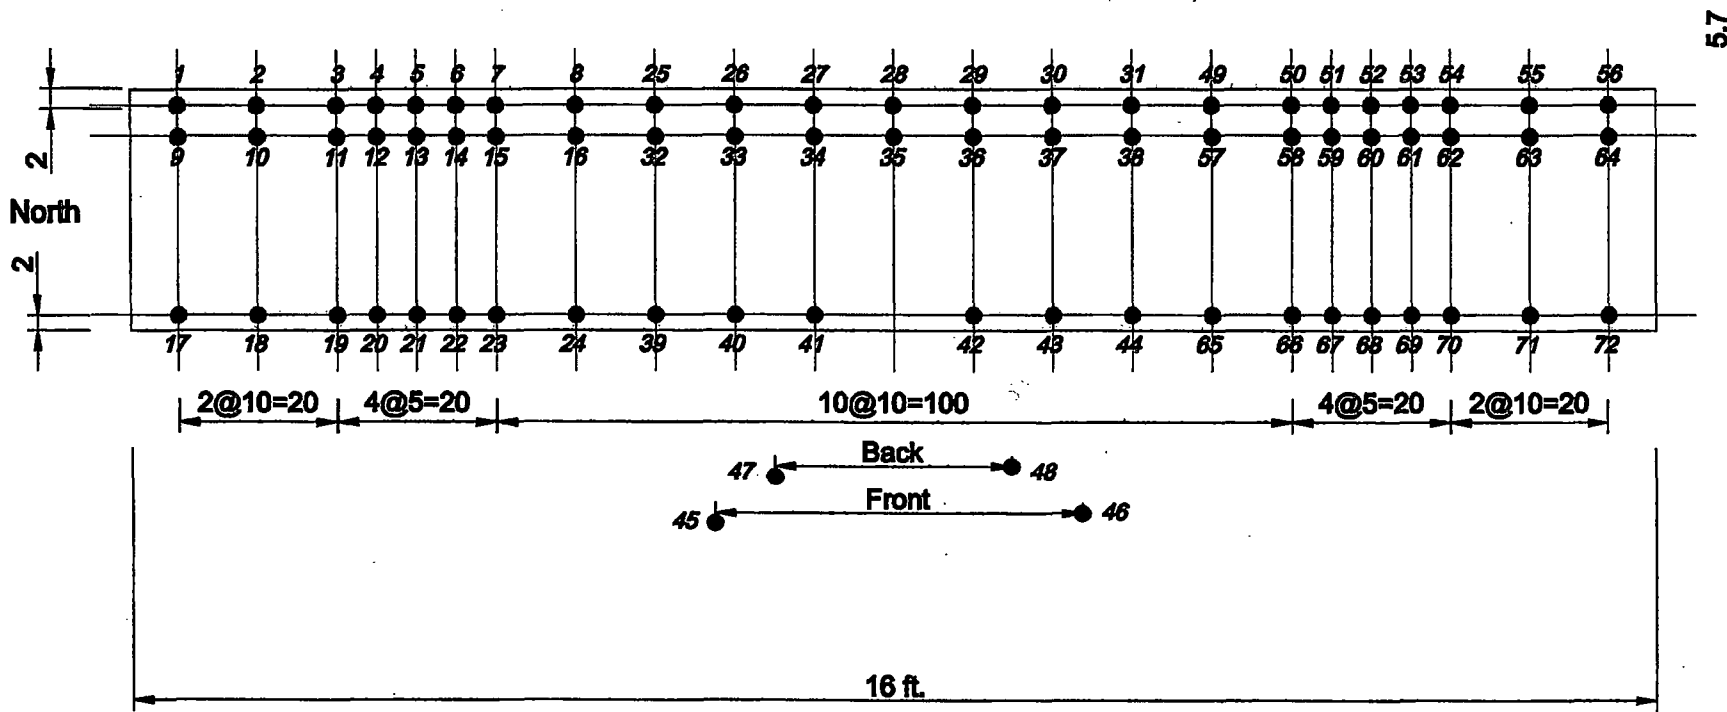

Specimen *A-4*

Behavior of Lap Splices of No. 11
Reinforcing Bars

Drawn by:

BPR



Checked by:

KAM

Date:


6/7/12

Data Acquisition System:								
Channel #	Gain	Excitation V.	Sensor	S.N.	(mV) Sensitivity	[in] Zero Offset	Location	Zeros (V) Comments
0 M1-0	1	3.333	PA-20	37100980	-6.197	-17.40	N. Overhang	2.808
1 M1-1	1	"	"	37100981	-6.167	-16.96	S. "	2.750
2 M1-2	1	"	PA-10	40010986	3.175	1.10	N. Splice End	0.349
3 M1-3	1	"	"	40010991	3.169	0.72	Midspan	0.230
4 M2-0	1	"	"	40010988	3.173	0.98	S. Splice End	0.310
5 M2-2	100	10	Lebow 50K	443	-2556	0.2 [K]	N. End	-0.000038
6 M2-3	100	10	"	442	-2563	0.2 [K]	S. "	-0.000037
7 M3-0	1	30	Lucas 2	J7250	0.208	0.006	N. Support	0.027 ^{BPR}
8 M3-1	1	30	"	J7251	0.209	-0.005	S. "	-0.026 ^{BPR}

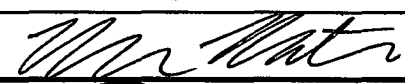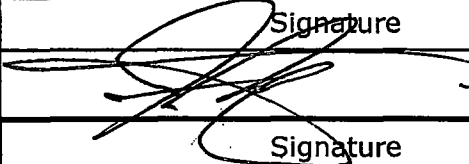

Operator	Signature	Date	Time
BPR		6/6/12	5:30 PM
Checked by	Signature	Date	Time
J.N.H.		6.6.12	5:45 P
Checked by	Signature	Date	Time

Notes:

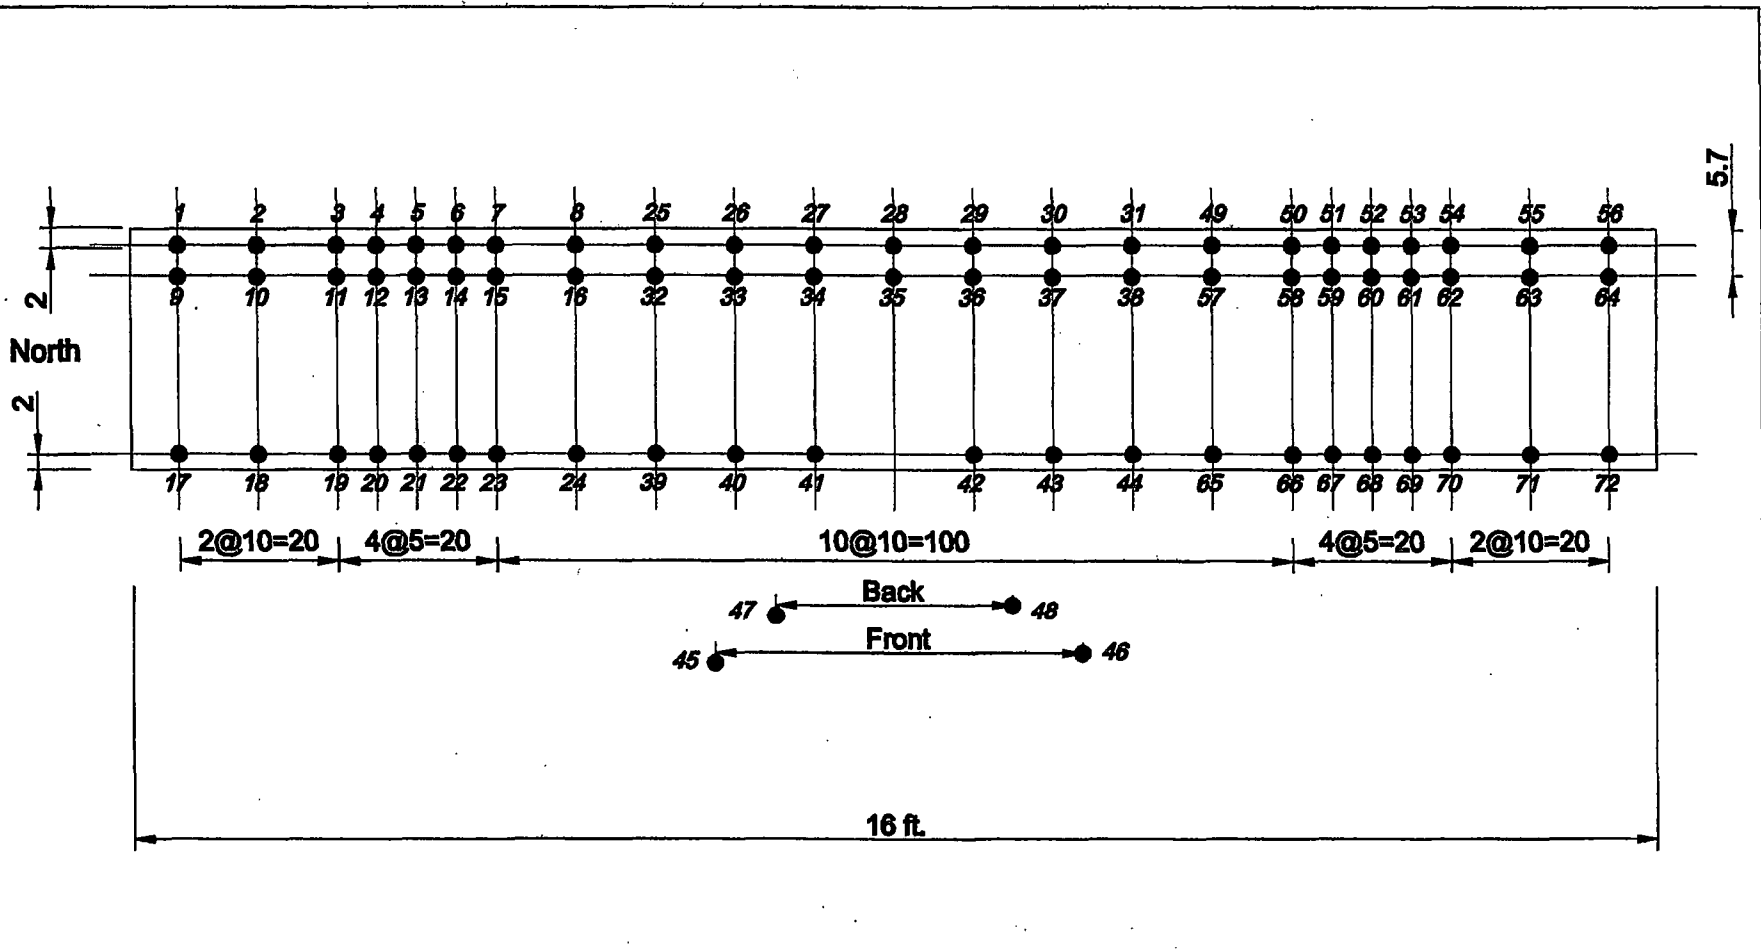
12-9
REDACTED VERSION



Specimen A-5	Behavior of Lap Splices of No. 11 Reinforcing Bars	Drawn by: BPR	Checked by: KAM
		Date: 6/6/12	

Data Acquisition System:								
Channel #	Gain	Excitation V.	Sensor	S.N.	(mV/V) Sensitivity	[in] Zero Offset	Location	Zeros (V) Comments
0 M1-0	1	3.333	PA-20	37100980	-6.197	^{BPR 6/5} 2.78 ^{-17.23}	N. Overhang	2.780
1 M1-1	1	"	"	37100981	-6.167	-17.01	S. "	2.758
2 M1-2	1	"	PA-10	40010986	3.175	1.10	N. Splice End	0.347
3 M1-3	1	"	"	40010991	3.169	0.84	Midspan	0.264
4 M2-0	1	"	"	40010988	3.173	1.00	S. Splice End	0.316
5 M2-2	100	10	Lebow 50K	443	-2556	^{BPR 6/5} 0.006 ^{0.3} [K]	N. End	-0.000057
6 M2-3	100	10	"	442	-2563	^{BPR 6/5} -0.007 ^{0.2} [K]	S. End	-0.000036
7 M3-0	1	30	Lucas 2	J7250	0.208	0.006	N. Support	0.029
8 M3-1	1	30	"	J7251	0.209	-0.007	S. "	-0.034
Operator			Signature		Date		Time	
BPR					6/4/12		11:00 AM	
Checked by			Signature		Date		Time	
KAM					6-4-12		11:00 am	
Checked by			Signature		Date		Time	

Notes:

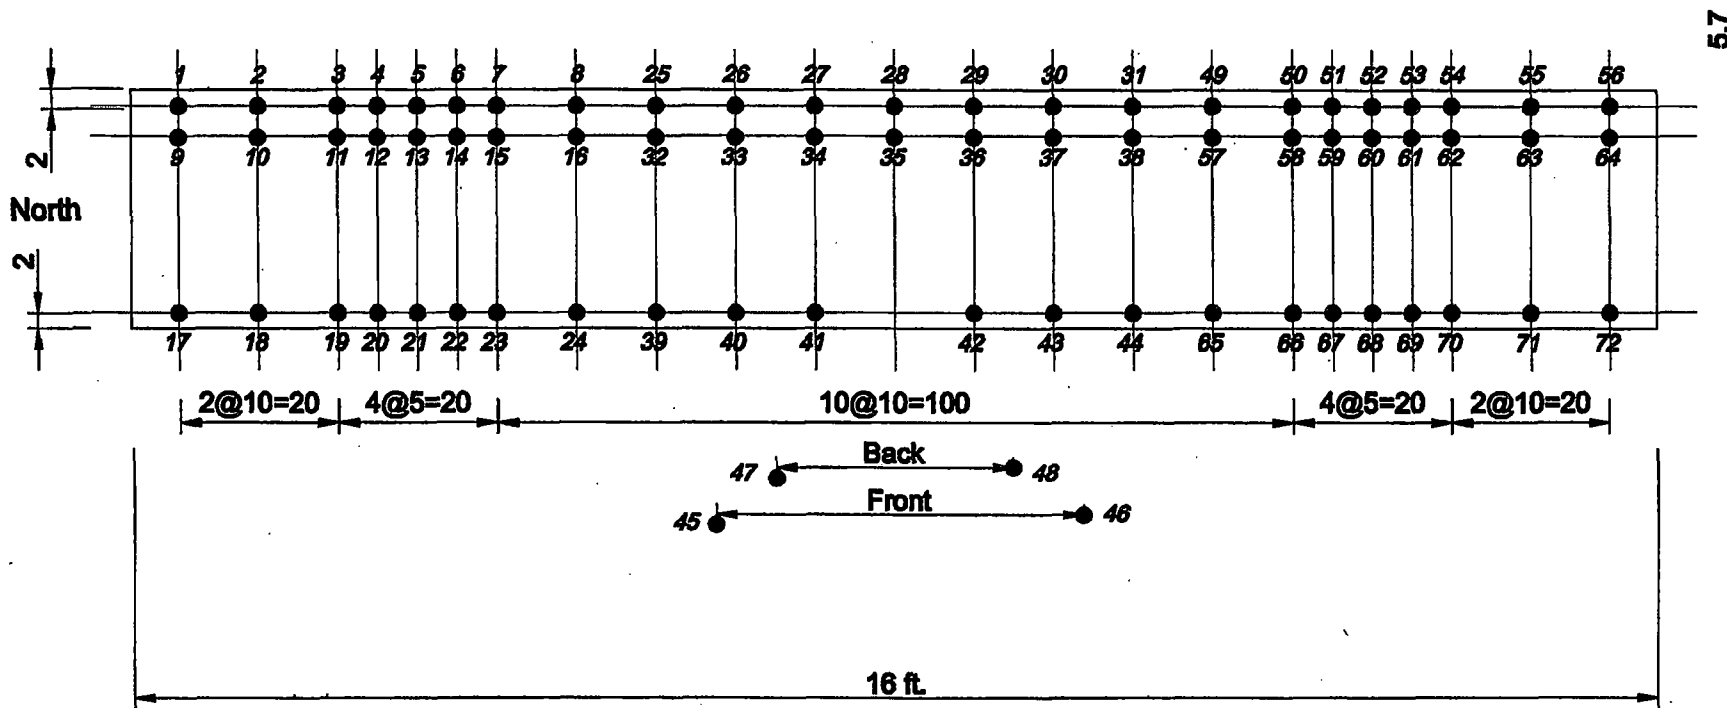

Specimen **A-6**

Behavior of Lap Splices of No. 11
Reinforcing Bars

Drawn by:

BPK

Checked by:

KAM

Date:

6/4/12


Project: Tests to Determine the Behavior of Spliced #11 Bars

Instrumentation Documentation v.1
(Rev. 04/01/2012)

Specimen: B-1
Sheet 1 of 1

Data Acquisition System:									
Channel #	Gain	Excitation V.	Sensor	S.N.	(m.V) Sensitivity	(in.) Zero Offset	Location	Zeros (V.) Comments	
0	M1-0	1	3.333	PA-20	371 00980	-6.197 /	-18.68	N. Overhang	3.013
1	" 1	1	"	"	371 00981	-6.167	-17.01	S. "	2.745
2	" 2	1	"	PA-10	400 10980 ✓	3.175 /	0.74	N. Splice end	0.235
3	" 3	1	"	"	400 10985 ✓	3.169 /	0.54	Midspan	0.170
4	M2-0	1	"	"	400 10977 ✓	3.173 /	0.91	S. Splice end	0.287
5	M2-2	100	10	Lebow 50k	443	-2556	0.2	N. End	-0.000042
6	" -3	100	10	"	442	-2563	0.2	S. End	-0.000029
7	M3-0	1	30V	Lucas 2"	J7250	0.208 /	-0.008	N. Support	-0.041
8	M3-1	1	30V	" 2"	J7251	0.209 /	-0.006	S. "	-0.027
Operator		Signature			Date		Time		
S.P.					5/10/12		11 AM		
Checked by		Signature			Date		Time		
A.J.C.					5/16/12		11 am		
Checked by		Signature			Date		Time		

Notes:

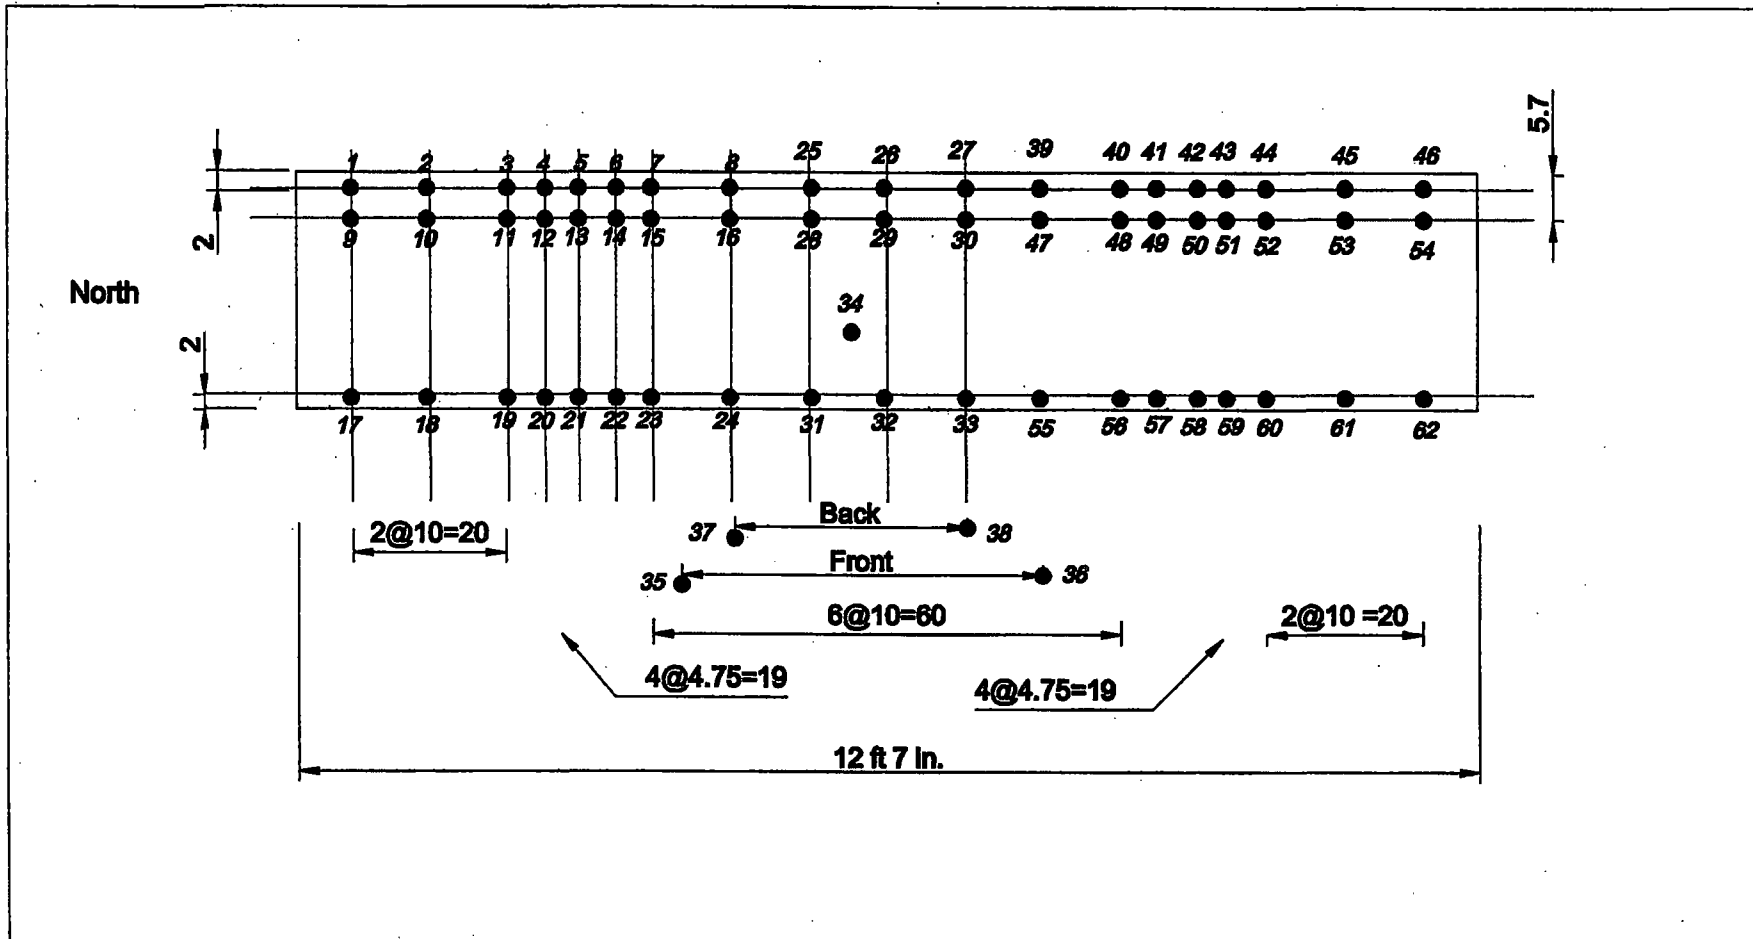

Specimen **B-1**

Behavior of Lap Splices of No. 11
Reinforcing Bars

Drawn by:



BPR

Checked by:


WM

Date:

5/10/12

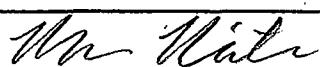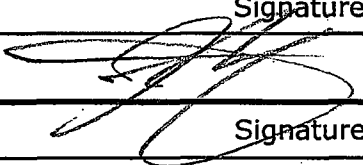Data Acquisition System:								
Channel #	Gain	Excitation V.	Sensor	S.N.	Sensitivity	[in] Zero Offset	Location	Zeros (V) Comments
0 M1-0	1	3.333	PA-20	37100980	-6.197	-18.60	N. Overhang	3.002
1 M1-1	1	"	"	37100981	-6.167	-17.13	S. Overhang	2.778
2 M1-2	1	"	PA-10	40010986	3.175	+0.74	N. Splice End	0.234
3 M1-3	1	"	"	40010991	3.169	+0.56	Midspan	0.177
4 M2-0	1	"	"	40010988	3.173	+1.12	S. Splice End	0.352
5 M2-2	100	10V	Lebow 50K	443	-2556	0.2 [K]	N. End	-0.000041
6 M2-3	100	10V	"	442	-2563	0.2 [K]	S. End	-0.000036
7 M3-0	1	30V	Lucas 2	J7250	0.208	+0.010	N. Support	0.051
8 M3-1	1	30V	"	J7251	0.209	-0.005	S. Support	-0.024
Operator		Signature			Date		Time	
BPR					5/22/12		6:15PM	
Checked by		Signature			Date		Time	
J.N.H.					5.22.12		6:25 PM	
Checked by		Signature			Date		Time	


Notes:

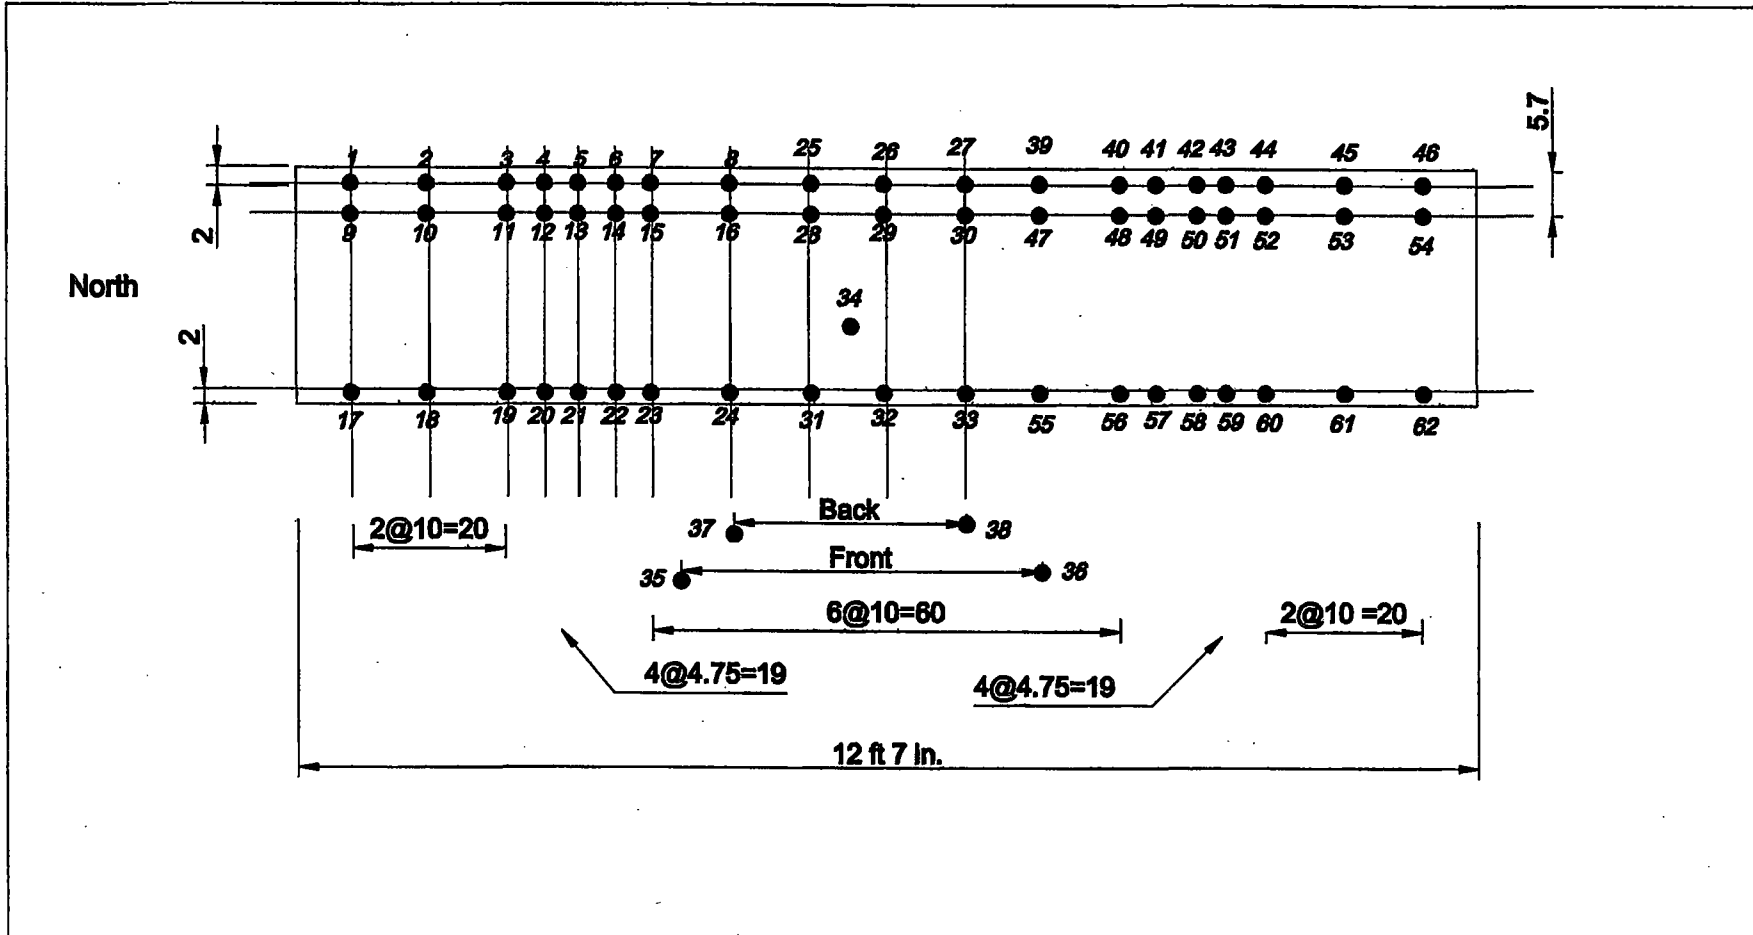

Specimen B-2 Behavior of Lap Splices of No. 11 Reinforcing Bars			
	Drawn by: BPR	Checked by: KAM	
	Date: 5/22/12		



Data Acquisition System:								
Channel #	Gain	Excitation V.	Sensor	S.N.	Sensitivity	[mV] Zero Offset	Location	Zeros (V) Comments
0 M1-0	1	3.333	PA-20	37100980	-6.197	-18.99	N. Overhang	3.064 ✓
1 M1-1	1	"	"	37100981	-6.167	-16.99	S. " "	2.755 ✓
2 M1-2	1	"	PA-10	40010986	3.175	0.97	N. Splice End	0.305 ✓
3 M1-3	1	"	"	40010991	3.169	0.64	Midspan	0.203 ✓
4 M2-0	1	"	"	40010988	3.173	1.07	S. Splice End	0.336 ✓
5 M2-2	100	10	Lebow 50K	443	-2556	0.3 [K]	N. End	-0.000060 ✓
6 M2-3	100	10	"	442	-2563	0.2 [K]	S. End	-0.000040 ✓
7 M3-0	1	30	Lucas 2	J7250	0.208	0.014	N. Support	0.067 ✓
8 M3-1	1	30	"	J7251	0.209	-0.006	S. " "	-0.028 ✓
Operator		Signature			Date		Time	
BPR		<i>Mr. Hite</i>			5/19/12		5:25 PM	
Checked by		Signature			Date		Time	
SP		<i>[Signature]</i>			5/19/12		7:15 PM	
Checked by		Signature			Date		Time	

Notes:

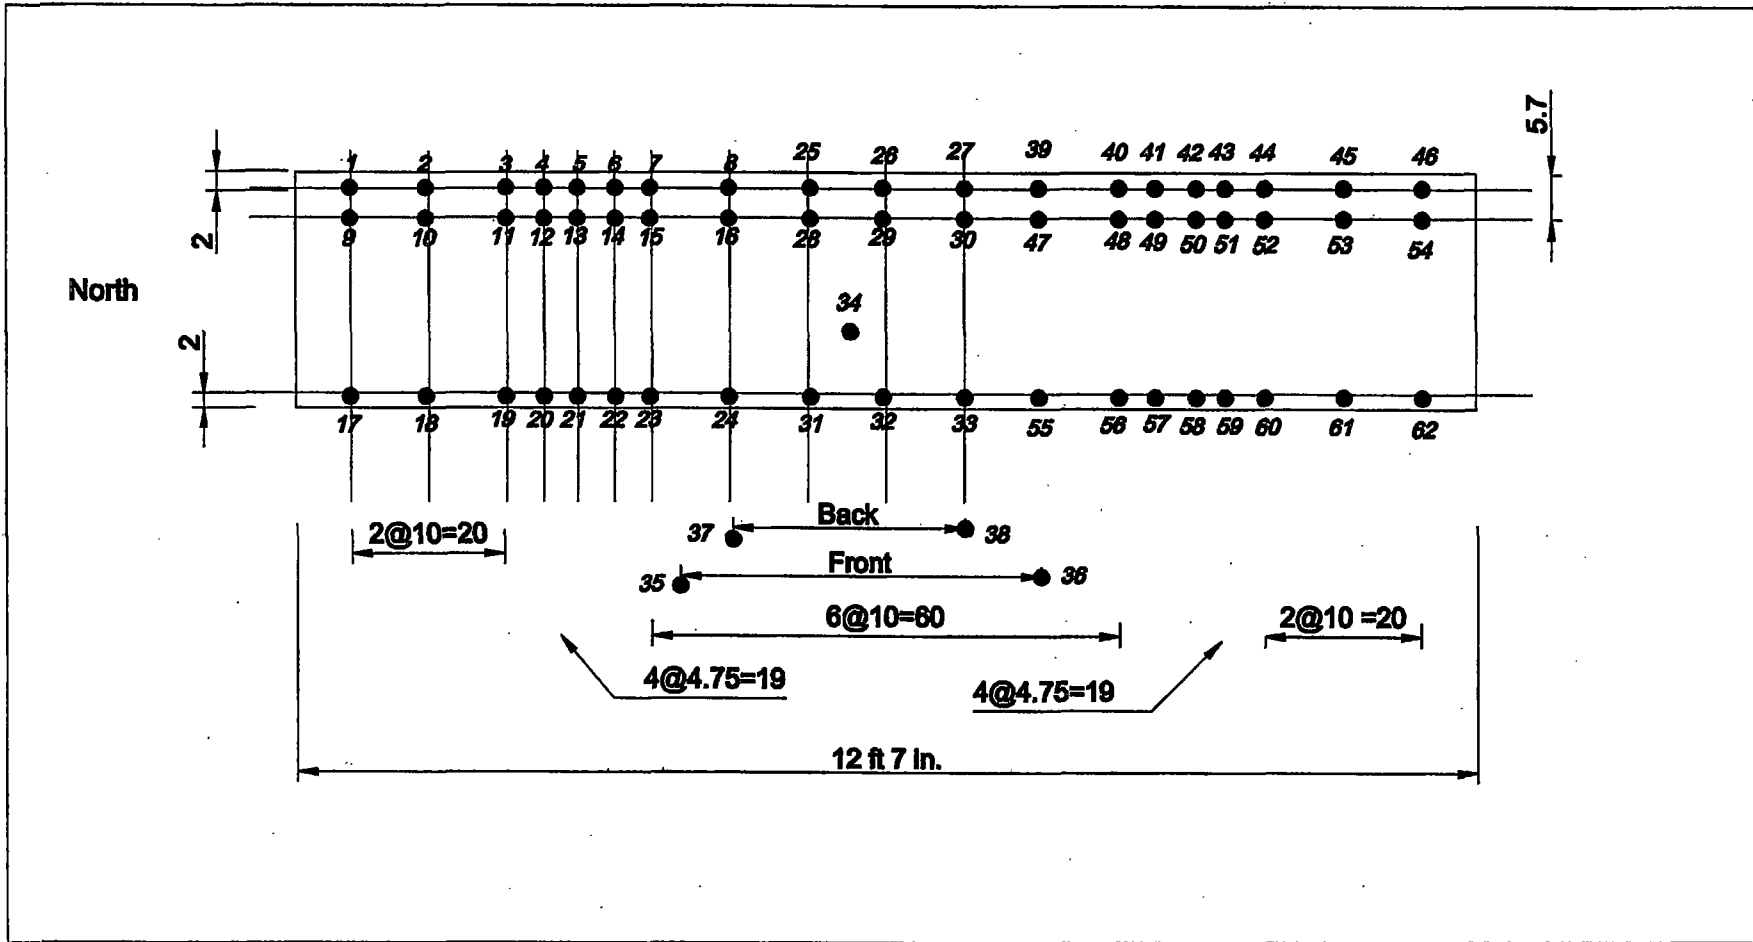


Specimen	B-3		
Behavior of Lap Splices of No. 11 Reinforcing Bars	Drawn by:	BPR	Checked by:
	Date:	5/19/12	
			WAM

Data Acquisition System:									
Channel #	Gain	Excitation V.	Sensor	S.N.	(m/V) Sensitivity	in. Zero Offset	Location	Zero Offset V. Comments	
0	M1-0	1	3.333	PA-20	37100980	-6.197	-18.37	N. Overhang	2.965
1	M1-1	1	"	"	37100981	-6.167	-17.04	S. "	2.764
2	M1-2	1	"	PA-10	40010986	3.175	0.62	N. Splice End	0.195
3	M1-3	1	"	"	40010991	3.169	0.46	Midspan	0.146
4	M2-0	1	"	"	40010988	3.173	0.99	S. Splice End	0.312
5	M2-2	100	10V	LC443	443	-2556	0.2	N. End	-0.000042
6	M2-3	100	10V	LC442	442	-2563	0.2	S. End	-0.000040
7	M3-0	1	30V	LVDT	J7250	0.208	-0.005	N. Support	-0.026
8	M3-1	1	30V	LVDT	J7251	0.209	-0.003	S. "	-0.014

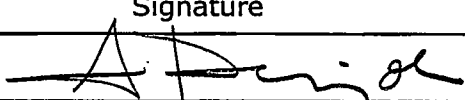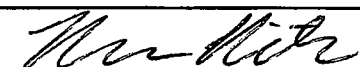Operator	Signature	Date	Time
S.P.		5/12/12	3:46 PM.
Checked by	Signature	Date	Time
BPR		5/12	4:00 PM
Checked by	Signature	Date	Time


Notes: All instruments & settings as in B-1

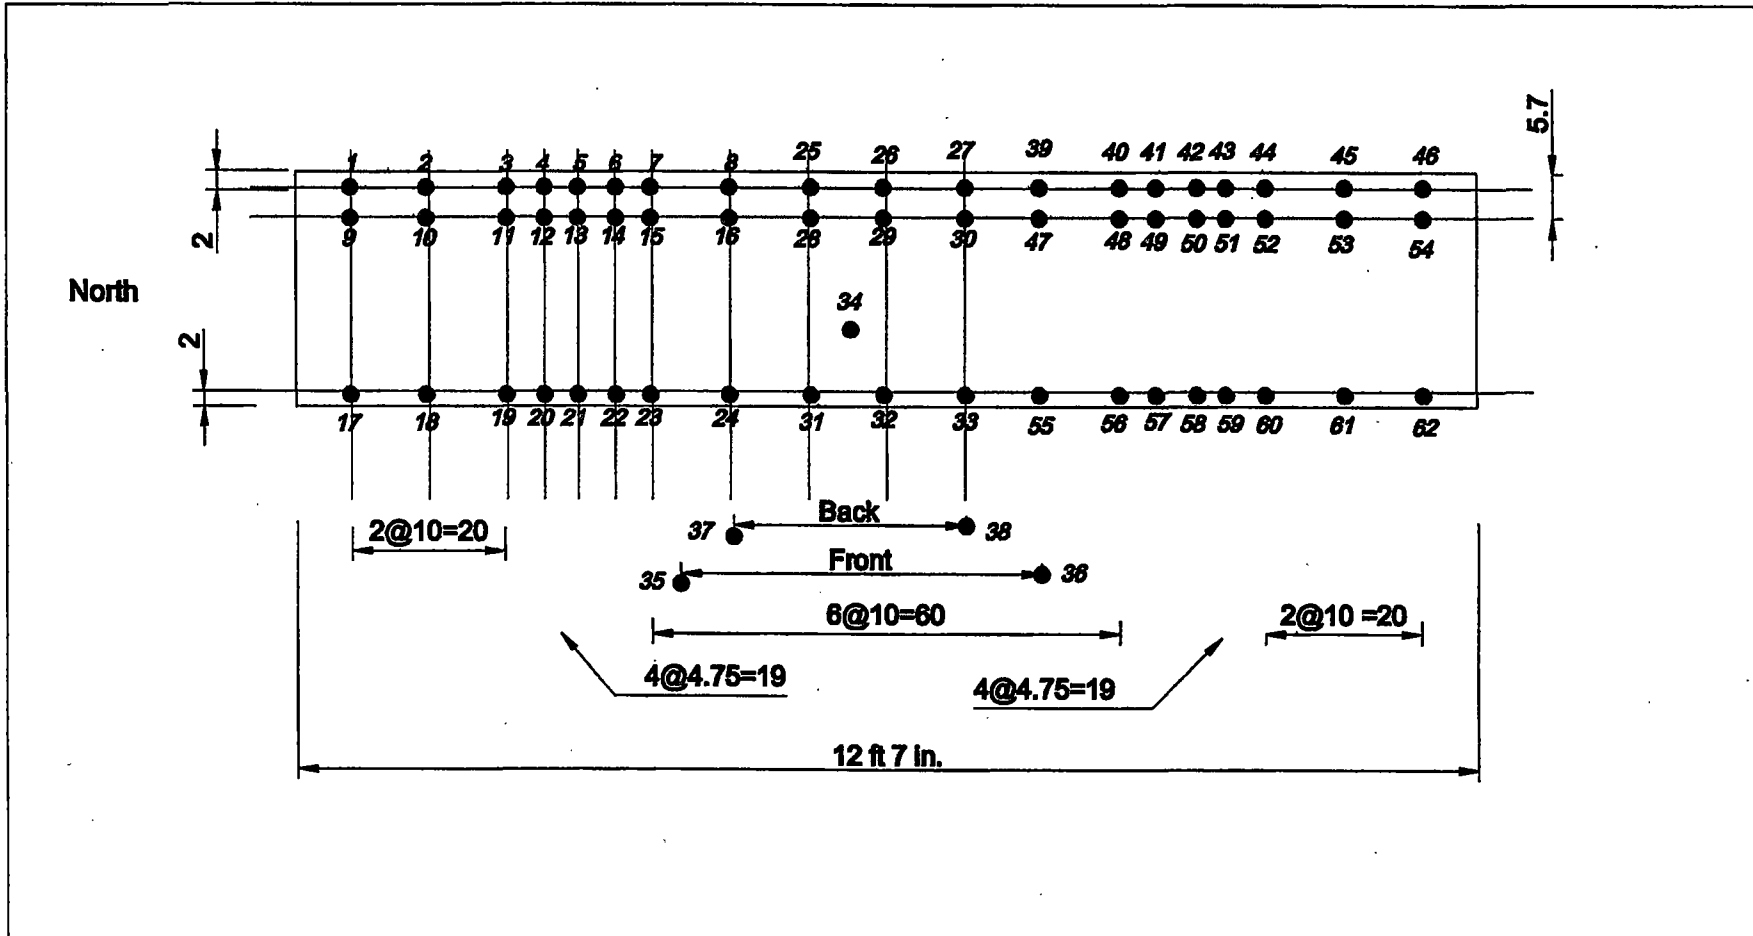

Specimen B-4	Behavior of Lap Splices of No. 11 Reinforcing Bars	Drawn by: BPR	Checked by: VM
		Date: 5/14/12	

Data Acquisition System:								
Channel #	Gain	Excitation V.	Sensor	S.N.	(mV/V) Sensitivity	[mV] Zero Offset	Location	Zeros(V) Comments
0 M1-0	1	3.333	PA-20	37100980	-6.197	-18.73	N. Overhang	3.022 ✓
1 M1-1	1	"	"	37100981	-6.167	-16.89	S. "	2.739 ✓
2 M1-2*	1	"	PA-10	40010986*	3.175	+0.72	N. Splice end	0.225 ✓
3 M1-3	1	"	"	40010991	3.169	+0.48	Midspan	0.153 ✓
4 M2-0	1	"	"	40010988	3.173	+0.97	S. Splice end	0.305
5 M2-2	100	10V	Lebow 50K	443	-2556	0.2 [K]	N. End	-0.000048
6 M2-3	100	10V	"	442	-2563	0.2 [K]	S. End	-0.000039
7 M3-0	1	30V	Lucas 2	J7250	0.208	-0.005	N. Support	-0.022
8 M3-1	1	30V	"	J7251	0.209	+0.011	S. "	0.054
Operator		Signature			Date		Time	
S. PUJOL								
Checked by		Signature			Date		Time	
BPR		<i>Mrs Nitr</i>			5/17/12		12:20PM	
Checked by		Signature			Date		Time	

Notes: * Cable Replaced.

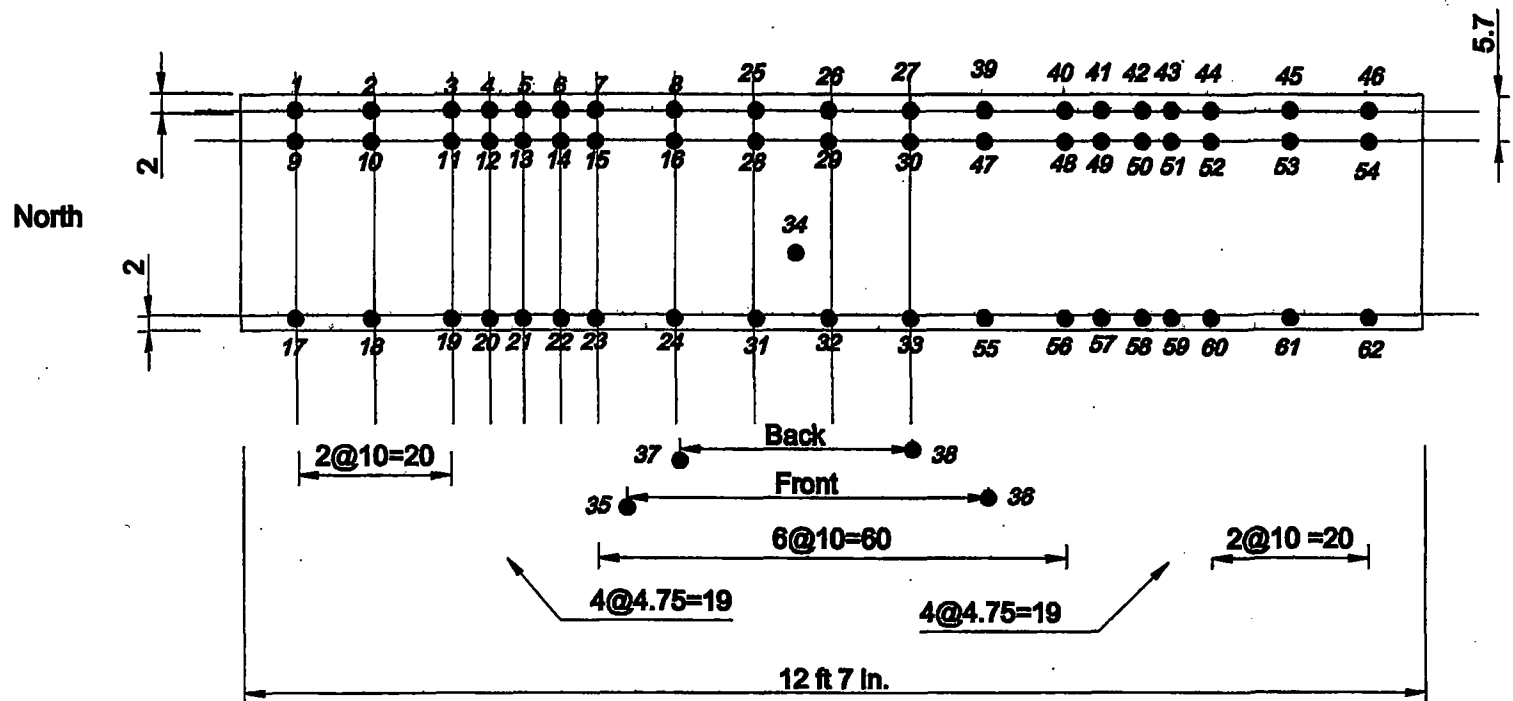


Specimen B-5 Behavior of Lap Splices of No. 11 Reinforcing Bars				
	Drawn by: BPR	Checked by: km		
	Date: 5/16/12			

Data Acquisition System:								
Channel #	Gain	Excitation V.	Sensor	S.N.	Sensitivity	[in] Zero Offset	Location	Zeros [V] Comments
0 M1-0	1	3.333	PA-20	37100980	-6.197	-18.86	N. Overhang	3.043
1 M1-1	1	"	"	37100981	-6.167	-17.11	S. Overhang	2.774
2 M1-2	1	"	PA-10	40010986	3.175	0.86	N. Splice End	0.271
3 M1-3	1	"	"	40010991	3.169	0.59	Midspan	0.185
4 M2-0	1	"	"	40010988	3.173	1.15	S. Splice End	0.362
5 M2-2	100	10V	Lebow 50K	443	-2556	0.2 [K]	N. End	-0.000033
6 M2-3	100	10V	"	442	-2563	0.2 [K]	S. End	-0.000036
7 M3-0	1	30V	Lucas 2	J7250	0.208	0.000	N. Support	0.000
8 M3-1	1	30V	"	J7251	0.209	0.002	S. Support	0.013
Operator		Signature			Date		Time	
BPR		<i>Norm White</i>			5/24		5:30 PM	
Checked by		Signature			Date		Time	
KAM		<i>KL LL</i>			5-24		5:30 pm	
Checked by		Signature			Date		Time	

Notes:

North

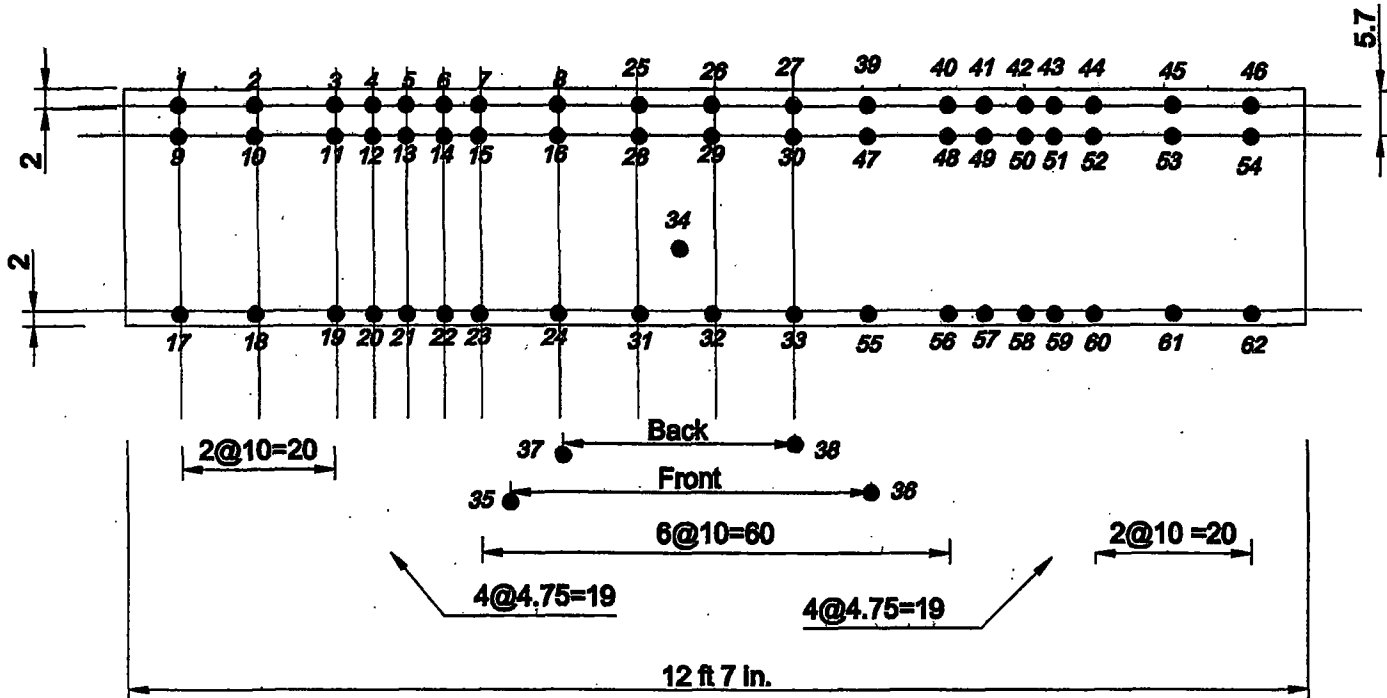

Specimen B-~~5~~6

Behavior of Lap Splices of No. 11 Reinforcing Bars

Drawn by:

BPR

Checked by:

KAM

Date:

5/24/12