


GENERAL NOTES



1. PIPING PENETRATES POOL BOUNDARY 3'-0" BELOW THE NORMAL WATER LEVEL OF THE POOL SECTION AT 5' BELOW NORMAL WATER LEVEL.
2. PIPING PENETRATES POOL BOUNDARY AT 18" BELOW THE NORMAL WATER LEVEL OF THE POOL.
3. PIPING PENETRATES POOL BOUNDARY 6'-0" BELOW NORMAL WATER LEVEL.
4. DELETED.
5. ALL PIPING THAT PENETRATES POOL BOUNDARY DOES SO AT EXTREME END OF FUEL TRANSFER CANAL OPPOSITE FUEL TRANSFER TUBE WITH THE EXCEPTION OF 79-HCD-3 & 86-HCD-2 1/2.
6. DELETED.
7. 3" DIA. VENT HOLES TO BE LOCATED WITH CENTERLINE AT ELEVATION 2843'-2".
8. PIPING PENETRATES POOL BOUNDARY 6 INCHES BELOW NORMAL POOL WATER LEVEL.
9. PIPING PENETRATES REFUELING LINES ABOVE NORMAL WATER LEVEL AT THE CONTROL ROD DRIVE MECHANISM (CRDM) SEISMIC SUPPORT POCKET. REMOVABLE ELBOW WHICH EXTENDS 1.5 INCHES BELOW NORMAL WATER LEVEL, WILL BE PROVIDED.
10. PIPING PENETRATES REFUELING LINES ABOVE NORMAL WATER LEVEL AT THE CONTROL ROD DRIVE MECHANISM (CRDM) SEISMIC SUPPORT POCKET. REMOVABLE ELBOW WHICH EXTENDS 1.5 INCHES BELOW NORMAL WATER LEVEL, WILL BE PROVIDED.
11. PIPING PENETRATES FUEL TRANSFER CANAL 1.2 INCHES ABOVE NORMAL WATER LEVEL.
12. REFUELING POOL DRAIN LINES, FLANGED ONLY DURING REFUELING.
13. 3/4" INCH DIA. VENT HOLES TO BE LOADED ON TOP OF PIPE.
14. EXPANSION JOINT FOR FUEL TRANSFER SLEEVE ONLY.
15. CONTAINMENT PENETRATIONS 067, 072, AND 081 TO BE SCHEDULE BBS.
16. LINE NO. 102, 103, 104, 105 ARE EMBEDDED & SLOPED & CONNECT THE FUEL TRANSFER SYSTEM'S CONTROL CONSOLE WITH THE UPENDING MACHINE.
17. LINE NO. 107-HCD-2 TO EXTEND TO AT LEAST ELEVATION 2850' BEFORE GOOSENECK.
18. DELETE.
19. INLET STRAINER.
20. AN OWNER APPROVED, OPEN-ENDED HOSE MAY BE INSTALLED INTO THE FLANGED END OF LINE EC-079-HCD-3. THE OPEN-ENDED PORTION OF THE HOSE MUST NOT REST BELOW LEVEL 2843'-2" IN ORDER TO ELIMINATE THE POSSIBILITY OF SIPHONING THE SPENT FUEL POOL TO WITHSTAND A SEISMIC EVENT THE HOSE MUST BE SECURED IN A MANNER TO WITHSTAND FIVE TIMES THE WEIGHT OF THE HOSE ASSEMBLY, INCLUDING THE WEIGHT OF WATER WHEN THE HOSE IS COMPLETELY FILLED.
21. PIPING SHALL BE FABRICATED PER MS-02, CLASS HCC, EXCEPT FOR MATERIAL TYPE WHICH SHALL BE TYPE 316L. PIPING ON THE EC SYSTEM MAY BE TYPE 304.
22. REMOVABLE STRAINER TO BE INSTALLED IN DRAIN INLET.
23. REMOVABLE SPOOL WITH SPACER RING INSTALLED. (REPLACEMENT FOR START-UP STRAINER)
24. AN OWNER APPROVED TEMPORARY SUBMERSIBLE PUMP AND A DISCHARGE HOSE (PUMP AND HOSE RATED AT LEAST 130' F) MAY BE ATTACHED TO END OF LINE EC-079-HCD-3 UNDER AN APPROVED PROCEDURE TO PERFORM THE TASK OF DRAINING THE FUEL TRANSFER CANAL AND/OR CASK PIT. PROCEDURE SHALL REQUIRE CLOSING VALVE HEB502B AND BYPASS VALVE HEB501B PRIOR TO STARTING THE PUMP FOR THE TASK. THE HOSE PRESSURE RATING MUST BE GREATER THAN THE PUMP FLUID PRESSURE. THE LIMITING PRESSURE FOR THIS TASK IS 130 PSI MAXIMUM. ONCE THE TASK IS COMPLETED, REMOVE THE PUMP, HOSE AND TO RESTORE THE SYSTEM.
25. THESE CONNECTIONS ARE FOR BEYOND-DESIGN-BASIS (FLEX) SPENT FUEL POOL MAKE-UP.
26. THIS IS FOR THE SFP ALTERNATE COOLING AND IS ONLY TO BE USED AT THE DIRECTION OF THE SHIFT MANAGER AND APPLICABLE PROCEDURES.

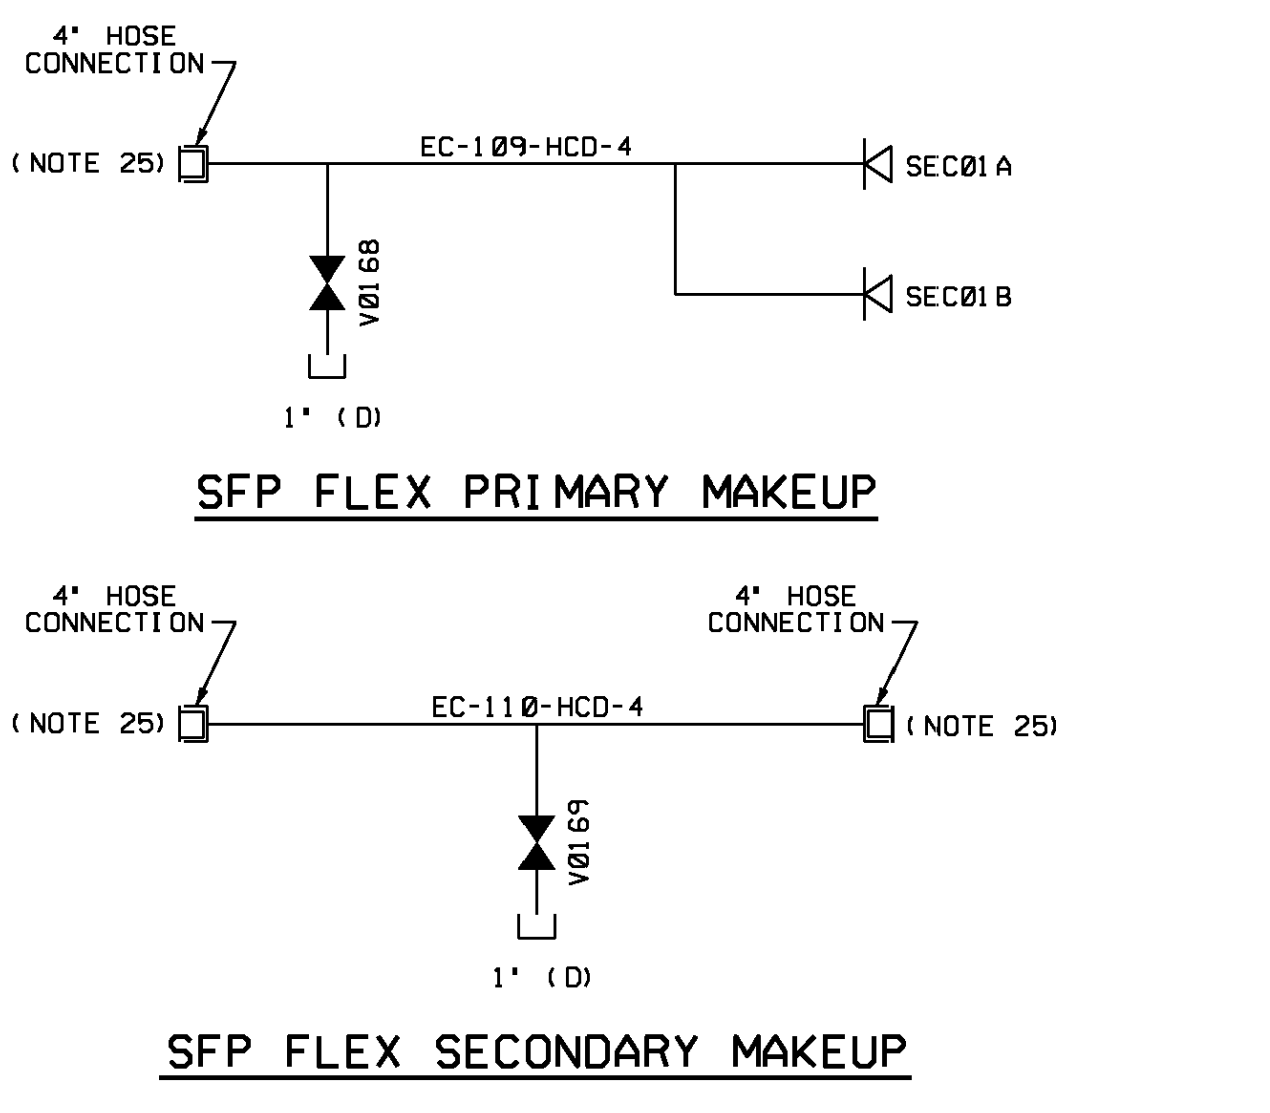

USAR FIG. 9.1-3-01


ESSENTIAL DRAWING

REVISED	INCORPORATED	CHANGE
ISSUED	CHG. DOC.	FIG. NO. 015241
THIS Dwg. SUPERSEDES BY REV. THIS Dwg. SUPERSEDES REV.		
WOLF CREEK NUCLEAR OPERATING CORPORATION		ELECTRONIC APPROVAL
PIPING & INSTRUMENTATION DIAGRAM FUEL POOL COOLING AND CLEAN-UP SYSTEM		
SCALE	DRAWING NUMBER	SHEET
NONE	M-12EC01	1 23
34444 E. SZE		

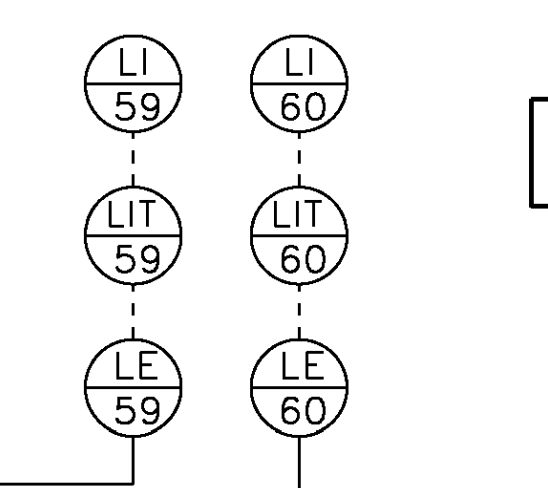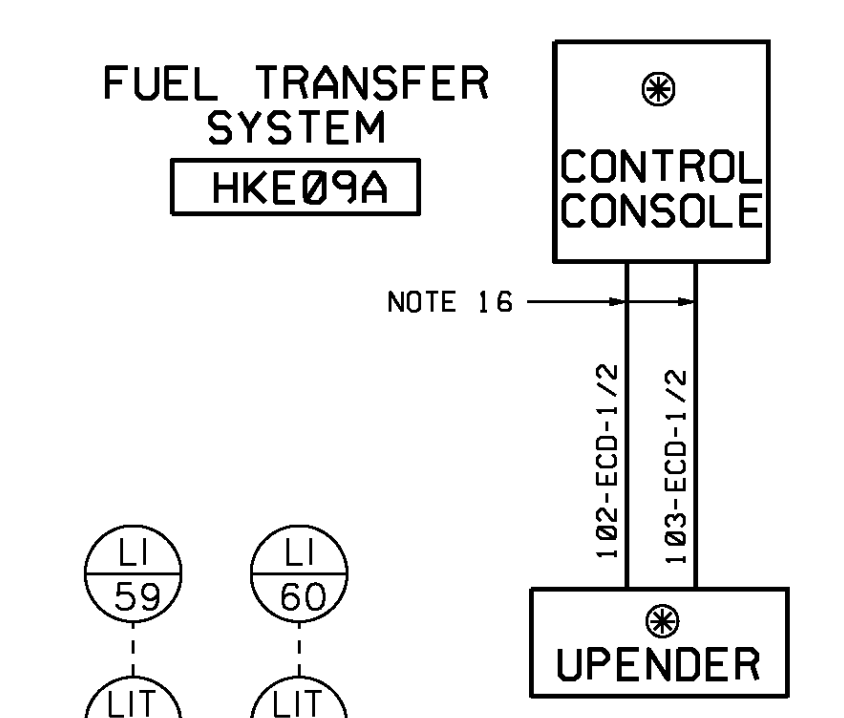

Jawa A. Schultz

NOTES
1. FOR GENERAL NOTES, SEE M-12EC01.

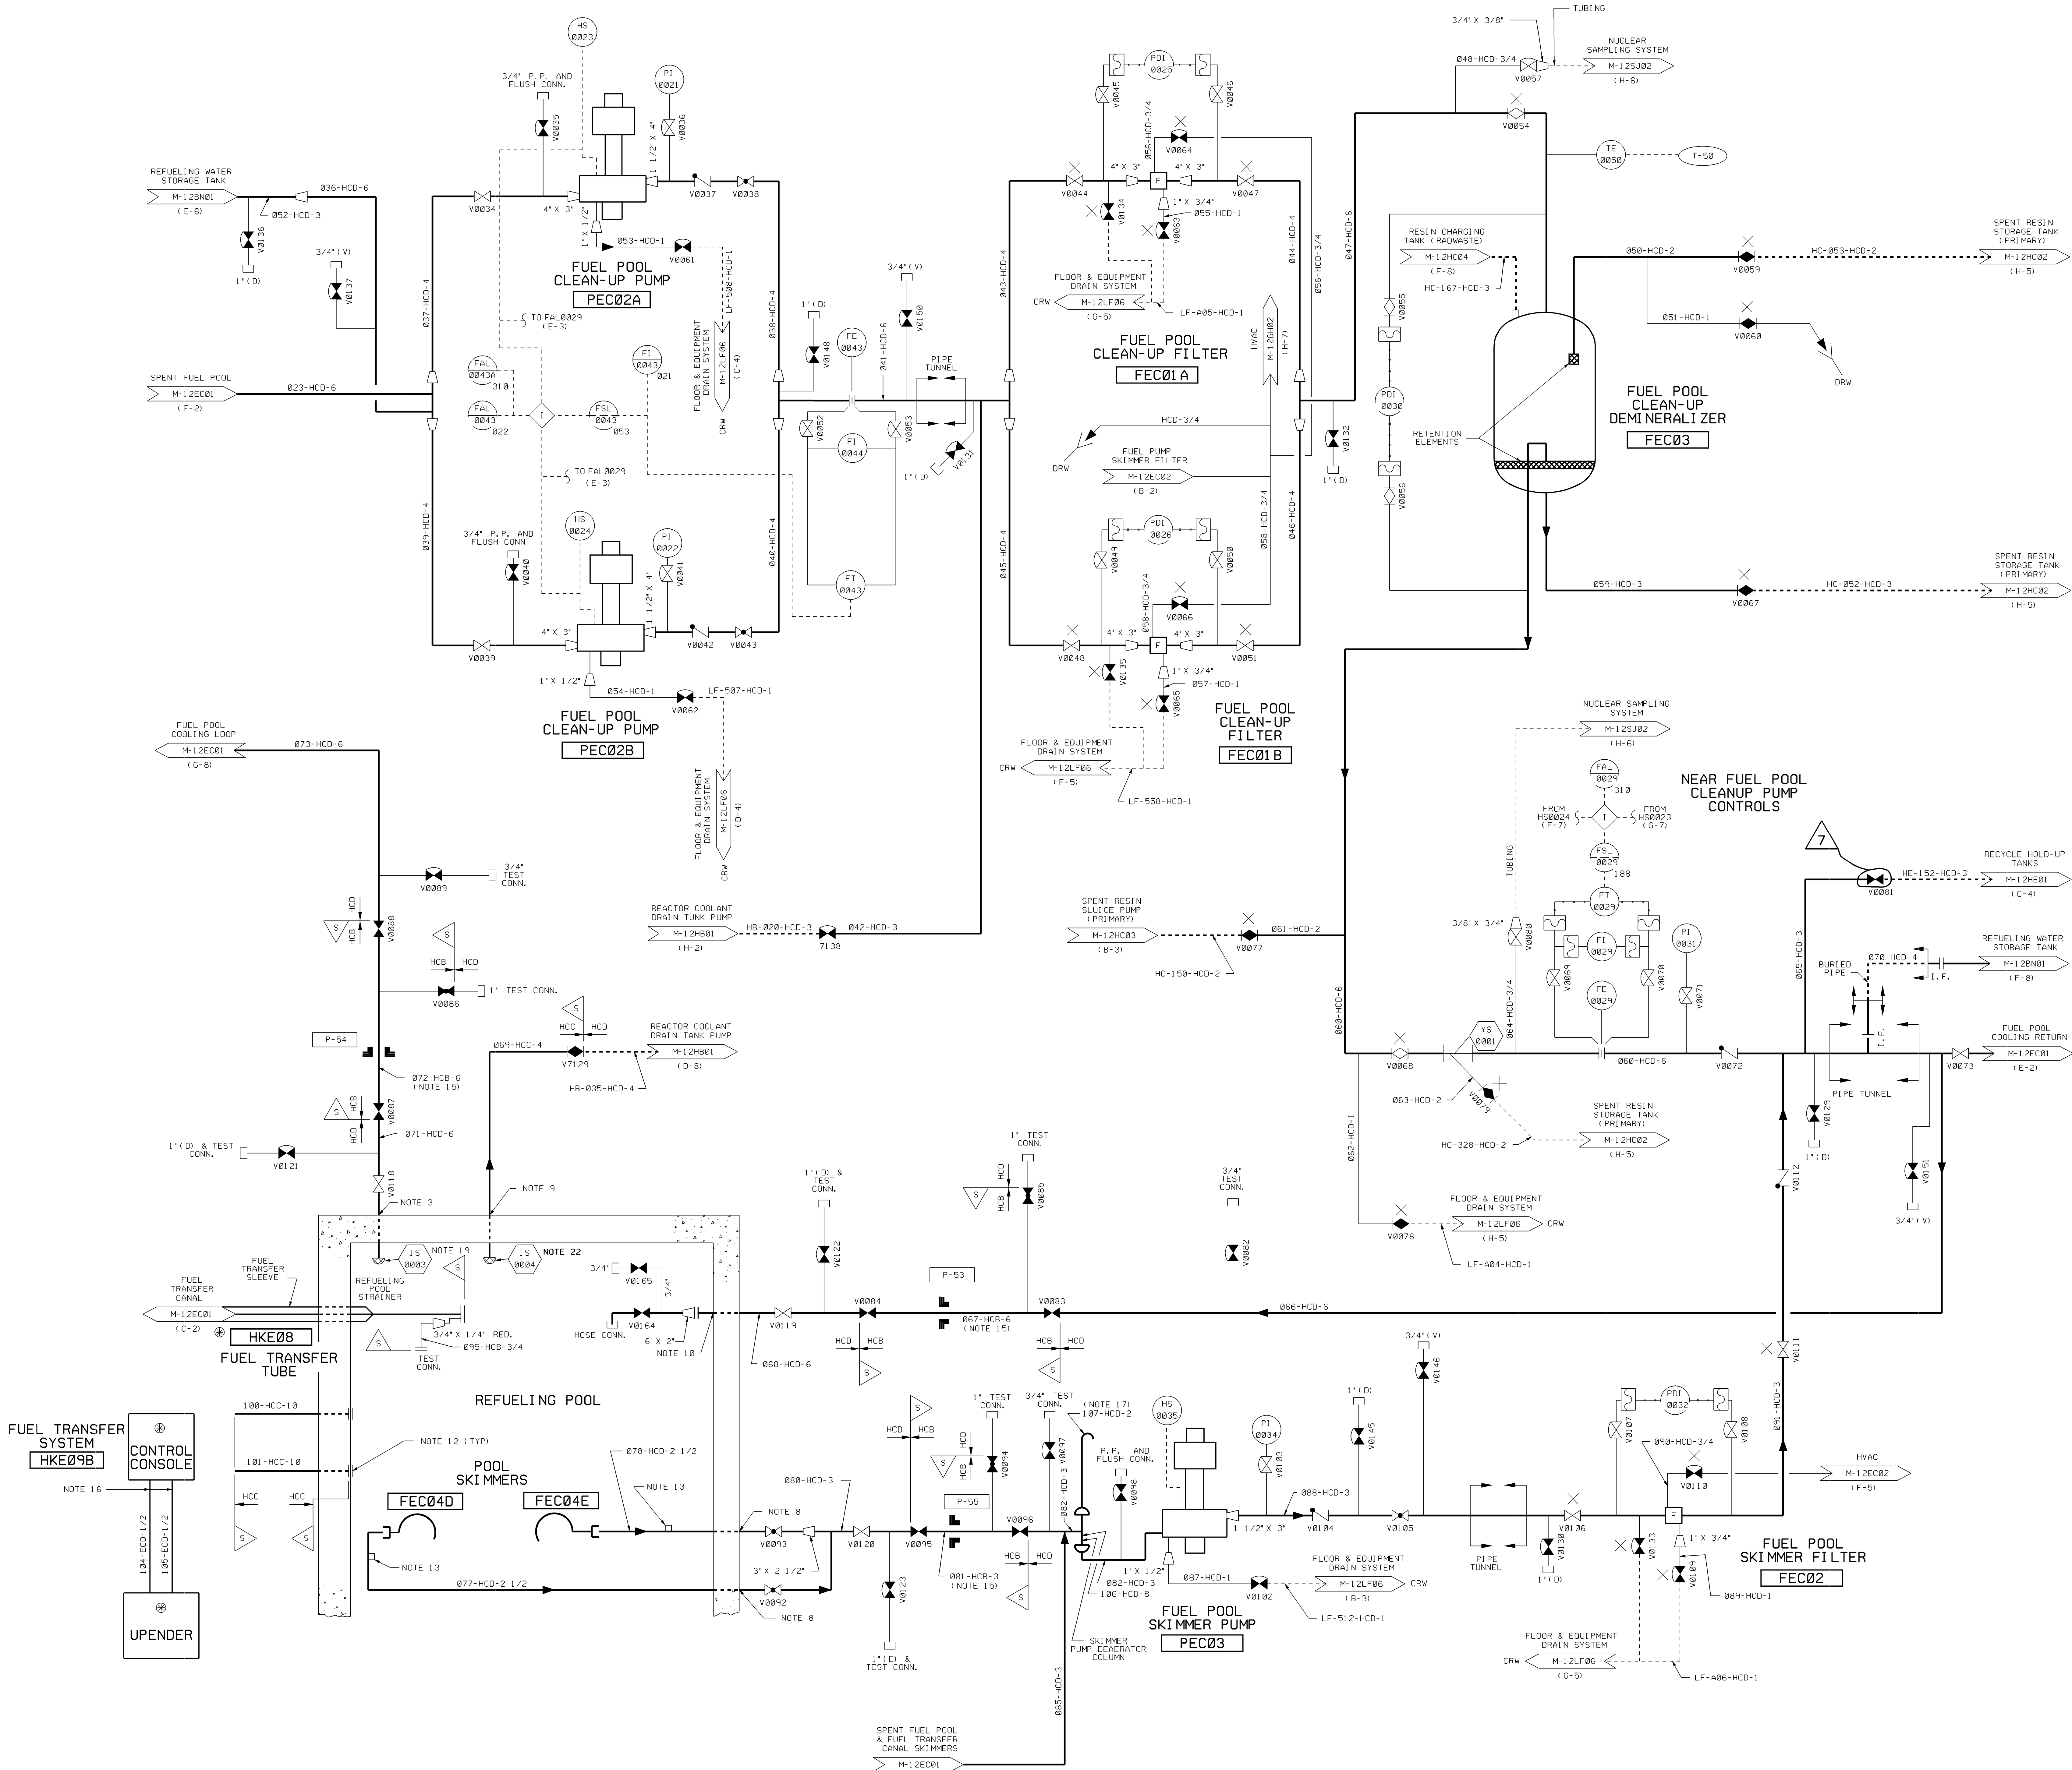

USAR FIG. 9.1-3-02

ESSENTIAL DRAWING

REVISED	INCORPORATED	WIP-M-12EC02-006-A-1, R/00	CHANGE	012564
ISSUED	CHG. DOC.			PKG. NO.
THIS ENG. SUPERSEDES BY		REV.	THIS ENG. SUPERSEDES	
REVISION NOTED				

WOLF CREEK
NUCLEAR OPERATING CORPORATION

ELECTRONIC APPROVAL

**PIPING & INSTRUMENTATION DIAGRAM
FUEL POOL COOLING
AND CLEAN-UP SYSTEM**

SCALE	DRAWING NUMBER	SHEET	REV
NONE	M-12EC02	07	



34944 E SIZE

Released by Document Services Release Date: 02/12/08

NOTES

- THIS IS A DUAL PURPOSE ORIFICE USED TO PROVIDE BOTH BACKPRESSURE AND FLOW MEASUREMENTS.
- CHEMICAL ADDITION TAP.
- MECHANICAL DESIGNATION PER M-12E001, SITE A/E (SHEED) & LUNDY SERVICE WATER (WS) P & T DRAWING NUMBER IS M-22.
- DELETED
- PIPING SHALL BE FABRICATED PER MS-2, CLASS HCD, EXCEPT FOR MATERIAL TYPE WHICH SHALL BE TYPE 316L SS. CLASS HBD MATERIAL IS ALSO ACCEPTABLE.
- ALTERNATE SUPPLY FOR BREATHING AIR COMPRESSORS, FOR FUTURE USE IF REQUIRED.
- THE SERVICE WATER TO THE MAKEUP DEMIN. SYSTEM CROSS-TIE SHALL NOT BE USED WHEN A CONTRACT VENDOR IS USED TO SUPPLY MAKEUP DEMIN. WATER FOR MAND.
- THE SERVICE WATER TO THE MAKEUP DEMIN. SYSTEM CROSS-TIE SHALL BE ISOLATED DURING COPPER/COPPER ADDITION TO THE SERVICE WATER SYSTEM.
- EAPCV0010 IS ALSO A SELF-CONTAINED CHECK VALVE.
- THE PORTION OF 124-HBD-15 BETWEEN V0157 AND FE(FI) 0038 IS BLIND FLANGED AND DRY.
- THIS CONNECTION IS FOR SPENT FUEL POOL ALTERNATE COOLING SUPPLY AND/OR RETURN.
- THIS IS ONLY TO BE USED AT THE DISCRETION OF THE SHIFT MANAGER AND APPLICABLE PROCEDURES.

22


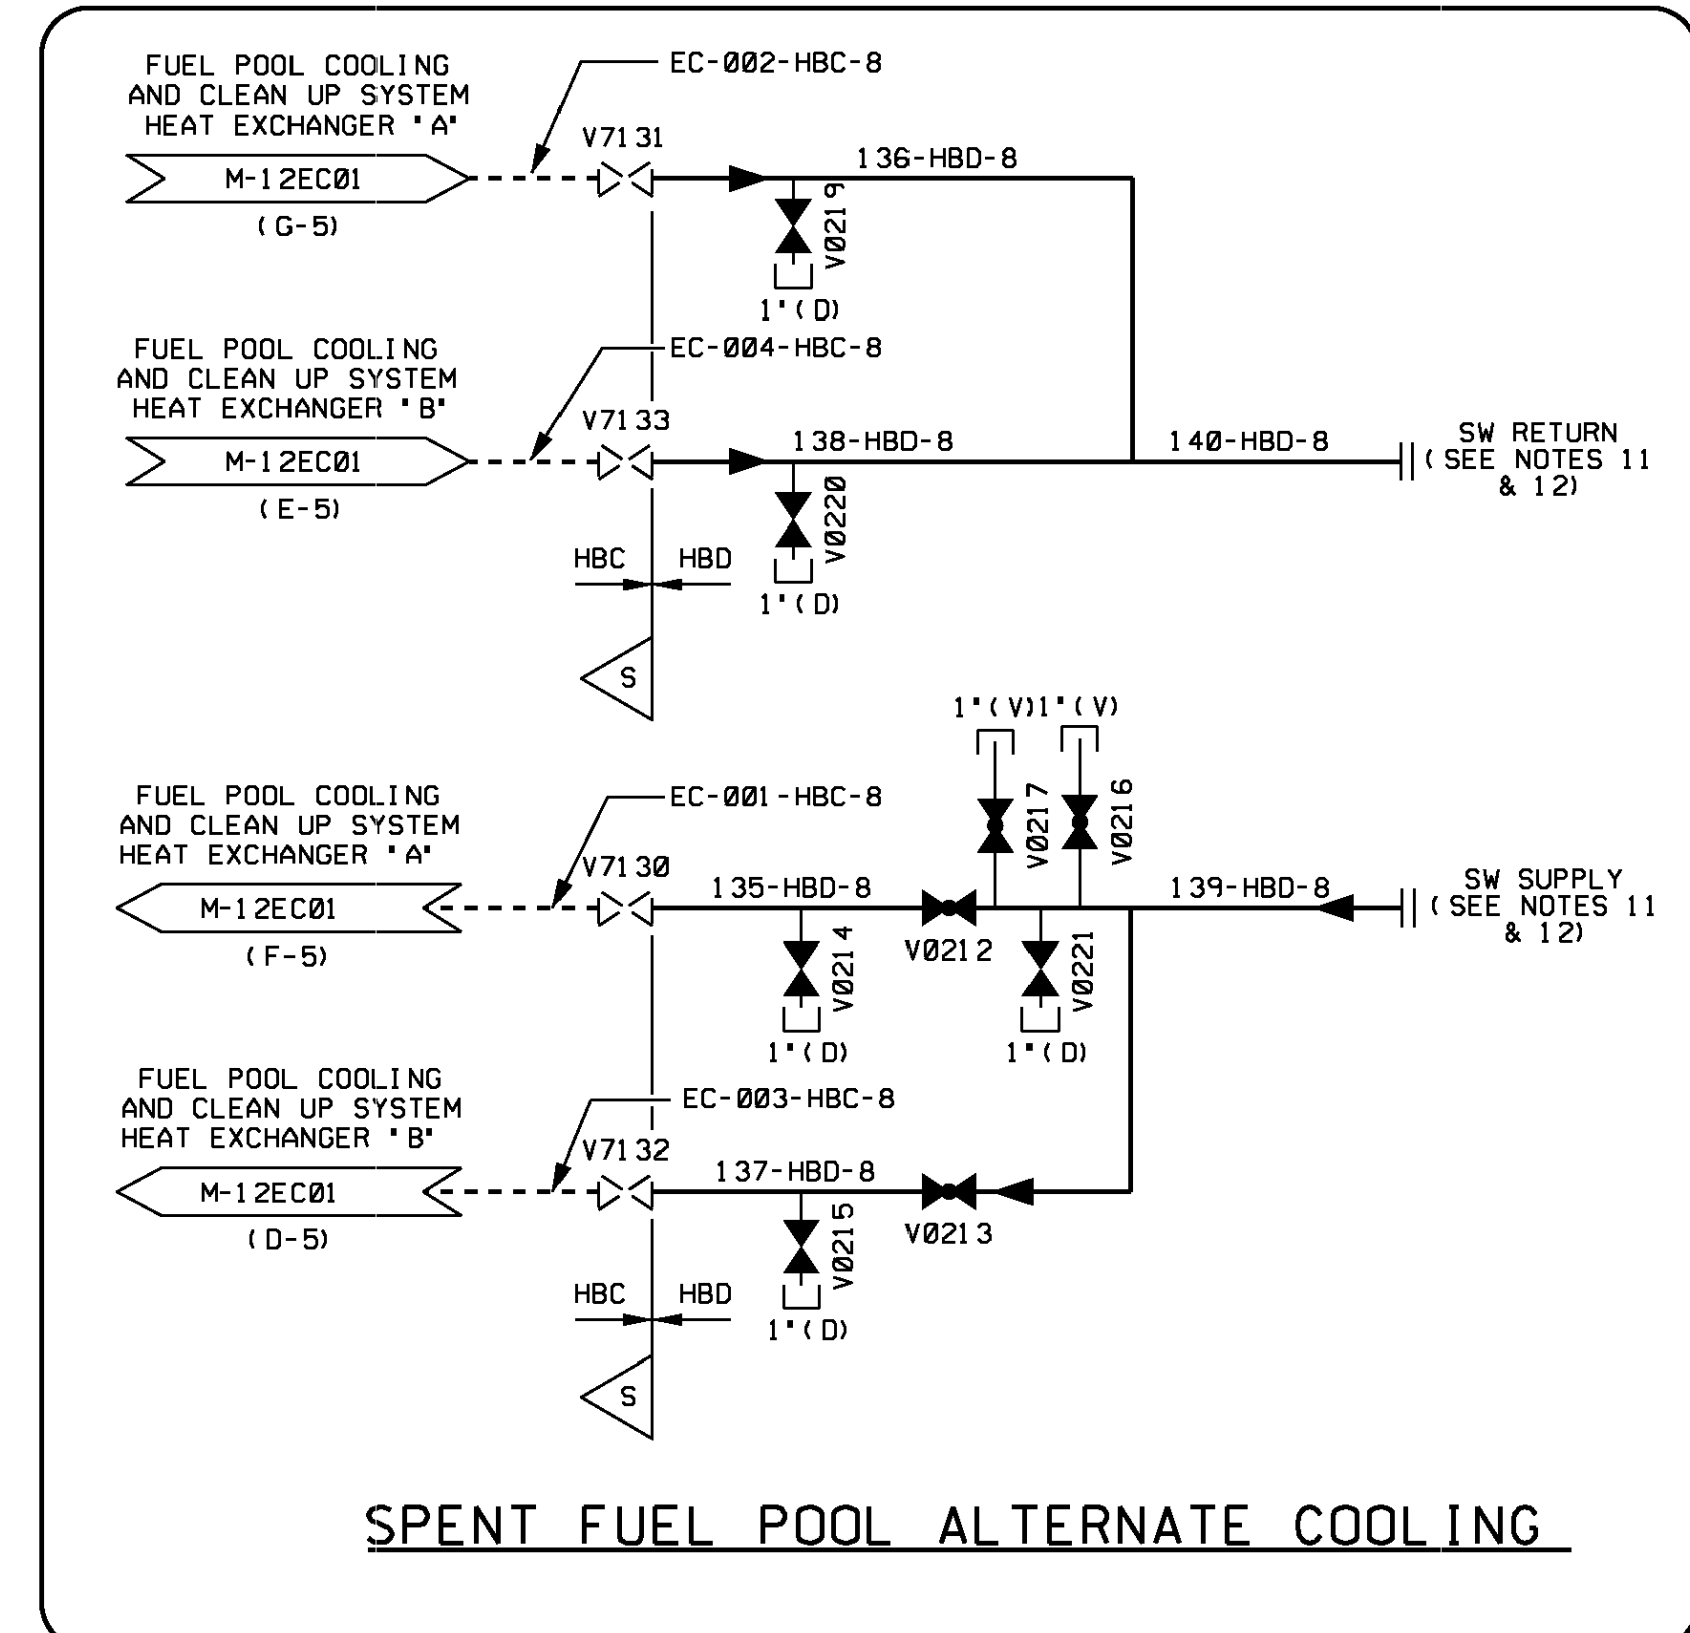
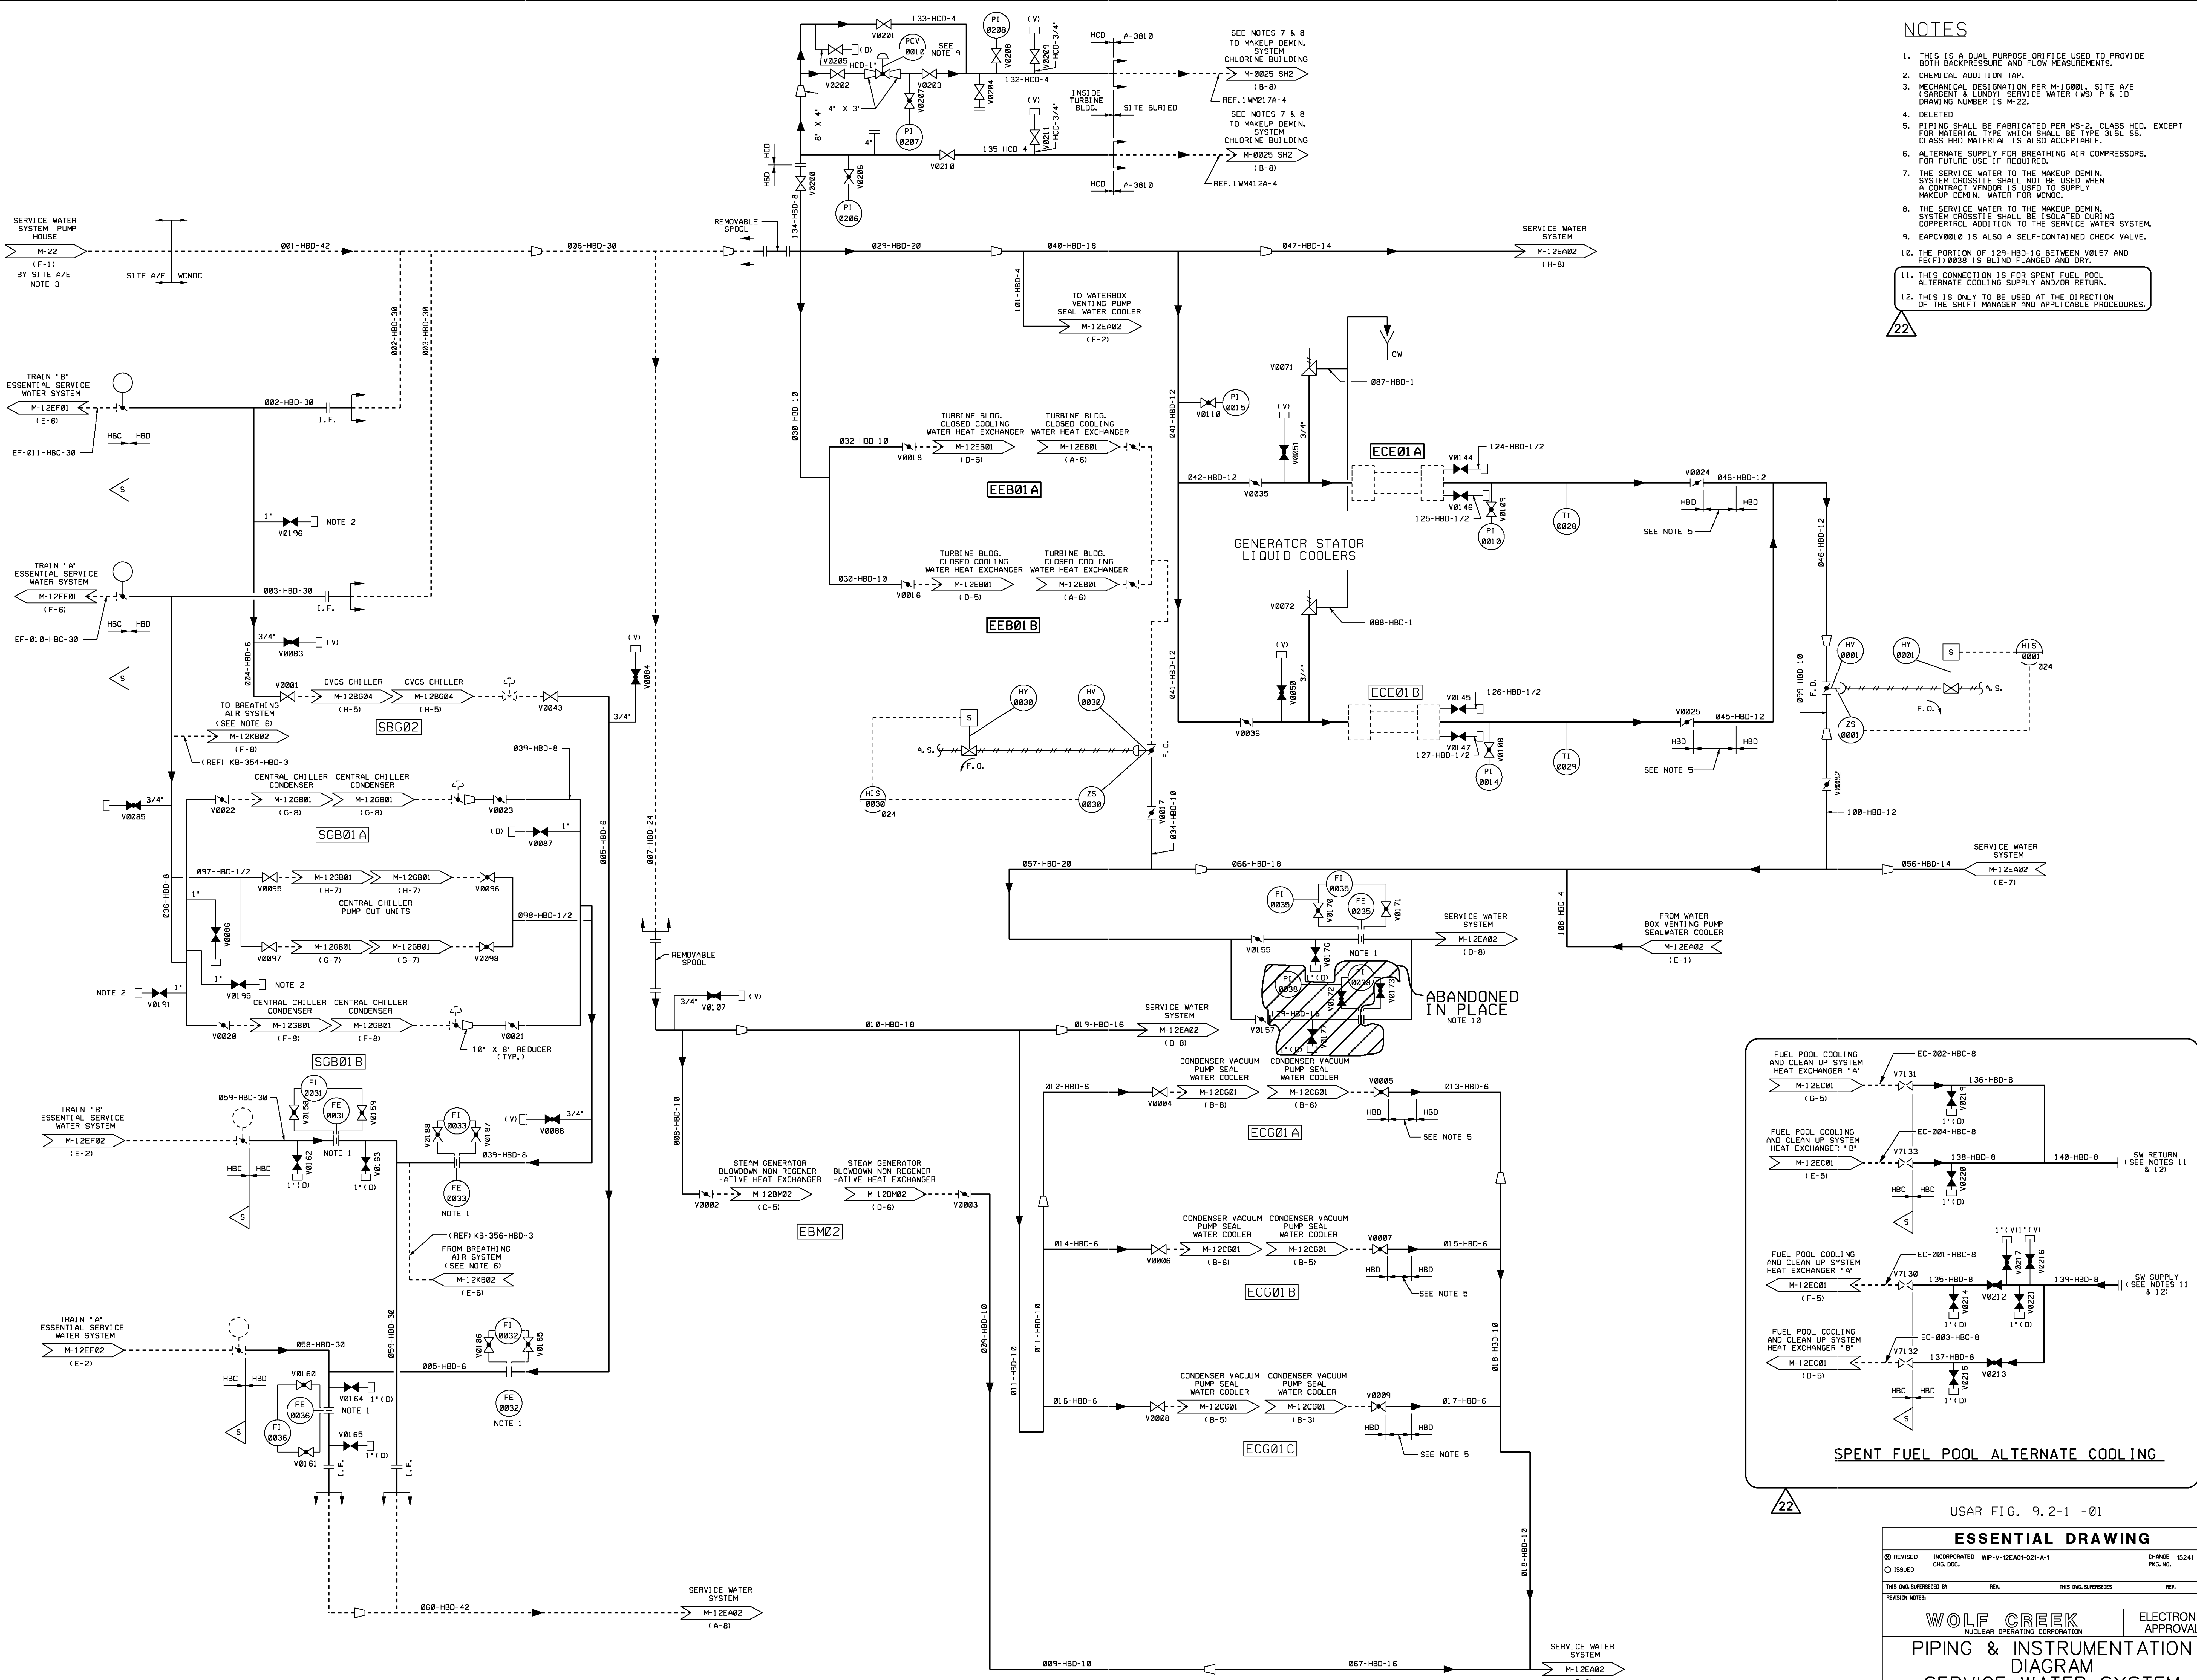


USAR FIG. 9.2-1 -01

ESSENTIAL DRAWING




REVISED	INCORPORATED	WIP-M-12EAD1-021-A-1	CHANGE 15241
ISSUED	CHG. DOC.		FIG. NO.
THIS Dwg. SUPERSEDES		THIS Dwg. SUPERSEDES	
REVISION NOTES		REV.	
<p>WOLF CREEK NUCLEAR OPERATING CORPORATION</p>		ELECTRONIC APPROVAL	
<p>PIPING & INSTRUMENTATION DIAGRAM SERVICE WATER SYSTEM</p>			
SCALE	DRAWING NUMBER	SHEET	REV
NONE	M-12EA01	22	22

Anna G. Schultz

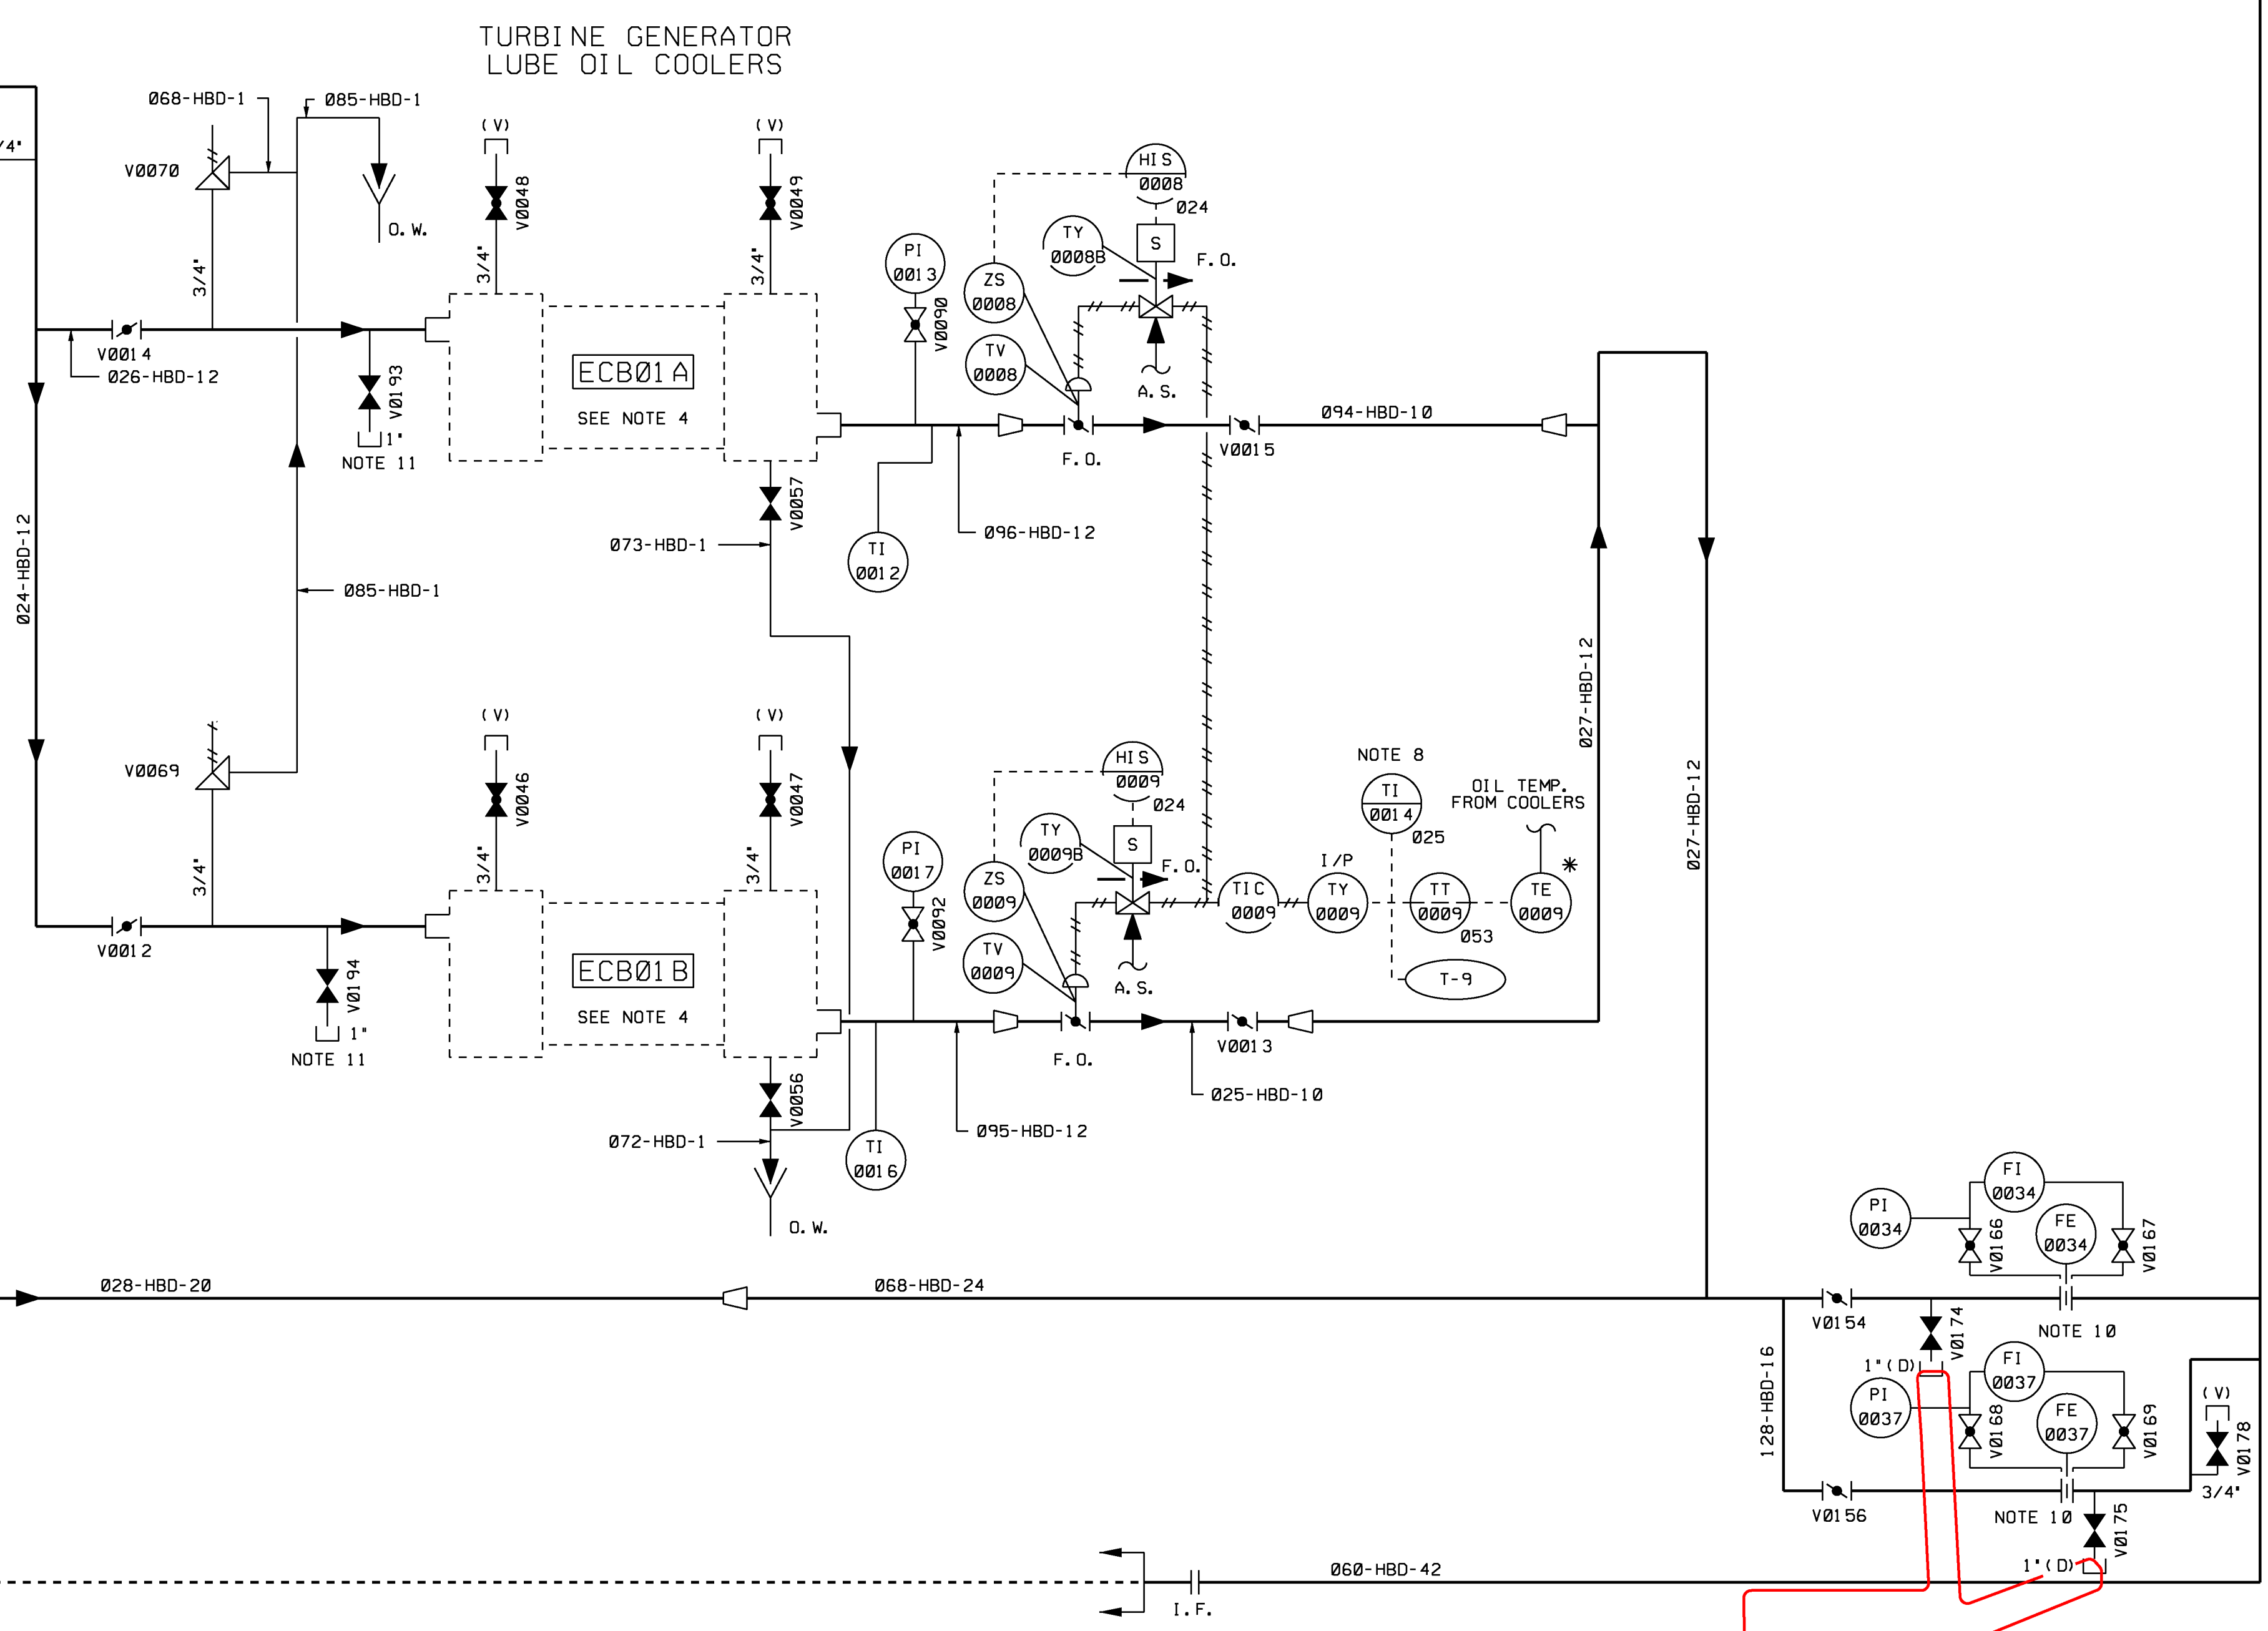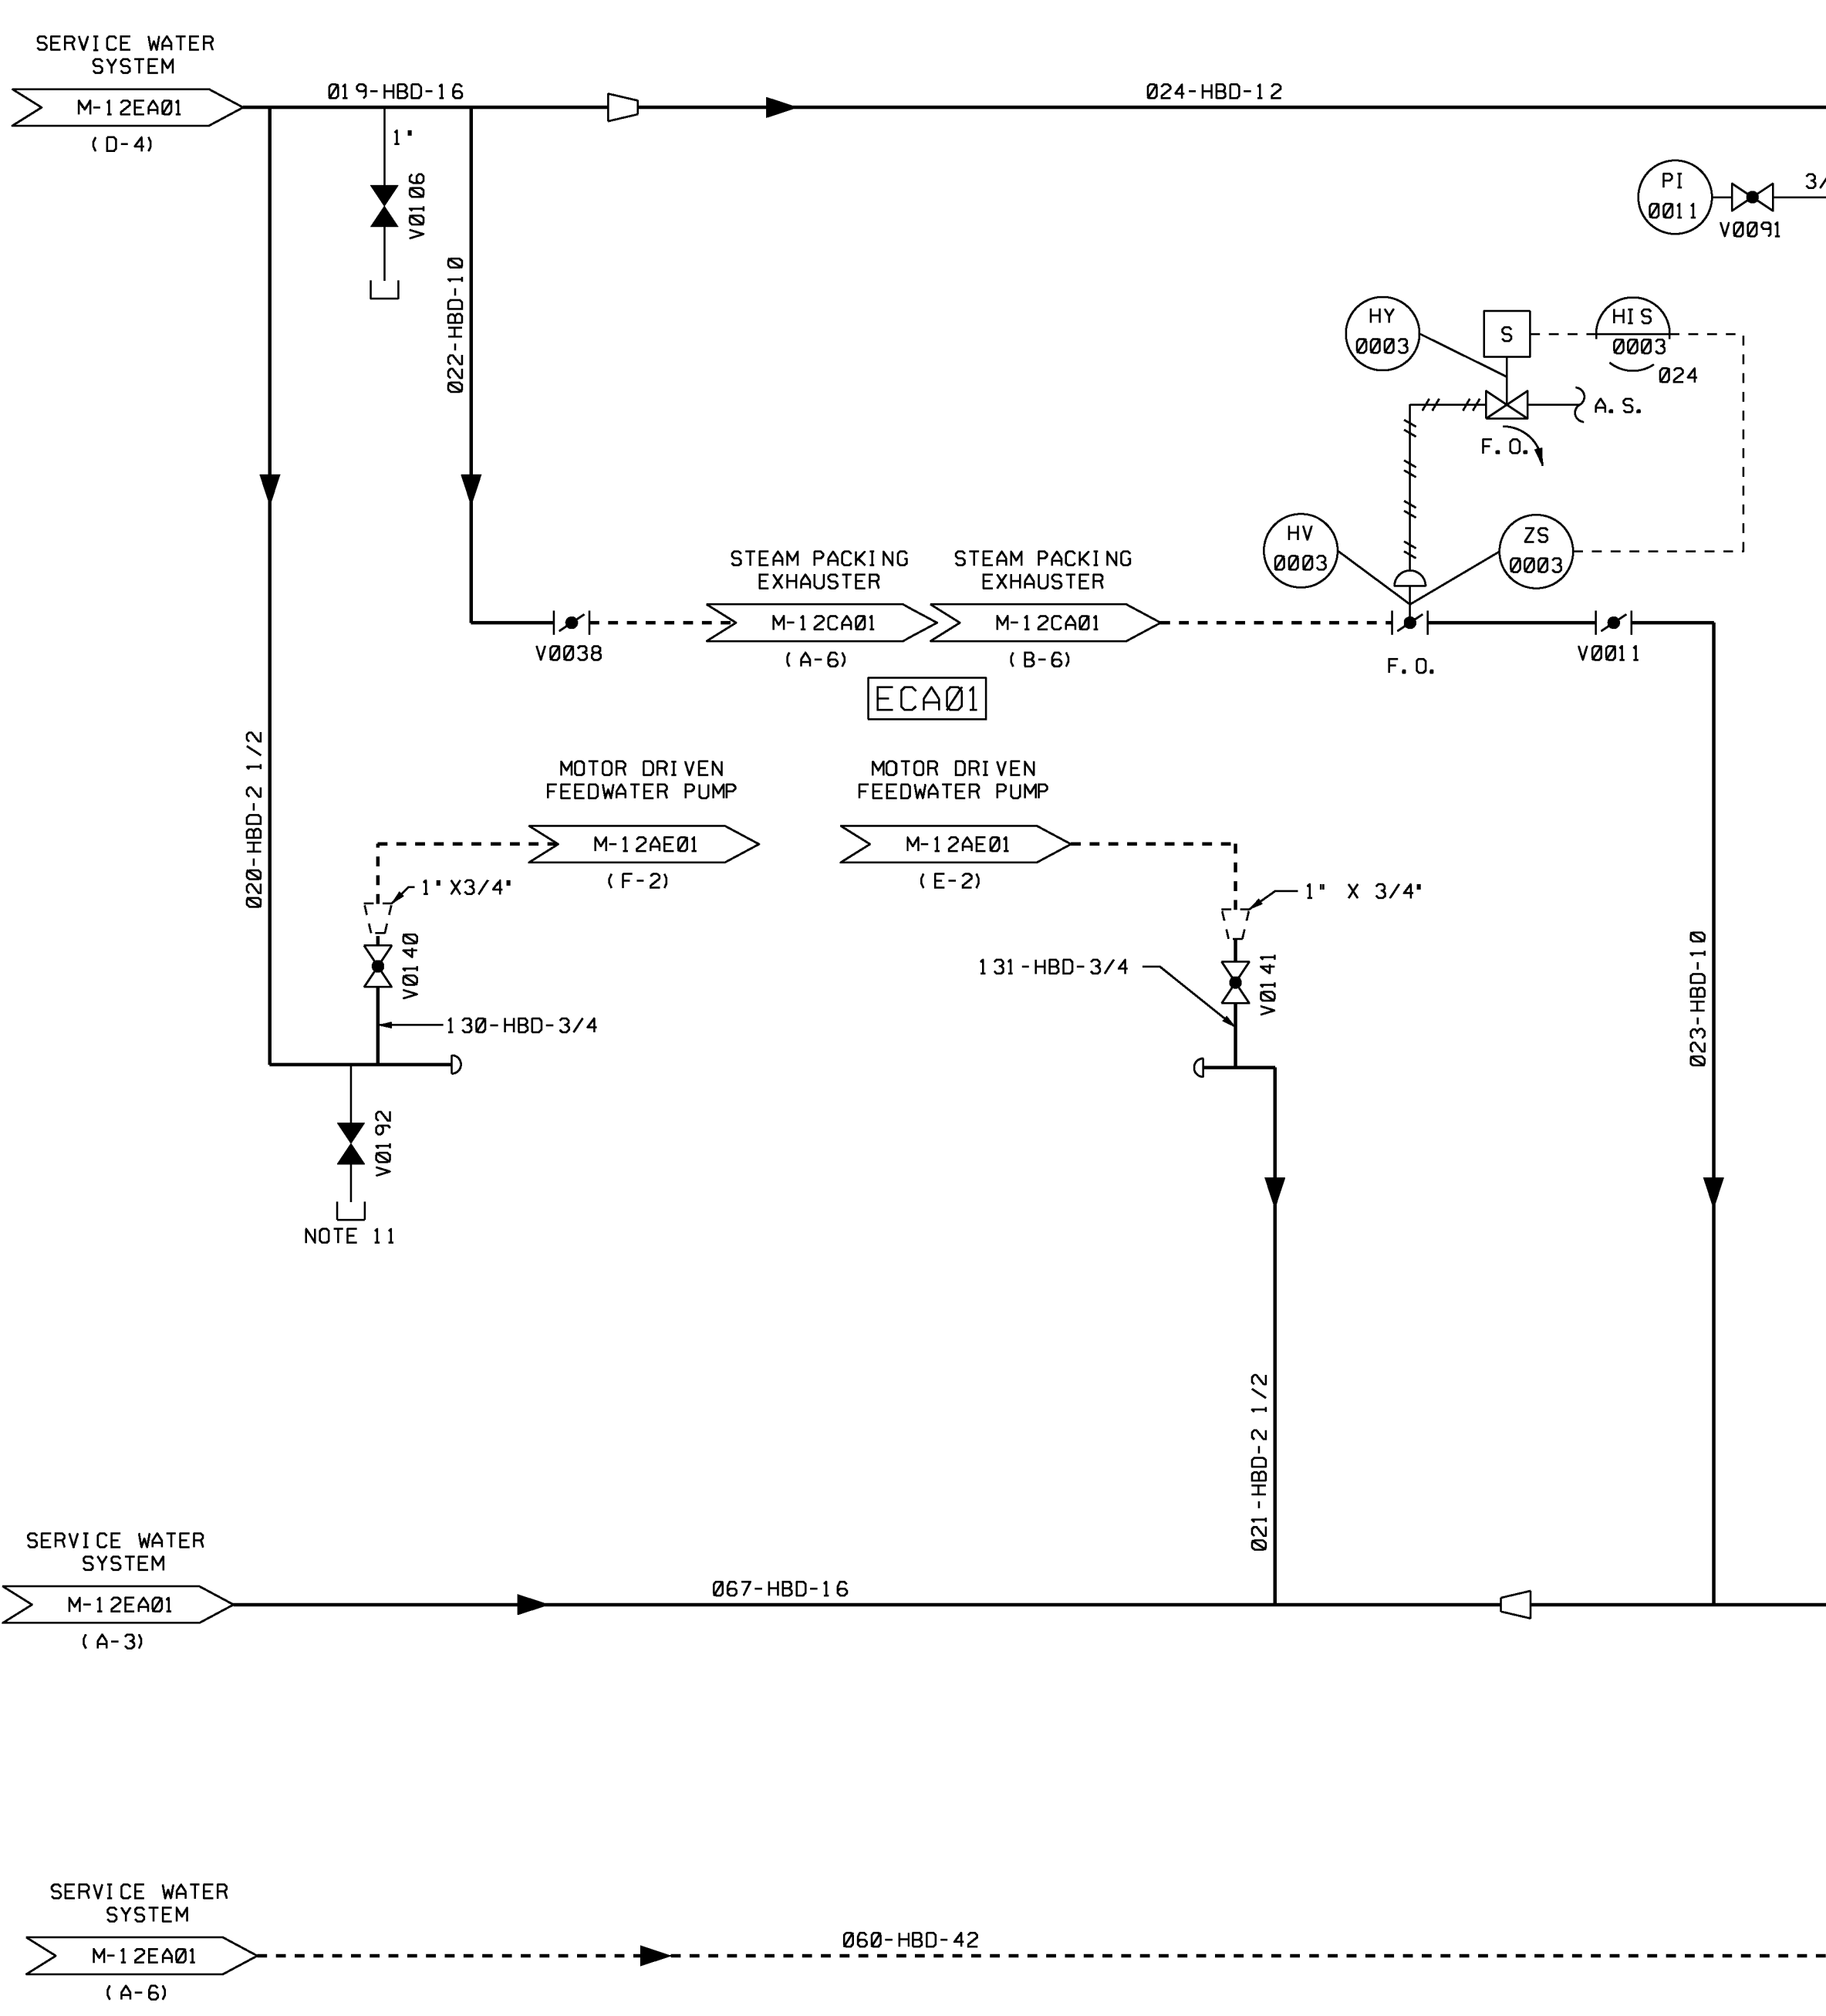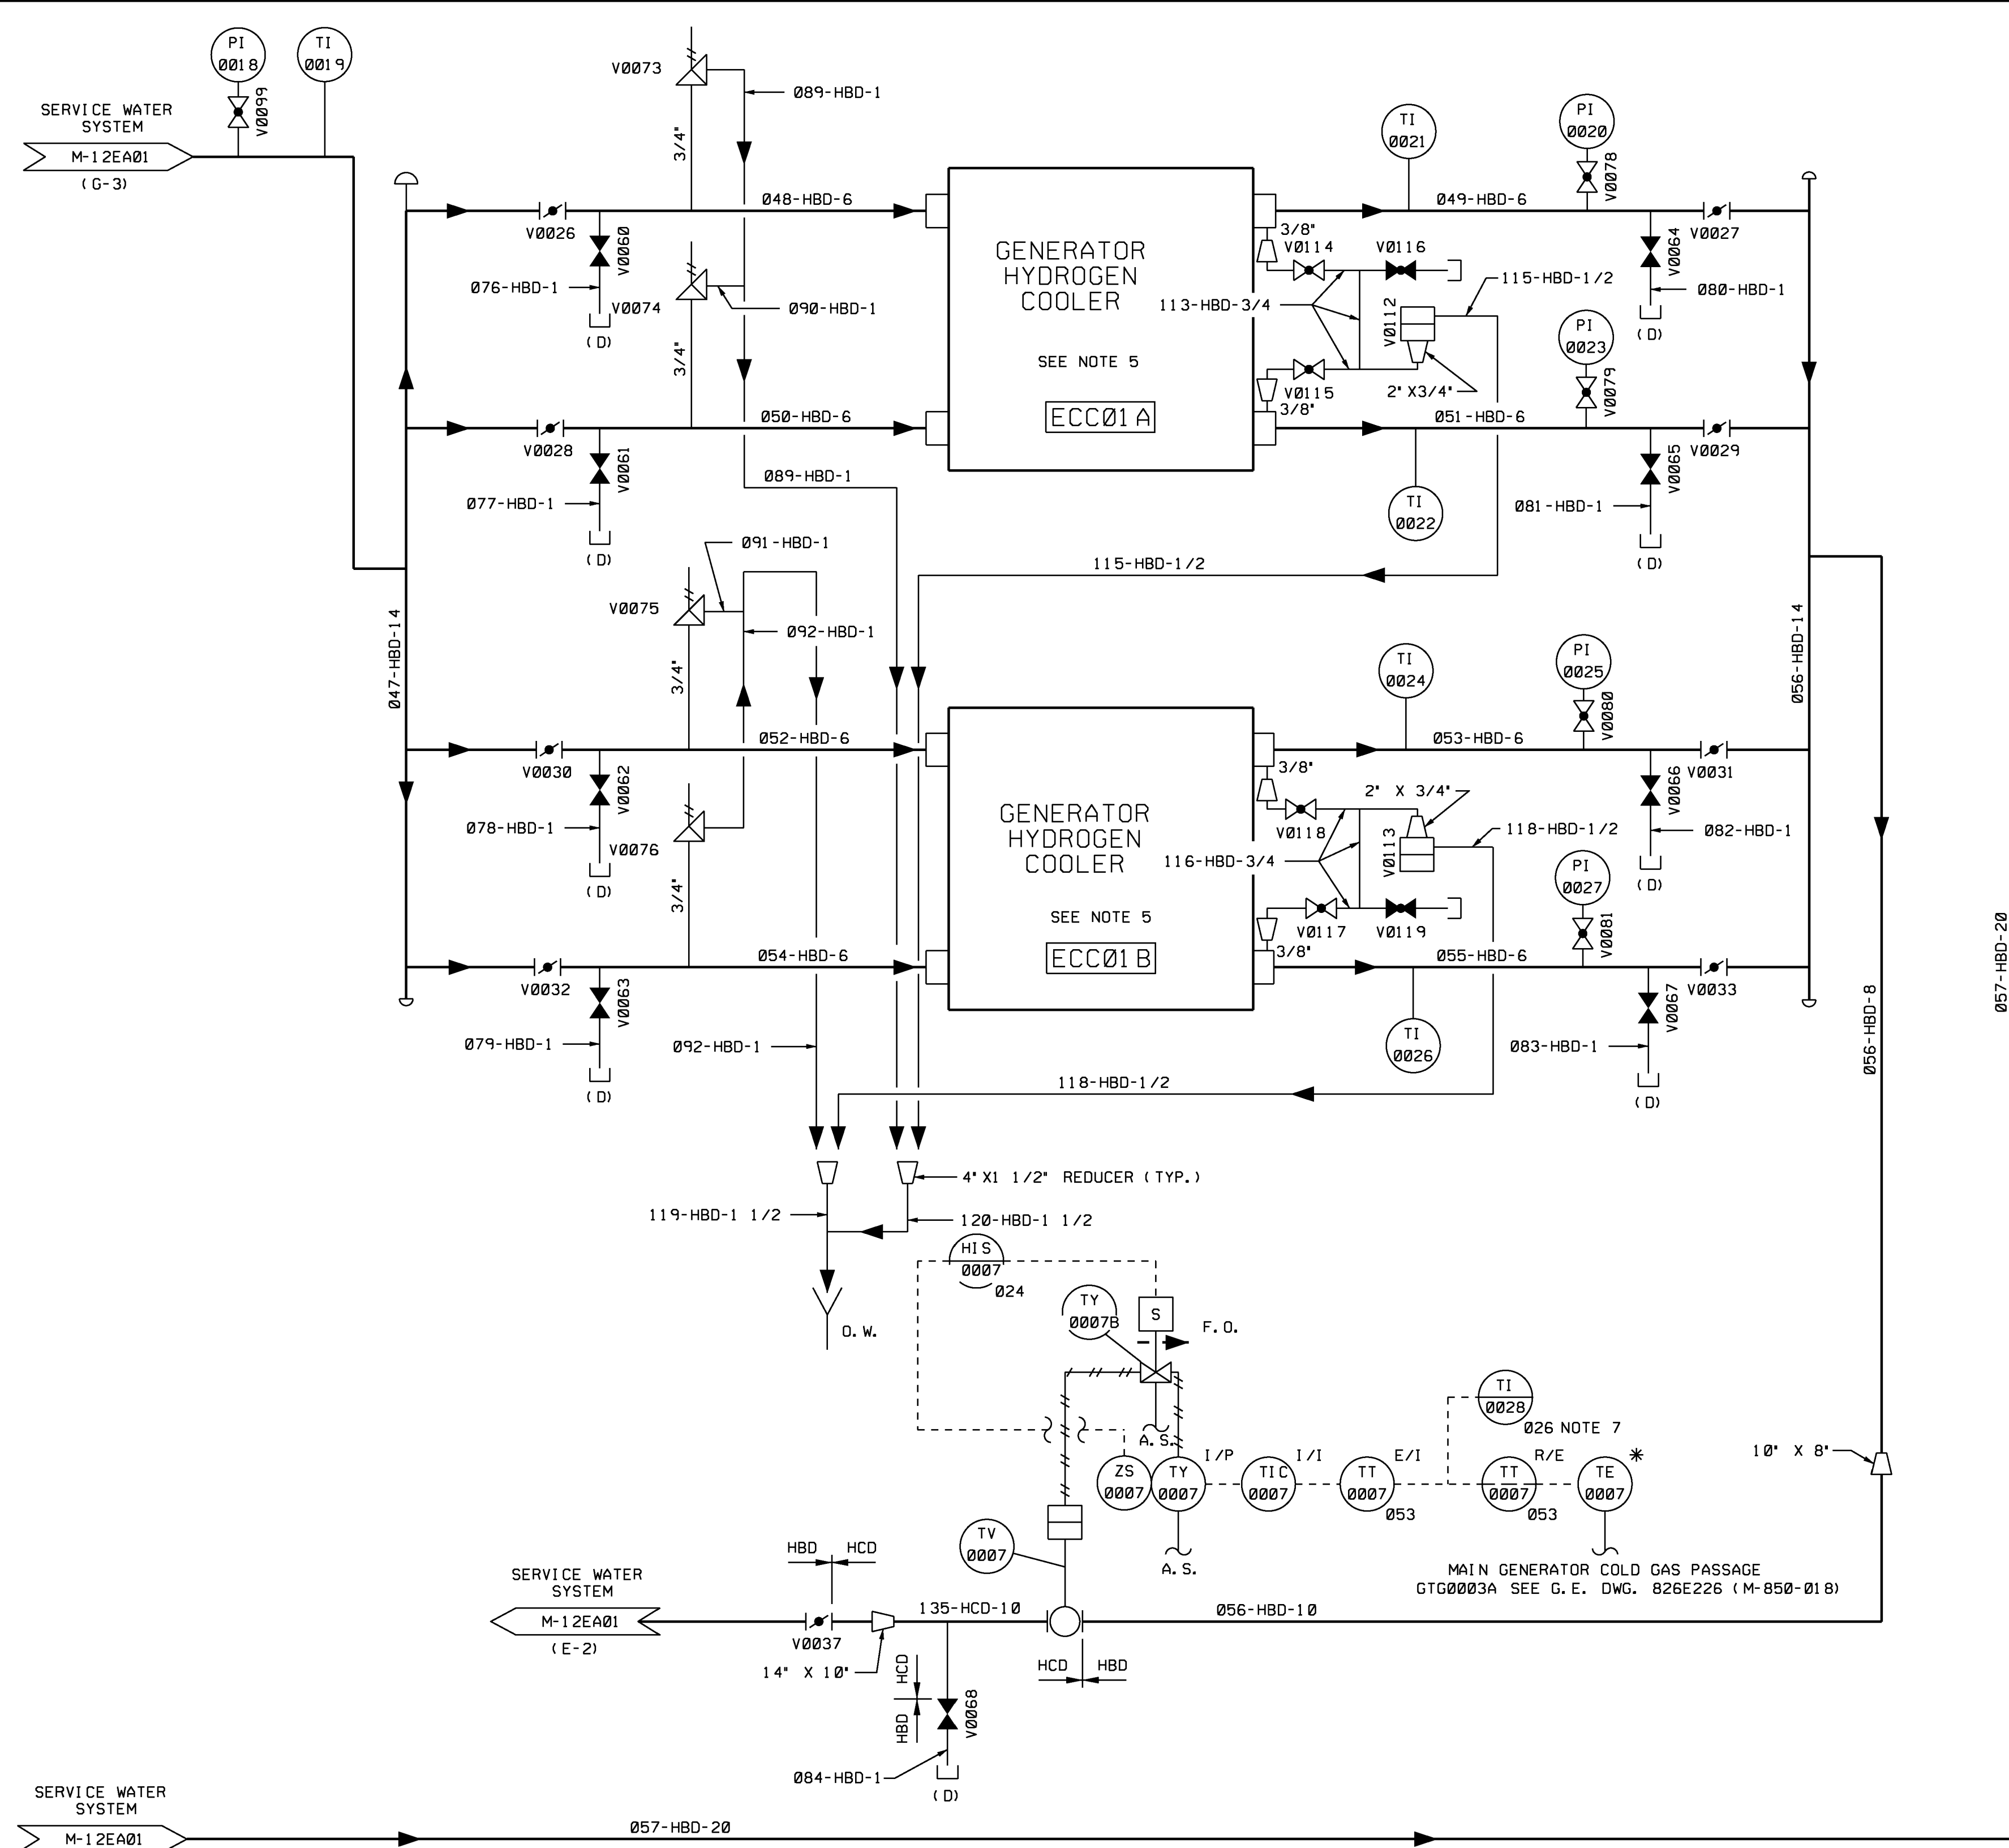

NOTES

1. FOR GENERAL NOTES AND REFERENCES SEE DWG M-12EA01.
2. DELETED
3. DELETED
4. REFER TO P&ID DRAWING NO. M-12CC01.
5. REFER TO P&ID DRAWING NO. M-12CC01.
6. DISCHARGE TO THE CIRCULATING WATER SYSTEM IS THROUGH ONE 42" LINE ONLY. HV-5 OR HV-6 IS CLOSED.
7. TI-28 BELONGS TO THE (C) SYSTEM
8. TI-14 BELONGS TO THE (CB) SYSTEM
9. VALVE(S) MAY BE THROTTLED AT THE 50% CLOSED POSITION.
10. THIS IS A DUAL PURPOSE ORIFICE USED TO PROVIDED BOTH BACKPRESSURE AND FLOW MEASUREMENTS.
11. CHEMICAL ADDITION TAP.
12. DELETED

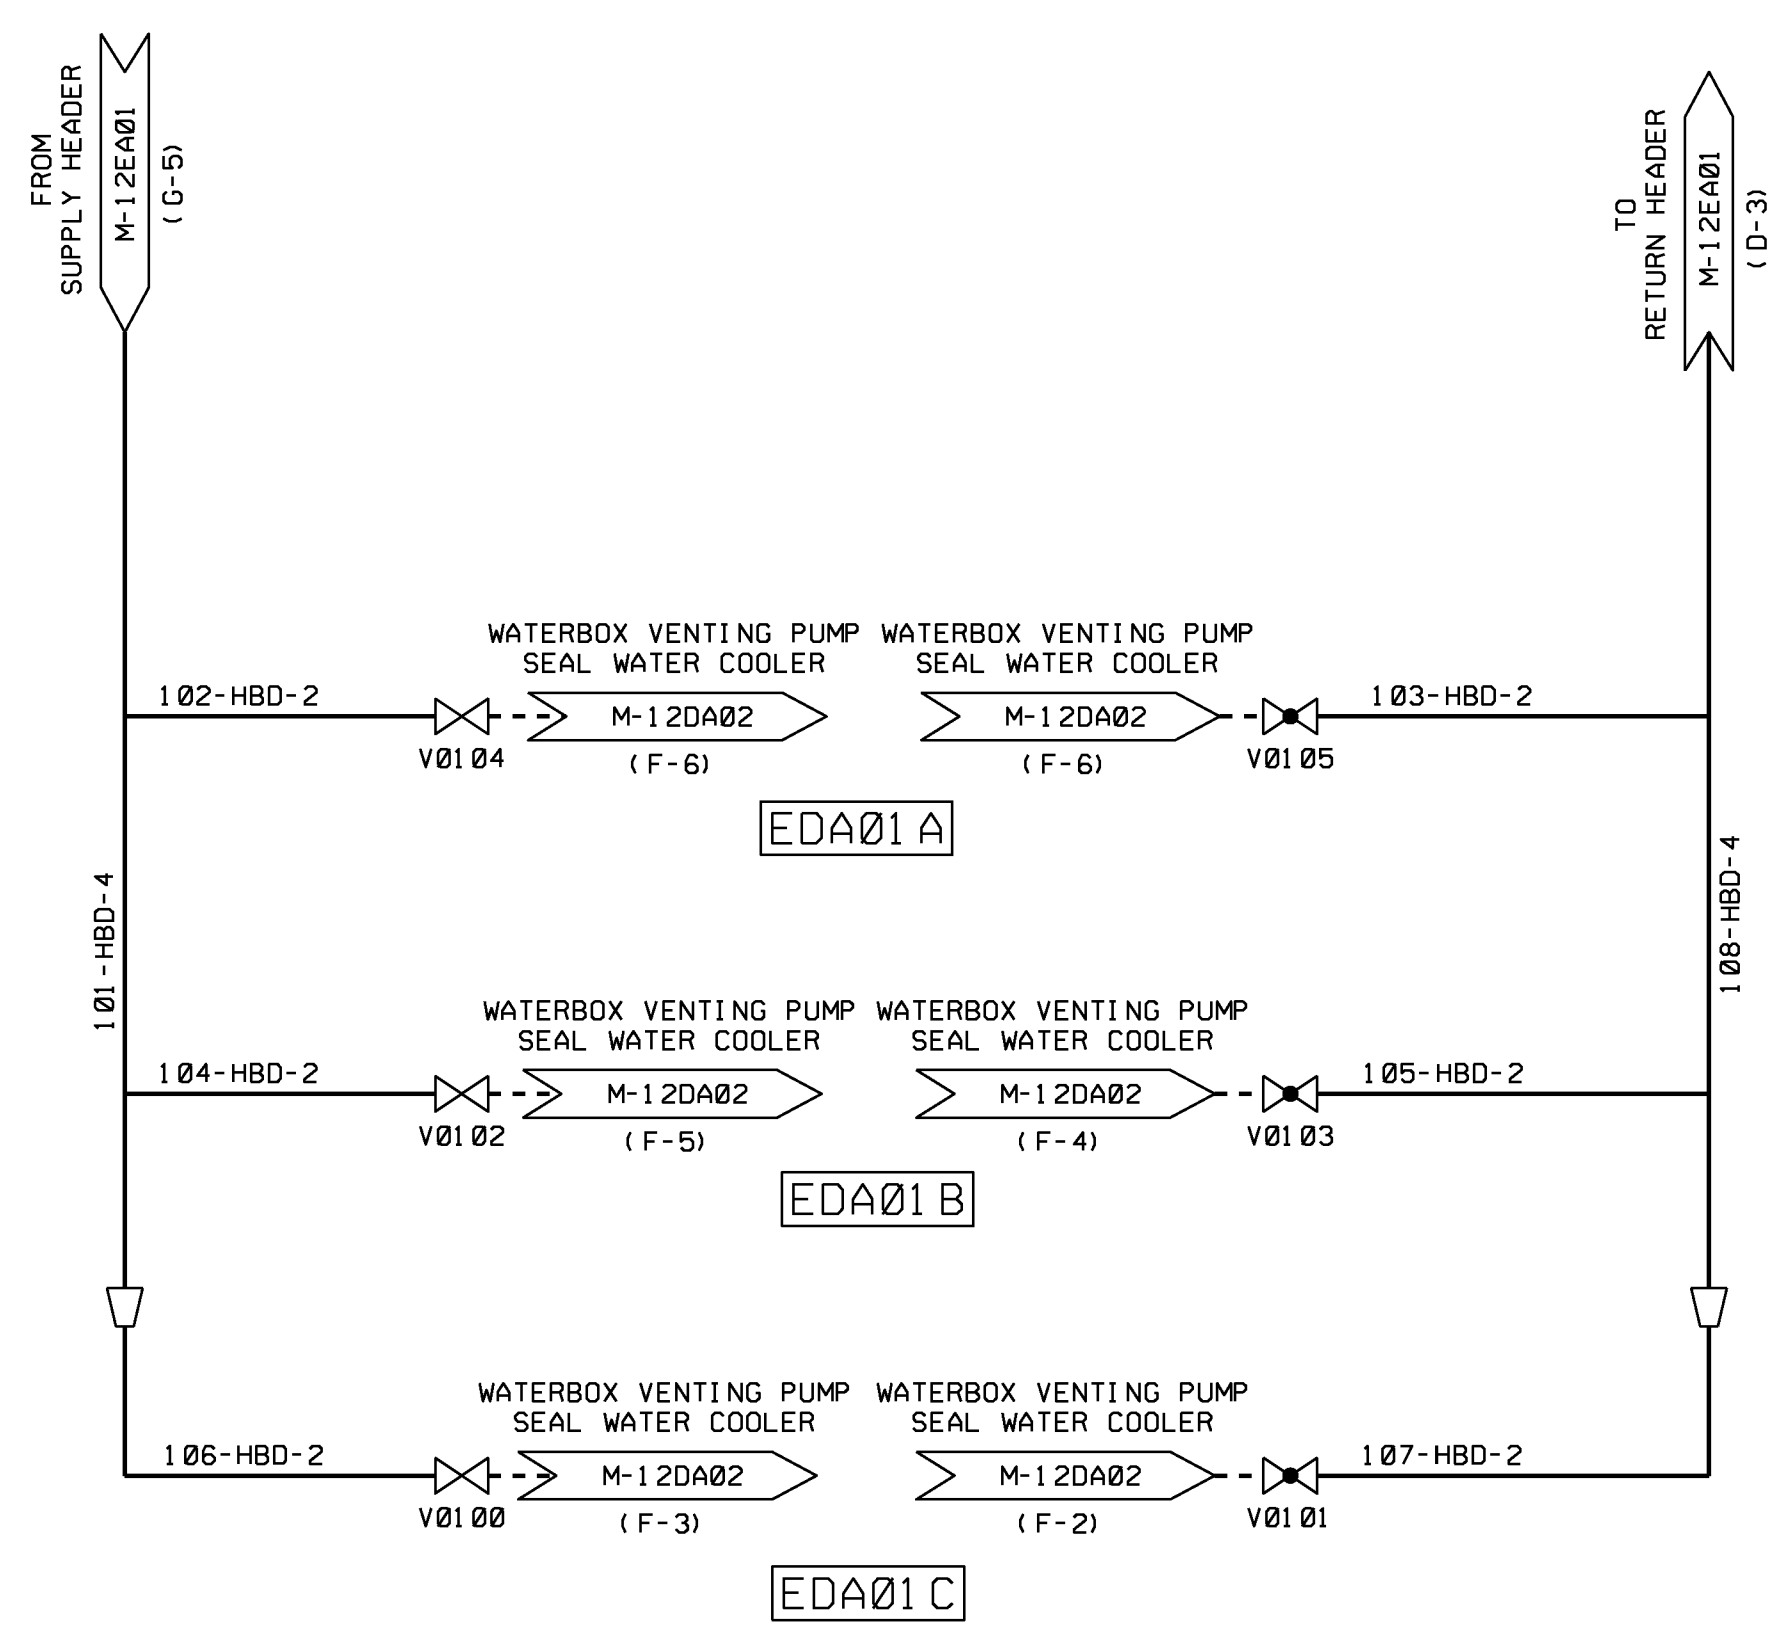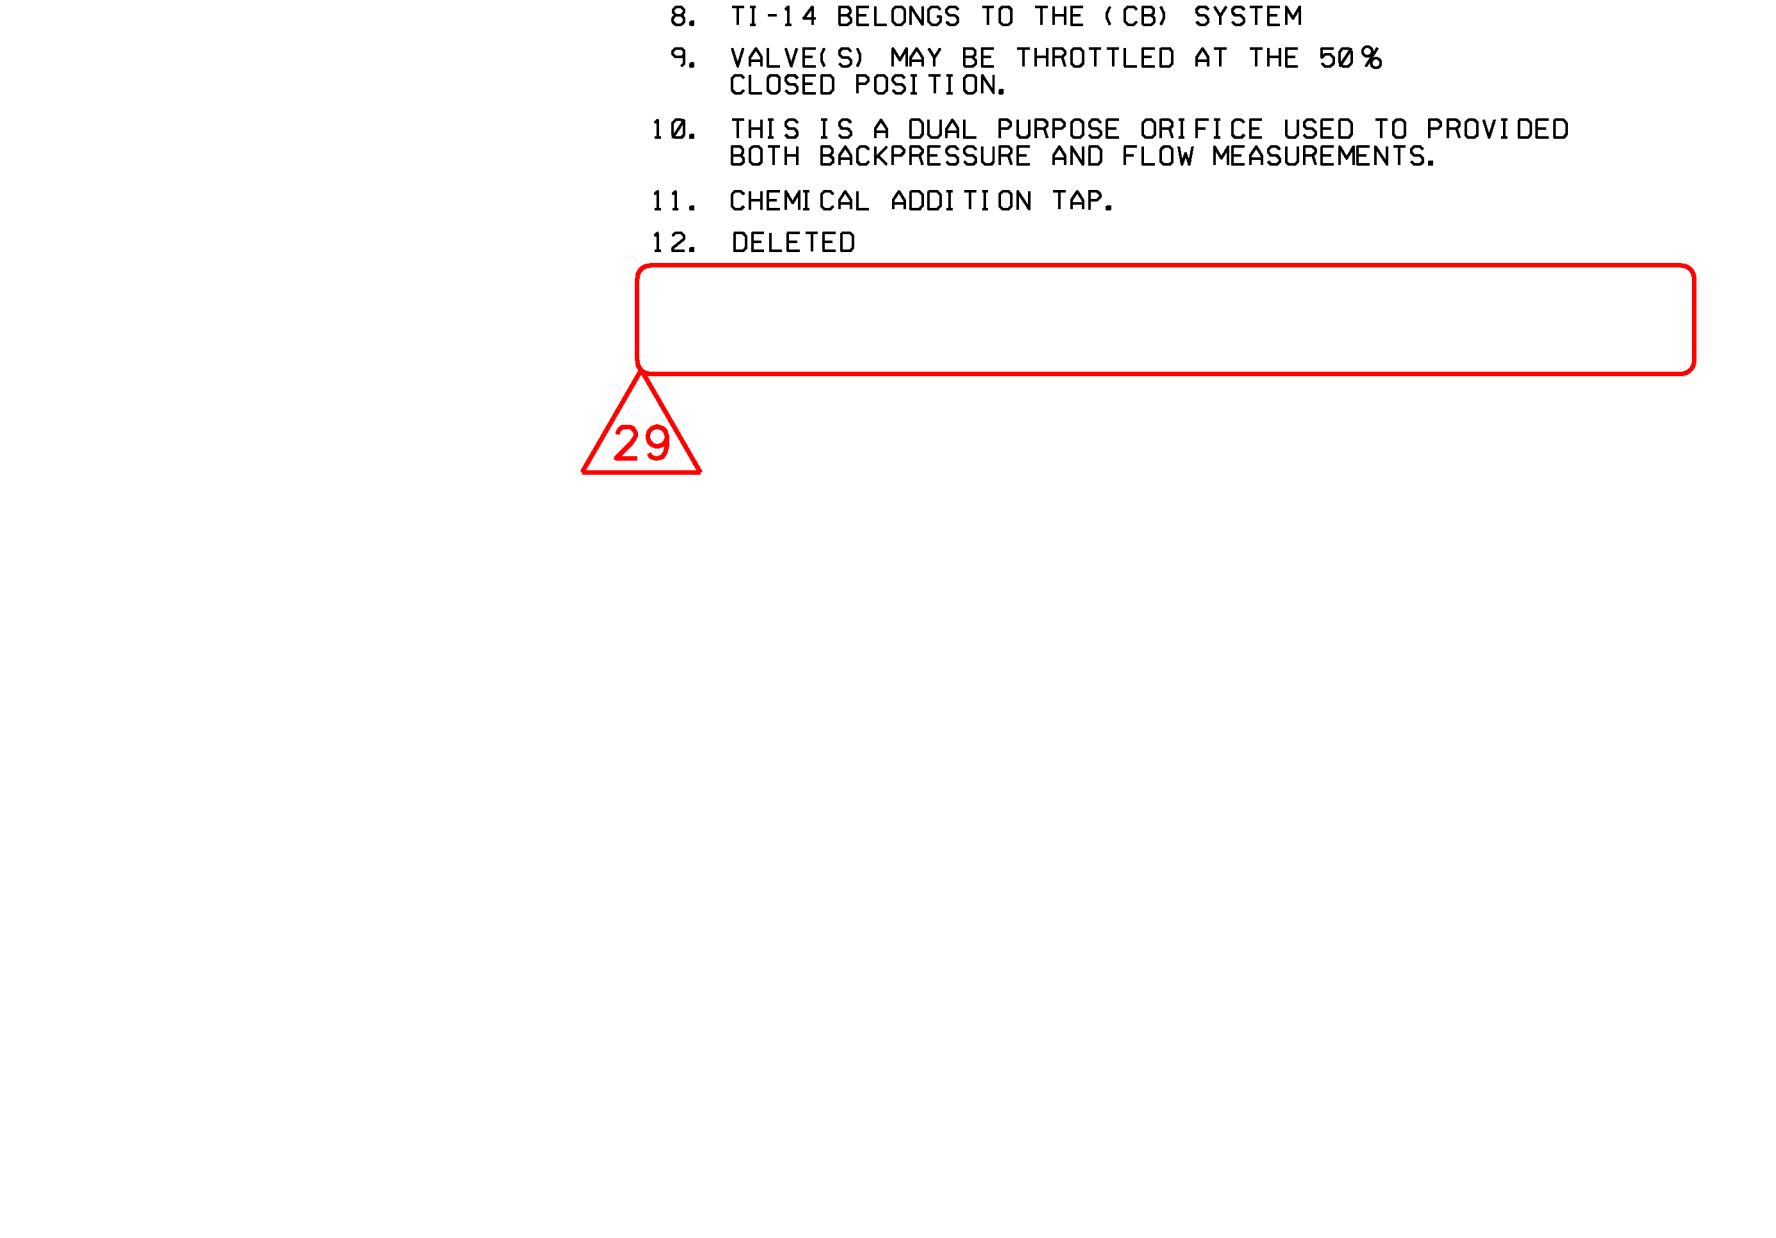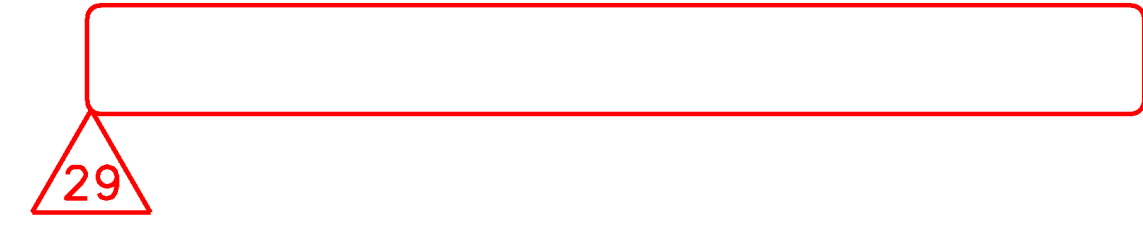

USAR FIG. 9.2-1-02


ESSENTIAL DRAWING			
REVISION	INCORPORATED	CHG. DOC.	CHANGE
ISSUED			PKG. NO.
THIS ENG. SUPERSEDES		REV.	
REVISION NOTES: REVISED TO REMOVE TCC TMP 15-002			
WOLF CREEK		ELECTRONIC APPROVAL	
PIPING & INSTRUMENTATION DIAGRAM			
SERVICE WATER SYSTEM			
SCALE	DRAWING NUMBER	SHEET	REV
NONE	M-12EA02	29	29



1 WS002P
LOW FLOW & START-UP PUMP
A-3816

1 WS001PA, 1 WS001PB, & 1 WS001PC
SERVICE WATER PUMPS
A-3816

1 WS001FA, & 1 WS001FB
SERVICE WATER STRAINERS
A-3823

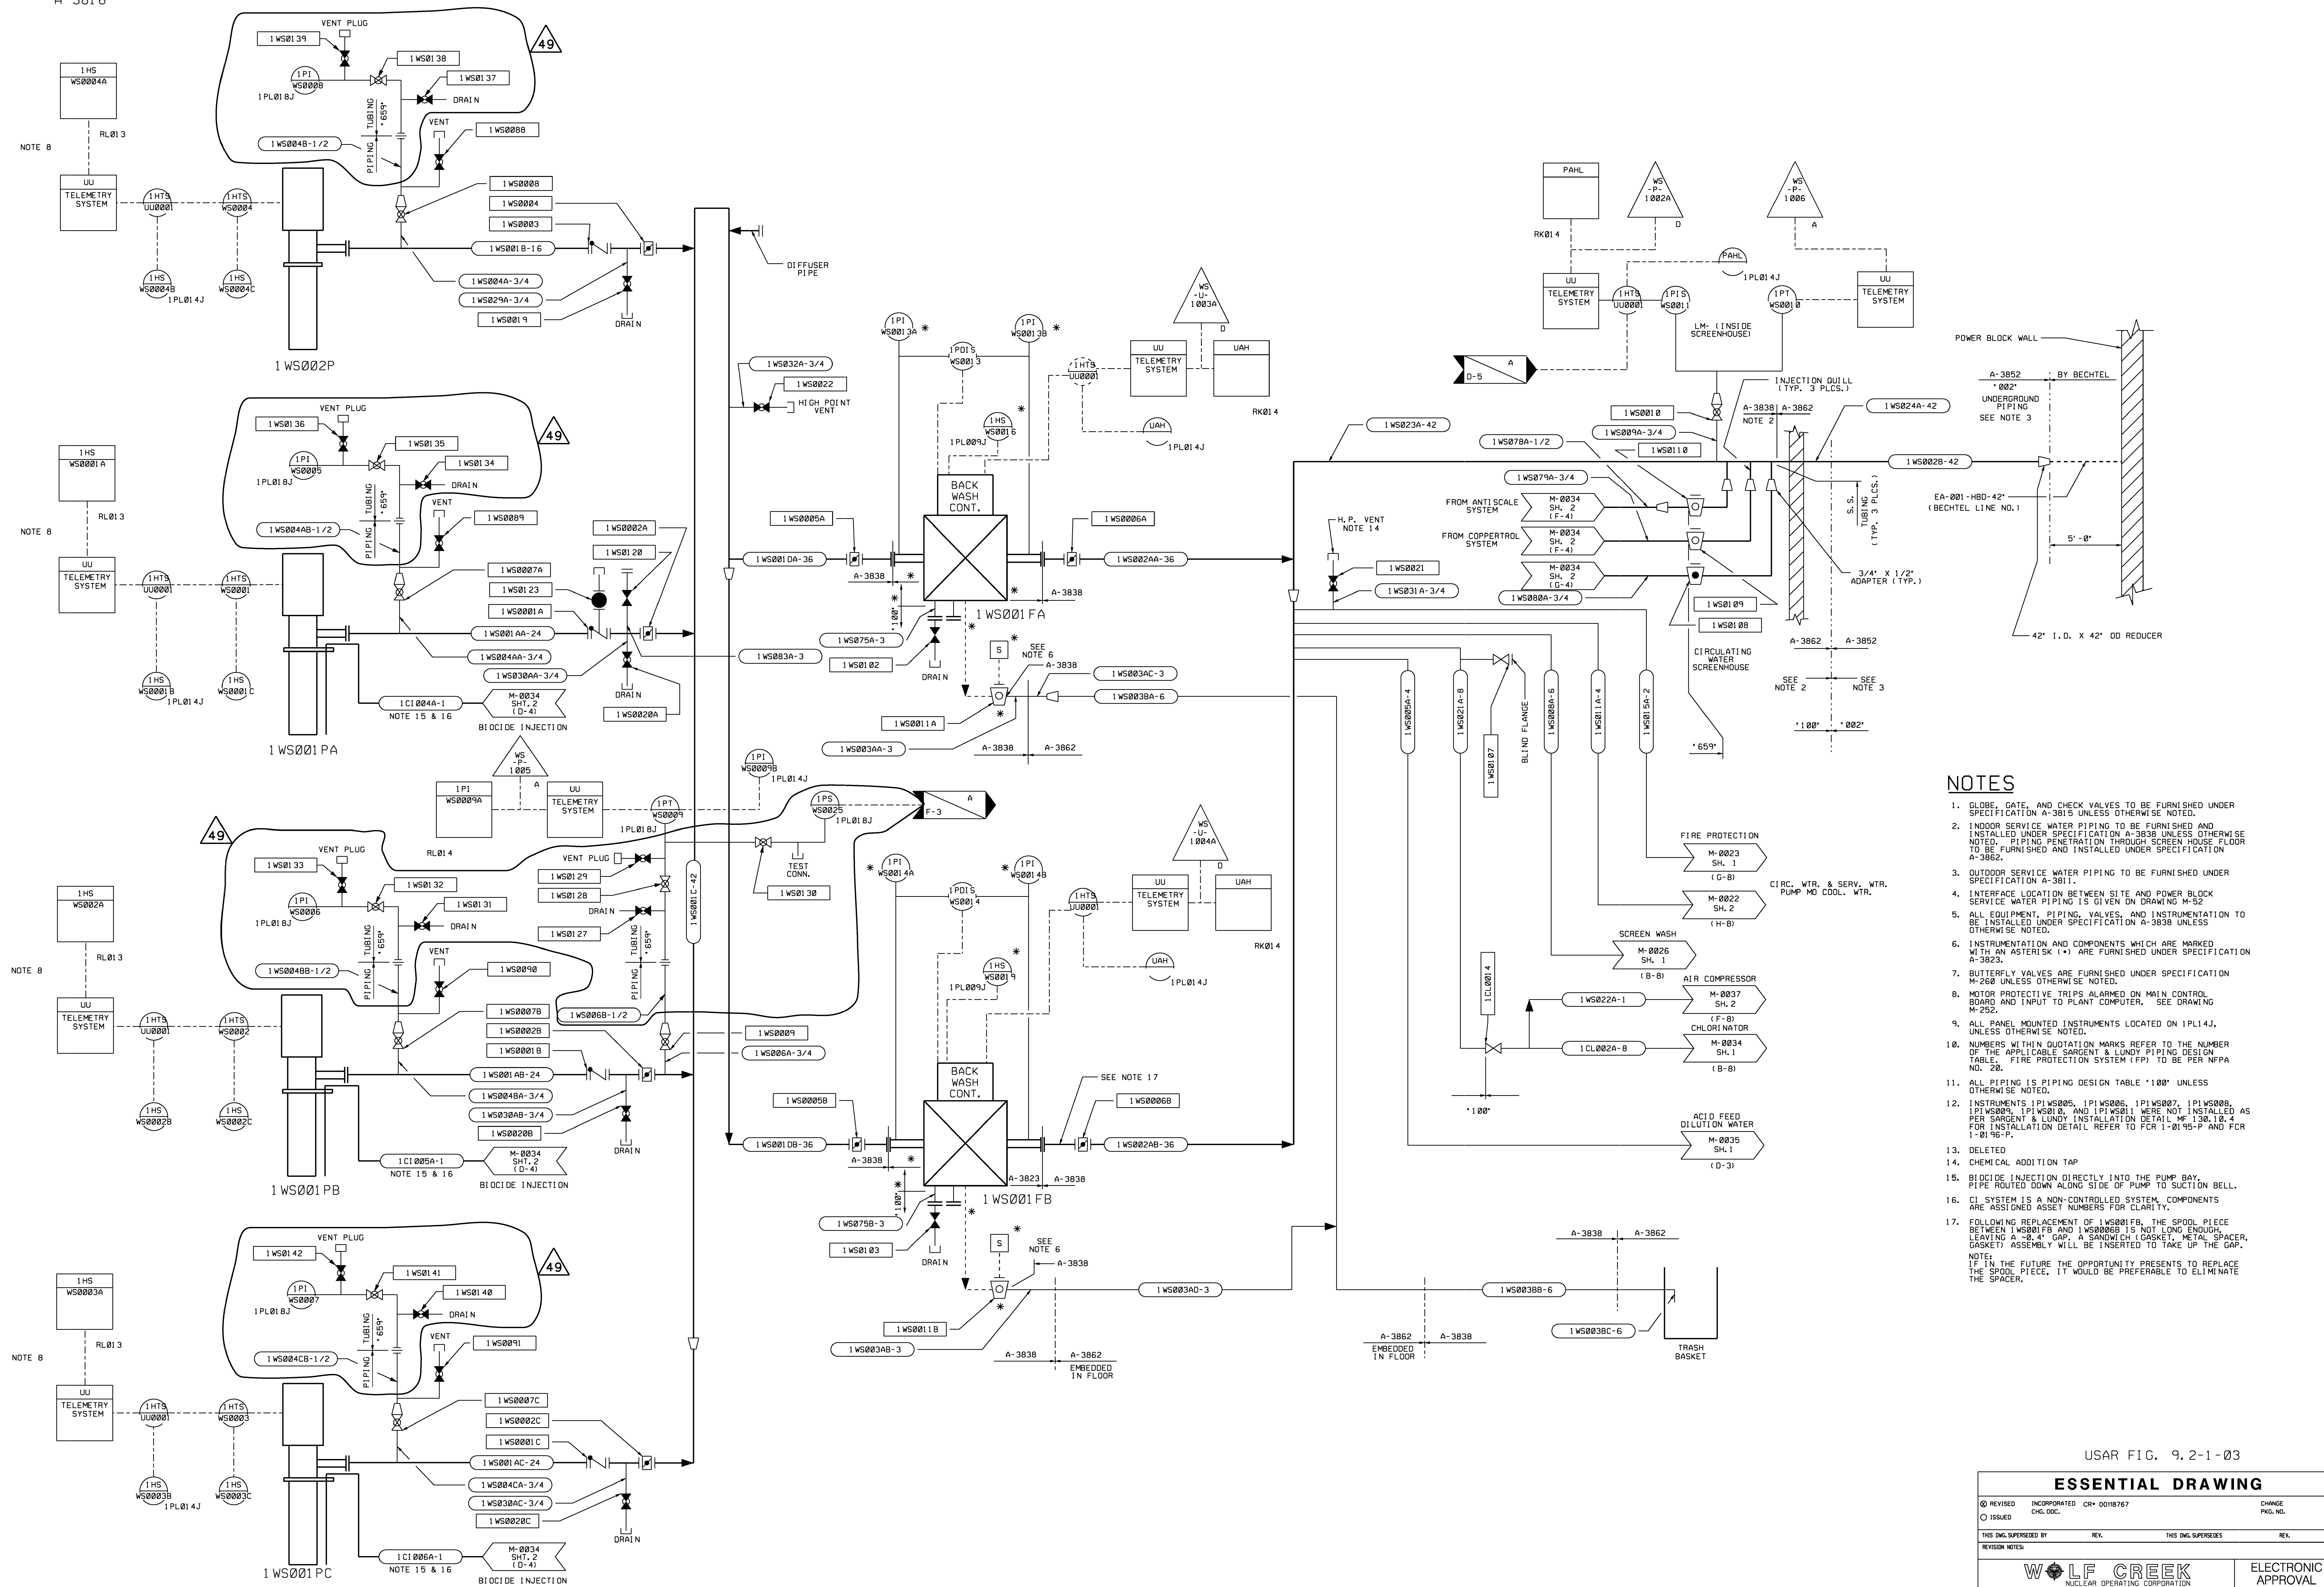


NOTES

1. GLOBE, GATE, AND CHECK VALVES TO BE FURNISHED UNDER SPECIFICATION A-3815 UNLESS OTHERWISE NOTED.
2. INDOOR SERVICE WATER PIPING TO BE FURNISHED AND INSTALLED UNDER SPECIFICATION A-3838 UNLESS OTHERWISE NOTED. PIPING PENETRATION THROUGH SCREEN HOUSE FLOOR TO BE FURNISHED AND INSTALLED UNDER SPECIFICATION A-3862.
3. OUTDOOR SERVICE WATER PIPING TO BE FURNISHED UNDER SPECIFICATION A-3811.
4. INTERFACE LOCATION BETWEEN SITE AND POWER BLOCK SERVICE WATER PIPING IS GIVEN ON DRAWING M-52.
5. ALL EQUIPMENT, PIPING, VALVES, AND INSTRUMENTATION TO BE INSTALLED UNDER SPECIFICATION A-3838 UNLESS OTHERWISE NOTED.
6. INSTRUMENTATION AND COMPONENTS WHICH ARE MARKED WITH AN ASTERISK (*) ARE FURNISHED UNDER SPECIFICATION A-3823.
7. BUTTERFLY VALVES ARE FURNISHED UNDER SPECIFICATION M-252.
8. MOTOR PROTECTIVE TRIPS ALARMED ON MAIN CONTROL BOARD AND INPUT TO PLANT COMPUTER. SEE DRAWING M-252.
9. ALL PANEL MOUNTED INSTRUMENTS LOCATED ON IPL14J, UNLESS OTHERWISE NOTED.
10. NUMBERS WITHIN QUOTATION MARKS REFER TO THE NUMBER OF THE APPLICABLE SARGENT & LUNDY PIPING DESIGN TABLE. FIRE PROTECTION SYSTEM (F-P) TO BE PER NFPA NO. 20.
11. ALL PIPING IS PIPING DESIGN TABLE '100' UNLESS OTHERWISE NOTED.
12. INSTRUMENTS IPI WS005, IPI WS006, IPI WS007, IPI WS008, IPI WS009, IPI WS010, AND IPI WS011 WERE NOT INSTALLED AS PER SARGENT & LUNDY INSTALLATION DETAIL '130.18.4' FOR INSTALLATION DETAIL REFER TO FCR 1-0195-P AND FCR 1-0196-P.
13. DELETED
14. CHEMICAL ADDITION TAP
15. BIOCIDE INJECTION DIRECTLY INTO THE PUMP BAY. PIPES ROUTED DOWN ALONG SIDE OF PUMP TO SUCTION BELL.
16. CI SYSTEM IS A NON-CONTROLLED SYSTEM. COMPONENTS ARE ASSIGNED ASSET NUMBERS FOR CLARITY.
17. FOLLOWING REPLACEMENT OF 1 WS001FB, THE SPOOL PIECE BETWEEN 1 WS001FB AND 1 WS0005B IS NOT LONG ENOUGH, LEAVING A 3.4" GAP. A SANDWICH (GASKET, METAL SPACER, GASKET) ASSEMBLY WILL BE INSERTED TO TAKE UP THE GAP. NOTE: IF IN THE FUTURE THE OPPORTUNITY PRESENTS TO REPLACE THE SPOOL PIECE, IT WOULD BE PREFERABLE TO ELIMINATE THE SPACER.

USAR FIG. 9.2-1-03

ESSENTIAL DRAWING			
REVISION	INCORPORATED	CR# 0018767	CHANGE
ISSUED	CHG. DOC.		FIG. NO.
THIS ENG. SUPERSEDES BY		REV.	THIS ENG. SUPERSEDES
REVISION NOTES			
		ELECTRONIC APPROVAL	
P&ID PLANT SERVICE WATER SYSTEM (WS)			
SCALE	DRAWING NUMBER	SHEET	REV.
NONE	M-0022	1	49

3/20/84
3018 14.00 43.21 4700

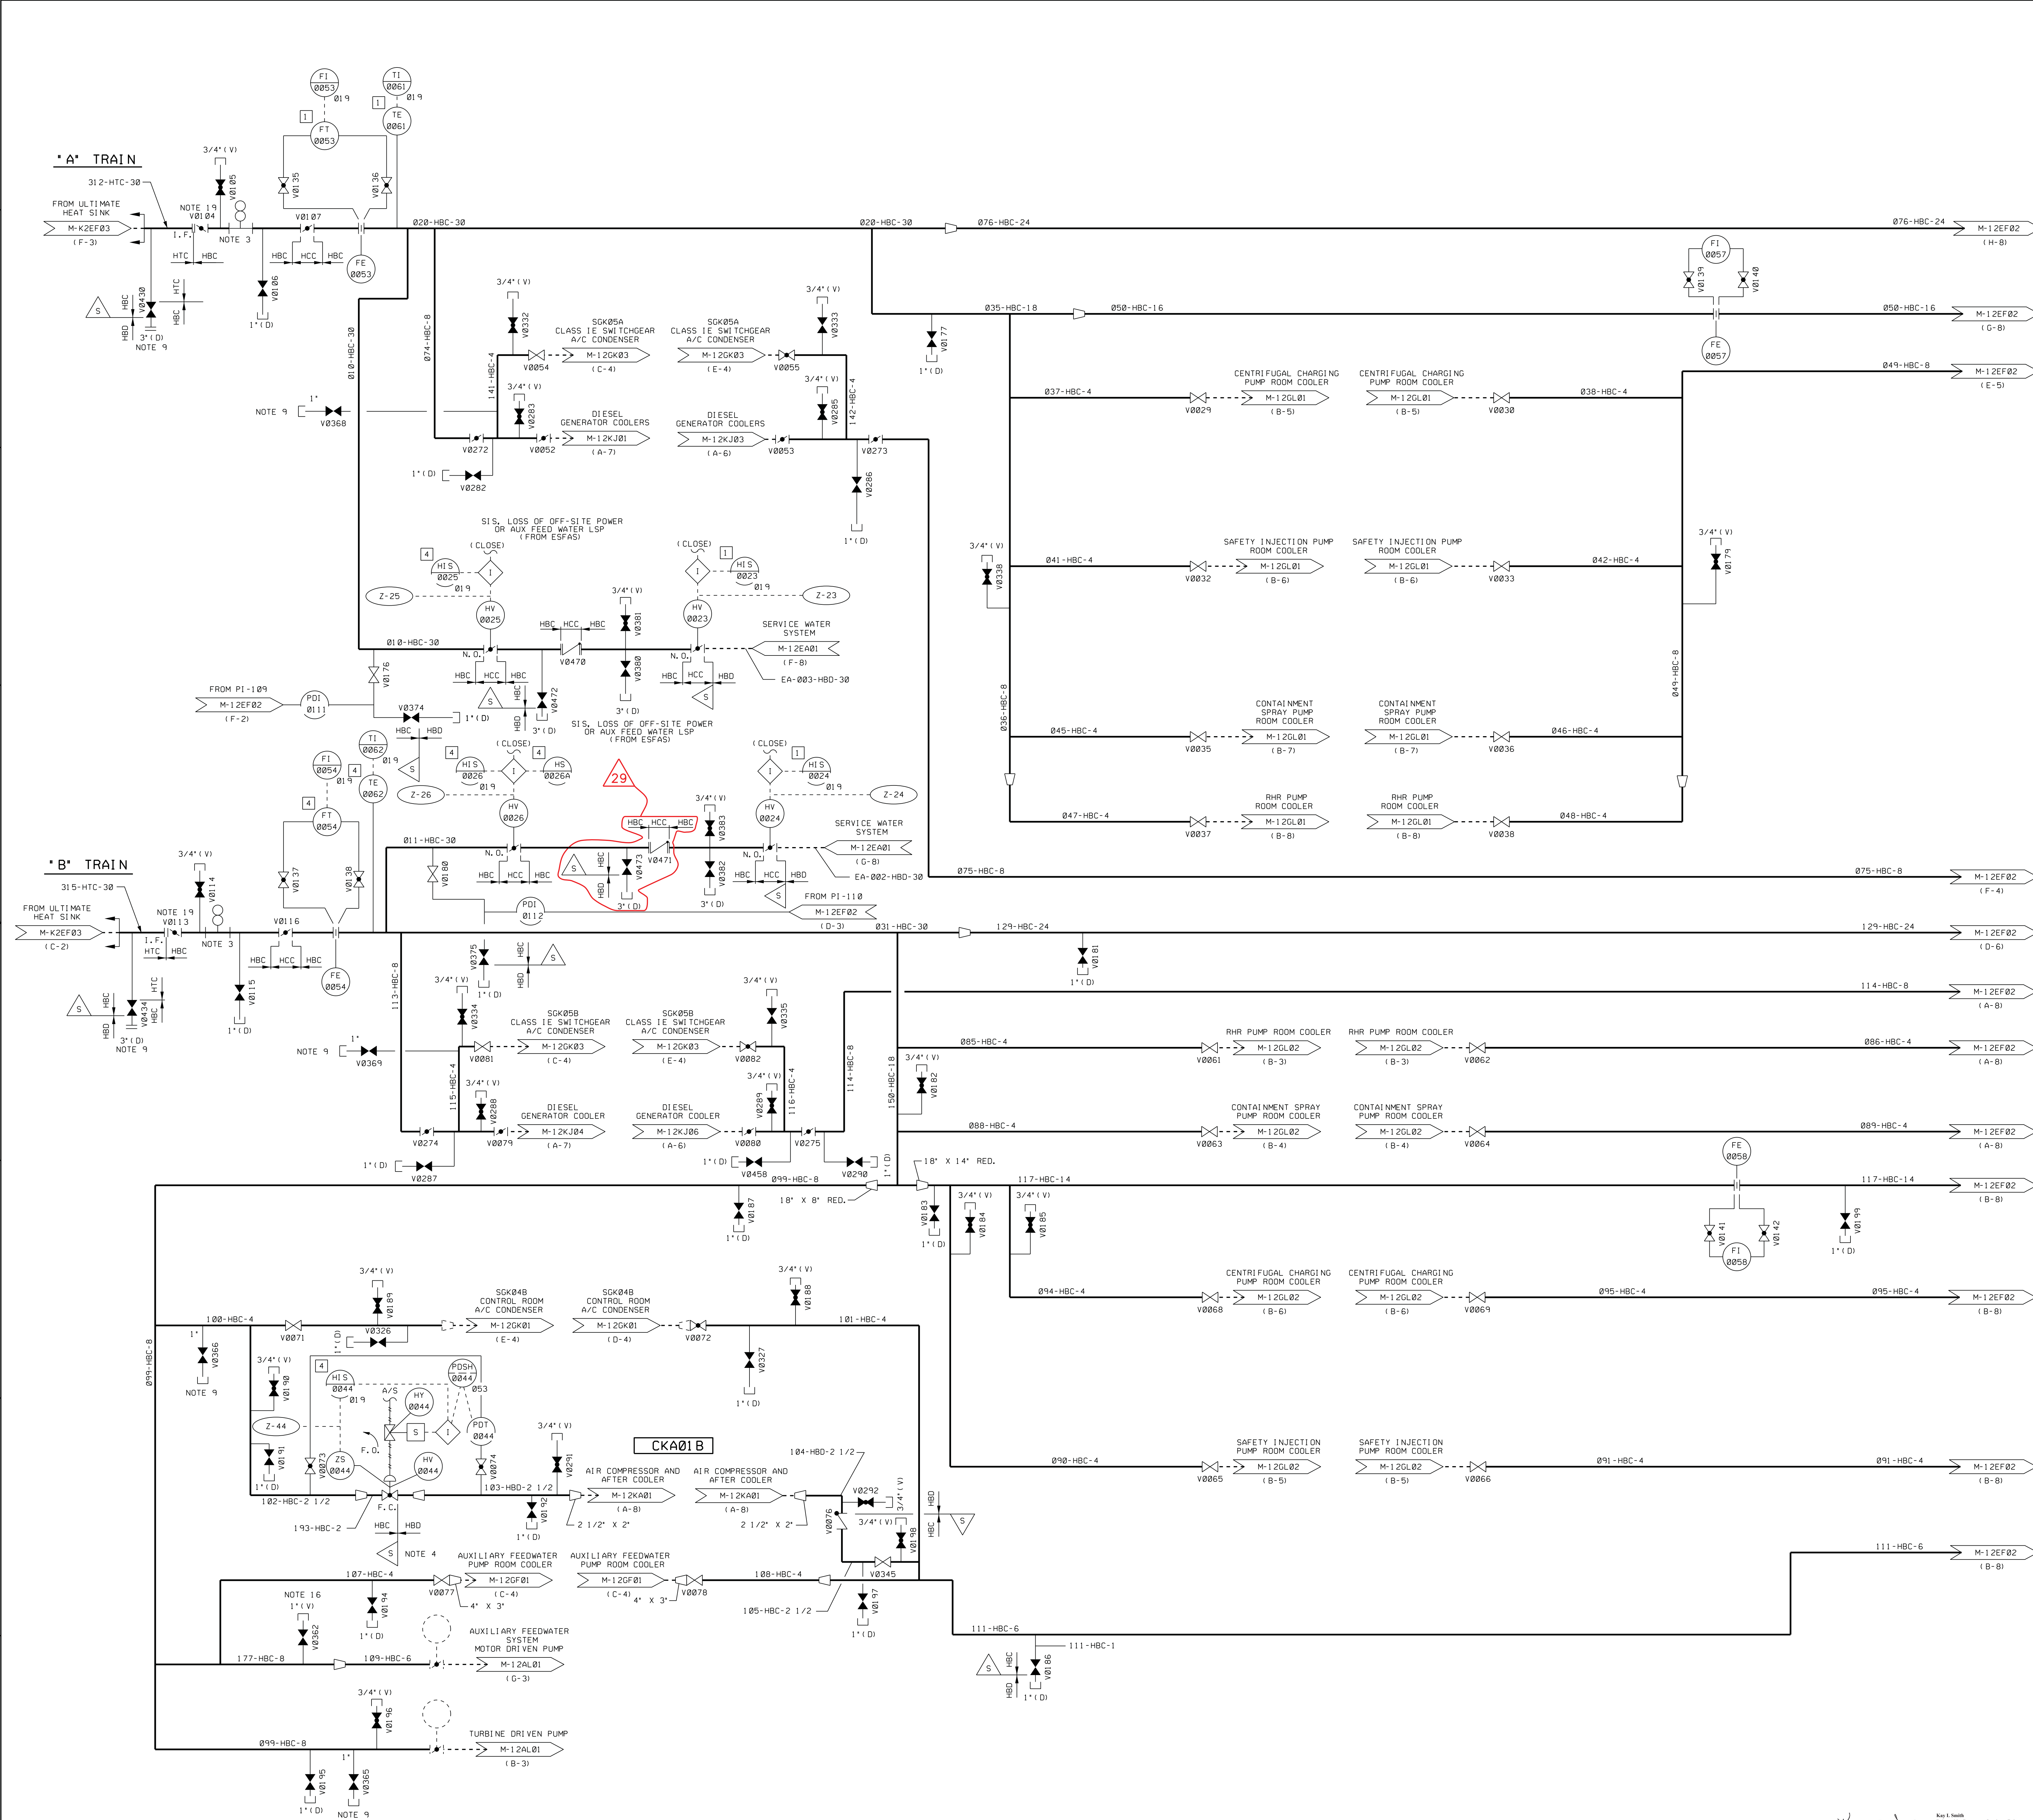

NOTES
 1. FOR NOTES SEE DRAWING M-12EF02

USAR FIG. 9.2-2 - 01

ESSENTIAL DRAWING			
REVISED	INCORPORATED	WP-M-12EF01-027-A-1	CHANGE 014750
ISSUED	CHG. DOC.		PKG. NO.
THIS DWG. SUPERSEDES BY		REV.	THIS DWG. SUPERSEDES
REVISION NOTES:			
		ELECTRONIC APPROVAL	
PIPING & INSTRUMENTATION DIAGRAM ESSENTIAL SVC WATER SYSTEM			
SCALE	DRAWING NUMBER	SHEET	REV.
NONE	M-12EF01	29	1



NOTES

- ALL MECHANICAL COMPONENTS, PIPING AND VALVES SHOWN ON THIS P&ID ARE SEISMIC CATEGORY 1.
- SPRAY PIPING BY WCMCO. SPRAY NOZZLES BY TRAVELING WATER SCREEN VENDOR.
- ESW PUMP START OPENS SCREEN WASH WATER VALVE.
- ROUTED TO JUST ABOVE FLOOR DRAIN TO ALLOW OPERATOR TO VISUALLY VERIFY FLOW.
- THIS IS A DUAL PURPOSE RESTRICTION ORIFICE USED TO PROVIDE BOTH BACKPRESSURE REDUCTION FOLLOWING A LOCA AND FLOW MEASUREMENT DURING NORMAL OPERATION AND NORMAL SHUTDOWNS.
- DELETED.
- TRAVELING WATER SCREEN STARTS AFTER ESW PUMP START AND SCREEN WASH WATER VALVE OPENS.
- VALVE CLOSES 15 SECONDS AFTER ESW PUMP STARTS.
- COMPUTER POINT ID FOR MOTOR LOWER GUIDE BEARING THERMOCOUPLE.
- COMPUTER POINT ID FOR MOTOR UPPER THRUST BEARING THERMOCOUPLE.
- THE FOLLOWING CODE/NON-CODE BOUNDARIES APPLY TO ALL CARBON STEEL VENTS AND DRAINS:
 - 70
- THE TEMPERATURE INDICATOR IS PROVIDED FOR MONITORING DURING COLD START CONDITIONS. THIS MONITORING IS REQUIRED TO ASSURE THAT THE VENT TEMPERATURES DO NOT DROP BELOW 32°F. IF A VENT TEMPERATURE REACHES 32°F, THE ESW PUMPS MUST BE STOPPED AND CONTINUE TO OPERATE UNTIL THE VENT TEMPERATURE WILL REMAIN ABOVE 32°F. THE VENT IS DESIGNED TO REMAIN DRY AND THE ASME PIPING IS NOT DESIGNED FOR SUBMERGENCE. THE STILLING WELLS ARE PROVIDED FOR PERIODIC MONITORING TO ENSURE THAT THE LONG TERM OPERABILITY OF THE PIPING IS NOT AFFECTED. A PUMP CAN BE LOWERED INTO THE WELLS TO ALLOW FOR WATER REMOVAL.
- REMOVABLE SPOOL TO SERVICE CHEMICAL ADDITION NOZZLE.
- DELETED.
- LOCATE CLOSE TO TRASH RACK IN A 3" DIA., SCH. 40S PIPE.
- 3" DIA., SCH. 40S PIPE CLOSE TO LAKE.
- TERMINATED AT LOCAL TEMPERATURE TESTPOINT PANEL.
- SEE M-K2EF01A FOR ABANDONED COMPONENTS.
- THE FOLLOWING ORIFICE PLATES ARE CLASS 2 ITEMS:
 - FO-0021 FO-0026 FO-0032 FO-0040
 - FO-0022 FO-0027 FO-0033 FO-0041
 - FO-0023 FO-0028 FO-0034 FO-0042
 - FO-0024 FO-0029 FO-0035
 - FO-0025 FO-0031 FO-0039
- SECTIONS OF THE ORIGINAL 007-HBC-30 AND 003-HBC-30 PIPING ARE REMOVED BETWEEN THE ESW PUMPHOUSE WALL AND THE ACCESS VAULT TO ALLOW INSTALLATION OF THE NEW ESW SUPPLY PIPING.
- PIPING FROM THE TANK NOZZLE TO THE FIRST FITTING WILL BE REPLACED WITH STAINLESS STEEL PIPING SA312 TYPE 304. THE FITTING SHALL REMAIN CARBON STEEL AND THE PIPING SIZE/SCHEDULE SHALL REMAIN THE SAME.
- THESE ARE ESW BEYOND-DESIGN-BASIS (FLEX) CONNECTIONS.
- TWO CONNECTION POINTS, SEE DRAWING M-KC091I FOR DETAILS.

70

DRAWING REFERENCE

M-K2EF01A ABANDONED ESW EQUIPMENT

USAR FIG. 9.2-2-03


ESSENTIAL DRAWING

REVISED	INCORPORATED	CHG. DOC.	CHANGE
ISSUED	CHG. DOC.		PKG. NO.
THIS DWG. SUPERSEDES BY		REV.	THIS DWG. SUPERSEDES
REVISION NOTES		REV.	REV.
WP-M-K2EF01-05B-A-1			014425



PIPING & INSTRUMENTATION DIAGRAM
ESSENTIAL SERVICE WATER SYS.

SCALE	DRAWING NUMBER	SHEET	REV
	M-K2EF01	1	70

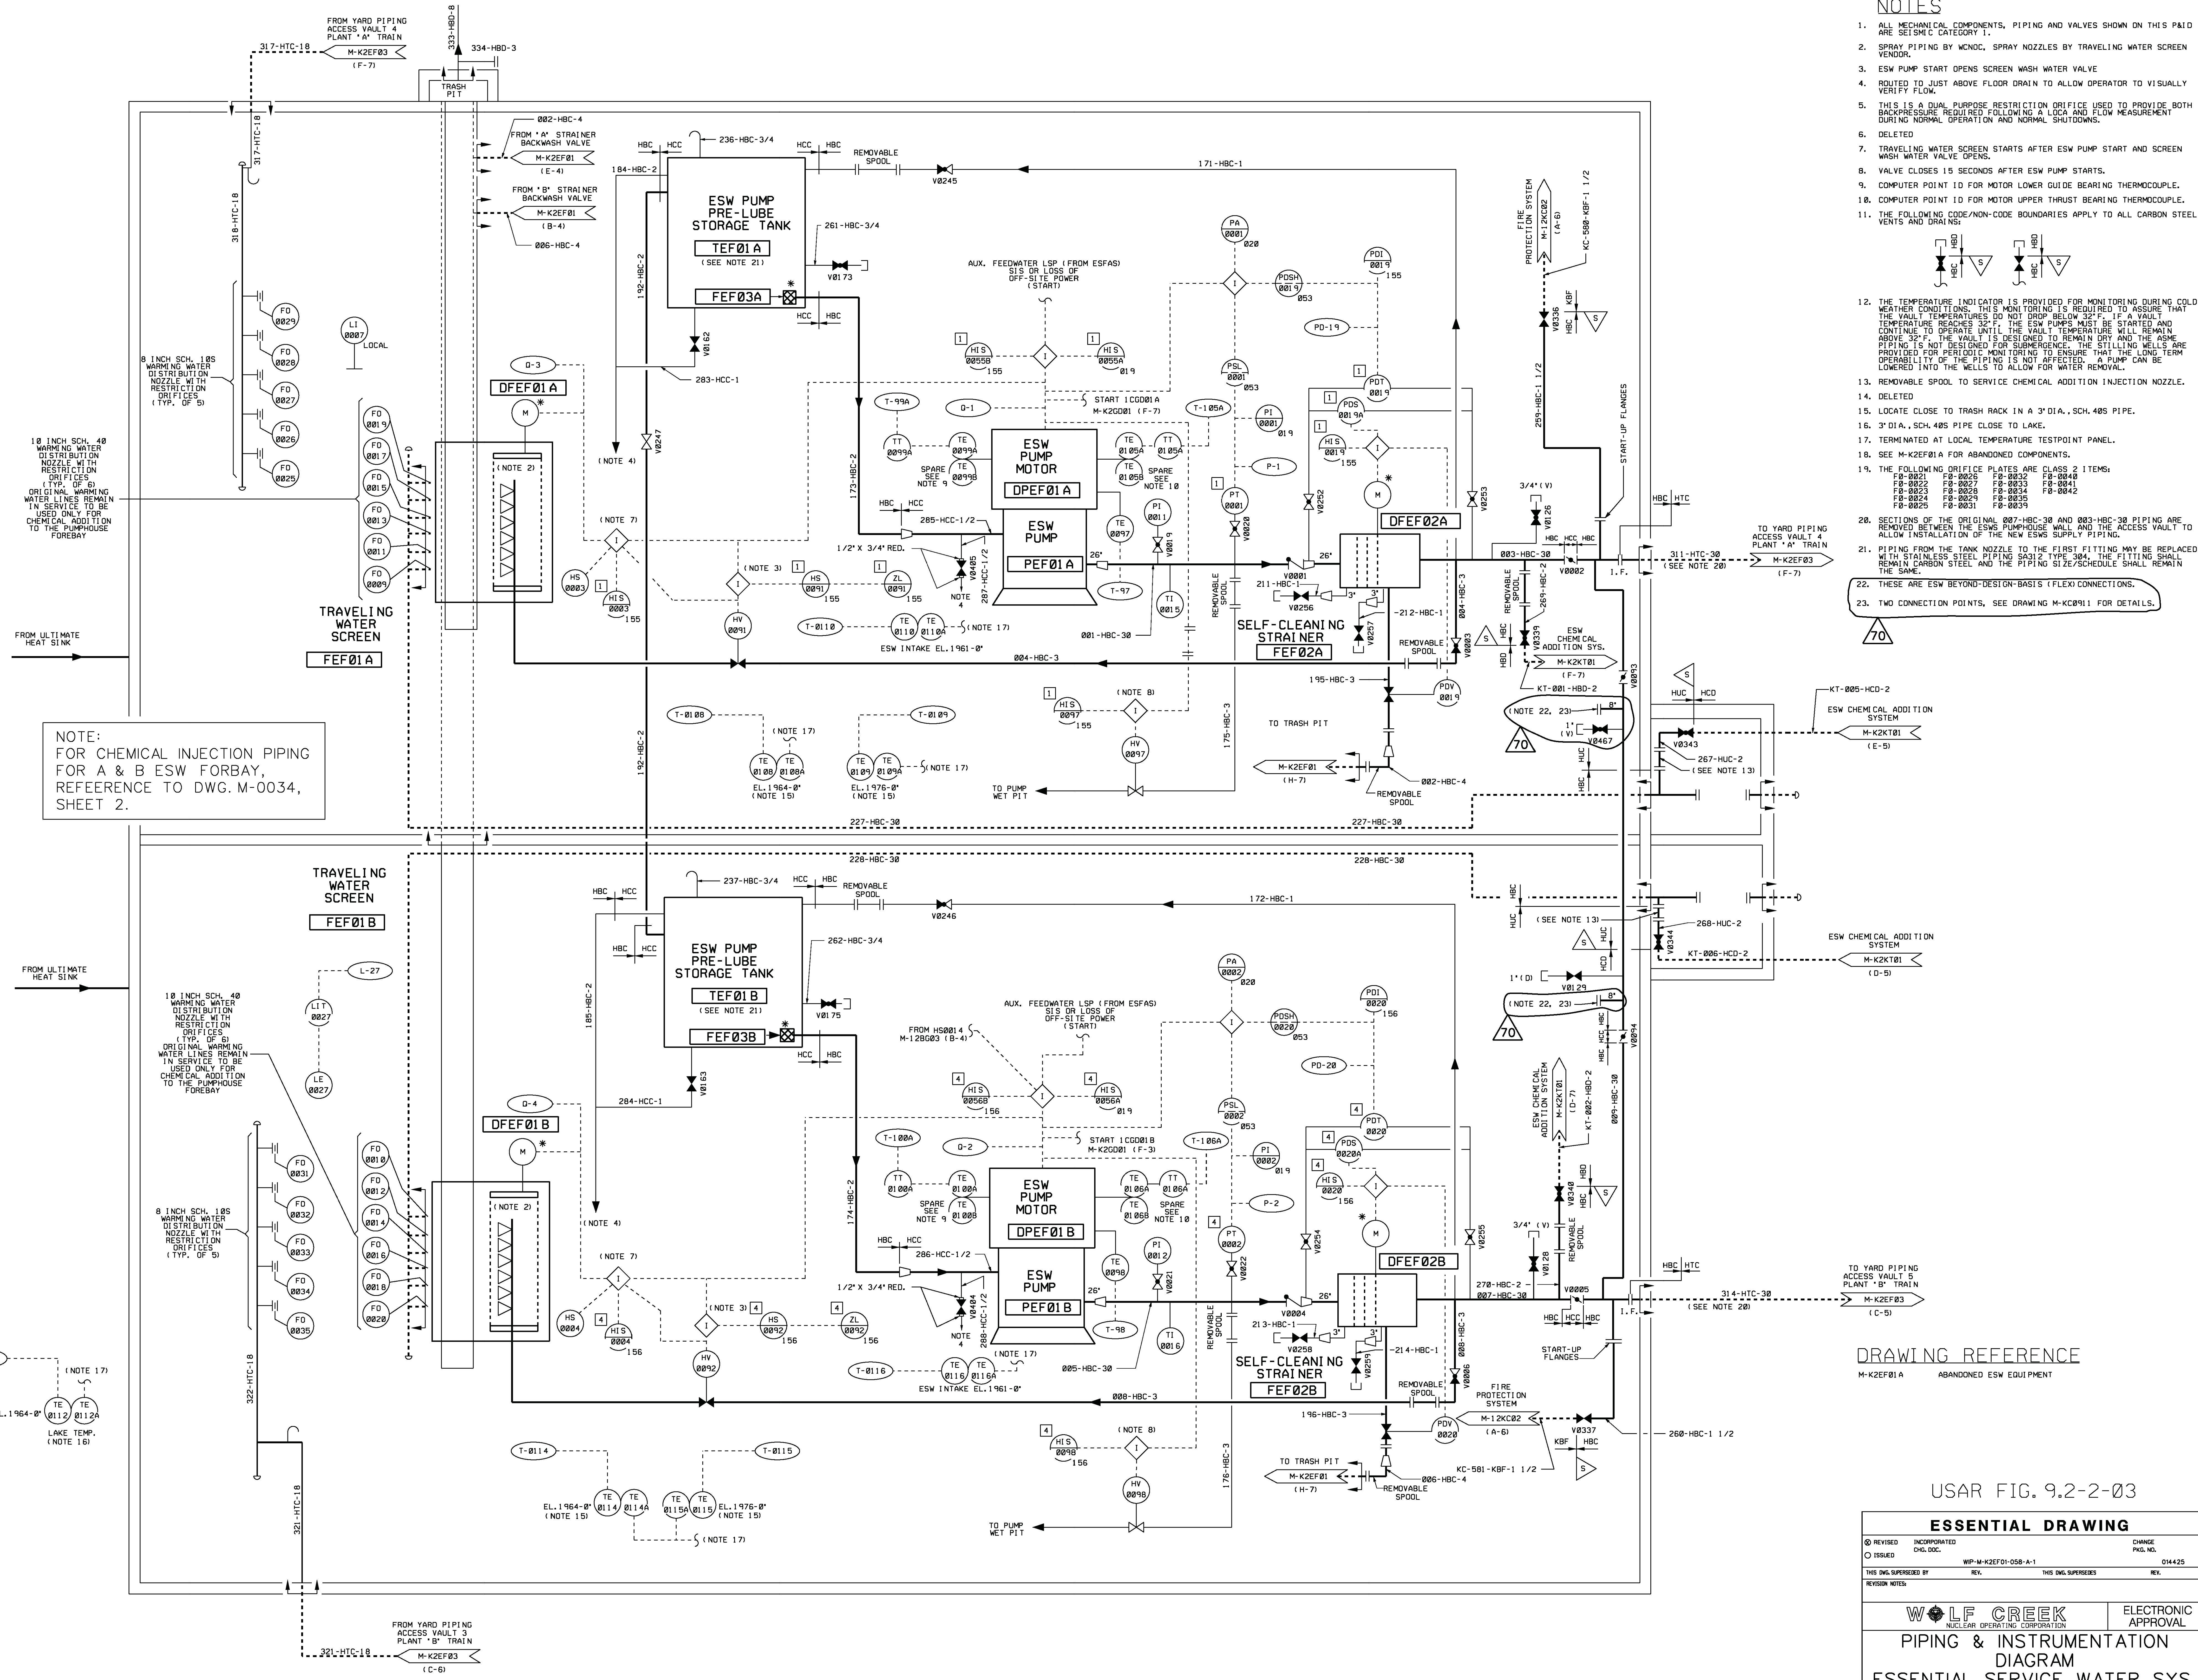

NOTE:
FOR CHEMICAL INJECTION PIPING
FOR A & B ESW FORBAY,
REFERENCE TO DWG. M-0034,
SHEET 2.

18 INCH SCH. 40
WARMING WATER
DISTRIBUTION
NOZZLE WITH
RESTRICTION
ORIFICES
(TYP. OF 6)
ORIGINAL WARMING
WATER LINES REMAIN
IN SERVICE TO BE
USED ONLY FOR
CHEMICAL ADDITION
TO THE PUMPHOUSE
FOREBAY

3444 E SHE

NOTES

1. DELETED
2. DELETED
3. DELETED
4. DELETED
5. FOR SYMBOLS AND LEGENDS SEE WOLF CREEK MASTER OPERATING COORDINATION W/NOCH DRAWING NUMBER M-0207 THROUGH M-0208A.
6. FOR PIPE CLASS CODE DEFINITION AND IDENTIFICATION SEE ESM BPPS REFERENCE TO W/NOCH DOCUMENT NUMBER W/NOCH PIPING CLASS SHEETS.
7. ALL INSTRUMENTING TO THE FLOW TRANSMITTERS SHALL BE USING CATEGORY 1 PPS, PROVISIONAL M-CAL. OFFICE LINE CONNECTIONS SHALL BE USED FOR INSTRUMENTING DURING WET WEATHER CONDITIONS. THIS MONITORING IS REQUIRED TO INSURE THAT THE TEMPERATURE REACHES 32°F. THE ESM PUMPS MUST BE STARTED AND CONTINUE TO OPERATE UNTIL THE VALVE TEMPERATURE WILL REMAIN ABOVE 32°F.
8. ISOLATED PIPING TERMINAL POINT IS IN USE CONTROL BUILDING AT BUTTERFLY VALVE NUMBERS V008 AND V010. SEE W/NOCH DRAWING NUMBER M-0207E.
9. ISOLATED PIPING TERMINAL POINT FOR SUPPLY LINES IS IN USE CONTROL BUILDING AT BUTTERFLY VALVE NUMBERS V008 AND V010. SEE W/NOCH DRAWING NUMBER M-0207E.
10. ISOLATED PIPING TERMINAL POINT IS IN USE CONTROL BUILDING AT EXISTING ISOLATED FLANGE. SEE W/NOCH DRAWING NUMBER M-0207E. AN ISOLATED FLANGE WILL NO LONGER BE NECESSARY AND WILL BE REMOVED.
11. TYPICAL SETUP FOR ALL CARBON STEEL VENTS AND DRAINS ON CARBON STEEL PIPING RUNS.
12. TYPICAL SETUP FOR ALL CARBON STEEL VENTS AND DRAINS ON CARBON STEEL PIPING RUNS.
13. THE WARNING LINE AND ESM SUPPLY LINE SHARE ACCESS VAULT 4 FOR TRAIN A.
14. INSTRUMENTATION SHALL HAVE LOCAL INDICATION INSIDE OF THE VALVE OPERATOR COMPARTMENT.
15. REMOVABLE SPOOL PIECE INSTALLED FOR TEMPORARY PIPE INSPECTION (AUGING) PPS COMPONENT INSTALLATION PIPE SUPPORTS FOR THE REMOVABLE SPOOL AND ISOLATED VALVE ARRANGEMENT ARE INCLUDED IN FOREMAN DESIGN FOR CONSTRUCTION. SHOULD THE PPS SUBCONTRACTOR REQUIRE ADDITIONAL PIPE SUPPORTS THEY SHALL BE SUPPLIED BY THE SUBCONTRACTOR. PIPING SUBCONTRACTOR SHALL SUPPLY TEMPORARY PUMP FOR PIPING OPERATIONS. WATER SOURCE AND DEGREE SHALL BE DETERMINED BY W/NOCH. MIN. AND MAXIMUM SO BENDS ARE REQUIRED TO ALLOW FOR PIPING OPERATIONS.
16. TERMINATED AT LOCAL TEMPERATURE TESTPOINT PANEL LOCATED IN THE ESM PUMPHOUSE.
17. FOR FE-0030A A MINIMUM STRAIGHT RUN OF 80' TO THE UPSTREAM REMOVAL OUTLET AND 350' TO THE DOWNSTREAM BUTTERFLY VALVE INLET WILL BE PROVIDED. FOR FE-0042, A MINIMUM STRAIGHT RUN OF 50' TO THE UPSTREAM AND 150' TO THE DOWNSTREAM BUTTERFLY VALVE INLET WILL BE PROVIDED.
18. THE SHIRT PORTION OF HSE PIPING BETWEEN ACCESS VAULT 2 AND TIE SHALL BE VISUALLY INSPECTED TO CONFIRM INTEGRITY OF THE PIPE INTERNALS IN ACCORDANCE WITH W/NOCH PROCEDURES.
19. BARBED TIES ARE REQUIRED TO ALLOW FOR PIPING OPERATION.
20. VALVES V008 & V010 ARE TO BE THROTTLED DURING WINTER WINDING LINE OPERATION PER W/NOCH PROCEDURE AP 21-001.
21. RESTRICTION ORIFICE TO BE SOLID TO STEEL WELD NICK FLANGE AND DUP-ON FLANGE.
22. VALVES V008 & V010 SHALL BE SUITABLE FOR THROTTLING SERVICE. THE OPERATION OF VALVES V008 & V010 SHALL BE ADDED TO THE W/NOCH PROGRAM IN ACCORDANCE WITH AP 20-000 PROCEDURE. VALVES WILL BE DESIGNED TO ALLOW VALVE OPERATION EXTERNAL TO THE ACCESS VAULT WITHIN THE VALVE OPERATOR COMPARTMENT.
23. FOR DETAILS REFER TO DRAWING C-230.
24. IF AN ISOLATING VALVE IS ALLOWED TO BE SHUT DOWN OF WINDING LINE PIPE INSIDE ESM PUMPHOUSE FOREBAY THE 1" VENT SHALL BE LOCATED ON THE ESM PIPE BELOW WHERE THE ESM PIPE TAKES DOWN INTO THE ESM PUMPHOUSE FOREBAY WATER AS CLOSE TO THE HORIZONTAL RUN AS POSSIBLE. THE VENT SHALL DISCHARGE IN THE DOWNWARD DIRECTION INTO THE ESM PUMPHOUSE FOREBAY.
25. FOR ABANDONED IN PLACE COMPONENTS SEE M-K2EF03A.
26. DELETED
27. DELETED
28. DELETED

USAR FIG. 9, 2-2 -4


ESSENTIAL DRAWING




REVISED	INCORPORATED	AS-BUILT UPDATE	CHANGE 014242
DATE	DATE	PER 4.8.13-076007-0410 AND C.R. 08080702.	NO. 02
ISSUED	DATE	BY	DATE
THIS DWG SUPERSEDES	REV.	THIS DWG SUPERSEDES	REV.





WOLF CREEK ELECTRONIC APPROVAL
 PIPING & INSTRUMENTATION DIAGRAM ESSENTIAL SERVICE WATER SYSTEM

TITLE NONE DRAWN BY M-K2EF03 SHEET NO. 19

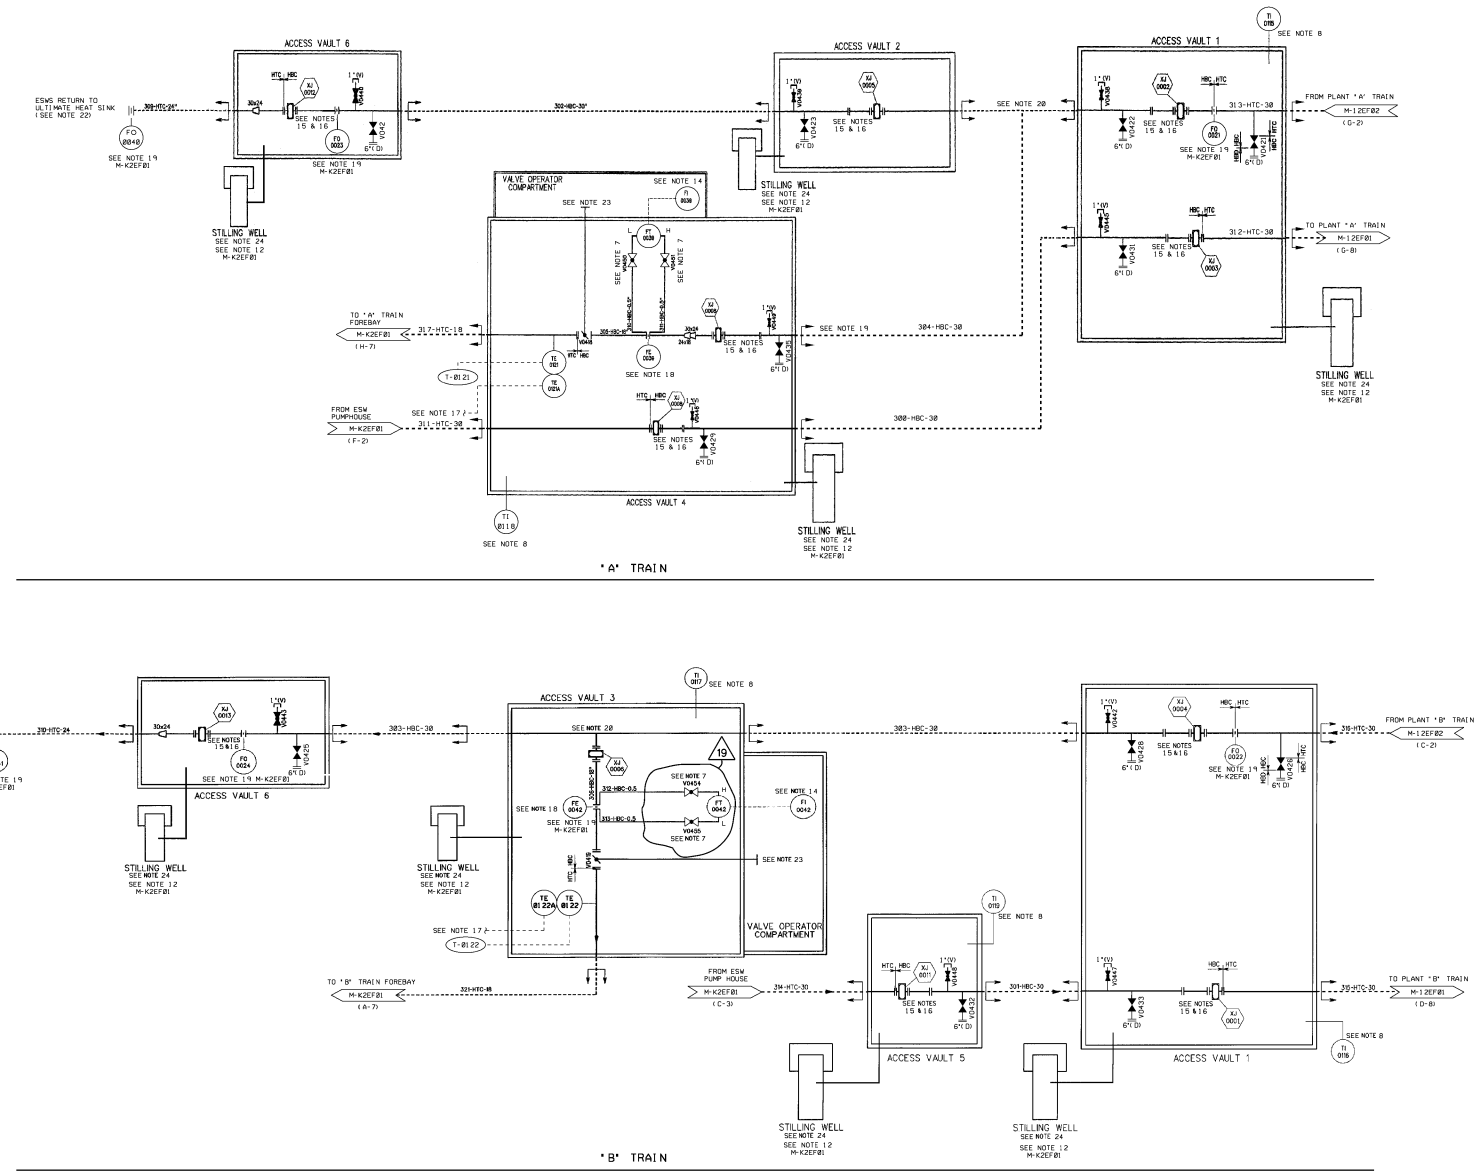

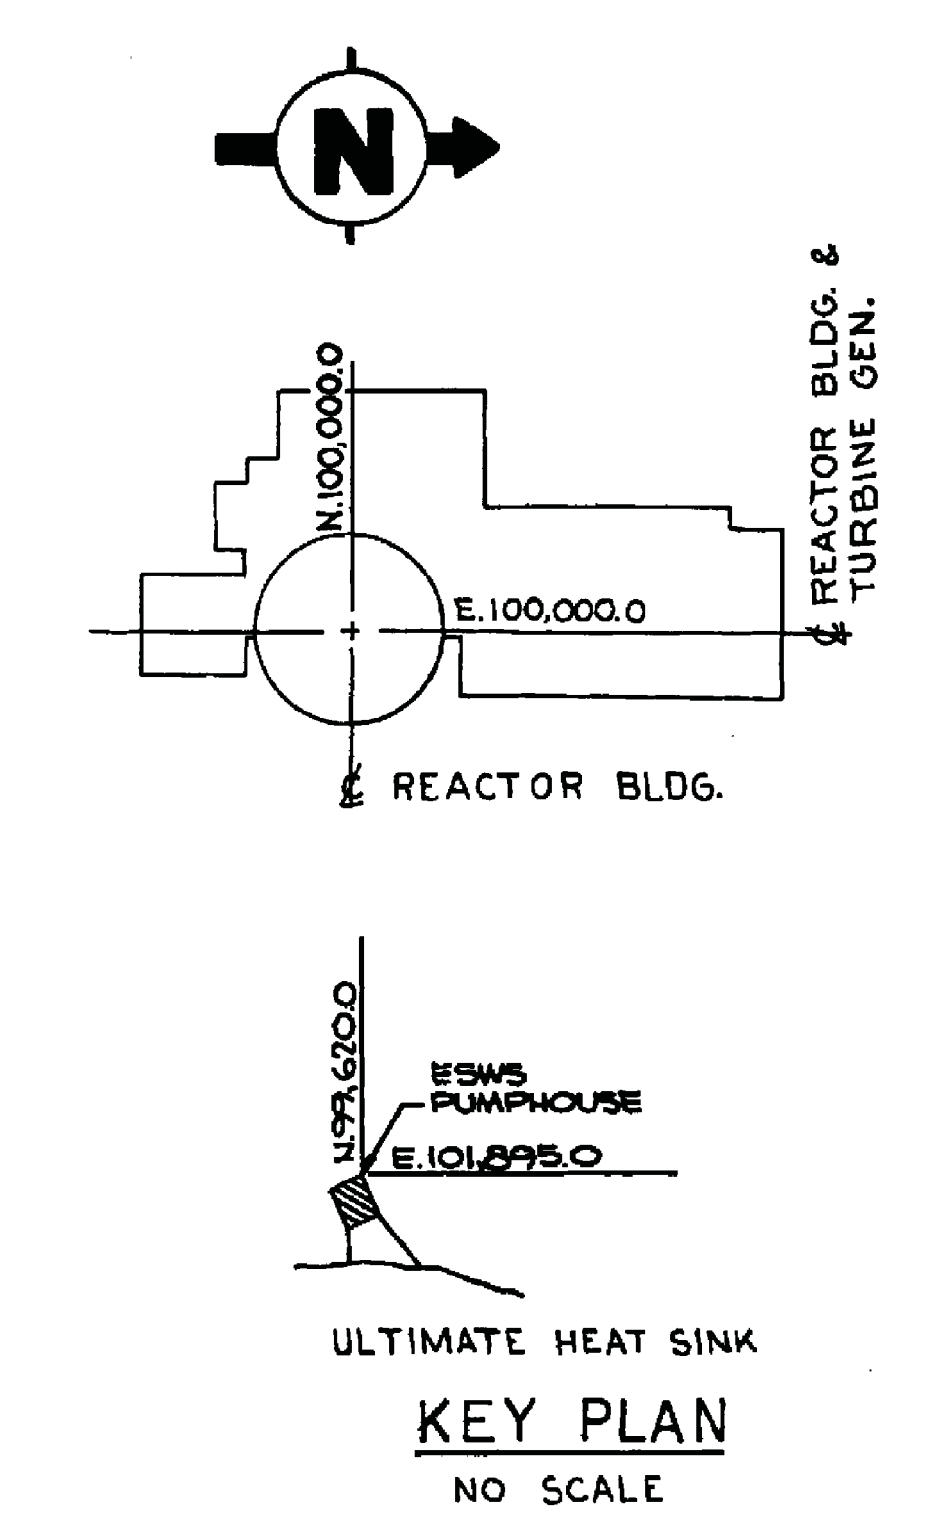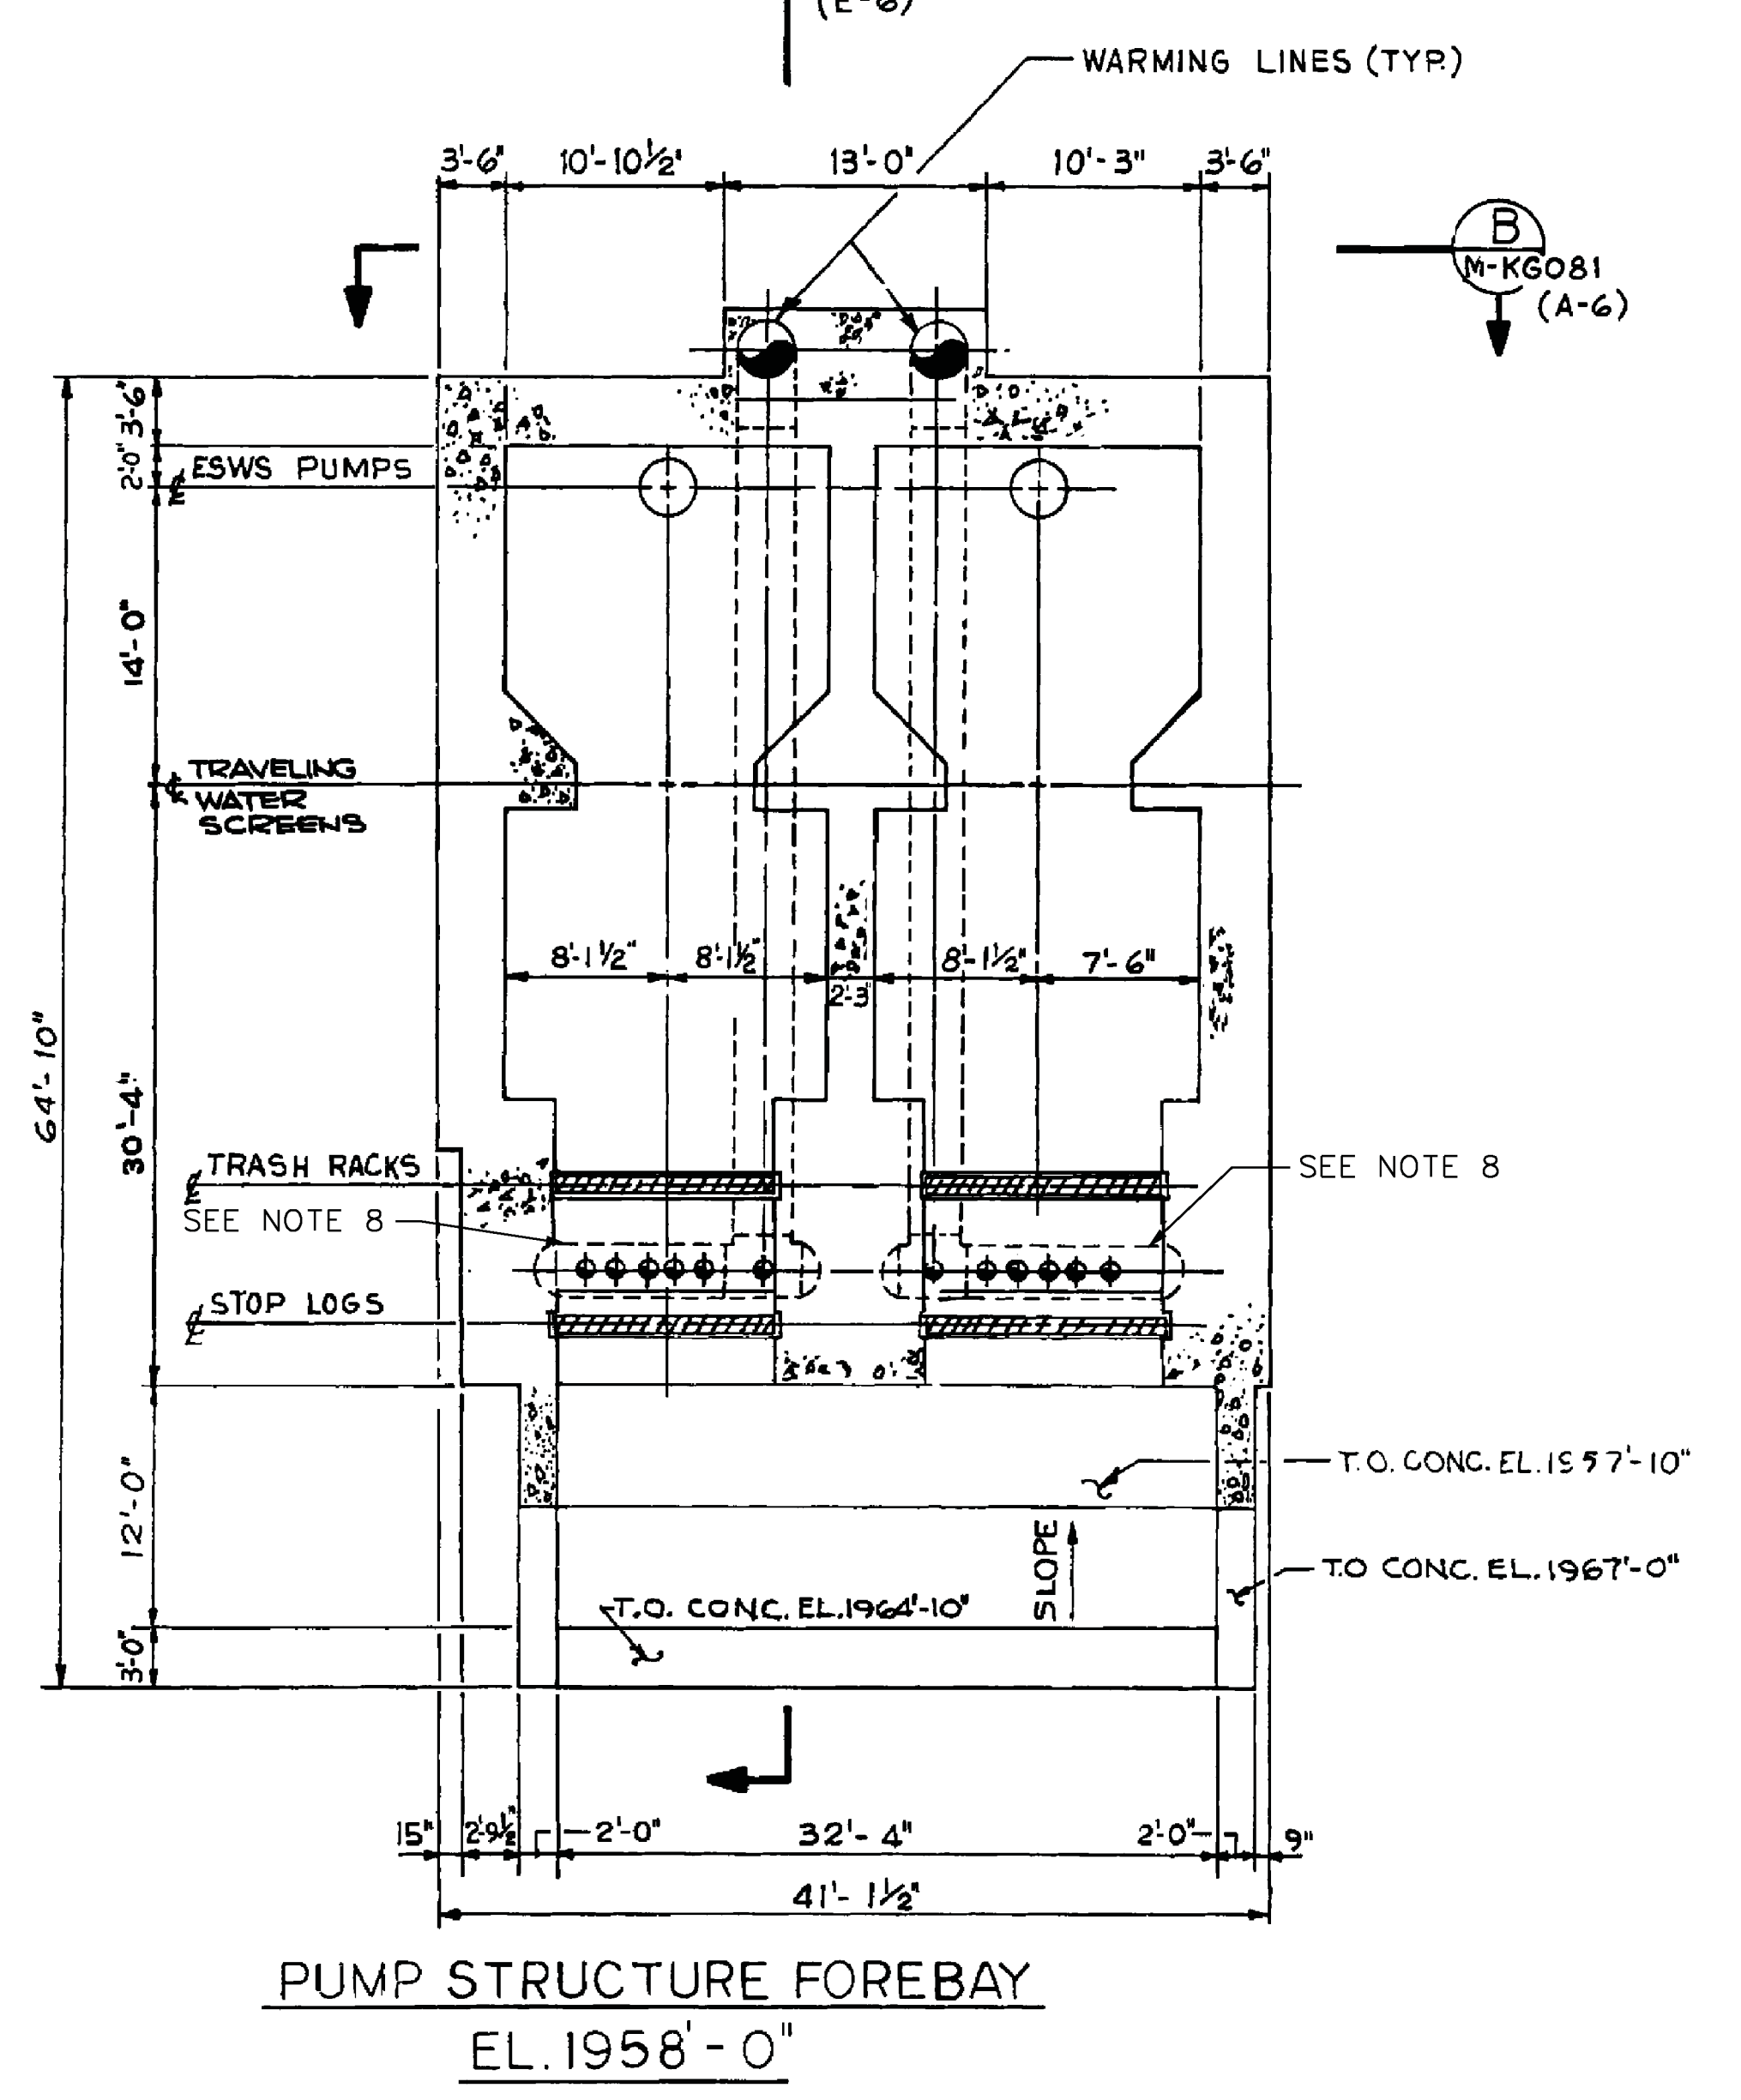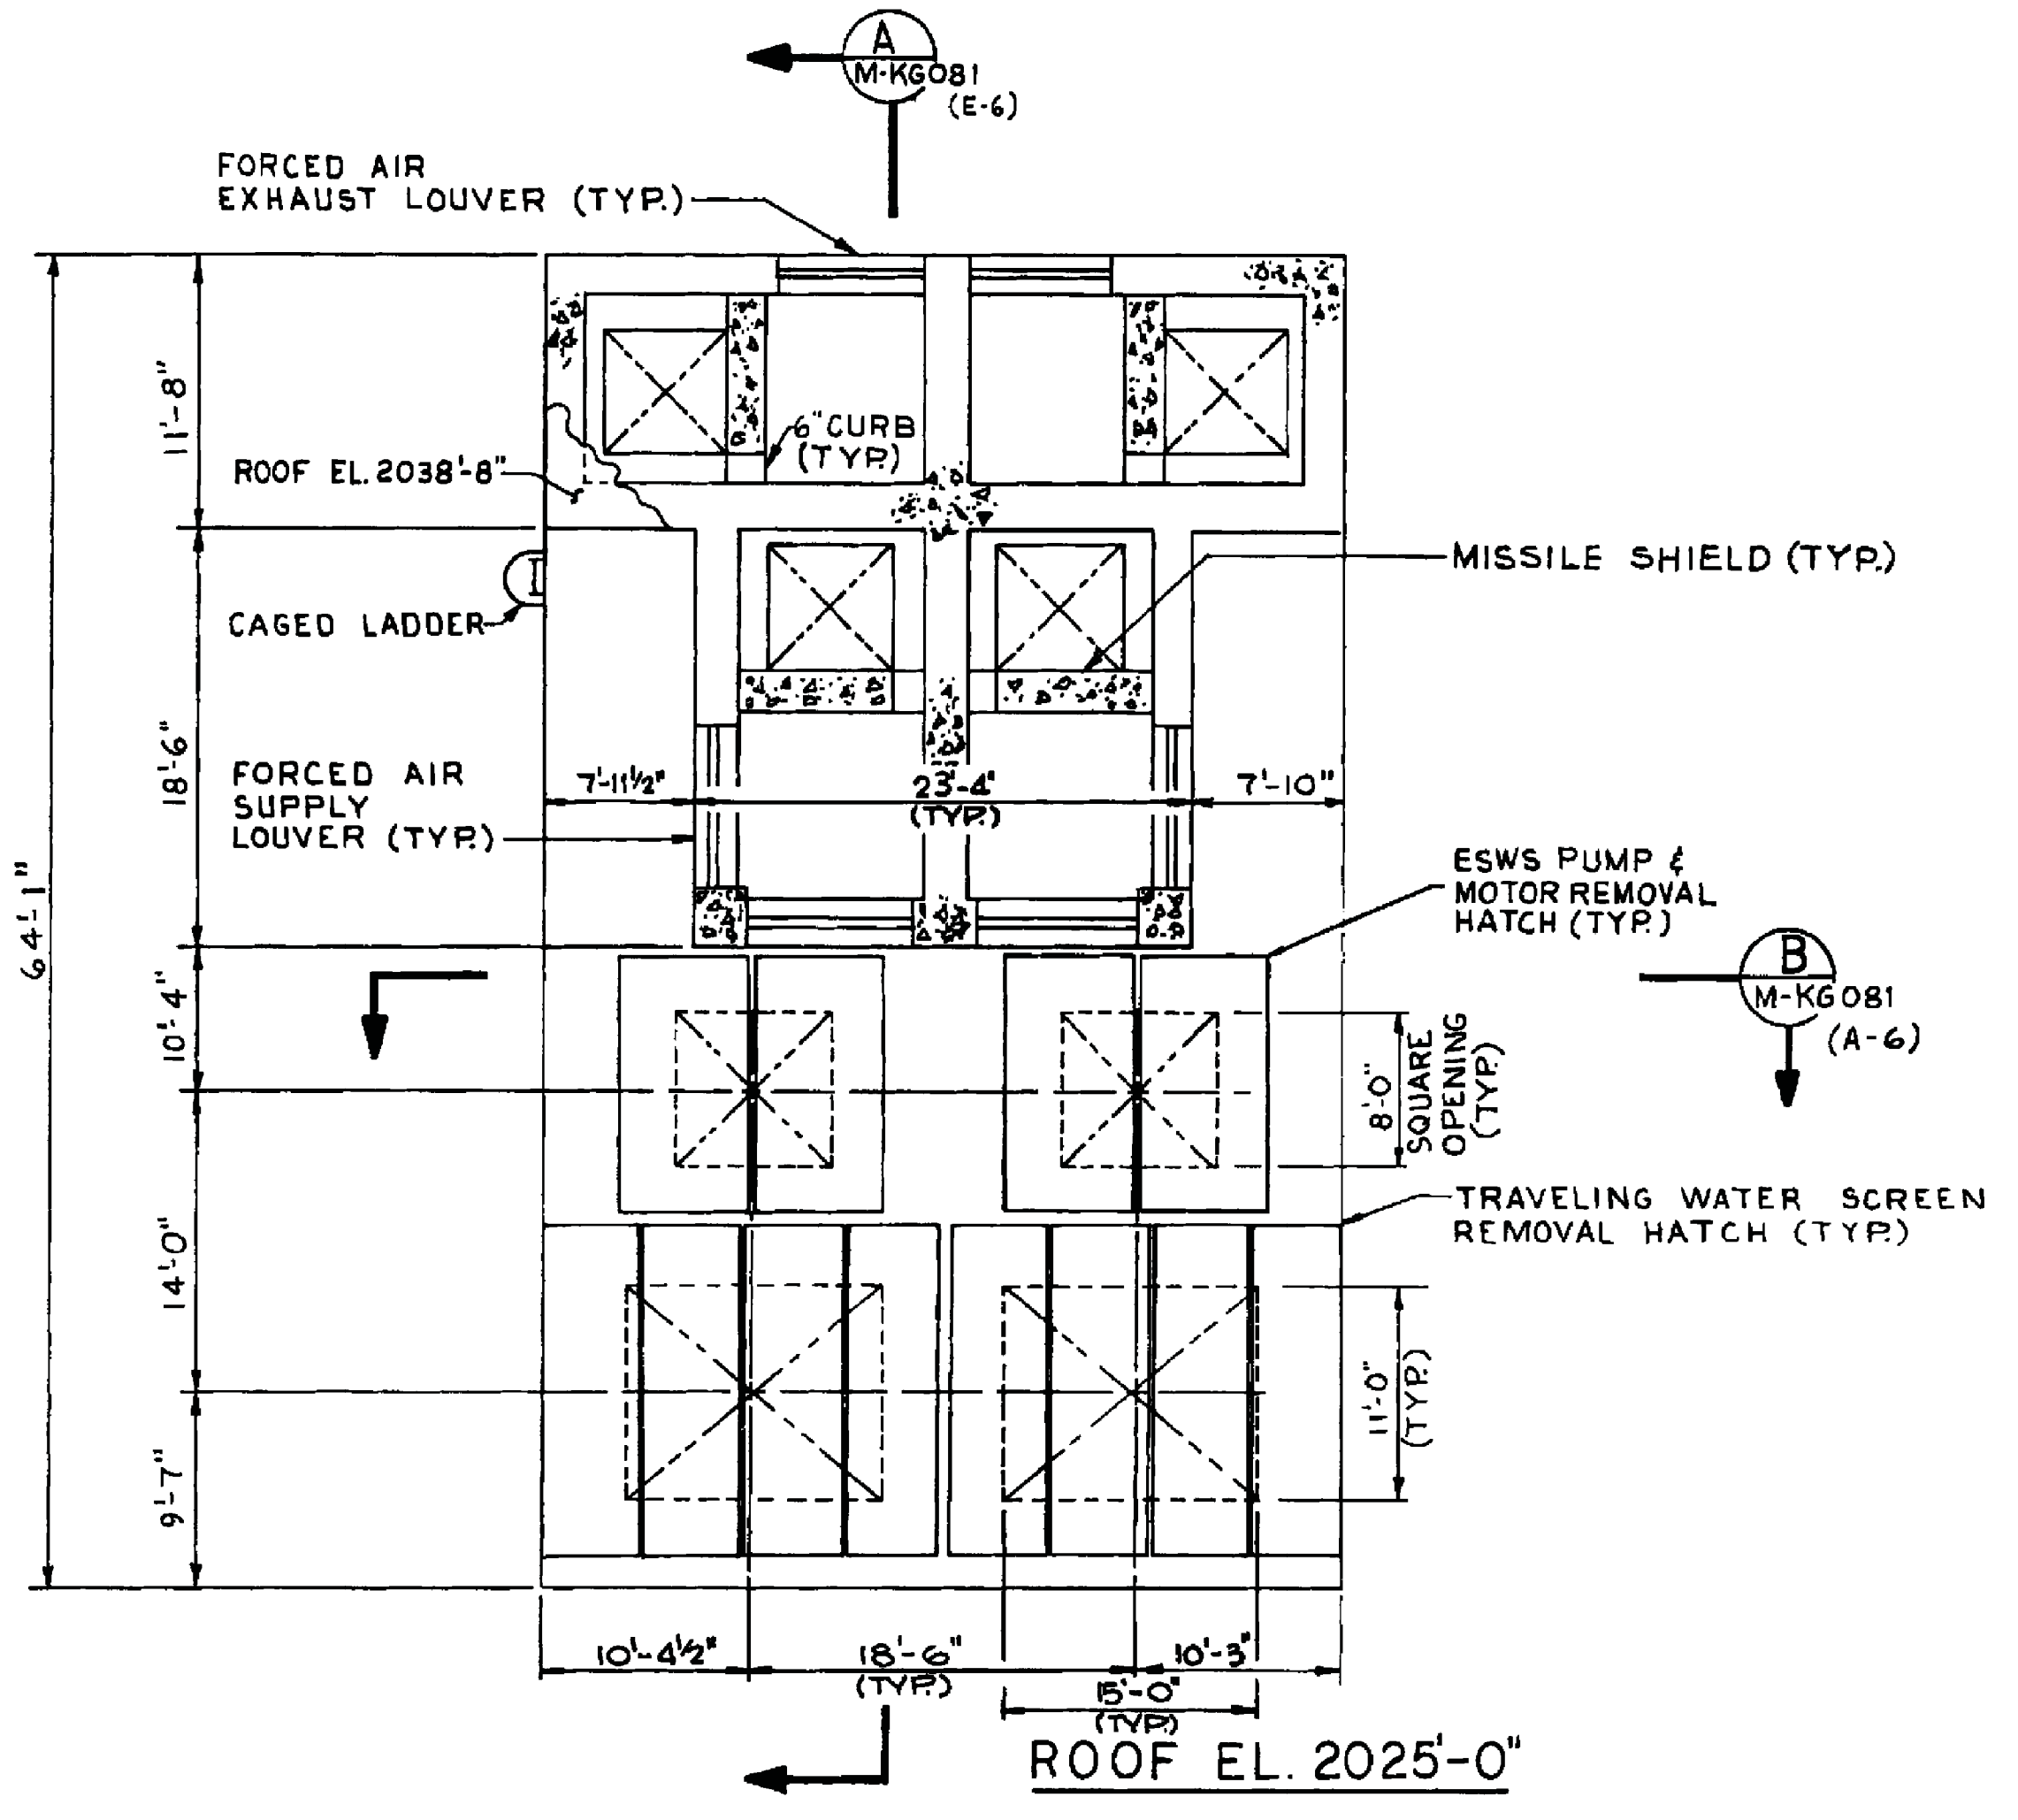


- NOTES:**
- DELETED.
 - SNUPPS STANDARD PLANT FLOOR ELEVATION OF 2000'-0" CORRESPONDS TO WOLF CREEK SITE ELEVATION OF 1100'-0".
 - PORTABLE EYE WASH & BODY SPRAY SHALL BE "HAWKS", MODEL 7601.37 OR EQUAL.
 - THE LADDERS CAN BE LEFT IN-PLACE OR REMOVED.
 - FOR SUPPORT DETAILS SEE WCNOCD DRAWING C-KS305.
 - FOR THESE FLANGE LOCATIONS ONLY, THAT ARE IN LAKE WATER, USE STUD BOLTS TO ASME SA193 88M, WITH HEAVY HEX NUTS TO ASME SA194 GR. 8M.
 - THE FOLLOWING ORIFICE PLATES ARE CLASS 2 ITEMS:
FO-0025 FO-0031
FO-0026 FO-0032
FO-0027 FO-0033
FO-0028 FO-0034
FO-0029 FO-0035
 - ORIGINAL WARMING WATER LINES REMAIN IN SERVICE TO BE USED ONLY FOR CHEMICAL ADDITION TO THE PUMPHOUSE FOREBAY.

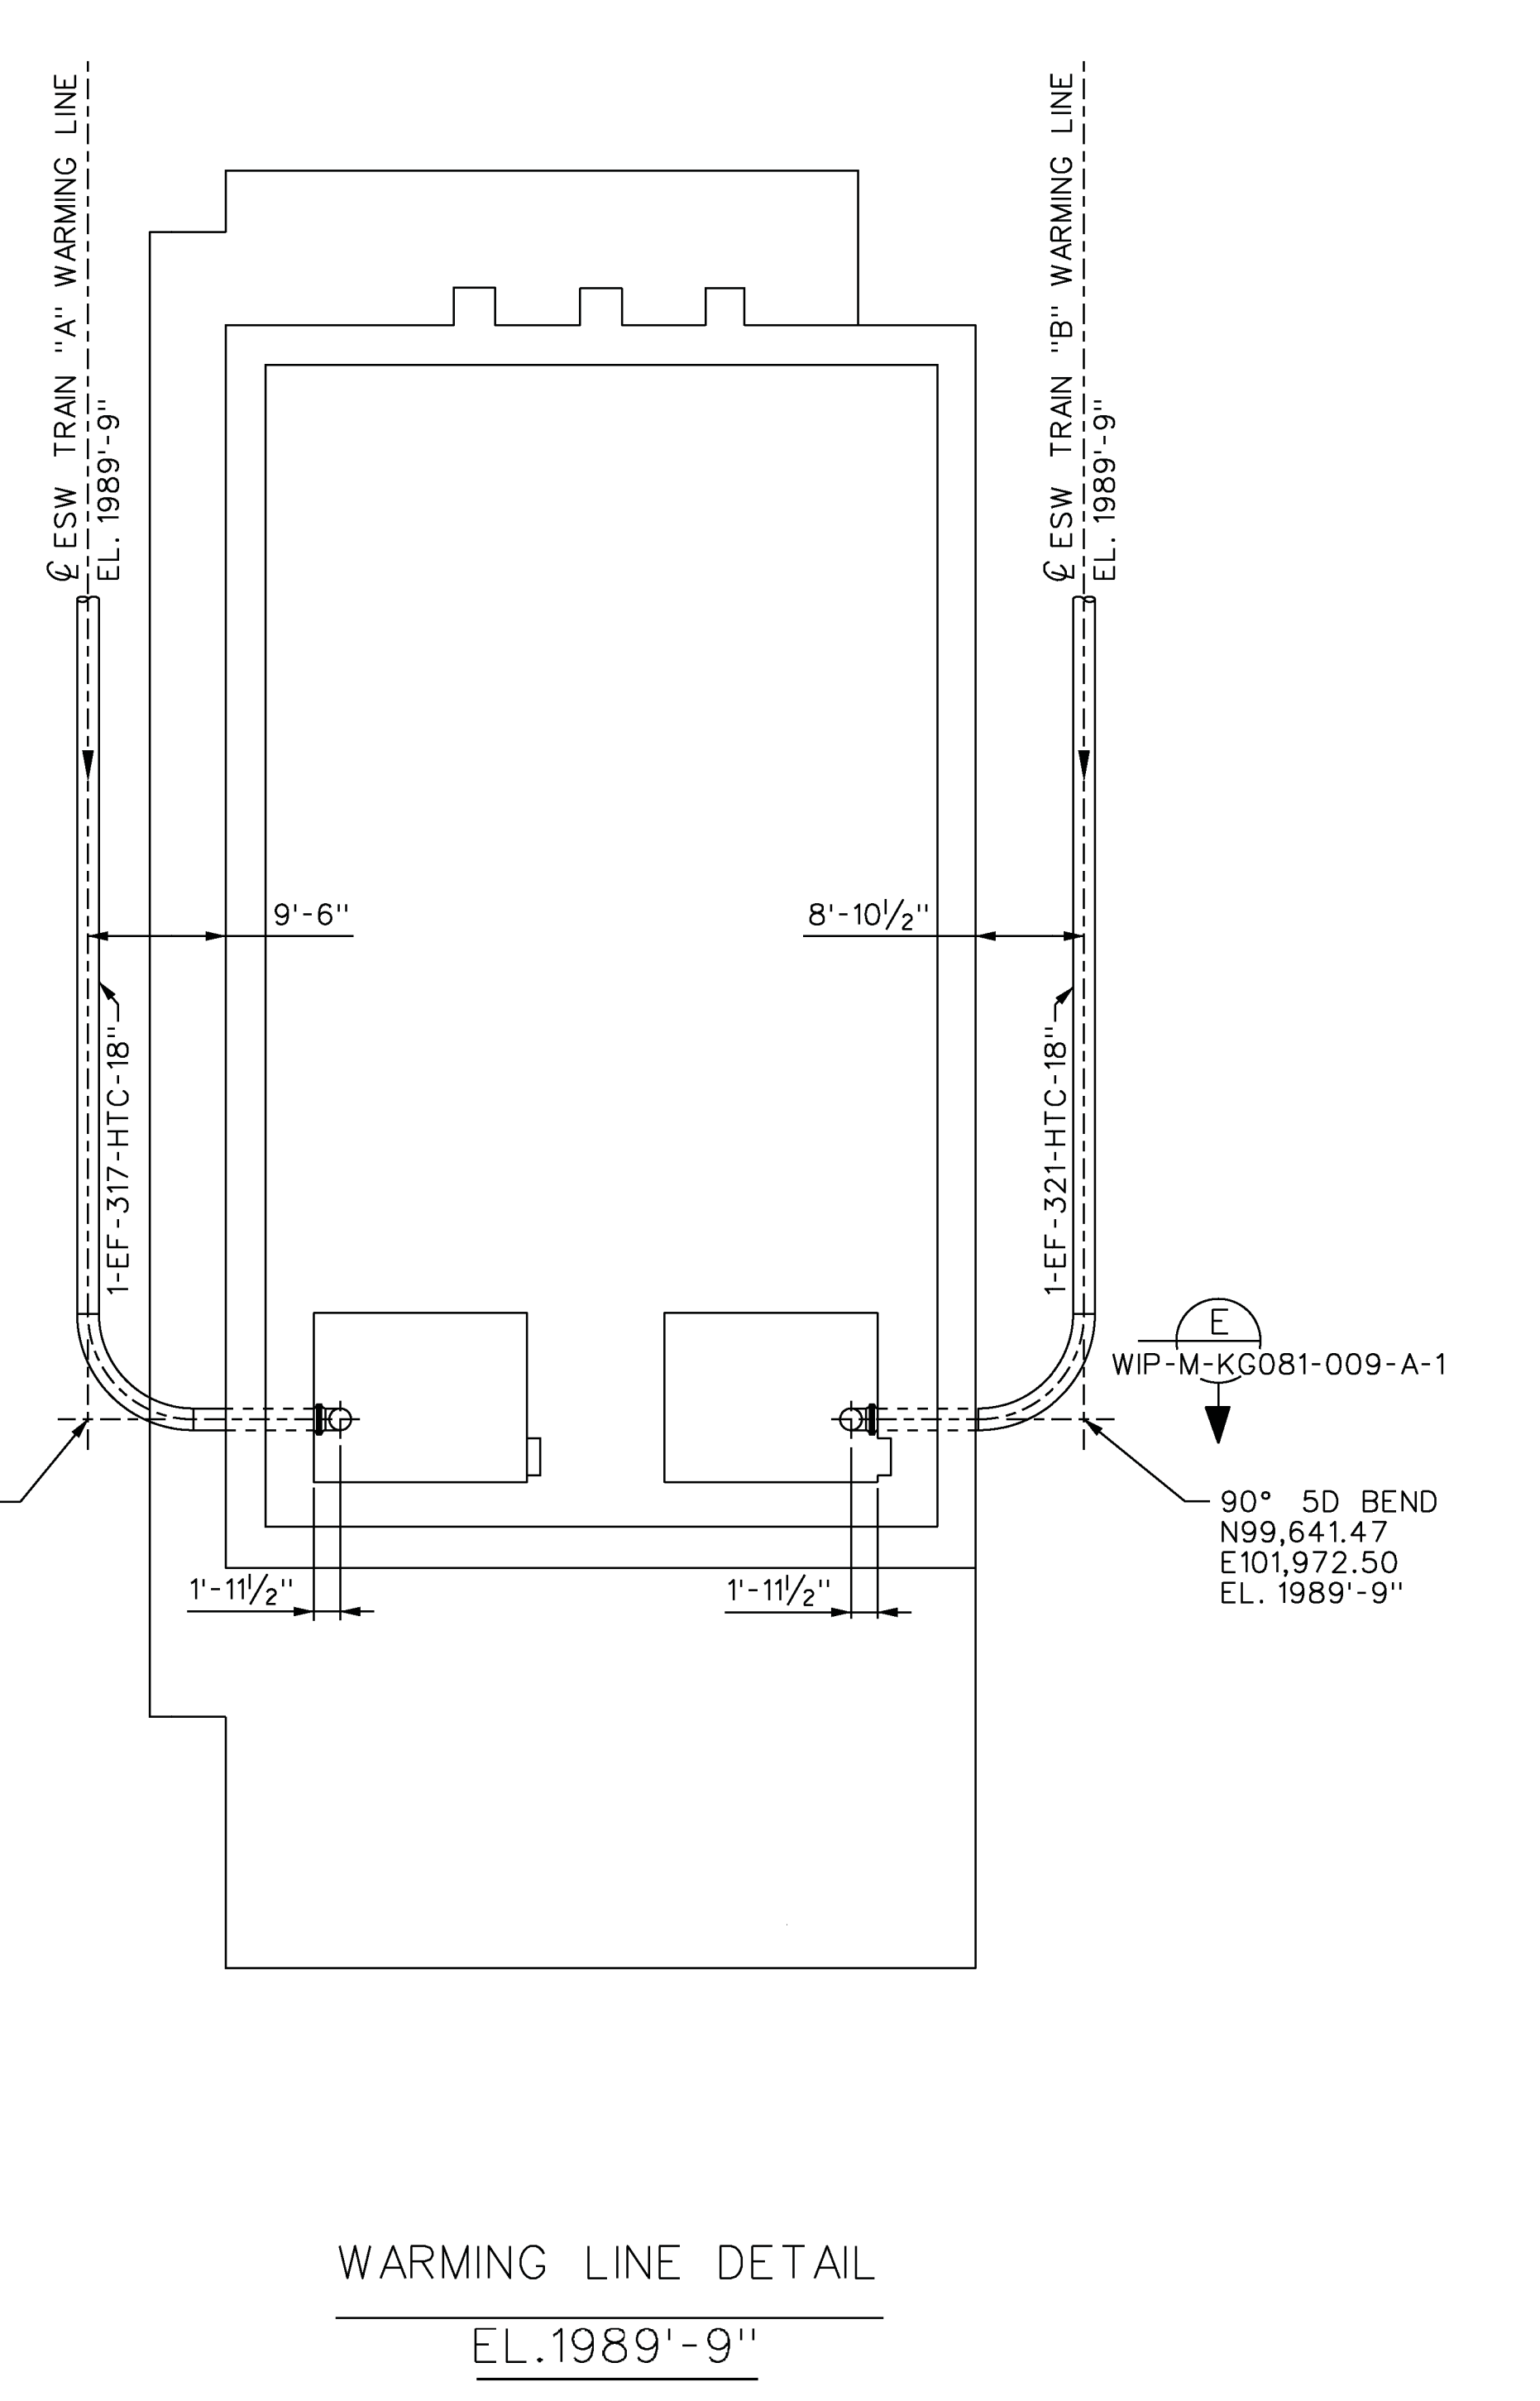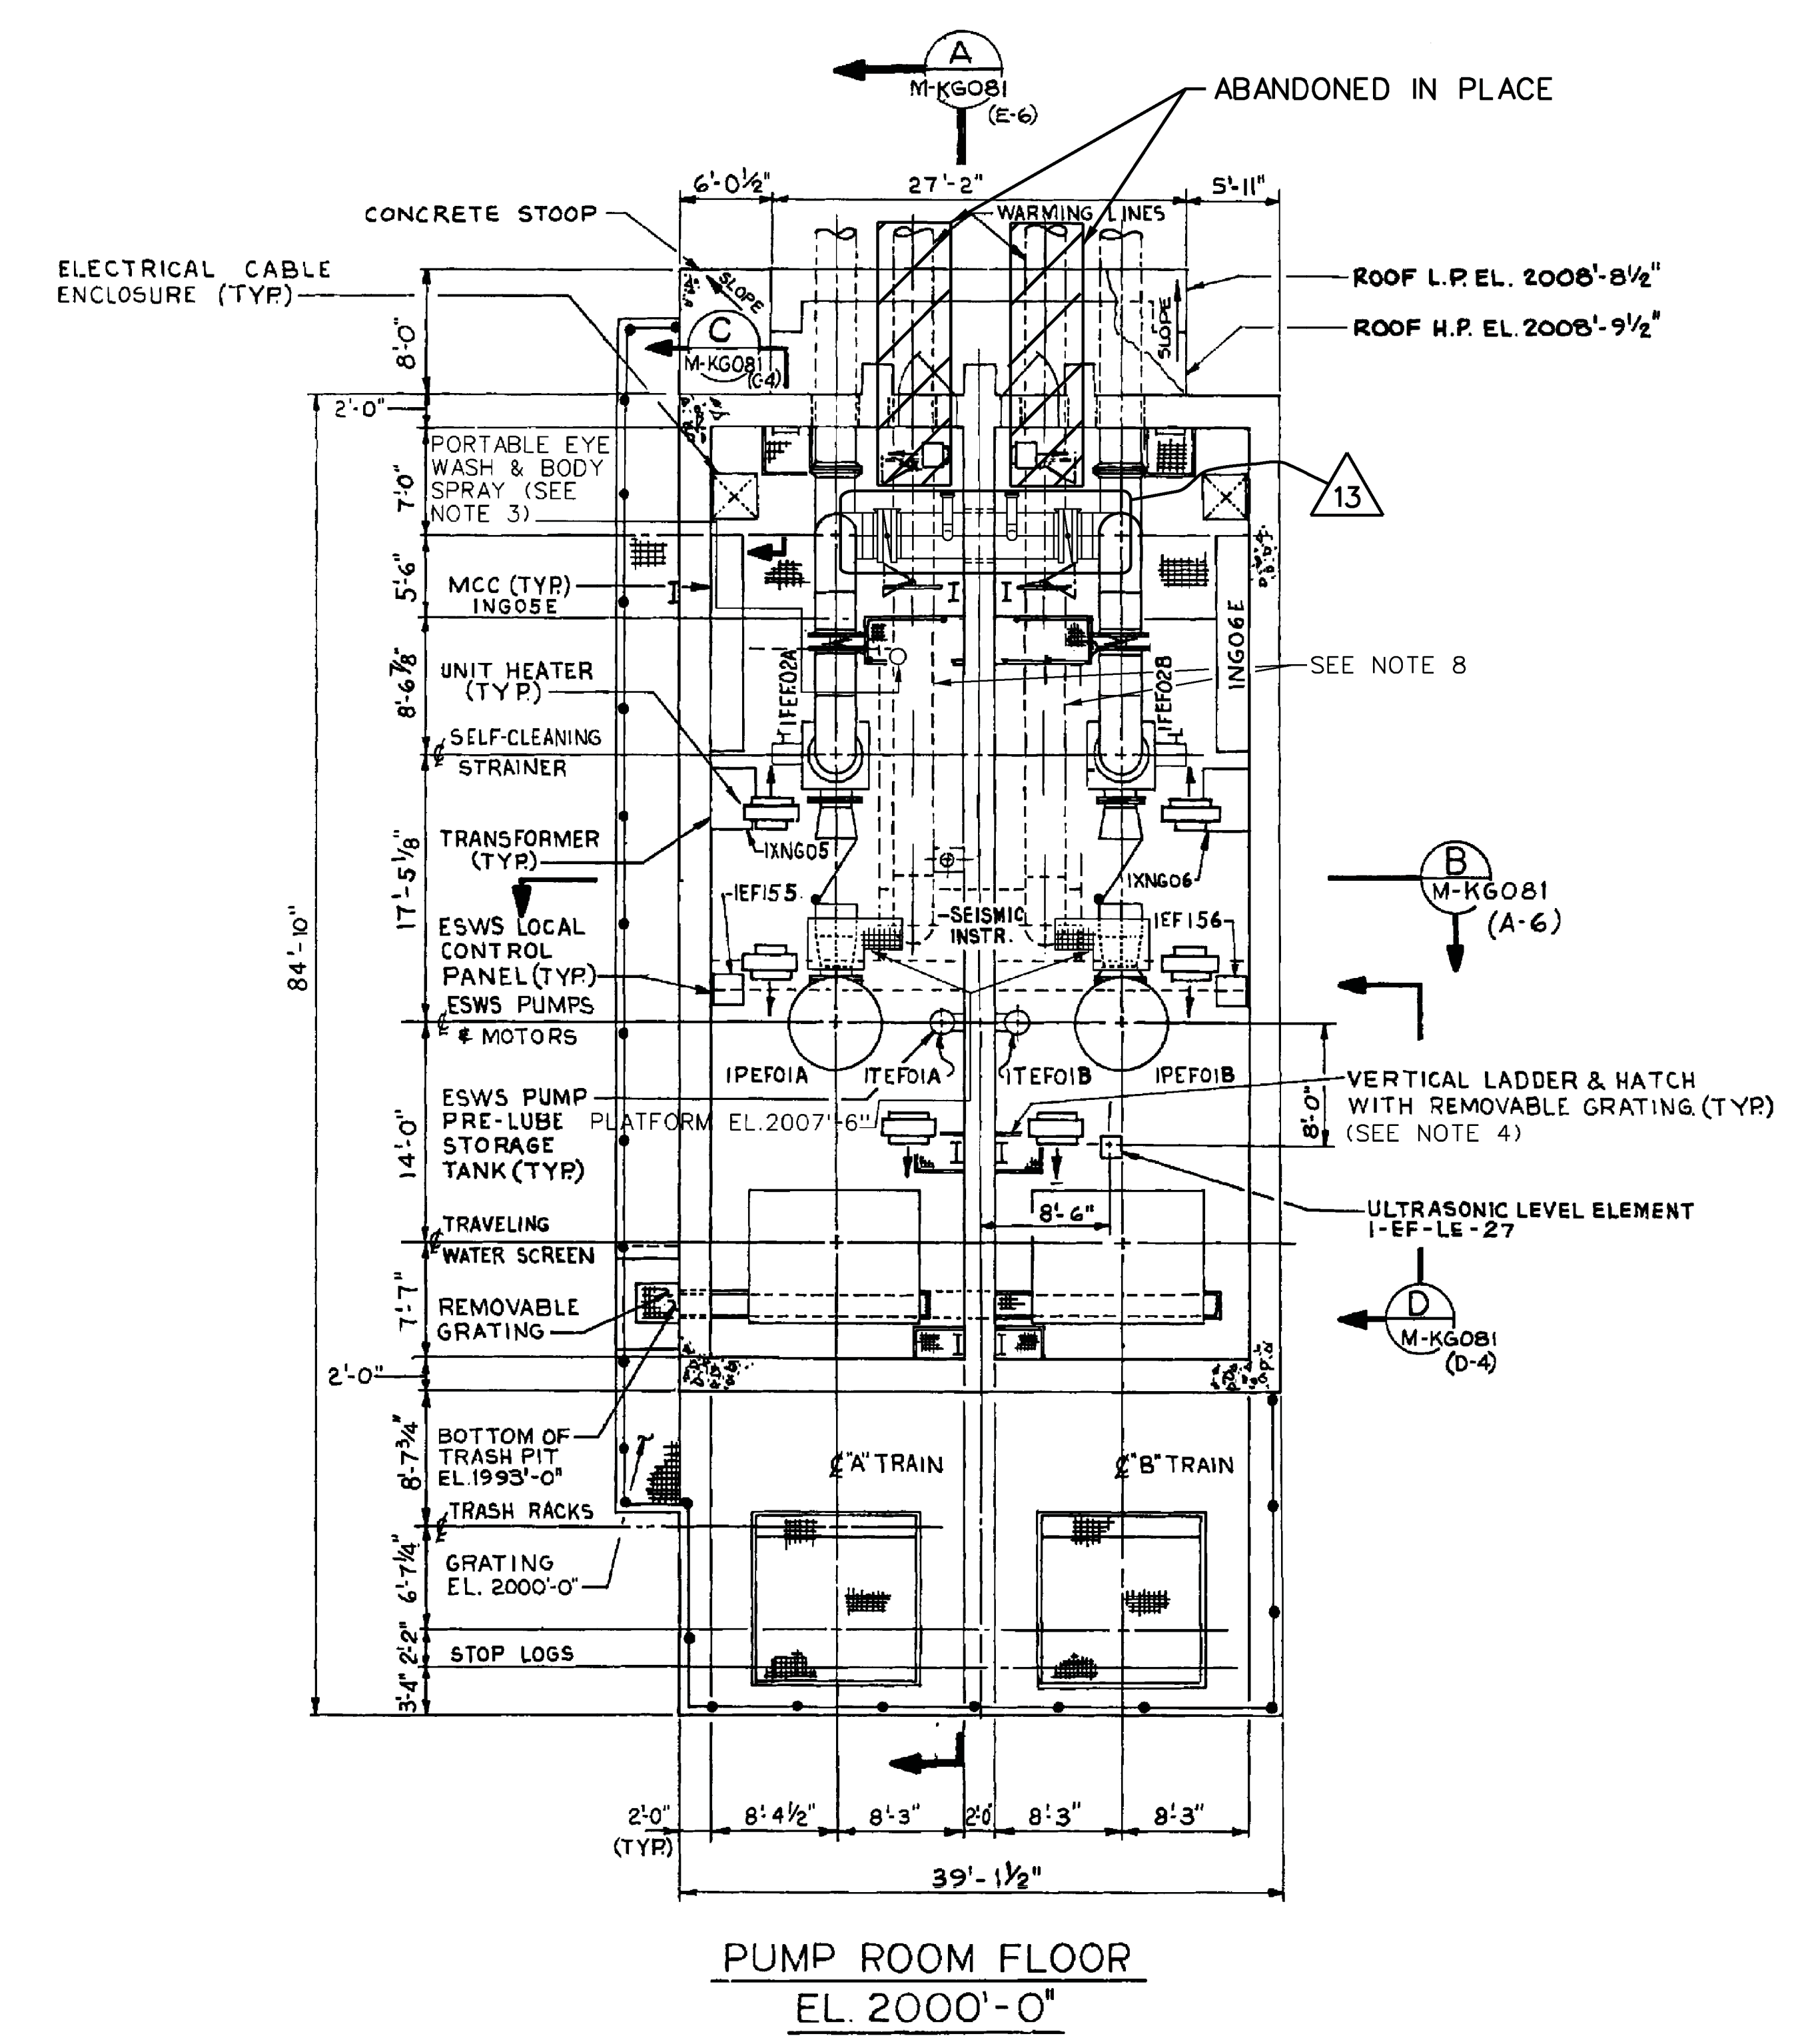


USAR FIG. 9.2-3

ESSENTIAL DRAWING			
REVISED	INCORPORATED	WIP-M-KG080-010-A-1	CHANGE 014425
ISSUED	ENG. DOC.		PWG. NO.
THIS ENG. SUPERSEDES		REV.	THIS ENG. SUPERSEDES
REVISION NOTES			
WOLF CREEK		ELECTRONIC APPROVAL	
ESSENTIAL SERVICE WATER SYSTEM PUMPHOUSE EQUIPMENT LOCATION PLAN			
SCALE	DRAWING NUMBER	SHEET	REV
NONE	M-KG080	13	13

Key E. Smith
Reviewed by: [Signature]
Date: [Date]
Drawn by: [Signature]

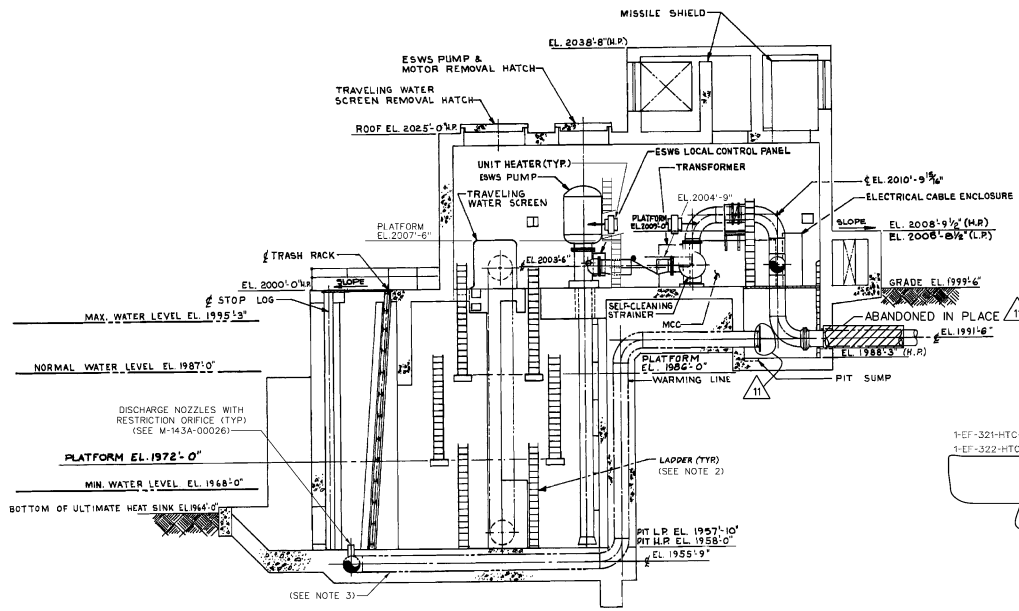


SECTION A
M-KG081
SEE DWG. M-KG080

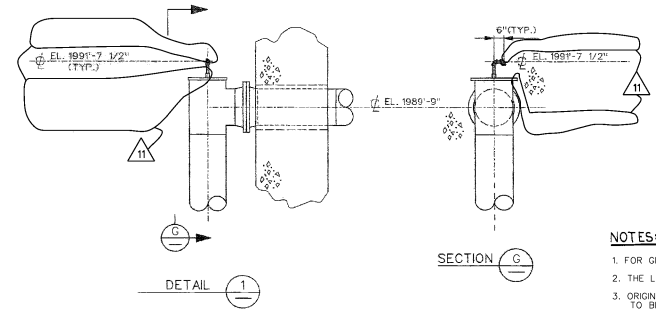


DETAIL 1


- NOTES:
1. FOR GENERAL NOTES SEE DWG. M-KG080.
 2. THE LADDERS CAN BE LEFT IN-PLACE OR REMOVED.
 3. ORIGINAL WARMING WATER LINES REMAIN IN SERVICE TO BE USED ONLY FOR CHEMICAL ADDITION TO THE PUMPHOUSE FOREBAY.

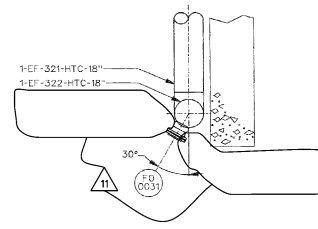


SECTION F

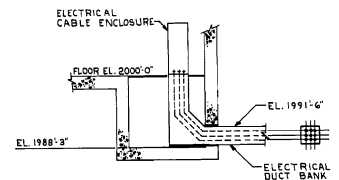


SECTION C
M-KG081
SEE DWG. M-KG080

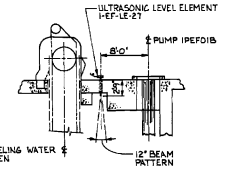

SECTION D
M-KG081
SEE DWG. M-KG080

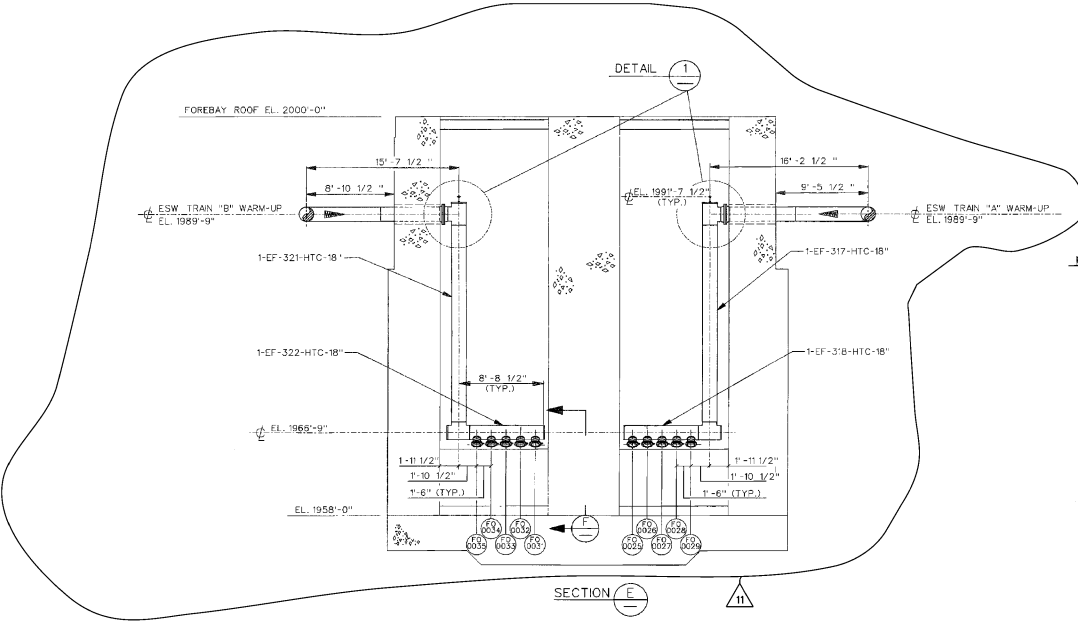

SECTION E

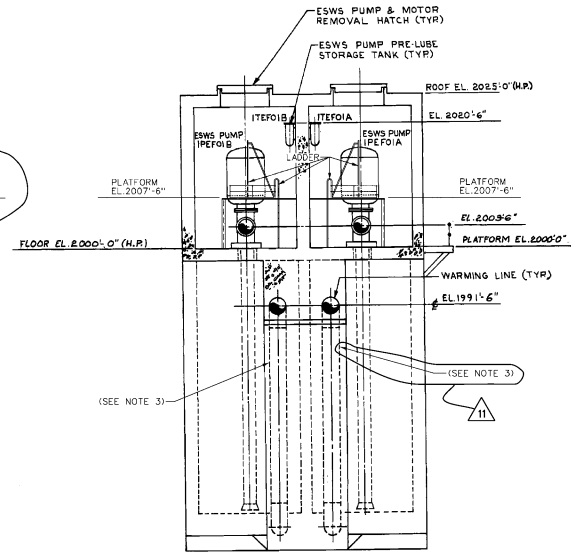

SECTION B
M-KG081
SEE DWG. M-KG080


USAR FIG. 9.2-4

ESSENTIAL DRAWING			
REVISED	INCORPORATED	DATE	BY
THIS Dwg. SUPPERS BY		REV.	THIS Dwg. SUPPERS BY
WOLF CREEK		ELECTRONIC APPROVAL	
ESSENTIAL SERVICE WATER SYSTEM			
PUMPHOUSE			
EQUIPMENT LOCATION-SECTIONS			
SCALE	DRAWING NUMBER	SHEET	REV.
1/8" = 1'-0"	M-KG081	11	

RAW WATER PUMPS
1WM001 PA & 1WM001 PB
A-3826

GENERAL NOTES

- FOR PIPING AND VALVES MARKED SKID MOUNTED OR COMPONENTS DRAWN WITH DASHED LINES ARE FURNISHED PRE-ASSEMBLED. OTHER PIPING OR VALVES MARKED * ARE FURNISHED BY A-3817 AND INSTALLED BY A-3838.
- INDICATES "HEAT" TRACED PIPING
- VALVES MARKED ** ARE FURNISHED BY A-3817.
- VALVES FURNISHED BY A-3817 ARE NOT IDENTIFIED WITH S & L VALVE NUMBERS
E. G. [1WM0001A]; HOWEVER, VENDOR NUMBERS ARE INDICATED WHERE IDENTIFIED ON A-3817 VENDOR DRAWINGS. S & L VALVE NOS. IDENTIFY VALVES BY A-3815 UNLESS OTHERWISE NOTED.
- THIS P & ID SHOWS GENERAL CONFIGURATION OF COMPONENTS FOR SKID MOUNTED PRE-ASSEMBLED EQUIPMENT AS AN AID FOR IDENTIFICATION ONLY. REFER TO VENDOR DRAWINGS AND/OR INSTRUCTION MANUALS PROVIDED BY A-3817 CONTRACTOR FOR DETAILED DESCRIPTION.
- ELECTRICAL CONNECTIONS ARE MADE FROM PANEL 1PL12J TO ALL SKID MOUNTED EQUIPT. HAND SWITCHES ARE PROVIDED ON 1PL12J FOR ALL SOLENOID VALVES CONTROLLING AIR-OPERATED PROCESS VALVES. SEE A-3817 PANEL 1PL12J VENDOR DRAWING FOR APPLICABLE CONTROL SWITCH.
- WHERE ELECTRICAL LINES ARE SHOWN (I. E., - - - -) TERMINATION IS AT PANEL 1PL12J, UNLESS OTHERWISE NOTED.

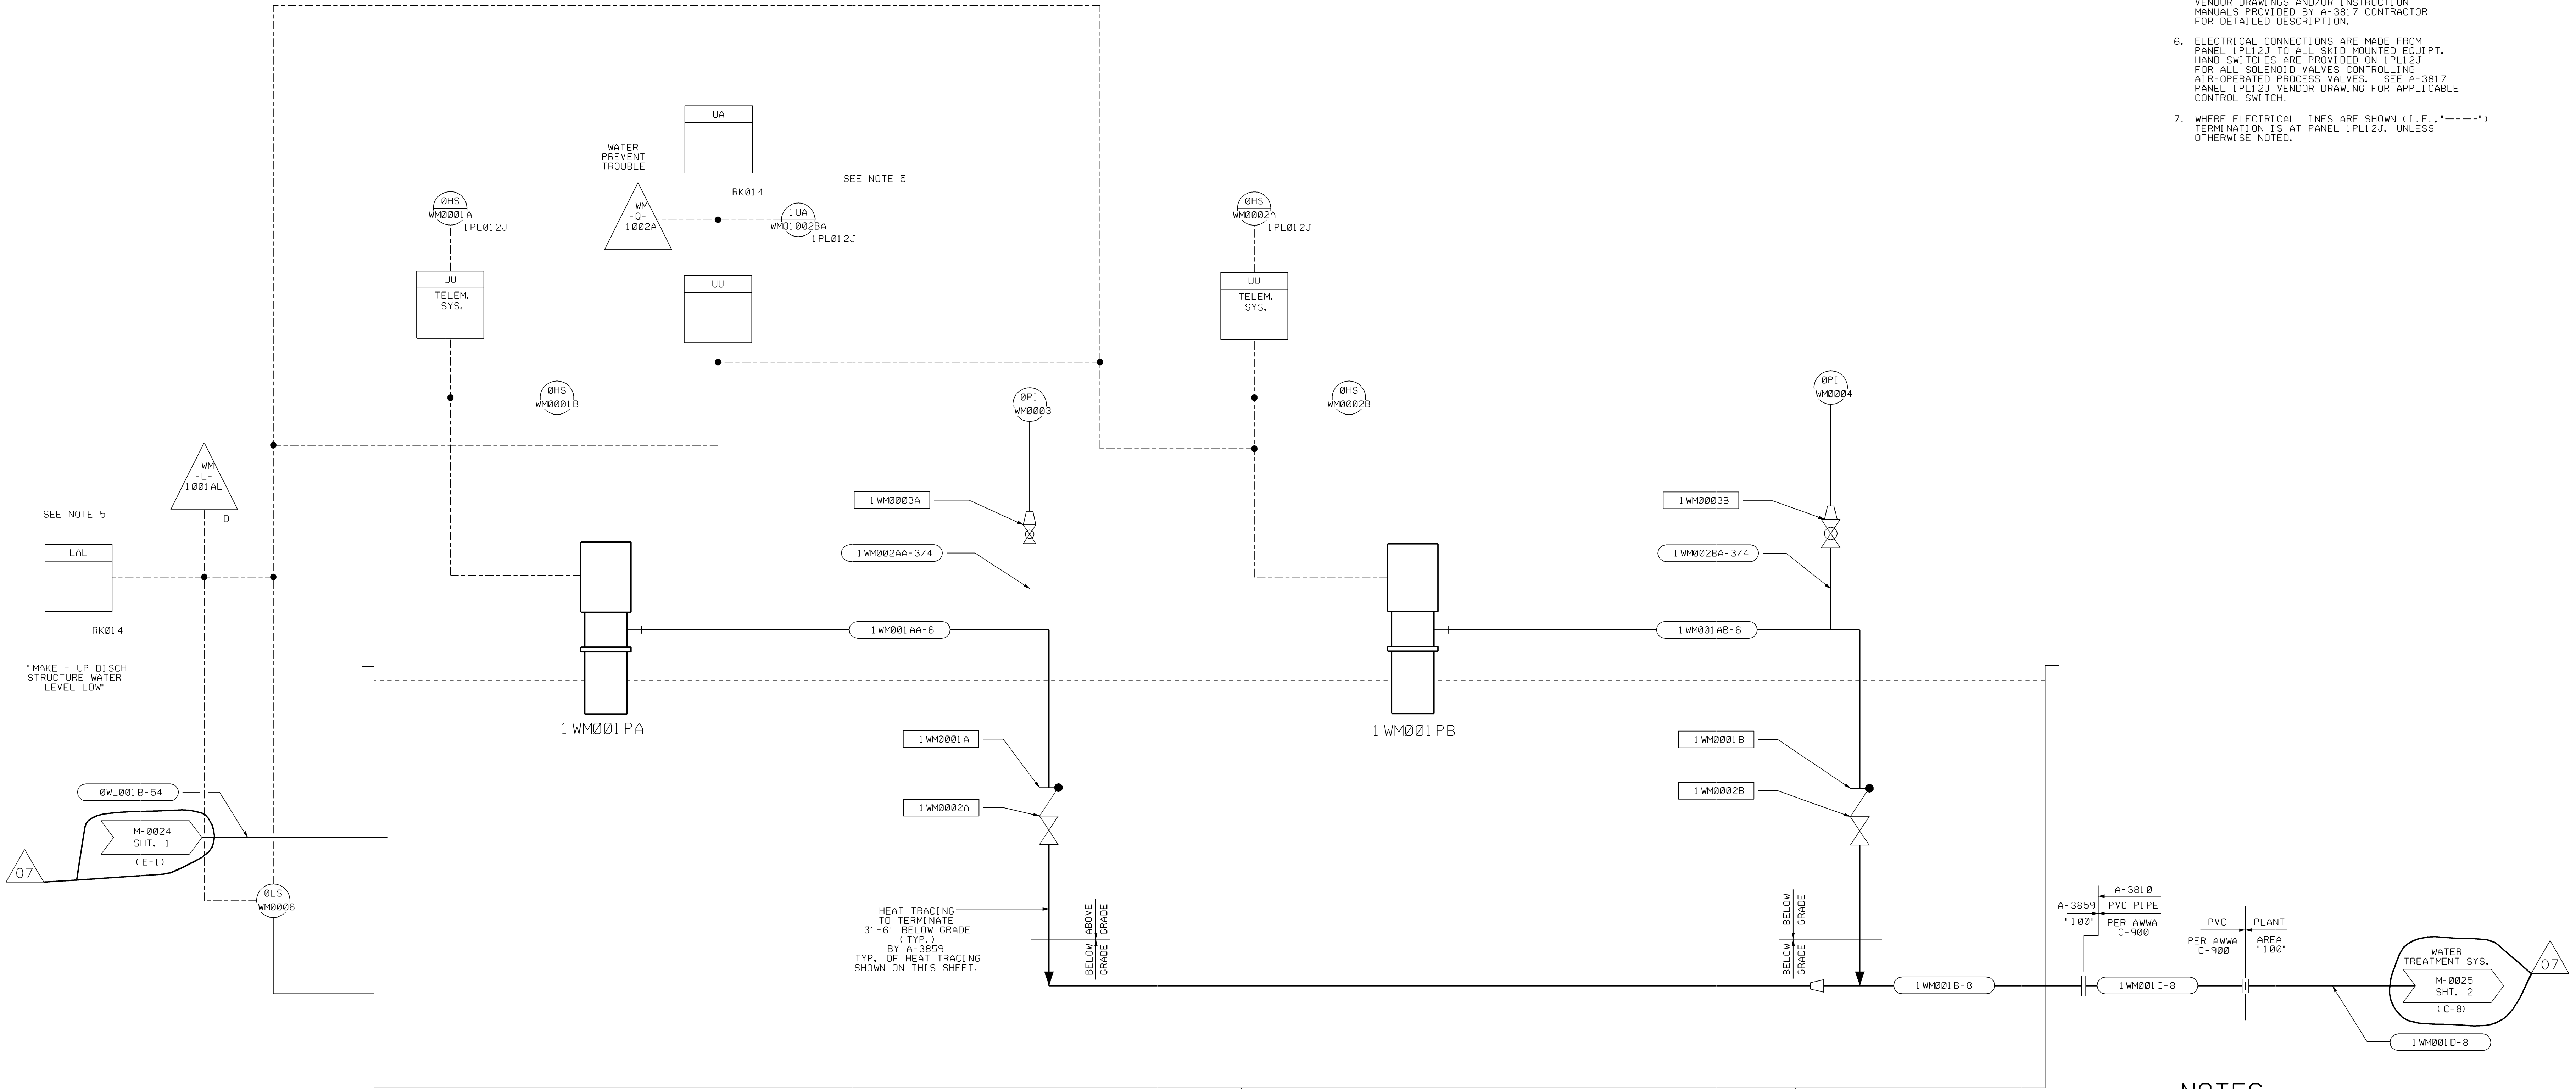


NOTES (THIS SHEET)

- SPECIFICATION A-3859 TO FURNISH ALL CHECK, GLOBE & GATE VALVES ON THIS SHEET.
- MUDS INSTRUMENTATION TO BE PURCHASED UNDER SPECIFICATION A-3859.
- PRESSURE INDICATION AND RAW WATER PUMP CONTROL TO BE PROVIDED ON WATER TREATMENT SYSTEM CONTROL PANEL 1PL12J LOCATED IN SHOP BUILDING.
- MOTOR PROTECTIVE TRIPS ALARMED ON 1PL12J. SEE DWG. M-0255.
- UA ALARMS AND COMPUTER INPUT WM-0-1002A ARE ALSO INITIATED BY ANY ALARM AT WATER TREATMENT PANEL 1PL12J.

USAR FIG. 9, 2-5-01

ESSENTIAL DRAWING			
① REVISED	INCORPORATED	CHANGE	PKG. NO.
○ ISSUED	CHG. DOC.		
THIS DWG. SUPERSEDES BY		REL.	THIS DWG. SUPERSEDES REL.
REVISION NOTES: REVISED PER AP 05-010, SECTION 6.10, TABLE A, TYPE 2			
WOLF CREEK		ELECTRONIC APPROVAL	
NUCLEAR OPERATING CORPORATION			
P&ID MAKEUP DEMINERALIZER SYSTEM WOLF CREEK GENERATING STA. UNIT 1			
SCALE	DRAWING NUMBER	SHEET	REV
NONE	M-0025	1	07

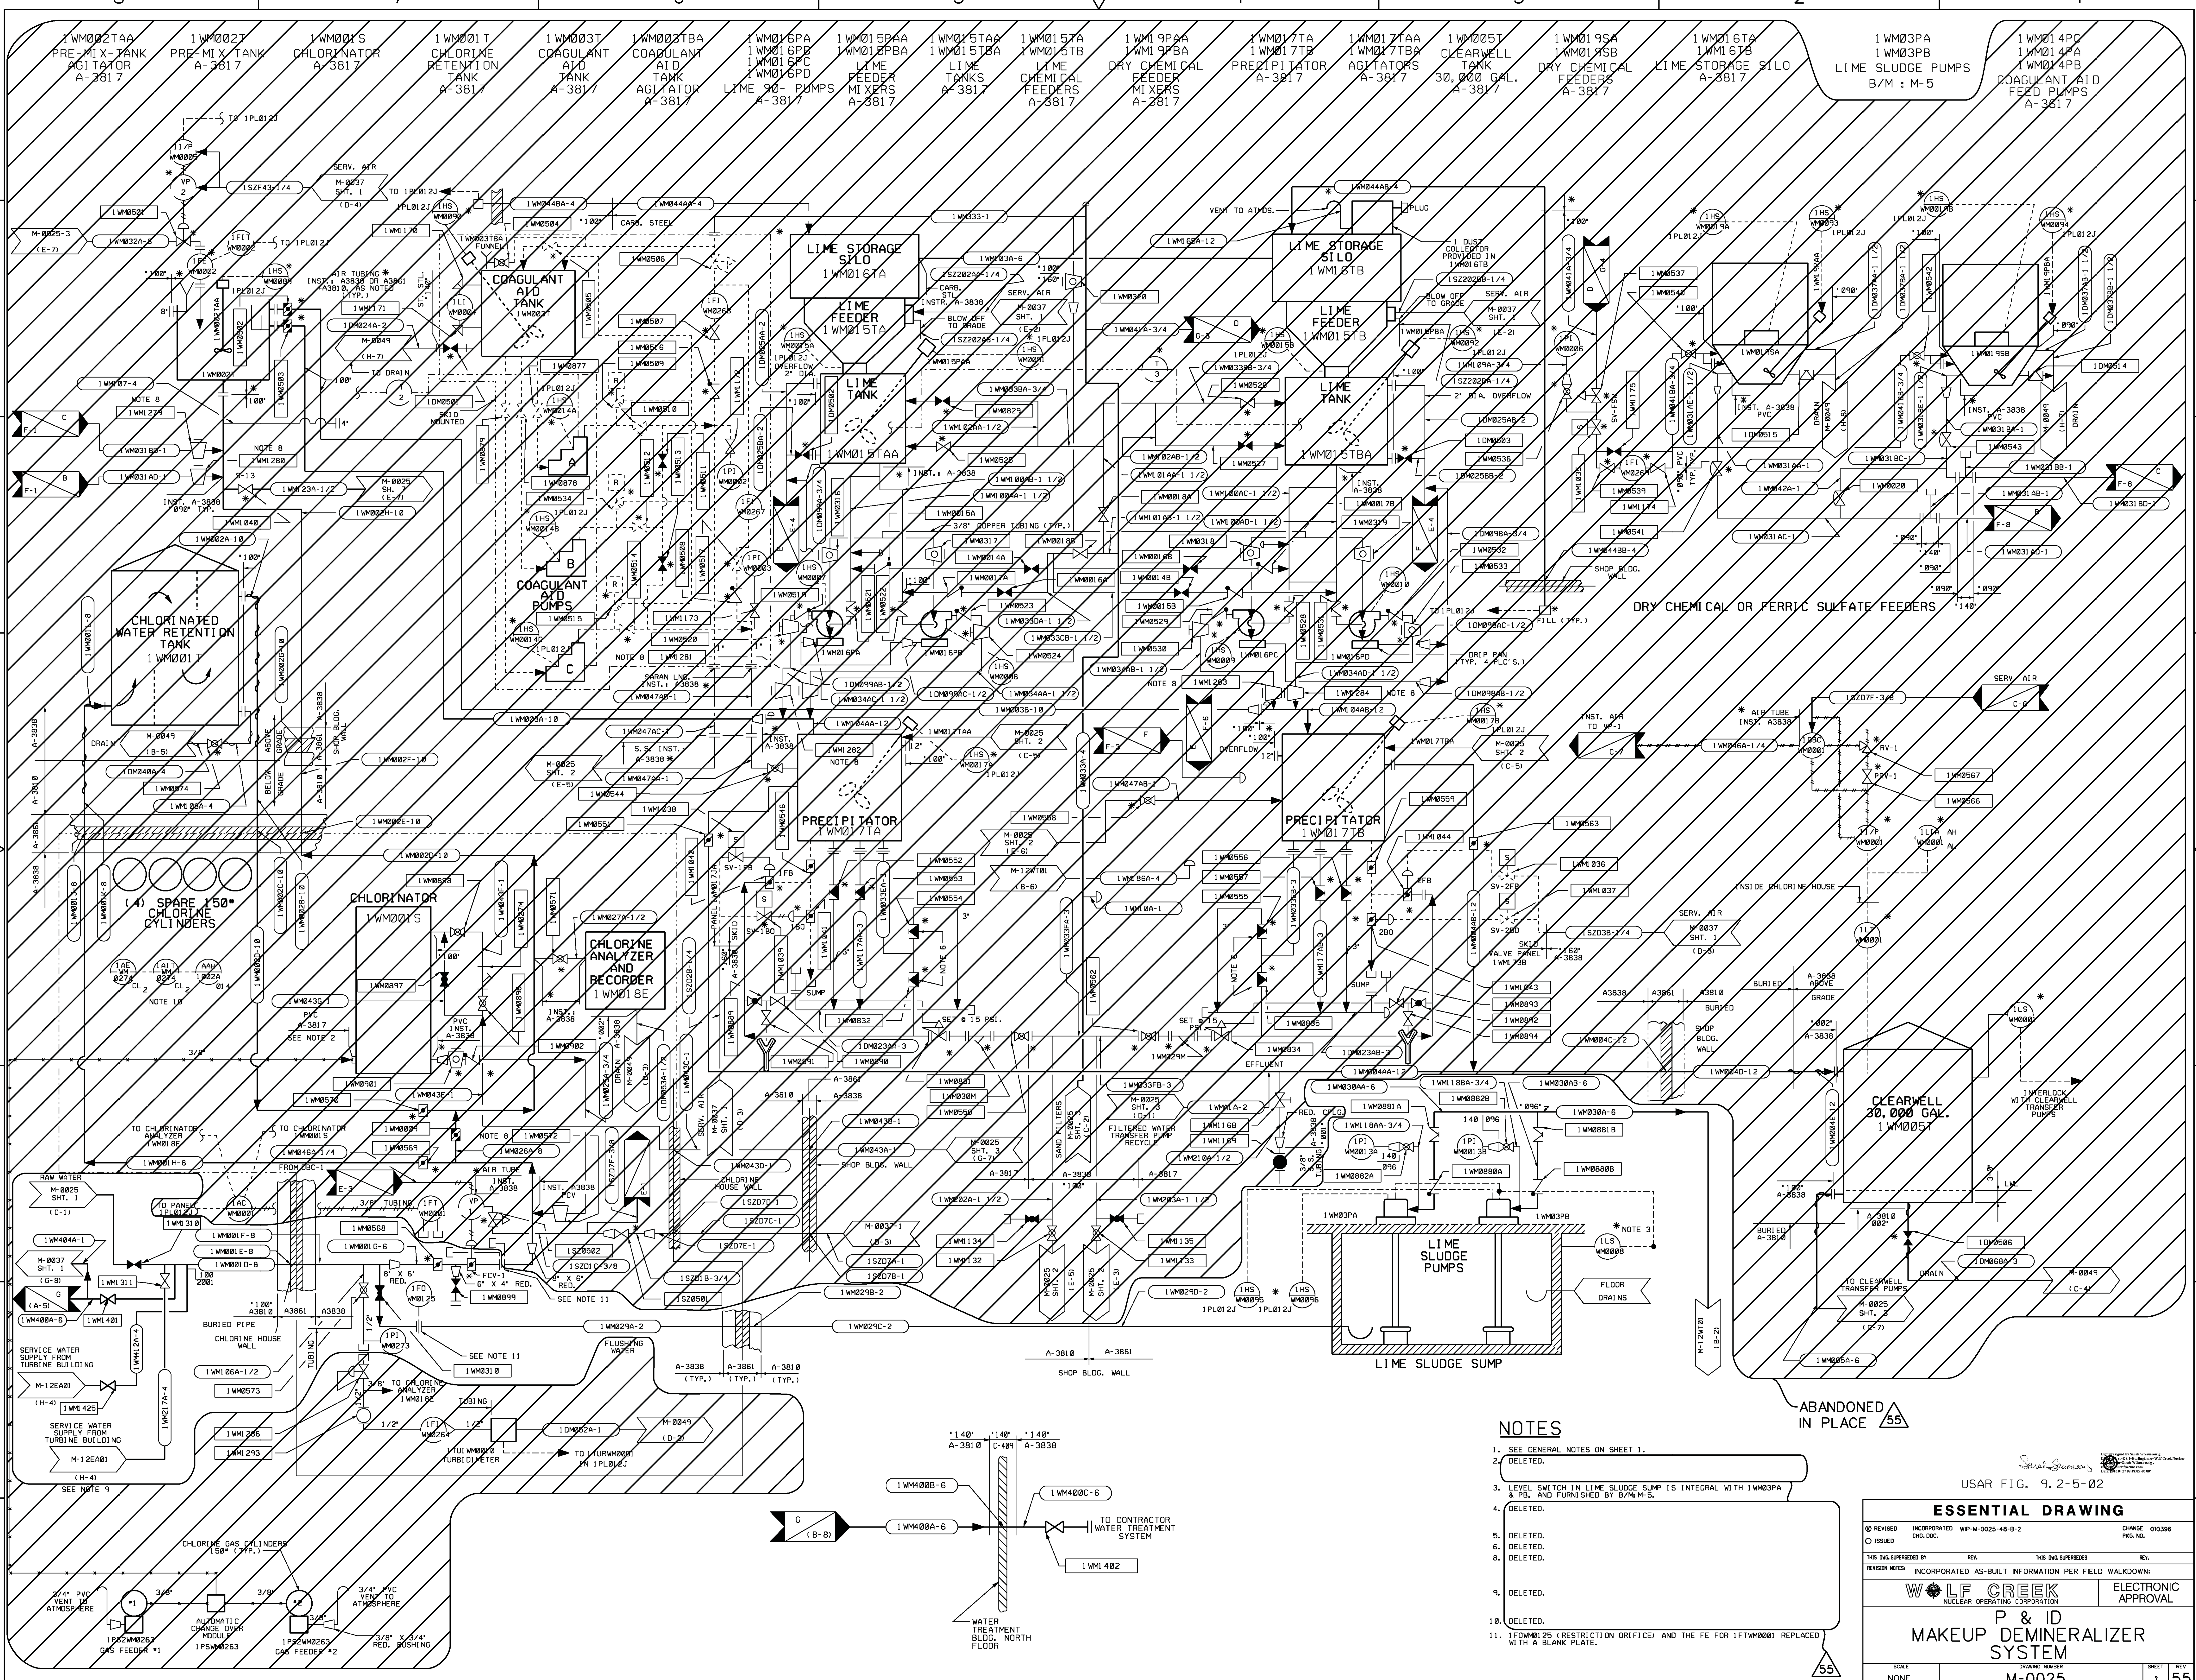

NOTES


1. SEE GENERAL NOTES ON SHEET 1.
2. DELETED.
3. LEVEL SWITCH IN LIME SLUDGE SUMP IS INTEGRAL WITH 1WM03PA & P&ID AND FURNISHED BY B/M-M-5.
4. DELETED.
5. DELETED.
6. DELETED.
7. DELETED.
8. DELETED.
9. DELETED.
10. DELETED.
11. 1FWM025 (RESTRICTION DRIFTE) AND THE FE FOR 1FWM001 REPLACED WITH A BLANK PLATE.

ABANDONED IN PLACE 55

USAR FIG. 9.2-5-02

ESSENTIAL DRAWING

REVISED	INCORPORATED	WIP-M-0025-48-B-2	CHANGE 010386
ISSUED	CHG. DOC.		FIG. NO.
THIS ENG. SUPERSEDES		REV.	REV.
INCORPORATED AS-BUILT INFORMATION PER FIELD WALKDOWN:			
		ELECTRONIC APPROVAL	
P & ID MAKEUP MINERALIZER SYSTEM			
SCALE	DRAWING NUMBER	SHEET	REV
NONE	M-0025	2	55

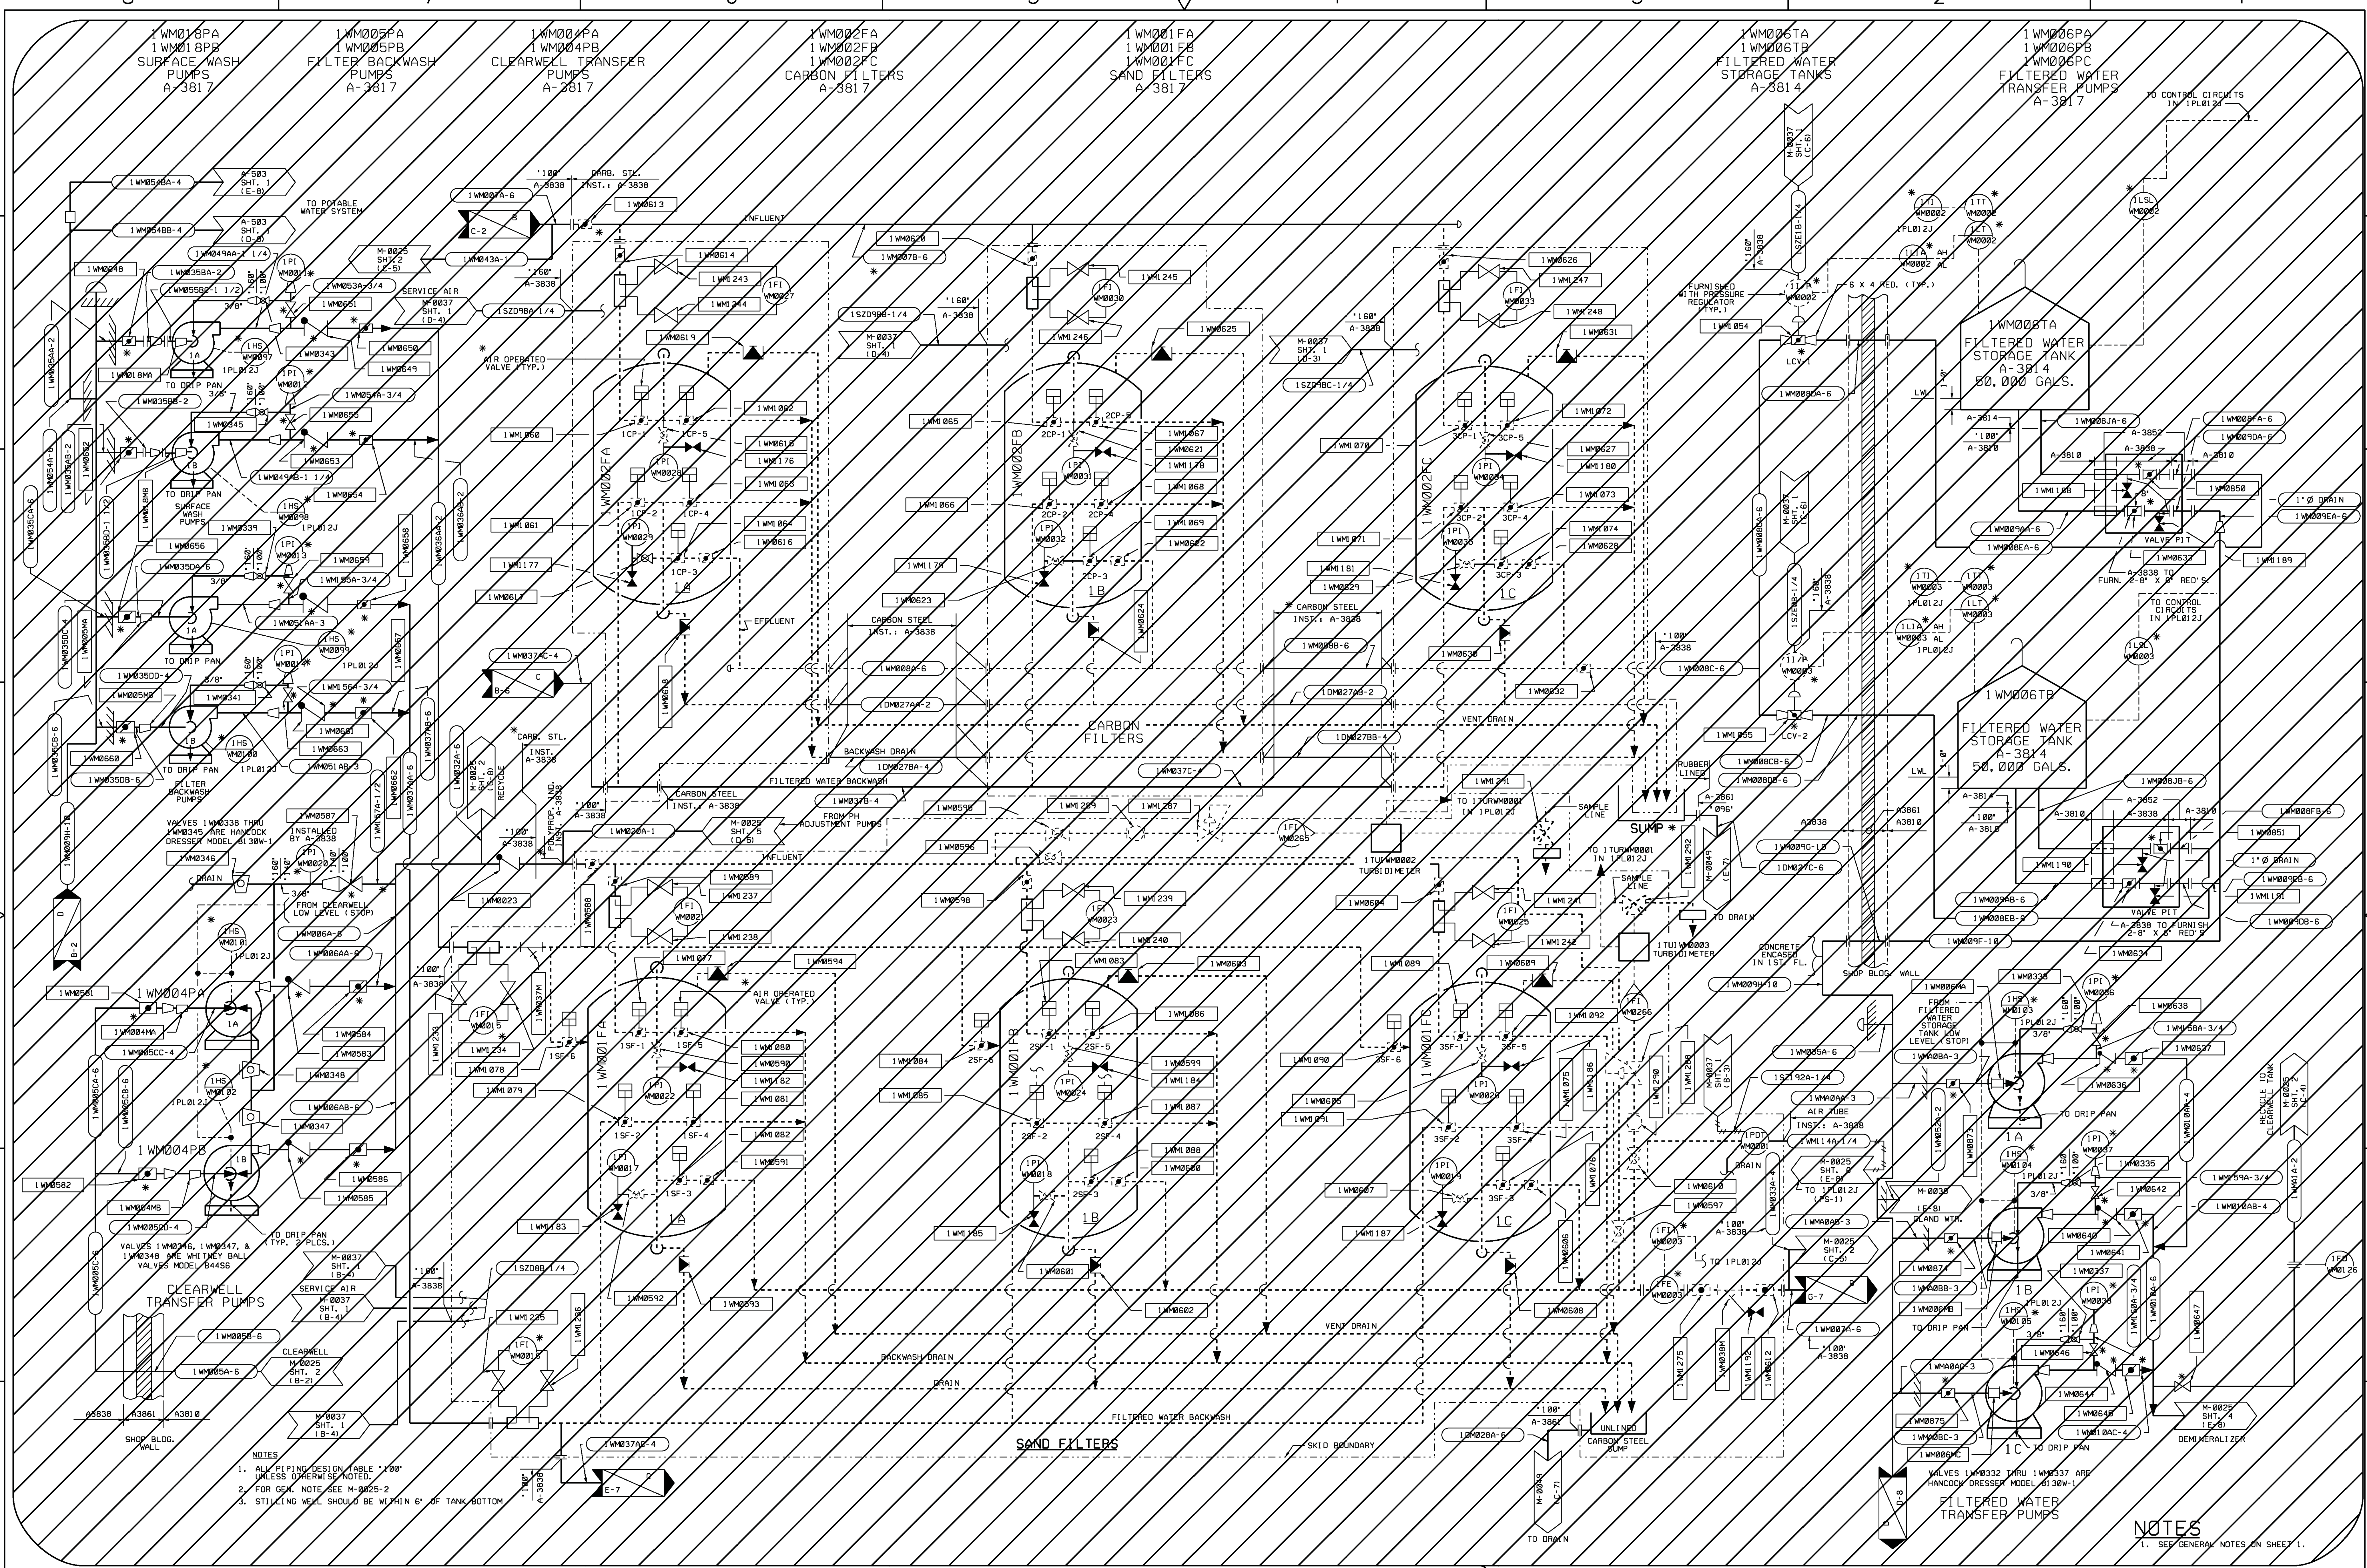

- NOTES
1. ALL PIPING DESIGN TABLE "100" UNLESS OTHERWISE NOTED.
 2. FOR GEA, NOTE SEE M-0025-2.
 3. STILLING WELL SHOULD BE WITHIN 6" OF TANK BOTTOM.

NOTES
1. SEE GENERAL NOTES ON SHEET 1.

ABANDONED IN PLACE 30

USAR FIG. 9.2-5-03

ESSENTIAL DRAWING			
REVISION	ISSUED	INCORPORATED	WIP-M-0025-28-A-3
THIS ENG. SUPERSEDES	REV.	THIS ENG. SUPERSEDES	REV.
WOLF CREEK NUCLEAR OPERATING CORPORATION		ELECTRONIC APPROVAL	
P&ID DEMINERALIZER SYSTEM			
SCALE	DRAWING NUMBER	SHEET	REV
NONE	M-0025	3	30
		3444 E 32E	

41 ABANDONED IN PLACE

ABANDONED IN PLACE 41

IWM11TA
IWM11TB
STRONG CATION
EXCHANGER

IWM12TA
IWM12TB
WEAK BASE ANION
EXCHANGER

IWM01E
HOT WATER
TANK
IWM02S
HOT WATER TANK
ELECTRIC HEATER


IWM13TA
IWM13TB
STRONG BASE
ANION
EXCHANGER

IWM07PA
IWM07PB
IWM07PC
IWM07PD
RECYCLE PUMPS

IWM08PA
IWM08PB
REGENERATION
WATER PUMPS

IWM14TA
IWM14TB
MIXED BED
EXCHANGER

IWM27F
FILTRATION UNIT

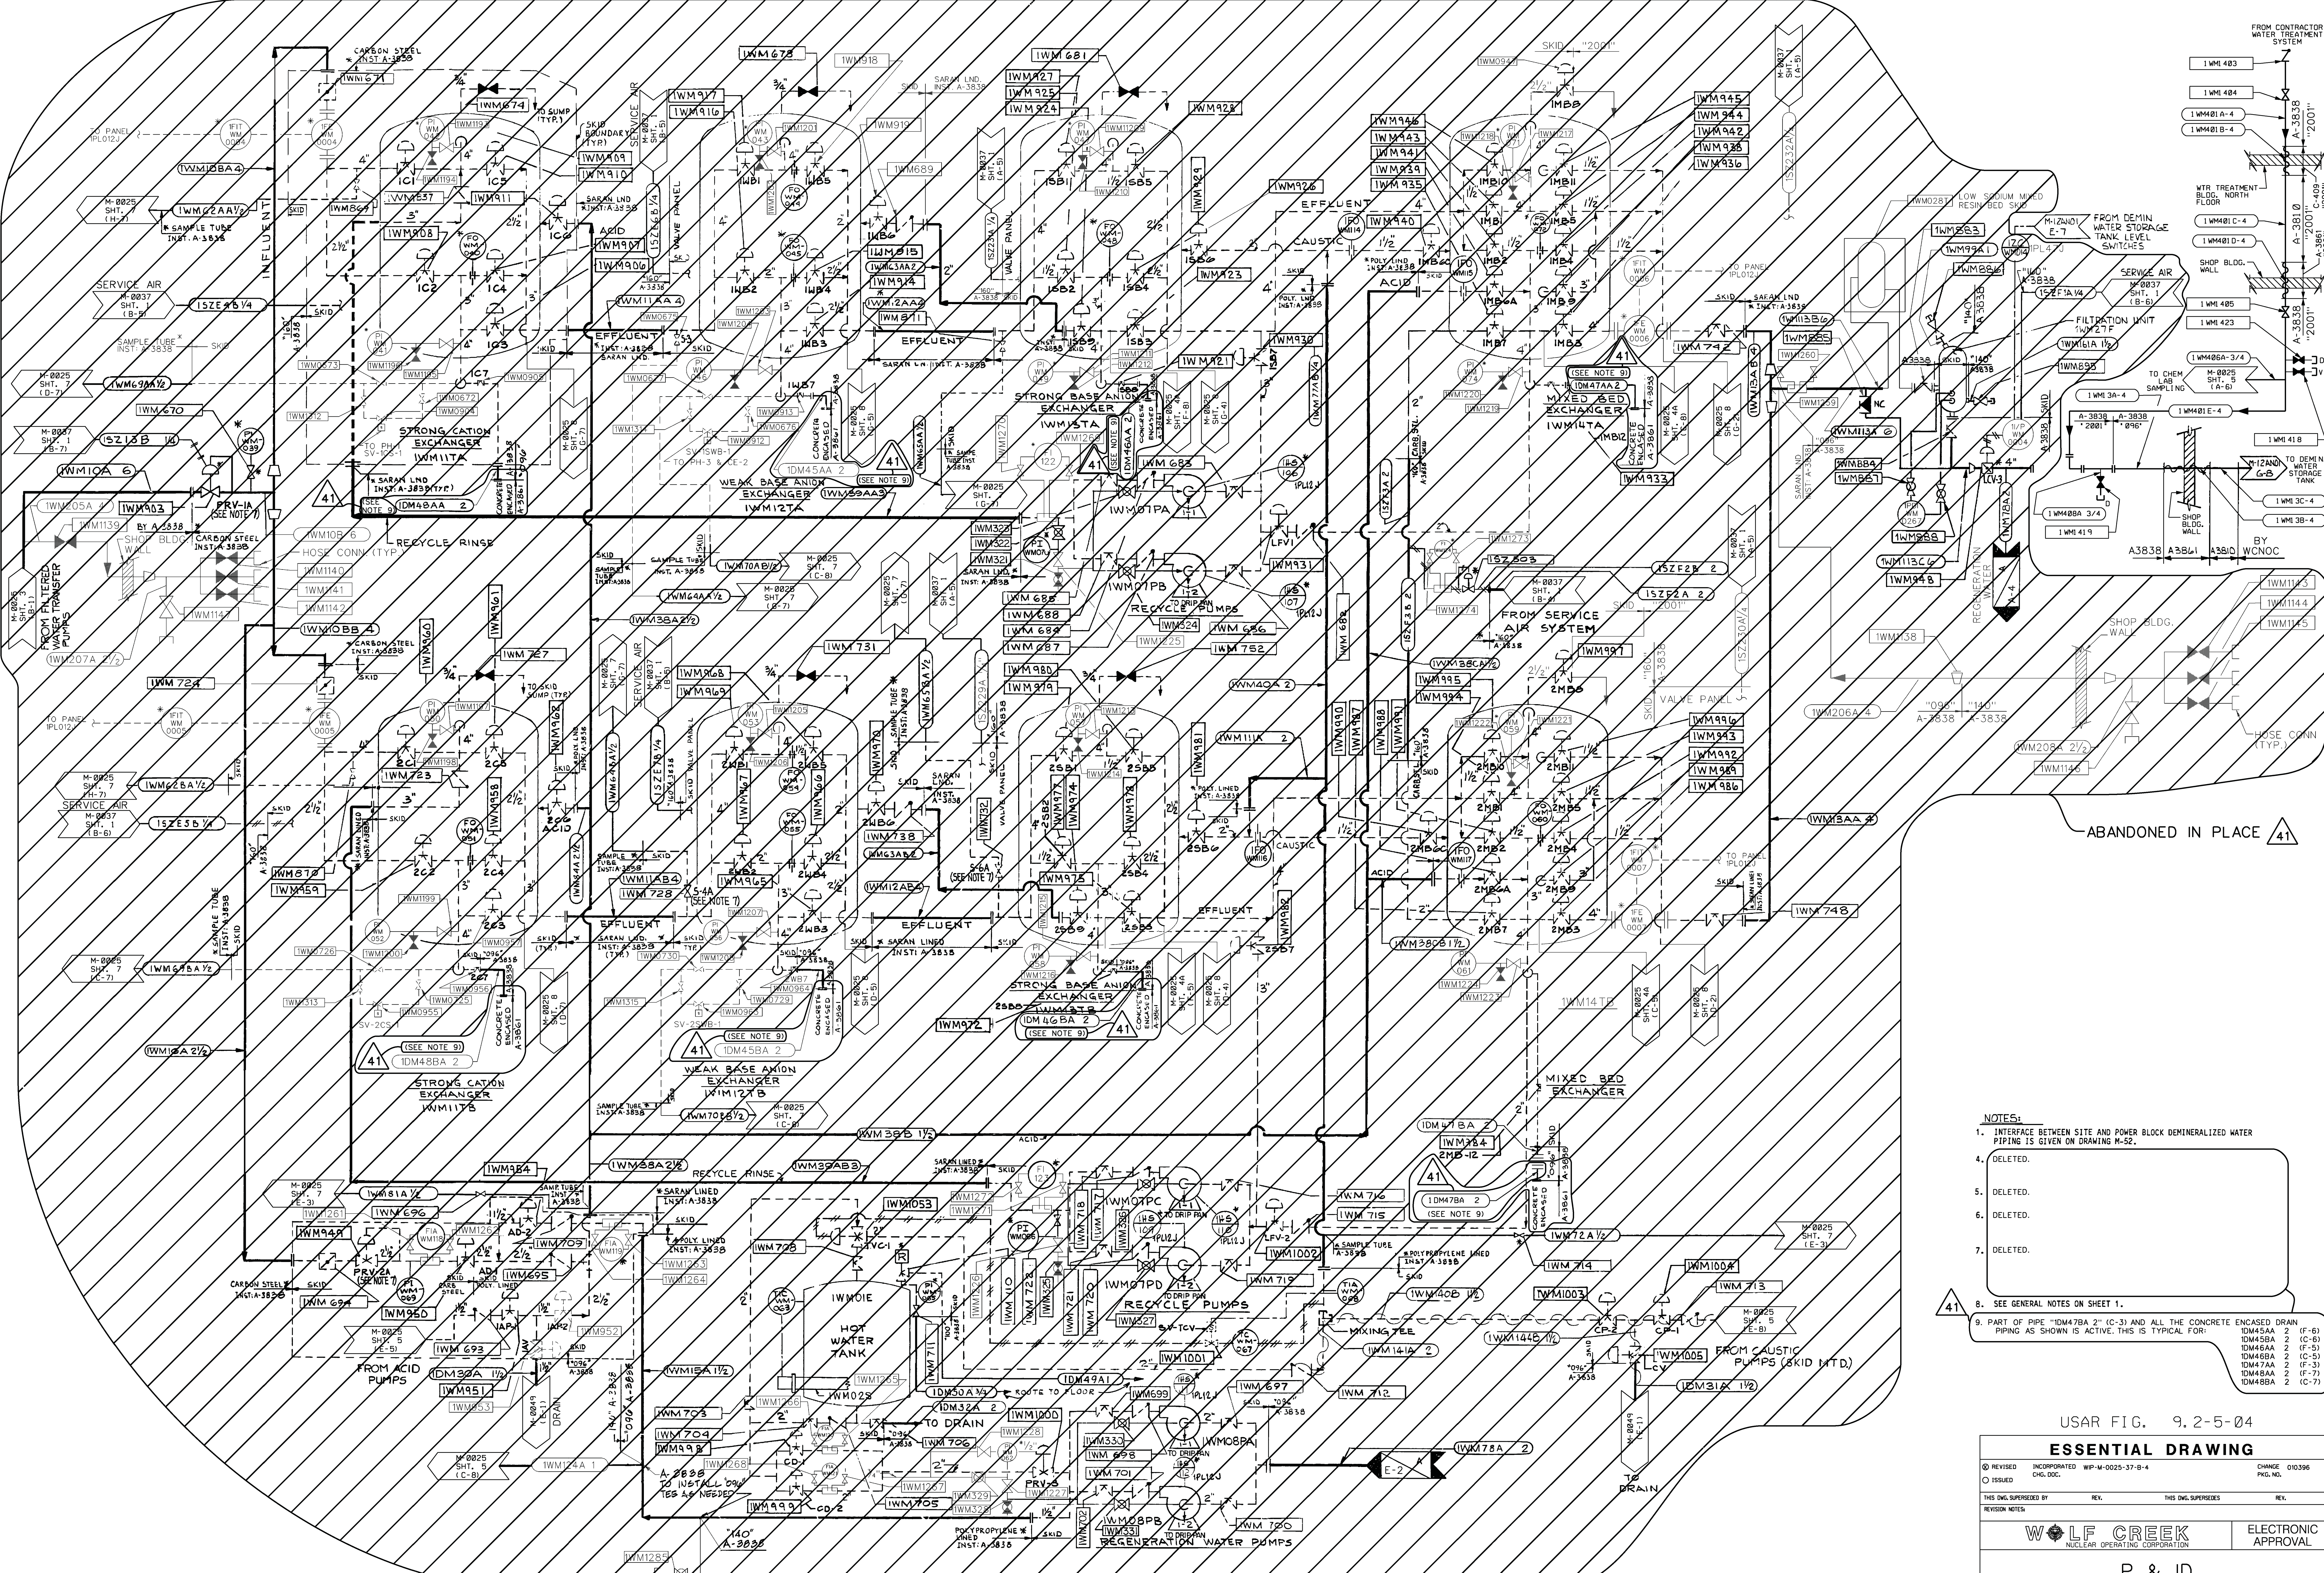

- NOTES:
1. INTERFACE BETWEEN SITE AND POWER BLOCK DEMINERALIZED WATER PIPING IS GIVEN ON DRAWING M-52.
 4. DELETED.
 5. DELETED.
 6. DELETED.
 7. DELETED.
 8. SEE GENERAL NOTES ON SHEET 1.
 9. PART OF PIPE "IDM47BA 2" (C-3) AND ALL THE CONCRETE ENCASED DRAIN PIPING AS SHOWN IS ACTIVE. THIS IS TYPICAL FOR:
 - IDM45AA 2 (F-6)
 - IDM45BA 2 (C-6)
 - IDM46AA 2 (F-5)
 - IDM46BA 2 (C-5)
 - IDM47AA 2 (F-3)
 - IDM48AA 2 (F-7)
 - IDM48BA 2 (C-7)

USAR FIG. 9, 2-5-04

ESSENTIAL DRAWING


(R) REVISED INCORPORATED WPM-0025-37-B-4 CHANGE 010396
 (I) ISSUED CNG, DOC. CNG, DOC. PGC, NO.

THIS ENG. SUPERSEDES REV. THIS ENG. SUPERSEDES REV.
 REVISION NOTES

WOLF CREEK ELECTRONIC APPROVAL
 NUCLEAR OPERATING CORPORATION

P & ID MAKEUP DEMINERALIZER SYSTEM

SCALE NONE DRAWING NUMBER M-0025 SHEET REV 4 41
 3444 E. 32E

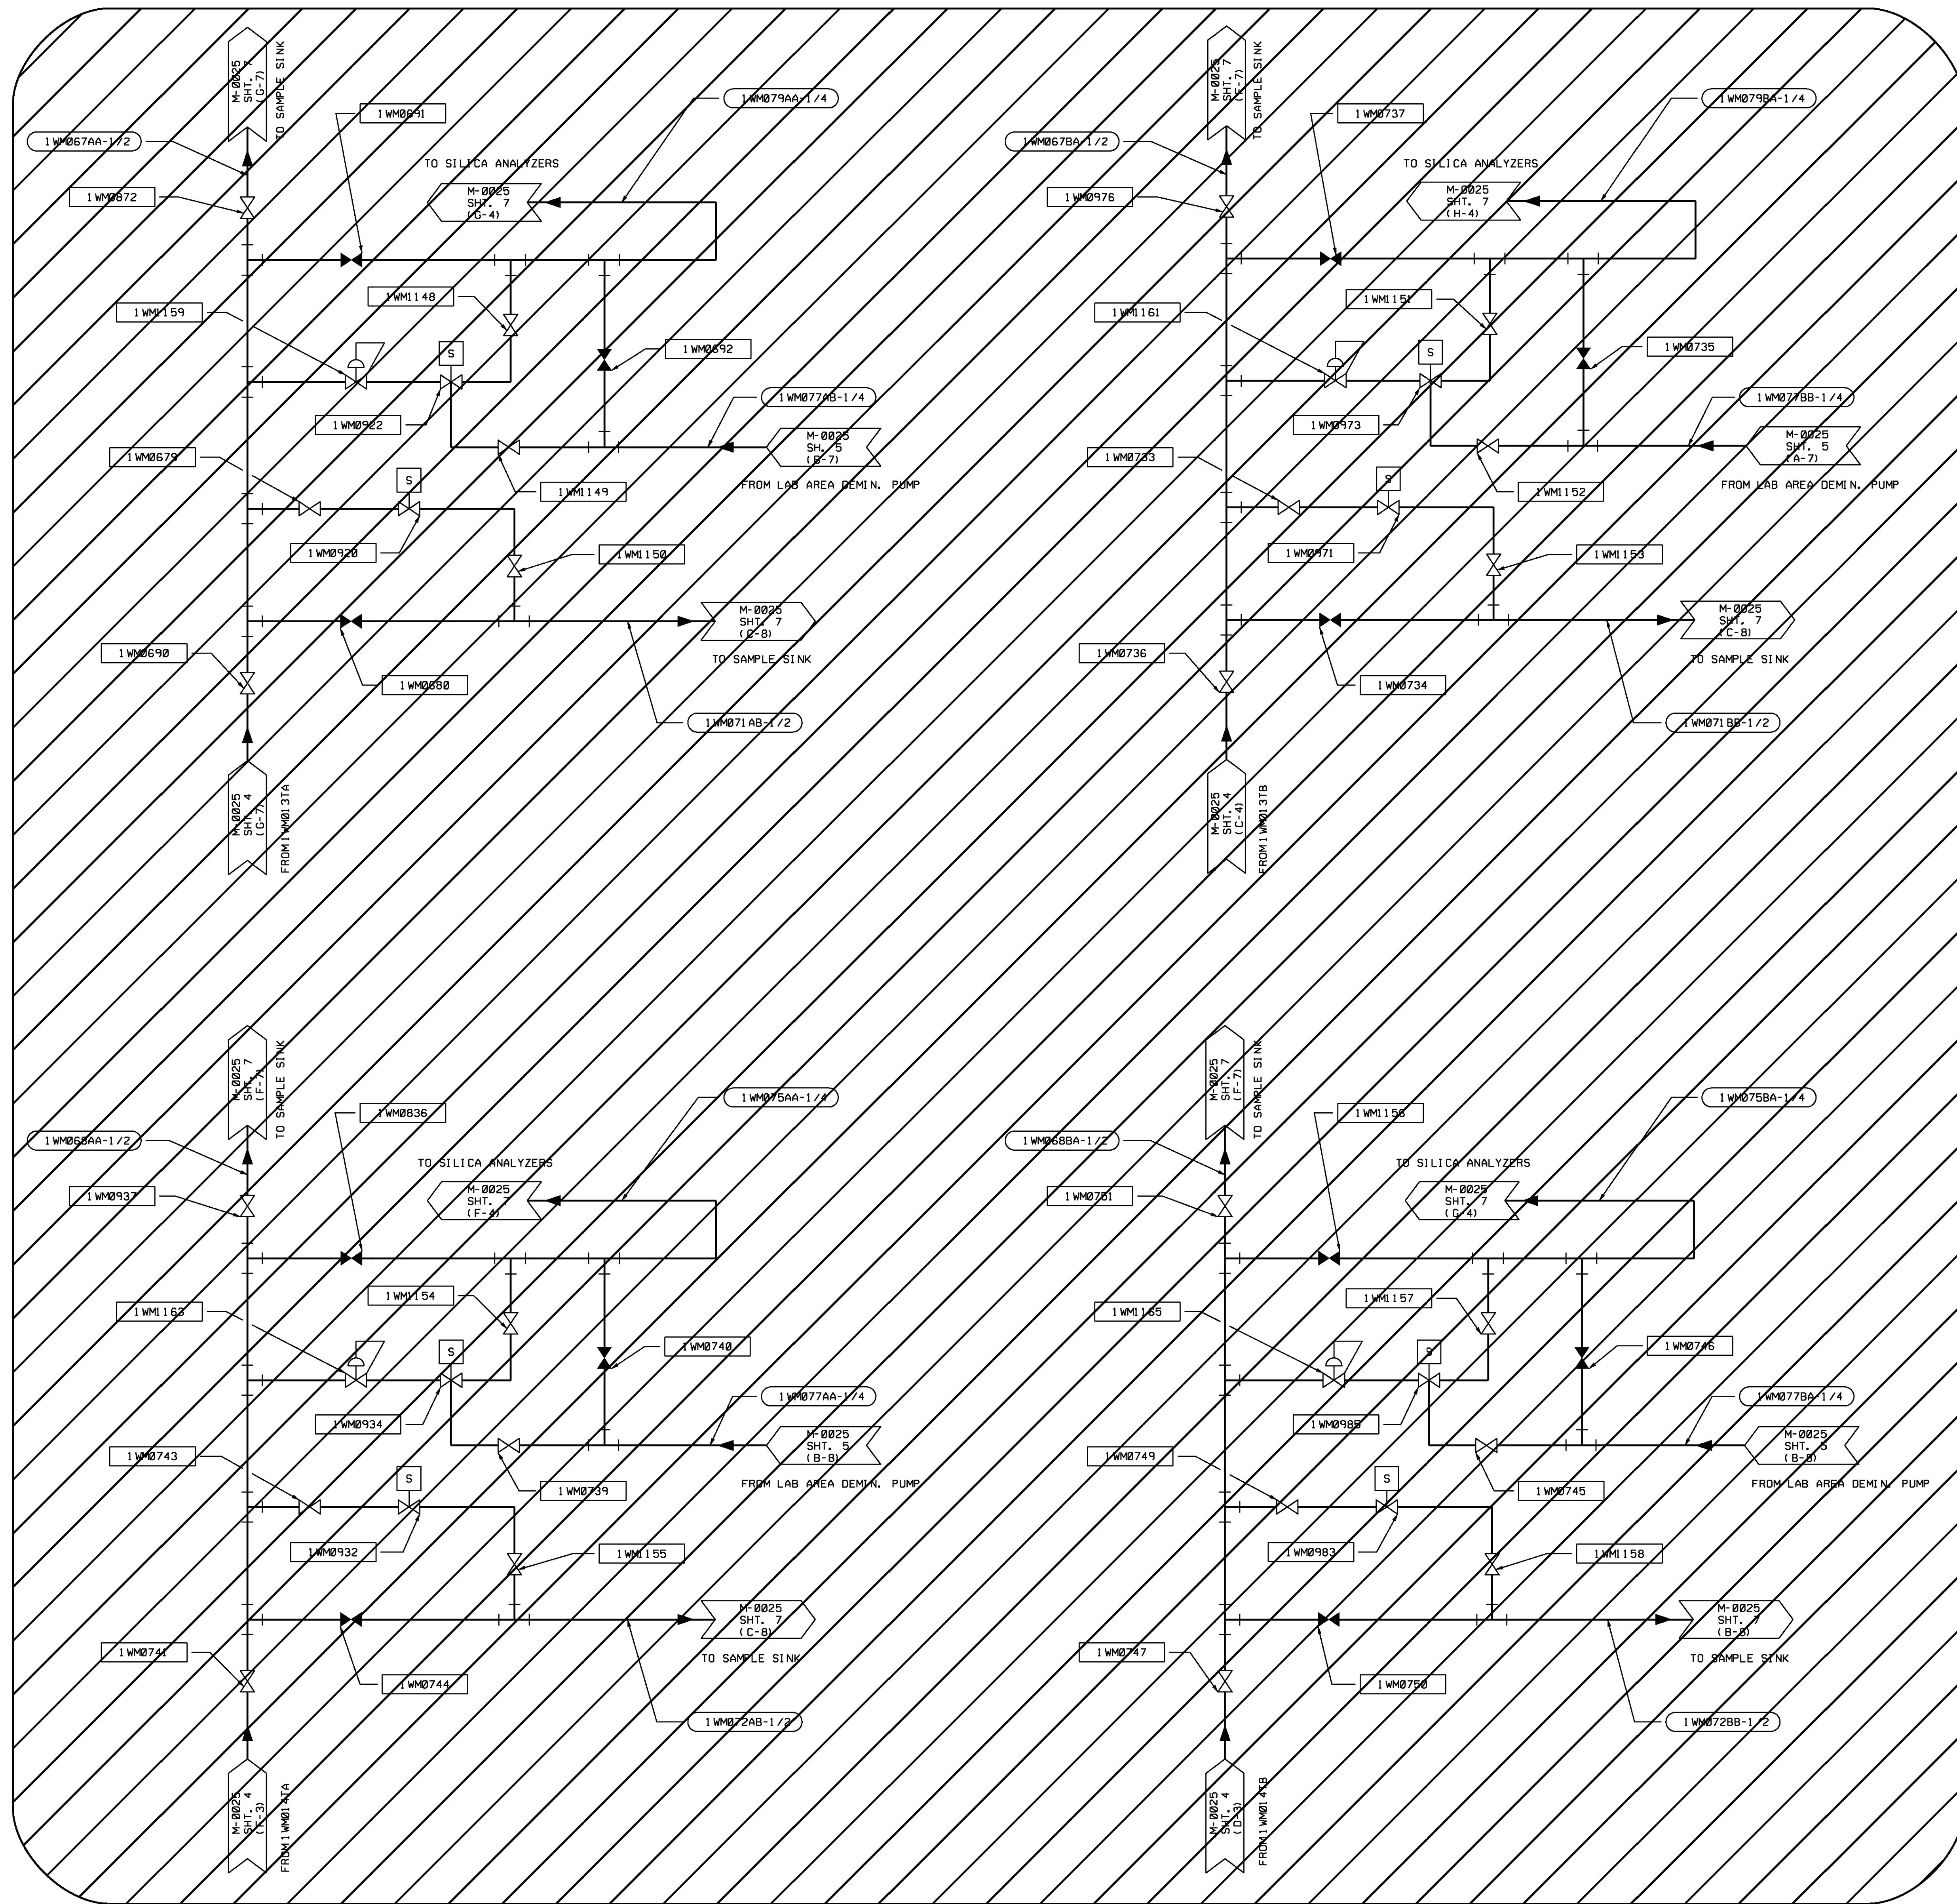

ABANDONED
IN PLACE

USAR FIG. 9.2-5-4A

ESSENTIAL DRAWING

REVISION	INCORPORATED	WIP-M-0025-04-A-4A	CHANGE	010398
ISSUED	CNG. DOC.		PKG. NO.	
THIS ENG. SUPERSEDES		REV.	THIS ENG. SUPERSEDES	

REVISION NOTES

WOLF CREEK
NUCLEAR OPERATING CORPORATION

ELECTRONIC
APPROVAL

**P & ID
MAKEUP DEMINERALIZER SYSTEM**

SCALE	DRAWING NUMBER	SHEET	REV
NONE	M-0025	4A	06

Ray J. Smith
Scale 1:None
Checked by: Raymond J. Smith, Radiation
Division
2004.08.05.00.00.00

H
G
F
E
D
C
B
A

8 7 6 5 4 3 2 1







FILTRATION UNIT 1WD002F POTABLE WATER TRANSFER PUMPS 1WD001PA, 1WD001PB CONTROL PANEL 1WD001J PNEUMATIC TANK 1WD003T (16-4 1/2" X 8-7" DIA) AIR COMPRESSOR 1WD001C RECIRCULATING WATER PUMP 1WD003P HOT WATER TANK 1WD009T

SHOP BUILDING

ABANDONED IN PLACE.

ABANDONED IN PLACE.

ABANDONED IN PLACE

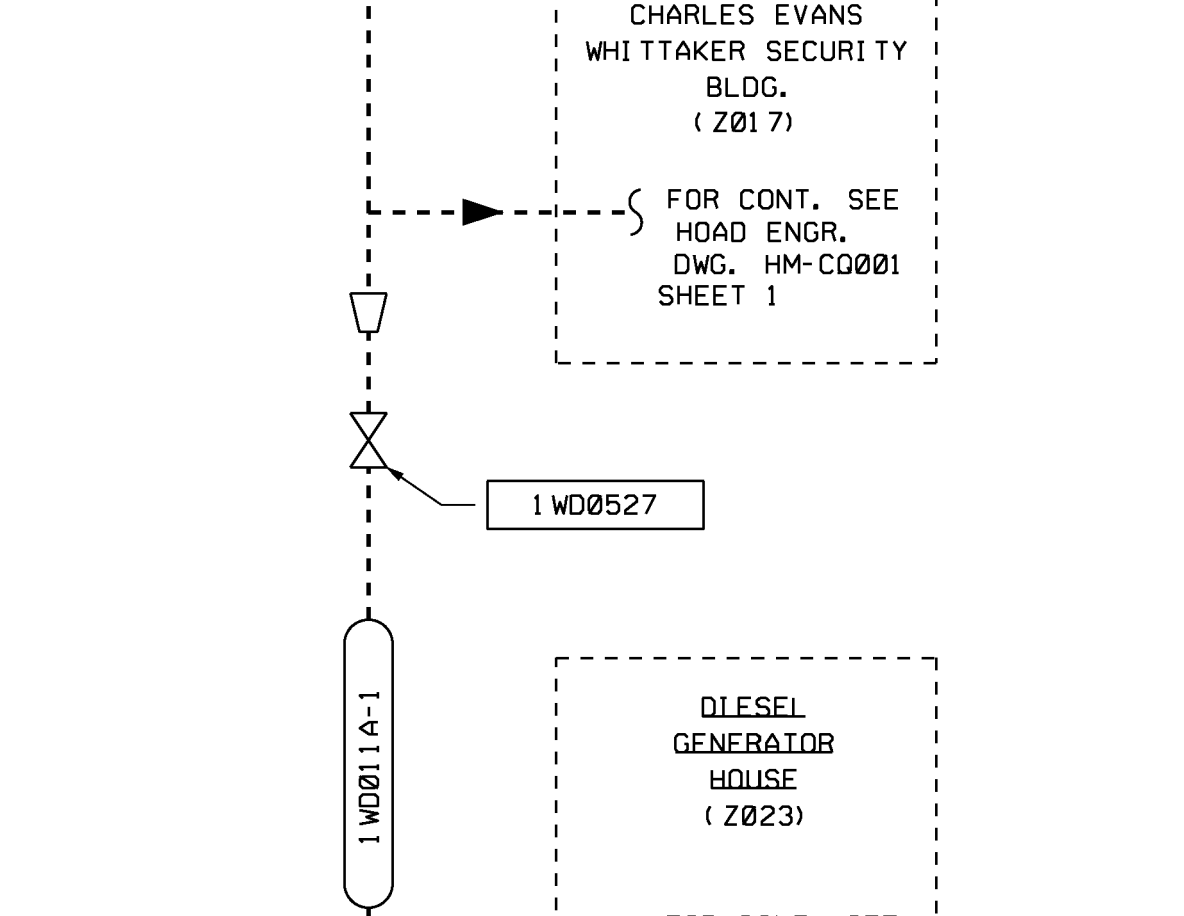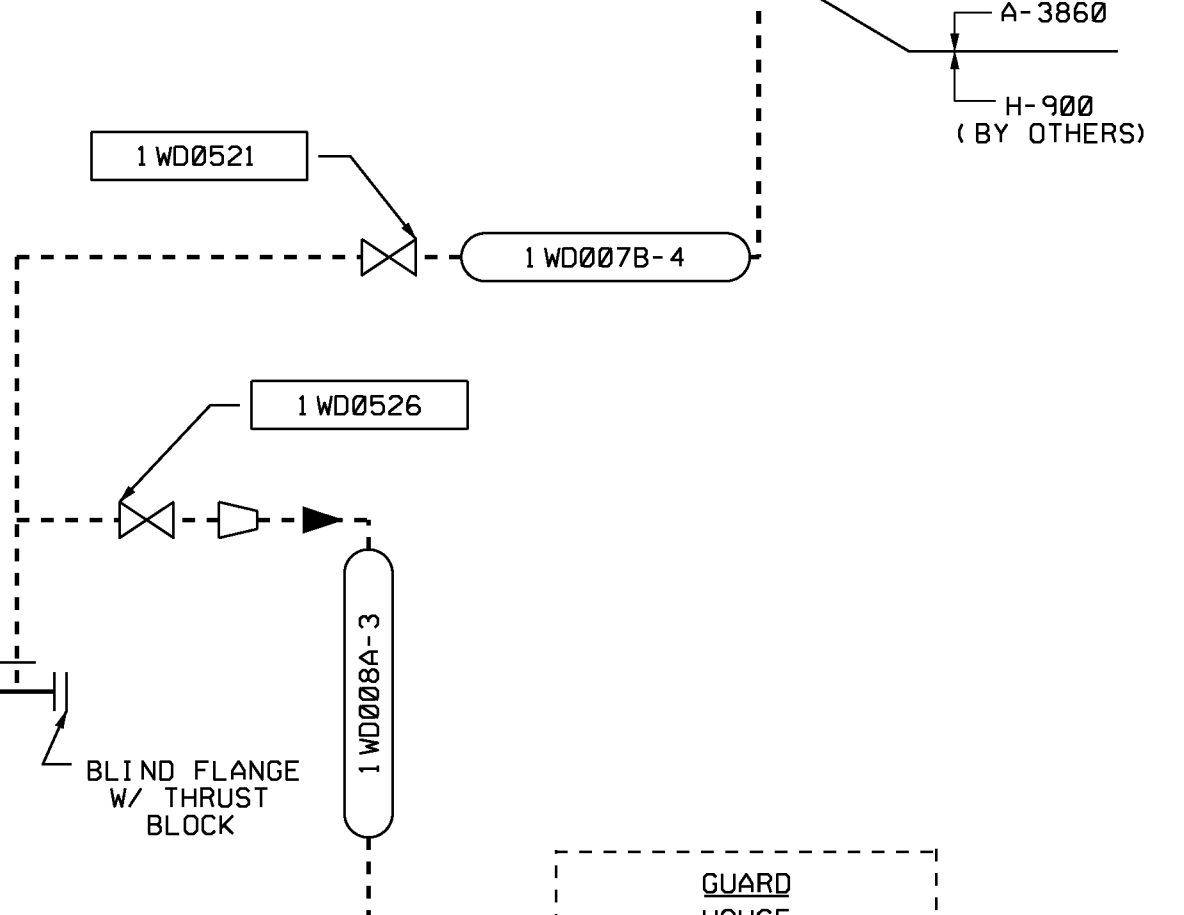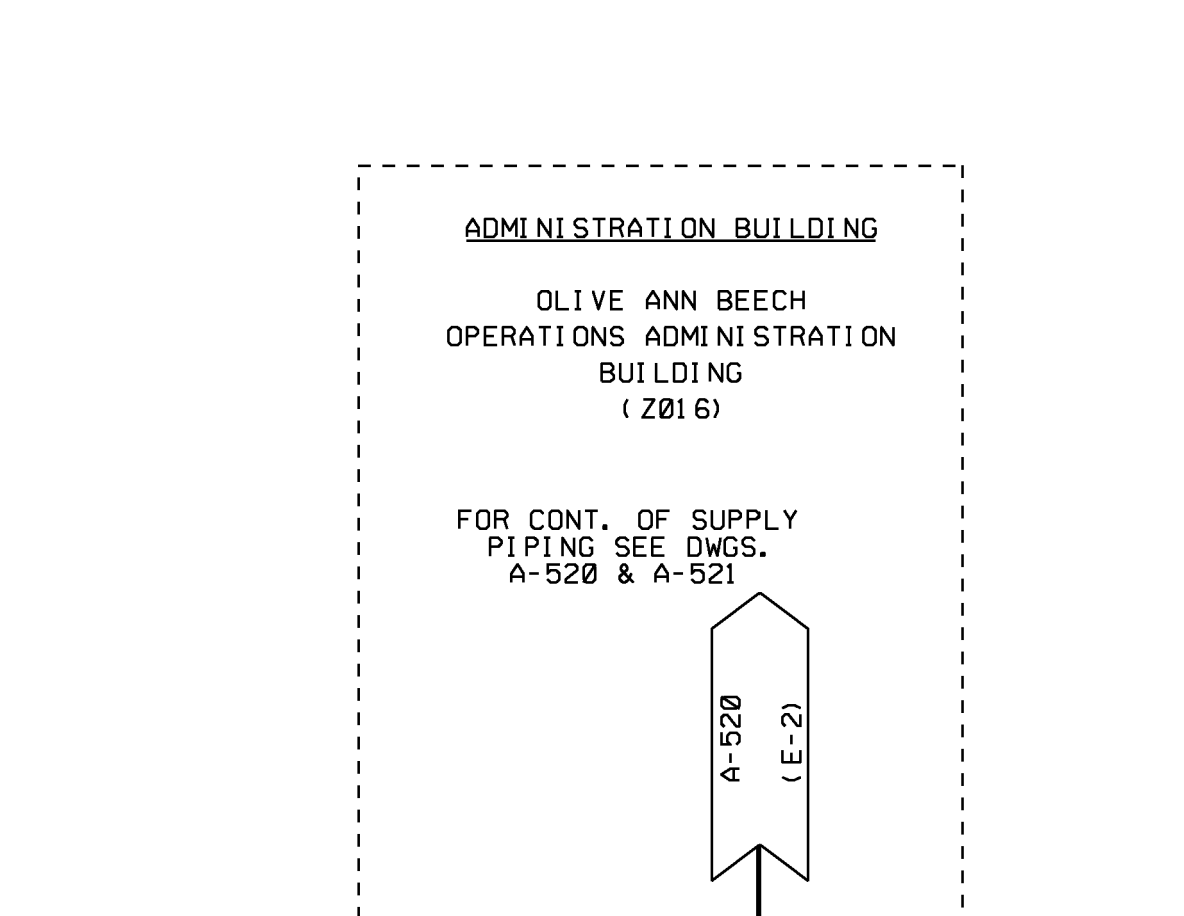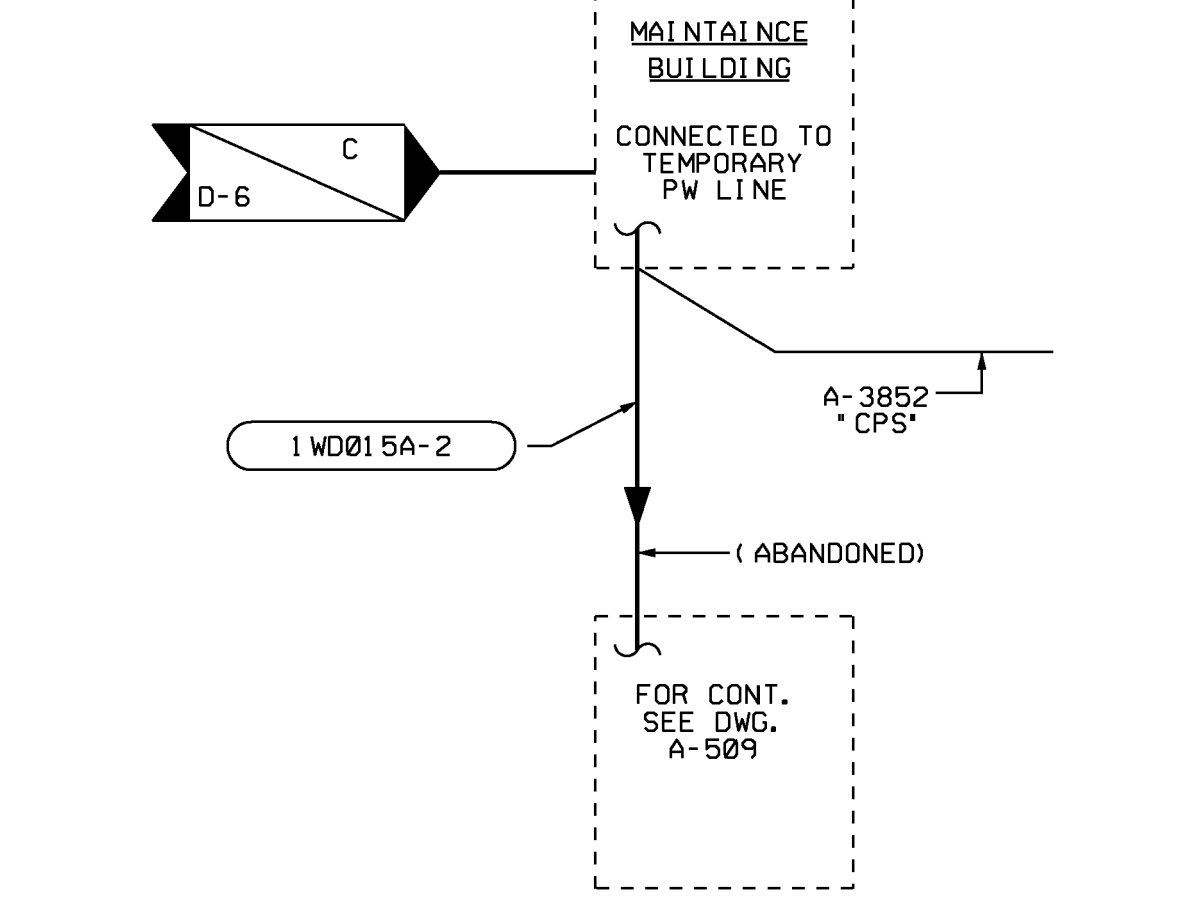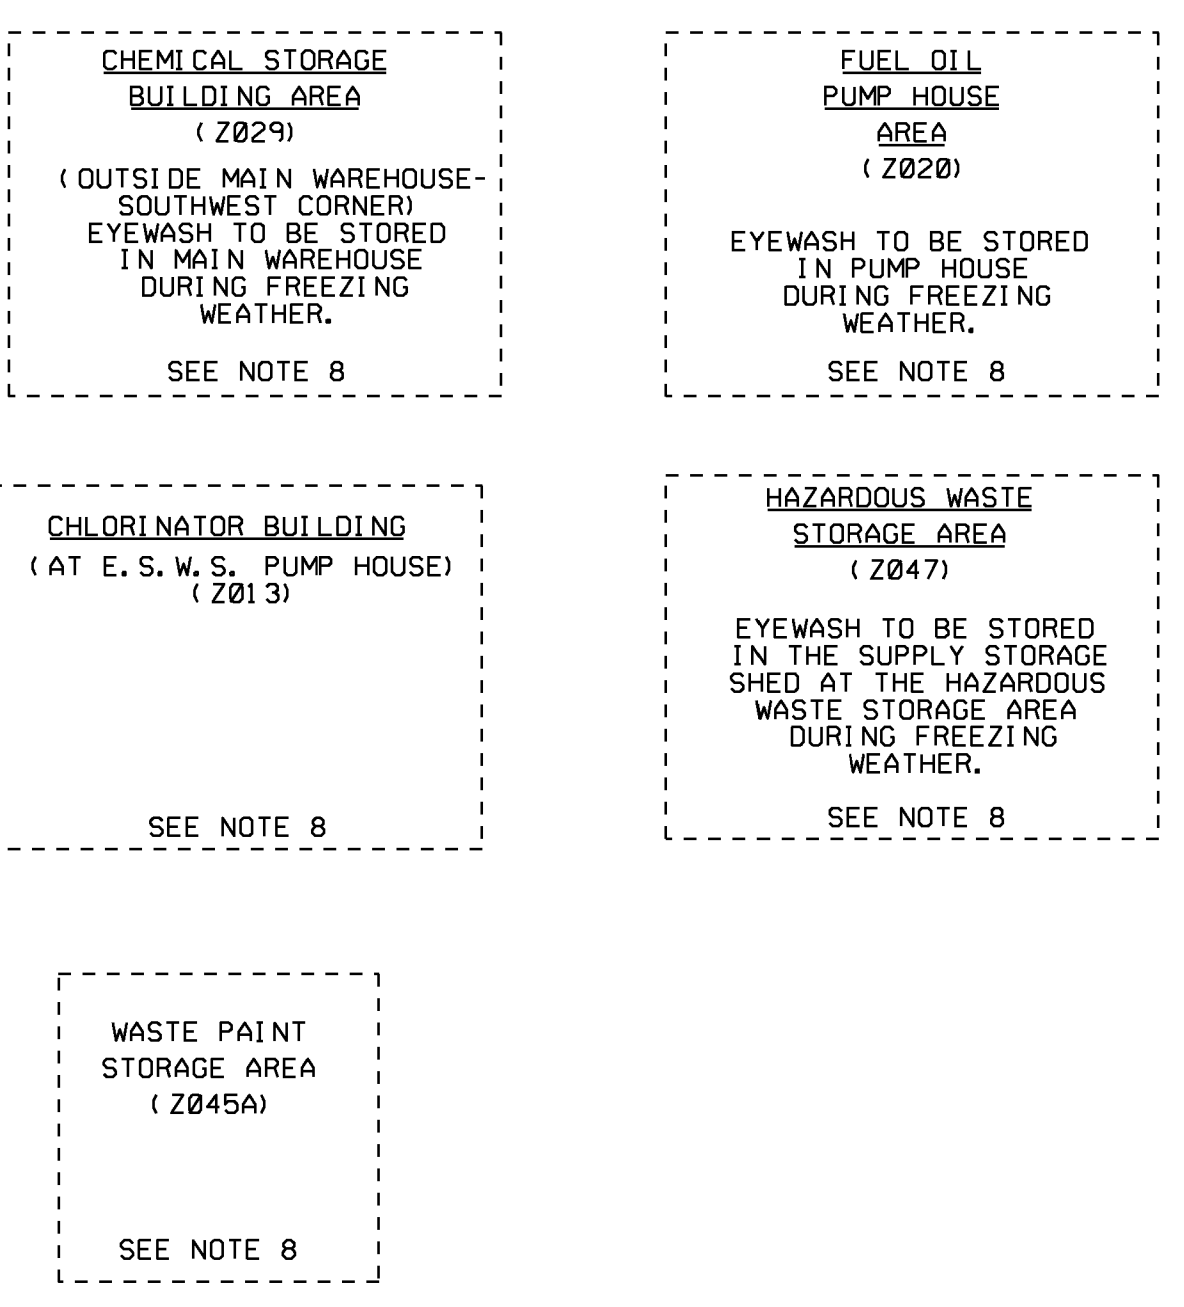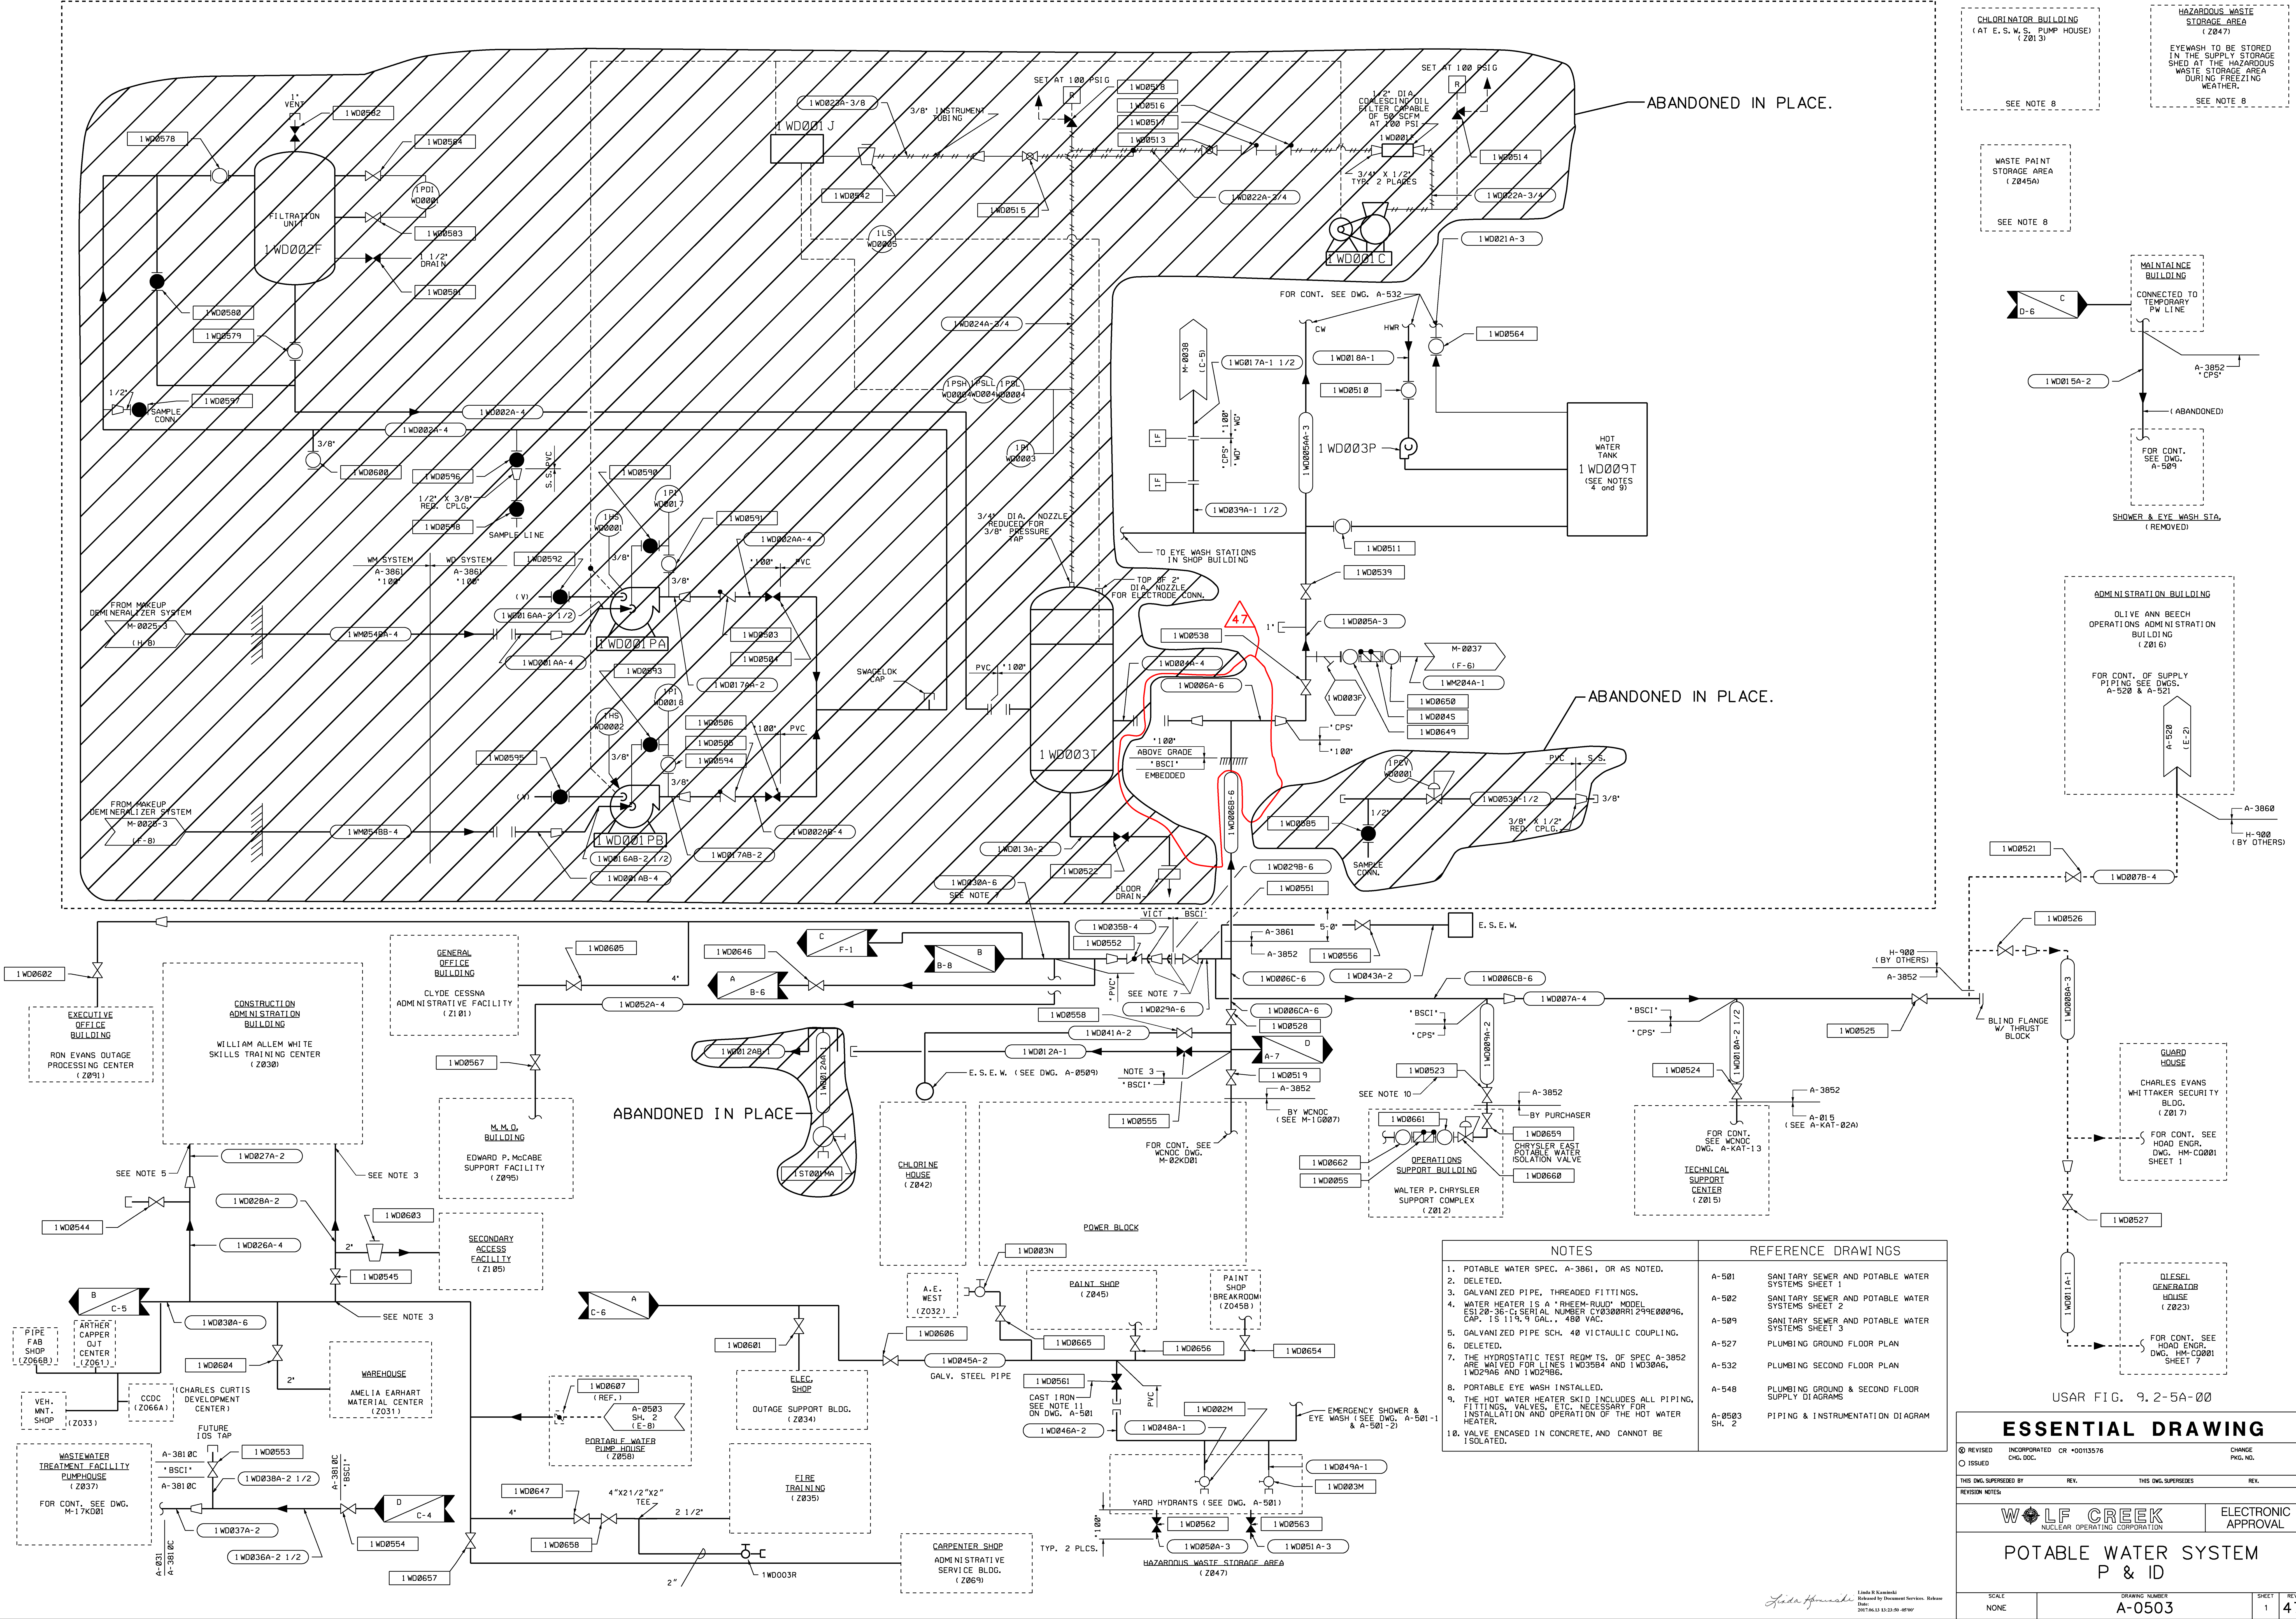

NOTES	REFERENCE DRAWINGS
1. POTABLE WATER SPEC. A-3861, OR AS NOTED.	A-501 SANITARY SEWER AND POTABLE WATER SYSTEMS SHEET 1
2. DELETED.	A-502 SANITARY SEWER AND POTABLE WATER SYSTEMS SHEET 2
3. GALVANIZED PIPE, THREADED FITTINGS.	A-509 SANITARY SEWER AND POTABLE WATER SYSTEMS SHEET 3
4. WATER HEATER IS A "RHEEM-RUUD" MODEL ESI 20-36-C SERIAL NUMBER CY0300RRI 299600096. CAP. IS 119.9 GAL., 400 VAC.	A-527 PLUMBING GROUND FLOOR PLAN
5. GALVANIZED PIPE SCH. 40 WICTALIC COUPLING.	A-532 PLUMBING SECOND FLOOR PLAN
6. DELETED.	A-548 PLUMBING GROUND & SECOND FLOOR SUPPLY DIAGRAMS
7. THE HYDROSTATIC TEST REQ'D TS. OF SPEC A-3852 ARE WAIVED FOR LINES 1WD0384 AND 1WD0386, 1WD0296 AND 1WD0298.	A-0503 PIPING & INSTRUMENTATION DIAGRAM
8. PORTABLE EYE WASH INSTALLED.	
9. THE HOT WATER HEATER SKID INCLUDES ALL PIPING, FITTINGS, VALVES, ETC. NECESSARY FOR INSTALLATION AND OPERATION OF THE HOT WATER HEATER.	
10. VALVE ENCASED IN CONCRETE, AND CANNOT BE ISOLATED.	

USAR FIG. 9.2-5A-00

ESSENTIAL DRAWING

REVISIONS: REVISED, INCORPORATED, OR ISSUED


WOLF CREEK NUCLEAR OPERATING CORPORATION

POTABLE WATER SYSTEM P & ID

SCALE: NONE

DRAWING NUMBER: A-0503


SHEET: 1 OF 47

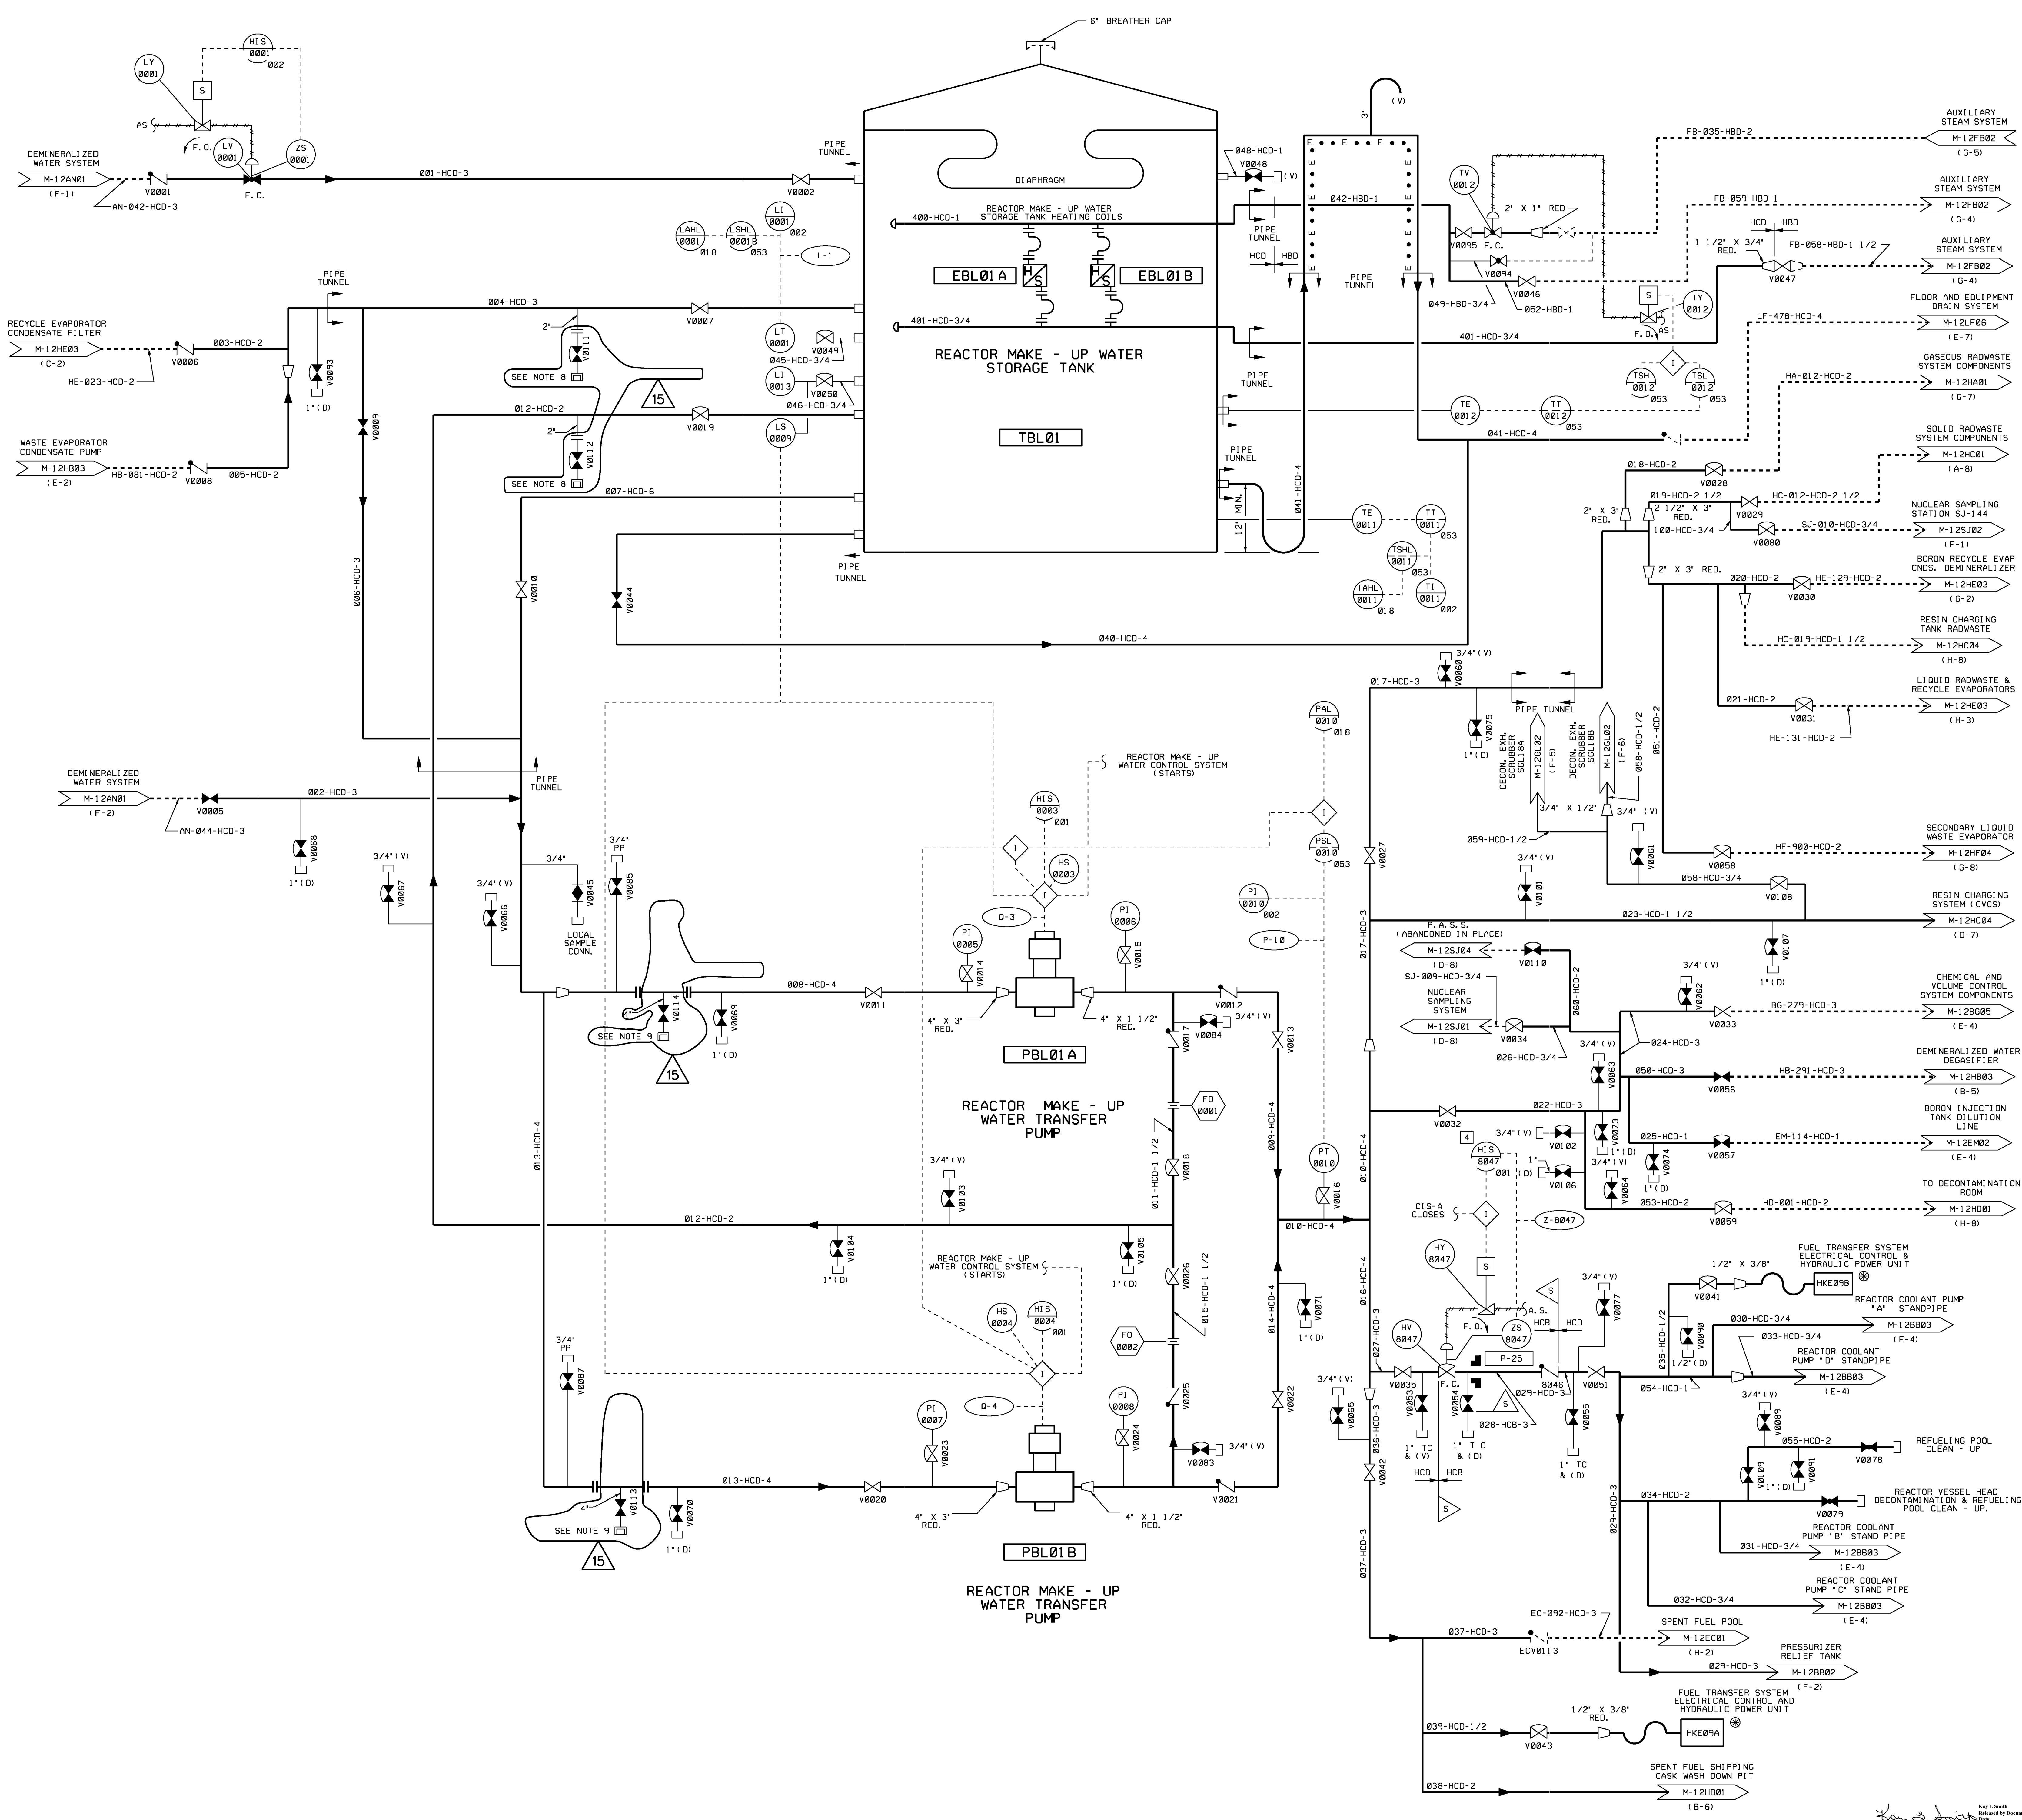

- NOTES**
1. THE PORTIONS OF THE REACTOR MAKE - UP WATER SYSTEM WHICH ARE D-LISTED INCLUDE THE PIPING AND VALVES ASSOCIATED WITH CONTAINMENT ISOLATION ONLY.
 2. DELETED.
 3. AN ABOVE GRADE STRUCTURE IS PROVIDED TO HOUSE PIPING AND VALVES ADJACENT TO THE REACTOR MAKEUP WATER STORAGE TANK.
 4. FOR P & I D LEGEND & SYMBOLS SEE DRAWINGS 0466-M-1201-01, M-1201-02, M-1201-03 AND M-8201-04.
 5. DELETED
 6. DELETED
 7. DELETED
 8. 2" NPT TO 4" 30 DEGREE ANGLE STORZ CONNECTOR, NFPA 1963-1998, 2800 PSI / 150°F MINIMUM, ASTM B247 B061 T6, CAPPED. INSTALL THE STORZ CONNECTOR WITH THE CONNECTION ANGLED UP. THIS CONNECTION IS FOR BEYOND-DESIGN BASIS (FLEX) USAGE ONLY.
 9. 4" NPT TO 4" STORZ CONNECTOR, NFPA 1963-1998, 2800 PSI / 150°F MINIMUM, ASTM B247 B061 T6, CAPPED. THIS CONNECTION IS FOR BEYOND-DESIGN BASIS (FLEX) USAGE ONLY.

USAR FIG. 9.2-13-00

ESSENTIAL DRAWING			
REVISED	INCORPORATED	WIP-M-12BL-01-010-B-1	CHANGE 014463
ISSUED	CIG. DOC.		PKG. NO.
THIS DWG SUPERSEDES		REV.	THIS DWG SUPERSEDES
REVISION NOTES			
		ELECTRONIC APPROVAL	
PIPING & INSTRUMENTATION DIAGRAM			
REACTOR MAKE-UP WATER SYSTEM			
SCALE	DRAWING NUMBER	SHEET	REV
NONE	M-12BL01	1	15

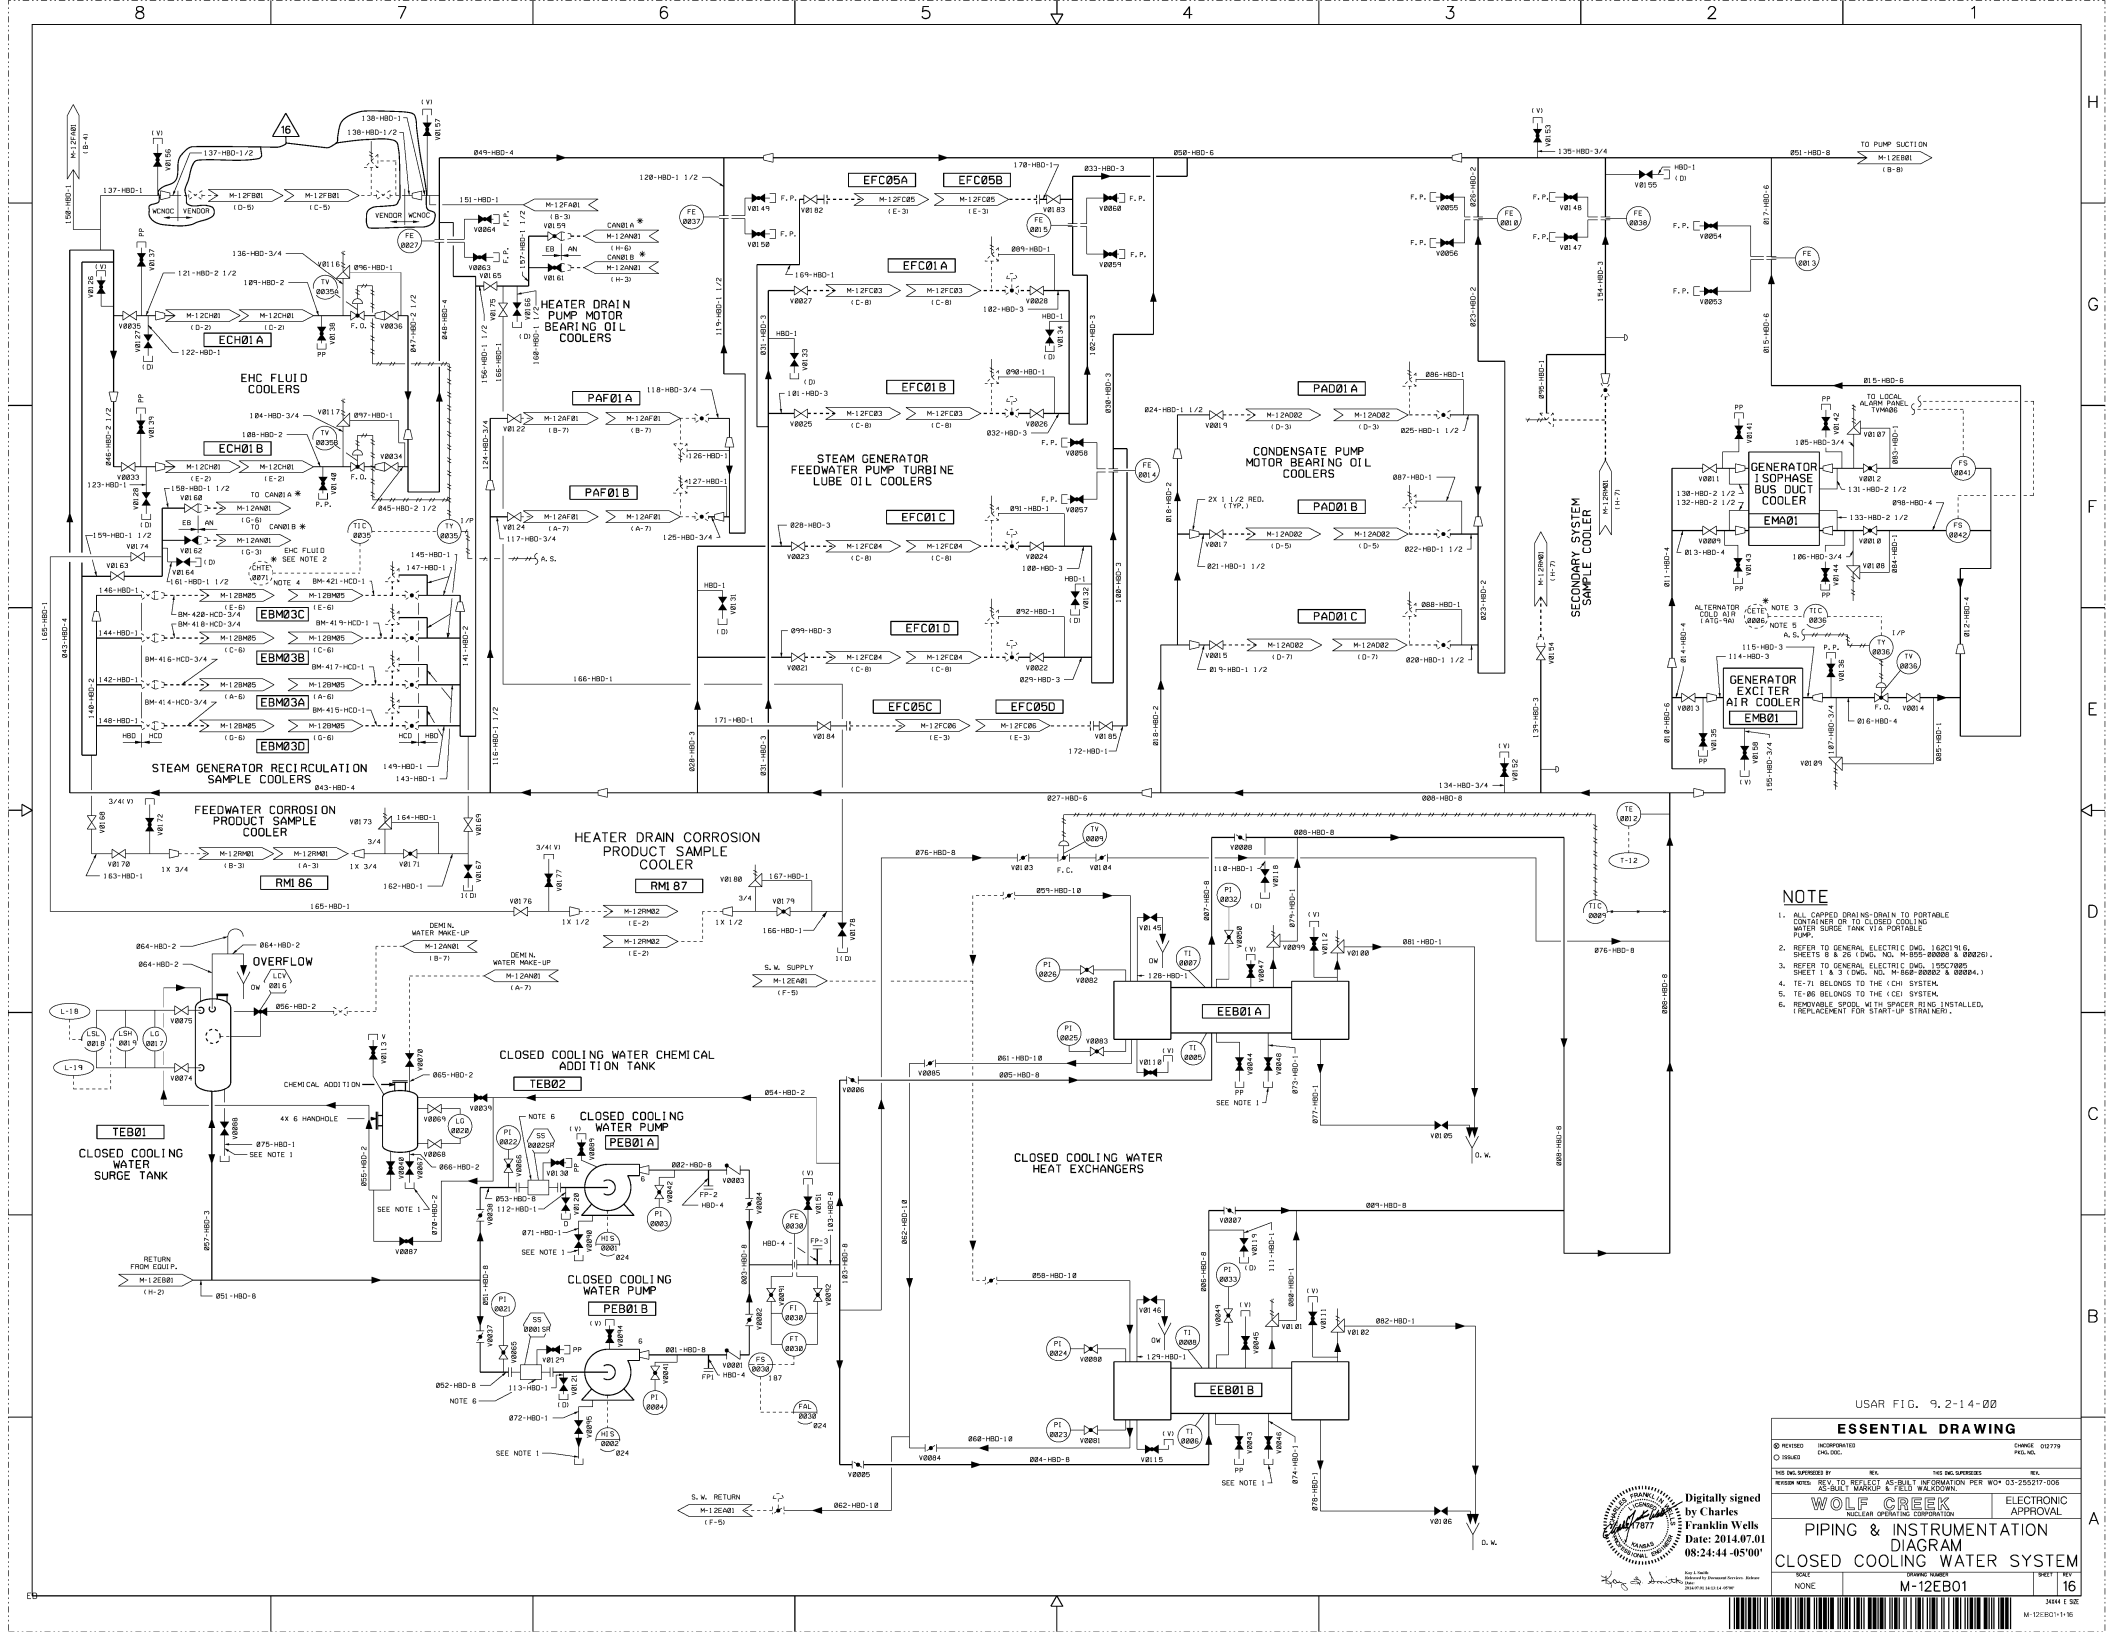

- NOTE**
1. ALL CORROSION DRAIN-INS TO PORTABLE CONTAINER OR TO CLOSED COOLING WATER SURGE TANK VIA PORTABLE PUMP.
 2. REFER TO GENERAL ELECTRIC (G.E.) INSTRUMENTATION SHEETS B & 26 (LONG NO. M-850-0000) & 000201.
 3. REFER TO GENERAL ELECTRIC (G.E.) INSTRUMENTATION SHEETS I & 31 (LONG NO. M-860-0000 & 00041).
 4. TE-71 BELONGS TO THE IHD SYSTEM.
 5. TE-80 BELONGS TO THE IED SYSTEM.
 6. REMOVABLE SPOON, WITH SPACER RING INSTALLED, REPLACEMENT FOR START-UP STRAINER.


USAR FIG. 9.2-14-00

ESSENTIAL DRAWING


REVISION	INCORPORATED	DATE	03/77
BY	WJ	DATE	03/77
DESIGN	WJ	DATE	03/77
INSTRUMENTATION	WJ	DATE	03/77
OPERATION	WJ	DATE	03/77
APPROVAL	WJ	DATE	03/77
WOLF CREEK			
PIPING & INSTRUMENTATION DIAGRAM			
CLOSED COOLING WATER SYSTEM			
SCALE	NONE	SHEET NO.	16
DRAWN BY: M-12E01		CHECKED BY: WJ	

Digitally signed by Charles Franklin Wells
 Date: 2014.07.01 08:24:44 -0500



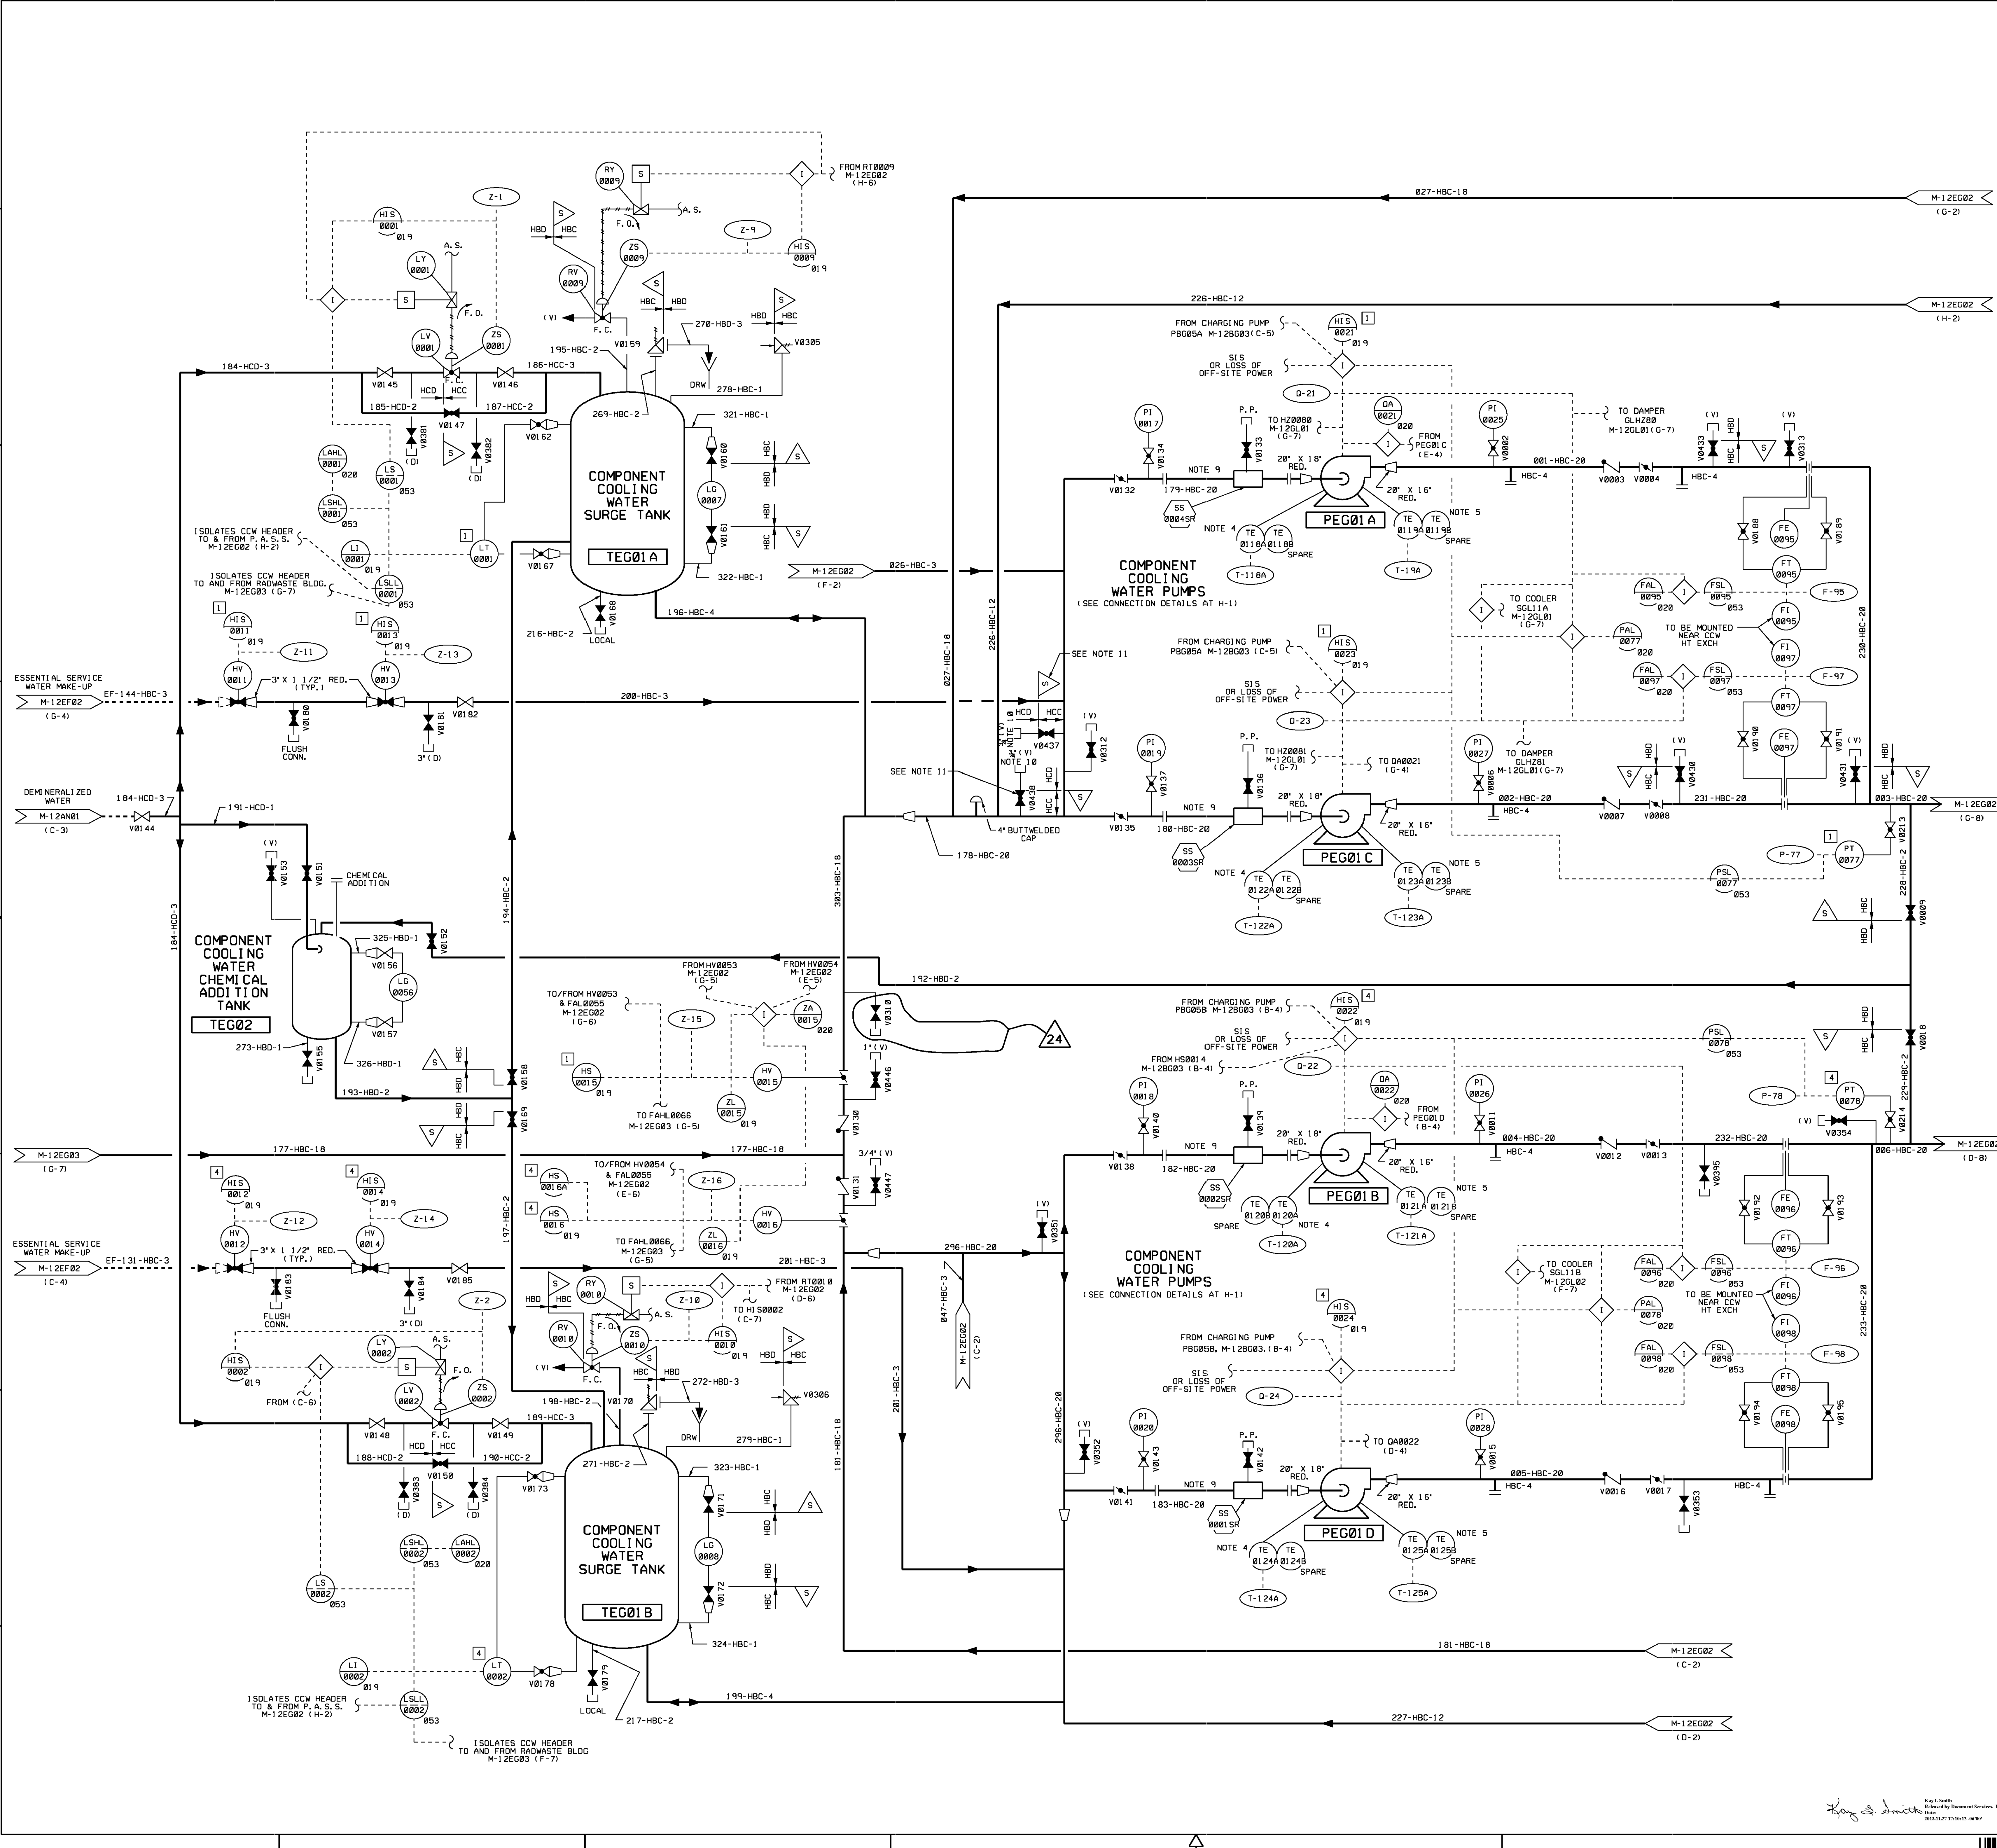

PUMP CONNECTION DETAILS
(SEE NOTE 2)

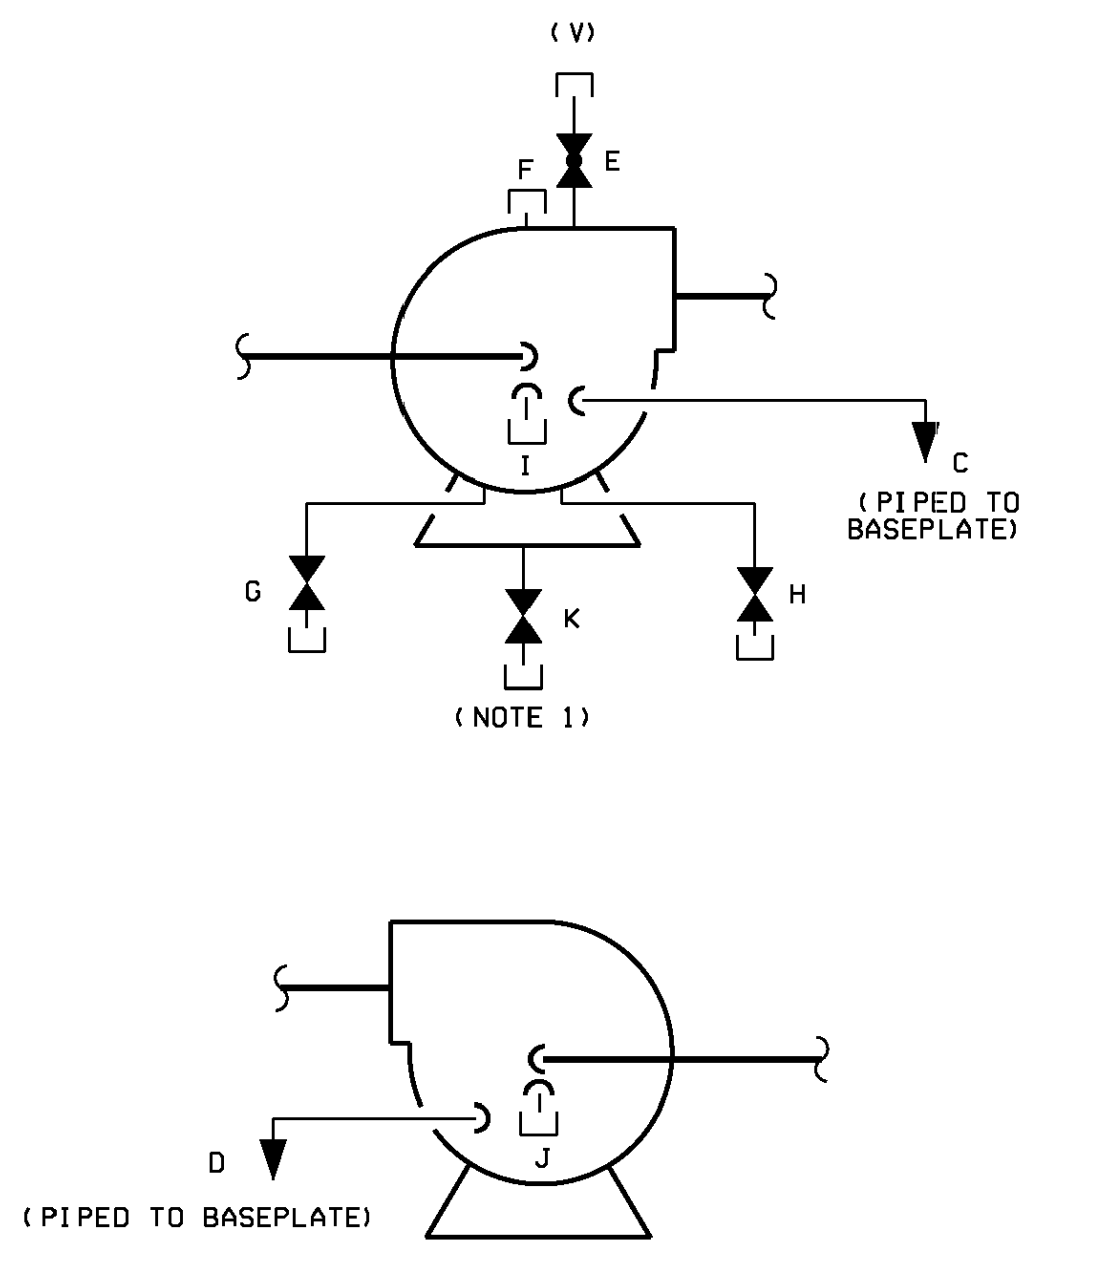

CONN.	PUMP	VALVE NO.	LINE NO.	PURPOSE
C			288-HBC-3/4"	STUFF. BOX OVERFLOW
A			281-HBC-3/4"	STUFF. BOX OVERFLOW
B			282-HBC-3/4"	STUFF. BOX OVERFLOW
D			283-HBC-3/4"	STUFF. BOX OVERFLOW
D			284-HBC-3/4"	STUFF. BOX OVERFLOW
C			285-HBC-3/4"	STUFF. BOX OVERFLOW
B			286-HBC-3/4"	STUFF. BOX OVERFLOW
D			287-HBC-3/4"	STUFF. BOX OVERFLOW
E		V8297		CASING VENT
A		V8299		CASING VENT
B		V8301		CASING VENT
D		V8303		CASING VENT
F	ALL	PLUGGED		CASING PRIME
G	A	V8343	288-HBC-3/4"	CASING DRAIN
	B	V8344	289-HBC-3/4"	CASING DRAIN
	C	V8345	290-HBC-3/4"	CASING DRAIN
	D	V8346	291-HBC-3/4"	CASING DRAIN
H	A	V8347	292-HBC-3/4"	CASING DRAIN
	C	V8348	293-HBC-3/4"	CASING DRAIN
	B	V8349	294-HBC-3/4"	CASING DRAIN
	D	V8350	295-HBC-3/4"	CASING DRAIN
I	ALL	PLUGGED		OIL DRAIN
J	ALL	PLUGGED		OIL DRAIN
K	A	V8298	274-HBC-1"	BASEPLATE DRAIN
	C	V8300	275-HBC-1"	BASEPLATE DRAIN
	B	V8302	276-HBC-1"	BASEPLATE DRAIN
	D	V8304	277-HBC-1"	BASEPLATE DRAIN

NOTES

- ALL CAPPED DRAINS; DRAIN TO PORTABLE CONTAINER OR TO THE COMPONENT COOLING WATER SURGE TANK VIA PORTABLE PUMP.
- THE FOLLOWING APPLIES TO ALL VENTS, DRAINS, LOCAL SAMPLES, FLUSH CONNECTIONS, TEST CONNECTIONS AND FLOW TAPS:
 - 3. DELETED
 - 4. PUMP MOTOR DRIVING END BEARING TEMPERATURE (THERMOCOUPLE)
 - 5. PUMP MOTOR OUTBOARD END BEARING TEMPERATURE (THERMOCOUPLE)
 - 6. DELETED
 - 7. DELETED
 - 8. DELETED
 - 9. REMOVABLE SPOOL WITH SPACER RING INSTALLED. (REPLACEMENT FOR START-UP STRAINER)
 - 10. TEST CONNECTION AND/OR VENT INSTALLED WITH CAM AND GROOVE ADAPTER AND DUST CAP WITH SUN-N-V GASKET.
 - 11. PER GENERAL NOTE 4.G.2 OF MS-82 WHICH STATES "FOR REASONS OF ECONOMY AND INTERCHANGEABILITY, THE USE OF VALVE(S) MANUFACTURED AT A HIGHER QUALITY GROUP AND PRESSURE RATING THAN SPECIFIED VALVE CLASS IN THE PIPING CLASS SHEET IS AN ACCEPTABLE ALTERNATE". VENT VALVE ASSEMBLIES SHALL BE FABRICATED WITH STAINLESS STEEL PIPING AND VALVES.



USAR FIG. 9.2-15-01

ESSENTIAL DRAWING

REVISED INCORPORATED
 ISSUED CHG. DOC.

THIS DNG. SUPERSEDES BY REV. THIS DNG. SUPERSEDES BY REV.

REVISION NOTES: REVISED TO REMOVE TMO 13-01-EG

WOLF CREEK
 NUCLEAR OPERATING CORPORATION


ELECTRONIC APPROVAL

PIPING & INSTRUMENTATION DIAGRAM COMPONENT COOLING WATER SYSTEM

SCALE: NONE DRAWING NUMBER: M-12EG01 SHEET: 24 OF 24

DATE: 11/13/01



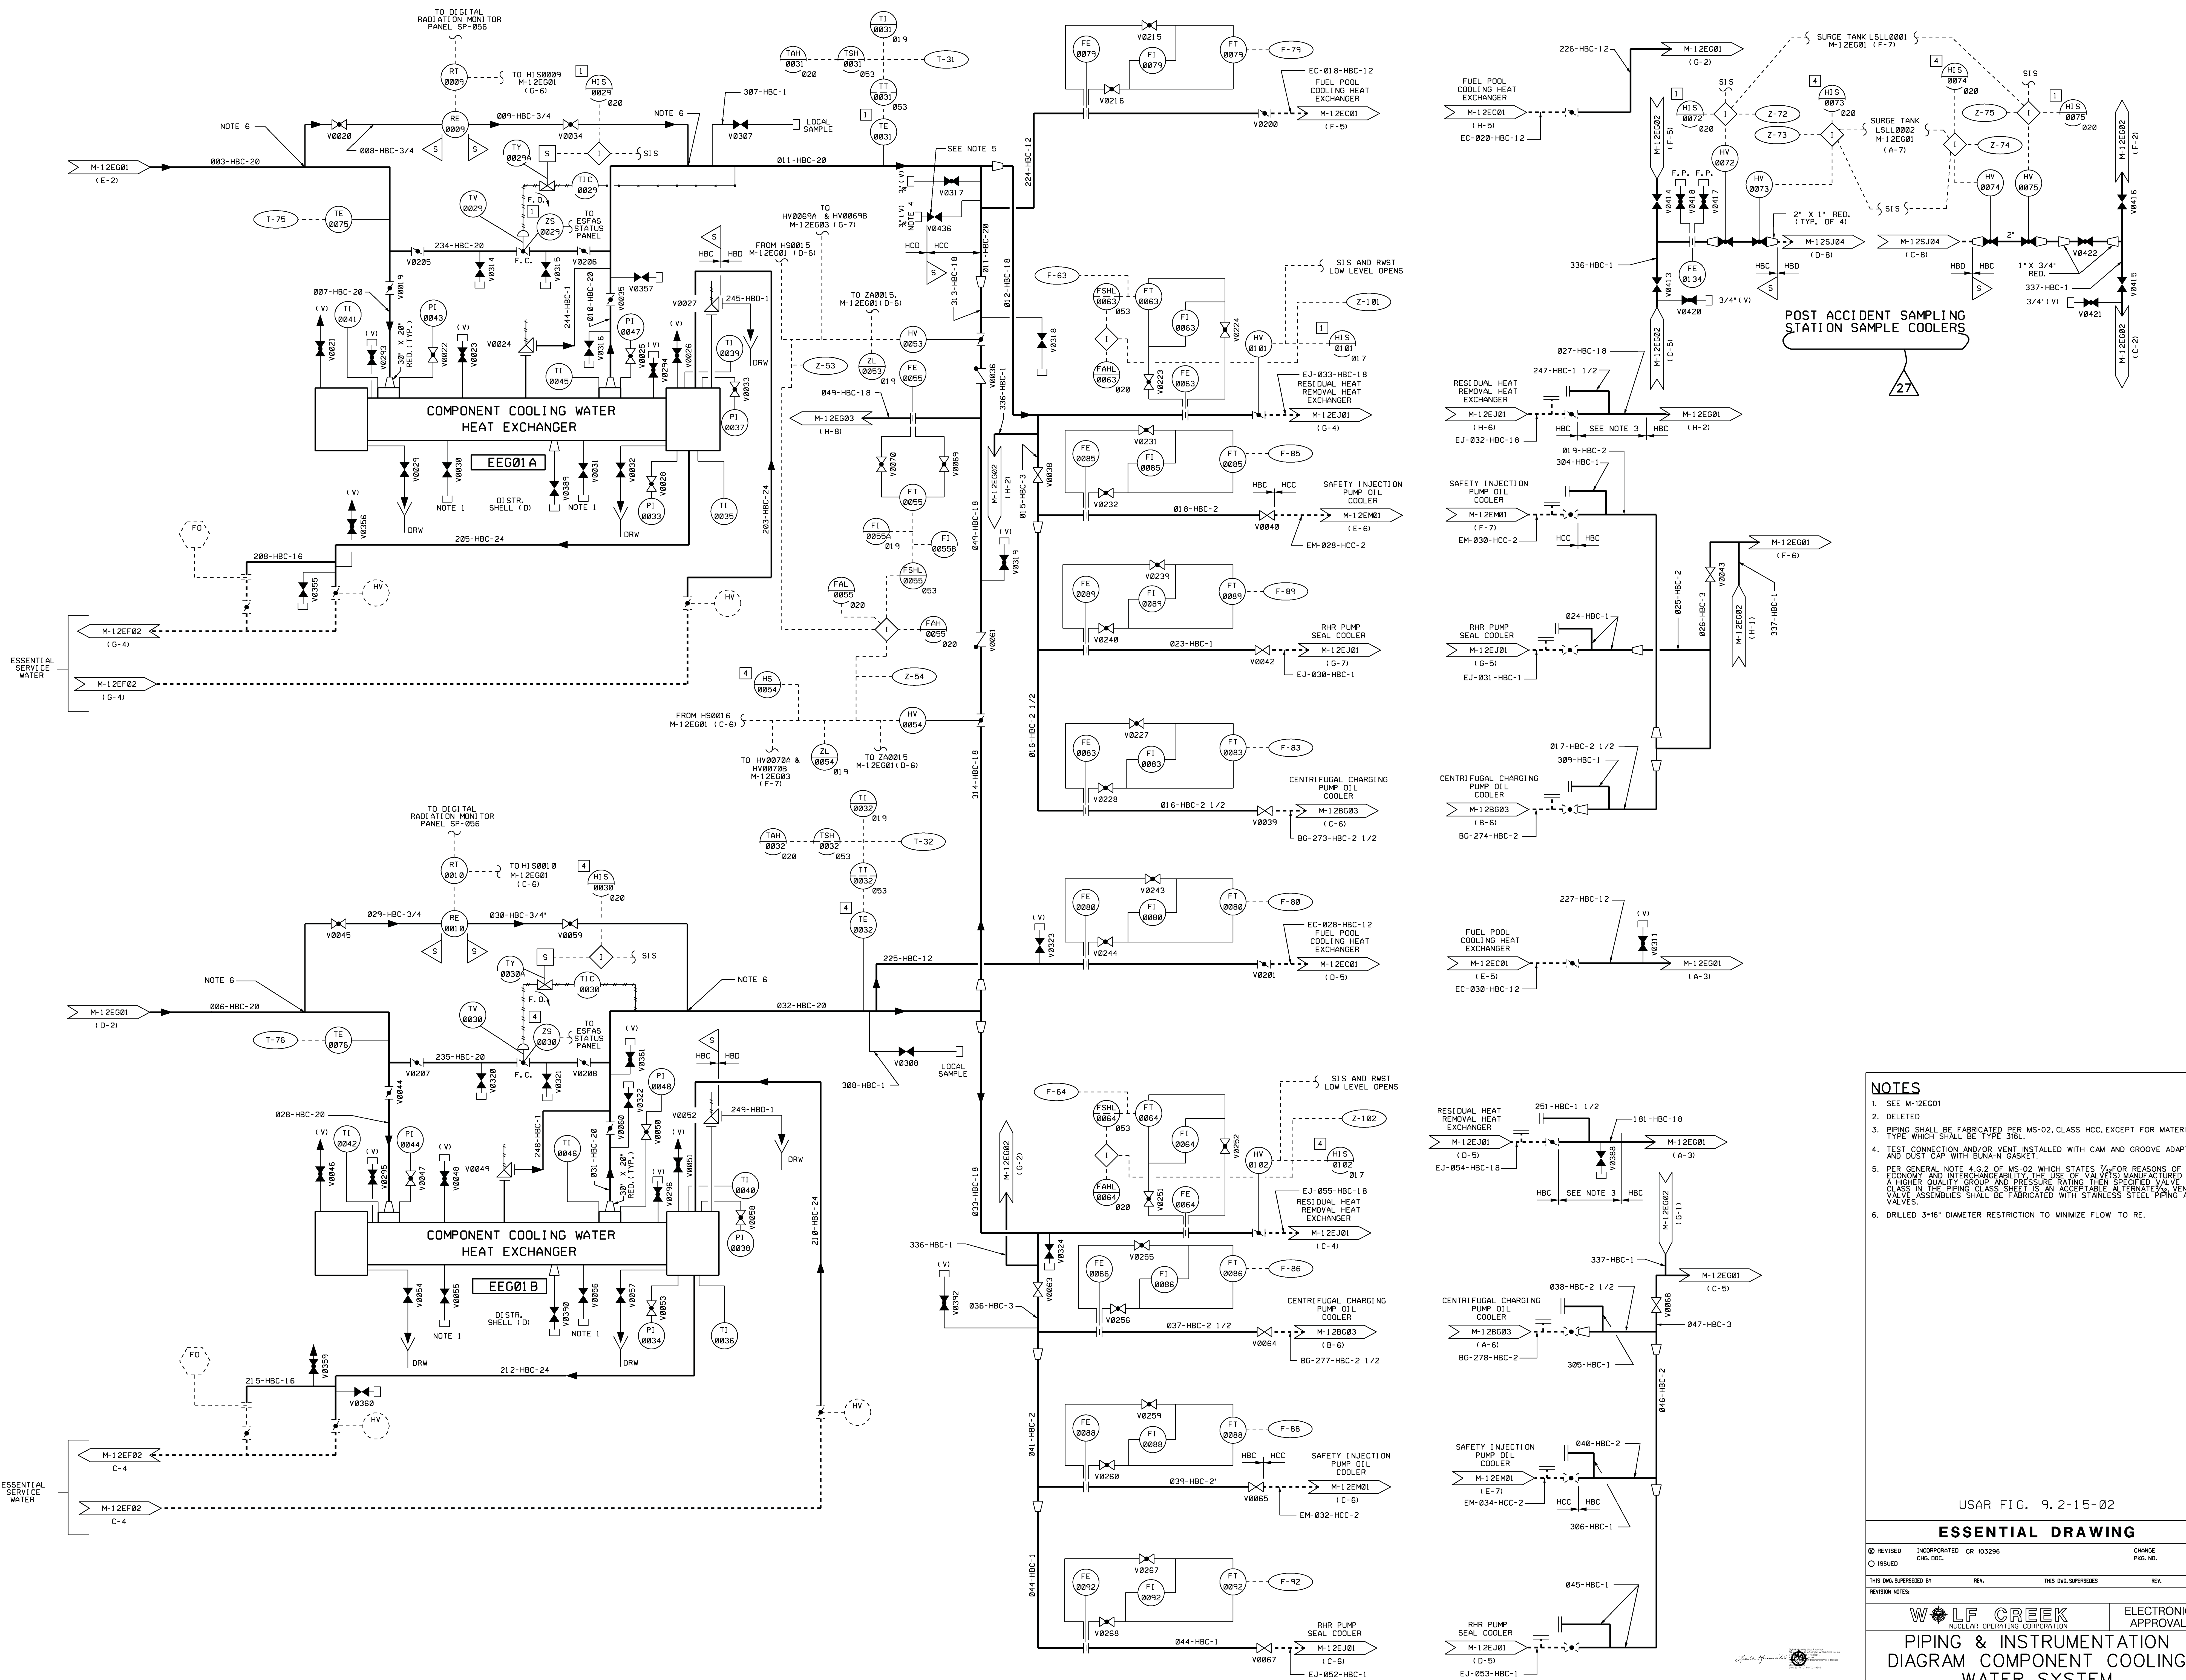

- NOTES**
1. SEE M-12EG01
 2. DELETED
 3. PIPING SHALL BE FABRICATED PER MS-02, CLASS HCC, EXCEPT FOR MATERIAL TYPE WHICH SHALL BE TYPE 316L
 4. TEST CONNECTION AND/OR VENT. INSTALLED WITH CAM AND GROOVE ADAPTER AND DUST CAP WITH BUNA-N GASKET.
 5. PER GENERAL NOTE 4.G.2 OF MS-02, WHICH STATES: "FOR REASONS OF ECONOMY AND INTERCHANGEABILITY, THE USE OF VALVES MANUFACTURED AT A HIGHER QUALITY GROUP AND PRESSURE RATING THAN SPECIFIED VALVE CLASS IN THE PIPING CLASS SHEET IS AN ACCEPTABLE ALTERNATE. VENT VALVE ASSEMBLIES SHALL BE FABRICATED WITH STAINLESS STEEL PIPING AND VALVES."
 6. DRILLED 3/16" DIAMETER RESTRICTION TO MINIMIZE FLOW TO RE.

USAR FIG. 9.2-15-02

ESSENTIAL DRAWING

REVISED	INCORPORATED	CR 103296	CHANGE
ISSUED	CHG. DEC.		PKG. NO.
THIS DWG. SUPERSEDES		REV.	THIS DWG. SUPERSEDES
REVISION NOTES			


WOLF CREEK
NUCLEAR OPERATING CORPORATION

ELECTRONIC APPROVAL

**PIPING & INSTRUMENTATION
DIAGRAM COMPONENT COOLING
WATER SYSTEM**

SCALE	DRAWING NUMBER	SHEET	REV
NONE	M-12EG02	27	27

34X44 E SIZE

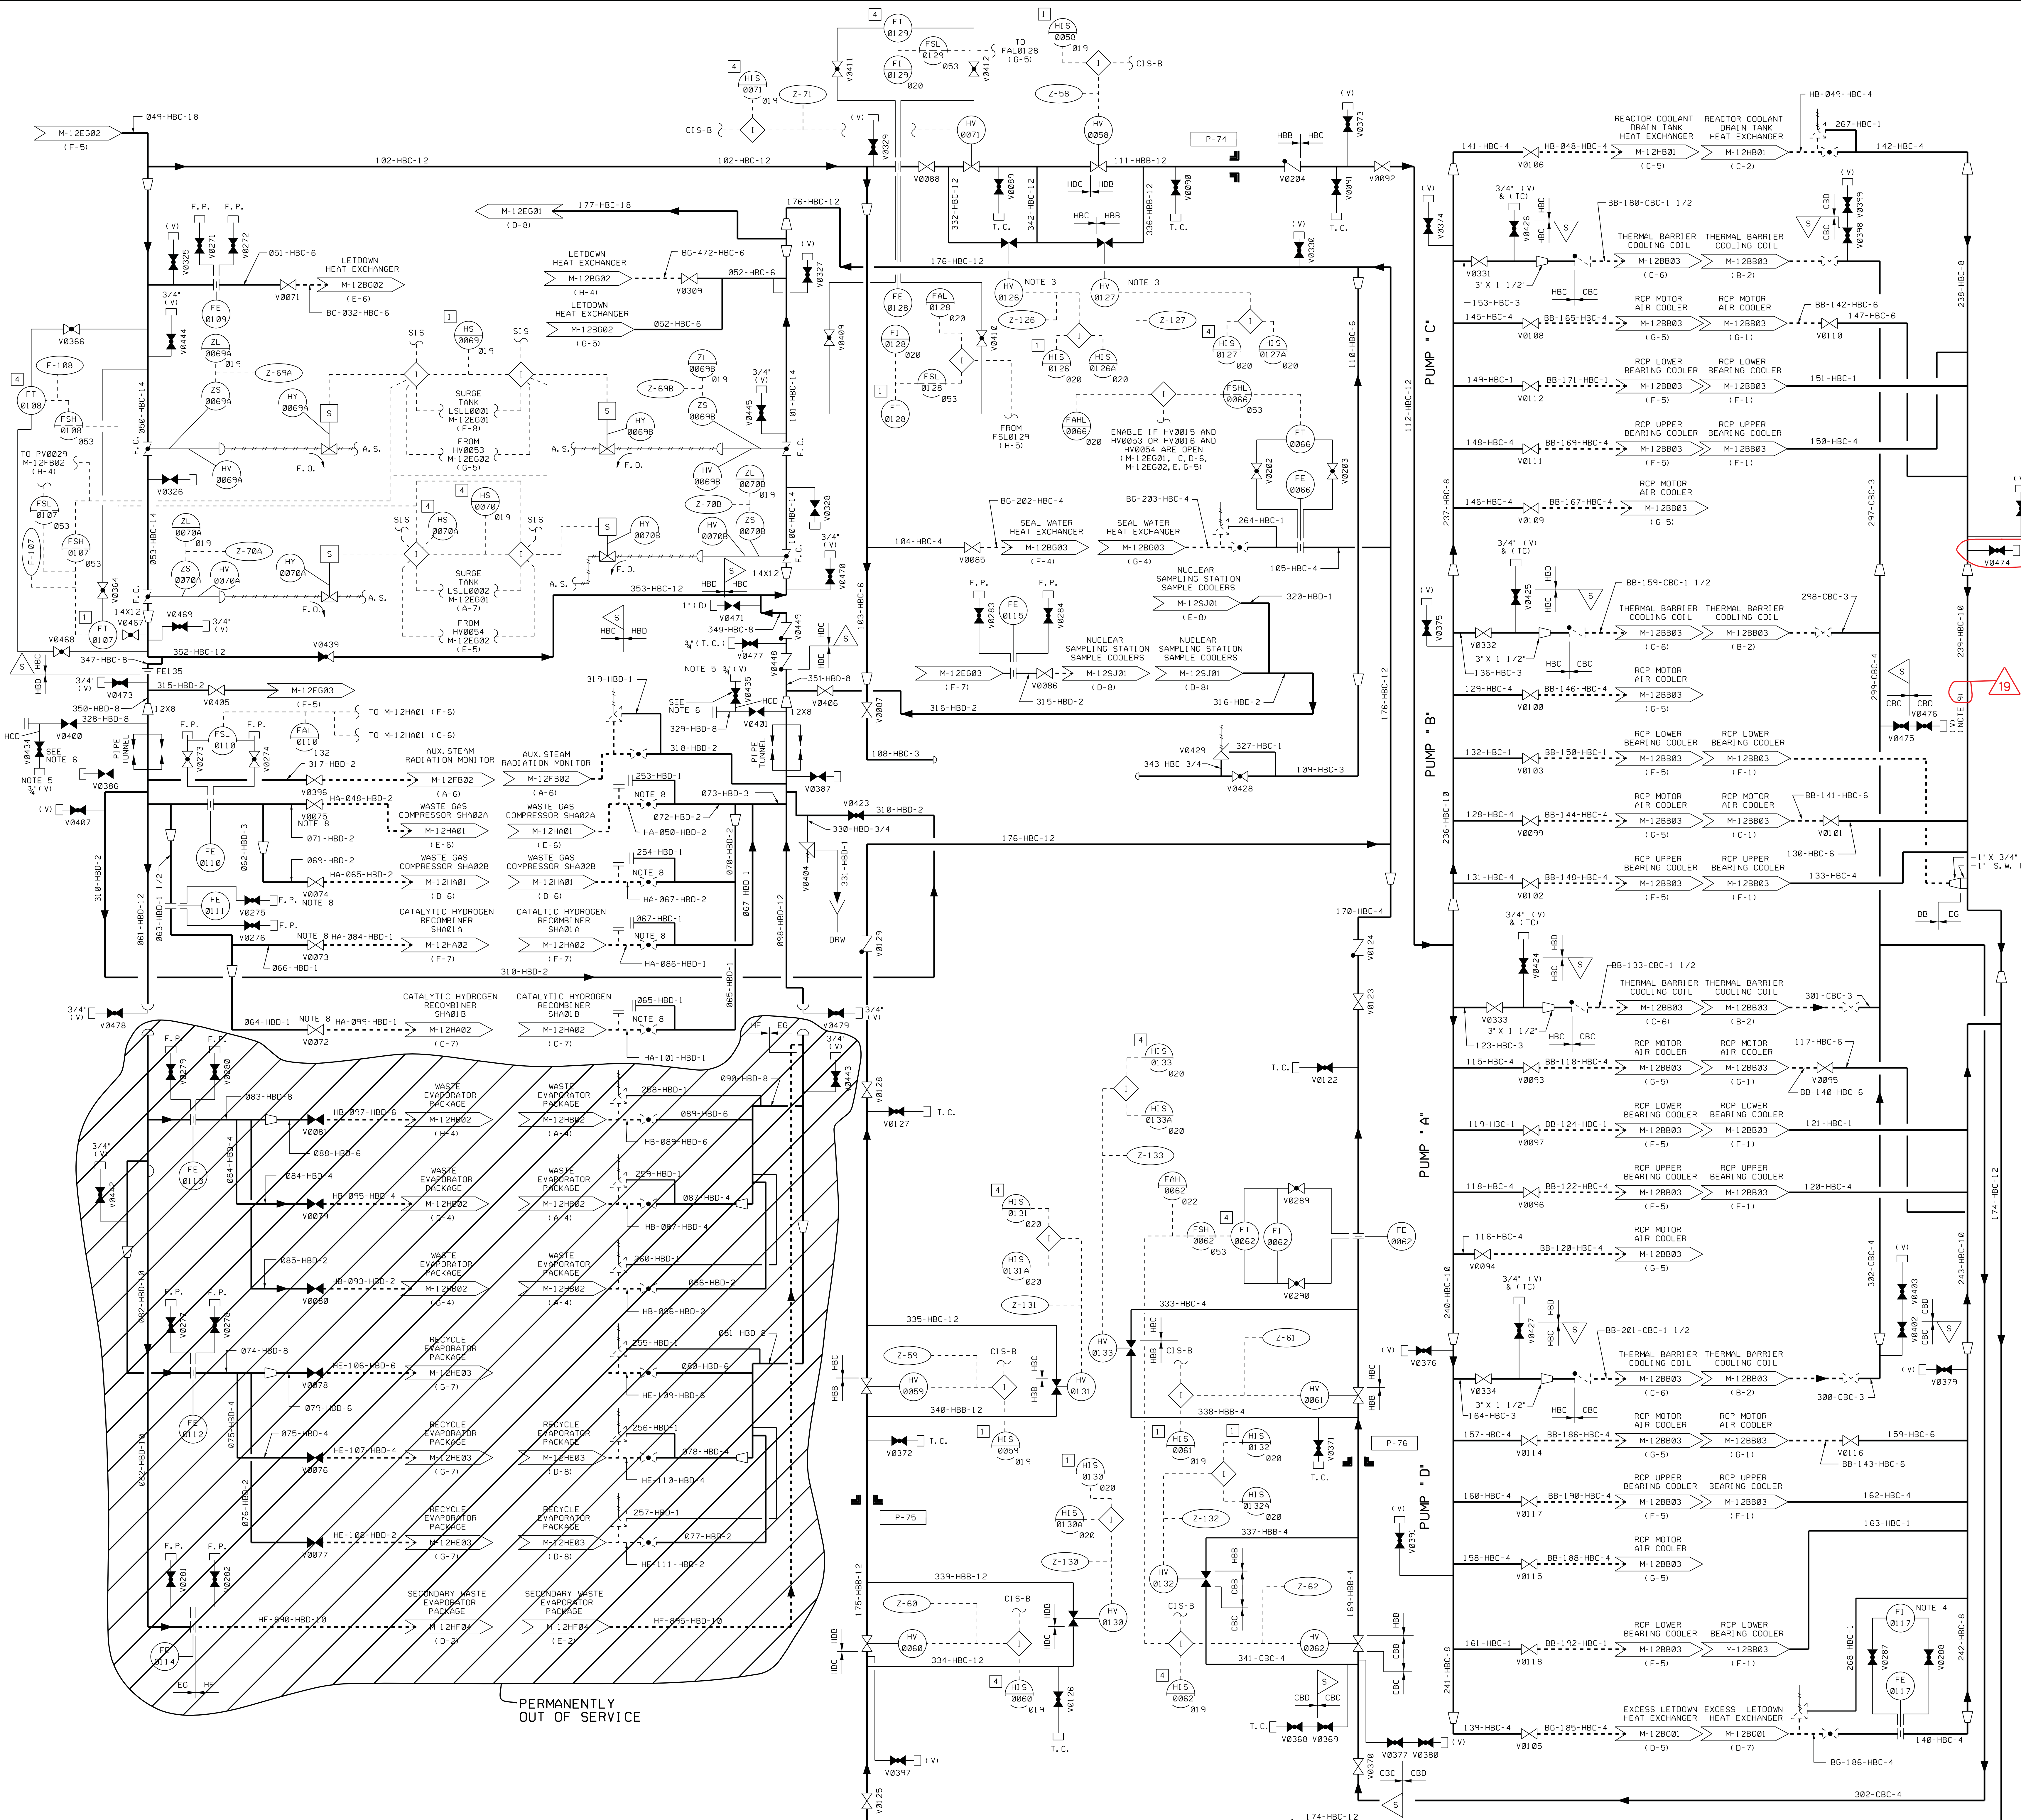

- NOTES**
- SEE M-12EG01
 - SEISMIC ANALYSIS AND SUPPORTS FOR PIPING EXTEND BEYOND THE INSTRUMENT CONNECTION FOR FT0187.
 - ISOLATION SWITCH PROVIDED IN THE CONTROL ROOM FOR POWER LOCKOUT OF VALVES HV0126, HV0127, HV0130, HV0132, AND HV0133. A CIS-B SIGNAL IS NOT REQUIRED FOR CLOSURE OF THESE VALVES SINCE THEY ARE MAINTAINED CLOSED.
 - FLOW INDICATOR EGF010117 IS ABANDONED IN PLACE.
 - TEST CONNECTION AND/OR VENT INSTALLED WITH CAM AND GROOVE ADAPTER AND DUST CAP WITH BUNA-N GASKET.
 - PER GENERAL NOTE 4.6.2 OF MS-02 WHICH STATES "FOR REASONS OF ECONOMY AND INTERCHANGEABILITY, THE USE OF VALVES MANUFACTURED AT A HIGHER QUALITY GROUP AND PRESSURE RATING THAN SPECIFIED VALVE CLASS IN THE PIPING CLASS SHEET IS AN ACCEPTABLE ALTERNATE - VENT VALVE ASSEMBLIES SHALL BE FABRICATED WITH STAINLESS STEEL PIPING AND VALVES."
 - DELETED
 - IF BOTH INLET AND OUTLET HEAT EXCHANGER VALVES ARE CLOSED THEN OPEN AT LEAST ONE OF THE PP OR VENT VALVES IN-BETWEEN THEM TO RELIEVE ANY POSSIBLE THERMAL EXPANSION.
 - CAM AND GROOVE COUPLINGS MAY BE SUBSTITUTED FOR THE PIPE CAPS IF DESIRED BY THE SYSTEM ENGINEER. SEE DRAWING M-13EG09, DETAIL 10.

USAR FIG. 9.2-15-03


ESSENTIAL DRAWING

REVISED	INCORPORATED	WP-M-12EG03-012-A-1	CHANGE	014173
ISSUED	CHG. DOC.			PKG. NO.
THIS Dwg. SUPERSEDES	REV.		THIS Dwg. SUPERSEDES	REV.

WOLF CREEK NUCLEAR OPERATING CORPORATION ELECTRONIC APPROVAL

PIPING AND INSTRUMENTATION DIAGRAM
COMPONENT COOLING WATER SYSTEM

SCALE	DRAWING NUMBER	SHEET	REV
NONE	M-12EG03	19	

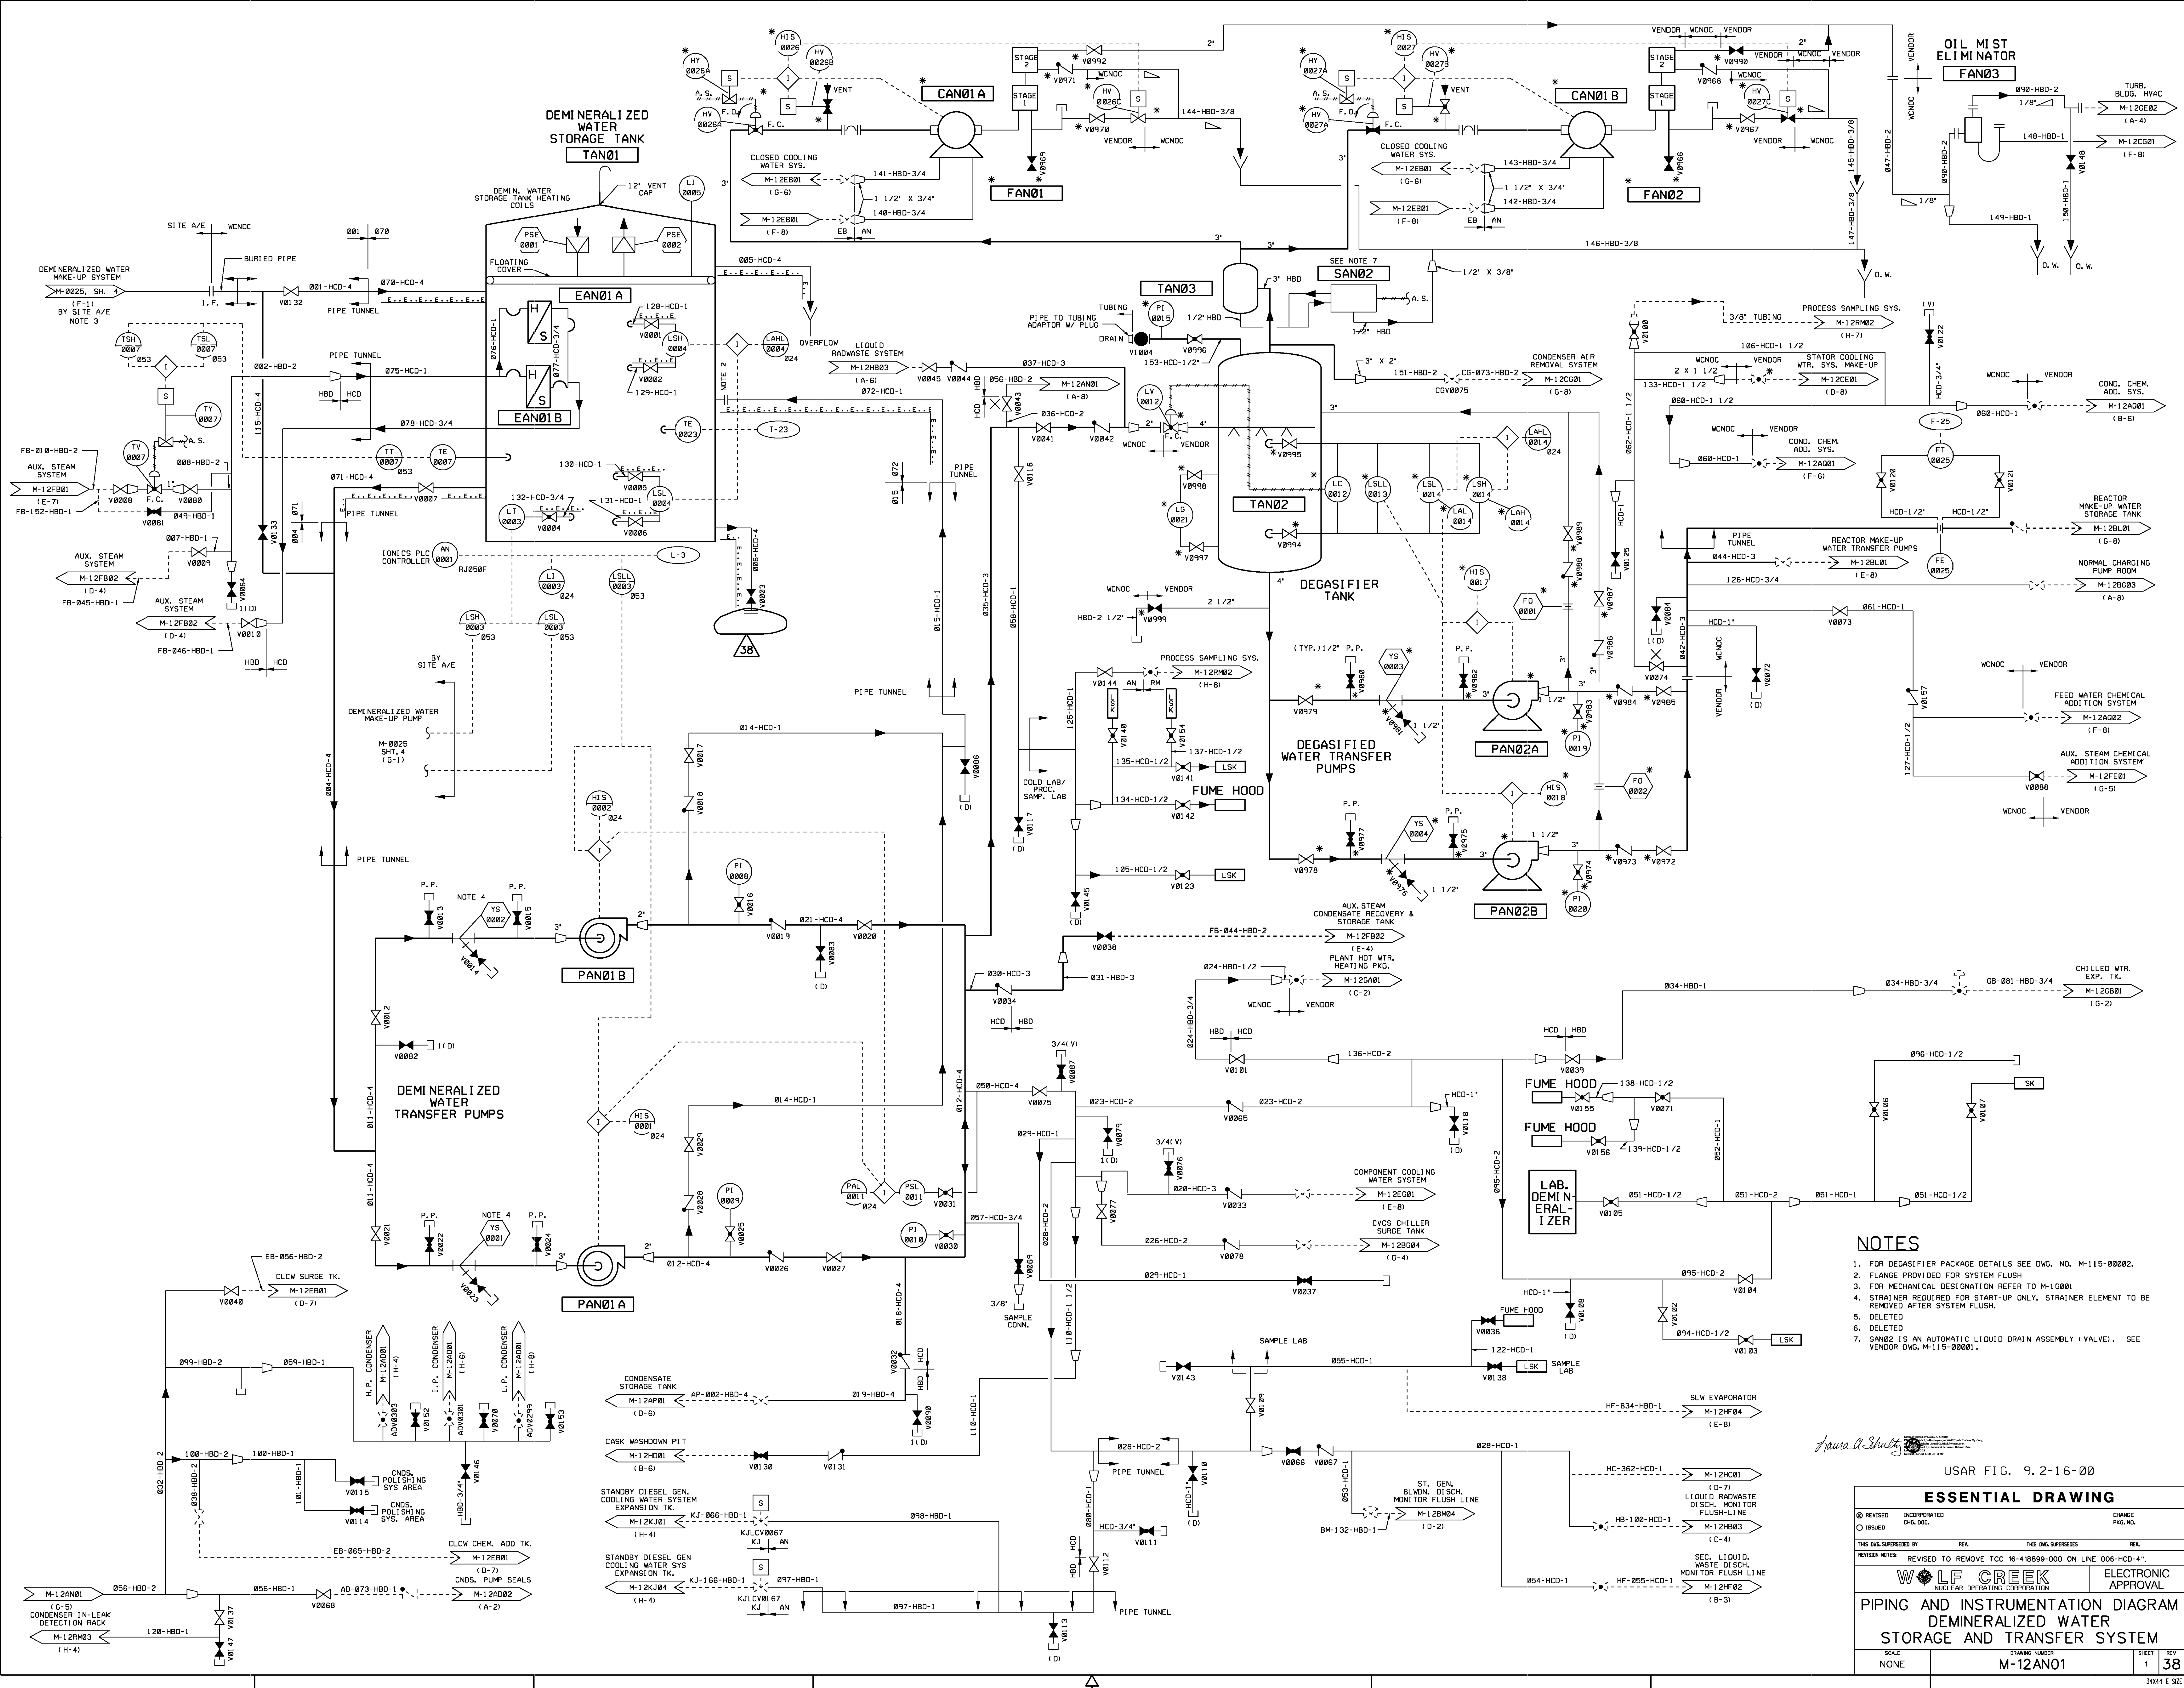

USAR FIG. 9.2-16-00

ESSENTIAL DRAWING

REVISED	INCORPORATED	CHANGE
ISSUED	ENG. DOC.	PKG. NO.

THIS DWG SUPERSEDES: REV. THIS DWG SUPERSEDES: REV.

REVISION NOTES: REVISED TO REMOVE TCC 16-14899-000 ON LINE 006-HCD-4'.


WOLF CREEK
NUCLEAR OPERATING CORPORATION

ELECTRONIC APPROVAL



PIPING AND INSTRUMENTATION DIAGRAM
DEMINERALIZED WATER
STORAGE AND TRANSFER SYSTEM

SCALE: NONE	DRAWING NUMBER: M-12AN01	SHEET: 1	REV: 38
-------------	--------------------------	----------	---------

34X44 E SIZE

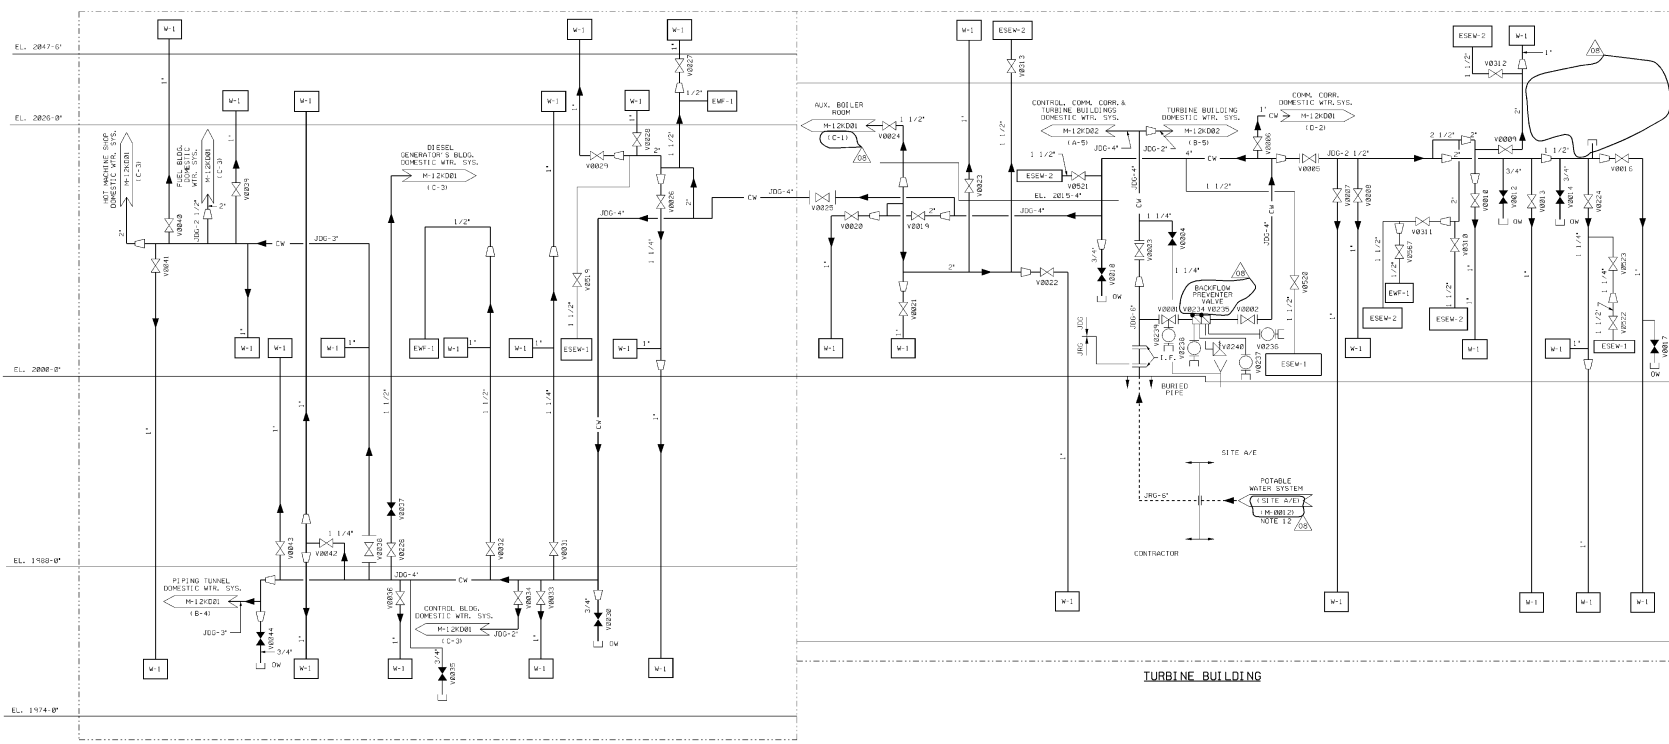


- NOTES**
1. PIPING, VALVES AND OTHER COMPONENTS AS INDICATED FOR THE DOMESTIC WATER SYSTEM SHALL BE FURNISHED, INSTALLED, CLEANED AND TESTED BY THE CONTRACTOR IN ACCORDANCE WITH THE DOMESTIC WATER SYSTEM AND THE APPLICABLE STATE AND/OR LOCAL CODE.
 2. FOR GENERAL NOTES, SYMBOLS, SCHEDULES, DETAILS AND SELECTION OF BRANCH SERVING INDIVIDUAL APPLIANCES, SEE SPEC. NO. M-12KDD1 AND M-12KDD2.
 3. FOR DOMESTIC WATER SYSTEM PIPING, VALVES, AND FITTINGS MATERIAL SEE SPEC. NO. A-208 AND M-12KDD1.
 4. FOR PLUMBING FIXTURES SEE SPEC. NO. A-208 AND M-12KDD1.
 5. SHOCK ABSORBERS SHALL BE INSTALLED ON COLD AND HOT WATER SUPPLIES TO ALL BRANCH FITTINGS AS SHOWN ON THE PIPING DWG. AIR CHARGES SHALL BE INSTALLED ON COLD AND HOT WATER SUPPLIES TO STORAGE TANKS AND PIPES.
 6. DOMESTIC WATER HEATERS SHALL BE SUPPLIED WITH EQUIPMENT INDICATED ON M-12KDD1. SEE SPEC. M-12KDD1.
 7. SEE DWG. M-12KDD1 FOR WASHDOWN (W-1) DETAILS.
 8. SHOCK ABSORBERS AND PRESSURE REGULATING VALVES SHALL BE INSTALLED AS SHOWN ON DWGS. M-12KDD1 AND M-12KDD2.
 9. SHOWERS TO BE USED FOR OTHER THAN EMERGENCY PURPOSES SHALL BE EQUIPPED WITH FLOW CONTROL DEVICES WHICH WILL LIMIT THE TOTAL FLOW THROUGH THE SHOWER HEAD TO A MAXIMUM OF 2.0 GPM, IN ACCORDANCE WITH THE WISCONSIN ADMINISTRATIVE CODE, MW 115.05.
10. DELETE

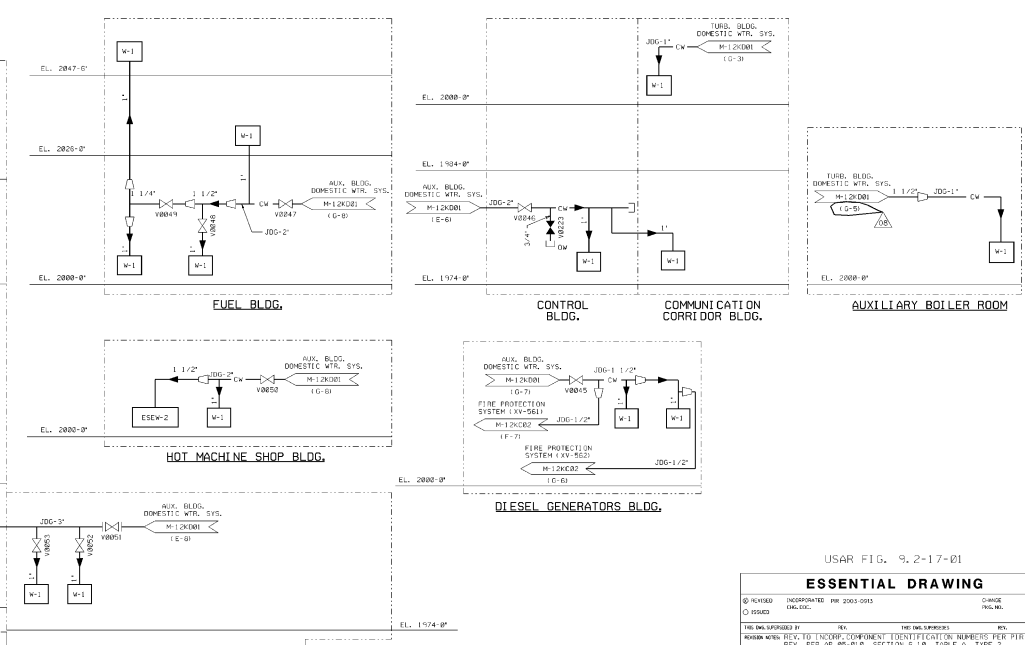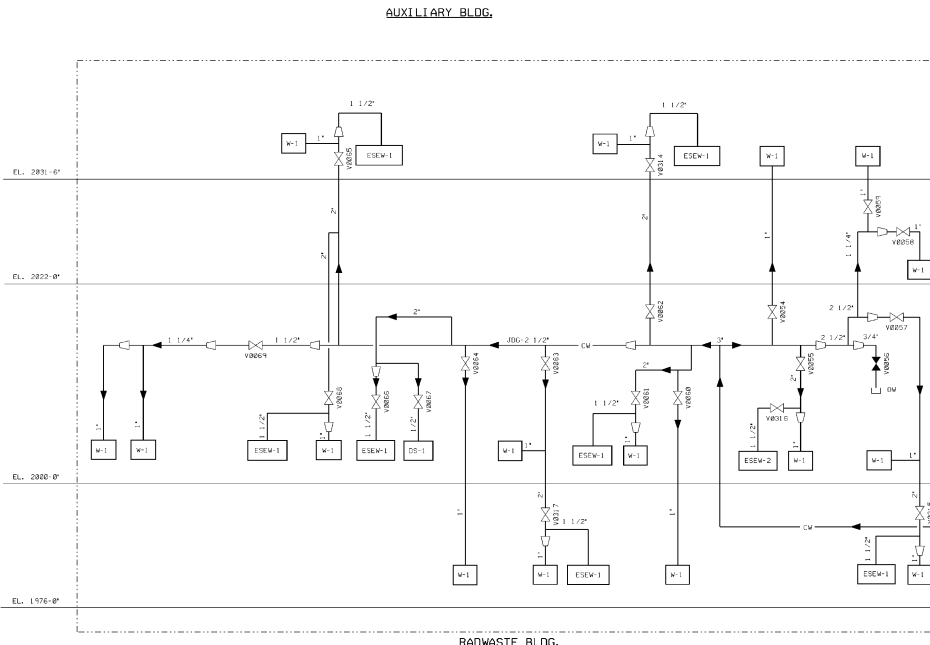

USAR FIG. 9.2-17-B1

ESSENTIAL DRAWING			
© 1990 INCORPORATED	REV. 2003 0015	DATE	REV.
© 2003			
THIS DWG. SUPPLIED BY:		NO. (DWG. NUMBER)	
SHOW WORK HERE TO INCORPORATE IDENTIFICATION NUMBER PER FIG. A REV. PER AP. 9.0.1.6. SECTION 5.1.1. TABLE A, TYPE 2			
		ELECTRONIC APPROVAL	
		APPROVAL	
PIPING & INSTRUMENTATION DIAGRAM			
DOMESTIC WATER SYSTEM			
SCALE	DWG. NUMBER	SHEET NO.	TOTAL SHEETS
NONE	M-12KDD1	08	08

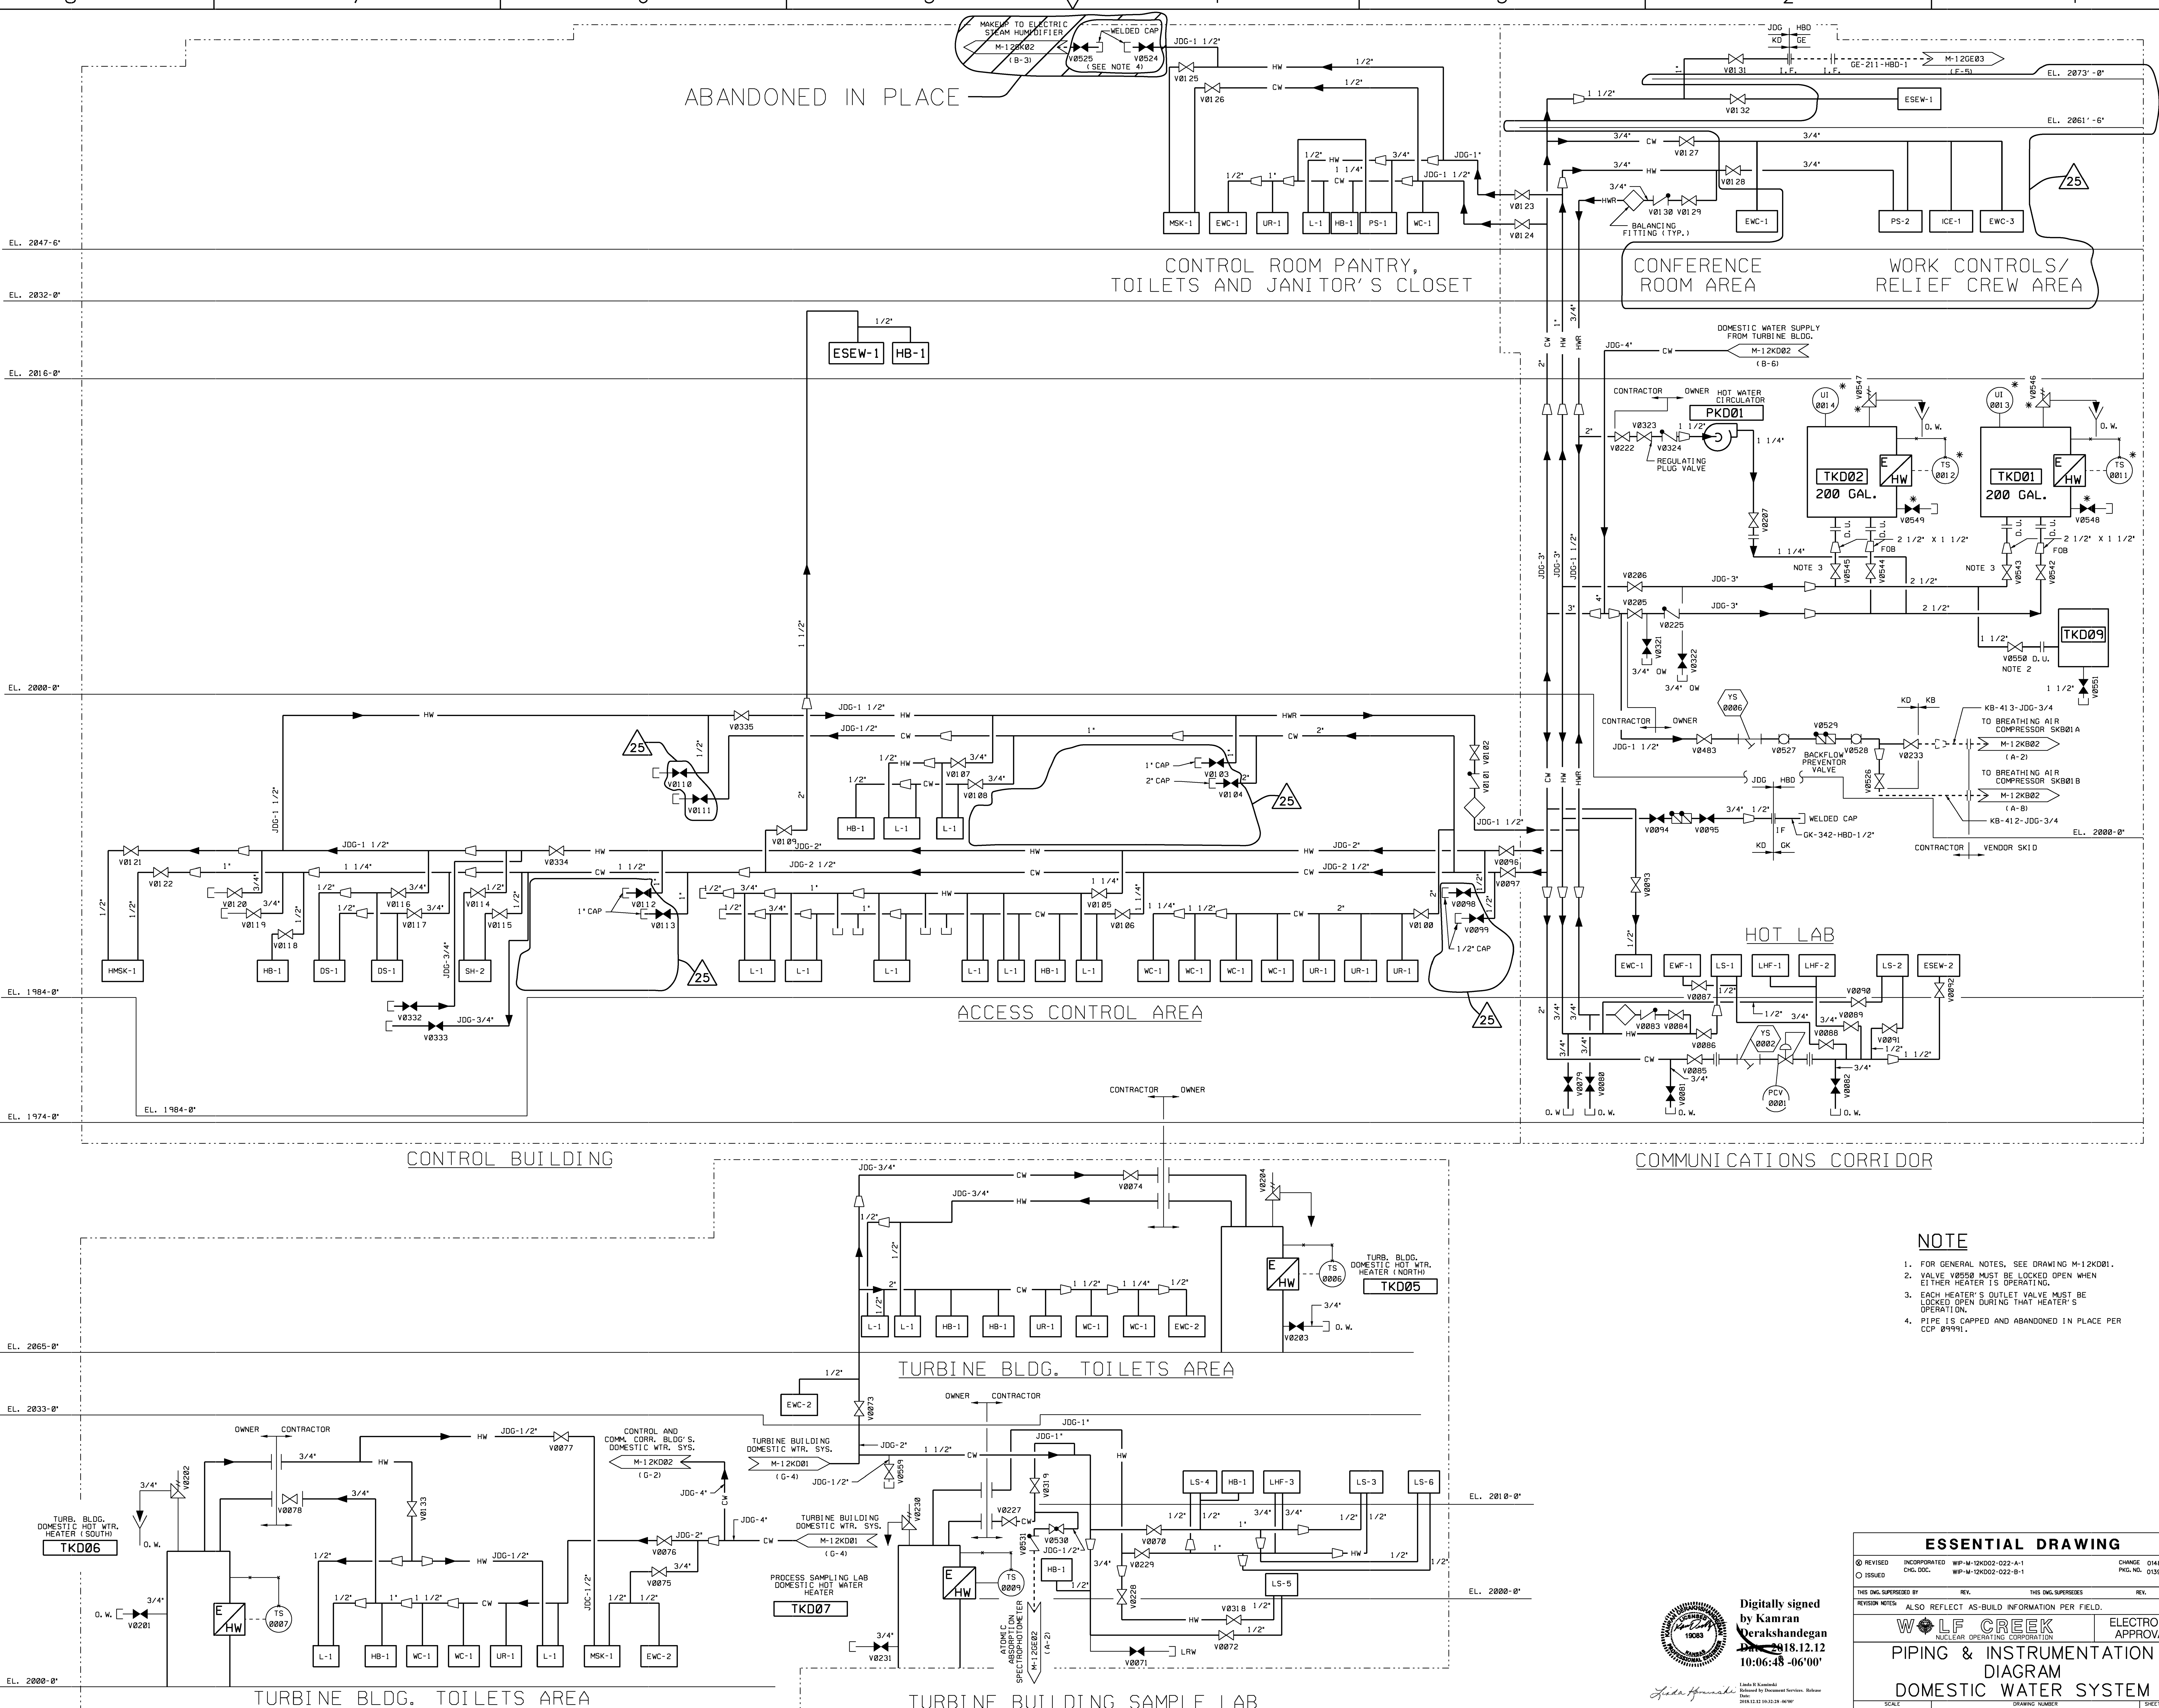

ABANDONED IN PLACE

CONTROL ROOM PANTRY,
TOILETS AND JANITOR'S CLOSET

CONFERENCE
ROOM AREA

WORK CONTROLS/
RELIEF CREW AREA

ACCESS CONTROL AREA

HOT LAB

CONTROL BUILDING

COMMUNICATIONS CORRIDOR

TURBINE BLDG. TOILETS AREA

TURBINE BLDG. TOILETS AREA

TURBINE BUILDING SAMPLE LAB

NOTE

1. FOR GENERAL NOTES, SEE DRAWING M-12KD01.
2. VALVE V0550 MUST BE LOCKED OPEN WHEN EITHER HEATER IS OPERATING.
3. EACH HEATER'S OUTLET VALVE MUST BE LOCKED OPEN DURING THAT HEATER'S OPERATION.
4. PIPE IS CAPPED AND ABANDONED IN PLACE PER CCP 09991.

ESSENTIAL DRAWING

REVISED	INCORPORATED	WP-M-12KD02-022-A-1	CHANGE	014806
ISSUED	CIG. DOC.	WP-M-12KD02-022-B-1	PKG. NO.	013979

THIS DWG. SUPERSEDES: REV. THIS DWG. SUPERSEDES: REV.
REVISION NOTES: ALSO REFLECT AS-BUILD INFORMATION PER FIELD.

Digitally signed
by **Kamran Qerakshandegan**
2018.12.12
10:06:48 -06'00'

Issued by Kamran Qerakshandegan
Reviewed by: [Signature]
2018.12.12 10:06:48 -06'00'

WOLF CREEK
NUCLEAR OPERATING CORPORATION
ELECTRONIC APPROVAL

**PIPING & INSTRUMENTATION
DIAGRAM
DOMESTIC WATER SYSTEM**


SCALE: NONE
DRAWING NUMBER: M-12KD02
SHEET: 25
REV: 25

NOTES

1. VENDOR PROCESSING CONNECTIONS (TYP. 3 PLCS).
2. PH GRAB SAMPLE POINT (TYP. 4 PLCS).
3. ALL VALVES (HV) AND BASIN MIXERS HAVE STATUS AND/OR CONTROL I/O SEE NOTE 3 AND DETAILS ON DWG. M-12WT03.
4. FLOATING SUCTION SHALL BE ADDED AT A LATER DATE.
5. ALL BURIED PROCESS PIPING SHALL BE INSTALLED IN ACCORDANCE WITH SPECIFICATION A-031.
6. PROCESS PIPING TO BE FURNISHED AND INSTALLED PER SPECIFICATION A-031 (UNLESS NOTED OTHERWISE).
7. FOR CATHODIC PROTECTION SEE S&L DRAWING E-0091 SH. 8.
8. DELETED
9. INSTRUMENT AND TUBING FIELD INSTALLATION TO BE IN ACCORDANCE WITH SPEC. A-3838 STD. M-138.1B.2.
10. DELETED

REFERENCE DRAWINGS


PROCESS FLOW DIAGRAM M-11WT01
P & ID M-12WT03

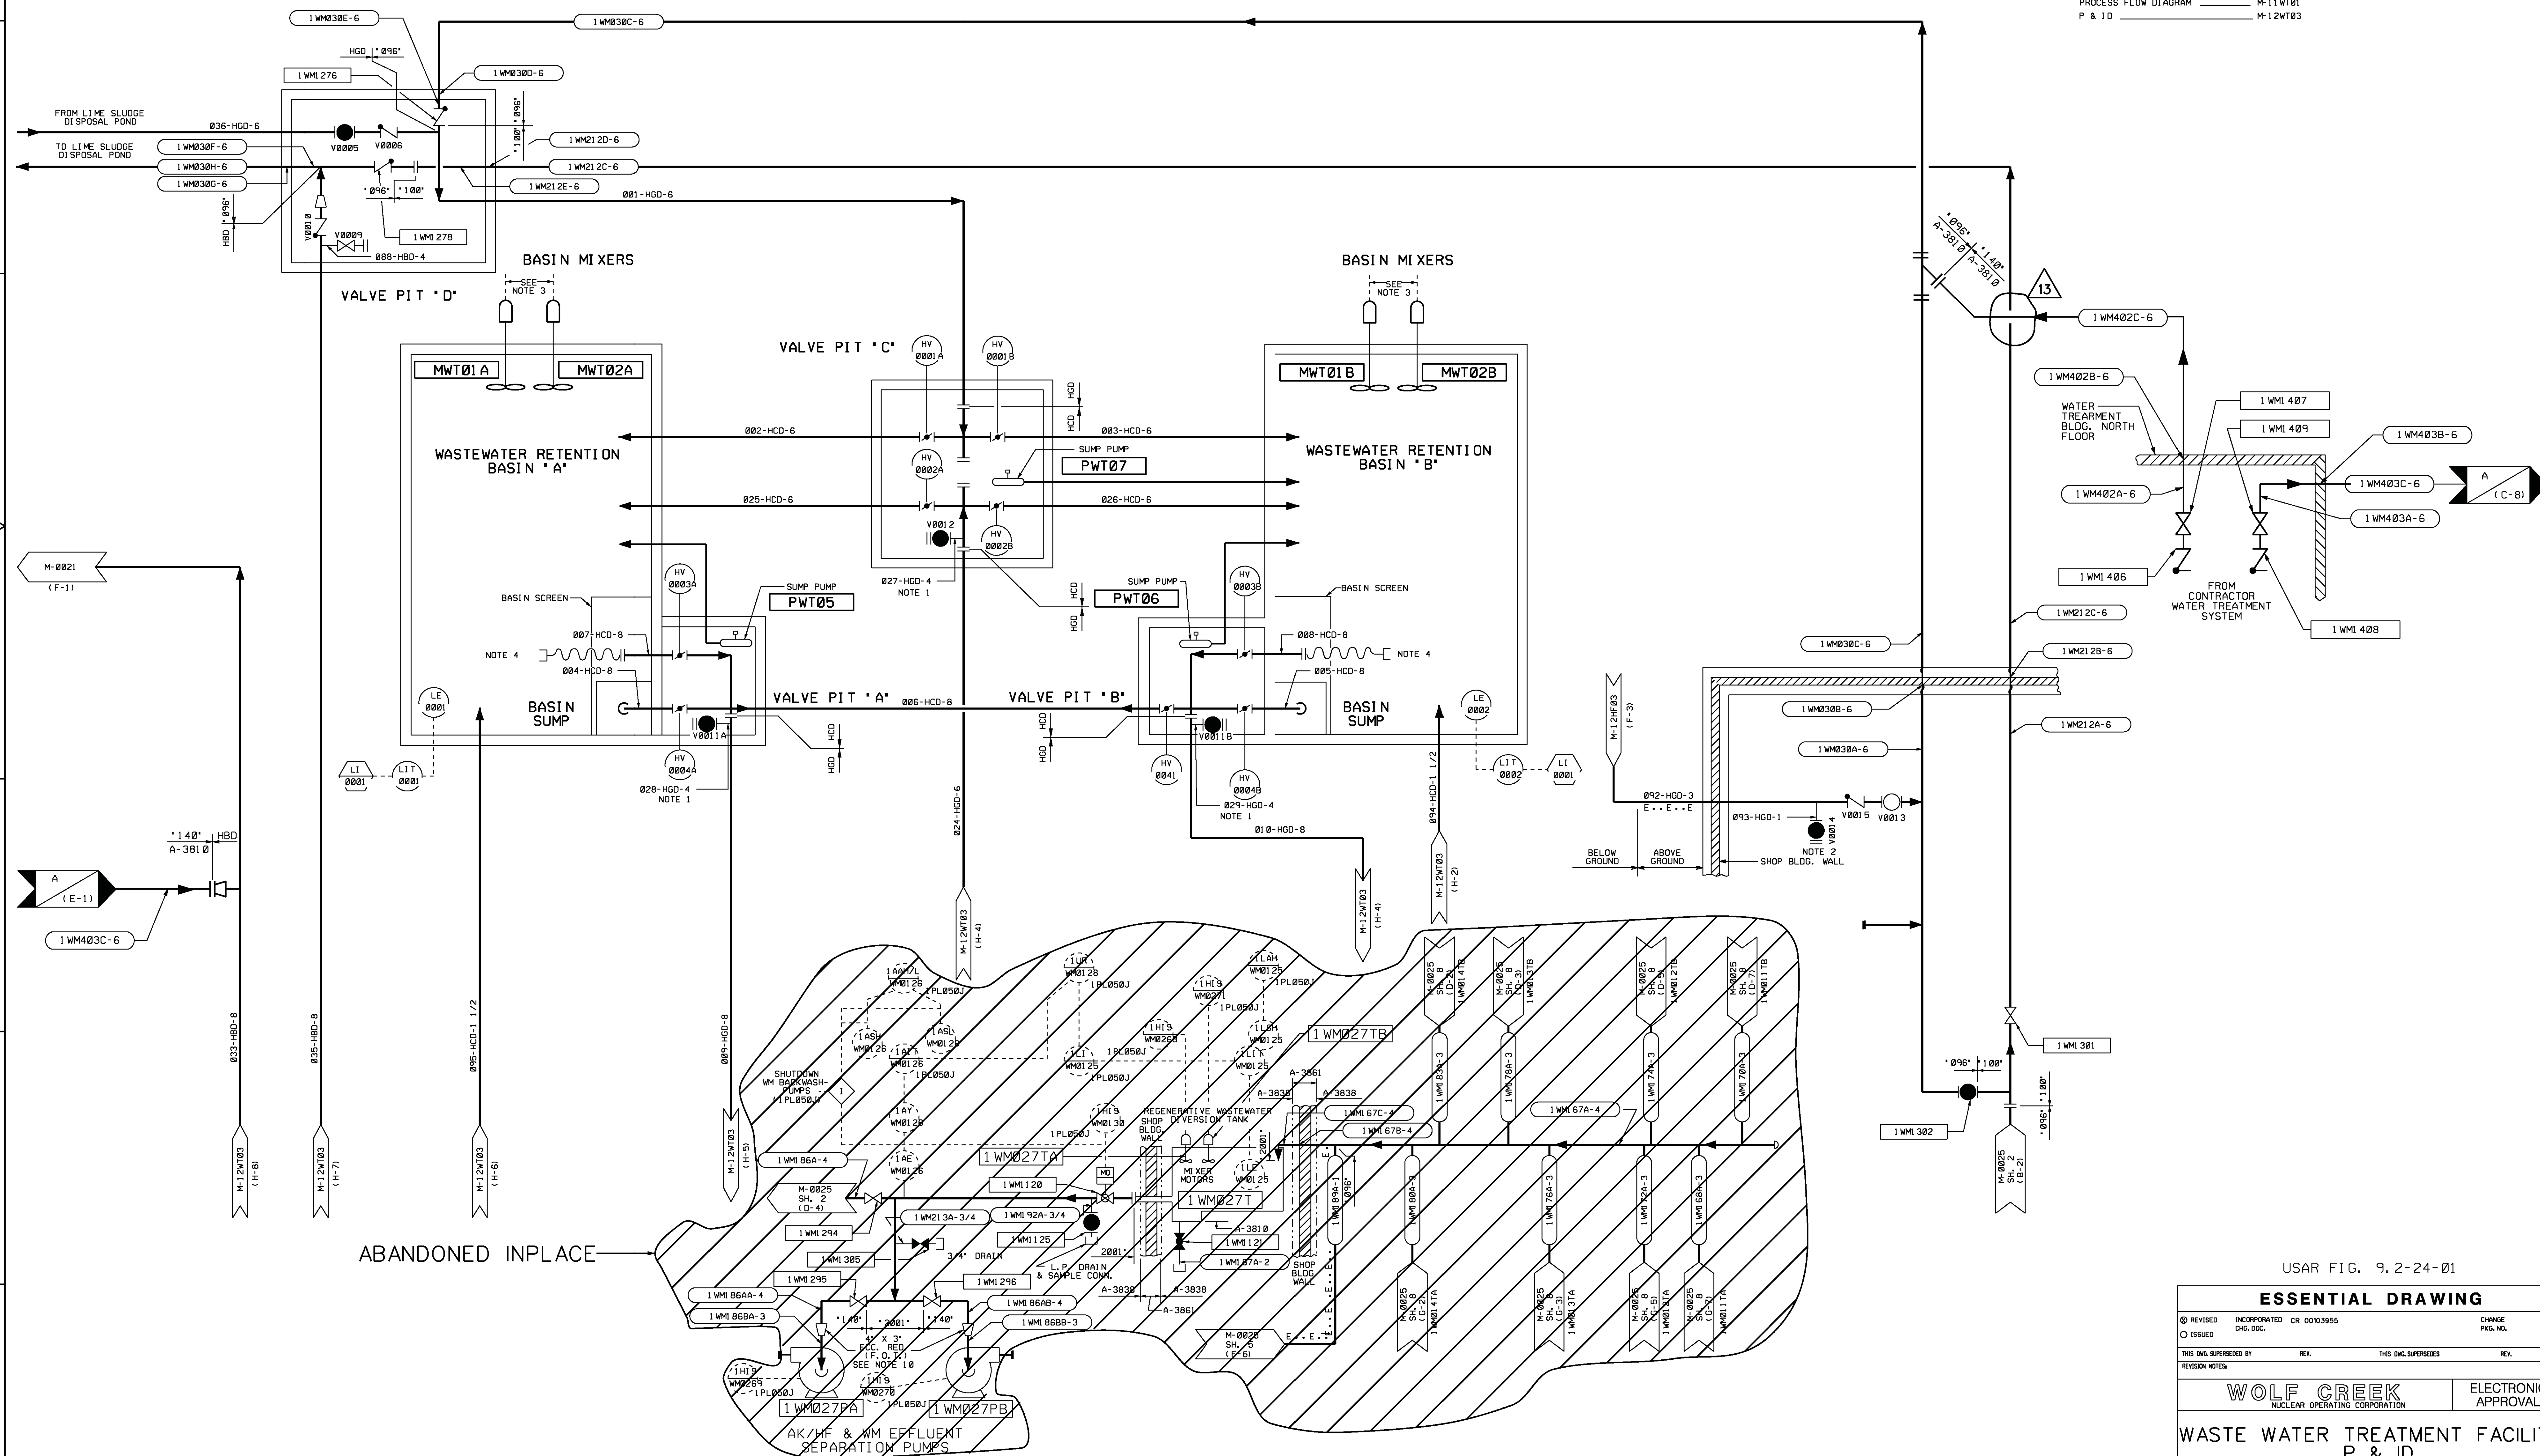

USAR FIG. 9.2-24-01

ESSENTIAL DRAWING

REVISED	INCORPORATED	CR 0003955	CHANGE
ISSUED	CHG. DOC.		PKG. NO.
THIS DWG SUPERSEDES		REV.	
REVISION NOTES			
WOLF CREEK		ELECTRONIC APPROVAL	
NUCLEAR OPERATING CORPORATION			
WASTE WATER TREATMENT FACILITY			
P & ID			
SCALE	DRAWING NUMBER	SHEET	REV
NONE	M-12WT01	13	13

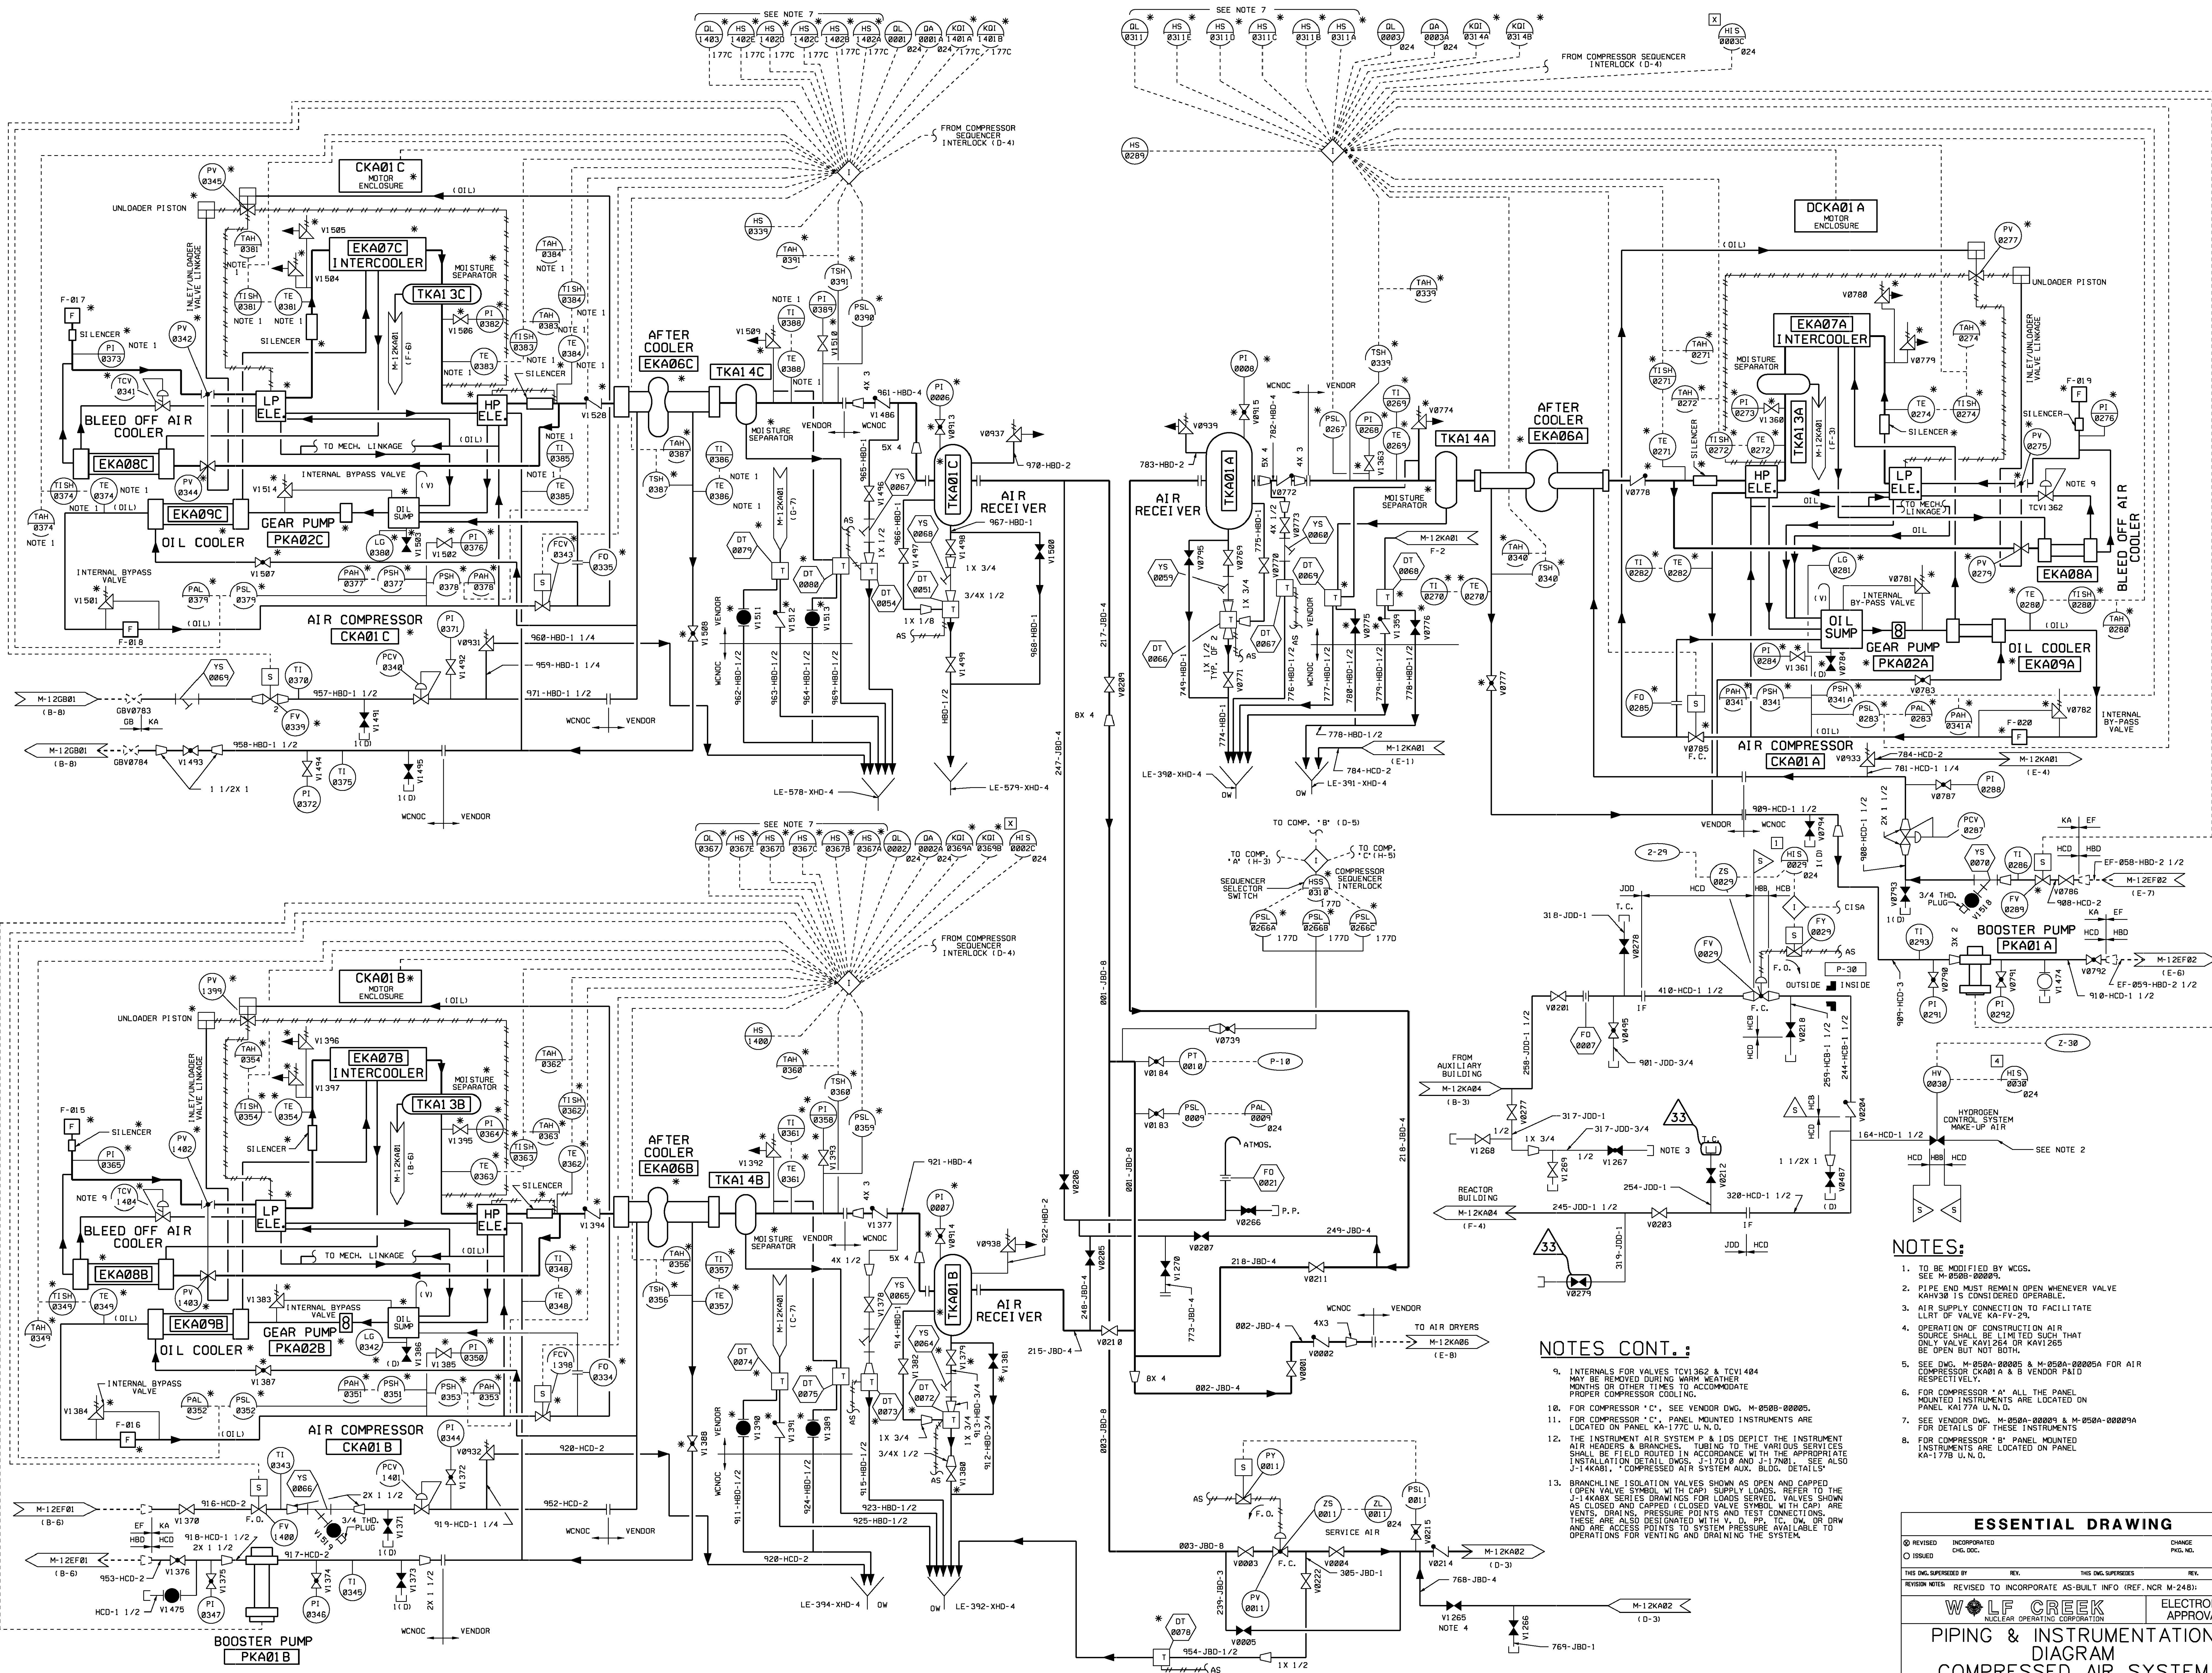

- NOTES:**
1. TO BE MODIFIED BY WCGS. SEE M-0508-00005.
 2. PI END MUST REMAIN OPEN WHENEVER VALVE KAH36 IS CONSIDERED OPERABLE.
 3. AIR SUPPLY CONNECTION TO FACILITATE LLRT OF VALVE KA-FV-29.
 4. OPERATION OF CONSTRUCTION AIR SOURCE SHALL BE LIMITED SUCH THAT ONLY VALVE KAV1264 OR KAV1265 BE OPEN BUT NOT BOTH.
 5. SEE Dwg. M-0508-00005 & M-0508-00005A FOR AIR COMPRESSOR CKA01A & B VENDOR P&ID RESPECTIVELY.
 6. FOR COMPRESSOR 'A' ALL THE PANEL MOUNTED INSTRUMENTS ARE LOCATED ON PANEL KA177A U.N.D.
 7. SEE VENDOR Dwg. M-0508-00009 & M-0508-00009A FOR DETAILS OF THESE INSTRUMENTS.
 8. FOR COMPRESSOR 'B' PANEL MOUNTED INSTRUMENTS ARE LOCATED ON PANEL KA177B U.N.D.

- NOTES CONT.:**
9. INTERNALS FOR VALVES TCV1362 & TCV1484 MAY BE REMOVED DURING WARM WEATHER MONTHS OR OTHER TIMES TO ACCOMMODATE PROPER COMPRESSOR COOLING.
 10. FOR COMPRESSOR 'C', SEE VENDOR Dwg. M-0508-00005.
 11. FOR COMPRESSOR 'C', PANEL MOUNTED INSTRUMENTS ARE LOCATED ON PANEL KA177A U.N.D.
 12. THE INSTRUMENT AIR SYSTEM P & IDs DEPICT THE INSTRUMENT AIR HEADERS & BRANCHES. TUBING TO THE VARIOUS SERVICES SHALL BE FIELD ROUTED IN ACCORDANCE WITH THE APPROPRIATE INSTALLATION DETAIL DWGS. J-1701B AND J-1702B. SEE ALSO J-14KAB1 - COMPRESSED AIR SYSTEM Rm. BLDG. DETAILS.
 13. BRANCHLINE ISOLATION VALVES SHOWN AS OPEN AND CAPPED (OPEN VALVE SYMBOL WITH CAP) SUPPLY LOADS. REFER TO THE J-14KABX SERIES DRAWINGS FOR LOADS SERVED. VALVES SHOWN AS CLOSED AND CAPPED (CLOSED VALVE SYMBOL WITH CAP) ARE VENTS, DRAINING PRESSURE POINTS AND TEST CONNECTIONS. THESE ARE ALSO DESIGNATED WITH V, D, L, O, W, OR DRW AND ARE ACCESS POINTS TO SYSTEM PRESSURE AVAILABLE TO OPERATIONS FOR VENTING AND DRAINING THE SYSTEM.

ESSENTIAL DRAWING

REVISED	INCORPORATED	CHANGE
ISSUED	CHG. Dwg.	PKG. NO.

THIS Dwg. SUPERSEDES: REV. THIS Dwg. SUPERSEDES: REV.

REVISION NOTES: REVISED TO INCORPORATE AS-BUILT INFO (REF. NCR M-2481)


WOLF CREEK NUCLEAR OPERATING CORPORATION ELECTRONIC APPROVAL

PIPING & INSTRUMENTATION DIAGRAM

COMPRESSED AIR SYSTEM

SCALE: _____ DRAWING NUMBER: M-12KA01 SHEET: 33

Amal K. Shetty

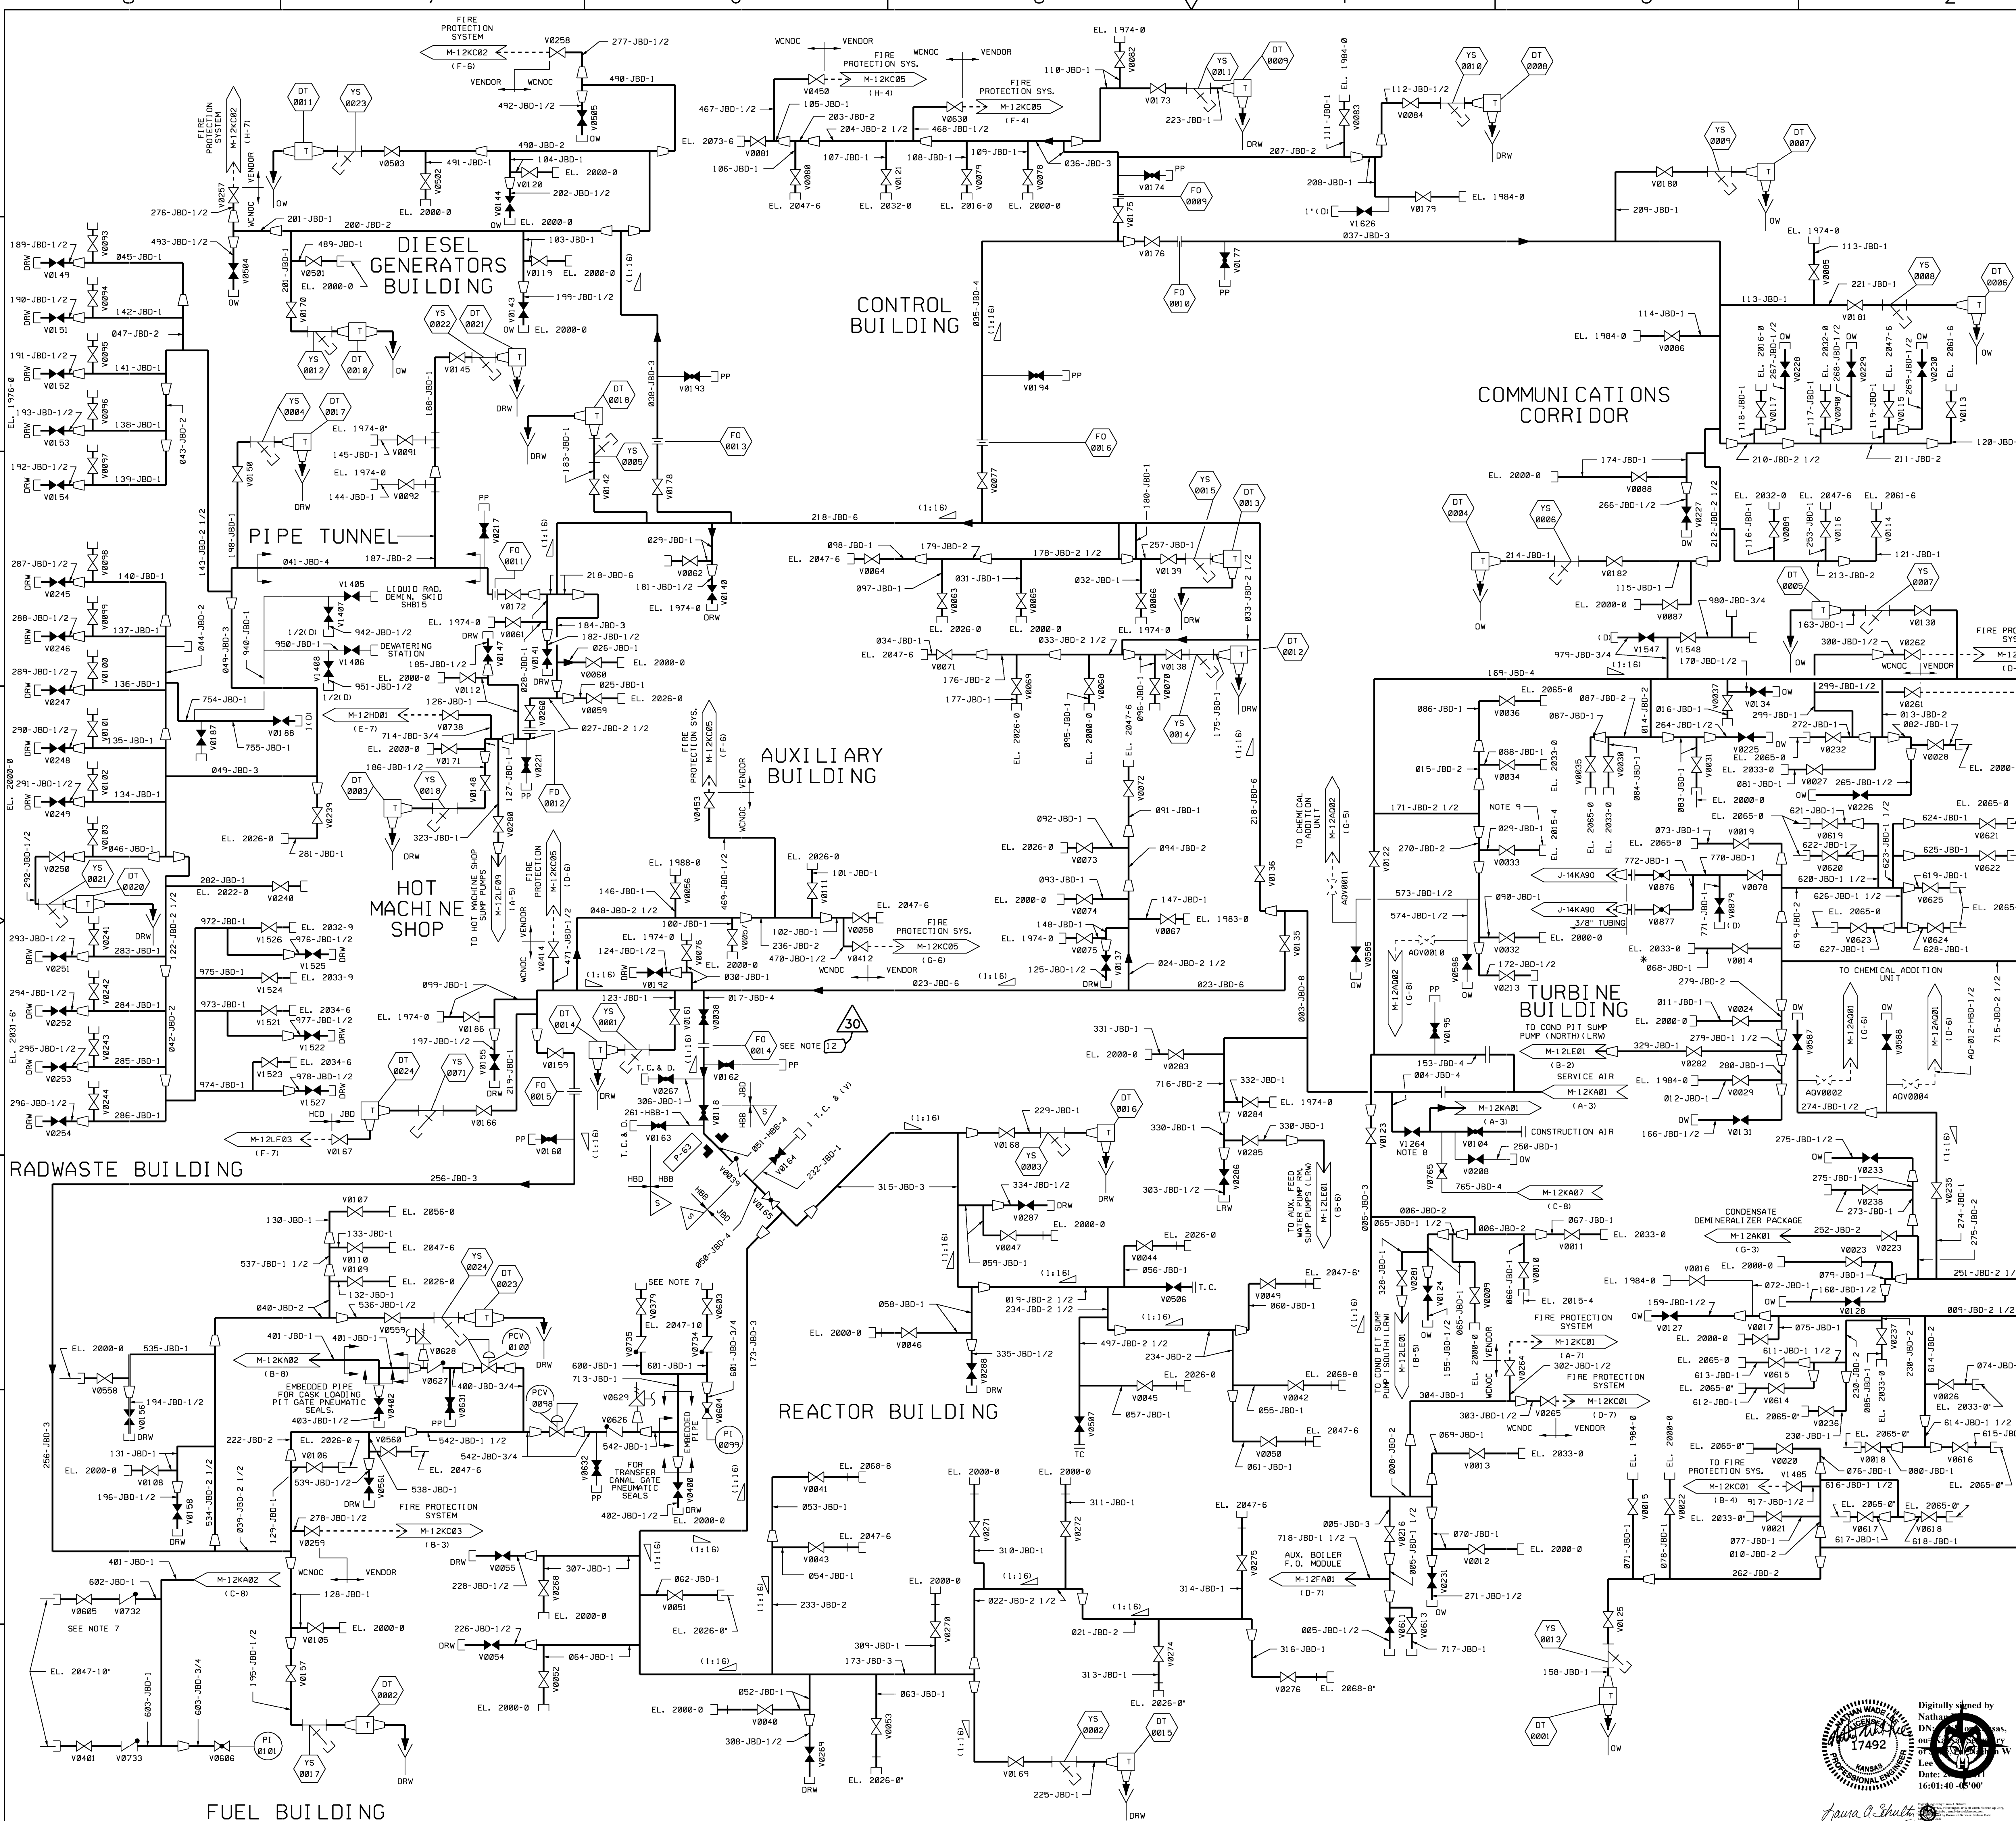

- NOTES:**
- DRAIN TRAPS MAY BE LOCATED AT THE LOWEST POINT OF THE CLOSED LOOP OR THE LOWEST ELEVATION OF THE OPEN ENDED SUPPLY HEADER, LOCATION MAY BE CHOSEN TO SUIT EXISTING FLOOR DRAIN.
 - ALL PIPING IS JBD UNLESS SHOWN OTHERWISE.
 - AIR JACKS (LOW COUPLING) ARE 1" UNLESS SHOWN OTHERWISE.
 - THE PORTION OF THIS SYSTEM THAT IS D-LISTED INCLUDES THE PIPING AND VALVES ASSOCIATED WITH CONTAINMENT ISOLATION ONLY.
 - ALL HORIZONTAL BRANCH RUNS SHALL BE PITCHED 1/16" PER FOOT BACK TOWARDS THE VERTICAL HEADER.
 - ELEVATIONS INDICATED ARE FLOOR ELEVATIONS.
 - EXHAUST HOSE, WITH HANSEN COUPLING SET PROVIDED FOR EACH PNEUMATIC SEAL (2 SEALS PER GATE), TO BE DISCONNECTED AFTER SEAL INFLATION AND DURING GATE USE.
 - OPERATION OF CONSTRUCTION AIR SOURCE SHALL BE LIMITED SUCH THAT ONLY VALVE KAVI264 OR KAVI265 BE OPEN BUT NOT BOTH.
 - SERVICE AIR CONNECTION TO STAIRWELL T-1 DIAPHRAGM PUMP.
 - BRANCHLINE ISOLATION VALVES SHOWN AS OPEN AND CAPPED (OPEN VALVE SYMBOL WITH CAP) SUPPLY LOADS. REFER TO THE J-14KAXX SERIES DRAWINGS FOR LOADS SERVED. VALVES SHOWN AS CLOSED AND CAPPED (CLOSED VALVE SYMBOL WITH CAP) ARE VENTS, DRAINING, PRESSURE POINTS AND TEST CONNECTIONS. THESE ARE ALSO DESIGNATED WITH V, O, PP, EL, LWR, OR DRW AND ARE ACCESS POINTS TO SYSTEM PRESSURE AVAILABLE TO OPERATIONS FOR VENTING AND DRAINING THE SYSTEM.
 - DELETED
 - FLOW ORIFICE KAF0201 MAY BE LEFT OUT PERMANENTLY OR REINSTALLED IF NEEDED TO SUPPORT PLANT ACTIVITIES.




ESSENTIAL DRAWING

REVISED	INCORPORATED	CHANGE
ISSUED	CIG. DOC.	020187
THIS Dwg. SUPERSEDES REV. 11 AND ADDED NOTE 12.		REV.
REVISION NOTES: DELETED NOTE 11 AND ADDED NOTE 12.		REV.

Digitally signed by Nathan D. ...
 Date: 16:01:40 -05'00'


WOLF CREEK
 NUCLEAR OPERATING CORPORATION
 ELECTRONIC APPROVAL
PIPING & INSTRUMENTATION DIAGRAM
COMPRESSED AIR SYSTEM
 (SERVICE AIR)

SCALE: NONE
 SHEET: 30
 REV: 1
 M-12KA02
 3444 E SIDE

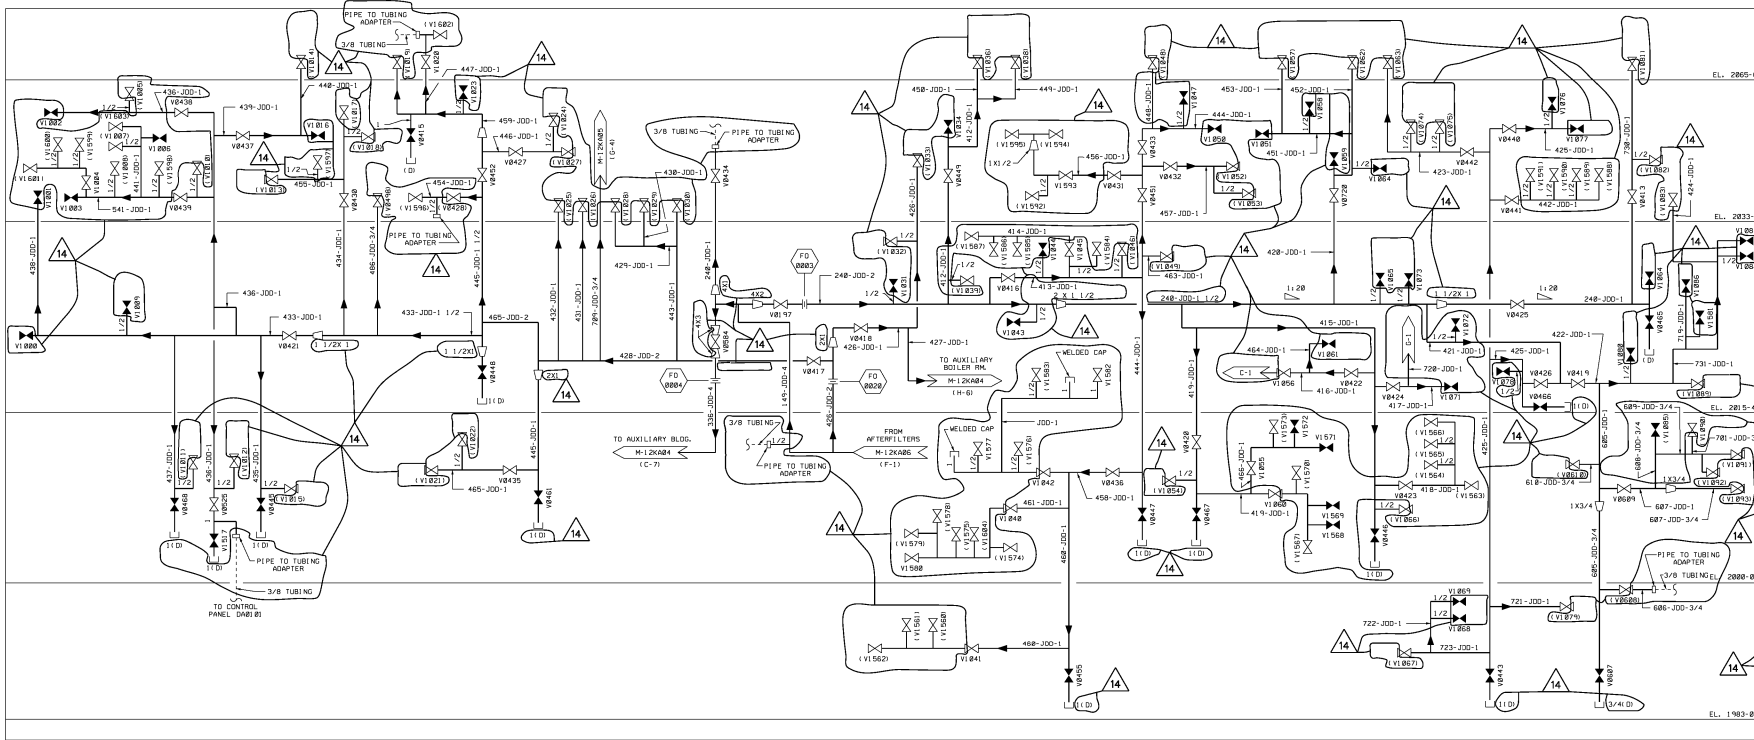


- NOTES**
1. THE INSTRUMENT AIR SYSTEM P & I LINE SYMBOLS AND THE INSTRUMENTATION BOUNDARIES SHOWN IN THIS DRAWING SHALL BE FIELD MOUNTED IN ACCORDANCE WITH THE APPROPRIATE INSTALLATION DETAIL DESIGNS REFERENCED HEREIN AND LATER.
 2. THE HORIZONTAL PIPE RUNS SHALL BE MOUNTED AT A MINIMUM OF 12 FEET PER FOOT UNLESS OTHERWISE NOTED.
 3. ALL BRANCH LINES AND TEES ARE CAPPED UNLESS OTHERWISE NOTED. THE SYSTEM PRESSURE BOUNDARY AND TO PARALLEL SYSTEM CAPS SHALL BE SHOWN AS REQUIRED WHEN INSTRUMENT AIR TUBING IS FIELD MOUNTED AND CONNECTED TO THE INSTRUMENT AIR SYSTEM.
 4. BRANCHES WITH FLOW LINE SEQUENCE NUMBERS ARE CAPPED TEES ONLY.
 5. DRAIN LINES CARRY THE LINE BEING DRAINED OFF THE LINE UNLESS OTHERWISE INDICATED.
 6. VALVE NUMBERS V1800 THROUGH V1899 AND THE ASSOCIATED INSTRUMENTATION VALUES ARE NOT SHOWN ON THIS DRAWING. THESE VALUES ARE SHOWN ON GRAPHIC C INSTRUMENT AIR DRAWINGS.
 7. DELETED
 8. PIPE CONTROL AND SEPARATE BUILDINGS BROUGHT IN WITH INSTRUMENT AIR SYSTEM AS OPEN AND CAPPED OPEN VALVE SYMBOLS. THESE VALUES ARE SHOWN AS REQUIRED ON THE INSTRUMENT AIR DRAWINGS FOR LOADS AND TEST CONNECTIONS. THESE VALUES ARE NOT SHOWN ON THIS DRAWING. THESE VALUES ARE SHOWN ON GRAPHIC C INSTRUMENT AIR DRAWINGS FOR TESTING AND ACCESS POINTS TO SYSTEM.
 9. FOR TUBING AND CONNECTION CORROSION PROTECTION IN A MINIMUM OF 12 FEET PER FOOT UNLESS OTHERWISE NOTED. THE SYSTEM PRESSURE BOUNDARY AND TO PARALLEL SYSTEM CAPS SHALL BE SHOWN AS REQUIRED WHEN INSTRUMENT AIR TUBING IS FIELD MOUNTED AND CONNECTED TO THE INSTRUMENT AIR SYSTEM. THESE VALUES ARE NOT SHOWN ON THIS DRAWING. THESE VALUES ARE SHOWN ON GRAPHIC C INSTRUMENT AIR DRAWINGS FOR TESTING AND ACCESS POINTS TO SYSTEM.


TURBINE BUILDING

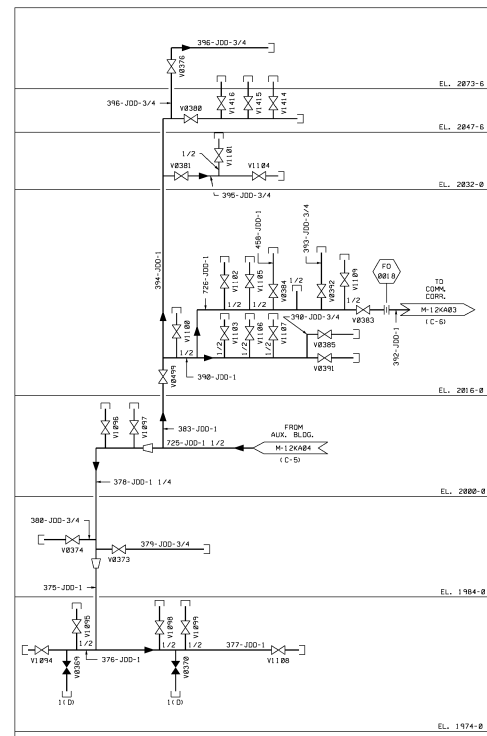

CONTROL BUILDING

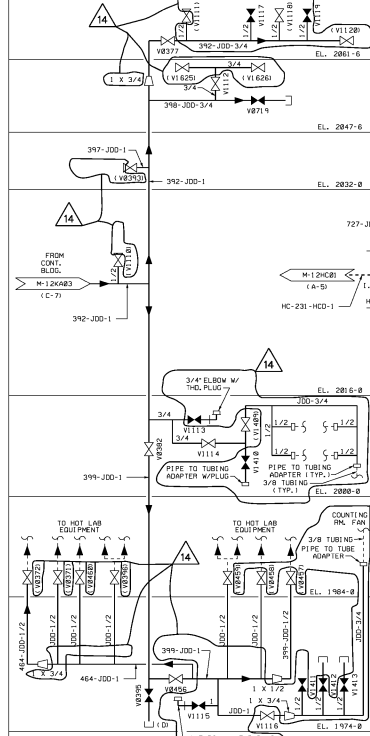


COMMUNICATIONS CORRIDOR

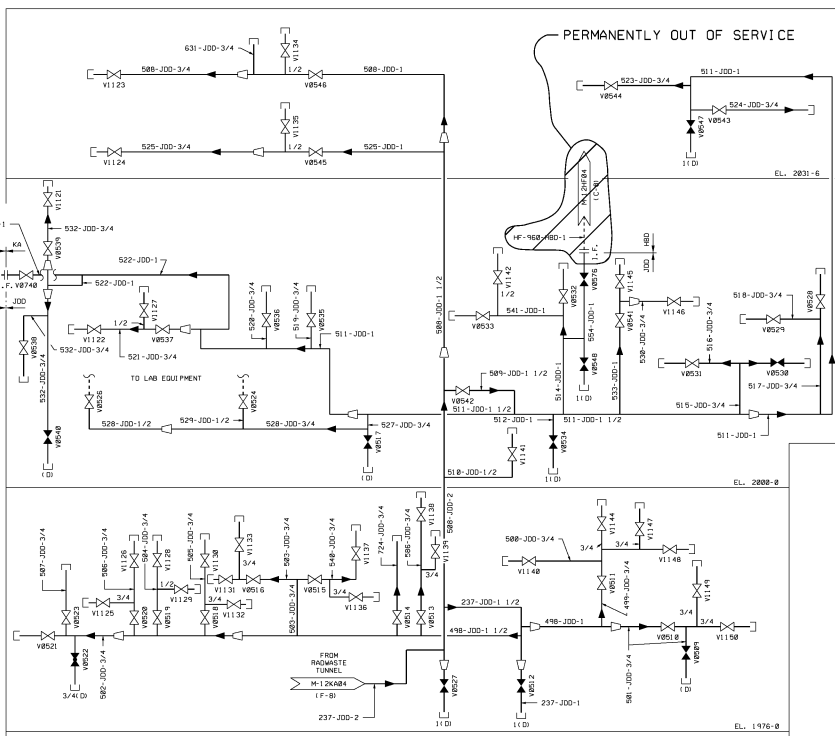

RADWASTE BUILDING

PERMANENTLY OUT OF SERVICE

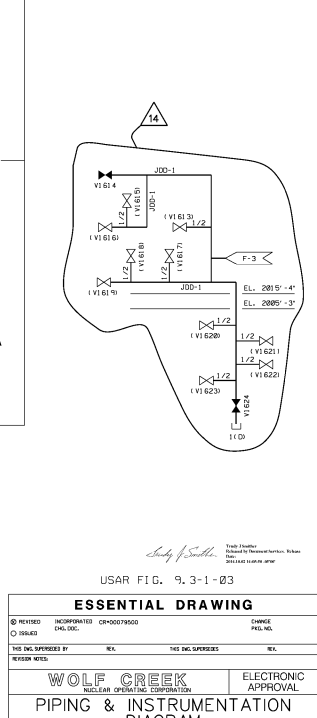

USAR FIG. 9.3-1-03

ESSENTIAL DRAWING

REVISIONS: REVISED, INCORPORATED, DELETED, CHECKED, FILED, THIS DRAWING IS NOT TO BE USED FOR CONSTRUCTION, THIS DRAWING IS NOT TO BE USED FOR CONSTRUCTION.


WOLF CREEK
NUCLEAR OPERATIONS DIVISION

ELECTRONIC APPROVAL

PIPING & INSTRUMENTATION DIAGRAM
INSTRUMENT AIR SYSTEM

SHEET NO. **M-12KA03** OF **14**



DATE: _____ DRAWN BY: _____

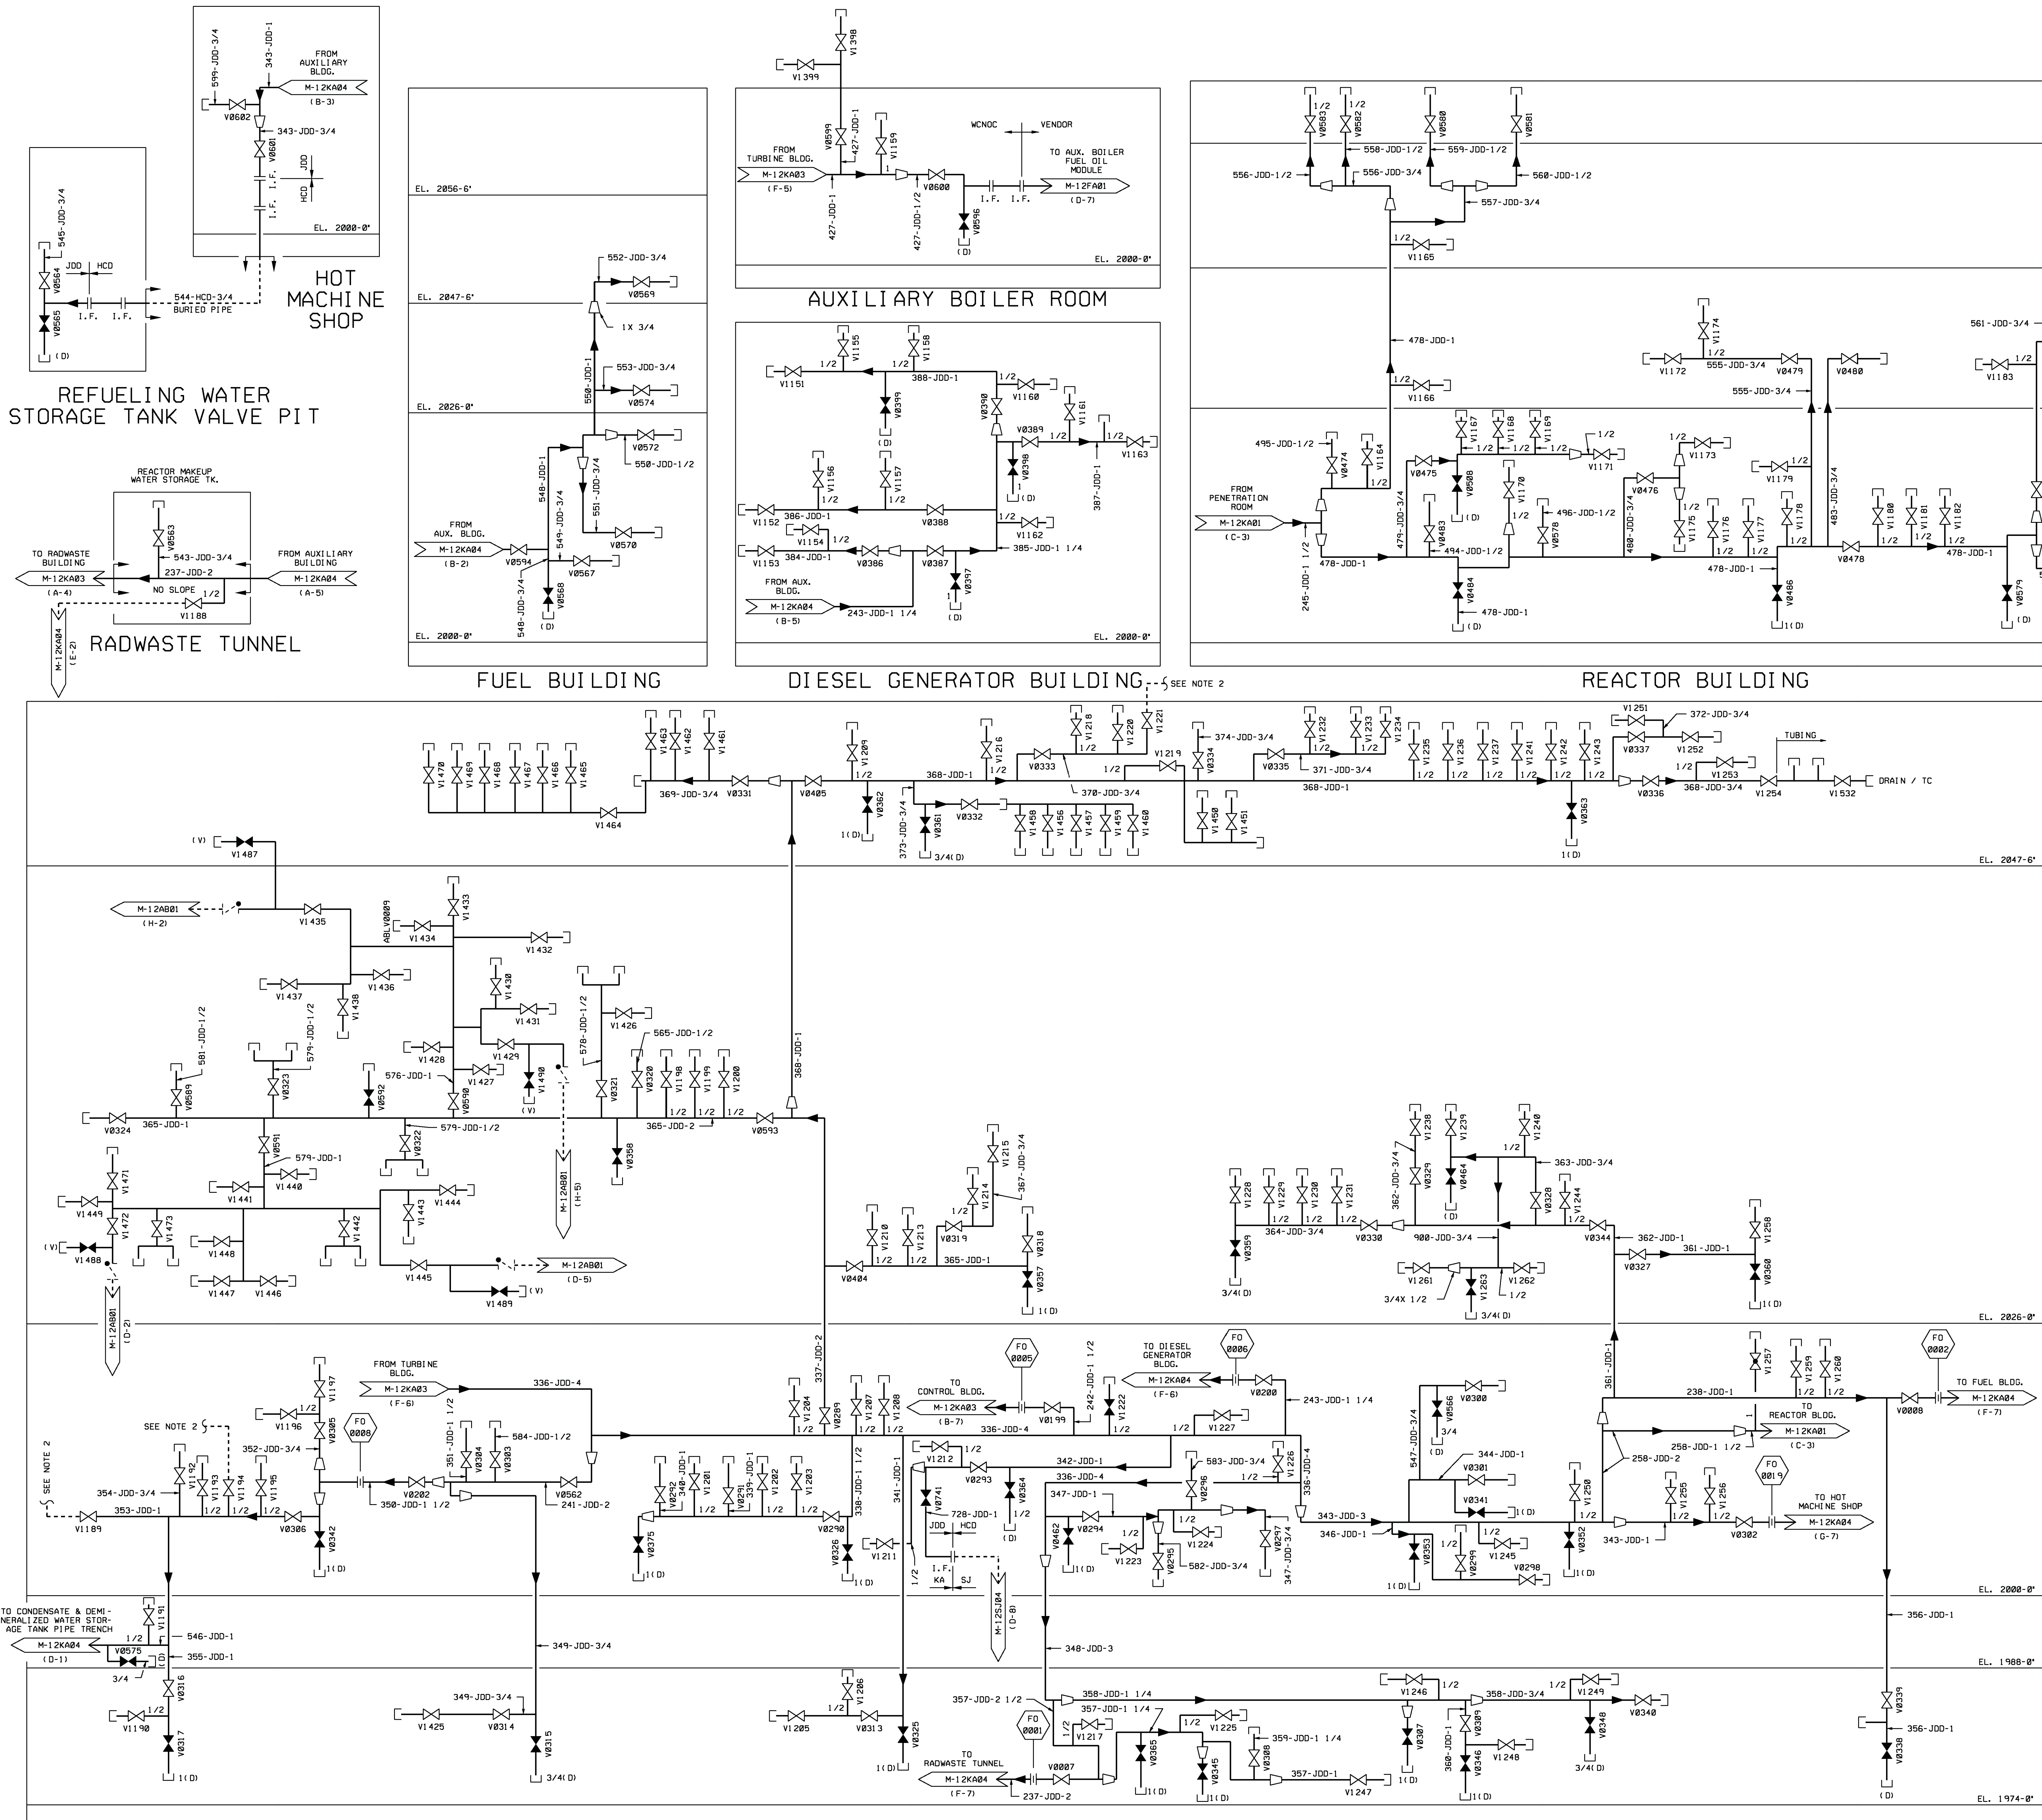

NOTES

- FOR NOTES SEE DWG. M-12KA03.
- SEE DWG. J-14KA01 FOR INSTRUMENT VALVES DOWNSTREAM OF ISOLATION VALVES.
- BRANCHLINE ISOLATION VALVES SHOWN AS OPEN AND CAPPED (OPEN VALVE SYMBOL WITH CAP) SUPPLY LOADS. REFER TO THE J-14KA03 SERIES DRAWINGS FOR LOADS SERVED. VALVES SHOWN AS CLOSED AND CAPPED CLOSED VALVE SYMBOL WITH CAP) ARE VENTS, DRAINS, PRESSURE POINTS AND TEST CONNECTIONS (EXCEPT FOR VALVE V1222, WHICH IS IN ACCORDANCE WITH J-14KA01). THESE ARE ALSO DESIGNATED WITH 'V', 'D', 'P', 'T', 'W', 'OR DRAW AND ARE ACCESS POINTS TO SYSTEM PRESSURE AVAILABLE TO OPERATIONS FOR VENTING AND DRAINING THE SYSTEM.


CONDENSATE & DEMINERALIZED WATER STORAGE TANKS PIPE TRENCH

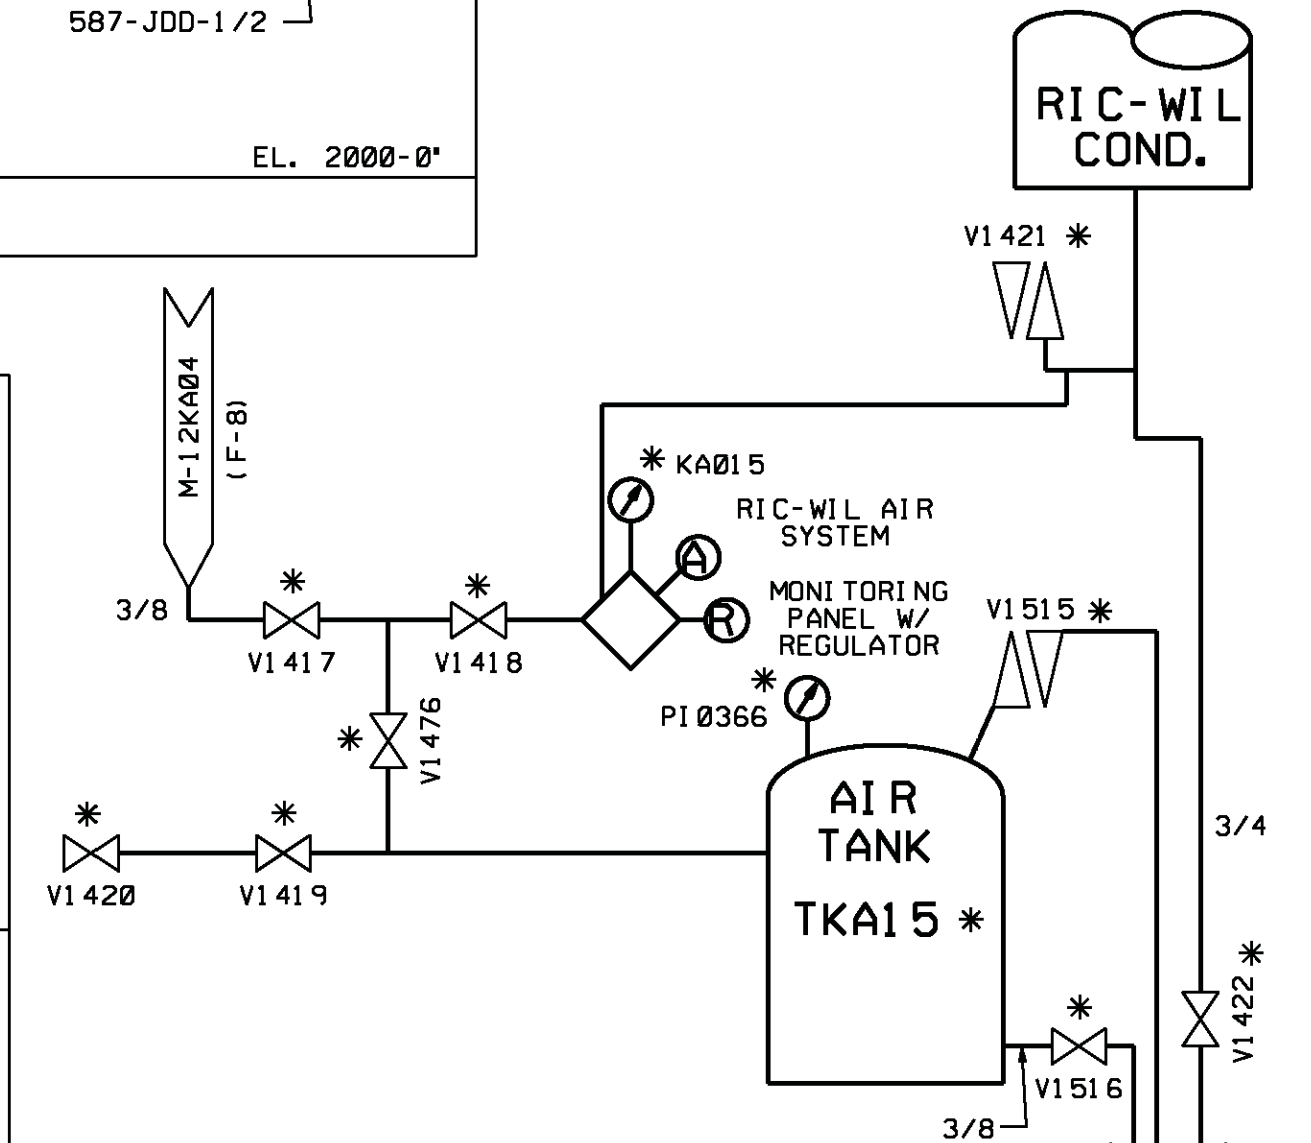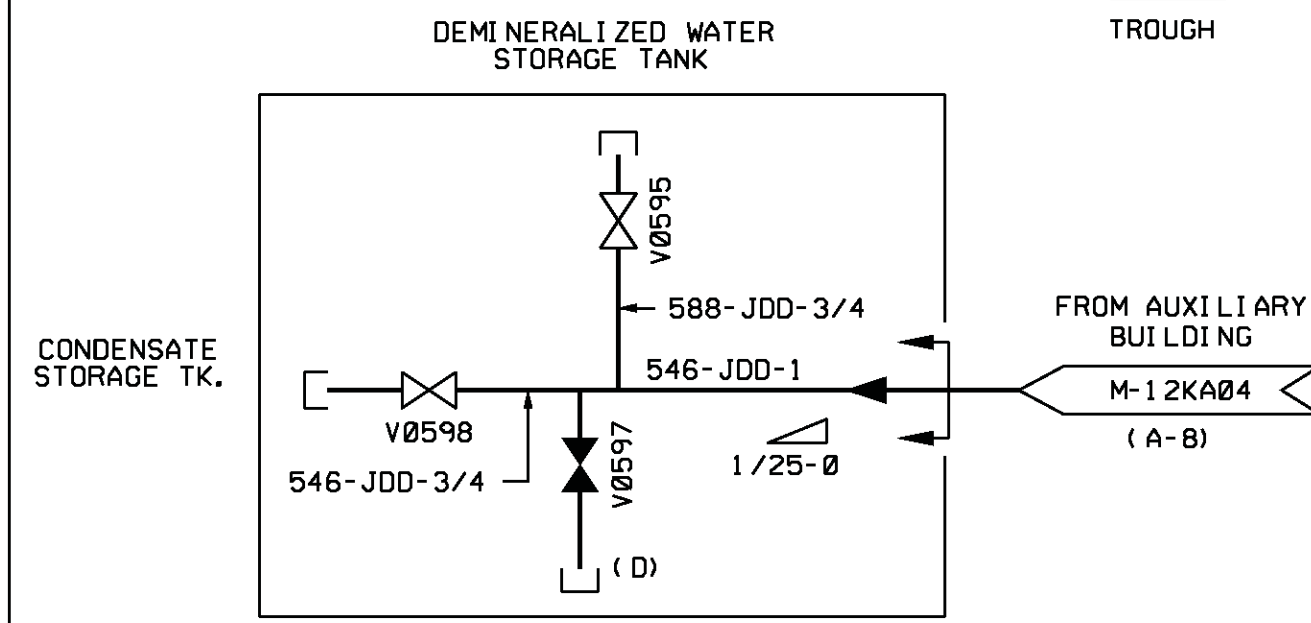


ESSENTIAL DRAWING			
REVISED	INCORPORATED	CHANGE	NO.
ISSUED	ORIG. DOC.	PKG.	
THIS DWG. SUPERSEDES		REV.	THIS DWG. SUPERSEDES
REVISED USAR FIGURE NUMBER THAT WAS ERRONEOUSLY REMOVED IN A PRIOR REVISION (REF. APO5-D10, Section 6.10, Table A).		REV.	REV.
PIPING & INSTRUMENTATION DIAGRAM INSTRUMENT AIR SYSTEM		ELECTRONIC APPROVAL	
SCALE	DRAWING NUMBER	SHEET	REV
NONE	M-12KA04	21	21

USAR FIG. 9, 3-1-04


REFUELING WATER STORAGE TANK VALVE PIT

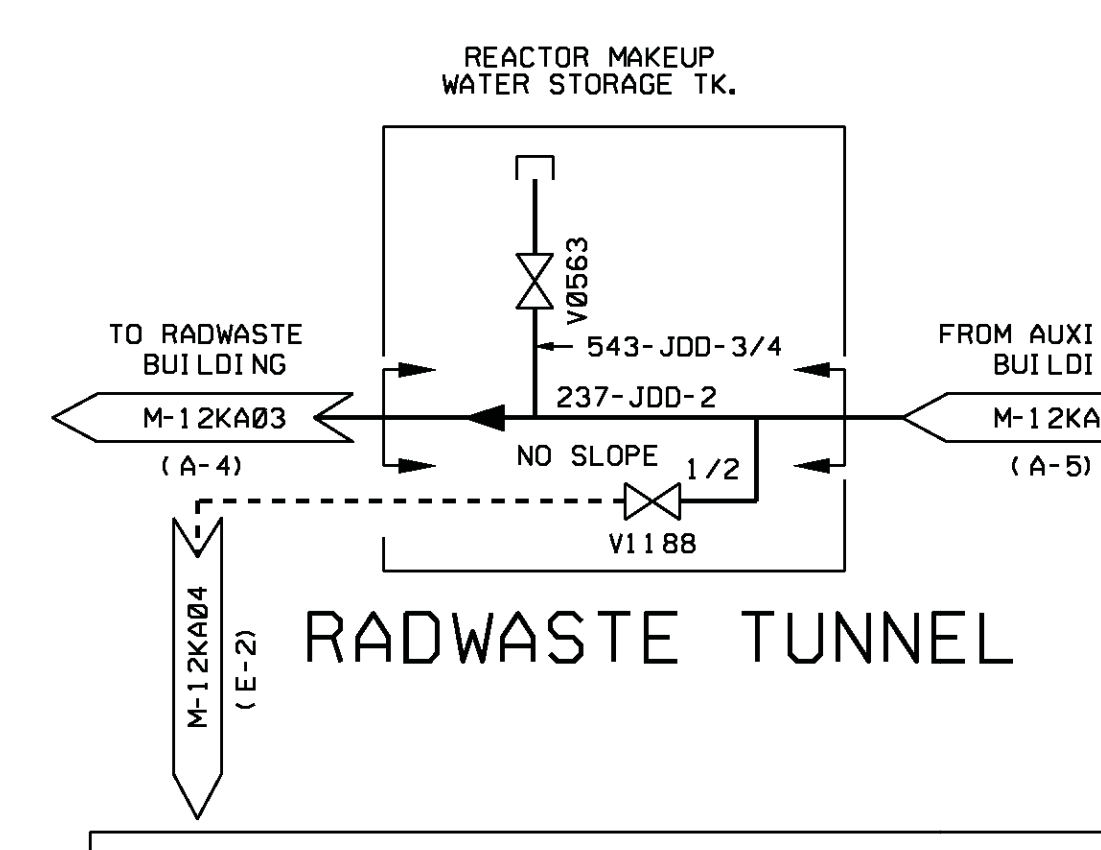


HOT MACHINE SHOP

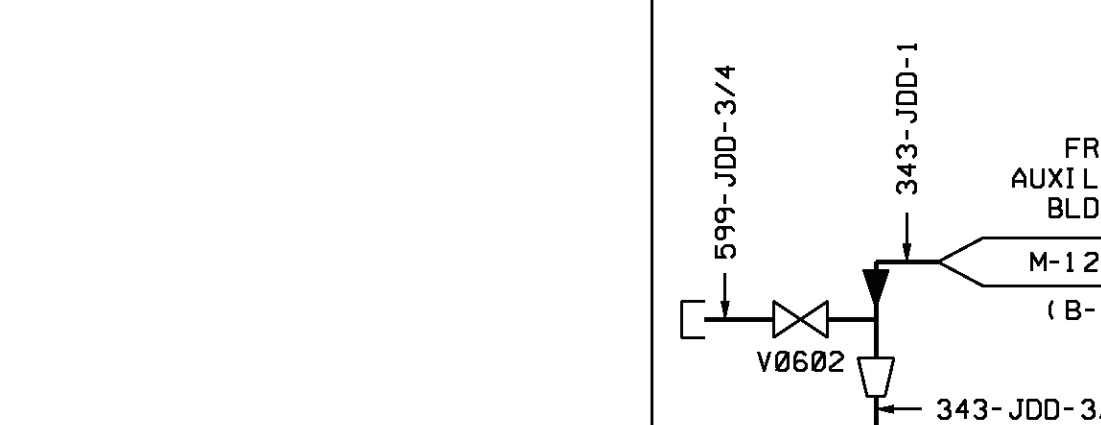


AUXILIARY BOILER ROOM

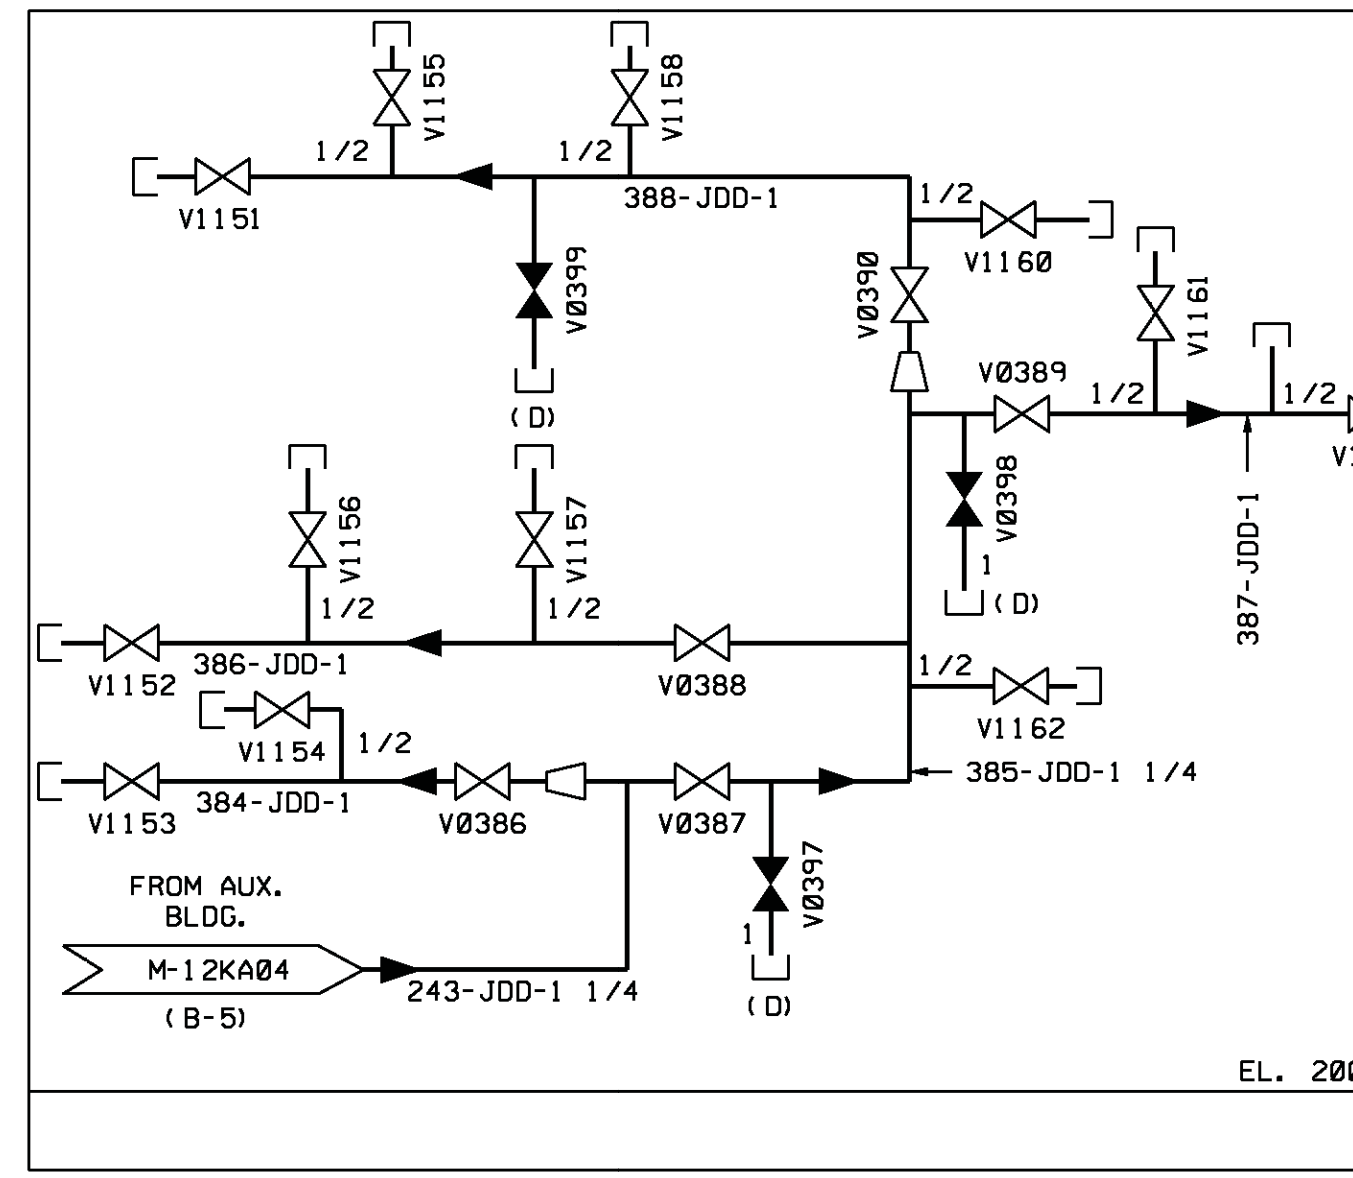


FUEL BUILDING

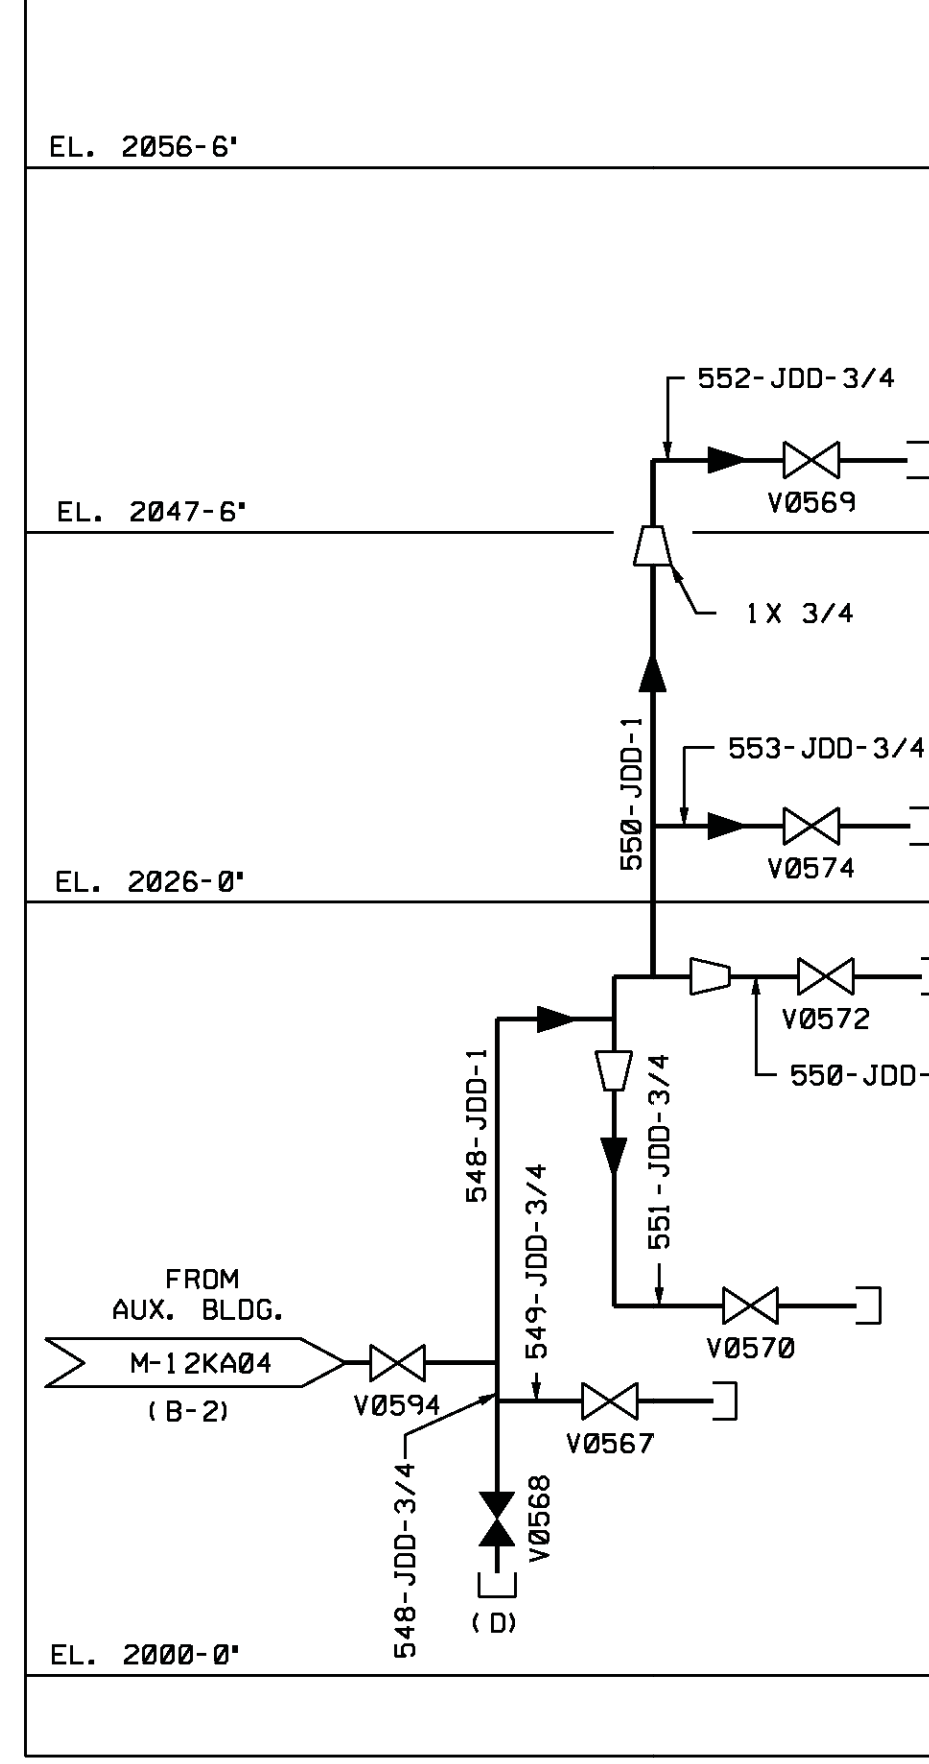


DIESEL GENERATOR BUILDING

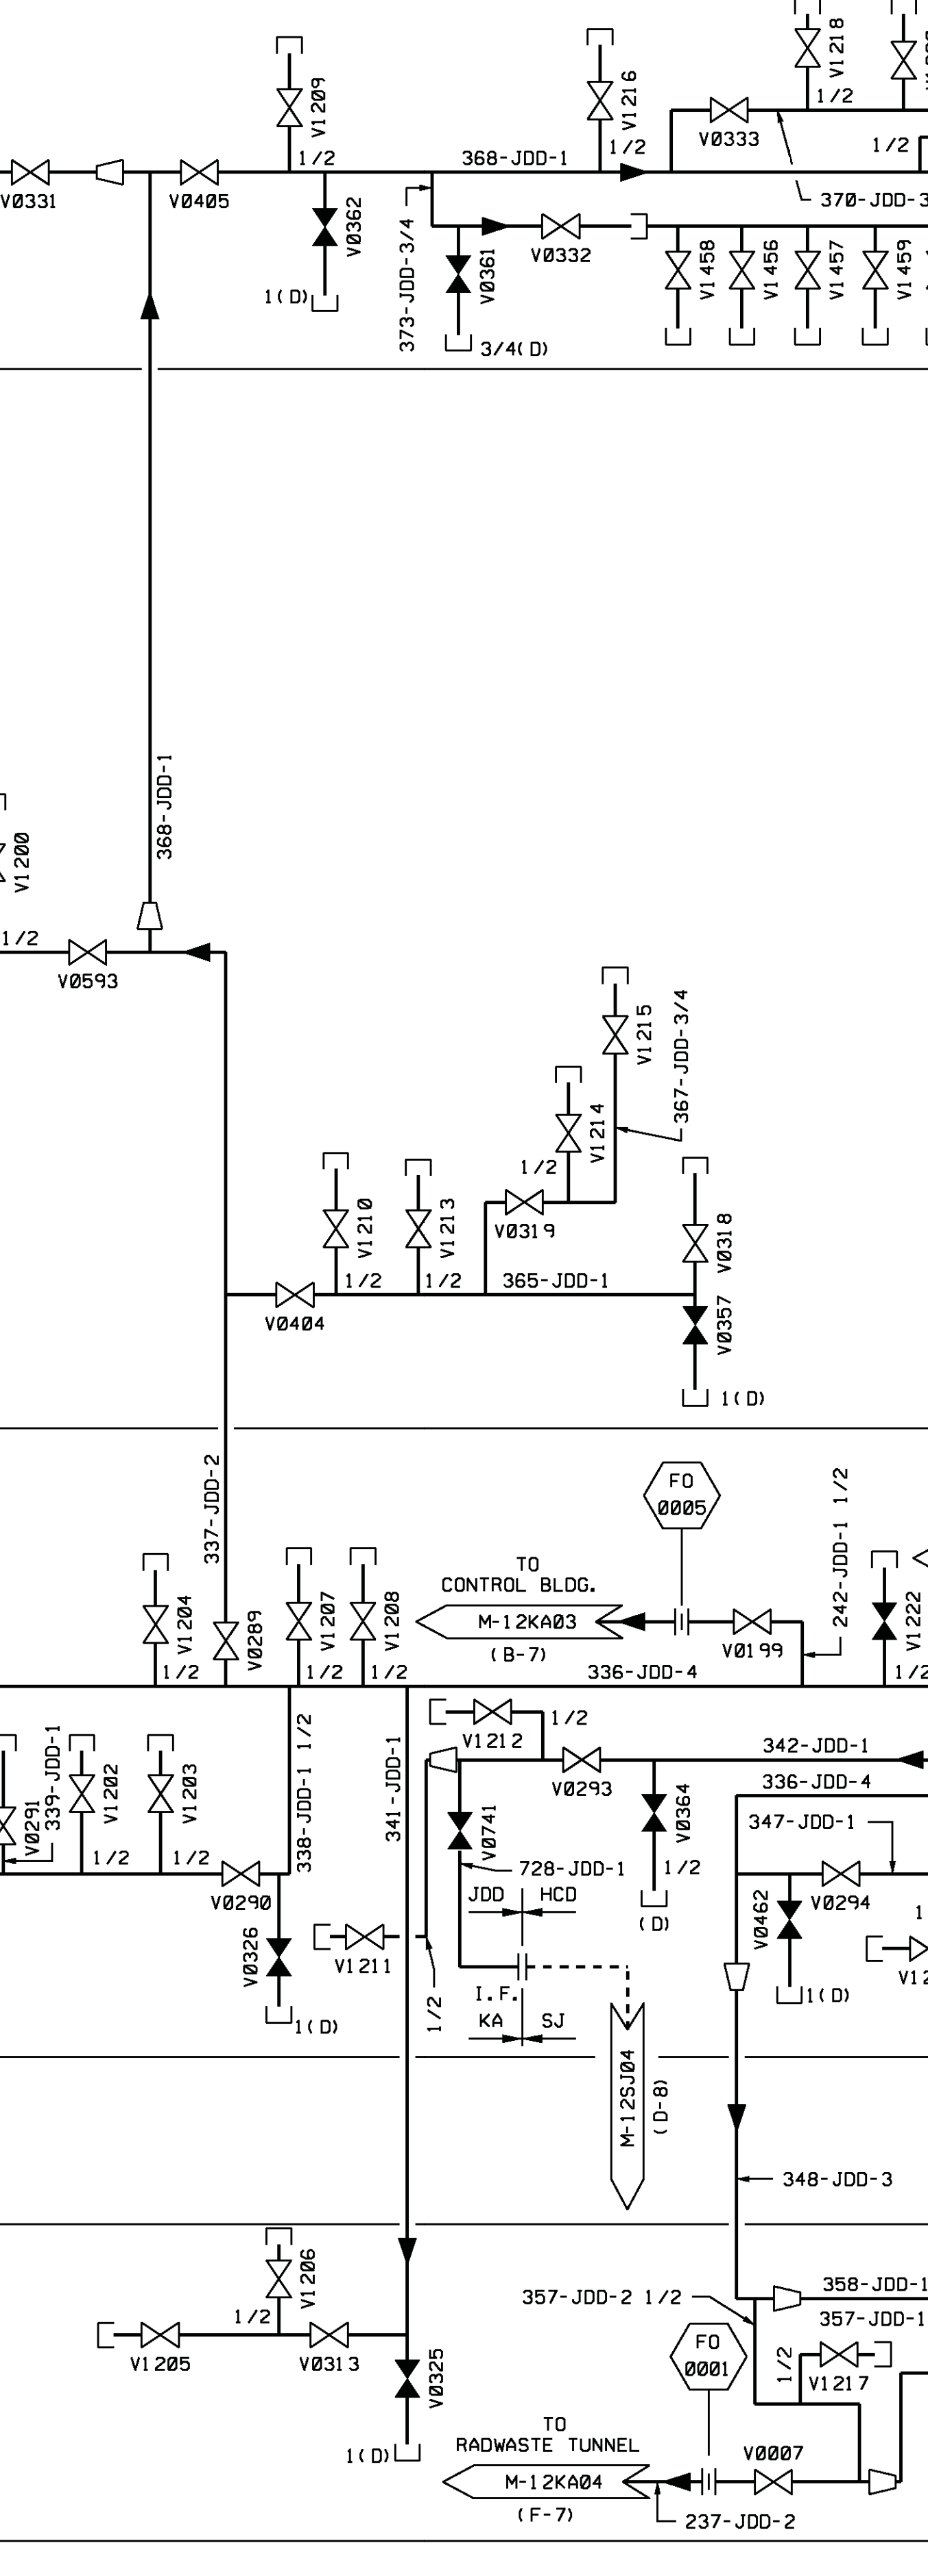


REACTOR BUILDING


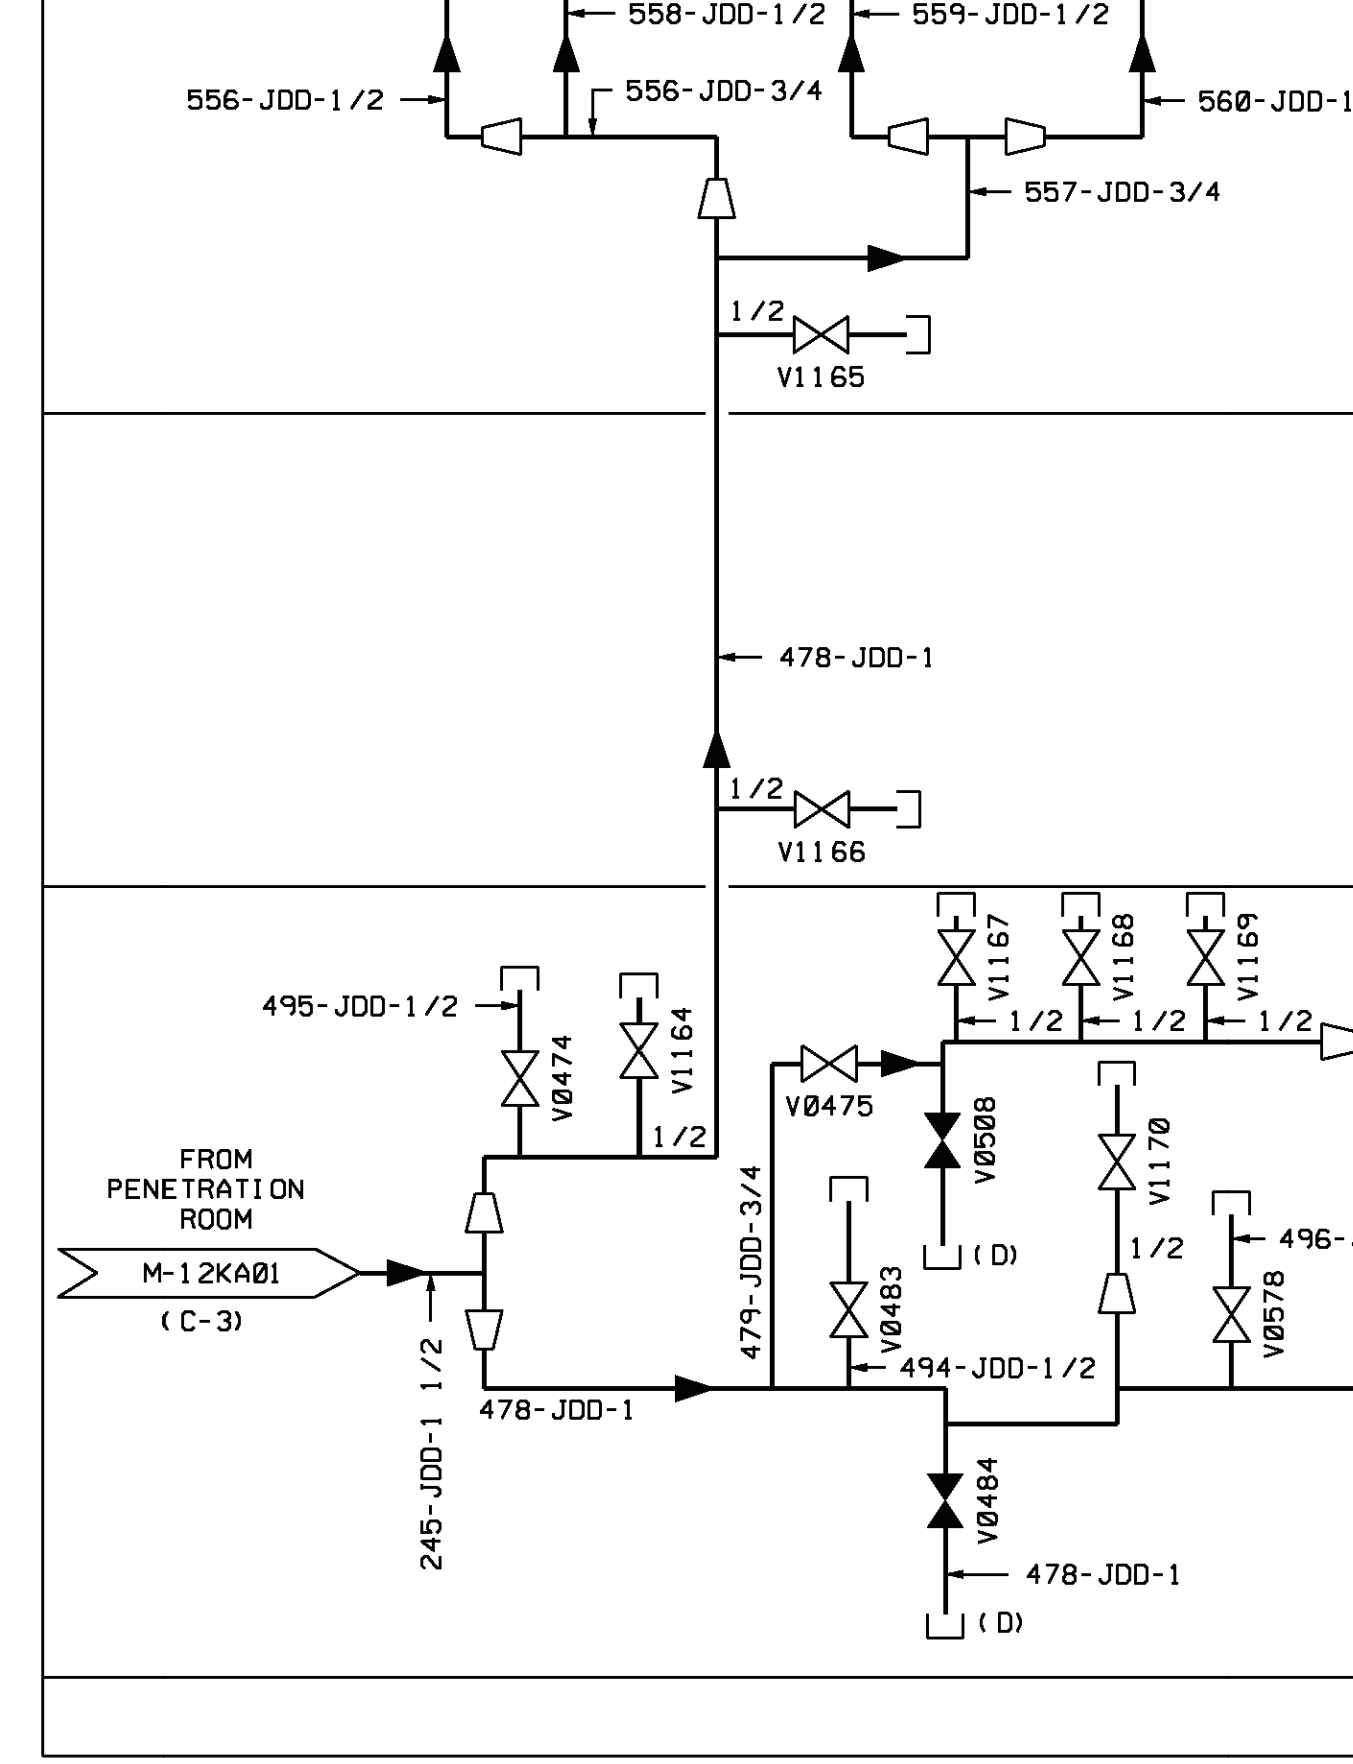


AUXILIARY BUILDING

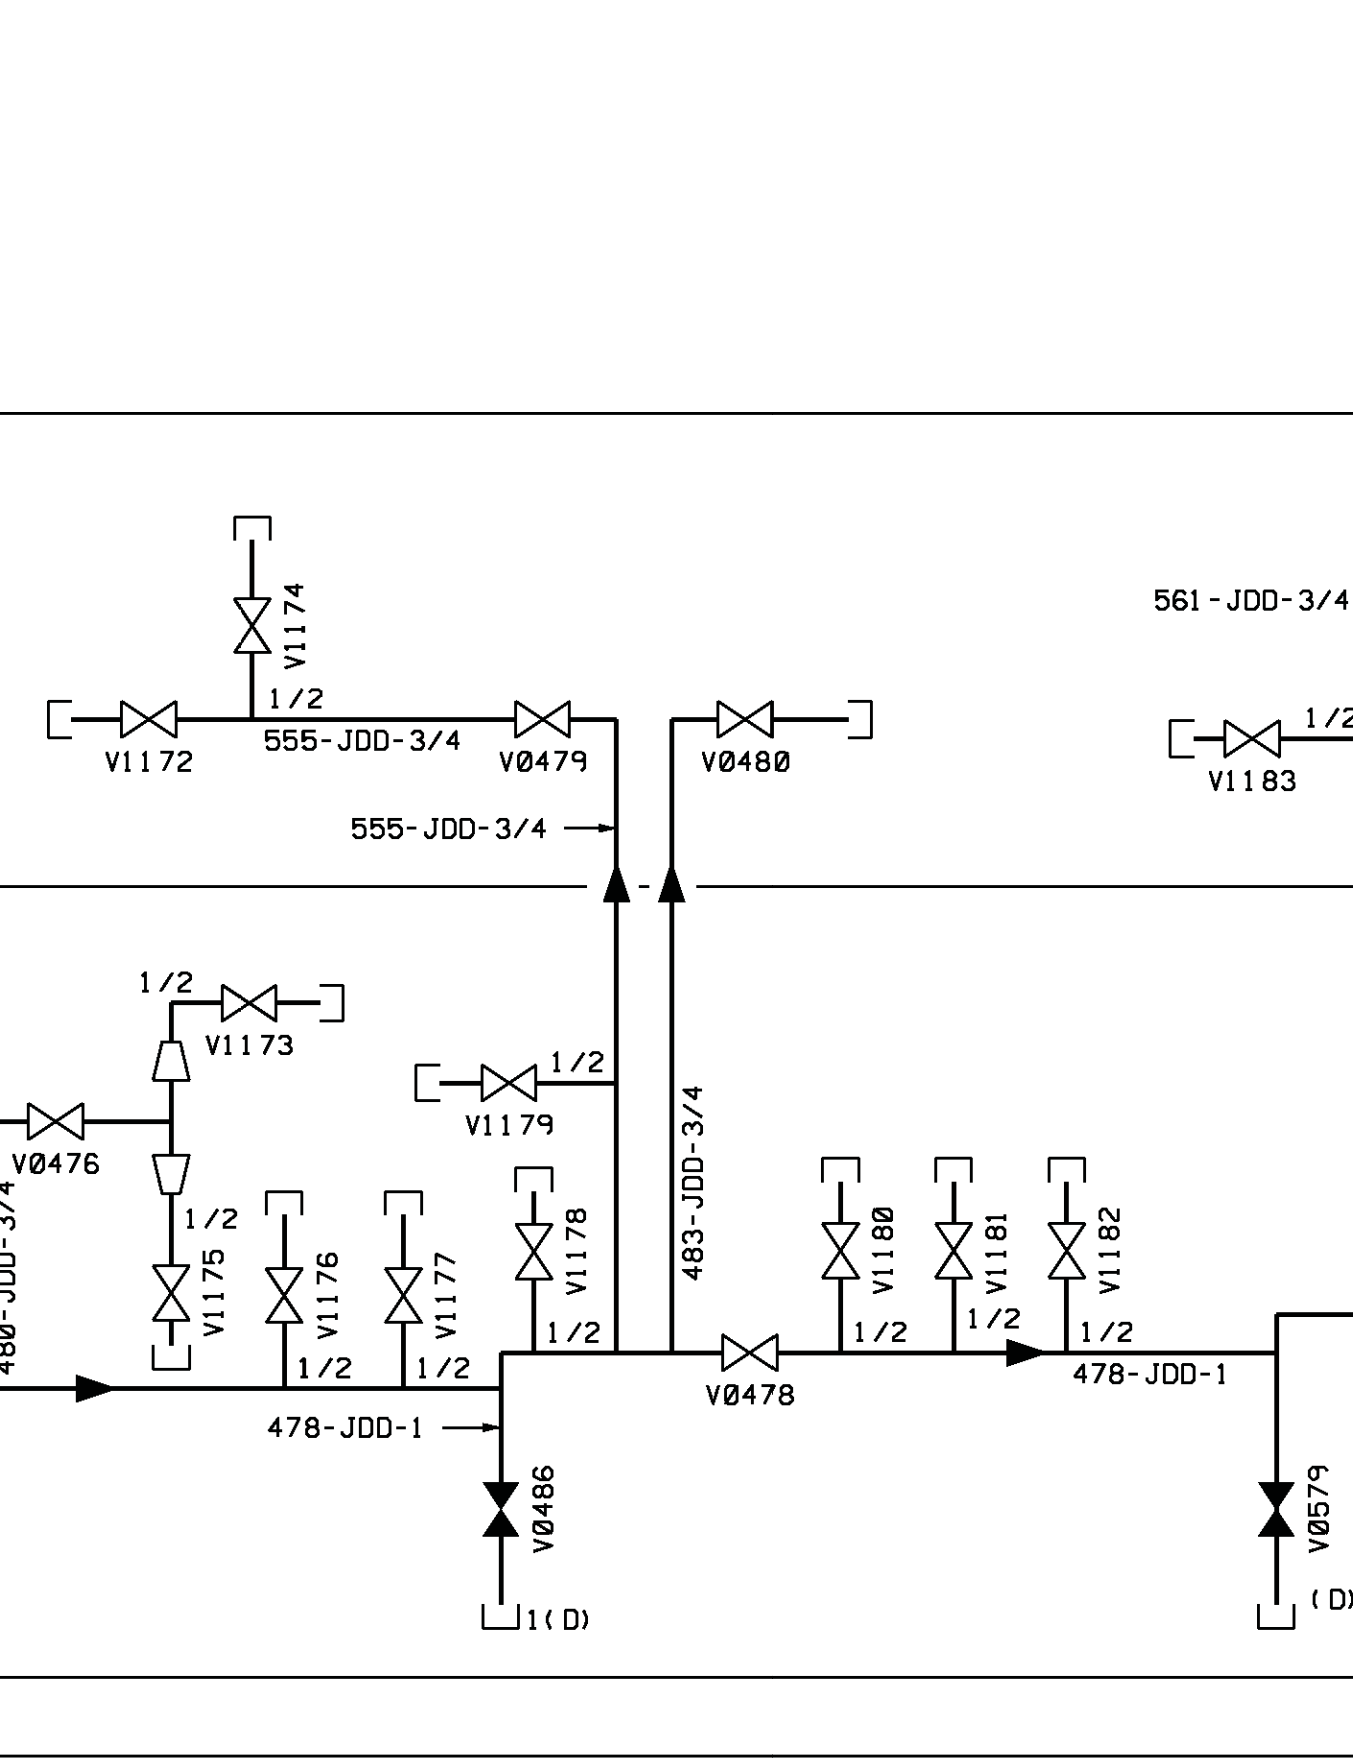

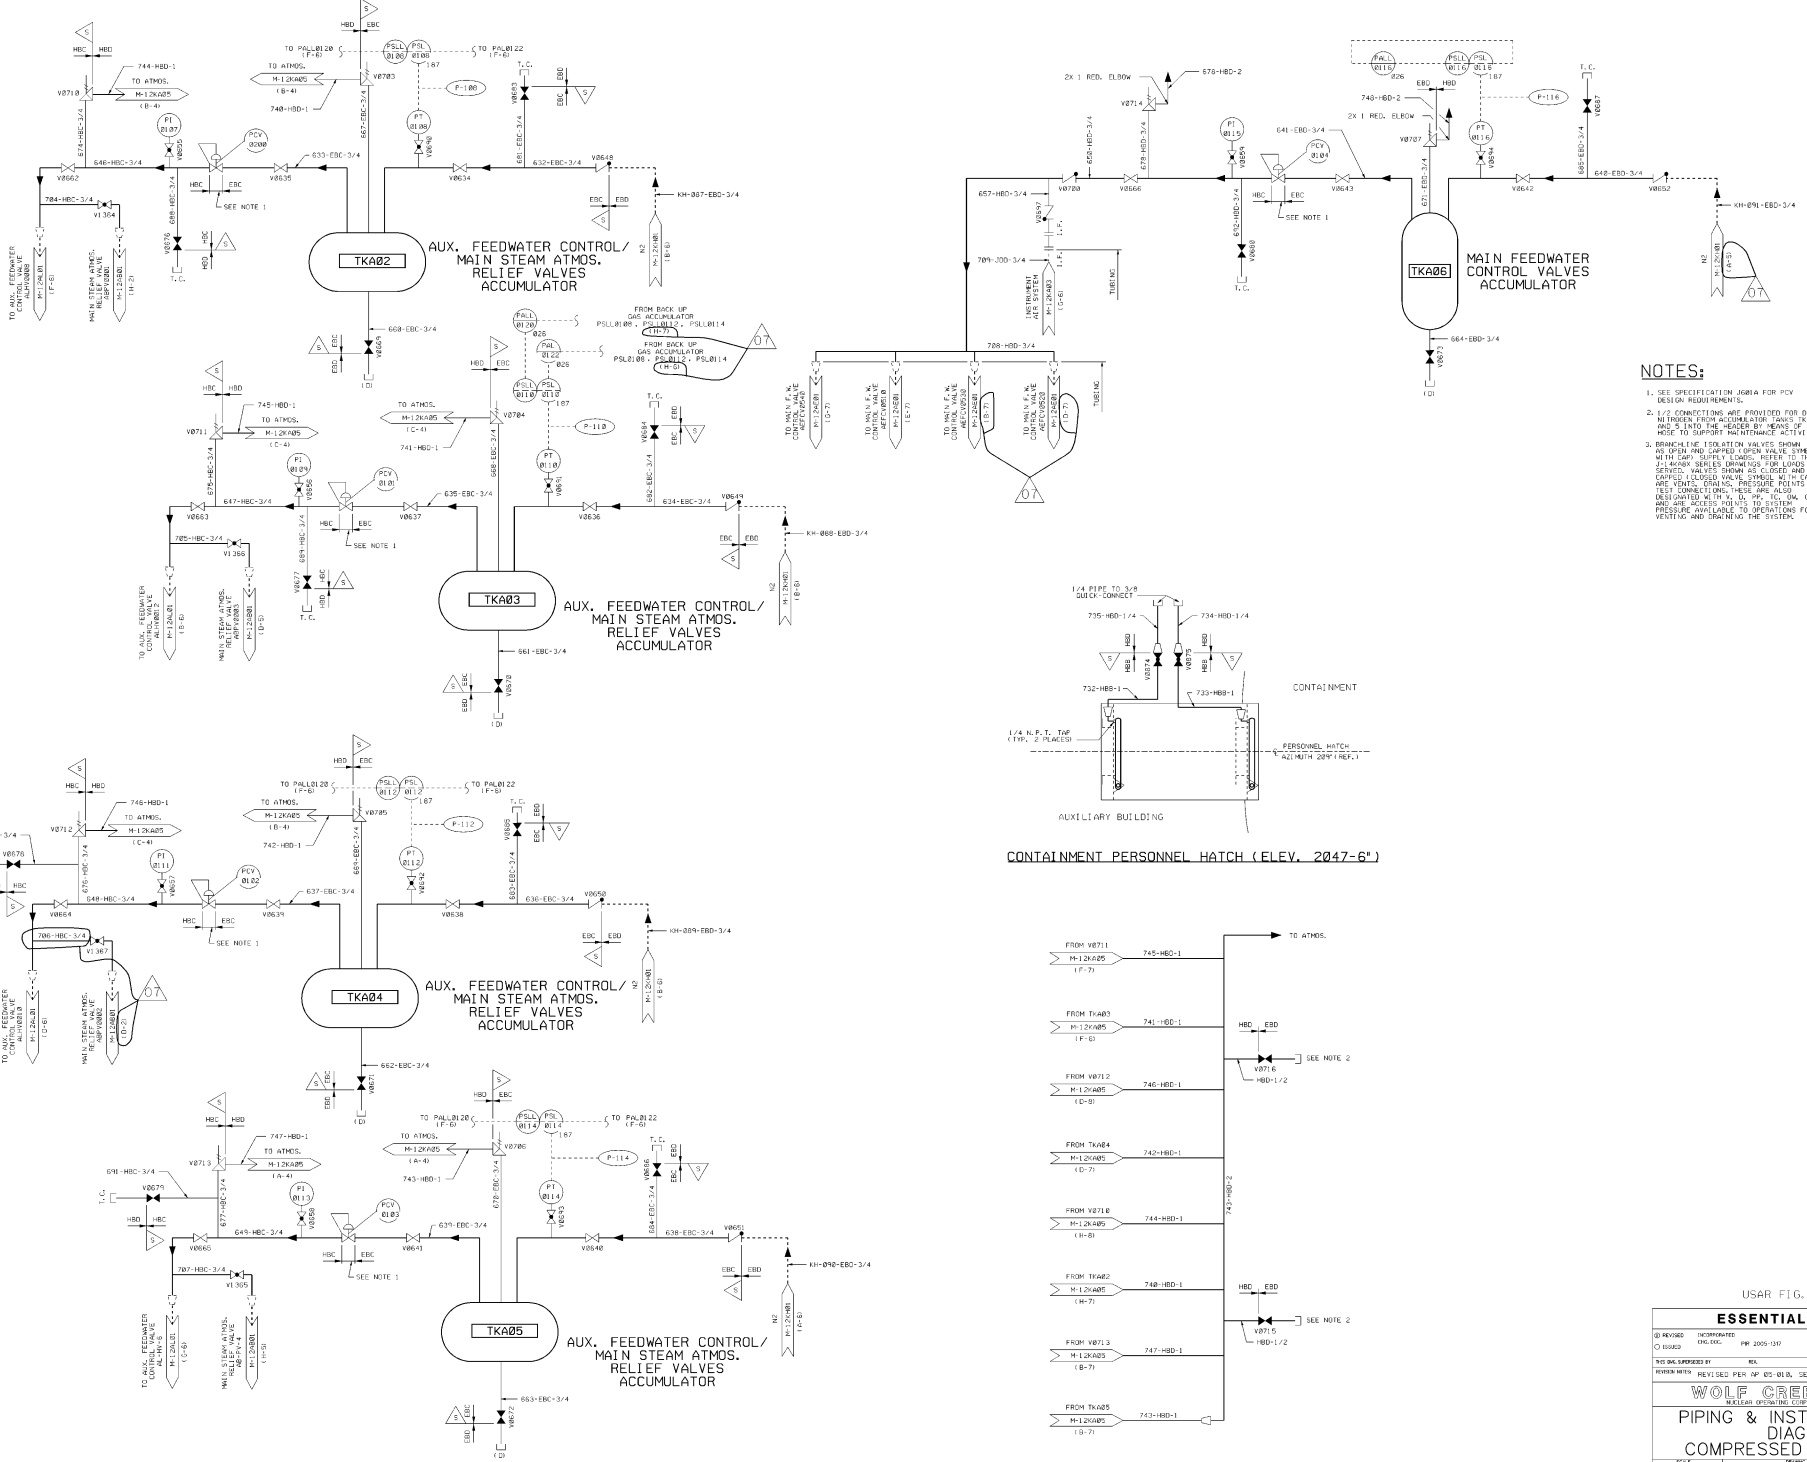

- NOTES:**
- SEE SPECIFICATION AREA FOR PCV DESIGN REQUIREMENTS.
 - 1/2" CONNECTIONS ARE PROVIDED FOR DISCHARGING AIR FROM ACCUMULATOR TANKS 3-4 AND 5 INTO THE HEADER OF MAIN FEEDWATER TANKS TO SUPPORT PERFORMANCE ACTIVITIES ON THE TANKS.
 - BRANCHLINE ISOLATION VALVES SHOWN ON OPEN AND CLOSED POSITION VALVE SYMBOL WITH SHIP SERIES LOGIC. REFER TO THE J-1400X SERIES DRAWINGS FOR LOGIC. SERVICE VALVES SHOWN AS CLOSED AND CAPPED (CLOSED VALVE SYMBOL WITH SHIP SERIES LOGIC). PRESSURE INDICATORS AND RELIEF CONNECTIONS: THESE ARE ALSO DESIGNATED AS 1/2" N.P.S. DIA. OR DRW PRESSURE APPLICABLE TO OPERATIONS FOR VENTING AND DESIGNING THE SYSTEM.

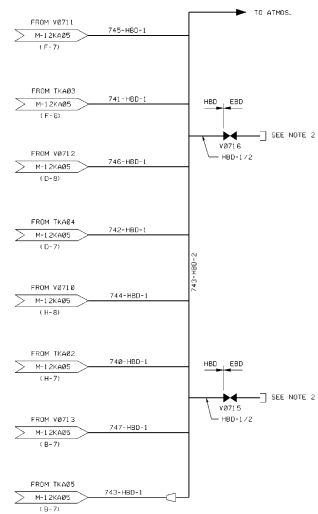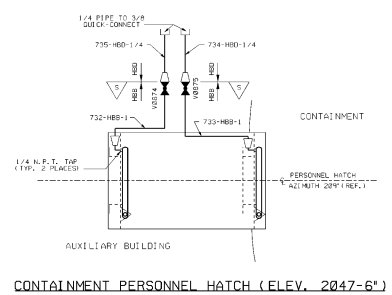


USAR FIG. 9.3-1-05

ESSENTIAL DRAWING

NO. 0000	REVISION	DATE	BY	CHKD.	APP. NO.
00000					
NO. 0000	REVISED PER	NO. 00-000	SECTION 6.1.0	TABLE A, TYPE 2	
WOLF CREEK			ELECTRONIC APPROVAL		
PIPING & INSTRUMENTATION			DIAGRAM		
COMPRESSED AIR SYSTEM			M-12KA05		
SCALE	DATE				NO.
NONE					07

07

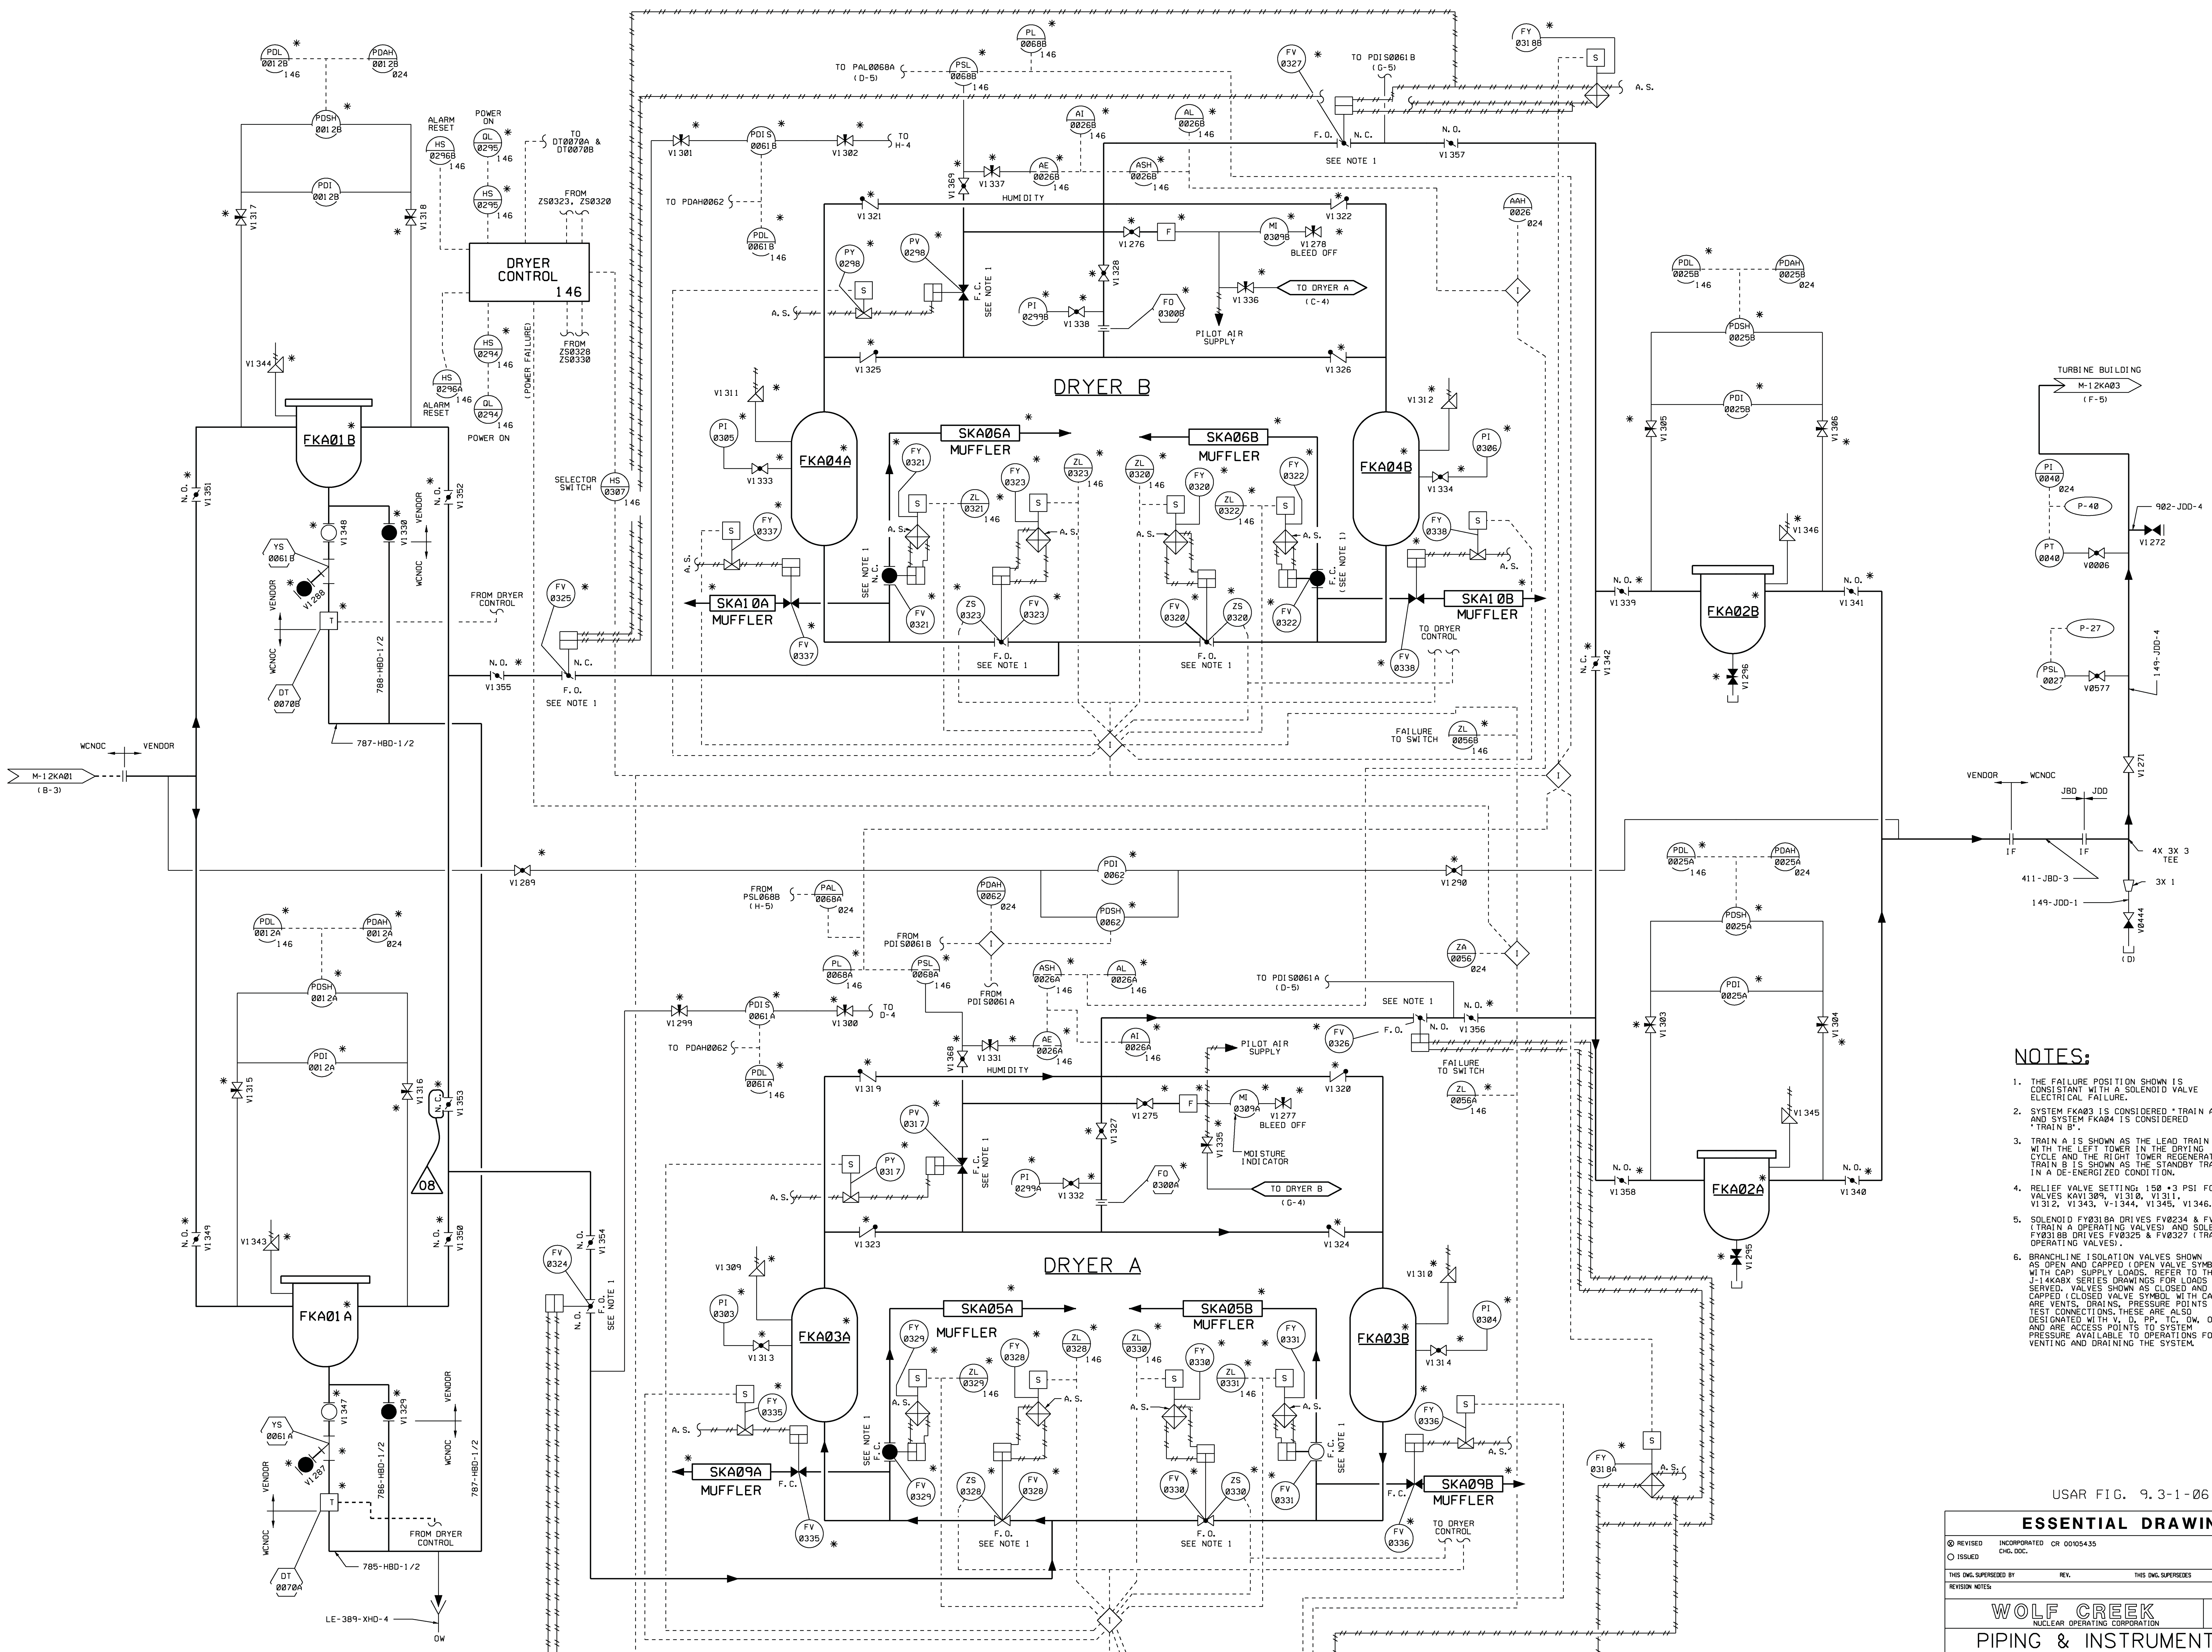



- NOTES:**
1. THE FAILURE POSITION SHOWN IS CONSTANT WITH A SOLENOID VALVE ELECTRICAL FAILURE.
 2. SYSTEM FKA03 IS CONSIDERED "TRAIN A", AND SYSTEM FKA04 IS CONSIDERED "TRAIN B".
 3. TRAIN A IS SHOWN AS THE LEAD TRAIN WITH THE LEFT TOWER IN THE DRYING CYCLE AND THE RIGHT TOWER REGENERATING. TRAIN B IS SHOWN AS THE STANDBY TRAIN IN A DE-ENERGIZED CONDITION.
 4. RELIEF VALVE SETTING: 150 +3 PSI FOR VALVES KAV1309, V1310, V1311, V1312, V1343, V1344, V1345, V1346.
 5. SOLENOID FV0318A DRIVES FV0234 & FV0226. TRAIN A OPERATING VALVES AND SOLENOID FV0318B DRIVES FV0325 & FV0327 (TRAIN B OPERATING VALVES).
 6. BRANCHLINE ISOLATION VALVES SHOWN AS OPEN AND CAPPED (OPEN VALVE SYMBOL WITH CAP SUPPLY LOADS. REFER TO THE J-14KABX SERIES DRAWINGS FOR LOADS SERVED. VALVES SHOWN AS CLOSED AND CAPPED (CLOSED VALVE SYMBOL WITH CAP) ARE VENTS, DRAINS, PRESSURE POINTS AND TEST CONNECTIONS. THESE ARE ALSO DESIGNATED WITH V, D, PP, TC, DW, OR DRV AND ARE ACCESS POINTS TO SYSTEM PRESSURE AVAILABLE TO OPERATIONS FOR VENTING AND DRAINING THE SYSTEM.

USAR FIG. 9.3-1-06

ESSENTIAL DRAWING			
REVISED	INCORPORATED	CR 0005435	CHANGE
ISSUED	CHG. DEC.		PKG. NO.
THIS DWG. SUPERSEDES		REV.	THIS DWG. SUPERSEDES
REVISION NOTES			
WOLF CREEK		ELECTRONIC APPROVAL	
NUCLEAR OPERATING CORPORATION			
PIPING & INSTRUMENTATION DIAGRAM			
COMPRESSED AIR SYSTEM			
SCALE	DRAWING NUMBER	SHEET	REV
NONE	M-12KA06	08	08


34X44 E SIZE

NOTES
 1. FOR NOTES SEE DWG. M-12KA02 AND M-12KA03

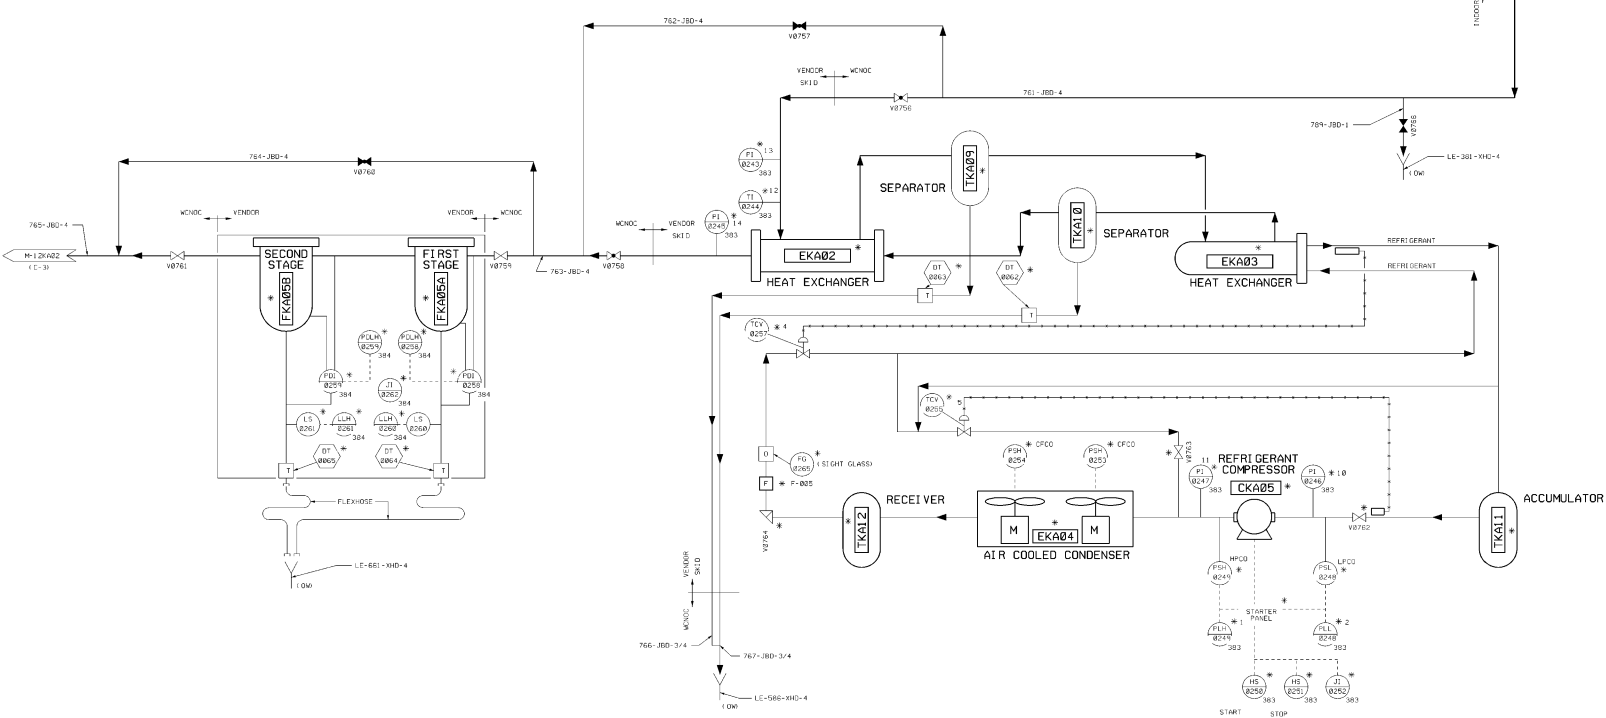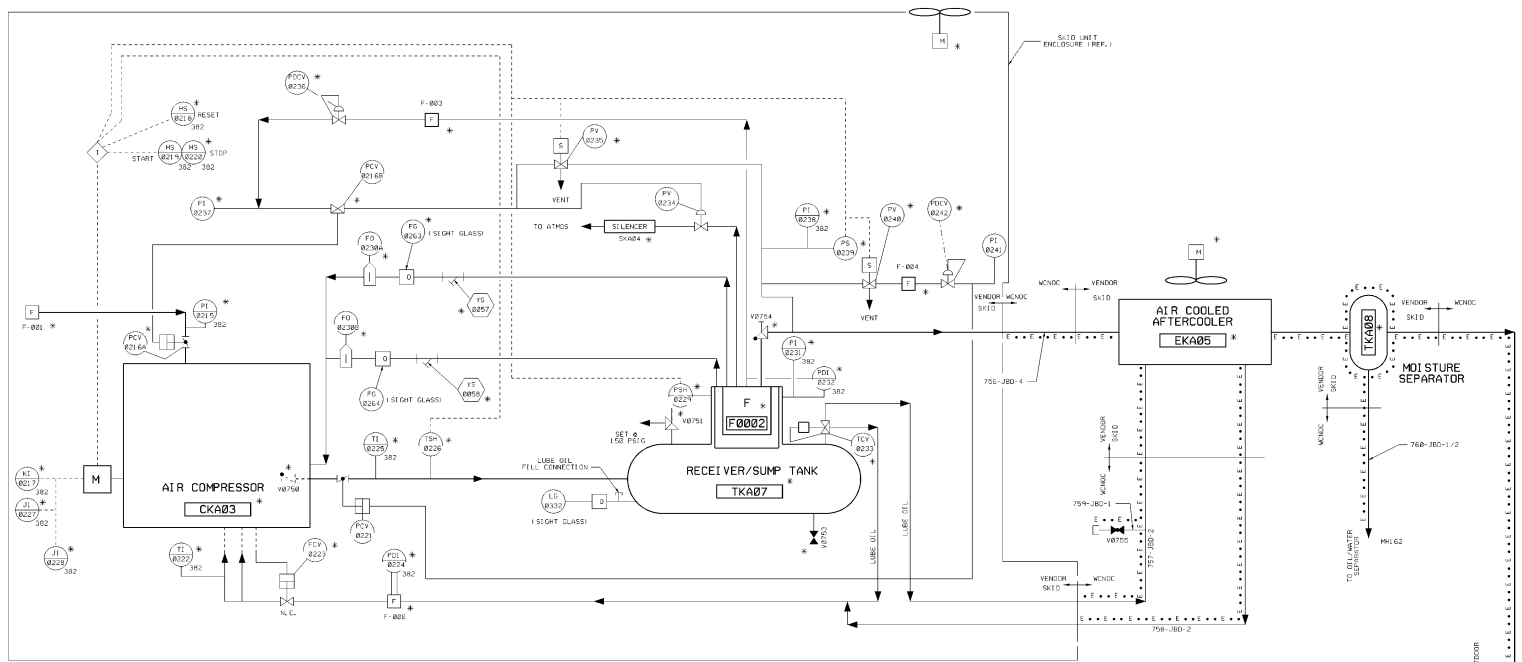

USAR FIG. 9.3-1 07


ESSENTIAL DRAWING			
© 191500	UNCLASSIFIED	DATE	07/10/07
© 151419	UNCLASSIFIED	FIG. NO.	101
THIS DRAWING IS THE PROPERTY OF WOLF CREEK		IT IS TO BE KEPT IN CONFIDENCE AND NOT REPRODUCED OR TRANSMITTED IN ANY FORM OR BY ANY MEANS, ELECTRONIC OR MECHANICAL, INCLUDING PHOTOCOPYING, RECORDING, OR BY ANY INFORMATION STORAGE AND RETRIEVAL SYSTEM.	
WOLF CREEK Nuclear Operations Corporation		ELECTRONIC APPROVAL	
PIPING & INSTRUMENTATION DIAGRAM			
COMPRESSED AIR SYSTEM			
SCALE	DATE	SHEET	NO.
NONE	M-12KA07	101	01

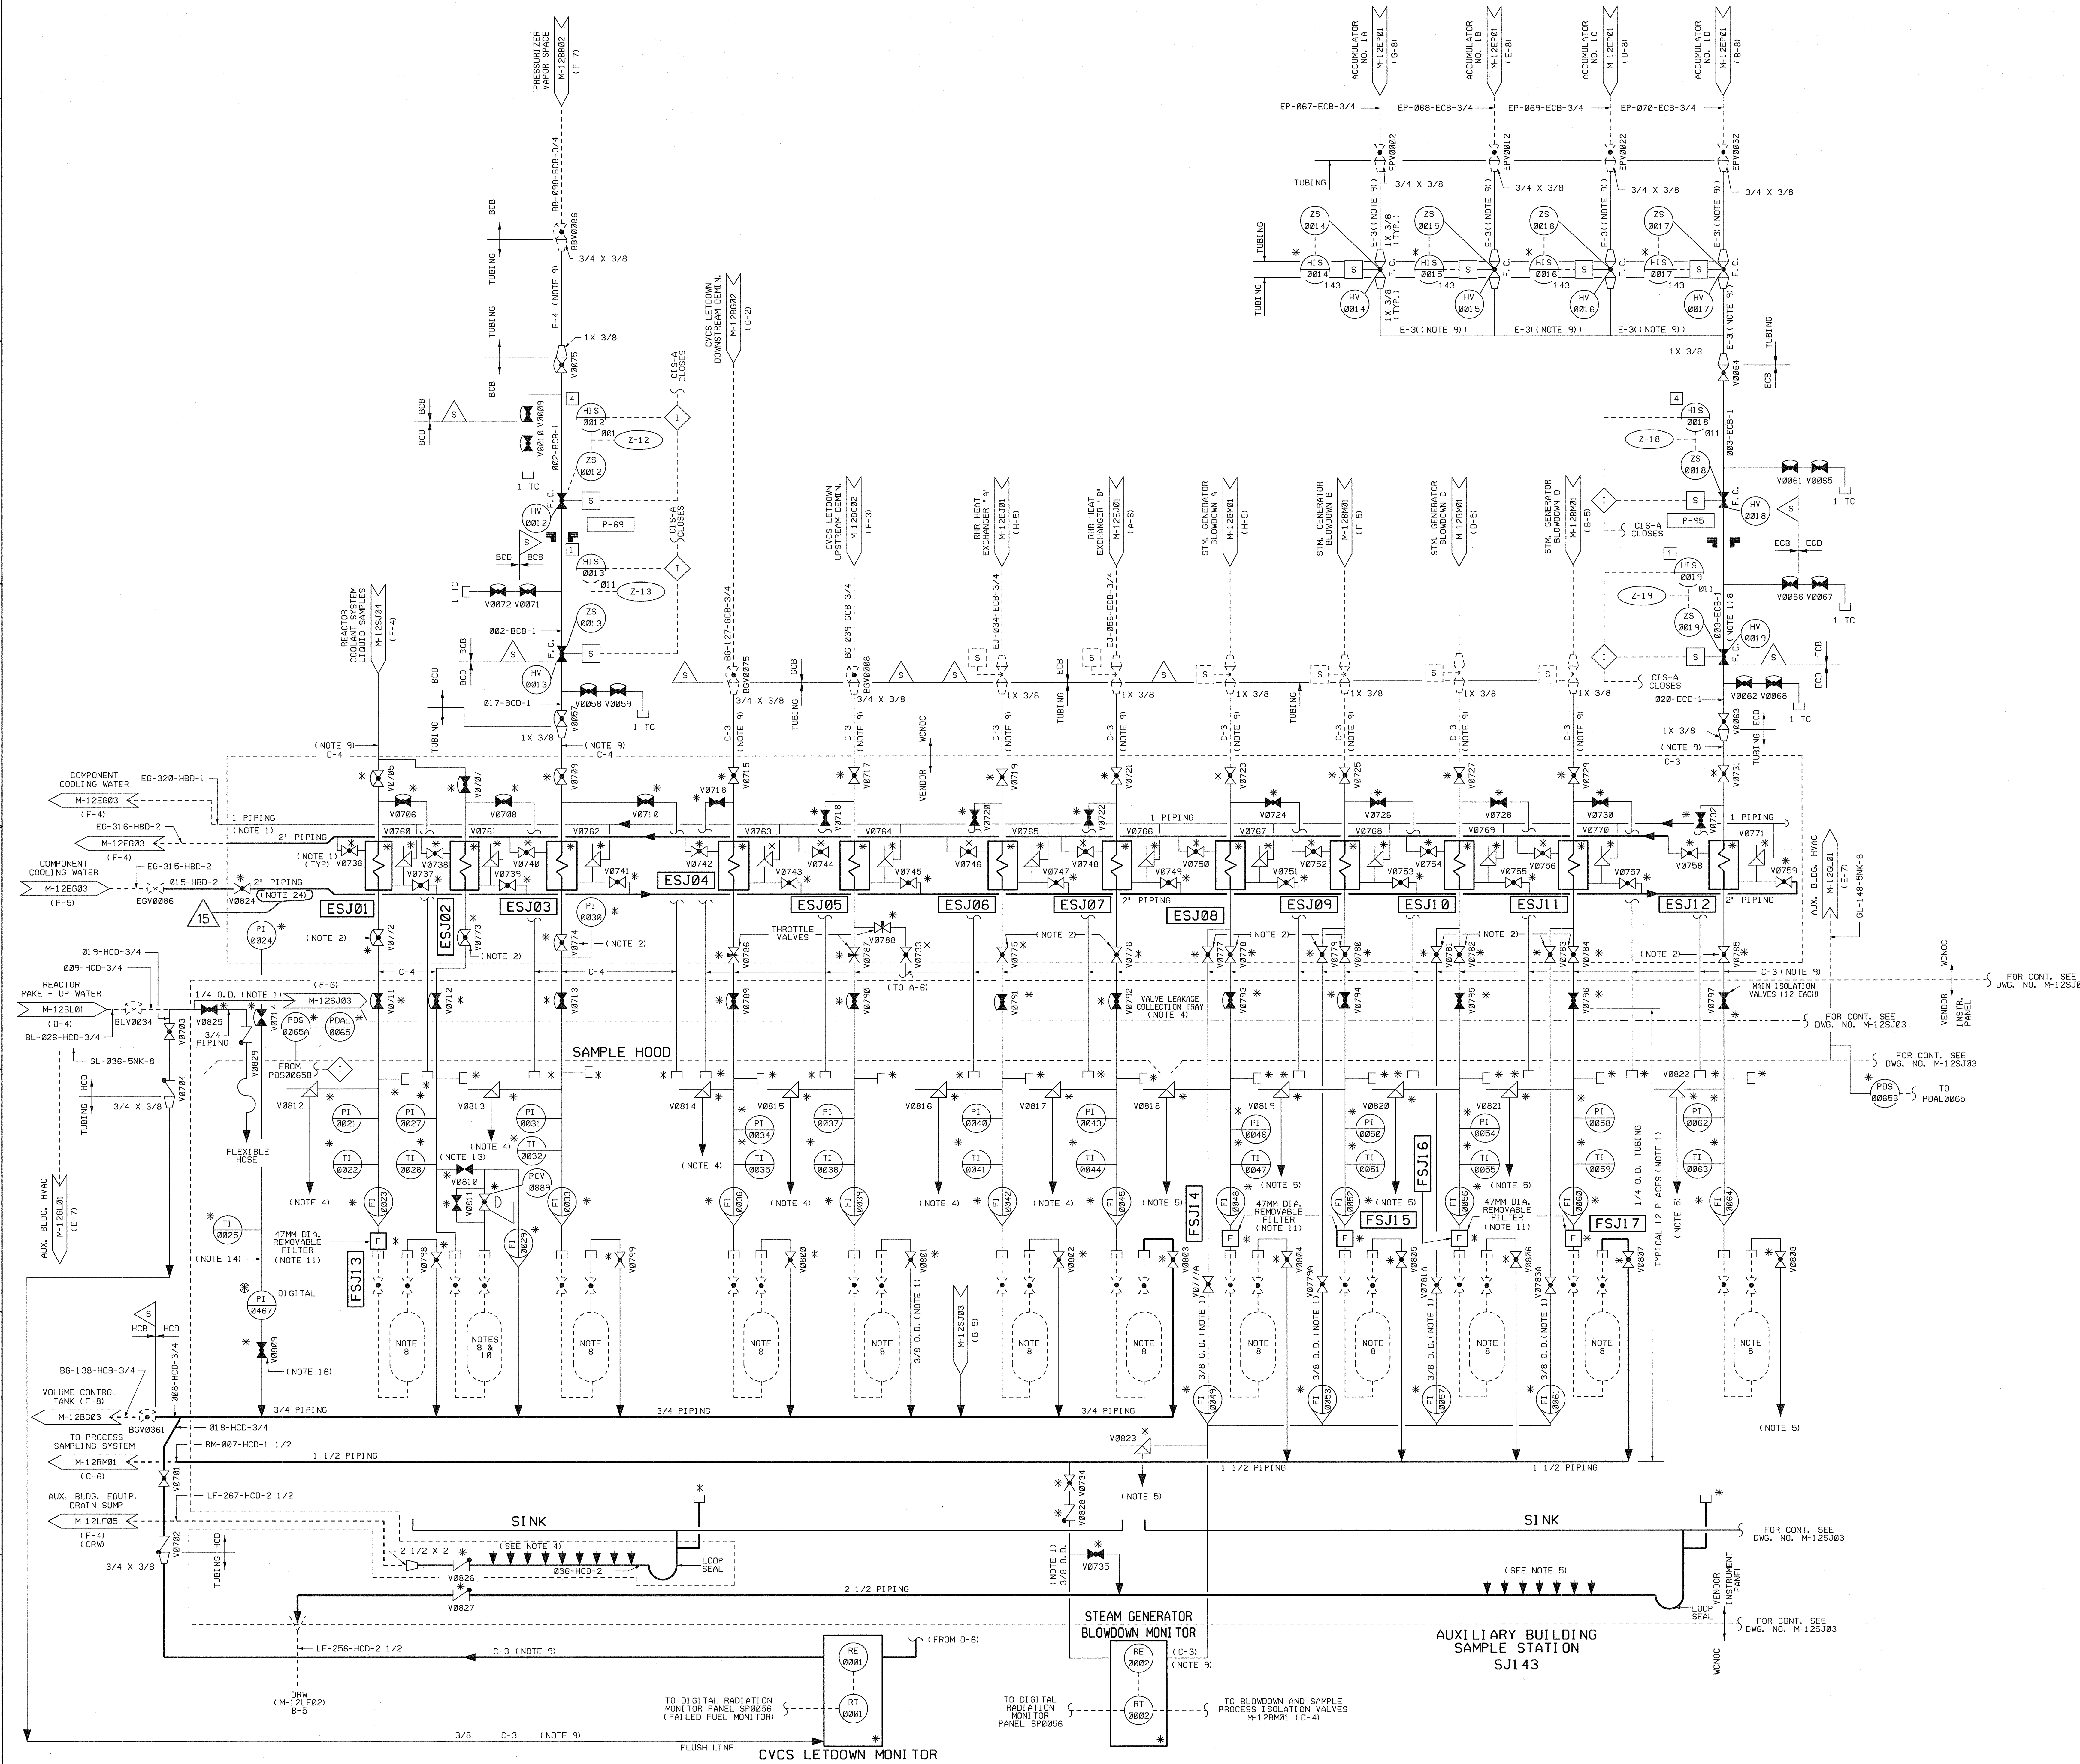

NOTES:


- ALL VENDOR SAMPLE LINES ARE AUSTENITIC STAINLESS STEEL TUBING IN ACCORDANCE WITH STANDARD CODES FOR POWER PIPING ANSI B31.1-1973. ALL TUBING IS 3/8 INCH O.D. X .065 INCH WALL. THE KNEES UNLESS NOTED OTHERWISE. TUBING THROUGH THE SAMPLE COOLERS MAY BE 1/4 INCH O.D. TUBING DOWNSTREAM OF THE MAIN ISOLATION VALVES MAY BE 1/4 INCH O.D. TUBING THROUGHOUT THE RADWASTE BUILDING PANEL (M-12S02) MAY BE 1/4 INCH O.D. DRAIN MANIFOLD HEADERS, AND COOLER PIPING/TUBING SHALL ALSO MEET THE REQUIREMENTS OF ANSI B31.1-1973.
- THIS VALVE IS AN ADJUSTABLE ROD - IN - TUBE TYPE FOR PRESSURE DROP AND FLOW CONTROL.
- VALVE POSITIONS ARE SHOWN WHEN THE SAMPLE SYSTEM IS NOT IN OPERATION.
- DIRECT DISCHARGE VIA A CLOSED CONNECTION TO A SINK DRAIN HEADER (TO AUX. BLDG. EQUIP. DRAIN SUMP (CRW)).
- DIRECT DISCHARGE VIA A CLOSED CONNECTION TO A SINK DRAIN HEADER (TO RADWASTE BLDG. EQUIP. DRAIN SUMP (CRW)).
- DIRECT DISCHARGE VIA A CLOSED CONNECTION TO A SINK DRAIN HEADER (TO RADWASTE BLDG. SUMP (DRW)).
- IDENTIFIES SAMPLING CONNECTIONS FOR SAMPLE VESSELS, GRAB SAMPLES AND HOOK UP FOR IN LINE ANALYZERS CONNECTIONS ARE QUICK DISCONNECT COUPLINGS. VENDOR SHALL SUPPLY TEN (10) 500 ML CAPACITY SAMPLE VESSELS AND AT LEAST SIX (6) FAUCET ASSEMBLIES USED TO PROMOTE GRAB SAMPLES TO AN OPEN CONTAINER.
- FOR INSTRUMENT PIPING CLASS SPECIFICATION FOR STAINLESS STEEL TUBING SEE DWG. J07010.
- THIS SAMPLE SHALL BE TAKEN AT HIGH PROCESS PRESSURES TO PREVENT FLASHING IN ANY PORTION OF THE SAMPLE LINE. FOR PURPOSES OF DETERMINING DISSOLVED GAS CONCENTRATIONS.
- REMOVABLE IN - LINE FILTERS. FOR TRANSPORT TO THE HOT LABORATORY FOR FURTHER ANALYSIS.
- FOUR (4) SPARE SAMPLE LINES, COMPLETE WITH TUBING, INSTRUMENTS, ISOLATION VALVES, QUICK DISCONNECTS AND THROTTLE VALVES, SHALL BE BUILT INTO THE VENDORS PANEL AS SHOWN, FOR FUTURE EXPANSION. THE VENDOR SHALL CAP EACH SAMPLE LINE, AT THE INLET AND OUTLET, ON THE EXTERNAL SIDE OF HIS S BULKHEAD FITTINGS.
- THIS VALVE IS USED TO RELEASE THE SAMPLE LINE PRESSURE TO ATMOSPHERE, BEFORE QUICK DISCONNECTING THE SAMPLE VESSEL, WHEN OBTAINING HIGH PRESSURE RCS PROCESS SAMPLES.
- THE PRESSURE SENSING LINE SHOULD FORM A DEAD LEG OR A LOOP SEAL TO PROVIDE THERMAL BARRIER, IN THE CASE OF LOSS OF COMPONENT COOLING WATER TO THE SAMPLE COOLER.
- ITEMS SUPPLIED BY WESTINGHOUSE ELECTRIC CORP (NSSL).
- DIGITAL PRESSURE INDICATOR BLEED VALVE SHALL BE PANEL MOUNTED IN CLOSE PROXIMITY TO THE INDICATOR. DIGITAL PRESSURE INDICATOR USED TO CALIBRATE REACTOR COOLANT SYSTEM PRESSURE INSTRUMENTATION.
- THE D-LISTED PORTION OF THIS SYSTEM IS ONLY THE PIPING AND VALVES ASSOCIATED WITH CONTAINMENT PENETRATIONS.
- CONTAINMENT PENETRATION PIPING 003-ECB-1 IS SOH. 005.
- SWITCH PROVIDED FOR POWER LOCKOUT.
- DELETED.
- AIR PURGE OPERATES DURING PASS OPERATION TO CLEAR LINE OF RADIOACTIVE EFFLUENT. (REFERENCE P/R 94-0744)
- FOR RADWASTE BUILDING SAMPLE STATION SJ144. MAIN ISOLATION VALVES MAY BE BALL TYPE.
- WESTINGHOUSE NUCLEAR SAFETY ADVISORY LETTER (NSAL) NSAL-00-000 "PRESSURE UPPER LEVEL INSTRUMENT LINE SAFETY CLASSIFICATION" HAS BEEN EVALUATED IN PIR 2002-1236. NRC LETTER DATED MAY 31, 2005 FROM USNRC TO WOLFCREEK LICENSE NO. 09-00019 AUTHORIZED THE ALTERNATIVE TO THE REQUIREMENTS OF 10 CFR 50.55A(C) IN RESPONSE TO NRC LETTER MM 04-0032. THIS HAS NO ASME CLASS CHANGE IS REQUIRED OF THE SUBJECT PIPING, TUBING, VALVES AND SUPPORTS.
- FOR RCS SYSTEM FLOW BALANCING, TOTAL PACKAGE COOLING WATER FLOW MINIMUM OF 60 GPM IS ACCEPTABLE.

15

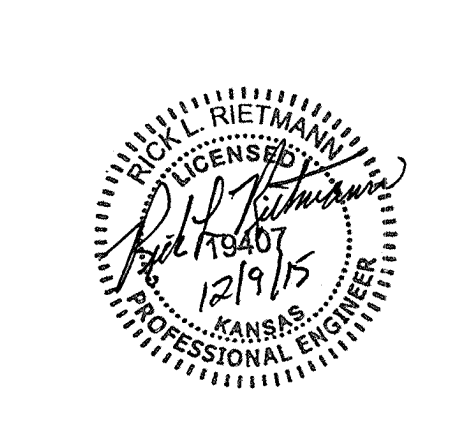

USAR FIG. 9.3-2-01

ESSENTIAL DRAWING			
REVISION	ISSUED	INCORPORATED	CHANGE 014990
		CHK. DCC	PKG. NO.
THIS Dwg. SUPERSEDES	REV.	THIS Dwg. SUPERSEDES	REV.
REVISION NOTES			Dec 12-14-15
WOLF CREEK		ELECTRONIC APPROVAL	
NUCLEAR OPERATING CORPORATION			
PIPING AND INSTRUMENTATION DIAGRAM			
NUCLEAR SAMPLING SYSTEM			
SCALE	DRAWING NUMBER	SHEET	REV
NONE	M-12SJ01	15	

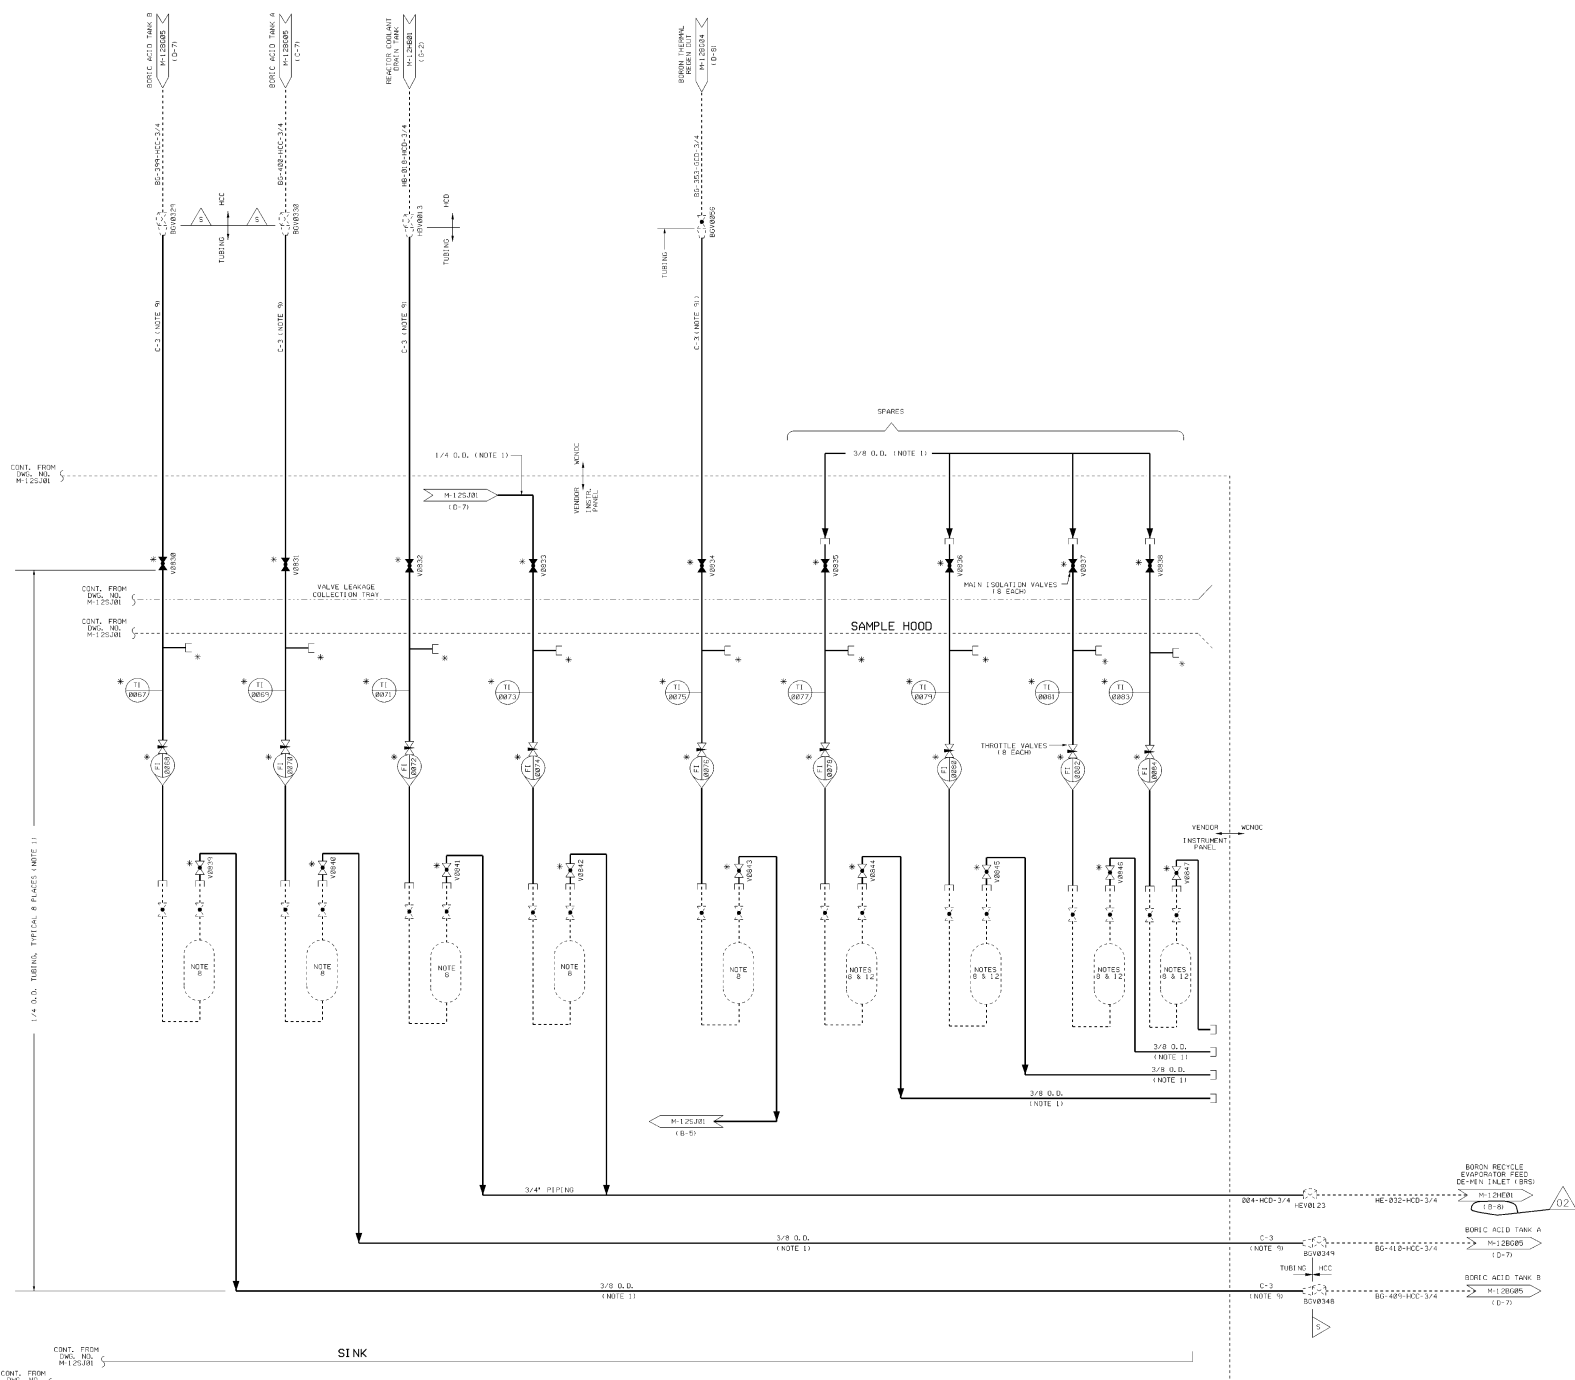

NOTES:
 1. SEE SHEET M-12S-001 FOR NOTES.



AUXILIARY BUILDING
 SAMPLE STATION
 SJ0143


USAR FIG. 9, 3-2-02

ESSENTIAL DRAWING			
© 1990	INCORPORATED	DATE	
D 05503		REV	
THIS DRAWING IS THE PROPERTY OF WOLF CREEK NUCLEAR OPERATING CORPORATION. IT IS TO BE USED ONLY FOR THE PROJECT AND SITE SPECIFICALLY IDENTIFIED HEREIN. IT IS NOT TO BE REPRODUCED OR TRANSMITTED IN ANY FORM OR BY ANY MEANS, ELECTRONIC OR MECHANICAL, INCLUDING PHOTOCOPYING, RECORDING, OR BY ANY INFORMATION STORAGE AND RETRIEVAL SYSTEM, WITHOUT THE WRITTEN PERMISSION OF WOLF CREEK NUCLEAR OPERATING CORPORATION.			
WOLF CREEK NUCLEAR OPERATING CORPORATION		ELECTRONIC APPROVAL	
PIPING & INSTRUMENTATION DIAGRAM			
NUCLEAR SAMPLING SYSTEM			
SCALE	DATE	SHEET NO.	REV.
NONE	M-12S-003	02	


NOTES

1. ALL VENDOR SAMPLE LINES ARE AUSTENITIC STAINLESS STEEL TUBING. IN ACCORDANCE WITH STANDARD CODES FOR POWER PIPING ANSI B31.1 - ALL TUBING IS 3/8 INCH O.D. X .065 INCH WALL UNLESS OTHERWISE NOTED. TUBING THRU THE SAMPLE COOLERS SHALL BE 1/2 INCH O.D. TUBING DOWNSTREAM OF THE CONDENSATE TAKE OFF LINE SHALL BE 1/4 INCH O.D. DRAIN MAINFOLD, HEADER, COOLERS, INSTRUMENT RACK AND OTHER PIPING / TUBING SHALL ALSO MEET THE REQUIREMENTS OF ANSI B31.1.
2. ALL INSTRUMENT VALVES ARE TO BE RATED FOR ANSI 1500 LB. CLASS.
3. INPUTS TO RECORDERS (LOCATED AT SAMPLE STATION) ARE LISTED IN THE TABLE ON DRAWING NO. M-12RM03.
4. THIS VALVE IS AN ADJUSTABLE ROD - IN TUBE TYPE FOR PRESSURE DROP AND FLOW CONTROL.
5. ALL VENDOR SUPPLIED EQUIPMENT SHALL BE CONTAINED WITHIN THE FOLLOWING INSTRUMENT PANELS AND RACK:
 - RM 171 PROCESS SAMPLING CONTROL & RECORDER INSTRUMENT PANEL (DRY PANEL)
 - RM 172 PROCESS SAMPLING CONDITIONING & ANALYSIS INSTRUMENT PANEL (WET PANEL)
 - RM 185 CONDENSER-1 LEAK DETECTION INSTRUMENT RACK
6. FOR INSTRUMENT PIPING CLASS SPECIFICATION FOR STAINLESS STEEL TUBING SEE DWG. J07610.
7. ALL INSTRUMENTS AND COMPONENTS DESIGNATED BY AN ASTERISK (*) ARE VENDOR SUPPLIED.
8. ALL ALARMS FROM THE SUPPLIER'S ANNUNCIATOR WILL BE IDENTIFIED BY A COMMON ALARM IN THE MAIN CONTROL ROOM (QA 624 AND COMPUTER 1/0 D 642).
9. SIX CONDENSER HOTWELL SAMPLES SHALL BE AUTOMATICALLY AND SEQUENTIALLY DRAWN BY A SIX STER SEQUENCER FOR A Dwell TIME AT 1.0 MINUTES EACH. EACH ANALYZER OUTPUT SHALL BE SEQUENTIALLY RECORDED ON A SEPARATE MULTIPPOINT RECORDER CHANNEL.
10. DELETED
11. DELETED
12. COMPONENT IS SUPPLIED AND INSTALLED BY OWNER.
13. DRAIN PAN AND DRAIN LINE SUPPLIED AND INSTALLED BY OWNER.
14. CONSTANT HEAD CHAMBER VENTS ROUTED TO EQUIPMENT DRAIN BY FIELD.
15. CAUTION: WHENEVER RM0789 IS CLOSED, THE PIPE PLUG M-12RM02 ZONE C-3 MUST BE REMOVED.
16. TEE BRANCH FITTING SHALL ALLOW CONNECTION OF 1/8" TEFLON TUBING FROM ION CHROMATOGRAPH. SWAGelok QUICK DISCONNECT COUPLINGS MAY BE USED TO CONNECT TEE BRANCH TO ION CHROMATOGRAPH 1/8" TEFLON TUBING.
17. DELETED

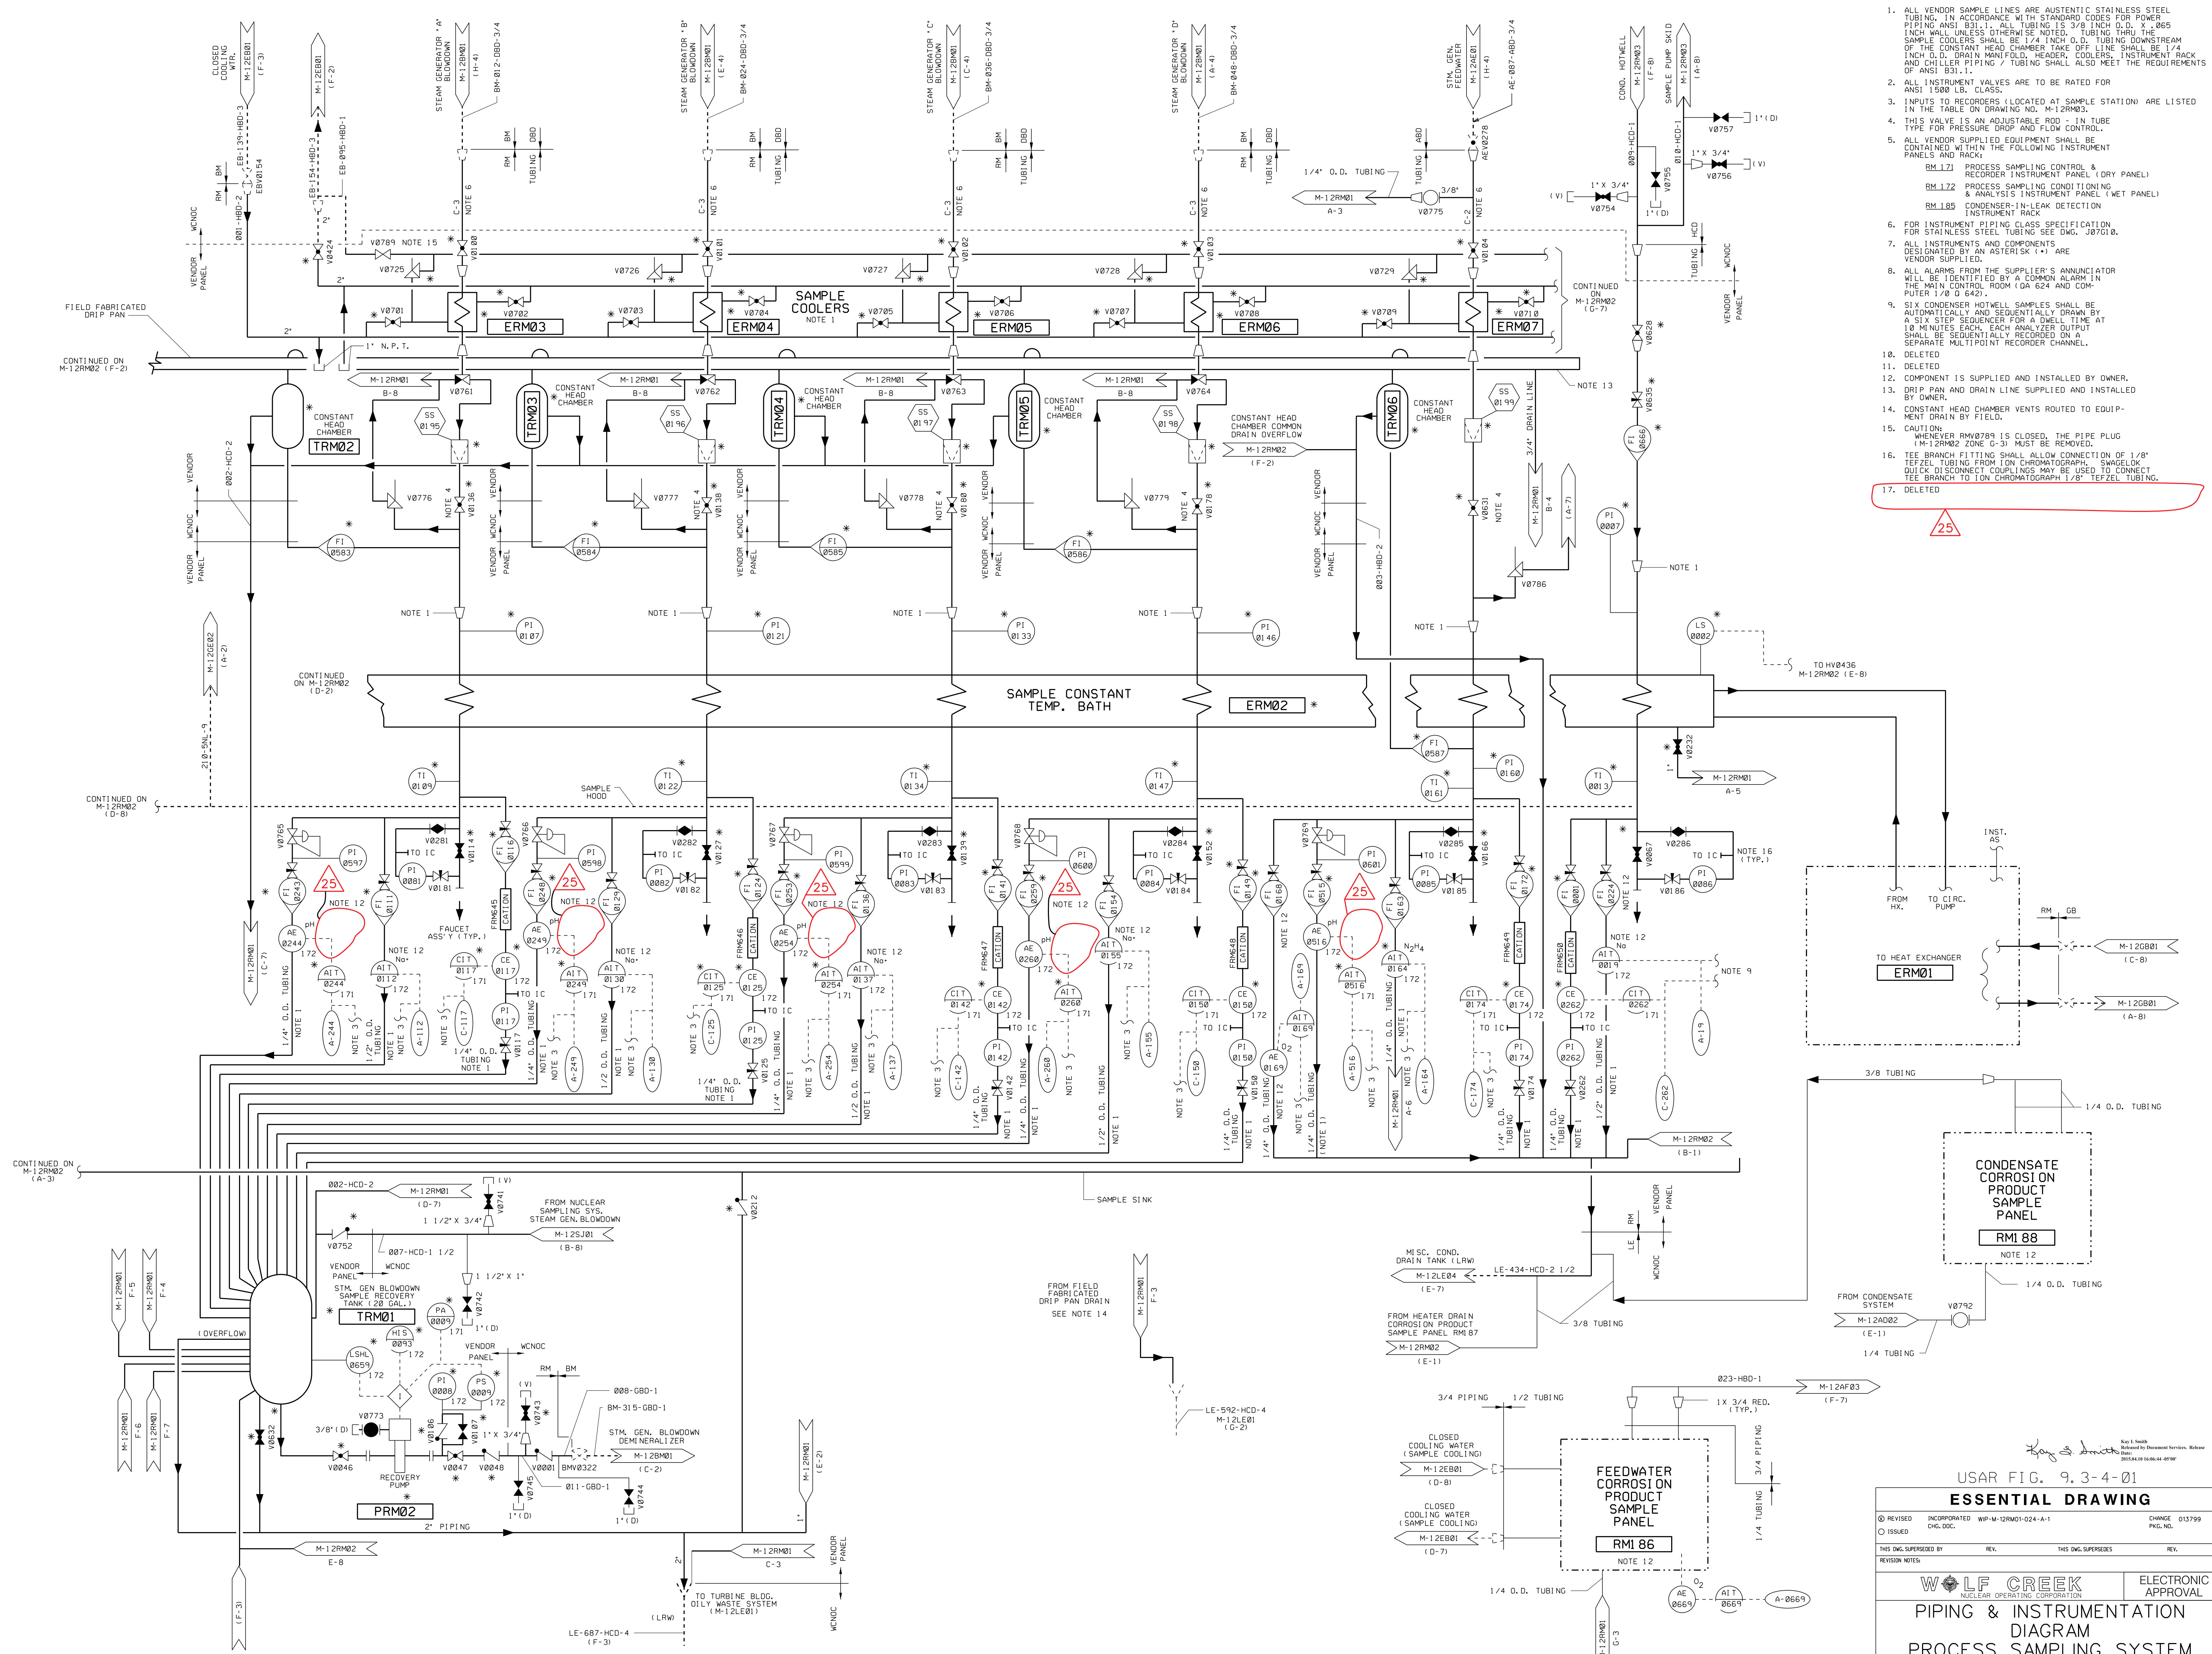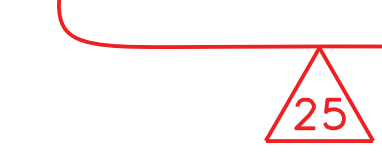

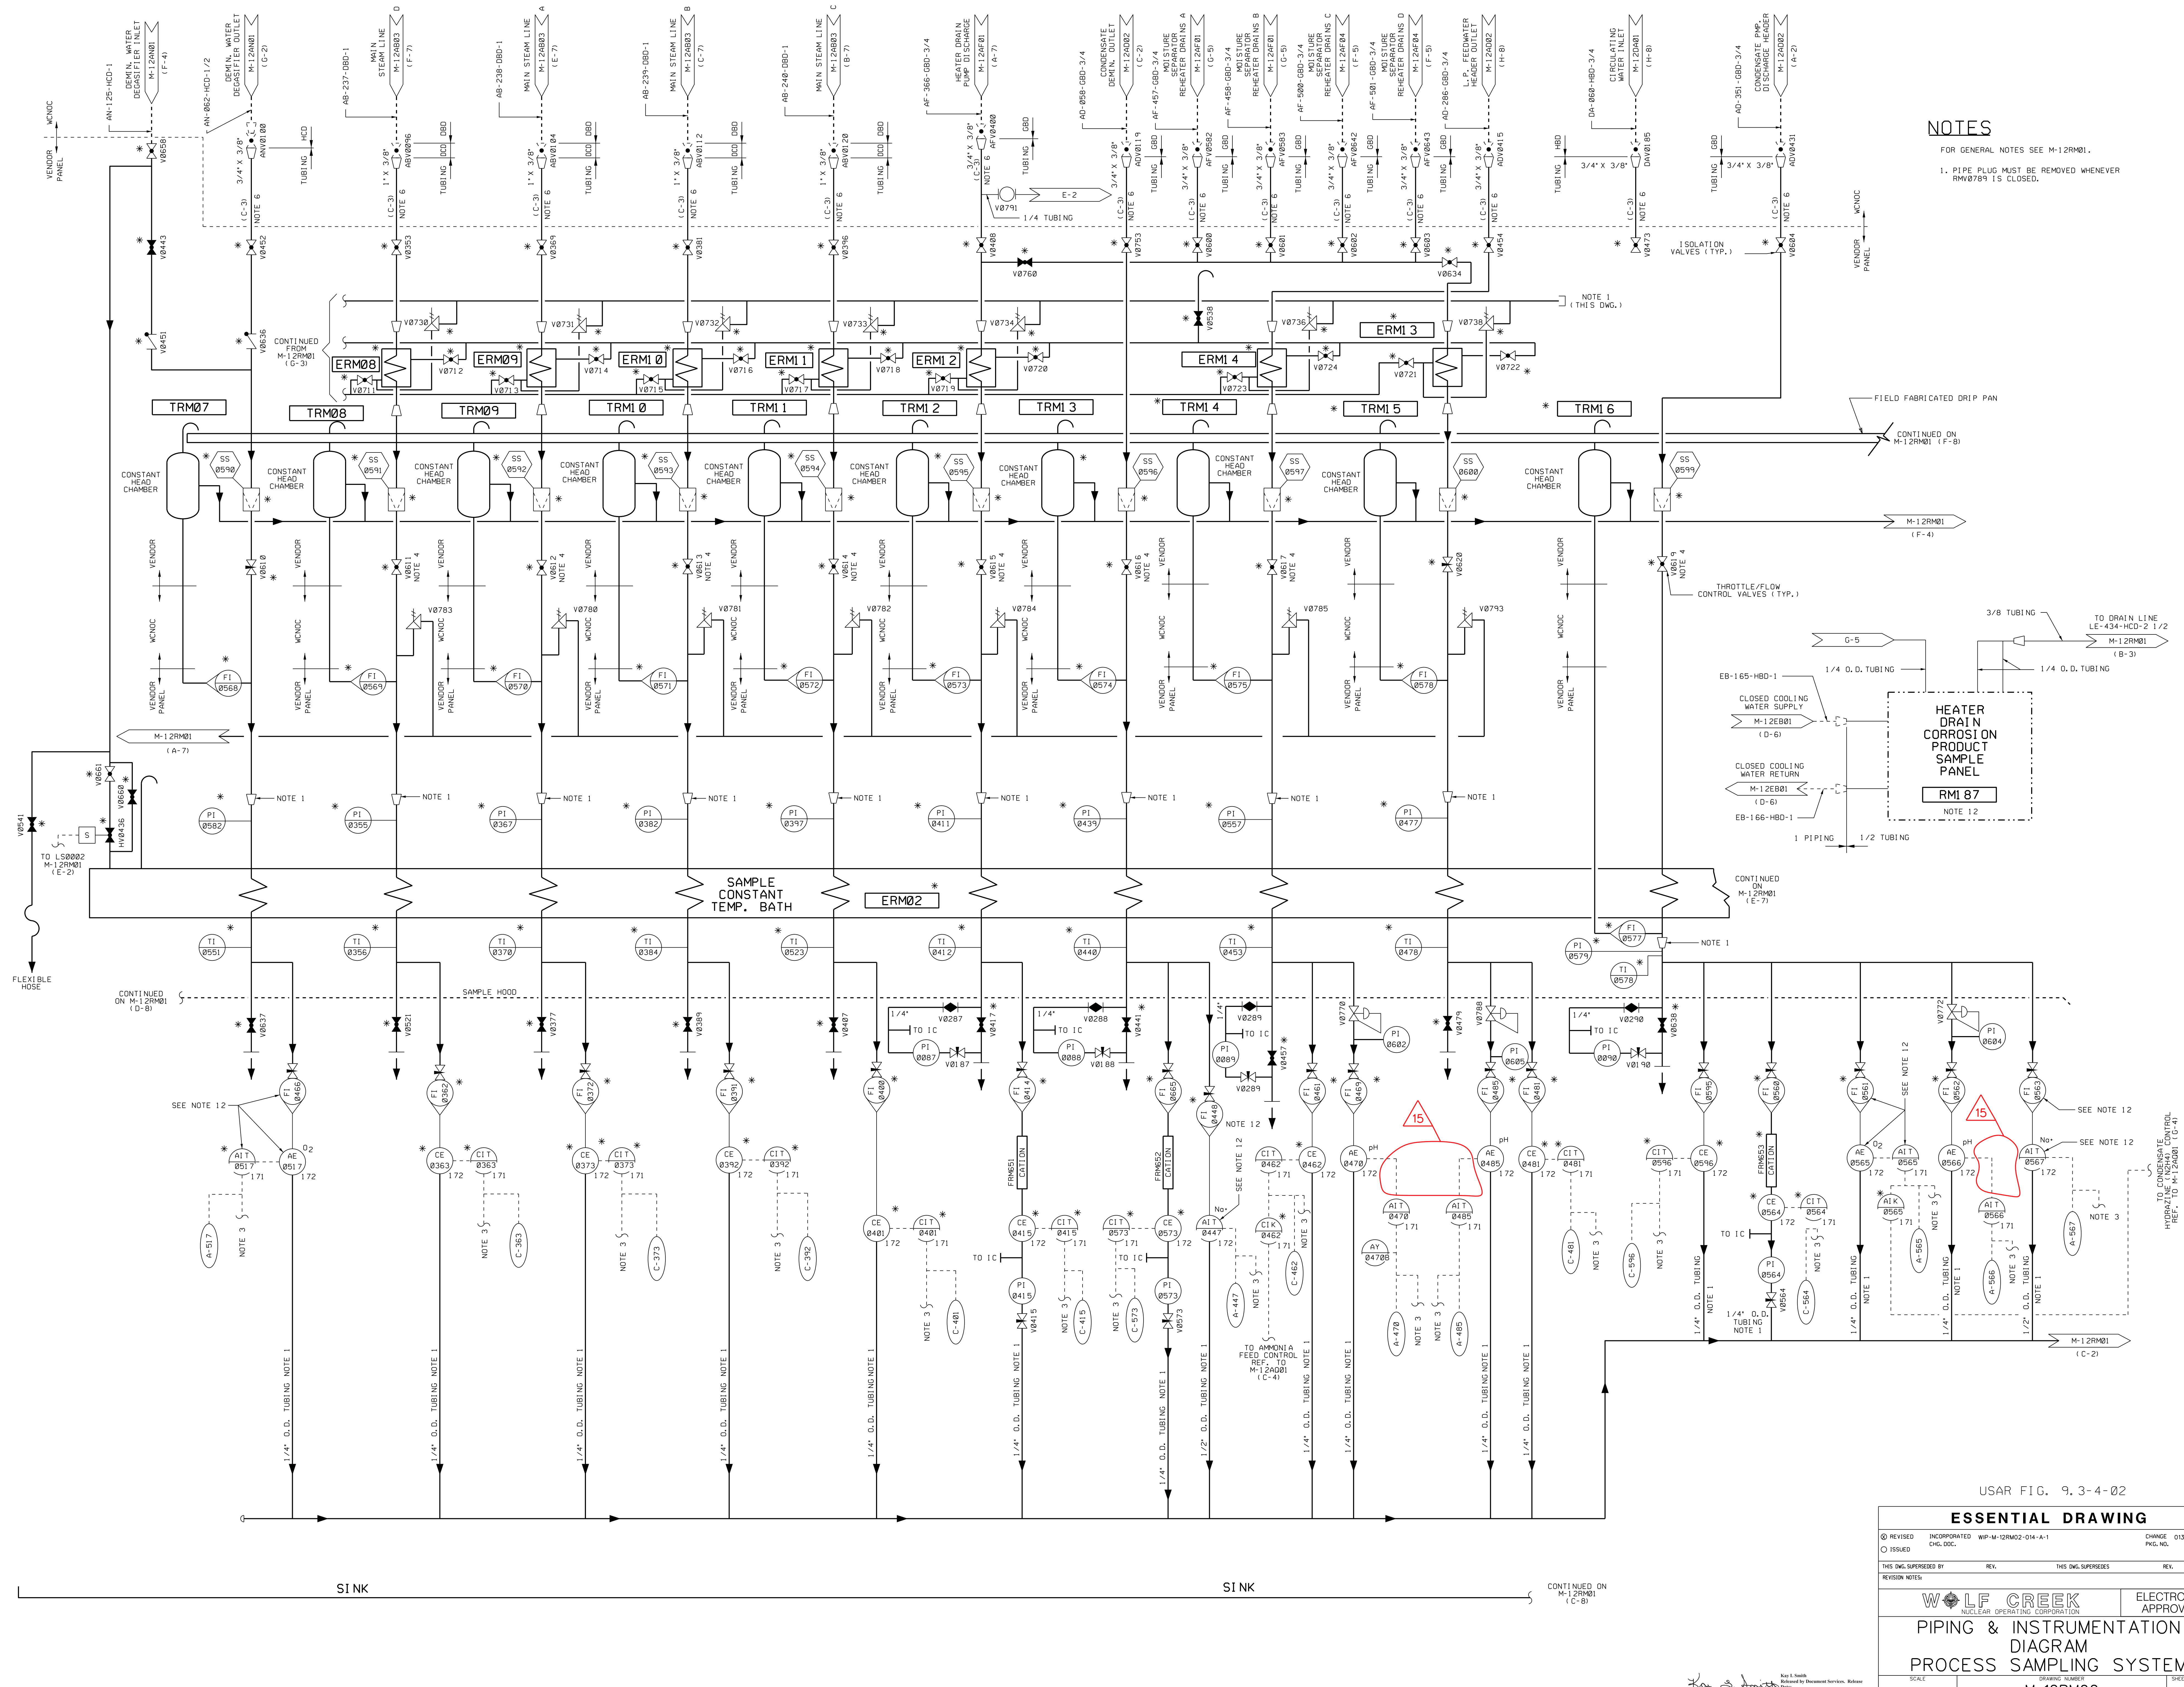

NOTES
 FOR GENERAL NOTES SEE M-12RM01.
 1. PI/FI PLUG MUST BE REMOVED WHENEVER RM0789 IS CLOSED.

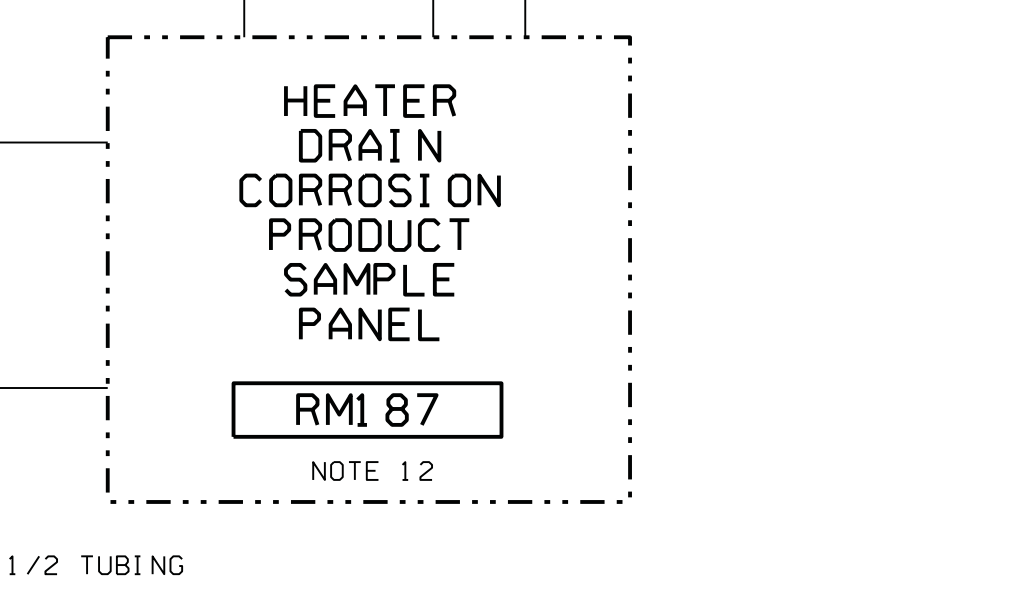

USAR FIG. 9.3-4-02

ESSENTIAL DRAWING

REVISIONS:
 1. REVISED INCORPORATED WP-M-12RM02-014-A-1 CHANGE 013799
 2. ISSUED CHG. DOC. PKG. NO.

THIS DWG SUPERSEDES BY: REV. THIS DWG SUPERSEDES: REV.

WOLF CREEK
 NUCLEAR OPERATING CORPORATION

**PIPING & INSTRUMENTATION
 DIAGRAM
 PROCESS SAMPLING SYSTEM**


SCALE: NONE DRAWING NUMBER: M-12RM02 SHEET: 1 REV: 15

CONTINUED ON M-12RM01 (C-B)

NOTES
FOR GENERAL NOTES SEE DRAWING M-12RM01.


REFERENCE NOTE 3:

SOURCE	PARAMETER	P & ID	INPUT	RECORDER NO.	SUPPL. LOGS ANALYZED (NOTE 5)
STM. GEN. A BLOWDOWN	PH	M-12RM01	AE0244 (D-7)	AR0001	AA40001
STM. GEN. B BLOWDOWN	PH	M-12RM01	AE0254 (D-8)	AR0002	AA40002
STM. GEN. C BLOWDOWN	PH	M-12RM01	AE0264 (D-9)	AR0003	AA40003
STM. GEN. D BLOWDOWN	PH	M-12RM01	AE0274 (D-10)	AR0004	AA40004
STEAM GEN. FEEDWATER	PH	M-12RM01	AE0316 (D-4)	AR0005	AA40005
L.P. F.W. HTR. OUTLET	PH	M-12RM02	AE0470 (C-4)	AR0006	AA40006
M.S.L.R. HEATER DRAINS	PH	M-12RM02	AE0489 (C-2)	AR0007	AA40007
COND. PUMP DISCH. HDR.	PH	M-12RM02	AE0505 (C-2)	AR0008	AA40008
STM. GEN. A BLOWDOWN	CAT. COND.	M-12RM01	CE0117 (D-6)	AR0002	AA40003
STM. GEN. B BLOWDOWN	CAT. COND.	M-12RM01	CE0125 (D-8)	AR0003	AA40004
STM. GEN. C BLOWDOWN	CAT. COND.	M-12RM01	CE0133 (D-9)	AR0004	AA40005
STM. GEN. D BLOWDOWN	CAT. COND.	M-12RM01	CE0141 (D-10)	AR0005	AA40006
STEAM GEN. FEEDWATER	CAT. COND.	M-12RM01	CE0159 (D-4)	AR0006	AA40007
HTR. DRAIN PUMP DISCH. COND. DRAIN. OUTLET	CAT. COND.	M-12RM02	CE0415 (C-5)	AR0007	AA40008
COND. PUMP DISCH. HDR.	CAT. COND.	M-12RM02	CE0513 (C-4)	AR0008	AA40009
HTR. DRAIN PUMP DISCH. COND. DRAIN. OUTLET	CAT. COND.	M-12RM02	CE0564 (C-2)	AR0009	AA40010
HTR. DRAIN PUMP DISCH. COND. DRAIN. OUTLET	SPEC. COND.	M-12RM02	CE0373 (C-6)	AR0003	AA40004
HTR. DRAIN PUMP DISCH. COND. DRAIN. OUTLET	SPEC. COND.	M-12RM02	CE0385 (C-8)	AR0004	AA40005
HTR. DRAIN PUMP DISCH. COND. DRAIN. OUTLET	SPEC. COND.	M-12RM02	CE0401 (C-7)	AR0005	AA40006
HTR. DRAIN PUMP DISCH. COND. DRAIN. OUTLET	SPEC. COND.	M-12RM02	CE0408 (C-2)	AR0006	AA40007
HTR. DRAIN PUMP DISCH. COND. DRAIN. OUTLET	SPEC. COND.	M-12RM02	CE0495 (C-3)	AR0007	AA40008
L.P. F.W. HTR. OUTLET	SPEC. COND.	M-12RM02	CE0462 (C-4)	AR0008	AA40009
STM. GEN. A BLOWDOWN	Na+	M-12RM01	AT1211 (D-7)	AR0004	AA40005
STM. GEN. B BLOWDOWN	Na+	M-12RM01	AT1230 (D-9)	AR0005	AA40006
STM. GEN. C BLOWDOWN	Na+	M-12RM01	AT1237 (D-9)	AR0006	AA40007
STM. GEN. D BLOWDOWN	Na+	M-12RM01	AT1255 (D-4)	AR0007	AA40008
COND. DRAIN. OUTLET	Na+	M-12RM02	AT1244 (D-4)	AR0008	AA40009
COND. PUMP DISCH. HDR.	Na+	M-12RM02	AT1257 (C-2)	AR0009	AA40010
STEAM GEN. FEEDWATER	G ₂	M-12RM01	AE0159 (C-4)	AR0005	AA40005
DEMIN. WATER EGGS	G ₂	M-12RM02	AE0517 (C-7)	AR0008	AA40008
COND. PUMP DISCH. HDR.	G ₂	M-12RM02	AE0505 (C-2)	AR0009	AA40009
STEAM GEN. FEEDWATER	NH ₃	M-12RM01	AT1064 (D-3)	AR0007	AA40007
CONDENSER HOT WELL	CAT. COND.	M-12RM01	CE0262 (1 SEC. SEL. 6 SAMPLE) (D-3)	AR0006	AA40006
CONDENSER HOT WELL	Na+	M-12RM01	AT1201 (1 SEC. SEL. 6 SAMPLE) (D-3)	AR0007	AA40007
SAMPLE RETURN OVER PRESSURE	PRESSURE	M-12RM02	N/A	N/A	FA2024

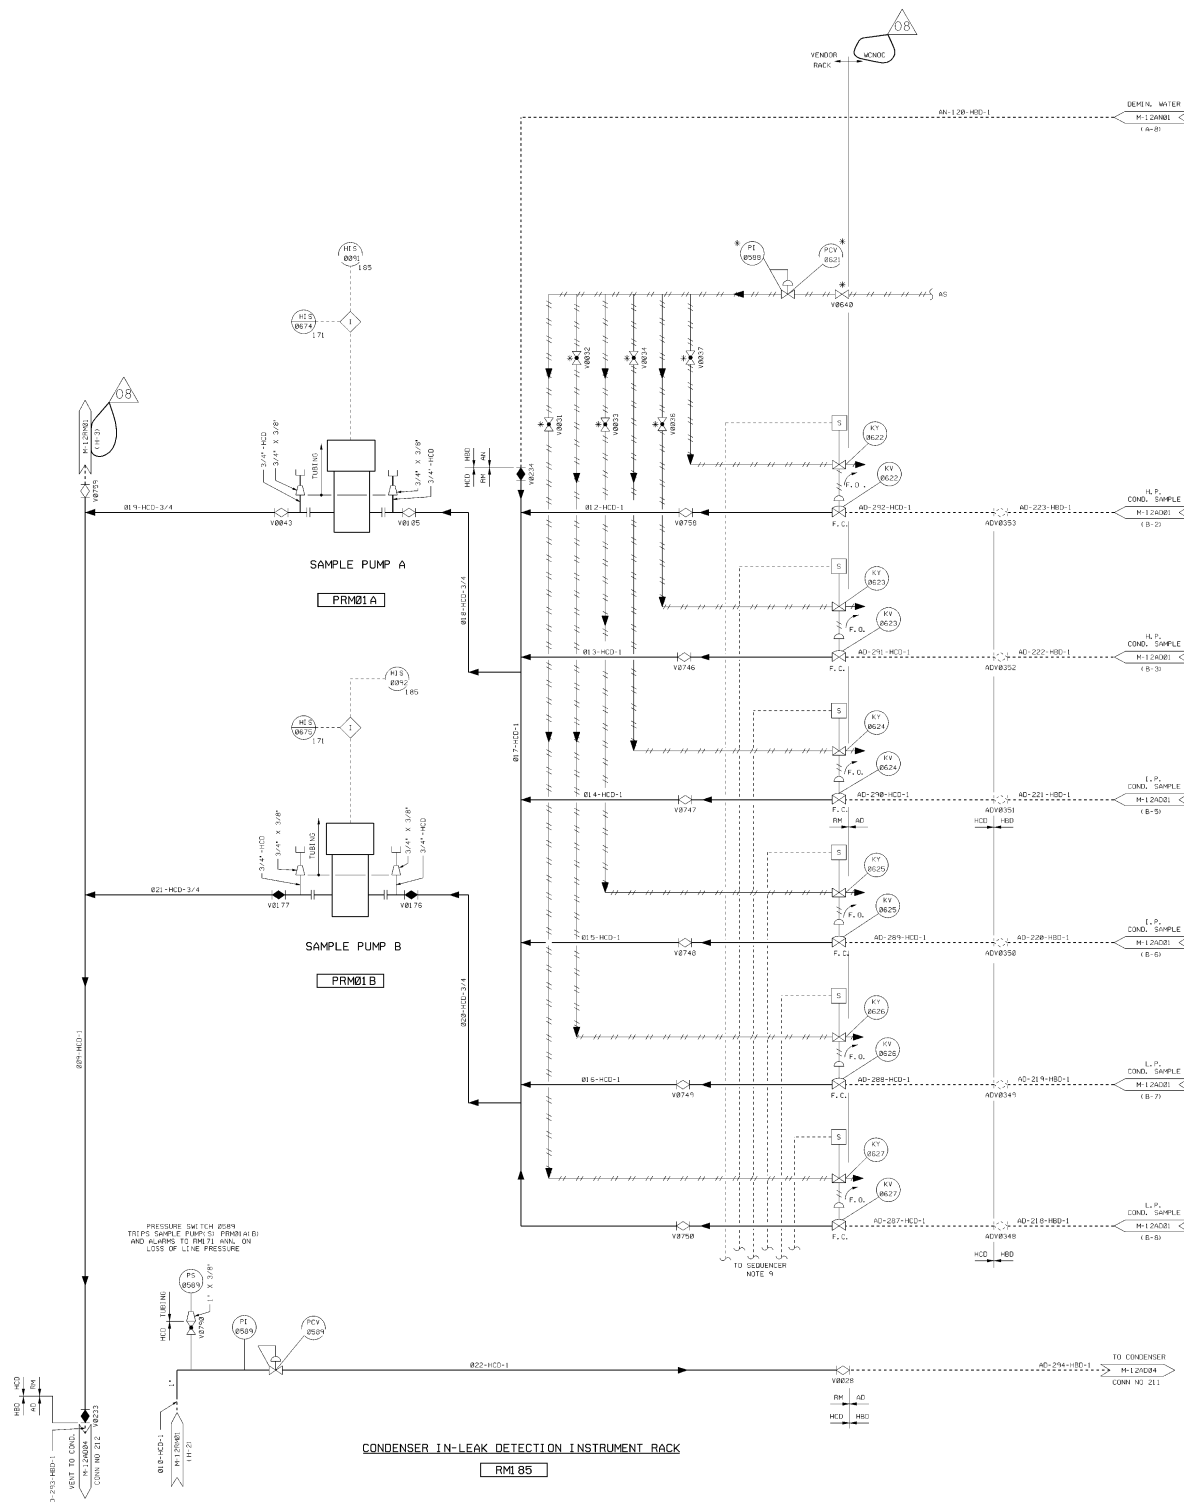

NOTES

1. PIPING, FITTINGS, VALVES, FIXTURES AND OTHER COMPONENTS ARE INDICATED FOR THE SANITARY DRAINAGE SYSTEM SHALL BE FURNISHED, INSTALLED, CLEANED AND TESTED IN ACCORDANCE WITH THE UNIFORM PLUMBING CODE (UPC) OR THE APPLICABLE LOCAL OR STATE CODE.
2. WATER CLOSETTS AND URINALS ARE PROVIDED WITH INTEGRAL TRAPS.
3. ADDITIONAL SYMBOLS NOT SHOWN ON DWG. M-820183 ARE AS FOLLOWS:
 ○ - CLEANOUT
 DS - DEEP SINK
 OS - OUBAGE DISPOSAL
 PS - PANTRY SINK
4. PIPING CLASS FOR THE SANITARY WASTE SYSTEM SHALL BE AS FOLLOWS EXCEPT AS NOTED:
 MATERIAL CLASS 200 EXTRA SERVICE WASTE PIPE, HEAVY CAST IRON CONTROL BLDG. A CONC. POLYETHYLENE PIPE AND BLUE LULU 200W" DP X 1/2" WALL
 CLASS 1500 GALVANIZED CARBON STEEL PIPE AND FIRM DRAINAGE FITTINGS
 CLASS 1500 GALVANIZED CARBON STEEL PIPE AND FIRM DRAINAGE FITTINGS
 CLASS 4000 CASTLE IRON PRESSURE FITTINGS
 PIPING WITH FLANGED CONNECTIONS
 OTHER SANITARY WASTE AND ALL VENT PIPING FROM THE SANITARY LIFT STATION SHALL BE CLASSIFIED AS NOTED BELOW
 SANITARY LIFT STATION DRAINAGE PIPING PENETRATING THROUGH EXTERIOR WALL OF THE COMM. BLDG.
5. PLUMBING FIXTURES SHALL BE PER THE REQUIREMENTS OF SPECIFICATION 95-200.
6. ALTERNATOR ALTERNATES PUMP OPERATION WHEN SUMP LEVEL IS HIGH BOTH PUMPS RUN WHEN SUMP LEVEL IS HIGH - HIGH AND BOTH PUMPS STOP ON LOW LEVEL.
7. MECHANICAL DESIGNATION PER M-10001.
8. THE SANITARY LIFT STATION PUMPS AND COVER ARE PROVIDED BY BESTSELL. ALL OTHER EQUIPMENT TO THE SYSTEM IS SAME PROVIDED EXCEPT WHERE INDICATED.

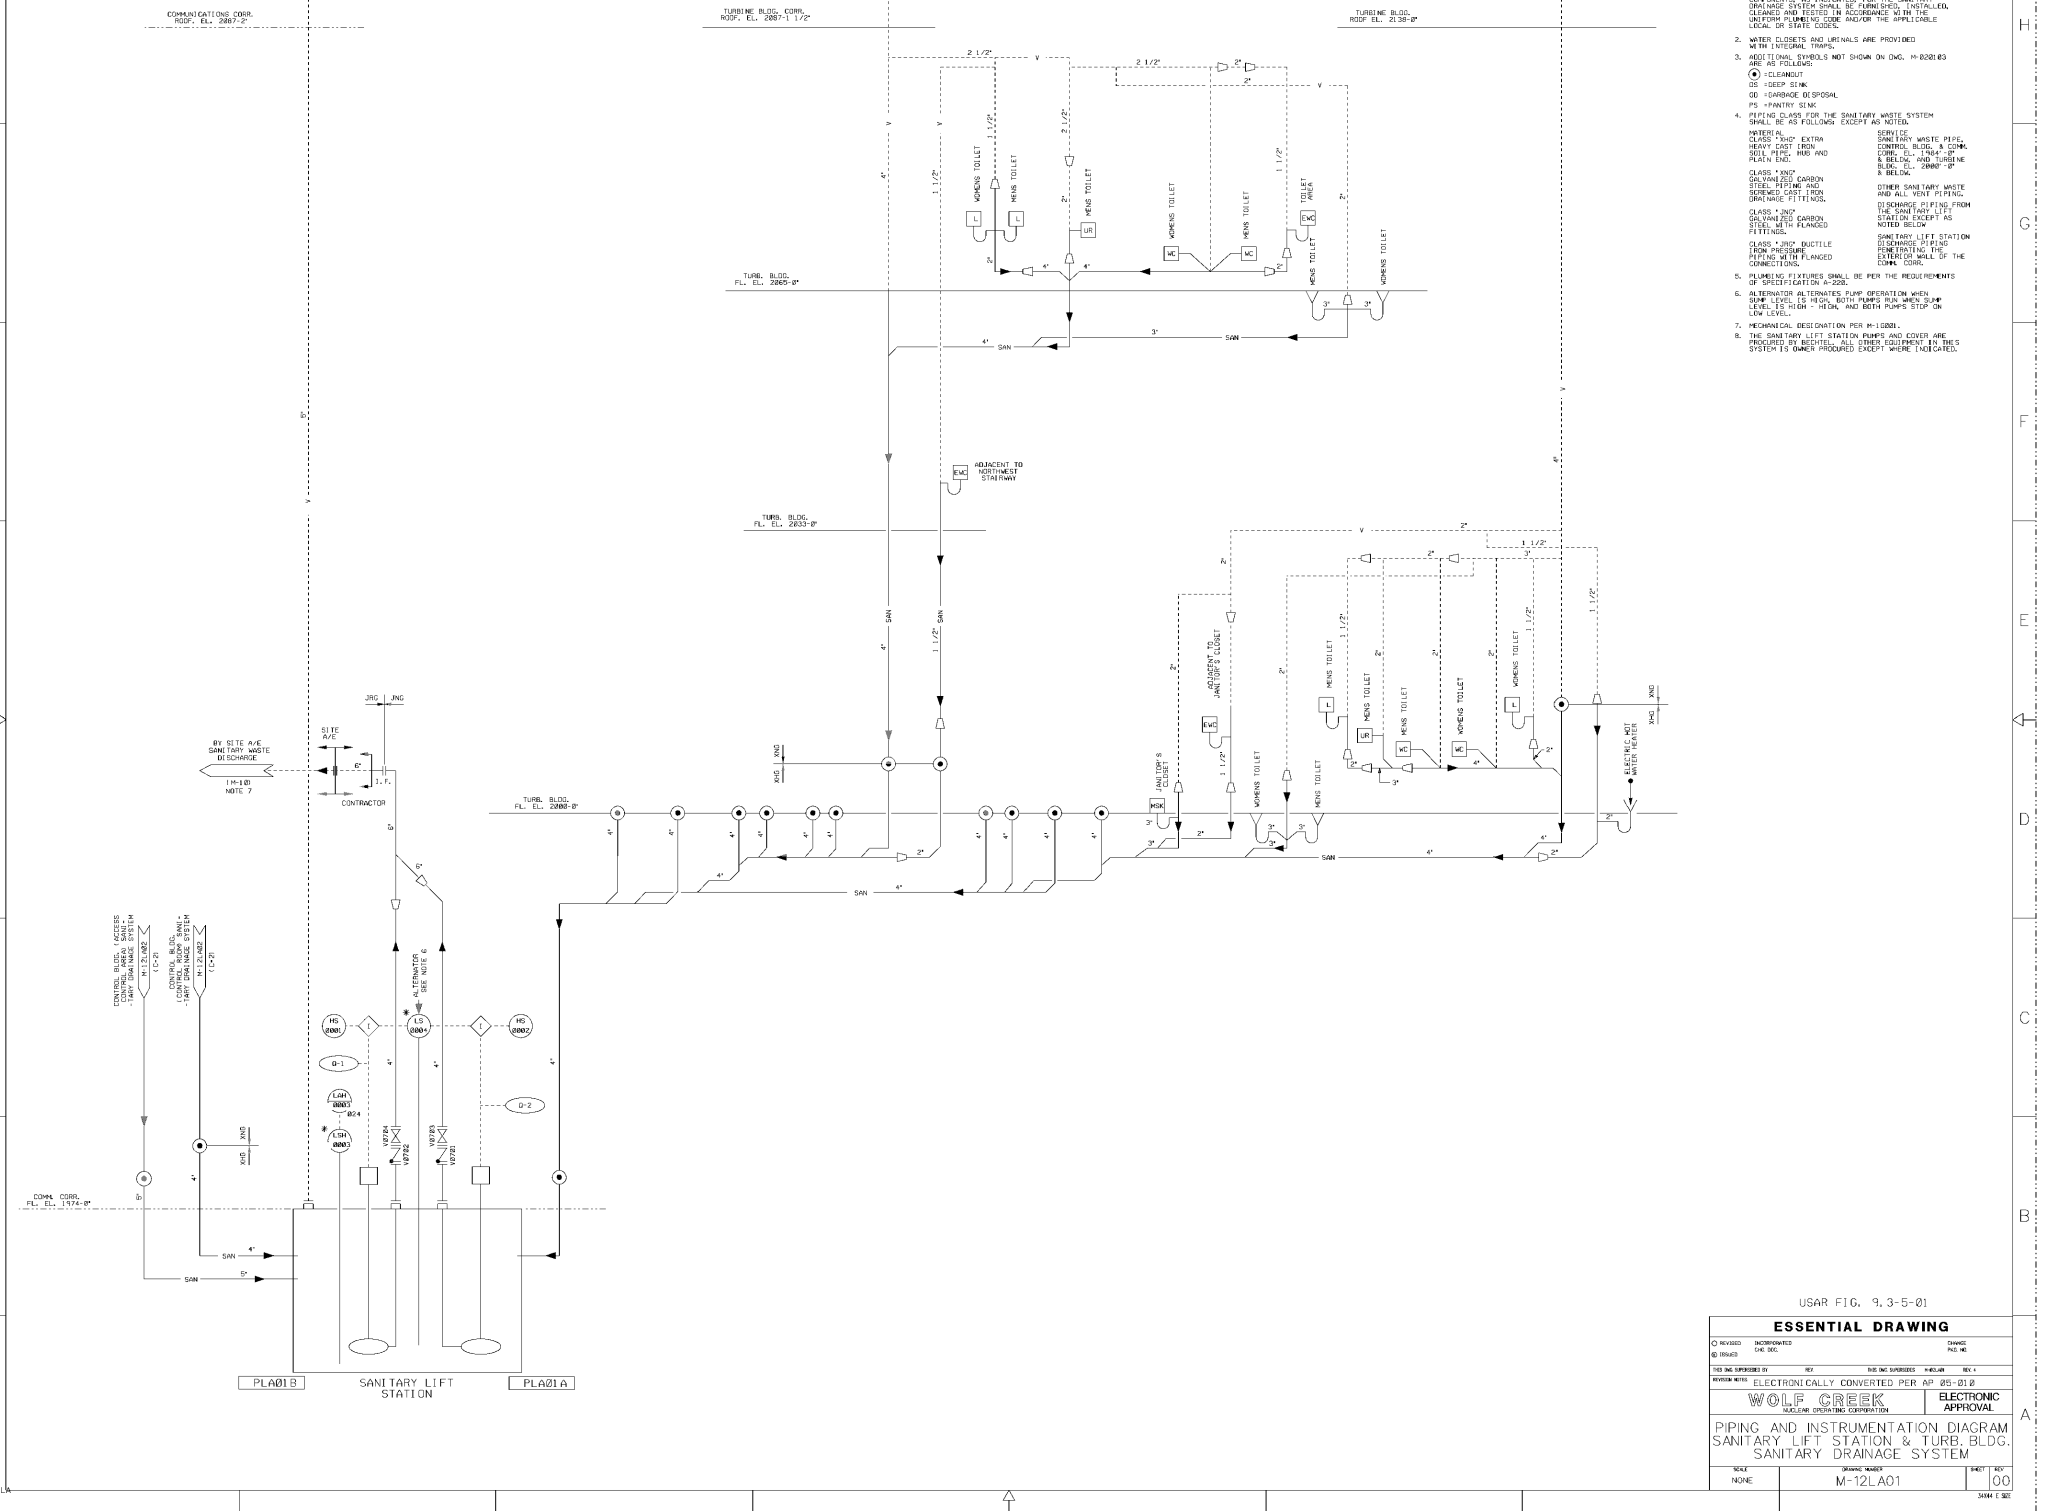

COMMUNICATIONS CORR. ROOF FL. 2087'-2"

TURBINE BLDG. CORN. ROOF FL. EL. 2087'-1 1/2"

TURBINE BLDG. ROOF FL. EL. 2139'-0"

BY SITE AVE. SANITARY WASTE DISCHARGE

11-18-00 NOTE 7

CONTRACTOR

CONTROL BLDG. SANITARY WASTE SYSTEM

CONTROL BLDG. SANITARY WASTE SYSTEM

USAR FIG. 9.3-5-01

ESSENTIAL DRAWING			
DESIGNED	INSTRUMENTED	CHECKED	DATE
DRAWN	CHK. DSC	PLZ	REV.
THIS DRAWING SUPERSEDES: NONE			
ELECTRONICALLY CONVERTED PER AP 25-012			
WOLF CREEK		ELECTRONIC APPROVAL	
PIPING AND INSTRUMENTATION DIAGRAM SANITARY LIFT STATION & TURB. BLDG. SANITARY DRAINAGE SYSTEM			
SCALE	DRAWING NUMBER	SHEET	REV.
NONE	M-12LA01	00	00
			SHAW E INC

CONTROL BLDG.
ROOF EL. 2087'-2"

COMMUNICATIONS CORRIDOR
ROOF EL. 2087'-2"

CONTROL BLDG.
AND COMM. CORRIDOR
FL. EL. 2047'-6"

SEE NOTE 2

FL. EL. 2032'-0"


FL. EL. 1984'-0"

FL. EL. 1984'-0"

ALL VENT LINES ARE PIPING CLASS 'XNG' EXCEPT AS NOTED

NOTES

- FOR GENERAL NOTES, SEE DWG. M-12LAB1.
- ALL THE JOINTS ON VENT PIPING PASSING THRU CONTROL BUILDING EL. 2032'-0" TO EL. 2087'-2" SHALL BE THREADED, FORGED 3000# STEEL FITTINGS.

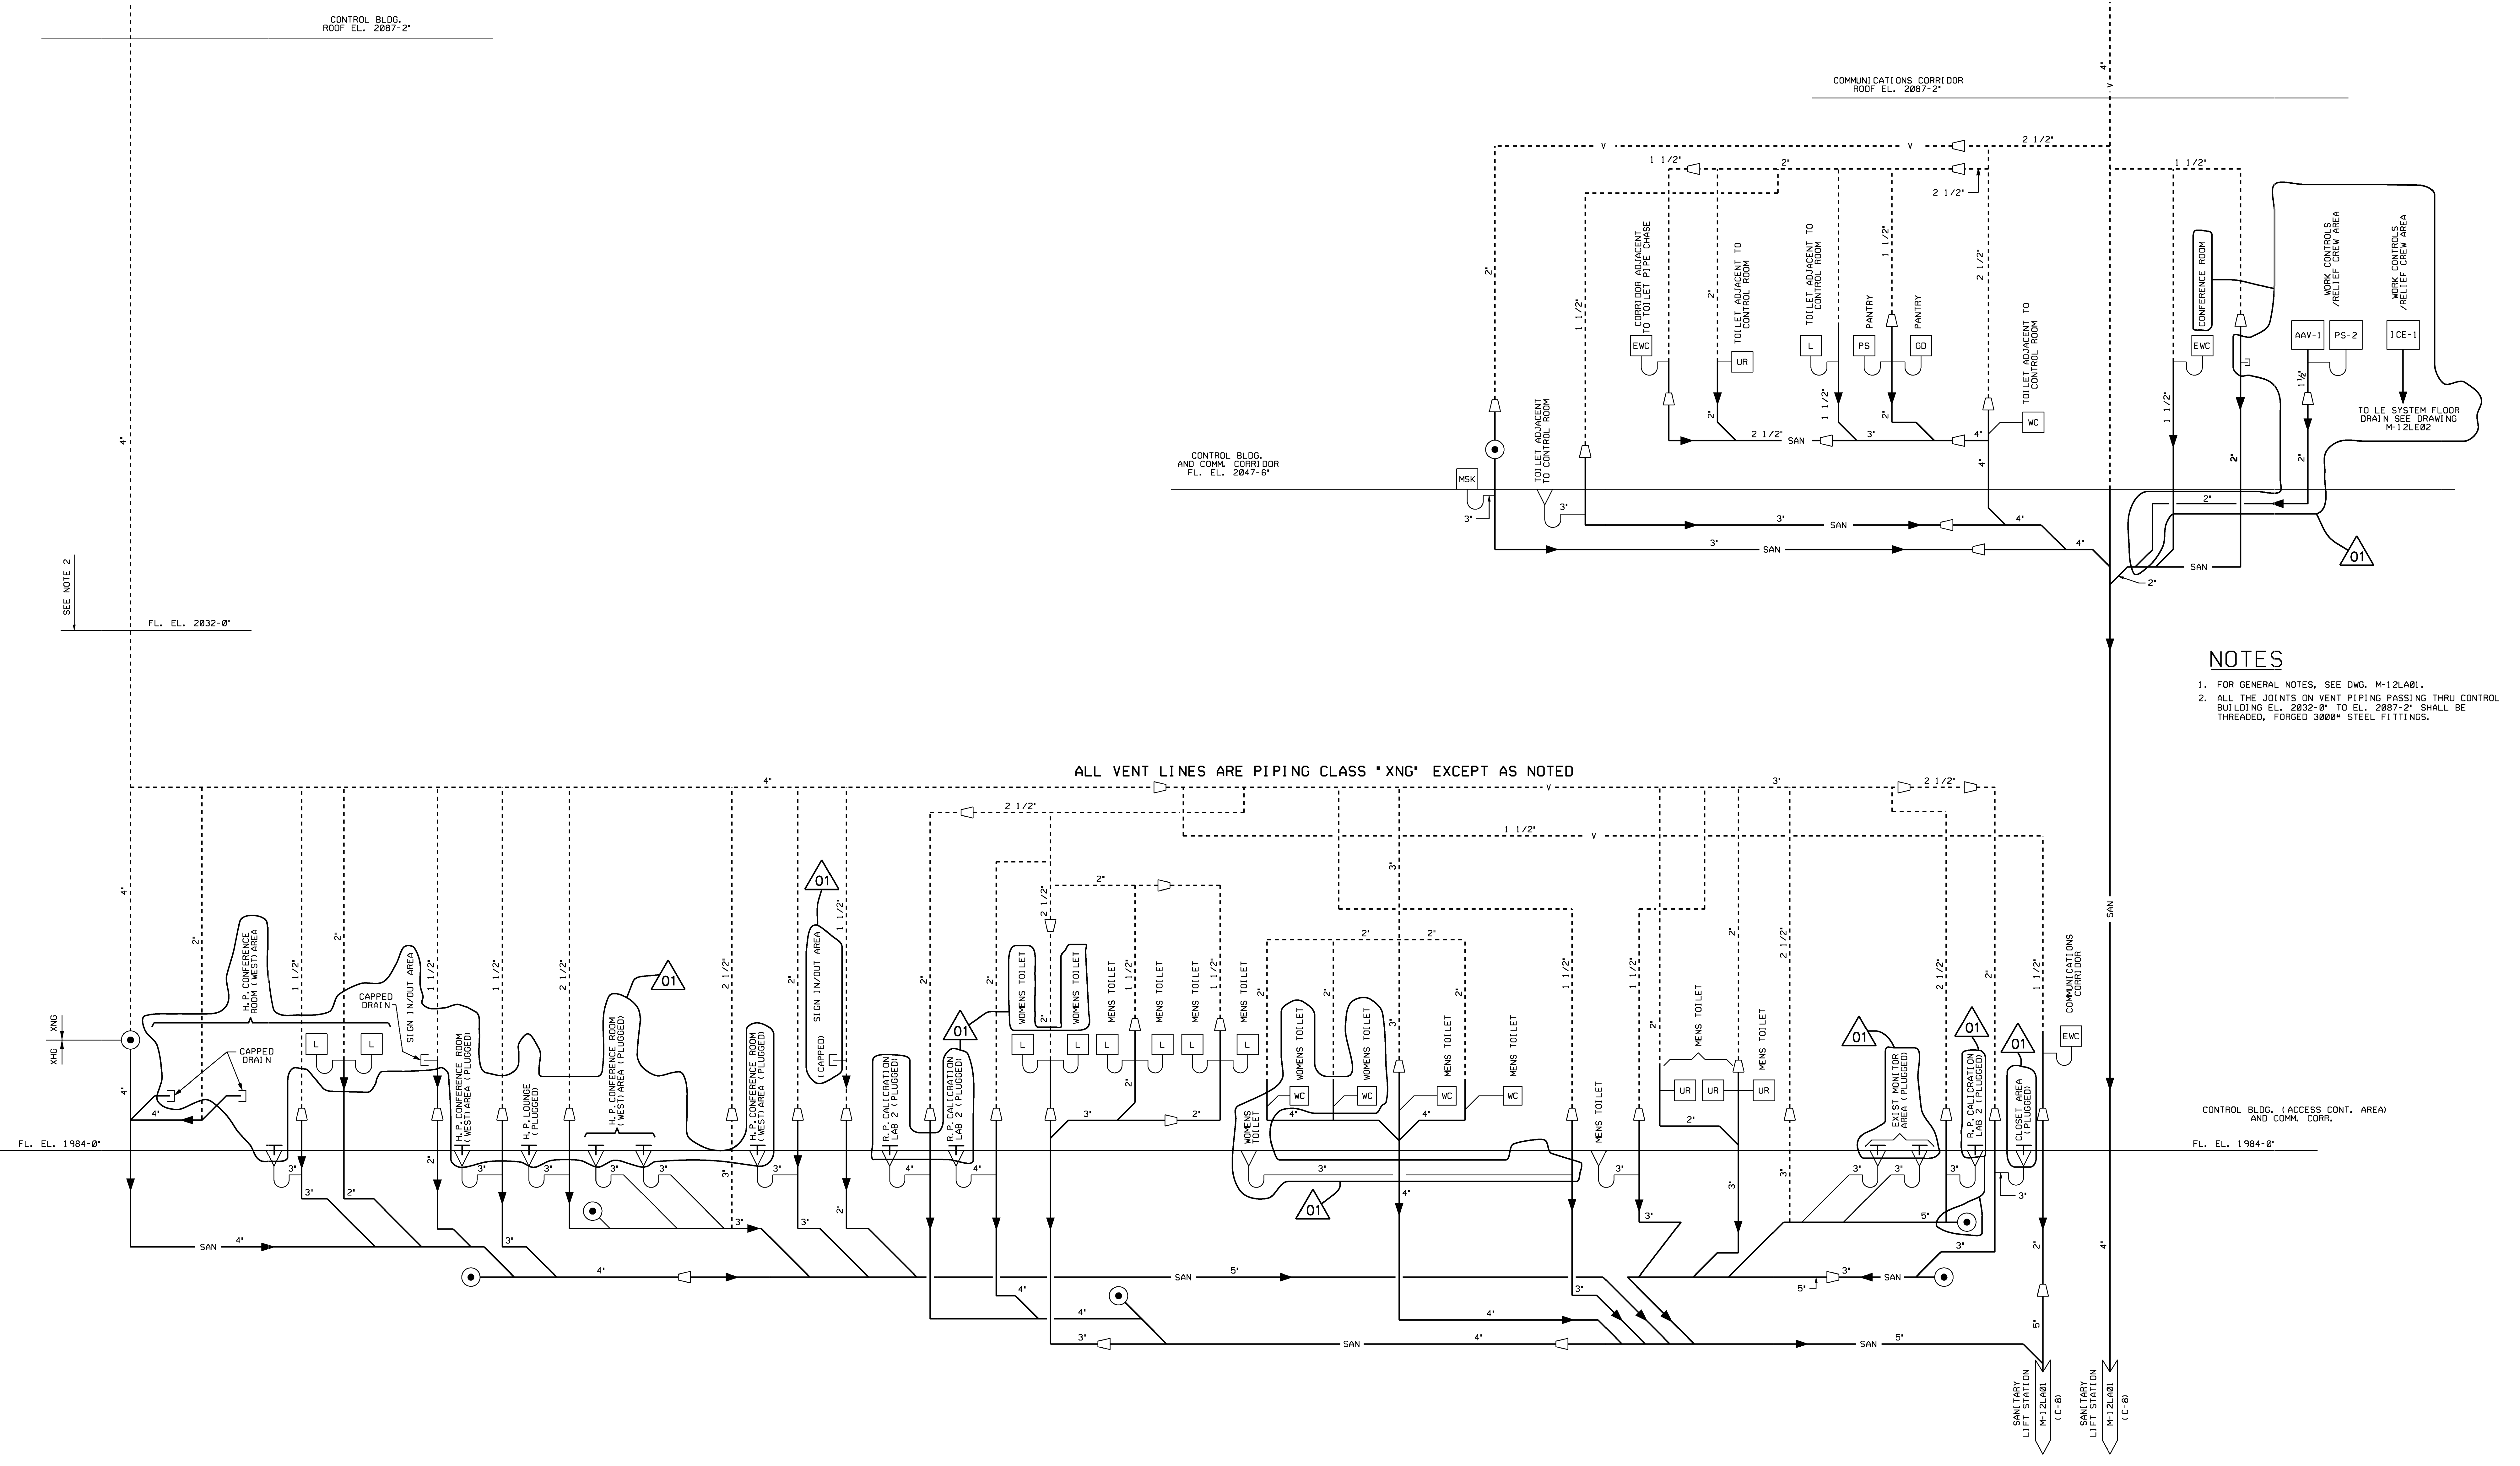

USAR FIG. 9.3-5-02

ESSENTIAL DRAWING

REVISED	INCORPORATED	WP-M-12LAB2-000-A-1	CHANGE	014806
ISSUED	CNG. DEC.	WP-M-12LAB2-000-B-1	PKG. NO.	013979

THIS DWG. SUPERSEDES BY REV. THIS DWG. SUPERSEDES REV.


REVISION NOTES: ALSO REFLECT AS-BUILT INFORMATION PER ENGINEER COMMENTS AND FIELD APPROVAL

WOLF CREEK NUCLEAR OPERATING CORPORATION ELECTRONIC APPROVAL



PIPING AND INSTRUMENTATION DIAGRAM COMMUNICATIONS CORRIDOR AND CONTROL BLDG. SANITARY DRAINAGE SYSTEM

SCALE: NONE DRAWING NUMBER: M-12LAB2 SHEET: 01 REV: 01

Digitally signed by Kamran Derakshandegan 2018.12.13 13:52:17 -06'00'

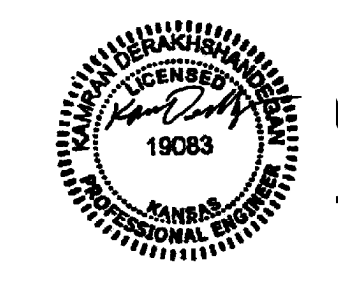

Issued By: Kamran Derakshandegan, P.E. Approved by: [Signature]

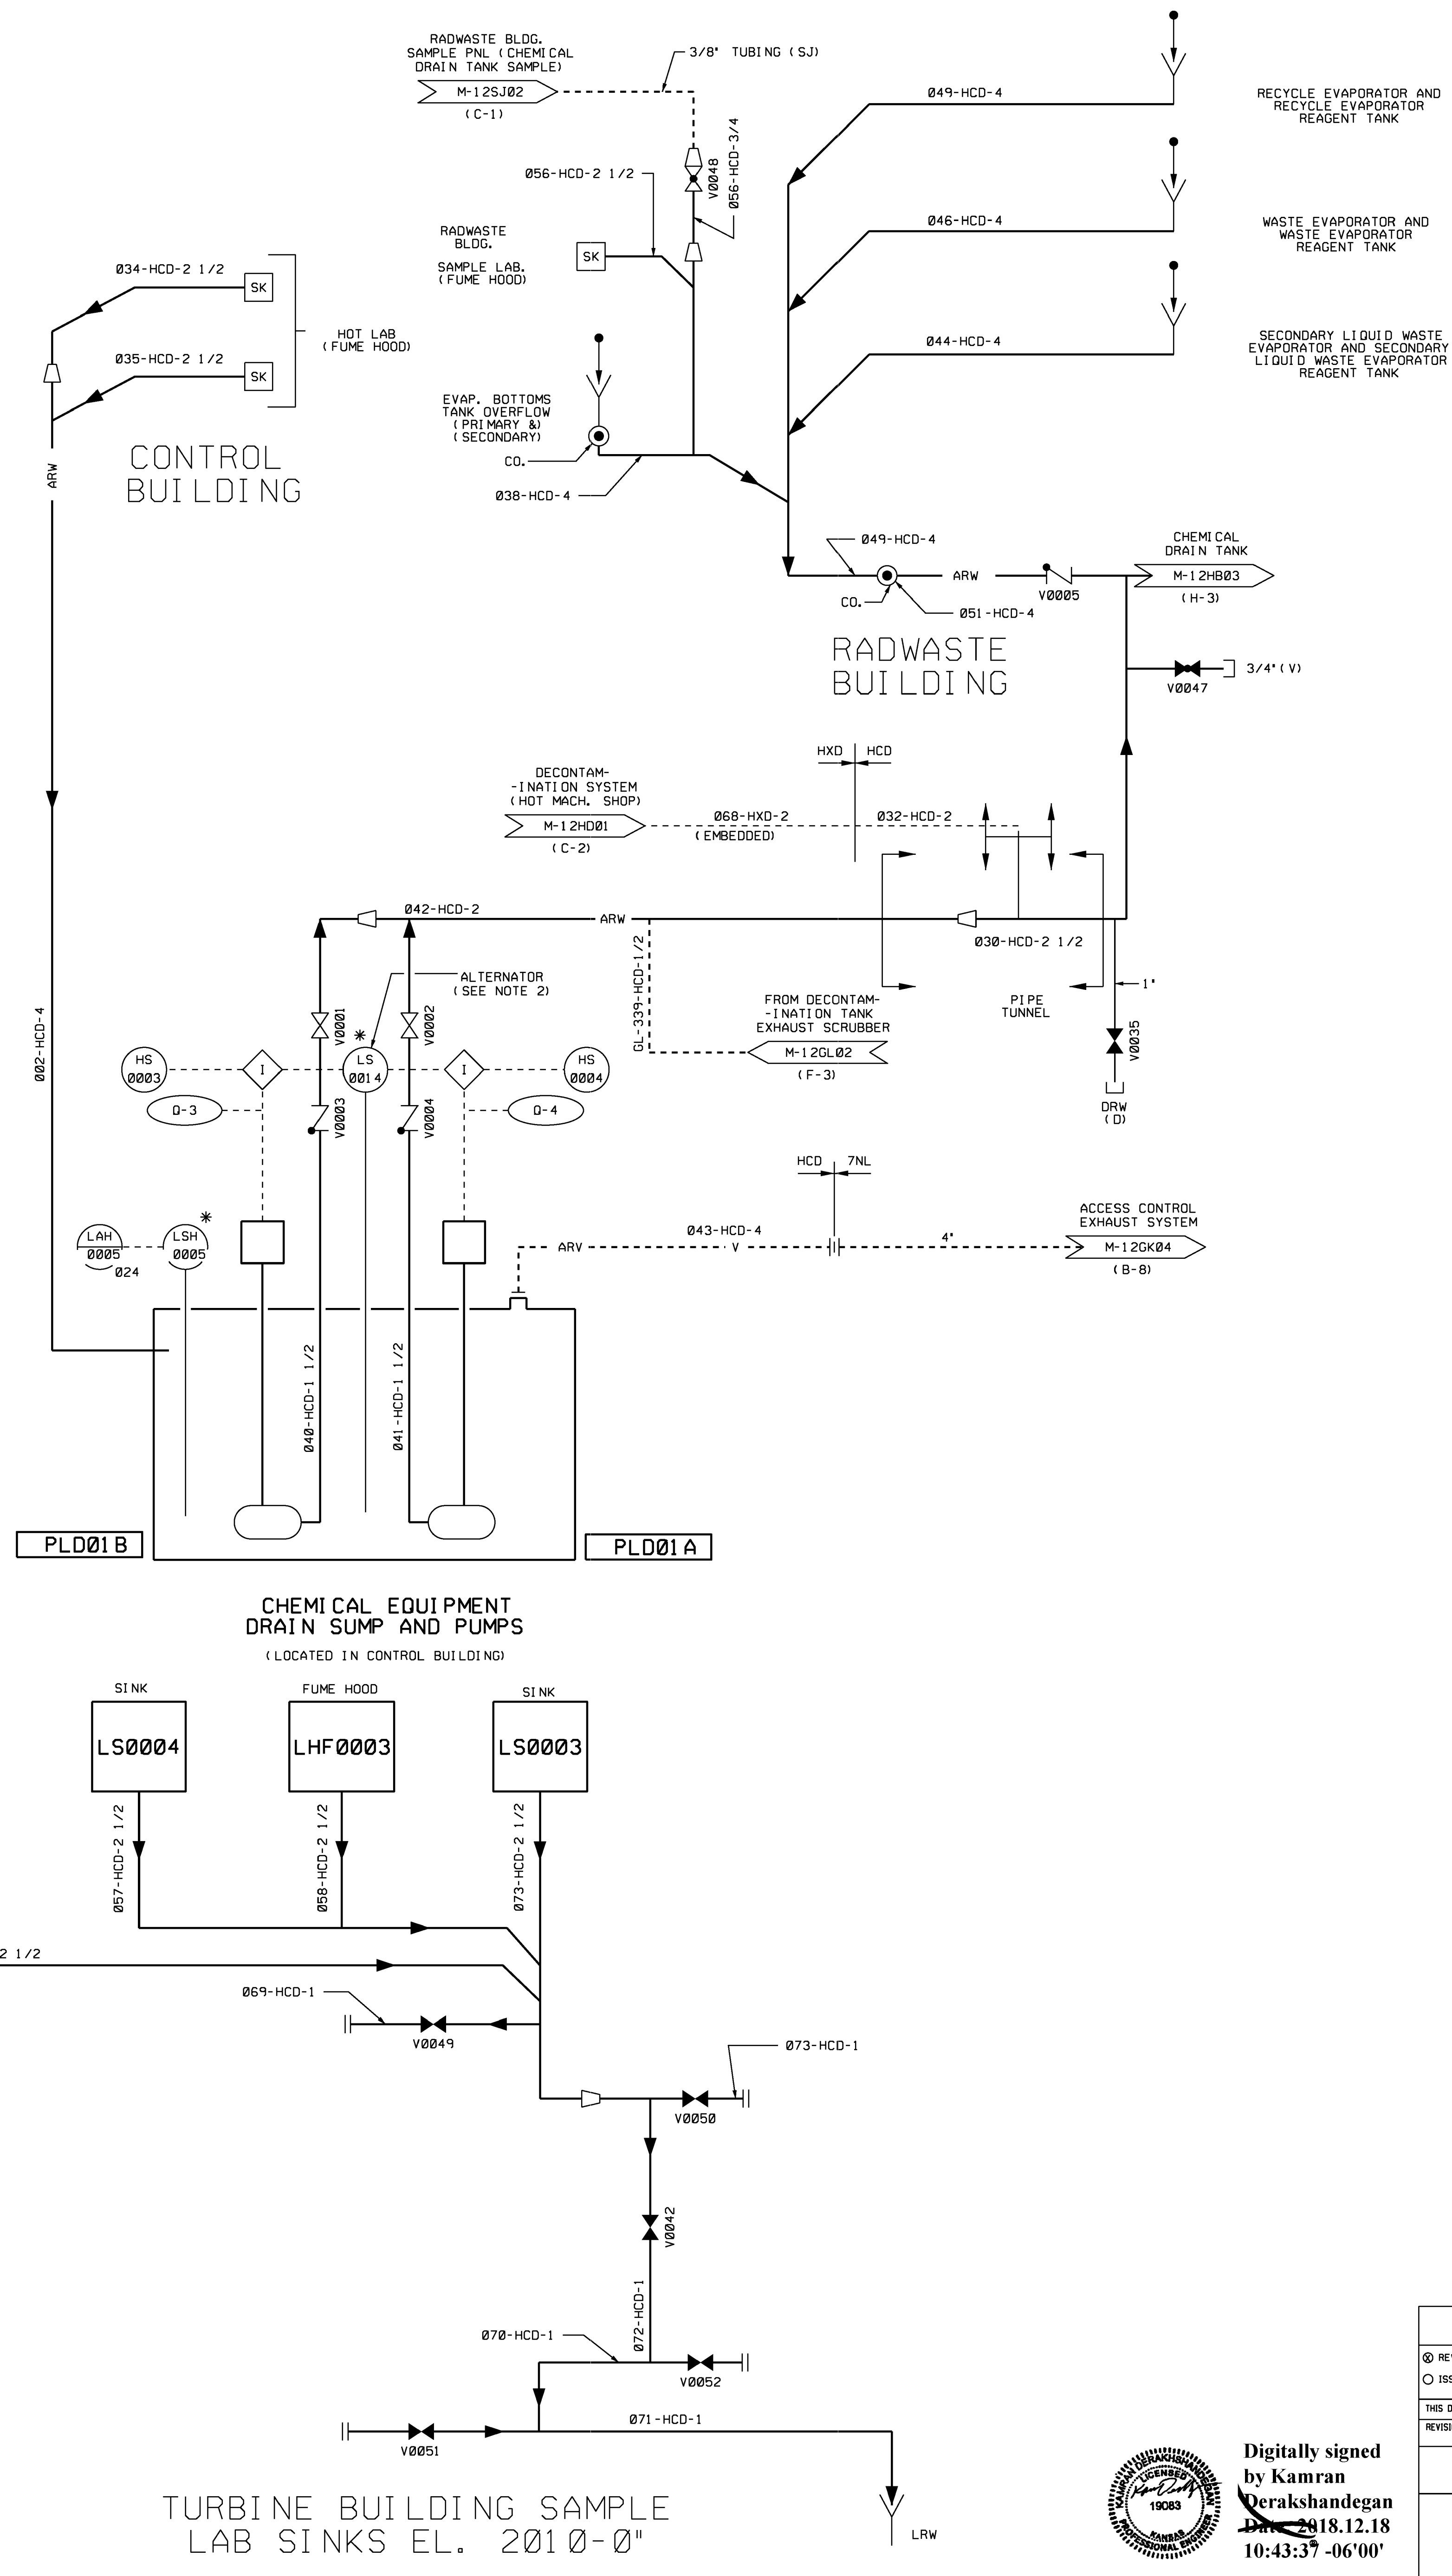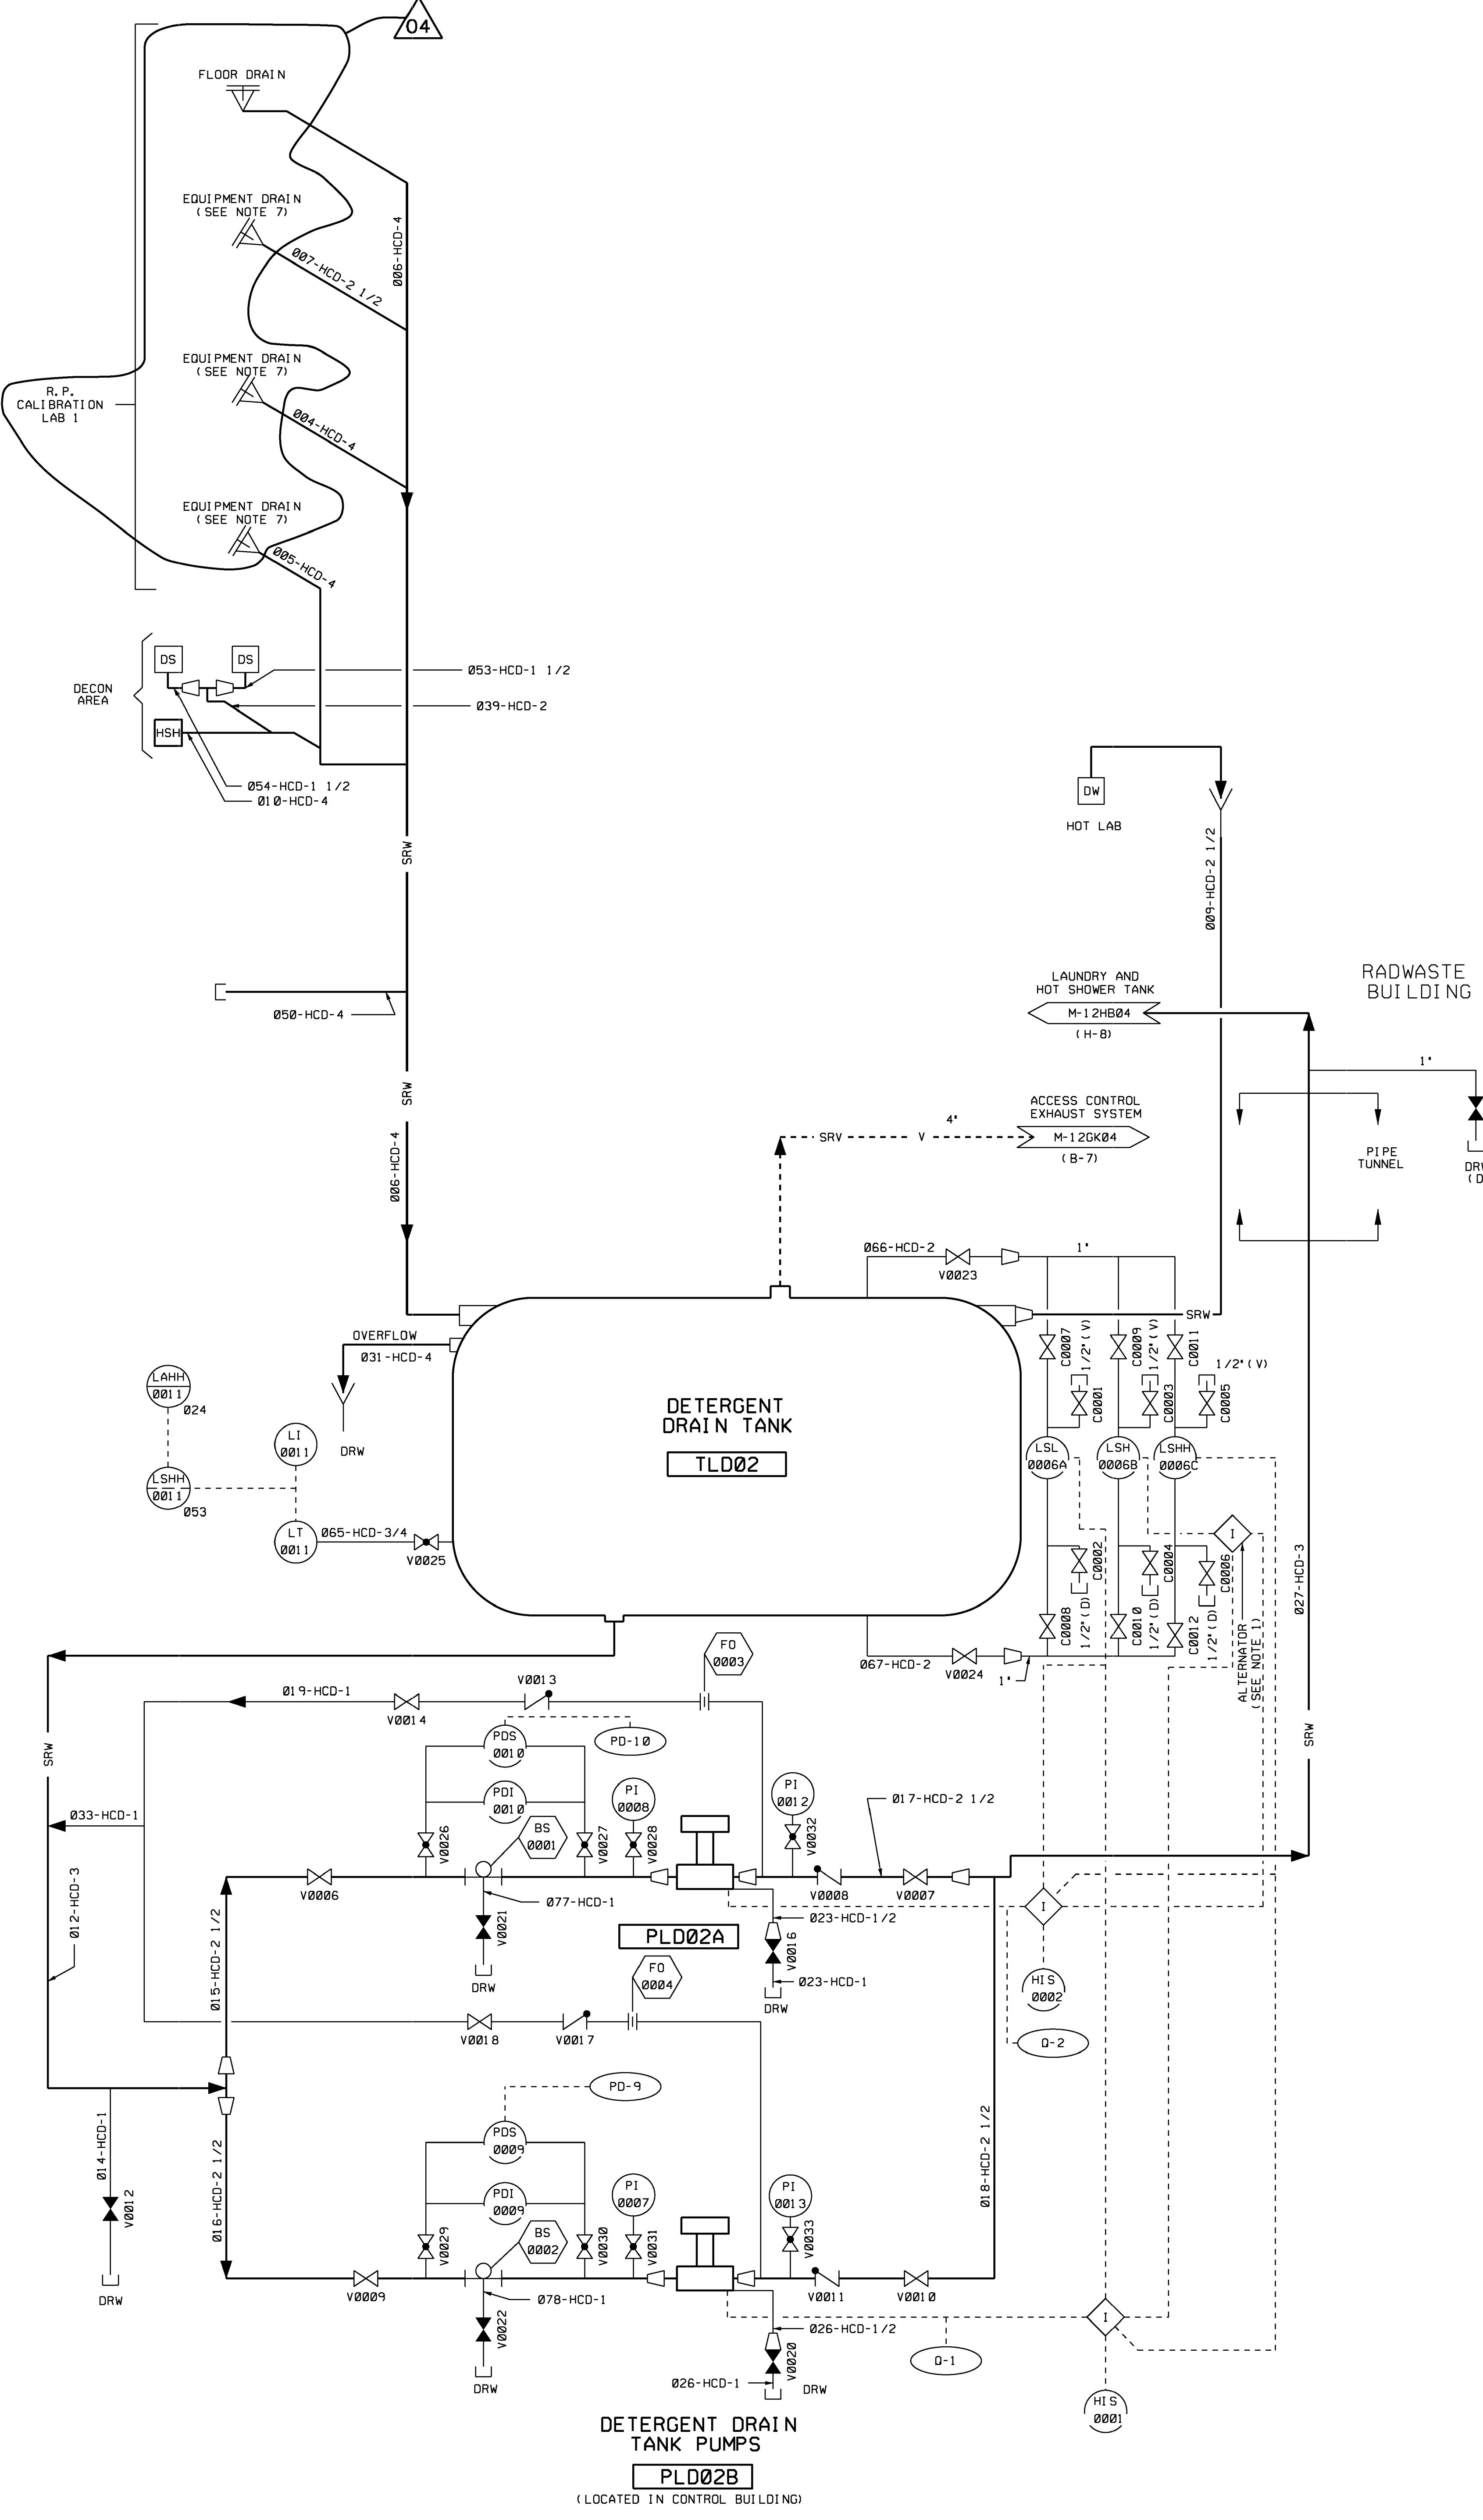

- NOTES**
- ELECTRICAL ALTERNATOR ALTERNATES PUMP OPERATION WHEN TANK LEVEL IS HIGH. BOTH PUMPS RUN WHEN TANK LEVEL IS HIGH - HIGH.
 - MECHANICAL ALTERNATOR ALTERNATES PUMP OPERATION WHEN SUMP LEVEL IS HIGH. BOTH PUMPS RUN WHEN SUMP LEVEL IS HIGH - HIGH.
 - DS - DEEP SINK.
 - HS AND DS TO BE USED FOR DECONTAMINATION PURPOSES ONLY.
 - HS - HOT SHOWER.
 - DELETED.
 - EQUIP. DRAINS IN R.P. CALIBRATION LAB 1 ARE CUT FLUSH WITH THE FLOOR AND PLUGGED WITH NON-SHRINK GROUT.

USAR FIG. 9.3-5-03

ESSENTIAL DRAWING

REVISED	INCORPORATED	WP-M-12LD01-003-A-1	CHANGE	013979
ISSUED	CIG. DEC.		PKG. NO.	
THIS DWG. SUPERSEDES		REV.	THIS DWG. SUPERSEDES	

WOLF CREEK NUCLEAR OPERATING CORPORATION

ELECTRONIC APPROVAL

PIPING & INSTRUMENTATION DIAGRAM CHEMICAL & DETERGENT WASTE


SCALE: NONE

DRAWING NUMBER: M-12LD01

SHEET: 04

REV: 04

Digitally signed by Kamran Qerakshandegan 2018.12.18 10:43:37 -06'00'

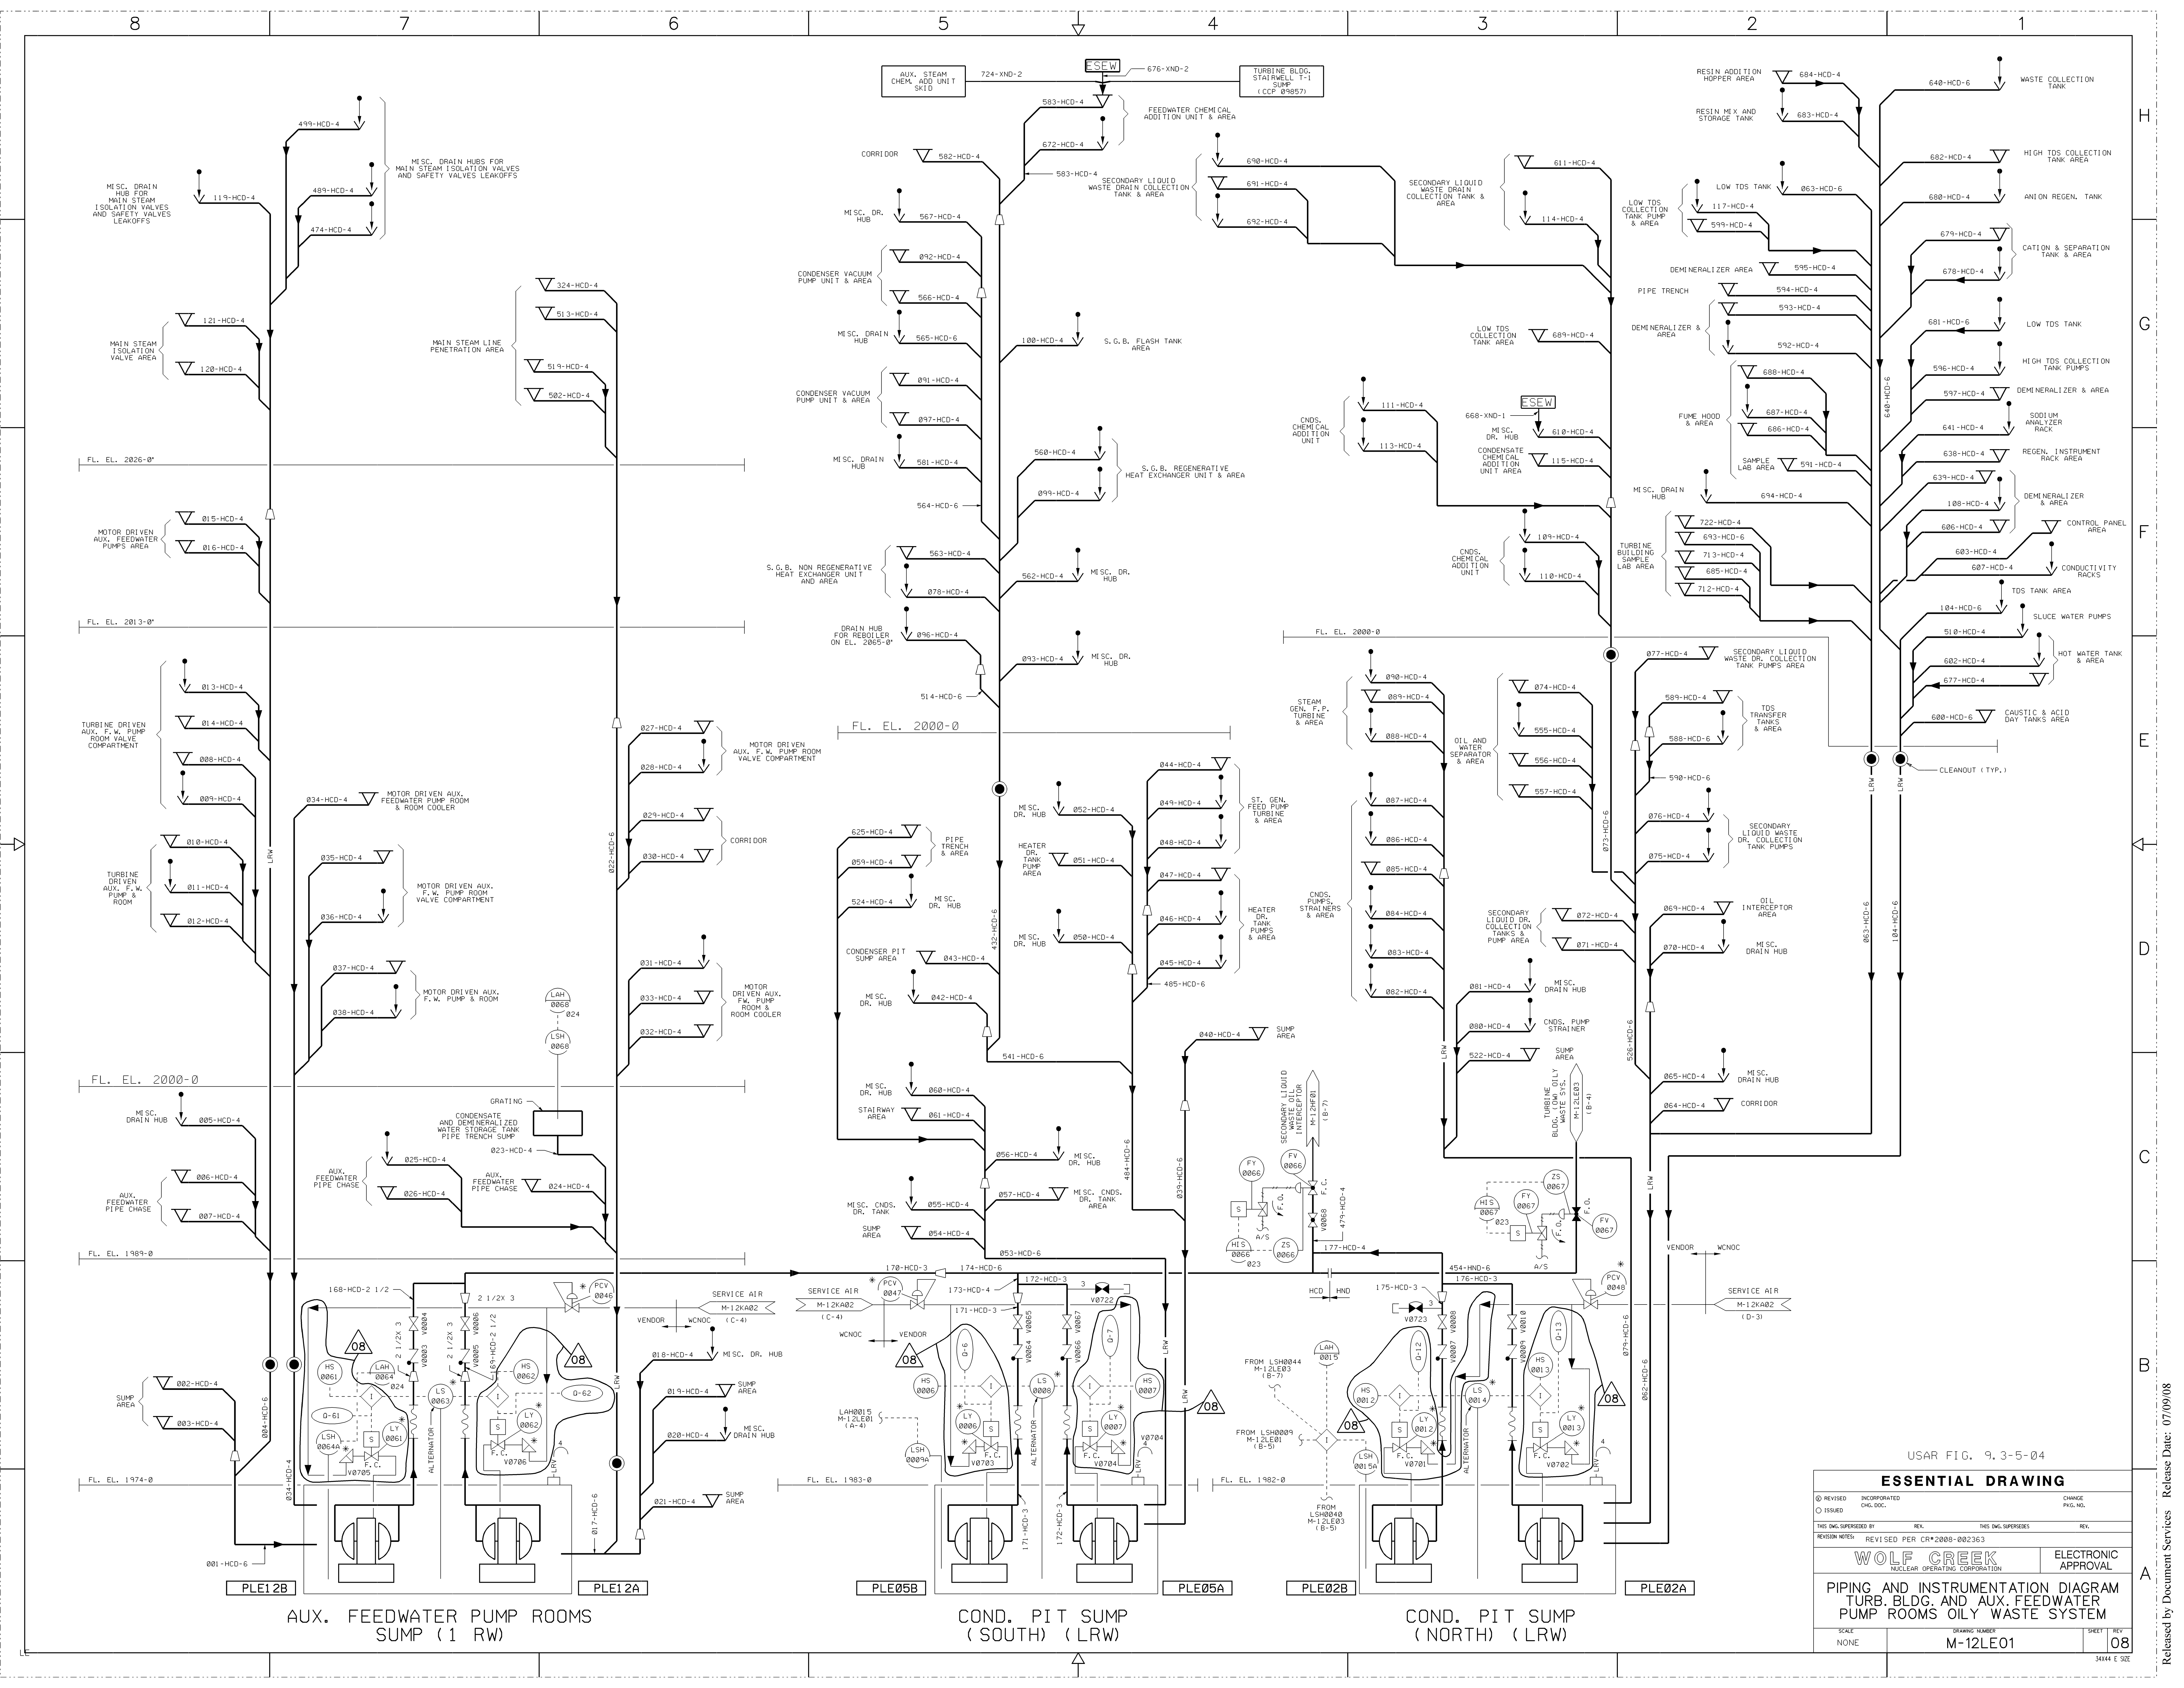

USAR FIG. 9.3-5-04

ESSENTIAL DRAWING


① REVISED	INCORPORATED	CHANGE	PKG. NO.
○ ISSUED	CNG. DOC.		
THIS DWG. SUPERSEDES		REV.	
REVISION NOTES		REVISED PER CR#2008-002363	
WOLF CREEK		ELECTRONIC APPROVAL	
NUCLEAR OPERATING CORPORATION		SHEET REV	
PIPING AND INSTRUMENTATION DIAGRAM			
TURB. BLDG. AND AUX. FEEDWATER PUMP ROOMS OILY WASTE SYSTEM			
SCALE	DRAWING NUMBER	SHEET REV	
NONE	M-12LE01	08	

3444 E SIZE

Released by Document Services Release Date: 07/09/08

NOTES

1. DRAWING Q-LIST PERTAINS TO LEVEL INDICATORS L10105 AND L10106.
2. ▽ CAPPED EQUIP. DRAIN.

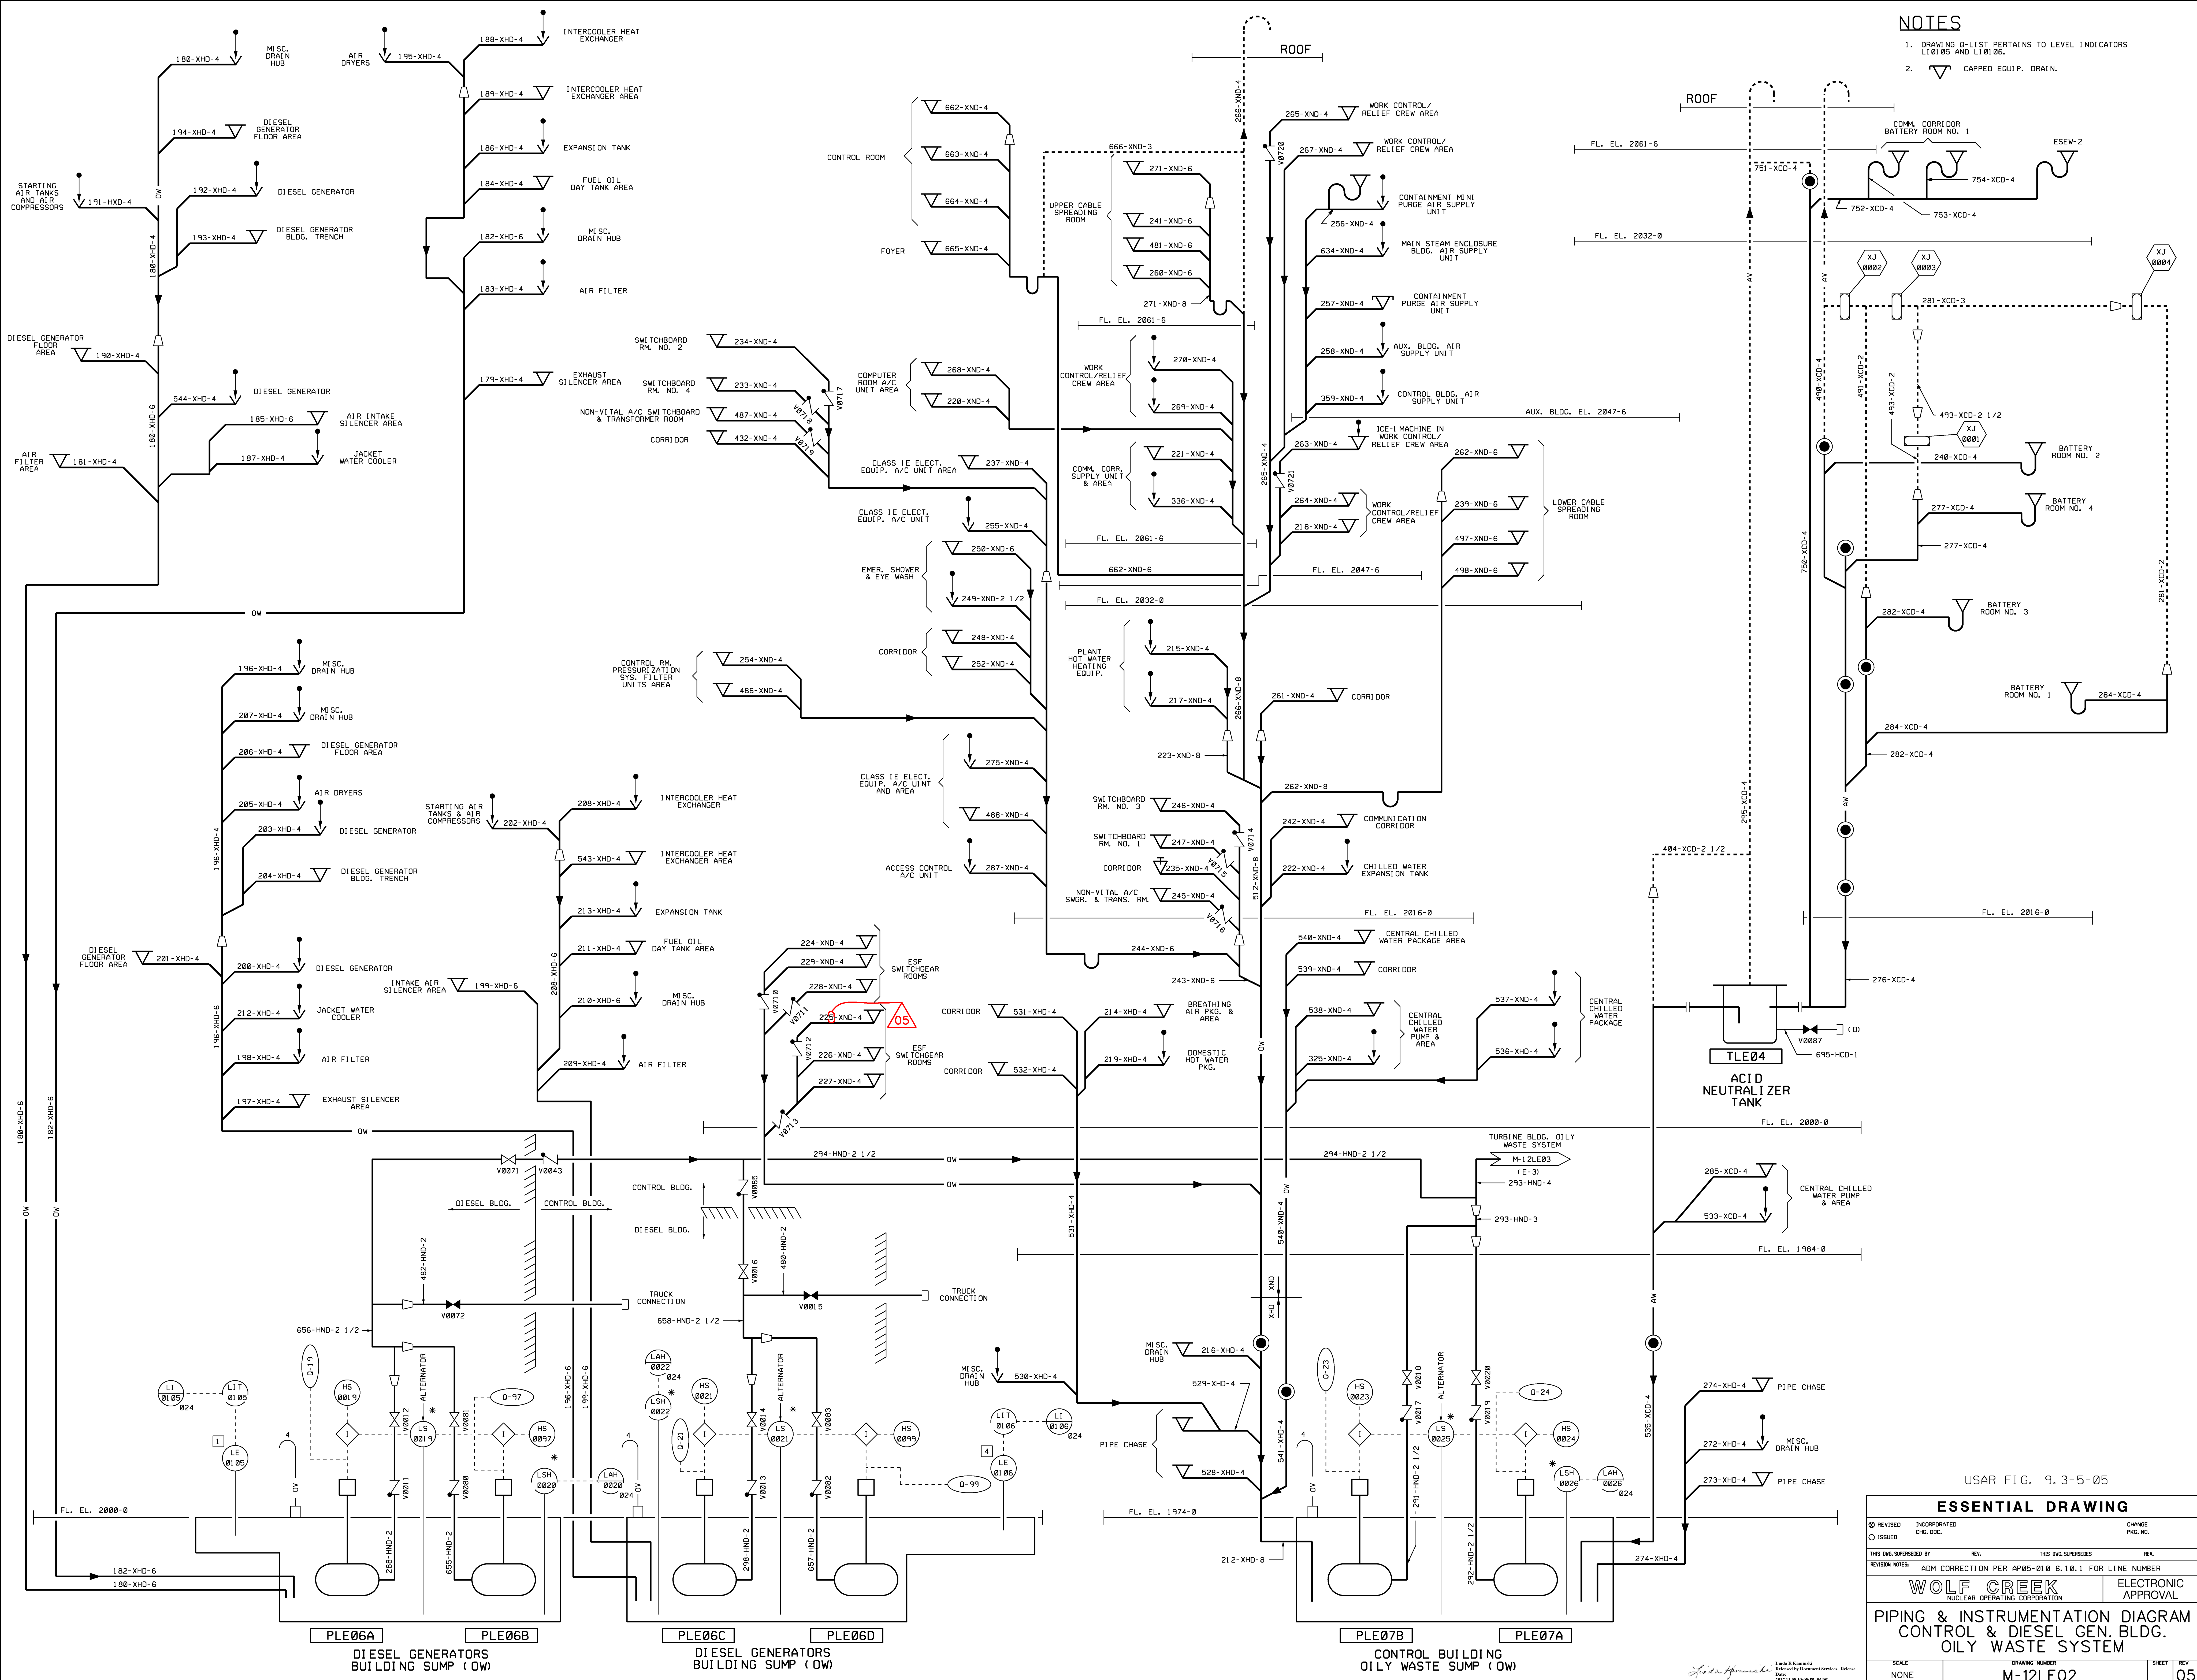


USAR FIG. 9.3-5-05

ESSENTIAL DRAWING

REVISION	ISSUED	INCORPORATED	CHG. DOC.	CHANGE	PKG. NO.
THIS ENG. SUPERSEDES	BY	REV.	THIS ENG. SUPERSEDES	REV.	
REVISION NUMBER: ADM CORRECTION PER AP05-010 G.10.1 FOR LINE NUMBER					
			ELECTRONIC APPROVAL		
PIPING & INSTRUMENTATION DIAGRAM CONTROL & DIESEL GEN. BLDG. OILY WASTE SYSTEM					
SCALE	NONE	DRAWING NUMBER	M-12LE02	SHEET	05

3444 E. SIDE

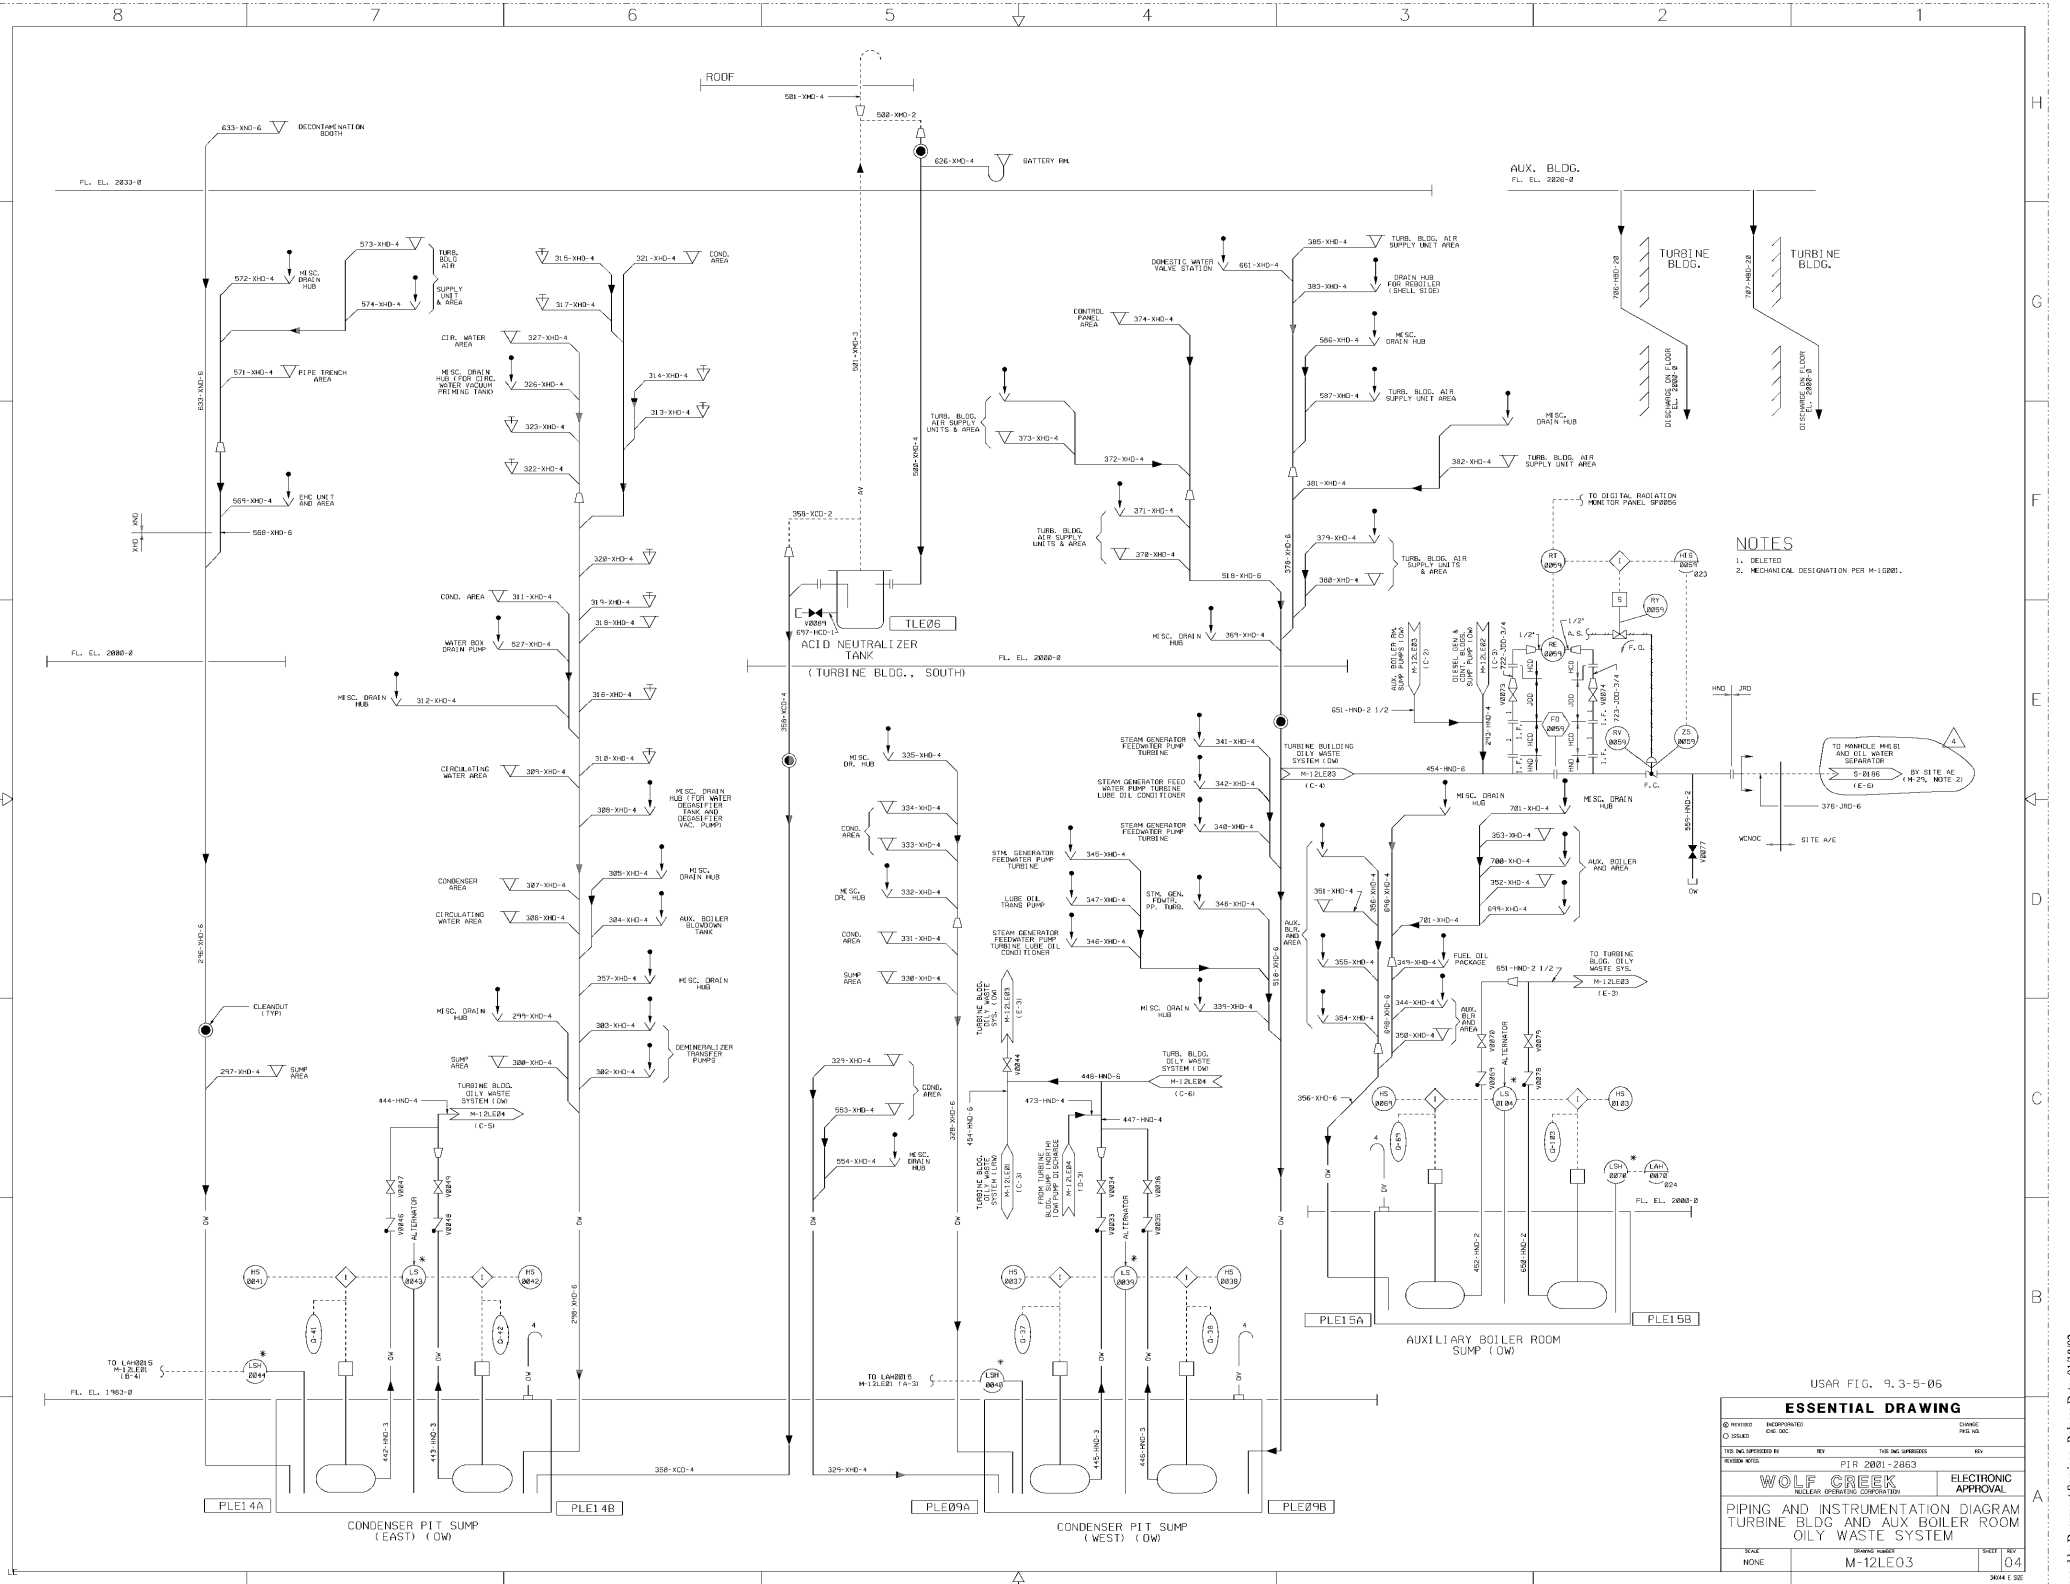


NOTES
 1. DELETED
 2. MECHANICAL DESIGNATION PER M-1081.


USAR FIG. 9.3-5-05

ESSENTIAL DRAWING			
DESIGNED BY	ENGINEERED BY	CHECKED BY	DATE
ISSUED BY	REVISED BY	DATE	
PROJECT NO.	REV.	THIS DRAWING	REV.
WOLF CREEK		ELECTRONIC APPROVAL	
NUCLEAR OPERATING CORPORATION			
PIPING AND INSTRUMENTATION DIAGRAM TURBINE BLDG. AND AUX. BOILER ROOM OILY WASTE SYSTEM			
SCALE	PROJECT NUMBER	SHEET	TOTAL
NONE	M-12LE03	04	04

Released by Document Services Release Date: 01/18/02

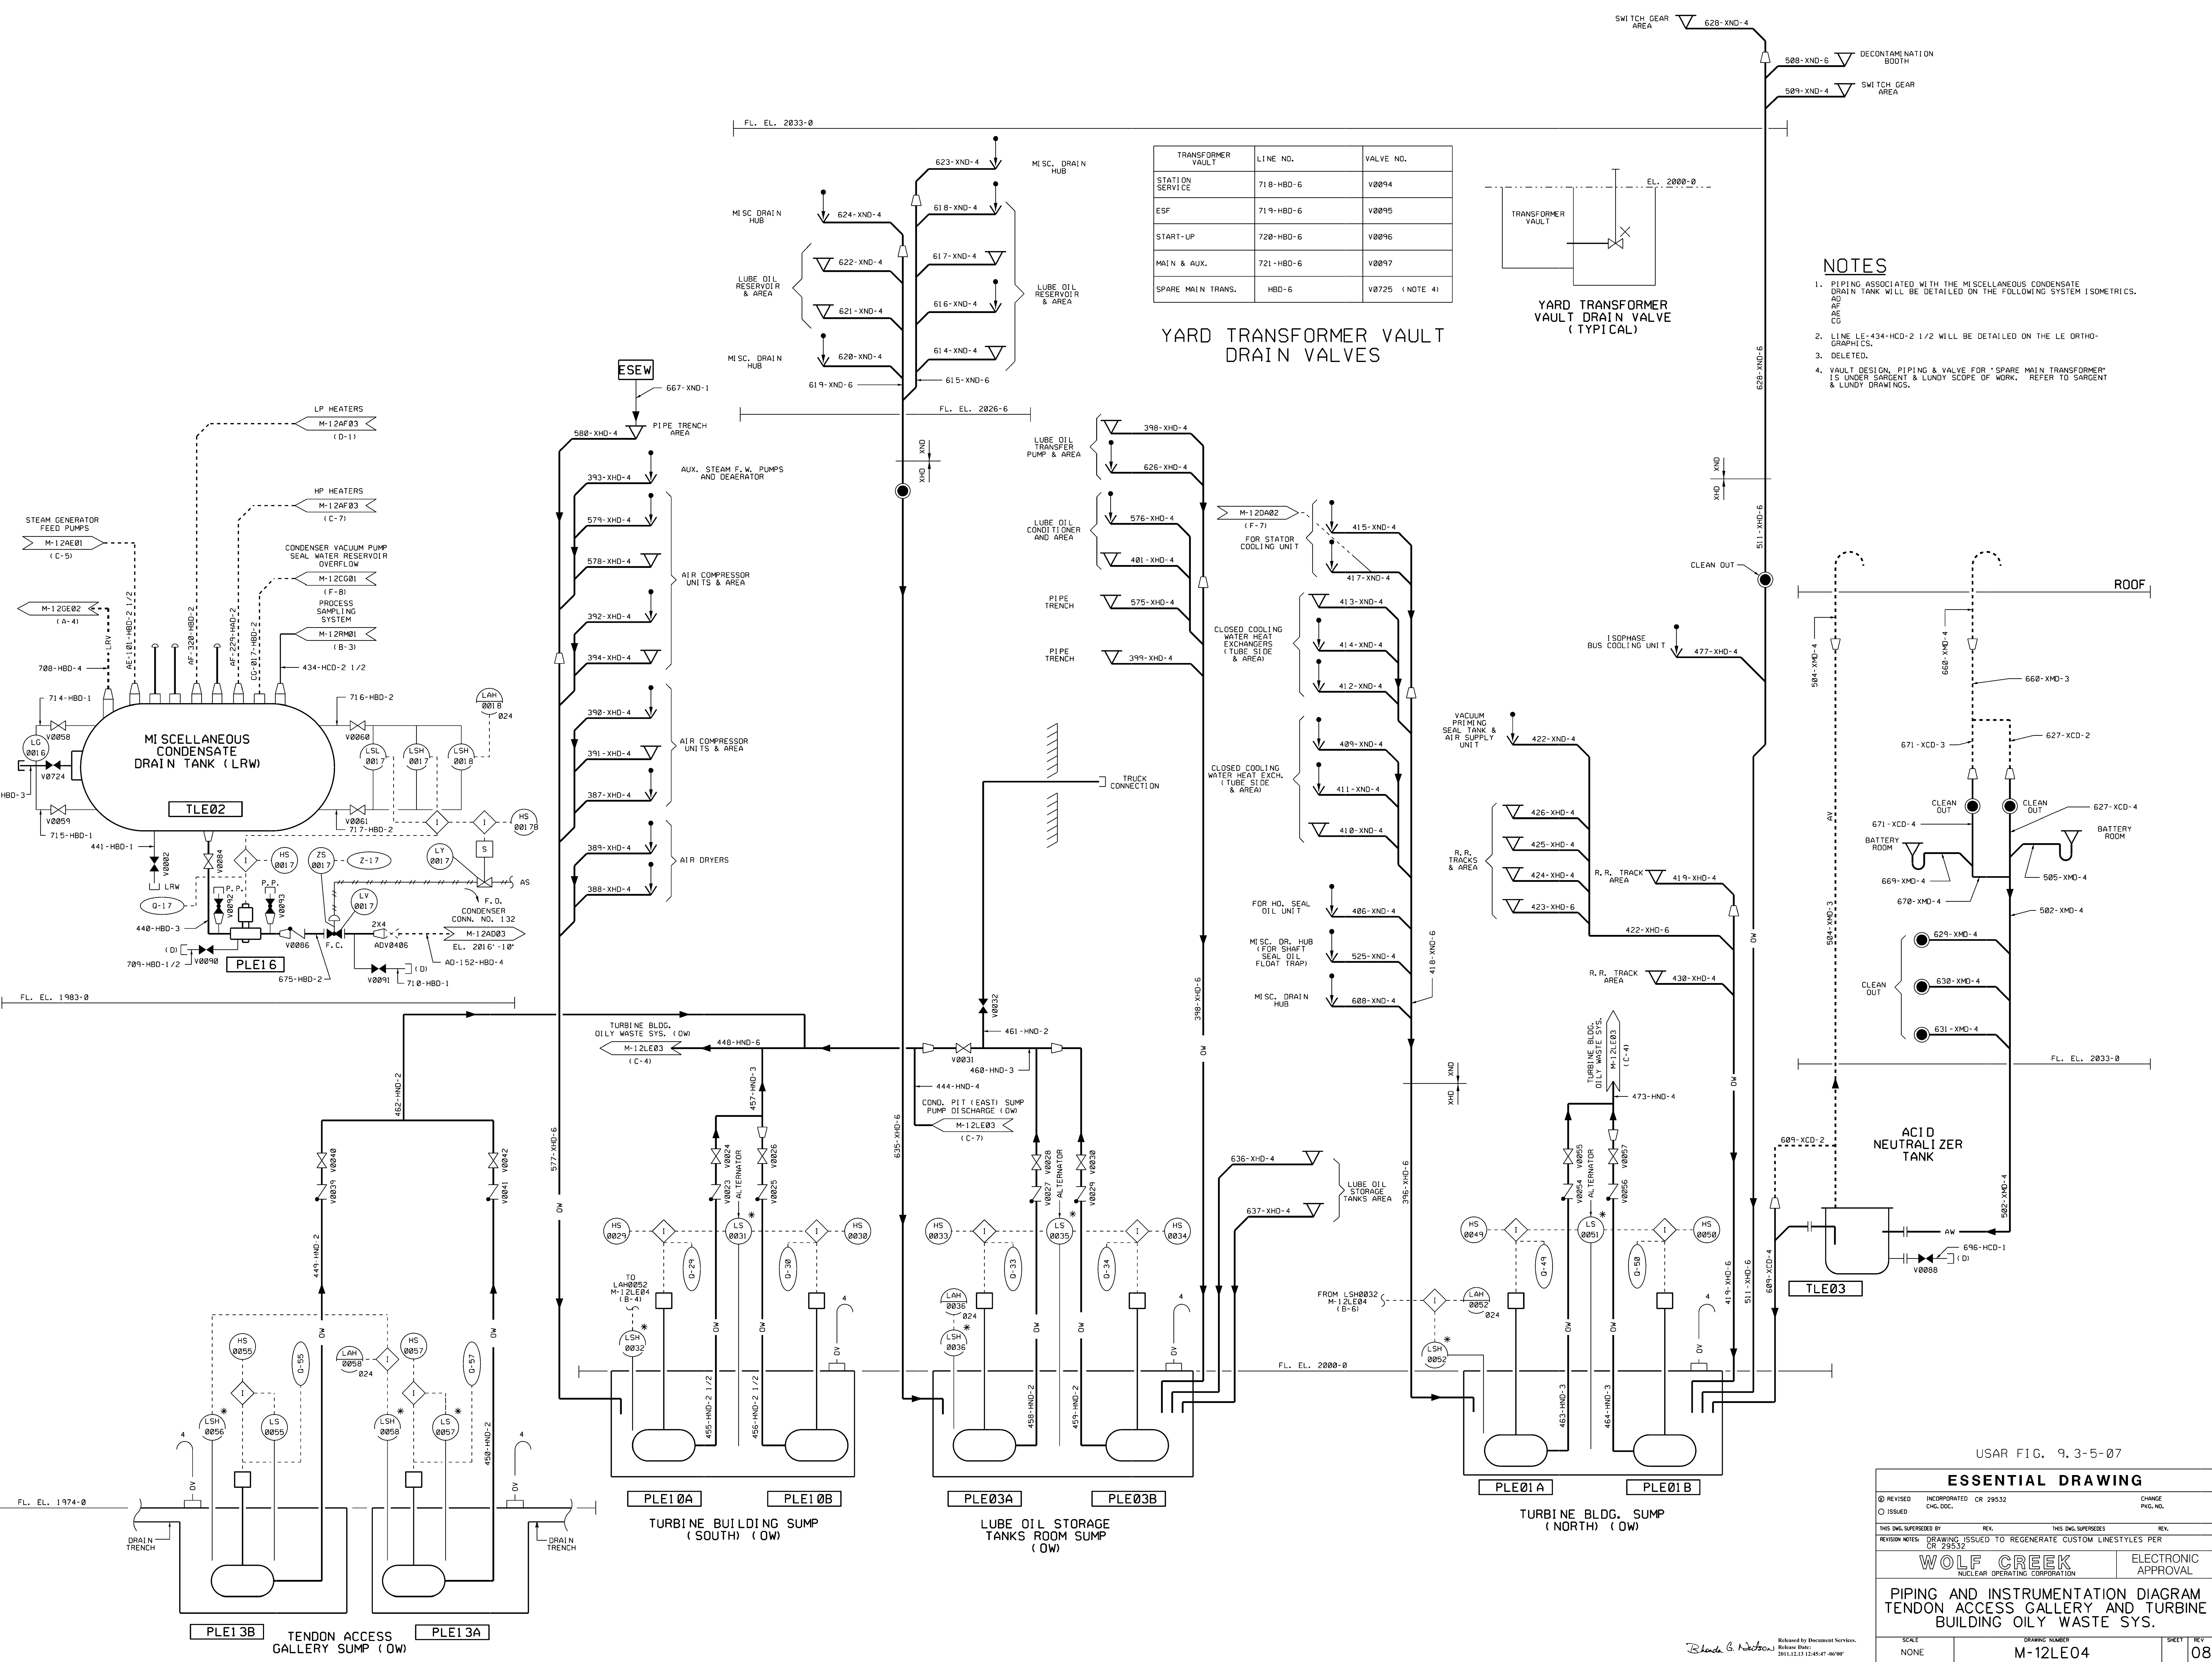

TRANSFORMER VAULT	LINE NO.	VALVE NO.
STATION SERVICE	718-HBD-6	V0094
ESF	719-HBD-6	V0095
START-UP	720-HBD-6	V0096
MAIN & AUX.	721-HBD-6	V0097
SPARE MAIN TRANS.	HBD-6	V0725 (NOTE 4)

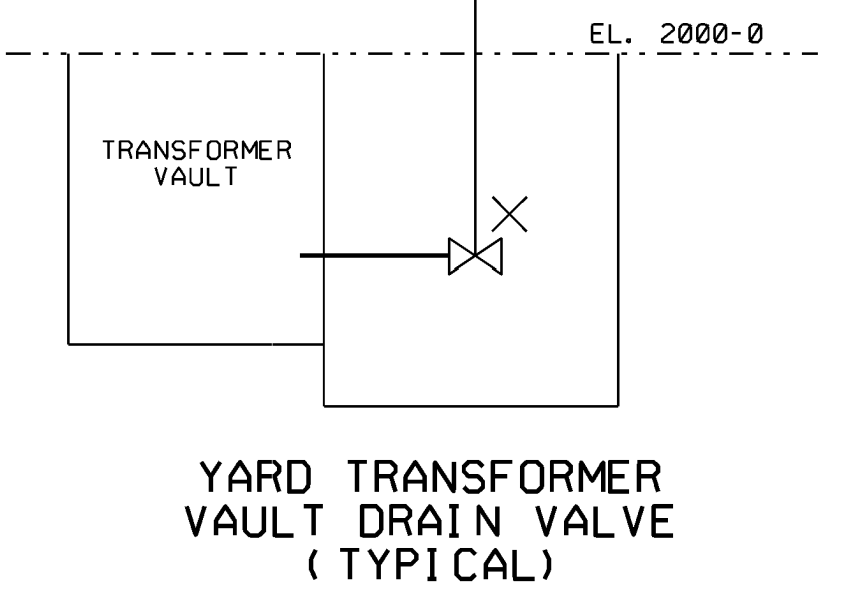

- NOTES**
1. PIPING ASSOCIATED WITH THE MISCELLANEOUS CONDENSATE DRAIN TANK WILL BE DETAILED ON THE FOLLOWING SYSTEM ISOMETRICS.
 2. LINE LE-434-HCD-2 1/2 WILL BE DETAILED ON THE LE ORTHO-GRAPHICS.
 3. DELETED.
 4. VAULT DESIGN, PIPING & VALVE FOR "SPARE MAIN TRANSFORMER" IS UNDER ARGENT & LUNDY SCOPE OF WORK. REFER TO ARGENT & LUNDY DRAWINGS.

USAR FIG. 9.3-5-07

ESSENTIAL DRAWING

REVISED	INCORPORATED	CR 29532	CHANGE
ISSUED	ENG. DOC.		PKG. NO.

THIS Dwg. SUPERSEDES BY REV. THIS Dwg. SUPERSEDES REV.

REVISION NOTES: DRAWING ISSUED TO REGENERATE CUSTOM LIFESTYLES PER

WOLF CREEK NUCLEAR OPERATING CORPORATION

PIPING AND INSTRUMENTATION DIAGRAM
TENDON ACCESS GALLERY AND TURBINE BUILDING OILY WASTE SYS.

SCALE: NONE DRAWING NUMBER: M-12LE04 SHEET: 08

Blair & Newton, Released by Document Services, 3444 E. SUE, M-12LE04-11-08

FL. EL. 1988-0
FL. EL. 1974-0

FL. EL. 1988-0
FL. EL. 1974-0

NOTES

1. THE AUXILIARY BUILDING AND PUMP ROOM SETBACK CATEGORY I LEVEL INDICATORS WILL BE INSTALLED ON A SEPARATE TRIANGULAR COVER PROVIDED BY BECHTEL. SPACE FOR THIS COVER WILL BE MADE BY MOVING A TRIANGULAR CUT-OUT SIGN SIZE ON DRILLING SIGN COVER PLATE. TRIANGULAR COVER WILL BE CATEGORY I.
2. DRAWING D-LIST PERTAINS TO LEVEL INDICATORS L-180, L-181, AND L-184 ONLY.
3. ▽ CAPPED EQUIP. DRAIN.
4. ◊ PLUGGED FLOOR DRAIN.
5. DRAINS SHOWN FOR VALVE STEM LEANOFFS ARE THE RECOMMENDED DRAINS. CONSTRUCTION MAY REDUCE VALVE STEM LEANOFFS TO ANY OTHER CONVENIENT DRAIN SI PROVIDED COW AND DOW DRAINS ARE SECREATED FROM EACH OTHER.
6. RECIRCULATION ORIFICES (DRILLED HOLES ARE TO EXTEND PUMP LIFE DURING SHUT-OFF CONDITIONS ON SITE.

FL. EL. 1974-0
FL. EL. 1967-0

FL. EL. 1974-0
FL. EL. 1967-0

BOTTOM OF SUMP EL. 1962-0

USAR FIG. 9.3-5-08

ESSENTIAL DRAWING

REVISION	INCORPORATED	DATE	BY	APPROVED
01	ISSUED	15:36:18-0600		


Digitally signed by Rickly L. Rietmann
Date: 2014.11.10 15:36:18 -0600

WOLF CREEK NUCLEAR OPERATING CORPORATION

PIPING AND INSTRUMENTATION DIAGRAM FLOOR AND EQUIPMENT DRAIN SYSTEM

DRWG NUMBER: M-12LF01

SCALE: NONE

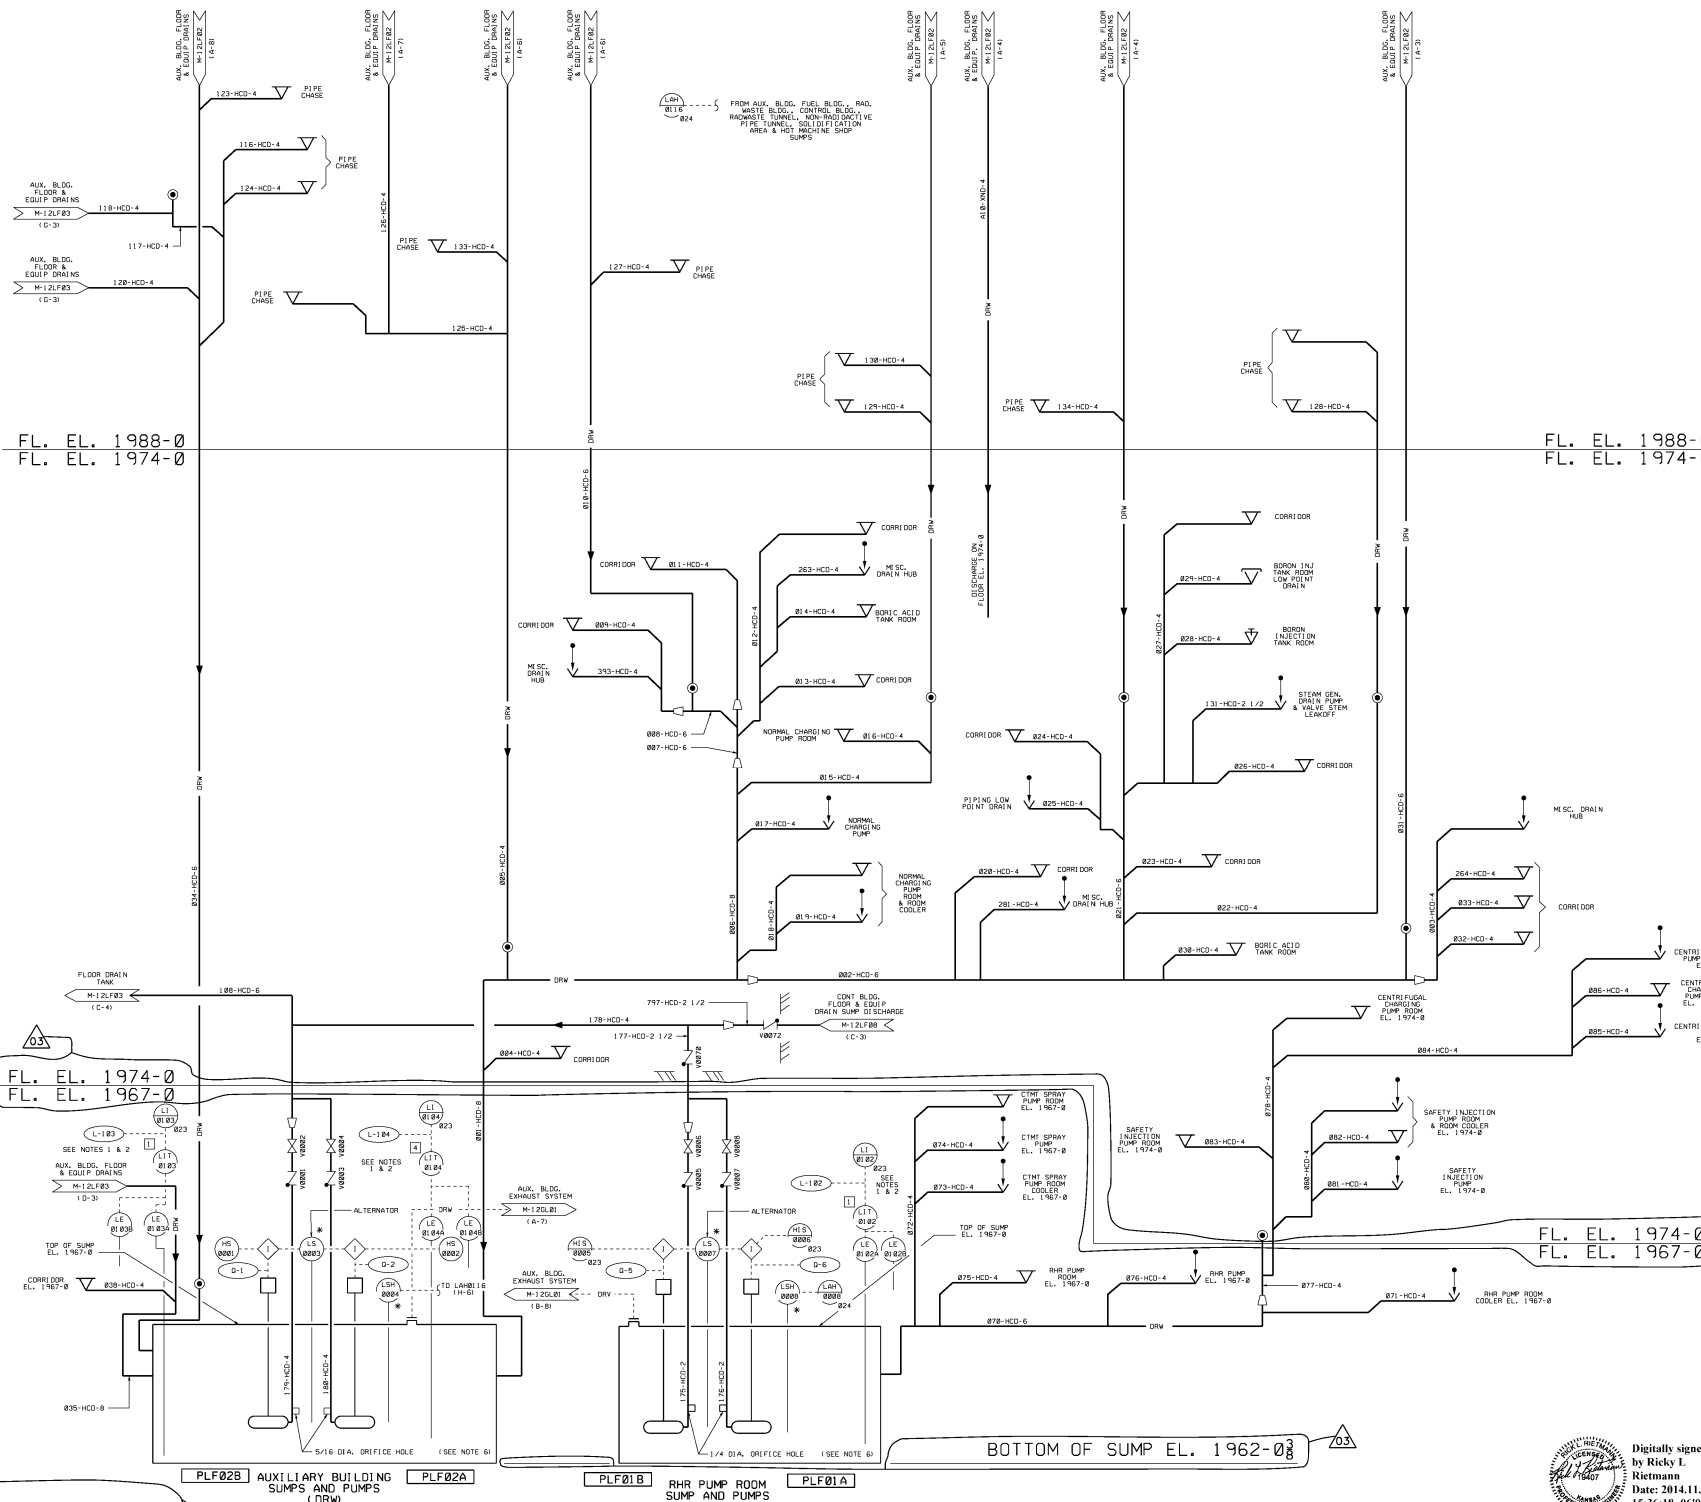


PLF02B AUXILIARY BUILDING SUMPS AND PUMPS (DRW)

PLF02A

PLF01B RHR PUMP ROOM SUMP AND PUMPS (DRW)

PLF01A

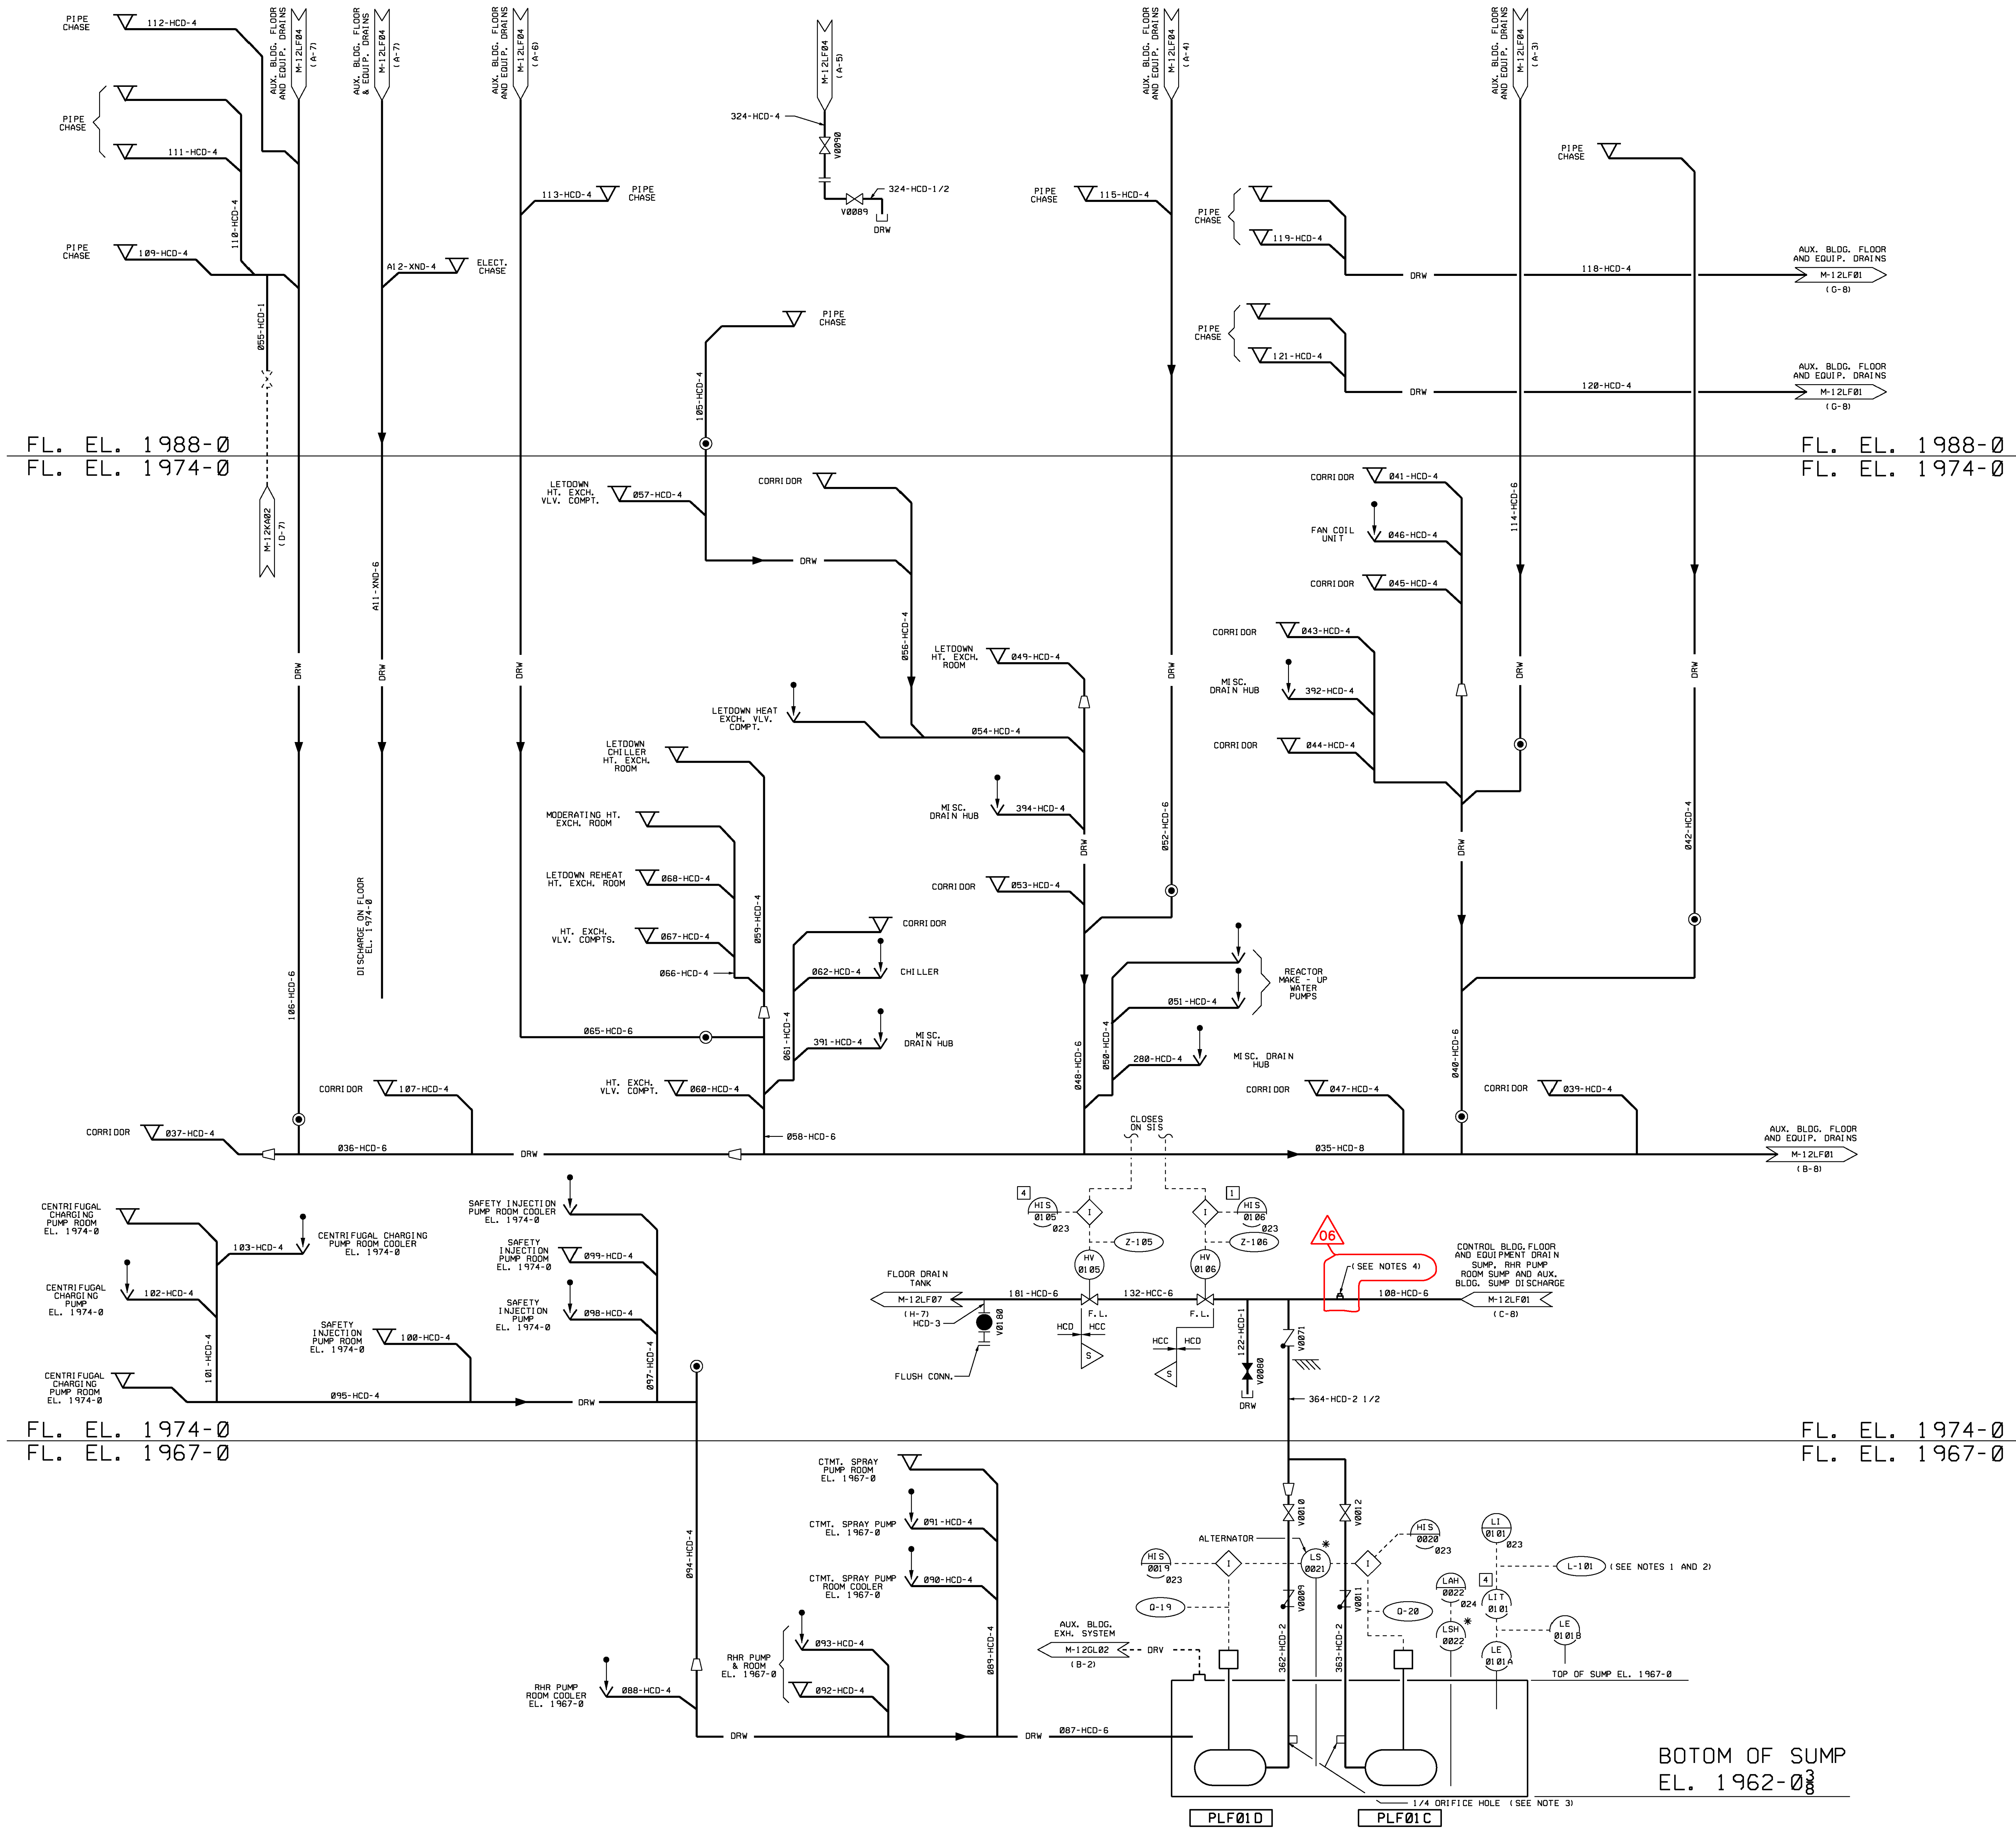

- NOTES**
1. THE RHR PUMP ROOM SEISMIC CATEGORY 1 LEVEL INDICATORS WILL BE INSTALLED ON A SEPARATE TRIANGULAR COVER PROVIDED BY BECTHEL. SPACE FOR THIS COVER WILL BE MADE BY HAVING A TRIANGULAR CUT OF SAME SIZE ON ORIGINAL SUMP COVER PLATE. COVER WILL BE CATEGORY 1.
 2. DRAWING Q - LIST PERTAINS TO LEVEL INDICATOR L-101 AND VALVES HV0105 AND HV0106 ONLY.
 3. RECIRCULATION ORIFICES (DRILLED HOLES) ARE TO EXTEND PUMP LIFE DURING SHUT - OFF CONDITION ON SIS.
 4. 3" STAINLESS STEEL THREADED INLET FOR INSPECTION/RETRIEVAL ACCESS. REFER TO DRAWING M-12LF02 FOR EXACT LOCATION.



FL. EL. 1988-0
FL. EL. 1974-0

FL. EL. 1988-0
FL. EL. 1974-0

FL. EL. 1974-0
FL. EL. 1967-0


FL. EL. 1974-0
FL. EL. 1967-0

BOTTOM OF SUMP
EL. 1962-0

USAR FIG. 9.3-5-10

ESSENTIAL DRAWING			
REVISION	INCORPORATED	WFP-M-12LF03-005-A-1	CHANGE 015050
ISSUED	DWG. DOC.		PGS. NO.
THIS Dwg. SUPERSEDES		REV.	THIS Dwg. SUPERSEDES
REVISION NOTES			
WOLF CREEK		ELECTRONIC APPROVAL	
NUCLEAR OPERATING CORPORATION			
PIPING AND INSTRUMENTATION DIAGRAM			
AUXILIARY BUILDING FLOOR AND EQUIPMENT DRAIN SYSTEM			
SCALE	DRAWING NUMBER	SHEET	REV
NONE	M-12LF03	06	
			34444 E SIZE

3000 Spring Street
Palo Alto, California 94303
Tel: (415) 851-2000

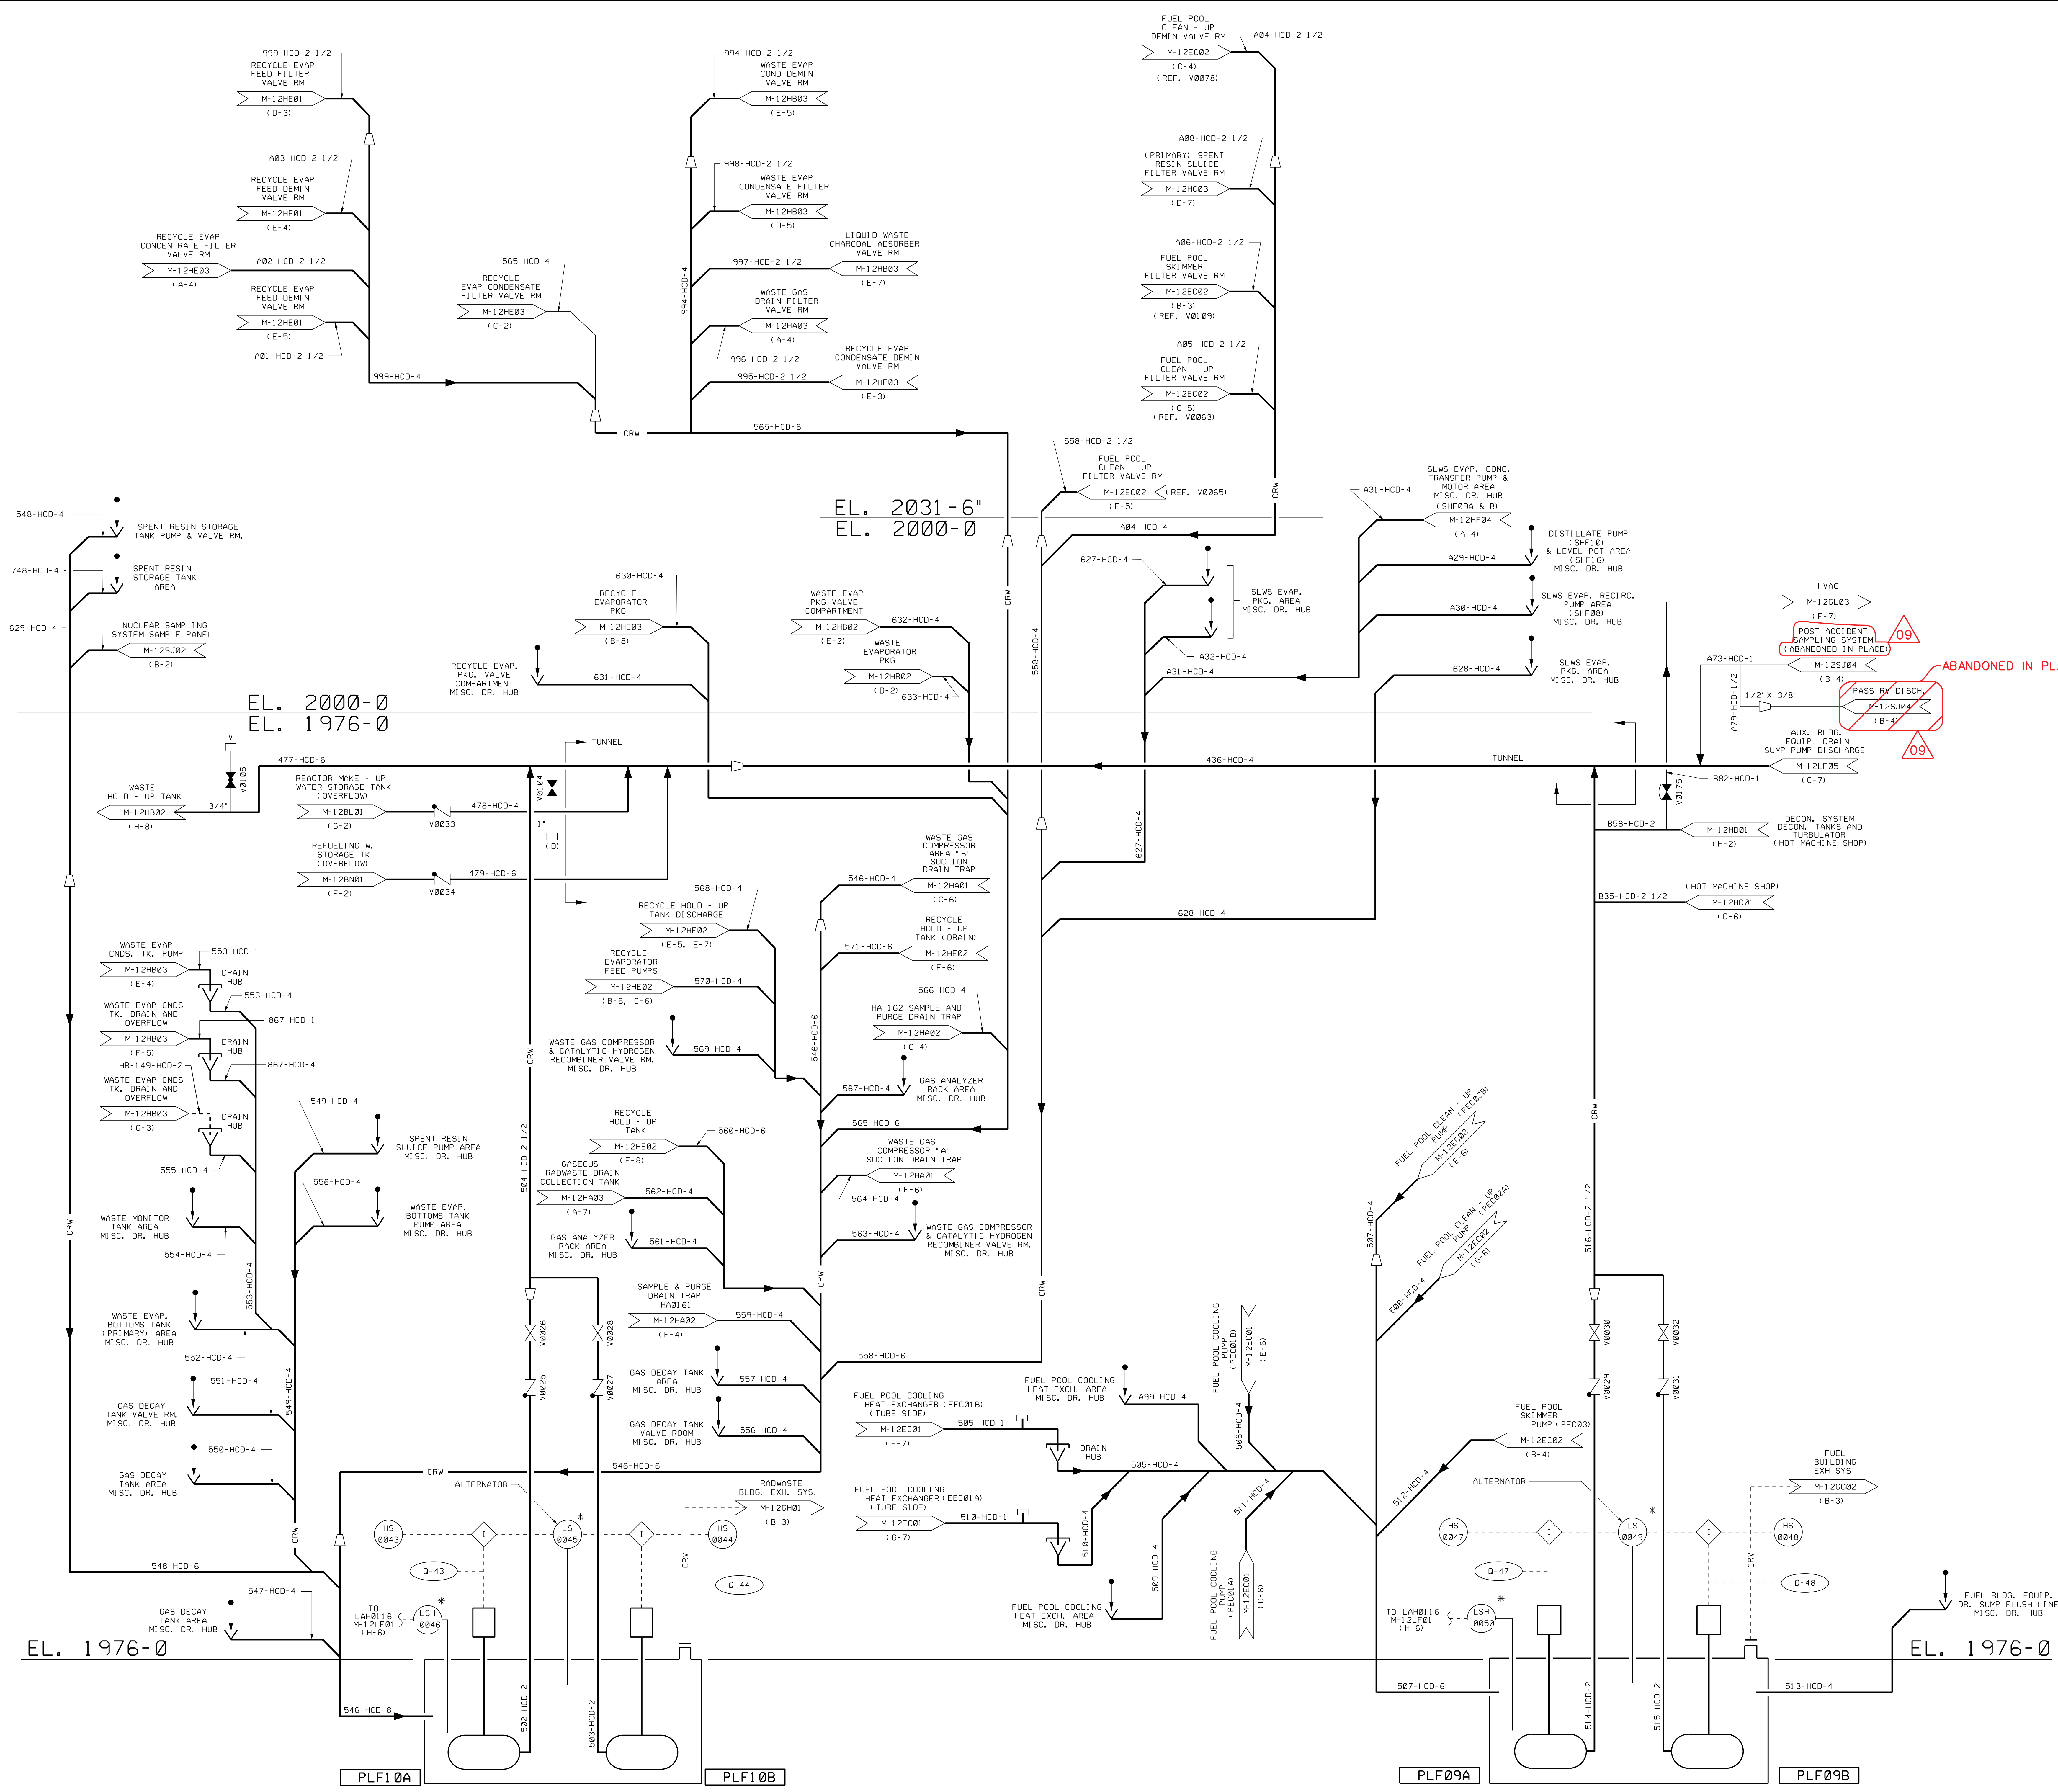


ABANDONED IN PLACE

USAR FIG. 9.3-5-13

ESSENTIAL DRAWING

REVISED	INCORPORATED	WIP-M-12LF06-006-A-1	CHANGE 06187
ISSUED	CHG. DOC.		PKG. NO.
THIS DWG. SUPERSEDES		REV.	THIS DWG. SUPERSEDES
REVISION NOTES			
WOLF CREEK		ELECTRONIC APPROVAL	
NUCLEAR OPERATING CORPORATION			
PIPING AND INSTRUMENTATION DIAGRAM RADWASTE AND FUEL BUILDINGS FLOOR AND EQUIP. DRAIN SYSTEM			
SCALE	DRAWING NUMBER	SHEET	REV.
NONE	M-12LF06	09	09

3444 E SIZE

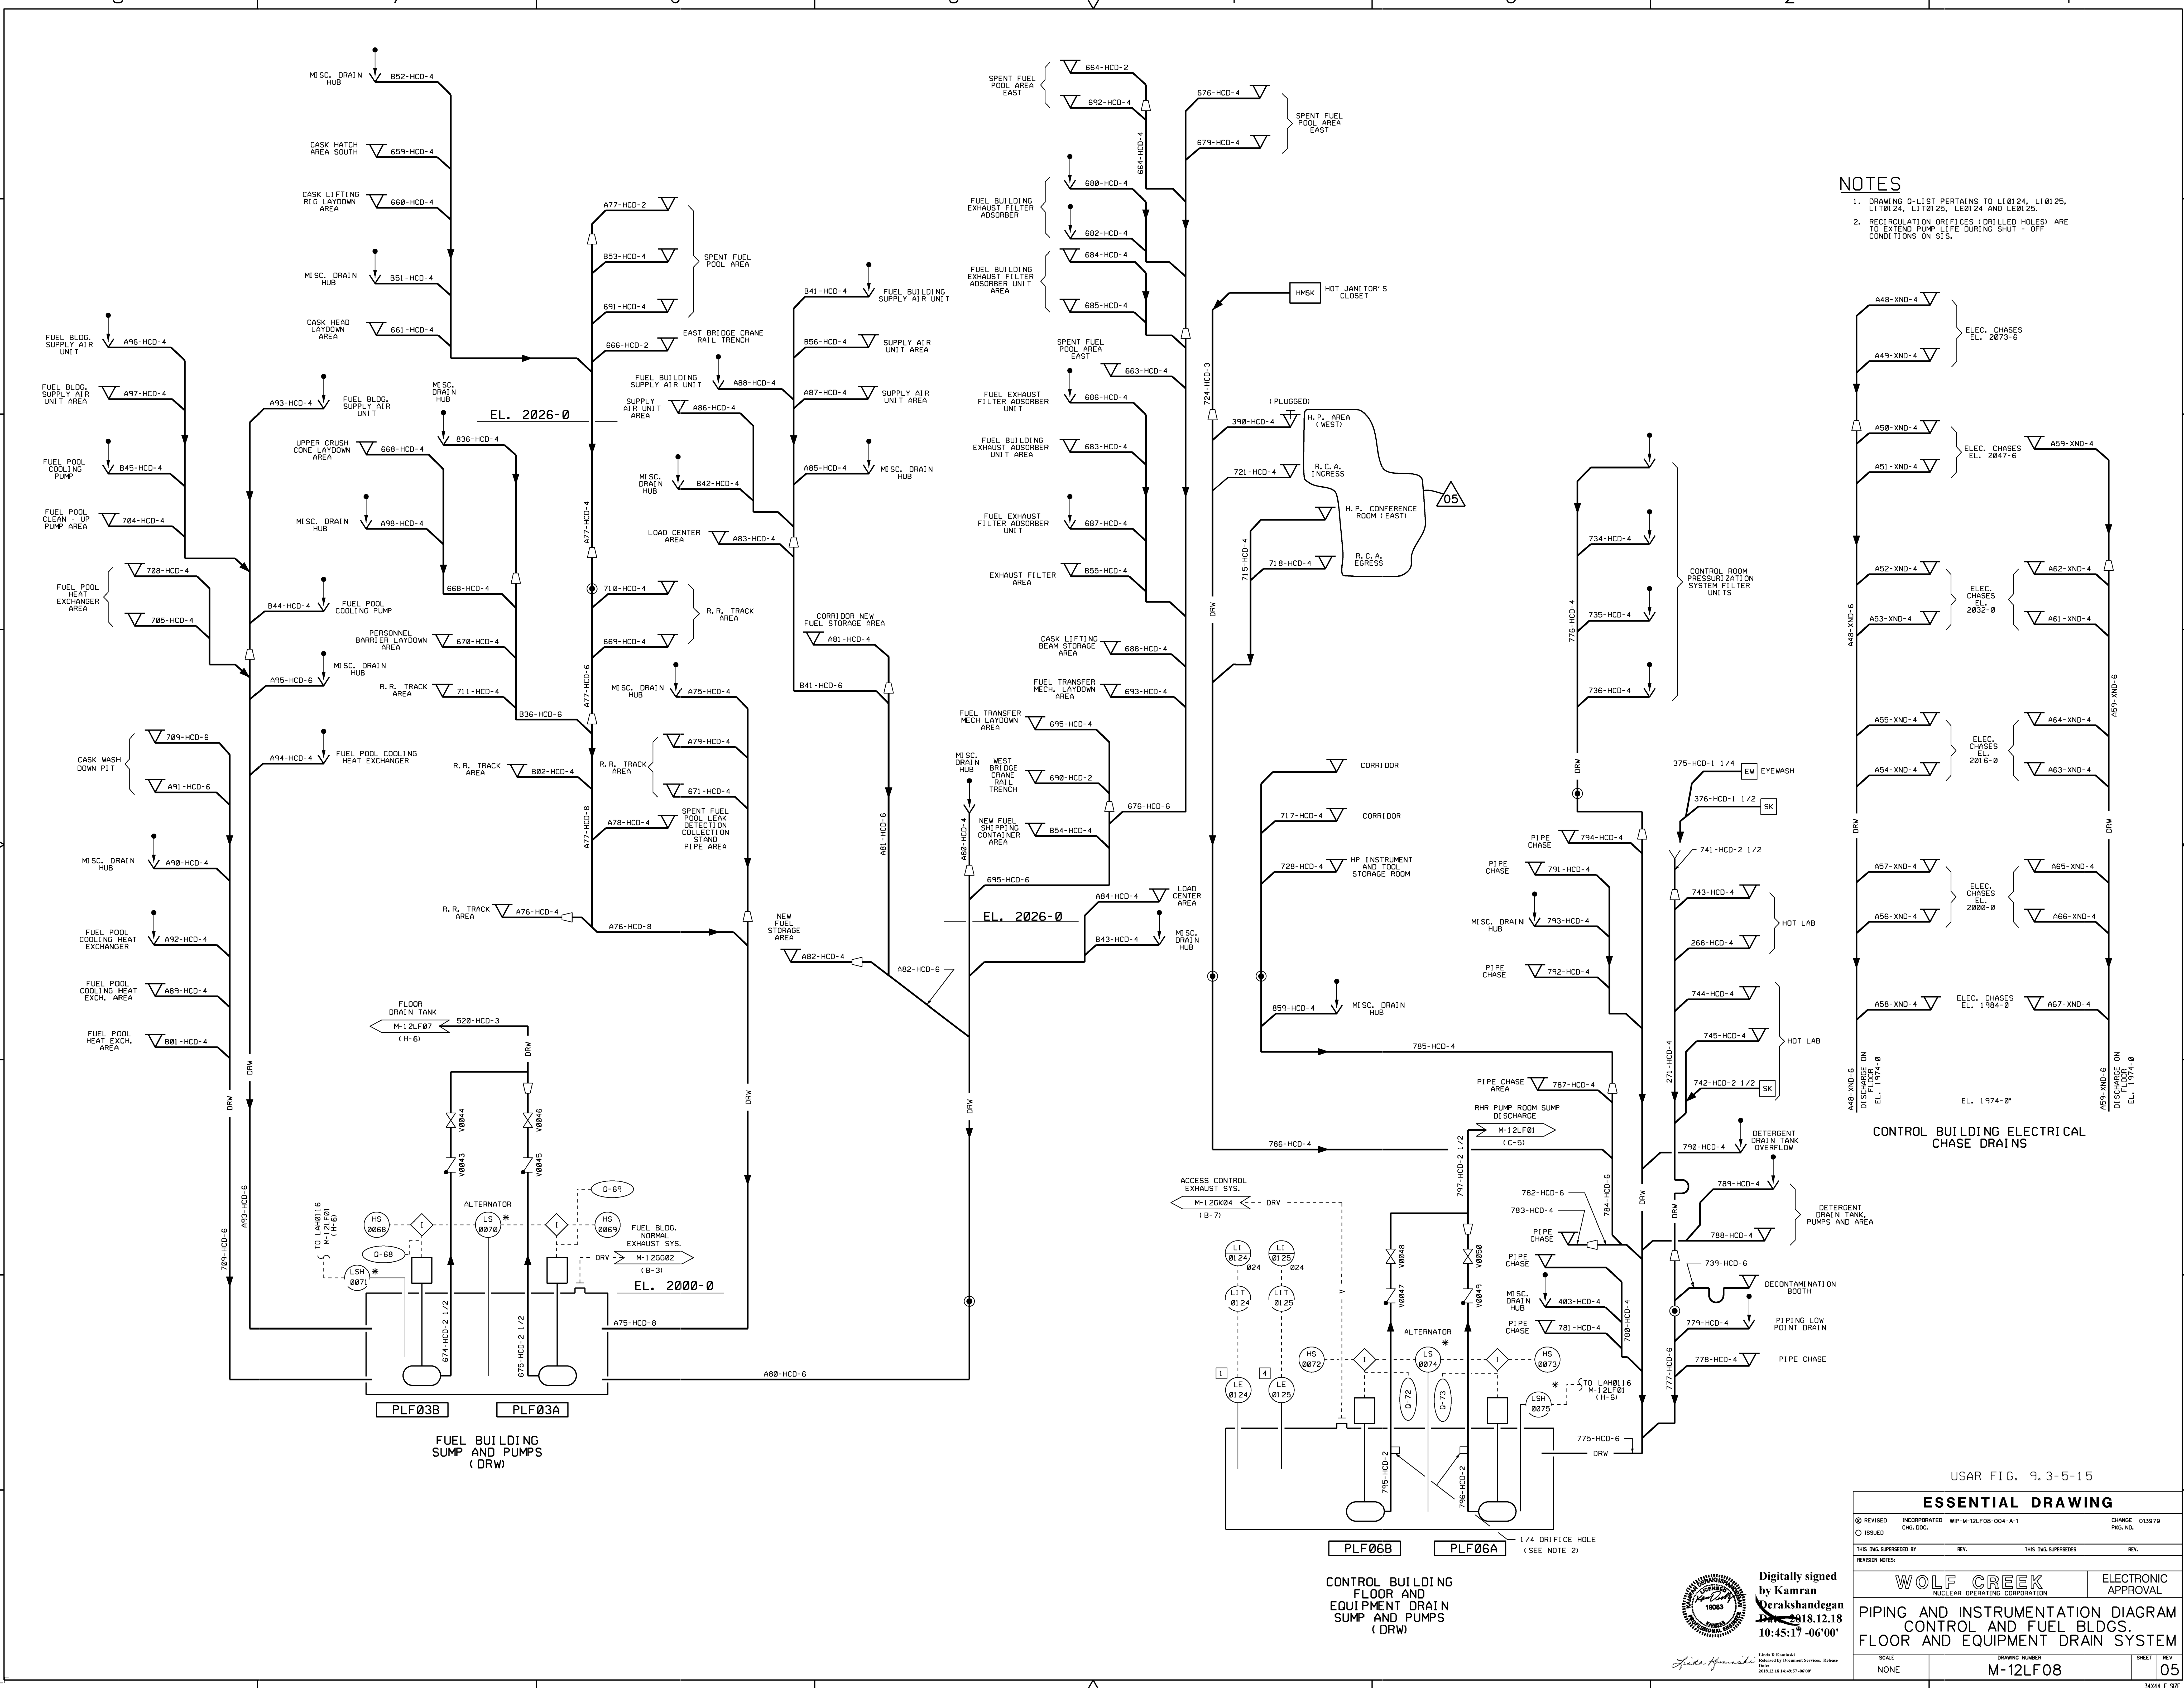

NOTES

- DRAWING 0-1151 PERTAINS TO L10124, L10125, L110124, L110125, L10124 AND L10125.
- RECIRCULATION ORIFICES (DRILLED HOLES) ARE TO EXTEND PUMP LIFE DURING SHUT-OFF CONDITIONS ON SIS.

CONTROL BUILDING ELECTRICAL CHASE DRAINS

FUEL BUILDING SUMP AND PUMPS (DRW)

CONTROL BUILDING FLOOR AND EQUIPMENT DRAIN SUMP AND PUMPS (DRW)

USAR FIG. 9.3-5-15

ESSENTIAL DRAWING			
REVISION	INCORPORATED	WP-M-12LF08-004-A-1	CHANGE 013979
ISSUED	CIG, DCC		PKG. NO.
THIS DWG. SUPERSEDES		REV.	THIS DWG. SUPERSEDES
REVISION NOTES			
WOLF CREEK		ELECTRONIC APPROVAL	
NUCLEAR OPERATING CORPORATION			
PIPING AND INSTRUMENTATION DIAGRAM CONTROL AND FUEL BLDGS. FLOOR AND EQUIPMENT DRAIN SYSTEM			
SCALE	DRAWING NUMBER	SHEET	REV
NONE	M-12LF08	05	05


Digitally signed by Kamran Derakshandegan
 Date: 2018.12.18 10:45:17 -06'00'



Scale & Standard
 Issued by Drawings Services, Release Date: 2018.12.18 10:45:17 -06'00'

NOTES

1. VALVE FV0095 IS NORMALLY OPEN. VALVE FV0096 IS NORMALLY CLOSED BUT OPENS IN EVENT OF SUMP PUMP ACTUATION.
2. THE O-LISTED PORTION OF THIS SYSTEM INDICATED ON THIS DRAWING INCLUDES THE PIPING AND VALVES ASSOCIATED WITH CONTAINMENT ISOLATION AND THE LEVEL INDICATORS L-9 AND L-10 ONLY.
3. FV0096 TO BE PROVIDED WITH THREE LIMIT SWITCHES ONE INDICATING OPEN POSITION AND TWO INDICATING CLOSED POSITION.
4. RECIRCULATION DEVICES (DRILLED HOLE) ARE PROVIDED IN DI CHARGE LINES TO EXTEND PUMP LIFE DURING CONTAINMENT ISOLATION CONDITION. ORIFICES FOR CONTAINMENT SUMP PUMPS PLF05A & B AND PLF05C & D ARE PROVIDED BY PUMP MANUFACTURER.
5. RCP LUBE OIL DRAIN TANK AND OIL COLLECTION PIPING DESIGNED TO SEISMIC CATEGORY 1 REQUIREMENTS IN ACCORDANCE WITH 10CFR50 APPENDIX K R.
6. ANY GIVEN TIME EITHER LT00798 OR LT00799A WILL BE IN THE CIRCUIT.

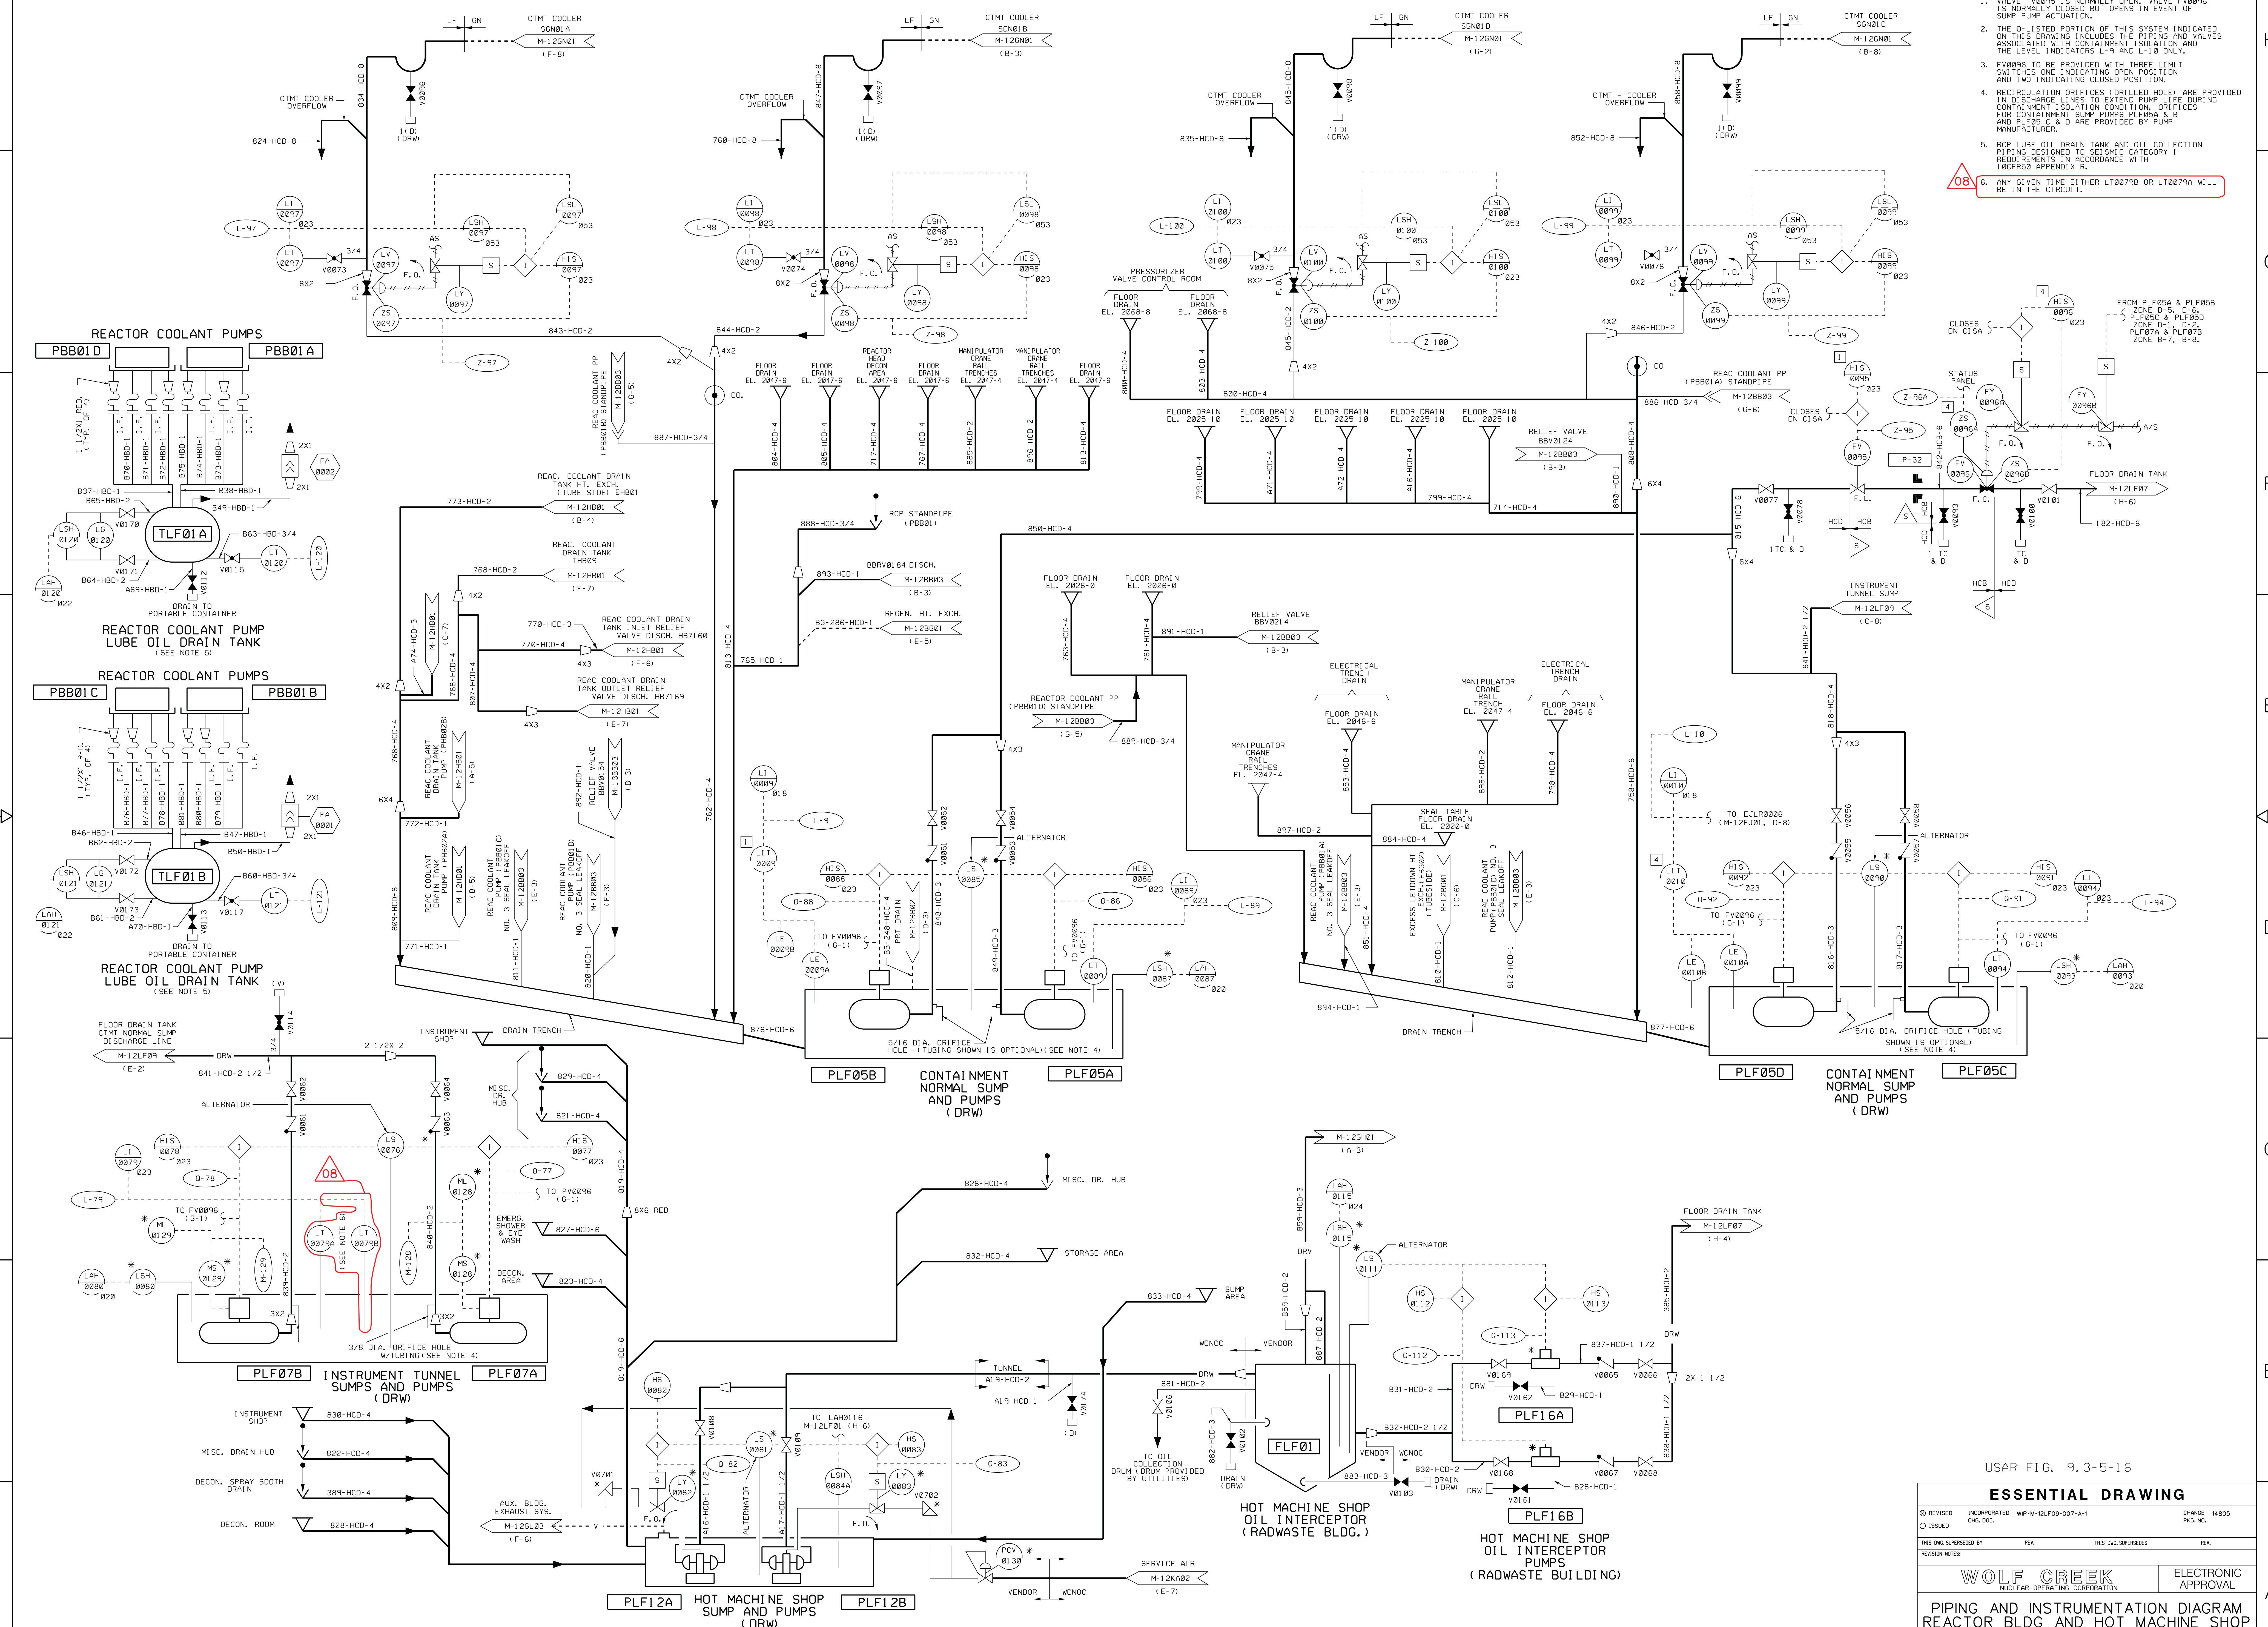

USAR FIG. 9.3-5-16

ESSENTIAL DRAWING

REVISION	INCORPORATED	WP-M-12LF09-007-A-1	CHANGE 14805
ISSUED	CHG. DOC.		PAG. NO.

THIS DWG. SUPERSEDES	REV.	THIS DWG. SUPERSEDES	REV.
REVISION NOTES:		ELECTRONIC APPROVAL	
WOLF CREEK		ELECTRONIC APPROVAL	
NUCLEAR OPERATING CORPORATION		ELECTRONIC APPROVAL	


PIPING AND INSTRUMENTATION DIAGRAM
REACTOR BLDG AND HOT MACHINE SHOP
FLOOR AND EQUIPMENT DRAIN SYSTEM

SCALE	DRAWING NUMBER	SHEET	REV
NONE	M-12LF09	08	02



NOTES:

1. BRACKETED VALVE NUMBERS INDICATE MULTI-VALVE SYSTEM LEAKOFF PIPING TO RADWASTE TUNNEL TRENCH.

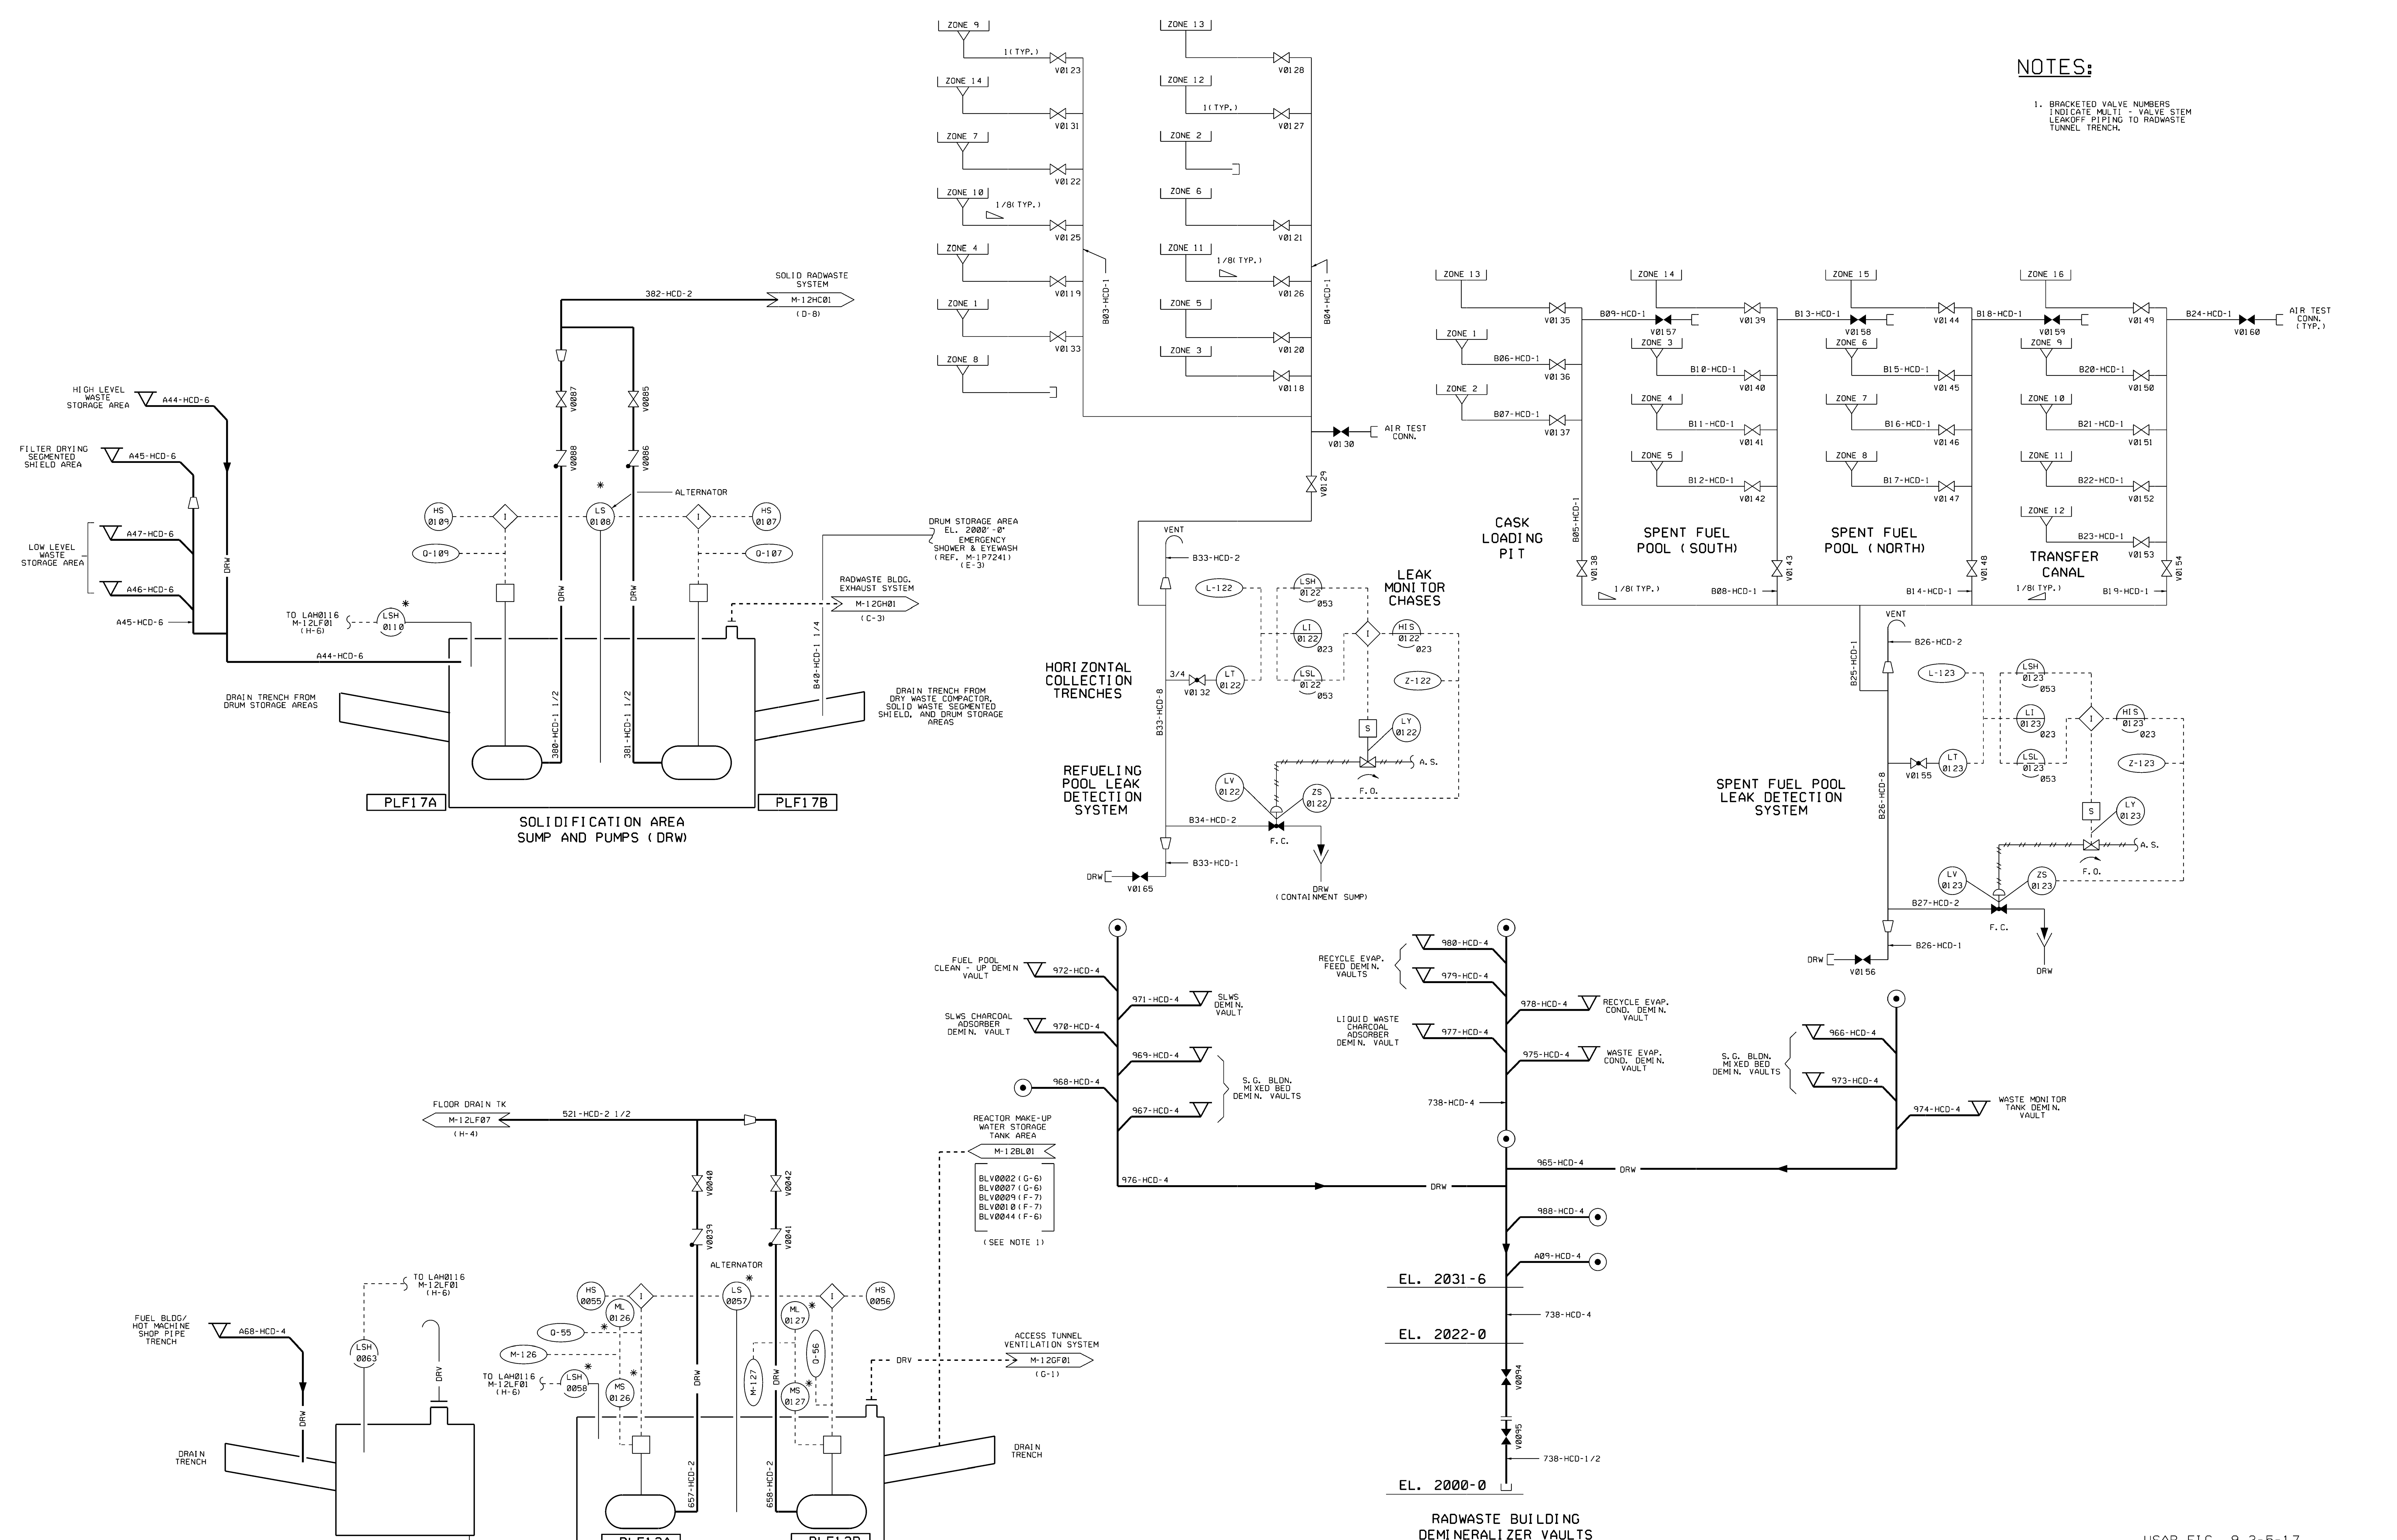

USAR FIG. 9.3-5-17

ESSENTIAL DRAWING

REVISED	INCORPORATED	CR Action 29532-01-05	CHANGE
ISSUED	CHG. DOC.		PKG. NO.
THIS DWG SUPERSEDES BY		REV.	THIS DWG SUPERSEDES
REVISION NOTES		REVISED TO REGENERATE CORRECT LINESYLES PER CR 29532.	




WOLF CREEK NUCLEAR OPERATING CORPORATION ELECTRONIC APPROVAL

PIPING AND INSTRUMENTATION DIAGRAM
RADWASTE BUILDING & TUNNEL
FLOOR AND EQUIPMENT DRAIN SYSTEM

SCALE	DRAWING NUMBER	SHEET	REV
NONE	M-12LF10	05	




Released by Document Services.
Revised by: [Signature]
Date: 2011.03.12 10:31:33 -0600



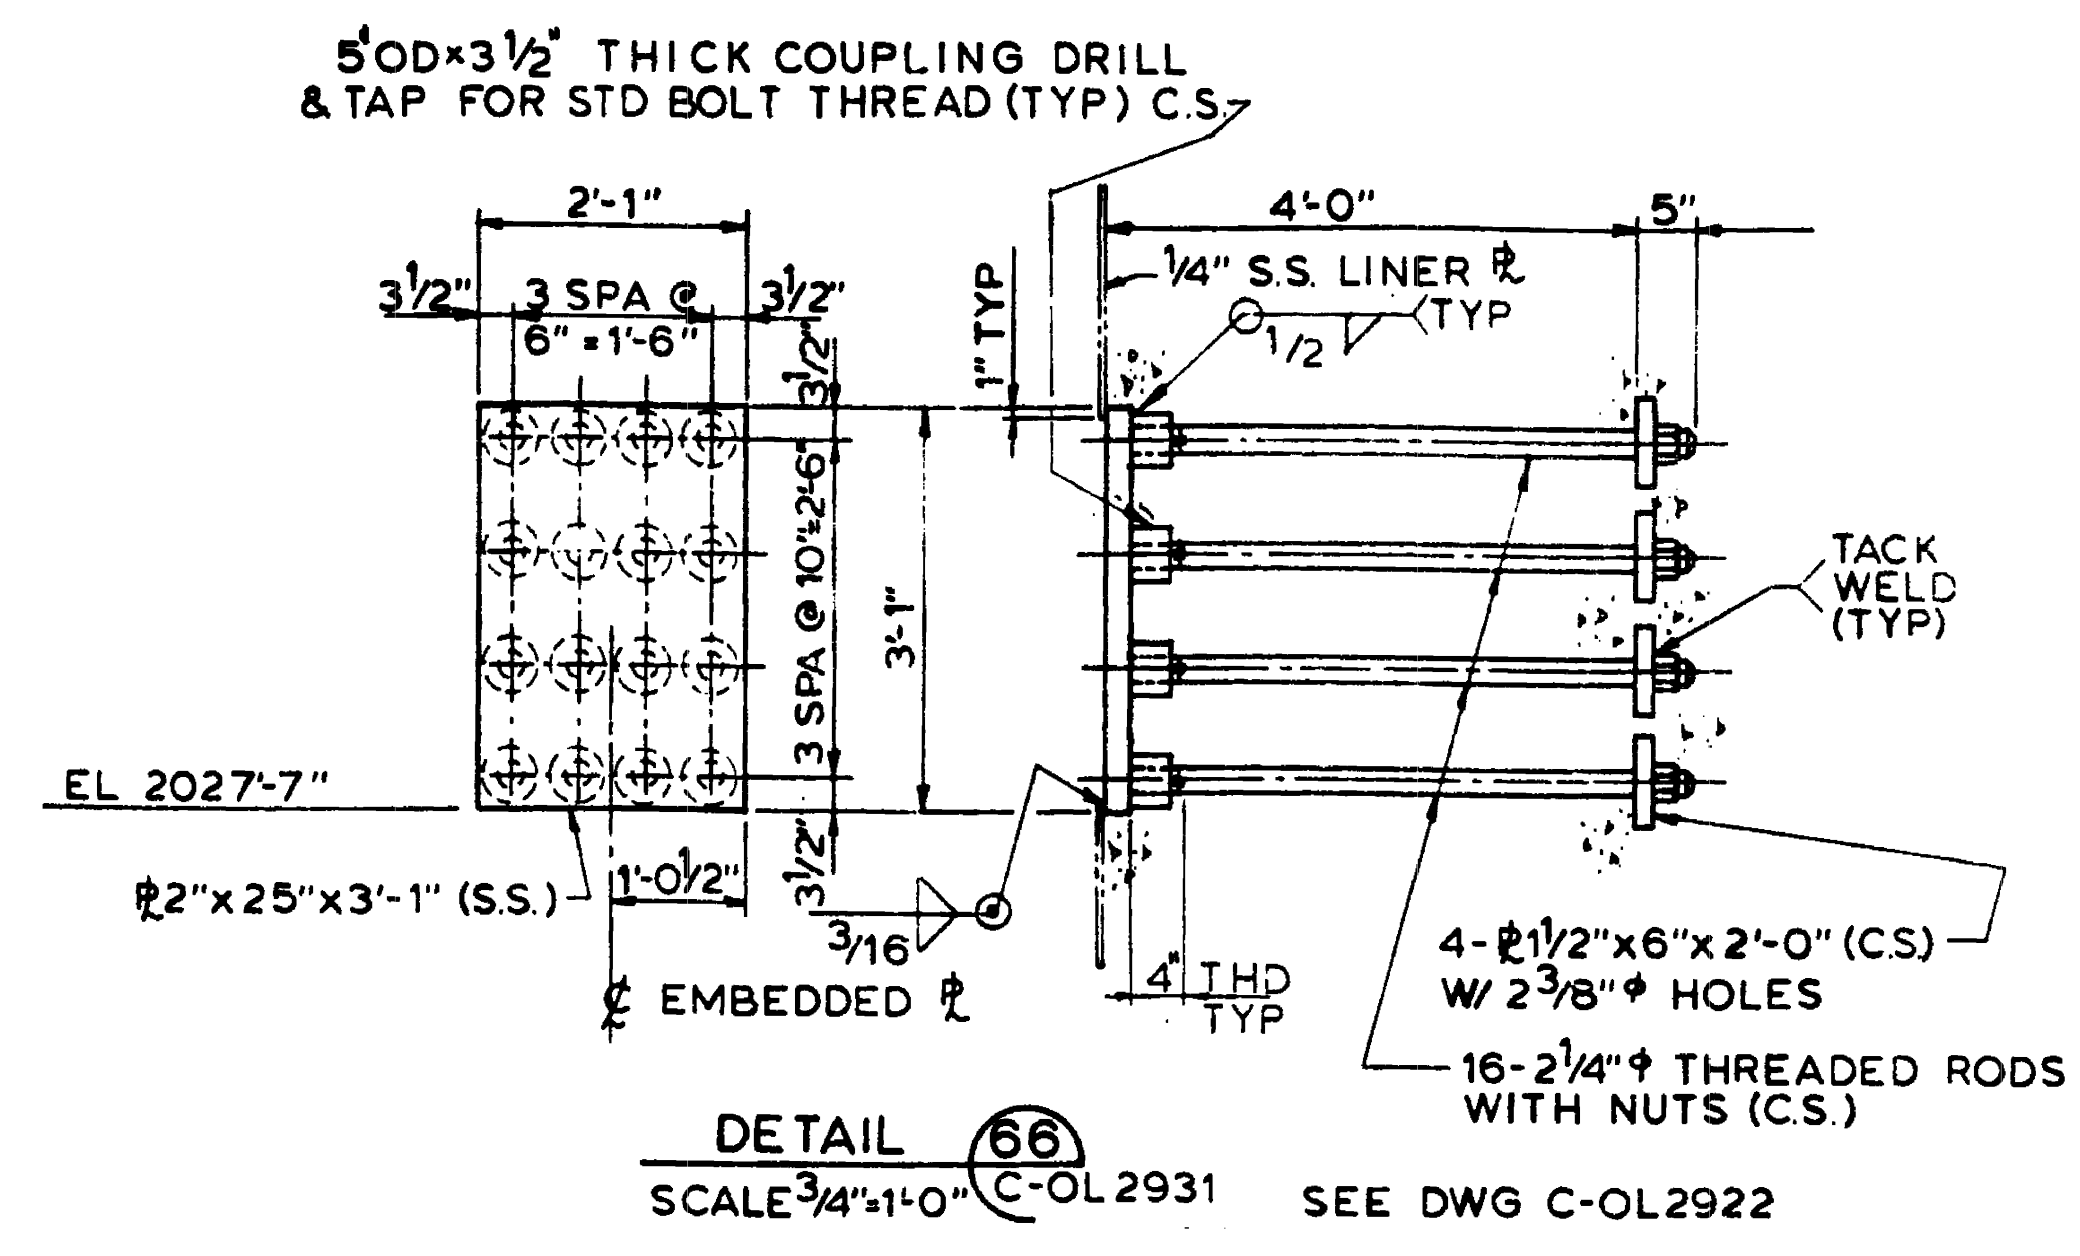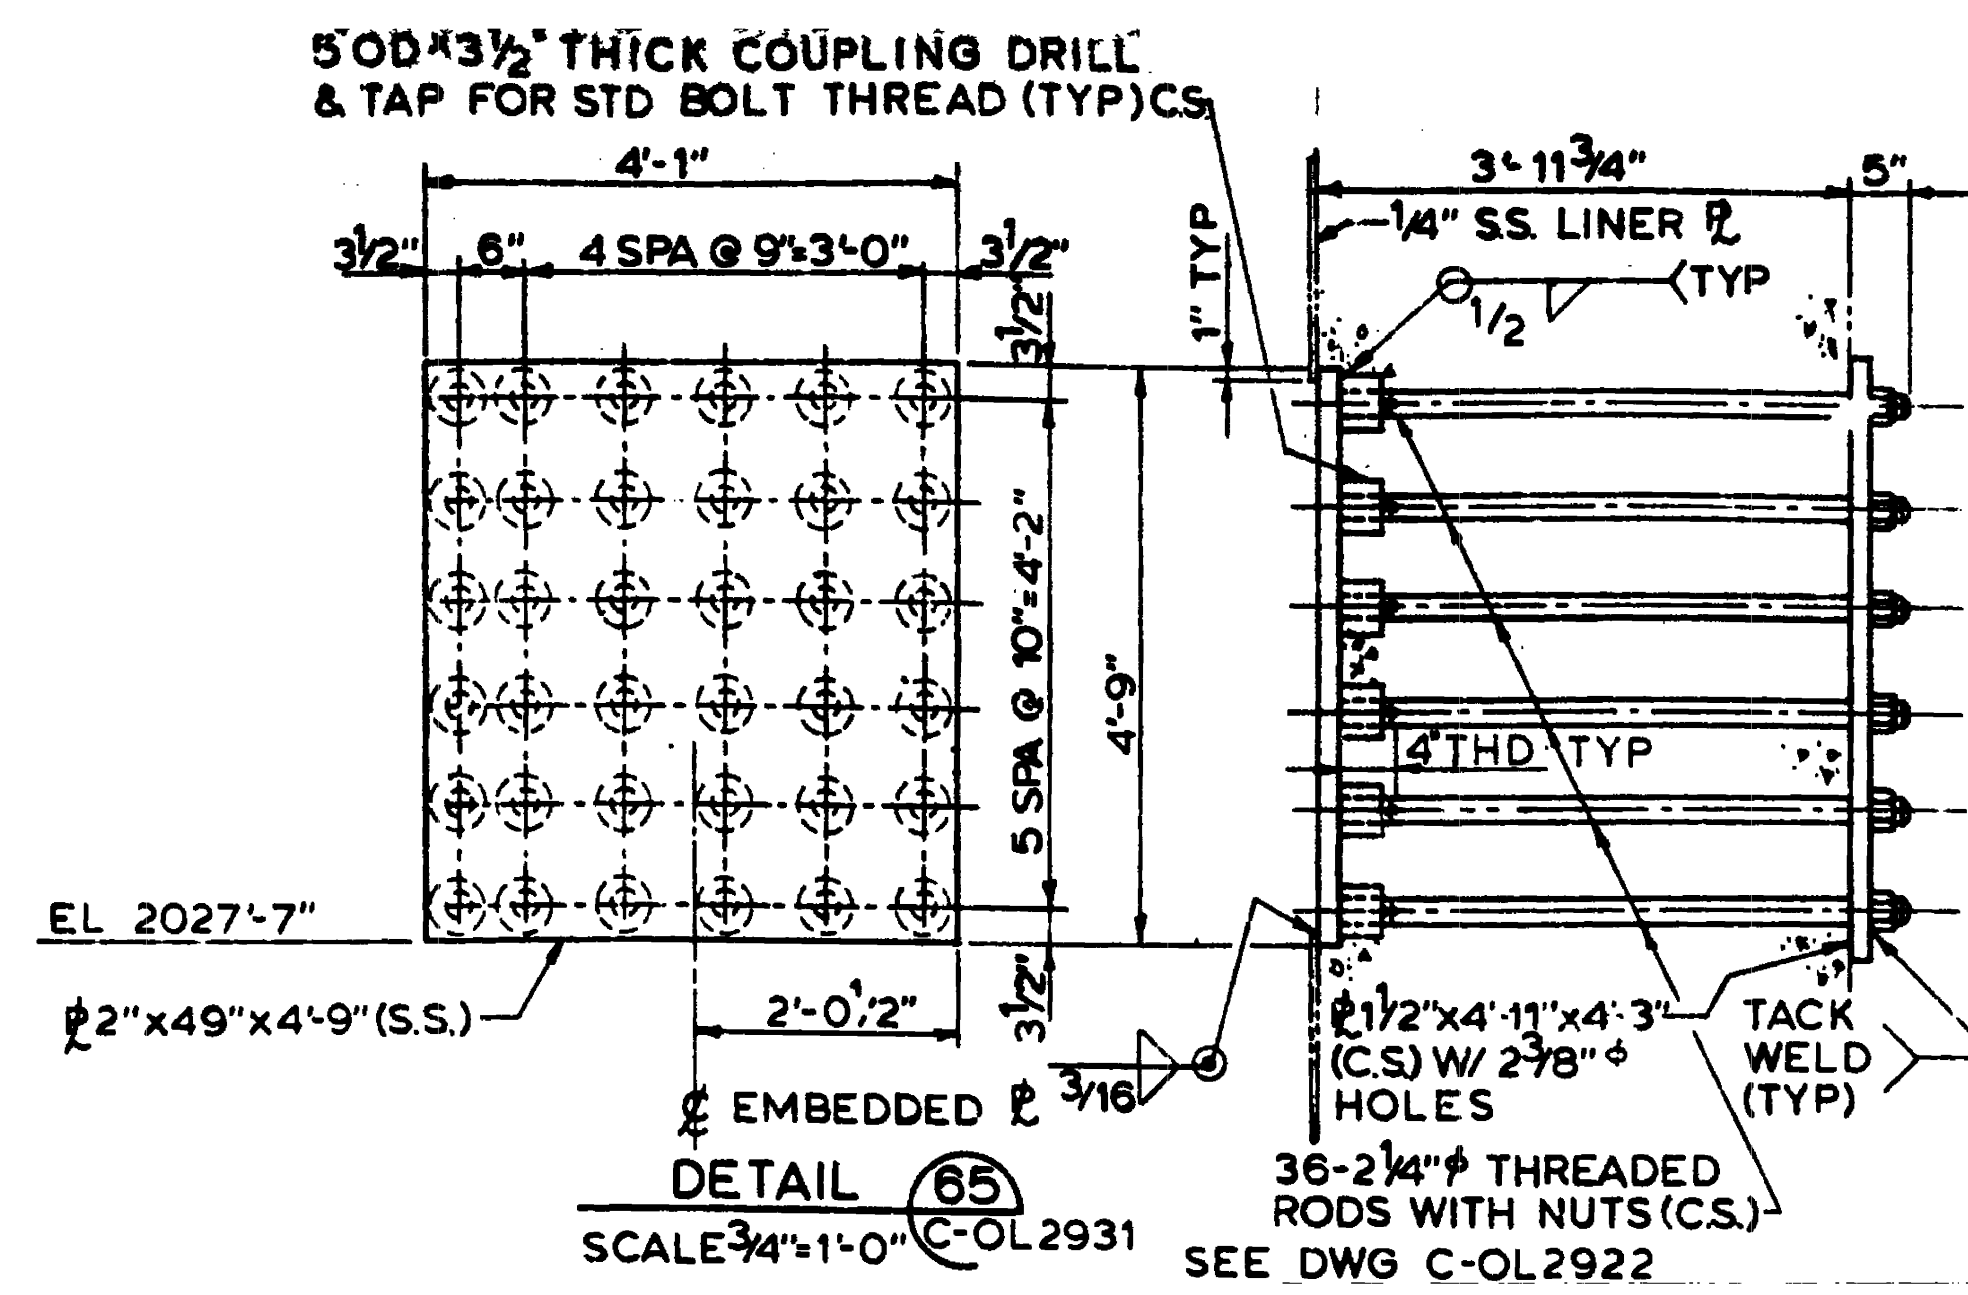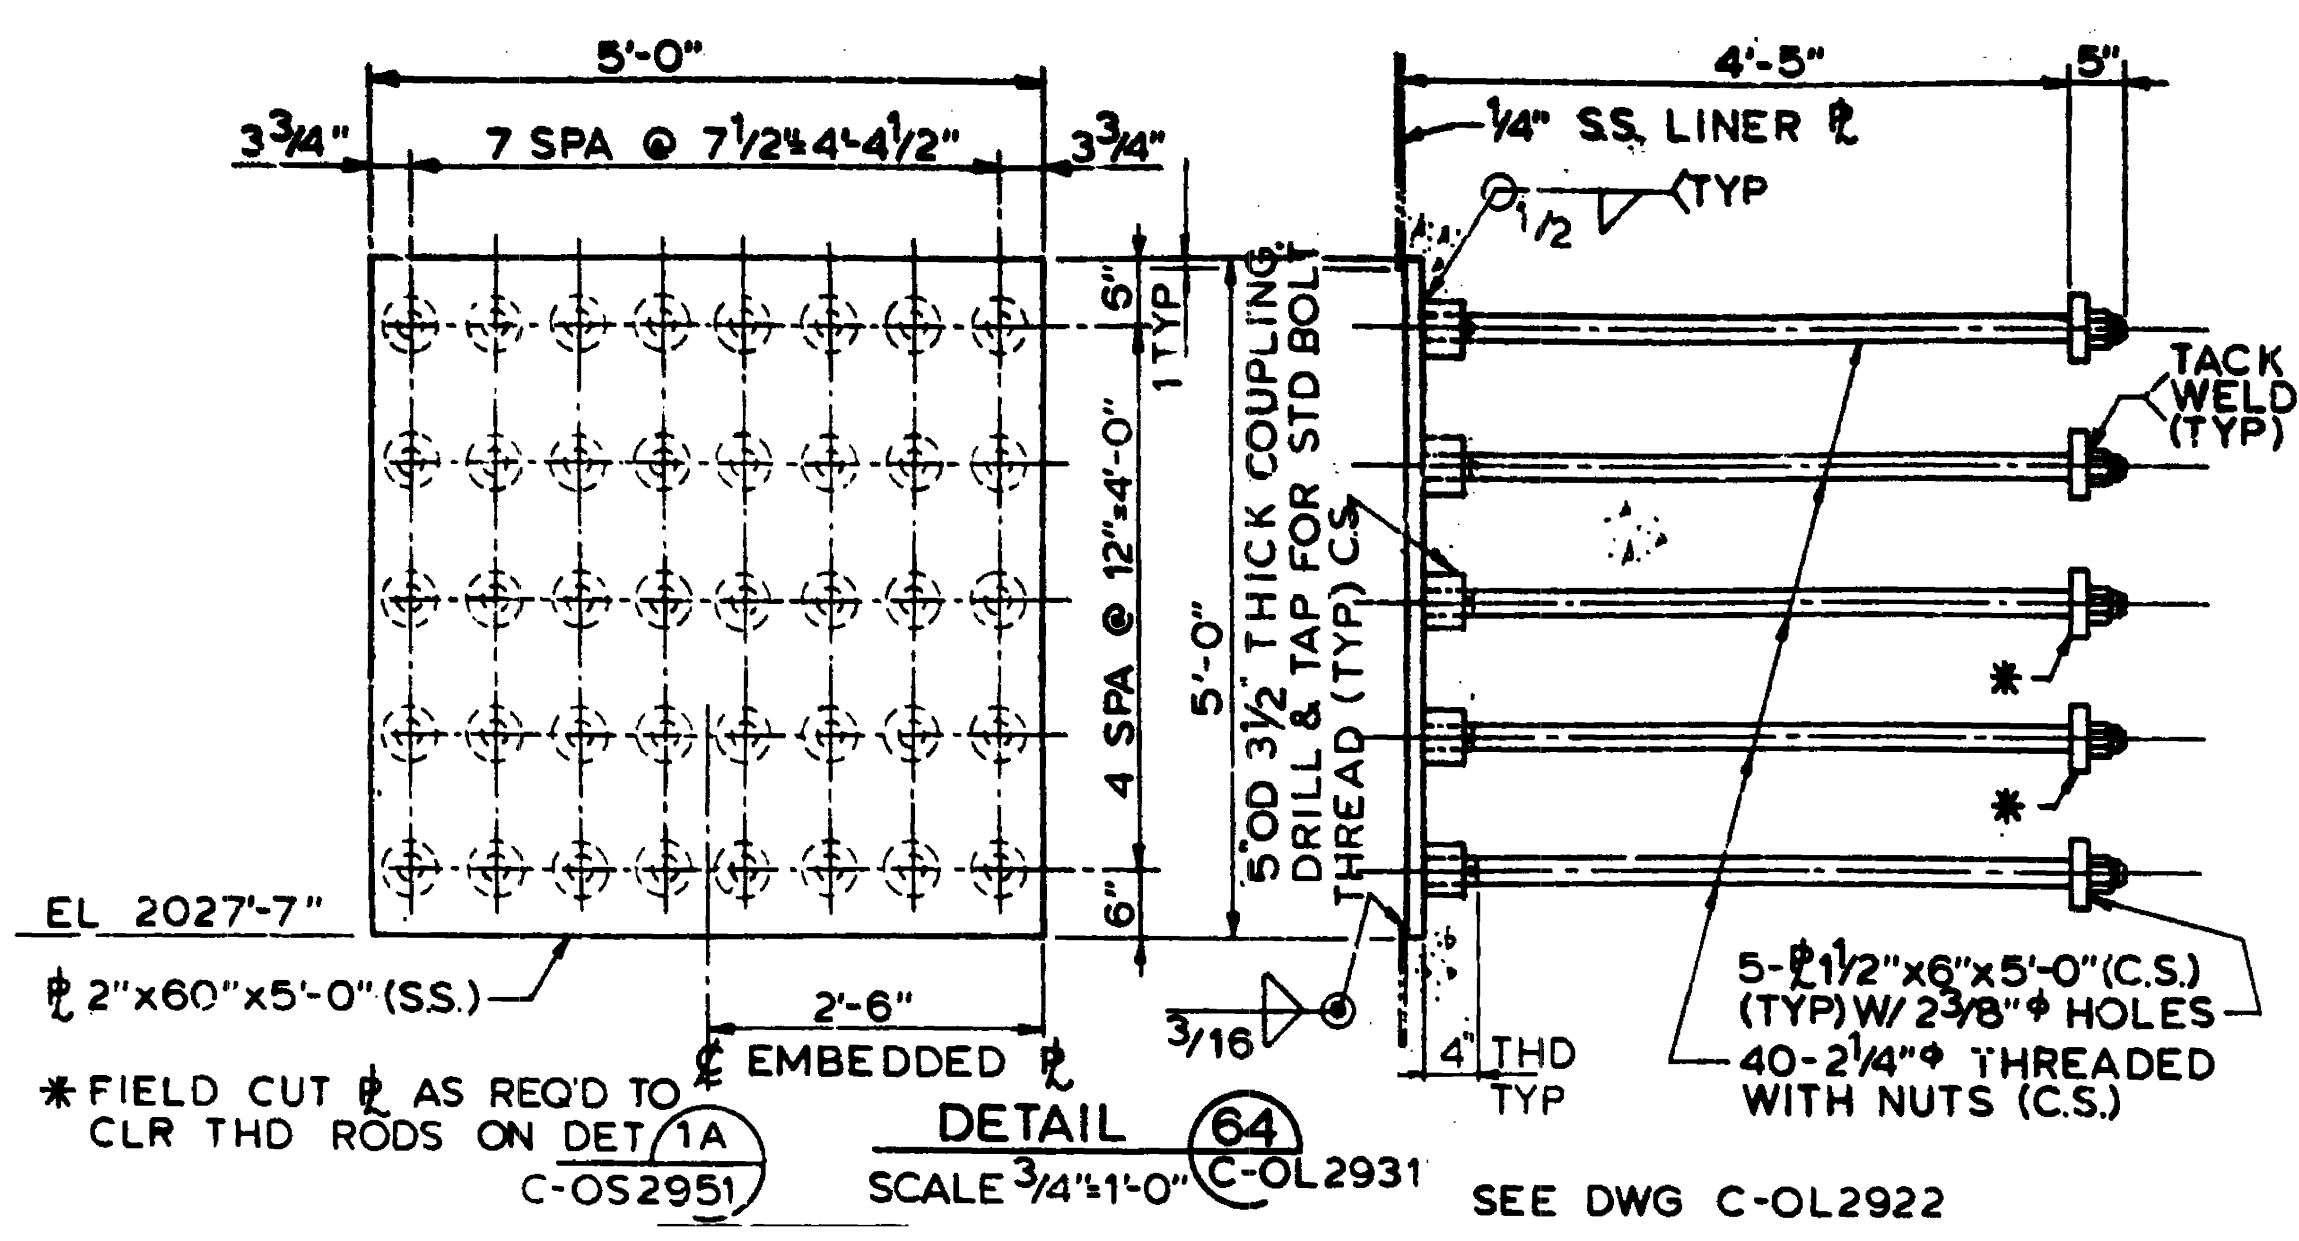




NOTES

- SEE DWG C-OL2921
- DETAILS 7, 64, 65, 66, 67, 67A, 68, & 71 ARE O. EVERYTHING ELSE IS NON-O
- THE COLLECTOR TRENCH PIPING IN THE FLOOR OF THE REFUELING POOL SHALL BE TESTED WITH A HYDROSTATIC HEAD OF 10 FEET

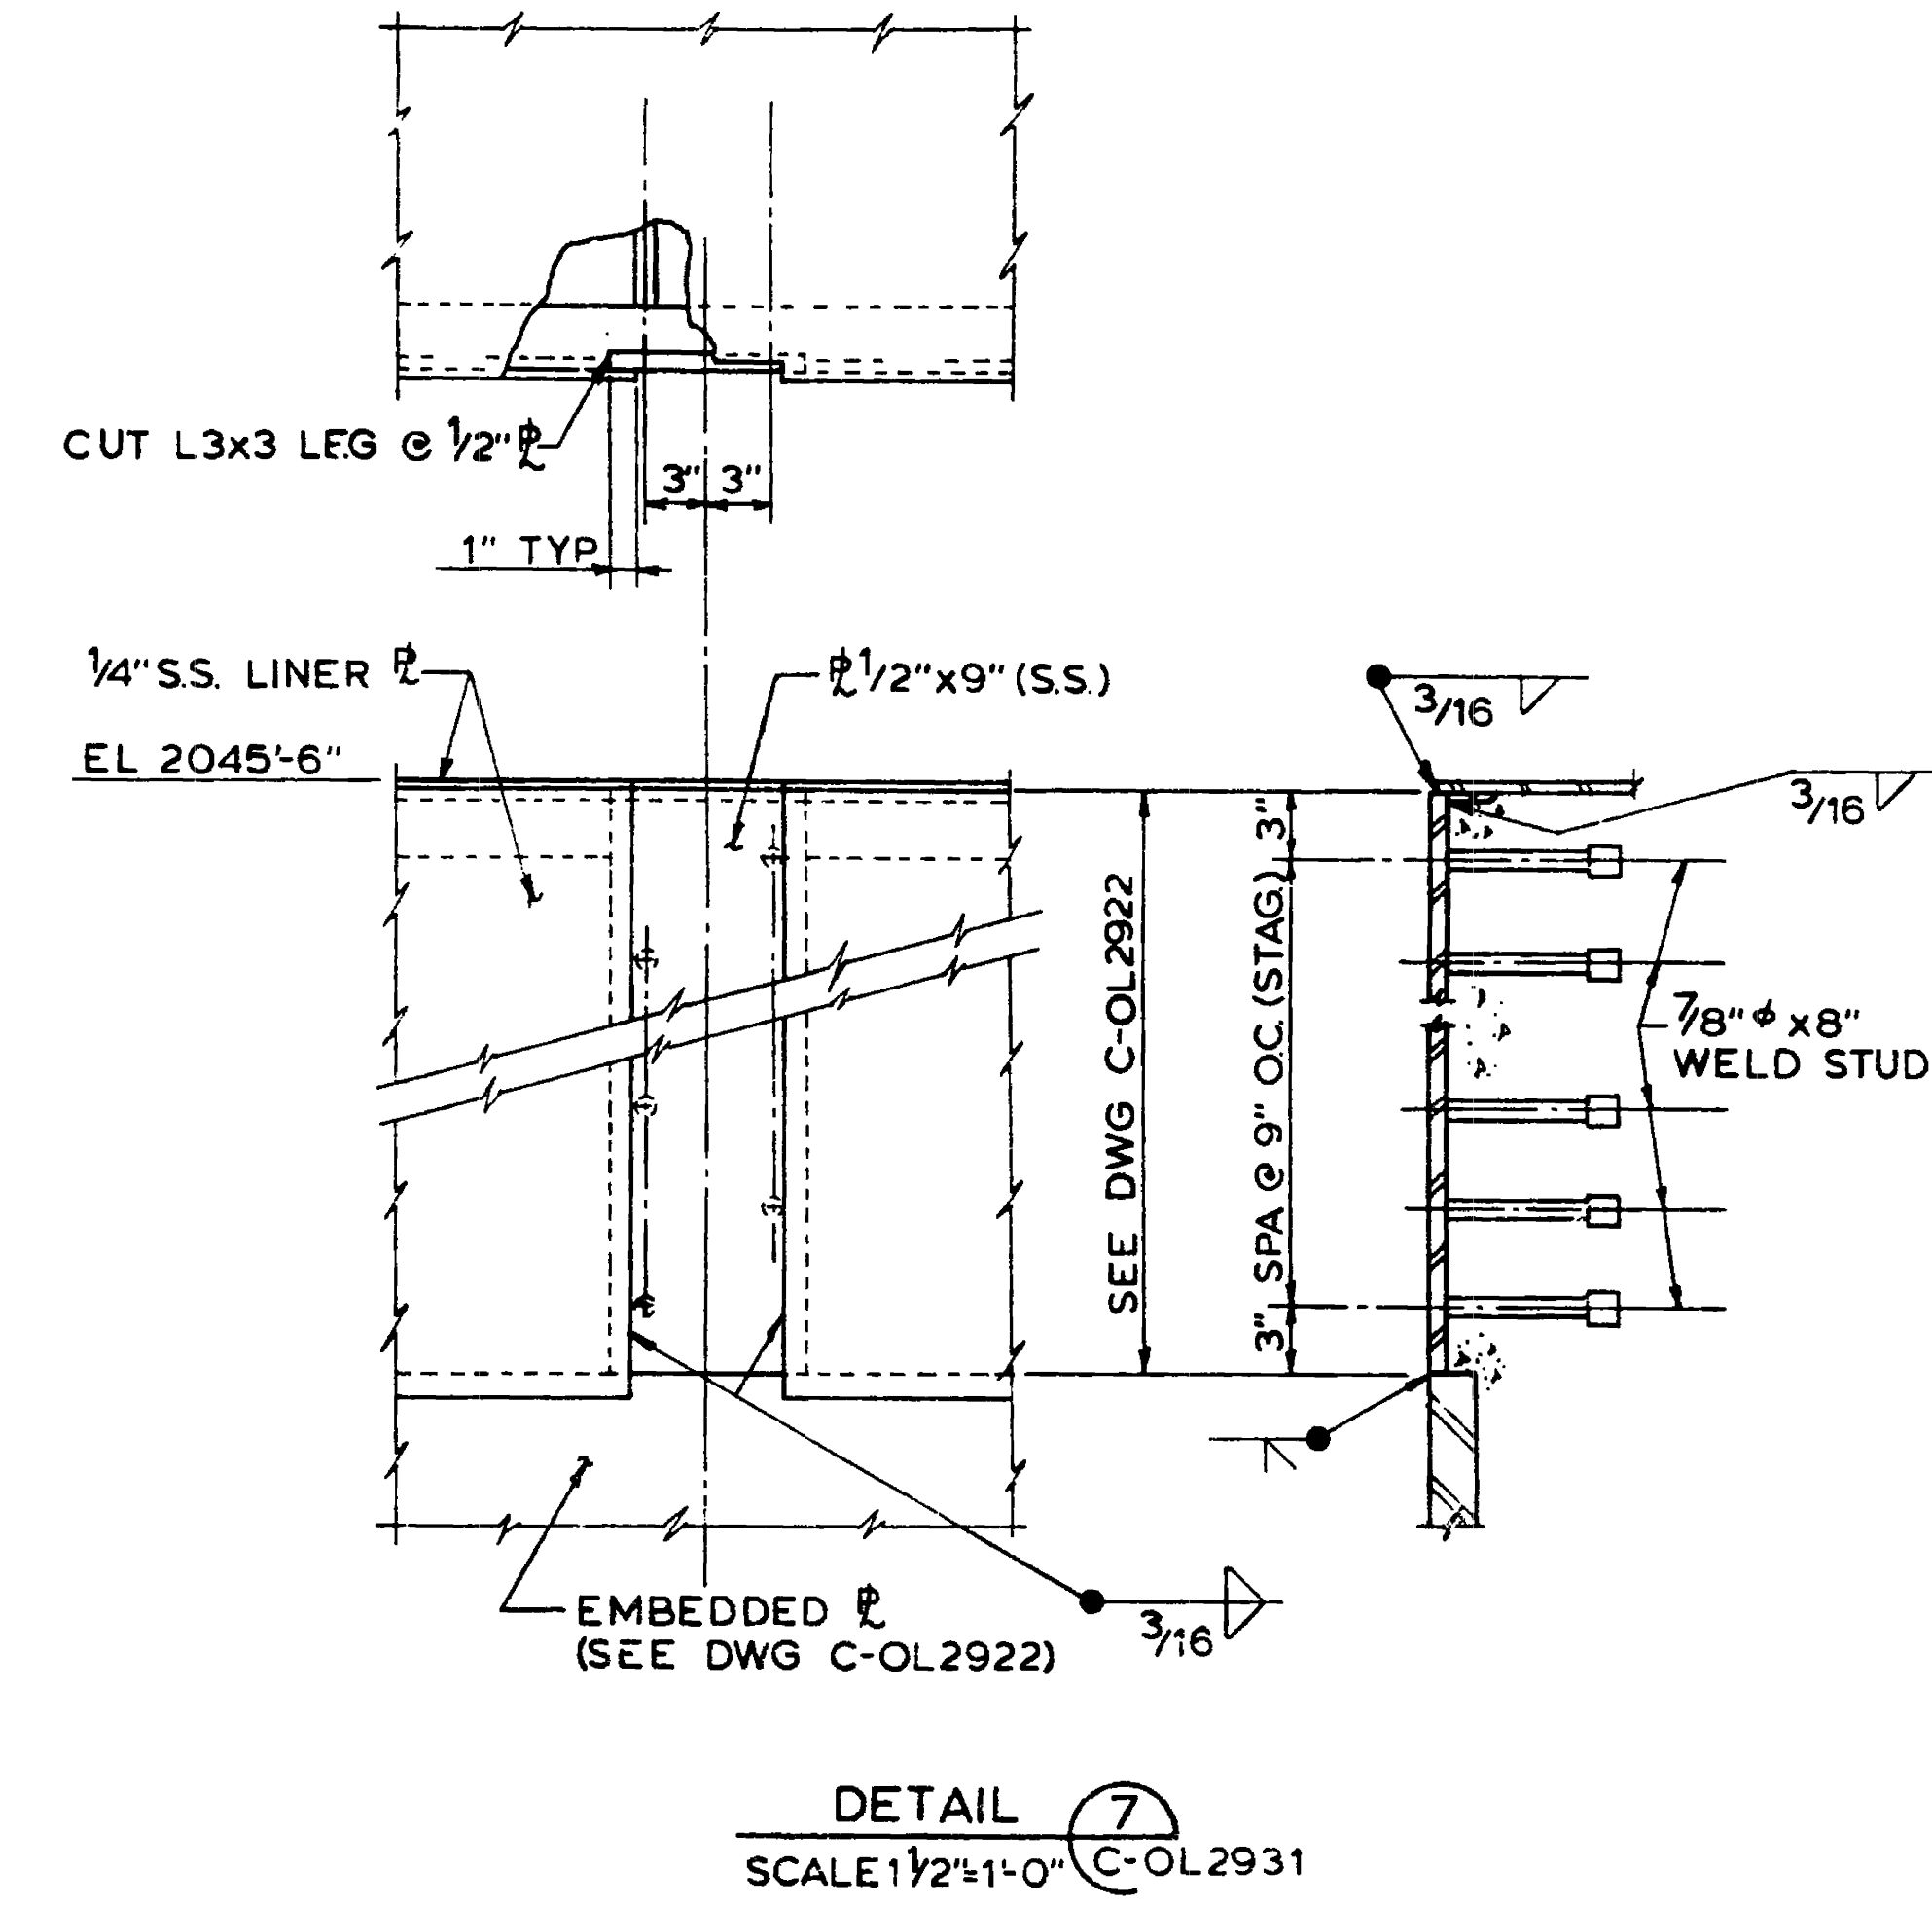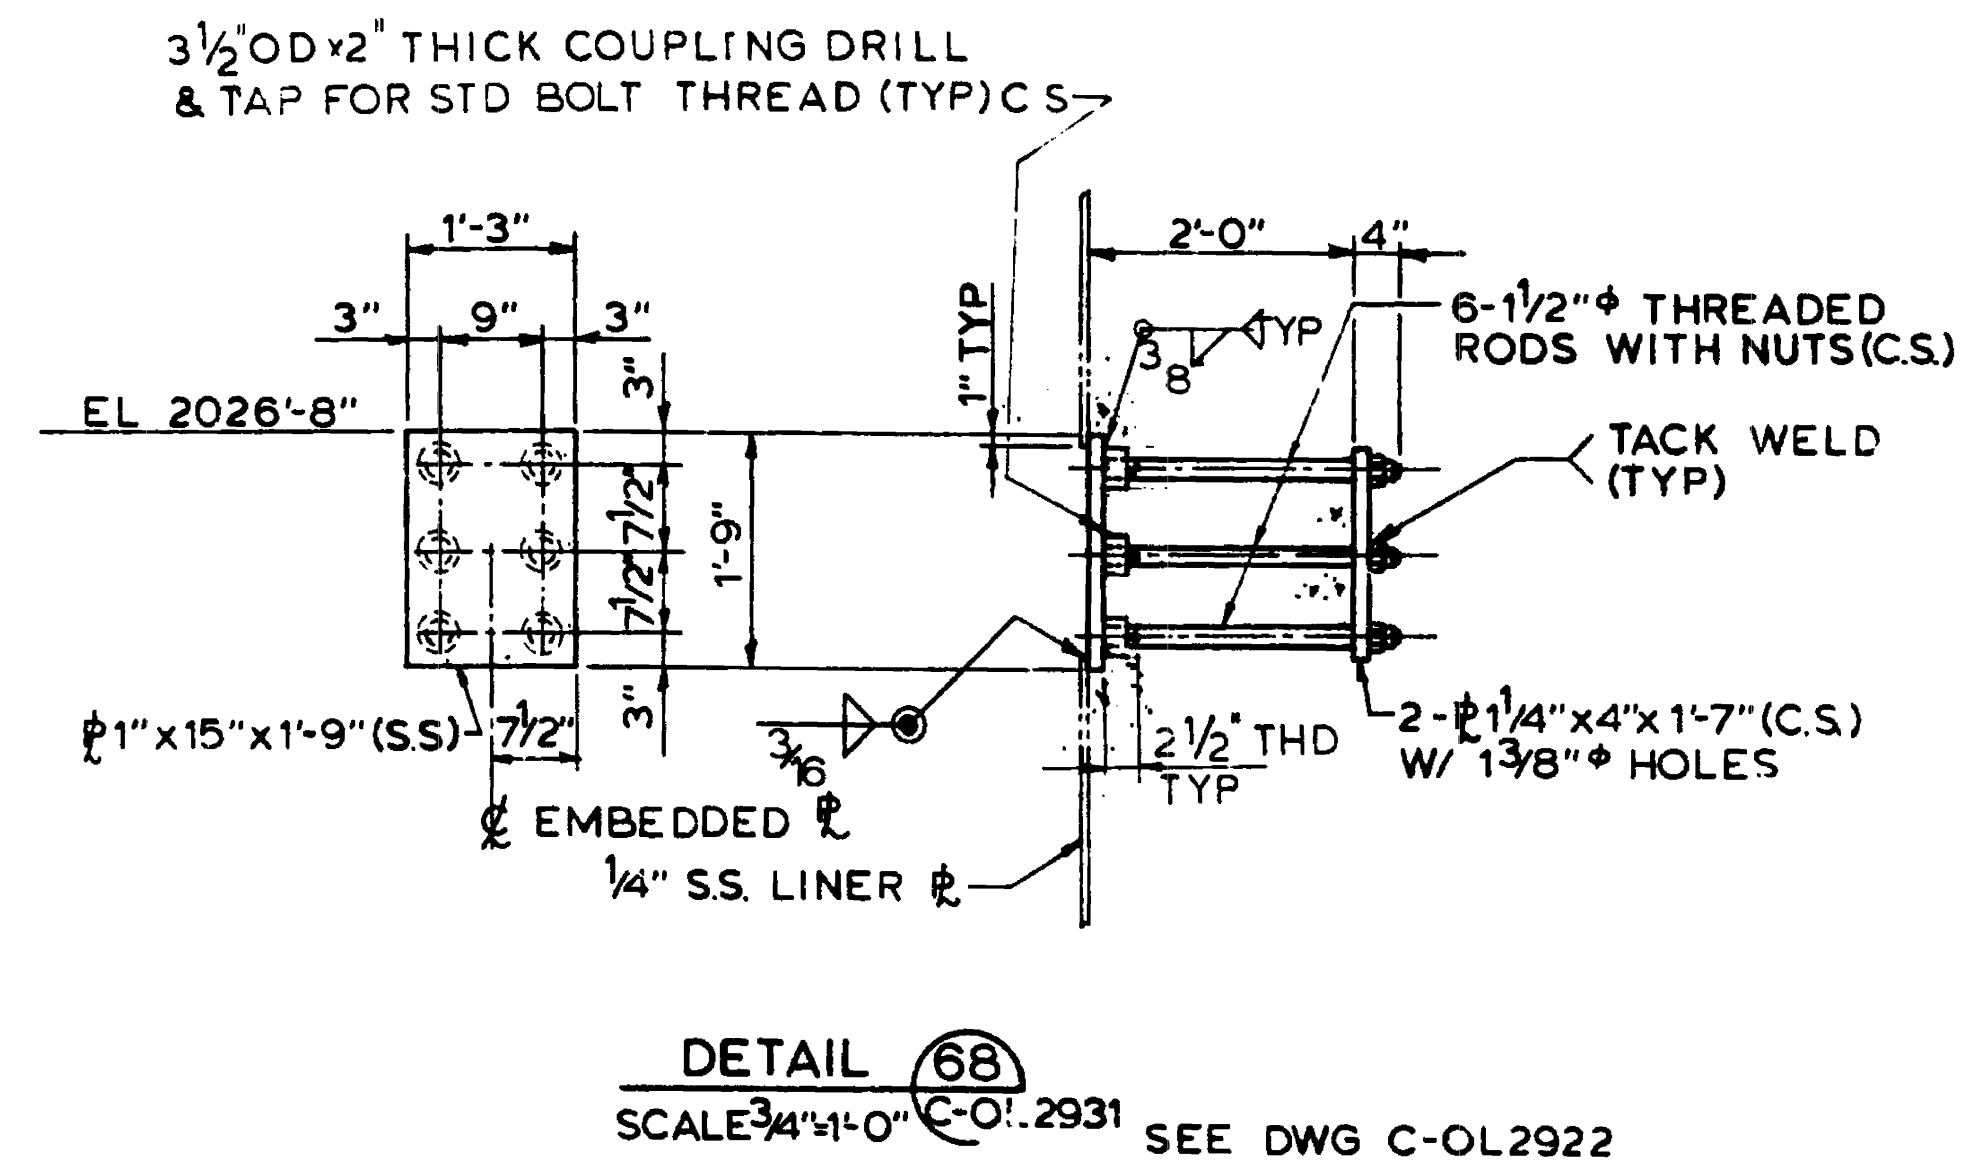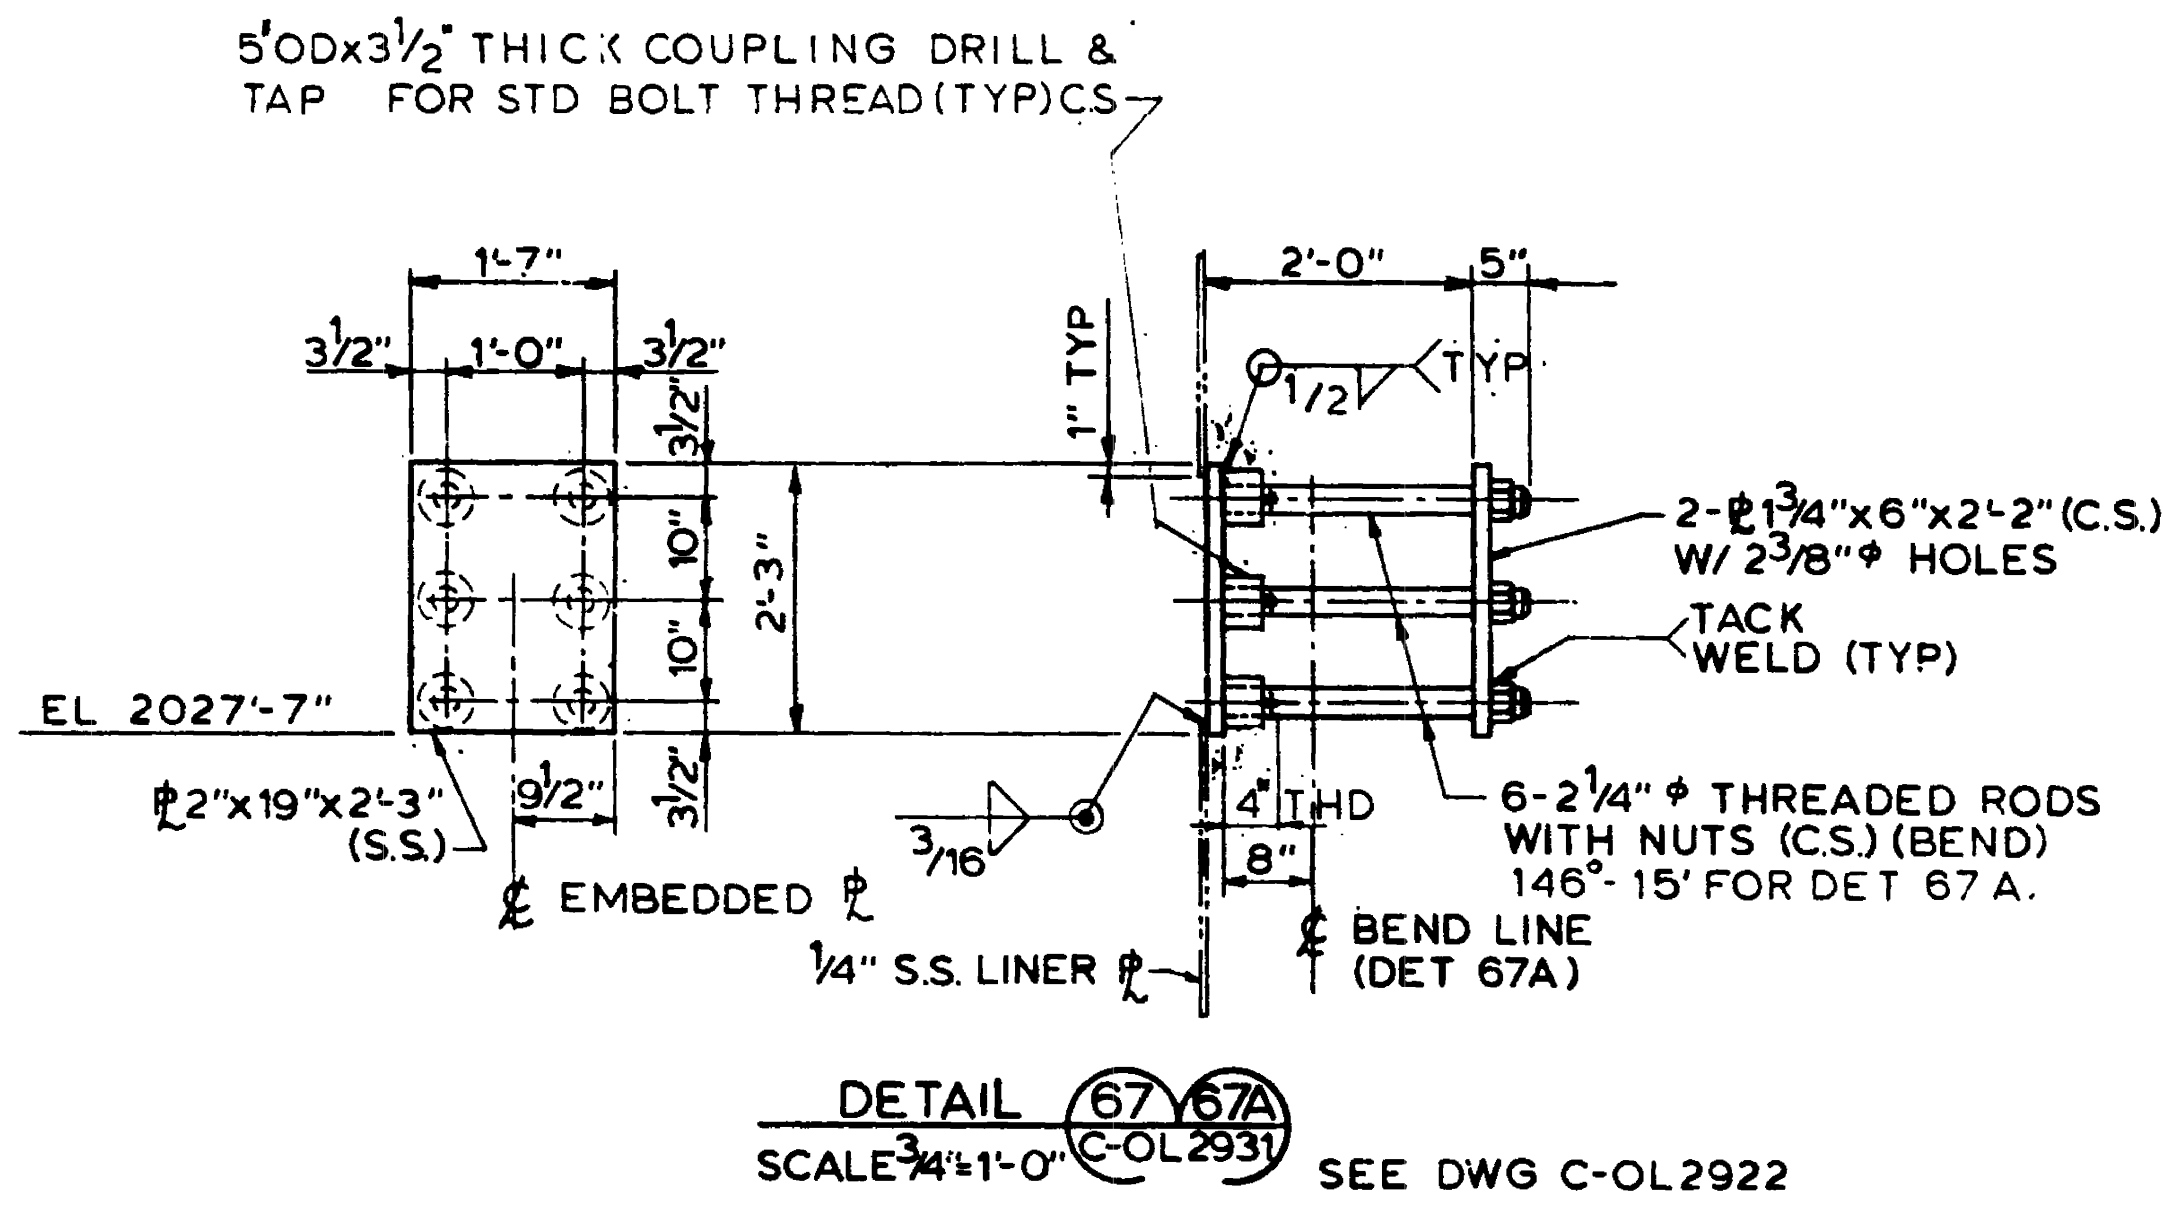


REFERENCE DRAWINGS

- SEE DWG C-OL2921
- SEE DWG M-03LF16 & M-03LF17 FOR LEAK CHASE PIPING ISO.

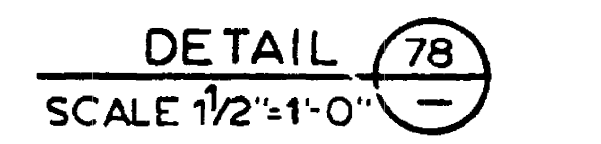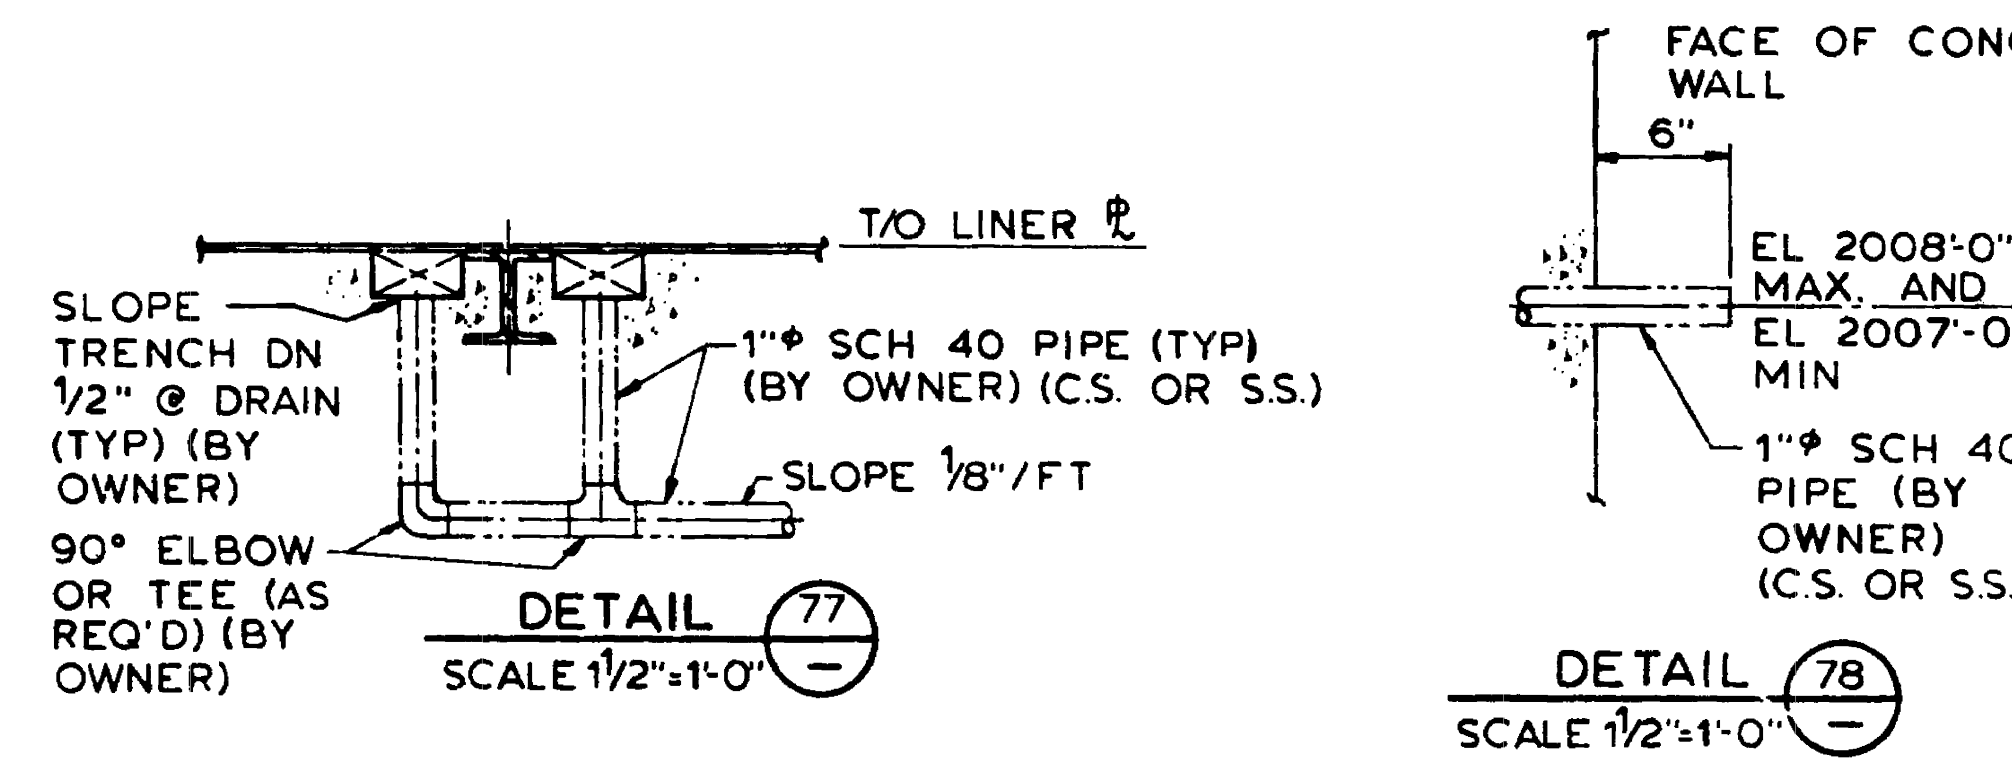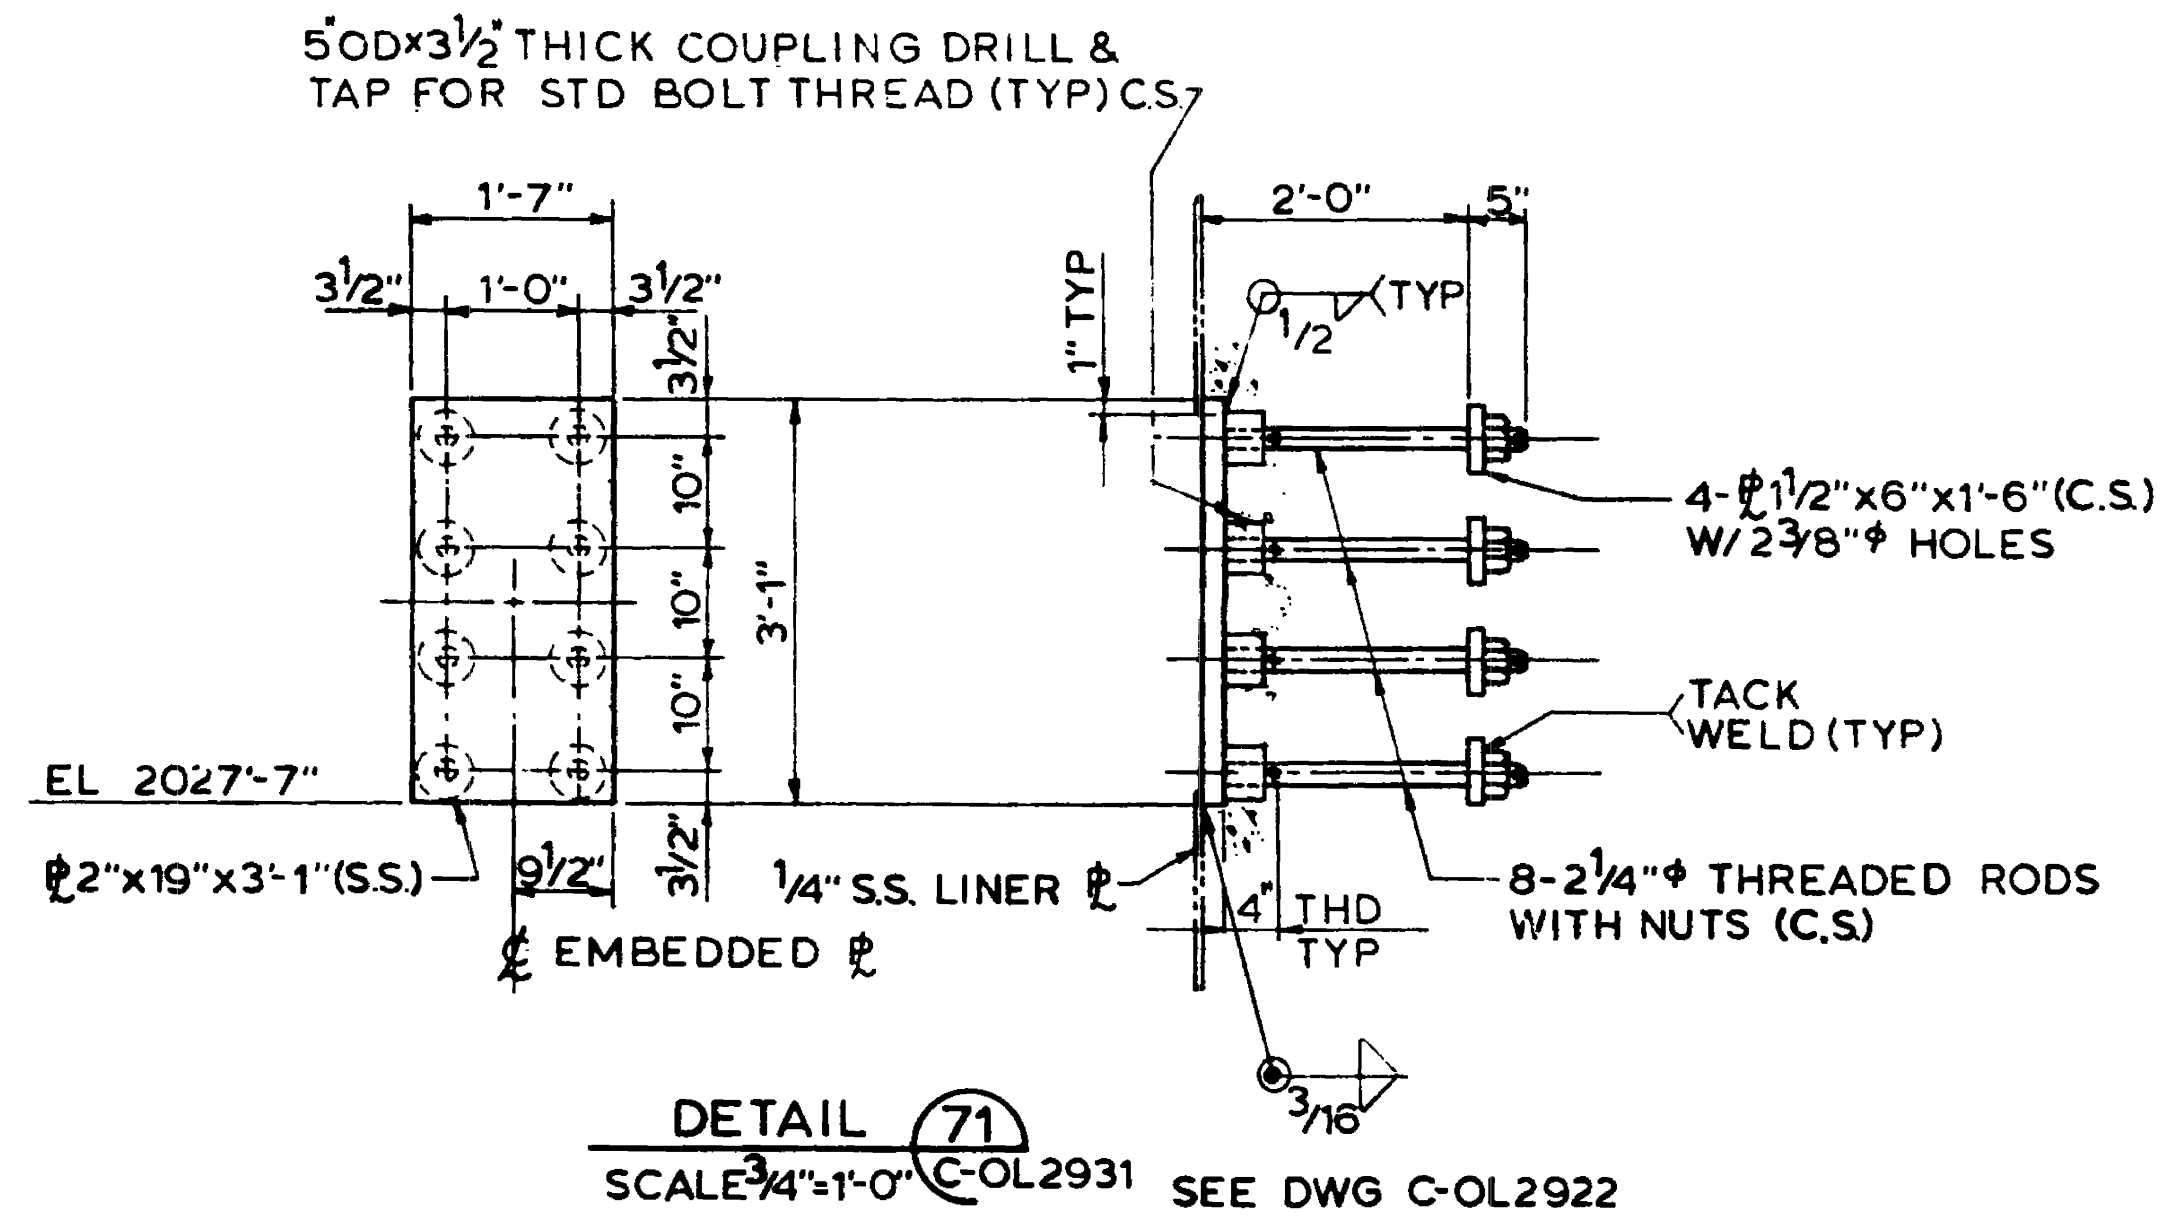

MATERIAL RESPONSIBILITY

- SEE DWG C-OL2921

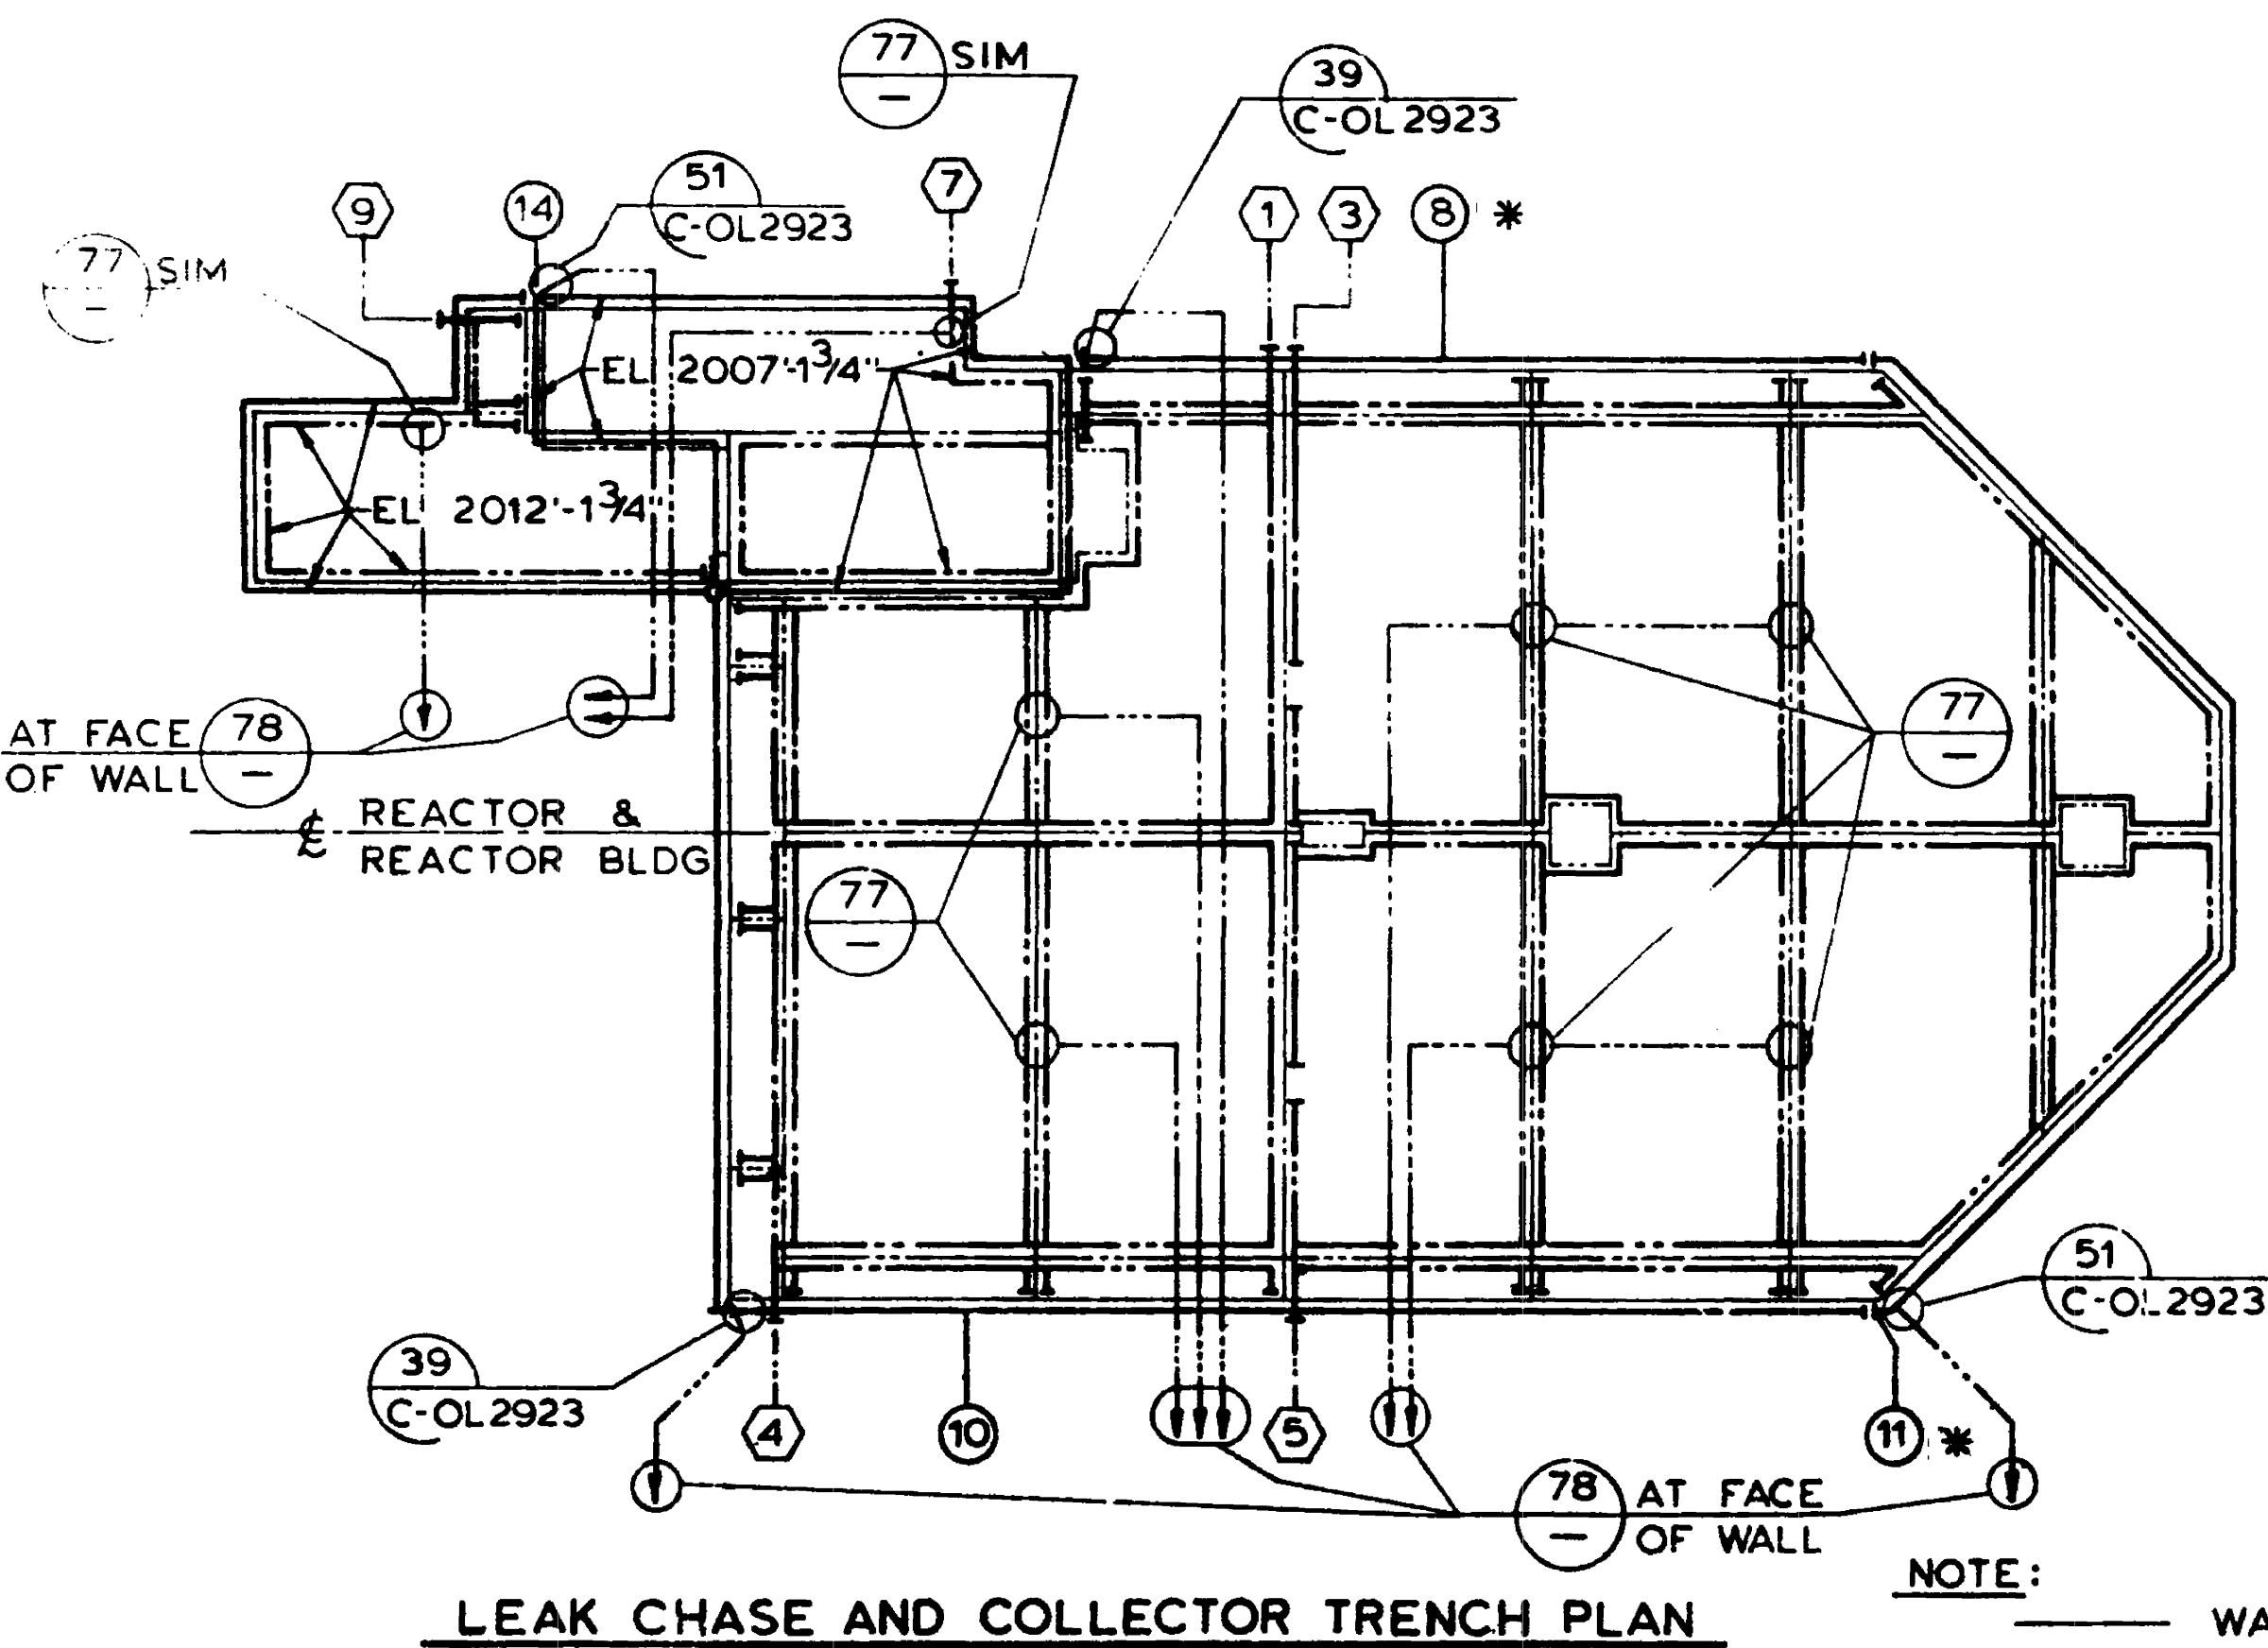


LEAK CHASE AND COLLECTOR TRENCH PLAN
(EL 2009'-8 3/4" UNO)

* - UNIT 1 DOES NOT HAVE ZONE 8. IT IS COMBINED WITH ZONE 11.

NOTE:

- WALL
- - - FLOOR SEAM
- COLLECTOR TRENCH
- LEAK CHASE
- SCH 40 PIPE (BY OWNER)

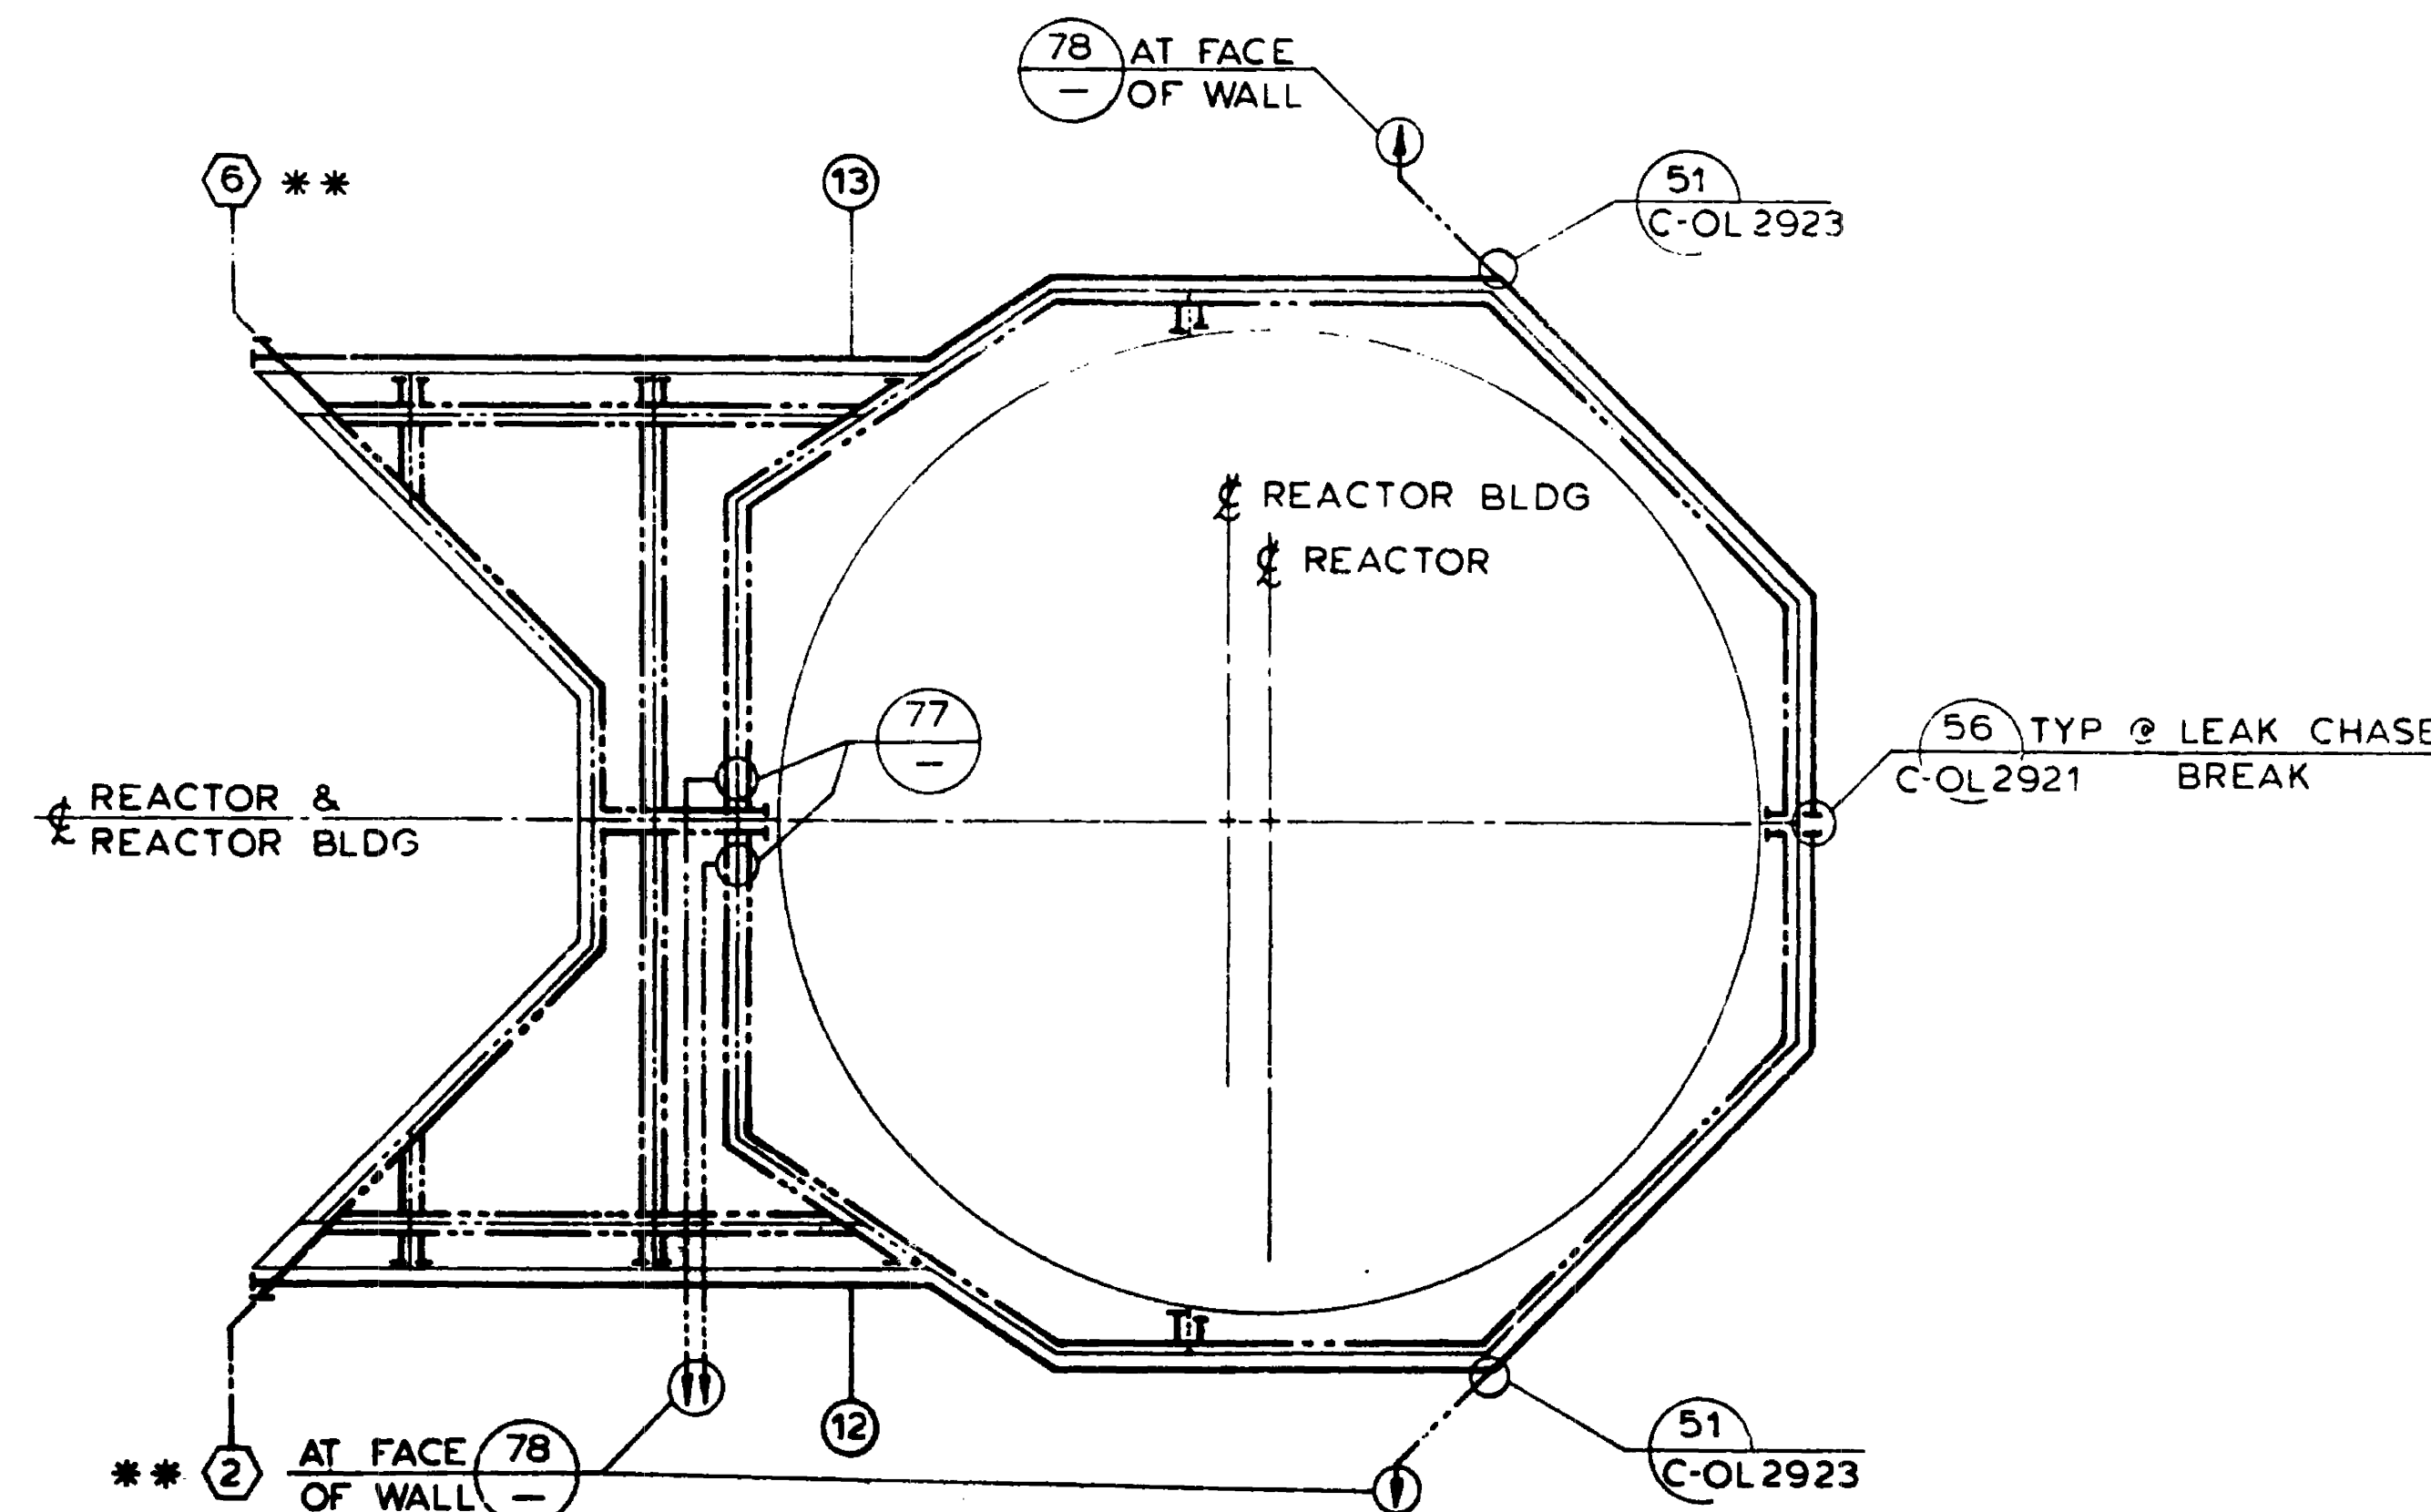

LEAK CHASE AND COLLECTOR TRENCH PLAN
(EL 2021'-7")



* * - UNIT 1 DOES NOT HAVE ZONE 2. IT IS COMBINED WITH ZONE 6.

USAR FIG. 9, 3-7




ESSENTIAL DRAWING

REVISION	INCORPORATED	CHANGE
ISSUED	CHG. DOC.	PKG. NO.
THIS DWG. SUPERSEDES	C-OL2921P	REV. 9
REVISION NOTES:	REF. CR 2007-000952	
WOLF CREEK NUCLEAR OPERATING CORPORATION		ELECTRONIC APPROVAL
REACTOR BUILDING S.S. LINER PLATE REACTOR REFUELING CANAL - DETAILS		
SCALE	DRAWING NUMBER	SHEET REV
NONE	C-1L2931	00

3444 E SIZE

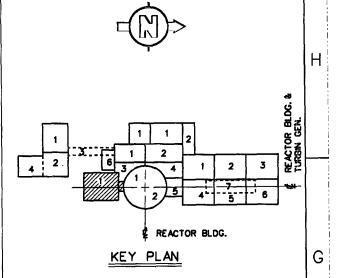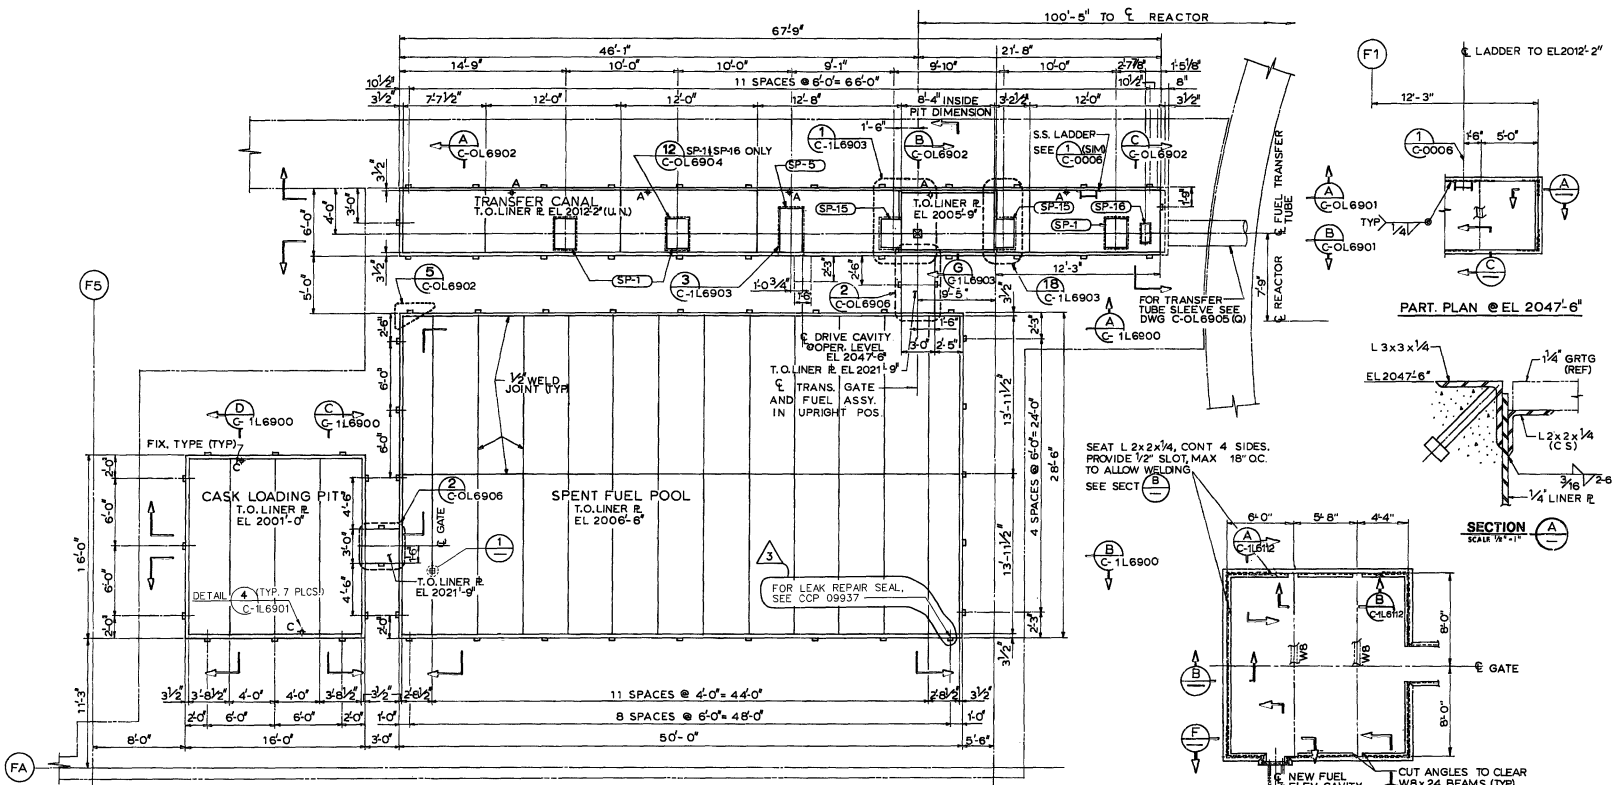

- NOTES**
1. STAINLESS STEEL LINER PLATE AND APPURTENANCES SHALL BE FURNISHED IN ACCORDANCE WITH SPEC 10466-C-171 AND ERECTED IN ACCORDANCE WITH SPEC 10466-C-174.
 2. TRANSFER GATES SHALL CONFORM TO THE REQUIREMENTS OF SPEC 10466-C-174.
 3. ALL DIMENSIONS OR ELEVATIONS ARE MEASURED ALONG THE INSIDE SURFACE OF STAINLESS STL LINER R (UN.O.).
 4. STAINLESS STL LINER R SHALL BE 1/4" THICK.
 5. THE STAINLESS STL LINER R IS DESIGNED AS FORMWORK. FORM TIES SHALL BE SPACED AT A MAXIMUM DISTANCE OF 6'-0" ALONG THE HORIZONTAL CHANNEL STIFFENERS.
 6. CONCRETE SHALL BE PLACED AT A MAX RATE OF 1.5 FT PER HOUR.
 7. REFERENCE EL 2000'-0" IS TOP OF FUEL BLDG GROUND FLOOR.
 8. ALL EXPOSED FIELD WELDS SHALL BE GROUND TO A SMOOTH FINISH.
 9. ALL UNDERCUT SECTIONS IN LINER R SEAMS AND CORNER WELDS SHALL BE COVERED WITH S.S. METAL.
 10. FOR DESIGNATION OF ALL SUPPORT PLATES SEE SCHEDULE ON DWG C-COL6904.
 11. ALL PLATES AND SHAPES SHALL CONFORM TO ASTM-A240 TYPE 304L UNLESS NOTED.
 12. DELETED
 13. CARBON STEEL PLATES AND SHAPES SHALL CONFORM TO ASTM-A36.
 14. BOLTS AND NUTS SHALL CONFORM TO ASTM-A325.
 15. FOR FUEL TRANSFER SYSTEM INSTALLATION REQUIREMENTS SEE DWG. C-COL6906.
 16. FORMWORK SHALL BE ADEQUATELY BRACED PRIOR TO CONCRETE PLACEMENT.
 17. TEMPORARY ERECTION BRACING SHALL BE PROVIDED BY THE ERECTOR WHEREVER NECESSARY TO TAKE CARE OF ALL LOADS TO WHICH THE STRUCTURE MAY BE SUBJECTED, INCLUDING WIND, ERECTION EQUIPMENT AND OPERATION OF SAME.
 18. FLOOR LEAK CHASE CHANNELS SHALL BE SET WITHIN THE FOLLOWING TOLERANCES:
LOCATION: ± 1/2"
ELEVATION: ± 1/2"
LEAK CHASE SHALL BE 10'-0" IN ANY DIRECTION ACROSS THE LEAK CHASE CHANNEL PATTERN.
 19. NOTED PLATES SHALL BE USED FOR GROUNDING.
 20. THE TOP OF THE CASK LOADING PIT LINER PLATE (EL 2047'-6") SHALL BE ADJUSTED AND BRACED TO MAINTAIN SQUARENESS. THE TOLERANCE FOR THE DIAGONAL DIMENSIONS AT THE TOP OF THE LINER PLATE IS ± 3/4".
 - 20A. FLOOR LINER REPAIR PLATE PER CHANGE PACKAGE 09189. SEE ALSO DWG. C-171-00086. PLATE INSTALLATION TOLERANCE IS ± 1/2" FROM DIMENSIONS SHOWN.

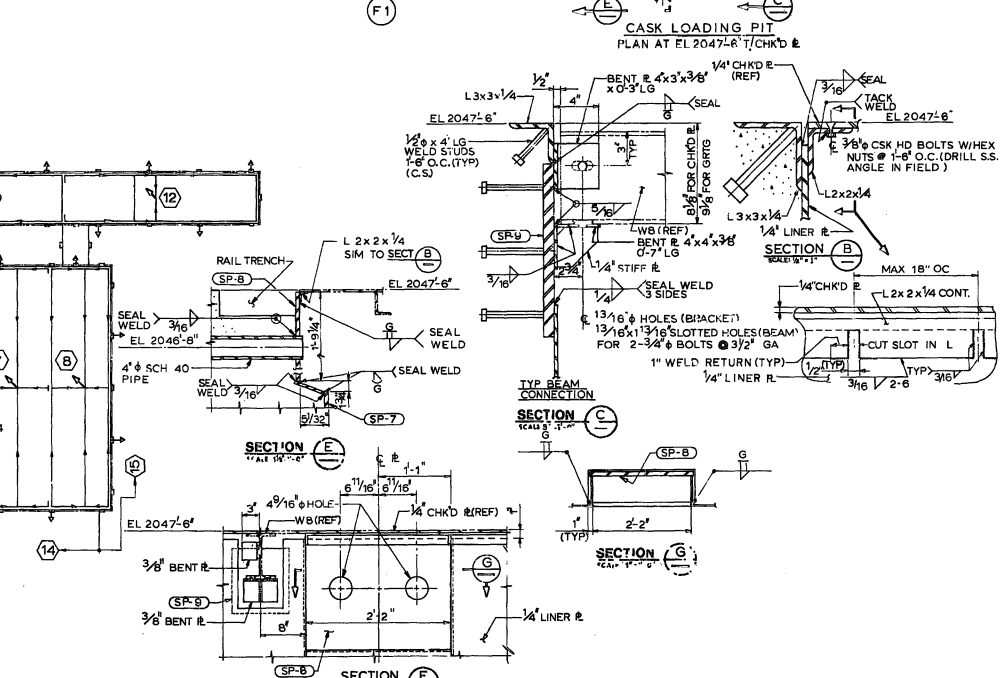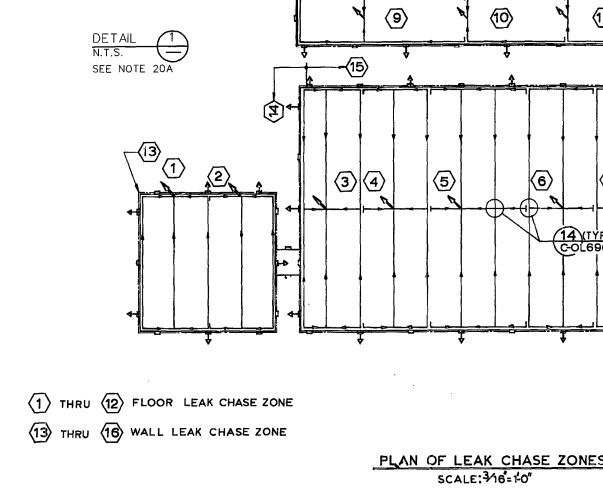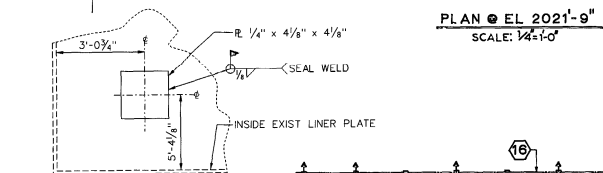

FOR CONT. OF NOTES SEE DWG. C-1L6900.

REFERENCE DRAWING
C-COL6905 S.S. LINER PLATE FUEL TRANSFER TUBE

MATERIAL RESPONSIBILITY

1. FURNISHING OF SPENT FUEL POOL S.S. LINER R. AND APPURTENANCES UNDER SPEC 10466-C-171
2. FURNISHING OF SPENT FUEL POOL GATES UNDER SPEC 10466-C-174.
3. FURNISHING OF S.S. LADDERS UNDER SPEC 10466-C-171A.
4. FURNISHING OF 2" W.B. R'S UNDER SPEC 10466-C-171B.


USAR FIG. 9.3-7-02

ESSENTIAL DRAWING

© REVISED INCORPORATED: WP-C-1610-02-A, 9/02 DWG. 0937 PCL. 02
© ISSUED
THIS DWG. APPROVED BY: M.L. 100 D.M. SP/0937 R.L.
REVISIONS: NONE

WOLF CREEK
CORPORATION
FUEL BUILDING-AREA 1
STAINLESS STEEL LINER PLATE
PLAN-SPENT FUEL POOL

SCALE: AS SHOWN
NOTED: C-1L6111 SHEET NO. 03

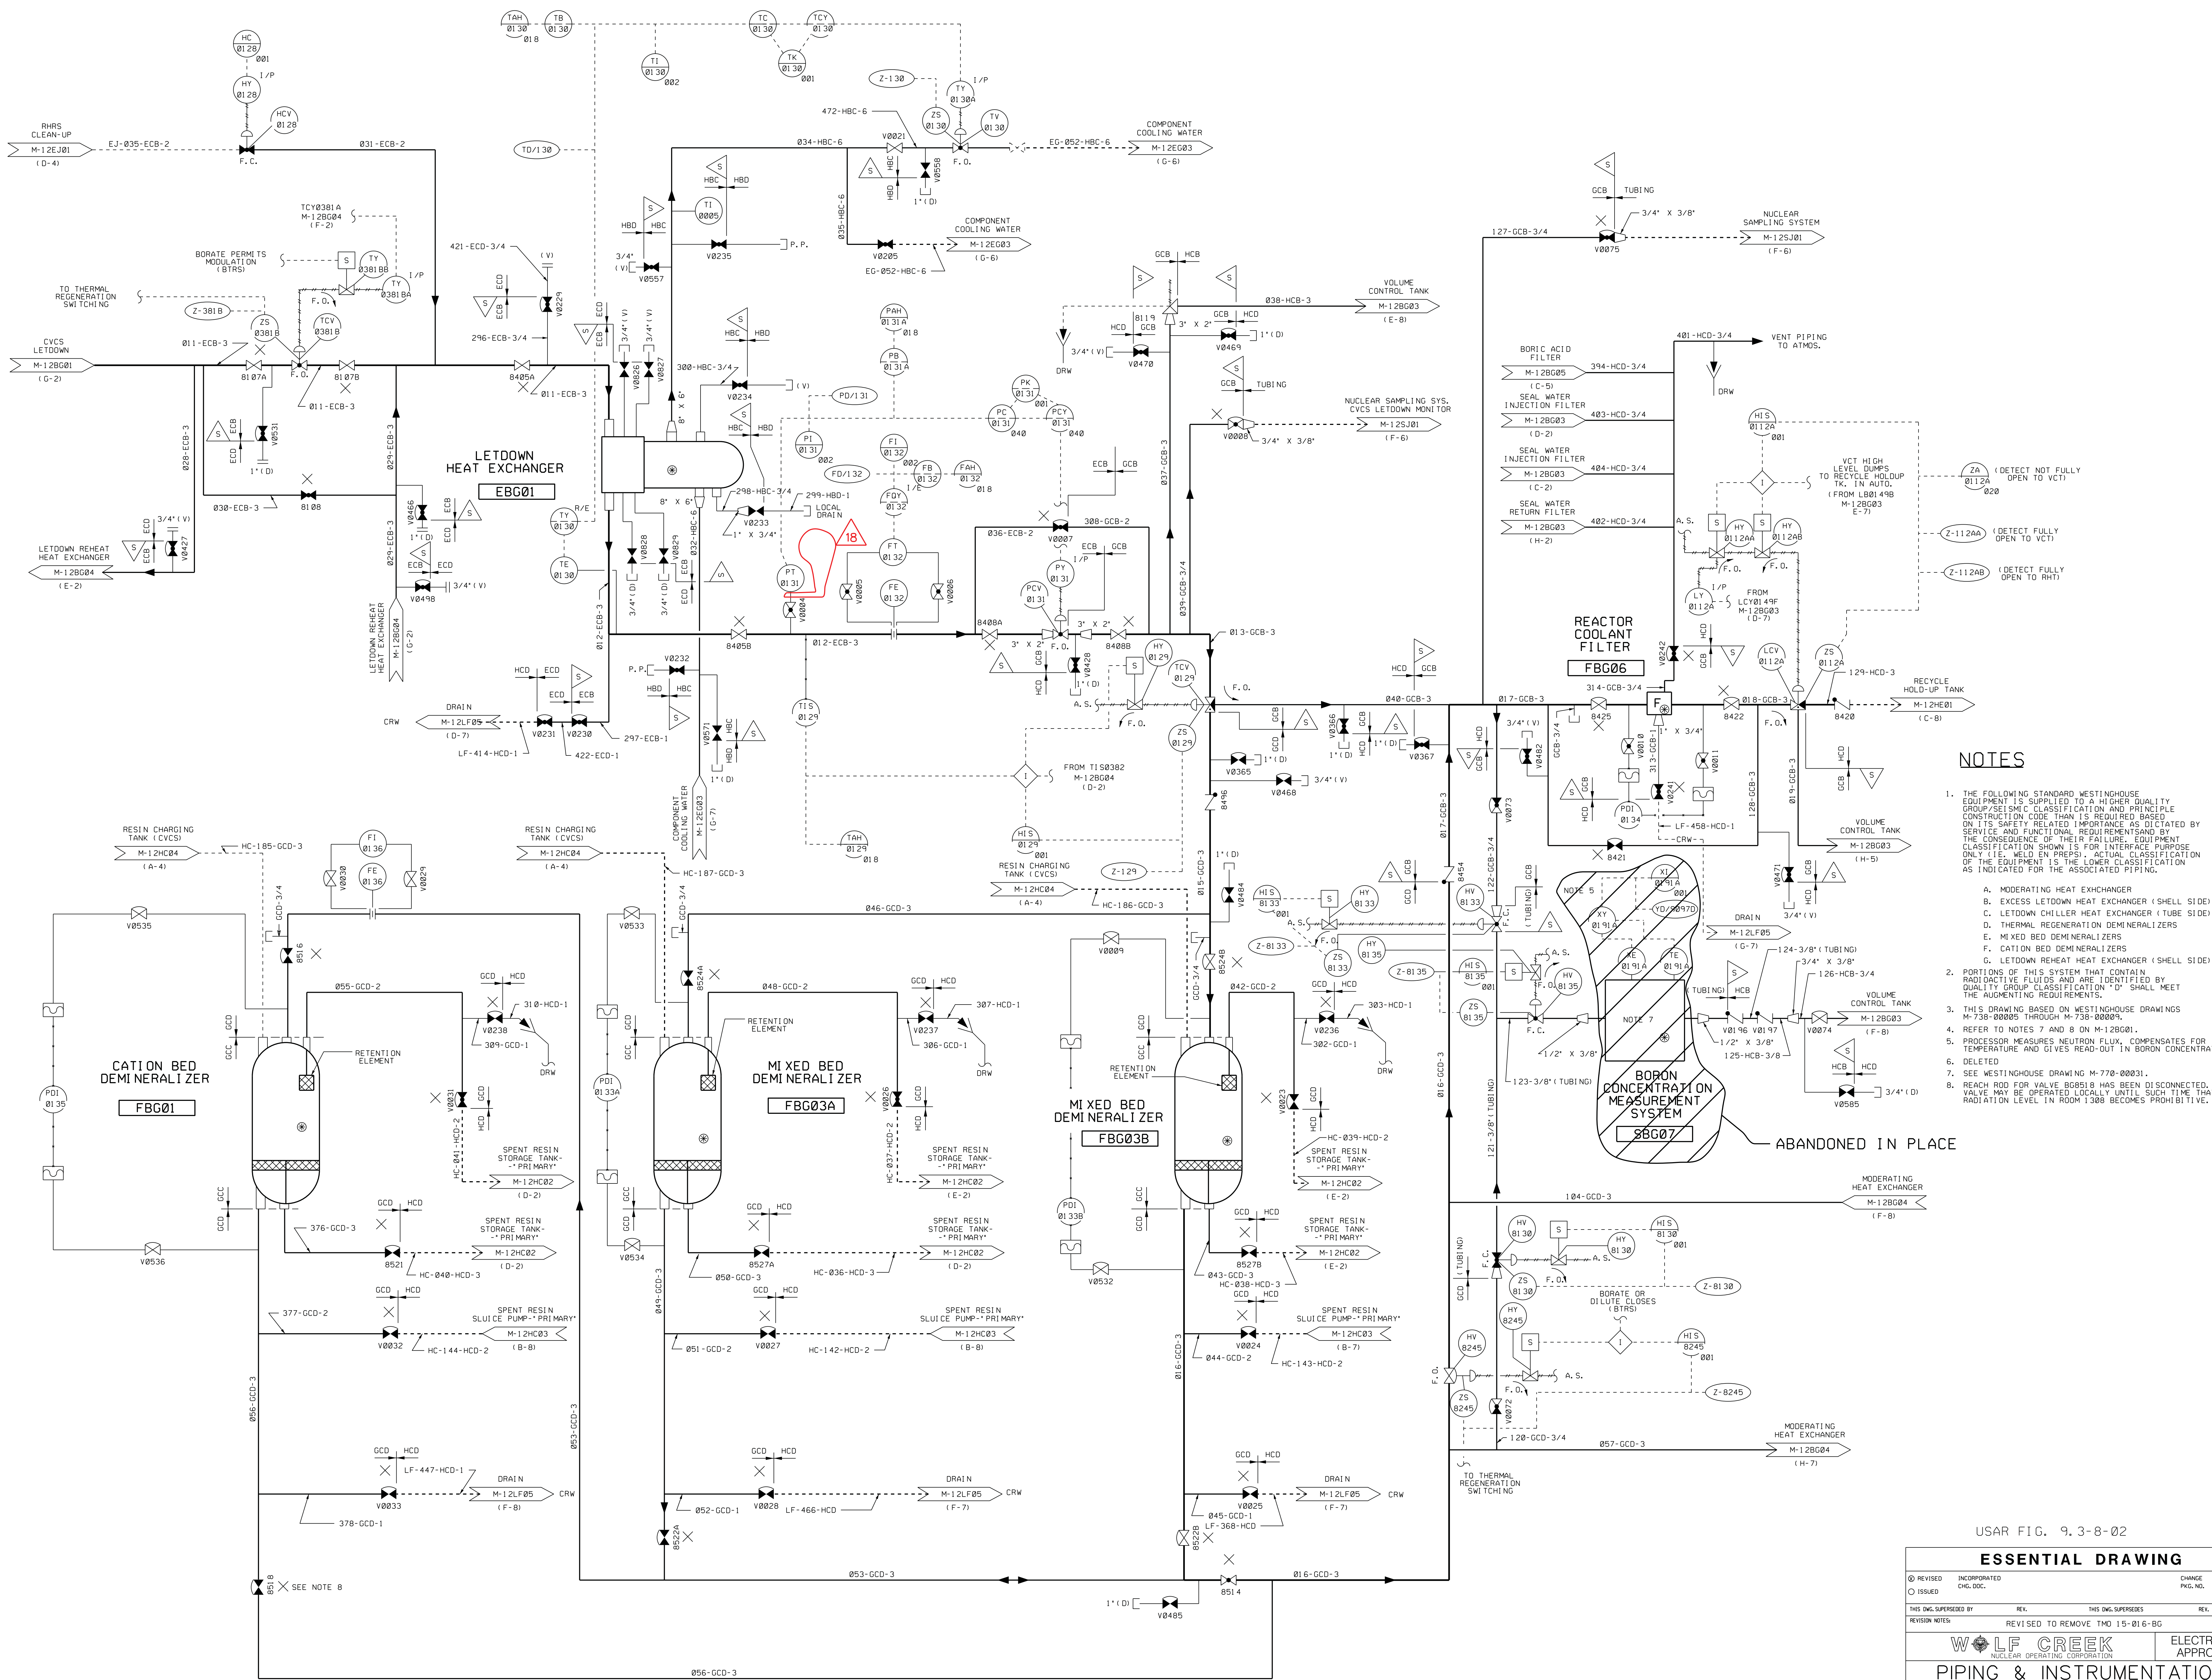

NOTES

- THE FOLLOWING STANDARD WESTINGHOUSE EQUIPMENT IS SUPPLIED TO A HIGHER QUALITY GROUP/SEISMIC CLASSIFICATION AND PRINCIPLE CONSTRUCTION CODE THAN IS REQUIRED BASED ON ITS SAFETY RELATED IMPORTANCE AS DICTATED BY SERVICE AND FUNCTIONAL REQUIREMENTS AND BY THE CONSEQUENCE OF THEIR FAILURE. EQUIPMENT CLASSIFICATION SHOWN IS FOR INTERFACE PURPOSE ONLY (I.E. WELD EN PREPS). ACTUAL CLASSIFICATION OF THE EQUIPMENT IS THE LOWER CLASSIFICATION AS INDICATED FOR THE ASSOCIATED PIPING.
 - A. MODERATING HEAT EXCHANGER
 - B. EXCESS LETDOWN HEAT EXCHANGER (SHELL SIDE)
 - C. LETDOWN CHILLER HEAT EXCHANGER (TUBE SIDE)
 - D. THERMAL REGENERATION DEMIONERALIZERS
 - E. MIXED BED DEMIONERALIZERS
 - F. CATION BED DEMIONERALIZERS
 - G. LETDOWN REHEAT HEAT EXCHANGER (SHELL SIDE)
- PORTIONS OF THIS SYSTEM THAT CONTAIN RADIOACTIVE FLUIDS AND ARE IDENTIFIED BY QUALITY GROUP CLASSIFICATION "D" SHALL MEET THE APPURTENANT REQUIREMENTS.
- THIS DRAWING IS BASED ON WESTINGHOUSE DRAWINGS M-738-00005 THROUGH M-738-00009.
- REFER TO NOTES 7 AND 8 ON M-12B001.
- PROCESSOR MEASURES NEUTRON FLUX. COMPENSATES FOR TEMPERATURE AND GIVES READ-OUT IN BORON CONCENTRATION.
- DELETED
- SEE WESTINGHOUSE DRAWING M-770-00031.
- REACH ROD FOR VALVE B0818 HAS BEEN DISCONNECTED. THIS VALVE MAY BE OPERATED LOCALLY UNTIL SUCH TIME THAT THE RADIATION LEVEL IN ROOM 1388 BECOMES PROHIBITIVE.


USAR FIG. 9, 3-8-02

ESSENTIAL DRAWING

REVISED	INCORPORATED	CHANGE
ISSUED	CHG. DOC.	PKG. NO.
THIS DWG. SUPERSEDES:		
REVISION NOTES	REV.	THIS DWG. SUPERSEDES
	REVISED TO REMOVE TMD 15-016-BG	REV.
PIPING & INSTRUMENTATION DIAGRAM CHEMICAL & VOLUME CONTROL SYSTEM		ELECTRONIC APPROVAL
SCALE	DRAWING NUMBER	SHEET
NONE	M-12B02	18

NOTES

- THE FOLLOWING STANDARD WESTINGHOUSE EQUIPMENT IS SUPPLIED TO A HIGHER QUALITY GROUP (SEMI CLASSIFICATION AND PRINCIPAL CONSTRUCTION CODE THAN IS REQUIRED BASED ON ITS SAFETY RELATED IMPORTANCE AS DETERMINED BY SERVICE AND FUNCTIONAL REQUIREMENTS AND BY THE CONSEQUENCE TO THEIR FAILURE. EQUIPMENT CLASSIFICATION SHOWN IS FOR INTERFACE PURPOSES ONLY. IT IS THE LOWER CLASSIFICATION OF THE EQUIPMENT IS THE LOWER CLASSIFICATION, AS INDICATED FOR THE ACTUAL PIPING.
- EXCEPT AS NOTED BY NOTE 6, PORTIONS OF THIS SYSTEM THAT CONTAIN RADIOACTIVE FLUIDS AND ARE INDICATED BY QUALITY GROUP 'D' NON-AUGMENTED.
- THIS DRAWING BASED ON WESTINGHOUSE DRAWINGS M-738-00005 THROUGH M-738-00009.
- DELETED.
- REFER TO NOTES 7 & 8 ON M-12B001.
- INDICATED PORTION OF THIS SYSTEM IDENTIFIED IN THIS NOTE ARE QUALITY GROUP 'D' NON-AUGMENTED.
- DELETED.
- DELETED.
- PRESSURE CONTROLLER IS VALVE MOUNTED.
- DELETED.
- REFERENCE DRAWING NUMBER M-721-00040 (SEE H-1).
- SEE WESTINGHOUSE DRAWING M-761-00003.
- DELETED.
- WELDS IN ASME SECTION III, CLASS 2 HIGH ENERGY PIPING CONTAINMENT PENETRATION AREA OF NOMINAL PIPE SIZE GREATER THAN ONE INCH, MAY BE SUBJECT TO VOLUMETRIC EXAMINATION DURING THE PSI AND/OR ISI PROGRAMS. THE BOUNDARIES OF THESE PIPING SYSTEMS EXTEND THROUGH THE ISOLATION RESTRAINT SYSTEMS INSIDE AND OUTSIDE OF CONTAINMENT WHICH PROTECTS THE CONTAINMENT PENETRATION. THE SPECIFIC WELDS AND THEIR INSPECTION REQUIREMENTS ARE DELINEATED IN THE PSI/ISI WORK PLANS PROVIDED UNDER SPECIFICATION 18466-M-189.
- U U SYMBOLS ARE PROVIDED FOR CLARITY TO INDICATE ASME SECTION III, CLASS 2 PIPING SYSTEMS WHICH ARE SUBJECT TO THE PSI/ISI PROGRAMS AND CONTINUE ON TO OTHER P & IDs.
- DELETED.
- HS0014 BELONGS TO NB SYSTEM.
- THIS POINT DEFINES THE "D" BOUNDARY. BEYOND THIS POINT THE HCB PIPING IS ANALYZED CONSIDERING A SINGLE DEGREE OF FREEDOM.
- DRIP POCKET DRAINS (TWO PER PUMP) FIELD ROUTED PER DNG. M-14801.
- REMOVABLE SPOOL WITH SPACER RING INSTALLED (REPLACEMENT FOR START-UP STRAINER).
- V0822 IS THE DRIVE END SEAL VENT FOR PB04. V0823 IS THE NON-DRIVE END SEAL VENT FOR PB04.
- REACH RODS FOR VALVES V010, V0102, V0105, V0106, V0271, V0272, V0273, V0274, V0275, V0276, V0346, & V0347 HAVE BEEN DISCONNECTED. THESE VALVES MAY BE OPERATED LOCALLY UNTIL SUCH TIME THAT THE RADIATION LEVELS IN ROOM 1306 BECOME PROHIBITIVE.
- VENT INSTALLED IN THE BOTTOM OF THE CHECK VALVE USING 3/8" INSTRUMENT FITTINGS AND VALVE.
- VENT INSTALLED WITH CAM AND GROOVE ADAPTER AND DUST CAP WITH BUNA-N GASKET.

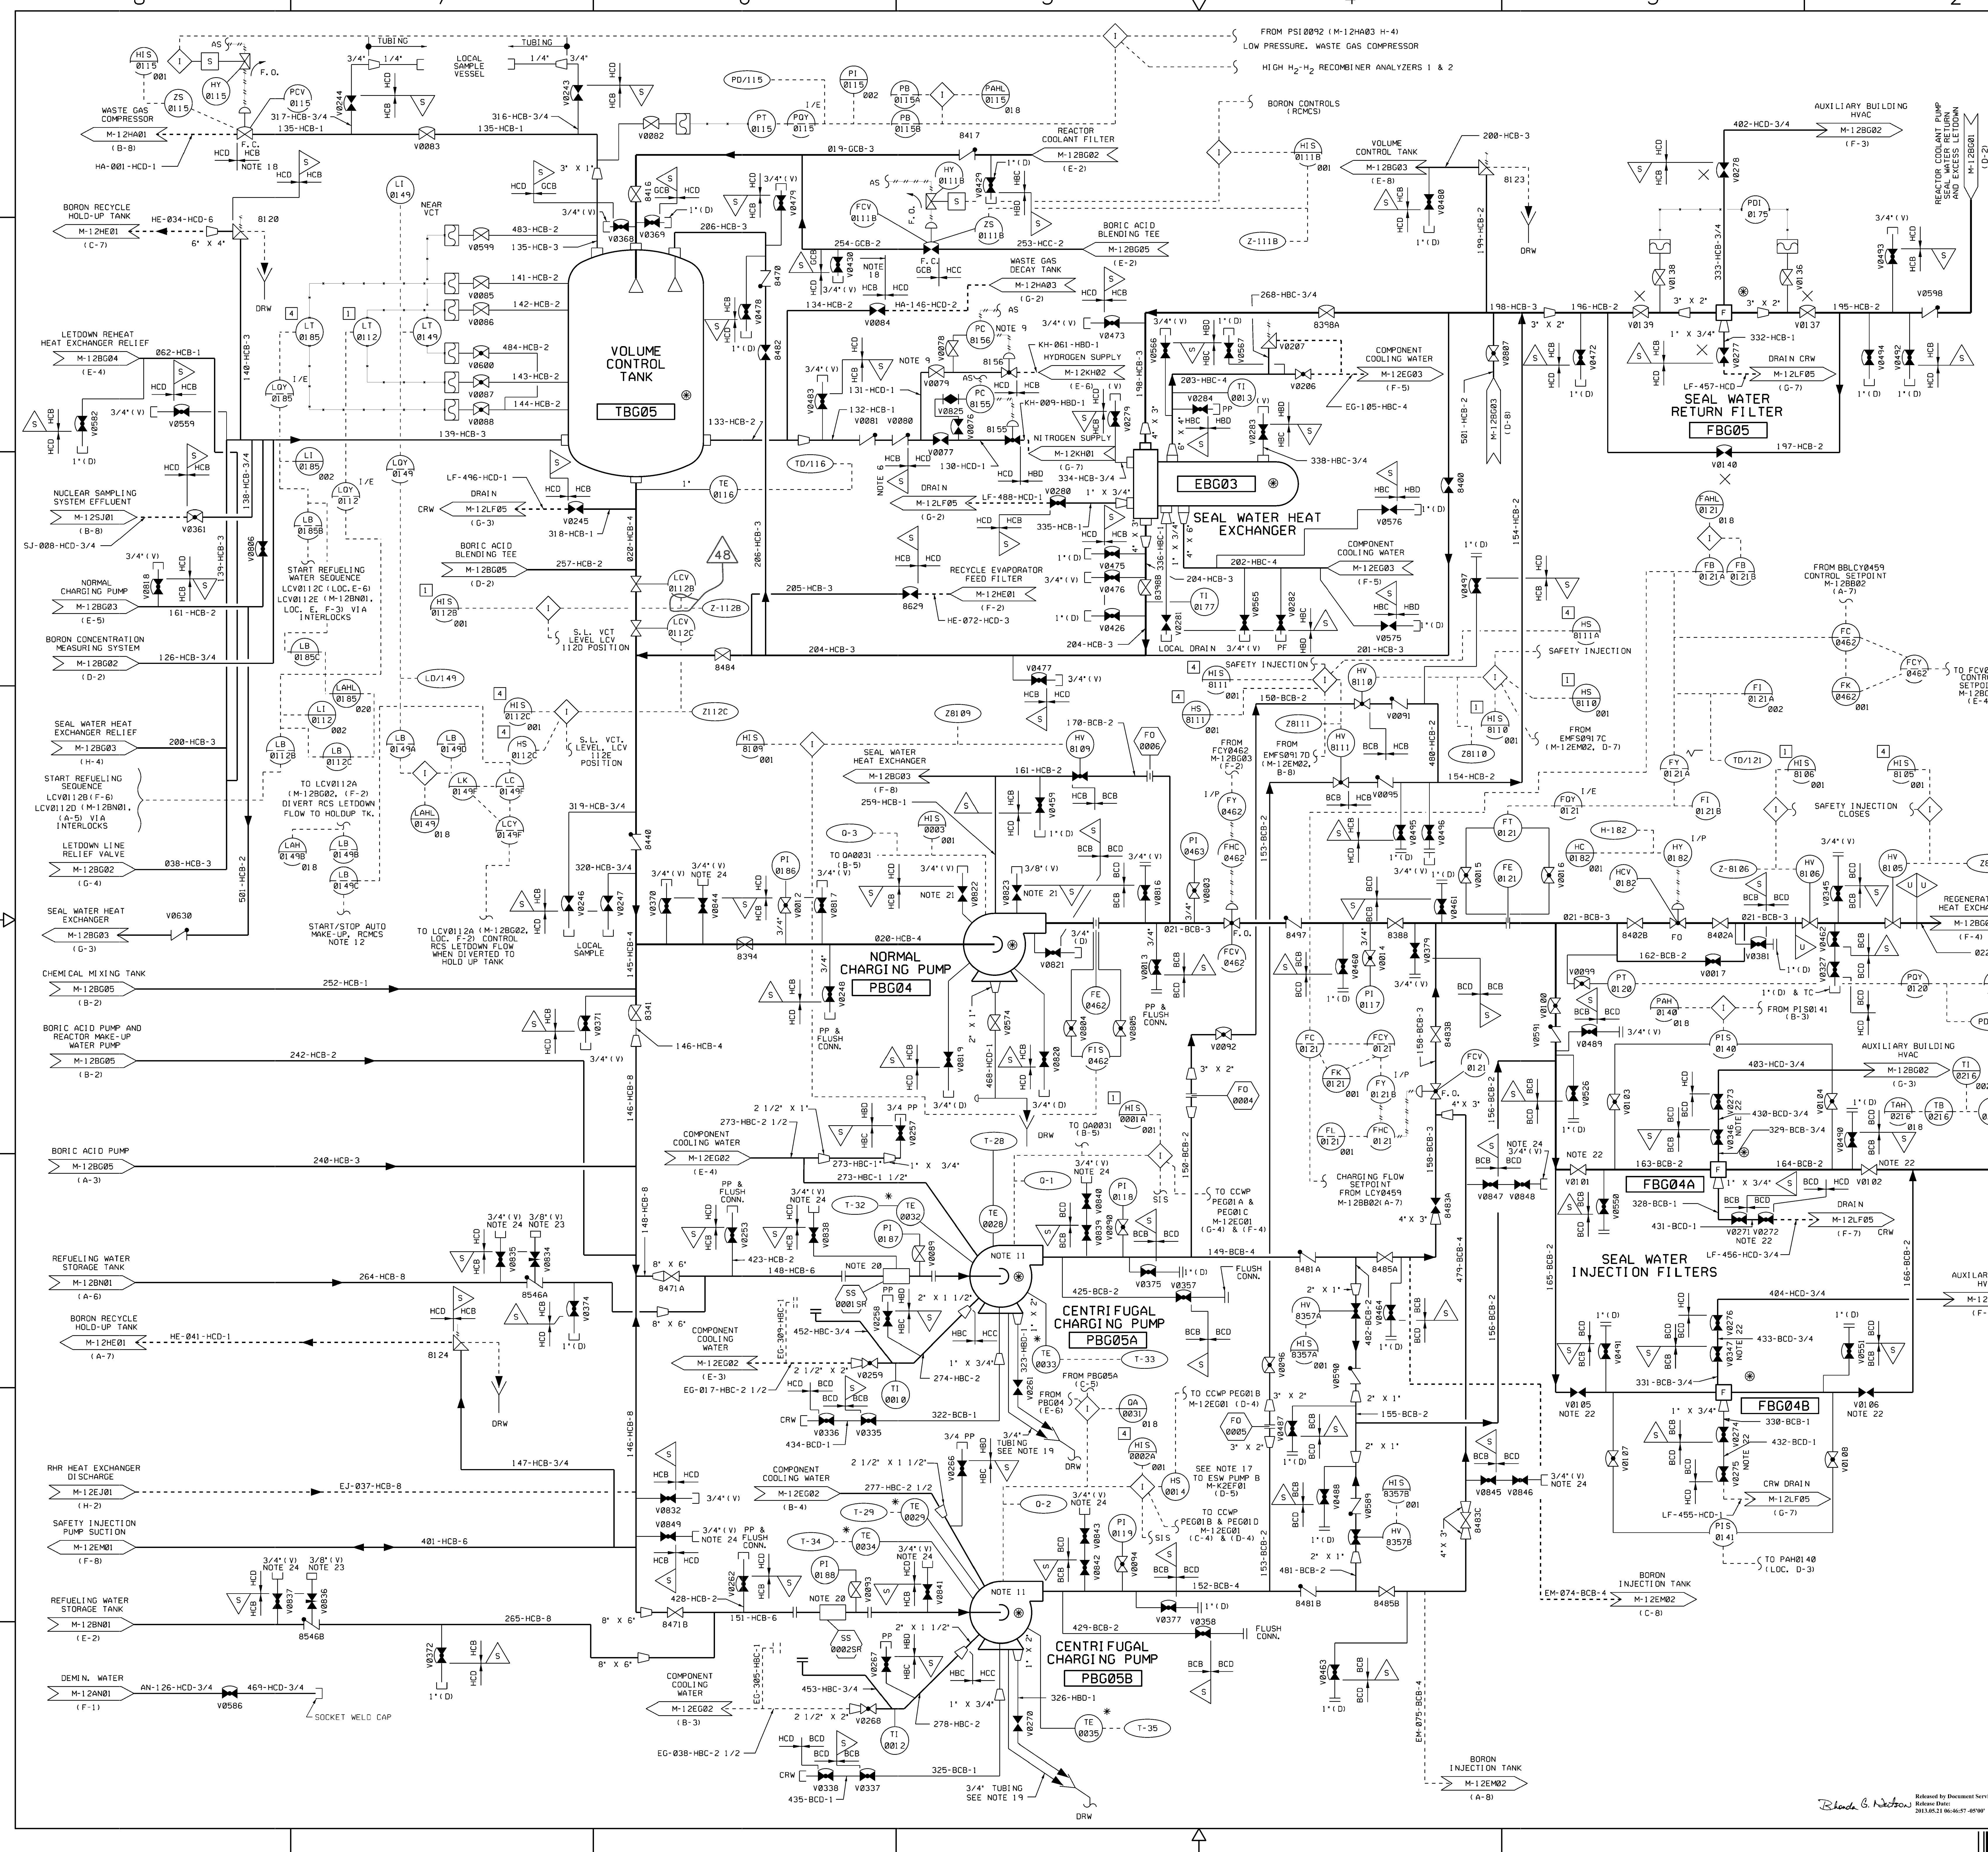

USAR FIG. 9.3-8-03


ESSENTIAL DRAWING

REVISION	INCORPORATED	CR-00099248	CHANGE
ISSUED	CHG. DOC.		PKG. NO.
THIS DNG. SUPERSEDES	REV.	THIS DNG. SUPERSEDES	REV.

WOLF CREEK NUCLEAR OPERATING CORPORATION ELECTRONIC APPROVAL

PIPING AND INSTRUMENTATION DIAGRAM CHEMICAL & VOLUME CONTROL SYSTEM

SCALE	DRAWING NUMBER	SHEET	REV.
NONE	M-12B003	48	

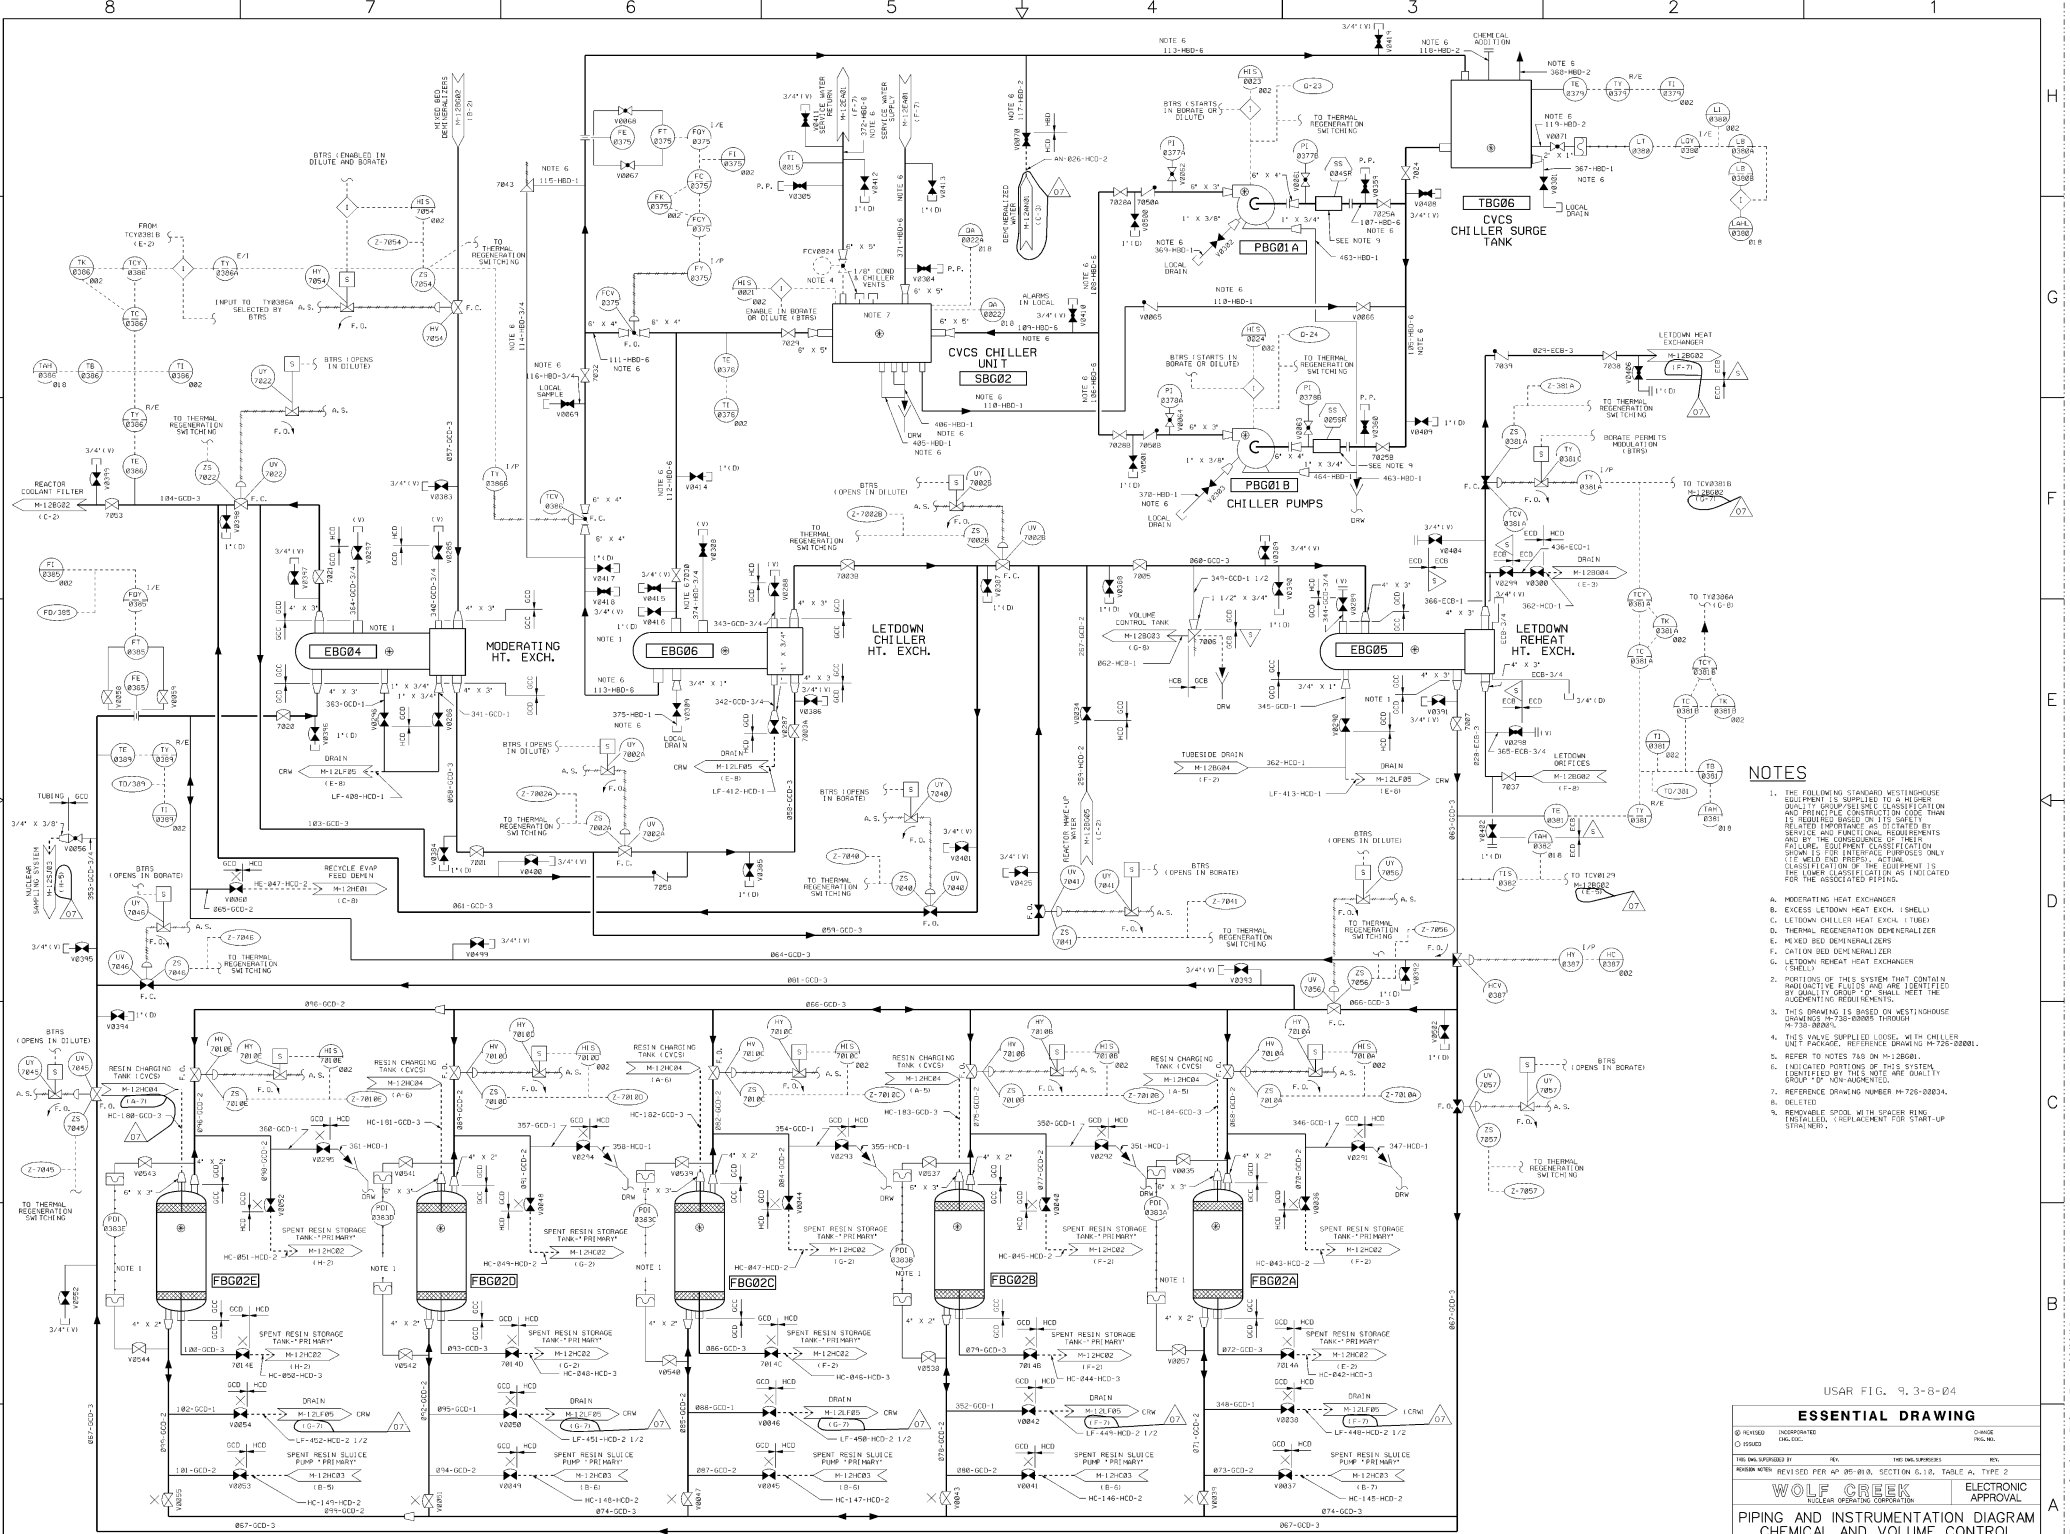


- NOTES**
1. THE FOLLOWING STANDARD WASTEWATER EQUIPMENT IS SUPPLIED TO A MINIMUM QUALITY SPECIFICATION. LOCATION AND PRELIMINARY CONNECTIONS FROM THE DRAWING SHOULD BE BASED ON THE QUALITY SPECIFICATION AND PRELIMINARY REQUIREMENTS AND BY THE CONSIDERATION OF THEIR FAILURE. EQUIPMENT CLASSIFICATION SHOULD BE FOR INTERFERENCE PURPOSES ONLY. CLASSIFICATION OF THE EQUIPMENT IS THE LOWER CLASSIFICATION AS INDICATED FOR THE ASSOCIATED PIPING.
 2. PORTING OF THIS SYSTEM MUST CONTAIN SUFFICIENTLY HIGH STRESS AND MEET THE FOLLOWING REQUIREMENTS:
 - A. MODERATING HEAT EXCHANGER
 - B. EXCESS LETDOWN HEAT EXCH. (SHELL)
 - C. LETDOWN CHILLER HEAT EXCH. (TUBES)
 - D. THERMAL REGENERATION DEMINERALIZER
 - E. HEAT BED DEMINERALIZERS
 - F. CATION BED DEMINERALIZER (SHELL)
 - G. LETDOWN REHEAT HEAT EXCHANGER (SHELL)
 3. THIS DRAWING IS BASED ON WASTEWATER SYSTEMS AND IS SUBJECT TO CHANGE WITHOUT NOTICE.
 4. THIS IS A SUPPLIED LOOSE, WITH CHILLER UNIT PACKAGE, INCLUDING DRAWING M-725-00001.
 5. REFER TO NOTES 745 ON M-725-00001.
 6. INDICATED PORTING OF THIS SYSTEM IS BASED ON THE QUALITY SPECIFICATION GROUP "B" NON-ANGULATED.
 7. REFERENCE DRAWING NUMBER M-725-00034, A. BELIEVED.
 8. REMOVABLE SPOOL WITH SPARE IN PLACE. MATERIAL REPLACEMENT FOR START-UP STRAINER.

BORON THERMAL REGENERATION DEMINERALIZERS (5)

USAR FIG. 3, 3-B-D4

ESSENTIAL DRAWING

DESIGNED BY	INTEGRATED	DATE
DRWING NO.	00000	00000
THIS DRAWING IS THE PROPERTY OF WOLF CREEK. IT IS TO BE USED ONLY FOR THE PROJECT AND SITE SPECIFIC TO WHICH IT WAS ISSUED. IT IS NOT TO BE REPRODUCED OR TRANSMITTED IN ANY FORM OR BY ANY MEANS, ELECTRONIC OR MECHANICAL, INCLUDING PHOTOCOPYING, RECORDING, OR BY ANY INFORMATION STORAGE AND RETRIEVAL SYSTEM, WITHOUT THE WRITTEN PERMISSION OF WOLF CREEK.	PROJECT NO.	00000
WOLF CREEK		ELECTRONIC APPROVAL
PIPING AND INSTRUMENTATION DIAGRAM		
CHEMICAL AND VOLUME CONTROL SYSTEM		
SCALE	AS SHOWN	SHEET NO. 07
M-12BG04		OF 07

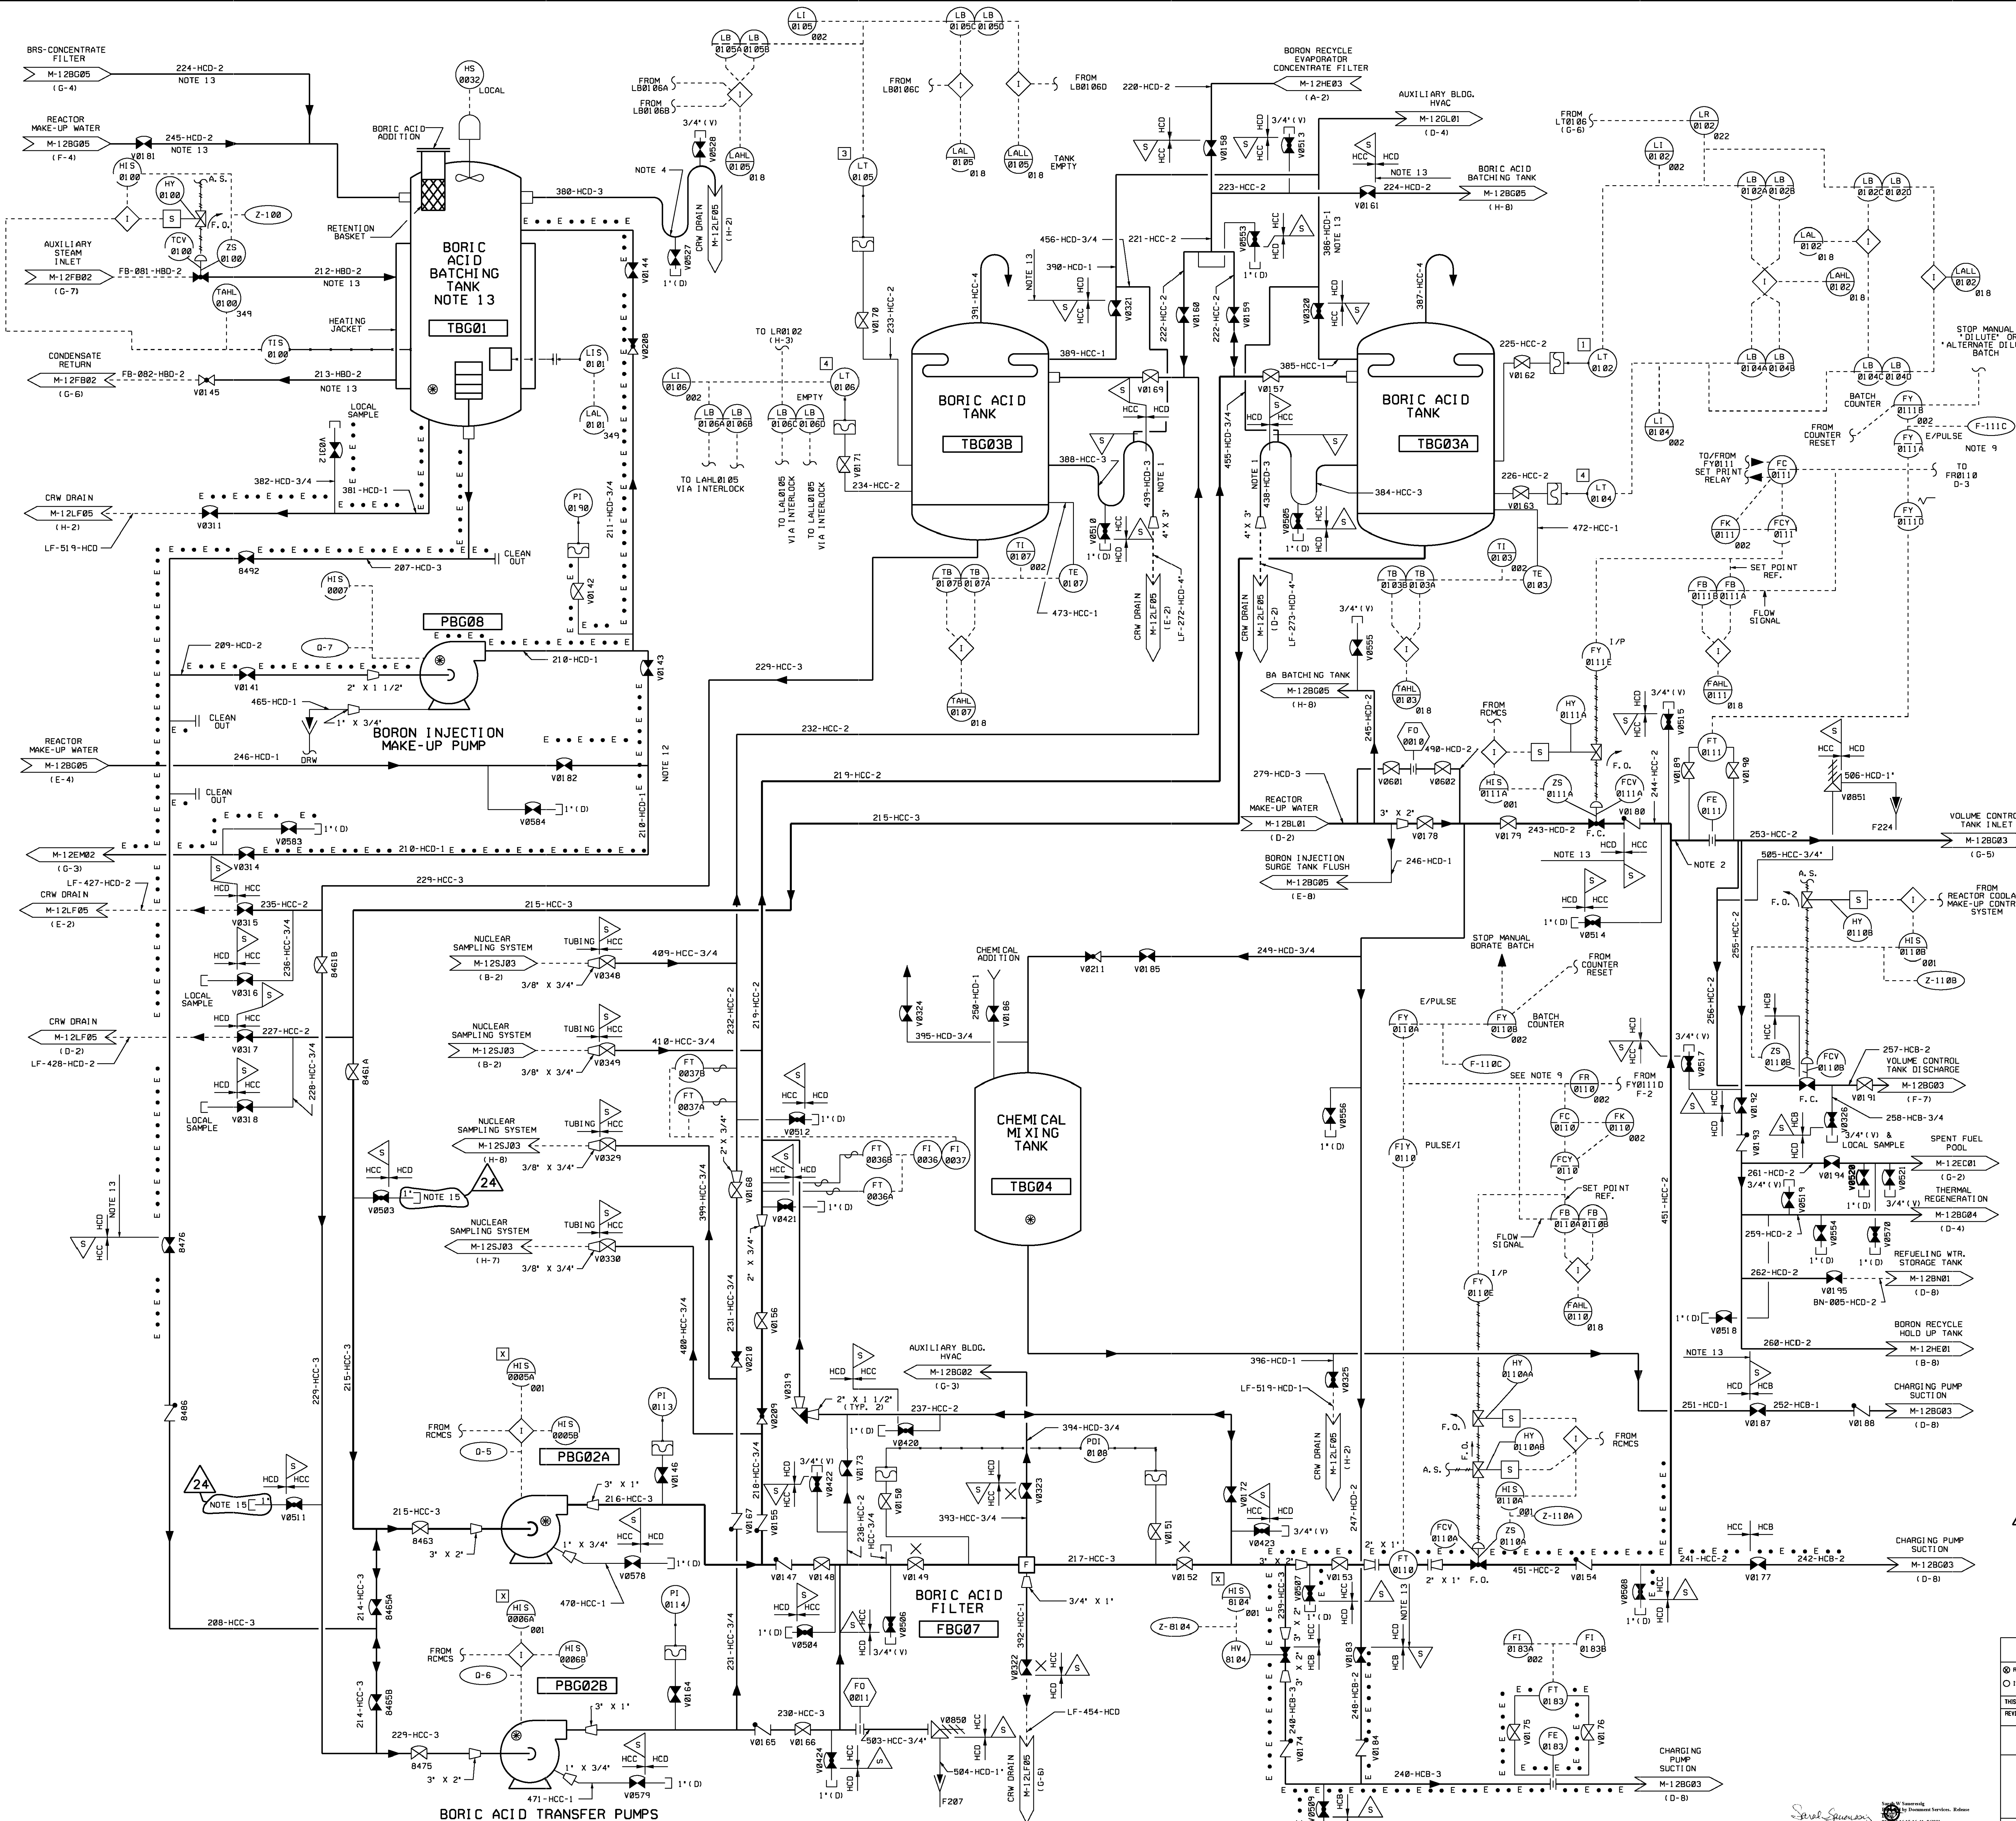

- ### NOTES
- LOWER LOOP TO EXTEND 12" BELOW NOZZLE, UPPER LOOP TO EXTEND 6" BELOW DIAPHRAGM FLANGE. SIPHON BREAK LOCATED AT TOP OF PIPE.
 - CONNECT PIPING TO BORIC ACID BLENDING TEE AS SHOWN.
 - THIS DRAWING BASED ON WESTINGHOUSE DRAWINGS M-738-00005, M-738-00006, M-738-00007, M-738-00008 & M-738-00009.
 - LOOP SEAL TO EXTEND 12" ABOVE AND BELOW TANK NOZZLE.
 - THE FOLLOWING STANDARD WESTINGHOUSE EQUIPMENT IS SUPPLIED TO A HIGHER DULY GROUP/SEISMIC CLASSIFICATION AND PRINCIPLE CONSTRUCTION CODE THAN IS REQUIRED BASED ON ITS SAFETY RELATED FUNCTIONAL REQUIREMENTS AND BY THE CONSEQUENCE OF THEIR FAILURE. EQUIPMENT CLASSIFICATION SHOWN IS FOR INTERFACE PURPOSES ONLY (I.E. WELD END PREPS). ACTUAL CLASSIFICATION OF THE EQUIPMENT IS THE LOWER CLASSIFICATION, AS INDICATED FOR THE ASSOCIATED PIPING.
 - A. MODERATING HEAT EXCHANGER
 - B. EXCESS LETDOWN HEAT EXCHANGER (SHELL SIDE)
 - C. LETDOWN CHILLER HEAT EXCHANGER (TUBE SIDE)
 - D. THERMAL REGENERATION DEMINERALIZER
 - E. MIXED BED DEMINERALIZER
 - F. CATION BED DEMINERALIZER
 - G. LETDOWN REHEAT HEAT EXCHANGER (SHELL SIDE)
 - PORTIONS OF THIS SYSTEM THAT CONTAIN RADIOACTIVE FLUIDS AND ARE IDENTIFIED BY QUALITY GROUP CLASSIFICATION 'D' SHALL MEET THE AUGMENTING REQUIREMENTS.
 - DELETED.
 - DELETED.
 - NSSS COMPUTER INPUT
 - REFER TO NOTES 7 & 8 ON DRAWING M-128G01.
 - DELETED
 - VALVES V-0143, V-0182, V-0314 TO BE LOCATED CLOSE TO EACH OTHER AND TO TEE OF LINE 246 WITH 218.
 - INDICATED PORTIONS OF THIS SYSTEM IDENTIFIED BY THIS NOTE ARE QUALITY GROUP D NON-AUGMENTED
 - DELETED
 - THESE CONNECTIONS ARE FOR BEYOND-DESIGN-BASIS (FLEX) REACTOR COOLANT SYSTEM MAKE-UP.

USAR FIG. 9.3-8-05

ESSENTIAL DRAWING

REVISED	INCORPORATED	WIP-M-128G05-021-A-1	CHANGE 01413
ISSUED	ENG. DOC.		REV. NO.

THIS ENG. SUPERSED BY: _____ REV. _____ THIS ENG. SUPERSEDES: _____


REVISION NOTES:

WOLF CREEK	ELECTRONIC APPROVAL
NUCLEAR OPERATING CORPORATION	

PIPING & INSTRUMENTATION DIAGRAM CHEMICAL & VOLUME CONTROL SYSTEM

SCALE: NONE DRAWING NUMBER: M-128G05 SHEET: 24











3444 E. SIDE

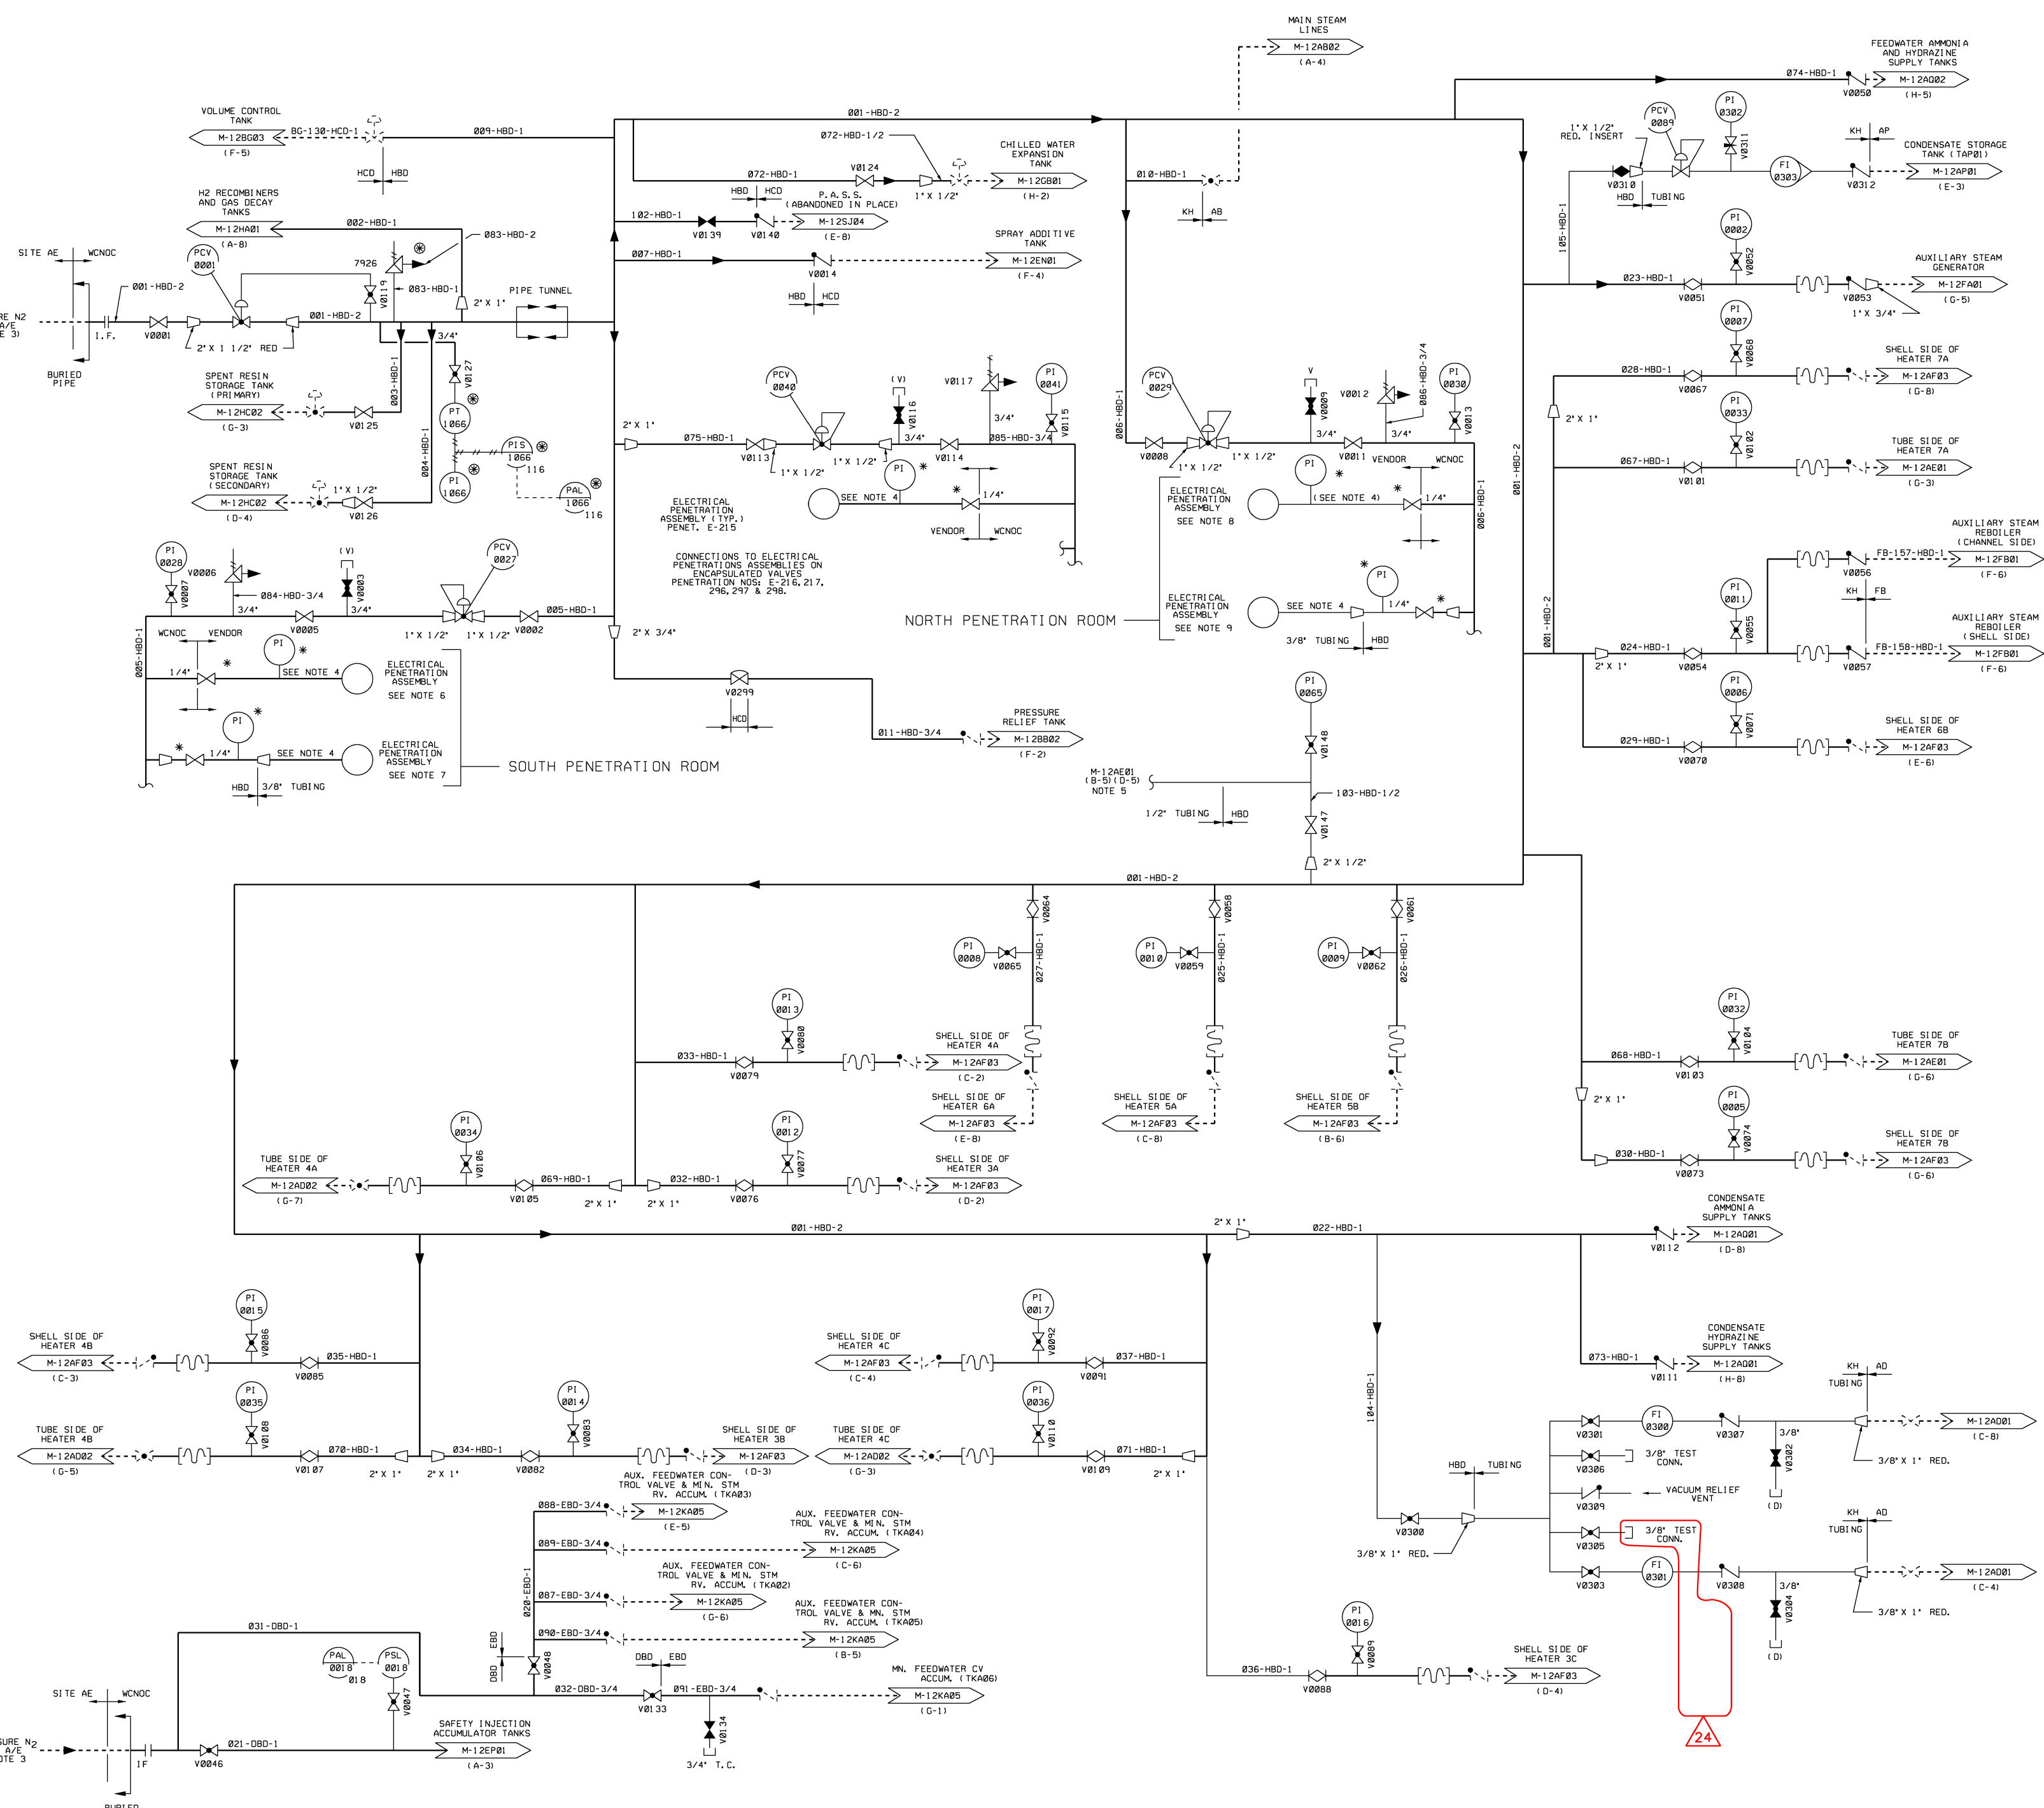

- NOTES**
- FOR P & ID LEGEND AND SYMBOLS SEE DRAWINGS M-0201-01 THRU M-0201-04.
 - DELETED.
 - MECHANICAL DESIGNATION PER M-00001.
 - COMPONENT NUMBERS FOR PIS ASSOCIATED WITH N2 SUPPLY TO ELECTRICAL PENETRATIONS WILL BE THE SAME AS THE PENETRATION NUMBER, ASSOCIATED VENDOR SUPPLIED VALVE WILL BE SIMILARLY NUMBERED, BUT WITH A LETTER 'V' PREFIX.
 - FIELD ROUTED TUBING TO SERVE AS NITROGEN BACK-UP FOR LOSS OF CONTROL AIR TO VALVES AE-FV-1B AND AE-FV-2B.
 - FOR PENETRATIONS NOS. E-249, 250, 252, 253, 254, 255 AND 256.
 - FOR PENETRATIONS NOS. E-297, 298, 210, 218, 219, 222, 223, 224, 225, 226, 233, 234, 248, AND 243.
 - FOR PENETRATIONS NOS. E-288, 289, 290, 291, 292, 293, 294 AND 295.
 - FOR PENETRATIONS NOS. E-264, 265, 267, 268, 269, 271, 272, 274, 275, 276, 277, 278, 279, 280, 281, 282, 283, 284, 285 AND 287.
 - NITROGEN GAS FROM THE LOW PRESSURE DISTRIBUTION PIPING (125 PSIG NOMINAL) MAY BE USED FOR PERFORMING AN EMERGENCY H2 PURGE OF THE MAIN GENERATOR IN THE ABSENCE OF A BULK CO2 SUPPLY.

USAR FIG. 9.3-9-01

ESSENTIAL DRAWING			
REVISED	INCORPORATED	CHANGE	
ISSUED	CNG. DEC.	PKG. NO.	
THIS ENG. SUPERSEDES		REV.	THIS ENG. SUPERSEDES
REVISION NOTES: REVISED TO REMOVE TCC SYS NT-120			
		ELECTRONIC APPROVAL	
PIPING AND INSTRUMENTATION DIAGRAM SERVICE GAS SYSTEM			
SCALE	DRAWING NUMBER	SHEET	REV
NONE	M-12KH01	24	24

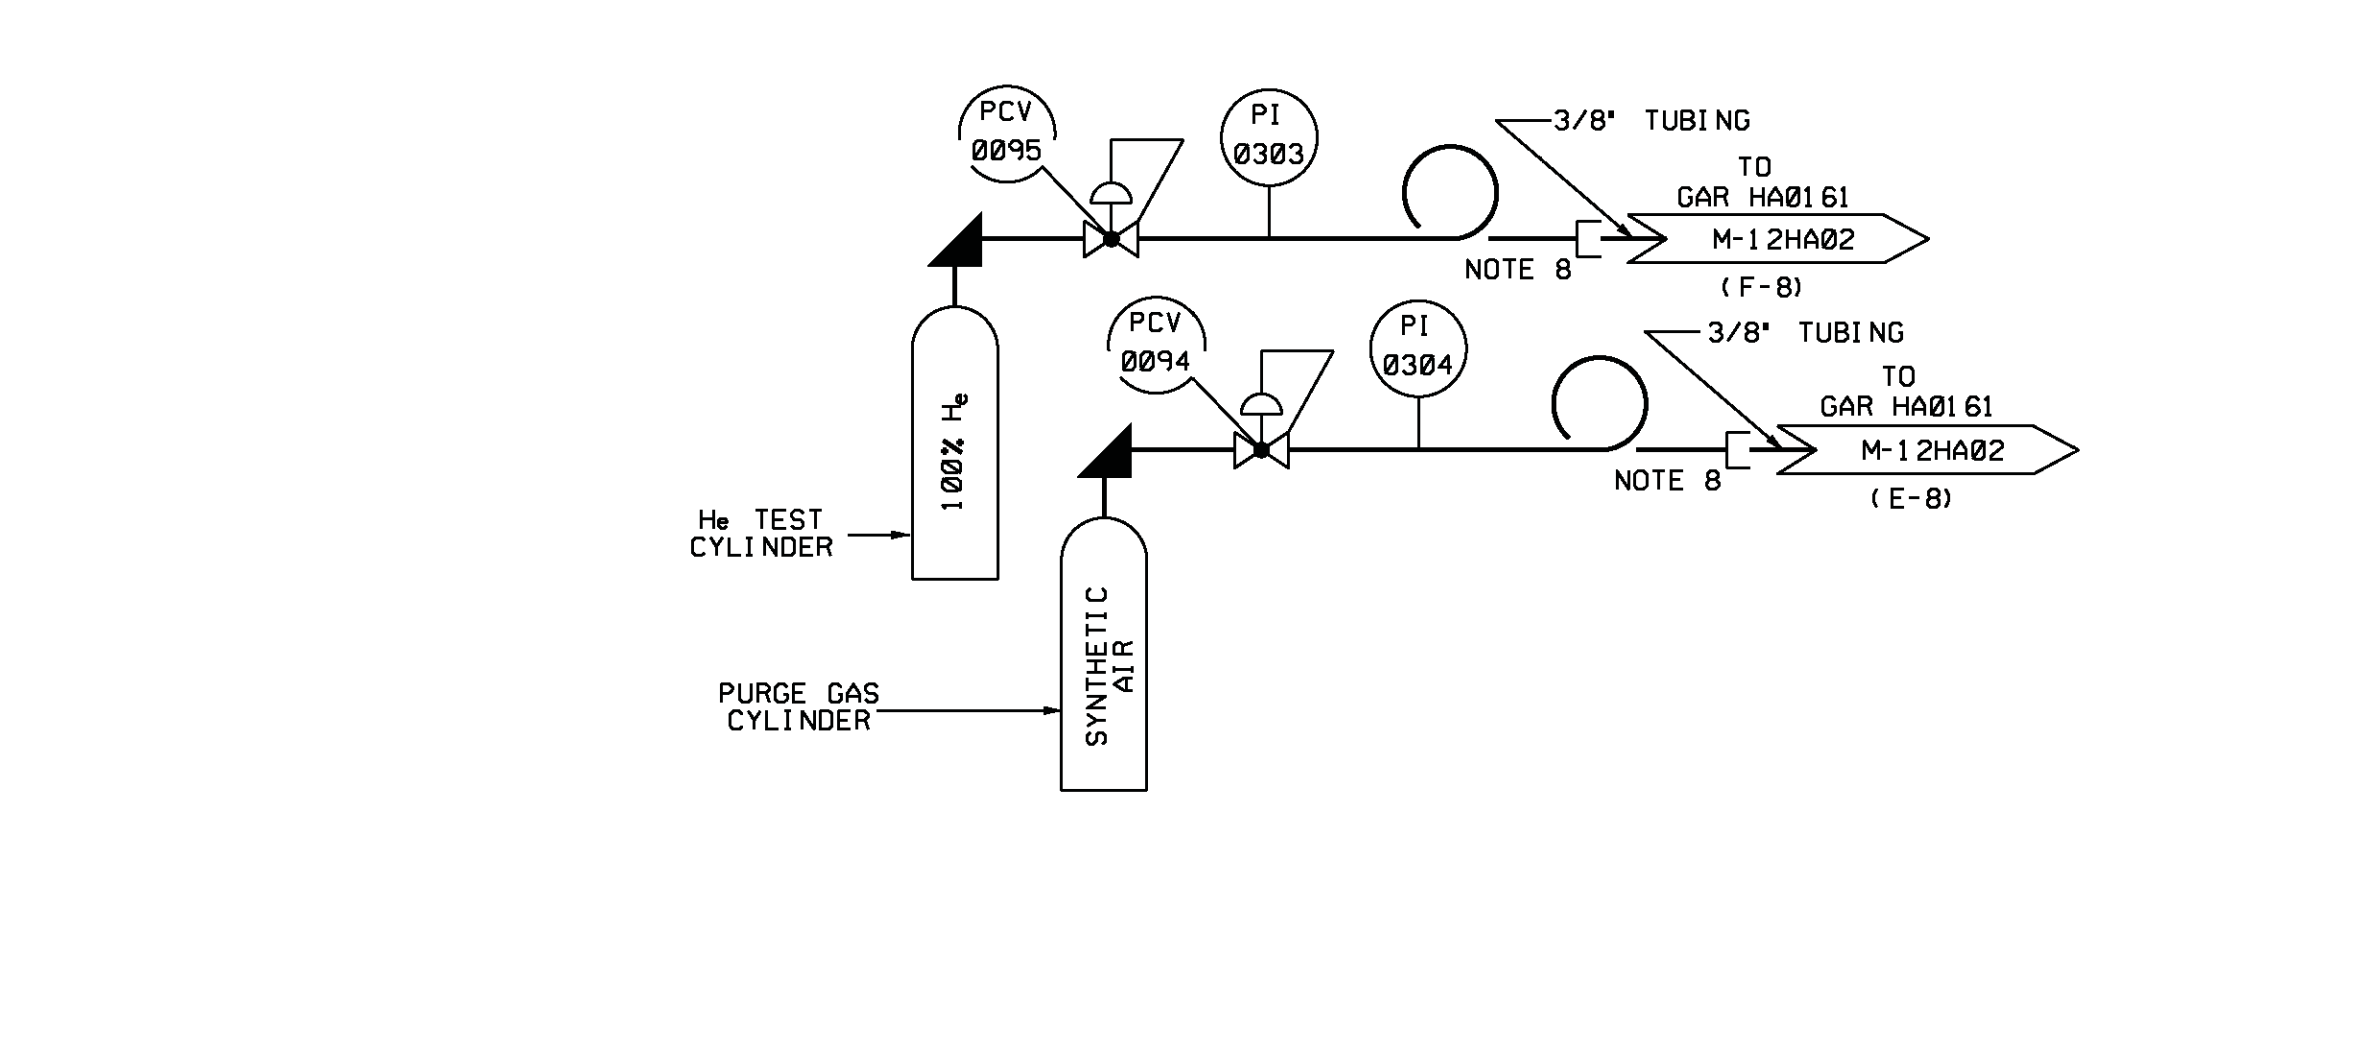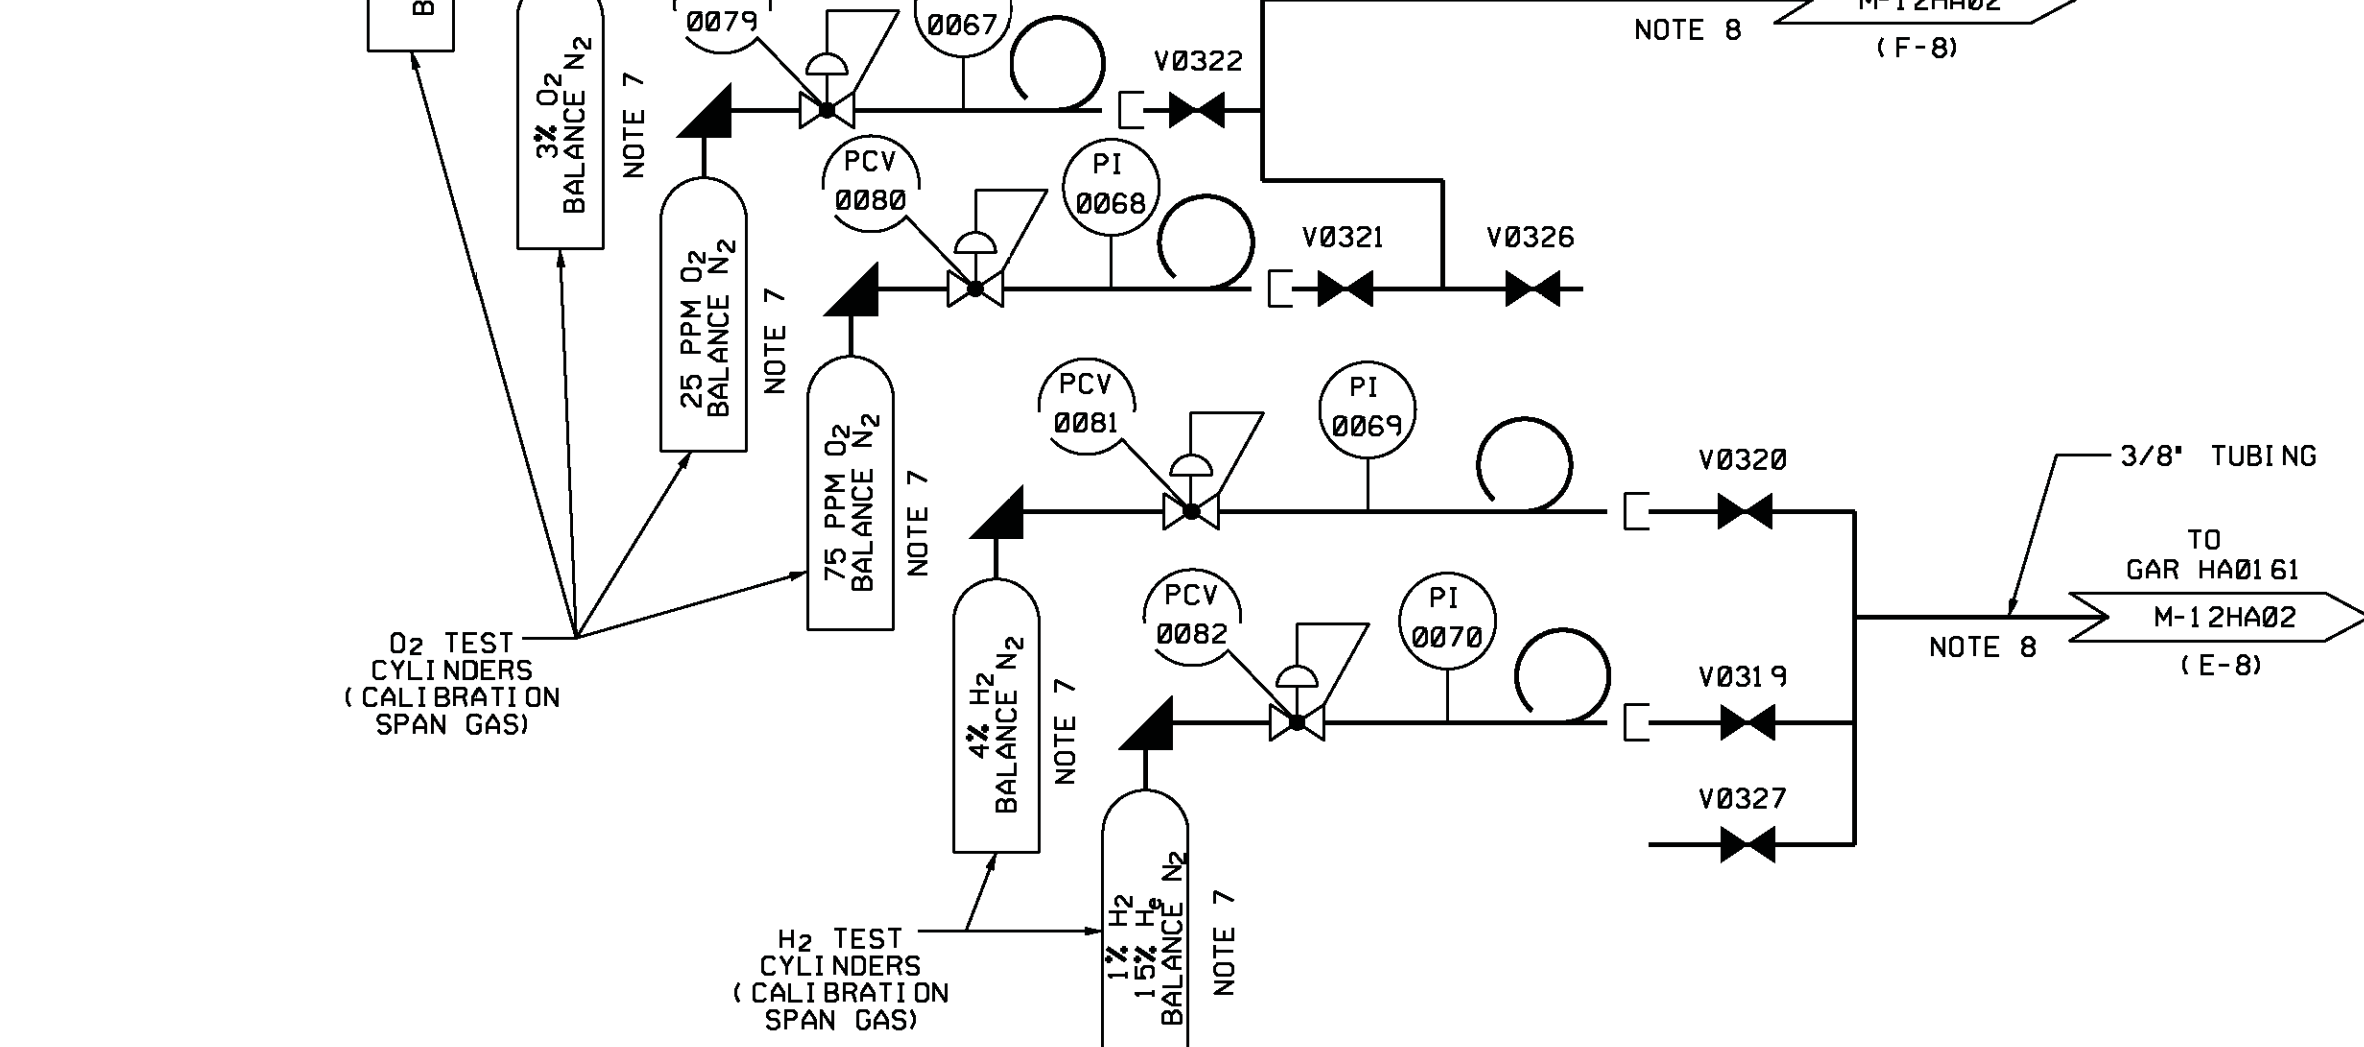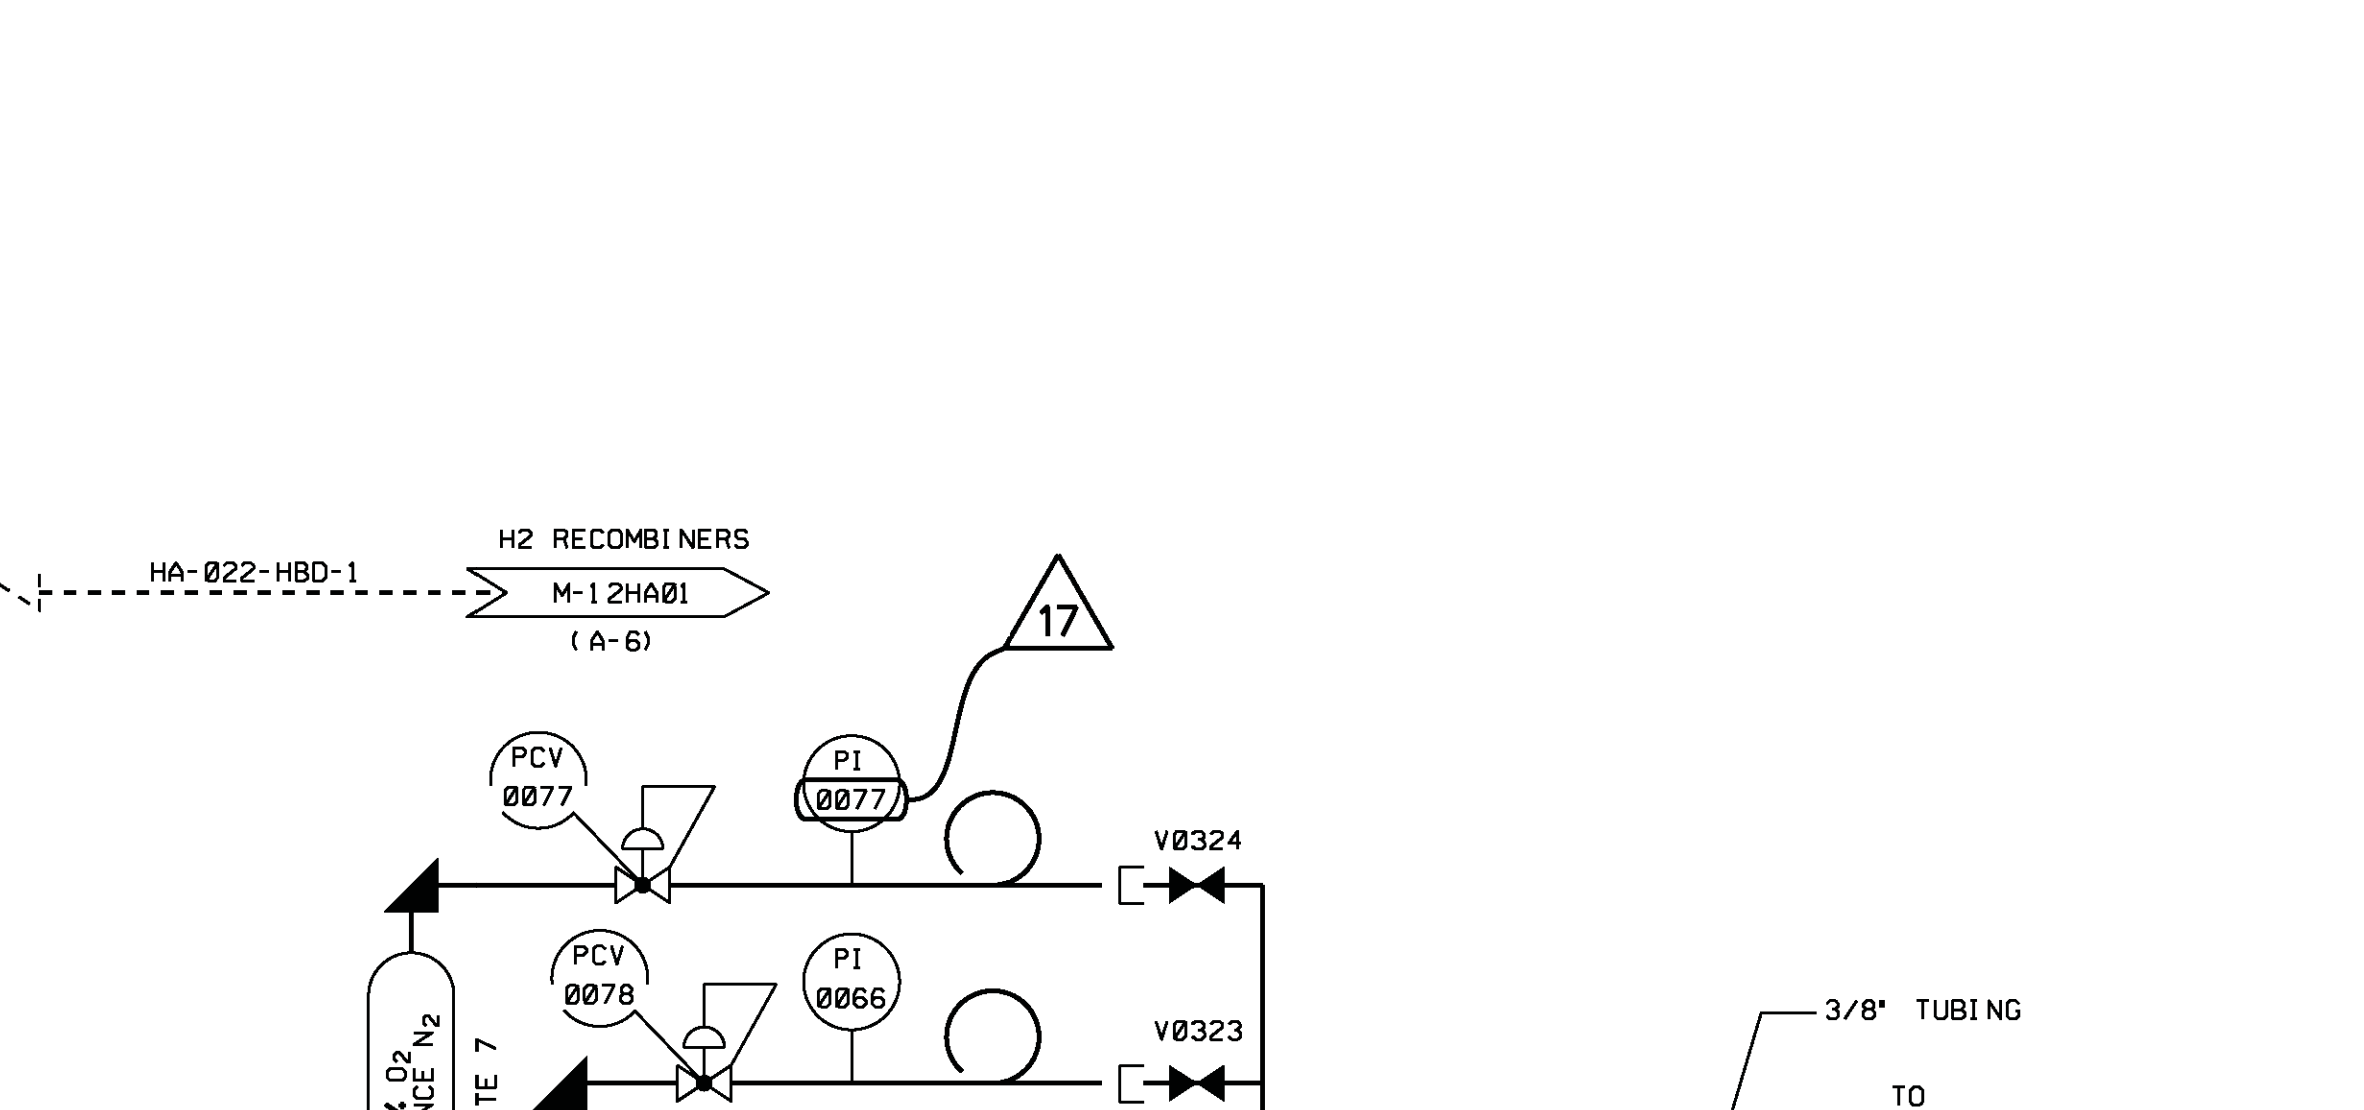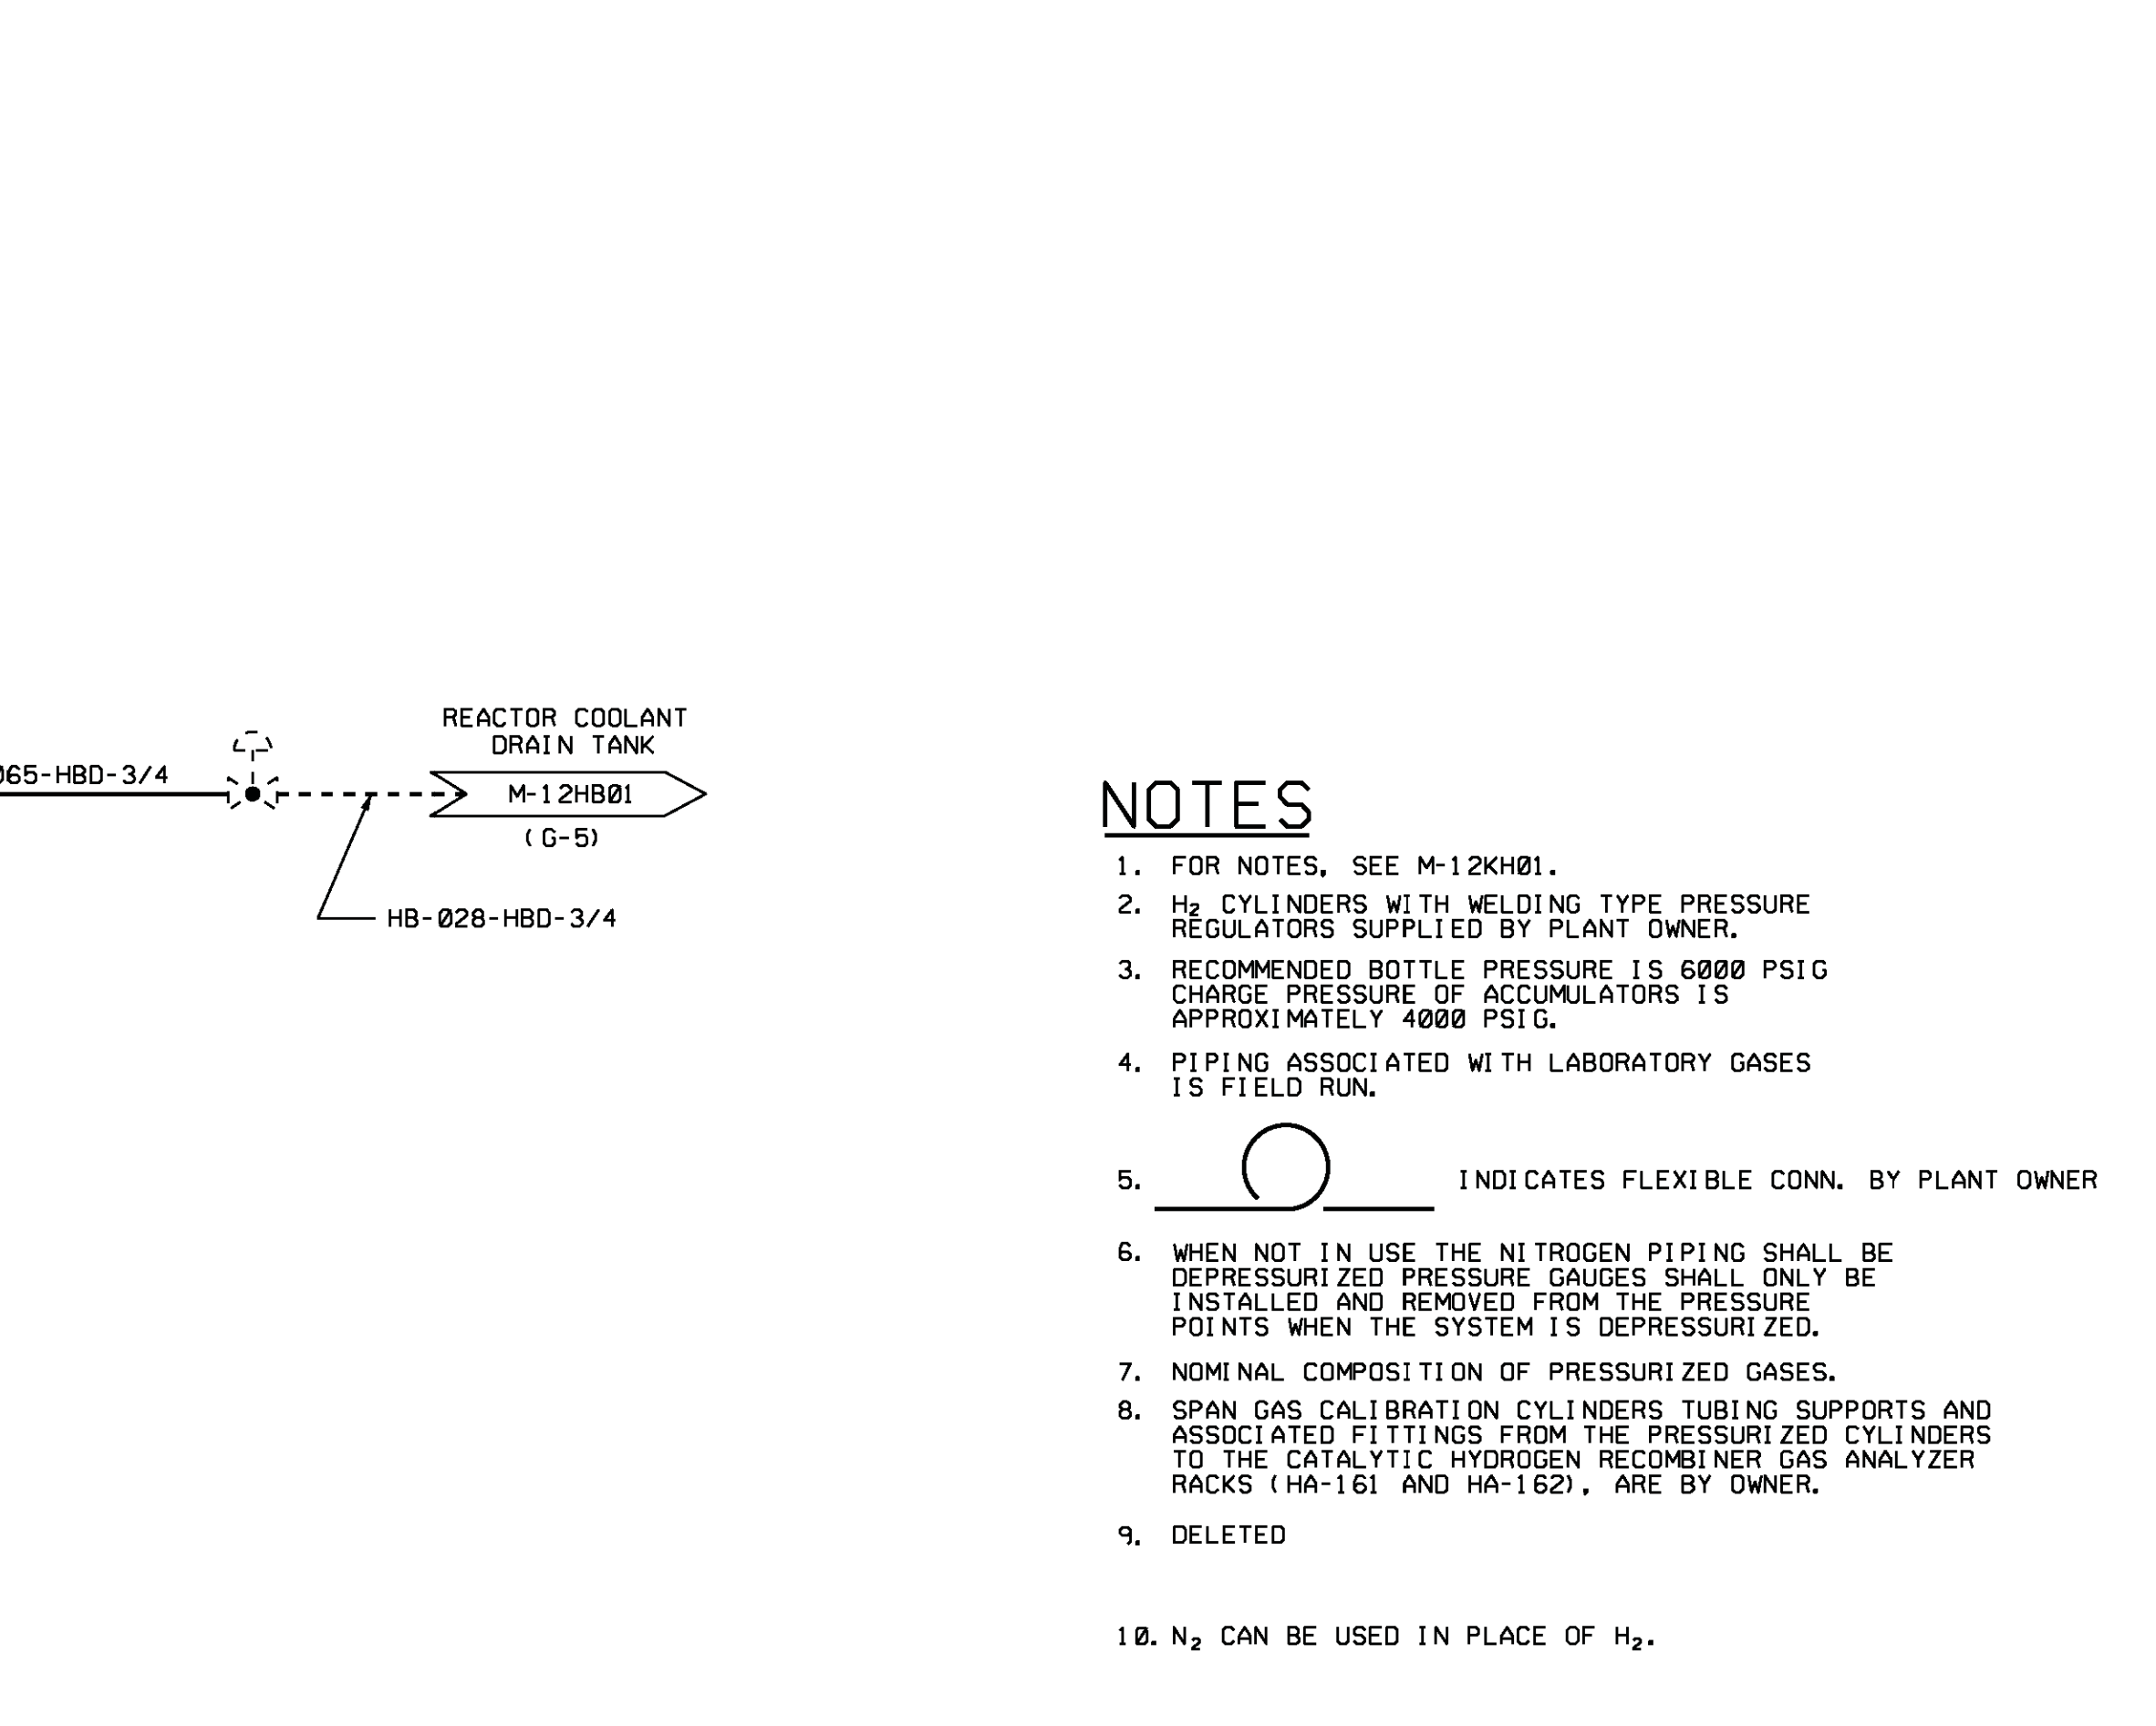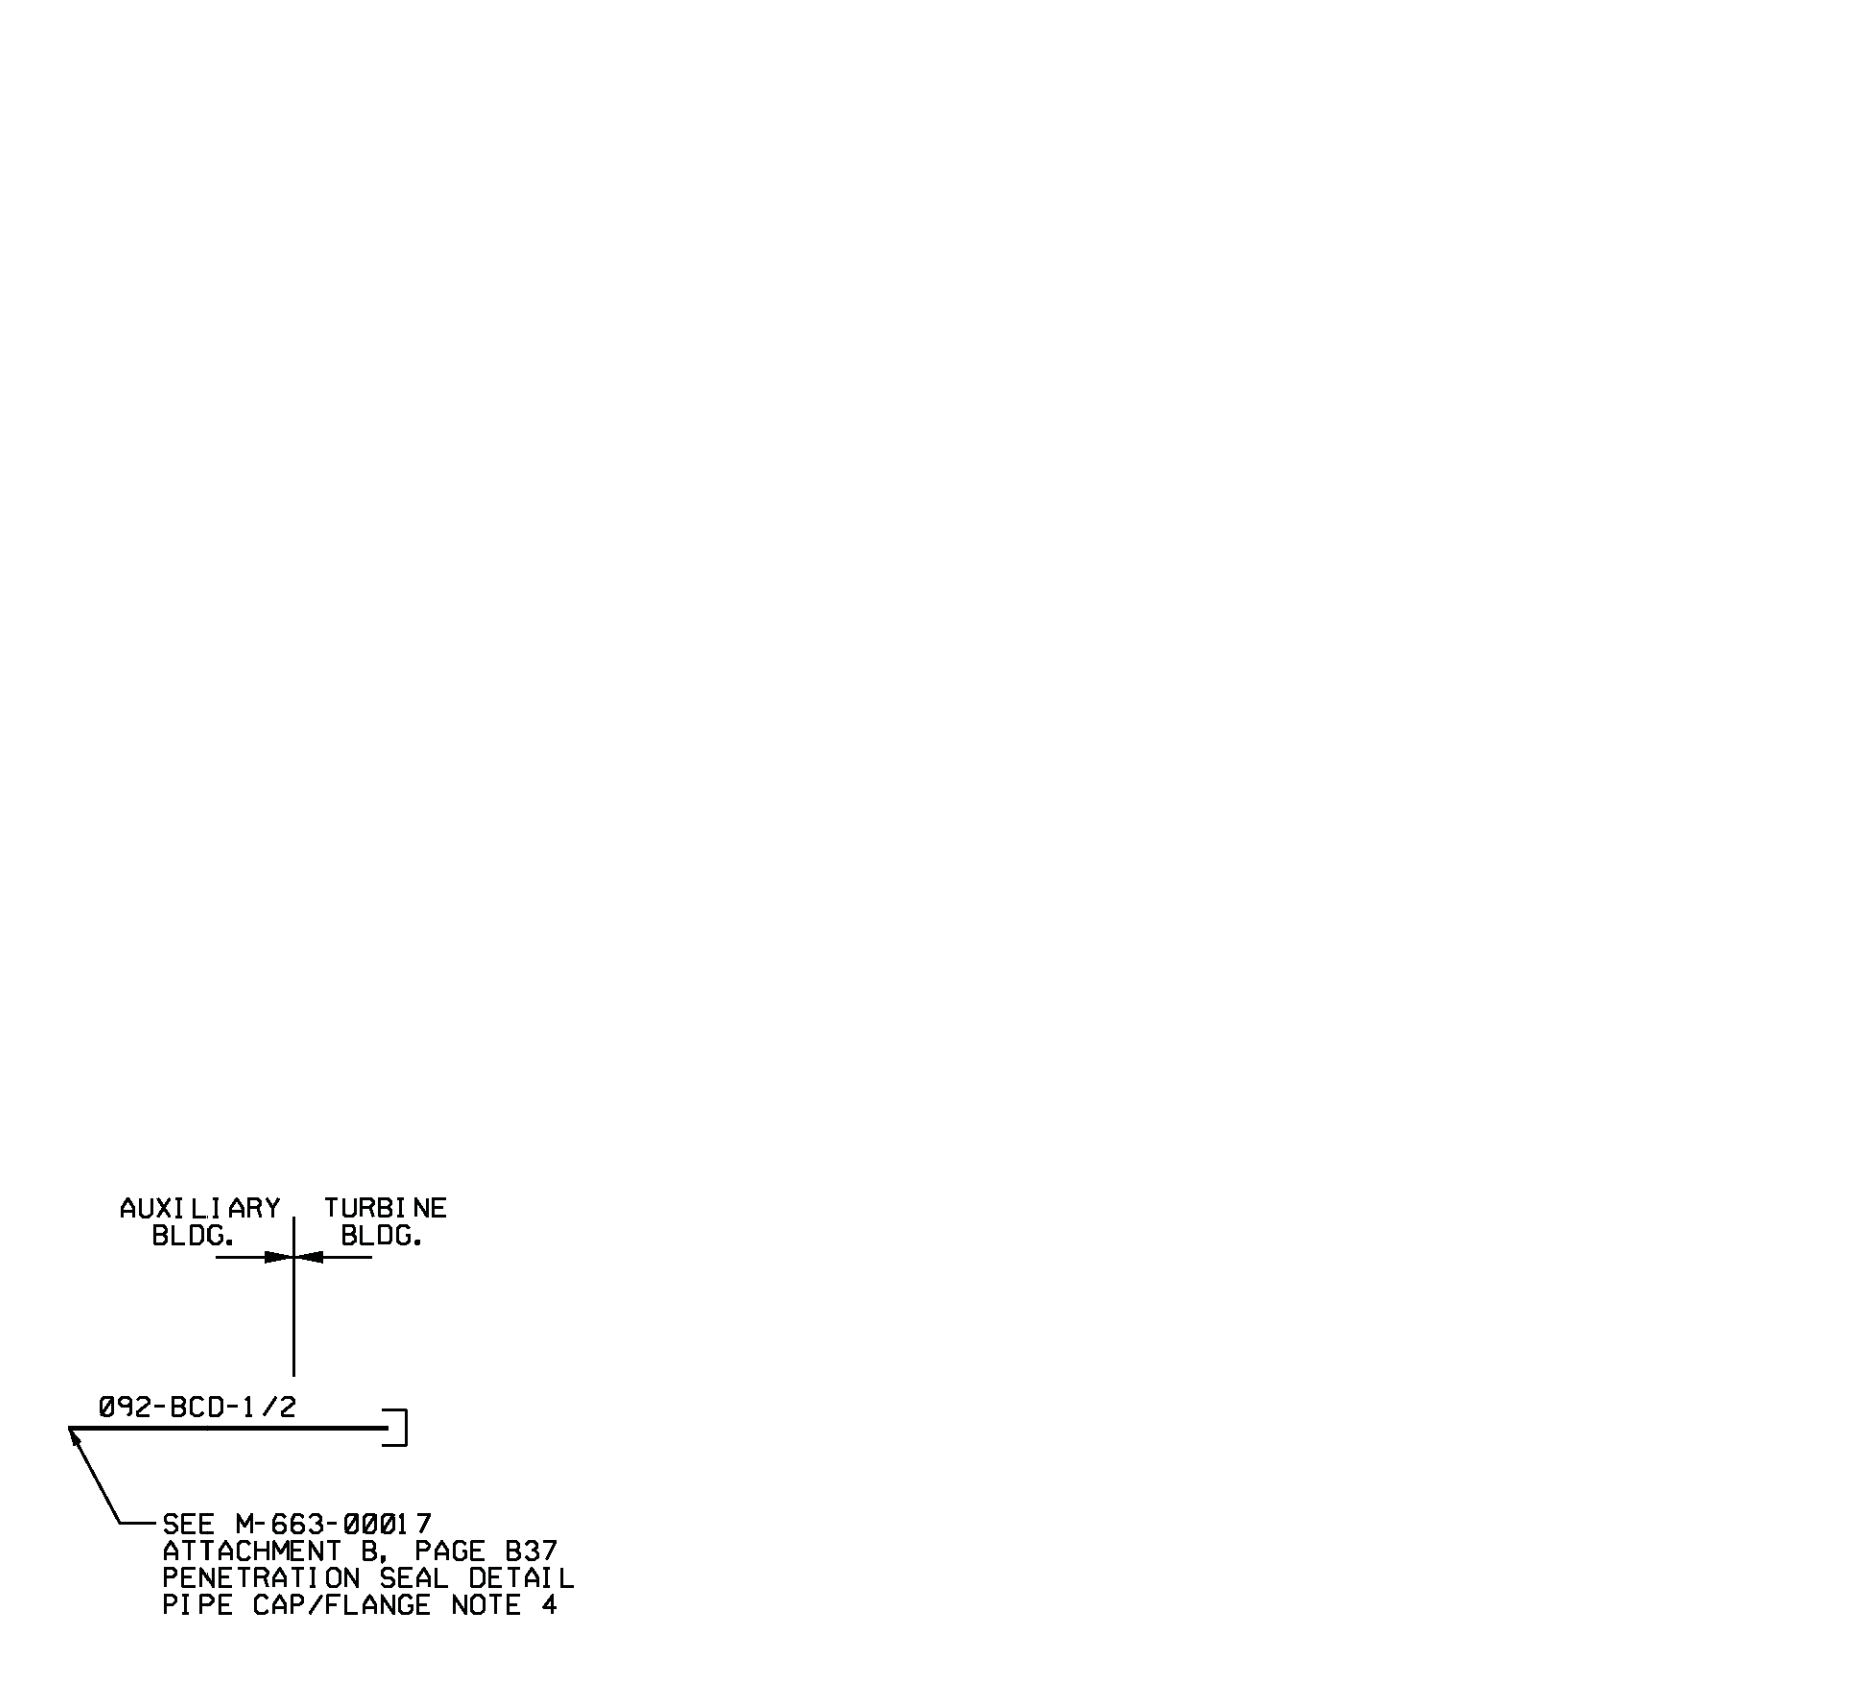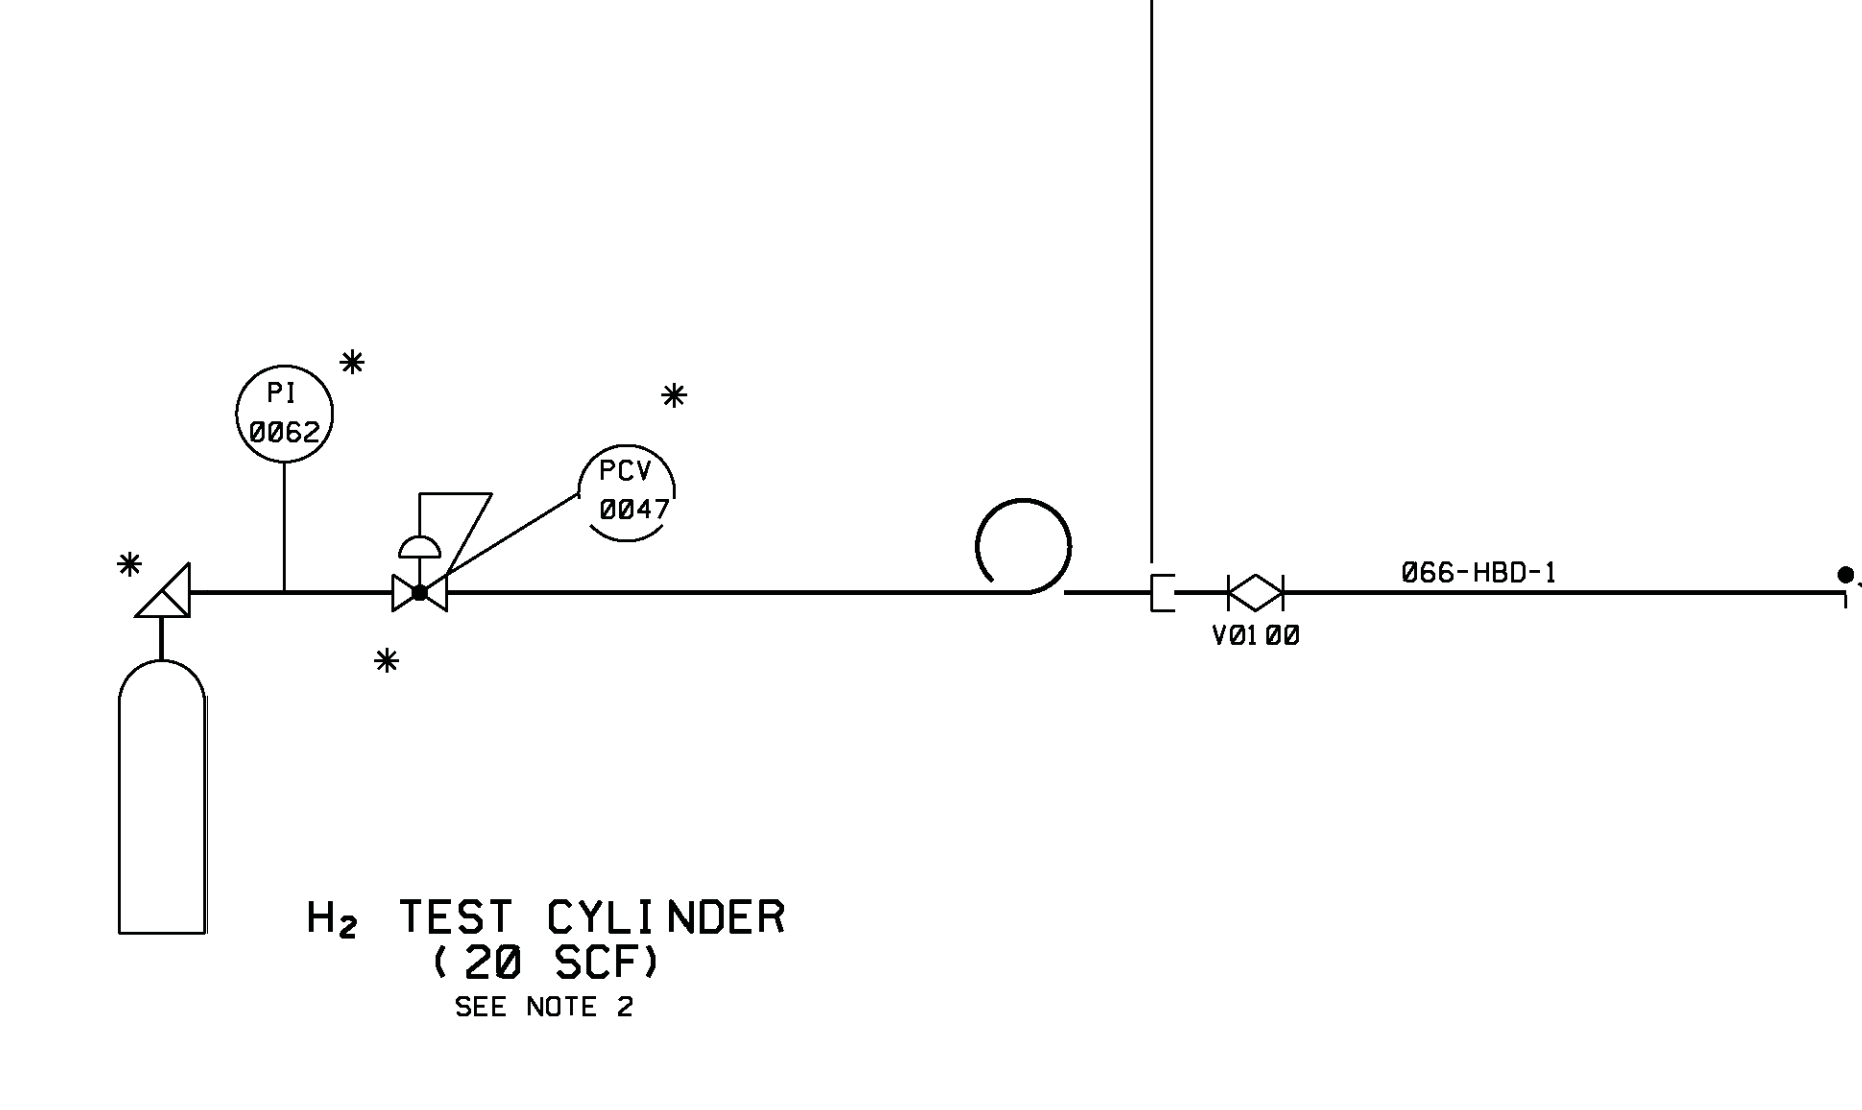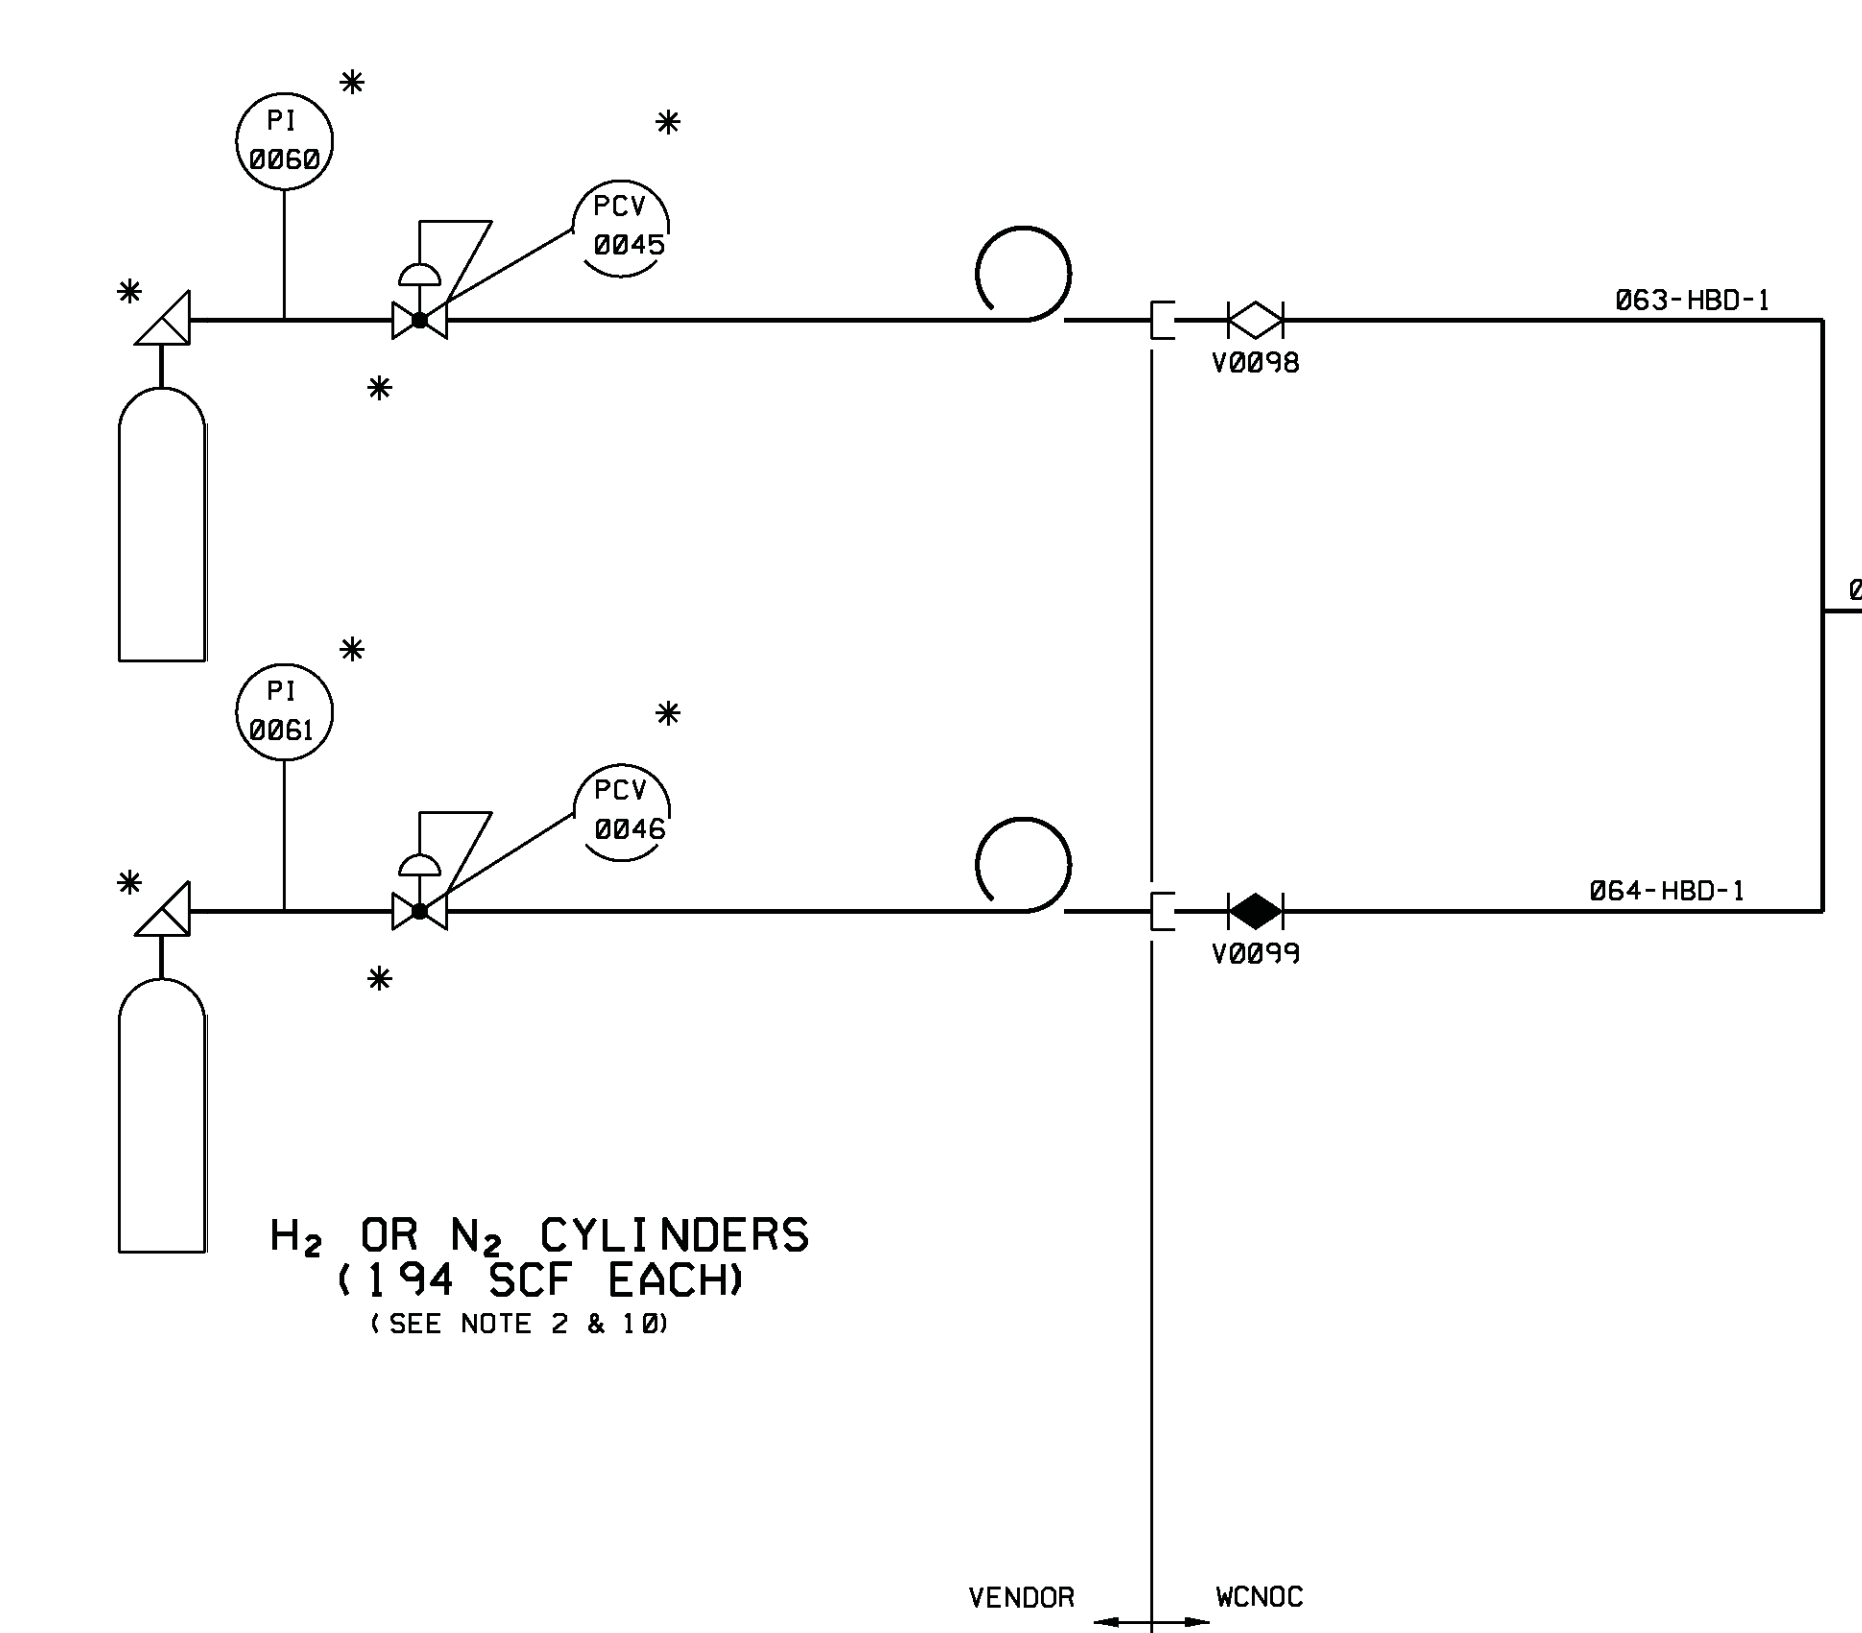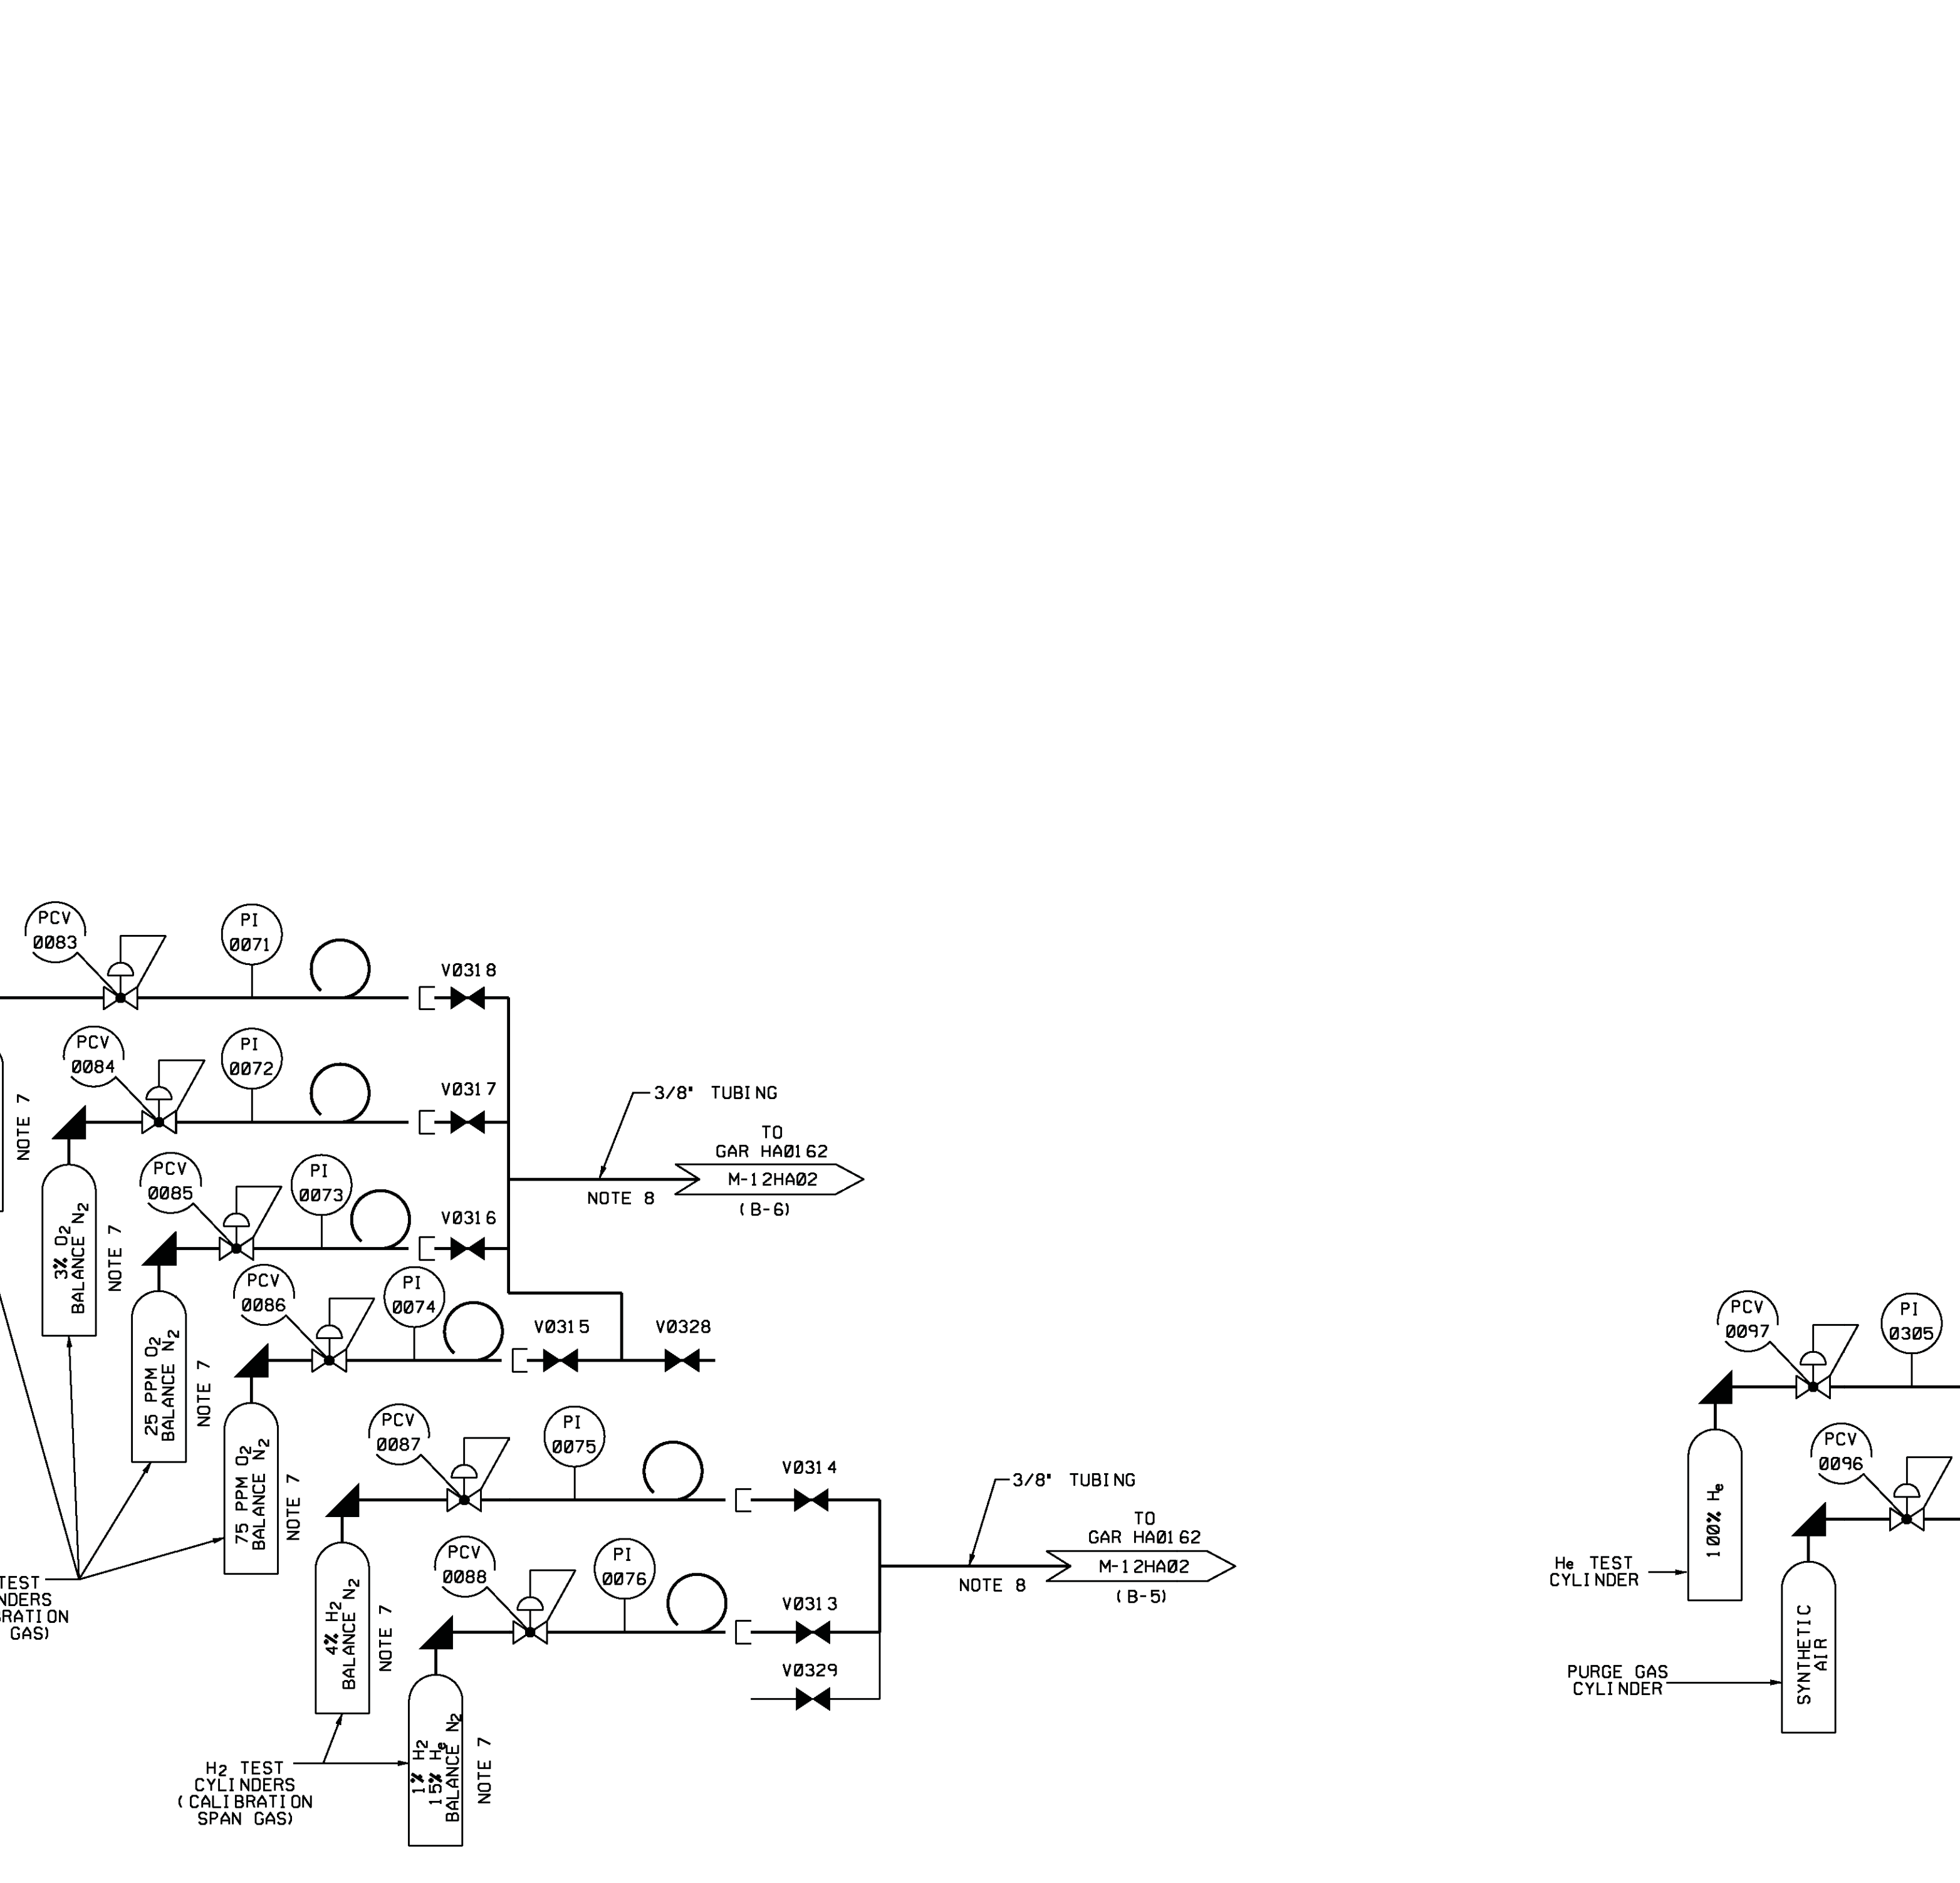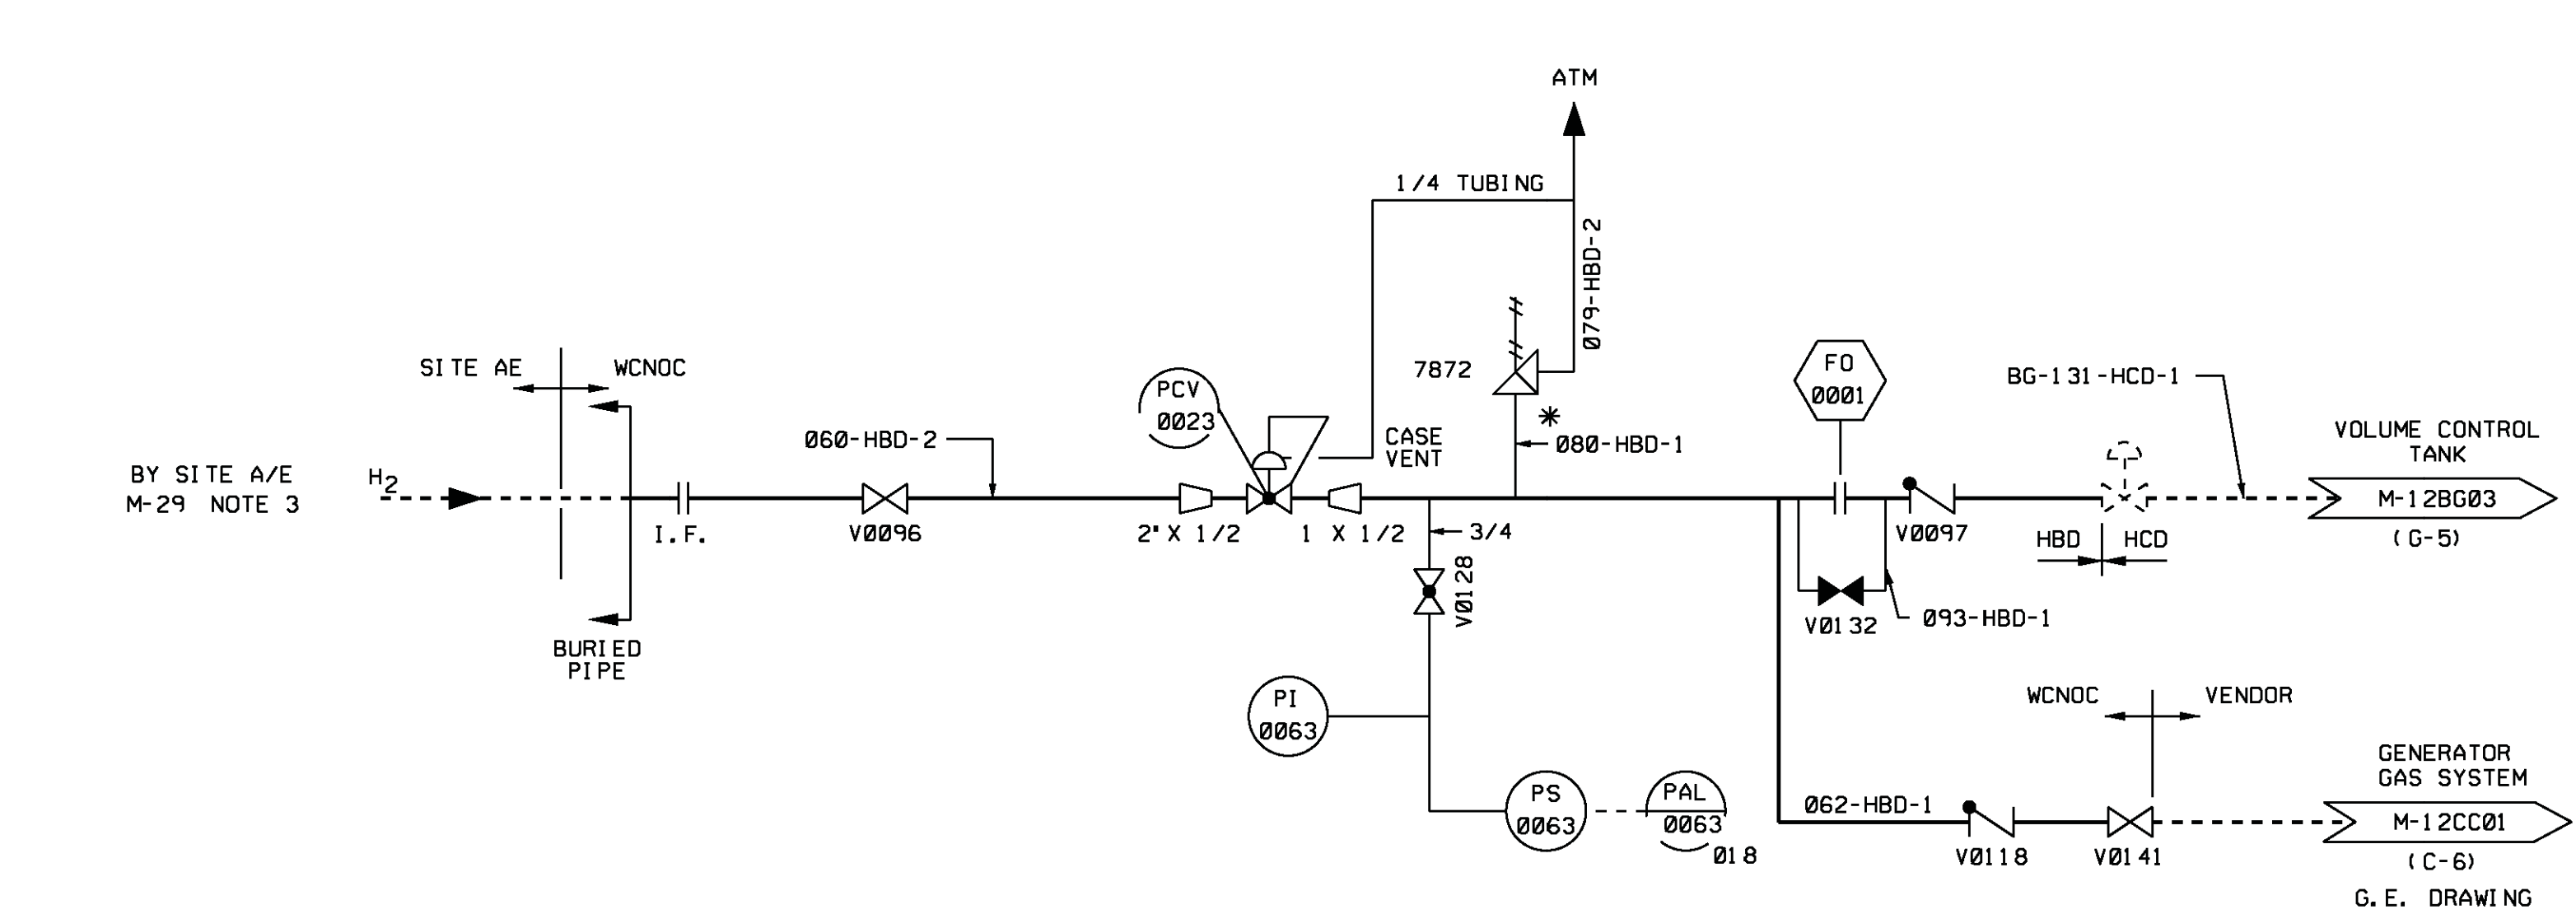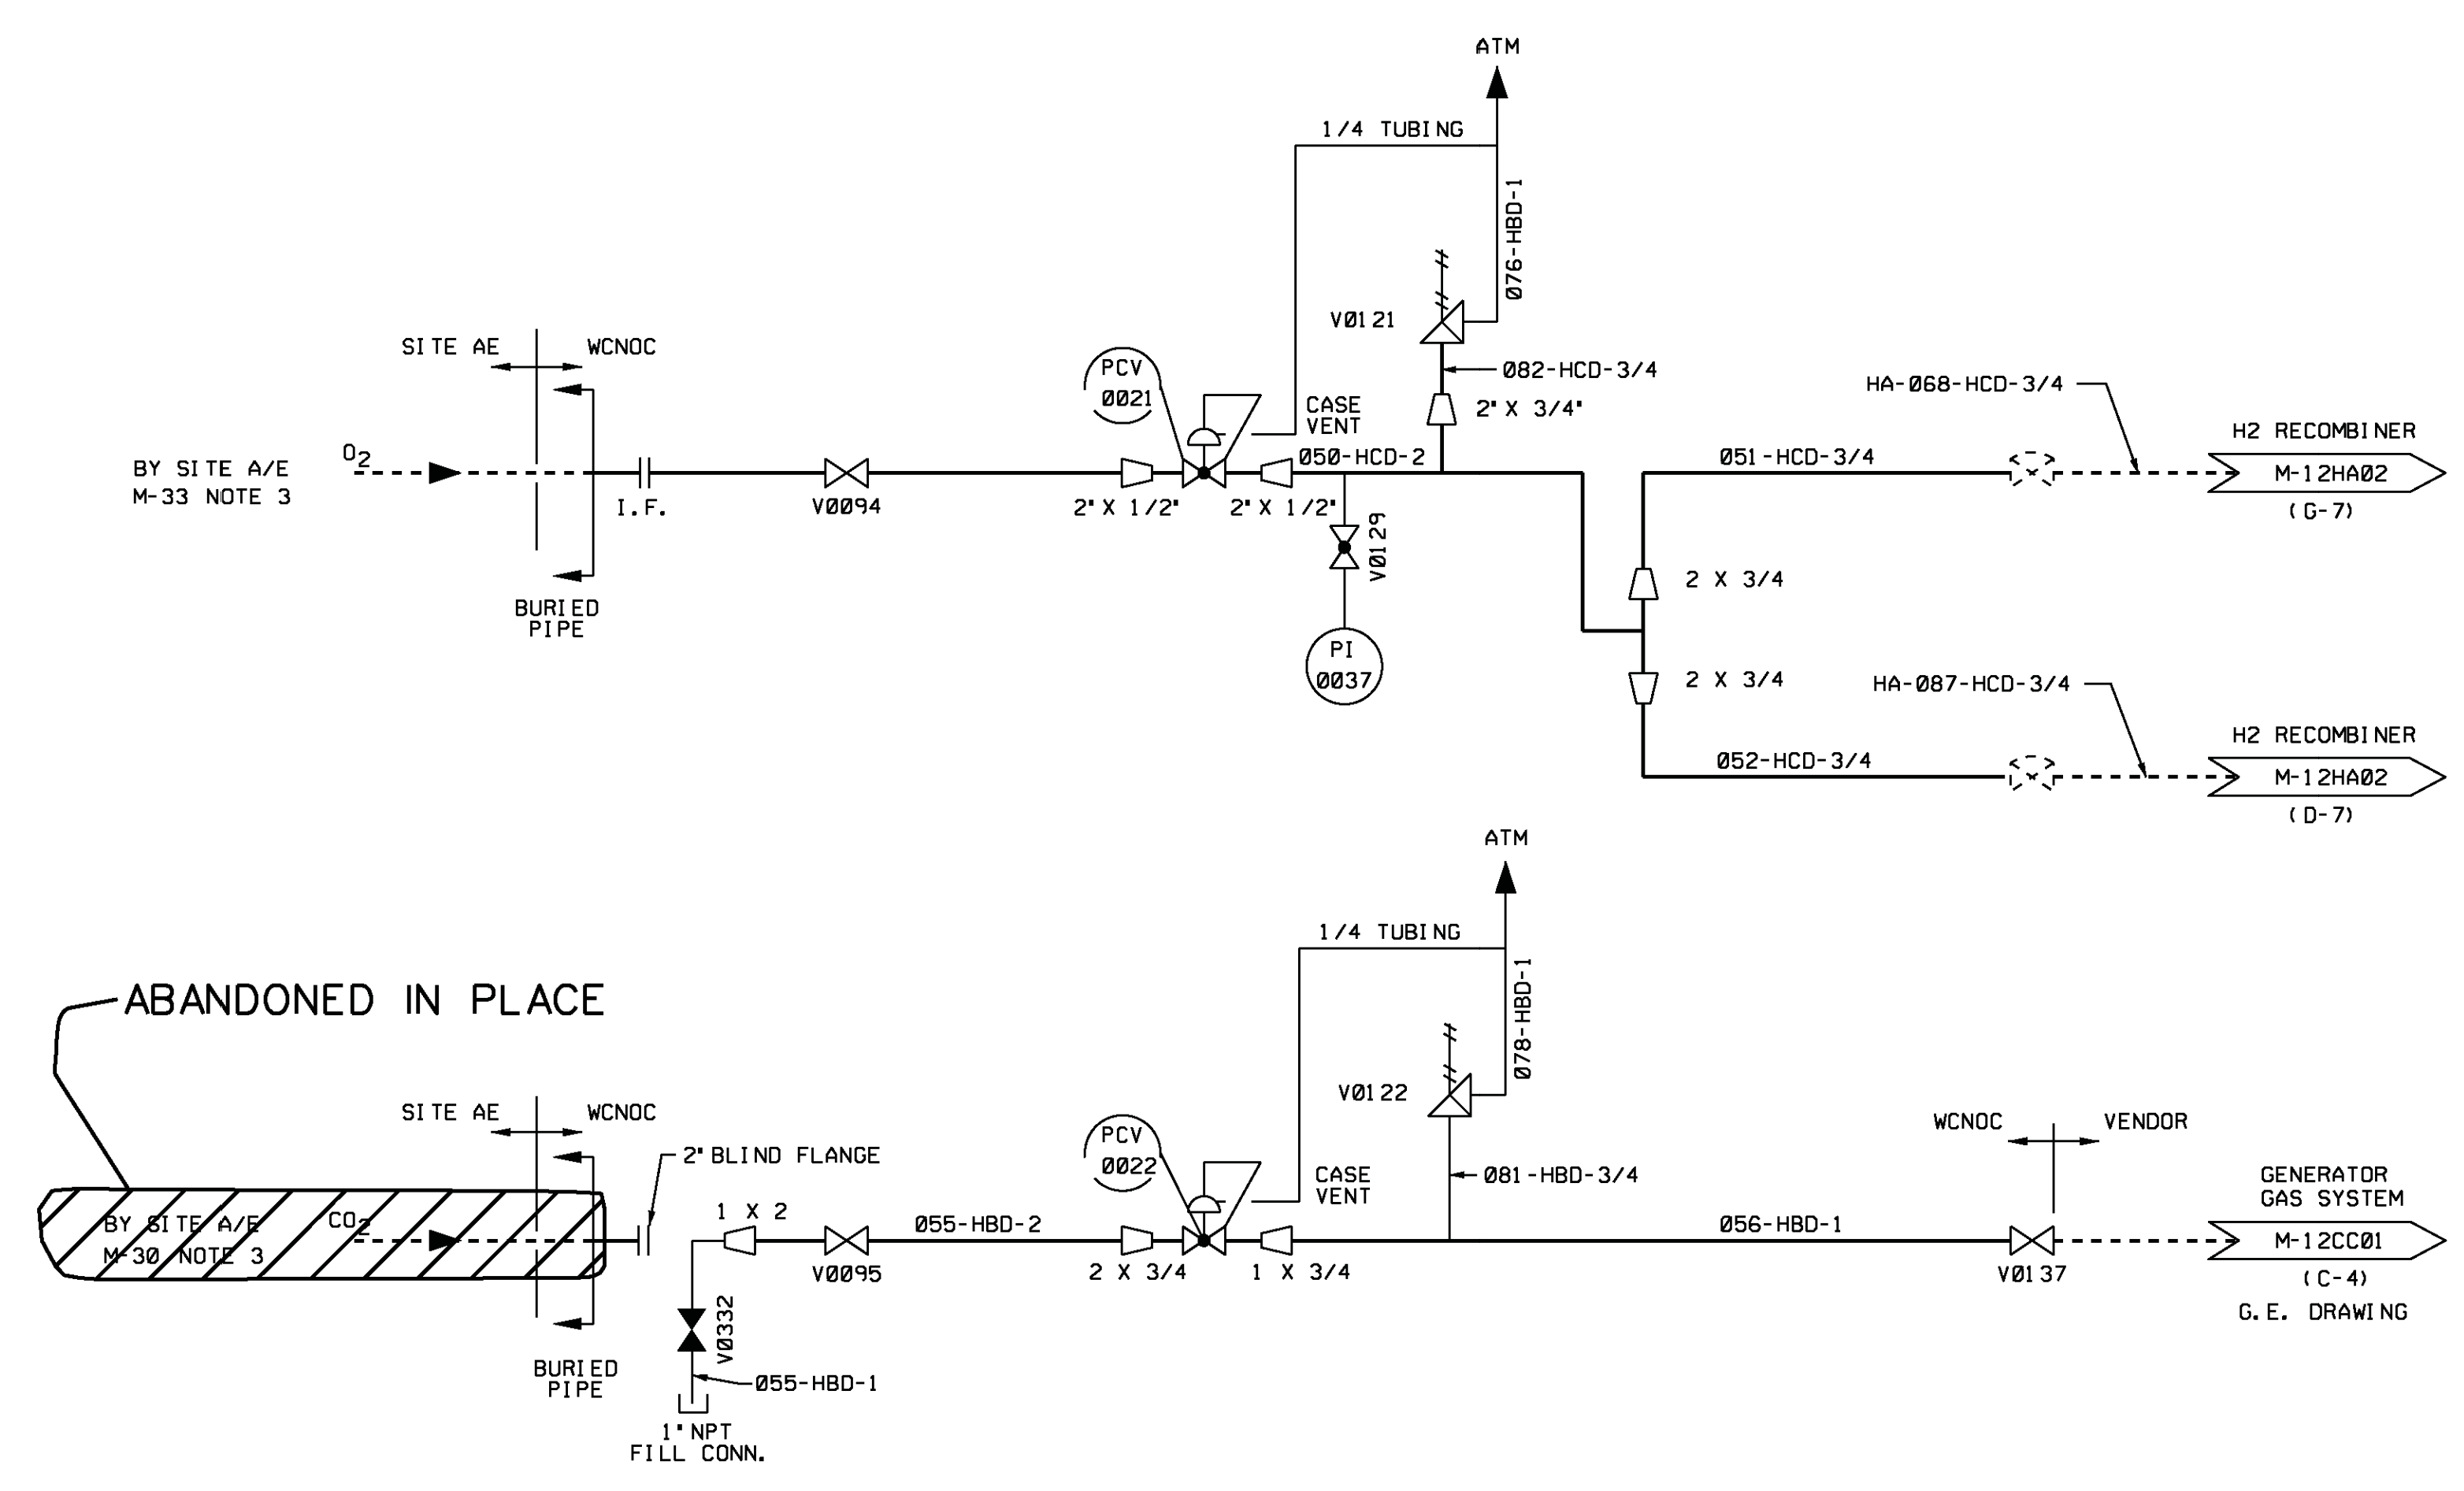

- NOTES**
- FOR NOTES, SEE M-12KH01.
 - H₂ CYLINDERS WITH WELDING TYPE PRESSURE REGULATORS SUPPLIED BY PLANT OWNER.
 - RECOMMENDED BOTTLE PRESSURE IS 6000 PSIG. CHANGE PRESSURE OF ACCUMULATORS IS APPROXIMATELY 4000 PSIG.
 - PIPING ASSOCIATED WITH LABORATORY GASES IS FIELD RUN.
 - INDICATES FLEXIBLE CONN. BY PLANT OWNER.
 - WHEN NOT IN USE THE NITROGEN PIPING SHALL BE DEPRESSURIZED. PRESSURE GAUGES SHALL ONLY BE INSTALLED AND REMOVED FROM THE PRESSURE POINTS WHEN THE SYSTEM IS DEPRESSURIZED.
 - NOMINAL COMPOSITION OF PRESSURIZED GASES.
 - SPAN GAS CALIBRATION CYLINDERS TUBING SUPPORTS AND ASSOCIATED FITTINGS FROM THE PRESSURIZED CYLINDERS TO THE CATALYTIC HYDROGEN RECOMBINER GAS ANALYZER RACKS (HA-161 AND HA-162), ARE BY OWNER.
 - DELETED.
 - N₂ CAN BE USED IN PLACE OF H₂.

USAR FIG. 9.3-9-02


ESSENTIAL DRAWING

REVISED	INCORPORATED	CR 00098464	CHANGE
ISSUED	ENG. DOC.		PKG. NO.
THIS ENG. SUPERSEDES		REV.	THIS ENG. SUPERSEDES
REVISION NOTES			
		ELECTRONIC APPROVAL	
PIPING AND INSTRUMENTATION DIAGRAM SERVICE GAS SYSTEM			
SCALE	DRAWING NUMBER		SHEET
NONE	M-12KH02		01 17

3444 E 32E


NOTES

- THE FOLLOWING WASTEWATER STANDING EQUIPMENT IS SUPPLIED TO BE CLASSIFIED BY GRADE/DESIGN CODE THAT IS REQUIRED BASED ON ITS SAFETY RELATED IMPORTANCE AS DETERMINED BY SERVICE AND FUNCTIONAL REQUIREMENTS AND BY THE EXPERIENCE OF THE FIELDING. EQUIPMENT CLASSIFICATION SHALL BE FOR INTERFACE PURPOSES ONLY. THE WELD END PRESSURE CLASSIFICATION OF THE EQUIPMENT IS THE LOWER CLASSIFICATION AS INDICATED FOR THE ASSOCIATED PIPING.
 - A. RECYCLE EVAPORATOR FEED DEMINERALIZER
 - B. RECYCLE EVAPORATOR FEED FILTER
 - C. RECYCLE EVAPORATOR FEED PUMPS
 - D. RECYCLE EVAPORATOR
 - E. P.W. 1. WASTE EVAPORATOR
 - F. RECYCLE EVAPORATOR CONDENSATE DEMINERALIZER
 - G. RECYCLE EVAPORATOR CONDENSATE FILTER
 - H. RECYCLE EVAPORATOR CONDENSATE PUMP
 - I. RECYCLE EVAPORATOR CONDENSATE PUMP
- PORTIONS OF THIS SYSTEM THAT CONTAIN RADIOACTIVE FLUIDS ARE AND IDENTIFIED BY QUALITY GROUP CLASSIFICATION "Q" SHALL MEET ASBESTOS REMEDIATION REQUIREMENTS.
- THIS DRAWING BASED ON WASTEWATER DRAWINGS M-730-0001-4 THROUGH M-730-0001-5.
- LOWER RECYCLE EVAPORATOR REAGENT TANK TO ALLOW GRAVITY DRAIN TO RECYCLE EVAPORATOR.
- THE FOLLOWING EQUIPMENT IS SUPPLIED WITH EVAPORATOR PACKAGE BY VENDORS.
 - A. FCV-316
 - B. FCV-304
 - C. FCV-317
 - D. S-STRAINER, SRE24
 - E. FCV-307
 - F. FCV-305
 - G. BEF-274
 - H. SRE03
- LOWER LOOP TO EXTEND 20 INCHES BELOW OVERFLOW CONNECTION, WSPR LOOP TO EXTEND 3 INCHES ABOVE OVERFLOW FLANGE. LOCATE STRAIN BREAK ON TOP OF UPPER LOOP.
- HIGH POINT OF PIPE DOWNSTREAM OF THIS POINT TO BE ONE FOOT BELOW OVERFLOW FLANGE.
- INDICATED KNOBLOCS OF THIS SYSTEM IDENTIFIED BY THIS NOTE ARE QUALITY GROUP "Q" NOT "ASSEMBLED."
- CONTROLS FOR THE RECYCLE EVAPORATOR ARE ON PANEL M-12C.
- PIPING AND INSTRUMENTATION DIAGRAM FOR THE RECYCLE EVAPORATOR IS SHOWN ON RECYCLED DRAWING M-730-0001-5.
- REMOVABLE SPOOL PROVIDED FOR START-UP.
- 1" VOLUME BREAKS (LINE 10) BE TERMINATED BETWEEN 15 AND 18 INCHES FROM LOCAL WASTE EXHAUST RESISTERS.

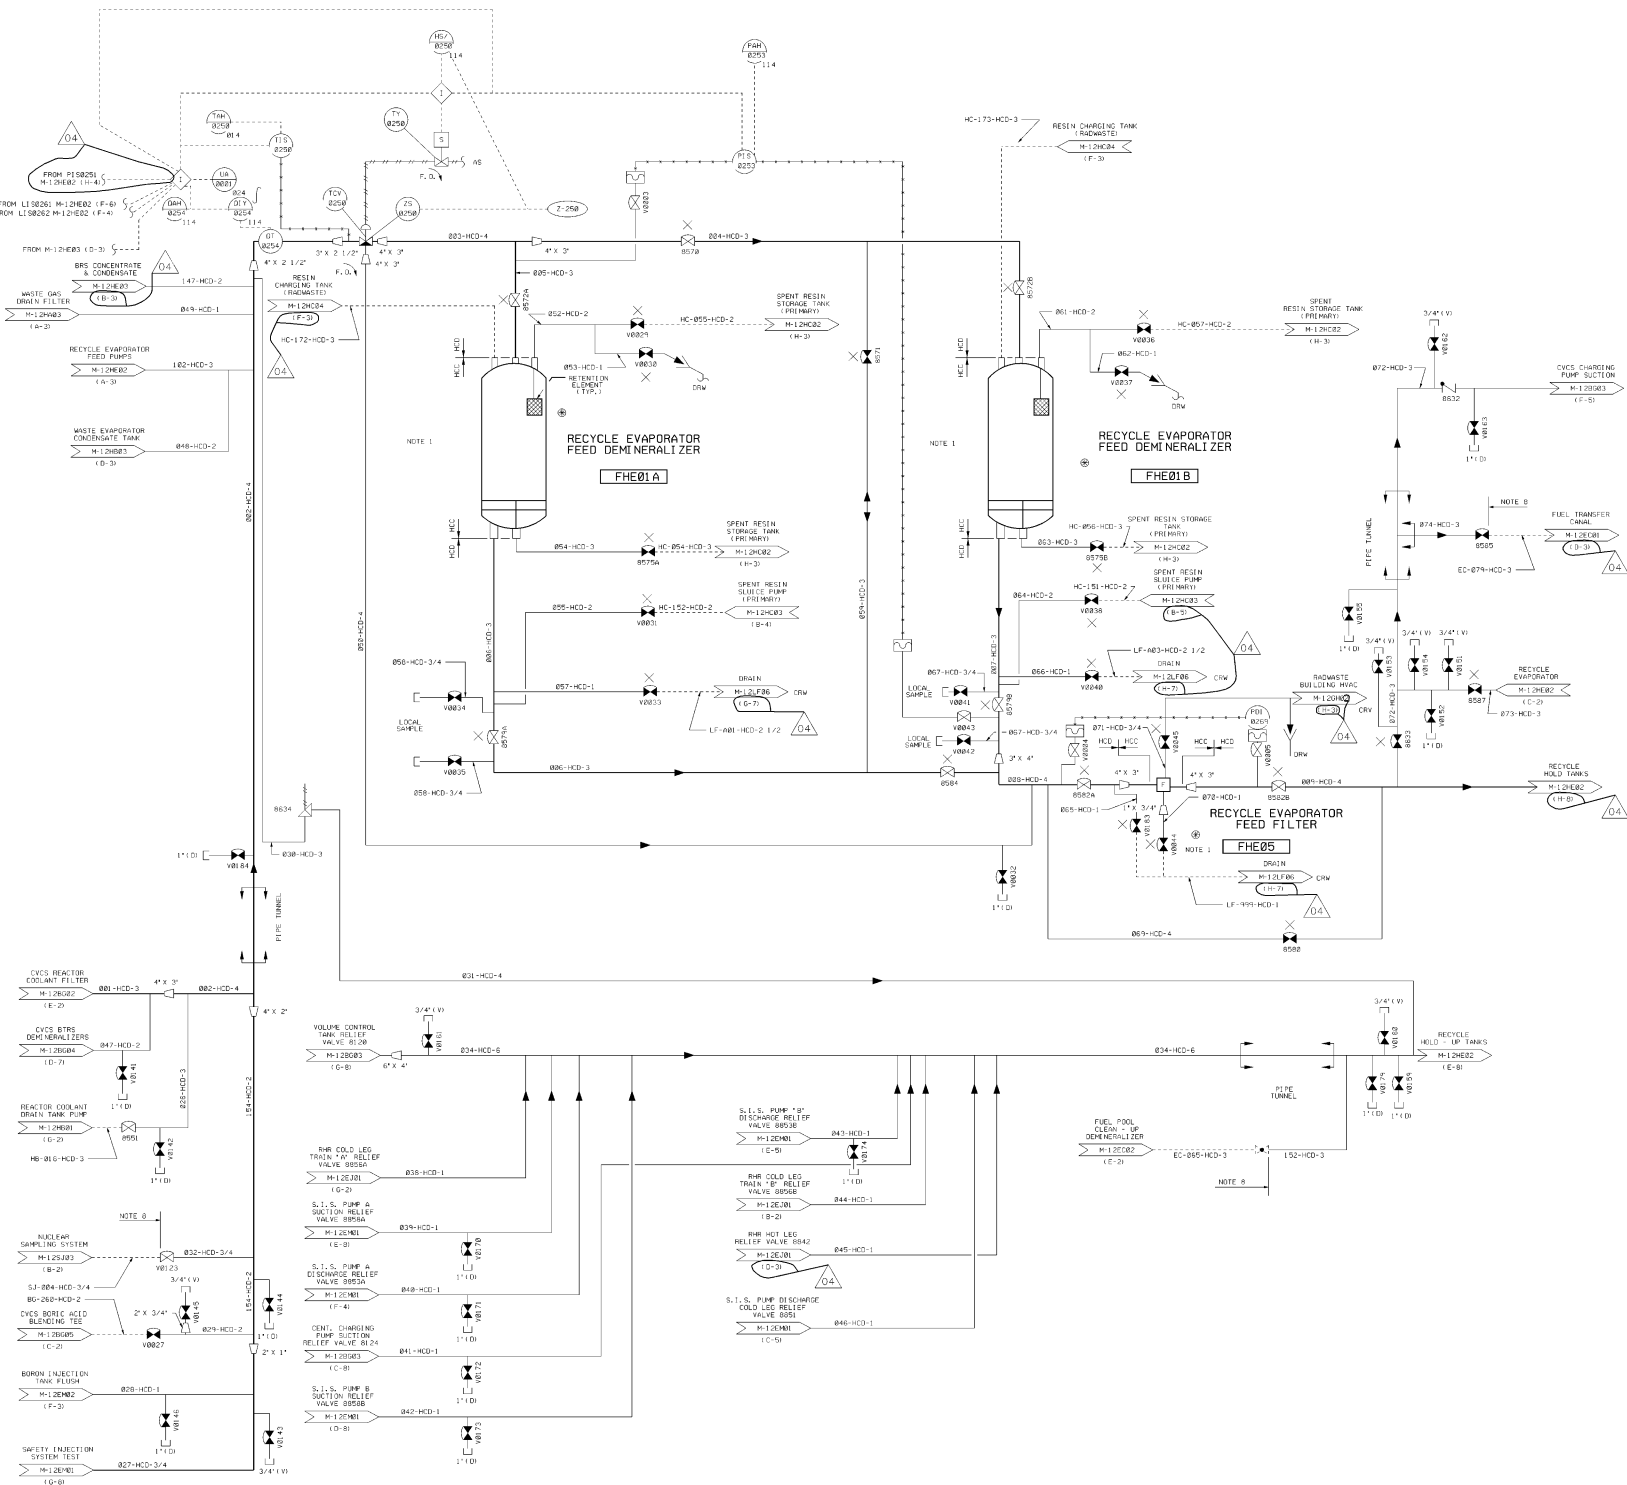

USAR FIG. 9.3-11-B1

ESSENTIAL DRAWING			
REVISED	UNCORRECTED	DATE	BY
01	01	01/14/03	WJL
THIS DRAWING IS THE PROPERTY OF THE U.S. GOVERNMENT AND IS TO BE REPRODUCED AND TRANSMITTED IN ANY FORM AND BY ANY MEANS WITHOUT RESTRICTION.			
WOLF CREEK NUCLEAR OPERATIONS CENTER		ELECTRONIC APPROVAL	
PIPING & INSTRUMENTATION DIAGRAM BORON RECYCLE SYSTEM			
SHEET NO.	DRAWING NUMBER	SHEET TOTAL	DATE
NONE	M-12HE01	04	01/14/03

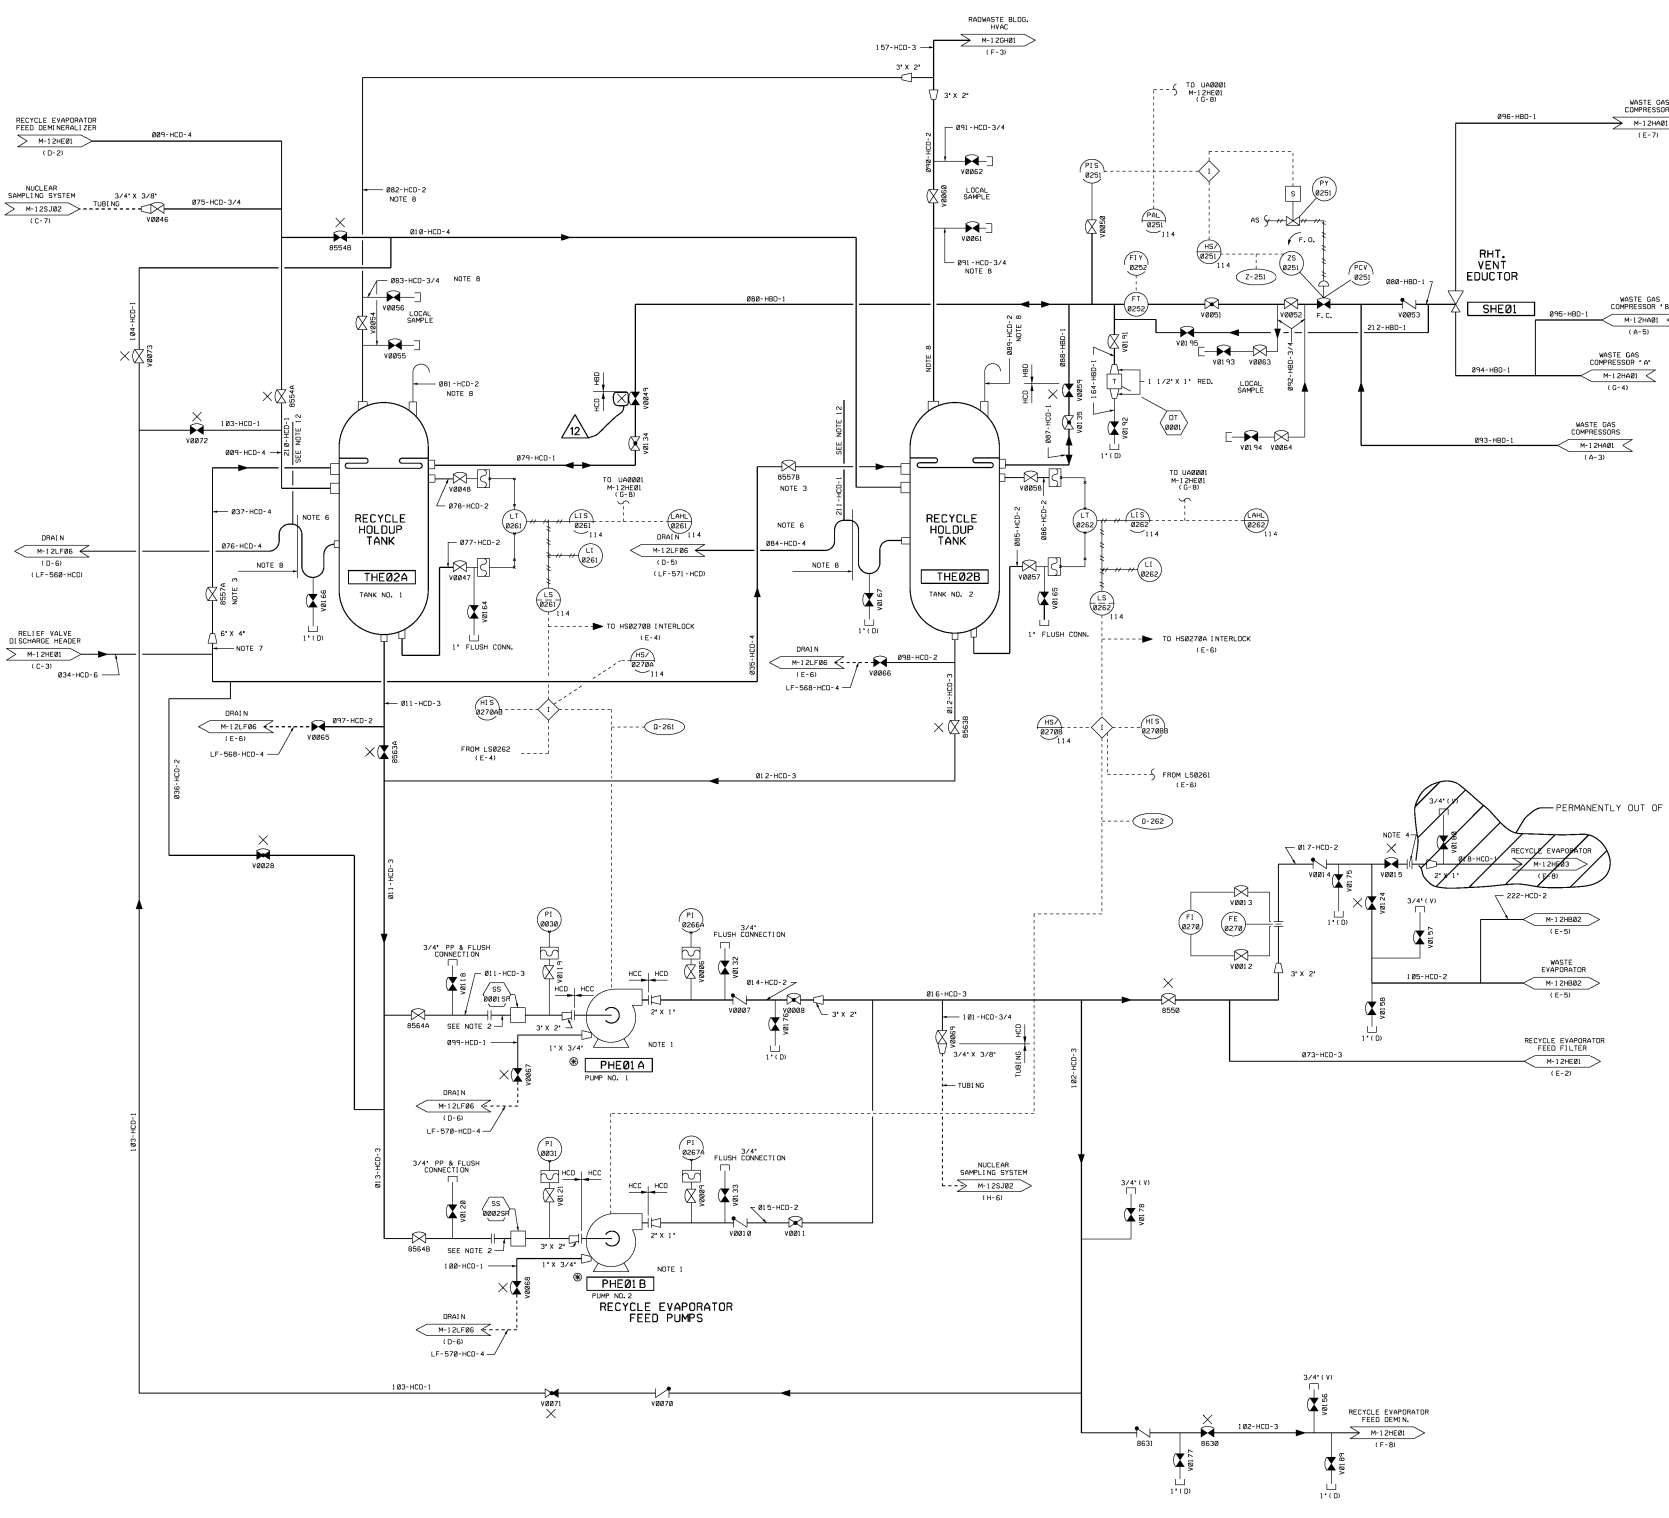

- NOTES**
1. FOR NOTES SEE DRAWING M-12HE01.
 2. REMOVABLE BPOOL WITH SPACER RING INSTALLED. (REPLACEMENT FOR START UP STRAINER).
 3. HEADWORK OR B MUST BE OPEN AT ALL TIMES TO ENSURE RELIEF LINE INTEGRITY.
 4. BLIND FLANGE INSTALLED FOR LINE ISOLATION.

USAR FIG. 9.3-11-02

ESSENTIAL DRAWING

REVISION	INCORPORATED OR 0000976	CHECK
DATE	04/00/02	FILE NO.
DESIGNED BY	REL	NO. INC. APPROVED
REVISION	NOTES	REL

WOLF CREEK
NUCLEAR OPERATING CORPORATION


PIPING & INSTRUMENTATION
DIAGRAM
BORON RECYCLE SYSTEM

DRAWING NUMBER: M-12HE02
SHEET NO: 12




NOTES

1. FOR GENERAL NOTES SEE DRAWING M-12HE01.
2. THE FOLLOWING EQUIPMENT IS SUPPLIED WITH EVAPORATOR PACKAGE BY VENDOR:
 - A. L100315, BELLOWS, AND ASSOCIATED TUBING.
3. BLIND FLANGE INSTALLED FOR LINE ISOLATION.

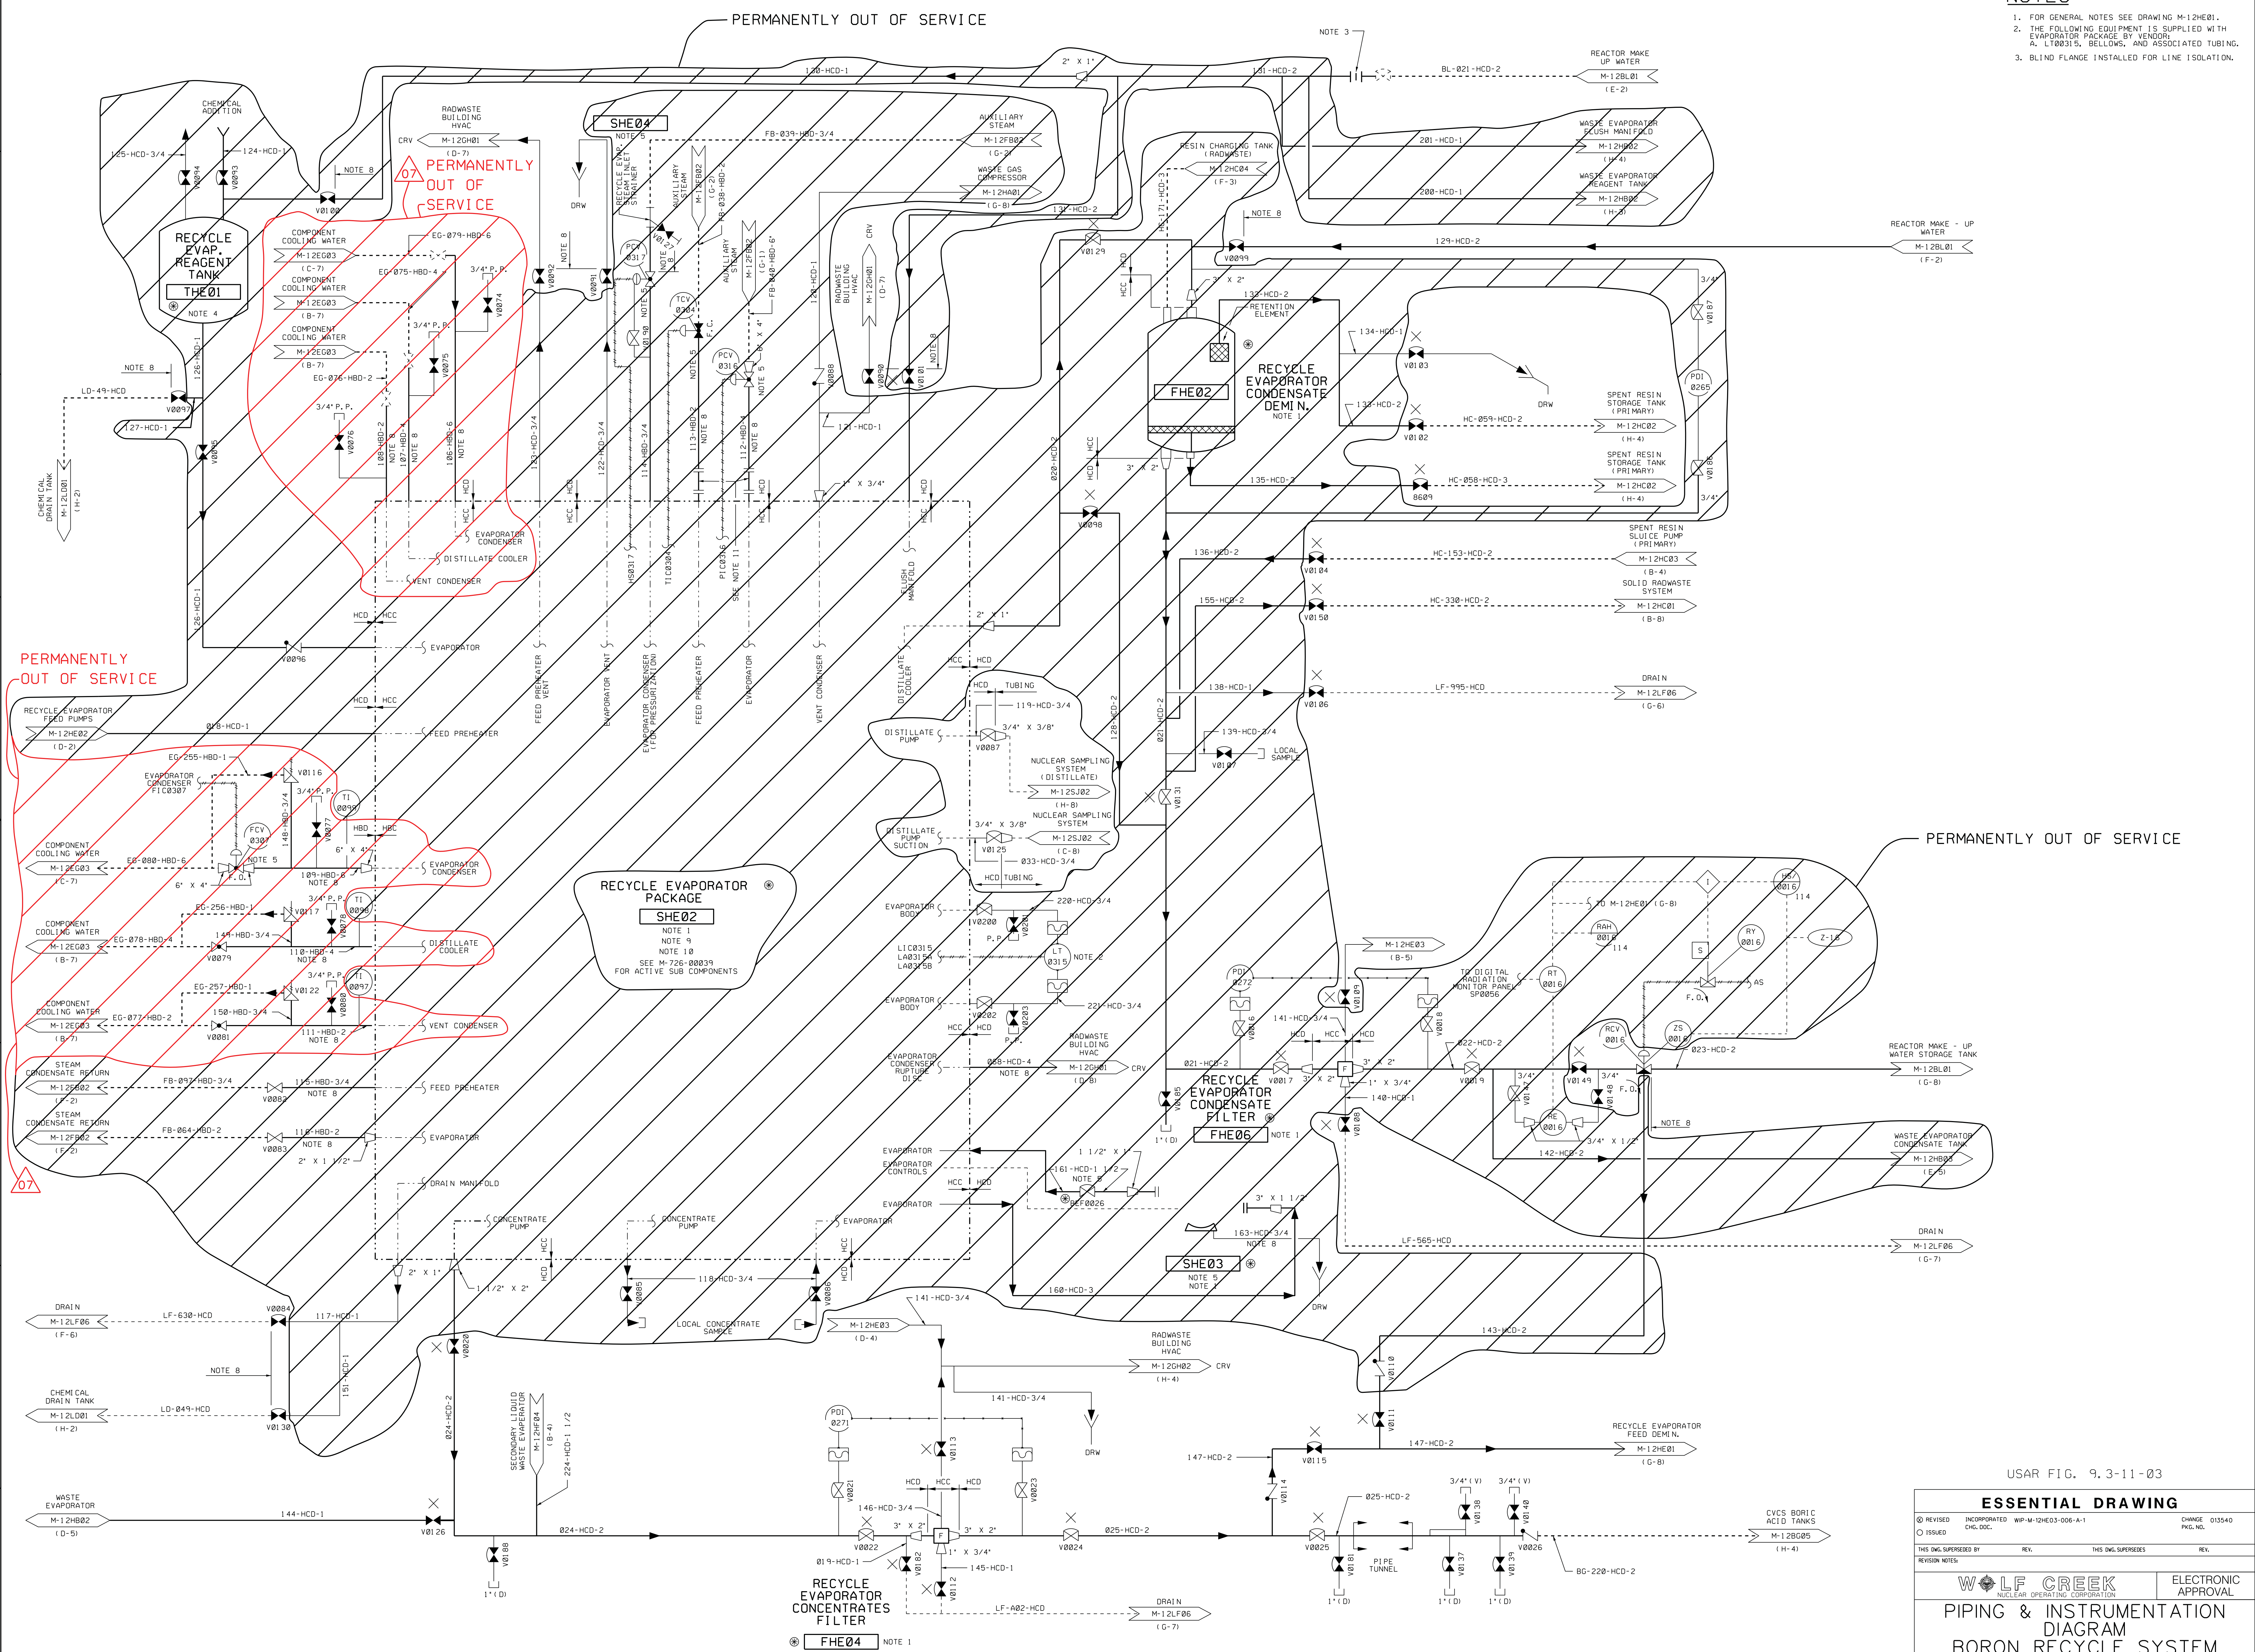

USAR FIG. 9.3-11-03

ESSENTIAL DRAWING			
REVISED	INCORPORATED	WP-M-12HE03-006-A-1	CHANGE 015540
ISSUED	CHG. DOC.		PKG. NO.
THIS DWG. SUPERSEDES		REV.	REV.
THIS DWG. SUPERSEDES		REV.	REV.
		ELECTRONIC APPROVAL	
PIPING & INSTRUMENTATION DIAGRAM BORON RECYCLE SYSTEM			
SCALE	SHEET NUMBER	SHEET	REV.
NONE	M-12HE03	07	01

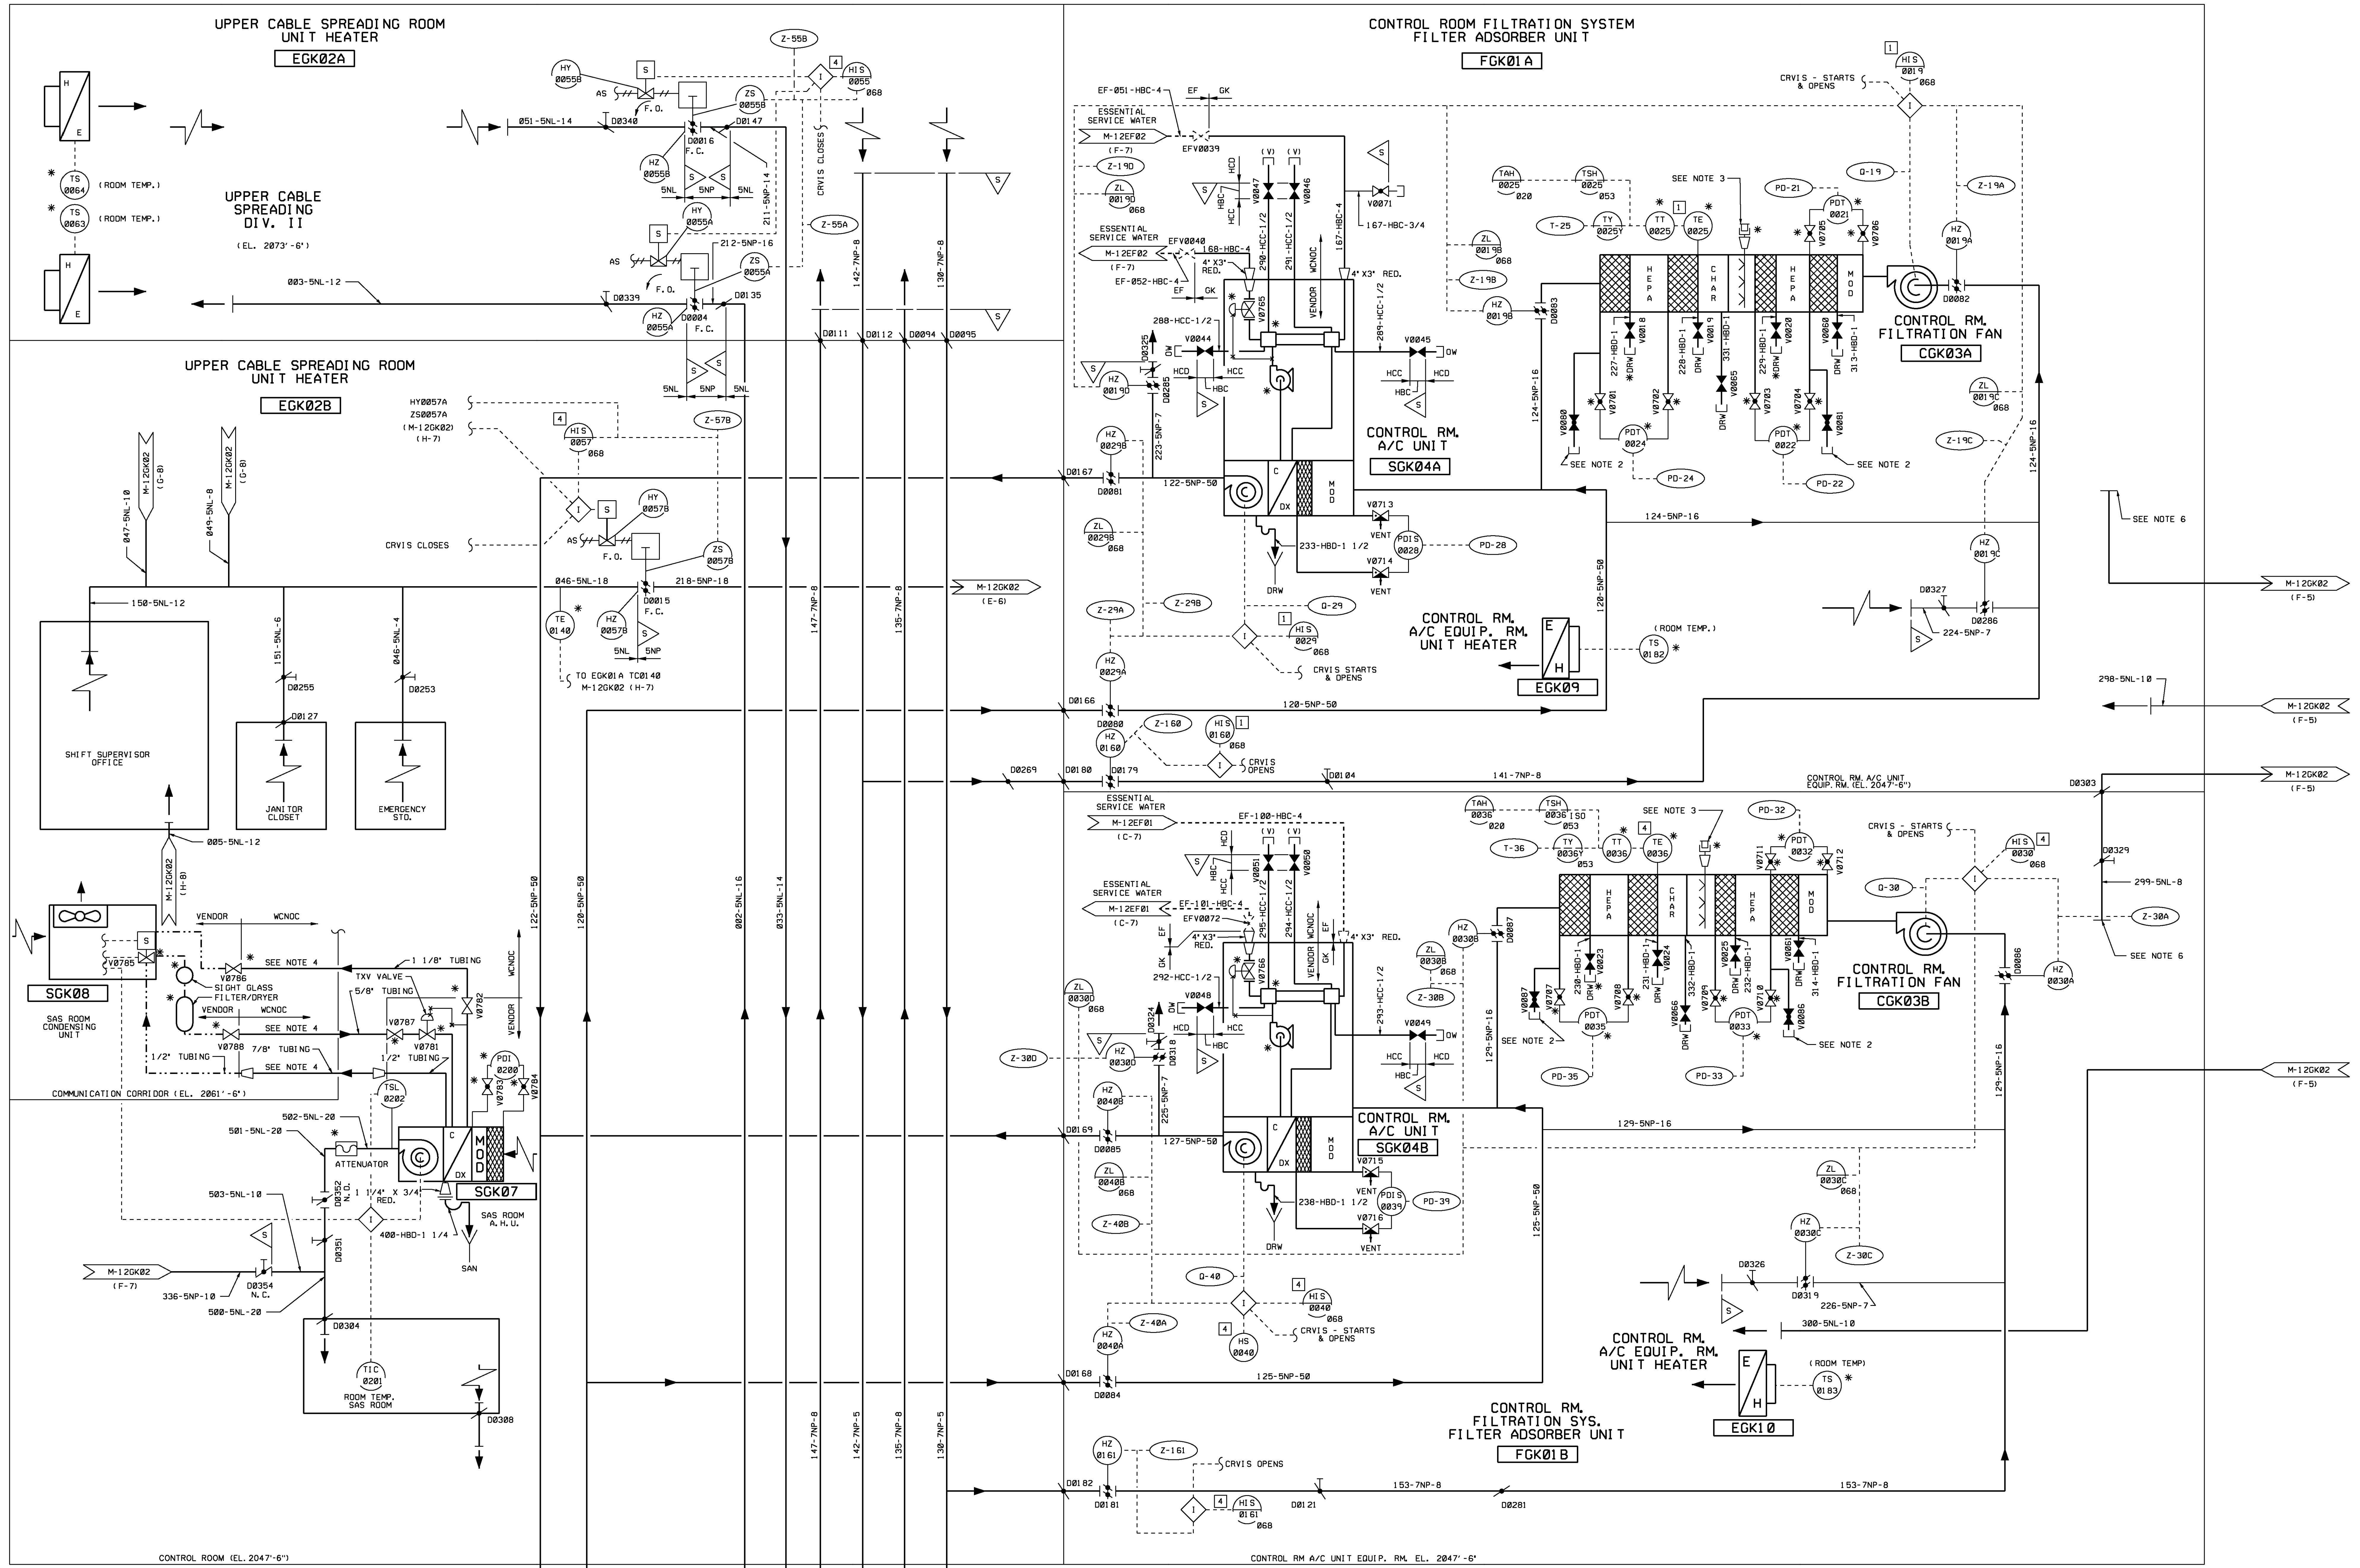

CONTROL BUILDING

AUXILIARY BUILDING

- NOTES**
1. CRVIS - CONTROL ROOM VENTILATION ISOLATION SIGNAL.
 2. CONNECTIONS ARE FOR OWNER SUPPLIED MANOMETER.
 3. FIRE HOSE FROM HOSE STATIONS 043 (FOR UNIT FGK01A) AND 038 (FOR UNIT FGK01B) TO CONNECT TO WATER SPRAY SYSTEM INLET WHEN REQUIRED.
 4. REFRIGERANT TUBING AND FITTINGS NOT INCLUDED WITH VENDOR PACKAGES FOR THE SAS ROOM A.H.U. AND SAS ROOM CONDENSING UNIT TO BE FURNISHED AND INSTALLED BY WOND.
 5. THE INDICATED PORTION OF PIPING REFERENCED TO THIS NOTE SHALL BE FABRICATED PER MS-2, CLASS HCC USING SCHEDULE 80 PIPE.
 6. EXHAUST REGISTERS FROM ROOMS 1501 AND 1512 ARE BLANKED OFF TO PRECLUDE A POTENTIAL UNMONITORED RELEASE PATH FROM THE AUXILIARY BUILDING PER DCP 06018.
 7. BOLTING MATERIAL MEETING THE REQUIREMENTS OF PIPE CLASS HBC OF SPECIFICATION MS-02 MAY BE USED TO INSTALL ESSENTIAL SERVICE WATER SUPPLIED PIPING AND COMPONENTS ON SGK04A/B.

USAR FIG. 9.4-1-01

ESSENTIAL DRAWING

REVISION	INCORPORATED	CHANGE	012860
ISSUED	ENG. DDC.	FIG. NO.	

THIS ENG. SUPERSEDES BY	REV.	THIS ENG. SUPERSEDES	REV.
REVISION NOTES	NOTE ADDED PER CHANGE PACKAGE ENGINEER		


WOLF CREEK ELECTRONIC APPROVAL
NUCLEAR OPERATING CORPORATION

PIPING & INSTRUMENTATION DIAGRAM

CONTROL BUILDING H.V.A.C.

SCALE	DRAWING NUMBER	SHEET	REV
NONE	M-12GK01	14	

3444 E SIZE
M-12GK01-11-14

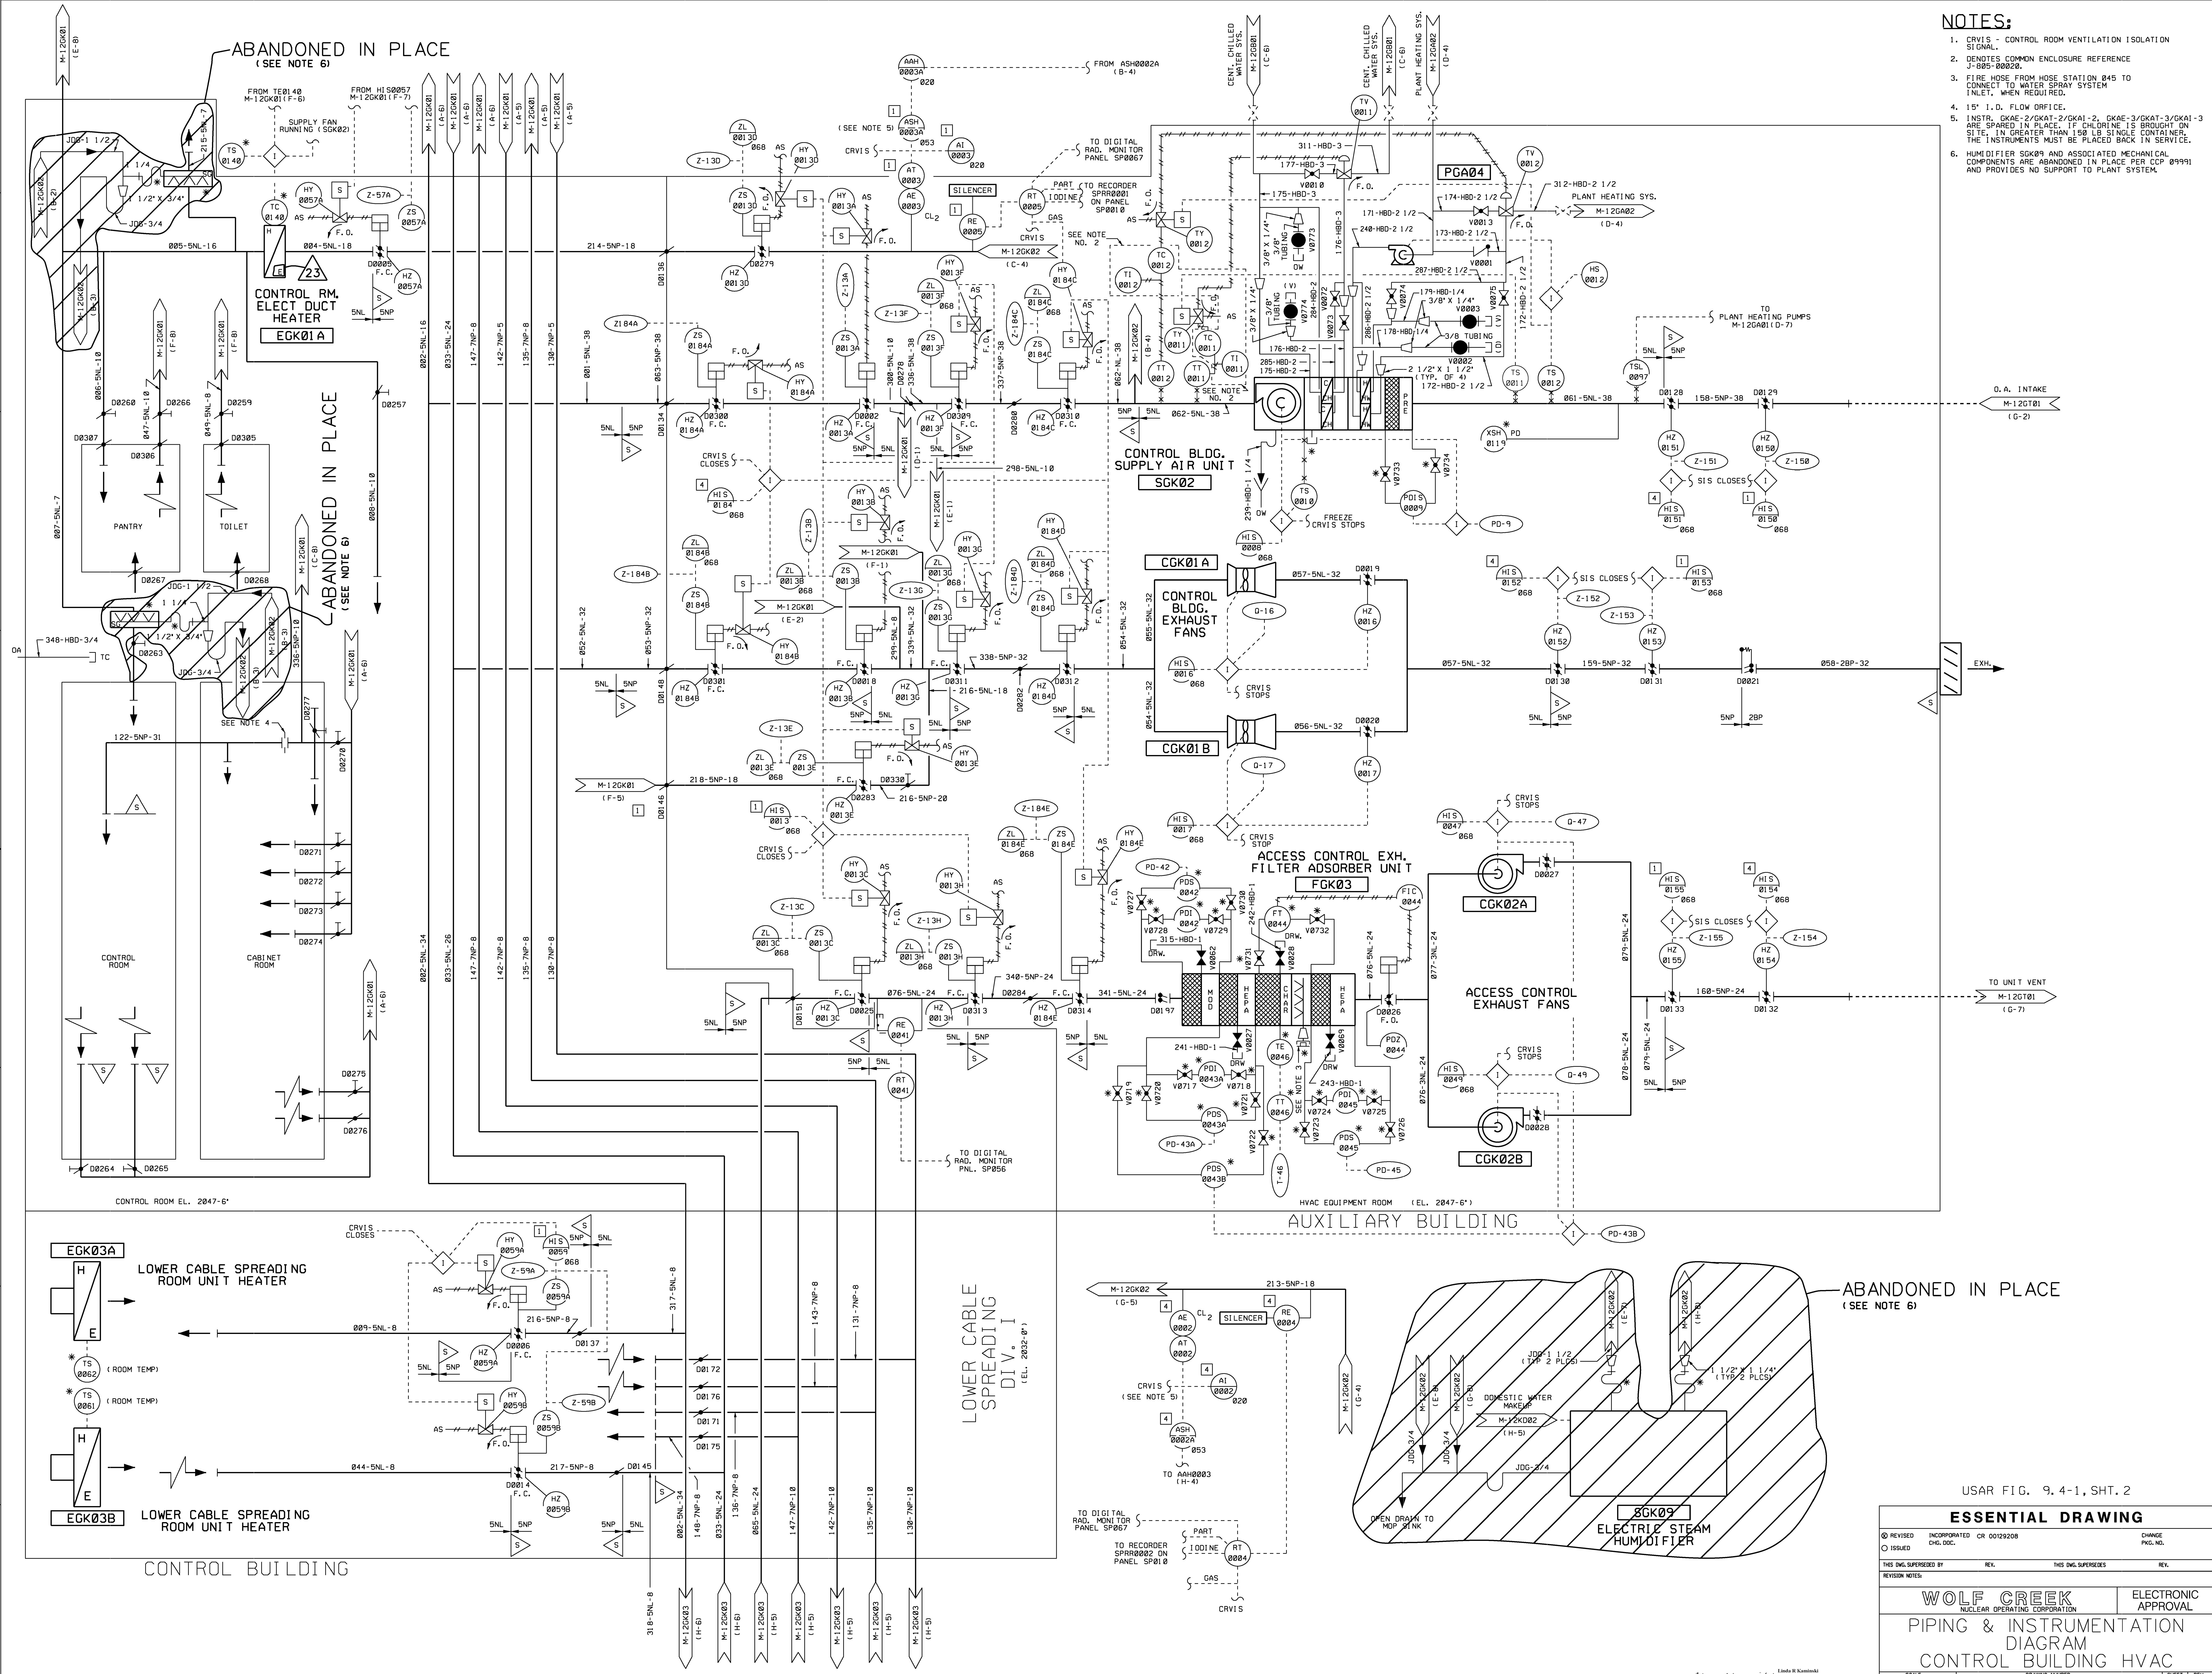

- NOTES:**
1. CRV1S - CONTROL ROOM VENTILATION ISOLATION SIGNAL.
 2. DENOTES COMMON ENCLOSURE REFERENCE J-B05-00020.
 3. FIRE HOSE FROM HOSE STATION 045 TO CONNECT TO WATER SPRAY SYSTEM INLET, WHEN REQUIRED.
 4. 1 1/2" I. D. FLOW ORIFICE.
 5. INSTR. GAKE-2/GKAT-2/GKAI-2, GAKE-3/GKAT-3/GKAI-3 ARE PREPARED IN PLACE. IF CHLORINE IS BROUGHT ON SITE, IN GREATER THAN 150 LB SINGLE CONTAINER, THE INSTRUMENTS MUST BE PLACED BACK IN SERVICE.
 6. HUMIDIFIER SGK09 AND ASSOCIATED MECHANICAL COMPONENTS ARE ABANDONED IN PLACE PER CCP 09991 AND PROVIDES NO SUPPORT TO PLANT SYSTEM.

USAR FIG. 9.4-1, SHT. 2


ESSENTIAL DRAWING

REVISION	INCORPORATED OR 00129208	CHANGE
ISSUED	CHG. DOC.	FIG. NO.
THIS ENG. SUPERSEDES	REV.	THIS ENG. SUPERSEDES
REVISION NUMBER		REV.

WOLF CREEK
NUCLEAR OPERATING CORPORATION

ELECTRONIC APPROVAL
PIPING & INSTRUMENTATION
CONTROL BUILDING HVAC

SCALE	DRAWING NUMBER	SHEET
NONE	M-12GK02	23

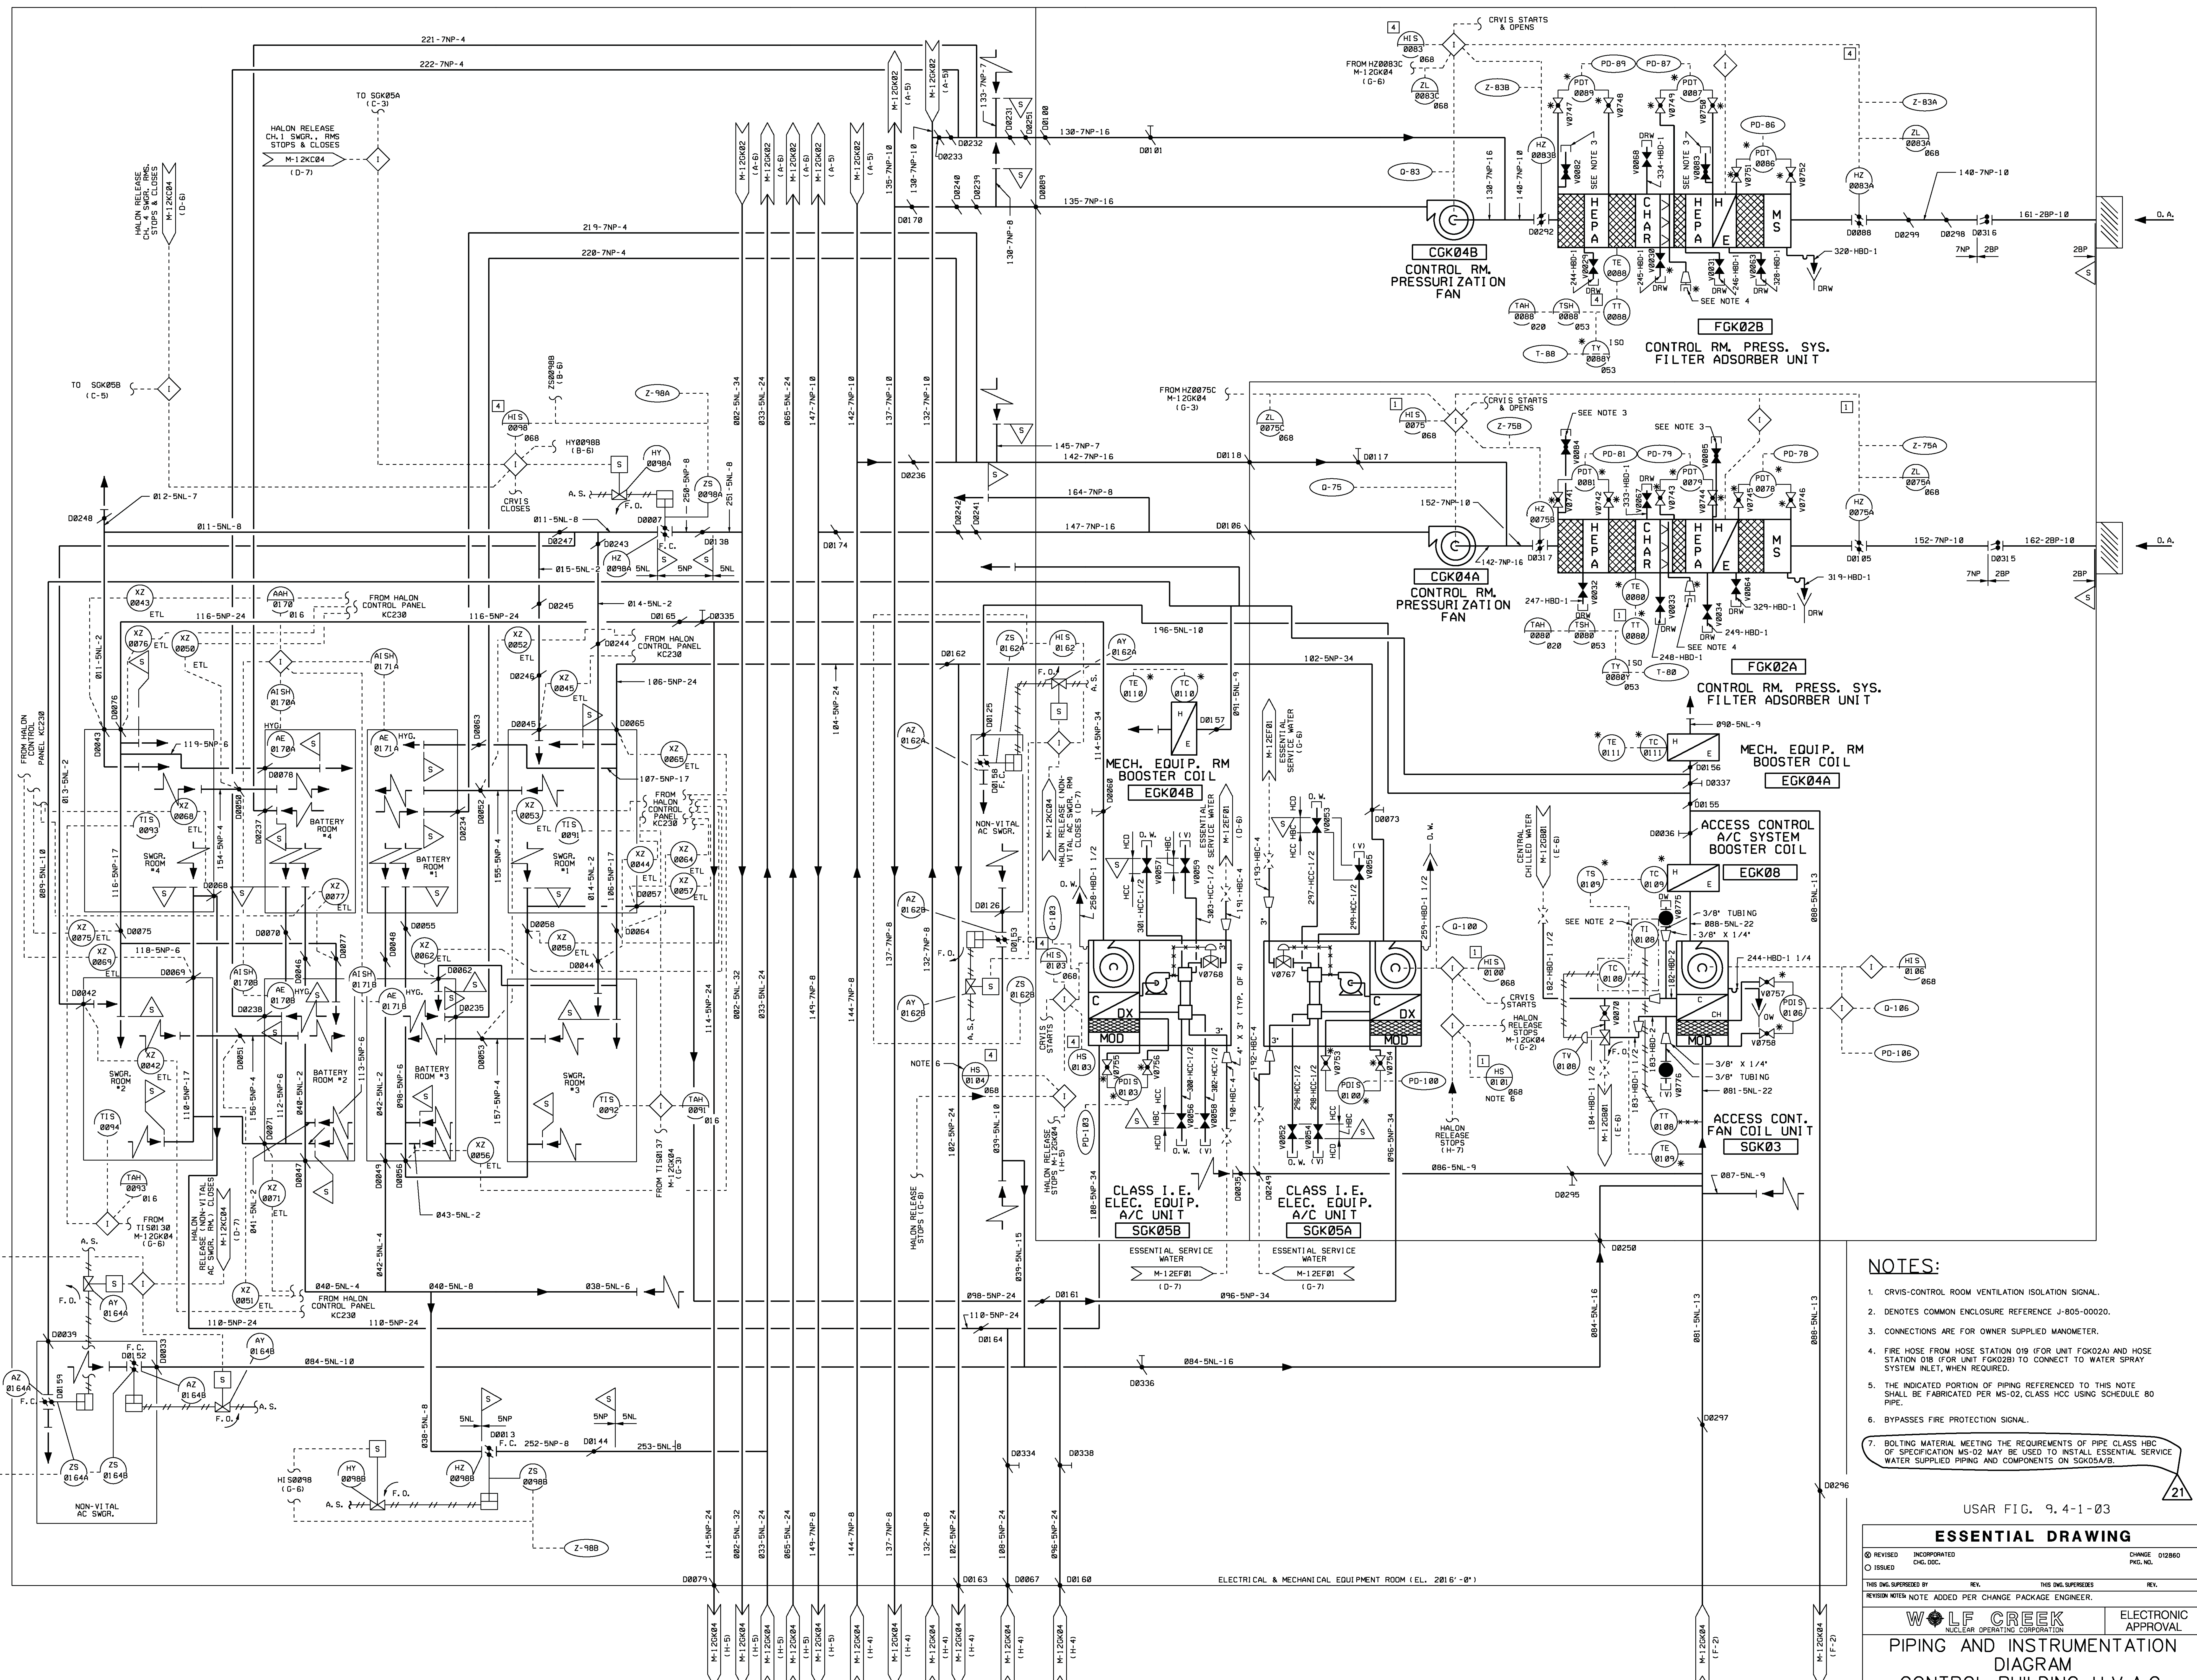

USAR FIG. 9.4-1-03

ESSENTIAL DRAWING

REVISED	INCORPORATED	CHANGE	012860
ISSUED	CHG. DOC.	PKG. NO.	

THIS Dwg. SUBMITTED BY: **REV.** THIS Dwg. SUPERSEDES: **REV.**

REVISION NOTE: NOTE ADDED PER CHANGE PACKAGE ENGINEER.

WOLF CREEK ELECTRONIC APPROVAL


PIPING AND INSTRUMENTATION DIAGRAM

CONTROL BUILDING H.V.A.C.

SCALE: NONE DRAWING NUMBER: **M-12GK03** SHEET: **21**

3444 E SIZE M-12GK03-11-21

ELECTRICAL & MECHANICAL EQUIPMENT ROOM (EL. 281.6' - 0")

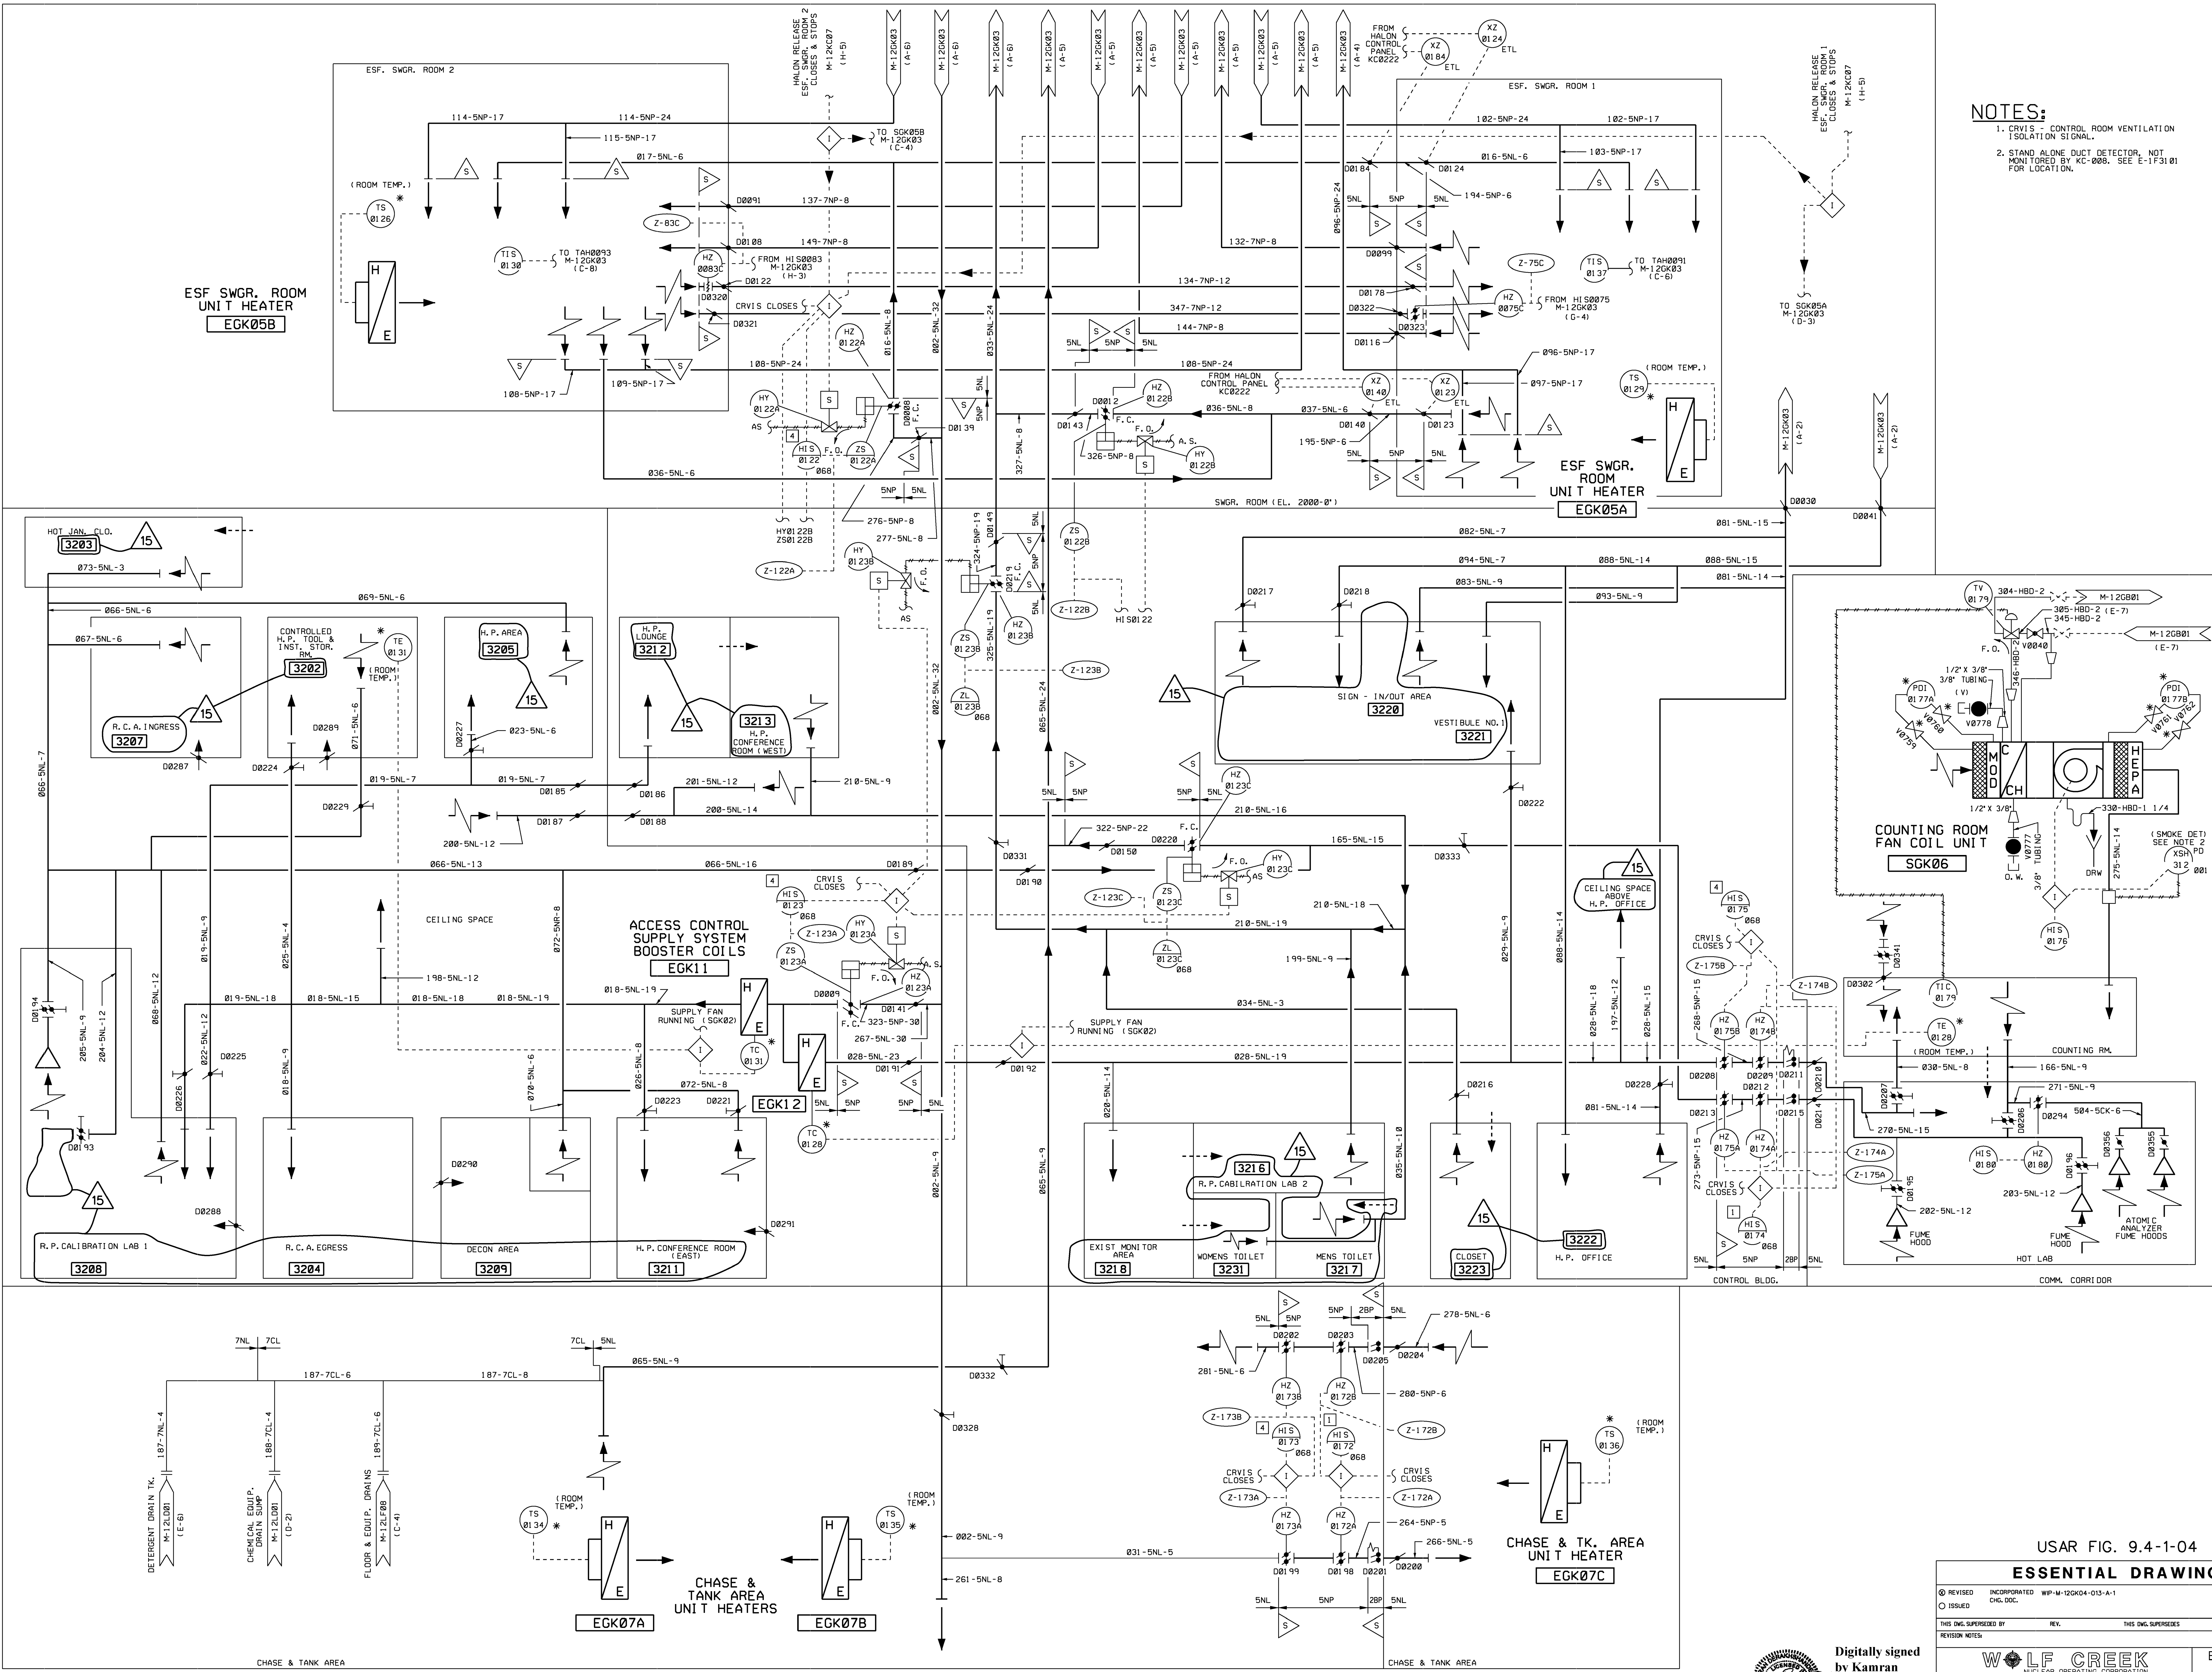

NOTES:
 1. CRV/S - CONTROL ROOM VENTILATION ISOLATION SIGNAL
 2. STAND ALONE DUCT DETECTOR, NOT MONITORED BY KC-005. SEE E-1F3101 FOR LOCATION.

USAR FIG. 9.4-1-04

ESSENTIAL DRAWING



REVISED	INCORPORATED	WIP-M-12GK04-013-A-1	CHANGE	013979
ISSUED	CIG. DOC.		PKG. NO.	
THIS DWG. SUPERSEDES		REV.	THIS DWG. SUPERSEDES	
REVISION NOTES				

Digitally signed by Kamran Qerakshandegan
 Date: 2018.12.18 10:37:57 -06'00'



Scale NONE
 Drawing Number M-12GK04
 Sheet 15 of 15

WOLF CREEK
 NUCLEAR OPERATING CORPORATION
 ELECTRONIC APPROVAL
 PIPING AND INSTRUMENTATION
 DIAGRAM CONTROL
 BUILDING H.V.A.C.

SPENT FUEL POOL AREA

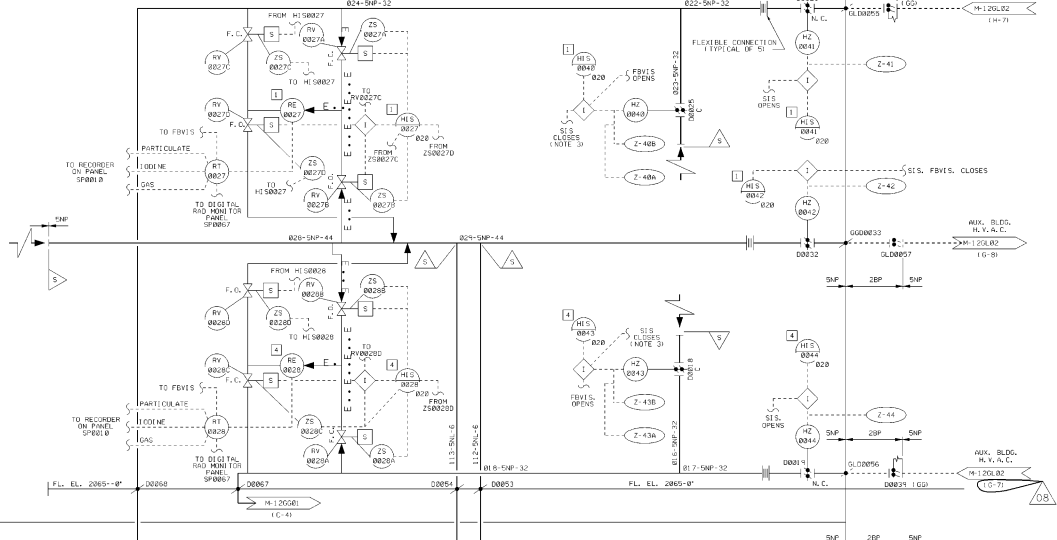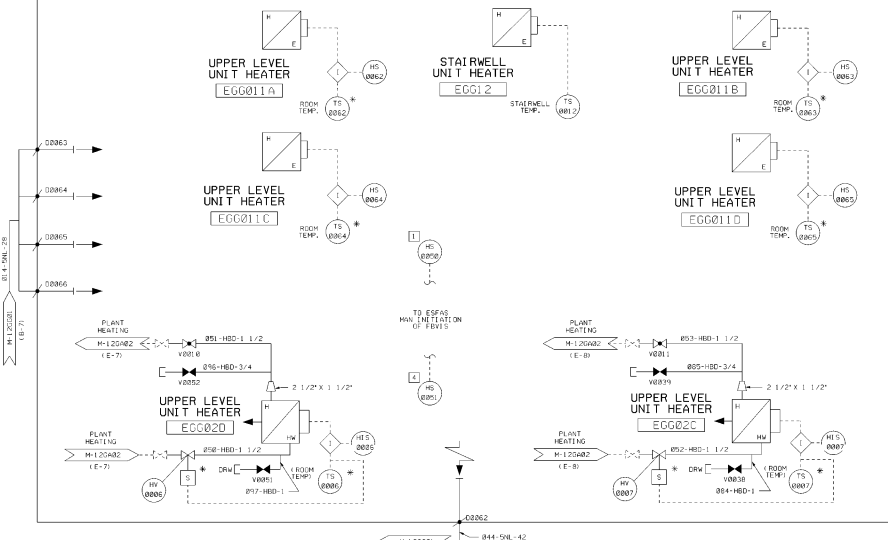


EMERGENCY EXHAUST FILTER ADSORBER ROOM

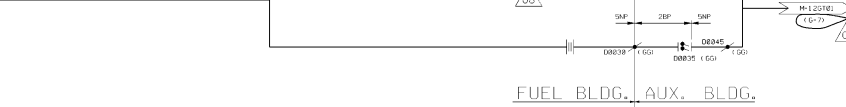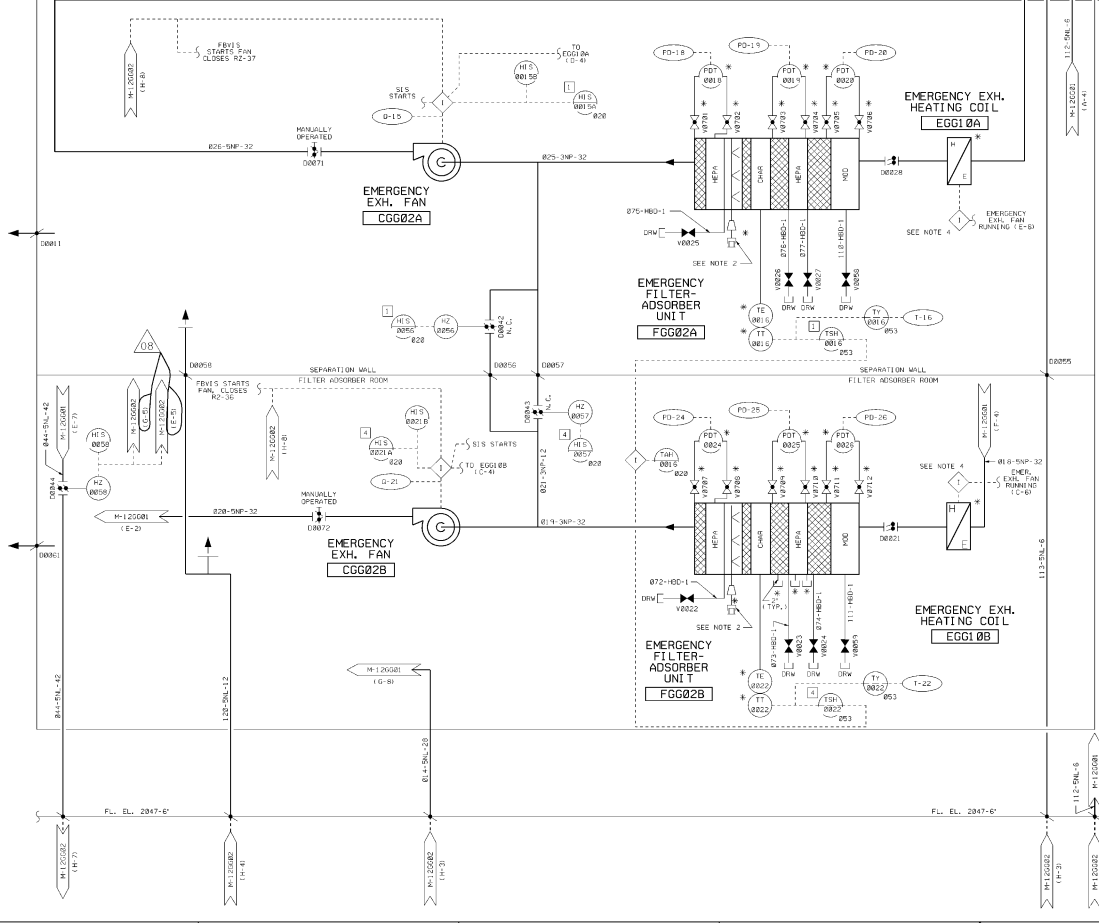

- NOTES:**
- DUCTWORK DIMENSIONS ARE EQUIVALENT ROUND.
 - FLUE HOSE FROM NODE STATION W/FL. COOL DR. IS PROVIDED AND HOSE STATION IS CONNECTED TO WATER SPRAY SYSTEM INLET, WHEN REQUIRED.
 - DAMPERS G00005 AND G00006 NO LONGER COMPLETELY ELIM. DAMPERS G00006 AND G00005 ARE PART PROVIDED FOR AN SEC 3 DETERMINED. DAMPERS G00005 AND G00006 SHOULD FULL OPEN UPON FV15 ACTION.
 - HUMIDITY CONTROLS FOR EMERGENCY EXHAUST SYSTEMS (FV15, FV16 AND FV17) SHOULD PROVIDE CONTROL OVER THE HEATERS. HUMIDITY CONTROLLERS ARE SPARED IN PLACE.

USAR FIG. 9, 4-2-01

ESSENTIAL DRAWING			
REVISED	INCORPORATED	DATE	BY
01	01		
THIS DRAWING IS THE PROPERTY OF WOLF CREEK		ELECTRONIC APPROVAL	
WOLF CREEK PIPING AND INSTRUMENTATION FUEL BUILDING HVAC			
SCALE	SHEET NUMBER	SHEET NO.	TOTAL SHEETS
NONE	M-12GG01	08	08

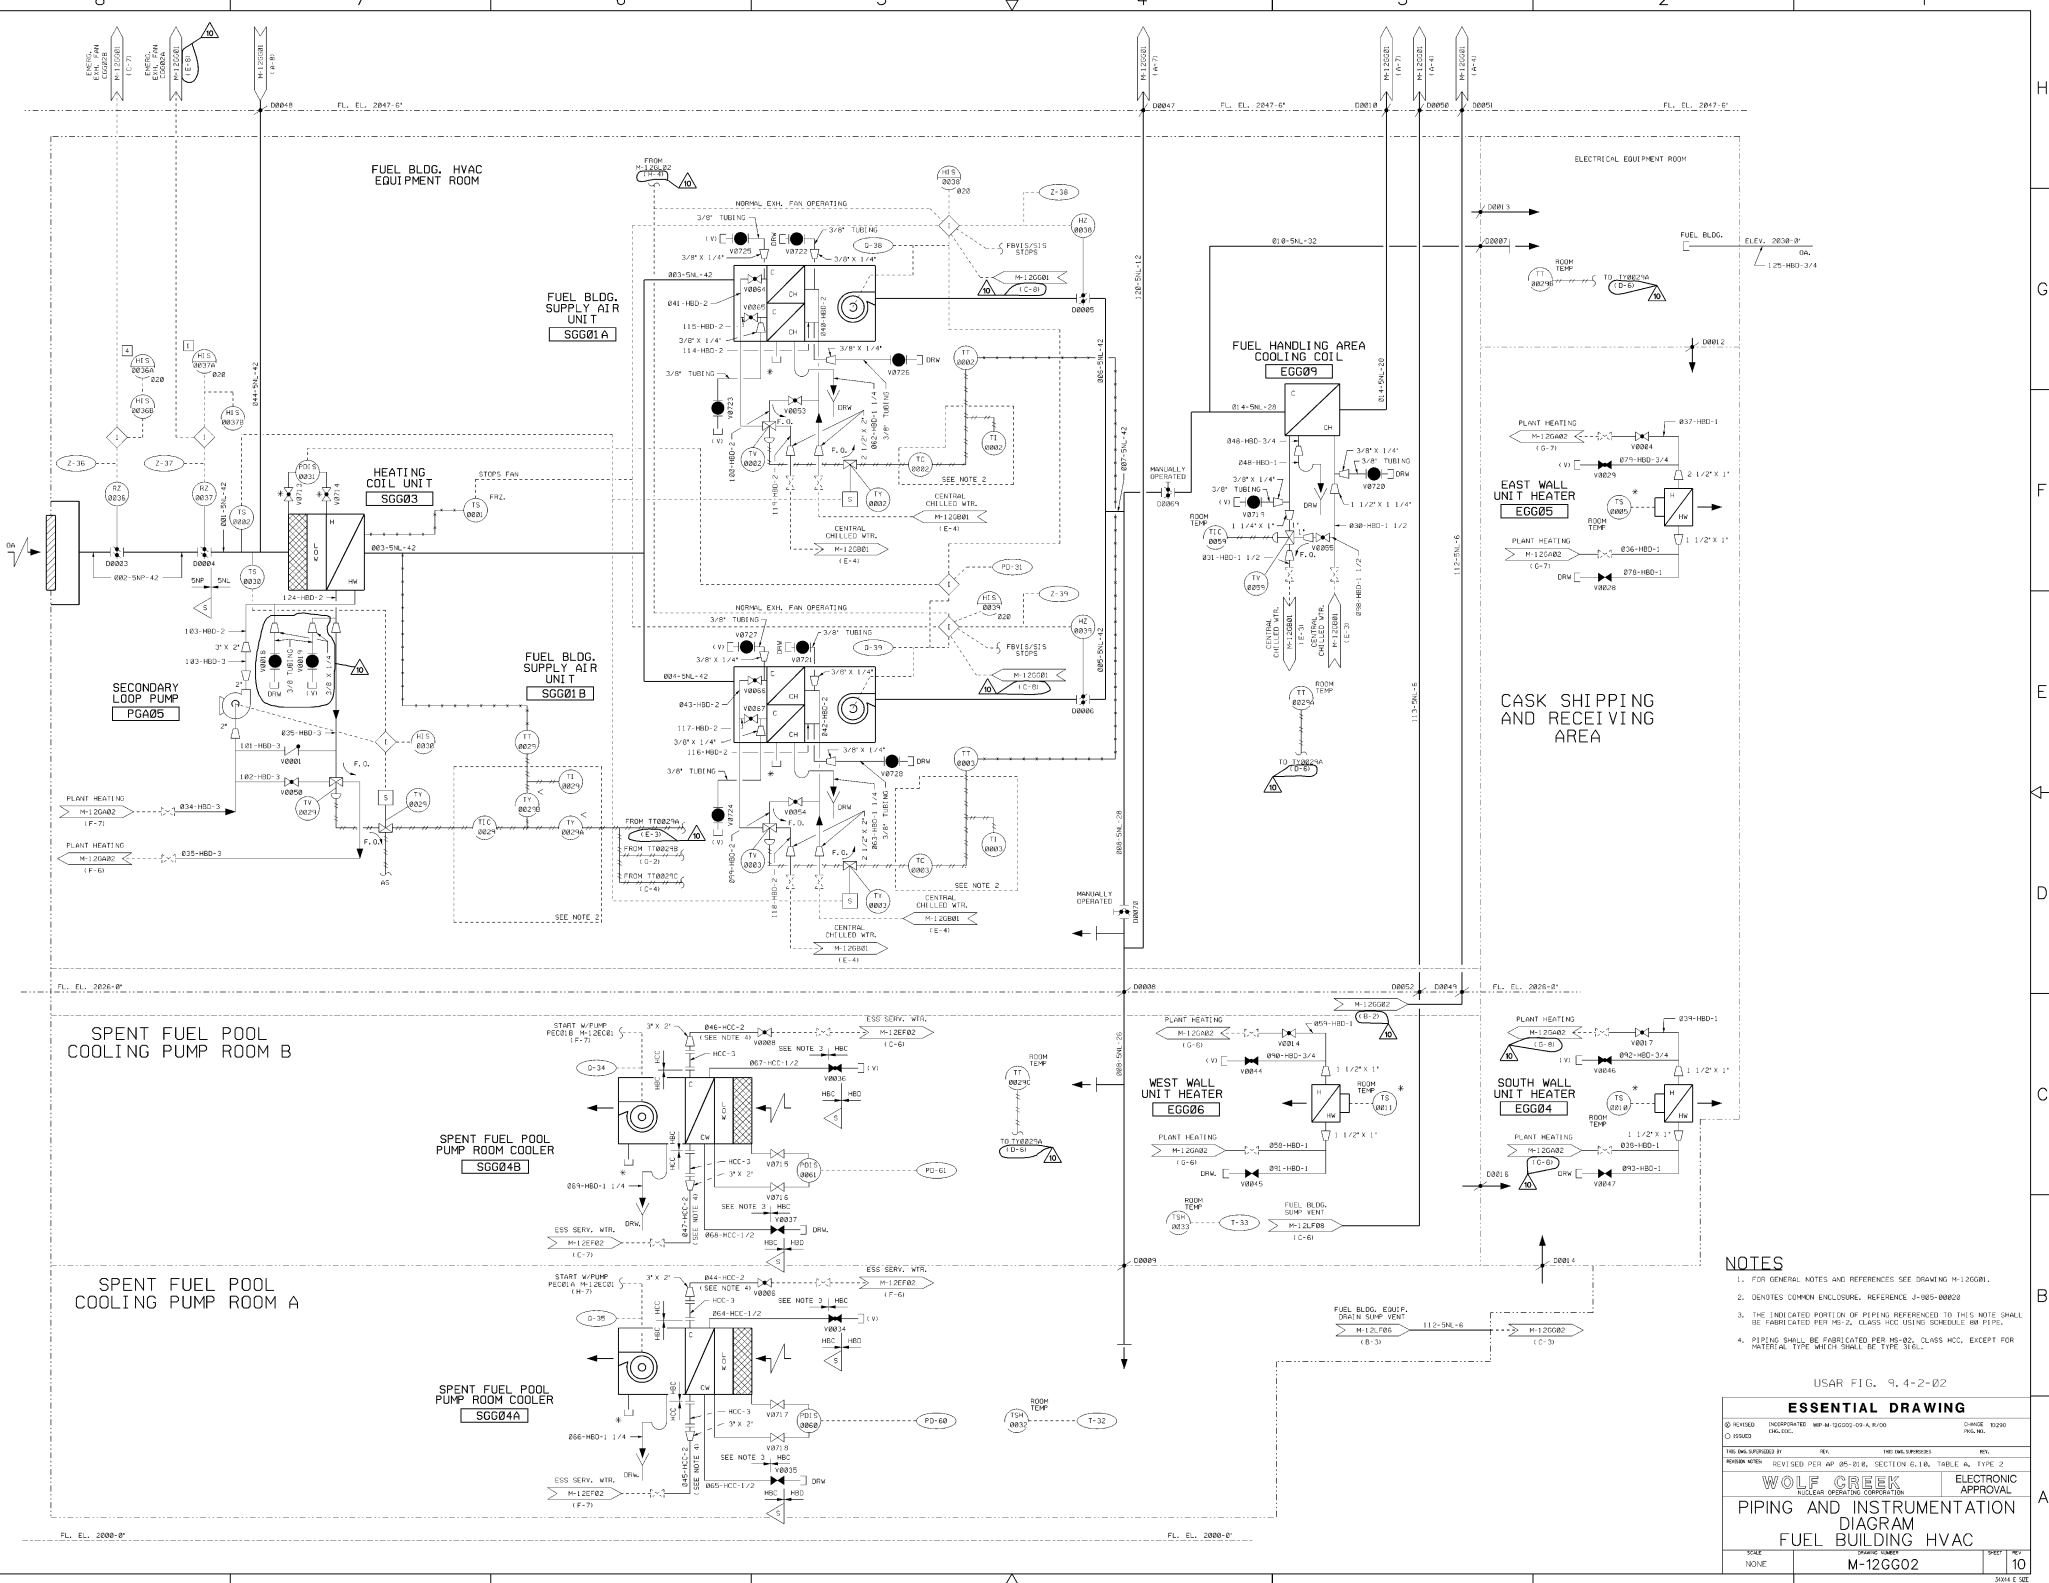


NOTES

- FOR GENERAL NOTES AND REFERENCES SEE DRAWING M-12GG01.
- IDENTIFY COMMON ENCLOSURE, REFERENCE J-NB0-NB20.
- THE INDICATED POINT (OR) OF PIPING REFERENCED TO THIS NOTE SHALL BE FABRICATED PER MS-2, CLASS MCC USING SCHEDULE 80 PIPE.
- PIPING SHALL BE FABRICATED PER MS-2, CLASS MCC, EXCEPT FOR MATERIAL TYPE WHICH SHALL BE TYPE 316L.

USAR FIG. 9, 4-2-B2

ESSENTIAL DRAWING			
REVISED FOR MS-2, CLASS MCC	DATE: 02/01/00	BY: J. W. HARRIS	NO. 10
WOLF CREEK		ELECTRONIC APPROVAL	
PIPING AND INSTRUMENTATION DIAGRAM			
FUEL BUILDING HVAC			
M-12GG02		SHEET NO. 10	

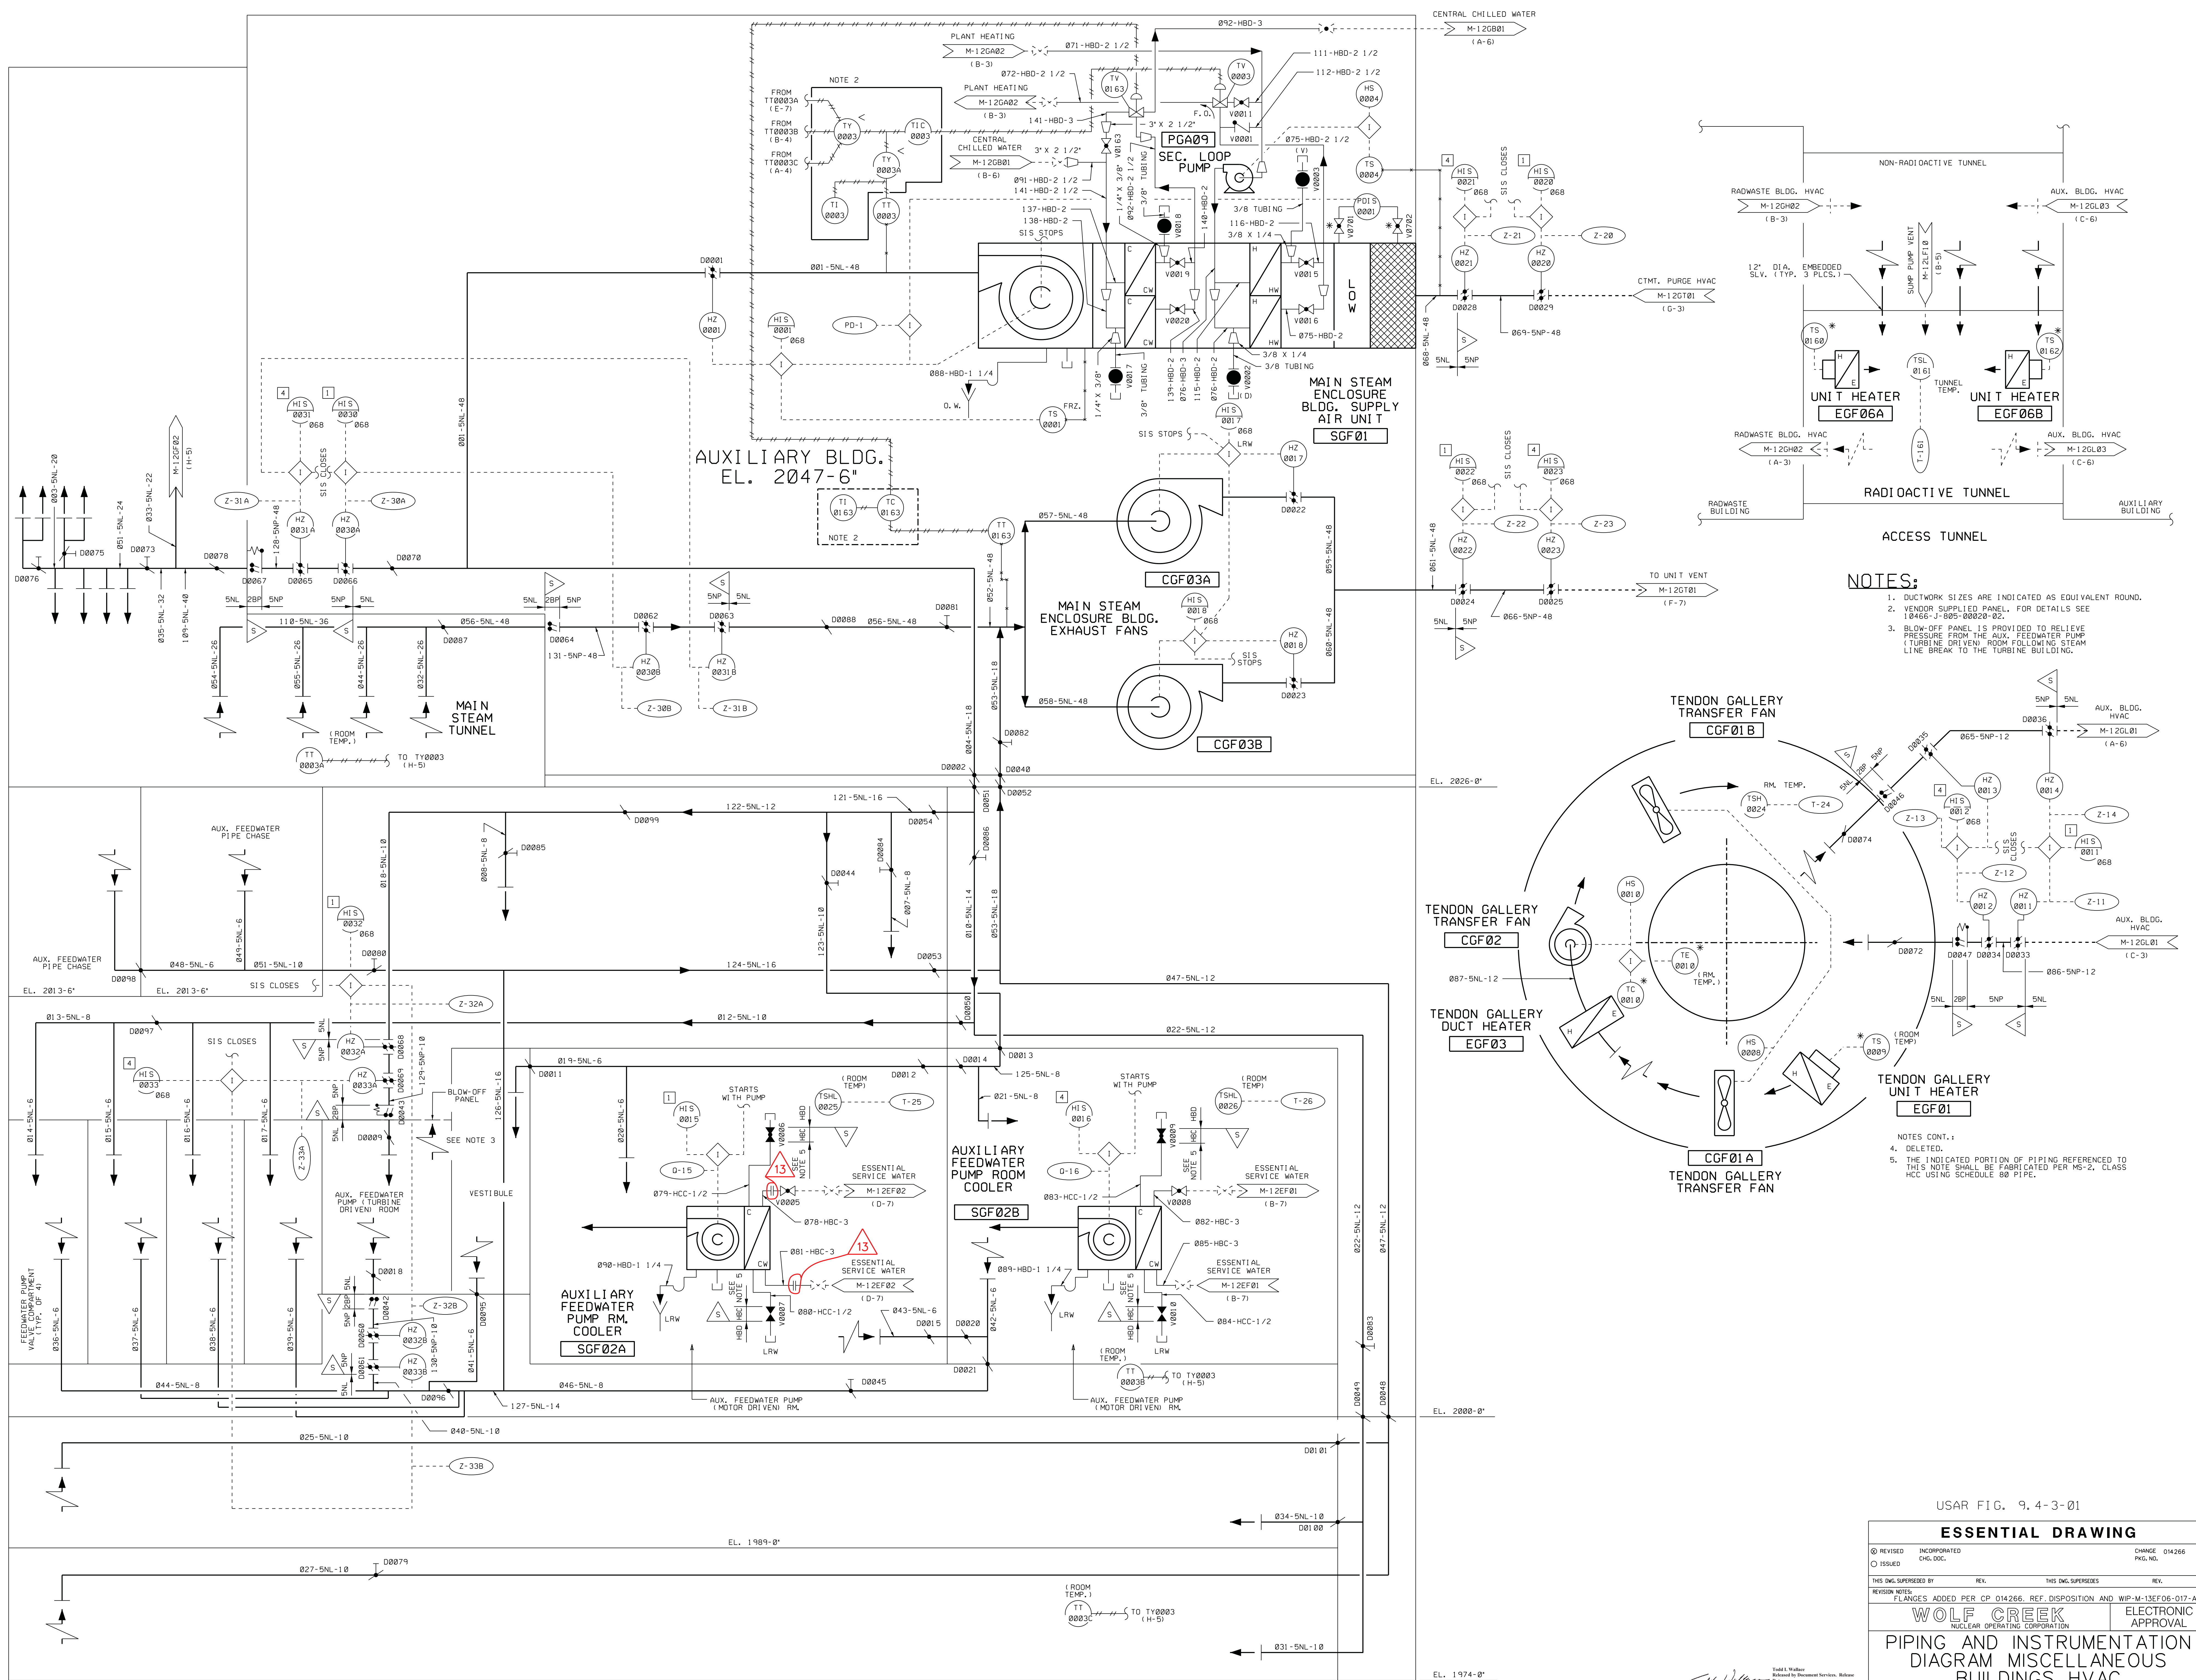

- NOTES:**
1. DUCTWORK SIZES ARE INDICATED AS EQUIVALENT ROUND.
 2. VENDOR SUPPLIED PANEL. FOR DETAILS SEE 10466-J-005-0020-02.
 3. BLOW-OFF PANEL IS PROVIDED TO RELIEVE PRESSURE FROM THE AUX. FEEDWATER PUMP (TURBINE DRIVEN) ROOM FOLLOWING STEAM LINE BREAK TO THE TURBINE BUILDING.



- NOTES CONT.:**
4. DELETED.
 5. THE INDICATED PORTION OF PIPING REFERENCED TO THIS NOTE SHALL BE FABRICATED PER MS-2, CLASS HCC USING SCHEDULE 80 PIPE.

MAIN STEAM ENCLOSURE BUILDING


USAR FIG. 9.4-3-01

ESSENTIAL DRAWING		
REVISION	INCORPORATED	CHANGE 014266
ISSUED	CHG. DOC.	PKG. NO.
THIS DWG. SUPERSEDES		
REV.	REV.	REV.
REVISION NOTES:		
FLANGES ADDED PER CP 014266, REF. DISPOSITION AND WIP-M-130E06-017-A-1		
WOLF CREEK		ELECTRONIC APPROVAL
NUCLEAR OPERATING CORPORATION		
PIPING AND INSTRUMENTATION DIAGRAM MISCELLANEOUS BUILDINGS HVAC		
SCALE	DRAWING NUMBER	SHEET
NONE	M-12GF01	13




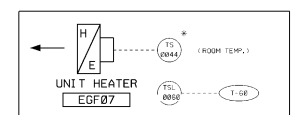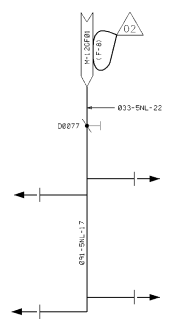


REFUELING WATER STORAGE TANK VALVE HOUSE

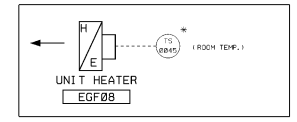

REACTOR MAKE-UP WATER STORAGE TANK VALVE HOUSE

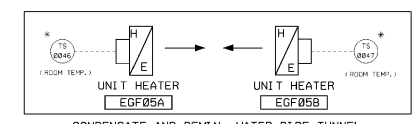

CONDENSATE AND DEMIN. WATER PIPE TUNNEL

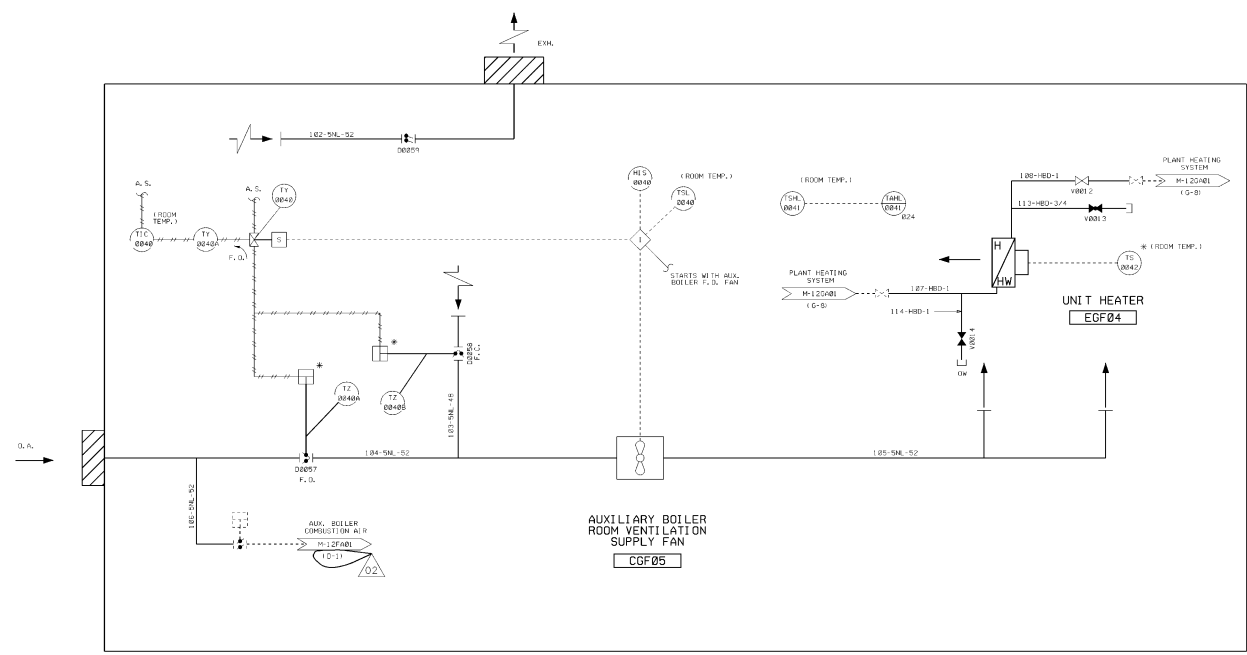


AUXILIARY BOILER ROOM

NOTES:

- 1. DUCTWORK SIZES ARE INDICATED AS EQUIVALENT ROUND.

USAR FIG. 9, 4-3-02

ESSENTIAL DRAWING			
Q REVISION	INCORPORATED	DATE	BY
D ISSUED	REVISION		
THIS DRAWING IS THE PROPERTY OF THE U.S. GOVERNMENT AND IS TO BE RETURNED TO THE U.S. GOVERNMENT UPON REQUEST.		NO. 100-1000000	
PROJECT NAME: REVISED PLAN OF ED-01A, SECT 1 ON 6, 1B, TABLE A, TYPE 2		ELECTRONIC APPROVAL	
		ELECTRONIC APPROVAL	
PIPING & INSTRUMENTATION DIAGRAM MISCELLANEOUS BUILDINGS HVAC			
SCALE	DWG. NUMBER	SHEET	NO.
NONE	M-12GF02	02	02

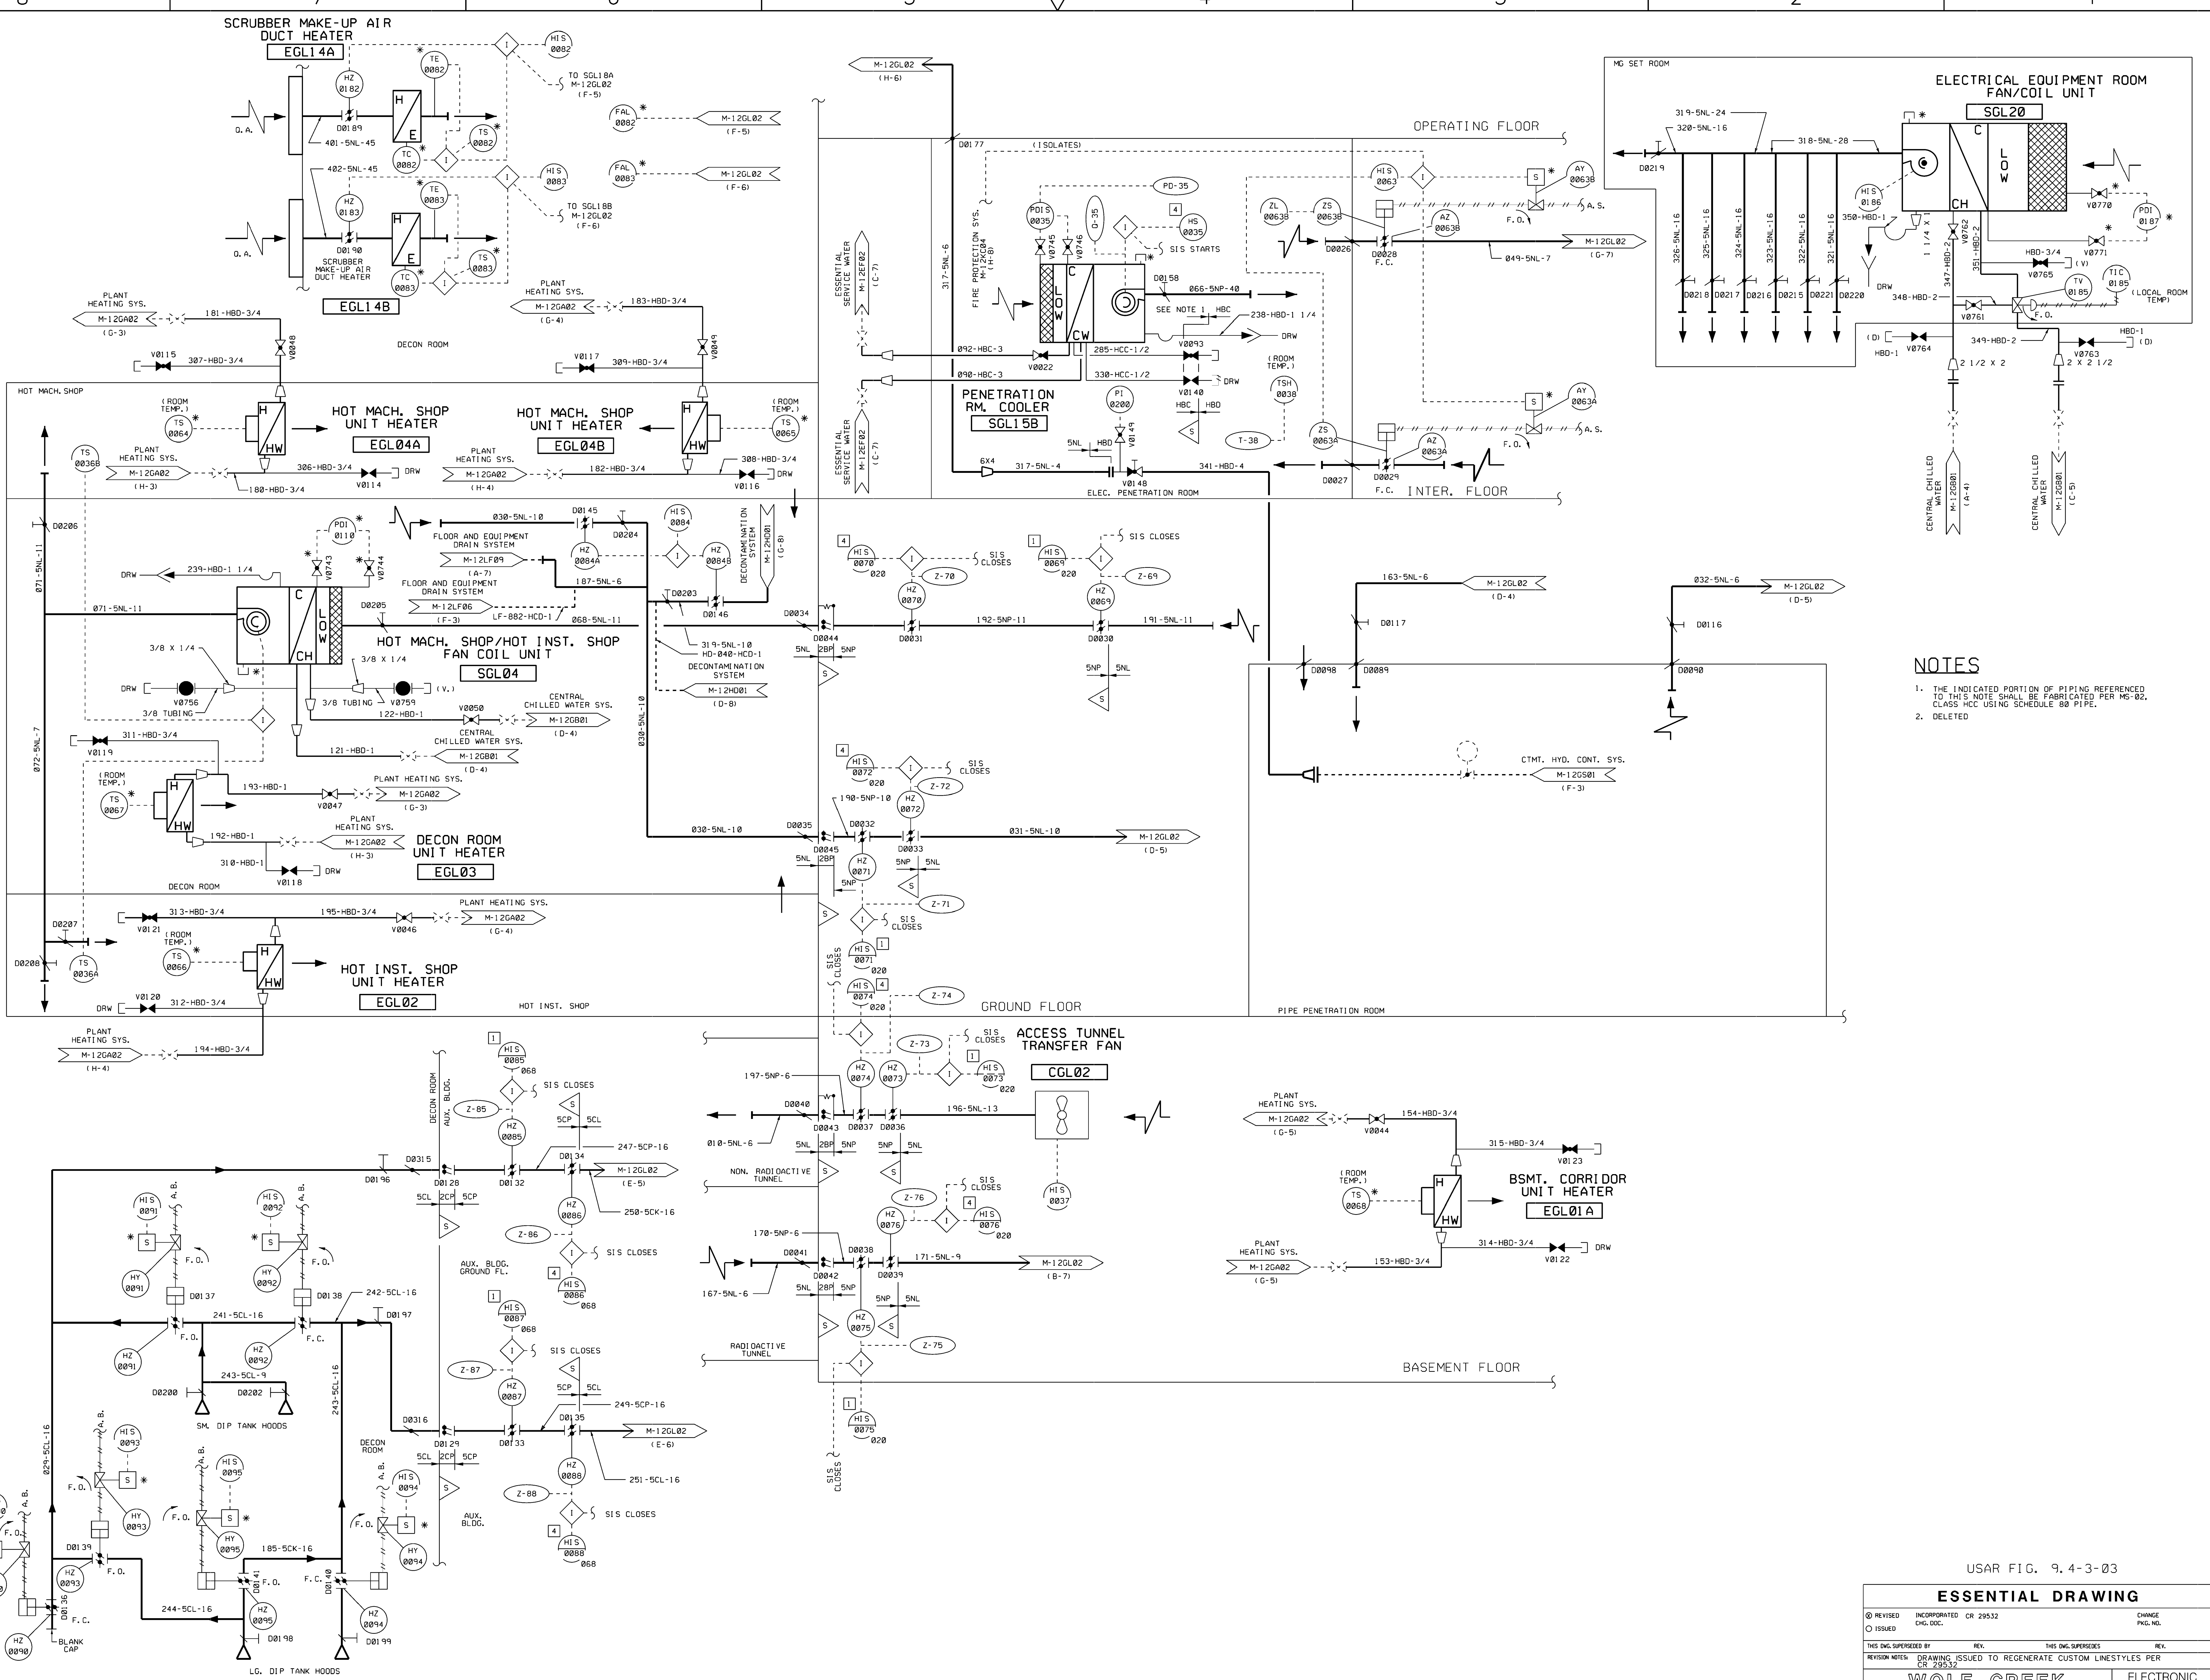


NOTES


1. THE INDICATED PORTION OF PIPING REFERENCED TO THIS NOTE SHALL BE FABRICATED PER MS-02, CLASS HCC USING SCHEDULE 80 PIPE.
2. DELETED

USAR FIG. 9.4-3-03

ESSENTIAL DRAWING			
REVISED	INCORPORATED CR 29532	CHANGE	
ISSUED	CHG. DOC.	PKG. NO.	
THIS DWG. SUPERSEDES BY		REV.	
REVISION NOTES: DRAWING ISSUED TO REGENERATE CUSTOM LIFESTYLES PER CR 29532			
WOLF CREEK		ELECTRONIC APPROVAL	
NUCLEAR OPERATING CORPORATION			
PIPING & INSTRUMENTATION DIAGRAM			
AUXILIARY BUILDING HVAC			
SCALE	DRAWING NUMBER	SHEET	REV
NONE	M-12GL03	12	

Black & Veatch

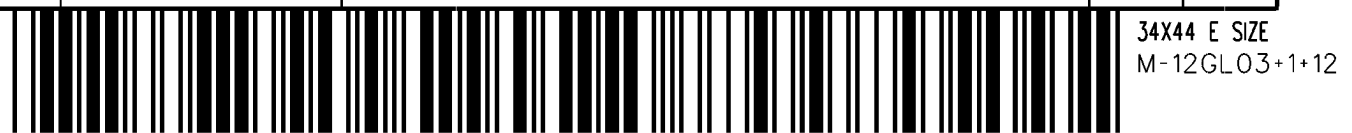

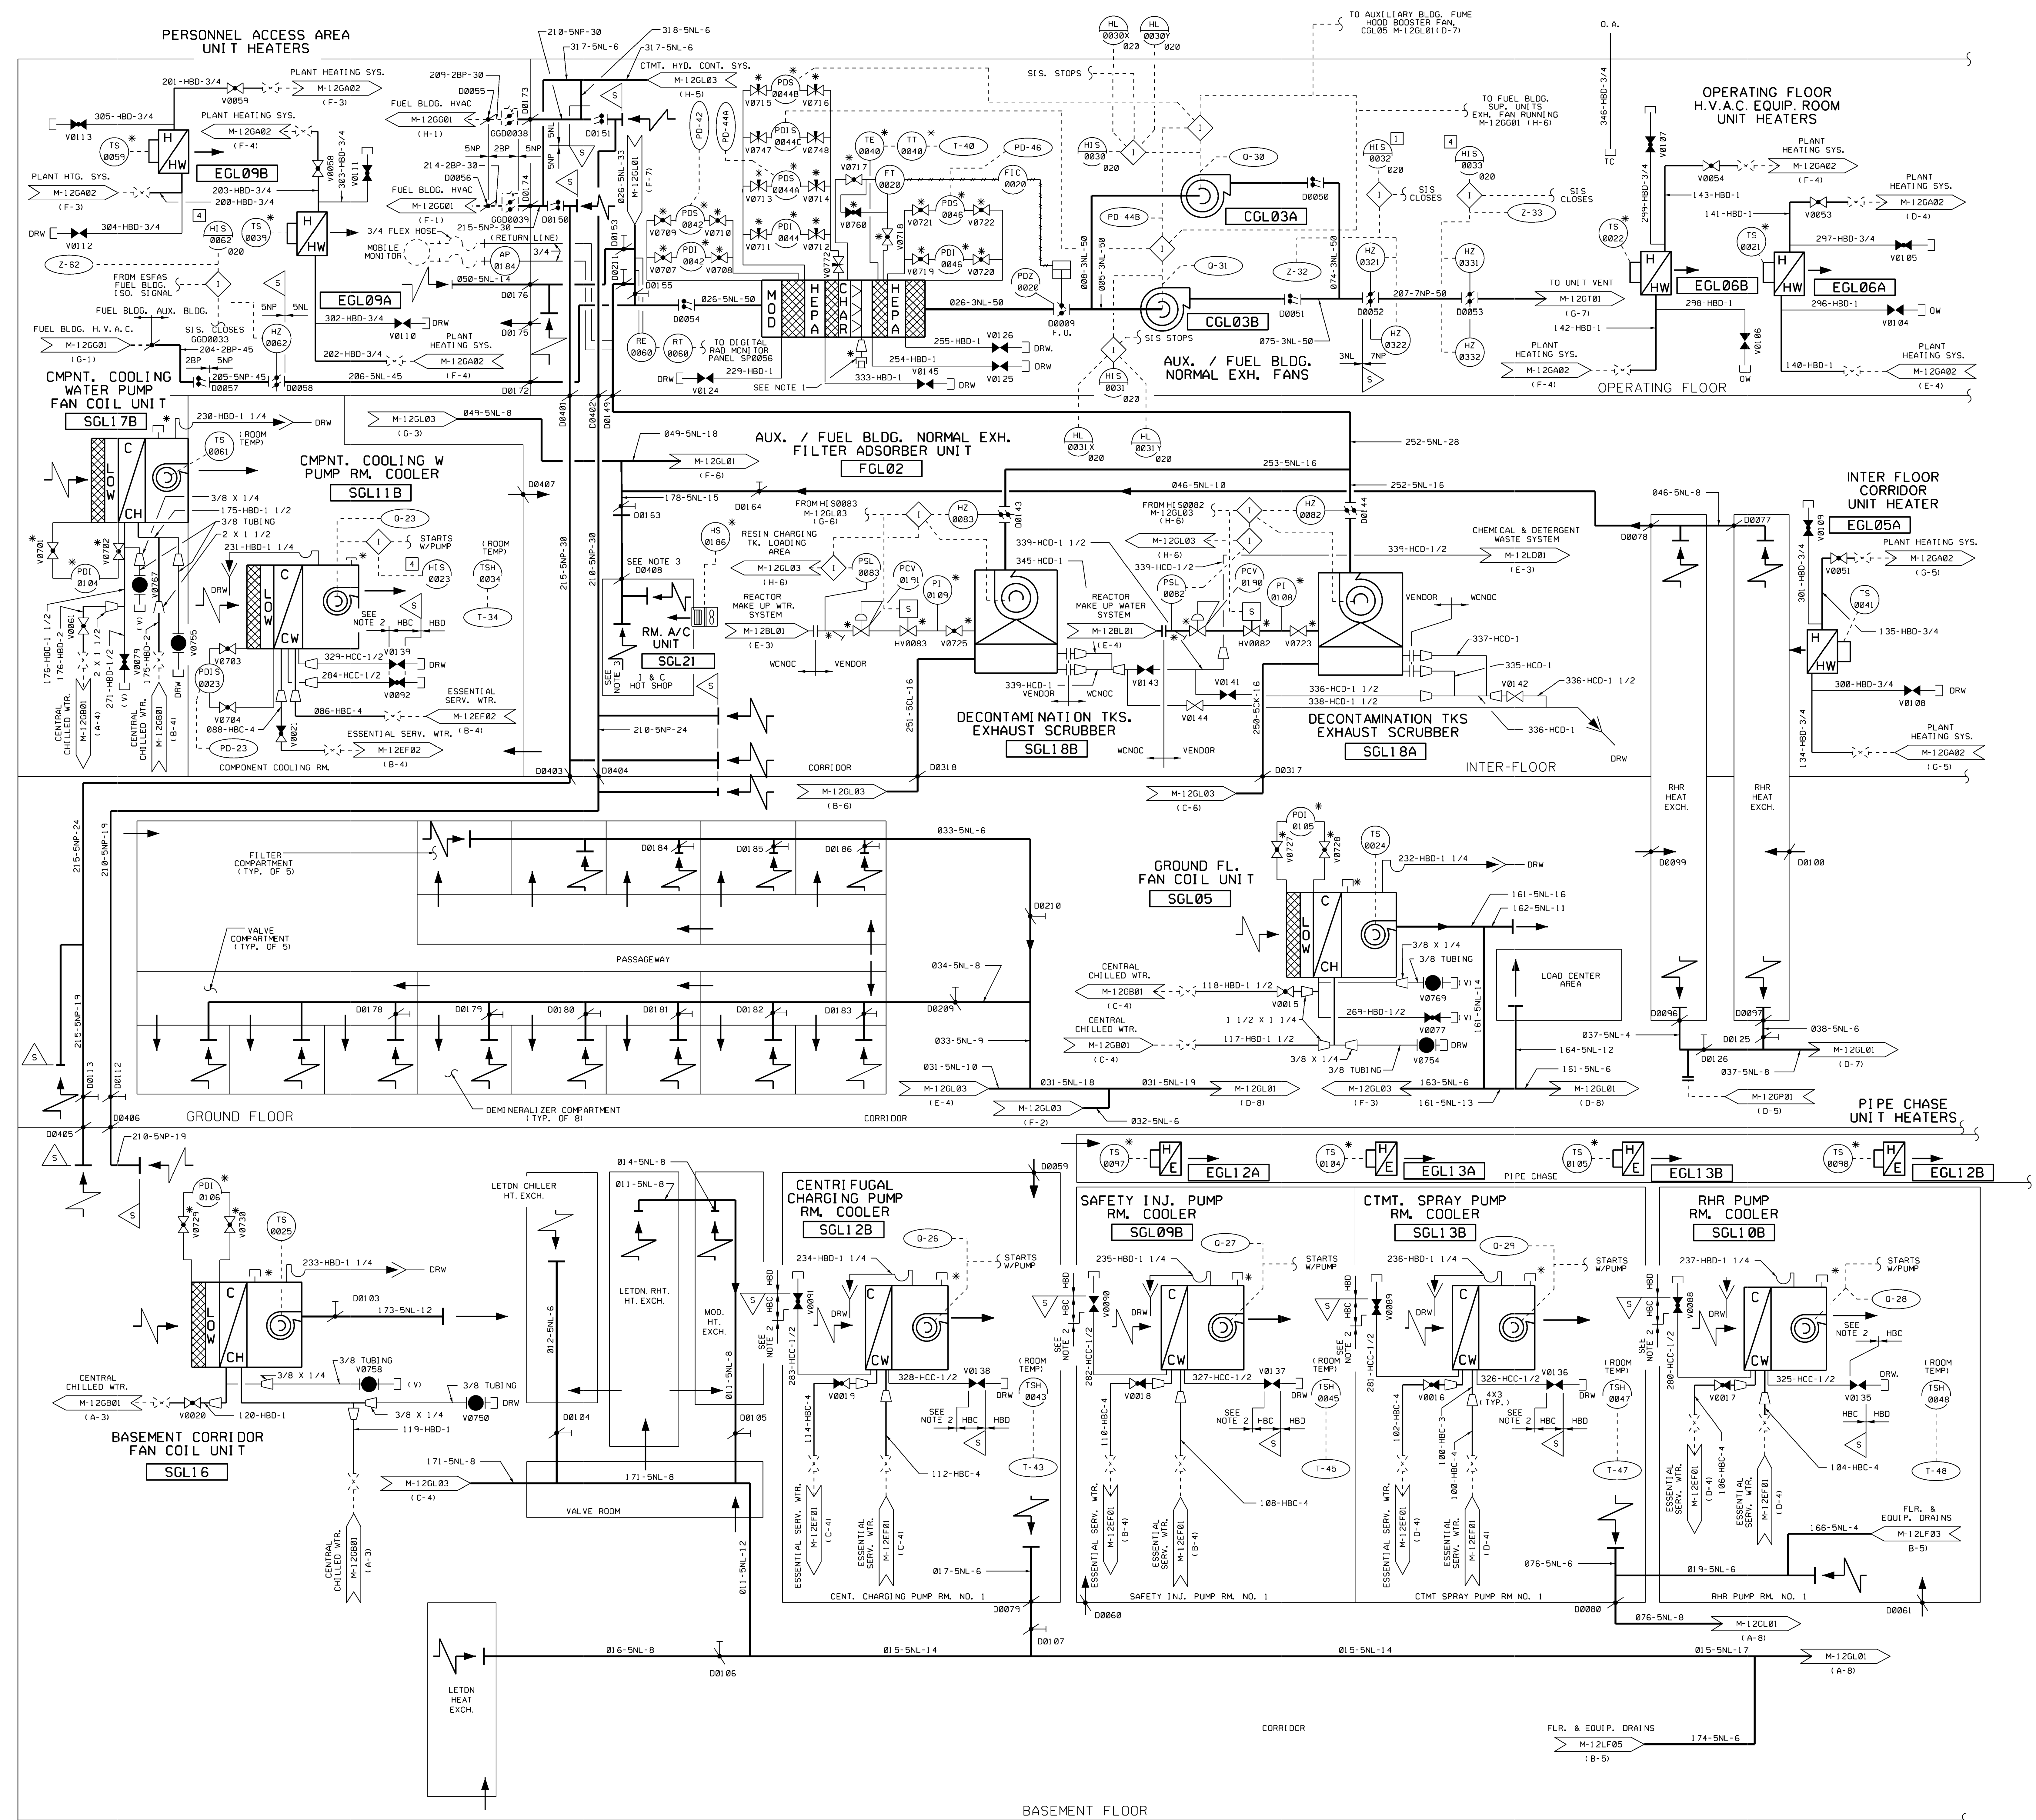

- NOTES**
- FIRE HOSE FROM HOSE STATION 033 TO CONNECT TO WATER SPRAY SYSTEM INLET, WHEN REQUIRED.
 - THE INDICATED PORTION OF PIPING REFERENCED TO THIS NOTE SHALL BE FABRICATED PER MS-02, CLASS MCC USING SCHEDULE 80 PIPE.
 - COMMUNICATES WITH RESIN CHARGING TANK, LOADING AREA ABOVE 1&C HOT SHOP SUSPENDED CEILING.




Blade & Victor, Released by Document Services, 2011.12.12 12:33:25 4630

USAR FIG. 9.4-3-04

ESSENTIAL DRAWING			
REVISION	INCORPORATED	CR 29532	CHANGE
ISSUED	CHG. DOC.		PKG. NO.
THIS Dwg. SUPERSEDES BY REV. THIS Dwg. SUPERSEDES BY REV.		REV.	
REVISION NOTES: DRAWING ISSUED TO REGENERATE CUSTOM LINESYLES PER CR 29532			
WOLF CREEK		ELECTRONIC APPROVAL	
NUCLEAR OPERATING CORPORATION			
PIPING AND INSTRUMENTATION DIAGRAM			
AUXILIARY BUILDING HVAC			
SCALE	DRAWING NUMBER	SHEET	REV
NONE	M-12GL02	17	



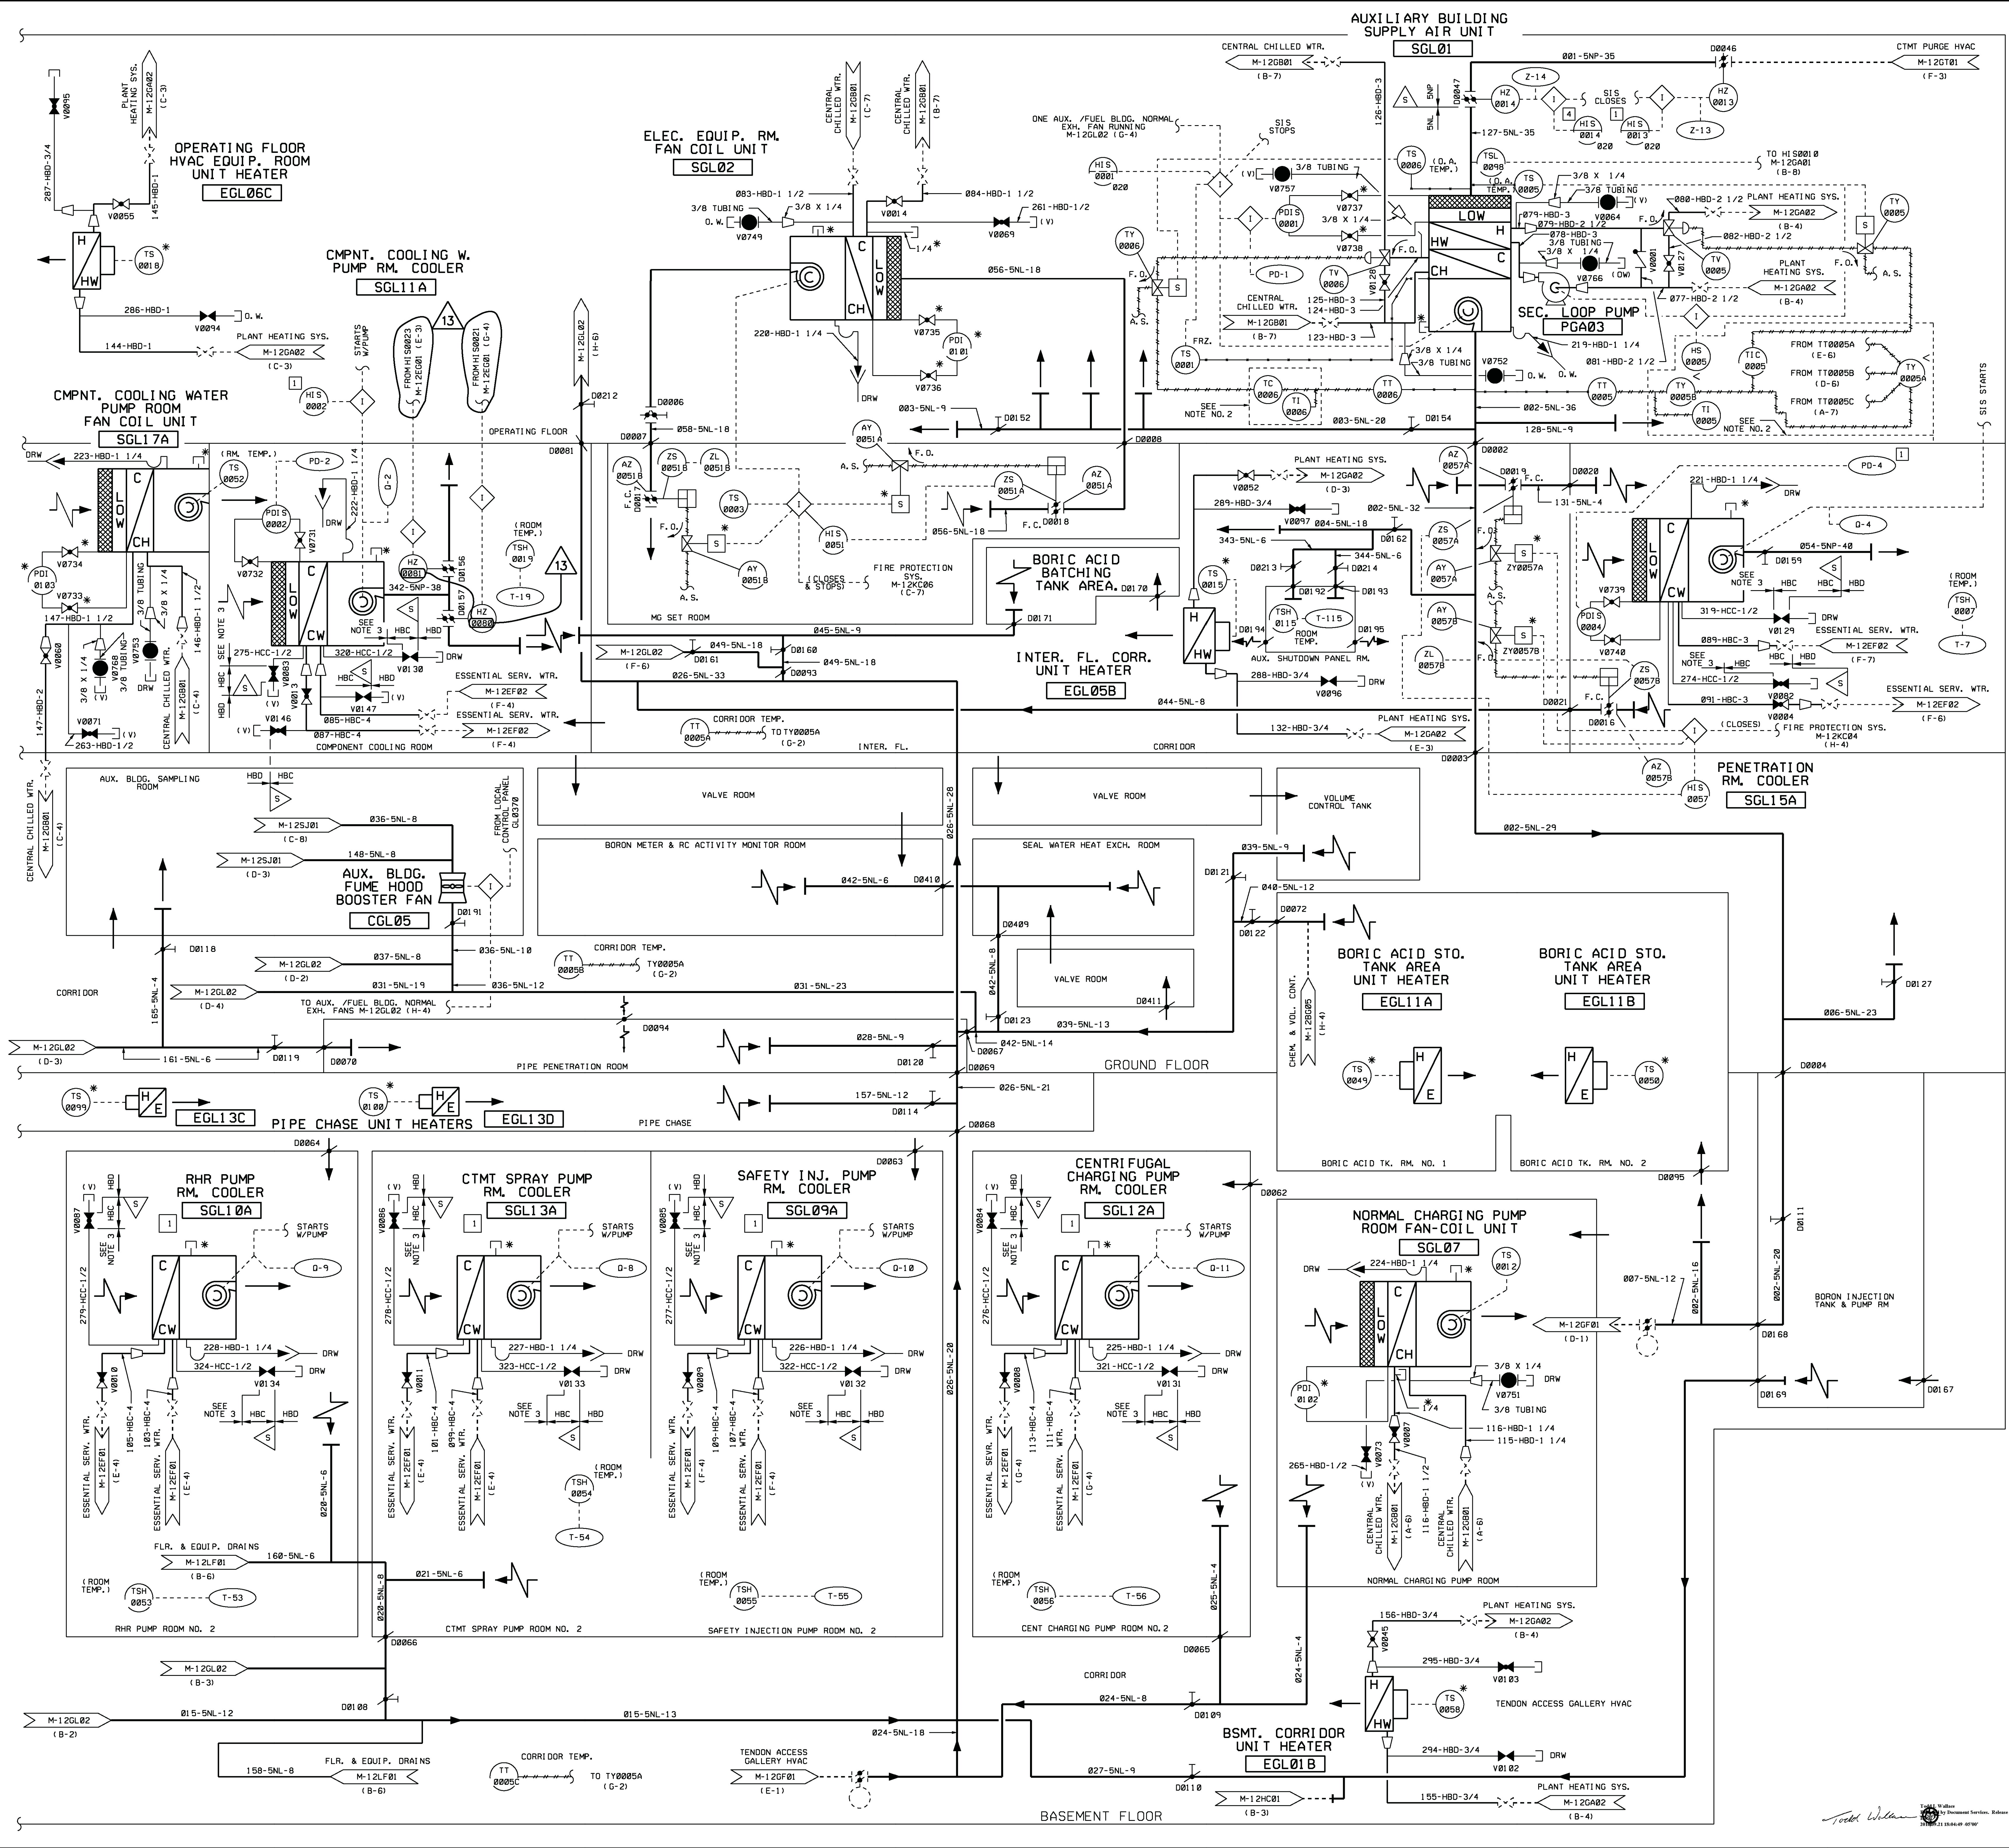


- NOTES**
- DUCTWORK SIZE ARE INDICATED AS EQUIVALENT ROUND.
 - LINE DENOTES UNIT ENCLOSURE REF. J-805-0020.
 - THIS NOTE SHALL BE FABRICATED PER MS-2, CLASS HCC USING SCHEDULE 80 PIPE.

USAR FIG. 9.4-3 - 05

ESSENTIAL DRAWING			
REVISED	INCORPORATED	C.R. #006996	CHANGE PRC. NO.
ISSUED	CHG. DOC.		
THIS ENG. SUPERSEDES		REV.	THIS ENG. SUPERSEDES
REVISION NOTES			
WOLF CREEK <small>NUCLEAR OPERATING CORPORATION</small>		<small>ELECTRONIC APPROVAL</small> PIPING AND INSTRUMENTATION DIAGRAM AUXILIARY BUILDING HVAC	
SCALE	DRAWING NUMBER	SHEET	REV
NONE	M-12GL01	13	

3444 E SIZE

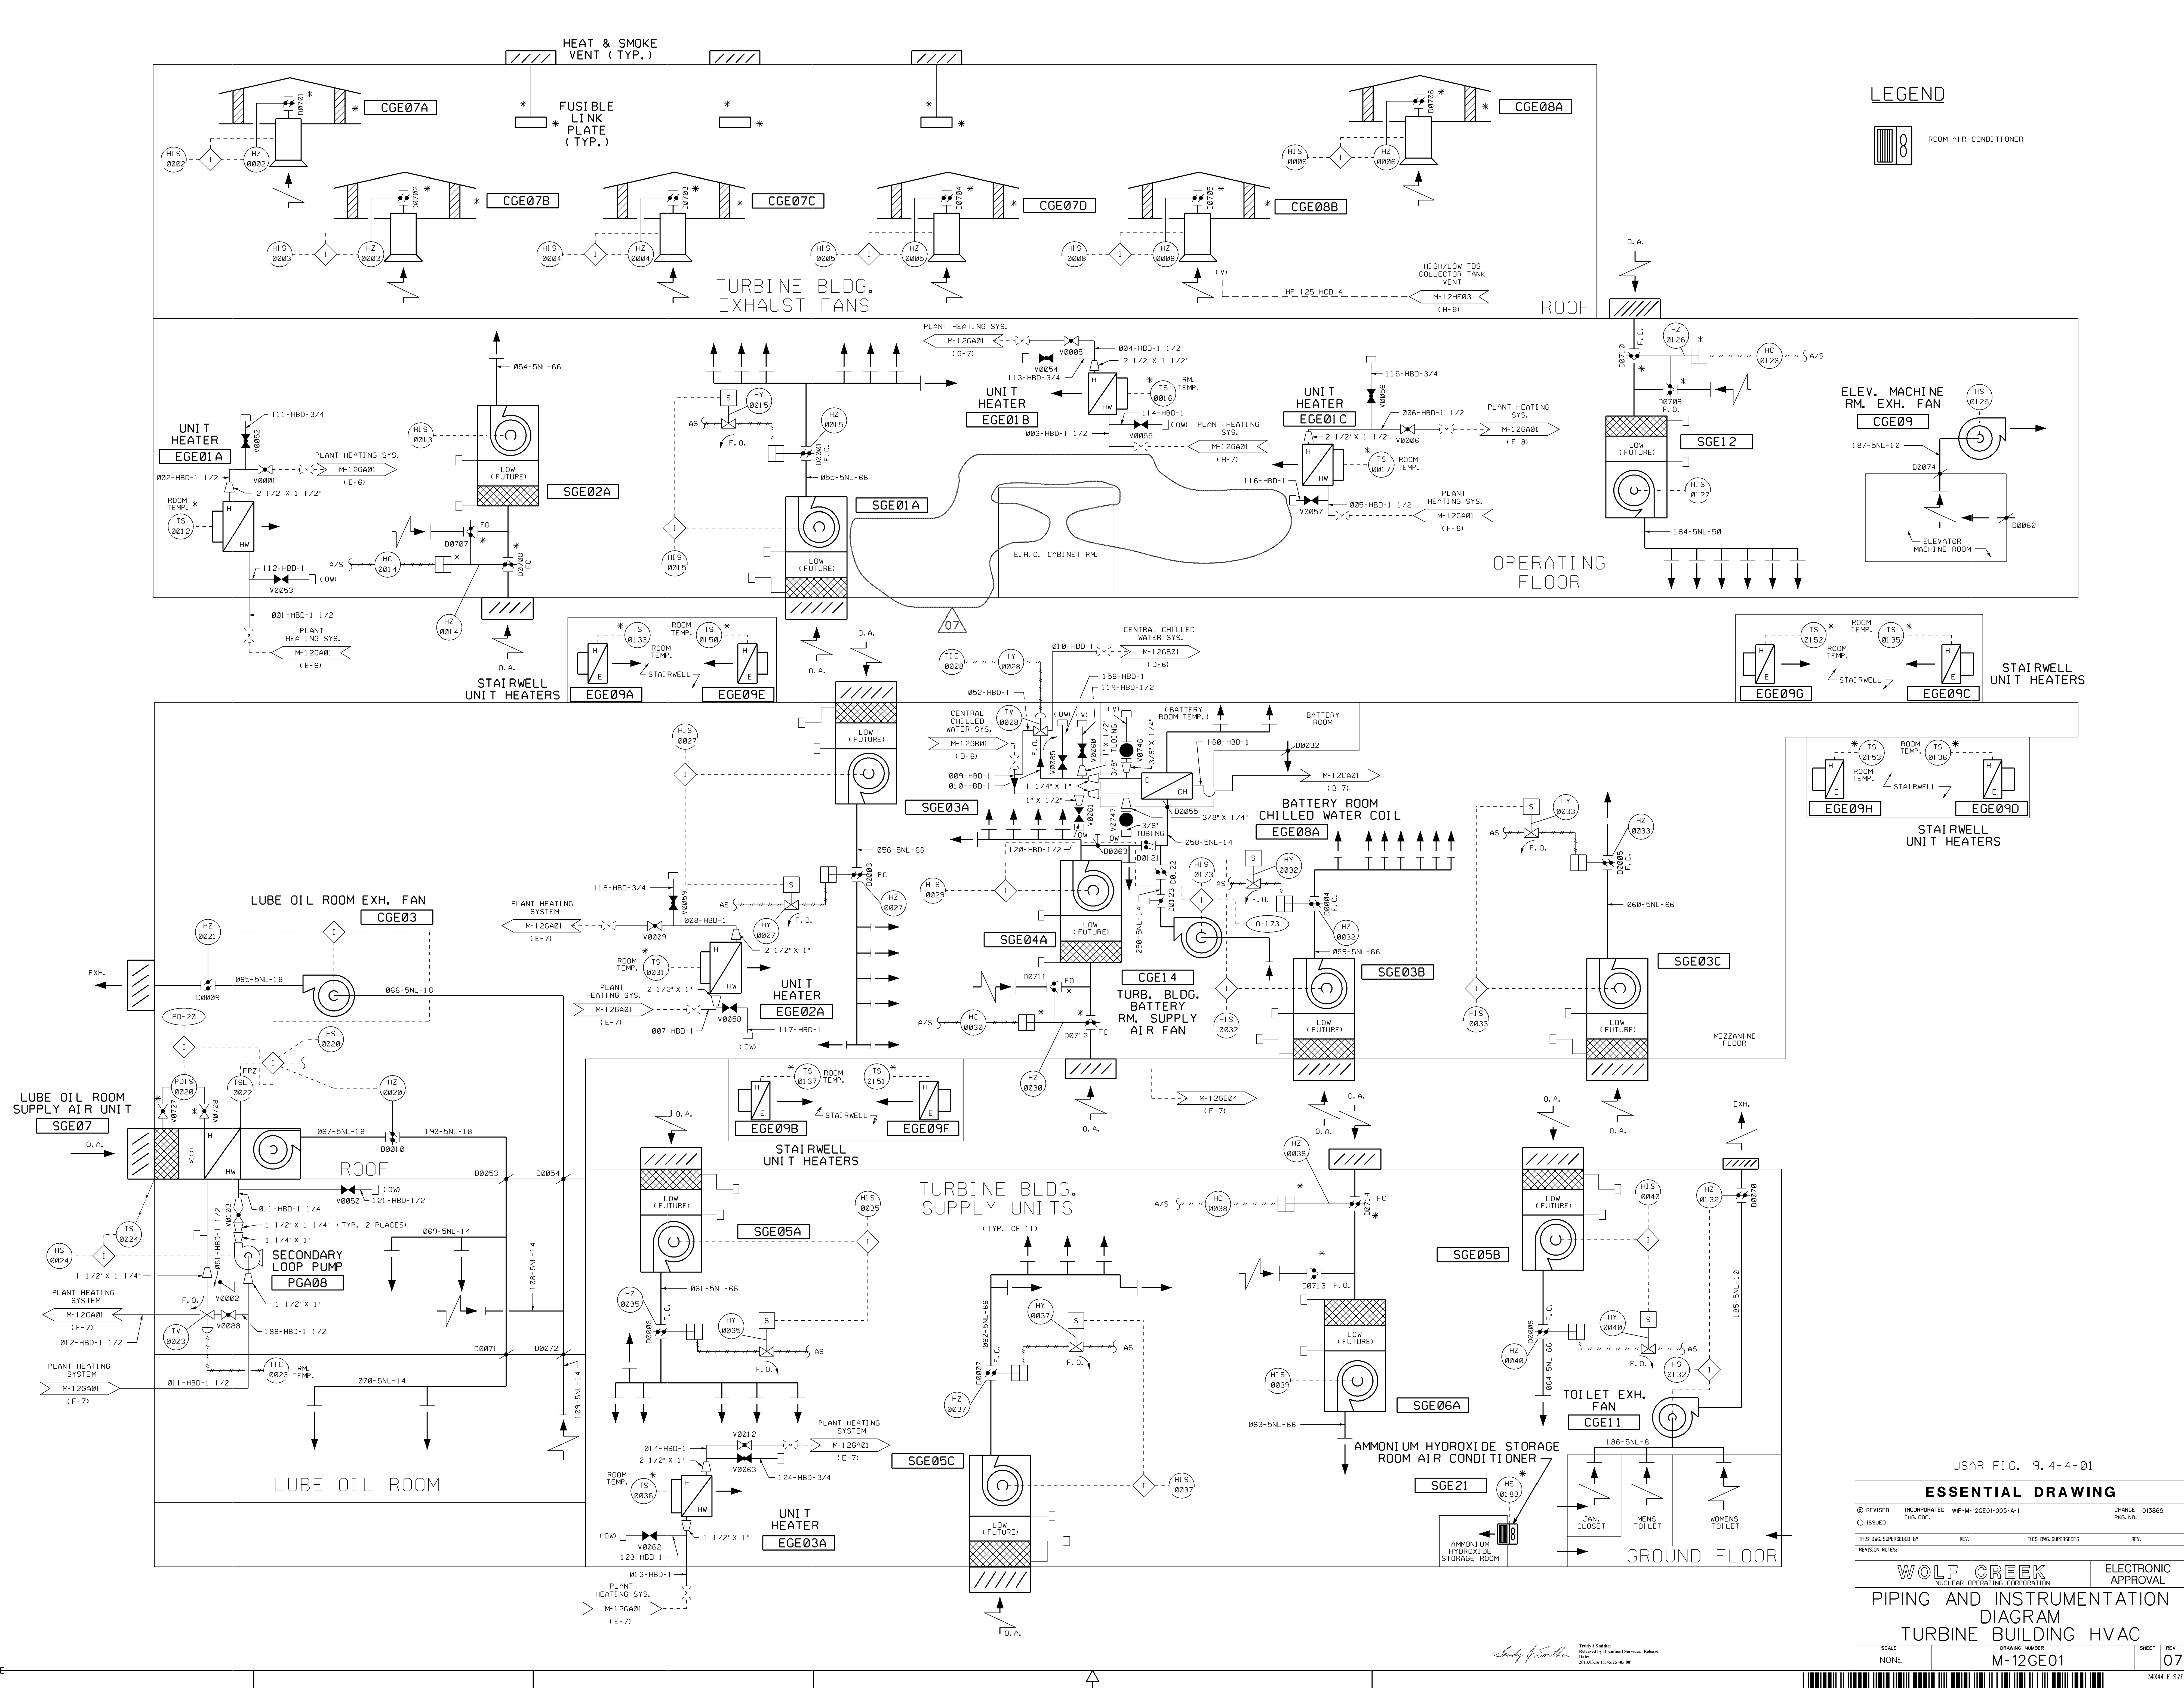

LEGEND

ROOM AIR CONDITIONER


USAR FIG. 9.4-4-01

ESSENTIAL DRAWING

REVISION: INCORPORATED WPP-M-12GE01-005-A-1 CHANGE D13865
 CNG.DOC. PKG.ND.
 THIS DWG SUPERSEDED BY: REV. THIS DWG SUPERSEDES: REV.
 REVISION NOTES:





WOLF CREEK NUCLEAR OPERATING CORPORATION ELECTRONIC APPROVAL
PIPING AND INSTRUMENTATION DIAGRAM
TURBINE BUILDING HVAC

SCALE: NONE DRAWING NUMBER: M-12GE01 SHEET: 07
 DATE: 09/18/04 11:40:25 AM

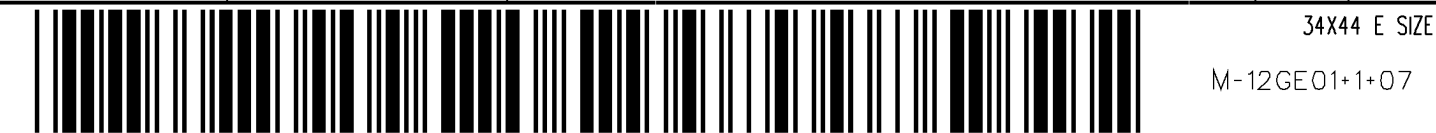

NOTES:


- REFRIGERANT PIPING, VALVES, FITTINGS AND OTHER SPECIALTIES FOR THE PROCESS SAMPLING LAB. HVAC SYSTEM TO BE SPECIFIED, FURNISHED AND INSTALLED BY THE CONSTRUCTOR.
- FIRE HOSE FROM HOSE STATION 050 TO CONNECT TO WATER SPRAY SYSTEM INLET.
- ATOMIC ABSORPTION SPECTROPHOTOMETER PROVIDED BY OWNER.

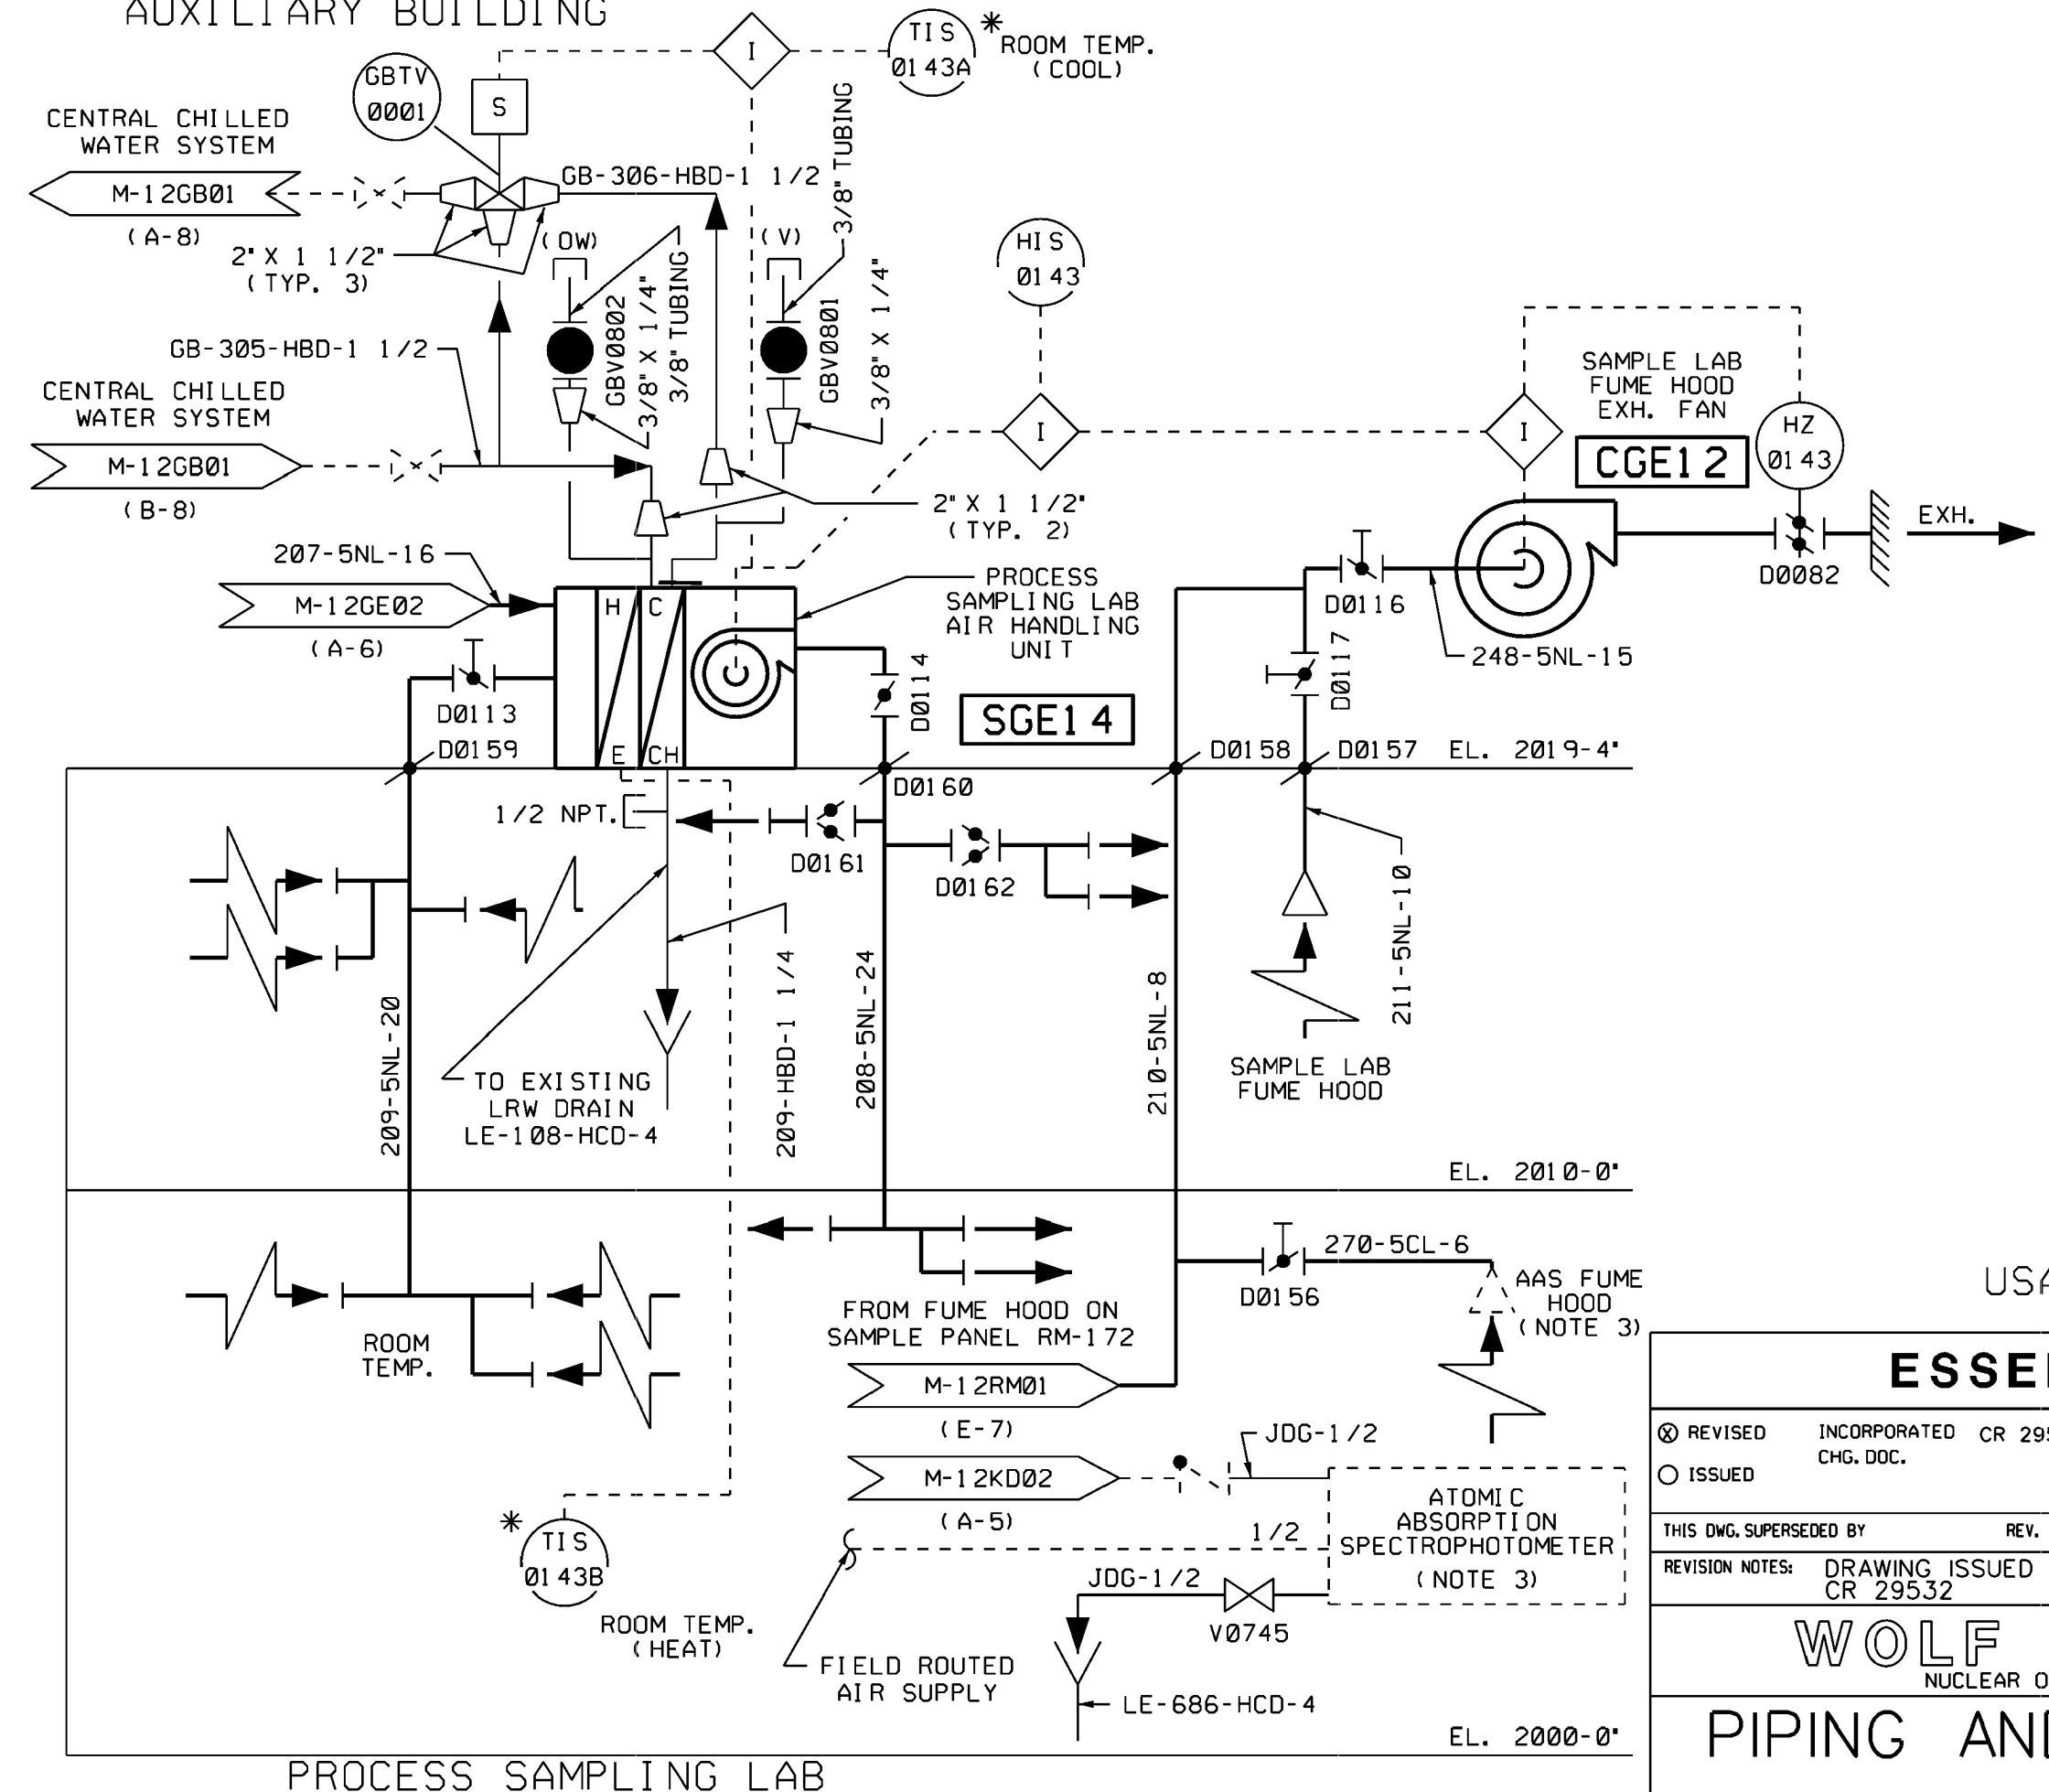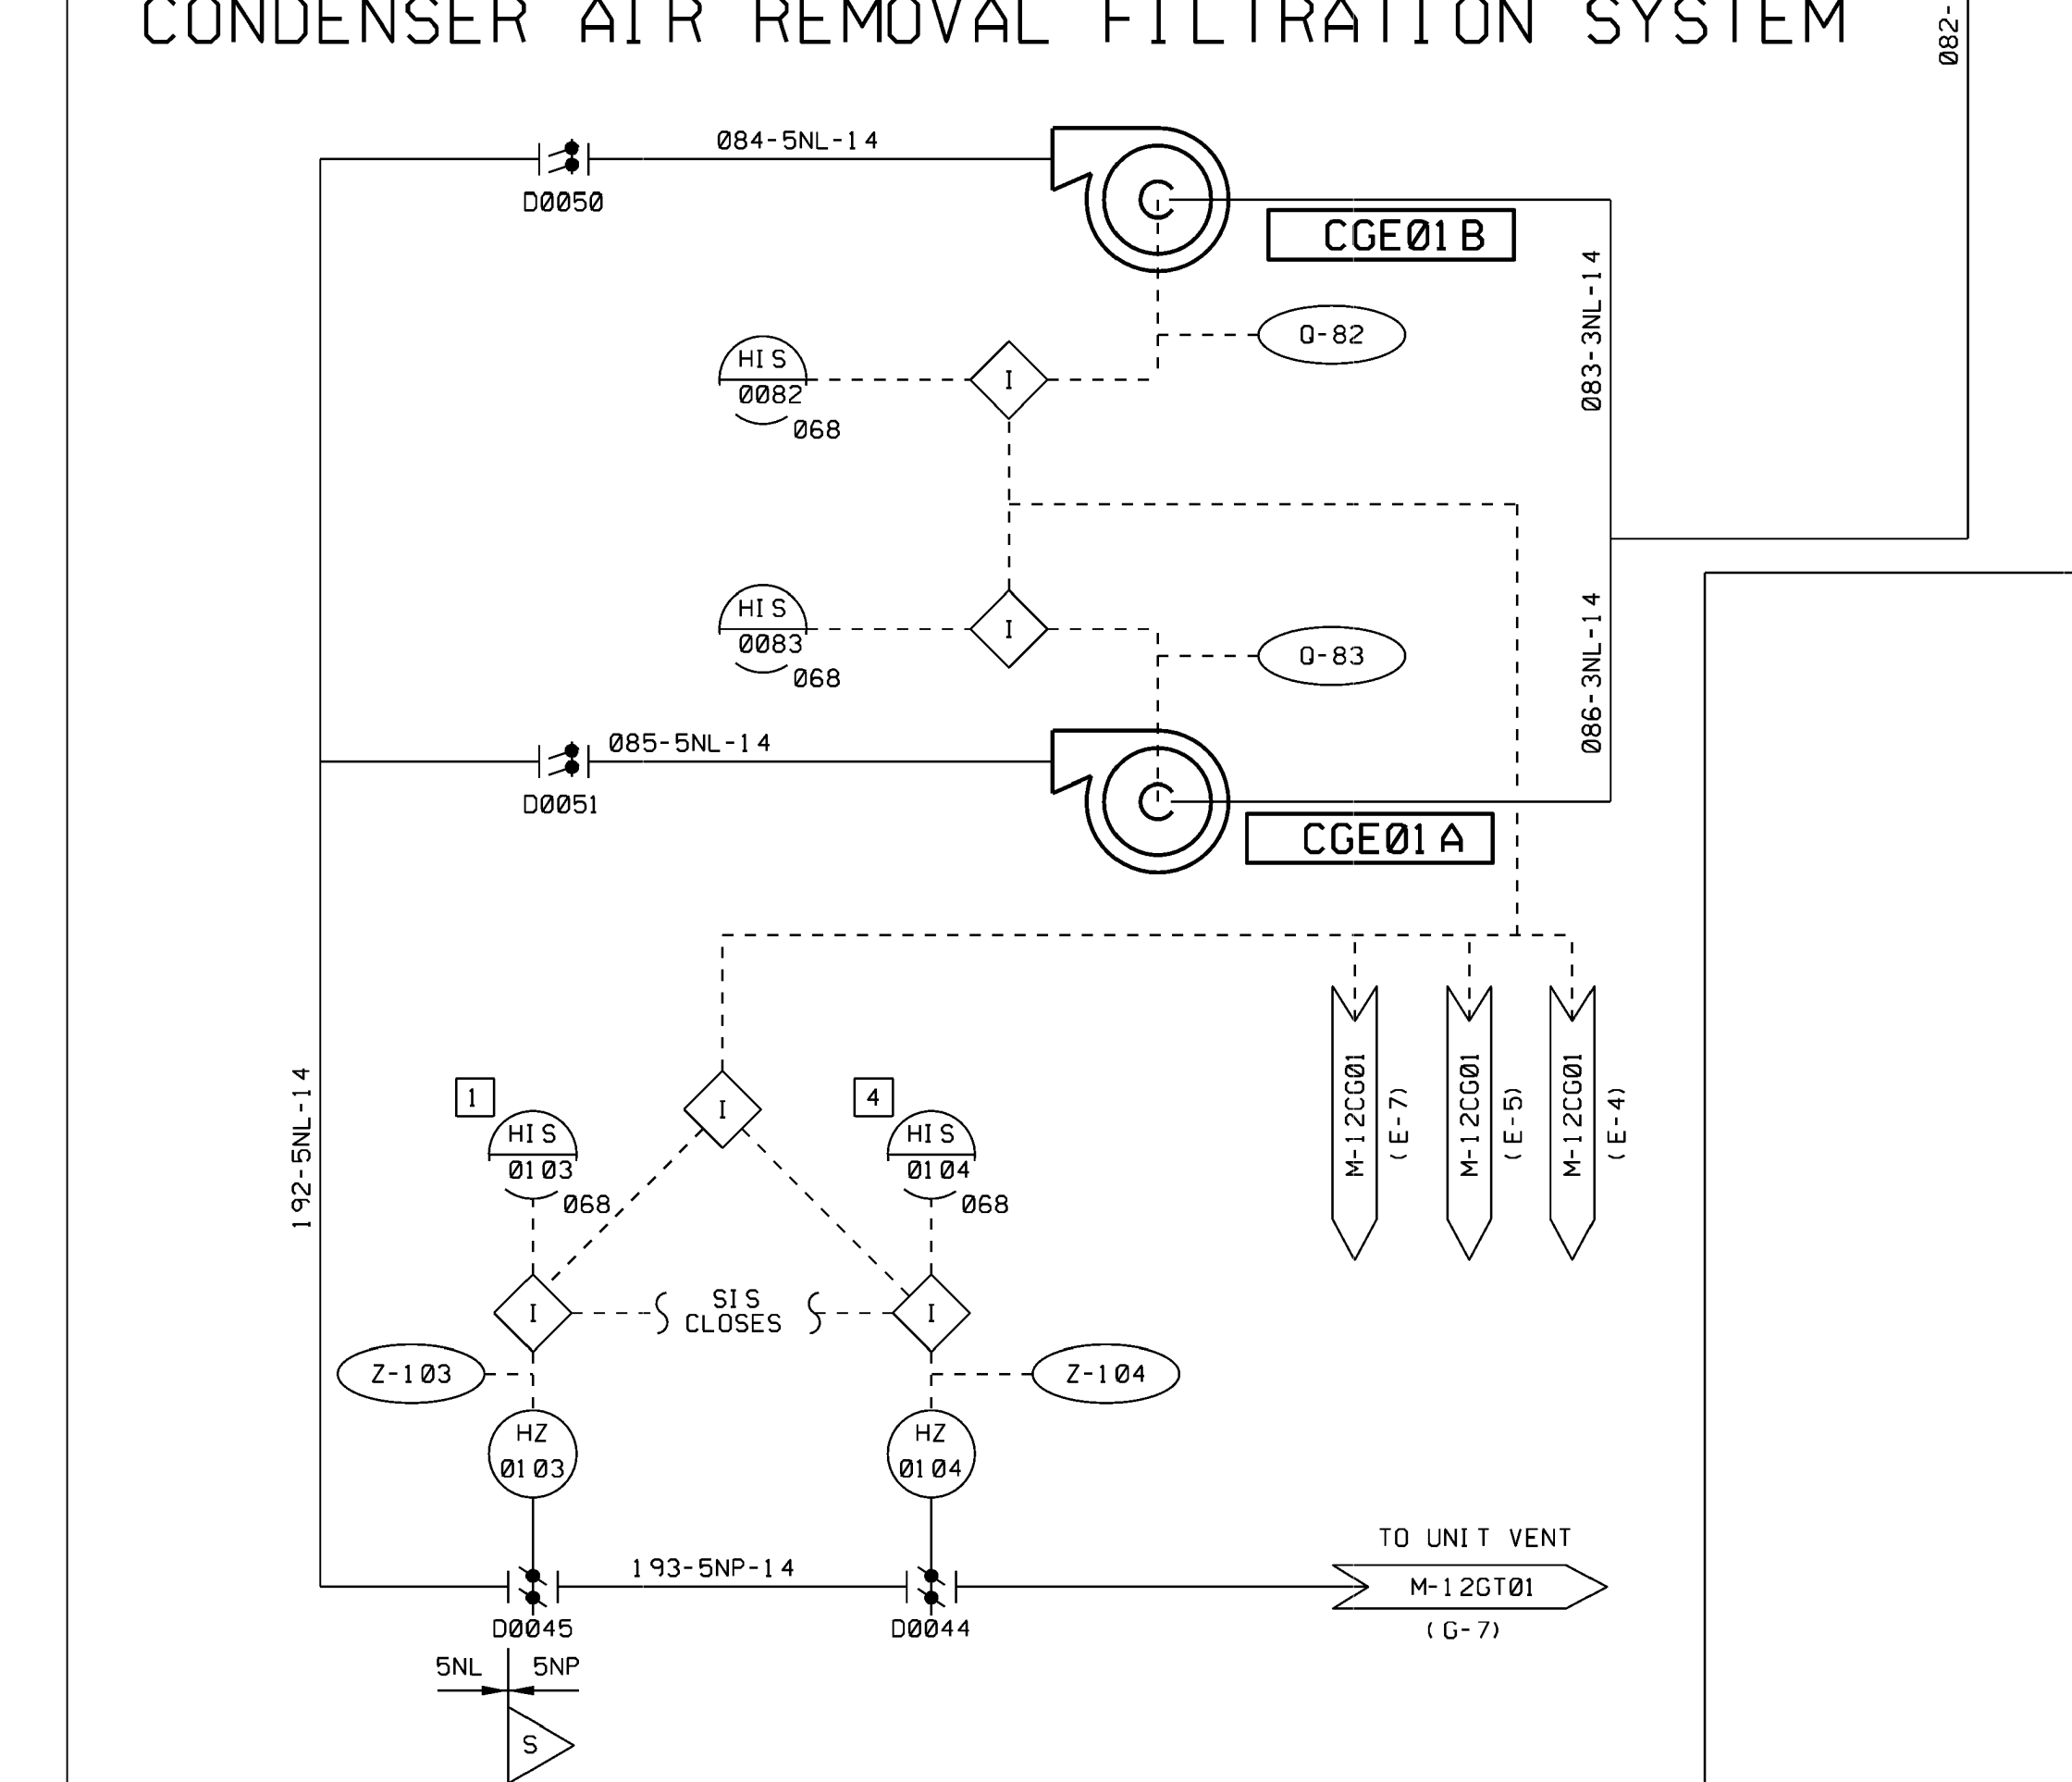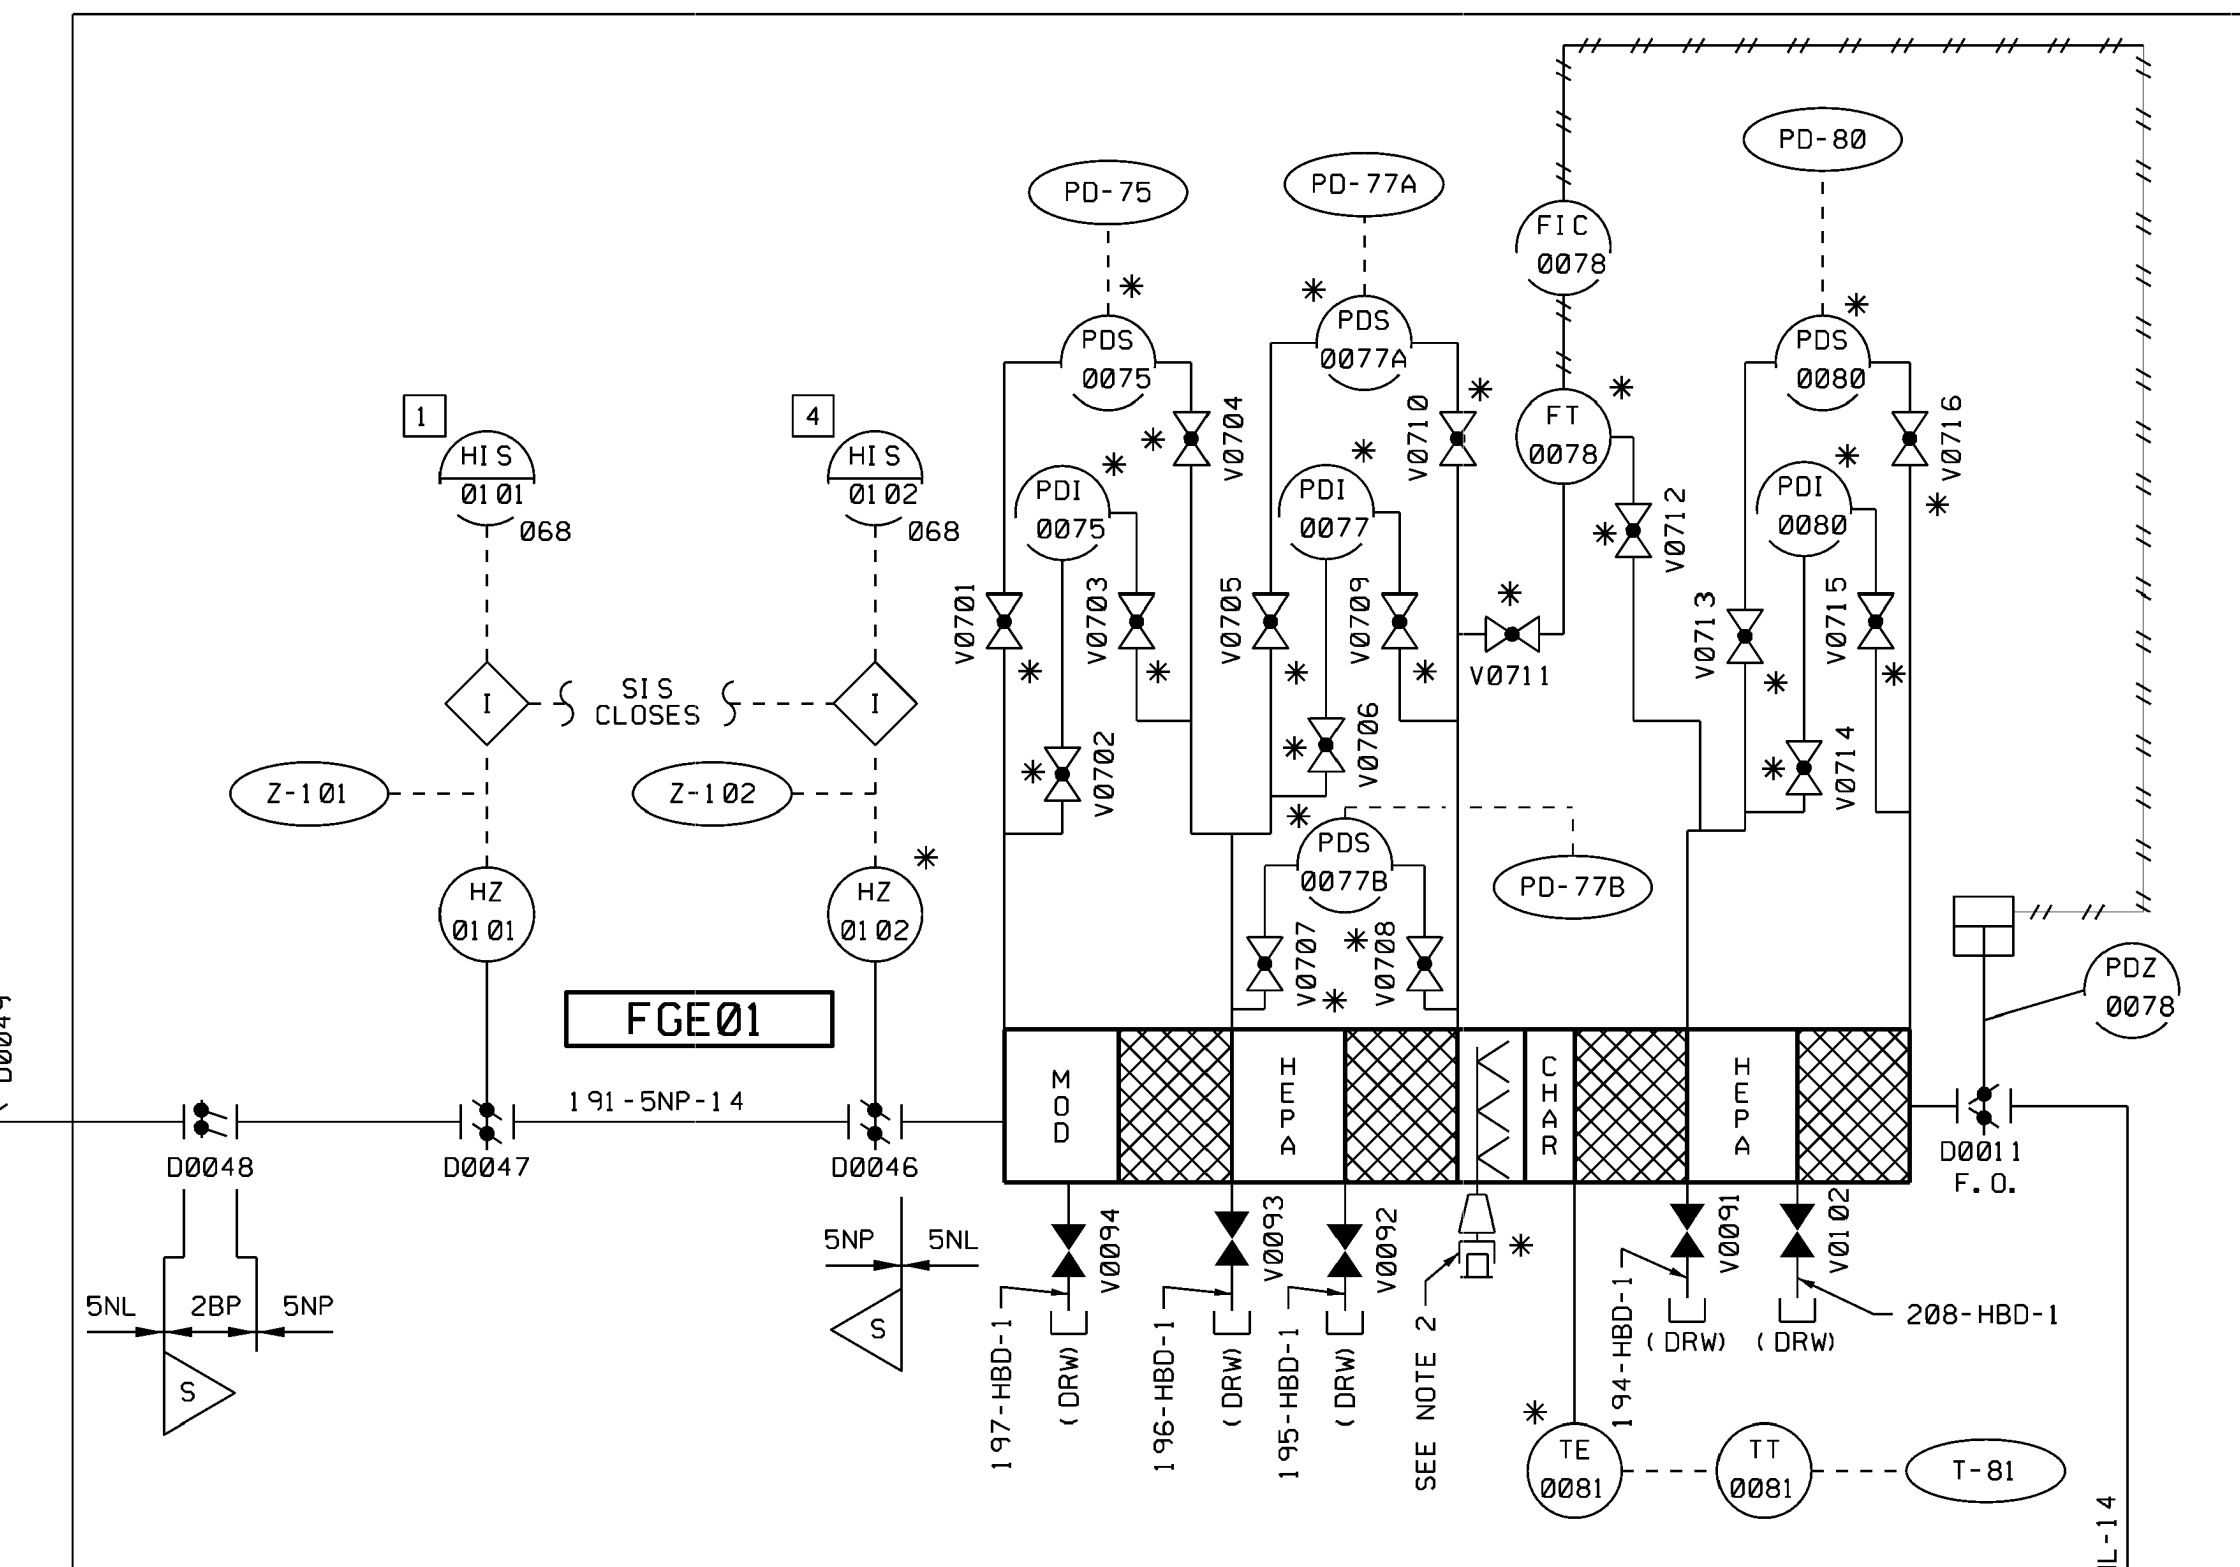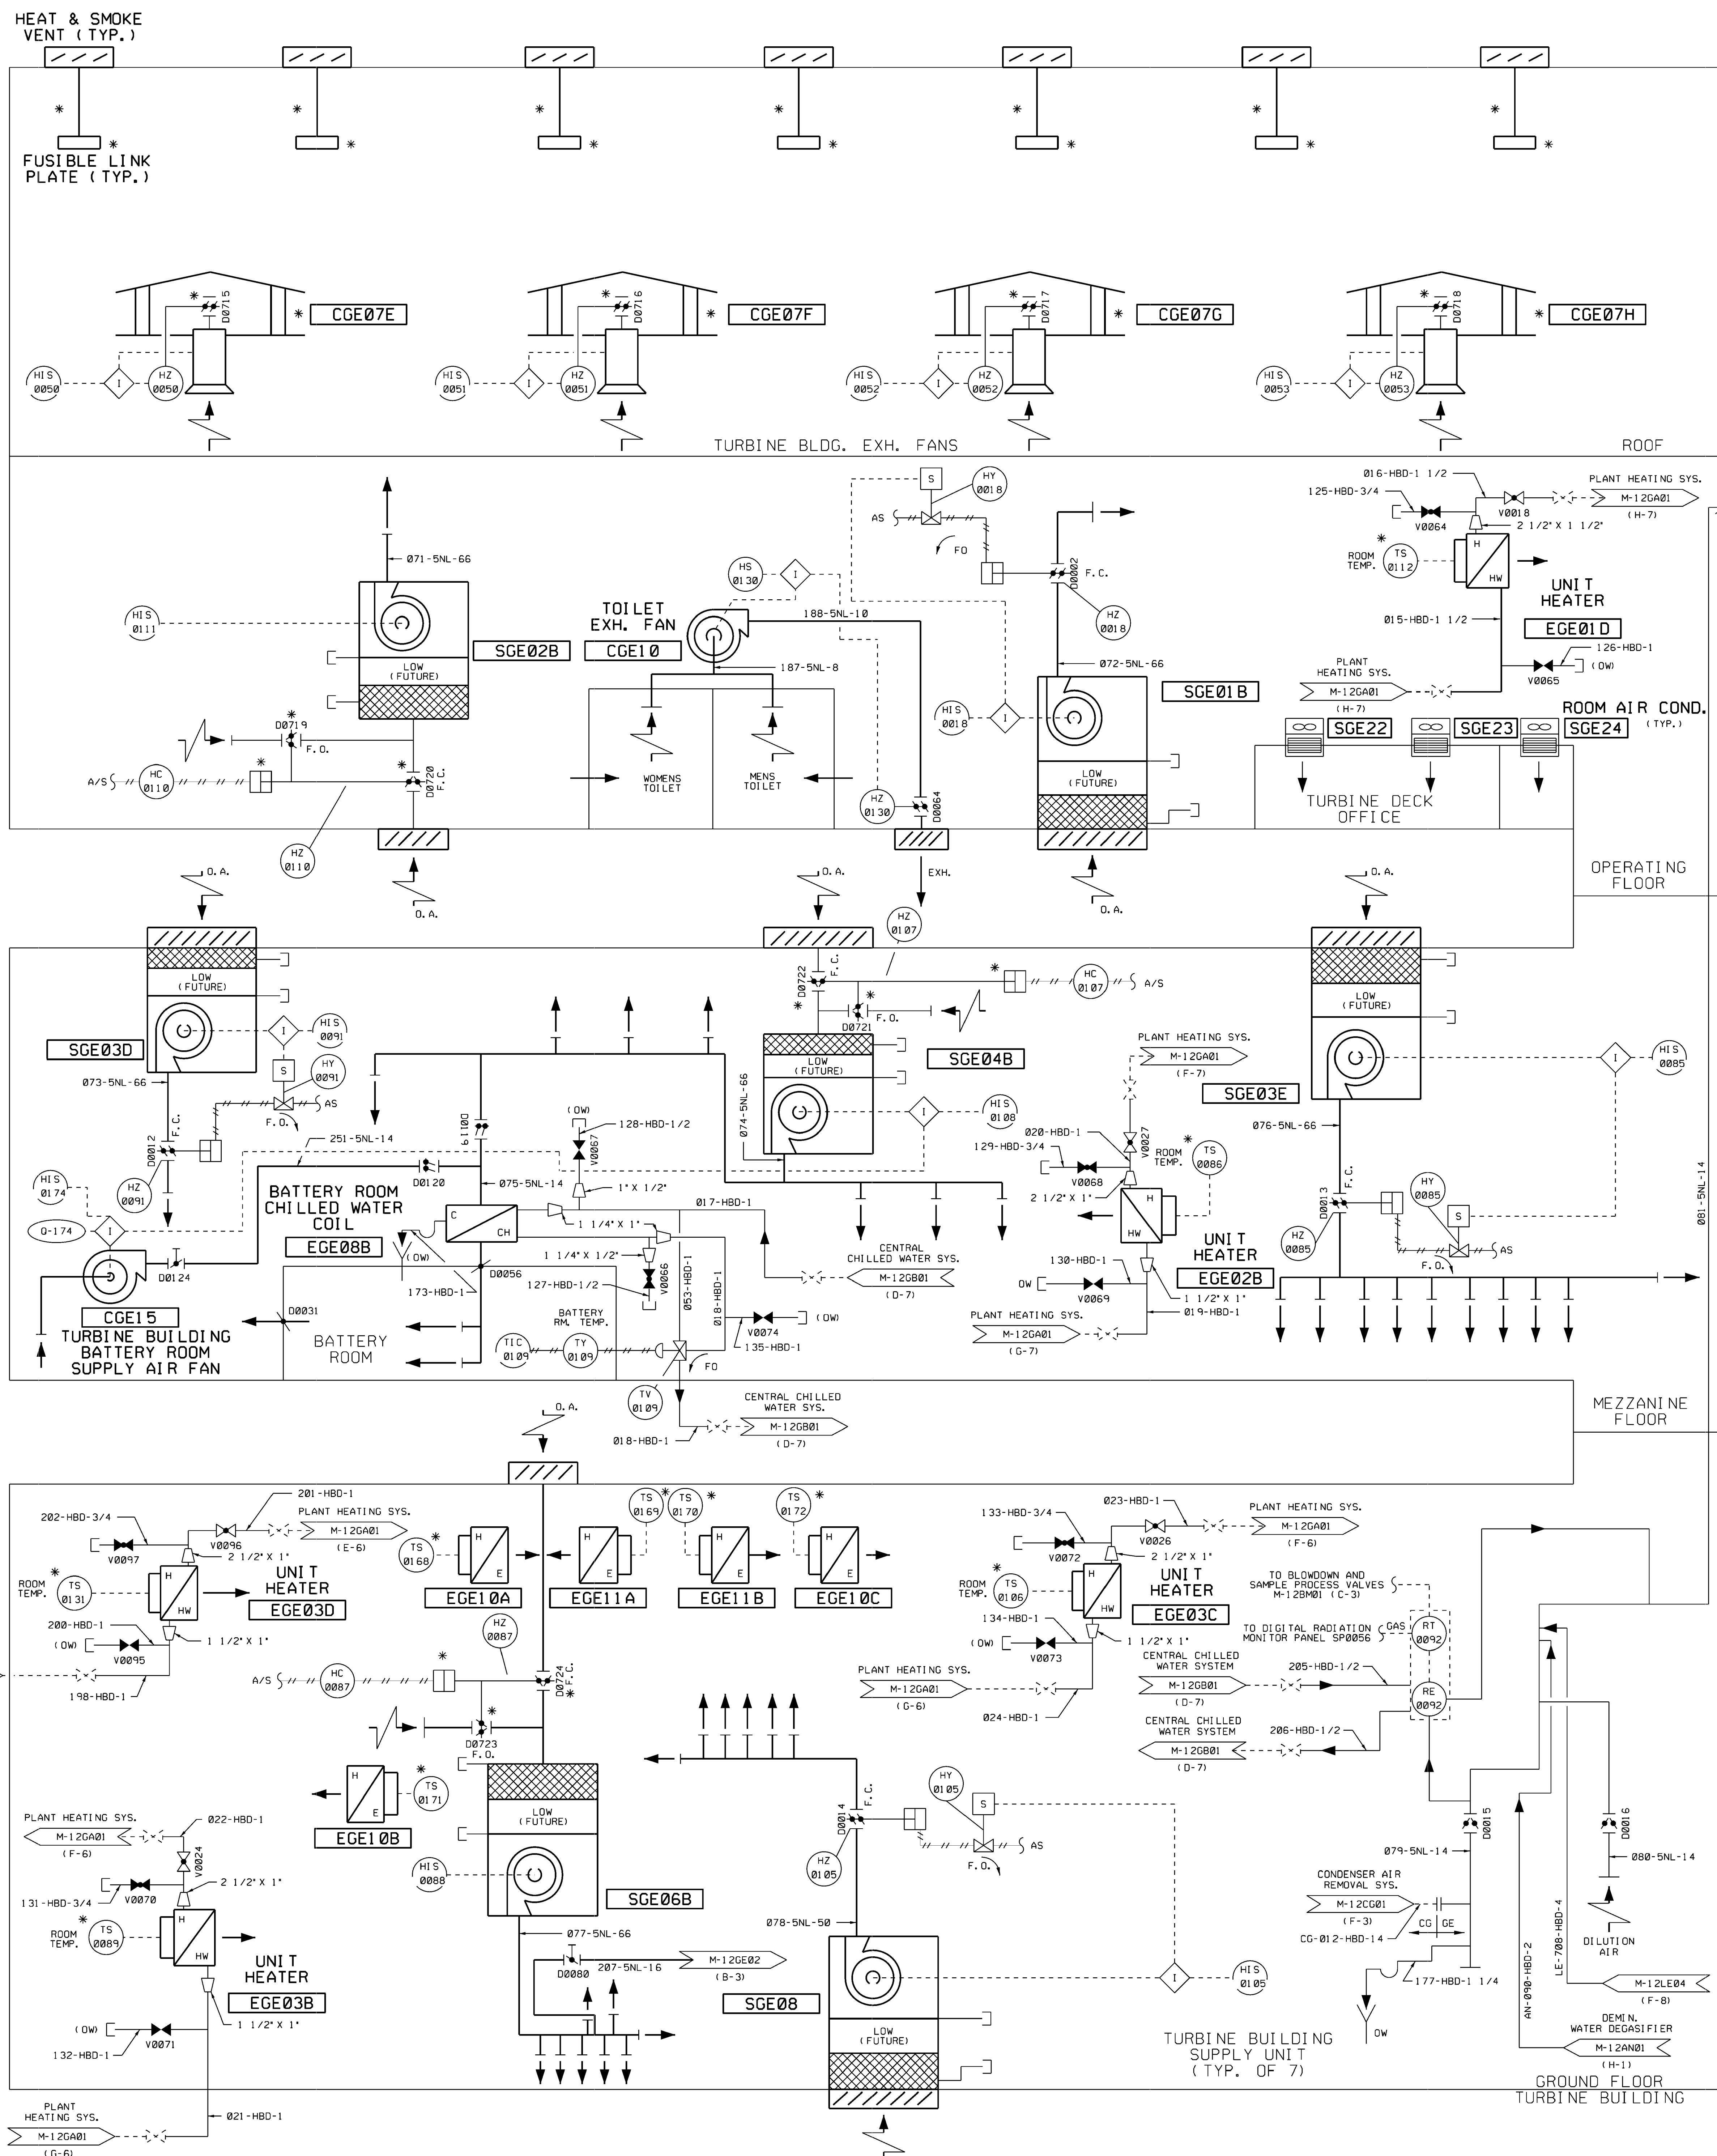

ESSENTIAL DRAWING

REVISION	DATE	BY	CHKD.	APP'D.
THIS DRAWING IS THE PROPERTY OF WOLF CREEK NUCLEAR OPERATING CORPORATION. IT IS TO BE USED ONLY FOR THE PROJECT AND SITE SPECIFICALLY IDENTIFIED HEREIN. IT IS NOT TO BE REPRODUCED, COPIED, OR TRANSMITTED IN ANY FORM OR BY ANY MEANS, ELECTRONIC OR MECHANICAL, WITHOUT THE WRITTEN PERMISSION OF WOLF CREEK NUCLEAR OPERATING CORPORATION.				
DRAWING NUMBER: M-12GE02		SHEET: 09		



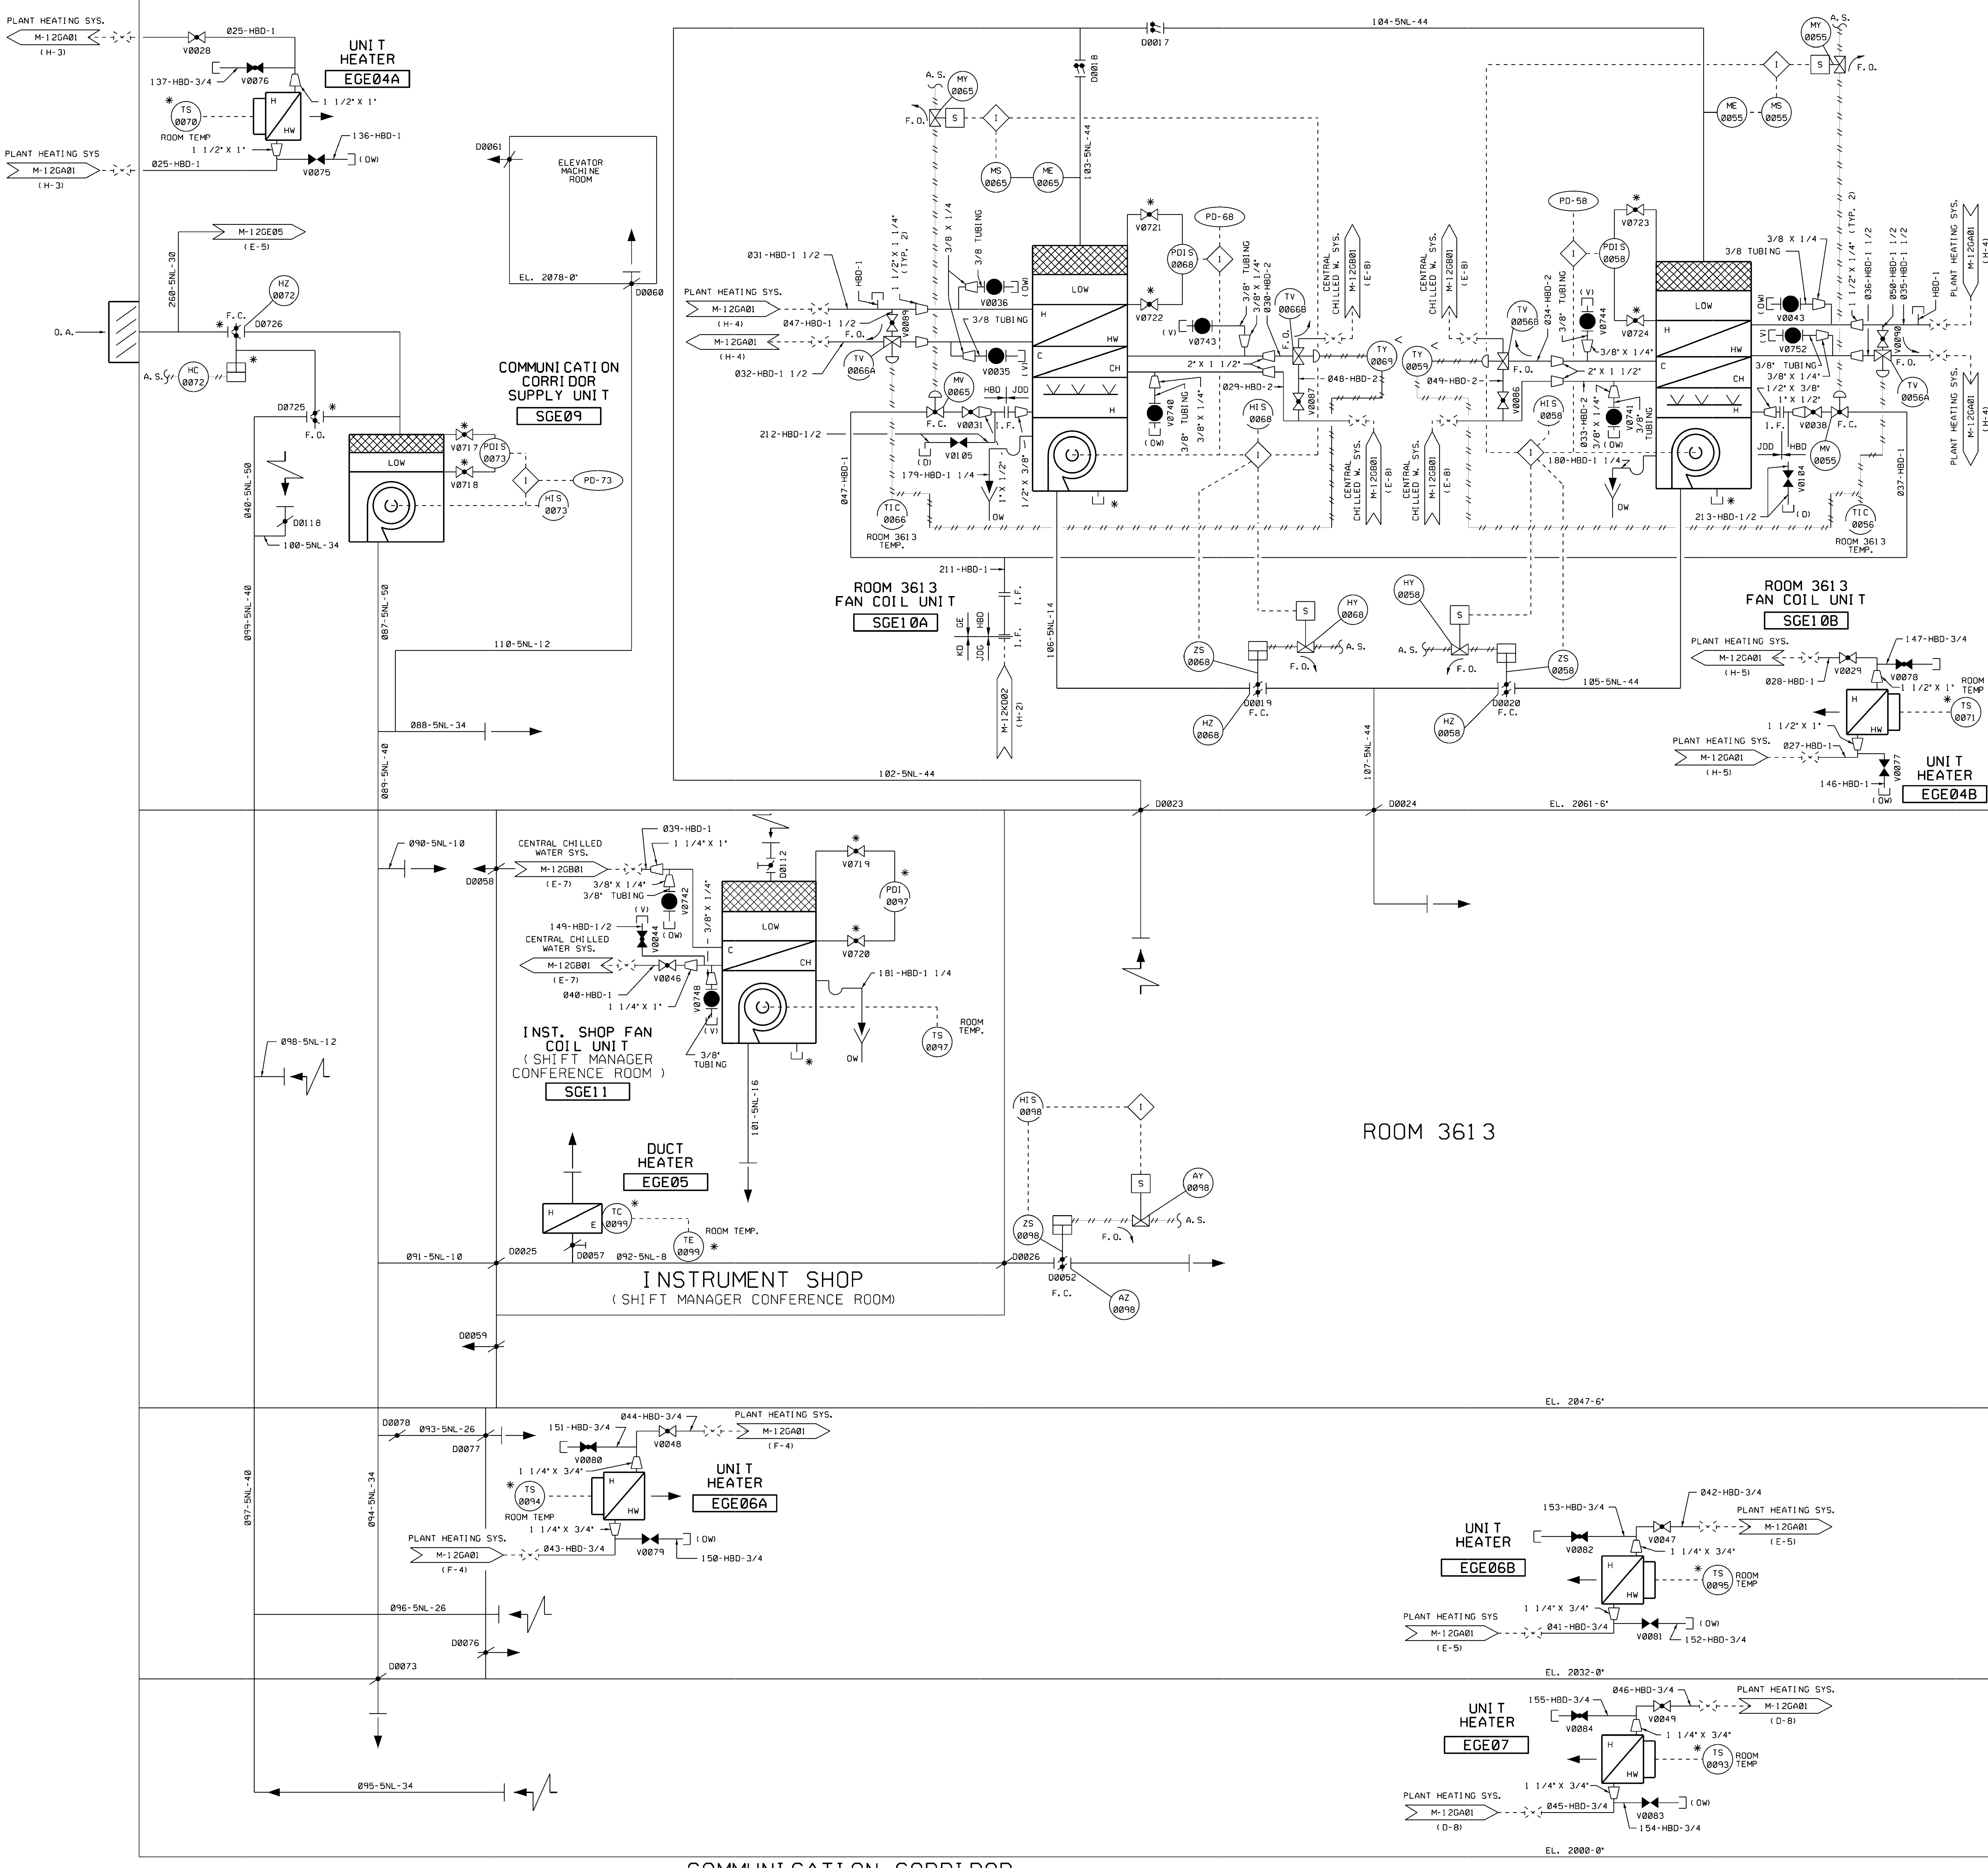

USAR FIG. 9.4-4-03

ESSENTIAL DRAWING

REVISED	INCORPORATED	CR 29532	CHANGE
ISSUED	DOC.		PKG. NO.
THIS DWG SUPERSEDES BY:		REV.	THIS DWG SUPERSEDES
REVISION NOTES: DRAWING ISSUED TO REGENERATE CUSTOM LIFESTYLES PER CR 29532			


WOLF CREEK
NUCLEAR OPERATING CORPORATION

ELECTRONIC APPROVAL

PIPING AND INSTRUMENTATION DIAGRAM
TURBINE BUILDING HVAC




SCALE	DRAWING NUMBER	SHEET	REV
NONE	M-12GE03	09	

Blair G. Jackson
Released by Document Services
Revision Date: 2011.11.12 08:52:39 -06'00'

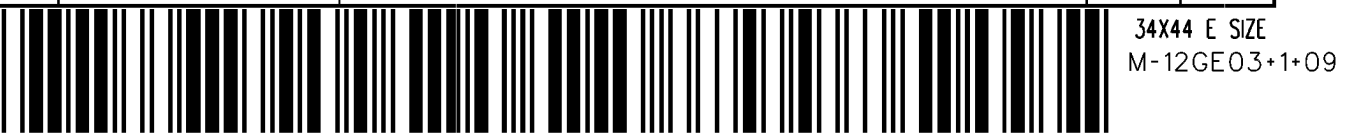

NOTES:


1. ALL T.E.'S ARE MONITORING CONCRETE TEMPERATURE.
2. DUCTWORK SIZES ARE INDICATED AS EQUIVALENT ROUND.
3. DENOTES COMMON ENCLOSURE REFERENCE J-805-00020.

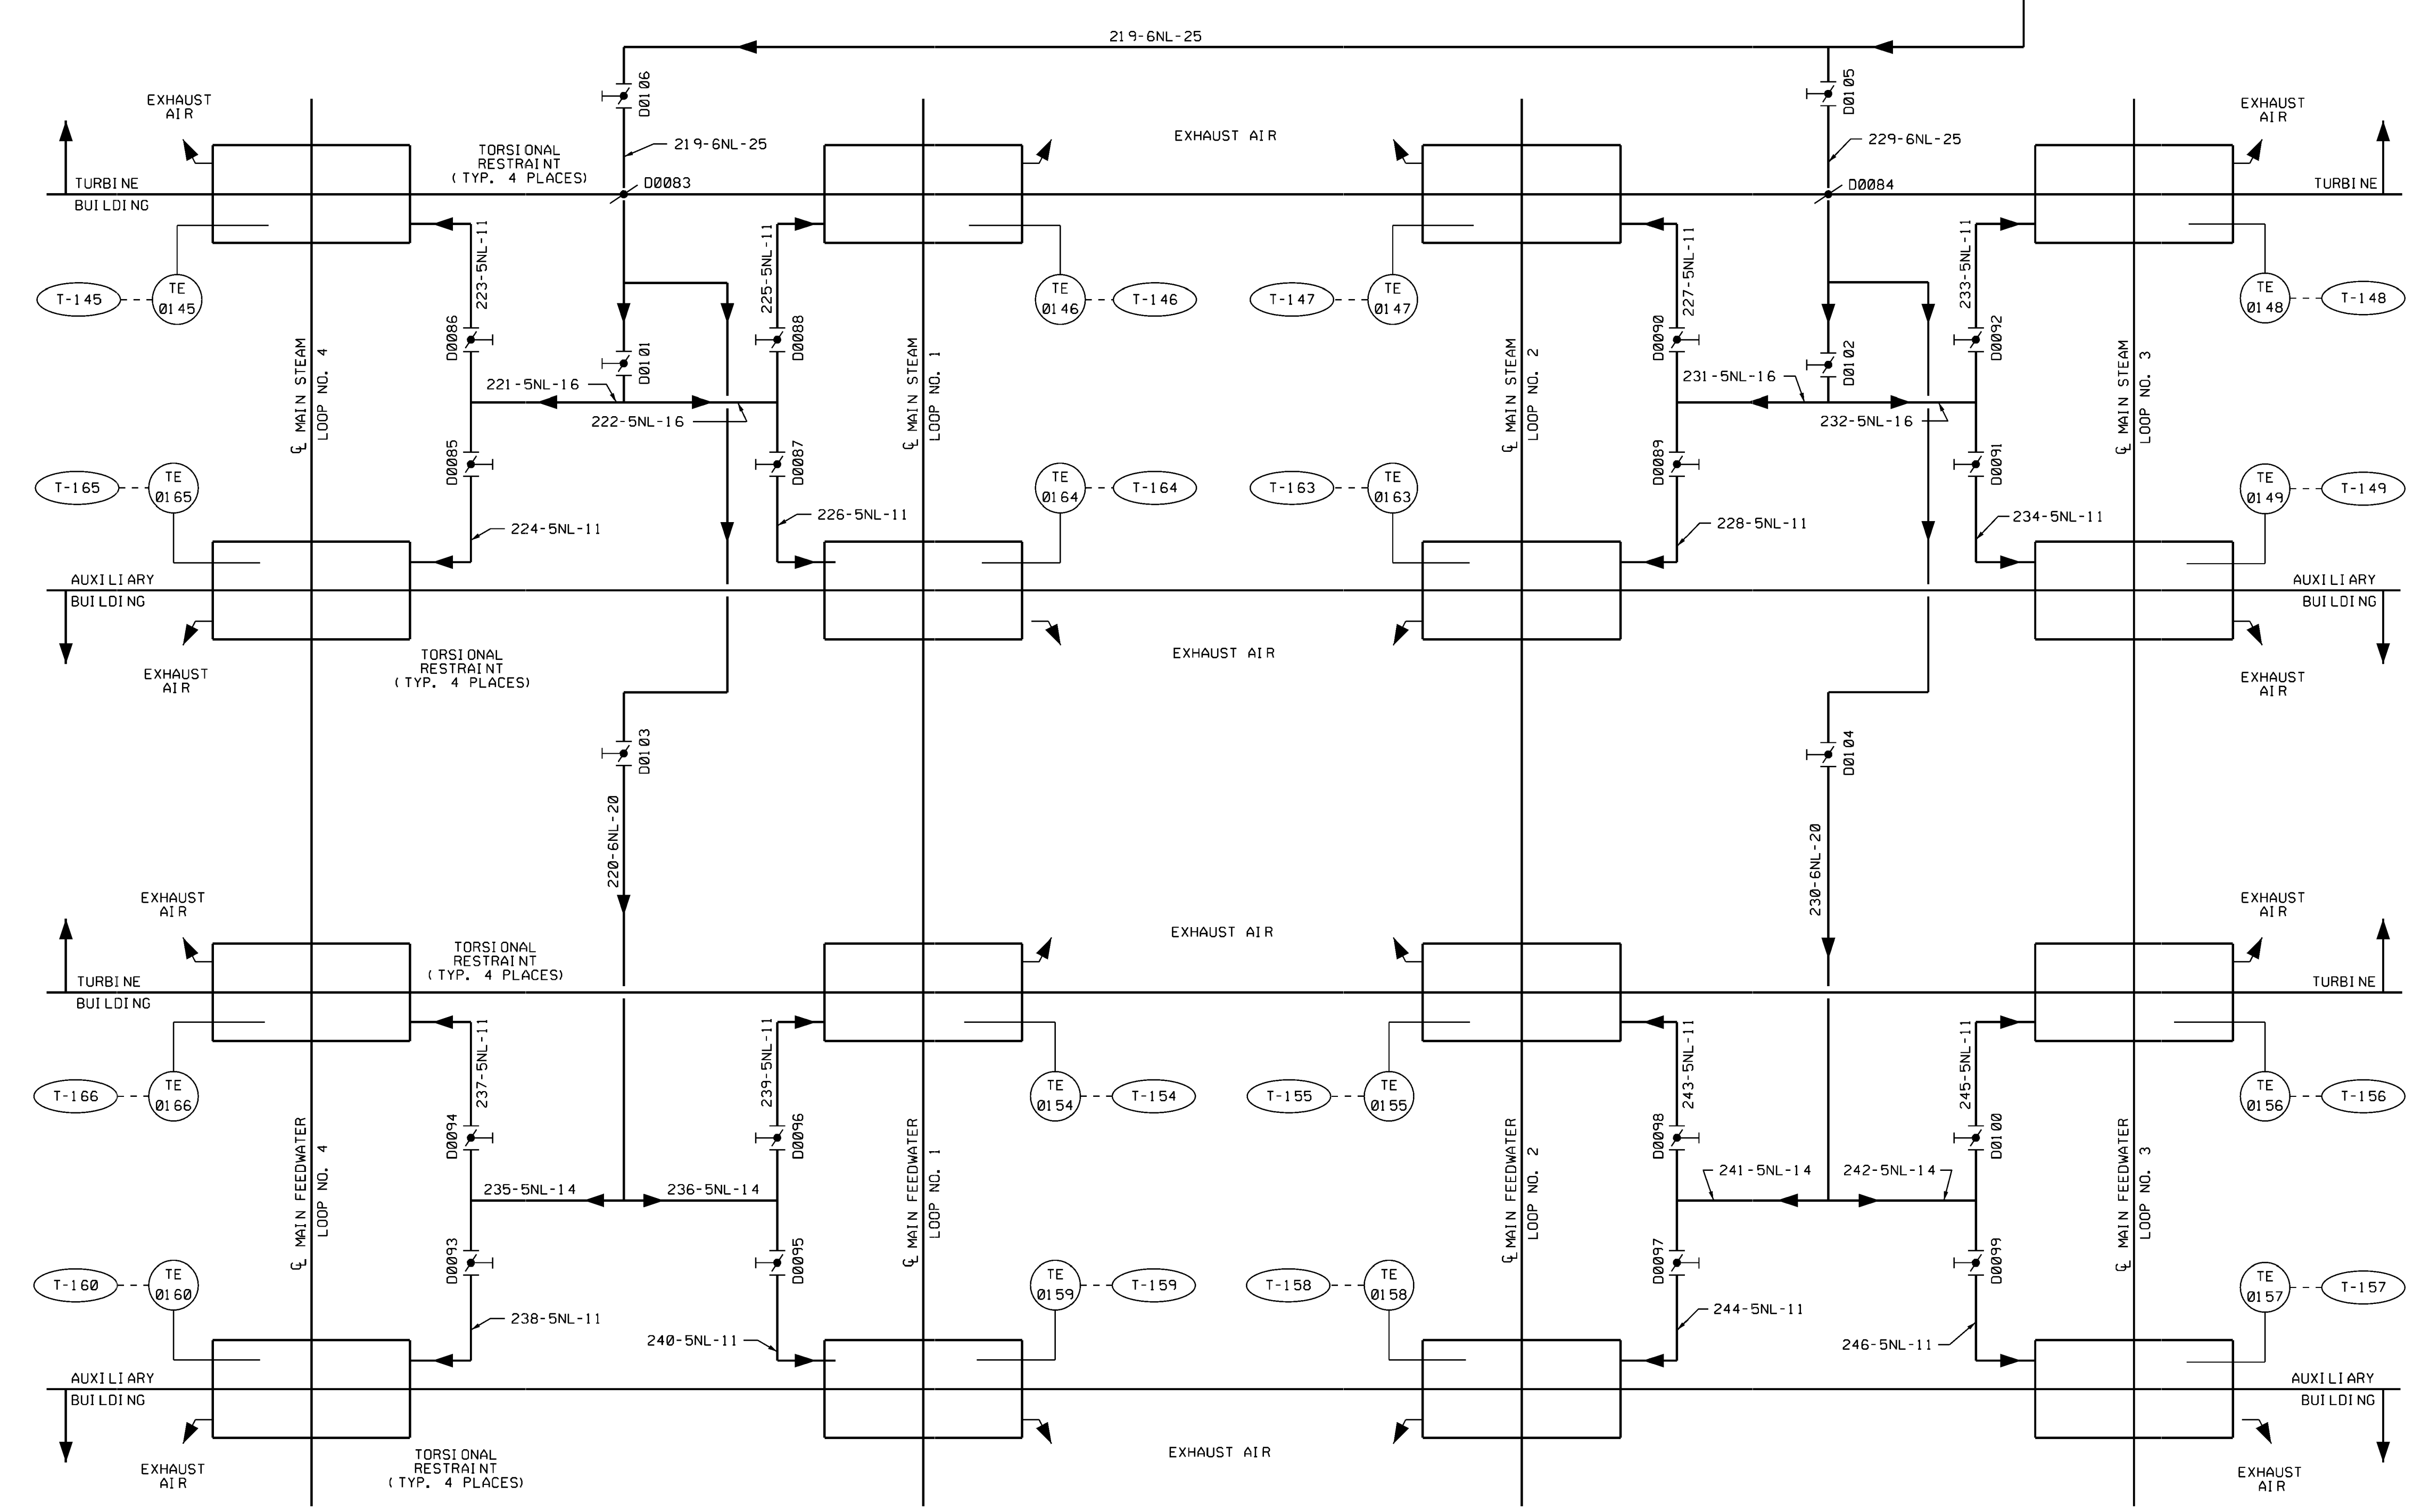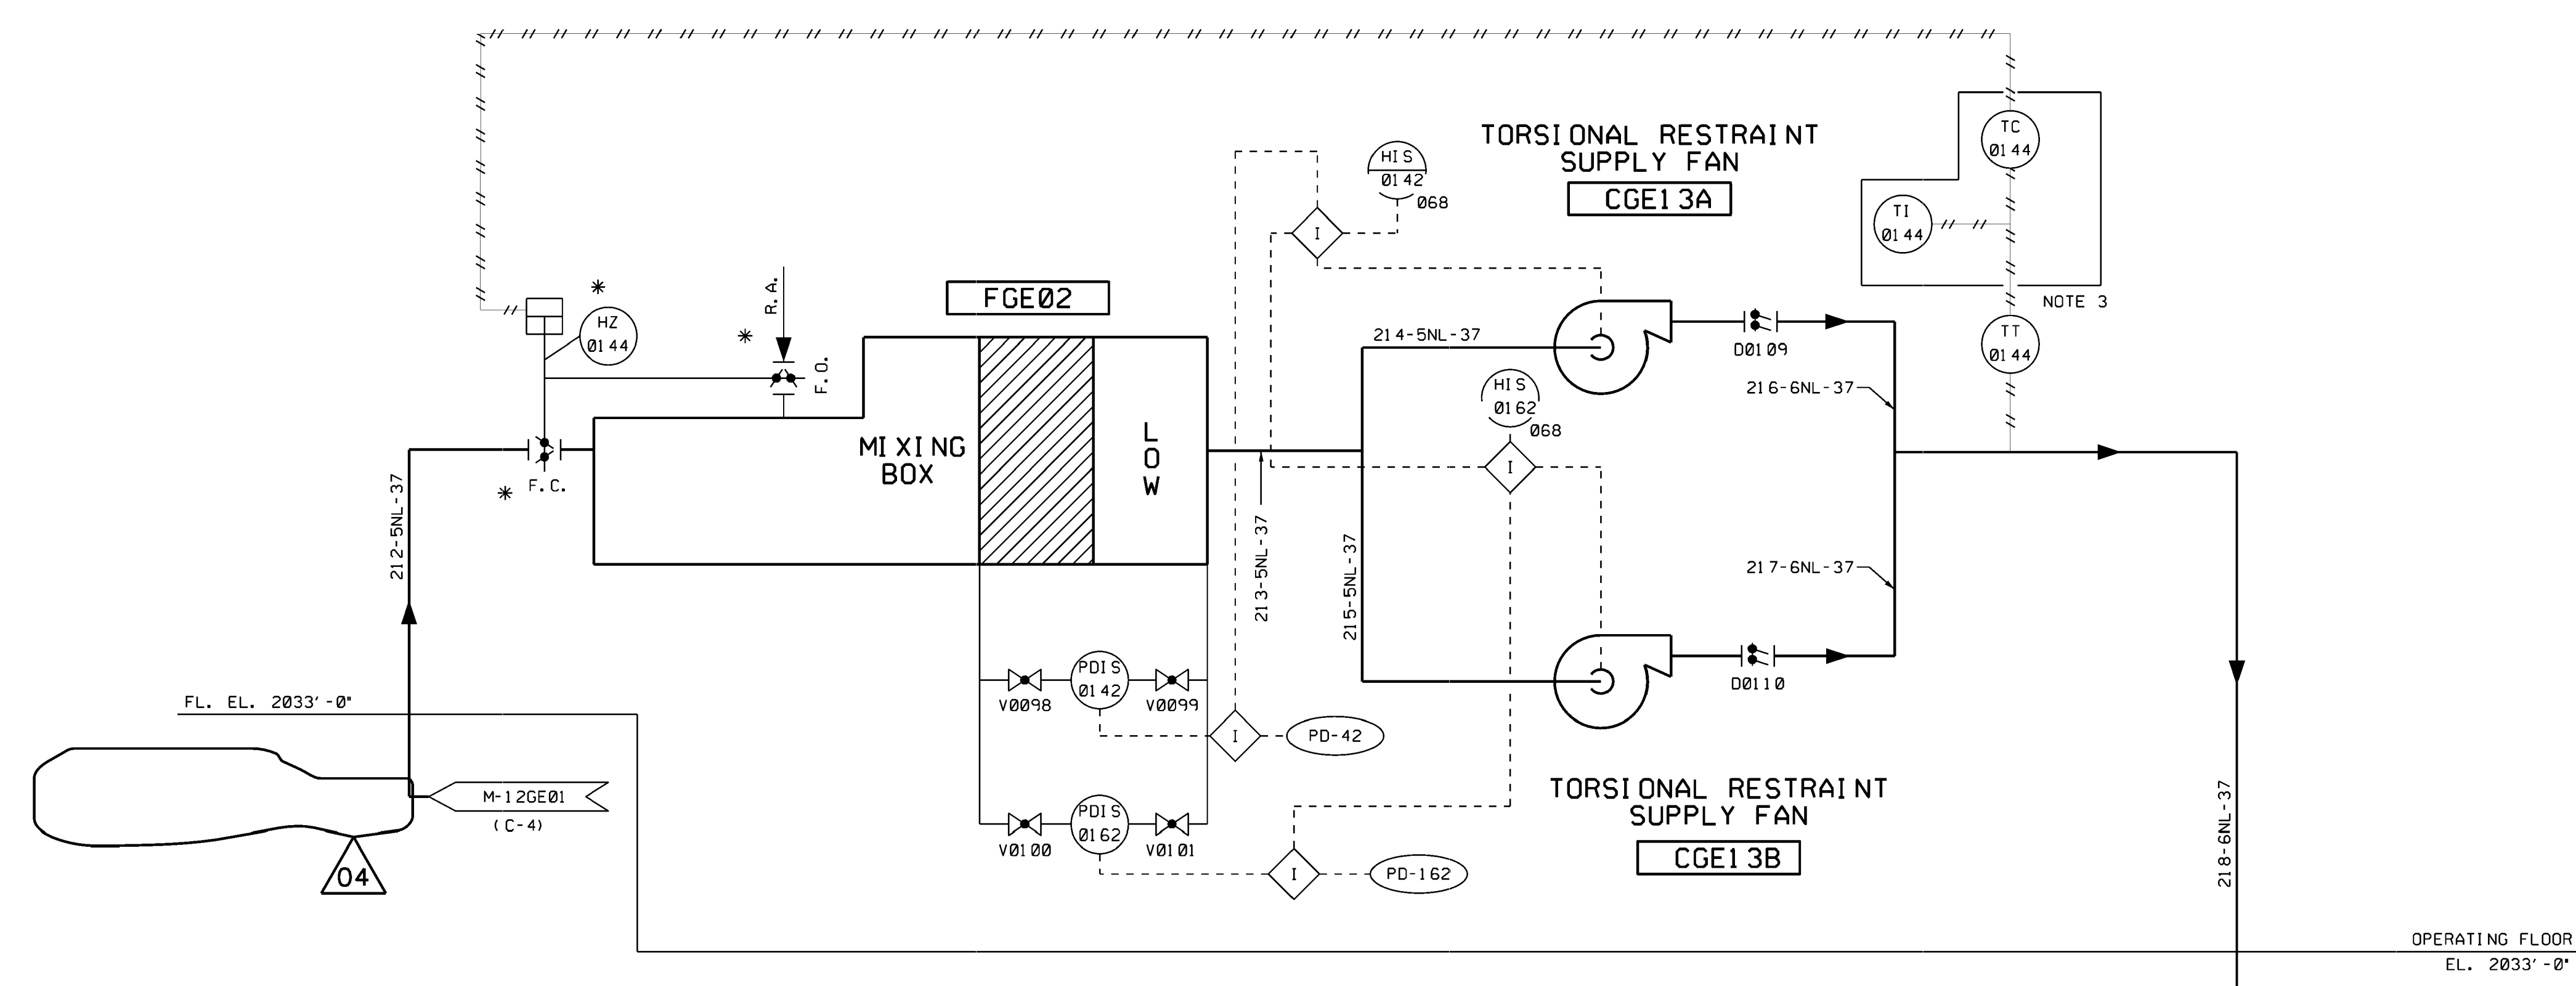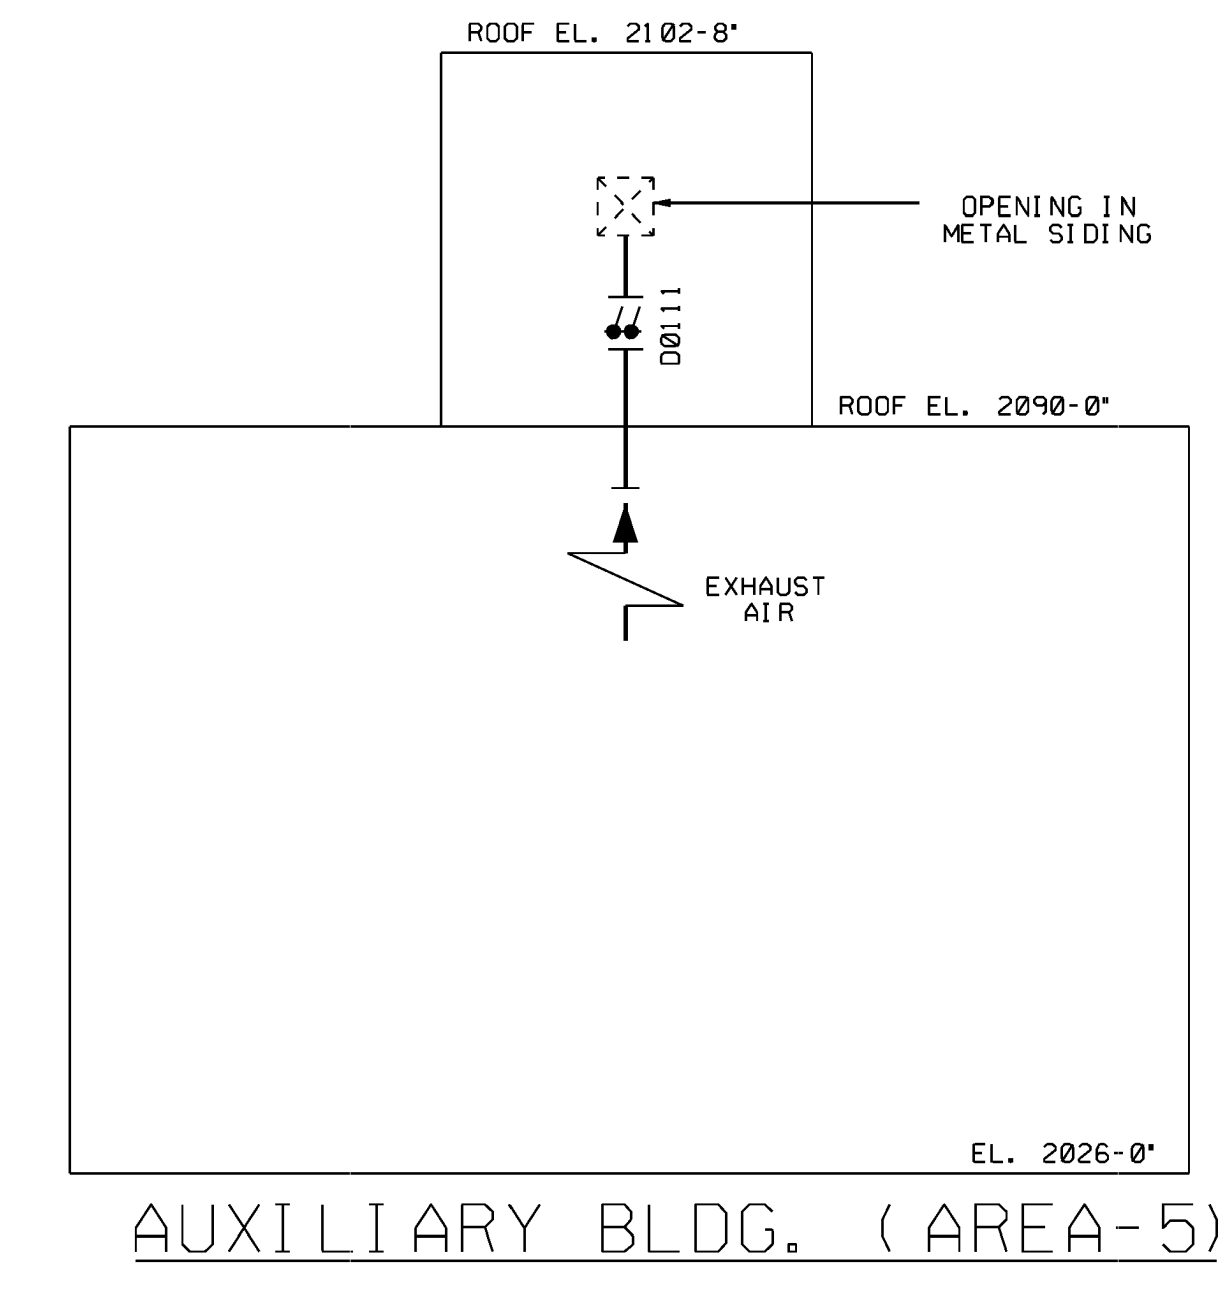


USAR FIG. 9.4-4-04

ESSENTIAL DRAWING			
REVISION	INCORPORATED	CR# 00043144	CHANGE
ISSUED	CHG. DOC.		PKG. NO.
THIS DWG. SUPERSEDES		REV.	THIS DWG. SUPERSEDES
REVISION NOTES:			
WOLF CREEK		ELECTRONIC APPROVAL	
NUCLEAR OPERATING CORPORATION			
PIPING AND INSTRUMENTATION DIAGRAM			
TURBINE BUILDING HVAC			
SCALE	DRAWING NUMBER	SHEET	REV
NONE	M-12GE04	04	

Ray Smith

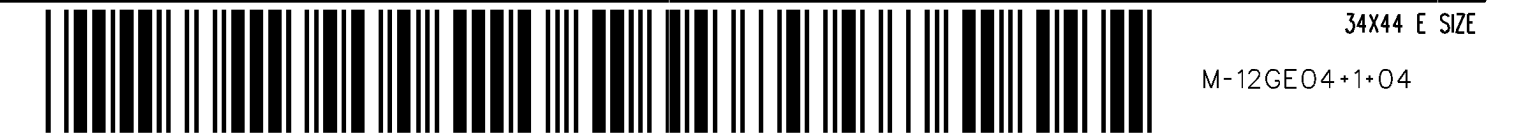

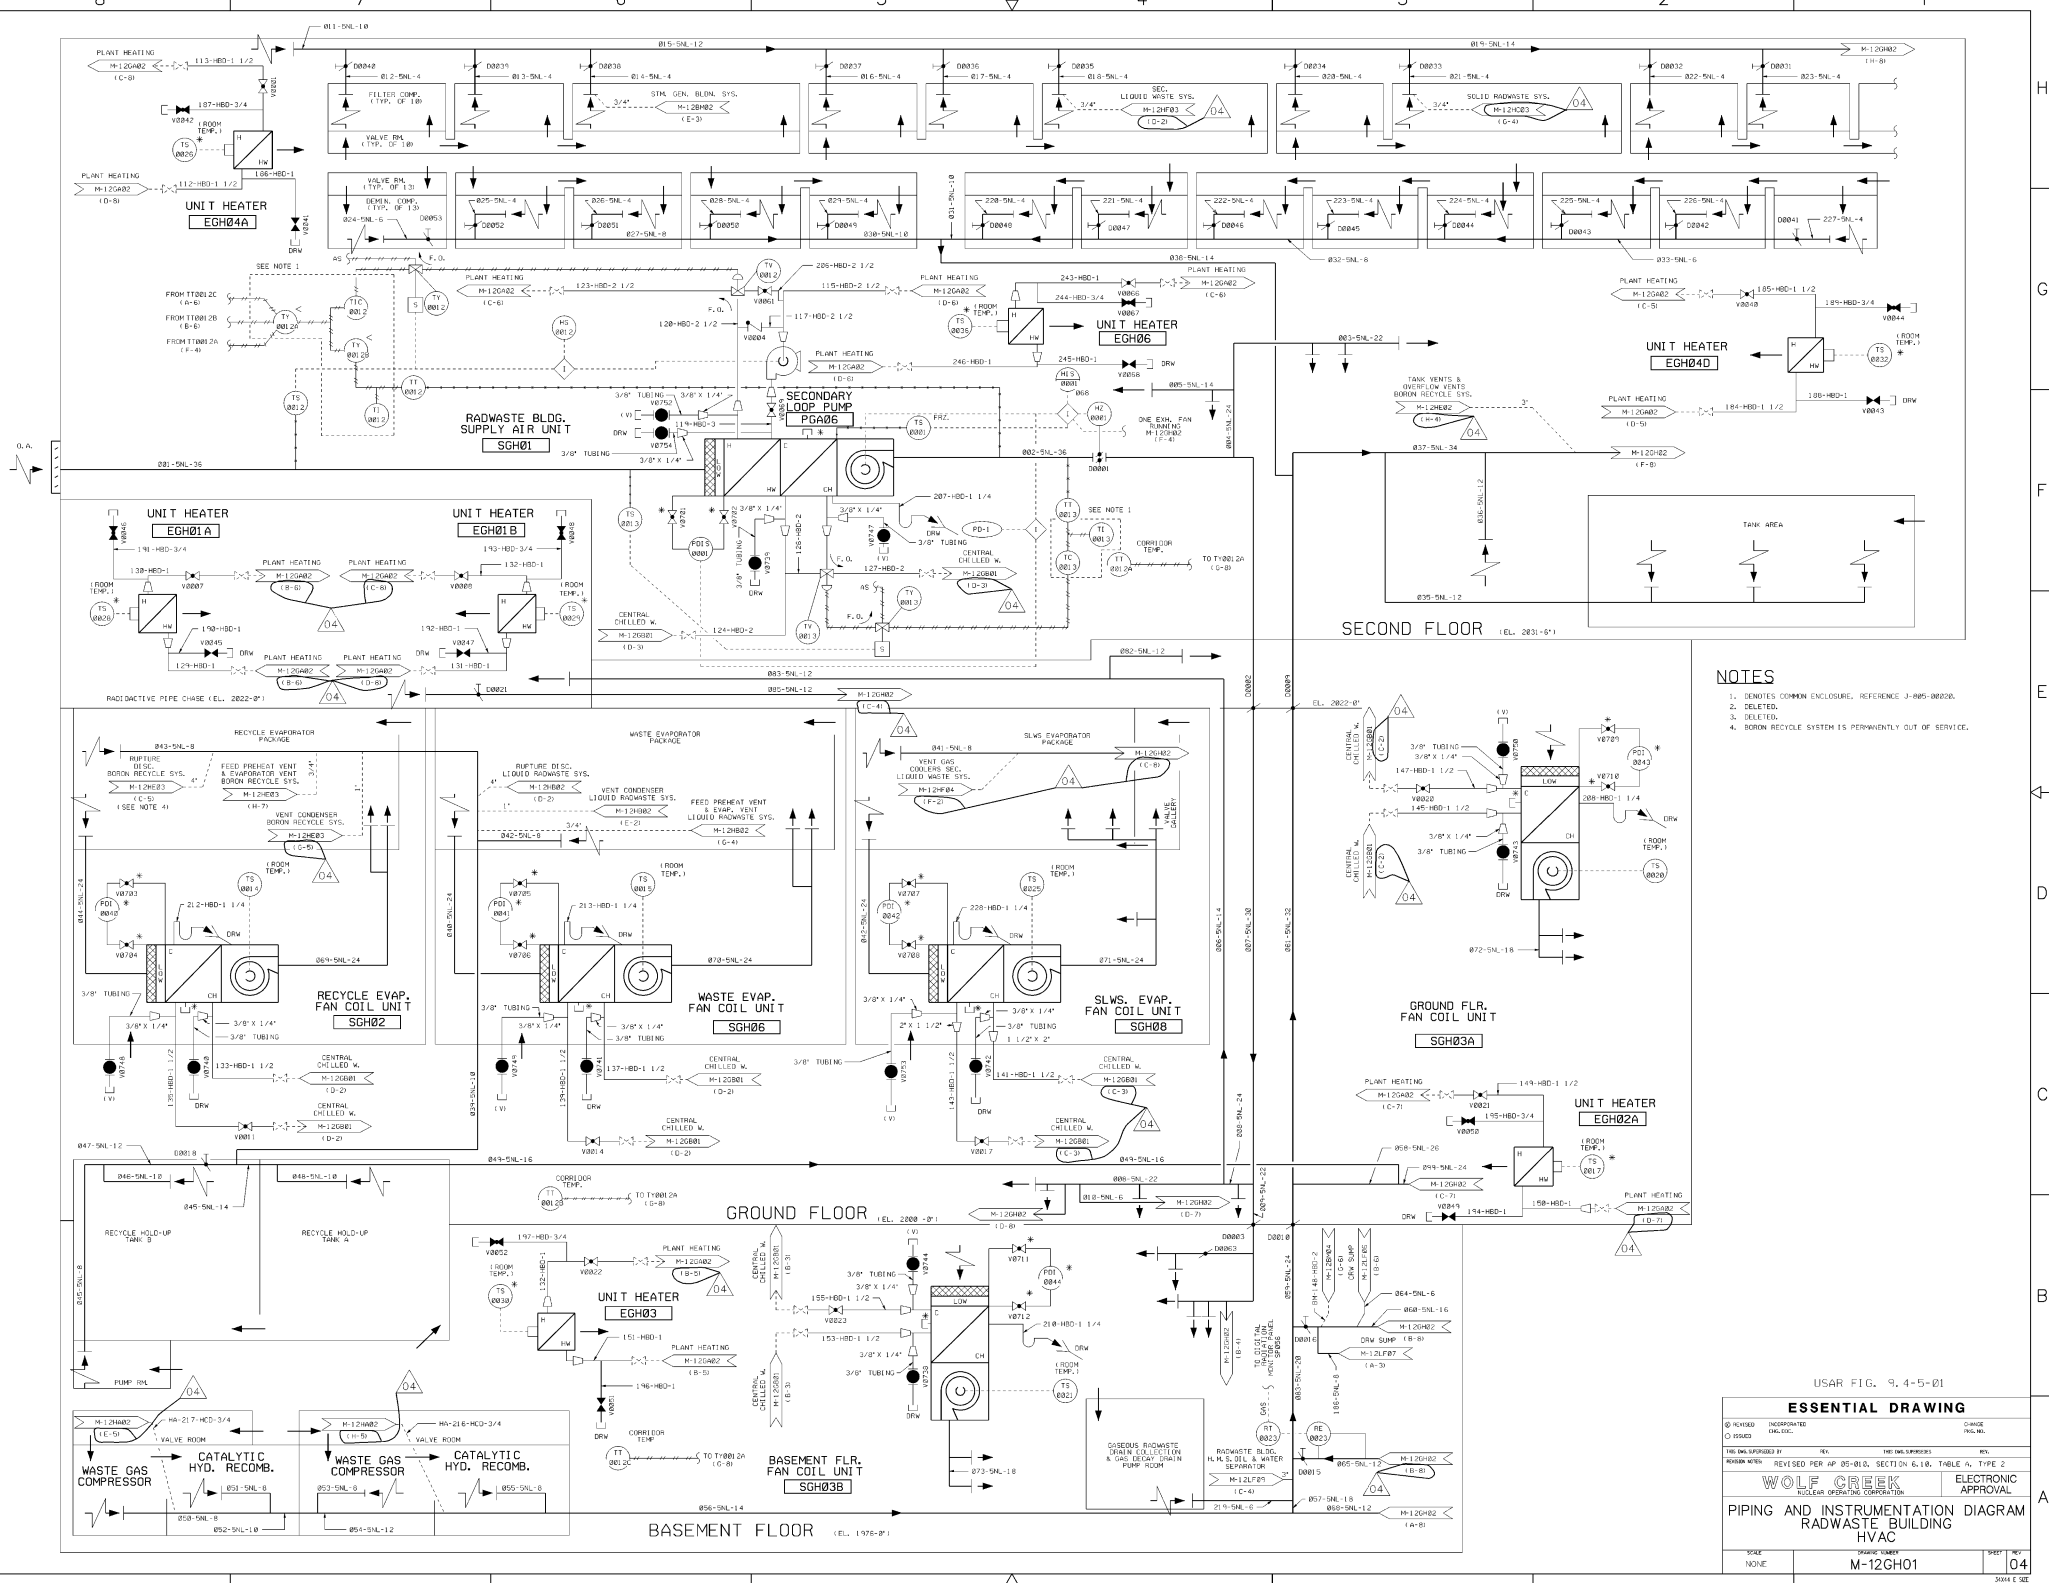

- NOTES**
1. IDENTIFY COMMON ENCLOSURE. REFERENCE J-895-00206.
 2. DELETED.
 3. DELETED.
 4. BORON RECYCLE SYSTEM IS PERMANENTLY OUT OF SERVICE.

USAR FIG. 3, 4-5-81

ESSENTIAL DRAWING

© 1980	INCORPORATED	DATE
010000	REVISED	10/16/05

THIS DRAWING IS THE PROPERTY OF WOLF CREEK CONSULTING ENGINEERS. IT IS TO BE USED ONLY FOR THE PROJECT AND SITE SPECIFICALLY IDENTIFIED HEREON. ANY REUSE OR MODIFICATION OF THIS DRAWING WITHOUT THE WRITTEN CONSENT OF WOLF CREEK CONSULTING ENGINEERS IS STRICTLY PROHIBITED.

WOLF CREEK CONSULTING ENGINEERS


PIPING AND INSTRUMENTATION DIAGRAM
RADWASTE BUILDING
HVAC

SCALE: NONE

SHEET NO. **04**

DATE: 10/16/05

Released by Document Services - Release Date: 09/16/05

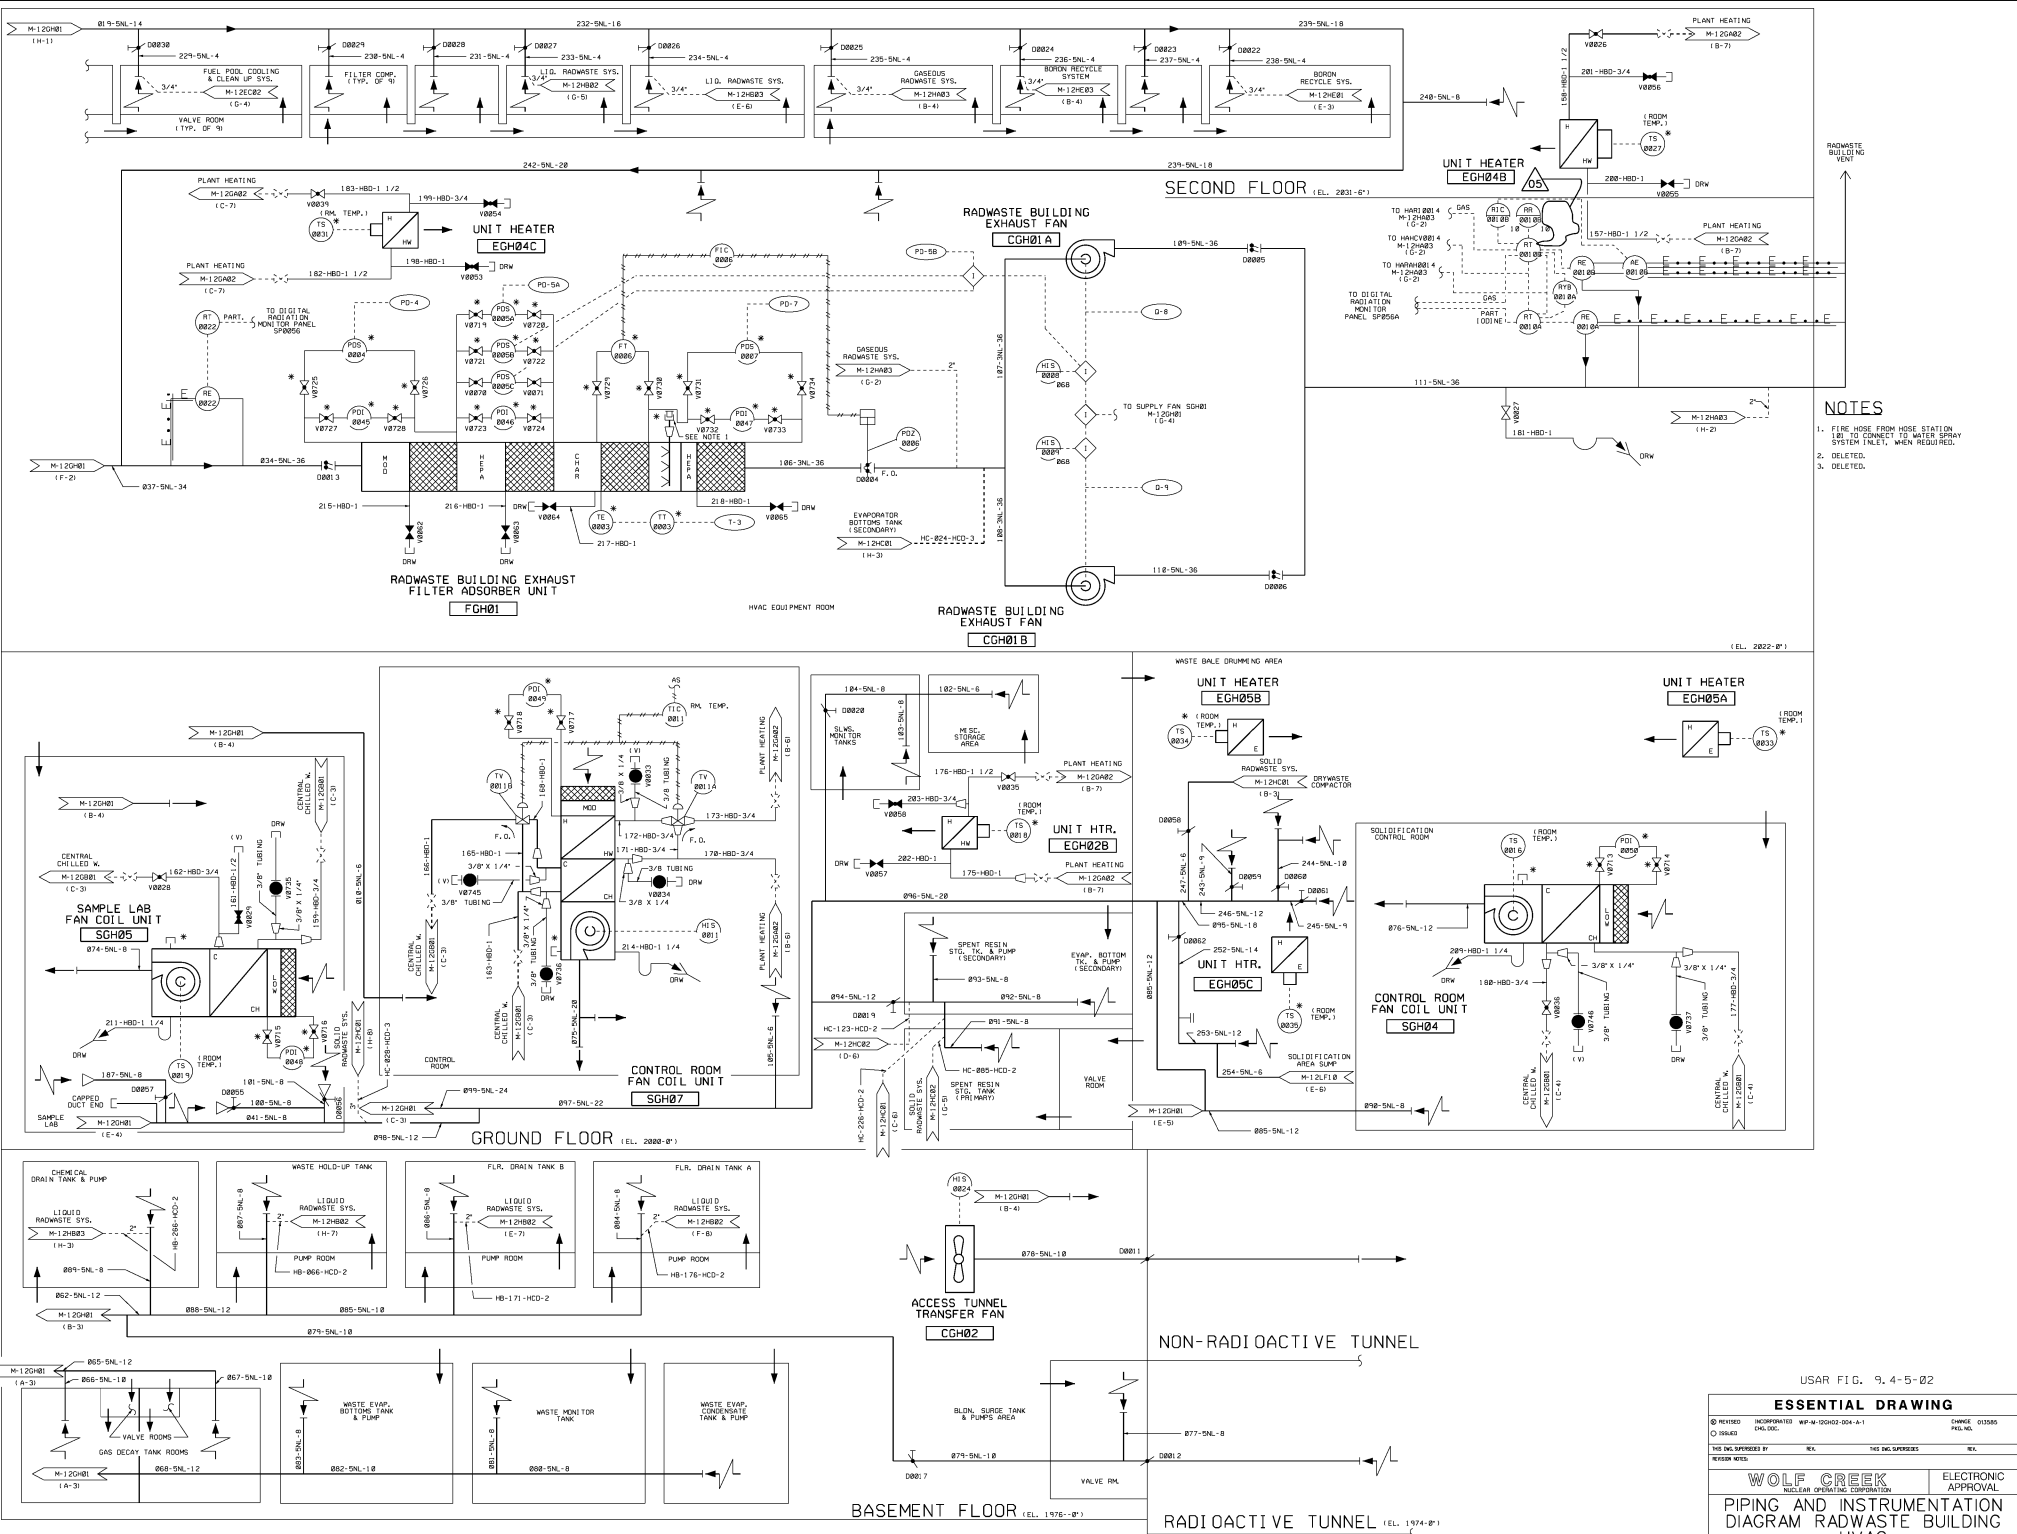

- NOTES**
1. FIRE HOSE FROM HOSE STATION IS TO CONNECT TO WATER SPRAY SYSTEM INLET, WHEN REQUIRED.
 2. DELETED.
 3. DELETED.

USAR FIG. 9.4-5-02

ESSENTIAL DRAWING


© REVISED INCORPORATED WP-4-200402-004-A-1 CHECKED 03580
 03/04/02 PLO/DOO
 THIS DRAWING IS THE PROPERTY OF WOLF CREEK. NO PARTS TO BE REPRODUCED OR TRANSMITTED IN ANY FORM OR BY ANY MEANS, ELECTRONIC OR MECHANICAL, WITHOUT PERMISSION IN WRITING FROM WOLF CREEK.

WOLF CREEK
 WOLF CREEK OPERATING CORPORATION
 ELECTRONIC APPROVAL

PIPING AND INSTRUMENTATION DIAGRAM RADWASTE BUILDING HVAC

SCALE: NONE DRAWING NUMBER: M-12GH02 SHEET NO: 05
 OF 05

DATE: 03/04/02
 W-12GH02-1-03

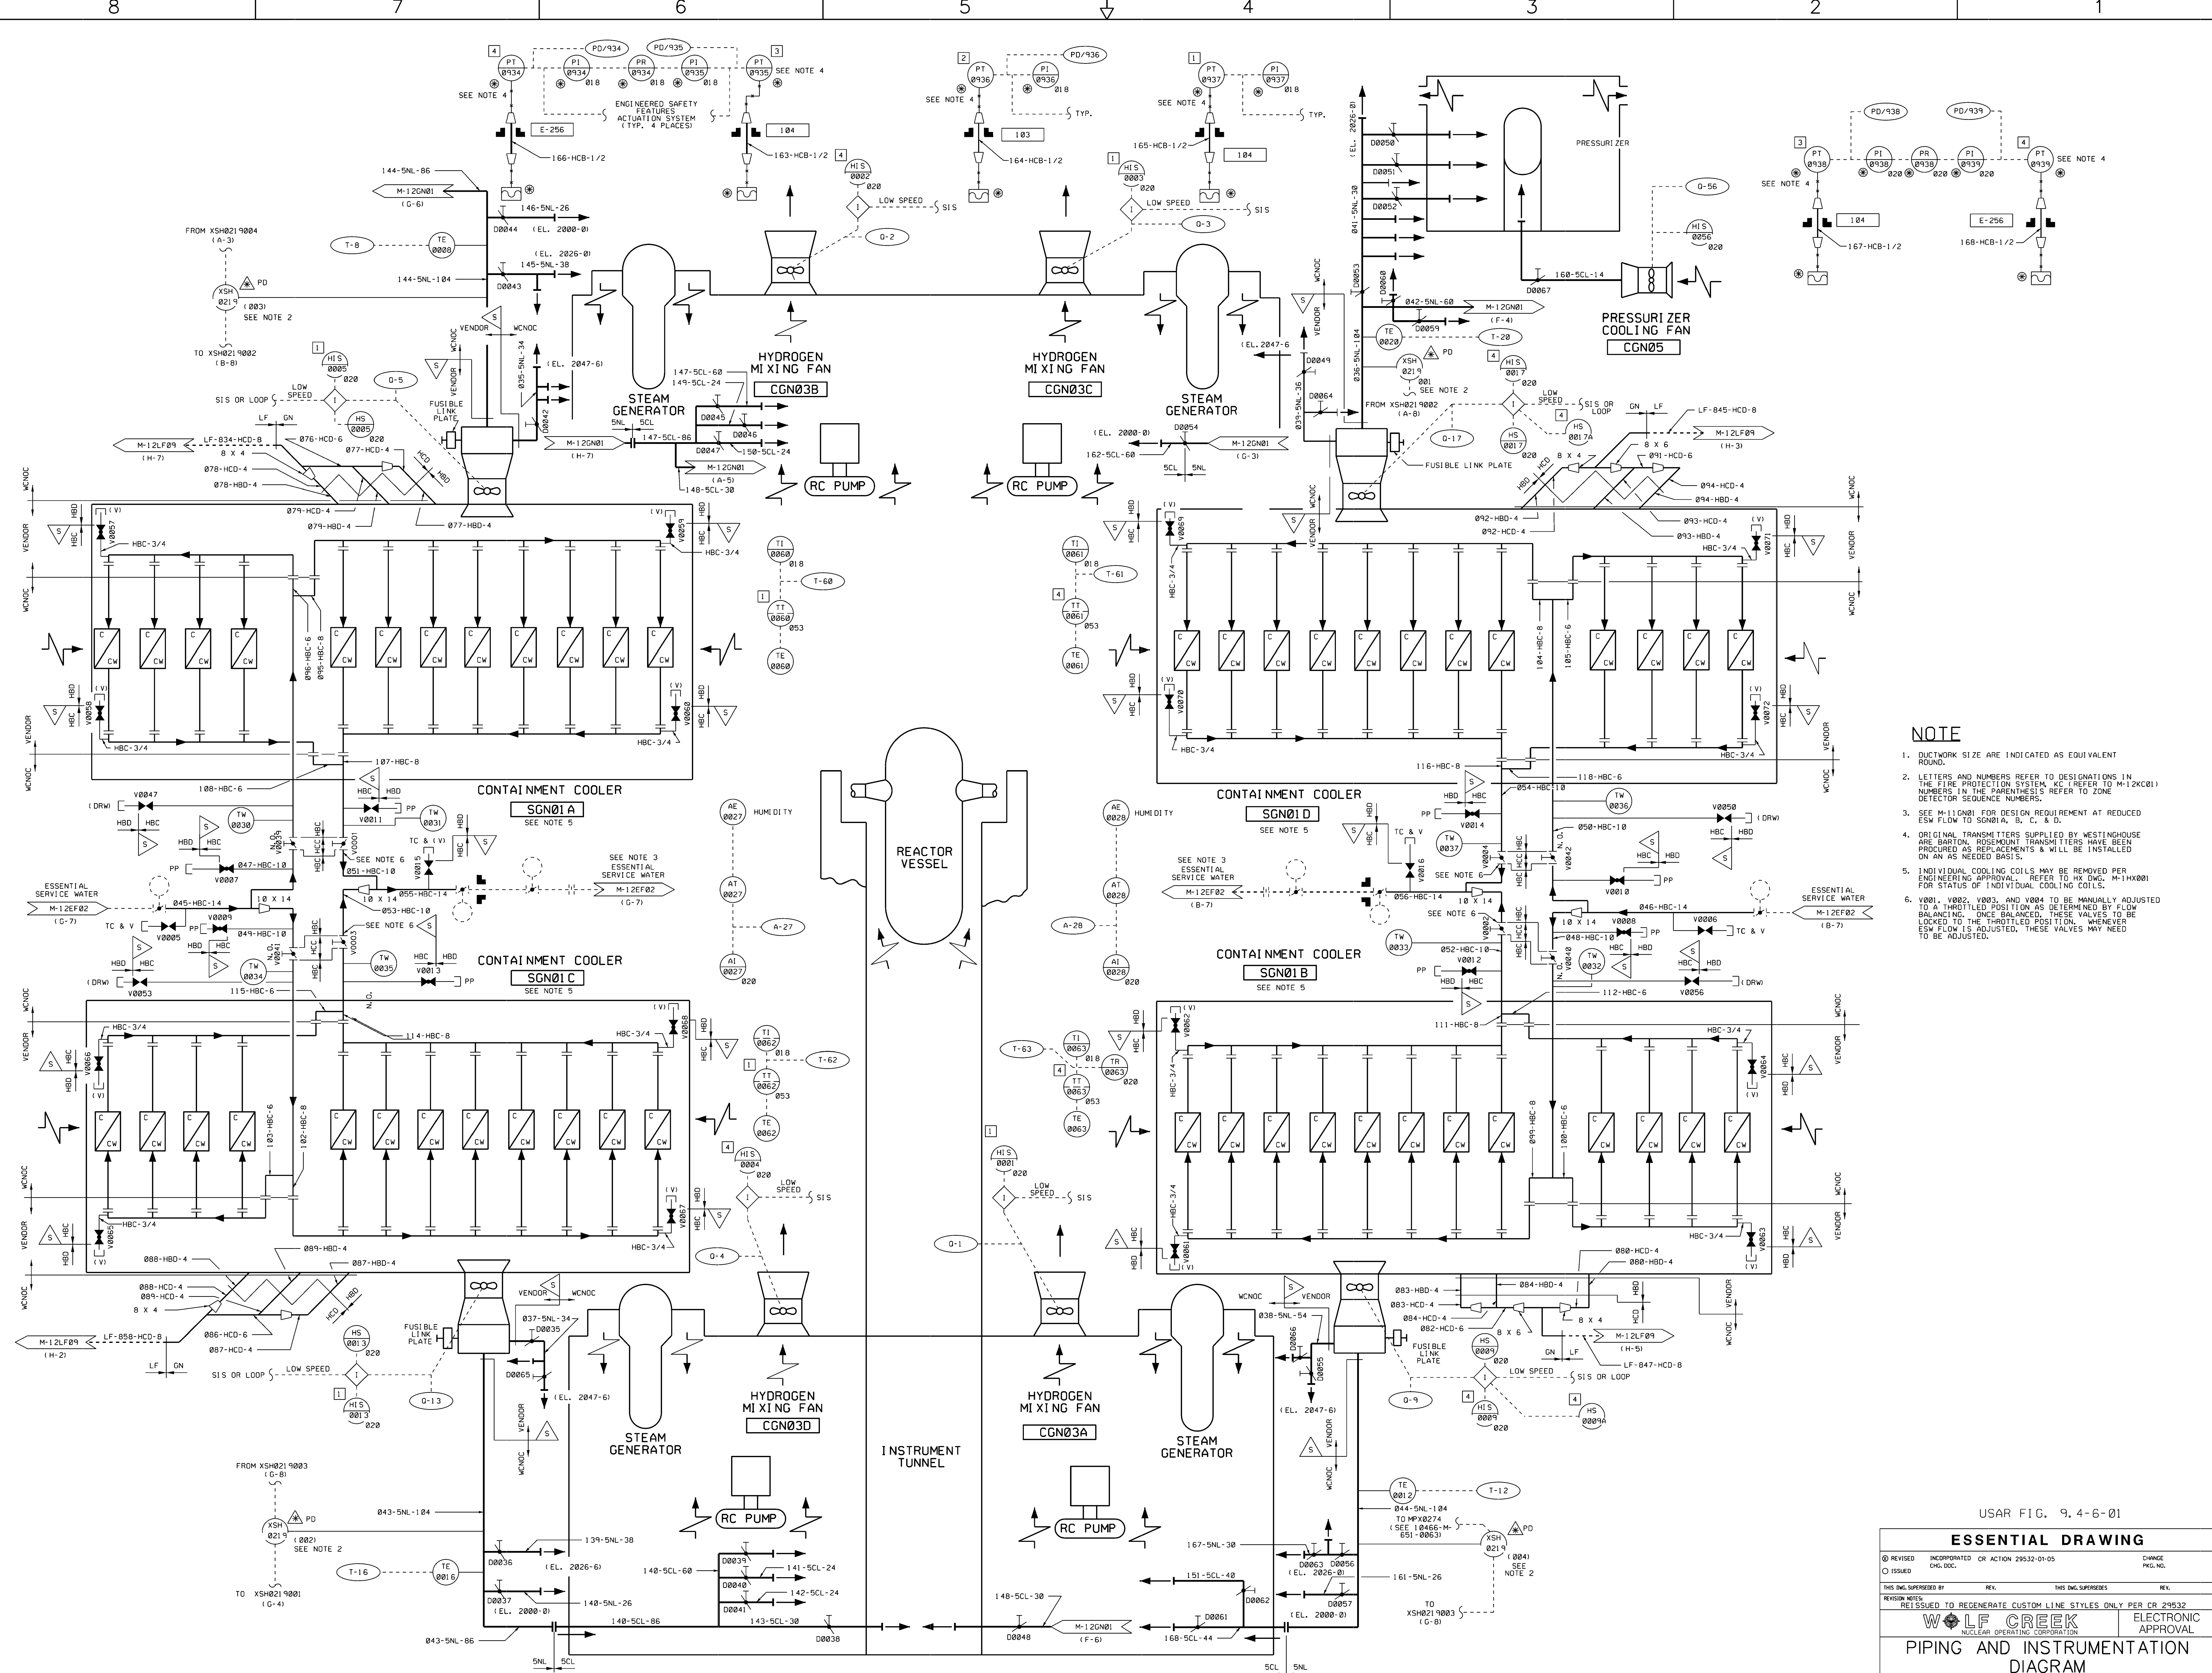


- NOTE**
1. DUCTWORK SIZE ARE INDICATED AS EQUIVALENT ROUND.
 2. LETTERS AND NUMBERS REFER TO DESIGNATIONS IN THE FIRE PROTECTION SYSTEM, KE (REFER TO M-12K01) NUMBERS IN THE PARENTHESES REFER TO ZONE DETECTOR SEQUENCE NUMBERS.
 3. SEE M-11GN01 FOR DESIGN REQUIREMENT AT REDUCED ESW FLOW TO SGN01A, B, C, & D.
 4. ORIGINAL TRANSMITTERS SUPPLIED BY WESTINGHOUSE ARE BARTON. ROSEMOUNT TRANSMITTERS HAVE BEEN PROCURED AS REPLACEMENTS & WILL BE INSTALLED ON AN AS NEEDED BASIS.
 5. INDIVIDUAL COOLING COILS MAY BE REMOVED PER ENGINEERING APPROVAL. REFER TO HK DWG, M-1X001 FOR STATUS OF INDIVIDUAL COOLING COILS.
 6. V0801, V0802, V0803, AND V0804 TO BE MANUALLY ADJUSTED TO A THROTTLED POSITION AS DETERMINED BY FLOW BALANCING. ONCE BALANCED, THESE VALVES TO BE LOCKED TO THE THROTTLED POSITION. WHENEVER ESW FLOW IS ADJUSTED, THESE VALVES MAY NEED TO BE ADJUSTED.

USAR FIG. 9, 4-6-01

ESSENTIAL DRAWING			
REVISION	DESCRIPTION OR ACTION	DATE	BY
0	ISSUED	29532-01-05	CHW/ML
THIS DWG SUPERSEDES		REV.	THIS DWG SUPERSEDES
<p>WOLF CREEK NUCLEAR OPERATING CORPORATION</p> <p>PIPING AND INSTRUMENTATION DIAGRAM</p> <p>CONTAINMENT COOLING SYSTEM</p>			
SCALE	DRAWING NUMBER	SHEET	REV.
NONE	M-12GN01	24	


Released by Document Services
Release Date: 2011.12.12 08:57:42 -0500

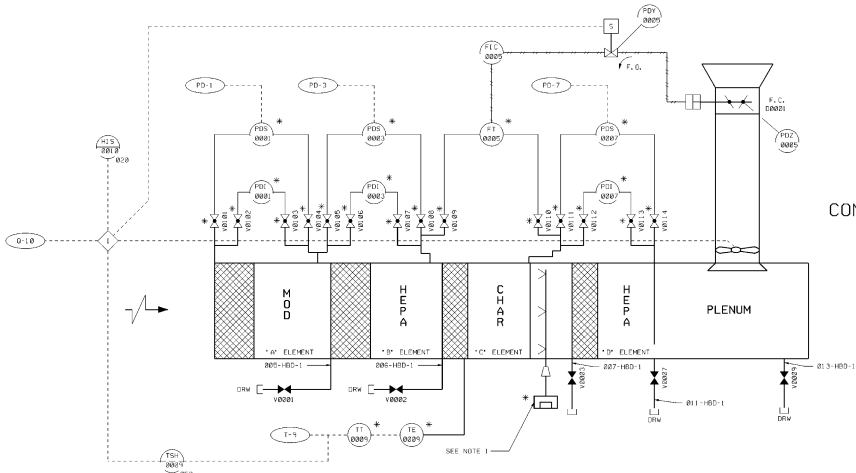

CONTAINMENT ATMOSPHERIC CONTROL SYSTEM FILTRATION TRAIN
FGR01 A

CONTAINMENT ATMOSPHERIC CONTROL SYSTEM FAN
CGR01 A

NOTES
1. FIRE HOSE FROM HOSE STATION 123 (FOR BOTH UNITS) TO CONNECT TO WATER SPRAY SYSTEM 1 MEET, WHEN REQUIRED.

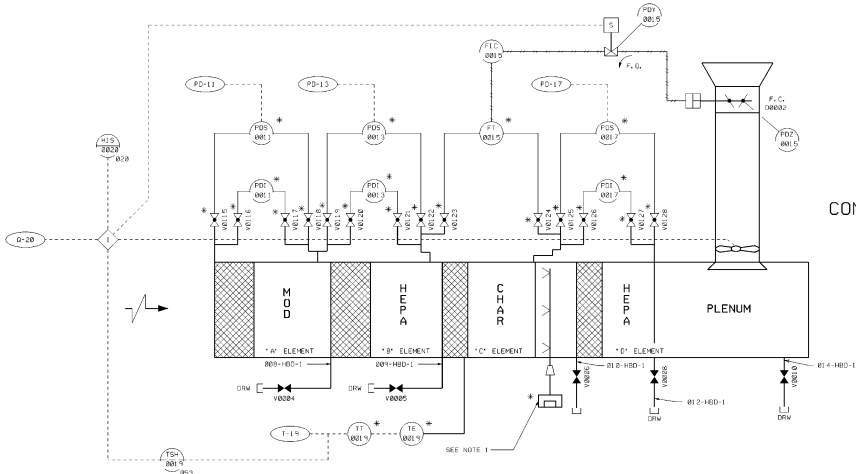


CONTAINMENT ATMOSPHERIC CONTROL SYSTEM FILTRATION TRAIN
FGR01 B


CONTAINMENT ATMOSPHERIC CONTROL SYSTEM FAN
CGR01 B

USAR FIG. 9.4-6-03

ESSENTIAL DRAWING			
REVISION	DESCRIPTION	DATE	BY
1	ISSUED	08-01-02	...
THIS WAS SUPERSEDED BY:		NO.	DATE
REVISION		NO.	DATE
ELECTRONICALLY CONVERTED PER AP 05-012			
WOLF CREEK		ELECTRONIC APPROVAL	
PIPING & INSTRUMENTATION DIAGRAM CONTAINMENT ATMOSPHERIC CONTROL SYSTEM			
TITLE	ISSUE NUMBER	SHEET	REV.
NONE	M-12GR01	01	01

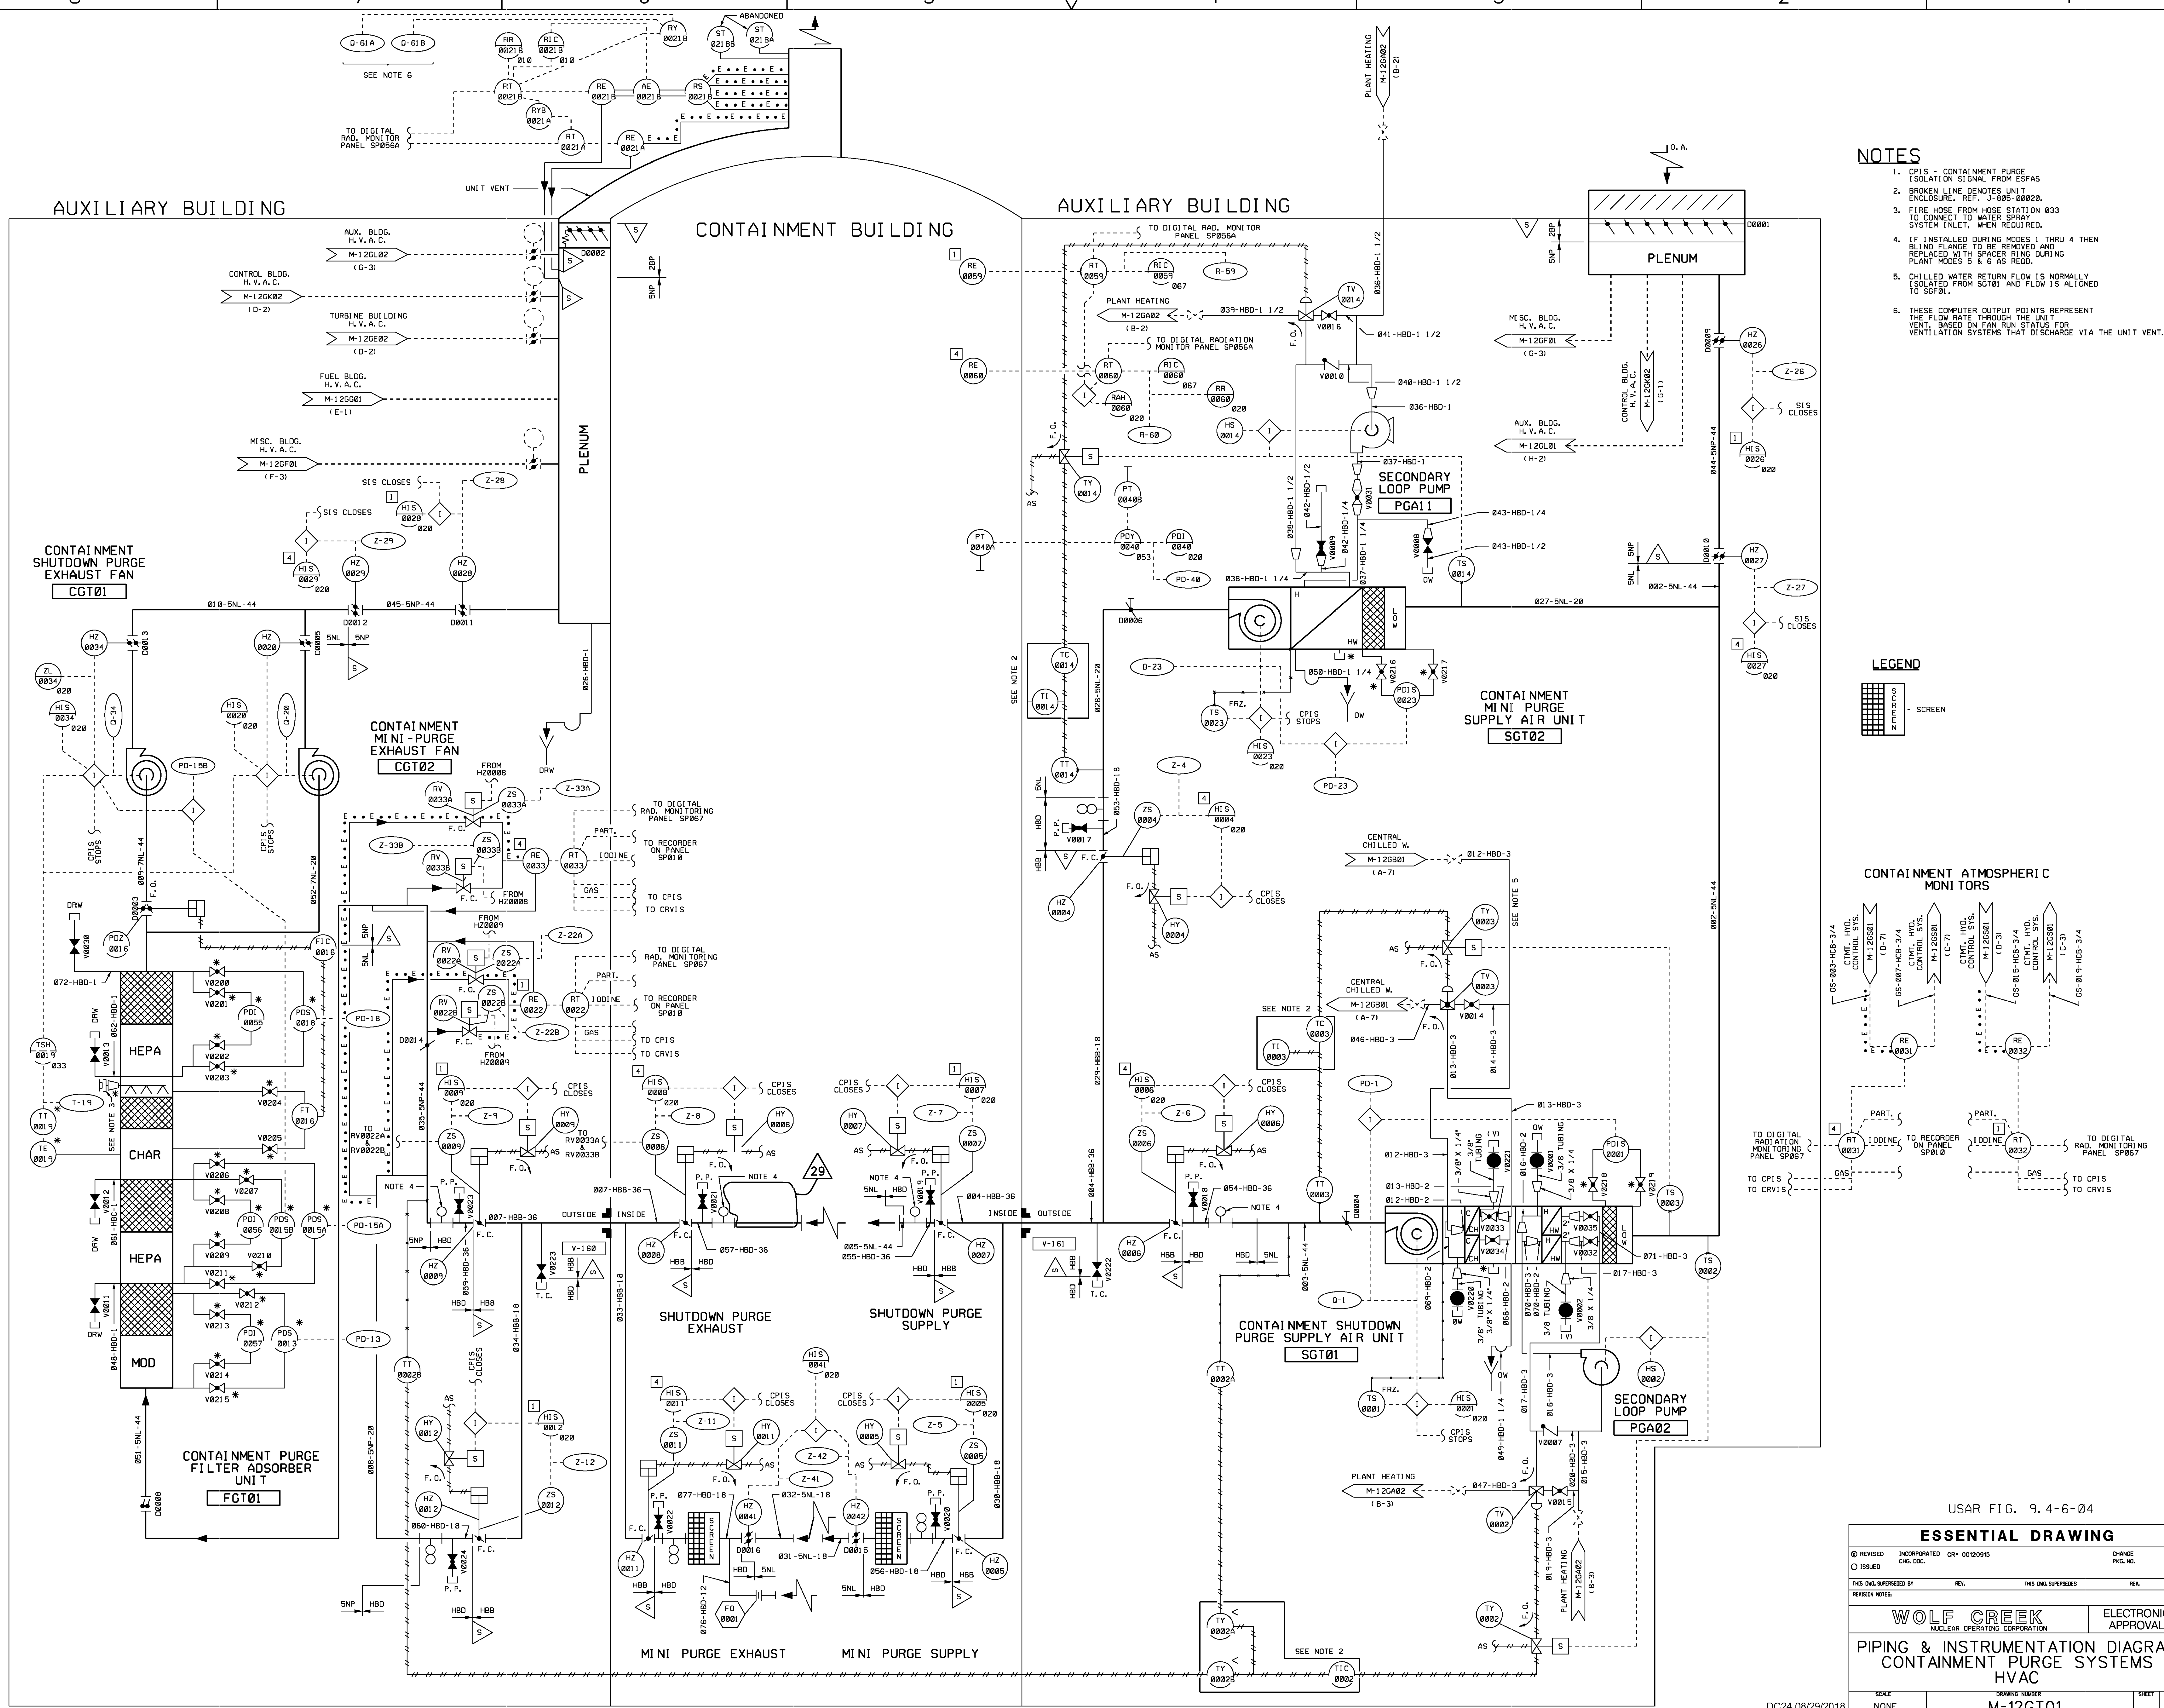

- NOTES**
1. CPIS - CONTAINMENT PURGE ISOLATION SIGNAL FROM ESPAS TO CONNECT TO WATER SPRAY SYSTEM INLET, WHEN REQUIRED.
 2. FIRE HOSE FROM HOSE STATION 033 TO CONNECT TO WATER SPRAY SYSTEM INLET, WHEN REQUIRED.
 3. IF INSTALLED DURING MODES 1 THRU 4 THEN BLEND FLANGE TO BE REMOVED AND REPLACED WITH SPACER RING DURING PLANT MODES 5 & 6 AS REQD.
 4. CHILLED WATER RETURN FLOW IS NORMALLY ISOLATED FROM SGT01 AND FLOW IS ALIGNED TO SGT01.
 5. THESE COMPUTER OUTPUT POINTS REPRESENT THE FLOW RATE THROUGH THE UNIT VENT, BASED ON FAN RUN STATUS FOR VENTILATION SYSTEMS THAT DISCHARGE VIA THE UNIT VENT.

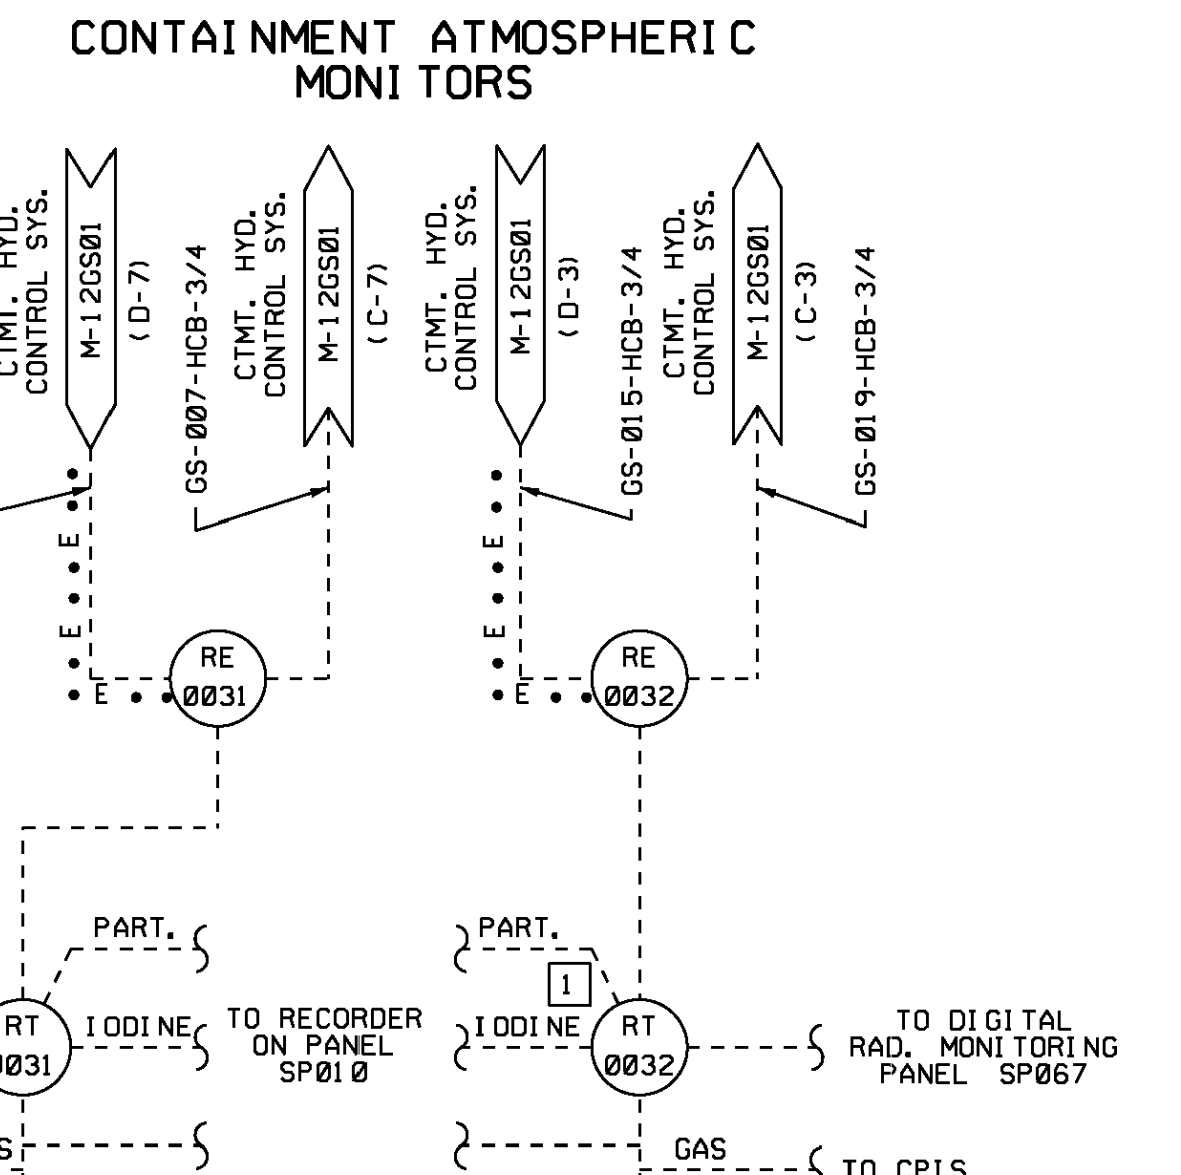



USAR FIG. 9.4-6-04

ESSENTIAL DRAWING

REVISED	INCORPORATED	CR# 00120915	CHANGE
ISSUED	CDC-000		REV. NO.
THIS Dwg. SUPERSEDES		REV. NO.	
REVISION NOTES		ELECTRONIC APPROVAL	
<p>WOLF CREEK NUCLEAR OPERATING CORPORATION</p>		<p>ELECTRONIC APPROVAL</p>	
<p>PIPING & INSTRUMENTATION DIAGRAM CONTAINMENT PURGE SYSTEMS HVAC</p>			
SCALE	DRAWING NUMBER	SHEET	REV.
NONE	M-12GT01	29	29

DC24 08/29/2018

3444 E SHE

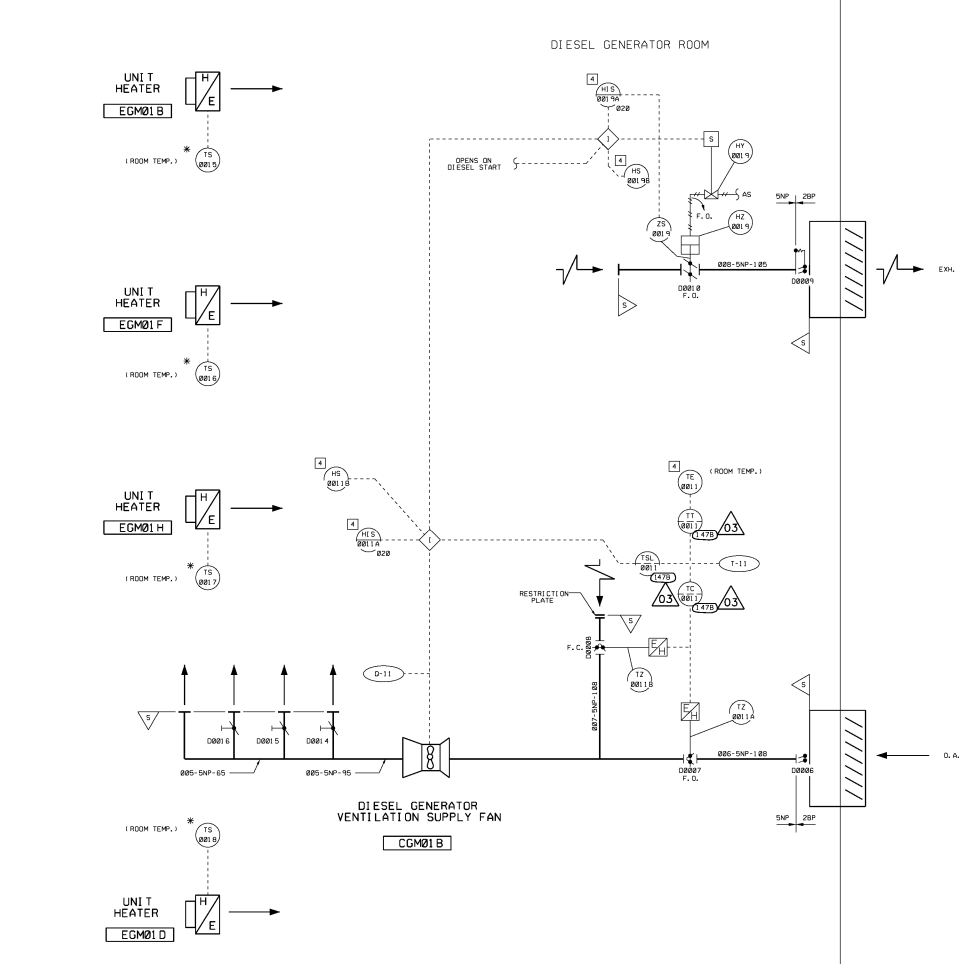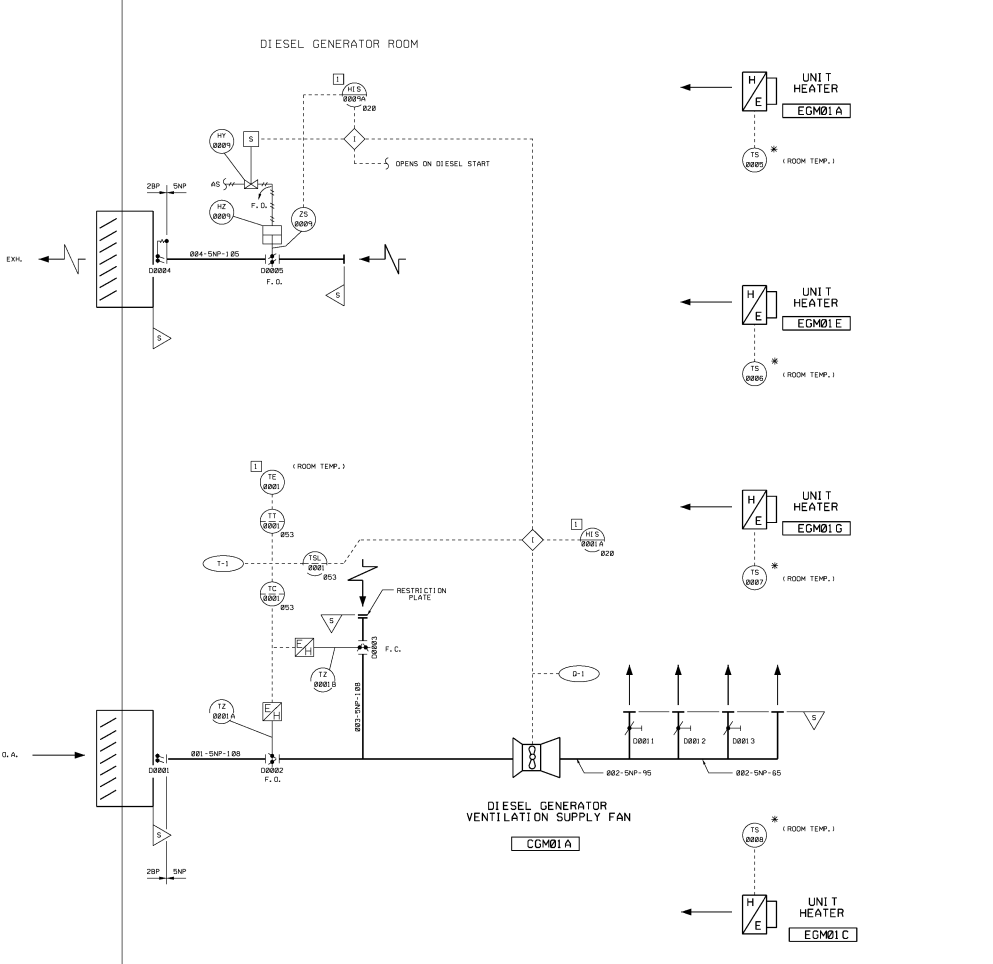

USAR FIG. 9.4-7-00

ESSENTIAL DRAWING

① REVISED INCORPORATED WFM/DCM/001A/1 CHANGE 010800
 ENG. DOC. FILE NO.
 ② ISSUED
 THIS ONE SUPERSEDES BY: N/A THIS ONE SUPERSEDES BY: N/A
 REVISION NOTES:

WOLF CREEK ELECTRONIC APPROVAL
 NUCLEAR OPERATING CORPORATION



PIPING & INSTRUMENTATION
DIAGRAM DIESEL GENERATORS
BUILDING HVAC

SCALE: NONE SHEET: 007
 NONE M-12GM01 01 03
 28911 C 02

Piping & Instrumentation
 Prepared by: [Name] Checked by: [Name]
 Date: 01/13/00



ESSENTIAL SERVICE WATER
PUMPHOUSE HVAC.

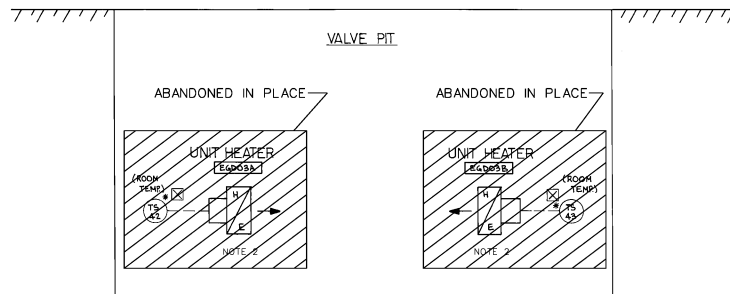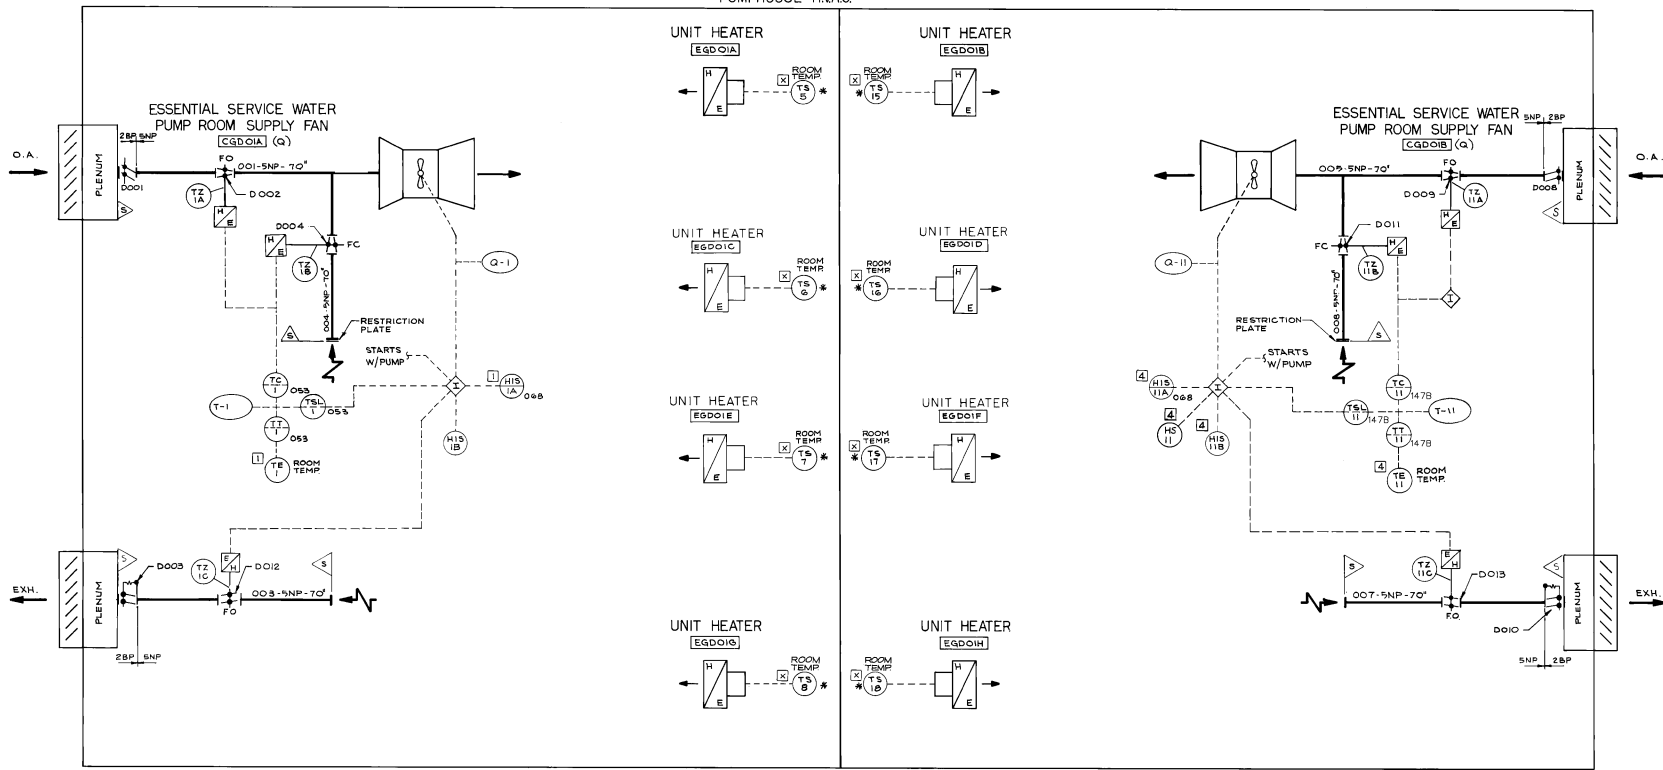


NOTE:
 1. DRAWING APPLICABLE TO WOLF CREEK UNIT 1 ONLY.
 2. UNIT HEATER & TEMPERATURE SWITCH ARE ABANDONED IN PLACE.

USAR FIG. 9.4-8-00

ESSENTIAL DRAWING			
REVISION	INCORPORATED	W-P-M-K2G001-008-A-1	CHANGE 014592
DATE	04/05/00		FILE NO.
DESIGNED BY	SK	NO. OF APPROVES	SK
REVISION NOTES	QUANTITIES REVISIONS TO NO. W-P-M-K2G001-008-A-1 NOT RECORDED.		
		ELECTRONIC APPROVAL	
PIPING & INSTRUMENTATION DIAGRAM ESSENTIAL SERVICE WATER PUMP HOUSE HVAC			

DATE: NONE PROJECT NAME: M-K2G001 SHEET NO: 12



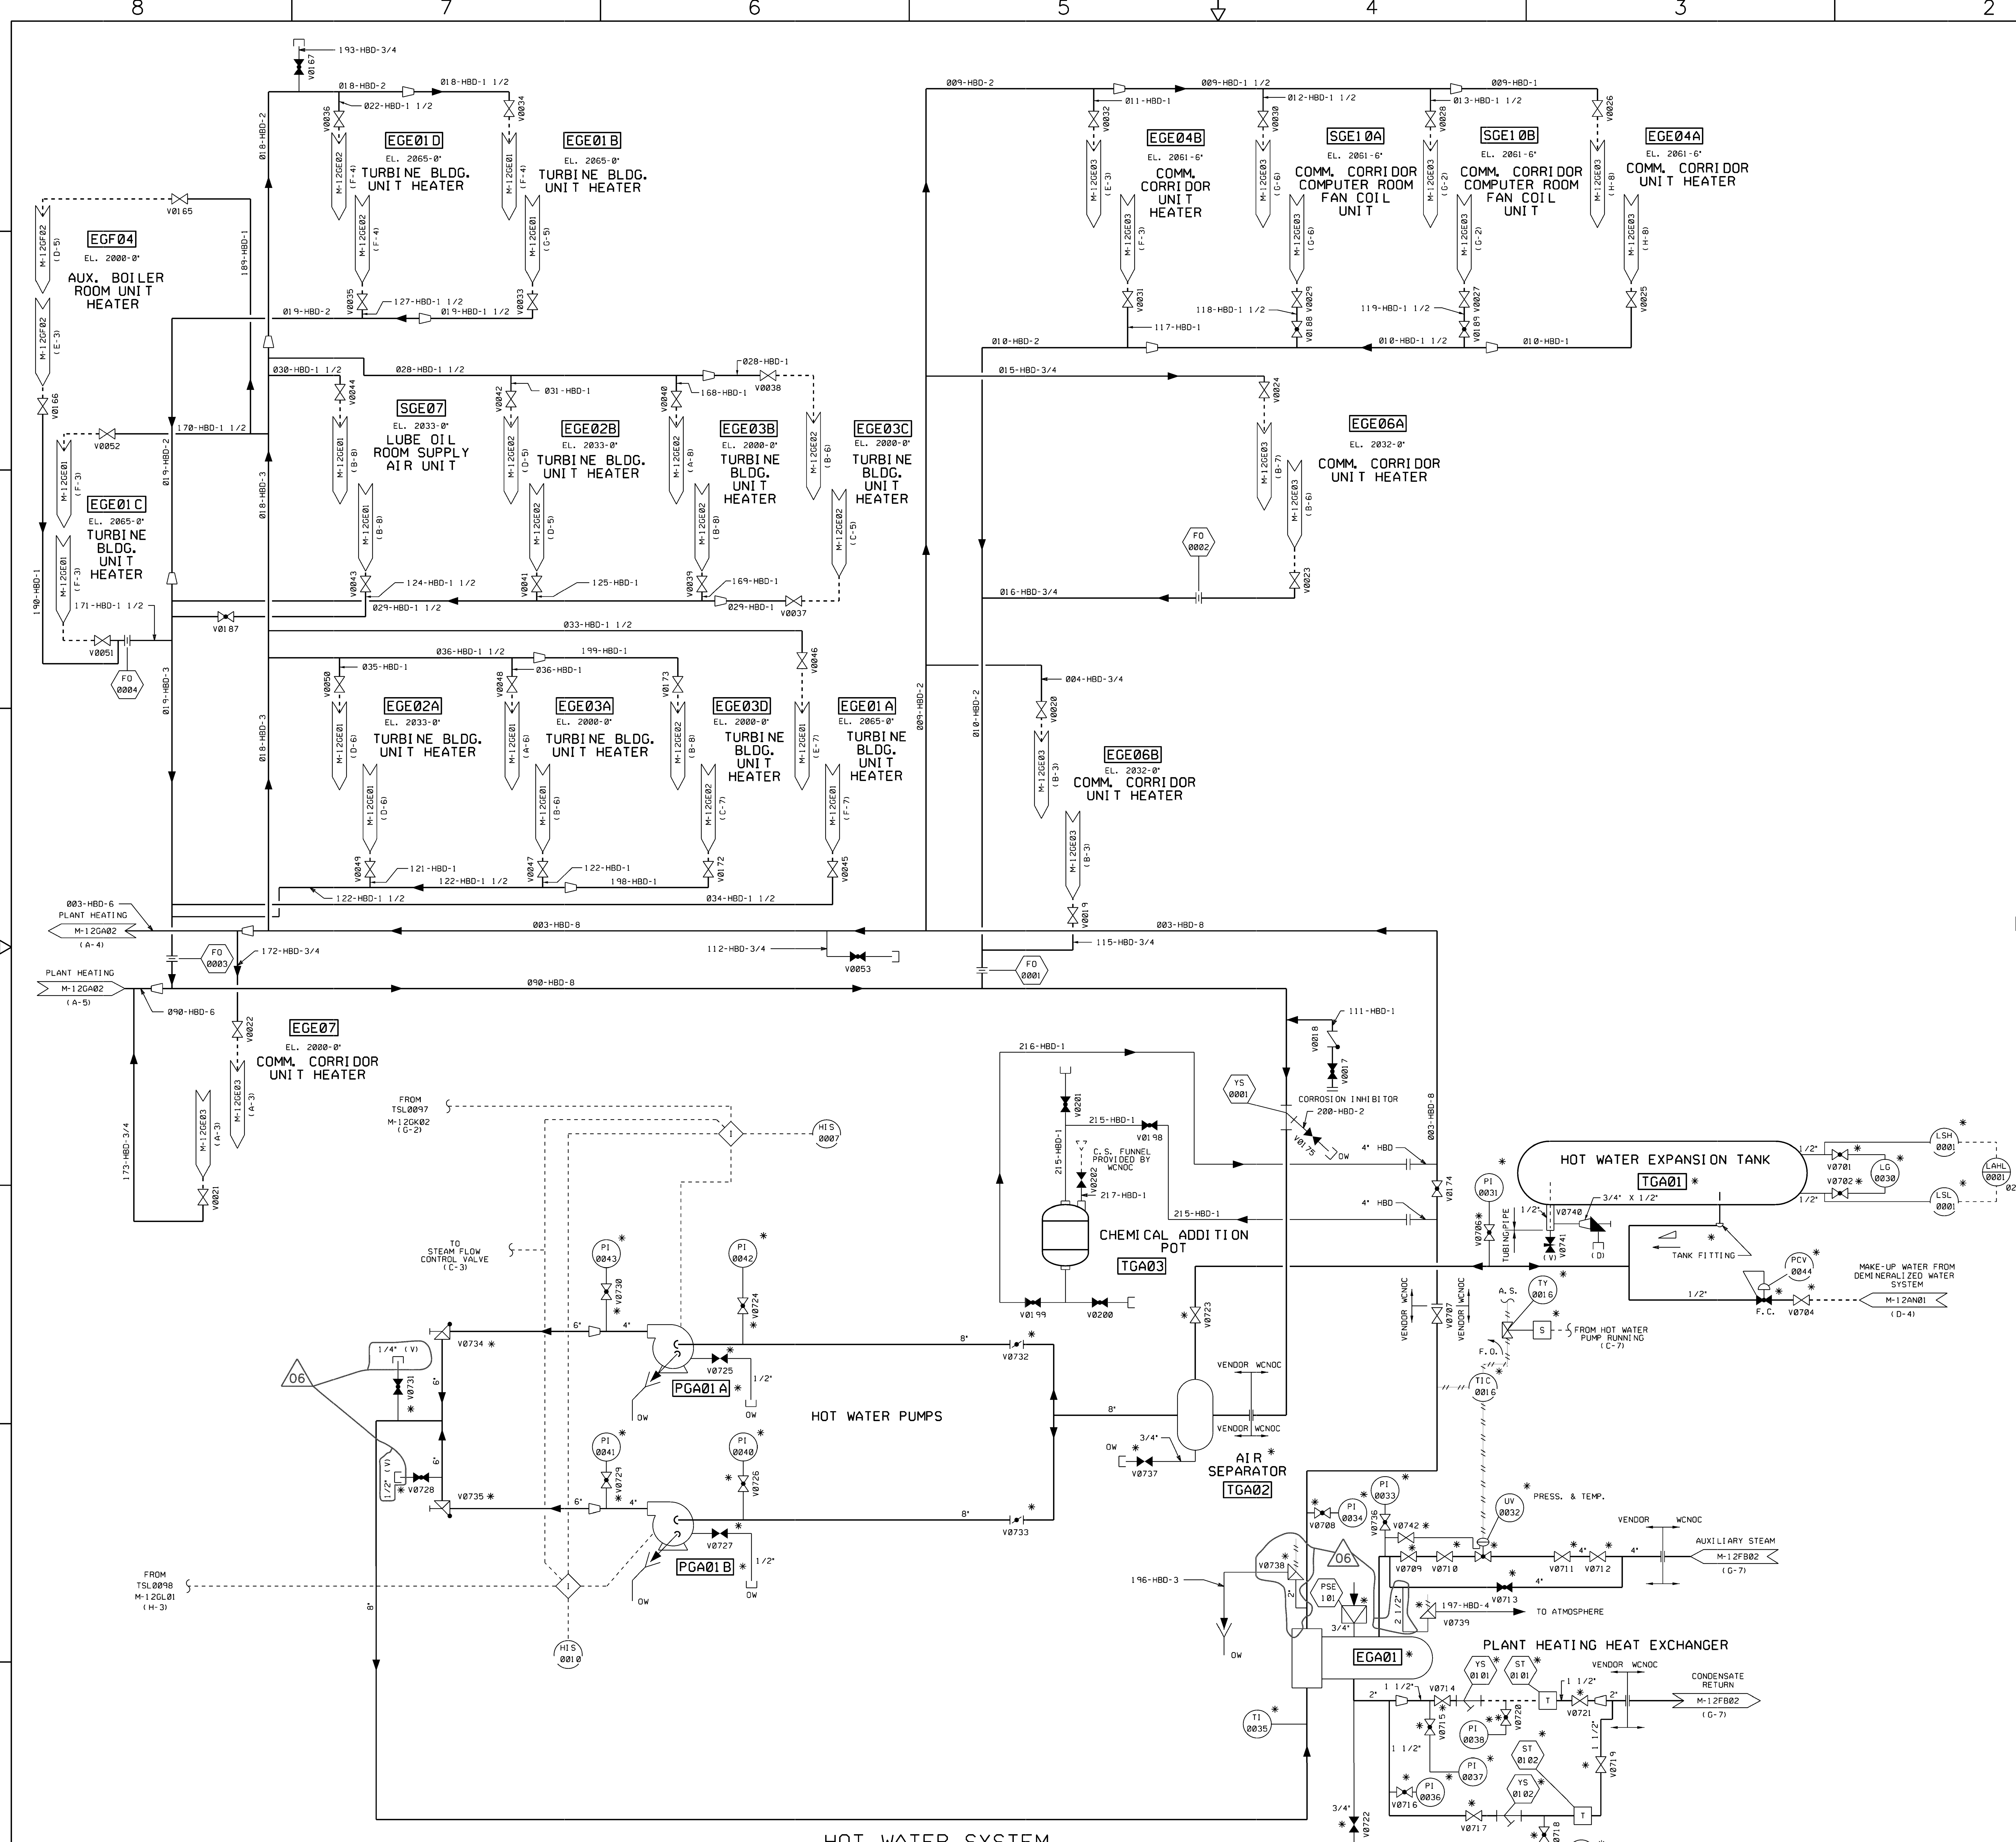



NOTES

1. HOT WATER PUMPS START WHEN OUTSIDE AIR ENTERING CONTROL BLDG. OR AUXILIARY BLDG. AIR SUPPLY IS BELOW TEMPERATURE SWITCH SET POINT.

USAR FIG. 9.4-9-01

ESSENTIAL DRAWING			
REVISED	INCORPORATED	CR# 0056306	CHANGE
ISSUED	ENG. DOC.		PKG. NO.
THIS ENG. SUPERSEDES BY		REV.	THIS ENG. SUPERSEDES
REV. 2 LINE FOR VALVES V0738 & V0739 PER AS-BUILT INFORMATION			
WOLF CREEK		ELECTRONIC APPROVAL	
NUCLEAR OPERATING CORPORATION			
PIPING AND INSTRUMENTATION			
DIAGRAM			
PLANT HEATING SYSTEM			
SCALE	DRAWING NUMBER	SHEET	REV.
NONE	M-12GA01	06	

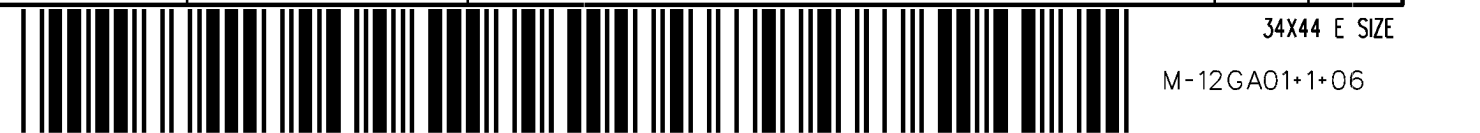

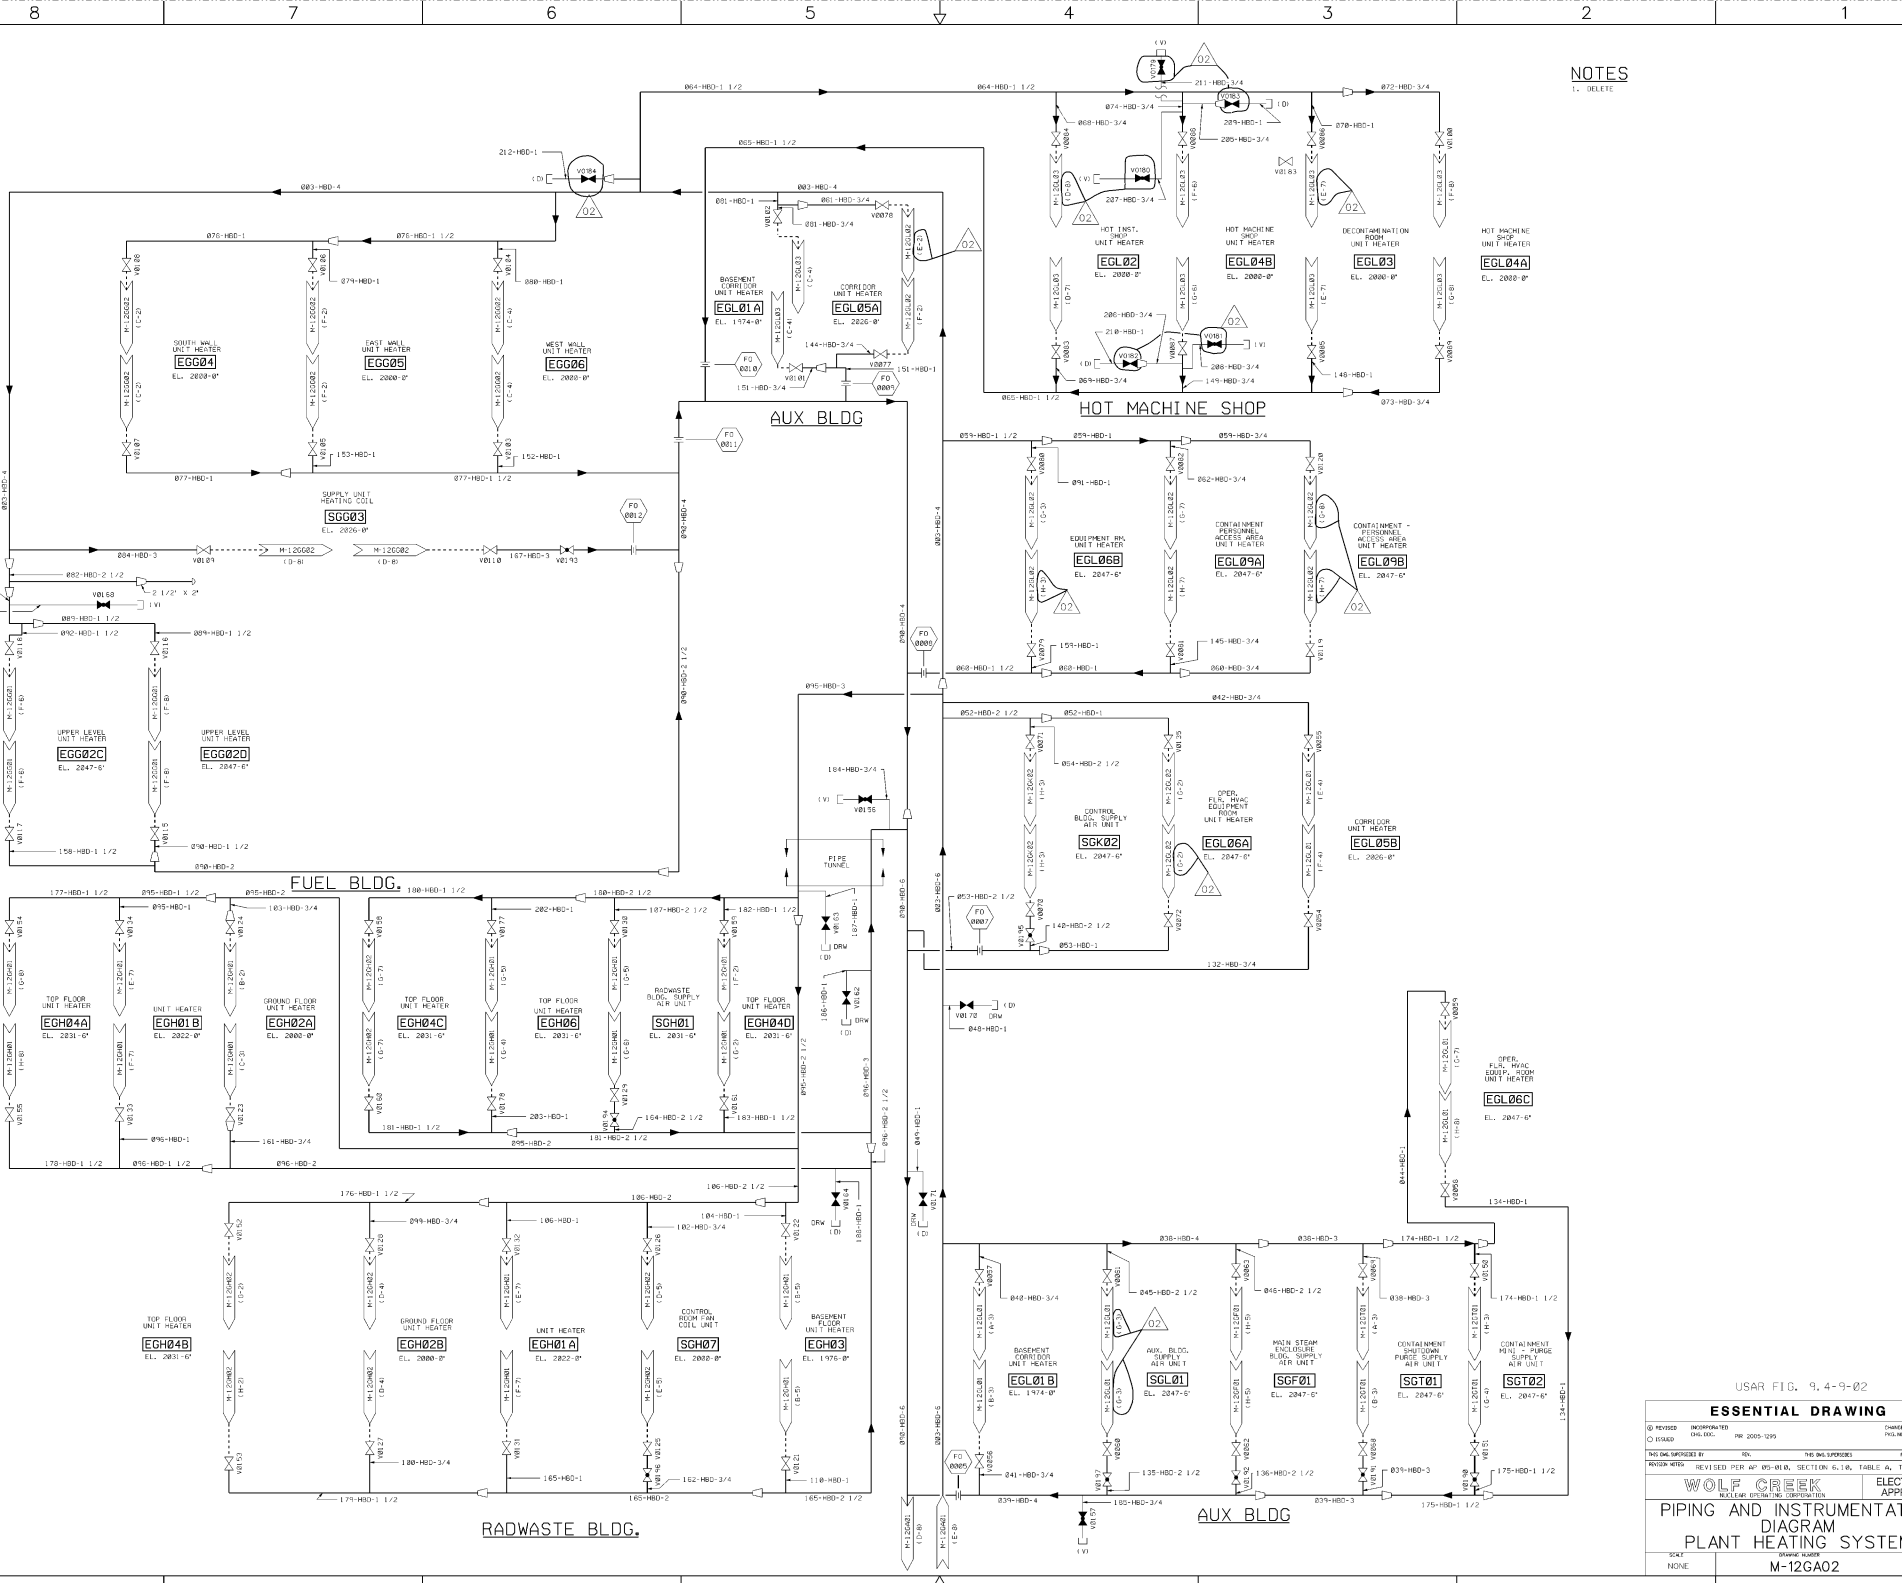


NOTES
1. DELETE

USAR FIG. 9.4-9-02

ESSENTIAL DRAWING			
DESIGNED BY	REVISIONS	DATE	BY
010000	01	09-2005-12/05	PHS/MS
PROJECT NO.	REV.	THE INSTRUMENT	DATE
010000	01	09-2005-12/05	PHS/MS
		ELECTRONIC APPROVAL	
PIPING AND INSTRUMENTATION DIAGRAM PLANT HEATING SYSTEM			
SHEET NO.	SHEET TOTAL		DATE
02	02		09/04/05

Released by Document Services Release Date: 08/04/05

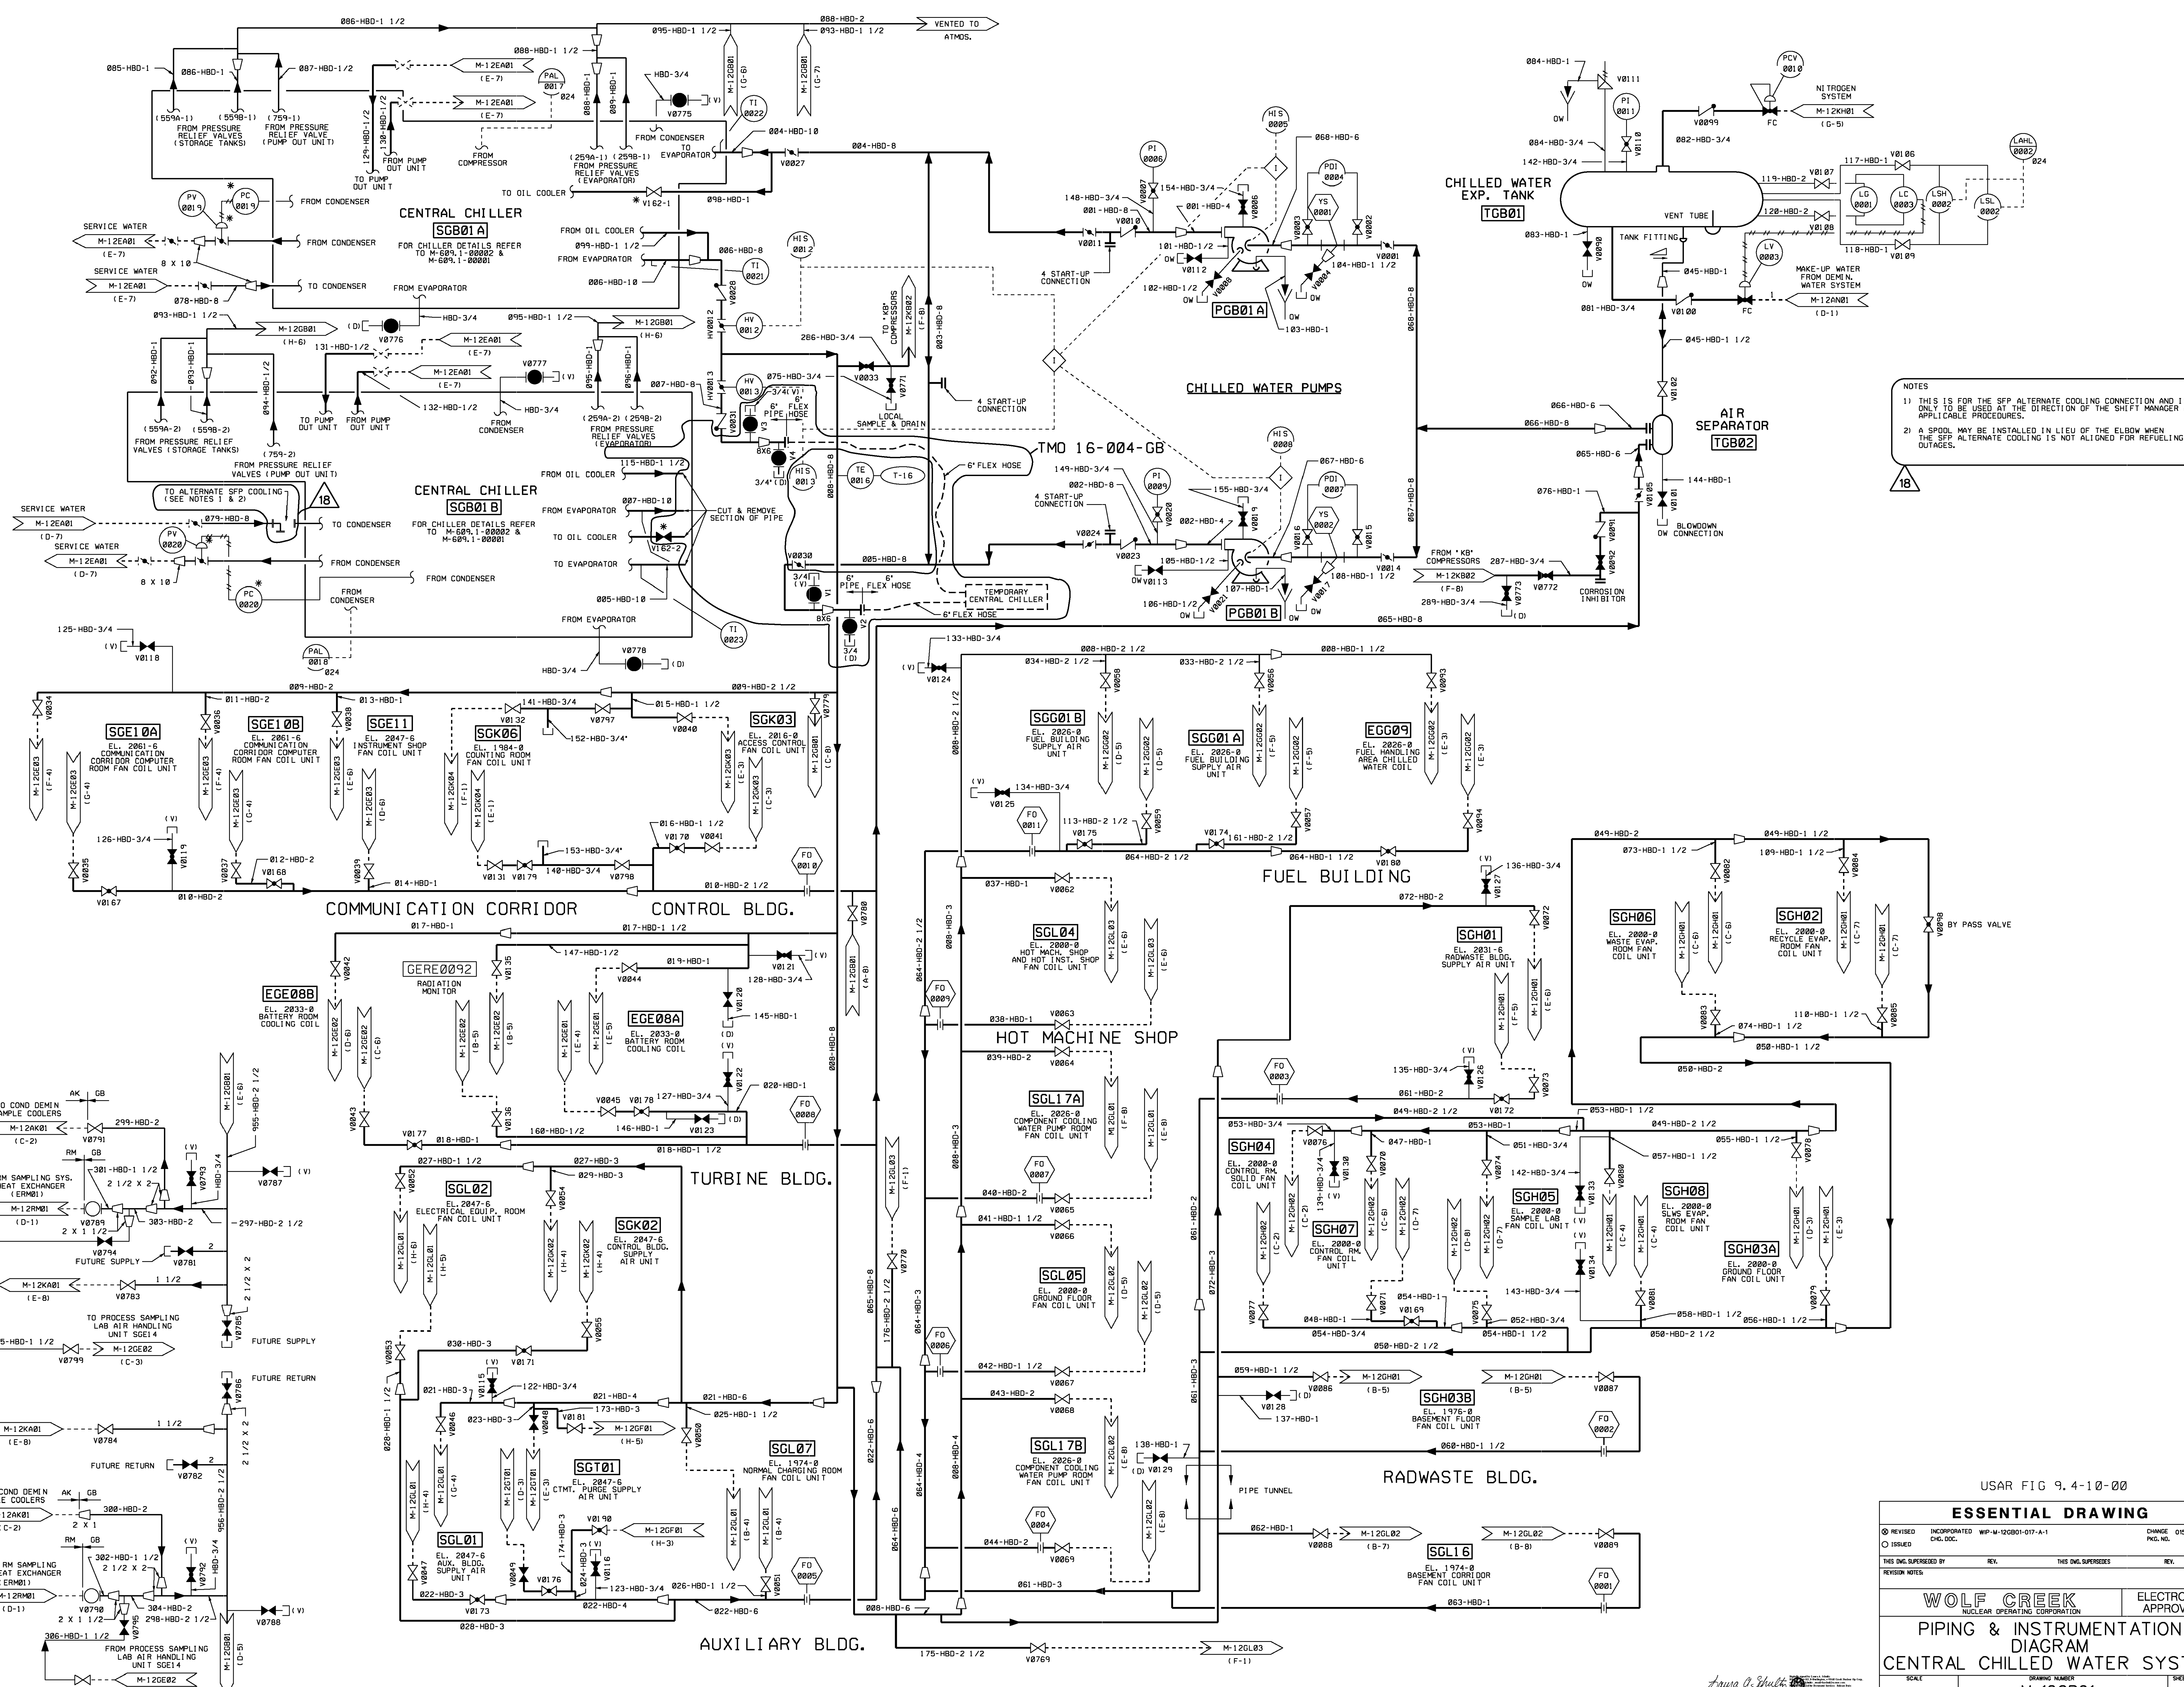


NOTES

- THIS IS FOR THE SFP ALTERNATE COOLING CONNECTION AND IS ONLY TO BE USED AT THE DIRECTION OF THE SHIFT MANAGER AND APPLICABLE PROCEDURES.
- A SPOOL MAY BE INSTALLED IN LIEU OF THE ELBOW WHEN THE SFP ALTERNATE COOLING IS NOT ALIGNED FOR REFUELING OUTAGES.

USAR FIG 9.4-10-00

ESSENTIAL DRAWING			
REVISED	INCORPORATED	WP-M-12GB01-017-A-1	CHANGE 015241
ISSUED	CHG. DOC.		PKG. NO.
THIS DWG SUPERSEDES	REV.	THIS DWG SUPERSEDES	REV.
WOLF CREEK		ELECTRONIC APPROVAL	
NUCLEAR OPERATING CORPORATION			
PIPING & INSTRUMENTATION			
DIAGRAM			
CENTRAL CHILLED WATER SYSTEM			
SCALE	DRAWING NUMBER	SHEET	REV
NONE	M-12GB01	18	

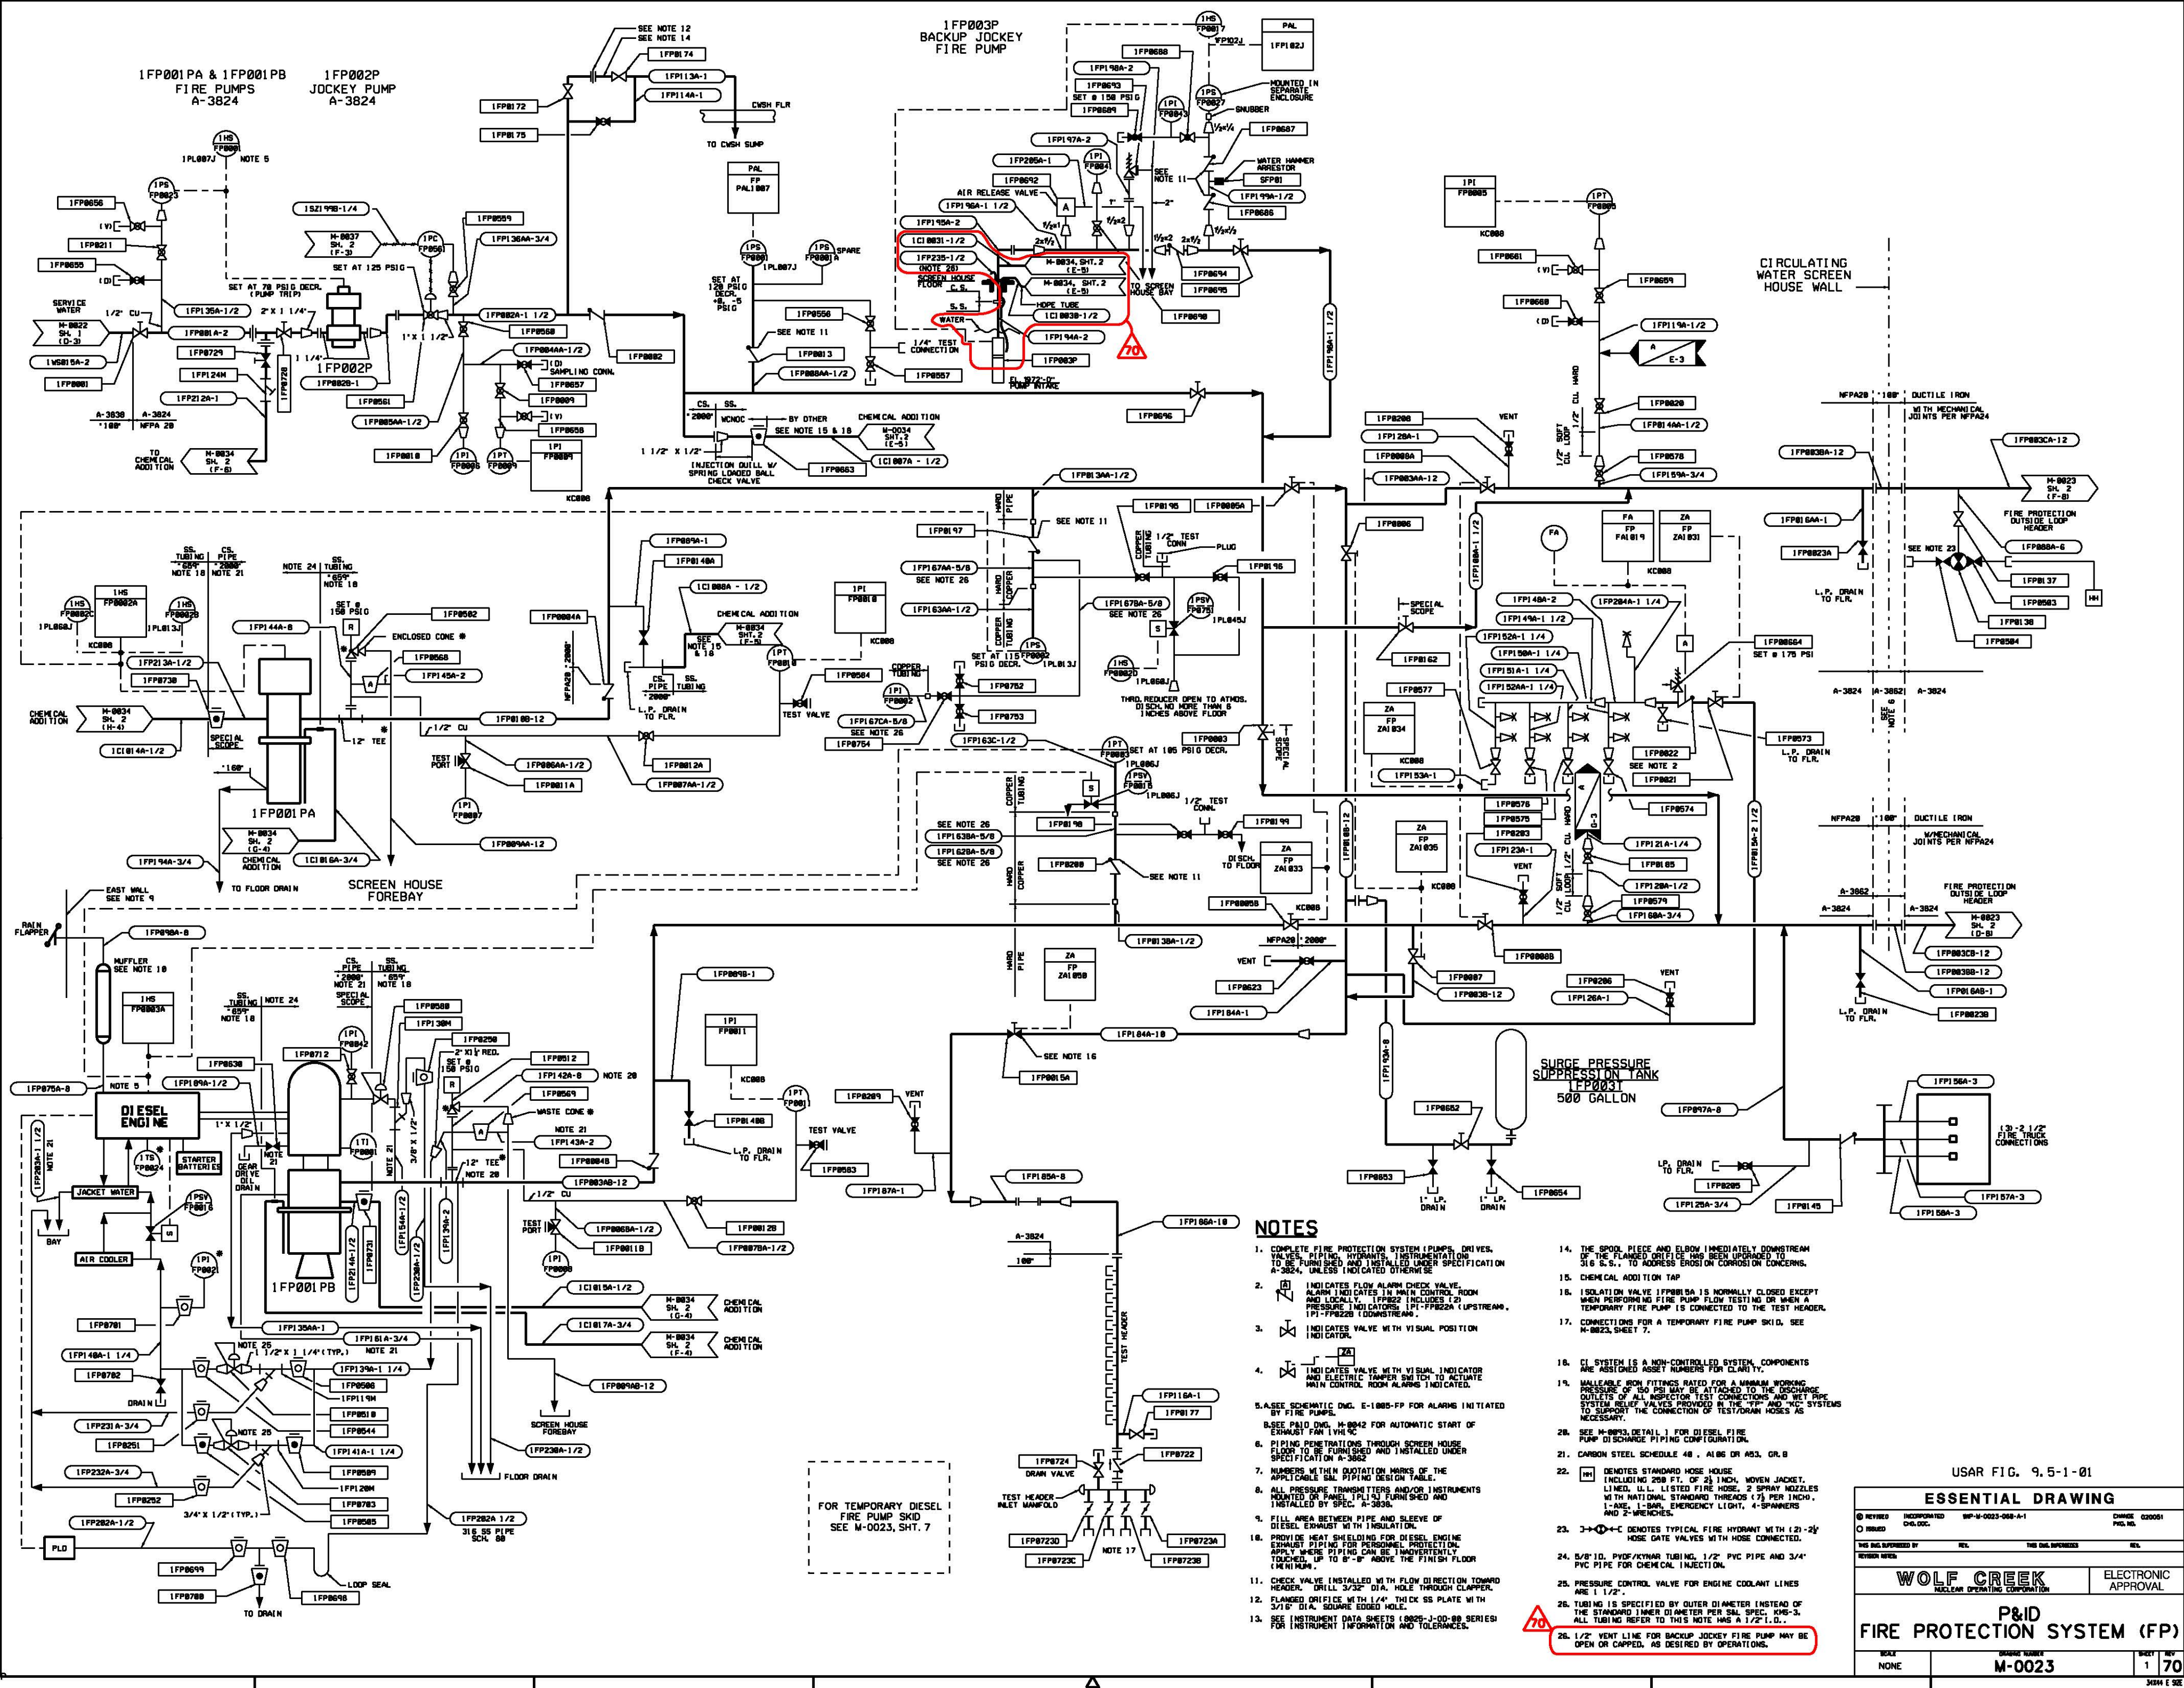

NOTES

1. COMPLETE FIRE PROTECTION SYSTEM (PUMPS, DRIVES, VALVES, PIPING, HYDRANTS, INSTRUMENTATION) TO BE FURNISHED AND INSTALLED UNDER SPECIFICATION A-3824, UNLESS INDICATED OTHERWISE.
2. [Symbol] INDICATES FLOW ALARM CHECK VALVE. ALARM INDICATES 1/4 MIN. CONTROL ROOM AND LOCALLY. [Symbol] INCLUDES (2) PRESSURE INDICATORS (PI-FF022A (UPSTREAM), PI-FF022B (DOWNSTREAM)).
3. [Symbol] INDICATES VALVE WITH VISUAL POSITION INDICATOR.
4. [Symbol] INDICATES VALVE WITH VISUAL INDICATOR AND ELECTRIC TAMPER SWITCH TO ACTIVATE MAIN CONTROL ROOM ALARMS INDICATED.
5. AS SEEN SCHEMATIC Dwg. E-1805-FP FOR ALARMS INITIATED BY FIRE PUMPS.
B. SET PRESSURE FOR AUTOMATIC START OF EXHAUST FAN 110 PSIG.
6. PIPING PENETRATIONS THROUGH SCREEN HOUSE FLOOR TO BE FURNISHED AND INSTALLED UNDER SPECIFICATION A-3824.
7. NUMBERS WITH QUOTATION MARKS OF THE APPLICABLE S&W PIPING DESIGN TABLE.
8. ALL PRESSURE TRANSMITTERS AND/OR INSTRUMENTS EXCEPT PIPING FOR PERSONNEL PROTECTION TO BE INSTALLED WITH INSULATION.
9. FILL AREA BETWEEN PIPE AND SLEEVE OF DIESEL EXHAUST WITH INSULATION.
10. PROVIDE HEAT SHELTING FOR DIESEL ENGINE EXHAUST PIPING FOR PERSONNEL PROTECTION.
11. CHECK VALVE INSTALLED WITH FLOW DIRECTION TOWARD HEADER. DRILL 3/32" DIA. HOLE THROUGH CLAMPER. FLANGED ORIFICE WITH 1/4" THICK SS PLATE WITH 3/16" DIA. SQUARE EDGE HOLE.
12. SEE INSTRUMENT DATA SHEETS (8025-J-00-88 SERIES) FOR INSTRUMENT INFORMATION AND TOLERANCES.
13. [Symbol] INDICATES FLOW ALARM CHECK VALVE. ALARM INDICATES 1/4 MIN. CONTROL ROOM AND LOCALLY. [Symbol] INCLUDES (2) PRESSURE INDICATORS (PI-FF022A (UPSTREAM), PI-FF022B (DOWNSTREAM)).
14. THE SPOOL PIECE AND ELBOW IMMEDIATELY DOWNSTREAM OF THE FLANGED ORIFICE HAS BEEN UPGRATED TO 316 S.S. TO ADDRESS EXHAUST CORROSION CONCERNS.
15. CHEMICAL ADDITION TAP.
16. ISOLATION VALVE 1FP0015A IS NORMALLY CLOSED EXCEPT WHEN PERFORMING FIRE PUMP FLOW TESTING OR WHEN A TEMPORARY FIRE PUMP IS CONNECTED TO THE TEST HEADER.
17. CONNECTIONS FOR A TEMPORARY FIRE PUMP SKID, SEE M-0023, SHEET 7.
18. CI SYSTEM IS A NON-CONTROLLED SYSTEM. COMPONENTS ARE ASSIGNED ASSESSMENT NUMBERS FOR CLARITY.
19. WALKER IRON FITTINGS RATED FOR A MINIMUM WORKING PRESSURE OF 150 PSI MAY BE ATTACHED TO THE DISCHARGE OUTLETS OF ALL ASPECTOR TEST CONNECTIONS AND WET PIPE SYSTEM RELIEF VALVES PROVIDED IN THE TFP AND WCC SYSTEMS TO SUPPORT THE CONNECTION OF TEST/DRAIN HOSES AS NECESSARY.
20. SEE M-0023, DETAIL 1 FOR DIESEL ENGINE PUMP DISCHARGE PIPING CONFIGURATION.
21. CARBON STEEL SCHEDULE 40, A106 OR A53, GR. B.
22. [Symbol] DENOTES STANDARD HOSE HOUSE (INCLUDING 250 FT. OF 2 1/2" INCH. MOVEN JACKET, 1" INCH. U.L. LISTED FIRE HOSE, 2 SPRAY NOZZLES WITH NATIONAL STANDARD THREADS (2) PER INCH., 1-AE, 1-S&R, EMERGENCY LIGHT, 4-SPANNERS AND 2-WRENCHES).
23. [Symbol] DENOTES TYPICAL FIRE HYDRANT WITH (2) 2 1/2" GATE VALVES WITH HOSE CONNECTED.
24. 5/8" I.D. PVDF/KYMAR TUBING, 1/2" PVC PIPE AND 3/4" PVC PIPE FOR CHEMICAL INJECTION.
25. PRESSURE CONTROL VALVE FOR ENGINE COOLANT LINES ARE 1 1/2".
26. TUBING IS SPECIFIED BY OUTER DIAMETER INSTEAD OF THE STANDARD INNER DIAMETER PER S&W SPEC. M-0023. ALL TUBING REFER TO THIS NOTE HAS A 1/2" I.D.
27. 1/2" VENT LINE FOR BACKUP JOCKEY FIRE PUMP MAY BE OPEN OR CAPPED, AS DESIRED BY OPERATIONS.

USAR FIG. 9.5-1-01

ESSENTIAL DRAWING


REVISION	DATE	BY	CHKD.

WOLF CREEK
NUCLEAR OPERATING CORPORATION

P&ID
FIRE PROTECTION SYSTEM (FP)

DRAWING NUMBER	SHEET	REV
M-0023	1	70

3044 1/20

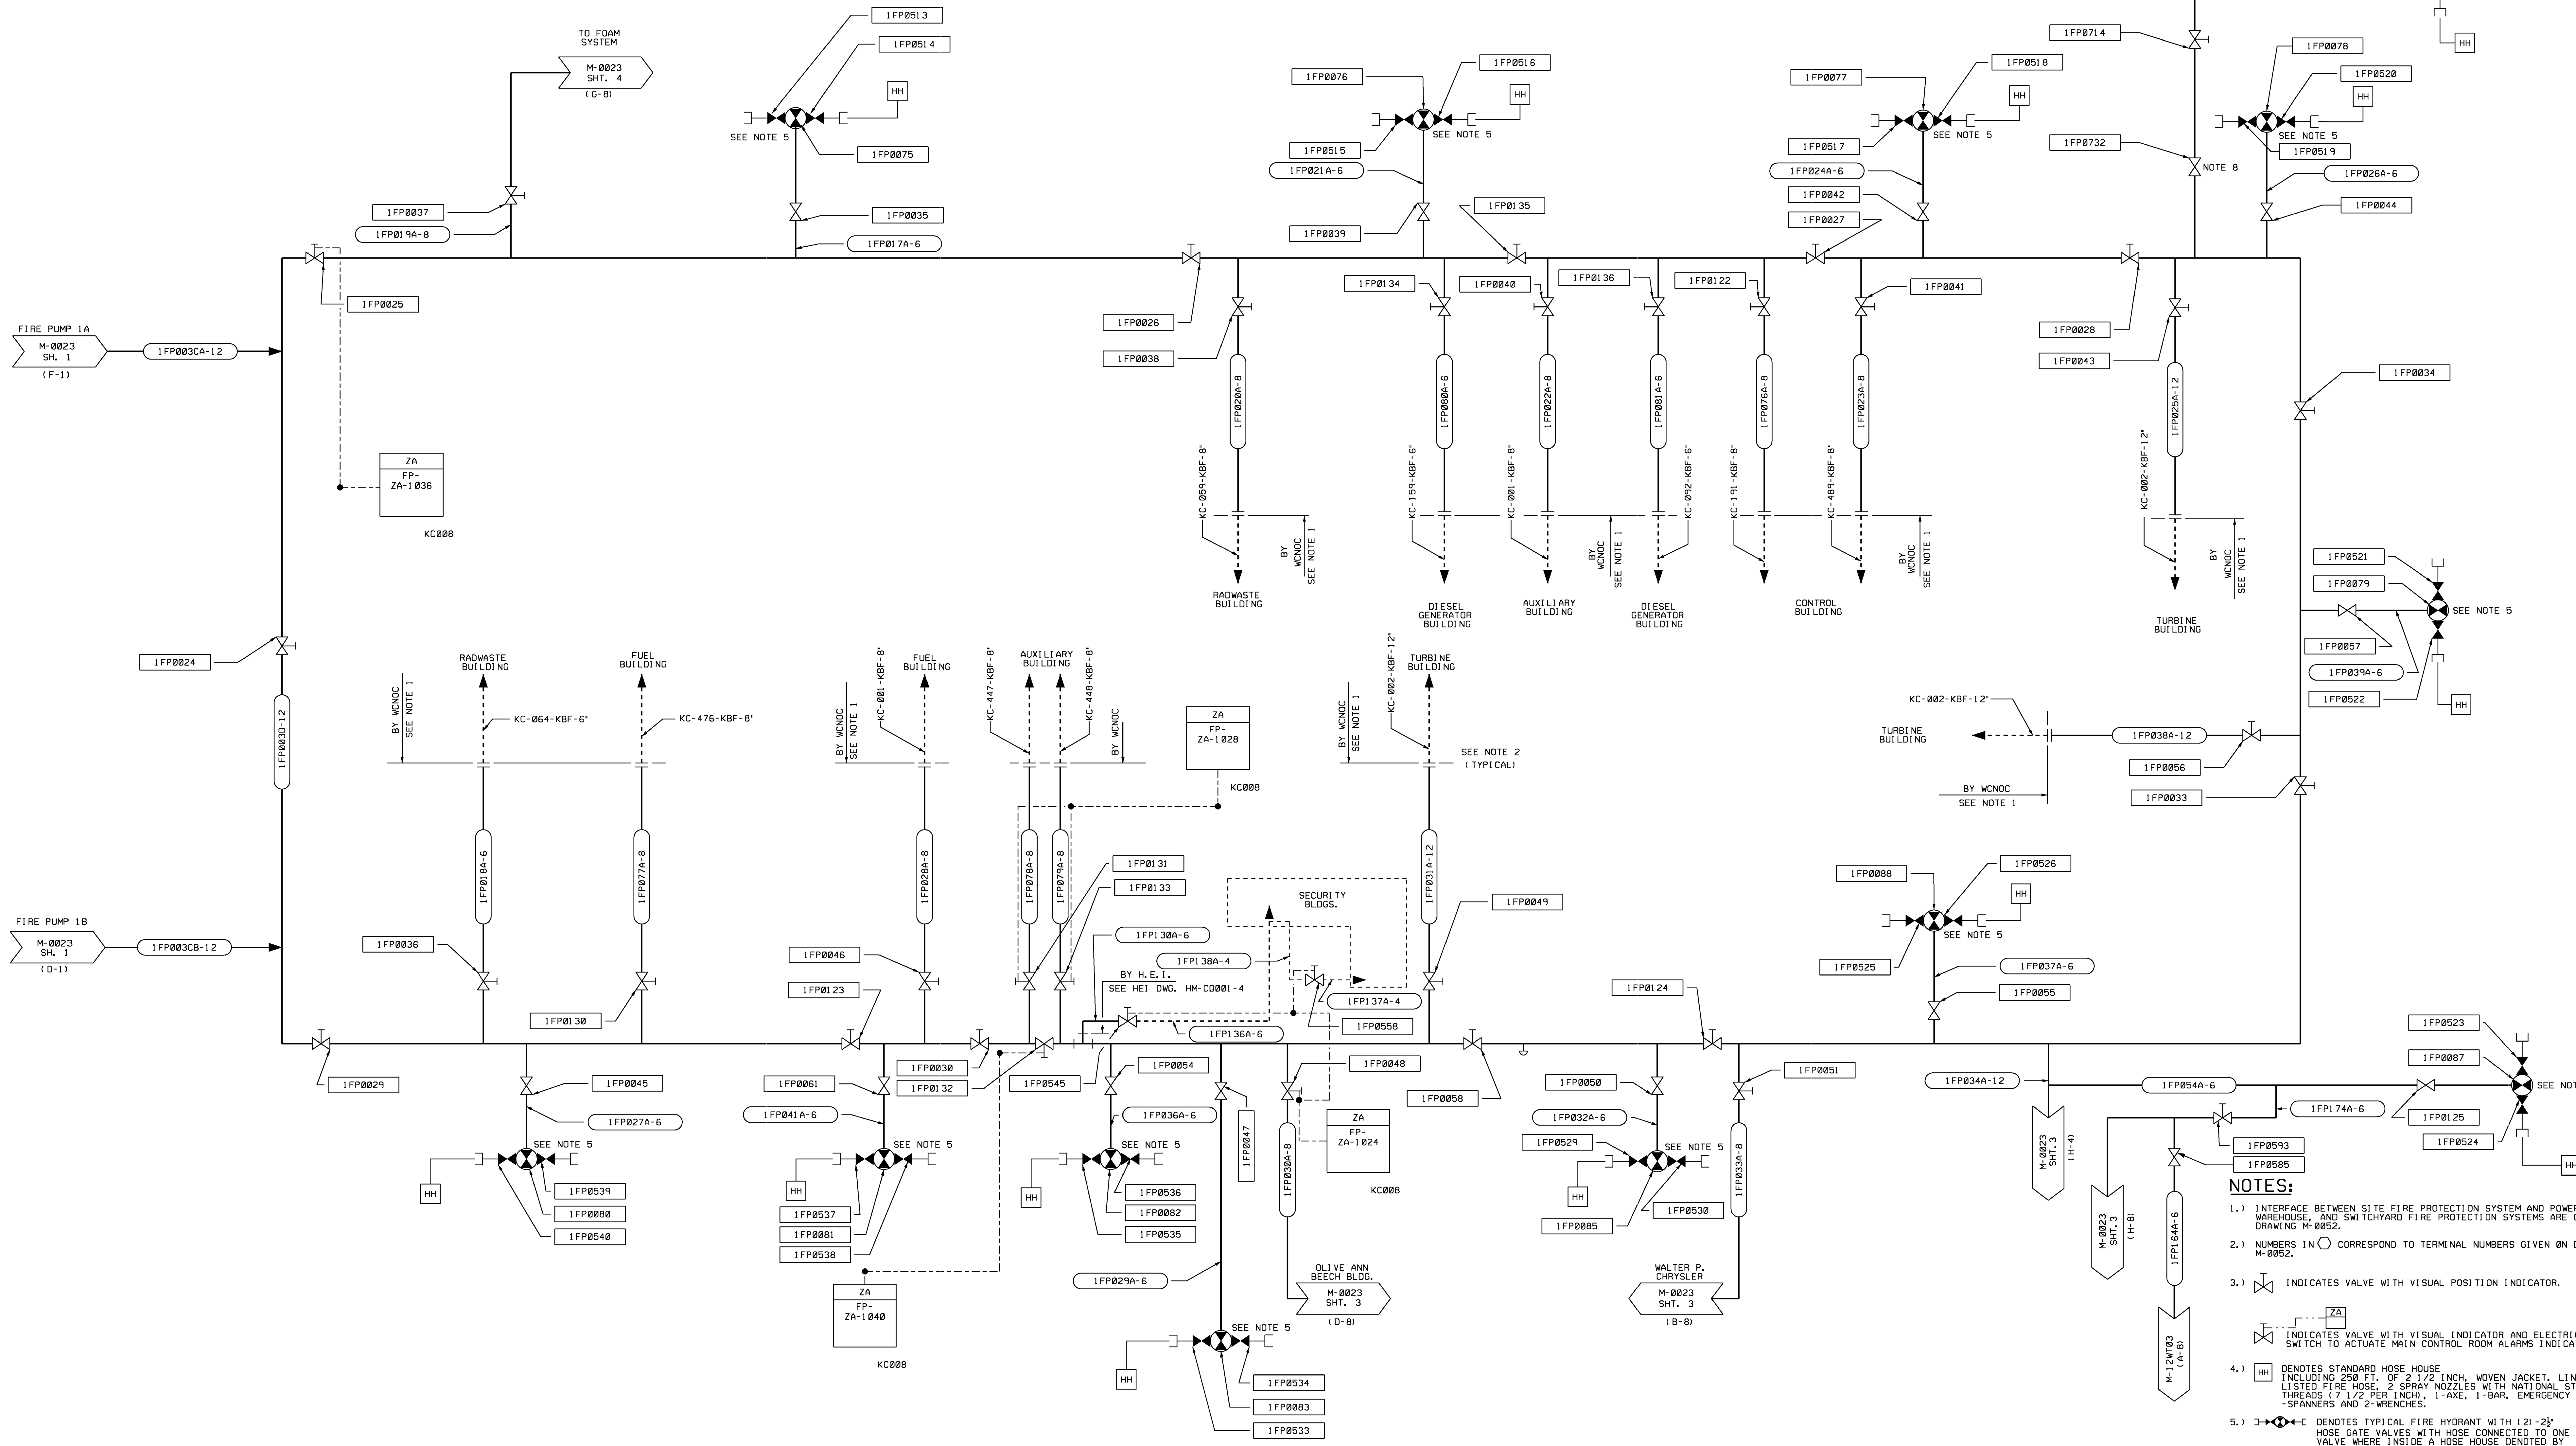


- NOTES:**
- 1.) INTERFACE BETWEEN SITE FIRE PROTECTION SYSTEM AND POWER BLOCK, WAREHOUSE, AND SWITCHYARD FIRE PROTECTION SYSTEMS ARE GIVEN ON DRAWING M-0052.
 - 2.) NUMBERS IN ○ CORRESPOND TO TERMINAL NUMBERS GIVEN ON DRAWING M-0052.
 - 3.) INDICATES VALVE WITH VISUAL POSITION INDICATOR.
 - 4.) INDICATES VALVE WITH VISUAL INDICATOR AND ELECTRIC TAMPER SWITCH TO ACTIVATE MAIN CONTROL ROOM ALARMS INDICATED.
 - 5.) DENOTES STANDARD HOSE HOUSE INCLUDING 250 FT. OF 2 1/2 INCH. WOVEN JACKET, LINED, U.L. LISTED FIRE HOSE, 2 SPRAY NOZZLES WITH NATIONAL STANDARD THREADS (1 1/2 PER INCH), 1-AXE, 1-BAR, EMERGENCY LIGHT, 4-SPANNERS AND 2-WRENCHES.
 - 6.) DENOTES TYPICAL FIRE HYDRANT WITH (2) 2-1/2" HOSE GATE VALVES WITH HOSE CONNECTED TO ONE VALVE WHERE INSIDE A HOSE HOUSE DENOTED BY THE SYMBOL .
 - 7.) UNDERGROUND FIRE PROTECTION YARD LOOP TO BE PER NFPA NO. 24.
 - 8.) NUMBERS WITHIN QUOTATION MARKS REFER TO THE NUMBER OF THE APPLICABLE S&L PIPING DESIGN TABLE.
 - 9.) VALVE INSTALLED AS CLOSE AS POSSIBLE TO THE MAIN FIRE PROTECTION LOOP HEADER 1FP0030-12, TO BE USED AS HOT TAP ISOLATION VALVE FOR THE HOT TAPPING PROCESS.

USAR FIG. 9.5-1-02

REVISION			
REVISED	INCORPORATED	CR# 00124102	CHANGE
ISSUED	CHG. DOC.		PKG. NO.
THIS DWG. SUPERSEDES		REV.	THIS DWG. SUPERSEDES
REVISED VALVE 1FP0715 TO SHOW OPEN.			
WOLF CREEK		ELECTRONIC APPROVAL	
NUCLEAR OPERATING CORPORATION			
P&ID FIRE PROTECTION SYSTEM (FP)			
SCALE	DRAWING NUMBER	SHEET	REV
NONE	M-0023	2	30

3444 E SHE

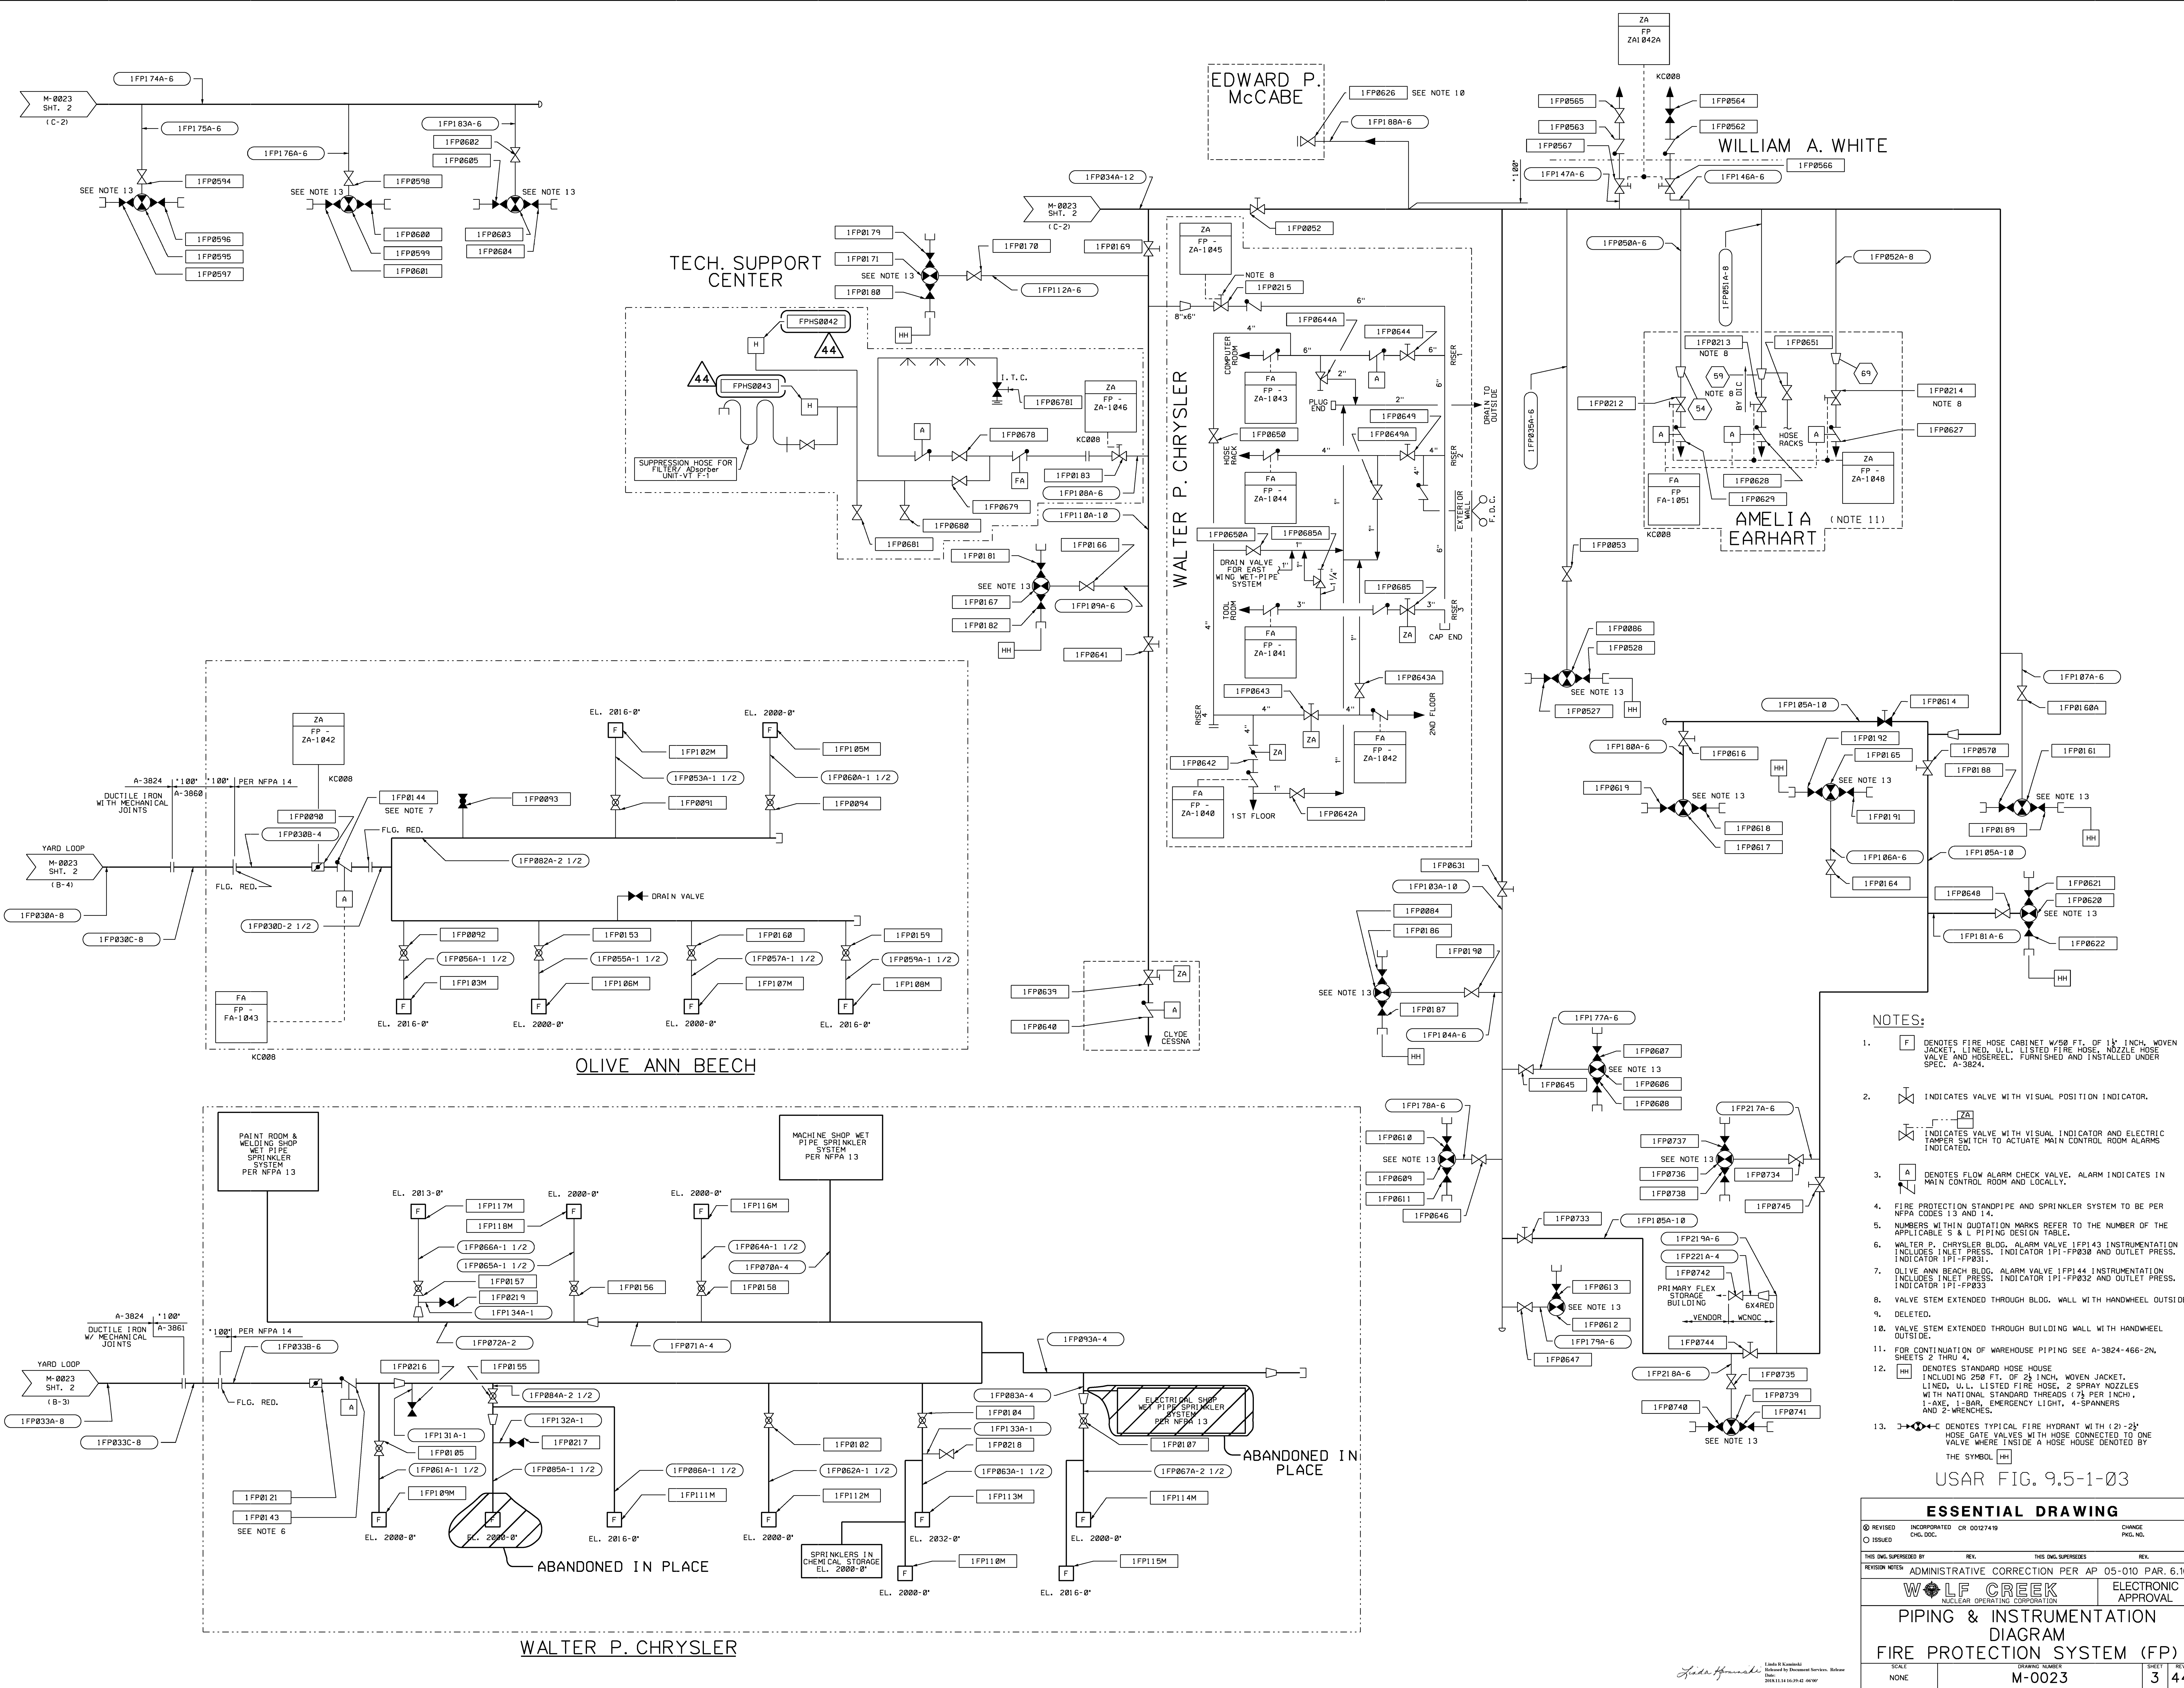

- NOTES:**
- [F] DENOTES FIRE HOSE CABINET W/50 FT. OF 1 1/2" INCH WOVEN JACKET, U.L. LISTED FIRE HOSE, NOZZLE HOSE VALVE AND HOSE REEL. FURNISHED AND INSTALLED UNDER SPEC. A-3824.
 - [V] INDICATES VALVE WITH VISUAL POSITION INDICATOR.
 - [V] INDICATES VALVE WITH VISUAL INDICATOR AND ELECTRIC TAMPER SWITCH TO ACTUATE MAIN CONTROL ROOM ALARMS INDICATED.
 - [A] DENOTES FLOW ALARM CHECK VALVE. ALARM INDICATES IN MAIN CONTROL ROOM AND LOCALLY.
 - FIRE PROTECTION STANDPIPE AND SPRINKLER SYSTEM TO BE PER NFPA CODES 13 AND 14.
 - NUMBERS WITHIN QUOTATION MARKS REFER TO THE NUMBER OF THE APPLICABLE S & L PIPING DESIGN TABLE.
 - WALTER P. CHRYSLER BLDG. ALARM VALVE 1FP143 INSTRUMENTATION INCLUDES INLET PRESS. INDICATOR 1FP1-PP038 AND OUTLET PRESS. INDICATOR 1FP1-PP031.
 - OLIVE ANN BEECH BLDG. ALARM VALVE 1FP144 INSTRUMENTATION INCLUDES INLET PRESS. INDICATOR 1FP1-PP032 AND OUTLET PRESS. INDICATOR 1FP1-PP033.
 - VALVE STEM EXTENDED THROUGH BLDG. WALL WITH HANDWHEEL OUTSIDE.
 - DELETED.
 - VALVE STEM EXTENDED THROUGH BUILDING WALL WITH HANDWHEEL OUTSIDE.
 - FOR CONTINUATION OF WAREHOUSE PIPING SEE A-3824-466-2N, SHEETS 2 THRU 4.
 - [HH] DENOTES STANDARD HOSE HOUSE INCLUDING 250 FT. OF 2 1/2" INCH, WOVEN JACKET, LINED, U.L. LISTED FIRE HOSE, 2 SPRAY NOZZLES WITH NATIONAL STANDARD THREADS (7/8" PER INCH, 1-AXE, 1-BAR, EMERGENCY LIGHT, 4-SPANNERS AND 2-WRENCHES.
 - [H] DENOTES TYPICAL FIRE HYDRANT WITH (2)-2 1/2" HOSE GATE VALVES WITH HOSE CONNECTED TO ONE VALVE WERE INSIDE A HOSE HOUSE DENOTED BY THE SYMBOL [HH].

USAR FIG. 9.5-1-03

ESSENTIAL DRAWING

REVISED INCORPORATED CR 00127419 CHANGE NO. 1
 ISSUED CIG. DCC. PKG. REV.

THIS DWG. SUPERSEDES REV. THIS DWG. SUPERSEDES REV.


REVISION NOTES ADMINISTRATIVE CORRECTION PER AP 05-010 PAR. 6.10.

WOLF CREEK NUCLEAR OPERATING CORPORATION ELECTRONIC APPROVAL

PIPING & INSTRUMENTATION DIAGRAM
FIRE PROTECTION SYSTEM (FP)

SCALE NONE DRAWING NUMBER M-0023 SHEET 3 OF 44

3444 E SIDE

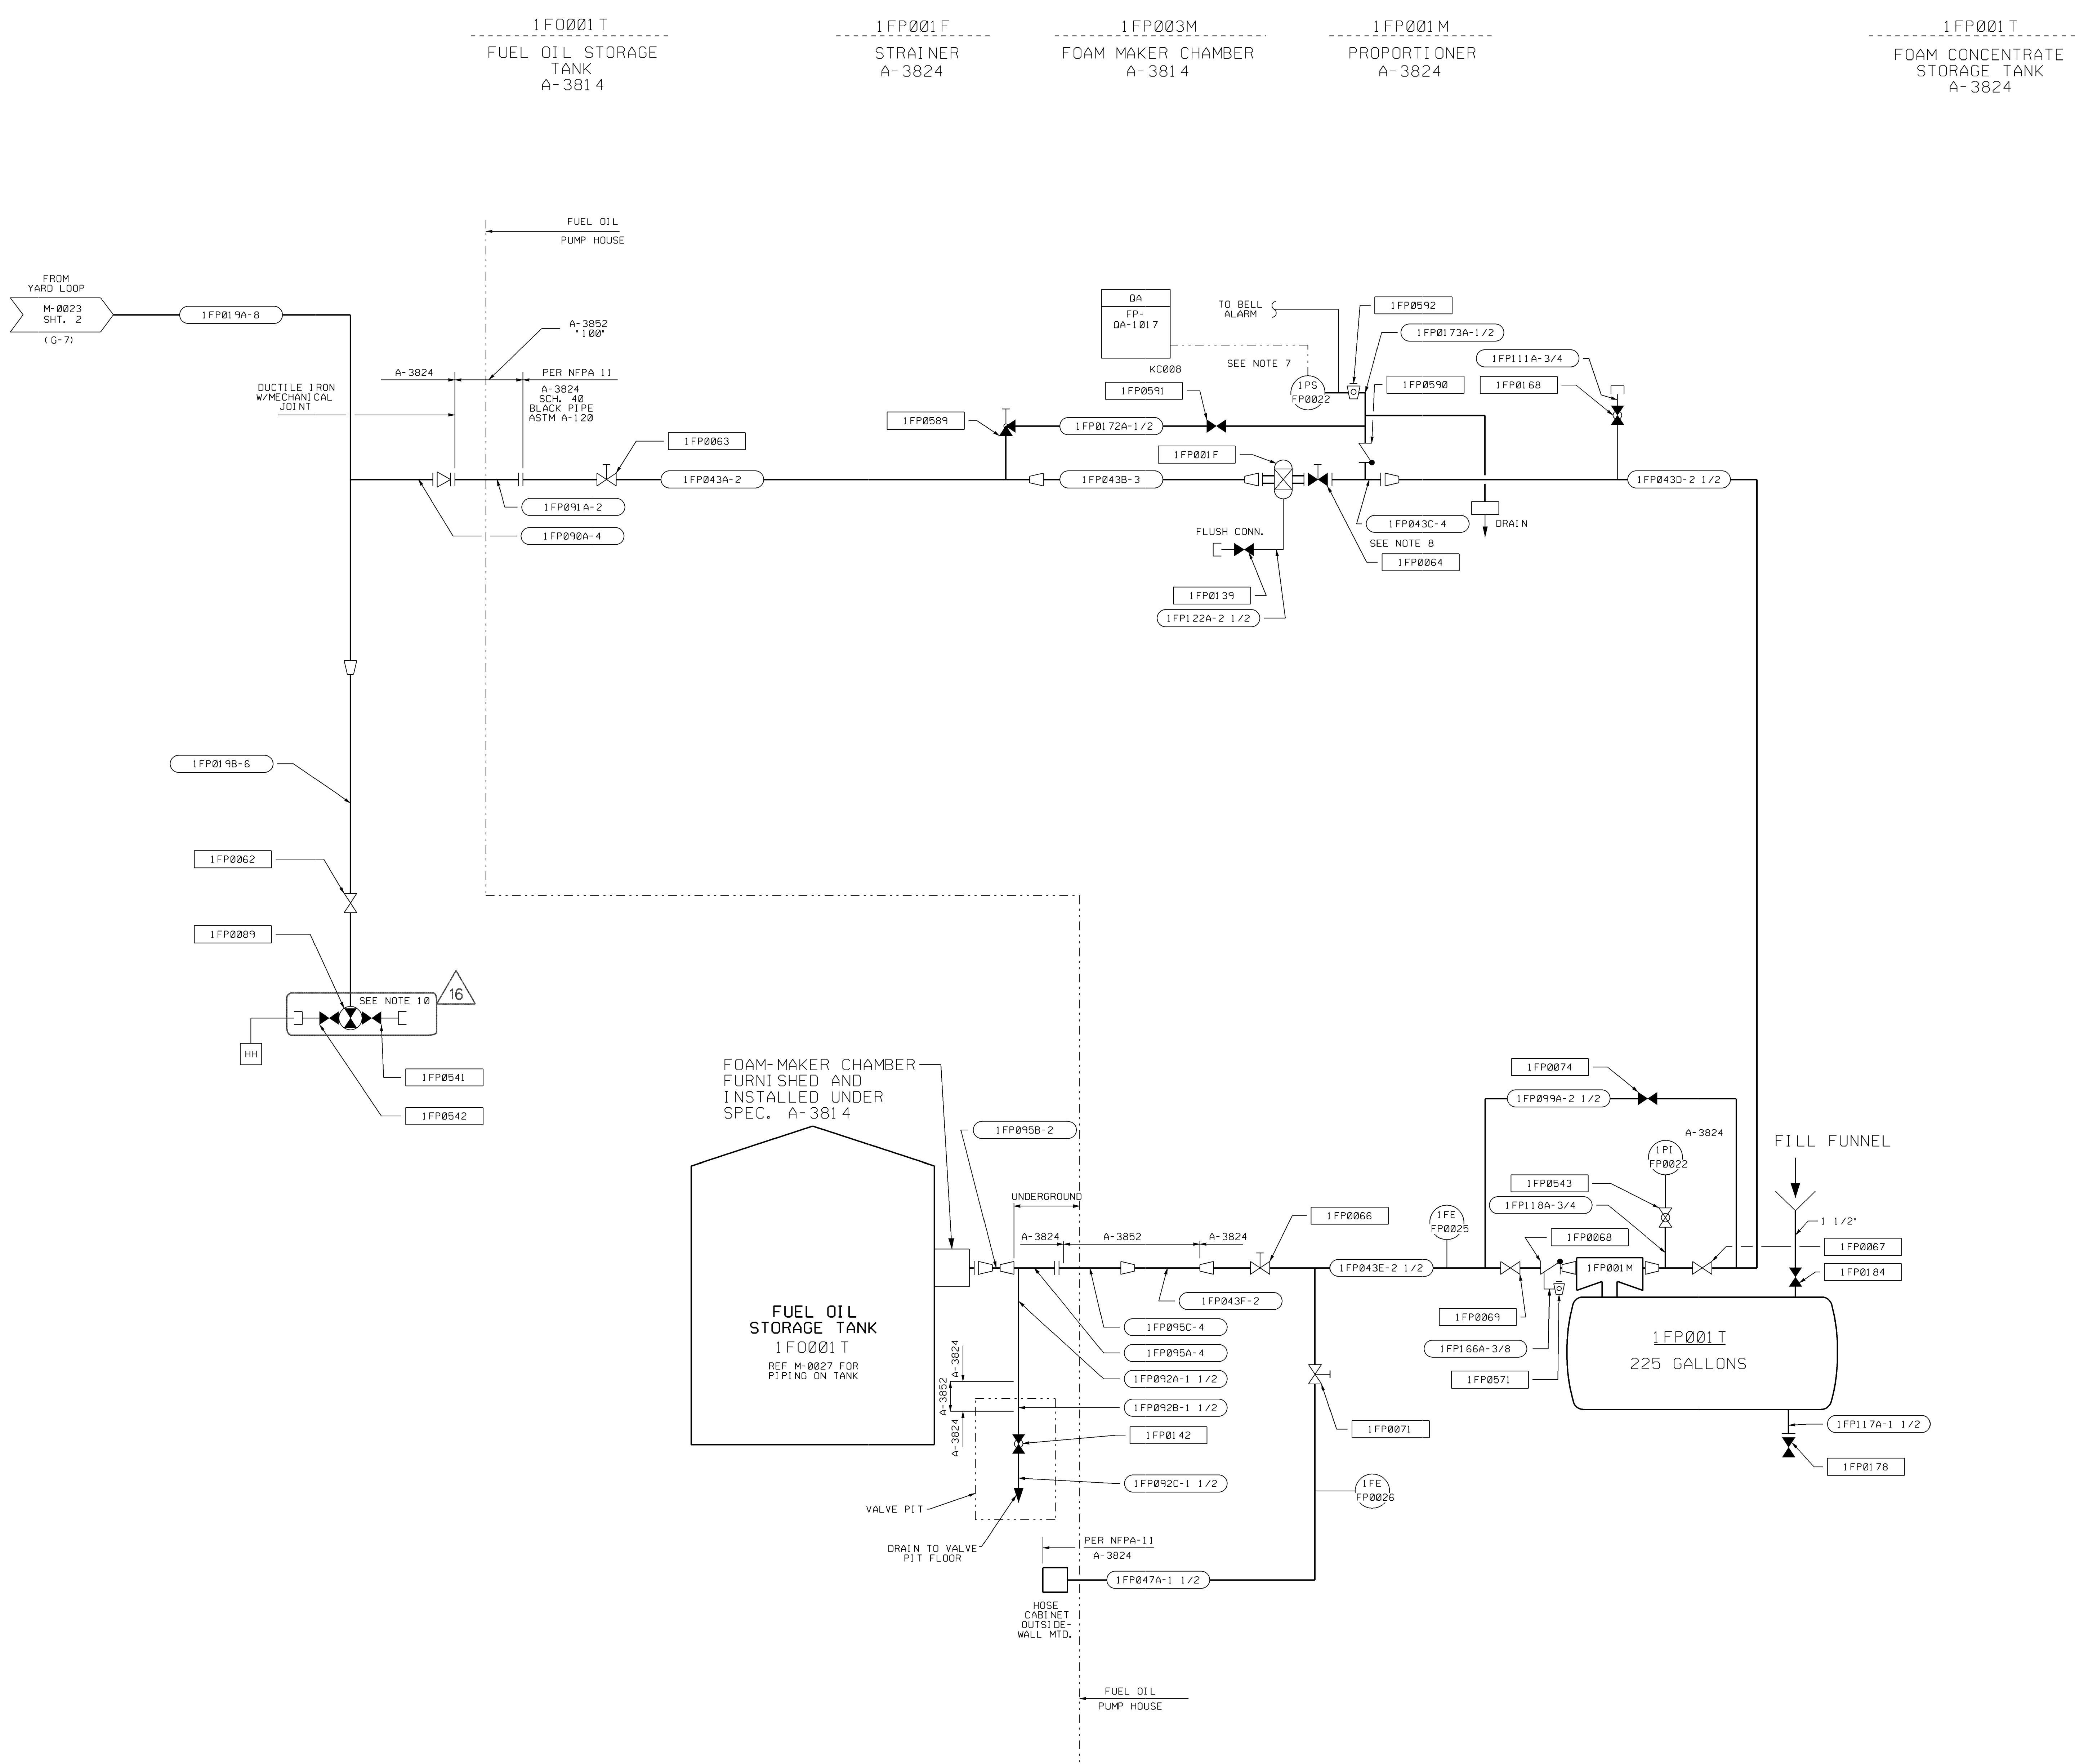


- NOTES:**
1. DELETED
 2. INDICATES VALVE WITH VISUAL POSITION INDICATION.
 3. FOAM FIRE PROTECTION SYSTEM TO BE FURNISHED & INSTALLED UNDER SPEC. A-3824, INDOOR PIPING IN THE FUEL OIL PUMP HOUSE TO BE FIELD ROUTED.
 4. FOAM FIRE PROTECTION SYSTEM TO BE PER NFPA NO. 11.
 5. NUMBERS WITHIN QUOTATION MARKS REFER TO THE NUMBER OF THE APPLICABLE S & L PIPING DESIGN TABLE.
 6. DELETED.
 7. SWITCH FACTORY SET @ 5 LBS. ± 1 LB.
 8. OPEN VALVE 1FP064 TO INITIATE THE FOAM SPRAY SYSTEM.
 9. DENOTES STANDARD HOSE HOUSE INCLUDING 250 FT. OF 2 1/2 INCH. WOVEN JACKET, LINED, U.L. LISTED FIRE HOSE, 2 SPRAY NOZZLES WITH NATIONAL STANDARD THREADS (7 1/2 PER 1 INCH), 1-AXE, 1-BAR, EMERGENCY LIGHT, 6-SPANNERS AND 2-WRENCHES.
 10. DENOTES TYPICAL FIRE HYDRANT WITH (2) 2 1/2" HOSE GATE VALVES WITH HOSE CONNECTED.

USAR FIG. 9.5-1-004

ESSENTIAL DRAWING			
① REVISED	INCORPORATED CR 57153	CHANGE	PKG. NO.
○ ISSUED	CHG. DOC.		
THIS DWG. SUPERSEDES BY		REV.	THIS DWG. SUPERSEDES
REVISION NOTES			
WOLF CREEK		ELECTRONIC APPROVAL	
NUCLEAR OPERATING CORPORATION			
SARGENT & LUNDY			
P & ID			
FIRE PROTECTION SYSTEM			
SCALE	DRAWING NUMBER	SHEET	REV.
NONE	M-0023	4	16

Key & Smith
 34344 E. SIDE
 M-0023-4-16



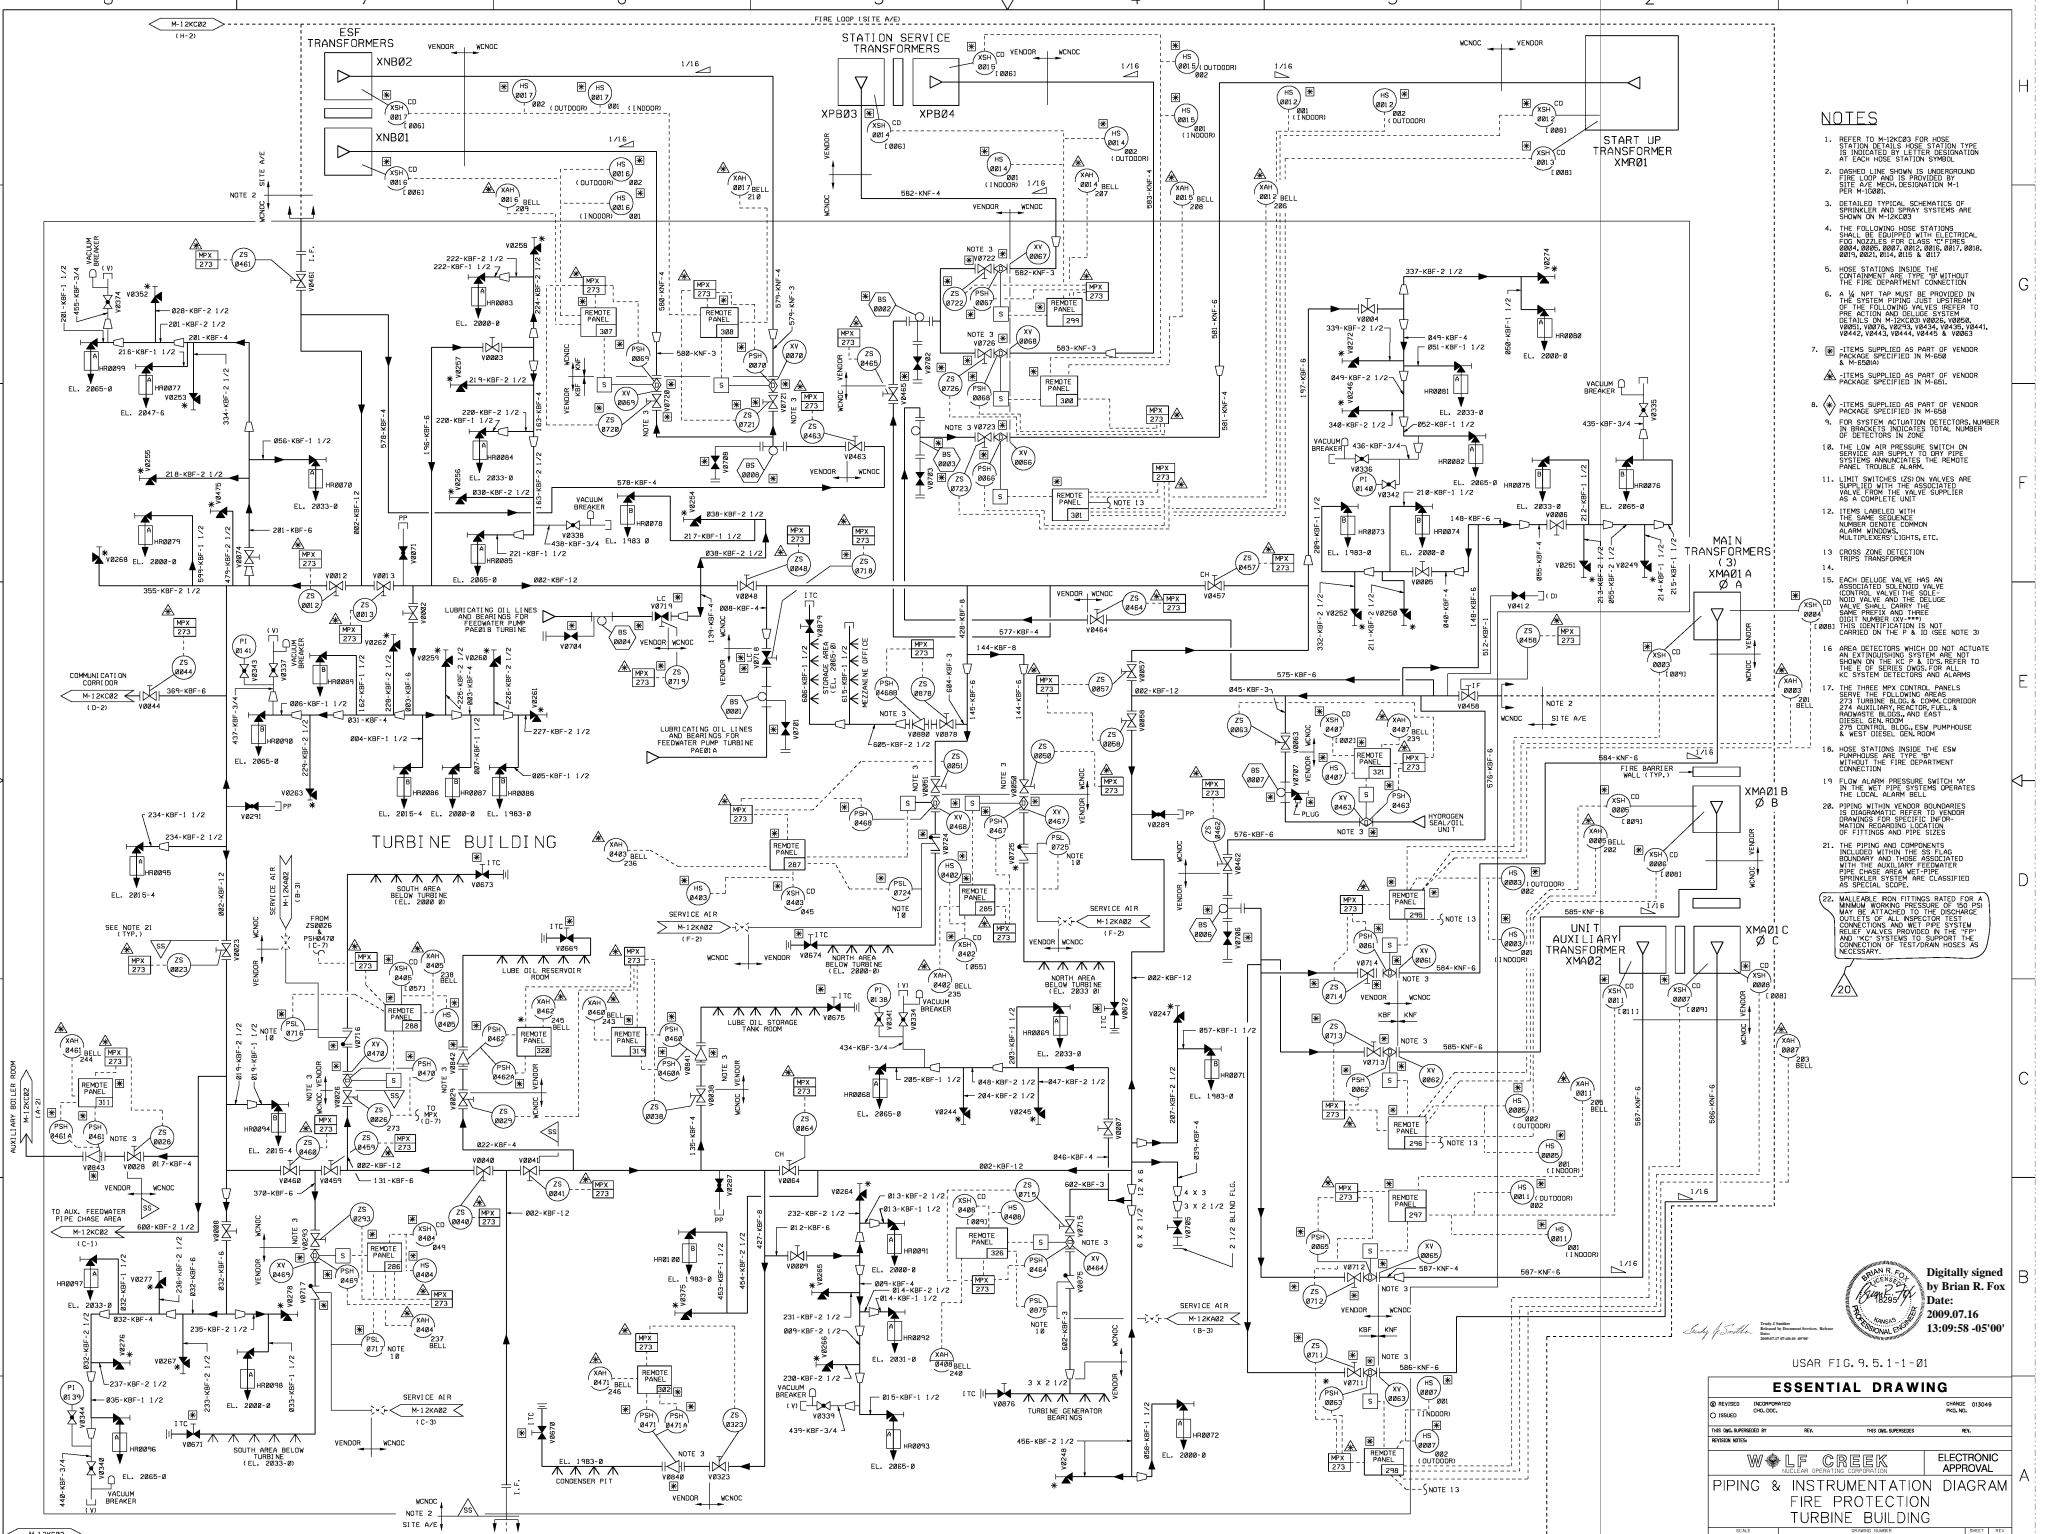

NOTES

- REFER TO M-12K02 FOR HOSE STATION TYPE OR HOSE STATION TYPE IDENTIFICATION AT EACH HOSE STATION SYMBOL.
- SIGNAL LINE SHOWN IS UNDERGROUND FIRE LOOP AND DESIGNATION M-1 PER M-12K02.
- STANDARD TYPICAL SCHEMATICS OF SHOWN ON M-12K02 SYSTEMS ARE USED.
- THE FOLLOWING HOSE STATIONS ARE SUPPLIED AS PART OF VENDOR PACKAGE SPECIFIED IN M-12K02: 2001, 2002, 2014, 2015, 2017, 2018, 2042, 2043, 2044, 2045 & 2053.
- HOSE STATIONS INSIDE THE CONFINEMENT ARE TYPE 1 WITHOUT THE FIRE DEPARTMENT CONNECTION.
- IF A HOSE STATION IS PROVIDED IN THE SYSTEM PURSUANT TO THE FOLLOWING, THE HOSE STATION SHALL BE IDENTIFIED TO THE DETAILS ON M-12K02 UNDER VENDOR PACKAGE SPECIFIED IN M-12K02: 2001, 2002, 2014, 2015, 2017, 2018, 2042, 2043, 2044, 2045 & 2053.
- ITEMS SUPPLIED AS PART OF VENDOR PACKAGE SPECIFIED IN M-12K02: 2001, 2002, 2014, 2015, 2017, 2018, 2042, 2043, 2044, 2045 & 2053.
- ITEMS SUPPLIED AS PART OF VENDOR PACKAGE SPECIFIED IN M-12K02: 2001, 2002, 2014, 2015, 2017, 2018, 2042, 2043, 2044, 2045 & 2053.
- FOR ITEM ACTUATION IDENTIFICATION, NUMBER 3 INDICATES TOTAL NUMBER OF DETECTORS IN ZONE.
- THE LOW AIR PRESSURE SWITCH ON SERVICE AIR SUPPLY TO FIRE PUMP SYSTEMS ANNUNCIATES THE REMOTE FIRE TRIP SIGNAL ALARM.
- LIMIT SWITCHES USED ON VALVES ARE SHOWN FROM THE VALVE SUPPLIER AS A COMPLETE UNIT.
- ITEMS LABELED WITH THE NUMBER IDENTIFY COMMON ALARMS, MULTIPLEXERS, ETC.
- CROSS ZONE DETECTION TRIPS TRANSFORMER.
- EACH DELUDE VALVE HAS AN ASSOCIATED DELUDE VALVE CONTROL VALVE THE DELUDE VALVE SHALL CARRY THE DELUDE SIGNAL TO THE DELUDE VALVE CONTROL VALVE. THIS IDENTIFICATION IS NOT CORRELATED TO THE DELUDE VALVE.
- AREA DETECTORS WHICH DO NOT ACTUATE AN EXTINGUISHING SYSTEM ARE NOT SHOWN ON THE DELUDE VALVE CONTROL VALVE. THIS IDENTIFICATION IS NOT CORRELATED TO THE DELUDE VALVE.
- THE THREE MPA CONTROL PANELS BEHIND THE MAIN CONDUIT ARE: 273 TURBINE BUILDING, 274 CONDUIT BEHIND AND EAST DIESEL GEN. ROOM, 275 CONDUIT BEHIND AND EAST DIESEL GEN. ROOM.
- HOSE STATIONS INSIDE THE ESW CONFINEMENT ARE TYPE 1 FIRE DEPARTMENT CONNECTION.
- FLOW ALARM PRESSURE SWITCH "M" BEHIND THE MAIN CONDUIT CONNECTION THE LOCAL ALARM BELL CONNECTION.
- PIPING WITHIN VENDOR BOUNDARIES IS DIAGRAMMATIC REFER TO VENDOR DRAWINGS FOR DETAILS OF THE CONNECTIONS AND FITTINGS AND PIPE SIZES.
- THE PIPING AND COMPONENTS INCLUDED WITHIN THE SCOPE OF THIS DRAWING SHALL BE IDENTIFIED WITH THE AUXILIARY FEEDWATER SPRINKLER SYSTEM ARE CLASSIFIED AS M-12K02.
- MALLEABLE IRON FITTINGS RATED FOR A MINIMUM OF 150 PSI SHALL BE USED. THIS SHALL BE ATTACHED TO THE DISCHARGE END OF EACH FIRE PUMP TO THE CONNECTIONS AND MET PIPE SYSTEM. MET VALVES PROVIDED SHALL BE THE CONNECTION OF TEST/DRINK HOSES AS NECESSARY.

Digitally signed by Brian R. Fox
Date: 2009.07.16
13:09:58 -05'00'

USAR FIG. 9.5.1-1-01


ESSENTIAL DRAWING

DESIGNED BY	INCORPORATED	CHANGED	03049
DATE	DATE	DATE	DATE
BY	BY	BY	BY
REVISION	REVISION	REVISION	REVISION

WOLF CREEK
NEUTRON CONSULTING CORPORATION
ELECTRONIC APPROVAL
PIPING & INSTRUMENTATION DIAGRAM
FIRE PROTECTION
TURBINE BUILDING

NONE M-12K01 SHEET 20













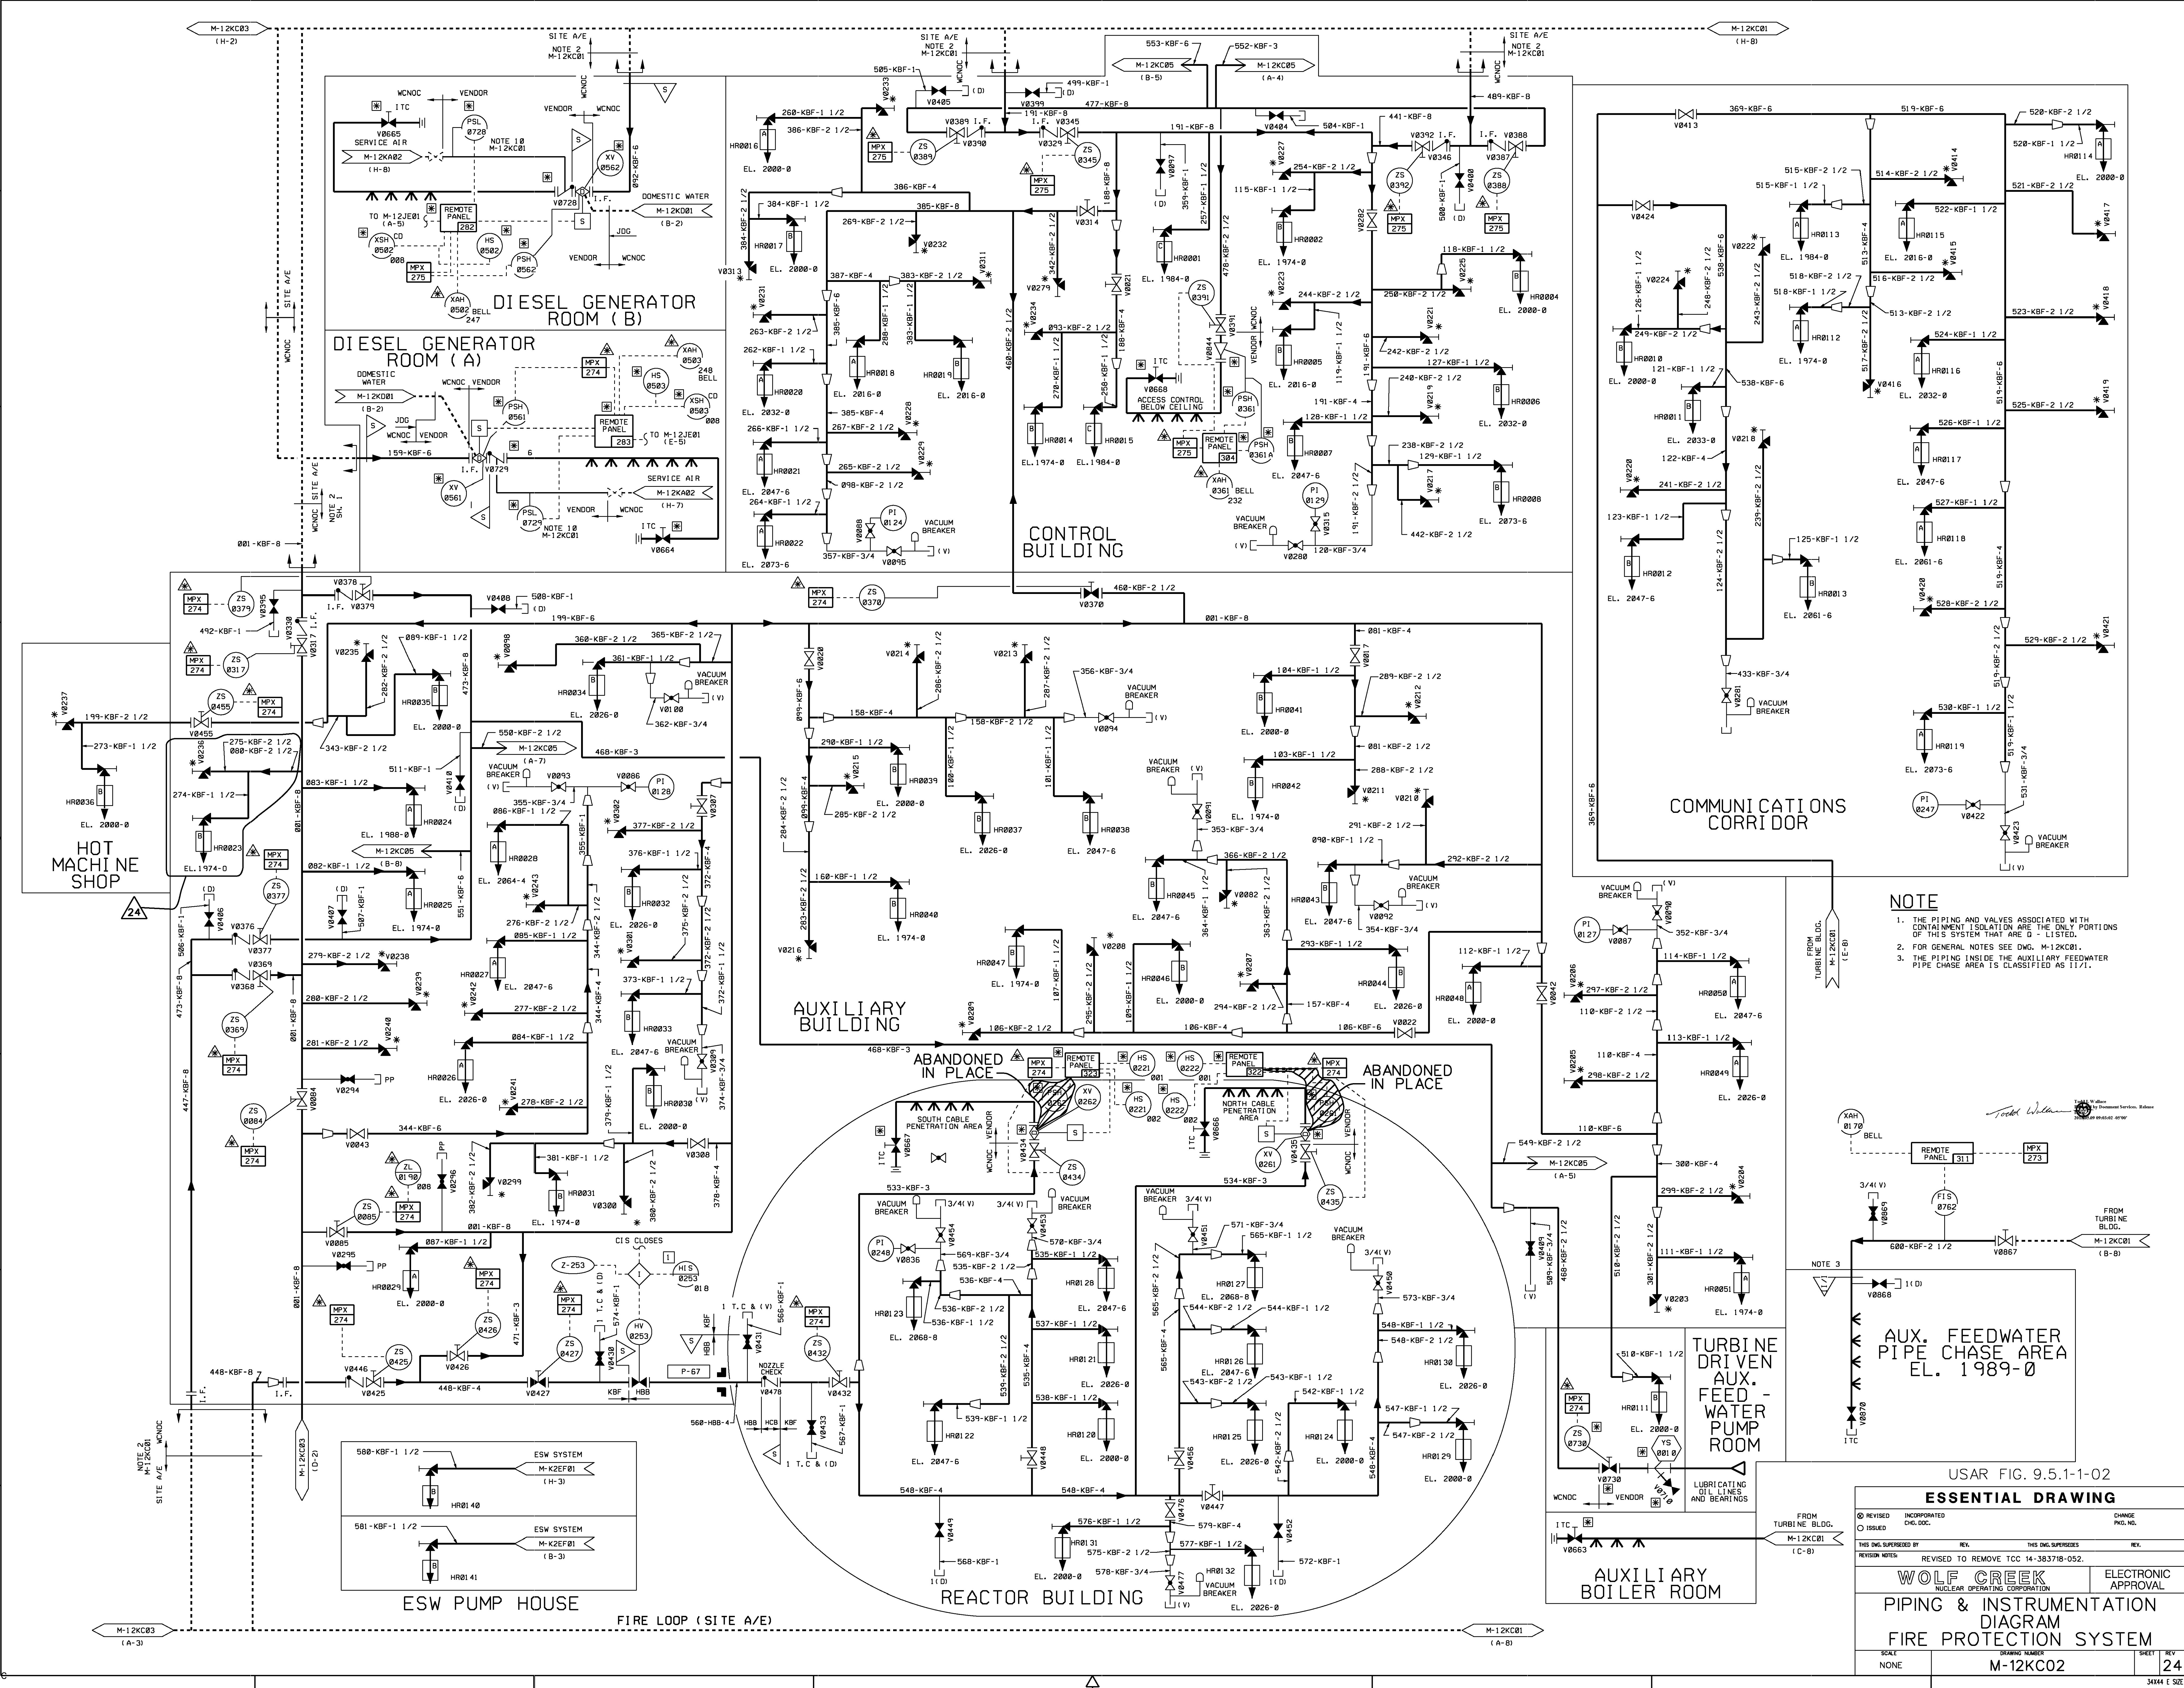


- NOTE**
1. THE PIPING AND VALVES ASSOCIATED WITH CONTAINMENT ISOLATION ARE THE ONLY PORTIONS OF THIS SYSTEM THAT ARE 0" LISTED.
 2. FOR GENERAL NOTES SEE DWG. M-12K001.
 3. THE PIPING INSIDE THE AUXILIARY FEEDWATER PIPE CHASE AREA IS CLASSIFIED AS I1/I.

USAR FIG. 9.5.1-1-02

ESSENTIAL DRAWING

REVISED	INCORPORATED	CHANGE
ISSUED	CHG. DOC.	PGG. NO.
THIS DWG. SUPERSEDES		
REVISION NUMBER	REVISED TO REMOVE TCC 14-383718-052.	REV.
WOLF CREEK NUCLEAR OPERATING CORPORATION		ELECTRONIC APPROVAL
PIPING & INSTRUMENTATION DIAGRAM FIRE PROTECTION SYSTEM		
SCALE	DRAWING NUMBER	SHEET
NONE	M-12K002	24
		REV
		3444 I. SZ

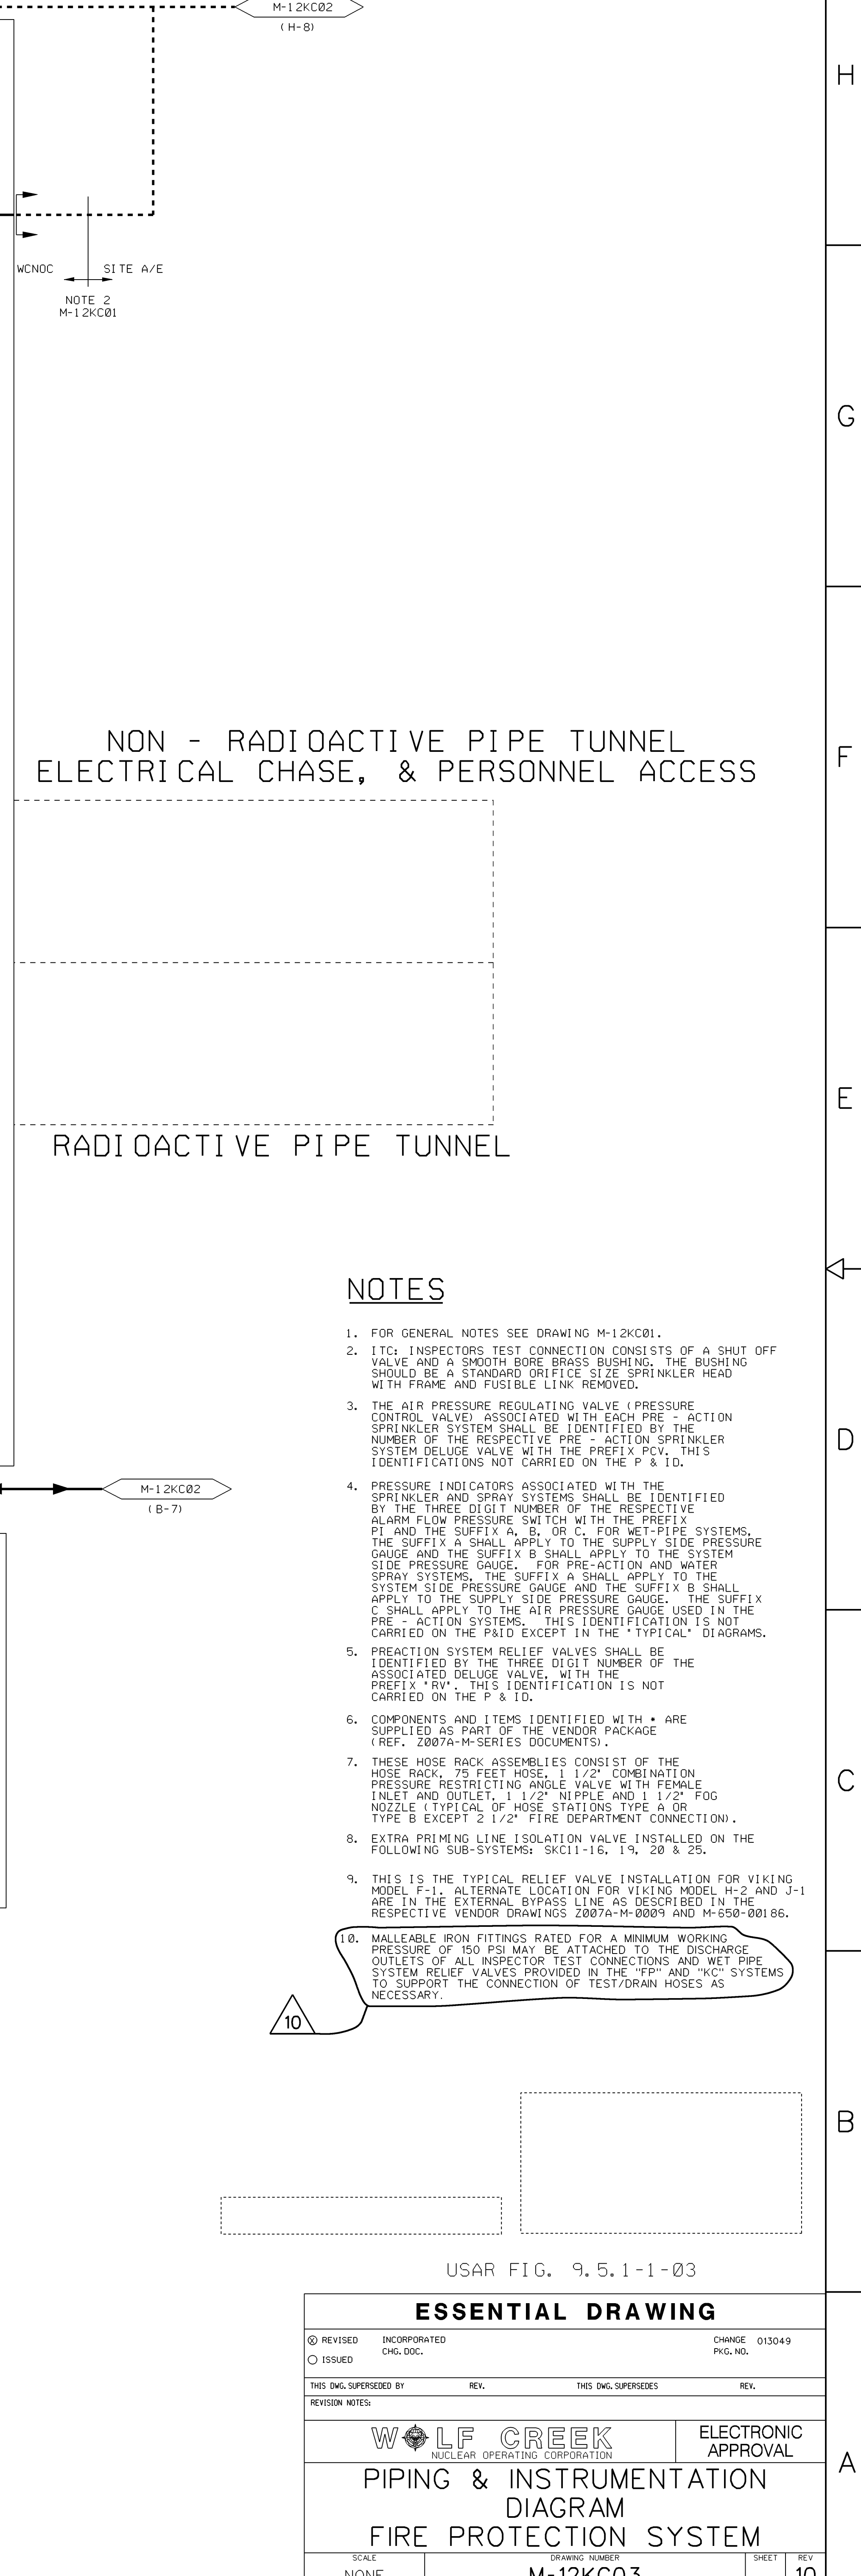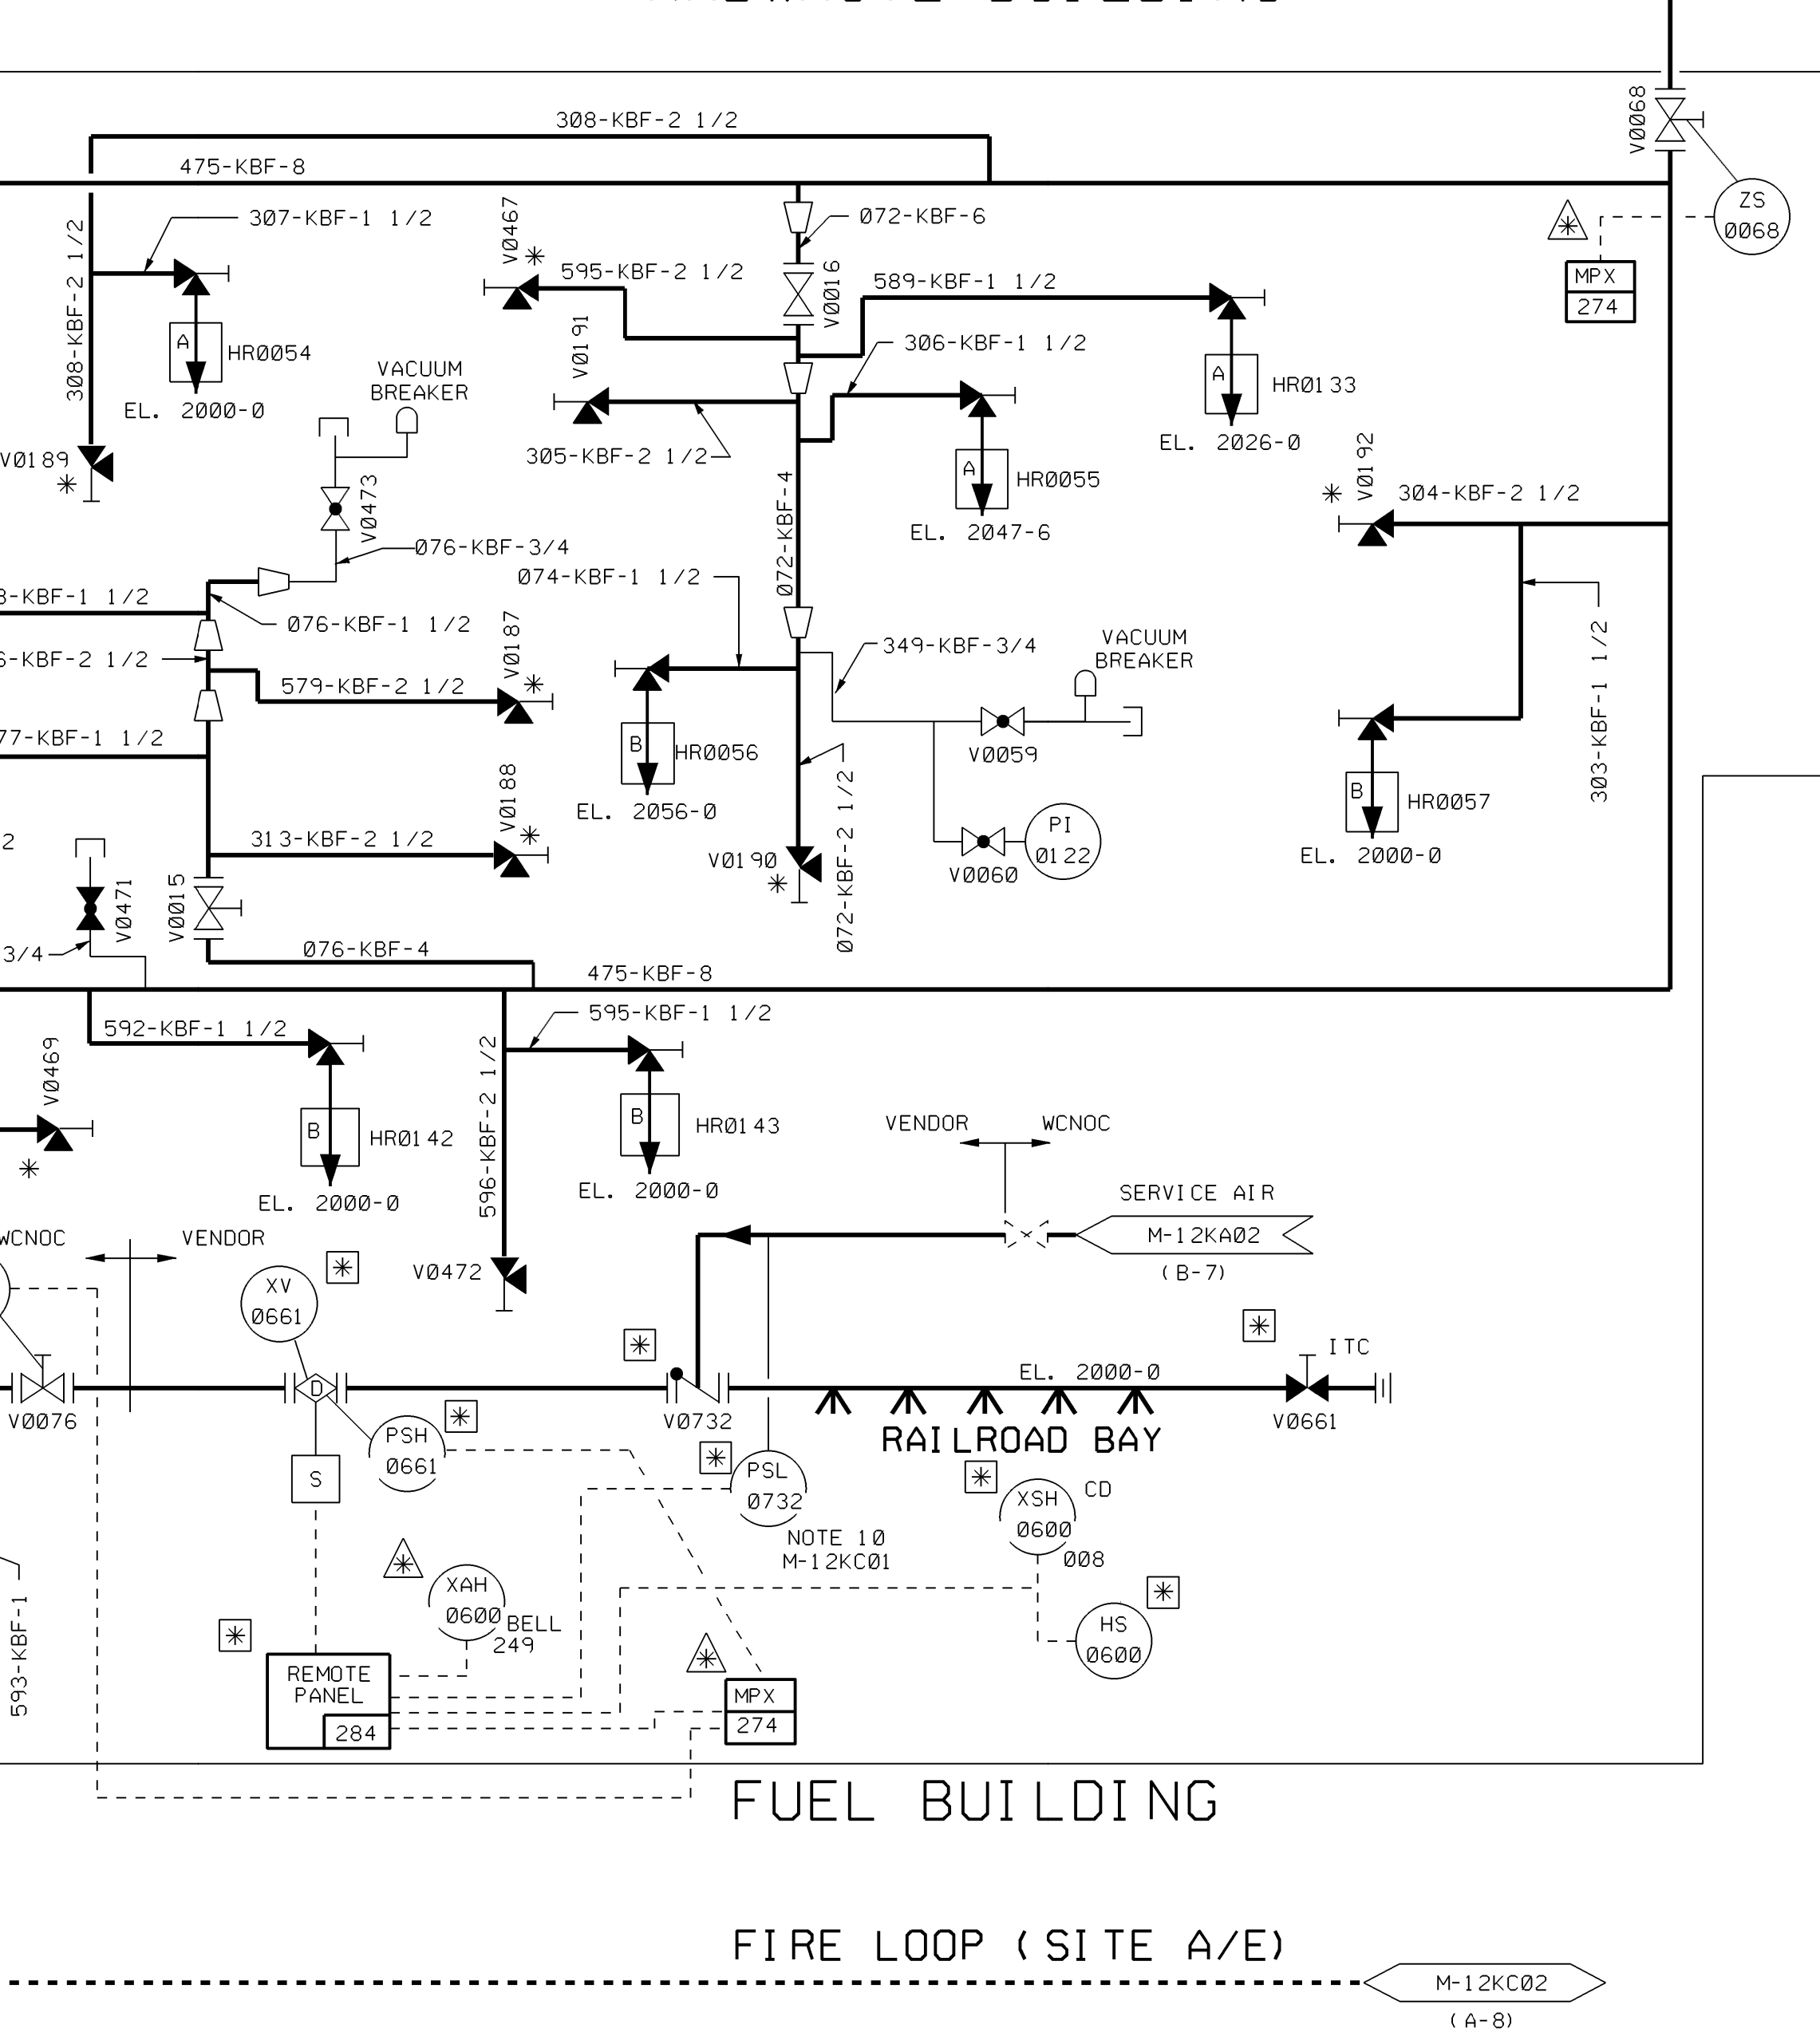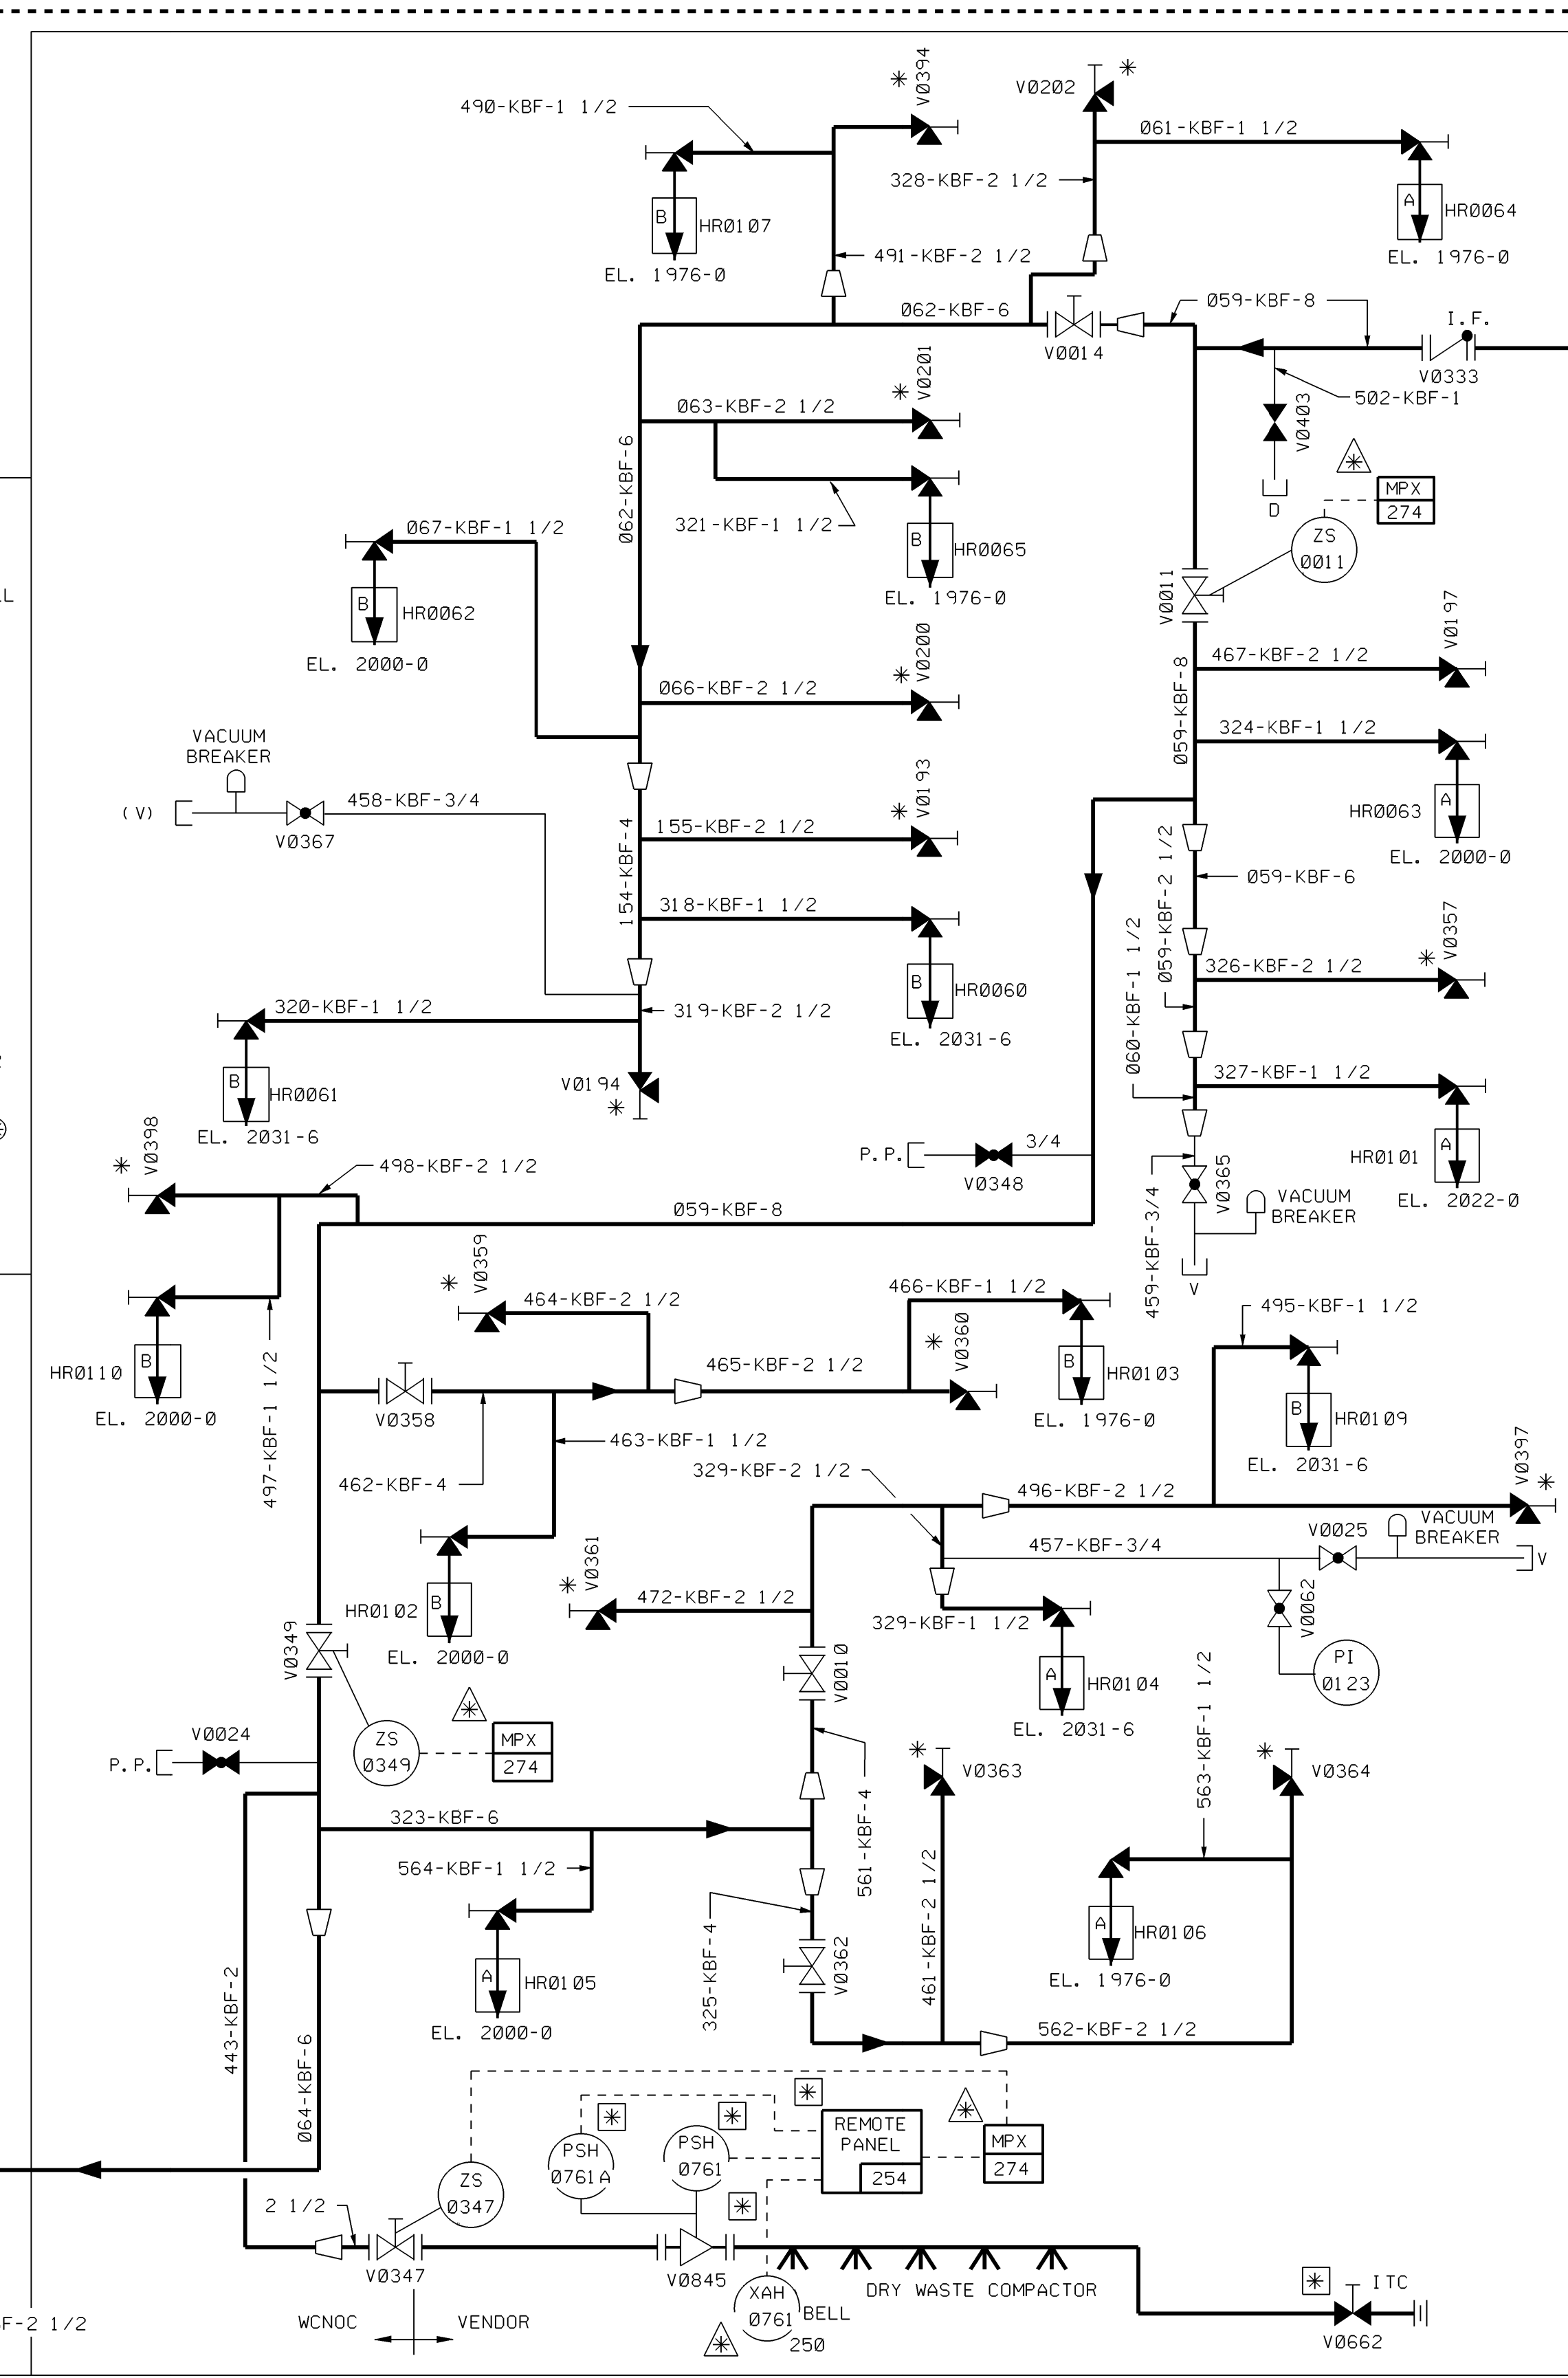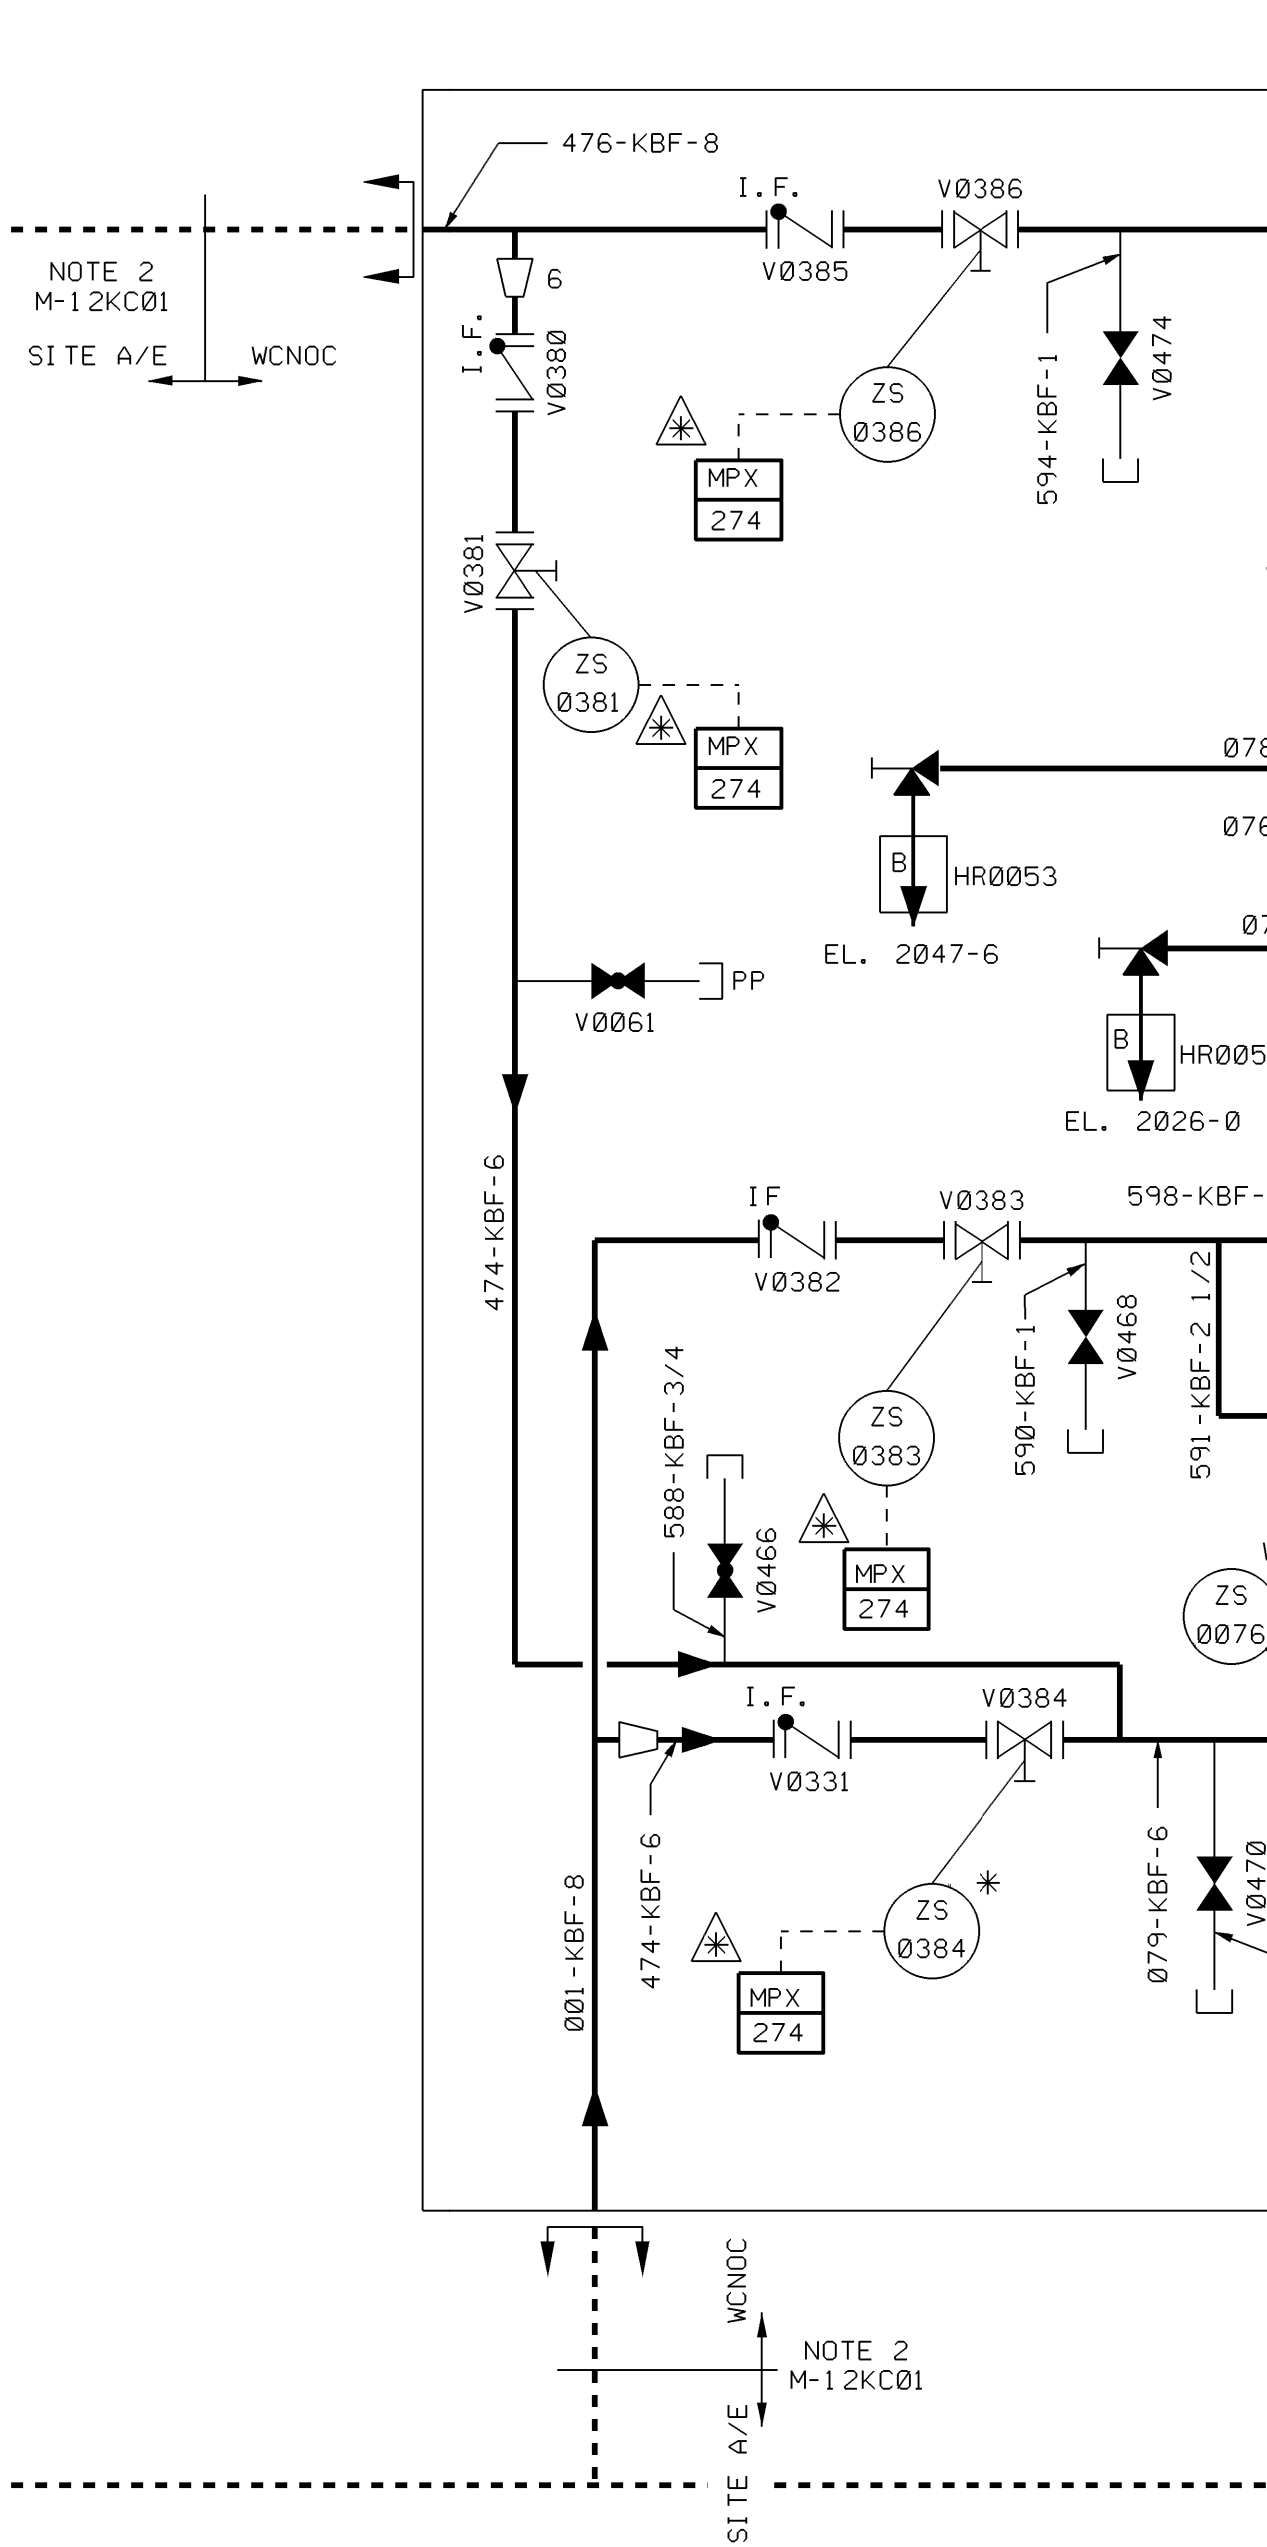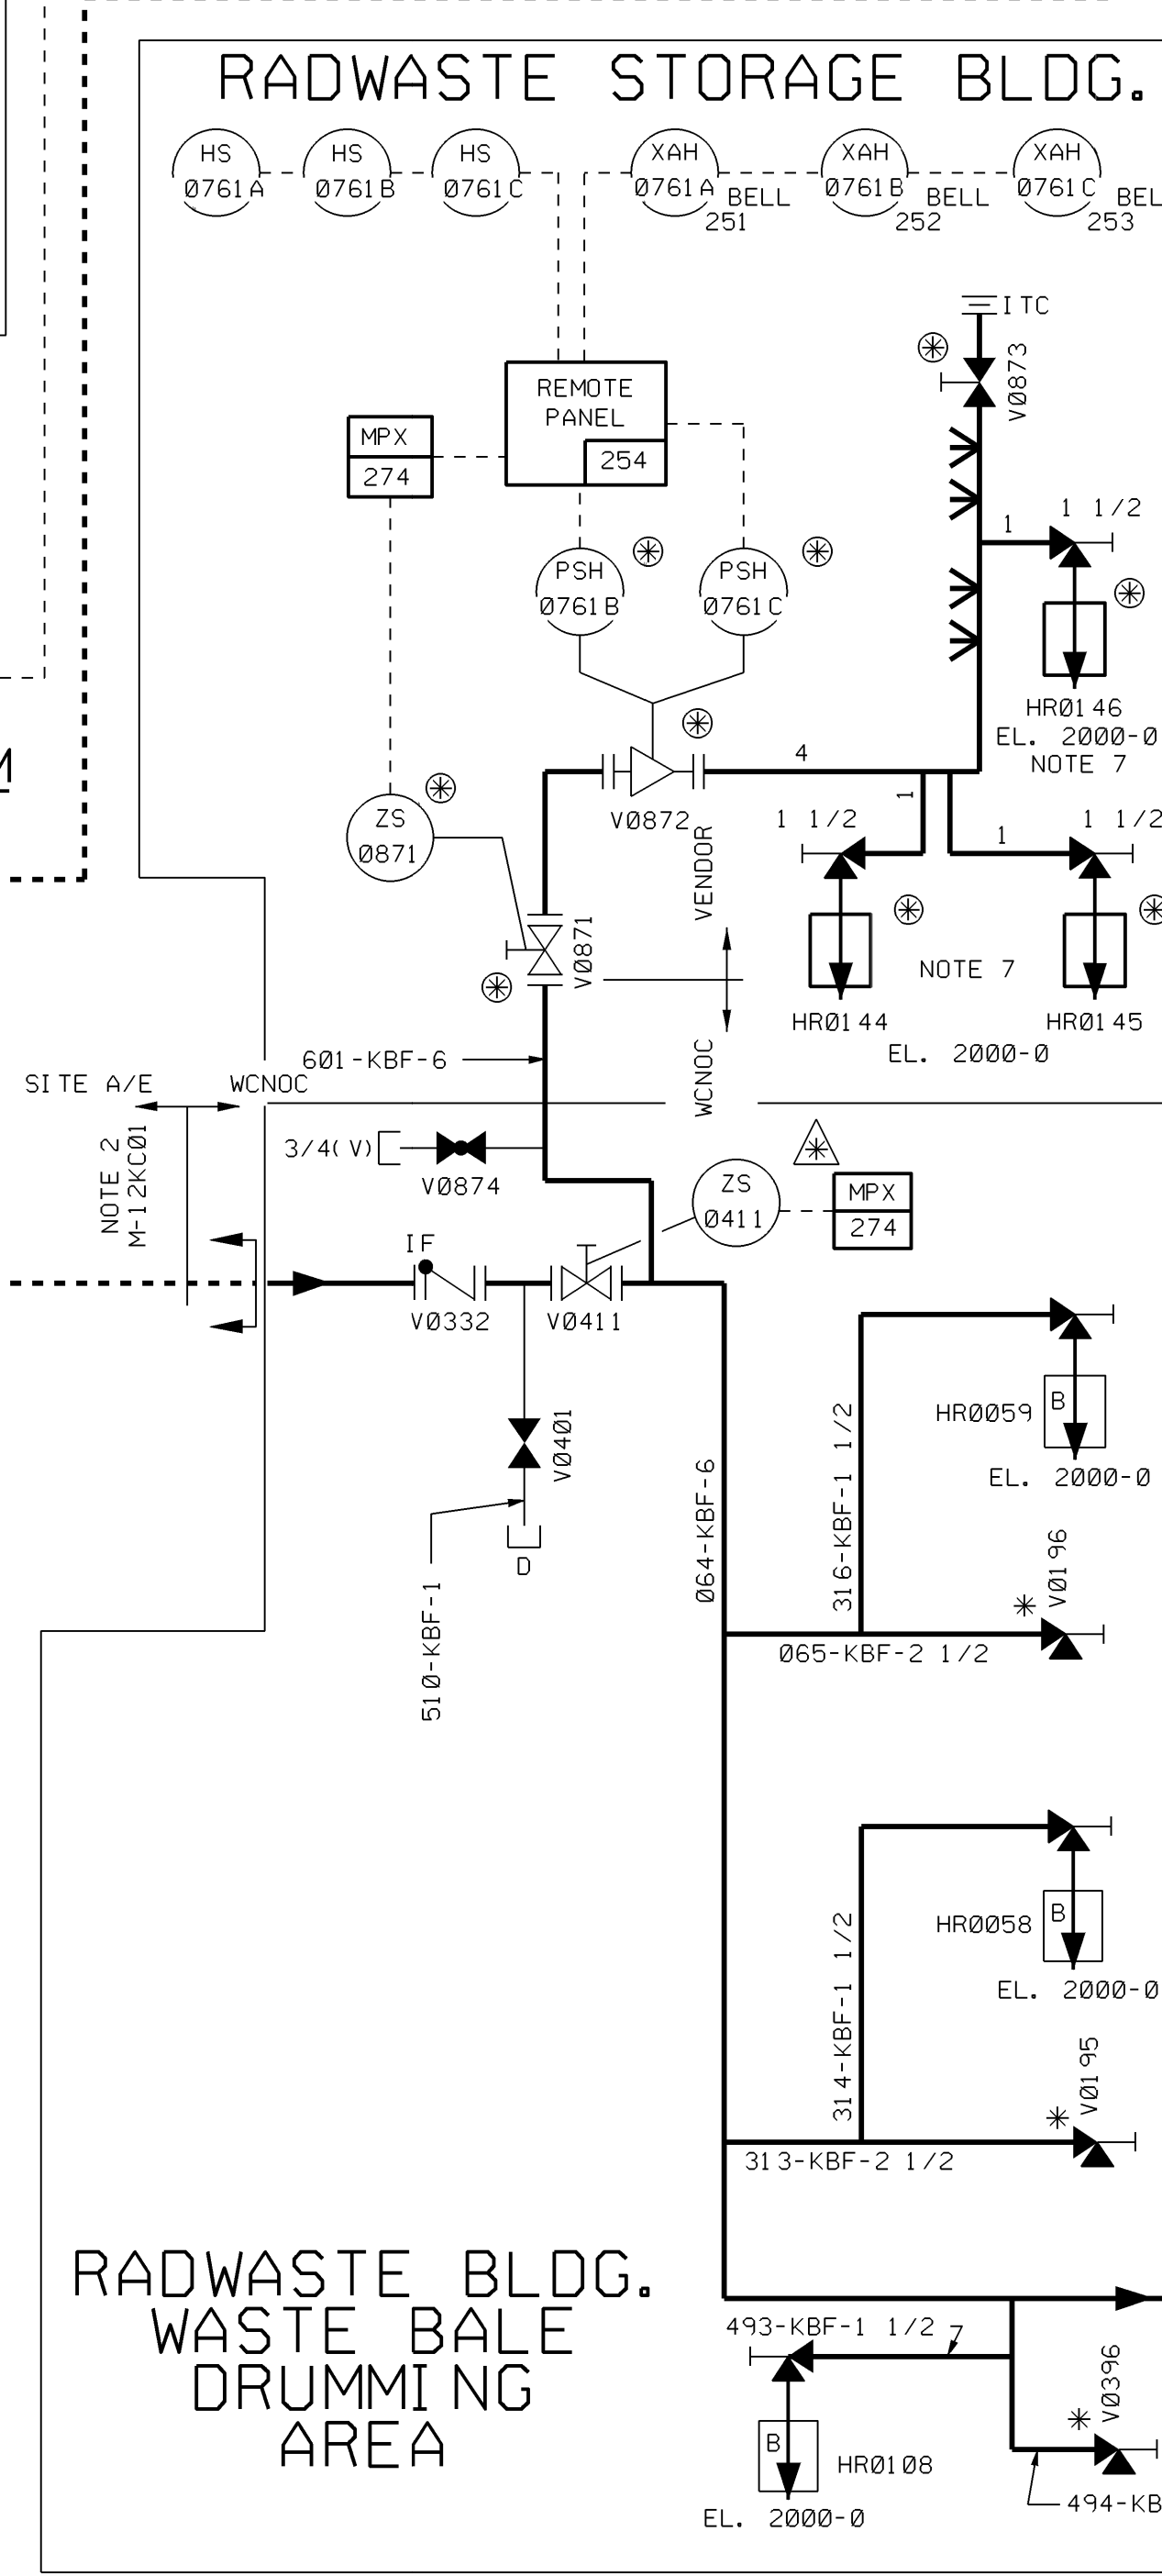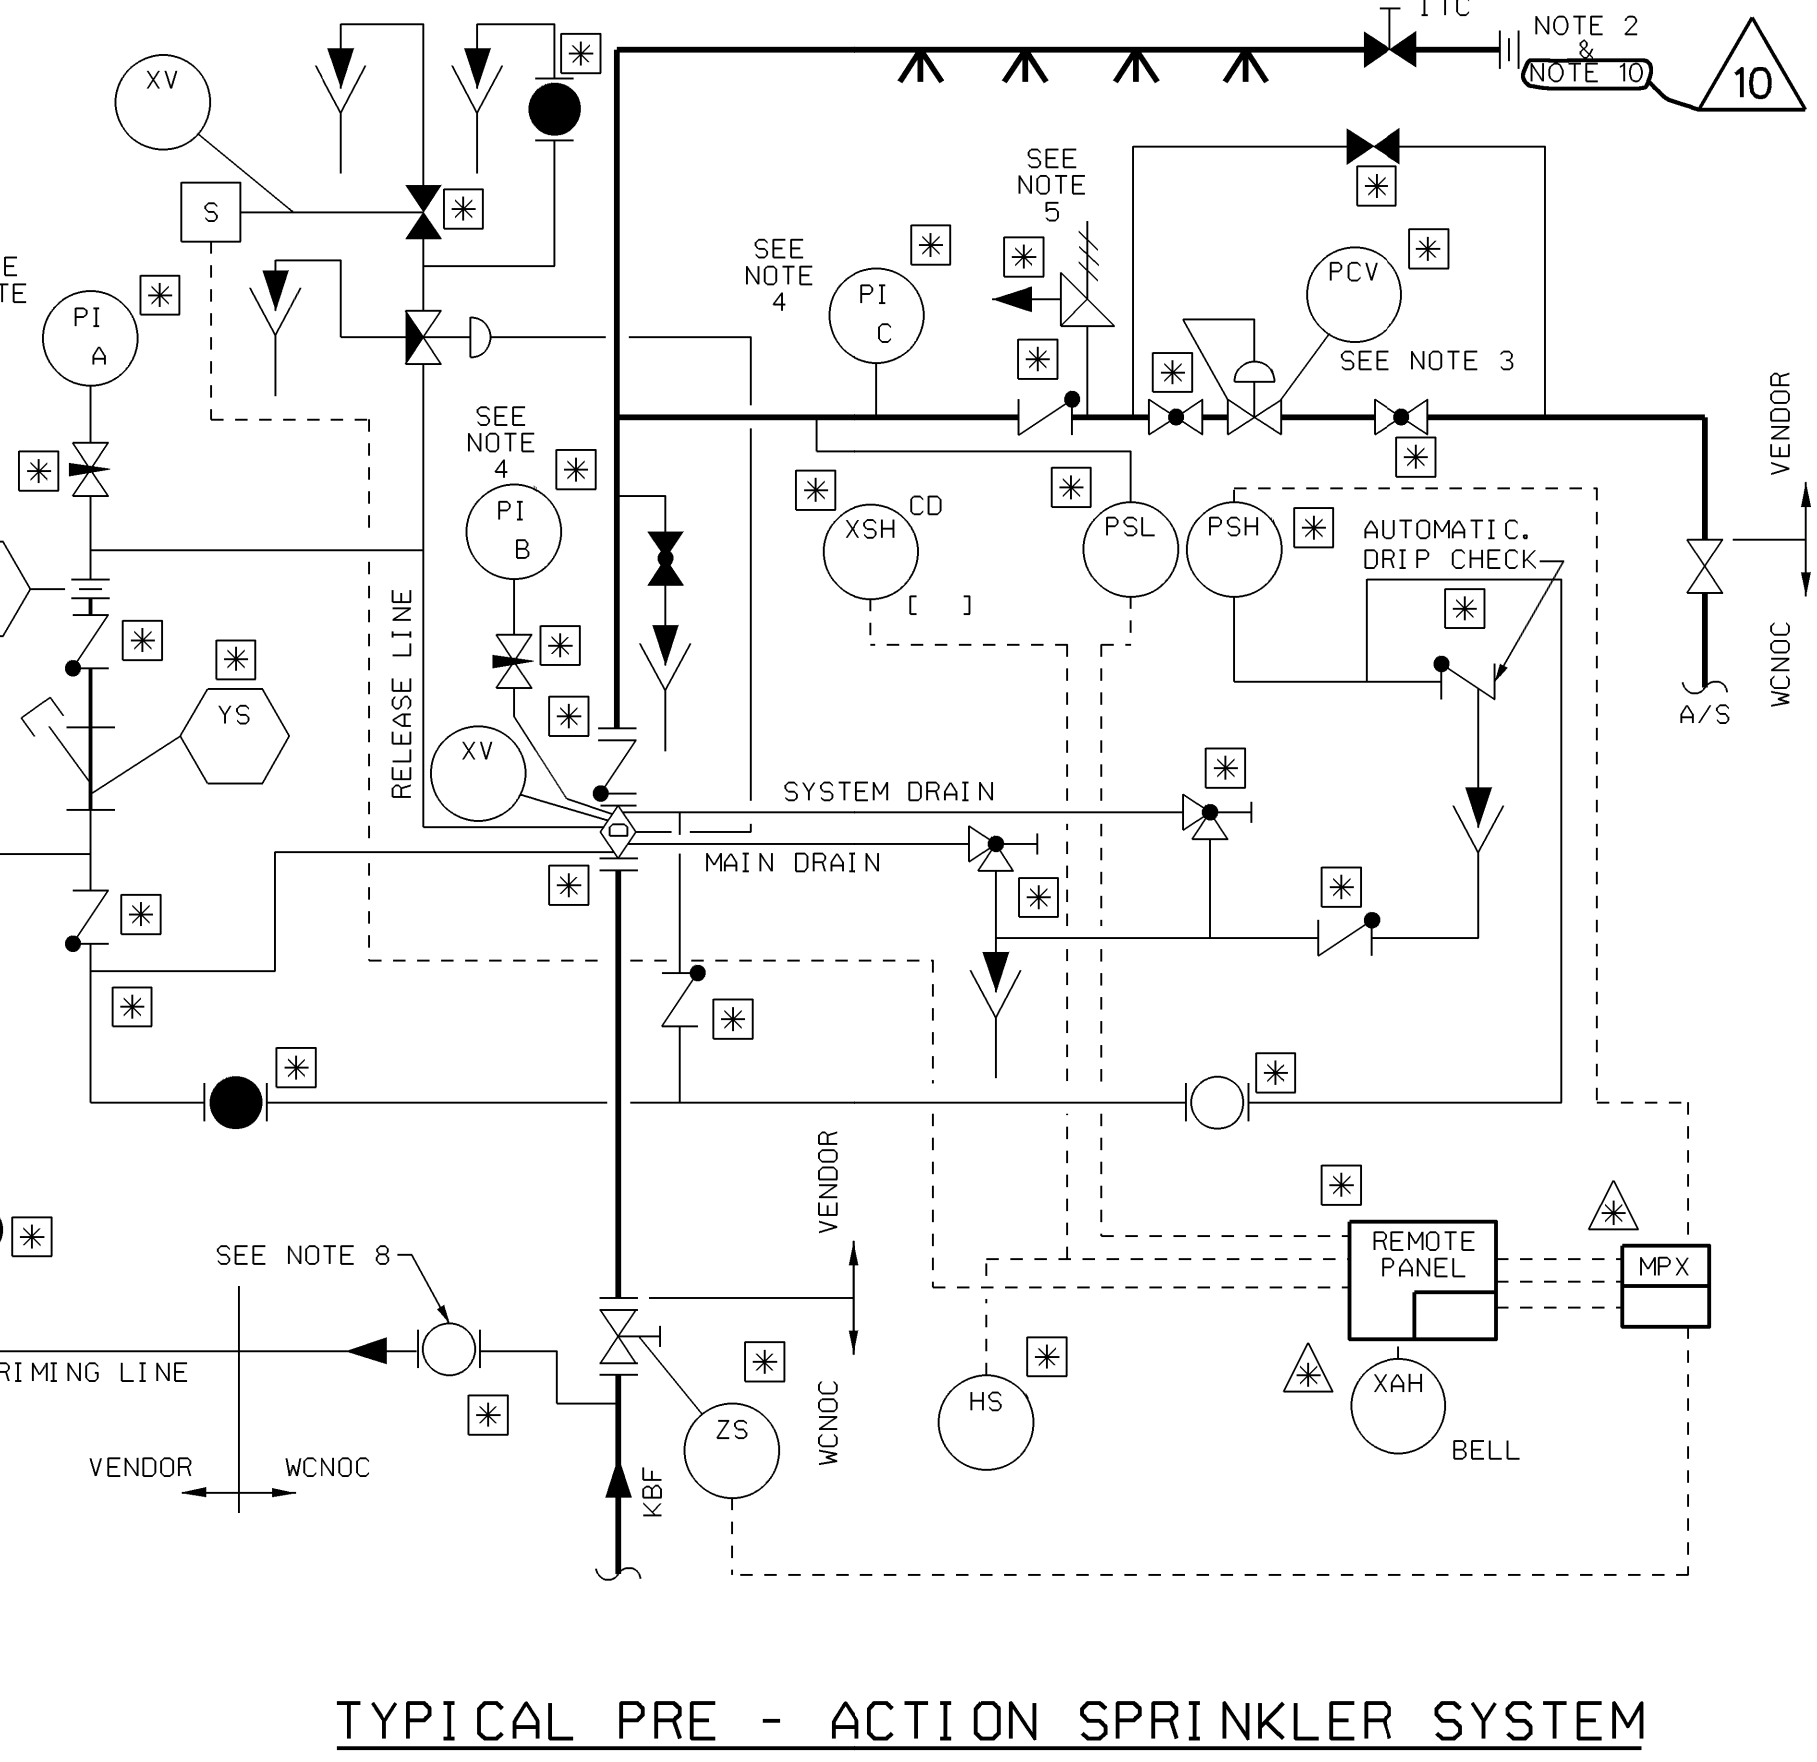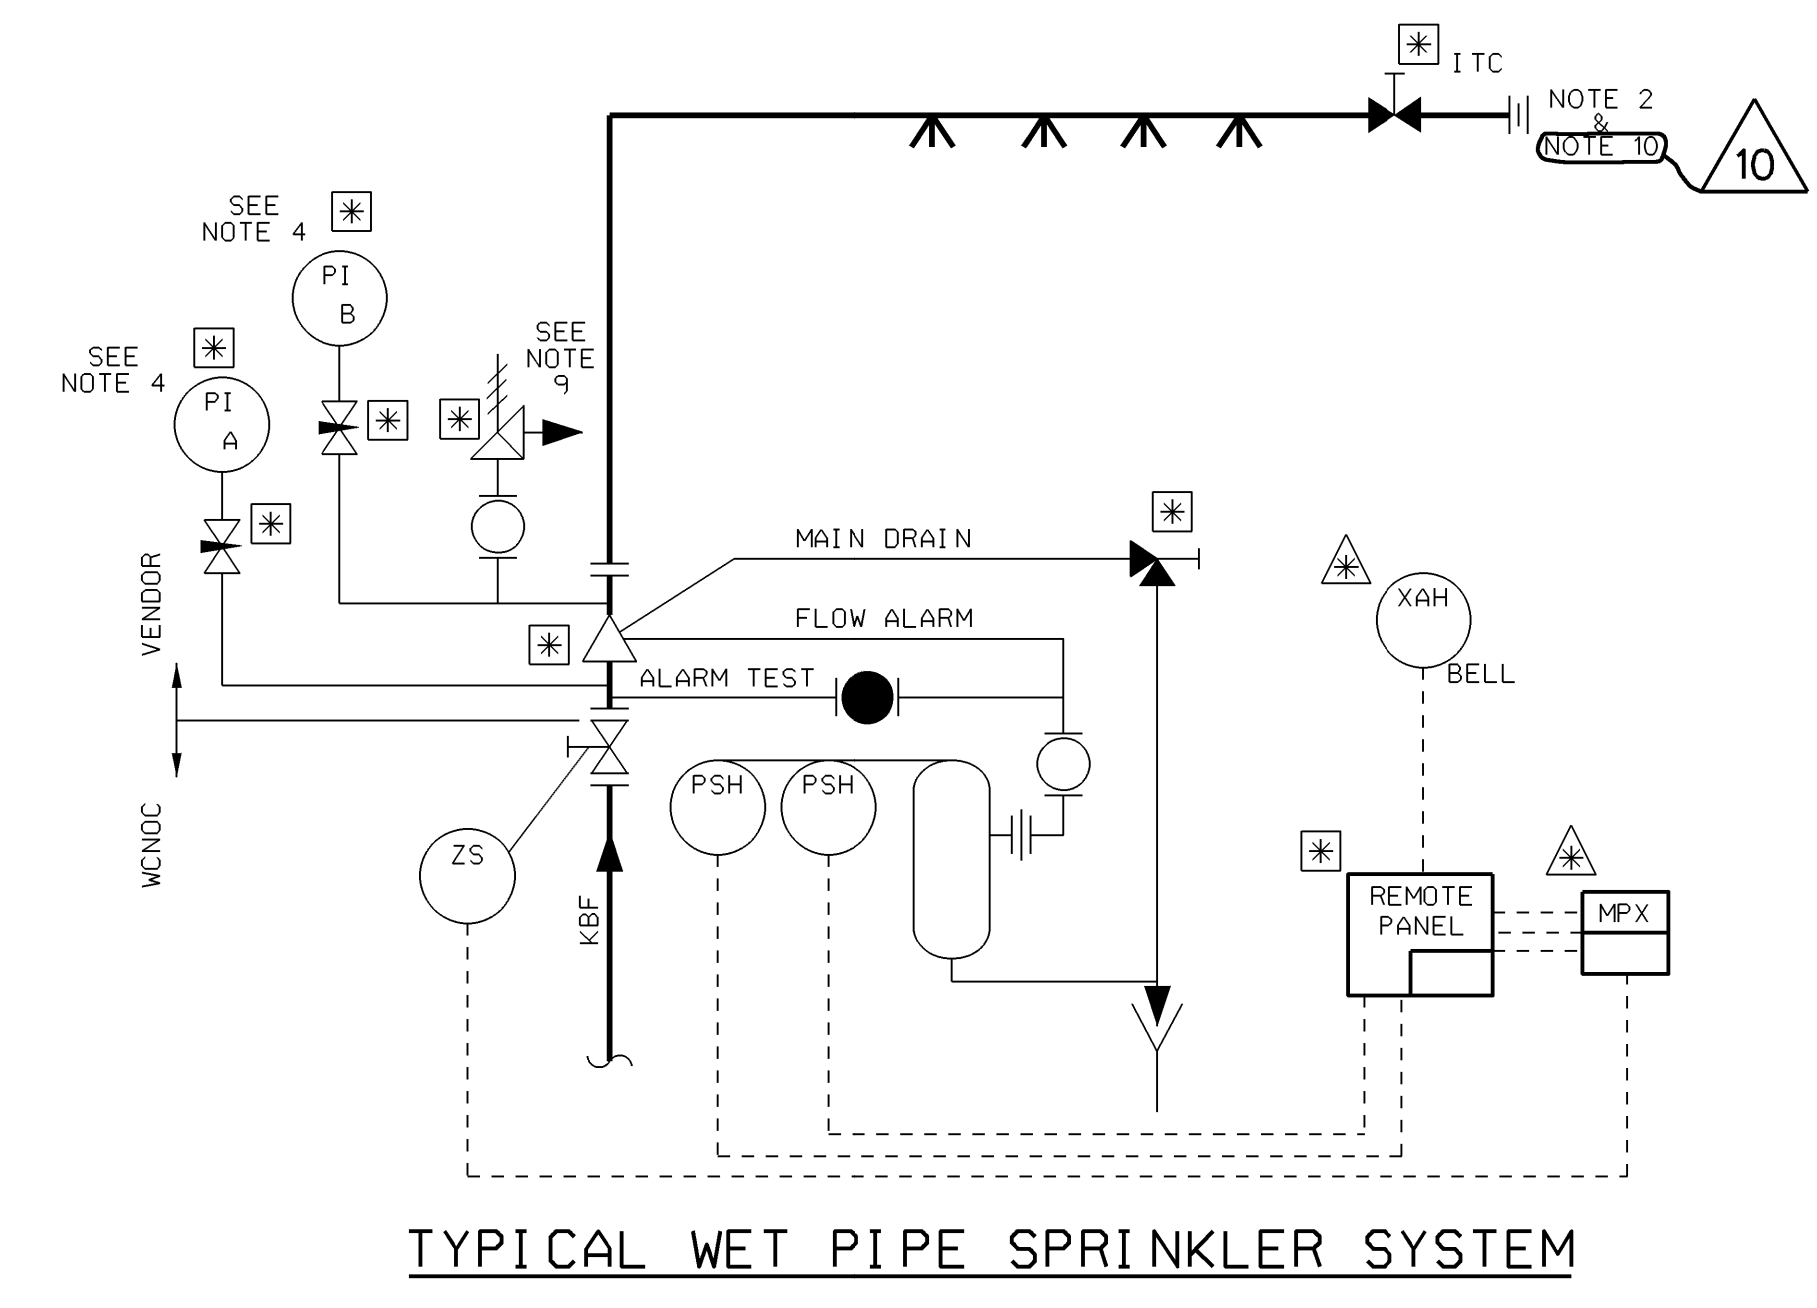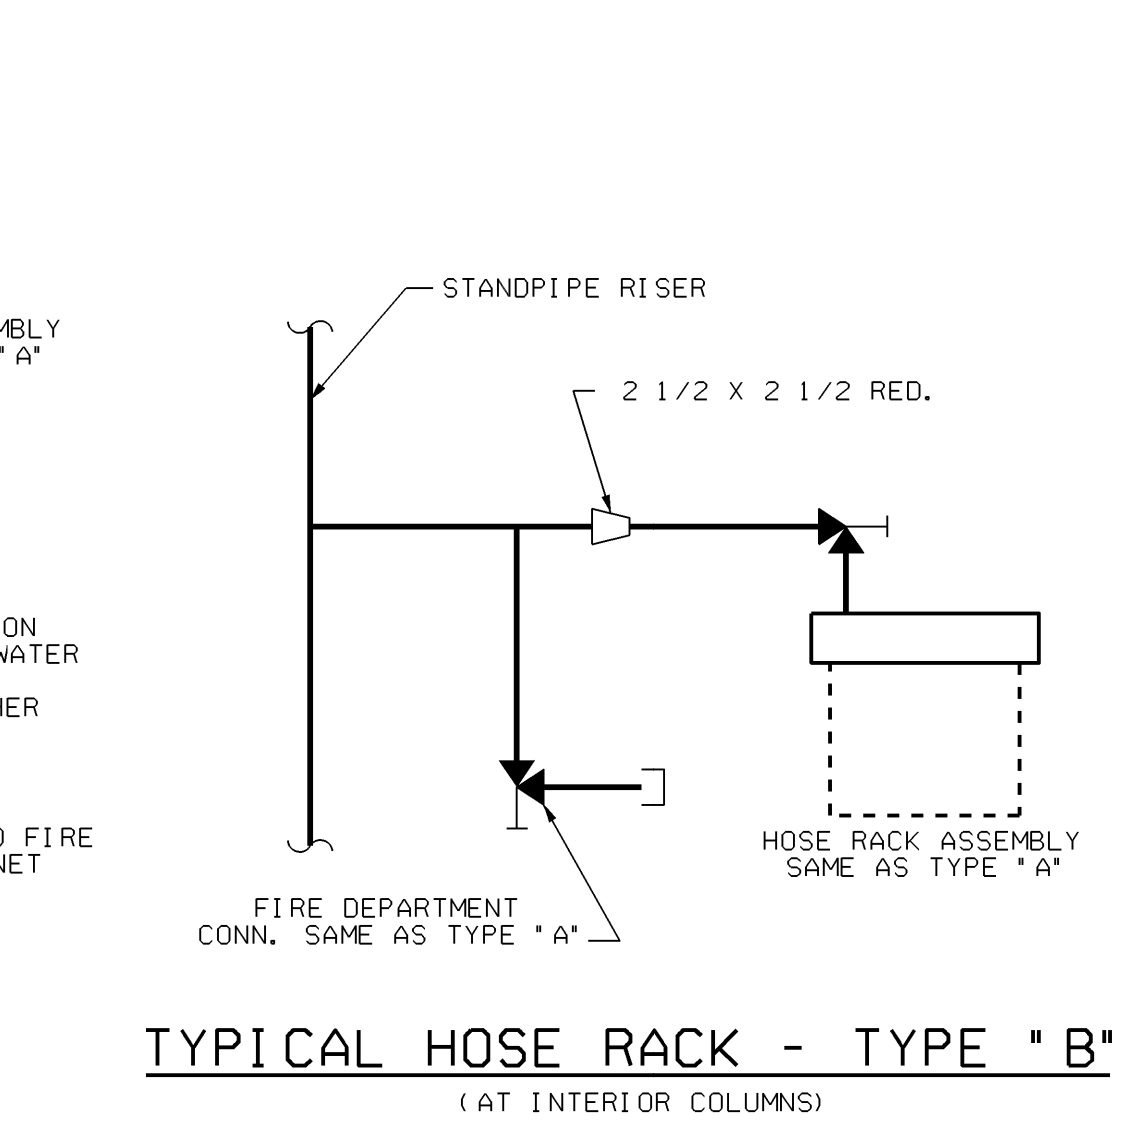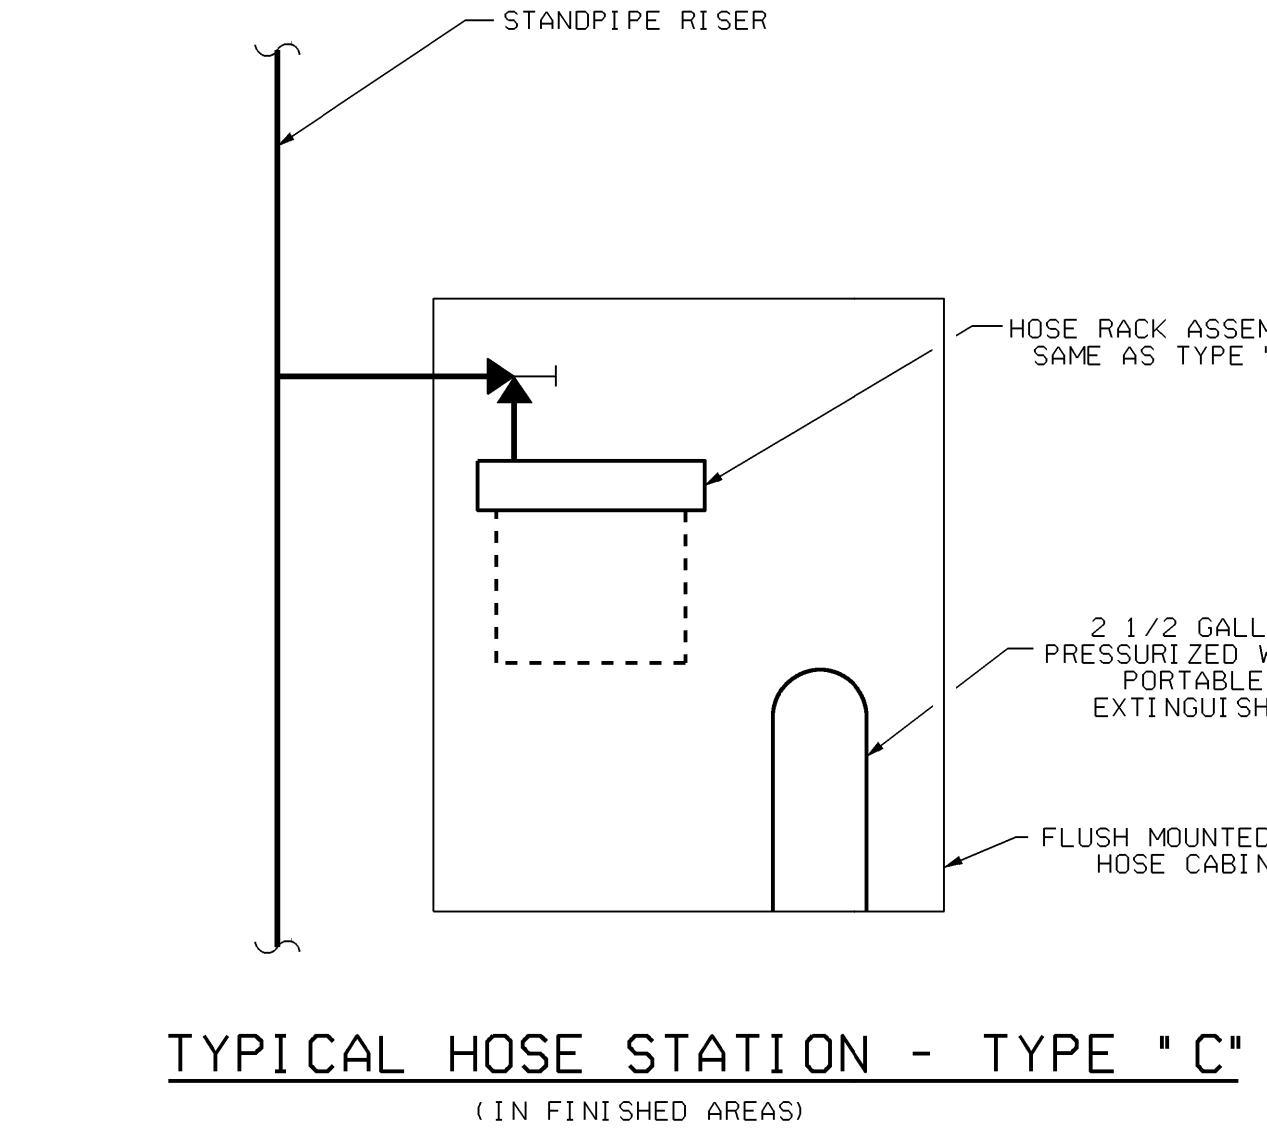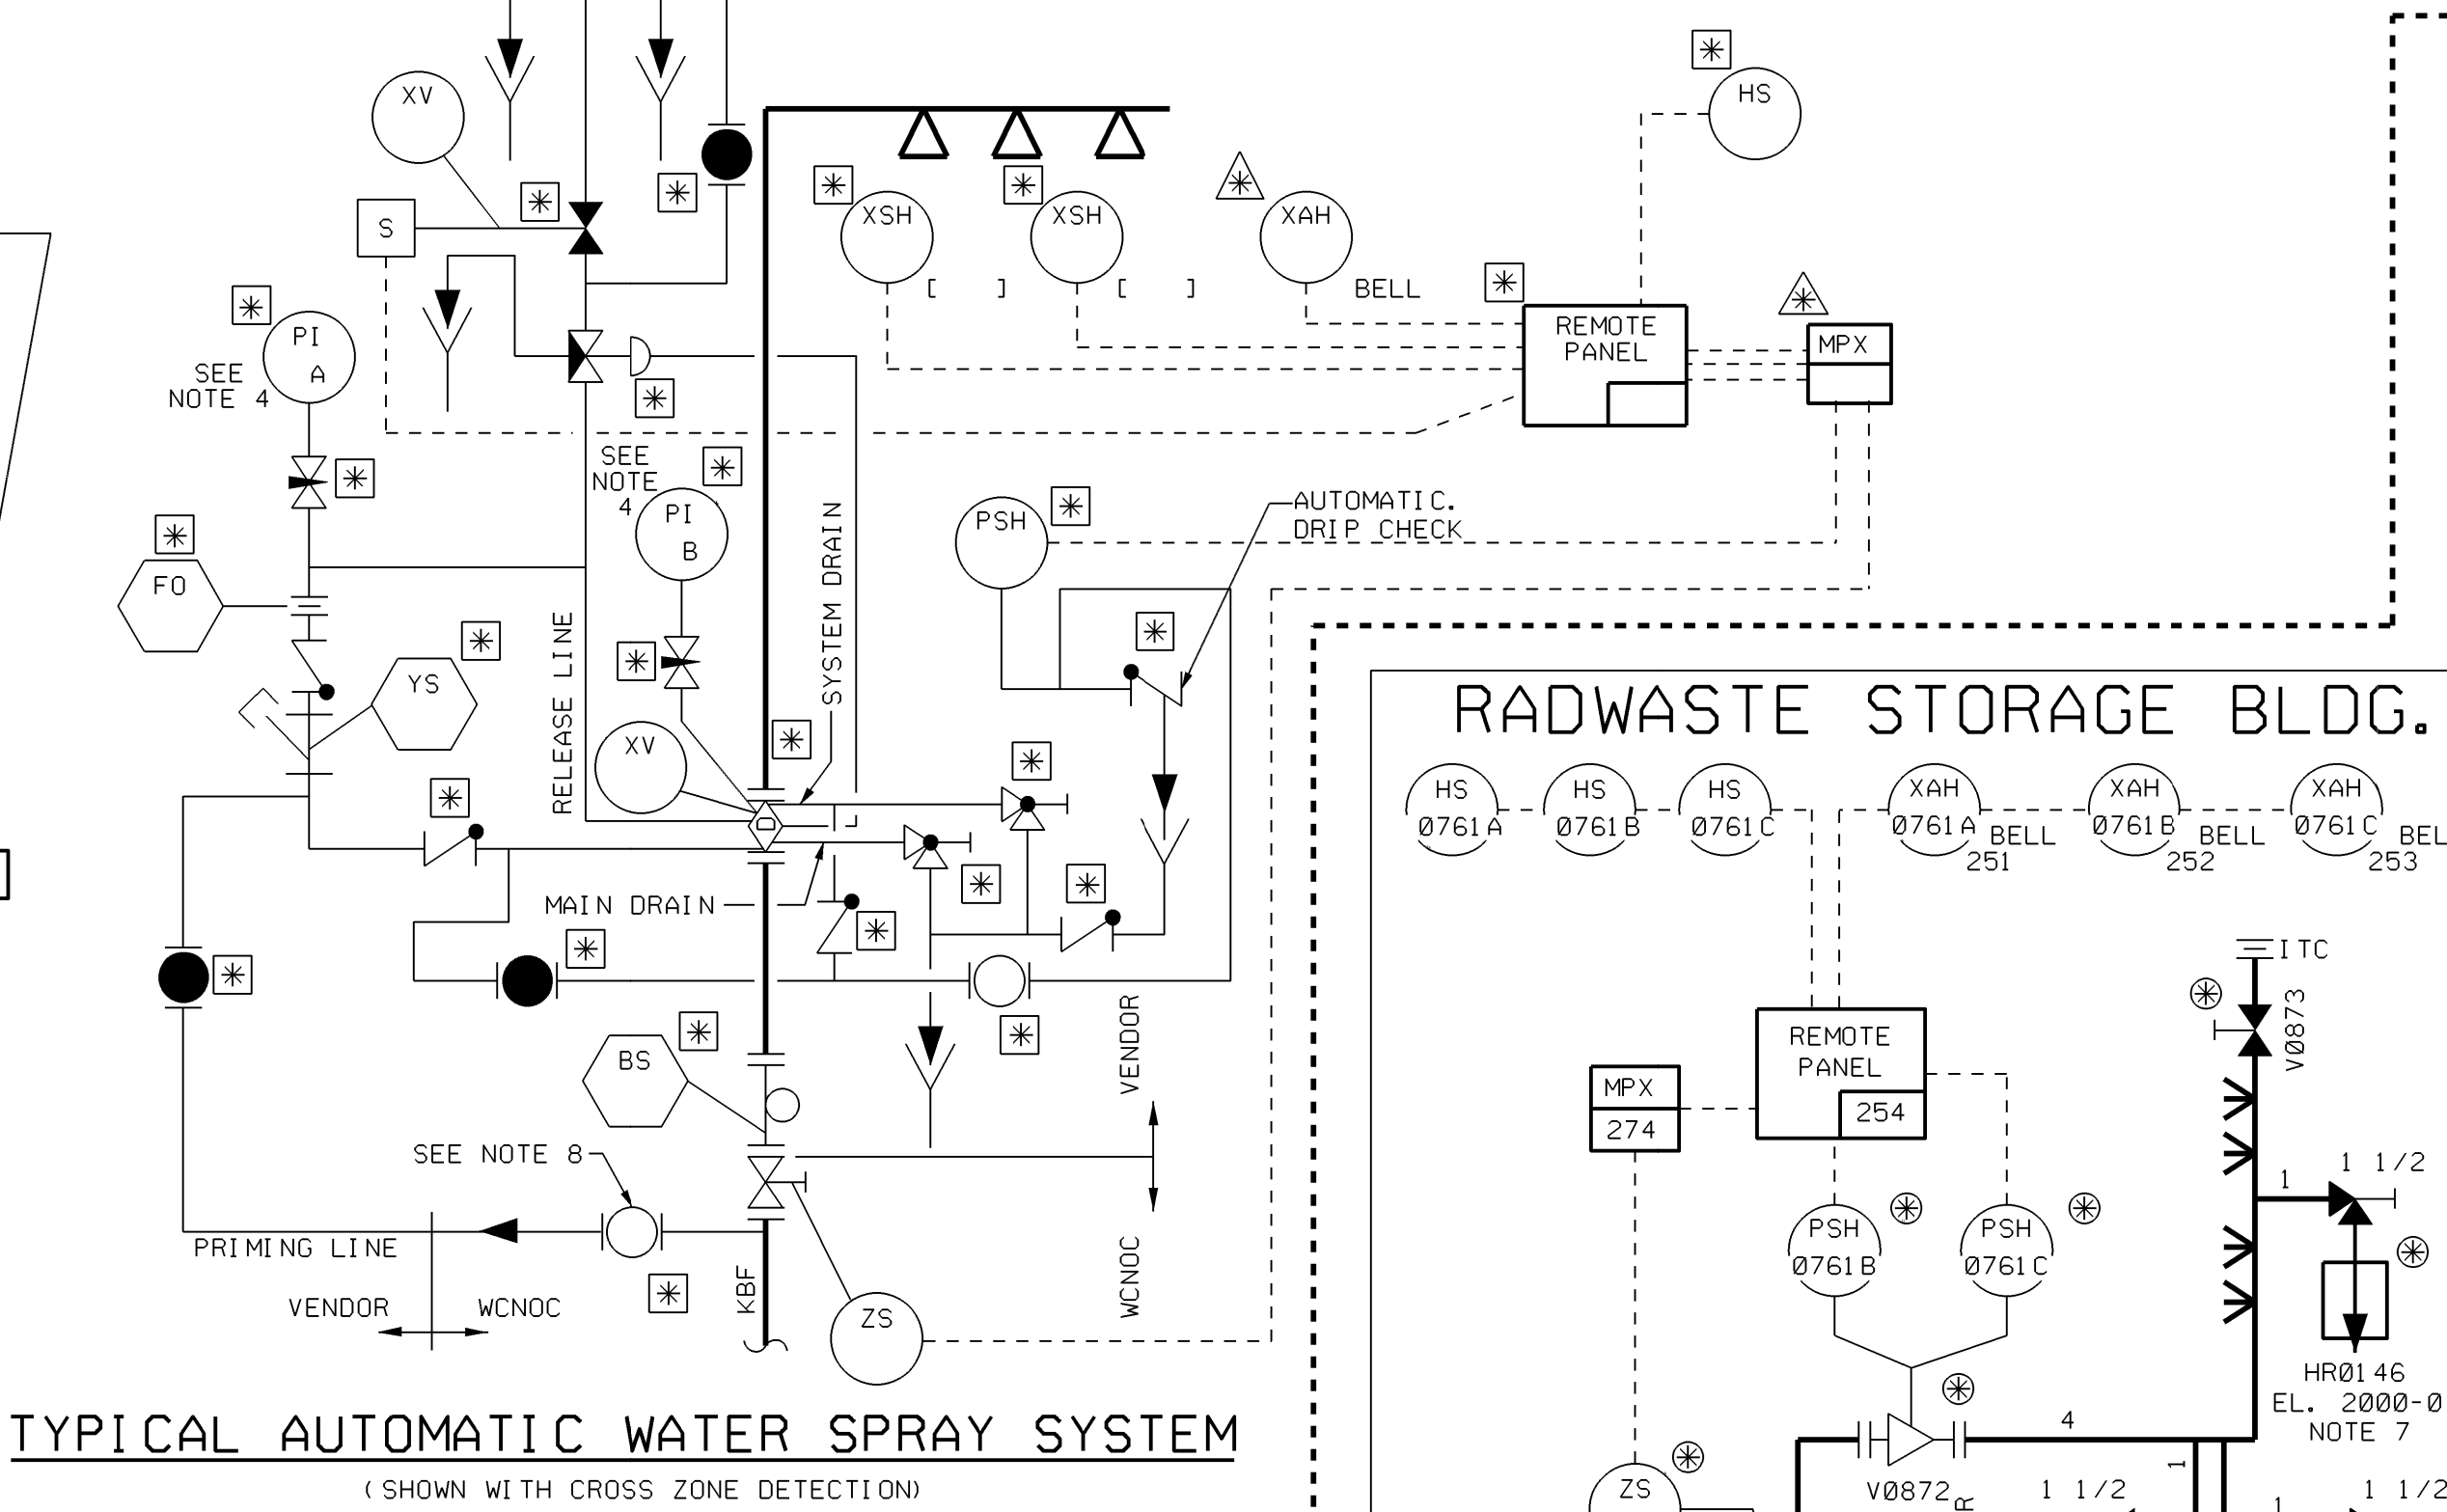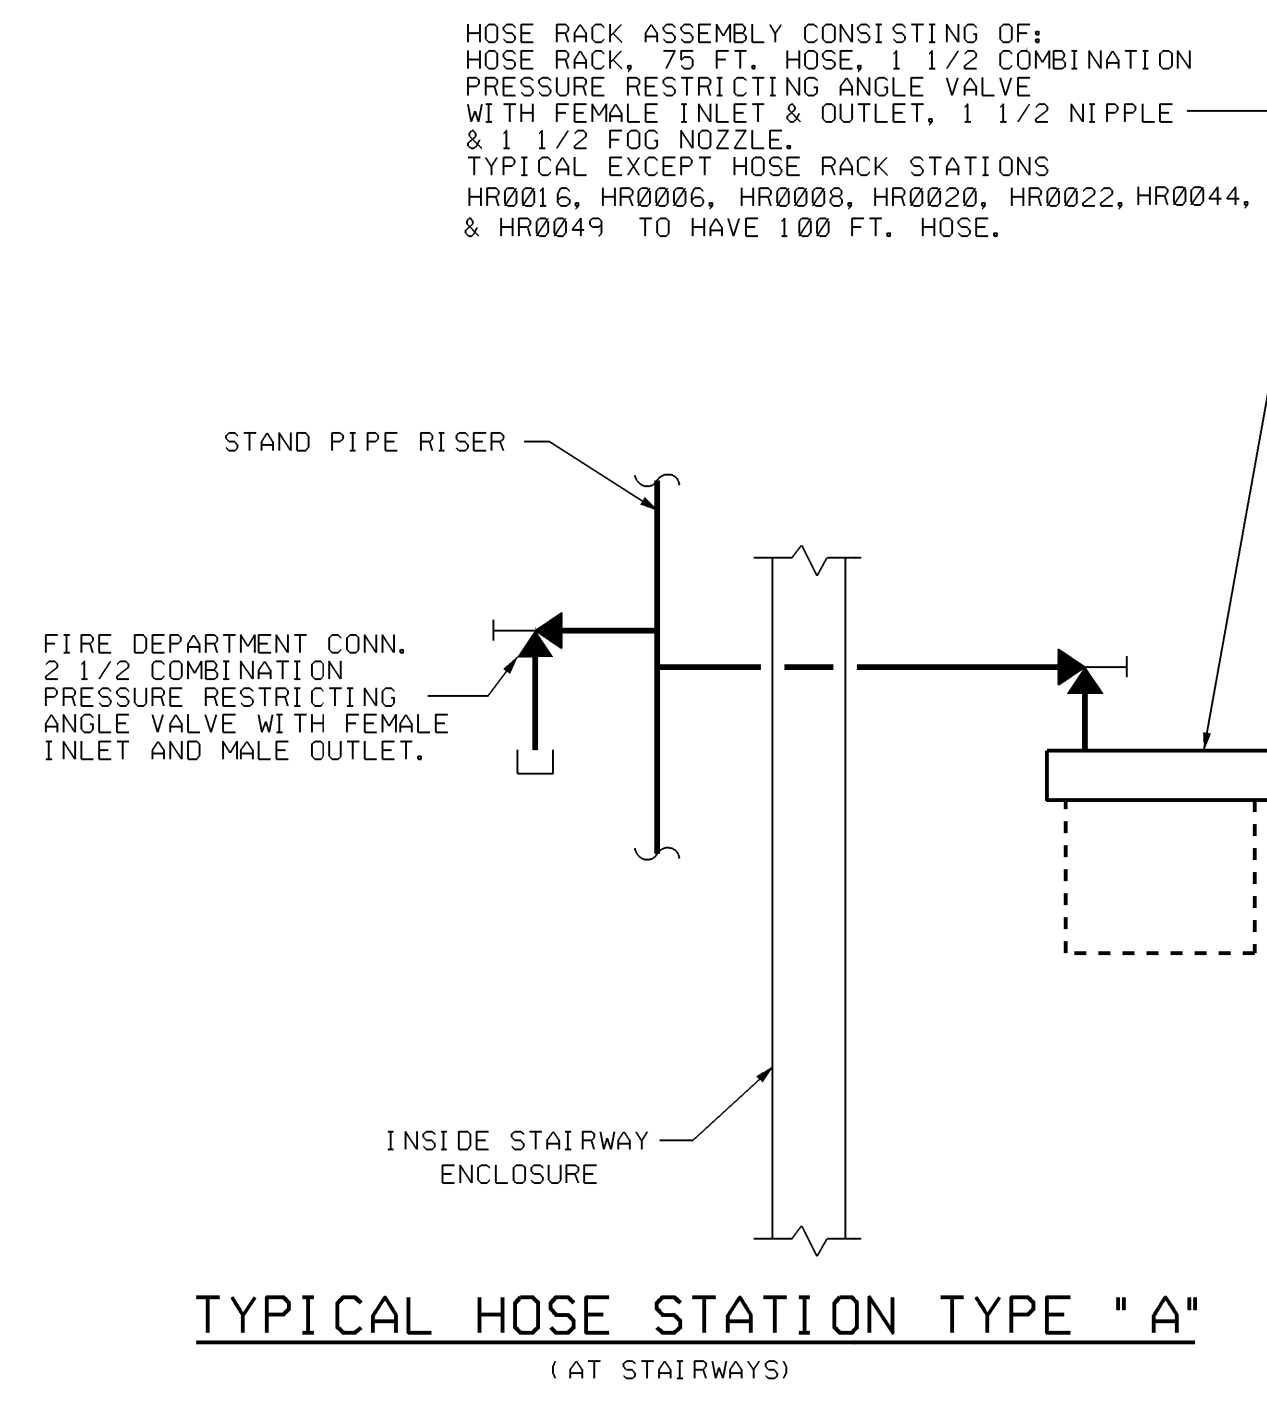

NON - RADIOACTIVE PIPE TUNNEL
ELECTRICAL CHASE, & PERSONNEL ACCESS

RADIOACTIVE PIPE TUNNEL

NOTES


- FOR GENERAL NOTES SEE DRAWING M-12K001.
- ITC INSPECTORS TEST CONNECTION CONSISTS OF A SHUT OFF VALVE AND A SMOOTH BORE BRASS BUSHING. THE BUSHING SHOULD BE A STANDARD DRIFCE SIZE SPRINKLER HEAD WITH FRAME AND FUSIBLE LINK REMOVED.
- THE AIR PRESSURE REGULATING VALVE (PRESSURE CONTROL VALVE) ASSOCIATED WITH EACH PRE - ACTION SPRINKLER SYSTEM SHALL BE IDENTIFIED BY THE NUMBER OF THE RESPECTIVE PRE - ACTION SPRINKLER SYSTEM DELUGE VALVE WITH THE PREFIX 'PCV'. THIS IDENTIFICATION IS NOT CARRIED ON THE P & ID.
- PRESSURE INDICATORS ASSOCIATED WITH THE SPRINKLER AND SPRAY SYSTEMS SHALL BE IDENTIFIED BY THE THREE DIGIT NUMBER OF THE RESPECTIVE ALARM FLOW PRESSURE SWITCH WITH THE PREFIX 'PI' AND THE SUFFIX 'A', 'B', OR 'C'. FOR WET-PIPE SYSTEMS, THE SUFFIX 'A' SHALL APPLY TO THE SUPPLY SIDE PRESSURE GAUGE AND THE SUFFIX 'B' SHALL APPLY TO THE SYSTEM SIDE PRESSURE GAUGE. FOR PRE-ACTION AND WATER SPRAY SYSTEMS, THE SUFFIX 'A' SHALL APPLY TO THE SYSTEM SIDE PRESSURE GAUGE AND THE SUFFIX 'B' SHALL APPLY TO THE SUPPLY SIDE PRESSURE GAUGE. THE SUFFIX 'C' SHALL APPLY TO THE AIR PRESSURE GAUGE USED IN THE PRE-ACTION SYSTEMS. THIS IDENTIFICATION IS NOT CARRIED ON THE P&ID EXCEPT IN THE "TYPICAL" DIAGRAMS.
- PREACTION SYSTEM RELIEF VALVES SHALL BE IDENTIFIED BY THE THREE DIGIT NUMBER OF THE ASSOCIATED DELUGE VALVE WITH THE PREFIX 'RV'. THIS IDENTIFICATION IS NOT CARRIED ON THE P & ID.
- COMPONENTS AND ITEMS IDENTIFIED WITH * ARE SUPPLIED AS PART OF THE VENDOR PACKAGE (REF. 2007A-M-SERIES DOCUMENTS).
- THESE HOSE RACK ASSEMBLIES CONSIST OF THE HOSE RACK, 75 FEET HOSE, 1 1/2" COMBINATION PRESSURE RESTRICTING ANGLE VALVE WITH FEMALE INLET AND OUTLET, 1 1/2" NIPPLE AND 1 1/2" FOG NOZZLE (TYPICAL OF HOSE STATIONS TYPE 'A' OR TYPE 'B' EXCEPT 2 1/2" FIRE DEPARTMENT CONNECTION).
- EXTRA PRIMING LINE ISOLATION VALVE INSTALLED ON THE FOLLOWING SUB-SYSTEMS: SKC11-16, 19, 20 & 25.
- THIS IS THE TYPICAL RELIEF VALVE INSTALLATION FOR VIKING MODEL F-1. ALTERNATE LOCATION FOR VIKING MODEL H-2 AND J-1 ARE IN THE EXTERNAL BYPASS LINE AS DESCRIBED IN THE RESPECTIVE VENDOR DRAWINGS 2007A-M-0009 AND M-950-00186.
- MALLEABLE IRON FITTINGS RATED FOR A MINIMUM WORKING PRESSURE OF 150 PSI MAY BE ATTACHED TO THE DISCHARGE OUTLETS OF ALL INSPECTOR TEST CONNECTIONS AND WET PIPE SYSTEM RELIEF VALVES PROVIDED IN THE "FP" AND "KC" SYSTEMS NECESSARY.

USAR FIG. 9.5.1-1-03


ESSENTIAL DRAWING

REVISED	INCORPORATED	CHANGE	013049
ISSUED	CHG. DOC.	CHG. NO.	PKG. NO.
THIS Dwg. SUPERSEDES		REV.	
REVISION NOTES		REV.	
		ELECTRONIC APPROVAL	
		PIPING & INSTRUMENTATION DIAGRAM FIRE PROTECTION SYSTEM	
SCALE	DRAWING NUMBER	SHEET	REV.
NONE	M-12K003	10	



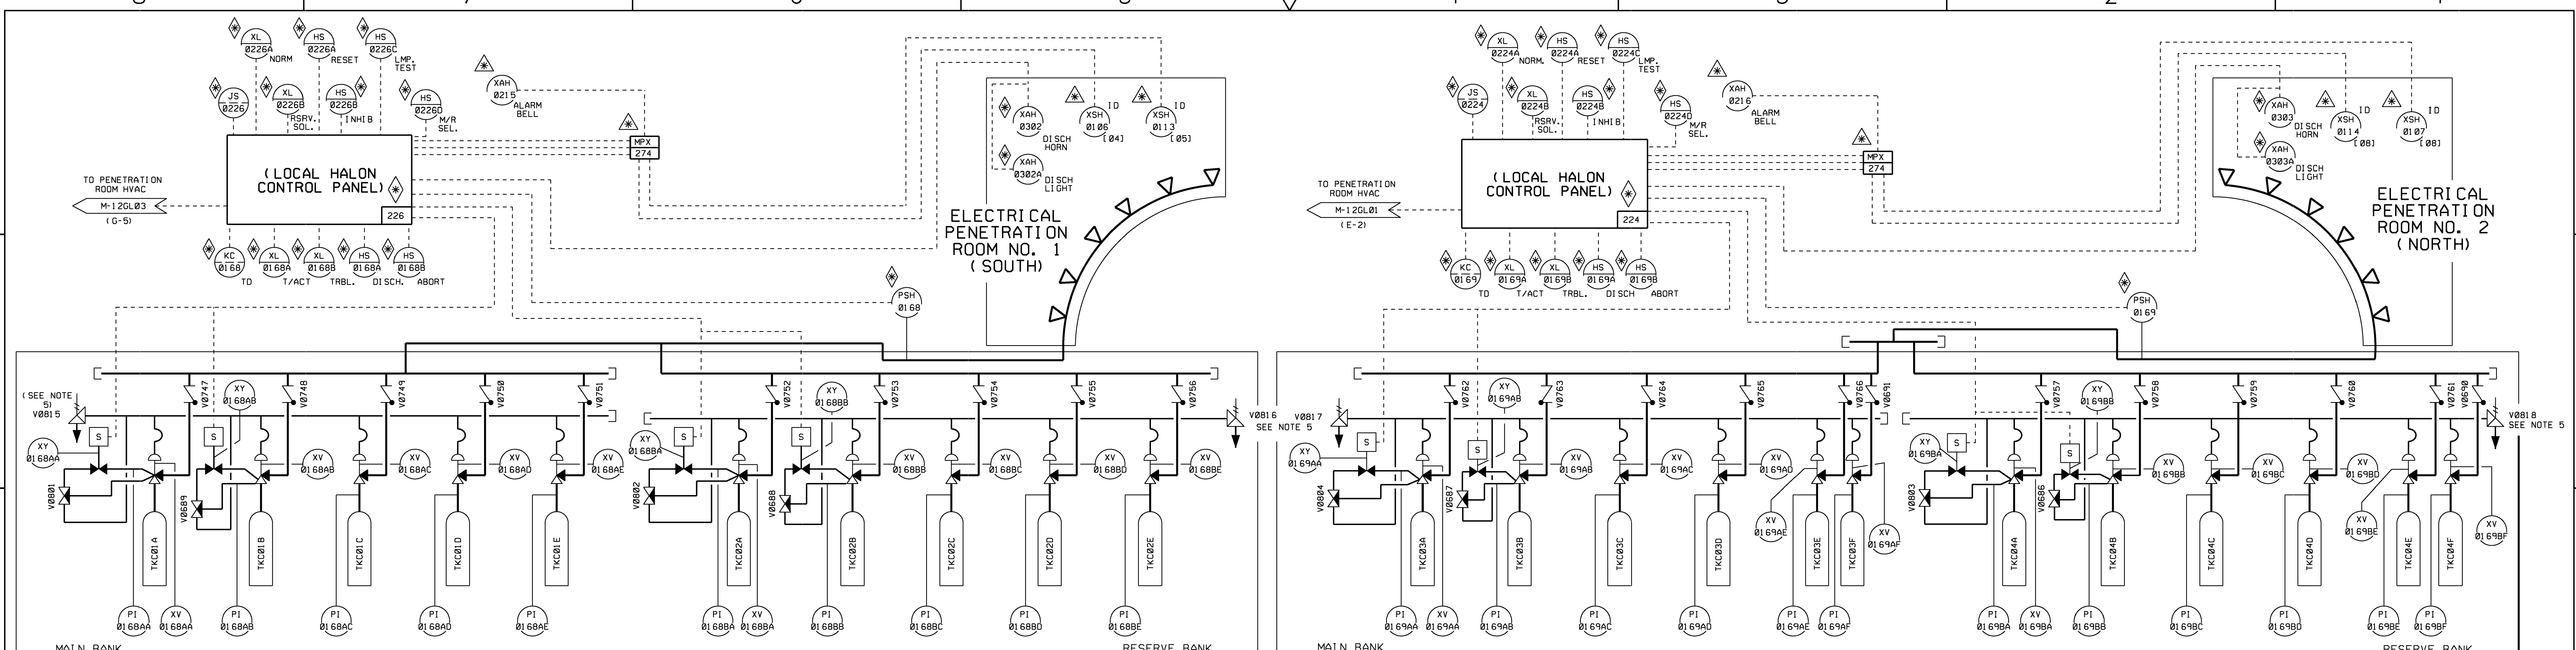

MAIN AND RESERVE HALON CYLINDER BANKS

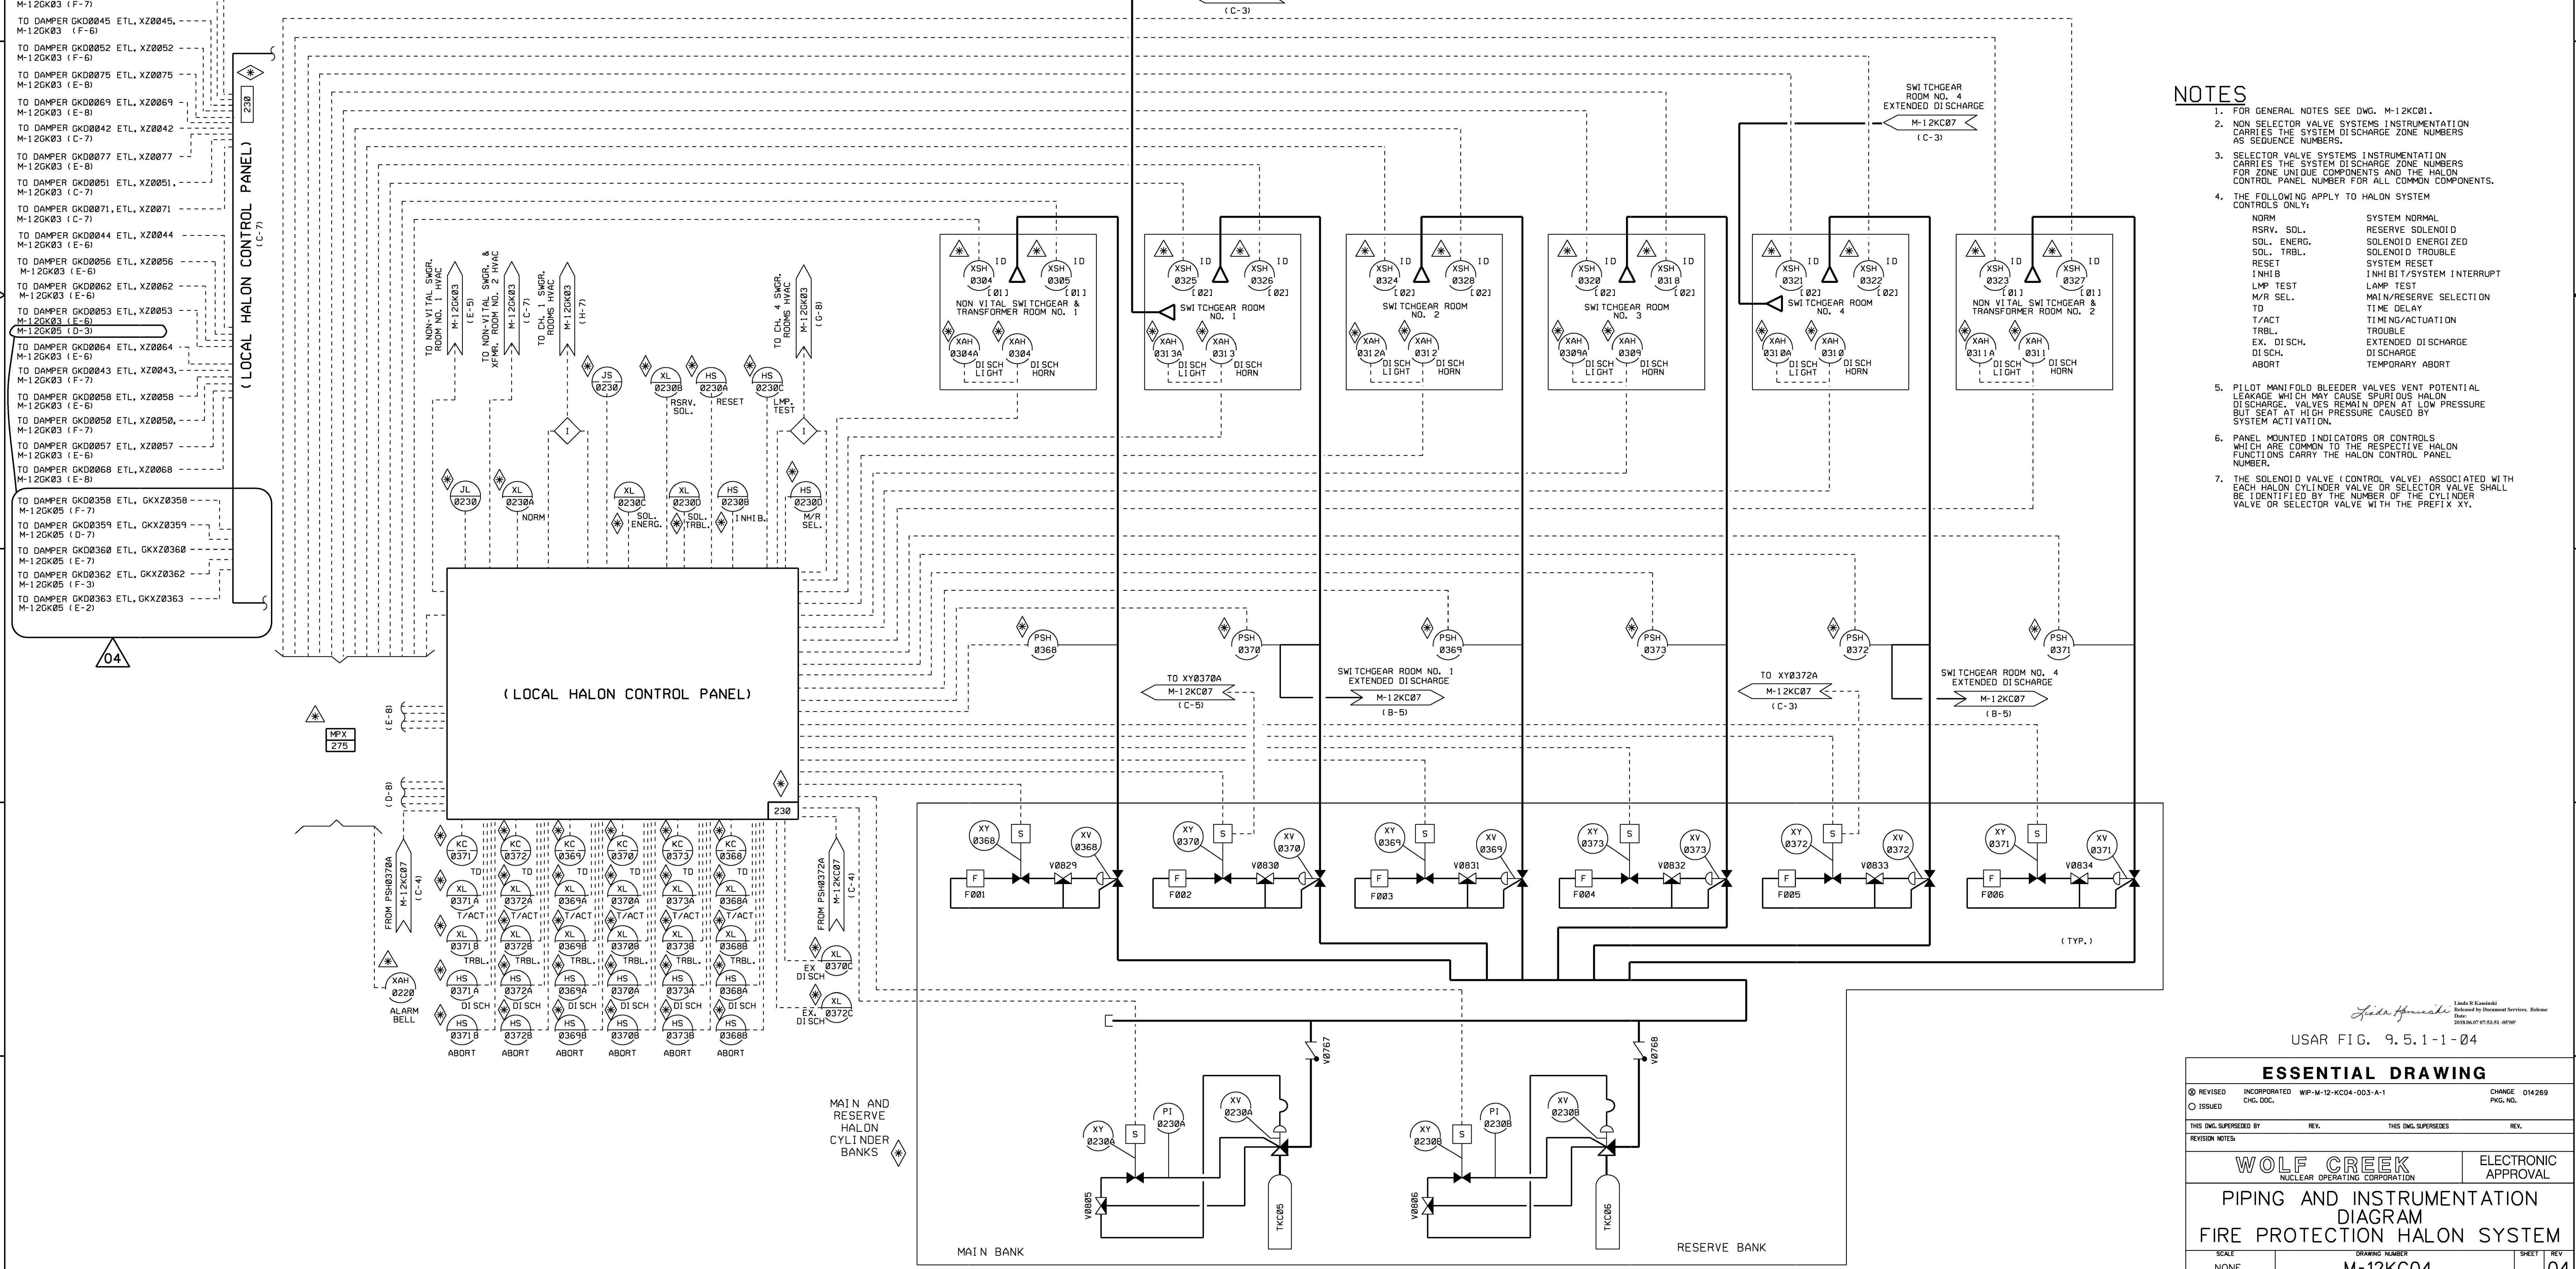

- NOTES**
- FOR GENERAL NOTES SEE DWG. M-12KC01.
 - NON SELECTOR VALVE SYSTEMS INSTRUMENTATION CARRIES THE SYSTEM DISCHARGE ZONE NUMBERS AS SEQUENCE NUMBERS.
 - SELECTOR VALVE SYSTEMS INSTRUMENTATION CARRIES THE SYSTEM DISCHARGE ZONE NUMBERS FOR ZONE UNIQUE COMPONENTS AND THE HALON CONTROL PANEL NUMBER FOR ALL COMMON COMPONENTS.
 - THE FOLLOWING APPLY TO HALON SYSTEM CONTROLS ONLY:

NORM	SYSTEM NORMAL
RSRV. SOL.	RESERVE SOLENOID
SOL. ENRG.	SOLENOID ENERGIZED
SOL. TRBL.	SOLENOID TROUBLE
RESET	SYSTEM RESET
INHIB	INHIBIT/SYSTEM INTERRUPT
LMP TEST	LAMP TEST
M/R SEL.	MAIN/RESERVE SELECTION
TO	TIME DELAY
T/ACT	TIME/ACTUATION
TRBL.	TROUBLE
EX. DI SCH.	EXTENDED DISCHARGE
DI SCH.	DISCHARGE
ABORT	TEMPORARY ABORT
 - PILOT MAIN FOLD BLEEDER VALVES VENT POTENTIAL LEAKAGE WHICH MAY CAUSE SPIRIOUS HALON DISCHARGE. VALVES REMAIN OPEN AT LOW PRESSURE BUT SEAT AT HIGH PRESSURE CAUSED BY SYSTEM ACTIVATION.
 - PANEL MOUNTED INDICATORS OR CONTROLS WHICH ARE COMMON TO THE RESPECTIVE HALON FUNCTIONS CARRY THE HALON CONTROL PANEL NUMBER.
 - THE SOLENOID VALVE (CONTROL VALVE) ASSOCIATED WITH EACH HALON CYLINDER VALVE OR SELECTOR VALVE SHALL BE IDENTIFIED BY THE NUMBER OF THE CYLINDER VALVE OR SELECTOR VALVE WITH THE PREFIX XY.

ESSENTIAL DRAWING

USAR FIG. 9.5.1-1-04

WOLF CREEK NUCLEAR OPERATING CORPORATION

PIPING AND INSTRUMENTATION DIAGRAM
FIRE PROTECTION HALON SYSTEM


SCALE: NONE

REV: M-12KC04

SHEET: 04

DATE: 08/05/87

NOTES
 1. FOR HALON SYSTEM GENERAL NOTES SEE DWG. M-12KC04.
 FOR FIRE PROTECTION SYSTEM GENERAL NOTES SEE
 DWG. M-12KC01.

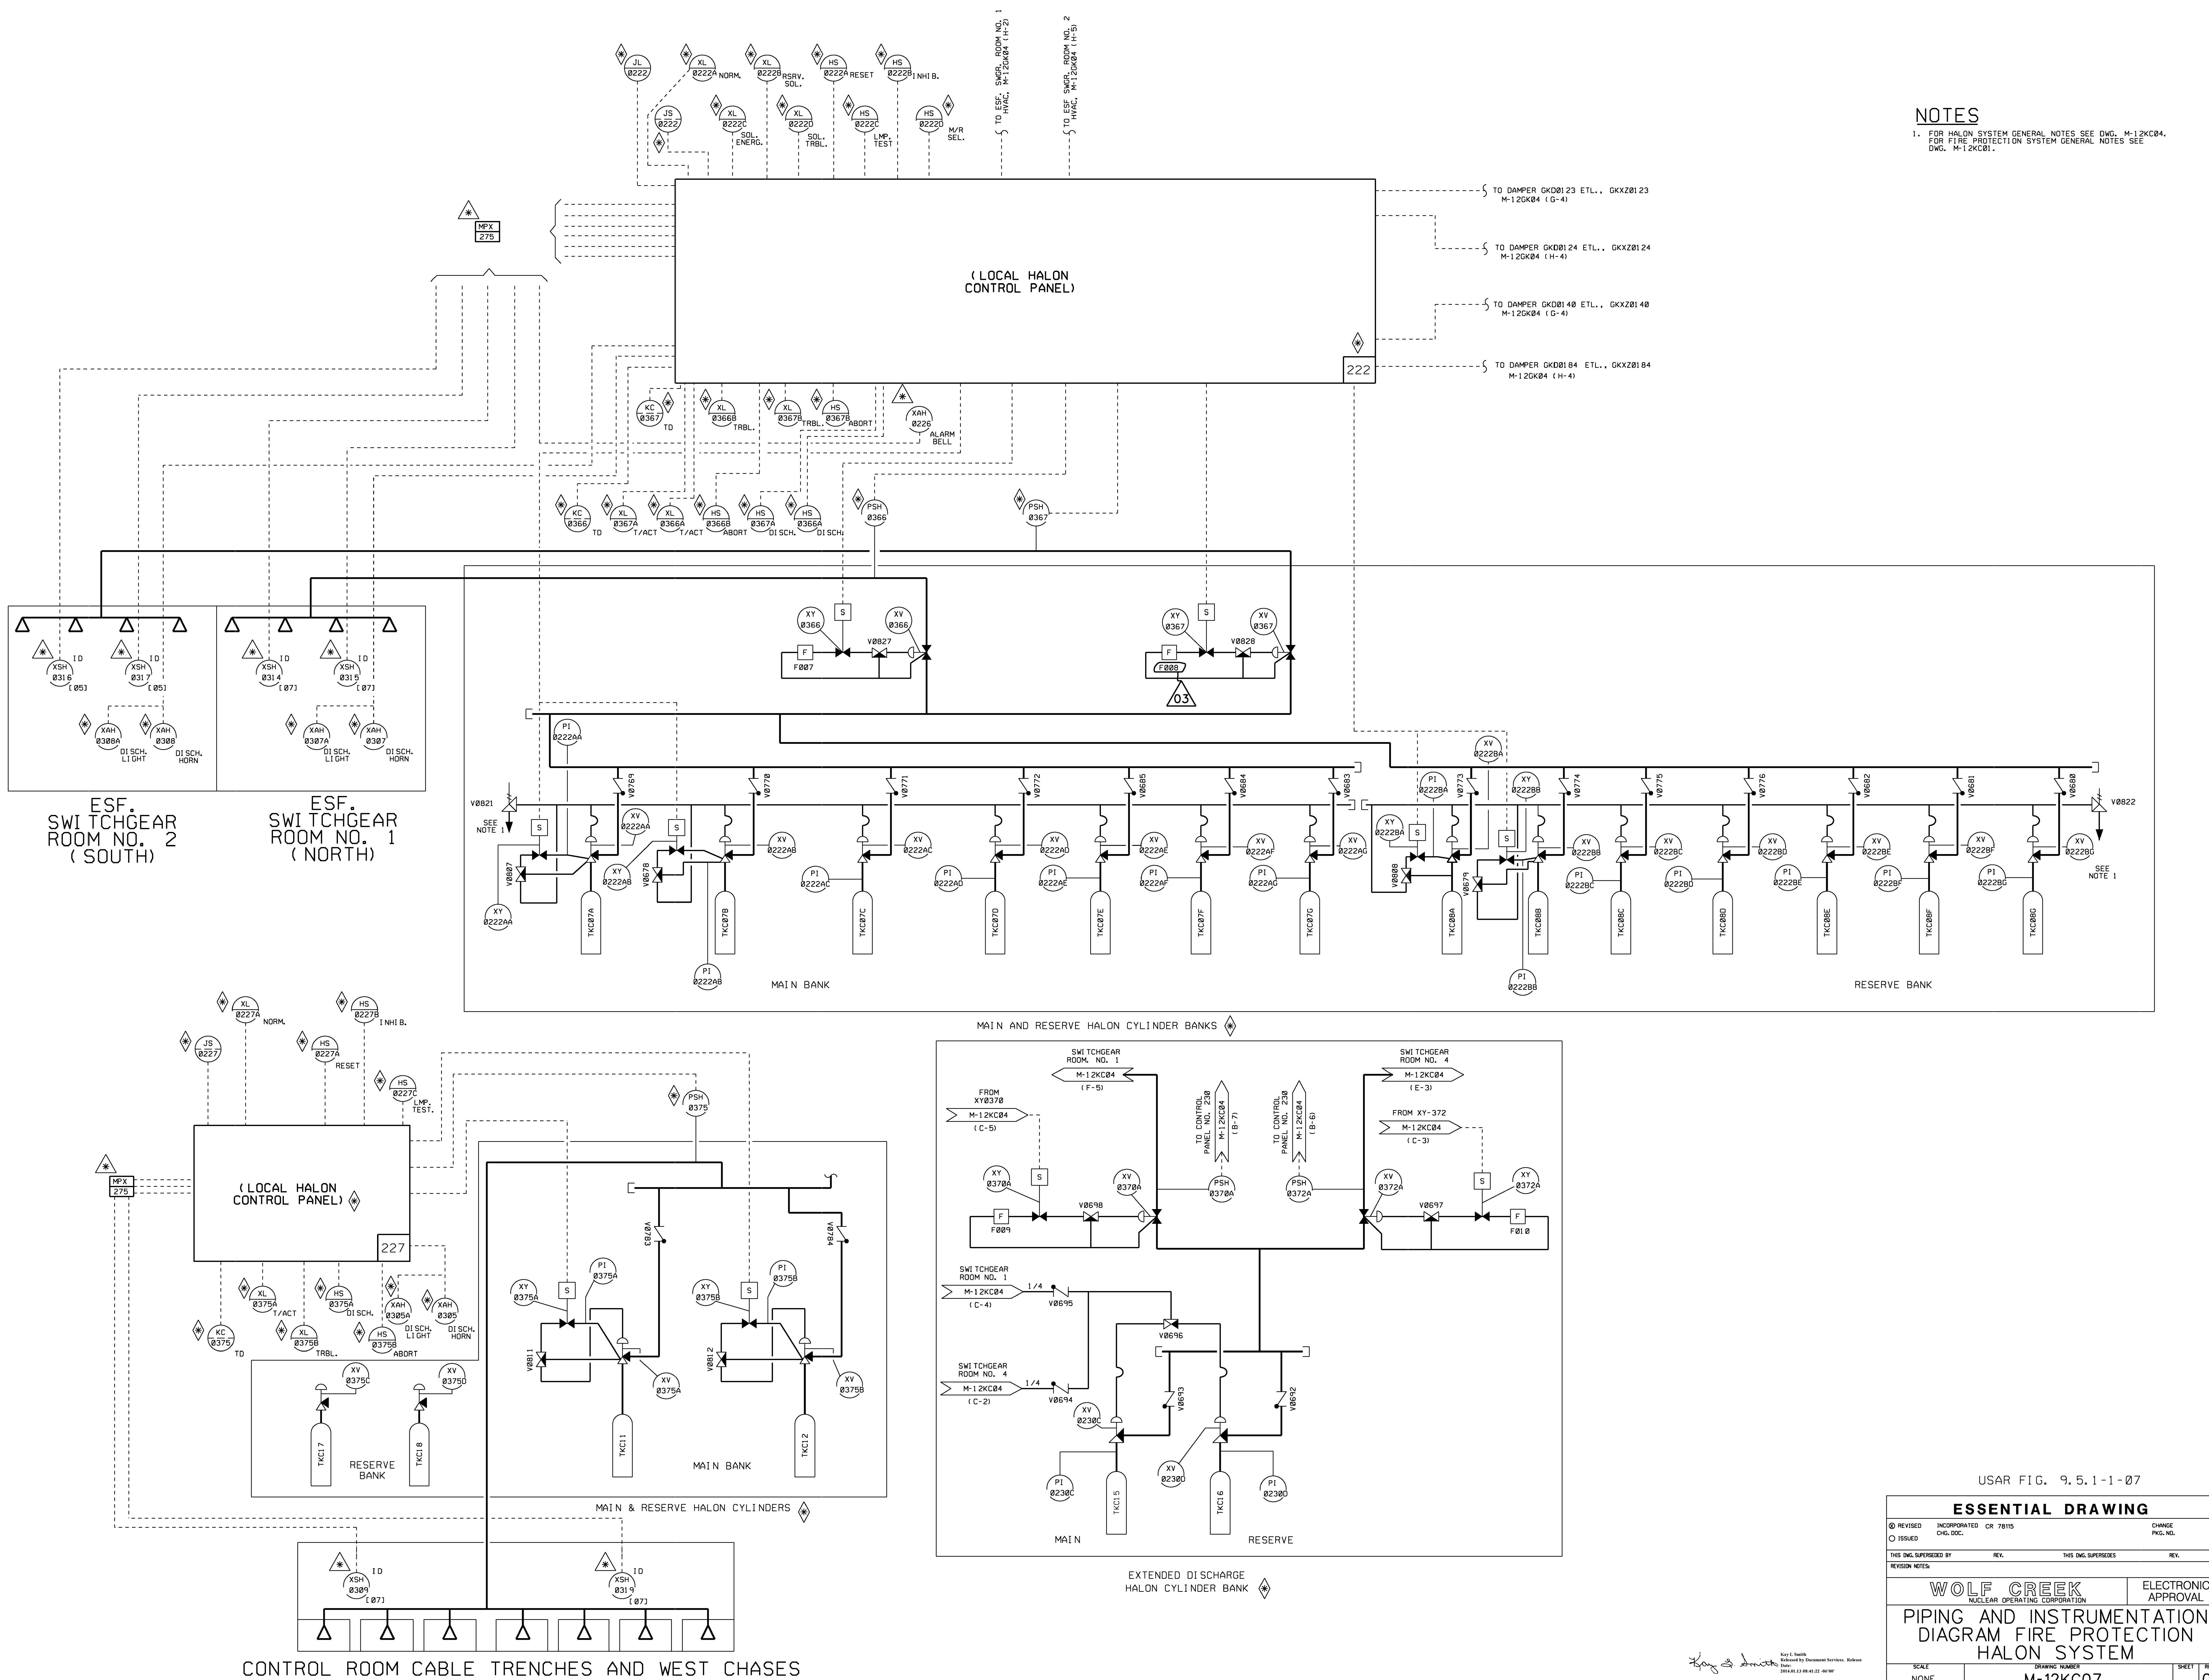


USAR FIG. 9.5.1-1-07

ESSENTIAL DRAWING			
REVISION	INCORPORATED	CR 78115	CHANGE
ISSUED	CHG. DOC.		PAGE NO.
THIS DWG. SUPERSEDED BY		REV.	THIS DWG. SUPERSEDES
REVISION NOTES			
WOLF CREEK		ELECTRONIC APPROVAL	
NUCLEAR OPERATING CORPORATION			
PIPING AND INSTRUMENTATION			
DIAGRAM FIRE PROTECTION			
HALON SYSTEM			
SCALE	DRAWING NUMBER	SHEET	REV.
NONE	M-12KC07	03	

Ray S. Smith
 Ray S. Smith
 Registered Professional Engineer, Nuclear
 State of Texas, License No. 11884-02-0078



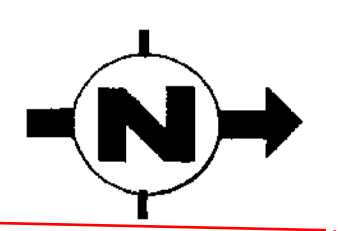

NOTES:

- 1) NUMBER SYSTEM (C-5, ETC., TYP.) RELATES TO SEPERATE FIRE HAZARDS ANALYSIS REPORT ZONE DATA SHEETS.
- 2) SEE SPEC. A-0126, SPEC. A-018 AND ARCHL. FINISH SCHEDULE FOR ADDITIONAL FIRE REQUIREMENTS.
- 3) EXTINGUISHING SYSTEMS (a, b, c or d) DO NOT NECESSARILY COVER ENTIRE AREA WHERE INDICATED-MAY ONLY PROTECT CABLE TRAY CONCERTRATIONS, SINGLE EQUIPMENT ITEMS, ETC.
- 4) WHERE LARGE CONDUIT IS WITHIN THE MINIMUM THICKNESS REQUIRED ON A FIREPROOFED MEMBER, THE FIREPROOFING SHALL BE INSTALLED BEHIND THE CONDUIT AND ON EACH SIDE, UP TO THE MINIMUM REQUIRED FOR THE MEMBER PROTECTED.
- 5) WHERE SMALL PIPE OR CONDUIT (OTHER THAN STAINLESS) IS WITHIN THE MINIMUM THICKNESS REQUIRED, THE FIREPROOFING SHALL BE BRIDGED OVER THE PIPE/CONDUIT TO MAINTAIN THE REQUIRED THICKNESS.
- 6) INTERIORS OF TUBE STEEL, JUNCTION BOXES, LIGHT PANELS AND OTHER COVERED ATTACHMENTS SHALL NOT BE COVERED.
- 7) TEMPORARY SERVICE LINES SHALL BE REMOVED FROM THE WORK SURFACE PRIOR TO FIREPROOFING.
- 8) ALL STRUCTURAL STEEL LARGER THAN 6" MEMBERS AND SHOWN ON THE CIVIL STRUCTURAL DRAWINGS SHALL, IN AREAS DESIGNATED ON THE FIRE DELINEATION DRAWINGS, BE FIREPROOFED TO THE CLASSIFICATION THICKNESS NOTED.
- 9) WHERE NOTED, ALL STRUCTURAL STEEL LARGER THAN 6" SHALL BE CONTOUR-COVERED WITH DURASPRAY FIREPROOFING TO THE FOLLOWING MINIMUM THICKNESS:
 2 HOUR BEAMS 1"
 2 HOUR COLUMNS 1 1/2"
 3 HOUR BEAMS 1 1/2" (BOTTOM FLANGE MESHED)
 3 HOUR COLUMNS 1 1/2"
 OR CONTOUR-COVERED WITH MONOKOTE Z-146 FIREPROOFING TO THE FOLLOWING MINIMUM THICKNESS:
 2 HOUR BEAMS *1 1/2"
 2 HOUR COLUMNS *1 1/2"
 3 HOUR BEAMS *2 1/4" (BOTTOM FLANGE MESHED)
 3 HOUR COLUMNS 2 1/4"
 COLUMNS IN FINISHED AREAS SHOWN AS BOXED CONSTRUCTIONS SHALL BE WRAPPED WITH 3/8" WIRE MESH AND COVERED TO THICKNESS NOTED ABOVE. COLUMNS SHALL HAVE A TROWEL SMOOTH FINISH TO THE HEIGHTS NOTED IN PARAGRAPH 10.4 OF SPEC. 10466-A-126.
 * W8X10 COLUMNS REQUIRES 1 1/2" FOR 2 HOUR BARRIER AND 3 3/4" FOR 3 HOUR BARRIER.
- 10) MANUFACTURER'S CERTIFICATION THAT THE MATERIAL FURNISHED IS THE SAME AS THAT RATED IN U.L. DESIGNS N-711, N-712, X-708, AND X-730, OR DESIGNS N-782 AND X-795, WILL MEET THE INTENT OF PARAGRAPH 4.1 OF SPEC. 10466-A-126.
- 11) STRUCTURAL STEEL SHOWN ON DRAWINGS LISTED BELOW ARE NOT PART OF THE STRUCTURAL BUILDING FRAME, AND SHALL NOT BE FIREPROOFED. THE DRAWINGS ARE:
 C-151212
 C-151222
 C-151242
 C-151312
- 12) FOR FIRE RATED CLOSURE DETAILS SEE MECHANICAL DRAWINGS.
- 13) CMU WALLS 3 HOUR FIRE RATED SHALL HAVE ALL CELLS FULLY GROUTED.
- 14) FIRE EXTINGUISHERS SHALL BE LOCATED IN COMPLIANCE WITH THE GENERAL LOCATIONS SHOWN ON THE DRAWINGS. THE MOUNTING LOCATION IS SUBJECT TO FIELD CONDITIONS AND THEREFORE MAY DEVIATE FROM THE INTENDED LOCATION BUT MUST COMPLY WITH THE REQUIREMENTS OF NFPA 10 (1975) SECTION 1-4. PRIOR APPROVAL MUST BE OBTAINED FOR DEVIATIONS FROM THE DESIGN LOCATION WHERE THE PLACEMENT REQUIREMENTS OF NFPA 10 (1975) CHAPTER 3 ARE IMPACTED. FIRE EXTINGUISHERS MUST NOT BE MOUNTED TO CATEGORY 1 CMU WALLS AS DENOTED BY AN (C) ON THE ARCHITECTURAL DRAWINGS OR CONTAINMENT LINER PLATES, WITHOUT PRIOR ENGINEERING APPROVAL. AN ALTERNATE METHOD FOR SUPPORT AT SUCH LOCATIONS IS TO SUPPORT THE EXTINGUISHERS FROM THE FLOOR. THESE SUPPORTS SHALL BE SUPPLIED BY OTHERS. IN THE REACTOR BUILDING UPWARD OPEN TUBE STEEL CAN BE CAPPED AS NECESSARY FOR SAFETY, CLEANLINESS, AND/OR PLANT NEEDS. THE CAP SHALL BE STAINLESS STEEL AND CAN BE HELD ON BY SETSCREWS. SEE DRAWING C-1063 & C-1064 FOR CAP DETAIL.
- 15) THE ROOFS OF THE POWER BLOCK ARE NOT FIRE BARRIERS.
- 16) BEAM POCKETS WHICH PENETRATE THROUGH CONCRETE WALLS AND HORIZONTAL GAPS BETWEEN STRUCTURAL STEEL BEAMS AND CONCRETE WALLS MAY BE CLOSED USING SPRAY FIREPROOFING AS A SEAL.
- 17) WATER MIST FIRE EXTINGUISHERS ARE NOT TO BE INSTALLED IN CONTAINMENT.
- 18) WATER SUPPLY FOR ESW VERTICAL LOOP CHASE FIRE PROTECTION IS SUPPLIED BY OUTSIDE FIRE PUMP TRUCK OR FIRE HYDRANT.
- 19) HILTl FIRE FINISH CFP-SP WB IS AN ACCEPTABLE ALTERNATIVE FOR FIRE PROOFING OF NEW STRUCTURAL STEEL. SEE SPEC. A-126A AND VENDOR MANUAL A-126A-00001 FOR ADDITIONAL INFORMATION.

15

Digitally signed by Aaron B. Holloway
 Date: 2017.07.20 15:27:05 -05'00'

USAR FIG.-9.5.1-2-01

ESSENTIAL DRAWING


REVISION	INCORPORATED	CHANGE	015274
ISSUED	CNG. DEC.	CNG. NO.	
THIS ENG. SUPERSEDES		REV.	
REVISION NOTES			
WOLF CREEK NUCLEAR OPERATING CORPORATION		ELECTRONIC APPROVAL	
ARCHITECTURAL FIRE DELINEATION FLOOR PLAN, EL. 1974'-0"			
SCALE	DRAWING NUMBER	SHEET	REV
1/16" = 1'-0"	10466-A-1801	15	15

LEGEND

---	EXIT ROUTE (ARROW POINTS TOWARDS EXIT)
HS	HOSE STATION
(E)	EXIT FIXTURE
-----	FOUR HOUR FIRE RESISTIVE RATING (INCLUDES ALL EXPOSED STR. STL. & PENETRATIONS)
-----	THREE HOUR FIRE RESISTIVE RATING (INCLUDES ALL EXPOSED STR. STL. & PENETRATIONS)
-----	TWO HOUR FIRE RESISTIVE RATING (INCLUDES ALL EXPOSED STR. STL. & PENETRATIONS)
---	ZONE BOUNDARY
a	AUTOMATIC PRE-ACTION SYSTEM
b	AUTOMATIC WET SPRINKLER SYSTEM
c	WATER SPRAY SYSTEM
d	HALON 1301 SYSTEM
(W) (C) (C)	PORTABLE EXTINGUISHERS (NOTE 17) W - PRESSURIZED WATER OR WATER MIST; D - DRY CHEMICAL; C - CARBON DIOXIDE (CO ₂)



H
G
F
E
D
C
B
A

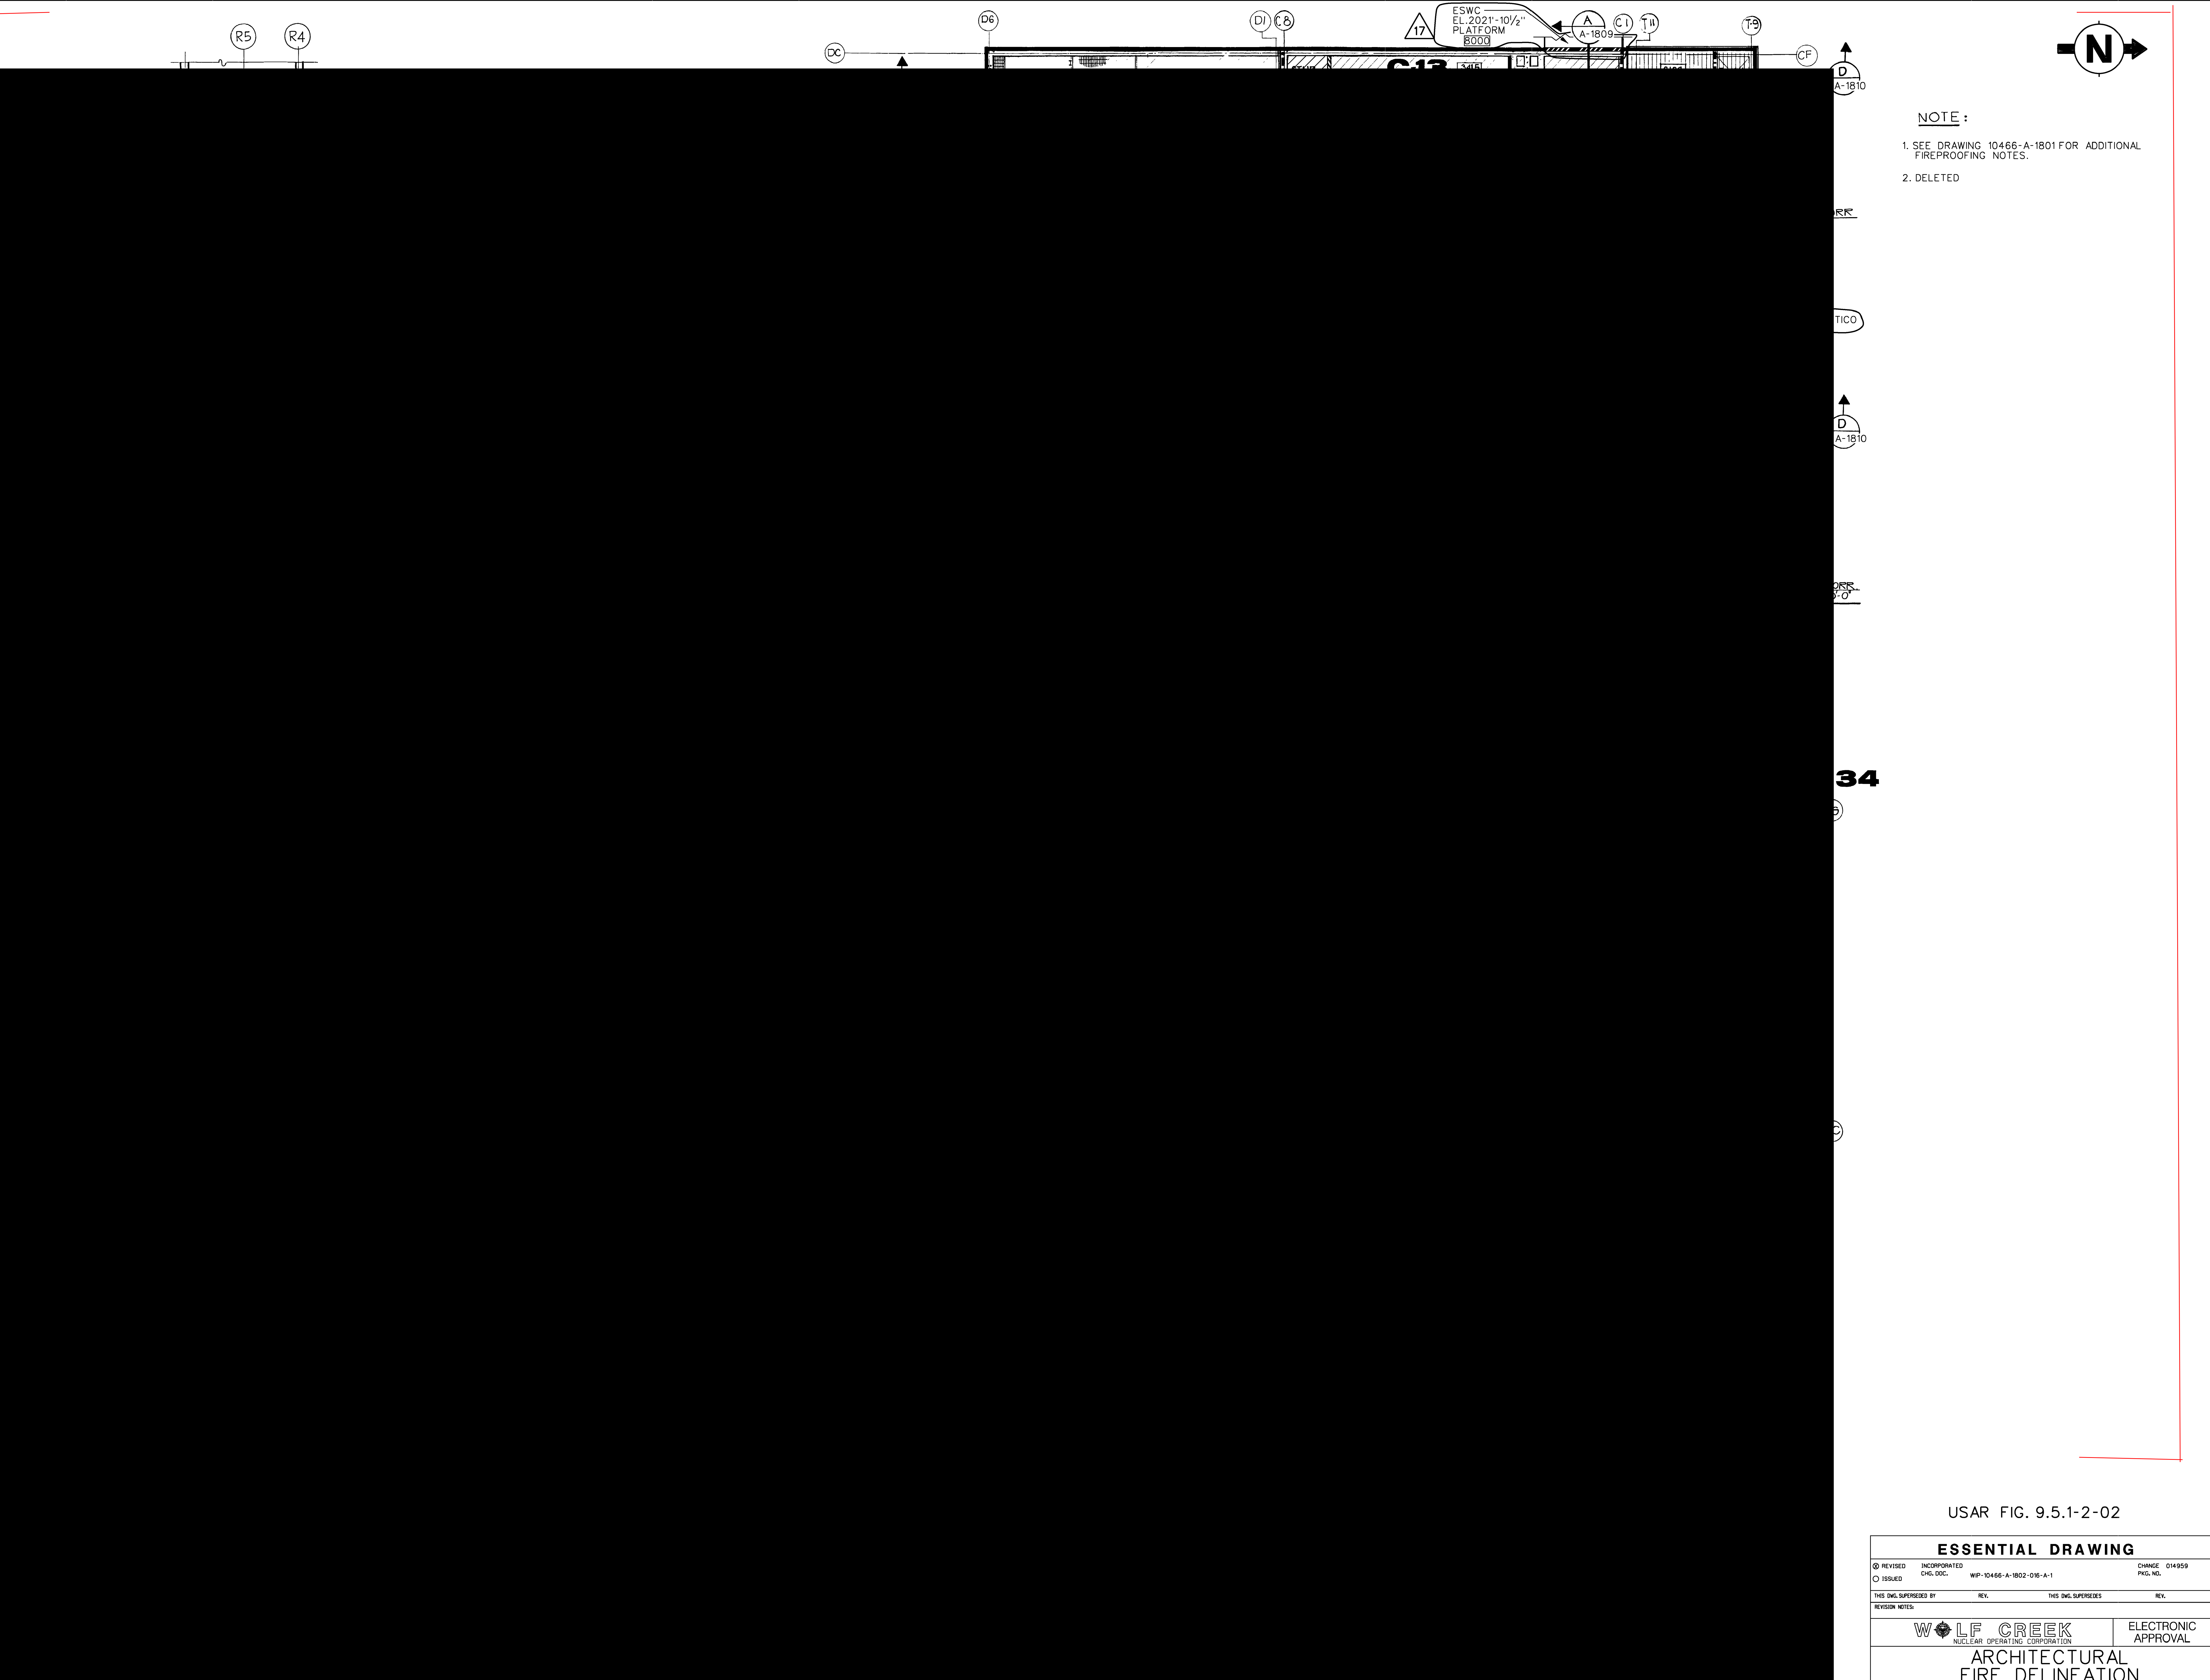

USAR FIG. 9.5.1-2-02


ESSENTIAL DRAWING			
⊗ REVISED	INCORPORATED	CHANGE	014959
○ ISSUED	CHG. DCC.	WP-10466-A-1802-016-A-1	FIG. NO.
THIS DNG. SUPERSEDES BY		REV.	THIS DNG. SUPERSEDES
REVISION NOTES:		REV.	REV.
		ELECTRONIC APPROVAL	
ARCHITECTURAL FIRE DELINEATION FLOOR PLAN EL.2000'-0"			
SCALE	DRAWING NUMBER	SHEET	REV
1/16" = 1'-0"	10466-A-1802	17	17

BEST COPY AVAILABLE.
MAY NOT REPRODUCE LEGIBLY.

Seal Swanson

34444 E. SIZE

8 7 6 5 4 3 2 1

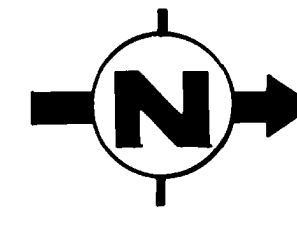

NOTE:
SEE DRAWING 10466-A-1801 FOR ADDITIONAL
REPROOFING NOTES.
DELETED

H
G
F
E
D
C
B

USAR FIG. 9.5.1-2-03

ESSENTIAL DRAWING			
<input type="checkbox"/> REVISED	INCORPORATED	WP-10466-A-1803-009-A-1	CHANGE 014959
<input type="checkbox"/> ISSUED	CHG. DCC.		FIG. NO.
THIS ENG. SUPERSEDES BY		REV.	THIS ENG. SUPERSEDES
REVISION NOTES:			
WOLF CREEK NUCLEAR OPERATING CORPORATION		ELECTRONIC APPROVAL	
FIRE DELINEATION FLOOR PLAN, EL. 2026'-0"			
SCALE	DRAWING NUMBER	SHEET	REV.
1/8" = 1'-0"	10466-A-1803	10	10

BEST COPY AVAILABLE.
MAY NOT REPRODUCE LEGIBLY.

Sam Semmes
Checked by Division Services
DATE: 08/03/09 09:43:02 AM

34444 E. SIZE

A


8 7 6 5 4 3 2 1

RG

RI

ESWC
EL. 2075'-2 1/2"

(C) (U)

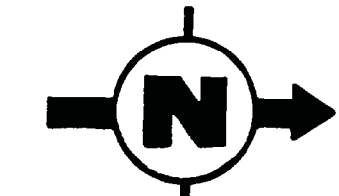

NOTE :

1. SEE DRAWING 10466-A-1801 FOR ADDITIONAL FIRE PROOFING NOTES.
2. DELETED
3. FIREPROOFING ON STRUCTURAL STEEL SHALL BE HAND TROWELLED SMOOTH FINISH FOR ROOMS 3T02 AND 3T03. SEE SPEC. A-126 AND DWG. A-1801, NOTE 9.
4. DELETED

D
A-1810

ION

13

D
A-1810

ION

D
A-1810

D
A-1809

USAR FIG. 9.5.1-2-04

ESSENTIAL DRAWING

REVISOR	INCORPORATED	WP-10466-A-1804-012-A-1	CHANGE	014959
ISSUED	CHG. DOC.		PKG. NO.	

THIS DWG. SUPERSEDES BY REV. THIS DWG. SUPERSEDES REV.

REVISION NOTES:



**ARCHITECTURAL
FIRE DELINEATION
FLOOR PLAN, EL. 2047'-6"**

SCALE	DRAWING NUMBER	SHEET	REV.
1/16" = 1'-0"	10466-A-1804	13	

REACTOR BLDG
FLAN @ EL. 2068'-8"

PLAN-EL. 2090'-0"

BEST COPY AVAILABLE.
MAY NOT REPRODUCE LEGIBLY.

Shirley Simmons
Checked by: Shirley W. Simmons
Designed by: [illegible]

H
G
F
E
D
C
B
A

GENERAL NOTES

- FOR PIPING AT JOHN REDMOND RESERVOIR DAM SEE M-0065.
 - FOR CIRCULATING WATER PIPING SEE M-0071 THRU M-0080 (SPEC. A-3089).
 - U.P.C. DENOTES MISCELLANEOUS UNDERGROUND PIPING CONTRACTOR (SPEC. A-3810).
 - F.P.S.C. DENOTES FIRE PROTECTION SYSTEM CONTRACTOR (SPEC. A-3824).
 - S.W.P.C. DENOTES SERVICE WATER (ITEM 'B') PIPING CONTRACTOR (SPEC. A-3811).
 - ALL PIPING IN SIZES LARGER THAN 24" EXCLUDING MANHOLES SHALL BE BASED ON CLEAR INTERNAL DIAMETER.
 - WALL THICKNESS OF STEEL PIPE IN SIZES GREATER THAN 24" SHALL BE 3/8" UNLESS OTHERWISE NOTED.
 - WALL THICKNESS OF STEEL PIPING IN SIZES 24" AND SMALLER SHALL BE AS FOLLOWS:
- | PIPE SIZE | WALL THICKNESS |
|--------------------|----------------|
| 2 1/2" AND SMALLER | SCHEDULE 80 |
| 2 1/2" THROUGH 10" | SCHEDULE 40 |
| 10" THROUGH 24" | 3/8" NOMINAL |
- ALL MISCELLANEOUS UNDERGROUND PIPING FURNISHED UNDER SPECIFICATION A-3810 TO BE INSTALLED BY ERECTION CONTRACTOR UNDER SPECIFICATION A-3832.
 - WARNING LINE AND SERVICE WATER PIPING TO BE FURNISHED UNDER SPECIFICATION A-3811 AND INSTALLED UNDER SPECIFICATION A-3852.
 - ALL FIRE PROTECTION SYSTEM PIPING, VALVES, AND INSTRUMENTATION TO BE FURNISHED AND INSTALLED UNDER SPECIFICATION A-3824.
 - WARNING LINE VALVE TO BE FURNISHED UNDER SPECIFICATION A-3822 AND INSTALLED BY ERECTION CONTRACTOR UNDER SPECIFICATION A-3838.
 - ALL VALVES, EXCEPT WARNING LINE VALVE AND FIRE PROTECTION SYSTEM VALVES, TO BE FURNISHED UNDER SPECIFICATION A-3815 AND INSTALLED BY ERECTION CONTRACTOR UNDER SPECIFICATION A-3838.
 - ERECTION CONTRACTOR AND FIRE PROTECTION SYSTEM CONTRACTOR SHALL BE RESPONSIBLE FOR ANCHORING, SUPPORTING, AND RESTRAINING PIPING TO ENSURE THE PHYSICAL INTEGRITY OF PIPING UNDER THEIR RESPECTIVE SCOPE OF WORK.
 - DIMENSIONS GIVEN ARE DESIGN DIMENSIONS; NO ALLOWANCES ARE MADE FOR CUT-SHORTS OR MAKE-LOGS UNLESS NOTED AS SUCH.
 - EXCAVATION OF SERVICE WATER PIPING (1 W82842) AND WARNING LINE (1 W03442) SHALL BE BY SITEWORK CONTRACTOR UNDER SPECIFICATION A-3858.
 - Ø DENOTES FIRE HYDRANT, SHUT-OFF VALVE, AND HOSE HOUSE CONTAINING 250 FT. OF 2 1/2 INCH. WOVEN JACKET, LINED, U.L. LISTED FIRE HOSE, 2 SPRAY NOZZLES WITH NATIONAL STANDARD THREADS (7 1/2 PER INCH) 1 AXE, 1 BAR, EMERGENCY LIGHT, 6 SPANNERS, AND 2 WRENCHES. FOR TYPICAL DETAIL SEE M-0066.
 - † DENOTES FIRE PROTECTION SYSTEM ISOLATION VALVE WITH POST INDICATOR AND CLOSED CIRCUIT ELECTRICALLY ACTUATED POSITION SWITCHES TO INDICATE VALVE IS NOT FULLY OPEN. FOR TYPICAL DETAIL SEE M-0066.
 - WALL THICKNESS REQUIREMENTS FOR MITER JOINT FITTINGS GIVEN IN SPECIFICATIONS.
 - DENOTES CATHODIC PROTECTION TEST POINT PER S & L STD. EP-316.
 - WHERE PIPING IS MARKED WITH PIPE PENETRATION NUMBERS (E.G., PP-103) REFER TO PIPE PENETRATION DRAWING FOR DETAILS.
 - PIPING MARKED A-3838 TO BE FURNISHED AND INSTALLED UNDER SPECIFICATION A-3838.
 - EQUIPMENT AND POWER FOR ACID UNLOAD PUMPS TO BE REMOVED WITH PIPE AND POWER CABLE TERMINATED 2 FEET BELOW GRADE.

REFERENCE DRAWINGS

- M-1G001 INTERFACE PEN. SITE ARRANGEMENT
- M-1G006 & M-1G007 INTERFACE UNDER GROUND PIPING LOCATIONS

USAR FIG. 9.5-2-00

ESSENTIAL DRAWING

REVISION	INCORPORATED	CHANGE	05586
ISSUED	CHG. DOC.	FIG. NO.	
THIS ENG. SUPERSEDES	REV.	THIS ENG. SUPERSEDES	REV.



REVISION NOTES

WOLF CREEK NUCLEAR OPERATING CORPORATION		ELECTRONIC APPROVAL
--	--	------------------------



OUTDOOR PIPING
KEY PLAN & GENERAL NOTES

SCALE	DRAWING NUMBER	SHEET	REV.
1"=100'-0"	M-0051	22	

Part 5: Piping
Revised 12/2000
Date: 09/28/00 12:00:00 AM

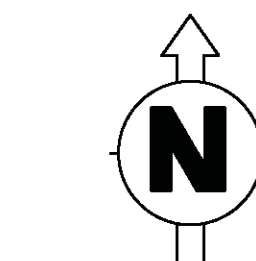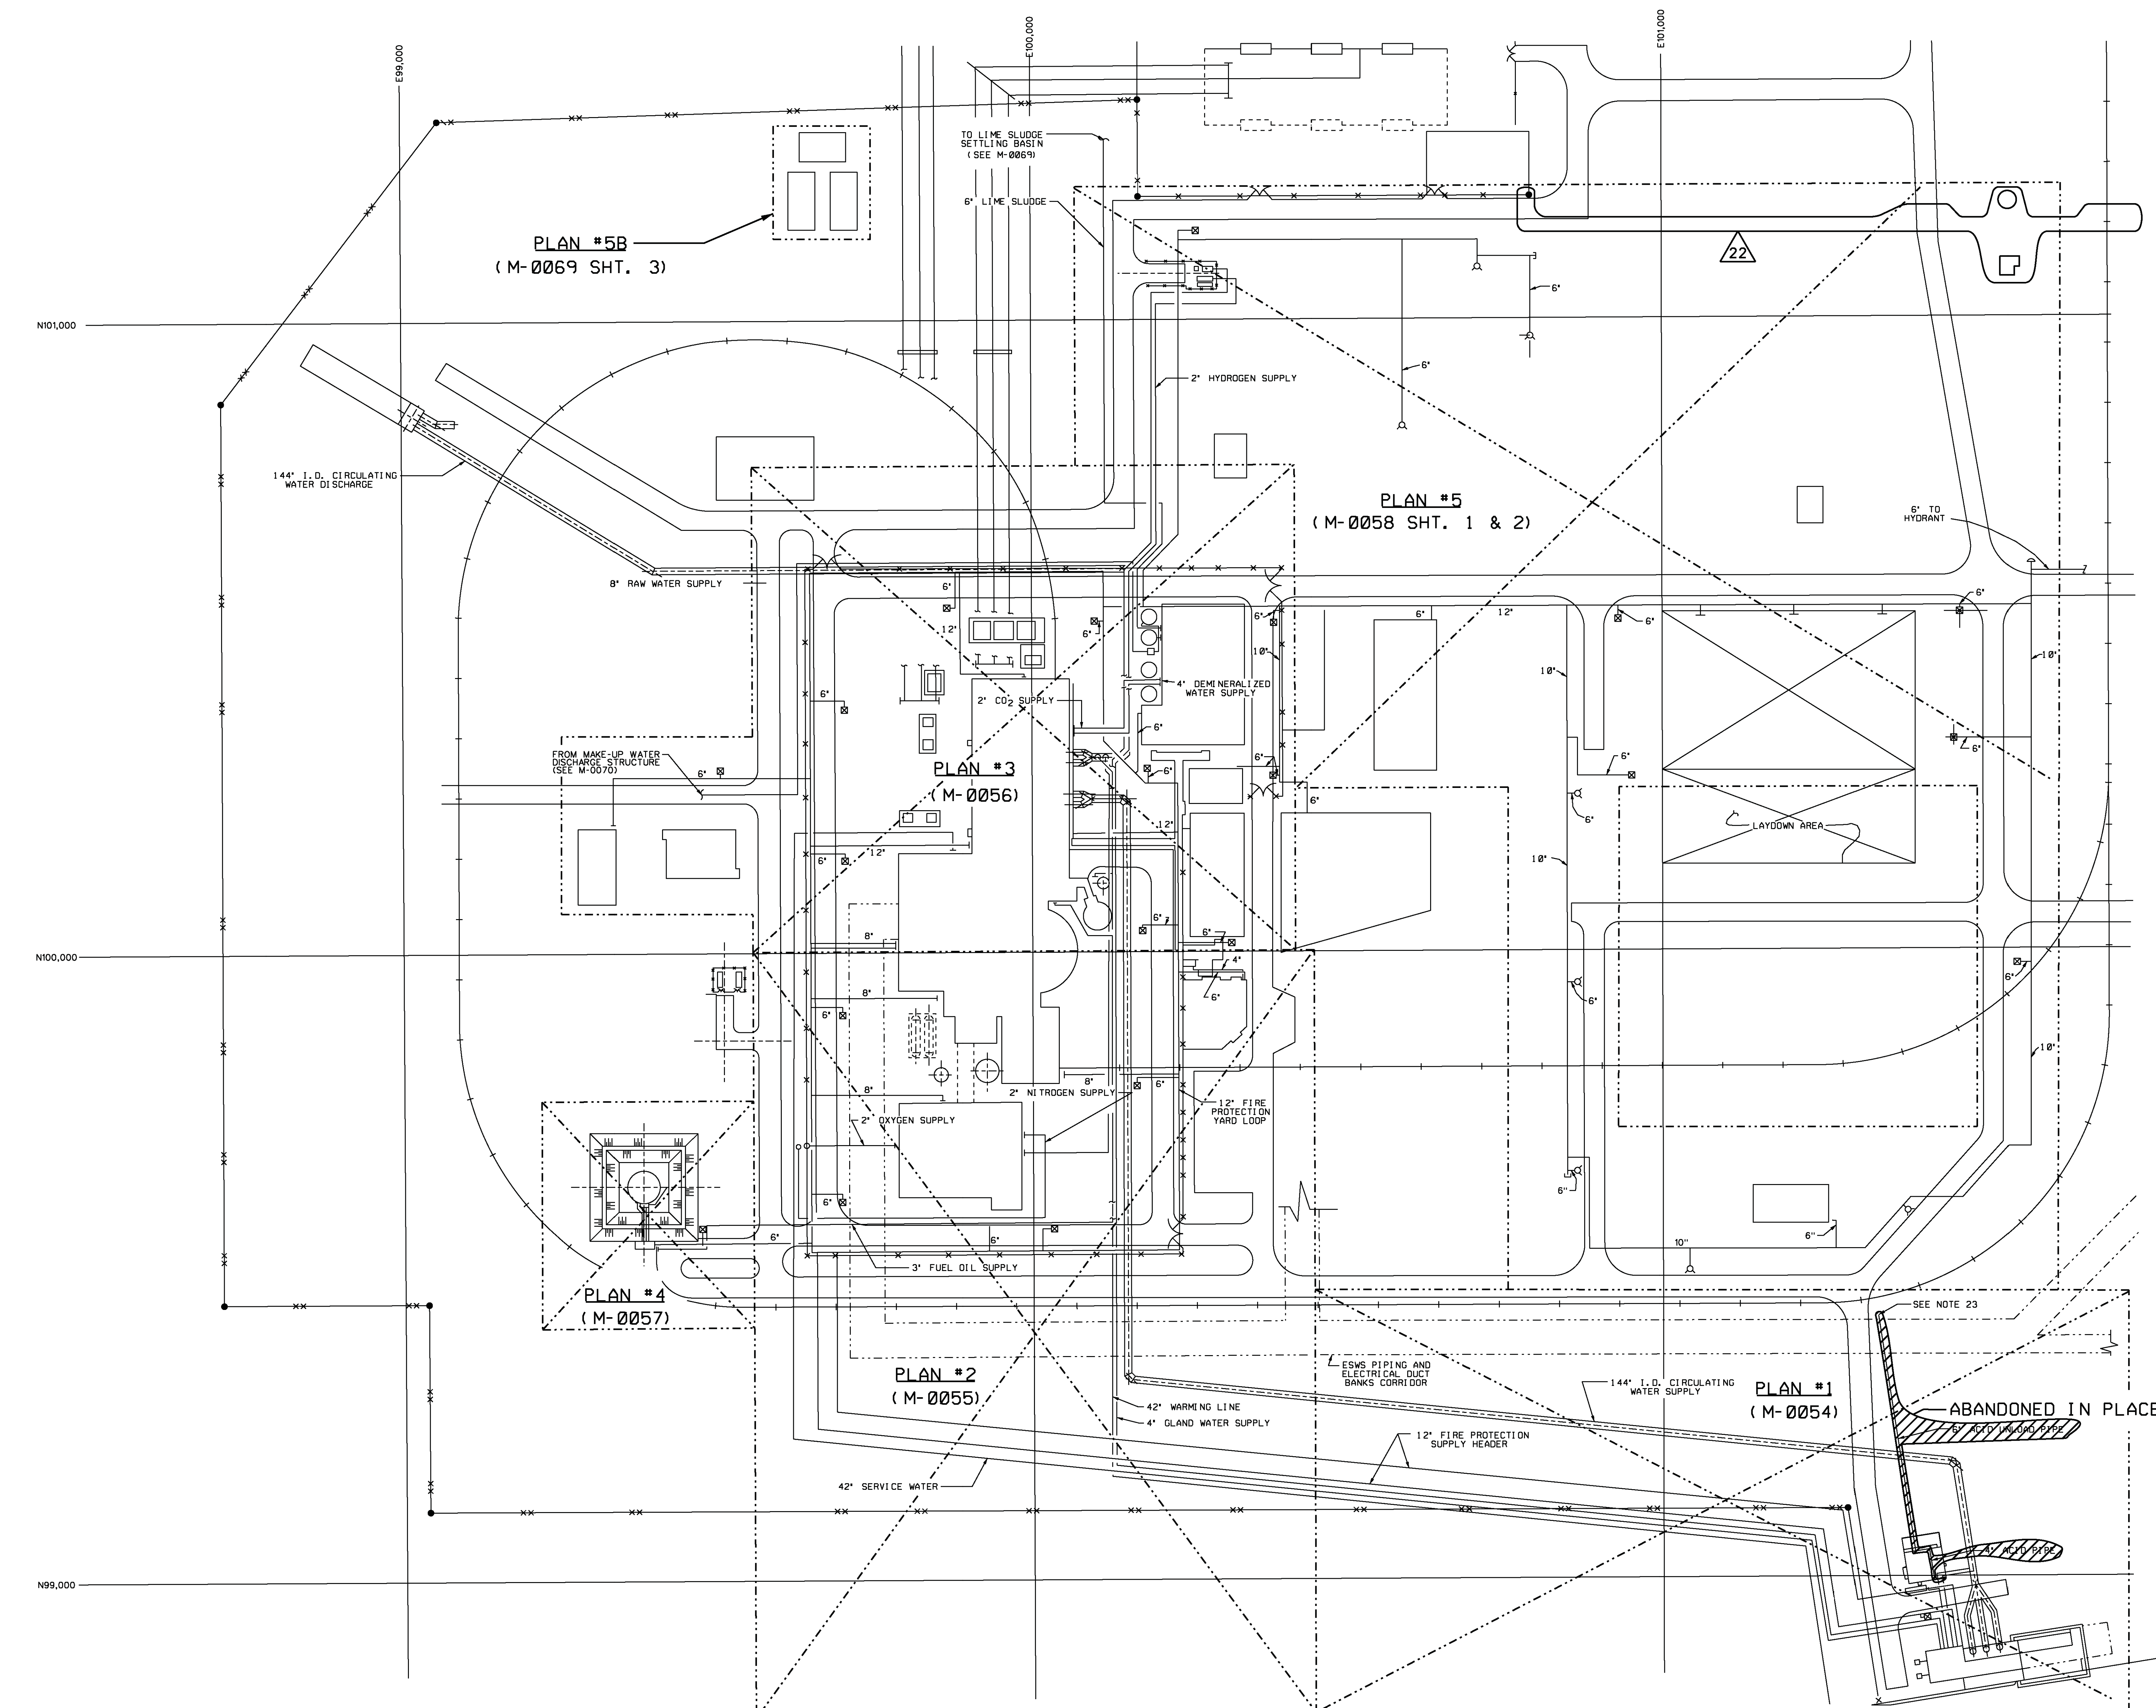

H
G
F
E
D
C
B
A

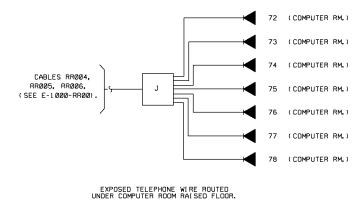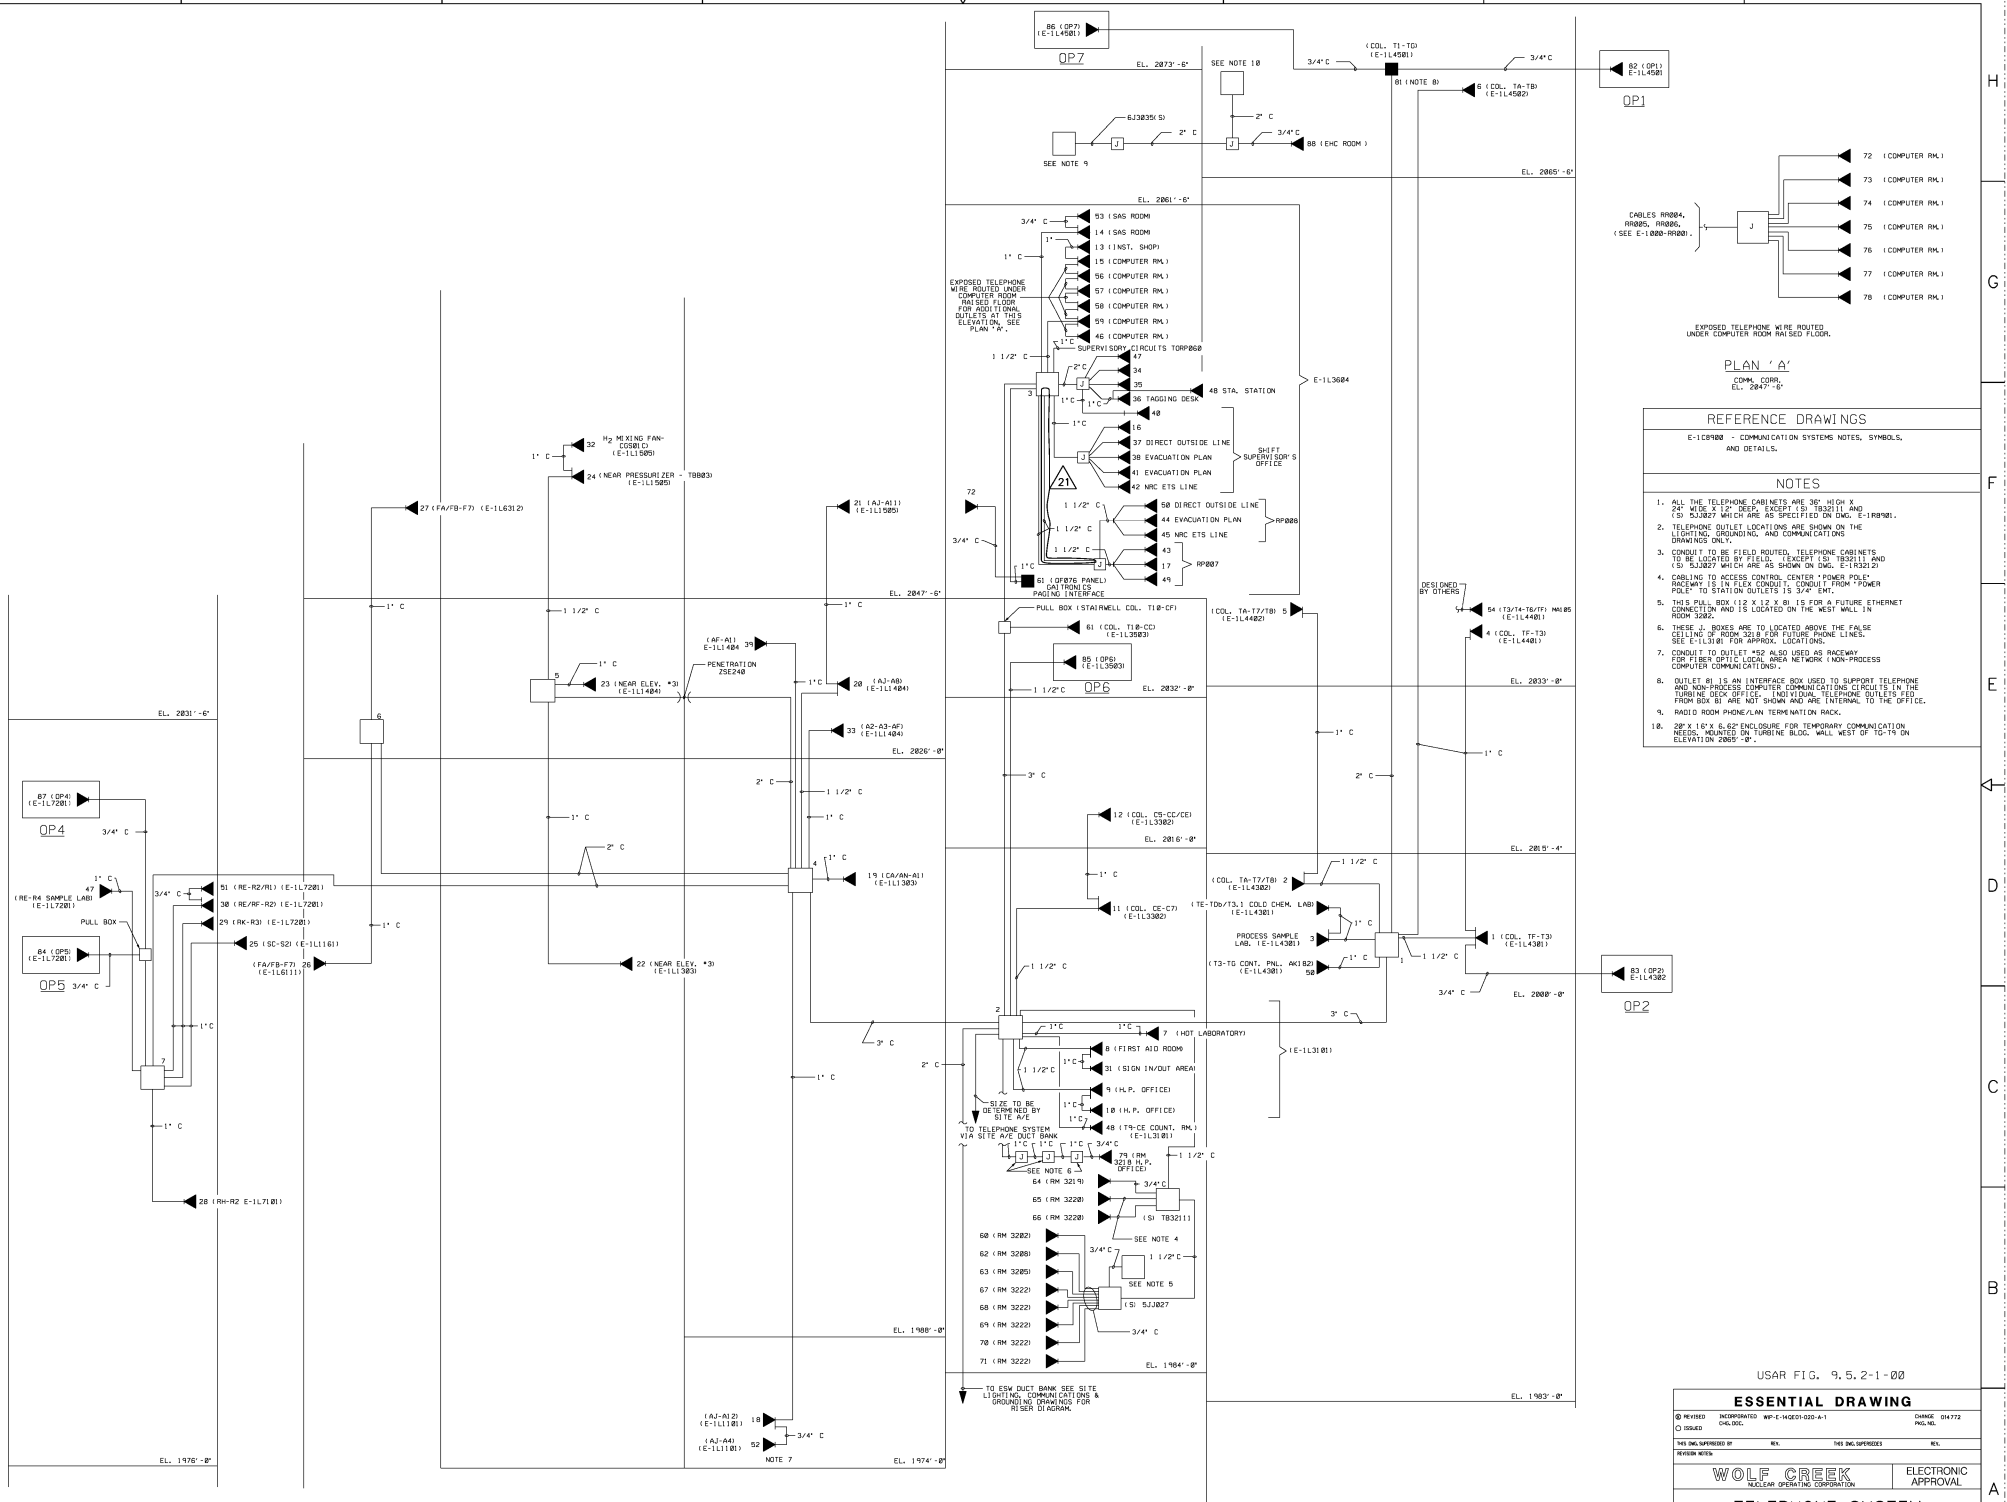


PLAN 'A'
COMM. CORR.
EL. 2047'-0"

REFERENCE DRAWINGS

E-10088 - COMMUNICATION SYSTEMS NOTES, SYMBOLS, AND DETAILS.

NOTES

1. ALL THE TELEPHONE CABINETS ARE 36" HIGH X 24" WIDE X 12" DEEP, EXCEPT (S) WHICH IS 48" HIGH X 24" WIDE X 12" DEEP, EXCEPT (S) WHICH IS 48" HIGH X 24" WIDE X 12" DEEP. ALL DRAWINGS MUST BE AS SPECIFIED ON DRAWING E-10088. DRAWINGS ONLY.
2. TELEPHONE OUTLET LOCATIONS ARE SHOWN ON THE LIGHTING, GRIDDING, AND COMMUNICATIONS DRAWINGS ONLY.
3. CONDUIT TO BE FIELD ROUNDED. TELEPHONE CABINETS TO BE LOCATED BY FIELD. (EXCEPT (S), (S)1), AND (S)2, WHICH ARE AS SHOWN ON DRAWING E-10088.)
4. CABLING TO ACCESS CONTROL CENTER (POWER POLE) RACKS IS IN FLEX CONDUIT. CONDUIT FROM "POWER POLE" TO STATION OUTLETS IS 3/4" EMT.
5. TWO 2" PULL BOX (12 X 12 X 24") IS FOR A FUTURE ETHERNET CONNECTION AND IS LOCATED ON THE WEST WALL IN ROOM 555C.
6. THESE J-BOXES ARE TO BE LOCATED ABOVE THE FALSE CEILING OF ROOM 555C FOR FUTURE PHONE LINES. SEE E-10301 FOR APPROX. LOCATIONS.
7. CONDUIT TO OUTLET #52 ALSO USED AS RACKWAY FOR FIBER OPTIC LOCAL AREA NETWORK (NON-PROCESS) COMPUTER COMMUNICATIONS.
8. OUTLET #1 IS AN INTERFACE BOX USED TO SUPPORT TELEPHONE AND NON-PROCESS COMPUTER COMMUNICATIONS. CIRCUITS IN THE TURNING DECK OFFICE (RADWASTE) TELEPHONE OUTLETS FROM BOX #1 ARE NOT SHOWN AND ARE INTERNAL TO THE OFFICE.
9. RADWASTE ROOM PHONE LINES TERMINATION RACK.
10. 28" X 6" X 6" 6-62 ENCLOSURE FOR TEMPORARY COMMUNICATION NEEDS. MOUNTED ON TURBINE BLDG. WALL WEST OF TG-19 ON ELEVATION 2085'-0".

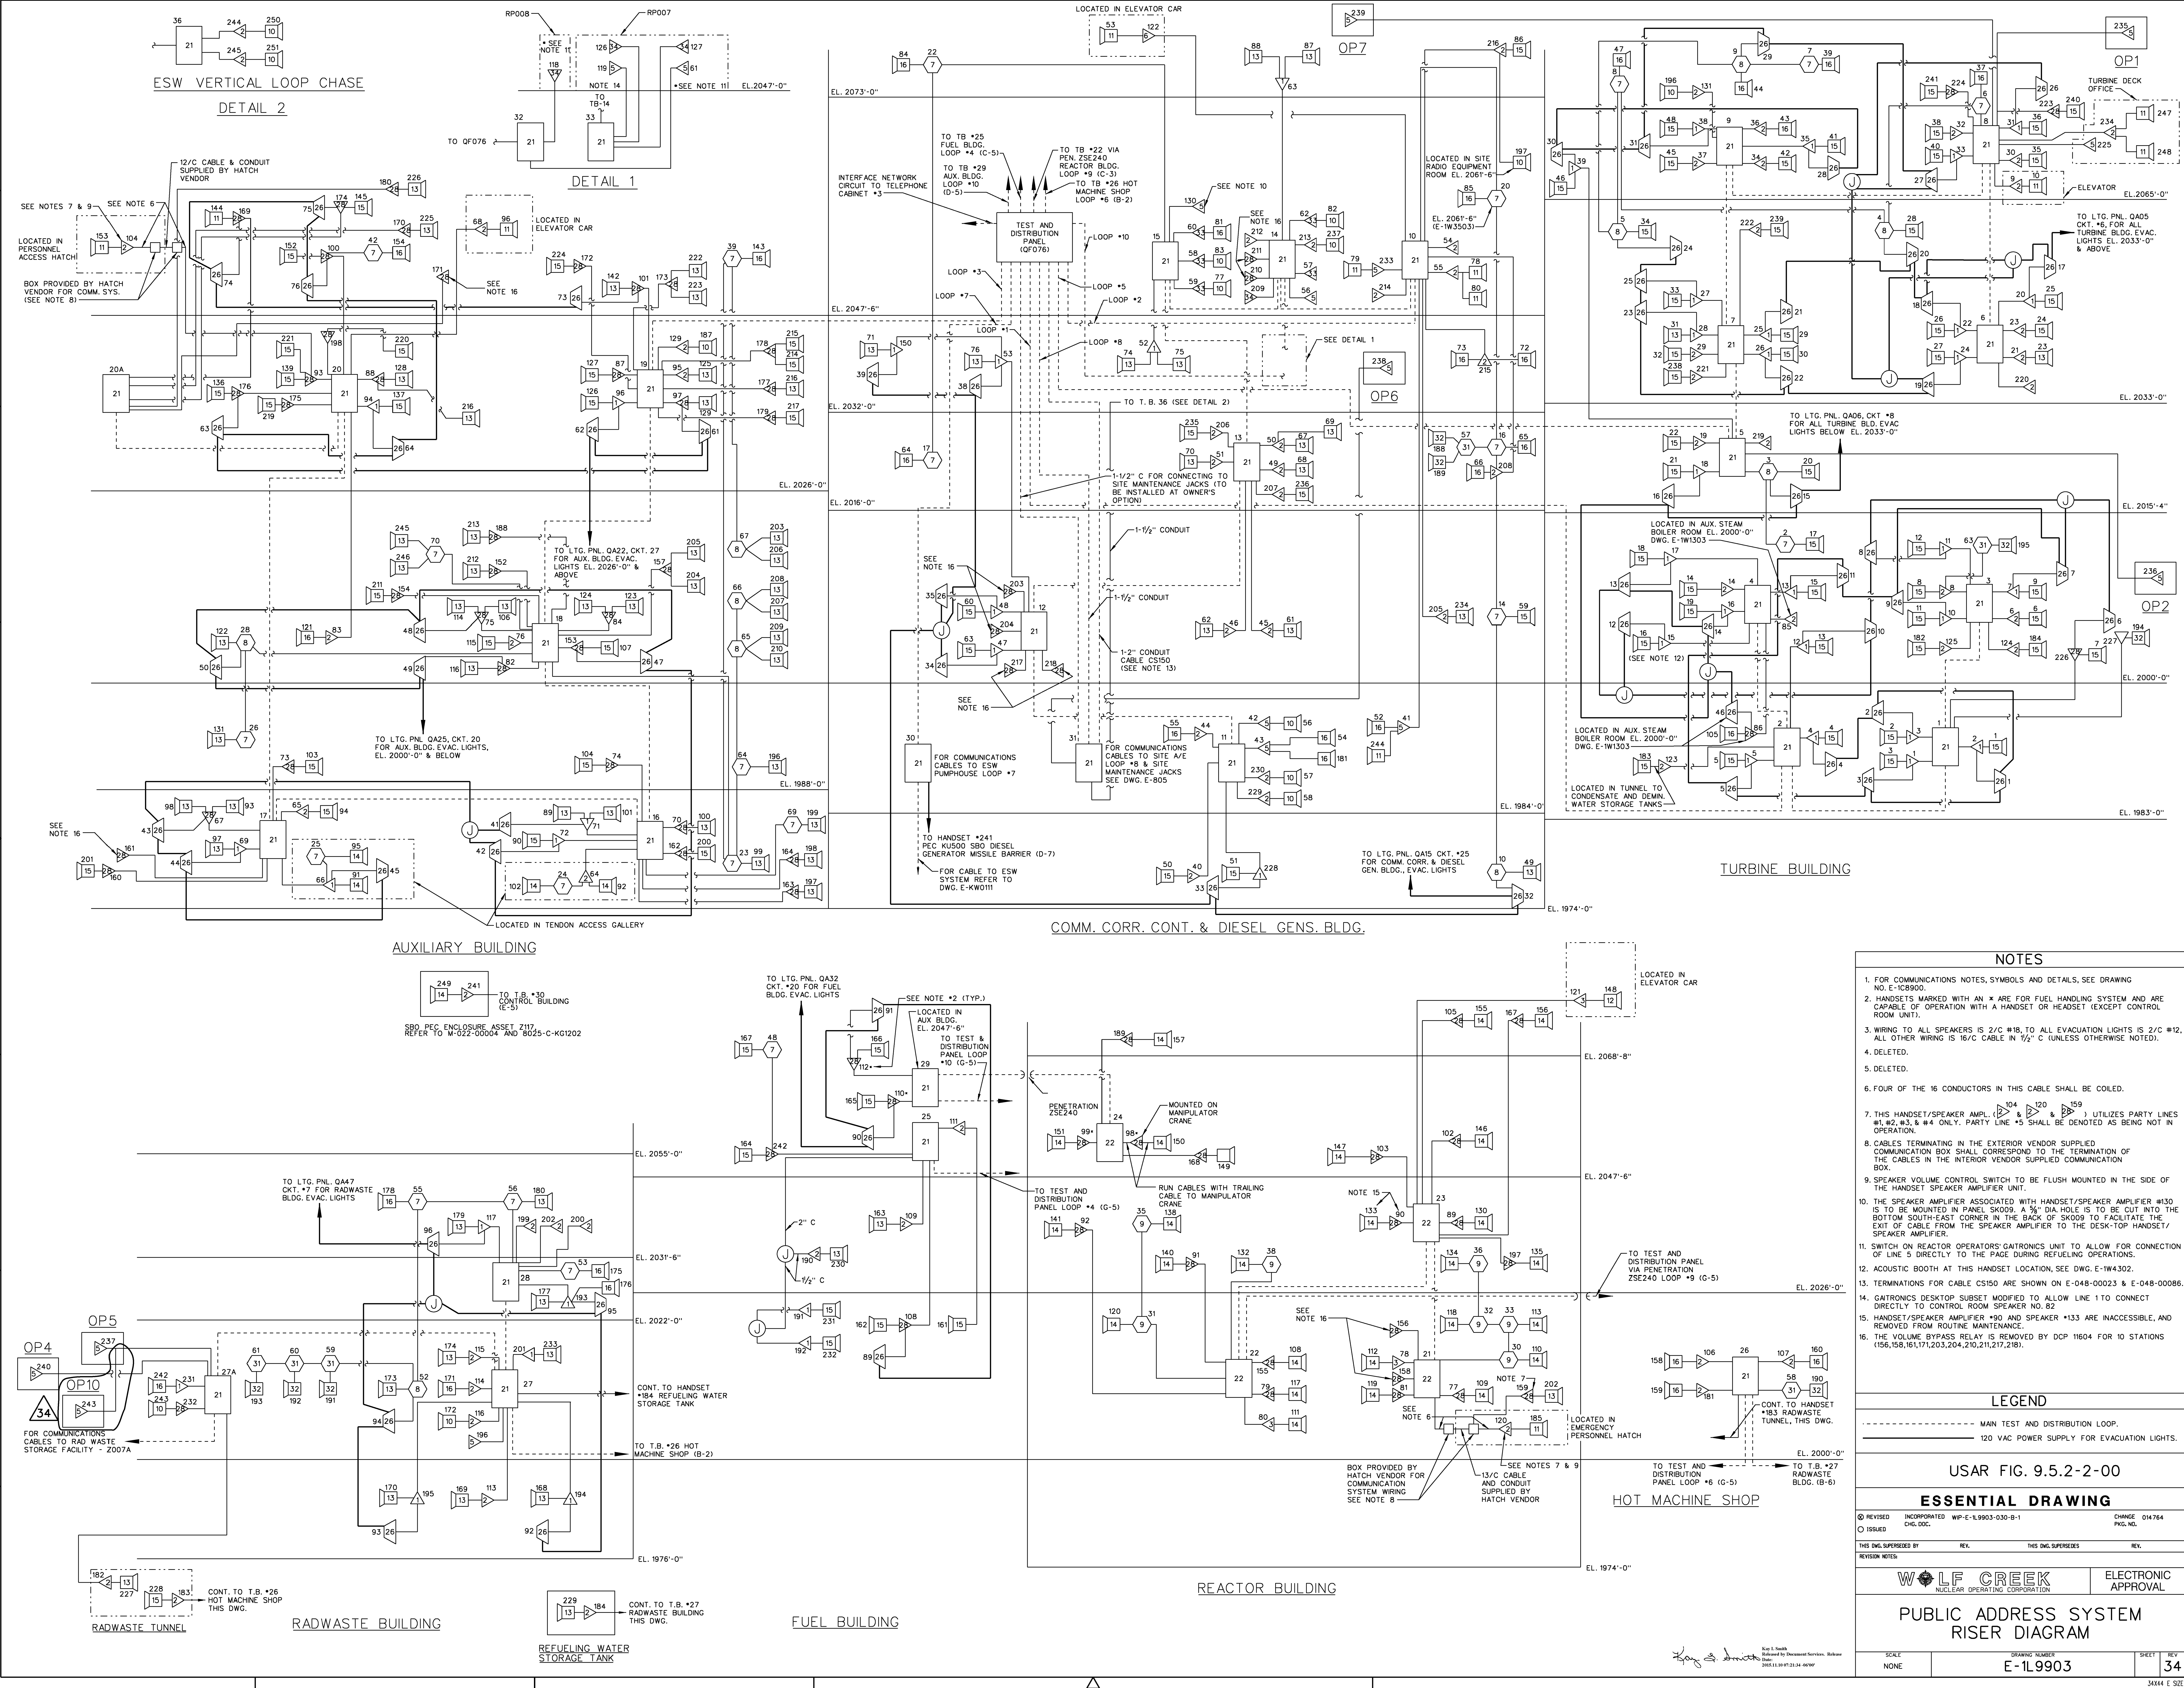

NOTES

- FOR COMMUNICATIONS NOTES, SYMBOLS AND DETAILS, SEE DRAWING NO. E-1C8900.
- HANDSETS MARKED WITH AN * ARE FOR FUEL HANDLING SYSTEM AND ARE CAPABLE OF OPERATION WITH A HANDSET OR HEADSET (EXCEPT CONTROL ROOM UNIT).
- WIRING TO ALL SPEAKERS IS 2/C #18, TO ALL EVACUATION LIGHTS IS 2/C #12, ALL OTHER WIRING IS 16/C CABLE IN 1/2" C UNLESS OTHERWISE NOTED.
- DELETED.
- DELETED.
- FOUR OF THE 16 CONDUCTORS IN THIS CABLE SHALL BE COILED.
- THIS HANDSET/SPEAKER AMP. UTILIZES PARTY LINES #1, #2, #3, & #4 ONLY. PARTY LINE #5 SHALL BE DENOTED AS BEING NOT IN OPERATION.
- CABLES TERMINATING IN THE EXTERIOR VENDOR SUPPLIED COMMUNICATION BOX SHALL CORRESPOND TO THE TERMINATION OF THE CABLES IN THE INTERIOR VENDOR SUPPLIED COMMUNICATION BOX.
- SPEAKER VOLUME CONTROL SWITCH TO BE FLUSH MOUNTED IN THE SIDE OF THE HANDSET/SPEAKER AMPLIFIER UNIT.
- THE SPEAKER AMPLIFIER ASSOCIATED WITH HANDSET/SPEAKER AMPLIFIER #130 IS TO BE MOUNTED IN PANEL SK009. A 3/8" DIA HOLE IS TO BE CUT INTO THE BOTTOM SOUTH-EAST CORNER IN THE BACK OF SK009 TO FACILITATE THE EXIT OF CABLE FROM THE SPEAKER AMPLIFIER TO THE DESK-TOP HANDSET/SPEAKER AMPLIFIER.
- SWITCH ON REACTOR OPERATORS' GATRONICS UNIT TO ALLOW FOR CONNECTION OF LINE 5 DIRECTLY TO THE PAGE DURING REFUELING OPERATIONS.
- ACOUSTIC BOOTH AT THIS HANDSET LOCATION, SEE DWG. E-1W4302.
- TERMINATIONS FOR CABLE CS150 ARE SHOWN ON E-048-00023 & E-048-00086.
- GATRONICS DESKTOP SUBSET MODIFIED TO ALLOW LINE 1 TO CONNECT DIRECTLY TO CONTROL ROOM SPEAKER NO. 82.
- HANDSET/SPEAKER AMPLIFIER #90 AND SPEAKER #133 ARE ACCESSIBLE, AND REMOVED FROM ROUTINE MAINTENANCE.
- THE VOLUME BYPASS RELAY IS REMOVED BY DCP 11604 FOR 10 STATIONS (156, 158, 161, 171, 203, 204, 210, 211, 217, 218).

LEGEND

- MAIN TEST AND DISTRIBUTION LOOP.
- 120 VAC POWER SUPPLY FOR EVACUATION LIGHTS.

USAR FIG. 9.5.2-2-00

ESSENTIAL DRAWING

REVISED INCORPORATED WP-E-19903-030-B-1 CHANGE 014764
 CHG. DOC. PPG. NO.
 ISSUED

THIS ENG. SUPERSEDES REV. THIS ENG. SUPERSEDES REV.



REVISION NOTES

WOLF CREEK
 NUCLEAR OPERATING CORPORATION

ELECTRONIC APPROVAL

PUBLIC ADDRESS SYSTEM RISER DIAGRAM

SCALE NONE DRAWING NUMBER E-1L9903 SHEET 34

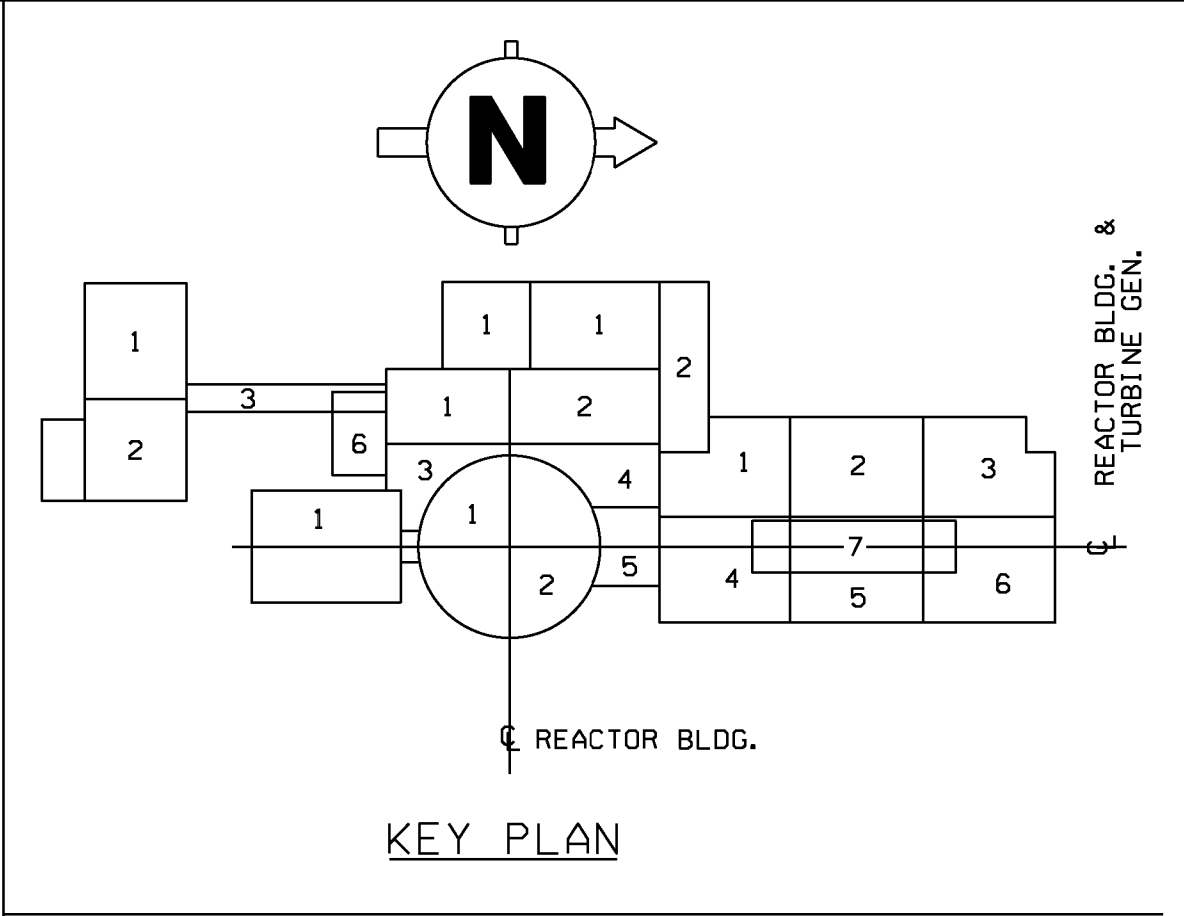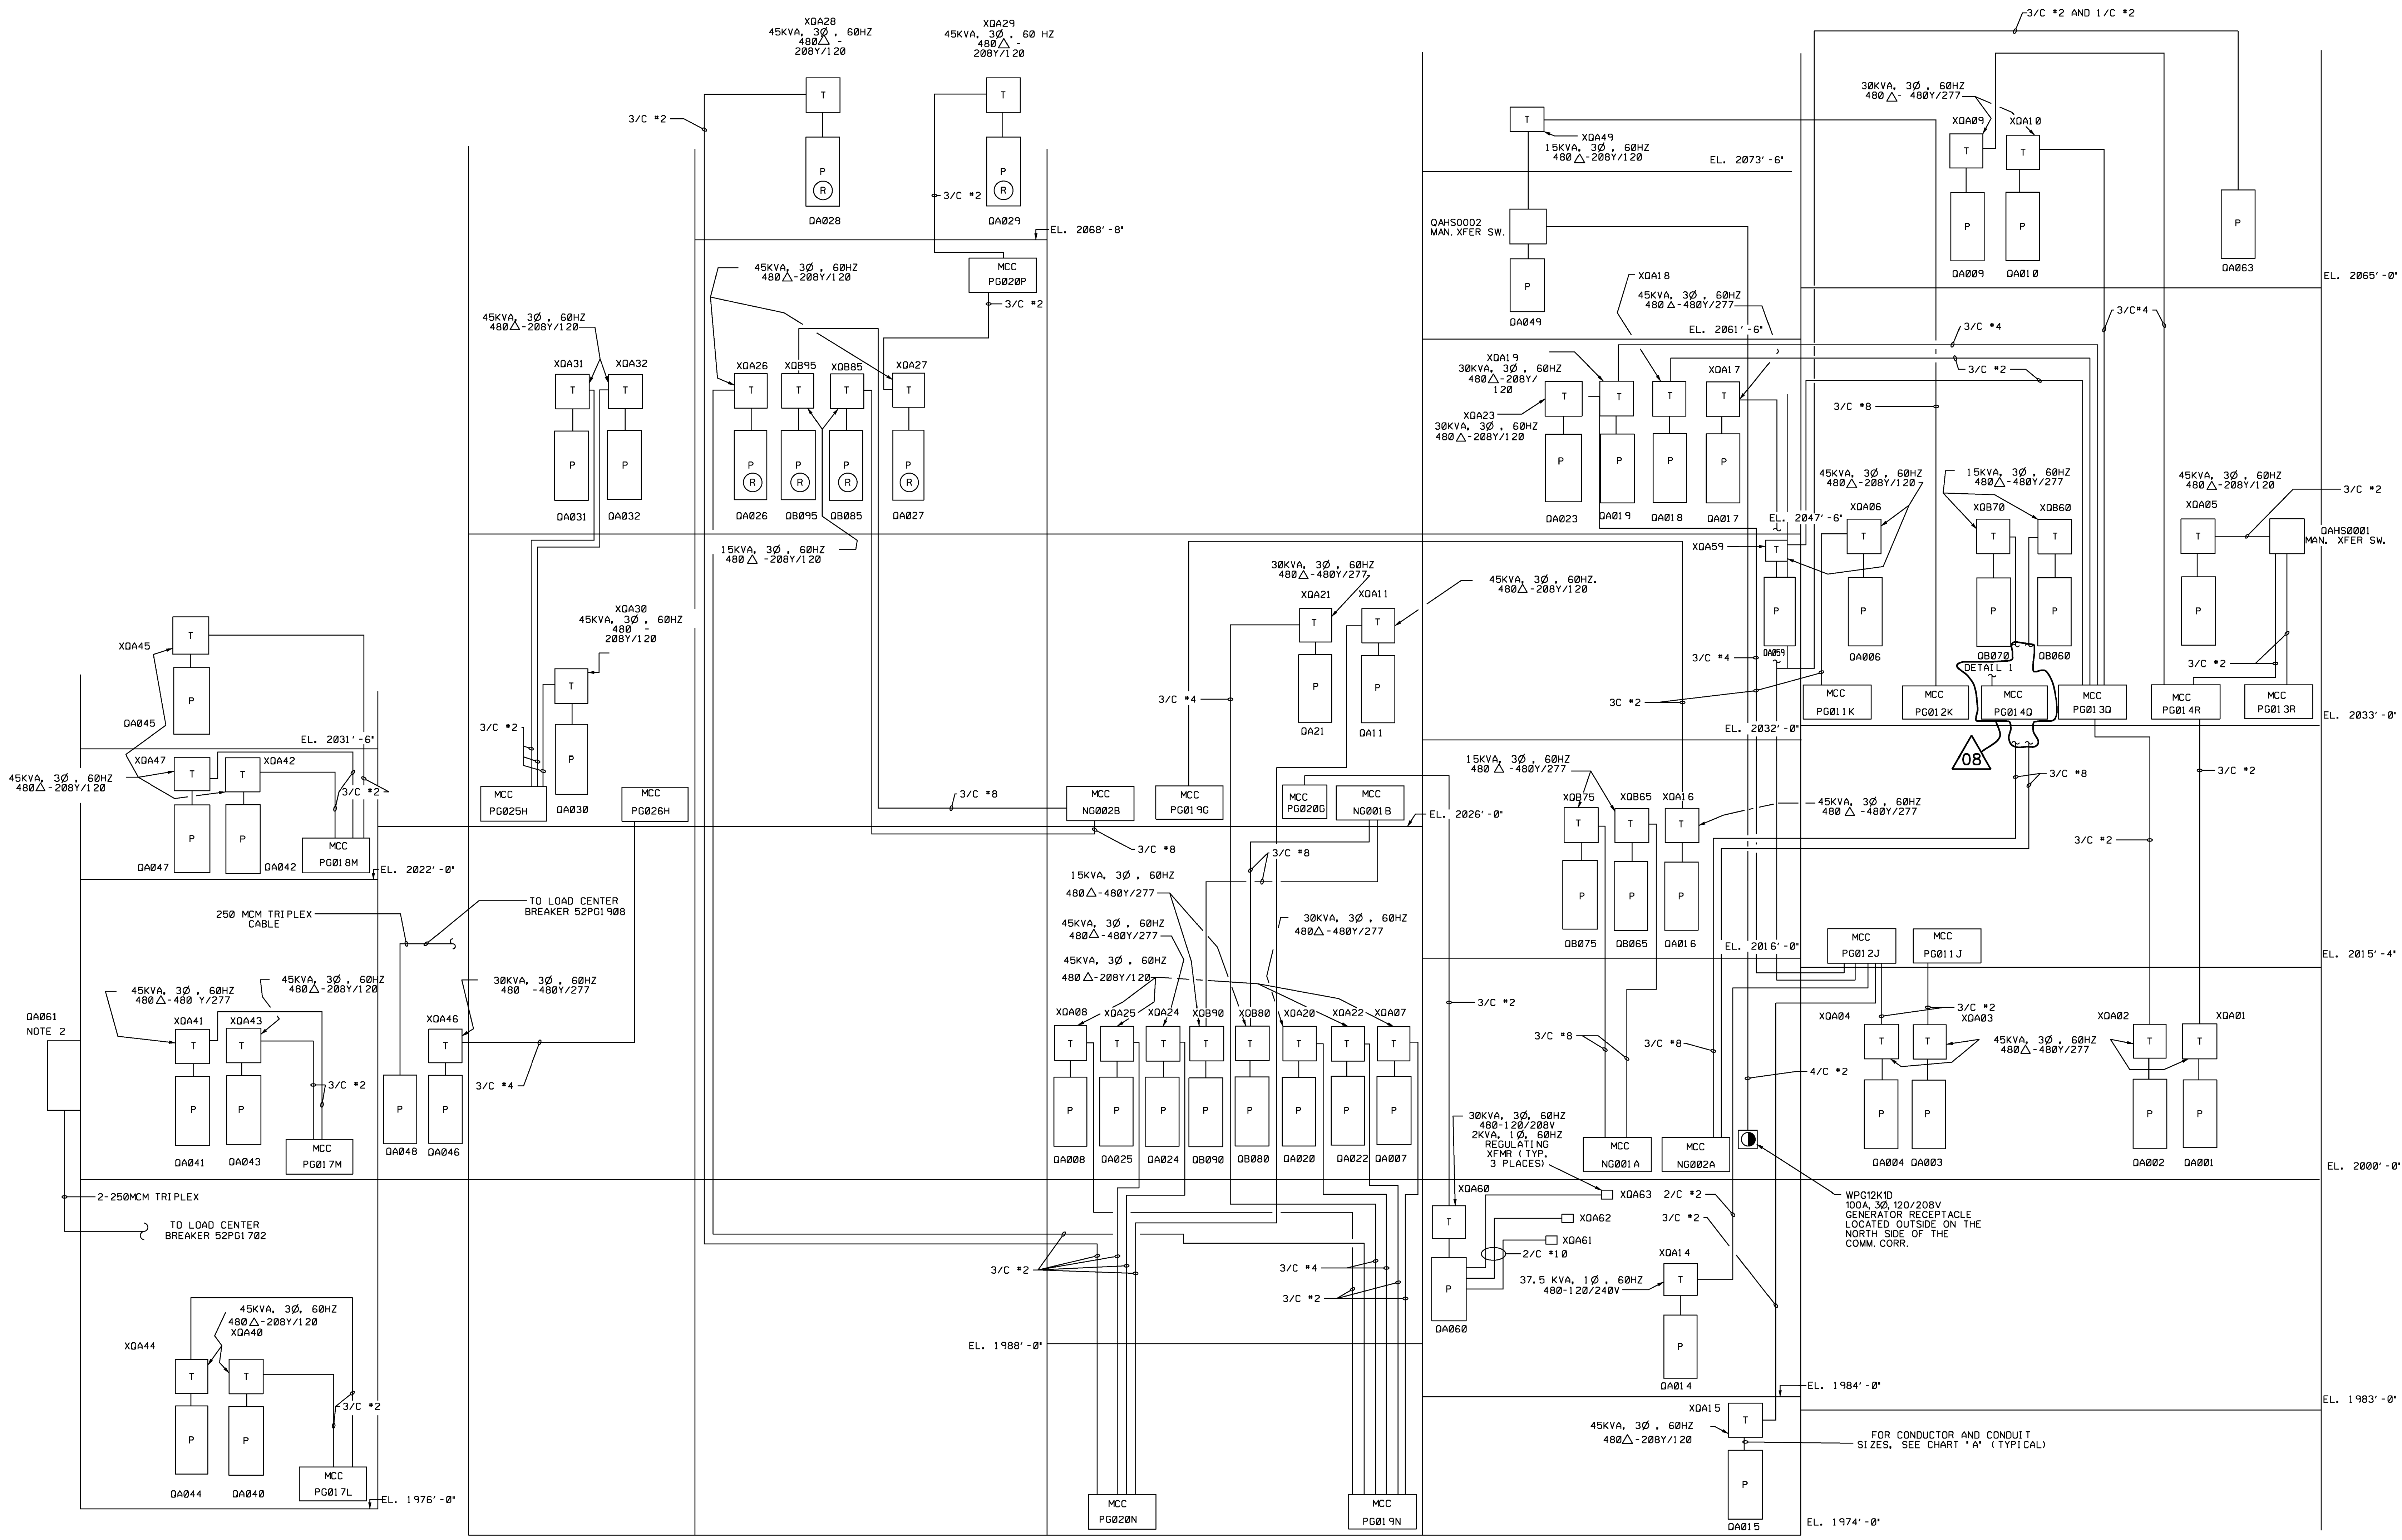

KEY PLAN
 REACTOR BLDG. & TURBINE GEN.

REFERENCE DRAWINGS
 E-1L9900 LIGHTING NOTES SYMBOLS AND DETAILS
 E-1L9900 PANEL SCHEDULES


NOTES
 1. (R) INDICATES RAINTIGHT ENCLOSURE, SEE E-1L9900.
 2. PANEL GA061 IS LOCATED ON THE EXTERIOR WALL OF THE RADWASTE BLDG. AND IS DEDICATED TO SUPPLY THE ADJOINING MAINTENANCE BUILDING.

RADWASTE BUILDING HOT MACHINE SHOP FUEL BUILDING REACTOR BUILDING AUXILIARY BUILDING COMM. CORR., CONT. & DIESEL GEN.'S BLDG. TURBINE BUILDING

TRANSFORMER TO PANEL WIRING INFO.

TRANSFORMER RATING	CONDUCTOR SIZE (MIN. SIZE (MIN.))	CONDUIT SIZE (MIN. SIZE (MIN.))
45kva (3Ø)	480Y/277	4/C *4
45kva (3Ø)	208Y/120	4/C 2/Ø
30kva (3Ø)	480Y/277	4/C *6
30kva (3Ø)	208Y/120	4/C *2
15kva (3Ø)	480Y/277	4/C *1Ø
15kva (3Ø)	208Y/120	4/C *6
37.5kva (1Ø)	12Ø/24Ø	3/C 4/Ø

CHART A

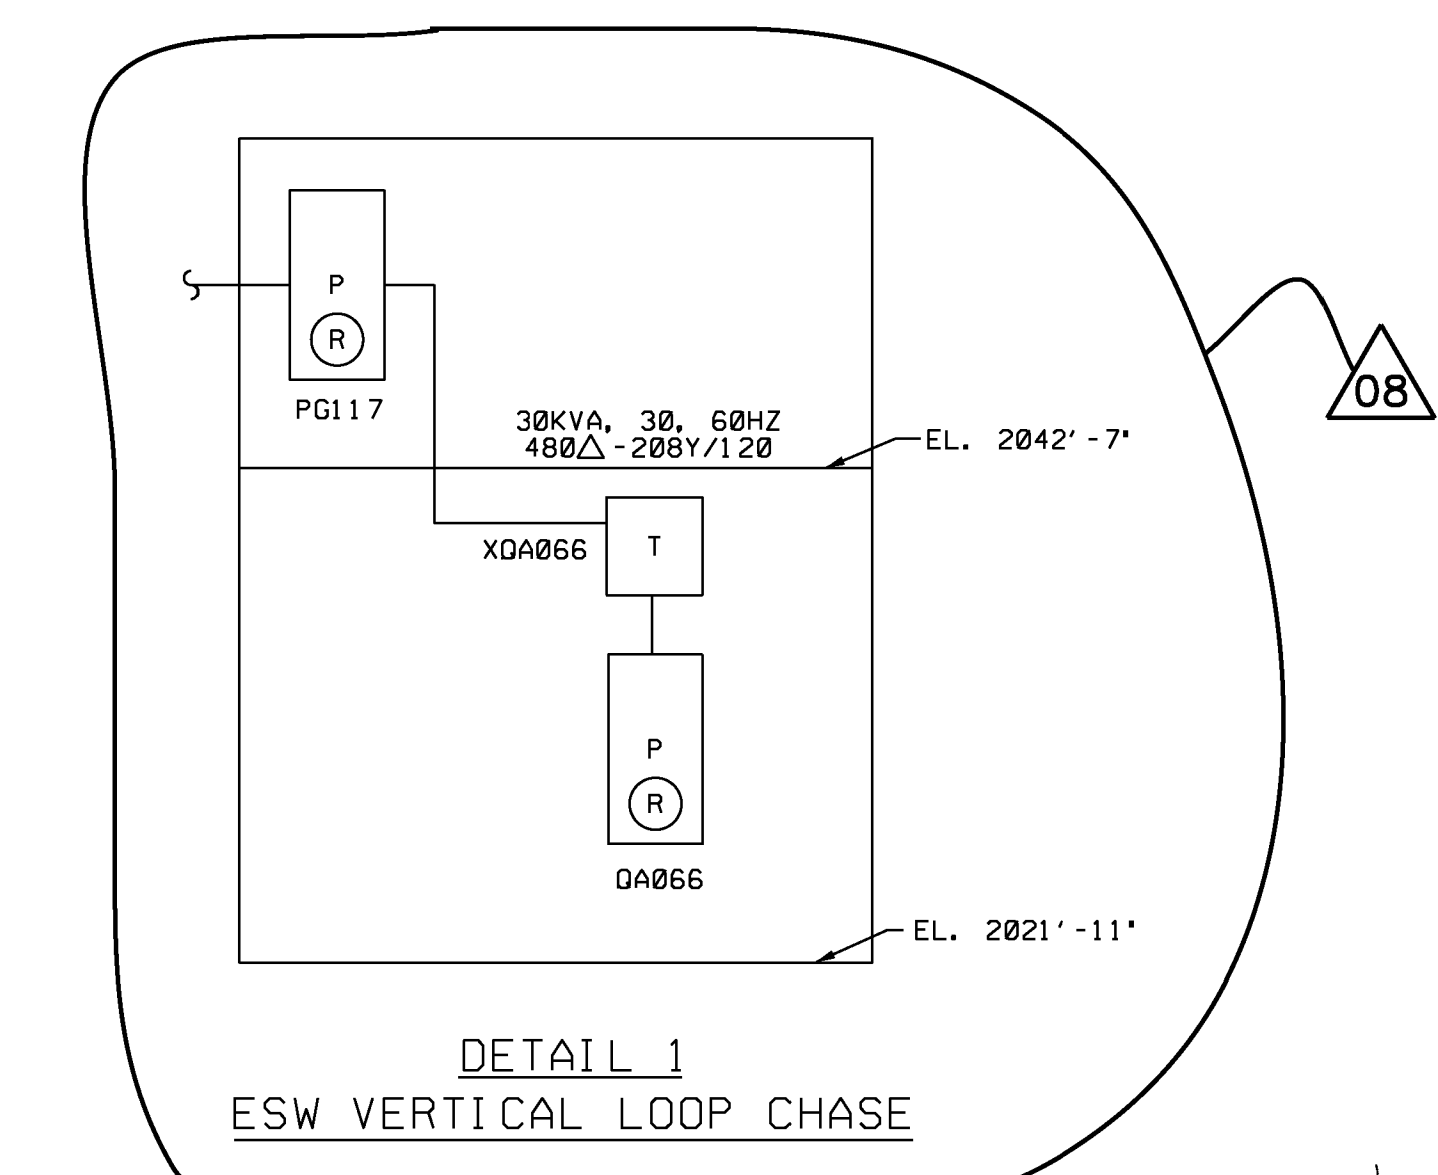

DETAIL 1
 ESW VERTICAL LOOP CHASE

USAR FIG. 9.5.3-1-00

ESSENTIAL DRAWING

REVISION NUMBER: INCORPORATED WP-E-19901-007-B-1
 CHG. DOC. CHANGE 014763
 ISSUED PPG. NO.

THIS ENG. SUPERSEDES: REV. THIS ENG. SUPERSEDES REV.


REVISION NUMBER: REVISED TO INCORPORATE WIP PER WO* 14-380612-068, STEPS 1 & 2.

WOLF CREEK NUCLEAR OPERATING CORPORATION ELECTRONIC APPROVAL

LIGHTING DISTRIBUTION RISER DIAGRAM

SCALE: NONE DRAWING NUMBER: E-1L9901 SHEET: 08 REV: 08

3414 E 50

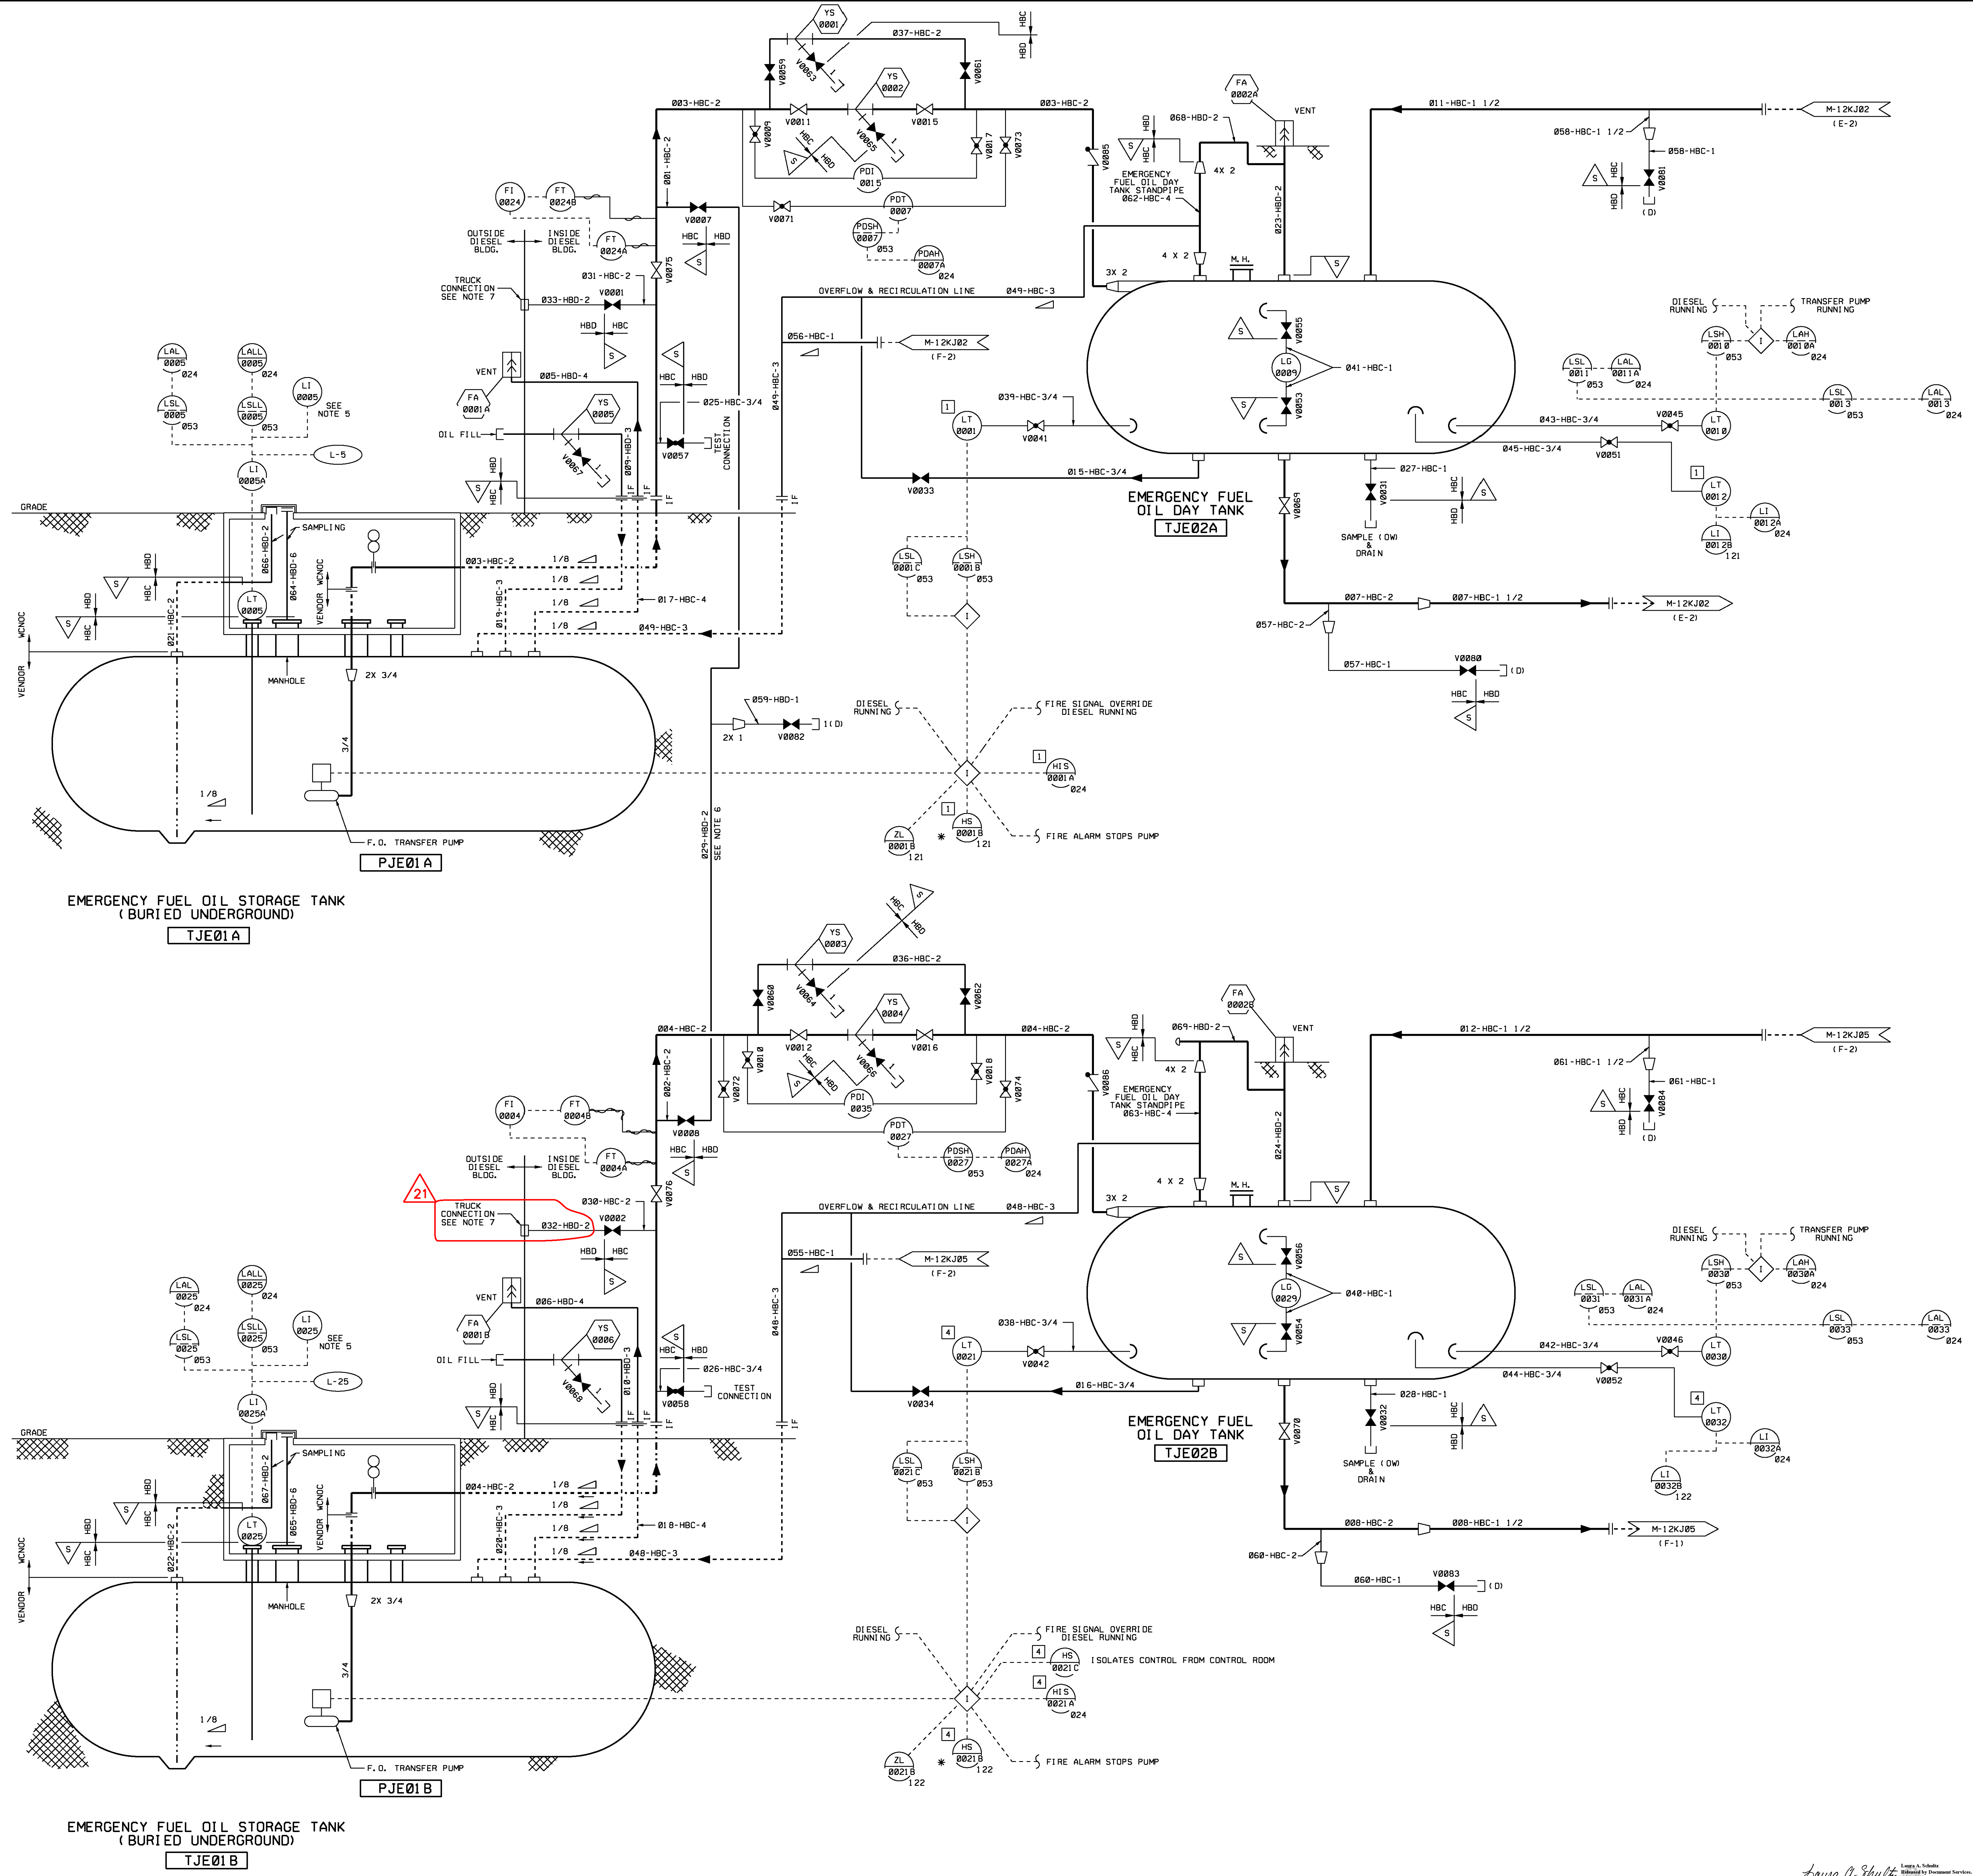

- NOTES**
1. THE ASME SECTION III, CLASS 3 COMPONENTS ARE SUBJECT TO VISUAL INSPECTION REQUIREMENTS.
 2. HYDROTESTING FOR INSERVICE INSPECTION SHALL BE WITH NO. 2 DIESEL OIL.
 3. ALL BURIED LINES TO SLOPE 1/8" PER FOOT TOWARD EMERGENCY FUEL OIL STORAGE TANKS.
 4. INSULATING FLANGES MATERIALS SHALL BE COMPATIBLE WITH NO. 2 DIESEL FUEL OIL.
 5. LI 0005 & LI 0025 ARE LOCATED OUTSIDE THE DIESEL BUILDING ADJACENT TO THE FILL CONNECTION.
 6. SEISMICALLY SUPPORTED.
 7. THE TRUCK CONNECTION IS RECESSED FROM THE EXTERIOR WALL SURFACE APPROXIMATELY 1" A 2" BUSHING IS WELDED TO THE END OF THE PIPE AND THREADED TO ACCEPT A 1" NPTF PIPE PLUG COVERED WITH A CARBON STEEL PLATE FOR TORNADO GENERATED MISSILE PROTECTION. REFERENCE DRAWING C-065903 FOR PLATE DETAIL.

USAR FIG. 9.5.4-1-00

ESSENTIAL DRAWING

REVISED	INCORPORATED	WP-M-12JE01-019-A-1	CHANGE 015264
ISSUED	CNG. DEC.		PKG. NO.

THIS ENG. SUPERSEDES	REV.	THIS ENG. SUPERSEDES	REV.
----------------------	------	----------------------	------


WOLF CREEK NUCLEAR OPERATING CORPORATION		ELECTRONIC APPROVAL
PIPING & INSTRUMENTATION DIAGRAM		
EMERGENCY FUEL OIL SYSTEM		

SCALE	DRAWING NUMBER	SHEET	REV
NONE	M-12JE01	21	1

Anna C. Schultz

NOTES


1. REPRESENTS A DUAL PLATE CHECK VALVE
2. THE INTERNALS OF VALVE V8773A HAVE BEEN REMOVED.
3. DELETED
4. KJHV81 IS ABANDONED IN PLACE AND BLOCKED CLOSED WITH THE ACTUATOR REMOVED.

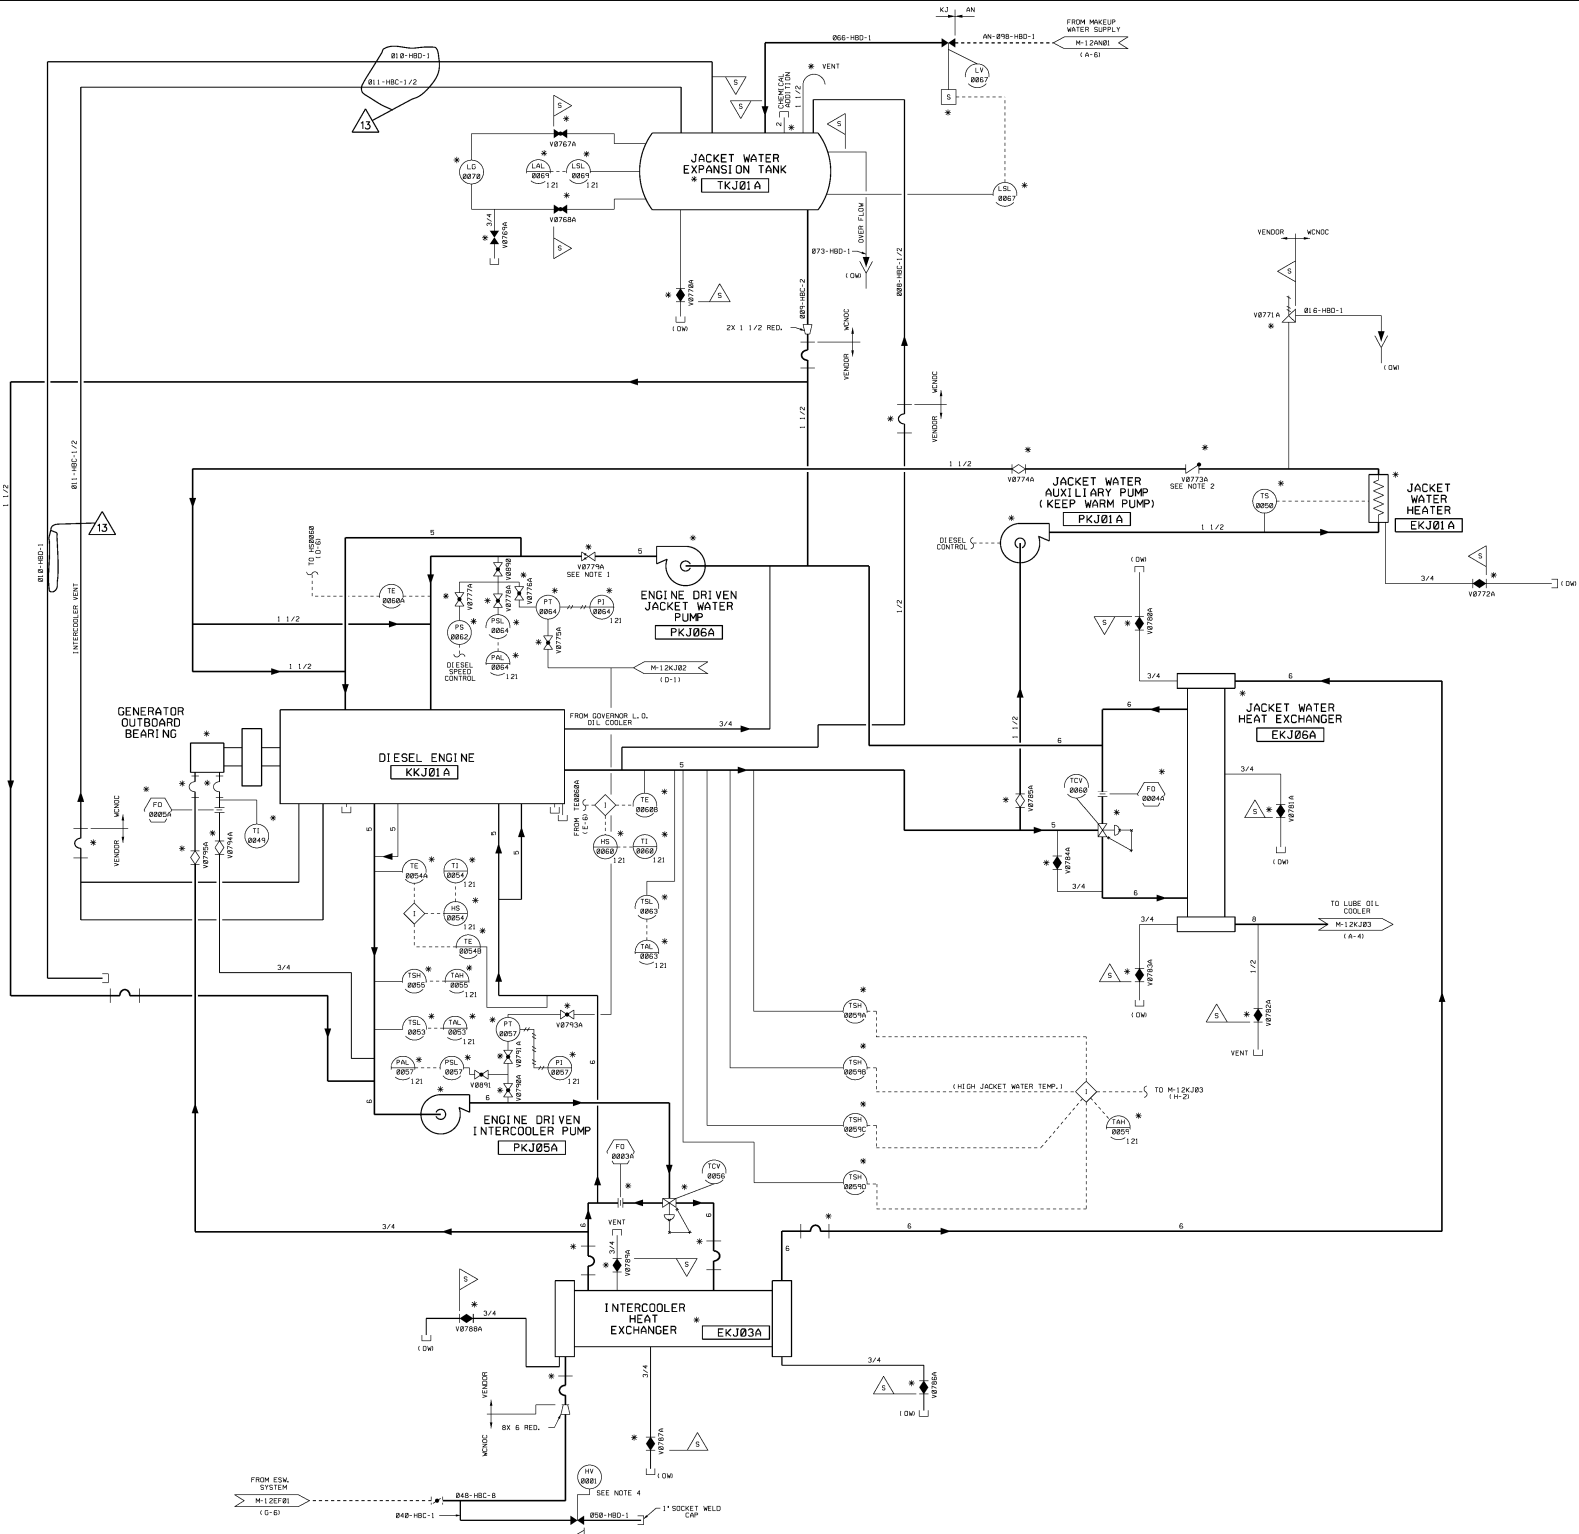

USAR FIG. 9.5.5-1-01

ESSENTIAL DRAWING			
REVISED	INCORPORATED	CR-0088438	CHANGE FILE NO.
DESIGNED	CHK'D		
THIS DRAWING BY	SK	SEE SK APPROVAL	REL.
REVISION NEEDED	REVIEWED TO DELETE NOTE 3 PER CR-0088438.		
		ELECTRONIC APPROVAL	
PIPING & INSTRUMENTATION DIAGRAM			
STANDBY DIESEL GENERATOR "A"			
COOLING WATER SYSTEM			
SCALE	AS SHOWN	DATE	13
NONE		M-12KJ01	



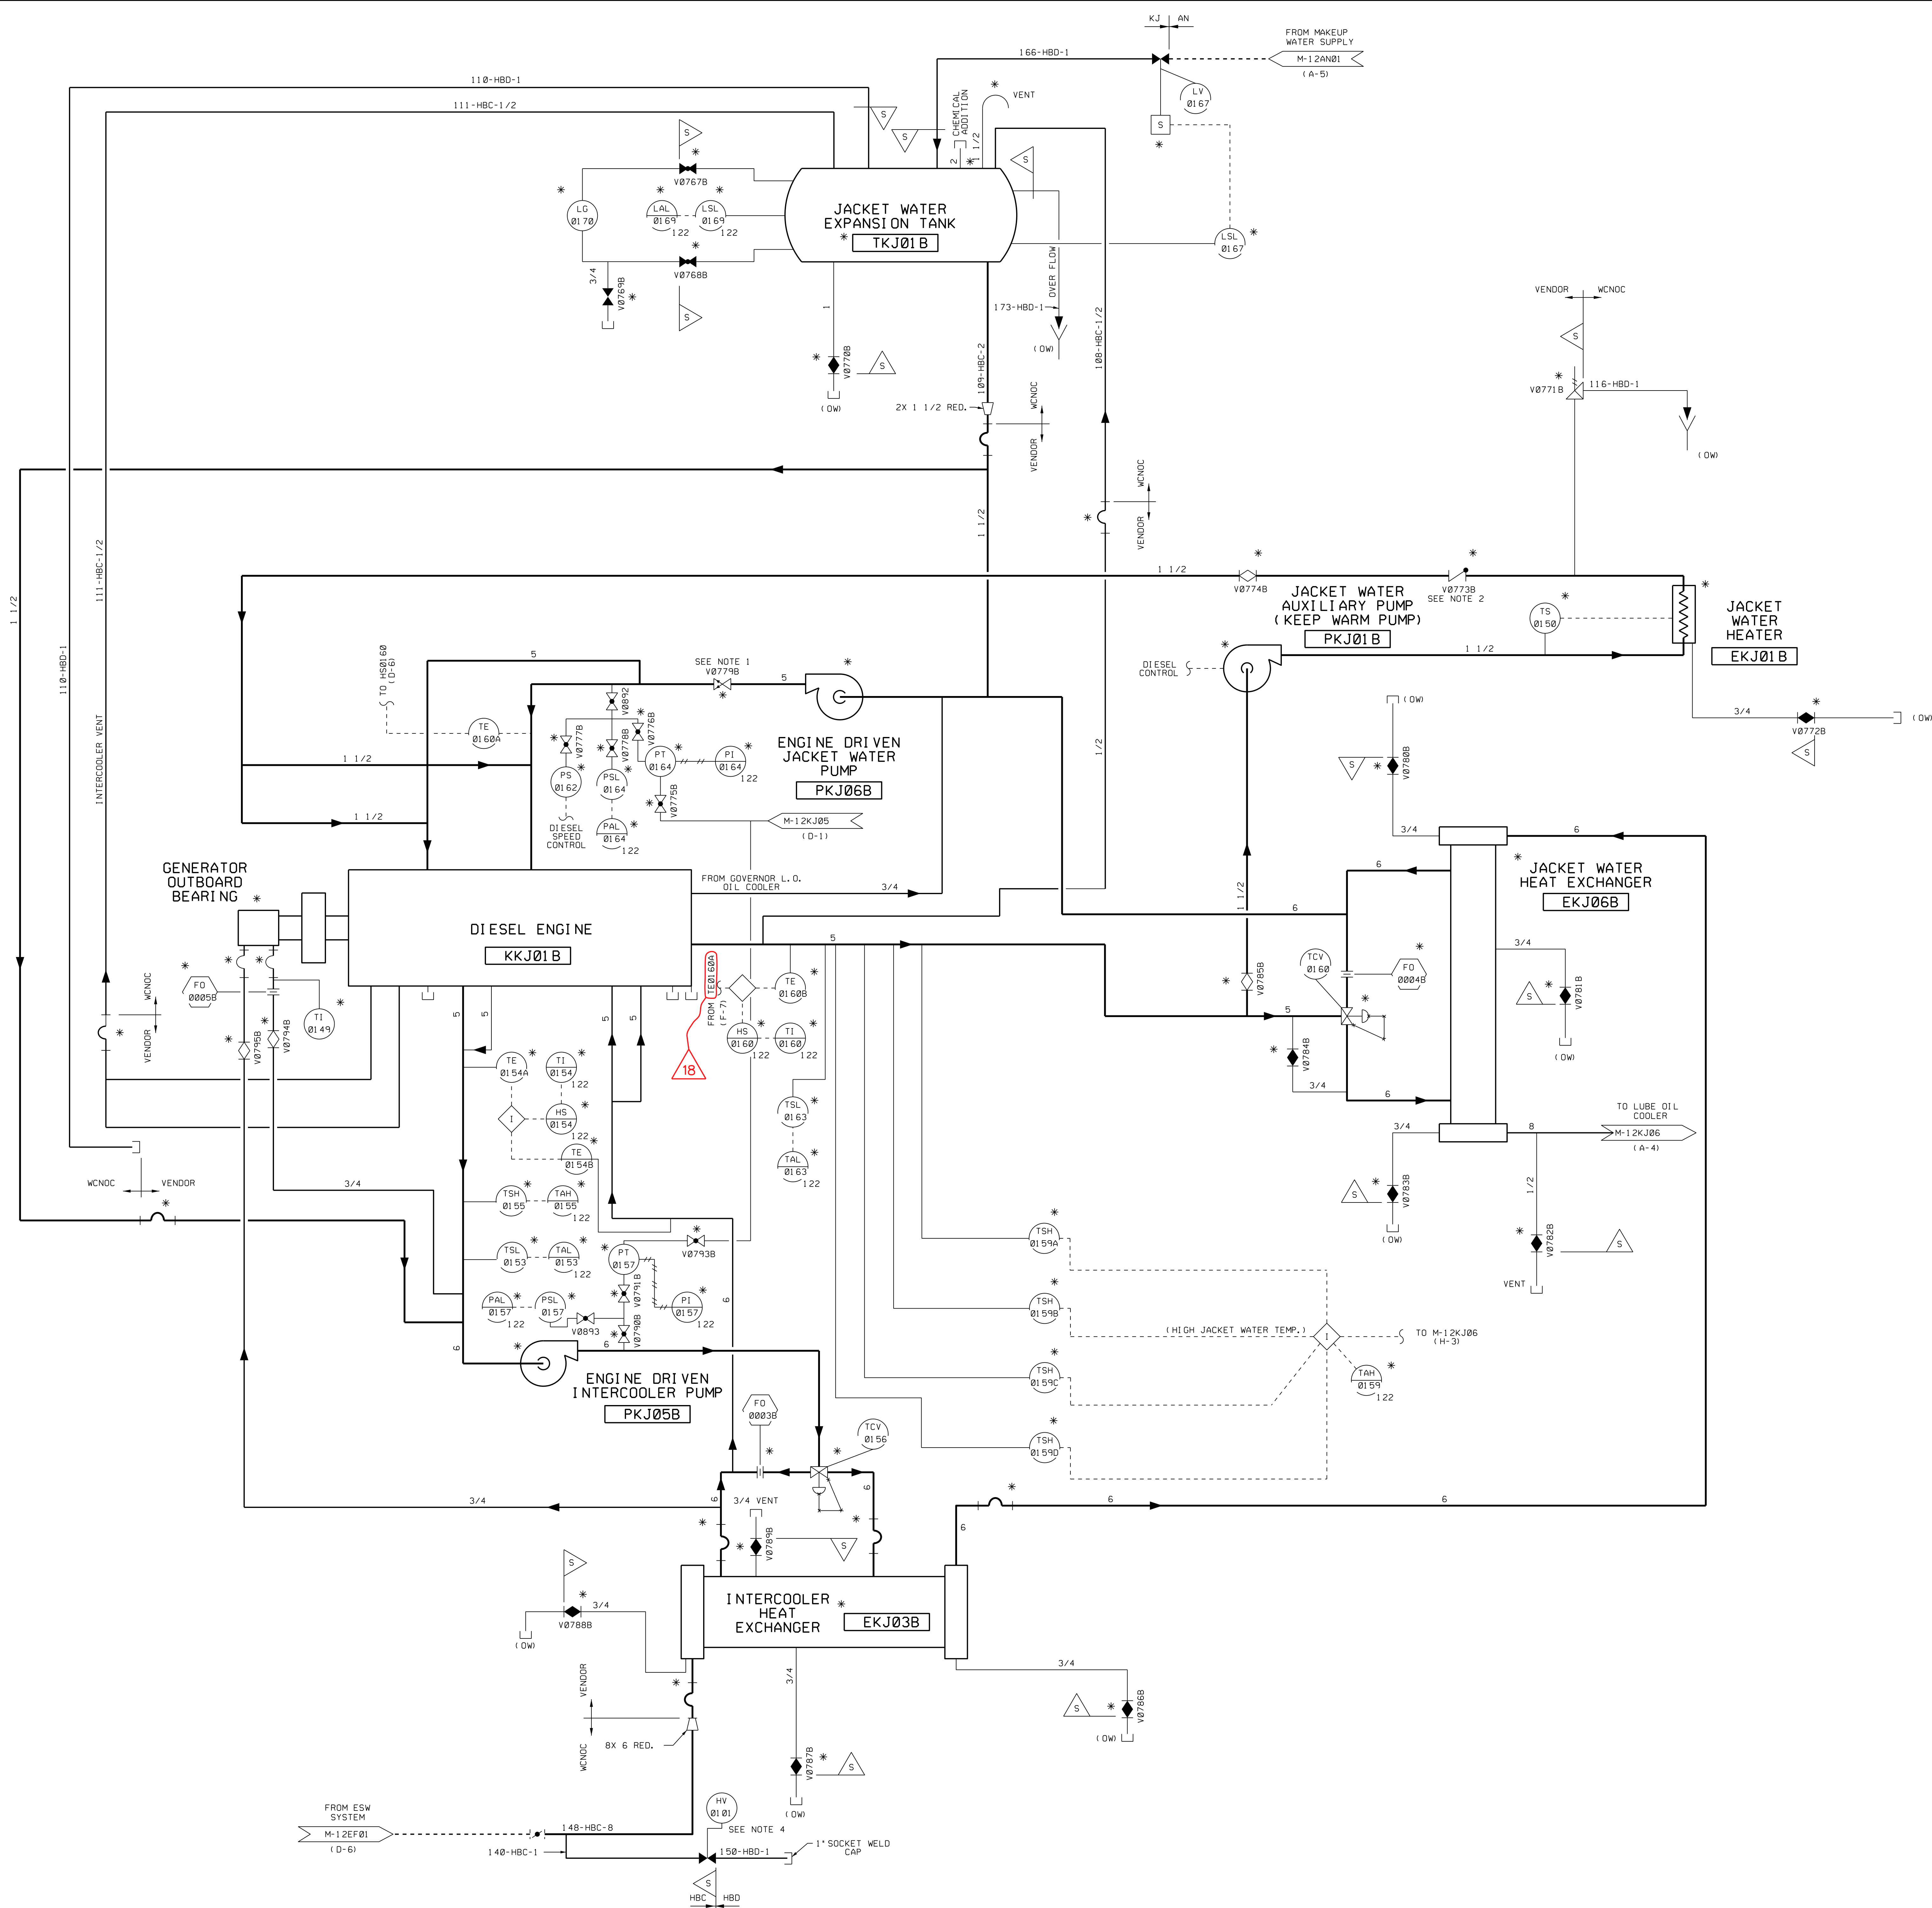

NOTES

1. REPRESENTS A DUAL PLATE CHECK VALVE.
2. THE INTERNALS OF VALVE V0773B HAS BEEN REMOVED.
3. DELETED
4. KJHV0101 IS ABANDONED IN PLACE AND BLOCKED CLOSED WITH THE ACTUATOR REMOVED.

USAR FIG. 9.5.5-1-02

ESSENTIAL DRAWING

REVISED	INCORPORATED	CR 00094692	CHANGE
ISSUED	CHG. DOC.		PKG. NO.
THIS ENG. SUPERSEDES BY		REV.	THIS ENG. SUPERSEDES
REVISION NOTES:			

WOLF CREEK
NUCLEAR OPERATING CORPORATION


ELECTRONIC
APPROVAL

**PIPING & INSTRUMENTATION DIAGRAM
STANDBY DIESEL GENERATOR "B"
COOLING WATER SYSTEM**



SCALE	DRAWING NUMBER	SHEET	REV
NONE	M-12KJ04	1	18



M-12KJ04-1-18

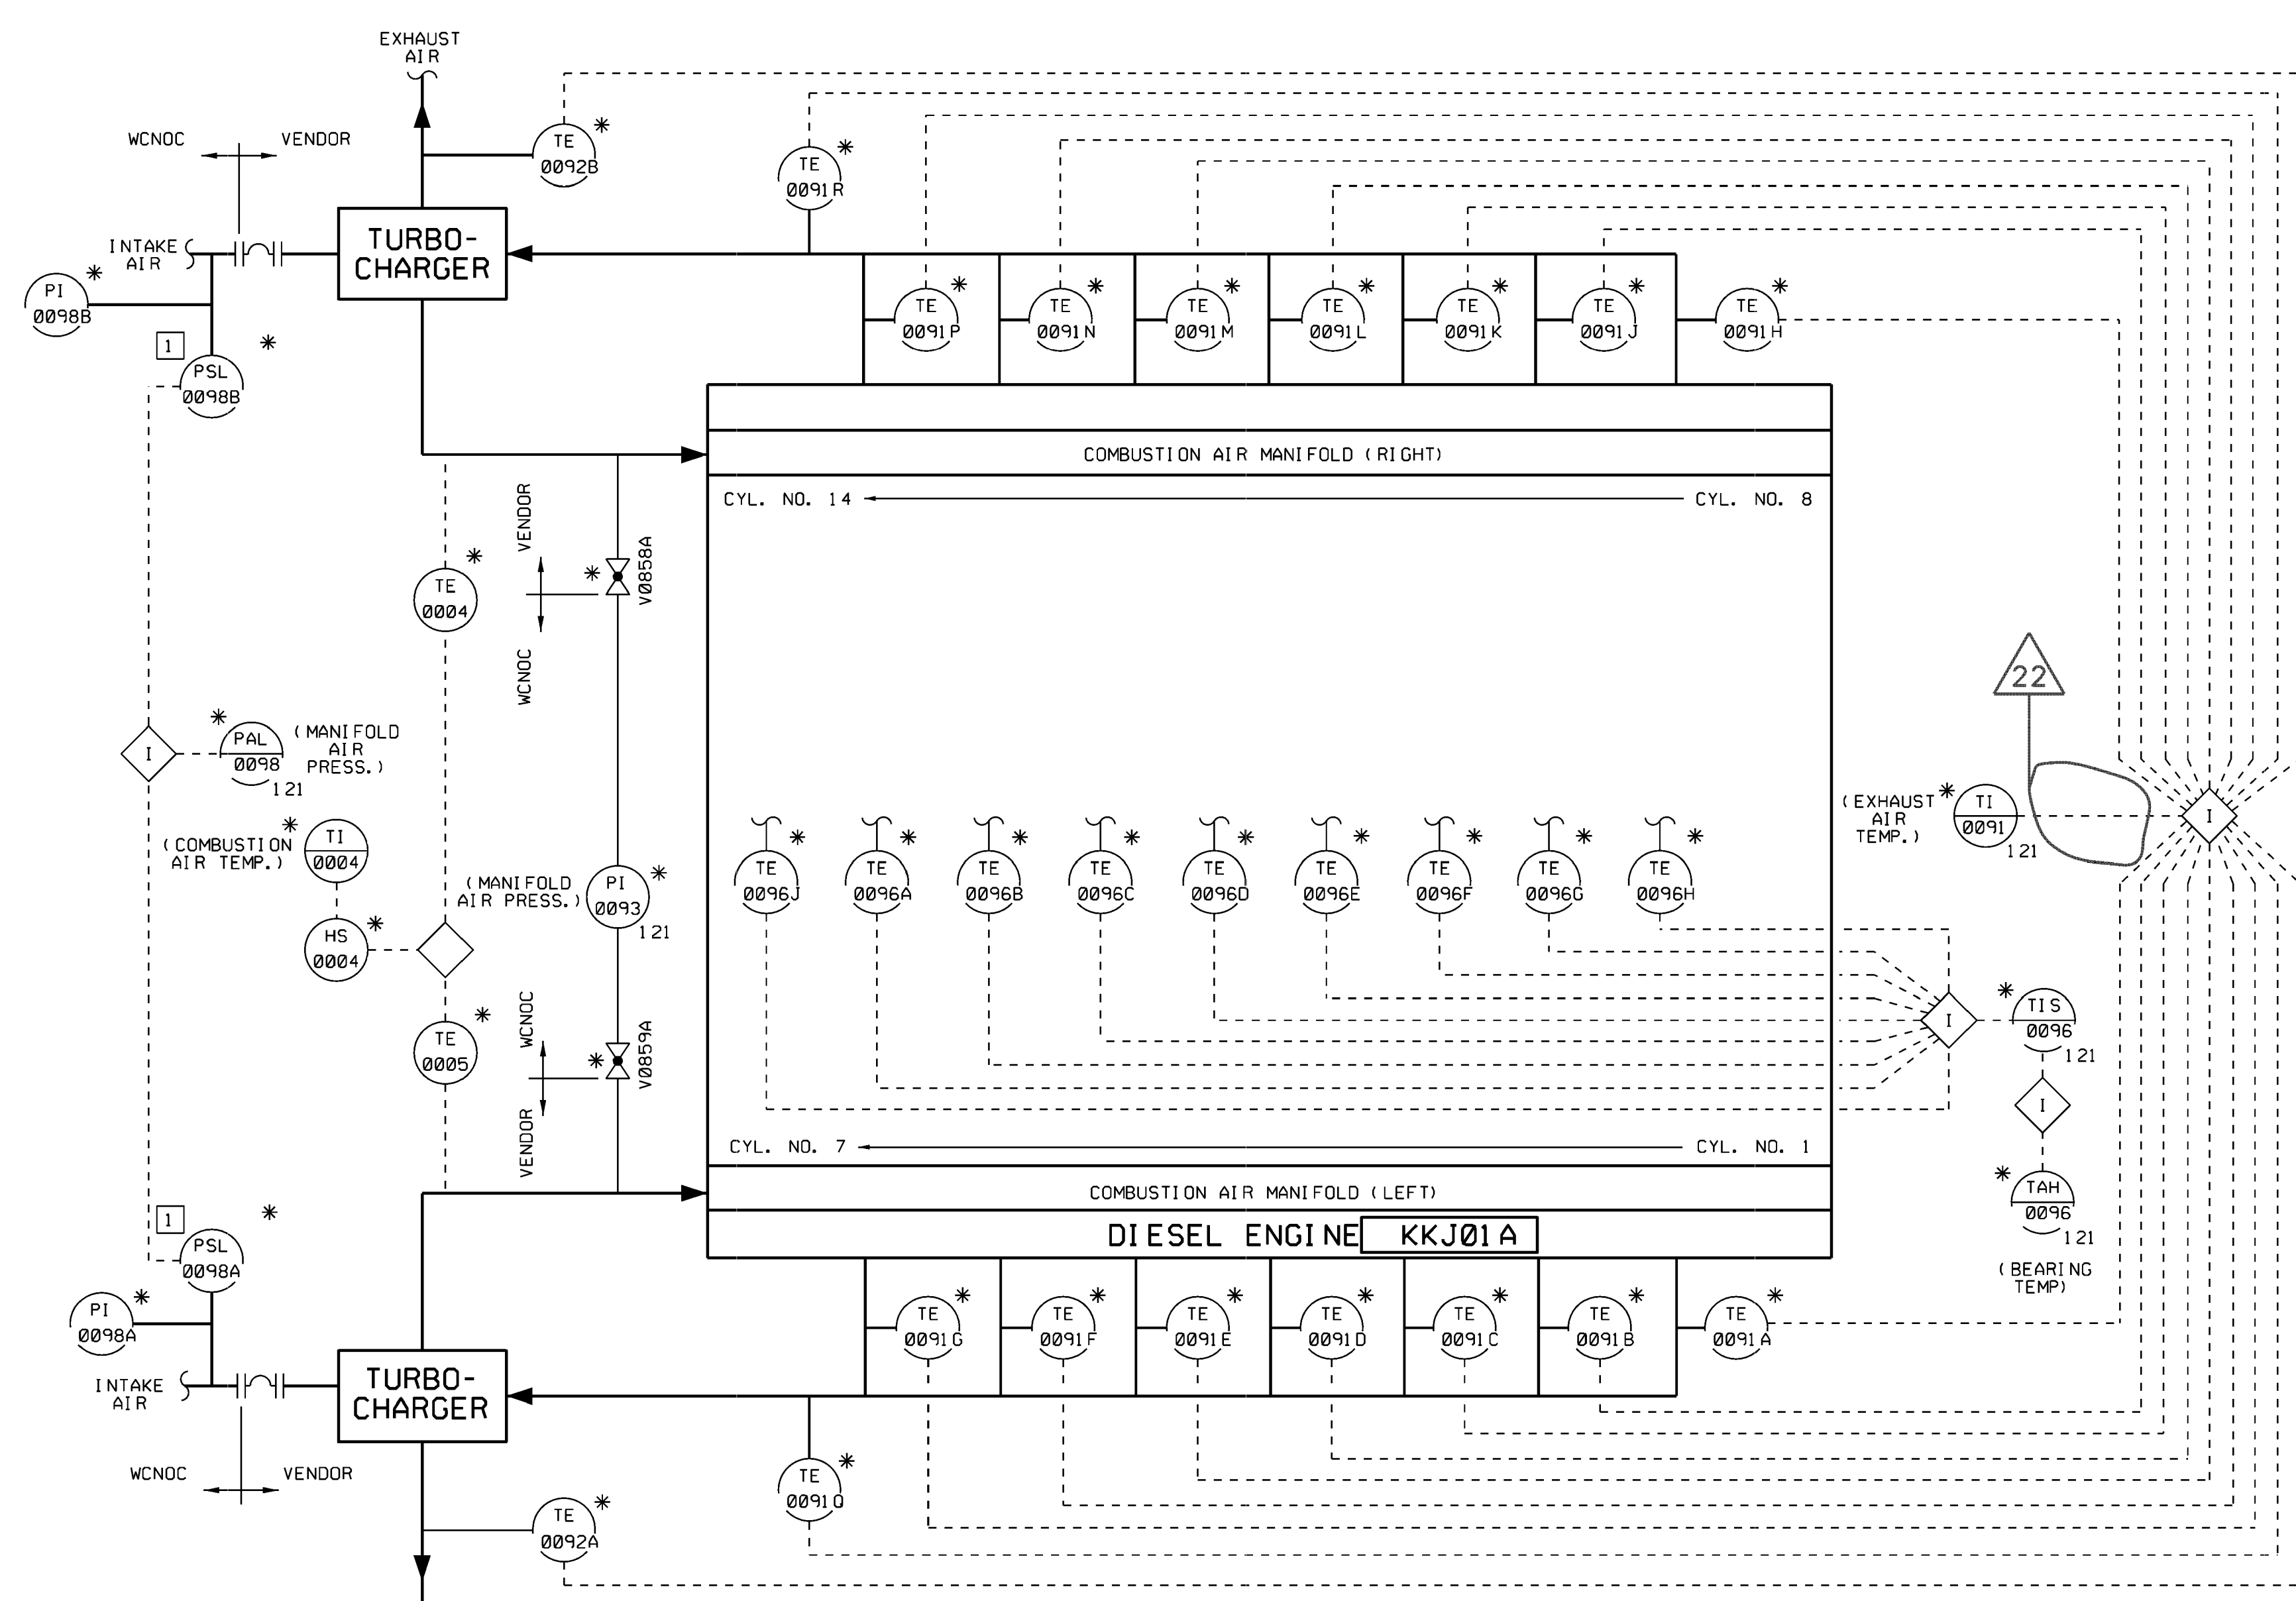

DETAIL "A"

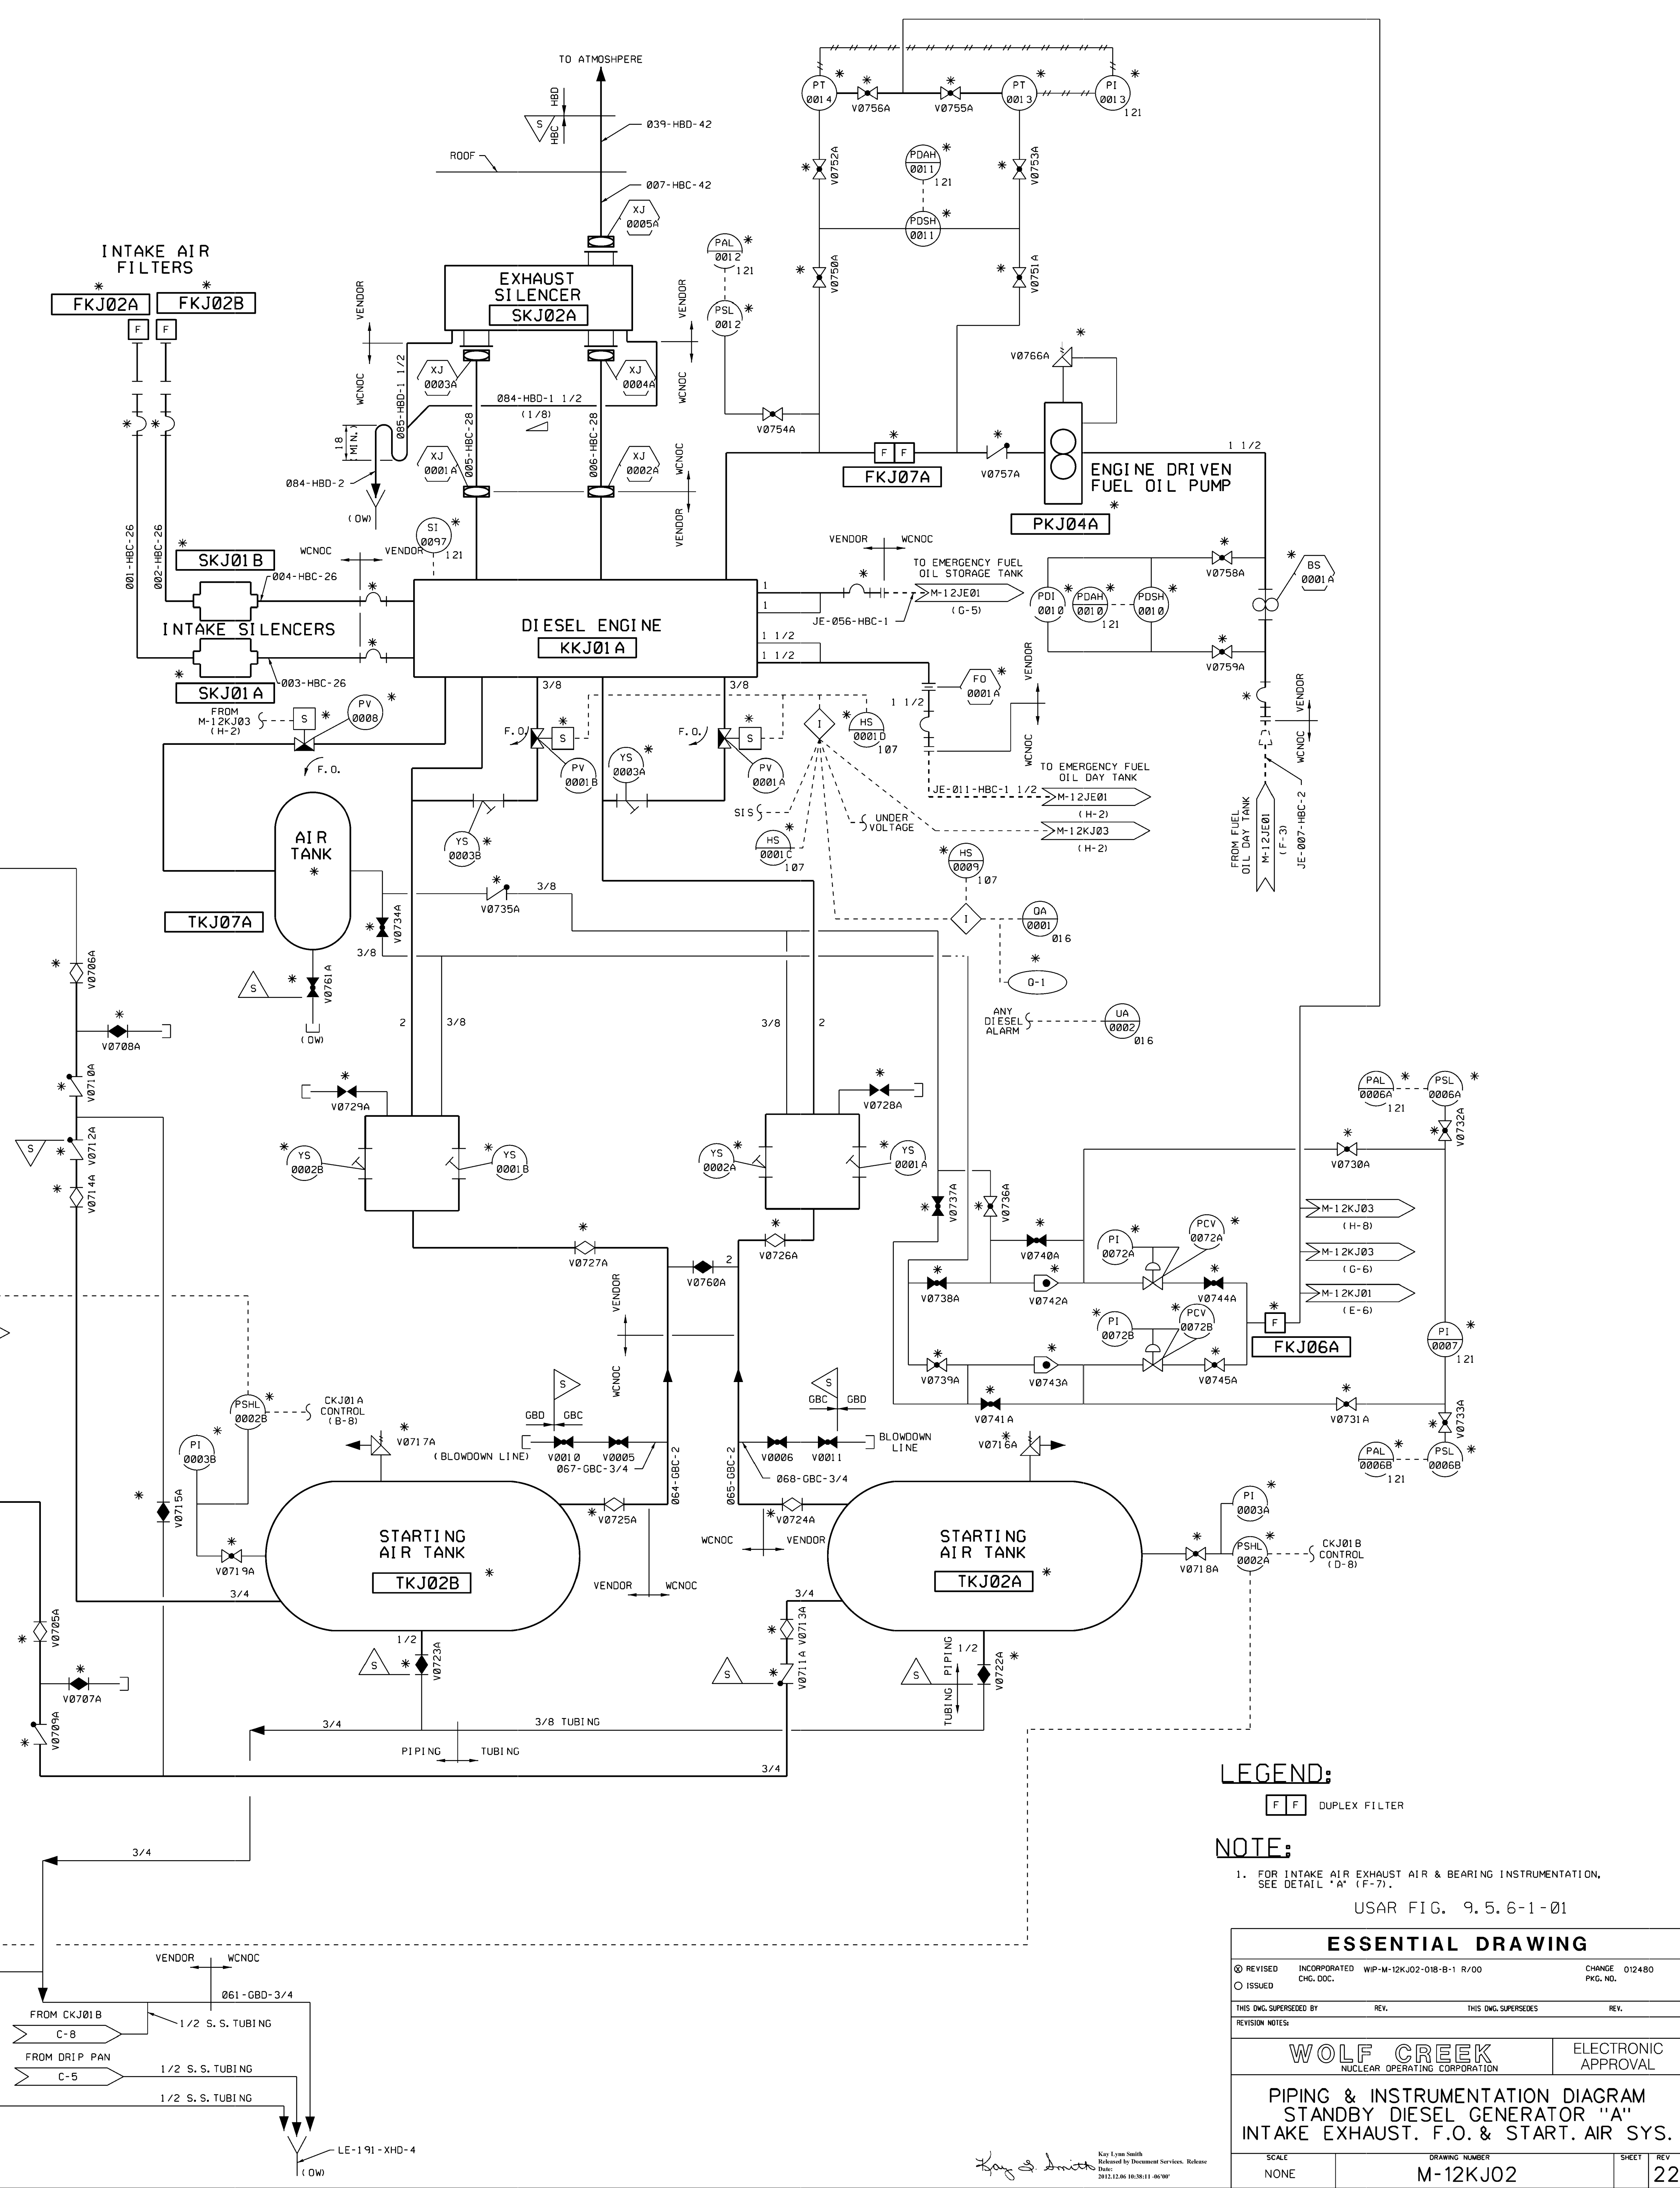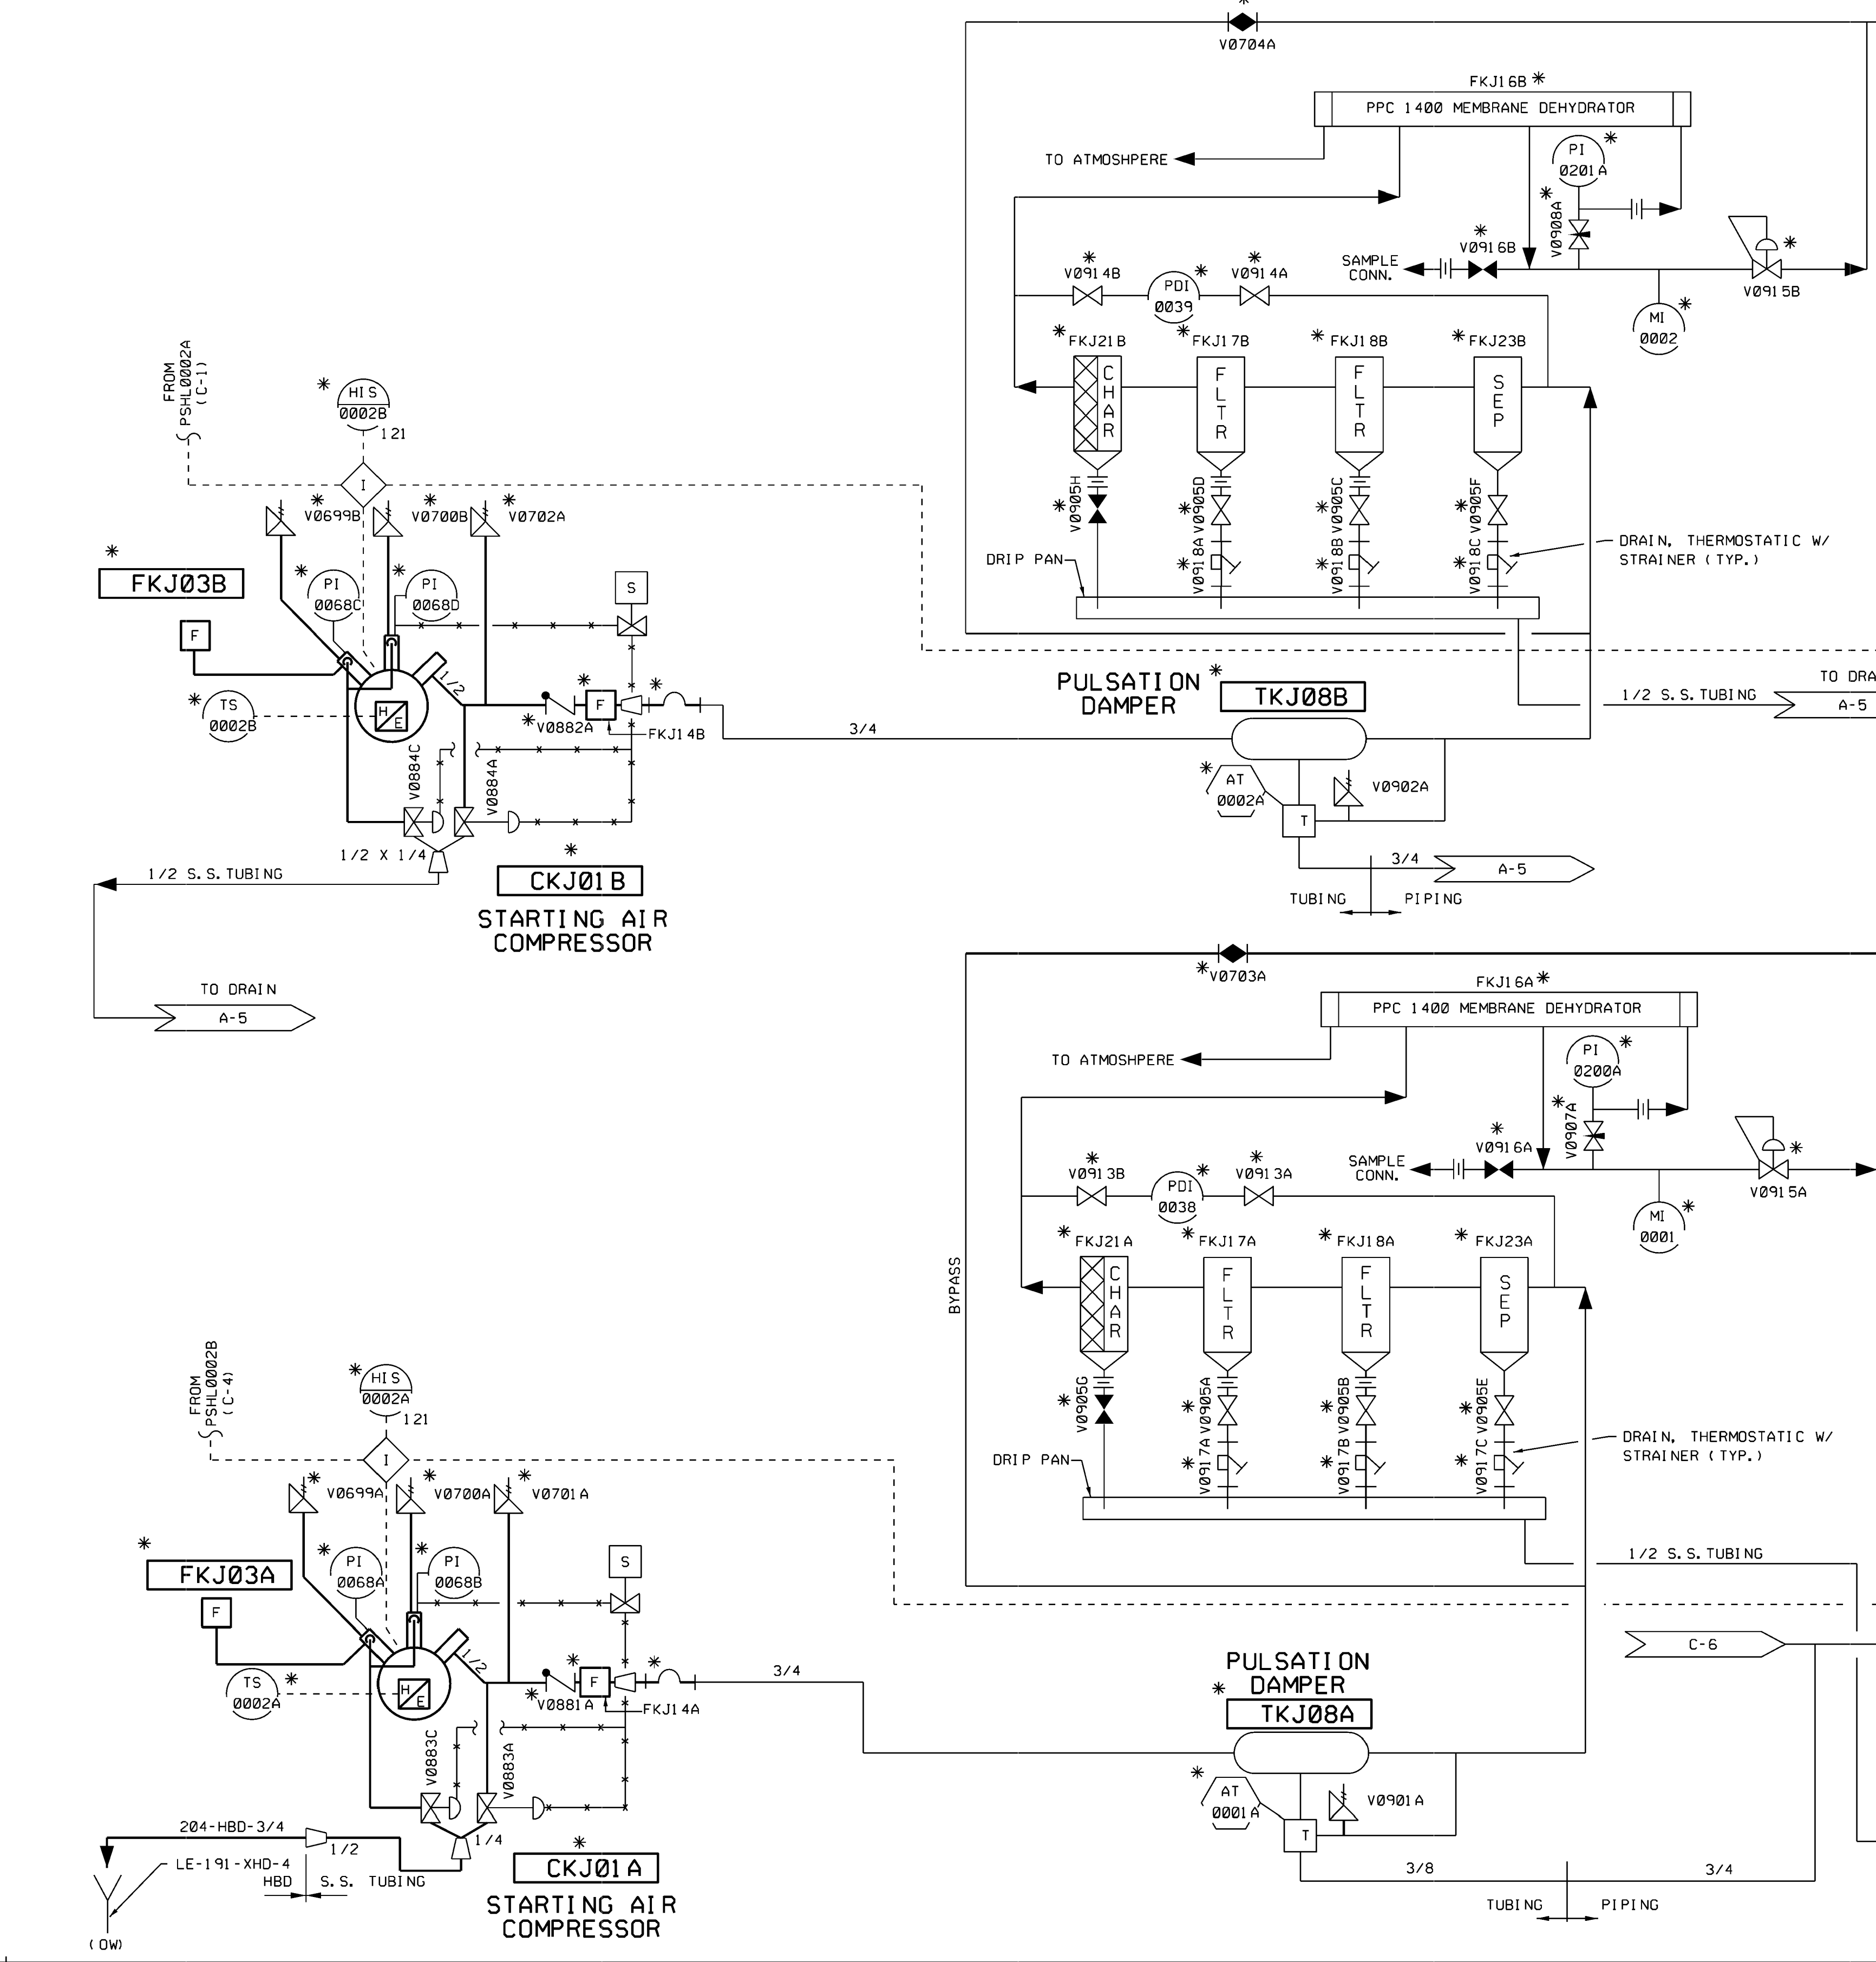


LEGEND:
 FF DUPLEX FILTER

NOTE:
 1. FOR INTAKE AIR EXHAUST AIR & BEARING INSTRUMENTATION, SEE DETAIL "A" (F-7).

USAR FIG. 9.5.6-1-01

ESSENTIAL DRAWING			
REVISED	INCORPORATED	W/P-M-12KJ02-01B-1 R/00	CHANGE 012480
ISSUED	CHG. DOC.		PKG. NO.
THIS ENG. SUPERSEDES BY		REV.	THIS ENG. SUPERSEDES
REVISION NOTES			REL.
WOLF CREEK		ELECTRONIC APPROVAL	
NUCLEAR OPERATING CORPORATION			
PIPING & INSTRUMENTATION DIAGRAM			
STANDBY DIESEL GENERATOR "A"			
INTAKE EXHAUST, F.O. & START. AIR SYS.			
SCALE	DRAWING NUMBER	SHEET	REV.
NONE	M-12KJ02	22	



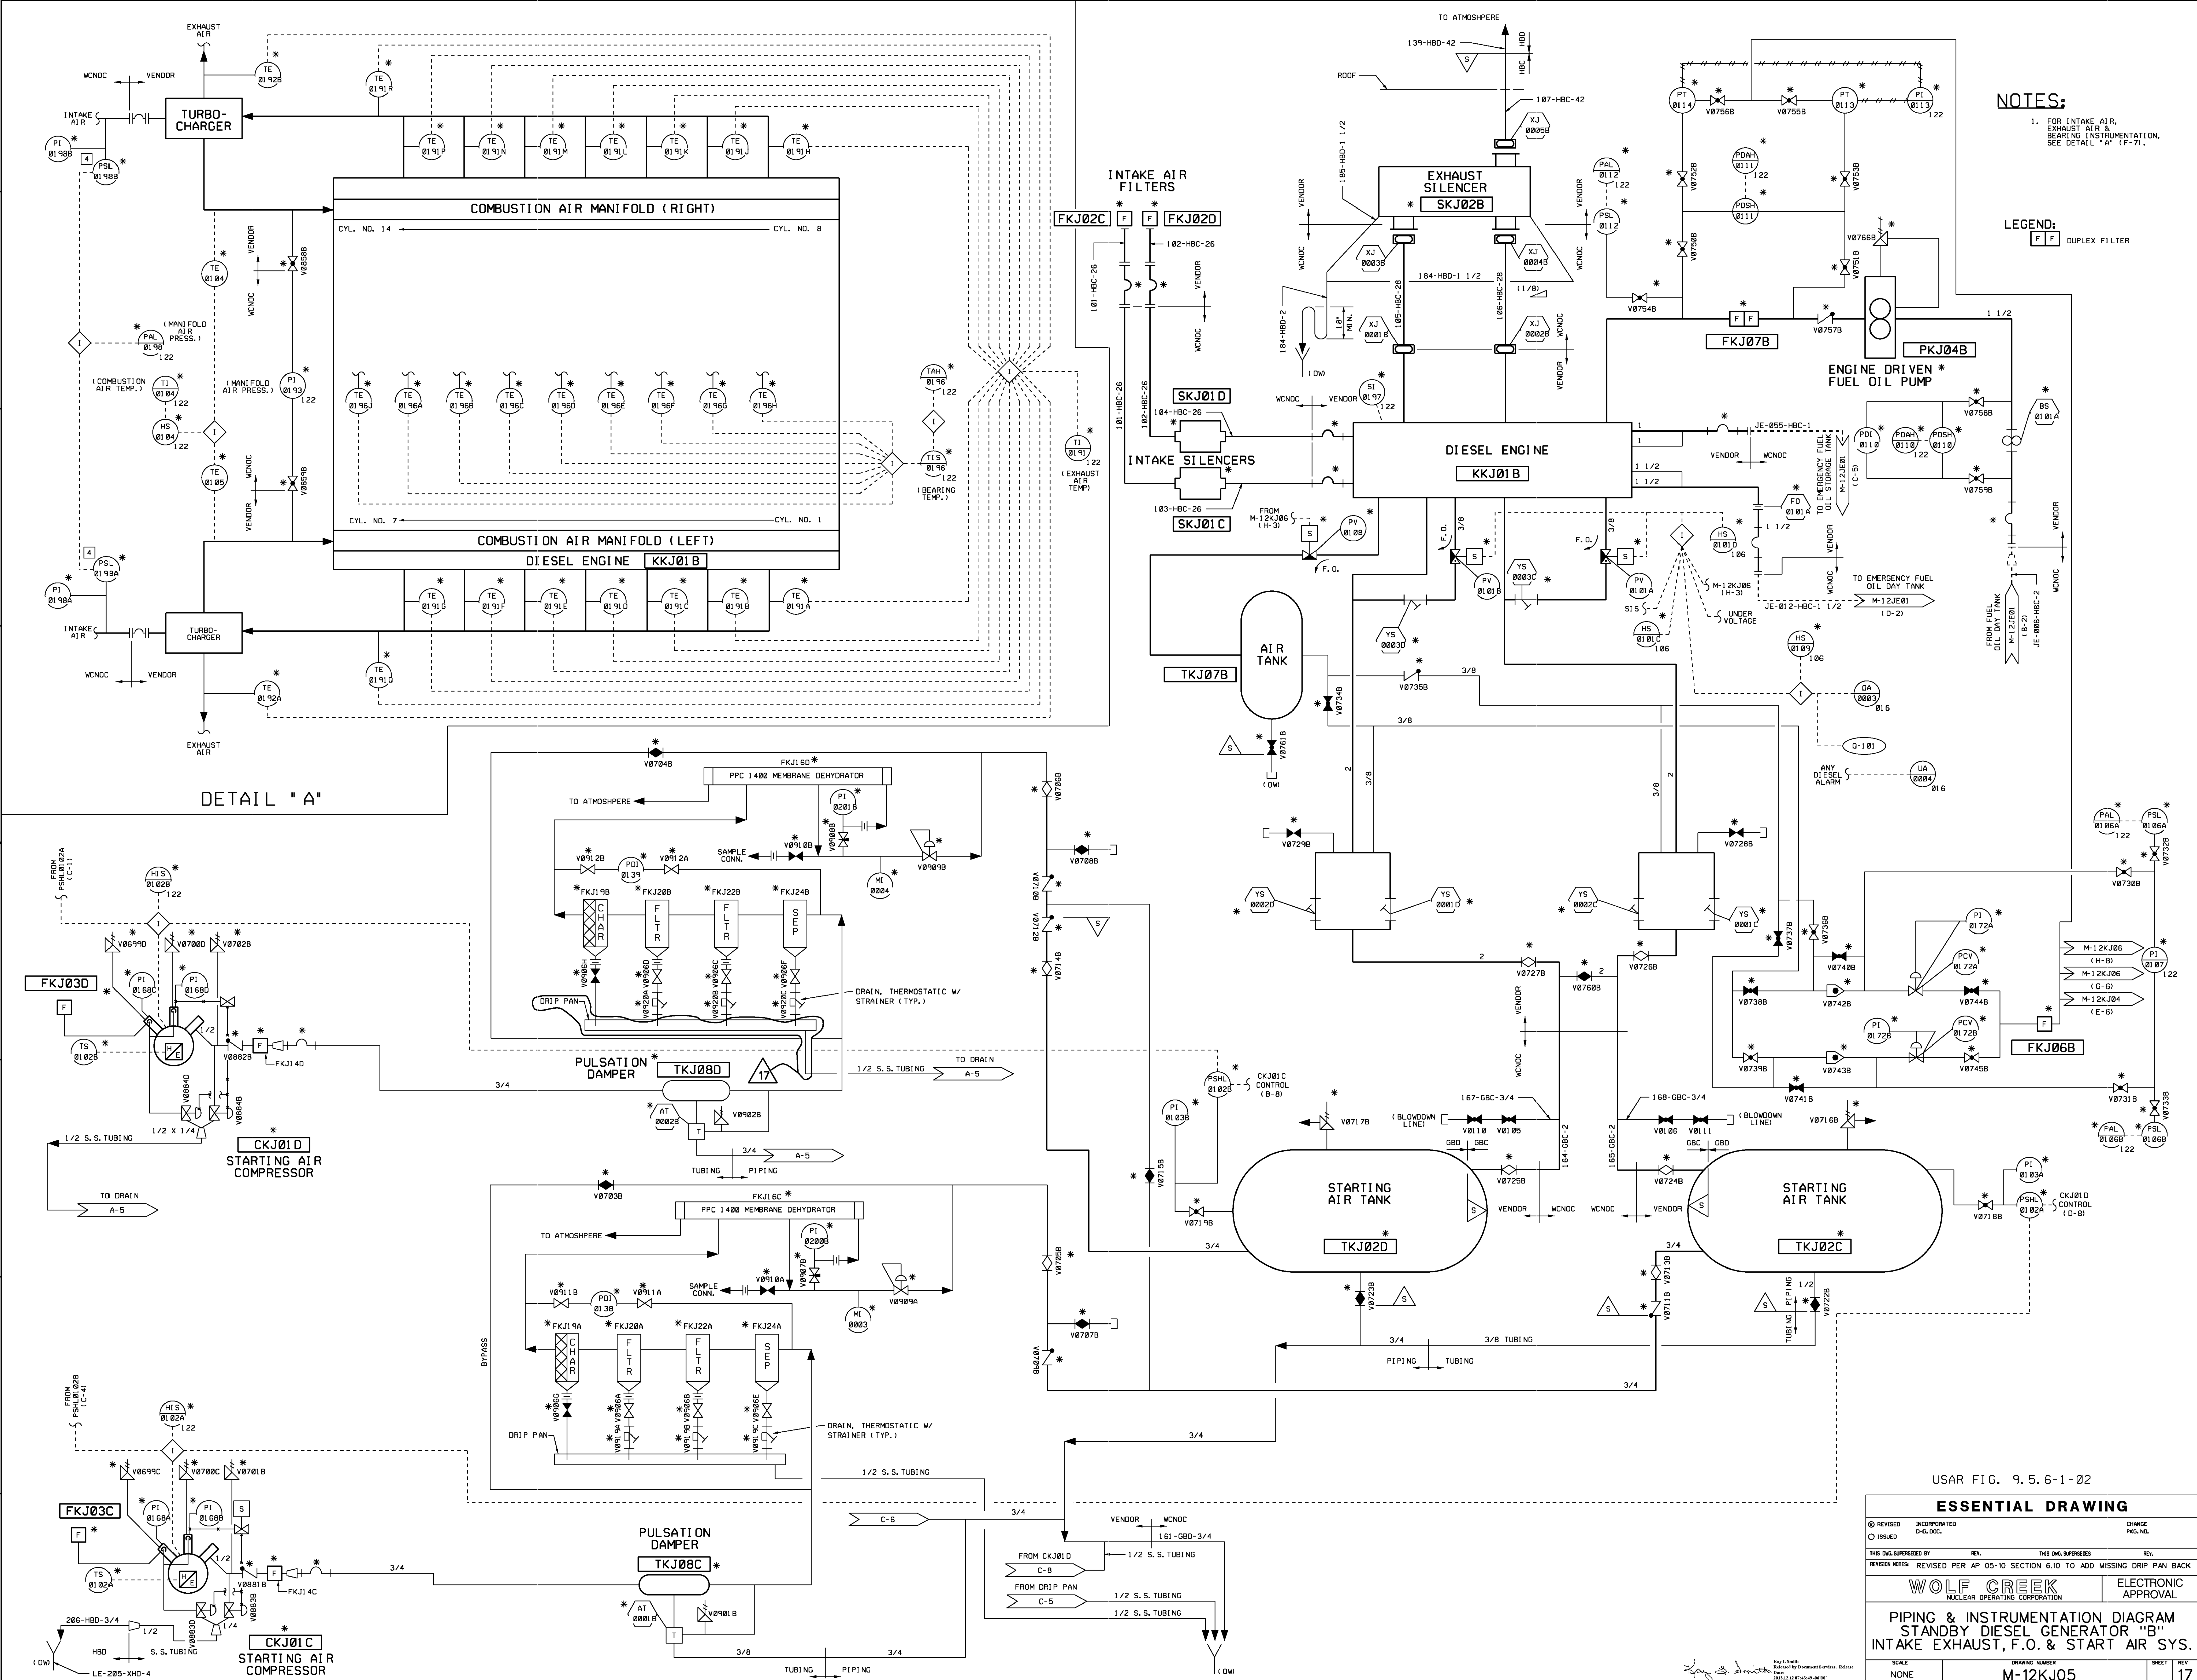

NOTES:
 1. FOR INTAKE AIR, EXHAUST AIR & BEARING INSTRUMENTATION, SEE DETAIL "A".

LEGEND:
 F F DUPLEX FILTER


DETAIL "A"

USAR FIG. 9.5.6-1-02

ESSENTIAL DRAWING

REVISION	INCORPORATED	CHANGE
ISSUED	ENG. DOC.	FIG. NO.
THIS ENG. SUPERSEDES		
REVISION NOTES	REVISED PER AP 05-10 SECTION 6.10 TO ADD MISSING DRIP PAN BACK	REV.
WOLF CREEK		ELECTRONIC APPROVAL
NUCLEAR OPERATING CORPORATION		
PIPING & INSTRUMENTATION DIAGRAM		
STANDBY DIESEL GENERATOR "B"		
INTAKE EXHAUST, F.O. & START AIR SYS.		
SCALE	DRAWING NUMBER	SHEET
NONE	M-12KJ05	17



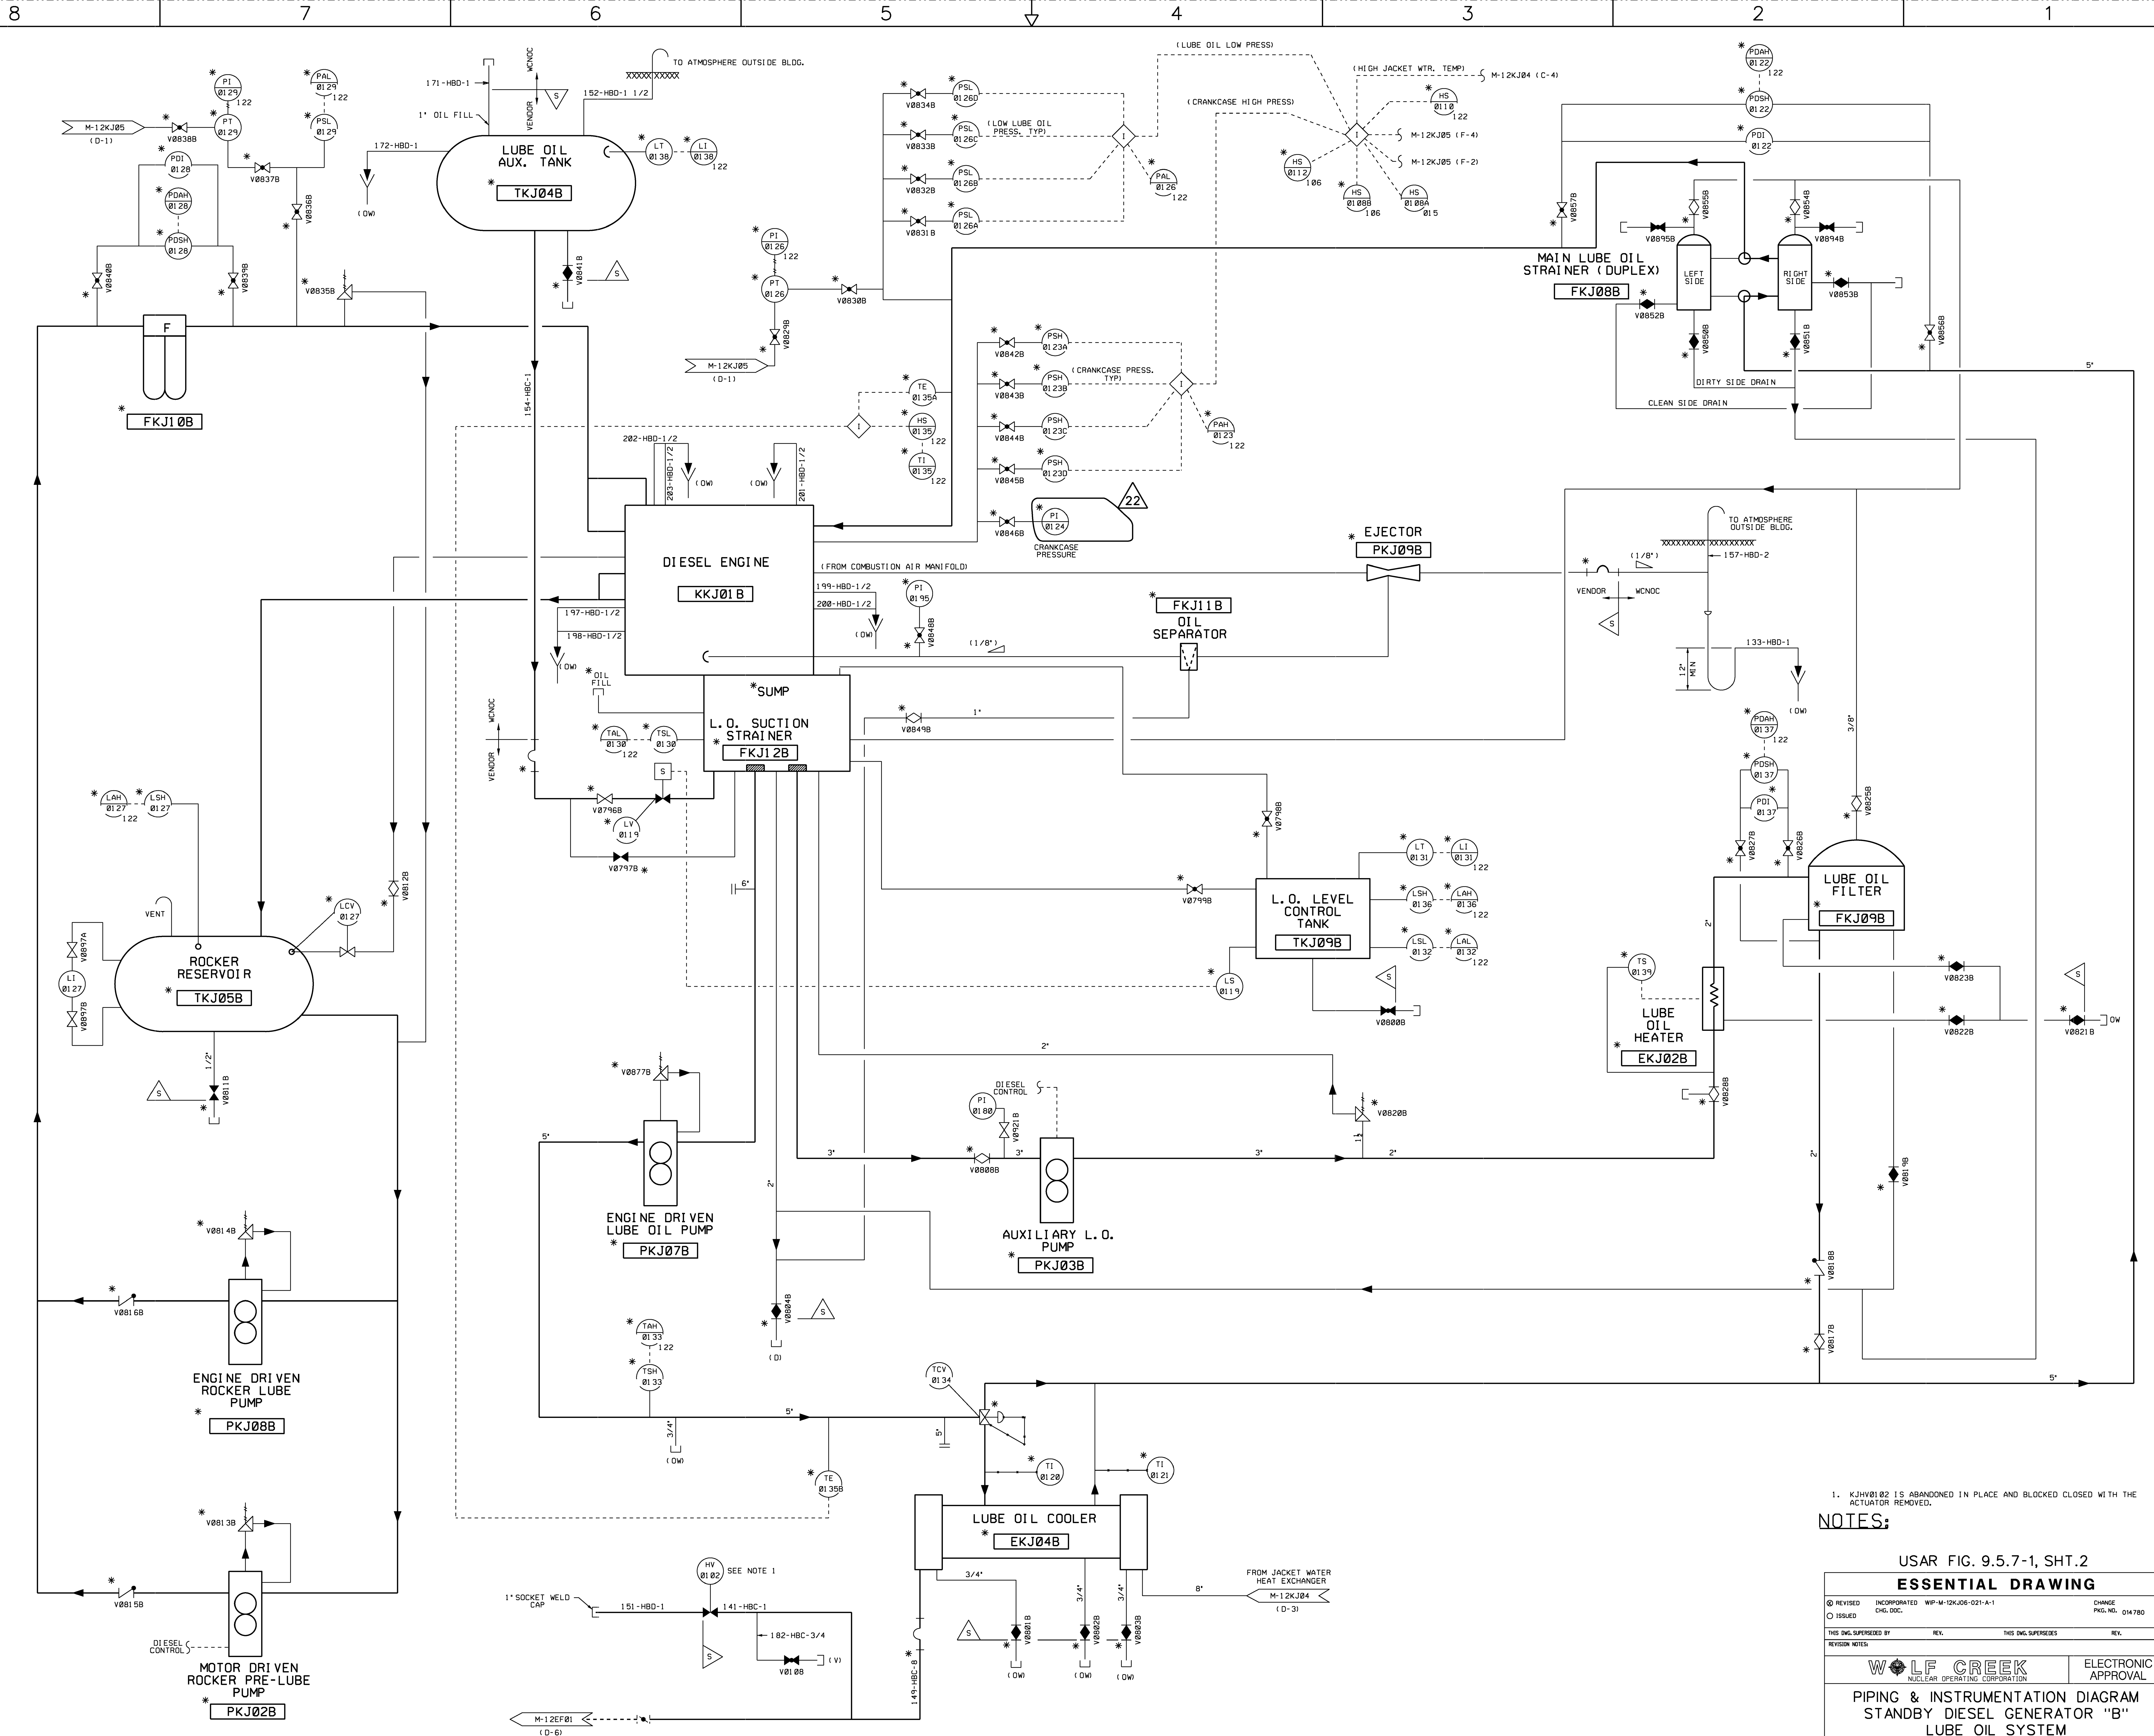


1. KJHV0102 IS ABANDONED IN PLACE AND BLOCKED CLOSED WITH THE ACTUATOR REMOVED.

NOTES:

USAR FIG. 9.5.7-1, SHT.2
ESSENTIAL DRAWING

REVISED	INCORPORATED	WFP-M-12KJ06-021-A-1	CHANGE
ISSUED	CHG. DOC.		FIG. NO. 014780
THIS ENG. SUPERSEDES BY		REV.	THIS ENG. SUPERSEDES
REVISION NOTES:			
		ELECTRONIC APPROVAL	
PIPING & INSTRUMENTATION DIAGRAM STANDBY DIESEL GENERATOR "B" LUBE OIL SYSTEM			
SCALE	NONE	DRAWING NUMBER	M-12KJ06
SHEET	22	REV.	22

John H. ...
1. Lube Oil Coolers
 2. Jacket Water Heat Exchanger
 3. Diesel Engine
 4. Diesel Generator
 5. Diesel Generator Control
 6. Diesel Generator Fuel System
 7. Diesel Generator Lube Oil System
 8. Diesel Generator Cooling System
 9. Diesel Generator Exhaust System
 10. Diesel Generator Ventilation System

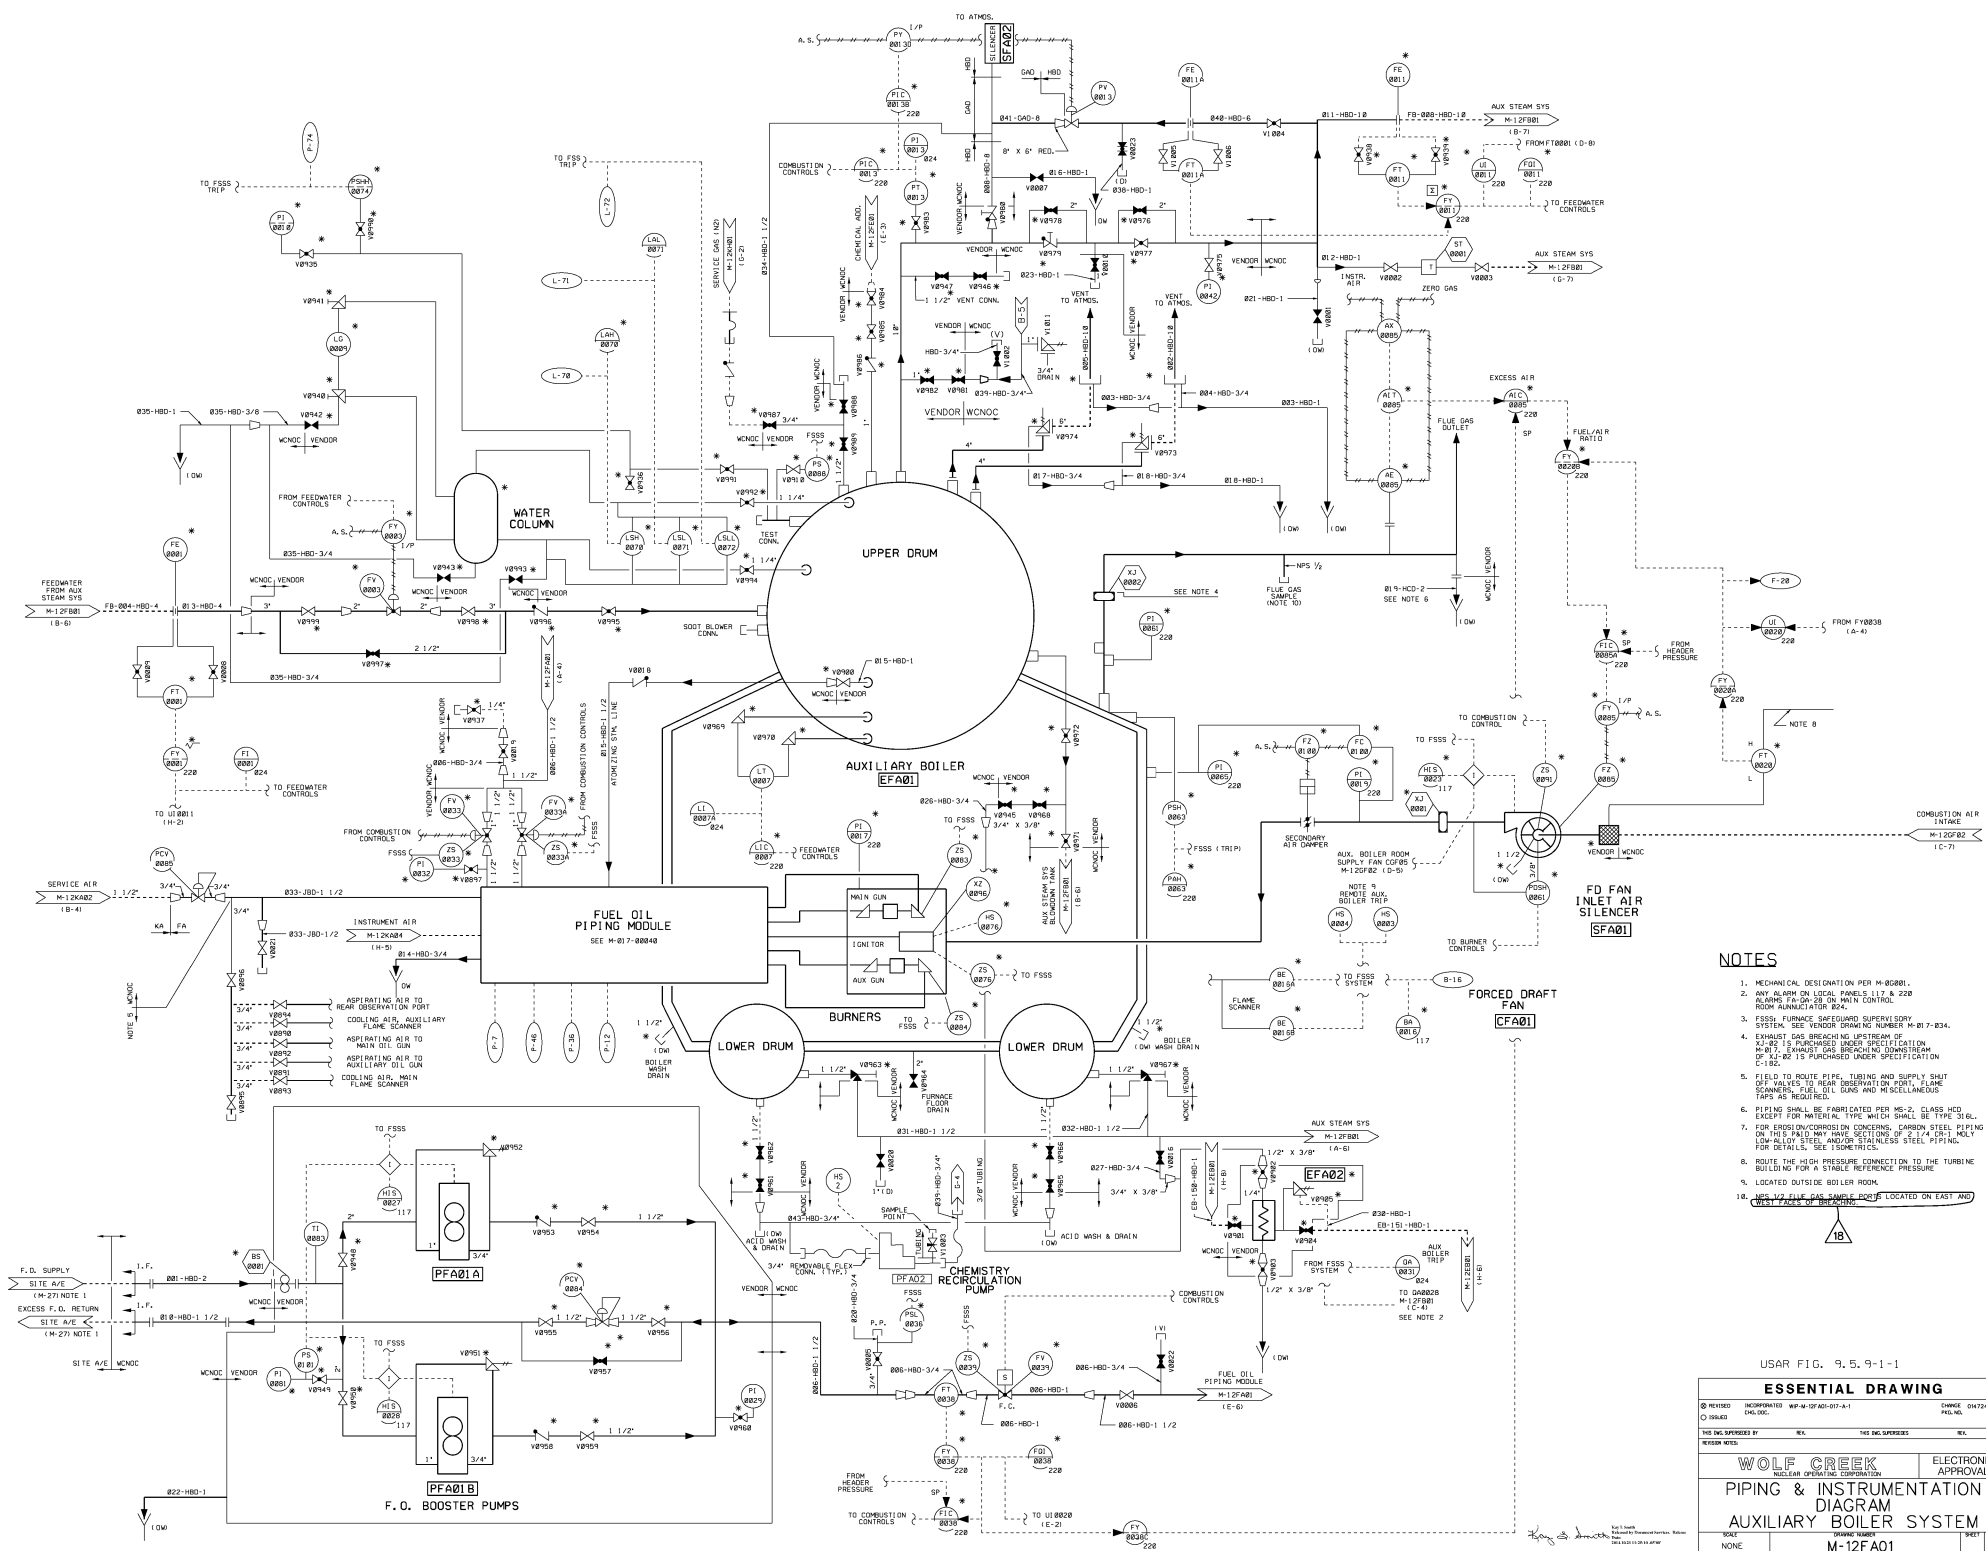

- NOTES**
- MECHANICAL DESIGNATION PER M-808R1.
 - ANY ALARM ON LOCAL PANELS 117 & 228 ALARMS FOR SH-28 OR MAIN CONTROL ROOM ALARMATOR B24.
 - FSSS: FURNACE SAFETY SYSTEM SUPERVISORY SYSTEM. SEE VENDOR DRAWING NUMBER M-817-834.
 - EXHAUST GAS BREACHING UPSTREAM OF A-2-27 IS PURCHASED UNDER SPECIFICATION M-817-834. EXHAUST GAS BREACHING DOWNSTREAM OF A-2-27 IS PURCHASED UNDER SPECIFICATION C-1-2.
 - FIELD TO ROUTE PIPE, TUBING AND SUPPLY SHUT OFF VALVES TO BEAR OBSERVATION POINT.
 - PIPING SHALL BE FABRICATED PER MS-2, CLASS HCD EXCEPT FOR MATERIAL TYPE WHICH SHALL BE TYPE 316L.
 - FOR EXHAUST/GAS/COOLING CONDENSING, CARBON STEEL PIPING ON THIS PAID MAY HAVE SECTIONS OF 3/4" (CR1) HOLEY LOW ALLOY STEEL AND/OR STAINLESS STEEL PIPING. FOR DETAILS, SEE ISOMETRICS.
 - ROUTE THE HIGH PRESSURE CONNECTION TO THE TURBINE BUILDING FOR A STABLE REFERENCE PRESSURE.
 - LOCATED OUTSIDE BOILER ROOM.
 - SEE THE PIPE PANEL FOR 18 LOCATED ON EAST AND WEST SIDE OF BOILER.

USAR FIG. 9.5.9-1-1

ESSENTIAL DRAWING

REVISION	INCORPORATED	WP-4-07-AD-017-A-1	CHANGE	014724
DATE	01/04/00			
THIS DRAWING IS BY	REL	HS INC. (SPRINGS)	REL	

WOLF CREEK
NUCLEAR OPERATIONS CORPORATION

ELECTRONIC APPROVAL


PIPING & INSTRUMENTATION DIAGRAM

AUXILIARY BOILER SYSTEM

NO. M-12FA01

REV. 18



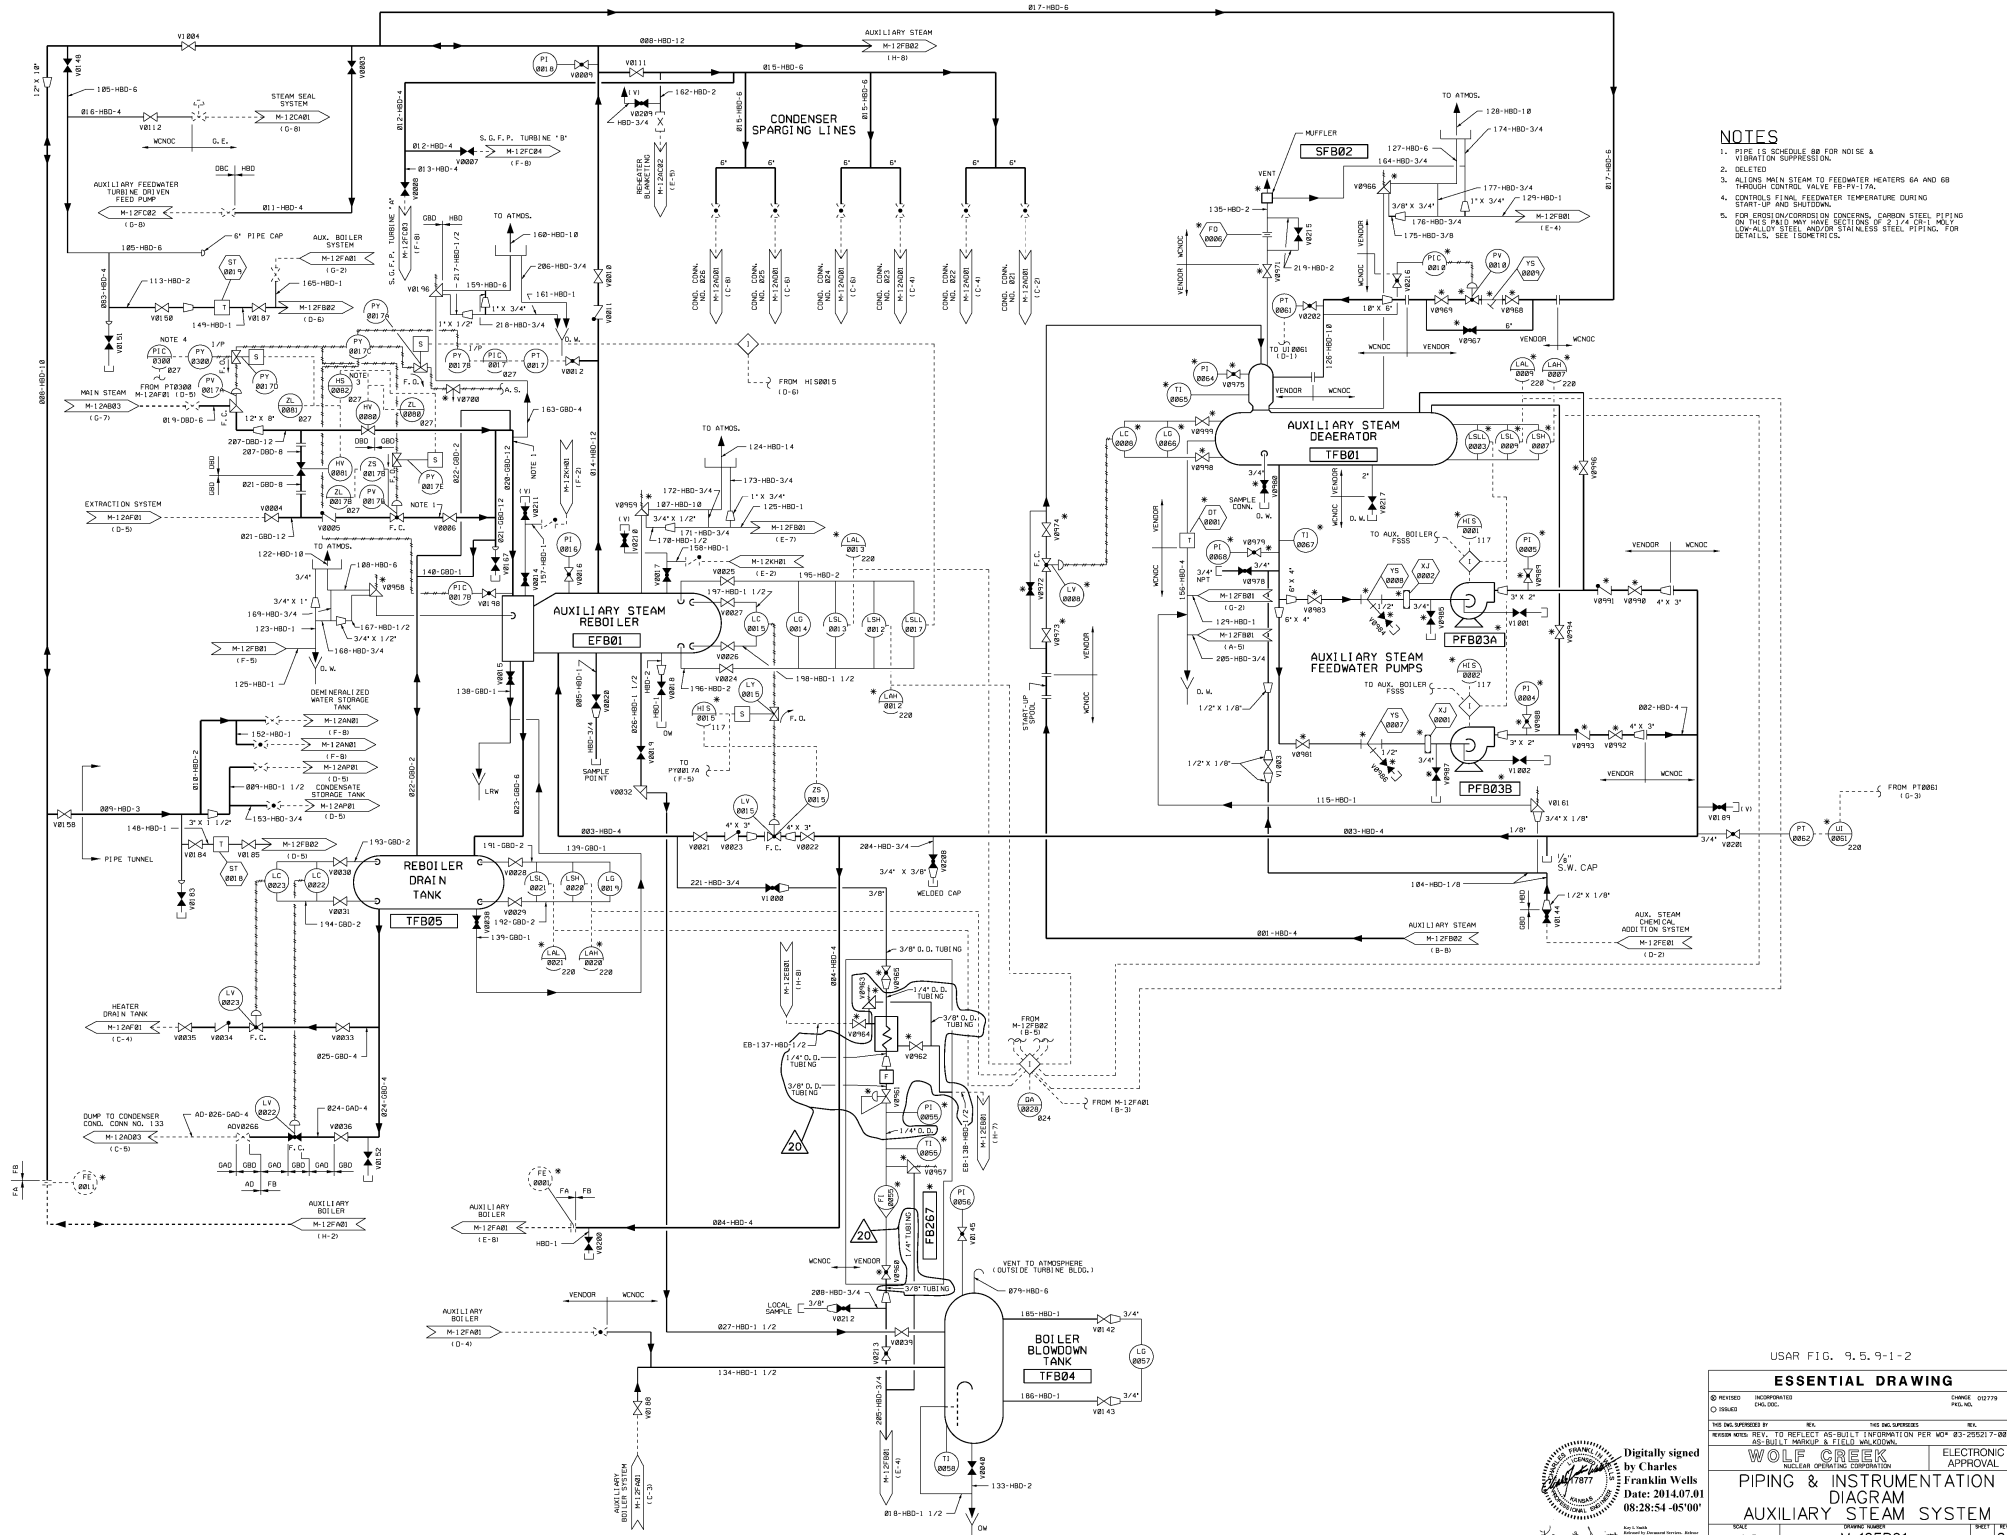

- NOTES**
1. PIPE IS SCHEDULE 80 FOR NOISE & VIBRATION SUPPRESSION.
 2. DELETED
 3. ALLOWS MAIN STEAM TO FEEDWATER HEATERS 6A AND 6B THROUGH CONTROL VALVE ES-PY-170.
 4. CONTROLS FINAL FEEDWATER TEMPERATURE DURING START-UP AND SHUTDOWN.
 5. FOR EROSION/CORROSION CONCERNS, CARBON STEEL PIPING ON THIS P&ID MAY HAVE SECTIONS OF 2" 1/4" O.D. 1" LOW-ALLOY STEEL AND/OR STAINLESS STEEL PIPING. FOR DETAILS, SEE ISOMETRIC.


USAR FIG. 9.5.9-1-2

ESSENTIAL DRAWING

REVISION	INCORPORATED	DATE	02/79
DESIGNED BY	CHKD BY	DATE	
THIS DRAWING IS THE PROPERTY OF THE UNITED STATES GOVERNMENT AND IS LOANED TO YOU. IT AND ITS CONTENTS ARE NOT TO BE DISTRIBUTED OUTSIDE YOUR ORGANIZATION.			
WOLFE ENGINEERING		ELECTRONIC APPROVAL	
PIPING & INSTRUMENTATION DIAGRAM			
AUXILIARY STEAM SYSTEM			
NO.	DATE	BY	REV.
1	2014.07.01		20
M-12FB01			

Digitally signed by Charles Franklin Wells
 Date: 2014.07.01 08:28:54 -05'00'



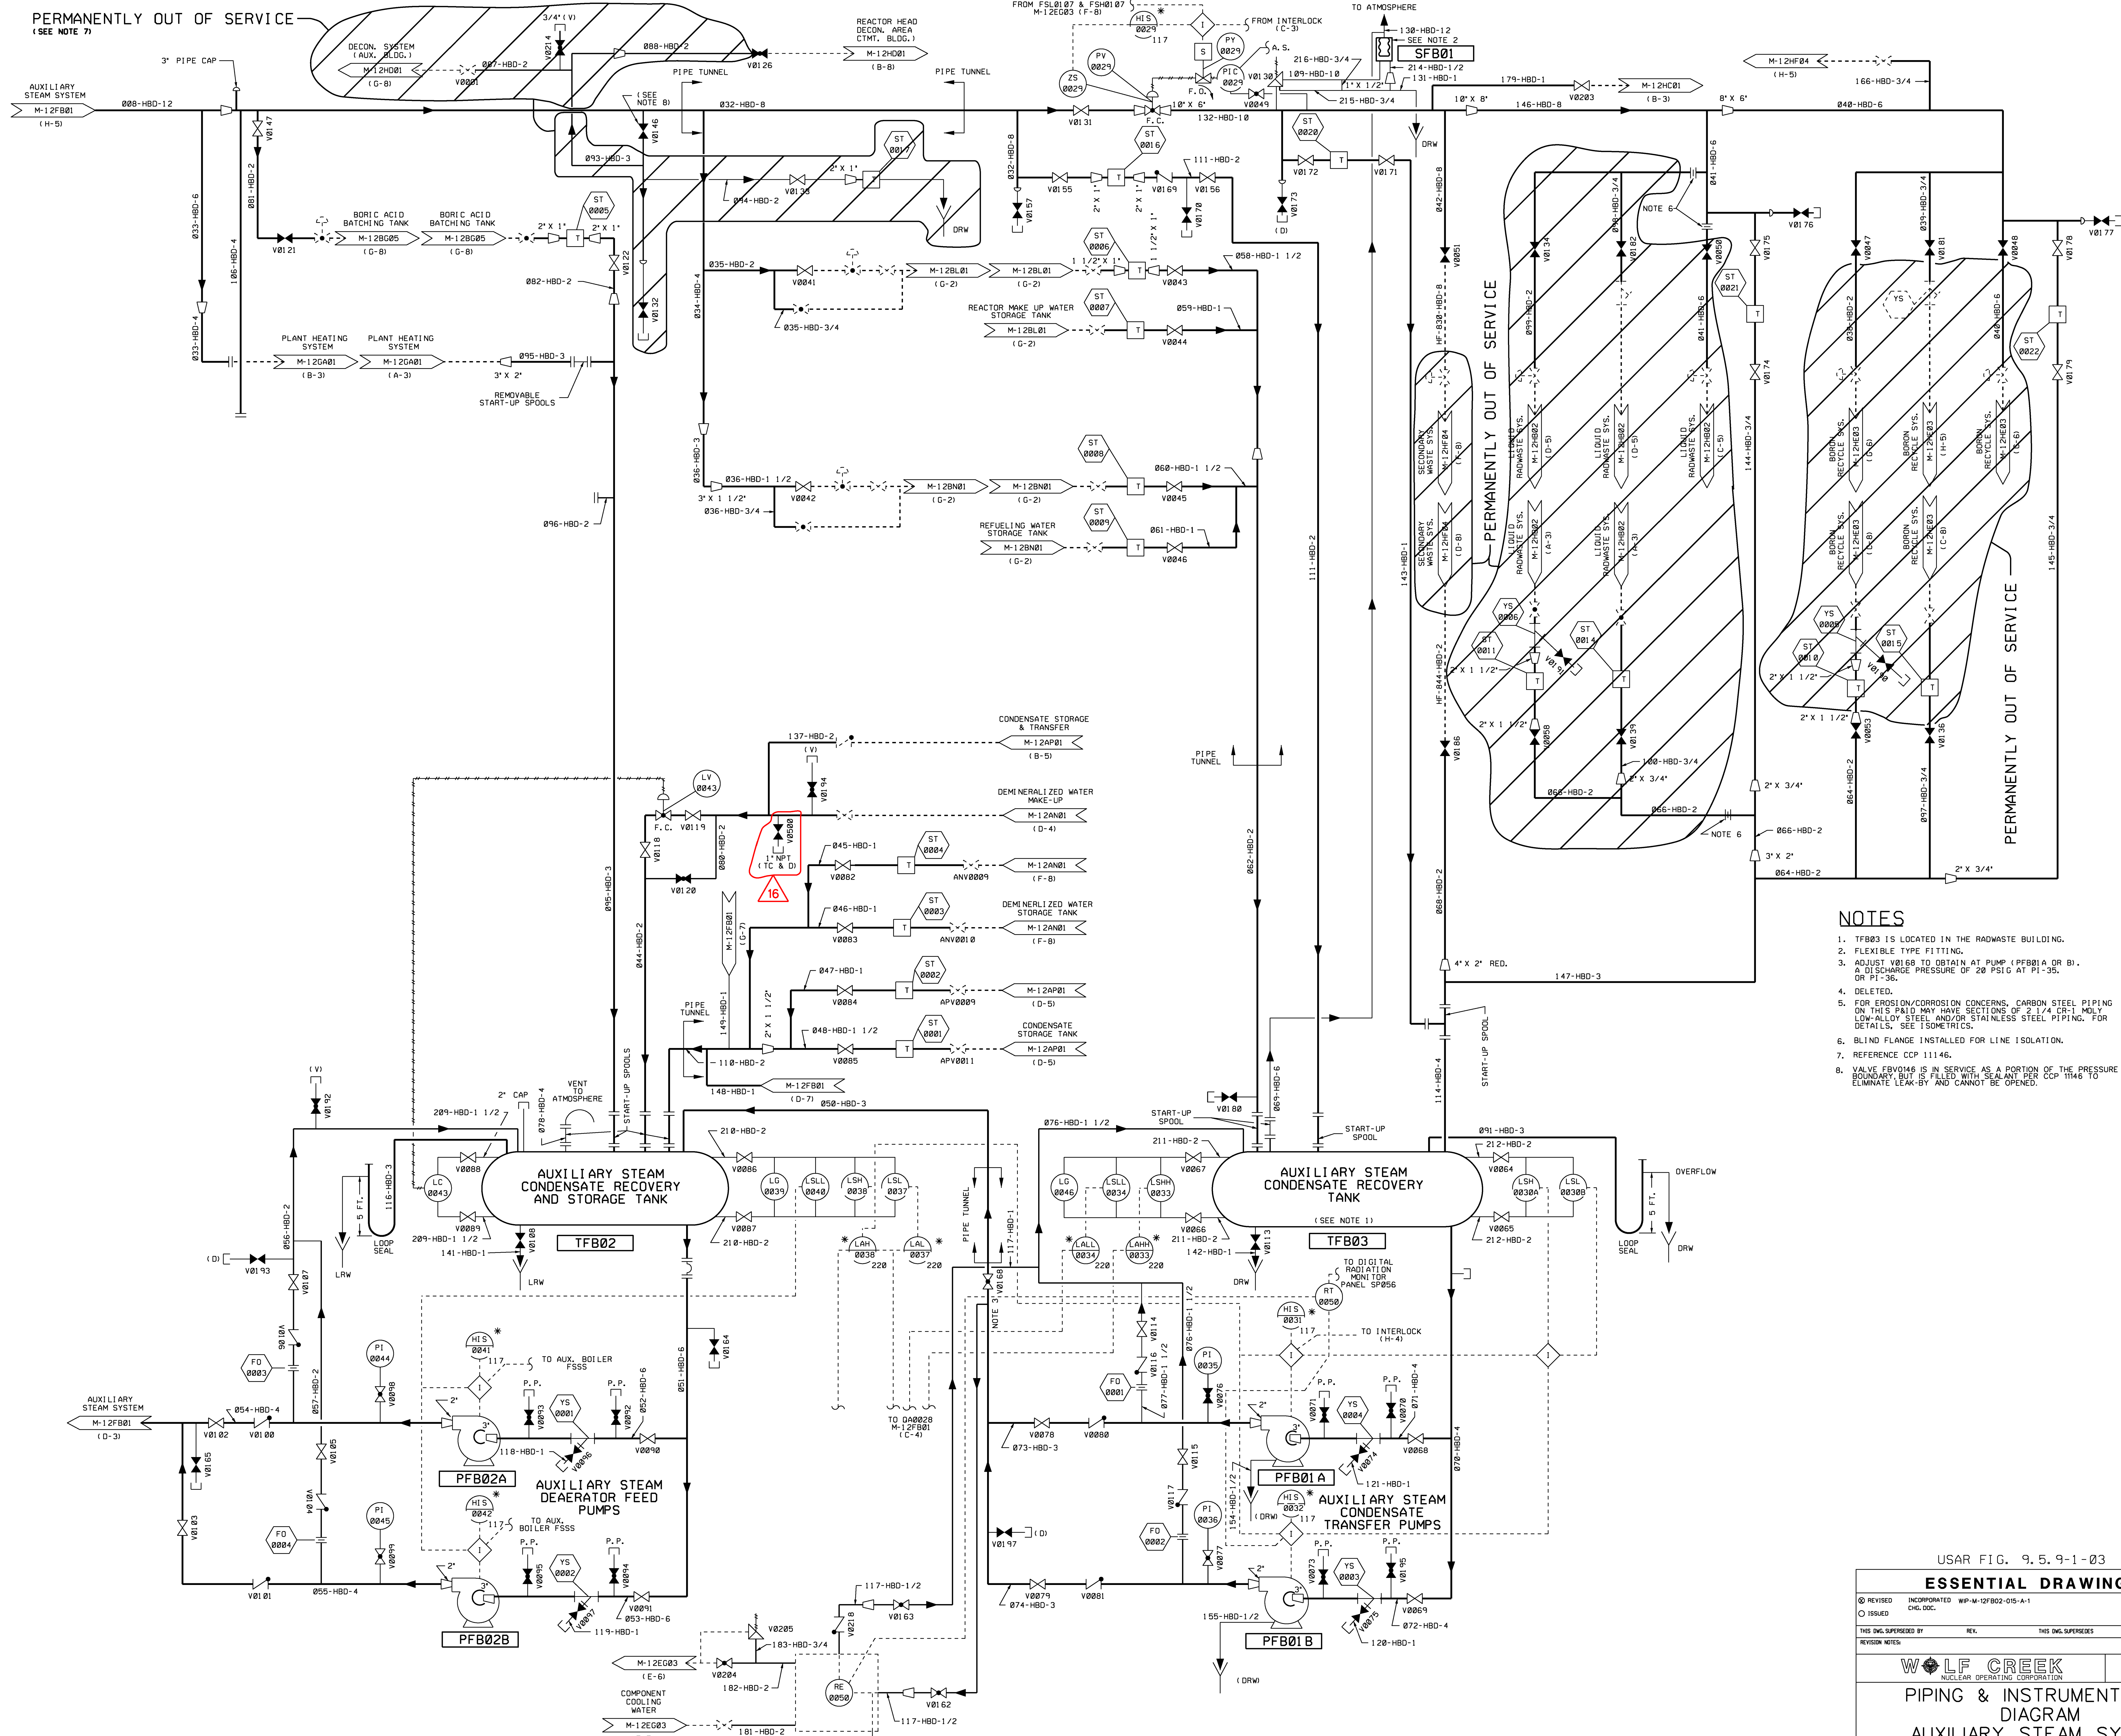

- NOTES**
1. TFB03 IS LOCATED IN THE RADWASTE BUILDING.
 2. FLEXIBLE TYPE FITTING.
 3. ADJUST V0166 TO OBTAIN AT PUMP (PFB01A OR B) A DISCHARGE PRESSURE OF 20 PSIG AT P1-35, OR P1-36.
 4. DELETED.
 5. FOR EROSION/CORROSION CONCERNS, CARBON STEEL PIPING ON THIS PAID MAY HAVE SECTIONS OF 2 1/4 CR-1 MILDY LOW-ALLOY STEEL AND/OR STAINLESS STEEL PIPING. FOR DETAILS, SEE ISOMETRICS.
 6. BLIND FLANGE INSTALLED FOR LINE ISOLATION.
 7. REFERENCE CCP 11146.
 8. VALVE FV0146 IS IN SERVICE AS A PORTION OF THE PRESSURE BOUNDARY, BUT IS FILLED WITH SEALANT PER CCP 11146 TO ELIMINATE LEAK-BY AND CANNOT BE OPENED.

USAR FIG. 9.5.9-1-03

ESSENTIAL DRAWING

REVISION	INCORPORATED	WP-M-12FB02-015-A-1	CHANGE 014237
ISSUED	CHG. DOC.		FIG. NO.
THIS ENG. SUPERSEDES BY		REV.	THIS ENG. SUPERSEDES
REVISION NUMBER			REV.

WOLF CREEK
NUCLEAR OPERATING CORPORATION

ELECTRONIC APPROVAL

PIPING & INSTRUMENTATION DIAGRAM


AUXILIARY STEAM SYSTEM

SCALE: NONE

DATE: 01/16/83

SHEET: 16

REV: 16

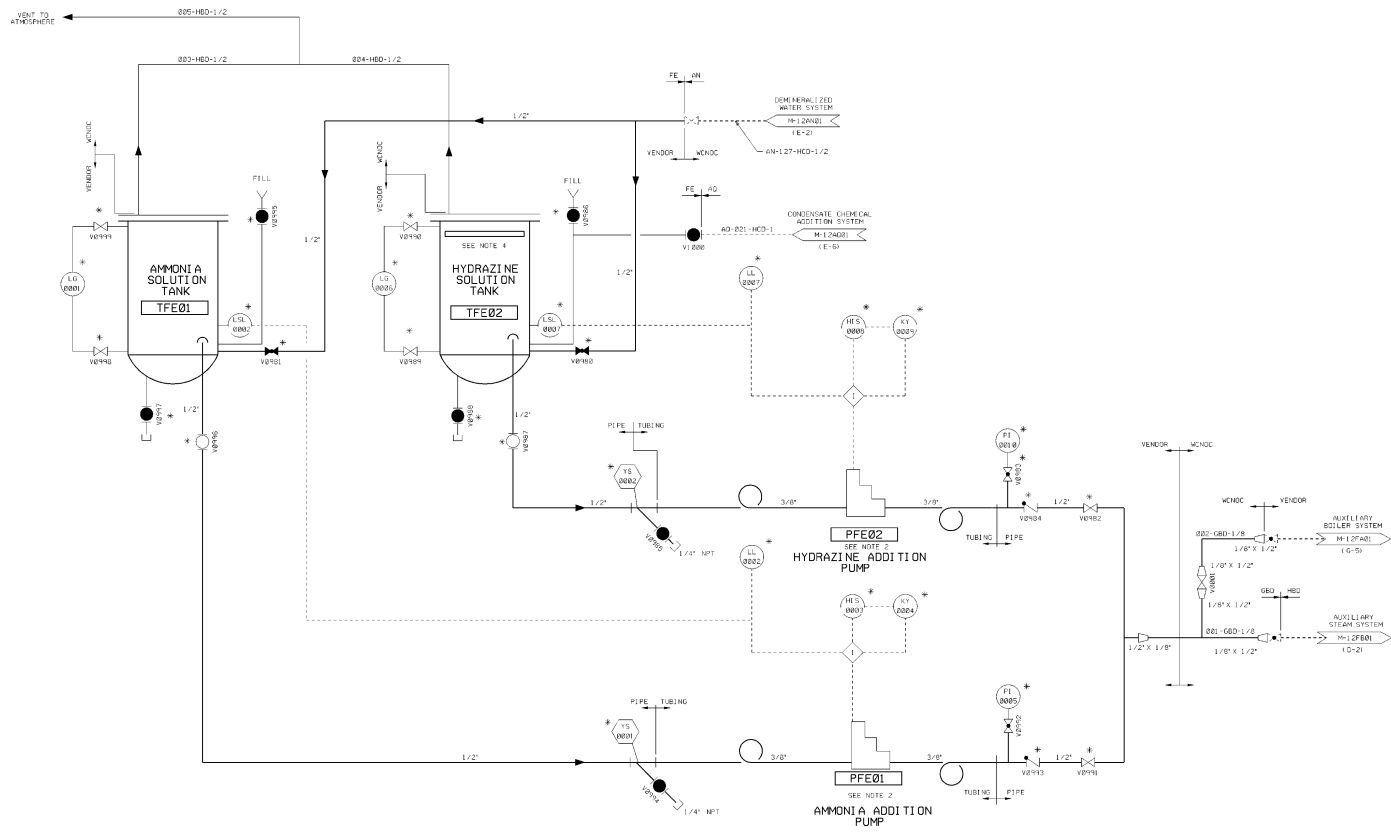


NOTES


1. FE SYSTEM IS MANUALLY OPERATED.
2. PUMPS ARE EQUIPPED WITH MANUAL SHUT OFF CONTROL.
3. TIMER HAS A RANGE OF 8 TO 30 HOURS.
4. HIGH DENSITY POLYETHYLENE FLUORINE COVER SUPPLIED WITH TANK.

USAR FIG. 9.5.9-1-04

ESSENTIAL DRAWING			
REVISION	DESCRIPTION	DATE	BY
1	ISSUED		
THIS DRAWING SUPERSEDES:		FIG. NO.	REV.
FIGURE NO.		DESIGNED LINE SIZES PER FIG. 20000-00042	
		ELECTRONIC APPROVAL	
		PIPING & INSTRUMENTATION DIAGRAM AUXILIARY STEAM CHEMICAL ADDITION SYSTEM	
TITLE	DESIGN NUMBER	SHEET NO.	TOTAL SHEETS
NONE	M-12FE01	10	10

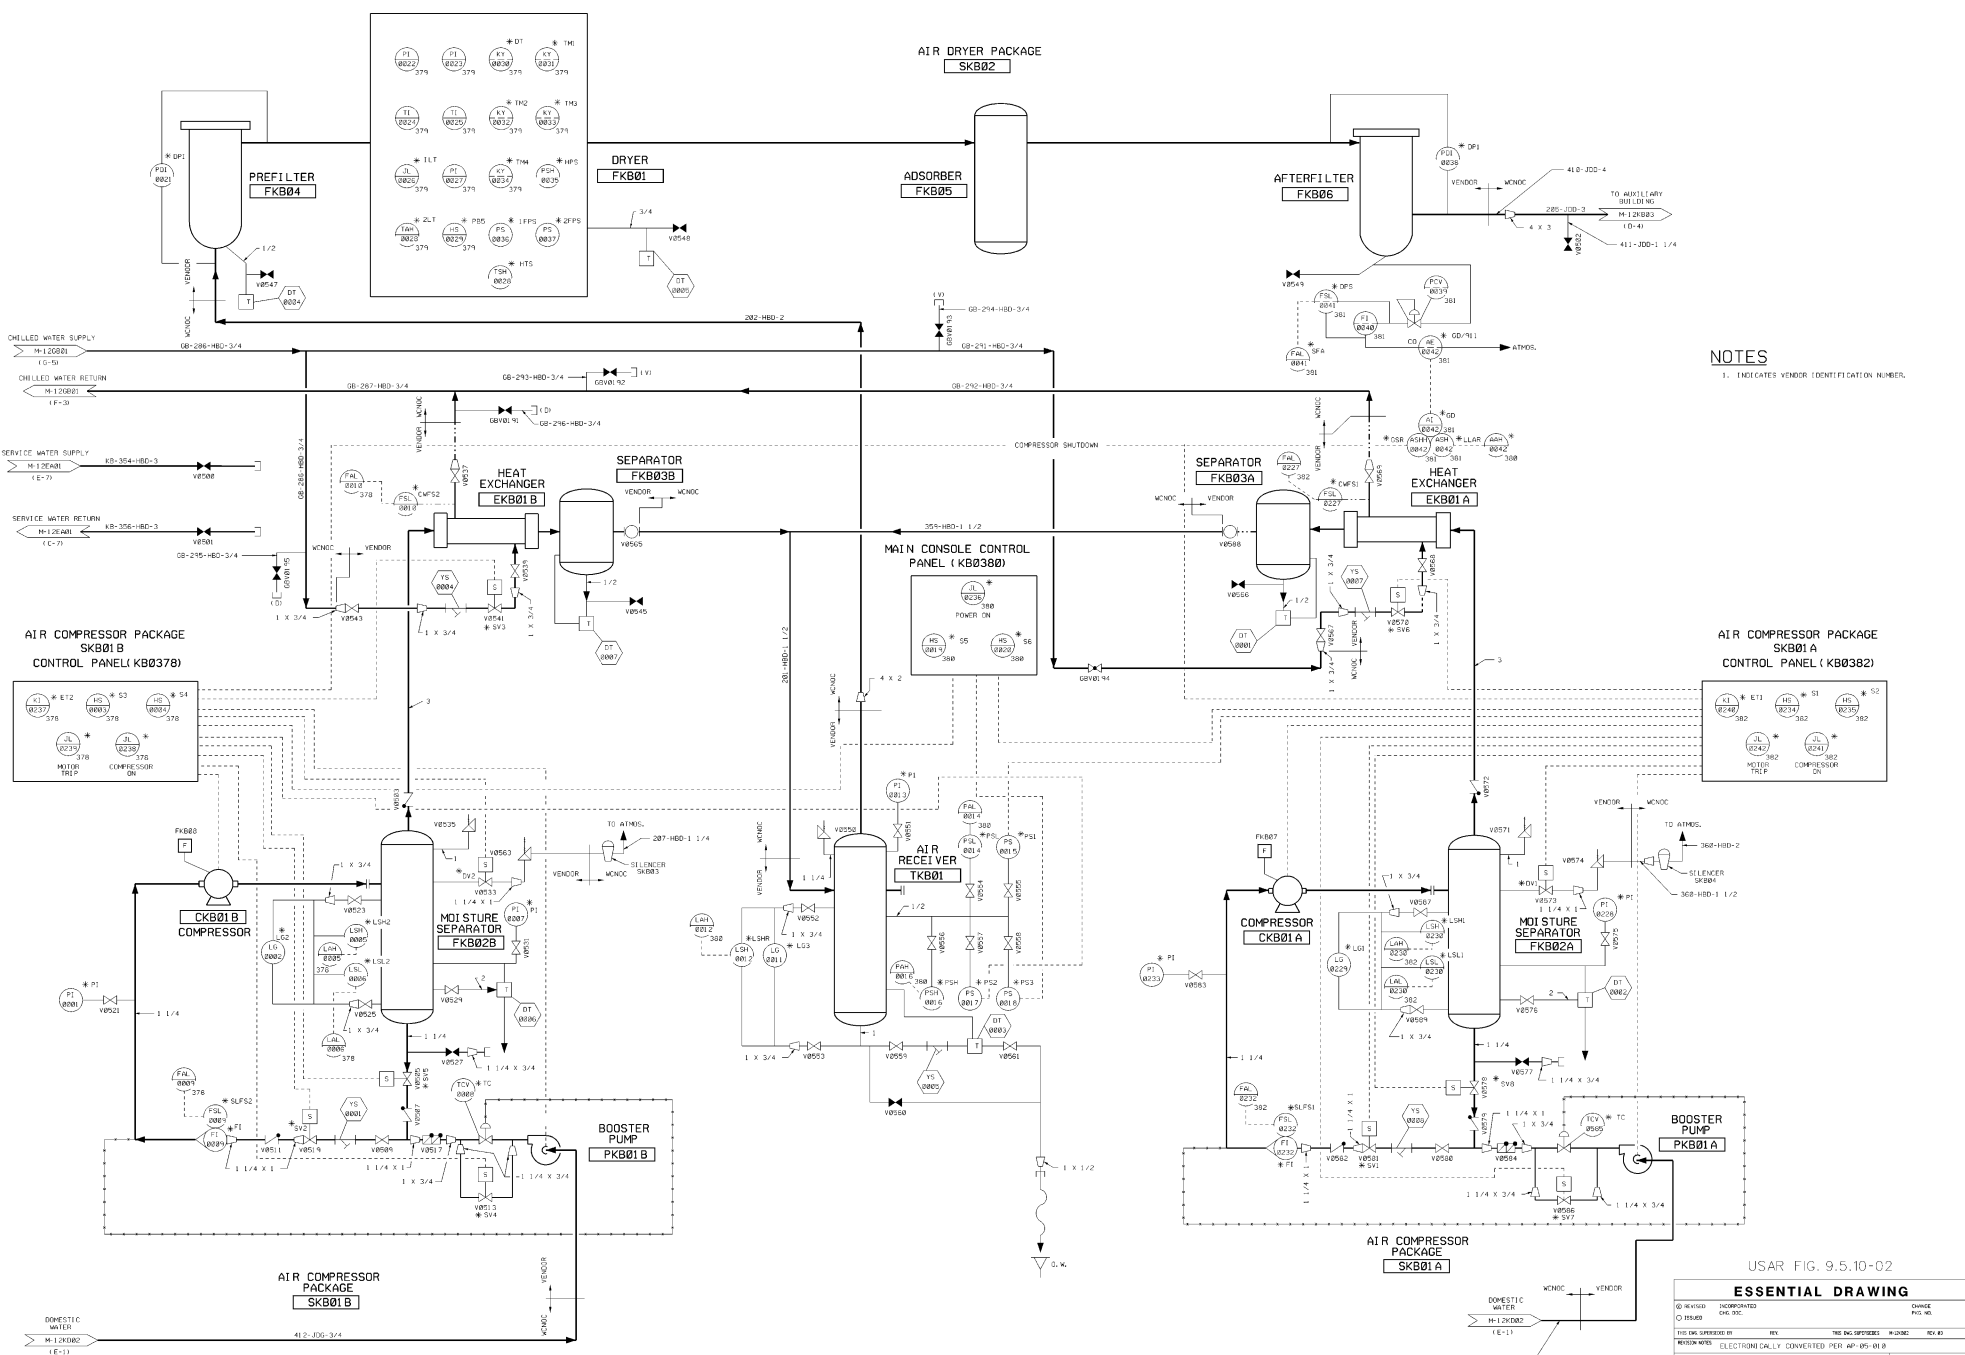

NOTES
 1. INDICATES VENDOR IDENTIFICATION NUMBER.

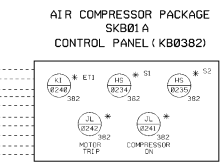

USAR FIG. 9.5.10-02

ESSENTIAL DRAWING			
© IN VESD	INCORPORATED	CHANGE	
○ ISSUED	DATE	FIG. NO.	
DESIGNED BY	REV.	NO. INC. SUPPLEMENTS	ISSUANCE
REVISION NOTES	ELECTRONICALLY CONVERTED PER AP. 05-01-B		
WOLF CREEK		ELECTRONIC APPROVAL	
PIPING & INSTRUMENTATION DIAGRAM			
BREATHING AIR SYSTEM			
SCALE	DATE	PROJECT NO.	04
NONE		M-12K02	

