

2



US Army Corps
of Engineers
Fort Worth District

FOUNDATION
REPORT

AD-A229 436

DTIC
ELECTE
NOV 27 1990
S D CG D

**COMPLETION OF
EMBANKMENT, SPILLWAY
AND OUTLET WORKS
RAY ROBERTS LAKE
ELM FORK, TRINITY RIVER, TEXAS**

DISTRIBUTION STATEMENT A
Approved for public release
Distribution Unlimited

August 1990

90 11 19264

CORPS OF ENGINEERS
FORT WORTH DISTRICT, TEXAS



FOUNDATION REPORT
COMPLETION OF EMBANKMENT AND SPILLWAY

RAY ROBERTS LAKE

Accession	
NTIS <input type="checkbox"/> <input checked="" type="checkbox"/>	
DTIC <input type="checkbox"/> <input checked="" type="checkbox"/>	
U. S. Army J. S. [unclear]	
By <i>per call</i>	
Distribution 1	
Availability	
Dist	Avail & 1/0 Special
<i>A-1</i>	

Statement "A" per telecon Caroline Solomon. U.S. Army Engineering District, Fort Worth/CESWF-IM-C. P. O. Box 17300. Fort Worth, TX 76102-0300.

VHG

11/26/90

AUGUST 1990

TABLE OF CONTENTS

<u>Para No.</u>	<u>TITLE</u>	<u>Page No.</u>
1	INTRODUCTION	
	a. Project Location and Description	1
	b. Construction Authority	1
	c. Purpose of the Report	1
	d. Project History	2
	e. Contractors, Supervision and Quality Control Organization	4
	(1) Quality Control	4
	(2) Contract Supervision	4
2	FOUNDATIONS	
	a. Investigations Prior to Construction	5
	b. Investigations During Construction	6
3	GEOLOGY	
	a. Physiography	6
	b. Site Geology	7
	(1) Overburden	7
	(2) Structure	8
	(3) Stratigraphy	8
	(a) Pawpaw Shale	8
	(b) Main Street Limestone	9
	(c) Grayson Marl	9
	(d) Woodbine Formation	9
	(4) Weathering	10
	(5) Ground Water	11
	c. Engineering Characteristics of Over- burden Materials	11
	(1) Outlet Works	11
	(2) Embankment	11
	(3) Weak Stratum	12
	(4) Spillway	13
	d. Engineering Characteristics of Bedrock Materials	13
	(1) Outlet Works	13
	(2) Embankment	14
	(3) Spillway	14

TABLE OF CONTENTS
(cont'd)

<u>Para No.</u>	<u>TITLE</u>	<u>Page No.</u>
	e. Unusual or Unanticipated Geologic Conditions Encountered During Construction	14
4	EXCAVATION PROCEDURES	
	a. Excavation Grades	14
	b. Dewatering Provisions	15
	c. Overburden Excavation	15
	d. Rock Excavation	15
	e. Line Drilling, Presplitting and Contour Blasting	26
	f. Foundation Preparation	26
	g. Gunite in Conduit Excavation Walls	26
	h. Safety Protection Against Slides and Rockfalls	42
5	PILE DRIVING AND SPECIAL FOUNDATIONS	42
6	TUNNELS, SHAFTS, AND UNDERGROUND STRUCTURES	42
7	FOUNDATION ANCHOR TEST	42
8	CHARACTER OF FOUNDATION	
	a. Character of Overburden Materials	47
	b. Character of Primary Materials	47
9	FOUNDATION TREATMENT	48
10	FOUNDATION INSTRUMENTATION	
	a. General	48
	(1) Initial Embankment and Closure Section	48
	(2) Left Abutment	56
	(3) Embankment Underseepage	56
	(4) Outlet Works	56
	(5) Embankment Crest	56

TABLE OF CONTENTS
(cont'd)

<u>Para No.</u>	<u>TITLE</u>	<u>Page No.</u>
	b. Schedule of Instrumentation Reading	56
	c. Settlement Plates and Deep Settlement Plates	57
	d. Inclinometers	57
	e. Piezometers	57
	f. Surface Reference Marks	58
	g. Reference Pins	58
	h. Seepage Interceptor System	58
11	POSSIBLE FUTURE PROBLEMS	59
12	RECORD OF FOUNDATION APPROVAL	59

PLATES

<u>Plate No.</u>	
1	Lake Map and Vicinity Map
2	General Plan
3	Dam Site Geology
4 - 7	Plan of Explorations
8 - 39	Logs of Borings
40 - 41	Outlet Works
42 - 43	Outlet Works, Plan and Profile
44 - 46	Geologic Profile, Embankment Centerline
47	Geologic Profile, Outlet Works
48	Spillway, Approach Channel, and Discharge Channel
49 - 60	Inspection Trench, Plan and Profile
61	Left Abutment, Deep Inspection Trench
62	Plan of Instrumentation
63	Record of Foundation Approval

RAY ROBERTS LAKE FOUNDATION REPORT

1. INTRODUCTION.

a. **Project Location and Description.** Ray Roberts Dam and Lake project is situated in northern Denton, south-central Cooke and western Grayson Counties. The Dam is at river mile 60.0 on Elm Fork of the Trinity River, approximately 30 river miles north of Lewisville Dam. The location of the project is shown on Plate 1. The principal features of the project include (1) a rolled earthfill embankment approximately 14,980 feet long; (2) a limited service spillway consisting of an uncontrolled trapezoidal broad-crested weir; the spillway crest length is 100 feet; and (3) the outlet works, consisting of an excavated approach channel, intake structure and service bridge, a 708-foot long by 13-foot diameter cut and cover conduit, stilling basin and excavated discharge channel (see Plate 2). For the future addition of hydropower, a separate steel-lined concrete 5-foot diameter low flow conduit was constructed beneath the main flood control conduit. (SDN)

b. **Construction Authority.** Congressional authority for construction of Aubrey Lake (now Ray Roberts Lake) is contained in the Public Works - Rivers and Harbor Act approved 27 October 1965 (Public Law 89-298) in accordance with the plan of improvement as outlined in House Document No. 276 (89th Congress, 1st Session).

c. **Purpose of the Report.** This report was prepared in accordance with requirements as set forth by the Office, Chief of Engineers in ER 1110-1-1801.

The purpose of this report is to provide a complete record of foundation conditions encountered during construction. Information contained in this report will be valuable when evaluating (1) necessary remedial action required to prevent or repair any problems resulting from foundation deficiencies; (2) contractor claims related to foundation conditions or alleged change of condition; and (3) planning and design of future comparable construction projects.

A copy of this report should be included in the permanent records maintained at the project office.

d. **Project History.** Four dam site locations were studied prior to final site selection. Site No. 1, the project document site, is at river mile 60.0. Sites 2, 3, and 4 are at river miles 55.9, 51.2, and 64.0, respectively. Three holes were drilled at Site 2 in 1970. No subsurface explorations were done at Sites 3 and 4.

Site No. 4, located upstream of the confluence of the Elm Fork and Isle du Bois Creek would require two embankments and in effect form two lakes. Site No. 4 would also require two outlet facilities or an equalizer channel. This was the uppermost site considered. Sites downstream from Site 3 would be in the flood pool of Lewisville Lake and would require a major railroad relocation.

Based on studies that included an appraisal of the physical, historic, economic, and social impacts at each site, and the results from a public meeting held in April 1971, Site No. 1 was selected as the recommended site. By Public Law 96-384, dated 6 October 1980, the

project name was officially changed from Aubrey Lake to Ray Roberts Lake.

Seven locations, designated A through G, for the spillway were investigated. Cost estimates were made for gated, broadcrested, and uncontrolled ogee spillways. Consideration was also given to a perched spillway with the crest elevation at 5 feet, and at 10 feet above the top of the flood control pool.

Site A was used for the gated spillway estimate for site selection. It was in the steep slope of the east abutment and proved to be undesirable from the standpoint of stability and excessive excavation. Site B, the recommended site, was used for the uncontrolled spillway estimate for site selection, and for various other plans. Site B proved to be the most economical spillway location regardless of type of spillway. Site E at Culp Branch on the west abutment was investigated, but spillways here were too costly because of excessive channel excavation and downstream land requirements. Sites C, D, F, and G were eliminated by inspection because of excessive excavation and additional land requirements.

Studies showed that a gated spillway had a higher first cost than the uncontrolled spillways. Annual operating and maintenance costs for a gated spillway would also be appreciably greater. Several studies were made of various plans with both broadcrested and ogee uncontrolled spillways, in order to optimize size and type of structure.

Studies were made for uncontrolled spillways with widths varying

from 100 feet to 1,000 feet. These studies indicated that the most economical project would be one with the narrowest spillway and highest embankment. A width of 100 feet was judged to be the practical minimum and was, therefore, selected for the recommended plan.

e. **Contractors Supervision and Quality Control Organization.** The embankment, spillway, and outlet works for Ray Roberts Lake were constructed under one contract. Pertinent data related to the contract are listed below:

Contractor: Phillips and Jordan, Inc., Knoxville, TN

Contract No.: DACW63-82-C-0083

Contractor's Bid: \$48,657,799

Notice to Proceed: 31 May 1982

Completion Date: 9 October 1986

Total Payment Including Modifications: \$51,491,731.27

(1) **Quality Control.** The quality control organization was furnished and compensated by the contractor.

(2) **Contract Supervision.** Construction was under the immediate supervision of the District Engineer, U.S. Army Engineer District, Fort Worth, Texas. The contracting officer's representative for administration of the contract was Mr. Webb Boland. The following personnel participated in administering the contract: Mr. Mark Gibson, outlet works construction, and Mr. David Bowie, embankment and spillway construction.

2. FOUNDATION EXPLORATIONS.

a. Investigations Prior to Construction. Dam Site No. 1 was first explored in 1939. Eight combination auger and core borings numbered C-1 through C-8 were drilled near the present alignment. The borings ranged from 67 to 217 feet in depth. In December 1960, three additional combination auger and core holes, numbered 9 through 11, were drilled on the right abutment slope, ranging in total depth from 30.6 to 106 feet. There are no testing records on either the overburden materials or the rock cores and the borings were not pressure tested. Boring locations are shown on Plates 4 through 7. Logs of boring are shown on Plates 8 through 39.

Twenty-two additional holes were drilled in 1971 and 1972 during the General Design Memo Study Phase. These holes were numbered 12 through 27, and B, C, D, E, F, J, and K. The following table shows the location, total footage, and purpose for these holes.

Location	: Number : Drilled	: Total : Footage	: :	Purpose
Right (West) Abutment	6	292.0		Embankment Foundation
Left (East) Abutment	1	51.0		" "
Valley Section	4	296.4		" "
Spillway	7	476.3		Spillway Location & Foundation
Right Abutment Outlet Works	2	95.2		Intake & Stilling Basin Foundation
*Left Abutment Outlet Works	2	105.8		Intake & Stilling Basin Foundation

*Alternate location considered for outlet works.

In late 1972 and 1973, 37 additional holes were drilled. These holes were numbered 28 through 77. Holes 41 through 49 were 3-inch

Shelby tube holes, drilled along the axis of the uncontrolled spillway. Holes 3S-52 through 3S-57 were 3-inch shelby tube holes drilled along the centerline of the outlet works discharge channel. The other 22 holes were drilled in the embankment foundation.

In 1975 and 1976, holes 83 through 99 were drilled in the outlet works area, with the exception of hole 3F-86, which was drilled on the left abutment.

In late 1975, nine 8A6C holes, designated 301 through 309, were drilled at Site E for spillway site selection. This site was was not selected.

In October 1980, holes 310 through 316 were drilled, and in April 1981, holes 358 through 366 were drilled, all in the outlet works area.

One calyx hole (42-inch auger) was drilled in March 1975, to a depth of 46.5 feet to investigate soft clay seams in the embankment foundation. The hole was located at Station 120+70, 130 feet upstream.

A total of 113 foundation borings were drilled at the project.

b. **Investigations During Construction.** No problems requiring additional subsurface explorations were encountered during construction.

3. GEOLOGY.

a. **Physiography.** Ray Roberts Dam and Reservoir lie within the Gulf Coastal Plain physiographic province. The coastal plain of Texas is characterized by a broad rolling landform extending from the outcrop of the basal Cretaceous sands to the northwest to the Gulf of Mexico on

the southeast. It has developed upon a sequence of sedimentary rock units which dip gently southeastward, resulting in successively younger formations cropping out Gulfward. The outcrop of each formation or group in the coastal plain of Texas has distinctive soil, vegetation, and erosion characteristics which are the basis for further physiographic subdivision. Ray Roberts Dam and Reservoir lie within two such subdivisions; the Grand Prairie and the Eastern Cross Timbers. Damsite Geology is shown on Plate 3. The Grand Prairie, a subdivision which has developed on the outcrop of the Washita Group of Lower Cretaceous age, occurs generally west of the Elm Fork of the Trinity River. It is characterized by a rolling to hilly topography supported by limestone, marl, clay shale, and sandy shale. Typically, it is a grassy country, the uplands being given largely to grazing, the valleys being important agriculturally. Situated east of the Elm Fork, the Eastern Cross Timbers has developed on the outcrop of the Woodbine Formation of Upper Cretaceous geologic age. The Eastern Cross Timbers is characterized by a rolling to moderately rugged topography which supports a prolific growth of post oak trees.

b. Site Geology.

(1) **Overburden.** Overburden on the abutments consisted of predominantly residual clay and clayey materials generally ranging from 25 to 35 feet in thickness. The embankment is founded on these materials. In the spillway area, 2 to 11 feet of clay and silty clay with scattered gravel were removed and this structure is founded on

weathered clay shale. Overburden materials in the floodplain consist of 35 to 45 feet of alluvial clays, silts, sands, and gravels, comprising the floodplain embankment foundation. In the outlet works area about 20 to 30 feet of alluvial clays, silts, sands, and gravels were removed and the outlet works is founded in unweathered clay shale of the Pawpaw Formation.

(2) **Structure.** Subsurface investigations and subsequent foundation mapping during construction of the dam, outlet works and spillway have not revealed faulting or any other structural anomalies that would adversely affect the foundation of these structures. Correlation of marker beds encountered in the foundation borings show that the strata strike northeast and dip about 60 feet per mile to the southeast. Locally, minor undulations occur within the strata.

(3) **Stratigraphy.** Primary materials at the site from oldest to youngest are Pawpaw shale, Main Street limestone and Grayson marl of Lower Cretaceous age, and the Woodbine Formation of Upper Cretaceous age. The broad Elm Fork River valley is partially filled with Recent floodplain alluvium, while the uplands bordering the valley are often covered with Quaternary age terrace deposits.

a. **Pawpaw Shale.** Except for some isolated remnants of Main Street limestone, the Pawpaw shale comprises the primary strata beneath the embankment between station 0+00 to the base of the left abutment, the outlet works, and spillway (see Plates 44 through 48). The formation is composed of a soft to moderately hard, gray to black,

medium bedded clay shale, often sandy with sand laminations and lenses up to several inches thick. Thin, limy, fossiliferous zones occur throughout the formation.

b. **Main Street Limestone.** The Main Street limestone conformably overlies the Pawpaw shale. A full section is present in the left abutment. Erosional remnants occur in the central part of the embankment foundation and on the right abutment slope above elevation 640. The limestone is about 12 feet thick, moderately hard to hard, gray, fossiliferous, massive at its base, and becomes shaly as it grades into the overlying Grayson marl.

c. **Grayson Marl.** The Grayson marl occurs only in the left abutment at the dam site. It is represented by a soft to moderately hard, gray, highly calcareous, thick bedded, fossiliferous shale, that becomes increasingly marly at its base. Often a thin shaly limestone bed caps the formation separating it from the unconformably overlying Woodbine Formation. The Grayson and Main Street Formations are usually mapped as one geologic unit. At the dam site, their combined thickness is about 30 feet.

d. **Woodbine Formation.** The left abutment, above approximate elevation 565, is comprised of sediments belonging to the Woodbine Formation. Core borings made for the embankment reveal a fine-to-coarse-grained sand with scattered ironstone concretions and thin, poorly cemented sandstone seams to approximate elevation 600. In the basal portion of the Woodbine, a soft to moderately hard, gray to

brown, sandy clay shale predominates, although sand and sandstone can occur. Carbonaceous fragments are often noted. These inclusions, along with the generally noncalcareous nature of the shale, distinguish the material from the underlying Grayson Formation. The Woodbine exhibits gradational changes, both laterally and vertically, in its lithologic composition that make correlation between even closely spaced borings very difficult. The most detailed description of the Woodbine was developed after excavation of the inspection trench of the left abutment. Plate 58 is a geologic section of the plan of the inspection trench along the left abutment prior to placement of the fill.

(4) Weathering. Chemical weathering (oxidation and hydration) has affected the primary strata at the dam site to varying degrees. The shale and sandy shale of the Pawpaw Formation that comprise the primary strata for most of the embankment section have been only slightly altered. Staining (oxidation) is present to a maximum depth of about 14 feet below the top of primary strata that underlie the upland soils of the right abutment, while the Pawpaw shale beneath the alluvium in the valley section is fresh. In contrast, the sand, soft sandstone and shale of the Woodbine Formation that comprise the left abutment are deeply weathered. The relatively permeable sands and sandstones receptive to percolating waters are generally weathered throughout to the top of the first significant shale beds. Weathering in the shale occurs primarily as oxidation along joints and bedding

planes.

(5) **Ground Water.** Water levels are shown on Plates 44 through 48. Significant quantities of ground water are found in the floodplain alluvium and in the basal sands and gravels of the low level terrace deposits. Lesser quantities occur in joints and fractures in the weathered section of the Pawpaw shale and in the basal portion of the Woodbine Formation near its contact with the underlying Grayson in the left abutment. Prior to impoundment, ground water in the floodplain alluvium occurred at depths of 20-25 feet. During excavation of the inspection trench in the left abutment, water seeps were encountered at the contacts of the more pervious sands and sandstones with the underlying clays (see Plate 58).

c. Engineering Characteristics of the Overburden Materials.

(1) **Outlet Works.** Overburden in the outlet works area was investigated using auger, Denison and Shelby tube samplers. The materials consist of sandy clays (CL and CH) with zones of clayey sands (SC) and gravels (GC-GP). The gravelly zones generally overlay the primary materials. Overburden thickness varies from about 5 to 25 feet along the approach channel, from 8 to 20 feet along the conduit, and from 12 to 45 feet along the discharge channel. Classification and index testing were performed on jar samples taken from various depths in the overburden.

(2) **Embankment.** The overburden materials in the embankment foundation consist of alluvial clays, sands, and gravel strata.

Classification tests, Q, R, and S strength tests, and consolidation tests were performed on Denison barrel samples taken at varying depths in the clay. Classification and index tests were performed on jar samples taken from auger borings and Denison barrel samples obtained from the overburden in the floodplain. The following properties were used for overburden materials in the floodplain:

Moisture content 20%

Dry density 107.5 pcf

<u>Type Test</u>	<u>c</u> <u>tsf</u>	<u>0</u> <u>Degrees</u>
Q	0.8	3
R	0.1	14
S	0	26

(3) Weak Stratum. The following soil parameters were used for the weak, sandy clay stratum which is located in the foundation near the base of the overburden beneath the floodplain embankment.

Moisture content 23%

Dry density 102.0 pcf

<u>Type Test</u>	<u>c</u> <u>tsf</u>	<u>0</u> <u>Degrees</u>
Q	0.35 and 0.40	2.5
R	0.1	14
S	0	26

The low, undrained shear strength of this weak stratum is the controlling factor in the stability of the floodplain embankment.

(4) Spillway. The broadcrested weir is founded in weathered shale. Overburden along the centerline of the spillway increases from 2 feet in the area of the weir to 7 feet in the approach channel and 4 to 6 feet in the discharge channel. The overburden consists of principally silty clay with some fine sand and locally scattered fine gravels.

d. Engineering Characteristics of the Bedrock Materials.

(1) Outlet Works. The primary materials in the outlet works area were investigated using Denison, Shelby tube and core barrel samplers. Boring locations are shown on Plate . Primary foundation materials consist of unweathered clay shales of the Pawpaw Formation. The shales contain interbedded sandstone seams and beds that vary from a few inches to approximately 4 feet in thickness. From station 27+00 to 34+00, a near surface limestone layer was encountered which varied from about 2 to 7 feet in thickness. Laboratory testing was performed on selected samples of primary materials taken from borings along the centerline of the outlet works. Tests performed were classification, index grain size, unconfined compression and Q-triaxial compression tests. The approach channel structure, intake tower, and stilling basin was founded in unweathered shale for which the following parameters were used:

Allowable bearing pressure	8.0 ksf
Shear Strength, ϕ	20°
Cohesion	0

(2) **Embankment.** Laboratory strength tests conducted on samples of primary materials indicate that the shale stratum underlying the overburden through the floodplain has a low to moderately low strength, but its strength increases with depth. Although the strength of the shale is relatively low in the upper portion of the stratum, its strength is greater than that of the overburden; therefore, it is not the governing factor in the stability of the embankment.

(3) **Spillway.** The spillway is founded on interbedded silty shale and soft sandstone of the Pawpaw Formation. The materials are adequate to support the light loads to be imposed.

e. **Unusual or Unanticipated Geologic Conditions Encountered During Construction.** No unusual or unanticipated geologic conditions were encountered during construction.

4. EXCAVATION PROCEDURES

a. **Excavation Grades.** Foundation conditions encountered during excavation of the outlet works, inspection trench, cutoff trench, and emergency spillway were about the same as described in the subsurface data in the plans and specifications. The design slopes were achieved without any problems. The only deviation from designed grade lines was overexcavation in the primary materials. In February 1984, overexcavation occurred in the area adjacent to the outlet works conduit, between stations 28+90 and 29+80. The maximum depth of overexcavation was 2 feet. Contractor backfilled the overexcavation with concrete.

b. **Dewatering Provisions.** No ground-water problems of a serious nature were experienced in the outlet works, inspection trench, cutoff trench, or spillway excavations. On occasion, heavy rains partially filled the excavations. Small seeps were present in all the excavations except the spillway and are noted on the drawings. Surface water and the small amount of ground-water seepage experienced were handled by pump and sump operations. See Figures 1 through 6. All concrete and impervious backfill placements were on foundations free of water.

c. **Overburden Excavation.** Overburden materials excavated consisted of residual clay and other clayey materials on the abutments; alluvial clays, silts, sands, and gravels in the floodplain inspection trench and outlet works; and clay and sandy clay with scattered gravel in the spillway area. See Figures 7 through 12. Bulk excavation was done by Caterpillar scrapers. Finished grades were achieved with motor graders. Overburden materials considered suitable were used as random and semicompacted fill.

d. **Rock Excavation.** All rock excavation was accomplished using rippers and scrapers. Much of the weathered shale was used in a manner similar to the overburden; as random or semicompacted fill. Excavation methods were also similar. After bulk excavations of weathered shale by caterpillar scrapers, final grade was accomplished using motor graders. Exposure of weathered or unweathered shale of the Pawpaw Formation was limited to 3 days. See Figures 13 through 20. When this limit was exceeded, the contractor was required to clean the exposed



Figure 1. Outlet Works excavation, showing peripheral ditches controlling ground water.



Figure 2. Same as above

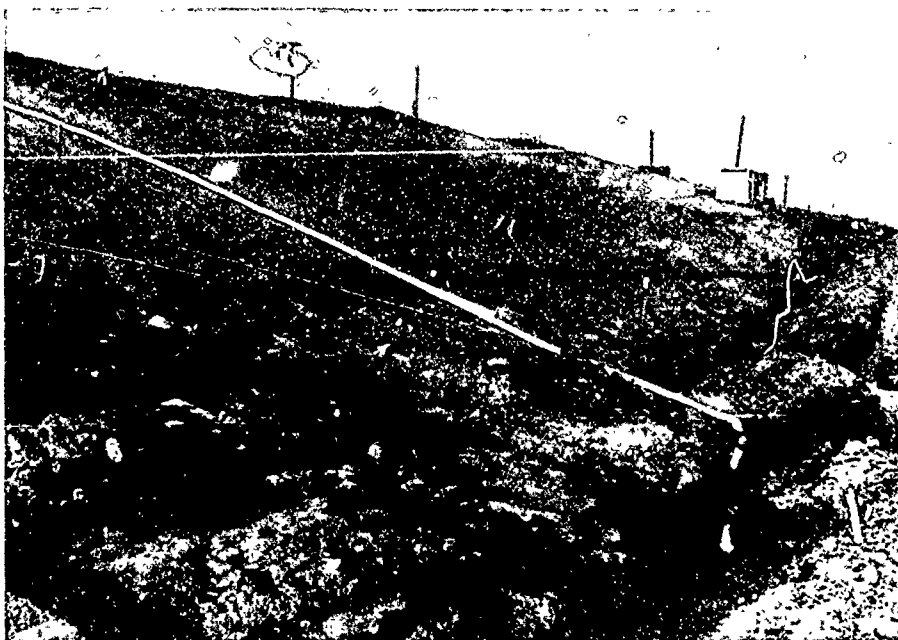


Figure 3. Outlet Works excavation showing peripheral ditches controlling ground water.



Figure 4. Same as above.



Figure 5. Outlet Works excavation showing peripheral ditches controlling ground water.



Figure 6. Same as above.

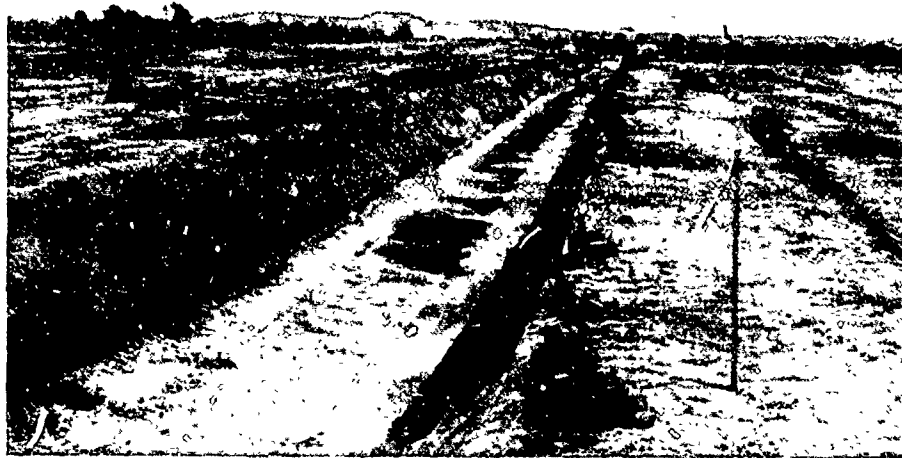


Figure 7. Right Abutment inspection trench looking east (Upstation)



Figure 8. Left Abutment looking east.



Figure 9. Downstream face of right abutment inspection trench approx. sta. 66+50 to 69+00, looking east (Upstation).



Figure 10. Upstream face of right abutment inspection trench Approx. sta. 66+50 to 69+00, looking east.

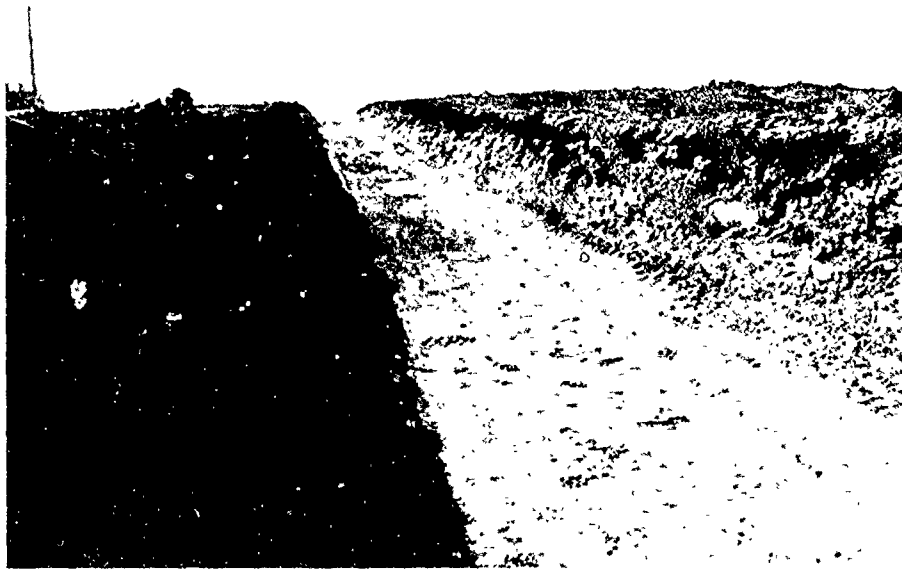


Figure 11. Right abutment inspection trench, looking west (downstream).



Figure 12. Same as above.

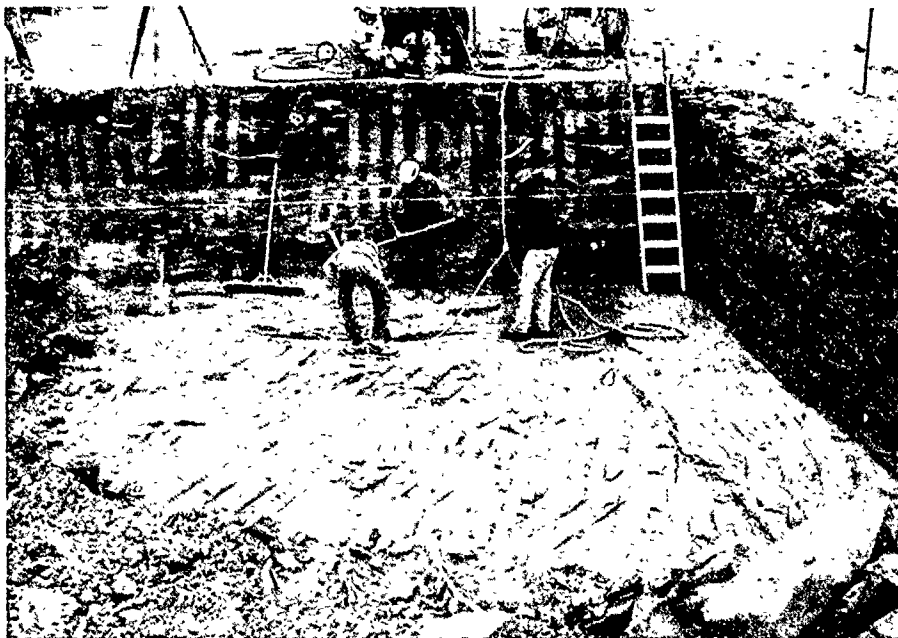


Figure 13. Intake Structure, hand cleaning shale foundation.



Figure 14. Intake Structure, placing re-bar for slab.



Figure 15. Looking Upstream from valve vault, showing fresh shale surface prior to placement of impervious material.

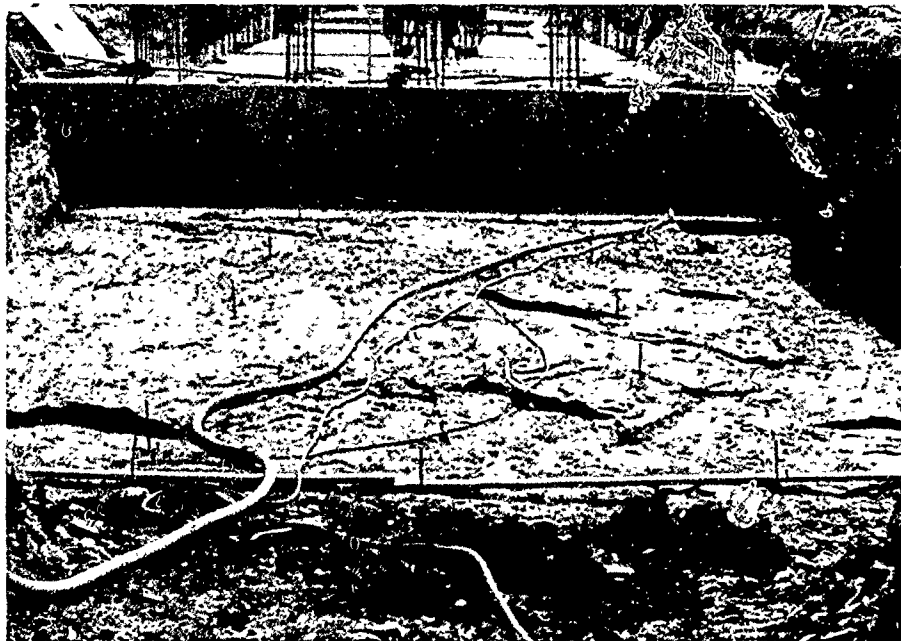


Figure 16. Foundation for approach slab.

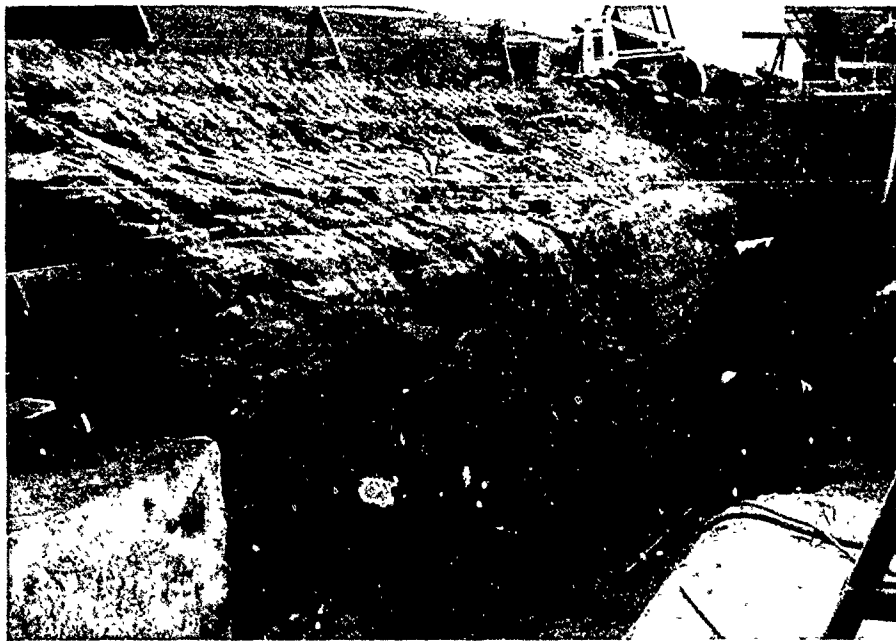


Figure 17. Excavation for intake for hydropower conduit at intake structure slab - looking downstream.

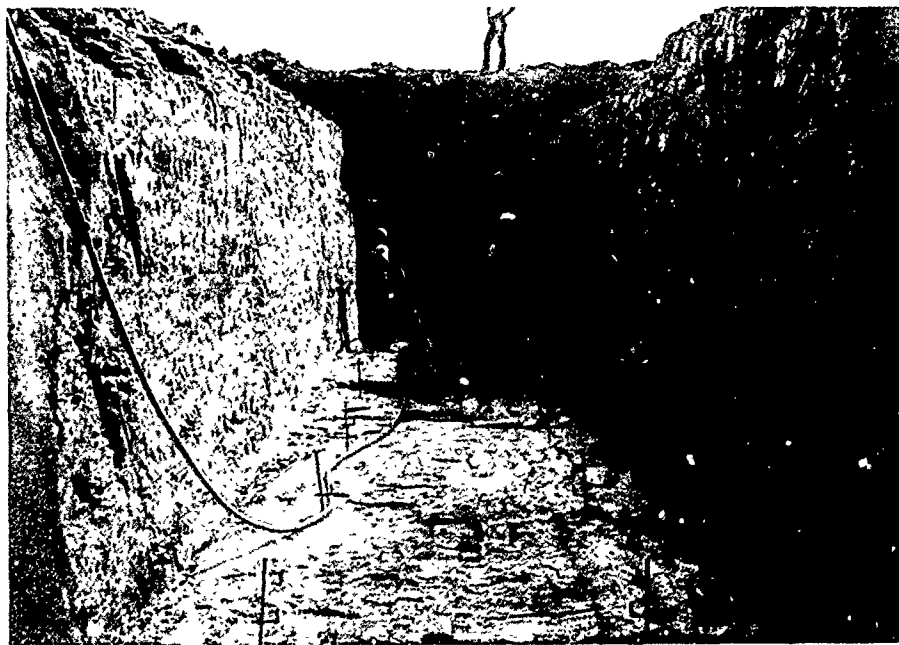


Figure 18. Hydropower conduit - placing gunite, Sta. 29+50-30+00.



Figure 19. Hydropower conduit, looking downstream,
Sta. 29+20.

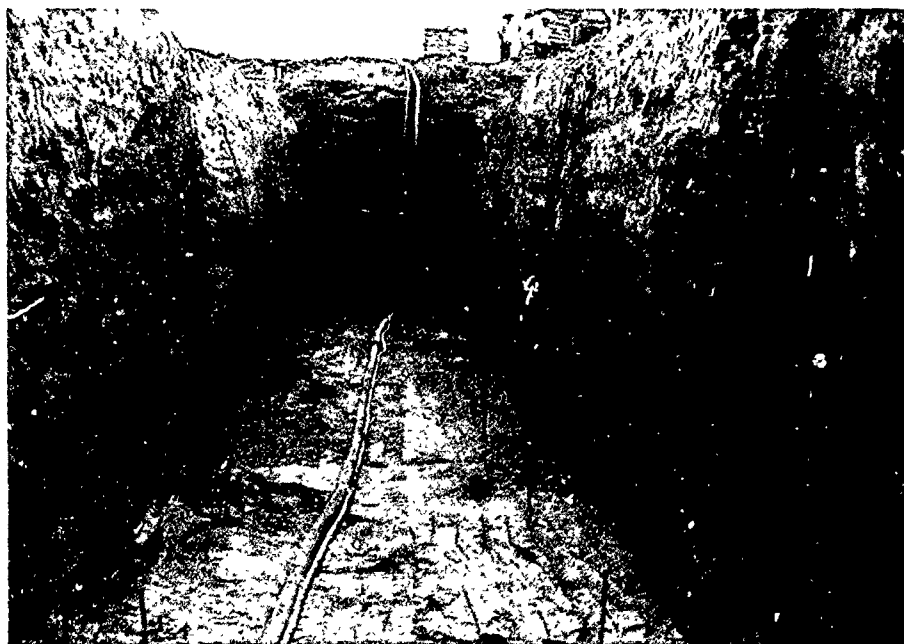


Figure 20. Hydropower conduit, looking downstream,
Sta. 30+10.

face by jackhammer and/or air jetting before protective concrete was placed.

e. **Line Drilling, Presplitting, and Contour Blasting.** No line drilling, presplitting, or contour blasting were performed during the course of construction.

f. **Foundation Preparation.** Clay shale of the Pawpaw Formation forms the majority of the foundation in the outlet works excavation and in the excavation for the sill of the limited-use spillway. See Figures 21 through 29. Primary materials in general were not exposed in cutoff or inspection trench excavations. See Figures 30 and 31. The most predominant material exposed was clay, especially CH clays. Since the clay shale deteriorates upon exposure to air, usually very noticeable within about 3 days, protective sealant or lean concrete (Gunitite) were specified for exposed shale surfaces. See Figures 34, 35, 36, 41, and 42.

g. **Gunitite in Conduit Excavation Walls.** Problems with Gunitite (protective concrete) developed in November 1982 in the hydropower conduit section between Stations 26+63 and 30+85. Excavation of the trench was done between 10 November 1982 and 23 November 1982. Gunitite was applied, as excavation progressed, on the floor and nearly vertical walls of the trench. Inspection on 24 November 1982 revealed numerous horizontal cracks, circular areas where Gunitite has fallen off the wall, and evidence that voids existed behind the Gunitite face. Inspection on 30 November 1982 revealed that deterioration of the Gunitite had greatly

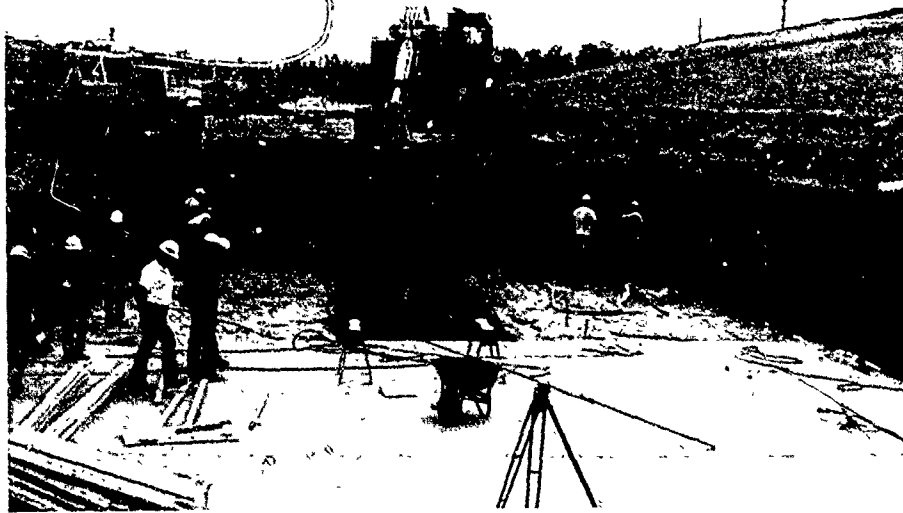


Figure 21. Excavation for hydropower conduit at intake structure slab.



Figure 22. Same as above.

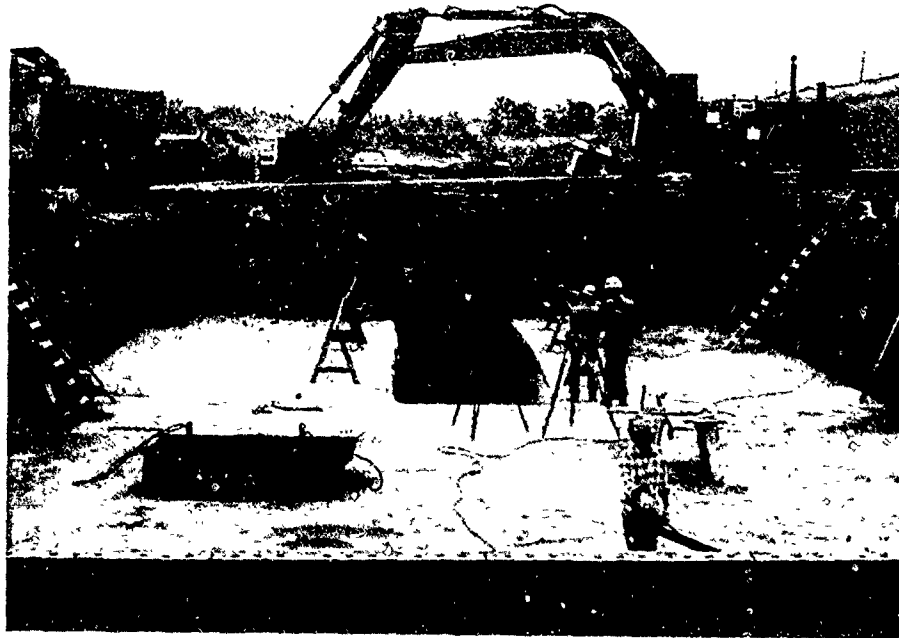


Figure 23. Excavation for hydropower conduit at intake structure slab.

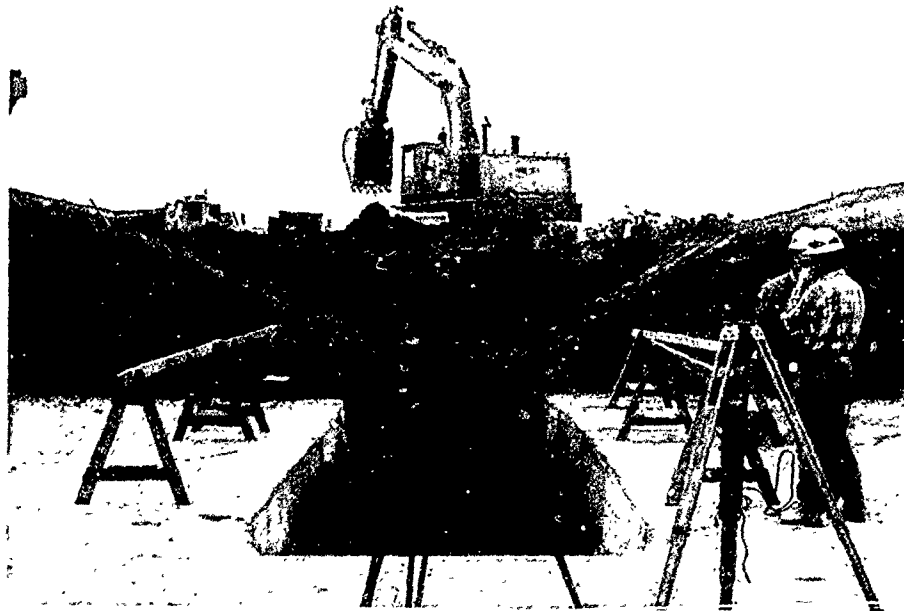


Figure 24. Same as above.

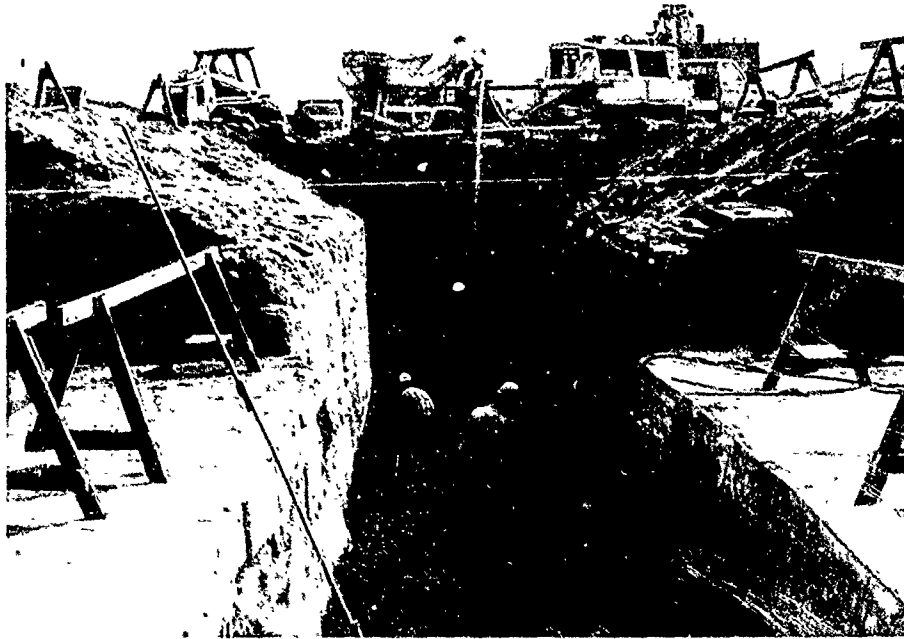


Figure 25. Excavation for hydropower conduit at intake structure slab.



Figure 26. Same as above.

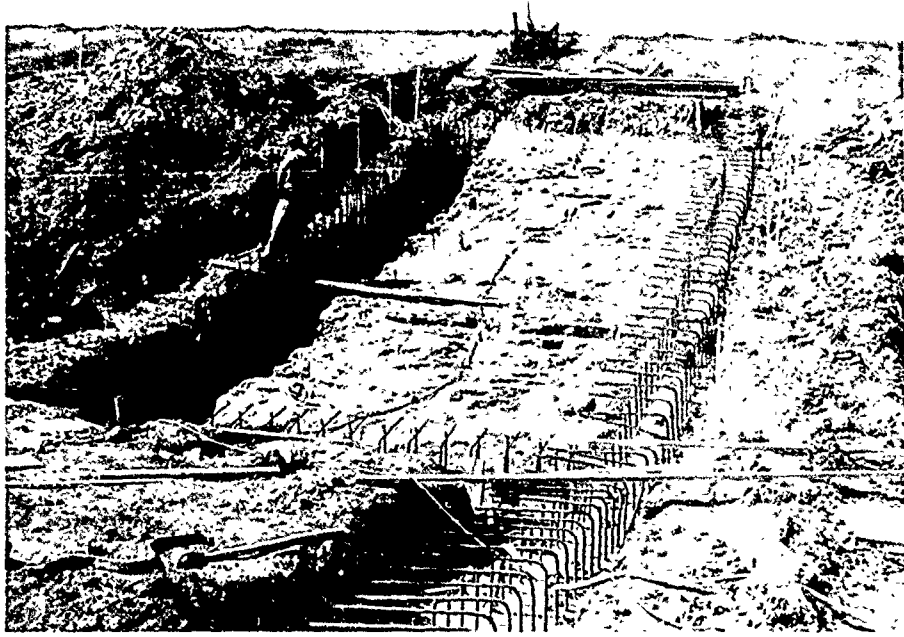


Figure 27. Construction of spillway sill.

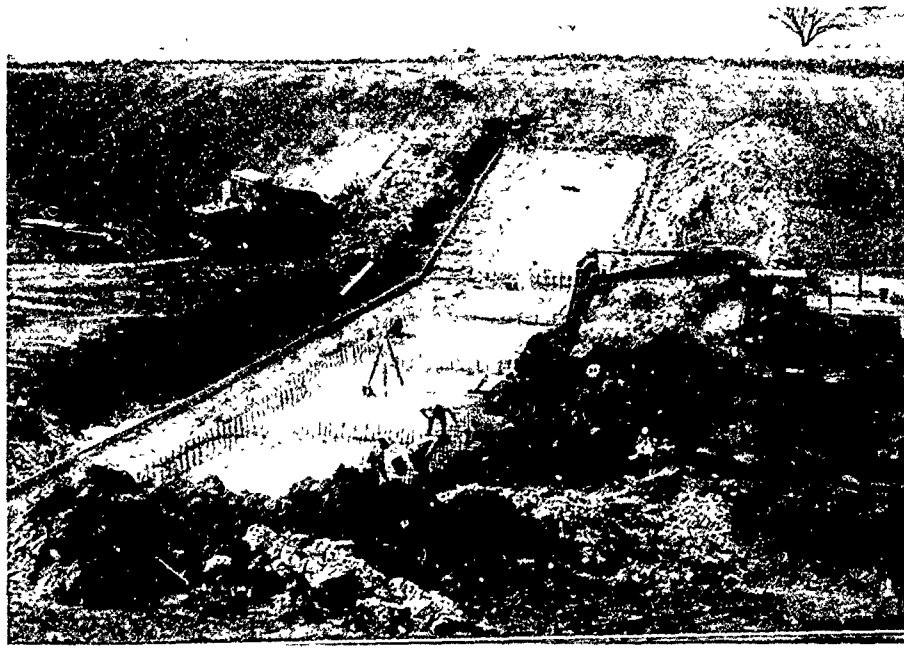


Figure 28. Same as above.

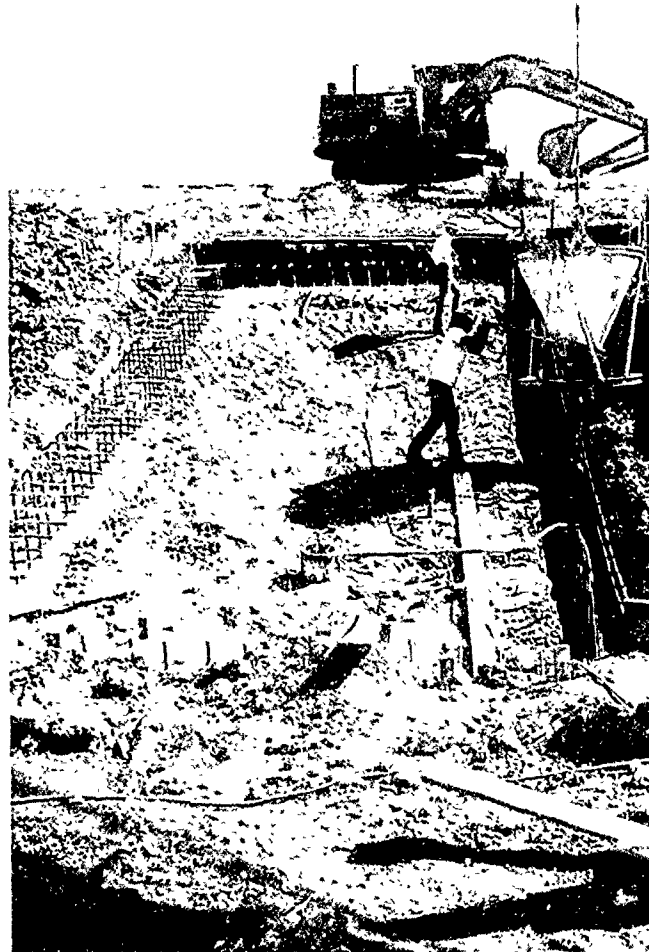


Figure. 29. Spillway - placing concrete footings.

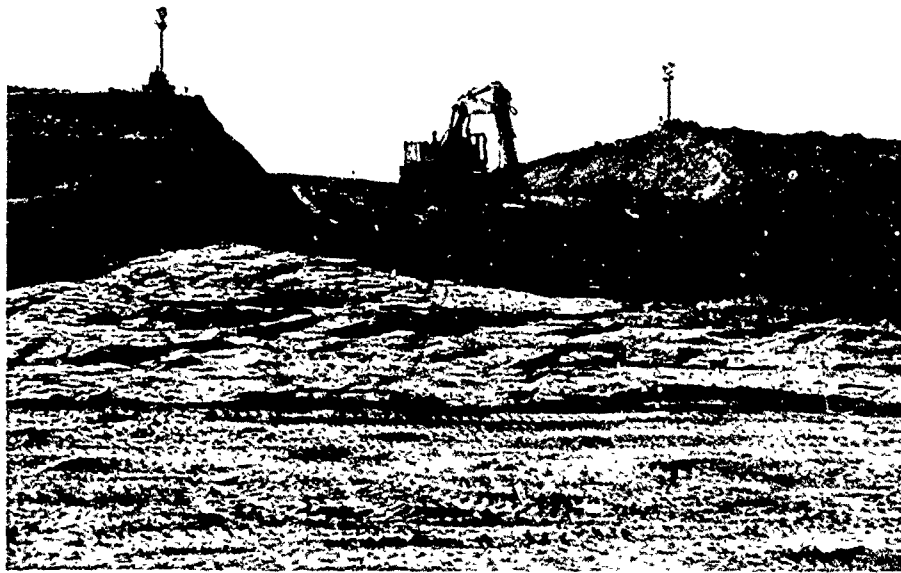


Figure 30. Looking downstation along dam centerline at intersection of embankment centerline and outlet works centerline.

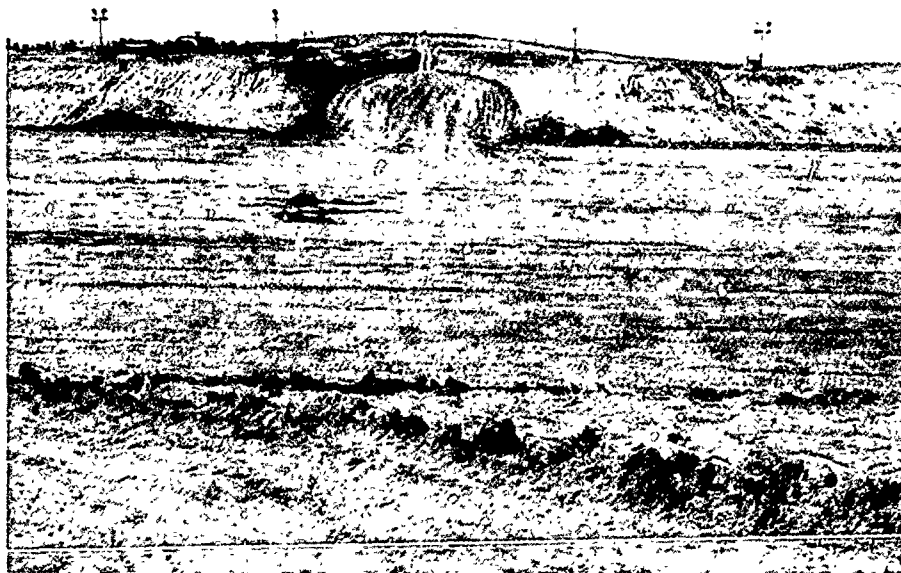


Figure 31. Later view of same area.

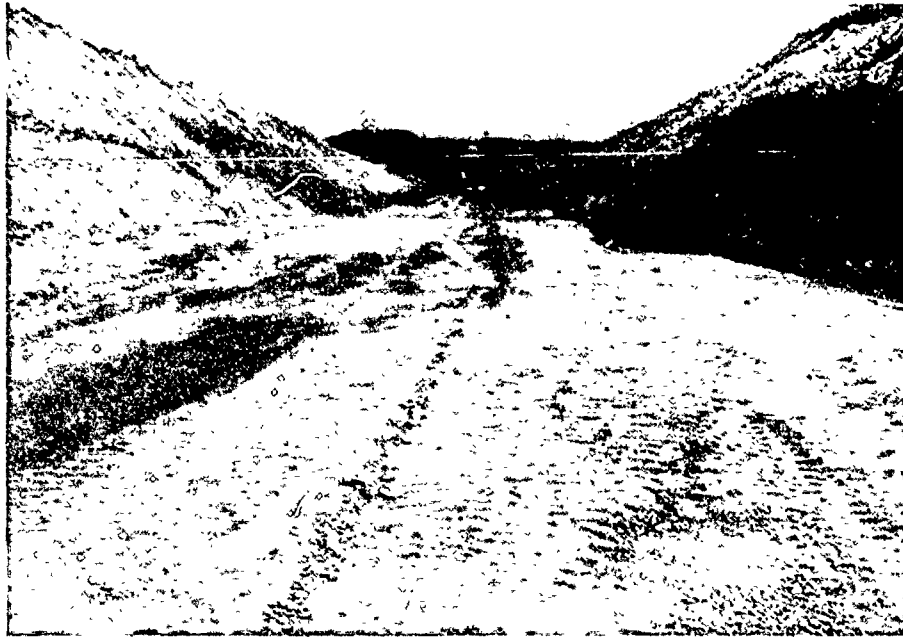


Figure 32. Inspection trench looking upstation (east).

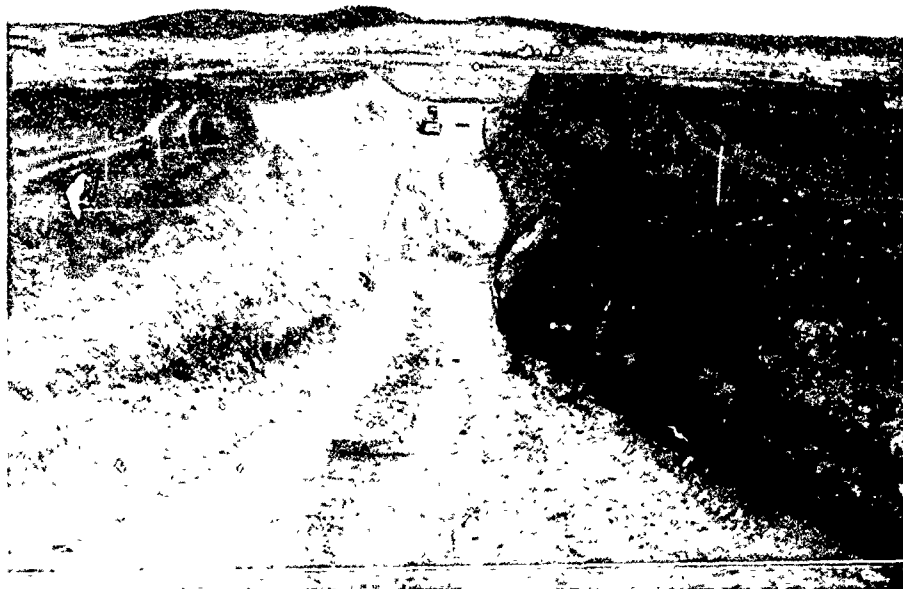


Figure 33. Inspection trench looking upstation.
Sta. 83+00 - 91+00.

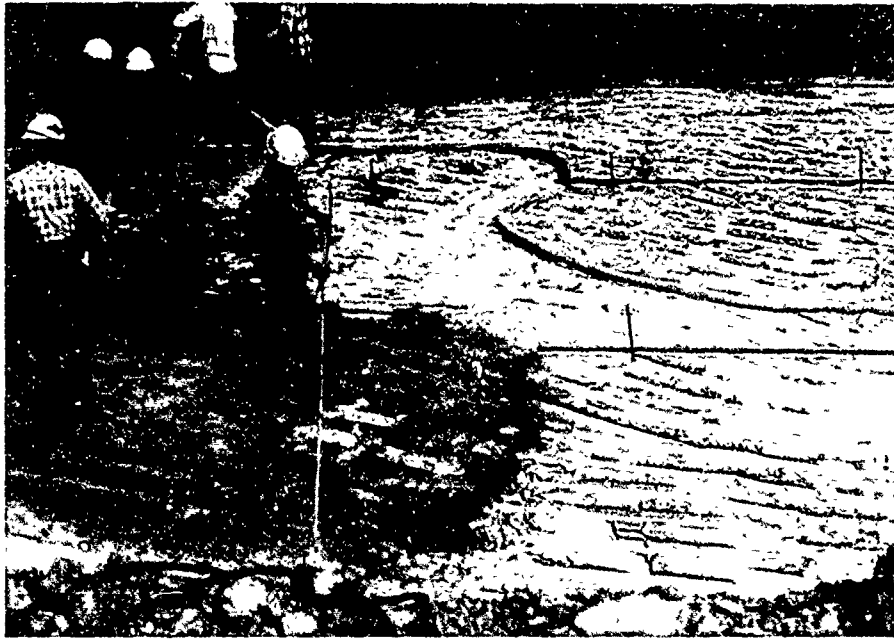


Figure 34. Intake structure foundation - spraying aerospray.

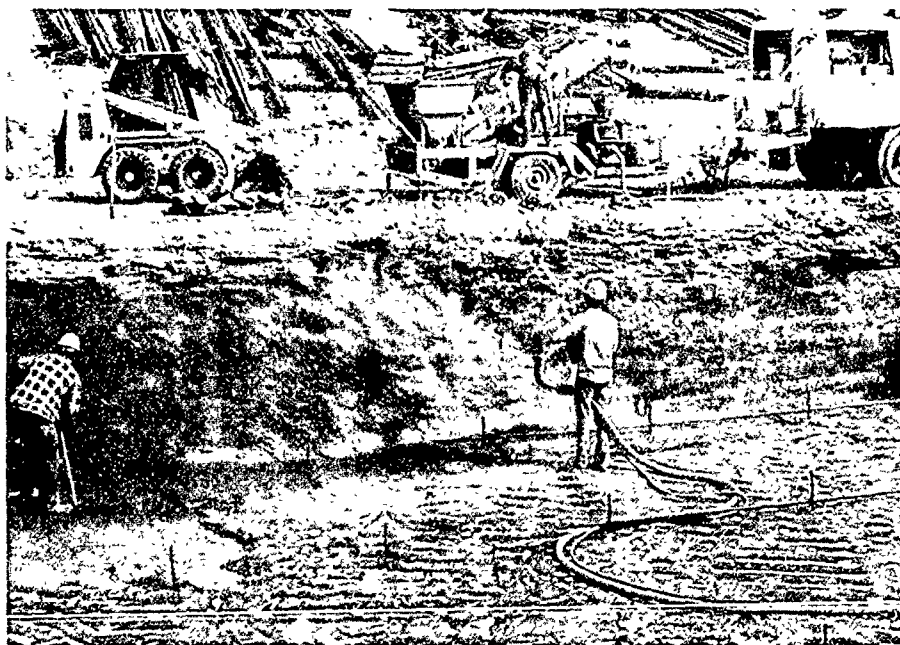


Figure 35. Intake structure foundation - applying gunite.



Figure 36. Intake structure foundation - placing protective concrete.



Figure 37. Forms for intake structure.



Figure 38. Outlet works, left side looking downstream at intake structure wing walls showing fresh shale surface.

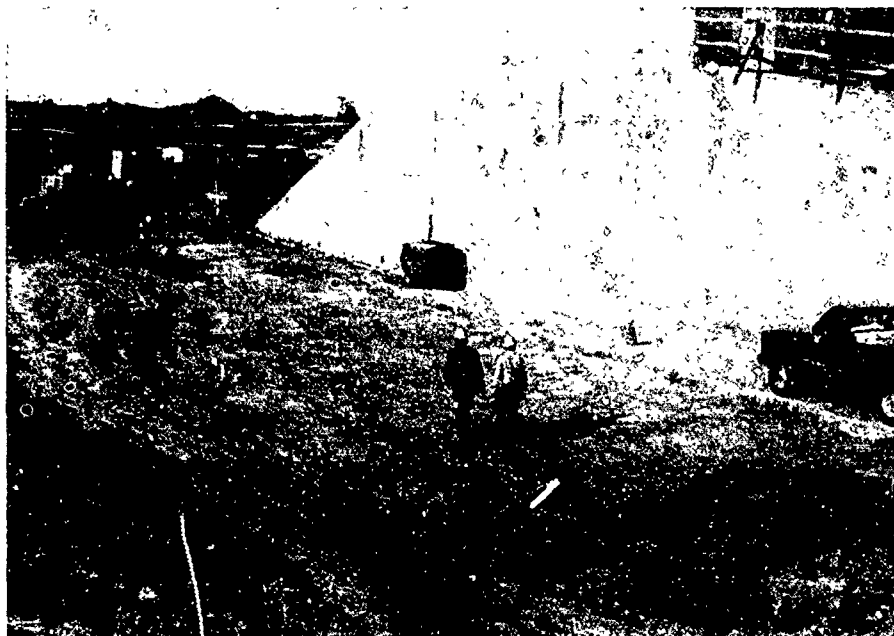


Figure 39. Intake structure, left side looking upstream. Fresh shale surface prior to placement of impervious.

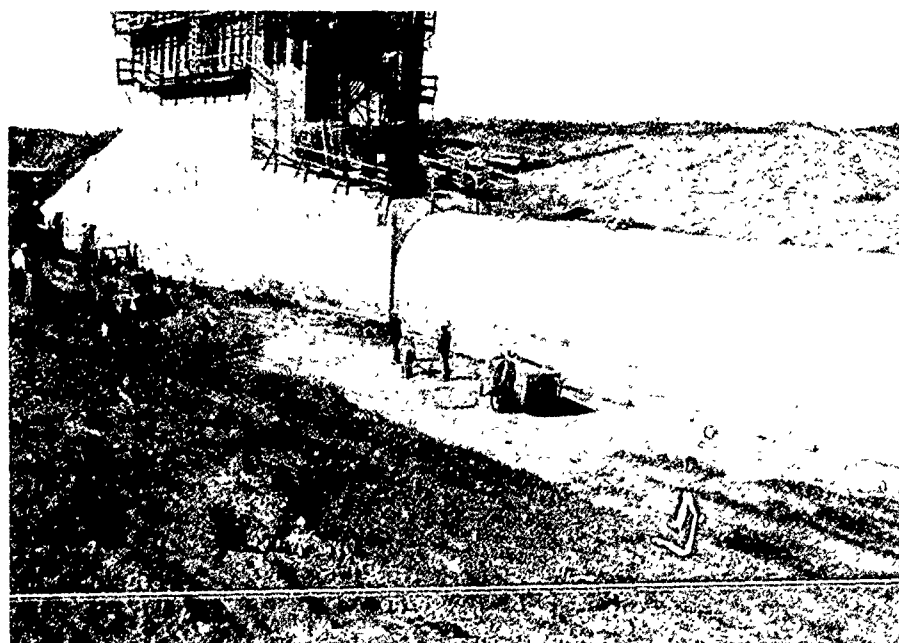


Figure 40. Same as above.

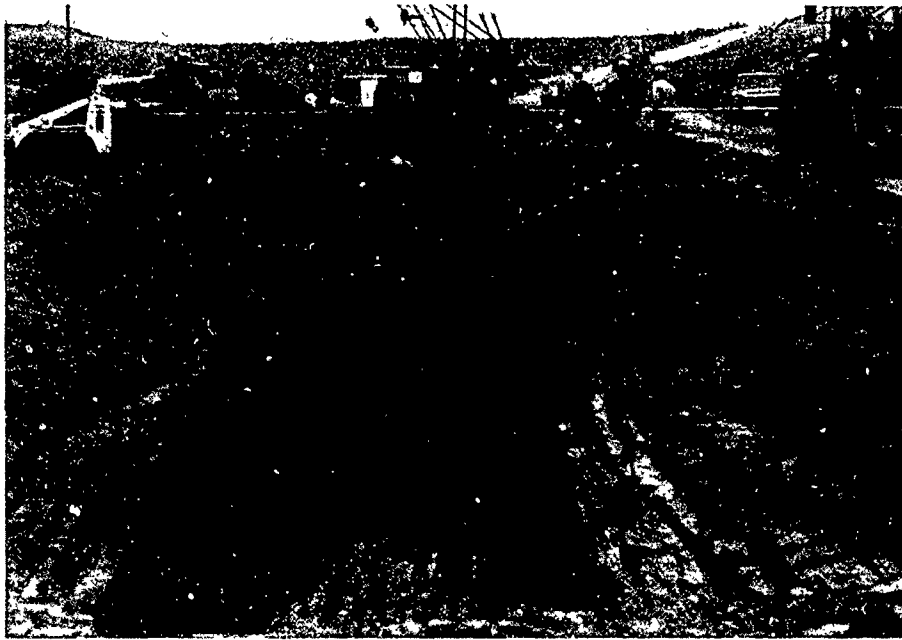


Figure 41. Hydropower conduit excavation showing gunite and aerospray application (looking upstream) Sta. 28+50 - 27+50.

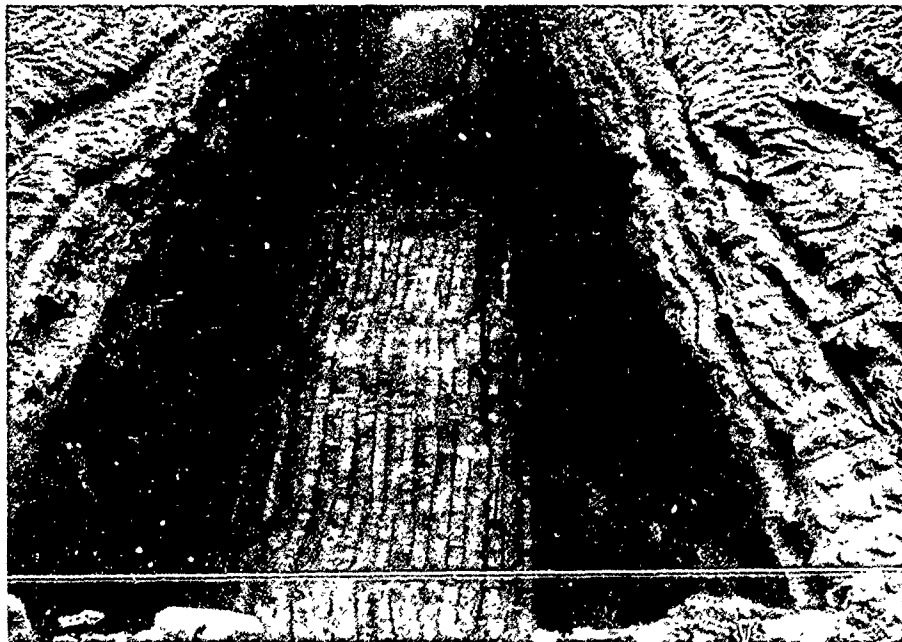


Figure 42. Same as above.

accelerated, apparently because of a heavy rain on 25-26 November 1982. See Figures 43 through 46. From Station 28+25 to 30+85 the Gunite was severely cracked and broken and an estimated 30-foot long section on the east wall of the trench had fallen. Most of the Gunite on both walls in this section appeared loose and ready to fall. Portions of the Gunite, though still in-place, had void space between the Gunite and the rock face. This space could provide a seepage path along the outside of the conduit connected directly to the reservoir pool. A contract modification was signed on 3 December 1982 which stated:

(1) On remainder of penstock excavation (Station 30+85 to Station 34+07), delete pneumatic concrete from the IV: .09 H slopes, and spray these slopes with Aero-spray 70 as often as required to prevent weathering of shale.

(2) Between Stations 28+22 and 30+75 remove all pneumatic concrete which is drummy, cracked, or loose. Spray exposed shale with Aero-spray 70 as often as required to prevent weathering of shale.

(3) All future penstock excavation (Station 30+85 to Station 34+07) and removal of existing pneumatic concrete (Station 28+22 to Station 30+75), will proceed at a rate to accommodate one placement at a time to minimize shale exposure.

The contractor agreed that no more than 3 days would pass between exposure of the clay shale and concrete encasement. On occasions when exposure was more than 3 days, deterioration, consisting of severe drying, cracking and checking, was often noted. Contractor was then

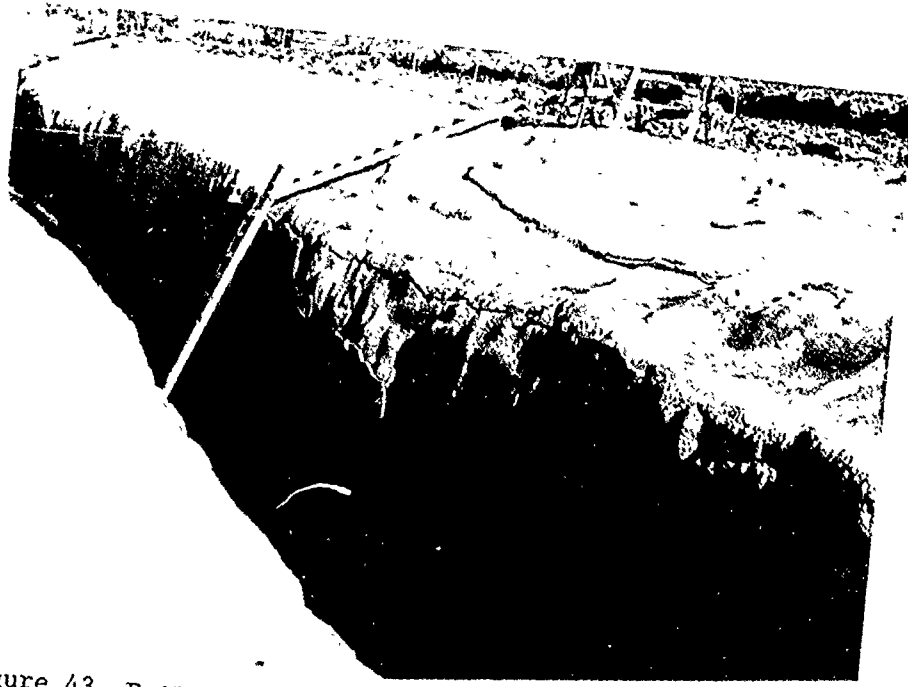


Figure 43. Failure of gunite on hydropower conduit excavation.



Figure 44. Same as above.

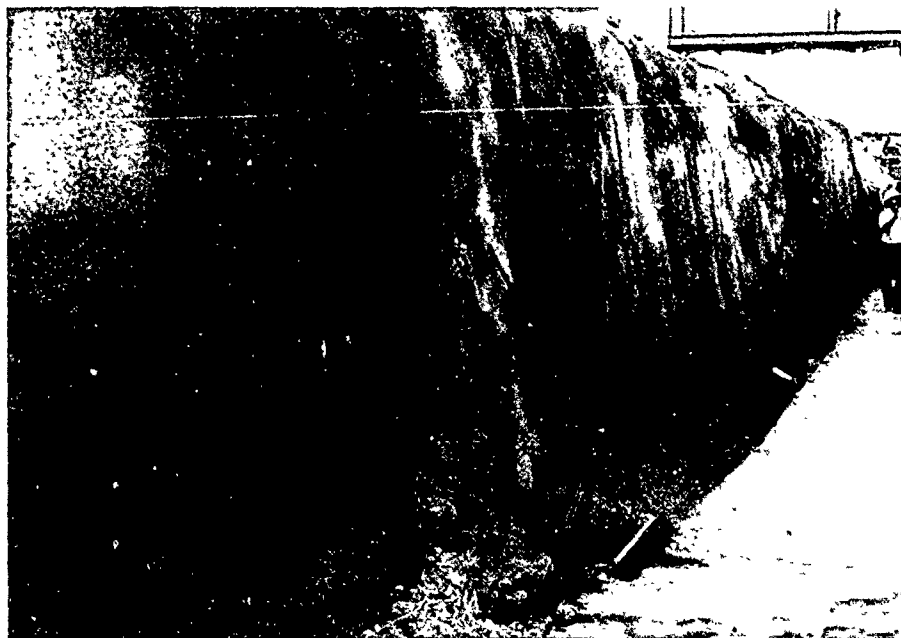


Figure 45. Failure of gunite on hydropower conduit excavation.

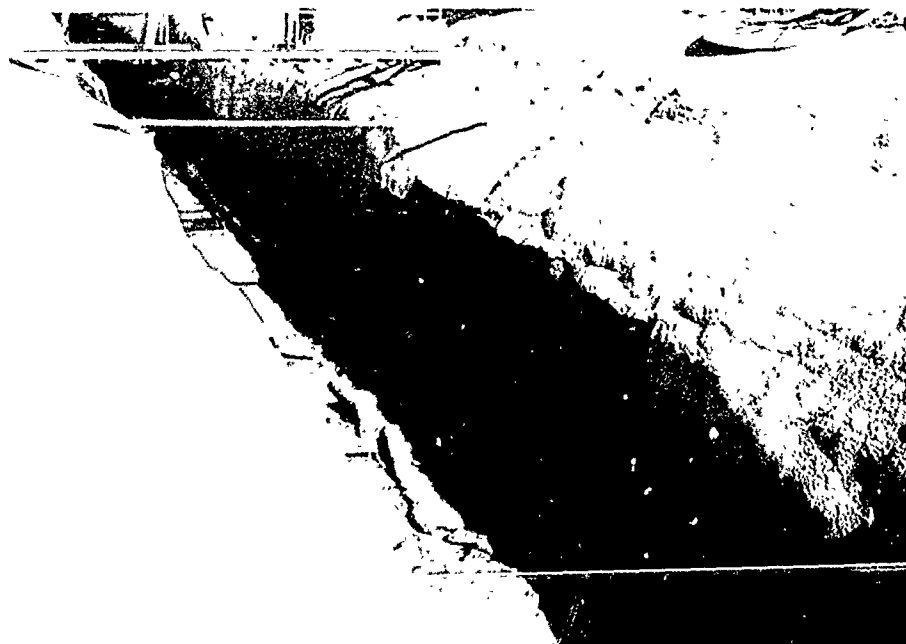


Figure 46. Same as above.

instructed to clean loose and drummy rock by jackhammer and to make final cleanup with compressed air before placement of concrete.

h. **Safety Protection Against Slides and Rock Falls.** Slopes excavated to design grade were generally not steep enough to require special protection against slides and rock falls.

5. **PILE DRIVING AND SPECIAL FOUNDATIONS.** No special foundations, such as driven piles, caissons, or drilled piers were utilized.

6. **TUNNELS, SHAFTS, AND UNDERGROUND STRUCTURES.** The construction of this project did not include any tunnel shafts or underground structures.

7. **FOUNDATION ANCHOR TEST.** A foundation anchor test was performed 4 April 1983 at Station 34+93.5, 5 feet west of outlet works centerline. See Figures 47 through 50. The surface elevation was 531.3. The test was performed in the chute foundation area on a 12-foot anchor with test results shown on pages 19 and 20.

8. **CHARACTER OF FOUNDATION.**

a. **General.** The limited service spillway is founded in weathered clay shale of the Pawpaw Formation of Lower Cretaceous age. The outlet works conduit, chute, and stilling basin are founded on unweathered clay shale of the Pawpaw Formation. Except for the left abutment, the inspection trench was almost entirely in overburden with clays and silty clays predominating. The Woodbine Formation, the basal formation of the Upper Cretaceous, was exposed in the inspection trench in the left abutment. It consists of weathered reddish-brown sands, clays,



Figure 47. Pullout test. Stilling Basin.

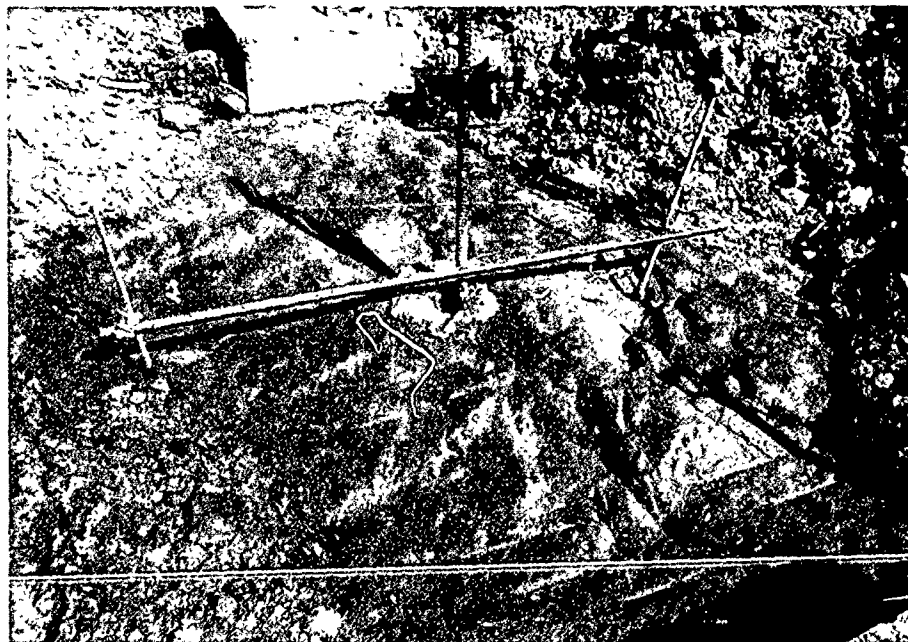


Figure 48. Same as above

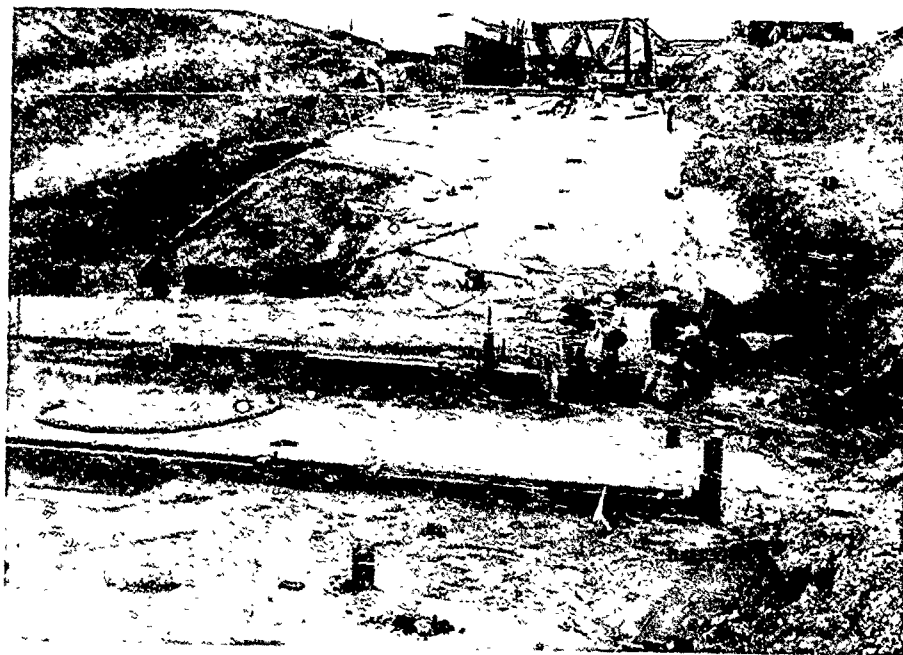


Figure 49. Pullout test. Stilling basin.



Figure 50. Same as above.

TEST NO. 1

<u>Time</u>	<u>Load In Tons</u>	<u>PSI</u>	<u>Deflection In Inches</u>
1044	0	0	.000
1044	5	930	.017
1049	5	930	.017
1050	12.7	2350	.026
1105	12.7	2350	.026
1105	17.7	3150	.035
1110	22.7		.046
1115	22.7		.046
1115	27.7		.059
1120	Stopped test - sag in "I" beam causing deflection in anchor bar.		

TEST NO. 2

<u>Time</u>	<u>Load In Tons</u>	<u>PSI</u>	<u>Deflection In Inches</u>
1137	5	930	.003
1142	5	930	.003
1142	12.7	2350	.015
1157	12.7	2350	.016
1157	17.7	3150	.023
1201	17.7	3150	.023
1201	22.7	4050	.034
1207	22.7	4050	.034
1207	27.7	4950	.045
1212	27.7	4950	.046
1212	32.7	5850	.060
1216	32.7	5850	.067
1216	36.0	6600	.075
1221	36.0	6600	.085
1222	32.7	5850	.085
1226	32.7	5850	.085
1226	27.7	4950	.078
1231	27.7	4950	.077
1231	22.7	4050	.068
1236	22.7	4050	.068
1236	17.7	3150	.057
1241	17.7	3150	.057
1241	12.7	2350	.043
1246	12.7	2350	.043

TEST NO. 2
(cont'd)

<u>Time</u>	<u>Load In Tons</u>	<u>PSI</u>	<u>Deflection In Inches</u>
1246	5	930	.018
1251	5	930	.018
1251	0	0	.000
1300	0	0	.000
1300	5	930	-.012
1305	5	930	-.012
1305	12.7	2350	.000
1310	0	0	.000
1310	5	930	-.006
1315	5	930	.000
Bar deflecting downward and horizontal under initial load.			
1320	5	930	.000
1320	12.7	2350	.016
1335	12.7	2350	.016
1335	5	930	.003
1340	5	930	.003
1340	0	0	-.006
1341	5	930	.001
1346	5	930	.001
1346	10	1820	.011
1351	10	1820	.011
1351	15	2750	.021
1356	15	2750	.023
1356	20	3650	.038
1401	20	3650	.038
1401	25	4550	.049
1406	25	4550	.050
1406	30	5450	.064
1411	30	5450	.064
1411	35	6300	.078
1416	35	6300	.083
1416	40	7200	.107
1421	40	7200	.109

Stop Test

and sandstones ranging from soft and friable to moderately hard.

b. **Character of Overburden Materials.** Overburden materials comprise the foundation for the embankment, in the outlet works approach and discharge channels, and in the approach and discharge channels for the spillway. Overburden materials exposed in the inspection trench and cutoff trench consist of alluvial clays, silts, sands, and gravels in the floodplain between Stations 105+00 and 136+00, and residual overburden on the abutments. Residual overburden consisting of clay and silty clay was exposed in the approach and discharge channels for the spillway. The outlet works approach and discharge channels were excavated in fluvial terrace and floodplain alluvial materials consisting of clay, sand, silt, and gravel.

c. **Character of Primary Materials.** The Pawpaw Formation comprises much of the foundation and was exposed in the outlet works and the spillway excavation. The Pawpaw is relatively level and finished grade was often on or near bedding planes. See Figures 13, 16, and 18. In the outlet works foundation, the clay shale is generally soft to moderately hard, unweathered, gray to dark gray and thin to medium bedded with scattered sandy seams and occasional sandstone seams north of Station 27+00. South of station 27+00 the clay shale contains up to 50 percent fine-to-medium grained sandstone and sandy seams. The base of the sandy phase was encountered at elevation 523, Station 36+15 in the chute foundation. A 2- to 3-inch thick fossiliferous zone was exposed near the base of the chute at elevation 520.0. Excavation,

cleaning of shale surfaces, and placement of fill are shown in Figures 51 through 64. The stilling basin foundation surface was described as shale, soft, slightly sandy with occasional sandy pockets and zones, fossiliferous, gray. See Figures 63 and 64.

The sill foundation for the limited use spillway was excavated down to a sandy, stiff, yellowish-brown to light gray clay, underlain by about 3 feet of gravelly clay. The edges and narrow sections in the middle, horizontal part of the foundation were keyed into weathered shale of the Pawpaw Formation. The approach and discharge channels were excavated in sandy clay. See Figures 27, 28, and 29.

9. **FOUNDATION TREATMENT.** No grouting was necessary at the project and no dental concrete or broom grouting were utilized.

10. **FOUNDATION INSTRUMENTATION.**

a. **General.** The instrumentation program at Ray Roberts Dam was designed to monitor five basic areas which are discussed below. A plan of instrumentation is shown on Plate 57. The following descriptions are taken from "Periodic Inspection No. 1, Ray Roberts Lake, July 1987."

(1) **Initial Embankment and Closure Section.** Nineteen piezometers were installed to monitor pore pressure development in the floodplain foundation during construction of the initial embankment and closure section. Settlement gages (12 deep settlement plates and 3 foundation surface settlement plates) were installed to monitor vertical movement of the foundation in the floodplain, and 8 surface



Figure 51. Outlet works, left side looking upstream. Fresh shale surface prior to placement of impervious material.



Figure 52. Same as above.

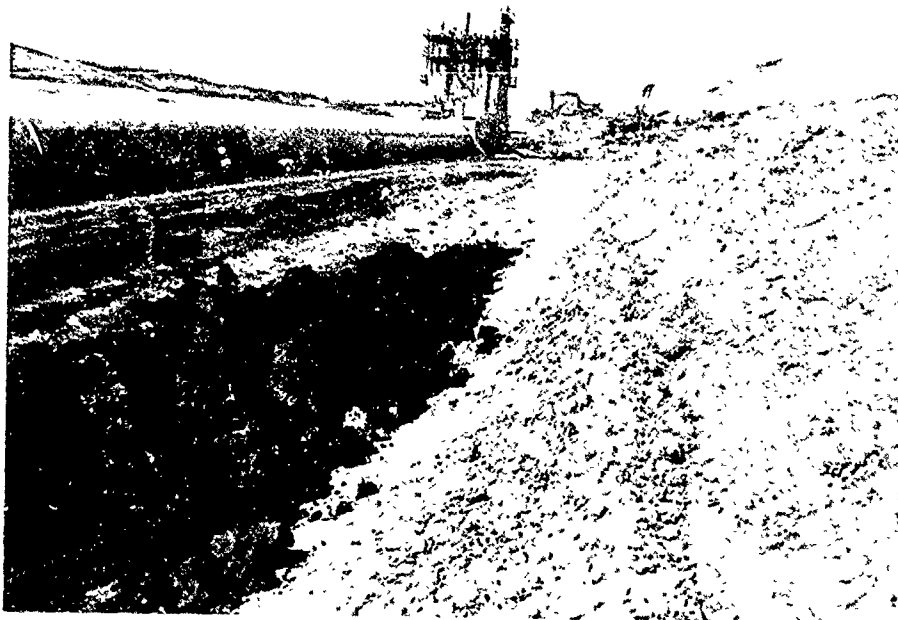


Figure 53. Outlet works conduit, left side, looking upstream. Placing fill on fresh shale surface.

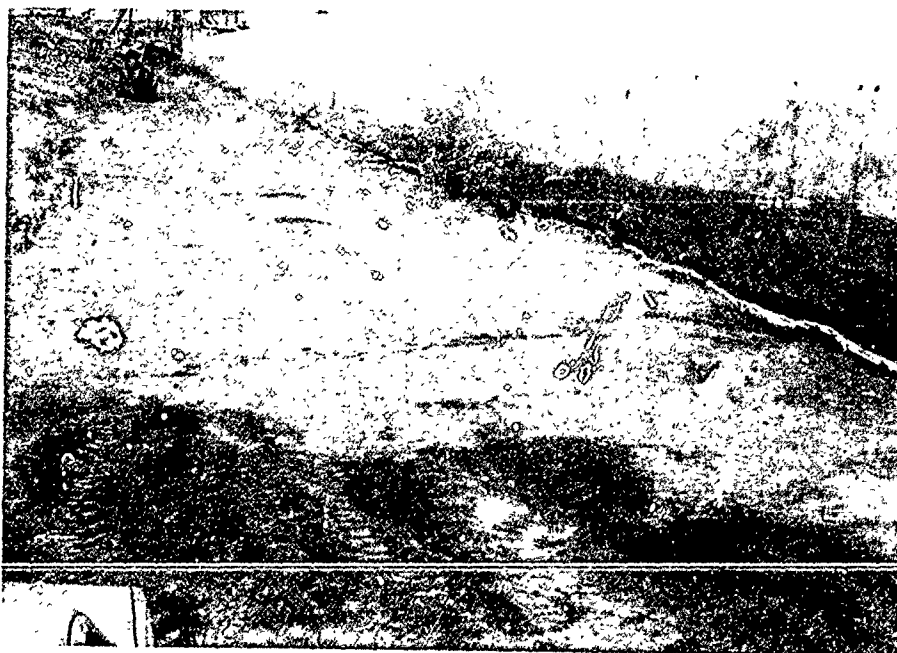


Figure 54. Outlet works conduit, right side, looking upstream. Fresh shale adjacent to conduit.

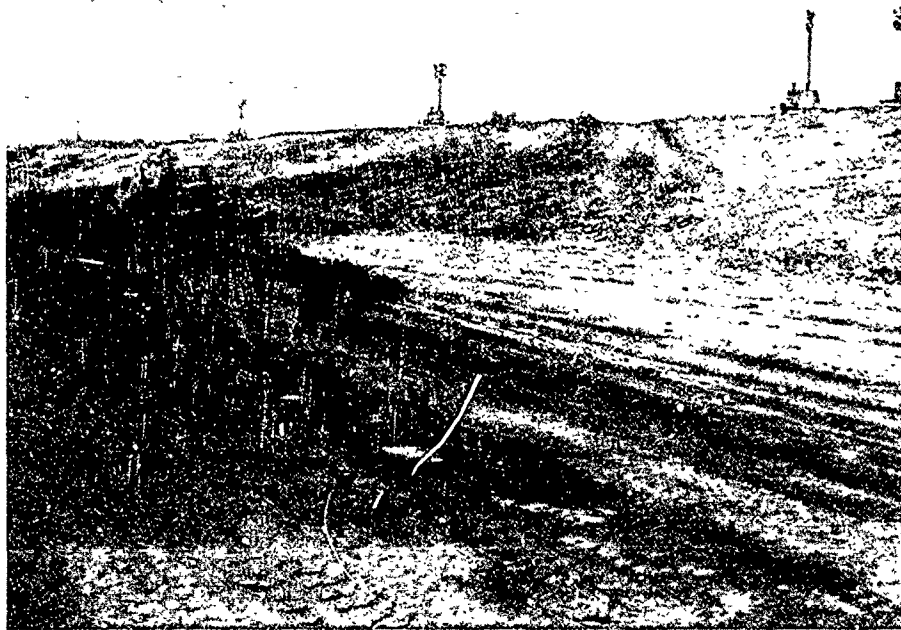


Figure 55. Outlet works excavation, right side looking downstream. Placing fill on fresh shale surface.



Figure 56. Outlet works, right side, looking upstream. Fresh shale surface.

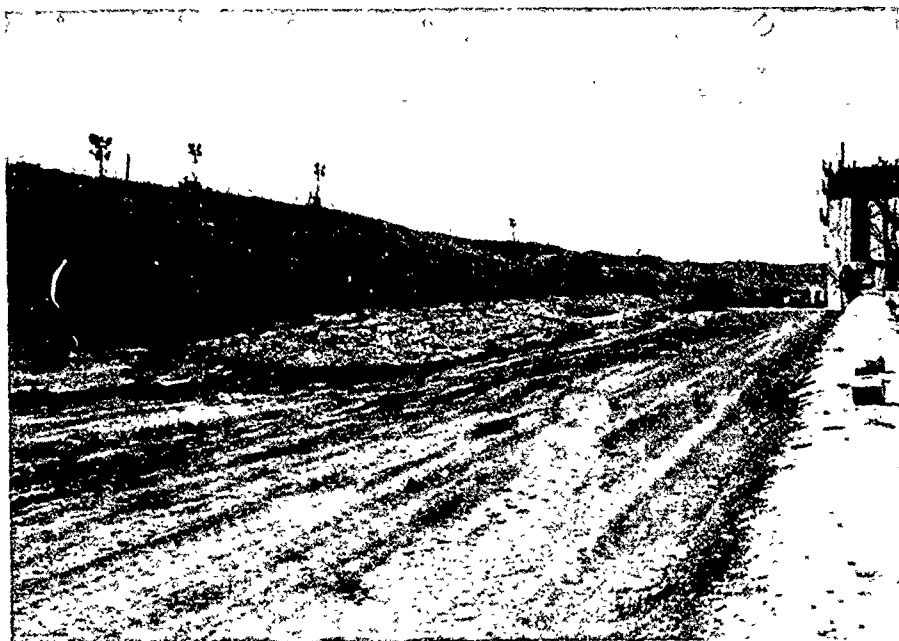


Figure 57. Outlet works, right side looking upstream. Cleaning shale surface in increments prior to placement of fill.

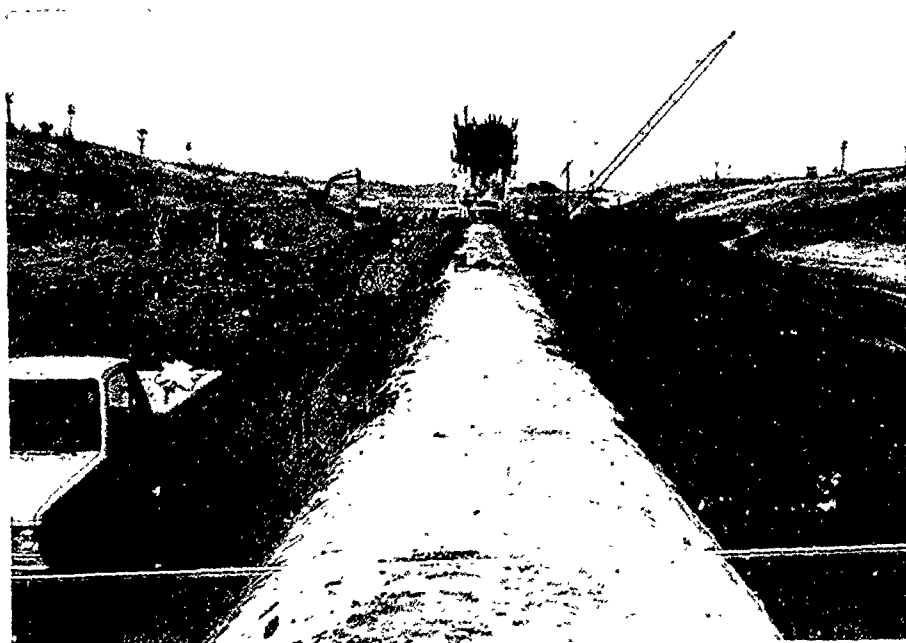


Figure 58. Outlets works conduit, looking upstream.



Figure 59. Outlet works looking downstream from tower.



Figure 60. Same as above.



Figure 61. Outlet works, right side, looking downstream. Cleaning shale surface prior to placement of fill.



Figure 62. Same area as above.



Figure 63. Stilling basin. Spraying aerospray.



Figure 64. Excavation for discharge from valve vault.

reference marks were provided to monitor embankment movement. Twelve inclinometers were installed to measure lateral displacement of the foundation during construction of the initial embankment and closure section. Of primary concern in planning the instrumentation program was the performance of the initial embankment which was designed to preload and consolidate the floodplain soils.

(2) **Left Abutment.** Nine piezometers were installed to monitor potential seepage effects at the left abutment (the upper portion of the abutment consists of pervious strata) including uplift pressures acting on the downstream portion of the embankment.

(3) **Embankment Underseepage.** Twenty-six seepage piezometers were installed in the embankment foundation to monitor underseepage.

(4) **Outlet Works.** To monitor movement of the outlet work structure, reference pins were installed within the conduit, on the stilling basin walls, and on the service bridge.

(5) **Embankment Crest.** A set of embankment station monuments has been installed along the downstream side of the crest to monitor post-construction settlement.

b. **Schedule of Instrumentation Reading.** Instrumentation located at the project will be read by CESWF-ED-G personnel according to the following schedule, or more frequently, if deemed necessary.

- o Piezometers - quarterly
- o Inclinometers - annually
- o Seepage Interceptor - monthly and when pool reaches 580, 590, 600, and 632.5

- o Settlement Gages - quarterly and when pool reaches 580, 590, 600, and 632.5
- o Outlet Works Reference Pins - semiannually
- o Embankment Reference Marks - quarterly

c. **Settlement Plates and Deep Settlement Plates.** Settlement Plates SP-1 through SP-3, and deep settlement Plates DSP-1 through DSP-12 were installed in the floodplain foundation prior to and during initial embankment construction to monitor foundation settlement. Settlement plates consist of a 36-inch square, $\frac{1}{4}$ -inch thick steel plate placed within the foundation materials and welded to a steel riser pipe extended through the embankment fill.

d. **Inclinometers.** I-1 through I-12 were installed within the floodplain embankment foundation prior to construction of the initial embankment to monitor horizontal deflection within the foundation. To provide a fixed frame of reference, all inclinometers were anchored in the primary clay shale. Inclinometers consist of a 3.34-inch diameter grooved ABS casing manufactured by Slope Indicator Company, Seattle Washington. Inclinometers were extended through the fill and steel casing.

e. **Piezometers.** Piezometers P-1 through P-43b have been installed within the embankment foundation materials to monitor foundation performance during construction and after impoundment. Open system piezometers utilizing porous plastic tips as manufactured by Slope Indicator Company, Seattle Washington, were installed using 3/8-inch diameter PVC risers and extended through the fill with steel casing.

Piezometers P-1 through P-19 were installed within the floodplain embankment foundation prior to construction of the initial embankment to monitor excess pore pressure development during construction. After embankment completion, piezometers P-20 through P-36 were installed on the downstream toe and slope within the sands and gravels overlying the shale. Piezometers P-37 through P-43b were installed after embankment completion, within the sandy abutment materials. All Piezometers (P-20 through P-43b) will monitor seepage within the foundation materials during and after reservoir filling.

f. **Surface Reference Marks.** Reference marks consisting of a brass monument, set into a 6-inch diameter pipe filled with concrete, were installed within the floodplain embankment to a depth of 5 feet to monitor vertical movement.

g. **Reference Pins.** Reference pins were installed along the outlet works conduit invert, stilling basin monolith walls, and service bridge. Reference pins which consist of bronze bolts embedded in concrete are used to monitor vertical movement of the monolith or slabs, and relative movement between monoliths or slabs.

h. **Seepage Interceptor System.** A seepage interceptor system has been installed within the left abutment embankment foundation to collect underseepage. The discharge is currently being monitored to record the normal ground-water flow. Flow from the system will be monitored, along with piezometers P-37 through P-43b, during impoundment when the pool reaches elevation 580, 590, 600, 620, and 632.5.

11. POSSIBLE FUTURE PROBLEMS. At the time foundations were approved and the dam completed in October 1986, no potential for future problems was apparent. The first periodic inspection was performed in July 1987. By that time several minor skin slides had occurred in the spillway approach channel slope. It was concluded that this problem could be easily remedied. Other minor problems are addressed in "Periodic Inspection Report No. 1, July 1987." The dam is considered to be in good general condition.

12. RECORD OF FOUNDATION APPROVAL. A record of the date when each section of the outlet works foundation was approved is shown on Plate 58. Records of approval of final foundation grades were kept for all foundations on which concrete was to be placed. The foundation for the emergency spillway was approved as a unit on 11 February 1984.



Figure 65. Outlet works, right side looking downstream. Cleaning shale surface in increments prior to placement of fill.



Figure 66. Placing fill.



Figure 67. Outlet works. Placing fill.

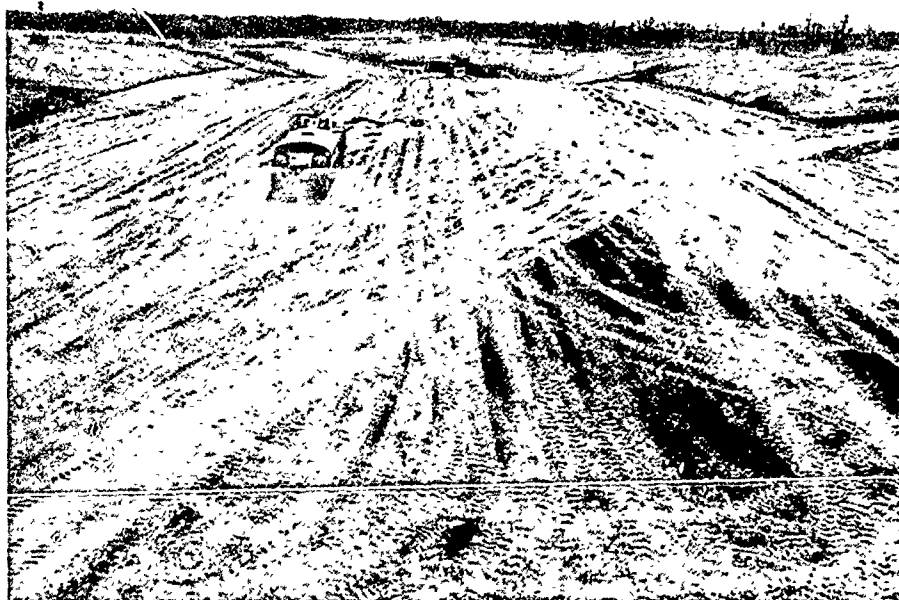


Figure 68. Outlet works backfill, looking downstream.



Figure 69. Excavation for valve vault.

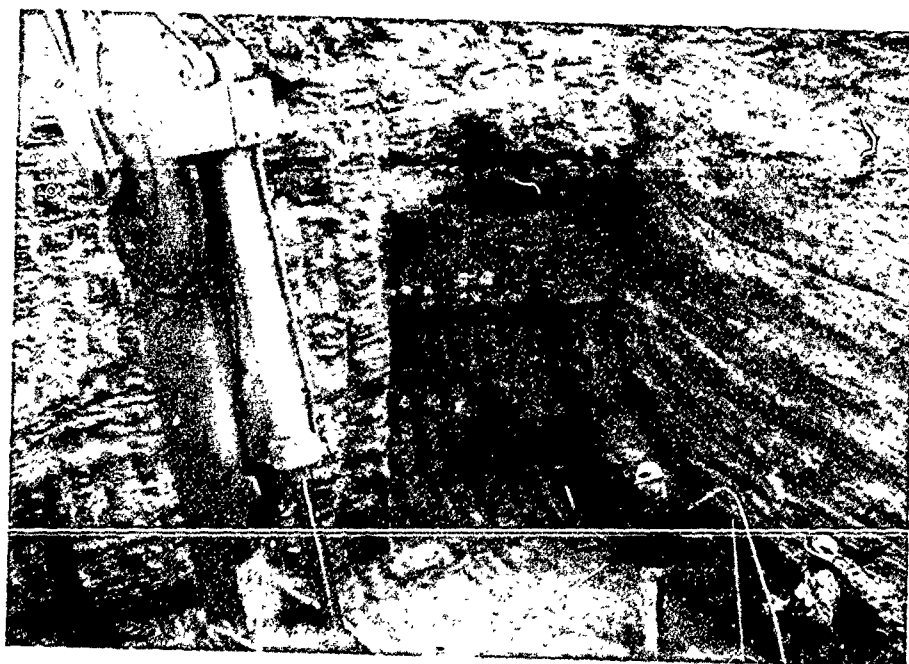


Figure 70. Same as above.

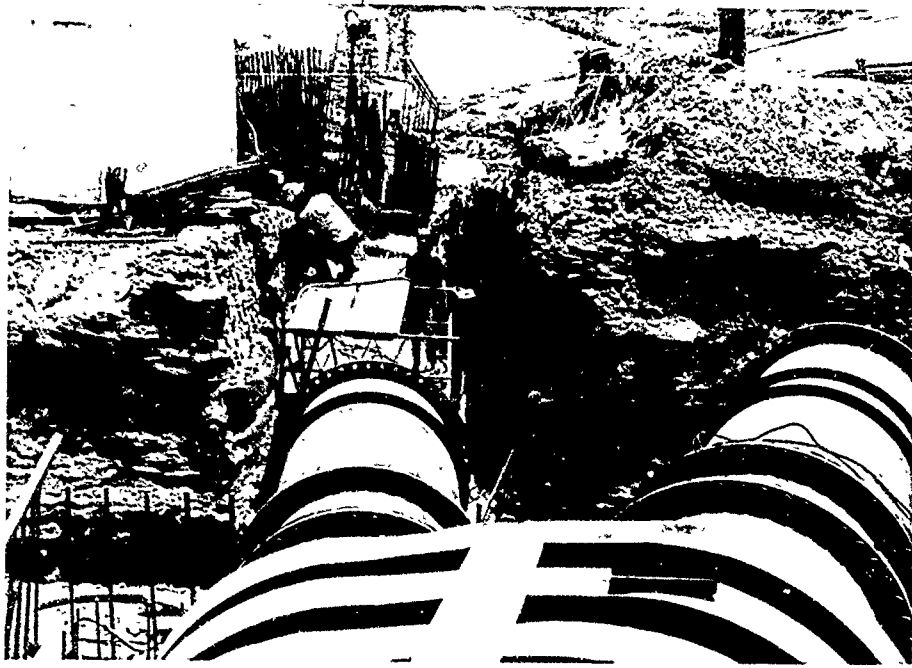


Figure 71. Discharge pipes from valve vault.



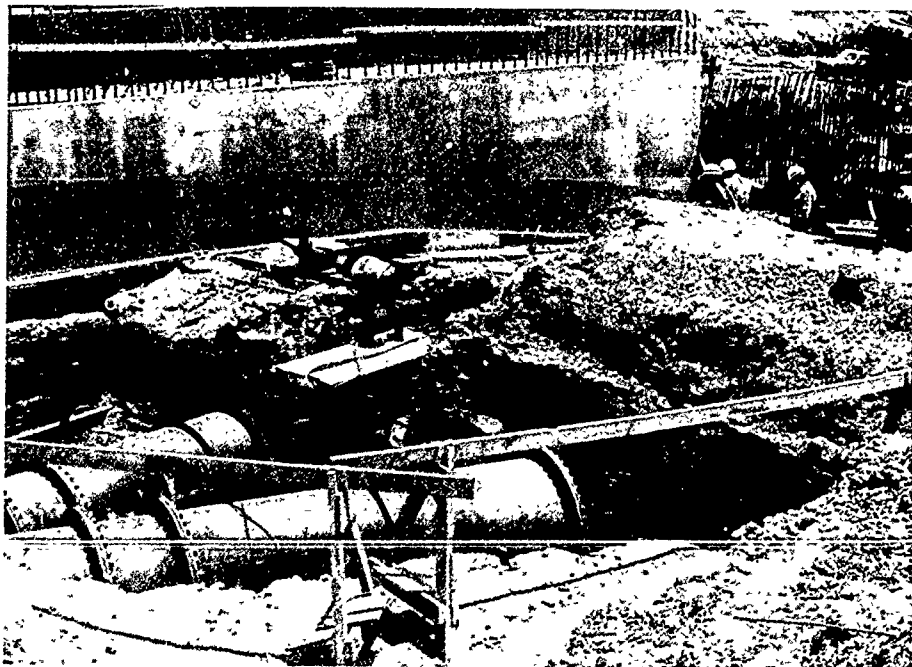


Figure 72. Same as above.

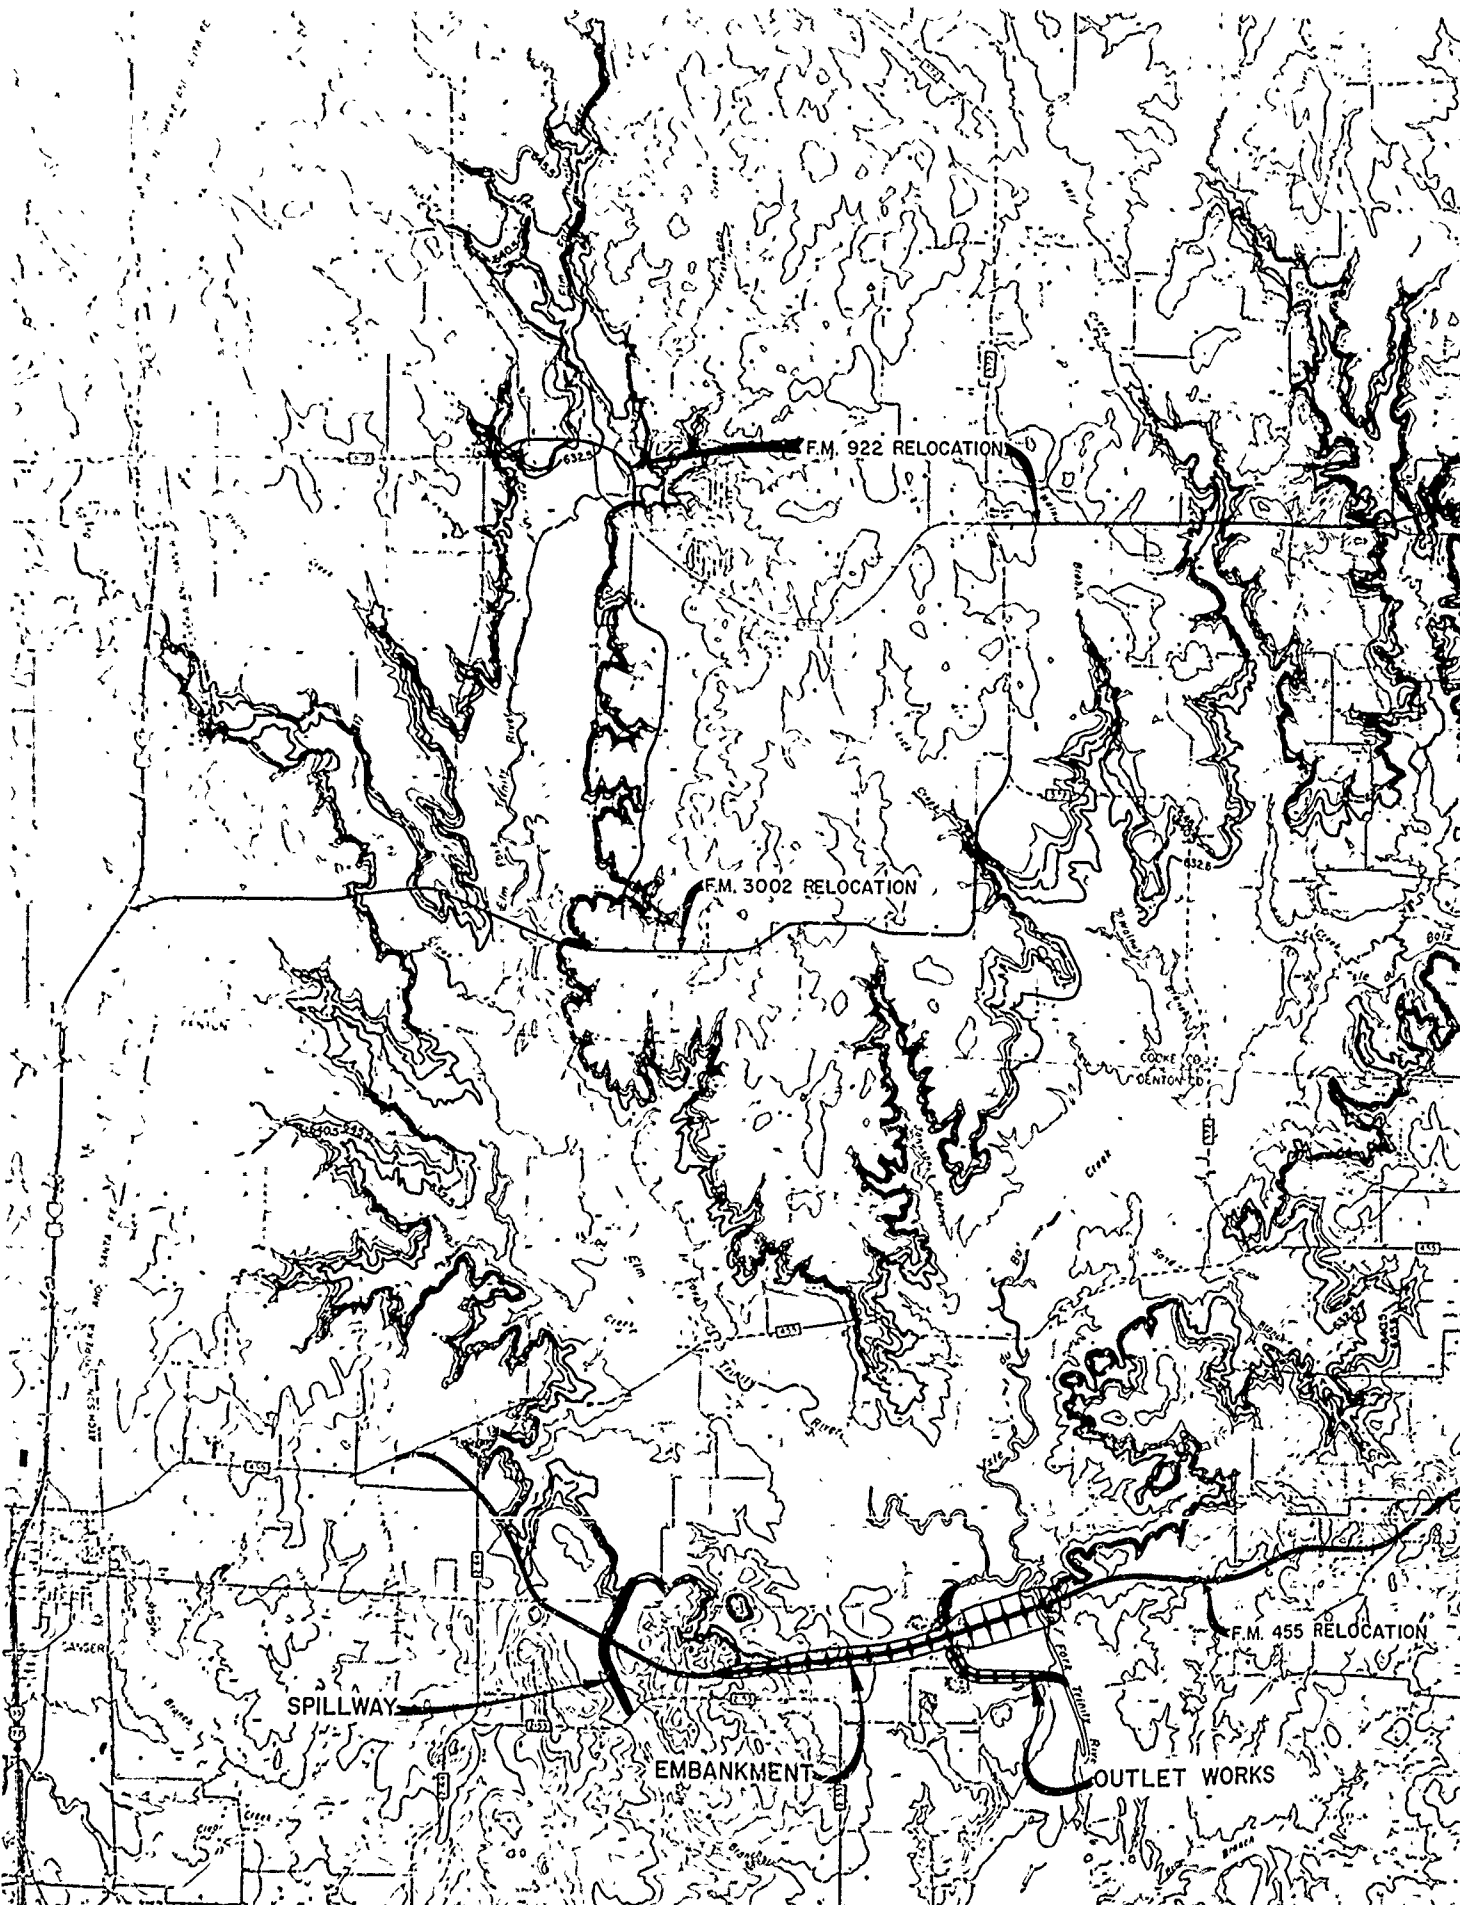

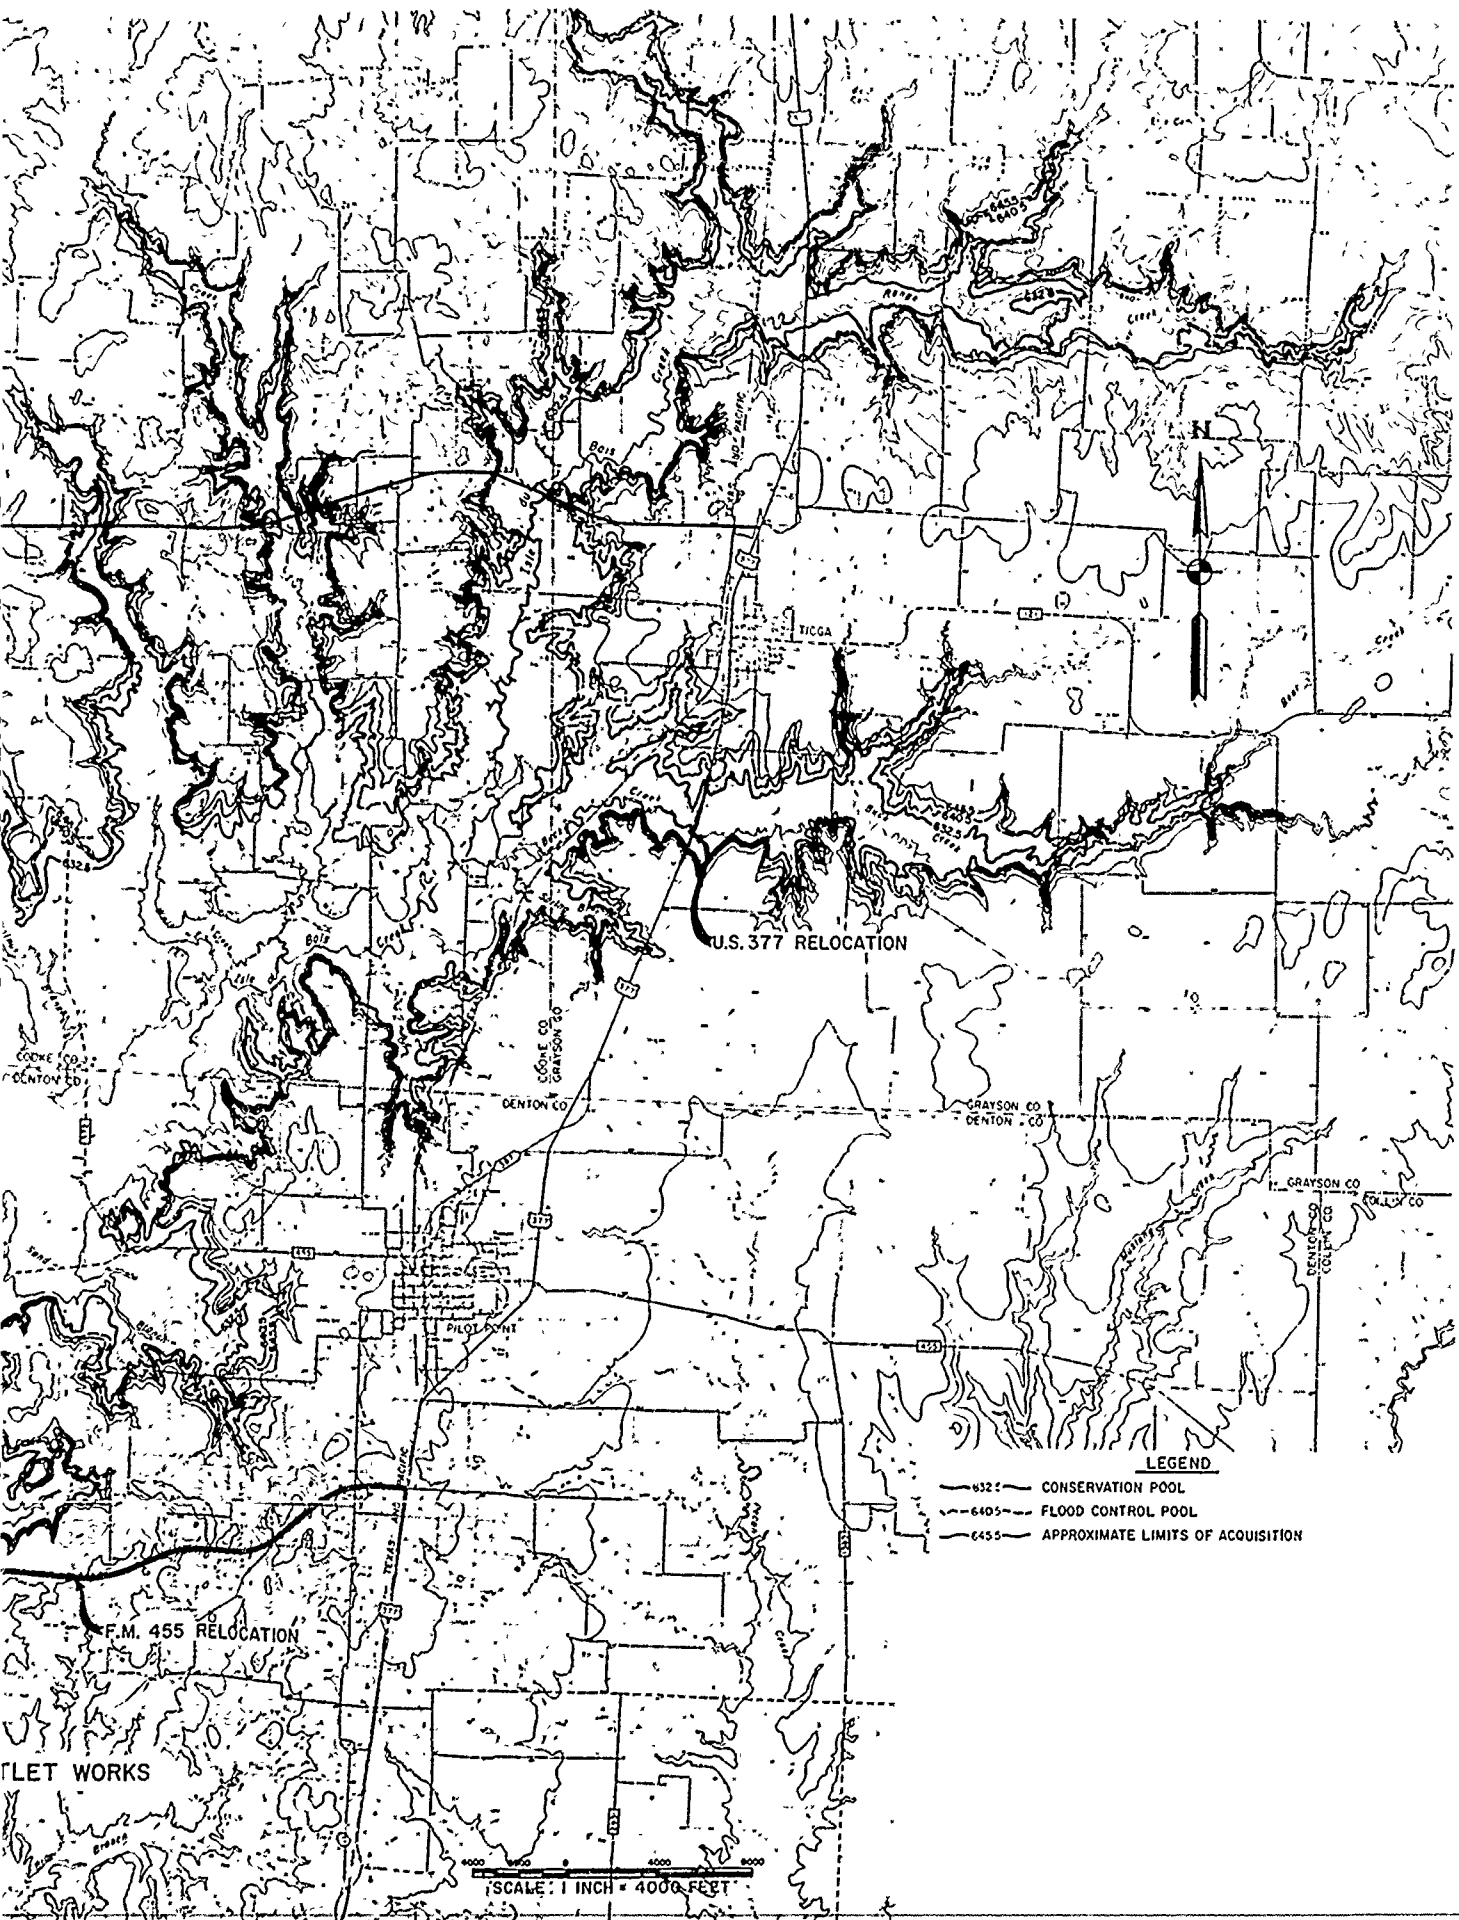

U.S. 377 RELOCATION



LEGEND

- 6322 — CONSERVATION POOL
- 6405 — FLOOD CONTROL POOL
- 6455 — APPROXIMATE LIMITS OF ACQUISITION

SCALE: 1 INCH = 4000 FEET

F.M. 455 RELOCATION


LET WORKS

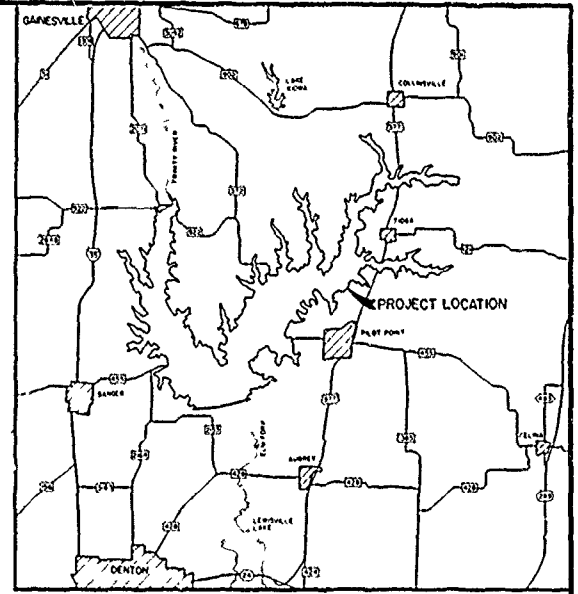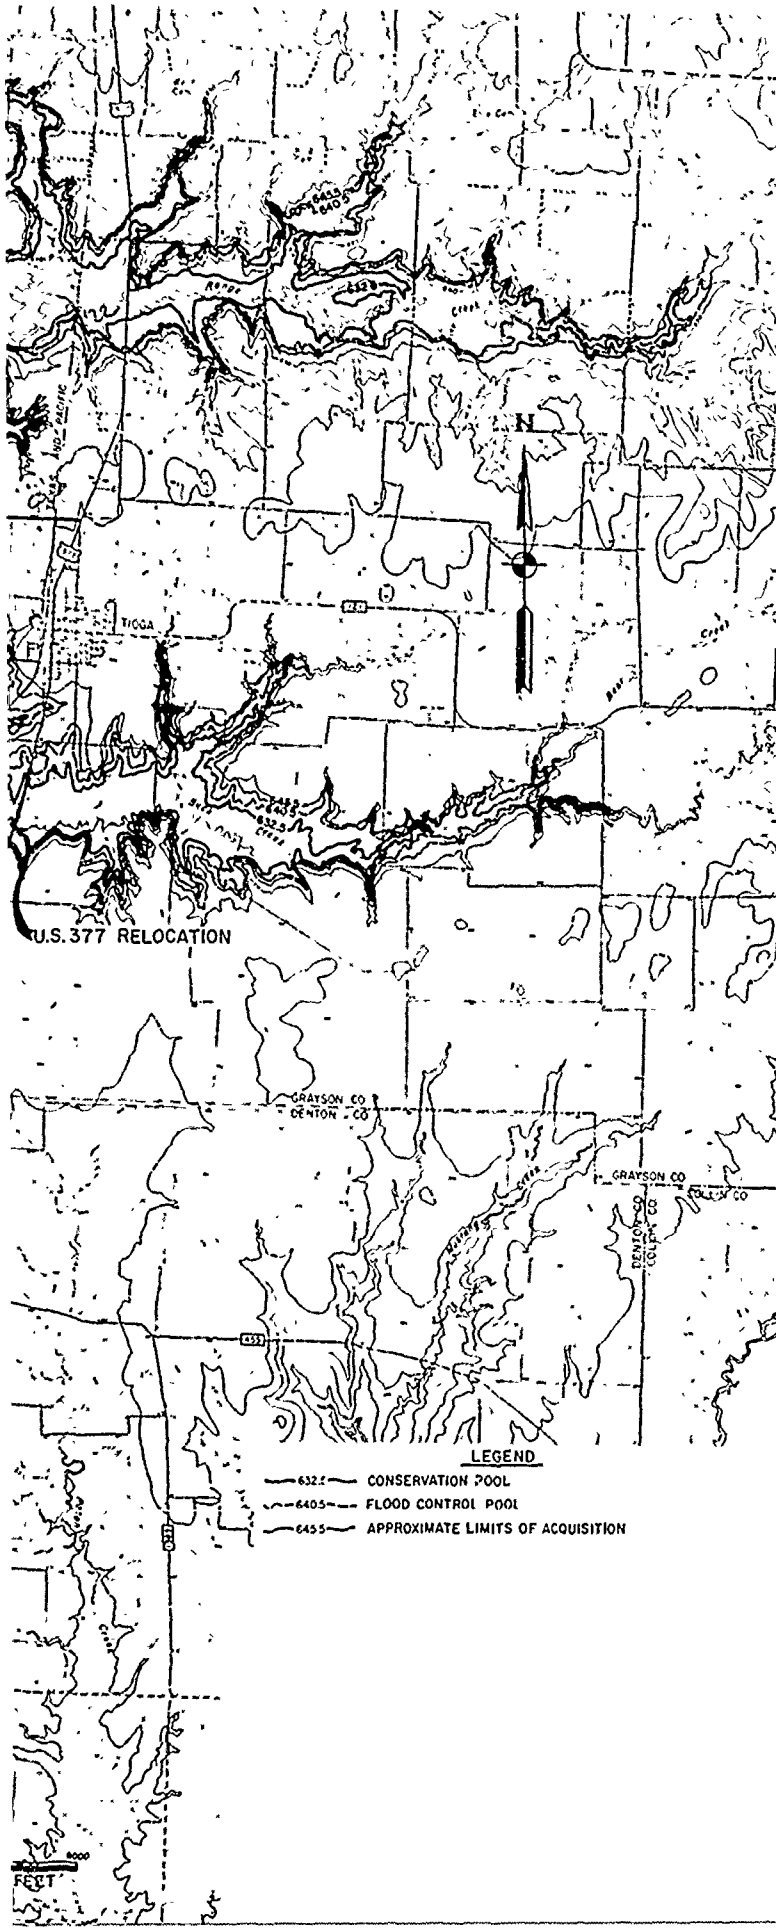

VICINITY MAP
SCALE: 1 INCH = 4 MILES APPROX.

SYM. OR. NO.	ACTION	DATE	DESCRIPTION OF REVISION
U.S. ARMY ENGINEER DISTRICT, FORT WORTH CORPS OF ENGINEERS FORT WORTH, TEXAS			
DESIGNED BY:	RAY ROBERTS LAKE ELM FORK, TRINITY RIVER, TEXAS FOUNDATION REPORT LAKE MAP AND VICINITY MAP		
DRAWN BY:			
REVIEWED BY:			
SUBMITTED BY:	INVITATION NO.	DATE:	
	CONTRACT NO.		

ATTACH 01

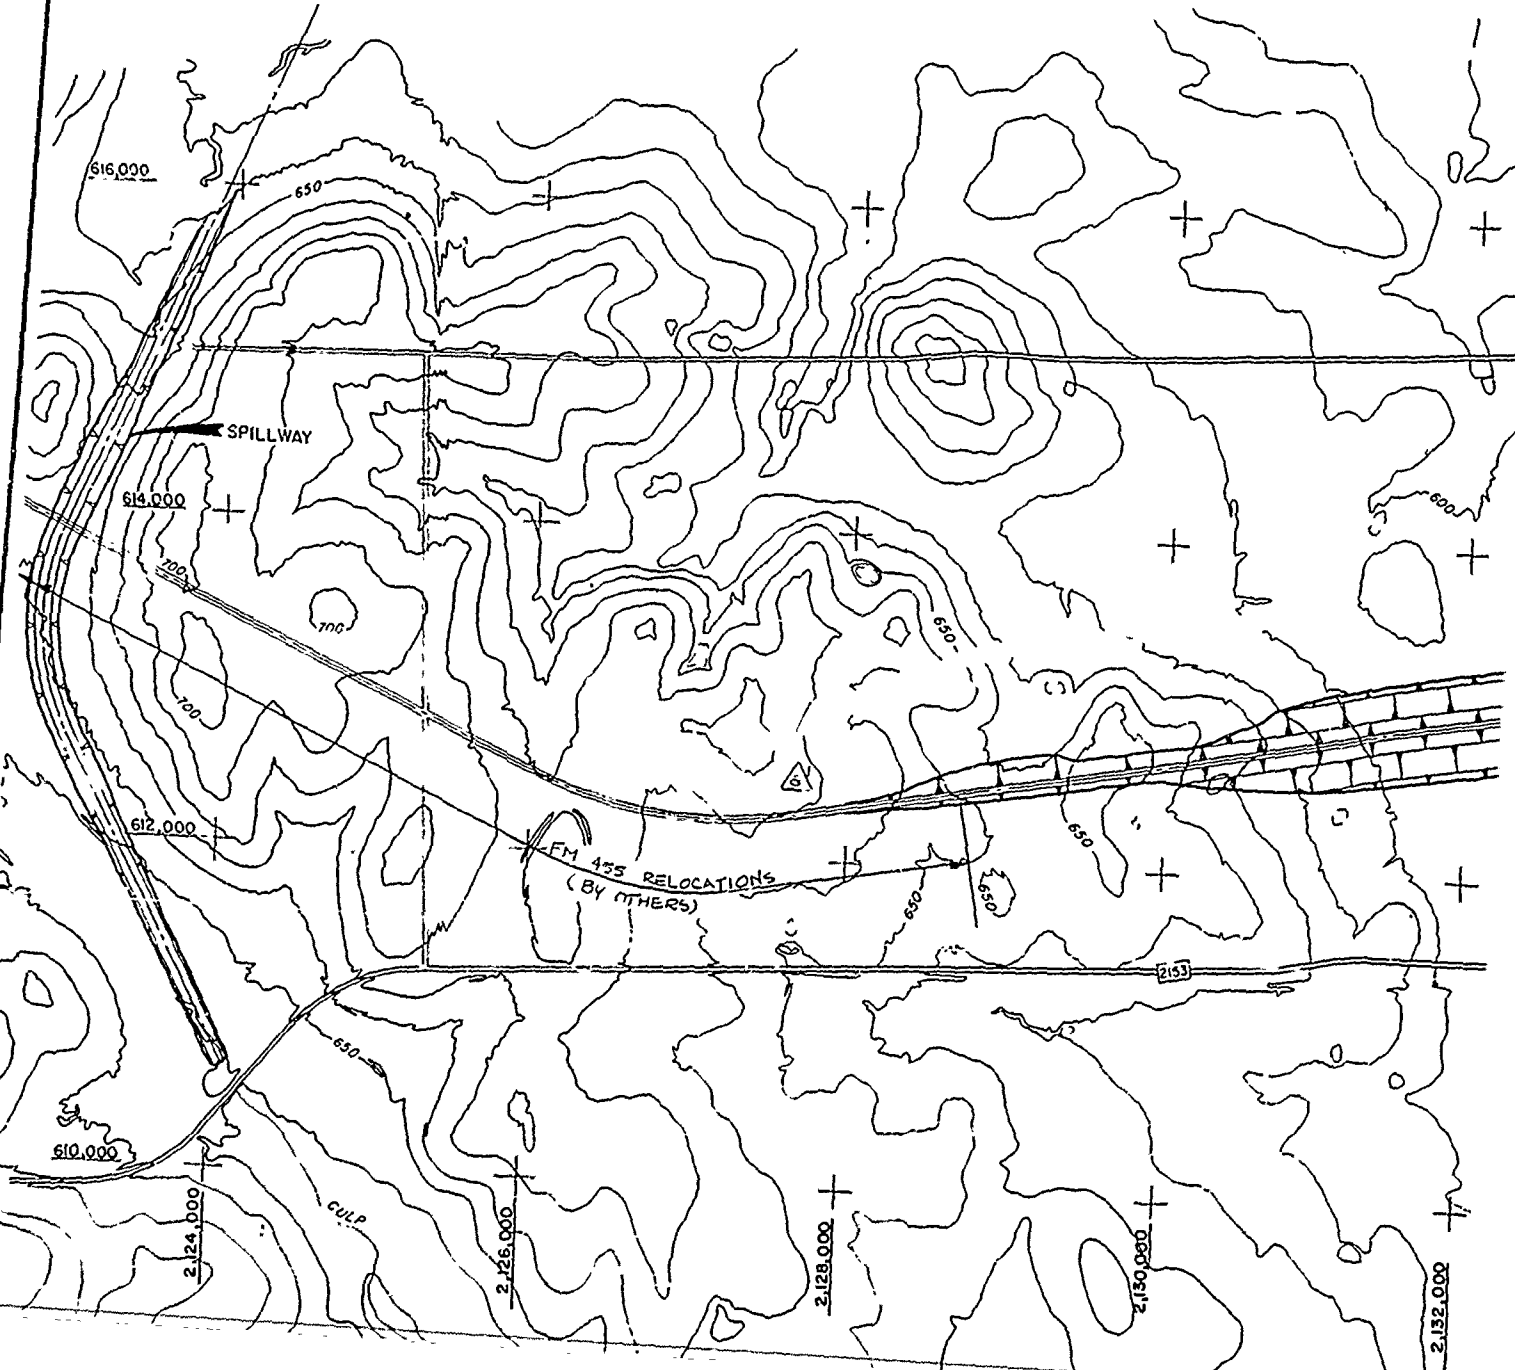

616,000

614,000

612,000

610,000

650

700

650

650

FM 455 RELOCATIONS
(BY OTHERS)

650

650

650

2133

2,128,000

2,130,000

2,132,000


2,124,000

2,126,000


2,128,000

2,130,000

2,132,000

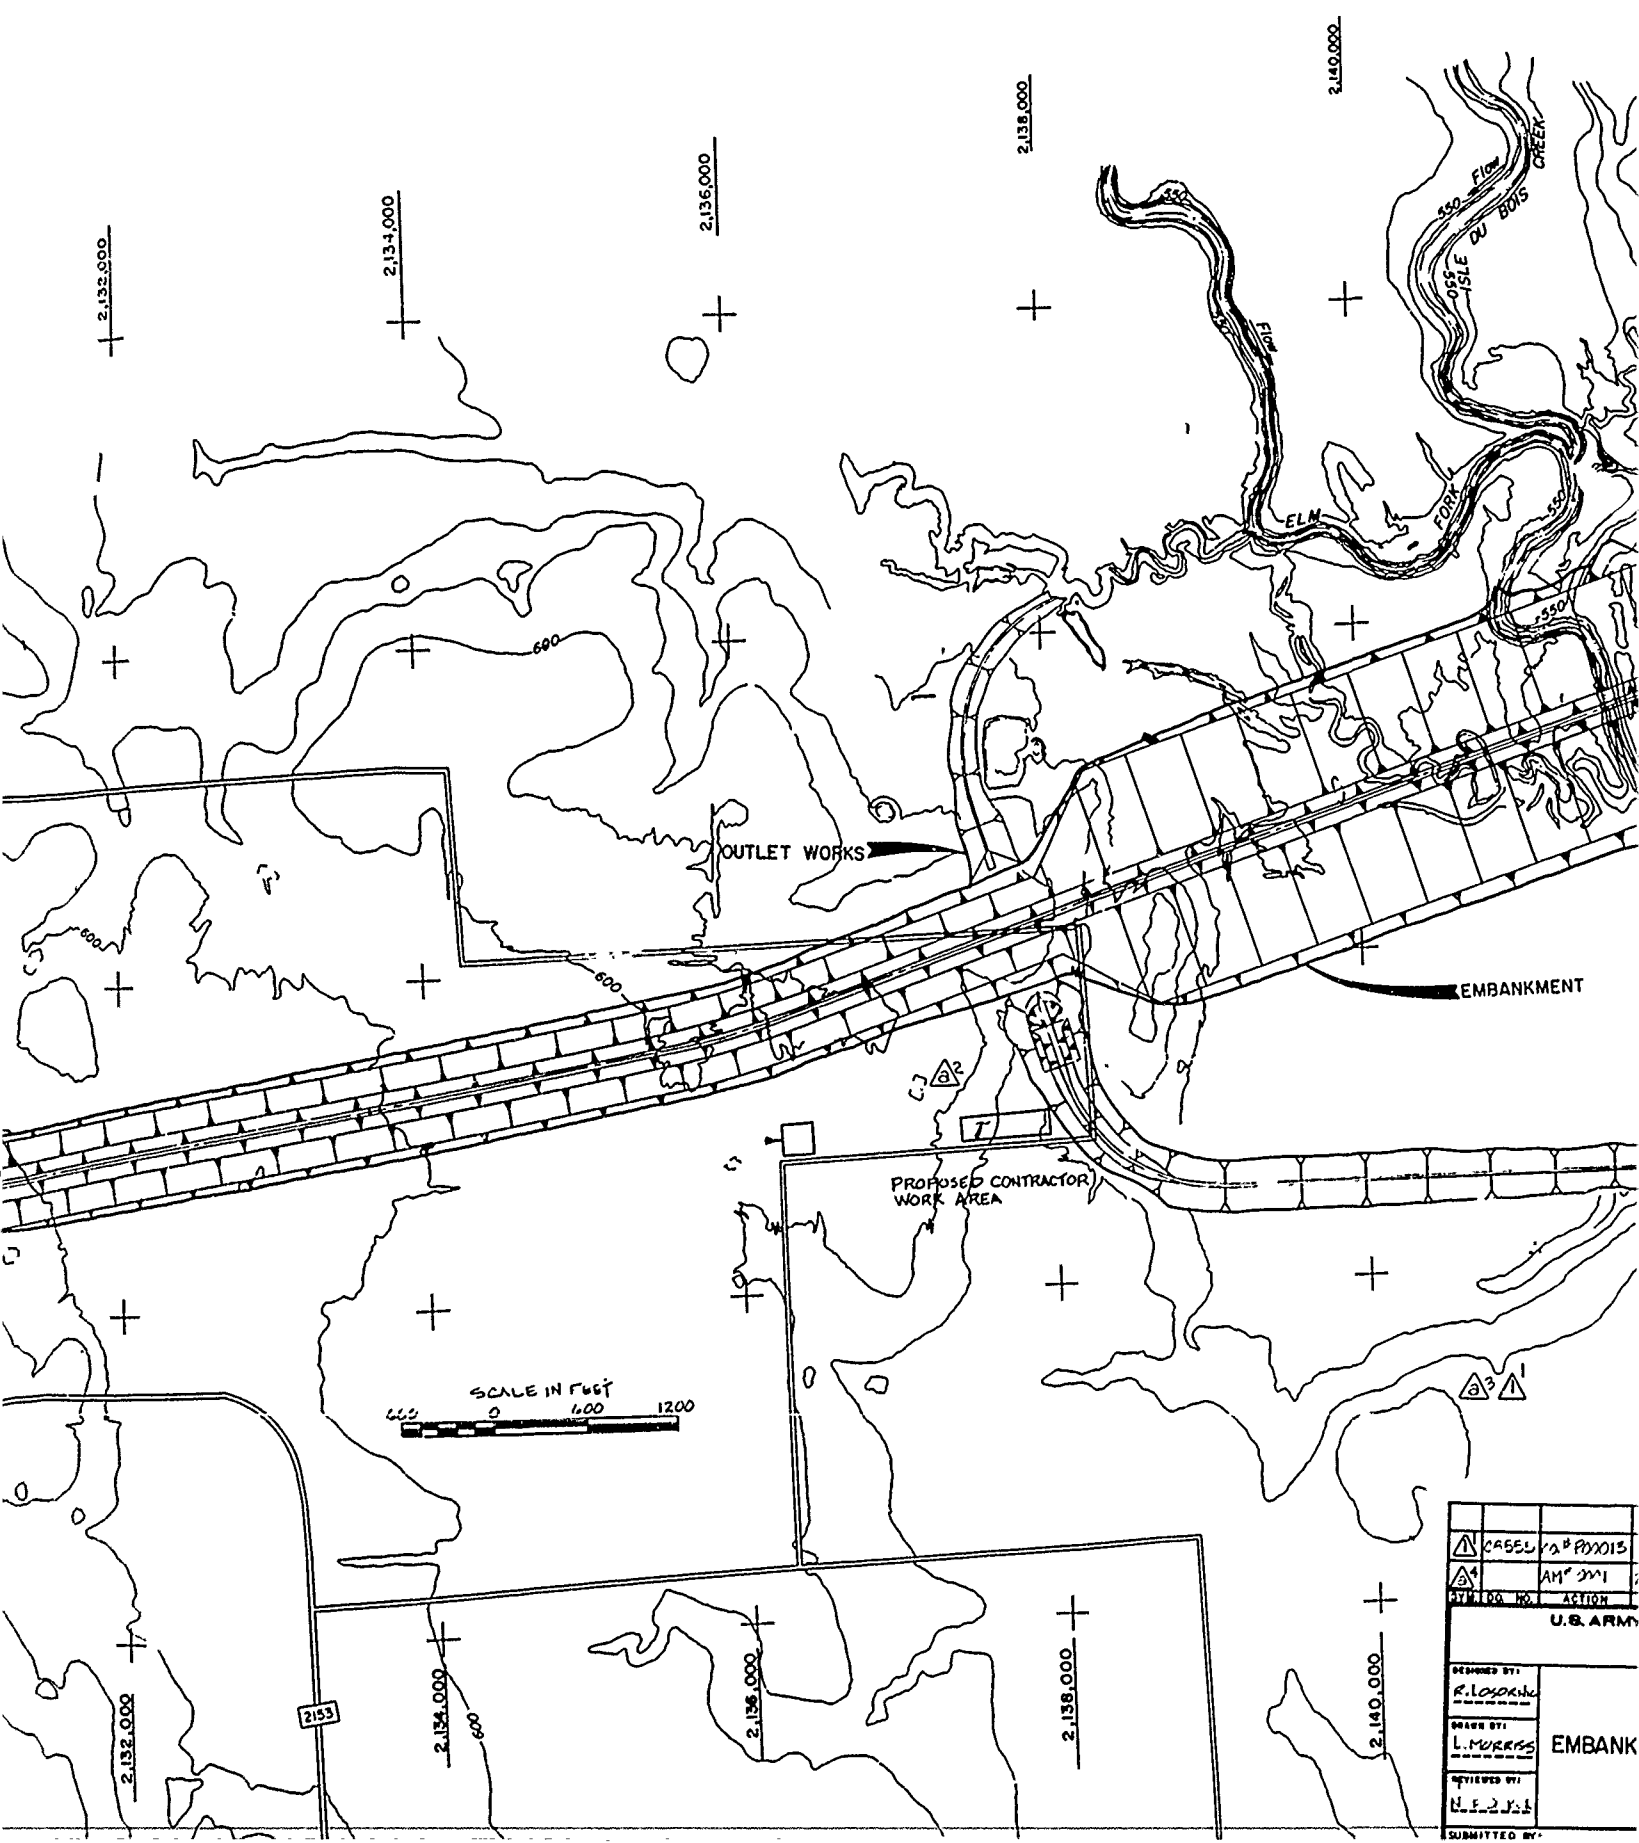

△	CASE NO. 2153
△	AM 211
△	ACTION
U.S. ARMY	
DESIGNED BY: <i>R. LOSORKE</i>	
DRAWN BY: <i>L. MURRES</i>	
CHECKED BY: <i>H. E. J. J.</i>	
SUBMITTED BY:	
EMBANK	

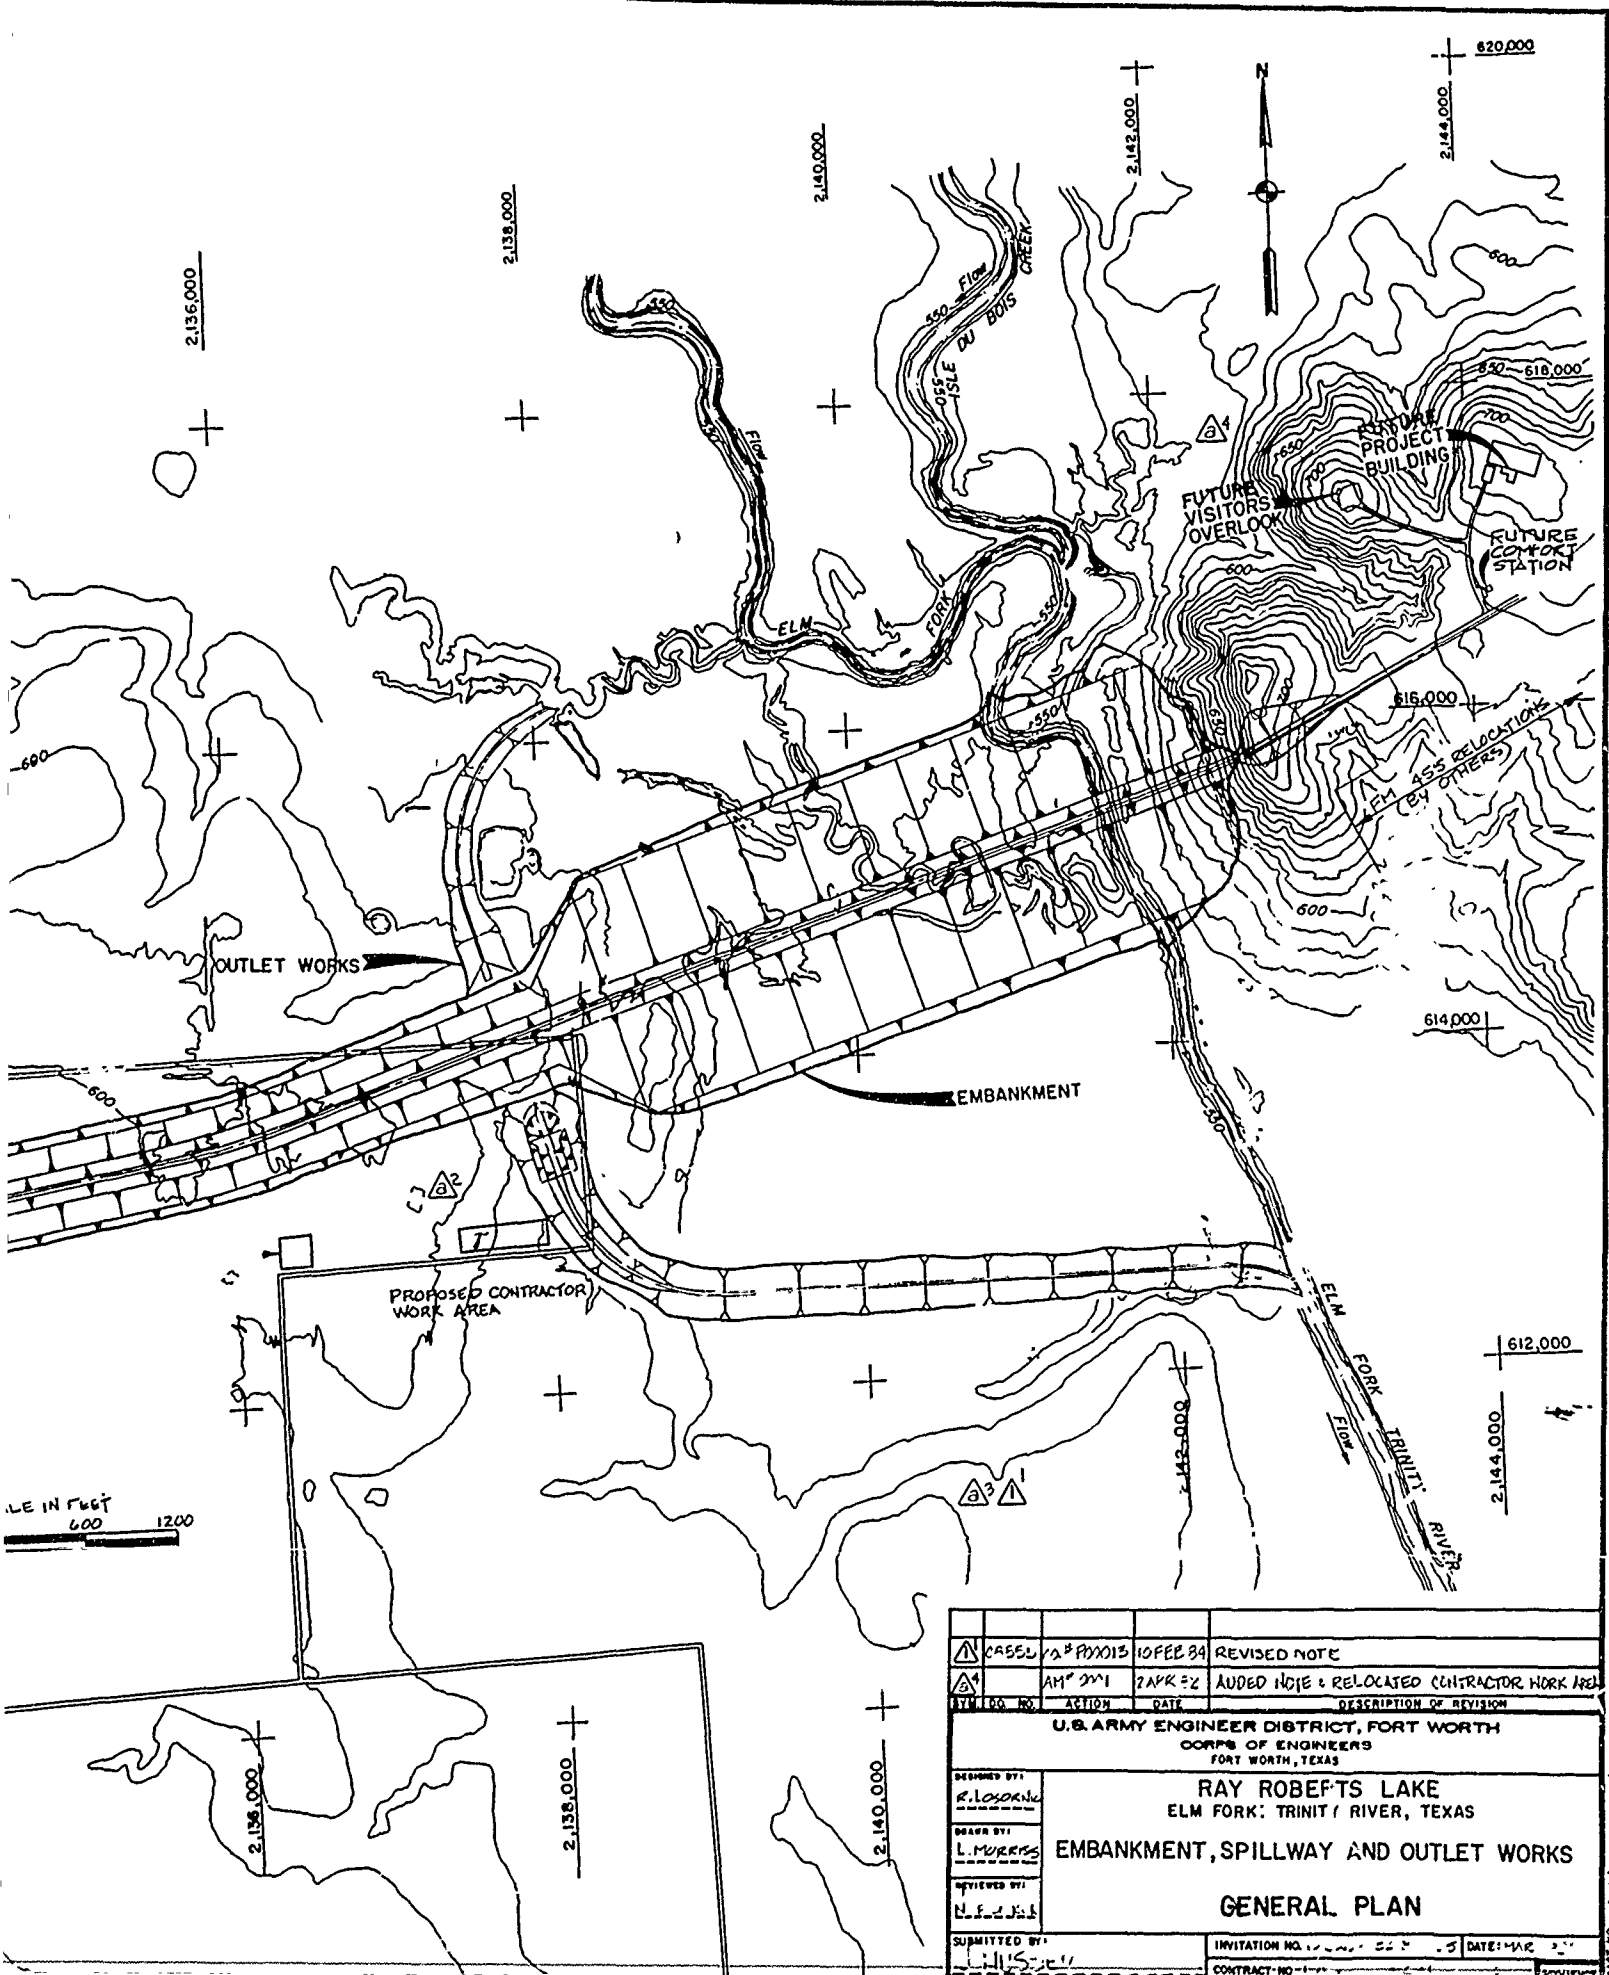

DESIGNED BY: R. LOSORNO	DATE: 10 FEB 84	REVISION: REVISED NOTE
DRAWN BY: L. MORRIS	DATE: 2 APR 82	REVISION: AUGDED NOTE & RELOCATED CONTRACTOR WORK AREA
CHECKED BY: L. F. J. J.	DATE:	REVISION:
SUBMITTED BY: L. F. J. J.	DATE:	REVISION:
U.S. ARMY ENGINEER DISTRICT, FORT WORTH CORPS OF ENGINEERS FORT WORTH, TEXAS		
RAY ROBERTS LAKE ELM FORK, TRINITY RIVER, TEXAS EMBANKMENT, SPILLWAY AND OUTLET WORKS GENERAL PLAN		
INVIATION NO.:	DATE:	DATE:
CONTRACT NO.:		


LEGEND

- 3F 3-INCH FISHTAIL BORING
- 8A 8-INCH AUGER BORING
- 3S 3-INCH SHELBY TUBE
- 4C 4-INCH CORE BORING
- 6C 6-INCH CORE BORING
- 6U 6-INCH DENISON BORING
- ==== COUNTY ROAD (GRAVEL)
- ==== FARM TO MARKET ROAD (PAVED)
- ⊗ GRAVEL PIT



- QAL ALLUVIUM
- QT FLUVIATILE TERRACE DEPOSIT
- KWB WOODBINE FORMATION
- KGY GRAYSON FORMATION
- KMS MAIN STREET FORMATION
- KPP PAWPAW FORMATION
- GEOLOGIC CONTACT (DASHED)
- ⊗ STOCK TANK

NOTES:

1. SEE PLATES III-6 THROUGH III-32 FOR DETAILED LOGS OF BORINGS.
2. GEOLOGY COMPILED FROM SUBSURFACE EXPLORATION AND SURFACE MAPPING.

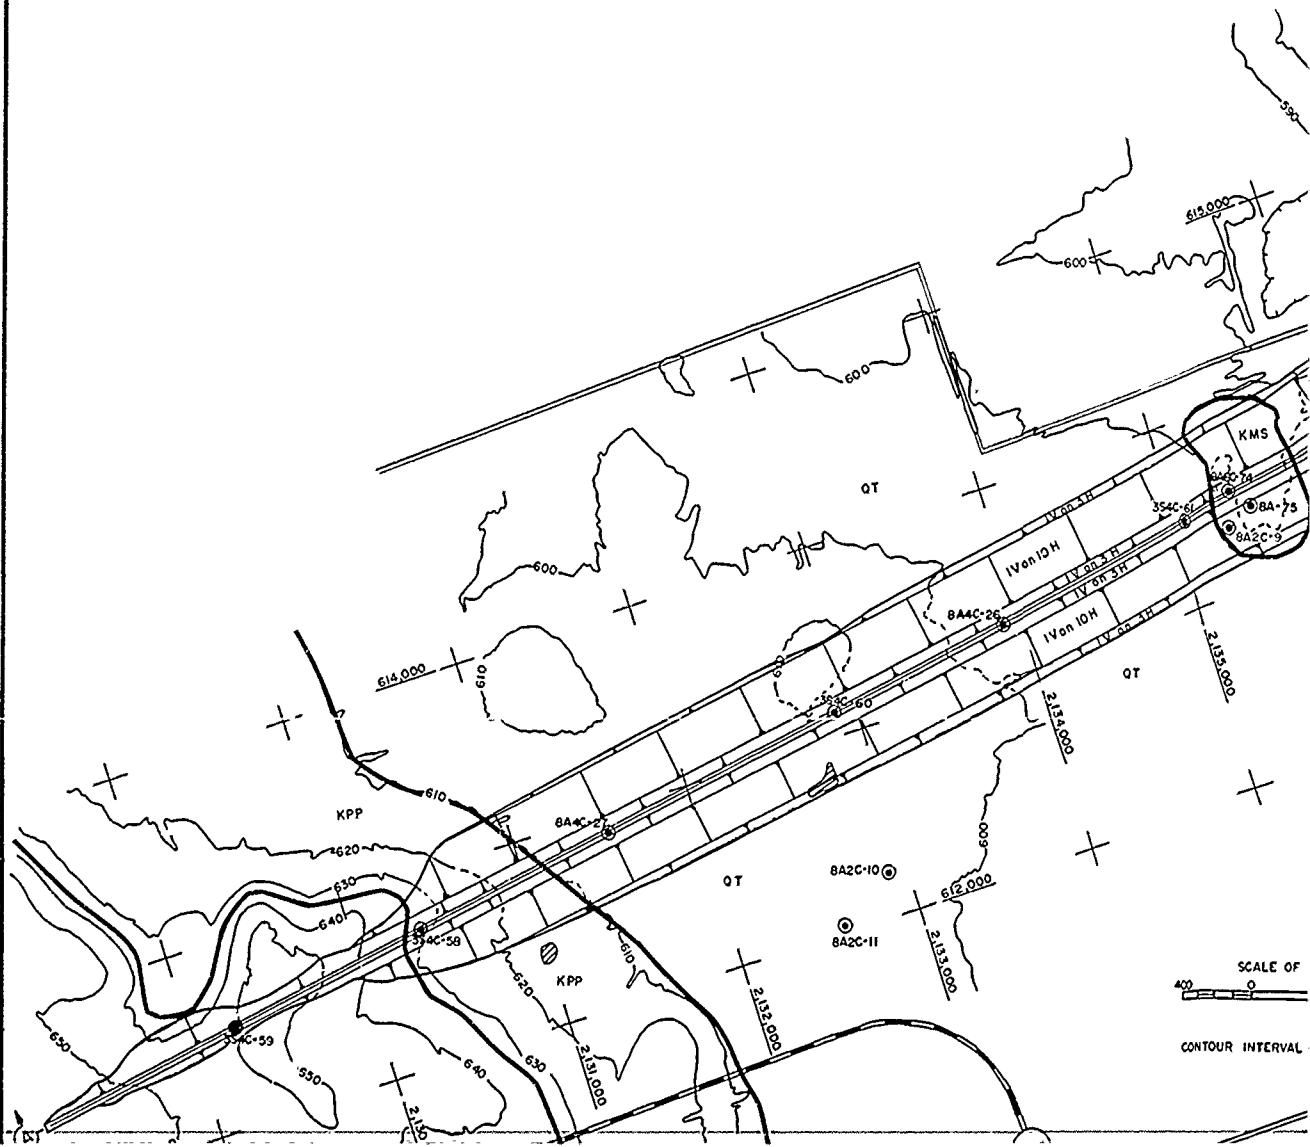



- ALLUVIUM
- FLUVIATILE TERRACE DEPOSIT
- WOODBINE FORMATION
- GRAYSON FORMATION
- MAIN STREET FORMATION
- PAWPAW FORMATION
- GEOLOGIC CONTACT (DASHED WHERE INFERRED)
- STOCK TANK

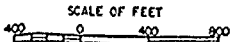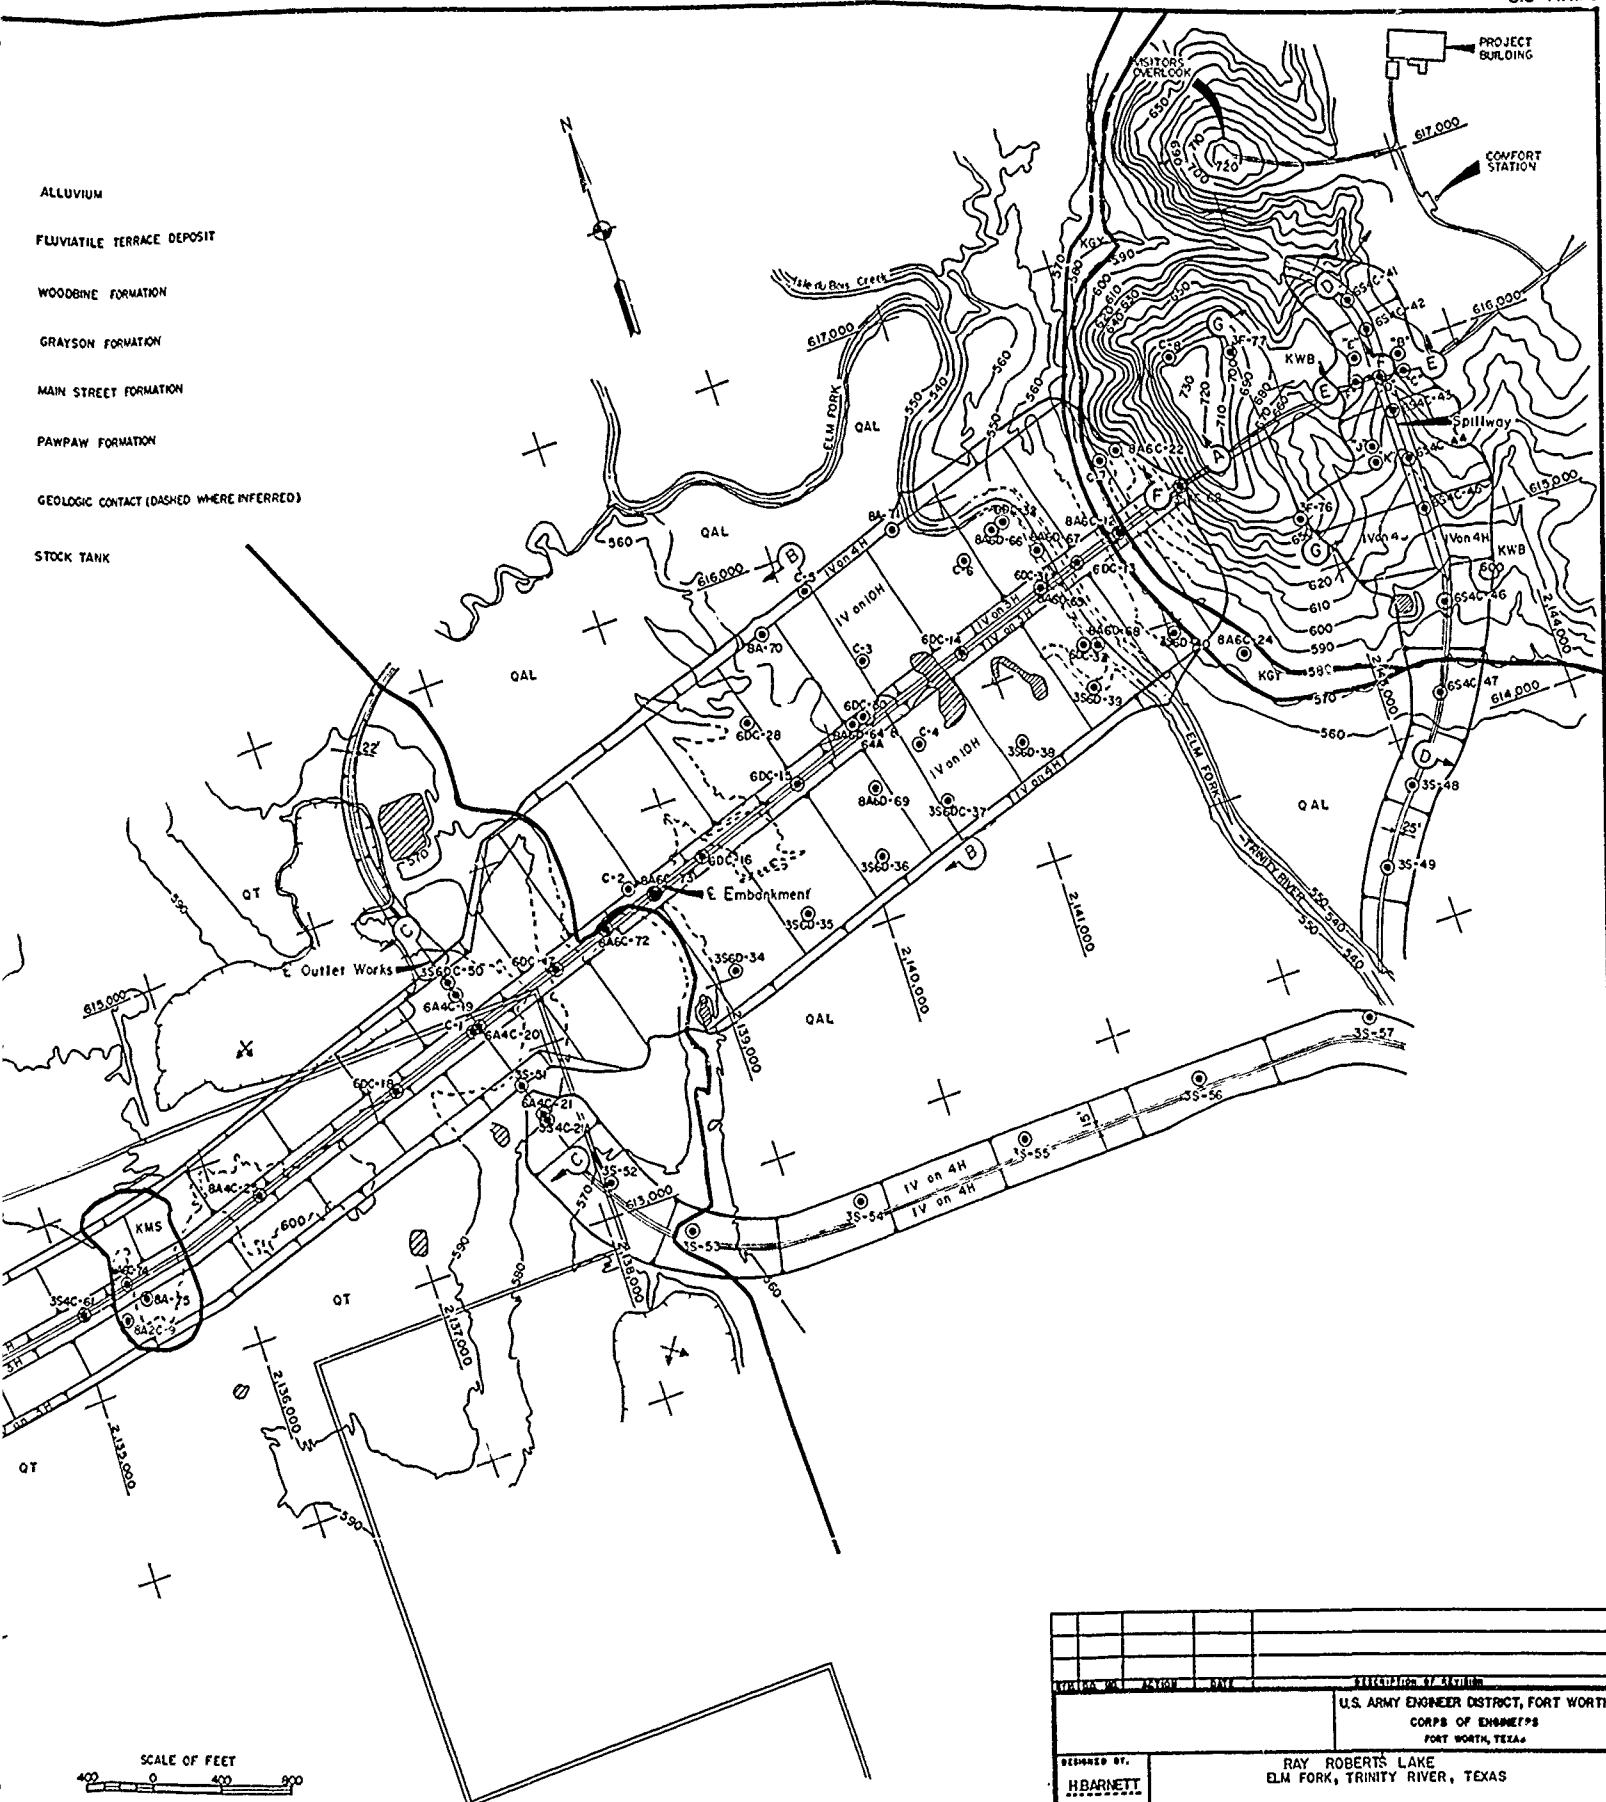


CONTOUR INTERVAL - 10 FEET


DESIGNED BY: H. BARNETT		RAY ROBERTS LAKE ELM FORK, TRINITY RIVER, TEXAS	
DRAWN BY: C. KIRBY		FOUNDATION REPORT	
REVIEWED BY: R. BEHM		DAM SITE GEOLOGY	
SUBMITTED BY: ROBERT C. BEHM		SOL. NO.	DATED:
		CONTR. NO.	REFERENCE NO.

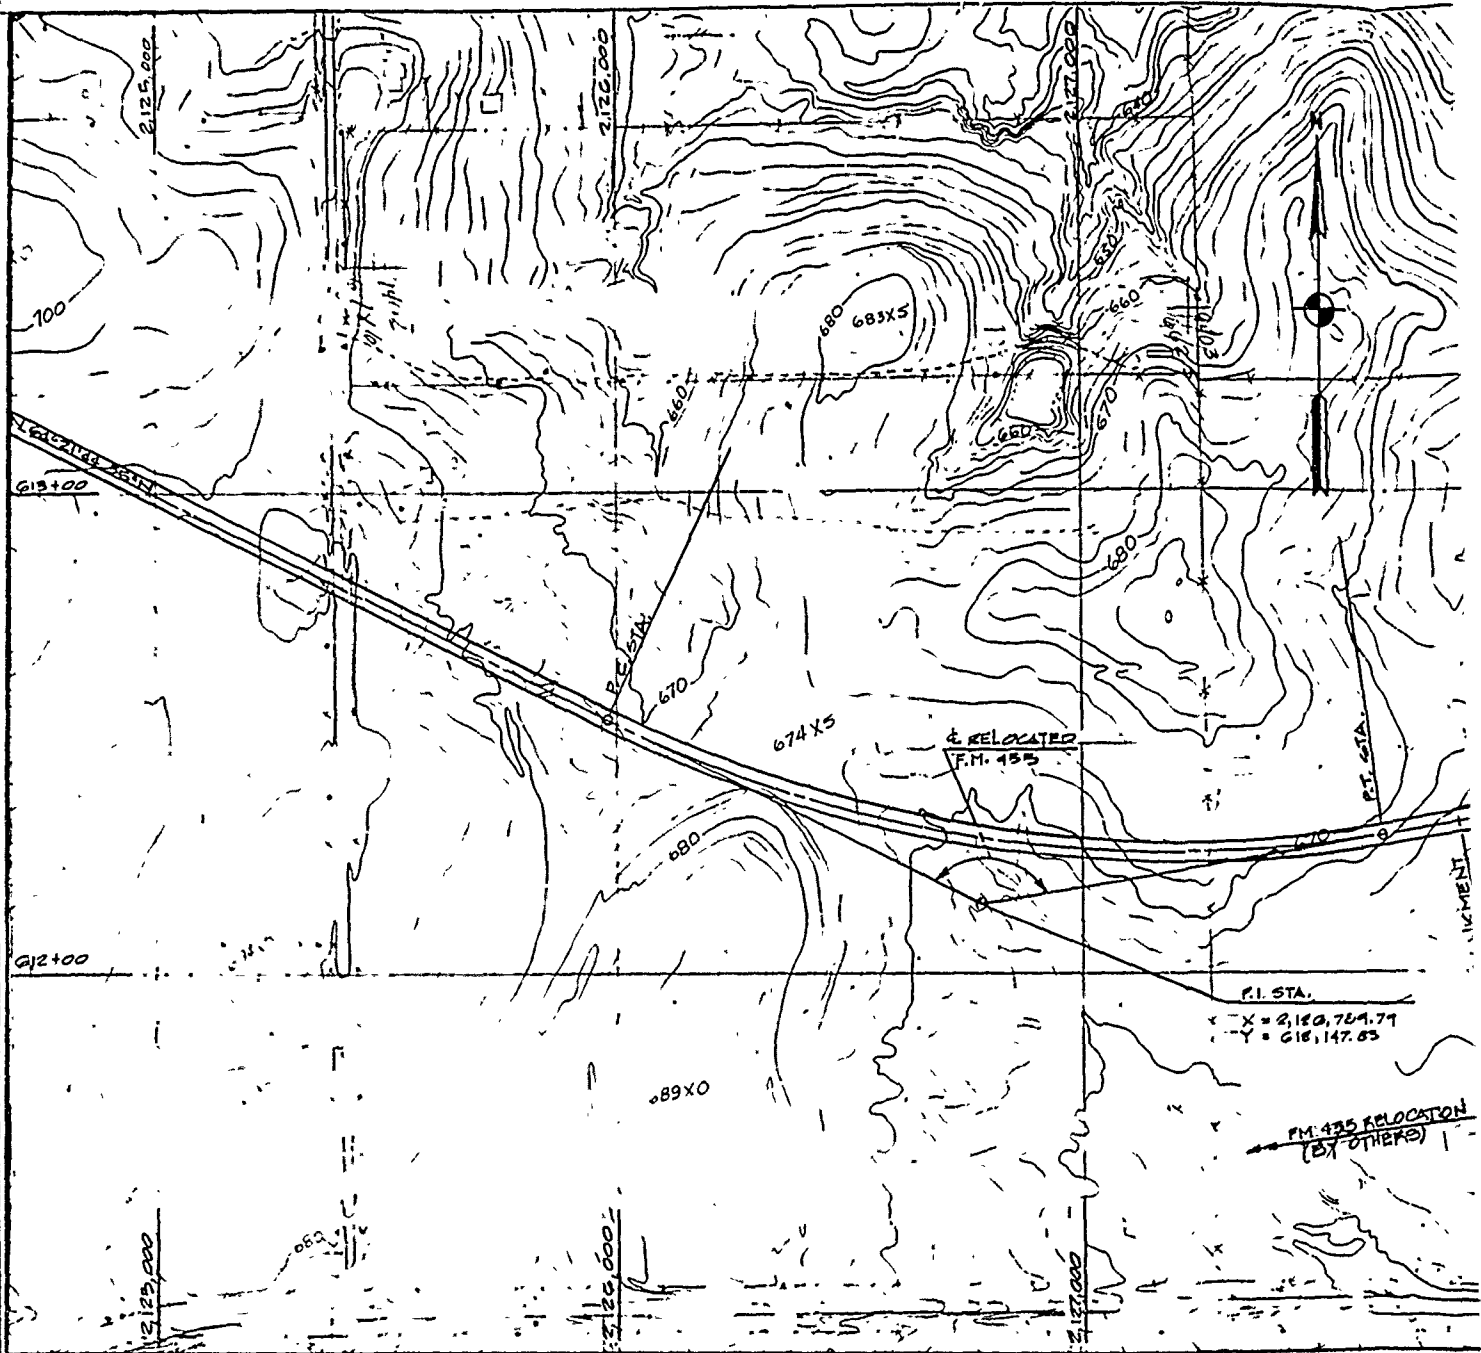

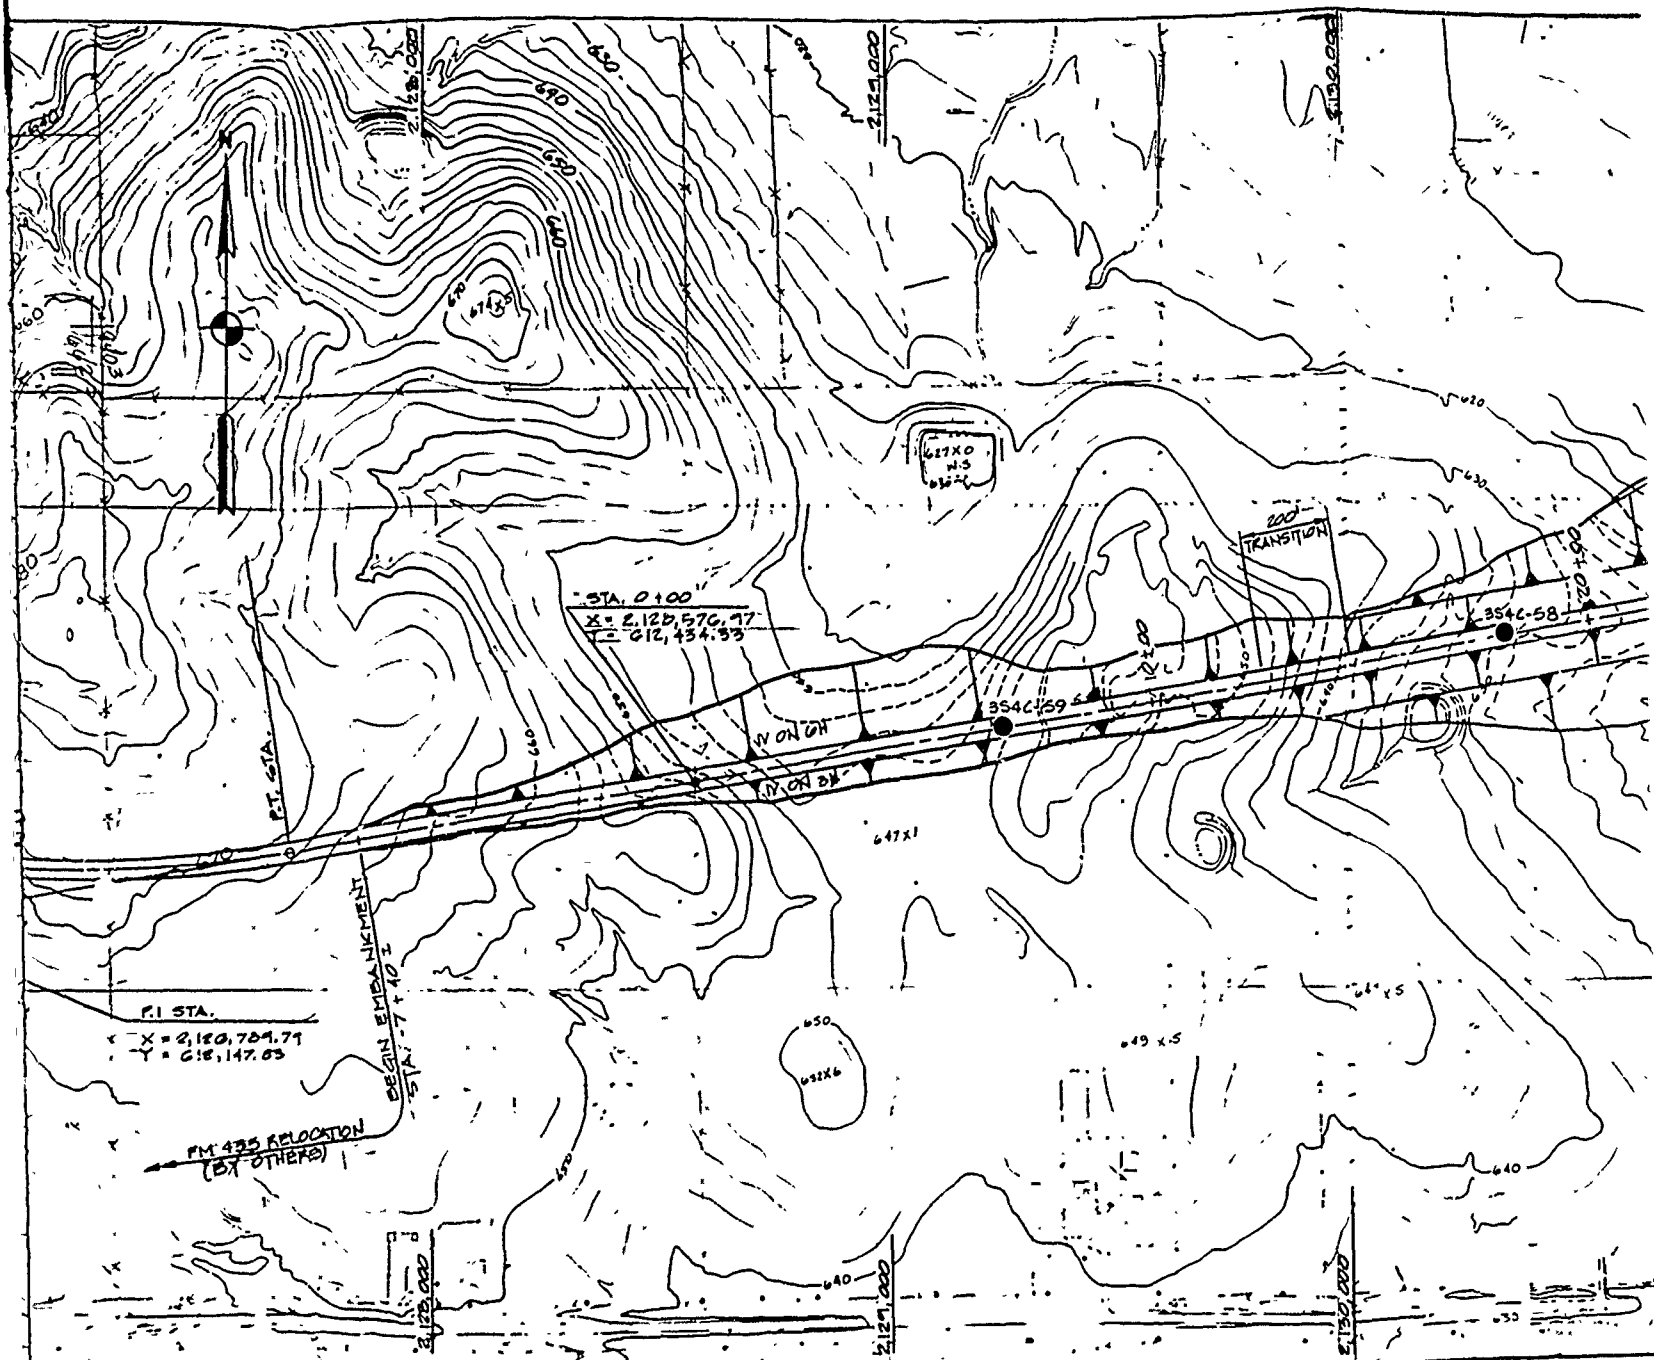

PLAN

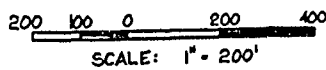


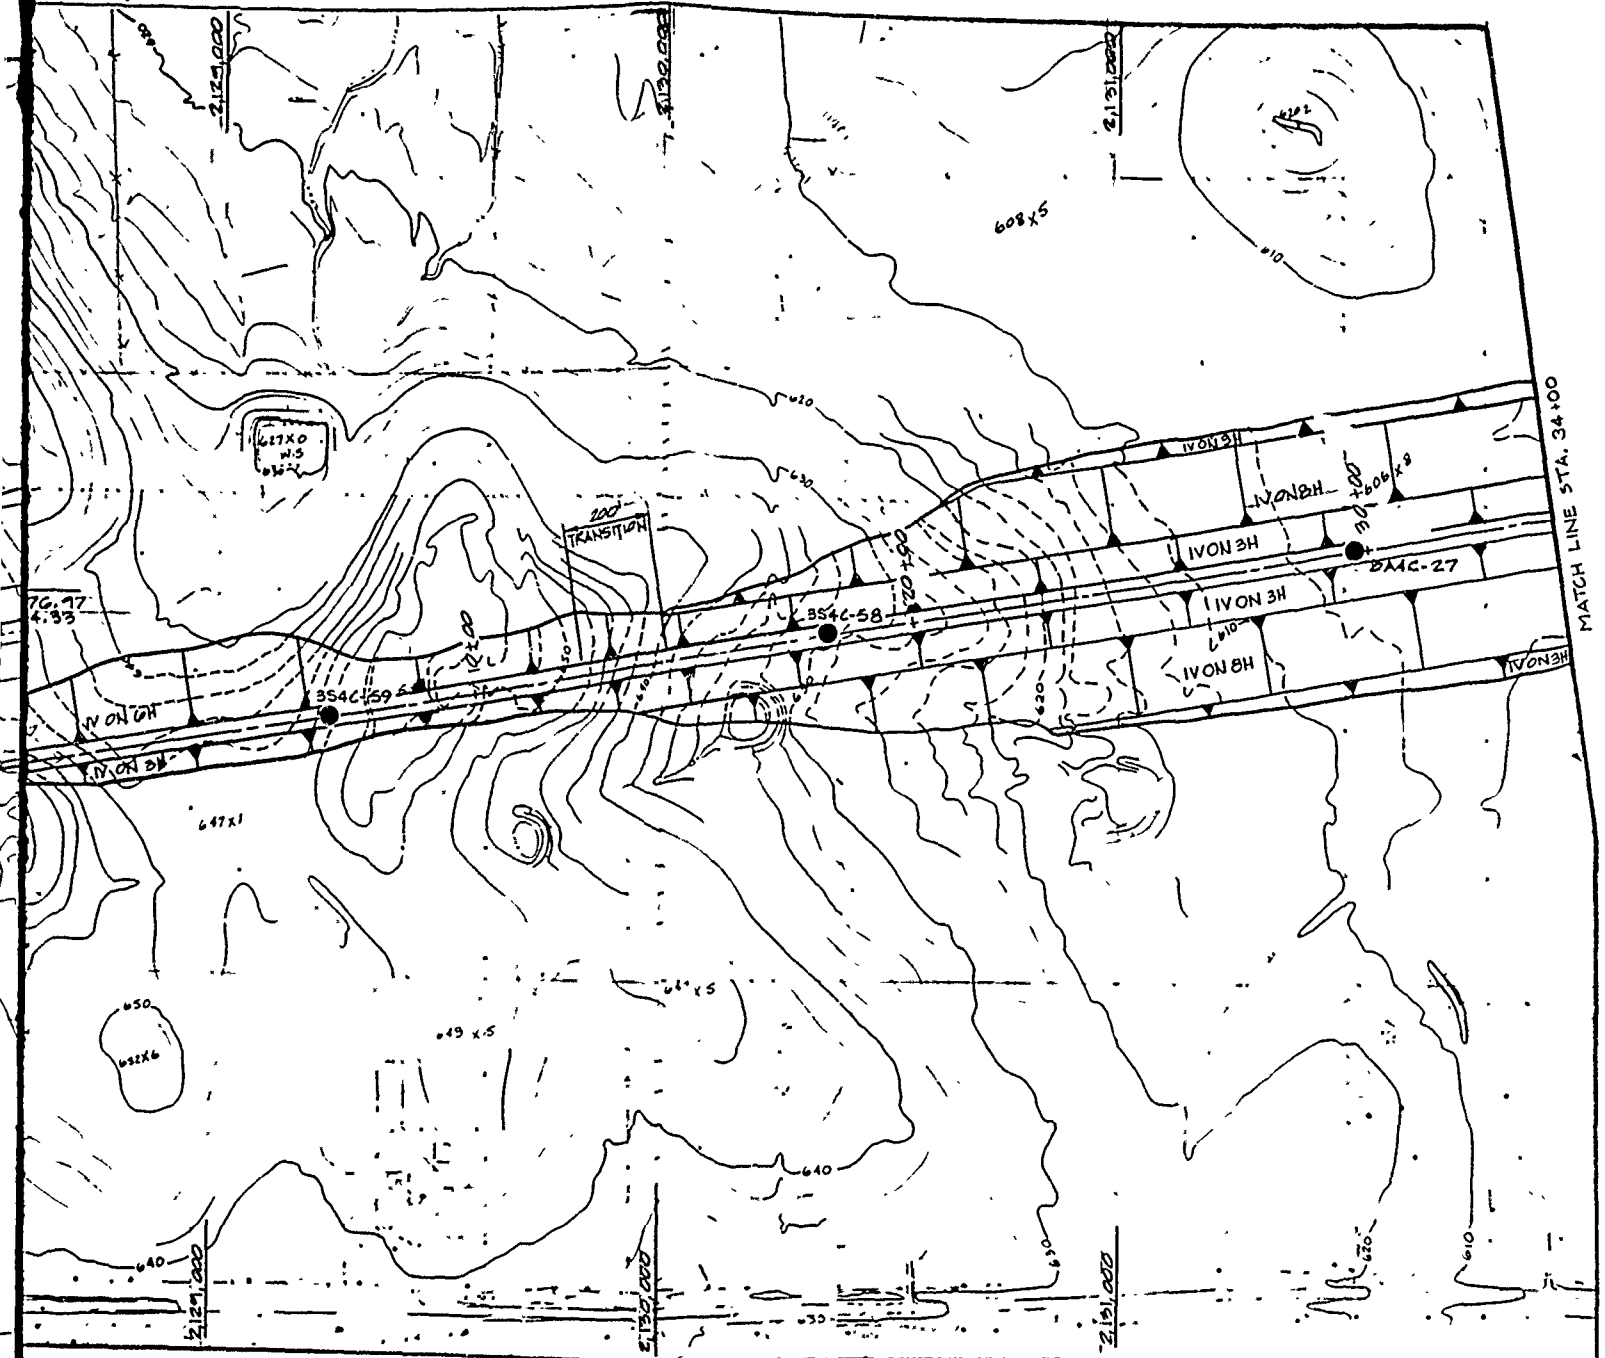

200' 400'

RECORD DRAWING-WORK AS BUILT

REVISION NO.	ACTION	DATE	DESCRIPTION OF REVISION
U.S. ARMY ENGINEER DISTRICT, FORT WORTH CORPS OF ENGINEERS FORT WORTH, TEXAS			
DESIGNED BY:	RAY ROBERTS LAKE ELM FORK, TRINITY RIVER, TEXAS EMBANKMENT PLAN OF BORINGS I		
DRAWN BY:			
REVIEWED BY:			
SUBMITTED BY:			
A. BRANCH R. BAILEY A. BRANCH H. KARBS	INVITATION NO. DACW 63-82-C-0026 DATE: MAR 71 CONTRACT NO. DACW 63-82-C-0093		

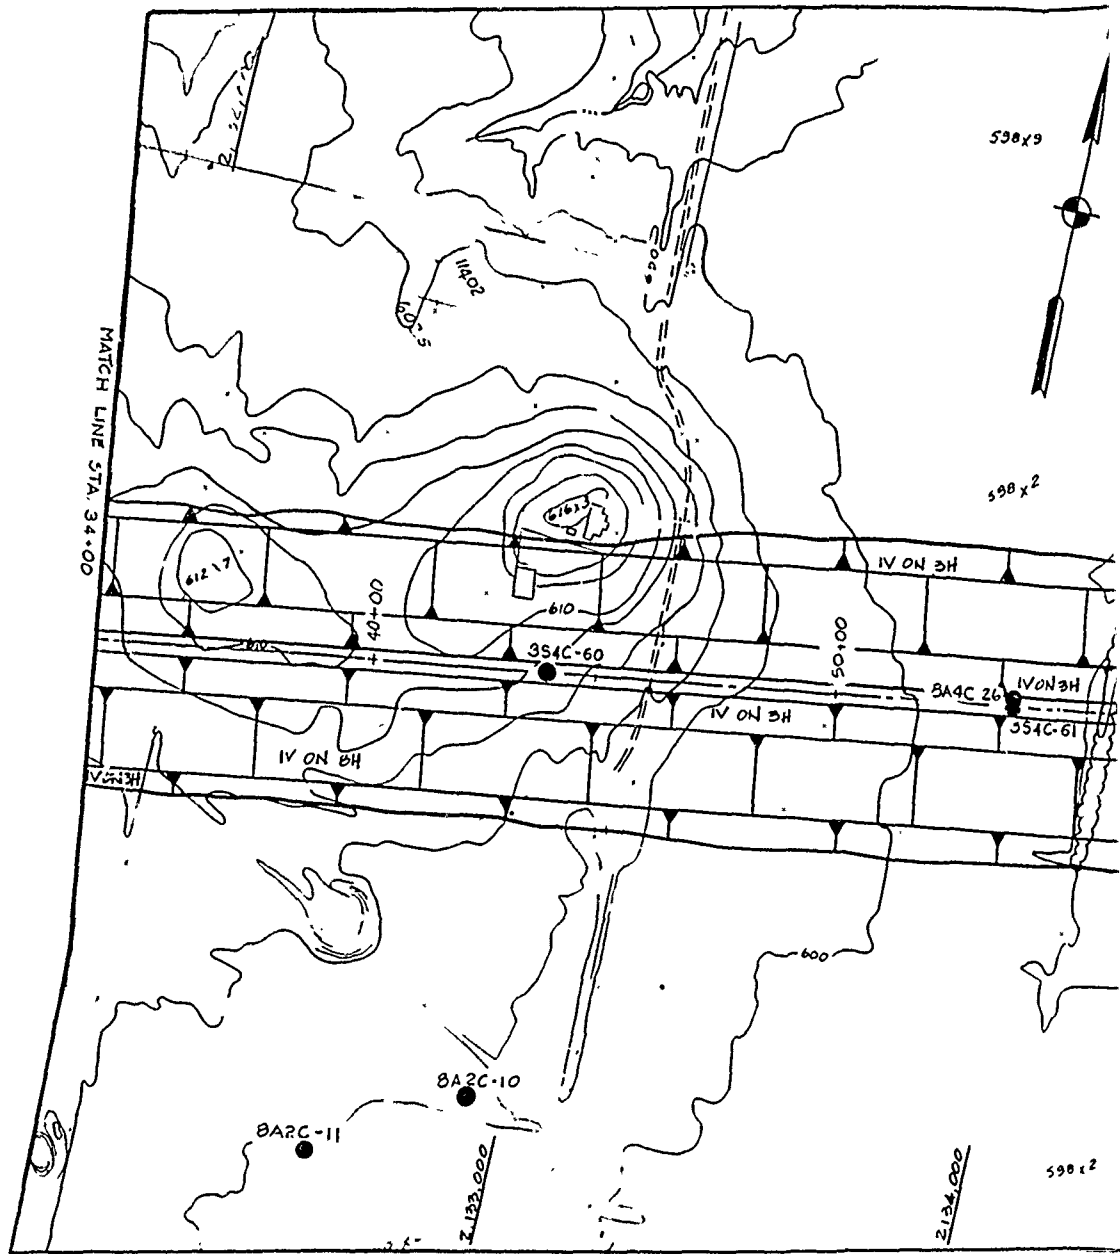

MATCH LINE STA. 34+00

598x9

598x2



612.17

40+00

610

354C-60

50+00

IV ON BH

8A2C 26

IV ON BH

354C-61

IV ON BH

IV ON BH

600


8A2C-10

8A2C-11


2122.000

2124.000


598x2

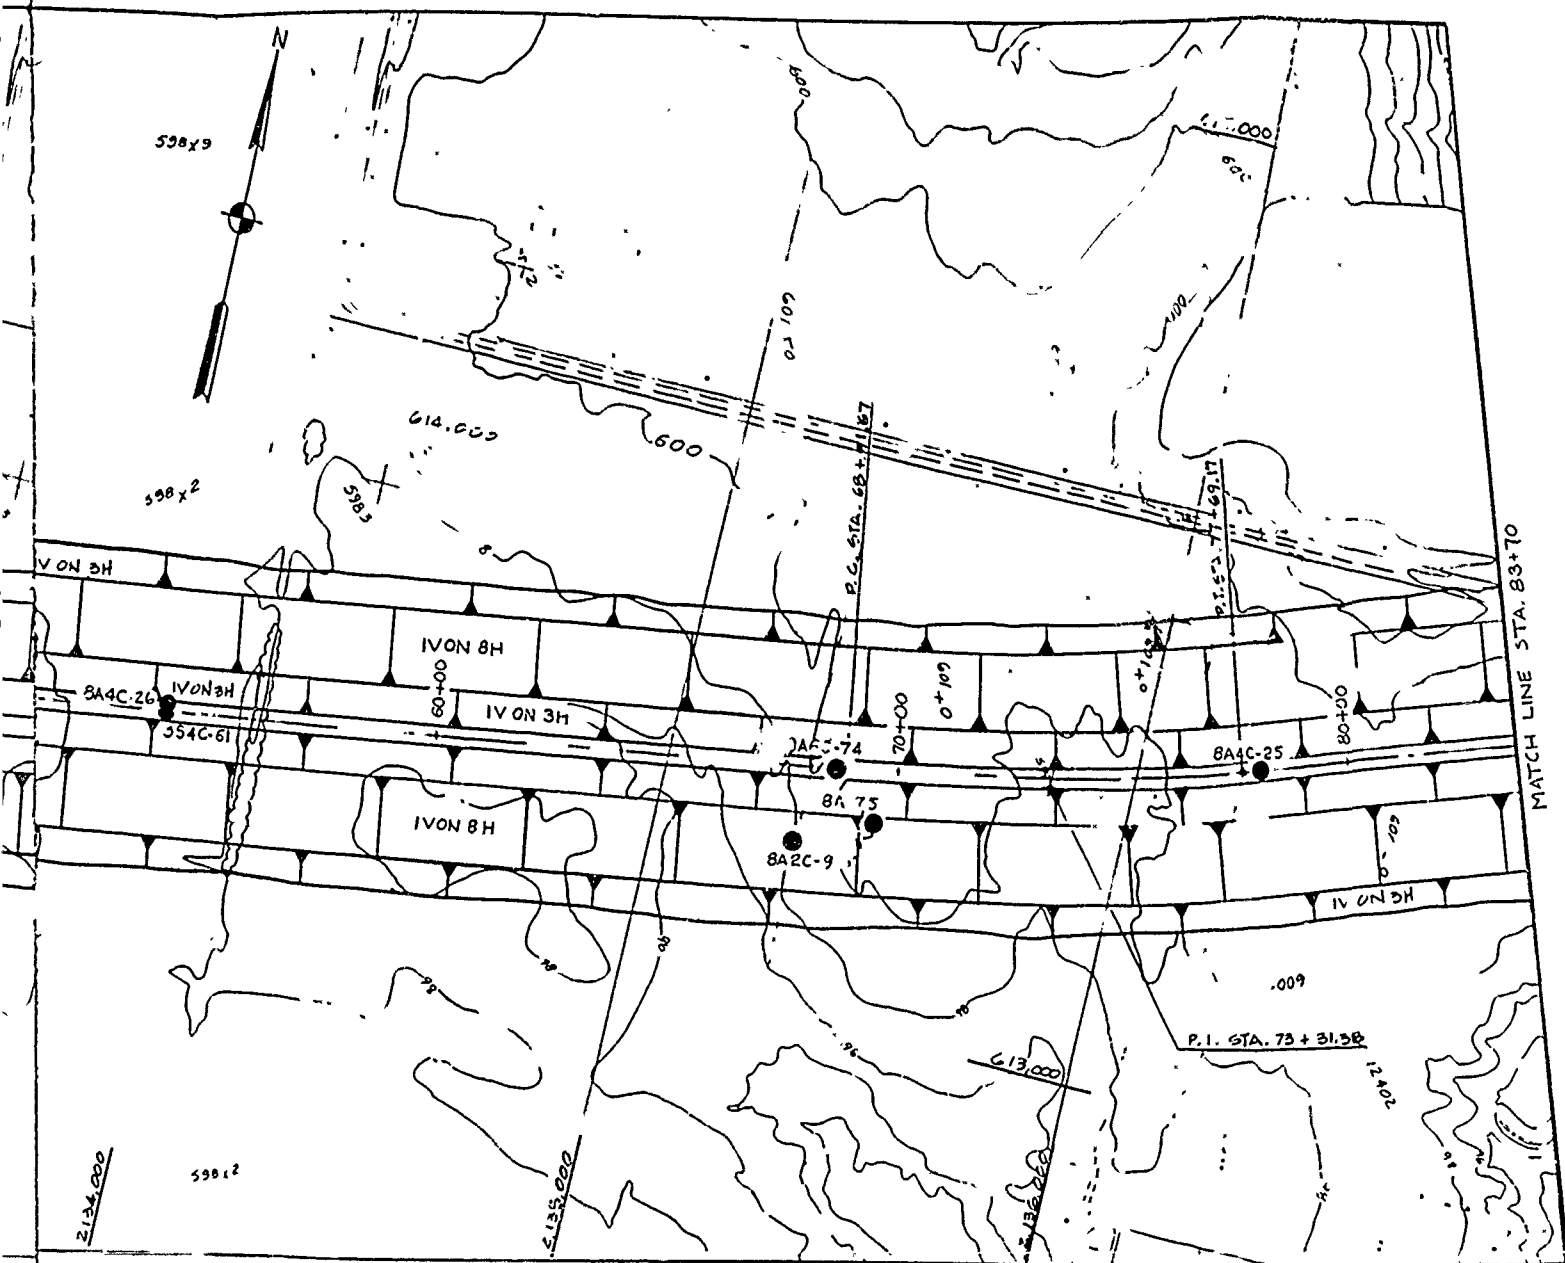

PLAN

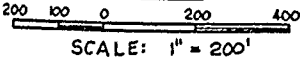

MATCH LINE STA. 83+70

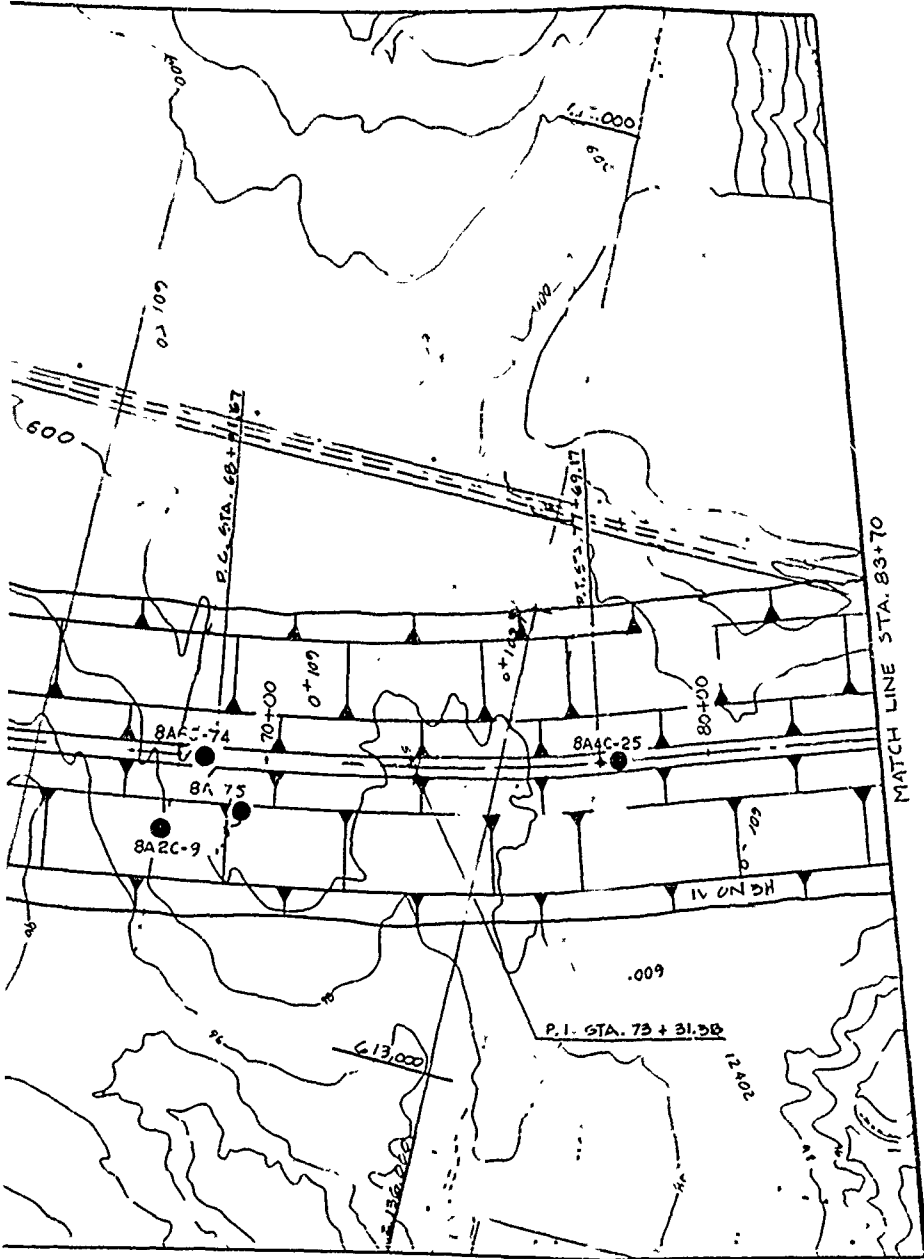


RECORD DRAWING-WORK AS BUILT

STATION
BAR

REV. NO.	ACTION	DATE	DESCRIPTION OF REVISION
U.S. ARMY ENGINEER DISTRICT, FORT WORTH CORPS OF ENGINEERS FORT WORTH, TEXAS			
DESIGNED BY:	RAY ROBERTS LAKE ELM FORK, TRINITY RIVER, TEXAS EMBANKMENT PLAN OF BORINGS II		
DRAWN BY:			
CHECKED BY:			
REVIEWED BY:			
SUBMITTED BY:			

INVESTIGATION NO. DA C 63-82-B-22 DATE: MAR 1959

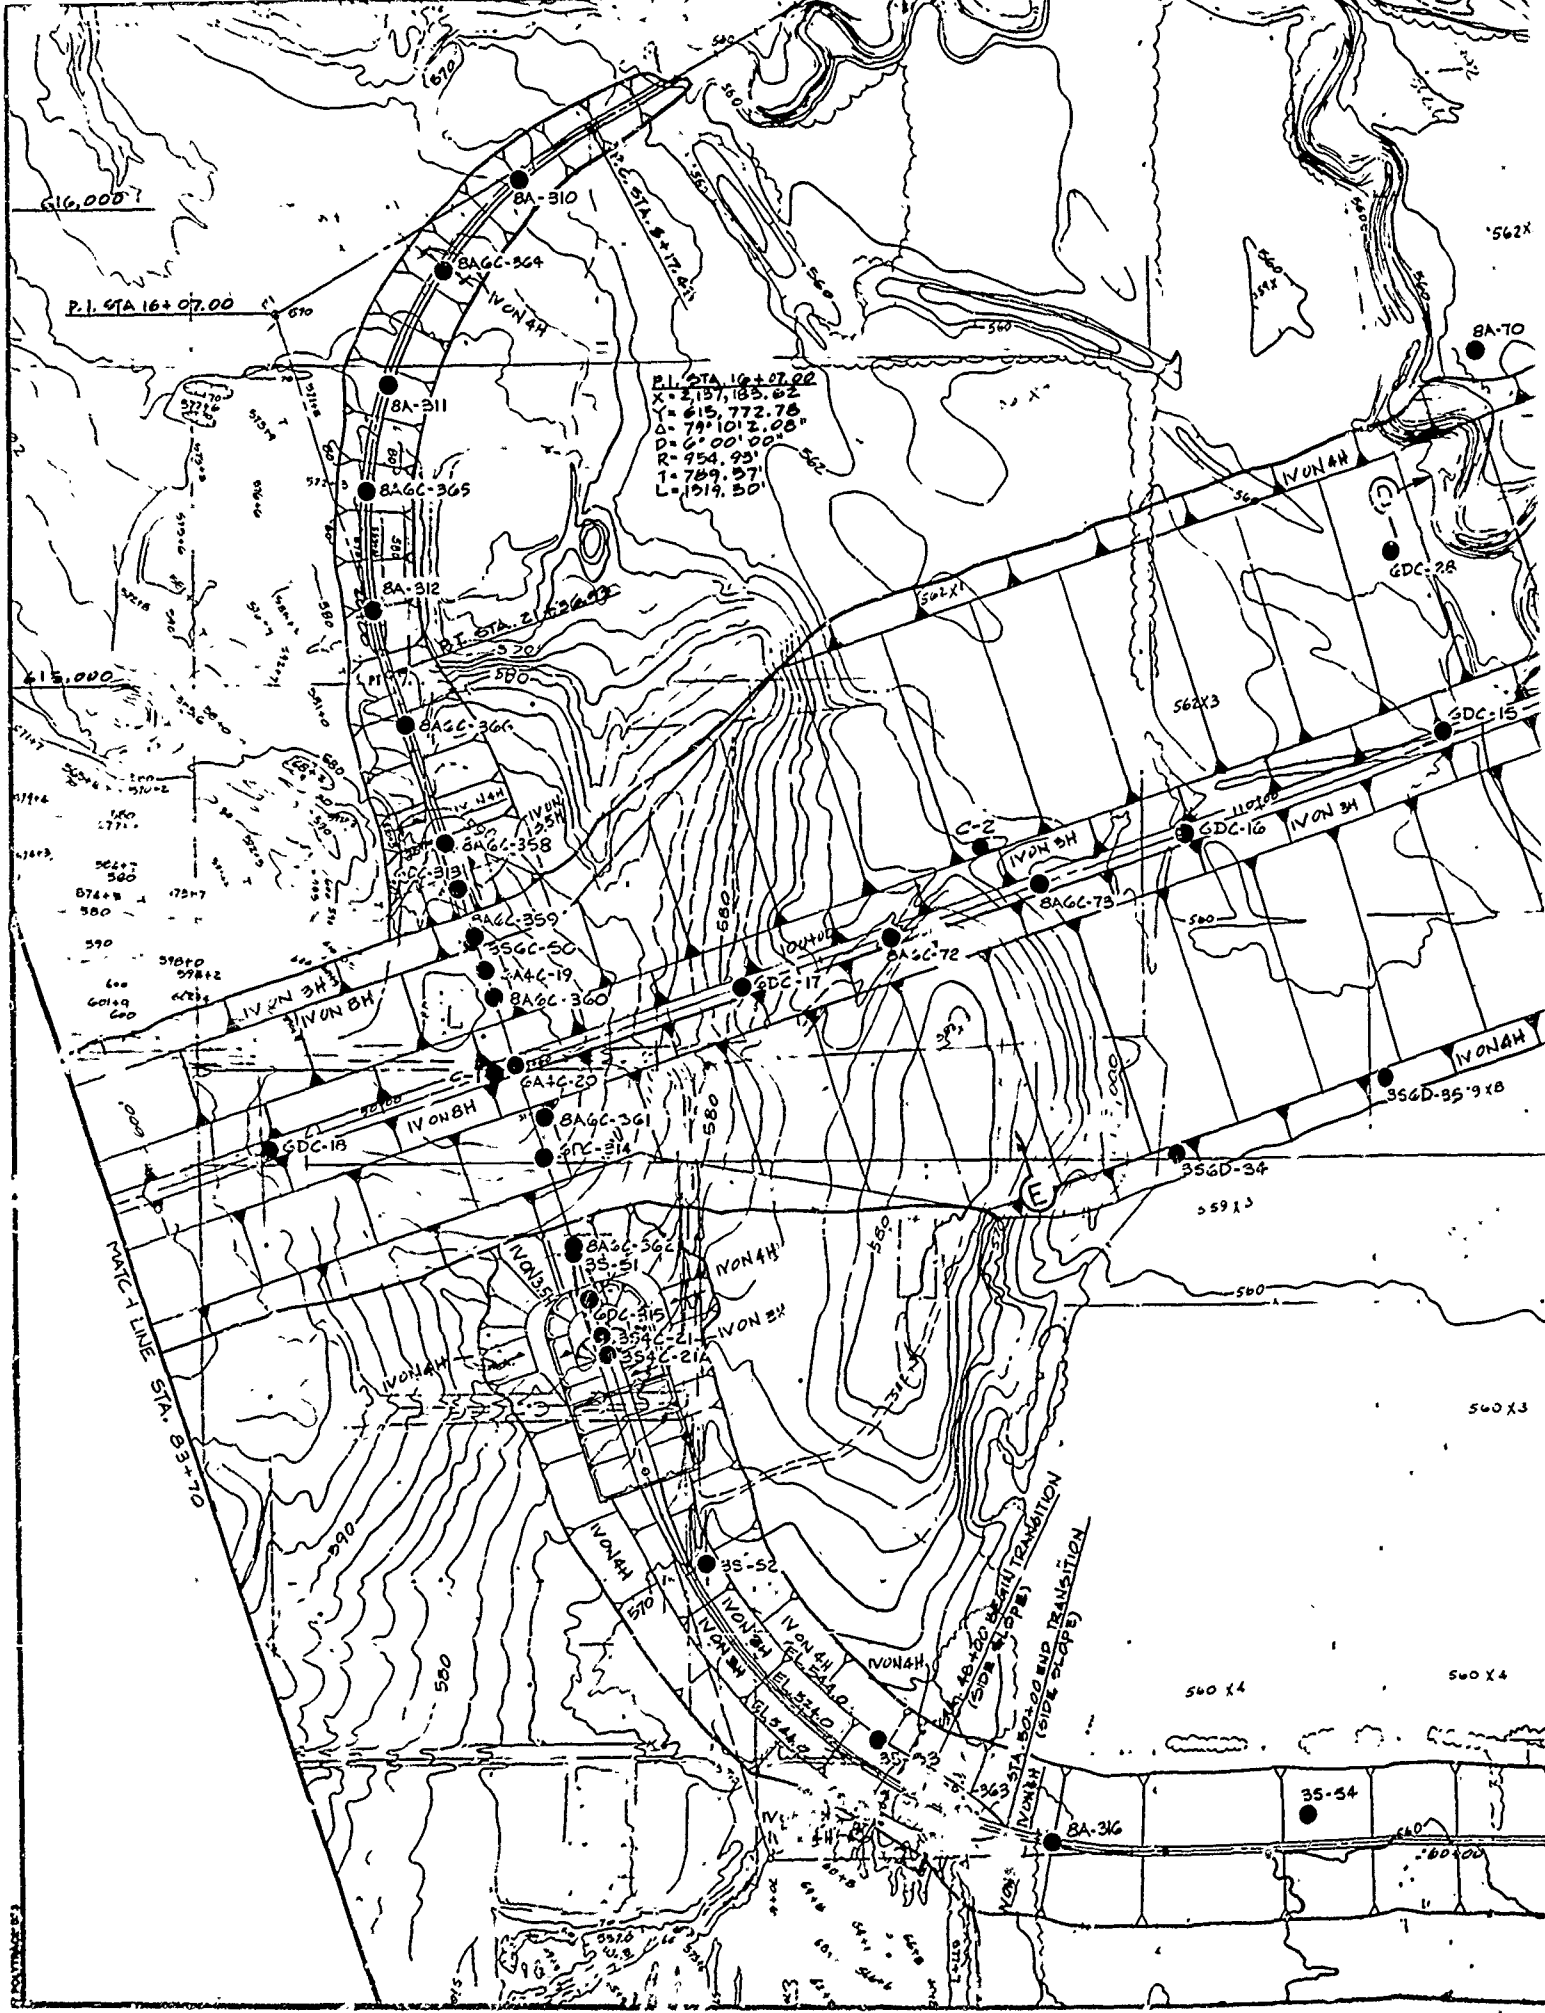

P.I. STA 16+07.00
 X = 2157.185, 02
 Y = 615.772, 78
 Δ = 79° 10' 2.00"
 D = 6° 00' 00"
 R = 954.93
 T = 789.37
 L = 1919.50

P.I. STA 16+07.00


P.I. STA 21+63.00

PONTIAC LINE STA. 85+10.00

IVONAH
 16+00 16+100
 (SIDE SLOPE) TRANSITION
 STA. 80+00 END SLOPE

35-34

BA-316

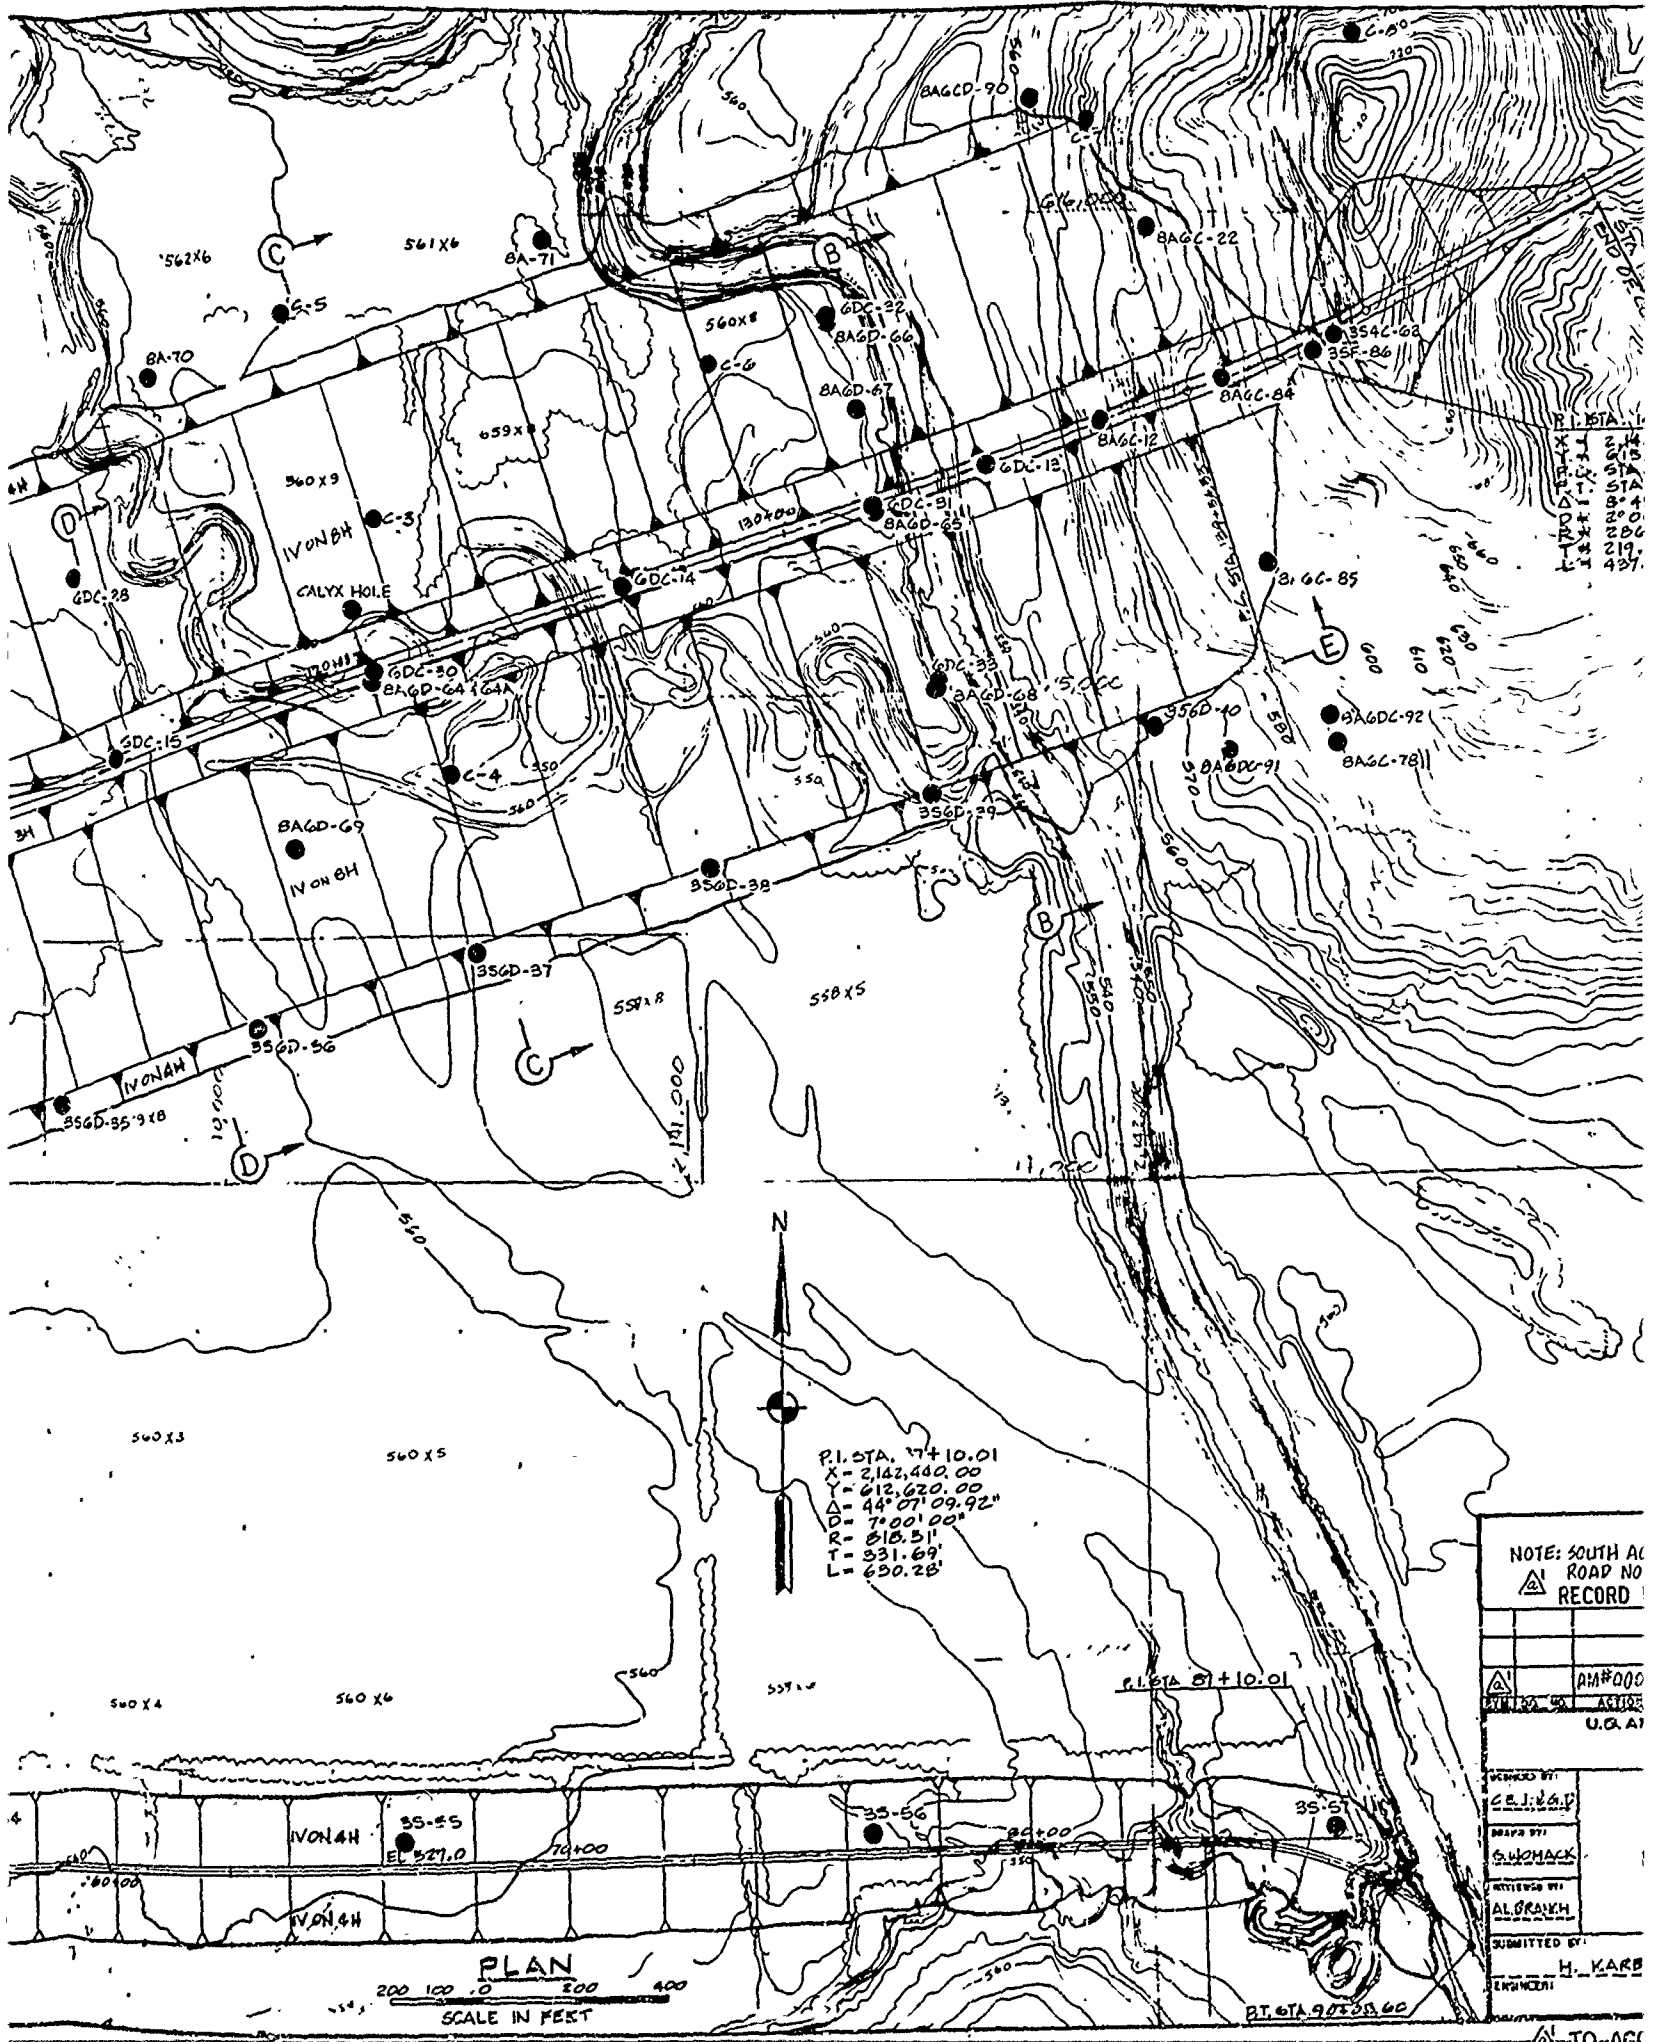


P.I. STA. 17+10.01
 X = 2142.400.00
 Y = 612.620.00
 $\Delta = 44^{\circ} 07' 09.92''$
 D = 700.00'
 R = 818.31'
 T = 331.69'
 L = 650.28'

NOTE: SOUTH AC
 ROAD NO
 RECORD

PROJECT NO.	AM#000
DATE	ASB
U.S.A.I.	
DESIGNED BY	C.E.J.G.P.
DRAWN BY	S.W.HACK
REVIEWED BY	AL GRAMM
SUBMITTED BY	H. KARB
ENGINEER	

PLAN
 200 100 0 100 200 400
 SCALE IN FEET

TO-AGC

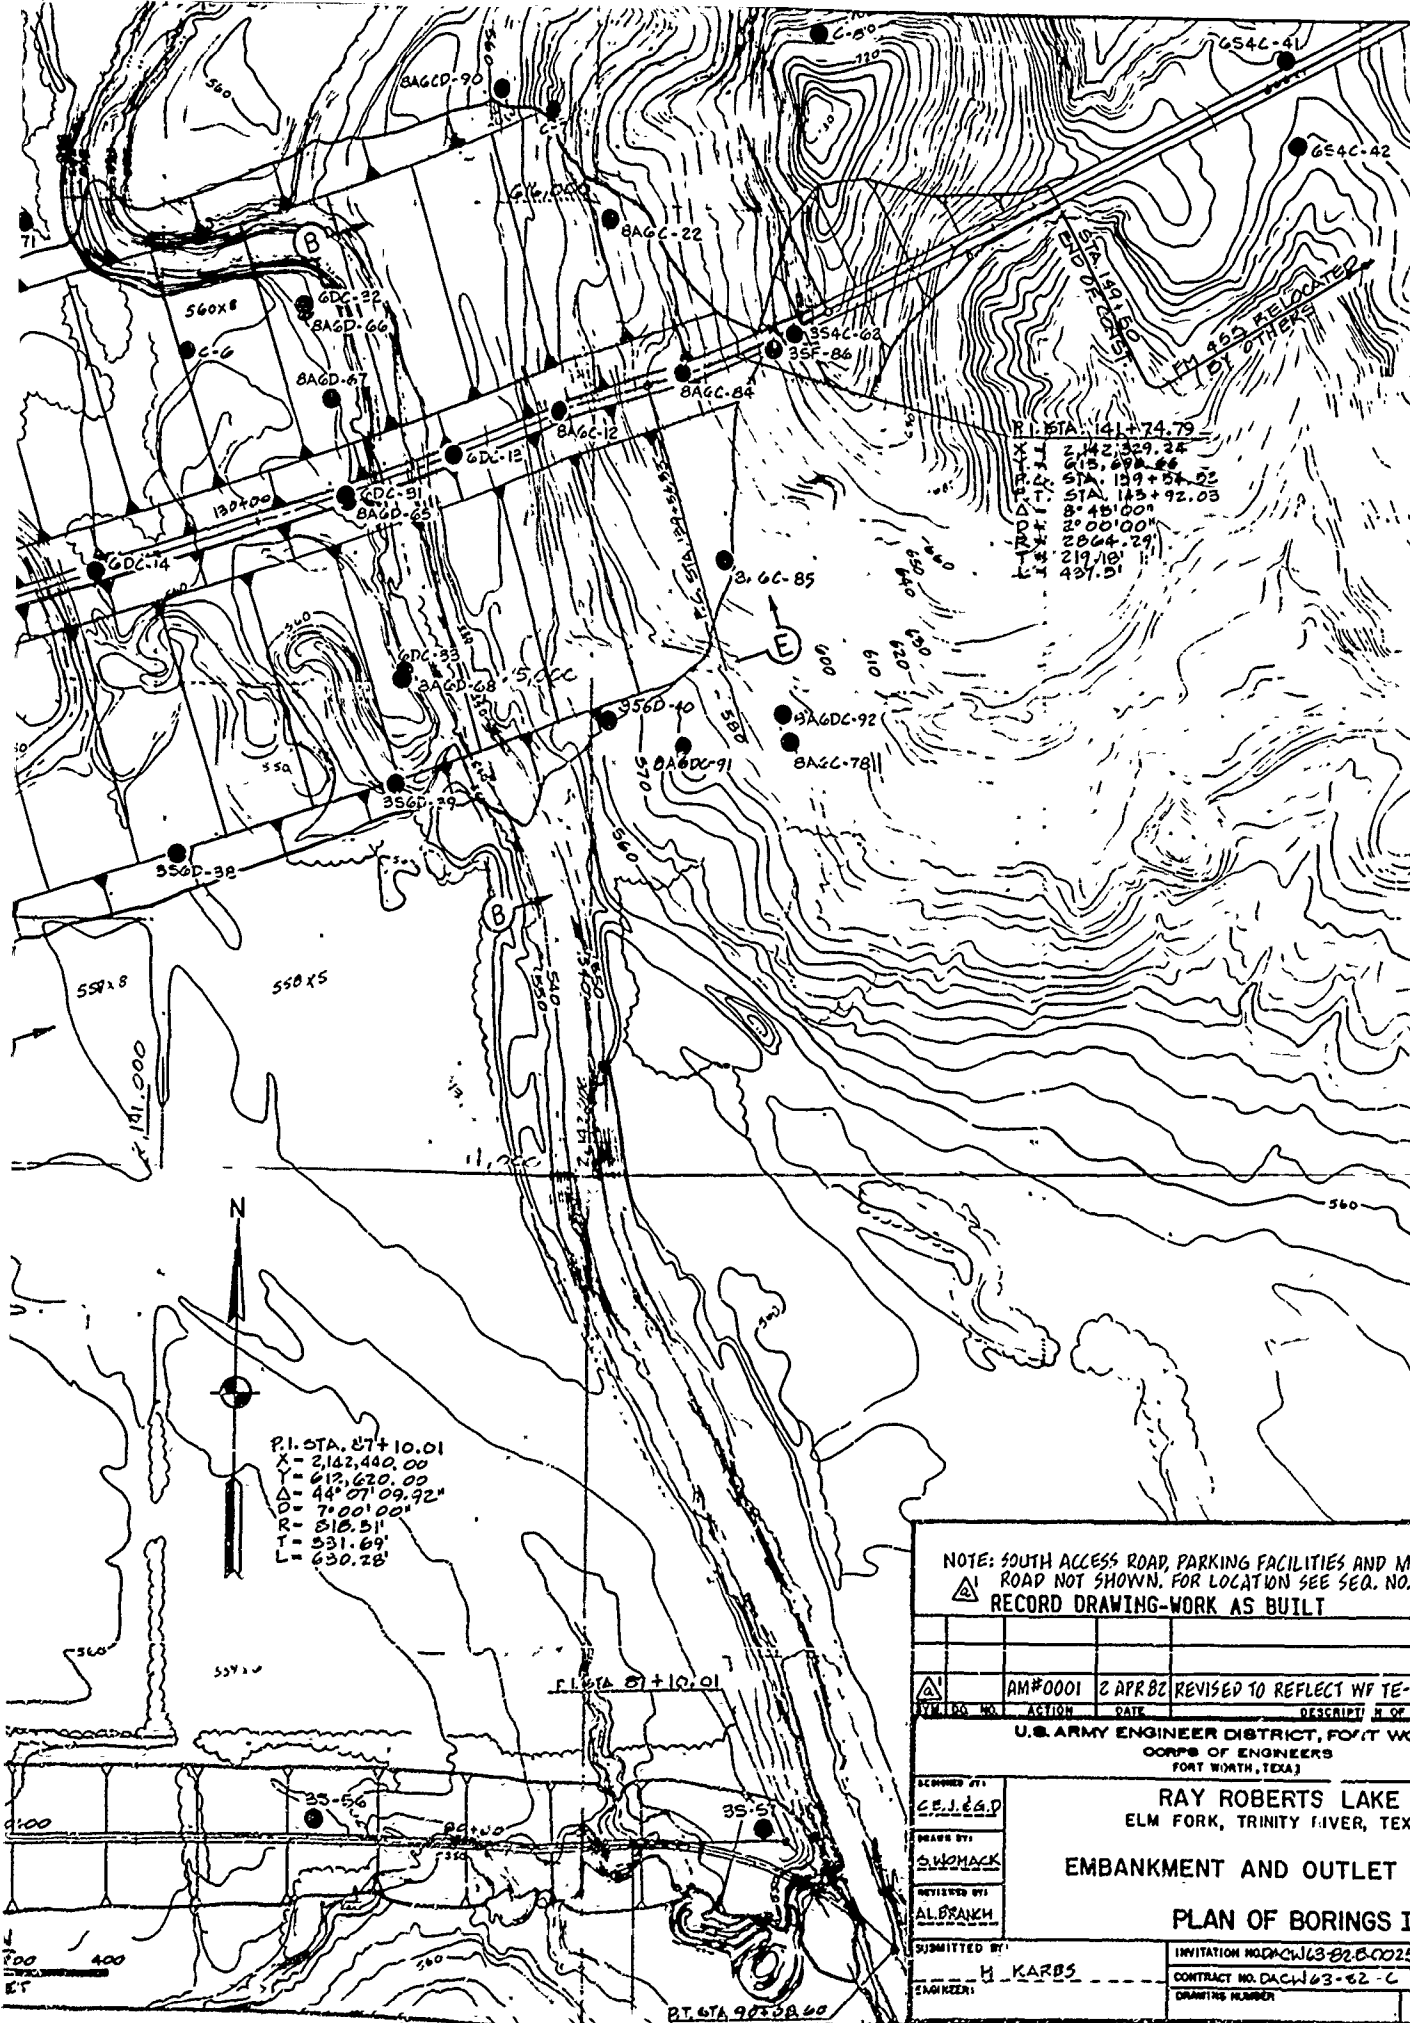

P.I. STA. 87+10.01
 X = 2,122,440.00
 Y = 612,620.00
 D = 44° 07' 09.92"
 R = 7,000.00'
 T = 818.51'
 L = 630.28'

P.I. STA. 141+74.79
 X = 2,142,329.25
 Y = 575,878.86
 STA. 139+54.22
 STA. 143+92.03
 S = 45° 00'
 R = 2864.29'
 T = 219.10'
 L = 437.51'

NOTE: SOUTH ACCESS ROAD, PARKING FACILITIES AND MAINTENANCE ROAD NOT SHOWN. FOR LOCATION SEE SEC. NO. 157 AND 158. RECORD DRAWING-WORK AS BUILT

AM#0001				2 APR 82		REVISED TO REFLECT WF TE-IN CHANGE				
WORKING NO.	ACTION	DATE	DESCRIPTION OF REVISION							
U.S. ARMY ENGINEER DISTRICT, FORT WORTH CORPS OF ENGINEERS FORT WORTH, TEXAS										
RAY ROBERTS LAKE ELM FORK, TRINITY RIVER, TEXAS EMBANKMENT AND OUTLET WORKS PLAN OF BORINGS III										
DESIGNED BY:	C.E. J. E. A. P.									
DRAWN BY:	S. W. MACK									
REVIEWED BY:	A. L. BRANK									
SUBMITTED BY:	H. KARBS									
ENGINEER:	INVITATION NO. DACW 63-82-C-0025				DATE: MAR, 1982		CONTRACT NO. DACW 63-82-C-0083		SEQUENCE NO. 5	
	DRAWING NUMBER				SHEET NO.		OF			

TO ACCOMPANY FOUNDATION REPORT

CONTRACT NO. DACW 63-82-C-0083


2125,000


Begin Sta. 0+00
X = 2124,500
Y = 617,205

2124,000

2123,000

2122,000

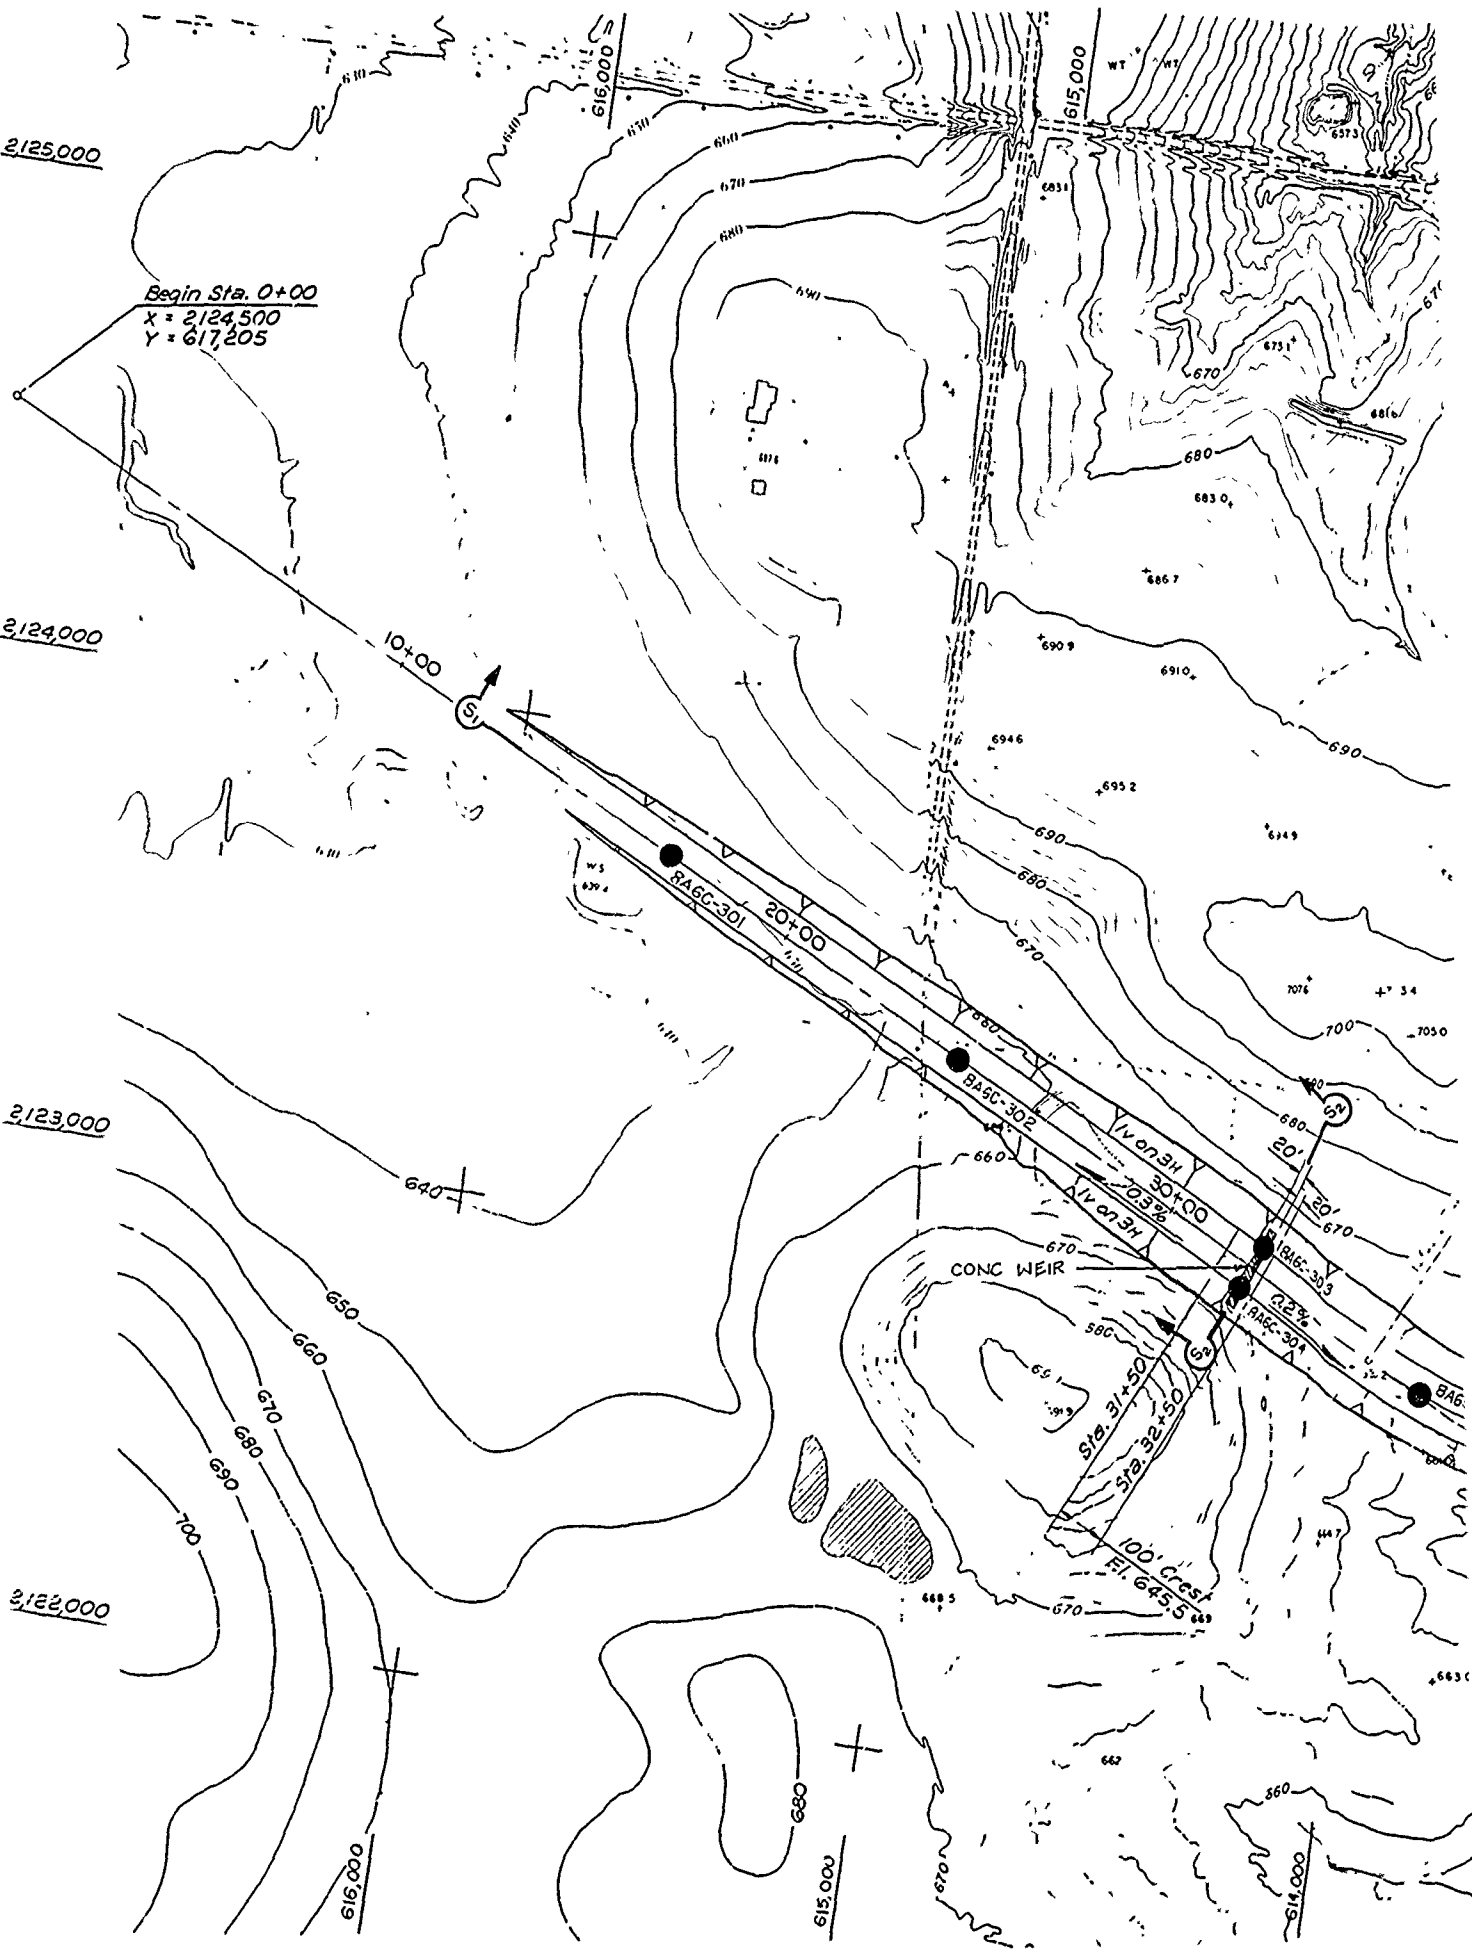


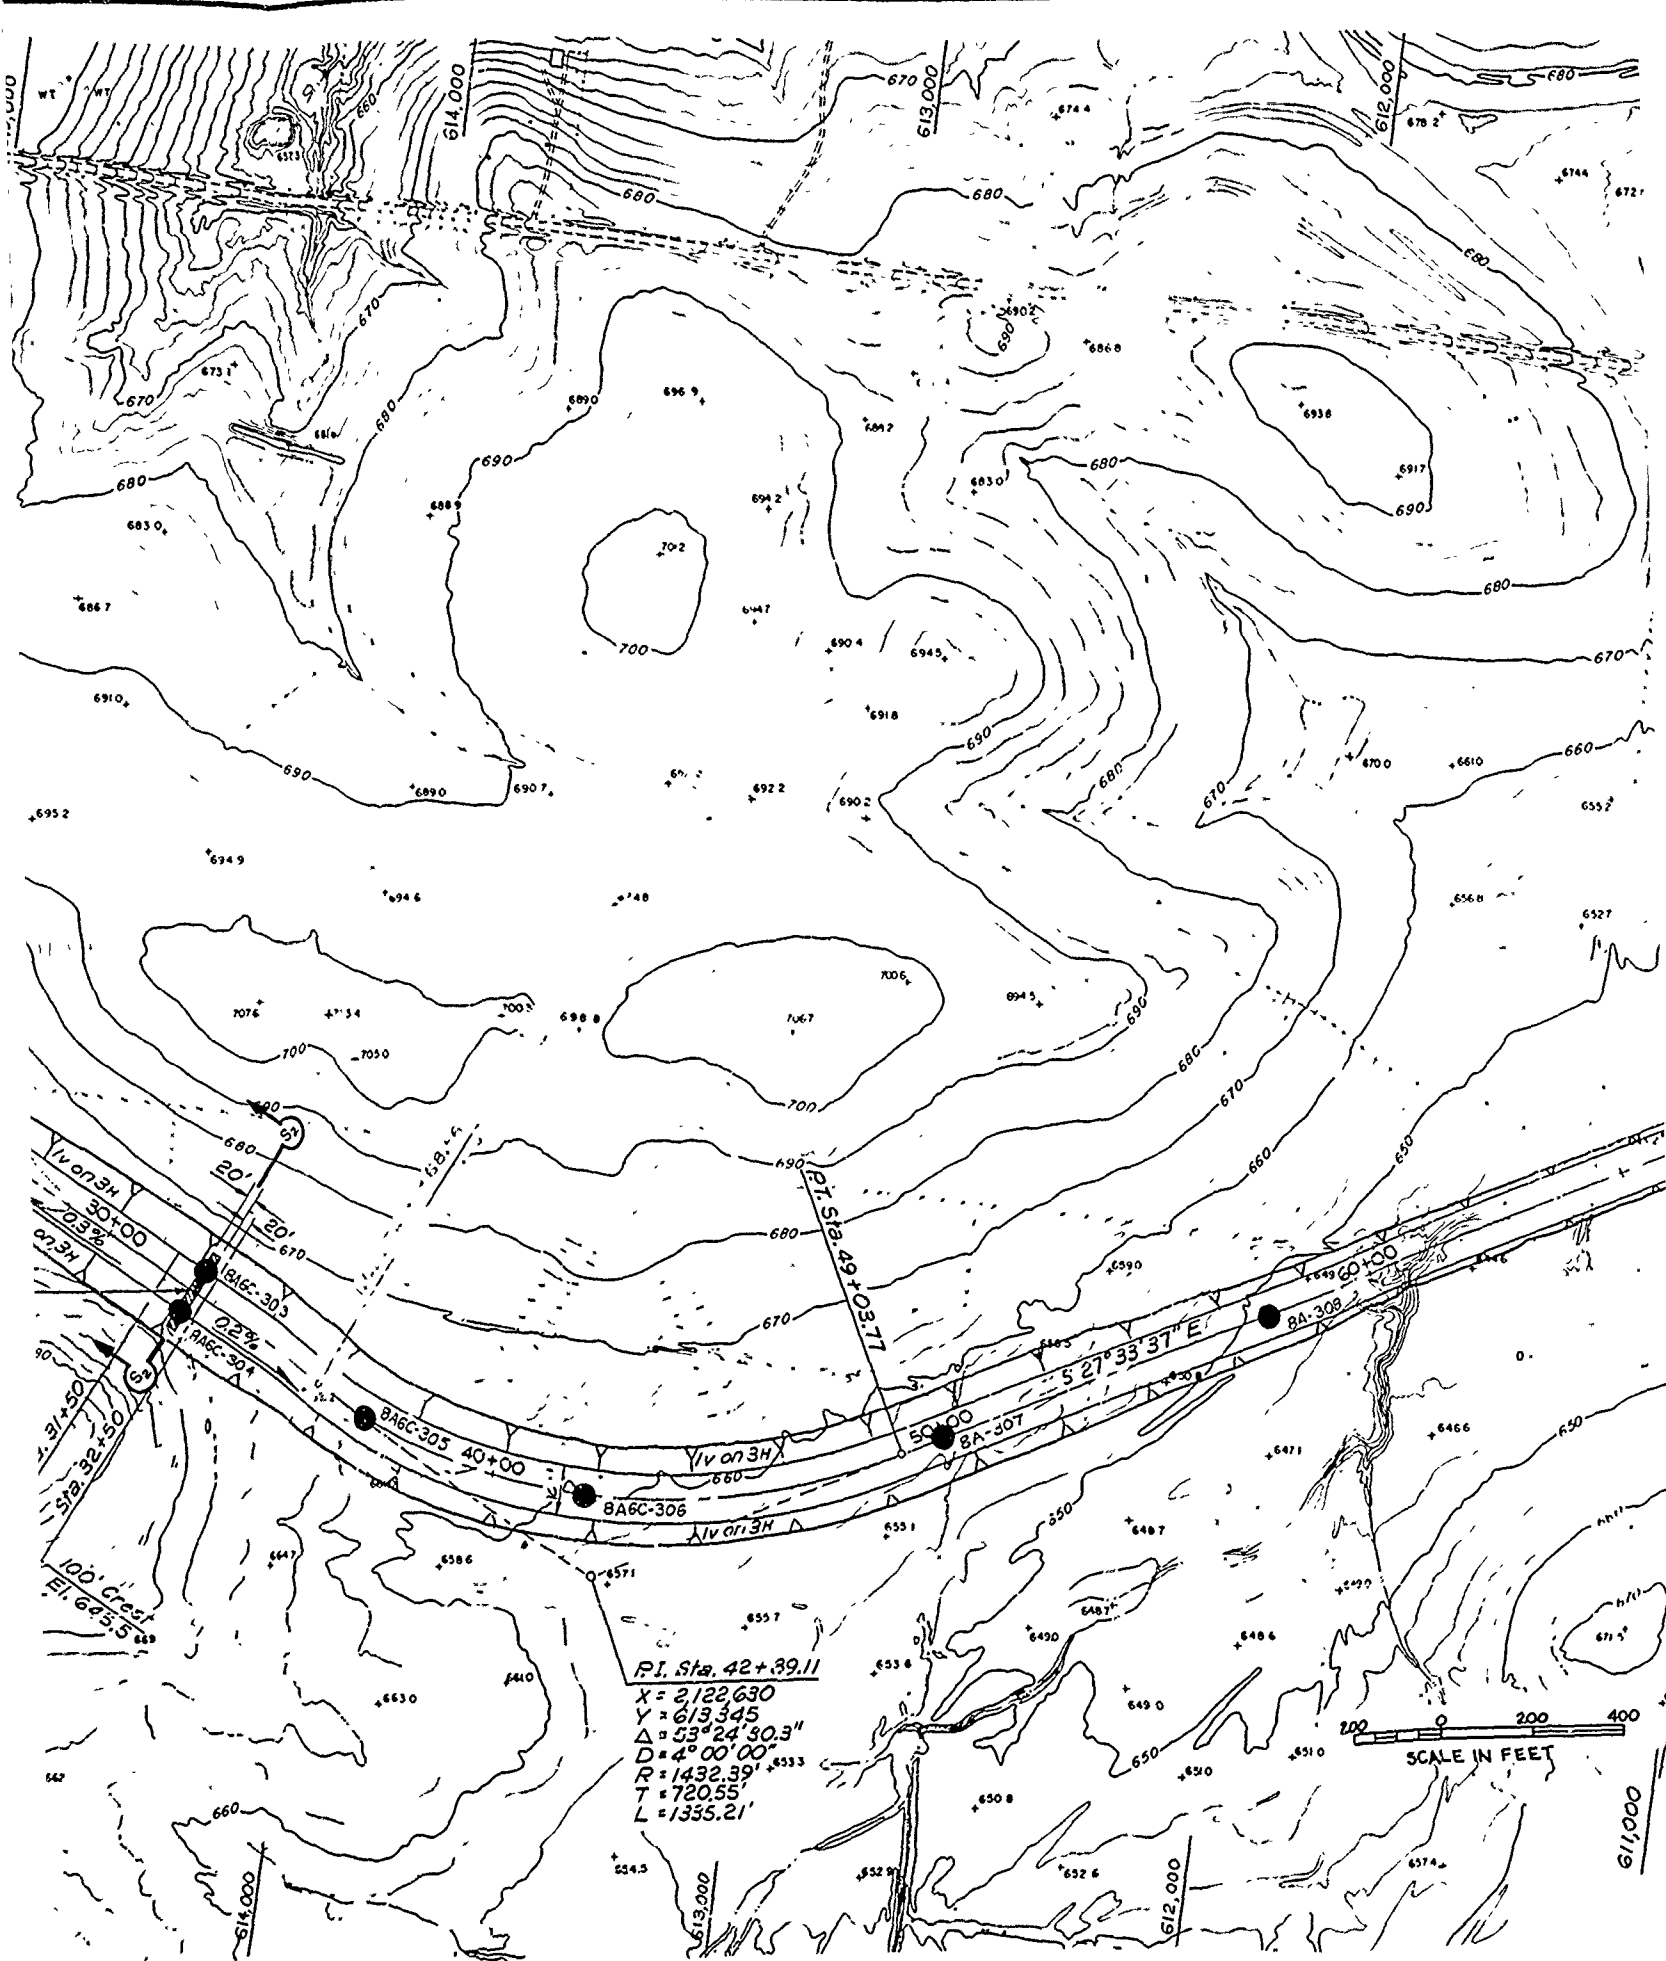

PI Sta. 42+39.11
 X = 2122.630
 Y = 613.345
 $\Delta = 53^{\circ}24'30.3''$
 $D = 4^{\circ}00'00''$
 $R = 1432.39'$
 $T = 720.55'$
 $L = 1335.21'$

0 200 400
 SCALE IN FEET

RECORD DRAWING-WORK AS BUILT

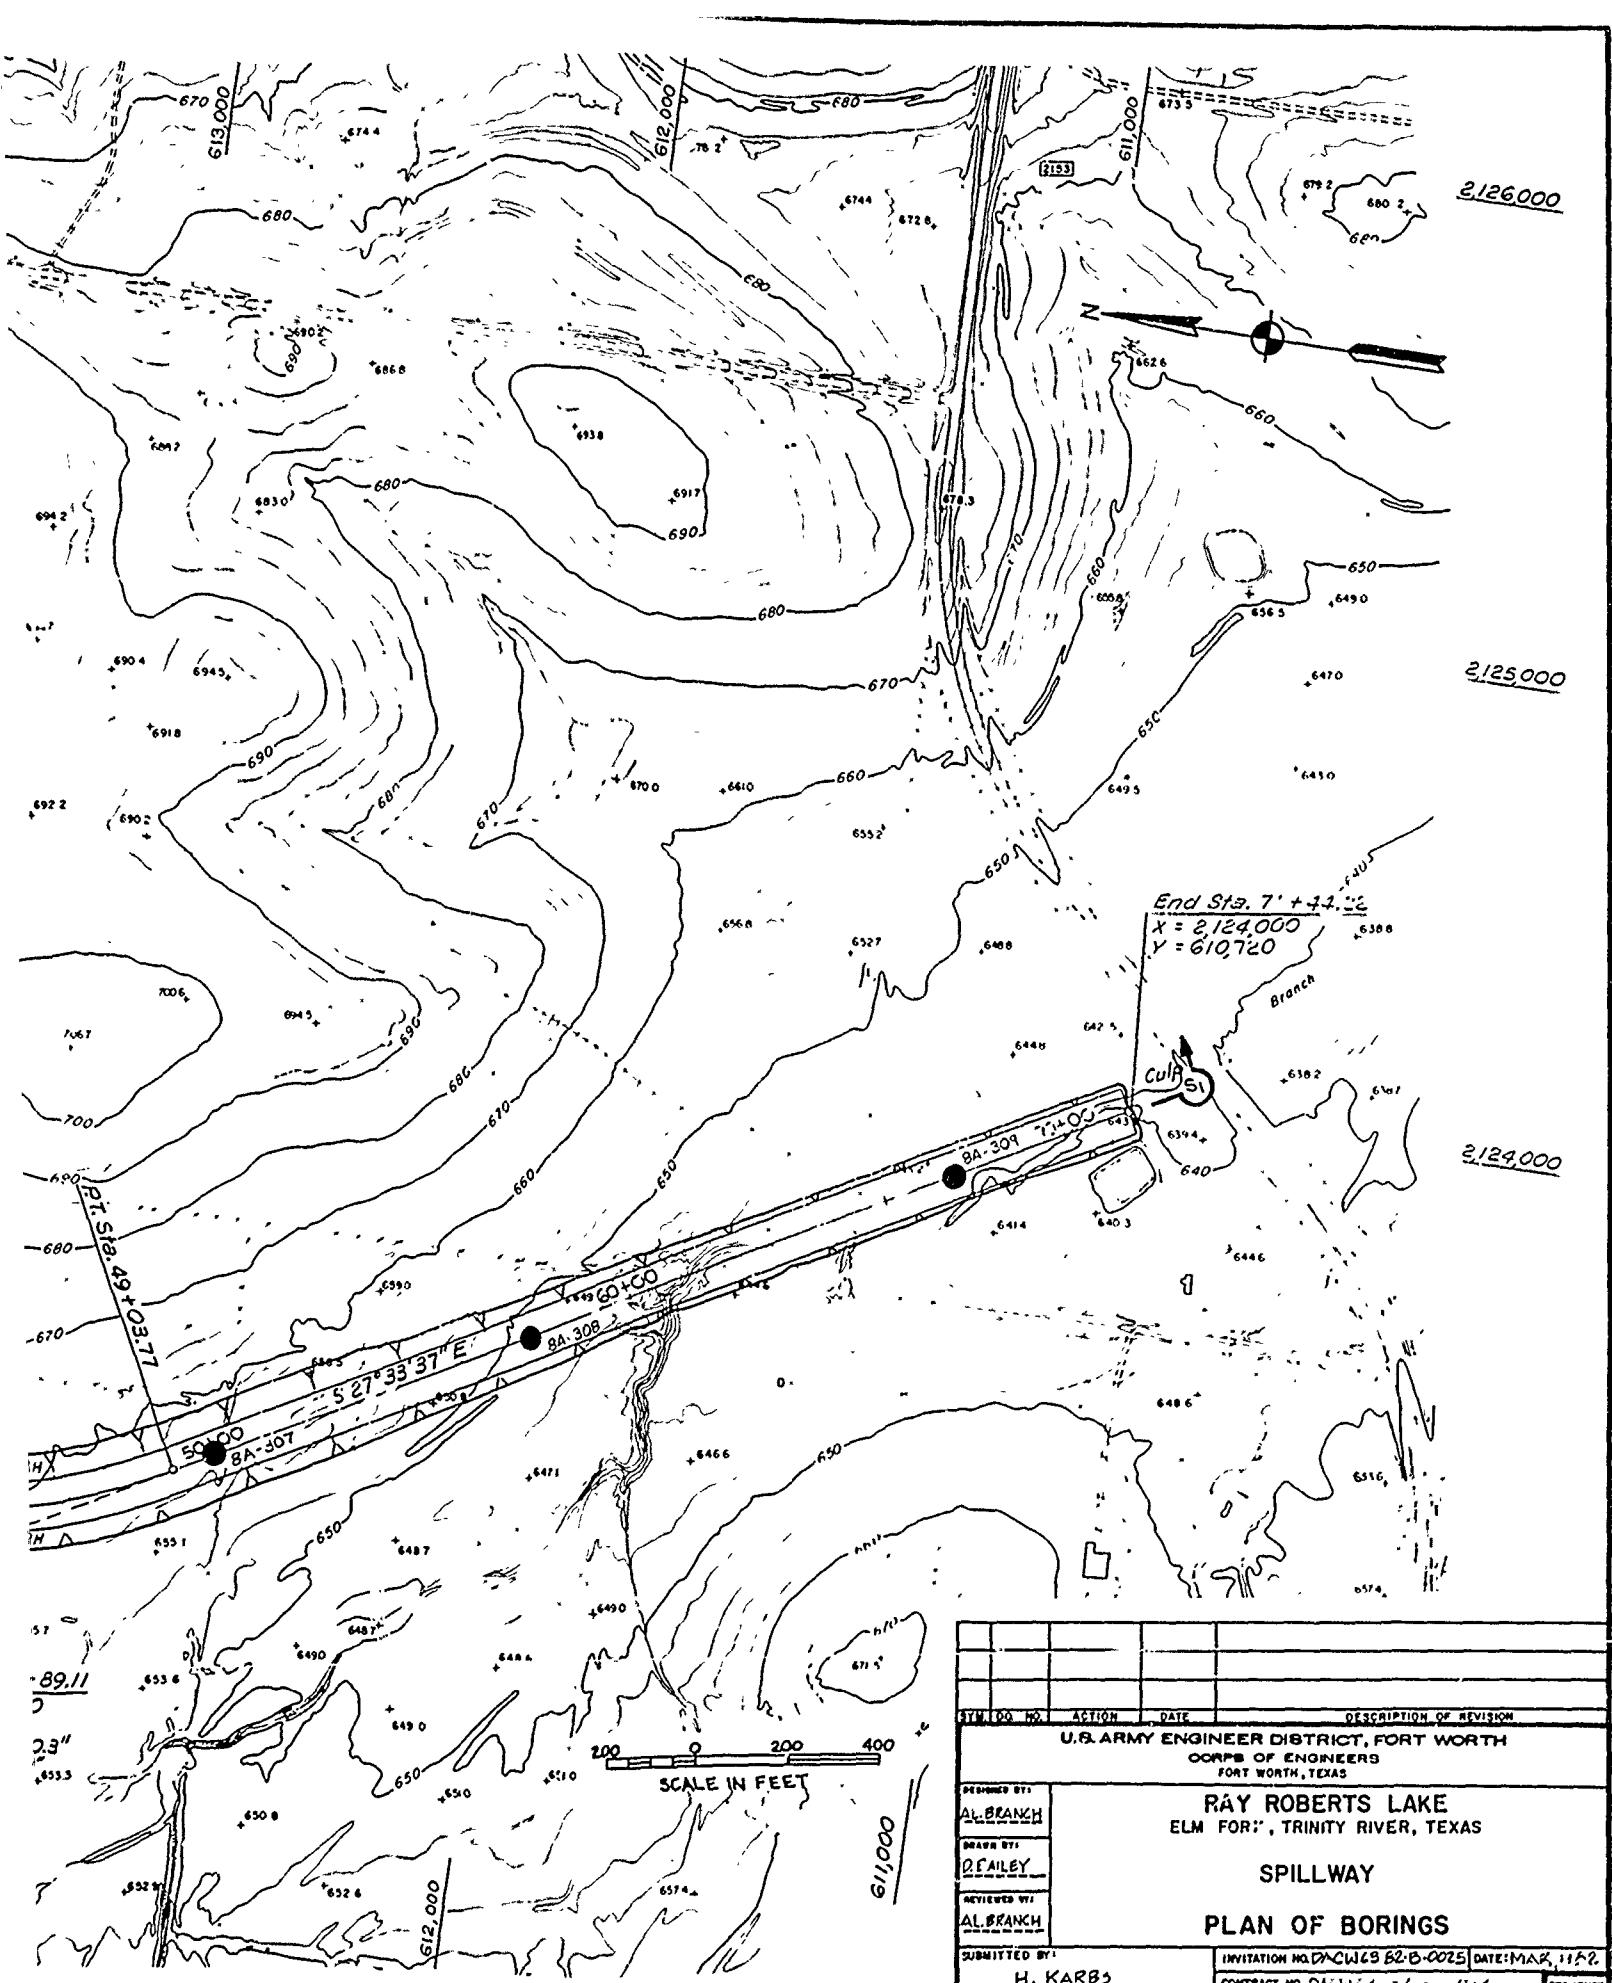

End Sta. 7 + 43.72
 X = 2124,000
 Y = 610,720

SYM. NO.	ACTION	DATE	DESCRIPTION OF REVISION
U.S. ARMY ENGINEER DISTRICT, FORT WORTH CORPS OF ENGINEERS FORT WORTH, TEXAS			
DESIGNED BY:	RAY ROBERTS LAKE ELM FOR, TRINITY RIVER, TEXAS SPILLWAY PLAN OF BORINGS		
DRAWN BY:			
REVIEWED BY:			
SUBMITTED BY:	INVITATION NO. DACW49 82-B-0025	DATE: MAR 11 1982	SEQUENCE NO.
H. KARBS	CONTRACT NO. DAJ402-74-C-0112	SHEET NO.	7

RECORD DRAWING-WORK AS BUILT

TO ACCOMPANY FOUNDATION REPORT

CONTRACT NO. DAJ402-74-C-0112

UNITED STATES ENGINEER OFFICE
ENGINEERING DIVISION
FIELD INVESTIGATIONS SECTION
GALVESTON, TEXAS

LOG OF CORE DRILLING


OF CORE DRILLING CONT

Site Aubrey Dam

Hole No. _____

Date 20 August 1946
 Site Aubrey Sheet 24 of 2
 U.S.L. Sta. 4724
 Hole No. C-1 Drill No. _____ Location Y
 Type of Bit _____ Elevation of Top of Hole 597.2'
 Size of Core 2-inch Depth of Overburden 16.0'
 Method of Arb. Sampling Earth Auger Elevation of Top of Bedrock 581.2'
 Set _____ of _____ Casing Pulled Casing Top () No ()
 Depth to Water Table _____ Elevation of Water Table _____
 Total Depth of Hole 97.0' Elevation of Bottom of Hole 500.2'
 Overburden Sampling 16.0' Core Drilling 81.0' % Recovery _____
 Date Hole Started 8 January 1946 Date Hole Completed 6 January 1946
 Number of Jars/Tubes 1 Marked Upper Elm Creek G.L. Sta. 4700
 Number of Boxes 7 Marked Upper Elm Creek G.L. Sta. 4700
 Classified by _____ Submitted by _____

BOX NOS	RUNS	LOSSES	DEPTH	ELEV.	CLASSIFICATION AND REMARKS
			0.0'	597.2'	
			8.0'	589.2'	0.0' to 8.0' CLAY, sandy, rust to dark brown.
			16.0'	581.2'	8.0' to 16.0' SAND, clayey, tan.
			19.4'	577.8'	16.0' to 19.4' Limestone, fossiliferous, maly, brown to tan, surface or near surface outcrops of this material have been colored by iron oxide.
			28.0'	569.2'	19.4' to 28.0' SHALE, sandy. - core washed away.
			32.0'	565.2'	28.0' to 32.0' SHALE, blue, stained by iron oxide.
			47.0'	500.2'	32.0' to 47.0' SHALE, compact, laminated, soft, thin shell seams.


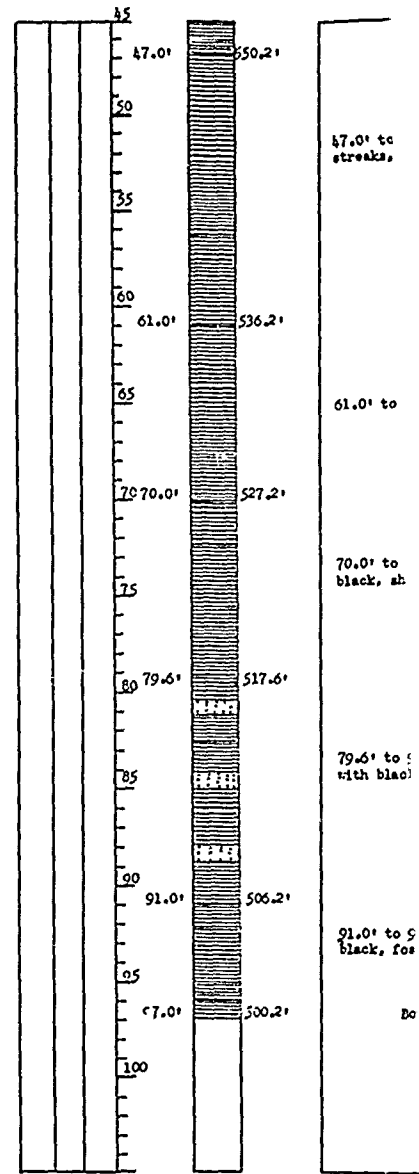


UNITED STATES ENGINEER OFFICE
ENGINEERING DIVISION
FIELD INVESTIGATIONS SECTION
GALVESTON, TEXAS

LOG OF CORE DRILLING

Site Aubrey Date 20 August 1946
Sheet 1 of 2

Hole No. <u>C-2</u>	Drill No. _____	Location <u>S.L. Sta. 11/27</u>
Type of Bit _____	Elevation of Top of Hole <u>562.0'</u>	Elevation of Top of Hole _____
Size of Core <u>2-Inch</u>	Depth of Overburden <u>28.0'</u>	Depth of Overburden _____
Method of Orb. Sampling <u>Earth Auger</u>	Elevation of Top of Bedrock <u>534.0'</u>	Elevation of Top of Bedrock _____
Set _____ of _____ Casings	Pulled Casing Top () No ()	Pulled Casing Top () No ()
Depth to Water Table _____	Elevation of Water Table _____	Elevation of Water Table _____
Total Depth of Hole <u>68.0'</u>	Elevation of Bottom of Hole <u>494.0'</u>	Elevation of Bottom of Hole _____
Overburden Sampling <u>28.0'</u>	Core Drilling <u>40.0'</u> % Recovery	Core Drilling <u>40.0'</u> % Recovery
Date Hole Started <u>4 January 1939</u>	Date Hole Completed <u>6 January 1939</u>	Date Hole Completed <u>6 January 1939</u>
Number of Jars/Tubes <u>1</u>	Marked <u>Upper Elm Creek C.L. Sta. 11/27</u>	Marked <u>Upper Elm Creek C.L. Sta. 11/27</u>
Number of Boxes <u>2</u>	Submitted by _____	Submitted by _____
Classified by _____		

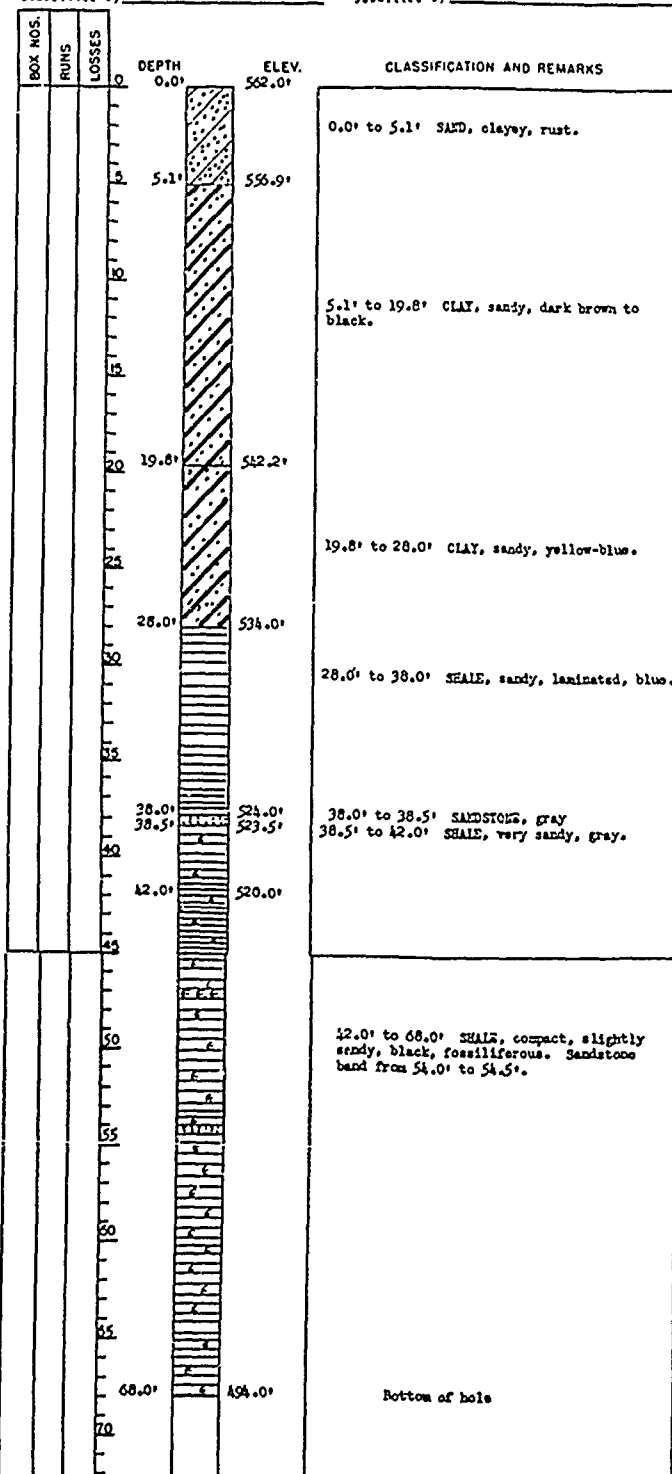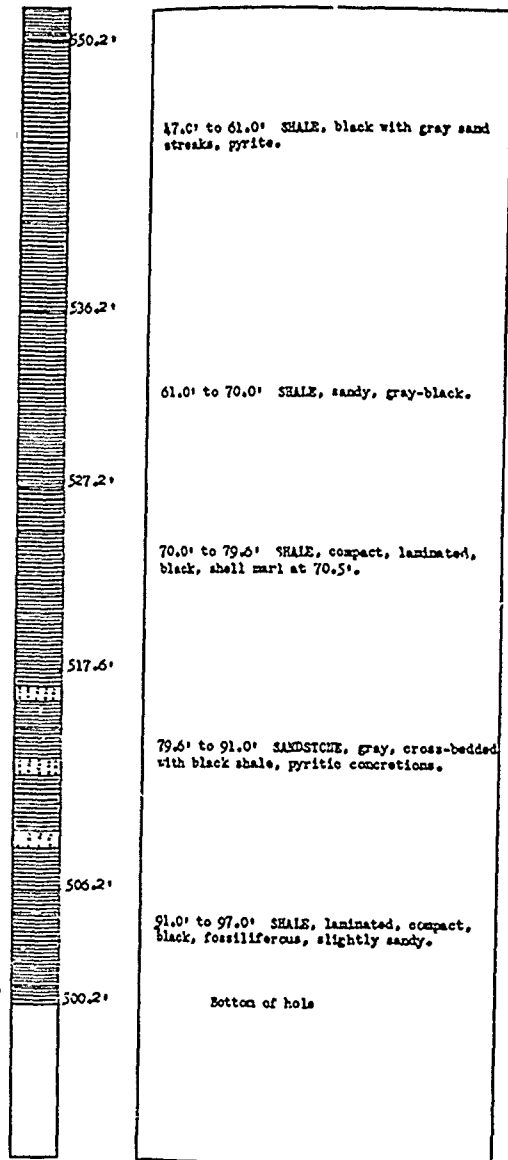


DATE	
BY	
CHECKED BY	
APPROVED BY	
SUBMITTED BY	
ENGINEER	

UNITED STATES ENGINEER OFFICE
ENGINEERING DIVISION
FIELD INVESTIGATIONS SECTION
GALVESTON, TEXAS

LOG OF CORE DRILLING

Site Aubrey Date 20 August 1946
Sheet 1 of 2
Location C.L. Sta. 11/27
Elevation of Top of Hole 562.0'
Depth of Overburden 28.0'
Elevation of Top of Bedrock 534.0'
Pulled Casing Yes () No ()
Elevation of Water Table _____
Elevation of Bottom of Hole 106.0'
Core Drilling 40.0' Recovery _____
Date Hole Completed 6 January 1939
Marked Upper Elm Creek C.L. Sta. 11/27
Marked Upper Elm Creek C.L. Sta. 11/27
Submitted by _____

Hole No. C-2 Drill No. _____
Type of Bit _____
Size of Core 2-Inch
Method of Obs. Sampling Earth Auger
Set _____ of _____ Casing
Depth to Water Table _____
Total Depth of Hole 68.0'
Overburden Sampling 28.0'
Date Hole Started 1 January 1939
Number of Jars/Tubes 1
Number of Boxes 2
Classified by _____

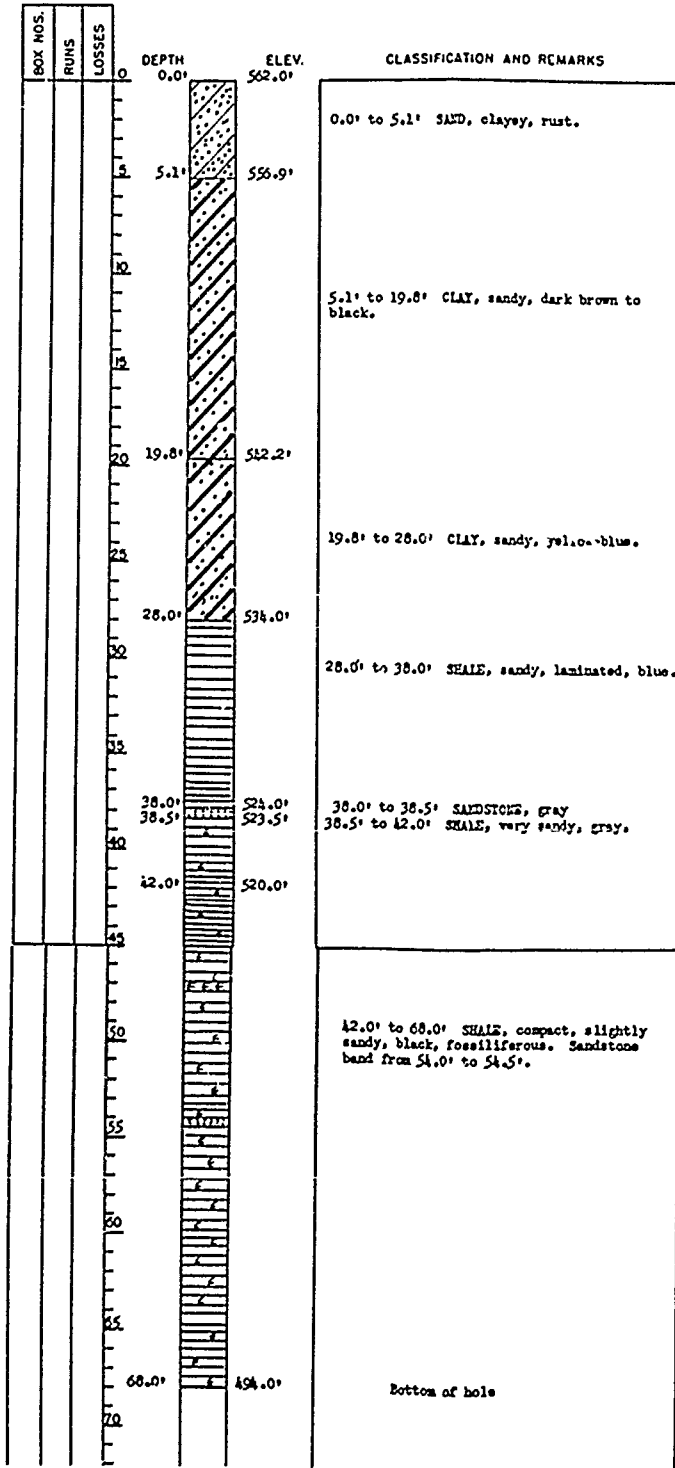

RECORD DRAWING-WORK AS BUILT

SYM	NO.	ACTION	DATE	DESCRIPTION OF REV
U.S. ARMY ENGINEER DISTRICT, FORT WORTH CORPS OF ENGINEERS FORT WORTH, TEXAS				
DESIGNED BY	RAY ROBERTS LAKE ELM FORK, TRINITY RIVER, TEXAS EMBANKMENT, SPILLWAY AND OUTLET WORKS LOGS OF BORINGS C-1 AND C-2			
DRAWN BY				
REVIEWED BY				
SUBMITTED BY				
ENGINEER	INVITATION NO. DACW63-820 C025	DATE MAR, 1942	SEQUENCE NO. 10	
	CONTRACT NO. DACW63-82-C-6093		DRAWING NUMBER	
			SHEET NO. 10	

TO ACCOMPANY FOUNDATION REPORT

PROJECT NO. DACW63-82-C-6093


UNITED STATES ENGINEER OFFICE
ENGINEERING DIVISION
FIELD INVESTIGATIONS SECTION
GALVESTON, TEXAS

LOG OF CORE DRILLING

Date 20 August 1946

Site Aubrey Sheet 1 of 2
C.L. Sta. 28700

Hole No. C-1 Drill No. _____ Location In _____
Type of Bit _____ Elevation of Top of Hole 559.2'
Size of Core 2-Inch Depth of Overburden 85.0'
Method of Ovb. Sampling Earth Auger Elevation of Top of Bedrock 514.2'
Set _____ of Casing Pulled Casing Yes () No ()
Depth to Water Table _____ Elevation of Water Table _____
Total Depth of Hole 67.0' Elevation of Bottom of Hole 592.2'
Overburden Sampling 45.0' Core Drilling 22.0' Recoveries _____
Date Hole Started 7 January 1939 Date Hole Completed 10 January 1939
Number of Jars/Tubes 1 Marker Upper Elm Creek C.L. Sta. 28400
Number of Boxes 1 Marker Lower Elm Creek C.L. Sta. 28400
Classified by _____ Submitted by _____

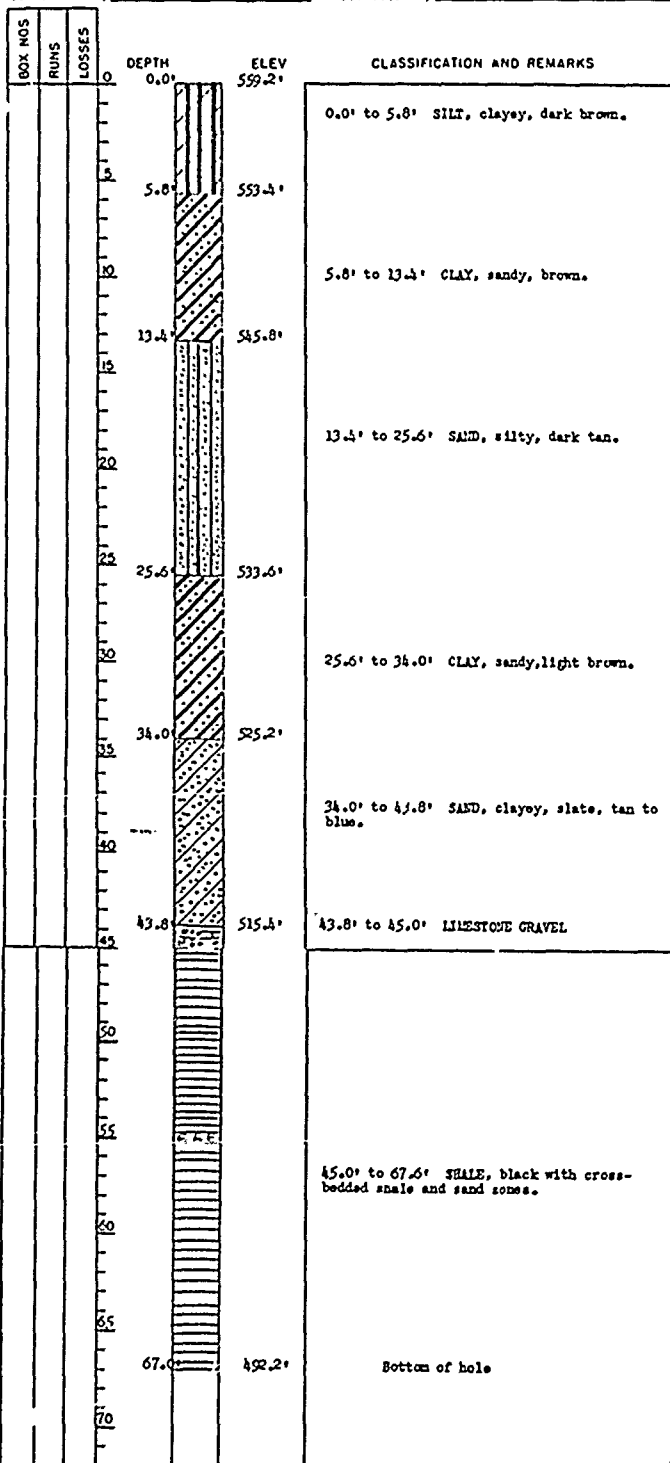


UNITED STATES ENGINEERING DIVISION
FIELD INVESTIGATIONS SECTION
GALVESTON, TEXAS

LOG OF CORE

Site Aubrey

Hole No. C-4 Drill No. _____ Location In _____
Type of Bit _____ Elevation of Top of Hole _____
Size of Core 2-Inch Depth of Overburden _____
Method of Ovb. Sampling Earth Auger Elevation of Top of Bedrock _____
Set _____ of Casing Pulled Casing Yes () No ()
Depth to Water Table _____ Elevation of Water Table _____
Total Depth of Hole 82.0' Elevation of Bottom of Hole _____
Overburden Sampling 16.0' Core Drilling _____ Recoveries _____
Date Hole Started 6 January 1939 Date Hole Completed _____
Number of Jars/Tubes 2 Marker _____
Number of Boxes 1 Marker _____
Classified by _____ Submitted by _____

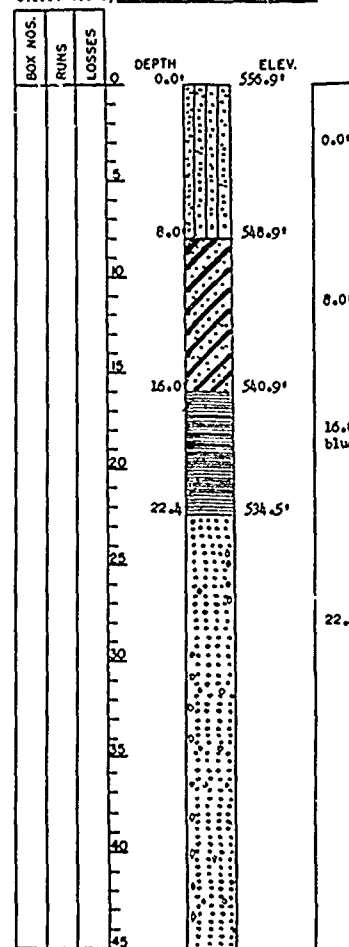


UNITED STATES ENGINEER OFFICE
ENGINEERING DIVISION
FIELD INVESTIGATIONS SECTION
GALVESTON, TEXAS

LOG OF CORE DRILLING

Date 20 August 1946

Site Aubrey C.L. Sta. 28735 500' below.

Hole No. C-4 Drill No. _____ Location No. _____
 Type of Bit _____ Elevation of Top of Hole 556.9'
 Size of Core 2-Inch Depth of Overburden 16.0'
 Method of Ovb. Sampling Wash Lucas Elevation of Top of Bedrock 530.9'
 Set _____ of _____ Casing Pulled Casing Yes () No ()
 Depth to Water Table _____ Elevation of Water Table _____
 Total Depth of Hole 82.0' Elevation of Bottom of Hole 478.9'
 Overburden Sampling 16.0' Core Drilling 76.0' Recovery _____
 Date Hole Started 6 January 1939 Bit Hole Completed 10 January 1939
 Number of Jars/Tubes 2 Marked Upper Elm Creek 500' below 28700
 Number of Boxes 1 Marked Upper Elm Creek 500' below 28700
 Classified by _____ Submitted by _____

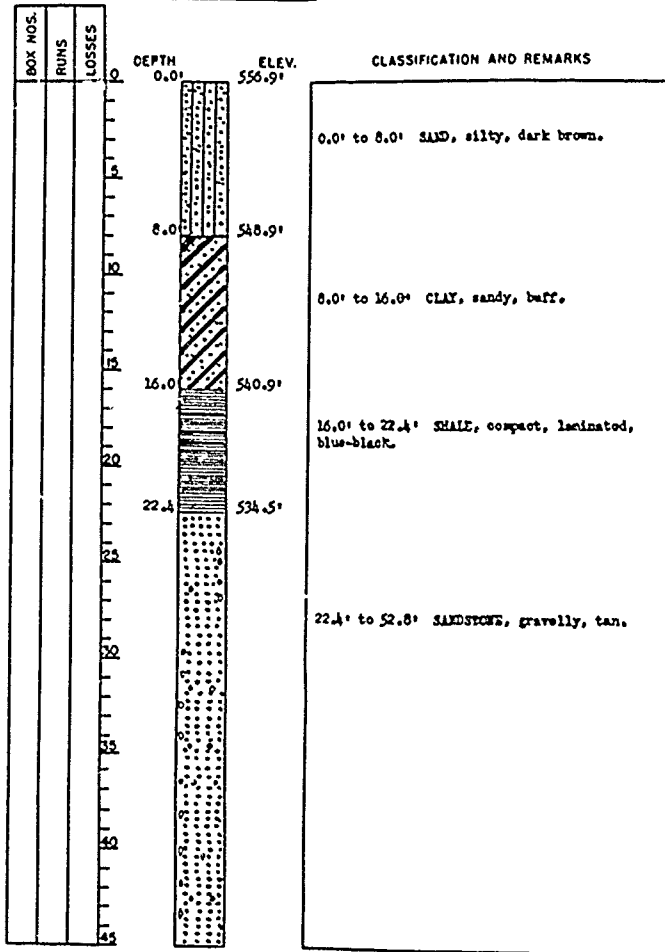



LOG OF CORE DRILLING CONTINUATION 3rd

Site Aubrey

Hole No. C-4

Sheet 2 of 2

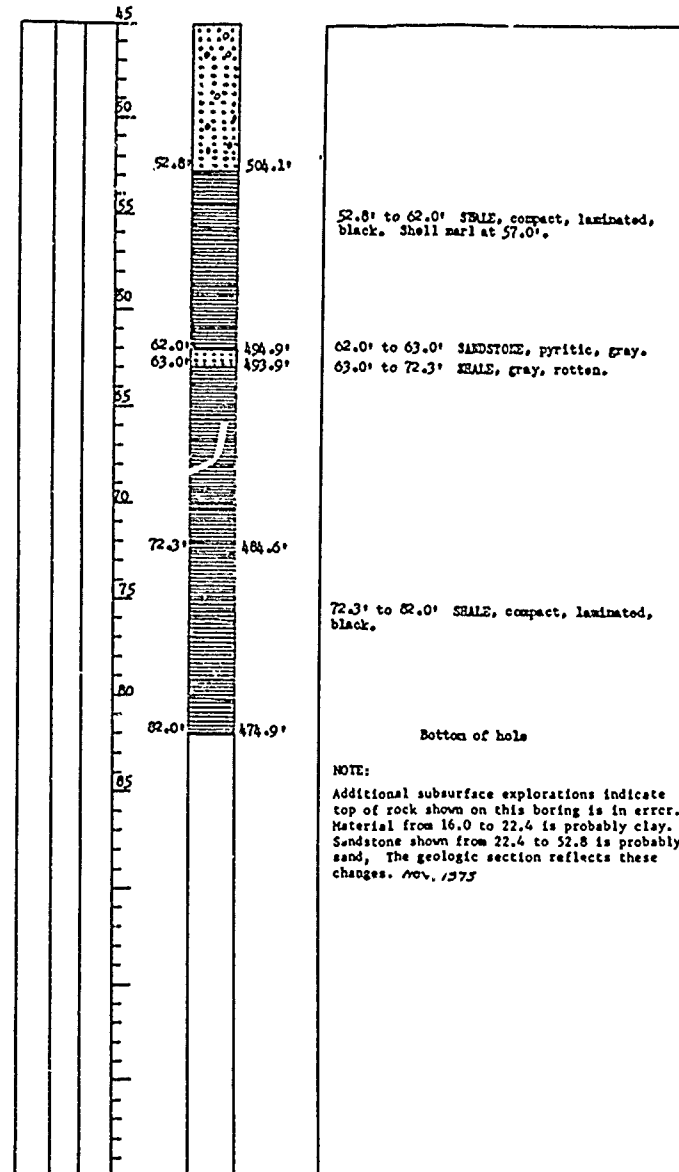

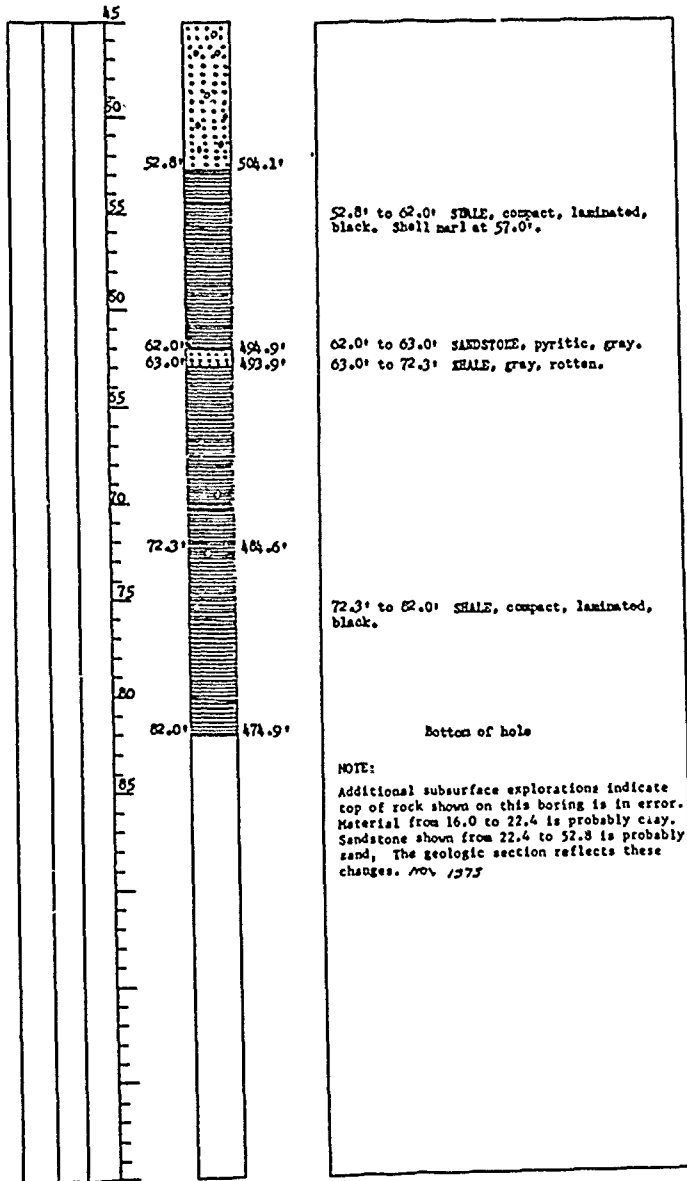


RECORD DRAWING-WORK AS BUILT

SYM	QC NO	ACTION	DATE	DESCR OF WORK	REV	SYM
U.S. ARMY ENGINEER DISTRICT, FORT WORTH CORPS OF ENGINEERS FORT WORTH, TEXAS						
DESIGNED BY:	RAY ROBERTS LAKE ELM FORK, TRINITY RIVER, TEXAS EMBANKMENT, SPILLWAY AND OUTLET WORKS LOGS OF BORINGS C-3 AND C-4					
DRAWN BY:						
REVIEWED BY:						
SUBMITTED BY:	INVITATION NO. DACW 63-82-B-0025	DATE	MAR, 1982			
ENGINEER	CONTRACT NO. DACW 63-72-C-0782	DRAWING NUMBER	SHEET NO. OF	9		

UNITED STATES ENGINEER OFFICE
ENGINEERING DIVISION
FIELD INVESTIGATIONS SECTION
GALVESTON, TEXAS

LOG OF CORE DRILLING


Site Aubrey Date 20 August 1946
 Hole No. C-5 Drill No. 1 Location 500' above Sta. 28700
 Type of Bit 2-Inch Elevation of Top of Hole 560.3'
 Size of Core 2-Inch Depth of Overburden 37.0'
 Method of Ovb. Sampling Earth Auger Elevation of Top of Bedrock 523.3'
 Set of Casing Pulled Casing Yes () No ()
 Depth to water Table Elevation of water Table
 Total Depth of Hole 68.0' Elevation of Bottom of Hole 492.3'
 Overburden Sampling 37.0' Core Drilling 31.0' Recovery
 Date Hole Started 18 January 1939 Date Hole Completed 20 January 1939
 Number of Jars/Tubes None Marked
 Number of Boxes 1 Marked Upper Elm Creek 500' Above Sta. 28700
 Classified by Submitted by

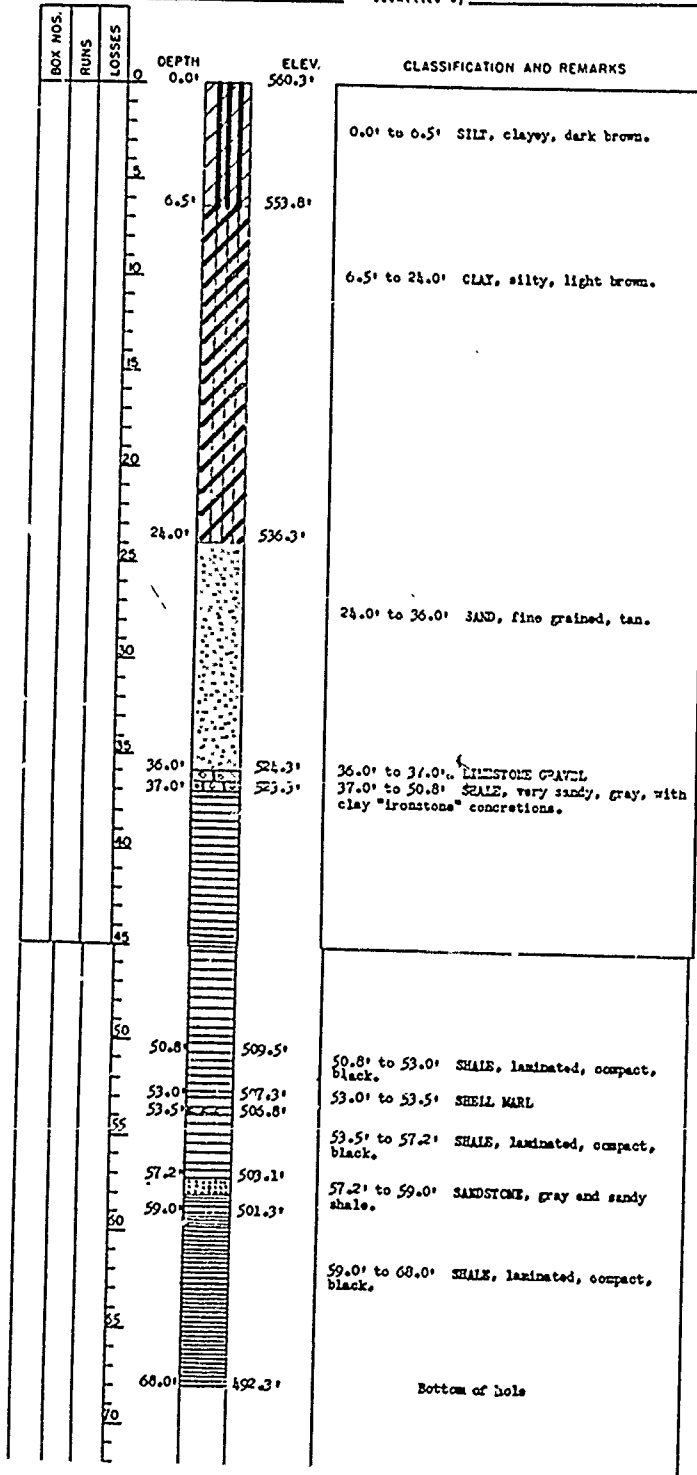

UNITED STATES ENGINEER OFFICE
ENGINEERING DIVISION
FIELD INVESTIGATIONS SECTION
GALVESTON, TEXAS

LOG OF CORE DRILLING

Site Aubrey Location
 Hole No. C-6 Drill No. Elevation of
 Type of Bit Depth of
 Size of Core 2-Inch Elevation of
 Method of Ovb. Sampling Earth Auger Elevation of
 Set of Casing Pulled Casing
 Depth to water Table Elevation of
 Total Depth of Hole 68.0' Elevation of
 Overburden Sampling 37.0' Core Drilling
 Date Hole Started 16 January 1939 Date Hole Completed
 Number of Jars/Tubes None Marked
 Number of Boxes 1 Marked Upper
 Classified by Submitted by

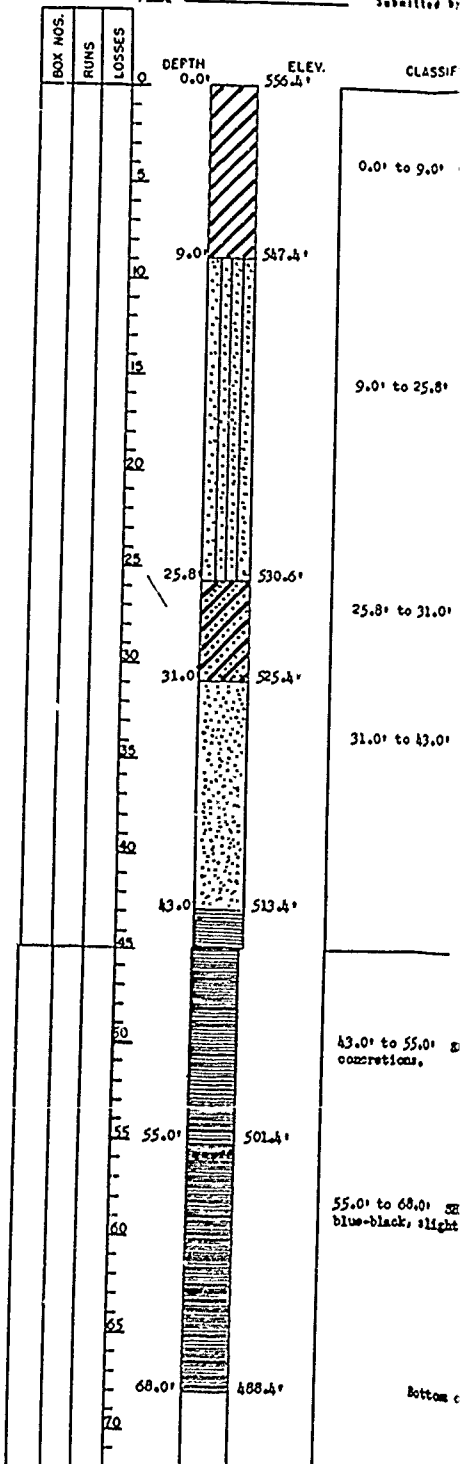


UNITED STATES ENGINEER OFFICE
ENGINEERING DIVISION
FIELD INVESTIGATIONS SECTION
GALVESTON, TEXAS

LOG OF CORE DRILLING

Date 20 August 1946

Site Aubrey Sheet 1 of 2
C.L. Sta. 36400
Hole No. C-6 Drill No. _____ Location In _____
Type of Bit _____ Elevation of Top of Hole 556.4'
Size of Core 2-inch Depth of Overburden 43.0'
Method of Overburden Sampling Earth Auger Elevation of Top of Bedrock 513.4'
Set _____ of _____ Casing Pulled Casing Top () No ()
Depth to Water Table _____ Elevation of Water Table _____
Total Depth of Hole 68.0' Elevation of Bottom of Hole 488.4'
Overburden Sampling 43.0' Core Drilling 25.0' Recovery _____
Date Hole Started 16 January 1939 Date Hole Completed 18 January 1939
Number of Jars/Tubes None Marked Upper Elm Creek C.L. Sta. 36400
Number of Boxes 1 Classified by _____
Submitted by _____

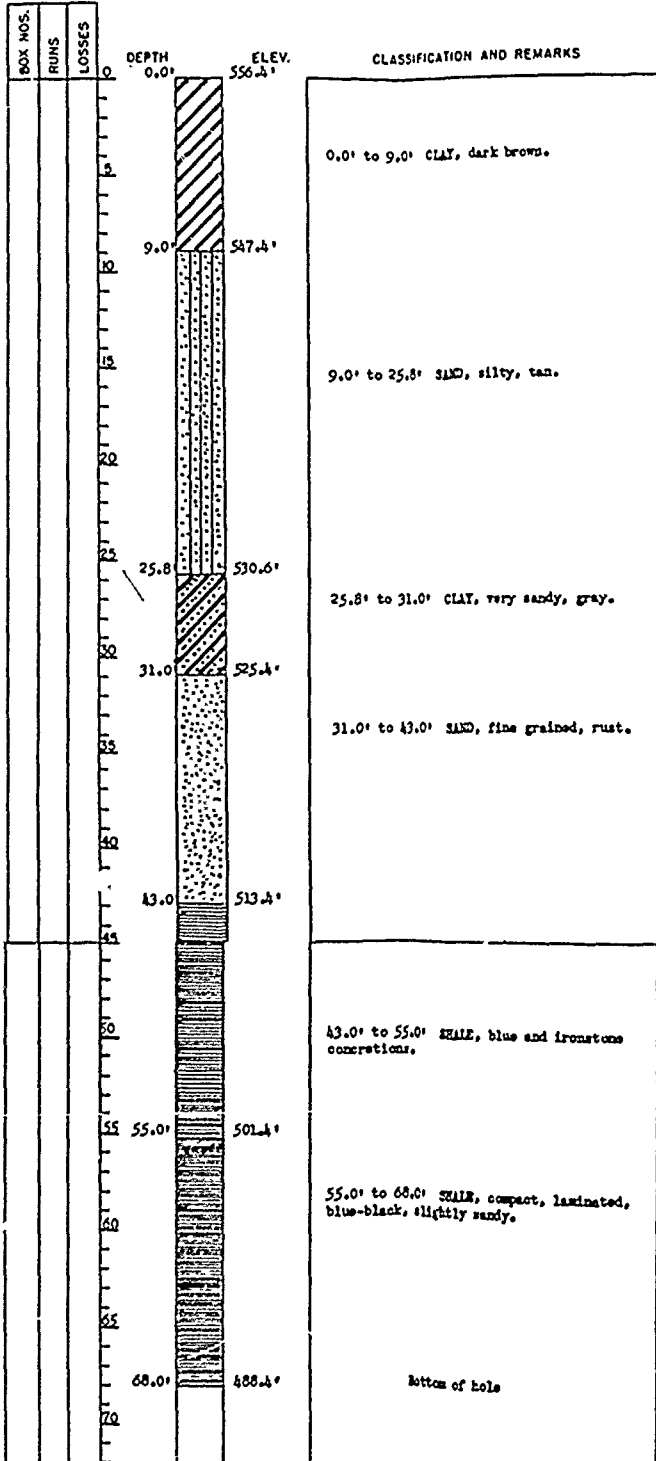


UNITED STATES ENGINEER OFFICE
ENGINEERING DIVISION
FIELD INVESTIGATIONS SECTION
GALVESTON, TEXAS

LOG OF CORE DRILLING

Date 20 August 1946

Site Aubrey Sheet 1 of 2
C.L. Sta. 45400
Hole No. C-7 Drill No. _____ Location In _____
Type of Bit _____ Elevation of Top of Hole 590.9'
Size of Core 2-inch Depth of Overburden 28.0'
Method of Overburden Sampling Earth Auger Elevation of Top of Bedrock 562.9'
Set _____ of _____ Casing Pulled Casing Top () No ()
Depth to Water Table _____ Elevation of Water Table _____
Total Depth of Hole 95.0' Elevation of Bottom of Hole 495.9'
Overburden Sampling 28.0' Core Drilling 67.0' Recovery _____
Date Hole Started 12 January 1939 Date Hole Completed 16 January 1939
Number of Jars/Tubes 1 Marked Upper Elm Creek C.L. Sta. 45400
Number of Boxes 2 Classified by _____
Submitted by _____

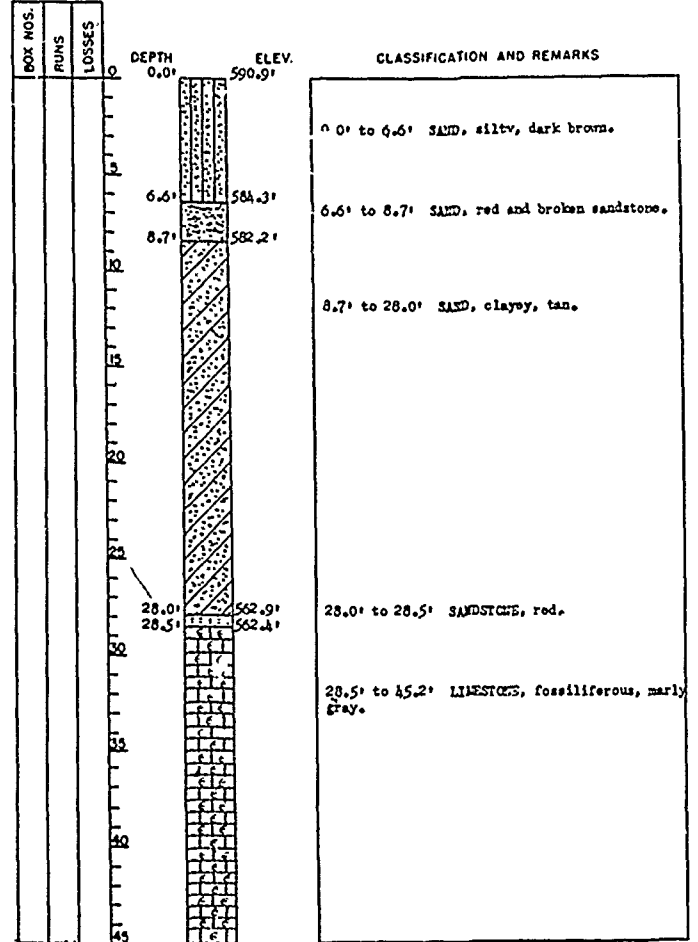


UNITED STATES ENGINEER OFFICE
ENGINEERING DIVISION
FIELD INVESTIGATIONS SECTION
GALVESTON, TEXAS

LOG OF CORE DRILLING

Date 20 August 1946
Sheet 1 of 2
Site Aubrey C.L. Sta. 45780
Drill No. C-7
Location In _____
Elevation of Top of Hole 500.01
Depth of Overburden 28.01
Elevation of Top of Bedrock 522.91
Pulled Casing Yes () No ()
Elevation of Water Table _____
Elevation of Bottom of Hole 505.01
Core Drilling 67.01 % Recovery
Date Hole Completed 16 January 1939
Marked Upper Elm Creek C. L. Sta. 45780
Marked Lower Elm Creek C. L. Sta. 45780
Submitted by _____

Core No. C-7 Drill No. _____
Type of Bit _____
Size of Core 2-Inch
Method of Casing Earth Auger
Depth to Water Table _____
Total Depth of Hole 95.01
Overburden Sampling 28.01
Date Hole Started 12 January 1939
Number of Jars/Tubes 1
Number of Boxes 2
Classified by _____

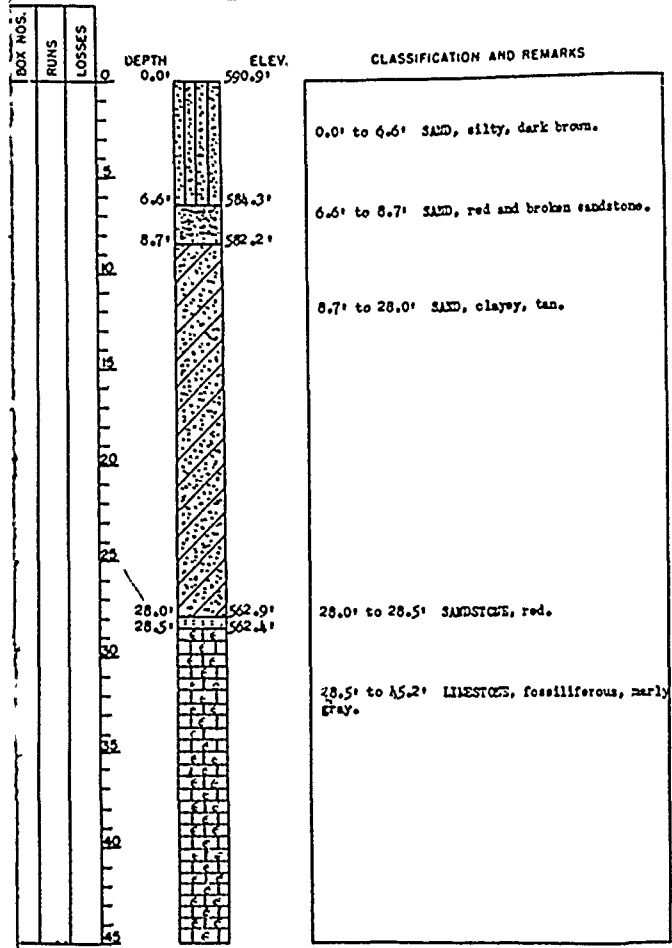


SM28-C-2

LOG OF CORE DRILLING CONTINUATION SM28-C-2

Site Aubrey

Hole No. C-7

Sheet 2 of 2

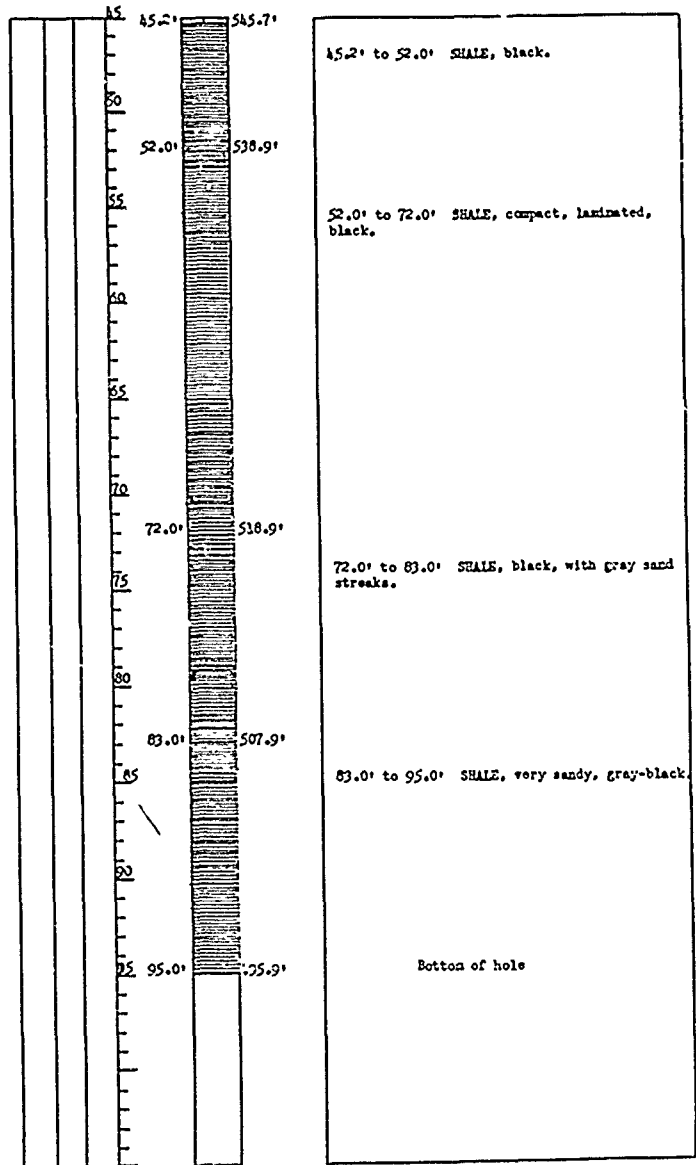

RECORD DRAWING-WORK AS BUILT

DESIGNED BY	RAY ROBERTS LAKE		
DRAWN BY	ELM FORK, TRINITY RIVER, TEXAS		
REVIEWED BY	EMBANKMENT, SPILLWAY AND		
	OUTLET WORKS		
	LOGS OF BORINGS		
	C-5, C-6 AND C-7		
SUBMITTED BY	INVITATION NO. DACW63-82-B-0025	DATE	MAR, 1962
ENGINEER	CONTRACT NO. DACW63-92-C-0095	SHEET NO.	10
	DRAWING NUMBER	OF	


TO ACCOMPANY FOUNDATION REPORT

SUB-C-1.

UNITED STATES ENGINEER OFFICE
ENGINEERING DIVISION
FIELD INVESTIGATIONS SECTION
GALVESTON, TEXAS

LOG OF CORE DRILLING


Site Aubrey Date 20 August 1946
 Hole No. C-8 Drill No. _____ Location Co. L. Sta. 51236
 Type of Bit _____ Elevation of Top of Hole 723.2'
 Size of Core 2-inch Depth of Overburden 17.0'
 Method of Ovb. Sampling Earth Auger Elevation of Top of Sadrack 706.2'
 Set _____ of Casing Pulled Casing Yes () No ()
 Depth to Water Table _____ Elevation of Water Table _____
 Total Depth of Hole 217.0' Elevation of Bottom of Hole 506.2'
 Overburden Sampling 17.0' Core Drilling 200.0' % Recovery _____
 Date Hole Started 12 January 1939 Date Hole Completed 30 January 1939
 Number of Jars/Tubes 1 Marked Upper Elm Creek C.L. Sta. 51236
 Number of Boxes 4 Marked Upper Elm Creek C.L. Sta. 51236
 Classified by _____ Submitted by _____

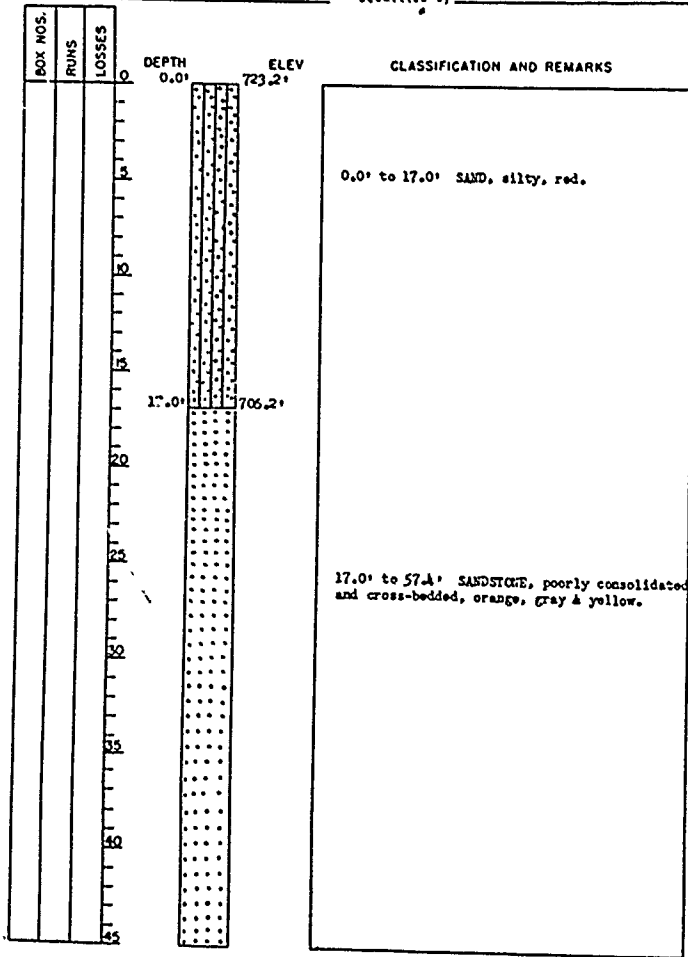

SUB-C-2.

LOG CORE DRILLING CONTINUATION 34

Site Aubrey Hole No. C-8

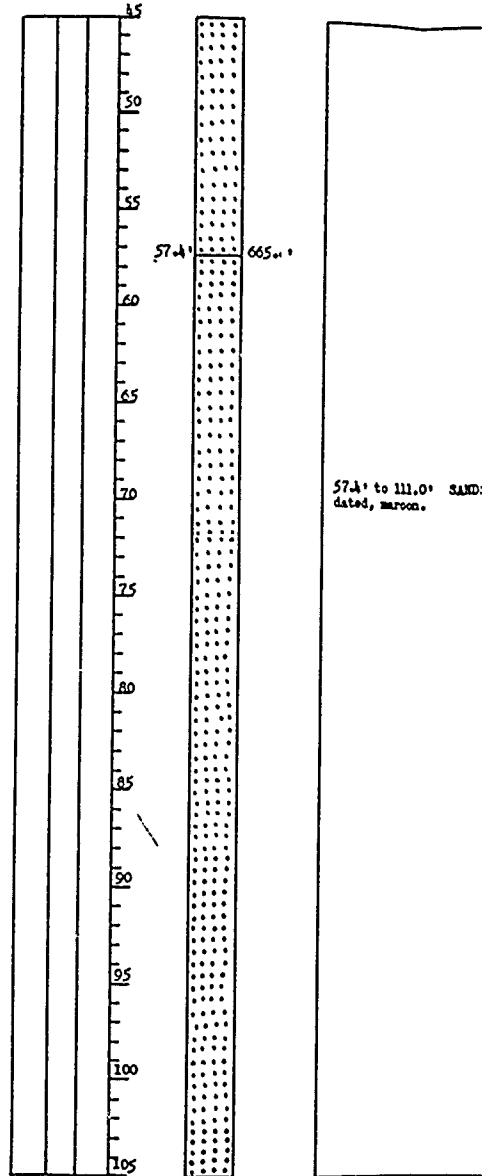

Hole No. C-8





Sheet 2 of 3



Site Aubrey

Hole No. C-8

Sheet 2 of 3

Site Aubrey

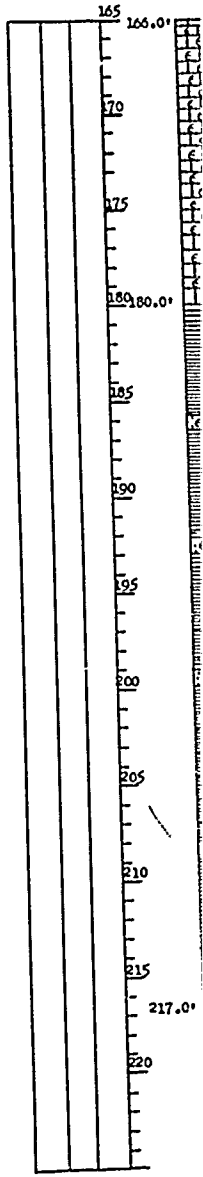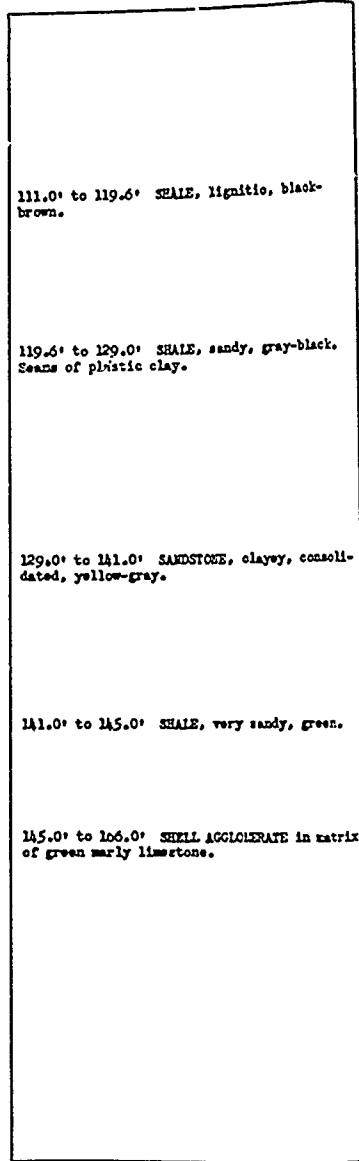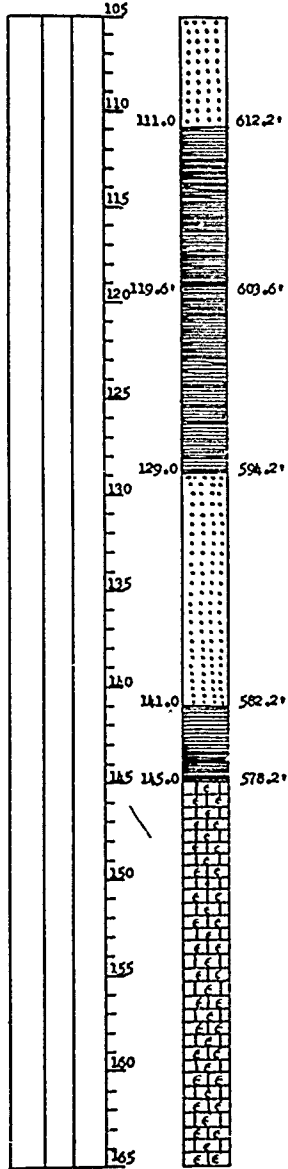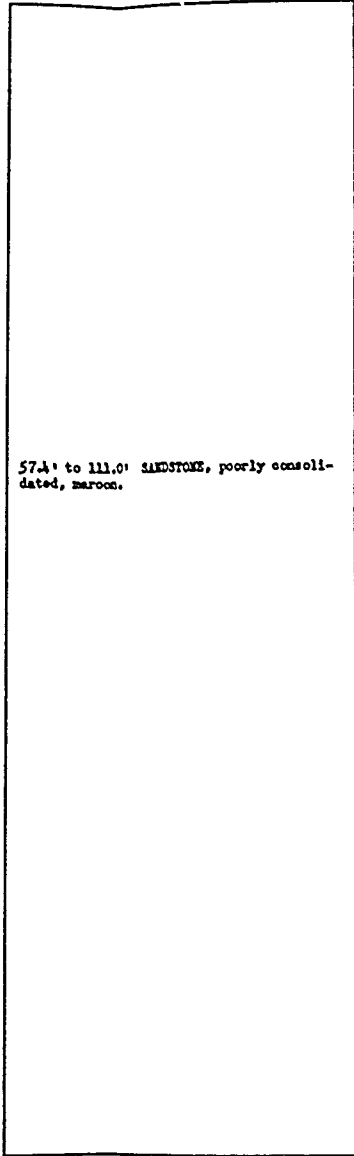

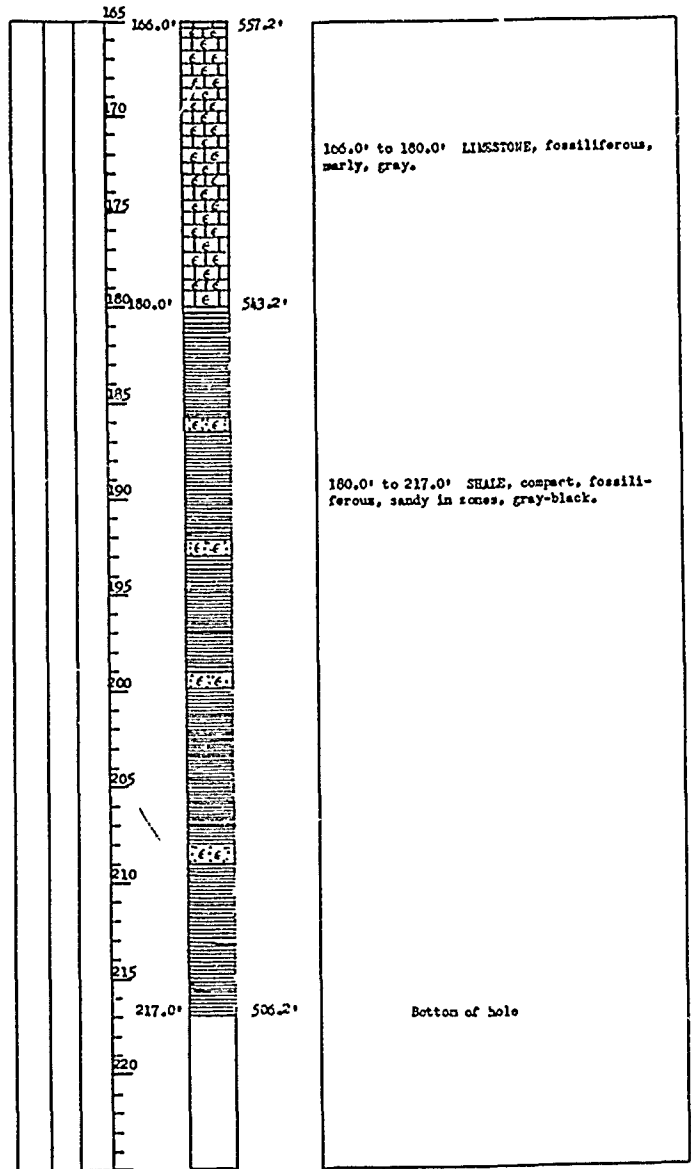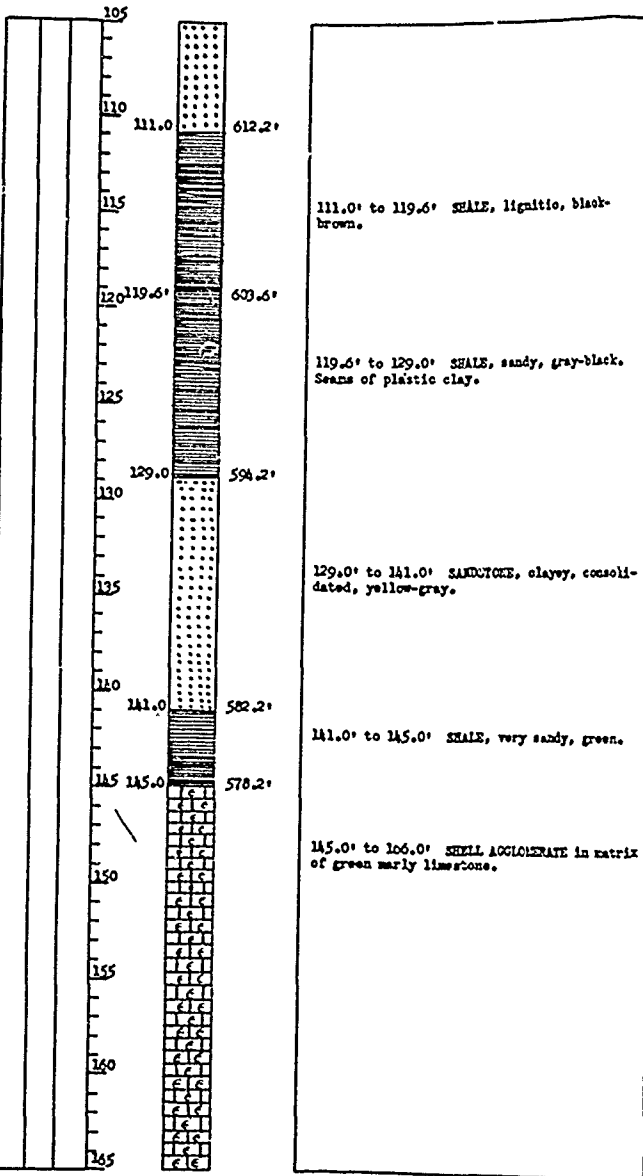

RECORD DRAWING - WORK AS BUILT

SYM	LOG NO	ACTION	DATE	DESCRIPTION OF REVISION
U.S. ARMY ENGINEER DISTRICT, FORT WORTH CORPS OF ENGINEERS FORT WORTH, TEXAS				
DESIGNED BY	RAY ROBERTS LAKE ELM FORK, TRINITY RIVER, TEXAS EMBANKMENT, SPILLWAY AND OUTLET WORKS LOGS OF BORINGS C-8			
DRAWN BY				
REVIEWED BY				
SUBMITTED BY				
ENGINEER	INVITATION NO. DACW63-82-B-0025	DATE: MAR, 1982	SEQUENCE NO. 11	
	CONTRACT NO. DACW63-72-C-0092		SHEET NO. OF 11	
	DRAWING NUMBER			

TO ACCOMPANY FOUNDATION REPORT

File No. 8A2C-9

DRILLING LOG			INSTALLATION		SHEET 1	
Description Southwestern			Port Worth District		of 3 SHEETS	
1. PROJECT Aubrey Dam Site			10. SIZE AND TYPE OF BIT 8" Auger 2" Core Bbl			
2. LOCATION (Commodity or Feature)			11. DATUM FOR ELEVATION (Elevation of H2O)			
3. DRILLING AGENCY Corps of Engineers			12. HOURS/FEET'S ORIENTATION - DRILL Falling 1500			
4. HOLE NO. (As shown on drawing note) and file number 8A2C-9			13. TOTAL NO. OF OVERBURDEN SAMPLES TAKEN 2		14. UNDISTURBED 0	
5. NAME OF DRILLER R. M. Dunn			15. TOTAL NUMBER CORE BOXES 5		16. ELEVATION GROUND WATER	
6. DIRECTION OF HOLE <input checked="" type="checkbox"/> Vertical <input type="checkbox"/> Inclined <input type="checkbox"/> Dev. from vert.			17. DATE HOLE STARTED 5 Dec 50		18. COMPLETED 8 Dec 60	
7. THICKNESS OF OVERBURDEN 4.5			19. ELEVATION TOP OF HOLE 600.5'			
8. DEPTH DRILLED INTO ROCK 101.5			20. TOTAL CORE RECOVERY FOR BORING 84			
9. TOTAL DEPTH OF HOLE 106.0			21. SIGNATURE OF INSPECTOR			
ELEVATION	DEPTH	LEGEND	CLASSIFICATION OF MATERIALS (Description)	1. CORE RECOVERY	2. CORE BOX NO.	REMARKS (Drilling time, water loss, depth of weathering, etc., if significant)
596.0'	4.5'		Start 2" core 4.5' to 3.9' limestone, marly, hard, siliceous, massive weathered, dark red oxidized streak from 8.0' to 8.4', gray to buff	75	Box 1	*Ground water elevation undetermined Jar Sample Depths A- 0.0 to 3.6' B- 3.6 to 4.3'
591.6'	8.9'		8.9 to 12.3 clay, shaly, sand lenses thru out, weathered, slightly laminated, tan to gray	80		
588.2'	12.3'		NOTE: Base of weathering zone	86		
			12.3 to 96.5' shale, clayey, sandy, firm to medium hard, very fossiliferous, laminated, dark gray	86		
			NOTE: Medium hard sandstone streaks at following depths: 16.7 to 16.9 24.7 to 25.3 40.0 to 40.4 43.1 to 43.3 48.0 to 48.4 55.0 (Siltstone)	86	Box 2	
				90		
				97		
504.0'	96.5'		96.5' to 100.0 LIMESTONE sandy, hard, massive, fossiliferous, gray			
			100' to 106.0' SHALE, clayey firm, laminated, gray	40	Box 5	
494.5'	106.0'		T. D. 106.0'			

ELEVATION	DEPTH	LEGEND	CLASSIFICATION OF MATERIALS (Description)	1. CORE RECOVERY	2. CORE BOX NO.
					Box 3
					84
					92
					Box 4
					90
					88
504.0'	96.5'		96.5' to 100.0 LIMESTONE sandy, hard, massive, fossiliferous, gray		100
			100' to 106.0' SHALE, clayey firm, laminated, gray	40	Box 5
494.5'	106.0'		T. D. 106.0'		

3. CORE RECOVERY %	4. BOX NO.	5. REMARKS (Drilling time, water flow, depth of weathering, etc., if significant)
84	Box 3	
92		
90	Box 4	
88		
100		
40	Box 5	

DRILLING LOG		Project		Installation		Hole No.		SHEET	
Southwestern		Fort Worth District		822		822C-10		1 of 2 INSETS	
Aubrey Dam Site		No. and type of bit		8" Auger 2" Core bit		Date		15 Aug 60	
1. LOCATION (Coordinates or Station)		2. DRILLING AGENCY		3. DRILLING AGENCY		4. CORE LOGS (When on drawing note and file number)		5. NAME OF DRILLER	
		Corps of Engineers		Falling 1500		8A2C-10		R. M. Dunn	
6. DIRECTION OF HOLE		7. THICKNESS OF OVERBURDEN		8. DEPTH DRILLED INTO ROCK		9. TOTAL DEPTH OF HOLE		10. ELEVATION GROUND WATER	
Vertical		19.5		45.5		60.0		610.8	
11. DATE HOLE		12. ELEVATION TOP OF HOLE		13. TOTAL CORE RECOVERY FOR BORING		14. SIGNATURE OF INSPECTOR			
15 Dec 60		610.8		90					
ELEVATION	DEPTH	LEGEND	CLASSIFICATION OF MATERIALS (Description)	3. CORE RECOVERY %	4. BOX NO.	5. REMARKS (Drilling time, water flow, depth of weathering, etc., if significant)			
596.3'	14.5'		Start 2" Core 14.5'			*Ground water elevation on 16 Dec 1960 was (8.0)			
			14.5' to 25.8' clay, shaly, firm, fine sand lenses thru out, soft sandstone; streak at 16.8, and 22.1, very hard limestone boulder at 17.6'; gray to yellow	72	Box 1	Jar Sample Depths: A - 0.0' to 5.5' B - 5.5' to 10.4' C - 10.4' to 13.8'			
585.0'	25.0'		25.8' to 41.8' SHALE, clayey firm weathering stains in upper 3.0'; sandy, laminated small fossils thru out dark gray	100					
			NOTE: Base of weathering at 29.0'. Lime seam at 35.0' which is 0.1 thick	90					
569.0'	41.8'		41.8' to 43.3' SAND, clayey, firm-almost sandstone, distinct bedding, fine to medium gray	100					
567.5'	43.3'		43.3' to 60.0' SHALE, clayey sandy firm to medium hard lime boulder at 44.8, very fossiliferous from 47.0 to 51.0, laminated, 4' sandstone at 58.0', dark gray	100	Box 2				
				97					
550.8'			T. D. 60.0'						

DRILLING LOG		Project		Installation		Hole No.		SHEET	
Southwestern		Fort Worth District		822		822C-11		1 of 2 INSETS	
Aubrey Dam Site		No. and type of bit		8" Auger 2" Core bit		Date		15 Aug 60	
1. LOCATION (Coordinates or Station)		2. DRILLING AGENCY		3. DRILLING AGENCY		4. CORE LOGS (When on drawing note and file number)		5. NAME OF DRILLER	
		Corps of Engineers		Falling 1500		8A2C-11		R. M. Dunn	
6. DIRECTION OF HOLE		7. THICKNESS OF OVERBURDEN		8. DEPTH DRILLED INTO ROCK		9. TOTAL DEPTH OF HOLE		10. ELEVATION GROUND WATER	
Vertical		7.0'		23.6'		30.6'		610.8	
11. DATE HOLE		12. ELEVATION TOP OF HOLE		13. TOTAL CORE RECOVERY FOR BORING		14. SIGNATURE OF INSPECTOR			
15 Dec 60		610.8		90					
ELEVATION	DEPTH	LEGEND	CLASSIFICATION OF MATERIALS (Description)	3. CORE RECOVERY %	4. BOX NO.	5. REMARKS (Drilling time, water flow, depth of weathering, etc., if significant)			
605.2'	7.0'		Start 2" core 7.0'						
			7.0' to 14.4' clay, sandy, firm to medium very weathered, horizontal fractures, yellow to tan						
597.8'	14.4'		14.4' to 15.8' sandstone medium hard, fine to grain, massive, tan to gray						
596.4'	15.8'		15.8' to 22.5' shale, firm to medium hard, containing seams of sand and shale, weathered to gray.			NOTE: Base of weathering zone			
589.7'	22.3'		22.5' to 30.6' shale, sandy, firm laminated, marine fossils, dark gray			T. D. 30.6'			
581.6'	30.6'								

ENG FORM 1836 PREVIOUS EDITIONS ARE OBSOLETE MAR 57

DESIGNED BY	
DRAWN BY	
REVIEWED BY	
SUBMITTED BY	
ENGINEER	

TO ACCOMPANY

Hole No. **8A2C-10**

PROJECT Southwestern	INSTALLATION Fort Worth District	SHEET 1 of 2 SHEETS
DATE 1962	NO. AND TYPE OF BIT 8" Auger 2" Core Bbl	DATE FOR ELEVATION MEASUREMENT 1962
AGENCY Engineers	MANUFACTURER'S DESIGNATION OF DRILL Falling 1500	TOTAL NO. OF OVERBURDEN SAMPLES TAKEN 0
DRILLER Dunn	TOTAL NUMBER CORE BORES 2	ELEVATION GROUND WATER *
DATE HOLE STARTED 15 Dec 60	DATE HOLE COMPLETED 15 Dec 60	ELEVATION TOP OF HOLE 610.8
THICKNESS OF OVERBURDEN 19.5	TOTAL CORE RECOVERY FOR BORING 90	SIGNATURE OF INSPECTOR
DEPTH OF HOLE 60.0		

DEPTH	LEGEND	CLASSIFICATION OF MATERIALS (Description)	NO. OF CORE RECOVERY	BOX OR SAMPLE NO.	REMARKS (Drilling time, water loss, depth of weathering, etc.; if significant)
0.0					*Ground water elevation on 16 Dec 1960 was (8.0)
0.0				A	
0.0				B	Jar Sample Depths: A - 0.0' to 5.5' B - 5.5' to 10.4' C - 10.4' to 13.8'
0.0				C	
4.5		Start 2" Core 14.5'			
16.5		16.5' to 25.8' clay, shaly, firm, fine sand lenses thru out, soft sandstone; streak at 16.8, and 22.1, very hard limestone boulder at 17.6'; gray to yellow	72	Box 1	
25.8		25.8' to 41.8' SHALE, clayey firm weathering stains in upper 3.0'; sandy, laminated small fossils thru out dark gray	75		
29.0		NOTE: Base of weathering at 29.0'. Lime seam at 35.0' which is 0.1 th thick	100		
41.8		41.8' to 43.3' SAND, clayey, firm-almost sandstone, distinct bedding, fine to medium gray.	90		
43.3		43.3' to 60.0' SHALE, clayey, sandy firm to medium hard lime boulder at 44.8, very fossiliferous from 47.0 to 51.0, laminated, 4' sandstone at 58.0', dark gray	95		
60.0		T. D. 60.0'	100		
				Box 2	
				97	

Hole No. **8A2C-11**

PROJECT Southwestern	INSTALLATION Fort Worth District	SHEET 1 of 1 SHEETS
DATE 1962	NO. AND TYPE OF BIT Auger, 2" Core Bbl	DATE FOR ELEVATION MEASUREMENT 1962
AGENCY Engineers	MANUFACTURER'S DESIGNATION OF DRILL Falling 1500	TOTAL NO. OF OVERBURDEN SAMPLES TAKEN 0
DRILLER Dunn	TOTAL NUMBER CORE BORES 1	ELEVATION GROUND WATER *
DATE HOLE STARTED 16 Dec 60	DATE HOLE COMPLETED 16 Dec 60	ELEVATION TOP OF HOLE 612.2'
THICKNESS OF OVERBURDEN 2.0'	TOTAL CORE RECOVERY FOR BORING 86	SIGNATURE OF INSPECTOR
DEPTH OF HOLE 30.6'		

ELEVATION	DEPTH	LEGEND	CLASSIFICATION OF MATERIALS (Description)	NO. OF CORE RECOVERY	BOX OR SAMPLE NO.	REMARKS (Drilling time, water loss, depth of weathering, etc.; if significant)
605.2	7.0		7.0' to 14.4' clay, shaly, sandy, firm to medium hard, very weathered, horizontal fractures, yellow to tan	100		*Ground water elevation on 19 Dec 60 (10')
597.8	14.4		14.4' to 15.8 sandstone, medium hard, fine to medium grain, massive, tan to gray	70		Jar Sample Depths A - 0.0 to 3.5' B - 3.5' to 6.5'
596.4	15.8		15.8' to 22.5 shale, sandy, firm to medium hard, alternating seams of sand stone and shale, weathered tan to gray.	75		
589.7	22.5		NOTE: Base of weathering zone	95		
581.6	30.6		22.5' to 30.6 shale, clayey, sandy, firm laminated, few marine fossils, dark gray	88		
			T. D. 30.6'			

ENG FORM 1836 PREVIOUS EDITIONS ARE OBSOLETE PROJECT HOLE NO

RECORD DRAWING-WORK AS BUILT

DESIGNED BY	RAY ROBERTS LAKE ELM FORK, TRINITY RIVER, TEXAS		
DRAWN BY	EMBANKMENT, SPILLWAY AND OUTLET WORKS		
REVIEWED BY	LOGS OF BORINGS 8A2C-9, 8A2C-10, AND 8A2C-11		
SUBMITTED BY	INVITATION NO. DACW 63-22-B-0026	DATE: MAR 1962	SEQUENCE NO.
ENGINEER	CONTRACT NO. DACW 63-97-C-0093	DRAWING NUMBER	SHEET NO. 12

TO ACCOMPANY FOUNDATION REPORT

CONTINUED ON DACW 63-97-C-0093

DRILLING LOG	Southwestern	INSTALLATION	Fort Worth	SHEET 1 OF 2 SHEETS
PROJECT	Aubrey Dam Site No. 1	NO. SIZE AND TYPE OF BIT	8" auger, 5" carboly, 6" diamond	
LOCATION	Sta. 134.70 - Centerline	DATE FOR ELEVATION	577.1	
DRILLING AGENCY	Corn of Engineers	MANUFACTURER'S DESIGNATION OF DRILL	Falling 1500	
HOLE NO. FOR WHICH THIS LOG WAS MADE	816C-12	TOTAL NO. OF OVERBURDEN SAMPLES TAKEN	5	
NAME OF DRILLER	Schoenover	TOTAL NUMBER CORE BOXES	7	
DIRECTION OF HOLE	VERTICAL	ELEVATION GROUND WATER	0000	
THICKNESS OF OVERBURDEN	13.7	DATE HOLE INSTALLED	12 Nov 71	
DEPTH DRILLED INTO ROCK	37.3	COMPLETED	4 Nov 71	
TOTAL DEPTH OF HOLE	51.0	TOTAL CORE RECOVERY FOR BORING	96.8%	
		SIGNATURE OF INSPECTOR	<i>Walter L. Chisum</i>	

ELEVATION	DEPTH	LEGEND	CLASSIFICATION OF MATERIALS (Description)	CORE LOSS ON PICKUP NO. OF SAMPLES	REMARKS (Drilling time, water loss, depth of casing, etc., if applicable)
0.0'	13.7'		SAND - - -	A	1. After completion, hole was bailed to 43.5'. Same level after 24 hours. 2. Jars: A. 0.0 to 4.7 B. 4.7 to 6.2 C. 6.2 to 8.2 D. 8.2 to 10.0 E. 10.0 to 13.7 3. Cartons: 1. 14.2 to 15.1 2. 18.3 to 19.3 3. 23.5 to 24.5 4. 29.0 to 30.0 5. 35.7 to 36.7 6. 42.9 to 43.9 7. 48.3 to 49.1 4. 8" casing set to 14.3'. 5. Drilling methods: 1. 0.0 to 13.7 - 8" auger. 2. 13.7 to 23.3 - 6" carboly 3. 23.3 to 26.4 - 6" diamond 4. 26.4 to 51.0 - 6" carboly.
0.0	10.0		0.0 to 10.0 - fine to medium grained, trace clay, medium compact, all. moist, red.	B	
10.0	13.7		10.0 to 13.7 - fine to medium grained, trace of fine-grained, well-rounded gravel (-5%), medium compact to dense, all. moist, red.	C	
13.7	13.7		--- Refusal w/auger @ 13.7'	D	
13.7	26.4		13.7' to 26.4' Limestone - - -	E	
13.7	18.7		13.7 to 23.3 - shaley, highly fossilif., m. hard, thick-bedded, unfractured and unjointed, all. stained to 22.0', gray.	L 1	
18.7	26.4		23.3 to 26.4 - very hard, diamond bit used in this section.	L 2	
20.0	26.4		26.4' to 51.0'	L 3	
20.0	30.0		SANDS, non-calc., m. hard, no visible bedding, unjointed and unfractured, occas. siltstone concretions, black.	G. 1.1	
20.0	34.0			G. 0.4	
20.0	38.1			G. 0.3	
20.0	41.2			L 0.6	
20.0	47.2			G. 0.7	
20.0	51.0			L 0.8	
50.0	51.0		T.D. - 51.0'	51.0	

DRILLING LOG	Southwestern	INSTALLATION	Fort Worth	SHEET 2 OF 2 SHEETS
PROJECT	Aubrey Dam Site No. 1	NO. SIZE AND TYPE OF BIT	8" auger, 5" carboly, 6" diamond	
LOCATION	Sta. 134.70 - Centerline	DATE FOR ELEVATION	577.1	
DRILLING AGENCY	Corn of Engineers	MANUFACTURER'S DESIGNATION OF DRILL	Falling 1500	
HOLE NO. FOR WHICH THIS LOG WAS MADE	816C-12	TOTAL NO. OF OVERBURDEN SAMPLES TAKEN	5	
NAME OF DRILLER	Schoenover	TOTAL NUMBER CORE BOXES	7	
DIRECTION OF HOLE	VERTICAL	ELEVATION GROUND WATER	0000	
THICKNESS OF OVERBURDEN	43.0	DATE HOLE INSTALLED	12 Nov 71	
DEPTH DRILLED INTO ROCK	52.2	COMPLETED	4 Nov 71	
TOTAL DEPTH OF HOLE	95.2	TOTAL CORE RECOVERY FOR BORING	96.8%	
		SIGNATURE OF INSPECTOR	<i>Walter L. Chisum</i>	

ELEVATION	DEPTH	LEGEND	CLASSIFICATION OF MATERIALS (Description)	CORE LOSS ON PICKUP NO. OF SAMPLES	REMARKS (Drilling time, water loss, depth of casing, etc., if applicable)
0.0'	24.6'		CLAY - - -		1. After completion, hole was bailed to 43.5'. Same level after 24 hours. 2. Jars: A. 0.0 to 4.7 B. 4.7 to 6.2 C. 6.2 to 8.2 D. 8.2 to 10.0 E. 10.0 to 13.7 3. Cartons: 1. 14.2 to 15.1 2. 18.3 to 19.3 3. 23.5 to 24.5 4. 29.0 to 30.0 5. 35.7 to 36.7 6. 42.9 to 43.9 7. 48.3 to 49.1 4. 8" casing set to 14.3'. 5. Drilling methods: 1. 0.0 to 13.7 - 8" auger. 2. 13.7 to 23.3 - 6" carboly 3. 23.3 to 26.4 - 6" diamond 4. 26.4 to 51.0 - 6" carboly.
0.0	6.6		0.0 to 6.6 - non-calc, moist, stiff to hard scattered rootlets, black.		
6.6	12.6		6.6 to 12.6 - non-calc., moist, all. sandy, hard scattered rootlets, dk. brown.		
12.6	24.6		12.6 to 24.6 - calc., sandy, hard to 22.6', stiff from 22.6 to 24.6, moist, tan.		
24.6	28.6		24.6' to 28.6'		
24.6	28.6		SAND, all. clayey, non-calc., moist, medium compact, tan.		
28.6	39.6		28.6' to 39.6'		
28.6	39.6		CLAY, sandy, all. calc., moisture increasing with depth, hardness decreasing with depth, saturated from 36.6', tan.		
39.6	39.6		-- Drilled into sandy gravel @ 39.6' with d. bbl. -- -- Start 8" auger @ 39.6' --		
39.6	43.0		39.6' to 43.0'		
39.6	43.0		GRAVEL, fine to medium grained, sandy, water-bearing, loose to medium dense.		

1	INSTALLATION	Port Worth
2	SIZE AND TYPE OF BIT	8" SUCR, 6" d.b., 6" ESTEEL
3	DATE	Falling 1900
4	TOTAL NO. OF OPEN LOGS	1
5	TOTAL NUMBER CORP. BOIES	9
6	DATE	18 Nov 71
7	ELEVATION TOP OF HOLE	592.77
8	TOTAL CORE RECOVERY FOR BOIES	SEE REMARKS
9	INITIALS OF INSPECTOR	

ELEVATION	DEPTH	LEGEND	DESCRIPTION OF MATERIALS	CORE NO.	BOX NO.	REMARKS
90.0	0.0		45.0 to 57.2 - thin to medium bedded, with core separating at sand seams listed below.	L	1	NOTE: Actual core loss from 45.0' to 53.2' was 14.6%. Hole tap for depth at 53.2'. Loss possibly occurred from 50.5 to 52.0, drilling was very rough in this zone. 53.2 to 95.2 - core recovery was 98%
90.0	2.6	A	1. After completion, hole was bailed to 90.0'. Water level will be set in at later date.			
90.0	6.6		2. Jar: A. 0.0 to 2.6			
90.0	12.6		3. Denison samples: 1. 2.6 to 4.6 2. 4.6 to 6.6 3. 6.6 to 8.6 4. 8.6 to 10.6 5. 10.6 to 12.6 6. 12.6 to 14.6 7. 14.6 to 16.6 8. 16.6 to 18.6 9. 18.6 to 20.6 10. 20.6 to 22.6 11. 22.6 to 24.6 12. 24.6 to 26.6 13. 26.6 to 28.6 14. 28.6 to 30.6 15. 30.6 to 32.6 16. 32.6 to 34.6 17. 34.6 to 36.6 18. 36.6 to 38.6 19. 38.6 to 39.6			
90.0	28.6		4. Carbons: 1. 46.7 to 47.6 2. 51.3 to 51.8 3. 59.2 to 60.2 4. 65.7 to 66.7 5. 71.5 to 72.5 6. 76.9 to 77.9 7. 85.4 to 86.4 8. 93.4 to 94.4			
90.0	39.6		5. 8" casing set to 45.0'			
90.0	43.0		6. Drilling methods: 1. 0.0 to 2.6 - sugar 2. 2.6 to 39.6 - 6" d.b.			
90.0	45.0		45.0' to 93.4'	L	2	
90.0	50.0		SHALE, non-calc. to sil. calc. with depth, m. hard black to gray.	L	3	
90.0	55.0		Sandstone, fine-grained, friable, laminated, @ following depths: 45.0 to 45.3, 45.6 (0.1) 51.3 to 52.3, 53.3 (0.1) 54.2 (0.1), 55.4 (0.1) 55.6 (0.1)	L	4	
90.0	58.8		61.2 to 61.7 - zone of numerous broken shells.	L	5	
90.0	62.8		From 62.8 to 93.4 - occas. thin, poorly-defined, friable sandstone seam.	L	6	
90.0	66.2		66.2 to 66.7 - zone of numerous broken shells.	L	7	
90.0	66.2		66.2 to 66.7 - zone of numerous broken shells.	L	8	
90.0	66.2		66.2 to 66.7 - zone of numerous broken shells.	L	9	
90.0	93.4		93.4' to 95.2'	L	9	
90.0	95.2		LIMESTONE, shaley, sil. nodular, fossilif., hard gray.	L	10	*** Marker bed - see GDC-14 at 88.4'
90.0	95.2		T.D. - 95.2'			

DESIGNED BY	
DRAWN BY	
CHECKED BY	
REVIEWED BY	
DATE	

ELEVATION	DEPTH	LEGEND	CLASSIFICATION OF MATERIALS (Description)	SCORE RECOVERY %	BOX OR SAMPLE NO.	REMARKS (Drilling time, water loss, depth of penetration, etc.)
			-- Augered into primary material @ 43.0' -- Set casing to cleaned out, and started 6" core @ 45.0'			3. 39.6 to 45.0 - surty L. 45.0 to 95.2 - 6" carbology.
	45.0'		45.0' to 93.4'	45.0		
			SHALE, non-calc. to all calc. with depth, m. hard, black to gray.	L C7	1	NOTE: Actual core loss from 45.0' to 53.2' was 12.6%. Hole top for depth at 53.2'. Loss possibly occur from 50.5 to 52.0, drilling was very rough in this zone.
	50.0		45.0 to 57.2 - thin to medium bedded, with core separating at sand seams listed below.	L C5		53.2 to 95.2 - core recovery was 98%
			57.2 to 93.4 - core removed from bb'l. as continuous stalks	53.2 09	2	
			Sandstone, fine-grained, friable, laminated, G following depths:	57.2		
	50.0		45.0 to 45.3, 45.6 (0.1)	01	3	
			51.3 to 52.3, 53.3 (0.1)	02		
			54.2 (0.1), 55.4 (0.1)	09		
			55.6 (0.1)	09		
			@ 58.8' - 0.05 seam of broken shells.	61.2		
			61.2 to 61.7 - zone of numerous broken shells	L C6	4	*** Marker bed - see 60C-14 at 56.2 to 56.8
			From 62.8' to 93.4' - occas. thin, poorly- defined, friable sand seams.	L C8	5	
	70.0			G 04		
				73.2	6	
				L C1		
				77.2		
				G C1	7	
				81.2		
				L 01		
				85.2	8	
				L 02		
				89.2		
				L 03	9	
			93.4' to 95.2'	93.2		*** Marker bed see 60C-14 at 88.4'
			LIMESTONE, shaley, all. nodular, fossilif., hard gray.	95.2		
			T.D. - 95.2' -			

RECORD DRAWING - WINK & RUIJL

SYMBOL NO.		ACTION		DATE		DESCRIPTION OF REV. NO.	
U.S. ARMY ENGINEER DISTRICT, FORT WORTH CORPS OF ENGINEERS FORT WORTH, TEXAS							
DESIGNED BY	RAY ROBERTS LAKE ELM FORK, TRINITY RIVER, TEXAS EMBANKMENT, SPILLWAY AND OUTLET WORKS LOGS OF BORINGS 8A6C-12 AND 6 DC-13						
DRAWN BY							
REVIEWED BY							
SUBMITTED BY	INVITATION NO. SACRWS-820-0025		DATE MAR. 1982				
ENGINEER	CONTRACT NO. SACRWS-F4 C 0013		SCALE		SHEET NO. 13		

TO ACCOMPANY FOUNDATION REPORT

DRILLING LOG		LOCATION		WELL NO.		SHEET	
Southwestern		Fort Worth		60C-14		1 of 3 sheets	
PROJECT		Aubrey Dam Site No. 1		WELL NO. AND TYPE OF BIT		8" ALUM., 6" d.b., 6" core	
LOCATION (Coordinates or Township)		Rising 1500		DATE WHEN WELL IDENTIFIED		16	
DRILLING AGENCY		Corns of Engineers		TOTAL NO. OF DAYS		17	
WELL NO. (As shown on existing logs and site number)		60C-14		TOTAL NUMBER CORE BORES		--	
NAME OF DRILLER		Suitts		ELEVATION GROUND WATER		6000	
DIRECTION OF HOLE		Vertical		DATE MOLE		28 Jan 71 / 1 Oct 71	
THICKNESS OF OVERBURDEN		45.3		ELEVATION TOP OF HOLE		559.5	
DEPTH DRILLED INTO ROCK		44.7		TOTAL CORE RECOVERY FOR BORING		99.0%	
TOTAL DEPTH OF HOLE		90.0		SIGNATURE OF SUPERVISOR		<i>James D. Williams</i>	
ELEVATION	DEPTH	LEGEND	CLASSIFICATION OF MATERIALS (Description)	NO. OF CORE RECOVERED	NO. OF SAMPLES	REMARKS (Drilling time, water loss, depth of measurement, etc., all as applicable)	SCORE
			0.0' to 38.6'		A	1. After completion, was bailed to 89.0' casing; was pulled. hour water check -	
			CLAY - - -		1		
			0.0 to 18.6 - calc., moist, hard, scattered rootlets to 8.6', tan.		2	2. Jars: A. 0.0 to 2.6	
					3		
			18.6 to 38.6 - calc., sandy, stiff, with hardness decreasing with depth, moist to very moist, tan.		4	3. Denison cans:	
					5	1. 2.6 to 4.6	
					6	2. 4.6 to 6.6	
					7	3. 6.6 to 8.6	
					8	4. 8.6 to 10.6	
					9	5. 10.6 to 12.6	
					10	6. 12.6 to 14.6	
					11	7. 14.6 to 16.6	
					12	8. 16.6 to 18.6	
					13	9. 18.6 to 20.6	
					14	10. 20.6 to 22.6	
					15	11. 22.6 to 24.6	
					16	12. 24.6 to 26.6	
					17	13. 26.6 to 28.6	
					18	14. 28.6 to 30.6	
					19	15. 30.6 to 32.6	
					20	16. 32.6 to 34.6	
					21	17. 34.6 to 36.6	
					22	17. 36.6 to 38.6	
			NOTE: 26.6 to 28.6 - attempted 3 times to recover sample. No recovery.		23	4. Penetrator tests on bottom of cans:	
					24	Cans 1 thru 7 - 4.5	
					25	8. 2.75	
					26	9. 1.75	
					27	10. 2.5	
					28	11. 2.0	
					29	12. 1.5	
					30	13. 1.25	
					31	14. 1.0	
					32	15. 2.0	
					33	16. 1.0	
					34	17. N.A.	
					35	5. All core was wrapped in aluminum foil and placed in cartons. Depths shown on p. 2	
					36		
					37	6. 8" casing set to 46.0'.	

ELEVATION	DEPTH	LEGEND	CLASSIFICATION OF MATERIALS (Description)	SCORE
			38.6' to 44.2'	
			SAND and GRAVEL, (recovered only trace in bottom of can 17.), logged by drill action and cutting.	
			--- Drilled into primary material @ 44.2', set casing to 46.0', cleaned out, and started 8" core @ 47.2'	
			47.2' to 88.4'	
			SPALE, all. to non-calc., sandy, hard (pen. # 4.5) thin to medium bedded from 75.1', thick-bedded from 75.1' to 88.4', unjointed and unfractured, unweathered, gray.	
			Sedimentary features:	
			Sandstone beds at the following depths:	
			47.5 to 47.8, 48.0 to 48.2, 48.5 to 48.9, 49.4 to 49.5, 50.7 to 51.1, 51.3 to 51.6, 59.1 to 59.3, 62.8 to 62.9, 64.8 to 65.0, 65.6 to 65.8, 67.4 to 67.6, 70.8 to 70.9, 71.3 to 71.5, 73.0 to 73.1, 74.7 to 74.9, 79.1 to 79.2, 81.2 to 81.4. Most beds were soft and crumbly, crushed with moderate amount of finger pressure.	
			56.2 to 56.8 - highly fossiliferous section, very calc. Possible marker bed - see 60C-15	
			Structural features:	
			None	
			88.4' to 90.0'	
			LIMESTONE, all. shaly, nodular, fossiliferous, hard, gray.	
			T.D. - 90.0'	
			Core was separated at the following depths:	
			47.5, 47.9, 48.3, 49.0, 49.4, 50.7, 51.0, 51.1, 51.4, 51.6, 59.1, 59.3, 60.1, 61.2, 62.0, 62.8, 63.1, 64.8, 65.0, 65.6, 65.8, 67.4, 67.6, 70.8, 70.9, 71.3, 71.5, 73.0, 73.1, 74.7, 74.9, 79.1, 79.2, 81.2, 81.4	
			was removed as continuous talks	

POSITION Southwestern	INSTALLATION Fort Worth	SHEET 2 OF 2 SHEETS
NO. 1	SIZE AND TYPE OF BIT 8" SURF, 6" d.b., 6" carbide core	
	MANUFACTURER'S DESIGNATION OF DRILL Palling 1500	
LINEAR 6DC-15	TOTAL NO. OF OVER- BURDEN SAMPLES TAKEN 16	UNSTUPPED 16
	TOTAL NUMBER CORE BORES 5	
	ELEVATION GROUND WATER 6000	
	DATE HOLE STARTED 21 Sept. 71	DATE HOLE STOPPED 24 Sept. 71
	ELEVATION TOP OF HOLE 588.48	
	TOTAL CORE RECOVERY FOR BORING 41.0%	
	SIGNATURE OF INSPECTOR <i>James L. Miller</i>	

CLASSIFICATION OF MATERIAL (Description)	1. CORE RECOVERY %	2. BOR OR SAMPLE NO.	REMARKS (Drilling time, water used, depth of penetration, etc., if significant)
0.0' to 38.7'		A	1. After completion, casing was pulled, and hole was balled to 55.0'. Water check after 24 hrs. was 24.0'.
CLAY, calc., sil. moist to 6.7', with gradual moisture increase with depth, hard to 8.7' with strength decreasing with depth (Note penetrometer tests in remarks column), brown to tan.		1	2. Jars: A. 0.0 to 2.7 Jar samples taken from Denison bb'l shoe except where noted by an asterisk.
		2	
		3	
		4	
		5	3. Denison cans. Depth Pen. test
		6	1. 2.7 - 4.7 4.5
		7	2. 4.7 - 6.7 4.25
		8	3. 6.7 - 8.7 4.5
		9	4. 8.7 - 10.7 4.25
		10	5. 10.7 - 12.7 "
		11	6. 12.7 - 14.7 "
		12	7. 14.7 - 16.7 3.75
		13	8. 16.7 - 18.7 "
		14	9. 18.7 - 20.7 "
		15	10. 20.7 - 22.7 "
		16	11. 22.7 - 24.7 3.0
		17	12. 24.7 - 26.7 "
		18	13. 26.7 - 28.7 "
		19	14. 28.7 - 30.7 2.75
		20	15. 30.7 - 32.7 1.75
		21	16. 32.7 - 34.7 1.75
		22	Note: Can #8 - sample slipped out on initial retrieve and was not covered on second attempt. Can #15 - poor recovery. Lost 1.0'
		23	
		24	4. Cartons: 1. 41.1 to 41.9
		25	2. 47.5 to 48.5
		26	3. 52.2 to 53.2
		27	4. 56.8 to 57.7
		28	5. 58.5 to 59.5
		29	5. 8" casing set to 40.0'.
		30	6. Drilling methods: 1. 0.0 to 2.7 - 8" auger 2. 2.7 to 40.7 - d. bit 3. 40.7 to 61.2 - 6" core
34.7' to 38.7' - no recovery except for a fine to med. grained sand from 38.2' to 38.7' loose, trace clay, gray.		31	
--- Drilled into primary material @ 38.7', set casing to 40.0', cleaned out, and started 6" core @ 40.7' ---		32	
40.7' to 61.2'	40.7	40.7	
SPALLS, sil. to non-calc. sandy, hard (pen. 4.5), medium to thin-bedded, unjointed and unfractured (except where noted) unweathered, gray.	45.2	1	Structural features: In the upper 10ft., core seems to have a slight dip (approx. 5').
Sedimentary features: Sandstone at the following depths: 42.6 to 43.3 - laminated shaly, sil. fissile, crumbly. 43.3 to 44.0 - scattered concretions. 53.2 to 53.4 - laminated, shaly, sil. fissile. 55.0 to 56.1 - laminated, shaly, sil. fissile.	49.2	2	0.2' fracture with poorly formed slickensides at 56.2'.
48.5 to 49.1 - highly fossilif. (broken shells), calc. possible marker bed	57.2	3	
T.D. - 61.2'	61.2	5	- See 6DC-14, 56.2 to 57.8

RECORD DRAWING - JOHN A. MILLER

DESIGNED BY	U.S. ARMY ENGINEER DISTRICT, FORT WORTH CORPS OF ENGINEERS FORT WORTH, TEXAS		
DRAWN BY	RAY ROBERTS LAKE ELM FORK, TRINITY RIVER, TEXAS EMBANKMENT, SPILLWAY AND OUTLET WORKS LOGS OF BORINGS 6 DC-14 AND 6 DC-15		
REVIEWED BY	INVESTIGATION NO. DACW63-82-E-0025	DATE MAR. 1982	SEQUENCE NO. 14
SUBMITTED BY	CONTRACT NO. DACW63-82-C-0083	DRAWING NUMBER	SHEET NO. 14

TO ACCOMPANY FOUNDATION REPORT

DRILLING LOG SHEET 3 of 3. Memo No. GDC-16. PROJECT: Aubrey Dam Site No. 1. LOCATION: Port North. DRILLING AGENCY: Coffey of Engineers. HOLE NO: GDC-17. NAME OF DRILLER: Schoodover. THICKNESS OF OVERBURDEN: 35.0. DEPTH DRILLED INTO ROCK: 12.0. TOTAL DEPTH OF HOLE: 50.0. CLASSIFICATION OF MATERIALS: I. DRILLING: 0.0' - 2.0' 8" FLIGHT AUGER; 2.0' - 2.6' 6" DENISON; 2.6' - 32.0' 8" FLIGHT AUGER; 32.0' - 41.0' 8" AUGER; 41.0' - 50.0' 6" CHINA BARREL. II. SAMPLES: A: 0.0' - 2.0'; B: 2.0' - 2.6'; C: 2.6' - 3.0'; D: 3.0' - 3.6'; E: 3.6' - 4.0'; F: 4.0' - 4.6'; G: 4.6' - 5.0'; H: 5.0' - 5.5'; I: 5.5' - 6.0'; J: 6.0' - 6.5'; K: 6.5' - 7.0'; L: 7.0' - 7.5'; M: 7.5' - 8.0'; N: 8.0' - 8.5'; O: 8.5' - 9.0'; P: 9.0' - 9.5'; Q: 9.5' - 10.0'; R: 10.0' - 10.5'; S: 10.5' - 11.0'; T: 11.0' - 11.5'; U: 11.5' - 12.0'. III. WATER LEVEL: 24.0. IV. DEPTH OF WATER: 28.0. V. MISC: POCKET PENETROMETER READINGS ARE IN COLUMN 'F'. ALSO THE SAMPLES WERE TAKEN FROM DENISON SHOE.

DRILLING LOG SHEET 3 of 3. Memo No. GDC-16. PROJECT: Aubrey Dam Site No. 1. LOCATION: Port North. DRILLING AGENCY: Coffey of Engineers. HOLE NO: GDC-17. NAME OF DRILLER: Schoodover. THICKNESS OF OVERBURDEN: 23.5. DEPTH DRILLED INTO ROCK: 26.5. TOTAL DEPTH OF HOLE: 50.0. CLASSIFICATION OF MATERIALS: 0.0' to 5.5' SAND, fine-grained, clayey, hard, sil. moist, brown; 5.5' to 22.0' CLAY, sandy, non-calc., sil. moist, hard, mottled tan and gray; 22.0' to 23.5' CLAY, calc., w/ scattered gravel and well-rounded siltstone concretions, moist, medium to stiff, tan; 23.5' to 26.5' SHALE, sandy, non-calc., hard (penetrometer 4.5), thin-bedded, fossilif., unjointed and unfractured to T.D., unweathered, gray; 26.5' to 30.0' Sandstone concretions avg. 0.1' in thickness at the following depths: 28.5', 29.3', 30.3', 31.2', 37.9'; 30.0' to 37.0' Shaley sandstone beds at the following depths: 27.0 to 27.4 - laminate; 36.8 to 37.1 - and 42.0 to 42.9 - and all fissile. Zone badly washed by core bit, action. T.D. - 50.0'

Hole No. 6DC-17

DRILLING LOG		Division	INSTALLATION	SHEET 1 of 2 SHEETS
PROJECT Aubrey Dam Site No. 1		SWD	FWD 129	
LOCATION (Continence or Stream)		PROJECT Aubrey Dam		
DRILLING AGENCY Corps of Engineers		MANUFACTURER'S DESIGNATION OF DRILL PAILING 1500		
HOLE NO. (As shown on drawing sheet and its number)		TOTAL NO. OF OVERBURDEN SAMPLES TAKEN		
6DC-17		1		
NAME OF DRILLER Schoonover		TOTAL NUMBER CORE BOXES		
DIRECTION OF HOLE <input checked="" type="checkbox"/> Vertical <input type="checkbox"/> Inclined		ELEVATION GROUND WATER		
THICKNESS OF OVERBURDEN 23.5		DATE MOLE		
DEPTH DRILLED INTO ROCK 26.5		STARTED 17 Sept. 71		
TOTAL DEPTH OF HOLE 50.0		COMPLETED 20 Sept. 71		
ELEVATION		ELEVATION TOP OF HOLE		
DEPTH		TOTAL CORE RECOVERY %		
LEGEND		SIGNATURE OF INSPECTOR		
CLASSIFICATION OF MATERIALS (Description)		REMARKS (Drilling time, water loss, depth of penetration, etc. if significant)		
0.0' to 5.5'		1. After completion, hole was bailed to 45.0' with casing pulled. 24 hour check		
SAND, fine-grained, clayey, hard, sil. moist, brown		2. Jar		
5.5' to 22.0'		A. 0.0 to 2.7		
CLAY, sandy, non-calc., sil. moist, hard, mottled tan and gray		3. Denison cast:		
① 14.7' - increase in moisture content to base of overburden		1. 2.7 to 4.7		
from 18.7' to 22.0' - calc.		2. 4.7 to 6.7		
		3. 6.7 to 8.7		
		4. 8.7 to 10.7		
		5. 10.7 to 12.7		
		6. 12.7 to 14.7		
		7. 14.7 to 16.7		
		8. 16.7 to 18.7		
		9. 18.7 to 20.7		
		10. 20.7 to 22.7		
		Note: Jar samples taken from shoe at each sample depth.		
22.0' to 23.5'		4. Cartons:		
CLAY, calc., w/ scattered gravel and well-rounded siltstone concretions, moist, medium to stiff, tan		1. 27.4 to 28.4		
-- Augured into primary material @ 23.5', set casing to 25.0', cleaned out, and started 6" core @ 25.2'		2. 31.6 to 32.6		
		3. 38.8 to 39.7		
		4. 43.8 to 44.5		
		5. 49.0 to 50.0		
26.2' to 50.0'		5. Shale weathered to 24.9'.		
SHALE, sandy, non-calc., hard (penetrometer 4.5), thin-bedded, fossilif., unjointed and unfractured to T.D., unweathered, gray		6. 8" casing set to 25.0'.		
		7. Drilling methods:		
		1. 0.0 to 2.7 - auger		
		2. 2.7 to 22.7 - d. b.		
		3. 22.7 to 26.2 - auger		
		4. 26.2 to 50.0 - 6" core		
Sandstone concretions avg. 0.1' in thickness at the following depths: 28.5', 29.3', 30.3', 31.2', 37.9.		3.		
Silty sandstone beds at the following depths:		4.		
27.0 to 27.4 - laminated		e.o		
36.8 to 37.1 - "		e.o		
42.0 to 42.9 - " and sil. fissile. Zone badly washed by core bbl. action.		e.o		
T.D. - 50.0' -				

Hole No. 6DC-18

DRILLING LOG		Division	INSTALLATION	SHEET 1 of 1 SHEETS
PROJECT Aubrey Dam		SWD	FWD 129	
LOCATION (Continence or Stream)		PROJECT Aubrey Dam		
DRILLING AGENCY USC&A		MANUFACTURER'S DESIGNATION OF DRILL PAILING 1500		
HOLE NO. (As shown on drawing sheet and its number)		TOTAL NO. OF OVERBURDEN SAMPLES TAKEN		
6DC-18		8		
NAME OF DRILLER G. Schuchler		TOTAL NUMBER CORE BOXES		
DIRECTION OF HOLE <input checked="" type="checkbox"/> Vertical <input type="checkbox"/> Inclined		ELEVATION GROUND WATER		
THICKNESS OF OVERBURDEN 18.2		DATE MOLE		
DEPTH DRILLED INTO ROCK 11.8		STARTED 7 SEPT. 71		
TOTAL DEPTH OF HOLE 30.0		COMPLETED 9 SEPT. 71		
ELEVATION		ELEVATION TOP OF HOLE		
DEPTH		TOTAL CORE RECOVERY %		
LEGEND		SIGNATURE OF INSPECTOR		
CLASSIFICATION OF MATERIALS (Description)		REMARKS (Drilling time, water loss, depth of penetration, etc. if significant)		
0.0' to 1.0'		I. DRILLING:		
CLAY: SILTY, W/ TRACE OF FINE SAND, STIFF, SIL. MOIST		8" RIGHT AUGER		
ROOT SOIL, DARK BROWN		0.0' - 1.6'		
1.0' to 6.6'		C. DENISON		
CLAY: W/ TRACE OF FINE SAND & SILT, W/ CARBON STAINS, MOIST, V. STIFF DOWN TO HARD		1.6' - 19.6'		
RUST BROWN		8" RIGHT AUGER		
6.6' to 10.0'		19.6' - 20.0'		
CLAY: SANDY, W/ CARBON STAINS, MOIST, V. STIFF, RUST BROWN		CLEANED OUT WITH 10" AUGER & SET CASING TO 20.0'		
10.0' to 18.6'		CLEANED OUT CASING TO 21.2'		
CLAY: SANDY, W/ CARBON STAINS, MOIST, V. STIFF, RUST BROWN		6" CORE BARREL: 21.1' - 30.0'		
18.6' to 30.0'		II. SAMPLES:		
CLAY: SANDY, W/ SILT TO MEDIUM GRAVEL, V. MOIST, STIFF TO V. STIFF, RUST BROWN		A. 0.0 - 1.0'		
12.6' to 14.6'		B. 3.6'		
SAND - GRAVEL: GRADED SAND, W/ FINE TO COARSE GRAVEL, W/ TRACE OF FINE SAND, RUST COL.		C. 5.6'		
14.6' to 18.2'		D. 7.6'		
SAND: MOD. WEATH. DOWN TO MED. UNWEATH.; W/ SANDY LAMINATIONS & OCCASIONAL SANDSTONE FRAGS; W/ PURPLE IRONSTONE CONCRETIONS IN UPPER THREE FEET; W/ TIGHT FRACTURES IN WEATH. ZONE; SIL. MOIST, SORT (ROCK CLASS); WEATH. ZONE PRD. GRAY BROWN W/ RUST YELLOW UNWEATH. ZONE IS BLISH GRAY.		E. 9.6'		
18.2' to 20.0'		F. 12.6'		
SAND: MOD. WEATH. DOWN TO MED. UNWEATH.; W/ SANDY LAMINATIONS & OCCASIONAL SANDSTONE FRAGS; W/ PURPLE IRONSTONE CONCRETIONS IN UPPER THREE FEET; W/ TIGHT FRACTURES IN WEATH. ZONE; SIL. MOIST, SORT (ROCK CLASS); WEATH. ZONE PRD. GRAY BROWN W/ RUST YELLOW UNWEATH. ZONE IS BLISH GRAY.		G. 12.6' - 14.6'		
20.0' to 21.2'		H. 14.6' - 18.2'		
SAND: MOD. WEATH. DOWN TO MED. UNWEATH.; W/ SANDY LAMINATIONS & OCCASIONAL SANDSTONE FRAGS; W/ PURPLE IRONSTONE CONCRETIONS IN UPPER THREE FEET; W/ TIGHT FRACTURES IN WEATH. ZONE; SIL. MOIST, SORT (ROCK CLASS); WEATH. ZONE PRD. GRAY BROWN W/ RUST YELLOW UNWEATH. ZONE IS BLISH GRAY.		I. 18.2' - 21.2'		
21.2' to 22.6'		DB 2: 1.6' - 3.6'		
SAND: MOD. WEATH. DOWN TO MED. UNWEATH.; W/ SANDY LAMINATIONS & OCCASIONAL SANDSTONE FRAGS; W/ PURPLE IRONSTONE CONCRETIONS IN UPPER THREE FEET; W/ TIGHT FRACTURES IN WEATH. ZONE; SIL. MOIST, SORT (ROCK CLASS); WEATH. ZONE PRD. GRAY BROWN W/ RUST YELLOW UNWEATH. ZONE IS BLISH GRAY.		2: 3.6' - 5.6'		
22.6' to 24.0'		3: 5.6' - 7.6'		
SAND: MOD. WEATH. DOWN TO MED. UNWEATH.; W/ SANDY LAMINATIONS & OCCASIONAL SANDSTONE FRAGS; W/ PURPLE IRONSTONE CONCRETIONS IN UPPER THREE FEET; W/ TIGHT FRACTURES IN WEATH. ZONE; SIL. MOIST, SORT (ROCK CLASS); WEATH. ZONE PRD. GRAY BROWN W/ RUST YELLOW UNWEATH. ZONE IS BLISH GRAY.		4: 7.6' - 9.6'		
24.0' to 25.4'		5: 10.6' - 12.6'		
SAND: MOD. WEATH. DOWN TO MED. UNWEATH.; W/ SANDY LAMINATIONS & OCCASIONAL SANDSTONE FRAGS; W/ PURPLE IRONSTONE CONCRETIONS IN UPPER THREE FEET; W/ TIGHT FRACTURES IN WEATH. ZONE; SIL. MOIST, SORT (ROCK CLASS); WEATH. ZONE PRD. GRAY BROWN W/ RUST YELLOW UNWEATH. ZONE IS BLISH GRAY.		NOTE: Lost sample from 9.6' - 10.6'; DENISON SAMPLE DESTROYED FROM 12.6' - 14.6'; TOOK JAR SAMPLE		
25.4' to 27.8'		C-1: 22.4' - 23.4'		
SAND: MOD. WEATH. DOWN TO MED. UNWEATH.; W/ SANDY LAMINATIONS & OCCASIONAL SANDSTONE FRAGS; W/ PURPLE IRONSTONE CONCRETIONS IN UPPER THREE FEET; W/ TIGHT FRACTURES IN WEATH. ZONE; SIL. MOIST, SORT (ROCK CLASS); WEATH. ZONE PRD. GRAY BROWN W/ RUST YELLOW UNWEATH. ZONE IS BLISH GRAY.		2: 26.2' - 27.2'		
27.8' to 30.0'		III. WATER LEVEL - BORING BAILED TO 29.2' ON 21st OF 8 SEPT & LEFT OPEN 24 HOURS; WATER LEVEL AT 15.6'		
T.D. 30.0'		IV. DEPTH OF WEATH.: MOD. WEATH. TO 28.2'		
		V. MISC. POCKET PENETROMETER READINGS IN COLUMN 'P' AND JAR SAMPLES WERE TAKEN FROM DENISON SHOES.		

Hole No. **6DC-16**

DIVISION SND	INSTALLATION END	SHEET 1 OF 1 SHEETS	
PROJECT DAM			NO. SIZE AND TYPE OF BIT 6" CAPACORV
MANUFACTURER'S DESIGNATION OF DRILL MSI			NO. DATE AND TYPE OF BIT MSI 1499
TOTAL NO. OF OVER-DRIVEN SUNDERS SAMPLES TAKEN 3			NO. DATE AND TYPE OF BIT MSI 1499
TOTAL NUMBER CORE BOXES 2			NO. DATE AND TYPE OF BIT MSI 1499
ELEVATION GROUND WATER 595.11			NO. DATE AND TYPE OF BIT MSI 1499
DATE MOLE 7 SEPT. 71, 8 SEPT. 71			NO. DATE AND TYPE OF BIT MSI 1499
ELEVATION TOP OF MOLE 595.11			NO. DATE AND TYPE OF BIT MSI 1499
TOTAL CORE RECOVERY FOR BORING 95			NO. DATE AND TYPE OF BIT MSI 1499
SIGNATURE OF INSPECTOR J. R. [Signature]			NO. DATE AND TYPE OF BIT MSI 1499
CLASSIFICATION OF MATERIALS (Description)			
0.0' to 1.0' CLAY: SILTY, WITH TRACE OF FINE SAND, STIFF, SLI. MOIST, ROOT ROSE, DARK BROWN.			
1.0' to 6.6' CLAY: WITH TRACE OF FINE SAND & SILT, W/ CARBON STAINS, MOIST, V. STIFF DOWN TO HARD ROOT BROWN.			
6.6' to 10.0' CLAY: SANDY, W/ CARBON STAINS, MOIST, V. STIFF, ROOT BROWN			
10.0' to 12.6' CLAY: V. SANDY, W/ FINE TO MEDIUM SANDS, V. MOIST, STIFF TO V. STIFF, ROOT BROWN			
12.6' to 14.6' SAND: FINE TO MED. GRAIN, W/ TRACE OF SAND & CLAY RUBBER, V. MOIST, ROOT BROWN			
14.6' to 18.2' SAND-GRAVEL: GRAINED SAND, W/ FINE TO COARSE GRAVEL, WITH TRACE OF FINE SAND, STIFF, ROOT BROWN			
18.2' to 20.0' SAND: MOD. WEATH. DOWN TO ASS. UNWEATH.; W/ SANDY LAMINATIONS & OCCASIONAL SANDSTONE GLASS; W/ RUBBER CONCRETE IN UPPER THREE FEET; W/ TRACED FRACTURES IN WEATH. ZONE;			
20.0' to 21.2' SLI. MOIST; SOFT (RACE CLASS); WRATH. ZONE. RUBBER GRAY BROWN W/ FINE YELL. W/			
21.2' to 22.2' UNWEATH. ZONE IS BLISHEN GRAY.			
22.2' to 23.2' MOD. WEATH. SLI. WEATH.			
23.2' to 24.2' MOD. WEATH. SLI. WEATH.			
24.2' to 25.2' MOD. WEATH. SLI. WEATH.			
25.2' to 26.2' MOD. WEATH. SLI. WEATH.			
26.2' to 27.2' MOD. WEATH. SLI. WEATH.			
27.2' to 28.2' MOD. WEATH. SLI. WEATH.			
28.2' to 29.2' MOD. WEATH. SLI. WEATH.			
29.2' to 30.0' MOD. WEATH. SLI. WEATH.			
T.D. 30.0'			

Hole No. **6DC-16**

PROJECT Aubrey Dam Site	INSTALLATION END	SHEET 1 OF 2 SHEETS	
LOCATION (Continuation of Station) Intake Structure			NO. DATE AND TYPE OF BIT MSI 1499
CALCULATED DEPTH Core 3 of Dr. 1000			NO. DATE AND TYPE OF BIT MSI 1499
MOLE NO. (As shown on drawing into and into number) 6DC-19			NO. DATE AND TYPE OF BIT MSI 1499
NAME OF DRILLER Crossin			NO. DATE AND TYPE OF BIT MSI 1499
DIRECTION OF MOLE <input checked="" type="checkbox"/> VERTICAL <input type="checkbox"/> INCLINED			NO. DATE AND TYPE OF BIT MSI 1499
THICKNESS OF OVERBURDEN 22.0			NO. DATE AND TYPE OF BIT MSI 1499
DEPTH DRILLED INTO ROCK 21.0			NO. DATE AND TYPE OF BIT MSI 1499
TOTAL DEPTH OF MOLE 43.0			NO. DATE AND TYPE OF BIT MSI 1499
ELEVATION DEPTH LEGEND CLASSIFICATION OF MATERIALS (Description)			
0.0' to 15.0'			
CLAY, mod-calc., moist, riff to hard, slt. sand, tan and gray.			
15.0' to 22.0'			
GRAVEL (max. size 1"), clayey, slt. sandy, med. dense, tan.			
22.0' to 43.0'			
SAND, slt. calc., med. to n. hard, medium bedded, unjointed and unfractured, tan to gray.			
SANDSTONE, med. cemented, n. hard, at the following depths: 25.8' to 26.1' 27.0' to 27.3' 33.0' to 33.9' 34.0' to 34.5' 35.1' to 35.3'			
LIMESTONE, very fossiliferous, n. hard, from 31.5' to 31.6'.			
T.D. = 43.0'			

RECORD DRAWING-WORK AS BUILT

SYMBOL NO.	ACTION	DATE	DESCRIPTION OF REVISION
U.S. ARMY ENGINEER DISTRICT, FORT WORTH CORPS OF ENGINEERS FORT WORTH, TEXAS			
DESIGNED BY	RAY ROBERTS LAKE ELM FORK, TRINITY RIVER, TEXAS EMBANKMENT, SPILLWAY AND OUTLET WORKS LOGS OF BORINGS 6 DC-16, 6DC-17, 6 DC-18, AND 6A4C-19		
DRAWN BY			
REVIEWED BY			
SUBMITTED BY			
ENGINEER	INVITATION NO. DACW63-82-B-0025	DATE MAR. 1982	SEQUENCE NO. 15
	CONTRACT NO. DACW63-82-C-0012		
	DRAWING NUMBER	SHEET NO.	

TO ACCOMPANY FOUNDATION REPORT

Hole No. 644C-20

DRILLING LOG		INSTALLATION	
Project: Southwestern		Port: Fort	
1. PROJECT: Aubrey Dam Site		11. DATE OF ELEVATION DETERMINATION: 18 May 72	
2. LOCATION (Contour or Station): Right abutment - stilling basin		12. MANUFACTURER'S DESIGNATION OF DRILL: Rolling 36	
3. DRILLING AGENCY: Corps of Engineers		13. TOTAL NO. OF CORES: 5	
4. HOLE NO. (As shown on drawing sheet and site number): 644C-20		14. TOTAL NUMBER CORE BOXES: 5	
5. NAME OF DRILLER: Crosman		15. ELEVATION GROUND WATER: 5000	
6. DIRECTION OF HOLE: <input checked="" type="checkbox"/> VERTICAL <input type="checkbox"/> INCLINED		16. DATE MOLE: 18 May 72	
7. THICKNESS OF OVERBURDEN: 31.7		17. ELEVATION TOP OF MOLE: 528.95	
8. DEPTH DRILLED INTO ROCK: 20.5		18. TOTAL CORE RECOVERY FOR BORING: 88.0%	
9. TOTAL DEPTH OF HOLE: 52.2		19. SIGNATURE OF SUPERVISOR: James R. Blumke	
ELEVATION	DEPTH	CLASSIFICATION OF MATERIALS (Description)	REMARKS (Drilling time, core loss, depth of overburden, etc., if significant)
0.0'	0.0'	CLAY -	1. After completion, ho was bailed to 42.1'. 3" I.D. perforated plastic casing was placed to T.D.
0.0'	1.3'	0.0' to 1.3' - sli. calc. moist, stiff, brown.	
1.3'	4.1'	1.3' to 4.1' - non-calc., moist, stiff, mottled, brown, tan.	
4.1'	7.8'	4.1' to 7.8' - increase in sand content, med., moist, tan.	
7.8'	19.0'	7.8' to 19.0' - non-calc., moist, stiff, tan.	2. Jars: A. 0.0 to 1.0 B. 2.0 to 3.0 C. 5.0 to 6.0 D. 10.0 to 11.0 E. 15.0 to 16.0
19.0'	19.0'	Start 4" core @ 19.0'	
19.0'	21.8'	LIMESTONE, stained, n. hard jointed, tan.	3. Cartons: 1. 21.8 to 22.8 2. 26.2 to 27.2 3. 30.0 to 31.0 4. 33.6 to 34.6 5. 42.5 to 43.4
21.8'	21.8'	Start 4" core @ 21.8'	
21.8'	22.8'	SHALE -	4. Weathered to 22.8'
22.8'	24.0'	21.8 to 22.8' - sli. calc., stiff, weathered, tan.	
24.0'	24.0'	22.8' to 24.0' - sli. calc., stiff to hard, unjointed and unfractured except from 24.0 to 24.5, sli. sandy, gray.	5. Drilled into unweathered primary material @ 29.2'
24.0'	24.5'	Start 6" core @ 24.5'	
24.5'	24.5'		Start 6" core @ 31.7'
24.5'	31.5'		
31.5'	31.5'		SHALE, sli. calc., unves. n. hard, thick-bedded, sli. sandy, some jointed zones below 42.1', gray
31.5'	36.0'		
36.0'	36.0'	36.0' to 36.1' - highly fossilif.	40.6' to 42.1' - SANDSTONE soft, with SHALE laminae, tan.
36.0'	40.6'		
40.6'	40.6'		T.D. = 47.0'
40.6'	47.0'		

Hole No. 644C-21

DRILLING LOG		INSTALLATION	
Project: Southwestern		Port: Fort	
1. PROJECT: Aubrey Dam Site		11. DATE OF ELEVATION DETERMINATION: 18 May 72	
2. LOCATION (Contour or Station): Right abutment - stilling basin		12. MANUFACTURER'S DESIGNATION OF DRILL: Rolling 1500	
3. DRILLING AGENCY: Corps of Engineers		13. TOTAL NO. OF CORES: 8	
4. HOLE NO. (As shown on drawing sheet and site number): 644C-21		14. TOTAL NUMBER CORE BOXES: 5	
5. NAME OF DRILLER: Crosman		15. ELEVATION GROUND WATER: 5000	
6. DIRECTION OF HOLE: <input checked="" type="checkbox"/> VERTICAL <input type="checkbox"/> INCLINED		16. DATE MOLE: 18 May 72	
7. THICKNESS OF OVERBURDEN: 31.7		17. ELEVATION TOP OF MOLE: 581.04	
8. DEPTH DRILLED INTO ROCK: 20.5		18. TOTAL CORE RECOVERY FOR BORING: 88.0%	
9. TOTAL DEPTH OF HOLE: 52.2		19. SIGNATURE OF SUPERVISOR: James R. Blumke	
ELEVATION	DEPTH	CLASSIFICATION OF MATERIALS (Description)	REMARKS (Drilling time, core loss, depth of overburden, etc., if significant)
0.0'	0.0'	CLAY, non-calc., sandy, moist, stiff, tan to gray.	1. After hole was and 3" I plastic, to T.D.
0.0'	1.3'		
1.3'	4.1'		
4.1'	7.8'		
7.8'	19.0'		2. Jars: A. 0.0 to 1.0 B. 2.0 to 3.0 C. 5.0 to 6.0 D. 10.0 to 11.0 E. 15.0 to 16.0
19.0'	19.0'		
19.0'	21.8'		3. Cartons: 1. 21.8 to 22.8 2. 26.2 to 27.2 3. 30.0 to 31.0 4. 33.6 to 34.6 5. 42.5 to 43.4
21.8'	21.8'		
21.8'	22.8'		4. Weathered to 22.8'
22.8'	24.0'		
24.0'	24.0'		5. Drilled into unweathered primary material @ 29.2'
24.0'	24.5'		
24.5'	24.5'		Start 6" core @ 31.7'
24.5'	31.5'		
31.5'	31.5'		SHALE, sli. calc., unves. n. hard, thick-bedded, sli. sandy, some jointed zones below 42.1', gray
31.5'	36.0'		
36.0'	36.0'		40.6' to 42.1' - SANDSTONE soft, with SHALE laminae, tan.
36.0'	40.6'		
40.6'	40.6'		T.D. = 52.2'
40.6'	52.2'		

Division Southwestern	INSTALLATION Fort Worth	SHEET OF 3 SHEETS
No. 1 of 12 17,124 Y: 613,500		
No. 1 of 12 17,124 Y: 613,500		
3S4C-21A Bill Stanton Ing Testing Corporation		
MED. DES. FROM VERT.		
JOB NO. 30.6	ELEVATION GROUND WATER See Note 2	
POCA 69.4	DATE MOLE STARTED 12-6-72	
E 100.0	DATE MOLE COMPLETED 12-13-72	
ELEVATION TOP OF MOLE 579.74		
ELEVATION RECOVERY FOR BORING 93.2		
SIGNATURE OF INSPECTOR		
See Note 1 under "Remarks"		

CLASSIFICATION OF MATERIALS (Designated)	% CORE RECOV. EST.	BOX OR SAMPLE NO.	REMARKS (Drilling time, water loss, depth of weathering, etc., of significance)
Brown Clay	100	W1	3" Shelby Tube
2.0'	100	W2	Samples 0.0'-28.0'
Reddish Brown Sandy Clay	100	W3	JAR SAMPLES
6.0'	100	W4	1. 2.0'-3.0'
	100	W5	2. 6.0'-7.0'
	100	W6	3. 10.0'-11.0'
	100	W7	4. 14.0'-15.0'
	100	W8	5. 18.0'-19.0'
	100	W9	6. 22.0'-23.0'
	100	W10	7. 26.0'-27.0'
	100	W11	8. 30.0'-31.0'
	100	W12	WRAP SAMPLES
	100	W13	1. 0.0'-1.0'
	100	W14	2. 1.0'-2.0'
	100	W15	3. 3.0'-4.5'
	100	W16	4. 4.5'-6.0'
	100	W17	5. 7.0'-8.5'
	100	W18	6. 8.5'-10.0'
	100	W19	7. 11.0'-12.5'
	100	W20	8. 12.5'-14.0'
	100	W21	9. 15.0'-16.5'
	100	W22	10. 16.5'-18.0'
	100	W23	11. 19.0'-20.0'
	100	W24	12. 20.0'-21.0'
	100	W25	13. 21.0'-22.0'
	100	W26	14. 23.0'-24.0'
	100	W27	15. 24.0'-25.0'
	100	W28	16. 25.0'-26.0'
	100	W29	17. 27.0'-28.0'
	100	W30	Moist at 18.0'-22.5'
	100	W31	Wet at 22.5'-30.6'
	100	W32	Set Tub at 28.0' and
	100	W33	Cleaned Hole to 30.0'
	100	W34	3" Shelby Tube Sample
	100	W35	30.0'-31.0'
	100	W36	(Continued)
	100	W37	Began Coring w/4"
	100	W38	bbl. at 31.0'
	100	W39	CARTON SAMPLES
	100	W40	1. 33.6'-34.5'
	100	W41	2. 36.7'-37.7'
	100	W42	3. 40.9'-41.8'
	100	W43	4. 45.6'-46.5'
	100	W44	5. 49.1'-49.7'
	100	W45	6. 50.7'-51.5'
	100	W46	7. 57.3'-57.8'
	100	W47	8. 61.2'-61.7'
	100	W48	9. 67.8'-68.7'
	100	W49	10. 70.0'-70.9'
	100	W50	11. 77.0'-77.9'
	100	W51	12. 83.6'-84.5'
	100	W52	13. 85.0'-85.9'
	100	W53	14. 90.0'-90.9'
	100	W54	15. 93.4'-94.3'
	100	W55	16. 98.0'-98.9'
	100	W56	BOXES
	100	W57	1. 31.0'-36.7'
	100	W58	2. 36.7'-43.5'
	100	W59	3. 43.5'-49.1'
	100	W60	4. 49.1'-56.6'
	100	W61	5. 56.6'-64.4'
	100	W62	6. 64.4'-71.3'
	100	W63	7. 71.3'-77.9'
	100	W64	8. 77.9'-82.8'
	100	W65	9. 82.8'-90.9'
	100	W66	10. 90.9'-96.3'
	100	W67	11. 96.3'-100.0'
SHALE, Soft-Mod. Hard, Unweath., Gray-Dark Gray, Thin-Bedded to Massive, Non-Jointed, Often Sandy, w/Numerous Sand Pockets and Lenses. 32.3' to 32.4', Sandstone, M.-Hard, Gray., Lam., W. 45.0'-45.3', Limestone, Gray, Hard, Fossiliferous, Oolitic. Sand Pockets and Lenses, Gray, Med.-Fine-Grained, Friable, Soft-Mod. Hard at: 31.5-31.7, 31.9- 32.1, 32.4-32.6, 40.0- 40.5, 40.9-41.0, 41.7- 42.1, 42.4-42.5, 43.8- 44.2, 44.6-45.0, 46.3- 46.5, 46.8-47.0, 48.0'-50.0'; Sandstone, Mod. Hard, Well- Cemented, Gray. 50.0'-80.0' SHALE, Moderately Hard, Unweathered, Dark Gray to Black, Laminated, Non-Jointed, w/Numerous Sand Pockets and Lenses. 53.5'-55.0', Sandstone, Hard, Fine-Med.-Grained, Well-Cemented, Gray. Sand Pockets and Lenses, Gray, Med.-Fine-Grained, Friable, Soft-Med. Hard, at: 55.0-55.9, 56.1- 56.2, 56.9-57.4, 58.1- 58.5, 57.2-71.3, 64.4'-65.0', Fossiliferous Zone, Hard, Calcareous. 79.3'-79.5', Sandstone, Mod. Hard, Gray, Fine- Med.-Grained, Well- Cemented 80.0'-96.3' SHALE, Mod. Hard-Hard, Unweath., Very Dark Gray to Black, Massive, Non- Jointed. 82.1', Numerous Siltstone Nodules, Tan, Very Hard.	R-1 90% 35.0 R-2 90% 40.0 R-3 90% 45.0 R-4 90% 50.0 R-5 86% 55.0 R-6 84% 60.0 R-7 100% 65.0 R-8 86% 70.0 R-9 100% 75.0 R-10 94% 80.0 R-11 100% 85.0 R-12 100% 90.0 R-13 100% 96.3	Box 1 Box 2 Box 2 Box 3 Box 4 Box 5 Box 6 Box 7 Box 8 Box 9	

ELEVATION	DEPTH	LOGGED	CLASSIFICATION OF MATERIALS (Designated)	% CORE RECOV. EST.	BOX OR SAMPLE NO.	REMARKS (Drilling time, water loss, depth of weathering, etc., of significance)
483.44	94			93.0	R-14	Box 10
	96			92.5		
	98		96.3'-100.0' LIMESTONE, Gray, Hard, Unweathered	97.0	R-15	Box 11
479.74	100		Total Depth = 100.0'	100.0		

Note 1:
Soils Logged By:
A. J. Simpson,
Trinity Engineering
Testing Corporation;
Primary Logged By:
Marr and Marple,
Corps of Engineers,
Fort Worth District
Note 2:
Installed 2" Plastic
Pipe from 581.34
to _____ for ground
water observations.

RECORD DRAWING-WORK AS BUILT

SYN	DO	NO	ACTION	DATE	DESCRIPTION OF REVISION
U.S. ARMY ENGINEER DISTRICT, FORT WORTH CORPS OF ENGINEERS FORT WORTH, TEXAS					
DESIGNED BY:	RAY ROBERTS LAKE ELM FORK, TRINITY RIVER, TEXAS				
DRAWN BY:	EMBANKMENT, SPILLWAY AND OUTLET WORKS				
REVIEWED BY:	LOGS OF BORINGS 6A4C-20, 6A4C-21, AND 3S4C-21A				
SUBMITTED BY:	INVITATION NO. DACW63-82-B-0025 DATE: MAR, 1982				
ENGINEER:	CONTRACT NO. DACW63-92-C-0083				SEQUENCE NO. 16
	DRAWING NUMBER				SHEET NO. OF

Hole No **BA6C-22**

DRILLING LOG		Division Southwestern		Installation Port Worth		SHEET 1 of 2 SHEETS	
1. PROJECT Aubrey Dam Site				10. HOLE NO. AND TYPE OF BIT 6" AUBREY 6" CARBOLLOY 6" diamond			
2. LOCATION (Continence or Station) Intake structure				11. DIVISION FOR ELEVATION INFORMATION Falling 350			
3. DRILLING AGENCY Corps of Engineers				12. MANUFACTURER'S DESIGNATION OF DRILL Falling 350			
4. HOLE NO. (As shown on drawing sheet and R/W number) BA6C-22				13. TOTAL NO. OF CORES UNDERSAMPLED 5 UNRECOVERED 0			
5. NAME OF DRILLER Johnson				14. TOTAL NUMBER CORE ROSES B			
6. DIRECTION OF HOLE <input checked="" type="checkbox"/> VERTICAL <input type="checkbox"/> INCLINED SEE FROM VIEW				15. ELEVATION GROUND WATER 28.5 17.2 17.2			
7. THICKNESS OF OVERBURDEN 8.0				16. DATE HOLE 4 MAY 72			
8. DEPTH DRILLED INTO ROCK 40.5				17. ELEVATION TOP OF HOLE 593.5			
9. TOTAL DEPTH OF HOLE 48.5				18. TOTAL CORE RECOVERY FOR BORING 96%			
19. SIGNATURE OF INSPECTOR Raymond E				20. SIGNATURE OF OPERATOR Bill J. Johnson			
ELEVATION	DEPTH	LEGEND	CLASSIFICATION OF MATERIALS (Description)	RECOVERED CORRECTION	NO. OF SAMPLES	REMARKS (Including core, water flow, depth of weathering, etc., if significant)	
	0.0'		0.0' to 2.6' SAND, sli. clayey, fine to med. grained, sli. moist brown.		A	1. After completion, bore was bailed to 45.0' and 2 1/2" I.D. perforated pipe was placed in hole.	
	2.6'		2.6' to 8.0' CLAY, sandy, moist, medium red to tan.		B		
	8.0'		8.0' to 10.0' CLAY-SHALE, calc., moist, stiff, tan.		C	2. Jars: A. 0.0 to 2.6 B. 2.6 to 6.5 C. 6.5 to 8.0 D. 8.0 to 9.0 E. 9.0 to 10.0	
	10.0'		-- Start 6" core @ 10.0' --		D		
	10.0'		10.0' to 19.0' CLAY-SHALE, calc., highly jointed, m. hard, numerous rootlets, open, highly-stained joint from 14.1 to 15.3, tan and gray.		E	3. Carbons: 1. 10.0 to 11.0 2. 17.2 to 18.2 3. 22.6 to 23.6 4. 27.7 to 28.7 5. 38.4 to 39.4 6. 45.2 to 46.2	
	19.0'		-- Transitional weathering contact @ 19.0' --			4. Weathered to 19.0'	
	19.0'		19.0' to 36.9' SHALE, calc., jointed and stained to 22.6', thick bedded, fossilif., gray		1	5. Base of jointing at 22.6'	
	36.9'		36.9' to 39.9' - m. hard		2		
	39.9'		39.9' to 36.9' - m. hard modular LIMESTONE pieces, hard.		3		
	36.9'		-- Transitional contact @ 36.9' --		4		
	36.9'		36.9' to 43.6' LIMESTONE --		5		
	43.6'		43.6' to 42.1' - m. hard fossilif., shaly, gray		6		
	42.1'		42.1' to 43.6' - sandy, fossilif., shaly, HARD gray.		7		
	43.6'		43.6' to 47.2' SHALE, calc., m. hard, scattered LIMESTONE concretions, gray.		8		
	47.2'		47.2' to 48.5' NO RECOVERY				
	48.5'		2.D. 48.5' -				

Hole No **BA6C-23**

DRILLING LOG		Division Southwestern		Installation Port Worth District		SHEET 1 of 2 SHEETS	
1. PROJECT Aubrey Dam				10. HOLE NO. AND TYPE OF BIT 6" AUBREY 6" CARBOLLOY 6" diamond			
2. LOCATION (Continence or Station) Sta 78+00, West Abutment C L				11. DIVISION FOR ELEVATION INFORMATION Falling 350			
3. DRILLING AGENCY USACE-C				12. MANUFACTURER'S DESIGNATION OF DRILL Falling 350			
4. HOLE NO. (As shown on drawing sheet and R/W number) BA6C-23				13. TOTAL NO. OF CORES UNDERSAMPLED 5 UNRECOVERED 0			
5. NAME OF DRILLER Jay Creman				14. TOTAL NUMBER CORE ROSES B			
6. DIRECTION OF HOLE <input checked="" type="checkbox"/> VERTICAL <input type="checkbox"/> INCLINED SEE FROM VIEW				15. ELEVATION GROUND WATER 28.5 17.2 17.2			
7. THICKNESS OF OVERBURDEN 19.0'				16. DATE HOLE 4 MAY 72			
8. DEPTH DRILLED INTO ROCK 51.0'				17. ELEVATION TOP OF HOLE 593.5			
9. TOTAL DEPTH OF HOLE 70.6				18. TOTAL CORE RECOVERY FOR BORING 96%			
19. SIGNATURE OF INSPECTOR Raymond E				20. SIGNATURE OF OPERATOR Bill J. Johnson			
ELEVATION	DEPTH	LEGEND	CLASSIFICATION OF MATERIALS (Description)	RECOVERED CORRECTION	NO. OF SAMPLES	REMARKS (Including core, water flow, depth of weathering, etc., if significant)	
	0.0'		0.0' to 17.6' CLAY-lean, sandy-fine; silty; dry.		A		
	17.6'		@ 0.6 - becomes moist. @ 1.7' - becomes stiff, well consolidated, fat @ 5.3' - becomes gravelly limestone, hard, max size 1"; lean, with color change. Yellowish brown.		B		
	17.6'		@ 13.6' - becomes very lean with more sand fines		C		
	17.6'		17.6' to 19.0' SHALE - hard, angular limestone size 1-1/2"; sand coarse; silty; moist; brown, gray, & yellowish-brown		D		
	19.0'		-- Start 4" core at 20.0' --		E		
	20.0'		20.0' to 69.2' SHALE, soft - moderately hard, moist, interbedded with scattered, thin sandstone seams.		F		
	69.2'		20.0' - 2500' - weathered, oxide stains, yellow-brown & gray.		G		
	25.0'		25.0' - 24.8' - SANDSTONE, fine, argillaceous, moderately cemented.		L-0.5		
	24.8'		25.0-33.3' - Predom dark gray with oxide staining limited to bedding planes.		L-0.2		
	33.3'		28.2-29.6' - Fossiliferous Sandstone		L-0.4		
	29.6'		29.6-29.8' - Sandstone		L-0.5		
	29.8'		32.8-33.2' - Sandstone		L-0.6		

Western	INSTALLATION Fort Worth District	SHEET 1 of 2 SHEETS
C.L.	10. SIZE AND TYPE OF BIT 4" Core Barrel	
84C-25	11. DATE OF ELEVATION MEASUREMENT	
	12. MANUFACTURER'S DESIGNATION OF DRILL Falling 350	
	13. TOTAL NO. OF CORES UNDISTURBED 7	UNDISTURBED 8
	14. TOTAL NUMBER CORE BOARDS 8	
	15. ELEVATION GROUND WATER	
	16. DATE MOLE STARTED 25 May 72	COMPLETED 26 May 72
	17. ELEVATION TOP OF MOLE 600.66	
	18. TOTAL CORE RECOVERY FOR BORING	
	19. SIGNATURE OF INSPECTOR Raymond E. Hagen	

DESCRIPTION OF MATERIALS (Description)	1. CORE RECOVERY %	2. BOX OR SAMPLE NO.	REMARKS (Drilling time, water loss, depth of casing, etc. if significant)
17.6'		A	JAR SAMPLES
lean, sandy-fine; dry.		B	A - 0.02' to 1.0'
becomes moist.		C	B - 3.0' to 4.0'
- becomes stiff, consolidated, fat		D	C - 6.0' to 7.0'
- becomes gravelly tone, hard, max 1"; lean, with change.		E	D - 9.0' to 10.0'
ish brown.		F	E - 12.0' to 13.0'
- becomes very		G	F - 15.0' to 16.0'
sh more sand fines		H	G - 18.0' to 19.5'
			CARTON SAMPLES
			1 - 22.3' to 23.3'
			2 - 29.4' to 30.4'
			3 - 34.0' to 35.0'
			4 - 36.4' to 37.4'
			5 - 46.9' to 47.9'
			6 - 49.0' to 49.8'
			7 - 52.0' to 53.0'
			8 - 58.8' to 59.8'
			PENTROMETER BLOWS
			13.6' to 14.1' - 43
			14.1' to 15.1' - 72
			Sec casing to 20.0' and started coring at that depth.
18.3'			
hard, rounded & limestone; max 1/2"; sandy-fine to silty; mottled-gray, & yellowish-			
" core at 20.0'----	L-0.5		
69.2'	L-0.2	1	
silt - moderately silty, interbedded, mottled, thin seams.	L-0.4		
Box 1	L-0.5		
100' - red, oxide stains, brown & gray.	L-0		
Box 2			
4.8' - SANDSTONE, argillaceous, silty cemented.	L-0.4	2	
Box 1	L-0.5		
Box 2			
Box 3		3	
Box 4			
Box 5			
Box 6			
Box 100			

ELEVATION	DEPTH	LEADER	CLASSIFICATION OF MATERIALS (Description)	1. CORE RECOVERY %	2. BOX OR SAMPLE NO.	REMARKS (Drilling time, water loss, depth of casing, etc. if significant)
	40		33.3'-69.2' Unweathered, dark gray, moderately hard.	41.5		
			36.5'-36.8' - SANDSTONE, moderately hard, moderately cemented, very silty, thinly bedded, light gray-tan.	L-1.0		
			37.3'-37.6' - Fossiliferous	46.5	5	
			46.7-47.4' - SANDSTONE	G-0.3	5	
			47.9-48.4' - "		6	
			50.4-50.6' - "		6	
			53.5-54.2' - "	50.5		
			54.6-54.9' - "			
			55.3-55.4' - "	L-0.9		
			56.4-56.5' - "		7	
			57.8-58.1' - "			
			58.2-58.7' - "			
			61.4-61.6' - "			
			62.9-64.4' - Fossiliferous	55.5		
			64.4-64.9' - Fossiliferous	55.5		
			66.6-66.9' - SANDSTONE	L-0.7		
			67.0-67.6' - "			
			67.6-68.0' - "			
			68.5-68.7' - "			
	60			62.5		
				L-0.2		
				65.5		
				G-0.8		
	70			70.0		
			7.0 72.0'			

Unable to obtain
Carton samples
for last 10' of hole
due to fragmentation
of core

SYM	DD	NO
DESIGNED BY		
DRAWN BY		
REVIEWED BY		
SUBMITTED BY		
ENGINEER		

ELEVATION	DEPTH	LEGEND	CLASSIFICATION OF MATERIALS (Description)	% CORE RECOVERY	BOX OR SAMPLE NO.	REMARKS (Distinguishing marks, depth of penetration, etc., if significant)
	40		33.3'-69.2' Unweathered, dark gray, moderately hard.	41.5		
				L-1.0		
			36.5'-36.8' - SANDSTONE, moderately hard, mod- erately cemented, very fine, thinly bedded, light gray-tan.	46.5		
			37.3-37.6' - Fossiliferous	55.5	5	
			46.7-47.6' - SANDSTONE			
			47.9-48.4' - "		6	
			50.4-50.6' - "			
	50		53.5-54.2' - "	50.5		
			54.6-54.9' - "			
			55.3-55.4' - "	L-0.9		
			56.4-56.5' - "			
			57.8-58.1' - "		7	
			58.2-58.7' - "			Unable to obtain Cordon samples for last 10' of hole due to fragmentation of core
			61.4-61.6' - "			
			62.9-64.4' - "	55.5		
			64.4-64.9' - Fossiliferous			
			66.6-66.9' - SANDSTONE	L-0.7		
			67.0-67.6' - "			
			67.6-68.0' - "			
			68.5-68.7' - "		8	
	60			62.5		
				L-0.2		
				65.5		
				60.8		
	70		7.0 70.0'	70.0		

DWG FORM 1036 PREVIOUS EDITIONS ARE OBSOLETE. PROJECT: Aubrey Dam. SHEET NO: 8A4C-25

RECORD DRAWING-WORK AS BUILT

ITEM	NO.	ACTION	DATE	DESCRIPTION OF REVISION
U.S. ARMY ENGINEER DISTRICT, FORT WORTH CORPS OF ENGINEERS FORT WORTH, TEXAS				
DESIGNED BY:	RAY ROBERTS LAKE ELM FORK, TRINITY RIVER, TEXAS EMBANKMENT, SPILLWAY AND OUTLET WORKS LOGS OF BORINGS 8A6C-22 AND 8A4C-25			
DRAWN BY:				
REVIEWED BY:				
SUBMITTED BY:	INVITATION NO. DACW63-B2-E-0025	DATE	MAR, 1982	
ENGINEER:	CONTRACT NO. DACW63-82-C-0083	DRAWING NUMBER	SHEET NO.	SEQUENCE NO.
			17	17

TO ACCOMPANY FOUNDATION REPORT

CONTRACT NO. DACW63-82-C-0083

8A-4C-26

DRILLING LOG		Southwestern		Port Vorch District		Sheet 1 of 2 sheets	
PROJECT: Aubrey Dam		LOCATION: Sta 29+50 West Abundant C.L.		NO. AND TYPE OF BIT: 6" Core Barrel		SITE IDENTIFICATION: MS1	
DRILLING AGENCY: USACE-C		HOLE NO. (As shown on drawing and this number): 8A-4C-26		TOTAL NO. OF OVERBURDEN SAMPLES TAKEN: 10		UNDISTURBED: 4	
NAME OF DRILLER: Jay Creeman		DIRECTION OF HOLE: <input type="checkbox"/> VERTICAL <input type="checkbox"/> INCLINED		DATE MOLE: 24 May 72		COMPLETED: 25 May 72	
THICKNESS OF OVERBURDEN: 30.5'		DEPTH DRILLED INTO ROCK: 24.5'		ELEVATION TOP OF HOLE: 598.91		TOTAL CORE RECOVERY FOR BORING: 5	
TOTAL DEPTH OF HOLE: 55.0'		SIGNATURE OF INSPECTOR: Raymond T. Hagen		CORRECTION: (During time, hour or date, check of overburden, etc., if significant)		REMARKS: (During time, hour or date, check of overburden, etc., if significant)	
ELEVATION	DEPTH	LEGEND	CLASSIFICATION OF MATERIALS (Description)	CORE RECOVERY (%)	BOX OR SAMPLE NO.	REMARKS	DEPTH OF HOLE
			0.0' to 18.8'		A	JAR SAMPLES	
			CLAY-dry, lean, loose, sandy-fine; dark grayish brown.		B	A - 0.0' to 1.0'	
			@ 0.8 becomes fat, stiff, wet		C	B - 3.0' to 4.0'	
			@ 2.3' color changes to light grayish-brown		D	C - 6.0' to 7.0'	
			@ 8.2' becomes very stiff, much fatter, well consolidated, with color change to dark grayish-brown		E	D - 9.0' to 10.0'	
			@ 11.2' becomes lean, very sandy-fine, with color change to yellowish brown.		F	E - 12.0' to 13.0'	
			18.8' to 26.6'		G	F - 15.0' to 16.0'	
			SAND-fine, clayey, lean, wet, silty; yellowish-brown		H	G - 18.0' to 19.0'	
			26.9' to 29.0'		I	H - 21.0' to 22.0'	
			GRAVEL-hard, well rounded, max size 1-1/2"; clayey, lean, sandy-fine; yellowish brown		J	I - 24.0' to 25.0'	
			@ 27.0 - becomes banded with Gravel & Sand bedding. Sand-fine to coarse; micaceous			J - 27.0' to 28.6'	
			--Start 4" Core at 31.5'--				
			31.5' to 34.6'				
			SHALE, moderately hard, moist, dark gray, fissile, unweathered (except for oxide staining to 33.1), non-jointed.				
			31.5-31.6 SANDSTONE, argillaceous, moderately hard, moderately cemented, thin bedded, oxide stained.	31.5			
			31.8-32.6 SANDSTONE	L-0.7			
			35.2-44.1 Interbedded with thin, very fine, thin bedded, tan-lt gray sandstone seams.	33.5			
			36.8-37.0 SANDSTONE	G-0.4			
			39.3-40.0 SANDSTONE	26.5			
			39.8-40.0 Fossiliferous	L-1.2			
			41.8-42.4 SANDSTONE	Box 1			
			42.8-43.8 "	Box 2			
			44.0-44.1 "	Box 3			
			46.9-49.8 Slightly fossiliferous throughout.	44.5			
			46.9-47.3 Sand with fossil detritus	L-0.7			
			49.4-49.8 Very fossiliferous, very well cemented, claystone - nodules from 49.4 - 49.6.	46.5			
			T.O. 55.0'	L-1.0			

DRILLING LOG		Southwestern		Port Vorch D		Sheet 1 of 2 sheets	
PROJECT: Aubrey Dam		LOCATION: Sta 29+50 West Abundant C.L.		NO. AND TYPE OF BIT: 6" Core Barrel		SITE IDENTIFICATION: MS1	
DRILLING AGENCY: USACE-C		HOLE NO. (As shown on drawing and this number): 8A-4C-27		TOTAL NO. OF OVERBURDEN SAMPLES TAKEN: 10		UNDISTURBED: 4	
NAME OF DRILLER: Jay Creeman		DIRECTION OF HOLE: <input type="checkbox"/> VERTICAL <input type="checkbox"/> INCLINED		DATE MOLE: 24 May 72		COMPLETED: 25 May 72	
THICKNESS OF OVERBURDEN: 28.0'		DEPTH DRILLED INTO ROCK: 16.9'		ELEVATION TOP OF HOLE: 598.91		TOTAL CORE RECOVERY FOR BORING: 5	
TOTAL DEPTH OF HOLE: 40.0'		SIGNATURE OF INSPECTOR: Raymond T. Hagen		CORRECTION: (During time, hour or date, check of overburden, etc., if significant)		REMARKS: (During time, hour or date, check of overburden, etc., if significant)	
ELEVATION	DEPTH	LEGEND	CLASSIFICATION OF MATERIALS (Description)	CORE RECOVERY (%)	BOX OR SAMPLE NO.	REMARKS	DEPTH OF HOLE
			0.0' to 20.6'			JAR SAMPLES	
			CLAY-fat, moist, sandy-fine to coarse; very dark gray.			A - 0.0' to 1.0'	
			@ 2.1' - becomes soft, wet			B - 3.0' to 4.0'	
			@ 5.2' - becomes stiff with more coarse sand (lime nodules) with color change to grayish-brown			C - 6.0' to 7.0'	
			@ 11.1' - Color change to mottled-yellowish brown, gray, and red.			D - 9.0' to 10.0'	
			@ 15.0' - loses coarse sand and becomes lean.			E - 12.0' to 13.0'	
			@ 17.6' - becomes gravelly, well rounded, hard, max size 1/2"			F - 15.0' to 16.0'	
			20.6' to 23.7' - GRAVEL-hard, rounded, max size 2"; clayey, very lean sandy-fine to coarse; yellowish brown.			G - 18.0' to 19.0'	
			Started 4" core at 25.0'			H - 21.0' to 22.0'	
			26.5' to 26.7' SANDSTONE, fine-grained, soft, tan, friable, stained.			I - 24.0' to 25.0'	
			26.7' to 32.7' SHALE, sandy, moderately hard, gray to brown, slightly stained, moderately hard sandstone bed at 29.3' to 29.4'.			J - 27.0' to 28.6'	
			32.7' to 40.0' SHALE, moderately hard, dark gray, fresh.				
			TOTAL DEPTH - 40.0'				

ENG FORM 1836 MAR 71 PREVIOUS EDITIONS ARE OBSOLETE. (TRANSLUCENT) PROJECT: Aubrey

Male No. 8AAC-27

Southwestern

Fort Worth District 1-9

4" Core Barrel

MSL

Falling Model 44

6DC-28

Boyd Lane Trinity Engineering Testing Corporation

27 May 72

407.03

40.0'

Raymond T. Nagen

LEGEND	CLASSIFICATION OF MATERIALS (Description)	SCORE PERCENT	BOX OR SAMPLE NO.	REMARKS (Drilling time, color logs, depth of penetration, etc., at 200 rpm and 100 rpm)
	0.0' to 20.6' - CLAY-fac, moist, sandy-fine to coarse; very dark gray.		A	Jar Samples A - 0.0' to 1.0' B - 3.0' to 4.0' C - 6.0' to 7.0' D - 9.0' to 10.0' E - 12.0' to 13.0' F - 15.0' to 16.0' G - 18.0' to 19.0' H - 21.0' to 22.0'
	@ 2.1' - becomes soft, wet		B	
	@ 5.2' - becomes stiff with more coarse sand (line nodules) with color change to grayish-brown		C	
	@ 11.1' - color change to mottled-yellowish brown, gray, and red.		D	
	@ 15.0' - loses coarse sand and becomes lean.		E	Set casing to 25.0'. Started coring at this depth.
	@ 17.6' - becomes gravelly, well rounded, hard, max size 1/2".		F	Bailed hole to 37.2'.
	20.6' to 23.7' - GRAVEL-hard, rounded, max size 2", clayey, very lean sandy-fine to coarse; yellowish brown.		G	
	Started 4" core at 25.0'.		H	
	26.5' to 26.7' SANDSTONE, fine-grained, soft, tan, friable, stained.	15.0		
	26.7' to 32.7' SHALE, sandy, moderately hard, gray to brown, slightly stained, moderately hard sandstone bed at 29.3' to 29.4'.	14.5 16.5 10.0 18.5		
	32.7' to 40.0' SHALE, moderately hard, dark gray, fresh.	16.3		
	TOTAL DEPTH - 40.0'.			

PREVIOUS EDITIONS ARE OBSOLETE. PROJECT: Aubrey Dam. HOLE NO.: 8AAC-27

Male No. 6DC-28

Southwestern

Fort Worth

Aubrey Dam Site No. 1

Not Shown

Corps of Engineers

6DC-28

Boyd Lane Trinity Engineering Testing Corporation

27 May 72

407.03

40.0'

Raymond T. Nagen

ELEVATION	DEPTH	LEGEND	CLASSIFICATION OF MATERIALS (Description)	% CORE RECOVERY	BOX OR SAMPLE NO.	REMARKS (Drilling time, color logs, depth of penetration, etc., at 200 rpm and 100 rpm)
556.84	2		Dark Brown Clay		J1	Used 8" Auger from 0.0'-3.0'
	4		Tan Clay	100	D1	Used 6" d, b, from 3.0'-38.0'
	6			100	D2	Jar sample taken from shoe of each Denison sample.
550.34	8		8.5'	100	D3	JAR SAMPLES
	10		Tan Sandy Clay	100	D4	1. 0.0'-3.0'
	12			100	D5	2. 5.0'
	14			100	D6	3. 7.0'
	16		16.5'	100	D7	4. 9.0'
542.34	18		Tan Clay	100	D8	5. 11.0'
	20		21.0'	100	D9	6. 13.0'
537.84	22		Tan Sandy Clay	100	D10	7. 15.0'
	24		25.0'	100	D11	8. 17.0'
533.84	26		Tan Sand and Gravel	50	D12	9. 19.0'
	28		29.0'	75	D13	10. 21.0'
529.84	30		Tan Gravel and Sand	25	D14	11. 23.0'
	32			75	D15	12. 25.0'
	34			75	D16	13. 27.0'
522.84	36		36.0'	0		14. 29.0'
	38		36.0'-44.9' SHALE, Mod. Hard, Non-Jointed, Laminated, Dark (Continued)	100	D17	15. 31.0'
	40		Gray, Often Sandy w/Thin Sandstone Seams.	R-1 100%	Box 1	16. 33.0'
	42		39.3'-41.5', Sand, Fine-Med.-Grained, Well-Compacted, Gray, Scat. Thin Tan Siltstone Nodules.	R-2 100%	Box 2	17. 35.0'
513.94	44		41.7'-42.9', Sand w/Scat. Siltstone Nodules.	R-3 48.0		CLEANED OUT FROM 35.5'-36.0'
	46		43.0'-44.1', Sand Seams.	R-4 100%	Box 3	Set casing to 36.0'
	48		44.1'-44.5', Sandstone, Well-Cemented, Mod. Hard, Med.-Fine-Grained, Sil. Friable, Gray.	R-5 53.0		Began coring w/6" bbl. at 38.0'
	50		44.5'-44.9', Sand w/Siltstone Nodules	R-6 100%	Box 4	
	52		44.9'-60.0'	R-7 58.0		
	54		SHALE, Mod. Hard, Non-Jointed, Laminated, Dark Gray, w/Sand Seams at 46.8-47.5, 52.9-53.0, 54.95-57.9, 58.5-60.0, 47.8'-48.0', Fossiliferous Zone.	R-8 100%	Box 5	
498.84	60		Total Depth = 60.0'			

Note 1: Soils Logged by: A. J. Simpson, Trinity Engineering Testing Corporation; Primary Logged By: Marr, Corps of Engineers, Fort Worth District

Note 2: Installed 4" Plastic Pipe from 560.34 to 529.74 for ground-water observations.

Memo No. 6DC-28

DRILLING LOG	Division: Southwestern	Installation: Fort Worth	Sheet 1 of 2
PROJECT: Subrey Dam Site No. 1	NO. SIZE AND TYPE OF BIT: 8" A.S., 6" Den, 6" Core		
LOCATION (Continuation of Form No. 1): 2, 119, 250 V: 415 255	DATE FOR ELEVATION DATA: 12-7-72		
DRILLING AGENCY: Corps of Engineers	MSL		
DATE NO. (As shown on drawing) or job number: 6DC-28	MFG. MANUFACTURER'S DESIGNATION OF DRILL: Falling Model 44		
NAME OF DRILLER: Trinity Engineering Testing Corporation	BOYD LANE		
SECTION OF HOLE: Vertical	NO. TOTAL NO. OF CORES: 18		
DIAMETER OF OVERBURDEN: 36.0'	NO. UNDISTURBED BONDH SAMPLES TAKEN: 18		
DEPTH DRILLED INTO ROCK: 24.0'	NO. TOTAL NUMBER CORE BOXES: 5		
TOTAL DEPTH OF HOLE: 60.0'	NO. ELEVATION GROUND WATER: See Note 2		
	NO. DATE MOLE: 11-14-72		
	NO. ELEVATION TOP OF HOLE: 558.84		
	NO. TOTAL CORE RECOVERY FOR BORING: 100.0		
	NO. SIGNATURE OF INSPECTOR: See Note 1 under "Remarks"		

DEPTH	LEGEND	CLASSIFICATION OF MATERIALS (Description)	% CORE RECOVERY	BOX OR SAMPLE NO.	REMARKS (Depth from, depth of, etc., of samples)
0-2		Dark Brown Clay		J1	Used 8" Auger from 0.0'-3.0'
2-3		Tan Clay	100	D1	Used 6" d. b. from 3.0'-38.0'
3-4			100	D2	Jar sample taken from shoe of each Denison sample.
4-8			100	D3	JAR SAMPLES
8-10		Tan Sandy Clay	100	D4	1. 0.0'-3.0'
10-12			100	D5	2. 5.0'
12-14			100	D6	3. 7.0'
14-16			100	D7	4. 9.0'
16-18			100	D8	5. 11.0'
18-20			100	D9	6. 13.0'
20-22			100	D10	7. 15.0'
22-24			100	D11	8. 17.0'
24-26			100	D12	9. 19.0'
26-28			100	D13	10. 21.0'
28-30			100	D14	11. 23.0'
30-32			100	D15	12. 25.0'
32-34			100	D16	13. 27.0'
34-36			100	D17	14. 29.0'
36-38			100	D17	15. 31.0'
38-40			100	D17	16. 33.0'
40-42			100	D17	17. 35.0'
42-44			100	D17	18. 38.0'
44-46			100	D17	
46-48			100	D17	
48-50			100	D17	
50-52			100	D17	
52-54			100	D17	
54-56			100	D17	
56-58			100	D17	
58-60			100	D17	

SHALE, Mod. Hard, Non-Jointed, Laminated, Dark (Continued) Gray, Often Sandy w/Thin Sandstone Seams.

39.3'-41.5', Sand, Fine-Med.-Grained, Well-Compacted, Gray, Scat. Thin Tan Siltstone Nodules.

41.7'-42.9', Sand w/Scat. Siltstone Nodules.

43.0'-44.1', Sand Seams.

44.1'-44.5', Sandstone, Well-Cemented, Mod. Hard, Med.-Fine-Grained, Sil. Friable, Gray.

44.5'-44.9', Sand w/Siltstone Nodules

44.9'-60.0'

SHALE, Mod. Hard, Non-Jointed, Laminated, Dark Gray, w/Sand Seams at: 46.8-47.5, 52.9-53.0, 54.95-57.9, 58.5-60.0, 47.8'-48.0', Fossiliferous Zone.

Total Depth = 60.0'

DEINSON SAMPLES

1. 3.0'-5.0'

2. 5.0'-7.0'

3. 7.0'-9.0'

4. 9.0'-11.0'

5. 11.0'-13.0'

6. 13.0'-15.0'

7. 15.0'-17.0'

8. 17.0'-19.0'

9. 19.0'-21.0'

10. 21.0'-23.0'

11. 23.0'-25.0'

12. 25.0'-27.0'

13. 27.0'-29.0'

14. 29.0'-31.0'

15. 31.0'-33.0'

16. 33.0'-35.0'

17. 35.0'-38.0'

CARTON SAMPLES

1. 39.8'-40.8'

2. 43.8'-44.8'

3. 50.0'-50.8'

4. 55.3'-56.3'

5. 58.8'-59.8'

Note 1:
Soils Logged By:
A. J. Simpson,
Trinity Engineering
Testing Corporation;

Primary Logged By:
Marr, Corps of
Engineers, Fort
Worth District

Note 2:
Installed 4" Plastic
Pipe from 560.34
to 529.74 for ground-
water observations.

RECORD DRAWING-WORK AS BUILT

SYM	DC	NO	ACTION	DATE	DESCRIPTION OF REVISION
U.S. ARMY ENGINEER DISTRICT, FORT WORTH CORPS OF ENGINEERS FORT WORTH, TEXAS					
RAY ROBERTS LAKE ELM FORK, TRINITY RIVER, TEXAS EMBANKMENT, SPILLWAY AND OUTLET WORKS LOGS OF BORINGS 8A4C-26, 8A4C-27, AND 6 DC-28					
DESIGNED BY:			INVESTIGATION NO. DACW 63-82-B-0025 DATE: MAR, 1962		
DRAWN BY:			CONTRACT NO. DACW 63-82-C-0083		
REVIEWED BY:			ENGINEER		
SUBMITTED BY:			DRAWING NUMBER		
			SHEET NO. OF 18		

TO ACCOMPANY FOUNDATION REPORT

CONTRACT NO. DACW 63-82-C-0083

DEPTH	LOG NO.	CLASSIFICATION OF MATERIALS (Description)	% CORE RECOVERED	LOG OF SAMPLE NO.	REMARKS (Drilling time, water loss, depth of penetration, etc., if applicable)
					<p>Note 1: Soils Logged By: A. J. Simpson, Trinity Engineering Testing Corporation;</p> <p>Primary Logged By: Green and Marr, Corps of Engineers, Fort Worth District.</p> <p>Note 2: Installed 4" Plastic Pipe from 558.50 to 520.50 for ground- water observations.</p>

PROJECT		LOCATION		DATE	
Aubrey Dam Site No. 1		Southwestern		Fort Worth	
X-2 141 403 7613 328 Sta. 132+00		6DC-31		12-18-72	
Corps of Engineers		Boyd Lane		12-29-72	
Trinity Engineering Testing Corporation		See Note 2			
ELEVATION OF SURFACE		ELEVATION OF TOP OF MOUND		ELEVATION OF TOP OF MOUND	
59.0'		555.18'		555.18'	
DEPTH OF MOUND		TOTAL CORE RECOVERED		TOTAL CORE RECOVERED	
51.0'		100%		100%	
TOTAL DEPTH OF MOUND		TOTAL DEPTH OF MOUND		TOTAL DEPTH OF MOUND	
90.0'		90.0'		90.0'	
DEPTH		ELEVATION		REMARKS	
2	550.38	Brown Clay	0	J1	Used 8" Auger from 0.0'-3.0'
4		5.0'	50	D1	Used 6" Denison bbl. 3.0'-40.0'
6		Brown Sandy Clay	100	D2	Jar sample taken from shoe of each Denison sample.
8	546.38	9.0'	100	D3	JAR SAMPLES
10		Brown Silty Clay w/Sand Lenses	100	D4	1. 0.0'-3.0'
12			80	D5	2. 5.0'
14	540.38		100	D6	3. 7.0'
16		Brown Silty Sand w/Clay Lenses	90	D7	4. 9.0'
18			100	D8	5. 11.0'
20			100	D9	6. 13.0'
22	532.38		50	D10	7. 15.0'
24	530.38	Tan and Gray Sandy Clay w/Silt Lenses	100	D11	8. 17.0'
26			50	D12	9. 19.0'
28		Tan and Gray Silty Clay w/Iron Ore	75	D13	10. 21.0'
30			90	D14	11. 23.0'
32	522.38		100	D15	12. 25.0'
34		Gray Silty Sand w/Scattered Gravel	90	D16	13. 27.0'
36			100	D17	14. 29.0'
38	516.38		0		15. 31.0'
40		39.0'-45.0' SHALE	40	D18	16. 33.0'
42		39.0'-45.0' SHALE, Mod. Hard, Dk. Gray Thin-Bedded-Massive, w/Num. Lt. Gray Sand Pockets and Lenses	100%	Box 1	17. 35.0'
44	510.38	43.4' Siltstone Nods., Hard Tan	100%	Box 2	18. 38.0'-40.0'
46		45.0'-55.6' Shale & Sandstone, Alt. Bed w/occas. Sand Lenses	100%	Box 3	Reamed from 0.0'-38.0' w/8" bit.
48		Shale is Gray, Massive, Mod. Hard, Sandy Unweathered	100%	Box 4	Began coring w/6" core bbl. at 40.0'
50	499.78	55.6'-64.0' Shale, Mod. Hard-Hard, Dk. Gray Laminated, Unweathered	100%	Box 5	Set 8" casing to 44.0'
52		58.6'-59.4' Fossiliferous sand Soft-Mod. Hard, Calc.	100%	Box 6	CARTON SAMPLES
54	491.38	64.0'-75.4' Shale & Sandstone, Alt. Bed w/occas. Sand Lenses	100%	Box 7	1. 42.3'-43.3'
56		Shale is Mod Hard-Hard, Dk. Gray, Laminated	69.0	Box 8	2. 46.2'-46.8'
58			100%	Box 9	3. 51.6'-52.6'
60			100%	Box 10	4. 56.5'-57.5'
62			100%	Box 11	5. 61.2'-62.2'
64			100%	Box 12	6. 64.7'-65.7'
66			100%	Box 13	7. 72.8'-73.8'
68			100%	Box 14	8. 75.4'-76.4'
70			100%	Box 15	9. 80.3'-81.3'
72			100%	Box 16	10. 85.5'-86.5'
74	479.38	75.4'-75.4'	74.0	Box 17	Note 1:
76		75.4'-90.0'	79.0	Box 18	Soils Logged By: A. J. Simpson, Trinity Engineering Testing Corporation
78		Shale, Gray-Dk. Gray, Mod. Hard-Hard, Laminated Calc.	100%	Box 19	Primary Logged By: Marr, Corps of Engineers, Fort Worth District
80			100%	Box 20	Note 2:
82			100%	Box 21	Installed 4" plastic pipe from 556.6 to 511.6 for ground-water observations.
84			100%	Box 22	
86			100%	Box 23	
88			100%	Box 24	
90	465.38	90.0'	79.0	Box 25	
		Total Depth = 90.0 Feet			

1834-A (MODIFIED) Aubrey Dam Site No. 1 6DC-31

DESIGNED BY	_____
DRAWN BY	_____
REVIEWED BY	_____
SUBMITTED BY	_____
ENGINEER	_____

TO ACCO

DRILLING LOG		PROJECT		LOCATION		DATE	
Aubrey Dam Site No. 1		Southwestern		Fort Worth		1972	
X-2, 131, 403, Y-245, 278- Sta. 132400		6DC-31		M. DATE MOLE		12-18-72	
Corps of Engineers		Boyd Lane Trinity Engineering Testing Corporation		ELEVATION ABOVE WATER		See Note 2	
6DC-31		See Note 1 under "Remarks"		ELEVATION TOP OF MOLE		555.38	
19.0'		See Note 1 under "Remarks"		TOTAL CORE RECOVERED FOR ANALYSIS		100.0	
51.0'		See Note 1 under "Remarks"		REMARKS			
90.0'		See Note 1 under "Remarks"					
ELEVATION	DEPTH	LOGS	EXPLANATION OF MATERIALS	PERCENTAGE	TEST NO.	REMARKS	REMARKS
550.38	2		Brown Clay	0	J1	Used 8" Auger from 0.0'-3.0'	
	4			50	D1	Used 6" Denison bbl. 3.0'-10.0'	
546.38	6		Brown Sandy Clay	100	D2	Jar sample taken from shoe of each Denison sample.	
	8			100	D3		
	10		Brown Silty Clay w/Sand Lenses	100	D4	JAR SAMPLES	
	12			80	D5	1. 0.0'-3.0'	
540.38	14			100	D6	2. 5.0'	
	16		Brown Silty Sand w/Clay Lenses	90	D7	3. 7.0'	
	18			100	D8	4. 9.0'	
	20			100	D9	5. 11.0'	
532.38	22			50	D10	6. 13.0'	
	24		Tan and Gray Sandy Clay w/Silt Lenses	100	D11	7. 15.0'	
530.38	26			50	D12	8. 17.0'	
	28		Tan and Gray Silty Clay w/Iron Ore	75	D13	9. 19.0'	
	30			90	D14	10. 21.0'	
522.38	32			100	D15	11. 23.0'	
	34		Gray Silty Sand w/Scattered Gravel	90	D16	12. 25.0'	
	36			100	D17	13. 27.0'	
516.38	38			0		14. 29.0'	
	40		39.0'-45.0' SHALE	40	D18	15. 31.0'	
	42		39.0'-45.0' SHALE, Mod. Hard, Dk. Gray Thin-Bedded-Massive, w/Num. Lt. Gray Sand Pockets and Lenses	100%	Box 1	16. 33.0'-35.0'	
510.38	44		43.4' Siltstone Nods., Hard Tan	45.0	R-2	17. 35.0'-37.0'	
	46		45.0'-55.6' Shale & Sandstone, Alt. Bed w/occas. Sand Lenses	100%	Box 2	18. 38.0'-40.0'	
	48		Shale is Gray, Massive, Mod. Hard, Sandy Unweathered	50.0	R-3	Reamed from 0.0'-38.0' w/8" bit.	
	50		Sandstone is Fine-Med. Grs Soft-Mod. Hard, Gray-Lt. Gray, Well Cemented	100%	Box 3	Began coring w/6" core bbl. at 40.0'	
499.78	52		55.6'-64.0' Shale, Mod. Hard-Hard, Dk. Gray Laminated, Unweathered	54.0	R-4	Set 8" casing to 44.0'	
	54		58.6'-59.4' Fossiliferous zone Soft-Mod. Hard, Calc.	59.0	R-5	CARTON SAMPLES	
	56		64.0'-75.4' Shale & Sandstone, Alt. Bed w/occas. Sand Lenses	100%	Box 4	1. 42.3'-43.3'	
491.38	58		Shale is Mod Hard-Hard, Dk. Gray, Laminated	64.0	R-6	2. 46.2'-46.8'	
	60			69.0	Box 5	3. 51.6'-52.6'	
	62			100%	Box 6	4. 56.5'-57.5'	
	64			100%	Box 7	5. 61.2'-62.2'	
	66			100%	Box 8	6. 64.7'-65.7'	
	68			100%	Box 9	7. 72.8'-73.8'	
	70			100%	Box 10	8. 75.4'-76.4'	
	72			100%	Box 11	9. 80.9'-81.9'	
	74			100%	Box 12	10. 85.5'-86.5'	
479.38	76		75.4'-90.0' Shale, Gray-Dk. Gray, Mod. Hard-Hard, Laminated Calc.	79.0	R-7	Note 1:	
	78			100%	Box 13	Soils Logged By: A. J. Simpson, Trinity Engineering Testing Corporation	
	80			100%	Box 14	Primary Logged By: Marr, Corps of Engineers, Fort Worth District	
	82			100%	Box 15	Note 2:	
	84			100%	Box 16	Installed 4" plastic pipe from 556.6 to 511.6 for ground-water observations.	
	86			100%	Box 17		
465.38	88			59.0	Box 18		
	90			100%	Box 19		
		Total Depth = 90.0 Feet					

1834-A (MODIFIED) Aubrey Dam Site No. 1 6DC-31

RECORD DRAWING-WORK AS BUILT

SYM	DO	NO	ACTION	DATE	DESCRIPTION OF REVISION
U.S. ARMY ENGINEER DISTRICT, FORT WORTH CORPS OF ENGINEERS FORT WORTH, TEXAS					
DESIGNED BY:	RAY ROBERTS LAKE				
DRAWN BY:	ELM FORK, TRINITY RIVER, TEXAS				
REVIEWED BY:	EMBANKMENT, SPILLWAY AND				
	OUTLET WORKS				
	LOGS OF BORINGS				
	6DC-30 AND 6DC-31				
SUBMITTED BY:	INVITATION NO. DACW63-82-B-0025		DATE MAR, 1982		
ENGINEER:	CONTRACT NO. DACW63-72-C-0093		SEQUENCE NO.		19
	DRAWING NUMBER		SHEET NO.		19

TO ACCOMPANY FOUNDATION REPORT

CONTRACT NO. DACW63-82-B-0025

DRILLING LOG		Division		Installation		Notes	
PROJECT		Southwestern		Fort Worth		of 2 sheets	
Aubrey Dam Site No. 1		MSL		MSL			
LOCATION (Coordinate as shown on map)		Not Shown		Y 2141.310		Y 415.790	
DRILLING AGENCY		Trinity Engineering Testing Corporation		Boyd Lane		356DC-32	
DIRECTION OF HOLE		Vertical					
THICKNESS OF OVERBURDEN		41.5					
DEPTH DRILLED INTO ROCK		18.5					
TOTAL DEPTH OF HOLE		60.0					
ELEVATION		DEPTH		LEGEND		CLASSIFICATION OF MATERIALS (Designated)	
555.05	2						Brown Clay 2.0'
	4						Brown Sandy Clay
548.05	8						9.0'
	10						Brown Silty Sand
539.05	18						18.0'
	20						Brown Clayey Sand
530.55	26						26.5'
	28						Tan Sandy Clay
525.05	32						32.0'
	34						Tan Sand and Gravel
515.55	42						41.5 Tan Sand and Gravel
	44						SHALE & SANDSTONE, Predominantly shale, w/num. layers and lenses of sandstone and siltstone nodules. Shale is soft-mod. hard, med bedded to massive, dark gray. Sandstone is fine-grained, soft-mod. hard, light gray to tan, friable. Siltstone nodules are hard, tan.
497.05	60						60.0'
Total Depth = 60.0 Feet							
CORRECTION							
REMARKS							

DRILLING LOG		Division		Installation		Notes	
PROJECT		Southwestern		Fort Worth		of 2 sheets	
Aubrey Dam Site No. 1		MSL		MSL			
LOCATION (Coordinate as shown on map)		Not Shown		Y 2141.310		Y 415.790	
DRILLING AGENCY		Trinity Engineering Testing Corporation		Boyd Lane		356DC-32	
DIRECTION OF HOLE		Vertical					
THICKNESS OF OVERBURDEN		41.5					
DEPTH DRILLED INTO ROCK		18.5					
TOTAL DEPTH OF HOLE		60.0					
ELEVATION		DEPTH		LEGEND		CLASSIFICATION OF MATERIALS (Designated)	
554.29	2						Brown Clay
	4						Brown Sandy Clay
542.29	8						8.0'
	10						Tan Sandy Clay
542.29	19						19.0'
	20						Tan Clay w/Calcareous Particles
538.79	22						22.5'
	24						Tan Sandy Clay w/Calcareous Particles
528.29	33						33.0'
	34						Tan Clayey Sand
523.59	37						37.7'
	38						Tan Clayey Sand w/Gravel
520.29	40						40.0'
	42						41.0' Tan Gravel w/Sand
515.29	44						44.0'
	46						44.0'-45.0' Gravel, 1 1/2" Max. Diam., Well Rounded
513.29	48						48.0'
	50						45.0'-46.0' Sand & Gravel 1 1/2" Max. Diam., Fine-Med. Grn., Gray Loosely Compacted Very Moist
	52						46.0'-59.0' SHALE AND SANDSTONE, All. Beds, w/occas. Sand Lenses
	54						Shale is Gray Soft-Mod Hard Laminated Unweathered Sandstone is Mod. Hard-Hard Gray Fine-Med. Grn., Loosely Cemented Siltstone Nodules, Tan, Hard at 47.5', 54.0', 58.2'
502.29	60						60.0'
Total Depth = 59.0 Feet							
CORRECTION							
REMARKS							

DRILLING LOG		Division		Installation		Notes	
PROJECT		Southwestern		Fort Worth		of 2 sheets	
Aubrey Dam Site No. 1		MSL		MSL			
LOCATION (Coordinate as shown on map)		Not Shown		Y 2141.310		Y 415.790	
DRILLING AGENCY		Trinity Engineering Testing Corporation		Boyd Lane		356DC-32	
DIRECTION OF HOLE		Vertical					
THICKNESS OF OVERBURDEN		41.5					
DEPTH DRILLED INTO ROCK		18.5					
TOTAL DEPTH OF HOLE		60.0					
ELEVATION		DEPTH		LEGEND		CLASSIFICATION OF MATERIALS (Designated)	
554.29	2						Brown Clay
	4						Brown Sandy Clay
542.29	8						8.0'
	10						Tan Sandy Clay
542.29	19						19.0'
	20						Tan Clay w/Calcareous Particles
538.79	22						22.5'
	24						Tan Sandy Clay w/Calcareous Particles
528.29	33						33.0'
	34						Tan Clayey Sand
523.59	37						37.7'
	38						Tan Clayey Sand w/Gravel
520.29	40						40.0'
	42						41.0' Tan Gravel w/Sand
515.29	44						44.0'
	46						44.0'-45.0' Gravel, 1 1/2" Max. Diam., Well Rounded
513.29	48						48.0'
	50						45.0'-46.0' Sand & Gravel 1 1/2" Max. Diam., Fine-Med. Grn., Gray Loosely Compacted Very Moist
	52						46.0'-59.0' SHALE AND SANDSTONE, All. Beds, w/occas. Sand Lenses
	54						Shale is Gray Soft-Mod Hard Laminated Unweathered Sandstone is Mod. Hard-Hard Gray Fine-Med. Grn., Loosely Cemented Siltstone Nodules, Tan, Hard at 47.5', 54.0', 58.2'
502.29	60						60.0'
Total Depth = 59.0 Feet							
CORRECTION							
REMARKS							

Handwritten notes on the left margin of the first log, including sample depths and descriptions.

Drilling log for Southwestern Fort Worth, Aubrey Dam Site No. 1. Includes header information, well details, and a main data table with columns for depth, legend, classification of materials, and core recovery.

Drilling log for Southwestern Fort Worth, Aubrey Dam Site No. 1. Includes header information, well details, and a main data table with columns for depth, legend, classification of materials, and core recovery.

Administrative form with fields for 'DESIGNED BY', 'DRAWN BY', 'REVIEWED BY', and 'SUBMITTED BY'.

356D-34
 SHEET NO 2 SHEETS
 4" d. b.
 UNDESIGNED
 1 20
 2
 356D-35
 2-5-73
 31.0', 31.0', 31.0'
 b. Set 8"
 0.0' Water depth and belted ring
 36.0'
 SAMPLES
 - 1.0'
 - 2.0'
 - 4.5'
 - 6.0'
 - 8.5'
 - 10.0'
 - 12.5'
 - 14.0'
 - 16.5'
 - 18.0'
 - 20.5'
 - 22.0'
 - 24.5'
 - 26.0'
 - 28.5'
 - 30.0'
 SAMPLES
 - 33.0'
 - 35.0'
 - 37.0'
 - 39.0'
 (PLES
 - 3.0'
 - 7.0'
 - 11.0'
 - 15.0'
 - 19.0'
 - 23.0'
 - 27.0'
 - 31.0'
 0'
 0'
 0'
 d by: JRM, JRM, JRM, JRM
 356D-34

ELEVATION	DEPTH	LEGEND	CLASSIFICATION OF MATERIALS (Description)	% CORE RECOVERY	SOIL OR SANDS NO	REMARKS (Disturbance, main logs, depth of weathering, etc., if significant)
546.58	13.0'	[Hatched]	Dark Brown Clay	75%	W1	Boring advanced with 3" Shelby tube from 0.0'-40.5'. Cleaned out 40.5'-41.0'.
539.58	20.0'	[Hatched]	Brown Clay w/Silt	100%	W2, W3, W4, W5, W6, W7, W8, W9, W10, W11, W12, W13, W14, W15, W16	Used 6" Denison barrel 41.0'-47.0'. Set 8" casing to 45.0' depth. Encountered moisture at 23.0' and water at 38.0'. JAR SAMPLES 1. 2.0'-3.0' 2. 6.0'-7.0' 3. 10.0'-11.0' 4. 14.0'-15.0' 5. 18.0'-19.0'
524.58	35.0'	[Hatched]	Brown Silty Clay	75%	W17, W18, W19, W20, W21	DENISON SAMPLES 1. 41.0'-43.0' 2. 43.0'-45.0' 3. 45.0'-47.0'
518.08	41.5'	[Hatched]	Tan and Brown Sandy Clay	75%	D1	WRAP SAMPLES 1. 0.0'-1.0' 2. 1.0'-2.0' 3. 3.0'-4.0' 4. 4.5'-6.0' 5. 7.0'-8.5' 6. 8.5'-10.0' 7. 11.0'-12.5' 8. 12.5'-14.0' 9. 15.0'-16.5' 10. 16.5'-18.0' 11. 19.0'-20.5' 12. 20.5'-22.0' 13. 23.0'-24.5' 14. 24.5'-26.0' 15. 27.0'-28.5' 16. 28.5'-30.0' 17. 31.0'-32.5' 18. 32.5'-34.0' 19. 35.0'-36.5' 20. 36.5'-38.0' 21. 39.0'-40.5'
515.08	44.5'	[Hatched]	Gray Sandy Clay	100%	D2	
514.58	4.50'	[Hatched]	Gray Sand w/Gravel	75%	D3	
512.58		[Hatched]	Gray Shale			
			Total Depth = 47.0 Feet			

RECORD DRAWING-WORK AS BUILT

Note 1:
 Soils logged by:
 A. J. Simpson,
 Trinity Engineering
 Testing Corporation.
 Note 2:
 4" plastic pipe in-
 stalled from
 for groundwater
 observations.

SYM	DC NO	ACTION	DATE	DESCRIPTION OF REVISION
U.S. ARMY ENGINEER DISTRICT, FORT WORTH CORPS OF ENGINEERS FORT WORTH, TEXAS				
DESIGNED BY:	RAY ROBERTS LAKE ELM FORK, TRINITY RIVER, TEXAS EMBANKMENT, SPILLWAY AND OUTLET WORKS LOGS OF BORINGS 3S6DC-32, 6DC-33, 3S6D-34, AND 3S6D-35			
APPROVED BY:				
REVIEWED BY:				
SUBMITTED BY:	INVITATION NO. DACW63-82 B-0025 DATE MAR, 1982			
ENGINEER	CONTRACT NO. DACW63-82 C 0043			SEQUENCE NO. 20
	DRAWING NUMBER		SHEET NO. OF 20	

UNTRACT NO. DACW63-82 C 0043

TO ACCOMPANY FOUNDATION REPORT

Hole No. 356D-36

DRILLING		INSTALLATION				
PROJECT: Fort Worth		HOLE NO. AND TYPE OF BIT: 3" Shelby, 6" Denison				
MSL		MSL				
Falling Model 44		Falling Model 44				
TOTAL NO. OF OVERBURDEN SAMPLES TAKEN: 14		TOTAL NO. OF OVERBURDEN SAMPLES TAKEN: 23				
TOTAL NUMBER CORE BORES: 0		TOTAL NUMBER CORE BORES: 0				
ELEVATION GROUND WATER: See Note 2		ELEVATION GROUND WATER: See Note 2				
DATE MOLE STARTED: 1-29-73		DATE MOLE COMPLETED: 1-30-73				
ELEVATION TOP OF MOLE: 557.89		ELEVATION TOP OF MOLE: 557.89				
TOTAL CORE RECOVERY FOR BORING: See Note 1 under "Remarks"		TOTAL CORE RECOVERY FOR BORING: See Note 1 under "Remarks"				
SIGNATURE OF INSPECTOR: See Note 1 under "Remarks"		SIGNATURE OF INSPECTOR: See Note 1 under "Remarks"				
ELEVATION	DEPTH	LEGEND	CLASSIFICATION OF MATERIALS (Description)	NO. OF CORE RECOVERY	NO. OF SAMPLES	REMARKS (Drilling time, water loss, depth of penetration, etc.)
549.38	2		Brown Clay		W1	Drilling
	4				W2	3" Shelby: 0.0'-26.0'
	6				W3	Cleaned out
	8				W4	Set 26.0' of 8" casing
	10				W5	6" d. b. from 26.0'-46.0'. Advanced casing to 45.0'.
	12				W6	WRAP SAMPLES
	14				W7	1. 0.0'-1.0'
	16				W8	2. 1.0'-2.0'
	18				W9	3. 3.0'-4.5'
	20				W10	4. 4.5'-6.0'
	22				W11	5. 7.0'-8.5'
	24				W12	6. 8.5'-10.0'
	26				W13	7. 11.0'-12.5'
	28				W14	8. 12.5'-14.0'
	30				J1	9. 15.0'-16.5'
	32				J2	10. 16.5'-18.0'
	34				J3	11. 19.0'-20.5'
	36				J4	12. 20.5'-22.0'
	38				J5	13. 23.0'-24.5'
	40				J6	JAR SAMPLES
	42				J7	1. 2.0'-3.0'
	44				J8	2. 6.0'-7.0'
	46				J9	3. 10.0'-11.0'
					J10	4. 14.0'-15.0'
					J11	5. 18.0'-19.0'
					J12	6. 22.0'-23.0'
					J13	7. 28.0'
					J14	8. 30.0'
					J15	9. 32.0'
					J16	10. 34.0'
					J17	11. 36.0'
					J18	12. 38.0'
					J19	13. 40.0'
					J20	14. 42.0'
					J21	15. 44.0'
					J22	16. 46.0'
					J23	DENISON SAMPLES
					D1	1. 26.0'-28.0'
					D2	2. 28.0'-30.0'
					D3	3. 30.0'-32.0'
					D4	4. 32.0'-34.0'
					D5	5. 34.0'-36.0'
					D6	6. 36.0'-38.0'
					D7	7. 38.0'-40.0'
					D8	8. 40.0'-42.0'
					D9	9. 42.0'-44.0'
					D10	10. 44.0'-46.0'
						Note 1: Soils logged by: A. J. Simpson, Trinity Engineering Testing Corporation.
						Note 2: Install 4" plastic pipe from 559.18 to 513.18 for groundwater observations.
						Boring was advanced to 26.0 feet below the ground surface prior to using drilling fluid and groundwater was encountered at the 18.0-foot depth.

Hole

DRILLING		INSTALLATION				
PROJECT: Southwestern		HOLE NO. AND TYPE OF BIT: 3" Shelby				
MSL		MSL				
Falling Model 44		Falling Model 44				
TOTAL NO. OF OVERBURDEN SAMPLES TAKEN: 15		TOTAL NO. OF OVERBURDEN SAMPLES TAKEN: 15				
TOTAL NUMBER CORE BORES: 0		TOTAL NUMBER CORE BORES: 0				
ELEVATION GROUND WATER: See Note 2		ELEVATION GROUND WATER: See Note 2				
DATE MOLE STARTED: 1-29-73		DATE MOLE COMPLETED: 1-29-73				
ELEVATION TOP OF MOLE: 556.0		ELEVATION TOP OF MOLE: 556.0				
TOTAL CORE RECOVERY FOR BORING: See Note 1 under "Remarks"		TOTAL CORE RECOVERY FOR BORING: See Note 1 under "Remarks"				
SIGNATURE OF INSPECTOR: See Note 1 under "Remarks"		SIGNATURE OF INSPECTOR: See Note 1 under "Remarks"				
ELEVATION	DEPTH	LEGEND	CLASSIFICATION OF MATERIALS (Description)	NO. OF CORE RECOVERY	NO. OF SAMPLES	REMARKS (Drilling time, water loss, depth of penetration, etc.)
553.68	2		Brown Clay		W1	DRILLING
	4				W2	3" Shelby
	6				W3	Cleaned out
	8				W4	Set 26.0' of 8" casing
	10				W5	6" d. b. from 26.0'-46.0'. Advanced casing to 45.0'.
	12				W6	WRAP SAMPLES
	14				W7	1. 0.0'-1.0'
	16				W8	2. 1.0'-2.0'
	18				W9	3. 3.0'-4.5'
	20				W10	4. 4.5'-6.0'
	22				W11	5. 7.0'-8.5'
	24				W12	6. 8.5'-10.0'
	26				W13	7. 11.0'-12.5'
	28				W14	8. 12.5'-14.0'
	30				W15	9. 15.0'-16.5'
	32				J1	10. 16.5'-18.0'
	34				J2	11. 19.0'-20.5'
	36				J3	12. 20.5'-22.0'
	38				J4	13. 23.0'-24.5'
	40				J5	JAR SAMPLES
	42				J6	1. 2.0'-3.0'
	44				J7	2. 6.0'-7.0'
	46				J8	3. 10.0'-11.0'
					J9	4. 14.0'-15.0'
					J10	5. 18.0'-19.0'
					J11	6. 22.0'-23.0'
					J12	7. 28.0'
					J13	8. 30.0'
					J14	9. 32.0'
					J15	10. 34.0'
					J16	11. 36.0'
					J17	12. 38.0'
					J18	13. 40.0'
					J19	14. 42.0'
					J20	15. 44.0'
					J21	16. 46.0'
					J22	DENISON SAMPLES
					D1	1. 26.0'-28.0'
					D2	2. 28.0'-30.0'
					D3	3. 30.0'-32.0'
					D4	4. 32.0'-34.0'
					D5	5. 34.0'-36.0'
					D6	6. 36.0'-38.0'
					D7	7. 38.0'-40.0'
					D8	8. 40.0'-42.0'
					D9	9. 42.0'-44.0'
					D10	10. 44.0'-46.0'
						Note 1: Soils logged by: A. J. Simpson, Trinity Eng. Testing Co.
						Note 2: Installed 4" pipe from: 511.68 for water obse

No. 1		356DC-37	
Southwestern		Fort Worth	
1. PROJECT		2. LOCATION (City, County or State)	
3. DRILLING AGENCY		4. NAME OF DRILLER	
5. DATE MOLE		6. DATE MOLE	
7. THICKNESS OF OVERBURDEN		8. DEPTH DRILLED INTO ROCK	
9. TOTAL DEPTH OF HOLE		10. SIGNATURE OF INSPECTOR	
11. CLASSIFICATION OF MATERIALS		12. CORE RECOVERY	
13. DRILLING LOG		14. REMARKS	

No. 1		356D-38	
Southwestern		Fort Worth	
1. PROJECT		2. LOCATION (City, County or State)	
3. DRILLING AGENCY		4. NAME OF DRILLER	
5. DATE MOLE		6. DATE MOLE	
7. THICKNESS OF OVERBURDEN		8. DEPTH DRILLED INTO ROCK	
9. TOTAL DEPTH OF HOLE		10. SIGNATURE OF INSPECTOR	
11. CLASSIFICATION OF MATERIALS		12. CORE RECOVERY	
13. DRILLING LOG		14. REMARKS	

No. 1		356D-38	
Southwestern		Fort Worth	
1. PROJECT		2. LOCATION (City, County or State)	
3. DRILLING AGENCY		4. NAME OF DRILLER	
5. DATE MOLE		6. DATE MOLE	
7. THICKNESS OF OVERBURDEN		8. DEPTH DRILLED INTO ROCK	
9. TOTAL DEPTH OF HOLE		10. SIGNATURE OF INSPECTOR	
11. CLASSIFICATION OF MATERIALS		12. CORE RECOVERY	
13. DRILLING LOG		14. REMARKS	

RECORD DRAWING-WORK AS BUILT

Division	Southwestern	INSTALLATION	Fort Worth	SHEET	1	of 2 SHEETS
PROJECT	Dam Site No. 1	NO. SIZE AND TYPE OF BIT	3" Shelby, 6" d.b.	DATE FOR ELEVATION	1-18-73	MSL
LOCATION	Not Shown	MANUFACTURER'S DESIGNATION OF DRILL	Falling Model 44	TOTAL NO. OF OVERBURDEN SAMPLES TAKEN	11	UNDISTURBED
DRILLING AGENCY	Corps of Engineers	MANUFACTURER'S DESIGNATION OF DRILL	Falling Model 44	TOTAL NO. OF OVERBURDEN SAMPLES TAKEN	19	UNDISTURBED
HOLE NO. FOR REFERENCE ON DRAWING	356D-38	NAME OF DRILLER	Boyd Lane	ELEVATION GROUND WATER	See Note 2	
DIRECTION OF HOLE	Vertical	DATE HOLE	1-18-73	DATE HOLE	1-20-73	
THICKNESS OF OVERBURDEN	44.0'	ELEVATION TOP OF HOLE	559.07	TOTAL CORE RECOVERY FOR BORING	---	
DEPTH DRILLED INTO ROCK	1.5'	SIGNATURE OF INSPECTOR		TOTAL DEPTH OF HOLE	47.0'	

DEPTH	LEGEND	CLASSIFICATION OF MATERIALS (Description)	% CORE RECOVERY	NO. OF SAMPLES	REMARKS (Drilling time, water loss, depth of overburden, etc., if significant)
0.0' - 3.0'		Dark Brown Clay		W1, W2, J1, W3	3" Shelby tube samples from 0.0'-30.0'. Boring was advanced to 30.0' prior to using drilling fluid.
3.0' - 8.5'		Brown Clay		W4, J2, W5	Water at 20.5'. 6" d.b. from 30.0'-45.5'.
8.5' - 26.0'		Light Brown Silty Clay		W6, J3, W7, W8, W9, W10, W11, W12, J7, W13, W14	Set 8" casing to 44.0'. WRAP SAMPLES: 1. 0.0'-1.0', 2. 1.0'-2.0', 3. 3.0'-4.5', 4. 4.5'-6.0', 5. 7.0'-8.5', 6. 8.5'-10.0', 7. 11.0'-12.5', 8. 12.5'-14.0', 9. 15.0'-16.5', 10. 16.5'-18.0', 11. 19.0'-20.5', 12. 20.5'-22.0', 13. 23.0'-24.5', 14. 24.5'-26.0'.
26.0' - 28.5'		Tan Sandy Clay		J8, W15, W16	15. 27.0'-28.5', 16. 28.5'-30.0'.
28.5' - 36.0'		Tan Sand w/Gravel	100% D1, 100% D2, 0%	D1, D2	DENISON SAMPLES: 1. 30.0'-32.0', 2. 32.0'-34.0', 3. 42.0'-44.0', 4. 44.0'-45.5'.
36.0' - 44.0'		Tan Sand and Gravel	0%, 10%	J11	JAR SAMPLES: 1. 2.0'-3.0', 2. 6.0'-7.0', 3. 10.0'-11.0', 4. 14.0'-15.0', 5. 18.0'-19.0', 7. 22.0'-23.0', 8. 26.0'-27.0', 9. 32.0', 10. 34.0', 11. 38.0'-40.0', 12. 44.0', 13. 45.5'.
44.0' - 45.5'		Gray Shale	100%	D4	
Total Depth = 45.5 Feet					

Note 1: Soils logged by: A. J. Simpson, Trinity Engineering Testing Corporation.

Note 2: Installed 4" plastic pipe from for groundwater observations.

RECORD DRAWING-WORK AS BUILT

Division	Southwestern	INSTALLATION	Fort Worth	SHEET	2	of 2 SHEETS
PROJECT	Aubrey Dam Site No. 1	NO. SIZE AND TYPE OF BIT	3" Shelby, 6" d.b.	DATE FOR ELEVATION	1-16-73	MSL
LOCATION	Not Shown	MANUFACTURER'S DESIGNATION OF DRILL	Falling Model 44	TOTAL NO. OF OVERBURDEN SAMPLES TAKEN	11	UNDISTURBED
DRILLING AGENCY	Corps of Engineers	MANUFACTURER'S DESIGNATION OF DRILL	Falling Model 44	TOTAL NO. OF OVERBURDEN SAMPLES TAKEN	19	UNDISTURBED
HOLE NO. FOR REFERENCE ON DRAWING	356D-39	NAME OF DRILLER	Boyd Lane	ELEVATION GROUND WATER	See Note 2	
DIRECTION OF HOLE	Vertical	DATE HOLE	1-16-73	DATE HOLE	1-17-73	
THICKNESS OF OVERBURDEN	45.5'	ELEVATION TOP OF HOLE	560.61	TOTAL CORE RECOVERY FOR BORING	---	
DEPTH DRILLED INTO ROCK	1.5'	SIGNATURE OF INSPECTOR		TOTAL DEPTH OF HOLE	47.0'	

ELEVATION	DEPTH	LEGEND	CLASSIFICATION OF MATERIALS (Description)	% CORE RECOVERY	NO. OF SAMPLES	REMARKS (Drilling time, water loss, depth of overburden, etc., if significant)
556.11	2.0' - 4.5'		Dark Brown Clay		W1, W2, J1, W3	3" Shelby tube samples from 0.0'-34.0'. 6" d.b. samples from 34.0'-47.0'. Boring was advanced to 34.0' prior to using drilling fluid.
533.61	6.0' - 27.0'		Brown Silty Clay		W4, J2, W5, W6, J3, W7, W8, J4, W9, W10, W11, W12, J6, W13, W14, J7	WRAP SAMPLES: 1. 0.0'-1.0', 2. 1.0'-2.0', 3. 3.0'-4.5', 4. 4.5'-6.0', 5. 7.0'-8.5', 6. 8.5'-10.0', 7. 11.0'-12.5', 8. 12.5'-14.0', 9. 15.0'-16.5', 10. 16.5'-18.0', 11. 19.0'-20.5', 12. 20.5'-22.0', 13. 23.0'-24.5', 14. 24.5'-26.0', 15. 27.0'-28.5', 16. 28.5'-30.0', 17. 31.0'-32.5', 18. 32.5'-34.0'.
532.11	28.0' - 30.0'		Tan Sandy Clay		W15, W16, J8	15. 27.0'-28.5', 16. 28.5'-30.0', 17. 31.0'-32.5', 18. 32.5'-34.0'.
521.11	30.0' - 39.5'		Tan Clayey Sand	100% D1, 100% D2, 75% D3	D1, D2, D3	DENISON SAMPLES: 1. 34.0'-36.0', 2. 36.0'-38.0', 3. 38.0'-40.0', 4. 40.0'-42.0', 5. 42.0'-44.0', 6. 45.5'-47.0'.
515.11	40.0' - 45.5'		Tan Sand and Gravel	85% D4, 90% D5, 33% J14	D4, D5, J14	A jar sample was taken from the shoe of each denison barrel run. JAR SAMPLES: 1. 2.0'-3.0', 2. 6.0'-7.0', 3. 10.0'-11.0', 4. 14.0'-15.0', 5. 18.0'-19.0', 6. 22.0'-23.0', 7. 26.0'-27.0', 8. 30.0'-31.0', 9. 36.0', 10. 38.0', 11. 40.0', 12. 42.0', 13. 44.0', 14. 44.0'-45.5', 15. 47.0'.
513.61	46.0' - 47.0'		Gray Shale	100%	D6	
Total Depth = 47.0 Feet						

Note 1: Soils logged by: A. J. Simpson, Trinity Engineering Testing Corporation.

DESIGNED BY:			
DRAWN BY:			
CHECKED BY:			
SUBMITTED BY:			
ENGINEER			
U.S. ARMY ENGINEER DISTRICT, FORT WORTH CORPS OF ENGINEERS FORT WORTH, TEXAS			
RAY ROBERTS LAKE ELM FORK, TRINITY RIVER, TEXAS EMBANKMENT, SPILLWAY AND OUTLET WORKS LOGS OF BORINGS 8S6D-36, 3S6DC-37, 3S6D-38, AND 3S6D-39			
INVITATION NO. DACW63-82-B-0025		DATE MAR, 1982	
CONTRACT NO. DACW63-82-C-0023		SEQUENCE NO. 21	
DRAWING NUMBER		SHEET NO. OF	

TO ACCOMPANY FOUNDATION REPORT

CONTRACT NO. DACW63-82-C-0023

DRILLING LOG		SWITCHED ON		No. No. 354D-40	
PROJECT: Aubrey Dam Site No. 1		INSTALLATION: Fort Worth		SHEET 1 OF 2 SHEETS	
COORDINATES: X = 2,142,040; Y = 616,930		MSL		NK-CORE	
CORPS OF ENGINEERS		DAMCO 1150		CORPS OF ENGINEERS	
BILL STATION: 354D-40		ELEVATION 640.04		DATE MOLE: 11-30-73	
TRINITY ENGINEERING TESTING CORPORATION		ELEVATION TOP OF MUD: 640.04		DATE MOLE: 2-8-73	
DEPTH OF MUD: 15.0'		ELEVATION 640.04		DATE MOLE: 2-8-73	
DEPTH DRILLED INTO ROCK: 12.0'		ELEVATION 640.04		DATE MOLE: 2-8-73	
TOTAL DEPTH OF MUD: 27.0'		ELEVATION 640.04		DATE MOLE: 2-8-73	
TOTAL DEPTH OF BORING: 59.0'		ELEVATION 640.04		DATE MOLE: 2-8-73	
ELEVATION		DEPTH		CLASSIFICATION OF MATERIALS	
562.3	2	Brown Silty Sand	W1	DRILLING: 0.0'-9.0'; 3" Shelby Tube	
559.3	4	Brown Silty Sand w/Clay Lenses	B1	9.0'-17.0'; 8" d.b. 17.0'-27.0'; NX-CORE. Set tub at 9.0'.	
557.3	6	Red and Brown Clayey Sand	J2	WRAP SAMPLES: 1. 0.0'-2.0'	
556.3	8	Brown and Light Gray Clayey Sand	D1	2. 6.0'-8.0'	
551.3	10	Gray Clay w/Sand Lenses and Iron Ore Particles	D2	3. 22.2'-22.9'	
	12	Tan Sandstone w/Shale Lenses	D3	4. 23.5'-24.4'	
	14		DA	1. 2.0'-4.0'	
	16		R-1	2. 6.0'-8.0'	
	18		Box 1	3. 11.0'	
	20		R-2	4. 13.0'	
	22		W1	5. 15.0'	
	24		W2	6. 17.0'	
	26		W3	Set 8" casing to the 17.0' depth.	
	28		W4	Note 1: Soils logged by: A. J. Simpson, Trinity Engineering Testing Corporation.	
				Note 2: Installed 4" plastic pipe from 650.0 to 631.0 for ground-water observations.	

ENG FORM 1836-A (MODIFIED) PROJECT: Aubrey Dam Site No. 1 356D-40

DRILLING LOG		SWITCHED ON		No. No. 354C-41	
PROJECT: Aubrey Dam Site No. 1		INSTALLATION: Fort Worth		SHEET 1 OF 2 SHEETS	
COORDINATES: X = 2,142,525; Y = 616,930		MSL		NK-CORE	
CORPS OF ENGINEERS		DAMCO 1250		CORPS OF ENGINEERS	
BILL STATION: 354C-41		ELEVATION 665.20		DATE MOLE: 11-13-73	
TRINITY ENGINEERING TESTING CORPORATION		ELEVATION 665.20		DATE MOLE: 2-15-73	
DEPTH OF MUD: 49.0'		ELEVATION 665.20		DATE MOLE: 2-15-73	
DEPTH DRILLED INTO ROCK: 10.0'		ELEVATION 665.20		DATE MOLE: 2-15-73	
TOTAL DEPTH OF MUD: 59.0'		ELEVATION 665.20		DATE MOLE: 2-15-73	
TOTAL DEPTH OF BORING: 100.0'		ELEVATION 665.20		DATE MOLE: 2-15-73	
ELEVATION		DEPTH		CLASSIFICATION OF MATERIALS	
664.70	2	0.4' Brown Clayey Sand	B1	DRILLING: 0.0'-9.0'; 3" Shelby Tube	
660.20	4	Red Clayey Silty Sand	J1	9.0'-49.0'; NX-CORE And 2" Split-Spoon And 2" Core	
	6		W1	49.0'-59.0'; 4" Core	
	8		W2	9.0'	
	10		W3	*All recovered NX-CORE Samples were placed in PETCO's cardboard core box	
	12	Red and Orange Sand (Cemented)	B2	Set 6" casing to 49.0' depth. Sand washed away with drilling fluid.	
	14		B3		
	16		B4		
	18		B5		
	20		B6		
	22		B7		
	24		B8		
	26		B9		
	28		B10		
	30		B11		
	32		B12		
	34		B13		
	36		B14		
	38		B15		
	40		B16		
	42		B17		
	44		B18		
	46		B19		
	48		B20		
	50		B21		
	52		B22		
	54		B23		
	56		B24		
	58		B25		
	60		B26		
				Total Depth of Boring = 59.0'	
				Note 1: Soils logged by: A. J. Simpson, Trinity Engineering Testing Corporation	
				Primary logged by: Max F. Fort Worth District, Corps of Engineers	
				Note 2: 2" plastic pipe installed from 666.2 to 616.2 for ground-water observations.	

ENG FORM 1836-A (MODIFIED) PROJECT: Aubrey Dam Site No. 1 354C-41

POLYTRACE-033

Well No. 354C-41	
DATE	1973
DEPTH	100.0
DRILLING LOG	Southwestern
CLIENT	Aubrey Dam Site No. 1
LOCATION	X = 2,143.550 Y = 616.150
DRILLING METHOD	354C-42
DRILLER	Trinity Engineering Testing Corp.
DATE	2-13-73
TIME	2-15-73
DEPTH	100.0
INDEX "Remarks"	
01	DRILLING:
02	0.0'-9.0' 3" Shelby
03	9.0'-49.0' NX-Core
04	and 2" Split-Spoon
05	49.0'-59.0' 4" Core
06	All covered NX-Core
07	Samples were placed in
08	TEST CO's cardboard core box
09	Set 6" casing to 49.0'
10	depth. Sand washed away
11	with drilling fluid.
12	JAR SAMPLES:
13	1. 2.0'-3.0'
14	2. 6.0'-7.0'
15	BAG SAMPLES:
16	1. 0.0'-1.0'
17	2. 7.0'-8.0'
18	3. 8.0'-9.0'
19	4. 18.0'-19.0'
20	5. 23.0'-24.0'
21	6. 28.0'-29.0'
22	7. 33.0'-34.0'
23	8. 38.0'-39.0'
24	9. 43.0'-44.0'
25	WRAP SAMPLES:
26	1. 1.0'-2.0'
27	2. 3.0'-4.0'
28	3. 8.0'-9.0'
29	4. 18.0'-19.0'
30	5. 23.0'-24.0'
31	6. 28.0'-29.0'
32	7. 33.0'-34.0'
33	8. 38.0'-39.0'
34	9. 43.0'-44.0'
35	CARTONS:
36	1. 52.5'-53.4'
37	BOXES:
38	1. 49.0'-54.0'
39	2. 54.0'-59.0'
40	Note 1:
41	Soils logged by:
42	A. J. Simpson,
43	Trinity Engineering
44	Testing Corporation
45	Primary logged by:
46	Marr,
47	Fort Worth District,
48	Corps of Engineers
49	Note 2:
50	2" plastic pipe installed
51	from 66.2 to 616.2
52	for groundwater observations.

Well No. 354C-42	
DATE	1973
DEPTH	100.0
DRILLING LOG	Southwestern
CLIENT	Aubrey Dam Site No. 1
LOCATION	X = 2,143.550 Y = 616.150
DRILLING METHOD	354C-42
DRILLER	Trinity Engineering Testing Corp.
DATE	2-13-73
TIME	2-15-73
DEPTH	100.0
INDEX "Remarks"	
01	DRILLING:
02	0.0'-13.0' 3" Shelby
03	13.0'-50.0' NX-Core
04	and 2" Split-Spoon
05	50.0'-55.0' 4" Core
06	Drilling fluid was used
07	below the 10.5' depth.
08	Set casing to 30.0'
09	WRAP SAMPLES:
10	1. 0.0'-2.0'
11	2. 3.0'-4.0'
12	3. 4.0'-5.0'
13	4. 5.0'-6.0'
14	5. 7.0'-8.0'
15	6. 8.0'-9.0'
16	7. 9.0'-10.0'
17	8. 43.2'-43.7'
18	9. 43.7'-44.3'
19	10. 45.0'-46.2'
20	11. 46.2'-46.8'
21	12. 46.8'-47.6'
22	JAR SAMPLES:
23	1. 2.0'-3.0'
24	2. 6.0'-7.0'
25	3. 10.0'-10.5'
26	BAG SAMPLES:
27	1. 10.5'-12.0'
28	2. 12.0'-13.0'
29	3. 16.0'-21.0'
30	4. 25.0'-26.0'
31	5. 30.0'-31.0'
32	6. 33.0'-35.6'
33	7. 40.0'-41.0'
34	BOX 1: 5.0'-55.0'
35	CARTON 1: 31.8'-52.7'
36	Note 1:
37	Soils Logged By:
38	A. J. Simpson,
39	Trinity Engineering
40	Testing Corporation
41	Primary Logged By:
42	Marr
43	Corps of Engineers
44	Fort Worth District
45	Note 2:
46	Installed 2" plastic
47	pipe from 63.0
48	to 613.0 for ground
49	water observations.

Well No. 356C-5	
DATE	1973
DEPTH	100.0
DRILLING LOG	Southwestern
CLIENT	Aubrey Dam Site No. 1
LOCATION	X = 137.145 Y = 614.466
DRILLING METHOD	356DC-50
DRILLER	Boyd Lane
DATE	1-25-73
TIME	3-15-73
DEPTH	100.0
INDEX "Remarks"	
01	DRILLING:
02	0.0'-14.0' Tan and Brown Clay
03	14.0'-18.0' Limestone Gravel,
04	Weathered, Tan Mod.
05	18.0' Hard
06	18.0'-22.0' Shale, Tan and Gray Weath-
07	ered, Soft w/Num. Fine
08	Grn. Soft, Friable, Tan
09	Sand Pockets
10	22.0'-28.7' Sandstone,
11	Red, Hard.
12	27.2'-28.7' Sandstone,
13	Fin. Grain, Soft, Friable,
14	Tan, Weathered, Ox.
15	Stained.
16	30.5'-90.0' Shale and Sandstone, Pre-
17	dominantly Shale w/Num.
18	Layers and Lenses of
19	Sandstone and Siltstone
20	Nodules.
21	30.5'-90.0' Shale and Sandstone, Pre-
22	dominantly Shale w/Num.
23	Layer and Lenses of
24	Sandstone, Scattered
25	Siltstone, Inclusions and
26	Fossil Shells.
27	Shale is Soft-Mid. Hard,
28	Med. Bedded to Massive,
29	Dark Gray, Unweathered,
30	Sandstone is Soft-Mod.
31	Hard, Lt. Gray, Fine-V.
32	Fin. Grn., Friable.
33	Siltstone is Hard Tan Below
34	60.0' Sandstone is very
35	Fine Grain and Hard.
36	Started coring with 6"
37	core barrel at 27.0'.
38	CARTON SAMPLES
39	1. 27.0'-27.5'
40	2. 31.3'-34.3'
41	3. 38.5'-39.2'
42	4. 41.7'-42.7'
43	5. 47.0'-48.0'
44	6. 50.5'-51.5'
45	7. 58.0'-59.0'
46	8. 60.8'-61.8'
47	9. 66.5'-67.5'
48	10. 71.5'-72.5'
49	11. 75.6'-76.6'
50	12. 80.9'-81.9'
51	13. 84.3'-85.3'
52	14. 89.0'-90.0'
53	BOXES
54	1. 27.0'-31.9'
55	2. 31.9'-37.2'
56	3. 37.2'-43.5'
57	4. 43.5'-49.5'
58	5. 49.5'-55.0'
59	6. 55.0'-62.1'
60	7. 62.1'-68.0'
61	8. 68.0'-73.6'
62	9. 73.6'-80.0'
63	10. 80.0'-86.0'
64	11. 86.0'-90.0'
65	Note 1:
66	Soils logged by:
67	A. J. Simpson,
68	Trinity Engineering
69	Testing Corporation
70	Primary logged by:
71	Greco & Marr
72	Corps of Engineers,
73	Fort Worth District.
74	Note 2:
75	Installed 4" plastic
76	pipe from 597.8 to 566.
77	for groundwater
78	observations.

Mole No. 354C-42	
SHEET 1 OF 2 SHEETS	
AUBREY DAM SITE NO. 1	
ENGINEERING DISTRICT OF FORT WORTH	
CORPS OF ENGINEERS	
356DC-50	
BOND LANE	
TRINITY ENGINEERING TESTING CORPORATION	
See Note 1	
See Note 2	
2-13-73	
662.00	
31	
Remarks	
RECORDS	
DRILLING:	
0.0'-13.0', 3" Shelby Tube	
13.0'-50.0', NX-Core	
21.0'-41.0', Split-Spoon Samples at 5' Intervals.	
50.0'-55.0', 4" Core	
Drilling fluid was used below the 10.5' depth. Set casing to 50.0'	
WRAP SAMPLES:	
1. 0.0' - 2.0'	
2. 3.0' - 4.0'	
3. 4.0' - 5.0'	
4. 5.0' - 6.0'	
5. 7.0' - 8.0'	
6. 8.0' - 9.0'	
7. 9.0' - 10.0'	
8. 43.2' - 43.7'	
9. 43.7' - 44.3'	
10. 45.0' - 46.2'	
11. 46.2' - 46.8'	
12. 46.8' - 47.6'	
JAR SAMPLES:	
1. 2.0' - 3.0'	
2. 6.0' - 7.0'	
3. 10.0' - 10.5'	
RAG SAMPLES:	
1. 10.5' - 12.0'	
2. 12.0' - 13.0'	
3. 16.0' - 21.0'	
4. 25.0' - 26.0'	
5. 30.0' - 31.0'	
6. 35.0' - 35.6'	
7. 40.0' - 41.0'	
BOX 1: 5.0' - 55.0'	
CARTON 1:	
31.8' - 52.7'	
Note 1:	
Soils Logged By: A. J. Simpson, Trinity Engineering Testing Corporation	
Primary Logged By: Marr Corps of Engineers Fort Worth District	
Note 2:	
Installed 2" plastic pipe from 653.0 to 613.0 for groundwater observations.	

Mole No. 354C-42		Mole No. 356DC-50	
SHEET 1 OF 2 SHEETS		SHEET 1 OF 2 SHEETS	
AUBREY DAM SITE NO. 1		AUBREY DAM SITE NO. 1	
ENGINEERING DISTRICT OF FORT WORTH		ENGINEERING DISTRICT OF FORT WORTH	
CORPS OF ENGINEERS		CORPS OF ENGINEERS	
356DC-50		356DC-50	
BOND LANE		BOND LANE	
TRINITY ENGINEERING TESTING CORPORATION		TRINITY ENGINEERING TESTING CORPORATION	
See Note 1		See Note 2	
See Note 2		See Note 1	
2-13-73		2-13-73	
662.00		556.34	
31		98.0	
Remarks		Remarks	
RECORDS		RECORDS	
DRILLING:		DRILLING:	
0.0'-13.0', 3" Shelby Tube		0.0'-24.5', 3" Shelby tube	
13.0'-50.0', NX-Core		2.0'-3.0', JAR SAMPLES	
21.0'-41.0', Split-Spoon Samples at 5' Intervals.		4.0'-7.0', JAR SAMPLES	
50.0'-55.0', 4" Core		10.0'-11.0', JAR SAMPLES	
Drilling fluid was used below the 10.5' depth. Set casing to 50.0'		14.0'-14.5', JAR SAMPLES	
WRAP SAMPLES:		18.0'-19.0', JAR SAMPLES	
1. 0.0' - 2.0'		22.0'-23.0', JAR SAMPLES	
2. 3.0' - 4.0'		26.0'-27.0', JAR SAMPLES	
3. 4.0' - 5.0'		27.0'-28.0', JAR SAMPLES	
4. 5.0' - 6.0'		28.0'-29.0', JAR SAMPLES	
5. 7.0' - 8.0'		29.0'-30.0', JAR SAMPLES	
6. 8.0' - 9.0'		30.0'-31.0', JAR SAMPLES	
7. 9.0' - 10.0'		31.0'-32.0', JAR SAMPLES	
8. 43.2' - 43.7'		32.0'-33.0', JAR SAMPLES	
9. 43.7' - 44.3'		33.0'-34.0', JAR SAMPLES	
10. 45.0' - 46.2'		34.0'-35.0', JAR SAMPLES	
11. 46.2' - 46.8'		35.0'-36.0', JAR SAMPLES	
12. 46.8' - 47.6'		36.0'-37.0', JAR SAMPLES	
JAR SAMPLES:		37.0'-38.0', JAR SAMPLES	
1. 2.0' - 3.0'		38.0'-39.0', JAR SAMPLES	
2. 6.0' - 7.0'		39.0'-40.0', JAR SAMPLES	
3. 10.0' - 10.5'		40.0'-41.0', JAR SAMPLES	
RAG SAMPLES:		41.0'-42.0', JAR SAMPLES	
1. 10.5' - 12.0'		42.0'-43.0', JAR SAMPLES	
2. 12.0' - 13.0'		43.0'-44.0', JAR SAMPLES	
3. 16.0' - 21.0'		44.0'-45.0', JAR SAMPLES	
4. 25.0' - 26.0'		45.0'-46.0', JAR SAMPLES	
5. 30.0' - 31.0'		46.0'-47.0', JAR SAMPLES	
6. 35.0' - 35.6'		47.0'-48.0', JAR SAMPLES	
7. 40.0' - 41.0'		48.0'-49.0', JAR SAMPLES	
BOX 1: 5.0' - 55.0'		49.0'-50.0', JAR SAMPLES	
CARTON 1:		50.0'-51.0', JAR SAMPLES	
31.8' - 52.7'		51.0'-52.0', JAR SAMPLES	
Note 1:		52.0'-53.0', JAR SAMPLES	
Soils Logged By: A. J. Simpson, Trinity Engineering Testing Corporation		53.0'-54.0', JAR SAMPLES	
Primary Logged By: Marr Corps of Engineers Fort Worth District		54.0'-55.0', JAR SAMPLES	
Note 2:		55.0'-56.0', JAR SAMPLES	
Installed 2" plastic pipe from 653.0 to 613.0 for groundwater observations.		56.0'-57.0', JAR SAMPLES	

Mole No. 354C-42		Mole No. 356DC-50	
SHEET 1 OF 2 SHEETS		SHEET 1 OF 2 SHEETS	
AUBREY DAM SITE NO. 1		AUBREY DAM SITE NO. 1	
ENGINEERING DISTRICT OF FORT WORTH		ENGINEERING DISTRICT OF FORT WORTH	
CORPS OF ENGINEERS		CORPS OF ENGINEERS	
356DC-50		356DC-50	
BOND LANE		BOND LANE	
TRINITY ENGINEERING TESTING CORPORATION		TRINITY ENGINEERING TESTING CORPORATION	
See Note 1		See Note 2	
See Note 2		See Note 1	
2-13-73		2-13-73	
662.00		556.34	
31		98.0	
Remarks		Remarks	
RECORDS		RECORDS	
DRILLING:		DRILLING:	
0.0'-13.0', 3" Shelby Tube		0.0'-24.5', 3" Shelby tube	
13.0'-50.0', NX-Core		2.0'-3.0', JAR SAMPLES	
21.0'-41.0', Split-Spoon Samples at 5' Intervals.		4.0'-7.0', JAR SAMPLES	
50.0'-55.0', 4" Core		10.0'-11.0', JAR SAMPLES	
Drilling fluid was used below the 10.5' depth. Set casing to 50.0'		14.0'-14.5', JAR SAMPLES	
WRAP SAMPLES:		18.0'-19.0', JAR SAMPLES	
1. 0.0' - 2.0'		22.0'-23.0', JAR SAMPLES	
2. 3.0' - 4.0'		26.0'-27.0', JAR SAMPLES	
3. 4.0' - 5.0'		27.0'-28.0', JAR SAMPLES	
4. 5.0' - 6.0'		28.0'-29.0', JAR SAMPLES	
5. 7.0' - 8.0'		29.0'-30.0', JAR SAMPLES	
6. 8.0' - 9.0'		30.0'-31.0', JAR SAMPLES	
7. 9.0' - 10.0'		31.0'-32.0', JAR SAMPLES	
8. 43.2' - 43.7'		32.0'-33.0', JAR SAMPLES	
9. 43.7' - 44.3'		33.0'-34.0', JAR SAMPLES	
10. 45.0' - 46.2'		34.0'-35.0', JAR SAMPLES	
11. 46.2' - 46.8'		35.0'-36.0', JAR SAMPLES	
12. 46.8' - 47.6'		36.0'-37.0', JAR SAMPLES	
JAR SAMPLES:		37.0'-38.0', JAR SAMPLES	
1. 2.0' - 3.0'		38.0'-39.0', JAR SAMPLES	
2. 6.0' - 7.0'		39.0'-40.0', JAR SAMPLES	
3. 10.0' - 10.5'		40.0'-41.0', JAR SAMPLES	
RAG SAMPLES:		41.0'-42.0', JAR SAMPLES	
1. 10.5' - 12.0'		42.0'-43.0', JAR SAMPLES	
2. 12.0' - 13.0'		43.0'-44.0', JAR SAMPLES	
3. 16.0' - 21.0'		44.0'-45.0', JAR SAMPLES	
4. 25.0' - 26.0'		45.0'-46.0', JAR SAMPLES	
5. 30.0' - 31.0'		46.0'-47.0', JAR SAMPLES	
6. 35.0' - 35.6'		47.0'-48.0', JAR SAMPLES	
7. 40.0' - 41.0'		48.0'-49.0', JAR SAMPLES	
BOX 1: 5.0' - 55.0'		49.0'-50.0', JAR SAMPLES	
CARTON 1:		50.0'-51.0', JAR SAMPLES	
31.8' - 52.7'		51.0'-52.0', JAR SAMPLES	
Note 1:		52.0'-53.0', JAR SAMPLES	
Soils Logged By: A. J. Simpson, Trinity Engineering Testing Corporation		53.0'-54.0', JAR SAMPLES	
Primary Logged By: Marr Corps of Engineers Fort Worth District		54.0'-55.0', JAR SAMPLES	
Note 2:		55.0'-56.0', JAR SAMPLES	
Installed 2" plastic pipe from 653.0 to 613.0 for groundwater observations.		56.0'-57.0', JAR SAMPLES	

RECORD DRAWING-WORK AS BUILT

DESIGNED BY	RAY ROBERTS LAKE		
DRAWN BY	ELM FORK, TRINITY RIVER, TEXAS		
REVIEWED BY	EMBANKMENT, SPILLWAY AND		
SUBMITTED BY	OUTLET WORKS		
ENGINEER	LOGS OF BORINGS		
	356D-40, 354C-41, 354C-42, 356DC-50 AND 35-51		
	INVITATION NO. DACW63-82-B-0025	DATE	MAR, 1982
	CONTRACT NO. DACW63-82-C-0083	SHEET NO.	22
	DRAWING NUMBER		

TO ACCOMPANY FOUNDATION REPORT

Hole No. 35-52

DRILLING: Division: Southwestern		INSTALLATION: Fort Worth		SHEET: 1 of 1 SHEETS	
PROJECT: Aubrey Dam Site No. 1		HOLE NO. AND TYPE OF BIT: 3" Shelby tube		DATE: 1-23-73	
LOCATION: Not Shown		M.S.L. (ELEVATION OF BENCH MARK): MSL		DATE FOR ELEVATION DATA: 1-23-73	
DRAWN BY: Corps of Engineers		FALLING MODEL: 44		TOTAL NO. OF OVERBURDEN SAMPLES TAKEN: 3	
HOLE NO. AS SHOWN ON DRAWING: 35-52		TOTAL NUMBER CORE BOXES: 0		TOTAL NUMBER CORE BOXES: 0	
NAME OF DRILLER: Boyd Lane		ELEVATION GROUND WATER: See Note 2		ELEVATION GROUND WATER: See Note 2	
TRINITY ENGINEERING TESTING CORPORATION		DATE MOLE: 1-23-73		DATE MOLE: 1-23-73	
THICKNESS OF OVERBURDEN: 17.5'		ELEVATION TOP OF HOLE: 568.34		ELEVATION TOP OF HOLE: 568.37	
DEPTH DRILLED INTO ROCK: 1.5'		TOTAL CORE RECOVERY FOR BORING: ---		TOTAL CORE RECOVERY FOR BORING: ---	
TOTAL DEPTH OF HOLE: 19.0'		SIGNATURE OF INSPECTOR: See Note 1 under "Remarks"		SIGNATURE OF INSPECTOR: See Note 1 under "Remarks"	

ELEVATION	DEPTH	LEGEND	CLASSIFICATION OF MATERIALS (Description)	SCORE RECOVERY (%)	BOX OR SAMPLE NO.	REMARKS (Drilling time, water level, depth of measuring, etc., if significant)
566.34	2		Brown Sandy Clay		W1	Boring was advanced to 15.0' prior to using drilling fluid. Water at 12.5'. All samples taken with 3" Shelby tube, except B2, which is a washed sample.
	4		Brown and Tan Sandy Clay w/Iron Ore		W2	
562.34	6		6.0'		W3	
	8		Brown and Light Gray Sandy Clay w/Iron Ore		W4	
560.04	10		Tan Clayey Silty Sand w/Gravel		W5	
	12				B1	WRAP SAMPLES 1. 0.0'-1.0' 2. 1.0'-2.0' 3. 3.0'-4.5' 4. 4.5'-6.0' 5. 7.0'-8.5' 6. 11.0'-12.5' 7. 12.5'-14.0'
	14				J3	
	16		17.5'		W6	
550.84	18		Gray Shale		W7	
	20		Total Depth = 19.0 Feet		J4	
549.34					B2	
					J5	
						BAG SAMPLES 1. 8.5'-10.0' 2. 15.0'-18.0'
						JAR SAMPLES 1. 2.0'-3.0' 2. 6.0'-7.0' 3. 10.0'-11.0' 4. 14.0'-15.0' 5. 18.0'-19.0'

ENG FORM 1836 PREVIOUS EDITIONS ARE OBSOLETE
MAR 71 (MODIFIED) (TRANSLUCENT)

PROJECT: Aubrey Dam Site No. 1 HOLE NO. 35-52

Hole No. 35-53

DRILLING: Division: Southwestern		INSTALLATION: Fort Worth		SHEET: 1 of 1 SHEETS	
PROJECT: Aubrey Dam Site No. 1		HOLE NO. AND TYPE OF BIT: 3" Shelby		DATE: 1-23-73	
LOCATION: Not Shown		M.S.L. (ELEVATION OF BENCH MARK): MSL		DATE FOR ELEVATION DATA: 1-23-73	
DRAWN BY: Corps of Engineers		FALLING MODEL: 44		TOTAL NO. OF OVERBURDEN SAMPLES TAKEN: 3	
HOLE NO. AS SHOWN ON DRAWING: 35-53		TOTAL NUMBER CORE BOXES: 0		TOTAL NUMBER CORE BOXES: 0	
NAME OF DRILLER: Boyd Lane		ELEVATION GROUND WATER: See Note 2		ELEVATION GROUND WATER: See Note 2	
TRINITY ENGINEERING TESTING CORPORATION		DATE MOLE: 1-23-73		DATE MOLE: 1-23-73	
THICKNESS OF OVERBURDEN: 12.5'		ELEVATION TOP OF HOLE: 562.37		ELEVATION TOP OF HOLE: 562.37	
DEPTH DRILLED INTO ROCK: 4.5'		TOTAL CORE RECOVERY FOR BORING: ---		TOTAL CORE RECOVERY FOR BORING: ---	
TOTAL DEPTH OF HOLE: 17.0'		SIGNATURE OF INSPECTOR: See Note 1 under "Remarks"		SIGNATURE OF INSPECTOR: See Note 1 under "Remarks"	

ELEVATION	DEPTH	LEGEND	CLASSIFICATION OF MATERIALS (Description)	SCORE RECOVERY (%)	BOX OR SAMPLE NO.	REMARKS (Drilling time, water level, depth of measuring, etc., if significant)
	2		Brown Sandy Clay w/Gravel		W1	Used 3" Shelby tube for all samples.
	4				W2	
	6				W3	
555.37	8				W4	
	10				W5	
	12		Brown and Light Gray Sandy Clay w/Scattered Gravel and Calcareous Particles		J2	WRAP SAMPLES 1. 0.0'-1.0' 2. 1.0'-2.0' 3. 3.0'-4.0' 4. 4.5'-6.0' 5. 7.0'-8.5' 6. 8.5'-10.0' 7. 11.0'-12.0' 8. 12.5'-14.0' 9. 15.0'-16.5'
549.87	14				W6	
	16		Light Gray and Yellow Weathered Shale w/Silt Layers		W7	JAR SAMPLES 1. 2.0'-3.0' 2. 6.0'-7.0' 3. 10.0'-11.0' 4. 14.0'-15.0'
546.37	18				W8	
545.37			Gray Shale w/Sandstone Lenses		J4	BAG SAMPLE 1. 16.5'-17.0'
					W9	
			Total Depth = 17.0 Feet		B1	

ENG FORM 1836 PREVIOUS EDITIONS ARE OBSOLETE
MAR 71 (MODIFIED) (TRANSLUCENT)

PROJECT: Aubrey Dam Site No. 1 HOLE NO. 35-53

Note 1:
Soils logged by:
A. J. Simpson,
Trinity Engineering
Testing Corporation.

Note 2:
Boring was advanced to 17.0 feet depth with out using drilling fluid and groundwater was not encountered some not depth.

Form for Dam Site No. 1 (35-53) with project details, soil log, and notes. Includes fields for PROJECT, COORDINATES (X=2,139,350; Y=612,635), FALLING 1500, and soil descriptions like Gray Clay and Tan Sand and Gravel. Includes notes about 3" Shelby tube samples and drilling fluid utilization.

Table for Dam Site No. 1 (35-54) showing soil log details. Columns include DEPTH (feet), CLASSIFICATION OF MATERIALS, SAMPLE LOCATION (W1-W9), and REMARKS. Soil layers include Gray Clay (0'-10.0'), Brown Clay w/Calcareous Particles (10.0'-20.0'), Tan Sandy Clay (20.0'-22.5'), Tan Sand and Gravel (22.5'-42.0'), and Gray Shale (42.0'-44.5'). Total Depth = 40.5 Feet.

1834-A (MODIFIED) Aubrey Dam Site No. 1 35-54

Table for Dam Site No. 1 (35-55) showing soil log details. Columns include DEPTH (feet), CLASSIFICATION OF MATERIALS, SAMPLE LOCATION (W1-W9), and REMARKS. Soil layers include Gray Clay (0'-5.5'), Brown Clay w/Calcareous Particles and Scattered Gravel (5.5'-25.0'), Tan Sandy Clay (25.0'-26.7'), Tan Sand (26.7'-31.0'), Tan Sand and Gravel (31.0'-42.0'), Tan Sand and Gravel (42.0'-44.5'), and Gray Shale (44.5'-46.0'). Total Depth = 46.5 Feet.

1834-A (MODIFIED) Aubrey Dam Site No. 1 35-55

Form for Dam Site No. 1 (35-55) with project details, soil log, and notes. Includes fields for PROJECT, COORDINATES (X=2,140,350; Y=612,640), FALLING 1500, and soil descriptions like Gray Clay and Tan Sand and Gravel. Includes notes about 3" Shelby tube samples and drilling fluid utilization.

1834-A (MODIFIED) Aubrey Dam Site No. 1 35-55

Map No. 35-54	
Sheet 1	Sheet 2
1. 0.0' - 2.0'	2. 2.0' - 4.0'
2. 2.0' - 4.0'	3. 4.0' - 6.0'
3. 4.0' - 6.0'	4. 6.0' - 8.0'
49. 96.0' - 98.0'	50. 98.0' - 100.0'

Map No. 35-55	
Sheet 1	Sheet 2
1. 0.0' - 2.0'	2. 2.0' - 4.0'
2. 2.0' - 4.0'	3. 4.0' - 6.0'
3. 4.0' - 6.0'	4. 6.0' - 8.0'
49. 96.0' - 98.0'	50. 98.0' - 100.0'

Map No. 35-56	
Sheet 1	Sheet 2
1. 0.0' - 2.0'	2. 2.0' - 4.0'
2. 2.0' - 4.0'	3. 4.0' - 6.0'
3. 4.0' - 6.0'	4. 6.0' - 8.0'
49. 96.0' - 98.0'	50. 98.0' - 100.0'

RECORD DRAWING-WORK AS BUILT

DESIGNED BY:	RAY ROBERTS LAKE		
DRAWN BY:	ELM FORK, TRINITY RIVER, TEXAS		
REVIEWED BY:	EMBANKMENT, SPILLWAY AND		
SUBMITTED BY:	OUTLET WORKS		
ENGINEER:	LOGS OF BORINGS		
	3S-52, 3S-53, 3S-54, 3S-55 AND 3S-56		
	INVIATION NO. DACW63-82B-0023	DATE	MAR, 1982
	CONTRACT NO. DACW63-82-C-0023	SHEET NO.	23
	DRAWING NUMBER	OF	

TO ACCOMPANY FOUNDATION REPORT

CONTRACT NO. DACW63-82-C-0023

DRILLING LOG		Southwestern		Fort Worth		No. 1	
Aubrey Dam Site No. 1		X42, 130.371, Y 6112.723		Sta. 18423		MSL	
Date of Drilling: 11-13-73		Fall of 1909		354C-58		Bill Stanton Trinity Engineering Testing Corporation	
Elevation of Surface: 549.5		Elevation of Top of Hole: 526.5		Total Depth of Hole: 30.0		See Note 1 under Remarks	

Elevation	Depth	Lesson	Classification of Material	Notes
549.5	0.0	2.0'	Gray Clay	W1 3" Shelby tube Samples from 0.0' - 2.0'
549.5	2.0'	16.5'	Brown Clay w/ Calcareous Particles	W2 Standard Penetration Values W3 No. Blows Depth Per Foot W4 22.0-23.5 33 W5 W6 W7 W100
526.5	30.0'		Total Depth = 30.0 Feet	

Note 1: Soils Logged By: A. J. Simpson, Trinity Engineering Testing Corporation
Note 2: Boring was advanced to 22.0 feet below the ground surface prior to using drilling fluid and groundwater was not encountered above that depth.

DRILLING LOG		Southwestern		Fort Worth		No. 1	
Aubrey Dam Site No. 1		X42, 130.371, Y 6112.723		Sta. 18423		MSL	
Date of Drilling: 11-13-73		Fall of 1909		354C-58		Bill Stanton Trinity Engineering Testing Corporation	
Elevation of Surface: 627.0		Elevation of Top of Hole: 561.0		Total Depth of Hole: 70.0		See Note 1 under Remarks	

Elevation	Depth	Lesson	Classification of Material	Notes
627.0	0.0	4.0'	Dark Brown Clay w/ Scattered Gravel	100 W1 3" Shelby tube Samples 0.0'-21.0'
624.0	4.0'	7.0'	4.0'-7.0' Shale, Severely Weath., Soft Tan, w/ Calcareous Noda. and Scatt. 7.0' Gravels	JAR SAMPLES 1. 2.0'-3.0' 2. 6.0'-7.0' 3. 10.0'-11.0' 4. 14.0'-15.0' 5. 18.0'-19.0'
613.0	18.0'	18.0'-40.5'	Shale, Weath., Tan and Gray Massive, Num. Tan Fine Grained Pockets and Lenses.	BAG SAMPLES 1. 4.0'-5.0' 2. 8.0'-9.0' 3. 16.0'-17.0'
590.5	35.3'	40.5'-53.2'	Siltstone Nodules	WRAP SAMPLES 1. 0.0'-1.0' 2. 1.0'-2.0' 3. 3.0'-4.0' 4. 5.0'-6.0' 5. 7.0'-8.0' 6. 9.0'-10.0' 7. 11.0'-12.0' 8. 12.0'-13.0' 9. 13.0'-14.0' 10. 15.0'-16.0' 11. 17.0'-18.0' 12. 19.0'-20.0' 13. 20.0'-21.0'
577.8	53.2'	53.2'-70.0'	46.8'-47.0' Siltstone nodules	CLEANED OUT HOLE AT 21.0' AND SET CASING TO 21.0'. STARTED CORING WITH 4" CORE BARREL AT 21.0'. BOXES 1. 24.8'-25.7' 2. 27.8'-28.7' 3. 32.8'-33.9' 4. 37.5'-38.3' 5. 43.1'-44.0' 6. 45.7'-46.6' 7. 51.7'-52.6' 8. 53.5'-54.4' 9. 59.3'-59.8' 10. 63.7'-64.4' 11. 69.1'-70.0'
561.0	70.0'		Total Depth = 70.0 Feet	BOXES 1. 21.0'-27.3' 2. 27.3'-32.8' 3. 32.8'-40.5' 4. 40.5'-47.3' 5. 47.3'-55.3' 6. 55.3'-59.8' 7. 59.8'-65.7' 8. 65.7'-70.0'

Note 1: Soils logged by: A. J. Simpson, Trinity Engineering Testing Corporation;
Primary logged by: Green and Marx, Corps of Engineers, Fort Worth District
Note 2: Installed 2" plastic pipe from 631.8 to 610.5 for groundwater observations.

DRILLING LOG		Southwestern		Fort Worth		No. 1	
Aubrey Dam Site No. 1		X42, 129.243, Y 6112.723		Sta. 18423		MSL	
Date of Drilling: 11-13-73		Fall of 1909		354C-58		Bill Stanton Trinity Engineering Testing Corporation	
Elevation of Surface: 646.51		Elevation of Top of Hole: 627.01		Total Depth of Hole: 19.5		See Note 1 under Remarks	

Elevation	Depth	Lesson	Classification of Material	Notes
646.51	0.0	19.5'	Gray Clay	W1 3" Shelby tube Samples 0.0'-21.0'
627.01	19.5'		Total Depth = 19.5 Feet	

File No 354C-62

DRILLING LOC. AUBREY DAM SITE # 1	DIVISION SOUTHWESTERN	INSTALLATION FT. WORTH DIST.	SHEET OF 3 SHEETS
PROJECT AUBREY DAM SITE # 1	DATE 11-19-62	NO. SIZE AND TYPE OF BIT 2" CORE NX CORE	11. DATE OF TEST, ELEVATION, DISTANCE TO TEST
LOCATION (Name of State) TX - 198-103	12. MANUFACTURER'S DESIGNATION OF DRILL M.S.L.	13. TOTAL NO. OF OVER BURDEN SAMPLES TAKEN	14. UNSTURBED
DRILLING AGENCY USCE	14. DAMCO 1250	15. TOTAL NUMBER CORE BOXES 15	16. ELEVATION GROUND WATER
17. HOLE NO. (As shown on drawing notes and file number) 354C-62	18. DATE MOLE STARTED 11/21/62 COMPLETED 11/23/62	19. ELEVATION TOP OF HOLE 652.0 653.35	20. TOTAL CORE RECOVERY FOR BORING 95%
19. NAME OF DRILLER TRINITY ENGE TESTING CORP.	21. SIGNATURE OF INSPECTOR Van Man		
2. THICKNESS OF OVERBURDEN 0			
3. DEPTH DRILLED INTO ROCK 120.0			
4. TOTAL DEPTH OF HOLE 120.0			

ELEVATION	DEPTH	LEGEND	CLASSIFICATION OF MATERIALS (Description)	NO. OF CORE RECOVERY	REMARKS (During run, notes on loss, depth of weathering, etc., if significant)
	0.0 - 35.5'		SAND & SANDSTONE POORLY CEMENTED BUT TIGHT, MED-COARSE GRN, RED, TAN, AND GRAY, SCAT GRAVELS		DRILLING 3" SHELBY TUBE 0.0 - 3.0' FISH-TAIL BIT 3.0 - 16.0' NX-CORE BBL 16.0 - 19.0 (no recn) 2 1/2" ROCK BIT 19.0 - 24.0' 6" ROCK-BIT 24.0 - 30.0' 4" CORE-BBL 30.0 - 35.5' (no recn) 4" CORE-BBL 35.5 - 108' NX CORE BBL 108 - 120'
	35.5 - 50.0'		SAND & SANDSTONE MED.-COARSE GRN, SOFT, V. POORLY CEMENTED, GRAVELLY, TAN & GRAY		SAMPLES JAR 1: 2.0-2.5' 2: 3.0-3.5' 3: 10.0-11.0' 4: 29.0-30.0' 5: 35.5-36.0'
	50.0 - 51.5'		SAND & GRAVEL 3" FINE TAN, MED-COARSE GRN SAND, LOOSELY CONS, TAN & COOL		SAMPLES (cont) CARTON 1: 46.5-47.5' 2: 52.5-53.5' 3: 57.4-58.2' 4: 62.8-63.7' 5: 67.3-69.2' 6: 72.3-73.2' 7: 78.3-79.2' 8: 81.9-82.8' 9: 88.7-89.6' 10: 93.1-95.0' 11: 96.5-97.4' 12: 112.4-113.5' 13: 116.1-117.1'
	51.5 - 57.5'		SANDSTONE, HARD, WEATH, CRUMBLY, SOFT-MED HARD TAN & BROWN		WATER LEVEL AFTER 36 HOURS WAS 65.6'
	57.5 - 61.0'		SHALY, LIGHTING SANDSTONE, GRAY TO DK. GRAY, SOFT-MOD. HARD, MASSIVE, FINE-MED GRN, OCCAS SILTSTONE NOS.		NOTE: HOLE WAS PRESSURE TESTED

ELEVATION	DEPTH	LEGEND	CLASSIFICATION OF MATERIALS (Description)	NO. OF CORE RECOVERY	REMARKS (During run, notes on loss, depth of weathering, etc., if significant)
	0 - 70				
	70 - 80		91.0-91.5 LIMESTONE NODULES HARD, GRAY		
	80 - 90		91.5-106.0' SHALE, MOD HARD, CALC, MASSIVE, GRAY		
	90 - 110		HARD, MASSIVE, FOSSILIFEROUS		
	110 - 120.0		SHALE, MOD HARD, DARK GRAY TO BLACK, MASSIVE, SCAT FOSS. ZONES		
	119.5-120.0'		VERY FOSSILIFEROUS		

ENG FORM 1836 MAR 71 PREVIOUS EDITIONS ARE OBSOLETE.

PROJECT AUBREY DAM SITE # 1

CLASSIFICATION OF MATERIALS (Overburden)	1 CORE RECOVERY LAY	2 CORE SAMPLE NO.	REMARKS (Depth, core, water loss, depth of weathering, etc., if significant)
91.0-91.5 Limestonic nodules HARD, GRAY			
91.5-106.0 SHALE, MOD. HARD, CALD, MASSIVE, GRAY			
106.0-111.0 LIMESTONE, HARD, MASSIVE TO NODULAR, FOSSILIFEROUS, GRAY			
111.0-120.0 SHALE, MOD. HARD, DARK GRAY TO BLACK, MASSIVE, SCAT. FOSS. ZONES			
119.5-120.0 VERY FOSSILIFEROUS			
NOTES ARE OBSOLETE.			
PROJECT AUBREY DAM SITE #1		HOLE NO. 354C-62	

Hole No. 816D-64

DRILLING LOG		DIVISION	INSTALLATION	SHEET 1 OF 2 SHEETS		
PROJECT Aubrey Dam Site		Southwestern	Fort Worth			
LOCATION (Coordinates of Bureau)		10 SITE AND TYPE OF BIT 8" Siger, 6" d, 3" fishtail				
DRILLING AGENCY Corps of Engineers		11 MANUFACTURER'S DESIGNATION OF DRILL Falling 1500				
HOLE NO. (As shown on drawing title) 816D-64		12 TOTAL NO. OF OVERBURDEN SAMPLES TAKEN 5				
NAME OF DRILLER Newhouse		13 TOTAL NUMBER CORE BORES --				
DIRECTION OF HOLE <input checked="" type="checkbox"/> VERTICAL <input type="checkbox"/> INCLINED DEG. FROM VERT.		14 ELEVATION GROUND WATER				
THICKNESS OF OVERBURDEN 44.0		15 DATE HOLE STARTED 9 April 73 COMPLETED 11 April 73				
DEPTH DRILLED INTO ROCK 57.0		16 ELEVATION TOP OF HOLE				
TOTAL DEPTH OF HOLE 101.0		17 TOTAL CORE RECOVERY FOR SPRING				
SIGNATURE OF INSPECTOR		18 SIGNATURE OF INSPECTOR				
ELEVATION	DEPTH	LEGEND	CLASSIFICATION OF MATERIALS (Description)	1 CORE RECOVERY LAY	2 CORE SAMPLE NO.	REMARKS (Drilling time, water loss, depth of weathering, etc., if significant)
			0.0' to 24.0' CLAY - - - 0.0 to 4.0 - calc., moist, stiff, brown. 4.0 to 14.0 - calc., sandy, moist, stiff, brown. 14.0 to 19.0 - calc., scattered gravel, moist, stiff, brown. 19.0 to 24.0 - calc., moist, stiff, gray and tan.			1. Water level not determined. 2. Jars: A. 26.0 B. 28.0 C. 36.0 D. 38.0 E. 38.6 NOTE: All jar samples taken from shoe and catcher of denison sampler. 3. Denison cans: 1. 24.0 to 26.0 2. 34.0 to 36.0 3. 36.0 to 38.0 4. Hole squeezing badly at 27.0'. 4" plastic pipe set to 45.0'. Another offset from 6DC-30, Hole 816D-64A, will be drilled to obtain denison samples from 26.0 to 34.0. Offset bearings and elevations will be furnished after completion.
			-- Start 6" d, bb'1 at 24.0' -- --			
			24.0' to 26.0' CLAY, calc., moist, stiff, gray and tan.			
			26.0' to 34.0' NO RECOVERY -			
			34.0' to 37.3' CLAY, sandy, moist, med. stiff, gray and tan.		Can 1	
			37.3' to 38.6' SAND, gravelly, clayey, saturated, med. dense, tan.			5. Drilling: 0.0' to 24.0' - 8" siger - no sample taken. 24.0' to 38.6' - 6" d, bb'1. 38.6' to 101.0' - 3" fishtail.
			-- Refusal w/d, bb'1, at 38.6' -- Start 3" fish- tail at 38.6' -- --			
			38.6' to 44.0' SAND and GRAVEL, med. dense. -- Drilled into primary material at 44.0' -- --		Can 2 Can 3	6. Identification of materials from 38. to 101' based on cuttings and drill action.
			44.0' to 101.0' SHALE, soft to m. hard w/LIMESTONE from 86.5' to 89.6'.			7. 2" log from 45' to 101'
			T.D. - 101.0'		101.0 101.0	

DRILLING LOG	
PROJECT	Aubrey Dam Site
LOCATION (Coordinates of Bureau)	
DRILLING AGENCY	Corps of Eng
HOLE NO. (As shown on drawing title)	
NAME OF DRILLER	Newhouse
DIRECTION OF HOLE	<input checked="" type="checkbox"/> VERTICAL <input type="checkbox"/> INCLIN
THICKNESS OF OVERBURDEN	
DEPTH DRILLED INTO ROCK	
TOTAL DEPTH OF HOLE	
ELEVATION	
DEPTH	
LEGEND	

ENG FORM 1836 PREVIOUS EDITIONS OBSOLETE

Hole No. 8A6D-64

Division Southwestern	INSTALLATION Fort Worth	SHEET 1 of 2 SHEETS
PROJECT Aubrey Dam Site	10 SIZE AND TYPE OF BIT 8" auger, 6" d. bb'l. 11 DATUM FOR ELEVATION INDUSTRIAL W.L.	11 MANUFACTURER'S DESIGNATION OF DRILL Palling 1500
ENGINEERS Corps of Engineers	12 TOTAL NO. OF OVER- BORDEN SAMPLES TAKEN 5	13 UNDISTURBED BORREN SAMPLES TAKEN 3
DATE 8A6D-64	14 TOTAL NUMBER CORE BORES --	15 ELEVATION GROUND WATER --
DATE 11 April 73	16 DATE MOLE STARTED 9 April 73	17 COMPLETED 11 April 73
DEPTH 57.0	18 ELEVATION TOP OF MOLE	19 TOTAL CORE RECOVERY FOR BORING
DEPTH 101.0	20 SIGNATURE OF INSPECTOR <i>James A. Christie</i>	

ELEVATION	DEPTH	LEGEND	CLASSIFICATION OF MATERIALS (Description)	NO. CORE RECOV. NO.	BOX OR SAMPLE NO.	REMARKS (Overlying soil, water table, depth of underlying, etc., if significant)
0.0' to 24.0'			CLAY - 0.0 to 4.0 - calc., moist, stiff, brown. 4.0 to 14.0 - calc., sandy, moist, stiff, brown. 14.0 to 19.0 - calc., scattered gravel, moist, stiff, brown. 19.0 to 24.0 - calc., moist, stiff, gray and tan. -- Start 6" d. bb'l. at 24.0'			1. Water level not determined. 2. Jars: A. 26.0 B. 28.0 C. 36.0 D. 38.0 E. 38.6 NOTE: All jar samples taken from shoe and catcher of denison sampler. 3. Denison cans: 1. 24.0 to 26.0 2. 34.0 to 36.0 3. 36.0 to 38.0 4. Hole squeezing badly at 27.0'. 4" plastic pipe set to 45.0'. Another offset from 60-30, Hole 8A6D-64A, will be drilled to obtain denison samples from 26.0 to 34.0. Offset bearings and elevations will be furnished after completion.
24.0' to 26.0'			CLAY, calc., moist, stiff, gray and tan.			5. Drilling: 0.0' to 24.0' - 8" auger - no sample taken. 24.0' to 38.6' - 6" d. bb'l. 38.6' to 101.0' - fishtail.
26.0' to 34.0'			NO RECOVERY -			6. Identification of materials from 38.6' to 101' based on cuttings and drill action.
34.0' to 37.3'			CLAY, sandy, moist, med. stiff, gray and tan.			7. 7" log from 45' to 101'
37.3' to 38.6'			SAND, gravelly, clayey, saturated, med. dense, tan. -- Refusal w/d. bb'l. at 38.6' - Start 3" fish- tail at 38.6' -	Can 1		
38.6' to 44.0'			SAND and GRAVEL, med. dense. -- Drilled into primary material at 44.0' -	Can 2		
44.0' to 101.0'			SHALE, soft to m. hard w/ Limestones from 86.5' to 89.6'. T.D. - 101.0'	Can 3		

Hole No. 8A6D-64A

Division Southwestern	INSTALLATION Fort Worth	SHEET 1 of 1 SHEETS
PROJECT Aubrey Dam Site	10 SIZE AND TYPE OF BIT 8" auger, 6" d. bb'l. 11 DATUM FOR ELEVATION INDUSTRIAL W.L.	11 MANUFACTURER'S DESIGNATION OF DRILL Palling 1500
ENGINEERS Corps of Engineers	12 TOTAL NO. OF OVER- BORDEN SAMPLES TAKEN 6	13 UNDISTURBED BORREN SAMPLES TAKEN 6
DATE 8A6D-64A	14 TOTAL NUMBER CORE BORES --	15 ELEVATION GROUND WATER --
DATE 11 Apr 73	16 DATE MOLE STARTED 11 Apr 73	17 COMPLETED 11 Apr 73
DEPTH 36.0	18 ELEVATION TOP OF MOLE	19 TOTAL CORE RECOVERY FOR BORING
	20 SIGNATURE OF INSPECTOR <i>James A. Christie</i>	

ELEVATION	DEPTH	LEGEND	CLASSIFICATION OF MATERIALS (Description)	NO. CORE RECOV. NO.	BOX OR SAMPLE NO.	REMARKS (Overlying soil, water table, depth of underlying, etc., if significant)
0.0' to 24.0'			CLAY, calc., moist, stiff, brown to gray and tan. -- Start 6" d. bb'l. at 24.0'			1. Water table not determined. 2. Jars: A. 26.0 B. 28.0 C. 30.0 D. 32.0 E. 34.0 F. 36.0 NOTE: Jar samples take from shoe of denison bb'l. 3. Denison Cans: 1. 24.0 to 26.0 2. 26.0 to 28.0 3. 28.0 to 30.0 4. 30.0 to 32.0 5. 32.0 to 34.0 6. 34.0 to 36.0 4. Drilling: 1. 0.0' to 24.0' - 8" auger 2. 24.0' to 36.0' - 6" d. bb'l.
24.0' to 34.0'			CLAY, calc., moist, med. stiff to stiff, sandy to 32.0' with sand increase at 32.0', tan and gray.			
34.0' to 36.0'			SAND, sil. clayey, med. dense, saturated, medium to coarse grained, tan. T.D. - 36.0'			

ENG FORM 1836 PREVIOUS EDITIONS ARE OBSOLETE PROJECT Aubrey Dam Site 8A6D-64A

RECORD DRAWING-WORK AS BUILT

SYN	DC	NO.	ACTION	DATE	DESCRIPTION OF REVISION
U.S. ARMY ENGINEER DISTRICT, FORT WORTH CORPS OF ENGINEERS FORT WORTH, TEXAS					
DESIGNED BY	RAY ROBERTS LAKE ELM FORK, TRINITY RIVER, TEXAS EMBANKMENT, SPILLWAY AND OUTLET WORKS LOGS OF BORINGS 3S4C-62, 3A6D-64, AND 8A6D-64A				
DRAWN BY					
REVIEWED BY					
SUBMITTED BY					
ENGINEER	INVITATION NO.	DACW63-02B-0025	DATE	MAR. 1962	SEQUENCE NO.
	CONTRACT NO.	DACW63-52 C 0093			25
	DRAWING NUMBER		SHEET NO.		OF

TO ACCOMPANY FOUNDATION REPORT

UNIFORM NO. DACW63-52 C 0093

DRILLING LOG		INSTALLATION		SHEET 1 OF 3 SHEETS	
Well No. PA62-4C		Port Fortin Dist			
1. NAME OF OPERATOR		2. SIZE AND TYPE OF BIT		3. CATEGORY OF ELEVATION (TOOTHEN = M)	
4. MANUFACTURER'S DESIGNATION OF DRILL		5. TOTAL NO. OF OVER-ROUNDER SAMPLES TAKEN		6. TOTAL NUMBER CORE BORES	
7. THICKNESS OF OVERBURDEN		8. ELEVATION TOP OF HOLE		9. DATE MOLE	
10. DEPTH DRILLED INTO HOLE		11. SIGNATURE OF SUPERVISOR		12. REMARKS	
13. TOTAL DEPTH OF HOLE		14. ELEVATION GROUND WATER		15. SIGNATURE OF OPERATOR	
16. DATE MOLE		17. ELEVATION TOP OF HOLE		18. TOTAL CORE RECOVERY FOR BORING	
19. SIGNATURE OF SUPERVISOR		20. SIGNATURE OF OPERATOR		21. SIGNATURE OF OPERATOR	

ELEVATION	DEPTH	LEGEND	CLASSIFICATION OF MATERIALS	NO. OF CORE SAMPLES	BOX OR SAMPLE NO.	REMARKS
0.0 - 17.0			CLAY			Drilling
0.0 - 5.5			CLAY			0.0 - 22.0 8" auger
5.5 - 11.0			CLAY			22.0 - 40.0 6" d bbl
11.0 - 15.0			CLAY			40.0 - 67.0 3" fishtrill
15.0 - 17.0			CLAY			67.0 - 97.5 2" cor.
17.0 - 26.2			SAND			Jar samples
26.2 - 31.0			SAND			A. 24.0
31.0 - 33.8			SAND			B. 26.0
33.8 - 34.0			SAND			C. 25.0
34.0 - 36.0			SAND			D. 30.0
36.0 - 38.0			SAND			E. 32.0
38.0 - 39.0			SAND			F. 33.8
39.0 - 40.0			SAND			G. 34.0
40.0 - 41.0			SAND			H. 36.0
41.0 - 42.0			SAND			I. 38.0
42.0 - 43.0			SAND			J. 38.0
43.0 - 44.0			SAND			K. 38.0
44.0 - 45.0			SAND			L. 38.0
45.0 - 46.0			SAND			M. 38.0
46.0 - 47.0			SAND			N. 38.0
47.0 - 48.0			SAND			O. 38.0
48.0 - 49.0			SAND			P. 38.0
49.0 - 50.0			SAND			Q. 38.0
50.0 - 51.0			SAND			R. 38.0
51.0 - 52.0			SAND			S. 38.0
52.0 - 53.0			SAND			T. 38.0
53.0 - 54.0			SAND			U. 38.0
54.0 - 55.0			SAND			V. 38.0
55.0 - 56.0			SAND			W. 38.0
56.0 - 57.0			SAND			X. 38.0
57.0 - 58.0			SAND			Y. 38.0
58.0 - 59.0			SAND			Z. 38.0
59.0 - 60.0			SAND			AA. 38.0
60.0 - 61.0			SAND			AB. 38.0
61.0 - 62.0			SAND			AC. 38.0
62.0 - 63.0			SAND			AD. 38.0
63.0 - 64.0			SAND			AE. 38.0
64.0 - 65.0			SAND			AF. 38.0
65.0 - 66.0			SAND			AG. 38.0
66.0 - 67.0			SAND			AH. 38.0
67.0 - 68.0			SAND			AI. 38.0
68.0 - 69.0			SAND			AJ. 38.0
69.0 - 70.0			SAND			AK. 38.0
70.0 - 71.0			SAND			AL. 38.0
71.0 - 72.0			SAND			AM. 38.0
72.0 - 73.0			SAND			AN. 38.0
73.0 - 74.0			SAND			AO. 38.0
74.0 - 75.0			SAND			AP. 38.0
75.0 - 76.0			SAND			AQ. 38.0
76.0 - 77.0			SAND			AR. 38.0
77.0 - 78.0			SAND			AS. 38.0
78.0 - 79.0			SAND			AT. 38.0
79.0 - 80.0			SAND			AU. 38.0
80.0 - 81.0			SAND			AV. 38.0
81.0 - 82.0			SAND			AW. 38.0
82.0 - 83.0			SAND			AX. 38.0
83.0 - 84.0			SAND			AY. 38.0
84.0 - 85.0			SAND			AZ. 38.0
85.0 - 86.0			SAND			BA. 38.0
86.0 - 87.0			SAND			BB. 38.0
87.0 - 88.0			SAND			BC. 38.0
88.0 - 89.0			SAND			BD. 38.0
89.0 - 90.0			SAND			BE. 38.0
90.0 - 91.0			SAND			BF. 38.0
91.0 - 92.0			SAND			BG. 38.0
92.0 - 93.0			SAND			BH. 38.0
93.0 - 94.0			SAND			BI. 38.0
94.0 - 95.0			SAND			BJ. 38.0
95.0 - 96.0			SAND			BK. 38.0
96.0 - 97.0			SAND			BL. 38.0
97.0 - 98.0			SAND			BM. 38.0
98.0 - 99.0			SAND			BN. 38.0
99.0 - 100.0			SAND			BO. 38.0

ELEVATION	DEPTH	LEGEND	CLASSIFICATION OF MATERIALS
15.5 - 30.2			SAND tan, sat'd, gravelly, med to coarse gr, med dense, calc
30.2 - 37.0			SHALE dk. gray, med hard (rock classification unrec, non-jointed, sh. calc)
37.0 - 55.0			SHALE dk. gray, med hard (rock classification unrec, non-jointed, sh. calc)
55.0 - 57.0			SILTSTONE hard, cemented, massive
57.0 - 67.1			LIMESTONE lt. gray, soft (rock classification), massive
67.1 - 88.9			SHALE dk. gray, med hard, non-jointed
88.9 - 92.3			SILTSTONE hard, cemented, massive
92.3 - 97.5			SHALE dk. gray, med hard, non-jointed
97.5 - 99.5			SILTSTONE hard, cemented, massive
99.5 - 100.0			SHALE dk. gray, med hard, non-jointed

ELEVATION	DEPTH	LEGEND	CLASSIFICATION OF MATERIALS (See Appendix)	COLE RECOVERY	BOX ON SAMPLE NO.	REMARKS (Drilling time, water level, depth of penetration, etc., if significant)
35.5	30.2		SAND dk. gray, gravelly, mod to coarse gr, mod dense, calc			
19.2	27.0		SHALE dk. gray, mod hard (rock classification unvea, non-jointed, sl. calc 43.2 - 50.0 signific- antly higher to fis- tall.			
87.0 - 87.1			SILTSTONE hard, cemented, massive			
87.1 - 90.2			LIMESTONE lt. gray, soft (rock classification), massive			
87.1 - 88.9			SHALE dk. gray, mod hard, non-jointed	05.0		
90.2 - 97.1			SHALE	L18		
97.1 - 97.5			SILTSTONE hard, cemented, massive	05.5		
TD @ 97.5						

Hole No. 8A6D-66

DRILLING LOG		DIVISION		INSTALLATION		SHEET	
southwest TN		Port North		8" dia. 2' deep, 6" d. bb'l.		of 1 sheets	
PROJECT Aubrey D.S.				DATE FOR TELEVISION-CONTROLLED LOGS Falling 1900			
LOCATION (Community or Station)				MANUFACTURER IDENTIFICATION OF DRILL Falling 1500			
DRILLING AGENCY Coles of Engineers				TOTAL NO. OF OVER- BURDEN SAMPLES TAKEN 6			
HOLE NO. (See Appendix for marking rules and file number) 8A6D-66				TOTAL NUMBER CORE BOXES 6			
NAME OF DRILLER Newhouse				ELEVATION GROUND WATER --			
DIRECTION OF HOLE <input checked="" type="checkbox"/> VERTICAL <input type="checkbox"/> INCLINED deg. from VERT				DATE MOLE 2 April 73			
THICKNESS OF OVERBURDEN --				ELEVATION TOP OF MOLE --			
DEPTH DRILLED INTO ROCK --				TOTAL CORE RECOVERY FOR BORING --			
TOTAL DEPTH OF HOLE 35.7				DATE MOLE COMPLETED 3 April 73			
				DRILLER'S SIGNATURE James L. Christie			

ELEVATION	DEPTH	LEGEND	CLASSIFICATION OF MATERIALS (See Appendix)	COLE RECOVERY	BOX ON SAMPLE NO.	REMARKS (Drilling time, water level, depth of penetration, etc., if significant)
0.0'	19.0'		CLAY - - 0.0 to 3.0 - sli. sandy medium to stiff, moist, brown. 3.0 to 16.0 - sandy to 16.0, very sandy from 16.0 to 19.0, stiff, moist, tan.			1. Elevation of ground water was not determined. 2. Jars: A. 24.0 B. 26.0 C. 28.0 D. 30.0 E. 32.0 F. 34.0 NOTE: All jar samples taken from Denison bb'l shoe. 3. Denison Cans: 1. 22.0 to 24.0 2. 24.0 to 26.0 3. 26.0 to 28.0 4. 28.0 to 30.0 5. 30.0 to 32.0 6. 32.0 to 34.0 4. Pocket penetrometer tests as follows: cm no. test 2. 2.75 3. 2.0 4. 1.5 5. 1.5 5. No jar samples taken from 0.0 to 22.0 6. 0.0 to 22.0 - 4' or 22.0 to 35.7 - 6' c.r.
19.0'	21.0'		SAND, sli. clayey, medium to coarse-grained, medium dense, moist, tan.			
21.0'	22.0'		CLAY, sandy, medium stiff moist, tan.			
			-- Start 6" d. b'l. at 22.0			
22.0'	24.0'		SAND, clayey, medium dense, moist, tan.	L. 1.0	1	
24.0'	30.0'		CLAY, sandy, stiff, moist tan.	L. 0.4	2	
30.0'	32.0'		BORDERLINE - sandy clay or clayey sand, moist, tan.	L. 0.0	3	
32.0'	35.7'		SAND, medium to coarse- grained, gravelly with gravel increase at 33.2' REFUGAL w/ d.b. @ 35.7'	L. 0.0	4	
				L. 0.3	5	
				No Rec.	6	

ENG FORM 1836 PREVIOUS EDITIONS ARE OBSOLETE PROJECT Aubrey, D.S. HOLE NO. 8A6D-66

Note No. 867/6

DRILLING LOG		DIVISION Southwest TN		INSTALLATION Fort Worth		SHEET of 1 sheets	
PROJECT Aubrey D.S.		NO. AND TYPE OF BIT 6" Auger, 6" C. B't.		DATE OF ELEVATION INDICATION (if any)			
LOCATION (Coordinate or Station)		MANUFACTURER'S DESIGNATION OF DRILL Falling 1500		TOTAL NO. OF OVER-BORE SAMPLES TAKEN 6		TOTAL NUMBER CORE BOXES 6	
DRILLING AGENCY Corps of Engineers		NAME OF DRILLER Newhouse		DATE HOLE STARTED 2 April 73		DATE HOLE COMPLETED 3 April 73	
HOLE NO. (As shown on drawing title and here recorded) 8A6D-66		DIRECTION OF HOLE <input checked="" type="checkbox"/> VERTICAL <input type="checkbox"/> INCLINED		THICKNESS OF OVERBURDEN		TOTAL CORE RECOVERY FOR BORING	
TOTAL DEPTH OF HOLE 35.7		CLASSIFICATION OF MATERIALS (Description)		CORRECTION (If any)		REMARKS (Including tool, water flow, depth of penetration, etc., if significant)	
ELEVATION	DEPTH	LEGEND		LOG NO.	TEST NO.		
	0.0		0.0' to 19.0' CLAY - 0.0 to 3.0 - sil. sandy medium to stiff, moist, brown. 3.0 to 16.0 - sandy to 16.0, very sandy from 16.0 to 19.0, stiff, moist, tan.				1. Elevation of ground water was not determined. 2. Jars: A. 24.0 B. 26.0 C. 28.0 D. 30.0 E. 32.0 F. 34.0 NOTE: All jar samples taken from Denison bb'l shoe.
	19.0		19.0' to 21.0' SAND, sil. clayey, medium to coarse-grained, medium dense, moist, tan.				3. Denison Cans: 1. 22.0 to 24.0 2. 24.0 to 26.0 3. 26.0 to 28.0 4. 28.0 to 30.0 5. 30.0 to 32.0 6. 32.0 to 34.0
	20.0		21.0' to 22.0' CLAY, sandy, medium stiff moist, tan.				4. Pocket penetrometer tests as follows: cm no. test 2. 2.75 3. 2.0 4. 1.5 5. 1.5
	20.0		-- Start 6" d. b'l. at 22.0'		22.0		5. No jar samples taken from 0.0 to 22.0
	22.0		22.0' to 24.0' SAND, clayey, medium dense, moist, tan.	L.	1		6. 0.0 to 22.0 - auger 22.0 to 35.7 - 6" d.
	24.0		24.0' to 30.0' CLAY, sandy, stiff, moist tan.	L.	2		7. Bentonite drill mud used from 22.0
	30.0		30.0' to 32.0' BORDELING - sandy clay or clayey sand, moist, tan.	L.	3		
	32.0		32.0' to 35.7' SAND, medium to coarse-grained, gravelly with gravel increase at 33.2'. REVEAL w/ d.b. to 35.7'	L.	4		
				L.	5		
				L.	6		
				No Rec.			

ENG FORM 1836 MAR 73 PREVIOUS EDITIONS ARE OBSOLETE

PROJECT: Aubrey D.S. HOLE NO: 8A6D-66

RECORD DRAWING-WORK AS BUILT

SYMBOL NO.	ACTION	DATE	DESCRIPTION OF REVISION
U.S. ARMY ENGINEER DISTRICT, FORT WORTH CORPS OF ENGINEERS FORT WORTH, TEXAS			
DESIGNED BY	RAY ROBERTS LAKE ELM FORK, TRINITY RIVER, TEXAS EMBANKMENT, SPILLWAY AND OUTLET WORKS LOGS OF BORINGS 8A6D-65 AND 8A6D-66		
DRAWN BY			
REVIEWED BY			
SUBMITTED BY			
ENGINEER	INVITATION NO. DACW63-82B-0025	DATE: MAR, 1982	SEQUENCE NO.
	CONTRACT NO. DACW63-82 C 0013	DRAWING NUMBER	SHEET NO. OF 26

TO ACCOMPANY FOUNDATION REPORT

Note No. 8162-67

DRILLING LOG		Division	INSTALLATION	SHEET
PROJECT		City Department	Post-Tank Method	1 of 2 SHEETS
1. PROJECT Audrey D. S.		10. SIZE AND TYPE OF BIT 6" D Btl		
2. LOCATION (Continent or Island)		11. DATE FOR ELEVATION (From 1911 to 1912)		
3. DRILLING AGENCY Corps of Engineers		12. HANDS/FEET OF ELEVATION OF DRILL Fadlan 1500		
4. HOLE NO. (As shown on drawing here) and its number 816D-67		13. TOTAL NO. OF OVERBURDEN SAMPLES TAKEN		14. UNDISTURBED
5. NAME OF DRILLER Mullins		15. ELEVATION GROUND WATER		16. TOTAL NUMBER CORE BORES
6. DIRECTION OF HOLE <input checked="" type="checkbox"/> VERTICAL <input type="checkbox"/> INCLINED		17. DATE HOLE STARTED 8 Aug 73		18. DATE HOLE COMPLETED 19 Aug 73
7. THICKNESS OF OVERBURDEN 35.3		19. ELEVATION TOP OF HOLE 559.6'		20. TOTAL CORE RECOVERY FOR SPINNING
8. DEPTH DRILLED INTO ROCK 0		21. SIGNATURE OF DRILLER Joseph A. Blum		22. SIGNATURE OF SUPERVISOR
9. TOTAL DEPTH OF HOLE 35.3				

ELEVATION	DEPTH	LEGEND	CLASSIFICATION OF MATERIALS (Description)	CORE RECOVERY	BOX OR SAMPLE NO.	REMARKS (Including thin, water loss, depth of penetration, etc., if significant)
0.0	33.3		CLAY -		Jar A	Drilling 0.0 to 15.0 10" sugar 15.0 to 33.3 6" D Btl 33.3 to 35.3 77/8" rock bit
0.0	3.0		medium plasticity, dark brown, medium stiff, moist		Jar B	Denison samples
3.0	9.4		low to medium plasticity, brown, very moist, stiff, slightly sandy		Jar C	1. 15.8 to 17.8 2. 19.8 to 21.8 3. 21.8 to 23.8 4. 23.8 to 25.8 5. 25.8 to 27.8 6. 27.8 to 29.8 7. 29.8 to 31.8 8. 31.8 to 33.3
9.4	16.5		medium plasticity, dark brown, stiff, moist		Jar D	Carton samples
16.5	26.5		low plasticity, dark brown, stiff to very stiff, moist, slightly sandy		COA 1	1. 18.1 to 19.0 Note: sample came from denison can.
26.5	30.5		medium plasticity, dark brown, stiff, moist		COA 2	Jar samples
30.5	33.3		medium plasticity, gray and tan, very stiff, moist		COA 3	A. 0.0 to 3.0 B. 3.0 to 9.4 C. 8.0 to 9.4 D. 9.4 to 15.8 E. 17.8 F. 19.8 G. 21.8 H. 23.8 I. 25.8 J. 27.8 K. 29.8 L. 31.8
33.3	35.3		GRAVEL -		COA 4	Note: samples E through L from shoe of Denison Btl.
					COA 5	Location
					COA 6	Hole offset 20.7' S35°W from staked location (X= 2,141.445; Y= 615,594). New elevation is 559.6 as determined by hand level.
					COA 7	T. D. @ 35.3
					COA 8	
						Hand penetrometer test
						depth tons/sq. ft.
						17.8 1.30
						19.8 1.50
						21.8 2.25
						23.8 2.25
						25.8 2.25
						27.8 1.75
						29.8 1.75
						31.8 3.30
						Note
						All samples are calcareous.
						Water table
						Hole was not bailed.
						4" slotted, plastic pipe set to 36.0'
						Daily measurements reported on supplemental sheet.

DRILLING LOG		Division
PROJECT		Southwestern
1. PROJECT Audrey D. S.		
2. LOCATION (Continent or Island)		X= 2,141,610 Y= 615,020
3. DRILLING AGENCY Corps of Engineers		
4. HOLE NO. (As shown on drawing here) and its number 816D-69		
5. NAME OF DRILLER Mullins		
6. DIRECTION OF HOLE <input checked="" type="checkbox"/> VERTICAL <input type="checkbox"/> INCLINED		
7. THICKNESS OF OVERBURDEN 45.5'		
8. DEPTH DRILLED INTO ROCK 0		
9. TOTAL DEPTH OF HOLE 45.5'		

ELEVATION	DEPTH	LEGEND	CLASSIFICATION OF MATERIALS (Description)
0.0	29.2		CLAY -
0.0	6.0		medium pl dark brown, medium stiff, moist, calcareous
6.0	14.6		medium pl brown, hard, moist (very stiff at 12.5)
14.6	18.0		medium plasticity, light brown, stiff, moist
18.0	22.0		high pl brown, very stiff, ve
22.0	28.2		medium plasticity, light brown a very n stiff to stiff moist, slightly sandy
28.2	29.2		low pla gray and tan, very st moist
29.2	32.6		SAND -
			tan, loose to medium saturated, non calcareous
32.6	36.0		CLAY -
32.6	34.5		medium plasticity, moist, stiff, and gray
34.0	36.0		low plastic and gray, soft to stiff, saturated, sandy
36.0	38.5		SAND -
			tan, medium dense, slightly clayey
38.5	45.5		GRAVEL -
			tan, loose, saturated, sandy, becomes coarse
			T. D. @ 45.5

Hole No. 1150-69

DRILLING LOG PROJECT: Aubrey D. S. LOCATION: Xr 2, 141, 610 Yr 615, 020 DRILLING AGENCY: Corps of Engineers HOLE NO. (as shown on drawing sheet and site number): 0A6D-69 NAME OF DRILLER: Mullins DIRECTION OF HOLE: <input checked="" type="checkbox"/> VERTICAL <input type="checkbox"/> INCLINED THICKNESS OF OVERBURDEN: 47.5' DEPTH DRILLED INTO ROCK: 0 TOTAL DEPTH OF HOLE: 45.5'	DIVISION: Southwestern INSTALLATION: Fort Worth District H. SIZE AND TYPE OF BIT: 6" D Bit I. DATE AND TIME OF START: 9 Aug 73 II. DATE AND TIME OF STOP: 10 Aug 73 III. MANUFACTURER'S DESIGNATION OF DRILL: Falling 1500 IV. TOTAL NO. OF OVER-BURDEN SAMPLE TAKEN: 20 V. TOTAL NUMBER CORE BOXES: 16 VI. ELEVATION GROUND WATER: 560.8' VII. ELEVATION TOP OF HOLE: 560.8' VIII. TOTAL CORE RECOVERY FOR BORING: 100% IX. SIGNATURE OF INSPECTOR: [Signature]	SHEET 1 OF 2 SHEETS REMARKS: (Print in ink, use of blue, check of measurements, etc., if significant)
---	---	--

ELEVATION	DEPTH	LEGEND	CLASSIFICATION OF MATERIAL (Description)	CORE RECOVERY %	BOX OR SAMPLE NO.	REMARKS (Print in ink, use of blue, check of measurements, etc., if significant)
0.0 to 29.2			CLAY --		1	Drilling
0.0 to 6.0			sedium plasticity, dark brown, sedium stiff to stiff, moist, calcareous		2	0.0 to 5.0 8" sugar 5.0 to 41.0 6" D Bit 41.0 to 45.5 7 7/8" rock bit no casing
6.0 to 14.6			sedium plasticity, brown, hard, moist (becomes very stiff at 12.5)		3	Denison samples
14.6 to 18.0			sedium plasticity, light brown, very stiff, moist		4	1. 5.0 to 7.0 2. 7.0 to 9.0 3. 9.0 to 11.0 4. 11.0 to 13.0 5. 13.0 to 15.0 6. 15.0 to 17.0 7. 17.0 to 19.0 8. 19.0 to 21.0 9. 21.0 to 23.0 10. 23.0 to 25.0 11. 25.0 to 27.0 12. 27.0 to 29.0 13. 31.0 to 33.0 14. 33.0 to 35.0 15. 35.0 to 37.0 16. 37.0 to 39.0
18.0 to 22.0			high plasticity, brown, very stiff, very moist		5	Notes: sand sample from 29.0 to 31.0 and gravel sample from 39.0 to 41.0 were disturbed.
22.0 to 26.2			sedium plasticity, light brown and gray, very stiff to stiff, moist, slightly sandy		6	Sand samples
26.2 to 29.2			low plasticity, gray and tan, very stiff, moist		7	A. 0.0 to 3.0 B. 3.0 to 5.0 C. 7.0 D. 9.0 E. 11.0 F. 13.0 G. 15.0 H. 17.0 I. 19.0 J. 21.0 K. 23.0 L. 25.0 M. 27.0 N. 29.0 O. 31.0 P. 33.0 Q. 35.0 R. 37.0 S. 39.0 T. 41.0
29.2 to 32.6			SAND --		8	tan, loose to medium dense, saturated, non calcareous
32.6 to 36.0			CLAY --		9	Notes: samples C through T obtained from shoe of Denison barrel.
36.0 to 38.5			SAND --		10	tan, medium dense, saturated, slightly clayey
38.5 to 45.5			GRAVEL --		11	tan, loose, saturated, sandy, because coarse at 40.5' T. D. @ 45.5'
					12	Water table Hole was bailed to 35.0' After 15 minutes, level at 15.0'. 4" slotted plastic pipe installed to 44.0'. Daily measurements reported on supplemental sheet.
					13	Hand measurements list Depth: 7.0 74.50 9.0 74.50 11.0 74.50 13.0 74.00 15.0 73.00 17.0 72.00 19.0 72.10 21.0 72.25 23.0 72.50 25.0 72.25 27.0 72.00 29.0 73.00 35.0 70.50

Hole No. 1150-69

DRILLING LOG PROJECT: Aubrey D. S. LOCATION: Xr 2, 140, 155 Yr 614, 685 DRILLING AGENCY: Corps of Engineers HOLE NO. (as shown on drawing sheet and site number): 0A6D-69 NAME OF DRILLER: Mullins DIRECTION OF HOLE: <input checked="" type="checkbox"/> VERTICAL <input type="checkbox"/> INCLINED THICKNESS OF OVERBURDEN: 43.0 DEPTH DRILLED INTO ROCK: 1.0 TOTAL DEPTH OF HOLE: 44.0	DIVISION: Southwestern INSTALLATION: Fort Worth District H. SIZE AND TYPE OF BIT: 6" D Bit I. DATE AND TIME OF START: 15 Aug 73 II. DATE AND TIME OF STOP: 15 Aug 73 III. MANUFACTURER'S DESIGNATION OF DRILL: Falling 1500 IV. TOTAL NO. OF OVER-BURDEN SAMPLE TAKEN: 16 V. TOTAL NUMBER CORE BOXES: 16 VI. ELEVATION GROUND WATER: 557.5' VII. ELEVATION TOP OF HOLE: 557.5' VIII. TOTAL CORE RECOVERY FOR BORING: 100% IX. SIGNATURE OF INSPECTOR: [Signature]	SHEET 1 OF 2 SHEETS REMARKS: (Print in ink, use of blue, check of measurements, etc., if significant)
---	--	--

ELEVATION	DEPTH	LEGEND	CLASSIFICATION OF MATERIAL (Description)	CORE RECOVERY %	BOX OR SAMPLE NO.	REMARKS (Print in ink, use of blue, check of measurements, etc., if significant)
0.0 to 32.0			CLAY --		1	Drilling
0.0 to 4.5			medium plasticity, brownish-gray, stiff, slightly moist		2	0.0 to 15.0 15.0 to 37.0 37.0 to 44.0 rockbit no casing
4.5 to 11.0			low to medium plasticity, brown, stiff to very stiff, moist, with some calcareous particles 5.2 to 11.0		3	Denison samples
11.0 to 20.0			high plasticity, light brown, moist to very moist, stiff		4	1. 0.0 to 4.5 2. 4.5 to 11.0 3. 11.0 to 15.0 4. 15.0 to 17.0 5. 17.0 to 19.0 6. 19.0 to 21.0 7. 21.0 to 23.0 8. 23.0 to 25.0 9. 25.0 to 27.0 10. 27.0 to 29.0 11. 29.0 to 31.0 12. 31.0 to 33.0 13. 33.0 to 35.0 14. 35.0 to 37.0 15. 37.0 to 39.0 16. 39.0 to 41.0
20.0 to 22.0			high plasticity, light brown, medium stiff, very moist to saturated		5	Notes: sample P taken from Denison barrel.
22.0 to 28.0			medium plasticity, brown, stiff to very stiff, moist, with some calcareous particles and a few small shells		6	Denison samples
28.0 to 30.0			medium plasticity, tan, stiff, very moist, slightly sandy		7	1. 15.0 to 17.0 2. 17.0 to 21.0 3. 21.0 to 23.0 4. 23.0 to 25.0 5. 25.0 to 27.0 6. 27.0 to 29.0 7. 29.0 to 31.0 8. 31.0 to 33.0 9. 33.0 to 35.0
30.0 to 32.0			low plasticity, tan, saturated, stiff, sandy		8	Notes: no sample 21.0 due to no sample 21.0 due to pre-
32.0 to 43.0			SAND --		9	tan, saturated, stiff, sandy
32.0 to 34.0			tan, medium dense, clayey, saturated		10	Notes: no sample 21.0 due to no sample 21.0 due to pre-
34.0 to 36.5			tan, loose, saturated, gravelly		11	Notes: no sample 21.0 due to no sample 21.0 due to pre-
36.5 to 43.0			with coarse gravel		12	Notes: no sample 21.0 due to no sample 21.0 due to pre-
43.0 to 44.0			SHALE --		13	dark gray, medium hard (rock classification), unweathered, non-jointed, moist

DRILLING LOG		INSTALLATION			
PROJECT: Southwestern		Hole No. 8167-00			
LOCATION: Abbey D. S.		Sheet 1 of 2 sheets			
X-2 140,155 Y-614,685		DATE: 15 AUG 73			
CORPS OF ENGINEERS		ELEVATION TOP OF HOLE: 557.5'			
HOLE NO. 816D-69		TOTAL CORE RECOVERY FOR BORING: 557.5'			
NAME OF DRILLER: WILLIS		DATE HOLE STARTED: 15 AUG 73			
DIRECTION OF HOLE: <input checked="" type="checkbox"/> VERTICAL <input type="checkbox"/> INCLINED		DATE HOLE COMPLETED: 16 AUG 73			
THICKNESS OF OVERBURDEN: 43.0		ELEVATION GROUND WATER: 80			
DEPTH DRILLED INTO ROCK: 1.0		ELEVATION TOP OF HOLE: 557.5'			
TOTAL DEPTH OF HOLE: 44.0		REMARKS: <i>Drilling</i>			
ELEVATION	DEPTH	LEGEND	CLASSIFICATION OF MATERIAL (Descriptive)	LABORATORY SYMBOL	REMARKS (Drilling time, water level, depth of casing, etc., if significant)
0.0	32.0		CLAY --	Jar A	0.0 to 15.0 10" auger
			0.0 to 4.5 medium plasticity, brownish-gray, stiff, slightly moist	Jar B	15.0 to 37.0 6" D Bbl rockbit
			4.5 to 11.0 low to medium plasticity, brown, stiff to very stiff, moist, with some calcareous particles 5.2 to 11.0	Jar C	37.0 to 44.0 7 7/8" no casing
			11.0 to 20.0 high plasticity, light brown, moist to very moist, stiff	Jar D	Jar samples
			20.0 to 22.0 high plasticity, light brown, medium stiff, very moist to saturated	Jar E	A. 0.0 to 4.5
			22.0 to 28.0 medium plasticity, brown, stiff to very stiff, moist, with some calcareous particles and a few small chells	Can 1	B. 4.5 to 5.2
			28.0 to 30.0 medium plasticity, tan, stiff, very moist, slightly sandy	Can 2	C. 5.2 to 10.2
			30.0 to 32.0 low plasticity, tan, saturated, stiff, sandy	Can 3	D. 10.2 to 11.0
			32.0 to 43.0	Can 4	E. 11.0 to 15.0
			SAND --	Can 5	F. 17.0 to 19.0
			32.0 to 34.0 tan, medium dense, clayey, saturated	Can 6	G. 19.0
			34.0 to 36.5 tan, loose, saturated, gravelly	Can 7	H. 21.0
			36.5 to 43.0 with coarse gravel	Can 8	I. 23.0
				Can 9	J. 25.0
					K. 27.0
					L. 29.0
					M. 31.0
					N. 33.0
					O. 35.0
					P. 37.0
					Denison samples
					1. 15.0 to 17.0
					2. 17.0 to 19.0
					3. 21.0 to 23.0
					4. 23.0 to 25.0
					5. 25.0 to 27.0
					6. 27.0 to 29.0
					7. 29.0 to 31.0
					8. 31.0 to 33.0
					9. 33.0 to 35.0
					Note: no sample 19.0 to 21.0 due to catchers
					no sample 35.0 to 37.0 due to presence of gravel
					Note
					All overburden material are calcareous.
					Hand penetrometer test
					depth tons/sq. ft.
					17.0 3.20
					19.0 2.75
					23.0 2.65
					25.0 2.65
					27.0 1.75
					29.0 1.50
					31.0 1.20
					**Water table
					Hole bailed to approximately 30.0' but making water very rapidly. After completion of bailing, water level at 9.8'. Additional water table information reported on supplemental sheet. 4" slotted plastic pipe set to 35.0'.
43.0	44.0		SHALE --		
			Dark gray, medium hard (rock classification), un-weathered, non-jointed, moist		

RECORD DRAWING-WORK AS BUILT

SYM	NO	ACTION	DATE	DESCRIPTION OF REVISION
U.S. ARMY ENGINEER DISTRICT, FORT WORTH CORPS OF ENGINEERS FORT WORTH, TEXAS				
DESIGNED BY:	RAY ROBERTS LAKE ELM FORK, TRINITY RIVER, TEXAS EMBANKMENT, SPILLWAY AND OUTLET WORKS LOGS OF BORINGS 8A6D-67, 8A6D-68, AND 8A6D-69			
DRAWN BY:				
REVIEWED BY:				
SUBMITTED BY:	INITIATION NO. DACW 63-82-C-0025 DATE: MAR 1982			
ENGINEER:	CONTRACT NO. DACW 63-82-C-0023			SEQUENCE NO. 27
	DRAWING NUMBER			SHEET NO. OF

DRILLING LOG		Division	INSTALLATION	Sheet 1 of 2 SHEETS
PROJECT Abrey D. S.		Southwestern	Port North District	
I. LOCATION (Continence or Island) Xt 2-140,700 Yt 615,945			II. DATE AND TYPE OF BIT 8" auger	
II. DRILLING AGENCY Corps of Engineers			III. MANUFACTURER'S DESIGNATION OF DRILL Falline 1500	
III. HOLE NO. 722 (shown on casing data) and site number		DA-71	IV. TOTAL NO. OF OVERBURDEN SAMPLES TAKEN 13	UNDISTURBED 0
IV. NAME OF DRILLER Hullins			V. TOTAL NUMBER CORE BOXES 1	VI. ELEVATION GROUND WATER 0
V. DIRECTION OF HOLE VERTICAL <input checked="" type="checkbox"/> INCLINED _____ DEG. FROM VERT.			VI. DATE HOLE STARTED 13 Aug 73	COMPLETED 14 Aug 73
VII. THICKNESS OF OVERBURDEN 45.5'			VII. ELEVATION TOP OF HOLE 560.0'	
VIII. DEPTH DRILLED INTO ROCK 0.5'			VIII. TOTAL CORE RECOVERY FOR SOILS 60%	
IX. TOTAL DEPTH OF HOLE 46.0'			SIGNATURE OF DRILLER <i>James C. Bunk</i>	
ELEVATION	DEPTH	LEGEND	CLASSIFICATION OF MATERIALS (Description)	REMARKS (Drilling time, water loss, depth of penetration, etc., if significant)
0.0 to 30.5			CLAY -- 0.0 to 6.5 medium plasticity, brown, medium stiff (becomes stiff at 4.0), slightly moist. 6.5 to 11.5 low plasticity, light brown, very stiff, slightly sandy. 11.5 to 16.5 medium plasticity, light brown, stiff, moist. 16.5 to 29.6 medium to high plasticity, brown, stiff, moist.	Drilling 0.0 to 43.0 8" auger 43.0 to 46.0 7 7/8 rockbit *Water table Because of squeezing, hole was bailed only to 16.0' slotted plastic set to 39.2'. See measurements reported on supplemental sheet.
		Jar A		
		Jar B		
		Jar C		
		Jar D		
		Jar E		
		Jar F		
		Jar G		
		Jar H		
		Jar I		
		Jar J		
		Jar K		
		Jar L		
		Jar M		
30.5 to 31.7			SAND -- tan, loose, saturated, coarse, gravelly	
31.7 to 37.0			CLAY -- 31.7 to 32.5 high plasticity, gray and tan mottled, medium stiff, very moist, calcareous. 32.5 to 37.0 high plasticity, grayish-brown, soft to medium stiff, very moist to saturated. Becomes slightly sandy at 35.0	
37.0 to 45.5			GRAVEL -- tan, loose, saturated, clayey, with some shells and small cobbles. Becomes very clayey at 42.0'.	T. D. @ 46.0

DRILLING LOG		Division	INSTALLATION	Sheet 1 of 1 SHEETS
PROJECT Abrey D. S.		Southwestern	Port North District	
I. LOCATION (Continence or Island)			II. DATE AND TYPE OF BIT 8" auger	
II. DRILLING AGENCY Corps of Engineers			III. MANUFACTURER'S DESIGNATION OF DRILL Falline 1500	
III. HOLE NO. 722 (shown on casing data) and site number		BA6C-72	IV. TOTAL NO. OF OVERBURDEN SAMPLES TAKEN 1	UNDISTURBED 0
IV. NAME OF DRILLER Kerubuse			V. TOTAL NUMBER CORE BOXES 1	VI. ELEVATION GROUND WATER 0
V. DIRECTION OF HOLE VERTICAL <input checked="" type="checkbox"/> INCLINED _____ DEG. FROM VERT.			VI. DATE HOLE STARTED 17 Aug 73	COMPLETED 21 Aug 73
VII. THICKNESS OF OVERBURDEN 31.0			VII. ELEVATION TOP OF HOLE 570.4	
VIII. DEPTH DRILLED INTO ROCK 7.0			VIII. TOTAL CORE RECOVERY FOR SOILS 60%	
IX. TOTAL DEPTH OF HOLE 28.0			SIGNATURE OF DRILLER <i>James C. Bunk</i>	
ELEVATION	DEPTH	LEGEND	CLASSIFICATION OF MATERIALS (Description)	REMARKS (Drilling time, water loss, depth of penetration, etc., if significant)
0.0 to 4.0			CLAY -- medium plasticity, brown, very stiff, slightly moist, slightly sandy.	location Hole offset 16.0' S40° W from staked location of X-2-138,510 and Y-614,460 *Water table
4.0 to 20.0			SAND -- 4.0 to 11.0 tan, medium dense, moist, fine, clayey; becomes silty at 10.0. 11.0 to 12.5 tan, medium dense, moist, silty, with small ironstone nodules. 12.5 to 15.0 tan and gray, loose, saturated, with ironstone. 15.0 to 17.0 gray, loose, saturated, silty. 17.0 to 20.0 tan, loose, saturated, silty.	4" slotted plastic pipe installed to 18.5' - hole bailed to 23.0'. Readings report on supplemental sheet. Drilling 0.0 to 24.0 8" auger 24.0 to 28.0 6" core *Water samples A. 0.0 to 4.0 B. 4.0 to 10.0 C. 10.0 to 11.0 D. 11.0 to 12.5 E. 12.5 to 15.0 F. 15.0 to 17.0 G. 17.0 to 20.0 H. 20.0 to 21.0
20.0 to 21.0			GRAVEL -- tan, loose, saturated, sandy, with cobbles up to 4" diameter	
21.0 to 21.2			SILTSTONE -- light gray, hard (rock classification), massive	
21.2 to 28.0			SHALE -- light gray, non-weathered, moderately hard (rock classification), laminated, non-jointed	
			T. D. @ 28.0	
		Jar A		
		Jar B		
		Jar C		
		Jar D		
		Jar E		
		Jar F		
		Jar G		
		Jar H		
		Jar I		
		Jar J		
		Jar K		
		Jar L		
		Jar M		
		Box		
		L 1.2		

ENG FORM 1836 PREVIOUS EDITIONS ARE OBSOLETE.
MAR 71

PROJECT
Abrey D. S.

HOLE NO.
BA6C-72

Notes No. 816C-72

PROJECT: Southwestern
INSTALLATION: Fort Worth District
SHEET: 1 of 1 SHEETS

1. PROJECT: Aubrey D. S.
2. LOCATION (Coordinates or Stationing): X = 2,138,837 Y = 614,570
3. DRILLING AGENCY: Corps of Engineers
4. NAME OF DRILLER: Mullins
5. DIRECTION OF HOLE: VERTICAL

11. MANUFACTURER'S DESIGNATION OF DRILL: Mullins 1500
12. TOTAL NO. OF OVERBURDEN SAMPLES TAKEN: 0
13. TOTAL NUMBER CORE BOXES: 1
14. ELEVATION GROUND WATER: 00
15. DATE HOLE STARTED: 17 Aug 73 COMPLETED: 21 Aug 73
16. ELEVATION TOP OF HOLE: 570.4
17. TOTAL CORE RECOVERY FOR BORING: 60%

CLASSIFICATION OF MATERIAL (Description):
0.0 to 4.0 CLAY - medium plasticity, brown, very stiff, slightly moist, slightly sandy.
4.0 to 20.0 SAND - 4.0 to 11.0 tan, medium dense, moist, fine, clayey; becomes silty at 10.0
11.0 to 12.5 tan, medium dense, moist, silty, with small ironstone nodules
12.5 to 15.0 tan and gray, loose, saturated, with ironstone
15.0 to 17.0 gray, loose, saturated, silty
17.0 to 20.0 tan, loose, saturated, silty
20.0 to 21.0 GRAVEL - tan, loose, saturated, sandy, with cobbles up to 4" diameter
21.0 to 21.2 SILTSTONE - light gray, hard (rock classification), massive
21.2 to 26.0 SHALES - light gray, non-weathered, moderately hard (rock classification), laminated, non-jointed
F. D. @ 26.0

REMARKS:
Location: Hole offset 16.0' S40°W from staked location of X = 2,138,510 and Y = 614,460
Water table: 4" slotted plastic pipe installed to 18.5 after hole bailed to 23.0. Readings reported on supplemental sheet.
Drilling: 0.0 to 24.0 8" auger 24.0 to 28.0 6" core
Jar samples: A. 0.0 to 4.0 B. 4.0 to 10.0 C. 10.0 to 11.0 D. 11.0 to 12.5 E. 12.5 to 15.0 F. 15.0 to 17.0 G. 17.0 to 20.0 H. 20.0 to 21.0
Carton sample: 1. 26.7 to 27.6
Note: Overburden is non-calcareous - top elevation is 571.0 8" casing to 24.0'

ENGINEERING FORM 1836 MAR 71 PREVIOUS EDITIONS ARE OBSOLETE.

Notes No. 816C-73

PROJECT: Southwestern
INSTALLATION: Fort Worth District
SHEET: 1 of 1 SHEETS

1. PROJECT: Aubrey D. S.
2. LOCATION (Coordinates or Stationing): X = 2,138,837 Y = 614,570
3. DRILLING AGENCY: Corps of Engineers
4. NAME OF DRILLER: Mullins
5. DIRECTION OF HOLE: VERTICAL

11. MANUFACTURER'S DESIGNATION OF DRILL: Mullins 1500
12. TOTAL NO. OF OVERBURDEN SAMPLES TAKEN: 4
13. TOTAL NUMBER CORE BOXES: 1
14. ELEVATION GROUND WATER: 00
15. DATE HOLE STARTED: 17 Aug 73 COMPLETED: 17 Aug 73
16. ELEVATION TOP OF HOLE: 560.4
17. TOTAL CORE RECOVERY FOR BORING: 100%

CLASSIFICATION OF MATERIAL (Description):
0.0 to 10.5 CLAY - 0.0 to 4.0 medium to high plasticity, dark brown, stiff, dry to slightly moist, non-calcareous.
4.0 to 6.0 medium plasticity, light brown, very stiff, moist, slightly sandy, calcareous
6.0 to 7.5 low plasticity, tan, stiff, moist, sandy, calcareous
7.5 to 10.5 low plasticity, tan and gray, very stiff, moist, sandy, non-calcareous, becomes slightly gravelly
10.5 to 19.0 SHALES - moderately weathered, dark gray to tan, moist, soft (rock classification) non-jointed, with clayey sand, tan, from 13.0 to 14.0
2. D. @ 19.0
Carton sample shows a mottled gray tan clay w/ small pockets of siltstone. No shale structure noted.
Date 9/17/74

REMARKS:
Drilling: 0.0 to 14.0 8" auger 14.0 to 19.0 6" core no casing
Jar samples: A. 0.0 to 2.0 B. 4.0 to 7.5 C. 6.0 to 7.5 D. 7.5 to 10.5 E. 10.5 to 13.0 F. 13.0 to 14.0
Carton sample: 1. 18.1 to 19.0
Water table: 4" slotted plastic pipe set to 19.0 after hole bailed to 17.2. Water table information reported on supplemental sheet.

ENGINEERING FORM 1836 MAR 71 PREVIOUS EDITIONS ARE OBSOLETE.

RECORD DRAWING-WORK AS BUILT

SYM	NO	ACTION	DATE	DESCRIPTION OF REVISION
U.S. ARMY ENGINEER DISTRICT, FORT WORTH CORPS OF ENGINEERS FORT WORTH, TEXAS				
DESIGNED BY	RAY ROBERTS LAKE			
DRAWN BY	ELM FORK, TRINITY RIVER, TEXAS			
ENGINEER BY	EMBANKMENT, SPILLWAY AND			
	OUTLET WORKS			
	LOGS OF BORINGS			
	8A-70, 8A-71, 8A6C-72, AND 8A6C-73			
SUBMITTED BY	INVITATION NO. DACW63-02-C-0025 DATE MAR, 1982			
BY	CONTRACT NO. DACW63-82-C-0083			
	DRAWING NUMBER	SHEET NO.	SEQUENCE	
		28	28	

TO ACCOMPANY FOUNDATION REPORT

CONTRACT NO. DACW63-82-C-0083

Hole No. D160-75

DIVISION		INSTALLATION		SHEET	
DRILLING LOG		Fort Worth District		of 1 SHEETS	
1. PROJECT Aubrey D. S.		10. SIZE AND TYPE OF BIT 8" auger; 6" core		11. DATE FOR ELEVATION INFORMATION 1973	
2. DRILLING AGENCY Corps of Engineers		12. MANUFACTURER'S DESIGNATION OF DRILL Palling 1500		13. TOTAL NO. OF OVERBURDEN SAMPLES TAKEN 0	
3. NAME OF DRILLER Newhouse		14. TOTAL NUMBER CORE BOXES 1		15. ELEVATION GROUND WATER []	
4. DIRECTION OF HOLE <input checked="" type="checkbox"/> VERTICAL <input type="checkbox"/> INCLINED		16. DATE HOLE STARTED 21 Aug 73		17. ELEVATION TOP OF HOLE []	
5. THICKNESS OF OVERBURDEN 3.5		18. TOTAL CORE RECOVERY FOR SPRING 75%		19. SIGNATURE OF INSPECTOR Joseph A. [Signature]	
6. DEPTH DRILLED INTO ROCK 5.6		19. GRAVITY OF SAMPLES []		REMARKS (Drilling time, water level, depth of overburden, etc., if significant)	
7. TOTAL DEPTH OF HOLE 9.1		20. CORE RECOVERY []		[]	

ELEVATION	DEPTH	LEGEND	CLASSIFICATION OF MATERIALS (Description)	A CORE RECOVERY	BOX OR SAMPLE NO.	REMARKS
0.0 to 3.5			CLAY -- 0.0 to 2.5 medium plasticity, dark brown, stiff to very stiff, slightly moist 2.5 to 3.5 low plasticity, brown, stiff, moist, slightly sandy; gravelly from 3.3 to 3.5		Box 1	Drilling 0.0 to 3.5 8" auger 3.5 to 9.1 6" core (short barrel) 0.0 to 3.5 8" casing Casing stable 5.4 to 6.0 Note Water measurements not taken. Overburden non-calcareous.
3.5 to 7.9			LIMESTONE -- hard (rock classification), well cemented, light gray, massive			
7.9 to 9.1			SHALS -- gray and tan, moderately hard, non-jointed, non-calcareous			
			T. D. @ 9.1			

Hole No. D160-75

DIVISION		INSTALLATION		SHEET	
DRILLING LOG		Fort Worth District		of 1 SHEETS	
1. PROJECT Aubrey D. S.		10. SIZE AND TYPE OF BIT 8" auger; 6" core		11. DATE FOR ELEVATION INFORMATION 1973	
2. DRILLING AGENCY Corps of Engineers		12. MANUFACTURER'S DESIGNATION OF DRILL Palling 1500		13. TOTAL NO. OF OVERBURDEN SAMPLES TAKEN 0	
3. NAME OF DRILLER Newhouse		14. TOTAL NUMBER CORE BOXES 1		15. ELEVATION GROUND WATER []	
4. DIRECTION OF HOLE <input checked="" type="checkbox"/> VERTICAL <input type="checkbox"/> INCLINED		16. DATE HOLE STARTED 22 Aug 73		17. ELEVATION TOP OF HOLE []	
5. THICKNESS OF OVERBURDEN 12.0'		18. TOTAL CORE RECOVERY FOR SPRING []		19. SIGNATURE OF INSPECTOR Joseph A. [Signature]	
6. DEPTH DRILLED INTO ROCK 80.8'		19. GRAVITY OF SAMPLES []		REMARKS (Drilling time, water level, depth of overburden, etc., if significant)	
7. TOTAL DEPTH OF HOLE 92.8'		20. CORE RECOVERY []		[]	

ELEVATION	DEPTH	LEGEND	CLASSIFICATION OF MATERIALS (Description)	A CORE RECOVERY	BOX OR SAMPLE NO.	REMARKS
0.0' to 39.5'			NO SAMPLES TAKEN			

ENG FORM 1836 MAR 51 PREVIOUS EDITIONS ARE OBSOLETE. (TRANSFERRING) PROJECT AD122

Hole No. D160-75

DIVISION		INSTALLATION		SHEET	
DRILLING LOG		Fort Worth District		of 1 SHEETS	
1. PROJECT Aubrey D. S.		10. SIZE AND TYPE OF BIT 8" auger; 6" core		11. DATE FOR ELEVATION INFORMATION 1973	
2. DRILLING AGENCY Corps of Engineers		12. MANUFACTURER'S DESIGNATION OF DRILL Palling 1500		13. TOTAL NO. OF OVERBURDEN SAMPLES TAKEN 0	
3. NAME OF DRILLER Newhouse		14. TOTAL NUMBER CORE BOXES 1		15. ELEVATION GROUND WATER []	
4. DIRECTION OF HOLE <input checked="" type="checkbox"/> VERTICAL <input type="checkbox"/> INCLINED		16. DATE HOLE STARTED 22 Aug 73		17. ELEVATION TOP OF HOLE []	
5. THICKNESS OF OVERBURDEN 5.5		18. TOTAL CORE RECOVERY FOR SPRING []		19. SIGNATURE OF INSPECTOR Joseph A. [Signature]	
6. DEPTH DRILLED INTO ROCK 0		19. GRAVITY OF SAMPLES []		REMARKS (Drilling time, water level, depth of overburden, etc., if significant)	
7. TOTAL DEPTH OF HOLE 5.5		20. CORE RECOVERY []		[]	


ELEVATION	DEPTH	LEGEND	CLASSIFICATION OF MATERIALS (Description)	A CORE RECOVERY	BOX OR SAMPLE NO.	REMARKS
0.0 to 5.5			CLAY -- 0.0 to 4.0 medium plasticity, dark brown, stiff to very stiff, slightly moist 4.0 to 5.5 becomes light brown, moist			Drilling 0.0 to 5.5 8" auger Note Water measurements not taken. Overburden non-calcareous. Auger refusal at 5.5'
5.5			LIMESTONE -- hard (rock classification), well cemented, light gray, massive			
			T. D. @ 5.5			

DRILLING LOG		SECTION		INSTALLATION		SHEET	
PROJECT: Southwestern		SECTION: Part North		INSTALLATION: 8165-01		SHEET: 1 OF 3	
PROJECT: Aubrey Lyle		SECTION: Part North		INSTALLATION: 8165-01		SHEET: 1 OF 3	
LOCATION: (Coordinates or Station)		SECTION: Part North		INSTALLATION: 8165-01		SHEET: 1 OF 3	
DRILLING AGENCY:		SECTION: Part North		INSTALLATION: 8165-01		SHEET: 1 OF 3	
HOLE NO. (As shown on drawing sheet and file number): 8165-01		SECTION: Part North		INSTALLATION: 8165-01		SHEET: 1 OF 3	
NAME OF DRILLER:		SECTION: Part North		INSTALLATION: 8165-01		SHEET: 1 OF 3	
DIRECTION OF HOLE: <input checked="" type="checkbox"/> VERTICAL <input type="checkbox"/> INCLINED		SECTION: Part North		INSTALLATION: 8165-01		SHEET: 1 OF 3	
THICKNESS OF OVERBURDEN: 4.0'		SECTION: Part North		INSTALLATION: 8165-01		SHEET: 1 OF 3	
DEPTH DRILLED INTO ROCK: 82.0'		SECTION: Part North		INSTALLATION: 8165-01		SHEET: 1 OF 3	
TOTAL DEPTH OF HOLE: 86.0'		SECTION: Part North		INSTALLATION: 8165-01		SHEET: 1 OF 3	
ELEVATION	DEPTH	LEGEND	CLASSIFICATION OF MATERIALS (Description)	SCORE RECORD NO.	BOX OR SAMPLE NO.	REMARKS (Drilling time, water loss, depth of weathering, etc., if significant)	
	0.0'		Drilling			0.0' to 9.0' 8" auger	
	33.5'		SAND --			9.0' to 26.0' 6" core	
	4.0'		brown, loose, very moist, medium-grained, non-calcareous			0.0' to 17.0' 8" casing	
	33.5'		SAND (primary) --				
	4.0'		red, massive, weathered, fine-grained, with some ironstone concretions and zones slightly clayey				
	16.3'		4.0' to 16.3' non-cemented				
	16.3'		poorly cemented				
	24.5'		24.5' to 27.3' non-cemented				
	27.3'		27.3' to 29.0' poorly cemented				
	29.0'		29.0' to 33.5' non-cemented, slightly clayey, becoming very clayey at base				
	33.5'		33.5' to 43.8' shale --				
	43.8'		light gray, moderately weathered, massive, non-calcareous, easy to drill, 4.25' to 4.5' on hand penetrometer down to 35.0' and 24.5' below 35.0' sandy to very sandy, with				

DRILLING LOG		SECTION		INSTALLATION		SHEET	
PROJECT: SFD		SECTION: FJD		INSTALLATION: 8165-01		SHEET: 1 OF 3	
PROJECT: Aubrey Lyle		SECTION: FJD		INSTALLATION: 8165-01		SHEET: 1 OF 3	
LOCATION: (Coordinates or Station)		SECTION: FJD		INSTALLATION: 8165-01		SHEET: 1 OF 3	
DRILLING AGENCY:		SECTION: FJD		INSTALLATION: 8165-01		SHEET: 1 OF 3	
HOLE NO. (As shown on drawing sheet and file number): 8165-02		SECTION: FJD		INSTALLATION: 8165-01		SHEET: 1 OF 3	
NAME OF DRILLER:		SECTION: FJD		INSTALLATION: 8165-01		SHEET: 1 OF 3	
DIRECTION OF HOLE: <input type="checkbox"/> VERTICAL <input checked="" type="checkbox"/> INCLINED		SECTION: FJD		INSTALLATION: 8165-01		SHEET: 1 OF 3	
THICKNESS OF OVERBURDEN:		SECTION: FJD		INSTALLATION: 8165-01		SHEET: 1 OF 3	
DEPTH DRILLED INTO ROCK:		SECTION: FJD		INSTALLATION: 8165-01		SHEET: 1 OF 3	
TOTAL DEPTH OF HOLE:		SECTION: FJD		INSTALLATION: 8165-01		SHEET: 1 OF 3	
ELEVATION	DEPTH	LEGEND	CLASSIFICATION OF MATERIALS (Description)	SCORE RECORD NO.	BOX OR SAMPLE NO.	REMARKS (Drilling time, water loss, depth of weathering, etc., if significant)	
			occasional pockets of tan sand; with numerous short, irregular, tight, iron-stained yellow-brown joints, some of which open upon handling				
	32.5'		32.5' to 34.8' black, iron-stained, high angle, tight joint				
	44.4'		44.4' to 46.8' badly jointed and very sandy; completely broken up with handling				
	48.0'		48.0' to 48.3' ironstone, red, soft				
	48.3'		48.3' to 65.4' shale --				
	48.3'		48.3' to 55.0' tan and light gray, slightly weathered, massive, calcareous				
	55.0'		55.0' to 65.4' light gray gray, non-weathered, thin-bedded, very calcareous; slightly fossiliferous in lower 0.1'				
	65.4'		65.4' to 79.2' limestone --				
	65.4'		65.4' to 72.7' gradational with above unit, light gray, argillaceous, with numerous lenses of gray shale; moderately well cemented				
	72.7'		72.7' to 78.6' well cemented with occasional lenses of shale, light gray				
	78.6'		78.6' to 79.2' transitional with unit below				
	79.2'		79.2' to shale --				
			dark gray, non-calcareous, thin-bedded, non-fractured, non-jointed, with numerous sandy lenses and lenses of fine, poorly cemented, thin-bedded to cross-bedded sandstone; contains scattered shells which tend to be concentrated along bedding planes				
			sandstone at 80.7' to 81.0', 81.7' to 82.0', 82.3' to 85.7' to 86.0'				
			siltstone, brownish-gray, well cemented at 79.6', 85.2'				

INSTALLATION		SHEET 2 OF 3 SHEETS	
10 SITE AND TYPE OF BIT			
11 DATE FOR ELEVATION INFORMATION (BY M)			
12 MANUFACTURER'S DESIGNATION OF DRILL			
13 TOTAL NO. OF OVERBURDEN SAMPLES TAKEN		14 DISTURBED	15 UNDISTURBED
16 TOTAL NUMBER CORE BOXES			
17 ELEVATION GROUND WATER			
18 DATE HOLE		19 STARTED	20 COMPLETED
21 ELEVATION TOP OF HOLE			
22 TOTAL CORE RECOVERY FOR BORING			
23 SIGNATURE OF INSPECTOR			
CLASSIFICATION OF MATERIALS (See legend)	1 CORE RECOVERY %	2 BOX OR SAMPLE NO.	3 REMARKS (Distinguishing, color, etc., depth of weathering, etc., if significant)
1 pockets of tan numerous short, tight, iron-stained joints, none open upon handling	41.0	7	
34.8' black, iron high angle, tight	45.0	8	
46.8' badly jointed sandy; completely with handling	49.0	9	
48.3' ironstone, .4'	53.0	10	
55.0' tan and slightly weathered, calcareous	57.0	11	
65.4' light gray weathered, thin, calcareous; fossiliferous in	61.0	12	
72.7' gradational unit, light gray, with numerous gray shale; reddish cemented	68.3	13	
78.6' well cemented lenses of gray	74.3	14	
79.2' transitional below	78.6	15	
80.7' to 81.0'	83.3	16	
82.0' to 82.6'	85.0	17	
86.0' brownish-gray, bedded at 79.6'			

INSTALLATION		SHEET 1 OF 2 SHEETS	
10 SITE AND TYPE OF BIT			
11 DATE FOR ELEVATION INFORMATION (BY M)			
12 MANUFACTURER'S DESIGNATION OF DRILL			
13 TOTAL NO. OF OVERBURDEN SAMPLES TAKEN		14 DISTURBED	15 UNDISTURBED
16 TOTAL NUMBER CORE BOXES			
17 ELEVATION GROUND WATER			
18 DATE HOLE		19 STARTED	20 COMPLETED
21 ELEVATION TOP OF HOLE			
22 TOTAL CORE RECOVERY FOR BORING			
23 SIGNATURE OF INSPECTOR			
CLASSIFICATION OF MATERIALS (See legend)	1 CORE RECOVERY %	2 BOX OR SAMPLE NO.	3 REMARKS (Distinguishing, color, etc., depth of weathering, etc., if significant)
0.0' to 3.5' SAND - - tan, loose, moist, fine to medium, silty, non-calcareous		Jar A	Drilling 0.0' to 7.0' 8" auger 7.0' to 67.0' 6" core 0.0' to 6.0' 8" casing
3.5' to 25.6' SAND (primary) - - 3.5' to 6.0' brown, non-cemented, non-calcareous, fine to medium, slightly clayey, very moist, with numerous ironstone concretions (to 6"), easy to auger		Jar B	Jar samples A. 0.0' to 3.5' B. 3.5' to 6.0'
6.0' to 8.6' reddish-brown, poorly cemented, with concretions, very difficult to auger		Box 1	Carton samples 1. 7.0' to 7.9' 2. 12.3' to 13.2' 3. 16.0' to 16.8' 4. 18.0' to 18.9' 5. 27.7' to 28.6' 6. 32.1' to 33.0' 7. 34.7' to 35.6' 8. 41.4' to 42.3' 9. 48.1' to 49.0' 10. 54.0' to 54.9' 11. 58.3' to 59.2' 12. 65.6' to 66.5'
8.6' to 14.2' reddish-brown, non-cemented, massive, very moist, non-calcareous, with scattered small ironstone concretions, carbonaceous inclusions, and decayed roots		3	Note Depth of weathering at 33.7'
14.2' to 25.6' becomes light gray with reddish-brown and yellowish-brown, clayey, with some carbonaceous matter and occasional thin veins of selenite		4	Water level Hole was not bailed but left open for water level checks.
18.0' to 19.8' CLAY, predominantly gray, sandy, with pockets of yellowish-brown clayey sand		5	
19.8' to 25.6' borderline clay, gray, massive with lenses of clayey sand and sandy clay		6	
25.6' to 45.0' SHALE - - 25.6' to 26.7' dark purple, sandy, massive, with ironstone nodules 26.7' to 28.6' light gray and gray, slightly weathered, approximately 4.0 on hand		7	

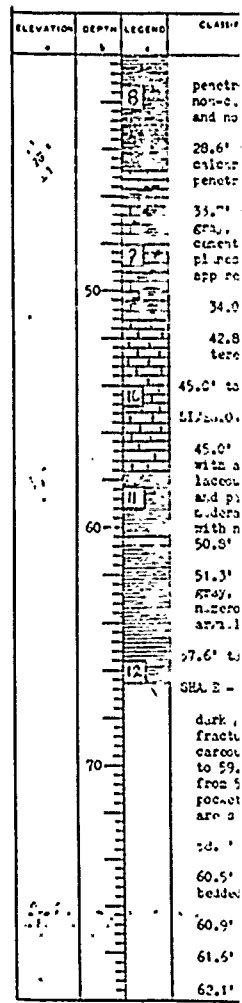

DIVISION So. Texas	INSTALLATION Fort Worth District	SHEET 1 OF 2 SHEETS
10 SIZE AND TYPE OF BIT OR AUGER FOR CORE 11 DEPTH FOR ELEVATION INDICATED IN HOLE		
12 MANUFACTURER'S DESIGNATION OF DRILL Palline 1500		
13 TOTAL NO. OF OVER-BOURDEN SAMPLES TAKEN DISTURBED 0 UNDISTURBED 0		
14 TOTAL NUMBER CORE BOXES 12		
15 ELEVATION GROUND WATER 0		
16 DATE HOLE STARTED 3 Dec 74 COMPLETED 6 Dec 74		
17 ELEVATION TOP OF HOLE 66.5' 59.5'		
18 TOTAL CORE RECOVERY FOR BORING 100%		
19 SIGNATURE OF INSPECTOR [Signature]		

TH LEGEND	CLASSIFICATION OF MATERIALS (Description)	A CORE RECOVERY PERCENT	BOX NO.	REMARKS (Depth from, water level, depth of weathering, etc. if significant)
	0.0' to 3.5' SAND -- tan, loose, moist, fine to medium, silty, non-calcareous		Jar A	Drilling 0.0' to 7.0' 8" auger 7.0' to 67.0' 6" core 0.0' to 6.0' 8" casing
	3.5' to 25.6' SAND (primary) -- 3.5' to 6.0' brown, non-cemented, non-calcareous, fine to medium, slightly clayey, very moist, with numerous ironstone concretions (to 6"), easy to auger		Jar B	Jar samples A. 0.0' to 3.5' B. 3.5' to 6.0'
	6.0' to 8.6' reddish-brown, poorly cemented, with concretions, very difficult to auger		Box 1	Carton samples 1. 7.0' to 7.9' 2. 12.3' to 13.2' 3. 16.0' to 16.8' 4. 18.0' to 18.9' 5. 27.7' to 28.6' 6. 32.1' to 33.0' 7. 34.7' to 35.6' 8. 41.4' to 42.3' 9. 48.1' to 49.0' 10. 54.0' to 54.9' 11. 58.3' to 59.2' 12. 65.6' to 66.5'
	8.6' to 14.2' reddish-brown, non-cemented, massive, very moist, non-calcareous, with scattered small ironstone concretions, carbonaceous inclusions, and decayed roots		Box 2	Note Depth of weathering at 33.7'
	14.2' to 25.6' becomes light gray with reddish-brown and yellowish-brown clayey, with some carbonaceous matter and occasional thin veins of selenite		Box 3	Water level Hole was not bailed but left open for water level check.
	18.0' to 19.8' CLAY, predominantly gray, sandy, with pockets of yellowish-brown clayey sand		Box 4	
	19.8' to 25.6' borderlime clay, gray, massive with lenses of clayey sand and sandy clay		Box 5	
	25.6' to 45.0' SHALE -- 25.6' to 26.7' dark purple, sandy, massive, with ironstone nodules 26.7' to 28.6' light gray and gray, slightly weathered, approximately 4.0 on hand		Box 6	

ELEVATION	DEPTH	LEGEND	CLASSIFICATION OF MATERIALS (Description)	A CORE RECOVERY PERCENT	REMARKS (Depth from, water level, depth of weathering, etc. if significant)
			penetrator, thin-bedded, non-calcareous, non-fractured, and non-jointed	41.0	
			28.6' to 33.7' becomes calcareous, 74.5 on hand penetrator	7	
			33.7' to 45.0' non-weathered, gray, very calcareous, silty, cemented, breccia along bedding planes, but bedding is not clearly apparent	00	
			34.0' to 34.2' rust-stained	17	50.3
			42.8' to 45.0' with scattered fossils	53.0	9
			45.0' to 57.6'	G 11	CC3
			51.3' to 51.6' transitional with above unit, very argillaceous, with numerous lenses and partings of shale, gray, moderately well cemented, with numerous fossils from 50.8' to 51.2'	60.0	10
			51.3' to 57.6' becomes light gray, well cemented, with numerous lenses of gray, argillaceous limestone	G 07	CC5
			57.6' to 60.5'	L 01	11
			SHALE -- dark gray, thin-bedded, non-fractured, non-jointed, calcareous on bedding planes to 59.0', non-calcareous from 59.0' to 70', scattered pockets of thin, thin bedded sand	67.0	12
			60.5' to 60.9' SAND, thin-bedded, very fine		
			60.9' to 61.0' SILTSTONE		
			61.6' fossils on bedding plane		
			62.1' to 62.3' fossiliferous		

ENG FORM 1836 MAR 73 PREVIOUS EDITIONS ARE OBSOLETE
 ITRAVEL "EXT"
 AUTHORITY: L30
 HOLE NO. 8A6C-85

RECORD DRAWING - WORK AS PULIT

DESIGNED BY	RAY ROBERTS LAKE
DRAWN BY	ELM FORK, TRINITY RIVER, TEXAS
REVIEWED BY	EMBANKMENT, SPILLWAY AND OUTLET WORKS
APPROVED BY	LOGS OF BORINGS 8A6C-84 AND 8A6C-85
CONTRACT NO.	INVITATION NO. DAC#63-B2-B 0025 DATE MAR, 1962
DATE	CONTRACT NO. DAC#63-92 C 0010
DESCRIPTION OF REVISION	DATE

DRILLING LOG		INSTALLATION	
PROJECT: Southwestern		Port Worth District	
LOCATION: Aubrey Lake		SHEET 1 of 2	
Left Abutment		NO. AND TYPE OF BIT: 3 1/8" fishtail	
SPILLING AGENCY: Corps of Engineers		DATE: 15 Dec 74	
HOLE NO. (See Uniform Drilling Log and Site Number): 337-86		STARTED: 6 Jan 75	
NAME OF DRILLER: Mullins		COMPLETED:	
DIRECTION OF HOLE: <input checked="" type="checkbox"/> VERTICAL <input type="checkbox"/> INCLINED		ELEVATION TOP OF HOLE: 0.0'	
THICKNESS OF OVERBURDEN: 0.0'		TOTAL CORE RECOVERY FOR BORING: %	
DEPTH DRILLED INTO ROCK: 140.0'		SIGNATURE OF INSPECTOR: Joseph A. Cherkov	
TOTAL DEPTH OF HOLE: 140.0'		REMARKS: (Drilling time, water loss, depth of penetration, etc., if significant)	

ELEVATION	DEPTH	LEGEND	CLASSIFICATION OF MATERIALS (Description)	CORE SECTION NO.	BOX OR SAMPLE NO.	REMARKS
0.0'	0.0'		SAND - red, fine-grained			Drilling 0.0' to 140.0' 3 1/8" fishtail
8.0'	8.0'		8.0' becomes firmer, possibly clayey			Jar sample
14.5'	14.5'		14.5' ironstone concretion			A. 45.0' (from split spoon; may be fall-in)
20.0'	20.0'		20.0' to 21.5' fairly hard, poorly cemented			Offset
						Die to inaccessibility, hole was offset approximately 50' NSZ from elevation 690.26' to elevation 674.8' (as measured by hand level). Packer lost in hole at 95.0', and hole was re-drilled 4.5' S at same elevation.
						Note
						Attempted unsuccessfully to obtain sand samples with shaly tube, split spoon, and BX core barrel. Hole was pressure tested and electric logged. Logging is by drilling action and cuttings.

ELEVATION	DEPTH	LEGEND	CLASSIFICATION OF MATERIALS (Description)	CORE SECTION NO.	BOX OR SAMPLE NO.	REMARKS
68.5'	68.5'		SHALE - gray, non-calcareous			
73.8'	73.8'		73.8' to 74.1' harder			
77.2'	77.2'		77.2' very hard			
79.5'	79.5'		79.5' to 81.5' very hard			
91.5'	91.5'		91.5' to 101.0' sandy, cuts very easily			
101.0'	101.0'		101.0' to 101.3' very hard			
101.3'	101.3'		SHALE - gray, calcareous, cuts easily to 105.0'			
106.8'	106.8'		106.8' very hard			
115.0'	115.0'		115.0' to 132.8' Limestone			
121.0'	121.0'		121.0' to 121.2' soft			
127.0'	127.0'		127.0' to 132.8' becomes very hard			
132.8'	132.8'		SHALE - dark gray, non-calcareous			
140.0'	140.0'		T. D. in shale @ 140.0'			

ELEVATION	DEPTH	LEGEND	CLASSIFICATION OF MATERIALS (Description)	LOG NO. (Sample No.)	REMARKS (Drilling time, water flow, depth of casing, etc., if significant)
70	68.5' to 101.3'	SHALE --	gray, non-calcareous		
	73.8' to 74.1'		harder		
	77.2'		very hard		
80	79.5' to 81.5'		very hard		
	91.5' to 101.0'		sandy, cuts easily		
90	101.0' to 101.3'		very hard		
	101.3' to 115.0'	SHALE --	gray, calcareous, cuts easily to 106.0'		
100	108.8'		very hard		
110	115.0' to 132.8'	LIMESTONE --			
120	121.0' to 121.2'		soft		
	127.0' to 132.8'		becomes very hard		
130	132.8' to 140.0'	SHALE --	dark gray, non-calcareous		
140			D. in shale @ 140.0'		

PROJECT		INSTALLATION		Hole No.	
Drilling Log		Southwestern		calyx hole	
Subvey Lake		Fort Worth District		Sheet 1 of 2 sheets	
LOCATION (Coordinates or Station)		SIZE AND TYPE OF BIT		DATE	
DRILLING AGENCY		CORPS OF ENGINEERS		3 Mar 75	
HOLE NO. (As shown on drawing title and file number)		MANUFACTURER'S DESIGNATION OF DRILL		STARTED	
CALYX HOLE				3 Mar 75	
NAME OF DRILLER		TOTAL NO. OF CORE SAMPLES TAKEN		COMPLETED	
BRYANT		0		3 Mar 75	
DIRECTION OF HOLE		TOTAL NUMBER CORE BOXES		ELEVATION GROUND WATER	
VERTICAL		0			
THICKNESS OF OVERBURDEN		DATE HOLE		ELEVATION TOP OF HOLE	
45.0'		3 Mar 75			
DEPTH DRILLED INTO ROCK		TOTAL CORE RECOVERY FOR BORING		SIGNATURE OF INSPECTOR	
1.5'				Joseph A. ...	
TOTAL DEPTH OF HOLE					
46.5'					
ELEVATION	DEPTH	LEGEND	CLASSIFICATION OF MATERIALS (Description)	LOG NO. (Sample No.)	REMARKS (Drilling time, water flow, depth of casing, etc., if significant)
	0.0' to 45.0'		CLAY --		Drilling
	0.0' to 6.0'		low to medium plasticity, dark brownish gray, very stiff, moist, silty		0.0' to 16.5' 42" auger
	6.0' to 8.0'		with small, irregular lime nodules		0.0' to 29.6' 43" casing
	8.0' to 12.0'		becomes brown, hard		Water level
	12.0' to 14.5'		low plasticity, brown, very stiff, moist, slightly sandy		Boring was making water from between 20.0' and 21.0' to 45.0'. Hole tended to cave from 21.0' to 22.0'
	14.5' to 16.0'		becomes stiff, sandy		Cylinder samples
	16.0' to 19.6'		low plasticity, brown, medium stiff, very moist, sandy		1 19.6' to 20.2'
	19.6' to 35.0'		becomes saturated, soft, very easy to auger		2 21.6' to 22.2'
	35.0' to 45.0'		becomes very sandy with gravel and small boulders in lower 1.5'		
	45.0' to 46.5'		SHALE --		D. @ 46.5' in shale

DRILLING LOG		DIVISION		INSTALLATION		SHEET	
Southwestern		Fort Worth District		Fort Worth		1 of 2 SHEETS	
PROJECT		PROJECT		PROJECT		PROJECT	
Ambrey Lake		Ambrey Dam		Ambrey Dam		Ambrey Dam	
LOCATION (Coordinate or Station)		Location (Coordinate or Station)		Location (Coordinate or Station)		Location (Coordinate or Station)	
Tunnel Outlet Works		Tunnel Outlet Works		Tunnel Outlet Works		Tunnel Outlet Works	
DRILLING AGENCY		DRILLING AGENCY		DRILLING AGENCY		DRILLING AGENCY	
Corps of Engineers		Corps of Engineers		Corps of Engineers		Corps of Engineers	
DATE NO. (As shown on drawing title of the number)		DATE NO. (As shown on drawing title of the number)		DATE NO. (As shown on drawing title of the number)		DATE NO. (As shown on drawing title of the number)	
calyx hole		calyx hole		calyx hole		calyx hole	
NAME OF DRILLER		NAME OF DRILLER		NAME OF DRILLER		NAME OF DRILLER	
Preyer		Preyer		Preyer		Preyer	
SECTION OF HOLE		SECTION OF HOLE		SECTION OF HOLE		SECTION OF HOLE	
VERTICAL <input type="checkbox"/> INCLINED <input type="checkbox"/>		VERTICAL <input type="checkbox"/> INCLINED <input type="checkbox"/>		VERTICAL <input type="checkbox"/> INCLINED <input type="checkbox"/>		VERTICAL <input type="checkbox"/> INCLINED <input type="checkbox"/>	
DEG FROM VERT.		DEG FROM VERT.		DEG FROM VERT.		DEG FROM VERT.	
THICKNESS OF OVERBURDEN		THICKNESS OF OVERBURDEN		THICKNESS OF OVERBURDEN		THICKNESS OF OVERBURDEN	
45.0'		45.0'		45.0'		45.0'	
DEPTH DRILLED INTO ROCK		DEPTH DRILLED INTO ROCK		DEPTH DRILLED INTO ROCK		DEPTH DRILLED INTO ROCK	
1.5'		1.5'		1.5'		1.5'	
TOTAL CORE RECOVERY FOR BORING		TOTAL CORE RECOVERY FOR BORING		TOTAL CORE RECOVERY FOR BORING		TOTAL CORE RECOVERY FOR BORING	
26.5'		26.5'		26.5'		26.5'	
TOTAL DEPTH OF HOLE		TOTAL DEPTH OF HOLE		TOTAL DEPTH OF HOLE		TOTAL DEPTH OF HOLE	
46.5'		46.5'		46.5'		46.5'	
CLASSIFICATION OF MATERIALS		CLASSIFICATION OF MATERIALS		CLASSIFICATION OF MATERIALS		CLASSIFICATION OF MATERIALS	
CLAY		CLAY		CLAY		CLAY	
0.0' to 6.0' low to medium plasticity, dark brownish-gray, very stiff, moist, silty		0.0' to 6.0' low to medium plasticity, dark brownish-gray, very stiff, moist, silty		0.0' to 6.0' low to medium plasticity, dark brownish-gray, very stiff, moist, silty		0.0' to 6.0' low to medium plasticity, dark brownish-gray, very stiff, moist, silty	
6.0' to 8.0' with small irregular lime nodules		6.0' to 8.0' with small irregular lime nodules		6.0' to 8.0' with small irregular lime nodules		6.0' to 8.0' with small irregular lime nodules	
8.0' to 12.0' becomes brown, hard		8.0' to 12.0' becomes brown, hard		8.0' to 12.0' becomes brown, hard		8.0' to 12.0' becomes brown, hard	
12.0' to 14.5' low plasticity, brown, very stiff, moist, slightly sandy		12.0' to 14.5' low plasticity, brown, very stiff, moist, slightly sandy		12.0' to 14.5' low plasticity, brown, very stiff, moist, slightly sandy		12.0' to 14.5' low plasticity, brown, very stiff, moist, slightly sandy	
14.5' to 16.0' becomes stiff, sandy		14.5' to 16.0' becomes stiff, sandy		14.5' to 16.0' becomes stiff, sandy		14.5' to 16.0' becomes stiff, sandy	
16.0' to 19.6' low plasticity, brown, medium stiff, very moist, sandy		16.0' to 19.6' low plasticity, brown, medium stiff, very moist, sandy		16.0' to 19.6' low plasticity, brown, medium stiff, very moist, sandy		16.0' to 19.6' low plasticity, brown, medium stiff, very moist, sandy	
1.5' to 9.2'		1.5' to 9.2'		1.5' to 9.2'		1.5' to 9.2'	
LIMESTONE - fine to medium grained, tan to rust brown, highly weathered, medium hard.		LIMESTONE - fine to medium grained, tan to rust brown, highly weathered, medium hard.		LIMESTONE - fine to medium grained, tan to rust brown, highly weathered, medium hard.		LIMESTONE - fine to medium grained, tan to rust brown, highly weathered, medium hard.	
9.2' to 30.0'		9.2' to 30.0'		9.2' to 30.0'		9.2' to 30.0'	
SHALE		SHALE		SHALE		SHALE	
9.2' to 13.5' - tan to gray, silty, soft, weathered.		9.2' to 13.5' - tan to gray, silty, soft, weathered.		9.2' to 13.5' - tan to gray, silty, soft, weathered.		9.2' to 13.5' - tan to gray, silty, soft, weathered.	
13.5' to 30.0' - dark gray, silty, horizontal bedding definition, soft, fossiliferous, non-calcareous except for fossils and fossil fragments. Light gray siltstone noted from 25.2' to 26.0'.		13.5' to 30.0' - dark gray, silty, horizontal bedding definition, soft, fossiliferous, non-calcareous except for fossils and fossil fragments. Light gray siltstone noted from 25.2' to 26.0'.		13.5' to 30.0' - dark gray, silty, horizontal bedding definition, soft, fossiliferous, non-calcareous except for fossils and fossil fragments. Light gray siltstone noted from 25.2' to 26.0'.		13.5' to 30.0' - dark gray, silty, horizontal bedding definition, soft, fossiliferous, non-calcareous except for fossils and fossil fragments. Light gray siltstone noted from 25.2' to 26.0'.	
T. D. 30.0'		T. D. 30.0'		T. D. 30.0'		T. D. 30.0'	

DRILLING LOG		DIVISION		INSTALLATION		SHEET	
Southwestern		Fort Worth		Fort Worth		1 of 1 SHEETS	
PROJECT		PROJECT		PROJECT		PROJECT	
Ambrey Dam		Ambrey Dam		Ambrey Dam		Ambrey Dam	
LOCATION (Coordinate or Station)		LOCATION (Coordinate or Station)		LOCATION (Coordinate or Station)		LOCATION (Coordinate or Station)	
Tunnel Outlet Works		Tunnel Outlet Works		Tunnel Outlet Works		Tunnel Outlet Works	
DRILLING AGENCY		DRILLING AGENCY		DRILLING AGENCY		DRILLING AGENCY	
Corps of Engineers		Corps of Engineers		Corps of Engineers		Corps of Engineers	
DATE NO. (As shown on drawing title of the number)		DATE NO. (As shown on drawing title of the number)		DATE NO. (As shown on drawing title of the number)		DATE NO. (As shown on drawing title of the number)	
8A6DC-90		8A6DC-90		8A6DC-90		8A6DC-90	
NAME OF DRILLER		NAME OF DRILLER		NAME OF DRILLER		NAME OF DRILLER	
Warehouse		Warehouse		Warehouse		Warehouse	
SECTION OF HOLE		SECTION OF HOLE		SECTION OF HOLE		SECTION OF HOLE	
VERTICAL <input checked="" type="checkbox"/> INCLINED <input type="checkbox"/>		VERTICAL <input checked="" type="checkbox"/> INCLINED <input type="checkbox"/>		VERTICAL <input checked="" type="checkbox"/> INCLINED <input type="checkbox"/>		VERTICAL <input checked="" type="checkbox"/> INCLINED <input type="checkbox"/>	
DEG FROM VERT.		DEG FROM VERT.		DEG FROM VERT.		DEG FROM VERT.	
THICKNESS OF OVERBURDEN		THICKNESS OF OVERBURDEN		THICKNESS OF OVERBURDEN		THICKNESS OF OVERBURDEN	
1.5'		1.5'		1.5'		1.5'	
DEPTH DRILLED INTO ROCK		DEPTH DRILLED INTO ROCK		DEPTH DRILLED INTO ROCK		DEPTH DRILLED INTO ROCK	
26.5'		26.5'		26.5'		26.5'	
TOTAL CORE RECOVERY FOR BORING		TOTAL CORE RECOVERY FOR BORING		TOTAL CORE RECOVERY FOR BORING		TOTAL CORE RECOVERY FOR BORING	
100		100		100		100	
TOTAL DEPTH OF HOLE		TOTAL DEPTH OF HOLE		TOTAL DEPTH OF HOLE		TOTAL DEPTH OF HOLE	
30.0'		30.0'		30.0'		30.0'	
CLASSIFICATION OF MATERIALS		CLASSIFICATION OF MATERIALS		CLASSIFICATION OF MATERIALS		CLASSIFICATION OF MATERIALS	
0.0' to 1.5'		0.0' to 1.5'		0.0' to 1.5'		0.0' to 1.5'	
SAND - fine to medium grained, brown, dry, clayey and limy.		SAND - fine to medium grained, brown, dry, clayey and limy.		SAND - fine to medium grained, brown, dry, clayey and limy.		SAND - fine to medium grained, brown, dry, clayey and limy.	
1.5' to 9.2'		1.5' to 9.2'		1.5' to 9.2'		1.5' to 9.2'	
LIMESTONE - fine to medium grained, tan to rust brown, highly weathered, medium hard.		LIMESTONE - fine to medium grained, tan to rust brown, highly weathered, medium hard.		LIMESTONE - fine to medium grained, tan to rust brown, highly weathered, medium hard.		LIMESTONE - fine to medium grained, tan to rust brown, highly weathered, medium hard.	
9.2' to 30.0'		9.2' to 30.0'		9.2' to 30.0'		9.2' to 30.0'	
SHALE		SHALE		SHALE		SHALE	
9.2' to 13.5' - tan to gray, silty, soft, weathered.		9.2' to 13.5' - tan to gray, silty, soft, weathered.		9.2' to 13.5' - tan to gray, silty, soft, weathered.		9.2' to 13.5' - tan to gray, silty, soft, weathered.	
13.5' to 30.0' - dark gray, silty, horizontal bedding definition, soft, fossiliferous, non-calcareous except for fossils and fossil fragments. Light gray siltstone noted from 25.2' to 26.0'.		13.5' to 30.0' - dark gray, silty, horizontal bedding definition, soft, fossiliferous, non-calcareous except for fossils and fossil fragments. Light gray siltstone noted from 25.2' to 26.0'.		13.5' to 30.0' - dark gray, silty, horizontal bedding definition, soft, fossiliferous, non-calcareous except for fossils and fossil fragments. Light gray siltstone noted from 25.2' to 26.0'.		13.5' to 30.0' - dark gray, silty, horizontal bedding definition, soft, fossiliferous, non-calcareous except for fossils and fossil fragments. Light gray siltstone noted from 25.2' to 26.0'.	
T. D. 30.0'		T. D. 30.0'		T. D. 30.0'		T. D. 30.0'	

RECORD DRAWING-WORK AS BUILT

SYMBOL NO.	ACTION	DATE	DESCRIPTION OF REVISION
<p align="center">U.S. ARMY ENGINEER DISTRICT, FORT WORTH CORPS OF ENGINEERS FORT WORTH, TEXAS</p>			
DESIGNED BY:	RAY ROBERTS LAKE		
DRAWN BY:	ELM FORK, TRINITY RIVER, TEXAS		
REVIEWED BY:	EMBANKMENT, SPILLWAY AND		
	OUTLET WORKS		
	LOGS OF BORINGS		
	3SF-86, CALYX HOLE AND 8A6DC-90		
SUBMITTED BY:	INVITATION NO. DACW63-82-C-0025	DATE	MAR, 1982
ENGINEER:	CONTRACT NO. DACW63-82-C-0025	SHEET NO.	31

CONTRACT NO. DACW63-82-C-0025

DRILLING LOG		INSTALLATION	SHEET			
PROJECT		Part 1 of 2 SHEETS				
Aubrey Dam		NO. SIZE AND TYPE OF BIT		1 1/2" DIA. 1 1/2" DIA.		
Tunnel Outlet Boring		NO. OF FEET FOR INDENTATION OF BIT		0		
CORPS OF ENGINEERS		MANUFACTURER'S TEST		Palix 1500		
BAG-91		NO. TOTAL NO. OF CORES		5		
Sagaprovee and Mullins		NO. TOTAL NUMBER CORES		5		
ELEVATION GROUND WATER		NO. ELEVATION GROUND WATER		00		
DATE HOLE STARTED		NO. DATE HOLE STARTED		11 Dec. 1975		
ELEVATION TOP OF HOLE		NO. ELEVATION TOP OF HOLE		16 Dec. 1975		
THICKNESS OF OVERBURDEN		NO. TOTAL CORE RECOVERY FOR SPRING		00		
DEPTH DRILLED INTO ROCK		NO. SIGNAL USE OF INSPECTOR		<i>[Signature]</i>		
TOTAL DEPTH OF HOLE		ELEVATION		64.1'		
ELEVATION	DEPTH	LEGEND	CLASSIFICATION OF MATERIALS (Description)	CORE RECOVERY	BOX OR SAMPLE NO.	REMARKS
0.0'	14.0'		SAND			Hole bailed to near T.D. upon completion with 27.0' of slotted plastic pipe installed for water level observation. Water level after: 20 hours = 29.0' 48 hours = 17.2'
0.0'	4.0'		very fine grained, light brown, unconsolidated, dry, non-calcareous.			
4.0'	7.0'		as above interval, light tan color, slightly damp, non-calcareous.			
7.0'	9.0'		very fine grained, rust brown, moist, becoming clayey (cohesive), non-calcareous.			
9.0'	14.0'		as above interval, more clayey, more moist, non-calcareous.			
14.0'	18.0'		CLAY - borders on gravelly clay, dark brown, poorly graded up to 1 1/2", becoming wet from 15.5' to 18.0', non-calcareous.			Electric log was used for this boring.
18.0'	24.0'		SHALE - light tan, soft, intermittently limy and gray below 20.0'. Very calcareous.			
24.0'	36.9'		LIMESTONE - light gray, fine to medium grained, medium hard, argillaceous, fossiliferous (less argillaceous, lighter in color from 29.5' to 34.5').			
36.9'	63.9'		SHALE - dark gray, silty, soft, intermittently fossiliferous, slightly calcareous. Light gray very fine grained sandstone noted from 54.5' to 54.8'. Gray, dense, micaceous siltstone noted from 57.2' to 59.0' with irregular (approximately 10° from horizontal) contact with shale below.			
			T. D. 64.1'			

DRILLING LOG		INSTALLATION	SHEET			
PROJECT		Part 2 of 2 SHEETS				
Aubrey Dam		NO. SIZE AND TYPE OF BIT		1 1/2" DIA. 1 1/2" DIA.		
Tunnel Outlet Boring		NO. OF FEET FOR INDENTATION OF BIT		0		
CORPS OF ENGINEERS		MANUFACTURER'S TEST		Palix 1500		
8460-92		NO. TOTAL NO. OF CORES		5		
Sagaprovee and Mullins		NO. TOTAL NUMBER CORES		5		
ELEVATION GROUND WATER		NO. ELEVATION GROUND WATER		00		
DATE HOLE STARTED		NO. DATE HOLE STARTED		11 Dec. 1975		
ELEVATION TOP OF HOLE		NO. ELEVATION TOP OF HOLE		19		
THICKNESS OF OVERBURDEN		NO. TOTAL CORE RECOVERY FOR SPRING		00		
DEPTH DRILLED INTO ROCK		NO. SIGNAL USE OF INSPECTOR		<i>[Signature]</i>		
TOTAL DEPTH OF HOLE		ELEVATION		25.5'		
ELEVATION	DEPTH	LEGEND	CLASSIFICATION OF MATERIALS (Description)	CORE RECOVERY	BOX OR SAMPLE NO.	REMARKS
0.0'	15.2'		CLAY AND SAND - clay dominates overburden with sand noted only at 6.0'. Clay from 0.0' to 2.0' light reddish brown, stiff, silty, sandy, medium to low plasticity, slightly moist; becoming dry, finely sandy, light rust brown at 4.0'. Sand at 6.0' fine grained, brown, clayey with scattered fine gravel. Clay was noted below and to 15.2'; reddish brown, some gray, silty, slightly sandy, medium to low plasticity, medium to stiff, moist, non-calcareous.			
15.2'	17.2'		SHALE - tan soft, silty, calcareous.			
17.2'	25.5'		LIMESTONE - gray, soft to medium hard, fine to medium grained, argillaceous, fossiliferous.			
			T. D. 25.5'			

Hole No. 8167C-02

Hole No. 816C-01

DRILLING LOG	Southwestern	INSTALLATION	Port North
PROJECT	Aubrey Dam	NO. SIZE AND TYPE OF BIT	8" Auger; 6" Core
LOCATION (County or Township)	Normal Outlet Works	DATE AND TIME OF INSTALLATION (M = MIN)	
DRILLING AGENCY	Corps of Engineers	MANUFACTURER'S DESIGNATION OF DRILL	Falling 1500
HOLE NO. (As shown on drawing and 175 number)	8167C-02	TOTAL NO. OF CORE BURDEN SAMPLES TAKEN	7
NAME OF DRILLER	Neppunga	TOTAL NUMBER CORE BOXES	2
DIRECTION OF HOLE	Vertical	ELEVATION GROUND WATER	00
THICKNESS OF OVERBURDEN	15.2'	DATE HOLE STARTED	19 Jan 1976
DEPTH DRILLED INTO ROCK	10.3'	DATE HOLE COMPLETED	20 Jan 1976
TOTAL DEPTH OF HOLE	25.5'	TOTAL CORE RECOVERY FOR BOXES	100%
		SIGNATURE OF INSPECTOR	<i>James D. Logan</i>

DRILLING LOG	Southwestern	INSTALLATION	Port North
PROJECT	Aubrey Lake	NO. SIZE AND TYPE OF BIT	8" Auger; 6" Core
LOCATION (County or Township)	Soilway Site #2	DATE AND TIME OF INSTALLATION (M = MIN)	
DRILLING AGENCY	Corps of Engineers	MANUFACTURER'S DESIGNATION OF DRILL	Falling 1500
HOLE NO. (As shown on drawing and 175 number)	816C-01	TOTAL NO. OF CORE BURDEN SAMPLES TAKEN	2
NAME OF DRILLER	Schooner	TOTAL NUMBER CORE BOXES	2
DIRECTION OF HOLE	Vertical	ELEVATION GROUND WATER	00
THICKNESS OF OVERBURDEN	7.0'	DATE HOLE STARTED	21 Nov 1975
DEPTH DRILLED INTO ROCK	13.0'	DATE HOLE COMPLETED	21 Nov 1975
TOTAL DEPTH OF HOLE	20.0'	TOTAL CORE RECOVERY FOR BOXES	100%
		SIGNATURE OF INSPECTOR	<i>James D. Logan</i>

ELEVATION	DEPTH	LEGEND	CLASSIFICATION OF MATERIALS (Description)	NO. CORE RECOVERY	BOX OR SAMPLE NO.	REMARKS (Drilling time, water level, depth of penetration, etc., if significant)
10.0	0.0' to 15.2'		CLAY AND SAND - clay dominates overburden with sand noted only at 6.0'. Clay from 0.0' to 2.0' light reddish brown, stiff, silty, sandy, medium to low plasticity, slightly moist; becoming dry, finely sandy, light rust brown at 4.0'. Sand at 6.0' fine grained, brown, clayey with scattered fine gravel. Clay was noted below and to 15.2'; reddish brown, some gray, silty, slightly sandy, medium to low plasticity, medium to stiff, moist, non-calcareous.			1. Hole was bailed upon completion and perforated plastic pipe installed for water level observation.
17.2	15.2' to 17.2'		SHALE - tan soft, silty, calcareous.			2. Drilling: 8" auger to 2.0'; Denison barrel to 17.0'; 6" core to 25.5'.
20.0	17.2' to 25.5'		LIMESTONE - gray, soft to medium hard to hard, fine to medium grained, argillaceous, fossiliferous.			3. Jars: A. 0.0' to 2.0' B. At 4.0' C. At 6.0' D. At 8.0' E. At 11.0' F. At 13.0' G. At 15.0' H. At 17.0'
						4. Denison Cans: 1. 2.0' to 4.0' 2. 4.0' to 6.0' 3. 6.0' to 8.0' 4. 9.0' to 11.0' 5. 11.0' to 13.0' 6. 13.0' to 15.0' 7. 15.0' to 17.0'
						5. Cartons: 1. 18.7' to 19.7' 2. 23.3' to 24.2'
						6. Core Boxes: 1. 17.0' to 21.5' 2. 21.5' to 25.5'

ELEVATION	DEPTH	LEGEND	CLASSIFICATION OF MATERIALS (Description)	NO. CORE RECOVERY	BOX OR SAMPLE NO.	REMARKS (Drilling time, water level, depth of penetration, etc., if significant)
10.0	0.0' to 2.0'		CLAY - as described in interval below.			1. Hole was bailed to near total depth upon completion. 4" plastic pipe, slotted, was installed in boring for future water level observations.
17.2	2.0' to 7.0'		CLAY			2. Drilling: 8" auger to 7.0'; 6" core to total depth of 20.0'.
20.0	7.0' to 13.9'		2.0' to 5.0' - medium plasticity, brown, hard, silty to finely sandy, slightly moist, non-calcareous. 5.0' to 7.0' - as above interval, slightly lighter in color, some very fine gravel widely scattered throughout.			3. Jars: A. 2.0' to 5.0' B. 5.0' to 7.0'
	13.9' to 20.0'		CLAY-SHALE - soft, rust brown and gray, silty, highly weathered, non-calcareous, occasional very fine gravel scattered throughout recovery.			4. Cartons: 1. 7.5' to 8.5' 2. 11.5' to 12.5' 3. 16.7' to 17.6' 4. 19.0' to 20.0'
			SHALE - tan with some gray marbling, soft, occasional soft white lily inclusions. Shale is non-calcareous and weathered to total depth. Sand lenses noted from 13.5' to 13.9'; fine grained, rust brown. Iron concretionary zone noted from 14.9' to 15.1'.			5. Core Boxes: 1. 7.0' to 13.4' 2. 13.4' to 20.0'

Hole No. 8A6C-301
 SHEET 1 of 1 SHEETS
DRILLING LOG *Southwestern* **INSTALLATION** *Fort Worth*
PROJECT *Aubrey Lake*
LOCATION *Spillway Site #2*
DATE *Falling 1950*
DRILLING AGENCY *Corps of Engineers*
DRILLER *Schoonover*
DATE MOLE *21 Nov. 1975*
DEPTH DRILLED INTO ROCK *13.0'*
TOTAL DEPTH OF HOLE *20.0'*

DEPTH	LEGEND	CLASSIFICATION OF MATERIALS (Description)	REMARKS
0.0' to 2.0'		CLAY - as described in interval below.	1. Hole was bailed to near total depth upon completion. 4" plastic pipe, slotted, was installed in boring for future water level observations. 2. Drilling: 8" auger to 7.0'; 6" core to total depth of 20.0'. 3. JARS: A. 2.0' to 5.0' B. 5.0' to 7.0' 4. CARBONS: 1. 7.5' to 8.5' 2. 11.5' to 12.5' 3. 16.7' to 17.6' 4. 19.0' to 20.0' 5. Core Boxes: 1. 7.0' to 13.4' 2. 13.4' to 20.0'
2.0' to 7.0'		CLAY	
7.0' to 13.9'		CLAY-SHALE - soft, rust brown and gray, silty, highly weathered, non-calcareous, occasional very fine gravel scattered throughout.	
13.9' to 20.0'		SHALE - tan with some gray marbling, soft, occasional soft white clay inclusions. Shale is non-calcareous and weathered to total depth. Sand lense noted from 13.5' to 13.9'; fine grained, rust brown. Iron concretionary zone noted from 14.9' to 15.1'.	

Hole No. 8A6C-302
 SHEET 1 of 1 SHEETS
DRILLING LOG *Southwestern* **INSTALLATION** *Fort Worth*
PROJECT *Aubrey Lake*
LOCATION *Spillway Site #2*
DATE *Falling 1950*
DRILLING AGENCY *Corps of Engineers*
DRILLER *Schoonover*
DATE MOLE *20 Nov. 1975*
DEPTH DRILLED INTO ROCK *19.2'*
TOTAL DEPTH OF HOLE *25.0'*

DEPTH	LEGEND	CLASSIFICATION OF MATERIALS (Description)	REMARKS
0.0' to 2.0'		CLAY - as described in interval below.	1. Installed slotted plastic pipe after bailing to near T. 2. Drilling: 6" auger to 8.0'; 6" core to total depth of 25.0'. 3. JARS: A. 2.0' to 4.0' B. 4.0' to 6.5' C. 6.5' to 8.0' D. 13.0' to 14.0' 4. CARBONS: 1. 8.0' to 9.0' 2. 14.0' to 15.0' 3. 20.1' to 21.1' 4. 24.7' to 25.5' 5. Core Box 2: 1. 8.0' to 15.0' 2. 15.3' to 15.0' 3. 19.8' to 25.0' 6. Actual bottom of 0.9' from 13.1' to 14.0' - 20 po. r.v. gravel 17.7' to 19.2' to 20.0'. Corals sample D.
2.0' to 6.5'		CLAY	
6.5' to 13.0'		CLAY-SHALE - soft, rust brown and gray, silty, highly weathered, non-calcareous, occasional fine gravel scattered throughout recovery; appears to be reworked shale. Core becoming calcareous at 12.0'.	
13.0' to 14.0'		CLAY - purpl. grad'd up to 2", clay to shaly matrix, angular to sub-angular, calcareous, easy to penetrate with core bit. (Labels in Jar D).	

RECORD DRAWING - WORK AS FULL

U S ARMY ENGINEER DISTRICT, FORT WORTH CORPS OF ENGINEERS 404 404th, TEXAS	
DESIGNED BY DRAWN BY CHECKED BY	RAY ROBERTS LAKE ELM FORK, TRINITY RIVER, TEXAS EMBANKMENT, SPILLWAY AND OUTLET WORKS LOGS OF BORINGS 8A6C-91, 8A6DC-92, 8A6C-301, AND 8A6C-302
DATE CONTRACT NO. <i>DA-CR-63-52</i> DRAWING NUMBER	DATE <i>MAR, 1982</i> SHEET NO. <i>37</i>

DRILLING LOG		DIVISION		INSTALLATION	
PROJECT: Southwest Term		DIVISION: Southwestern		INSTALLATION: SW	
LOCATION: Aubrey Lake Spillway Site #2		PROJECT: Aubrey Lake Spillway Site #2		DATE AND TYPE OF INSTALLATION: 6" Core	
DRILLING AGENCY: Corps of Engineers		DRILLING AGENCY: Corps of Engineers		MANUFACTURER'S TAG NO.: 11	
HOLE NO. (SEE APPROPRIATE MAP AND AIR PHOTO): 816C-303		HOLE NO. (SEE APPROPRIATE MAP AND AIR PHOTO): 816C-303		TOTAL NO. OF CORE SAMPLES: 11	
NAME OF DRILLER: Schoonover		NAME OF DRILLER: Schoonover		TOTAL NUMBER OF CORES: 7	
DIRECTION OF HOLE: <input checked="" type="checkbox"/> VERTICAL <input type="checkbox"/> INCLINED		DIRECTION OF HOLE: <input checked="" type="checkbox"/> VERTICAL <input type="checkbox"/> INCLINED		DATE HOLE: 21 Nov. 1975	
THICKNESS OF OVERBURDEN: 11.0'		THICKNESS OF OVERBURDEN: 2.0'		ELEVATION TOP OF HOLE: 25 Nov. 1975	
DEPTH DRILLED INTO ROCK: 40.0'		DEPTH DRILLED INTO ROCK: 49.0'		TOTAL CORE REC'D: 51.0'	
TOTAL DEPTH OF HOLE: 51.0'		TOTAL DEPTH OF HOLE: 51.0'		SIGNATURE OF INSPECTOR: <i>[Signature]</i>	

ELEVATION	DEPTH	LEGEND	CLASSIFICATION OF MATERIALS (Description)	CORE RECOVERY	BOX OR SAMPLE NO.	REMARKS
0.0'	0.0'		0.0' to 11.0'		No Sample	1. Hole was bailed to near total depth upon completion. Unable to determine where hole is making water, but making water slowly. Installed slotted plastic pipe for water level observations.
0.0'	7.0'		CLAY		A	Water Levels:
7.0'	11.0'		CLAY - rust brown, marbled gray, soft, non-calcareous; appears to be reworked shale; scattered ferrous nodules; very gravelly and calcareous from 18.3' to 19.3' with very fine grained light rust brown sand from 19.3' to 19.6'.		B	26 Nov. '75 - 17.0' 1 Dec. '75 - 16.5'
11.0'	22.0'		11.0' to 22.0'			2. Drilling 8" auger to 11.0'; 6" core to total depth of 51.0'. Set 3.0' of 8" casing due to fluid loss near surface.
22.0'	50.7'		22.0' to 50.7'			3. Jars:
22.0'	40.7'		SHALE			A. 2.0' to 7.0' B. 7.0' to 11.0'
40.7'	50.7'		22.0' to 40.7' - light tan to grayish tan, soft, non-calcareous, bedding angle approximately 5° from horizontal, occasional ferrous nodule with distinct iron concretionary zone from 26.3' to 26.8'; very fine grained light rust brown sandstone from 35.8' to 36.0' and from 37.4' to 37.7'; approaching base of extensive weathering from 38.0' to 40.7' as evidenced by intermittent short intervals of light bluish-gray shale.			4. Cartons:
40.7'	50.7'		40.7' to 50.7' - shale is light bluish-gray, soft, slightly silty, very fossiliferous (numerous fossils along parting at 44.3' and in Carton No. B at 49.7'); bedding is near horizontal; shale is calcareous from 40.7' to recovery depth of 50.7'.			1. 11.3' to 12.2' 2. 16.0' to 17.0' 3. 22.1' to 23.1' 4. 28.5' to 29.5' 5. 35.1' to 35.8' 6. 39.7' to 40.7' 7. 45.3' to 46.2' 8. 49.7' to 50.7'
50.7'	51.0'		50.7' to 51.0'			5. Core Boxes:
50.7'	51.0'		50.7' to 51.0'			1. 11.0' to 17.5' 2. 17.5' to 23.5' 3. 23.5' to 28.3' 4. 28.3' to 33.9' 5. 33.9' to 39.0' 6. 39.0' to 44.3' 7. 44.3' to 50.7'

ELEVATION	DEPTH	LEGEND	CLASSIFICATION OF MATERIALS (Description)	CORE RECOVERY	BOX OR SAMPLE NO.	REMARKS
0.0'	0.0'		0.0' to 2.0'			CLAY - medium plasticity, brown, hard, silty to finely sandy, slightly moist, non-calcareous.
2.0'	15.7'		2.0' to 15.7'			CLAY-SHALE
2.0'	7.0'		2.0' to 7.0' - rust brown soft, non-calcareous; appears to be reworked shale; more moist from 4.0' to 7.0'.			7.0' to 15.7' - as described above with some gray marbling and scattered ferrous nodules.
15.7'	14.0'		15.7' to 14.0'			SANDSTONE - very fine grained, light rust brown, soft, well consolidated, non-calcareous.
14.0'	17.0'		14.0' to 17.0'			SHALE - light tan to grayish tan, soft, silty, non-calcareous.
17.0'	17.6'		17.0' to 17.6'			SANDSTONE - as described in interval 15.7' to 14.0'.
17.6'	19.8'		17.6' to 19.8'			SHALE - as described above.
19.8'	20.2'		19.8' to 20.2'			SANDSTONE - as described above.
20.2'	20.6'		20.2' to 20.6'			SHALE - as described above.
20.6'	22.8'		20.6' to 22.8'			SANDSTONE - as described above with approximately 5° from horizontal bedding angle.
22.8'	32.7'		22.8' to 32.7'			SHALE - as described above, approaching base of extensive weathering from 28.7' to 32.7' as evidenced by intermittent thin beds of bluish gray shale.
32.7'	51.0'		32.7' to 51.0'			Distinct iron concretionary zone was noted from 28.7' to 29.2'. Shale becoming calcareous below 24.7'.
51.0'	51.0'		51.0' to 51.0'			SHALE - unweathered, soft, bluish gray, varies from waxy to silty to very finely sandy, fossiliferous, calcareous.

Southwestern	INSTALLATION	SHEET 1 OF 2 SHEETS
10 SITE AND TYPE OF BIT	Port Worth	8" Auger; 6" Core
11 DATE FOR ELEVATION PROJECTIONS	11 Dec. 1975	
12 MANUFACTURER'S DESIGNATION OF DRILL	Falling 1500	
13 TOTAL NO. OF OVERBURDEN SAMPLES TAKEN	0	0
14 TOTAL NUMBER CORE BOXES	8	
15 ELEVATION GROUND WATER	8'	
16 DATE MOLE	1 Dec. 1975	3 Dec. 1975
17 ELEVATION TOP OF MOLE	2.0'	
18 TOTAL CORE RECOVERY FOR BORING	49.0'	
19 SIGNATURE OF INSPECTOR	<i>James T. Logan</i>	

CLASSIFICATION OF MATERIALS (Description)	ELEVATION	DEPTH	LEGEND	REMARKS (Disturbance, water level, etc.)
CLAY - medium plasticity, brown, hard, silty to finely sandy, slightly moist, non-calcareous.	0.0' to 2.0'	0.0' to 2.0'	1	1. Hole was bailed to near total depth upon completion. Water level 24 hours after completion at 16.0'. Hole was backfilled.
CLAY-SHALE	2.0' to 7.0'	2.0' to 7.0'	2	2. Drilling: 8" auger to 7.0'; 6" core to total depth of 51.0'. Jars: A. 2.0' to 4.0' B. 4.0' to 7.0'
CLAY-SHALE - rust brown, soft, some gray mixed and scattered ferrous nodules.	7.0' to 13.7'	7.0' to 13.7'	3	3. Jars: A. 7.5' to 8.5' B. 12.5' to 13.5' C. 17.8' to 18.8' D. 23.4' to 24.4' E. 27.6' to 28.6' F. 31.0' to 32.0' G. 39.5' to 40.5' H. 45.5' to 46.5' I. 50.0' to 51.0'
SANDSTONE - very fine grained, light rust brown, soft, well consolidated, non-calcareous.	13.7' to 14.0'	13.7' to 14.0'	4	4. Core Boxes: 1. 7.0' to 12.5' 2. 12.5' to 18.9' 3. 18.9' to 24.7' 4. 24.7' to 30.3' 5. 30.3' to 36.0' 6. 36.0' to 41.7' 7. 41.7' to 47.5' 8. 47.5' to 51.0'
SHALE - light tan to grayish tan, soft, silty, non-calcareous.	14.0' to 17.6'	14.0' to 17.6'	5	5. Core Boxes: 1. 7.0' to 12.5' 2. 12.5' to 18.9' 3. 18.9' to 24.7' 4. 24.7' to 30.3' 5. 30.3' to 36.0' 6. 36.0' to 41.7' 7. 41.7' to 47.5' 8. 47.5' to 51.0'
SHALE - as described above.	17.6' to 19.8'	17.6' to 19.8'	6	
SANDSTONE - as described above.	19.8' to 20.2'	19.8' to 20.2'	7	
SHALE - as described above.	20.2' to 20.6'	20.2' to 20.6'	8	
SHALE - as described above.	20.6' to 22.8'	20.6' to 22.8'	9	
SANDSTONE - as described above with approximately 5° from horizontal bedding angle.	22.8' to 32.7'	22.8' to 32.7'	10	
SHALE - as described above, approaching base of extensive weathering from 26.7' to 32.7' as evidenced by intermittent thin beds of bluish gray distinct iron concretionary zone was noted from 7' to 29.2'. Shale coating calcareous below 7'.	32.7' to 51.0'	32.7' to 51.0'	11	

Southwestern	INSTALLATION	SHEET 1 OF 2 SHEETS
10 SITE AND TYPE OF BIT	Port Worth	8" Auger; 6" Core
11 DATE FOR ELEVATION PROJECTIONS	11 Dec. 1975	
12 MANUFACTURER'S DESIGNATION OF DRILL	Falling 1500	
13 TOTAL NO. OF OVERBURDEN SAMPLES TAKEN	0	0
14 TOTAL NUMBER CORE BOXES	4	
15 ELEVATION GROUND WATER	8'	
16 DATE MOLE	3 Dec. 1975	4 Dec. 1975
17 ELEVATION TOP OF MOLE	2.0'	
18 TOTAL CORE RECOVERY FOR BORING	100	
19 SIGNATURE OF INSPECTOR	<i>James T. Logan</i>	

CLASSIFICATION OF MATERIALS (Description)	ELEVATION	DEPTH	LEGEND	REMARKS (Disturbance, water level, etc.)
CLAY	0.0' to 6.0'	0.0' to 6.0'	1	1. Hole was bailed to near total depth upon completion and slotted plastic pipe installed for water level observation. Water level after 24 hours at 10.9'.
CLAY	6.0' to 12.0'	6.0' to 12.0'	2	2. Drilling: 8" auger to 7.0'; 6" core to total depth of 30.0'. Jars: A. 2.0' to 4.0' B. 4.0' to 6.0' C. 6.0' to 7.0'
CLAY-SHALE - rust brown, soft, some gray mixed, scattered gravel and ferrous nodules, non-calcareous.	12.0' to 21.0'	12.0' to 21.0'	3	3. Jars: 1. 7.5' to 8.5' 2. 12.9' to 13.9' 3. 14.5' to 15.5' 4. 21.0' to 22.0' 5. 29.0' to 30.0'
SHALE AND SANDSTONE - shale is dominant; light tan to grayish tan, silty, non-calcareous. Shale is interrupted with occasional thin beds of sandstones, notably from 14.5' to 17.3'; sandstone is light rust brown, very fine grained, soft and non-calcareous. Maximum thickness without shale interruption was 1.0' (Carton No. 3 from 14.5' to 15.5'). Shale was dominant from 17.3' to 20.7'. Last sandstone in this boring was logged from 20.7' to 21.0'.	21.0' to 30.0'	21.0' to 30.0'	4	4. Core Boxes: 1. 7.0' to 12.6' 2. 12.6' to 19.2' 3. 19.2' to 24.8' 4. 24.8' to 30.0'
SHALE - soft, light tan to grayish tan, silty, some very widely scattered calcite; iron concretionary zone, very calcareous noted from 27.4' to 29.9'. Shale is silty calcareous from this point to total depth and is weathered throughout.	30.0' to 51.0'	30.0' to 51.0'	5	

Southwestern	INSTALLATION	SHEET 1 OF 2 SHEETS
10 SITE AND TYPE OF BIT	Port Worth	8" Auger; 6" Core
11 DATE FOR ELEVATION PROJECTIONS	11 Dec. 1975	
12 MANUFACTURER'S DESIGNATION OF DRILL	Falling 1500	
13 TOTAL NO. OF OVERBURDEN SAMPLES TAKEN	0	0
14 TOTAL NUMBER CORE BOXES	4	
15 ELEVATION GROUND WATER	8'	
16 DATE MOLE	3 Dec. 1975	4 Dec. 1975
17 ELEVATION TOP OF MOLE	2.0'	
18 TOTAL CORE RECOVERY FOR BORING	100	
19 SIGNATURE OF INSPECTOR	<i>James T. Logan</i>	

CLASSIFICATION OF MATERIALS (Description)	ELEVATION	DEPTH	LEGEND	REMARKS (Disturbance, water level, etc.)
CLAY	0.0' to 6.0'	0.0' to 6.0'	1	1. Hole was bailed to near total depth upon completion and slotted plastic pipe installed for water level observation. Water level after 24 hours at 10.9'.
CLAY	6.0' to 12.0'	6.0' to 12.0'	2	2. Drilling: 8" auger to 7.0'; 6" core to total depth of 30.0'. Jars: A. 2.0' to 4.0' B. 4.0' to 6.0' C. 6.0' to 7.0'
CLAY-SHALE - rust brown, soft, some gray mixed, scattered gravel and ferrous nodules, non-calcareous.	12.0' to 21.0'	12.0' to 21.0'	3	3. Jars: 1. 7.5' to 8.5' 2. 12.9' to 13.9' 3. 14.5' to 15.5' 4. 21.0' to 22.0' 5. 29.0' to 30.0'
SHALE AND SANDSTONE - shale is dominant; light tan to grayish tan, silty, non-calcareous. Shale is interrupted with occasional thin beds of sandstones, notably from 14.5' to 17.3'; sandstone is light rust brown, very fine grained, soft and non-calcareous. Maximum thickness without shale interruption was 1.0' (Carton No. 3 from 14.5' to 15.5'). Shale was dominant from 17.3' to 20.7'. Last sandstone in this boring was logged from 20.7' to 21.0'.	21.0' to 30.0'	21.0' to 30.0'	4	4. Core Boxes: 1. 7.0' to 12.6' 2. 12.6' to 19.2' 3. 19.2' to 24.8' 4. 24.8' to 30.0'
SHALE - soft, light tan to grayish tan, silty, some very widely scattered calcite; iron concretionary zone, very calcareous noted from 27.4' to 29.9'. Shale is silty calcareous from this point to total depth and is weathered throughout.	30.0' to 51.0'	30.0' to 51.0'	5	

Male No. 8A6C-305 SHEET 1 OF 1 SHEETS

INSTALLATION Port Worth

10 SIZE AND TYPE OF BIT 8" AUGER 6" CORE

11 LOCATION (COUNTY AND CITY OR TOWNSHIP AND ELEVATION) Spillway Site "K"

12 MANUFACTURER'S DESIGNATION OF DRILL Falling 1500

13 TOTAL NO. OF OVERBURDEN SAMPLES TAKEN 2 0

14 TOTAL NUMBER CORE BOXES 5

15 ELEVATION GROUND WATER

16 DATE MOLE STARTED 3 Dec. 1975 COMPLETED 4 Dec. 1975

17 ELEVATION TOP OF MOLE

18 TOTAL CORE RECOVERY FOR BORING 100

19 DEPTH DRILLED INTO ROCK 25.2'

20 SIGNATURE OF INSPECTOR *James H. Logan*

21 TOTAL DEPTH OF MOLE 30.0'

CLASSIFICATION OF MATERIALS (Description)

1. Hole was bailed to near total depth upon completion and slotted plastic pipe installed for water level observation. Water level after 24 hours at 10.9'.

2. Drilling: 8" auger to 7.0'; 6" core to total depth of 30.0'.

3. Jars:
A. 2.0' to 4.0'
B. 4.0' to 6.0'
C. 6.0' to 7.0'

4. Cartons:
1. 7.5' to 8.5'
2. 12.9' to 13.9'
3. 14.5' to 15.5'
4. 21.0' to 22.0'
5. 29.0' to 30.0'

5. Core Boxes:
1. 7.0' to 12.6'
2. 12.6' to 19.2'
3. 19.2' to 24.8'
4. 24.8' to 30.0'

SHALE - rust brown, soft, some gray mixed, scattered gravel and ferruginous nodules, non-calcareous.

SHALE AND SANDSTONE - shale is dominant; light tan to grayish tan, silty, non-calcareous. Shale is interrupted with occasional thin beds of sandstone, notably from 14.5' to 17.3'; sandstone is light rust brown, very fine grained, soft and non-calcareous. Maximum thickness without shale interruption was 4.0' (Carton No. 3 from 14.5' to 15.5'). Shale was dominant from 17.3' to 20.7'. Last sandstone in this boring was logged from 20.7' to 21.0'.

SHALE - light tan to gray, (predominantly gray below 25.0'), silty, scattered small crystals of selenite, slightly calcareous; iron concretionary zone, very calcareous, noted from 21.9' to 22.4'. Some very fine-grained gray sand interbedded with shale below 29.0'. Shale is weathered to total depth.

T. D. 30.0'

PROJECT Aubrey Lake HOLE NO. 8A6C-305

Male No. 8A6C-306 SHEET 1 OF 1 SHEETS

DRILLING LOCATION Southwestern

INSTALLATION Port Worth

10 SIZE AND TYPE OF BIT 8" AUGER 6" CORE

11 LOCATION (COUNTY AND CITY OR TOWNSHIP AND ELEVATION) Spillway Site "K"

12 MANUFACTURER'S DESIGNATION OF DRILL Falling 1500

13 TOTAL NO. OF OVERBURDEN SAMPLES TAKEN 1 0

14 TOTAL NUMBER CORE BOXES 4

15 ELEVATION GROUND WATER

16 DATE MOLE STARTED 4 Dec. 1975 COMPLETED

17 ELEVATION TOP OF MOLE

18 TOTAL CORE RECOVERY FOR BORING 100

19 DEPTH DRILLED INTO ROCK 25.2'

20 SIGNATURE OF INSPECTOR *James H. Logan*

21 TOTAL DEPTH OF MOLE 30.2'

CLASSIFICATION OF MATERIALS (Description)

1. Hole was bailed to near total depth upon completion and slotted plastic pipe was installed for water level observation.

2. Drilling: 8" auger to 7.0'; 6" core to total depth of 30.2'.

3. Jars:
A. 2.0' to 5.0'
B. 5.0' to 7.0'

4. Cartons:
1. 8.0' to 9.0'
2. 14.5' to 15.5'
3. 20.9' to 21.9'
4. 24.6' to 25.5'
5. 28.2' to 29.1'

5. Core Boxes:
1. 7.0' to 12.9'
2. 12.9' to 18.6'
3. 18.6' to 24.2'
4. 24.2' to 30.2'

SHALE - light tan to gray, (predominantly gray below 25.0'), silty, scattered small crystals of selenite, slightly calcareous; iron concretionary zone, very calcareous, noted from 21.9' to 22.4'. Some very fine-grained gray sand interbedded with shale below 29.0'. Shale is weathered to total depth.

T. D. 30.2'

PROJECT Aubrey Lake HOLE NO. 8A6C-306

RECORD DRAWING-WORK AS BUILT

SYN	DC	NO	ACTION	DATE	DESCRIPTION OF REVISION
U.S. ARMY ENGINEER DISTRICT, FORT WORTH CORPS OF ENGINEERS FORT WORTH, TEXAS					
DESIGNED BY:	RAY ROBERTS LAKE				
CHECKED BY:	ELM FORK, TRINITY RIVER, TEXAS				
REVIEWED BY:	EMBANKMENT, SPILLWAY AND				
APPROVED BY:	OUTLET WORKS				
ENGINEER	LOGS OF BORINGS				
			8A6C-303, 8A6C-304, 8A6C-305, AND 8A6C-306		
			INVITATION NO. DACW63-82-B-0025		DATE: MAR, 1982
			CONTRACT NO. DACW63-82-C-0093		SEQUENCE NO.
			DRAWING NUMBER		33

TO ACCOMPANY FOUNDATION REPORT

CONTRACT NO. DACW63-82-C-0093

DRILLING LOG	Division Southwestern	INSTALLATION	Port 7
PROJECT	Aubrey Lake	NO. RECORD TYPE OF BIT	6" Auger
LOCATION (Continent, State, County)	Guillevy Site #2	DATE FOR ELEVATION	1975
DRILLING AGENCY	Corps of Engineers	DATE FOR ELEVATION	1975
HOLE NO. (As shown on drawing sheet and file number)	816C-308	DATE FOR ELEVATION	1975
NAME OF DRILLER	Seboonover	DATE FOR ELEVATION	1975
DIRECTION OF HOLE	VERTICAL	DATE FOR ELEVATION	1975
THICKNESS OF OVERBURDEN	3.5'	DATE FOR ELEVATION	1975
DEPTH DRILLED INTO ROCK	17.1'	DATE FOR ELEVATION	1975
TOTAL DEPTH OF HOLE	20.6'	DATE FOR ELEVATION	1975

ELEVATION	DEPTH	LEGEND	CLASSIFICATION OF MATERIALS (Description)	REMARKS (Drilling time, water loss, etc., if significant)
0.0'	4.5'		CLAY - medium plasticity, brown, hard, silty, sandy, slightly moist, non-calcareous.	No Sample
4.5'	10.0'		CLAY-SHALE - rust brown, some gray mottled, soft, appears to be reworked shale, scattered small ferrous nodules, non-calcareous.	1. Hole bailed to near total depth upon completion and slotted plastic pipe installed for water level observation.
10.0'	24.7'		SHALE, SILTSTONE AND SANDSTONE - shale is light tan, some gray marbling, soft, variously grades into thin beds of siltstone and very fine grained sandstones; light rust brown and non-calcareous. Maximum thickness of sandstone is 0.8' from 18.3' to 19.1'. Last sandstone logged this interval from 22.0' to 22.3', brown, fine grained and calcareous. Shale as previously described becoming gray, slightly calcareous below 22.3'. Iron concretionary zone, very calcareous, noted from 24.5' to 24.7'.	2. Drilling: 6" auger to 7.0'; 6" core to total depth of 25.0'. 3. Jars: A. 2.0' to 4.5' B. 4.5' to 7.0' 4. Cartons: 1. 7.7' to 8.7' 2. 12.7' to 13.5' 3. 19.2' to 20.0' 4. 23.0' to 24.0' 5. Core Boxes: 1. 7.0' to 12.7' 2. 12.7' to 18.3' 3. 18.3' to 24.7'
20.0'	25.0'			

DRILLING LOG	Division Southwestern	INSTALLATION	Port 7
PROJECT	Aubrey Lake	NO. RECORD TYPE OF BIT	6" Auger
LOCATION (Continent, State, County)	Guillevy Site #2	DATE FOR ELEVATION	1975
DRILLING AGENCY	Corps of Engineers	DATE FOR ELEVATION	1975
HOLE NO. (As shown on drawing sheet and file number)	816C-308	DATE FOR ELEVATION	1975
NAME OF DRILLER	Seboonover	DATE FOR ELEVATION	1975
DIRECTION OF HOLE	VERTICAL	DATE FOR ELEVATION	1975
THICKNESS OF OVERBURDEN	3.5'	DATE FOR ELEVATION	1975
DEPTH DRILLED INTO ROCK	17.1'	DATE FOR ELEVATION	1975
TOTAL DEPTH OF HOLE	20.6'	DATE FOR ELEVATION	1975

ELEVATION	DEPTH	LEGEND	CLASSIFICATION OF MATERIALS (Description)	REMARKS (Drilling time, water loss, etc., if significant)
0.0'	3.5'		CLAY - medium plasticity, brown, hard, silty to finely sandy, slightly moist, non-calcareous.	No Sample
3.5'	4.5'		CLAY-SHALE - rust brown to reddish brown, some gray, soft, gravelly (composed mostly of small ferrous nodules), some calcareous granules.	1. Hole bailed total depth and slotted plastic pipe installed for water level observation.
10.0'	20.6'		SHALE AND SANDSTONE - predominantly shale, light tan to grayish tan, soft, non-calcareous with interruptions of light rust brown, fine grained sandstone noted at the following intervals: 10.5' to 11.0'; 11.5' to 12.3'; 12.8' to 14.9'; 16.9' to 17.2'. Shale becoming slightly calcareous from 17.2' to total depth. Iron concretionary zone, very calcareous from 20.0' to 20.4'.	2. Drilling: 6" auger to 7.0'; 6" core to total depth. 3. Jars: A. 2.0' to 3.5' B. 3.5' to 4.5' 4. Cartons: 1. 8.4' to 12.7' 2. 14.4' to 19.0' 3. 19.0' to 20.0' 5. Core Boxes: 1. 7.0' to 12.7' 2. 12.8' to 18.3' 3. 20.0' to 20.4'
20.0'	20.6'			

Hole No. 816C-309

DIVISION Southwestern		INSTALLATION Port North		SHEET 1 of 1 SHEETS	
PROJECT Aubrey Lake		HOLE NO. AND TYPE OF BIT 6" AUGER 6" CORE		DATE AND TIME OF ELEVATION (1975)	
SUBJECT Spillway Site #7		11. MANUFACTURER'S DESIGNATION OF DRILL Falling 1500		12. TOTAL NO. OF OVERBURDEN SAMPLES TAKEN 1	
DRILLING AGENCY Corps of Engineers		13. TOTAL NUMBER CORE BORES 3		14. ELEVATION GROUND WATER 0	
DRILLER Schoonover		15. DATE HOLE STARTED 9 Dec, 1975		16. DATE HOLE COMPLETED 9 Dec, 1975	
17. ELEVATION TOP OF HOLE 3.5'		18. TOTAL CORE RECOVERY FOR BORING 100		19. SIGNATURE OF INSPECTOR <i>James H. Logan</i>	
18. ELEVATION GROUND WATER 0		20. SIGNATURE OF INSPECTOR <i>James H. Logan</i>		21. SIGNATURE OF INSPECTOR <i>James H. Logan</i>	

DEPTH	LEGEND	CLASSIFICATION OF MATERIALS (Description)	1. CORE RECOVERY %	2. BOX OR SAMPLE NO.	REMARKS (Drilling time, water flow, depth of overburden, etc., if significant)
0.0'		0.0' to 3.5'	No Sample		1. Hole bailed to near total depth upon completion and slotted plastic pipe installed for water level observation.
3.5'		3.5' to 4.5'	A		
4.5'		4.5' to 20.6'	C		2. Drilling: 8" auger to 7.0'; 6" core to total depth of 20.6'.
10.0'		CLAY-SHALE - rust brown to reddish brown, some gray, soft, gravelly (composed mostly of small ferrous nodules), some calcareous greenish.	L 0.4'	Bx 1	3. Jars: A. 2.0' to 3.5' B. 3.5' to 4.5' C. 4.5' to 7.0'
15.0'		SHALE AND SANDSTONE - predominantly shale, light tan to grayish tan, soft, non-calcareous with interruptions of light rust brown, fine grained sandstone noted at the following intervals: 10.5' to 11.0'; 11.5' to 12.3'; 12.8' to 14.9'; 16.9' to 17.2'. Shale becoming slightly calcareous from 17.2' to total depth. Iron concretionary zone, very calcareous from 20.0' to 20.4'.	L 0.5'	Bx 2	4. Cartons: 1. 8.4' to 9.4' 2. 14.4' to 15.4' 3. 19.0' to 20.0'
20.0'			0 0.9'		5. Core Boxes: 1. 7.0' to 12.8' 2. 12.8' to 20.0' 3. 20.0' to 20.6'
20.6'		T. D. 20.6'			

Hole No. 816C-309

DIVISION Southwestern		INSTALLATION Port North		SHEET 1 of 1 SHEETS	
PROJECT Aubrey Lake		HOLE NO. AND TYPE OF BIT 6" AUGER 6" CORE		DATE AND TIME OF ELEVATION (1975)	
SUBJECT Spillway Site #7		11. MANUFACTURER'S DESIGNATION OF DRILL Falling 1500		12. TOTAL NO. OF OVERBURDEN SAMPLES TAKEN 1	
DRILLING AGENCY Corps of Engineers		13. TOTAL NUMBER CORE BORES 3		14. ELEVATION GROUND WATER 0	
DRILLER Schoonover		15. DATE HOLE STARTED 10 Dec, 1975		16. DATE HOLE COMPLETED 10 Dec, 1975	
17. ELEVATION TOP OF HOLE 4.5'		18. TOTAL CORE RECOVERY FOR BORING 100		19. SIGNATURE OF INSPECTOR <i>James H. Logan</i>	
18. ELEVATION GROUND WATER 0		20. SIGNATURE OF INSPECTOR <i>James H. Logan</i>		21. SIGNATURE OF INSPECTOR <i>James H. Logan</i>	

ELEVATION	DEPTH	LEGEND	CLASSIFICATION OF MATERIALS (Description)	1. CORE RECOVERY %	2. BOX OR SAMPLE NO.	REMARKS (Drilling time, water flow, depth of overburden, etc., if significant)
0.0'			0.0' to 4.5'	No Sample		1. Hole was bailed to near total depth upon completion and slotted plastic pipe installed for water level observation.
4.5'			4.5' to 9.9'	A		
10.0'			CLAY-SHALE - appears to be reworked shale, rust brown, marbled gray, soft, abundant calcareous nodules throughout, moist. Clay-shale is gravelly (mostly ferrous nodules) throughout this interval. Calcareous from 9.3' to 9.9'.	Actual Loss 1.4'	B	2. Drilling: 8" auger to 7.0'; 6" core to total depth of 15.0'.
10.0'			9.9' to 11.3'	L 0.6'	Bx 1	3. Jars: A. 2.0' to 4.5' B. 4.5' to 7.0'
11.3'			Core lost due to grinding.	G 0.6'		4. Cartons: 1. 7.5' to 8.5' 2. 14.0' to 15.0'
11.3'			11.3' to 15.0'			5. Core Box: 1. 7.0' to 15.0'
15.0'			SHALE AND SANDSTONE - shale is tan, to grayish tan, soft, silty, finely sandy and is interrupted by tan very fine grained sandstone at the following intervals: 11.8' to 12.0'; 12.5' to 13.3'. Ironstone noted from 13.3' to 13.4'. Shale and sandstone is non-calcareous.			
15.0'			T. D. 15.0'			

36 PREVIOUS EDITIONS ARE OBSOLETE. PROJECT Aubrey Lake HOLE NO. 816C-309

ENG FORM 18 36 PREVIOUS EDITIONS ARE OBSOLETE. PROJECT Aubrey Lake HOLE NO. 816C-309

Hole No. 816C-309

Division Southwestern		INSTALLATION Fort Worth		SHEET 1 of 1 SHEETS	
PROJECT Aubrey Lake		NO. HOLE AND TYPE OF BIT 8" Auger 6" Core		DATE 10 Dec 1975	
LOCATION Spillway Site #2		11. DATE FOR ELEVATION IDENTIFICATION Falling 1500			
CORPORATION Corps of Engineers		12. MANUFACTURER'S DESIGNATION OF DRILL Falling 1500			
DRAWING NO. 816C-309		13. TOTAL NO. OF OVERBURDEN SAMPLES TAKEN UNDISTURBED: 1 DISTURBED: 0			
OPERATOR Schoonover		14. TOTAL NUMBER CORE BORES 1			
DESIGNER DES. FROM VERT.		15. ELEVATION GROUND WATER **			
DATE 10 Dec 1975		16. DATE HOLE STARTED 10 Dec 1975		17. DATE HOLE COMPLETED 10 Dec 1975	
ELEVATION TOP OF HOLE 10.5'		18. ELEVATION TOP OF HOLE 10.5'		19. TOTAL CORE RECOVERY FOR BORING 100	
SIGNATURE OF INSPECTOR 15.0'		SIGNATURE OF INSPECTOR <i>H. W. ...</i>			
CLASSIFICATION OF MATERIALS (Description)		1. CORE RECOVERY a	2. SOX OR SAMPLE NO. b	REMARKS (Drilling time, water loss, depth of overburden, etc., if significant)	
0.0' to 4.5'		No Sample		1. Hole was bailed to near total depth upon completion and slotted plastic pipe installed for water level observation.	
CLAY - medium plasticity, brown, hard, silty to finely sandy, slightly moist, becoming more moist from 2.0' to 4.5', slightly calcareous.		A			
4.5' to 9.9'		B			
CLAY-SHALE - appears to be reworked shale, rust brown, marbled gray, soft abundant calcareous nodules throughout, moist. Clay-shale is gravelly (mostly ferrous nodules) throughout this interval. Calcareous from 9.3' to 9.9'.	Actual Loss 1.4'	EX 1		2. Drillings: 8" auger to 7.0'; 6" core to total depth of 15.0'.	
9.9' to 11.3'				3. Jars: A. 2.0' to 4.5' B. 4.5' to 7.0'	
Core lost due to grinding.				4. Cartons: 1. 7.5' to 8.5' 2. 14.0' to 15.0'	
11.3' to 15.0'				5. Core Box: 1. 7.0' to 15.0'	
SHALE AND SANDSTONE - shale is tan, to grayish tan, soft, silty, finely sandy and is interrupted by tan very fine grained sandstone at the following intervals: 11.8' to 12.0', 12.5' to 13.3'. Ironstone noted from 13.3' to 13.4'. Shale and sandstone is non-calcareous.					
T.D. 15.0'					

PREVIOUS EDITIONS ARE OBSOLETE.
(TRANSLUCENT)

PROJECT: **Aubrey Lake** HOLE NO.: **816C-309**

Hole No. 8A-310

Division Southwestern		INSTALLATION Fort Worth		SHEET 1 of 1 SHEETS	
PROJECT Aubrey Dam		NO. HOLE AND TYPE OF BIT 8" Auger		DATE 19 Sep 83	
LOCATION Outlet Works		11. DATE FOR ELEVATION IDENTIFICATION Offsee elev 8422			
CORPORATION USCE		12. MANUFACTURER'S DESIGNATION OF DRILL Falling 1500			
DRAWING NO. 8A-310		13. TOTAL NO. OF OVERBURDEN SAMPLES TAKEN UNDISTURBED: 3 DISTURBED: 0			
OPERATOR Mullins		14. TOTAL NUMBER CORE BORES 3			
DESIGNER DES. FROM VERT.		15. ELEVATION GROUND WATER **			
DATE 19 Sep 83		16. DATE HOLE STARTED 19 Sep 83		17. DATE HOLE COMPLETED 19 Sep 83	
ELEVATION TOP OF HOLE 10.3'		18. ELEVATION TOP OF HOLE 10.3'		19. TOTAL CORE RECOVERY FOR BORING 100	
SIGNATURE OF INSPECTOR 11.0'		SIGNATURE OF INSPECTOR <i>J. L. ...</i>			
CLASSIFICATION OF MATERIALS (Description)		1. CORE RECOVERY a	2. SOX OR SAMPLE NO. b	REMARKS (Drilling time, water loss, depth of overburden, etc., if significant)	
0.0' to 1.0'		A		*** 1. Hole was dry after completion. 16 hour check, hole was dry.	
CLAY, low plasticity, hard dry, silty, dark gray.		B			
1.0' to 4.0'		C		2. Jars: A. 0.0 to 1.0 B. 1.0 to 4.0 C. 4.0 to 6.0 D. 6.0 to 9.0 E. 9.0 to 10.3 F. 10.3 to 11.0	
CLAY, medium plasticity, hard, dry, gray.		D			
4.0' to 6.0'		E			
CLAY, medium plasticity, silty, stiff, gravelly, some caliche, tan and white.		F		3. Hole offset 10' East.	
6.0' to 10.3'					
CLAY, low plasticity, medium stiff, sandy, moist to 2', wet from 2' to 10.3', tan.					
10.3' to 11.0'					
SHALE, weathered to 10.5', unweathered from 10.3' to 11', stiff, dark gray.					
T.D. - 11.0' -					

PREVIOUS EDITIONS ARE OBSOLETE.

PROJECT: **Aubrey Dam** HOLE NO.: **8A-310**

RECORD DRAWING-WORK AS BUILT

SYM	NO	ACTION	DATE	DESCRIPTION OF REVISION
U.S. ARMY ENGINEER DISTRICT, FORT WORTH CORPS OF ENGINEERS FORT WORTH, TEXAS				
RAY ROBERTS LAKE ELM FORK, TRINITY RIVER, TEXAS CORPORATION, SPILLWAY AND OUTLET WORKS LOGS OF BORINGS 8A6C-307, 8A6C-308, 8A6C-309 AND 8A-310				
DESIGNED BY:		INVESTIGATION NO. DACW63-B2-B-0025 DATE MAR, 1982		
DRAWN BY:		CONTRACT NO. DACW63-82-C-0083		
REVIEWED BY:		DRAWING NUMBER		
SUBMITTED BY:		SHEET NO. 34		
ENGINEER:		SEQUENCE NO.		

CONTRACT NO. **DACW63-82-C-0083**

TO ACCOMPANY FOUNDATION REPORT

Map No. **8A-311**

DRILLING LOG		DIVISION Southwestern		INSTALLATION Fort Worth		SHEET of 4 SHEETS	
1. PROJECT Aubrey Dam				16. SIZE AND TYPE OF BIT BUGER			
2. LOCATION (Name of Dam or Structure) Outlet Works				17. DATE FOR ELEVATION TOOK (T.M. or M.D.)			
3. DRILLING AGENCY USCE				18. MANUFACTURER'S DESIGNATION OF DRILL Falling 1500			
4. HOLE NO. (As shown on drawing sheet and file marked) 8A-311				19. TOTAL NO. OF OVERBURDEN SAMPLES TAKEN		20. UNDISTURBED	
5. NAME OF DRILLER Mullina				19. TOTAL NUMBER CORE BORES		21. ELEVATION GROUND WATER	
6. DIRECTION OF HOLE <input type="checkbox"/> VERTICAL <input type="checkbox"/> INCLINED _____ DEG. FROM VERT.				14. DATE HOLE 5		15. DATE HOLE 19 Sep 80	
7. THICKNESS OF OVERBURDEN 13.8				17. ELEVATION TOP OF HOLE 573.6 (offset elev)			
8. DEPTH DRILLED INTO ROCK 2.2				18. TOTAL CORE RECOVERY FOR BORING			
9. TOTAL DEPTH OF HOLE 16.0				19. SIGNATURE OF INSPECTOR <i>J.P. [Signature]</i>			
ELEVATION	DEPTH	LEGEND	CLASSIFICATION OF MATERIALS (Description)	% CORE RECOVERY	BOX OR SAMPLE NO.	REMARKS (Disturb from water level, depth of weathering, etc., if significant)	TESTING IN LABORATORY
			0.0' to 1.0' SILT , medium stiff, dry, low plasticity, dark brown.		A	**** 1. Hole was dry after completion. 16 hour check, level was 15.4' 2. Jars: A. 0.0 to 1.0 B. 1.0 to 6.7 C. 6.7 to 12.0 D. 12.0 to 13.8 E. 13.8 to 16.0 3. Hole offset 30 ft. on a bearing of N 90° E.	
			1.0' to 6.7' CLAY , low plasticity, medium stiff, silty, sandy, slightly moist, red and tan.		B		
			6.7' to 12.0' CLAY , low plasticity, medium stiff, sandy, moist, tan and gray.		C		
			12.0' to 13.8' SAND , gravelly, medium dense, clayey, tan and brown.		D		
			13.8' to 16.0' SHALE , reworked in upper 0.3', unweathered dark gray.		E		
			T.D. - 16.0' -				

ENG FORM 1836 MAR 71 PREVIOUS EDITIONS ARE OBSOLETE. PROJECT **Aubrey Dam** HOLE NO. **8A-311**

Map No. **8A-311**

DRILLING LOG		DIVISION Southwestern		INSTALLATION Fort Worth		SHEET of 4 SHEETS	
1. PROJECT Aubrey Dam				16. SIZE AND TYPE OF BIT BUGER			
2. LOCATION (Name of Dam or Structure) Outlet Works				17. DATE FOR ELEVATION TOOK (T.M. or M.D.)			
3. DRILLING AGENCY USCE				18. MANUFACTURER'S DESIGNATION OF DRILL Falling 1500			
4. HOLE NO. (As shown on drawing sheet and file marked) 8A-312				19. TOTAL NO. OF OVERBURDEN SAMPLES TAKEN		20. UNDISTURBED	
5. NAME OF DRILLER Mullina				19. TOTAL NUMBER CORE BORES		21. ELEVATION GROUND WATER	
6. DIRECTION OF HOLE <input checked="" type="checkbox"/> VERTICAL <input type="checkbox"/> INCLINED _____ DEG. FROM VERT.				14. DATE HOLE 5		15. DATE HOLE 19 Sep 80	
7. THICKNESS OF OVERBURDEN 15.0				17. ELEVATION TOP OF HOLE 56			
8. DEPTH DRILLED INTO ROCK 0.5				18. TOTAL CORE RECOVERY FOR BORING			
9. TOTAL DEPTH OF HOLE 15.5				19. SIGNATURE OF INSPECTOR <i>J.P. [Signature]</i>			
ELEVATION	DEPTH	LEGEND	CLASSIFICATION OF MATERIALS (Description)	% CORE RECOVERY	BOX OR SAMPLE NO.	REMARKS (Disturb from water level, depth of weathering, etc., if significant)	TESTING IN LABORATORY
			0.0' to 2.0' SAND , fine grained, medium dense, dry, brown.		A	**** 1. Aug rated 24 hours 2. Jars: A. 0. B. 2. C. 5. D. 7. E. 12. F. 15 3. Ho. on : N80° Ina: Ele: tail	
			2.0' to 12.0' GRAVEL , coarse to fine grained, medium dense, moist from 2' to 3', damp from 5' to 7', becomes saturated at 7'.		B		
			12.0' to 15.0' CLAY , medium plasticity, very stiff, moist, gravelly, brown.		C		
			15.0' to 15.5' SHALE , unweathered, soft, dark gray.		D		
			T.D. - 15.5' -		E		

ENG FORM 1836 MAR 71 PREVIOUS EDITIONS ARE OBSOLETE. PROJECT **Aubrey Lake** HOLE NO. **8A-312**

Hole No. BA-312

INSTALLATION Fort Worth		SHEET 1 of 1 SHEETS	
1. PROJECT Aubrey Dam			
2. LOCATION (Company or Station) Outlet			
3. DRILLING AGENCY USCE-C			
10. SIZE AND TYPE OF BIT Falling 1500		11. DATE AND TIME OF ELEVATION MEASUREMENT 19 Sep 80	
12. MANUFACTURER'S DESIGNATION OF DRILL Falling 1500		13. TOTAL NO. OF OVERBURDEN SAMPLES TAKEN 6	
14. TOTAL NUMBER CORE BORES 1		15. ELEVATION GROUND WATER ****	
16. DATE HOLE STARTED 19 Sep 80		17. DATE HOLE COMPLETED 19 Sep 80	
18. ELEVATION TOP OF HOLE 567.9		19. THICKNESS OF OVERBURDEN 29.5	
20. TOTAL CORE RECOVERY FOR BORING 0.5		21. DEPTH DRILLED INTO ROCK 53.6	
22. SIGNATURE OF INSPECTOR J.P. White		23. TOTAL DEPTH OF HOLE 83.2	
REMARKS (Listing time, time from, depth of overburden, etc., if significant)			
1. Augered into saturated gravel at 7'. 24 hour check - level was same.			
2. Jars: A. 0.0 to 2.0 B. 2.0 to 3.0 C. 3.0 to 7.0 D. 7.0 to 12.0 E. 1. ? to 15.0 F. 15.0 to 15.5			
3. Hole offset 80. ft. on a bearing of N80°E due to inaccessible terrain. Elevation was obtained with level.			
T.D. - 15.5'			

Hole No. GDC-313

INSTALLATION FWD		SHEET 1 of 3 SHEETS	
1. PROJECT Aubrey Dam			
2. LOCATION (Company or Station) Outlet			
3. DRILLING AGENCY USCE-C			
10. SIZE AND TYPE OF BIT Falling 1500		11. DATE AND TIME OF ELEVATION MEASUREMENT 29 Aug	
12. MANUFACTURER'S DESIGNATION OF DRILL Falling 1500		13. TOTAL NO. OF OVERBURDEN SAMPLES TAKEN 14	
14. TOTAL NUMBER CORE BORES 10		15. ELEVATION GROUND WATER ****	
16. DATE HOLE STARTED 29 Aug		17. DATE HOLE COMPLETED 10 Sep 80	
18. ELEVATION TOP OF HOLE 567.9		19. THICKNESS OF OVERBURDEN 99	
20. TOTAL CORE RECOVERY FOR BORING 99		21. DEPTH DRILLED INTO ROCK 53.6	
22. SIGNATURE OF INSPECTOR McVern to 39', Cole to T.D.		23. TOTAL DEPTH OF HOLE 83.2	
REMARKS (Listing time, time from, depth of overburden, etc., if significant)			
1. Balled hole to near T.D., 24 hr. check, water @ 23.5'.			
2. Jars: ** from den. cas A. 0.0 to 4.0 B. 4.0 to 5.0 C. 5.0 to 5.5 D. 7.0 E. 9.0 F. 11.0 G. 11.0 to 13.0 H. 15.0 I. 17.0 J. 18.0 K. 20.0 L. 20.0 to 21.5 M. 21.5 to 26.5 N. 26.5 to 29.5 O. 29.5 to 32.0			
3. Denison cans: 1. 5.5 to 7.0 2. 7.0 to 9.0 3. 9.0 to 11.0 4. 13.0 to 15.0 5. 15.0 to 17.0 6. 18.0 to 20.0			
4. Cartons: 1-35.3 to 36.3 2-41.9 to 42.9 3-45.6 to 46.5 4-50.5 to 51.3 5-57.3 to 58.3 6-65.8 to 66.8 7-69.9 to 70.6 8-75.3 to 76.3 9-81.9 to 82.9			
5. Drillings: 0.0' to 5.0', 8" auger, Set 5.0' casing 5.0' to 21.5', 6" denison casing as drill progressed 21.5' to 32.0', 8" auger			

INSTALLATION FWD		SHEET 1 of 3 SHEETS	
1. PROJECT AUB			
2. LOCATION (Company or Station)			
3. DRILLING AGENCY			
4. HOLE NO. (As shown on plan and site map)			
5. NAME OF DRILLER			
6. DIRECTION OF HOLE <input type="checkbox"/> VERTICAL <input type="checkbox"/> INCLINED			
7. THICKNESS OF OVERBURDEN			
8. DEPTH DRILLED INTO ROCK			
9. TOTAL DEPTH OF HOLE			
ELEVATION	DEPTH	LEGEND	CLASSIFICATION OF MATERIALS (Description)
			0.0' to 16.0' CLAY
			0.0' to 4.0', low plasticity, hard, dry, brown, silty.
			4.0' to 6.5', med. plast., v. stiff, dry, strong brown, sl. sandy.
			6.5' to 16.0', med./low plast., stiff, dry, yellowish brown, silty, lime nodules and sand below 15.0'.
			16.0' to 21.5' SAND, fine grained, clayey & silty seams within, sl. gravelly, dry, strong brown, & yellow brown w/ light gray.
			21.5' to 29.5' GRAVEL, coarse to fine & round, damp to moist? (drill fluid still in hole), strong brn. clayey, sandy.
			29.5' to 82.9' CLAY SHALE, unweath., dk, gray, soft to mod. soft (R. classif) massive, silty w/ interbeds of thin silty & sandy seams @ 10-12 degrees.
			Several med. hard SANDSTONE seams as indicated below: 45.6-45.9 49.6-50.9 50.4-52.1 57.0-57.3 61.2-61.4 64.1-64.4 64.9-65.0 66.7-66.8
			Highly fossilif. zone from 69.9 to 70.4 (ctn. #7).
			Structural features as follows: 43.4 open fract 47.1 " " 51.5 " " 64.2 " "

RECORD DRAWING-WORK AS BUILT

Male No. 6DC-313

LOG DIVISION SWD	INSTALLATION FWD	SHEET 1 OF 3 SHEETS
ry Dam	10. SIZE AND TYPE OF BIT 11. SYM FOR ELEVATION IDENTIFICATION	
12. MANUFACTURER'S DESIGNATION OF DRILL Falling 1500	13. TOTAL NO. OF OVERBURDEN SAMPLES TAKEN 14	14. UNDISTURBED BUREN SAMPLES TAKEN 6
15. TOTAL NUMBER CORE BOXES 10	16. ELEVATION GROUND WATER 0000	17. DATE HOLE STARTED 29 Aug
18. ELEVATION TOP OF HOLE 29.5	19. ELEVATION TOP OF HOLE 29.5	20. DATE HOLE COMPLETED 10 Sep 50
21. TOTAL CORE RECOVERY FOR BORING 99	22. SIGNATURE OF INSPECTOR McVern to 39', Cole to T.D.	

LEGEND	CLASSIFICATION OF MATERIALS (Description)	15. CORE RECOVERY %	16. CORE SAMPLE NO.	REMARKS (Drilling time, water loss, depth of measuring, etc., if significant)
	0.0' to 16.0' CLAY		A	1. Bailed hole to near T.D., 24 hr. check, water @ 23.5'.
	0.0' to 4.0', low plasticity, hard, dry, brown, silty.		B	
	4.0' to 6.3', med. plast., v. stiff, dry, strong brown, sl. sandy.		C	2. Jams: from den. ca
	6.3' to 16.0', med./low plast., stiff, dry, yellowish brown, silty, lime nodules and sand below 15.0'.		D	A. 0.0 to 4.0
	16.0' to 21.3'		E	B. 4.0 to 5.0
	SAND, fine grained, clayey & silty seams within, sl. gravelly, dry, strong brown, & yellow brown w/ light grey.		F	C. 5.0 to 5.5
	21.3' to 29.5'		G	D. 7.0
	GRAVEL, coarse to fine & rounded, clasp to soil? (drill fluid still in hole), strong brn. clayey, sandy		H	E. 9.0
	29.5' to 62.9'		I	F. 11.0
	CLAYSHALE, unweath., dk, grey, soft to mod. soft (Rx. classif) massive, silty w/ interbeds of thin silty & sandy seams @ 10-12 degrees.		J	G. 11.0 to 13.0
	Several med. hard SANDSTONE seams as indicated below		K	H. 15.0
	45.6-45.9		L	I. 17.0
	49.6 50.9		M	J. 18.0
	50.4 52.1		N	K. 20.0 to 21.3
	57.0 57.3		O	L. 20.0 to 21.3
	61.2 61.4			M. 21.3 to 26.3
	64.1 64.4			N. 26.3 to 29.5
	64.9 65.0			O. 29.5 to 32.0
	66.7 66.8			
	Highly fossilif. zone from 69.9 to 70.4 (ctn. #7).			3. Denison cans:
	Structural features as follows:			1. 5.5 to 7.0
	43.4 open fract			2. 7.0 to 9.0
	47.1 " "			3. 9.0 to 11.0
	51.3 " "			4. 13.0 to 15.0
	64.2 " "			5. 15.0 to 17.0
				6. 18.0 to 20.0
				4. Cartons:
				1-35.3 to 36.3
				2-41.9 to 42.9
				3-45.6 to 46.3
				4-50.5 to 51.3
				5-57.3 to 58.3
				6-65.8 to 66.8
				7-69.9 to 70.6
				8-75.3 to 76.3
				9-81.9 to 82.9
				5. Drilling:
				0.0' to 5.0', 8" auger, Set 5.0' casing
				5.0' to 21.5', 6" denison 8" casing as drill progressed
				21.5' to 32.0', 8" auger

PREVIOUS EDITIONS ARE OBSOLETE.

PROJECT: 6DC-313

Male No. 6DC-313

LOG DIVISION SWD	INSTALLATION FWD	SHEET 1 OF 3 SHEETS
ry Dam	10. SIZE AND TYPE OF BIT 11. SYM FOR ELEVATION IDENTIFICATION	
12. MANUFACTURER'S DESIGNATION OF DRILL Falling 1500	13. TOTAL NO. OF OVERBURDEN SAMPLES TAKEN 14	14. UNDISTURBED BUREN SAMPLES TAKEN 6
15. TOTAL NUMBER CORE BOXES 10	16. ELEVATION GROUND WATER 0000	17. DATE HOLE STARTED 29 Aug
18. ELEVATION TOP OF HOLE 29.5	19. ELEVATION TOP OF HOLE 29.5	20. DATE HOLE COMPLETED 10 Sep 50
21. TOTAL CORE RECOVERY FOR BORING 99	22. SIGNATURE OF INSPECTOR McVern to 39', Cole to T.D.	

LEGEND	CLASSIFICATION OF MATERIALS (Description)	15. CORE RECOVERY %	16. CORE SAMPLE NO.	REMARKS (Drilling time, water loss, depth of measuring, etc., if significant)
	0.0' to 16.0' CLAY		A	1. Bailed hole to near T.D., 24 hr. check, water @ 23.5'.
	0.0' to 4.0', low plasticity, hard, dry, brown, silty.		B	
	4.0' to 6.3', med. plast., v. stiff, dry, strong brown, sl. sandy.		C	2. Jams: from den. ca
	6.3' to 16.0', med./low plast., stiff, dry, yellowish brown, silty, lime nodules and sand below 15.0'.		D	A. 0.0 to 4.0
	16.0' to 21.3'		E	B. 4.0 to 5.0
	SAND, fine grained, clayey & silty seams within, sl. gravelly, dry, strong brown, & yellow brown w/ light grey.		F	C. 5.0 to 5.5
	21.3' to 29.5'		G	D. 7.0
	GRAVEL, coarse to fine & rounded, clasp to soil? (drill fluid still in hole), strong brn. clayey, sandy		H	E. 9.0
	29.5' to 62.9'		I	F. 11.0
	CLAYSHALE, unweath., dk, grey, soft to mod. soft (Rx. classif) massive, silty w/ interbeds of thin silty & sandy seams @ 10-12 degrees.		J	G. 11.0 to 13.0
	Several med. hard SANDSTONE seams as indicated below		K	H. 15.0
	45.6-45.9		L	I. 17.0
	49.6 50.9		M	J. 18.0
	50.4 52.1		N	K. 20.0 to 21.3
	57.0 57.3		O	L. 20.0 to 21.3
	61.2 61.4			M. 21.3 to 26.3
	64.1 64.4			N. 26.3 to 29.5
	64.9 65.0			O. 29.5 to 32.0
	66.7 66.8			
	Highly fossilif. zone from 69.9 to 70.4 (ctn. #7).			3. Denison cans:
	Structural features as follows:			1. 5.5 to 7.0
	43.4 open fract			2. 7.0 to 9.0
	47.1 " "			3. 9.0 to 11.0
	51.3 " "			4. 13.0 to 15.0
	64.2 " "			5. 15.0 to 17.0
				6. 18.0 to 20.0
				4. Cartons:
				1-35.3 to 36.3
				2-41.9 to 42.9
				3-45.6 to 46.3
				4-50.5 to 51.3
				5-57.3 to 58.3
				6-65.8 to 66.8
				7-69.9 to 70.6
				8-75.3 to 76.3
				9-81.9 to 82.9
				5. Drilling:
				0.0' to 5.0', 8" auger, Set 5.0' casing
				5.0' to 21.5', 6" denison 8" casing as drill progressed
				21.5' to 32.0', 8" auger

PREVIOUS EDITIONS ARE OBSOLETE.

PROJECT: 6DC-313

- T.D. 83.1 -

HOLE TAPPED 72.9

RECORD DRAWING-WORK AS BUILT

SYN	QC NO.	ACTION	DATE	DESCRIPTION OF REVISION
U.S. ARMY ENGINEER DISTRICT, FORT WORTH CORPS OF ENGINEERS FORT WORTH, TEXAS				
DESIGNED BY:	RAY ROBERTS LAKE ELM FORK, TRINITY RIVER, TEXAS EMBANKMENT, SPILLWAY AND OUTLET WORKS LOGS OF BORINGS 8A-311, 8A-312, 6DC-313			
DRAWN BY:				
REVIEWED BY:				
SUBMITTED BY:	INVITATION NO. DACW63-82B-0085		DATE MAR. 1982	
ENGINEER:	CONTRACT NO. DACW63-82-C-0093		SEQUENCE NO. 25	
	DRAWING NUMBER		SHEET NO. 18	

TO ACCOMPANY FOUNDATION REPORT

Hole No. 502 312

DRILLING LOG		PROJECT		SHEET	
Aubrey Dam		Outlet Works		1 of 3	
LOCATION: 60C-314		DATE: 10 Sep 80		SHEET NO. 1	
DIRECTION OF HOLE: Vertical		DATE HOLE: 10 Sep 80		SHEET NO. 2	
THICKNESS OF OVERBURDEN: 18.5		DATE HOLE: 15 Sep 80		SHEET NO. 3	
DEPTH OF CORE: 70.5		DATE HOLE: 15 Sep 80		SHEET NO. 4	
TOTAL DEPTH OF HOLE: 89.0		DATE HOLE: 15 Sep 80		SHEET NO. 5	

ELEVATION	DEPTH	LEGEND	CLASSIFICATION OF MATERIALS	SCORE	FOR ON	NO.	NO.
89.0	0.0'		CLAY, low plasticity, hard, silty, dark brown.	1			5
87.5	2.5'		CLAY, medium plasticity, hard, moist, brown.	2			6
86.0	5.0'		CLAY (CALICHE), medium to low plasticity, hard, slightly moist, silty, calcareous nodules, brown.	3			7
84.5	7.5'		GRAVEL, well-graded, medium dense, clayey, brown.	4			8
83.0	10.0'		CLAY (CALICHE), low plasticity, hard, moist, calcareous nodules, light brown.	5			9
81.5	12.5'		SHALE, highly weathered to 22.0', partly weathered from 22.0' to 24.5', soft, numerous fractures to 22.0', tan and gray.	6			10
80.0	15.0'		SHALE, unweathered, moderately hard, massive, gray, with interbeds of moderate hard SANDSTONE as shown below:	7			11
78.5	17.5'			8			12
77.0	20.0'			9			13
75.5	22.5'			10			14
74.0	25.0'			11			15
72.5	27.5'			12			
71.0	30.0'			13			
69.5	32.5'			14			
68.0	35.0'			15			
66.5	37.5'			16			
65.0	40.0'			17			
63.5	42.5'			18			
62.0	45.0'			19			
60.5	47.5'			20			
59.0	50.0'			21			
57.5	52.5'			22			
56.0	55.0'			23			
54.5	57.5'			24			
53.0	60.0'			25			
51.5	62.5'			26			
50.0	65.0'			27			
48.5	67.5'			28			
47.0	70.0'			29			
45.5	72.5'			30			
44.0	75.0'			31			
42.5	77.5'			32			
41.0	80.0'			33			

ELEVATION	DEPTH	LEGEND	CLASSIFICATION OF MATERIALS	SCORE	FOR ON	NO.	NO.
89.0	0.0'			110			5
87.5	2.5'			G1			6
86.0	5.0'		44.3' to 44.5' - SANDSTONE	03			7
84.5	7.5'		44.7' to 44.9' - SANDSTONE	105			8
83.0	10.0'			100			9
81.5	12.5'			585			10
80.0	15.0'			6			11
78.5	17.5'		54.3' to 54.9' - SANDSTONE	05			12
77.0	20.0'			570			13
75.5	22.5'			G1			14
74.0	25.0'			01			15
72.5	27.5'		60.6' to 60.8' - SANDSTONE	615			
71.0	30.0'			G1			
69.5	32.5'		62.1' to 62.4' - SANDSTONE	04			
68.0	35.0'		62.7' to 62.9' - SANDSTONE	655			
66.5	37.5'			L			
65.0	40.0'		65.0' to 65.3' - SANDSTONE	00			
63.5	42.5'		66.0' to 70.0' - SANDSTONE	695			
62.0	45.0'			L			
60.5	47.5'			07			
59.0	50.0'		72.3' to 75.5' - very fossiliferous, numerous claystone lenses	785			
57.5	52.5'			G1			
56.0	55.0'			04			
54.5	57.5'			780			
53.0	60.0'			810			
51.5	62.5'			G1			
50.0	65.0'			02			
48.5	67.5'			860			
47.0	70.0'			403			
45.5	72.5'			890			
44.0	75.0'						
42.5	77.5'						
41.0	80.0'						

ENG FORM 1836 PREVIOUS EDITIONS ARE OBSOLETE

PROJECT: Aubrey Dam

HOLE NO: 60C 312


DEPTH	LEGEND	CLASSIFICATION OF MATERIALS (Description)	SCORE RECOVERY %	BOX OR SAMPLE NO.	REMARKS (Dist. from, water level, depth of weathering, etc., if significant)
40.3			A10	5	
		44.3' to 44.5' - SANDSTONE	G	6	
		44.7' to 44.9' - SANDSTONE	O3	6	
			495	7	
			L 00	7	
			S35	7	
		54.3' to 54.9' - SANDSTONE	L 05	8	
			S70	8	
		60.6' to 60.8' - SANDSTONE	G 01	9	
			G15	9	
		62.1' to 62.4' - SANDSTONE	G 04	10	
		62.7' to 62.9' - SANDSTONE	G 04	10	
		65.0' to 65.5' - SANDSTONE	L 00	11	
		65.0' to 70.0' - SANDSTONE	L 00	11	
			L 07	12	
		72.3' to 72.5' - very fossiliferous, numerous claystone lenses	G 01	13	
			G 01	13	
			780	13	
			810	14	
			G 02	14	
			860	14	
			G 03	15	
			G 03	15	
			890	15	
		T.D. - 89.0' -			

DRILLING LOG				Hole No. 60C-315		
ELEVATION	DEPTH	LEGEND	CLASSIFICATION OF MATERIALS (Description)	SCORE RECOVERY %	BOX OR SAMPLE NO.	REMARKS (Dist. from, water level, depth of weathering, etc., if significant)
	0.0'		CLAY, low plasticity, hard, dry, brown.		A	1. After completion, hole was bailed to T.D. 24 hr check, water level was 31.5'
	2.5'		CLAY, medium plasticity, very stiff, slightly moist, brown.		B	2. Jars:
	6.5'				C	A. 0.0 to 2.5
	18.5'		CLAY, medium plasticity, hard, moist, gravelly except from 17.5' to 18.5', calcareous nodules.		D	* B. 4.5
	30.0'		SHALE, moderately soft, weathered as shown below:		E	* C. 6.5
	18.5' to 20.5'		unweathered.		F	D. 6.5 to 11.5
	20.5' to 25.4'		highly weathered, soft, tan.		G	E. 11.5 to 12.5
	25.4' to 30.0'		slightly weathered, gray and tan.		H	F. 12.5 to 17.5
	30.0' to 94.8'		SANDSTONE, moderately soft, unweathered, unjointed, unfractured, massive, gray.		I	G. 17.5 to 18.5
			Interbeds of hard SANDSTONE at the following depths:		J	H. 18.5 to 20.5
	21.0' to 21.6'				K	* taken from Denison shoe.
	38.9' to 40.3'				L	3. Denison cans:
	42.7' to 43.0'				M	1. 2.5 to 4.5
	45.7' to 45.9'				N	2. 4.5 to 6.5
	49.3' to 50.0'				O	
	57.3' to 58.3'				P	
	58.4'		very fossiliferous.		Q	4. Castons:
					R	1. 22.5 to 23.6
					S	2. 25.7 to 27.7
					T	3. 30.0 to 31.0
					U	4. 35.4 to 36.4
					V	5. 38.9 to 39.9
					W	6. 44.5 to 45.5
					X	7. 51.2 to 52.2
					Y	8. 56.0 to 57.0
					Z	9. 59.8 to 60.6
					aa	10. 65.4 to 66.4
					ab	11. 70.6 to 71.6
					ac	12. 77.0 to 77.8
					ad	13. 80.8 to 81.8
					ae	14. 85.8 to 86.8
					af	15. 90.0 to 90.9
					ag	16. 93.8 to 94.8
					ah	5. Drilling methods:
					ai	0.0 to 2.5 - auger
					aj	2.5 to 6.5 - denison
					ak	bb'1
					al	6.5 to 20.5 - auger
					am	20.5 to 94.8 - core bb'1
					an	6. Base of weathering at 30'
					ao	
					ap	
					aq	
					ar	
					as	
					at	
					au	
					av	
					aw	
					ax	
					ay	
					az	
					ba	
					bb	
					bc	
					bd	
					be	
					bf	
					bg	
					bh	
					bi	
					bj	
					bk	
					bl	
					bm	
					bn	
					bo	
					bp	
					bq	
					br	
					bs	
					bt	
					bu	
					bv	
					bw	
					bx	
					by	
					bz	
					ca	
					cb	
					cc	
					cd	
					ce	
					cf	
					cg	
					ch	
					ci	
					cj	
					ck	
					cl	
					cm	
					cn	
					co	
					cp	
					cq	
					cr	
					cs	
					ct	
					cu	
					cv	
					cw	
					cx	
					cy	
					cz	
					da	
					db	
					dc	
					dd	
					de	
					df	
					dg	
					dh	
					di	
					dj	
					dk	
					dl	
					dm	
					dn	
					do	
					dp	
					dq	
					dr	
					ds	
					dt	
					du	
					dv	
					dw	
					dx	
					dy	
					dz	
					ea	
					eb	
					ec	
					ed	
					ee	
					ef	
					eg	
					eh	
					ei	
					ej	
					ek	
					el	
					em	
					en	
					eo	
					ep	
					eq	
					er	
					es	
					et	
					eu	
					ev	
					ew	
					ex	
					ey	
					ez	
					fa	
					fb	
					fc	
					fd	
					fe	
					ff	
					fg	
					fh	
					fi	
					fj	
					fk	
					fl	
					fm	
					fn	
					fo	
					fp	
					fq	
					fr	
					fs	
					ft	
					fu	
					fv	
					fw	
					fx	
					fy	
					fz	
					ga	
					gb	
					gc	
					gd	
					ge	
					gf	
					gg	
					gh	
					gi	
					gj	
					gk	
					gl	
					gm	
					gn	
					go	
					gp	
					gq	
					gr	
					gs	
					gt	
					gu	
					gv	
					gw	
					gx	
					gy	
					gz	
					ha	
					hb	
					hc	
					hd	
					he	
					hf	
					hg	
					hh	
					hi	
					hj	
					hk	
					hl	
					hm	
					hn	
					ho	
					hp	
					hq	
					hr	
					hs	
					ht	
					hu	

Hole No. 6DC 315

DRILLING LOG PROJECT Aubrey Dam LOCATION (Name of Section) Outlet Works DRILLING AGENCY USCE NO. AND SHEET ON DRAWING THIS Hole No. 6DC-315 NO. OF SHEETS Mullins LOCATION OF HOLE CRITICAL () INCLINED () BEG FROM VENT THICKNESS OF OVERBURDEN 18.5 IN DRILLED INTO ROCK 76.3 TOTAL DEPTH OF HOLE 94.8	INSTALLATION Fort Worth	SHEET 1 OF 3 SHEETS
	10 SIZE AND TYPE OF BIT Auger, d bb'1, core bb'1	11 DATE FOR ELEVATION 13 Sept 80
12 MANUFACTURER'S DESIGNATION OF BIT Falling 1500	13 TOTAL NO. OF OVER- BURDEN SAMPLES TAKEN 8	UNDISTURBED 2
14 TOTAL NUMBER CORE SOLES 16	15 ELEVATION GROUND WATER **	
16 DATE HOLE 13 Sept 80	17 DATE LOG 18 Sept 80	
18 ELEVATION TOP OF HOLE	19 TOTAL CORE RECOVERY FOR BORING 98.4	
20 DATE OF LOG	21 NAME OF LOGGERS D.P. Cole, J. J. Jee	

DEPTH ft	LEGEND a	CLASSIFICATION OF MATERIALS (Description) d	SCORE RECORD NO. e	BOX OR SAMPLE NO. f	REMARKS (Drilling time, water loss, depth of weathering, etc., if significant)
0.0' to 2.5'		CLAY, low plasticity, hard, dry, brown.		A	** 1. After completion, hole was bailed to T.D. 24 hr check, water level was 31.5'
2.5' to 6.5'		CLAY, medium plasticity, very stiff, slightly moist, brown.		1 2 C	2. Jars: A. 0.0 to 2.5 * B. 4.5 * C. 6.5 D. 6.5 to 11.5 E. 11.5 to 12.5 F. 12.5 to 17.5 G. 17.5 to 18.5 * H. 18.5 to 20.5 * taken from Denison shoe.
6.5' to 18.5'		CLAY, medium plasticity, hard, moist, gravelly except from 17.5' to 18.5', calcareous nodu- les.		D E	3. Denison cons: 1. 2.5 to 4.5 2. 4.5 to 6.5
18.5' to 30.0'		SHALE, moderately soft, weathered as shown be- low: 18.5' to 20.5' - unwea- thered. 20.5' to 25.4' - highly weathered, soft, tan. 25.4' to 30.0' - slight weathered, gray and tan		F G H 20.5 20.5	4. Cartons: 1. 22.5 to 23.6 2. 25.7 to 27.7 3. 30.0 to 31.0 4. 35.4 to 36.4 5. 38.9 to 39.9 6. 44.5 to 45.5 7. 51.2 to 52.2 8. 56.0 to 57.0 9. 59.8 to 60.6 11. 65.4 to 65.4 11. 70.6 to 71.6 12. 77.0 to 77.8 13. 80.8 to 81.8 14. 85.8 to 86.8 15. 90.0 to 90.9 16. 93.8 to 94.8
30.0' to 94.8'		SHALE, moderately soft, unweathered, unjointed, unfractured, massive, gray Interbeds of hard SAND- STONE at the following depths: 21.0' to 21.4' 38.9' to 40.2' 42.7' to 43.0' 45.7' to 45.9' 49.3' to 50.0' 57.3' to 58.3' 58.4' - very fossilif- ferous.		I J K L M N O P Q R S T U V W X Y Z AA AB AC AD AE AF AG AH AI AJ AK AL AM AN AO AP AQ AR AS AT AU AV AW AX AY AZ BA BB BC BD BE BF BG BH BI BJ BK BL BM BN BO BP BQ BR BS BT BU BV BW BX BY BZ CA CB CC CD CE CF CG CH CI CJ CK CL CM CN CO CP CQ CR CS CT CU CV CW CX CY CZ DA DB DC DD DE DF DG DH DI DJ DK DL DM DN DO DP DQ DR DS DT DU DV DW DX DY DZ EA EB EC ED EE EF EG EH EI EJ EK EL EM EN EO EP EQ ER ES ET EU EV EW EX EY EZ FA FB FC FD FE FF FG FH FI FJ FK FL FM FN FO FP FQ FR FS FT FU FV FW FX FY FZ GA GB GC GD GE GF GG GH GI GJ GK GL GM GN GO GP GQ GR GS GT GU GV GW GX GY GZ HA HB HC HD HE HF HG HH HI HJ HK HL HM HN HO HP HQ HR HS HT HU HV HW HX HY HZ IA IB IC ID IE IF IG IH II IJ IK IL IM IN IO IP IQ IR IS IT IU IV IW IX IY IZ JA JB JC JD JE JF JG JH JI JJ JK JL JM JN JO JP JQ JR JS JT JU JV JW JX JY JZ KA KB KC KD KE KF KG KH KI KJ KK KL KM KN KO KP KQ KR KS KT KU KV KW KX KY KZ LA LB LC LD LE LF LG LH LI LJ LK LM LN LO LP LQ LR LS LT LU LV LW LX LY LZ MA MB MC MD ME MF MG MH MI MJ MK ML MN MO MP MQ MR MS MT MU MV MW MX MY MZ NA NB NC ND NE NF NG NH NI NJ NK NL NM NO NP NQ NR NS NT NU NV NW NX NY NZ OA OB OC OD OE OF OG OH OI OJ OK OL OM ON OO OP OQ OR OS OT OU OV OW OX OY OZ PA PB PC PD PE PF PG PH PI PJ PK PL PM PN PO PP PQ PR PS PT PU PV PW PX PY PZ QA QB QC QD QE QF QG QH QI QJ QK QL QM QN QO QP QQ QR QS QT QU QV QW QX QY QZ RA RB RC RD RE RF RG RH RI RJ RK RL RM RN RO RP RQ RR RS RT RU RV RW RX RY RZ SA SB SC SD SE SF SG SH SI SJ SK SL SM SN SO SP SQ SR SS ST SU SV SW SX SY SZ TA TB TC TD TE TF TG TH TI TJ TK TL TM TN TO TP TQ TR TS TT TU TV TW TX TY TZ UA UB UC UD UE UF UG UH UI UJ UK UL UM UN UO UP UQ UR US UT UU UV UW UX UY UZ VA VB VC VD VE VF VG VH VI VJ VK VL VM VN VO VP VQ VR VS VT VU VV VW VX VY VZ WA WB WC WD WE WF WG WH WI WJ WK WL WM WN WO WP WQ WR WS WT WU WV WW WX WY WZ XA XB XC XD XE XF XG XH XI XJ XK XL XM XN XO XP XQ XR XS XT XU XV XW XX XY XZ YA YB YC YD YE YF YG YH YI YJ YK YL YM YN YO YP YQ YR YS YT YU YV YW YX YY YZ ZA ZB ZC ZD ZE ZF ZG ZH ZI ZJ ZK ZL ZM ZN ZO ZP ZQ ZR ZS ZT ZU ZV ZW ZX ZY ZZ	

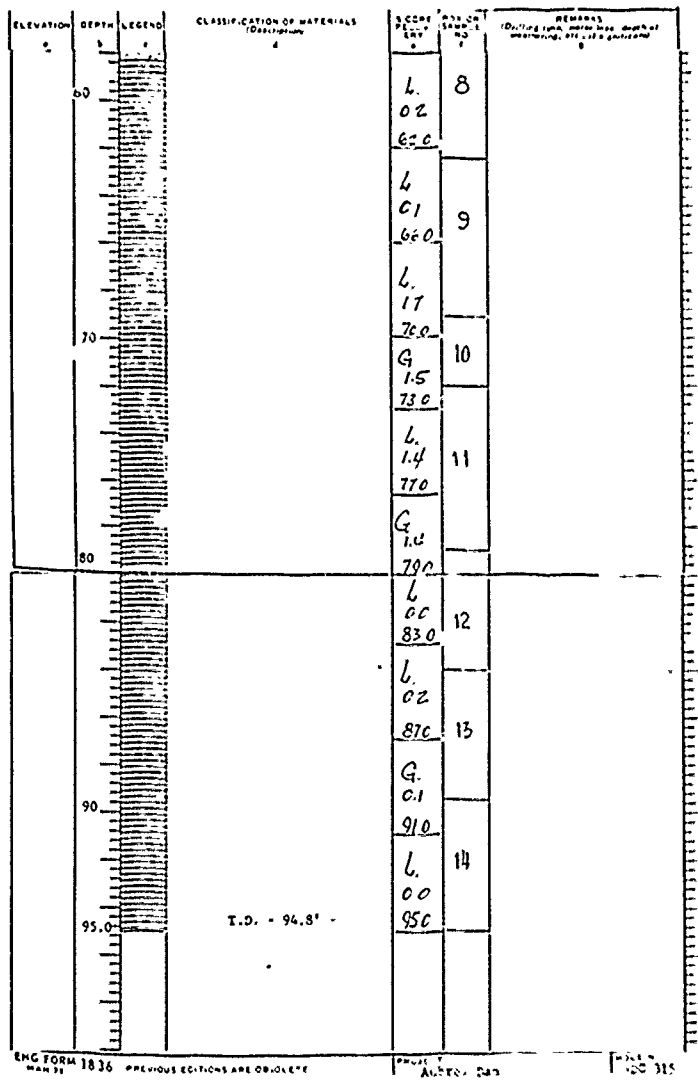

ENG FORM 1836 PREVIOUS EDITIONS ARE OBSOLETE
 DATE: 11/20/80
 PROJECT: AUBREY DAM
 HOLE NO: 6DC 315

RECORD DRAWING WORK AS FILED

DESIGNED BY	RAY ROBERTS LAKE ELM FORK, TRINITY RIVER, TEXAS EMBANKMENT, SPILLWAY AND OUTLET WORKS LOGS OF BORINGS 6 DC-314 AND 6DC-315
DRAWN BY	
CHECKED BY	
APPROVED BY	
SUBMITTED BY	INVITATION NO. SACAES-82 B-0025 DATE MAR. 11, 1982 CONTRACT NO. SACAES-82 C-1085 DRAWING NO. 1162
DATE	SHEET NO. 36

TO ACCOMPANY FOUNDATION REPORT

Hole No. BA-315

DRILLING LOG		Southwestern		Installation		Fort Worth		SHEET	
PROJECT		Aubrey Dam		NO. AND TYPE OF BIT		11		OF SHEETS	
LOCATION		Outlet Works		DATE FOR ELEVATION INDENTIFICATION		12			
DRILLING AGENCY		USCE		MANUFACTURER'S DESIGNATION OF DRILL		Pallins 1500			
HOLE NO. TAG AND HOLE NUMBER		BA-315		TOTAL NO. OF OVERBURDEN SAMPLES TAKEN		7		UNDISTURBED	
NAME OF DRILLER		Mullins		TOTAL NUMBER CORE BORES		-			
DIRECTION OF HOLE		VERTICAL		ELEVATION GROUND WATER		99.6			
THICKNESS OF OVERBURDEN		27.7'		DATE HOLE STARTED		19 Sep 80		COMPLETED	
DEPTH DRILLED INTO ROCK		74.8'		ELEVATION TOP OF HOLE		19 Sep 80			
TOTAL DEPTH OF HOLE		104.5'		TOTAL CORE RECOVERY FOR BORING		3			
				SIGNATURE OF DIRECTOR		[Signature]			

ELEVATION	DEPTH	LEGEND	CLASSIFICATION OF MATERIALS (Description)	SCORE RECOVERY	BOX OR TAG NO.	REMARKS (Drying time, water loss, depth of penetration, etc., if significant)
0.0'	11.0'		CLAY, medium to high plasticity, stiff, moist black and white.	A		1. After completion, water level in hole was 12.4'. 16 hour check - level was 12.4'
11.0'	23.0'		CLAY, high plasticity, medium stiff, moist to 16', very moist from 16' to 23', scattered gravel, tan and gray.	B		2. Jars: A. 0.0 to 5.0 B. 5.0 to 11.0 C. 11.0 to 16.0 D. 16.0 to 21.0 E. 21.0 to 23.0 F. 23.0 to 29.0 G. 29.0 to 35.0
23.0'	29.0'		CLAY, medium plasticity, soft, wet, sandy, gray-green.	C		
29.0'	35.0'		CLAY, medium plasticity, soft, wet, sandy, gray-green.	D		
			T.D. - 35.0'	E		
				F		
				G		

ENG FORM 1836 PREVIOUS EDITIONS ARE OBSOLETE. MAR 71 PROJECT Aubrey Dam HOLE NO. BA 316

DRILLING LOG		SWO		Installation		Fort Worth		SHEET	
PROJECT		AUBREY DAM - OULET WORKS		NO. AND TYPE OF BIT		11		OF SHEETS	
LOCATION		STA 2 +10		DATE FOR ELEVATION INDENTIFICATION		12			
DRILLING AGENCY		USCE		MANUFACTURER'S DESIGNATION OF DRILL		Pallins 1500			
HOLE NO. TAG AND HOLE NUMBER		BA-315		TOTAL NO. OF OVERBURDEN SAMPLES TAKEN		7		UNDISTURBED	
NAME OF DRILLER		MULLINS		TOTAL NUMBER CORE BORES		-			
DIRECTION OF HOLE		VERTICAL		ELEVATION GROUND WATER		99.6			
THICKNESS OF OVERBURDEN		27.7'		DATE HOLE STARTED		19 Sep 80		COMPLETED	
DEPTH DRILLED INTO ROCK		74.8'		ELEVATION TOP OF HOLE		19 Sep 80			
TOTAL DEPTH OF HOLE		104.5'		TOTAL CORE RECOVERY FOR BORING		3			
				SIGNATURE OF DIRECTOR		[Signature]			

ELEVATION	DEPTH	LEGEND	CLASSIFICATION OF MATERIALS (Description)	SCORE RECOVERY	BOX OR TAG NO.	REMARKS (Drying time, water loss, depth of penetration, etc., if significant)
0.0'	13.5'		CLAY, 0.0-13' MED/HIGH PLASTICITY, STIFF, MOIST; D.C. BRN, SANDY, LIME 1.3'-5.6' 25' ABOVE, COLOR GRAYES TO GRN 5.6'-13.5' LOW PLASTICITY, HARD; D.CY, REDDISH YELLOW; SANDY & SILTY, VERY SANDY AFTER 10 G	A		
13.5'	16.1'		GRAVEL COARSE TO FINE, DRY; STRONG BEN VERY SANDY, CLAYEY	B		
16.1'	20.2'		SAND, FINE-GRAINED; DRY REDDISH YELLOW; SLT. GRAVELLY	C		
20.2'	27.7'		GRAVEL COARSE TO FINE; DAMP; VERY SANDY STRONG BEN TO BEN BY 24.2'	D		
27.7'	43.1'		SHALE: 27.7'-28.3' WEATHERED; GRAY; MASSIVE; SAND IS OLIVE, VERY FRAGILE E WICKLY CEMENTED 28.3'-43.1' UNWEATHERED; D.C. GRAY, MOD. SOFT; MASSIVE; SILTY; NUMEROUS THIN (<0.1" THICK) SAND-STONE SEAMS SCATTERED EXCEPT WHERE NOTED: @ 30.0' @ 30.3'-30.5' @ 31.5' 33.3'-34.2' VERY SILTY	E		
				F		
				G		
				H		
				Box 1		
				Box 2		

ENG FORM 1836 PREVIOUS EDITIONS ARE OBSOLETE. MAR 71 PROJECT AUBREY

Hole No. **BALC-358**

DRILLING LOG		SWD		INSTALLATION		FWD		SHEET 1 OF 3 SHEETS	
PROJECT AUBREY DAM - OUTLET WORKS		NO. HOLE AND TYPE OF BIT AUGER 6" CORE		DATE AND TIME OF DRILLING STA 25+10		ELEVATION OF BENCH MARK 1500			
1. LOCATION (Compass or Transit) STA 25+10		2. DRILLING AGENCY USCE-C		3. MANUFACTURER'S DESIGNATION OF BIT FWNING 1500		4. TOTAL NO. OF OVERBURDEN SAMPLES TAKEN 8		5. UNDISTURBED	
6. HOLE NO. (As shown on drawing sheet and this number) BALC-358		7. NAME OF DRILLER MULLINS		8. TOTAL NUMBER CORE BORES 16		9. ELEVATION GROUND WATER # SEE REMARKS		10. DATE HOLE STARTED 9 FEB 81	
11. DIRECTION OF HOLE <input checked="" type="checkbox"/> VERTICAL <input type="checkbox"/> INCLINED SEE FROM VERT.		12. THICKNESS OF OVERBURDEN 27.7'		13. DEPTH DRILLED INTO ROCK 74.8'		14. TOTAL CORE RECOVERY FOR BORING 99.3'		15. SIGNATURE OF INSPECTOR MEVEY	
16. TOTAL DEPTH OF HOLE 104.5'		17. ELEVATION TOP OF HOLE		18. SIGNATURE OF DRILLER		19. DATE HOLE COMPLETED 13 FEB 81		20. SIGNATURE OF INSPECTOR	

ELEVATION	DEPTH	LEGEND	CLASSIFICATION OF MATERIALS (Description)	LOG CODE	BOX OR SAMPLE NO.	REMARKS (Including time, water level, depth of overburden, etc., if significant)
0.0'	0.0'		0.0' TO 13.5' CLAY 0.0'-1.3' MED/HIGH PLASTICITY, STIFF, MOIST, DK. BRN, SANDY LIME 1.3'-5.6' 25 ABOVE, COLOR GRAYES TO BEN 5.6'-13.5' LOW PLASTICITY, HARD, DRY, REDDISH YELLOW, SANDY & SILTY, VERY SANDY AFTER 10.6'		A	1. WATER LEVEL: 84 HRS AFTER BAILING WATER LEVEL WAS @ 27.1'
13.5'	16.1'		13.5' TO 16.1' GRAVEL COARSE TO FINE, DRY; STRONG BRN, VERY SANDY, CLAYEY		B	
16.1'	20.2'		16.1' TO 20.2' SAND FINE-GRAINED; DRY; REDDISH YELLOW; SLI GRAVELLY		C	2. JAR SAMPLES: A: 0.0'-1.3' B: 1.3'-5.6' C: 5.6'-10.6' D: 10.6'-13.5' E: 13.5'-16.1' F: 16.1'-20.2' G: 20.2'-24.2' H: 24.2'-27.7' I: 27.7'-28.3' J: 28.3'-29.0'
20.2'	27.7'		20.2' TO 27.7' GRAVEL COARSE TO FINE; DAMP; VERY SANDY, STRONG BRN TO BEN BY 24.2'		D	3. DRILLING: AUGER 0.0'-29.0' SET 30.0' OF CASING. CLEANED HOLE OUT TO 30.0'. 6" CORE 30.0'-105.0.'
27.7'	43.1'		27.7' TO 43.1' SHALE : 27.7'-28.3' WEATHERED; GRAY, MASSIVE; SAND IS OLIVE, VERY FRAGILE & WEAKLY CEMENTED 28.3'-43.1' UNWEATHERED, DK GRAY; MOD SOFT; MASSIVE; SILTY; NUMEROUS THIN (< 0.1" THICK) SANDSTONE SEAMS SCATTERED EXCEPT WHERE NOTED: @ 30.0' 30.3'-32.2' @ 31.5' 33.3'-34.2' VERY SILTY		E	4. E-LOGGING: BORING DRILLED 15' SOUTH OF BALC-358 & WAS E-LOGGED.
43.1'	28.3'				F	5. BASE OF WEATHERING: @ 28.3'
					G	
					H	
					I	
					J	
					Box 1	
					Box 2	

ENG FORM 1836 PREVIOUS EDITIONS ARE OBSOLETE. PROJECT AUBREY DAM HOLE NO. BALC-358

Hole No. **BALC 358**


DRILLING LOG		SWD		INSTALLATION		FWD		SHEET 2 OF 3 SHEETS	
PROJECT AUBREY DAM - OUTLET WORKS		NO. HOLE AND TYPE OF BIT AUGER 6" CORE		DATE AND TIME OF DRILLING STA 25+10		ELEVATION OF BENCH MARK 1500			
1. LOCATION (Compass or Transit) STA 25+10		2. DRILLING AGENCY USCE-C		3. MANUFACTURER'S DESIGNATION OF BIT FWNING 1500		4. TOTAL NO. OF OVERBURDEN SAMPLES TAKEN 8		5. UNDISTURBED	
6. HOLE NO. (As shown on drawing sheet and this number) BALC-358		7. NAME OF DRILLER MULLINS		8. TOTAL NUMBER CORE BORES 16		9. ELEVATION GROUND WATER # SEE REMARKS		10. DATE HOLE STARTED 9 FEB 81	
11. DIRECTION OF HOLE <input checked="" type="checkbox"/> VERTICAL <input type="checkbox"/> INCLINED SEE FROM VERT.		12. THICKNESS OF OVERBURDEN 27.7'		13. DEPTH DRILLED INTO ROCK 74.8'		14. TOTAL CORE RECOVERY FOR BORING 99.3'		15. SIGNATURE OF INSPECTOR MEVEY	
16. TOTAL DEPTH OF HOLE 104.5'		17. ELEVATION TOP OF HOLE		18. SIGNATURE OF DRILLER		19. DATE HOLE COMPLETED 13 FEB 81		20. SIGNATURE OF INSPECTOR	

ELEVATION	DEPTH	LEGEND	CLASSIFICATION OF MATERIALS (Description)	LOG CODE	BOX OR SAMPLE NO.	REMARKS (Including time, water level, depth of overburden, etc., if significant)
0.0'	0.0'		0.0' TO 13.5' CLAY 0.0'-1.3' MED/HIGH PLASTICITY, STIFF, MOIST, DK. BRN, SANDY LIME 1.3'-5.6' 25 ABOVE, COLOR GRAYES TO BEN 5.6'-13.5' LOW PLASTICITY, HARD, DRY, REDDISH YELLOW, SANDY & SILTY, VERY SANDY AFTER 10.6'		A	1. WATER LEVEL: 84 HRS AFTER BAILING WATER LEVEL WAS @ 27.1'
13.5'	16.1'		13.5' TO 16.1' GRAVEL COARSE TO FINE, DRY; STRONG BRN, VERY SANDY, CLAYEY		B	
16.1'	20.2'		16.1' TO 20.2' SAND FINE-GRAINED; DRY; REDDISH YELLOW; SLI GRAVELLY		C	2. JAR SAMPLES: A: 0.0'-1.3' B: 1.3'-5.6' C: 5.6'-10.6' D: 10.6'-13.5' E: 13.5'-16.1' F: 16.1'-20.2' G: 20.2'-24.2' H: 24.2'-27.7' I: 27.7'-28.3' J: 28.3'-29.0'
20.2'	27.7'		20.2' TO 27.7' GRAVEL COARSE TO FINE; DAMP; VERY SANDY, STRONG BRN TO BEN BY 24.2'		D	3. DRILLING: AUGER 0.0'-29.0' SET 30.0' OF CASING. CLEANED HOLE OUT TO 30.0'. 6" CORE 30.0'-105.0.'
27.7'	43.1'		27.7' TO 43.1' SHALE : 27.7'-28.3' WEATHERED; GRAY, MASSIVE; SAND IS OLIVE, VERY FRAGILE & WEAKLY CEMENTED 28.3'-43.1' UNWEATHERED, DK GRAY; MOD SOFT; MASSIVE; SILTY; NUMEROUS THIN (< 0.1" THICK) SANDSTONE SEAMS SCATTERED EXCEPT WHERE NOTED: @ 30.0' 30.3'-32.2' @ 31.5' 33.3'-34.2' VERY SILTY		E	4. E-LOGGING: BORING DRILLED 15' SOUTH OF BALC-358 & WAS E-LOGGED.
43.1'	28.3'				F	5. BASE OF WEATHERING: @ 28.3'
					G	
					H	
					I	
					J	
					Box 3	
					Box 4	
					Box 5	
					Box 6	
					Box 7	
					Box 8	
					Box 9	
					Box 10	
					Box 11	
					Box 12	

ENG FORM 1836 PREVIOUS EDITIONS ARE OBSOLETE. PROJECT AUBREY DAM HOLE NO. BALC-358

Hole No. BA6C-358


DRILLING LOG	SWD	INSTALLATION	FWD	SHEET 2 OF 3 SHEETS
PROJECT	AUBREY DAM - OUTLET WORKS			
LOCATION (County or Station)	STA 25+10			
DRILLING AGENCY	USOE-C			
HOLE NO. (As shown on drawing title & number)	BA6C-358			
NAME OF DRILLER	HULLINS			
DIRECTION OF HOLE	VERTICAL			
THICKNESS OF OVERBURDEN	27.7'			
DEPTH DRILLED INTO ROCK	76.8'			
TOTAL DEPTH OF HOLE	104.5'			
MANUFACTURER'S DESIGNATION OF DRILL	FALING 1500			
TOTAL NO. OF OVERBURDEN SAMPLES TAKEN	8			
TOTAL NUMBER CORE BOXES	16			
ELEVATION GROUND WATER	SEE CHARTS			
DATE MOLE STARTED	9 FEB 81			
DATE MOLE COMPLETED	13 FEB 81			
ELEVATION TOP OF HOLE	99.1'			
TOTAL CORE RECOVERY FOR BORING	99.1'			
SIGNATURE OF INSPECTOR	M. VEY			

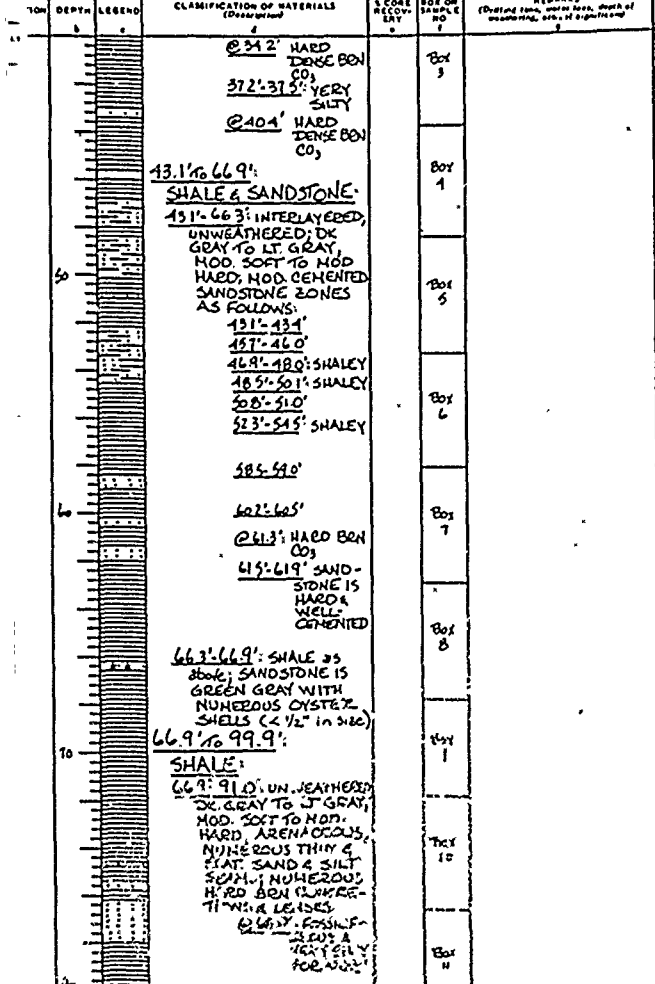

1836 PREVIOUS EDITIONS ARE OBSOLETE. AUBREY DAM HOLE NO. BA6C-358

Hole No. BA6C-358

DRILLING LOG	SWD	INSTALLATION	FWD	SHEET 3 OF 3 SHEETS
PROJECT	AUBREY DAM - OUTLET WORKS			
LOCATION (County or Station)	STA 25+10			
DRILLING AGENCY	USOE-C			
HOLE NO. (As shown on drawing title & number)	BA6C-358			
NAME OF DRILLER	BEEWEB			
DIRECTION OF HOLE	VERTICAL			
THICKNESS OF OVERBURDEN	27.7'			
DEPTH DRILLED INTO ROCK	76.8'			
TOTAL DEPTH OF HOLE	104.5'			
MANUFACTURER'S DESIGNATION OF DRILL	FALING 1500			
TOTAL NO. OF OVERBURDEN SAMPLES TAKEN	8			
TOTAL NUMBER CORE BOXES	16			
ELEVATION GROUND WATER	SEE REMARKS			
DATE MOLE STARTED	9 FEB 81			
DATE MOLE COMPLETED	13 FEB 81			
ELEVATION TOP OF HOLE	99.1'			
TOTAL CORE RECOVERY FOR BORING	99.1'			
SIGNATURE OF INSPECTOR	M. VEY			

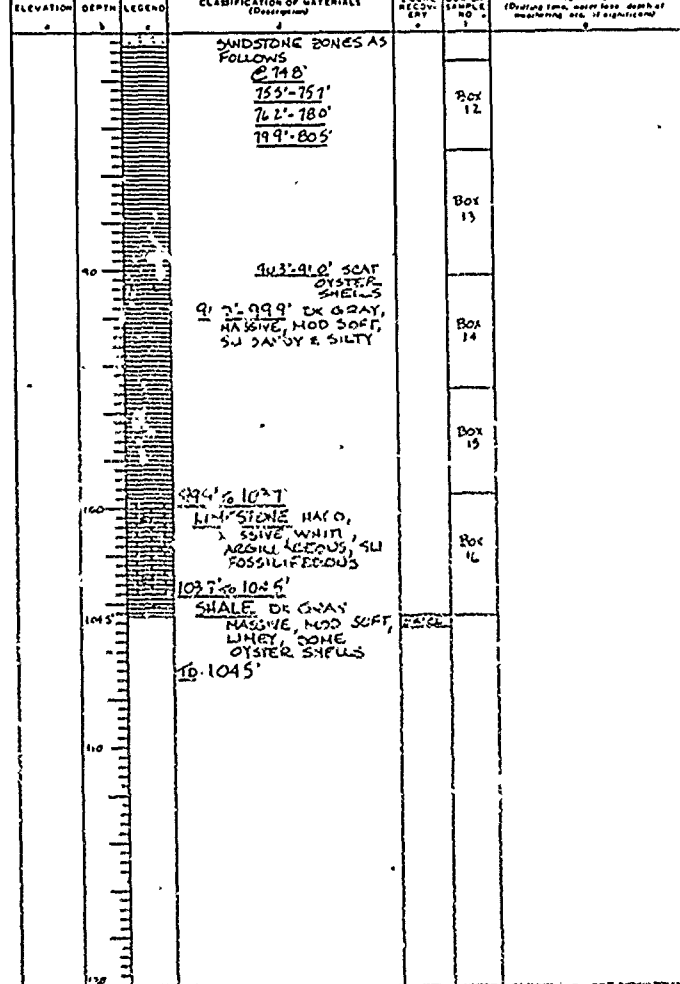

1836 PREVIOUS EDITIONS ARE OBSOLETE. AUBREY DAM HOLE NO. BA6C-358

RECORD DRAWING WORK AS BUILT

U.S. ARMY ENGINEER DISTRICT, FORT WORTH	
NAME OF ENGINEER	
DATE	
RAY ROBERTS LAKE	
SLW FORK, TRINITY RIVER, TEXAS	
EMBANKMENT, SPILLWAY AND	
OUTLET WORKS	
LOGS OF BORINGS	
BA-310 AND BA6C-358	
DATE	27

TO ACCOMPANY FOUNDATION REPORT

H-1 No. **BAGC-359**

DRILLING LOG		INSTALLATION	
SWD		FWD	
PROJECT: AUBREY DAM - OUTLET WORKS			
LOCATION: STA 27+20			
DRILLING OBJECT: USCE-C			
M.O.E. NO. (As shown on drawing sheet and job number): BAGC-359			
NAME OF DRILLER: MULLINS			
DIRECTION OF HOLE: <input checked="" type="checkbox"/> VERTICAL <input type="checkbox"/> INCLINED BEG FROM VFO			
THICKNESS OF OVERBURDEN: 17.0'			
DEPTH DRILLED INTO ROCK: 5.5'			
TOTAL DEPTH OF HOLE: 22.5'			
NO. AND TYPE OF BIT AUGER; 6" CORE		SHEET 1 OF 2 SHEETS	
11. DATE FOR ELEVATION (FROM TOP OF HOLE)		12. MANUFACTURER'S DELIGATION OF DRILL	
		FALLING 1500	
13. TOTAL NO. OF OVERBURDEN SAMPLES TAKEN: 5		14. TOTAL NUMBER CORE BOXES: 3	
15. ELEVATION GROUND WATER: SEE REMARKS		16. DATE HOLE STARTED: 18 FEB 61	
17. ELEVATION TOP OF HOLE		18. DATE HOLE COMPLETED: 19 FEB 61	
19. TOTAL CORE RECOVERY FOR BORING: 100%		SIGNATURE OF INSPECTOR: MCVEY	

ELEVATION	DEPTH	LEGEND	CLASSIFICATION OF MATERIALS (Description)	3 CORE RECON. NO.	BOX OR SAMPLE NO.	REMARKS (Detail top, water level, depth of penetration, etc., if significant)
00'	00'		00' to 17.0' CLAY: 00'-3.0' MED/HIGH PLASTICITY; HARD; DRY; BRN; SANDY & SILTY 3.0'-4.9' as above; VERY STIFF; DAMP; BRN 4.9'-8.0' MED/HIGH PLASTICITY; HARD; DRY; YELLOW BRN & BRN; LIMY; SILTY & SANDY 8.0'-14.1' MED/LOW PLASTICITY; VER. STIFF; DRY; RED YELLOW; SILTY & SANDY 14.1'-17.0' as above; STIFF; DAMP		A	1. WATER LEVEL: 24 HRS AFTER BAILING WATER LEVEL WAS @ 21.4'
17.0'	18.7'		17.0' to 18.7' LIMESTONE HARD; MASSIVE, WEATHER-STAINED, WHITE & YELLOW-BRN; FOSSILIF. ERAS; 0.1" THICK LIMONITE SEAM @ BASE		Box 1	2. JAR SAMPLES A: 00'-3.0' B: 3.0'-4.9' C: 4.9'-8.0' D: 8.0'-14.1' E: 14.1'-17.0'
18.7'	31.5'		18.7' to 31.5' SHALE: 18.7'-28.9' WEATHERED; YELLOW BRN & GRAY; SOFT TO MOD. SOFT MASSIVE, SCAT. THIN SILT & SAND SEAMS, SLT TO NON-CALC. 28.9'-29.9' MOD. HARD UNDO. CEMENTED SANDSTONE SEAMS 29.9'-27.2' VERY SANDY ZONE 27.2'-21.6' HARD LIMONITE SEAM 21.6'-28.9' THIN VERY SHELLY & SANDY 28.9'-31.5' UNWEATHERED DK GRAY; FOSSILIF. ERAS; 3" AMMONITE @ 31.0'		Box 2 Box 3	3. DRILLING: AUGERED 0.0'-17.5'. AUGER REFUSAL @ 17.5'. 6" CORE @ 17.5'-32.5' LEFT 10' OF CORE IN BORING (31.5'-32.5') ON LAST RUN. BAILED BORING. 4. BASE OF WEATHERING @ 28.7'

ENG FORM 1836 PREVIOUS EDITIONS ARE OBSOLETE MAR 71 PROJECT: **AUBREY DAM** HOLE NO.: **BAGC-359**

H-1 No. **BAGC-359**

DRILLING LOG		INSTALLATION	
SWD		FWD	
PROJECT: AUBREY DAM - OUTLET WORKS			
LOCATION: STA 28+20			
DRILLING OBJECT: USCE-C			
M.O.E. NO. (As shown on drawing sheet and job number): BAGC-360			
NAME OF DRILLER: MULLINS			
DIRECTION OF HOLE: <input checked="" type="checkbox"/> VERTICAL <input type="checkbox"/> INCLINED BEG FROM VFO			
THICKNESS OF OVERBURDEN: 15.3'			
DEPTH DRILLED INTO ROCK: 14.7'			
TOTAL DEPTH OF HOLE: 30.0'			
NO. AND TYPE OF BIT AUGER; 6" CORE		SHEET 1 OF 2 SHEETS	
11. DATE FOR ELEVATION (FROM TOP OF HOLE)		12. MANUFACTURER'S DELIGATION OF DRILL	
		FALLING 15	
13. TOTAL NO. OF OVERBURDEN SAMPLES TAKEN: 1		14. TOTAL NUMBER CORE BOXES: 3	
15. ELEVATION GROUND WATER: SEE R		16. DATE HOLE STARTED: 19 FEB 61	
17. ELEVATION TOP OF HOLE		18. DATE HOLE COMPLETED: 19 FEB 61	
19. TOTAL CORE RECOVERY FOR BORING: 100%		SIGNATURE OF INSPECTOR: MCVEY	

ELEVATION	DEPTH	LEGEND	CLASSIFICATION OF MATERIALS (Description)	3 CORE RECON. NO.	BOX OR SAMPLE NO.	REMARKS (Detail top, water level, depth of penetration, etc., if significant)
00'	00'		00' to 15.3' CLAY: 00'-2.4' MED/HIGH PLASTICITY; STIFF; DAMP; DK. BRN; SANDY & SILTY 2.4'-7.4' HIGH/MED PLASTICITY; STIFF; DAMP TO MOIST; RED YELLOW; SILTY & SANDY; LIME NODULES 7.4'-12.7' as above; MED/LOW PLASTICITY; MED STIFF; SANDIER 12.7'-15.3' MED/HIGH PLASTICITY; HARD; DRY; YELLOW BRN; SANDY & SILTY; LIMY		A	1. WATER LEVEL: 16 HRS AFTER BAILING WATER LEVEL @ 23.1'
15.3'	17.3'		15.3' to 17.3' LIMESTONE WHITE & YELLOW BRN STAINS; HARD; MASSIVE; FOSSILIFEROUS		Box 1	2. JAR SAMPLES A: 00'-2' B: 2.4'-7' C: 7.4'-11' D: 12.7'-15.3'
17.3'	29.7'		17.3' to 29.7' SHALE WEATHERED TO YELLOW BRN & LT. GRAY TO 29.2'; THEN UNWEATHERED DK GRAY; MASSIVE, MOD. SOFT; SILTY & SANDY; NUMEROUS SCAT. THIN SAND SEAMS; FEW LIMONITE CONCRETIONS 26.3'-26.7' MOD. CEMENTED SANDSTONE 27.8'-28.1' MOD. CEMENTED SANDSTONE		Box 2 Box 3	3. DRILLING: AUGERED 0.0'-17.5'. AUGER REFUSAL @ 17.5'. 6" CORE @ 17.5'-32.5' LEFT 10' OF CORE IN BORING (31.5'-32.5') ON LAST RUN. BAILED BORING. 4. BASE OF WEATHERING @ 28.7'
29.7'	29.7'		10' to 29.7'		Box 3	5. BASE OF @ 29.2'

ENG FORM 1836 PREVIOUS EDITIONS ARE OBSOLETE MAR 71 PROJECT: **AUBREY DAM** HOLE NO.: **BAGC-359**

LOG NO. SWD	INSTALLATION FWD	SHEET 1 OF 3 SHEETS
PROJECT AUBREY DAM - OUTLET WORKS		
10 SIZE AND TYPE OF BIT: AUGER, 6" CORE		
11 LOCATION (Elevation or Station): STA 32+00		
12 MANUFACTURER'S DESIGNATION OF DRILL: FAILING 1500		
13 TOTAL NO. OF OVER-BURDEN SAMPLES TAKEN: 0	14 TOTAL NUMBER CORE BOXES: 5	15 ELEVATION GROUND WATER # SEE REMARKS
16 DATE MOLE STARTED 14 FEB 81 COMPLETED 19 FEB 81		
17 ELEVATION TOP OF HOLE 98.5		
18 TOTAL CORE RECOVERY FOR BORING 98.5		
19 SIGNATURE OF INSPECTOR: McVEY		

DEPTH	LEGEND	CLASSIFICATION OF MATERIALS (Description)	SCORE RECOVERY	BOX OR SAMPLE NO.	REMARKS (Drilling time, water level, depth of weathering, etc., if significant)
0.0' to 15.3'		CLAY: 00'-24': MED/HIGH PLASTICITY, STIFF, DAMP, DK. BRN; SANDY & SILTY 24'-74': HIGH/MED PLASTICITY, STIFF, DAMP TO MOIST; RED YELLOW; SILTY & SANDY; LIME NODULES 74'-127': as above, MED/LOW PLASTICITY; MED. STIFF; SANDIER 127'-153': MED/HIGH PLASTICITY, HARD; DRY, YELLOW BRN, SANDY & SILTY, LIMEY 153' to 173'			1. WATER LEVEL: 18 HRS. AFTER BAUNG WATER LEVEL WAS @ 23.1' 2. JAR SAMPLES: A: 0.0'-24' B: 24'-74' C: 74'-127' D: 127'-153' 3. DRILLING: AUGERED 0.0'-15.0', 6" CORE 15.0'-30.0', BAILED BORING. 4. E-LOGGING C. ON HOLE DELETED 21' NORTH OF BACC-360. 5. BASE OF WEATHERING @ 29.2'
17.3' to 29.7'		LIMESTONE: WHITE & YELLOW BRN STAINS, JARD; MASSIVE; FOSSILIFEROUS SHALE WEATHERED TO YELLOW BRN & LT. GRAY TO 29.2'; THEN UNWEATHERED DK GRAY; MASSIVE; MOD. SOFT; SILTY & SANDY; NUMEROUS SCALY THIN SAND SEAMS; FEW LIMONITE CONCRETIONS 26.3'-26.7': MOD. CEMENTED SANDSTONE 27.8'-28.1': MOD. CEMENTED SANDSTONE 10: 29.7'		Box 1 Box 2 Box 3	

LOG NO. SWD	INSTALLATION FWD	SHEET 1 OF 1 SHEETS
PROJECT AUBREY DAM - OUTLET WORKS		
10 SIZE AND TYPE OF BIT: AUGER, 6" CORE		
11 LOCATION (Elevation or Station): STA 32+00		
12 MANUFACTURER'S DESIGNATION OF DRILL: FAILING 1500		
13 TOTAL NO. OF OVER-BURDEN SAMPLES TAKEN: 0	14 TOTAL NUMBER CORE BOXES: 3	15 ELEVATION GROUND WATER # SEE REMARKS
16 DATE MOLE STARTED 29 JAN 81 COMPLETED 30 JAN 81		
17 ELEVATION TOP OF HOLE 99.5		
18 TOTAL CORE RECOVERY FOR BORING 99.5		
19 SIGNATURE OF INSPECTOR		

ELEVATION	DEPTH	LEGEND	CLASSIFICATION OF MATERIALS (Description)	SCORE RECOVERY	BOX OR SAMPLE NO.	REMARKS (Drilling time, water level, depth of weathering, etc., if significant)
0.0'	0.0' to 13.0'		CLAY: 00'-50': MED. TO HIGH PLASTICITY; STIFF TO VERY STIFF; MOIST; RED-BRN WITH YELLOW-BRN & STEAKY BRN; SILTY, SLI. CALC 50'-81': HIGH PLASTICITY, VERY STIFF; SLI. MOIST; YELLOW-BRN; SANDY & SILTY, LIMEY; CALC 81'-130': MED-LOW PLASTICITY; VERY STIFF; SLI. MOIST; YELLOW-BRN; SANDY & SILTY; SL. GRAVELLY @ 85' 130' to 192'			1. WATER LEVEL: ENCOUNTERED NO WATER WHILE AUGERING. 24 HRS. AFTER BAUNG WATER LEVEL WAS @ 17.5' 2. JAR SAMPLES: A: 0.0'-5.0' B: 5.0'-8.1' C: 8.1'-13.0' 3. DRILLING 8" AUGER 0.0'-13.0' AUGER REFUSAL @ 13.0'. SET CASING TO 13.0'. 6" CORING 13.0'-24.0'. BAILED HOLE. 4. E-LOGGING BORING DRILLED 5' WEST OF BACC-361 TO DEPTH OF 120.0' & WAS C-LOGGED
19.2'	19.2' to 23.8'		LIMESTONE: ARGILLA-CEOUS, WEATHER-STAINED YELLOW-BRN & WHITE, MASSIVE; HARD; OYSTER SHELLS, IRREGULAR THIN JOFT SHALE SEAMS; LIMONITE CONCRETIONS 188' M.L. HARD RED LIMONITE SEAM SHALE: DK. GRAY WITH YELLOW-BRN WEATHERED JOINTS; MOD. SOFT; MASSIVE; LIMONITE CONCRETIONS; MOD HARD, MOD. CEMENTED PALE BRN OR GRAY THIN SANDSTONE SEAMS @ 22.0', 22.3', 22.8', & 23.5' 19.2'-20.5': WEATHERED YELLOW-BRN & LT. GRAY TO 23.8'		Box 1 Box 2 Box 3	

Male No. 8A6C-361

SYMBOL	SWD	INSTALLATION	FWD	SHEET 1 OF 2 SHEETS
PROJECT	OUTLET WORKS	NO. SIZE AND TYPE OF BIT	8" AUGER 6" CORE	11. DATE FOR ELEVATION QUANTIFICATION
LOCATION		12. MANUFACTURER'S DESIGNATION OF DRILL	FALLING 1500	
DRILLING AGENCY	USOEC	13. TOTAL NO. OF OVERBURDEN SAMPLES TAKEN	3	14. UNDISTURBED
1. HOLE NO. (As shown on drawing title and field notes)	8A6C-361	15. TOTAL NUMBER CORE SOLES	3	
2. NAME OF CHILLER	MULLINS	16. ELEVATION GROUND WATER	SEE REMARKS	
3. DIRECTION OF HOLE	VERTICAL	17. DATE HOLE STARTED	24 JAN 81	18. DATE HOLE COMPLETED
4. THICKNESS OF OVERBURDEN	6.7'	19. ELEVATION TOP OF HOLE		
5. DEPTH DRILLED INTO ROCK	21.9'	20. TOTAL CORE RECOVERY FOR BORING	99.5'	
6. TOTAL DEPTH OF HOLE	28.6'	21. SIGNATURE OF INSPECTOR		

CLASSIFICATION OF MATERIALS (Disturbance)	SCORE RECOVERY %	BOX OR SAMPLE NO.	REMARKS (Drilling time, water loss, depth of weathering, etc., if significant)
0.0' to 13.0' CLAY 0.0'-5.0' MED. TO HIGH PLASTICITY; STIFF TO VERY STIFF; MOIST; RED-BRN WITH YELLOW-BRN & STRONG BEN; SILTY; SLI. CALC 5.0'-8.1' HIGH PLASTICITY; VERY STIFF; SLI. MOIST; YELLOW-BRN; SANDY & SILTY; LIMY; CALC 8.1'-13.0' MED. LOW PLASTICITY; VERY STIFF; SLI. MOIST; YELLOW-BRN; SANDY & SILTY; SH. GRAVELLY @ 8.5'		A	1. WATER LEVEL ENCOUNTERED NO WATER WHILE AUGERING. 24 HRS. AFTER BAILING WATER LEVEL WAS @ 17.5'
13.0' to 19.2' LIMESTONE ARGILLA - OCEOUS, WEATHER-STAINED YELLOW-BRN & WHITE, MASSIVE; HARD; OYSTER SHELLS; IRREGULAR THIN SOFT SHALE SEAMS; LIMONITE CONCRETIONS 18.8'-19.2' HARD RED LIMONITE SEAM		Box 1	3. DRILLING 8" AUGER 0.0'-13.0' AUGER REFUSAL @ 13.0'. SET CASING TO 13.0'. 6" CORING 13.0'-24.0'. BAILED HOLE
19.2' to 23.8' SHALE DK. GRAY WITH YELLOW-BRN WEATHERED JOINTS; MOD. SOFT; MASSIVE; LIMONITE CONCRETIONS; MOD. HARD; MOD. CEMENTED PALE BRN OR GRAY THIN SANDSTONE SEAMS @ 22.0'; 22.3'; 22.8'; & 23.5' 19.2'-20.5' WEATHERED YELLOW-BRN & LT. GRAY		Box 2 Box 3	4. E-LOGGING BORING DRILLED 5' WEST OF 8A6C-361 TO DEPTH OF 120.0' & WAS C-LOGGED

1. EDITIONS ARE OBSOLETE PROJECT AUBREY DAM HOLE NO. 8A6C-361

Male No. 8A6C-362

SYMBOL	SWD	INSTALLATION	FWD	SHEET 1 OF 2 SHEETS
PROJECT	AUBREY DAM-OUTLET WORKS	NO. SIZE AND TYPE OF BIT	8" AUGER 6" CORE	11. DATE FOR ELEVATION QUANTIFICATION
LOCATION	STA. 33+95	12. MANUFACTURER'S DESIGNATION OF DRILL	FALLING 1500	
DRILLING AGENCY	USOEC	13. TOTAL NO. OF OVERBURDEN SAMPLES TAKEN	3	14. UNDISTURBED
1. HOLE NO. (As shown on drawing title and field notes)	8A6C-362	15. TOTAL NUMBER CORE SOLES	3	
2. NAME OF CHILLER	MULLINS	16. ELEVATION GROUND WATER	SEE REMARKS	
3. DIRECTION OF HOLE	VERTICAL	17. DATE HOLE STARTED	30 JAN 81	18. DATE HOLE COMPLETED
4. THICKNESS OF OVERBURDEN	6.7'	19. ELEVATION TOP OF HOLE		
5. DEPTH DRILLED INTO ROCK	21.9'	20. TOTAL CORE RECOVERY FOR BORING	99.5'	
6. TOTAL DEPTH OF HOLE	28.6'	21. SIGNATURE OF INSPECTOR		

ELEVATION	DEPTH	LEGEND	CLASSIFICATION OF MATERIALS (Disturbance)	SCORE RECOVERY %	BOX OR SAMPLE NO.	REMARKS (Drilling time, water loss, depth of weathering, etc., if significant)
0.0'	0.0'		0.0' to 6.7' CLAY 0.0'-1.3' MED PLASTICITY; STIFF; DRY, DK. BEN, SANDY & SILTY 1.3'-2.2' HIGH PLASTICITY; STIFF, SLI. MOIST, STRONG BEN 2.2'-6.7' MED. LOW PLASTICITY, VERY STIFF, DRY, RED-DISH, YELLOW; SANDY & SILTY; LIMY		A	1. WATER LEVEL BAILED BORING 2 FEB 81 3 FEB 81 WL = 21.0' 4 FEB 81 WL = 20.2' 6 FEB 81 WL = 19.1' 9 FEB 81 WL = 18.9'
6.7'	6.7'		6.7' to 12.6' LIMESTONE ARGILLA - OCEOUS, WEATHER-STAINED YELLOW-BRN & WHITE; MASSIVE; HARD; OYSTER SHELLS 12.3'-12.6' HARD RED LIMONITE SEAM		Box 1 Box 2	2. JAR SAMPLES A 0.0'-1.3' B 1.3'-2.2' C 2.2'-6.7'
12.6'	12.6'		12.6' to 24.1' SHALE WEATHERED YELLOW-BRN & GRAY TO UNWEATHERED DK. GRAY @ 24.3'. SOFT TO MOD. SOFT; MASSIVE; LIMONITE CONCRETIONS; SOFT THIN SANDY SEAMS; MOD. HARD; MOD. CEMENTED PALE BRN SANDSTONE SEAMS @ 15.6'-16.0' & @ 16.9'		Box 3 Box 4 Box 5	3. DRILLING 8" AUGER 6" CORE
24.1'	24.1'		24.1' to 28.3' SANDSTONE & SHALE INTERBEDDED DK. GRAY SOFT TO MOD. SOFT UNWEATHERED SHALE & PALE BRN MOD. HARD MOD. CEMENTED SANDSTONE 24.1'-24.2' HARD, WELL-CEMENTED SANDSTONE 28.1'-28.3' HARD, WELL-CEMENTED SANDSTONE			4. E-LOGGING BORING DRILLED 5' WEST OF 8A6C-361 TO DEPTH OF 120.0' & WAS C-LOGGED

ENG FORM 1836 MAR 71 PREVIOUS EDITIONS ARE OBSOLETE PROJECT AUBREY DAM HOLE NO. 8A6C-362

RECORD DRAWING-WORK AS BUILT

SYMBOL	LOG NO.	ACTION	DATE	DESCRIPTION OF REVISION
U.S. ARMY ENGINEER DISTRICT, FORT WORTH CORPS OF ENGINEERS FORT WORTH, TEXAS				
DESIGNED BY	RAY ROBERTS LAKE ELM FORK, TRINITY RIVER, TEXAS EMBANKMENT, SPILLWAY AND OUTLET WORKS LOGS OF BORINGS 8A6C-359, 8A6C-360, 8A6C-361 AND 8A6C-362			
REVIEWED BY				
SUBMITTED BY	INVITATION NO. DACW63-82-B-0025 DATE MAR 1982			
ENGINEER	CONTRACT NO. DACW63-82-C-0093		SHEET NO.	SEQUENCE NO.
			30	30

TO ACCOMPANY FOUNDATION REPORT

CONTRACT NO. DACW63-82-C-0093

Hole No. BA-363

DRILLING LOG	DIVISION	SWD	INSTALLATION	FWD	SHEET 1 OF 1 SHEETS	
1. PROJECT AUBREY DAM - OUTLET WORKS			10. SIZE AND TYPE OF BIT & AUGER 1 1/2" DIA. FOR ELEVATION 1300 (17 1/2" DIA.)			
2. LOCATION (Company or Station) STA. 12+50			11. MANUFACTURER'S DESIGNATION OF DRILL FAILING 1500			
3. DRILLING AGENCY USCE-C			12. TOTAL NO. OF OVERBURDEN SAMPLES TAKEN 0 (Disturbed) 0 (Undisturbed)			
4. HOLE NO. (As shown on drawing sheet and No. marked) BA-363			13. TOTAL NUMBER CORE BOXES N/A			
5. NAME OF DRILLER MULLINS			14. ELEVATION GROUND WATER & SEE REMARKS			
6. DIRECTION OF HOLE <input checked="" type="checkbox"/> VERTICAL <input type="checkbox"/> INCLINED SEE FROM VERT.			15. DATE HOLE STARTED 1 JAN 81 COMPLETED 1 JAN 81			
7. THICKNESS OF OVERBURDEN 24.6'			16. ELEVATION TOP OF HOLE			
8. DEPTH DRILLED INTO ROCK 1.4'			17. TOTAL CORE RECOVERY FOR BORING N/A			
9. TOTAL DEPTH OF HOLE 26.0'			18. SIGNATURE OF INSPECTOR MEVEY			
ELEVATION	DEPTH	LEGEND	CLASSIFICATION OF MATERIALS (Description)	SCORE RECOVERY	BOX OR SAMPLE NO.	REMARKS (Drilling time, total hole, depth of overburden, etc., if significant)
00'	00'		00' to 24.6' CLAY 00'-4.3' LOW PLASTICITY @ SURFACE, GRADING TO HIGH PLASTICITY BY 1.0'; SOFT TO MED. STIFF, MOIST; DK BEN; SILTY 4.3'-16.0' HIGH-MED. PLASTICITY; STIFF BECOMING SOFT BY 1.0'; MOIST; YELLOW BEN & LT GRAY; SANDY & SILTY; SOME FINE GRAVELS			1. WATER LEVEL: BORING MAKING WATER @ 13.0'. WATER LEVEL IMMEDIATELY AFTER DRILLING WAS @ 7.0'. 24 HRS AFTER DRILLING WATER LEVEL WAS @ 4.8'. 6 FEB 81: WL @ 4.6' 9 FEB 81: WL @ 4.6'
			16.0' to 23.0' GRAY & STRONG BEN; AS ABOVE; THIN YELLOW SAND SEAM AFTER 20.0'			2. NO SAMPLES TAKEN.
			23.0' to 24.6' DK. GRAY, AS ABOVE, STIFF 24.6' to 26.0' SHALE DK. GRAY; DRY; MOD SOFT; BLOCKY CLEAVAGE. ID: 26.0'			3. DRILLING NOTE BORING OFFSET 17' NE.

ENG FORM 1836 MAR 71 PREVIOUS EDITIONS ARE OBSOLETE. PROJECT AUBREY DAM HOLE NO. BA-363

Hole No. BA-364

DRILLING LOG	DIVISION	SWD	INSTALLATION	FWD	SHEET 1 OF 1 SHEETS	
1. PROJECT AUBREY DAM - OUTLET WORKS			10. SIZE AND TYPE OF BIT & AUGER 1 1/2" DIA. FOR ELEVATION 1300 (17 1/2" DIA.)			
2. LOCATION (Company or Station) STA. 12+50			11. MANUFACTURER'S DESIGNATION OF DRILL FAILING 1500			
3. DRILLING AGENCY USCE-C			12. TOTAL NO. OF OVERBURDEN SAMPLES TAKEN 1 (Disturbed) 1 (Undisturbed)			
4. HOLE NO. (As shown on drawing sheet and No. marked) BA6C-364			13. TOTAL NUMBER CORE BOXES 4			
5. NAME OF DRILLER MULLINS			14. ELEVATION GROUND WATER & SEE REMARKS			
6. DIRECTION OF HOLE <input checked="" type="checkbox"/> VERTICAL <input type="checkbox"/> INCLINED SEE FROM VERT.			15. DATE HOLE STARTED 23 FEB 81 COMPLETED 23 FEB 81			
7. THICKNESS OF OVERBURDEN 12.0'			16. ELEVATION TOP OF HOLE			
8. DEPTH DRILLED INTO ROCK 23.0'			17. TOTAL CORE RECOVERY FOR BORING N/A			
9. TOTAL DEPTH OF HOLE 35.0'			18. SIGNATURE OF INSPECTOR MEVEY			
ELEVATION	DEPTH	LEGEND	CLASSIFICATION OF MATERIALS (Description)	SCORE RECOVERY	BOX OR SAMPLE NO.	REMARKS (Drilling time, total hole, depth of overburden, etc., if significant)
00'	00'		00' to 8.0' CLAY 0.0'-3.1' LOW PLASTICITY; STIFF, MOIST, BLACK; SILTY & SANDY 3.1'-5.1' HIGH PLASTICITY; STIFF, MOIST; DK. BEN; SILTY 5.1'-8.0' HIGH PLASTICITY; HARD, SL DAMP; YELLOW BEN & LT GRAY; LIMY; SANDY & SILTY 8.0' to 12.0' GRAVEL : WELL-GRADED; MED. DENSE; SUB-ROUNDED; SANDY; CLAYEY; BRN			1. WATER LEVEL: 24 HRS. AFTER WATER LEVEL 8.5'
			12.0' to 16.0' SHALE & SANDSTONE SLI. WEATHERED; YELLOW BEN & LT. TO DK. GRAY; SOFT TO MOD SOFT MASSIVE; SOME SAND & GRAVEL TO 14.0' (REWORKED OR DUE TO AUGER)			2. JAR SAMPLING A: 0.0' - 2.0' B: 2.1' - 5.1' C: 5.1' - 8.0' D: 8.0' - 12.0' E: 12.0' - 16.0'
			16.0' to 35.0' SHALE : UNWEATHERED; DK GRAY; MOD SOFT; MASSIVE; SILTY & SANDY; SLI. FOSSILIFEROUS WITH PLANT REMAINS & CARBON; ABUNDANT MOD. HARD MOD CEMENTED SANDSTONE SEAMS 16.9'-17.4' SANDSTONE 18.1'-18.8' SANDSTONE 20.8'-21.0' SANDSTONE 21.1'-21.4' SANDSTONE 21.7'-21.9' SANDSTONE 22.2'-22.5' SANDSTONE 23.8'-24.0' SANDSTONE 24.3'-24.8' SANDSTONE 24.9'-25.5' SANDSTONE 26.6'-32.4' SANDSTONE 32.6'-34.7' SHALEY SANDSTONE 34.7' HARD BRN CONCRETION			3. DRILLING AUGERED & SET CASIN CLEANED & CORED 16.0' BAILED TO 1. BASE OF WEA @ 16.0'

ENG FORM 1836 MAR 71 PREVIOUS EDITIONS ARE OBSOLETE. PROJECT AUBREY DAM HOLE NO. BA-364

Hole No. **816C-365** SHEET 1 OF 1 SHEETS

PROJECT USCEC	INSTALLATION FWD	DATE 17450	SHEET 1
1. PROJECT USCEC		2. DATE 17450	
3. HOLE NO. 816C-365		4. SHEET NO. 1	
5. HOLE NAME MULLINS		6. HOLE TYPE FWD	
7. HOLE LOCATION SEE REMARKS		8. HOLE DEPTH 34.7'	
9. HOLE DIAMETER 16.0"		10. HOLE INCLINATION 0°	
11. HOLE OVERBURDEN 16.0'		12. HOLE TO ROCK 18.7'	
13. HOLE TO CORE RECOVERY 98.3'		14. HOLE TO INSPECTOR MCVEY	
15. HOLE TO WATER LEVEL 12.2'		16. HOLE TO JAR SAMPLES 10.0' to 20.0'	
17. HOLE TO DRILLING 12.2' to 16.0'		18. HOLE TO SANDSTONE SEAM 23.5' to 24.6'	

16 PREVIOUS EDITIONS ARE OBSOLETE PROJECT **USCEC** HOLE NO. **816C-365**

Hole No. **816C-365** SHEET 1 OF 1 SHEETS

PROJECT USCEC	INSTALLATION FWD	DATE 17450	SHEET 1
1. PROJECT USCEC		2. DATE 17450	
3. HOLE NO. 816C-365		4. SHEET NO. 1	
5. HOLE NAME MULLINS		6. HOLE TYPE FWD	
7. HOLE LOCATION SEE REMARKS		8. HOLE DEPTH 34.7'	
9. HOLE DIAMETER 16.0"		10. HOLE INCLINATION 0°	
11. HOLE OVERBURDEN 16.0'		12. HOLE TO ROCK 18.7'	
13. HOLE TO CORE RECOVERY 98.3'		14. HOLE TO INSPECTOR MCVEY	
15. HOLE TO WATER LEVEL 12.2'		16. HOLE TO JAR SAMPLES 10.0' to 20.0'	
17. HOLE TO DRILLING 12.2' to 16.0'		18. HOLE TO SANDSTONE SEAM 23.5' to 24.6'	

16 PREVIOUS EDITIONS ARE OBSOLETE PROJECT **USCEC** HOLE NO. **816C-365**

RECORD DRAWING-WORK AS BUILT

RECORD DRAWING-WORK AS BUILT

Hole No. BA6C-365

SWD	INSTALLATION	FWD
1. OUTLET WORKS	10. SIZE AND TYPE OF BIT AUGER, L-CORE	11. DATE FOR ELEVATION INFORMATION - HWS
USCC-C	12. MANUFACTURER DESIGNATION OF DRILL	FALLING 1500
8A6C-365	13. TOTAL NO. OF OVER BURDEN SAMPLES TAKEN	0
MULLINS	14. TOTAL NUMBER CORE BOXES	3
	15. ELEVATION GROUND WATER # SEE REMARKS	
	16. DATE HOLE STARTED	6 FEB 81
	17. ELEVATION TOP OF HOLE	
	18. TOTAL CORE RECOVERY FOR BORING	98.9
	19. SIGNATURE OF INSPECTOR	MCVEY

ELEVATION	DEPTH	LEGEND	CLASSIFICATION OF MATERIALS (Description)	SCORE RECOVERY %	BOX OR SAMPLE NO.	REMARKS (Drilling time, water level, depth of overburden, etc., if significant)
00' to 12.2'			CLAY: 00'-24' LOW PLASTICITY, MED. STIFF, MOIST, YELLOW-BRN, VERY SANDY, GRAVELLY 24'-35' MED/HIGH PLASTICITY, MED. STIFF, MOIST, BROWNISH-GRAY, SANDY, SILTY, GRAVELLY 35'-83' MED/HIGH PLASTICITY, HARD; DRY; BRN GRAY, SANDY & SILTY 83'-12.2' MED/HIGH PLASTICITY, HARD; DRY, YELLOW-BRN & LT. GRAY, SANDY & SILTY 12.2' to 16.0' GRAVEL: 12.2'-13.1' COARSE TO FINE, ROUND, DRY, STRONG BRN, SANDY & CLAYEY 13.1'-16.0' as above, MOIST, YELLOW-BRN & LT. GRAY 16.0' to 34.7'			1. WATER LEVEL: 72 HRS. AFTER BAILING WATER LEVEL WAS @ 14.0'. 2. JAR SAMPLES: A: 00'-24' B: 24'-35' C: 35'-83' D: 83'-12.2' E: 12.2'-13.1' F: 13.1'-16.0' G: 16.0'-20.0' 3. DRILLING: NOTE: BORING OFFSET 50' WEST AUGER 00'-16.0' SET 19' OF CASING. CLEANED OUT TO 20.0'. L-CORE 20.0'-35.0'
TO: 34.7'			SHALE & SANDSTONE: INTERLAYERED; UNWEATHERED; DK. GRAY TO LT. GRAY; MOD. SOFT TO MOD. HARD; MOD. CEMENTED; MASSIVE 23.5'-24.6' SANDSTONE SEAM		Box 1 Box 2 Box 3	

THIS EDITION IS OBSOLETE. PROJECT: AUBREY DAM. HOLE NO.: BA6C-365

Hole No. BA6C-366

SWD	INSTALLATION	FWD
1. PROJECT	10. SIZE AND TYPE OF BIT AUGER, L-CORE	11. DATE FOR ELEVATION INFORMATION - HWS
AU' 2BY DAM - OUTLET WORKS	12. MANUFACTURER DESIGNATION OF DRILL	FALLING 1500
USCC-C	13. TOTAL NO. OF OVER BURDEN SAMPLES TAKEN	0
8A6C-366	14. TOTAL NUMBER CORE BOXES	2
	15. ELEVATION GROUND WATER # SEE REMARKS	
	16. DATE HOLE STARTED	4 FEB 81
	17. ELEVATION TOP OF HOLE	
	18. TOTAL CORE RECOVERY FOR BORING	96.9
	19. SIGNATURE OF INSPECTOR	MCVEY

ELEVATION	DEPTH	LEGEND	CLASSIFICATION OF MATERIALS (Description)	SCORE RECOVERY %	BOX OR SAMPLE NO.	REMARKS (Drilling time, water level, depth of overburden, etc., if significant)
00' to 17.0'			CLAY: 00'-31' HIGH PLASTICITY, STIFF, MOIST, RED & REDDISH-BRN, SANDY & SILTY 31'-12.3' MED-HIGH PLASTICITY, HARD; DRY, YELLOW-BRN & LT. GRAY, SANDY & SILTY 12.3'-17.0' LOW-MED PLASTICITY, MED STIFF TO SOFT, MOIST, PALE BRN & YELLOW-BRN, VERY SANDY, SAND SEAMS 17.0' to 25.0' GRAVEL: 17.0'-19.8' FINE TO COARSE, ROUND, VERY MOIST TO WET, STRONG BRN; SANDY & CLAYEY 19.8'-25.0' as above, YELLOW-BRN & LT. GRAY, VERY MOIST 25.0' to 34.6'			1. WATER LEVEL: 18 HRS. AFTER BAILING WATER LEVEL WAS @ 17.0'. 72 HRS. AFTER BAILING WATER LEVEL WAS @ 17.5'. 2. JAR SAMPLES: A: 00'-31' B: 31'-81' C: 81'-12.3' D: 12.3'-17.0' E: 17.0'-19.8' F: 19.8'-25.0' 3. DRILLING: NOTE GRAVEL ON SURFACE @ BORING LOCATION 8" AUGER 00'-25.0' AUGER REFUSAL @ 25.0' SET CASING TO 25.0' 6" COBBING 25.0'-35.0'
TO: 34.6'			SHALE ARENACEOUS, SOFT TO MOD. SOFT, UNWEATHERED, MASSIVE; BENTONITE-LOOKING @ 25.4' SOFT SANDSTONE SEAMS; SOFT DOLOMITE SEAMS; MANY THIN SCAT. SAND SEAMS, MOD. SOFT TO MOD. HARD, MOD. CEMENTED, & LT. GRAY 25.0'-25.4' VERY HARD BRN DOLOMITE SEAM 26.1'-26.3' SANDSTONE 27.8' HARD DOLOMITE 28.5'-29.2' SHALEY SANDSTONE 31.3'-31.6' SANDSTONE 31.9'-32.0' SANDSTONE 32.0'-32.1' DOLOMITE 32.8'-34.6' SHALEY SANDSTONE		Box 1 Box 2	


ENG FORM 1236 PREVIOUS EDITIONS ARE OBSOLETE. PROJECT: AUBREY DAM. HOLE NO.: BA6C-366


RECORD DRAWING-WORK AS BUILT

SYN	DC	NO	ACTION	DATE	DESCRIPTION OF REVISION
<p>U.S. ARMY ENGINEER DISTRICT, FORT WORTH CORPS OF ENGINEERS FORT WORTH, TEXAS</p> <p>DESIGNED BY: 8A RAY ROBERTS LAKE ELM FORK, TRINITY RIVER, TEXAS</p> <p>DRAWN BY: EMBANKMENT, SPILLWAY AND OUTLET WORKS</p> <p>LOGS OF BORINGS 8A-363, 8A6C-364, 8A6C-365 AND 8A6C-366</p> <p>REVIEWED BY: SUBMITTED BY: ENGINEER:</p> <p>INVITATION NO. DACW63-82-0-0025 DATE: MAR, 1982 CONTRACT NO. DACW63-82-C-0089 DRAWING NUMBER: SHEET NO. 30</p>					

CONTRACT NO. DACW63-82-C-0089

G
F
E
D
C
B
A

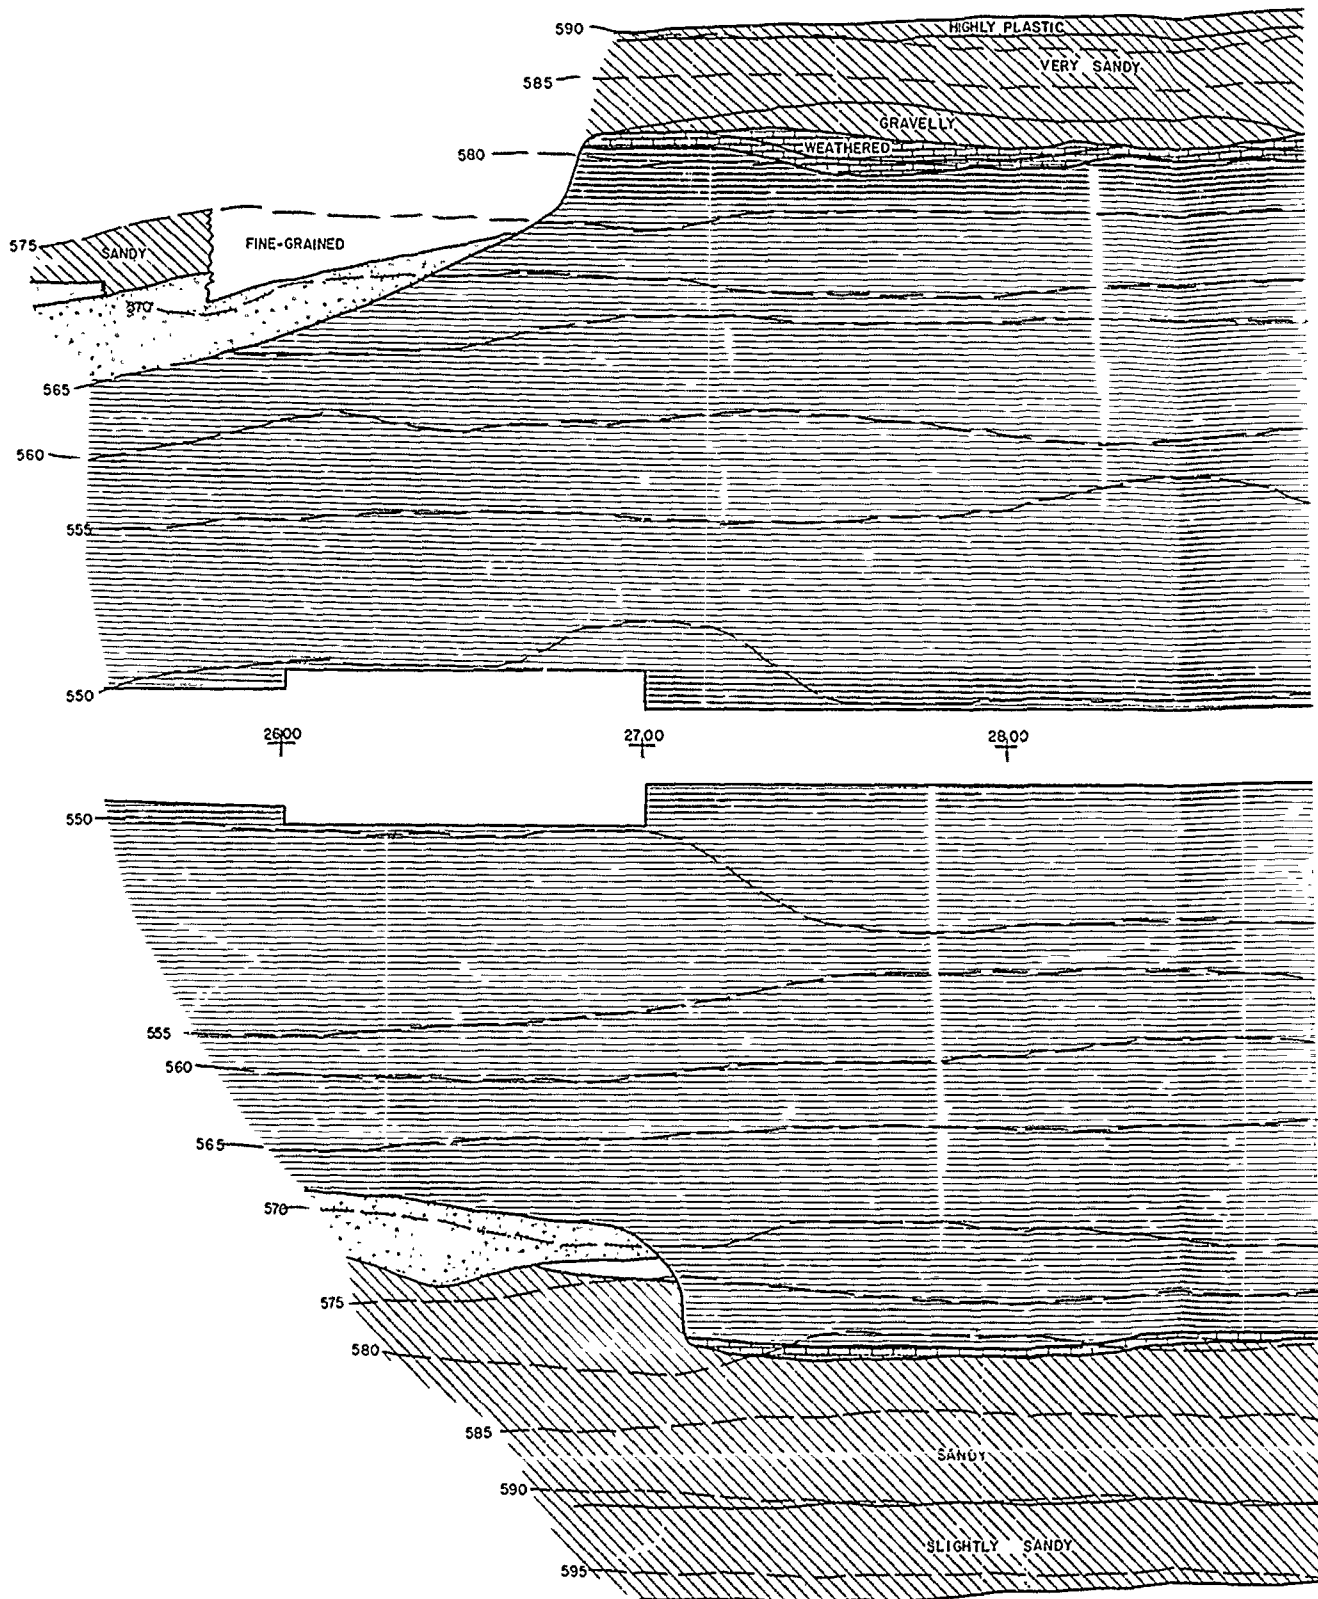


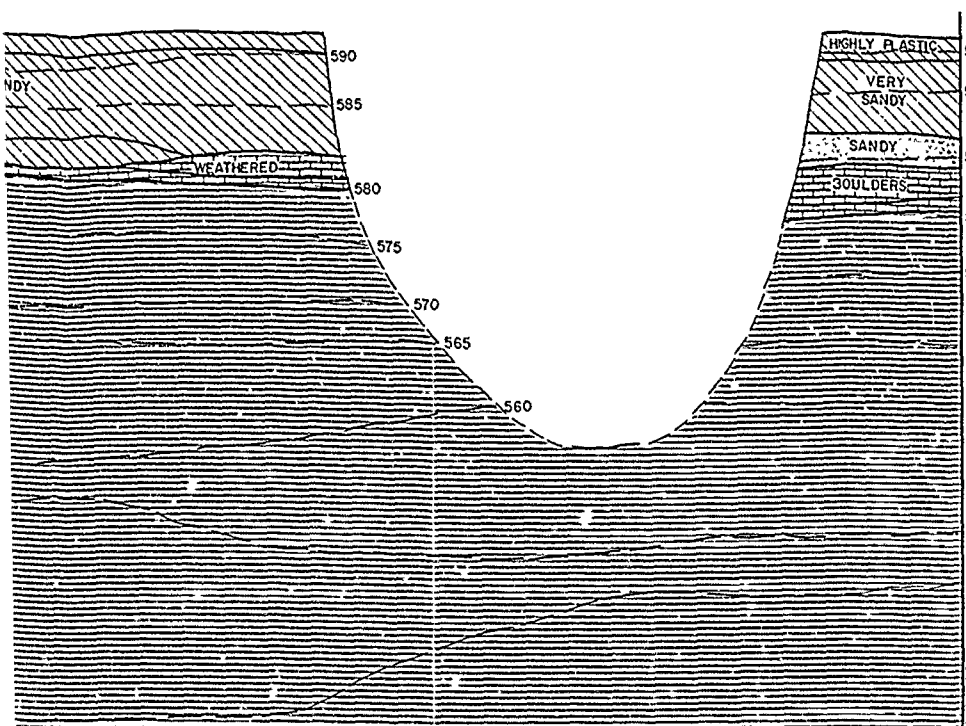

29+00

30+00


MATCH LINE STA 31+00

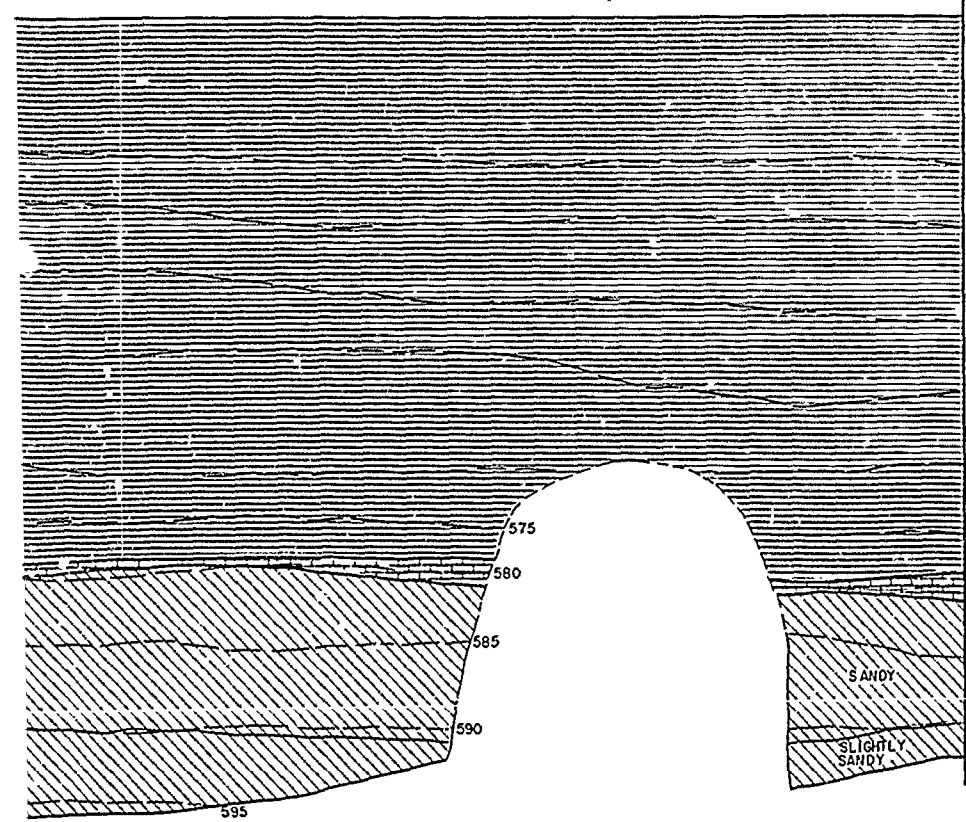


LEGEND

- SAND
- GRAVEL
- CLAY
- SANDSTONE
- LIMESTONE
- SHALE






DESIGNED BY: H. BARNETT		RAY ROBERTS LAKE ELM FORK, TRINITY RIVER, TEXAS	
DRAWN BY: C. KIRBY		FOUNDATION REPORT	
REVIEWED BY: R. BEHM		OUTLET WORKS STA. 25+50 TO 31+00	
SUBMITTED BY: ROBERT C. BEHM ENGINEER		SOL. NO.	DATE:
		CONTR. NO.	SEQUENCE NO.
		DRAWING NUMBER	SHEET NO. 40



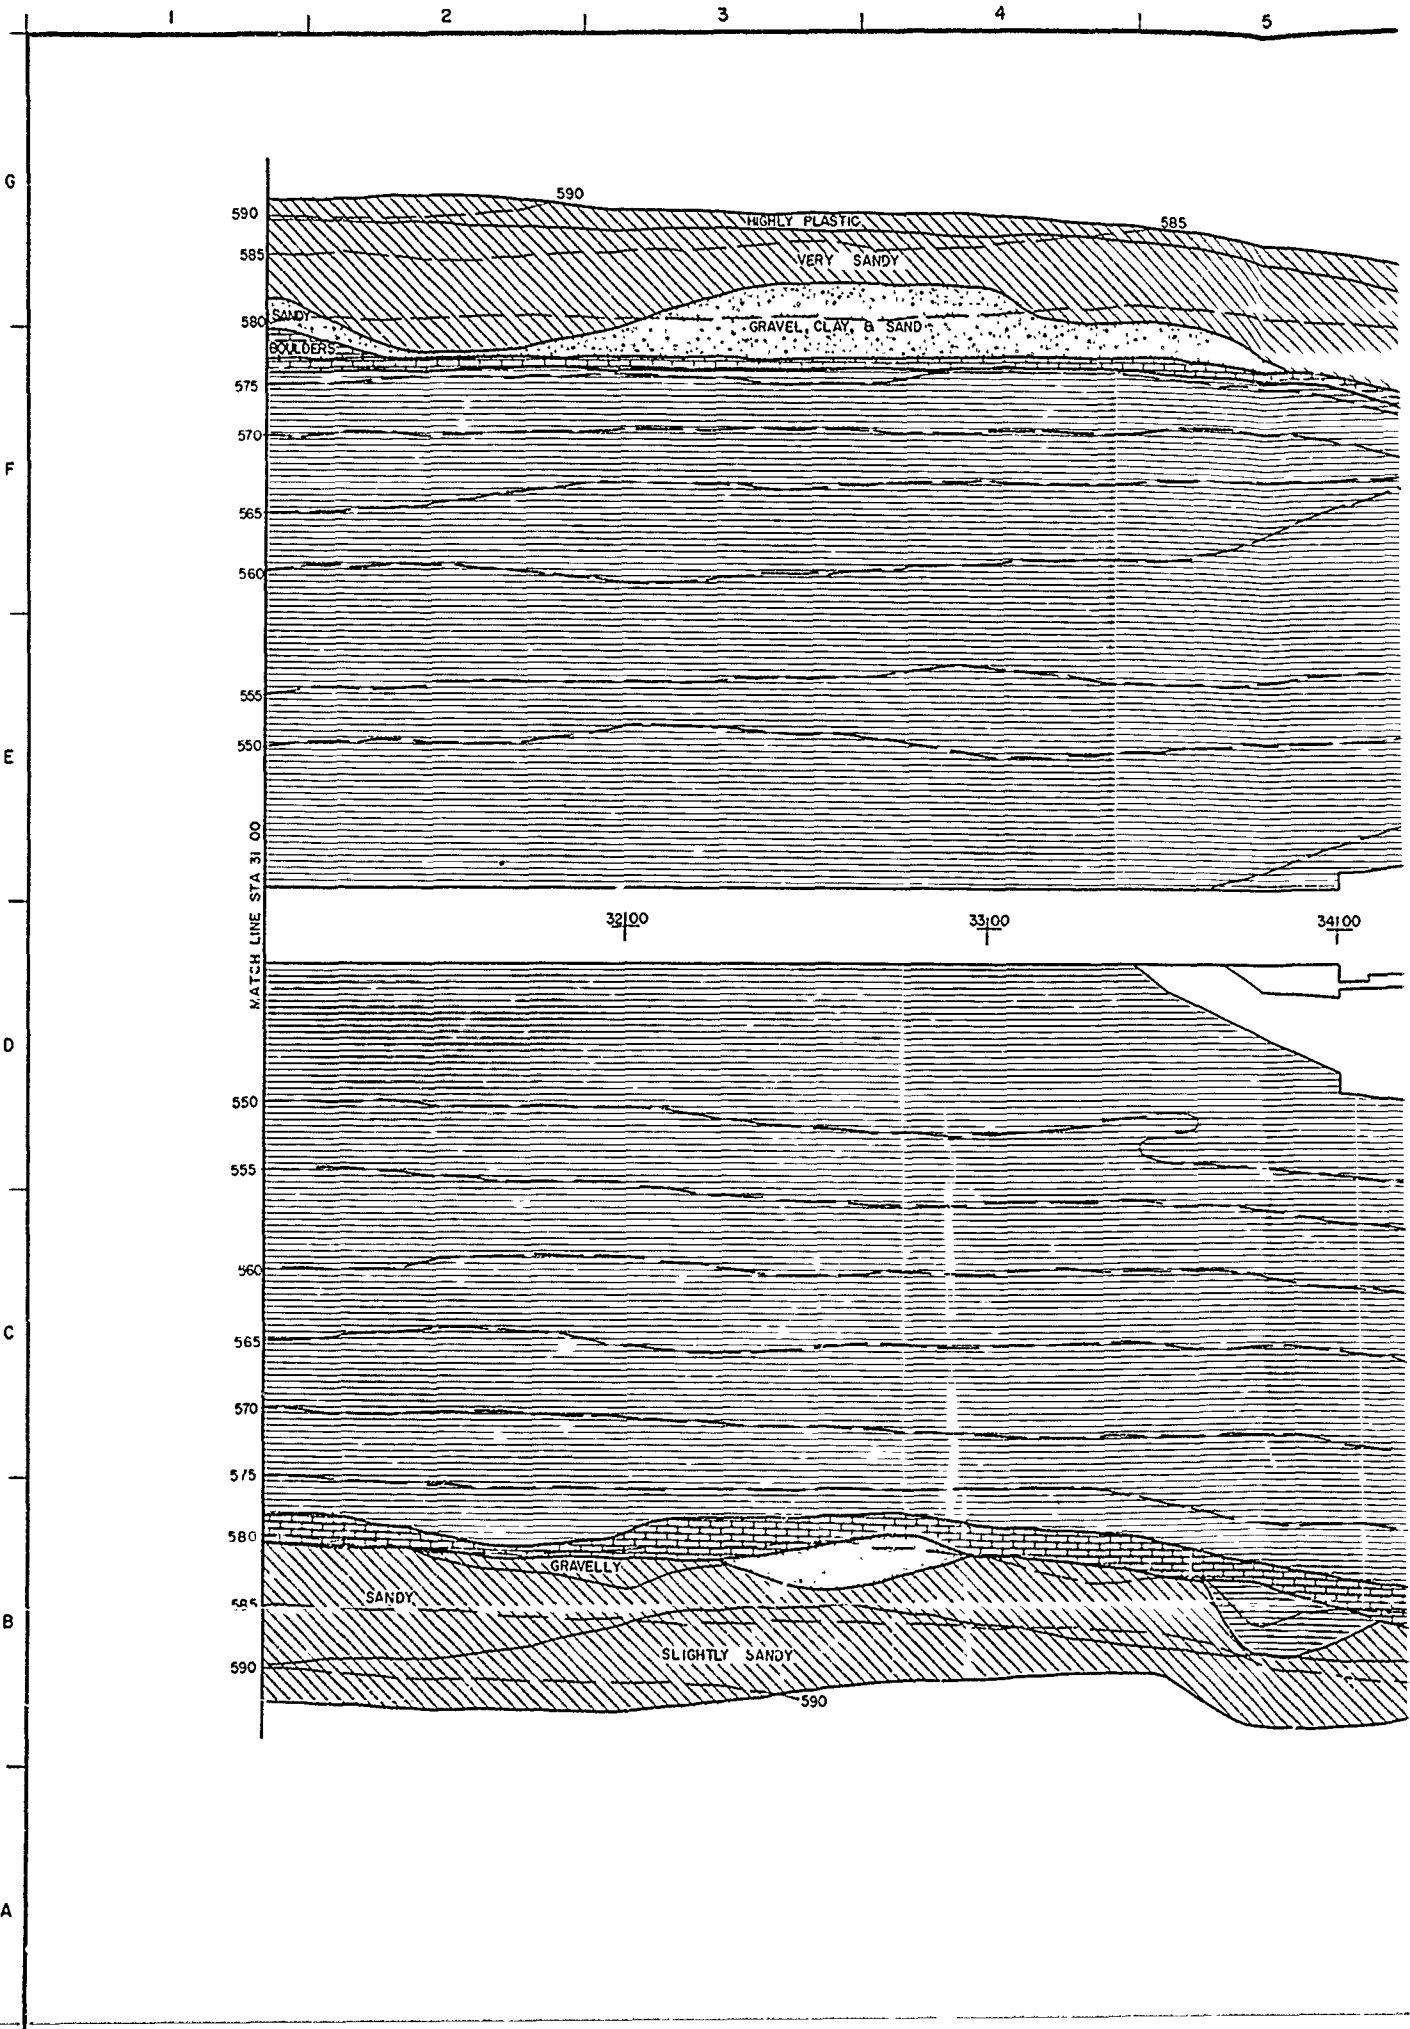


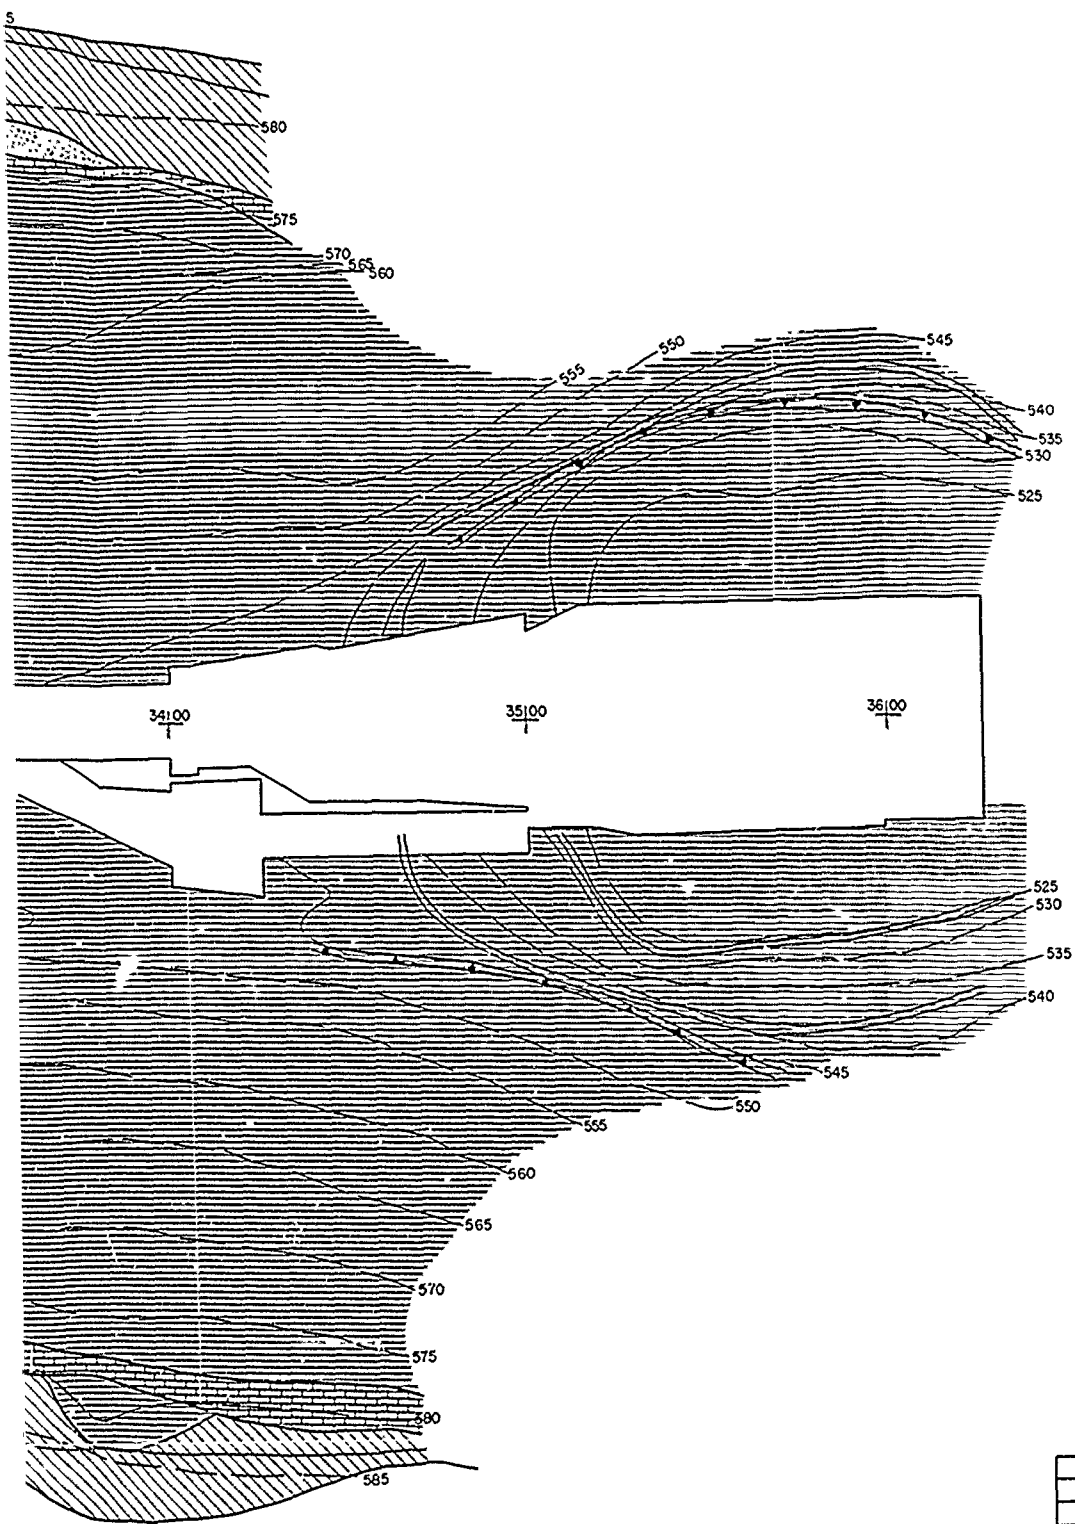
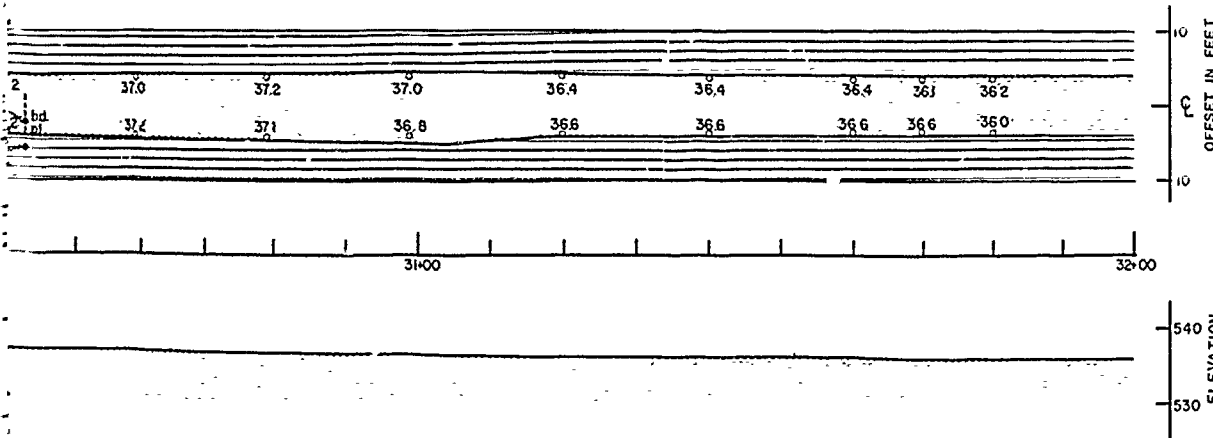
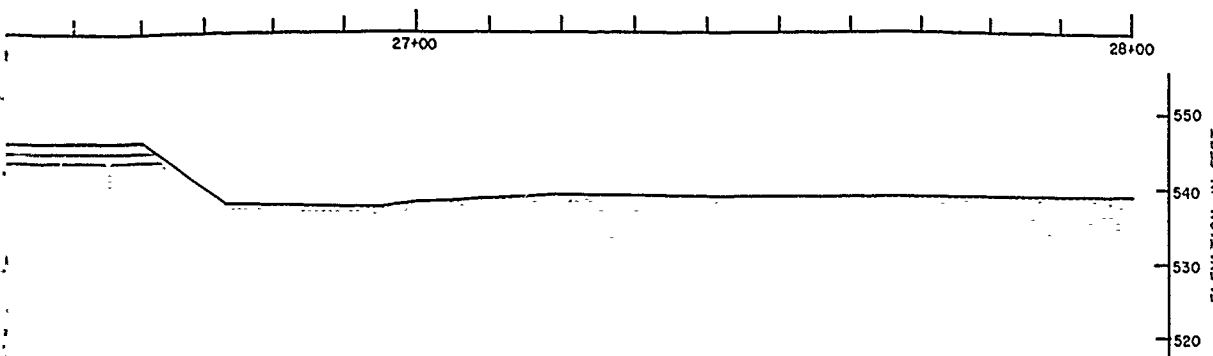
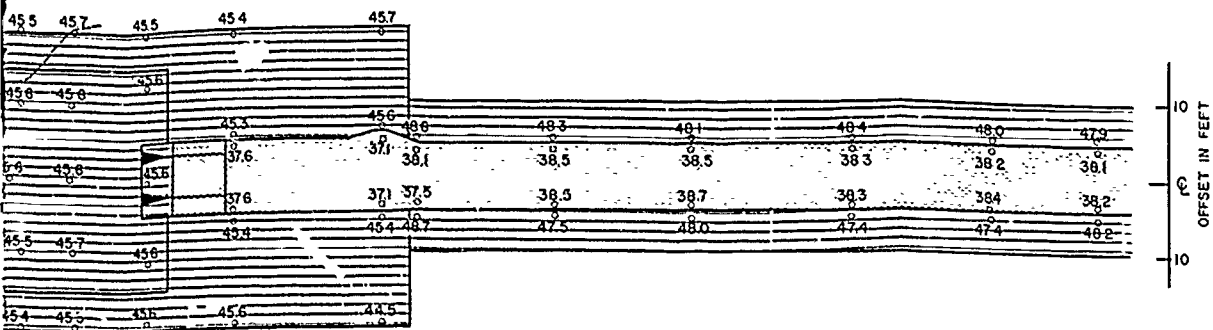


DESIGNED BY: H. BARNETT		RAY ROBERTS LAKE ELM FORK, TRINITY RIVER, TEXAS	
DRAWN BY: C. KIRBY		FOUNDATION REPORT OUTLET WORKS STA. 31+00 TO 36+28	
REVIEWED BY: R. BEHM			
SUBMITTED BY: ROBERT C. BEHM		SOL. NO.	DATED:
ENGINEER:		CONTR. NO.	SEQUENCE NO.
		DRAWING NUMBER	SHEET NO. OF
			41




 

G
F
E
D
C
B

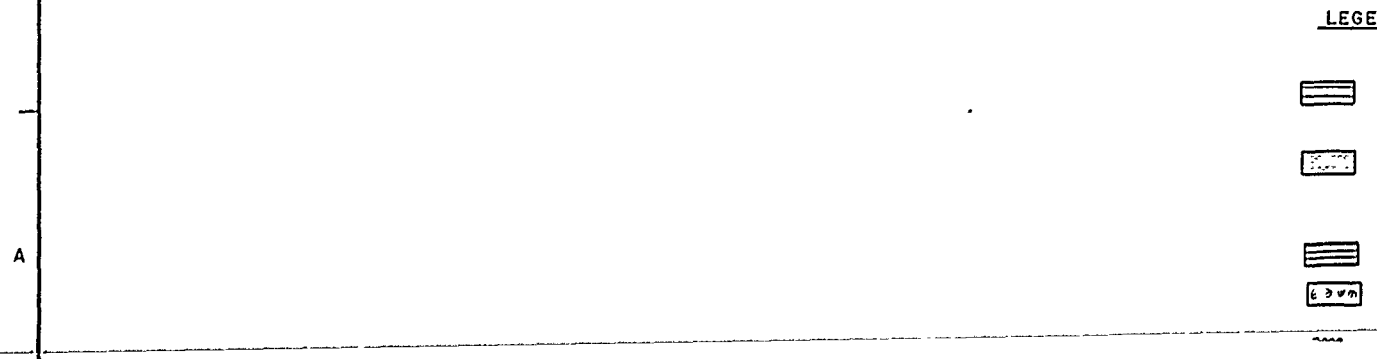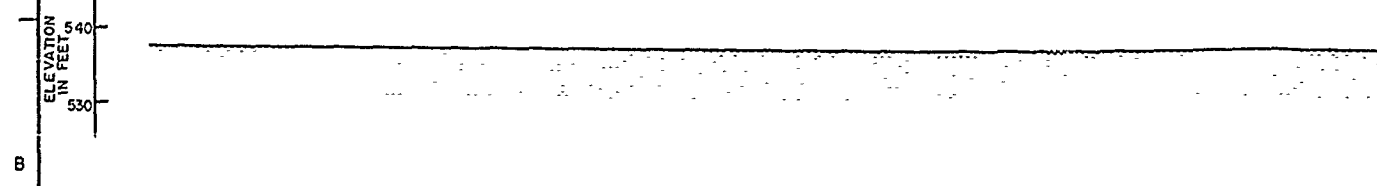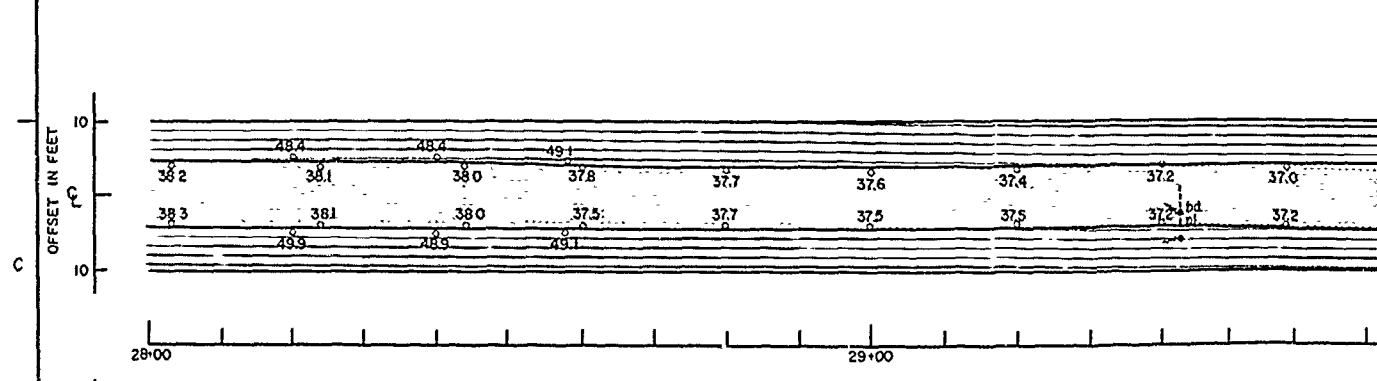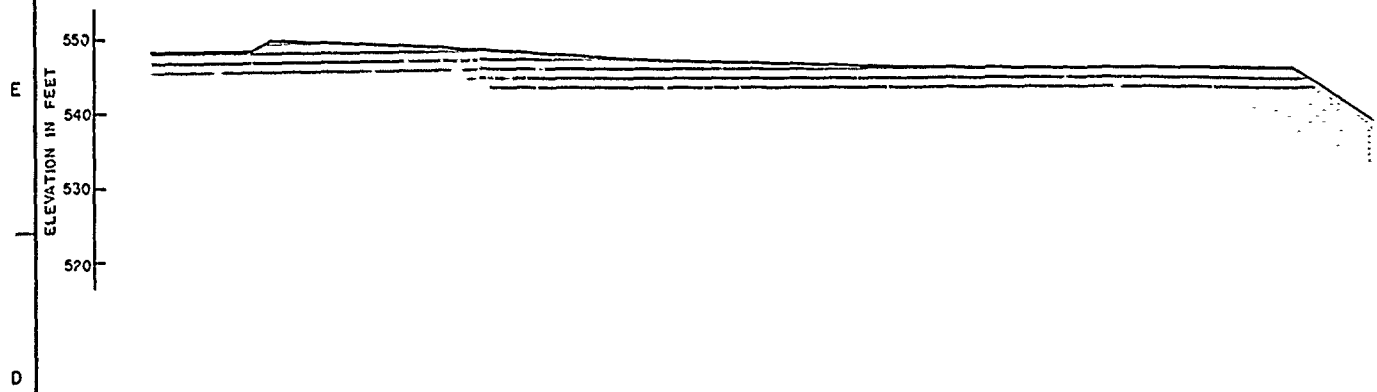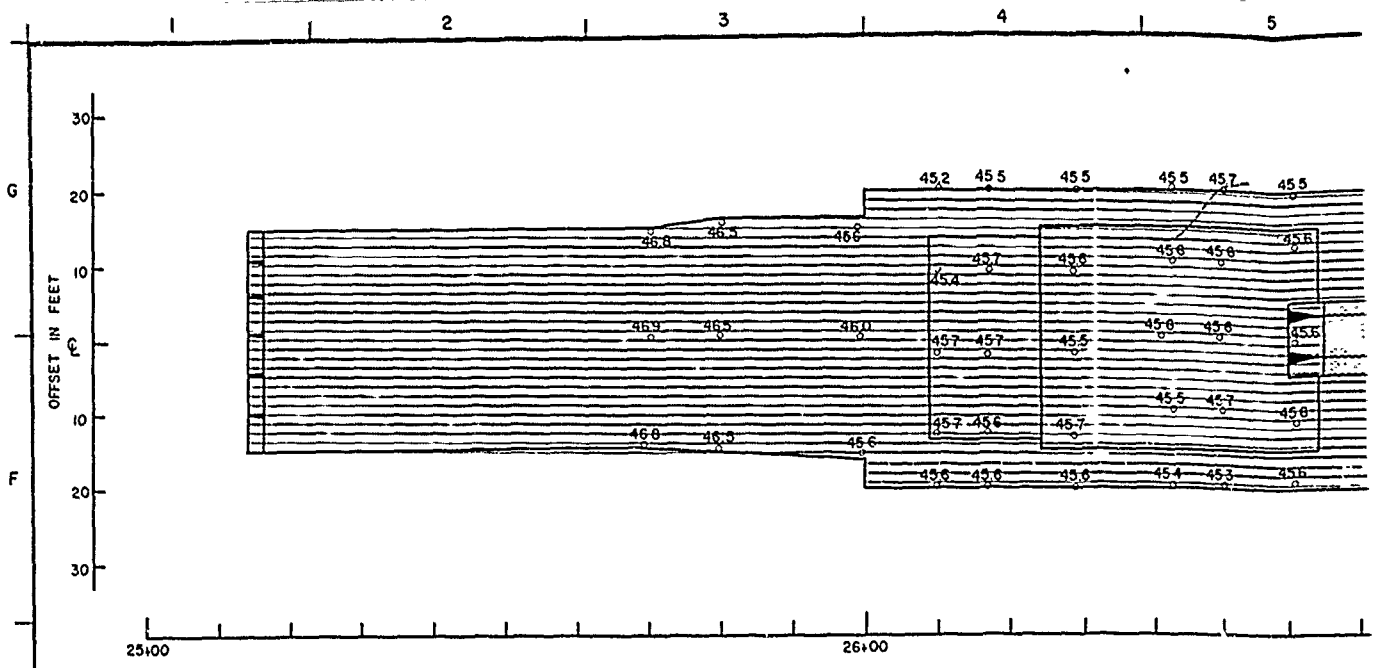

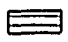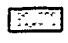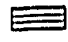
- LEGEN**
- 
 - 
 - 
 - 



LEGEND

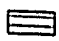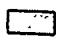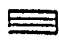
-  CLAY-SHALE, SOFT TO MODERATELY HARD, GREENISH TO DARK GRAY w/SAND AND SANDSTONE LENSES.
-  ALTERNATING CLAY SHALE AND SANDSTONE SEAMS, SOFT TO MODERATELY HARD, DARK GRAY, SANDSTONE, FINE TO MEDIUM GRAINED, COMPRISES UP TO 50% OF MATERIAL.
-  CLAY-SHALE, SOFT TO MODERATELY HARD, MOIST, DARK GRAY, SLIGHTLY FOSSILIFEROUS.
-  HIGHLY FOSSILIFEROUS
-  WATER SEEP

REVISION NO.		DATE	DESCRIPTION OF REVISION
U.S. ARMY ENGINEER DISTRICT, FORT WORTH			CORPS OF ENGINEERS FORT WORTH, TEX. 8
DESIGNED BY:	RAY ROBERT'S LAKE ELM FORK, TRINITY RIVER, TEXAS		
DRAWN BY:	FOUNDATION REPORT OUTLET WORKS		
REVIEWED BY:	PLAN AND PROFILE STA. 25+00 TO 31+00		
APPROVED BY:	R. BEHM		
SUBMITTED BY:		SCL. NO.	DATED:
ROBERT C BEHM		CONTR. NO.	SEQUENCE NO.
DRAWING NUMBER		SHEET NO.	
		42	

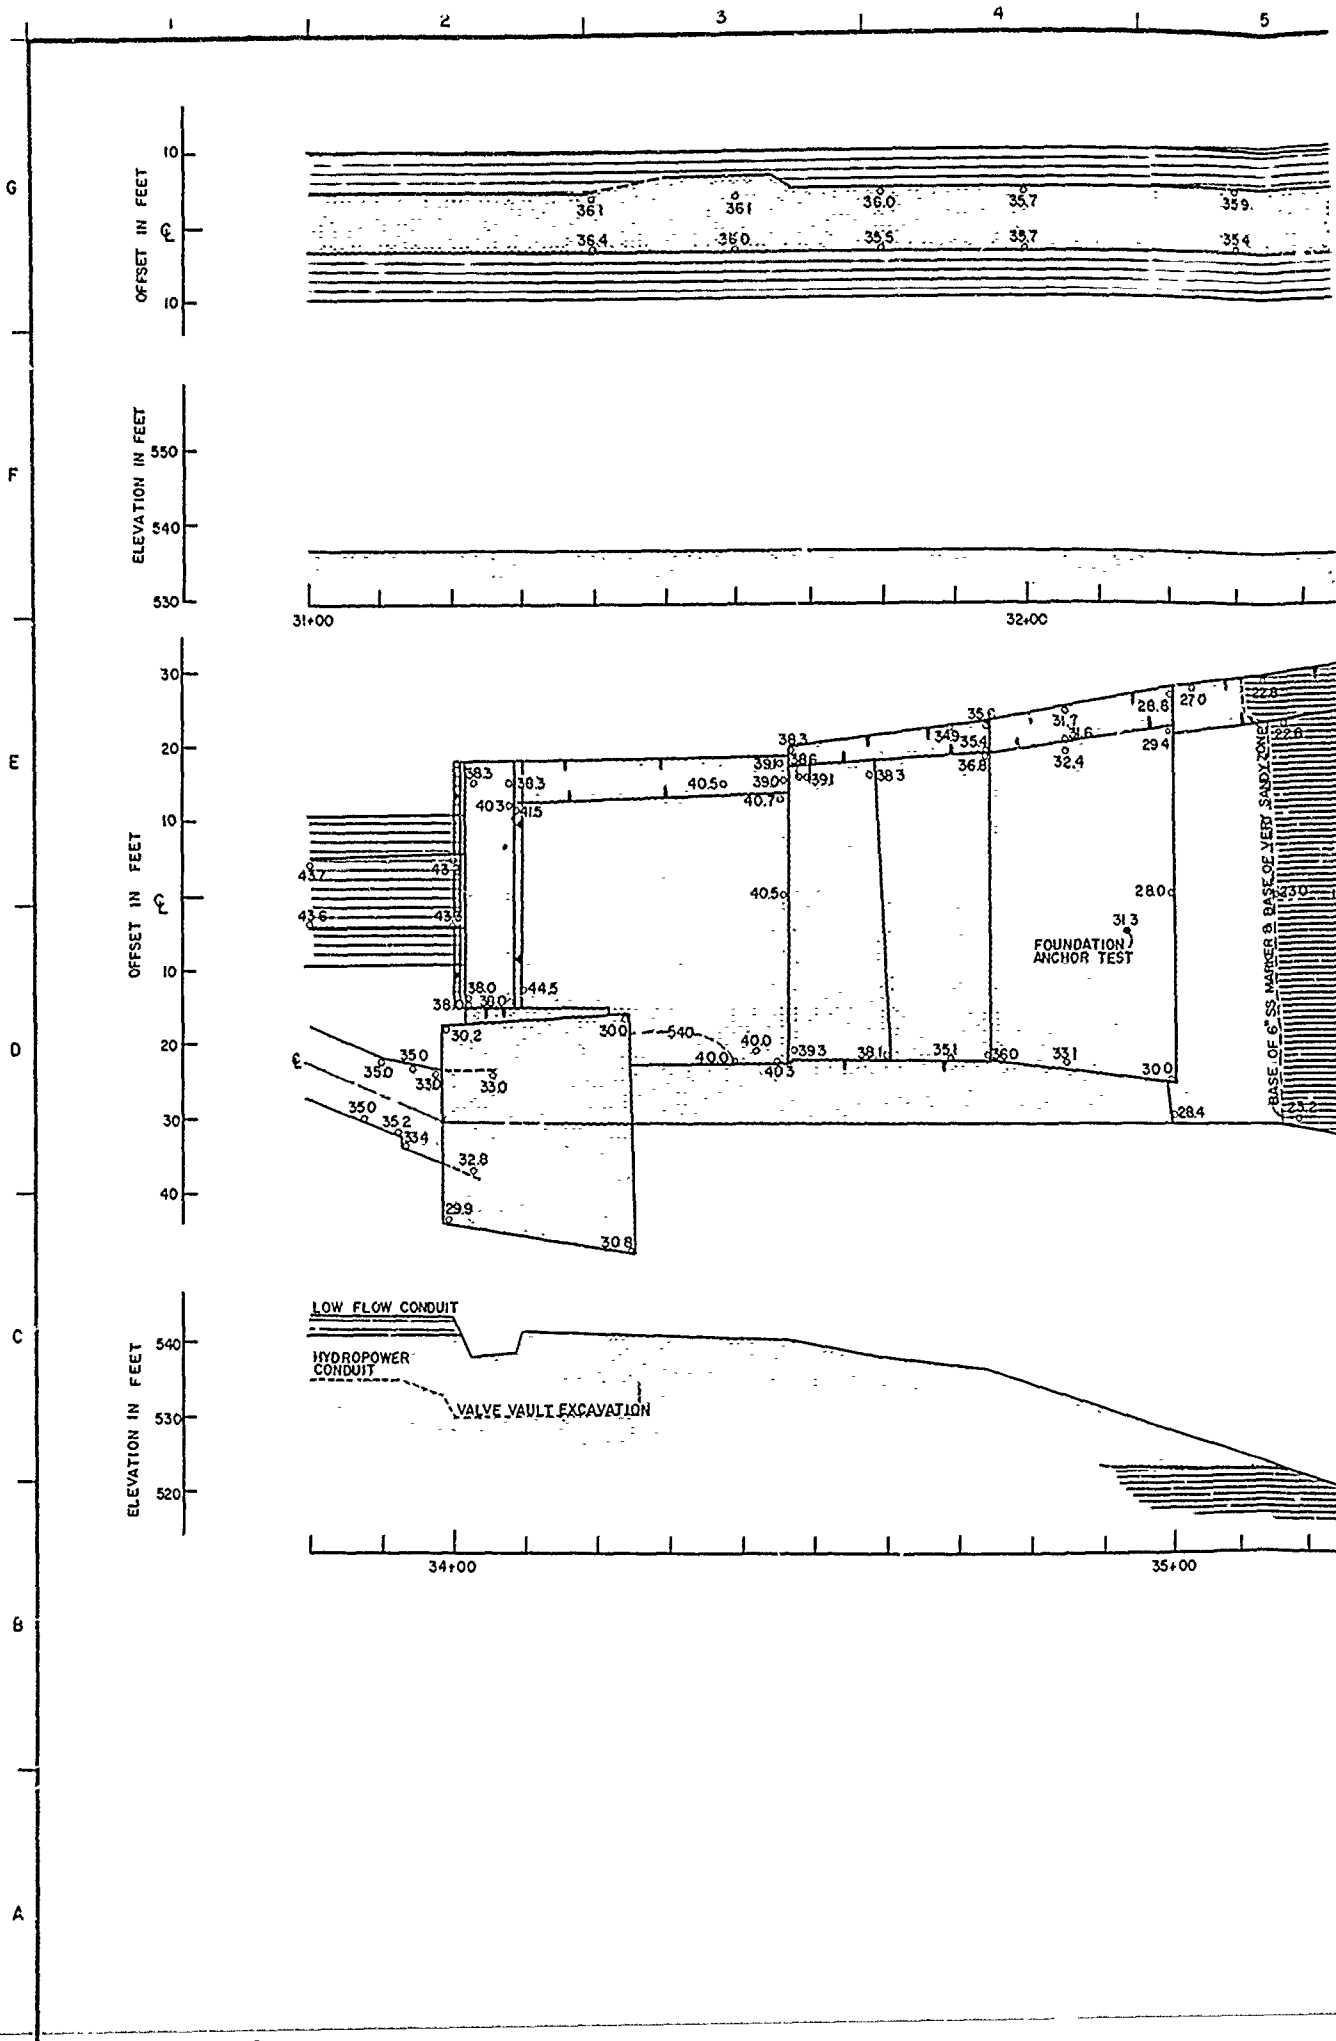


G

OFFSET IN FEET
10
0
10

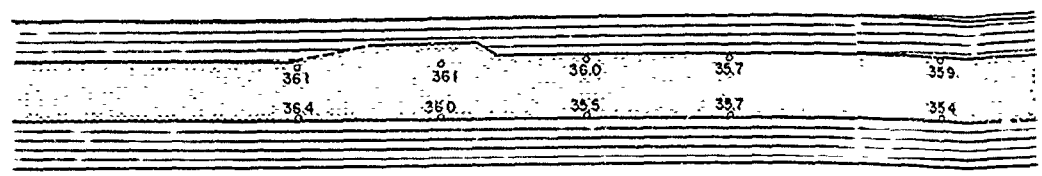


F

ELEVATION IN FEET
550
540
530

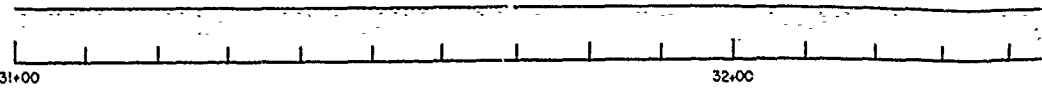


E

OFFSET IN FEET
30
20
10
0
10
10
10
20
30
40

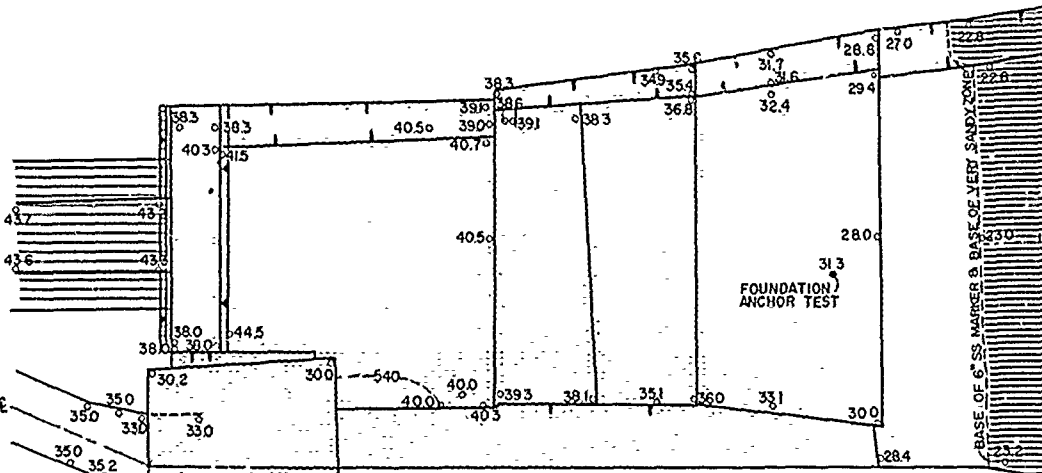


D

OFFSET IN FEET
20
30
40

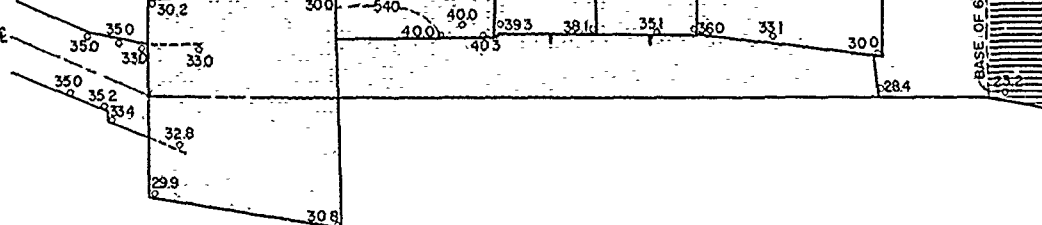






C

ELEVATION IN FEET
540
530
520

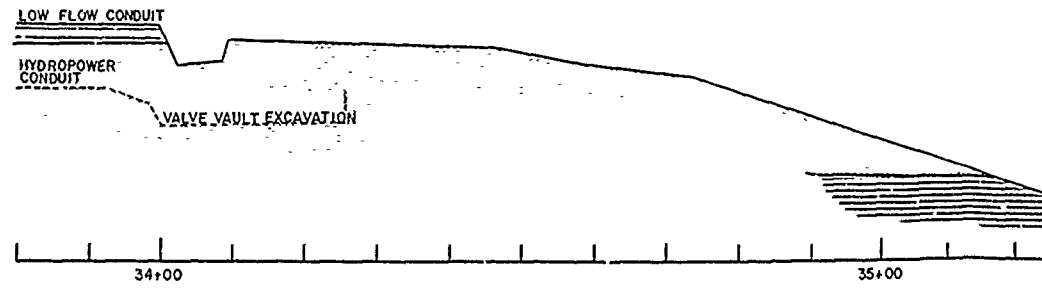


B

A

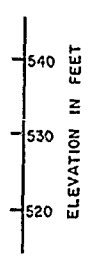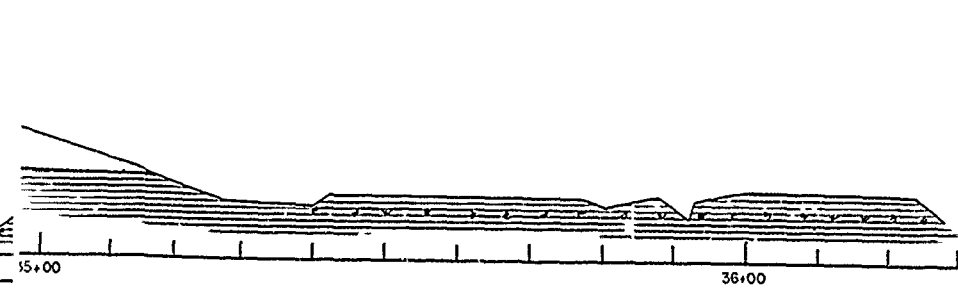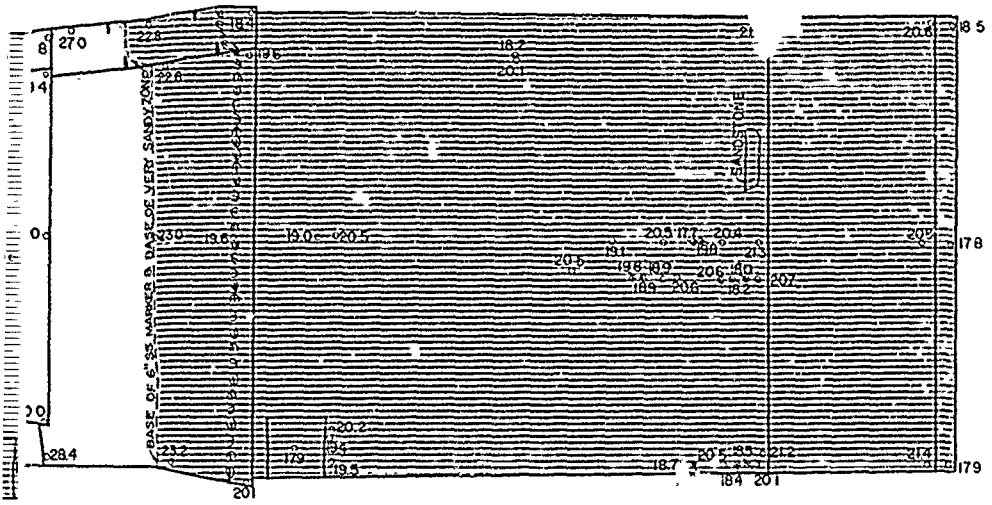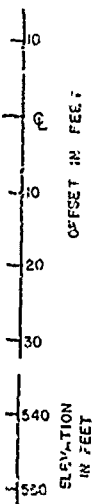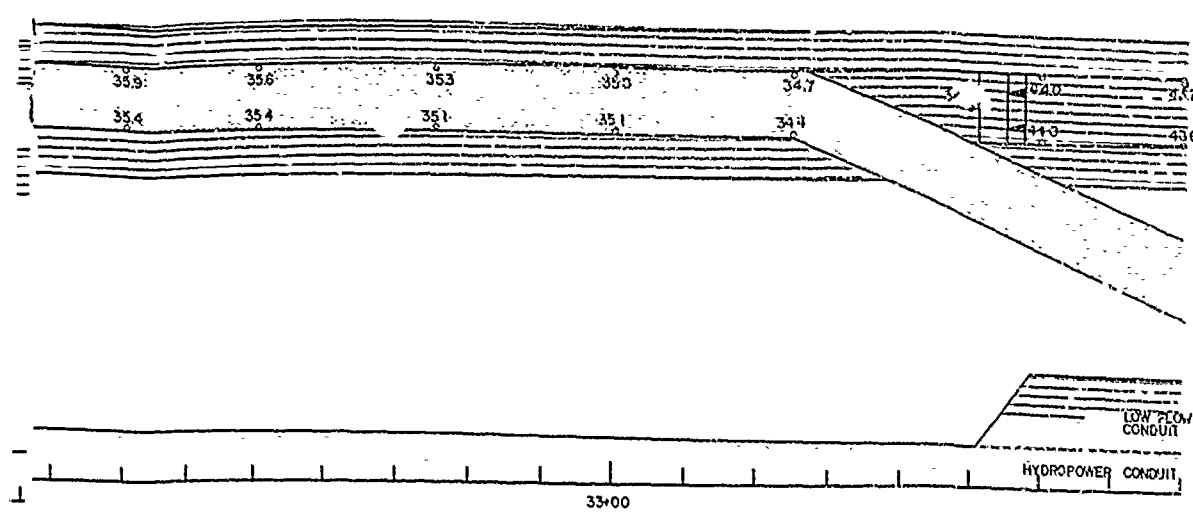





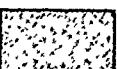


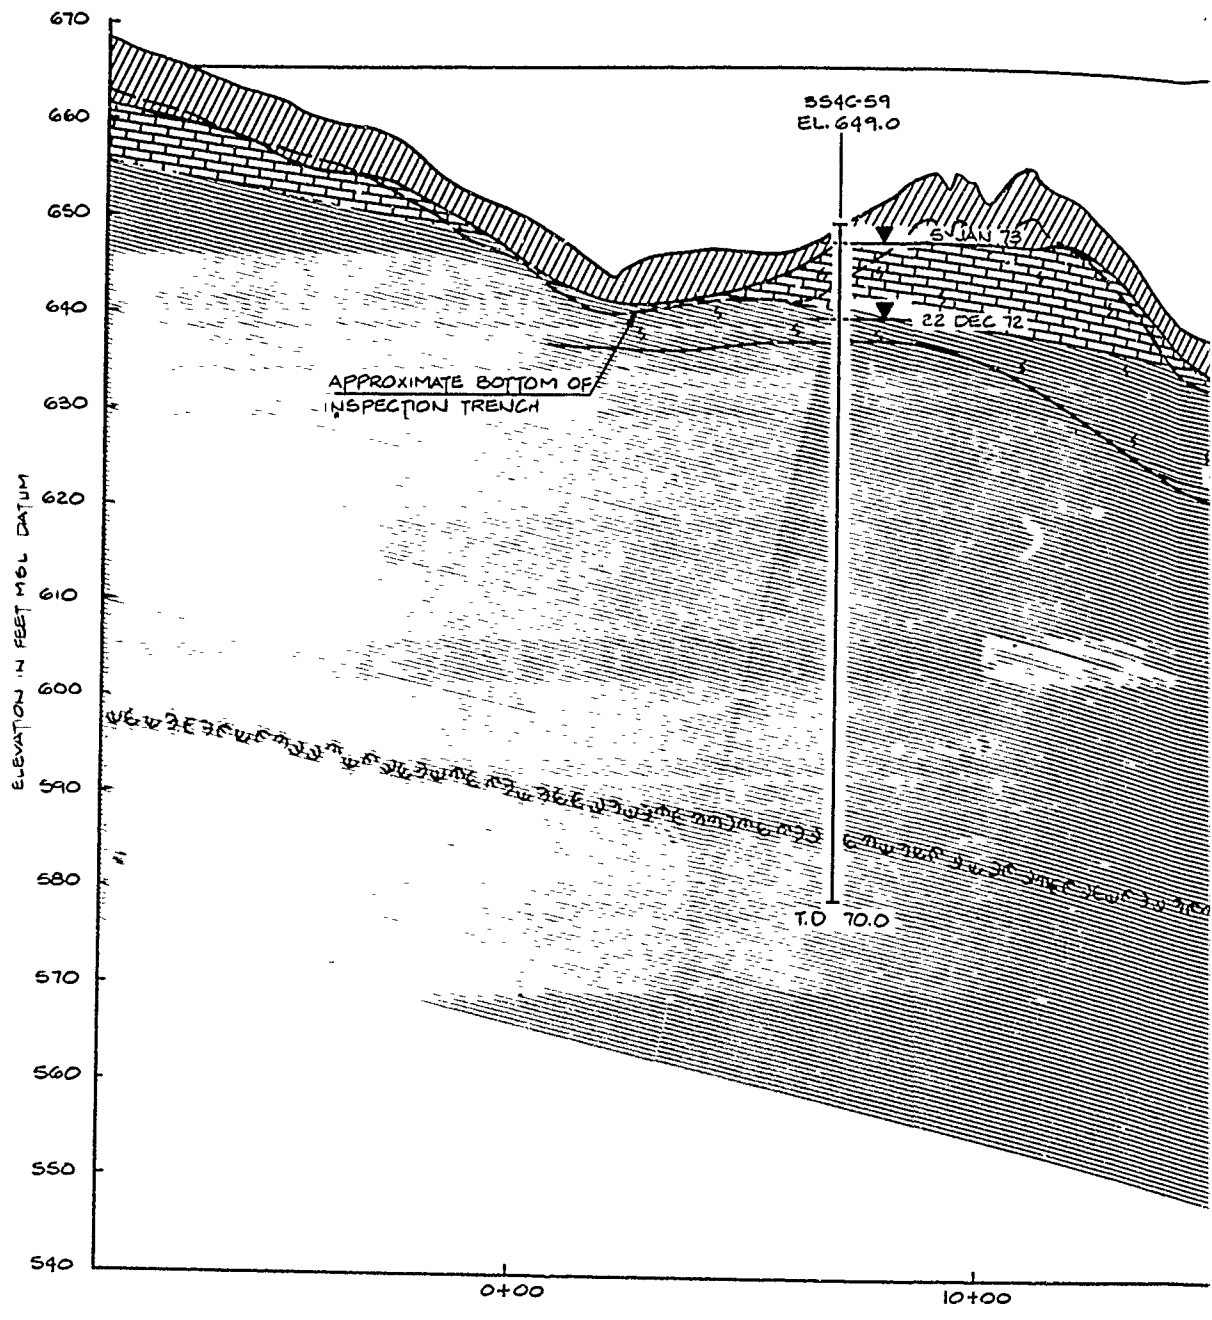


NOTE:
FOR LEGEND, SEE PLATE NO. 42.

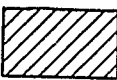
DESIGNED BY: H. BARNETT	RAY ROBERTS LAKE ELM FORK, TRINITY RIVER, TEXAS FOUNDATION REPORT OUTLET WORKS STA. 31+00 TO 36+25	
DRAWN BY: C. KIRBY		
REVIEWED BY: R. BEHM		
APPROVED BY: R. BEHM		
SUBMITTED BY: ROBERT C. BEHM ENGINEER	SOL. NO. CONTR. NO. DRAWING NUMBER	DATED: SHEET NO. 43



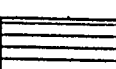


LEGEND

- | | | | | | |
|---|--|---|--|---|----------------------------|
|  | CLAY, VARIABLY SILTY AND SANDY |  | SHALE & SANDY SHALE |  | SANDSTONE, VARIAB |
|  | CLAY, GRAVELLY |  | SHALE CALCAREOUS |  | LIMESTONE, MODERAT TO HARD |
|  | SAND, VARIABLY CLAYEY SANDY & GRAVELLY |  | SHALE, SANDY W/ NUMEROUS LENSES OF MODERATELY TO WELL CEMENTED SANDSTONE | | |
|  | GRAVEL, VARIABLY SANDY & CLAYEY |  | SHALE, NON-SANDY | | |

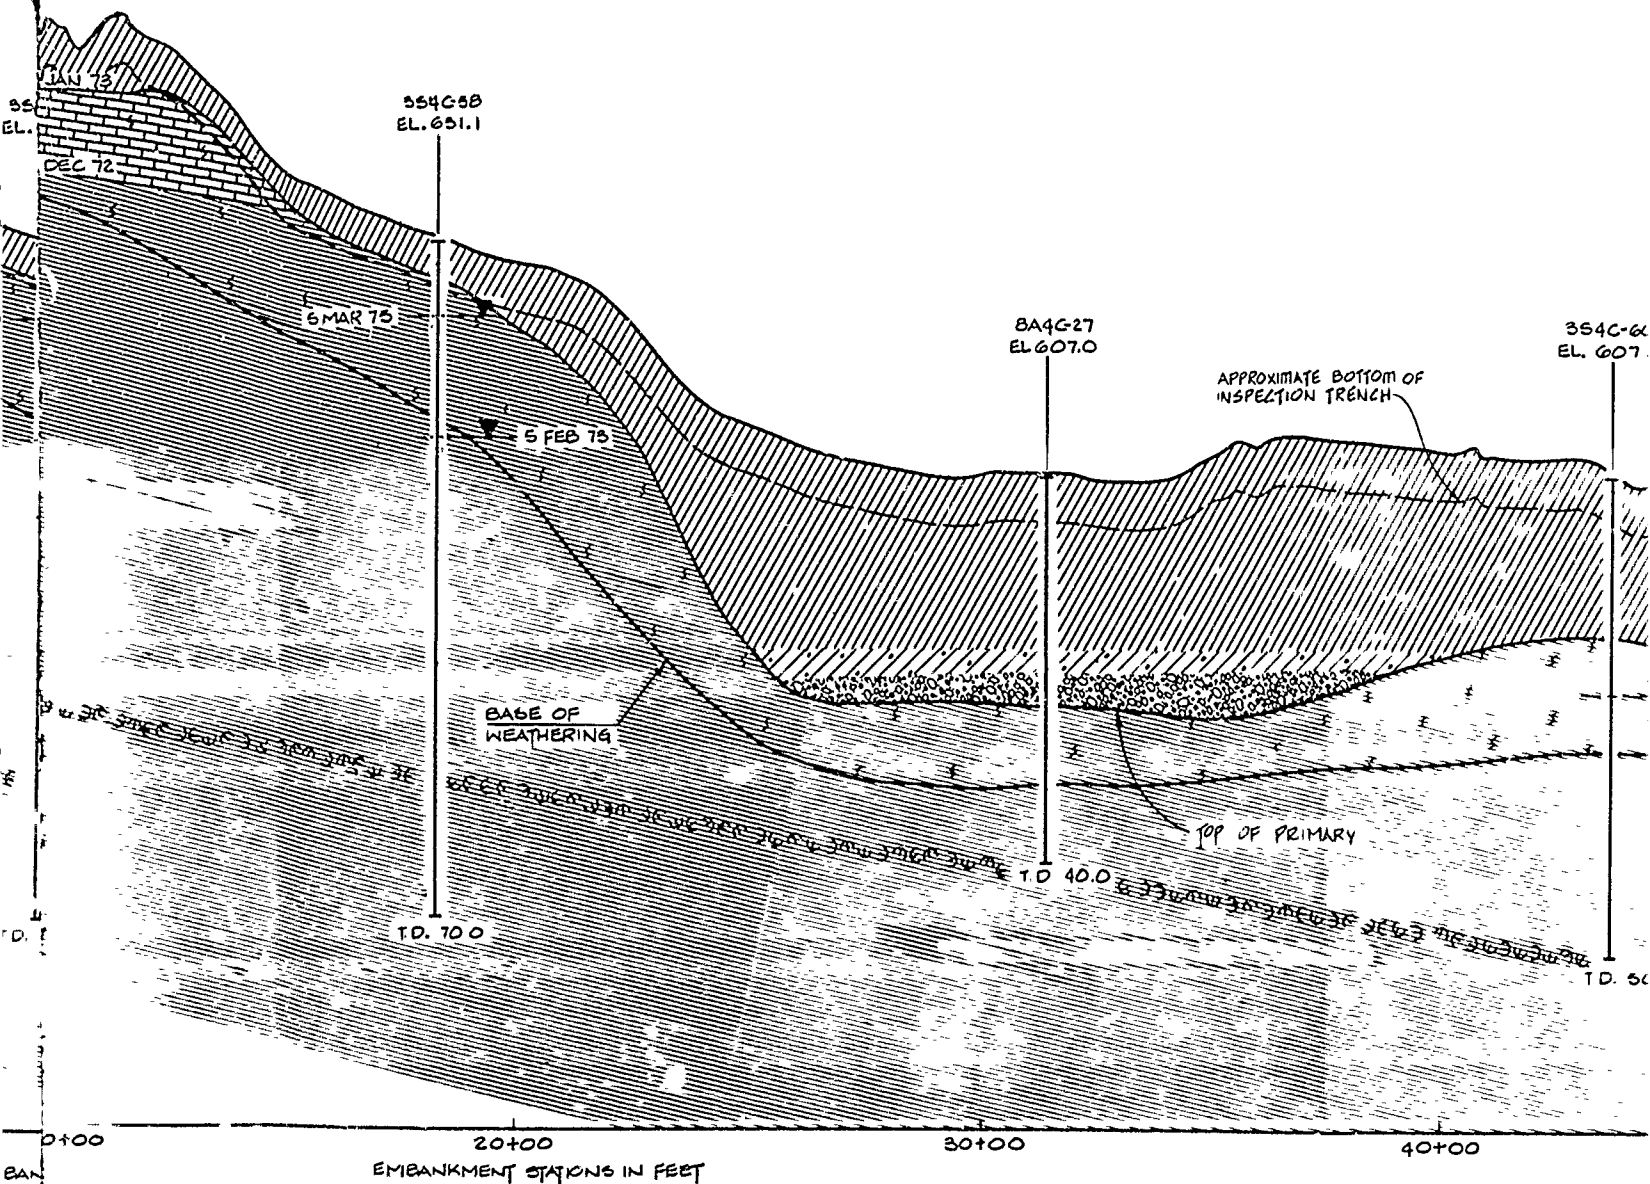TOP OF DAM EL. 665.0




-  SANDSTONE, VARIABLY CEMENTED
-  LIMESTONE, MODERATELY HARD TO HARD

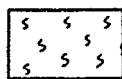

▼ WATER LEVEL ON DATE INDICATED

WEATHERED ZONE

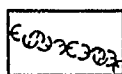


FOSSILIFEROUS ZONE

100 OHM RESISTIVITY LOG

- 8A 8-INCH AUGER BORING
- 6D 6-INCH DENISON BORING
- 6C 6-INCH CORE BORING
- 4C 4-INCH CORE BORING
- 3S 3-INCH SHGLBY TUBE
- 2C 2-INCH CORE BORING
- F FISHTAIL WASH BORING
- C CORE BORING
- T.D. TOTAL DEPTH

GENERAL NOTES

1. OVERBURDEN AND PRIMARY STRATA DESCRIPTIONS ARE GENERALIZED SEE SEQUENCES 205 THROUGH 236 FOR DETAILED LOGS OF BORINGS.
2. ABSENCE OF GROUND WATER LEVELS OPPOSITE BORING LOGS DOES NOT NECESSARILY MEAN THAT GROUND WATER WILL NOT BE ENCOUNTERED AT THE LOCATION OR WITHIN THE VERTICAL REACHES OF THE BORINGS. WATER LEVELS WILL FLUCTUATE DEPENDING ON SEASON AND RAINFALL.
3. FOR DETAIL OF CUTOFF AND INSPECTION TRENCH SEE SEQ. 171 AND 172.

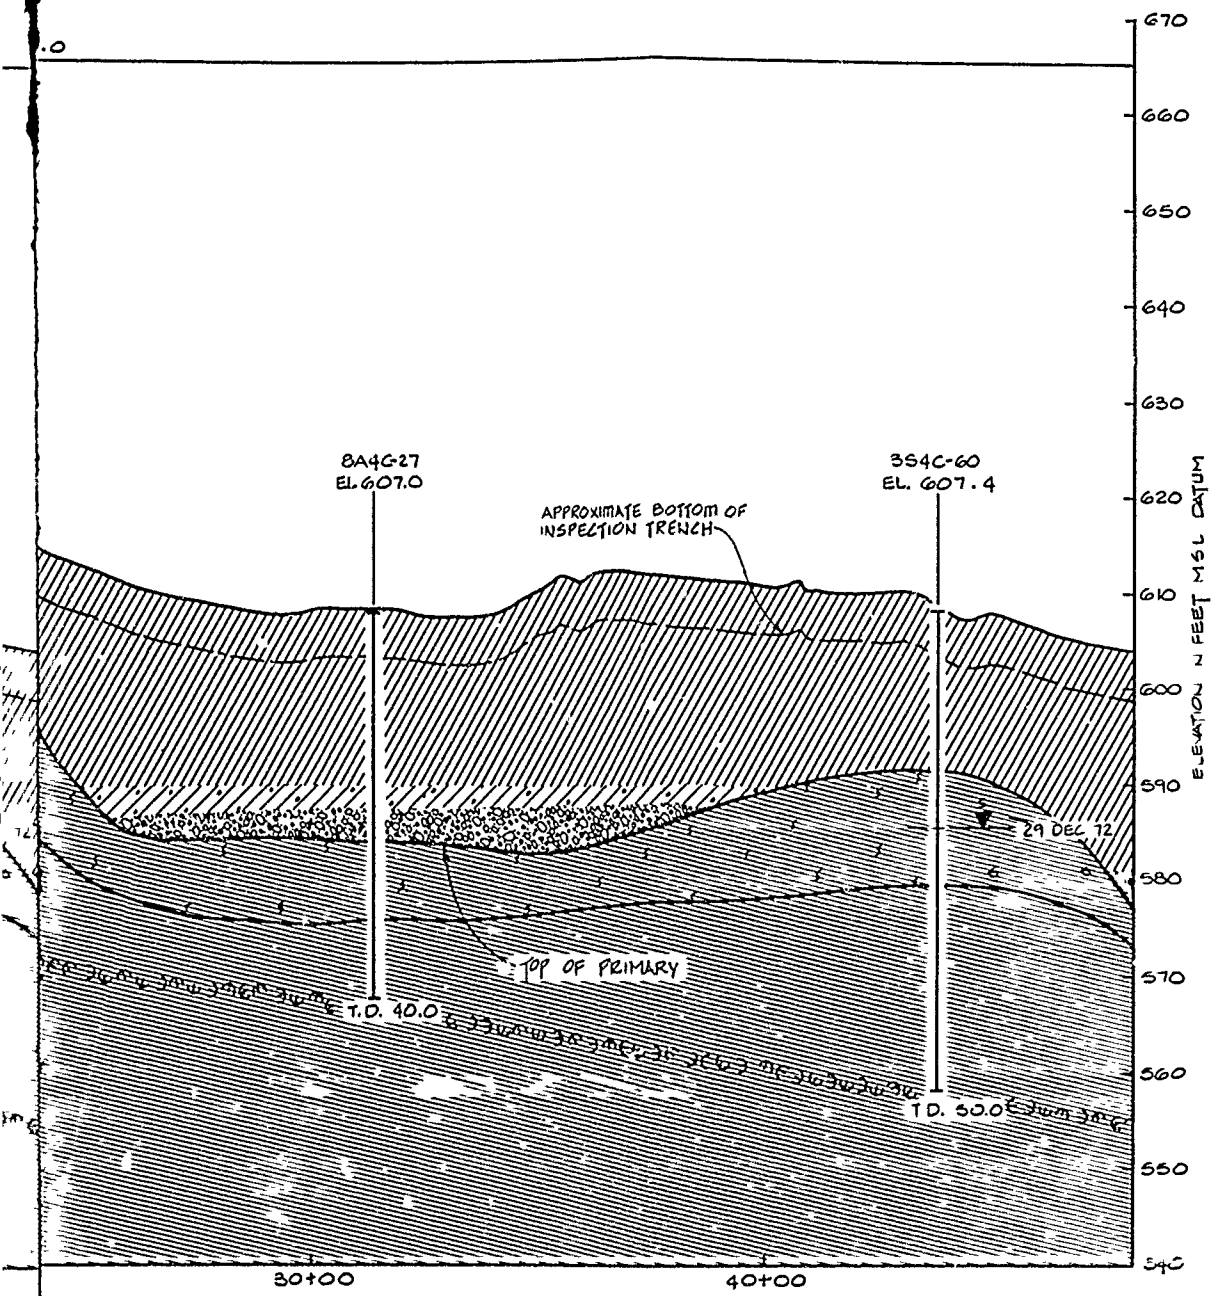

GENERAL NOTES

1. OVERBURDEN AND PRIMARY STRATA DESCRIPTIONS ARE GENERALIZED SEE SEQUENCES 225 THROUGH 236 FOR DETAILED LOGS OF BORINGS.
2. ABSENCE OF GROUND WATER LEVELS OPPOSITE BORING LOGS DOES NOT NECESSARILY MEAN THAT GROUND WATER WILL NOT BE ENCOUNTERED AT THE LOCATION OR WITHIN THE VERTICAL REACHES OF THE BORINGS. WATER LEVELS WILL FLUCTUATE DEPENDING ON SEASON AND RAINFALL.
3. FOR DETAIL OF CUTOFF AND INSPECTION TRENCH SEE SEQ. 171 AND 172.

RECORD DRAWING-WORK AS BUILT

- LEVEL ON INDICATED
- 8A 8-INCH AUGER BORING
 - 6D 6-INCH DENISON BORING
 - 6C 6-INCH CORE BORING
 - 4C 4-INCH CORE BORING
 - 3S 3-INCH SHELBY TUBE
 - 2C 2-INCH CORE BORING
 - F FISHTAIL WASH BORING
 - C CORE BORING
 - T.D. TOTAL DEPTH


RED ZONE

UNSATURATED ZONE

PERMEABILITY LOG

REVISION NO.	ACTION	DATE	DESCRIPTION OF REVISION
U.S. ARMY ENGINEER DISTRICT, FORT WORTH CORPS OF ENGINEERS FORT WORTH, TEXAS			
RAY ROBERTS LAKE ELM FORK TRINITY RIVER, TEXAS EMBANKMENT GEOLOGIC PROFILE EMBANKMENT CENTERLINE (STA. 0+00 TO STA. 48+00)			
DESIGNED BY: E. HAGEN	INVITATION NO. DACW163-82-B-0025 DATE: MAR 1982 CONTRACT NO. DACW163-82-C-0083 DRAWING NUMBER _____ SHEET NO. OF 44		
DRAWN BY: H. RUTHERFORD			
REVIEWED BY: E. HAGEN			
SUBMITTED BY: M. GREEN ENGINEER			

TO ACCOMPANY FOUNDATION REPORT

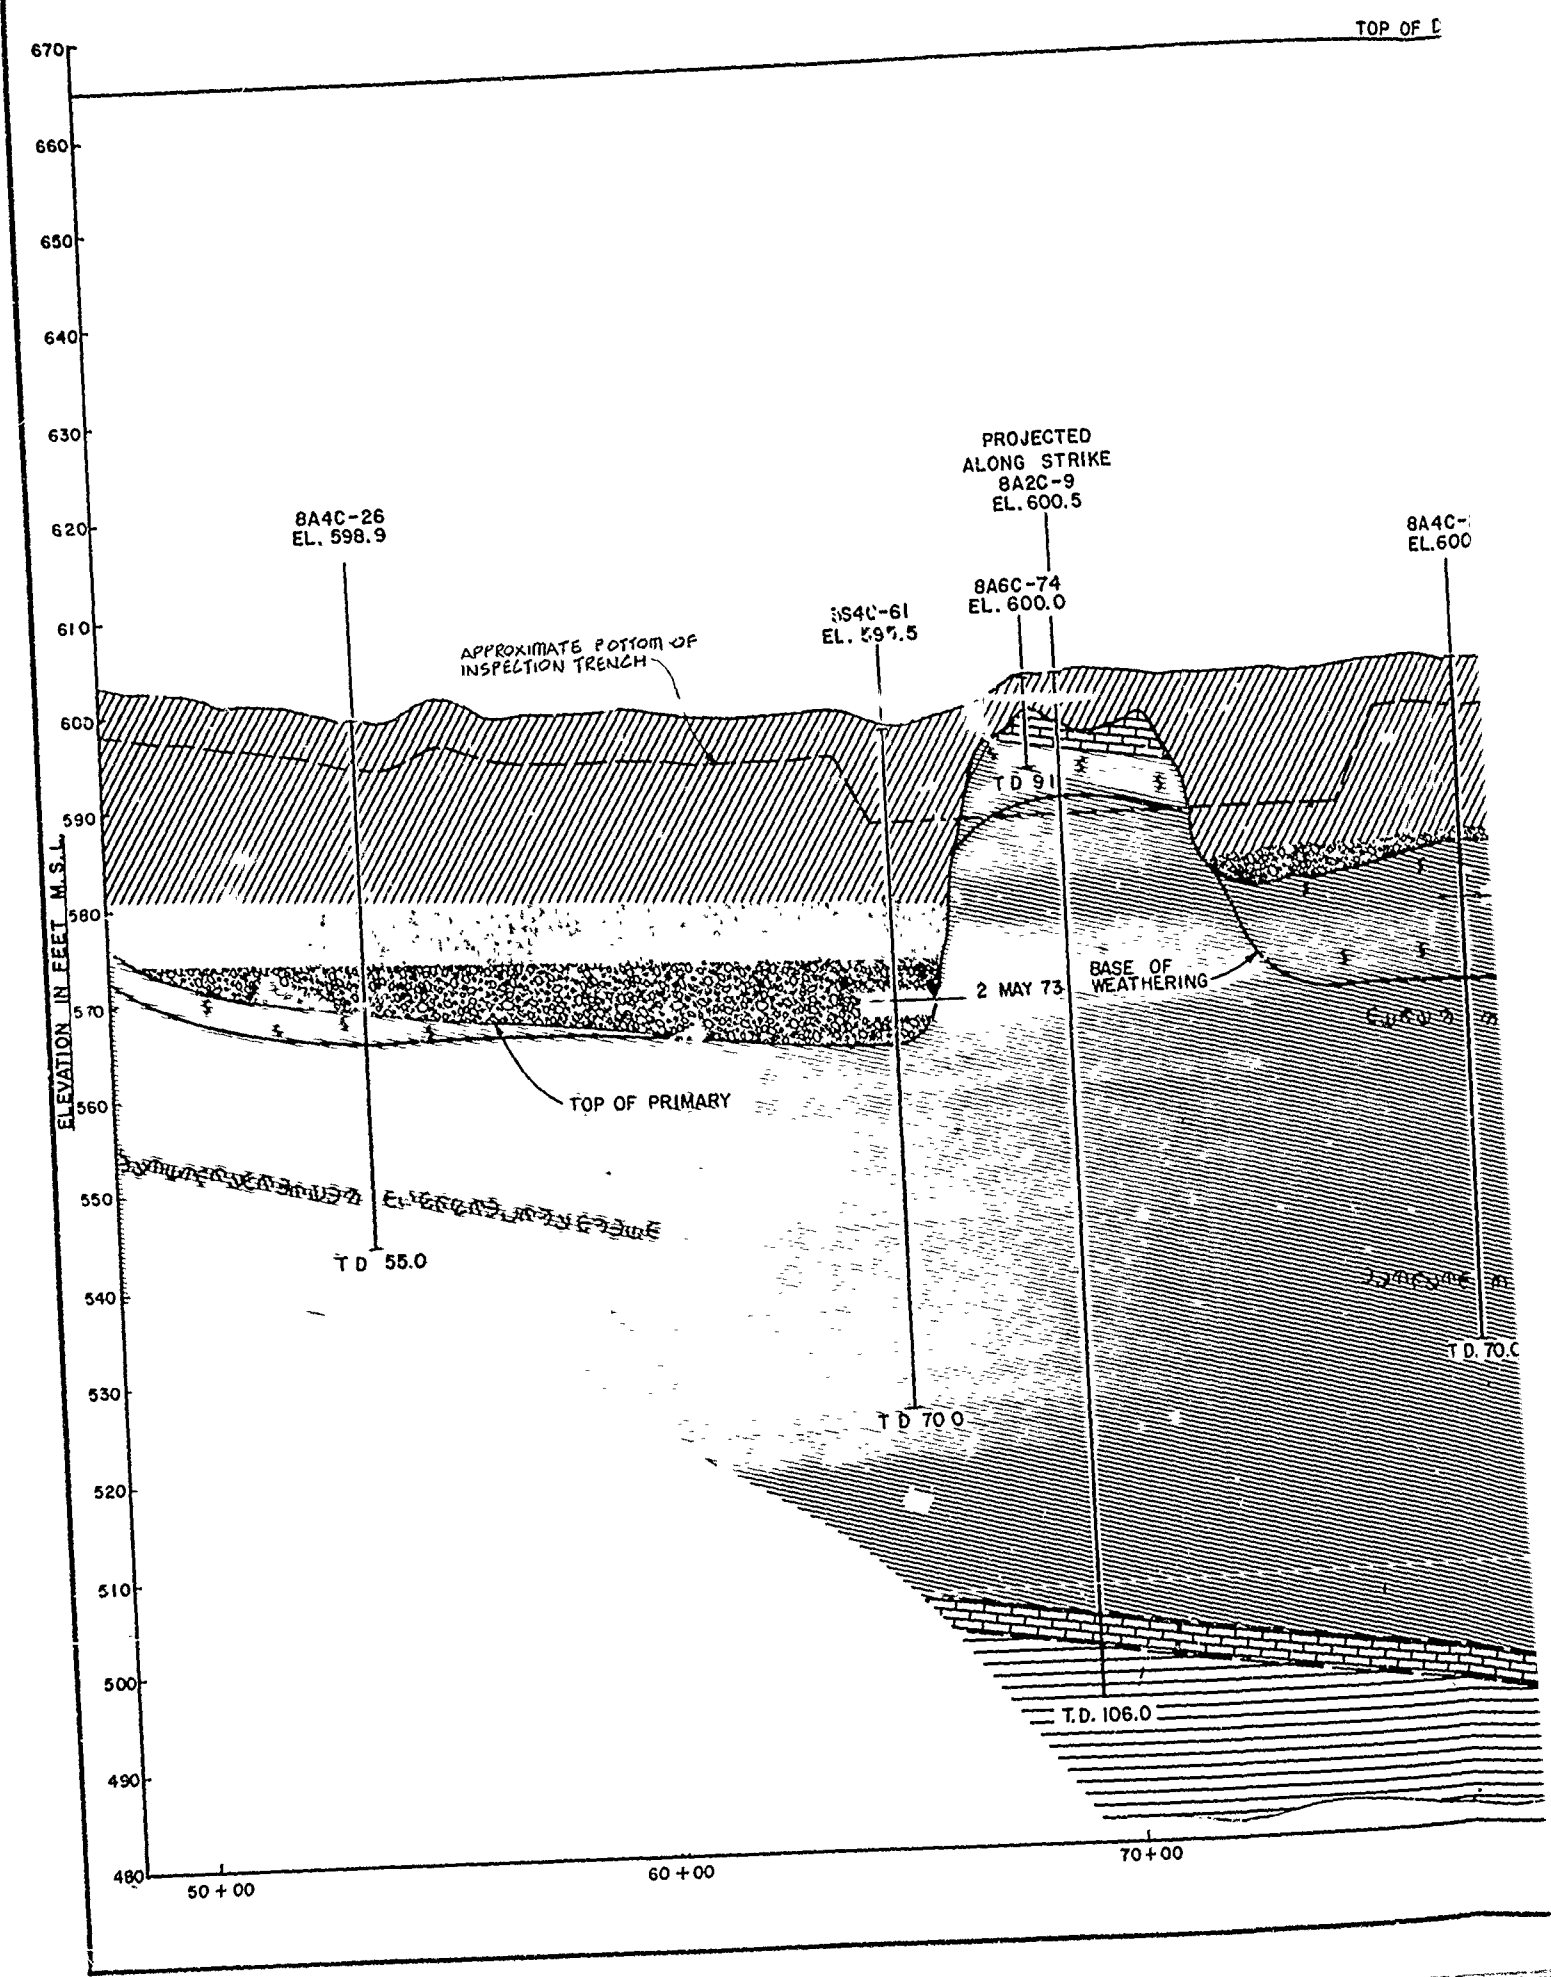

TOP OF DAM EL. 665.0

ELEVATION IN FEET M.S.L.
670
660
650
8A4C-25
EL. 600.4

6DC-18
EL. 595.1

C-1
EL. 597.2

6A4C-20
EL. 597.0

6DC-17
EL. 578.2

PROJ
8A6C-72
EL. 571.1

8A6C-73
EL. 560.4

7 AUG 72

9 SEPT 71

5 MAR 75

4 MAR 75

22 AUG 73

START OF CUTOFF TRENCH
STATION 86+00

APPROXIMATE BOTTOM OF
CUTOFF TRENCH

APPROXIMATE OUTLET
WORKS EXCAVATION

OUTLET
WORKS

END OF CUTOFF TRENCH
STATION 102+50

TOP OF PRIMARY
STRATA

T.D. 700

T.D. 300

T.D. 470

T.D. 280

T.D. 190

T.D. 500


T.D. 970


80+00

90+00

100+00

EXISTING GROUND SURFACE

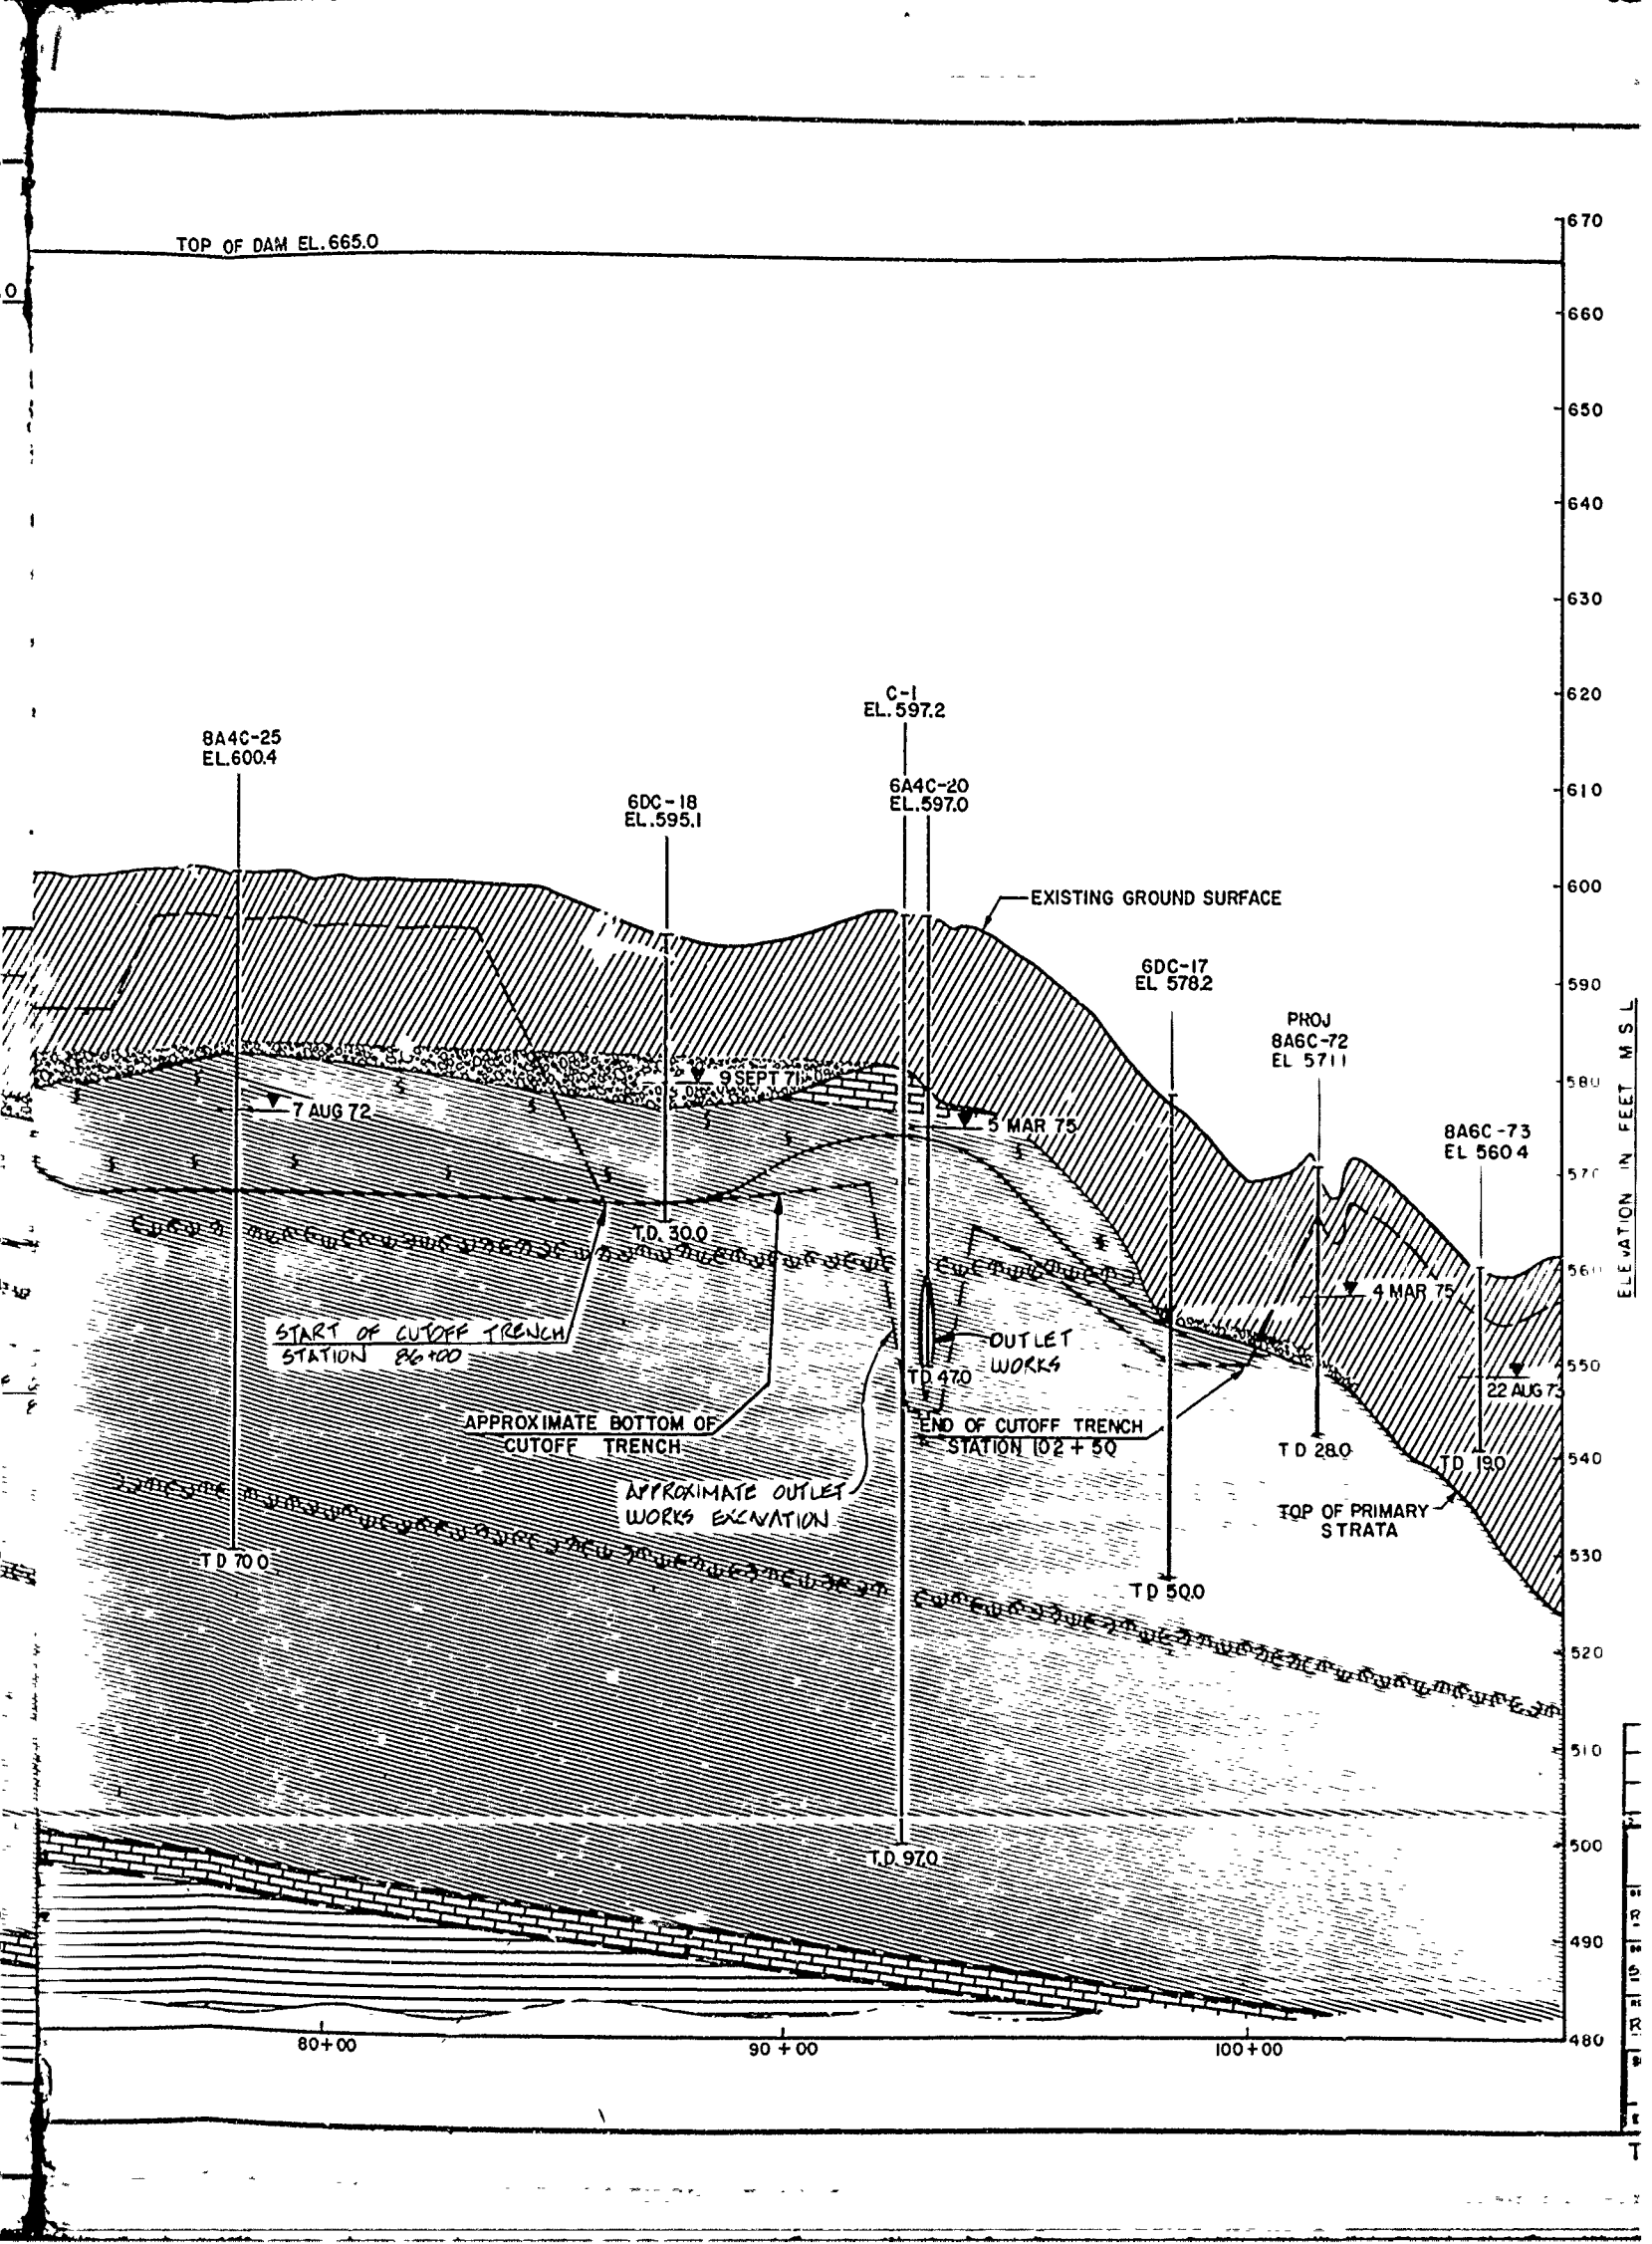

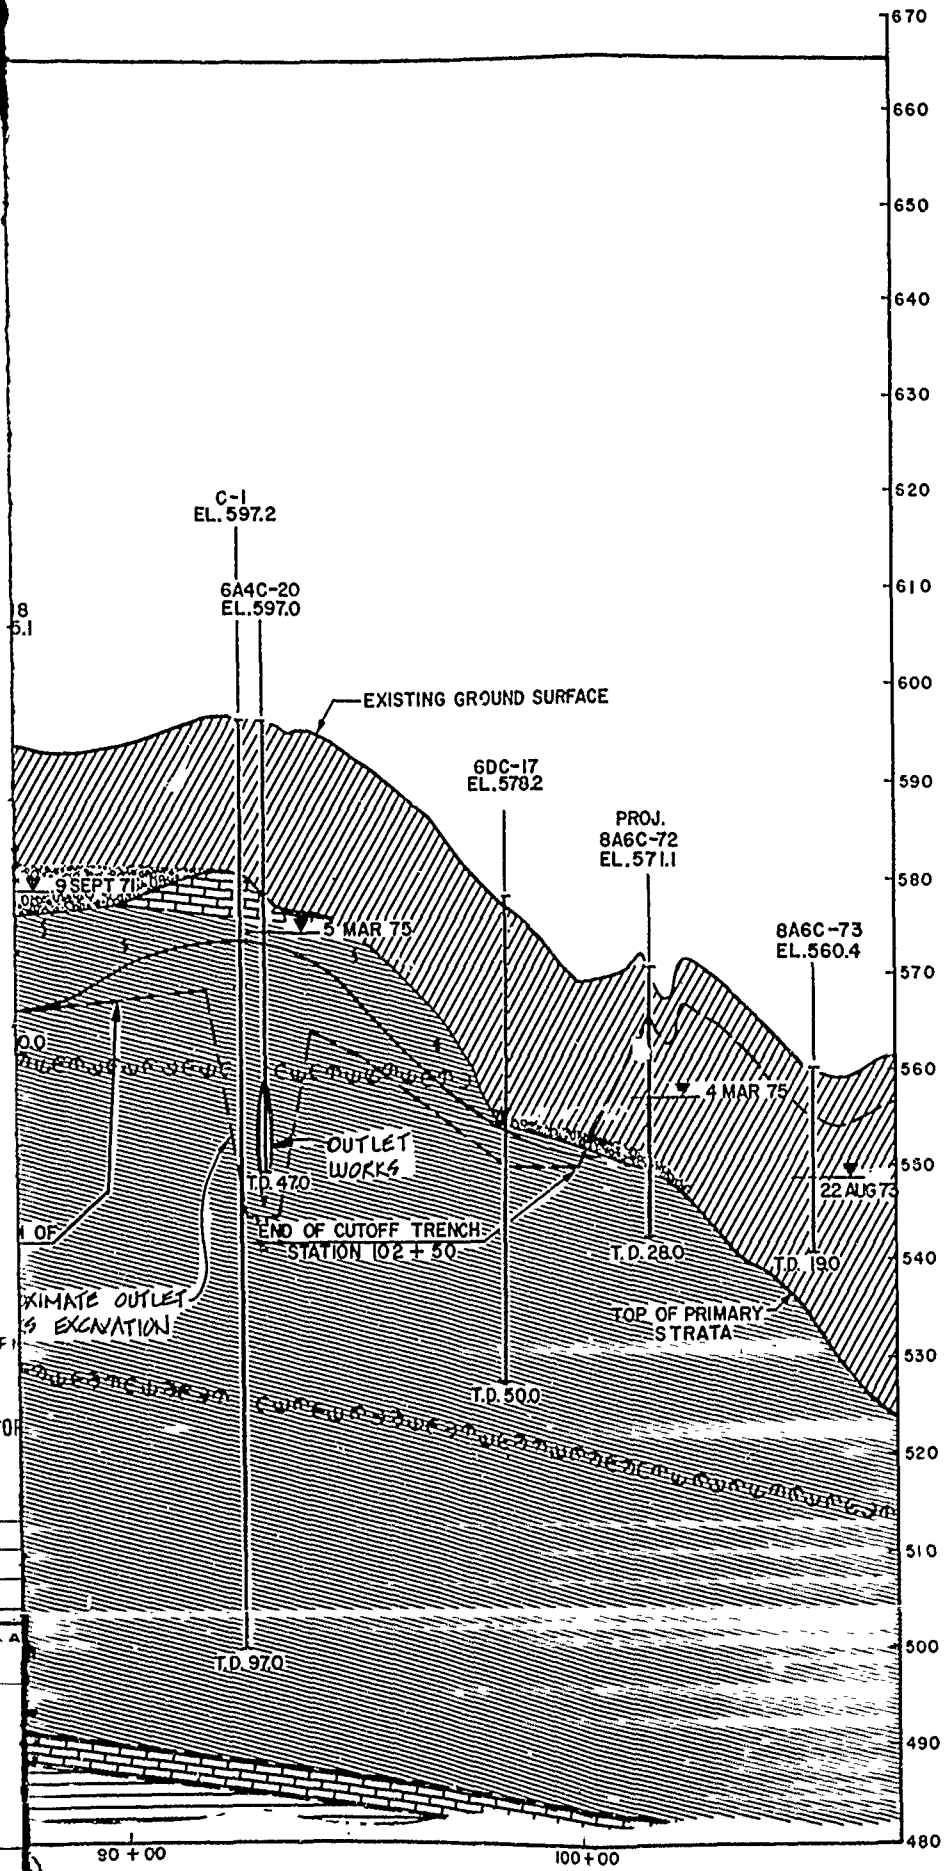


FOR LEGEND AND GENERAL NOTES, SEE SEQ 199


RECORD DRAWING-WORK AS BUILT


SYM	NO	ACTION	DATE	DESCRIPTION OF REVISION
U.S. ARMY ENGINEER DISTRICT, FORT WORTH CORPS OF ENGINEERS FORT WORTH, TEXAS				
RAY ROBERTS LAKE ELM FORK, TRINITY RIVER, TEXAS				
EMBANKMENT GEOLOGIC PROFILE EMBANKMENT CENTERLINE (STATION 48+00 TO 107+00)				
DESIGNED BY	R. HAGEN			
DRAWN BY	S. KOMACK			
REVIEWED BY	R. HAGEN			
SUBMITTED BY	A. Green		INVITATION NO. DACW 63-82-B-0025	DATE: MAR, 1982
ENGINEER			CONTRACT NO. DACW 63-82-C-0083	SEQUENCE NO. 45
			DRAWING NUMBER	SHEET NO. OF

TO ACCOMPANY FOUNDATION REPORT

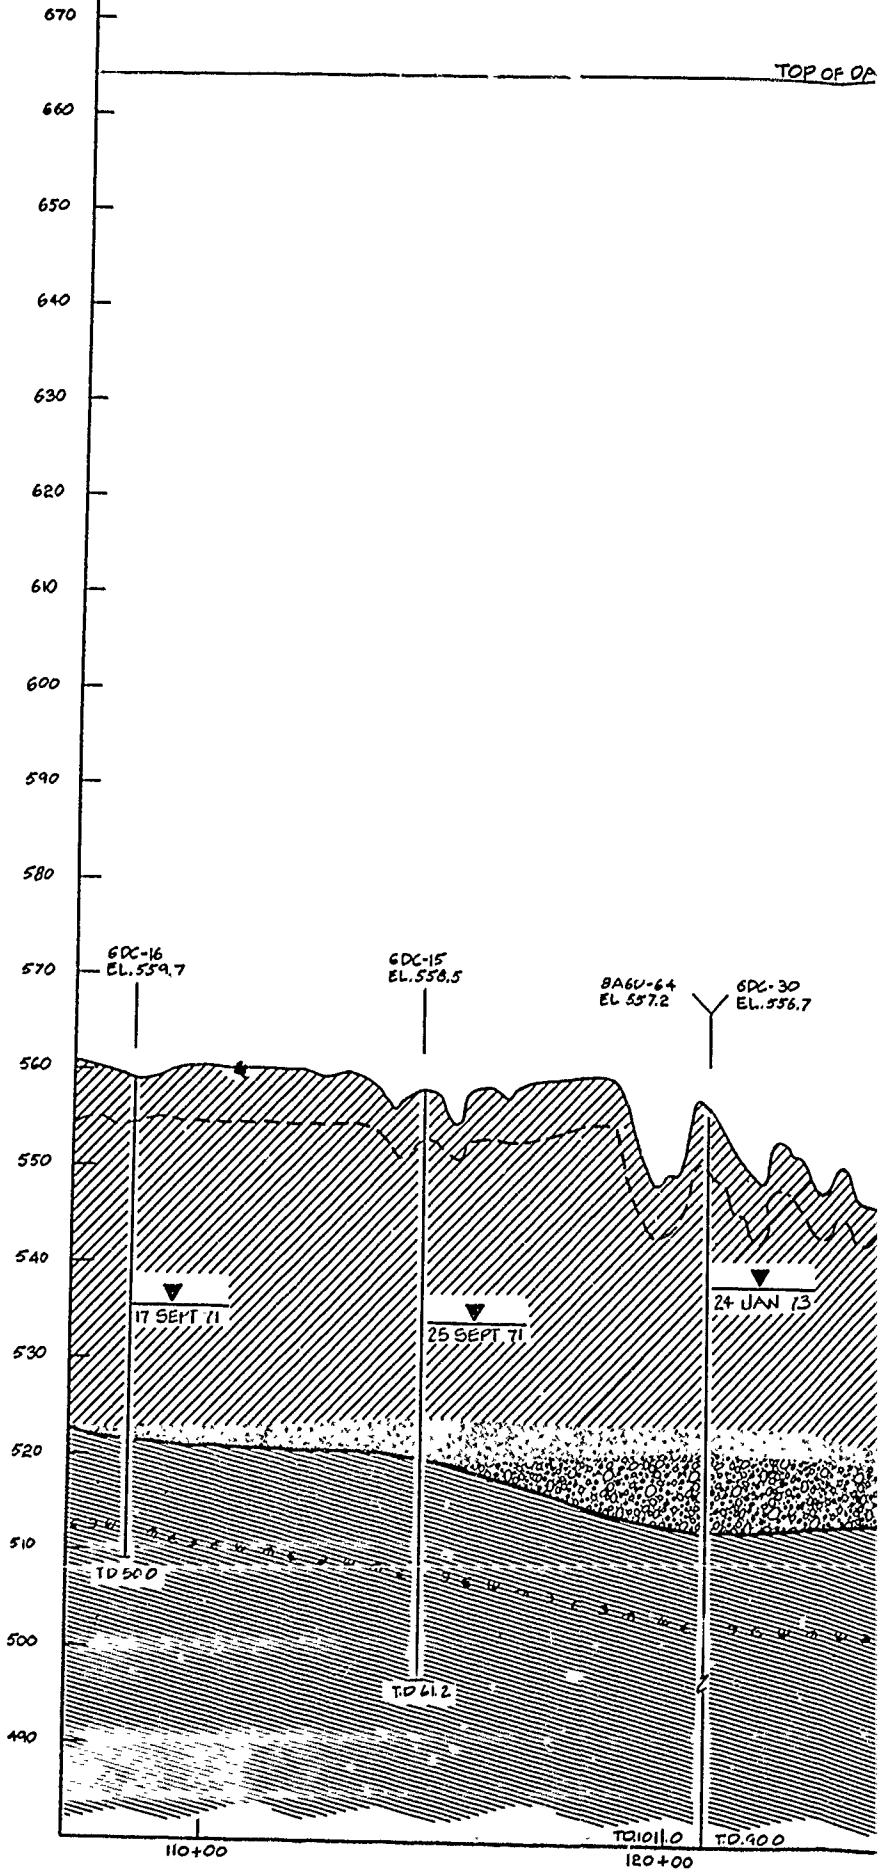

SCALE 1:100

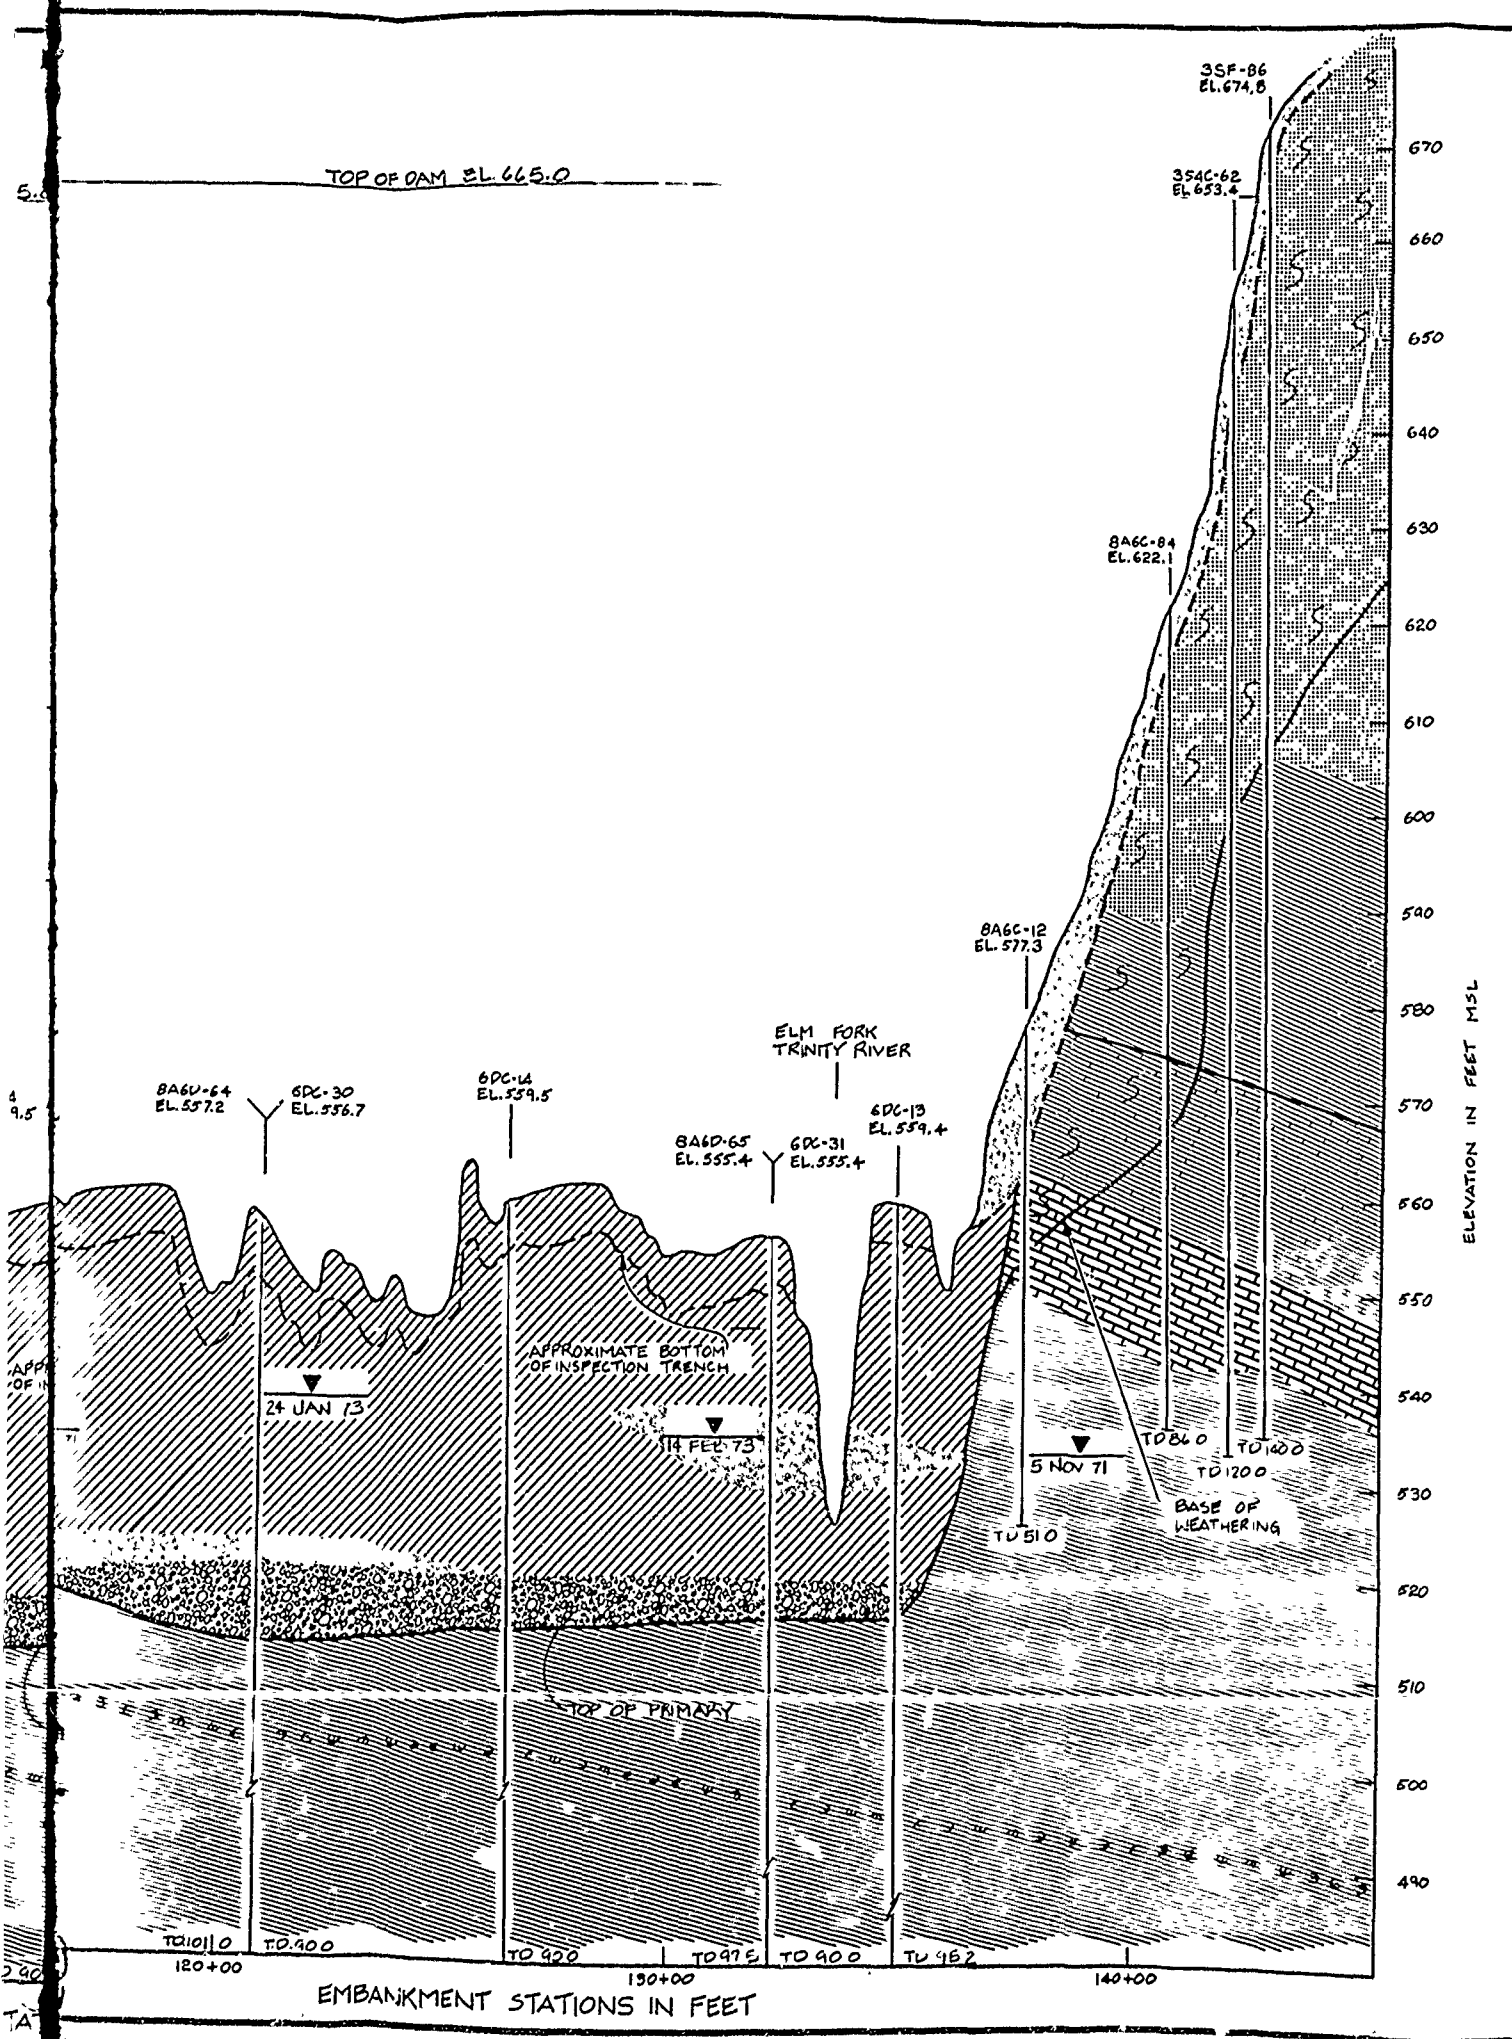

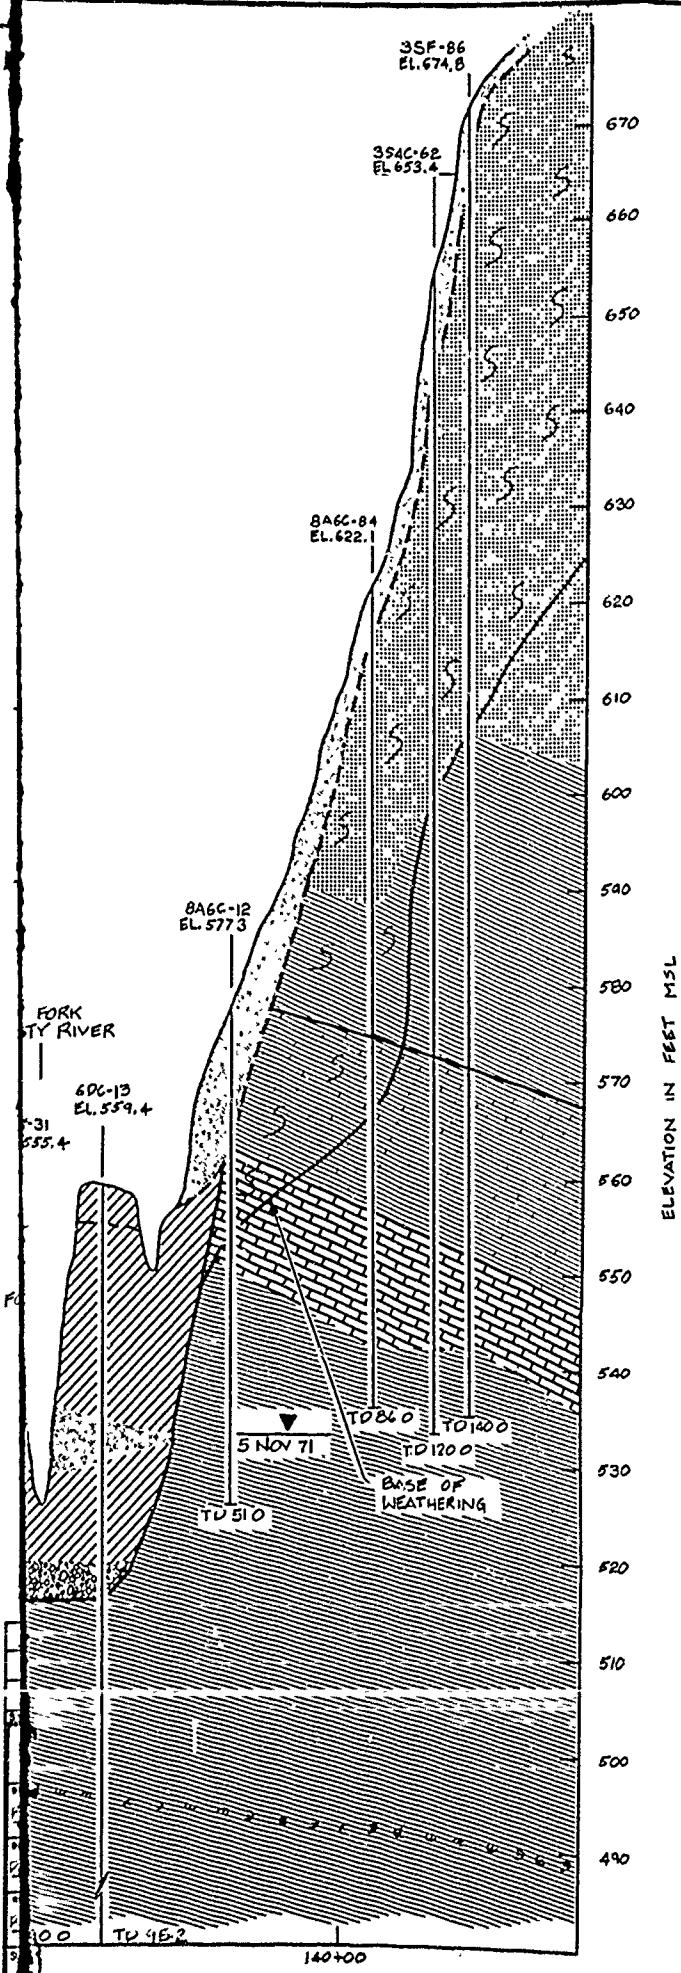



FOR LEGEND AND GENERAL NOTES SEE SEQ 19.1.

RECORD DRAWING-WORK AS BUILT

REV	LOG NO.	ACTION	DATE	DESCRIPTION OF REVISION
U.S. ARMY ENGINEER DISTRICT, FORT WORTH CORPS OF ENGINEERS FORT WORTH, TEXAS				
DESIGNED BY:	RAY ROBERTS LAKE ELM FORK, TRINITY RIVER, TEXAS EMBANKMENT GEOLOGIC PROFILE EMBANKMENT CENTERLINE (STATION 107+00 TO 142+25)			
DRAWN BY:				
CHECKED BY:				
REVIEWED BY:				
SUBMITTED BY:	INVITATION NO. DACW43-82B-0025	DATE: MAR., 1983		
ENGINEER:	CONTRACT NO. DACW43-82C-0083			
	DRAWING NUMBER		SHEET NO.	OF
			4	4

TO ACCOMPANY FOUNDATION REPORT

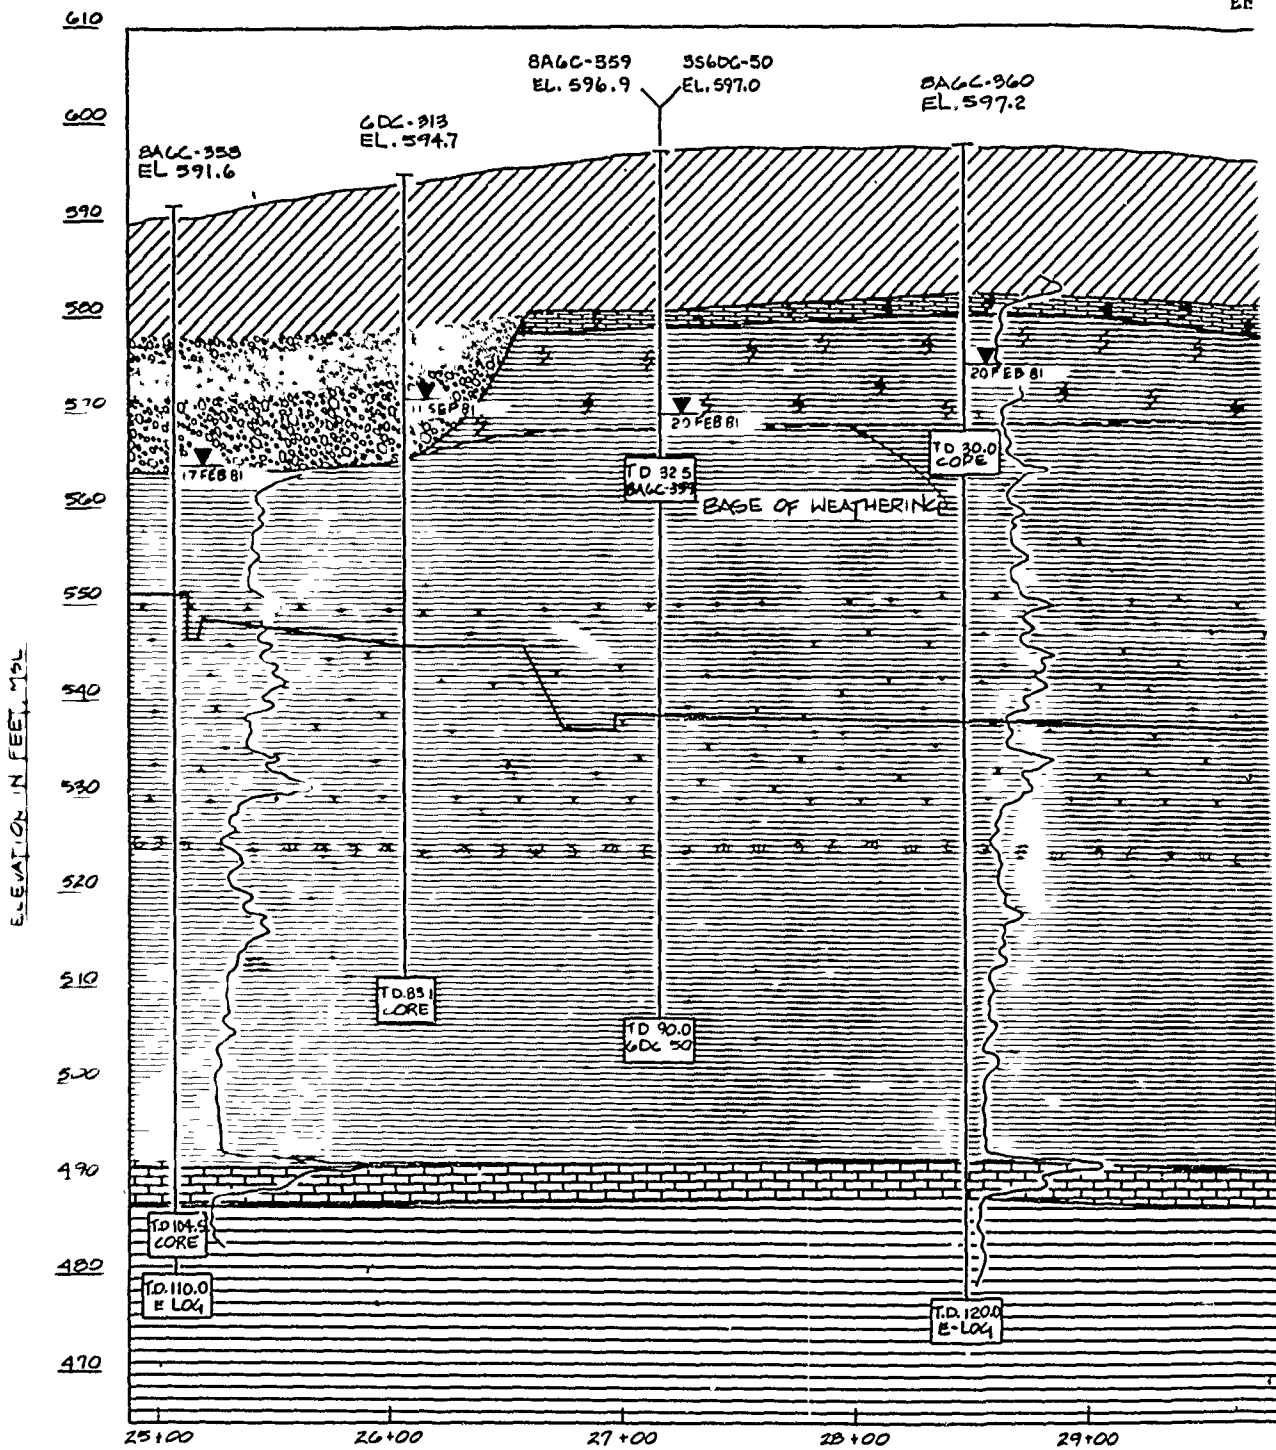

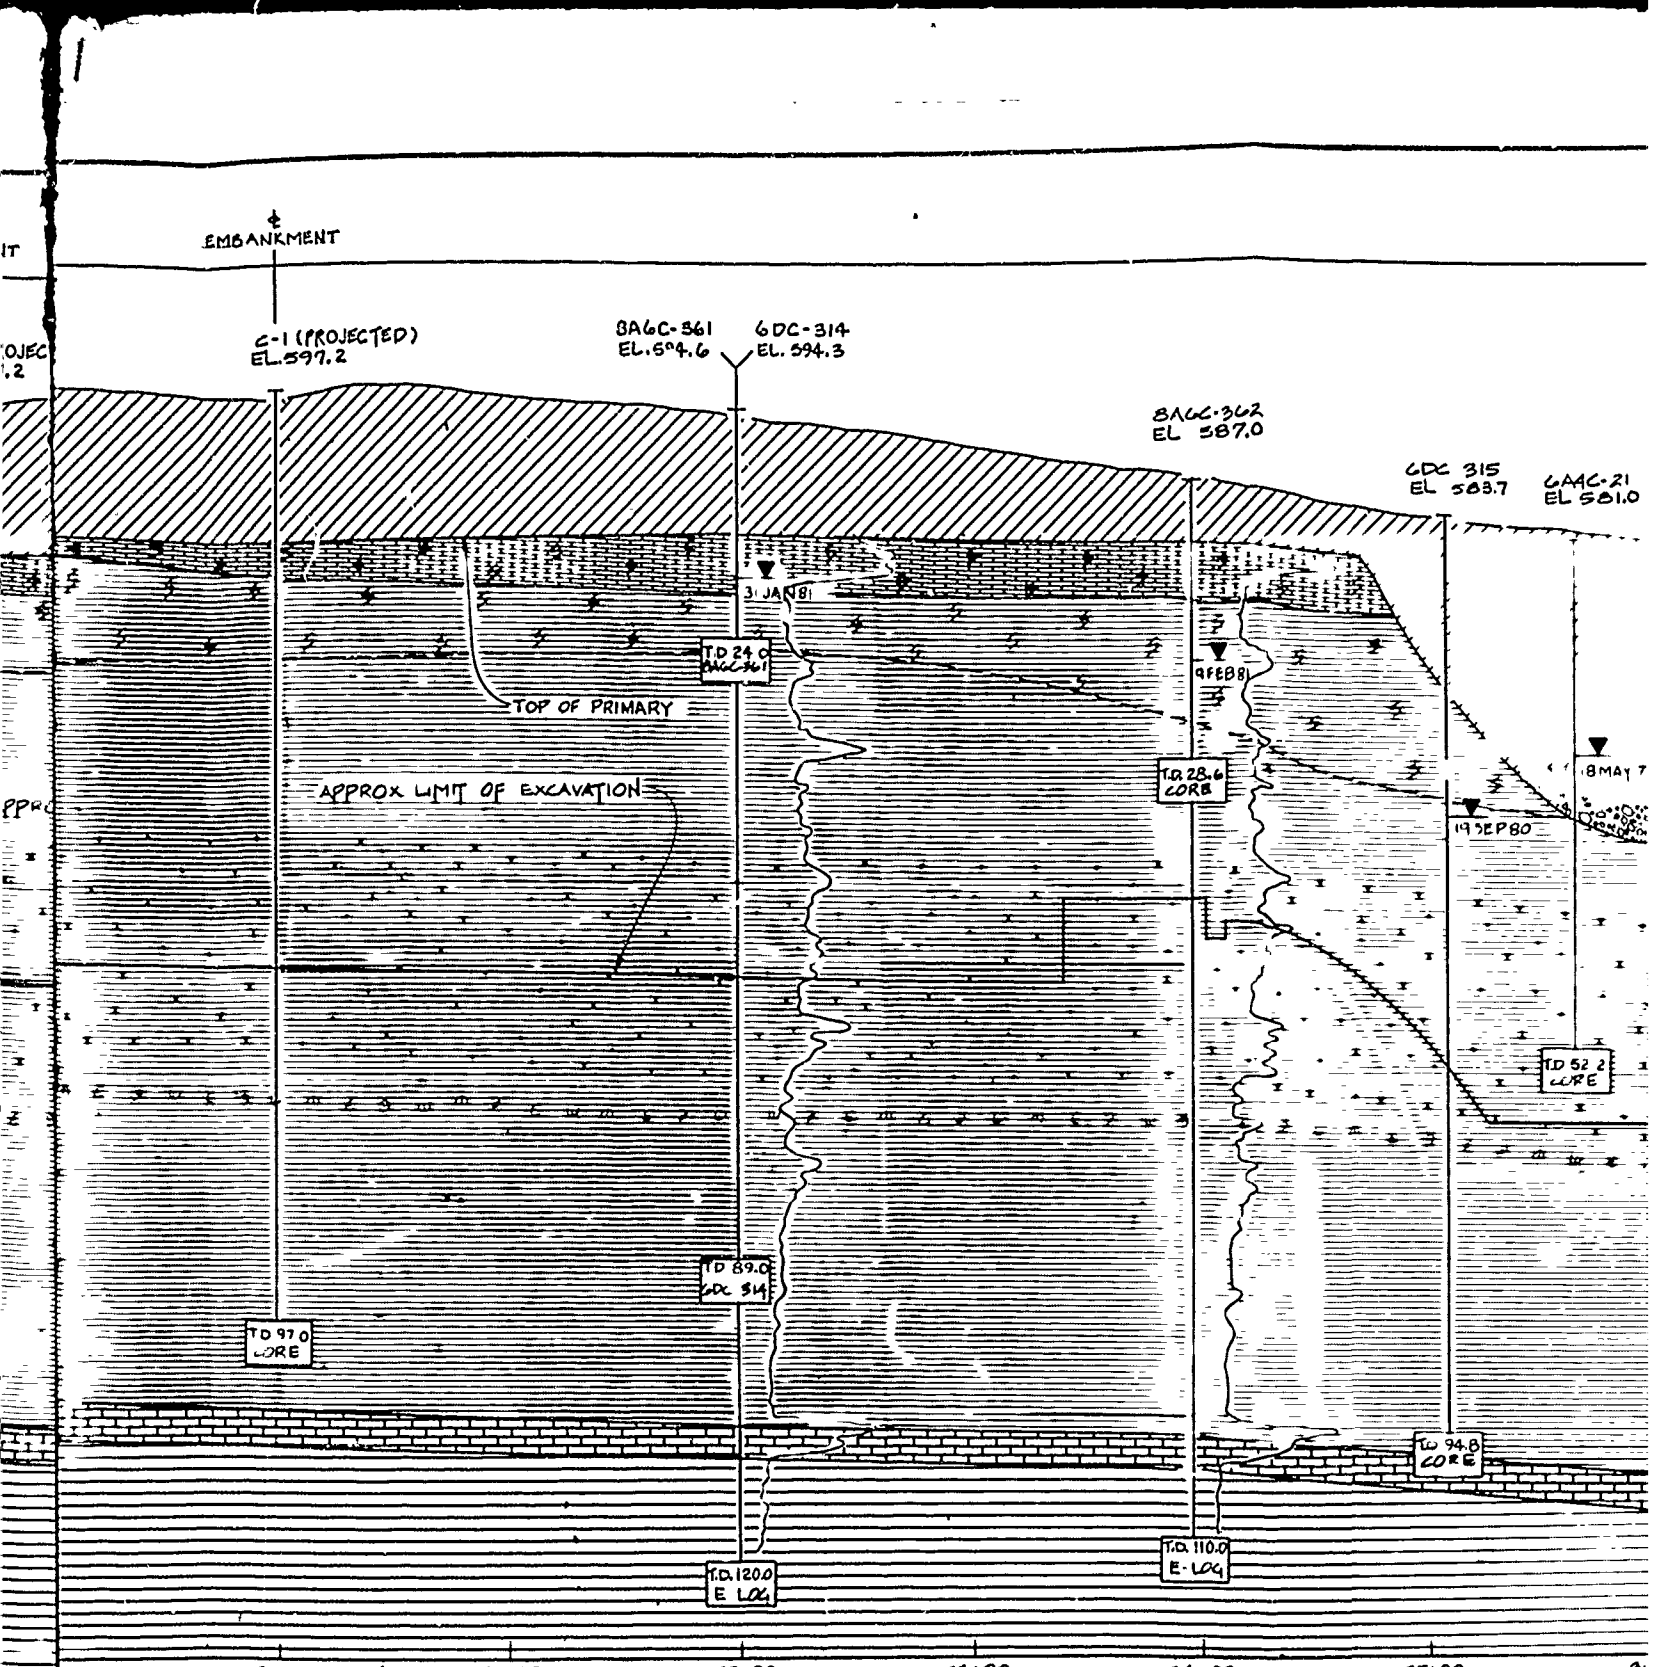


00 30+00 31+00 32+00 33+00 34+00 35+00 36

DISTANCES IN STATIONS ALONG OUTLET WORKS

FOR LEGEND AND GENERAL NOTES SEE SEQ 199.

RECORD DRAWING-WORK AS BUILT

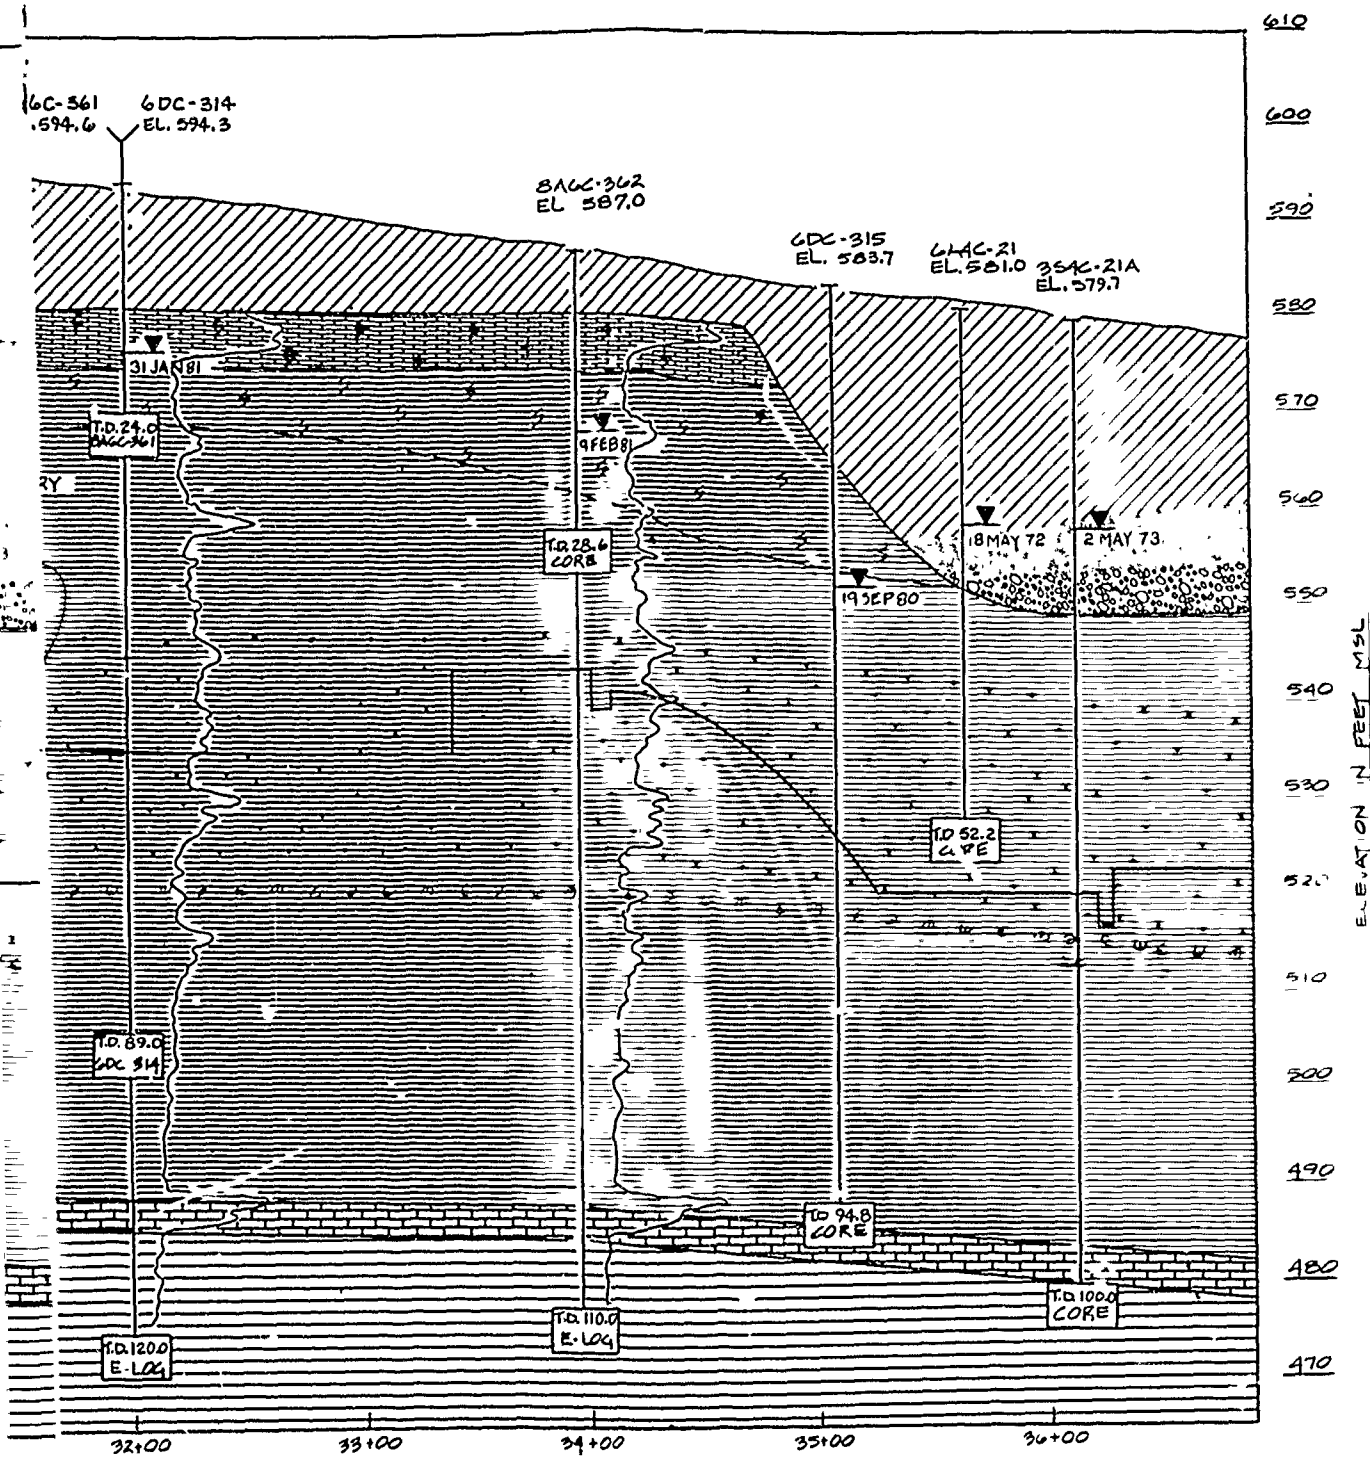



LET WORKS


FOR LEGEND AND GENERAL NOTES SEE SEC 199.

RECORD DRAWING-WORK AS BUILT

NO.	ACTION	DATE	DESCRIPTION OF REVISION
U.S. ARMY ENGINEER DISTRICT, FORT WORTH CORPS OF ENGINEERS FORT WORTH, TEXAS			
DESIGNED BY: R. HAGEN		RAY ROBERTS LAKE ELM FORK, TRINITY RIVER, TEXAS OUTLET WORKS GEOLOGIC PROFILE STATION 25+11 TO STATION 36+27	
DRAWN BY: M. BLAIN			
REVIEWED BY: R. HAGEN			
SUBMITTED BY: M. GREEN ENGINEER		INVITATION NO. DACHW8-82-0002E DATE: MAR 82	SHEET NO. OF 47
CONTRACT NO. DACH 63-82-C-0083		DRAWING NUMBER	SHEET NO. OF 47

TO ACCOMPANY FOUNDATION REPORT

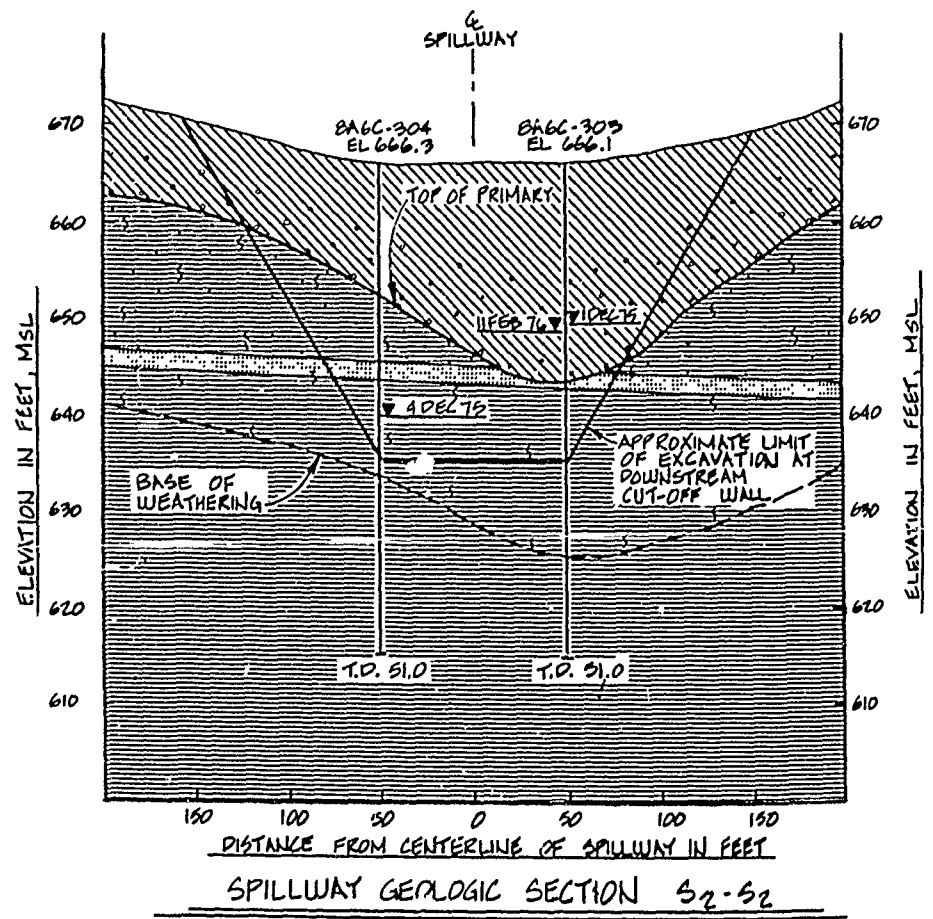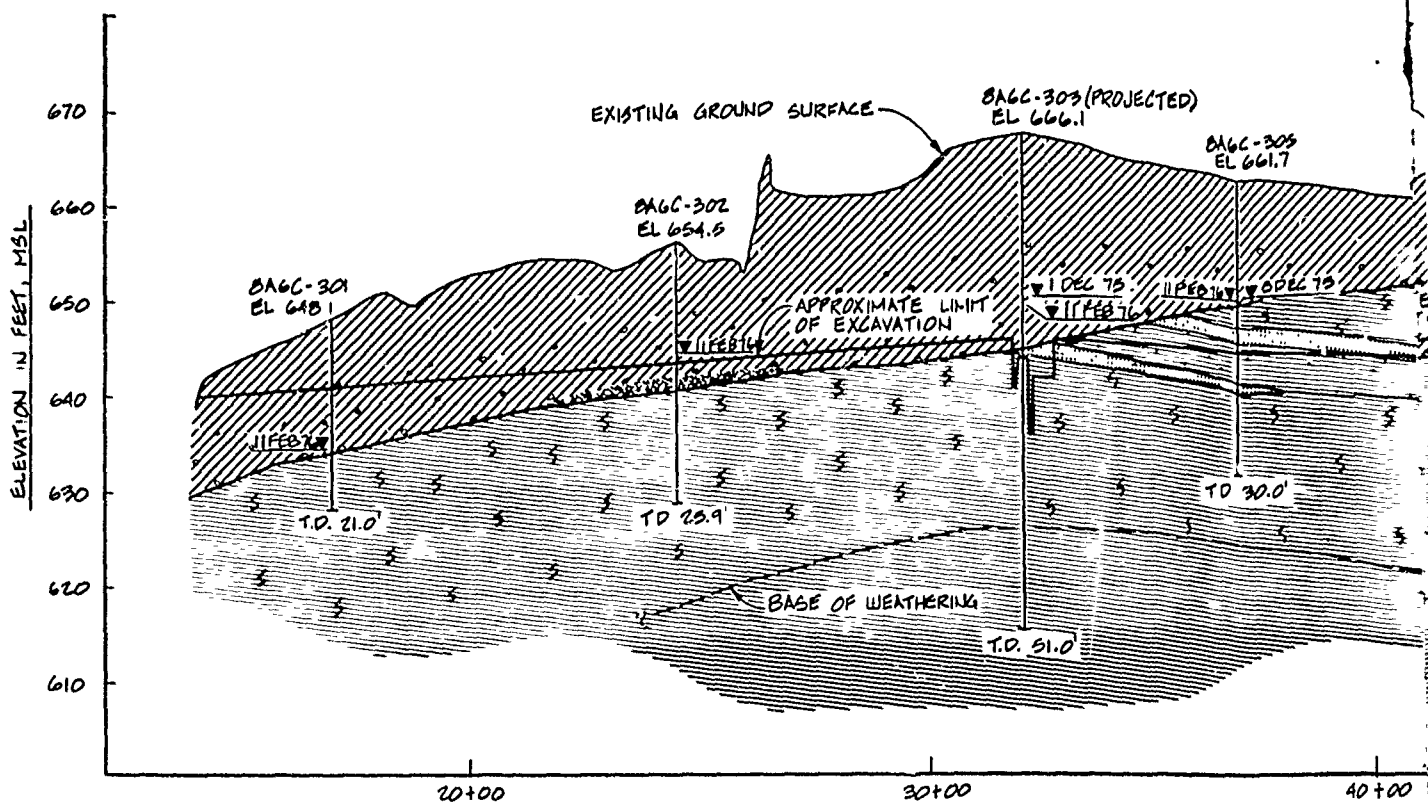

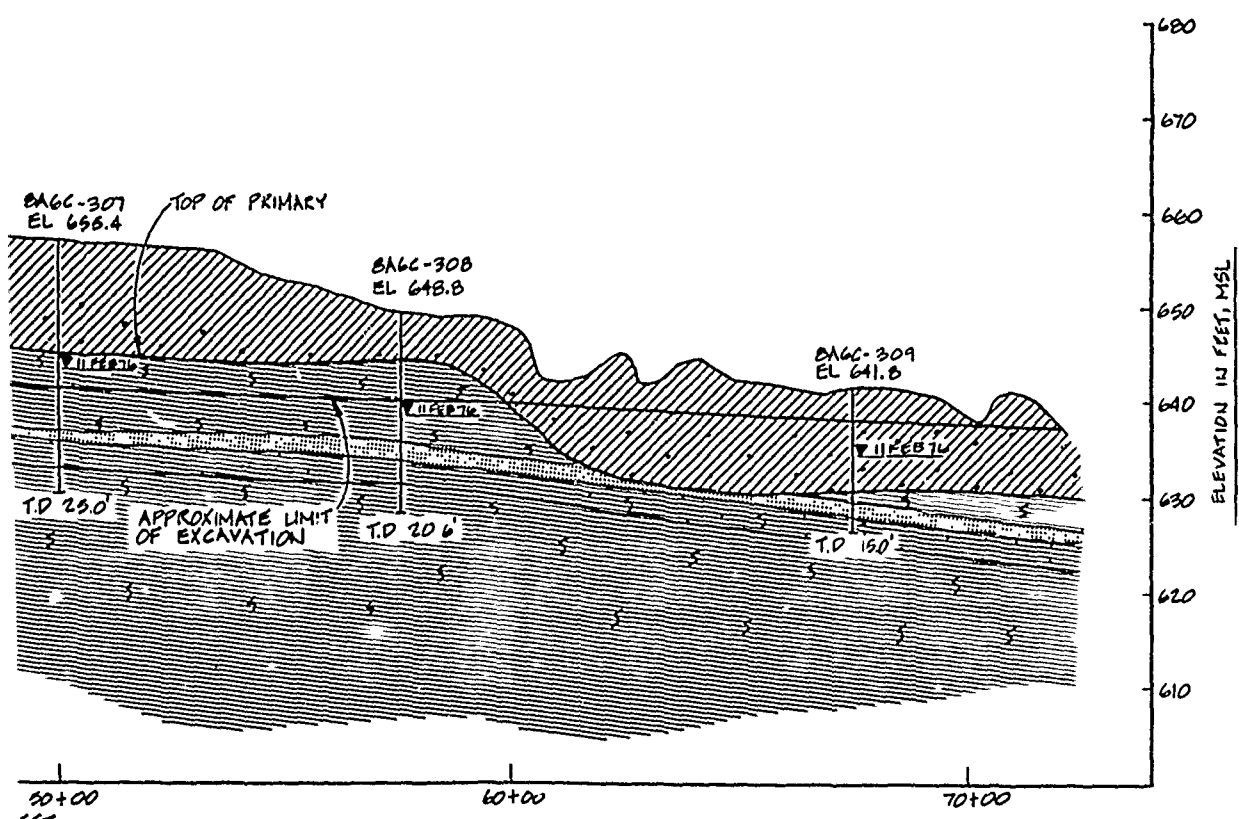


PROFILE S1-S1

- NOTES:
1. FOR LEGEND AND GENERAL NOTES SEE SEQ. 199.
 2. FOR LOCATION OF PROFILE AND SECTION SEE SEQ. 180.

RECORD DRAWING-WORK AS BUILT

REV. NO.	NO.	ACTION	DATE	DESCRIPTION OF REVISION
U.S. ARMY ENGINEER DISTRICT, FORT WORTH CORPS OF ENGINEERS FORT WORTH, TEXAS				
DESIGNED BY:	RAY ROBERTS LAKE			
DRAWN BY:	ELM FORK, TRINITY RIVER, TEXAS			
REVISOR BY:	SPILLWAY, APPROACH CHANNEL AND DISCHARGE CHANNEL			
SUBMITTED BY:	GEOLOGIC PROFILE S1-S1 AND SECTION S2-S2			
ENGINEER:	INVESTIGATION NO. DACHW 63-82-C-0025	DATE: MAR. 1962	SEQUENCE NO. 48	
	CONTRACT NO. DACHW 63-82-C-0025		SHEET NO. OF	48

TO-ACCOMPANY-FOUNDATION-REPORT

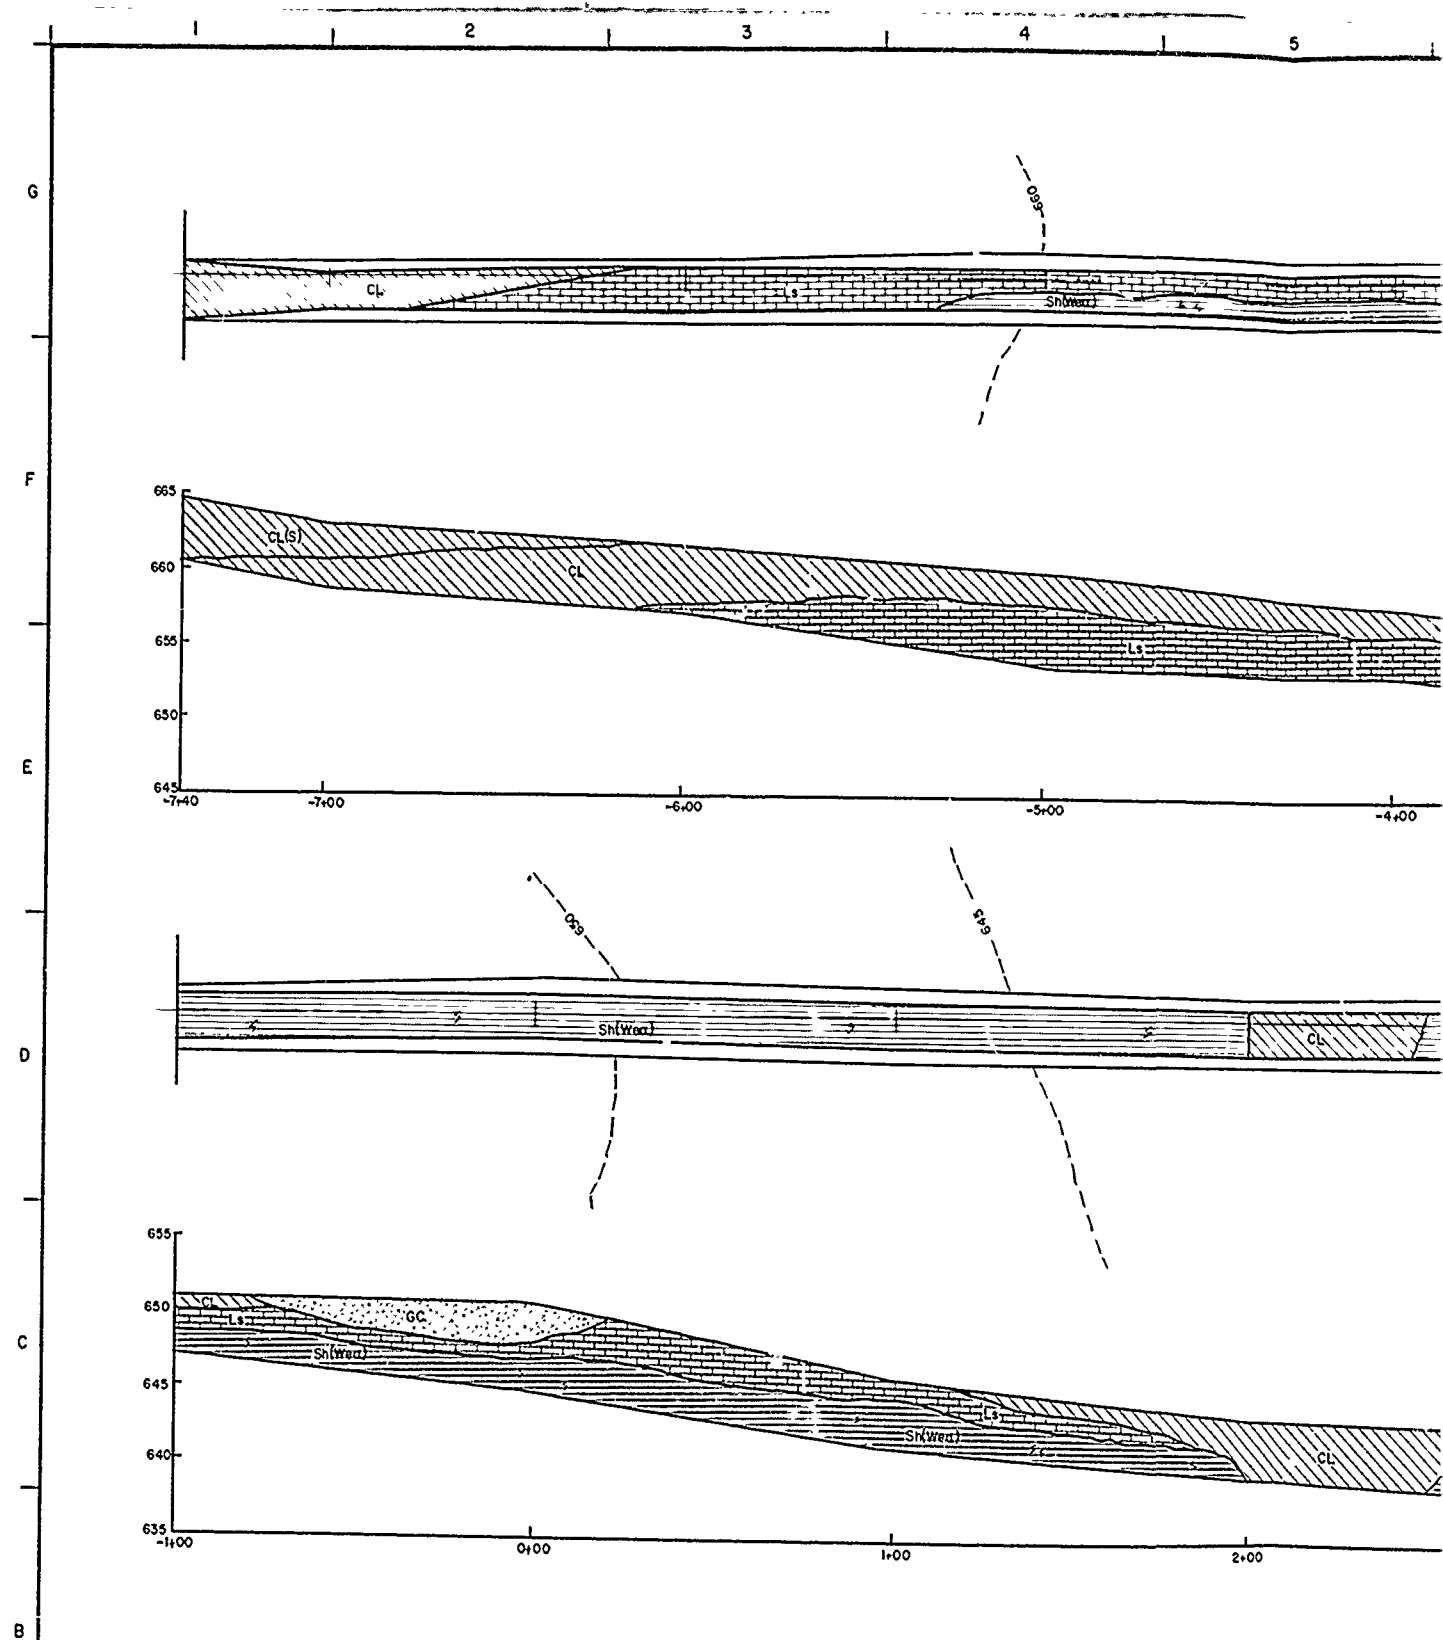



LEGEND

- CL CLAY, MEDIUM TO HIGH PLASTICITY, DARK BROWN
- CL CLAY, LEAN
- CL CLAY, LEAN, SANDY
- CL CLAY, GRAVELLY
- CL CLAY, HIGH PLASTICITY, ORGANIC, BLACK
- SC SAND, CLAYEY, FINE
- SP SAND, FINE, POORLY GRADED
- GC GRAVEL, VARIABLY CLAYEY
- Sh(wea) CLAY, STIFF, HAS APPEARANCE OF WEATHERED SHALE INCLUDING SHALE-LIKE STRUCTURE.
- Sh SHALE, WEATHERED
- Sh SHALE, UNWEATHERED

NOTES

- 1. SECTION
- 2. NO INSI
- 3. PLAN V
- GEOLOG


A

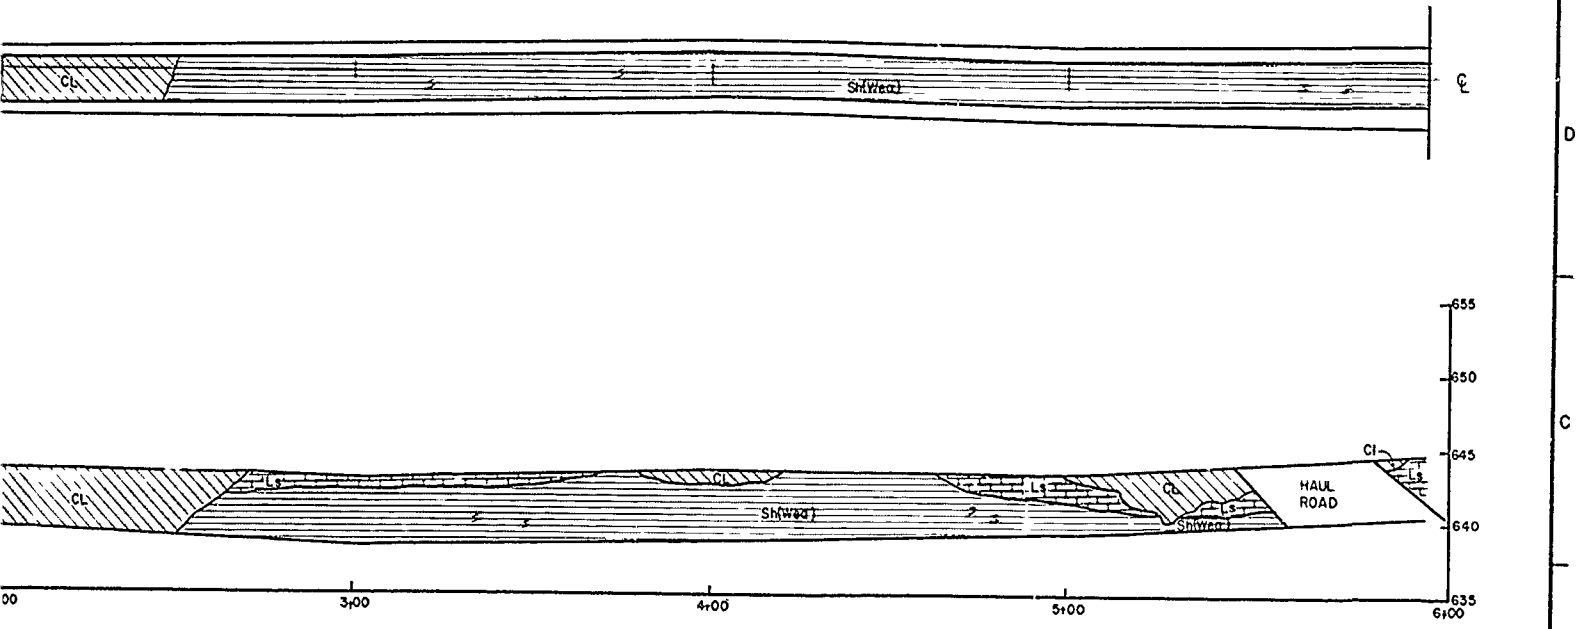
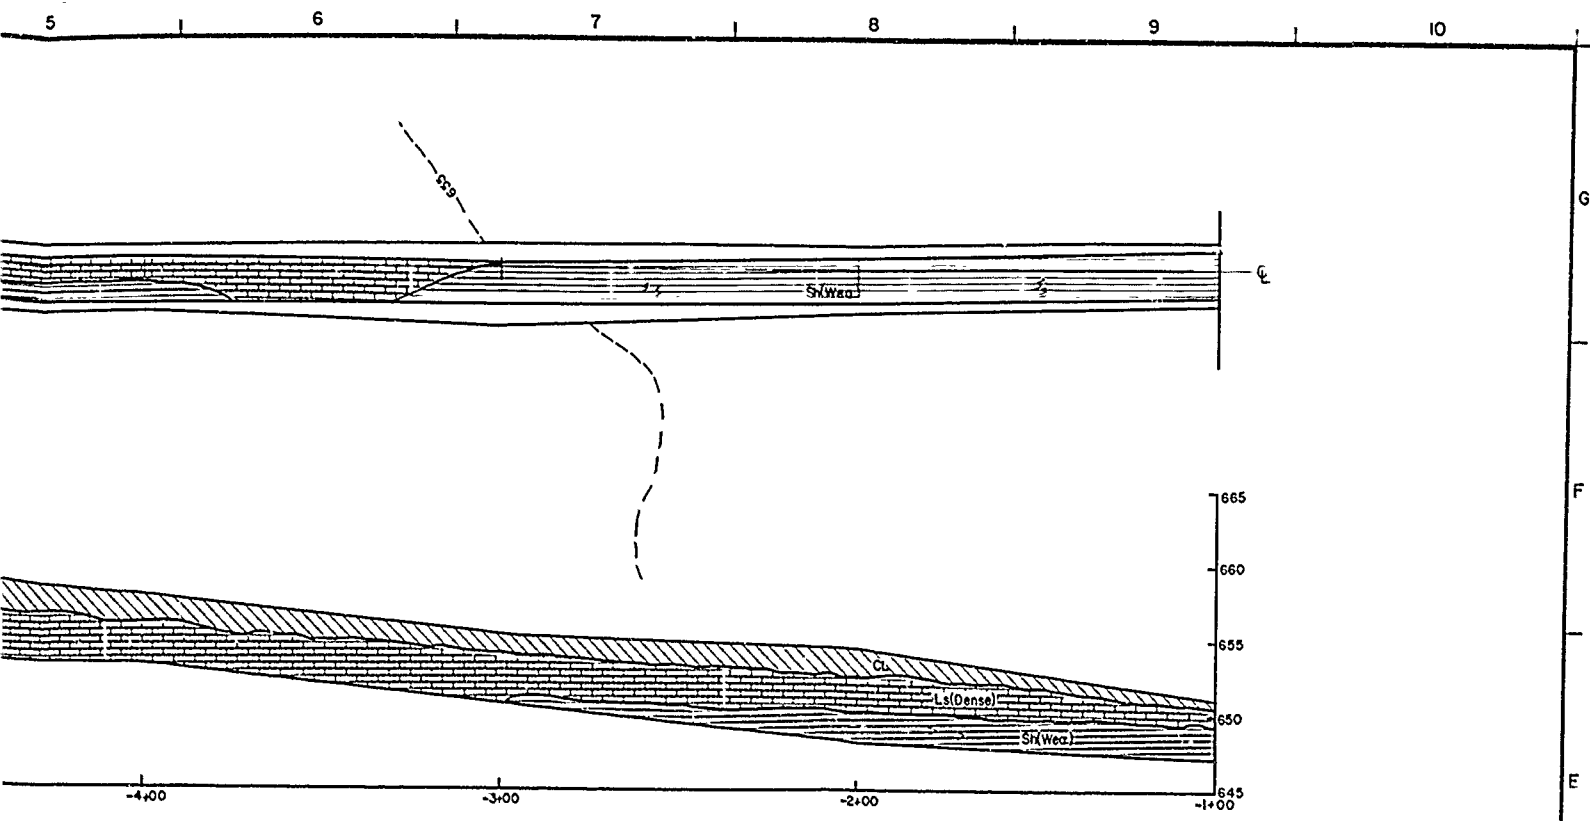


NOTES


1. SECTIONS REPRESENT UPSTREAM(LEFT) FACE OF INSPECTION TRENCH
2. NO INSPECTION TRENCH WAS EXCAVATED BETWEEN STATIONS 117+50 AND 125+50.
3. PLAN VIEW OF INSPECTION TRENCH PRESENTS GEOLOGY OF THE FLOOR ONLY. GEOLOGY OF SIDE SLOPES IS PRESENTED IN THE SECTION.


DESIGNED BY: H. BARNETT		RAY ROBERTS LAKE ELM W'ORK, TRINITY RIVER, TEXAS	
DRAWN BY: C. KIRBY		FOUNDATION REPORT INSPECTION TRENCH AS-BUILT PLAN AND PROFILE STA. -7+40 TO 6+00	
REVIEWED BY: R. BEHM			
SUBMITTED BY: ROBERT C. BEHM		SOL. NO.	DATED:
ENGINEER:		CONTR. NO.	SEQUENCE NO.
		DRAWING NUMBER	SHEET NO.

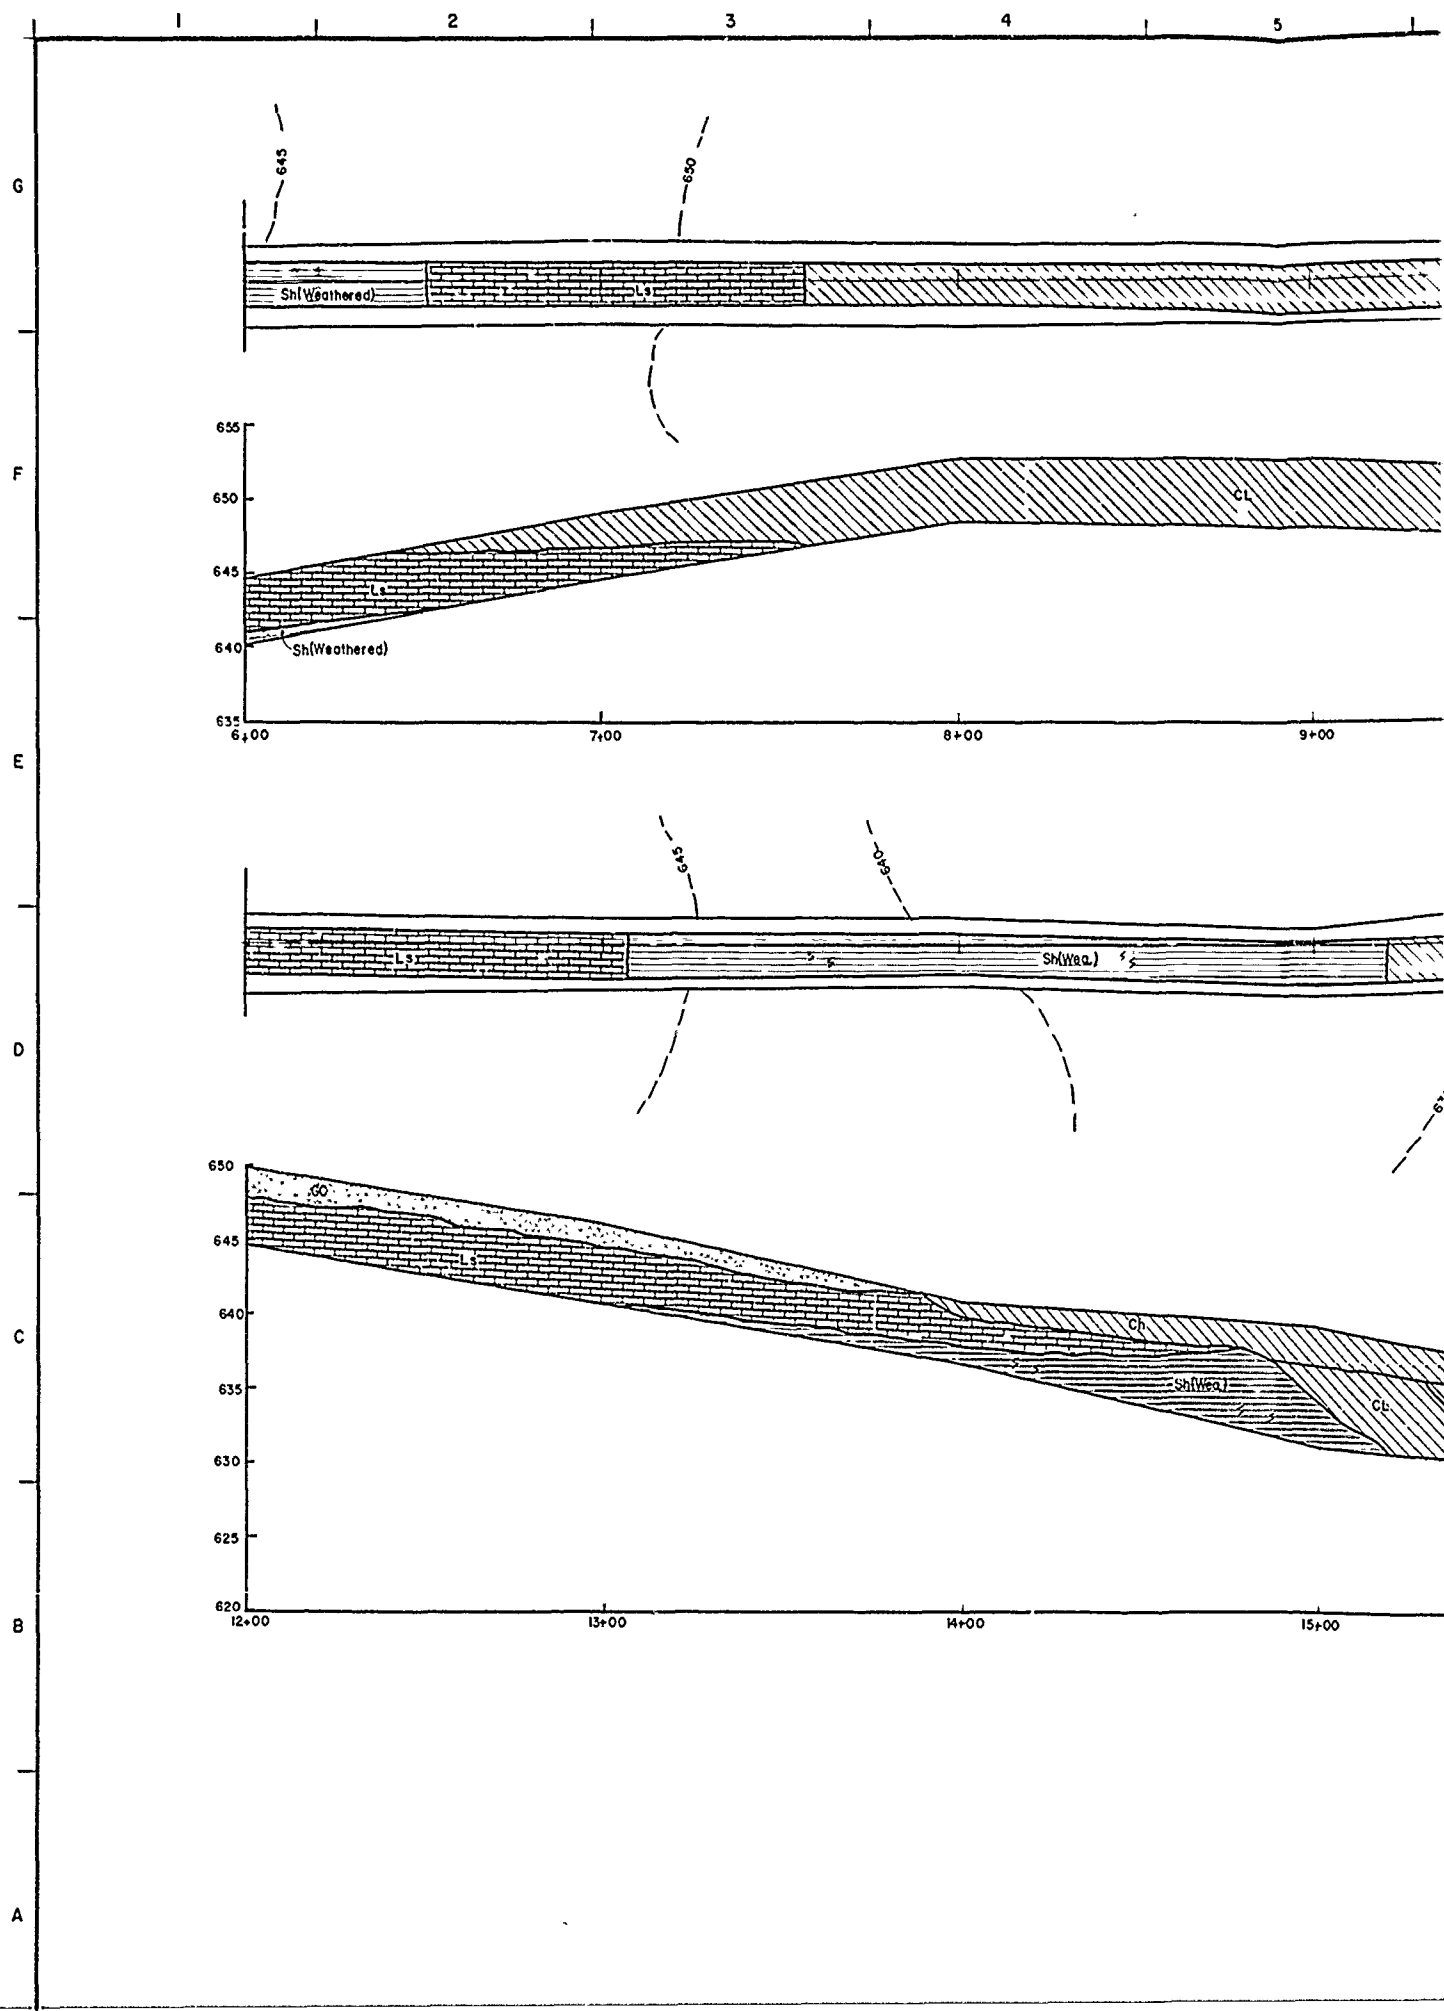

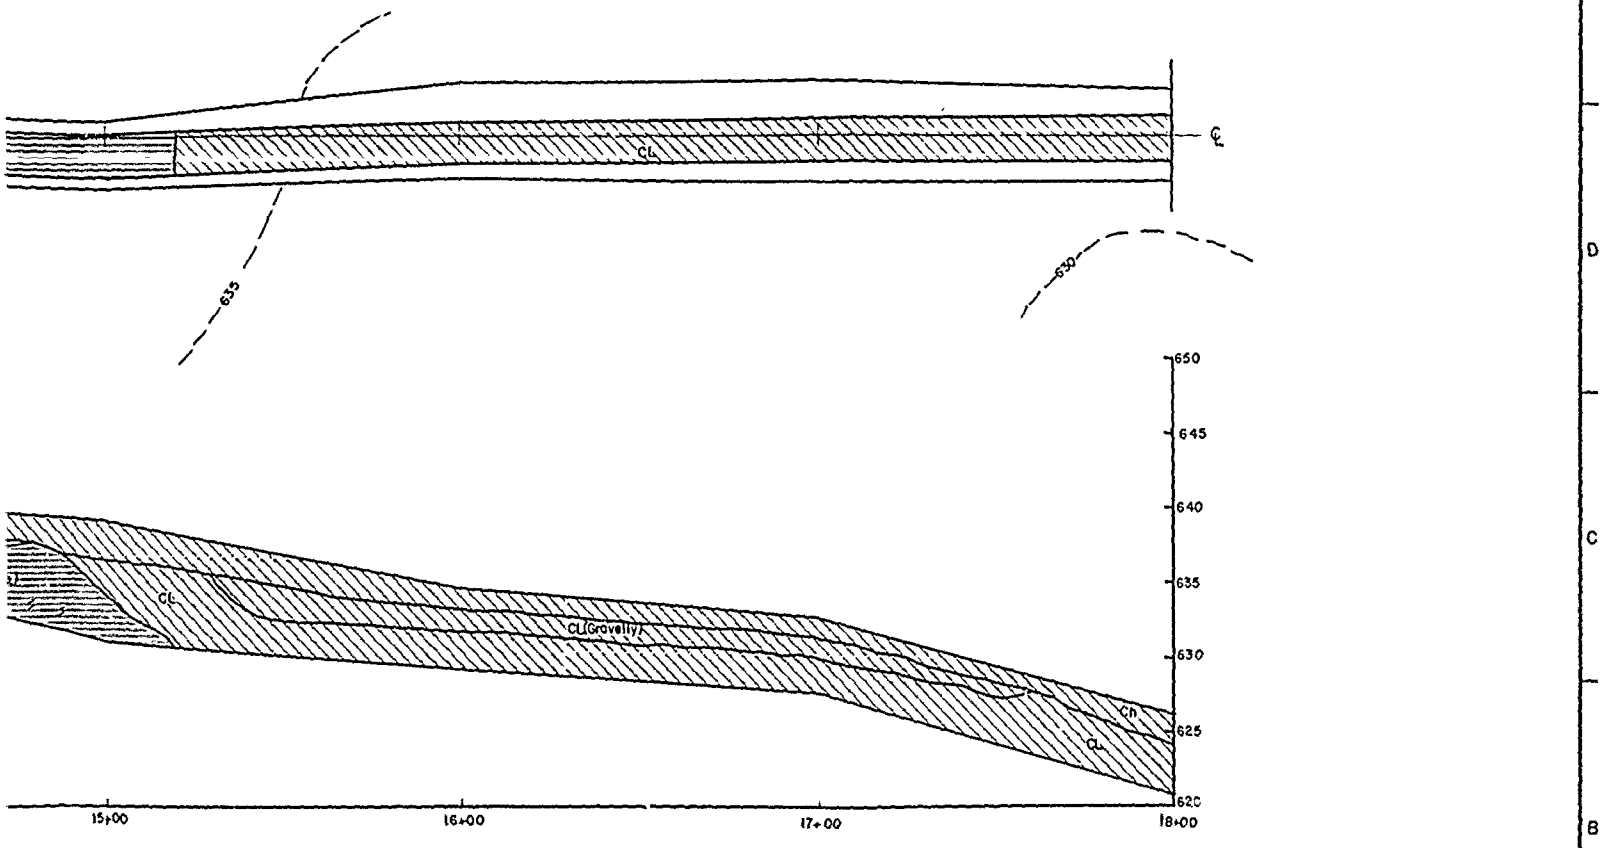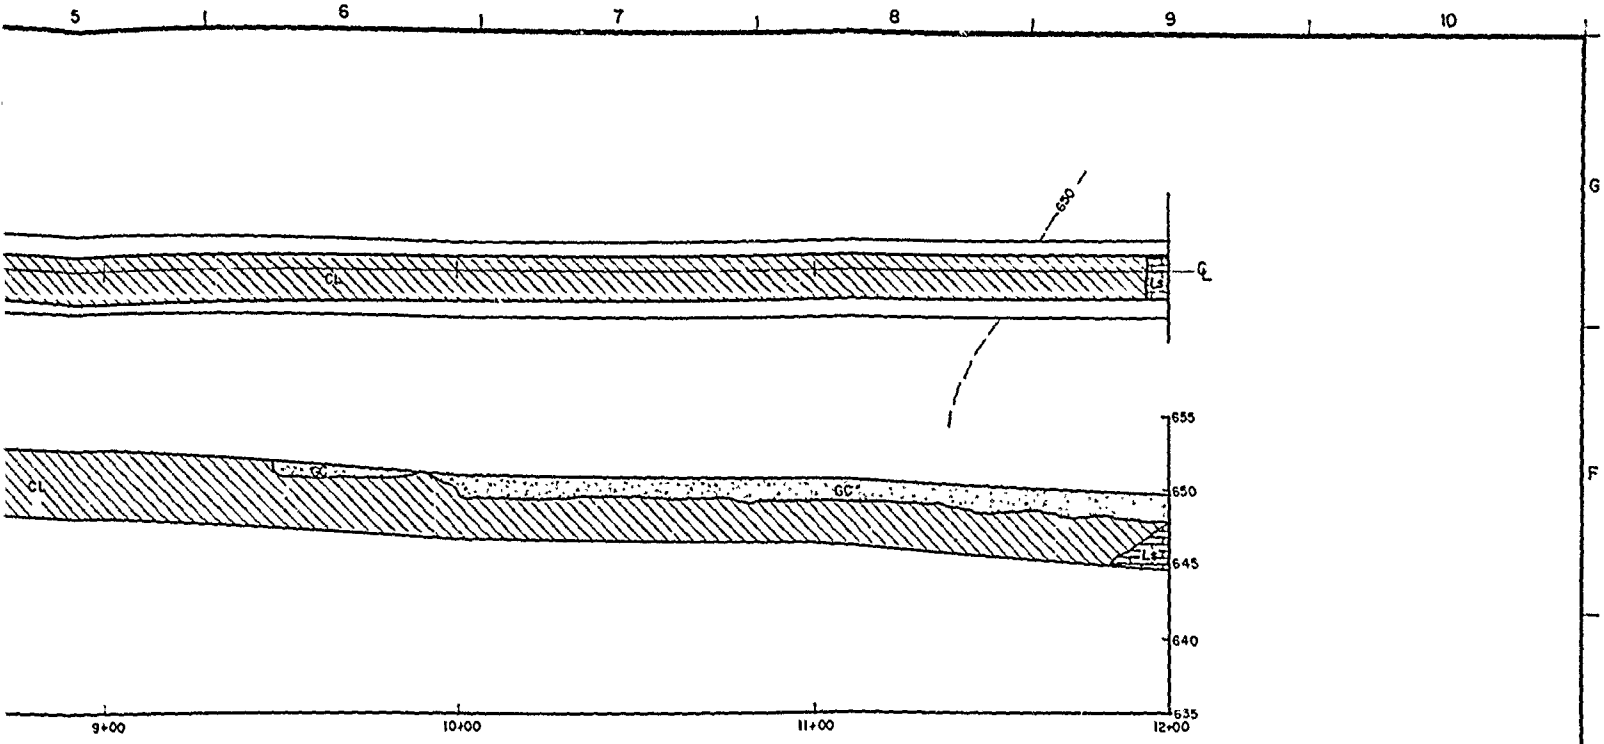



DESIGNED BY: H. BARNETT		DRAWN BY: C. KIRBY		REVIEWED BY: R. BEHM		SUBMITTED BY: ROBERT C. BEHM		ENGINEER:		SOL. NO.		DATED:		SEQUENCE NO. 50	
U.S. ARMY ENGINEER DISTRICT, FORT WORTH CORPS OF ENGINEERS FORT WORTH, TEX 8 RAY ROBERTS LAKE ELM FORK, TRINITY RIVER, TEXAS FOUNDATION REPORT INSPECTION TRENCH AS-BUILT PLAN AND PROFILE STA. 6+00 TO 18+00															

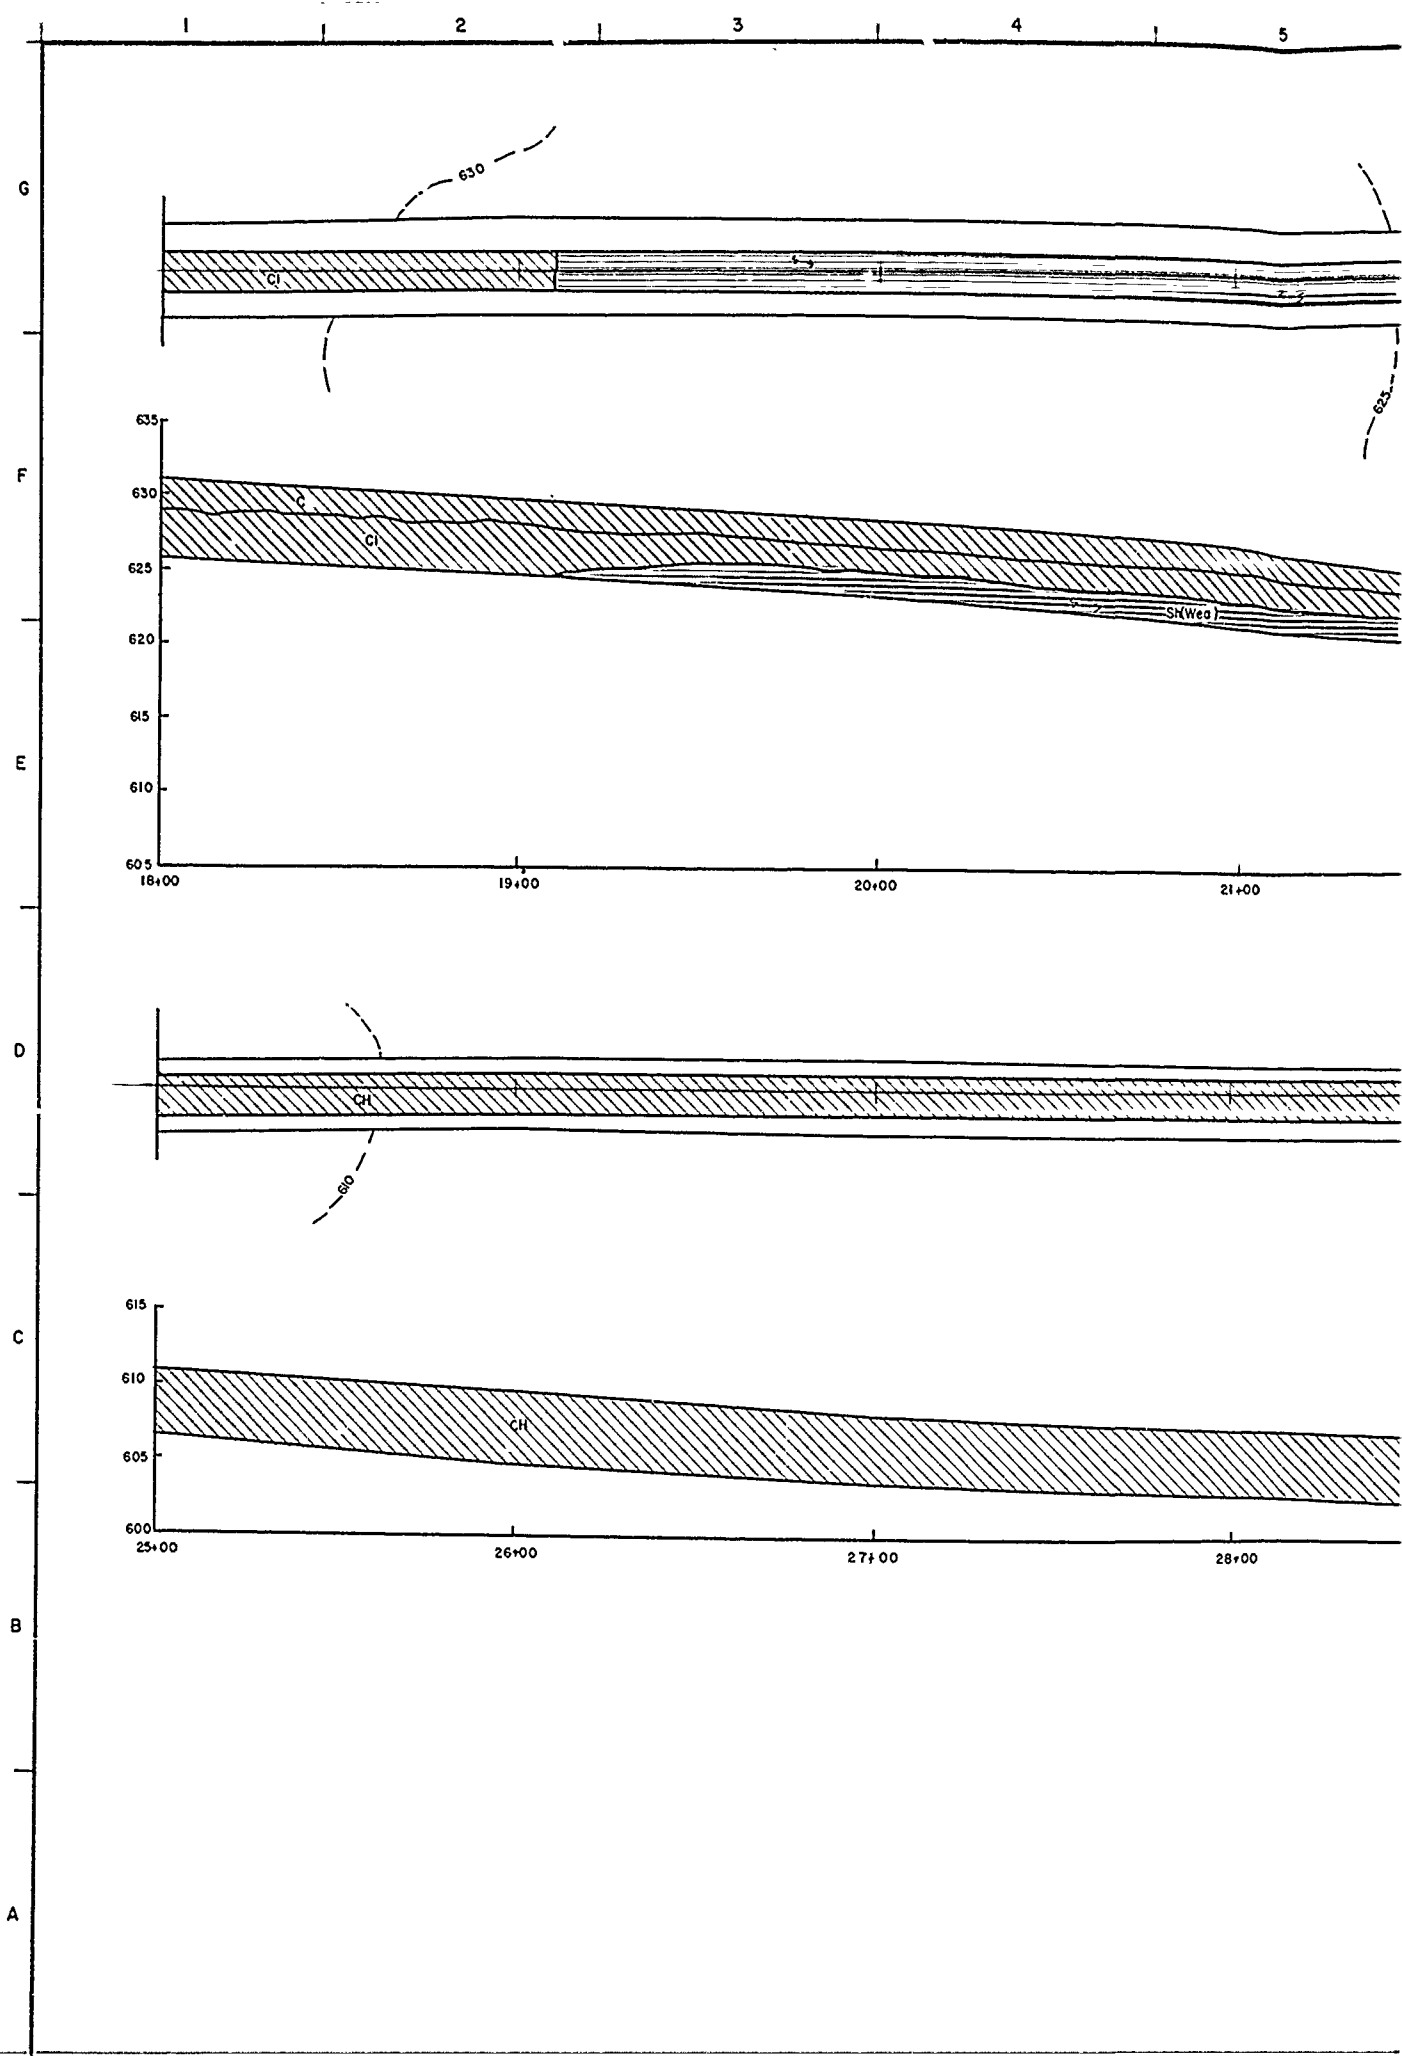

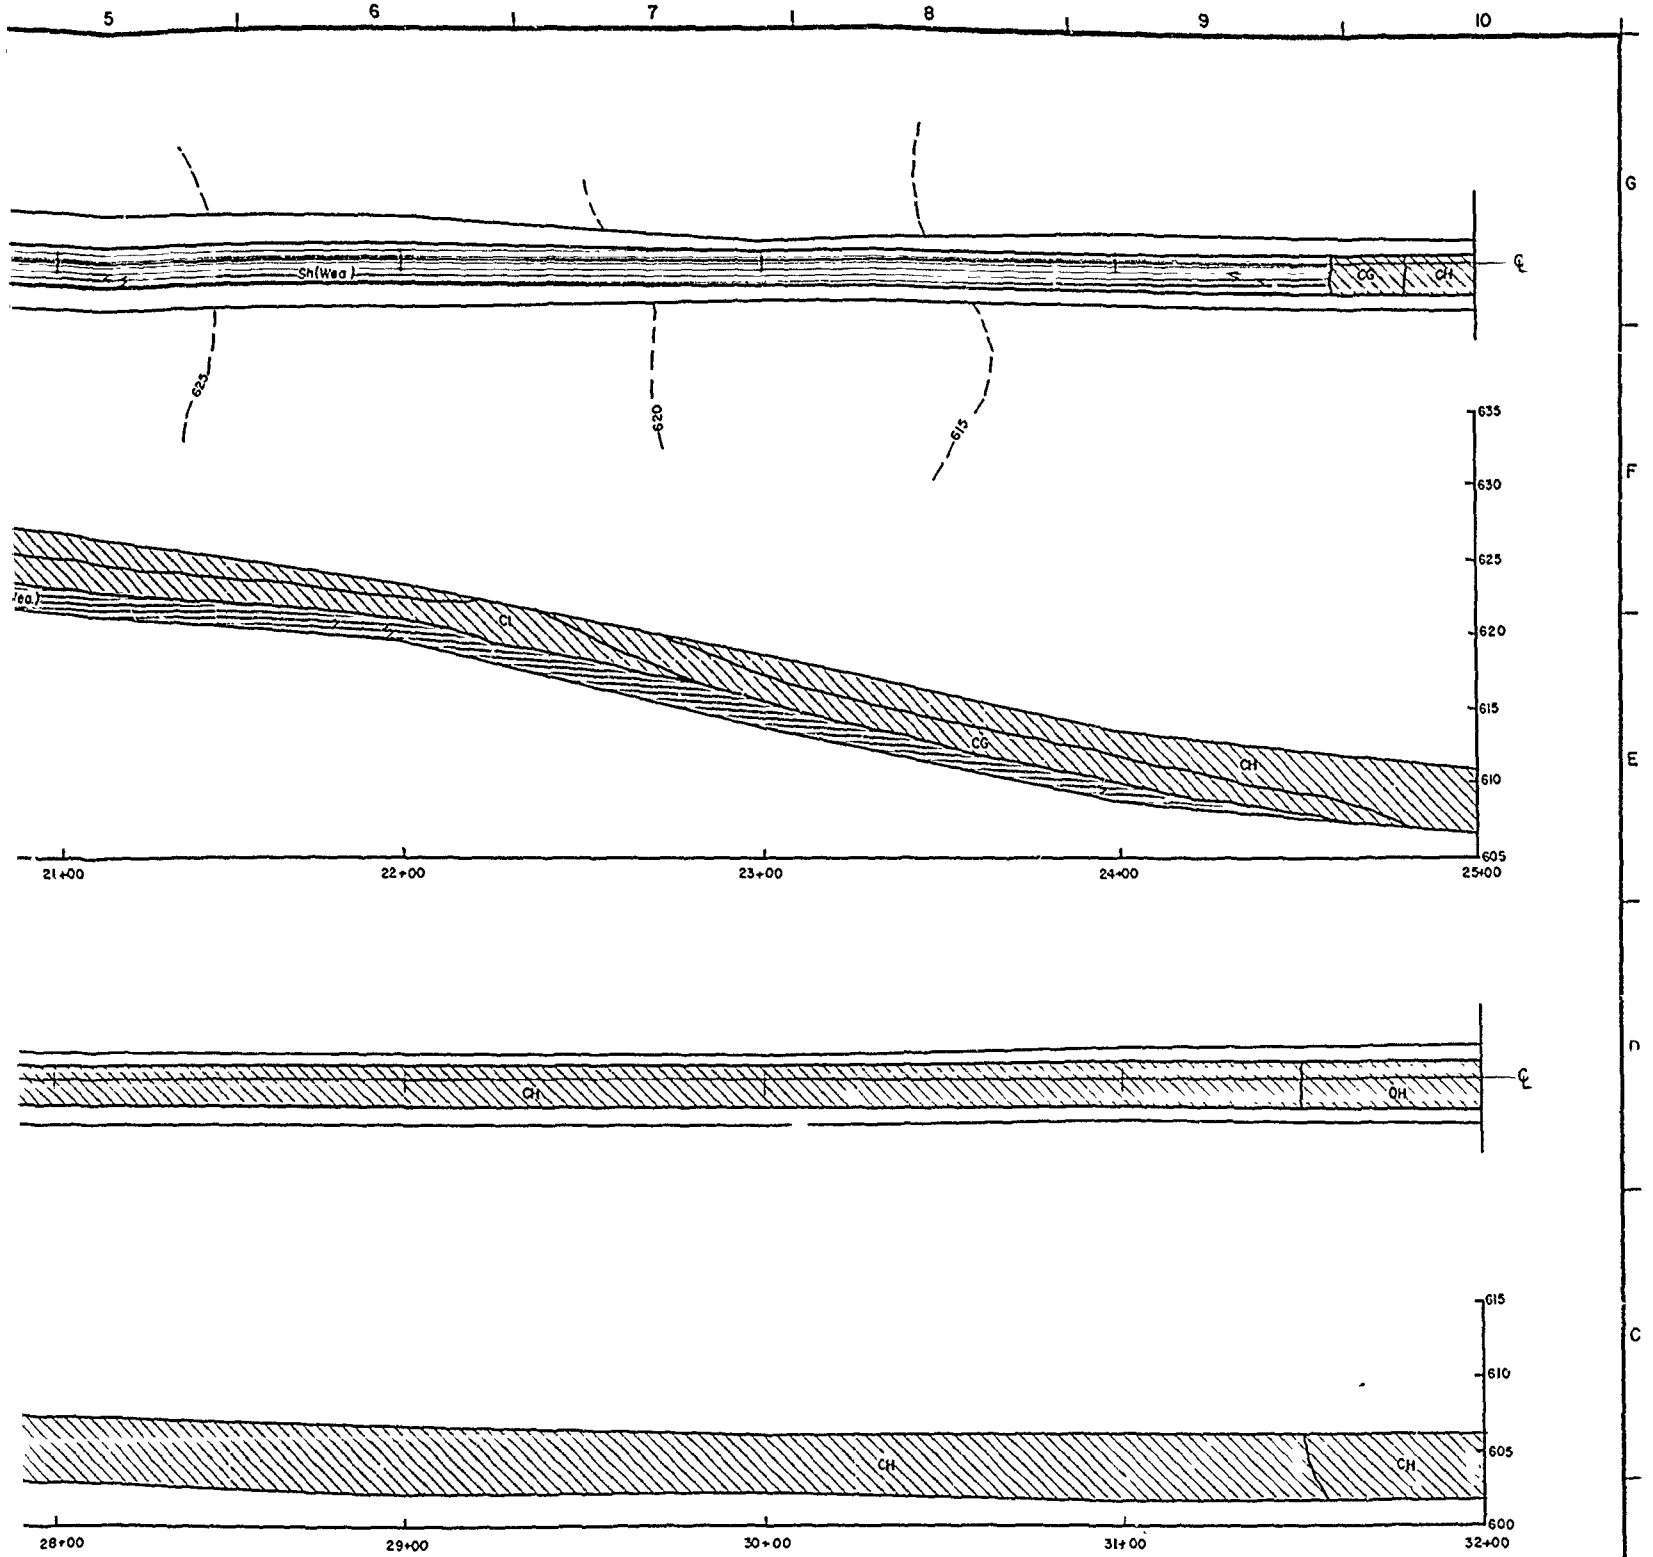



DESIGNED BY: H. BARNETT	RAY ROBERTS LAKE ELM FORK, TRINITY RIVER, TEXAS FOUNDATION REPORT INSPECTION TRENCH AS-BUILT PLAN AND PROFILE STA. 18+00 TO 32+00
DRAWN BY: C. KIRBY	
REVIEWED BY: R. BEHM	
SUBMITTED BY: ROBERT C. BEHM	
U.S. ARMY ENGINEER DISTRICT, FORT WORTH CORPS OF ENGINEERS FORT WORTH, TEXAS	SOIL NO. _____ DATED: _____ CONTR. NO. _____ DRAWING NUMBER _____ SHEET NO. _____ OF _____ SEQUENCE NO. 51

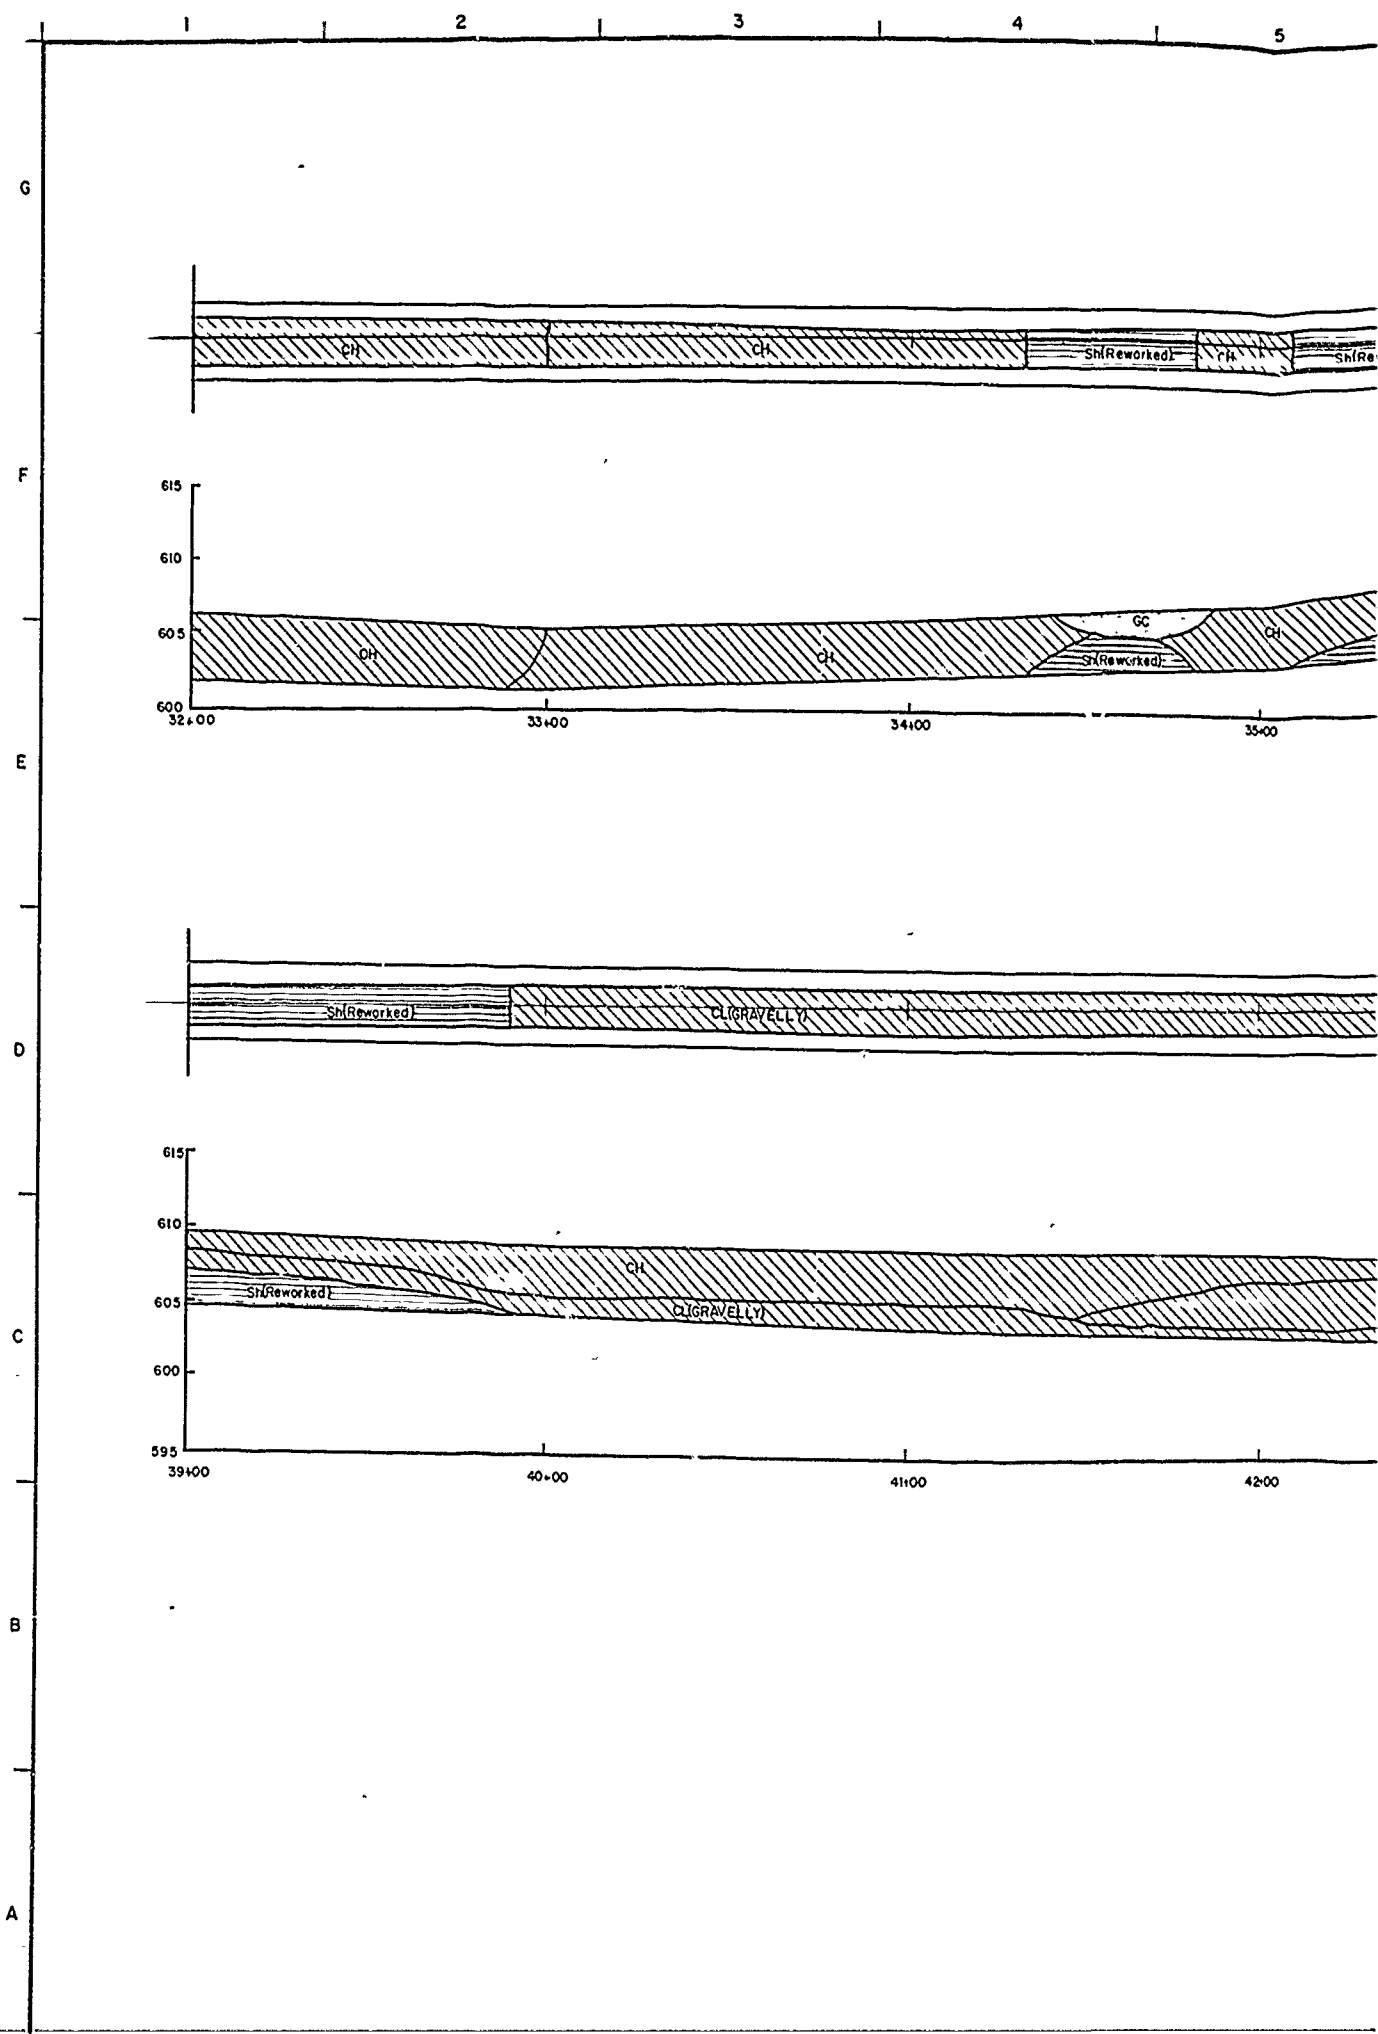

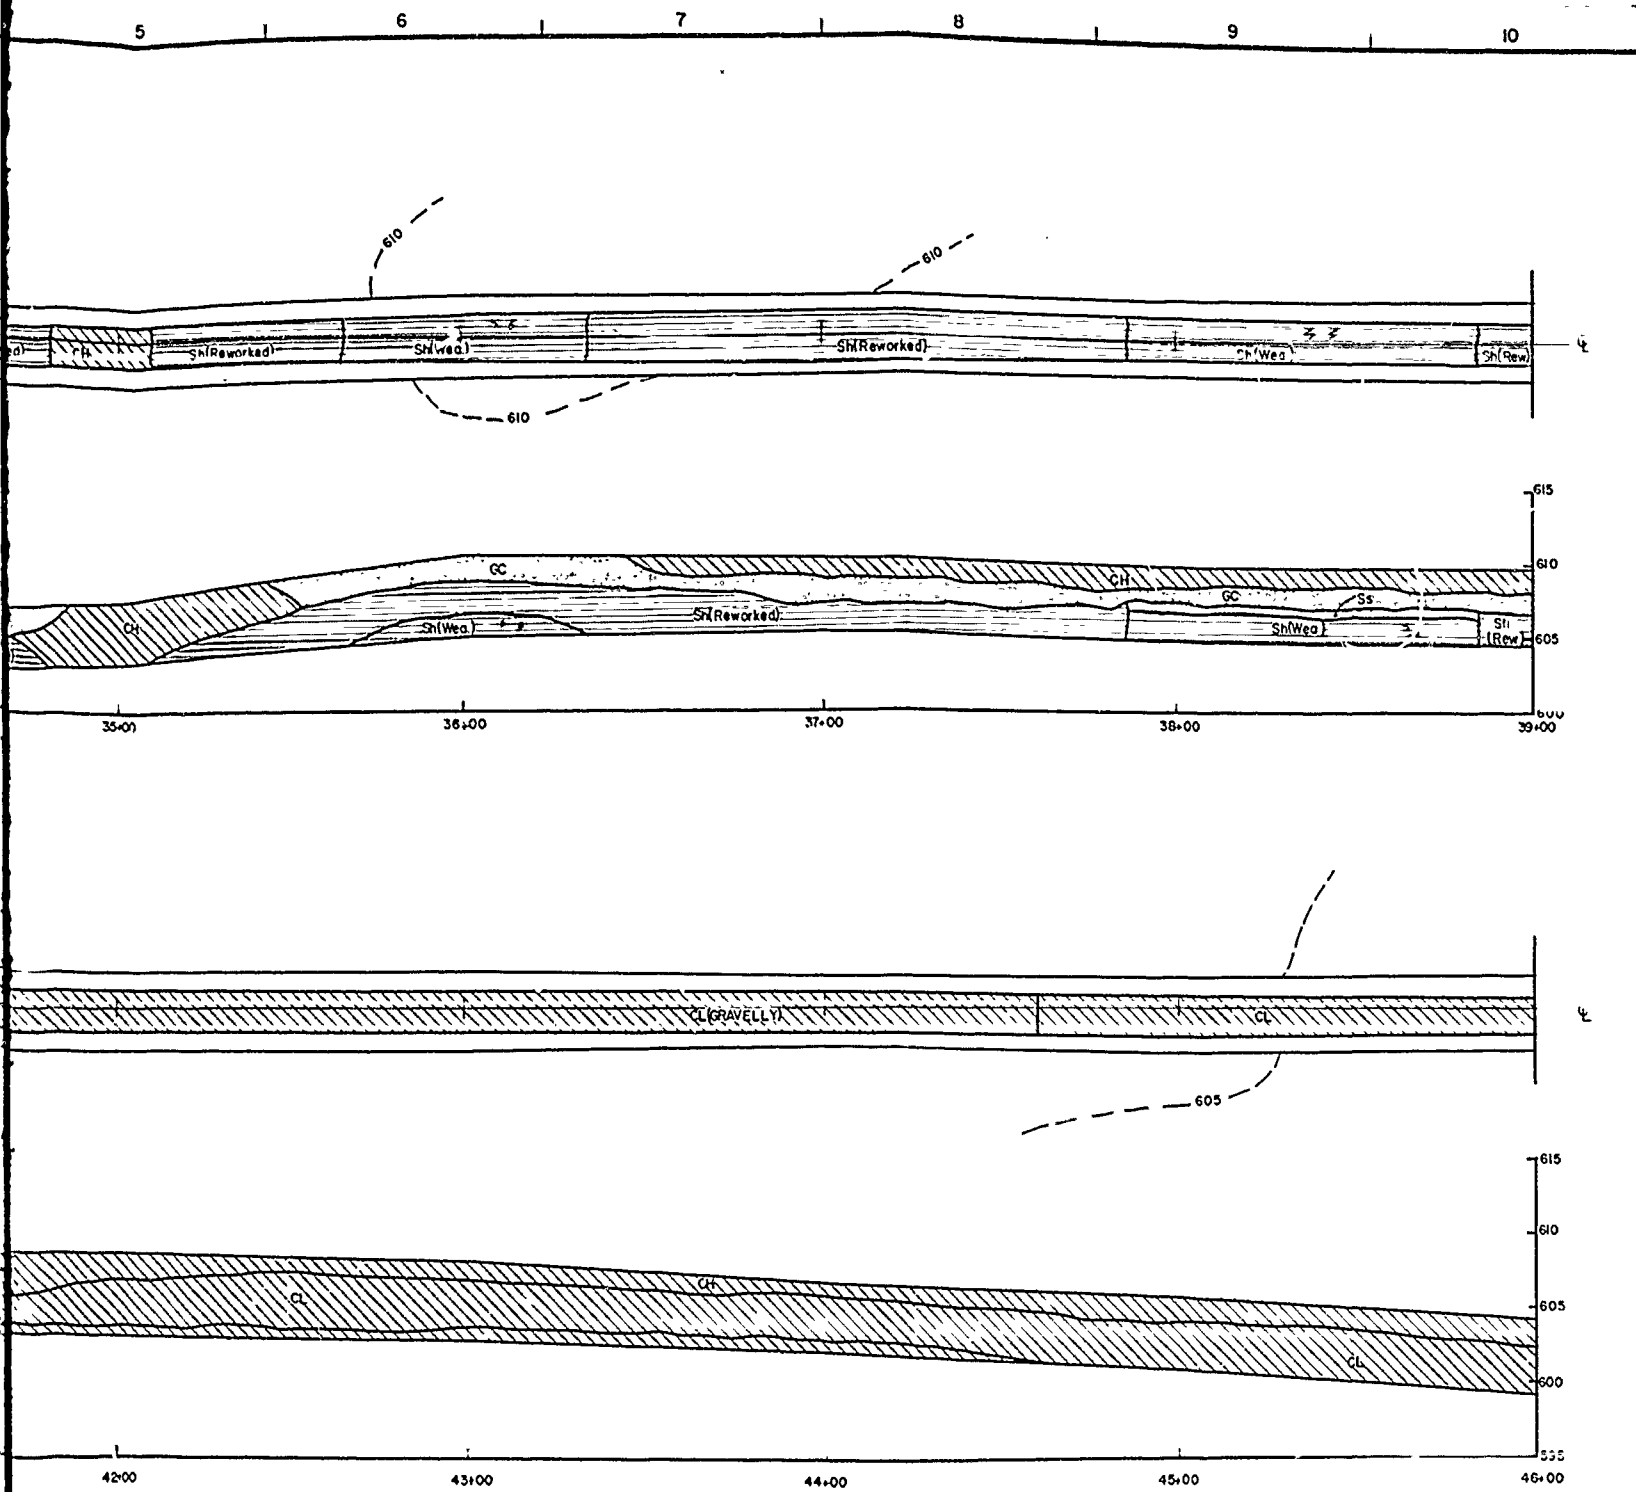



DESIGNED BY: H. BARNETT		RAY		ALLEGATION OF SECTION	
DRAWN BY: C. KIRBY		U.S. ARMY ENGINEER DISTRICT, FORT WORTH CORPS OF ENGINEERS FORT WORTH, TEXAS			
REVIEWED BY: R. BEHM		RAY ROBERTS LAKE ELM FORK, TRINITY RIVER, TEXAS FOUNDATION REPORT INSPECTION TRENCH AS-BUILT PLAN AND PROFILE STA. 32+00 TO 46+00			
SUBMITTED BY: ROBERT C. BEHM					
CONTR. NO.		SOL. NO.		DATED	

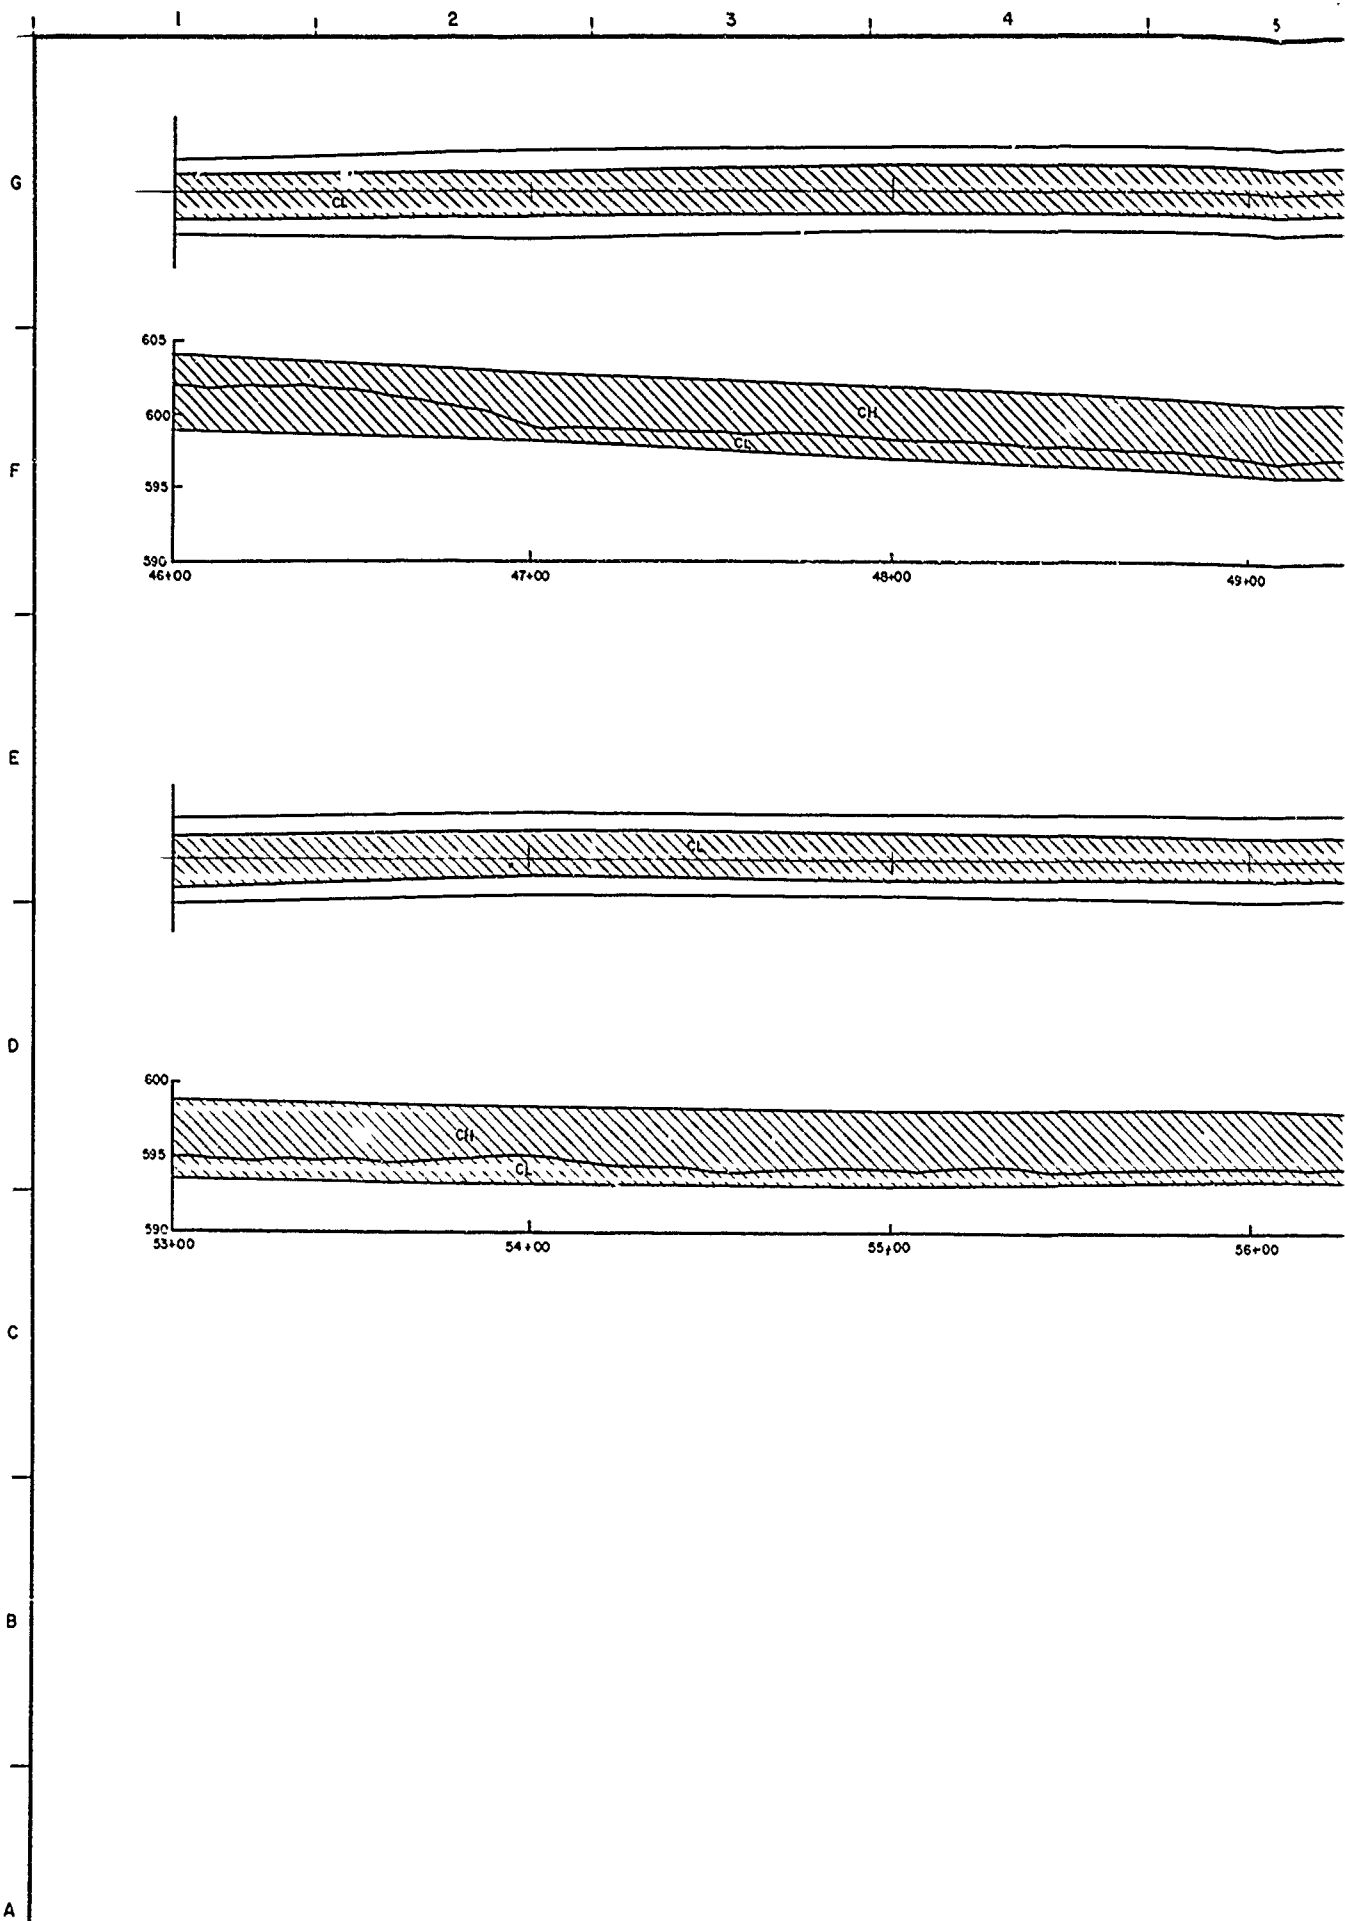

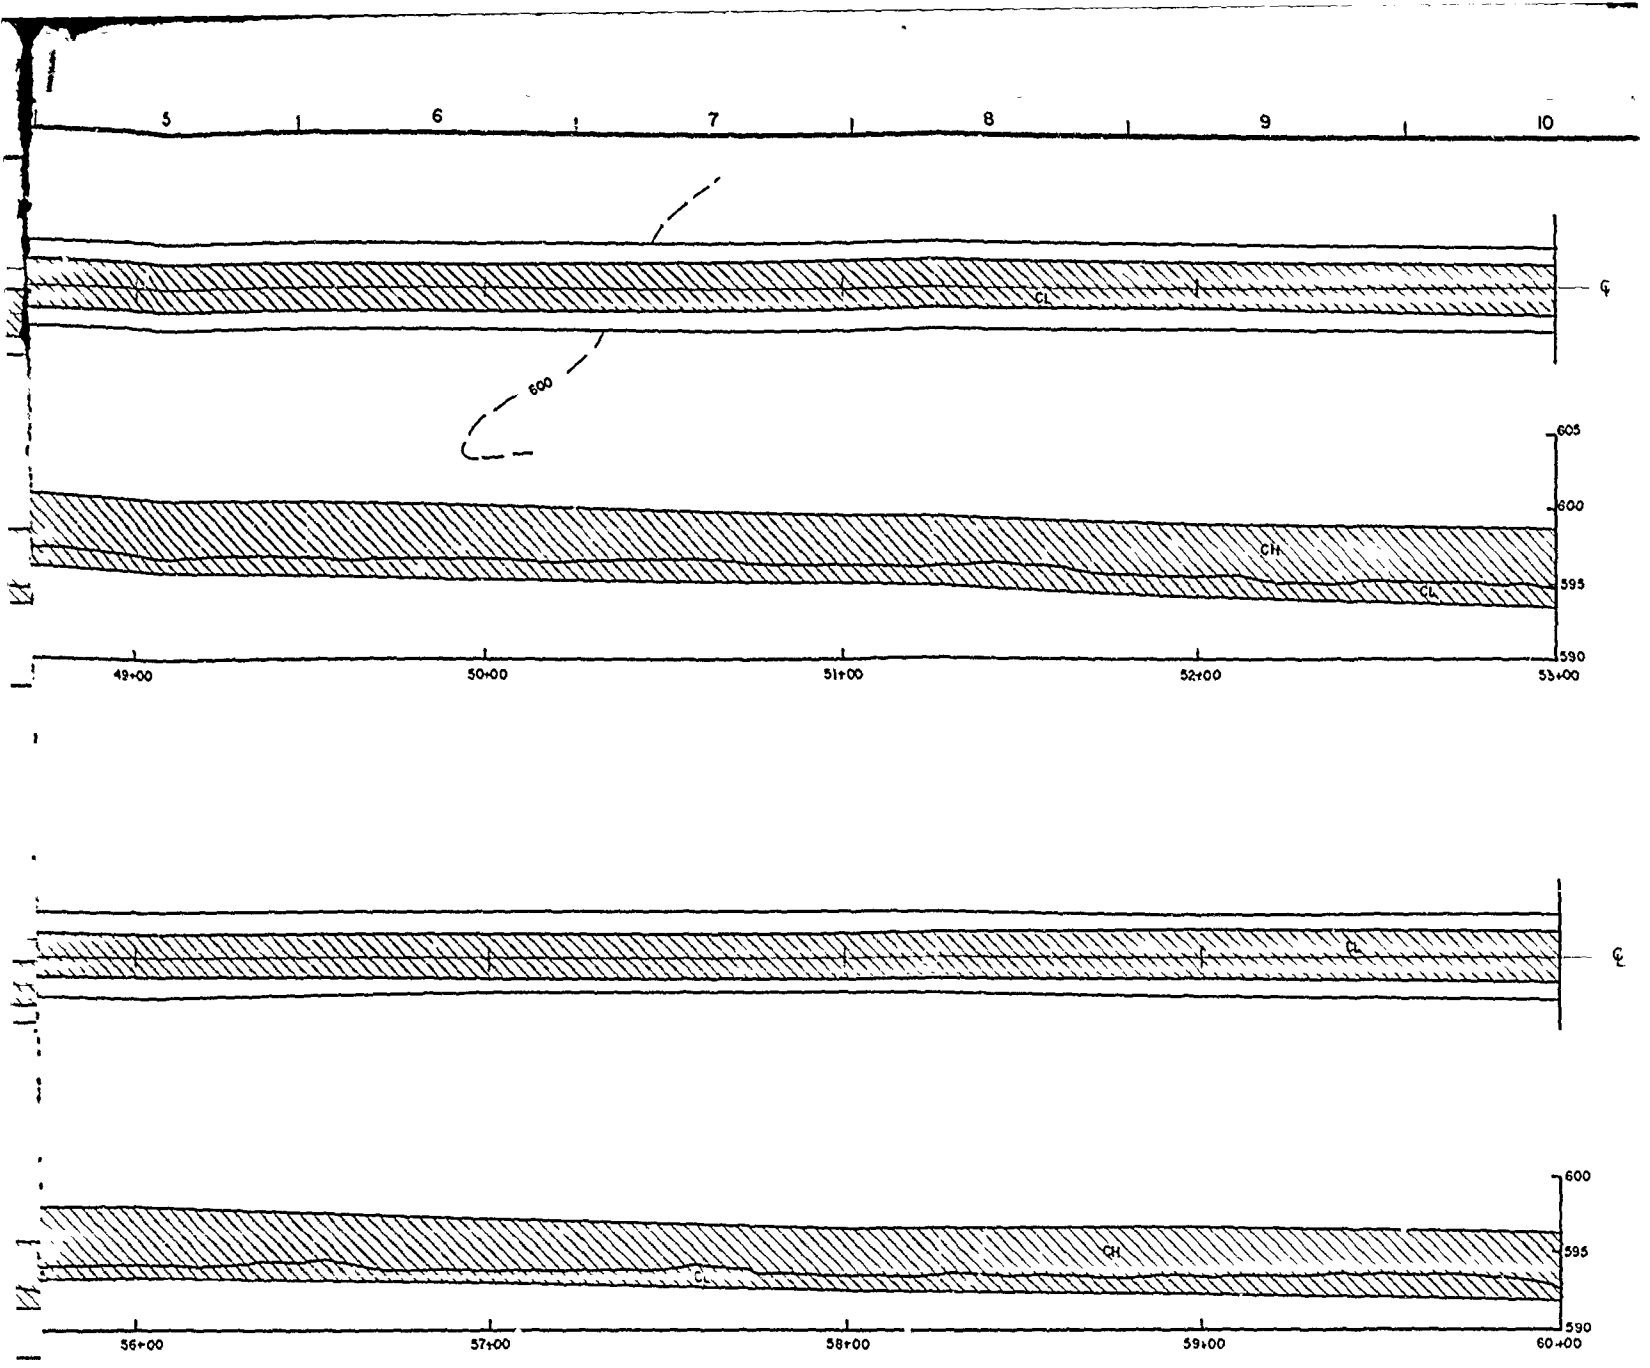

DESIGNED BY: H. BARNETT	RAY ROBERTS LAKE ELM FORK, TRINITY RIVER, TEXAS
DRAWN BY: C. KIBBY	FOUNDATION REPORT INSPECTION TRENCH AS-BUILT PLAN AND PROFILE STA. 46+00 TO 60+00
REVIEWED BY: R. BEHM	
SUBMITTED BY: ROBERT C. BEHM	SOL. NO. _____
ENGINEER	CONTR. NO. _____
	DRAWING NUMBER _____
	DATE _____
	SCALE _____

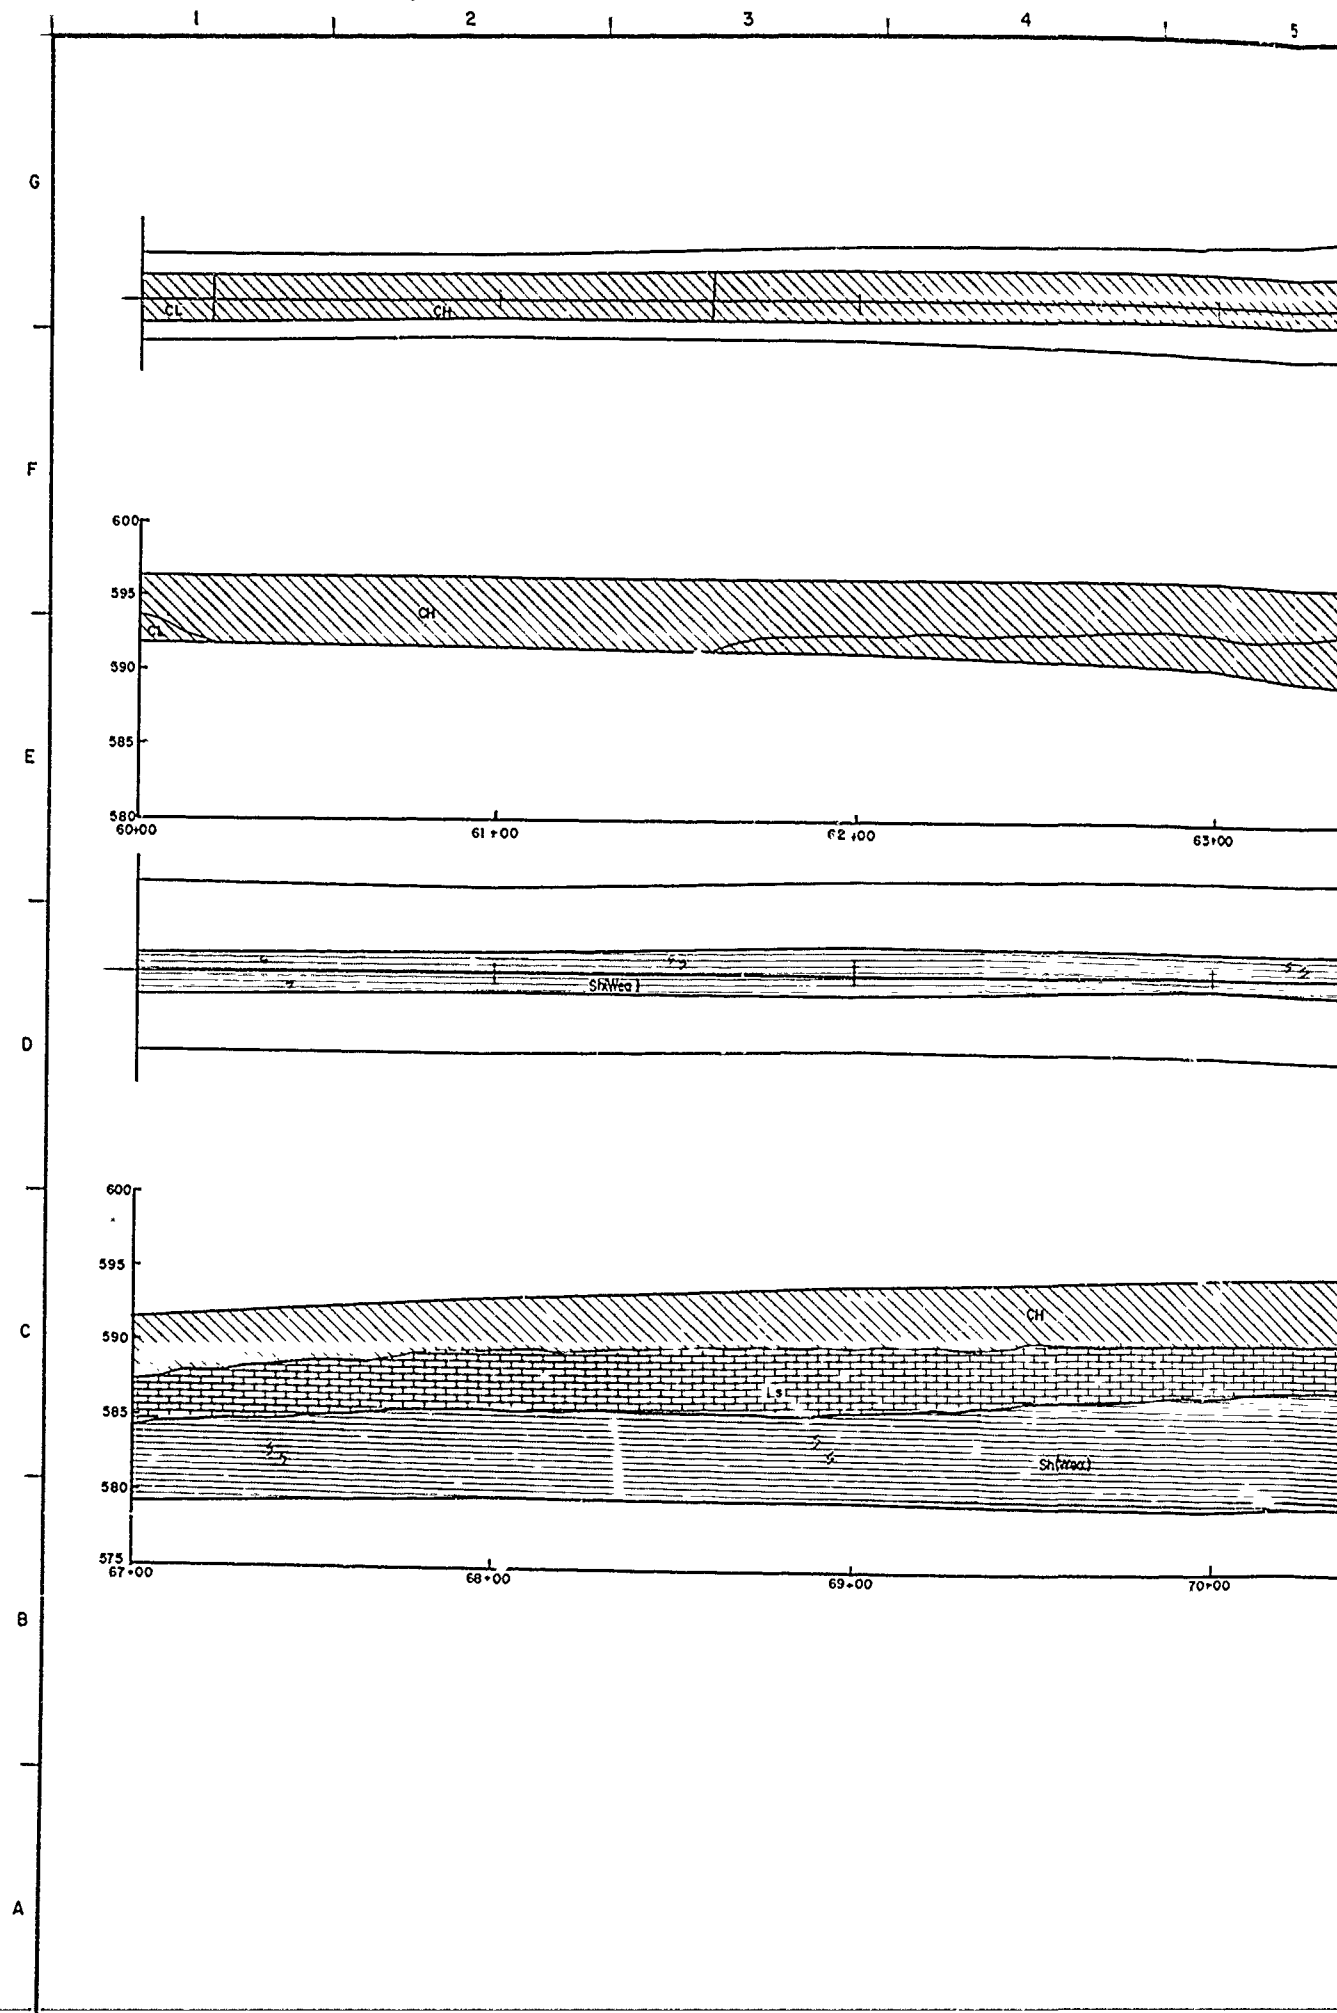


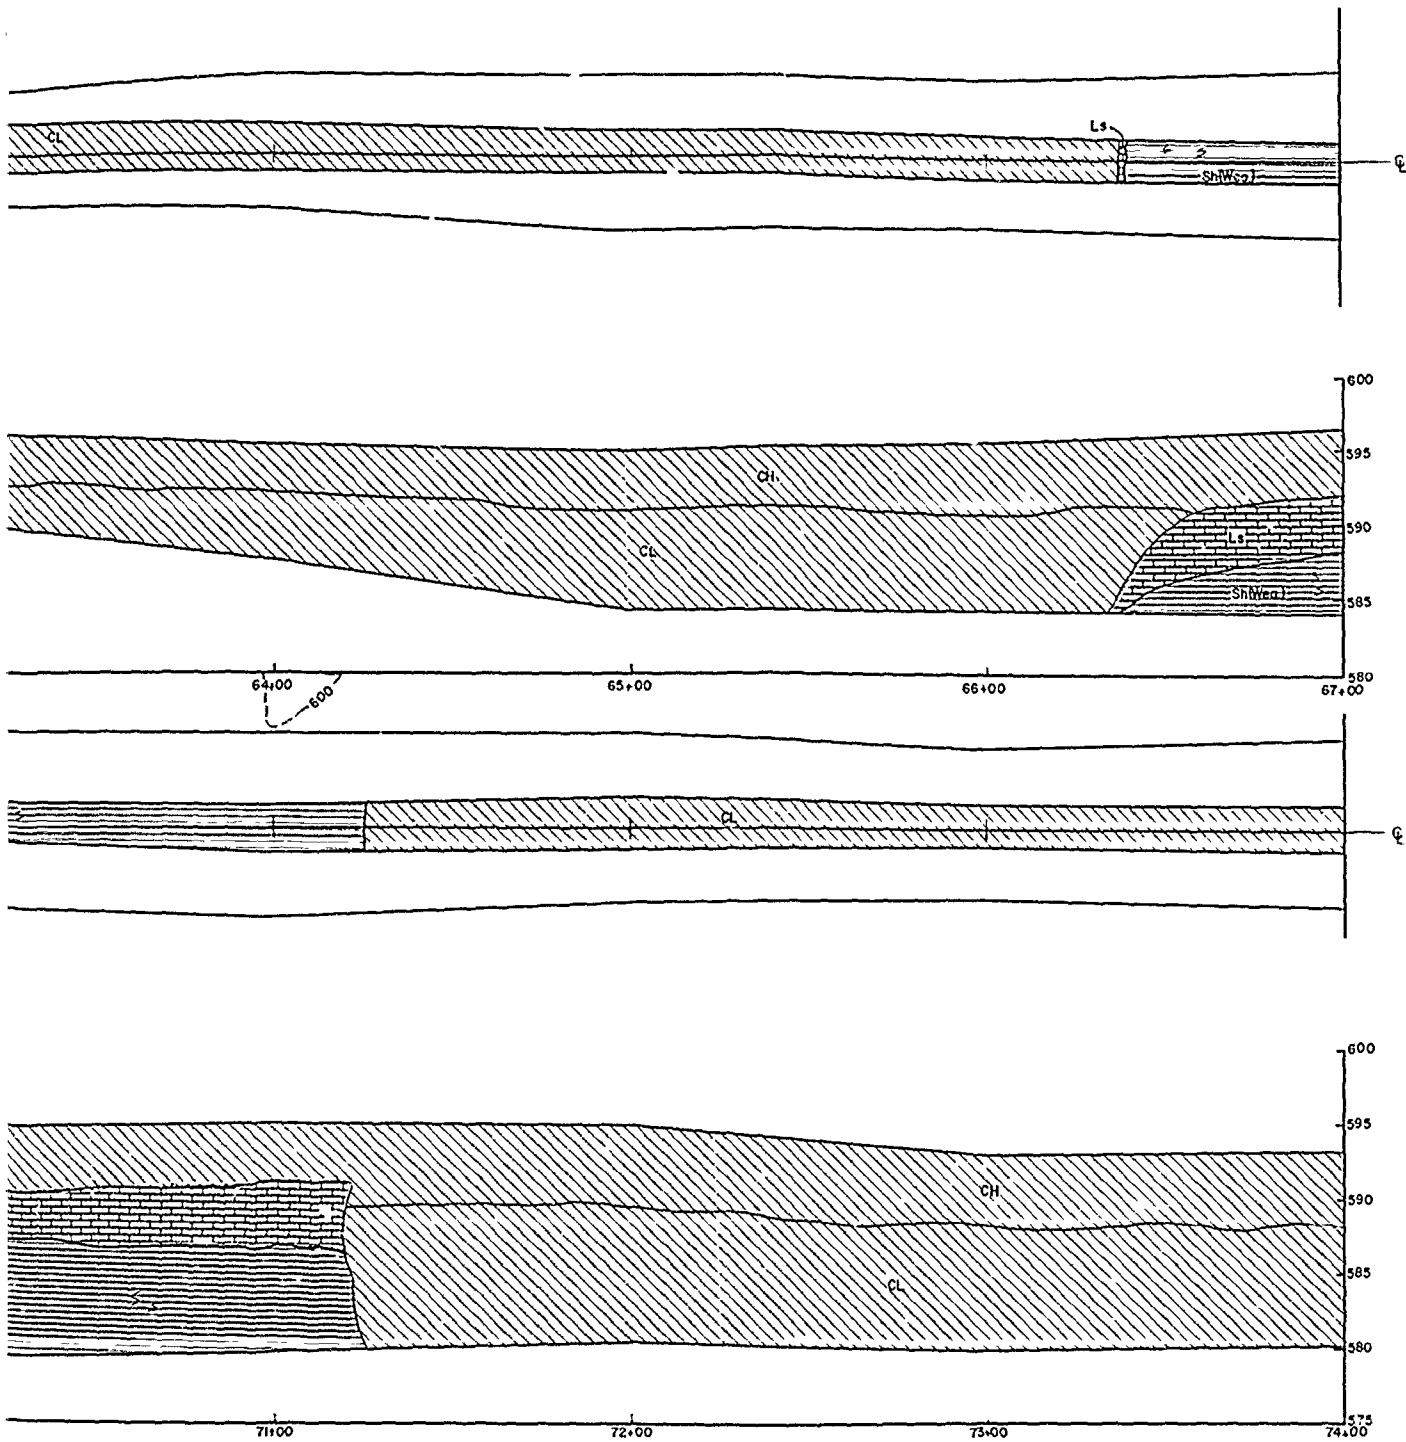


DESIGNED BY: H. BARNETT		RAY ROBERTS LAKE ELM FORK, TRINITY RIVER, TEXAS	
DRAWN BY: C. KIRBY		FOUNDATION REPORT	
REVIEWED BY: R. BEHM		INSPECTION TRENCH AS-BUILT PLAN AND PROFILE STA. 60+00 TO 74+00	
SUBMITTED BY: ROBERT C. BEHM ENGINEER		SOL. NO.	DATED:
		CONTR. NO.	SEQUENCE NO.
		DRAWING NUMBER	SHEET NO. OF
			54

TO ACCOMPANY FOUNDATION REPORT

G

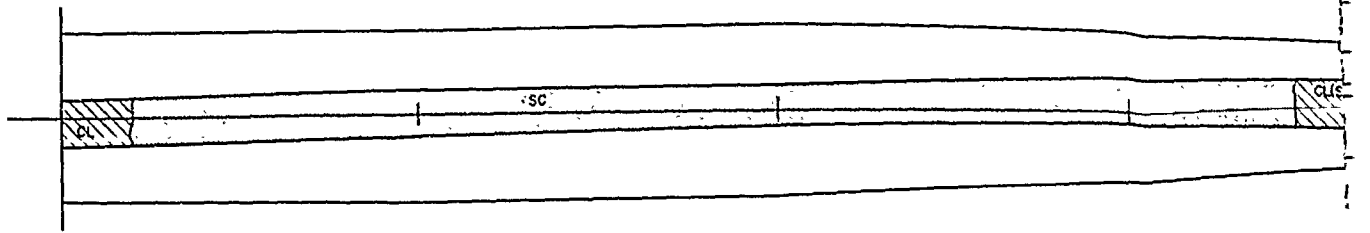


F

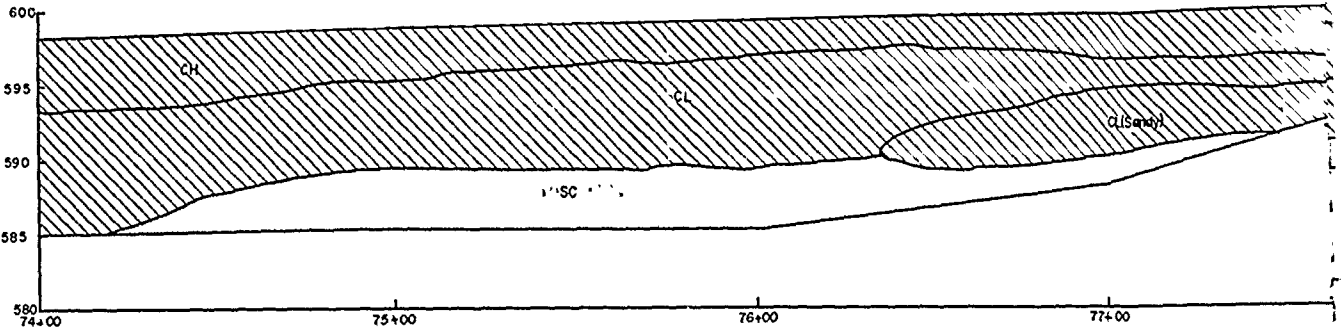


E

D

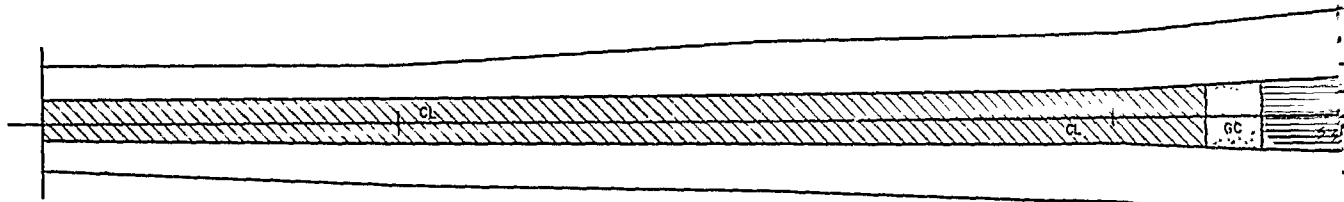






C

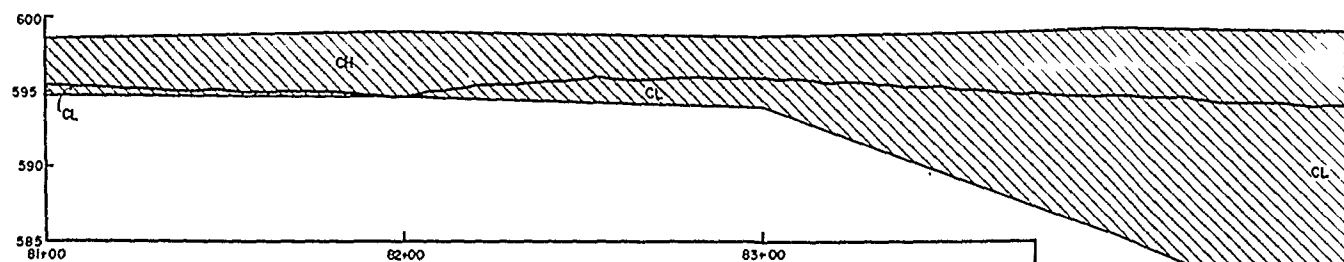

B

A

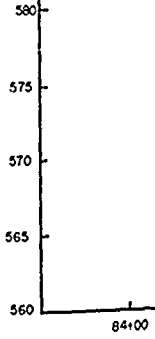

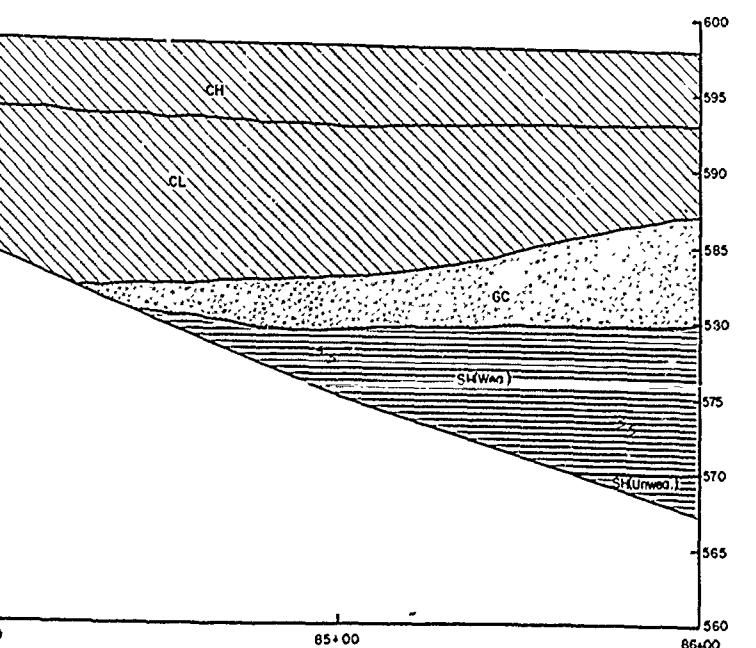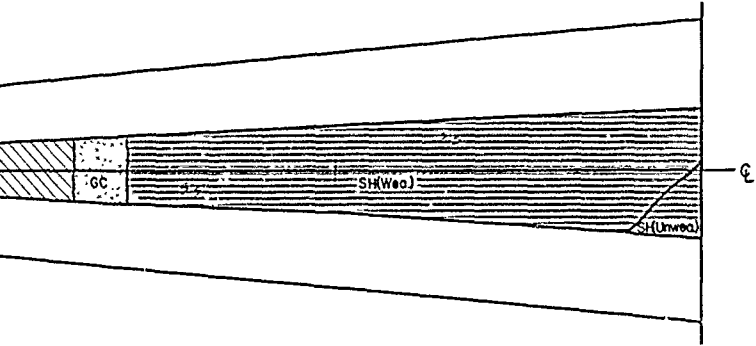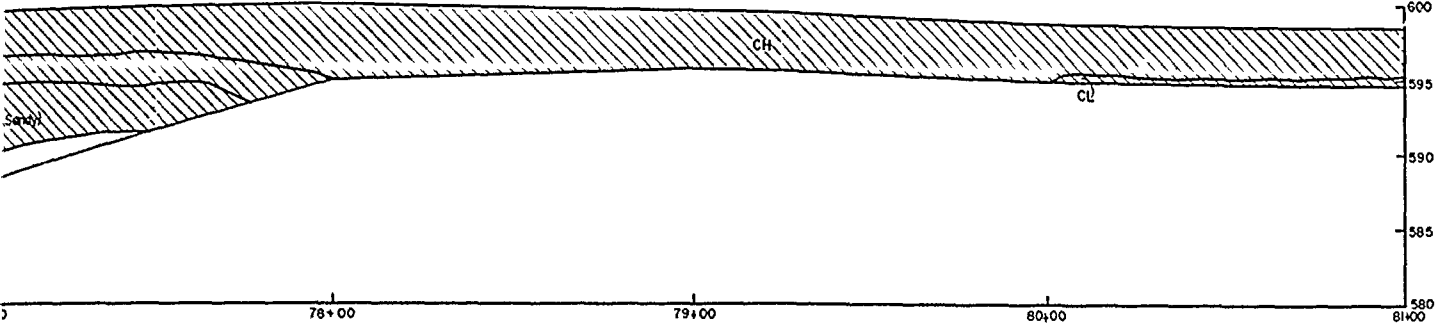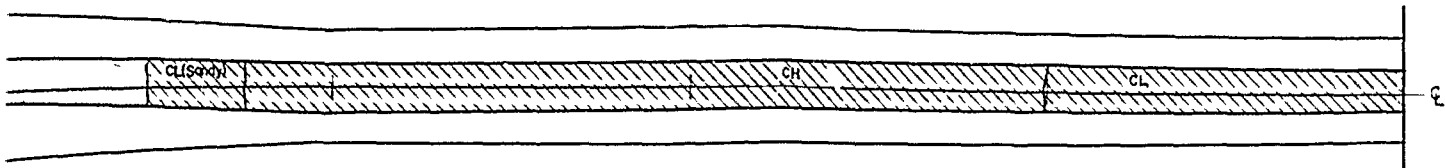

DESIGNED BY H. BARNETT		RAY ROBERTS LAKE ELM FORK, TRINITY RIVER, TEXAS	
DRAWN BY C. KIRBY		FOUNDATION REPORT	
REVIEWED BY R. BEHM		INSPECTION TRENCH	
SUBMITTED BY ROBERT C. BEHM		AS-BUILT PLAN AND PROFILE	
ENGINEER		STA 74+00 TO 86+00	
CONTR. NO.		SHEET NO. 55	
DRAWING NUMBER		OF	

TO ACCOMPANY FOUNDATION REPORT

G
F
E
D
C
B

5 6 7 8

G

F


E

D


C

B

A

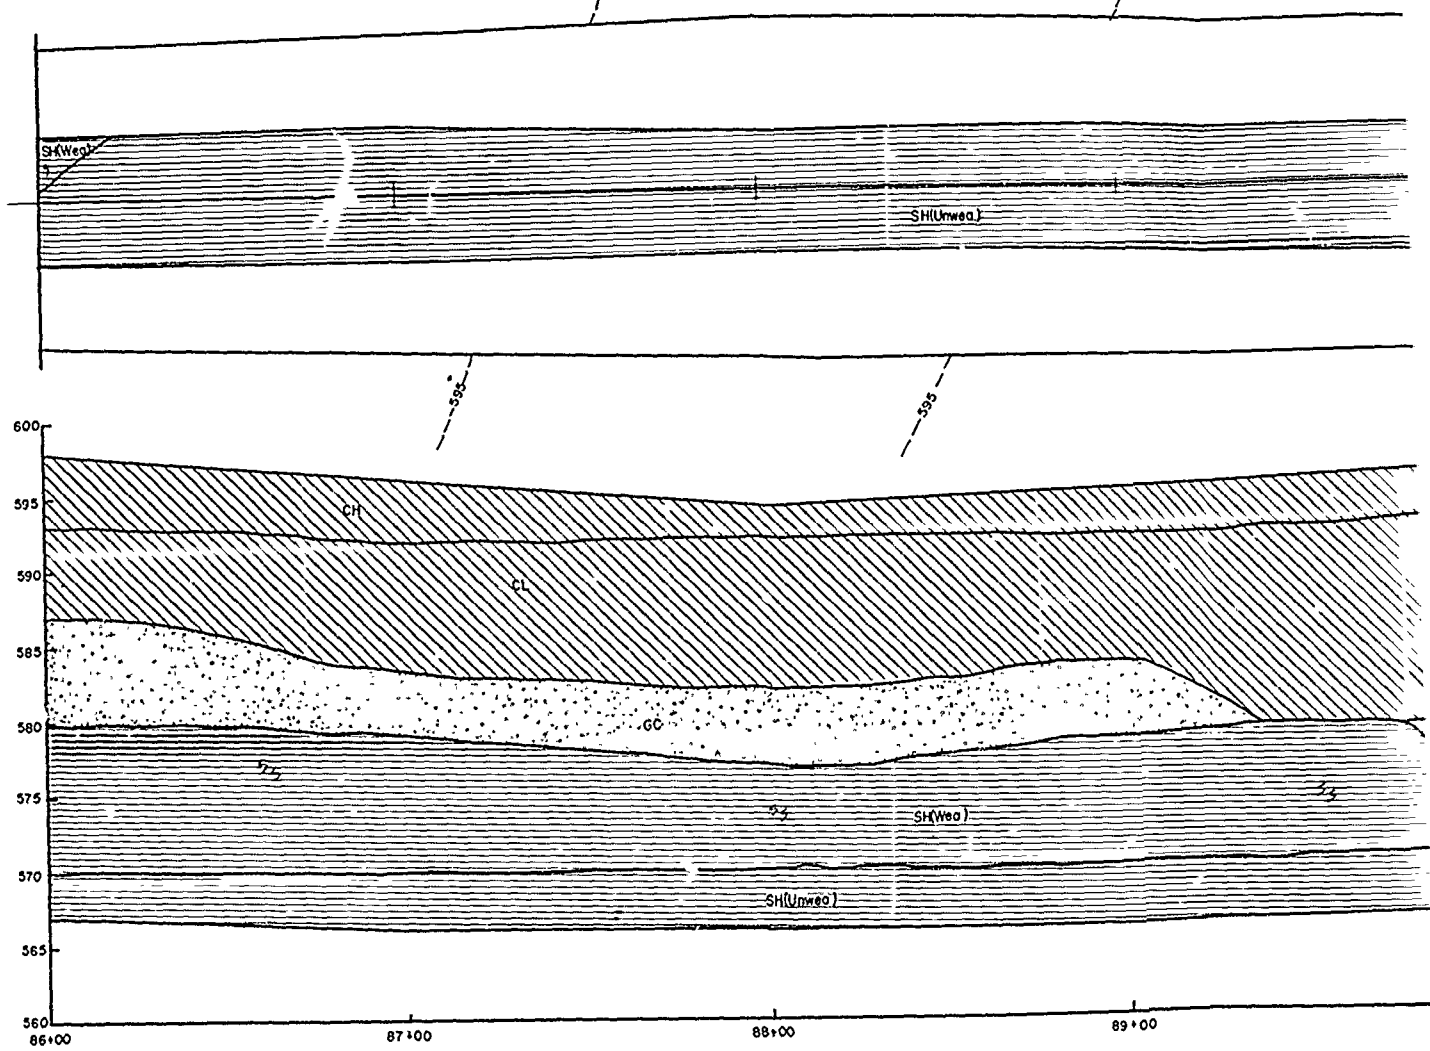

G
F
E
D
C
B


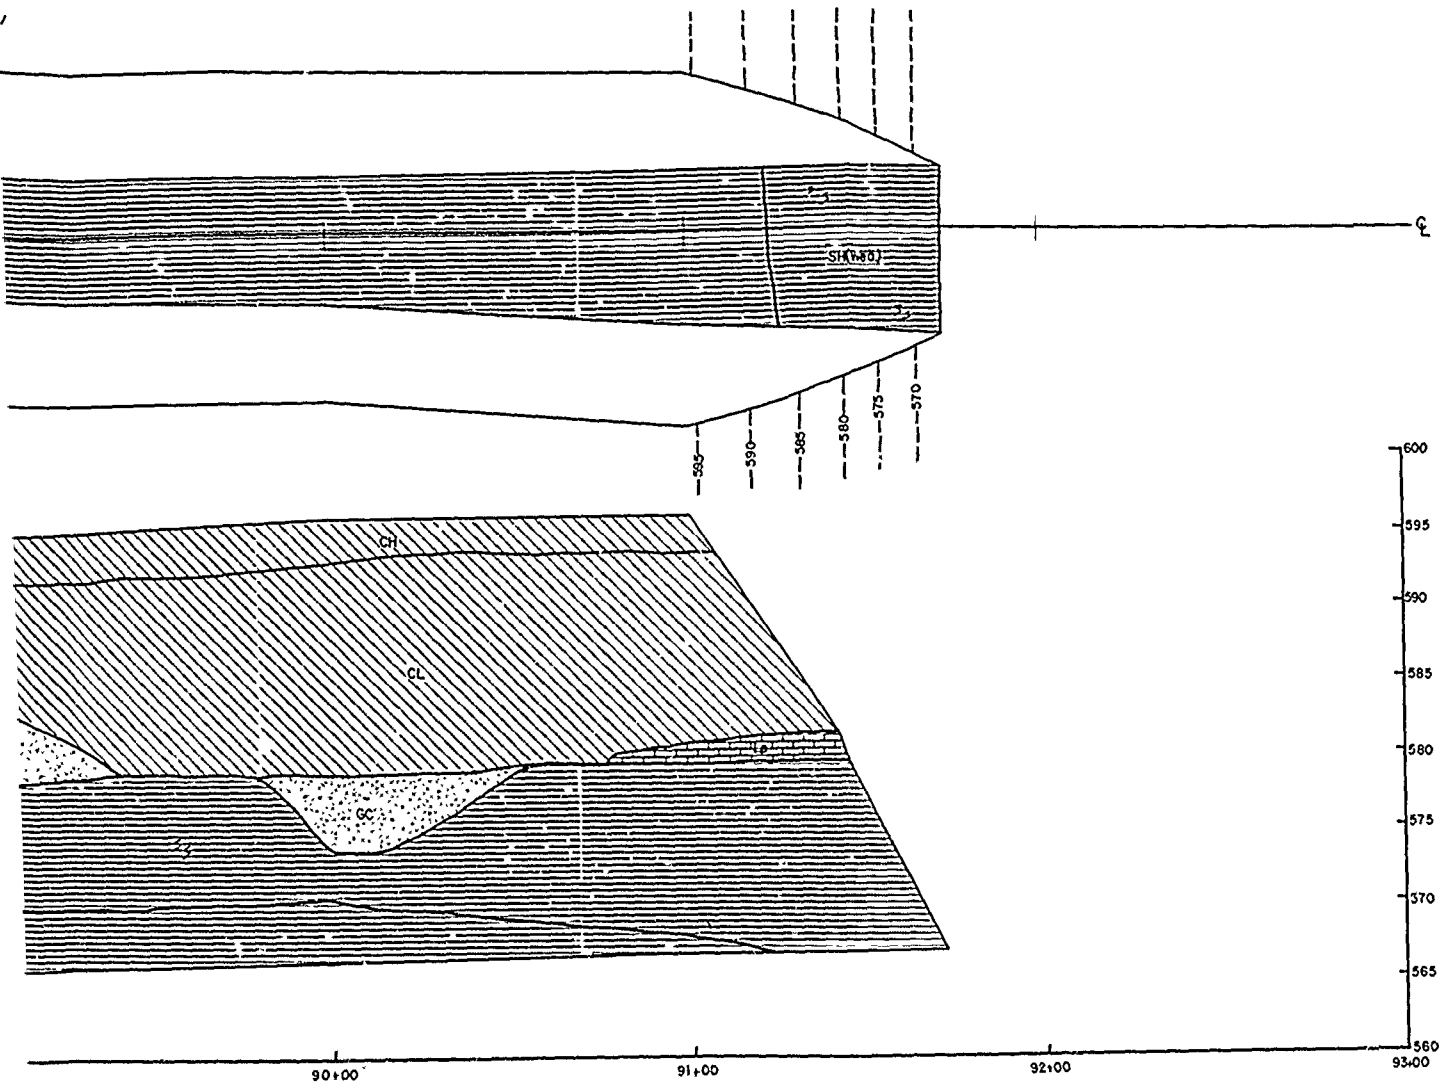


DESIGNED BY: H. RAPPETTI		DRAWN BY: C. KIRBY		REVIEWED BY: R. BEHM	
SUBMITTED BY: ROBERT C. BEHM		CONTR. NO.		DATED:	
ENGINEER:		DRAWING NUMBER		SHEET NO. OF	
				SEQUENCE NO. 56	



TO ACCOMPANY FOUNDATION REPORT

5 6 7 8

G
F
E
D
C
B
A

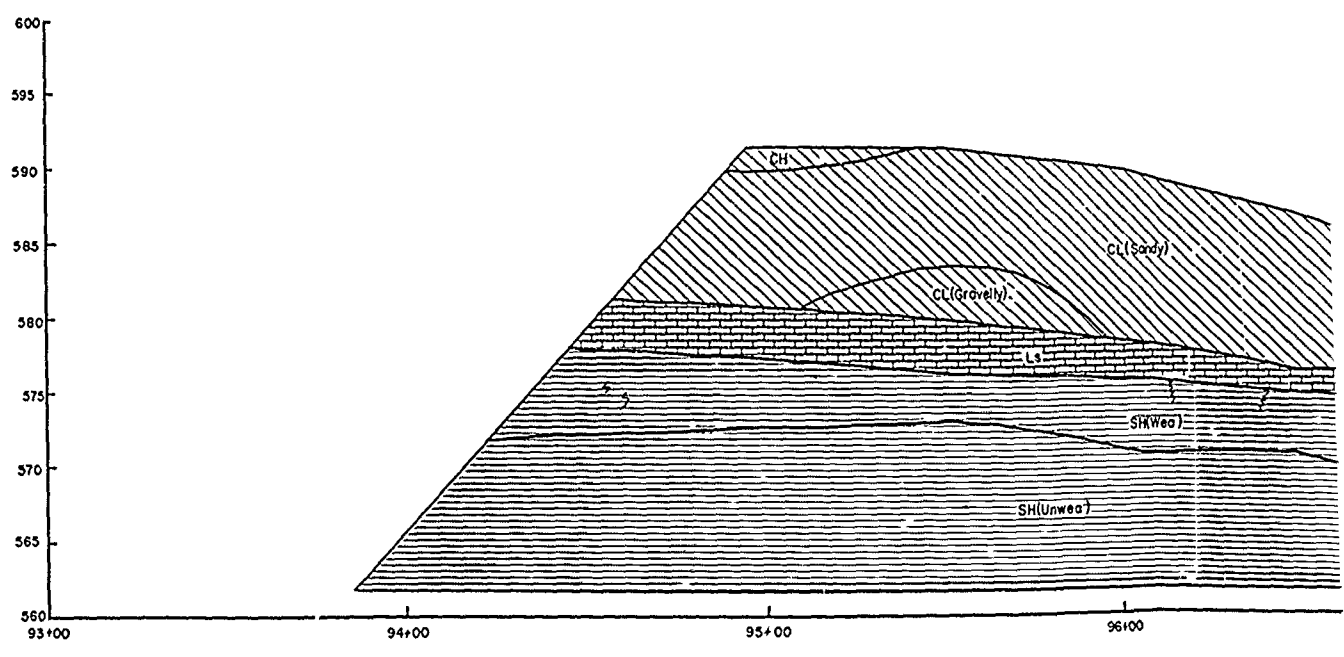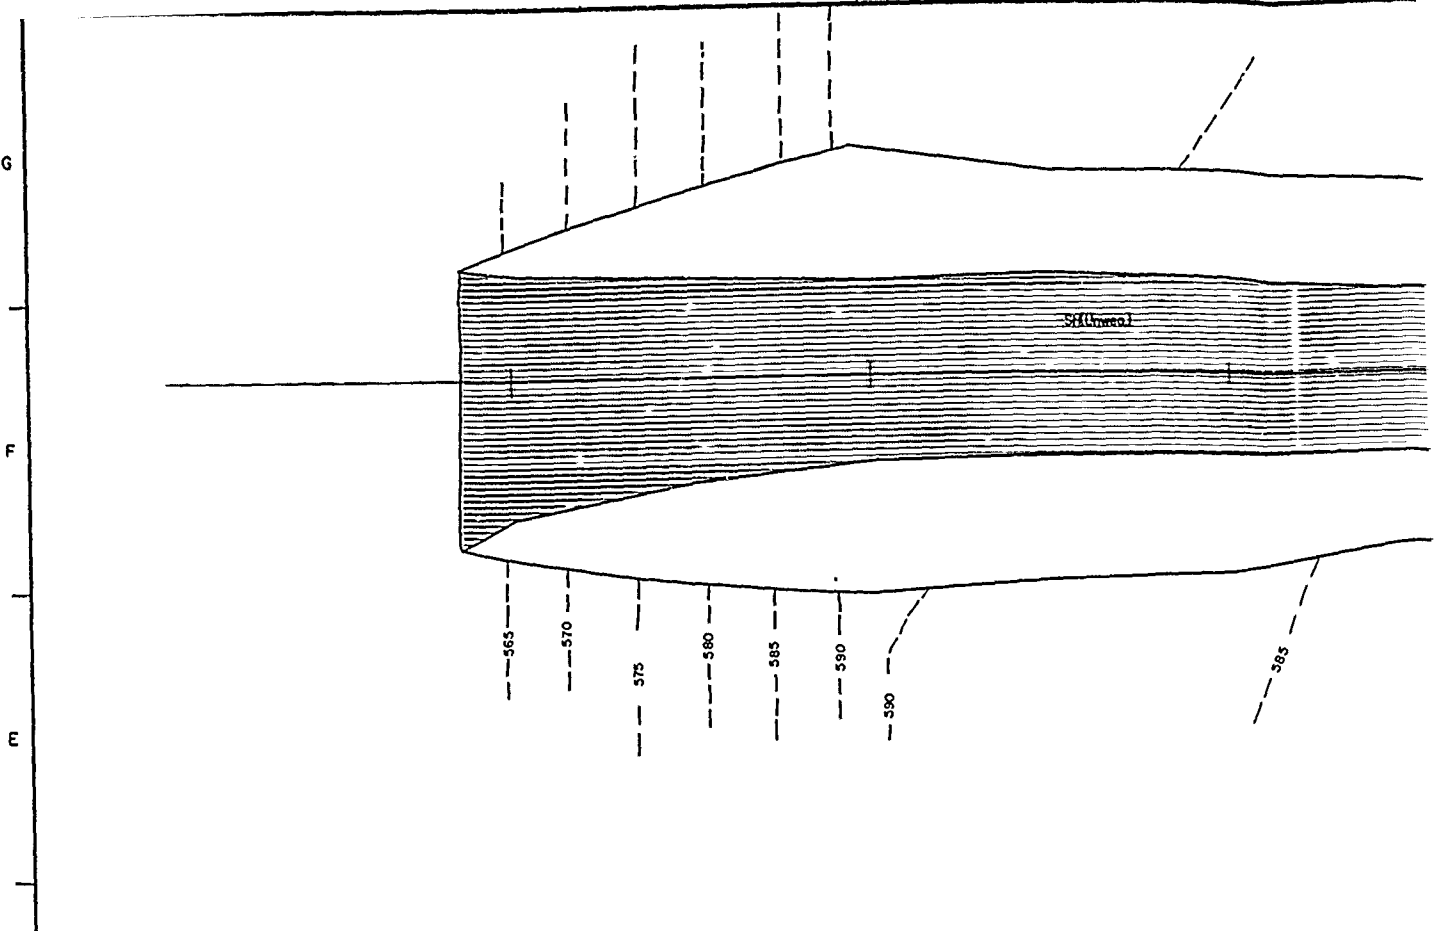






1 2 3 4 5

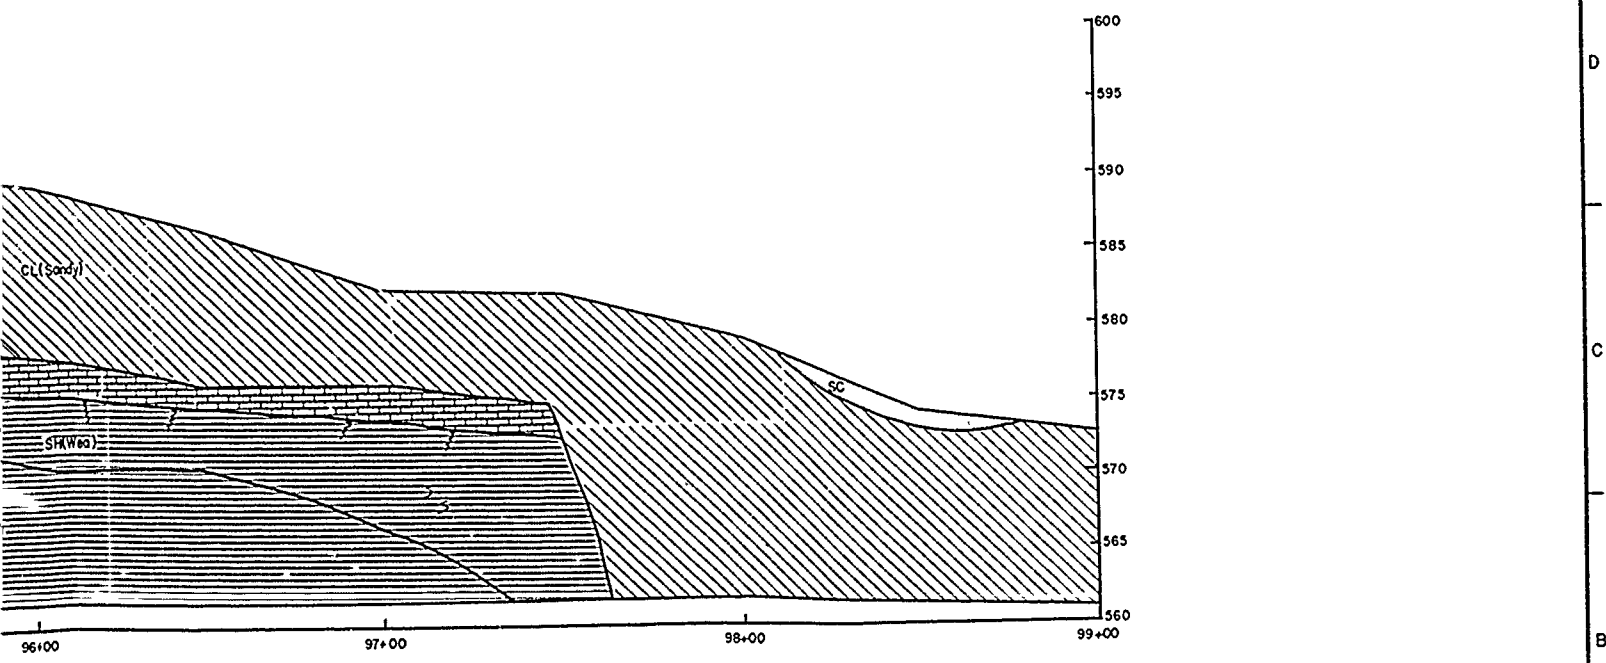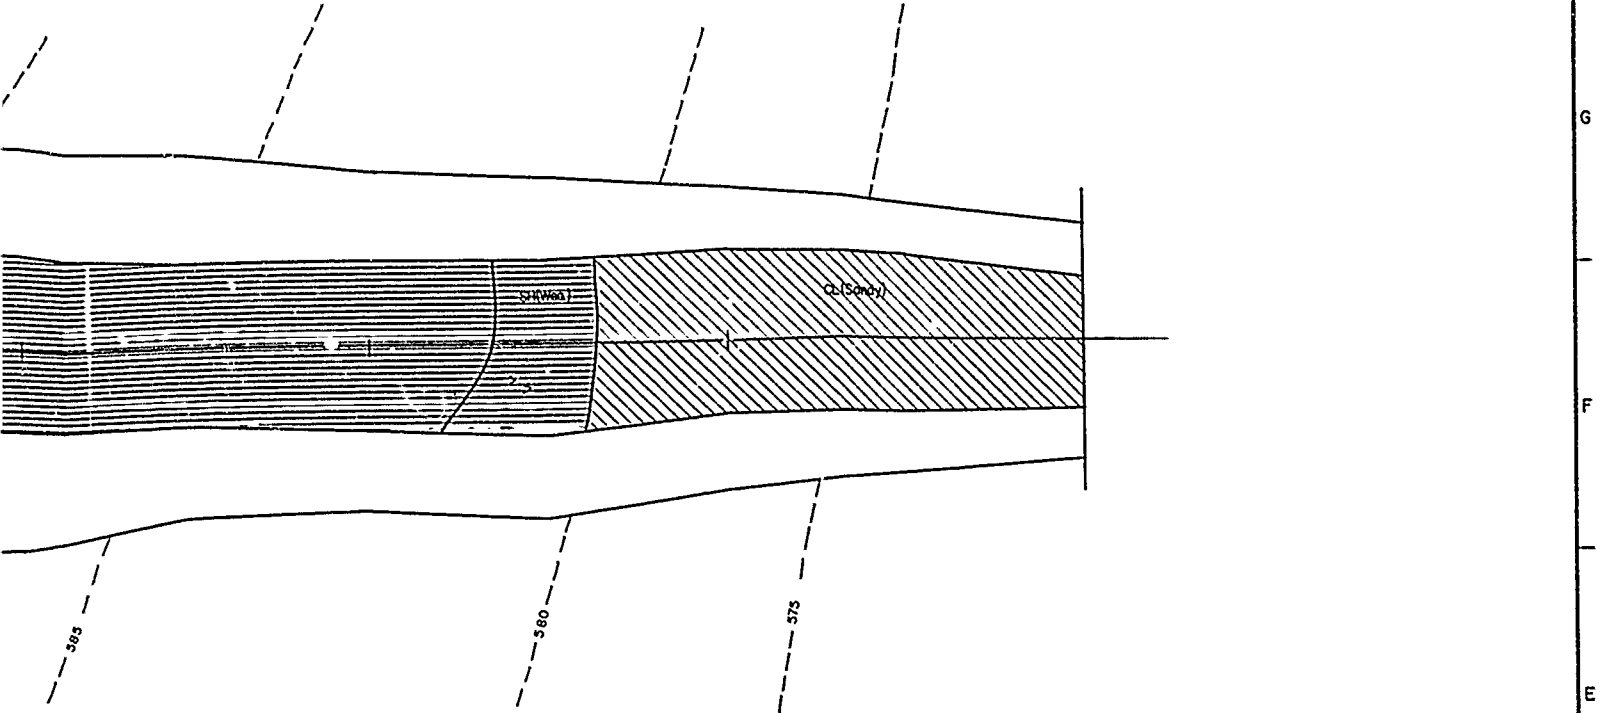


DESIGNED BY: H. BARNETT		RAY ROBERTS LAKE ELM FORK, TRINITY RIVER, TEXAS	
DRAWN BY: C. KIRBY		FOUNDATION REPORT INSPECTION TRENCH	
REVIEWED BY: R. BEHM		AS-BUILT PLAN AND PROFILE STA. 93 00 TO 99 00	
SUBMITTED BY: ROBERT C. BEHM ENGINEER		SOL. NO.	DATED:
		CONTR. NO.	REC. NO. 57
		DRAWING NUMBER	SHEET NO. OF


TO ACCOMPANY FOUNDATION REPORT

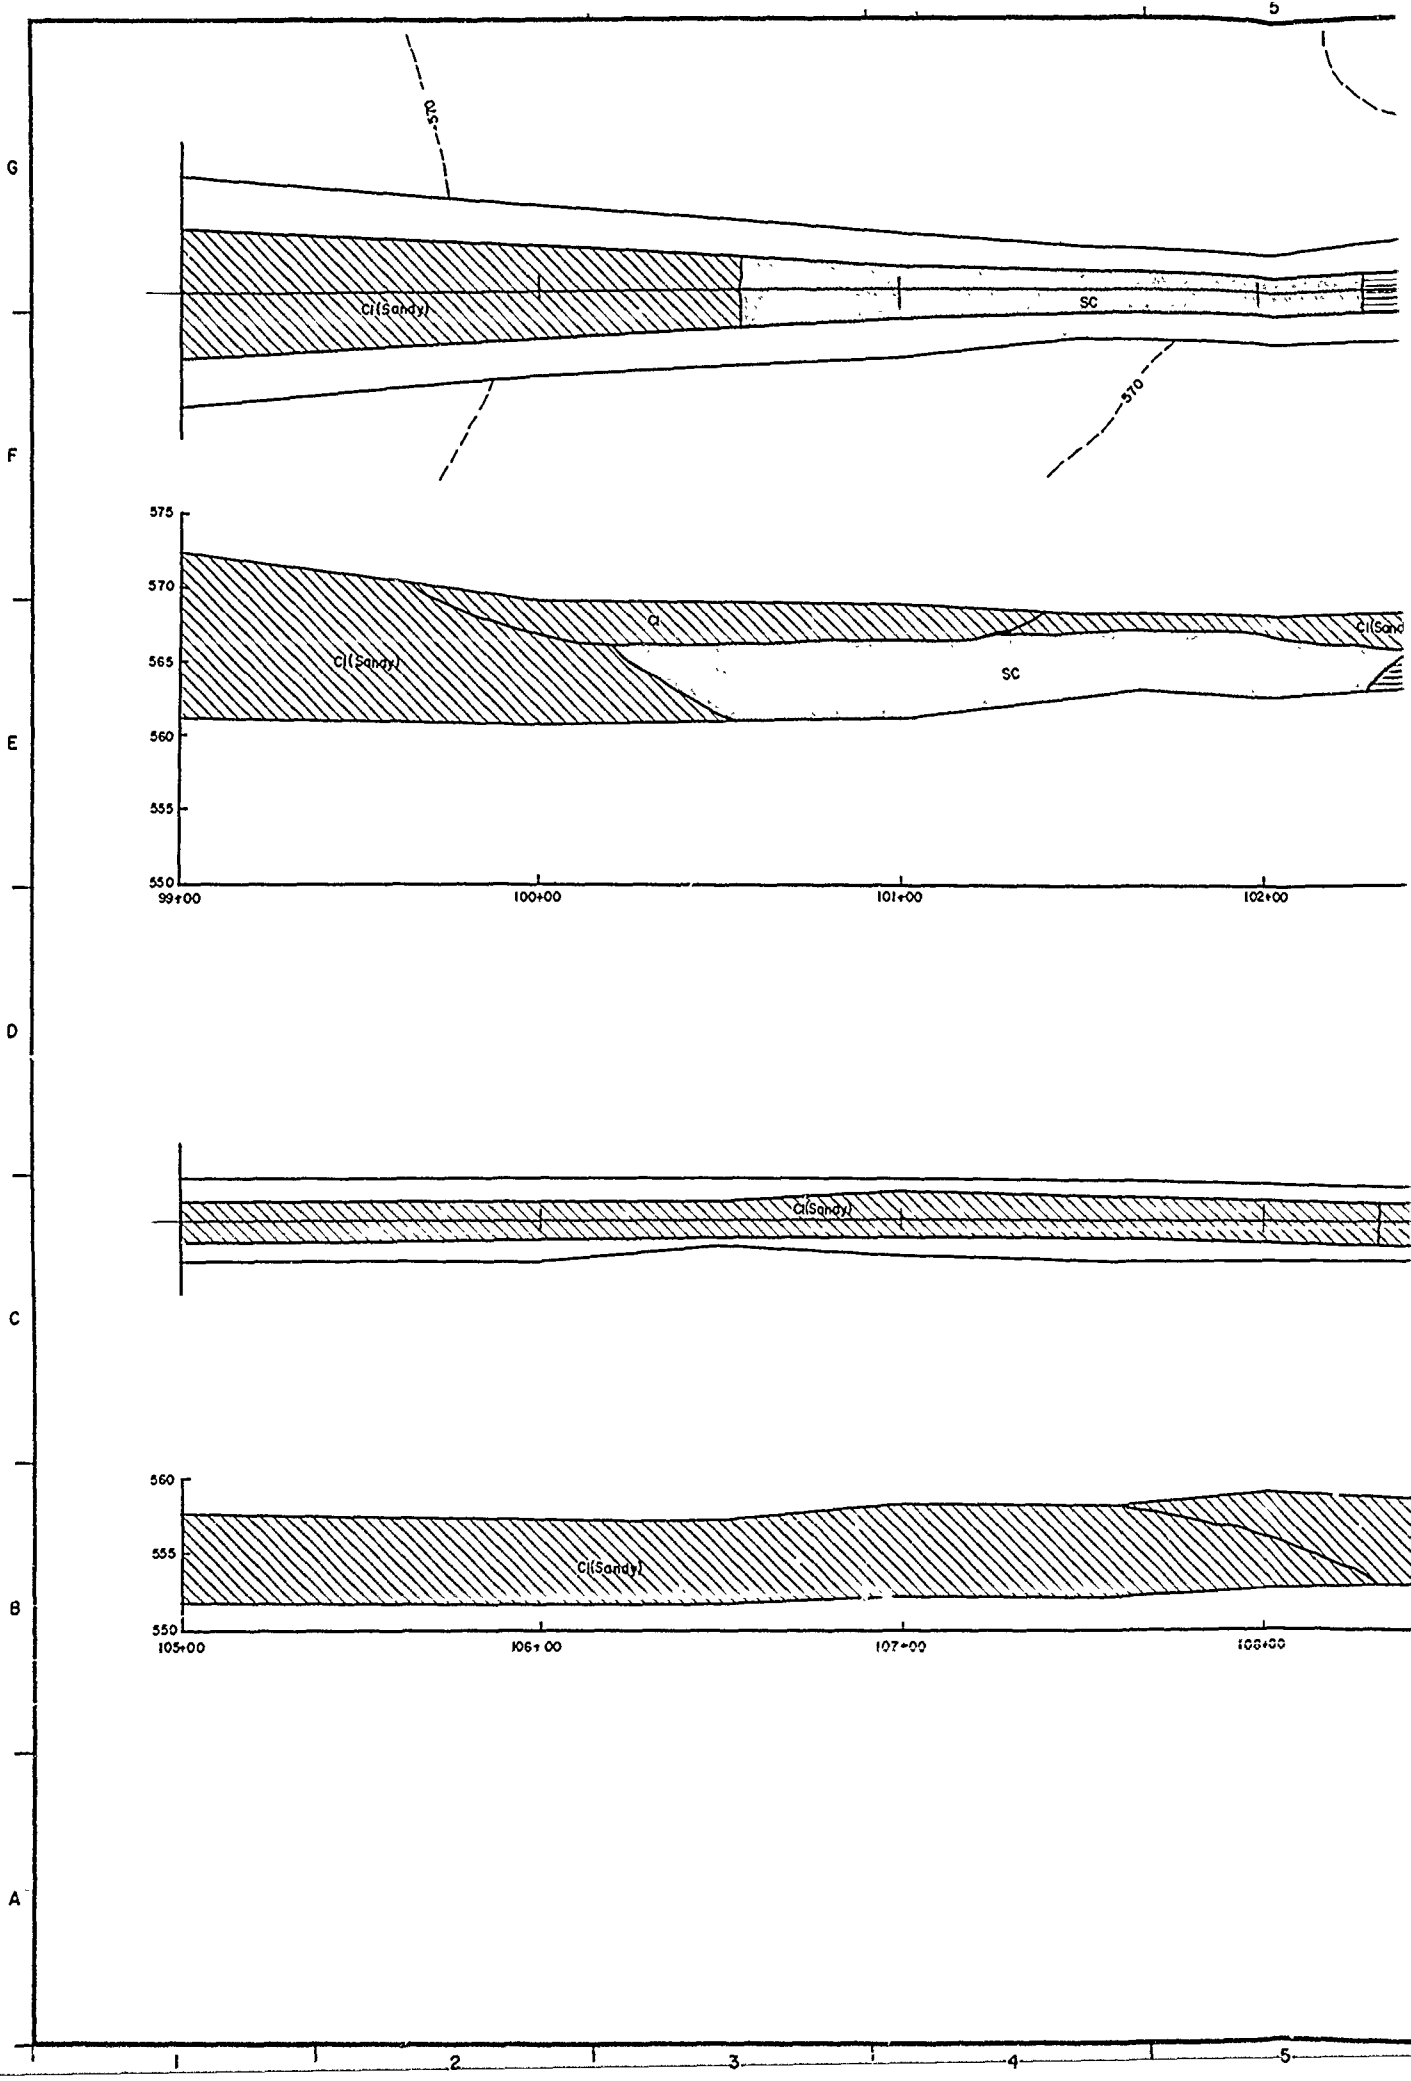

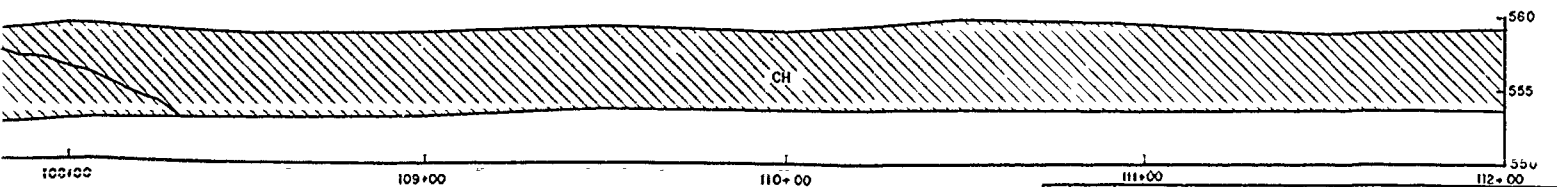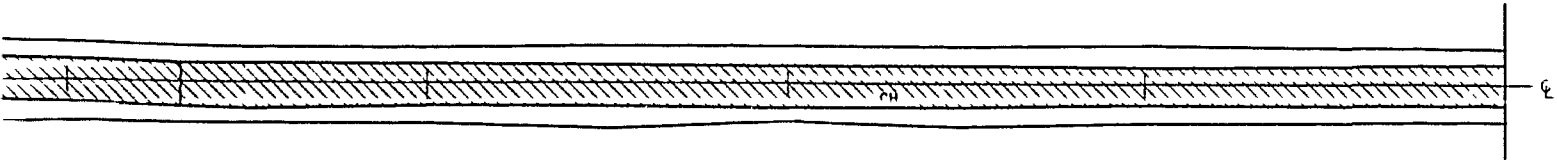
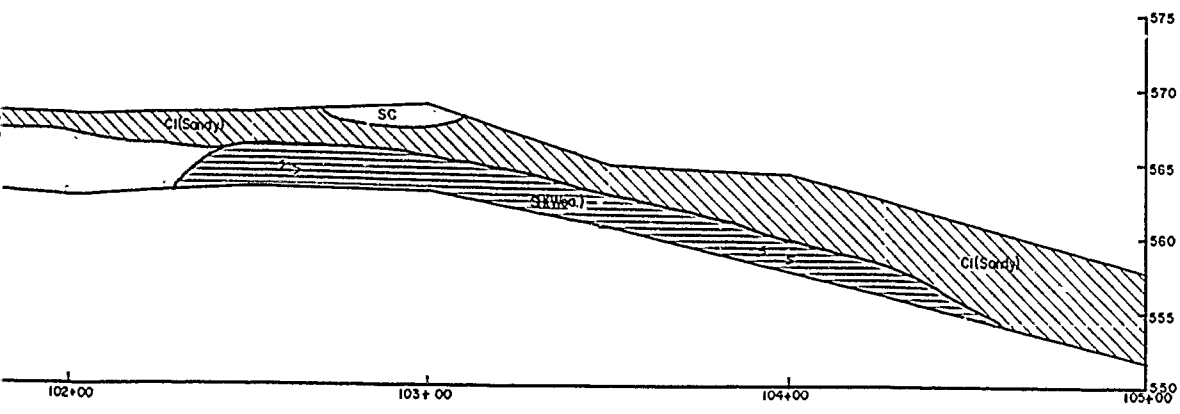
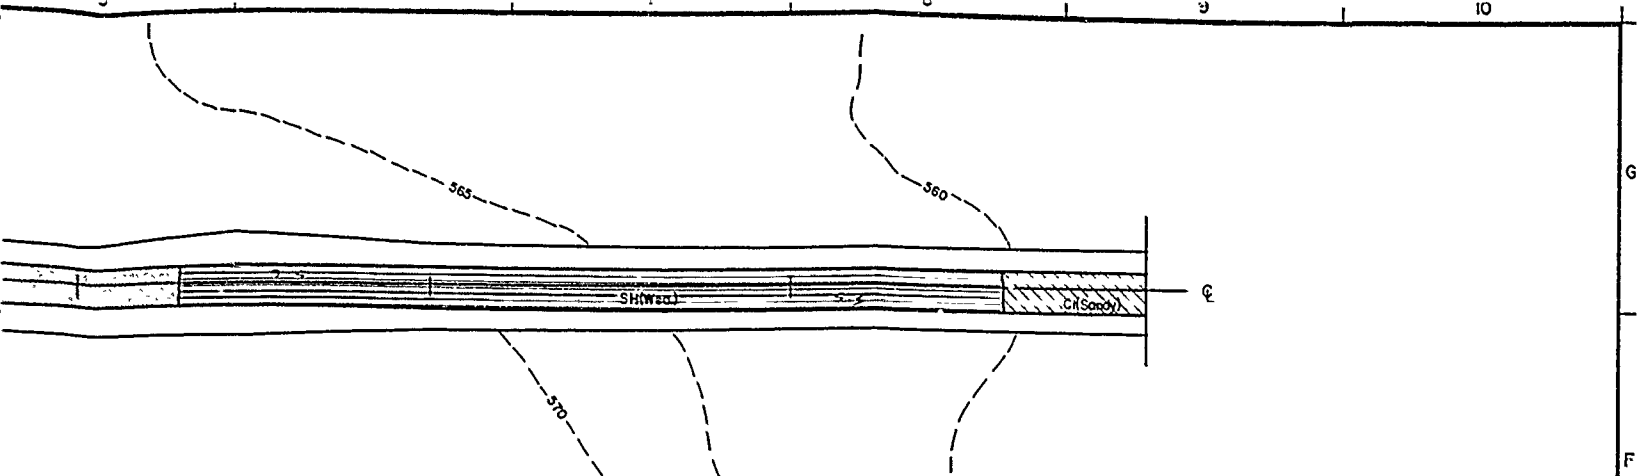


DESIGNED BY: <u>H. BARNETT</u>		RAY ROBERTS LAKE ELM FORK, TRINITY RIVER, TEXAS FOUNDATION REPORT INSPECTION TRENCH AS-BUILT PLAN AND PROFILE STA. 99+00 TO 112+00	
DRAWN BY: <u>C. KIRBY</u>			
REVIEWED BY: <u>R. BEHM</u>			
SUBMITTED BY: <u>ROBERT C. BEHM</u>			
CONTR. NO.		DATED:	
DRAWING NUMBER		SEQUENCE NO.	
SHEET NO.		58	

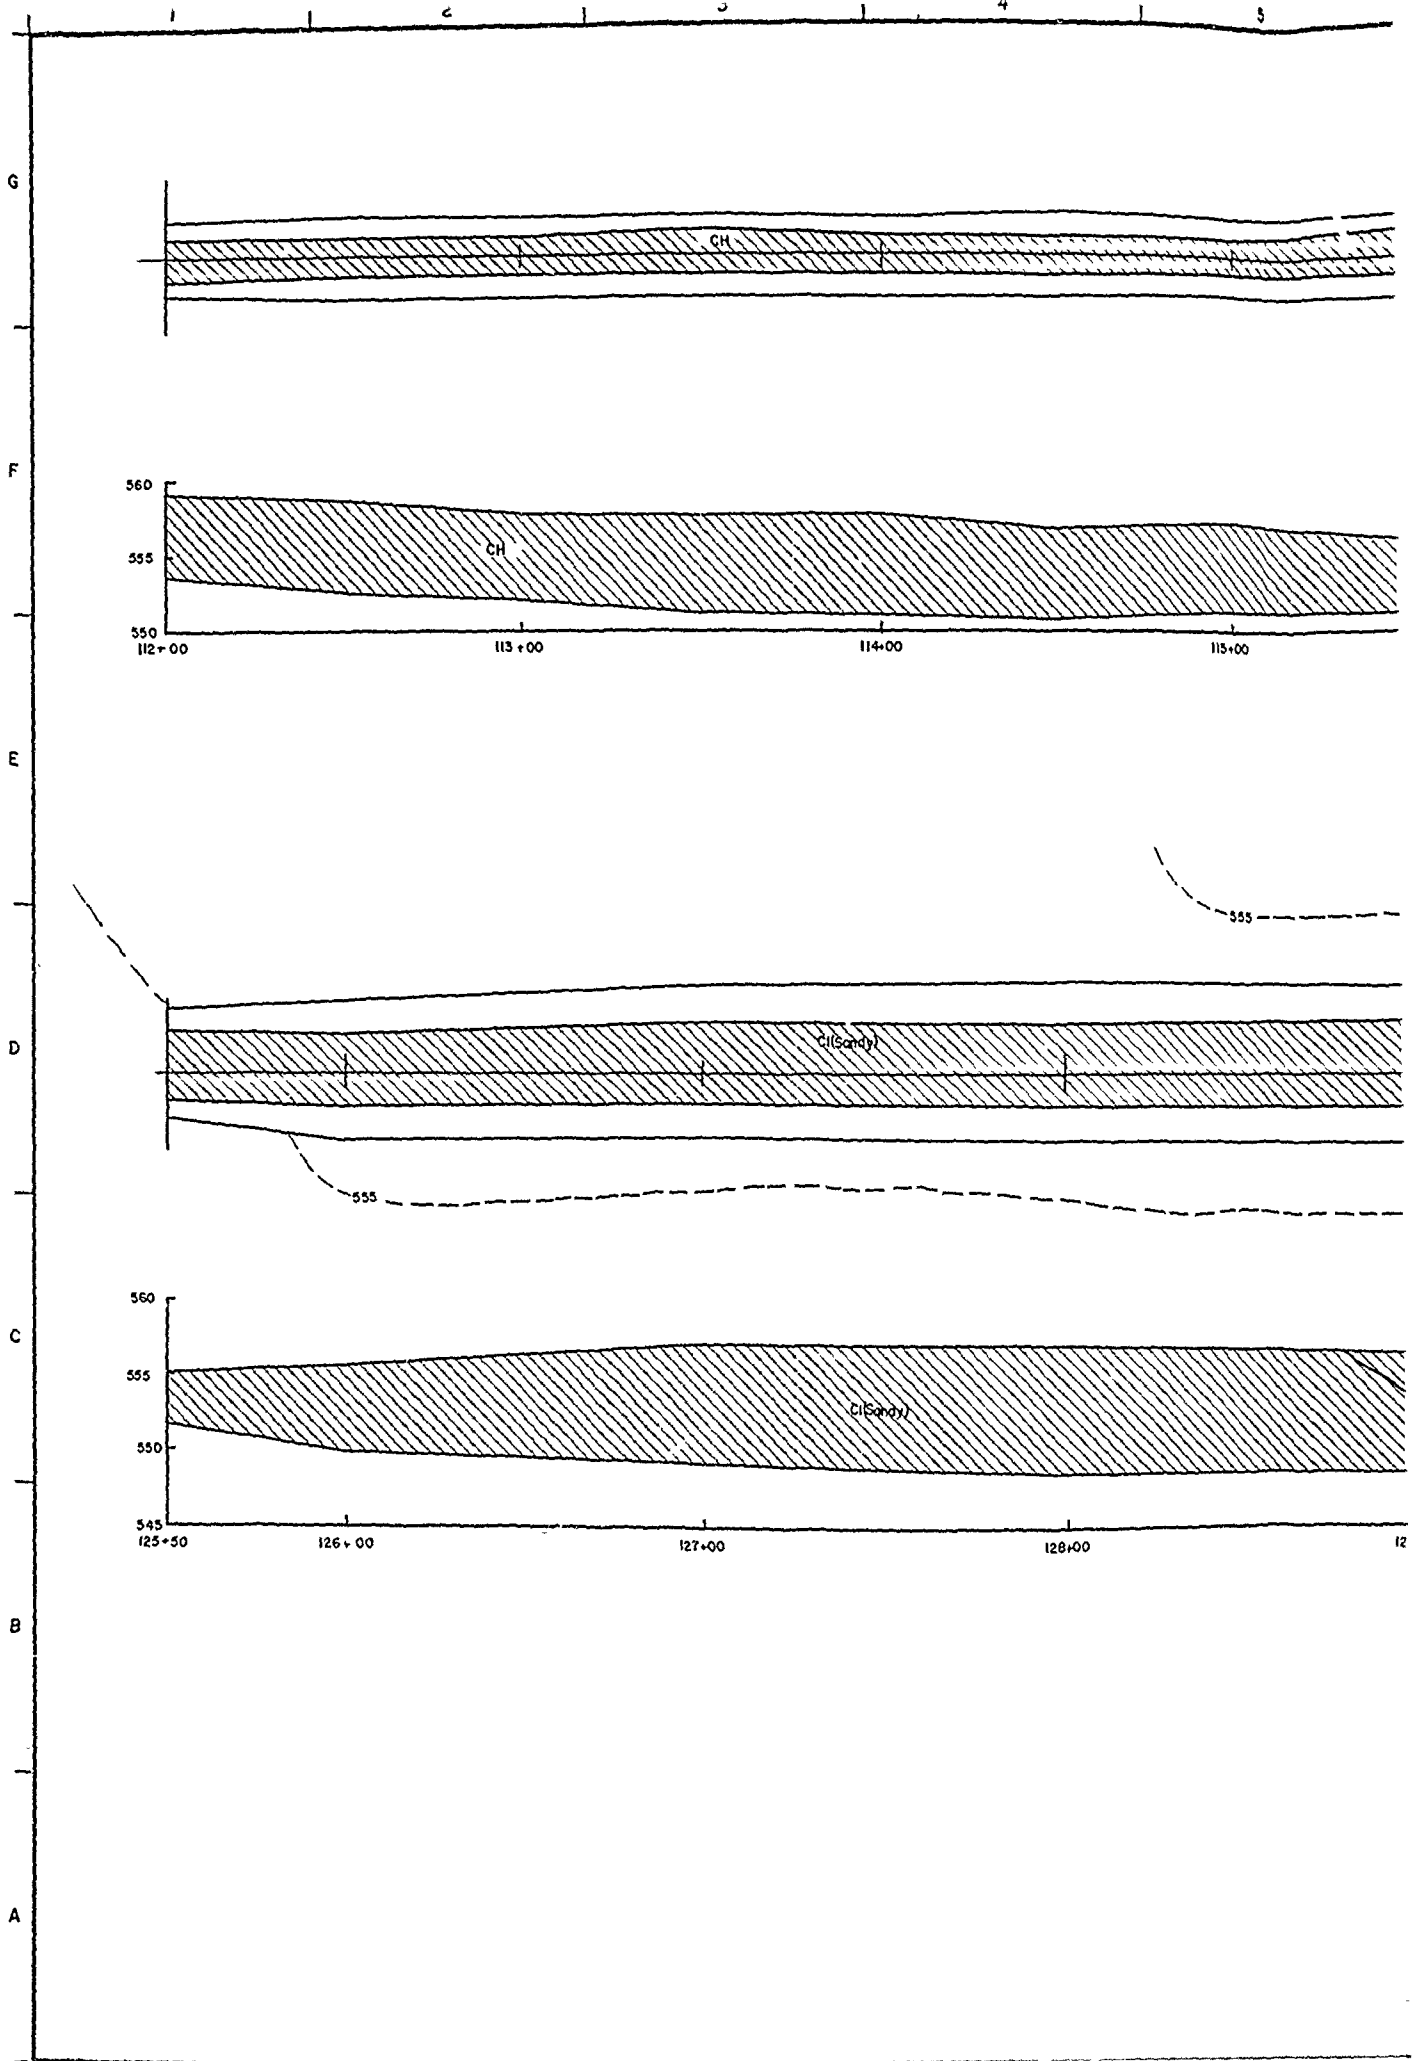

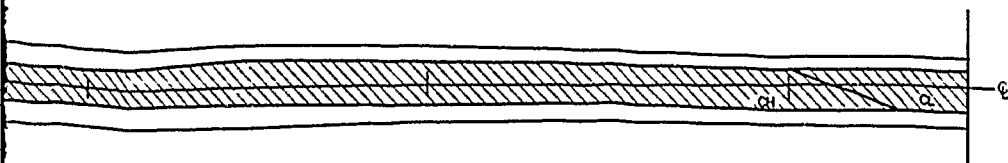




NOTE
 NO INSPECTION TRENCH WAS EXCAVATED BETWEEN
 STATIONS 117+50 AND 125+50

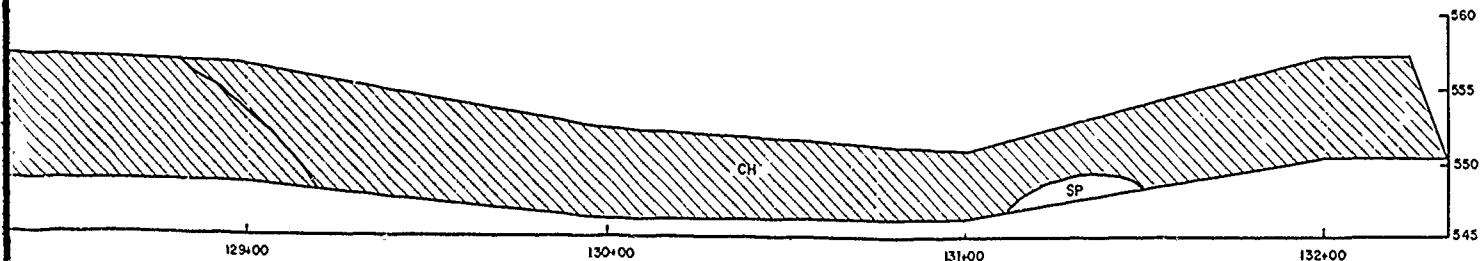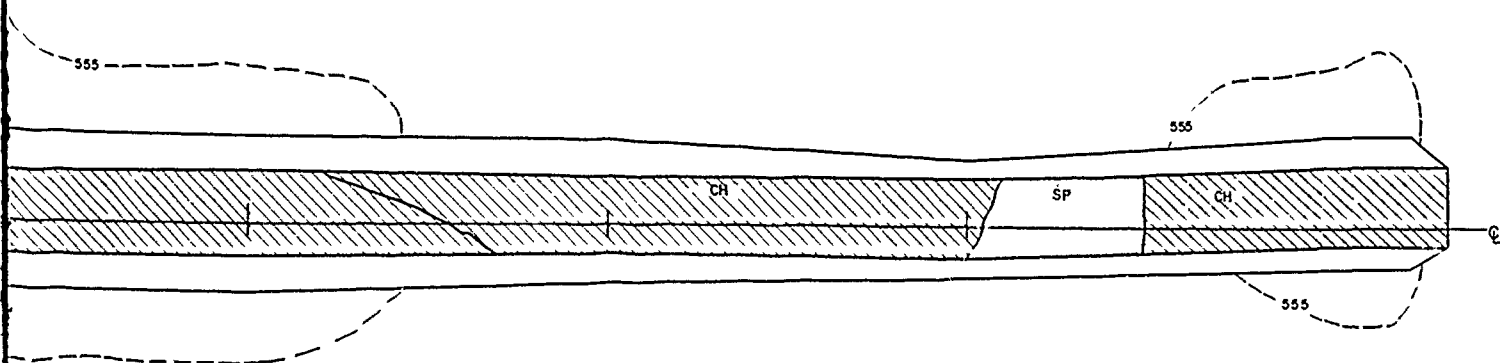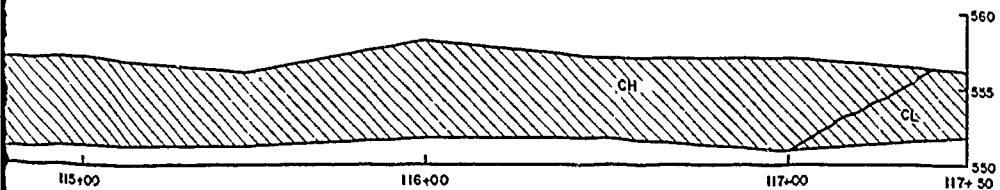

DESIGNED BY: H. BARNETT	RAY ROBERTS LAKE ELM FORK, TRINITY RIVER, TEXAS FOUNDATION REPORT INSPECTION TRENCH AS-BUILT PLAN AND PROFILE STA. 112+00 TO 117+50/125+50 TO 132+35	SCALE NO.	DATED:	SEQUENCE NO. 59	
DRAWN BY: C. KIRBY		CONTR. NO.	DRAWING NUMBER	SHEET NO. OF	
REVIEWED BY: R. BEHM		ENGINEER:			
ROBERT C. BEHM					


TO ACCOMPANY FOUNDATION REPORT

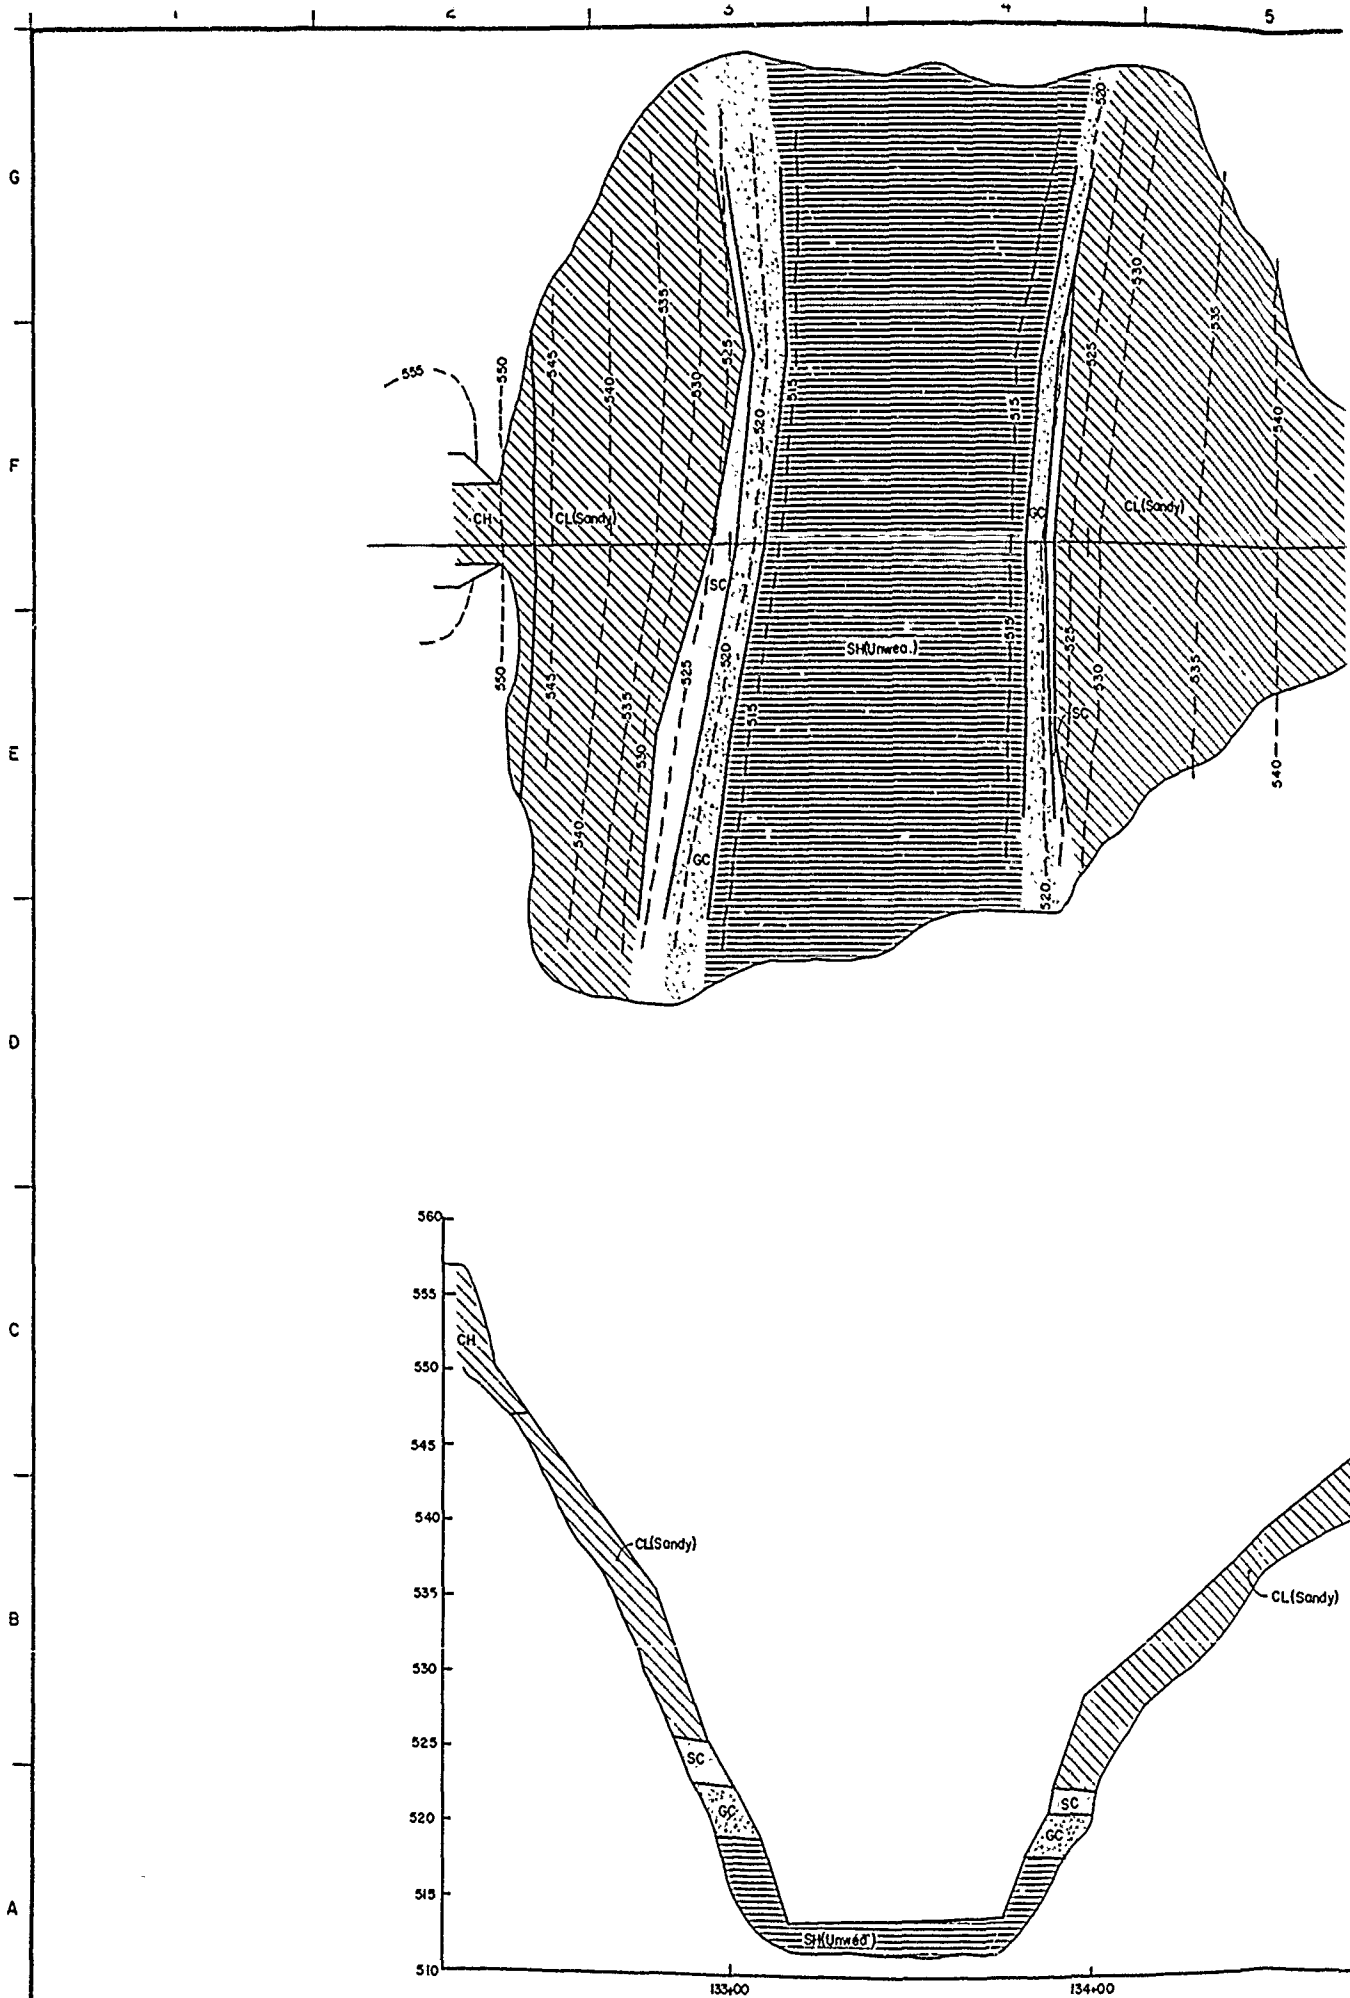

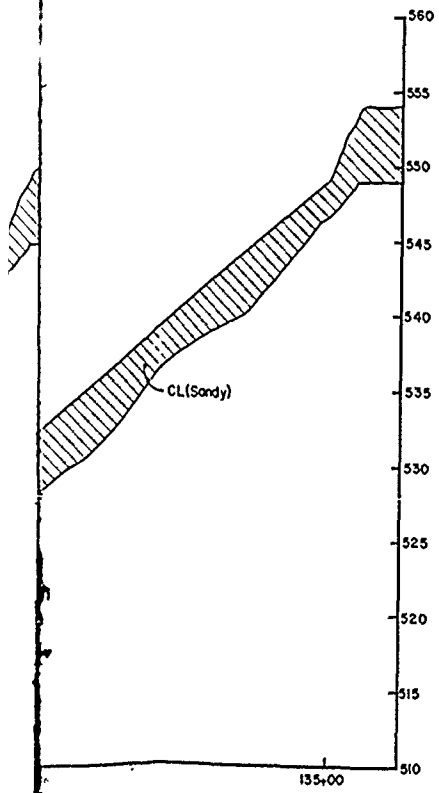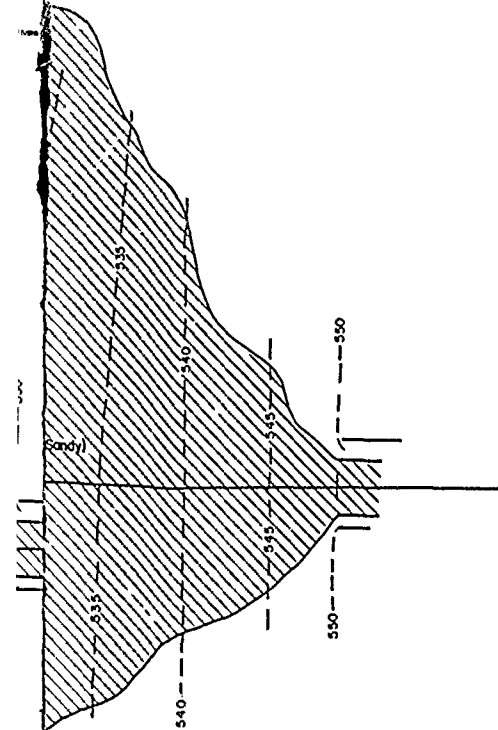

DESIGNED BY: H. BARNETT		RAY ROBERTS LAKE ELM FORK, TRINITY RIVER, TEXAS	
DRAWN BY: C. KIRBY		FOUNDATION REPORT INSPECTION TRENCH	
REVIEWED BY: R. BEHM		AS BUILT PLAN AND PROFILE STA. 132+35 TO 135+20	
SUBMITTED BY: ROBERT C BEHM		SOL. NO.	DATED:
ENGINEER:		CONTR. NO.	SHEET NO.
		DRAWING NUMBER	OF

TO ACCOMPANY FOUNDATION REPORT


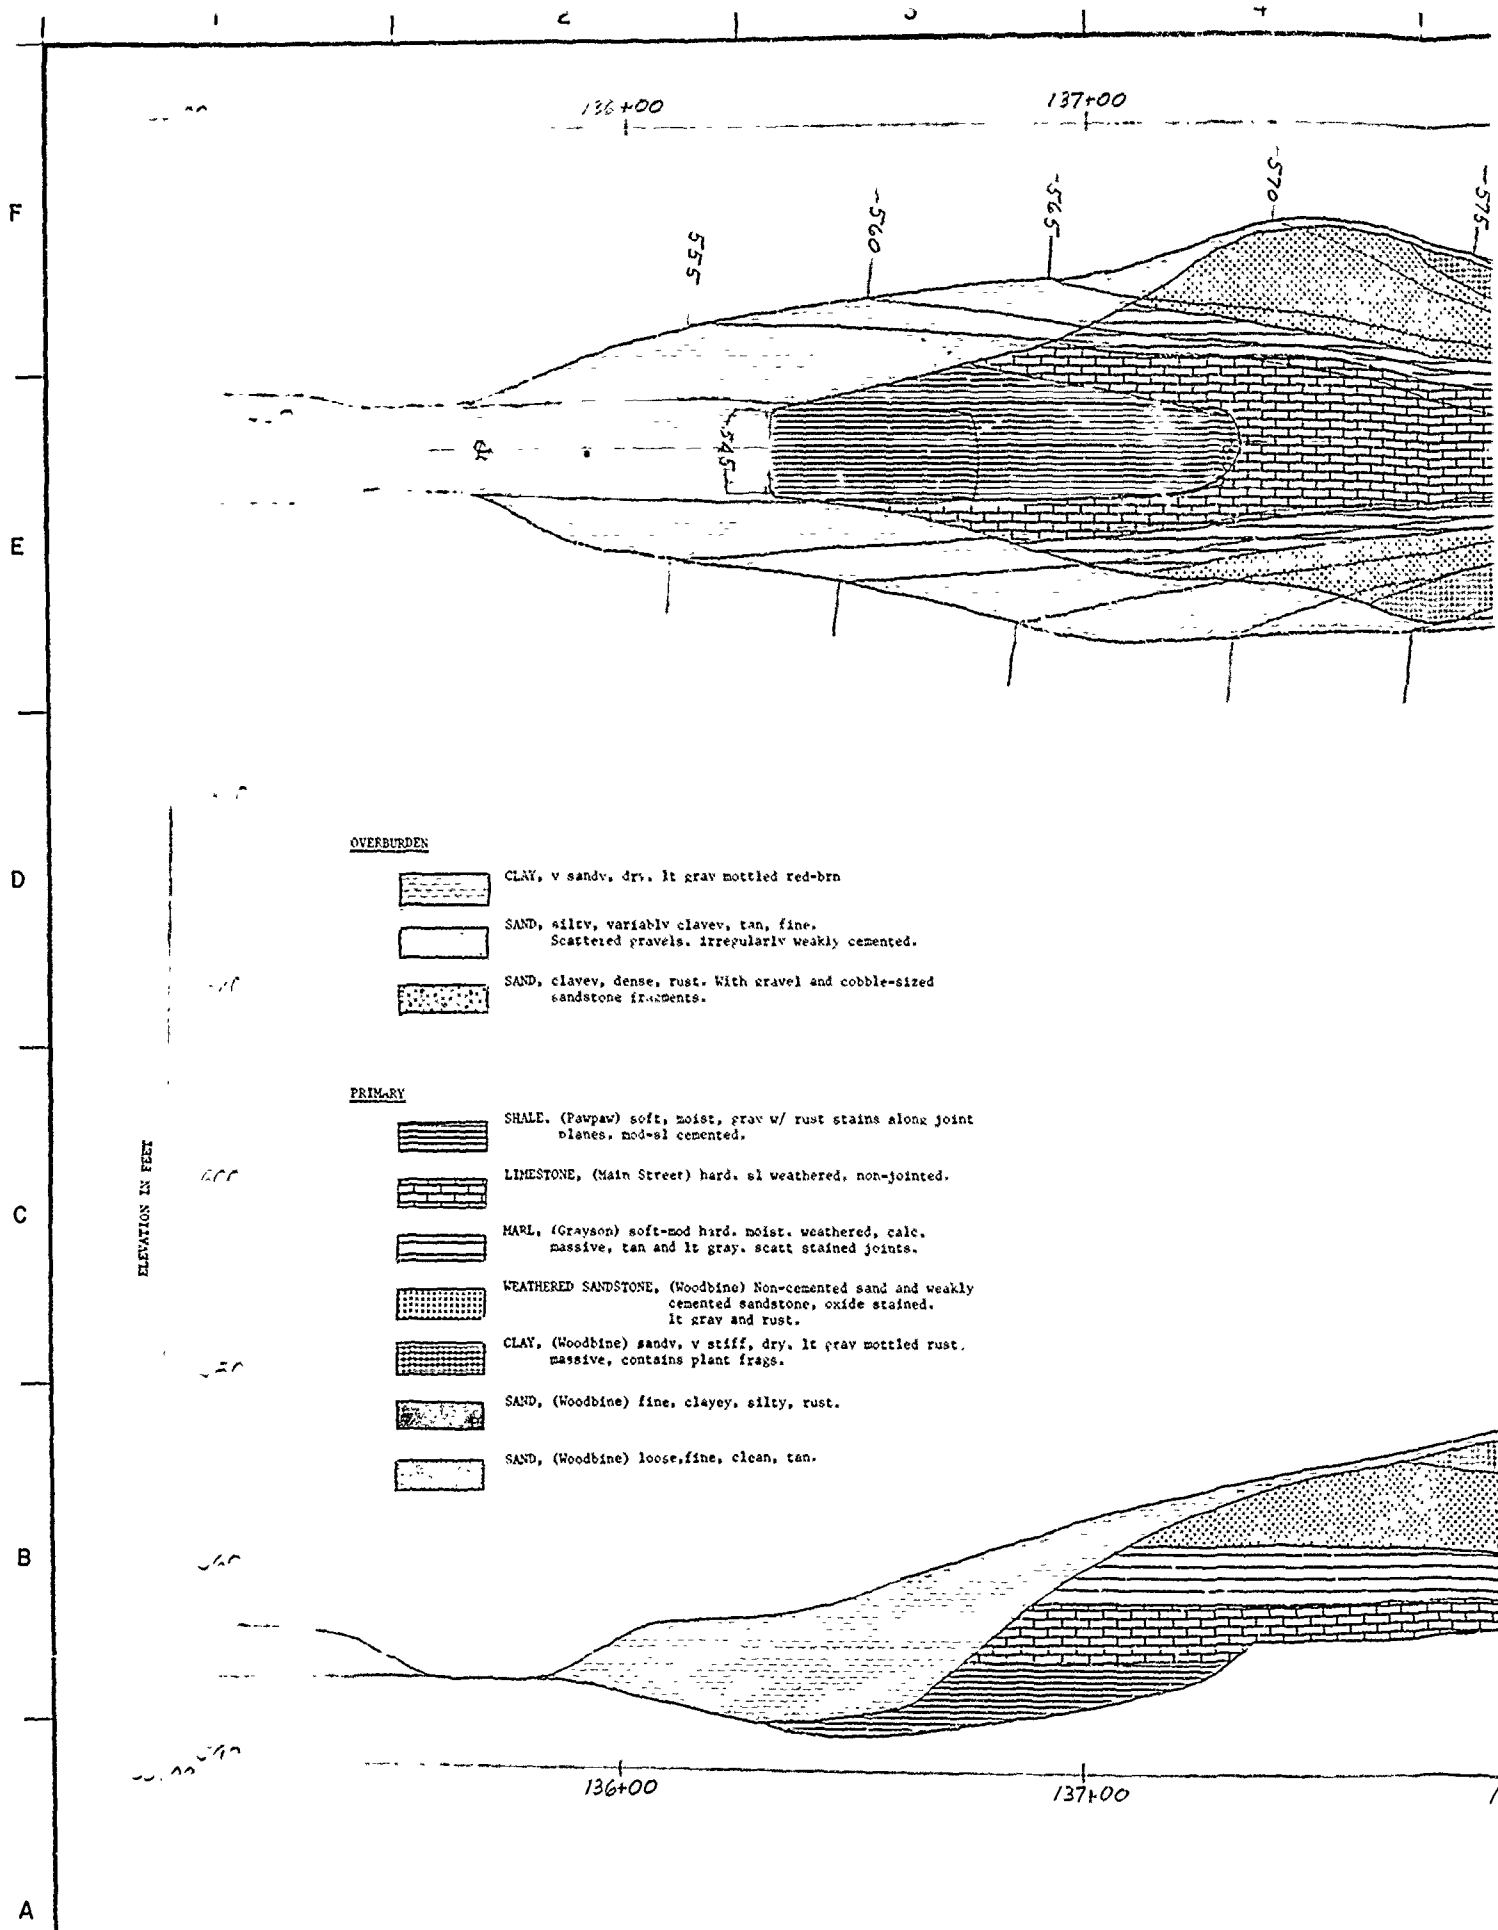


OVERBURDEN

- CLAY, v sandv, dry. lt gray mottled red-brn
- SAND, silty, variably clayey, tan, fine. Scattered gravels, irregularly weakly cemented.
- SAND, clayey, dense, rust. With gravel and cobble-sized sandstone fragments.



PRIMARY

- SHALE, (Pawpaw) soft, moist, gray w/ rust stains along joint planes, mod-sl cemented.
- LIMESTONE, (Main Street) hard, sl weathered, non-jointed.
- MARL, (Grayson) soft-mod hard, moist, weathered, calc. massive, tan and lt gray, scatt stained joints.
- WEATHERED SANDSTONE, (Woodbine) Non-cemented sand and weakly cemented sandstone, oxide stained. lt gray and rust.
- CLAY, (Woodbine) sandv, v stiff, dry, lt gray mottled rust. massive, contains plant frags.
- SAND, (Woodbine) fine, clayey, silty, rust.
- SAND, (Woodbine) loose, fine, clean, tan.

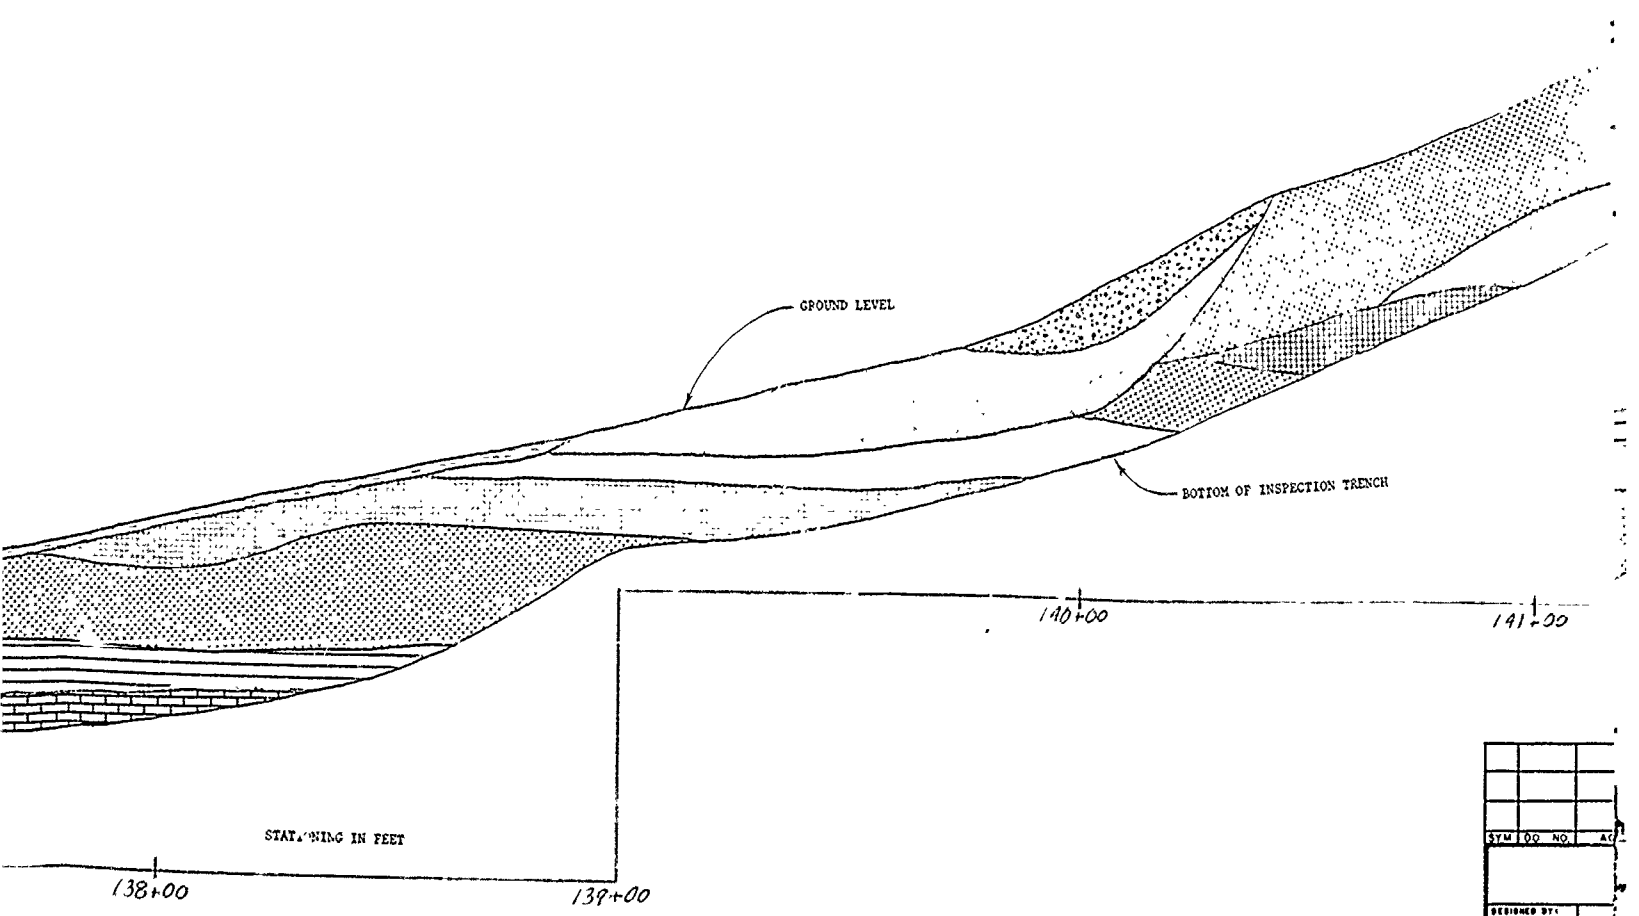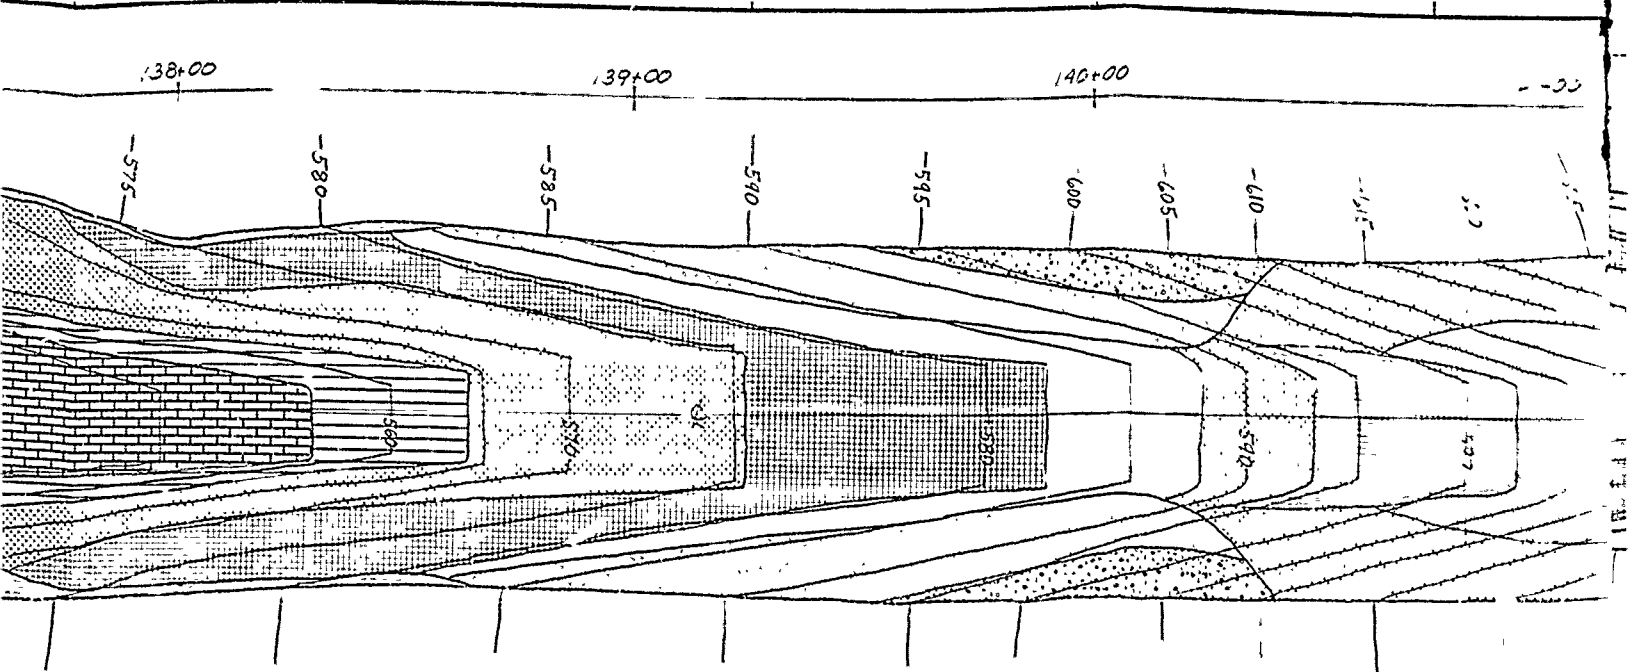


STATIONING IN FEET

DESIGNED BY:	R. HAGEN
DRAWN BY:	R. HAGEN
REVIEWED BY:	R. HAGEN

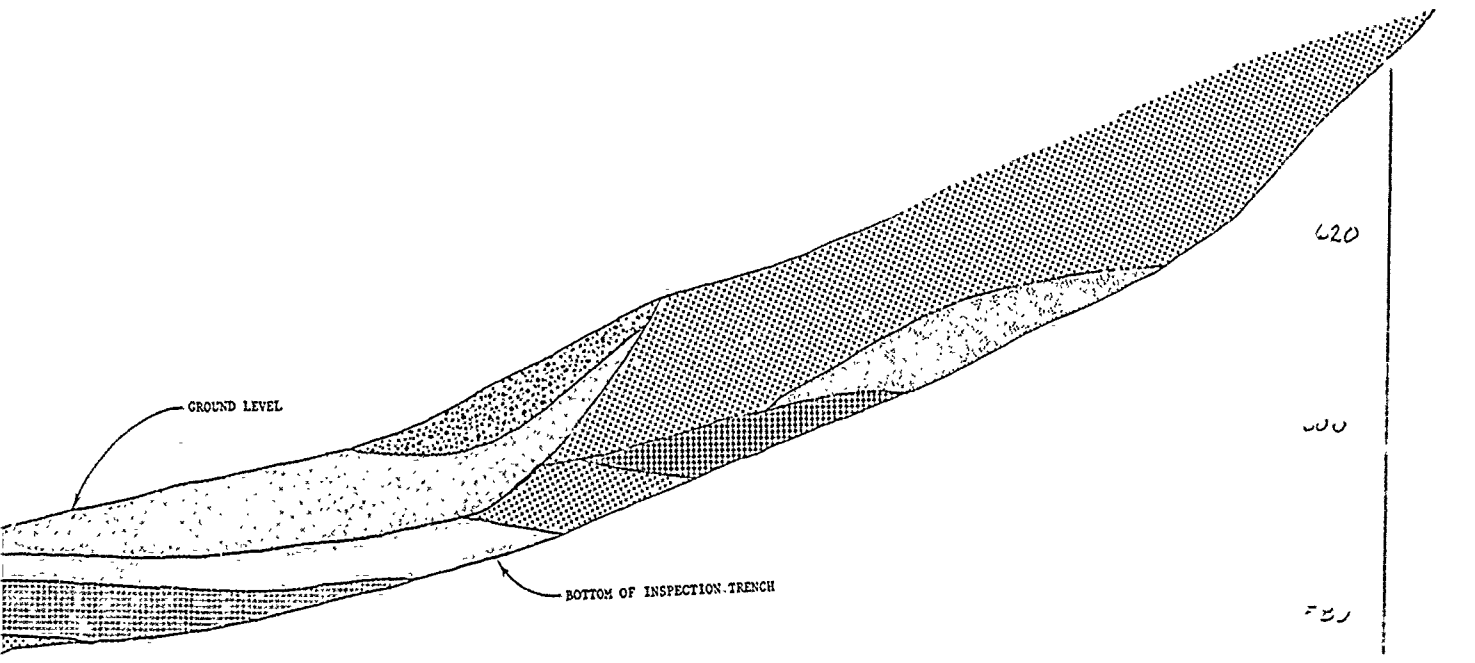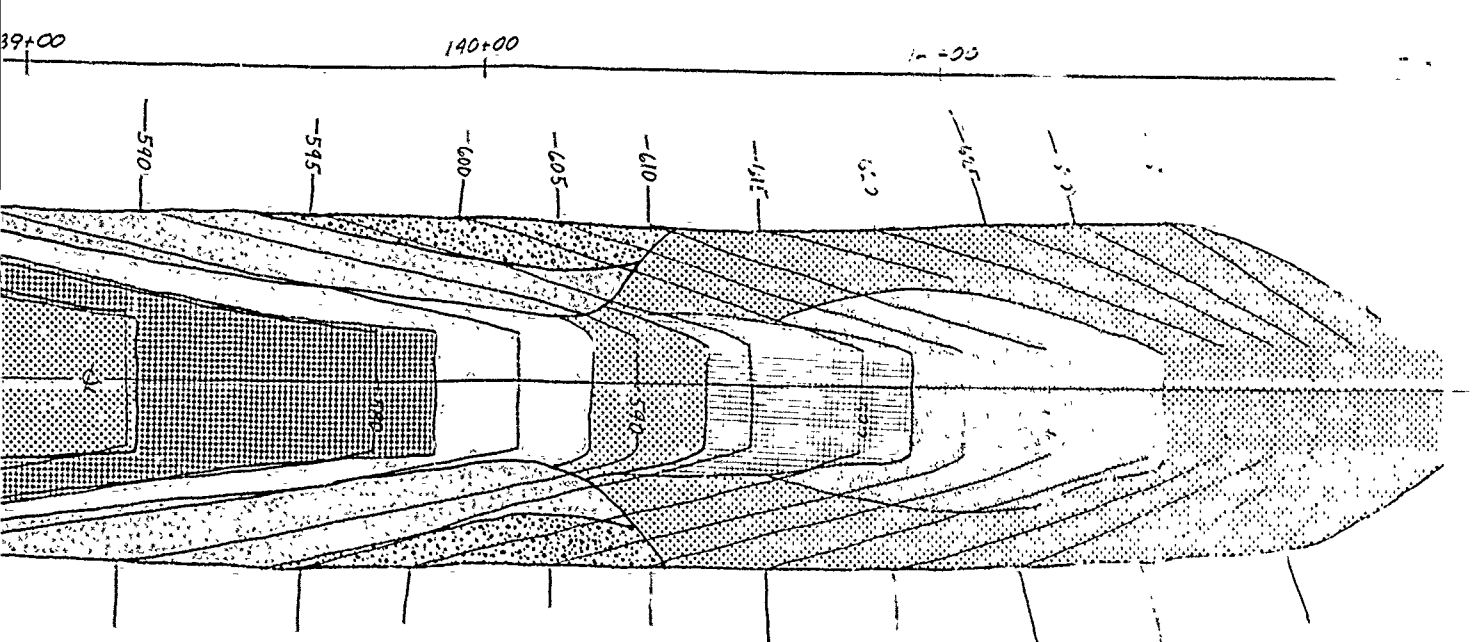

SYM	NO	NO	ACTION	DATE	DESCRIPTION OF REVISION
					U.S. ARMY ENGINEER DISTRICT, FORT WORTH CORPS OF ENGINEERS FORT WORTH, TEXAS
DESIGNED BY:	RAY ROBERTS LAKE ELM-FORK TRINITY RIVER, TEXAS				
DRAWN BY:	LEFT ABUTMENT INSPECTION TRENCH				
REVIEWED BY:	GEOLOGIC PLAN AND PROFILE STA. 135+00 TO STA. 142+00				
SUBMITTED BY:	ROBERT C. BEHAM			INVITATION NO.	DATE:

© DBM-1

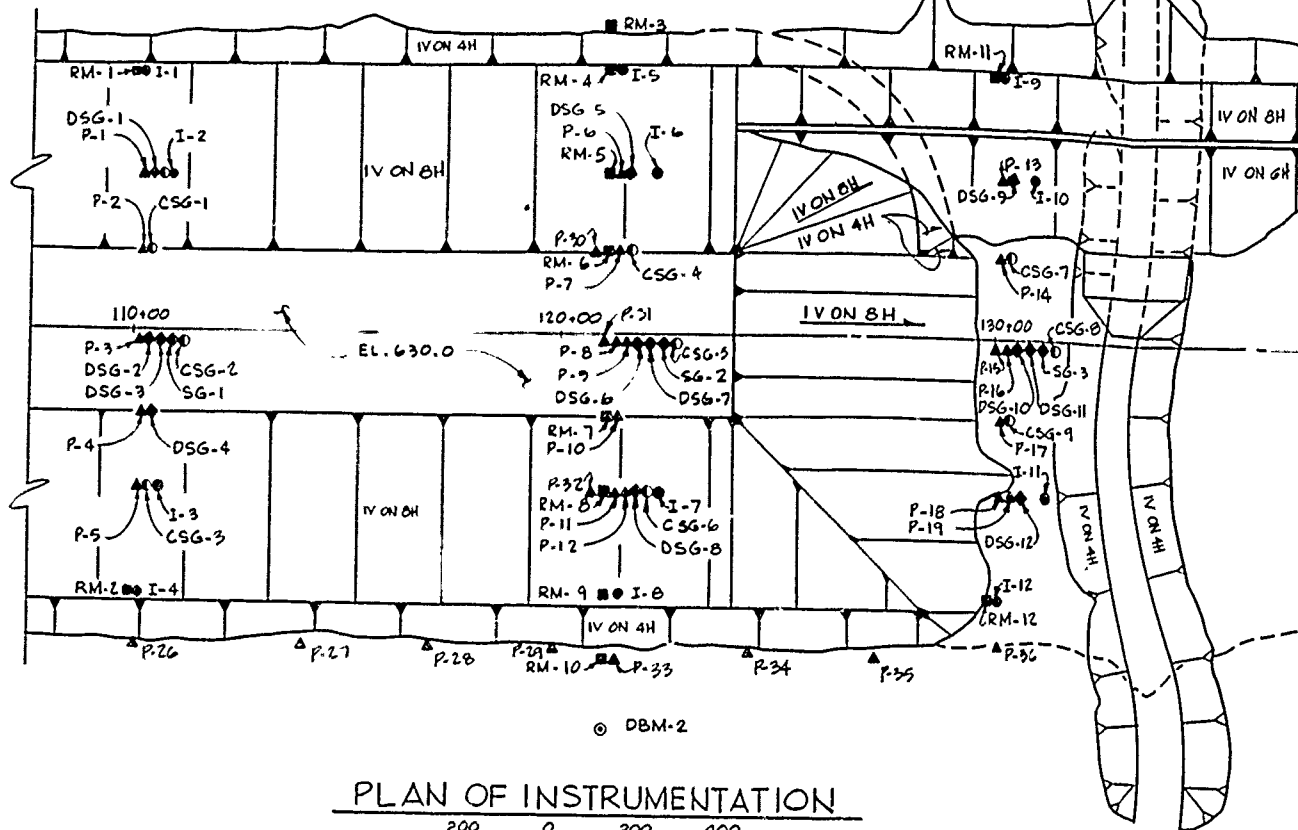

© DBM-2

PLAN OF INSTRUMENTATION






REFERENCE MARKS				
LINE	NO.	STATION	OFFSET	INSTALLATION SCHEDULE
A	RM-1	109+90.2	580.6 U/S	3
	RM-2	109+90.1	580.3 O/S	3
B	RM-3	120+89.4	579.6 U/S	1
	RM-4	120+90.3	579.1 U/S	3
	RM-5	120+90.7	350.0 U/S	3
	RM-6		U/S	3
	RM-7		O/S	3
C	RM-8	120+92.3	351.1 O/S	3
	RM-9	120+77.6	580.2 O/S	3
	RM-10	120+78.3	589.8 O/S	3
	RM-11		U/S	3
	RM-12		O/S	3

POROUS PLASTIC TIP PIEZOMETERS						
LINE NO.	STATION	OFFSET	FILTER LOCATION	APPROX. FILTER EL. FT., MSL	INSTALLATION SCHEDULE	
A	P-1	110+15	349' U/S	WK CI	624-629	
	P-2	110+10	179' U/S	WK CI	529-534	
	P-3	110+10	24' O/S	WK CI	524-529	
	P-4	110+18	181' O/S	WK CI	525-530	
	P-5	110+10	350' O/S	WK CI	526-531	
B	P-6	121+10	350' U/S	WK CI	538-543	
	P-7	121+11	180' U/S	WK CI	538-543	
	P-8	121+01	24' O/S	WK CI	522-527	
	P-9	121+10	24' O/S	SH	492-496	
	P-10	121+10	180' O/S	WK CI	530-535	
	P-11	121+20	350' O/S	WK CI	536-541	
	P-12	121+10	350' O/S	SH	499-504	
C	P-13	129+99	351' U/S	WK CI	533-538	2
	P-14	130+11	112' U/S	WK CI	527-532	2
	P-15	130+00	24' O/S	WK CI	529-534	2
	P-16	130+10	24' O/S	SH	501-506	2
	P-17A	130+01	116' O/S	WK CI	526-531	2
	P-18	129+99	349' O/S	WK CI	524-529	2
	P-11	130+10	349' O/S	SH	499-504	2
SEEPAGE PIEZOMETERS	P-21	28+47	297' O/S	SD+GR	583-588	4
	P-22	32+46	299' O/S	SD+GR	581-586	4
	P-23	54+02	323' O/S	SD+GR	565-570	4
	P-24	63+00	327' O/S	SD+GR	565-570	4
	P-25	73+25	328' O/S	SD+GR	576-581	4
	P-26	85+07	320' O/S	SD+GR	576-581	4
	P-27	110+05	666' O/S	SD+GR	523-528	4
	P-28	114+00	678' O/S	SD+GR	521-526	4
	P-29	116+99	678' O/S	SD+GR	520-525	4
	P-30	119+99	678' O/S	SD+GR	518-523	4
	P-31	121+40	182' U/S	SD+GR	520-525	4
	P-32	120+40	26' O/S	SD+GR	512-518	4
P-33	121+00	345' O/S	SD+GR	524-529	4	
P-34	121+09	677' O/S	SD+GR	518-523	4	
P-35	124+30	675' O/S	SD+GR	520-525	4	
P-36	127+29	672' O/S	SD+GR	521-526	4	
	130+10	675' O/S	SD+GR	522-527	4	


SETTLEMENT			
LINE NO.	STATION	OFF.	
A	DSG-1	110+30	350
	DSG-2	110+20	24
	DSG-3	110+30	24
	SG-1	110+50	25
	DSG-4	110+20	350
B	DSG-5	121+20	350
	DSG-6	121+20	24
	DSG-7	121+40	24
	SG-2	121+31	25
	DSG-8	121+30	350
C	DSG-9	130+09	351
	DSG-11	130+19	24
	SG-3	130+40	24
	DSG-12	130+19	350

POROUS PLASTIC TIP P			
LINE NO.	STATION	OFFSET	L
P-14B	130+07	120' U/S	5
P-31	137+62	104' U/S	
P-35	137+59	361' O/S	
P-37	137+58	621' O/S	
P-40	139+06	107' O/S	
P-41	139+04	565' O/S	
P-42	140+53	326' O/S	
P-43A	141+41	92' O/S	
P-43B	141+39	95' O/S	

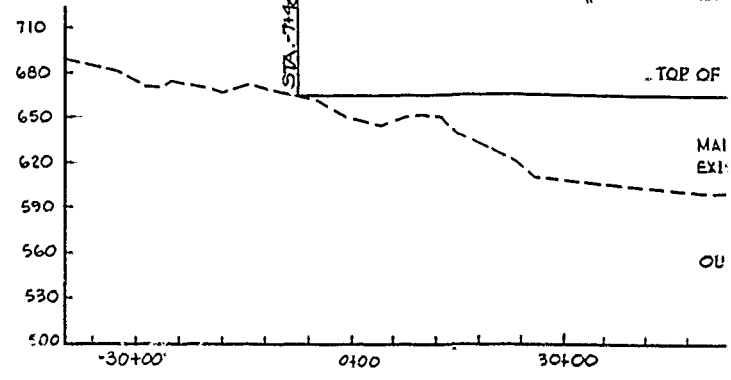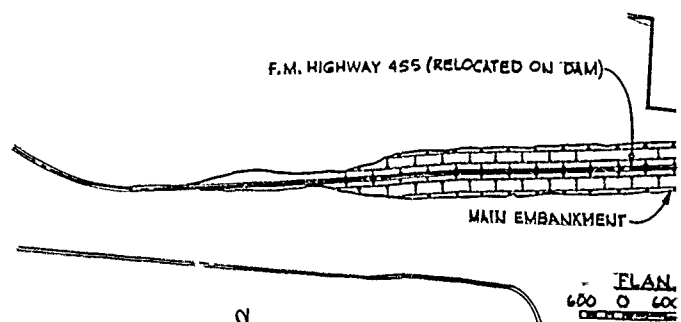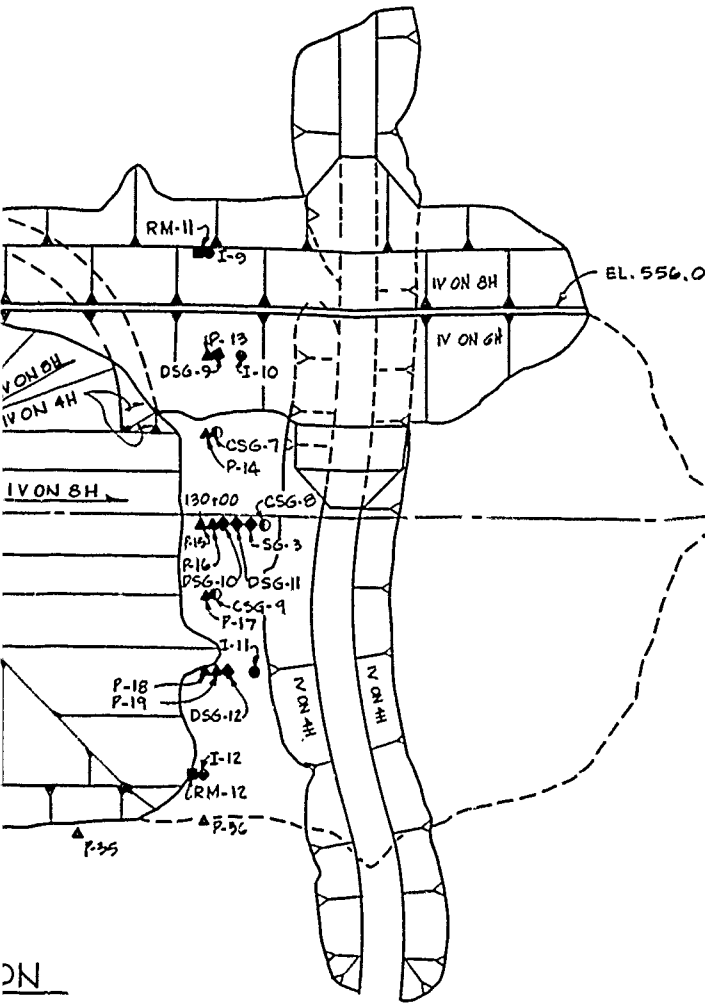

PLAN
0 60'

PRO

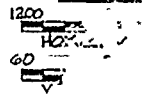

PER TION	APPROX. FILTER EL. FT., MSL	INSTALLATION SCHEDULE
CI	524-529	
CI	529-534	
CI	524-529	
CI	525-530	
CI	526-531	
CI	530-535	
CI	530-535	
CI	522-527	
CI	490-495	
CI	630-635	
CI	536-541	
H	499-504	
CI	533-538	2
CI	527-532	2
CI	524-529	2
CI	501-506	2
CI	526-531	2
CI	524-529	2
CI	499-504	2
GR	583-588	4
GR	581-586	4
GR	585-590	4
GR	585-590	4
GR	576-581	4
GR	576-581	4
GR	523-528	4
GR	521-526	4
GR	520-525	4
GR	513-518	4
GR	524-529	4
GR	518-523	4
GR	520-525	4
GR	521-526	4
GR	522-527	4

SETTLEMENT GAGES					
LINE	NO.	STATION	OFFSET	APPROX. PLATE EL.	INSTALLATION SCHEDULE
A	DSG-1	110+30	350' U/S	536	1
	DSG-2	110+20	24' D/S	503	1
	DSG-3	110+30	24' D/S	526	1
	SG-1	110+50	25' D/S	560	1
	DSG-4	110+20	550' D/S	527	1
B	DSG-5	121+20	350' U/S	540	1
	DSG-6	121+20	24' D/S	526	1
	DSG-7	121+40	24' D/S	508	1
	SG-2	121+31	25' D/S	557	1
	DSG-8	121+30	350' D/S	540	1
C	DSG-9	130+07	351' U/S	536	2
	DSG-10	130+19	24' D/S	532	2
	DSG-11	130+27	24' D/S	516	2
	SG-3	130+40	24' U/S	558	2
DSG-12	130+19	350' D/S	526	2	

INCLINOMETERS					
LINE	NO.	STATION	OFFSET	APPROX. BOTTOM	INSTALLATION SCHEDULE
A	I-1	110+10	580' U/S	490	1
	I-2	110+30	350' U/S	490	1
	I-3	110+30	350' D/S	480	1
	I-4	110+20	580' D/S	488	1
B	I-5	121+10	580' U/S	500	1
	I-6	121+30	350' U/S	498	1
	I-7	121+50	350' D/S	494	1
	I-8	121+10	580' D/S	494	1
C	I-9	130+10	580' U/S	490	2
	I-10	130+30	350' U/S	496	2
	I-11	130+40	350' D/S	494	2
	I-12	130+10	580' D/S	494	2

INSTALLATION SCHEDULE

1. AFTER STRIPPING STA
2. AFTER STRIPPING STA
3. AS EMBANKMENT RELEVATION AT THIS ST OFFSET (BEFORE TOP)
4. AFTER ENTIRE EMBANKMENT TOPPED-OUT

LEGEND


- ▲ PIEZOMETER
- ◆ SETTLEMENT GAGE
- COLLAPSIBLE SETTLEMENT GAGE
- INCLINOMETER
- REFERENCE MARK
- ⊙ BENCHMARK

COLLAPSIBLE SETTLEMENT GAGES					
LINE	NO.	STATION	OFFSET	APPROX. BOTTOM	INSTALLATION SCHEDULE
A	CSG-1	110+20	180' U/S	490	1
	CSG-2	110+50	24' U/S	480	1
	CSG-3	110+40	350' D/S	480	1
B	CSG-4	121+20	180' U/S	496	1
	CSG-5	121+60	24' D/S	486	1
	CSG-6	121+40	350' D/S	494	1
C	CSG-7	130+20	180' U/S	496	2
	CSG-8	130+60	24' D/S	486	2
	CSG-9	130+20	180' D/S	494	2


POROUS PLASTIC TIP PIEZOMETERS (CONT.)						
LINE	NO.	STATION	OFFSET	FILTER LOCATION	APPROX. FILTER EL. FT., MSL	INSTALLATION SCHEDULE
P	P-14	130+07	120' U/S	SD & CI		
	P-31	137+62	104' U/S	SD		
	P-38	137+59	36' D/S			
	P-37	137+58	62' D/S			
	P-40	139+06	107' D/S	SD & CI		
	P-41	139+04	565' D/S	SD		
	P-42	140+53	326' D/S	SD		
	P-43A	141+41	92' D/S	SD		
	P-43B	141+39	95' D/S	SD		
	P-44	141+39	95' D/S	SD		

DEEP BENCHMARK				
LINE	NO.	STATION	OFFSET	APPROX. BOTTOM
B	BM-1	21+00	380' D/S	500
B	BM-2	21+00	380' D/S	490
B	BM-3	143+00	50' D/S	650


SEE EMBANKMENT INSTRUMENTATION PLAN THIS SEQUENCE

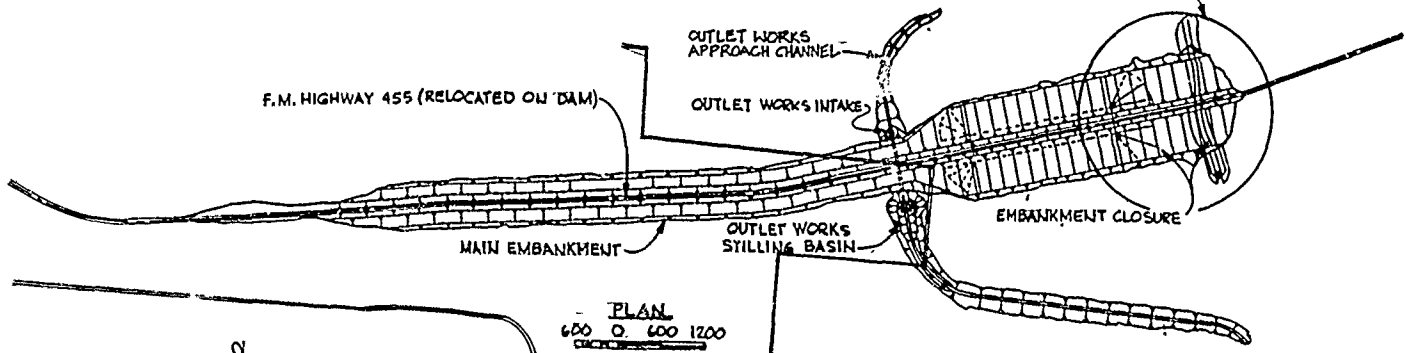

PLAN
600 O. 600 1200

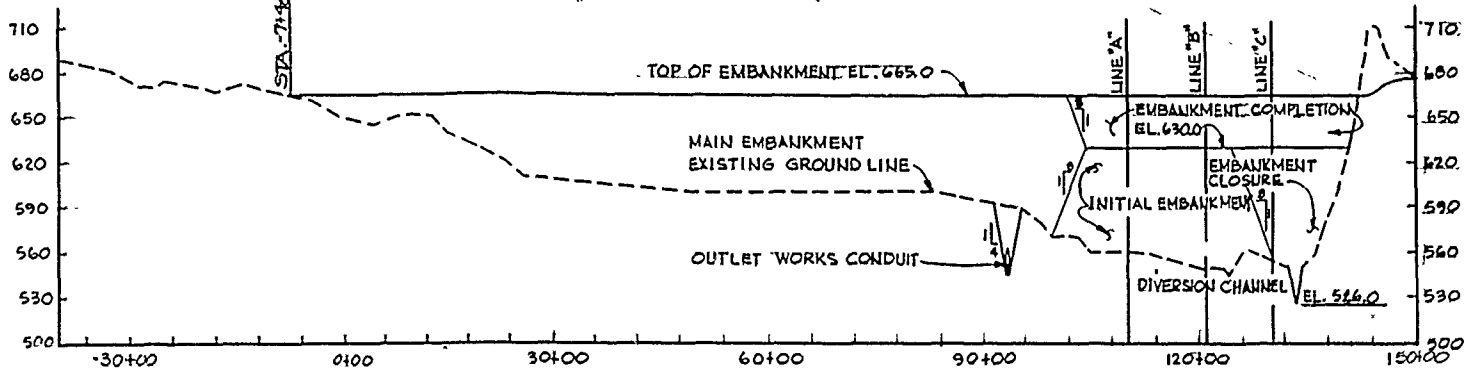

PROFILE

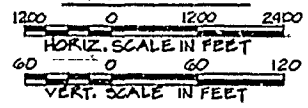

INCLINOMETERS					
LINE	NO.	STATION	OFFSET	APPROX. BOTTOM	INSTALLATION SCHEDULE
A	I-1	110+10	580' U/S	490	1
	I-2	110+30	350' U/S	490	1
	I-3	110+30	350' D/S	480	1
	I-4	110+20	580' D/S	488	1
B	I-5	121+10	580' U/S	500	1
	I-6	121+30	350' U/S	498	1
	I-7	121+50	350' D/S	494	1
	I-8	121+10	580' D/S	494	1
C	I-9	130+10	580' U/S	490	2
	I-10	130+30	350' U/S	496	2
	I-11	130+40	350' D/S	494	2
	I-12	130+20	580' D/S	494	2

INSTALLATION SCHEDULE LEGEND

- AFTER STRIPPING STAGE I
- AFTER STRIPPING STAGE III C
- AS EMBANKMENT REACHES FINISHED ELEVATION AT THIS STATION AND OFFSET (BEFORE TOPSOIL).
- AFTER ENTIRE EMBANKMENT IS TOPPED-OUT

LEGEND

- ▲ PIEZOMETER
- ◆ SETTLEMENT GAGE
- ◇ COLLAPSIBLE SETTLEMENT GAGE
- ⊖ INCLINOMETER
- REFERENCE MARK
- ⊙ BENCHMARK

COLLAPSIBLE SETTLEMENT GAGES					
LINE	NO.	STATION	OFFSET	APPROX. BOTTOM	INSTALLATION SCHEDULE
A	CS4-1	110+20	180' U/S	490	1
	CS4-2	110+50	24' U/S	480	1
	CS4-3	110+40	350' D/S	480	1
B	CS4-4	121+20	180' U/S	496	1
	CS4-5	121+60	24' D/S	486	1
	CS4-6	121+40	350' D/S	494	1
C	CS4-7	130+20	180' U/S	496	2
	CS4-8	130+60	24' D/S	486	2
	CS4-9	130+20	180' D/S	494	2

DEEP BENCHMARK					
LINE	NO.	STATION	OFFSET	APPROX. BOTTOM EL.	INSTALLATION SCHEDULE
B	DB1	121+00	380' D/S	500	1
B	DB2	121+00	380' D/S	490	1
C	DB3	143+00	50' D/S	650	1

NOTES:







- FOR SECTION THRU LINE A, SEE SEQ. NO. 44
- FOR SECTION THRU LINE B, SEE SEQ. NO. 45
- FOR SECTION THRU LINE C, SEE SEQ. NO. 46
- ALL INSTRUMENT ELEVATIONS ARE APPROXIMATE. ACTUAL ELEVATIONS WILL BE DETERMINED AT TIME OF INSTALLATION.
- ALL INSTRUMENTATION WILL HAVE PROTECTIVE FENCE, EXCEPT THOSE ALONG THE DOWNSTREAM CREST. FOR PROTECTIVE FENCE DETAILS, SEE SEQ. 41





RECORD DRAWING-WORK AS-BUILT

10182 2000000 304884 REVISD TO REFLECT AS-BUILT CHANGES 10182 2000000 304884 REVISD TO REFLECT AS-BUILT CHANGES			
DESIGNED BY	RAY ROBERTS LAKE		
DESIGNED BY	ELM FORK, TRINITY RIVER, TEXAS		
DESIGNED BY	CORPS OF ENGINEERS		
DESIGNED BY	FORT WORTH, TEXAS		
DESIGNED BY	A. BRANCH		
DESIGNED BY	J. FIESLER		
DESIGNED BY	A. BRANCH		
DESIGNED BY	H. KARBS		
DESIGNED BY	ENGINEER		
INVESTIGATION NO.	DACHW3-82-B-0026	DATE	MAR. 1982
CONTRACT NO.	DACHW3-82-C-0093	SHEET NO.	62
DRAWING NUMBER		SEQUENCE NO.	

DRAWING NO. DACHW3-82-C-0093

G
F
E
D
C
B
A

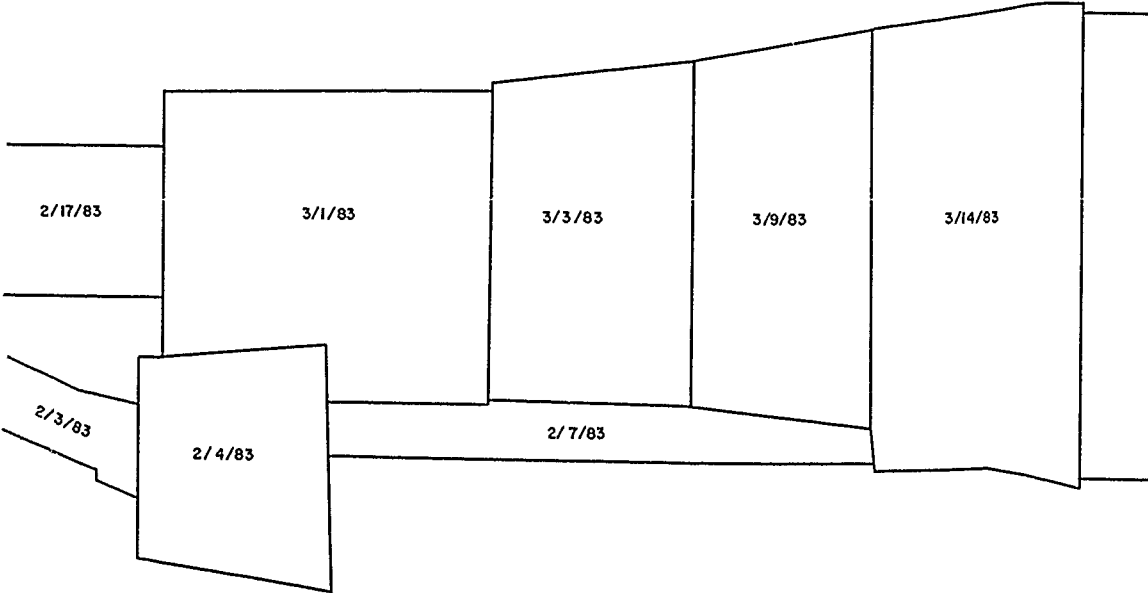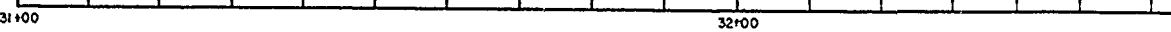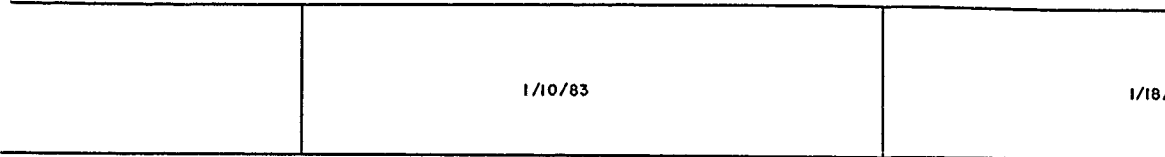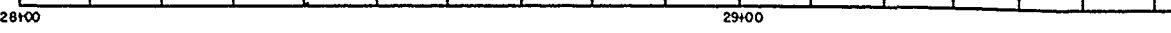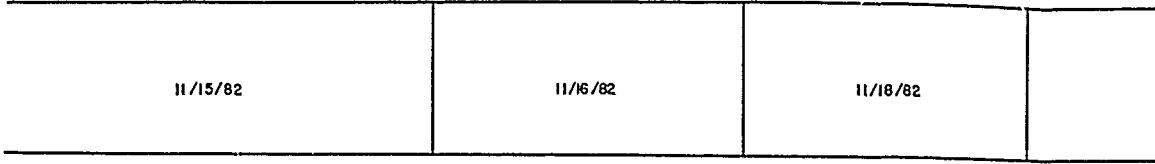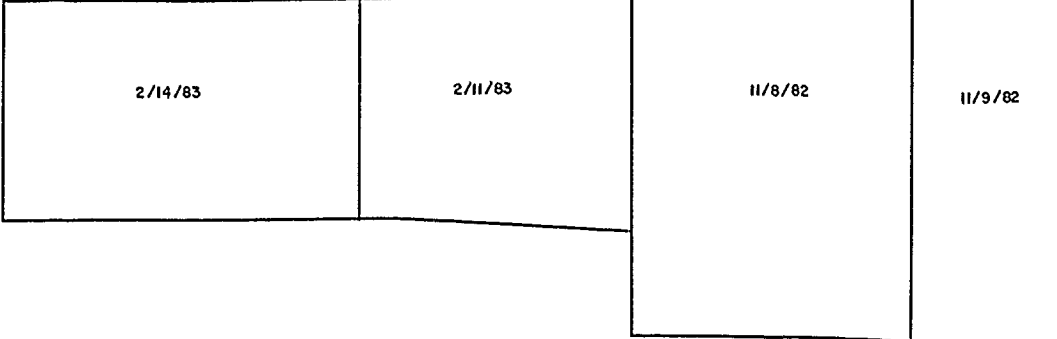

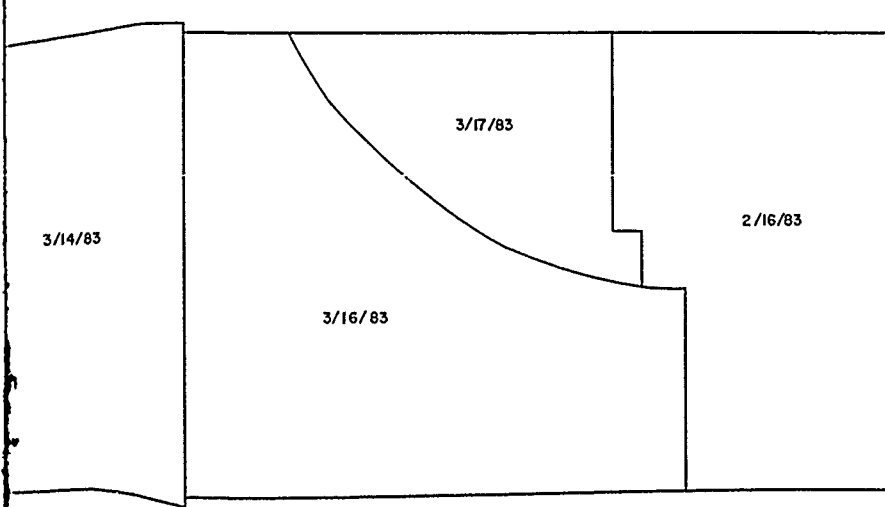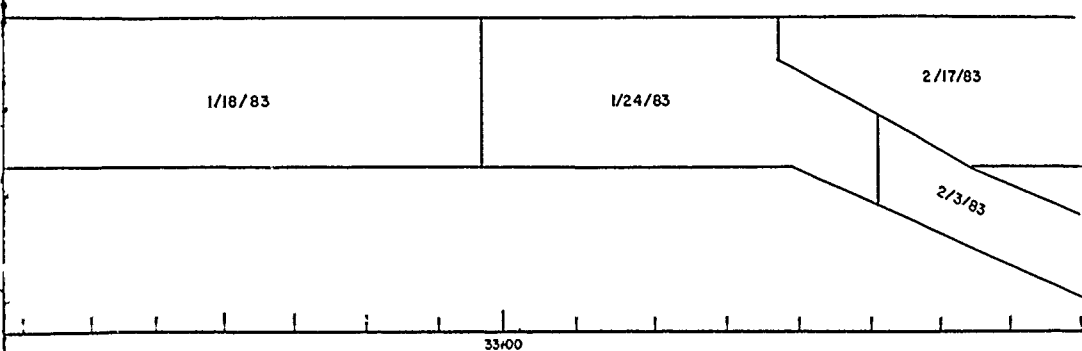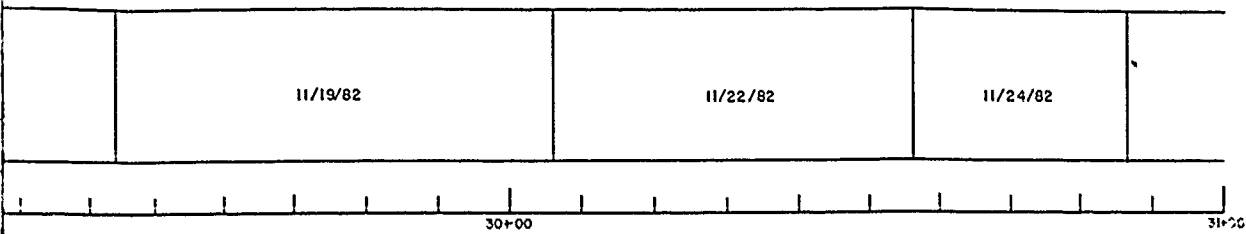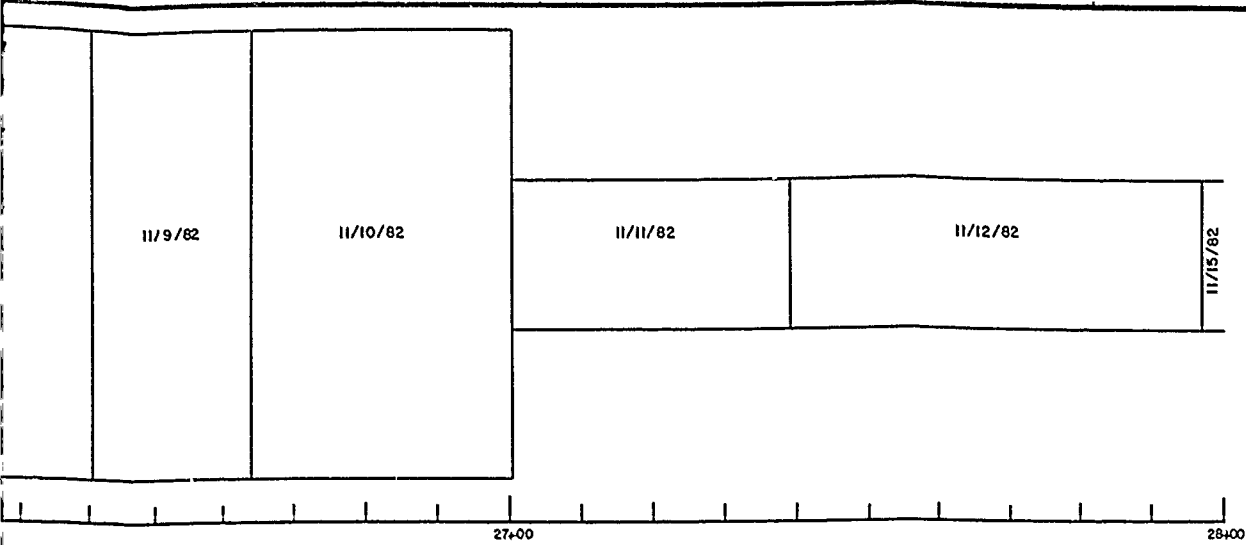

DESIGNED BY: HBARNETT		U.S. ARMY ENGINEER DISTRICT, FORT WORTH CORPS OF ENGINEERS FORT WORTH, TEXAS RAY ROBERTS LAKE ELM FORK, TRINITY RIVER, TEXAS FOUNDATION REPORT RECORD OF FOUNDATION APPROVAL
DRAWN BY: C. KIRBY		
REVIEWED BY: R. BEHM		
DATE: _____		