

SEEDING AND MULCHING

THE FOLLOWING QUANTITIES ARE PROVIDED TO PROMOTE GROWTH AND CARE OF PERMANENT SEEDED AREAS:

| | |
|----------------------------------|----------------|
| 659, SOIL ANALYSIS TEST | 2 EACH |
| 659, TOPSOIL | 6,020 CU. YD. |
| 659, SEEDING AND MULCHING | 54,238 SQ. YD. |
| 659, REPAIR SEEDING AND MULCHING | 2,712 SQ. YD. |
| 659, INTER-SEEDING | 2,712 SQ. YD. |
| 659, COMMERCIAL FERTILIZER | 7.57 TON |
| 659, LIME | 11.21 ACRES |
| 659, WATER | 300 M GALS |
| 659, MOWING | 122 SQ. FT. |

SEEDING AND MULCHING SHALL BE APPLIED TO ALL AREAS OF EXPOSED SOIL BETWEEN THE RIGHT-OF-WAY LINES, AND WITHIN THE CONSTRUCTION LIMITS FOR AREAS OUTSIDE THE RIGHT-OF-WAY LINES COVERED BY WORK AGREEMENT OR SLOPE EASEMENT. QUANTITY CALCULATIONS FOR SEEDING AND MULCHING ARE BASED ON THESE LIMITS.

ITEM 606 - ANCHOR ASSEMBLY, MGS TYPE E (MASH 2016)

THIS ITEM SHALL CONSIST OF FURNISHING AND INSTALLING ANY OF THE GUARDRAIL END TERMINALS FOR TYPE MGS GUARDRAIL AS LISTED ON ROADWAY ENGINEERING'S WEB PAGE UNDER ROADSIDE SAFETY DEVICES FOR APPROVED GUARDRAIL END TREATMENTS. INSTALLATION SHALL BE AT THE LOCATIONS SPECIFIED IN THE PLANS, IN ACCORDANCE WITH THE MANUFACTURER'S SPECIFICATIONS.

THE FACE OF THE TYPE E IMPACT HEAD SHALL BE COVERED WITH A SHEET OF TYPE G REFLECTIVE SHEETING, PER CMS 730.19.

REFER TO THE MANUFACTURER'S INSTRUCTIONS REGARDING THE INSTALLATION OF, AND THE GRADING AROUND THE FOUNDATION TUBES AND GROUND STRUT. THE TOP OF ANY FOUNDATION TUBE SHOULD BE LESS THAN 4 INCHES ABOVE THE GROUND. THE PLACEMENT OF THE FOUNDATION TUBES SHOULD BE AN APPROPRIATE DEPTH BELOW THE LEVEL LINE IN ORDER TO MAINTAIN THE FINISHED GUARDRAIL HEIGHT OF 31 INCHES FROM THE EDGE OF THE SHOULDER.

ON-SITE GRADING IS REQUIRED IF THE TOP OF THE FOUNDATION TUBES OR TOP OF THE GROUND STRUT DOES PROJECT MORE THAN 4 INCHES ABOVE THE GROUND LINE.

PAYMENT FOR THE ABOVE WORK SHALL BE MADE AT THE UNIT PRICE BID FOR ITEM 606, ANCHOR ASSEMBLY, MGS TYPE E, EACH, AND SHALL INCLUDE ALL LABOR, TOOLS, EQUIPMENT AND MATERIALS NECESSARY TO CONSTRUCT A COMPLETE AND FUNCTIONAL ANCHOR ASSEMBLY SYSTEM, INCLUDING ALL RELATED TRANSITIONS, REFLECTIVE SHEETING, HARDWARE, GRADING, EMBANKMENT AND EXCAVATION NOT SEPARATELY SPECIFIED, AS REQUIRED BY THE MANUFACTURER.

CONNECTION BETWEEN EXISTING AND PROPOSED GUARDRAIL

WHEN IT IS NECESSARY TO SPLICE PROPOSED GUARDRAIL TO EXISTING GUARDRAIL, ONLY THE EXISTING GUARDRAIL SHALL BE CUT, DRILLED, OR PUNCHED. THE CONNECTION SHALL BE MADE USING A "W-BEAM RAIL SPLICE" AS SHOWN IN AASHTO M 180. PAYMENT SHALL BE INCLUDED IN THE CONTRACT PRICE FOR THE RESPECTIVE GUARDRAIL ITEMS.

PART WIDTH CONSTRUCTION

BECAUSE OF THE NECESSITY TO BUILD THIS PROJECT UNDER TRAFFIC AND TO CONSTRUCT THE FULL PAVEMENT WIDTH IN STAGES, EXERCISE CARE TO PREVENT THE CONSTRUCTION OF A BUTT JOINT IN THE BASE COURSES. LAP LONGITUDINAL JOINTS AS SHOWN ON STANDARD DRAWING BP-3.1.

ITEM 206 - MIXTURE DESIGN FOR CHEMICALLY STABILIZED SOILS, AS PER PLAN

OBTAIN SOIL SAMPLES AS OUTLINED IN SUPPLEMENT 1120 FOLLOWING EXCAVATION OR EMBANKMENT PLACEMENT TO THE DESIGN SUBGRADE LEVEL. THE SOIL SAMPLES FOR SUPPLEMENT 1120 TESTING ARE TO BE OBTAINED FROM THE ACTUAL SUBGRADE SOILS. SAMPLING OF THE SOILS OUTSIDE THE ACTUAL STABILIZATION LIMITS OR FROM A BORROW AREA IS PROHIBITED. THE CONSTRUCTION SCHEDULE SHALL INCLUDE SPECIFIC ACTIVITIES FOR SAMPLING AND TESTING OF THE SUBGRADE SOILS FOR ALL PHASES OR PARTIAL PHASES OF CONSTRUCTION. PERFORM THE MIXTURE DESIGN PROCEDURE FOR EACH PHASE AS OUTLINED IN SUPPLEMENT 1120. DURING CONSTRUCTION, OBTAIN FIELD VERIFICATION SAMPLES FOR EACH PHASE OF CONSTRUCTION AND SUBMIT THE TEST RESULTS FOR EACH PHASE AS THE LABORATORY TESTING IS COMPLETE.

ITEM 204 - PROOF ROLLING

THE FOLLOWING QUANTITY IS PROVIDED IN THE GENERAL SUMMARY TO ADDRESS LOCATIONS REQUIRING PROOF ROLLING. SEE PLAN SHEET 159 FOR ADDITIONAL INFORMATION.

ITEM 204 - PROOF ROLLING 30 HOURS.

PROTECTION OF RIGHT-OF-WAY LANDSCAPING

PRIOR TO BEGINNING WORK, THE CONTRACTOR, THE PROJECT ENGINEER, AND A REPRESENTATIVE OF THE MAINTAINING AGENCY WILL REVIEW AND RECORD ALL LANDSCAPING ITEMS WITHIN THE RIGHT OF WAY (BOTH WITHIN AND OUTSIDE THE CONSTRUCTION LIMITS) A RECORD OF THIS REVIEW WILL BE KEPT IN THE PROJECT ENGINEER'S FILES. PRIOR TO FINAL ACCEPTANCE, A FINAL REVIEW OF LANDSCAPING ITEMS WILL BE MADE.

CONSTRUCT ALL ACTIVITIES, EQUIPMENT STORAGE, AND STAGING TO WITHIN THE CONSTRUCTION LIMITS. UNLESS OTHERWISE IDENTIFIED IN THE PLANS OR PROPOSAL, THE CONSTRUCTION LIMITS ARE IDENTIFIED AS 30 FEET FROM THE EDGE OF PAVEMENT.

SUBMIT A WRITTEN REQUEST TO THE PROJECT ENGINEER TO USE ANY AREA OUTSIDE THESE LIMITS. THE DOCUMENT SUBMITTED MUST CLEARLY IDENTIFY THE AREA AND EXPLAIN THE PROPOSED USE AND RESTORATION OF THE AREA. EXCEPT AS INDICATED ON SHEET --- USE OF THESE AREAS FOR DISPOSAL OF WASTE MATERIAL AND CONSTRUCTION DEBRIS, EXCAVATION OF BORROW MATERIAL AND PLACEMENT OF PORTABLE PLANTS IS PROHIBITED. THE REQUEST MUST BE APPROVED, IN WRITING, BEFORE THE CONTRACTOR HAS PERMISSION TO USE THE AREA.

ANY ITEMS DAMAGED BEYOND THE CONSTRUCTION LIMITS AS DEFINED ABOVE WILL BE REPLACED IN KIND OR AS APPROVED BY THE PROJECT ENGINEER.

BENCHING OF FOUNDATION SLOPES

ALTHOUGH CROSS-SECTIONS INDICATE SPECIFIC DIMENSIONS FOR PROPOSED BENCHING OF THE EMBANKMENT FOUNDATIONS IN CERTAIN AREAS, NO WAIVER OF THE SPECIFICATIONS IS INTENDED. BENCH ALL OTHER SLOPED EMBANKMENT AREAS AS SET FORTH IN 203.05. NO ADDITIONAL PAYMENT WILL BE MADE FOR BENCHING REQUIRED UNDER THE PROVISIONS OF 203.05.

ITEM 202 - BUILDING DEMOLISHED, AS PER PLAN

REMOVAL AND DEMOLITION OF THE STRUCTURE SHALL INCLUDE REMOVAL OF ALL FOOTINGS, FLOOR SLABS, BASEMENT WALLS, UNDERGROUND TANKS AND ANY OTHER BELOW GRADE ITEMS. THE STRUCTURE SHALL BE REMOVED ENTIRELY. REMOVE AND DISPOSAL OF ALL STRUCTURE DEBRIS OFF-SITE. BACKFILL THE STRUCTURE VOID ACCORDING TO CMS 202.02.

ITEM 204 - ENBANKMENT, AS PER PLAN

ANY NEW EMBANKMENT REQUIRED TO ESTABLISH THE UPPER 12" OF THE DESIGN PAVEMENT SUBGRADE SHALL CONSIST OF NATURAL SOIL. THE NATURAL SOIL SHALL CONSIST OF COHESIVE MATERIAL CLASSIFYING AS A-7-6 OR A-6B PER THE ODOT SOIL CLASSIFICATION SYSTEM AND SHALL HAVE A PLASTICITY INDEX OF 16% OR GREATER. THE ITEM 204 EMBANKMENT, AS PER PLAN SHALL ALSO MEET THE SULFATE REQUIREMENTS OUTLINED IN SUPPLEMENT 1120. ALL OTHER ITEMS OUTLINED IN ITEM 204 SHALL APPLY TO THIS PAY ITEM. SHALE AND LIMESTONE BEDROCK EXCAVATED IN THE PROJECT AREA SHALL NOT BE UTILIZED AS EMBANKMENT WITHIN THE UPPER 12" OF THE DESIGN PAVEMENT SUBGRADE.

ITEM 619 - FIELD OFFICE, TYPE C, AS PER PLAN

IN ADDITION TO THE REQUIREMENTS PROVIDED IN CMS FOR THE TYPE OF FIELD OFFICE SPECIFIED, PROVIDE THE FOLLOWING ITEMS:

[1] FOR EACH TELEPHONE AND/OR COMPUTER STATION SPECIFIED, PROVIDE ALL ETHERNET WIRING NECESSARY TO CONNECT THE PHONE AND/OR COMPUTER AND MULTI-FUNCTION COPIER TO THE INTERNET COMPANY SYSTEM.

[5] PROVIDE A BROADBAND INTERNET CONNECTION CAPABLE OF MINIMUM DOWNLOAD SPEEDS AS FOLLOWS:

30 MBPS DOWNLOAD 5 MBPS UPLOAD - NETWORK LATENCY LESS THAN 50 MILLISECONDS. IF SPEEDS ARE NOT AVAILABLE THROUGH AN INDIVIDUAL OR SINGULAR CIRCUIT, PROVIDE THE HIGHEST SPEED AVAILABLE IN THE AREA AND INSTALL MULTIPLE CIRCUITS TO ACHIEVE THE SPECIFIED SPEEDS. WHEN MULTIPLE BROADBAND SERVICES ARE AVAILABLE, THE FOLLOWING IS THE DESCENDING ORDER OF PRECEDENCE: CABLE, DSL, CELLULAR, AND WIRELESS RADIO (SATELLITE COMMUNICATION IS NOT COMPATIBLE WITH ODOT VPN CONNECTION AND WILL NOT BE ACCEPTED). SUPPLY MODEMS CAPABLE OF BEING CONFIGURED IN BRIDGE MODE. IF A CELLULAR NETWORK IS USED, PROVIDE THE CELLULAR EQUIPMENT, INCLUDING SOFTWARE AND ROUTER EQUIPMENT TO CONNECT TO THE ODOT PROVIDED CISCO ASA 5505 FIREWALL. SUPPLY ODOT WITH ALL DOCUMENTATION FOR THE BROADBAND CIRCUIT INCLUDING ALL USERNAME/USER IDS, PASSWORDS AND ACCOUNT INFORMATION. VERIFY THAT THE BROADBAND INTERNET CONNECTION IS ACTIVE AND WORKING AS SPECIFIED. ODOT IT PERSONNEL WILL CONFIRM THAT BANDWIDTH AND NETWORK LATENCY ARE COMPLIANT WITH THE REQUIRED FIELD OFFICE SPECIFICATIONS. ALL FIELD OFFICE INTERNET CONNECTIONS ARE FOR ODOT USE ONLY.

PHASING JOINT

THE FOLLOWING QUANTITIES HAVE BEEN CALCULATED TO ACCOUNT FOR THE PHASING JOINT LOCATED AT ALL SAWCUT LINES.

SAWCUT LENGTH = 13,292' (SEE TYPICAL SECTIONS FOR LOCATIONS)

ITEM 202, PAVEMENT REMOVED = 1,846 SY

ITEM 442 ASPHALT CONCRETE SURFACE COURSE = 77 CY

ITEM 442, ASPHALT CONCRETE INTERMEDIATE COURSE = 72 CY

ITEM 302, ASPHALT CONCRETE BASE COURSE = 308 CY

CALCULATED
MSW
CHECKED
WAA

GENERAL NOTES

CLE-32-3.50
(PHASE 5)

ITEM 614 - MAINTAINING TRAFFIC (CONT'D)

DELINEATION OF PORTABLE AND PERMANENT BARRIER

BARRIER REFLECTORS AND OBJECT MARKERS SHALL BE INSTALLED ON ALL PORTABLE BARRIER (PB) USED FOR TRAFFIC CONTROL AND ON PERMANENT CONCRETE BARRIER (INCLUDING BRIDGE PARAPETS) LOCATED WITHIN 5 FEET OF THE EDGE OF THE ADJACENT TRAVEL LANE.

BARRIER REFLECTORS SHALL CONFORM TO C&MS 626, EXCEPT THAT THE SPACING SHALL BE AS PER TRAFFIC SCD MT-101.70. OBJECT MARKERS AND THEIR INSTALLATION SHALL CONFORM TO C&MS 614.03 AND SCD MT-101.70. WHEN THE PB CONTAINS GLARE SCREEN, ONE SET OF THREE VERTICAL STRIPES OF SHEETING SHALL BE CONSIDERED EQUIVALENT TO AN OBJECT MARKER, ONE-WAY.

THE FOLLOWING ESTIMATED QUANTITIES HAVE BEEN INCLUDED IN THE PLANS AND CARRIED TO THE GENERAL SUMMARY:

ITEM 614, BARRIER REFLECTOR, TYPE 1 (ONE-WAY) 1519 EACH
 ITEM 614, OBJECT MARKER, ONE-WAY 1669 EACH

PAYMENT SHALL BE FULL COMPENSATION FOR ALL MATERIAL, LABOR, INCIDENTALS AND EQUIPMENT NECESSARY FOR FURNISHING, INSTALLING, MAINTAINING AND REMOVING EACH OF THE ABOVE ITEMS.

ITEM 614 LONGITUDINAL CHANNELIZER

LONGITUDINAL CHANNELIZERS SHALL BE PROVIDED AS CALLED FOR IN THE PLANS. A LONGITUDINAL CHANNELIZER CONSISTS OF A COMBINATION OF VERTICAL COMPONENTS AND LONGITUDINAL BASE COMPONENTS, FIT TOGETHER TO CREATE A CONTINUOUS CHANNELIZING DEVICE, AS DETAILED IN TRAFFIC PIS 2010180. USE OF TUBULAR MARKERS, AS IDENTIFIED IN THE

OMUTCD, FIGURE 6F-7, SHALL NOT QUALIFY FOR USE AS A LONGITUDINAL CHANNELIZER.

THE VERTICAL COMPONENT SHALL BE EQUIPPED WITH TWO 3-INCH WIDE RETRO-REFLECTIVE BANDS, PLACED A MAXIMUM OF 2 INCHES FROM THE TOP, WITH A MAXIMUM OF 6 INCHES BETWEEN THE BANDS. THE LONGITUDINAL BASE COMPONENTS SHALL BE EQUIPPED WITH REFLECTORS.

LONGITUDINAL CHANNELIZERS SHALL COMPLY WITH THE REQUIREMENTS CONTAINED WITHIN TRAFFIC PIS 2010180.

FURNISH LONGITUDINAL CHANNELIZERS FROM THE APPROVED LIST FOUND ON THE OFFICE OF MATERIALS MANAGEMENT WEBSITE. FOR INSTALLATION PROCEDURES, FOLLOW THE MANUFACTURER'S INSTRUCTIONS.

LONGITUDINAL CHANNELIZERS SHALL BE MONITORED TO DETERMINE WHETHER THERE IS SIGNIFICANT DAMAGE FROM ERRANT VEHICLES.

LONGITUDINAL CHANNELIZERS WILL BE MADE AT THE UNIT PRICE PER FOOT FOR:

ITEM 614, LONGITUDINAL CHANNELIZER 226 FOOT

DELINEATION OF TEMPORARY AND PERMANENT GUARDRAIL

BARRIER REFLECTORS SHALL BE INSTALLED ON ALL TEMPORARY GUARDRAIL USED FOR TRAFFIC CONTROL AND ON ALL PERMANENT GUARDRAIL LOCATED WITHIN 5 FEET OF THE EDGE OF THE ADJACENT TRAVEL LANE. BARRIER REFLECTORS SHALL CONFORM TO C&MS 626.

OBJECT MARKERS SHALL BE INSTALLED ON ALL TEMPORARY AND PERMANENT GUARDRAIL LOCATED WITHIN 5 FEET OF THE EDGE OF THE ADJACENT TRAVEL LANE. GUARDRAIL-MOUNTING OF OBJECT MARKERS SHALL BE MADE BY INSTALLING THE OBJECT MARKERS ON THE EXTENSION BLOCKS RATHER THAN DIRECTLY ONTO THE GUARDRAIL ITSELF. OBJECT MARKERS SHALL CONFORM TO C&MS 614.03 AND THE SPACING SHALL BE APPROXIMATELY 50 FEET.

THE FOLLOWING ESTIMATED QUANTITIES HAVE BEEN INCLUDED IN THE PLANS AND CARRIED TO THE GENERAL SUMMARY:

ITEM 614, BARRIER REFLECTOR, TYPE 3 ONE-WAY 150 EACH
 ITEM 614, OBJECT MARKER, ONE-WAY 150 EACH

PAYMENT SHALL BE FULL COMPENSATION FOR ALL MATERIAL, LABOR, INCIDENTALS AND EQUIPMENT NECESSARY FOR FURNISHING, INSTALLING, MAINTAINING AND REMOVING THE ABOVE ITEM(S).

ITEM 614 - WORK ZONE RAISED PAVEMENT MARKER, AS PER PLAN

WORK ZONE RAISED PAVEMENT MARKERS, AS PER PLAN, AND THEIR INSTALLATION SHALL CONFORM TO C&MS 614 OR C&MS 621 AS SPECIFIED HEREIN.

RAISED PAVEMENT MARKERS IN USE DURING THE SNOW-PLOWING SEASON SHALL CONFORM TO 621.

RAISED PAVEMENT MARKERS IN USE DURING THE NON-SNOW-PLOW SEASON SHALL CONFORM TO EITHER 614 OR TO 621.

THE SNOW-PLOWING SEASON SHALL RUN FROM OCTOBER 15 THROUGH APRIL 1.

IF PROJECT DELAYS, NOT THE FAULT OF ODOT, CAUSE THE WORK TO EXTEND INTO THE SNOW-PLOWING SEASON, THE CONTRACTOR SHALL BE RESPONSIBLE FOR REPLACING WORK ZONE RAISED PAVEMENT MARKERS (WZRPMS) CONFORMING TO C&MS 614, WITH RAISED PAVEMENT MARKERS CONFORMING TO 621, AS DETERMINED BY THE ENGINEER, AT THE CONTRACTOR'S EXPENSE.

THIS ITEM SHALL INCLUDE PURCHASE, INSTALLATION AND REMOVAL OF ITEM 614 WORK ZONE RAISED PAVEMENT MARKER, AS PER PLAN, INCLUDING FILLING OF ANY DEPRESSIONS CREATED IN THE PAVEMENT AS PER C&MS 621.08.

RESURFACING OF THE TRANSITION AREAS SHALL BE PERFORMED AT THE TIME THAT THE SURFACE COURSE IS BEING APPLIED TO THE ENTIRE PROJECT. PRIOR TO APPLICATION OF THE SURFACE COURSE ON THE PROJECT, THE EXISTING PAVEMENT WITHIN THE TRANSITION AREA SHALL BE REMOVED TO A DEPTH NECESSARY TO REACH THE LEVEL OF THE INTERMEDIATE COURSE OF THE PAVEMENT, AS DETERMINED BY THE ENGINEER.

THE FOLLOWING BID ITEMS SHOULD BE INCLUDED IN THE PLANS:

ITEM 614 WORK ZONE RAISED PAVEMENT MARKER, AS PER PLAN 688 EACH (SEE SHEET 137)

PAYMENT FOR RESURFACING WITHIN THE TRANSITION AREA SHALL BE PAID FOR UNDER THE APPROPRIATE BID ITEMS FOR THE WORK REQUIRED, AS PROVIDED FOR IN THE PLANS.

NOTICE OF TRAFFIC RESTRICTIONS

THROUGHOUT THE DURATION OF THE PROJECT, THE CONTRACTOR SHALL NOTIFY THE PROJECT ENGINEER IN WRITING OF ALL TRAFFIC RESTRICTIONS AND UPCOMING MAINTENANCE OF TRAFFIC CHANGES. THE CONTRACTOR SHALL ENSURE THE WRITTEN NOTIFICATION IS SUBMITTED IN A TIMELY MANNER TO ALLOW THE PROJECT ENGINEER TO MEET THE REQUIRED TIME FRAMES SET FORTH IN THE TABLE BELOW TO INFORM THE OFFICE OF COMMUNICATIONS. THIS NOTIFICATION SHALL BE RECEIVED BY THE PROJECT ENGINEER PRIOR TO THE PHYSICAL SETUP OF ANY APPLICABLE SIGNS OR MESSAGE BOARDS.

INFORMATION SHOULD INCLUDE, BUT IS NOT LIMITED TO, ALL CONSTRUCTION ACTIVITIES THAT IMPACT OR INTERFERE WITH TRAFFIC AND SHALL LIST THE SPECIFIC LOCATION, TYPE OF WORK, ROAD STATUS, DATE AND TIME OF RESTRICTION, DURATION OF RESTRICTION, NUMBER OF LANES MAINTAINED, NUMBER OF LANES CLOSED, DETOUR ROUTES, IF APPLICABLE, AND ANY OTHER INFORMATION REQUESTED BY THE PROJECT ENGINEER.

NOTICE TO OFFICE OF COMMUNICATION TIME TABLE:

| ITEM | DURATION OF CLOSURE | NOTICE DUE TO OFFICE OF COMMUNICATION |
|---|------------------------|---|
| | >= 2 WEEKS | 21 CALENDAR DAYS PRIOR TO CLOSURE |
| RAMP & ROAD CLOSURES | > 12 HOURS & < 2 WEEKS | 14 CALENDAR DAYS PRIOR TO CLOSURE |
| | < 12 HOURS | 4 BUSINESS DAYS PRIOR TO CLOSURE |
| LANE CLOSURES & RESTRICTIONS | >= 2 WEEKS & < 2 WEEKS | 14 CALENDAR DAYS PRIOR TO CLOSURE 2 BUSINESS DAYS PRIOR TO CLOSURE |
| START OF CONSTRUCTION & TRAFFIC PATTERN CHANGES | N/A | 14 CALENDAR DAYS PRIOR TO IMPLEMENTATION |

ANY UNFORESEEN CONDITIONS NOT SPECIFIED IN THE PLANS REQUIRING TRAFFIC RESTRICTIONS SHALL ALSO BE REPORTED TO THE PROJECT ENGINEER USING THE NOTICE TO OFFICE OF COMMUNICATIONS TIME TABLE.

ITEM 614, REPLACEMENT SIGN

FLATSHEET SIGNS FURNISHED BY THE CONTRACTOR IN ACCORDANCE WITH THE REQUIREMENTS OF THE PLANS, SPECIFICATIONS AND PROPOSAL WHICH BECOME DAMAGED BY TRAFFIC FOR REASONS BEYOND THE CONTROL OF THE CONTRACTOR SHALL BE REPLACED IN KIND WHEN ORDERED BY THE ENGINEER. REPLACEMENT SIGNS SHALL BE NEW. OTHER MATERIALS MAY BE IN USED, BUT GOOD, CONDITION SUBJECT TO APPROVAL BY THE ENGINEER.

PAYMENT FOR THE NEW SIGNS SHALL BE MADE AT THE CONTRACT PRICE PER EACH FOR ITEM 614, REPLACEMENT SIGN, AND SHALL INCLUDE THE COST OF REMOVING AND DISPOSING OF DAMAGED SIGNS, HARDWARE AND SUPPORTS, AND PROVIDING THE NECESSARY REPLACEMENT HARDWARE, SUPPORTS, ETC.

AN ESTIMATED QUANTITY OF 30 EACH HAS BEEN PROVIDED

NOTICE OF CLOSURE SIGN

NOTICE OF CLOSURE SIGNS (W20-H13) SHALL BE ERECTED BY THE CONTRACTOR PRIOR TO THE SCHEDULED ROAD OR RAMP CLOSURE IN ACCORDANCE WITH THE NOTICE OF CLOSURE TIME TABLE BELOW. AT THE APPROVAL OF THE ENGINEER, PORTABLE CHANGEABLE MESSAGE SIGNS MAY BE USED IN LIEU OF THE STANDARD FLATSHEET SIGN FOR CLOSURE DURATIONS OF LESS THAN 1 WEEK.

THE SIGNS SHALL BE ERECTED ON THE RIGHT-HAND SIDE OF THE ROAD/RAMP FACING TRAFFIC. THEY SHALL BE PLACED SO AS NOT TO INTERFERE WITH THE VISIBILITY OF ANY OTHER TRAFFIC CONTROL SIGNS. ON ROADWAYS, THEY SHOULD BE ERECTED AT OR NEAR THE POINT OF CLOSURE. THE SIGNS MAY BE ERECTED ANYWHERE ON RAMPS AS LONG AS THEY ARE VISIBLE TO THE MOTORISTS USING THE RAMP. ON ENTRANCE RAMPS, THE SIGN SHALL BE ERECTED WELL IN ADVANCE OF THE MERGE AREA TO AVOID DISTRACTING MOTORISTS.

NOTICE OF CLOSURE SIGN TIME TABLE:

| ITEM | DURATION OF CLOSURE | SIGN DISPLAYED TO PUBLIC |
|----------------------|------------------------|--|
| | >= 2 WEEKS | 14 CALENDAR DAYS PRIOR TO CLOSURE |
| RAMP & ROAD CLOSURES | > 12 HOURS & < 2 WEEKS | 7 CALENDAR DAYS PRIOR TO CLOSURE 2 BUSINESS DAYS PRIOR TO CLOSURE |
| | < 12 HOURS | 2 BUSINESS DAYS PRIOR TO CLOSURE |

THE SIGN SHALL DISPLAY THE DATE OF THE CLOSURE IN MMM-DD FORMAT AND THE NUMBER OF DAYS OF THE CLOSURE. THE LAST LINE OF THE W20-H13 SIGN LISTS A PHONE NUMBER WHICH A MOTORIST MAY CALL FOR ADDITIONAL INFORMATION. THIS IS TO BE A SPECIFIC OFFICE WITHIN THE DISTRICT RATHER THAN THE GENERAL SWITCHBOARD NUMBER.

PHASE 1:

- NONE

PHASE 2:

- 2 SIGNS FOR ELICK LN CLOSURE, LOCATE AT INTERSECTION OF ELICK LN AND OLD SR74

PHASE 3:

- 2 SIGNS FOR WYLER PARK DR CLOSURE, LOCATE AT INTERSECTION OF WYLER PARK DR AND EASTGATE NORTH DR
 - 2 SIGNS FOR GLEN ESTE-WITHAMSVILLE RD CLOSURE, LOCATE AT INTERSECTION OF GLEN ESTE-WITHAMSVILLE RD AND CLEPPER LN

PHASE 4:

*- 2 SIGNS FOR GLEN ESTE-WITHAMSVILLE RD CLOSURE, LOCATE AT INTERSECTION OF GLEN ESTE-WITHAMSVILLE RD AND CLEPPER LN
 *- 2 SIGNS FOR FAYARD DR CLOSURE, LOCATE AT INTERSECTION OF FAYARD DR AND CLEPPER LN

6 <= TOTAL NUMBER OF SIGNS
 * REMAINS FROM PREVIOUS PHASE/PROJECT

| SHEET NUM. | | | | | | | | | | PART. | | ITEM | ITEM EXT | GRAND TOTAL | UNIT | DESCRIPTION | SEE SHEET NO. |
|------------|----|-------|--------|---------|-----|-----------|-----------|---------|--|-------|-------|---------|----------|--|------|-------------|---------------|
| 27 | 28 | 148 | 152 | 158 | 167 | 01/NHS/OT | 04/NHS/BR | | | | | | | | | | |
| | 8 | | 12 | | | | | 20 | | 601 | 21050 | 20 | SY | EROSION CONTROL | | | |
| | | 107 | | | | | | 107 | | 601 | 21060 | 107 | SY | TIED CONCRETE BLOCK MAT WITH TYPE 1 UNDERLAYMENT | | | |
| | | 10 | | 165 | | | | 175 | | 601 | 32204 | 175 | CY | ROCK CHANNEL PROTECTION, TYPE C WITH GEOTEXTILE FABRIC | | | |
| | | 1,458 | | | | | | 1,458 | | 601 | 37501 | 1,458 | FT | PAVED GUTTER, TYPE 1-2, AS PER PLAN | | | |
| | | 338 | | | | | | 338 | | 601 | 38501 | 338 | FT | PAVED GUTTER, TYPE 3, AS PER PLAN | | | |
| 2 | | | | | | | | 2 | | 659 | 00100 | 2 | EACH | SOIL ANALYSIS TEST | | | |
| 6,020 | | | | | | | | 6,020 | | 659 | 00300 | 6,020 | CY | TOPSOIL | | | |
| 54,238 | | | | | | | | 54,238 | | 659 | 10000 | 54,238 | SY | SEEDING AND MULCHING | | | |
| 2,712 | | | | | | | | 2,712 | | 659 | 14000 | 2,712 | SY | REPAIR SEEDING AND MULCHING | | | |
| 2,712 | | | | | | | | 2,712 | | 659 | 15000 | 2,712 | SY | INTER-SEEDING | | | |
| 7.57 | | | | | | | | 7.57 | | 659 | 20000 | 7.57 | TON | COMMERCIAL FERTILIZER | | | |
| 11.21 | | | | | | | | 11.21 | | 659 | 31000 | 11.21 | ACRE | LIME | | | |
| 300 | | | | | | | | 300 | | 659 | 35000 | 300 | MGAL | WATER | | | |
| 122 | | | | | | | | 122 | | 659 | 40000 | 122 | MSF | MOWING | | | |
| | | | | 1,903 | | | | 1,903 | | 670 | 00500 | 1,903 | SY | SLOPE EROSION PROTECTION | | | |
| | | | | LS | | | | LS | | 832 | 15000 | LS | | STORM WATER POLLUTION PREVENTION PLAN | | | |
| | | | | LS | | | | LS | | 832 | 15002 | LS | | STORM WATER POLLUTION PREVENTION INSPECTIONS | | | |
| | | | | LS | | | | LS | | 832 | 15010 | LS | | STORM WATER POLLUTION PREVENTION INSPECTION SOFTWARE | | | |
| | | | | 229,747 | | | | 229,747 | | 832 | 30000 | 229,747 | EACH | EROSION CONTROL | | | |
| | | | | | | | | | | | | | | DRAINAGE | | | |
| | | 2.1 | | 1.2 | | | | 3.3 | | 602 | 20000 | 3.3 | CY | CONCRETE MASONRY | | | |
| | | | 20,025 | | | | | 20,025 | | 605 | 11110 | 20,025 | FT | 6" SHALLOW PIPE UNDERDRAINS WITH GEOTEXTILE FABRIC | | | |
| 200 | | | | | | | | 200 | | 605 | 13300 | 200 | FT | 6" UNCLASSIFIED PIPE UNDERDRAINS | | | |
| | | | 14,163 | | | | | 14,163 | | 605 | 14020 | 14,163 | FT | 6" BASE PIPE UNDERDRAINS WITH GEOTEXTILE FABRIC | | | |
| 200 | | | | | | | | 200 | | 611 | 00406 | 200 | FT | 4" CONDUIT, TYPE F | | | |
| | | | 2,222 | | | | | 2,222 | | 611 | 00510 | 2,222 | FT | 6" CONDUIT, TYPE F FOR UNDERDRAIN OUTLETS | | | |
| | | 1,415 | | | | | | 1,415 | | 611 | 04400 | 1,415 | FT | 12" CONDUIT, TYPE B | | | |
| | | 44 | | | | | | 44 | | 611 | 04600 | 44 | FT | 12" CONDUIT, TYPE C | | | |
| | | 1,103 | | | | | | 1,103 | | 611 | 05900 | 1,103 | FT | 15" CONDUIT, TYPE B | | | |
| | | 141 | | | | | | 141 | | 611 | 06100 | 141 | FT | 15" CONDUIT, TYPE C | | | |
| | | 618 | | | | | | 618 | | 611 | 06100 | 618 | FT | 15" CONDUIT, TYPE C, TYPE C, 706.02, JOINTS PER 706.11 | | | |
| | | 43 | | | | | | 43 | | 611 | 06700 | 43 | FT | 15" CONDUIT, TYPE F, 707.05 TYPE C OR 707.21 | | | |
| | | 196 | | | | | | 196 | | 611 | 07400 | 196 | FT | 18" CONDUIT, TYPE B | | | |
| | | 460 | | | | | | 460 | | 611 | 07600 | 460 | FT | 18" CONDUIT, TYPE C | | | |
| | | 769 | | | | | | 769 | | 611 | 10400 | 769 | FT | 24" CONDUIT, TYPE B | | | |
| | | 40 | | | | | | 40 | | 611 | 10600 | 40 | FT | 24" CONDUIT, TYPE C | | | |
| | | | 40 | | | | | 40 | | 611 | 13600 | 40 | FT | 30" CONDUIT, TYPE C | | | |
| | | 450 | | | | | | 450 | | 611 | 16400 | 450 | FT | 36" CONDUIT, TYPE B | | | |
| | | 559 | | | | | | 559 | | 611 | 19400 | 559 | FT | 42" CONDUIT, TYPE B | | | |
| | | 276 | | | | | | 276 | | 611 | 20900 | 276 | FT | 48" CONDUIT, TYPE B | | | |
| | | 66 | | | | | | 66 | | 611 | 96600 | 66 | FT | CONDUIT, BORED OR JACKED: 15" TYPE B | | | |
| | | 69 | | | | | | 69 | | 611 | 96600 | 69 | FT | CONDUIT, BORED OR JACKED: 18" TYPE B | | | |
| | | 176 | | | | | | 176 | | 611 | 96600 | 176 | FT | CONDUIT, BORED OR JACKED: 24" TYPE B | | | |
| | | 55 | | | | | | 55 | | 611 | 96600 | 55 | FT | CONDUIT, BORED OR JACKED: 42" TYPE B | | | |
| | | 3 | | | | | | 3 | | 611 | 98150 | 3 | EACH | CATCH BASIN, NO. 3 | | | |
| | | 4 | | | | | | 4 | | 611 | 98151 | 4 | EACH | CATCH BASIN, NO. 3, AS PER PLAN | | | |
| | | 16 | | | | | | 16 | | 611 | 98180 | 16 | EACH | CATCH BASIN, NO. 3A | | | |
| | | 1 | | | | | | 1 | | 611 | 98181 | 1 | EACH | CATCH BASIN, NO. 3A, AS PER PLAN | | | |
| | | 6 | | | | | | 6 | | 611 | 98410 | 6 | EACH | CATCH BASIN, NO. 8 | | | |
| | | 5 | | | | | | 5 | | 611 | 98434 | 5 | EACH | CATCH BASIN, NO. 8A | | | |
| | | 6 | | | | | | 6 | | 611 | 98470 | 6 | EACH | CATCH BASIN, NO. 2-2B | | | |
| | | 1 | | | | | | 1 | | 611 | 98630 | 1 | EACH | CATCH BASIN ADJUSTED TO GRADE | | | |
| | | 8 | | | | | | 8 | | 611 | 99114 | 8 | EACH | INLET, NO. 3 FOR SINGLE SLOPE BARRIER, TYPE D | | | |
| | | 20 | | | | | | 20 | | 611 | 99574 | 20 | EACH | MANHOLE, NO. 3 | | | |
| | | 2 | | | | | | 2 | | 611 | 99654 | 2 | EACH | MANHOLE ADJUSTED TO GRADE | | | |
| | 4 | | 6 | | | | | 10 | | 611 | 99710 | 10 | EACH | PRECAST REINFORCED CONCRETE OUTLET | | | |
| | | | | 1 | | | | 1 | | 611 | 99854 | 1 | EACH | WATER QUALITY BASIN, DETENTION | | | |
| | | | | 1 | | | | 1 | | 611 | 99855 | 1 | EACH | WATER QUALITY BASIN, DETENTION, AS PER PLAN | | | |

GENERAL SUMMARY

CLE-32-3.50
(PHASE 5)

129
736

...303.205\103954_CG501.dgn 11/19/2021 1:31:47 PM mswhttt

| SHEET NUM. | | | | | | | | | | PART. | | ITEM | ITEM EXT | GRAND TOTAL | UNIT | DESCRIPTION | SEE SHEET NO. | CALCULATED MSW | CHECKED WAA | |
|------------|-------|-------|-----|-----|--|--|--|--|--|-----------|-----------|------|----------|-------------|------|--|---------------|----------------|-------------|--|
| 487 | 488 | 501 | 502 | 503 | | | | | | 01/NHS/OT | 04/NHS/BR | | | | | | | | | |
| | | | | 374 | | | | | | 374 | | 621 | 00100 | 374 | EACH | TRAFFIC CONTROL | | | | |
| | | | | 450 | | | | | | 450 | | 621 | 54000 | 450 | EACH | RAISED PAVEMENT MARKER REMOVED | | | | |
| | | | | | | | | | | | | 15 | 625 | 32000 | 15 | EACH | GROUND ROD | | | |
| | | 50 | | | | | | | | 50 | | 626 | 00102 | 50 | EACH | BARRIER REFLECTOR, TYPE 1, 1WAY | | | | |
| | | 111 | | | | | | | | 111 | | 626 | 00110 | 111 | EACH | BARRIER REFLECTOR, TYPE 2, 1WAY | | | | |
| 1,102.5 | | | | | | | | | | 1,102.5 | | 630 | 03100 | 1,102.5 | FT | GROUND MOUNTED SUPPORT, NO. 3 POST | | | | |
| 36.3 | | | | | | | | | | 36.3 | | 630 | 07600 | 36.3 | FT | GROUND MOUNTED STRUCTURAL BEAM SUPPORT, W10X12 | | | | |
| 116 | | | | | | | | | | 116 | | 630 | 08004 | 116 | FT | ONE WAY SUPPORT, NO. 3 POST | | | | |
| 130 | | | | | | | | | | 130 | | 630 | 08200 | 130 | EACH | GROUND MOUNTED SUPPORT, PIPE | | | | |
| 27 | | | | | | | | | | 27 | | 630 | 08600 | 27 | EACH | SIGN POST REFLECTOR | | | | |
| 2 | | | | | | | | | | 2 | | 630 | 09000 | 2 | EACH | BREAKAWAY STRUCTURAL BEAM CONNECTION | | | | |
| 2 | | | | | | | | | | 2 | | 630 | 09050 | 2 | EACH | TRIANGULAR SLIP BASE CONNECTION | | | | |
| 5 | | | | | | | | | | 5 | | 630 | 72320 | 5 | EACH | OVERHEAD SIGN SUPPORT, TYPE TC-12.31, DESIGN 6 | | | | |
| 5 | | | | | | | | | | 5 | | 630 | 72330 | 5 | EACH | OVERHEAD SIGN SUPPORT, TYPE TC-12.31, DESIGN 10 | | | | |
| 1 | | | | | | | | | | 1 | | 630 | 72340 | 1 | EACH | OVERHEAD SIGN SUPPORT, TYPE TC-12.31, DESIGN 12 | | | | |
| 2 | | | | | | | | | | 2 | | 630 | 72410 | 2 | EACH | OVERHEAD SIGN SUPPORT, TYPE TC-15.116, DESIGN 1 | | | | |
| 1 | | | | | | | | | | 1 | | 630 | 79500 | 1 | EACH | SIGN SUPPORT ASSEMBLY, POLE MOUNTED | | | | |
| 3 | | | | | | | | | | 3 | | 630 | 79610 | 3 | EACH | SIGN SUPPORT ASSEMBLY, BARRIER MOUNTED | | | | |
| 741.26 | | | | | | | | | | 741.26 | | 630 | 80100 | 741.26 | SF | SIGN, FLAT SHEET | | | | |
| | 56 | | | | | | | | | 56 | | 630 | 80200 | 56 | SF | SIGN, GROUND MOUNTED EXTRUSHEET | | | | |
| | 1,674 | | | | | | | | | 1,674 | | 630 | 80224 | 1,674 | SF | SIGN, OVERHEAD EXTRUSHEET | | | | |
| | 2 | | | | | | | | | 2 | | 630 | 84500 | 2 | EACH | GROUND MOUNTED STRUCTURAL BEAM SUPPORT FOUNDATION | | | | |
| | 15 | | | | | | | | | 15 | | 630 | 84510 | 15 | EACH | RIGID OVERHEAD SIGN SUPPORT FOUNDATION | | | | |
| | 2 | | | | | | | | | 2 | | 630 | 84600 | 2 | EACH | GROUND MOUNTED PIPE SUPPORT FOUNDATION | | | | |
| | 168 | | | | | | | | | 168 | | 630 | 84900 | 168 | EACH | REMOVAL OF GROUND MOUNTED SIGN AND DISPOSAL | | | | |
| | 2 | | | | | | | | | 2 | | 630 | 85400 | 2 | EACH | REMOVAL OF GROUND MOUNTED MAJOR SIGN AND DISPOSAL | | | | |
| | 1 | | | | | | | | | 1 | | 630 | 85600 | 1 | EACH | REMOVAL OF GROUND MOUNTED MAJOR SIGN AND REERECTION | | | | |
| | 193 | | | | | | | | | 193 | | 630 | 86002 | 193 | EACH | REMOVAL OF GROUND MOUNTED POST SUPPORT AND DISPOSAL | | | | |
| | 8 | | | | | | | | | 8 | | 630 | 86102 | 8 | EACH | REMOVAL OF GROUND MOUNTED STRUCTURAL BEAM SUPPORT AND DISPOSAL | | | | |
| | 7 | | | | | | | | | 7 | | 630 | 87400 | 7 | EACH | REMOVAL OF OVERHEAD MOUNTED SIGN AND DISPOSAL | | | | |
| | 2 | | | | | | | | | 2 | | 630 | 89810 | 2 | EACH | REMOVAL OF OVERHEAD SIGN SUPPORT AND DISPOSAL, TYPE TC-17.10 | | | | |
| | | 553 | | | | | | | | 553 | | 642 | 01200 | 553 | FT | PARKING LOT STALL MARKING, TYPE 1 | | | | |
| | | 1.23 | | | | | | | | 1.23 | | 644 | 00100 | 1.23 | MILE | EDGE LINE, 4" | | | | |
| | | 0.46 | | | | | | | | 0.46 | | 644 | 00200 | 0.46 | MILE | LANE LINE, 4" | | | | |
| | | 0.81 | | | | | | | | 0.81 | | 644 | 00300 | 0.81 | MILE | CENTER LINE | | | | |
| | | 4,373 | | | | | | | | 4,373 | | 644 | 00400 | 4,373 | FT | CHANNELIZING LINE, 8" | | | | |
| | | 351 | | | | | | | | 351 | | 644 | 00500 | 351 | FT | STOP LINE | | | | |
| | | 332 | | | | | | | | 332 | | 644 | 00600 | 332 | FT | CROSSWALK LINE | | | | |
| | | 2,455 | | | | | | | | 2,455 | | 644 | 00700 | 2,455 | FT | TRANSVERSE/DIAGONAL LINE | | | | |
| | | 211 | | | | | | | | 211 | | 644 | 00720 | 211 | FT | CHEVRON MARKING | | | | |
| | | 547 | | | | | | | | 547 | | 644 | 00900 | 547 | SF | ISLAND MARKING | | | | |
| | | 108 | | | | | | | | 108 | | 644 | 01300 | 108 | EACH | LANE ARROW | | | | |
| | | 6 | | | | | | | | 6 | | 644 | 01350 | 6 | EACH | LANE REDUCTION ARROW | | | | |
| | | 2 | | | | | | | | 2 | | 644 | 01360 | 2 | EACH | WRONG WAY ARROW | | | | |
| | | 24 | | | | | | | | 24 | | 644 | 01400 | 24 | EACH | WORD ON PAVEMENT, 72" | | | | |
| | | 592 | | | | | | | | 592 | | 644 | 01500 | 592 | FT | DOTTED LINE, 4" | | | | |
| | | 308 | | | | | | | | 308 | | 644 | 30000 | 308 | FT | REMOVAL OF PAVEMENT MARKING | | | | |
| | | 2 | | | | | | | | 2 | | 644 | 30020 | 2 | EACH | REMOVAL OF PAVEMENT MARKING | | | | |
| | | 0.1 | | | | | | | | 0.1 | | 644 | 30030 | 0.1 | MILE | REMOVAL OF PAVEMENT MARKING | | | | |
| | | 0.01 | | | | | | | | 0.01 | | 646 | 10200 | 0.01 | MILE | CENTER LINE | | | | |
| | | 401 | | | | | | | | 401 | | 646 | 10300 | 401 | FT | CHANNELIZING LINE, 8" | | | | |
| | | 96 | | | | | | | | 96 | | 646 | 10400 | 96 | FT | STOP LINE | | | | |

GENERAL SUMMARY

CLE-32-3.50
(PHASE 5)

...303.205\103954_CG501.dgn 11/19/2021 1:33:04 PM mswhtt

...303.205\103954_CG501.dgn 11/19/2021 1:33:04 PM mswhtt

| SHEET NUM. | | | | | | PART. | | ITEM | ITEM EXT | GRAND TOTAL | UNIT | DESCRIPTION | SEE SHEET NO. |
|------------|-------|-------|--|--|--|-----------|-----------|------|----------|-------------|------|--|---------------|
| 501 | 502 | 567 | | | | 01/NHS/OT | 04/NHS/BR | | | | | | |
| | | | | | | | | | | | | TRAFFIC CONTROL (CONT.) | |
| | 4 | | | | | 4 | | 646 | 20300 | 4 | EACH | LANE ARROW | |
| | 4 | | | | | 4 | | 646 | 20400 | 4 | EACH | WORD ON PAVEMENT, 72" | |
| | 527 | | | | | 527 | | 646 | 20502 | 527 | FT | DOTTED LINE, 4" | |
| | 0.06 | | | | | 0.06 | | 807 | 12000 | 0.06 | MILE | WET REFLECTIVE EPOXY PAVEMENT MARKING, EDGE LINE, 4" | |
| | 0.04 | | | | | 0.04 | | 807 | 12100 | 0.04 | MILE | WET REFLECTIVE EPOXY PAVEMENT MARKING, LANE LINE, 4" | |
| | 2.9 | | | | | 2.9 | | 807 | 14010 | 2.9 | MILE | WET REFLECTIVE THERMOPLASTIC PAVEMENT MARKING, EDGE LINE, 6" | |
| | 1.13 | | | | | 1.13 | | 807 | 14110 | 1.13 | MILE | WET REFLECTIVE THERMOPLASTIC PAVEMENT MARKING, LANE LINE, 6" | |
| 5,037 | | | | | | 5,037 | | 807 | 14310 | 5,037 | FT | WET REFLECTIVE THERMOPLASTIC PAVEMENT MARKING, CHANNELIZING LINE, 12" | |
| | 1,523 | | | | | 1,523 | | 807 | 14410 | 1,523 | FT | WET REFLECTIVE THERMOPLASTIC PAVEMENT MARKING, DOTTED LINE, 6" | |
| | 1,260 | | | | | 1,260 | | 807 | 14420 | 1,260 | FT | WET REFLECTIVE THERMOPLASTIC PAVEMENT MARKING, DOTTED LINE, 8" | |
| | 544 | | | | | 544 | | 807 | 14430 | 544 | FT | WET REFLECTIVE THERMOPLASTIC PAVEMENT MARKING, DOTTED LINE, 12" | |
| 4.03 | | | | | | 4.03 | | 850 | 10010 | 4.03 | MILE | GROOVING FOR 6" RECESSED PAVEMENT MARKING, (ASPHALT) | |
| | 1,523 | | | | | 1,523 | | 850 | 10110 | 1,523 | FT | GROOVING FOR 6" RECESSED PAVEMENT MARKING, (ASPHALT) | |
| | 1,260 | | | | | 1,260 | | 850 | 10120 | 1,260 | FT | GROOVING FOR 8" RECESSED PAVEMENT MARKING, (ASPHALT) | |
| 5,037 | 544 | | | | | 5,581 | | 850 | 10130 | 5,581 | FT | GROOVING FOR 12" RECESSED PAVEMENT MARKING, (ASPHALT) | |
| | 0.1 | | | | | 0.1 | | 850 | 20000 | 0.1 | MILE | GROOVING FOR 4" RECESSED PAVEMENT MARKING, (CONCRETE) | |
| | | | | | | | | | | | | TRAFFIC SIGNALS | |
| | | 6 | | | | 6 | | 625 | 18201 | 6 | EACH | BRACKET ARM, 15', AS PER PLAN | 549 |
| | | 1,300 | | | | 1,300 | | 625 | 23306 | 1,300 | FT | NO. 10 AWG 600 VOLT DISTRIBUTION CABLE | |
| | | 162 | | | | 162 | | 625 | 25504 | 162 | FT | CONDUIT, 3", 725.051 | |
| | | 1,172 | | | | 1,172 | | 625 | 25908 | 1,172 | FT | CONDUIT, JACKED OR DRILLED, 725.052, 4" | |
| | | 6 | | | | 6 | | 625 | 27551 | 6 | EACH | LUMINAIRE, DECORATIVE, AS PER PLAN | 549 |
| | | 81 | | | | 81 | | 625 | 29400 | 81 | FT | TRENCH IN PAVED AREA | |
| | | 7 | | | | 7 | | 625 | 30706 | 7 | EACH | PULL BOX, 725.08, 24" | |
| | | 6 | | | | 6 | | 625 | 32000 | 6 | EACH | GROUND ROD | |
| | | 81 | | | | 81 | | 625 | 36010 | 81 | FT | UNDERGROUND WARNING/MARKING TAPE | |
| | | 4 | | | | 4 | | 630 | 79100 | 4 | EACH | SIGN HANGER ASSEMBLY, MAST ARM | |
| | | 6 | | | | 6 | | 630 | 79500 | 6 | EACH | SIGN SUPPORT ASSEMBLY, POLE MOUNTED | |
| | | 33 | | | | 33 | | 630 | 80100 | 33 | SF | SIGN, FLAT SHEET | |
| | | 6 | | | | 6 | | 630 | 80500 | 6 | EACH | SIGN, DOUBLE FACED, STREET NAME | |
| | | 24 | | | | 24 | | 632 | 05007 | 24 | EACH | VEHICULAR SIGNAL HEAD, (LED), 3-SECTION, 12" LENS, 1-WAY, POLYCARBONATE, AS PER PLAN, BLACK | 550 |
| | | 24 | | | | 24 | | 632 | 25000 | 24 | EACH | COVERING OF VEHICULAR SIGNAL HEAD | |
| | | 8,775 | | | | 8,775 | | 632 | 40700 | 8,775 | FT | SIGNAL CABLE, 7 CONDUCTOR, NO. 14 AWG | |
| | | 6 | | | | 6 | | 632 | 64010 | 6 | EACH | SIGNAL SUPPORT FOUNDATION | |
| | | 44 | | | | 44 | | 632 | 68200 | 44 | FT | POWER CABLE, 2 CONDUCTOR, NO. 6 AWG | |
| | | 75 | | | | 75 | | 632 | 68300 | 75 | FT | POWER CABLE, 3 CONDUCTOR, NO. 6 AWG | |
| | | 250 | | | | 250 | | 632 | 69500 | 250 | FT | SERVICE CABLE, 2 CONDUCTOR, NO. 6 AWG | |
| | | 1 | | | | 1 | | 632 | 70001 | 1 | EACH | POWER SERVICE, AS PER PLAN | 550 |
| | | 1 | | | | 1 | | 632 | 78361 | 1 | EACH | COMBINATION SIGNAL SUPPORT, TYPE TC-12.31 DESIGN 10 POLE, WITH MAST ARMS TC-81.22 DESIGN 13 AND DESIGN 2, AS PER PLAN | 550 |
| | | 1 | | | | 1 | | 632 | 78369 | 1 | EACH | COMBINATION SIGNAL SUPPORT, TYPE TC-12.31 DESIGN 10 POLE, WITH MAST ARMS TC-81.22 DESIGN 13 AND DESIGN 12, AS PER PLAN | 550 |
| | | 1 | | | | 1 | | 632 | 79101 | 1 | EACH | COMBINATION SIGNAL SUPPORT, TYPE TC-81.22, DESIGN 2, AS PER PLAN | 550 |
| | | 3 | | | | 3 | | 632 | 79141 | 3 | EACH | COMBINATION SIGNAL SUPPORT, TYPE TC-81.22, DESIGN 13, AS PER PLAN | 550 |
| | | 3 | | | | 3 | | 632 | 90103 | 3 | EACH | REMOVAL OF TRAFFIC SIGNAL INSTALLATION FOR STORAGE, AS PER PLAN | 551 |
| | | 1 | | | | 1 | | 633 | 67101 | 1 | EACH | CABINET FOUNDATION, AS PER PLAN | 552 |
| | | 1 | | | | 1 | | 633 | 67201 | 1 | EACH | CONTROLLER WORK PAD, AS PER PLAN | 551 |
| | | 1 | | | | 1 | | 633 | 75001 | 1 | EACH | UNINTERRUPTIBLE POWER SUPPLY (UPS), 1000 WATT, AS PER PLAN | 551 |
| | | 1 | | | | 1 | | 633 | 99000 | 1 | EACH | CONTROLLER ITEM, MISC.: CDMA MODEM, FURNISH ONLY | 551 |
| | | 1 | | | | 1 | | 633 | 99000 | 1 | EACH | CONTROLLER ITEM, MISC.: CONTROLLER UNIT, TYPE 2070E WITH 2070-1C CPU AND ASC/3 SOFTWARE | 551 |
| | | 2 | | | | 2 | | 809 | 69000 | 2 | EACH | ADVANCE RADAR DETECTION | |
| | | 6 | | | | 6 | | 809 | 69100 | 6 | EACH | STOP LINE RADAR DETECTION | |

GENERAL SUMMARY

CLE-32-3.50 (PHASE 5)

...303.205\103954_CS501.dgn 11/19/2021 1:34:29 PM mswwhit

| SHEET NO. | REFERENCE NO. | ALIGNMENT | STATION | | SIDE | 606 | | | | | | | | | | 607 | | 608 | 609 | 609 | 609 | |
|--|---------------|-----------------|-----------|-----------|-------|---------------------|---|-----------------------------|--------------------------------------|--------------------------------------|--|---------|-------|---------|-----------------|----------------|--------------------------------|-----------|-------------------------------------|---------------|--------------|--|
| | | | FROM | TO | | GUARDRAIL, TYPE MGS | ANCHOR ASSEMBLY, MGS TYPE E (MASH 2016) | ANCHOR ASSEMBLY, MGS TYPE T | MGS BRIDGE TERMINAL ASSEMBLY, TYPE 1 | MGS BRIDGE TERMINAL ASSEMBLY, TYPE 2 | | | | | FENCE, TYPE CLT | GATE, TYPE CLT | FENCELINE SEEDING AND MULCHING | CURB RAMP | COMBINATION CURB AND GUTTER, TYPE 2 | CURB, TYPE 4C | CURB, TYPE 6 | CURB, MISC.: CLERMONT COUNTY CURB AND GUTTER |
| | | | | | | | | | | | | | | | | | | | | | | |
| 193 | C-3 | GLEN ESTE-WITH. | 16+74.17 | 19+28.09 | RT | | | | | | | | | | | | | | | | 311.3 | |
| 194 | C-5 | GLEN ESTE-WITH. | 21+05.69 | 23+07.40 | RT | | | | | | | | | | | | | | | | 203.1 | |
| 194 | C-6 | GLEN ESTE-WITH. | 20+69.91 | 24+12.43 | LT | | | | | | | | | | | | | | | | 406.2 | |
| 197 | C-8 | BACH BUXTON | 332+72.11 | 338+50.18 | LT | | | | | | | | | | | | | | | | 572.1 | |
| 197 | C-9 | BACH BUXTON | 332+72.11 | 340+45.25 | RT | | | | | | | | | | | | | | | | 790.1 | |
| 198 | G-34 | BACH BUXTON | 335+52.08 | 340+07.64 | RT | 413.0 | 1 | | | | | | | | | | 86.5 | | | | | |
| 198 | C-11 | BACH BUXTON | 337+35.45 | 338+12.85 | RT | | | | | | | | | | | | | | | | | |
| 200 | G-36 | BACH BUXTON | 346+21.37 | 346+70.01 | RT | 37.5 | | 1 | | | | | | | | | | | | | | |
| 200 | G-37 | BACH BUXTON | 343+88.79 | 349+27.72 | LT | 477.3 | 1 | | | | | | | | | | | | | | | |
| 200 | C-13 | BACH BUXTON | 346+23.32 | 348+68.26 | RT | | | | | | | | | | | | | | | | 248.9 | |
| 200 | C-14 | BACH BUXTON | 343+86.53 | 348+68.26 | LT | | | | | | | | | | | | | | | | 469.1 | |
| 202 | C-16 | FAYARD N. | 10+00.00 | 11+29.00 | LT/RT | | | | | | | | | | | | | | | | 264.4 | |
| 203 | C-18 | ELICK LN S. | 47+96.51 | 49+83.77 | RT | | | | | | | | | | | | | | | | 282.0 | |
| 203 | C-19 | ELICK LN S. | 50+22.59 | 50+85.32 | LT/RT | | | | | | | | | | | | | | | | 164.1 | |
| 204 | C-21 | ELICK LN N. | 60+00.61 | 63+55.12 | LT/RT | | | | | | | | | | | | | | | | 599.5 | |
| 205 | C-23 | EX OLD 74 | 201+48.71 | 202+41.60 | LT/RT | | | | | | | | | | | | | | | | 175.3 | |
| 206 | C-24 | EX OLD 74 | 204+49.59 | 205+50.00 | LT/RT | | | | | | | | | | | | | | | | 220.2 | |
| 206 | C-25 | EX OLD 74 | 205+25.81 | 205+50.00 | RT | | | | | | | | | | | | | | | | 58.9 | |
| 206 | C-26 | EX OLD 74 | 204+94.80 | 205+05.80 | RT | | | | | | | | | | | | | | | | 66.8 | |
| 435 | C-27 | ACCESS ROAD | 5+33.88 | 5+55.00 | RT | | | | | | | | | | | | | | | | 39.8 | |
| 435 | C-28 | ACCESS ROAD | 5+14.13 | 5+55.00 | LT | | | | | | | | | | | | | | | | 50.1 | |
| 435 | F-17 | ACCESS ROAD | 5+54.00 | 6+59.48 | LT | | | | | | | | 227.9 | 1 | 227.9 | | | | | | | |
| 435 | F-18 | ACCESS ROAD | 5+54.00 | 8+15.87 | RT | | | | | | | 299.7 | | 299.7 | | | | | | | | |
| 436 | F-19 | ACCESS ROAD | 6+59.48 | 9+62.52 | LT | | | | | | | 144.5 | | 144.5 | | | | | | | | |
| 641 | F-1 | BACH BUXTON | 332+50.00 | 338+79.23 | LT | | | | | | | 661.2 | | 661.2 | | | | | | | | |
| 641 | F-2 | BACH BUXTON | 332+50.00 | 340+28.56 | RT | | | | | | | 817.3 | | 817.3 | | | | | | | | |
| 643 | F-3 | BACH BUXTON | 343+77.05 | 348+74.76 | LT | | | | | | | 484.6 | | 484.6 | | | | | | | | |
| 644 | F-4 | BACH BUXTON | 346+35.37 | 348+74.87 | RT | | | | | | | 247.6 | | 247.6 | | | | | | | | |
| 645 | F-6 | SR-32 | 158+28.34 | 158+97.55 | LT | | | | | | | 69.6 | | 69.6 | | | | | | | | |
| 646 | F-7 | SR-32 | 185+50.00 | 195+53.45 | RT | | | | | | | 1,011.9 | | 1,011.9 | | | | | | | | |
| 646 | F-8 | SR-32 | 185+73.17 | 196+93.11 | LT | | | | | | | 1,142.3 | | 1,142.3 | | | | | | | | |
| 647 | F-9 | SR-32 | 201+05.90 | 202+59.38 | LT | | | | | | | 156.4 | | 156.4 | | | | | | | | |
| 647 | F-10 | SR-32 | 204+23.84 | 208+85.34 | LT | | | | | | | 519.2 | | 519.2 | | | | | | | | |
| 647 | F-11 | SR-32 | 204+07.35 | 210+35.98 | RT | | | | | | | 652.2 | | 652.2 | | | | | | | | |
| 648 | F-12 | SR-32 | 212+98.31 | 214+21.17 | LT | | | | | | | 119.9 | | 119.9 | | | | | | | | |
| 648 | F-13 | SR-32 | 212+12.04 | 232+50.00 | RT | | | | | | | 596.5 | | 596.5 | | | | | | | | |
| 649 | F-14 | SR-32 | 232+95.63 | 236+39.23 | LT | | | | | | | 354.2 | | 354.2 | | | | | | | | |
| 649 | F-15 | SR-32 | 235+05.16 | 238+76.91 | RT | | | | | | | 372.4 | | 372.4 | | | | | | | | |
| SUBTOTAL FROM THIS SHEET | | | | | | 927.8 | 2 | 1 | | | | 7,877.3 | 1 | 7,877.3 | | 86.5 | | 3,555.1 | 1,366.6 | | | |
| SUBTOTAL FROM SHEET 144 | | | | | | 8,348.7 | 9 | 7 | 8 | 5 | | | | | | 403.4 | | 402.6 | 512.8 | | | |
| TOTALS CARRIED TO GENERAL SUMMARY | | | | | | 9,277 | 11 | 8 | 8 | 5 | | | 7,877 | 1 | 7,877 | 403 | 87 | 403 | 4,068 | 1,367 | | |

ROADWAY ESTIMATED QUANTITIES

CLE-32-3.50 (PHASE 5)

CALCULATED
 MSW
 CHECKED
 WAA

11/19/2021 1:35:28 PM mswwhitt
...303.205\103954_CS501.dgn

| SHEET NO. | STATION | | 203 | 203 | 659 |
|--------------|-----------|-----------|------------------|------------------|----------------------------|
| | FROM | TO | EXCAVATION CY | EMBANKMENT CY | SEEDING AND MULCHING SY |
| SR-32 | | | | | |
| 270 | 133+50.00 | 134+50.00 | 127 | 14 | 250 |
| 271 | 135+00.00 | 136+00.00 | 169 | 89 | 632 |
| 272 | 136+50.00 | 137+50.00 | 49 | 139 | 519 |
| 273 | 138+00.00 | 139+00.00 | 27 | 131 | 481 |
| 274 | 139+50.00 | 140+50.00 | 25 | 136 | 477 |
| 275 | 141+00.00 | 142+00.00 | 28 | 121 | 477 |
| 276 | 142+50.00 | 143+00.00 | 180 | 15 | 581 |
| 277 | 143+50.00 | 144+00.00 | 220 | 11 | 626 |
| 278 | 144+50.00 | 145+00.00 | 248 | 15 | 560 |
| 279 | 145+50.00 | 146+00.00 | 64 | 17 | 346 |
| 280 | 146+50.00 | 147+50.00 | 88 | 29 | 519 |
| 281 | 148+00.00 | 148+50.00 | 59 | 19 | 346 |
| 282 | 149+00.00 | 149+50.00 | 58 | 20 | 346 |
| 283 | 150+00.00 | 151+00.00 | 69 | 21 | 505 |
| 284 | 151+50.00 | 152+50.00 | 63 | 20 | 495 |
| 285 | 153+00.00 | 154+00.00 | 36 | 25 | 210 |
| 286 | 157+00.00 | 158+50.00 | 11 | 31 | 197 |
| 287 | 159+00.00 | 160+00.00 | 107 | 24 | 263 |
| 288 | 160+50.00 | 171+00.00 | 7 | 5 | 56 |
| 289 | 171+50.00 | 172+50.00 | 143 | 37 | 420 |
| 290 | 173+00.00 | 174+00.00 | 189 | 39 | 459 |
| 291 | 174+50.00 | 175+50.00 | 160 | 92 | 559 |
| 292 | 176+00.00 | 177+00.00 | 175 | 7 | 312 |
| 293 | 177+50.00 | 178+50.00 | 198 | 18 | 325 |
| 294 | 179+00.00 | 180+00.00 | 221 | 7 | 308 |
| 295 | 180+50.00 | 181+50.00 | 226 | 94 | 500 |
| 296 | 182+00.00 | 183+00.00 | 189 | 148 | 448 |
| 297 | 183+50.00 | 184+50.00 | 168 | 124 | 290 |
| 298 | 185+00.00 | 186+00.00 | 254 | 107 | 337 |
| 299 | 186+50.00 | 187+50.00 | 484 | 132 | 351 |
| 300 | 188+00.00 | 189+00.00 | 593 | 125 | 492 |
| 301 | 189+50.00 | 190+50.00 | 118 | 173 | 826 |
| 302 | 191+00.00 | 191+50.00 | 40 | 279 | 690 |
| 303 | 192+00.00 | 192+50.00 | 33 | 417 | 772 |
| 304 | 193+00.00 | 193+50.00 | | 596 | 545 |
| 305 | 194+50.00 | 194+50.00 | | 679 | 421 |
| 306 | 195+00.00 | 195+50.00 | 1 | 1087 | 494 |
| 307 | 196+00.00 | 196+50.00 | 99 | 1606 | 610 |
| 308 | 197+00.00 | 197+50.00 | 154 | 1598 | 603 |
| 309 | 198+00.00 | 198+50.00 | 77 | 120 | 143 |
| 310 | 199+00.00 | 199+50.00 | 58 | 1746 | 454 |
| 311 | 200+00.00 | 200+50.00 | 15 | 2360 | 674 |
| 312 | 201+00.00 | 201+50.00 | 8 | 2194 | 667 |
| 313 | 202+00.00 | 202+50.00 | 2 | 2150 | 669 |
| 314 | 203+00.00 | 203+50.00 | | 1,798 | 647 |
| 315 | 204+00.00 | 205+00.00 | | 1854 | 865 |
| 316 | 205+50.00 | 206+00.00 | | 586 | 578 |
| 317 | 206+50.00 | 207+00.00 | 41 | 842 | 644 |
| 318 | 207+50.00 | 208+00.00 | 133 | 815 | 614 |
| 319 | 208+50.00 | 209+00.00 | 279 | 754 | 715 |
| 320 | 209+50.00 | 210+00.00 | 168 | 503 | 538 |
| 321 | 210+50.00 | 211+00.00 | 160 | 362 | 445 |
| 322 | 211+50.00 | 212+00.00 | 136 | 283 | 394 |
| 323 | 212+50.00 | 213+00.00 | 140 | 214 | 390 |
| 324 | 213+50.00 | 214+50.00 | 314 | 151 | 682 |
| 325 | 215+00.00 | 216+00.00 | 357 | 93 | 641 |
| 326 | 216+50.00 | 232+00.00 | 96 | 64 | 291 |
| 327 | 232+50.00 | 233+50.00 | 48 | 60 | 500 |
| 328 | 234+00.00 | 235+00.00 | 76 | 91 | 654 |
| 329 | 235+50.00 | 236+50.00 | 135 | 135 | 856 |

| SHEET NO. | STATION | | 203 | 203 | 203 | 659 | 840 |
|--|-----------|-----------|------------------|------------------|----------------------------------|----------------------------|-----------------------------------|
| | FROM | TO | EXCAVATION CY | EMBANKMENT CY | EMBANKMENT, AS PER PLAN CY | SEEDING AND MULCHING SY | SELECT GRANULAR BACKFILL CY |
| SR-32 (CONT.) | | | | | | | |
| 330 | 237+00.00 | 238+00.00 | 54 | 33 | | 294 | |
| 331 | 238+50.00 | 239+50.00 | 32 | 13 | | 186 | |
| SR-32 SUBTOTAL: | | | 7,409 | 25,468 | | 30,189 | |
| REVISED SUBTOTAL FOR EMBANKMENT, APP: | | | | -305 | 305 | | |
| RAMP N | | | | | | | |
| 332 | 188+43.69 | 189+50.00 | 128 | 116 | | 201 | |
| 333 | 190+00.00 | 191+00.00 | 354 | 159 | | 343 | |
| 334 | 191+50.00 | 192+50.00 | 82 | 322 | | 395 | |
| 335 | 193+00.00 | 194+00.00 | 54 | 1,643 | | 494 | |
| 336 | 194+50.00 | 195+00.00 | 31 | 2,374 | | 433 | |
| 337 | 195+50.00 | 196+00.00 | 36 | 3,402 | | 542 | 18 |
| 338 | 196+50.00 | 197+00.00 | 33 | 4,651 | | 734 | |
| 339 | 197+50.00 | 197+50.00 | 10 | 3,406 | | 374 | |
| RAMP N SUBTOTAL: | | | 728 | 16,073 | | 3,516 | 18 |
| REVISED SUBTOTAL FOR EMBANKMENT, APP: | | | | -1,040 | 1,040 | | |
| RAMP O | | | | | | | |
| 340 | 188+87.44 | 189+50.00 | 112 | 14 | | 9 | |
| 341 | 190+00.00 | 191+00.00 | 168 | 27 | | 29 | |
| 342 | 191+50.00 | 192+50.00 | 12 | 224 | | 122 | |
| 343 | 193+00.00 | 194+00.00 | | 1813 | | 326 | |
| 344 | 194+50.00 | 195+00.00 | | 2690 | | 342 | |
| 345 | 195+50.00 | 196+00.00 | | 3494 | | 356 | |
| 346 | 196+50.00 | 196+93.90 | | 1675 | | | |
| RAMP O SUBTOTAL: | | | 292 | 9,937 | | 1,184 | |
| REVISED SUBTOTAL FOR EMBANKMENT, APP: | | | | -1,047 | 1,047 | | |
| RAMP P | | | | | | | |
| 347 | 198+50.00 | 199+00.00 | 14 | 1420 | | 279 | |
| 348 | 199+50.00 | 200+00.00 | 25 | 1324 | | 181 | |
| 349 | 200+50.00 | 201+00.00 | 22 | 2049 | | 233 | |
| 350 | 201+50.00 | 202+00.00 | 20 | 1801 | | 215 | |
| 351 | 202+50.00 | 203+00.00 | 21 | 1056 | | 86 | |
| 352 | 203+50.00 | 204+50.00 | 44 | 1912 | | 367 | |
| 353 | 205+00.00 | 205+49.91 | 52 | 1188 | | 426 | |
| RAMP P SUBTOTAL: | | | 198 | 10,750 | | 1,787 | |
| REVISED SUBTOTAL FOR EMBANKMENT, APP: | | | | -1,107 | 1,107 | | |
| RAMP Q | | | | | | | |
| 354 | 199+00.00 | 199+50.00 | | 2,121 | | | |
| 355 | 200+00.00 | 200+50.00 | 140 | 6,562 | | 708 | |
| 356 | 201+00.00 | 201+50.00 | 185 | 5,863 | | 879 | |
| 357 | 202+00.00 | 202+50.00 | 240 | 3,606 | | 829 | |
| 358 | 203+00.00 | 203+50.00 | 231 | 1,933 | | 733 | |
| 359 | 204+00.00 | 205+00.00 | 239 | 1,982 | | 799 | |
| 360 | 205+50.00 | 206+50.00 | 146 | 1,947 | | 690 | |
| 361 | 207+00.00 | 208+05.69 | 218 | 976 | | 617 | |
| RAMP Q SUBTOTAL: | | | 1,399 | 24,990 | | 5,255 | |
| REVISED SUBTOTAL FOR EMBANKMENT, APP: | | | | -1,336 | 1,336 | | |
| EX OLD 74 | | | | | | | |
| 398 | 201+00.00 | 202+01.56 | 124 | 1 | | 66 | |
| 399 | 202+50.00 | 205+25.00 | 21 | 40 | | 93 | |
| 400 | 205+50.00 | 205+75.00 | 8 | 5 | | 30 | |
| EX OLD 74 SUBTOTAL: | | | 153 | 46 | | 189 | |

| SHEET NO. | STATION | | 203 | 203 | 203 | 659 | 840 |
|--|-----------|-----------|------------------|------------------|----------------------------------|----------------------------|-----------------------------------|
| | FROM | TO | EXCAVATION CY | EMBANKMENT CY | EMBANKMENT, AS PER PLAN CY | SEEDING AND MULCHING SY | SELECT GRANULAR BACKFILL CY |
| GLEN ESTE-WITHAMSVILLE RD. | | | | | | | |
| 362 | 16+57.00 | 17+50.00 | 18 | 96 | | 276 | |
| 363 | 18+00.00 | 18+80.00 | 10 | 181 | | 534 | |
| 364 | 21+20.00 | 22+00.00 | 41 | 562 | | 488 | |
| 365 | 22+50.00 | 23+50.00 | 18 | 256 | | 828 | |
| 366 | 23+95.00 | 25+00.00 | 4 | 77 | | 237 | |
| GLEN ESTE-WITH. SUBTOTAL: | | | 91 | 1,172 | | 2,363 | |
| BACH BUXTON RD. | | | | | | | |
| 367 | 332+43.25 | 333+50.00 | 641 | 70 | | 360 | |
| 368 | 334+00.00 | 335+00.00 | 984 | 304 | | 452 | |
| 369 | 335+50.00 | 336+00.00 | 108 | 1071 | | 482 | |
| 370 | 336+50.00 | 336+50.00 | | 1445 | | 323 | |
| 371 | 337+00.00 | 337+00.00 | | 2127 | | 384 | |
| 372 | 337+50.00 | 337+50.00 | | 2939 | | 450 | |
| 373 | 338+00.00 | 338+00.00 | | 3648 | | 503 | |
| 374 | 338+50.00 | 338+50.00 | | 4066 | | 500 | |
| 375 | 339+00.00 | 339+00.00 | | 4975 | | 529 | |
| 376 | 339+50.00 | 339+50.00 | | 5248 | | 448 | |
| 377 | 340+41.63 | 340+41.63 | | 9129 | | | |
| 378 | 340+71.63 | 340+71.63 | | | | | |
| 379 | 342+24.45 | 342+24.45 | | | | | |
| 380 | 342+54.45 | 342+54.45 | | | | | |
| 381 | 343+50.00 | 343+50.00 | 67 | 12076 | | | |
| 382 | 344+00.00 | 344+00.00 | 57 | 6832 | | 642 | |
| 383 | 344+50.00 | 344+50.00 | 29 | 6664 | | 731 | |
| 384 | 345+00.00 | 345+00.00 | 11 | 5673 | | 633 | |
| 385 | 345+50.00 | 345+50.00 | 15 | 4695 | | 547 | |
| 386 | 346+00.00 | 346+00.00 | 15 | 3802 | | 486 | |
| 387 | 346+50.00 | 347+00.00 | 6 | 4834 | | 805 | |
| 388 | 347+50.00 | 348+50.00 | 927 | 670 | | 452 | |
| 389 | 348+68.26 | 348+68.26 | 47 | | | 78 | |
| BACH BUXTON SUBTOTAL: | | | 3,277 | 80,268 | | 8,805 | |
| REVISED SUBTOTAL FOR EMBANKMENT, APP: | | | | -4,074 | 4,074 | | |
| FAYARD DR. (NORTH) | | | | | | | |
| 390 | 10+35.00 | 11+00.00 | 163 | 15 | | 128 | |
| 391 | 11+29.00 | 11+29.00 | 39 | 10 | | 70 | |
| FAYARD SUBTOTAL: | | | 202 | 25 | | 198 | |
| ELICK LN (SOUTH) | | | | | | | |
| 392 | 47+50.00 | 48+50.00 | 7 | 11 | | 58 | |
| 393 | 49+00.00 | 50+00.00 | 14 | 36 | | 196 | |
| 394 | 50+50.32 | 50+50.32 | 39 | 3 | | 41 | |
| ELICK LN (SOUTH) SUBTOTAL: | | | 60 | 50 | | 295 | |
| ELICK LN (NORTH) | | | | | | | |
| 395 | 60+35.61 | 61+00.00 | 101 | 21 | | 149 | |
| 396 | 61+50.00 | 62+50.00 | 120 | 51 | | 225 | |
| 397 | 63+00.00 | 63+55.12 | 15 | 7 | | 83 | |
| ELICK LN (NORTH) SUBTOTAL: | | | 236 | 79 | | 457 | |
| GRAND TOTALS CARRIED TO GENERAL NOTES | | | | | | 54,238 | |
| GRAND TOTALS CARRIED TO GENERAL SUMMARY | | | 14,045 | 159,948 | 8,605 | | 18 |

CALCULATED
MSW
CHECKED
WAA

EARTHWORK SUBSUMMARY

CLE-32-3.50 (PHASE 5)

147
736

...103954DS001.dgn 11/19/2021 1:35:31 PM mswwhit

| SHEET NO. | REF NO. | STATION | | CHAIN | SIDE | 601 | 601 | 601 | 602 | 611 | 611 |
|--|---------|-----------|-----------|----------|------|---------------------------------------|--|---|------------------------|---------------------------|---------------------------|---------------------------|---------------------------|--|--|---------------------------|---------------------------|---------------------------|---------------------------|---|-----------------------------|--|----------------------------|-----------------------------|-------------------------------|---------------------------------------|---|------------------------|-----------------------------------|-----|-----|
| | | FROM | TO | | | TIED CONCRETE BLOCK MAT, TYPE 2 SY | ROCK CHANNEL PROTECTION, TYPE C WITH GEOTEXTILE FABRIC CY | PAVED GUTTER, TYPE 1-2, AS PER PLAN FT | CONCRETE MASONRY CY | 12" CONDUIT, TYPE B FT | 12" CONDUIT, TYPE C FT | 15" CONDUIT, TYPE B FT | 15" CONDUIT, TYPE C FT | 15" CONDUIT, TYPE C, 706.02, JOINTS PER 706.11 FT | 15" CONDUIT, TYPE F, 707.05 TYPE C OR 707.21 FT | 18" CONDUIT, TYPE B FT | 18" CONDUIT, TYPE C FT | 24" CONDUIT, TYPE B FT | 48" CONDUIT, TYPE B FT | CATCH BASIN, NO. 3, AS PER PLAN EACH | CATCH BASIN, NO. 3A EACH | CATCH BASIN, NO. 3A, AS PER PLAN EACH | CATCH BASIN, NO. 8 EACH | CATCH BASIN, NO. 8A EACH | CATCH BASIN, NO. 2-2B EACH | CATCH BASIN ADJUSTED TO GRADE EACH | INLET, NO. 3 FOR SINGLE SLOPE BARRIER, TYPE D EACH | MANHOLE, NO. 3 EACH | MANHOLE ADJUSTED TO GRADE EACH | | |
| 439 | D1 | 333+50.00 | 333+50.00 | BACH BUX | LT | | | | | 10 | | | | | | | | | | | | | | | | | | | | | |
| 439 | D2 | 333+50.00 | 332+68.87 | BACH BUX | LT | | | | | | | | 77 | | | | | 1 | | | | | | | | | | | | | |
| 439 | D3 | 335+00.00 | 333+50.00 | BACH BUX | LT | | | | | | 150 | | | | | | | 1 | | | | | | | | | | | | | |
| 439 | D4 | 335+05.00 | 335+00.00 | BACH BUX | RT | | | | | 82 | | | | | | | | 1 | | | | | | | | | | | | | |
| 439 | D5 | 335+75.00 | 335+05.00 | BACH BUX | RT | | | | | 71 | | | | | | | | 1 | | | | | | | | | | | | | |
| 440 | D6 | 337+00.00 | 335+00.00 | BACH BUX | LT | | | | | 200 | | | | | | | | 1 | | | | | | | | | | | | | |
| 440 | D7 | 337+00.00 | 337+00.00 | BACH BUX | RT | | | | | 99 | | | | | | | | 1 | | | | | | | | | | | | | |
| 440 | D8 | 339+00.00 | 337+00.00 | BACH BUX | RT | | | | | 204 | | | | | | | | 1 | | | | | | | | | | | | | |
| 440 | D9 | 196+13.22 | 196+48.37 | RAMP O | LT | | | | | | 46 | | | | | | | 1 | | | | | | | | | | | | | |
| 440 | D10 | 339+35.63 | 196+48.37 | BACH BUX | LT | | | | | | 48 | | | | | | | 1 | | | | | | | | | | | | | |
| 440 | D11 | 196+48.37 | 195+87.27 | RAMP O | RT | | | | | | 43 | | 43 | | | | | | | | | | | | | | | | 1 | | |
| 440 | D12 | 198+87.27 | 194+51.00 | RAMP O | RT | | | | | | | | | | 142 | | | | | | | 1 | | | | | | | | | |
| 440 | D13 | 338+78.31 | | BACH BUX | RT | | | | | 15 | | | | | | | | 1 | | | | | | | | | | | | | |
| 440 | D87 | 198+50.00 | 199+00.00 | RAMP P | RT | | | | | | | | 70 | | | | | | | | | 1 | | | | | | | | | |
| 440 | D88 | 198+69.00 | 203+91.00 | RAMP P | RT | | | 556 | | | | | | | | | | | | | | | | | | | | | | | |
| 441 | D14 | 344+50.00 | 344+50.00 | BACH BUX | LT | | | | | 113 | | | | | | | | 1 | | | | | | | | | | | | | |
| 441 | D15 | 344+50.00 | 346+00.00 | BACH BUX | RT | | | | | 154 | | | | | | | | | | | | | | | | | | | | | |
| 441 | D16 | 346+00.00 | 346+00.00 | BACH BUX | LT | | | | | 109 | | | | | | | | 1 | | | | | | | | | | | | | |
| 441 | D17 | 346+00.00 | 347+50.00 | BACH BUX | RT | | | | | 154 | | | | | | | | | | | | | | | | | | | | | |
| 441 | D18 | 197+00.00 | 198+28.18 | RAMP N | LT | | 5 | | 1.1 | | | | | | | 276 | | | | | | 1 | | | | | | | | | |
| 441 | D19 | 199+31.00 | | RAMP Q | RT | 56 | | | | | | | | | | | | | | | | | | | | | | | | | |
| 442 | D20 | 347+50.00 | 347+50.00 | BACH BUX | LT | | | | | 93 | | | | | | | | | | | | 1 | | | | | | | | | |
| 442 | D21 | 347+50.00 | 348+70.00 | BACH BUX | RT | | | | | 121 | | | | | | | | | | | | 1 | | | | | | | | | |
| 443 | D22 | 16+76.00 | | GEW | RT | | | | | | 10 | | | | | | | 1 | | | | | | | | | | | | | |
| 443 | D23 | 18+75.43 | | GEW | RT | | | | | | | 7 | | | | | | | | | | | | | | | | | | | |
| 443 | D24 | 18+75.75 | | GEW | RT | | | | | | | | 10 | | | | | 1 | | | | | | | | | | | | | |
| 444 | D25 | 22+08.86 | 22+09.45 | GEW | RT | | | | | | 10 | | | | | | | | | | | 1 | | | | | | | | | |
| 444 | D26 | 22+09.45 | | GEW | RT | | | | | | | | 5 | | | | | | | | | | | | | | | | | | |
| 444 | D27 | 24+05.27 | 24+01.48 | GEW | LT | | | | | | 19 | | | | | | | 1 | | | | | | | | | | | | | |
| 444 | D28 | 24+01.48 | | GEW | LT | | | | | | 5 | | 5 | | | | | | | | | | | | | | | | | | |
| 446 | D29 | 50+55.70 | 50+45.62 | BACH CDS | RT | | | | | | 28 | | | | | | | 1 | | | | | | | | | | | | | |
| 446 | D30 | 50+45.62 | | BACH CDS | RT | | | | | | 10 | | | | | | | | | | | | | | | | | | | | |
| 446 | D31 | 62+09.04 | | ELICK | LT | | | | | | | | | | | | | | | | | | | | | | | | | | |
| 446 | D32 | 62+03.08 | | ELICK | LT | | | | | | 10 | | | | | | | | | | | | | | | | | | | | |
| 446 | D33 | 61+92.43 | | ELICK | LT | | | | | | | | | | | | | | | | | 1 | | | | | | | | | |
| 446 | D34 | 60+52.00 | 189+00.00 | ELICK | LT | | | | | | | | | | | 94 | | | | | | | | | | | | | | | |
| 449 | D35 | NOT USED | | | | | | | | | | | | | | | | | | | | | | | | | | | | | |
| 449 | D36 | NOT USED | | | | | | | | | | | | | | | | | | | | | | | | | | | | | |
| TOTALS CARRIED TO DRAINAGE SUBSUMMARY | | | | | | 56 | 5 | 556 | 1.1 | 1415 | 44 | 345 | 17 | 70 | 43 | 87 | 142 | 94 | 276 | 4 | 15 | 1 | 2 | 1 | 4 | 1 | 2 | 2 | 2 | 2 | |

DRAINAGE ESTIMATED QUANTITIES

CLE-32-3.50 (PHASE 5)

CALCULATED
MHT
CHECKED
WAA

...103954DS001.dgn 11/19/2021 1:35:32 PM mswwhitt

| SHEET NO. | REF NO. | STATION | | CHAIN | SIDE | 601 | 601 | 601 | 602 | 611 | 611 | 611 | 611 | 611 | 611 | 611 | 611 | 611 | 611 | | |
|--|---------|-----------|-----------|--------|------|---------------------------------------|--|---|------------------------|---------------------------|--|---------------------------|---------------------------|---------------------------|--|----------------------------|----------------------------|-----------------------------|-------------------------------|---|------------------------|
| | | FROM | TO | | | TIED CONCRETE BLOCK MAT, TYPE 2 SY | ROCK CHANNEL PROTECTION, TYPE C WITH GEOTEXTILE FABRIC CY | PAVED GUTTER, TYPE 1-2, AS PER PLAN FT | CONCRETE MASONRY CY | 15" CONDUIT, TYPE B FT | 15" CONDUIT, TYPE C, 706.02, JOINTS PER 706.11 FT | 18" CONDUIT, TYPE C FT | 24" CONDUIT, TYPE B FT | 42" CONDUIT, TYPE B FT | CONDUIT, BORED OR JACKED: 42" TYPE B FT | CATCH BASIN, NO. 3 EACH | CATCH BASIN, NO. 8 EACH | CATCH BASIN, NO. 8A EACH | CATCH BASIN, NO. 2-2B EACH | INLET, NO. 3 FOR SINGLE SLOPE BARRIER, TYPE D EACH | MANHOLE, NO. 3 EACH |
| 458 | D69 | 196+50.00 | 196+50.00 | SR 32 | C | | | | | | | | | | | 55 | | | | 1 | |
| 458 | D70 | 196+50.00 | 197+00.00 | SR 32 | LT | | | | | | | | | | 158 | | | 1 | | | |
| 458 | D71 | NOT USED | | | | | | | | | | | | | | | | | | | |
| 458 | D72 | 198+43.00 | 202+92.00 | SR 32 | RT | | | 449 | | | | | | | | | | | | | |
| 458 | D84 | 197+00.00 | 197+33.00 | SR 32 | LT | | | 31 | | | | | | | | | | | | | |
| 458 | D85 | 198+91.00 | 199+22.00 | SR 32 | LT | | | 31 | | | | | | | | | | | | | |
| 458 | D89 | 199+00.00 | 201+73.00 | RAMP P | RT | | | | | | 273 | | | | | | | | | 1 | |
| 459 | D73 | 202+70.34 | 202+68.50 | RAMP P | LT | | | | | 7 | | | | | | | | | 1 | | |
| 459 | D74 | 202+68.50 | 204+51.00 | RAMP P | LT | | | | | 182 | | | | | | | | | | 1 | |
| 459 | D75 | 204+00.00 | 204+50.96 | SR 32 | RT | | | | | 61 | | | | | | 1 | | | | | |
| 459 | D76 | 204+50.96 | 204+51.00 | SR 32 | RT | | | | | 13 | | | | | | | | | | 1 | |
| 459 | D77 | 204+51.00 | 204+50.00 | RAMP P | LT | | 2 | | 0.3 | 52 | | | | | | | | | | 1 | |
| 459 | D78 | NOT USED | | | | | | | | | | | | | | | | | | | |
| 459 | D79 | 206+75.00 | 206+50.00 | RAMP Q | LT | | | | | 38 | | | | | | 1 | | | | | |
| 459 | D80 | 206+50.00 | 205+80.70 | SR 32 | LT | | | | | | 68 | | | | | | 1 | | | | |
| 459 | D81 | 205+80.70 | 205+69.70 | SR 32 | LT | | 2 | | 0.5 | | | | 78 | | | | | | | 1 | |
| 459 | D86 | 204+46.00 | | RAMP P | LT | 12 | | | | | | | | | | | | | | | |
| 459 | D90 | 201+73.00 | 201+73.00 | RAMP P | RT | | | | | | 17 | | | | | | | | 1 | | |
| 459 | D91 | 201+73.00 | 204+00.00 | RAMP P | RT | | | | | | 228 | | | | | | | | | 1 | |
| 459 | D92 | 204+00.00 | 204+25.00 | RAMP P | RT | | 1 | | 0.3 | | 30 | | | | | | | | | 1 | |
| 461 | D82 | NOT USED | | | | | | | | | | | | | | | | | | | |
| 462 | D83 | 202+40.97 | | OLD 74 | RT | | | | | 10 | | | | | | 1 | | | | | |
| TOTALS CARRIED TO DRAINAGE SUBSUMMARY | | | | | | 12 | 5 | 511 | 1.0 | 363 | 548 | 68 | 78 | 158 | 55 | 2 | 2 | 1 | 2 | 1 | 7 |


DRAINAGE ESTIMATED QUANTITIES

CLE-32-3.50 (PHASE 5)


CALCULATED
MHT
CHECKED
WAA

151
736

SR-32
CURVE #1
 P.I. Sta. 139+83.95
 $\Delta = 3^\circ 53' 06''$ (LT)
 $D_c = 0^\circ 20' 00''$
 $R = 17,188.74'$
 $T = 582.99'$
 $L = 1,165.53'$
 $E = 9.88'$
 $e_{max} = NC$
 PC Sta. 134+00.97
 PT Sta. 145+66.49

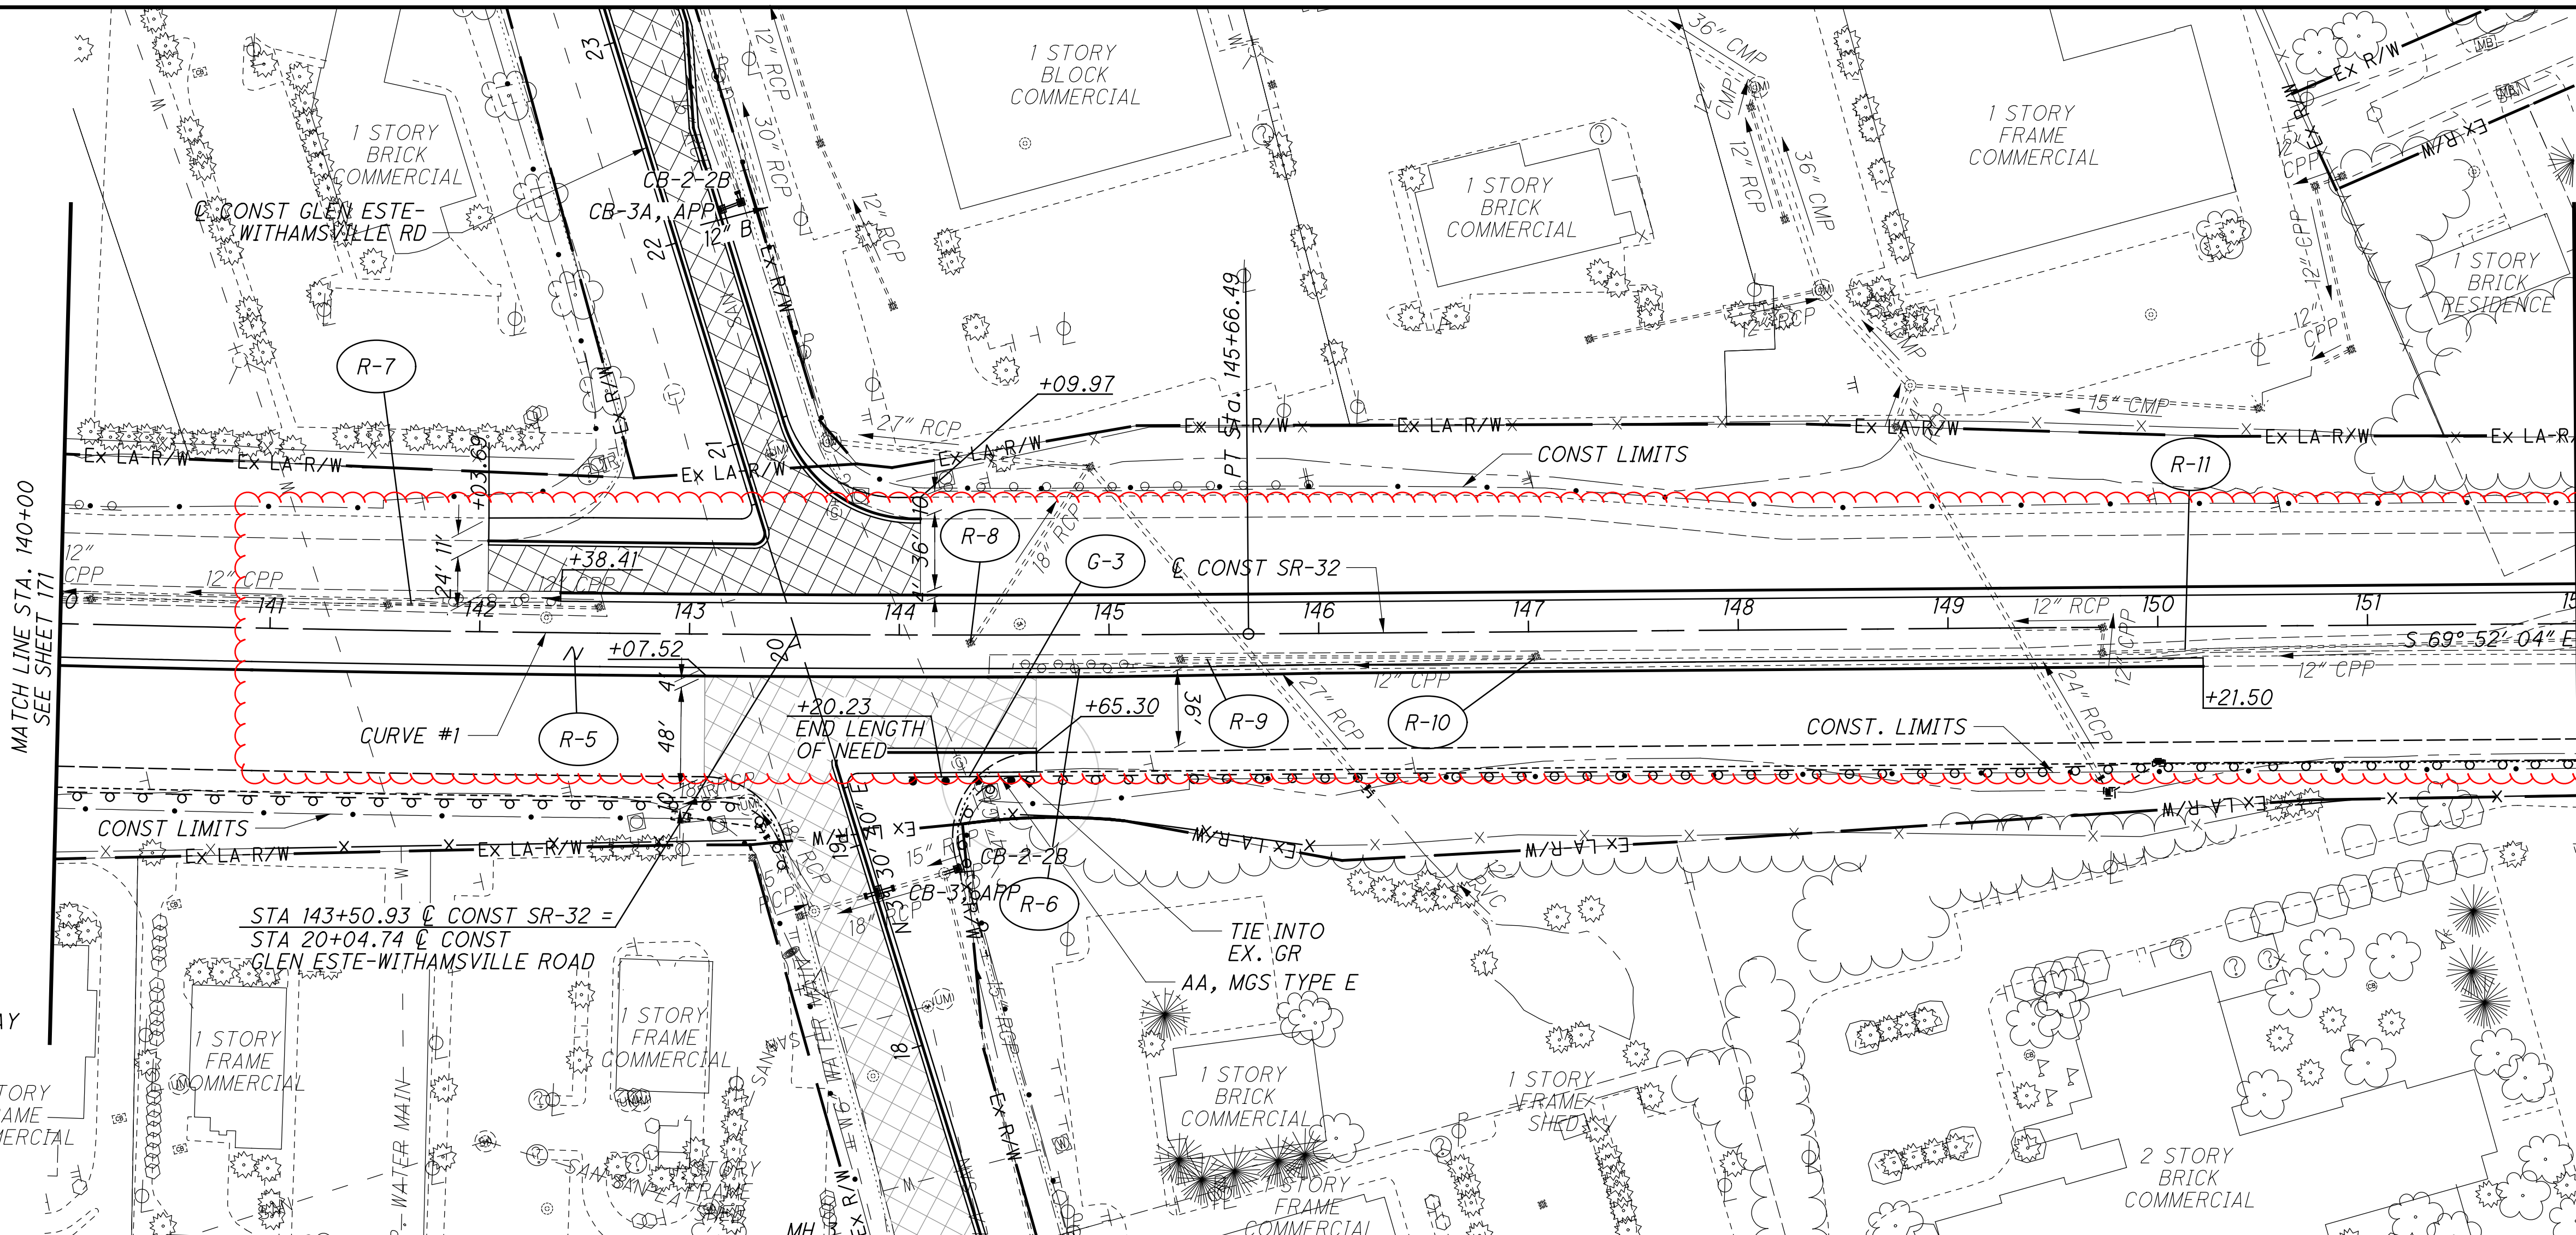




VARIABLE DEPTH OVERLAY

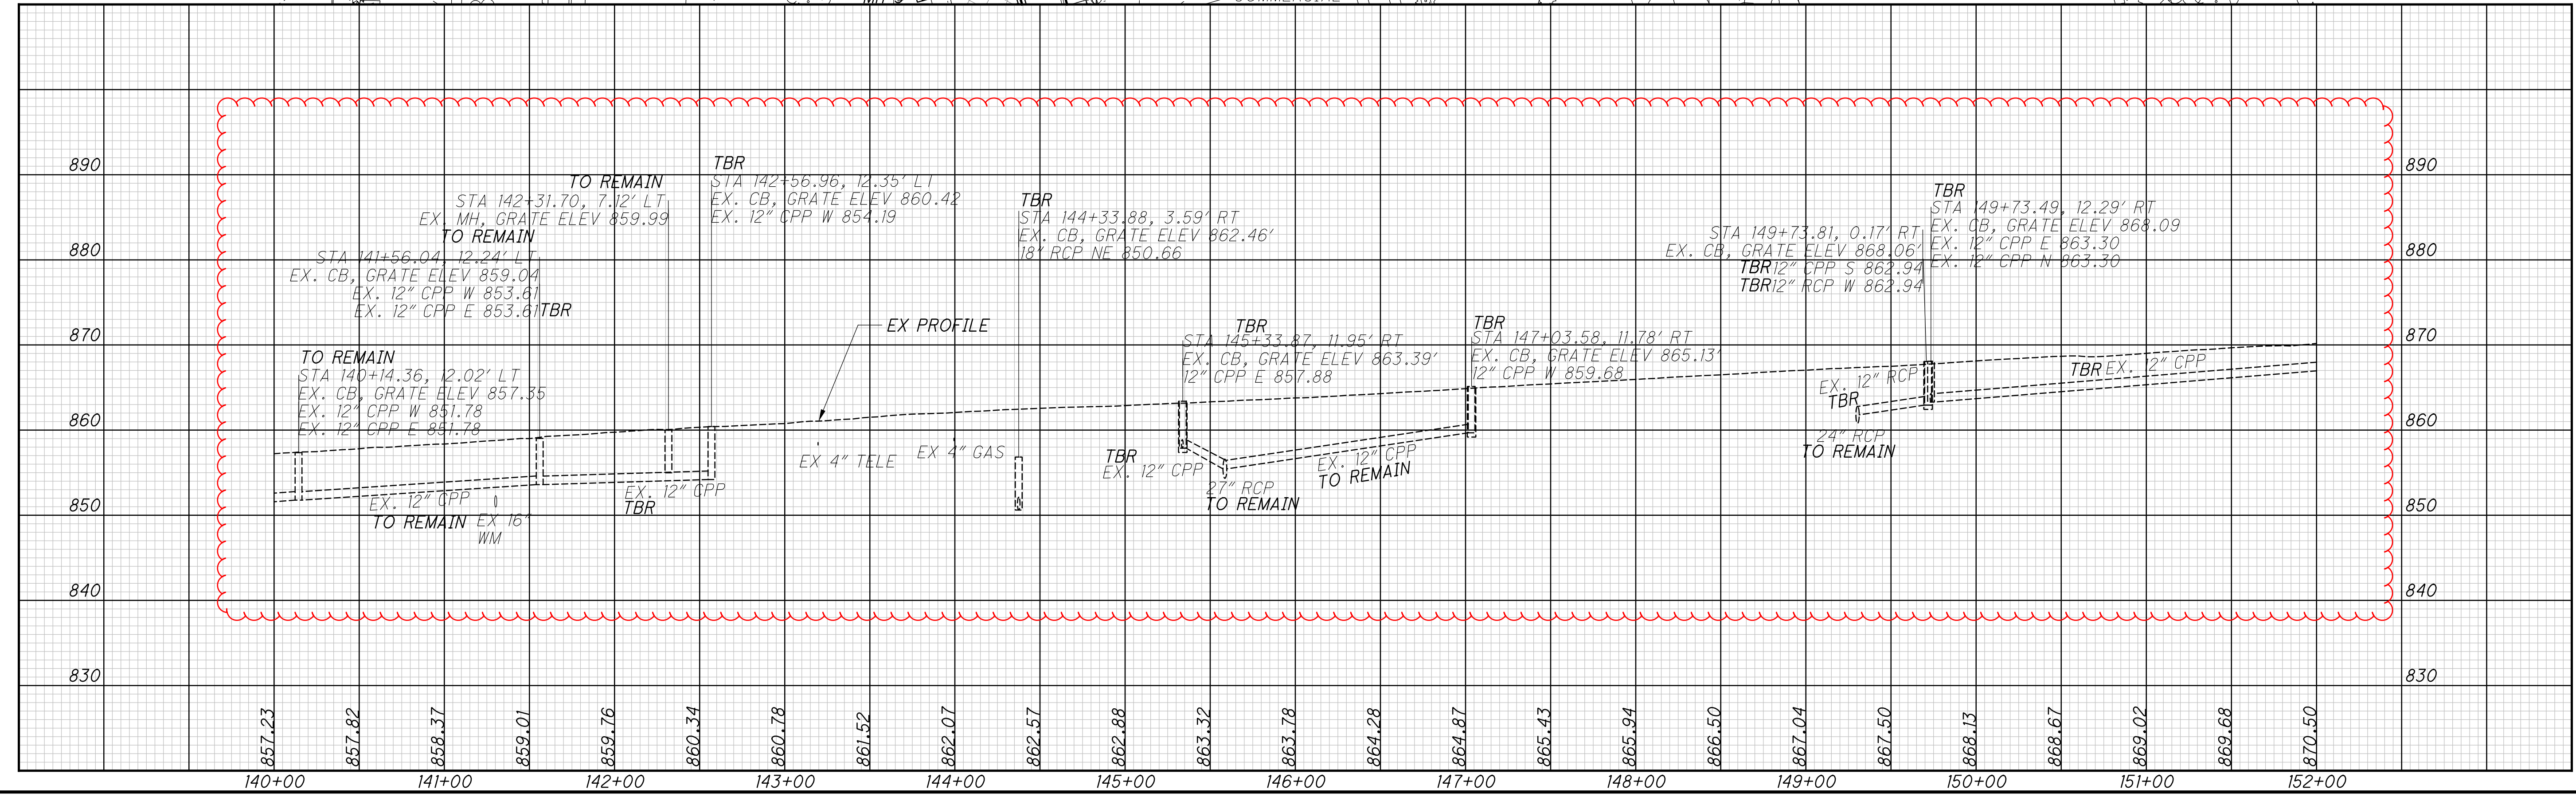

PLAN AND PROFILE - SR-32
 STA. 140+00 TO STA. 152+00

CLE-32-3.50
 (PHASE 5)

...303.205\103954_CP502.dgn 11/19/2021 1:37:25 PM mswitt

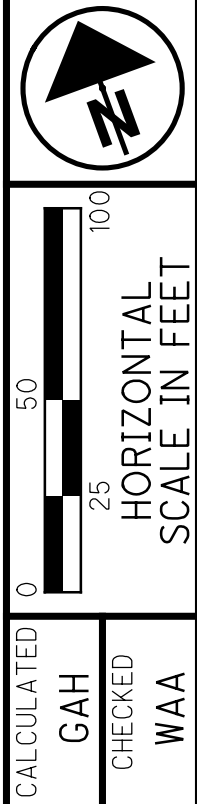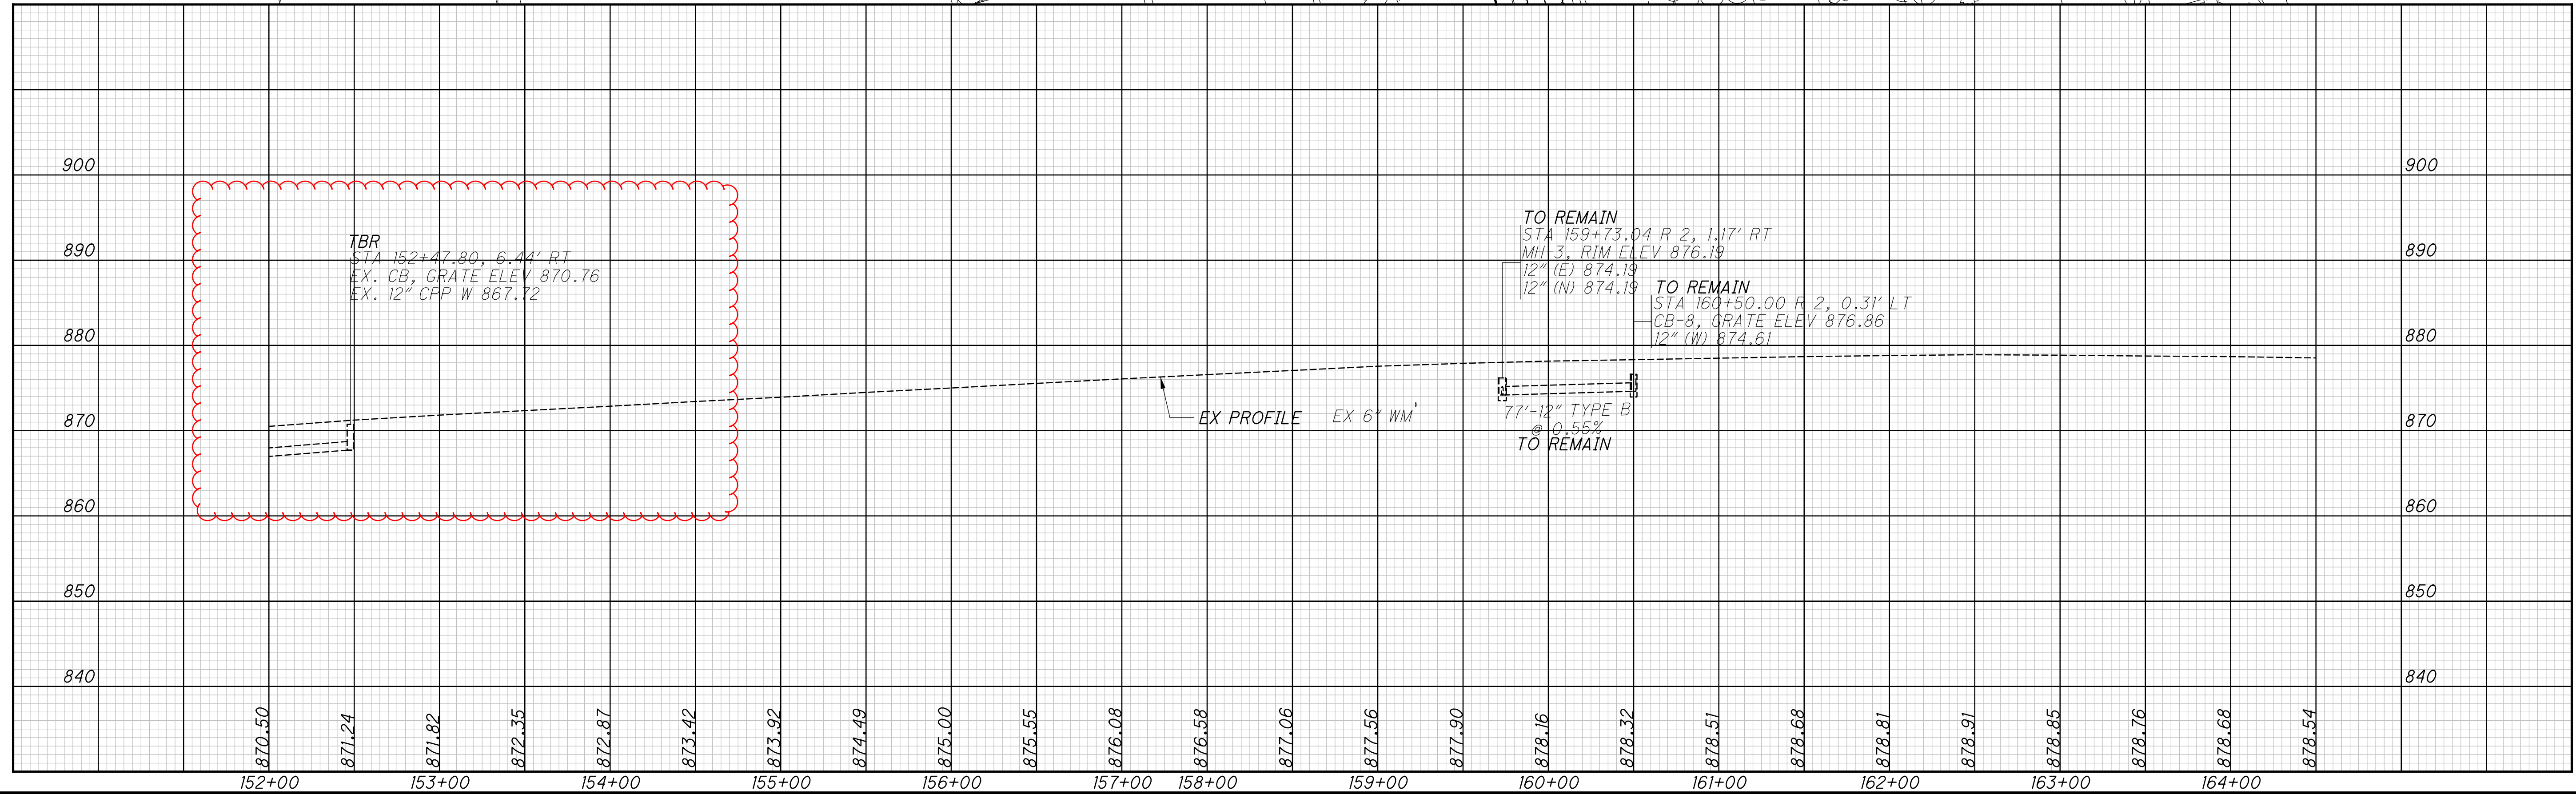
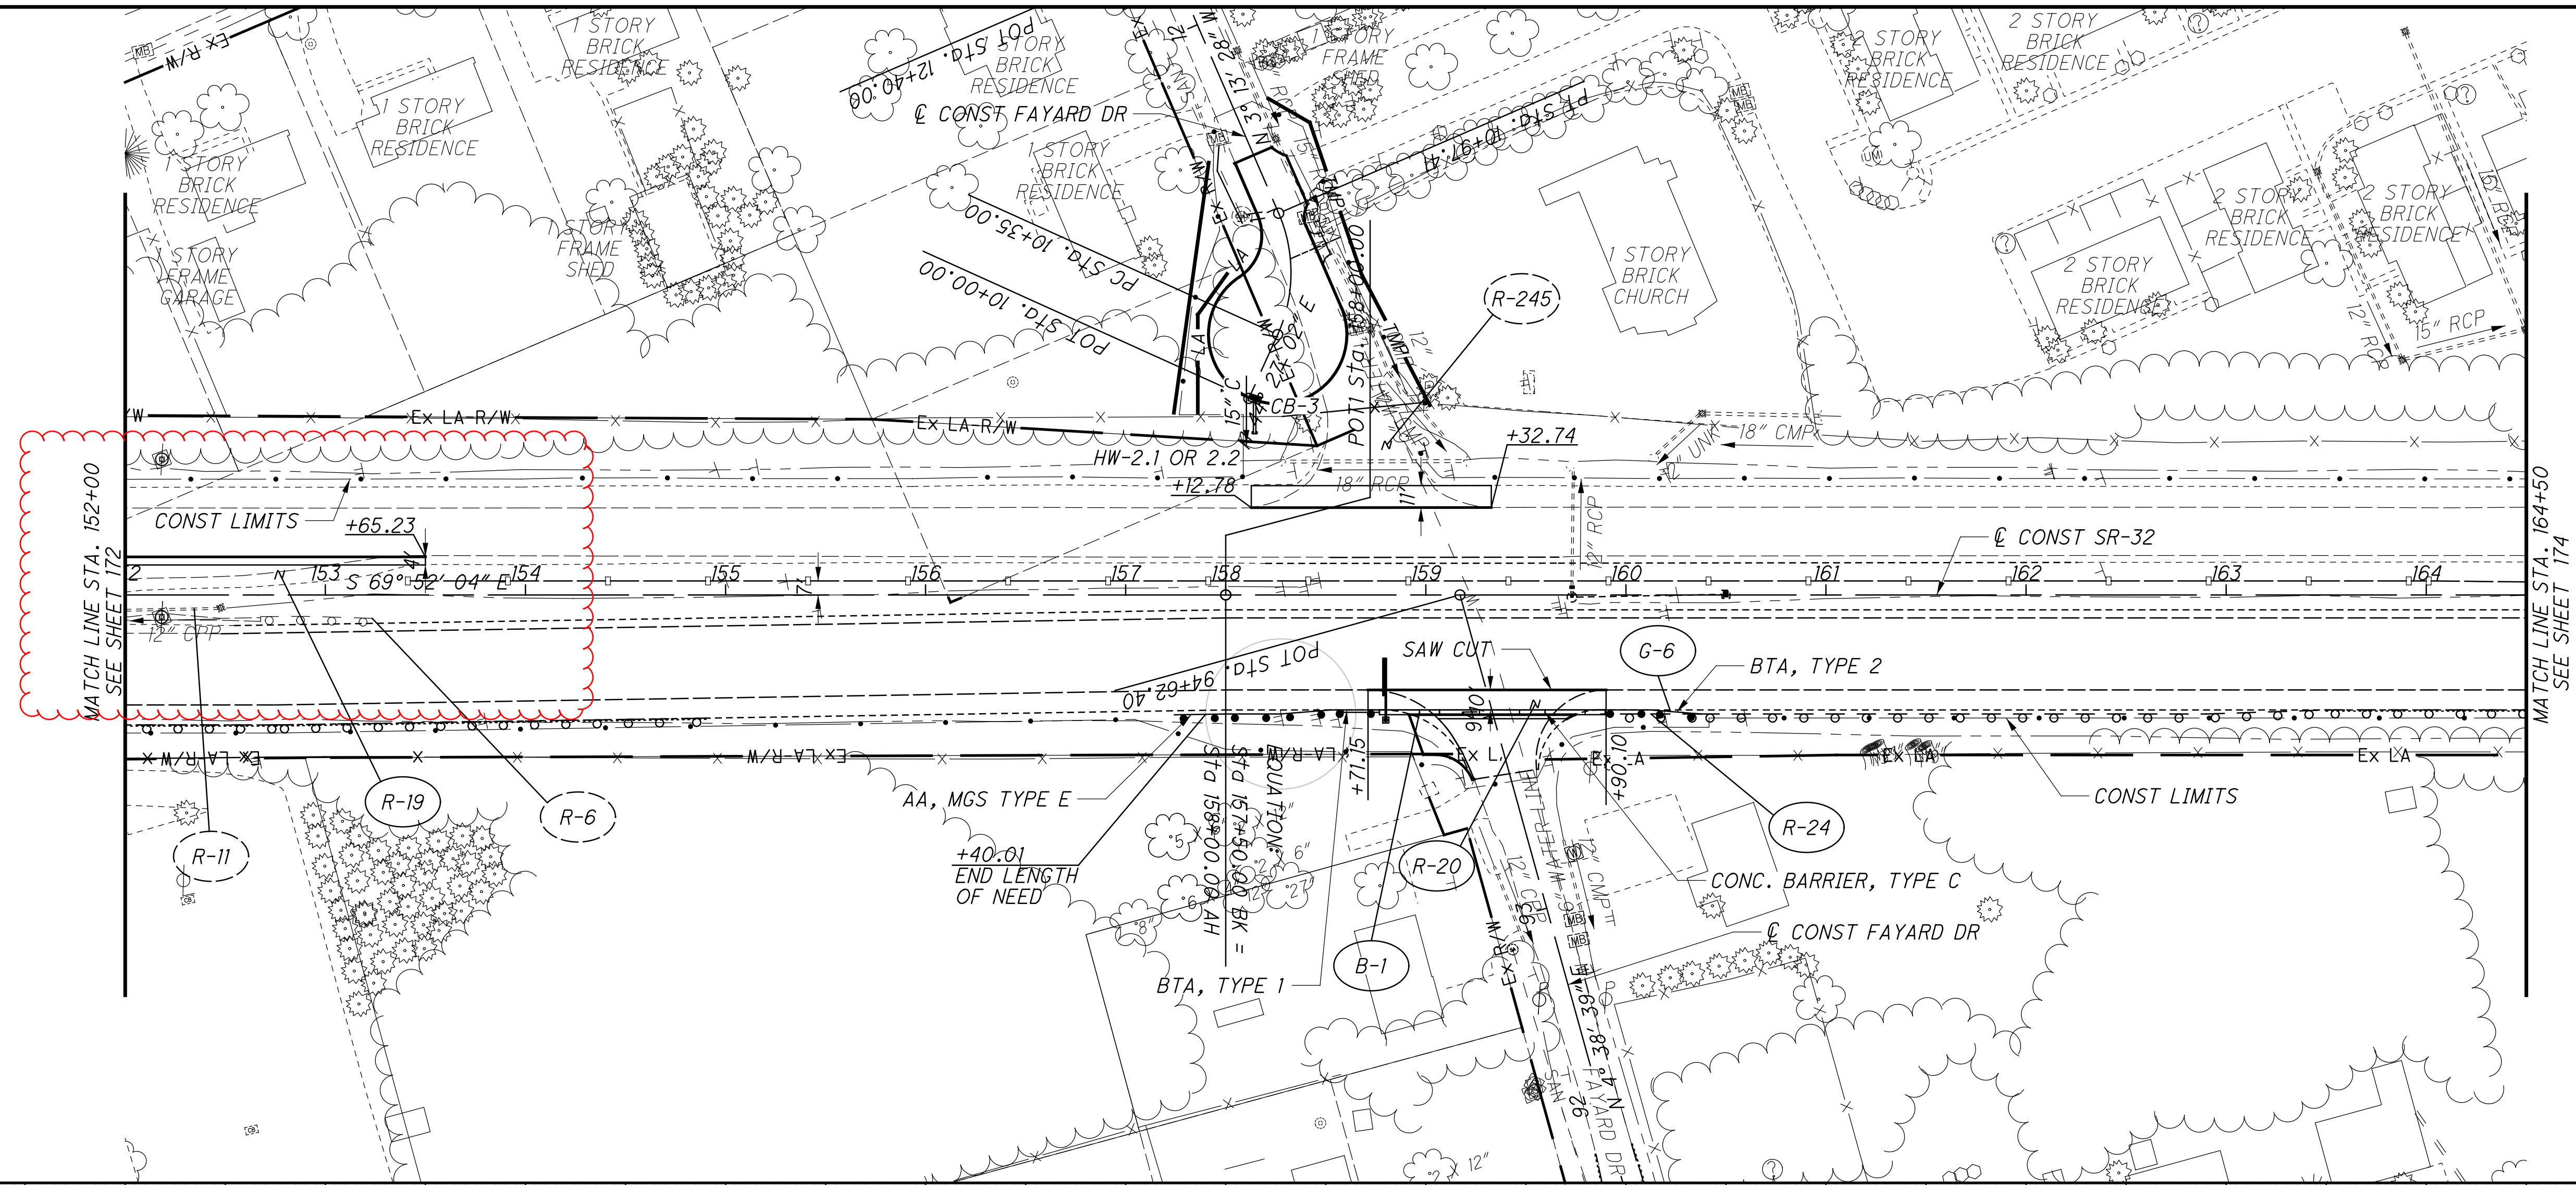


CALCULATED
GAAH
CHECKED
WAA


**PLAN AND PROFILE - SR-32
STA. 152+00 TO STA. 164+50**

**CLE-32-3.50
(PHASE 5)**

BARRIER LEGEND
 Δ END SECTION, TYPE D
 □ END ANCHORAGE, TYPE D
 ∅ END SECTION, TYPE CI

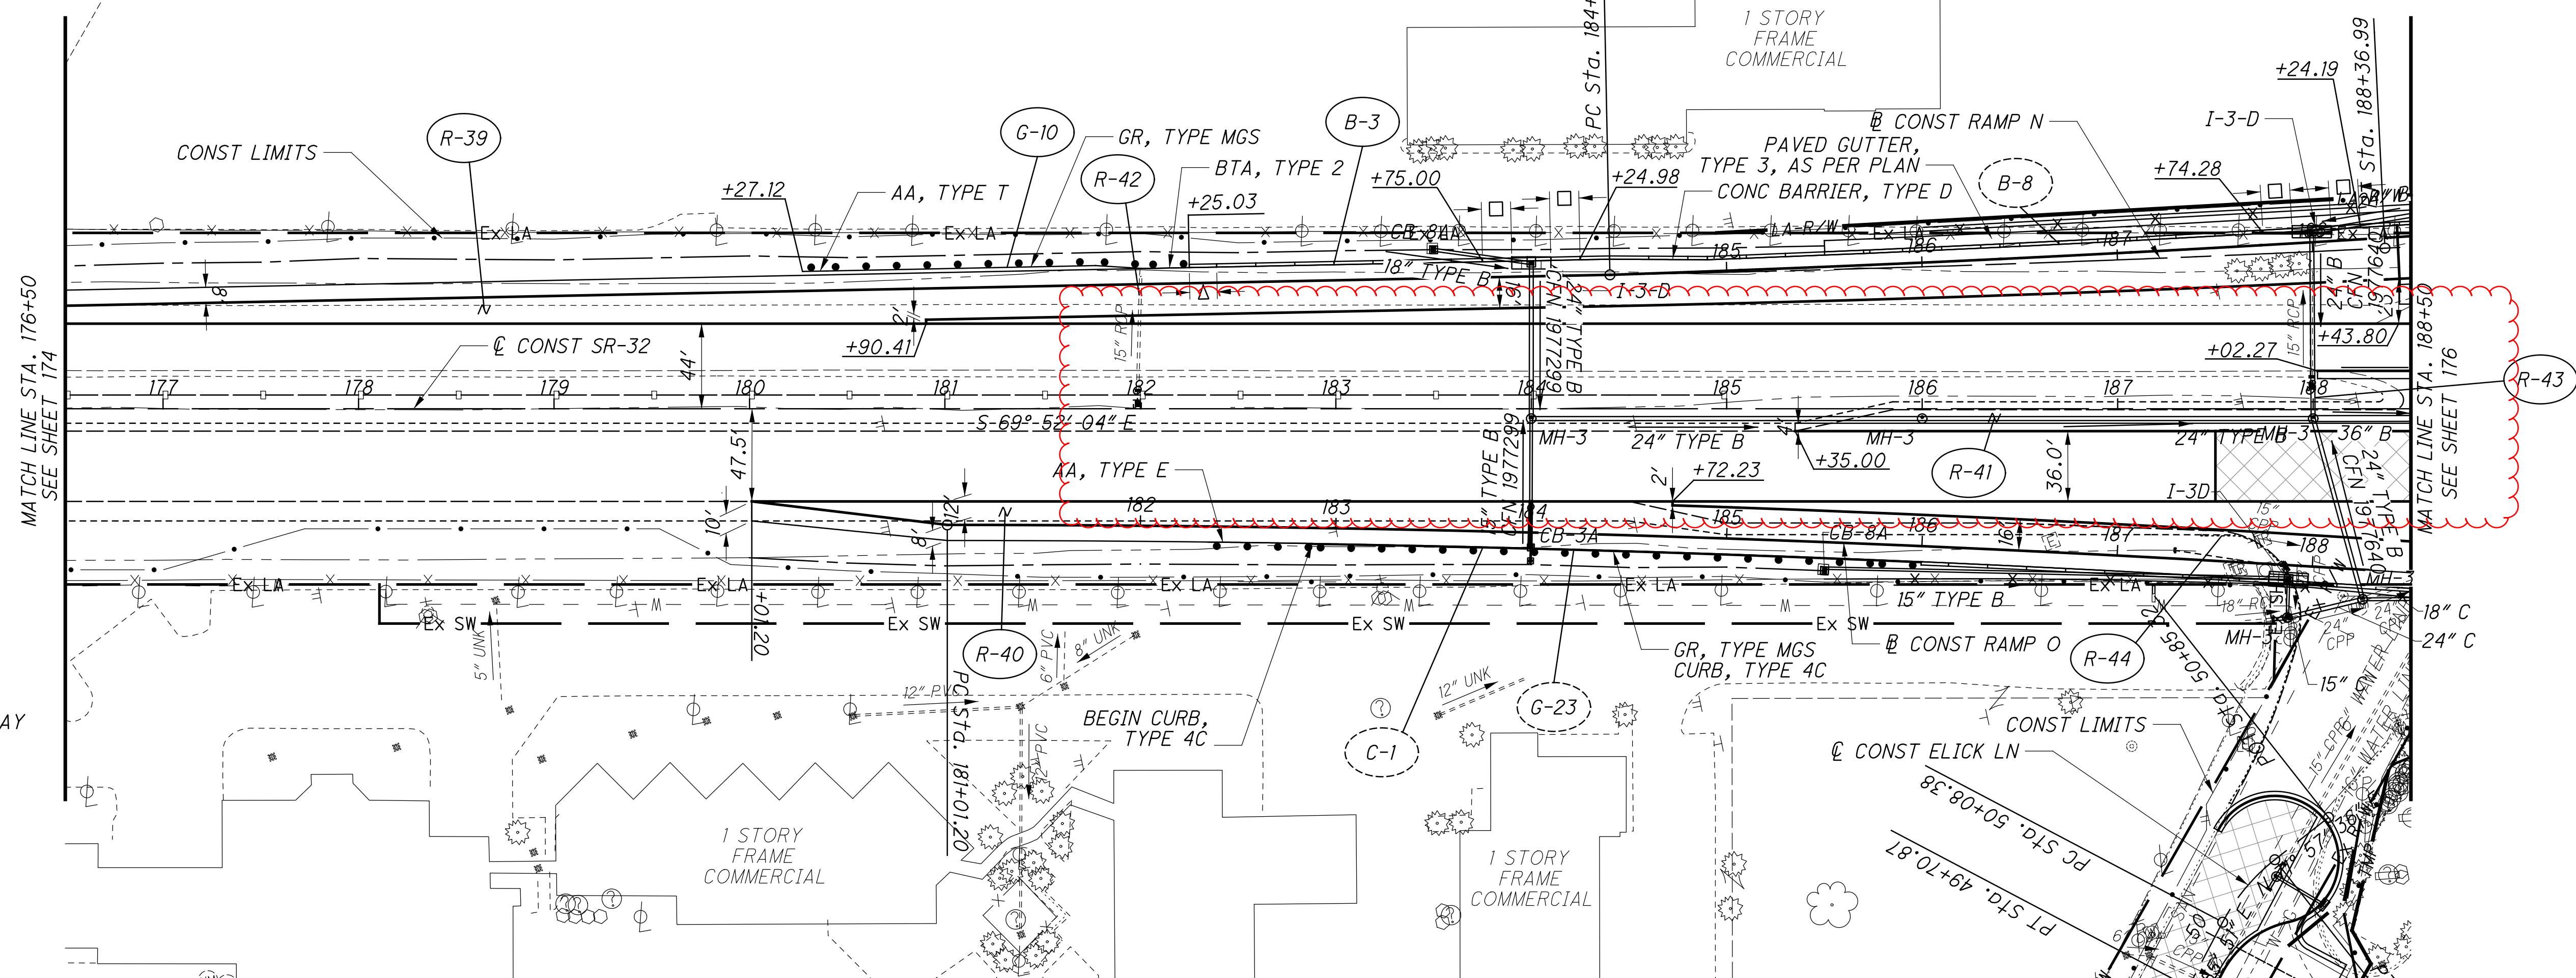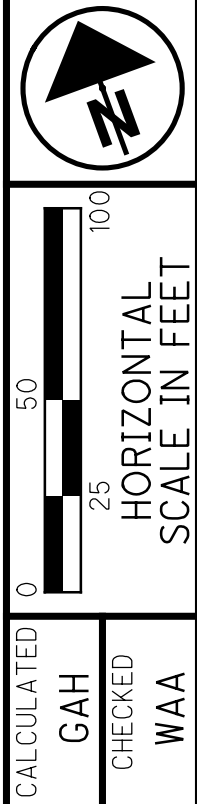

VARIABLE DEPTH OVERLAY

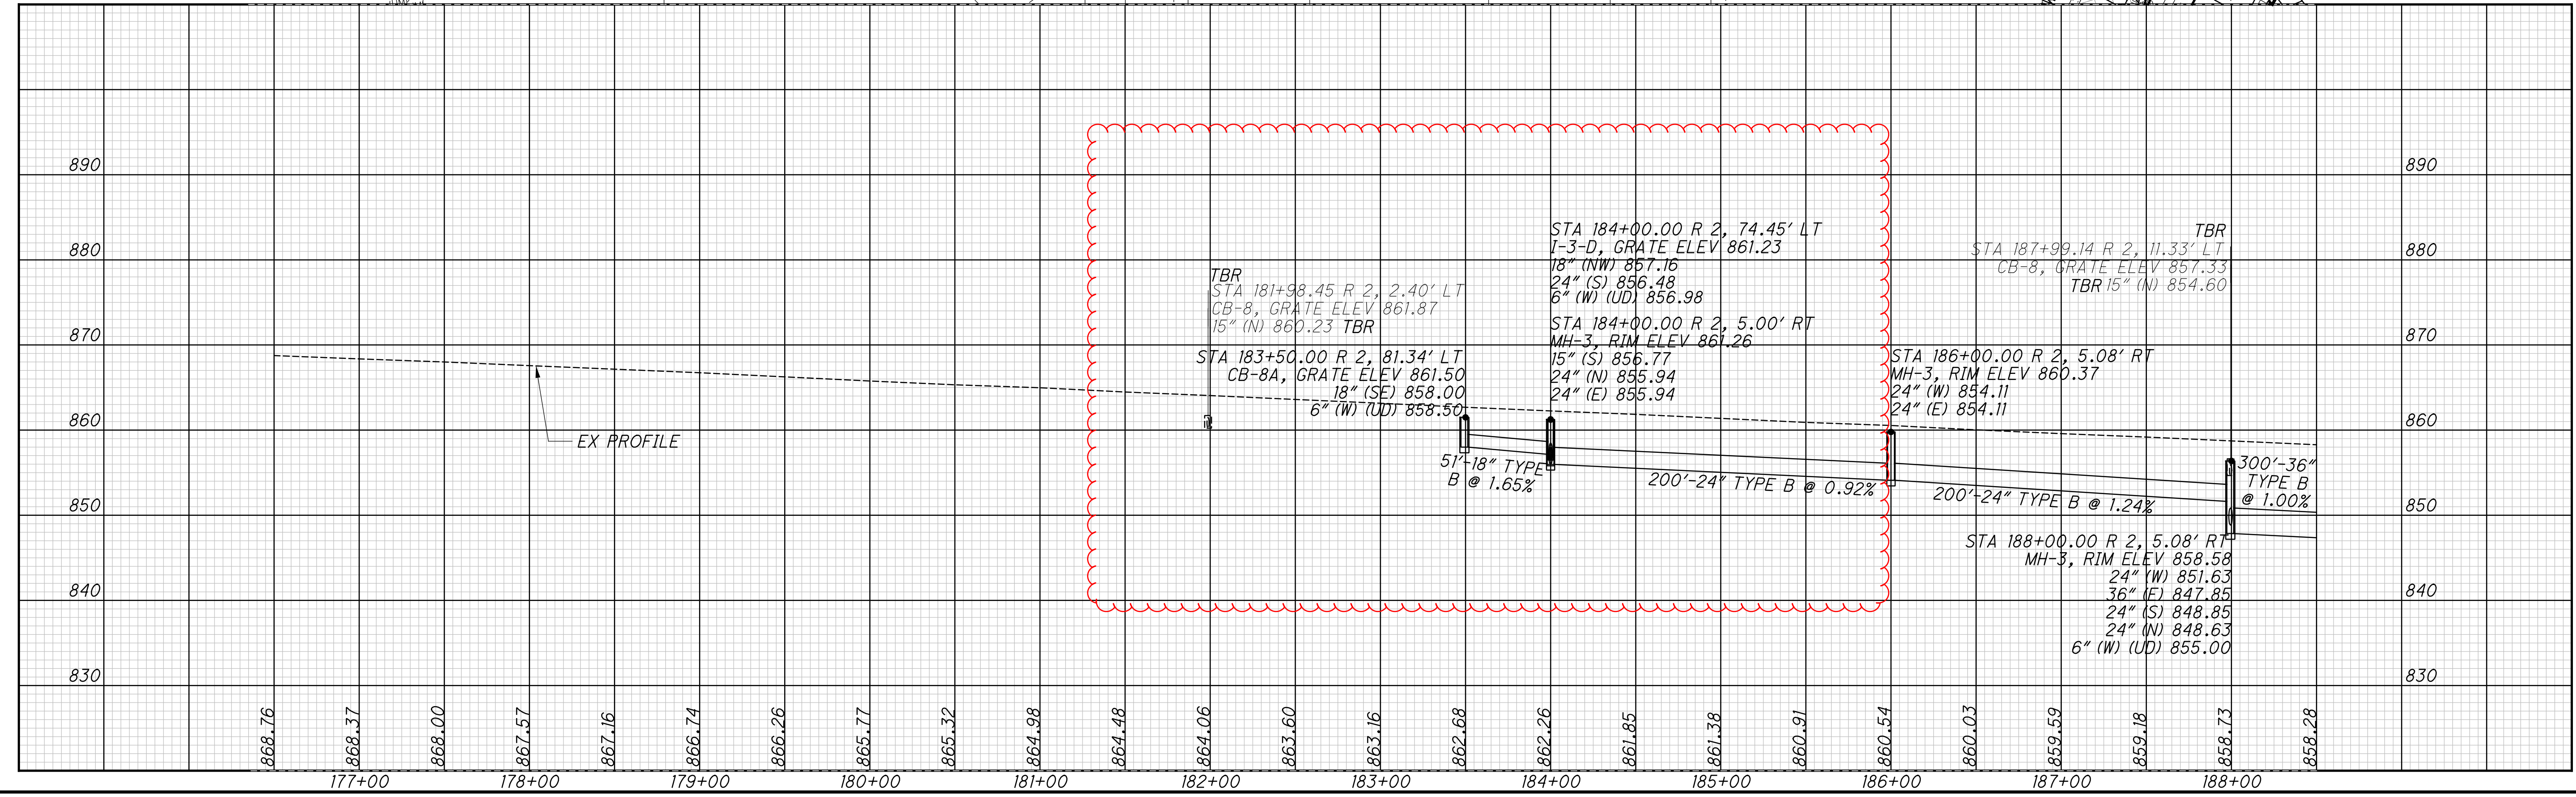


PLAN AND PROFILE - SR-32
 STA. 176+50 TO STA. 188+50

CLE-32-3.50
 (PHASE 5)

175
 736

...303.205\103954_CP505.dgn 11/19/2021 1:37:30 PM mswntt



...303.205\103954_CP506.dgn 11/19/2021 1:37:33 PM mswinn

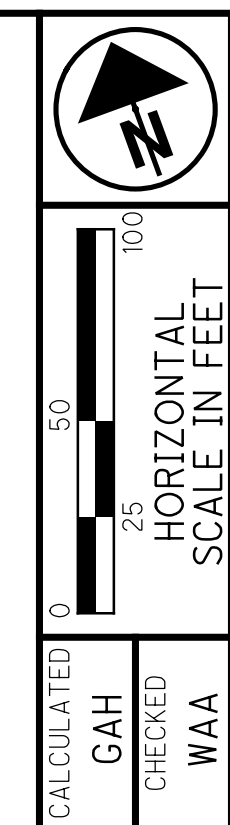



**PLAN AND PROFILE - SR-32
STA. 188+50 TO STA. 200+50**

**CLE-32-3.50
(PHASE 5)**

176
736

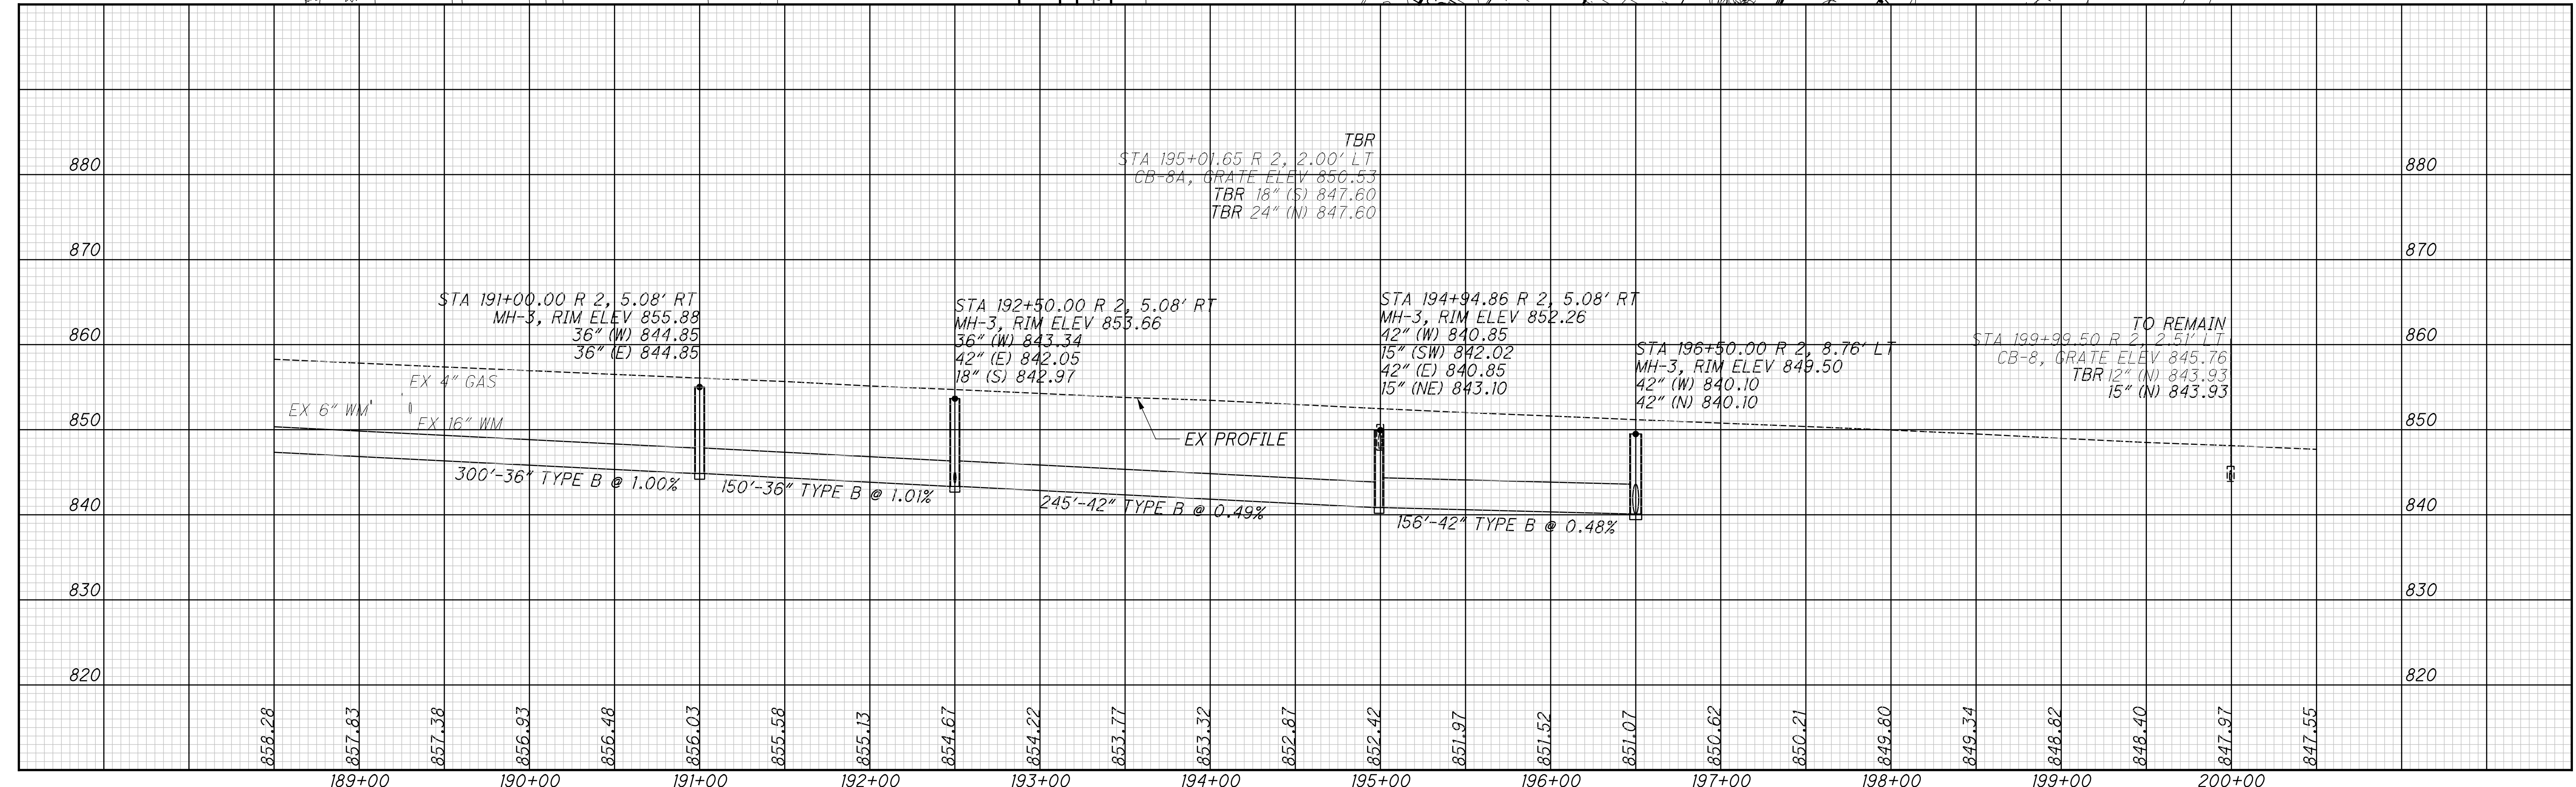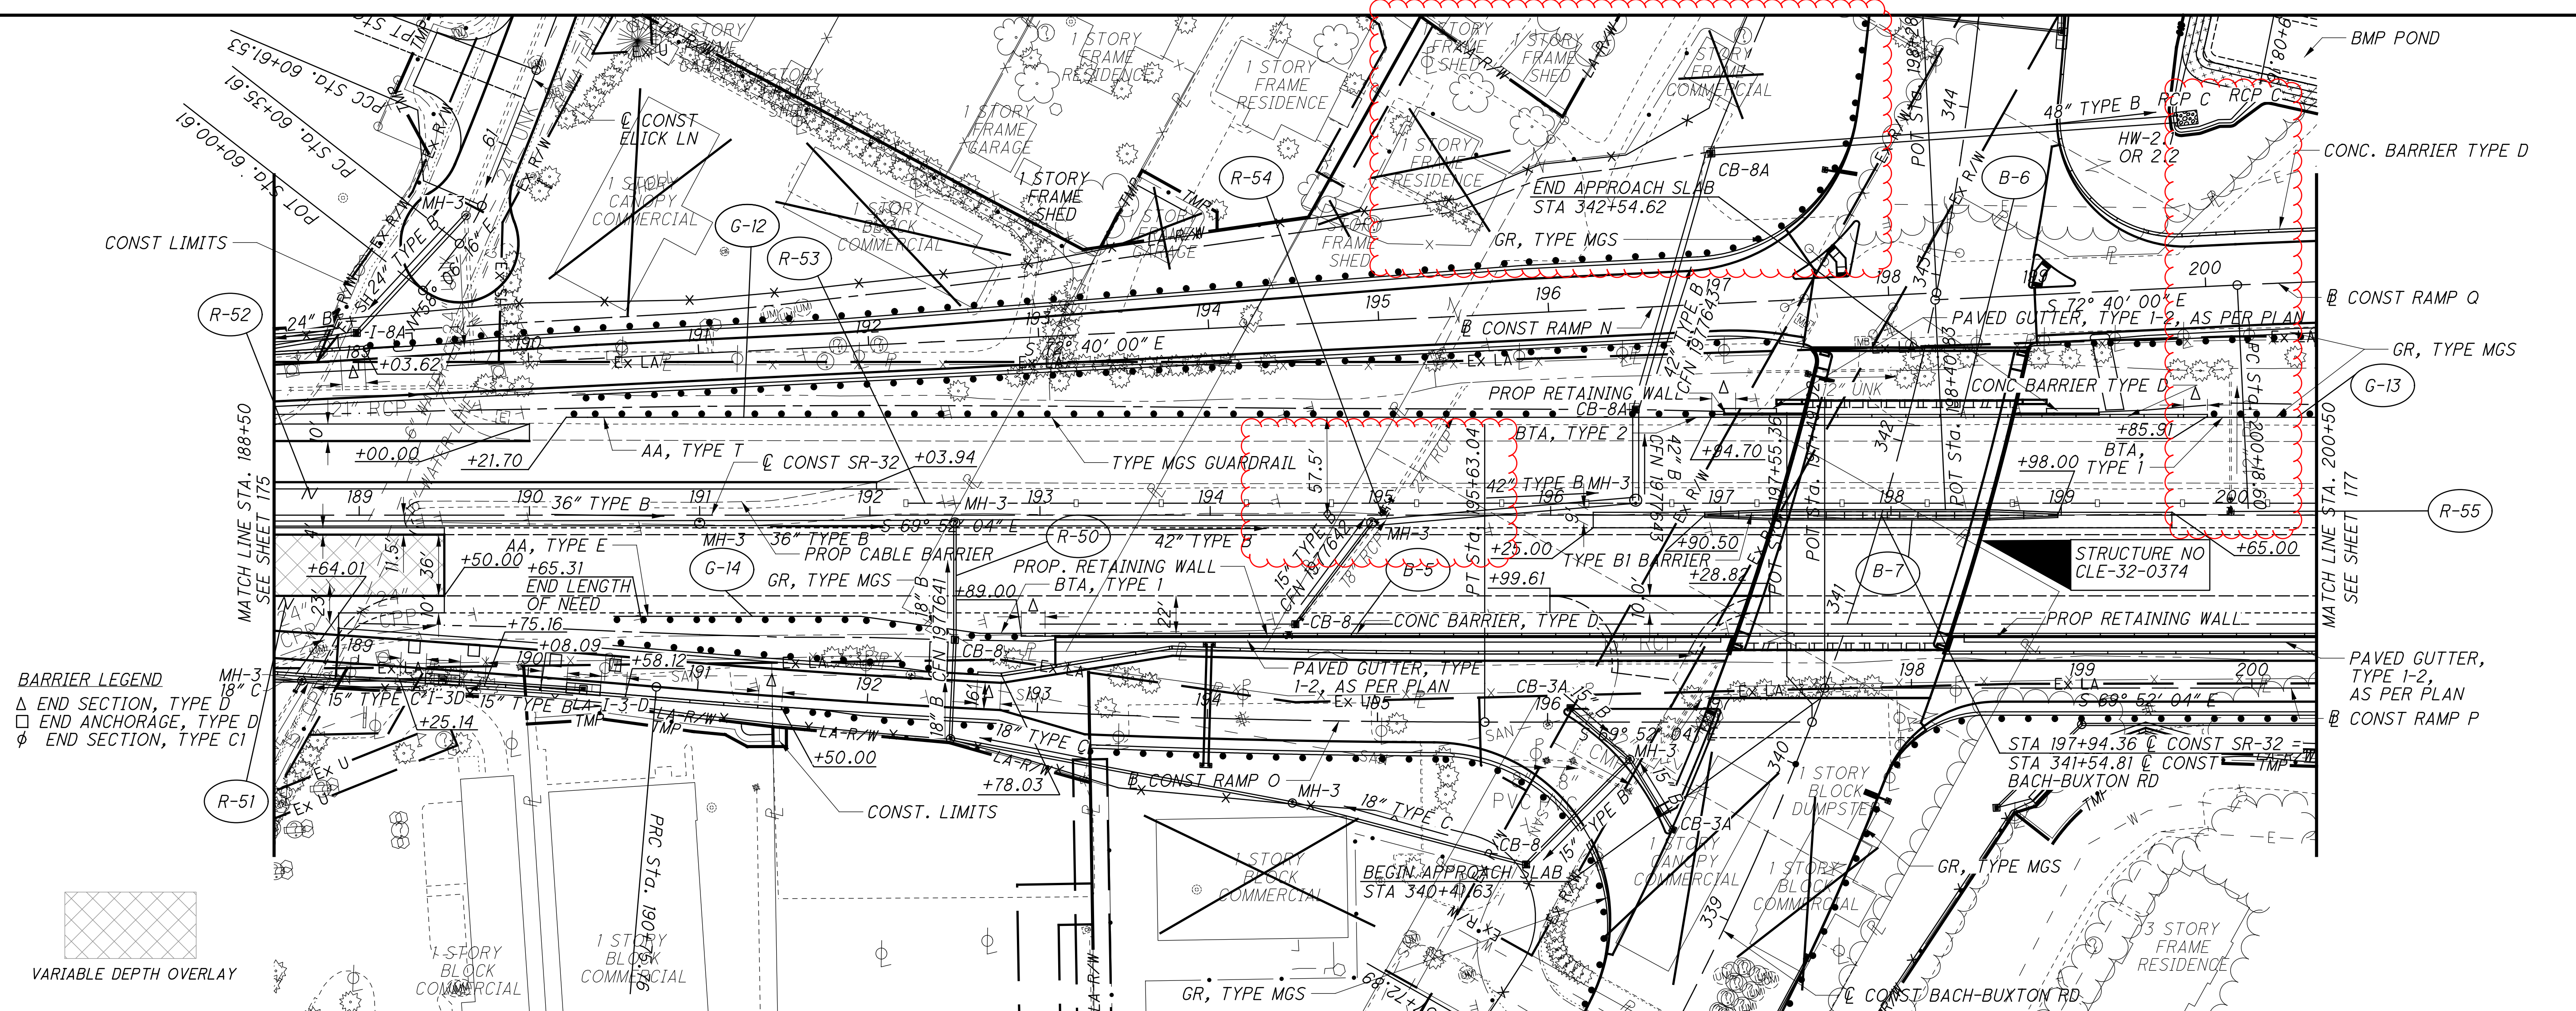

...303.205\103954_GP507.dgn 11/19/2021 1:37:37 PM mshwitt

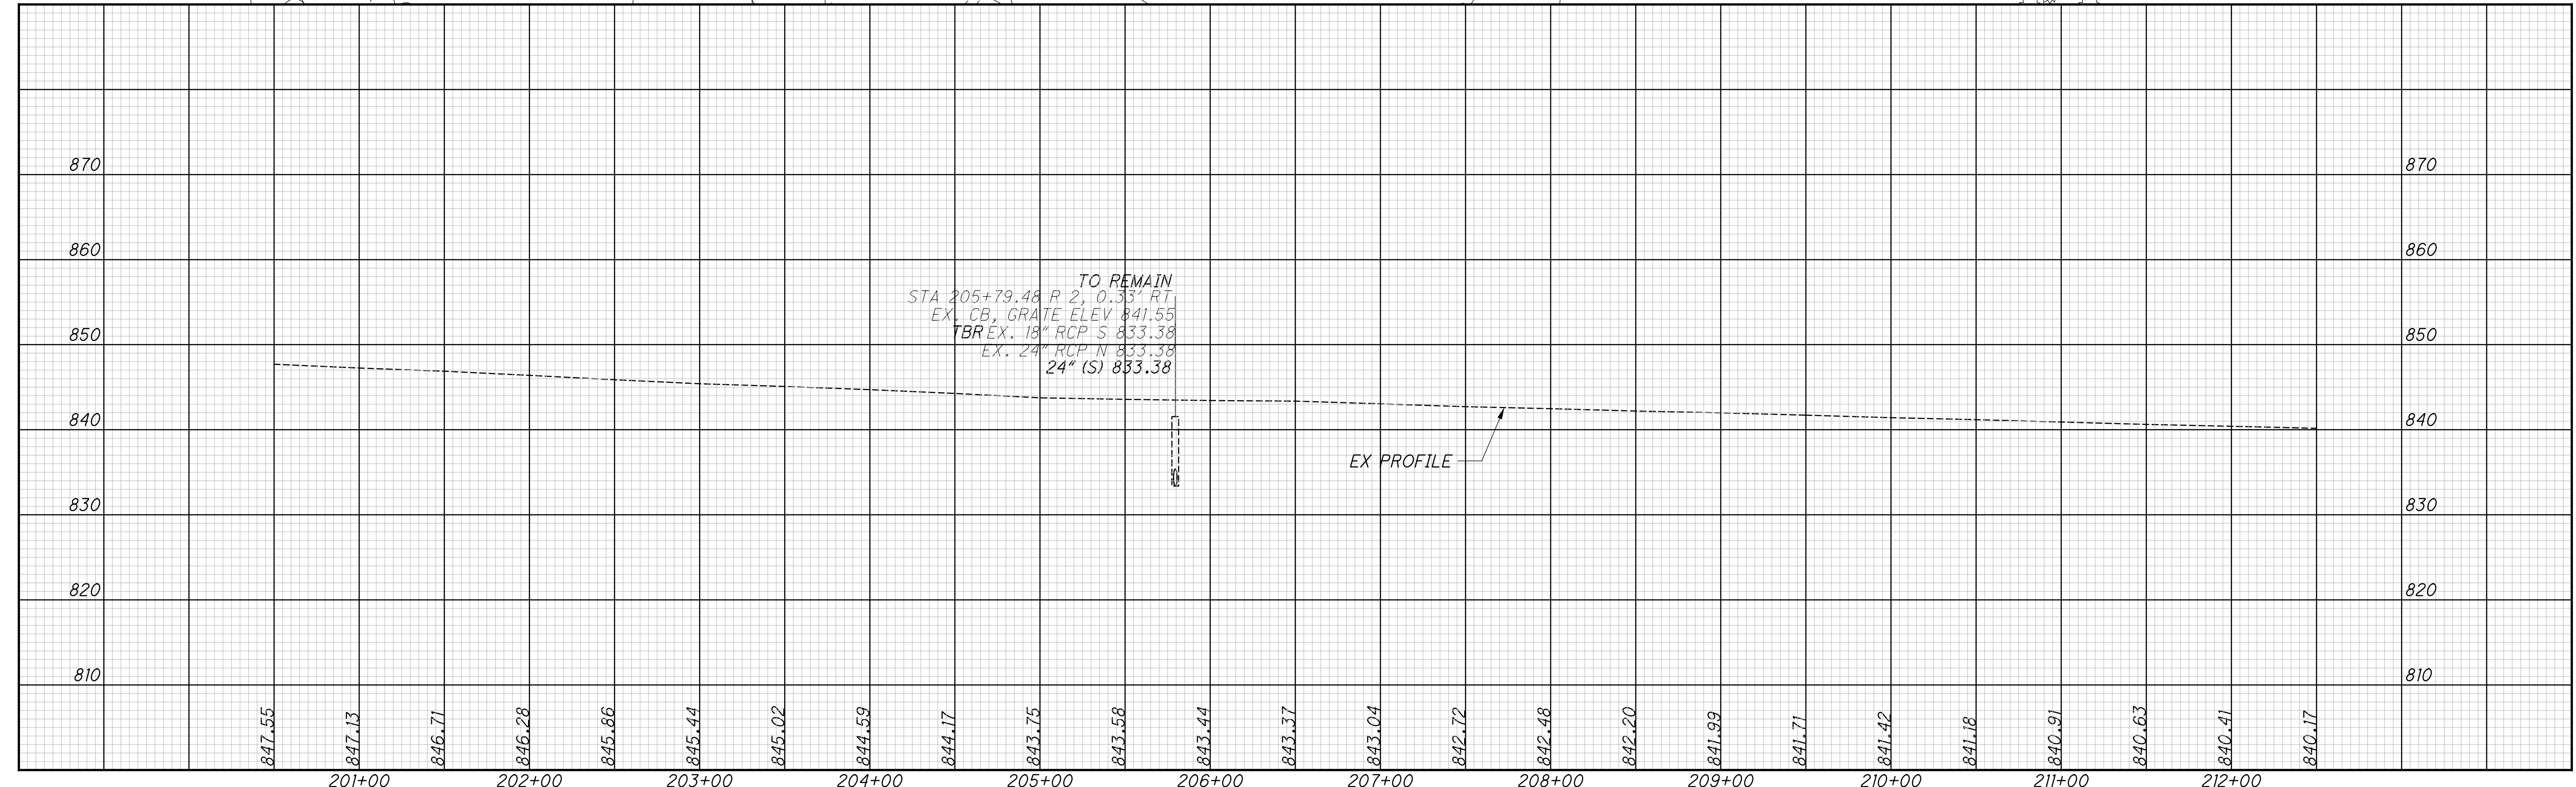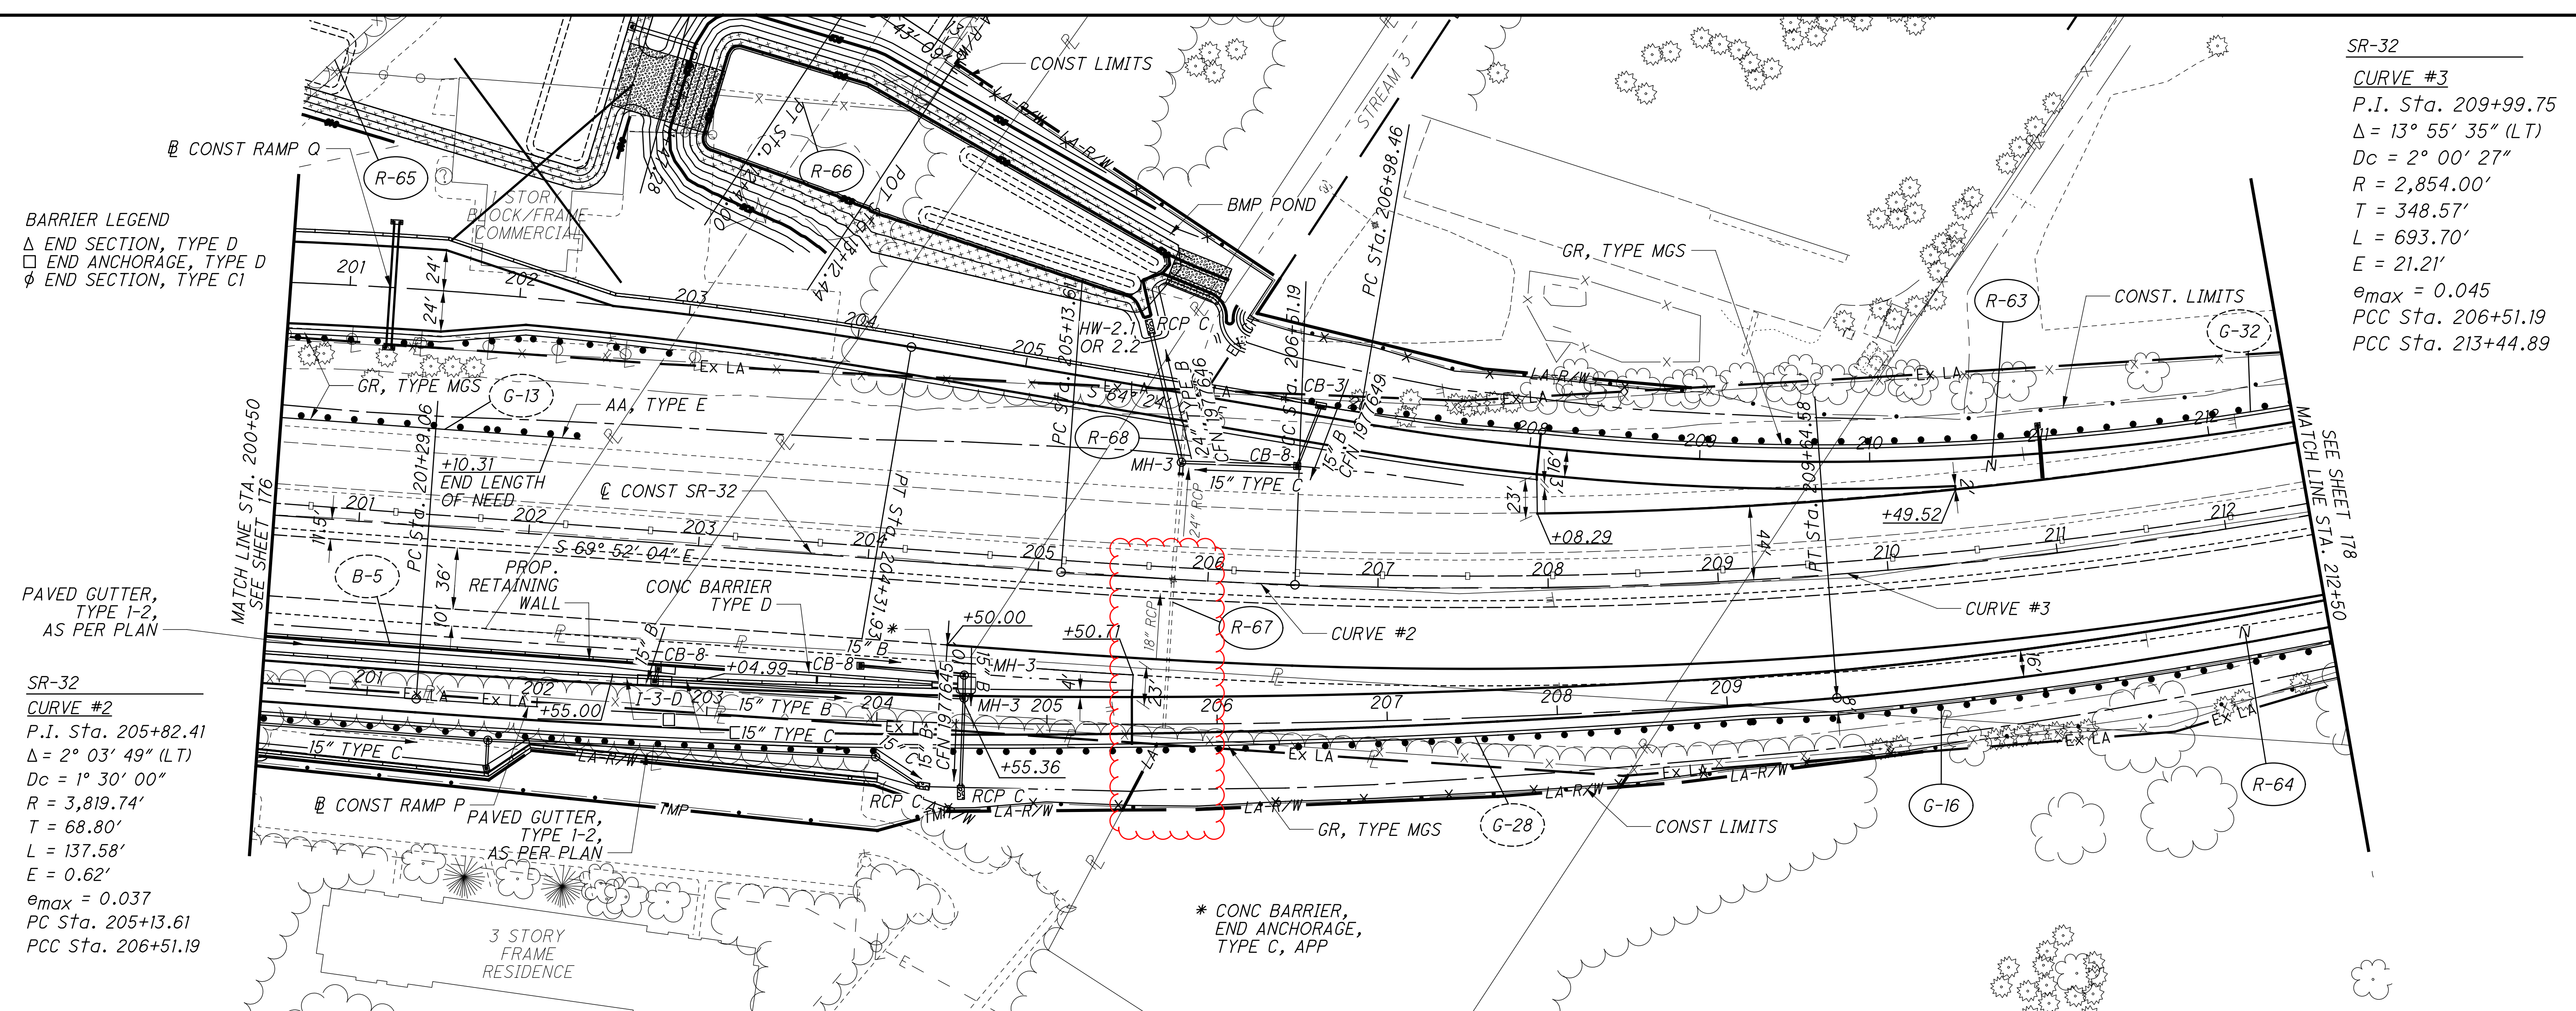


BARRIER LEGEND
 Δ END SECTION, TYPE D
 □ END ANCHORAGE, TYPE D
 φ END SECTION, TYPE C1

PAVED GUTTER, TYPE 1-2, AS PER PLAN

SR-32
CURVE #2
 P.I. Sta. 205+82.41
 $\Delta = 2^\circ 03' 49''$ (LT)
 $Dc = 1^\circ 30' 00''$
 $R = 3,819.74'$
 $T = 68.80'$
 $L = 137.58'$
 $E = 0.62'$
 $e_{max} = 0.037$
 PC Sta. 205+13.61
 PCC Sta. 206+51.19

SR-32
CURVE #3
 P.I. Sta. 209+99.75
 $\Delta = 13^\circ 55' 35''$ (LT)
 $Dc = 2^\circ 00' 27''$
 $R = 2,854.00'$
 $T = 348.57'$
 $L = 693.70'$
 $E = 21.21'$
 $e_{max} = 0.045$
 PCC Sta. 206+51.19
 PCC Sta. 213+44.89

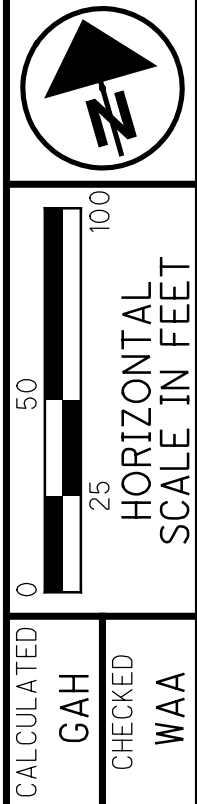




PLAN AND PROFILE - SR-32
STA. 200+50 TO STA. 212+50

CLE-32-3.50
(PHASE 5)

177
736

SR-32
CURVE #3
 P.I. Sta. 209+99.75
 $\Delta = 13^\circ 55' 35''$ (LT)
 $D_c = 2^\circ 00' 27''$
 $R = 2,854.00'$
 $T = 348.57'$
 $L = 693.70'$
 $E = 21.21'$
 $e_{max} = 0.045$
 PCC Sta. 206+51.19
 PCC Sta. 213+44.89

SR-32
CURVE #4
 P.I. Sta. 214+11.75
 $\Delta = 2^\circ 00' 21''$ (LT)
 $D_c = 1^\circ 30' 00''$
 $R = 3,819.74'$
 $T = 66.86'$
 $L = 133.72'$
 $E = 0.59'$
 $e_{max} = 0.037$
 PCC Sta. 213+44.89
 PT Sta. 214+78.60

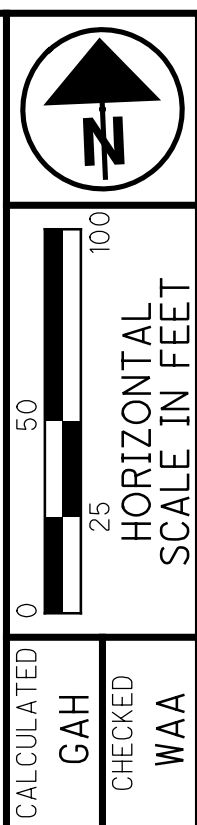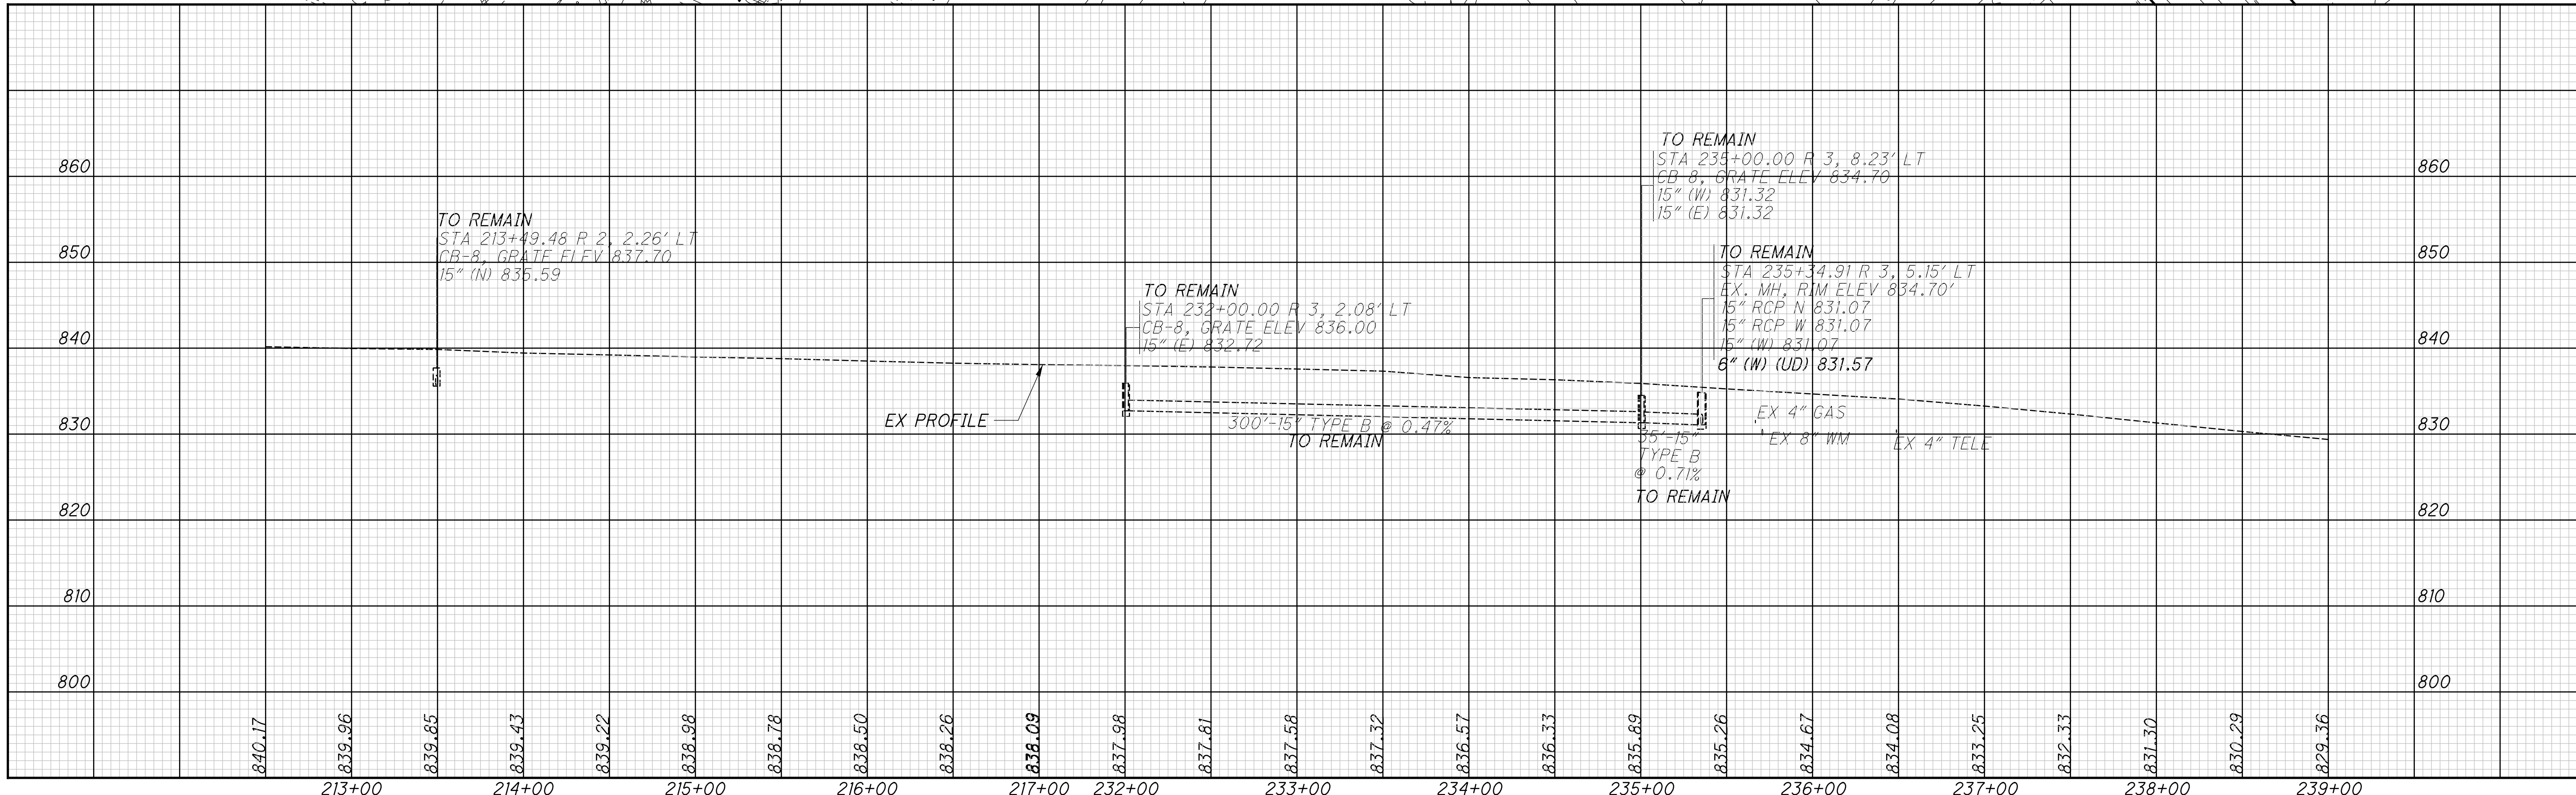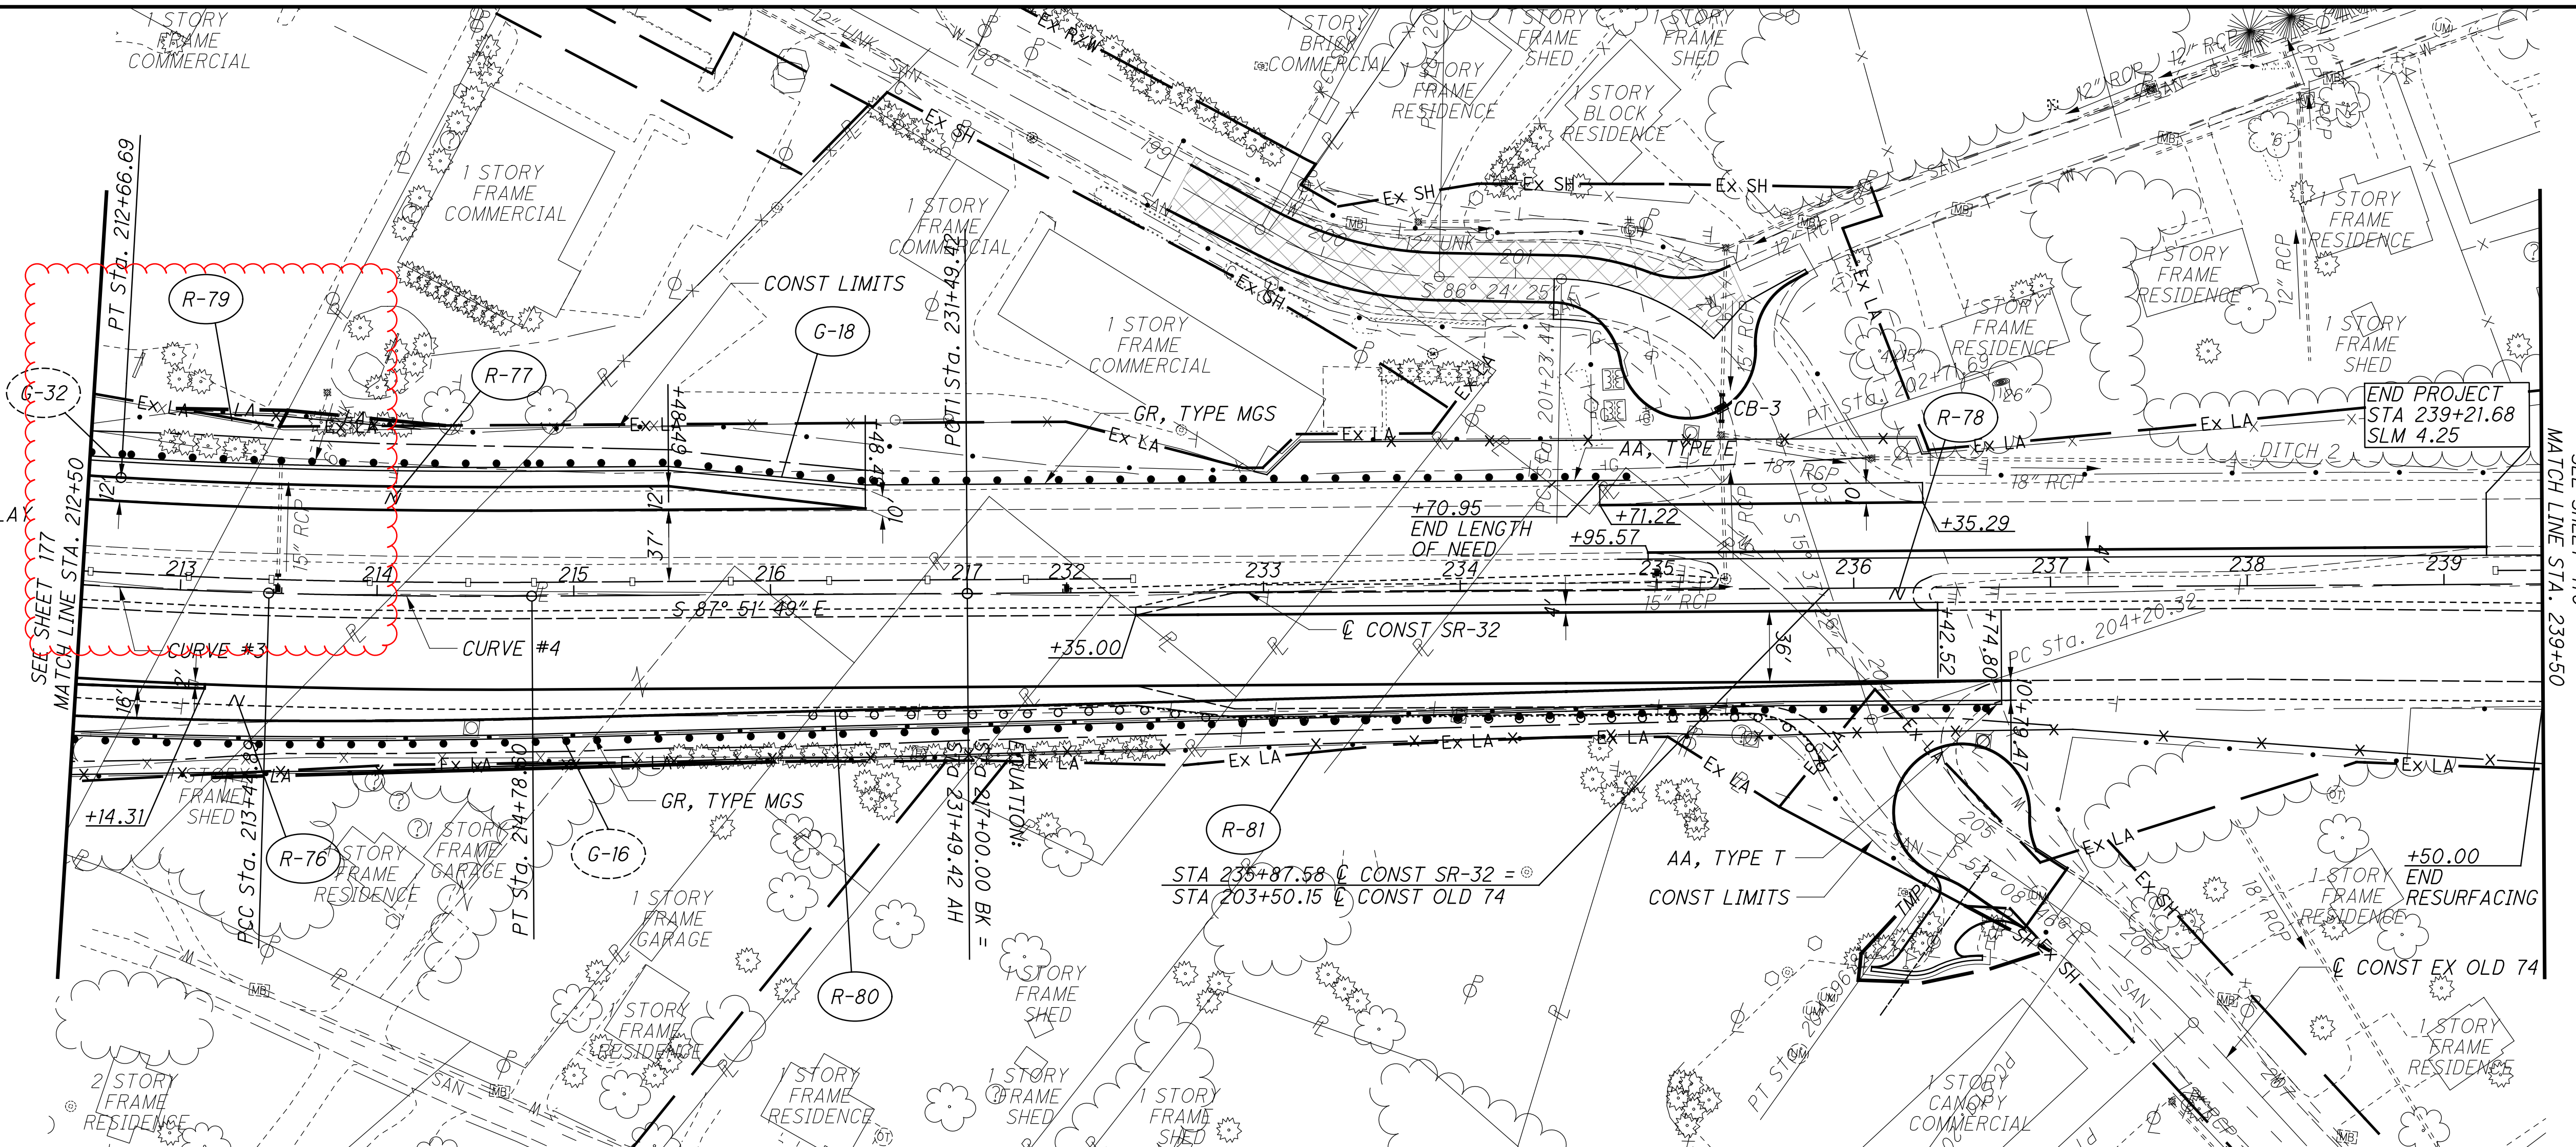

PLAN AND PROFILE - SR-32
 STA. 212+50 TO STA. 239+50



CLE-32-3.50
 (PHASE 5)

178
 736

...303.205\103954_GP508.dgn 11/19/2021 1:37:40 PM mshwitt

BARRIER LEGEND
 Δ END SECTION, TYPE D
 □ END ANCHORAGE, TYPE D
 φ END SECTION, TYPE C1

MATCHLINE STA. 194+00
 SEE SHEET 181

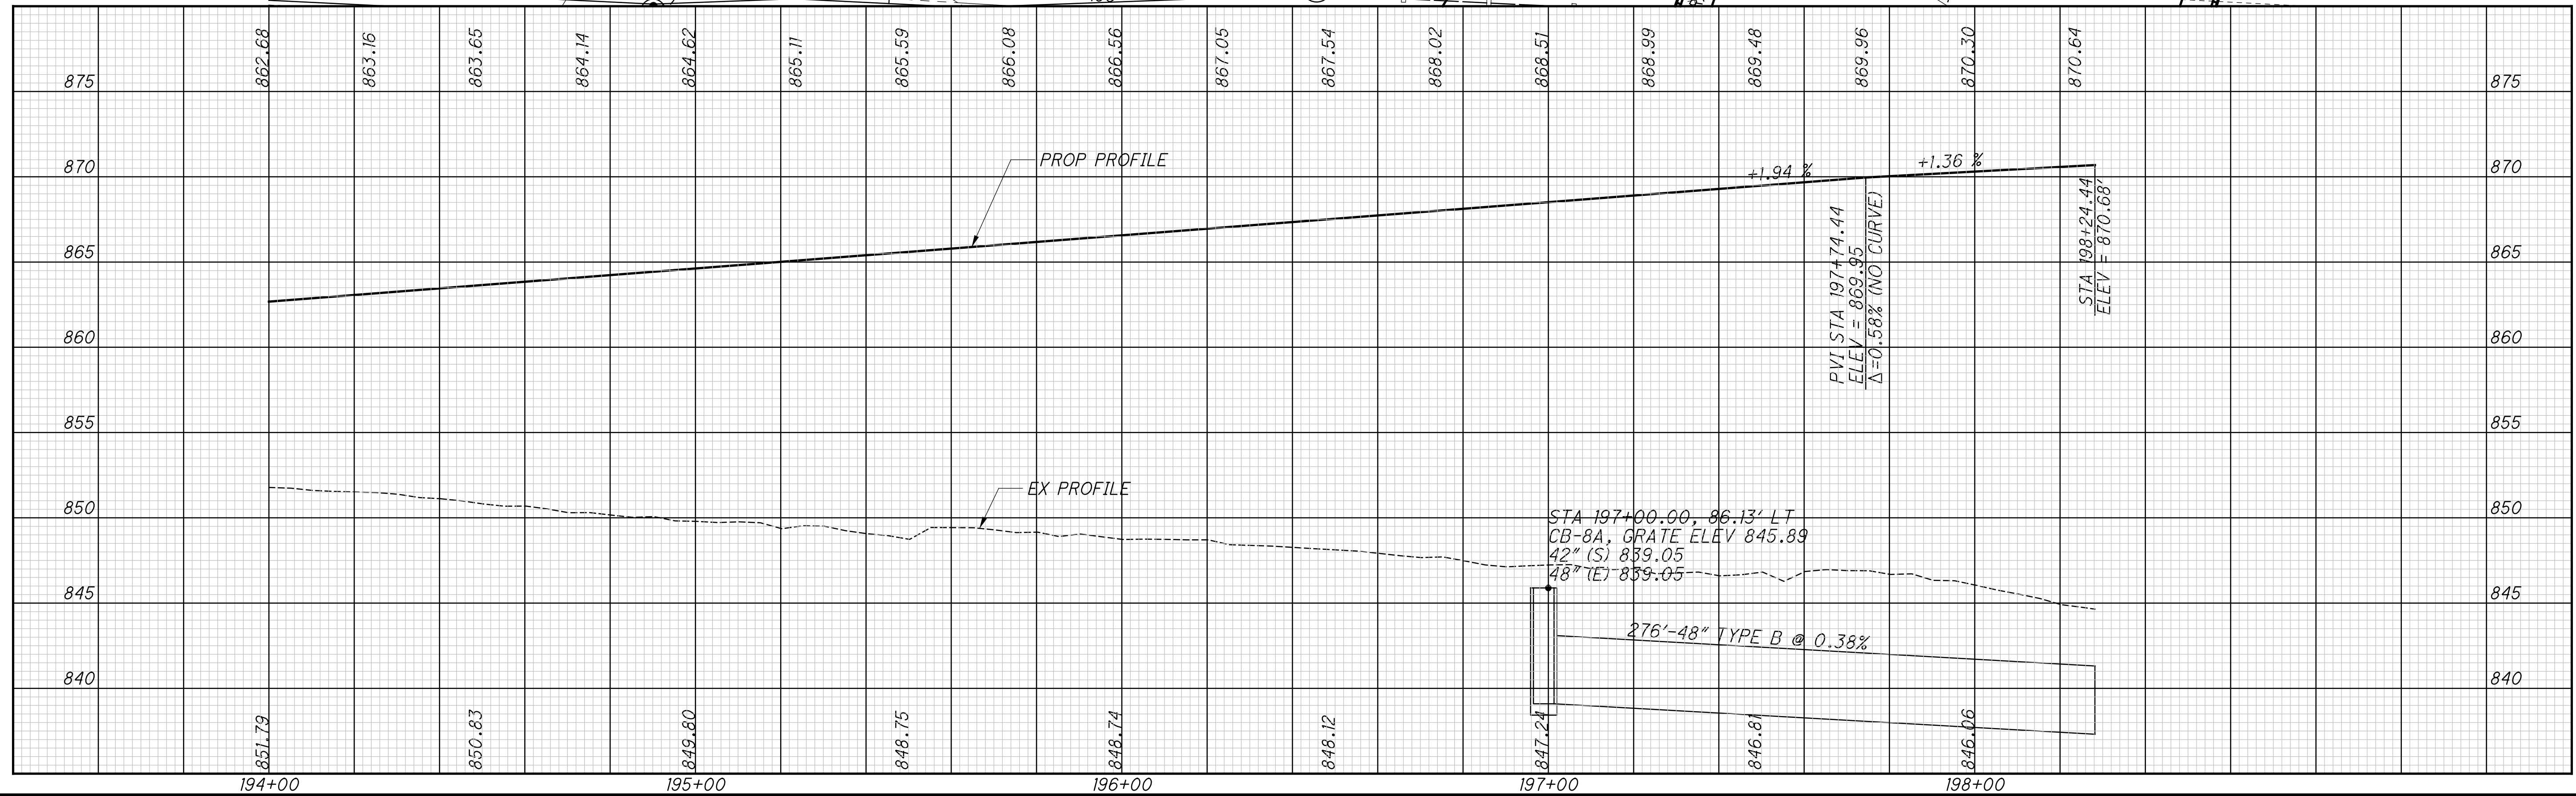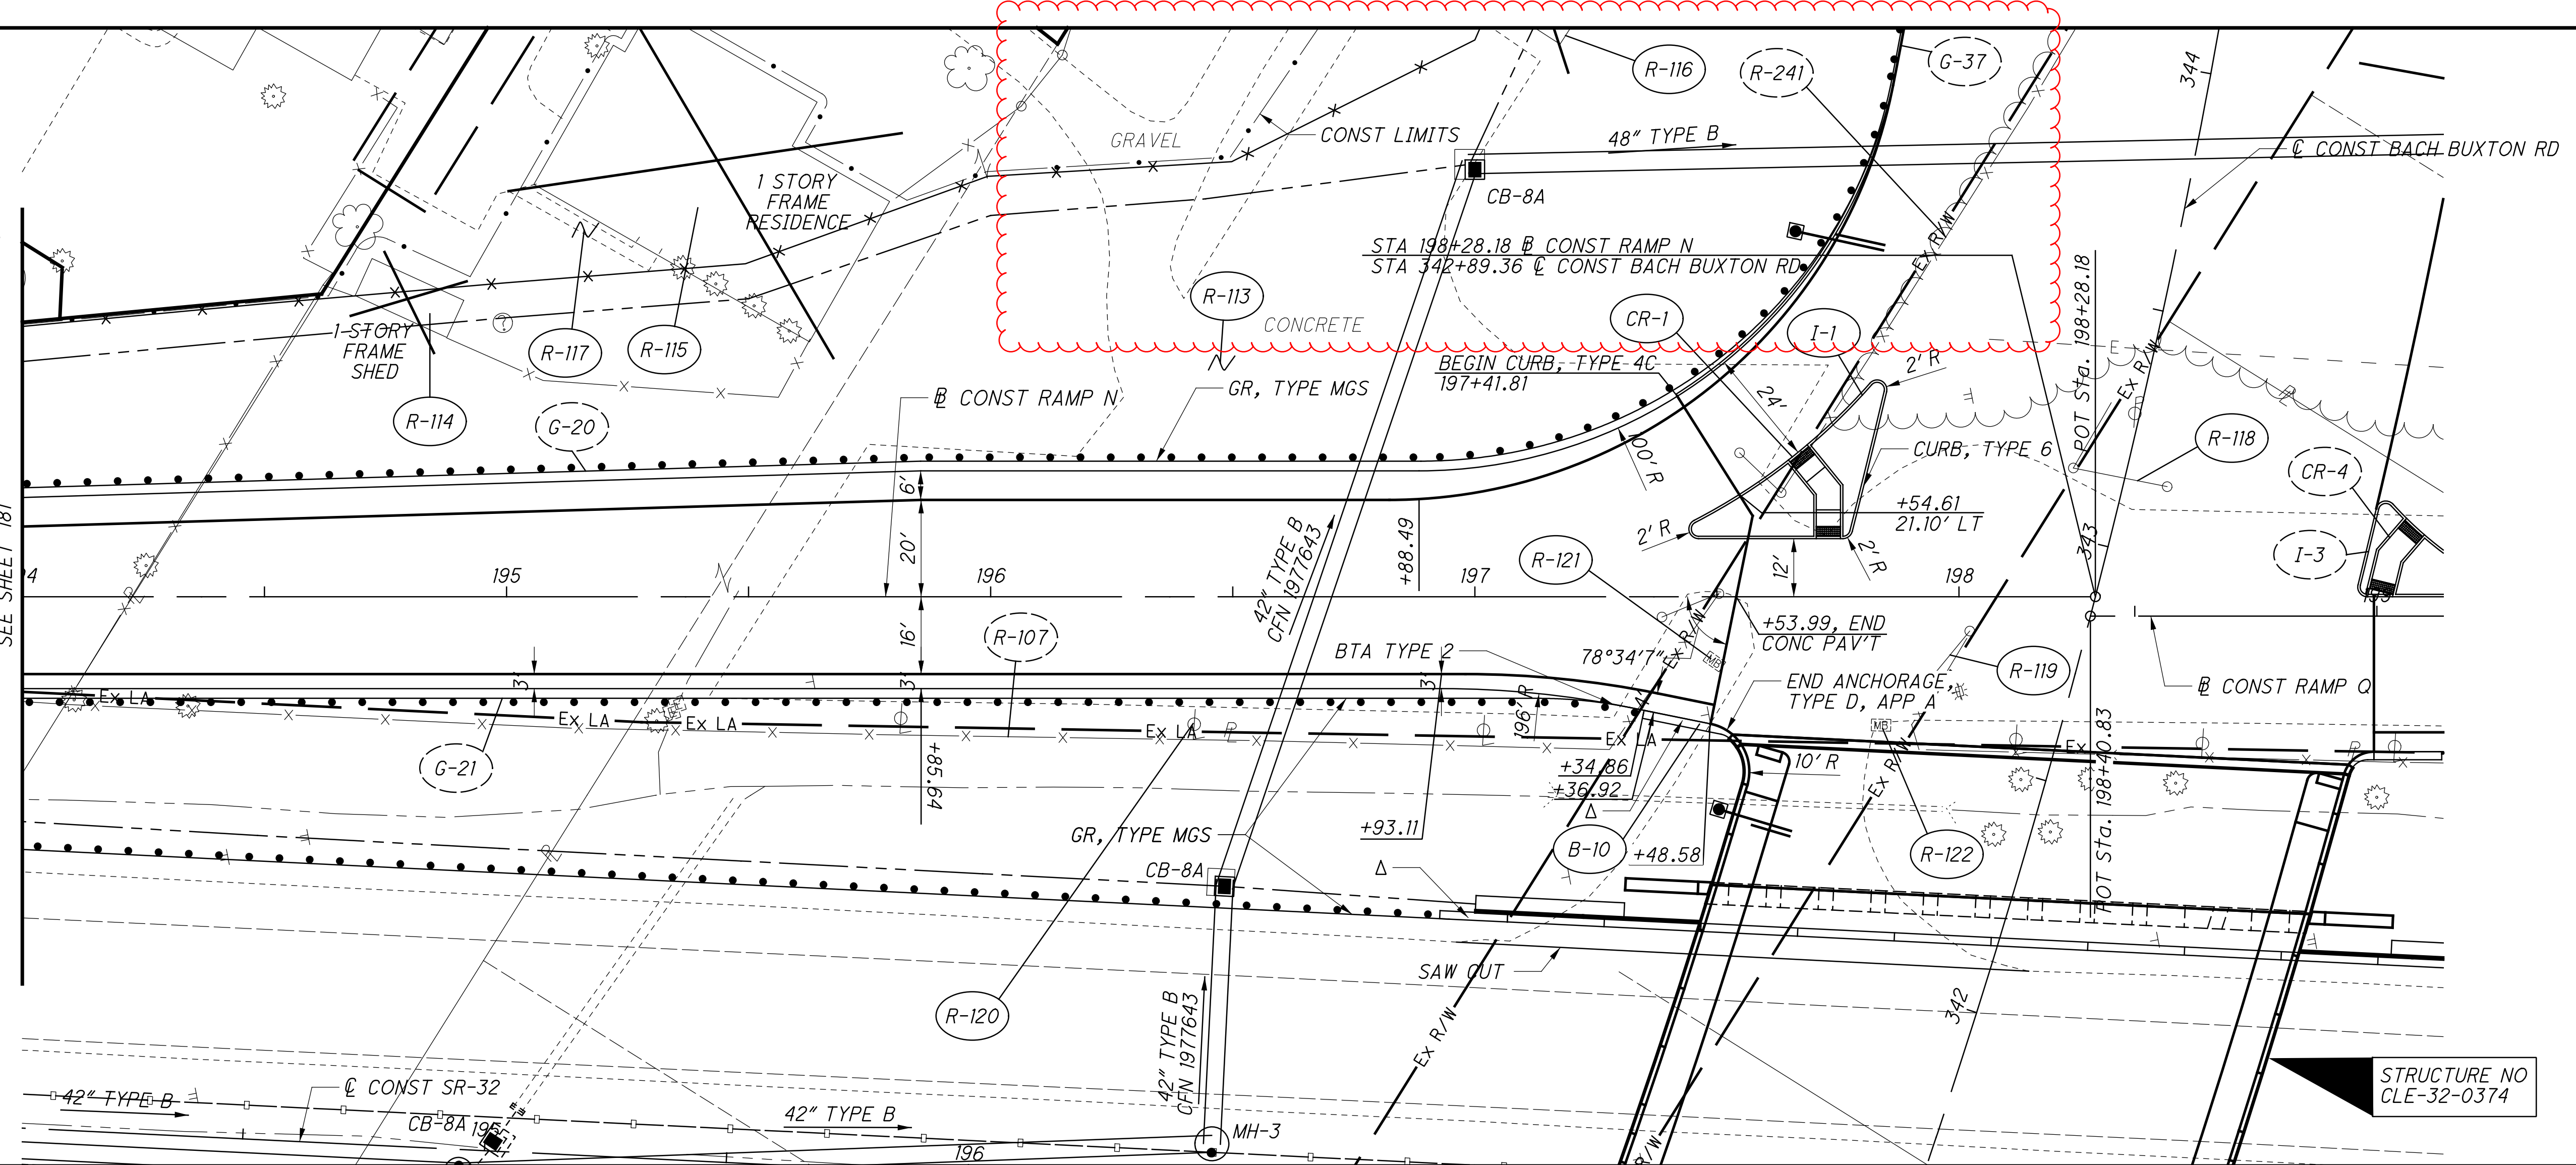



CALCULATED MSW CHECKED WAA

**PLAN AND PROFILE-RAMP N
 STA 194+00 TO STA 198+28.18**

**CLE-32-3.50
 (PHASE 5)**

...303.205\103954_GP5333.dgn 11/19/2021 1:38:51 PM mswwhitt

BACH-BUXTON RD
 CURVE #15
 P.I. Sta. 342+87.56
 $\Delta = 34^\circ 54' 20''$ (LT)
 $D_c = 3^\circ 30' 00''$
 $R = 1,637.02'$
 $T = 514.67'$
 $L = 997.30'$
 $E = 79.00'$
 $e_{max} = NC$
 PC Sta. 337+72.89
 PT Sta. 347+70.20

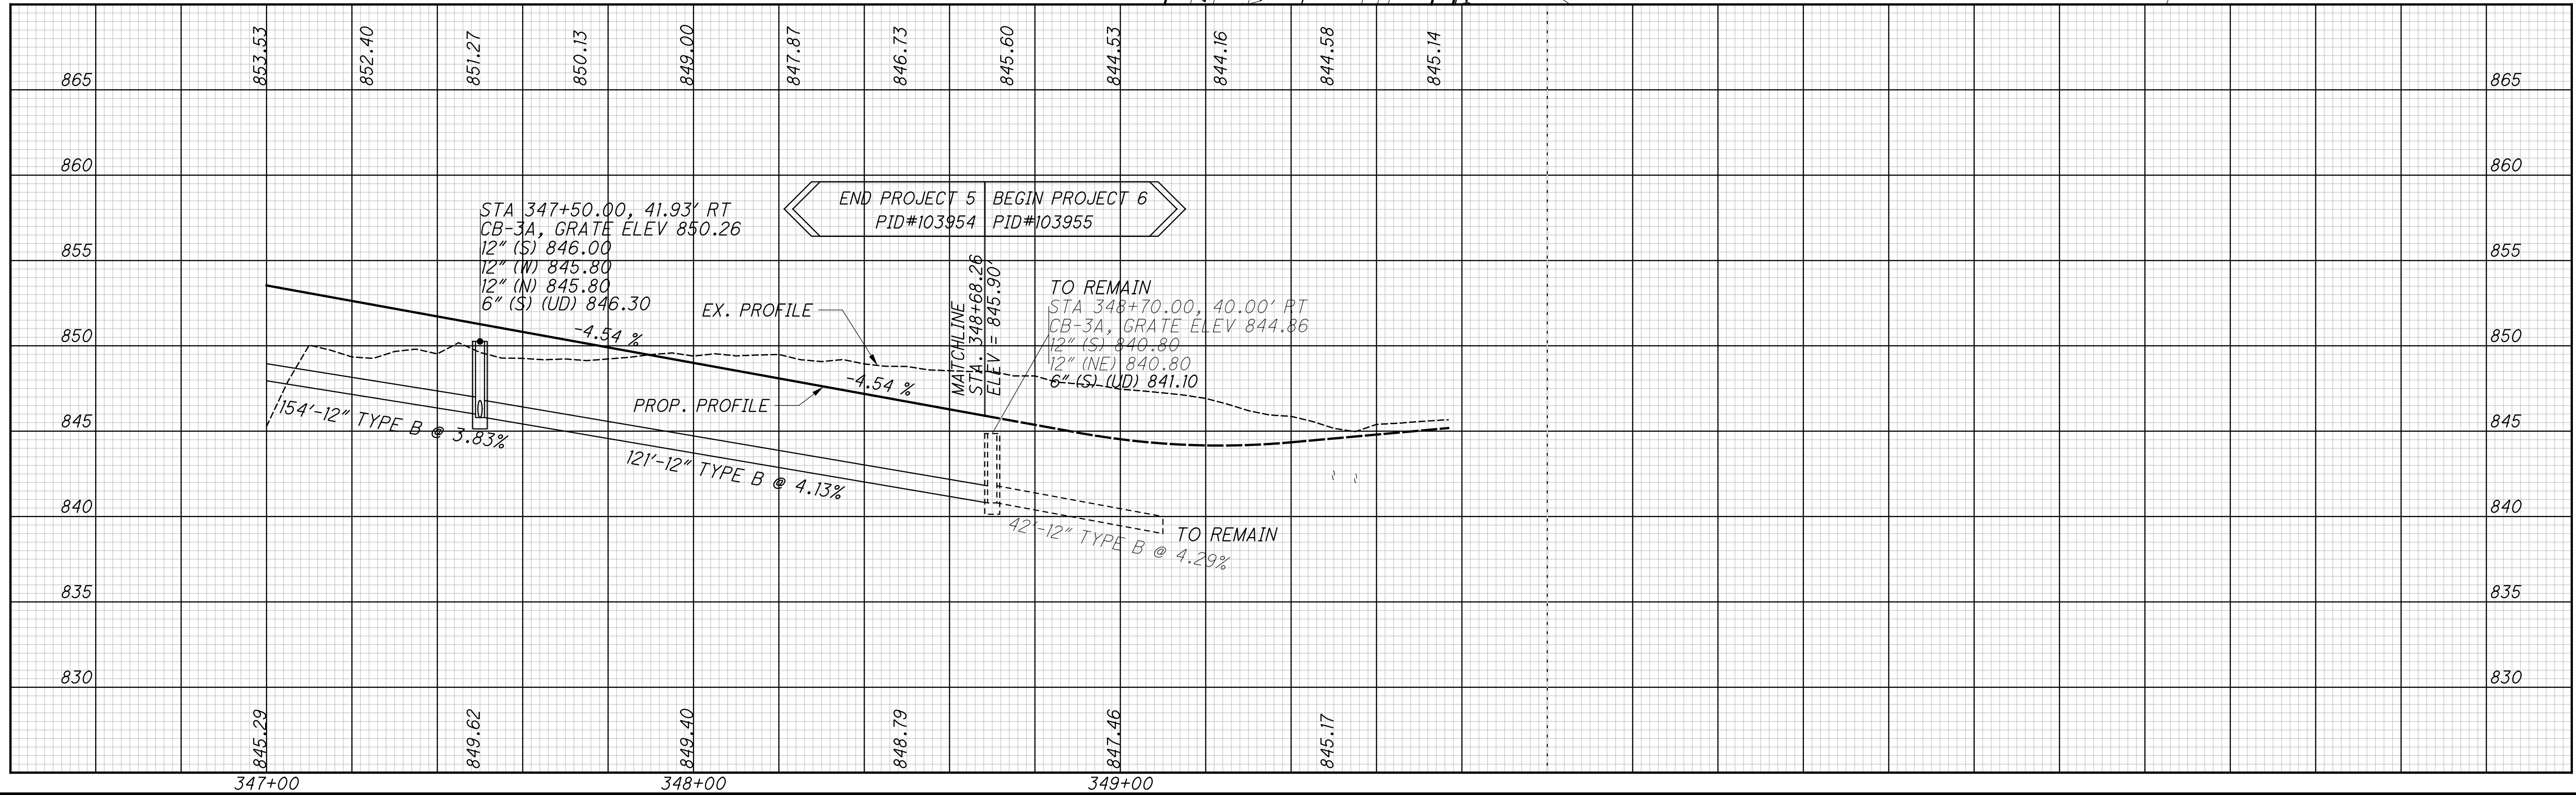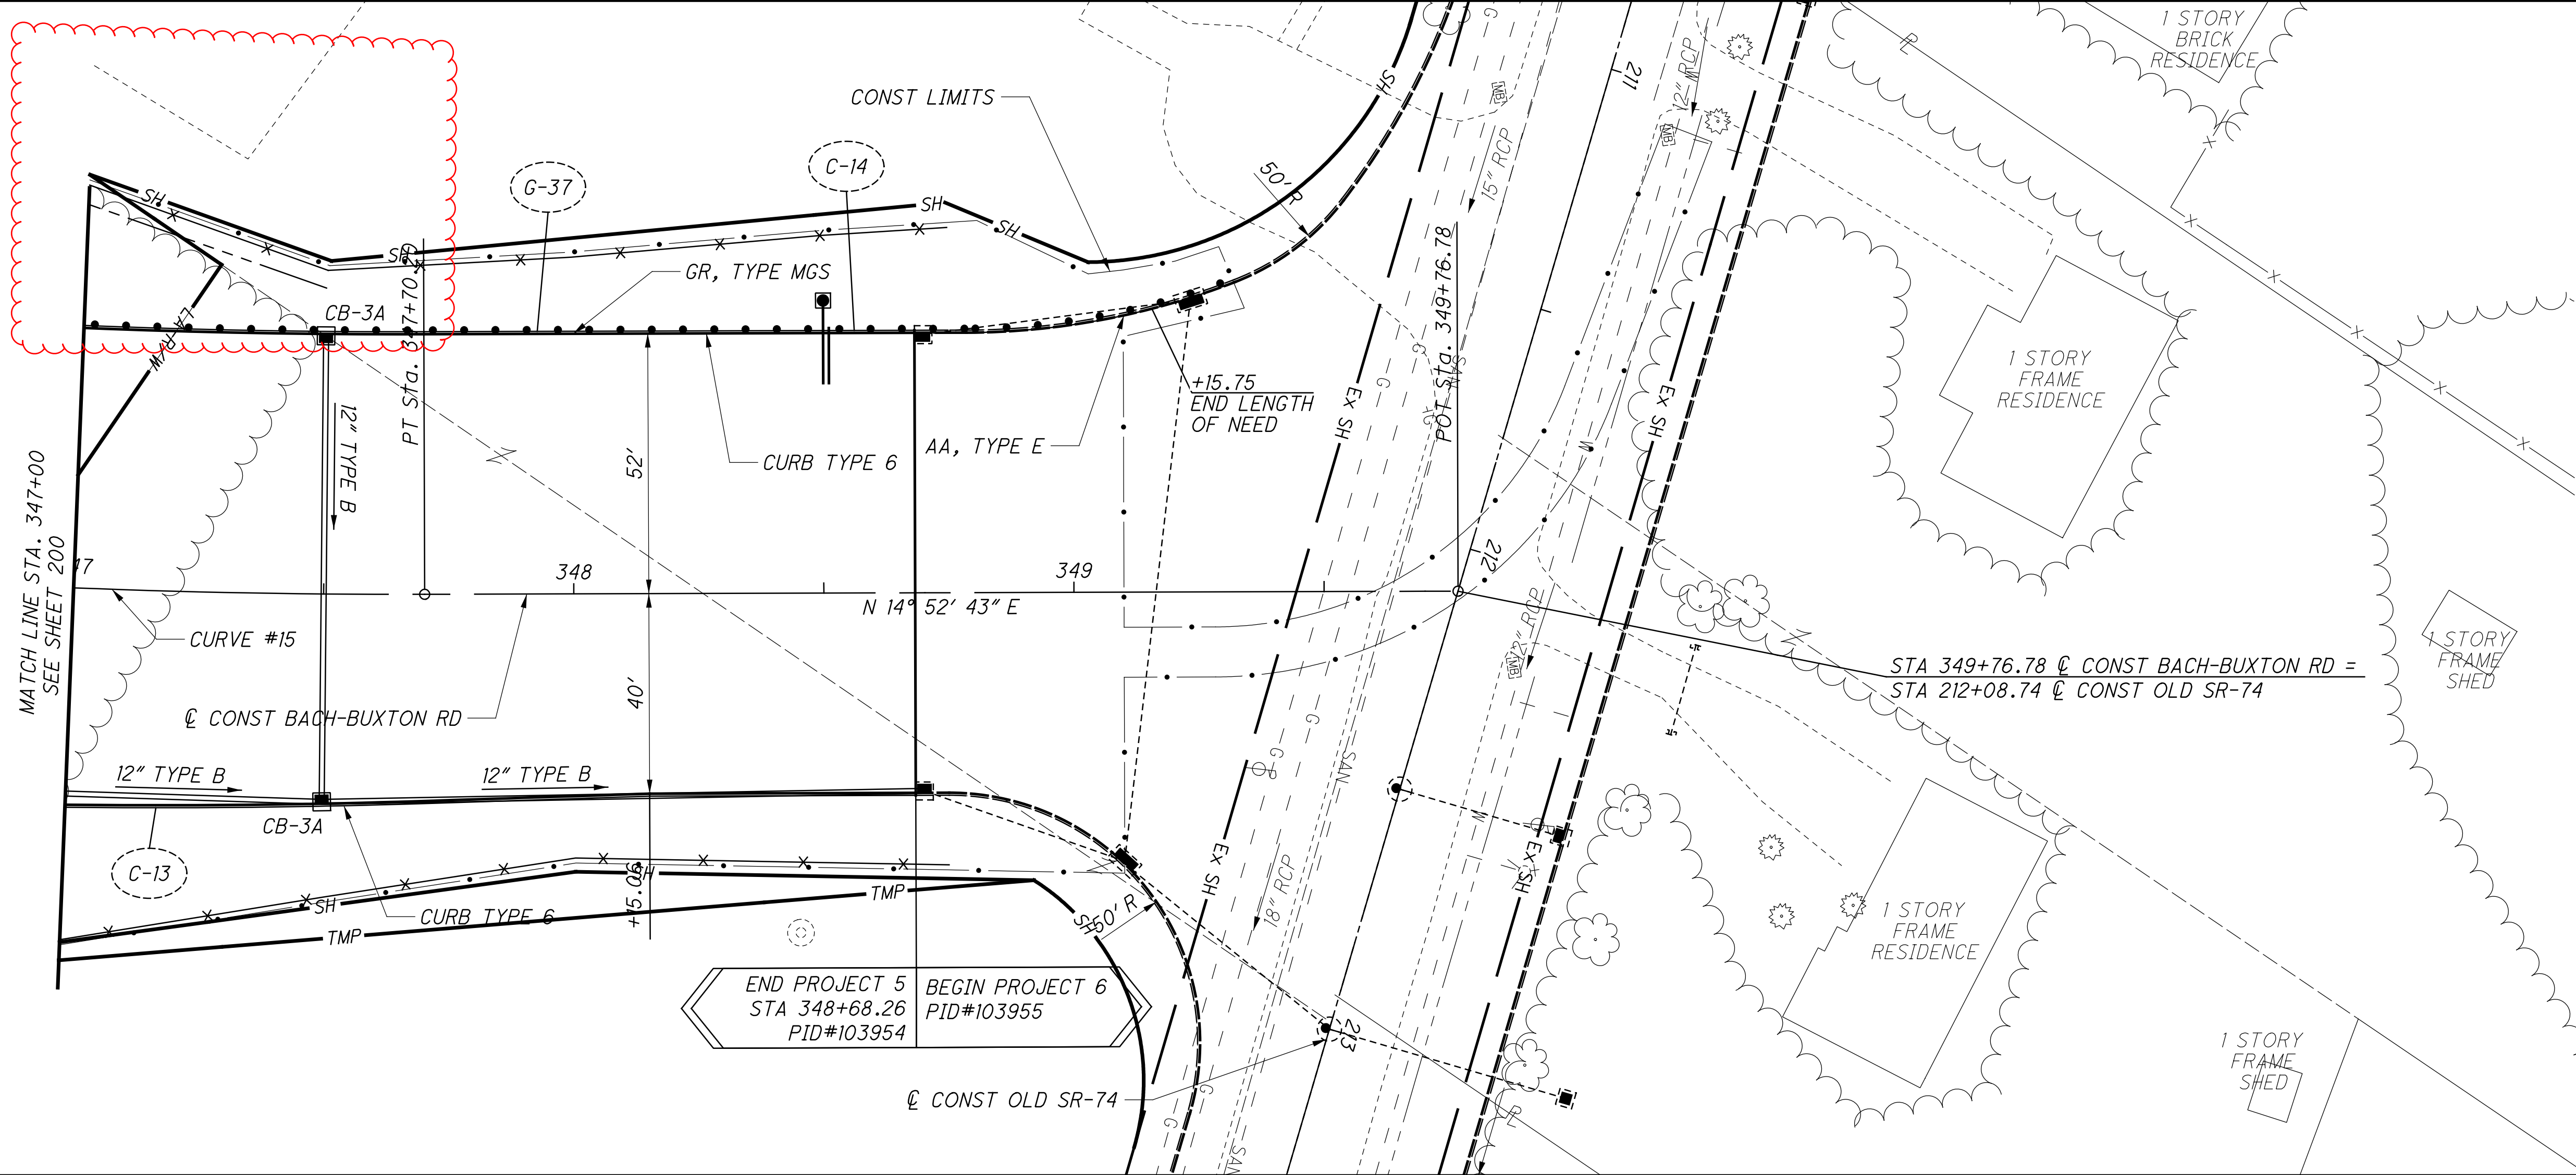

CALCULATED GAH
 CHECKED WAA

PLAN AND PROFILE - BACH-BUXTON RD
 STA 347+00 TO STA 349+76.78

CLE-32-3.50
 (PHASE 5)


...303.205\103954_CP570.dgn 11/19/2021 1:40:01 PM mswwhitt

...303.205\103954_XS501L.dgn 11/19/2021 1:42:00 PM mswhatt

SEEDING
END WIDTH SQ. YDS.

NOTE:
FOR SR-32 LEFT AND RIGHT EARTHWORK
AND SEEDING & MULCHING QUANTITIES,
SEE SHEETS 270-331.

END AREA VOLUME
CUT FILL CUT FILL
CALCULATED MSW CHECKED WAA

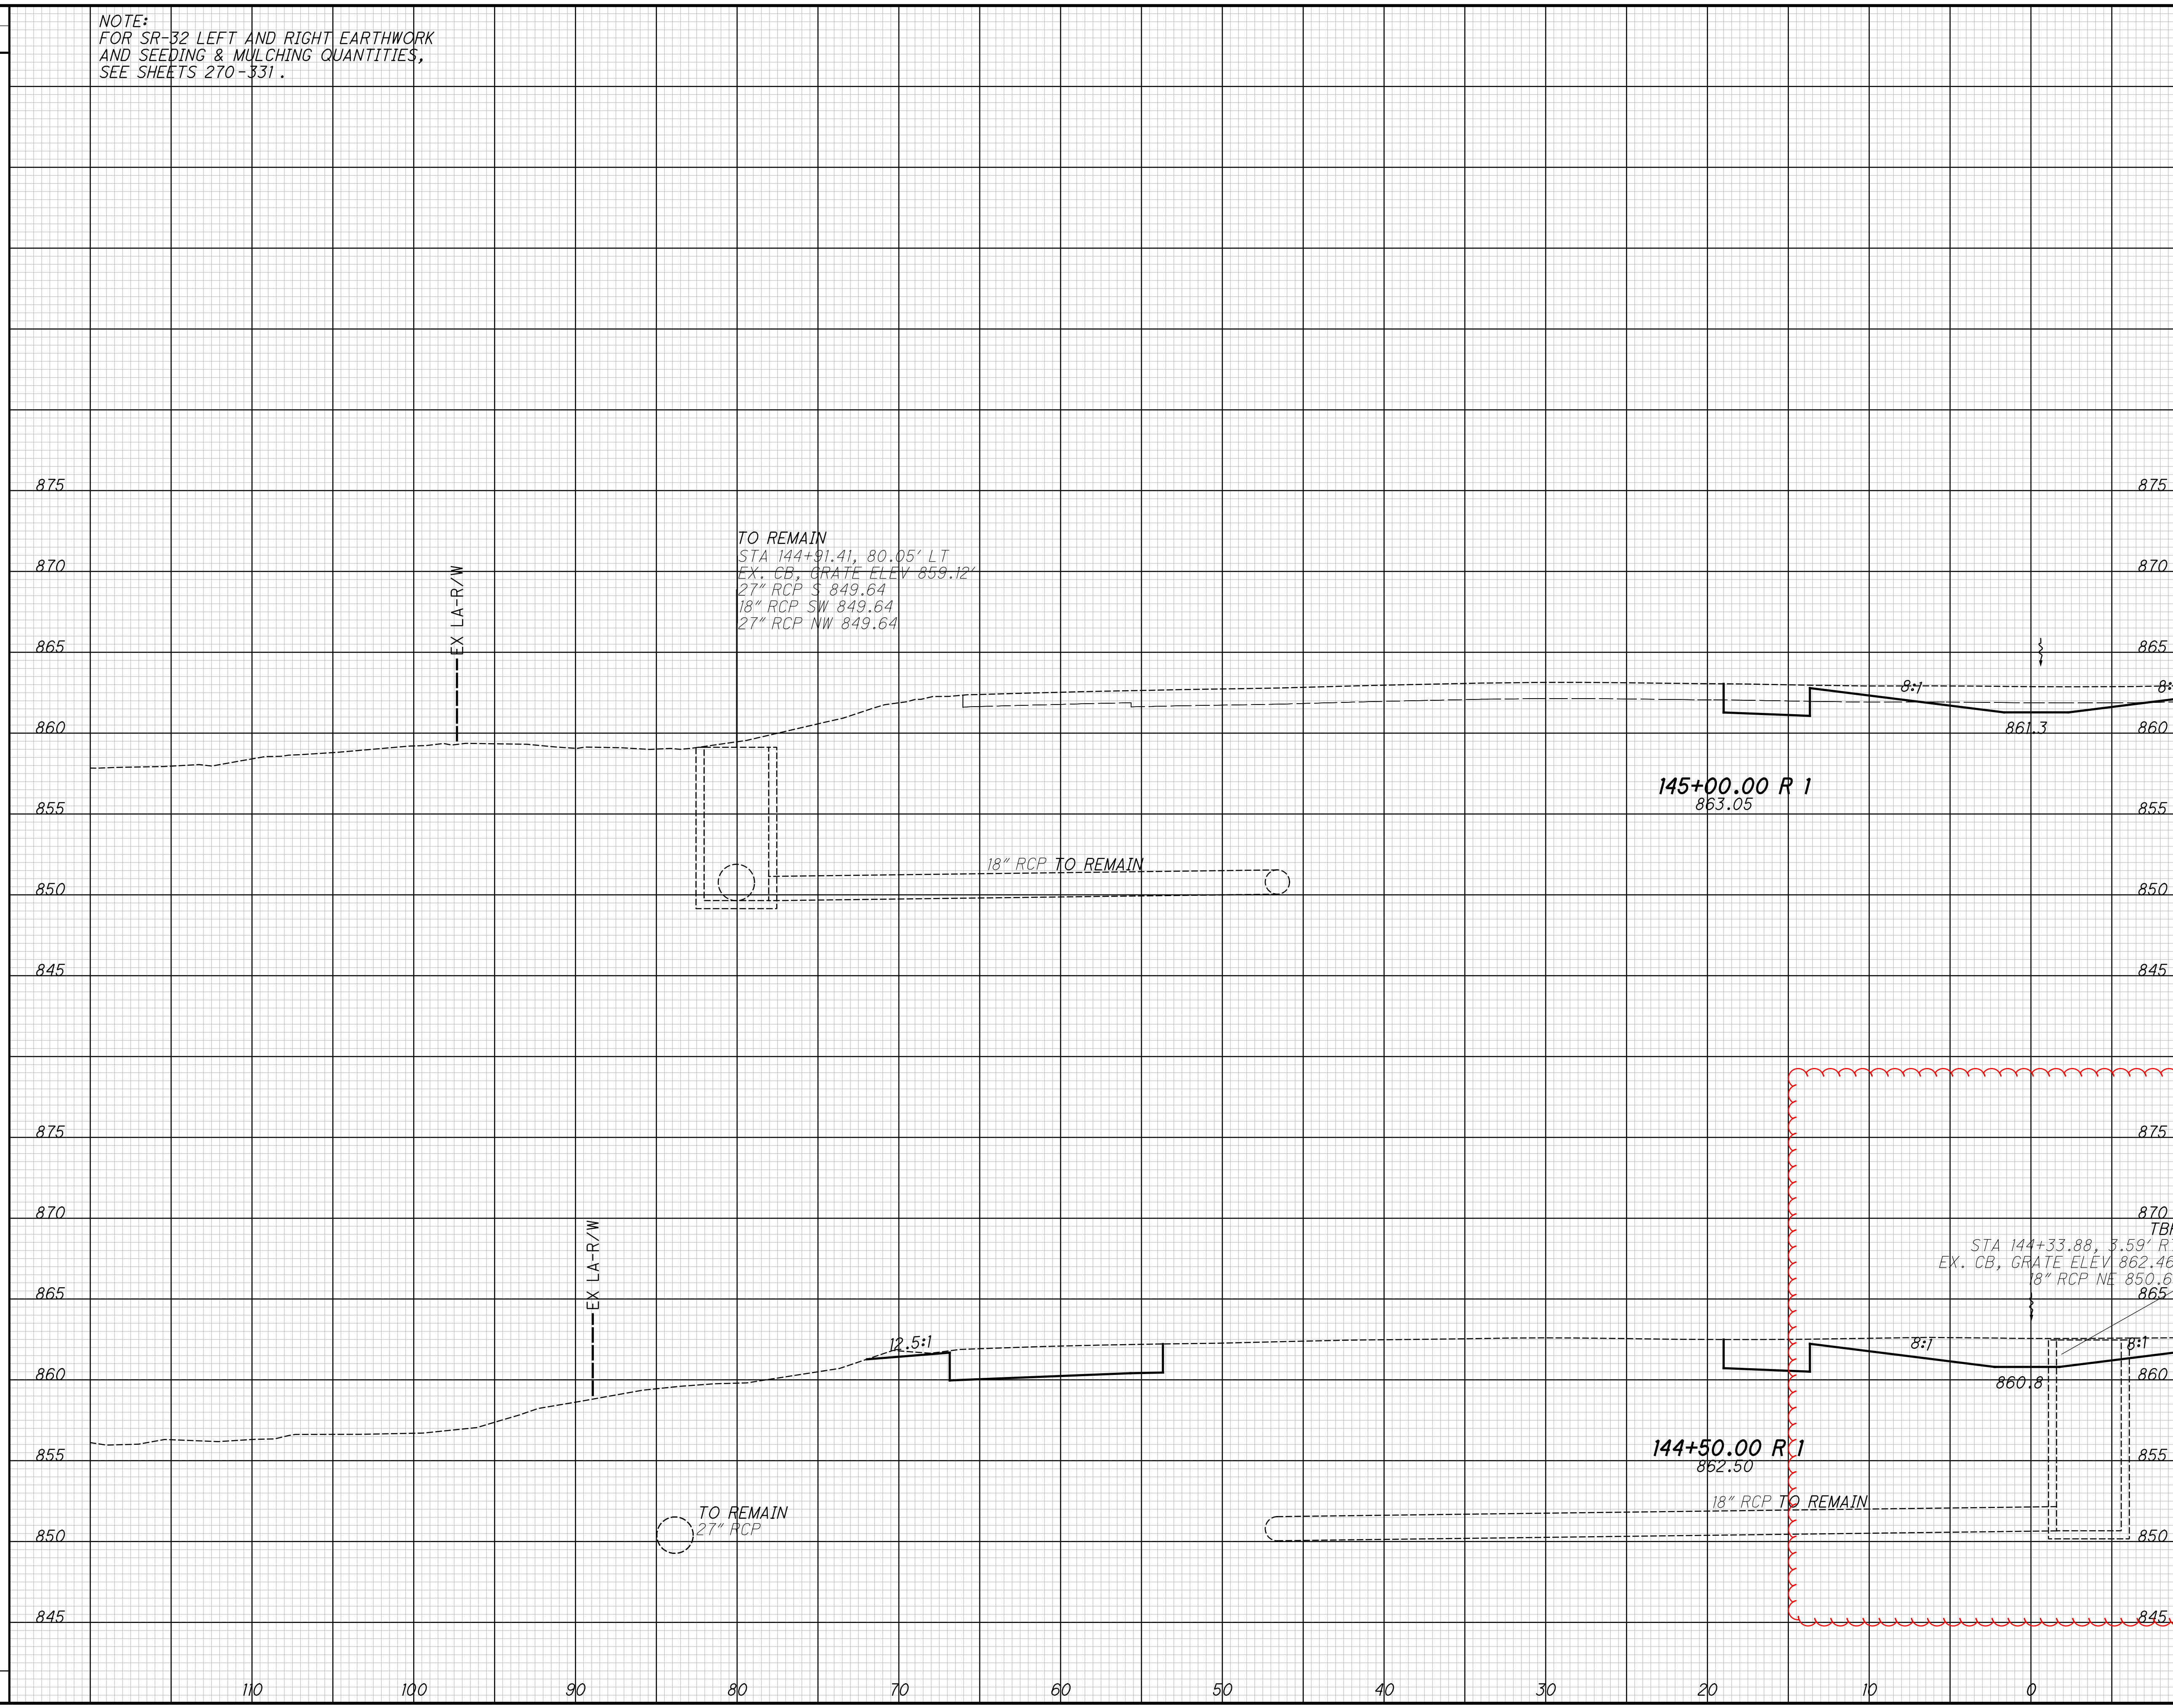

CROSS SECTIONS - SR-32 LT
STA. 144+50.00 TO STA. 145+00.00

CLE-35-3.50
PHASE 5


216
736

...303.205\103954_XS501L.dgn 11/19/2021 1:42:30 PM mswwhitt

SEEDING
END WIDTH SQ. YDS.

NOTE:
FOR SR-32 LEFT AND RIGHT EARTHWORK
AND SEEDING & MULCHING QUANTITIES,
SEE SHEETS 270-331.

END AREA VOLUME
CUT FILL CUT FILL
CALCULATED MSW CHECKED WAA

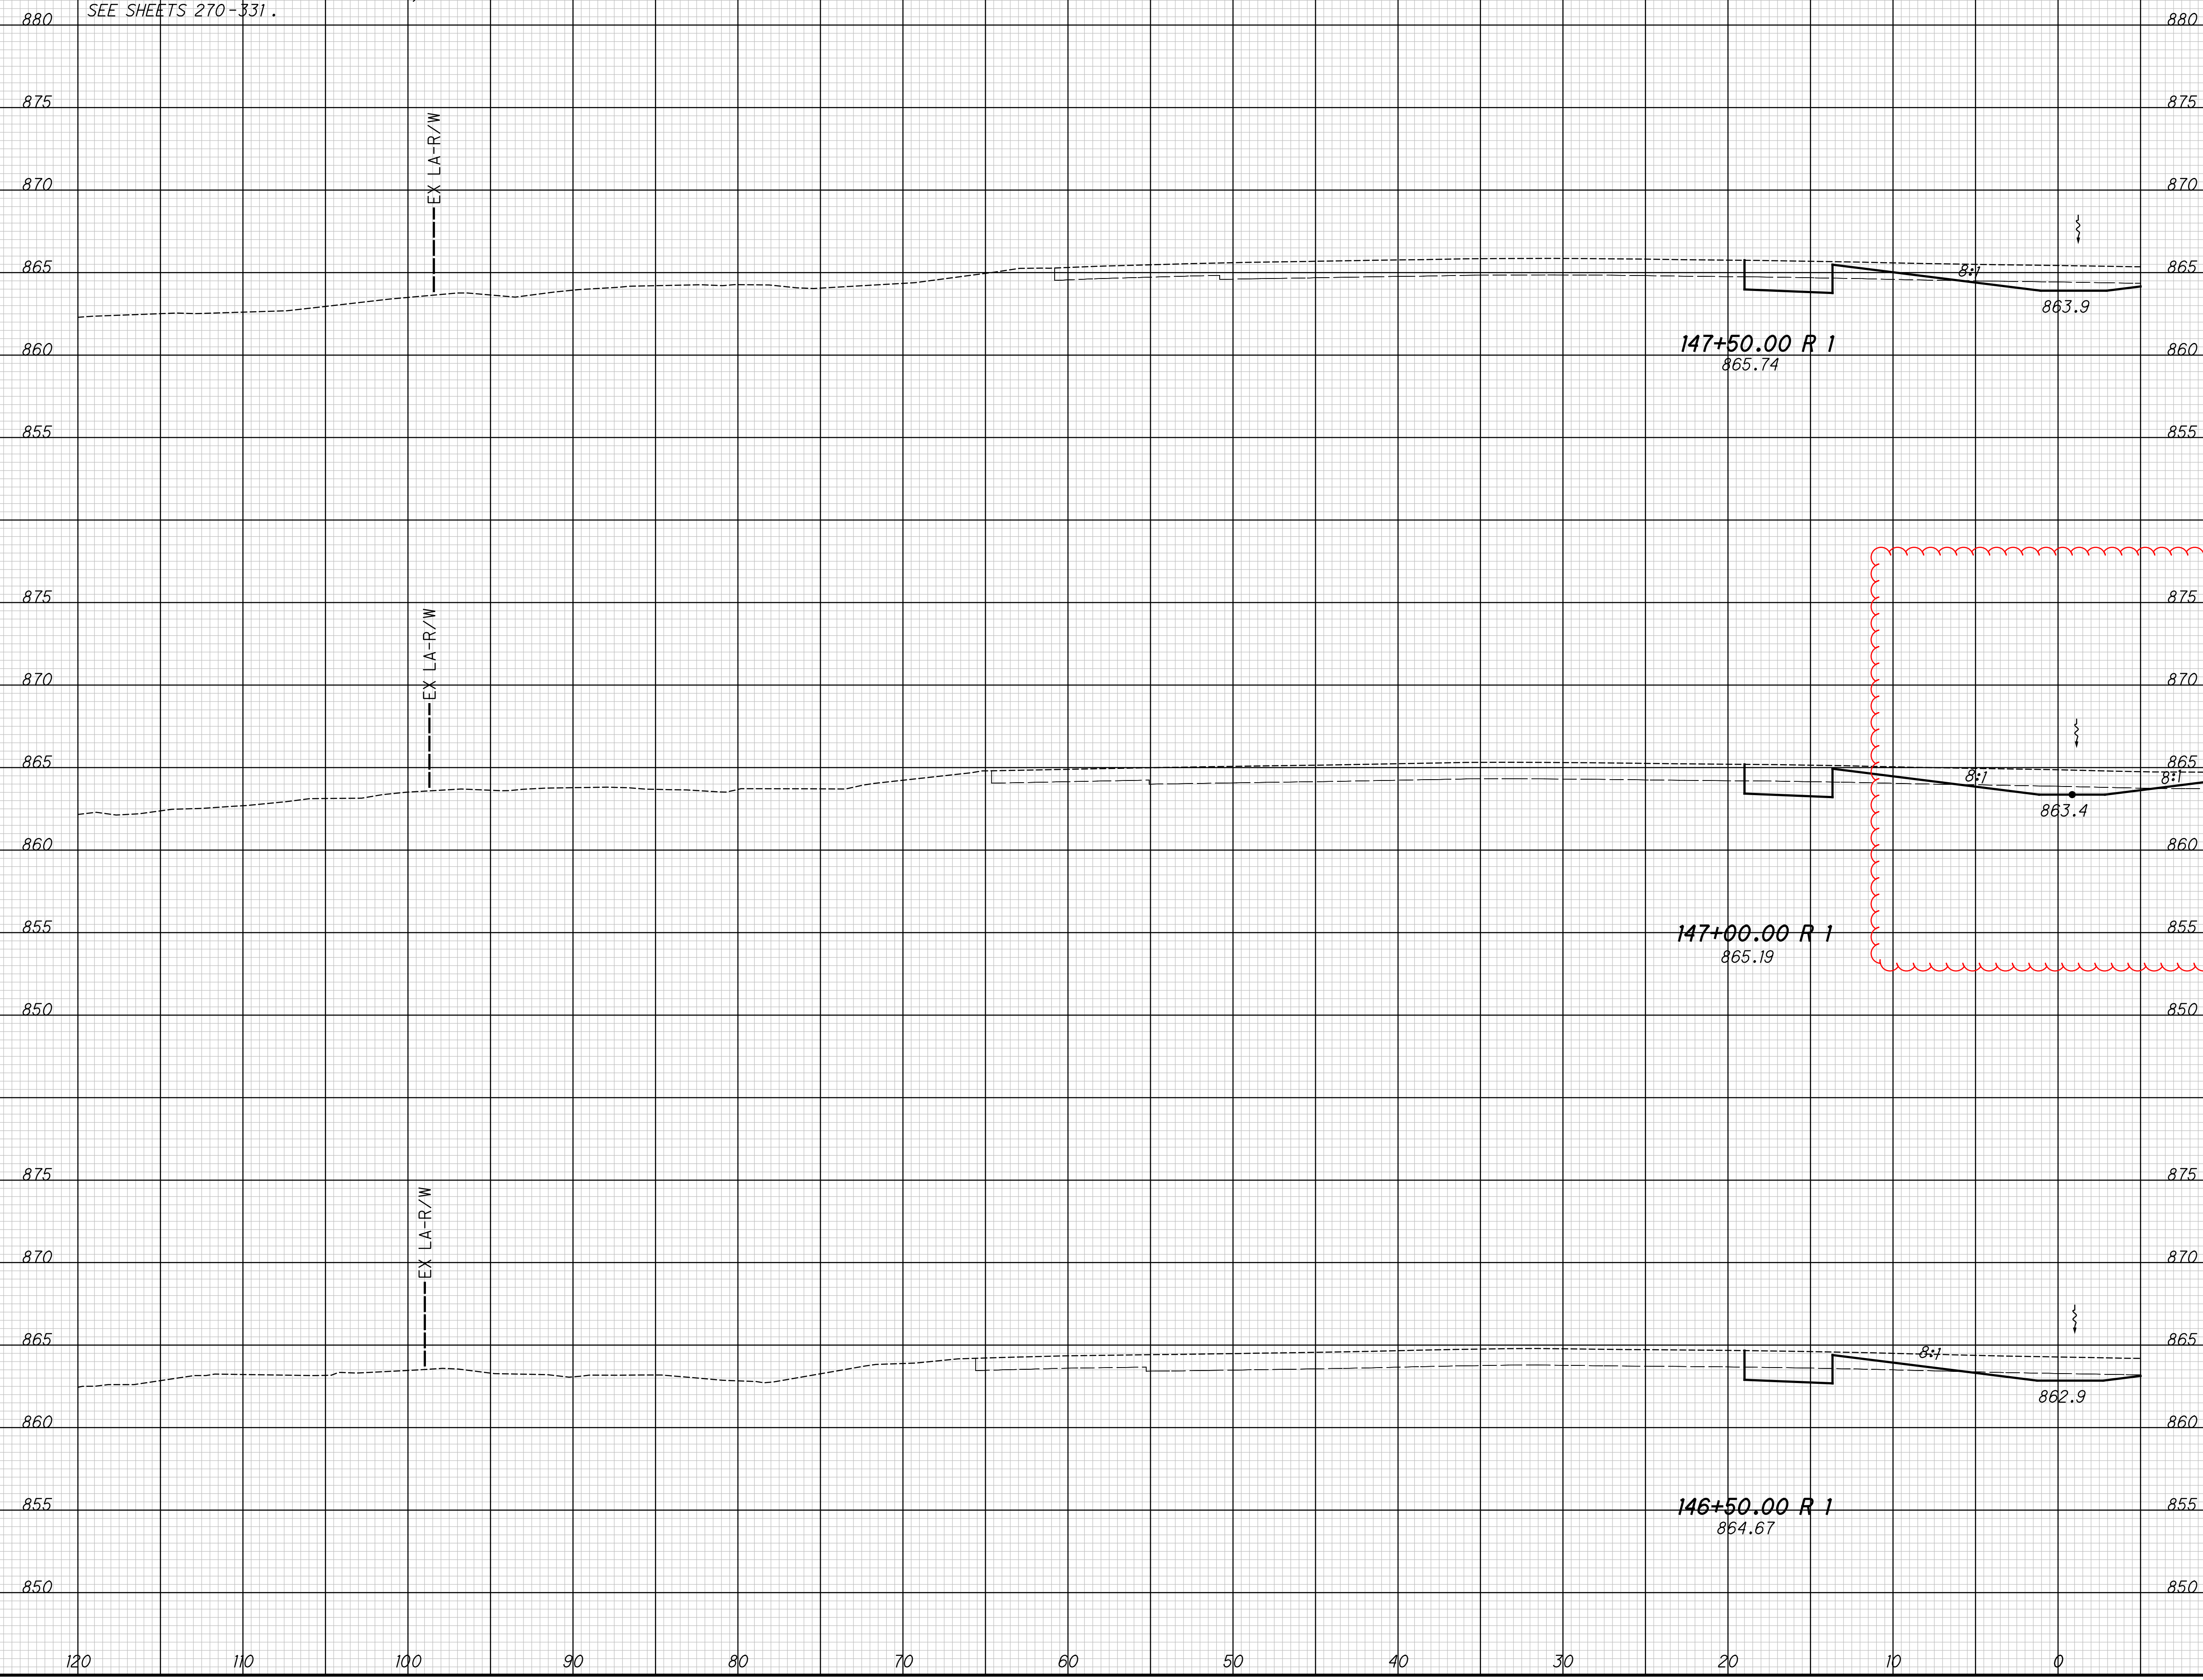

CROSS SECTIONS - SR-32 LT
STA. 146 + 50.00 TO STA. 147 + 50.00

CLE-35-3.50
PHASE 5


218
736

...303.205\103954_XS501L.dgn 11/19/2021 1:43:20 PM mshwhitt

SEEDING
END WIDTH SQ. YDS.

NOTE:
FOR SR-32 LEFT AND RIGHT EARTHWORK
AND SEEDING & MULCHING QUANTITIES,
SEE SHEETS 270-331.

END AREA VOLUME
CUT FILL CUT FILL
CALCULATED MSW CHECKED WAA

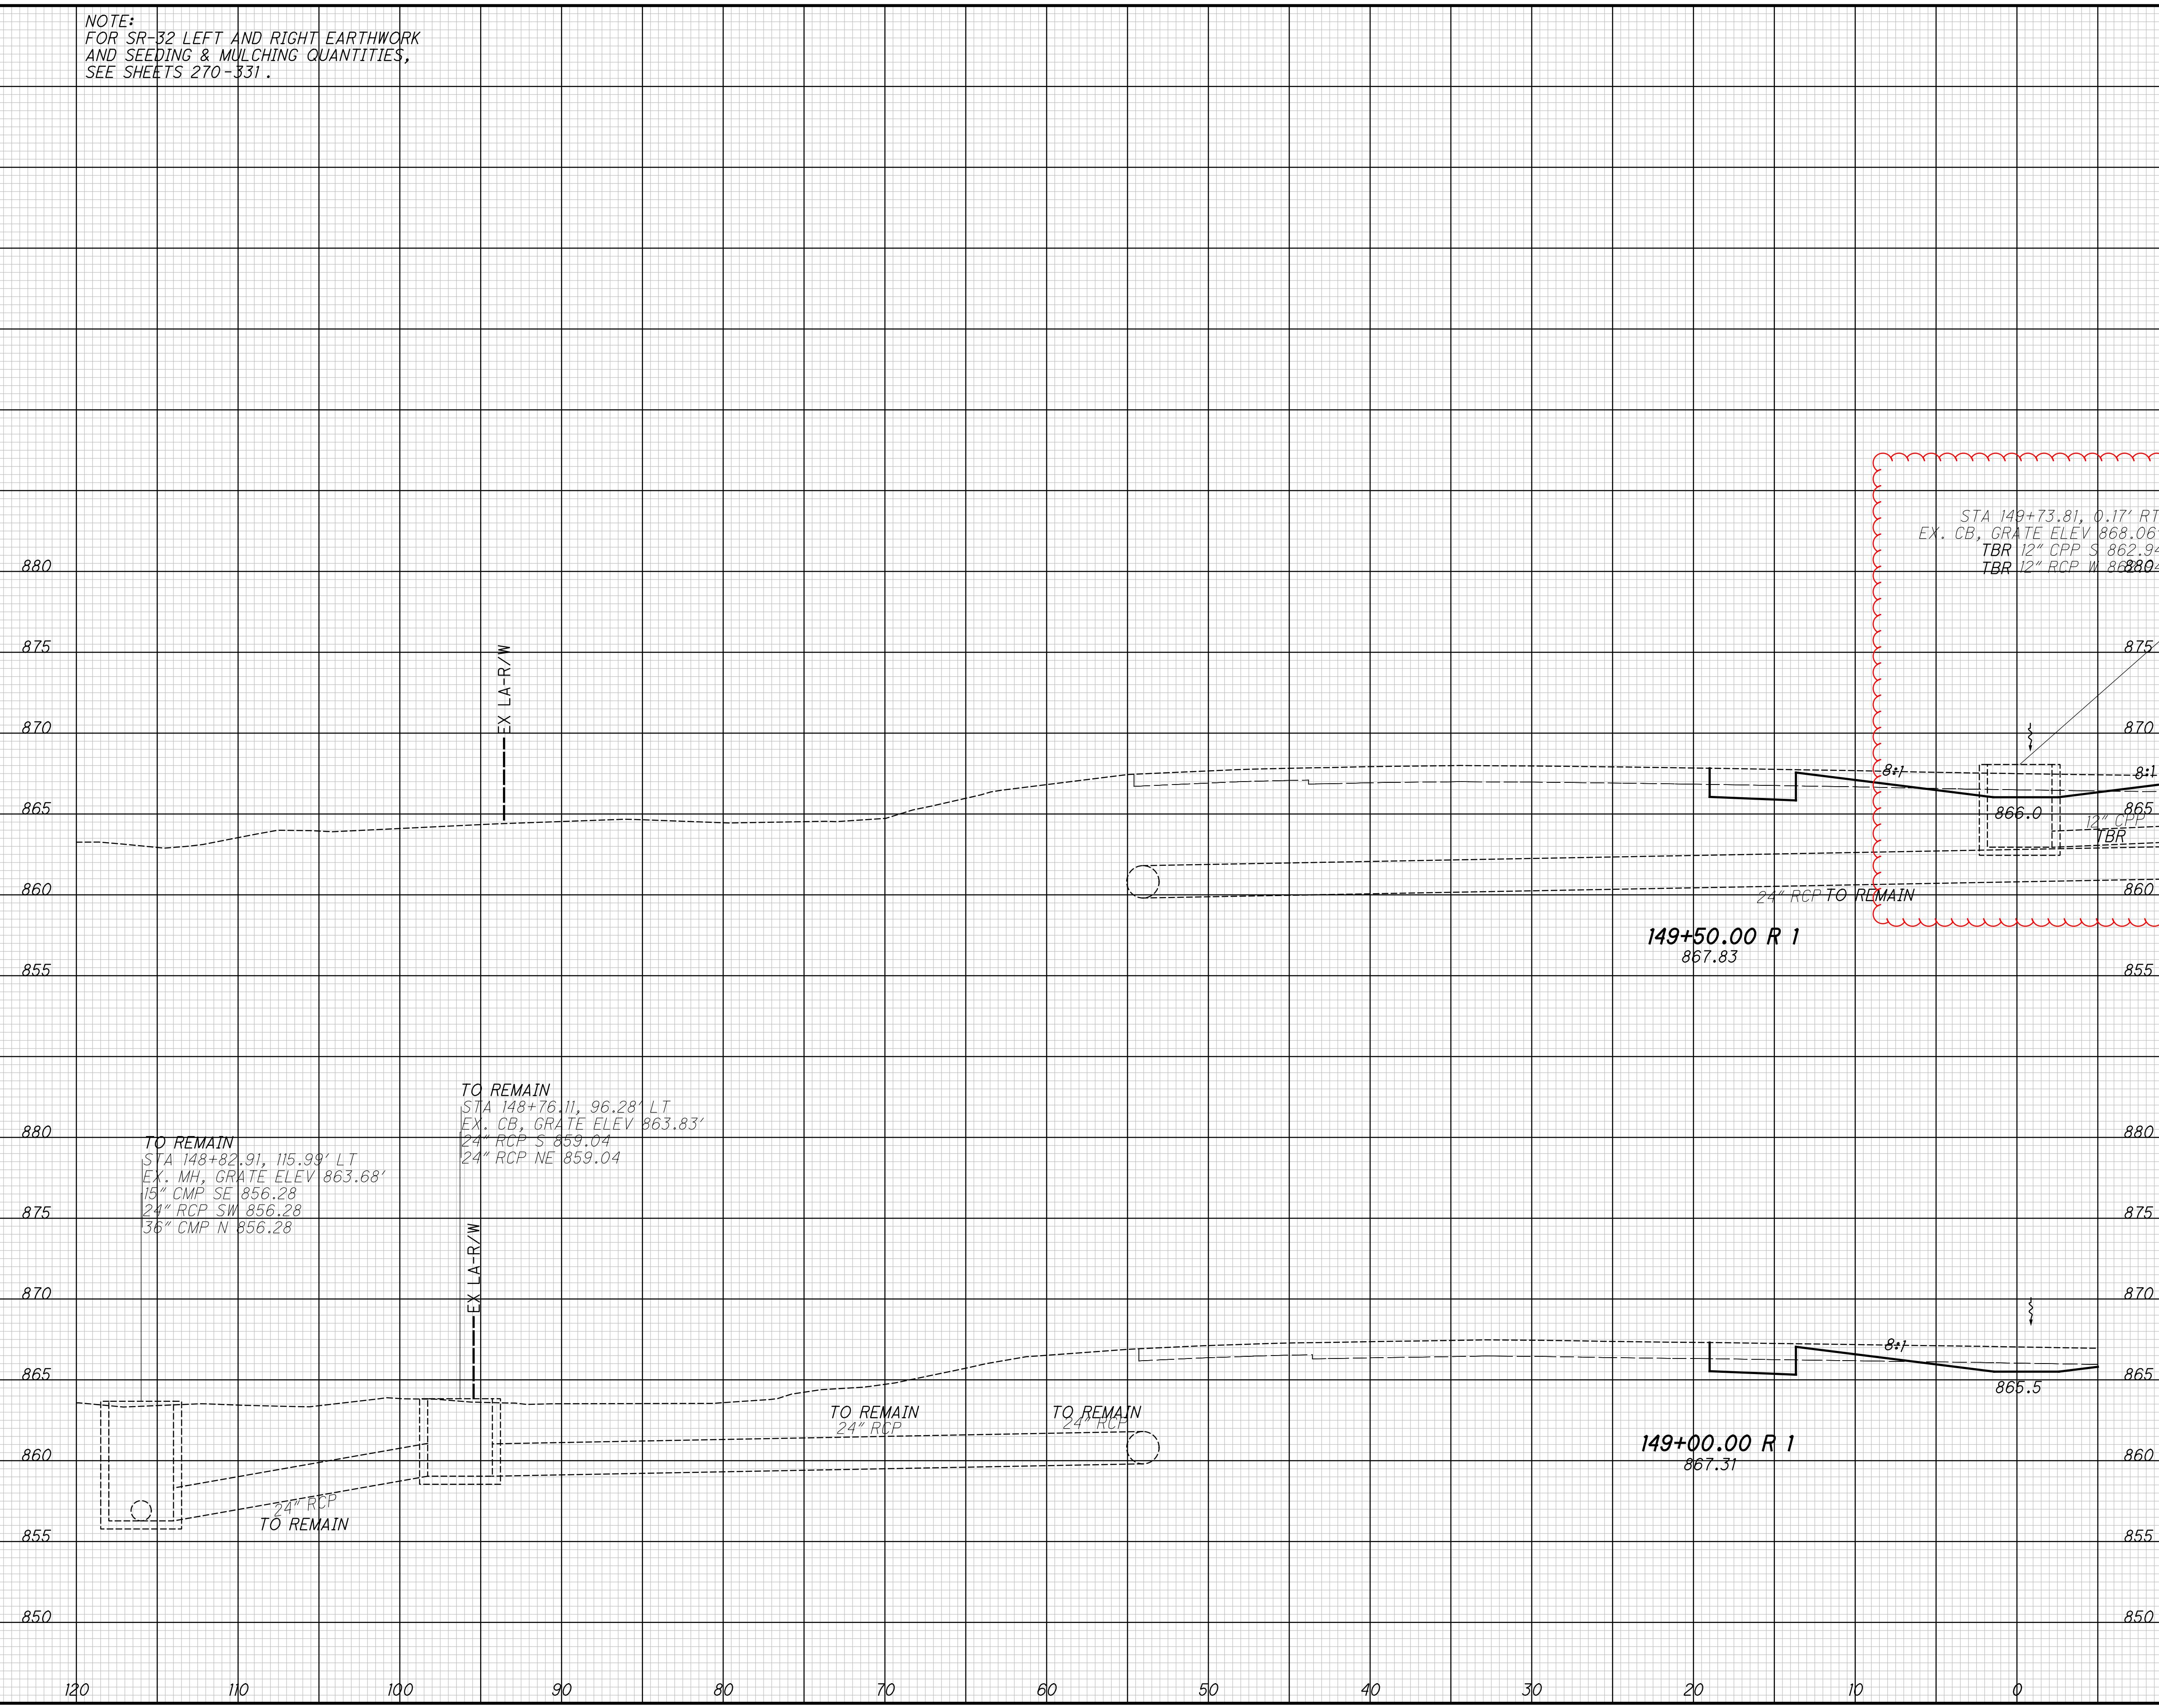

STA 149+73.81, 0.17' RT
EX. CB, GRATE ELEV 868.06'
TBR 12" CPP S 862.94'
TBR 12" RCP W 868.04'

TO REMAIN
STA 148+82.91, 115.99' LT
EX. MH, GRATE ELEV 863.68'
15" CMP SE 856.28
24" RCP SW 856.28
36" CMP N 856.28

TO REMAIN
STA 148+76.11, 96.28' LT
EX. CB, GRATE ELEV 863.83'
24" RCP S 859.04
24" RCP NE 859.04

149+50.00 R 1
867.83

149+00.00 R 1
867.31

CROSS SECTIONS - SR-32 LT
STA. 149+00.00 TO STA. 149+50.00

CLE-35-3.50
PHASE 5


220
736

...303.205\103954_XS501L.dgn 11/19/2021 1:43:20 PM mswhtt

| SEEDING | |
|-----------|----------|
| END WIDTH | SO. YDS. |

NOTE:
FOR SR-32 LEFT AND RIGHT EARTHWORK
AND SEEDING & MULCHING QUANTITIES,
SEE SHEETS 270-331.

| END AREA | | VOLUME | | CALCULATED | |
|----------|------|--------|------|------------|-----|
| CUT | FILL | CUT | FILL | MSW | WAA |

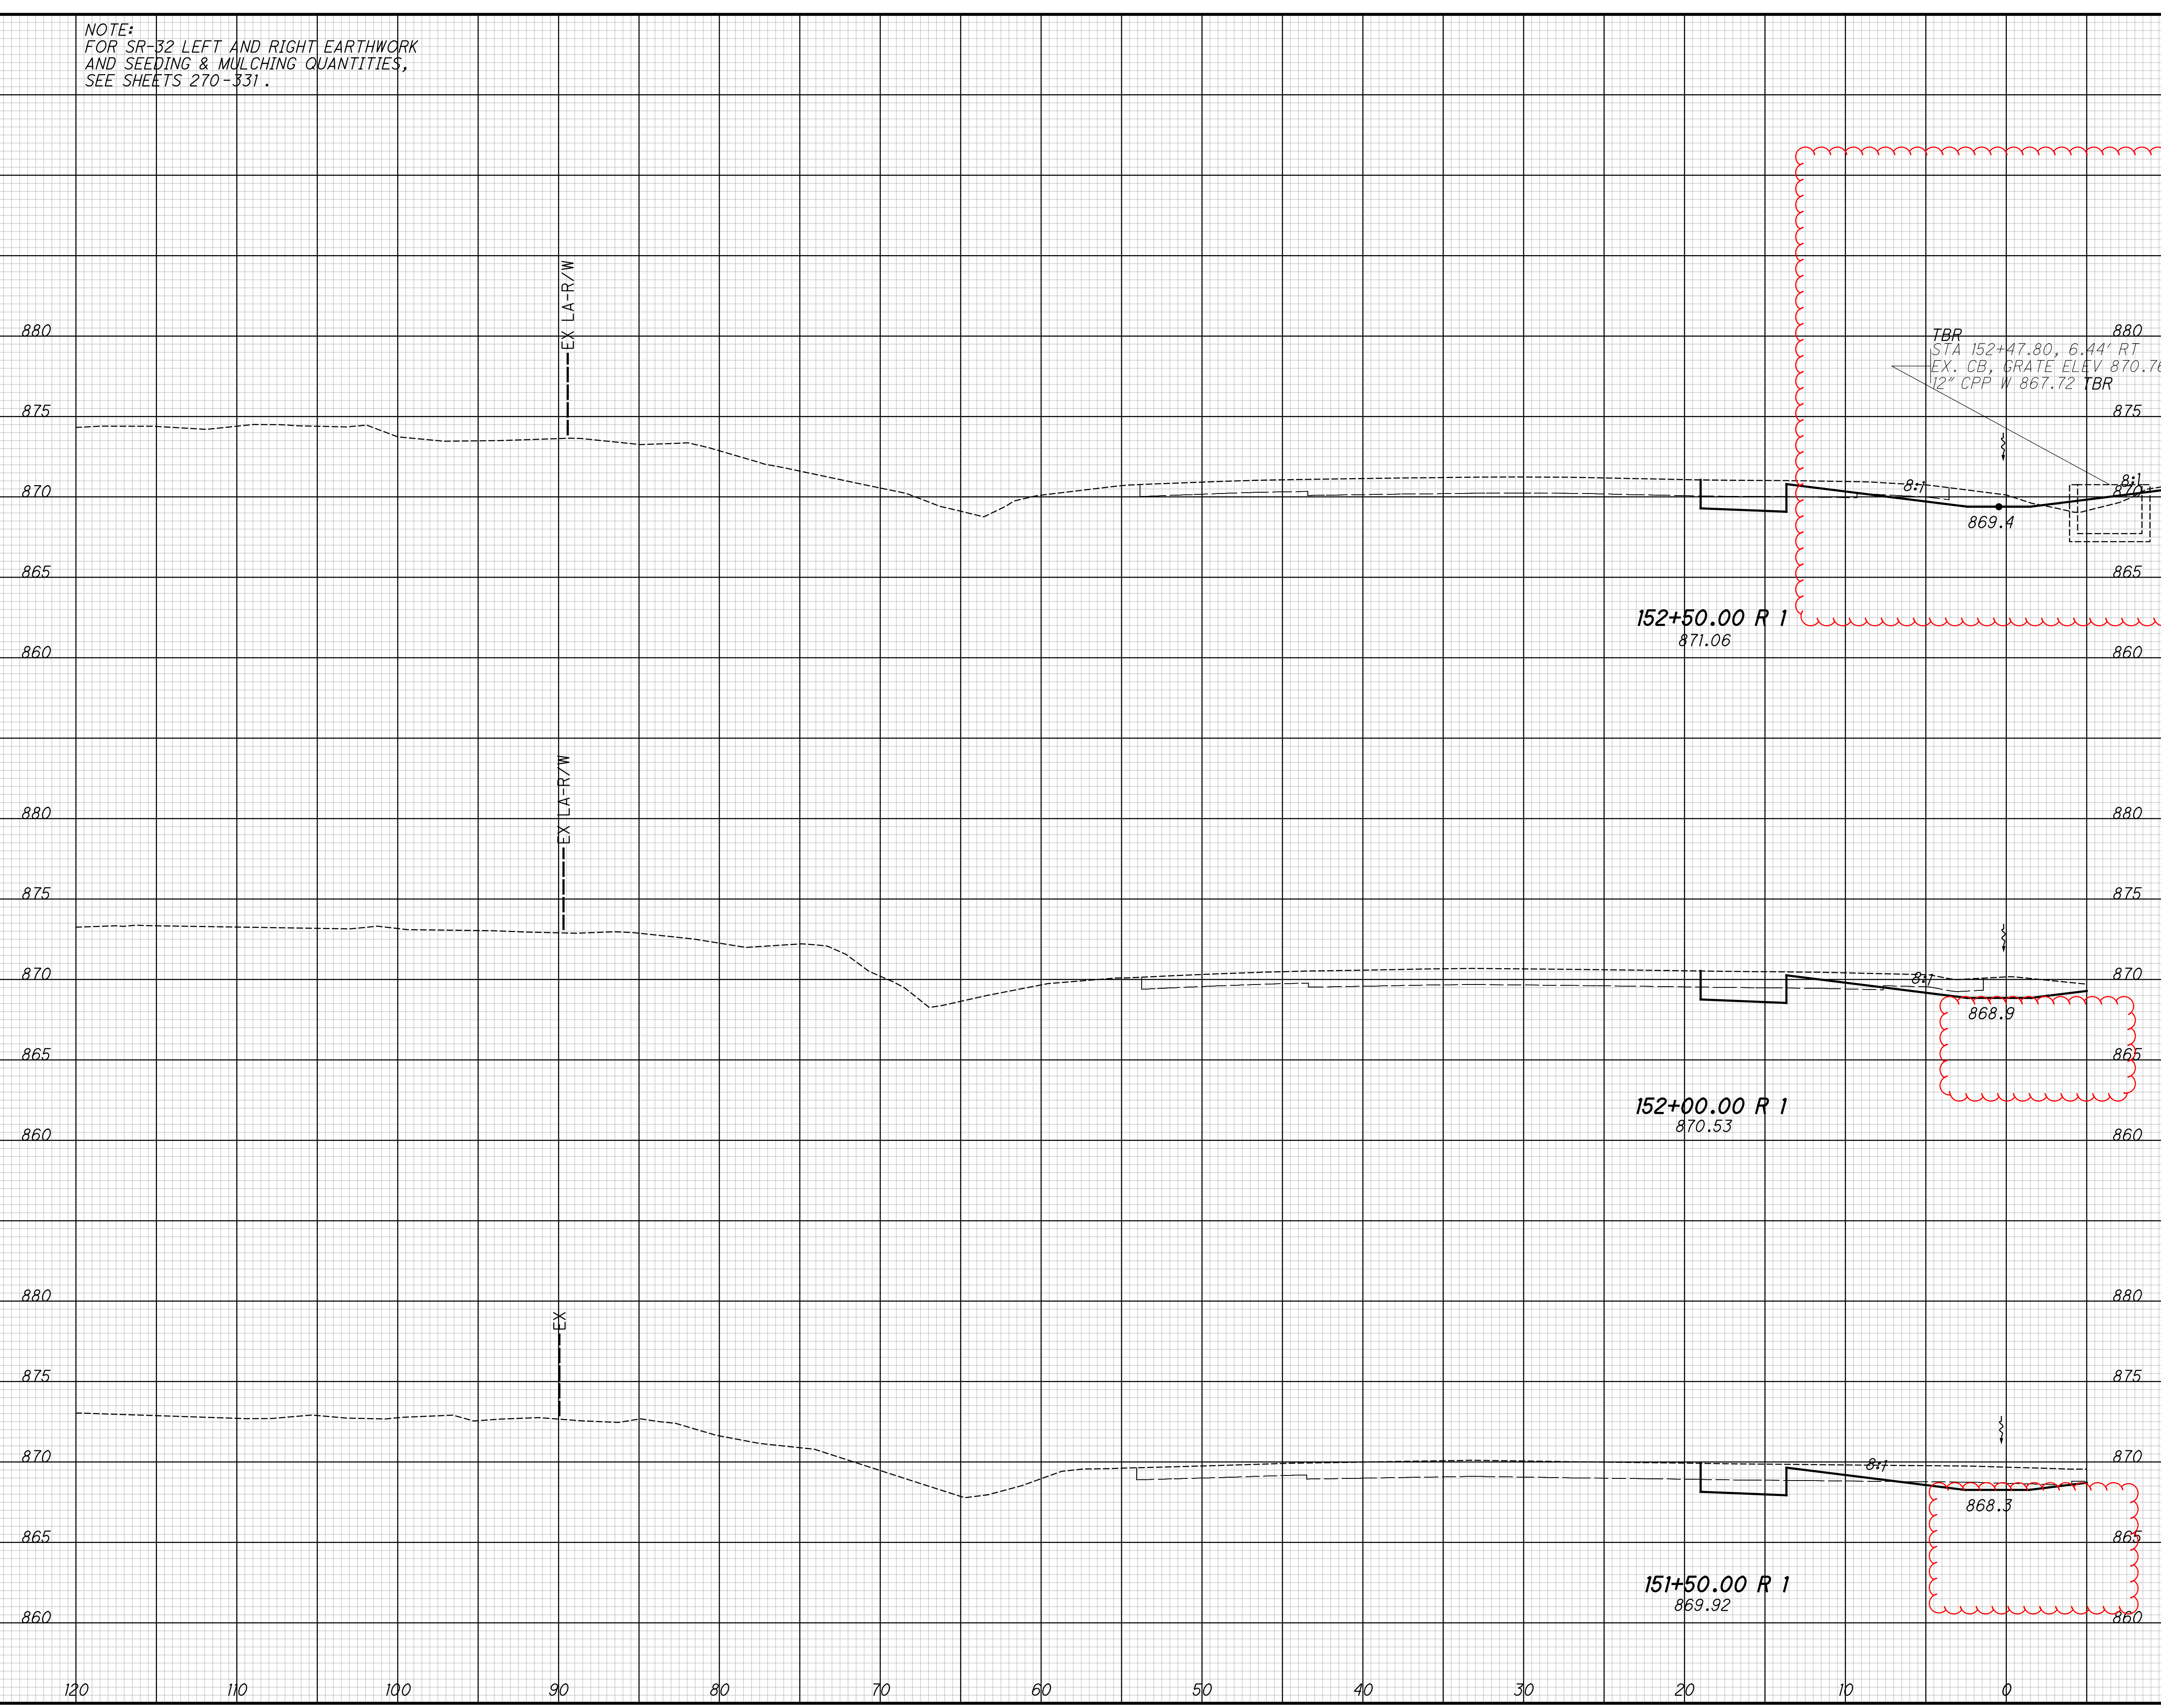

CROSS SECTIONS - SR-32 LT
STA. 151+50.00 TO STA. 152+50.00


CLE-35-3.50
PHASE 5

...303.205\103954_XS501L.dgn 11/19/2021 1:44:06 PM mswhttt

| SEEDING | |
|-----------|----------|
| END WIDTH | SO. YDS. |
| | |

NOTE:
FOR SR-32 LEFT AND RIGHT EARTHWORK
AND SEEDING & MULCHING QUANTITIES,
SEE SHEETS 270-331.

| END AREA | | VOLUME | | CALCULATED | |
|----------|------|--------|------|------------|-----|
| CUT | FILL | CUT | FILL | MSW | WAA |
| | | | | | |

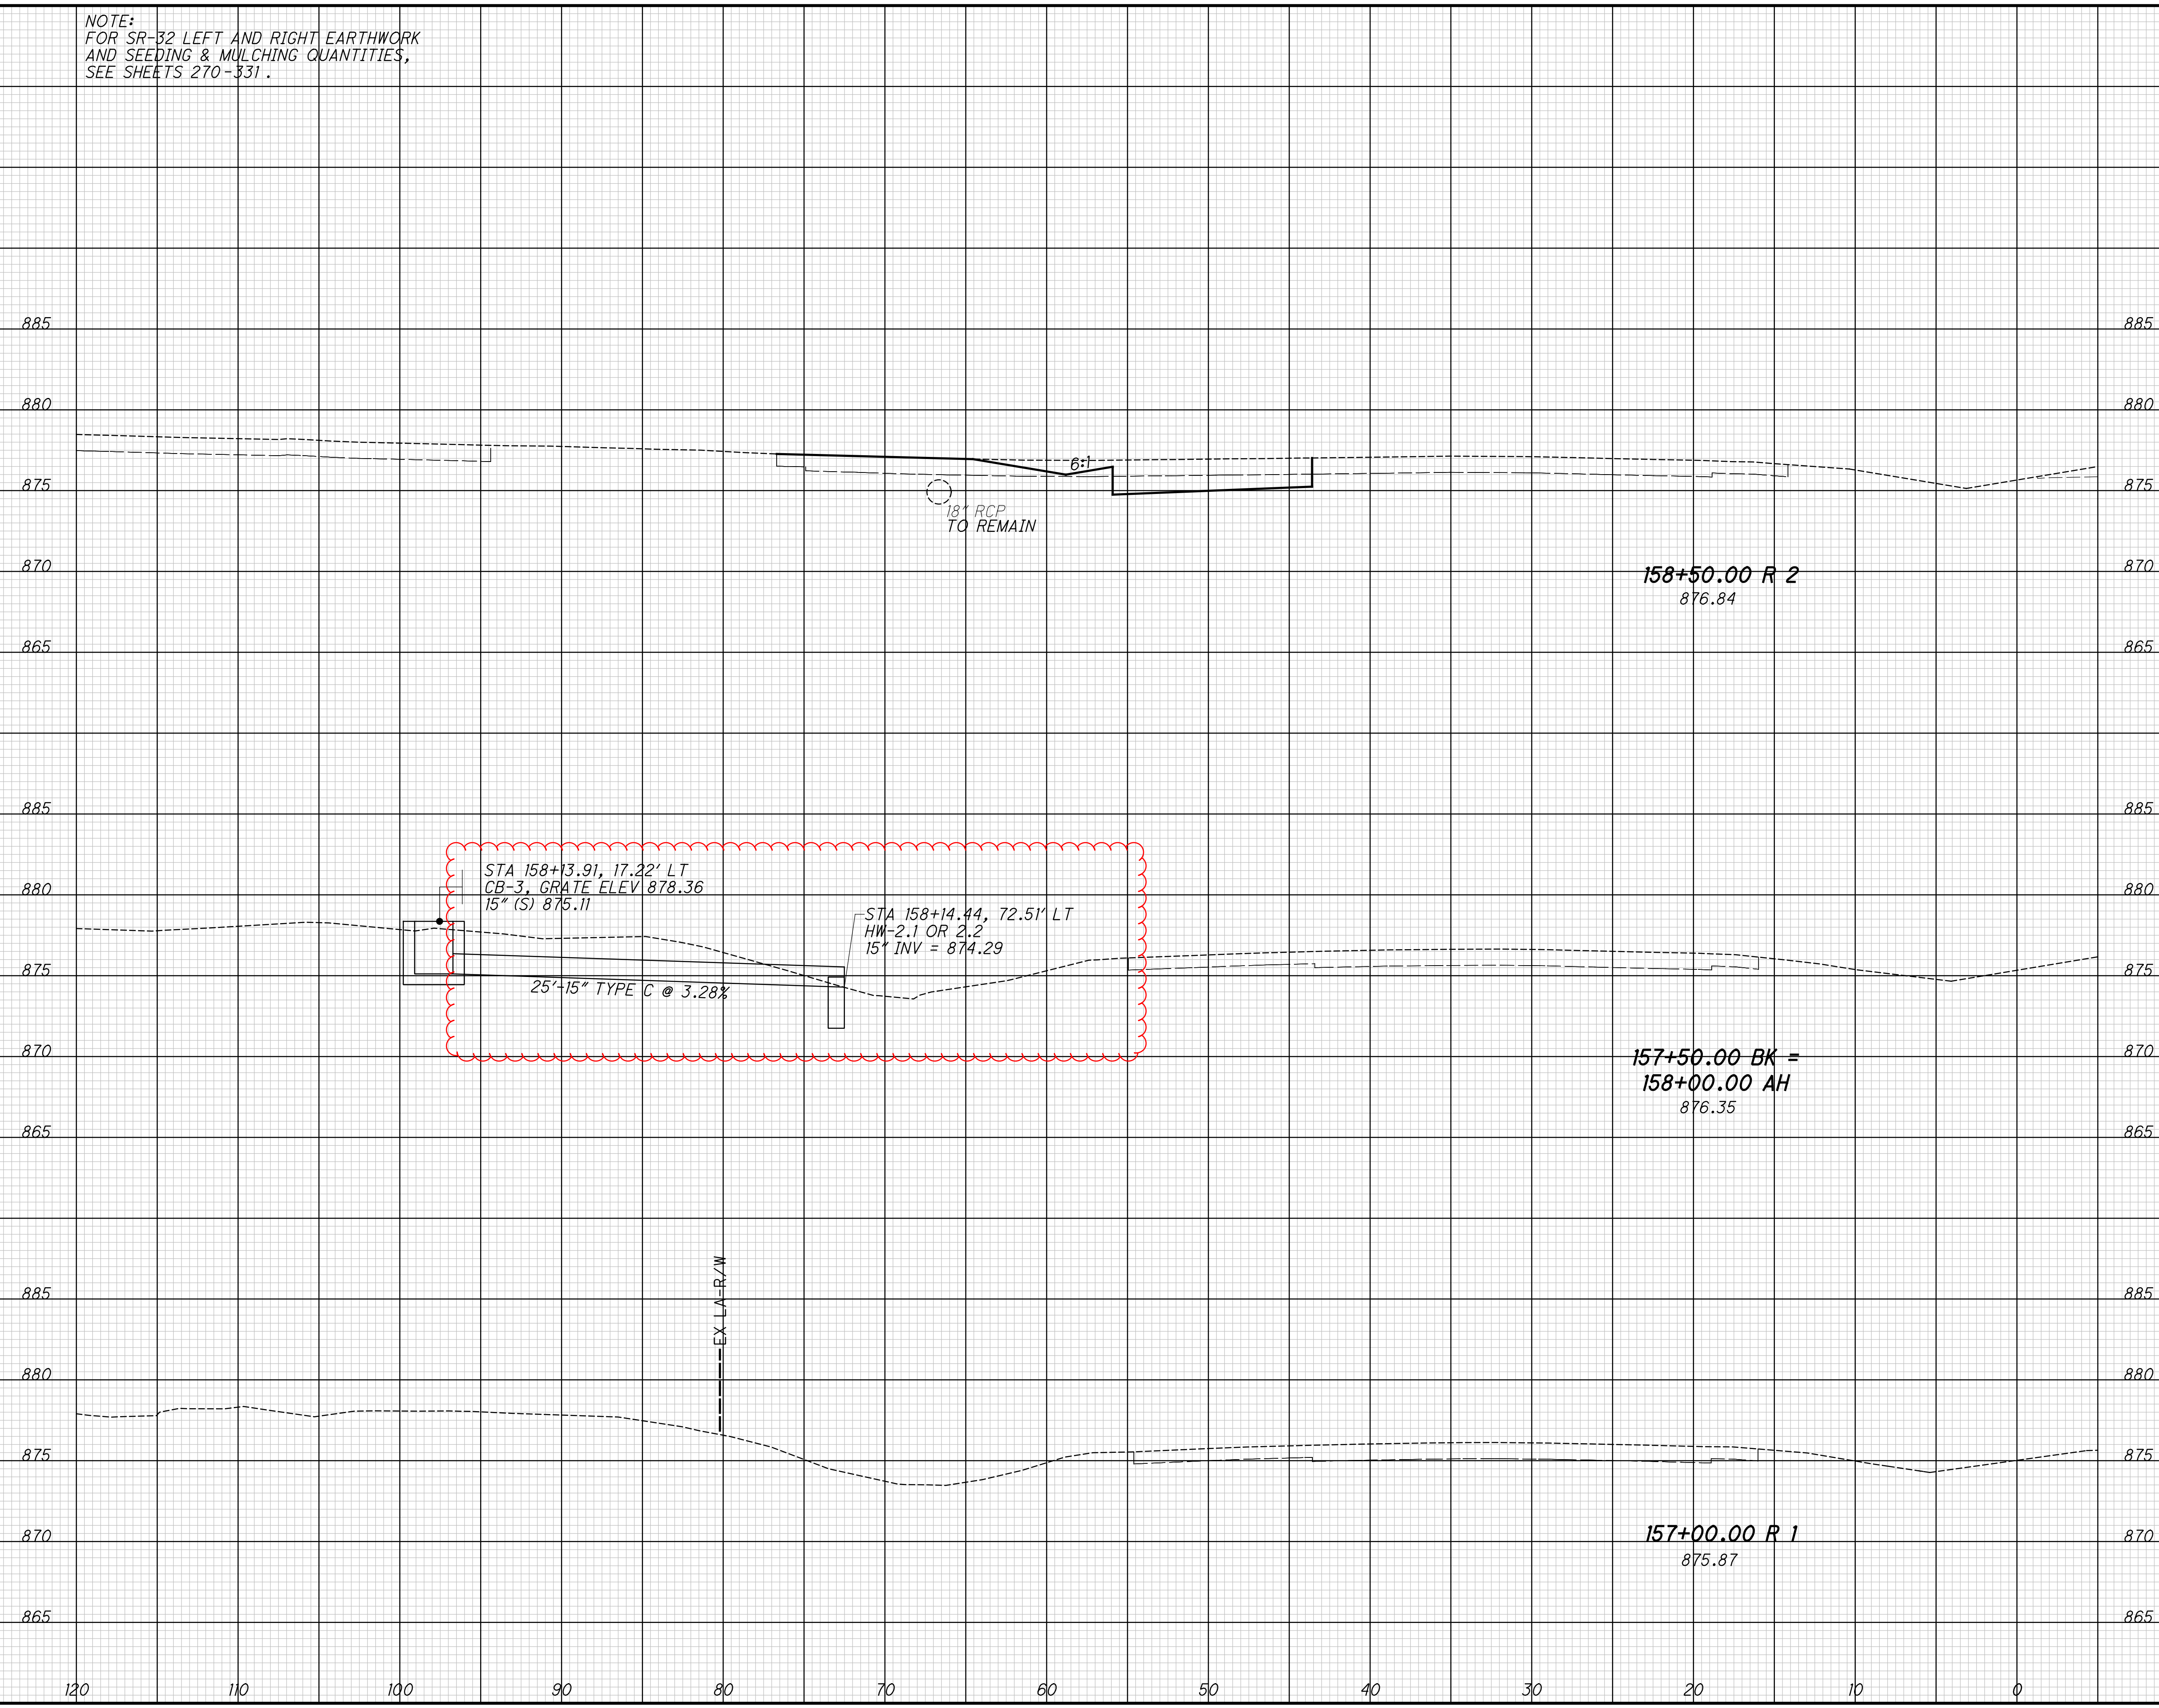

CROSS SECTIONS - SR-32 LT
STA. 157+00.00 TO STA. 158+50.00


CLE-35-3.50
PHASE 5

...303.205\103954_XS501L.dgn 11/19/2021 1:46:32 PM mswwhitt

SEEDING
END WIDTH SQ. YDS.

NOTE:
FOR SR-32 LEFT AND RIGHT EARTHWORK
AND SEEDING & MULCHING QUANTITIES,
SEE SHEETS 270-331.

END AREA VOLUME
CUT FILL CUT FILL
CALCULATED MSW CHECKED WAA

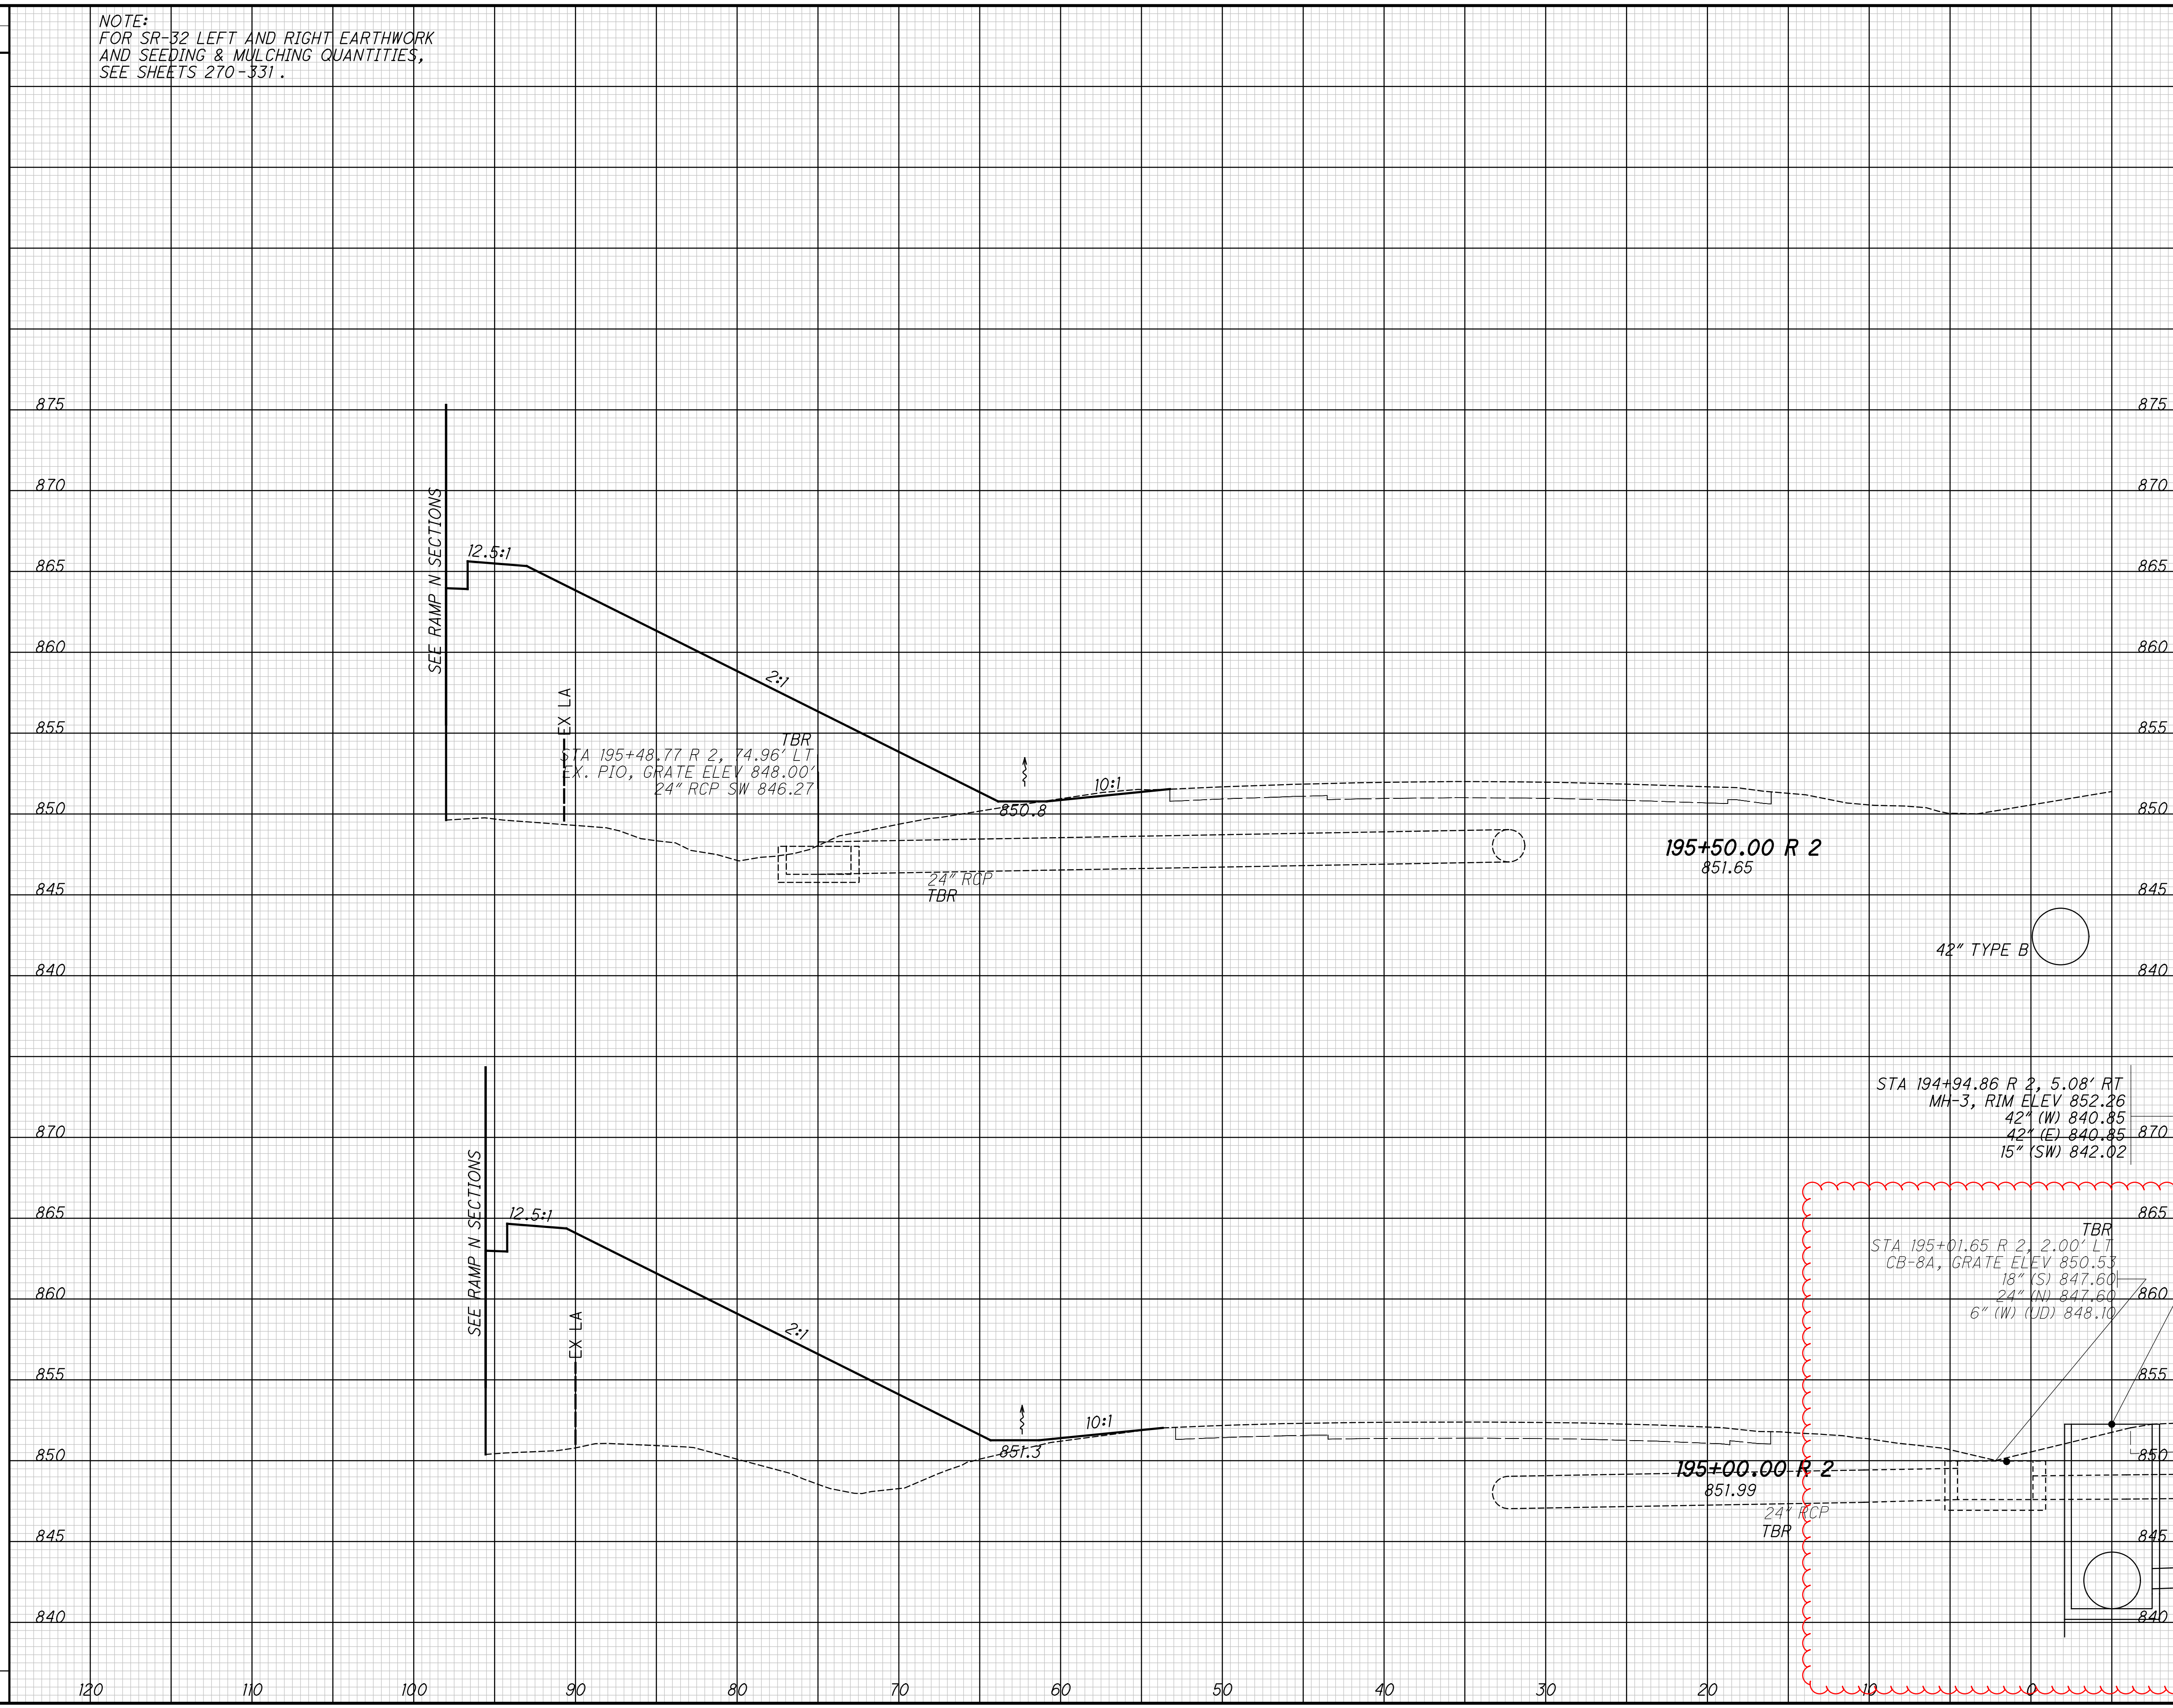

CROSS SECTIONS - SR-32 LT
STA. 195+00.00 TO STA. 195+50.00

CLE-35-3.50
PHASE 5


244
736

...303.205\103954_XS501L.dgn 11/19/2021 1:46:32 PM mswwhitt

SEEDING
END WIDTH SQ. YDS.

NOTE:
FOR SR-32 LEFT AND RIGHT EARTHWORK
AND SEEDING & MULCHING QUANTITIES,
SEE SHEETS 270-331.

END AREA VOLUME
CUT FILL CUT FILL
CALCULATED
MSW
CHECKED
WAA

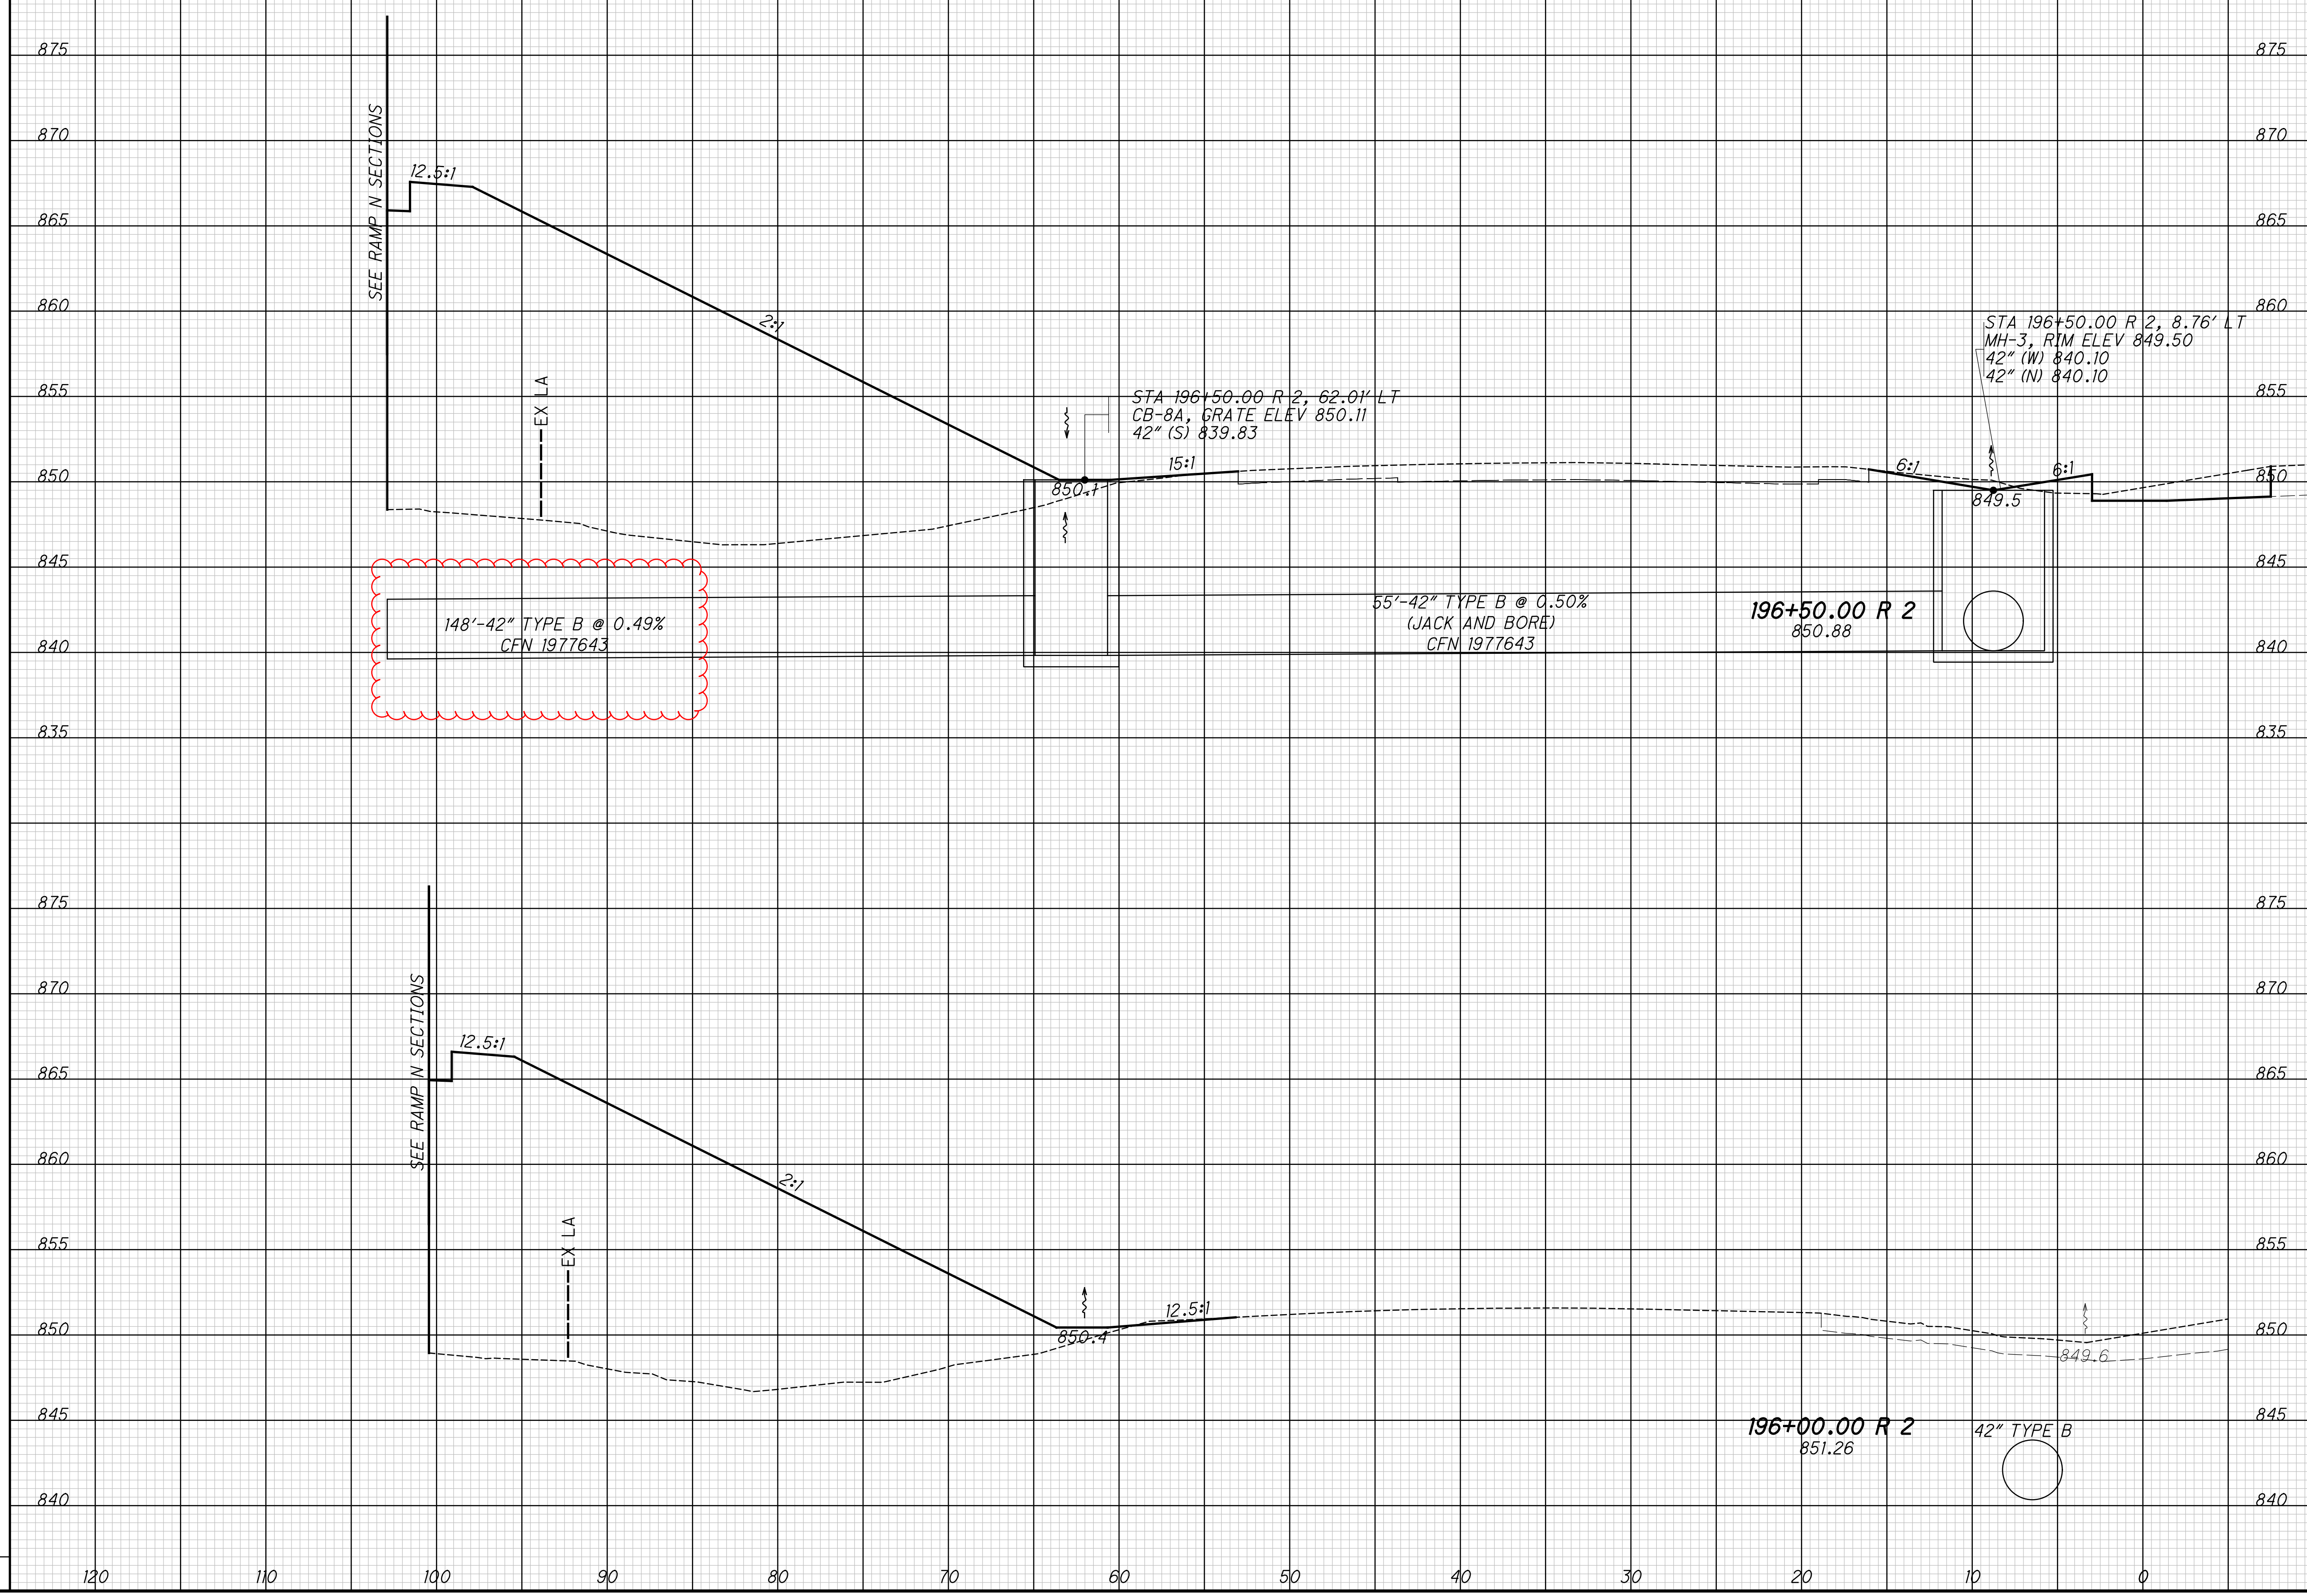

CROSS SECTIONS - SR-32 LT
STA. 196+00.00 TO STA. 196+50.00

CLE-35-3.50
PHASE 5


245
736

...303.205\103954_XS501L.dgn 11/19/2021 1:47:52 PM mswhtt

SEEDING
END WIDTH SQ. YDS.

NOTE:
FOR SR-32 LEFT AND RIGHT EARTHWORK
AND SEEDING & MULCHING QUANTITIES,
SEE SHEETS 270-331.

END AREA VOLUME
CUT FILL CUT FILL
CALCULATED
MSW CHECKED
WAA

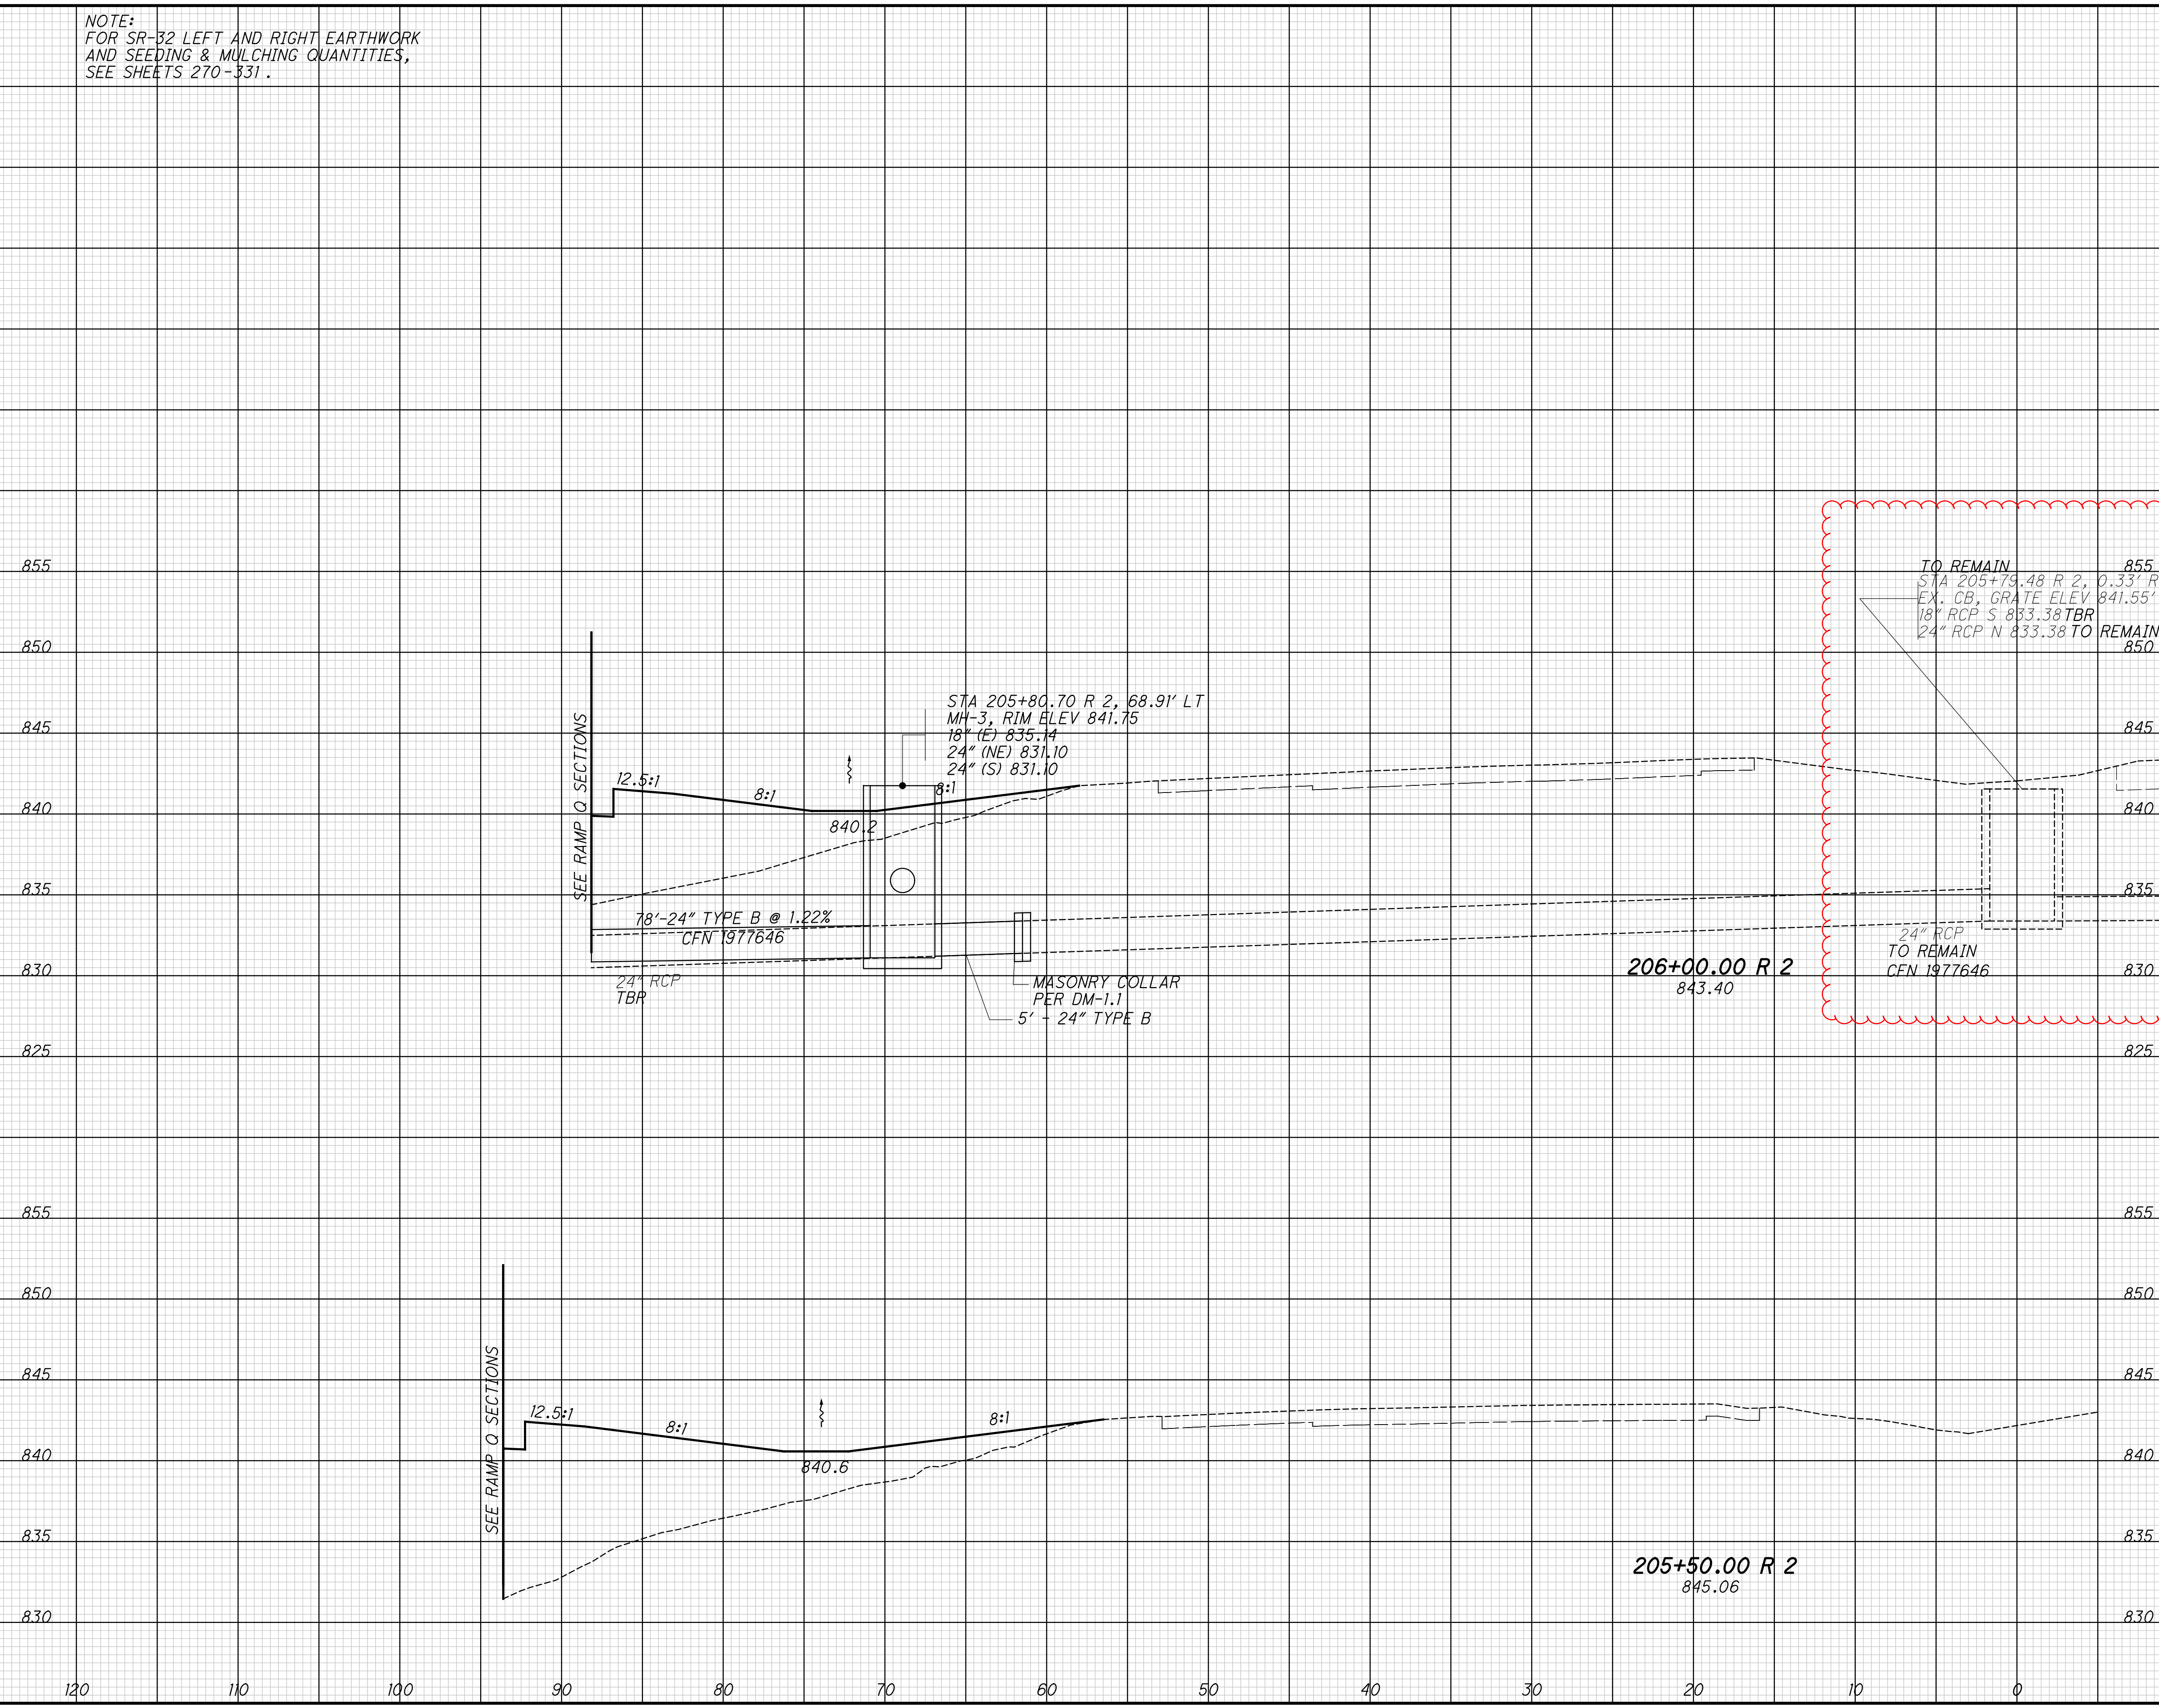


CROSS SECTIONS - SR-32 LT
STA. 205+50.00 TO STA. 206+00.00

CLE-35-3.50
PHASE 5

254
736

...303.205\103954_XS504.dgn 11/19/2021 1:50:40 PM mshwhitt

| SEEDING | |
|-----------|----------|
| END WIDTH | SO. YDS. |
| 734 | 90 |
| 356 | 80 |
| 66 | 70 |
| 378 | 60 |
| 70 | 50 |

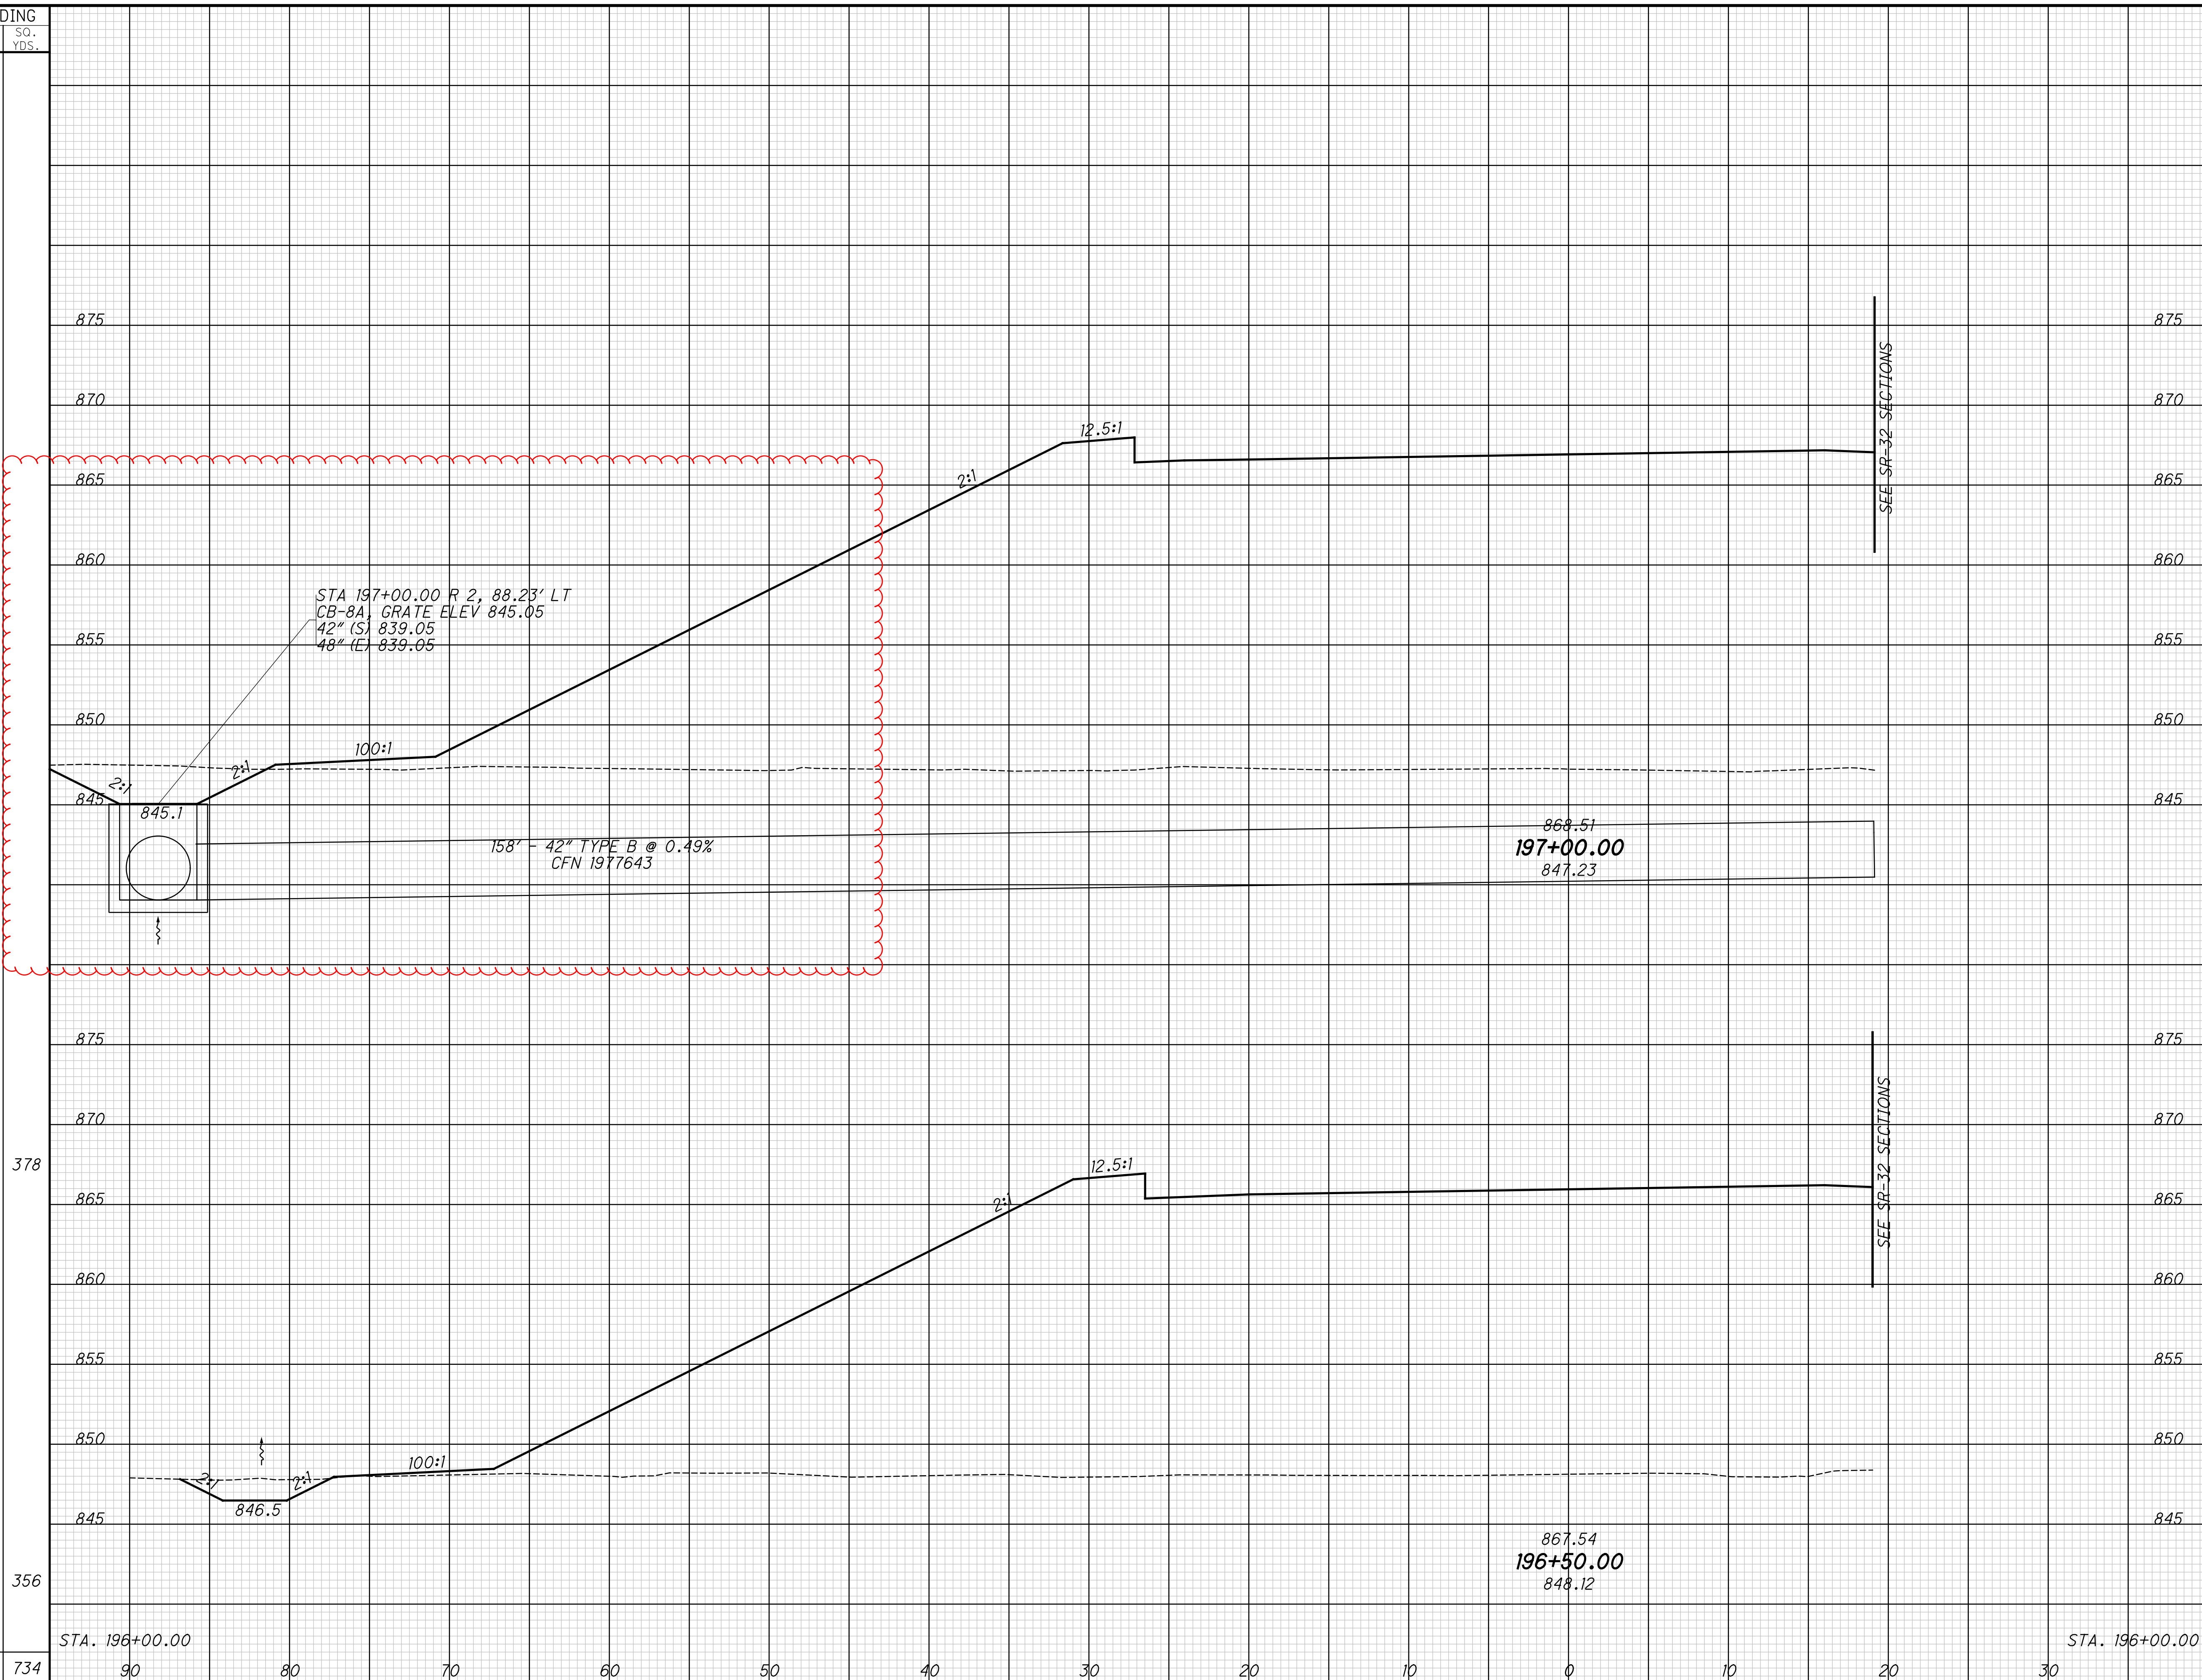



| END AREA | VOLUME | CALCULATED | | CHECKED |
|----------|--------|------------|------|---------|
| | | CUT | FILL | |
| 10 | 1432 | | | |
| 9 | 1246 | | | |
| 8 | 1098 | | | |
| 33 | 4651 | | | |

CROSS SECTIONS - RAMP N
STA. 196+50.00 TO STA. 197+00.00
CLE-32-3.50 (PHASE 5)
338
736

...303.205\103954_XS512.dgn 11/19/2021 1:53:34 PM mswhit


SEEDING
END SO.
WIDTH YDS.

| END AREA | | VOLUME | | CALCULATED | CHECKED |
|----------|------|--------|------|------------|---------|
| CUT | FILL | CUT | FILL | GAH | WAA |
| 38 | 3519 | 0 | 3305 | 2381 | 2736 |

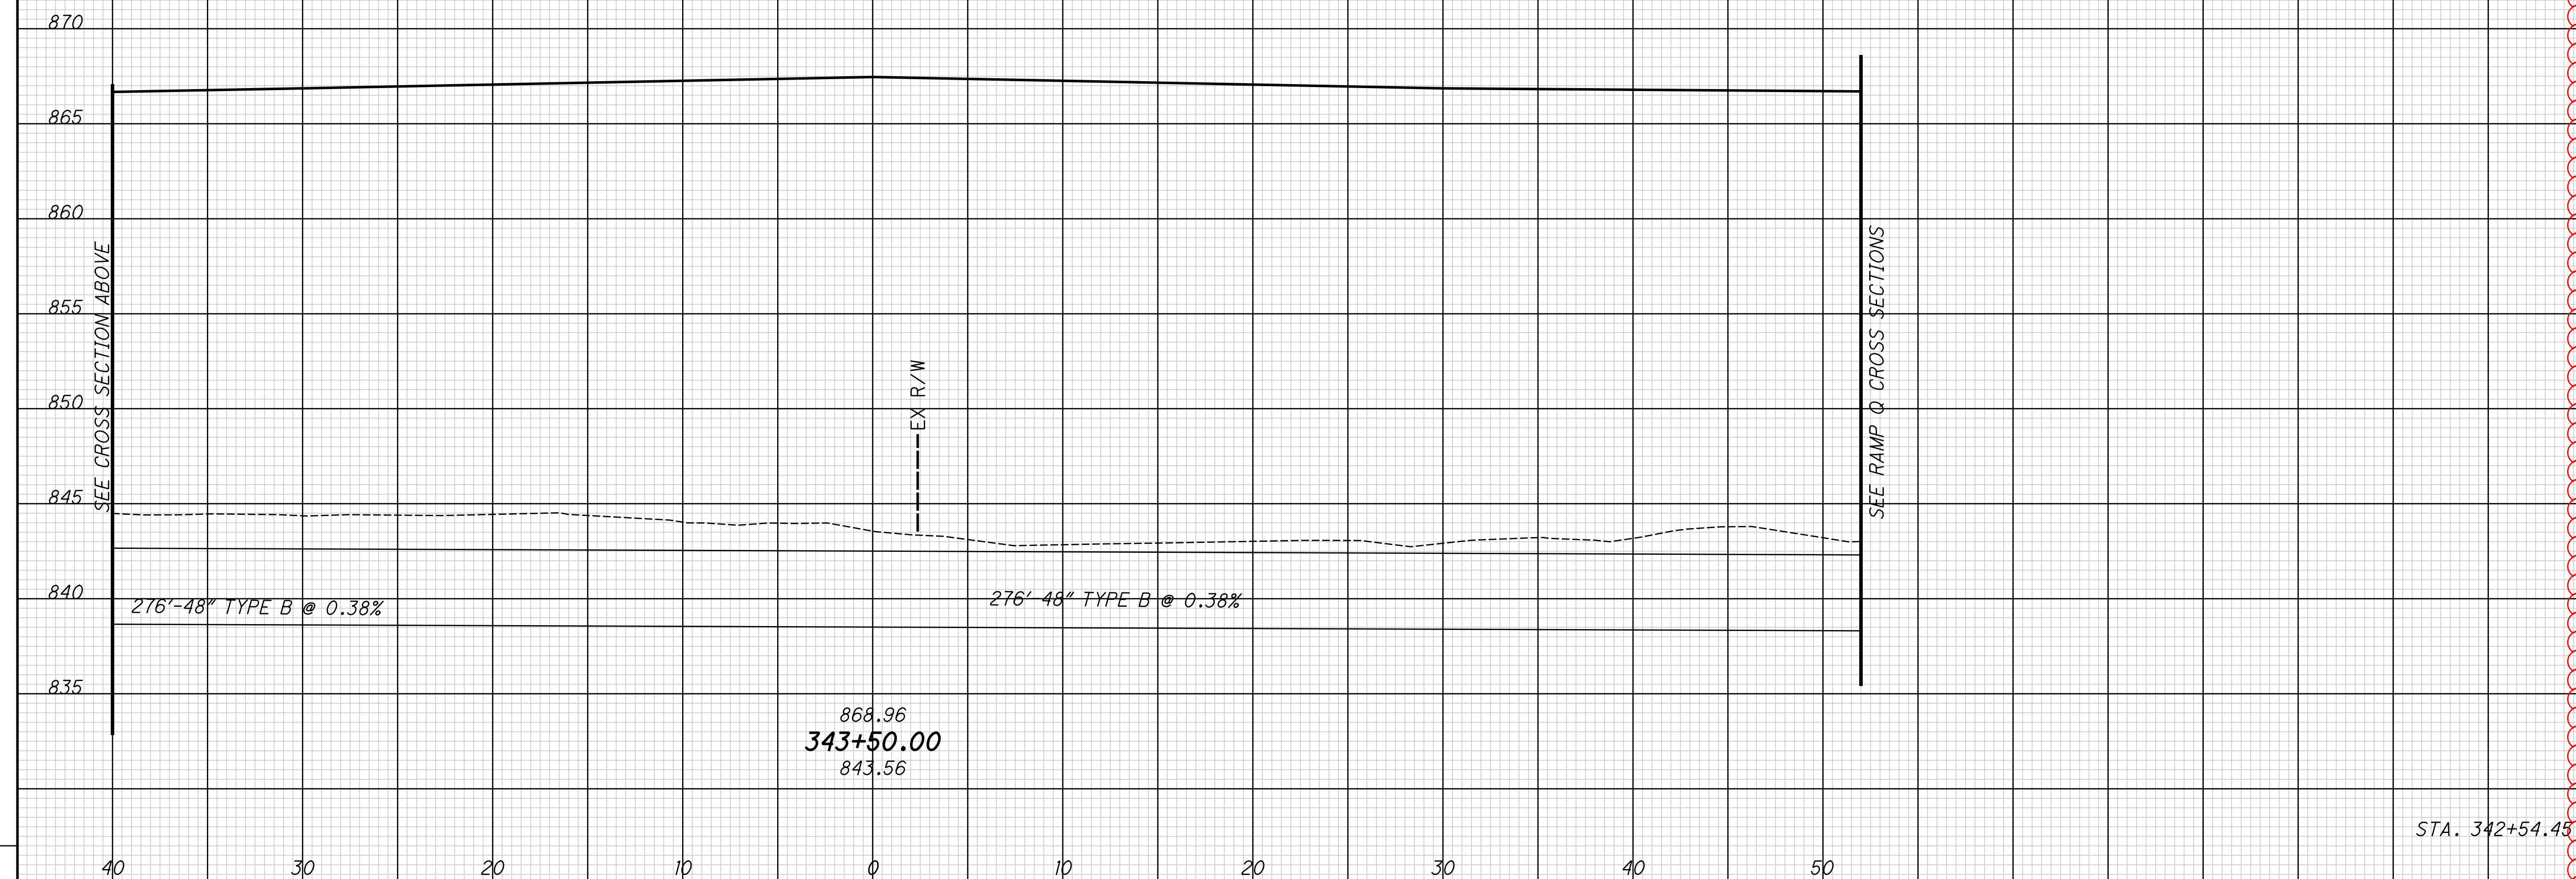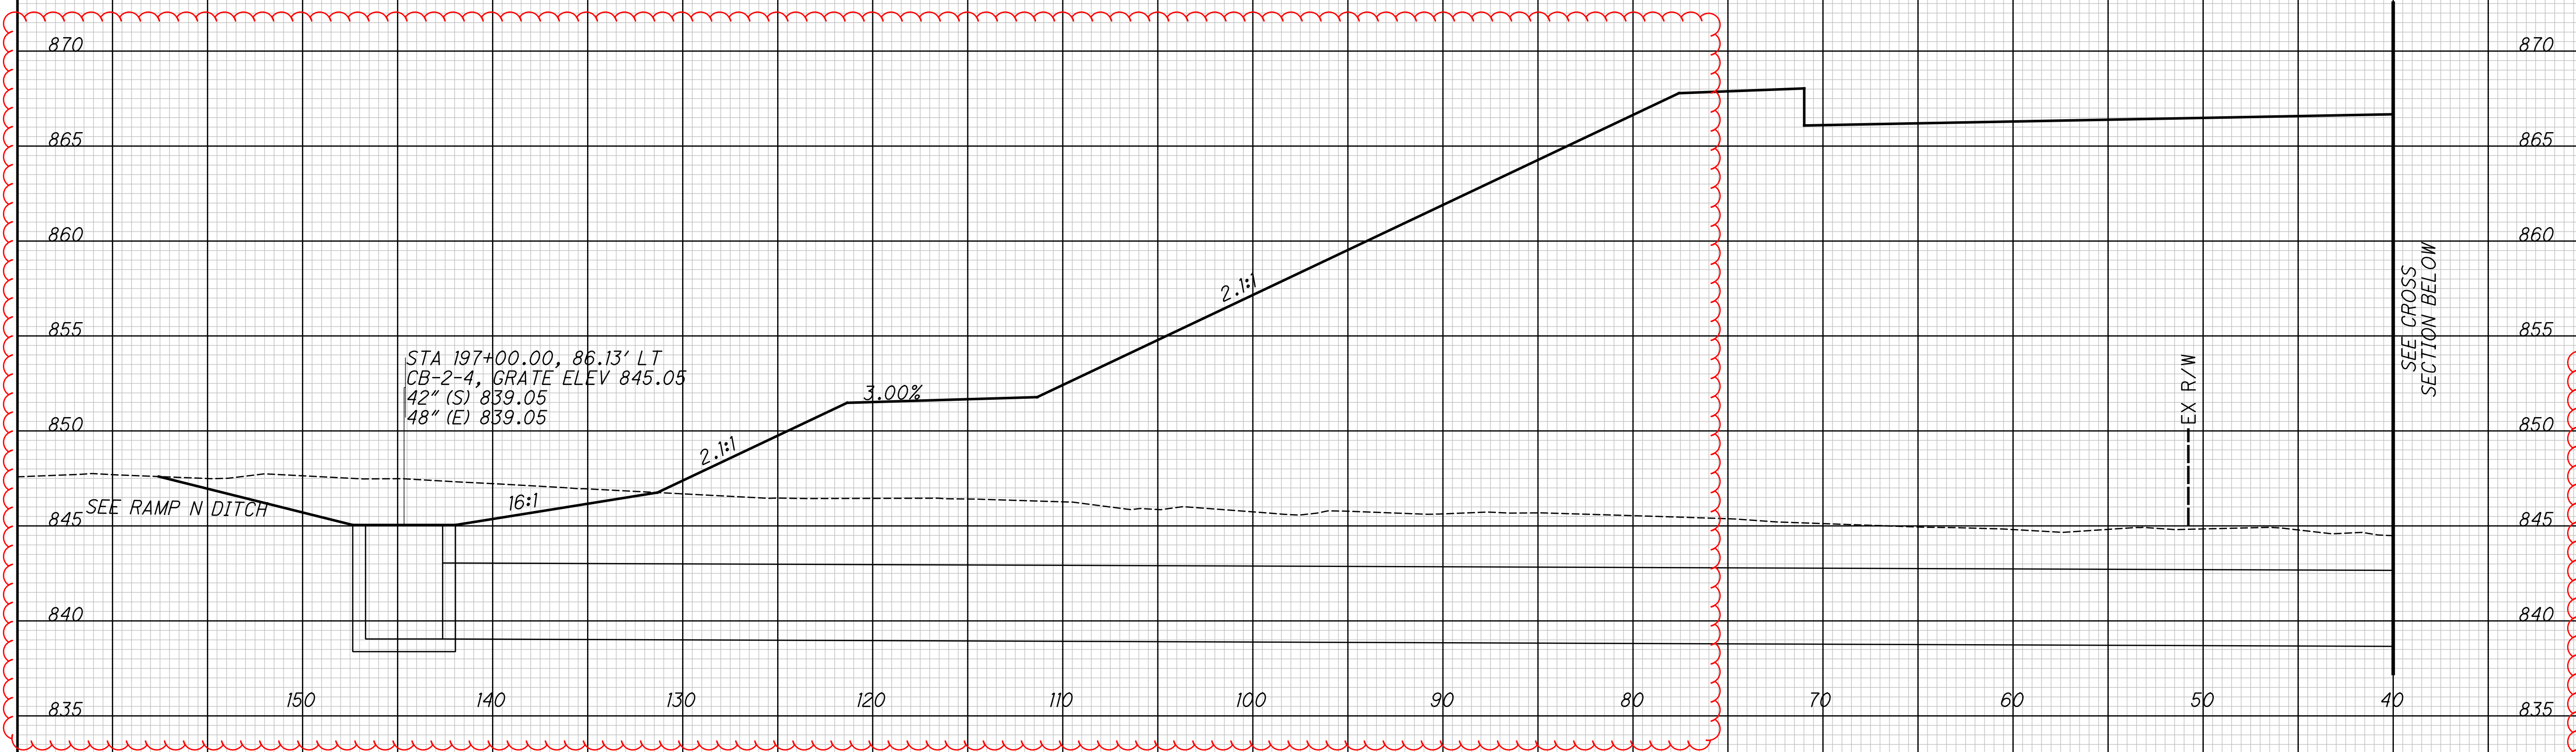

CROSS SECTIONS - BACH-BUXTON RD
STA. 343+50.00
CLE-32-3.50
(PHASE 5)

2381
2736

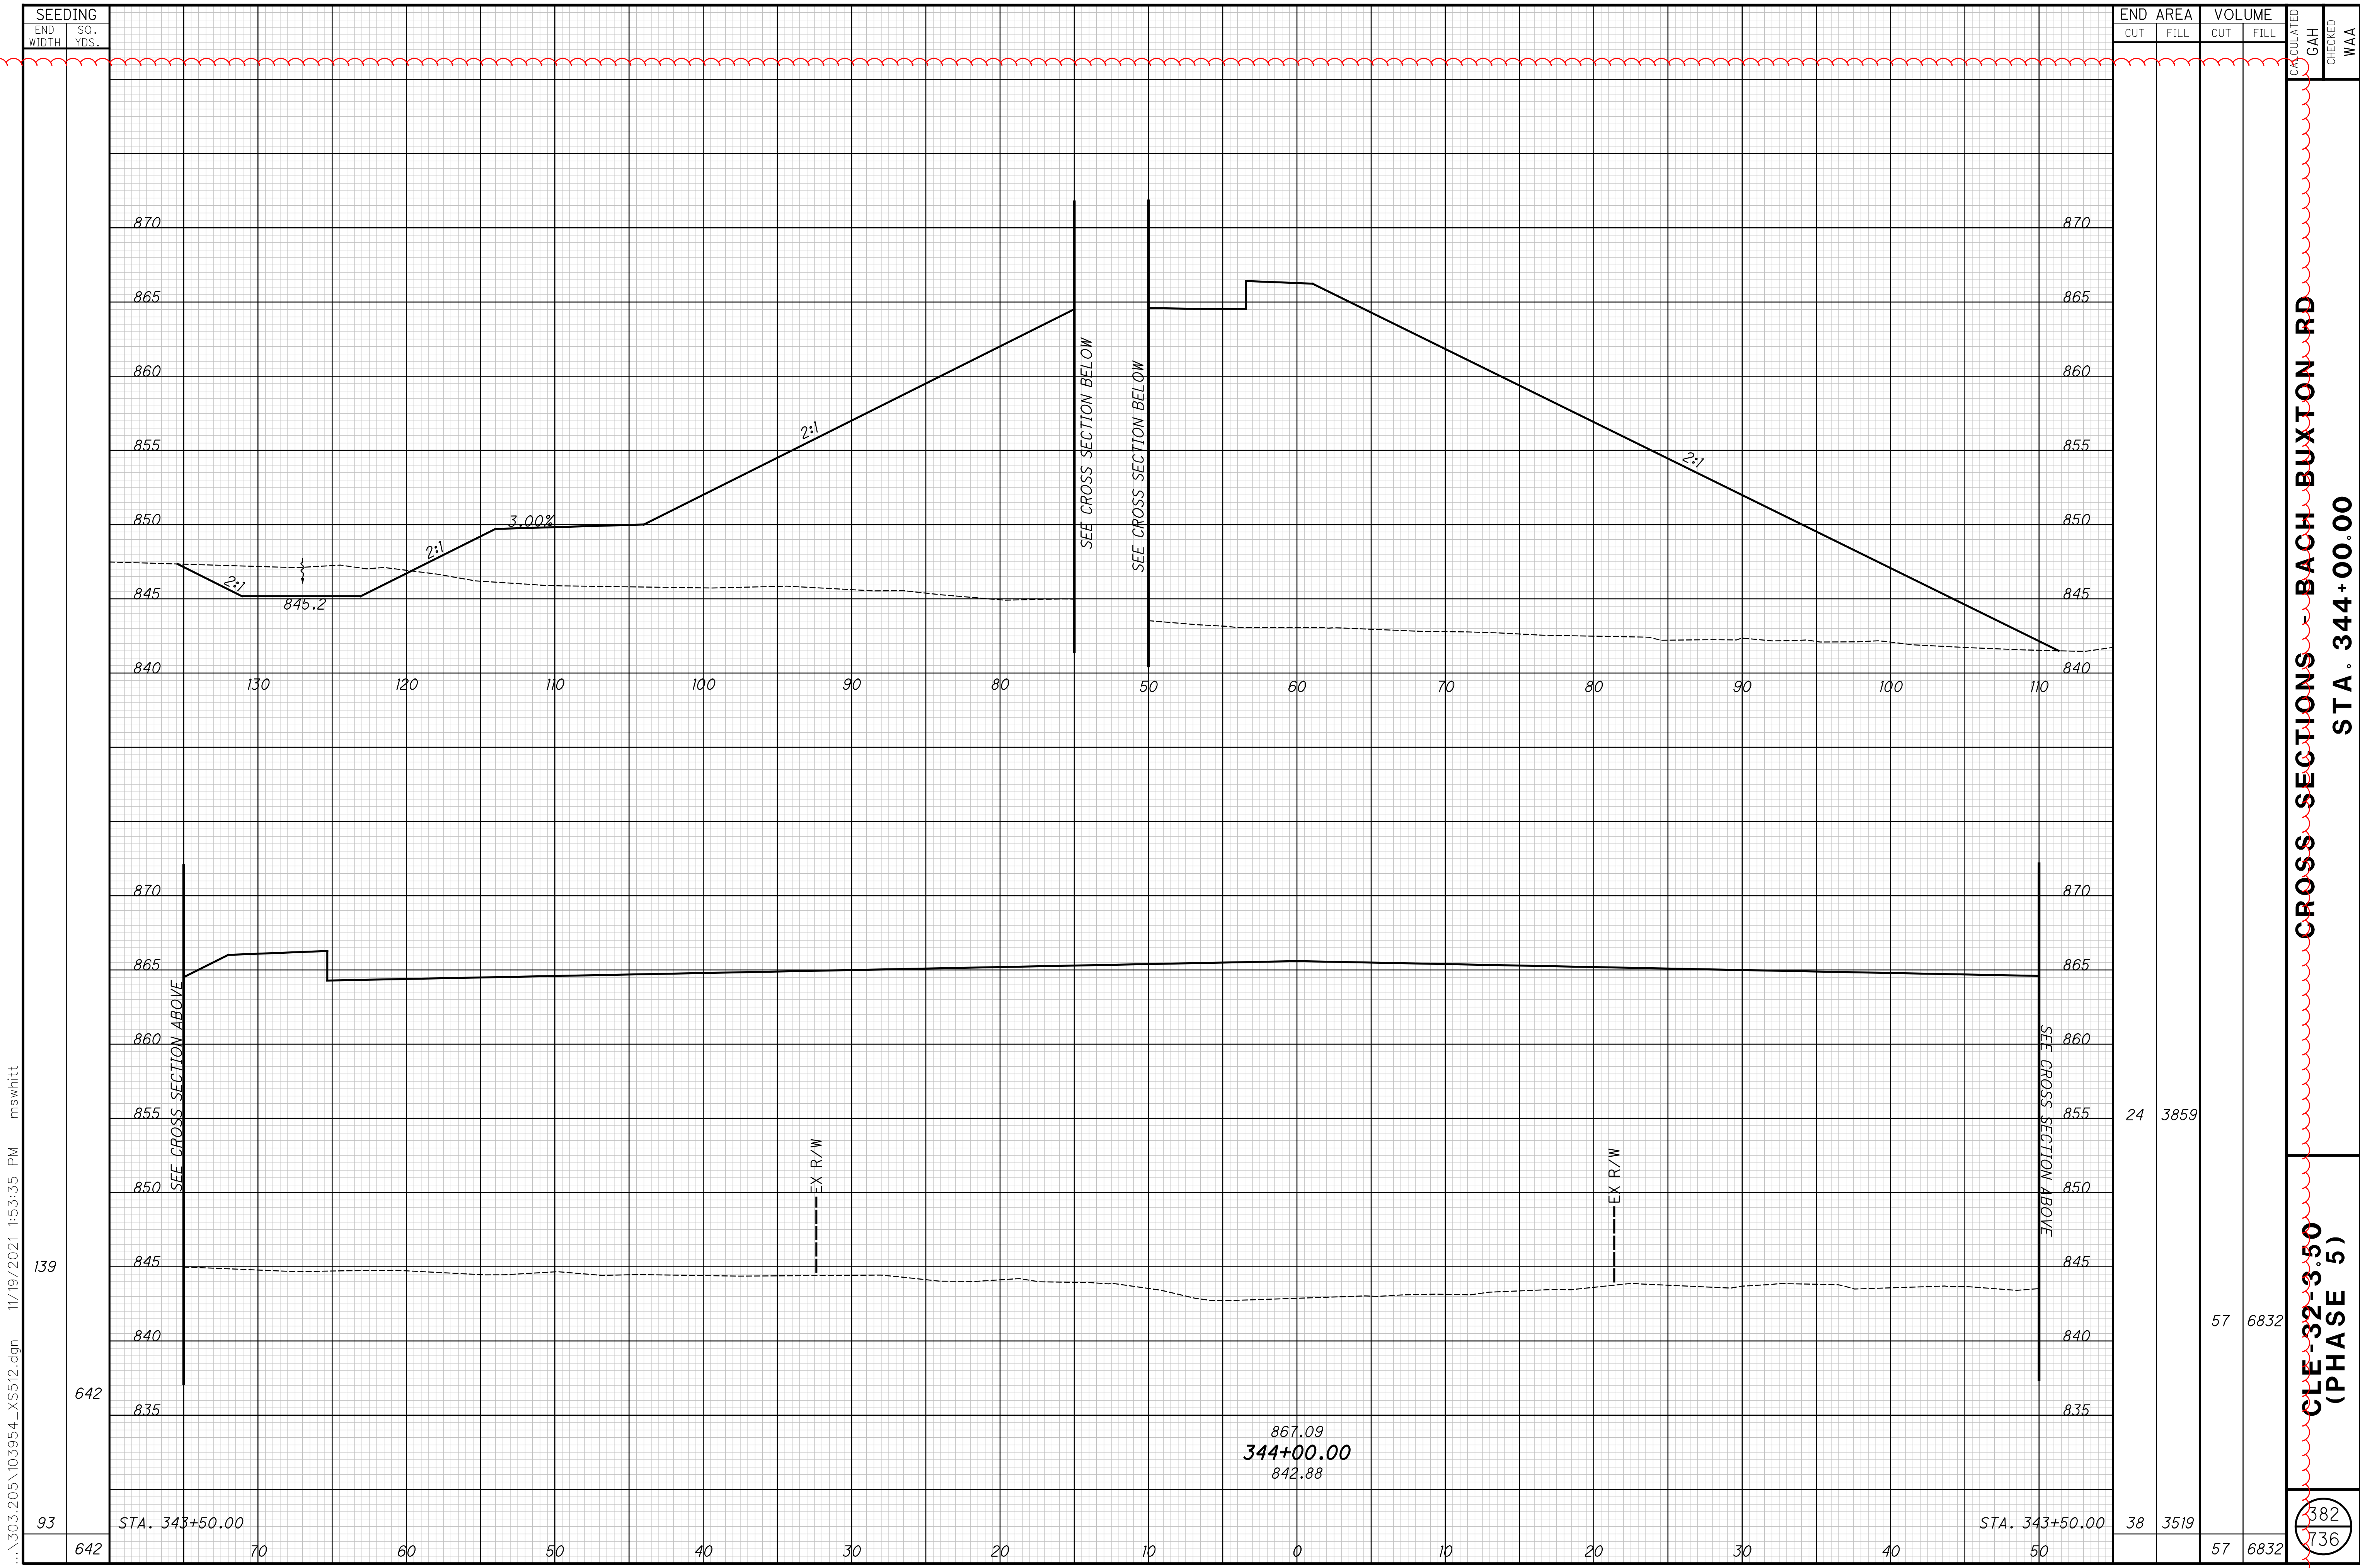

...303.205\103954_XS512.dgn 11/19/2021 1:53:35 PM msw:hit

CROSS SECTIONS - BACH BUXTON RD
STA. 344+00.00

CLE-32-3.50 (PHASE 5)


382
736

| END AREA | | VOLUME | |
|----------|------|--------|------|
| CUT | FILL | CUT | FILL |
| 38 | 3519 | 57 | 6832 |

...303.205\103954_XS512.dgn 11/19/2021 1:53:35 PM mswwhit

| SEEDING | |
|-----------|----------|
| END WIDTH | SO. YDS. |
| | |

| END AREA | | VOLUME | | CALCULATED | CHECKED |
|----------|------|--------|------|------------|---------|
| CUT | FILL | CUT | FILL | GAH | WAA |
| | | | | | |

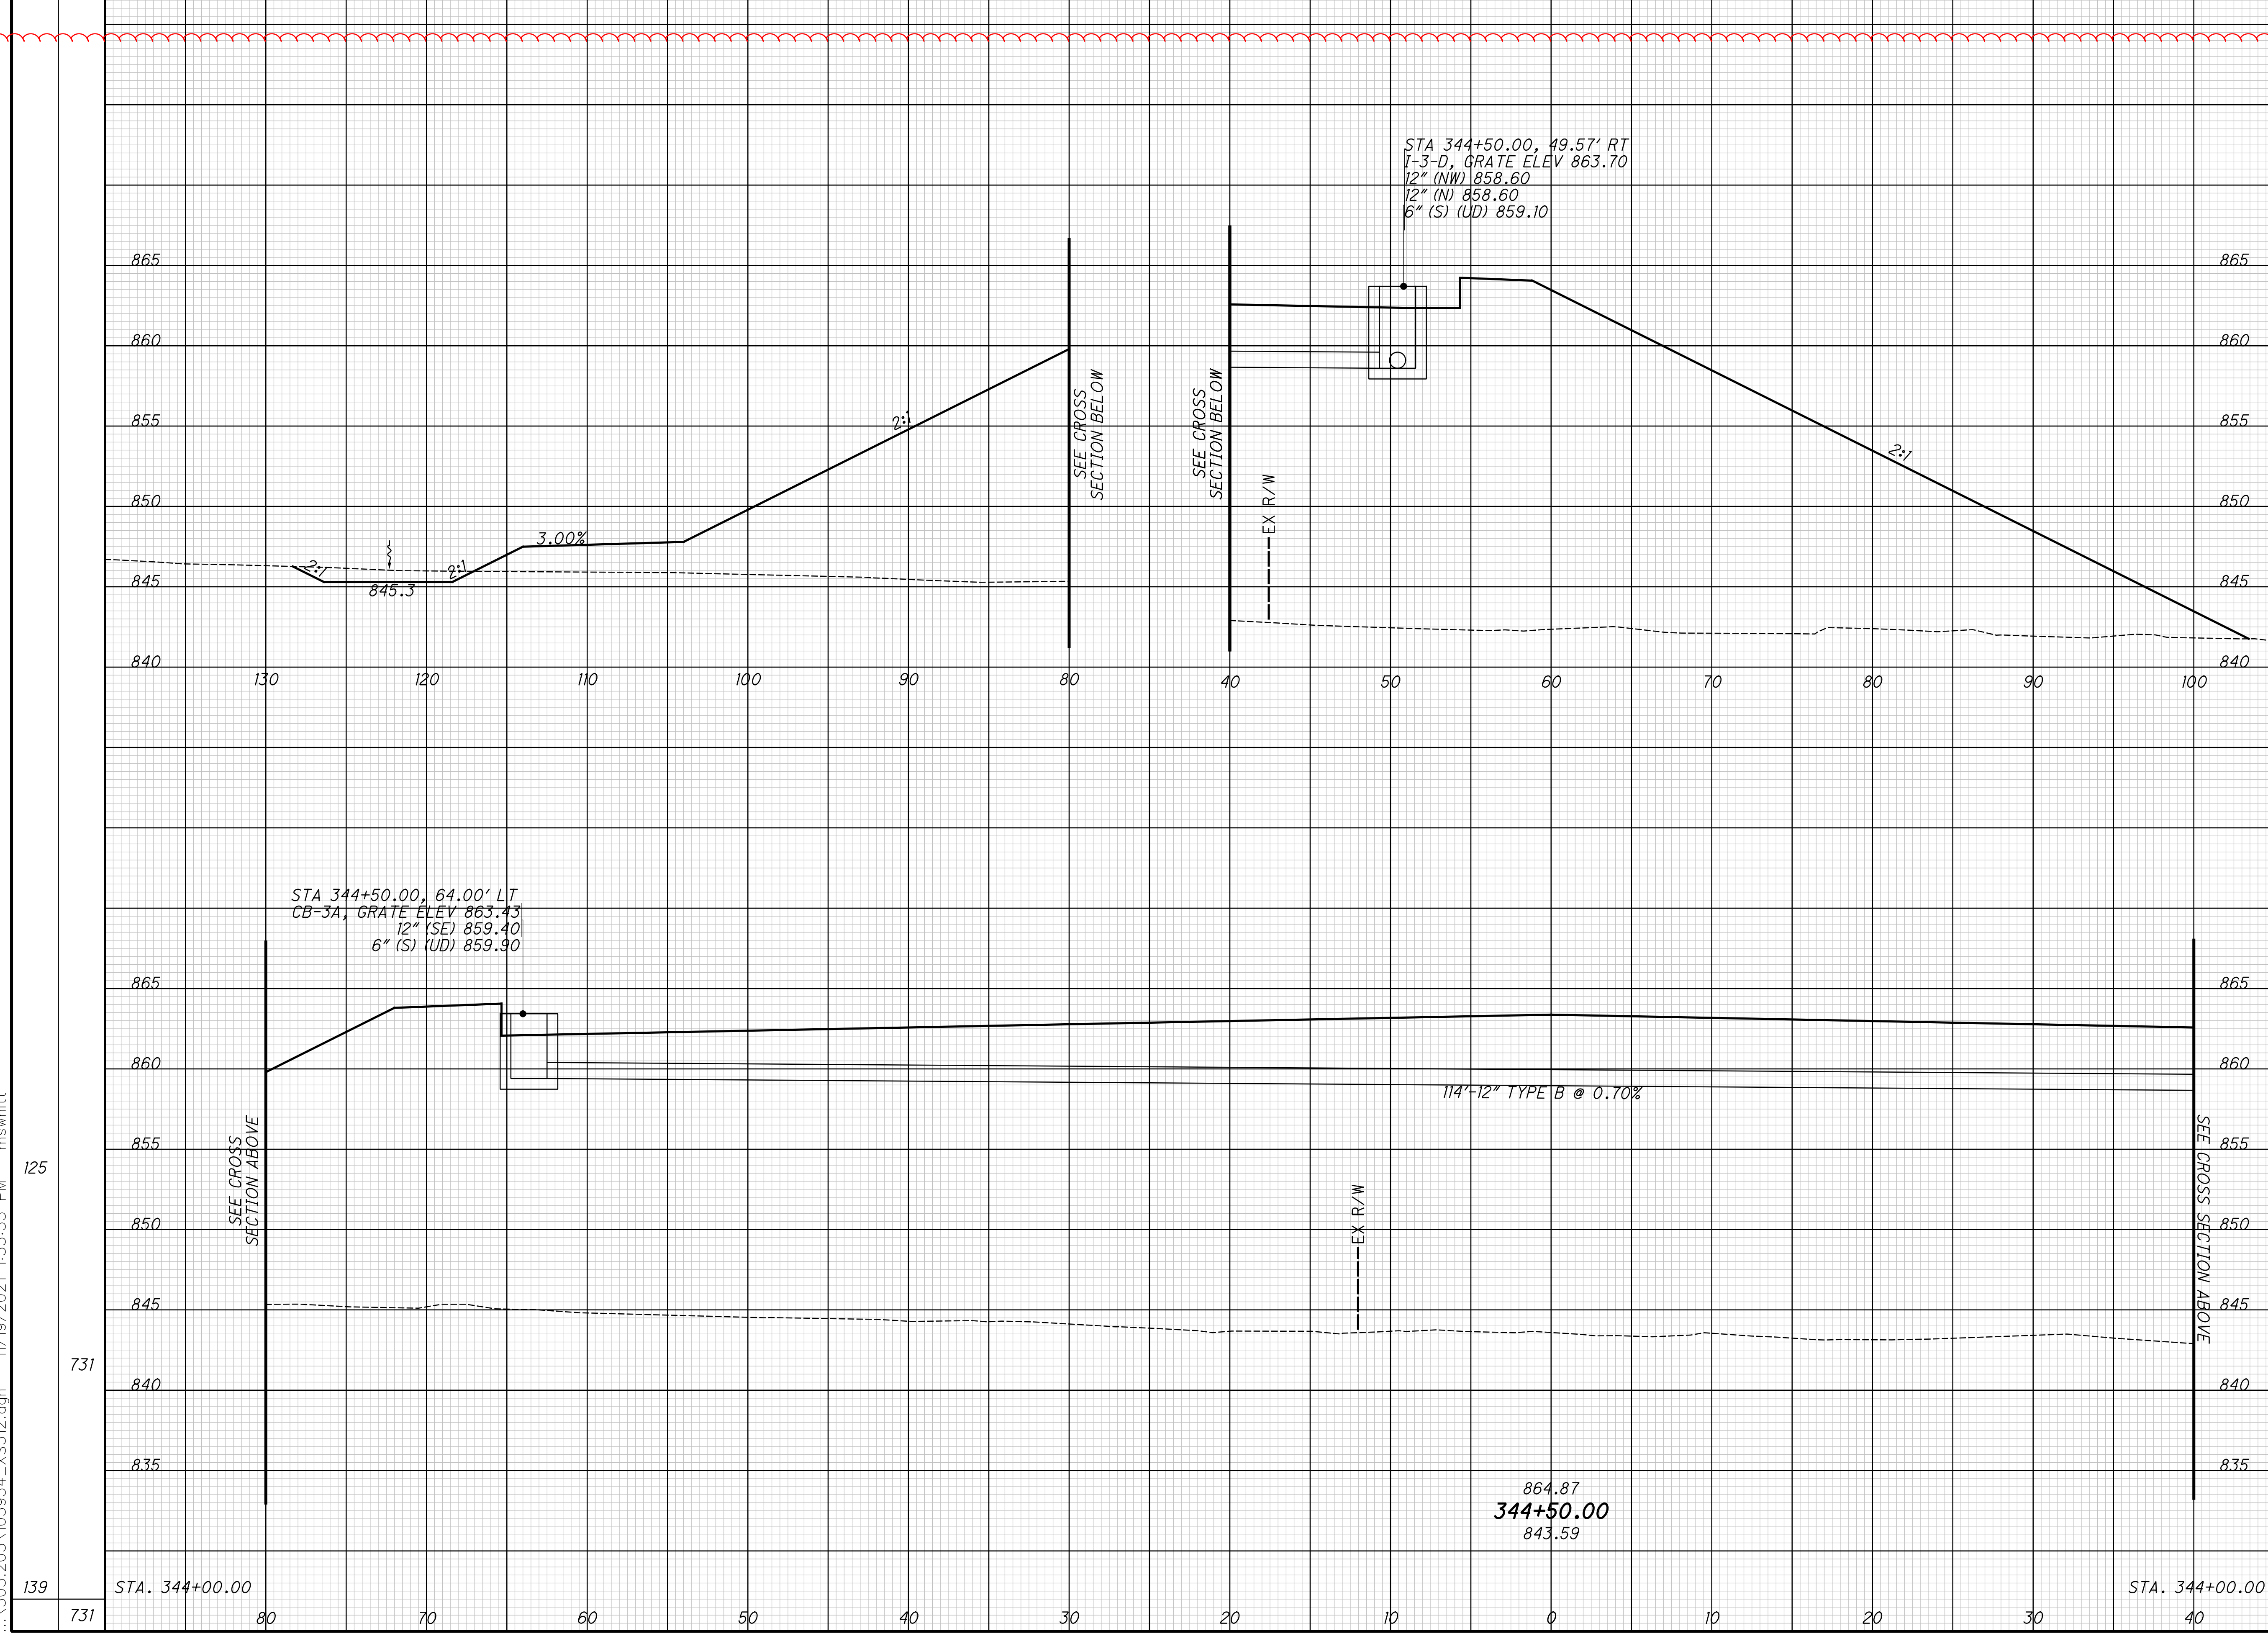

STA 344+50.00, 49.57' RT
 I-3-D, GRATE ELEV 863.70
 12" (NW) 858.60
 12" (N) 858.60
 6" (S) (UD) 859.10

STA 344+50.00, 64.00' LT
 CB-3A, GRATE ELEV 863.43
 12" (SE) 859.40
 6" (S) (UD) 859.90

114"-12" TYPE B @ 0.70%


864.87
344+50.00
 843.59

CROSS SECTIONS - BACH BUXTON RD
 STA. 344+50.00

CLE-32-3.50
 (PHASE 5)

| | | | | | |
|----|------|--|--|--|--|
| 7 | 3338 | | | | |
| 29 | 6664 | | | | |
| 24 | 3859 | | | | |
| 29 | 6664 | | | | |

383
 736

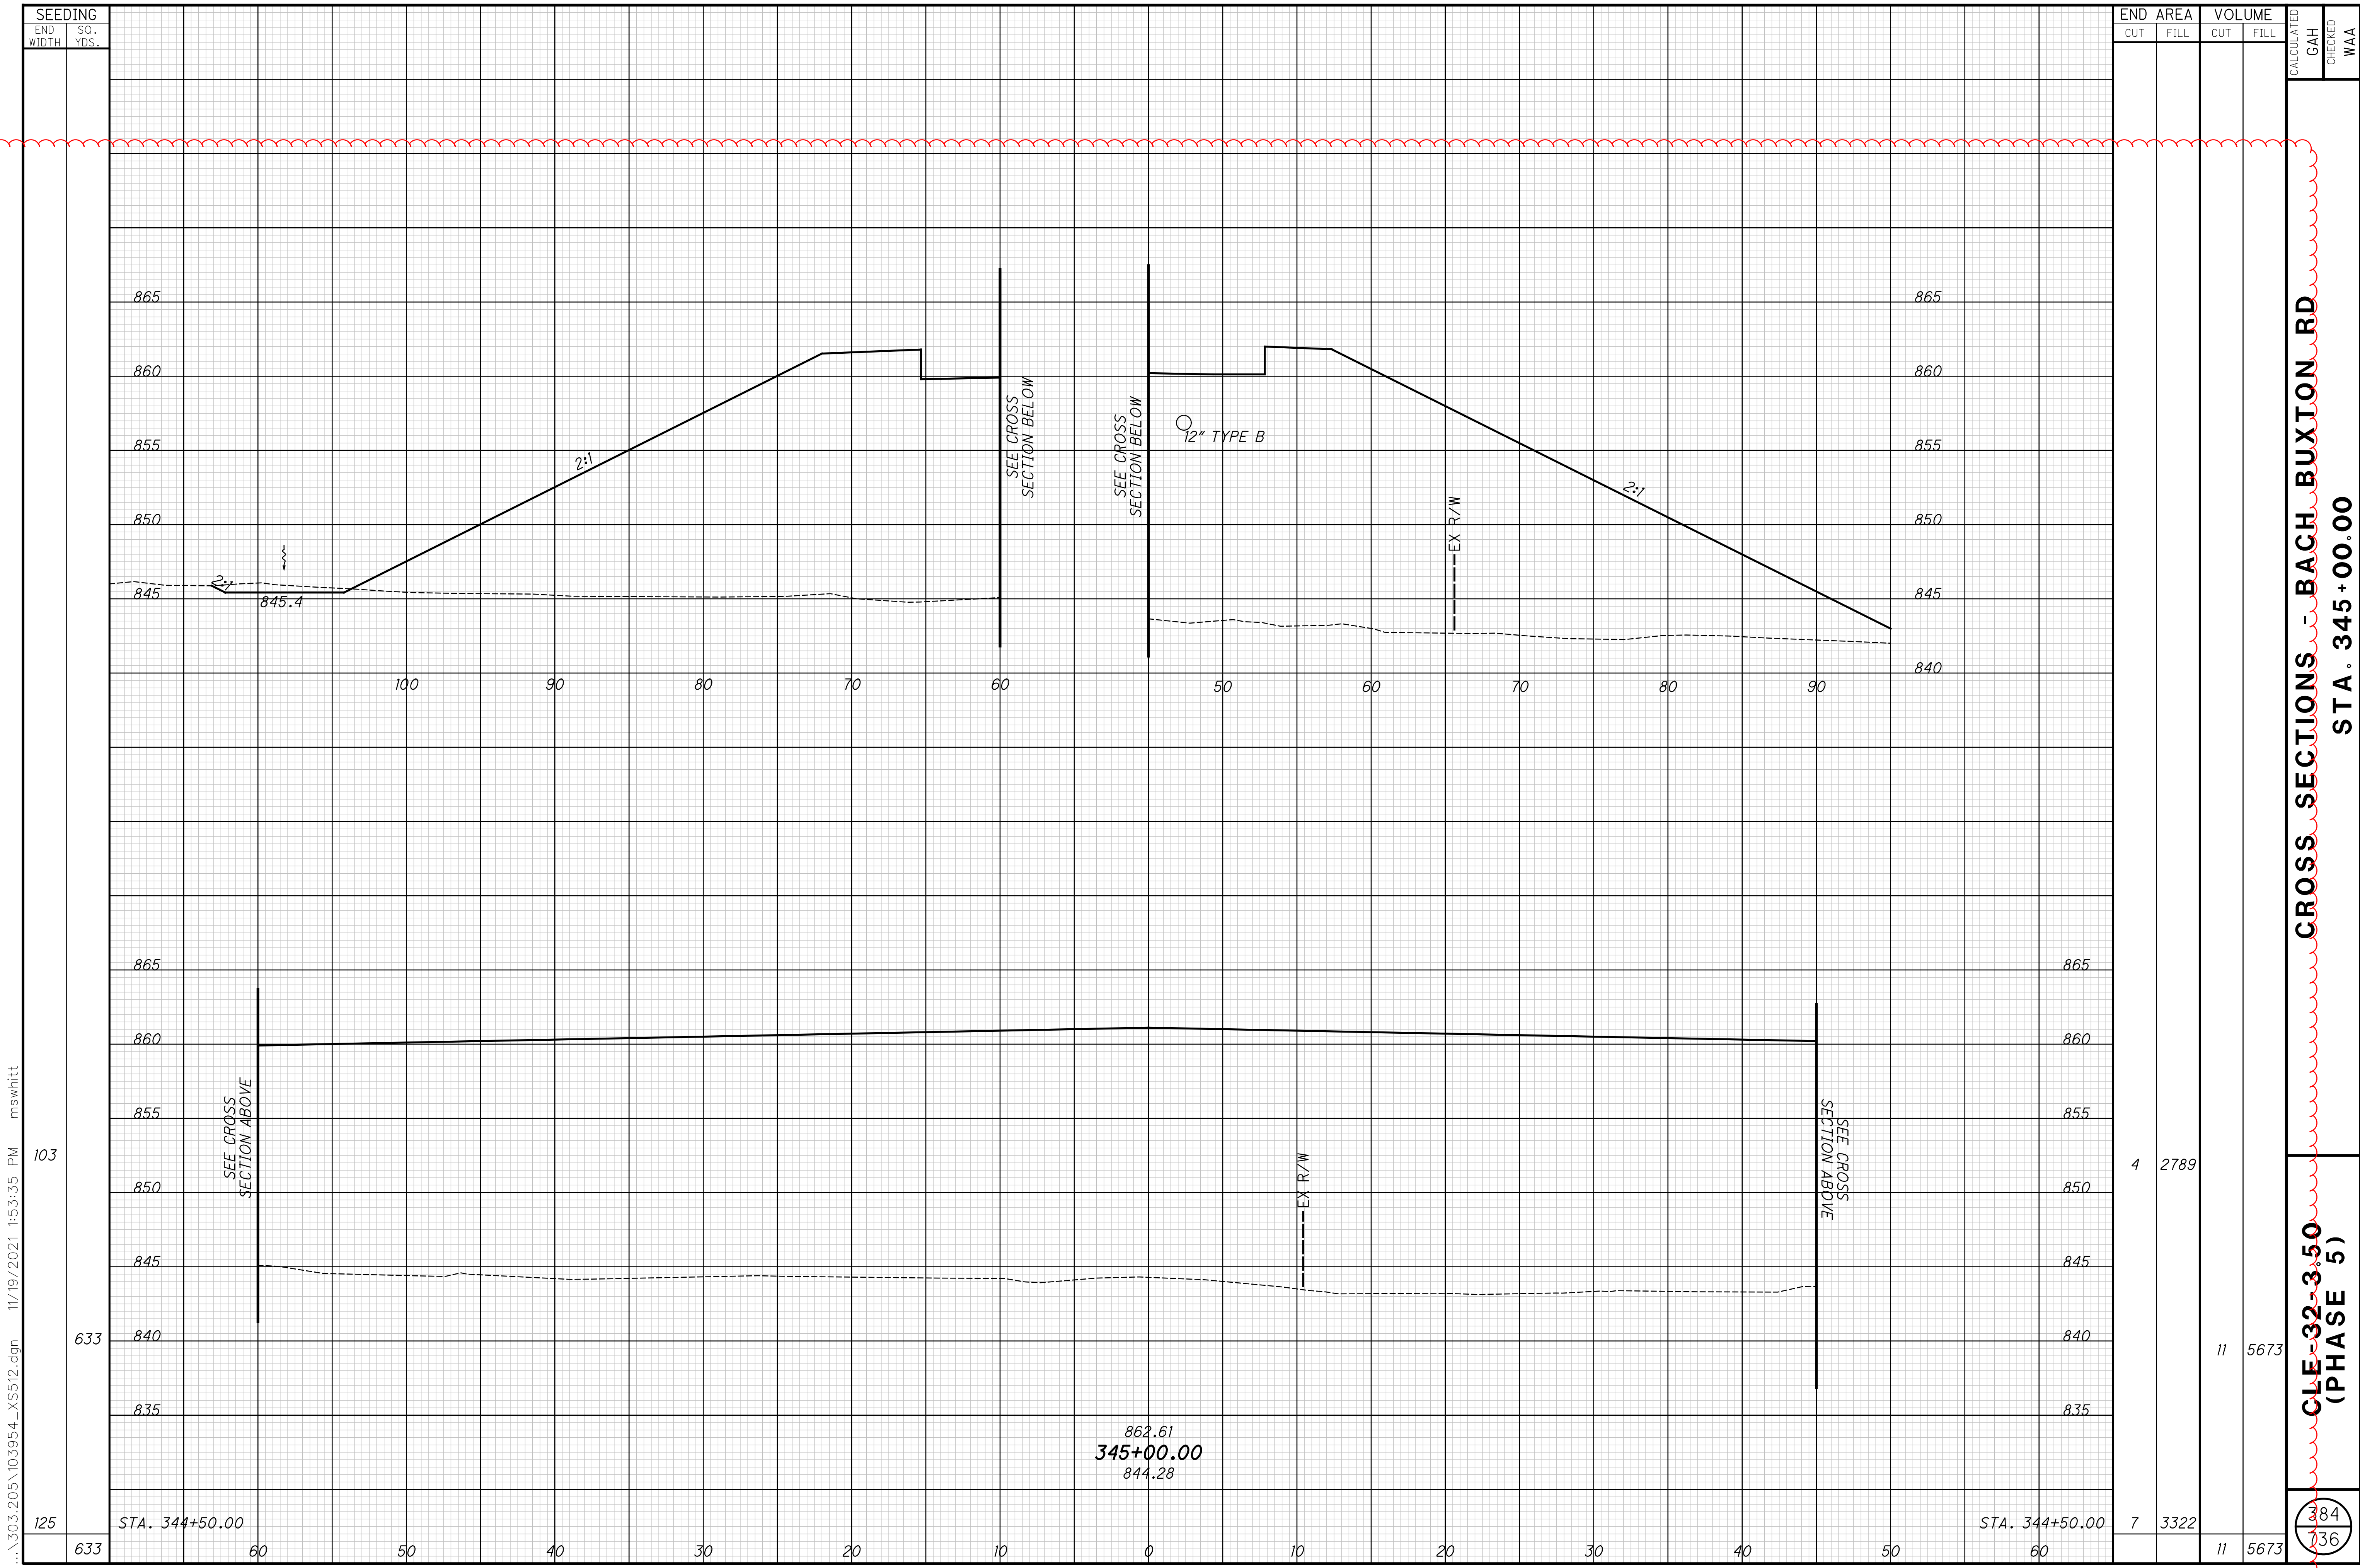


...303.205\103954_XS512.dgn 11/19/2021 1:53:35 PM mswhtt

| SEEDING | |
|-----------|----------|
| END WIDTH | SO. YDS. |
| 633 | 125 |
| 60 | 103 |
| 50 | 633 |

| END AREA | | VOLUME | | CALCULATED GAH | CHECKED WAA |
|----------|------|--------|------|-------------------|----------------|
| CUT | FILL | CUT | FILL | | |
| 4 | 2789 | 11 | 5673 | | |
| 7 | 3322 | 11 | 5673 | | |

CROSS SECTIONS - BACH BUXTON RD
STA. 345+00.00
CLE 32-3.50 (PHASE 5)

384
336

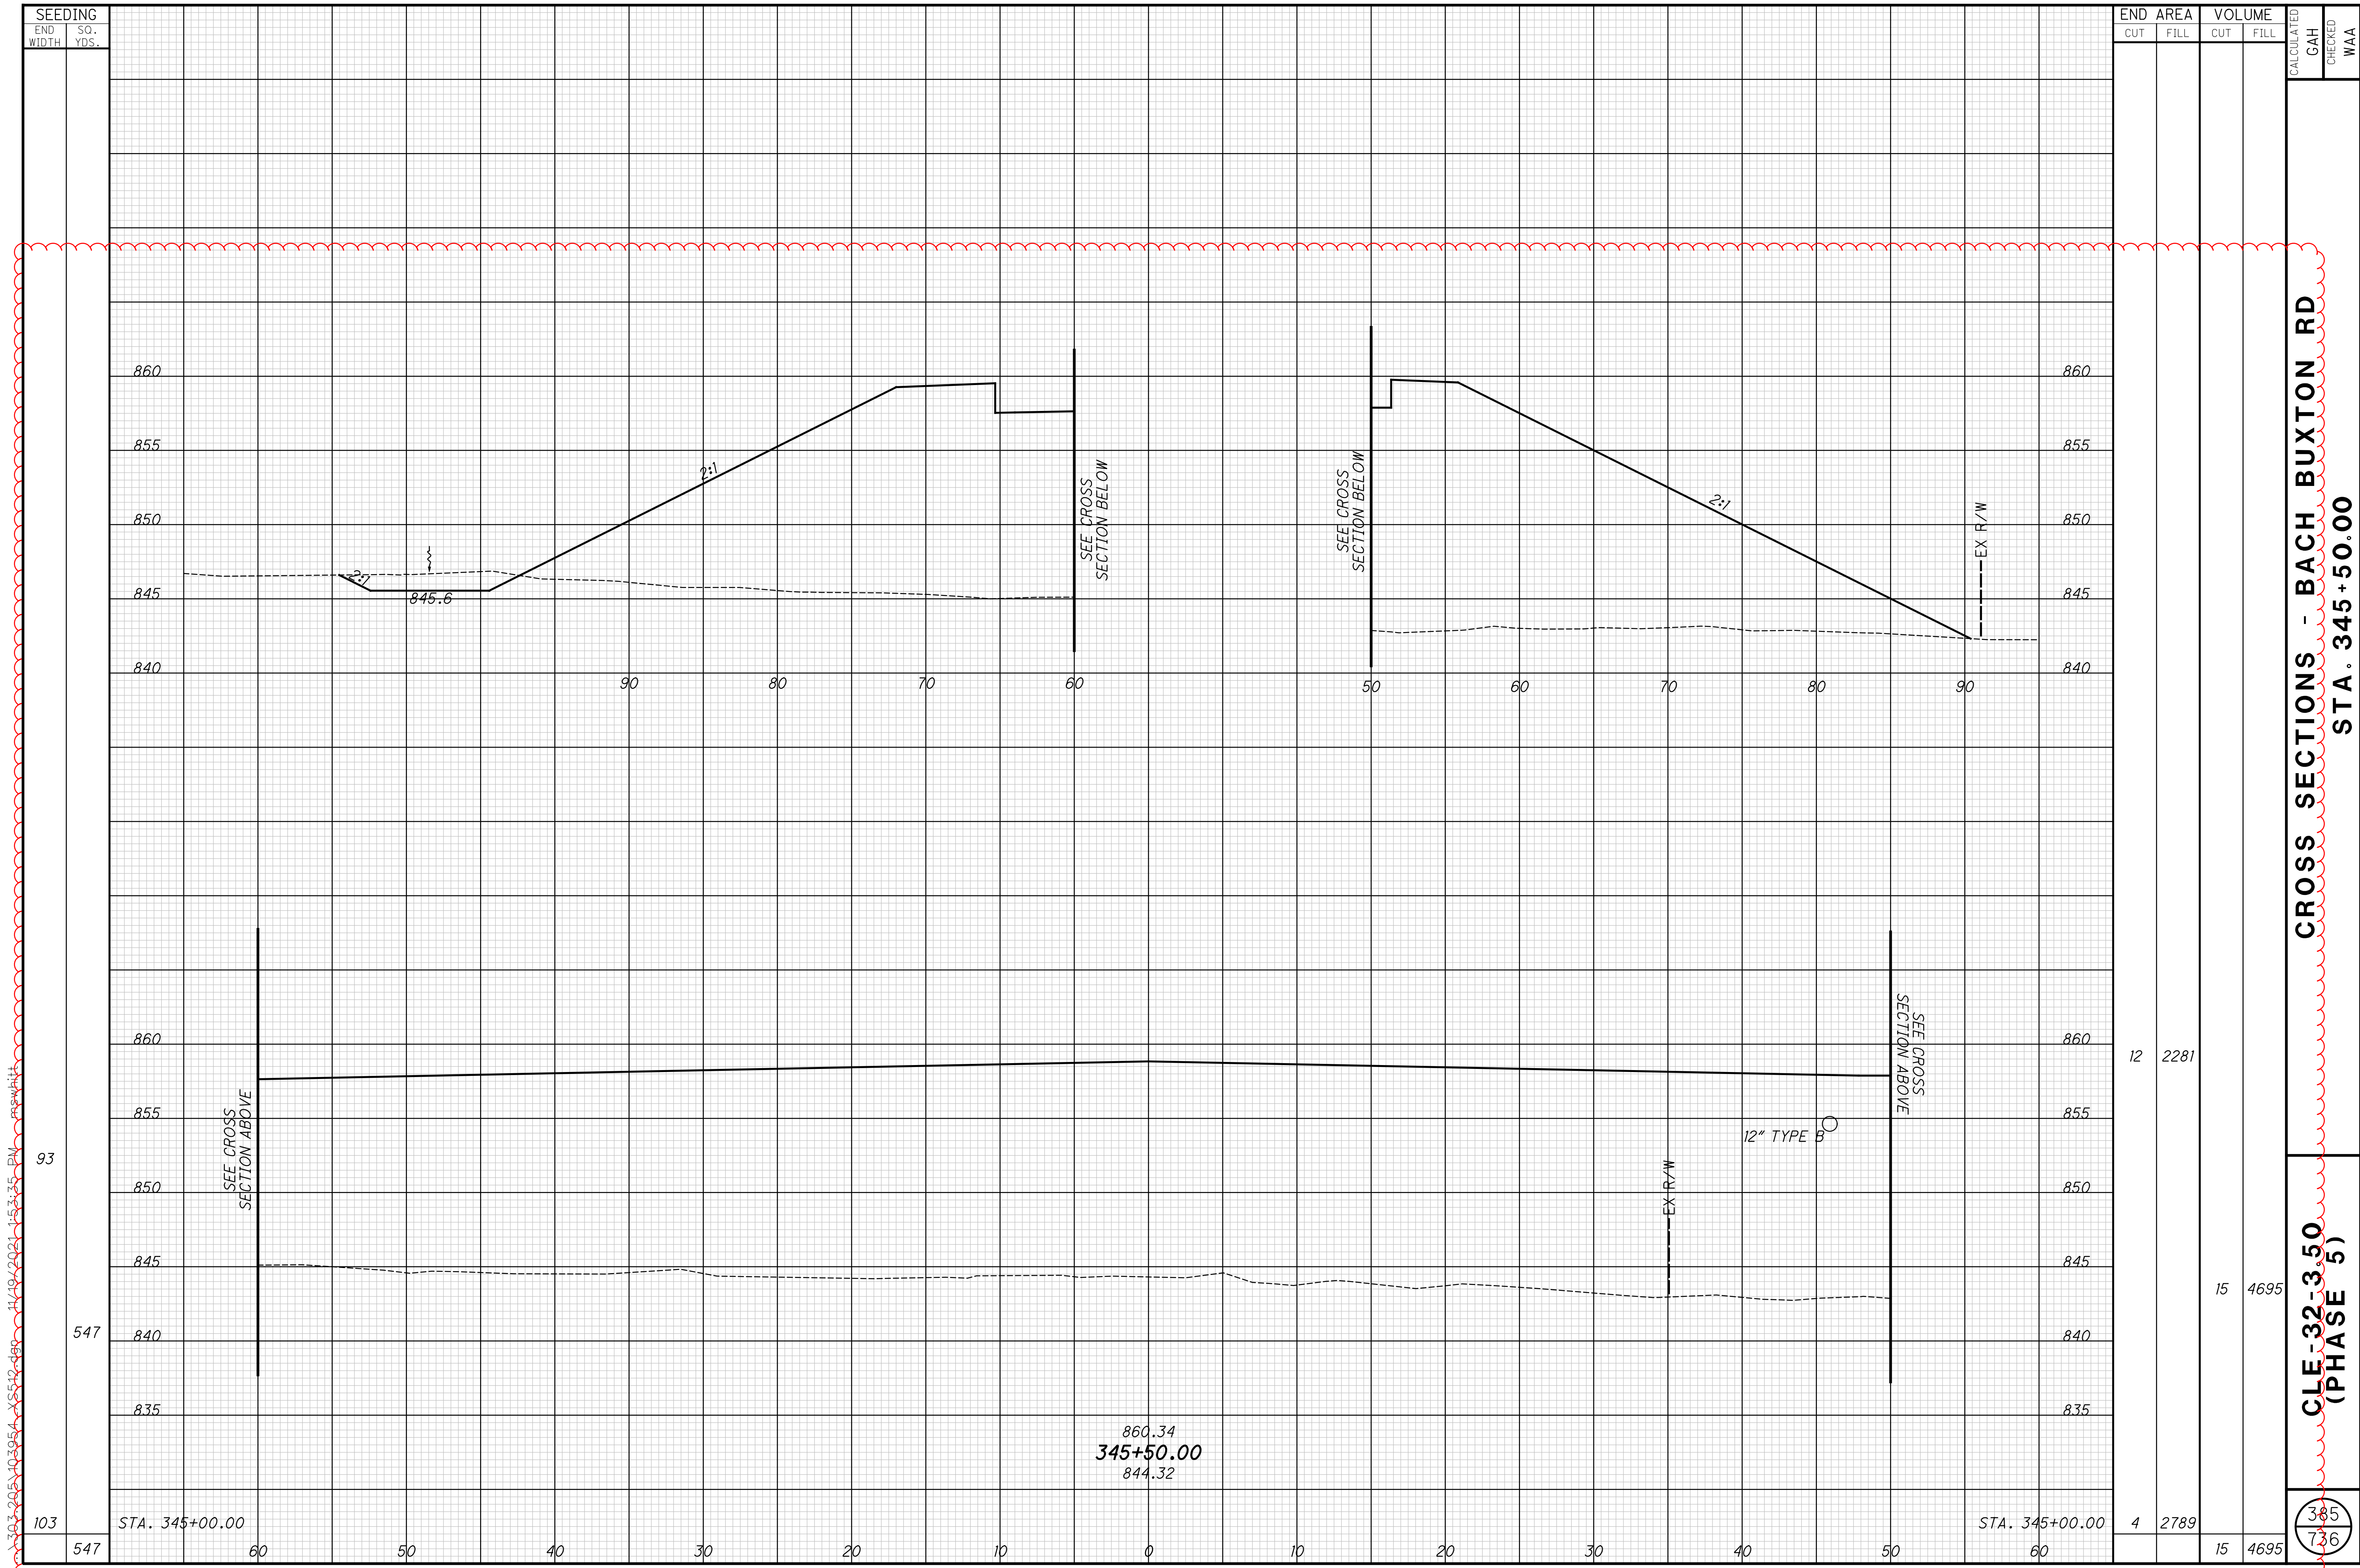

CROSS SECTIONS - BACH BUXTON RD
STA. 345+50.00


CLE-32-3.50
(PHASE 5)

385
736

11/19/2021 1:53:35 PM
103954 15542-889

...303.205\103954_XS512.dgn 11/19/2021 1:53:36 PM msw/whitt


| SEEDING | |
|-----------|----------|
| END WIDTH | SO. YDS. |
| 81 | |
| 486 | |
| 93 | |
| 486 | |

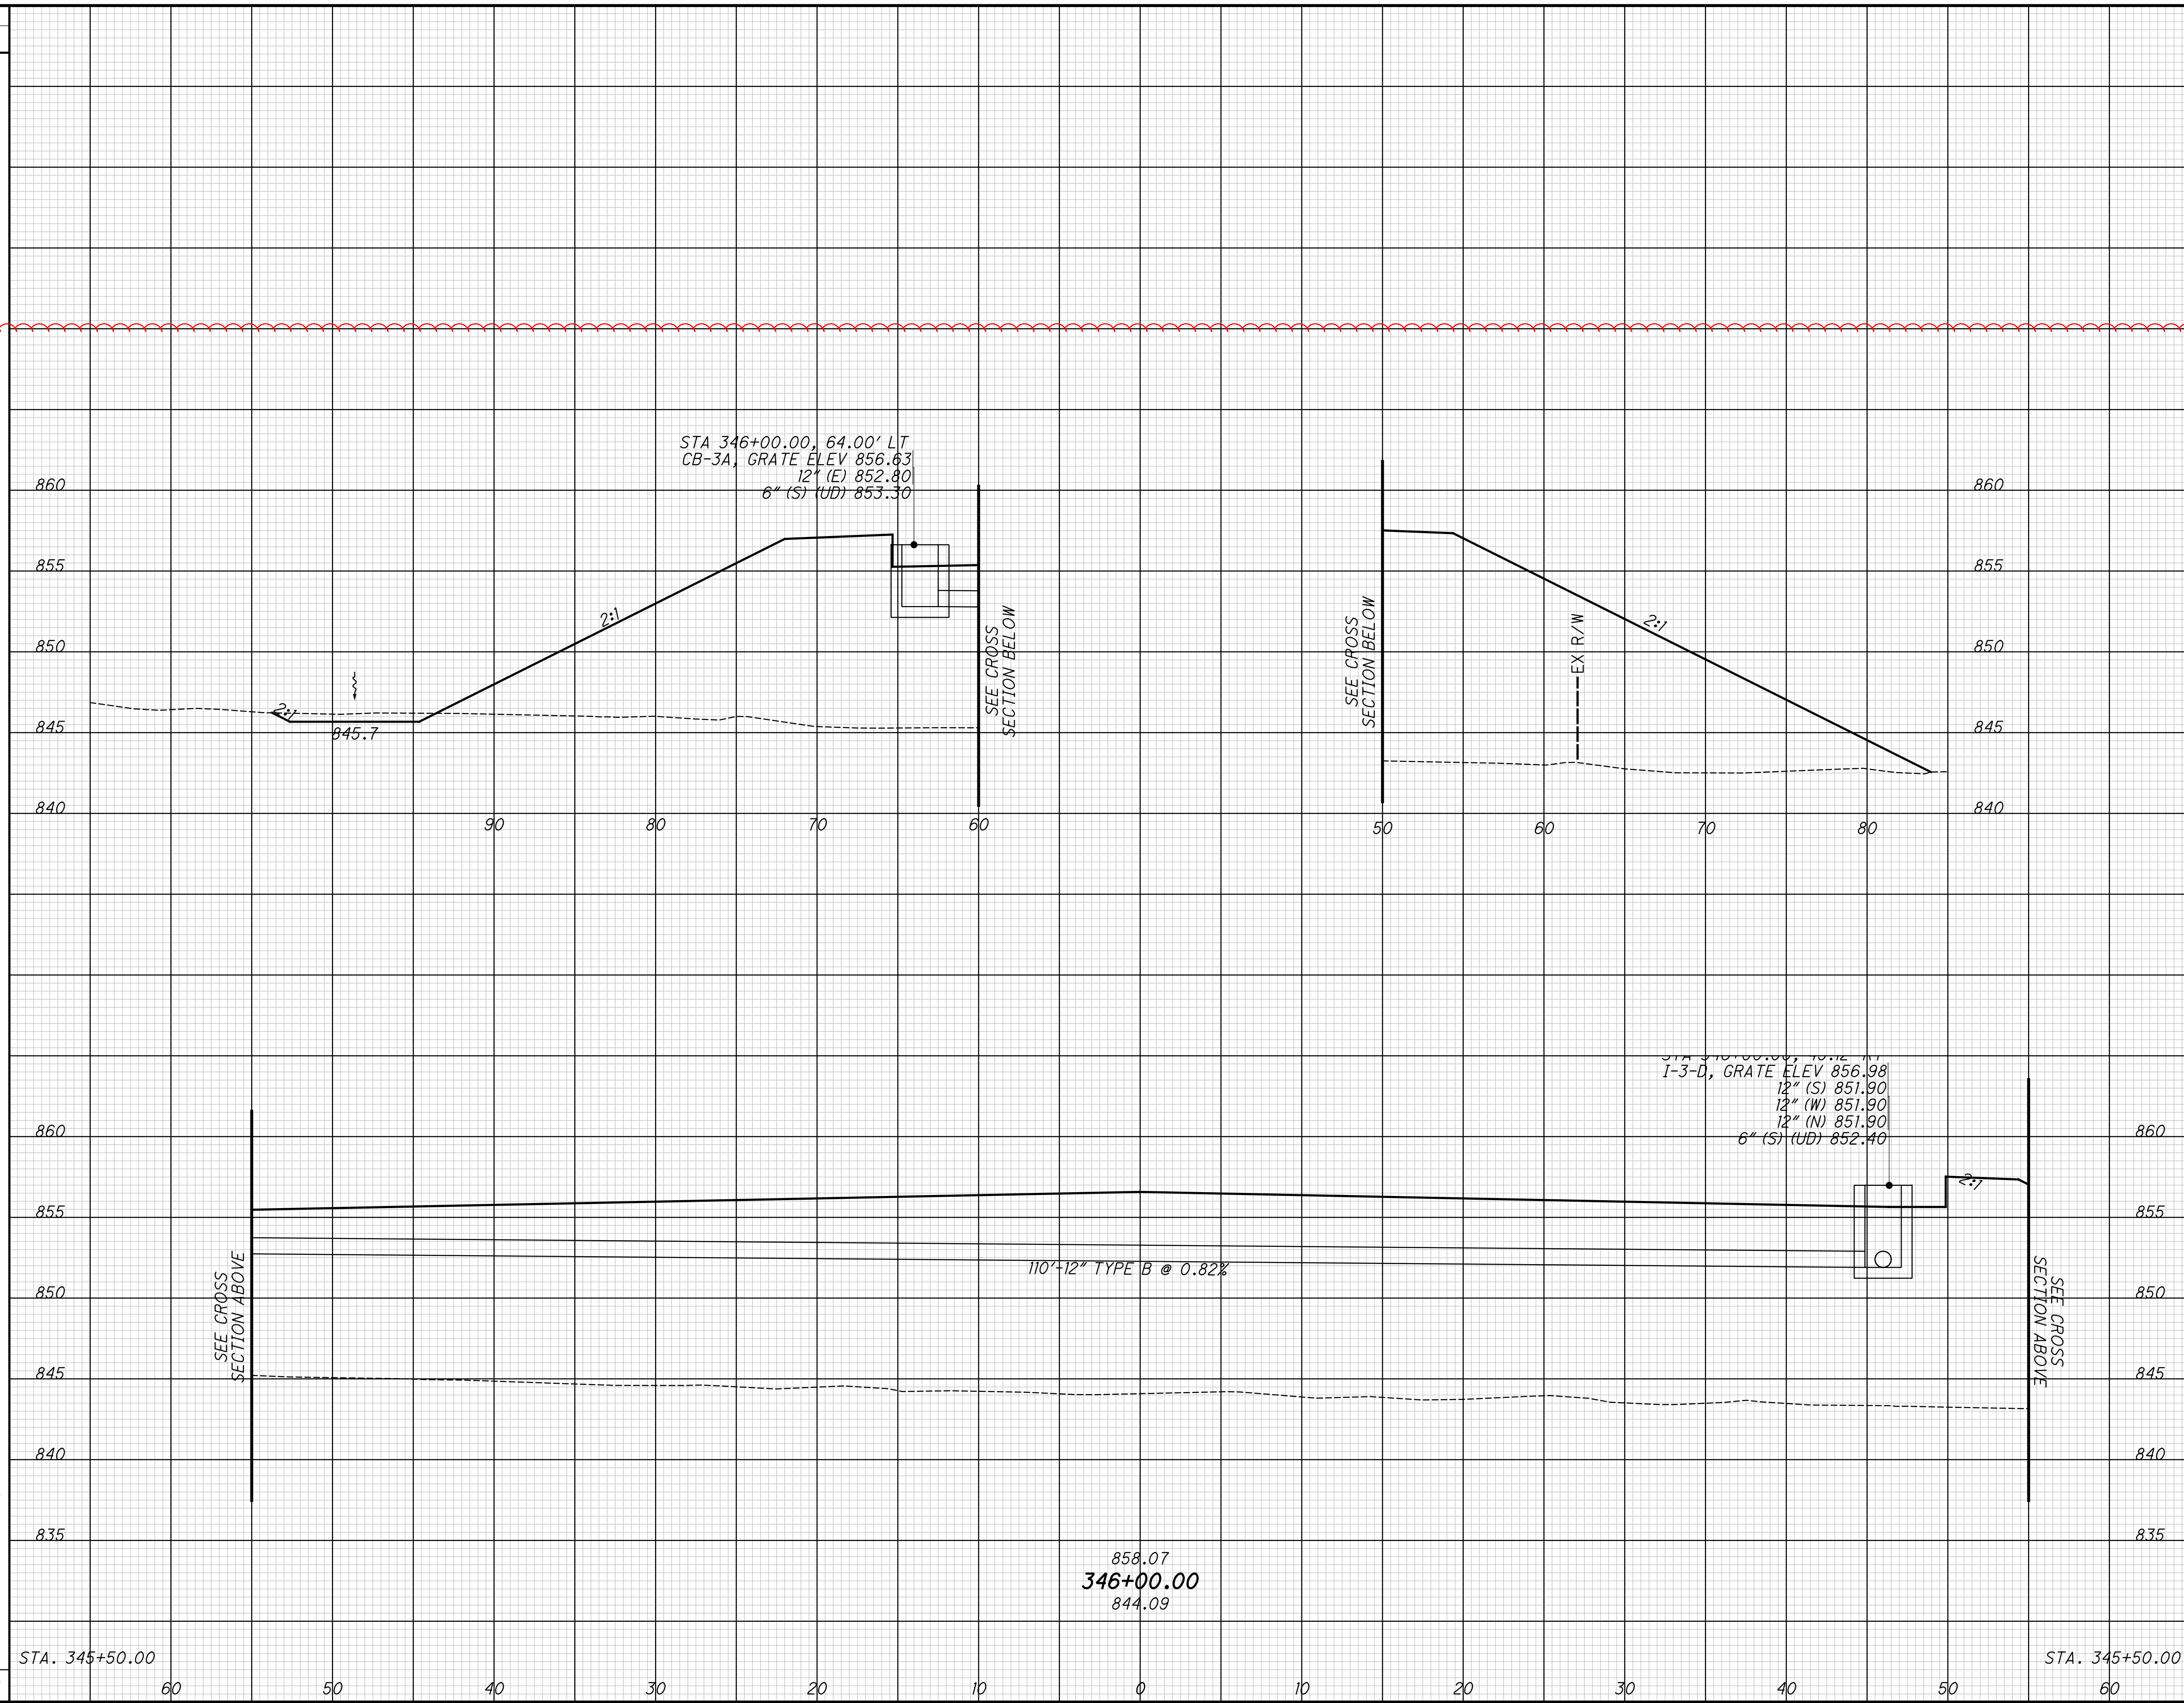

| END AREA | | VOLUME | | CALCULATED | |
|----------|------|--------|------|------------|-----|
| CUT | FILL | CUT | FILL | GAH | WAA |
| 5 | 1825 | | | | |
| 15 | 3802 | | | | |
| 12 | 2281 | | | | |
| 15 | 3802 | | | | |

CROSS SECTIONS - BACH BUXTON RD
STA. 346+00.00
CLE 32-3.50
(PHASE 5)

386
336

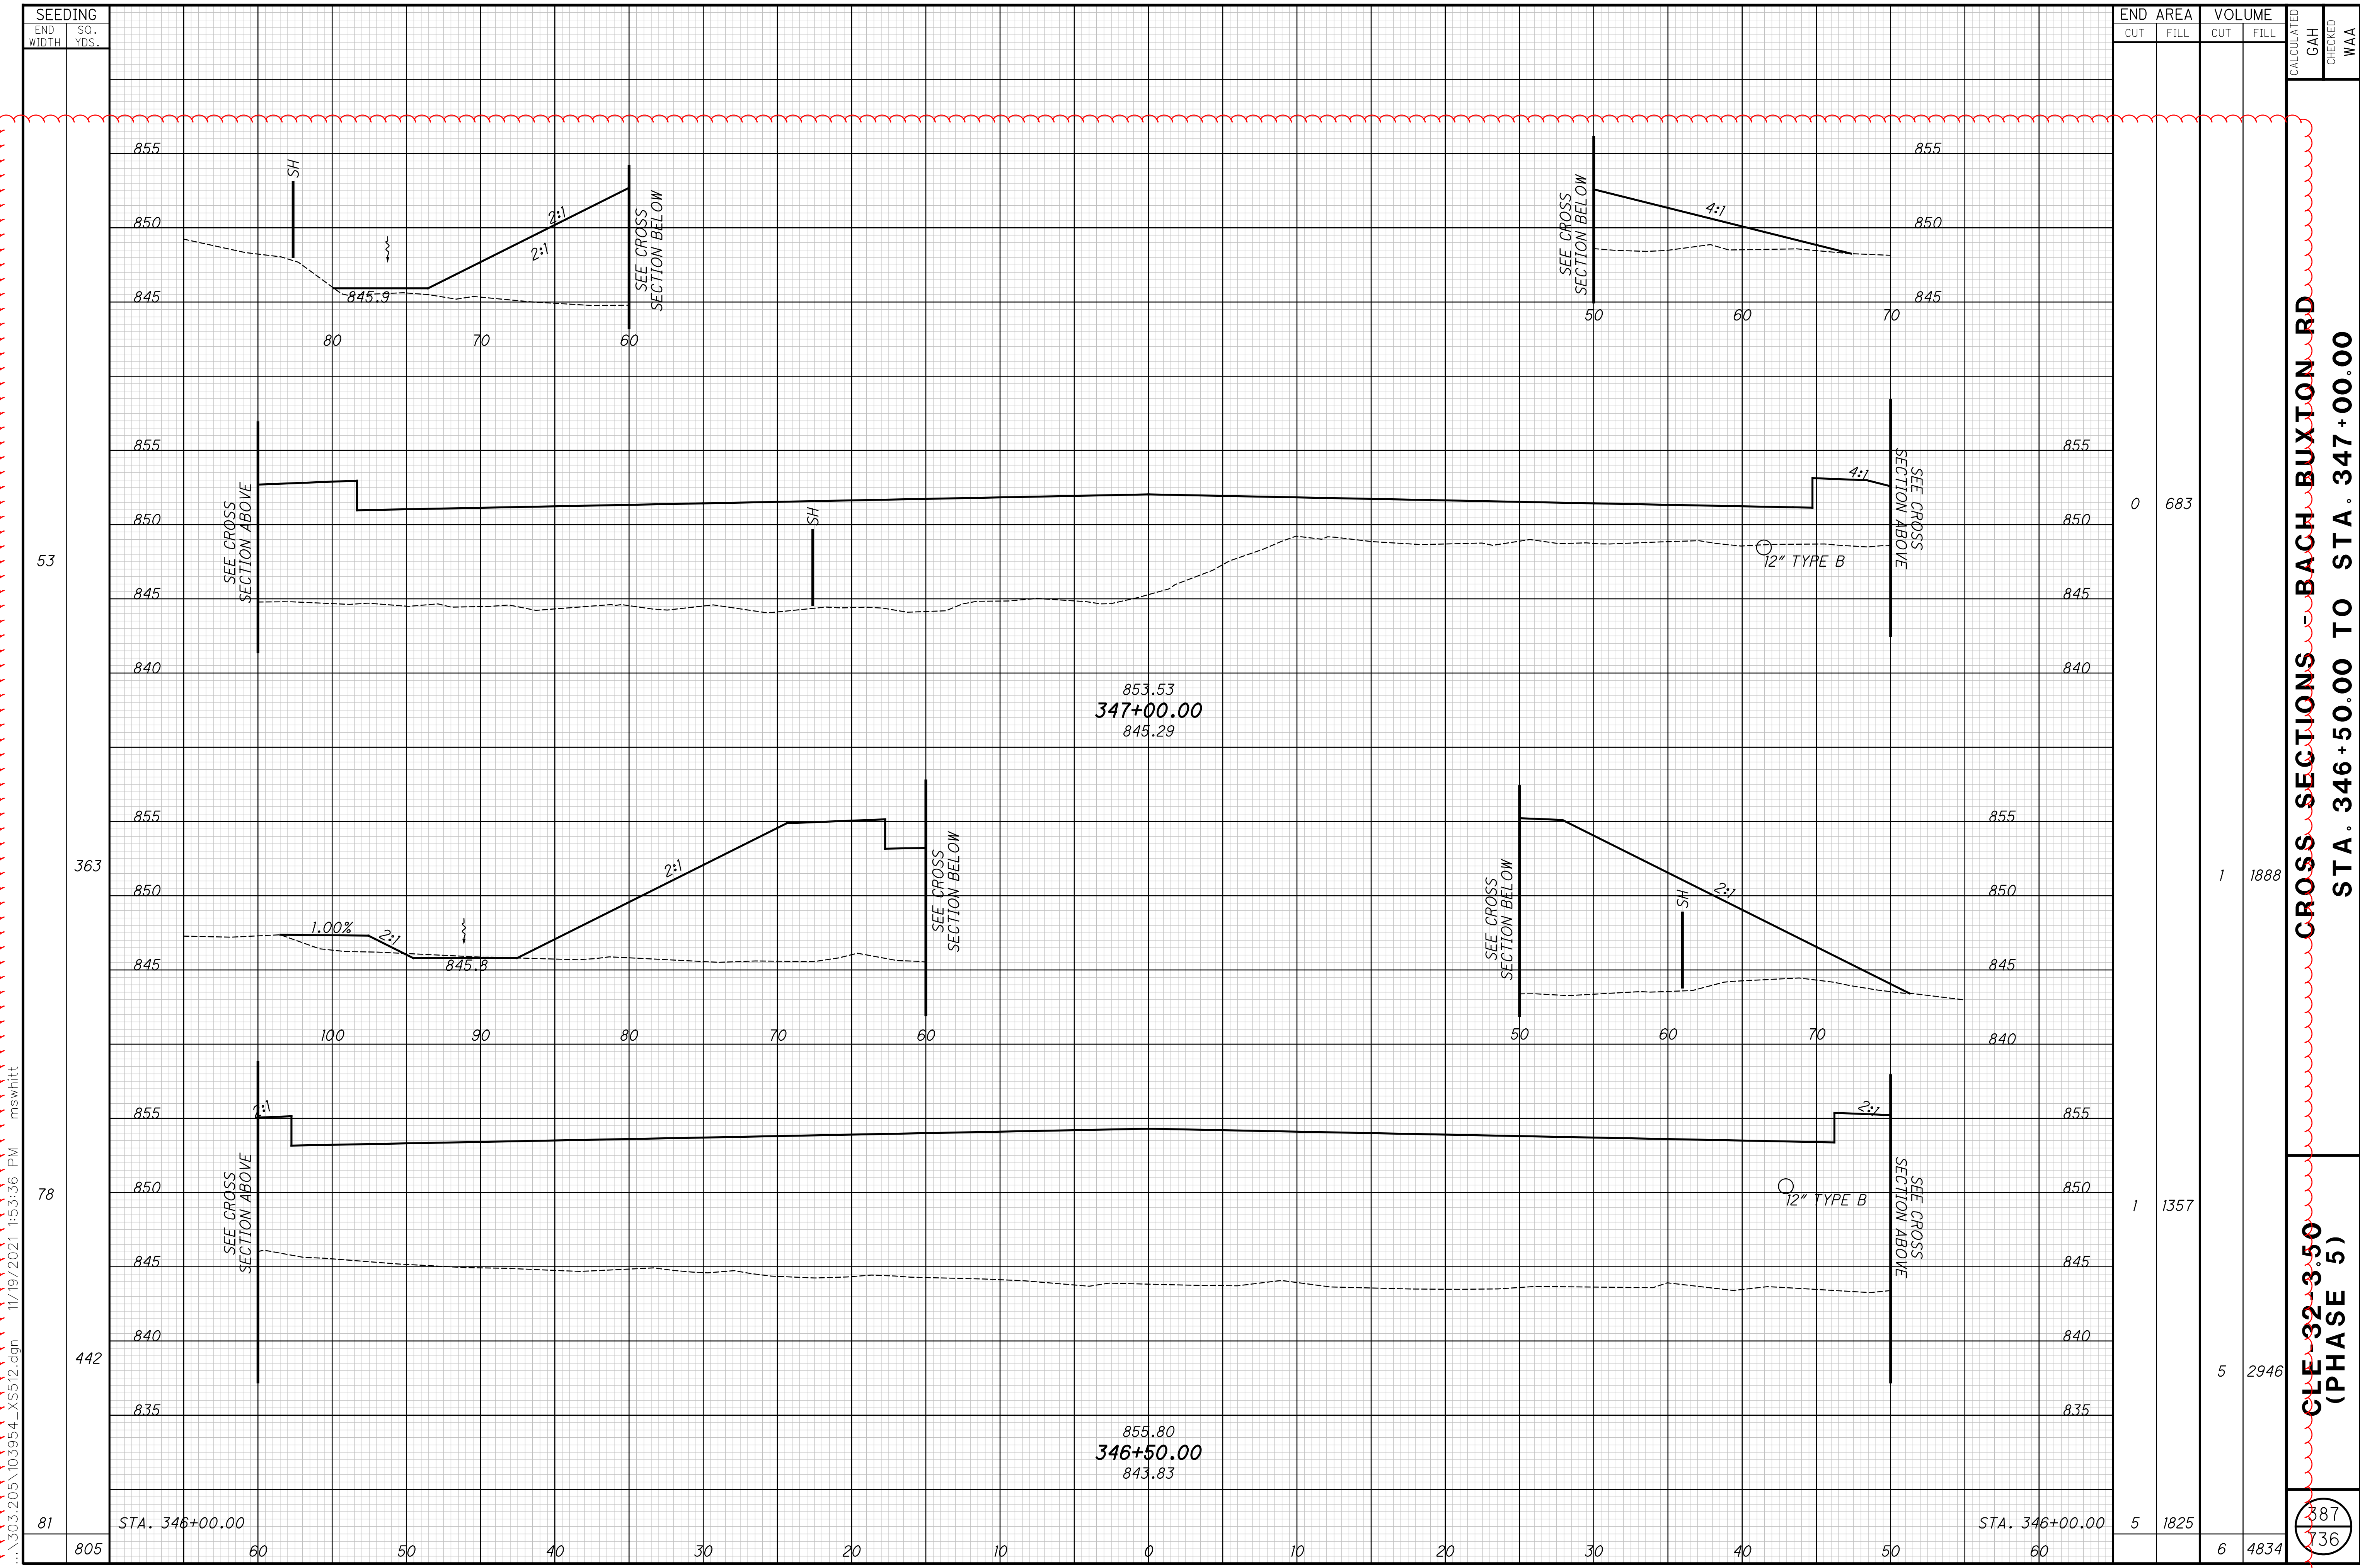

| SEEDING | |
|-----------|----------|
| END WIDTH | SO. YDS. |
| 805 | |
| 81 | |
| 442 | |
| 78 | |
| 363 | |
| 53 | |

| END AREA | VOLUME | CALCULATED | CHECKED | | |
|----------|--------|------------|---------|-----|------|
| | | | | CUT | FILL |
| 0 | 683 | | | | |
| 1 | 1888 | | | | |
| 1 | 1357 | | | | |
| 5 | 2946 | | | | |
| 5 | 1825 | | | | |
| 6 | 4834 | | | | |


CROSS SECTIONS - BACH BUXTON RD
STA. 346+50.00 TO STA. 347+00.00
CLE 32-3-50 (PHASE 5)

387
36

...303.205\103954_XS512.dgn 11/19/2021 1:53:36 PM mswhtt

SEEDING

| END WIDTH | SO. YDS. |
|-----------|----------|
| 27 | |
| 133 | |
| 20 | |
| 115 | |
| 20 | |
| 204 | |
| 53 | |
| 452 | |

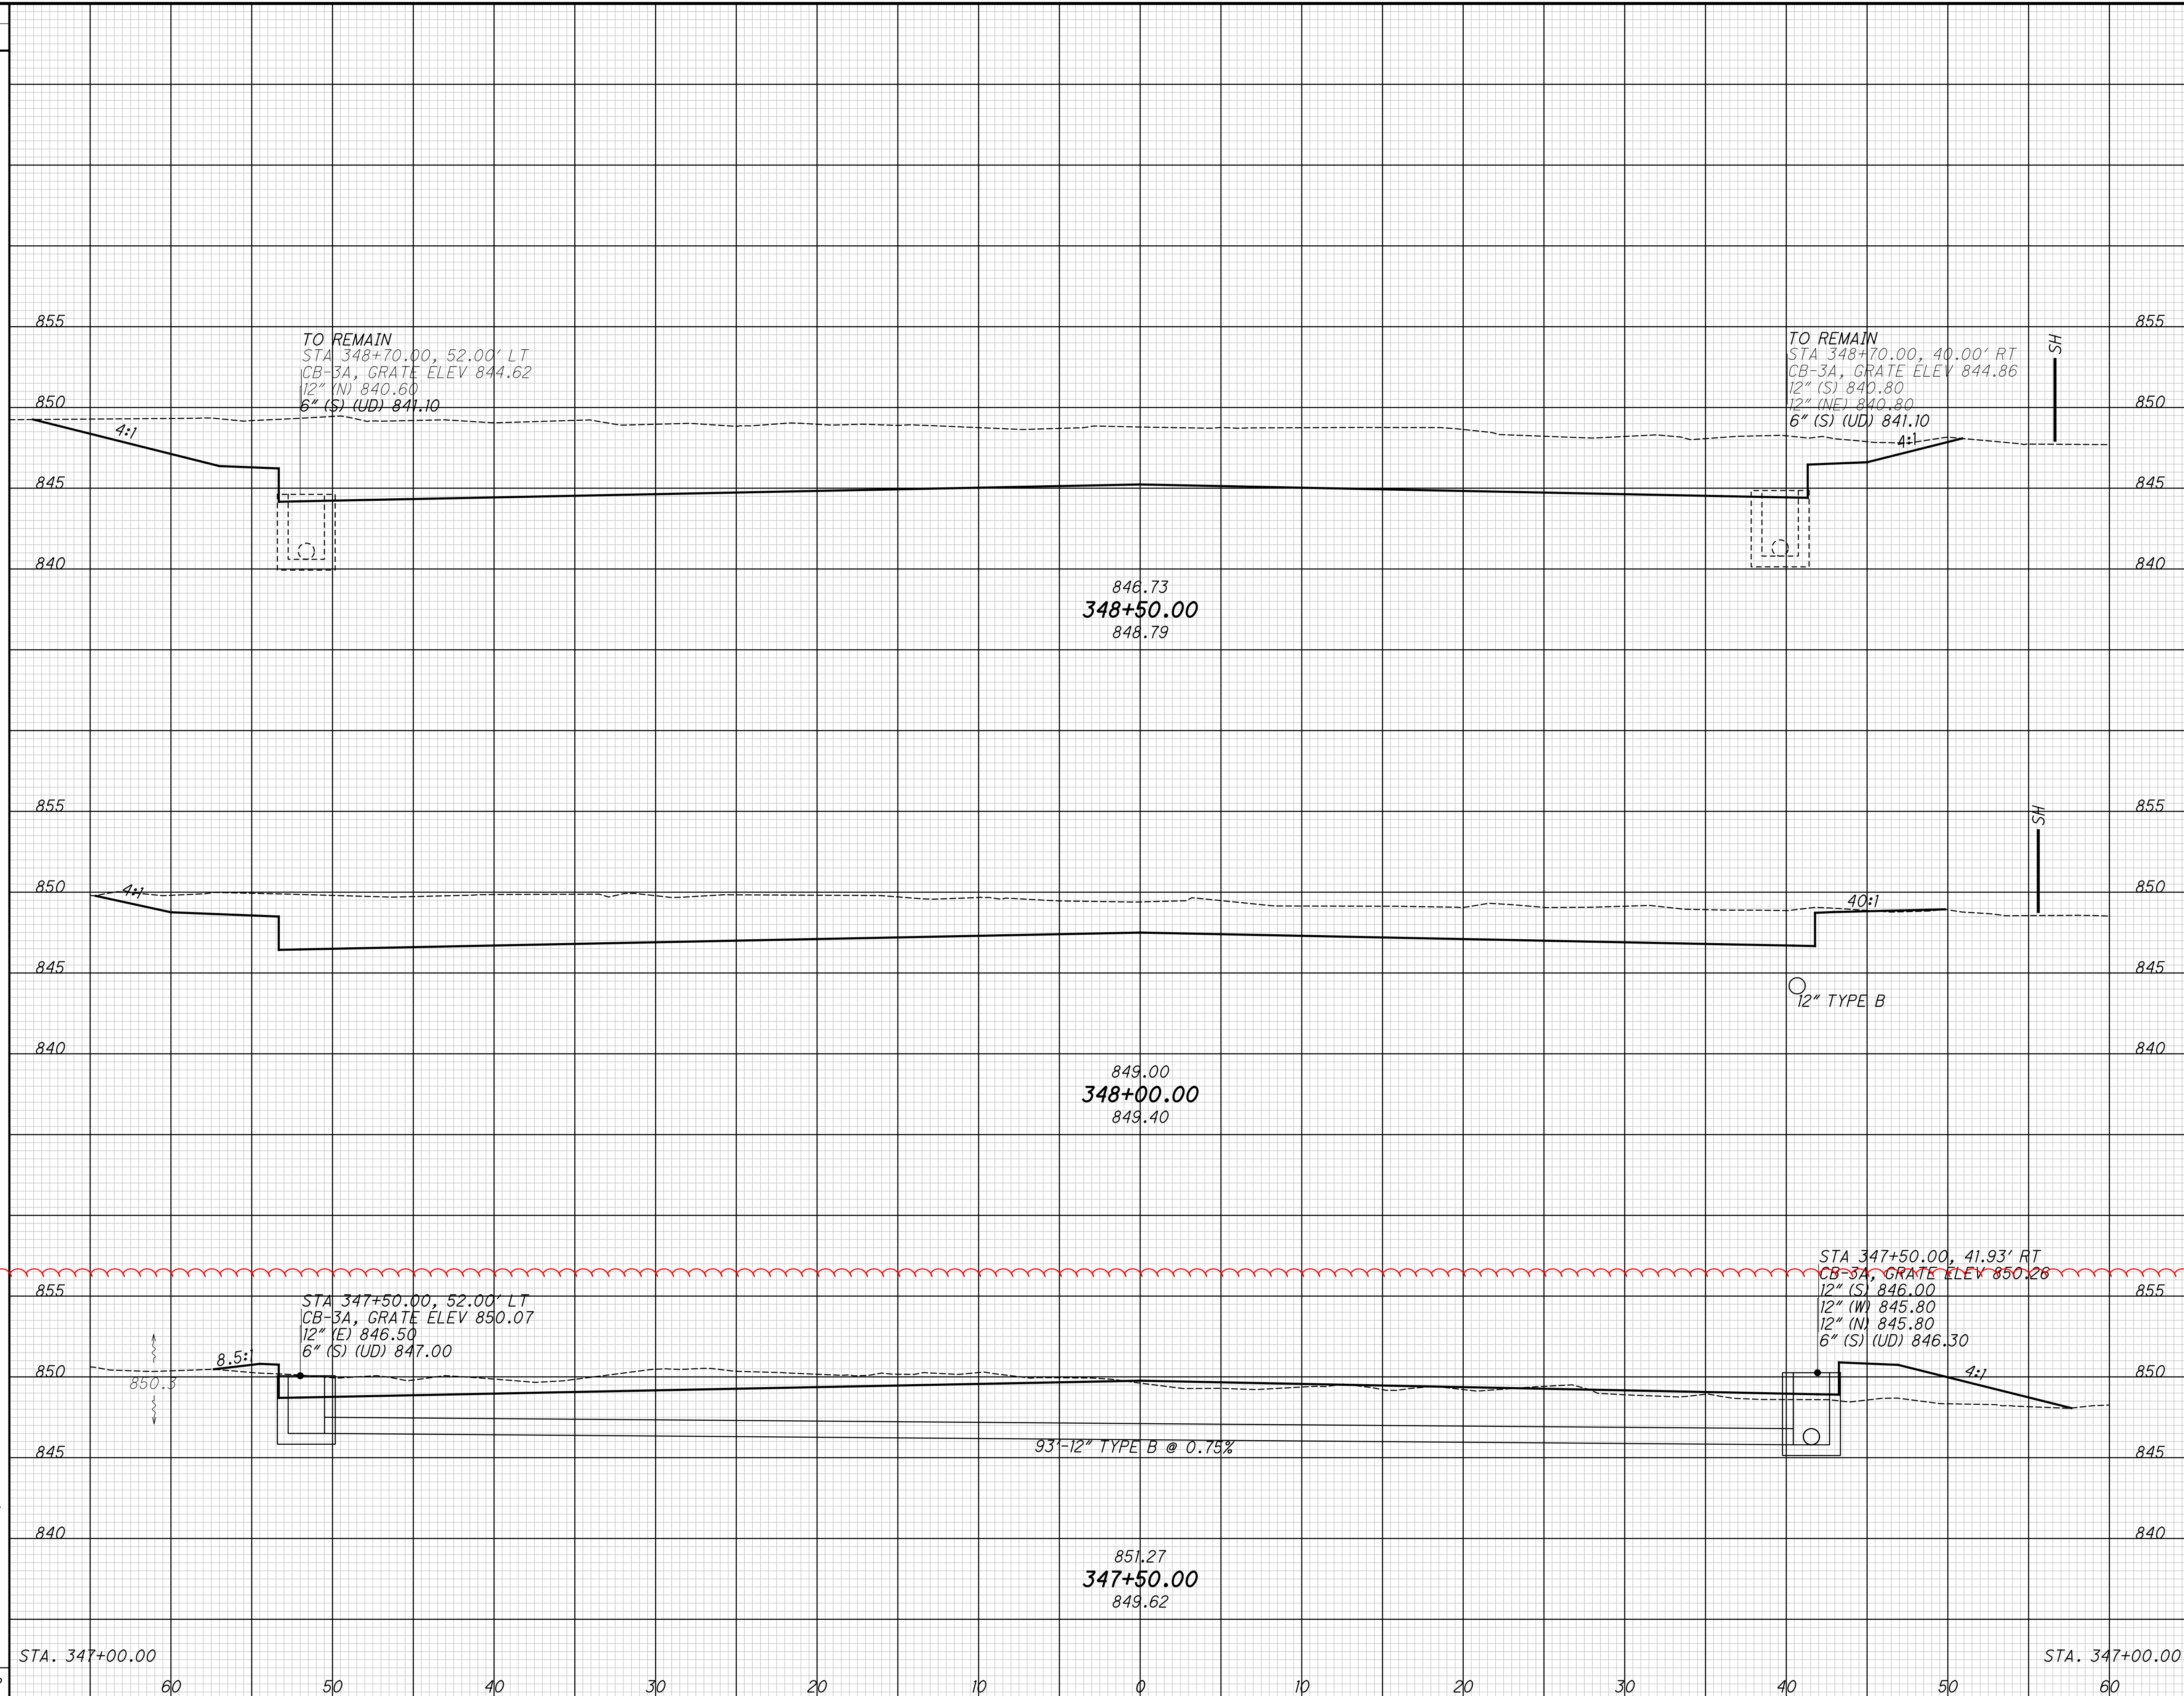


| END AREA | | VOLUME | |
|----------|------|--------|------|
| CUT | FILL | CUT | FILL |
| 417 | 0 | 614 | 0 |
| 245 | 0 | 270 | 29 |
| 46 | 31 | 43 | 661 |
| 0 | 683 | 927 | 670 |

CROSS SECTIONS - BACH BUXTON RD
 STA. 347+50.00 TO STA. 348+50.00

CLE-32-3-50
 (PHASE 5)

388
 736

11/19/2021 1:53:37 PM mswhit
 ...303.205\103954_XS512.dgn

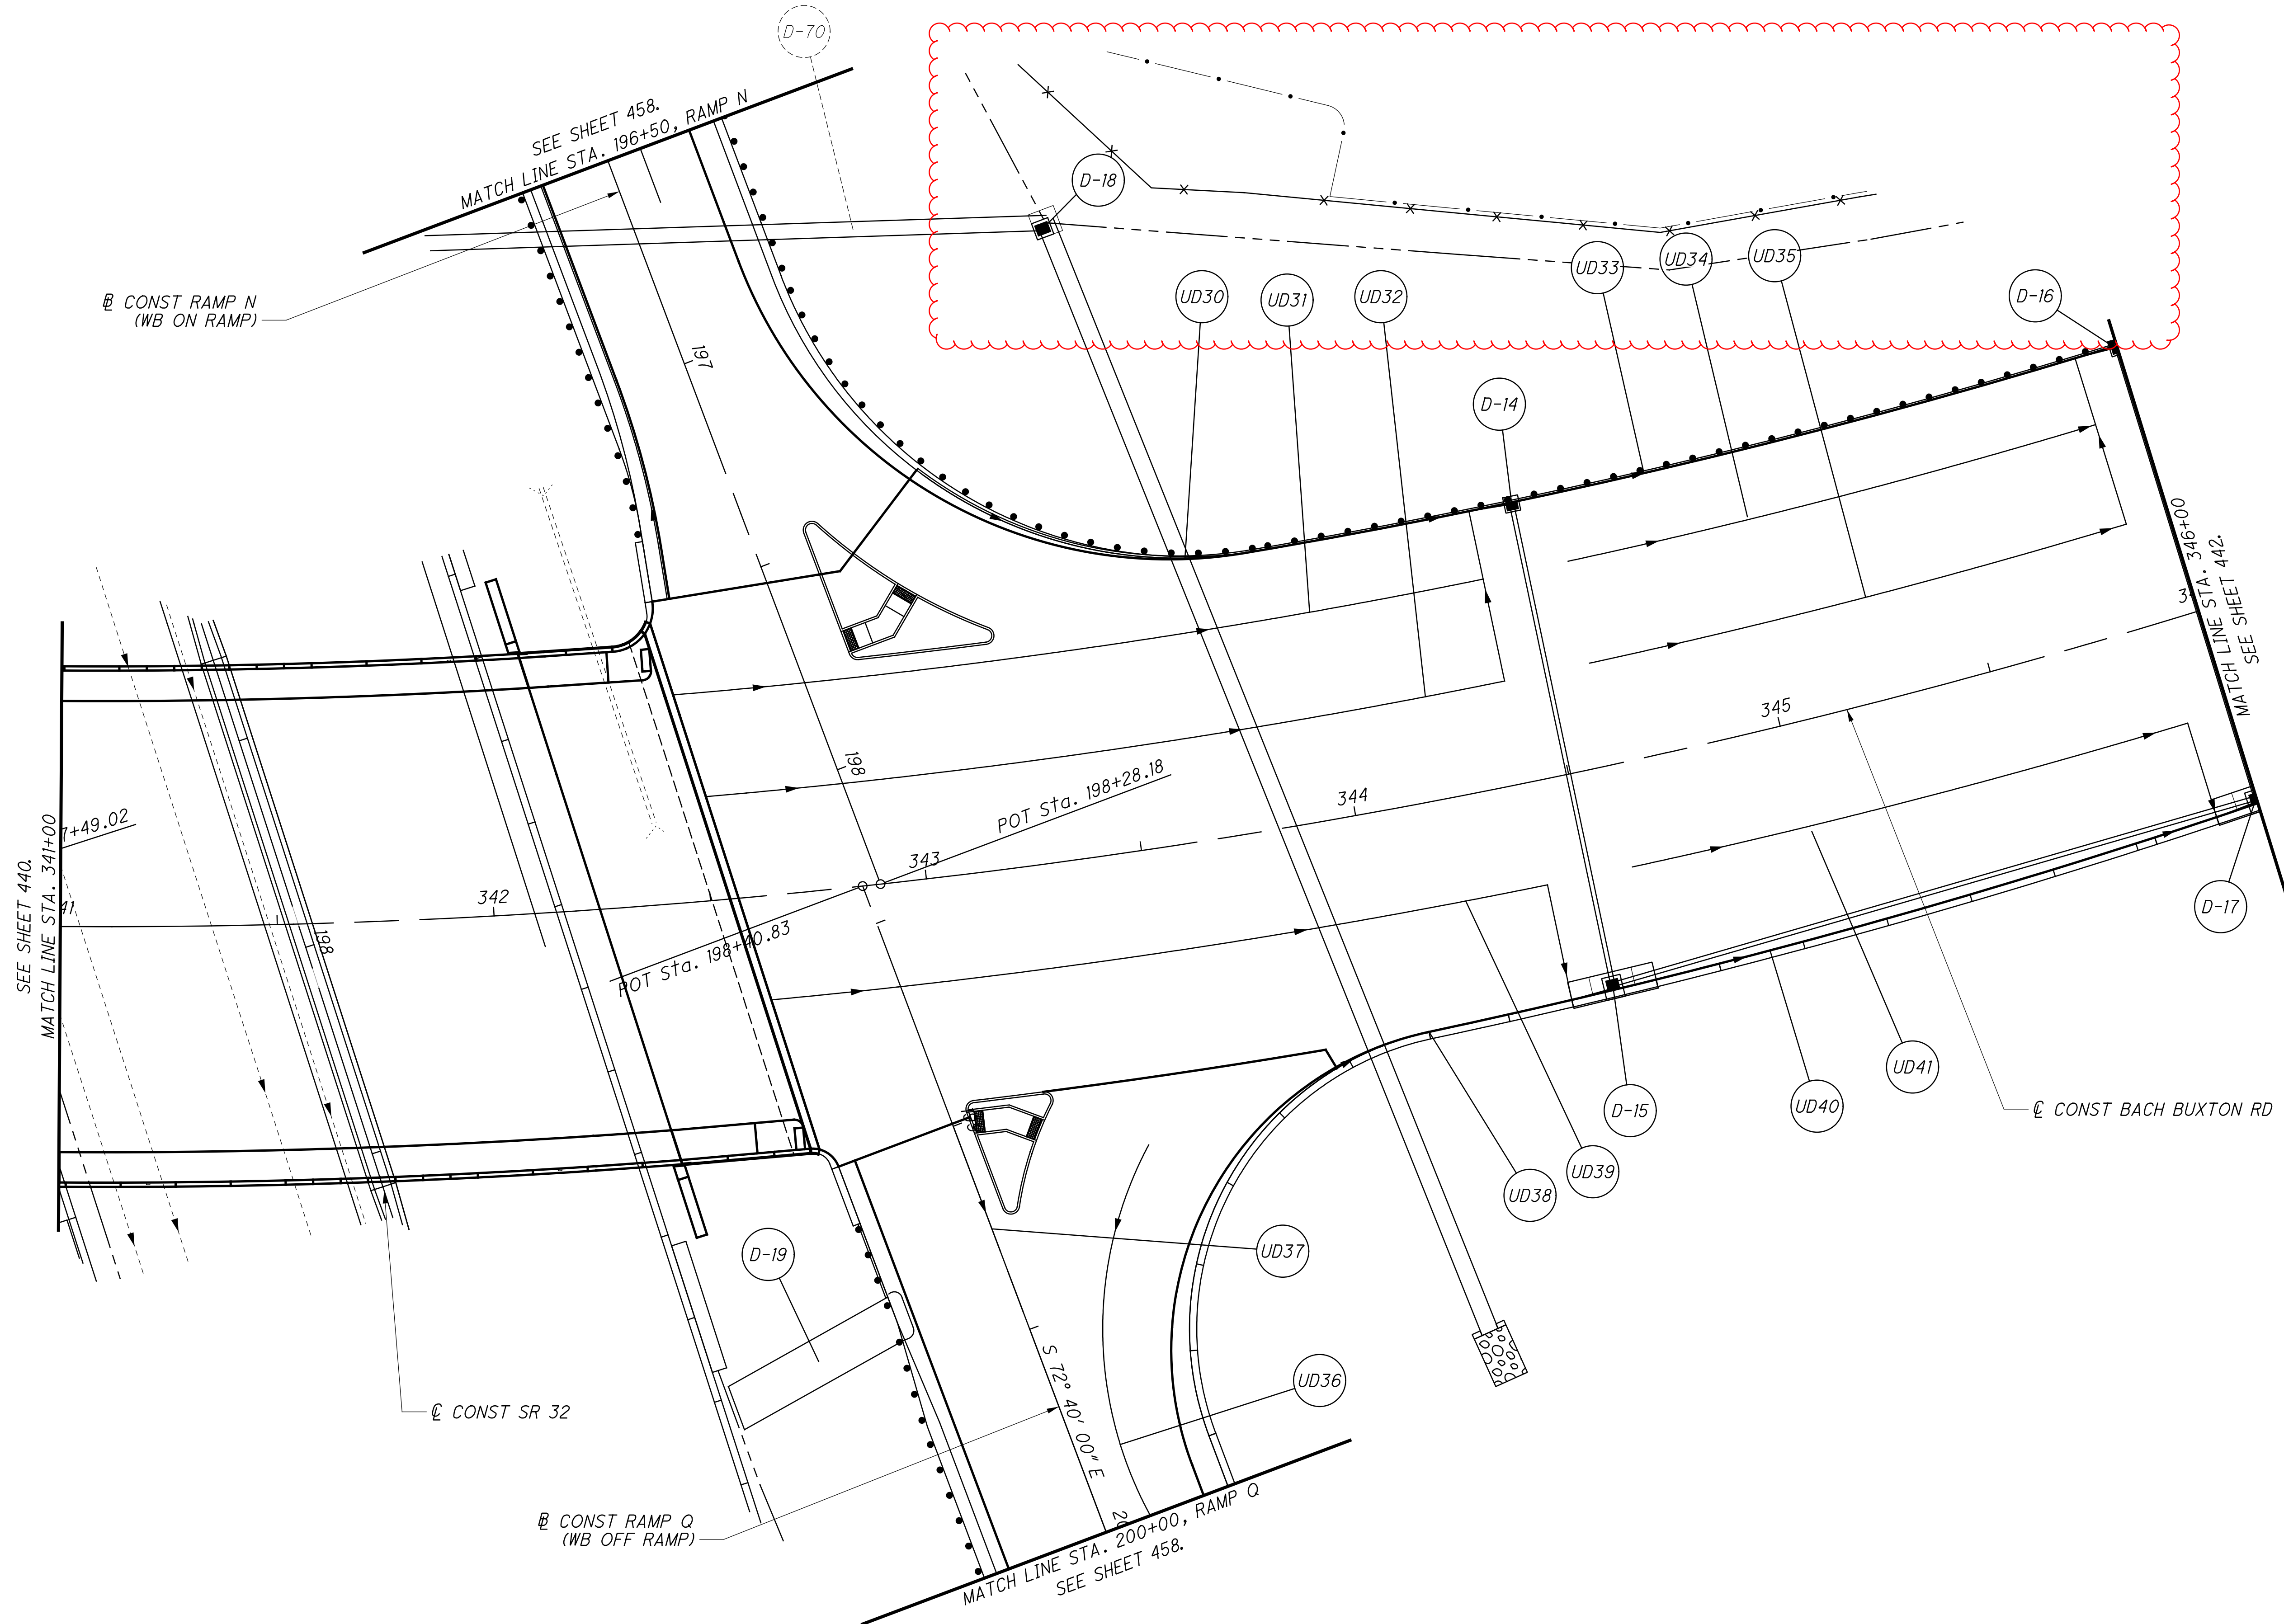


CALCULATED MHT
CHECKED WAA

0 20 40
HORIZONTAL SCALE IN FEET

DRAINAGE & UNDERDRAIN PLAN
BACH BUXTON RD STA. 341+00 TO STA. 346+00

CLE-32-3.50 (PHASE 5)

441
736

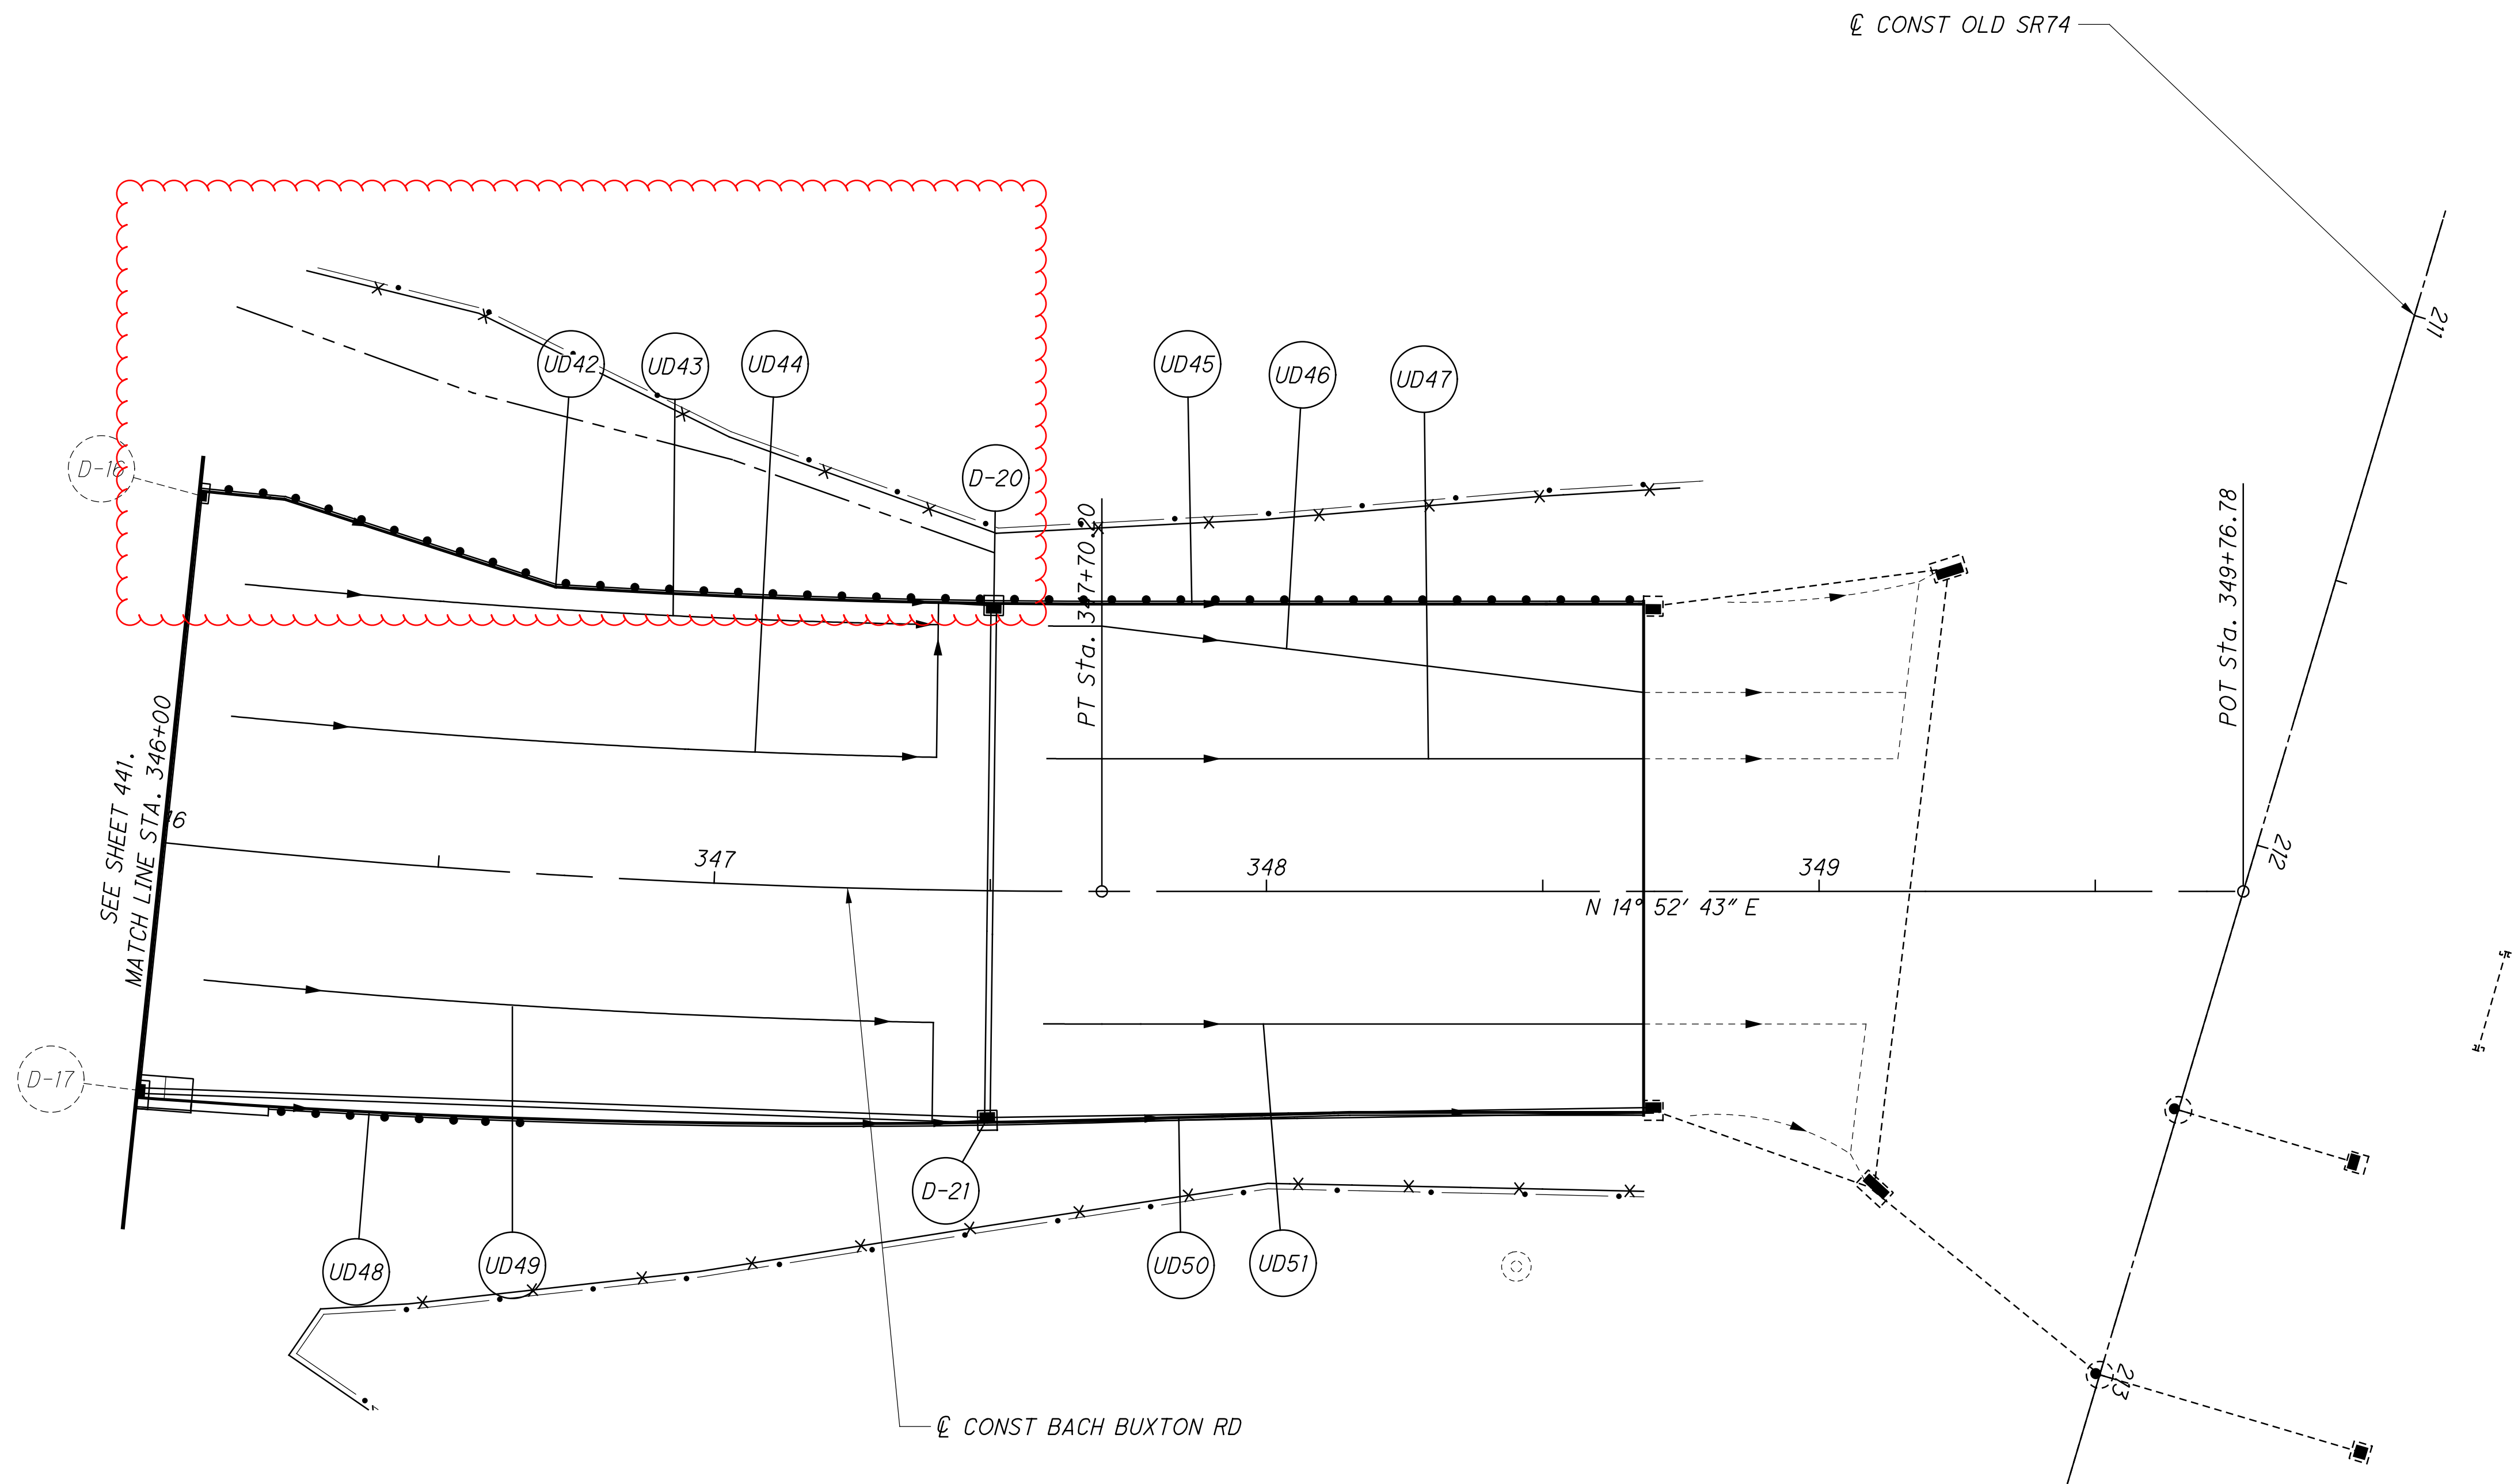


| | |
|------------|-----|
| CALCULATED | MHT |
| CHECKED | WAA |

0 20 40
HORIZONTAL
SCALE IN FEET

DRAINAGE & UNDERDRAIN PLAN
BACH BUXTON RD STA. 346+00 TO END WORK

CLE-32-3.50
(PHASE 5)

| |
|-----|
| 442 |
| 736 |

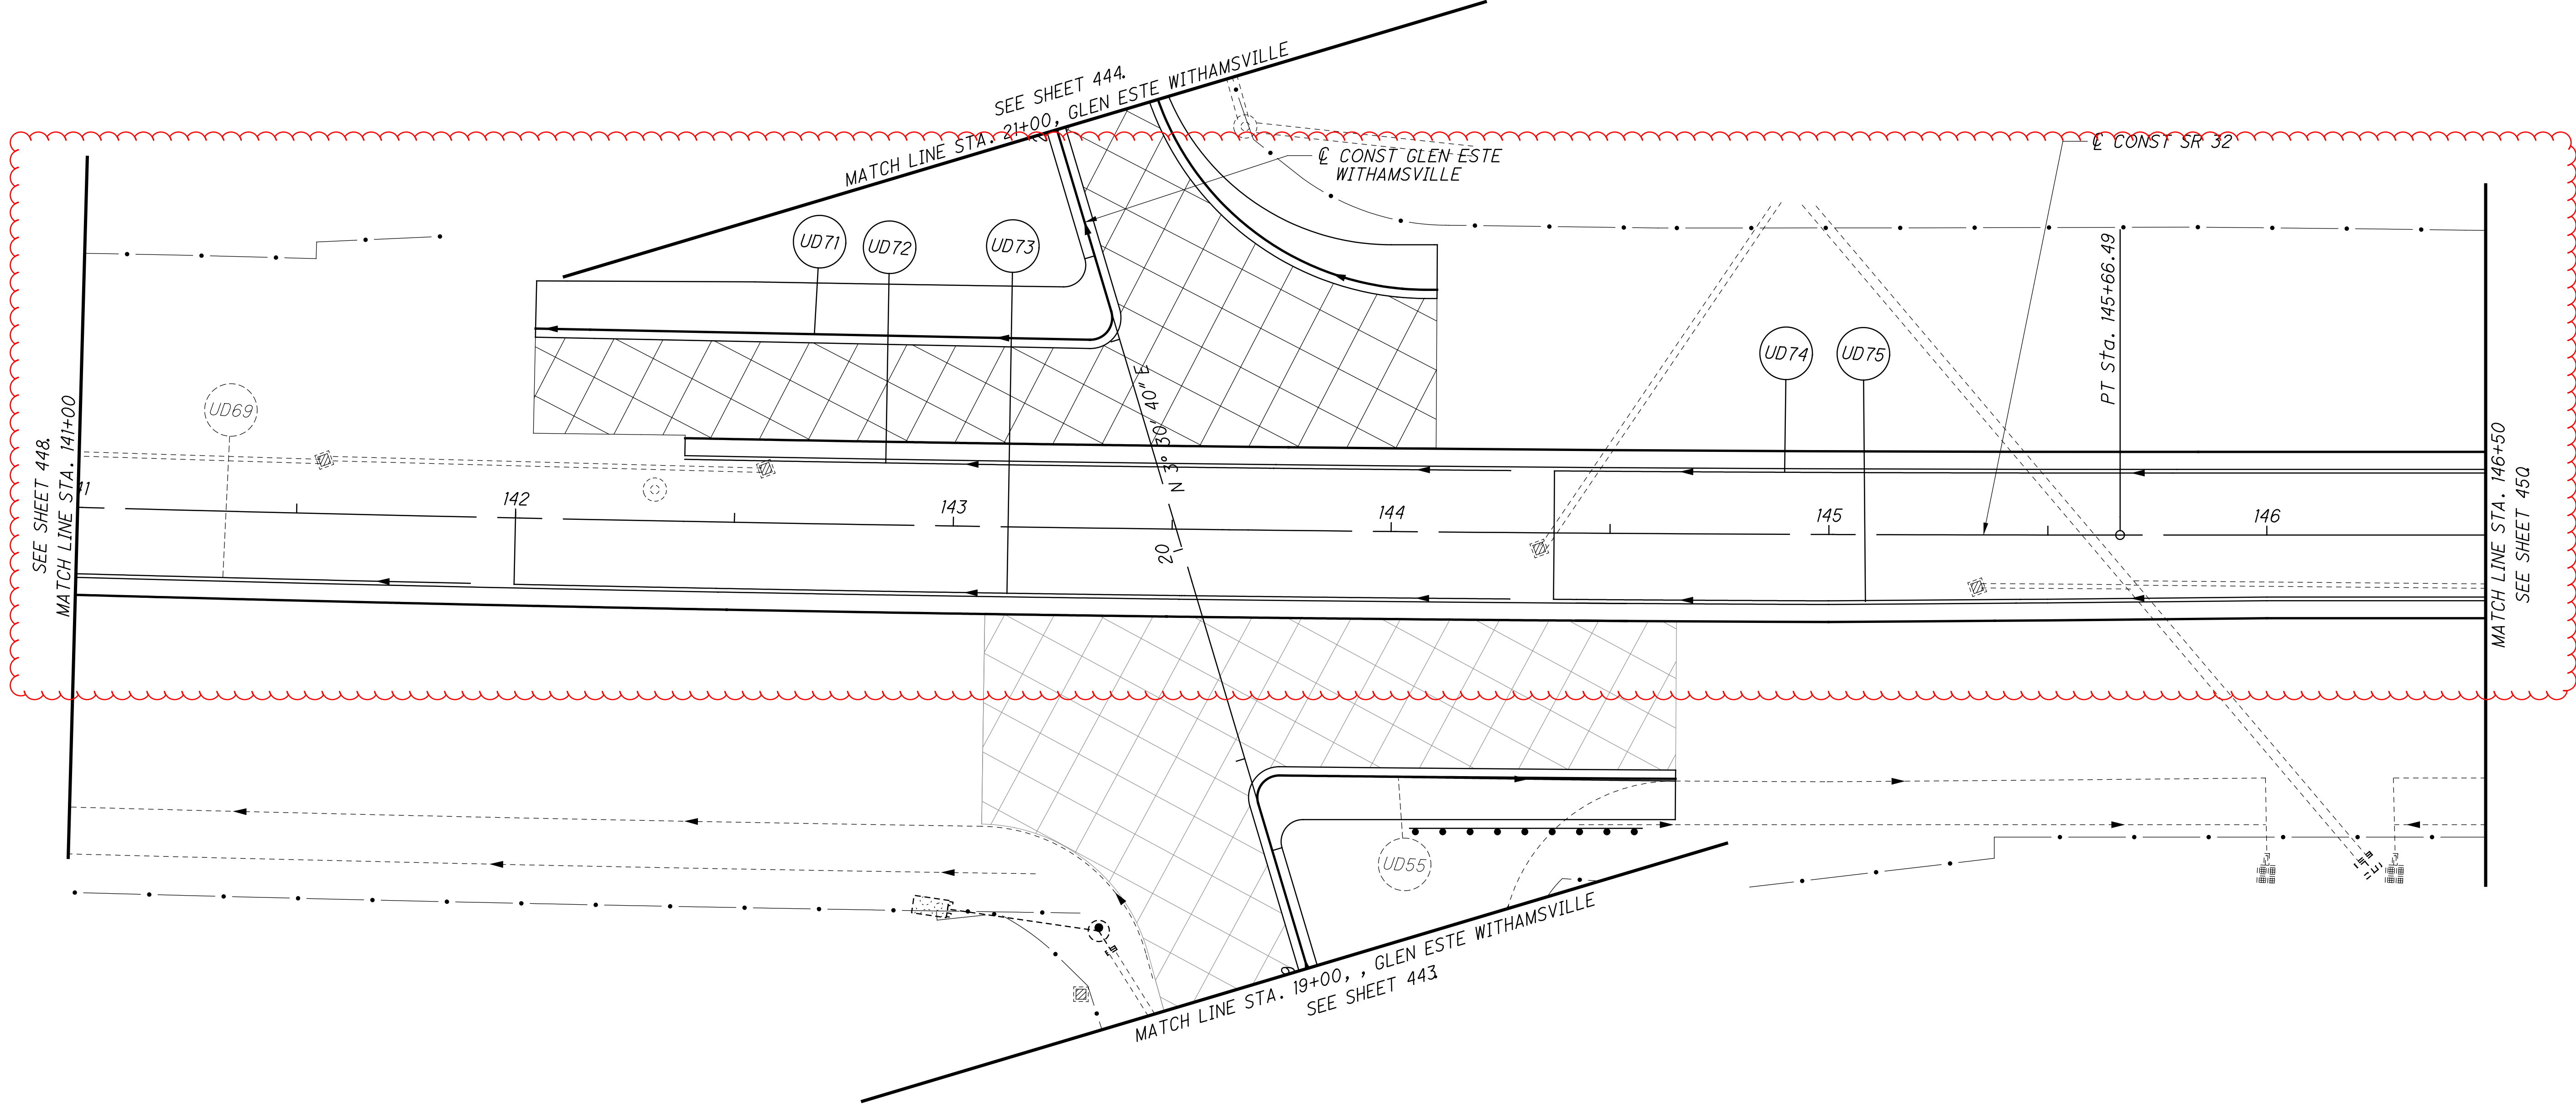




CALCULATED MHT
CHECKED WAA


0 10 20 40
HORIZONTAL SCALE IN FEET

DRAINAGE & UNDERDRAIN PLAN - SR 32
STA. 141+00 TO STA. 146+50

CLE-32-3.50
(PHASE 5)

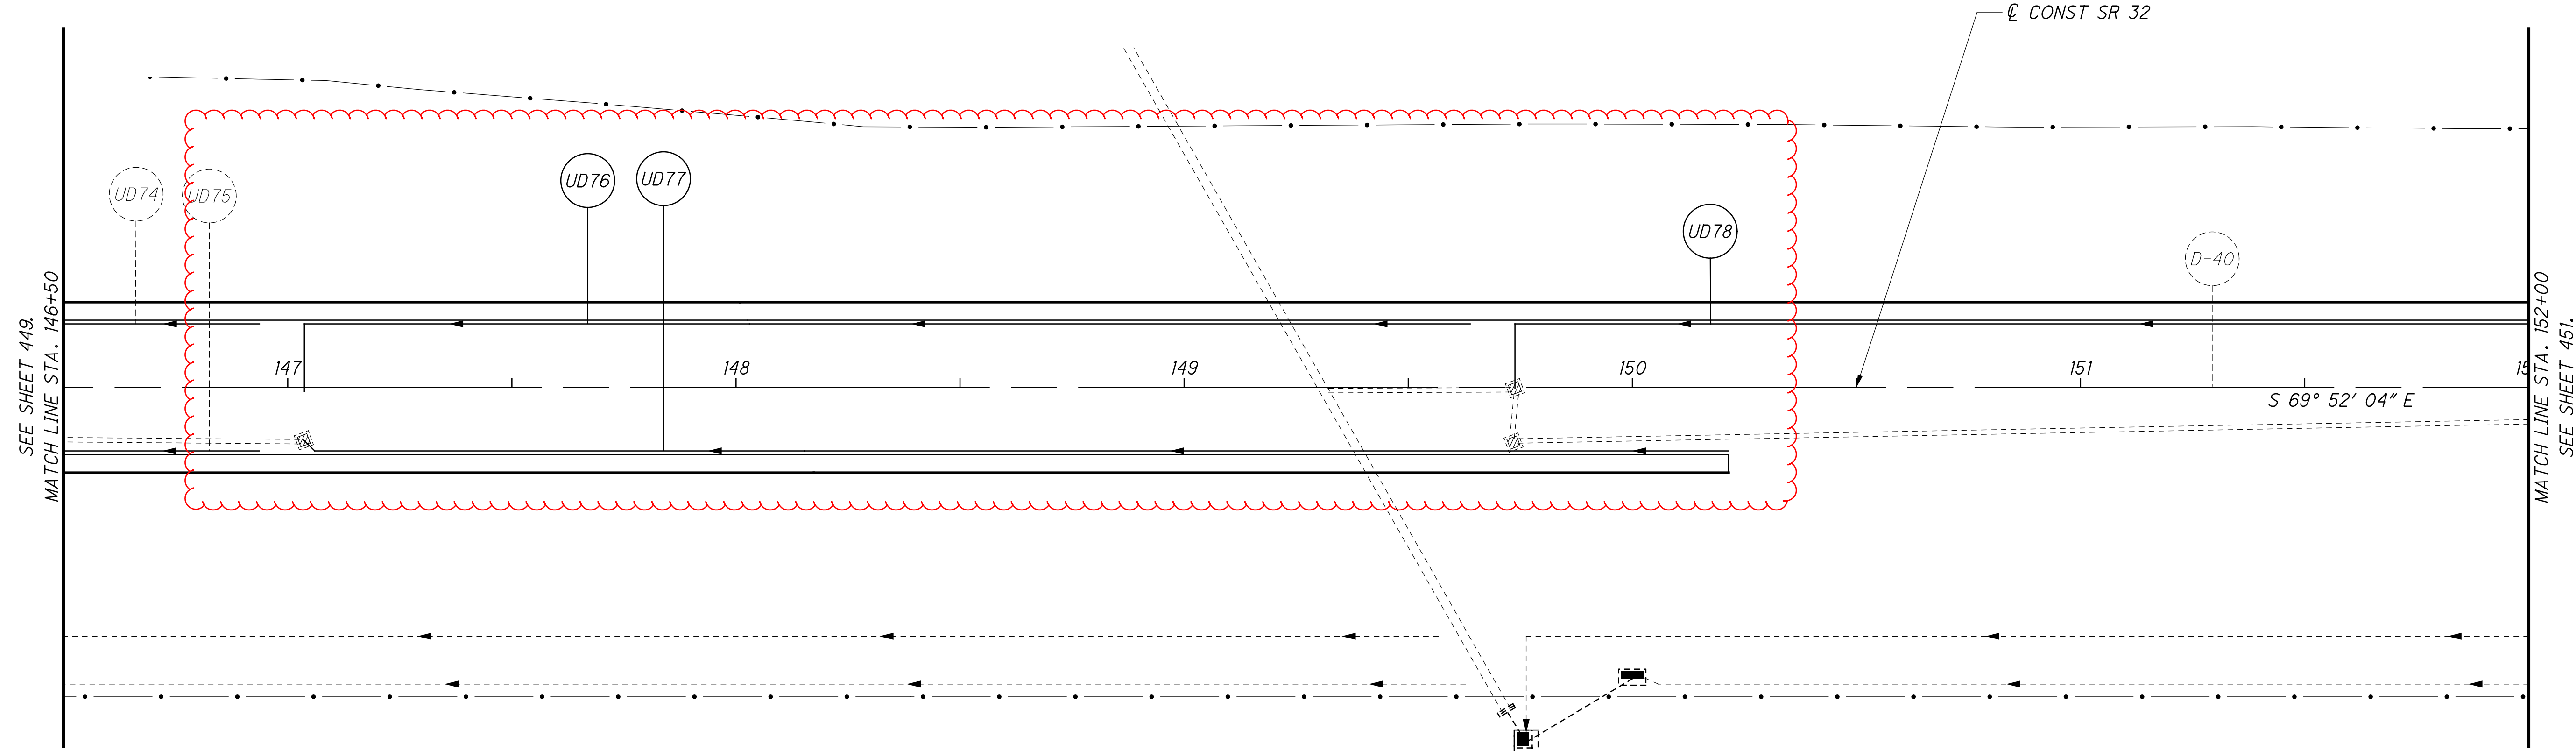

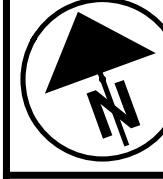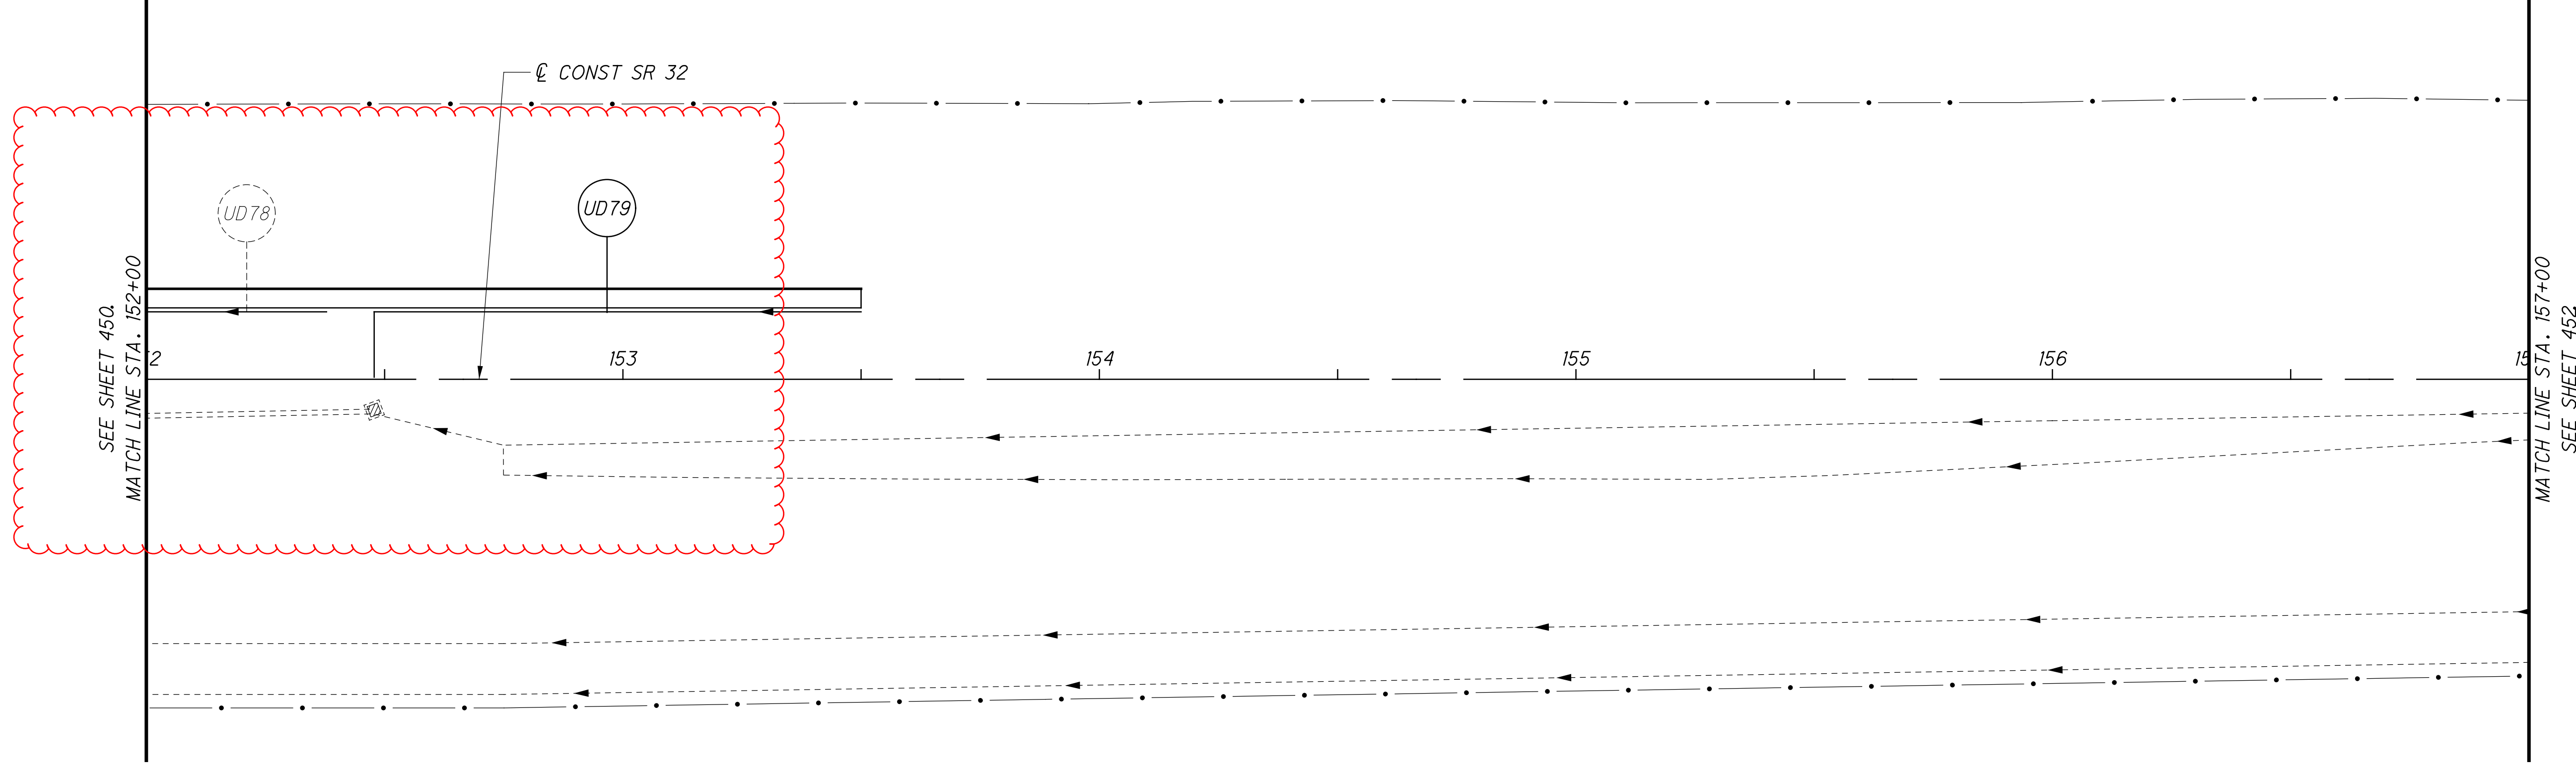

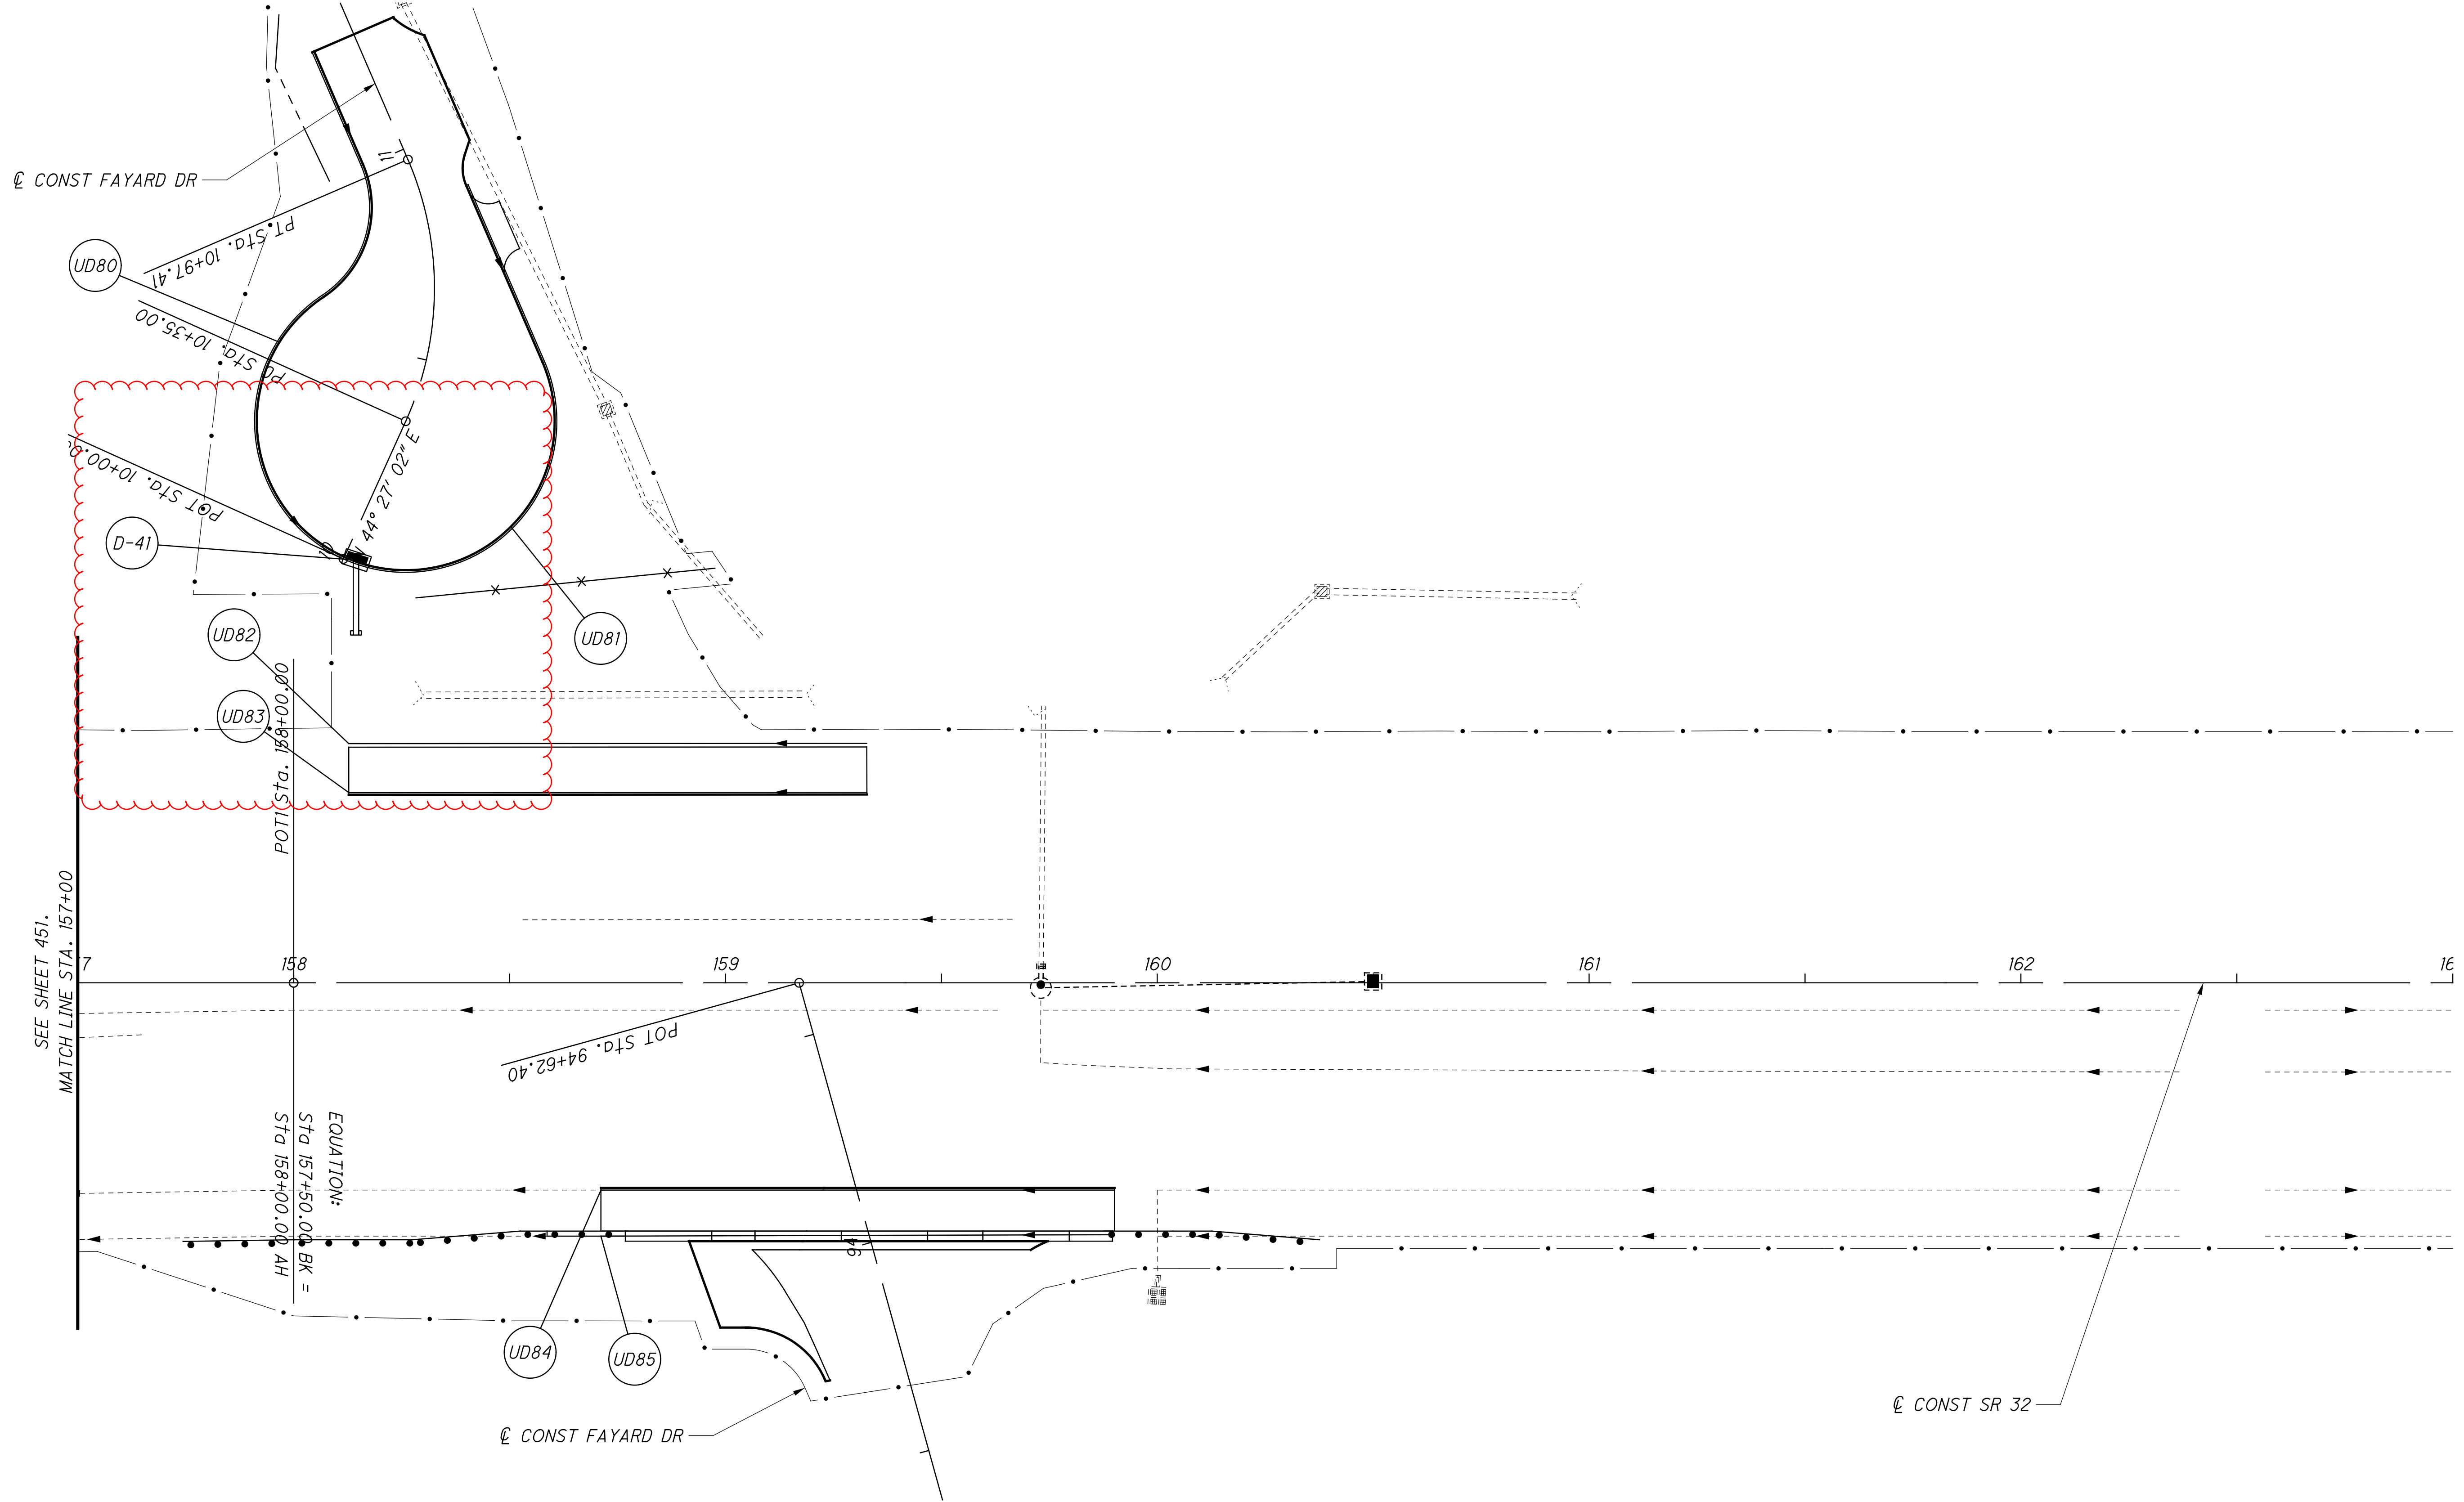


| | |
|------------|-----|
| CALCULATED | MHT |
| CHECKED | WAA |

0 20 40
HORIZONTAL SCALE IN FEET

UNDERDRAIN PLAN - SR 32
STA. 157+00 (BK) TO STA. 163+00 (AH)

CLE-32-3.50
(PHASE 5)

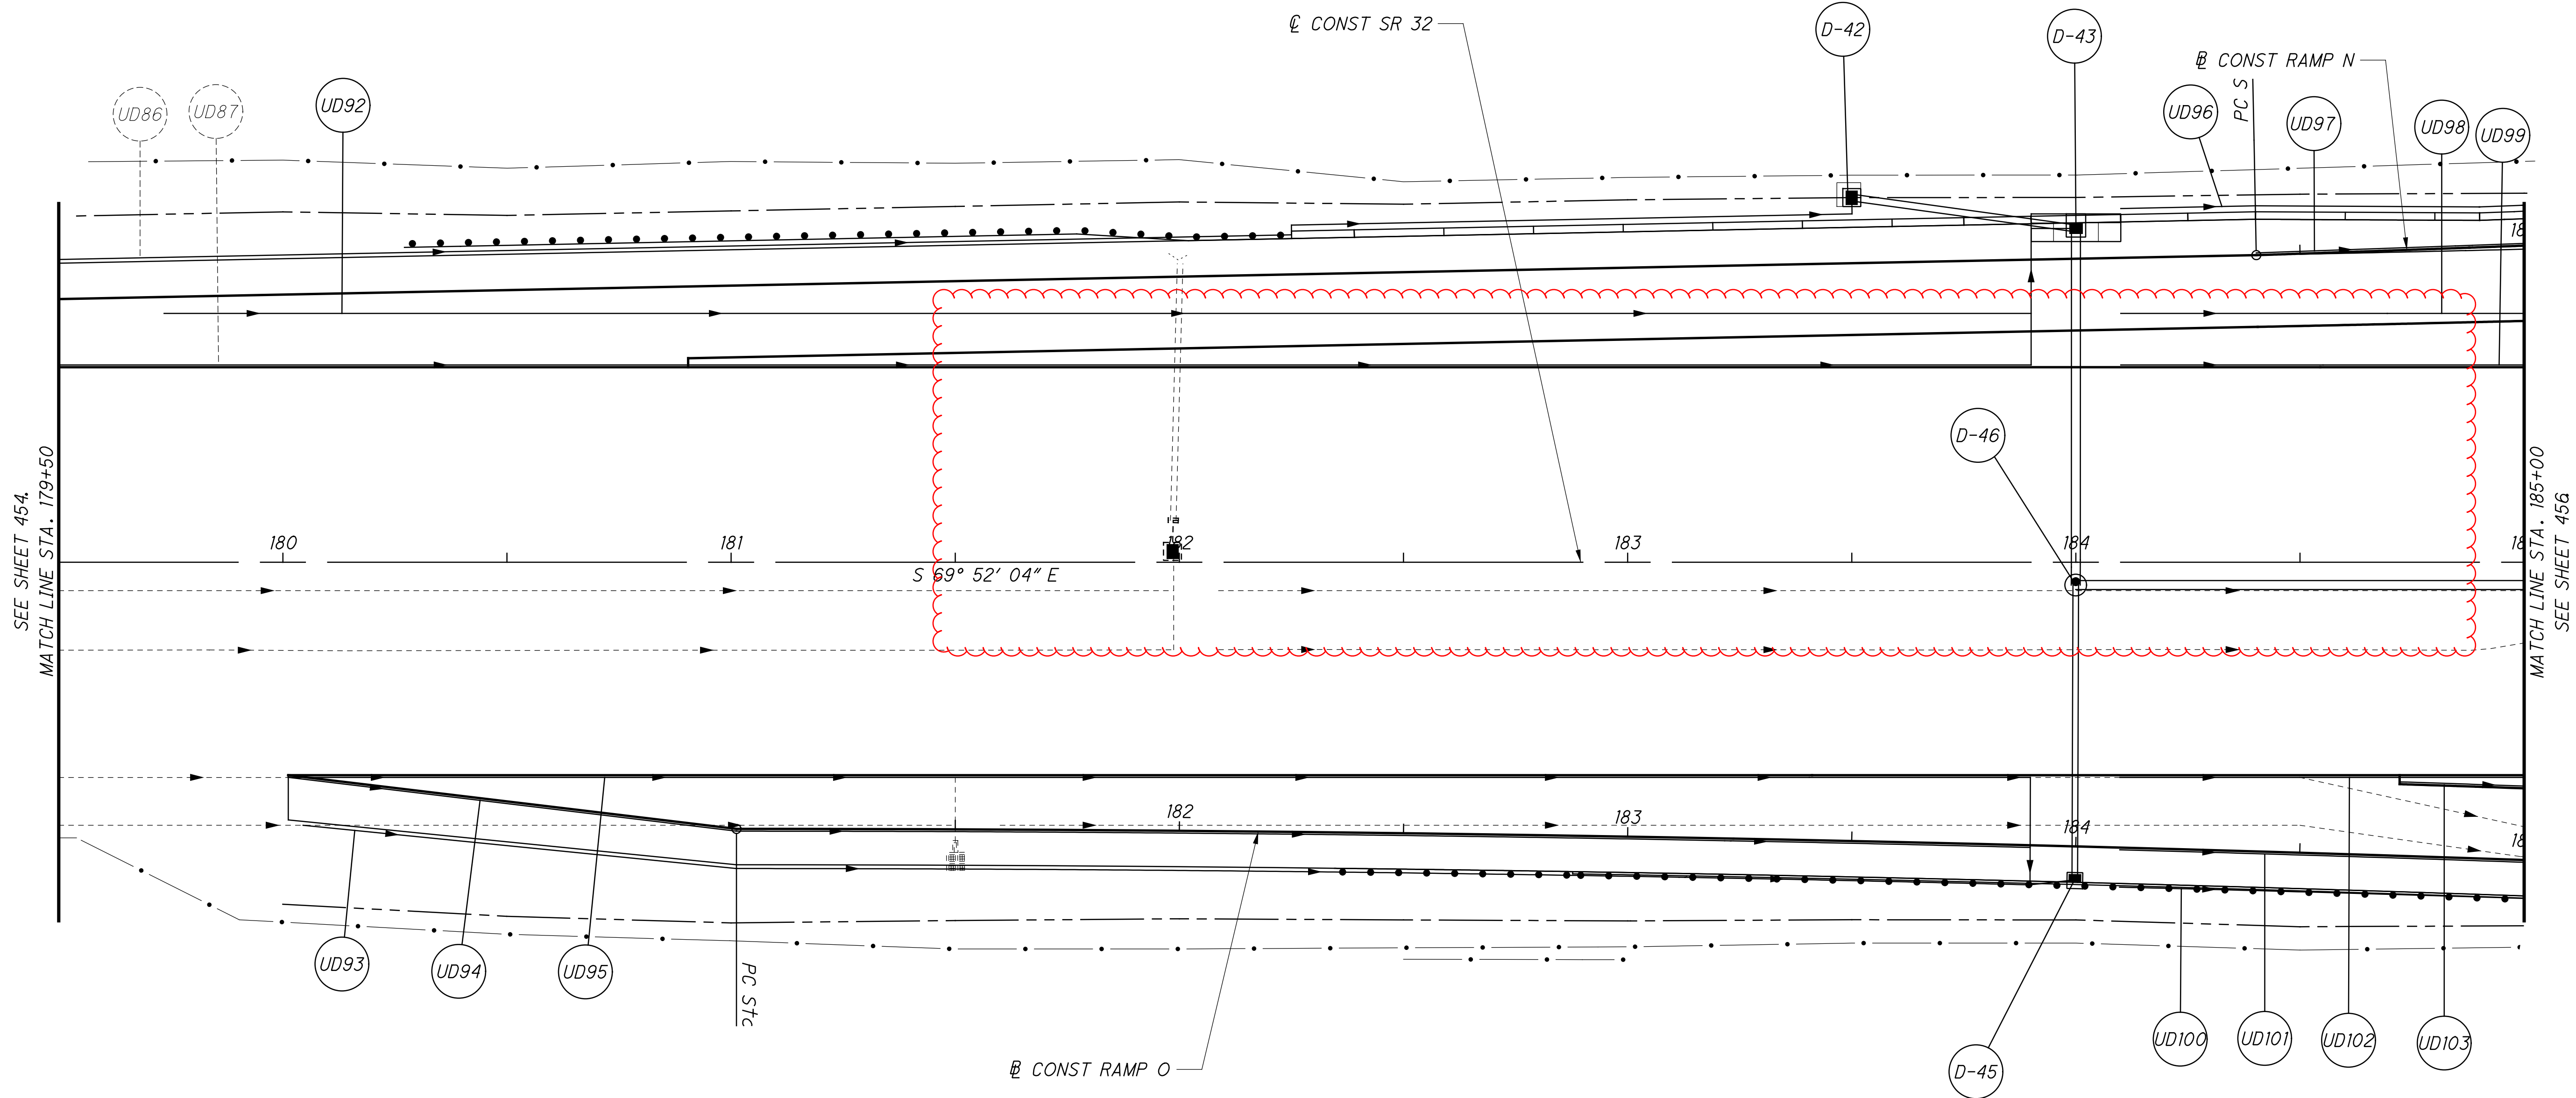


CALCULATED MHT
CHECKED WAA

0 20 40
HORIZONTAL SCALE IN FEET

DRAINAGE & UNDERDRAIN PLAN - SR 32
STA. 179+50 TO STA. 185+00

CLE-32-3.50
(PHASE 5)

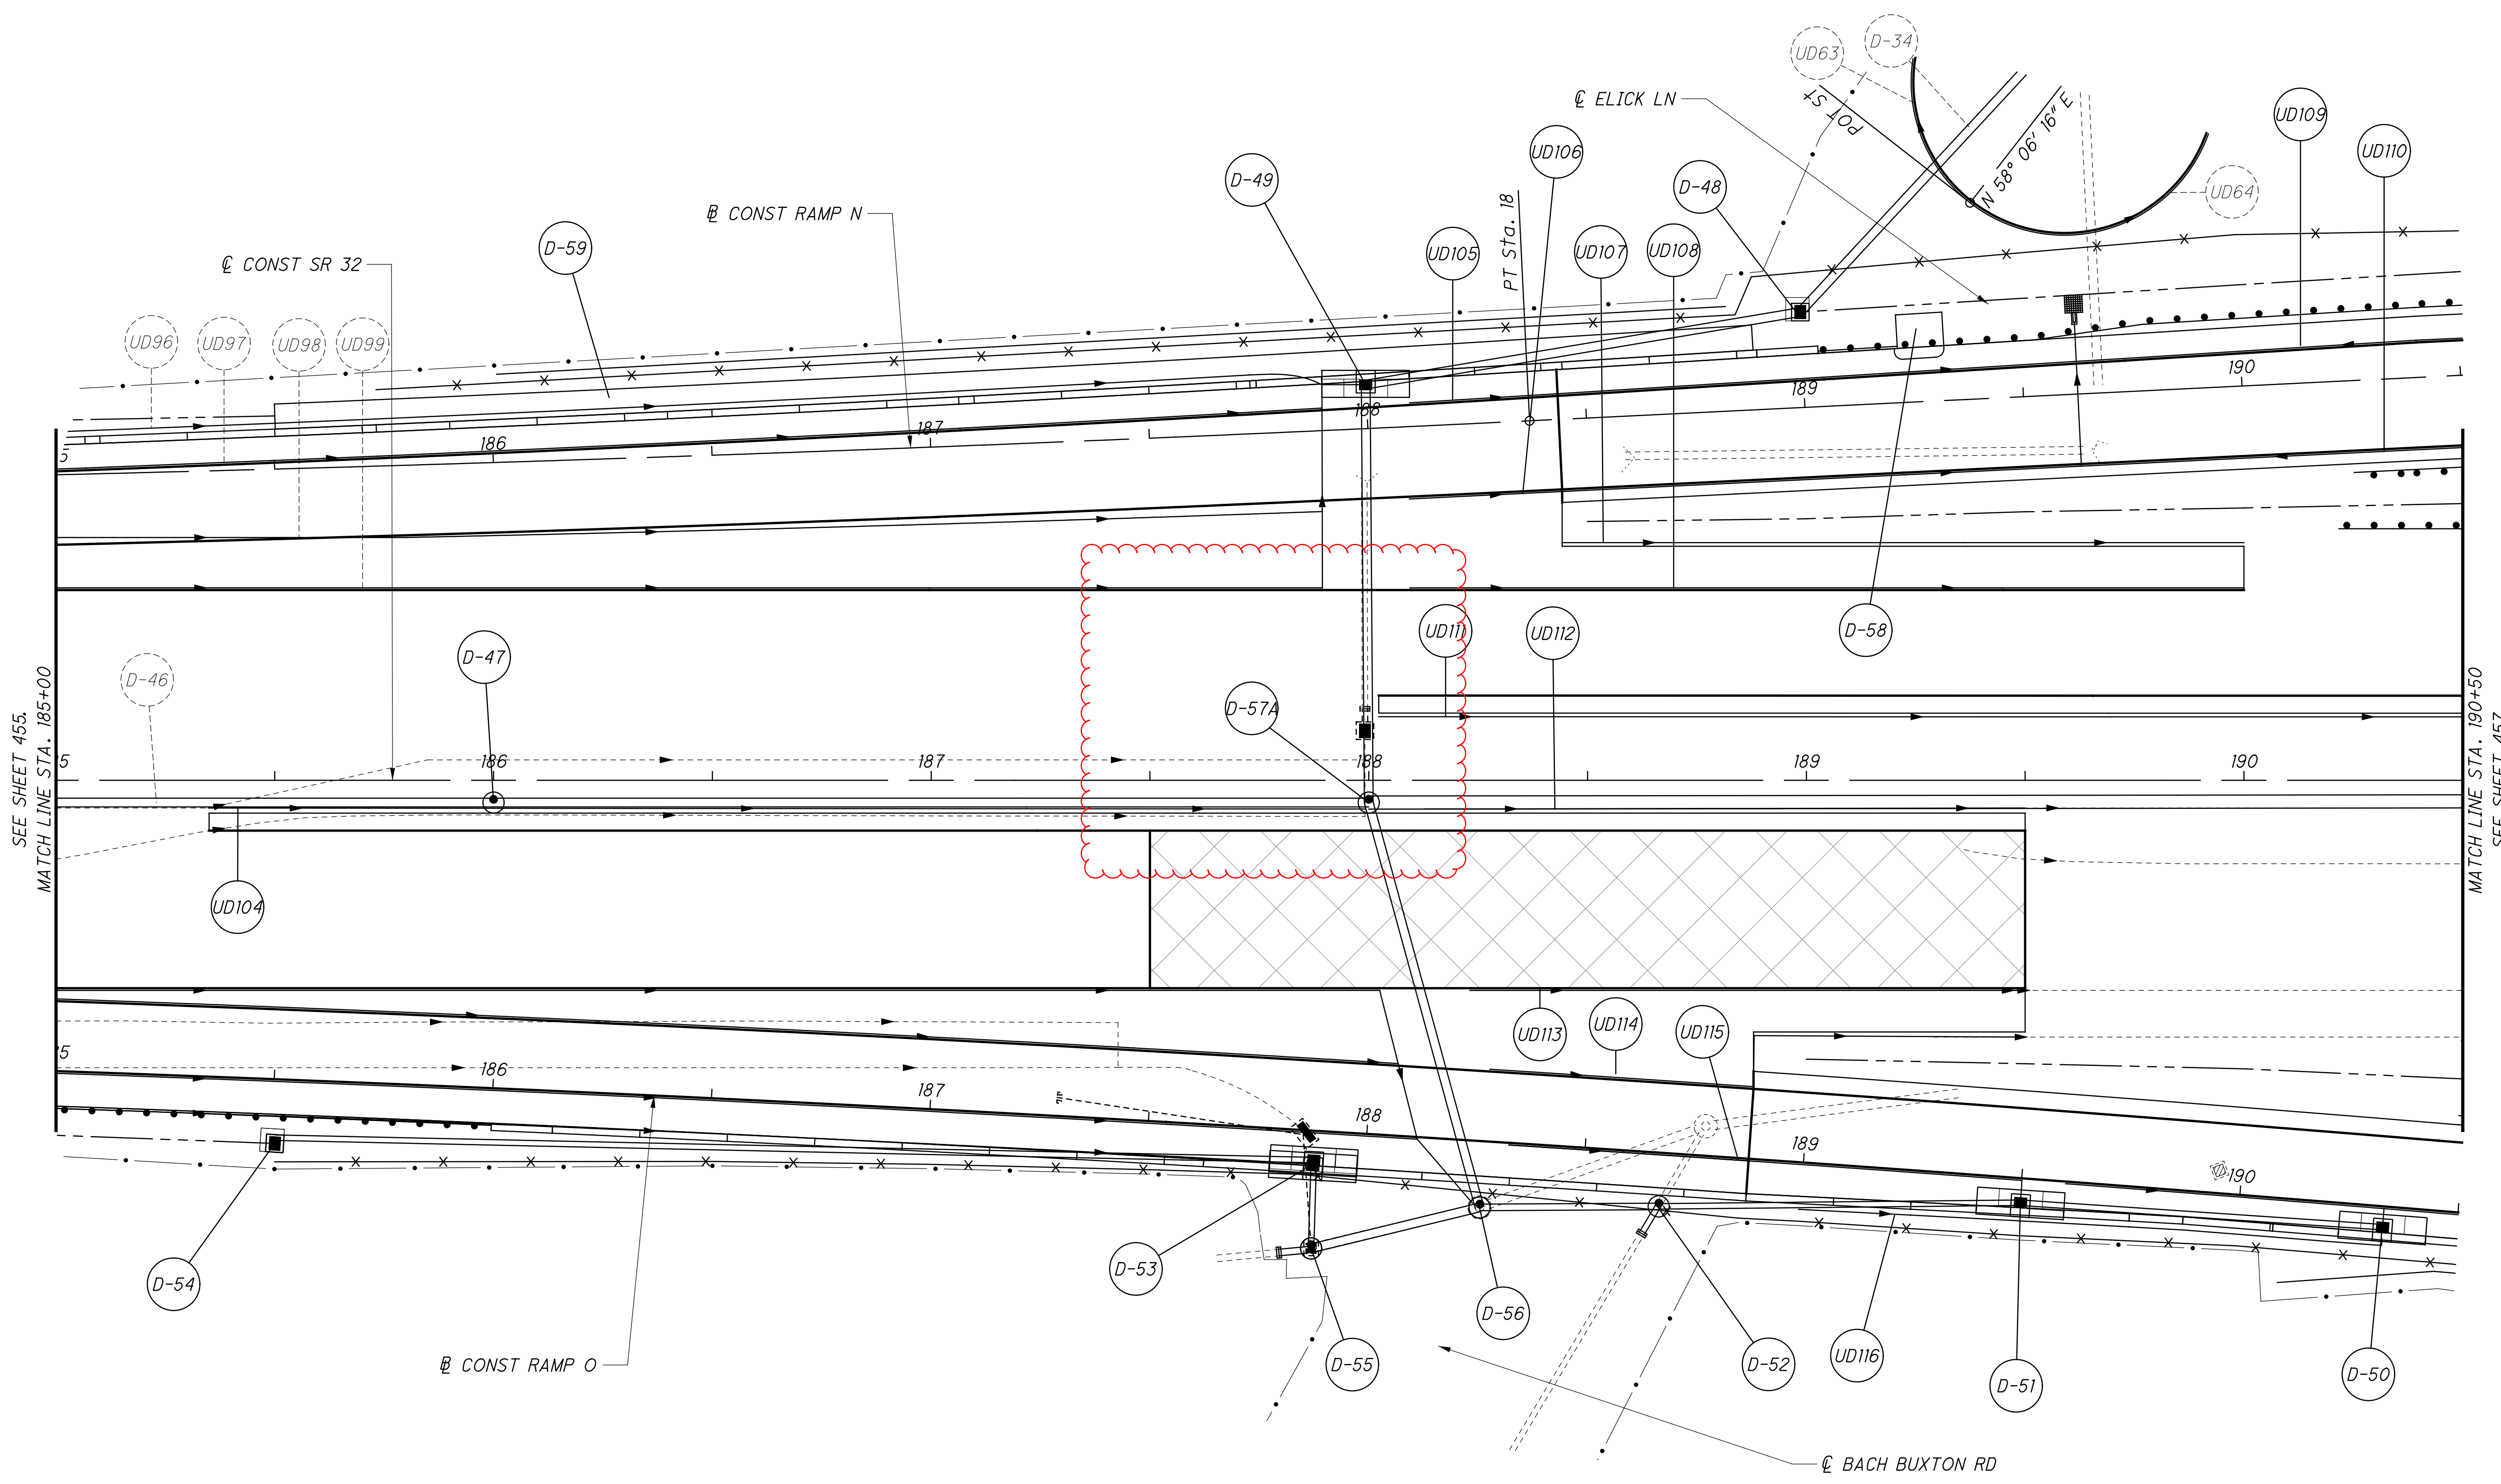


CALCULATED MHT
CHECKED WAA

0 20 40
HORIZONTAL SCALE IN FEET

DRAINAGE & UNDERDRAIN PLAN - SR 32
STA. 185+00 TO STA. 190+50

CLE-32-3.50
(PHASE 5)

SEE SHEET 456.
MATCH LINE STA. 190+50

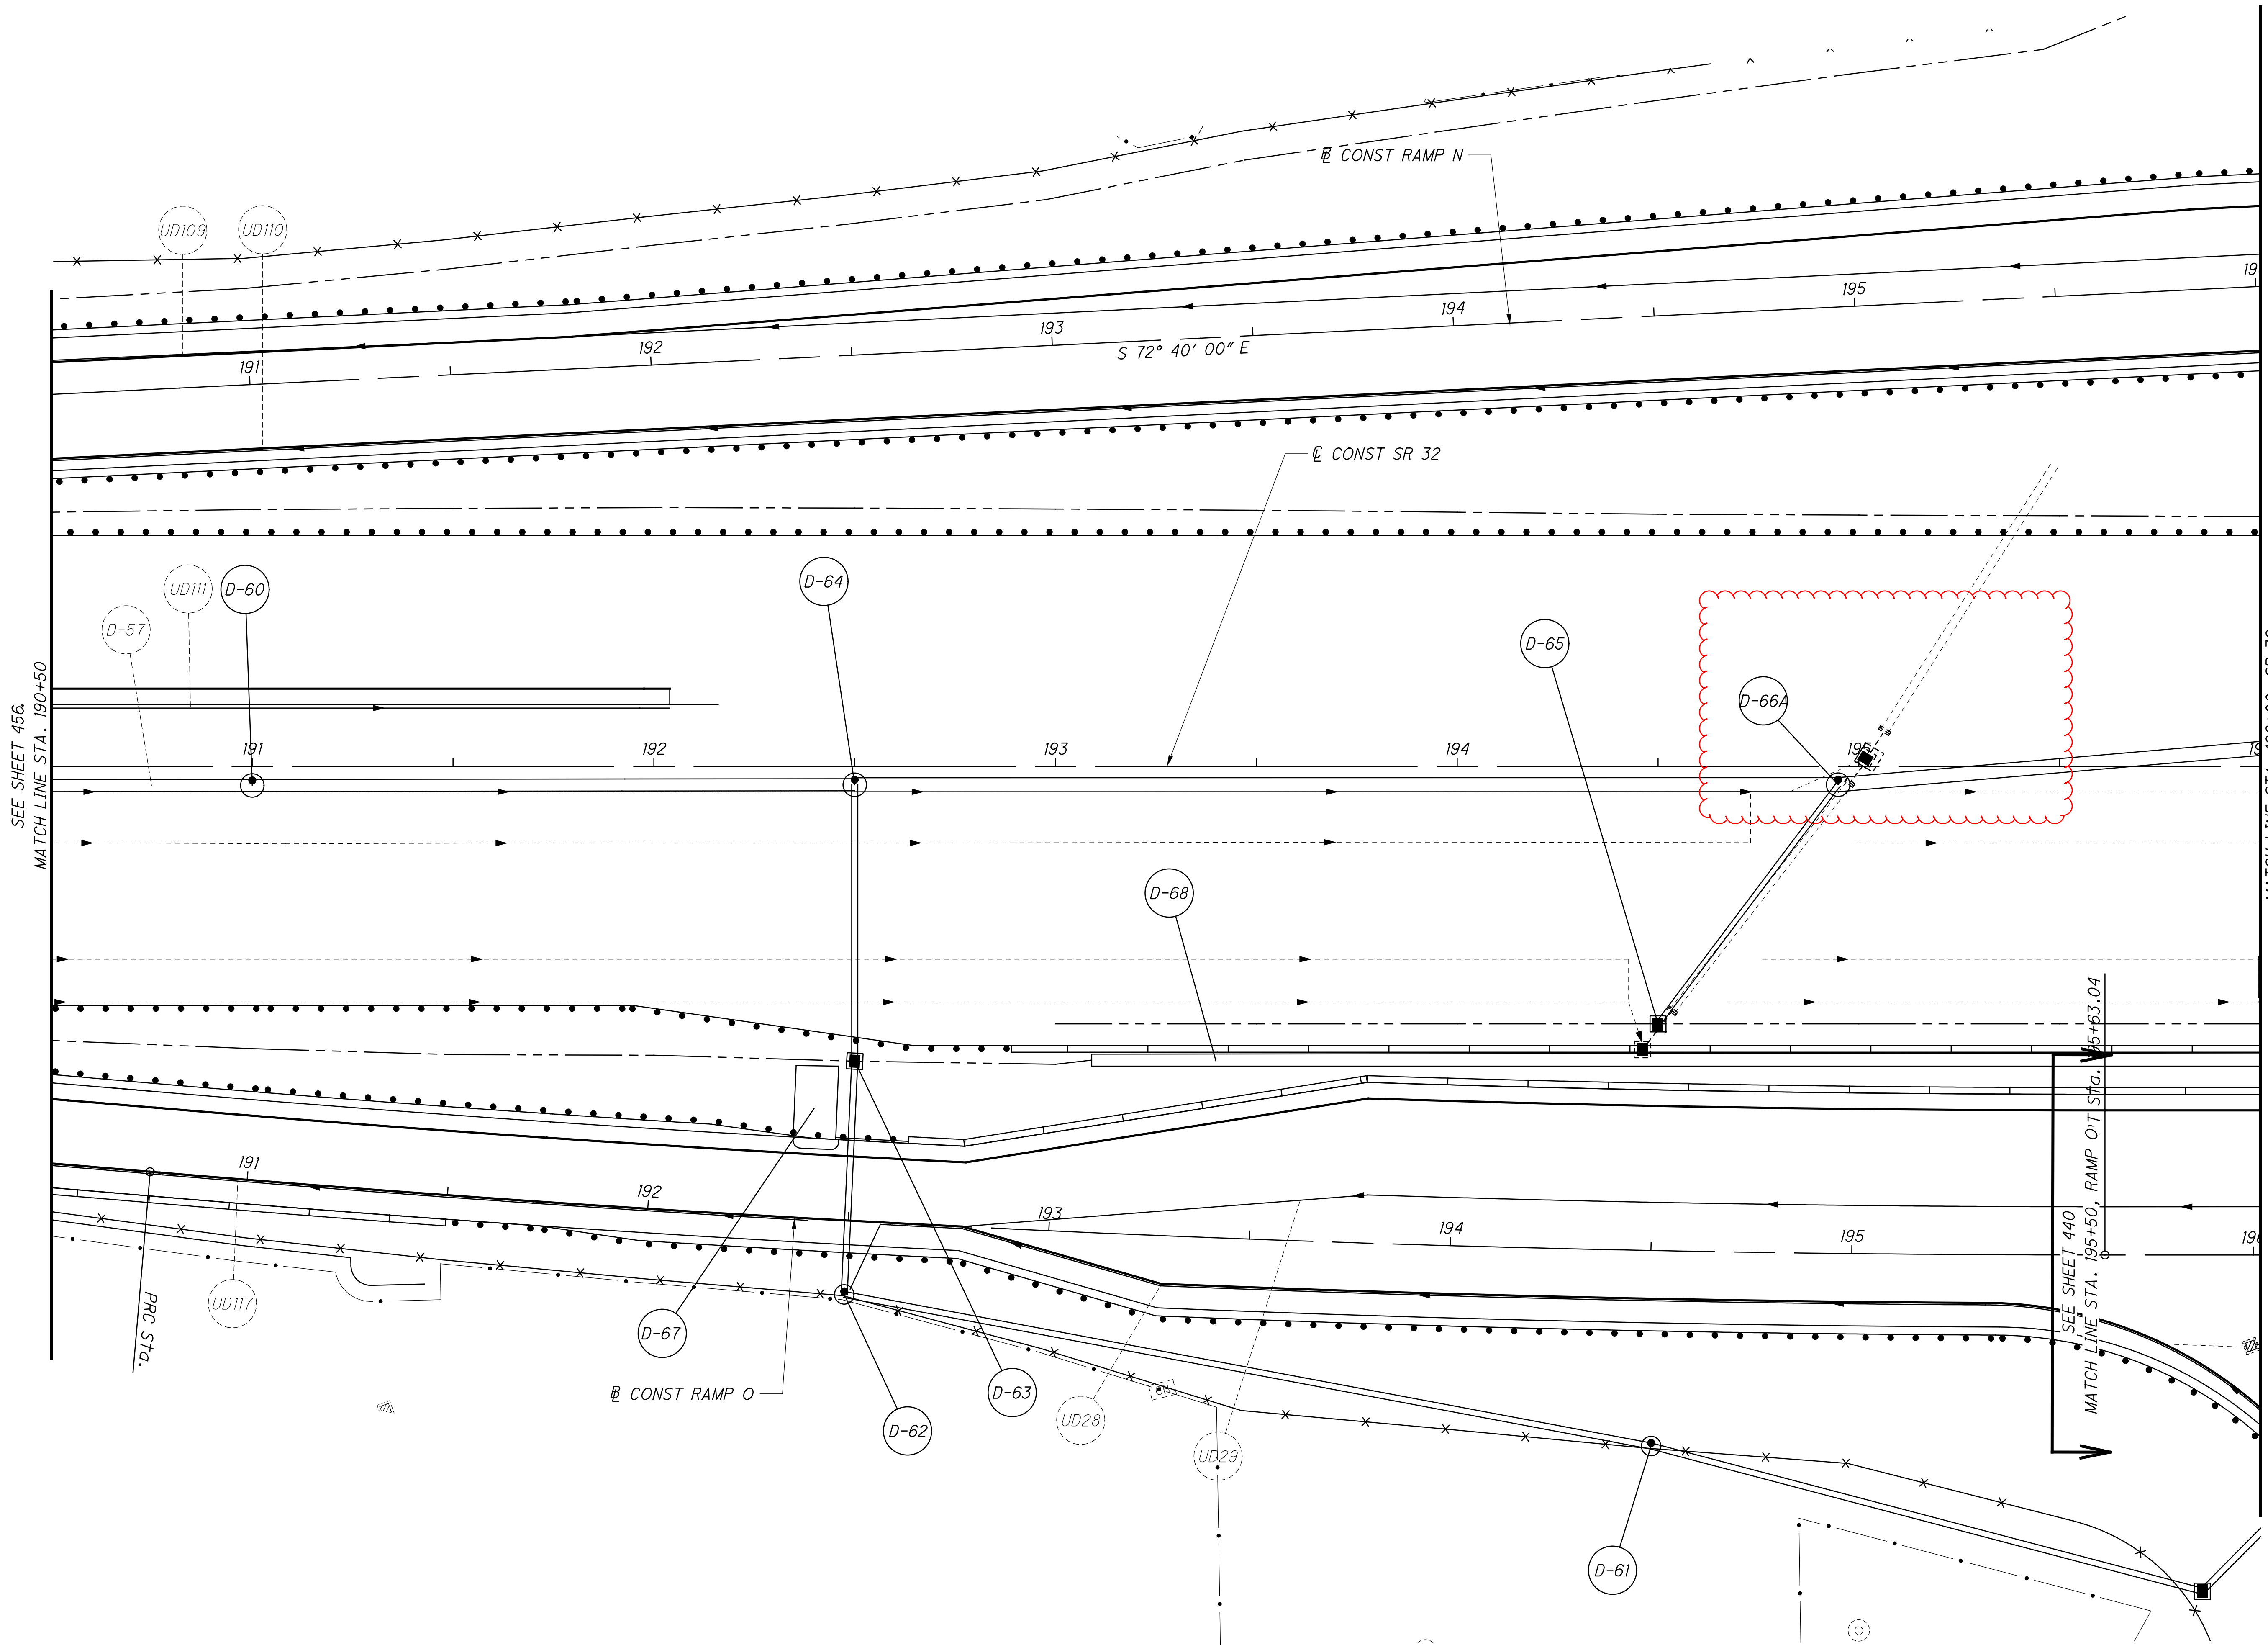


CALCULATED MHT CHECKED WAA

0 10 20 40
HORIZONTAL SCALE IN FEET

DRAINAGE & UNDERDRAIN PLAN - SR 32
STA. 190+50 TO STA. 196+00

CLE-32-3.50
(PHASE 5)

...103954DP523.dgn 11/19/2021 1:58:14 PM mswwhitt

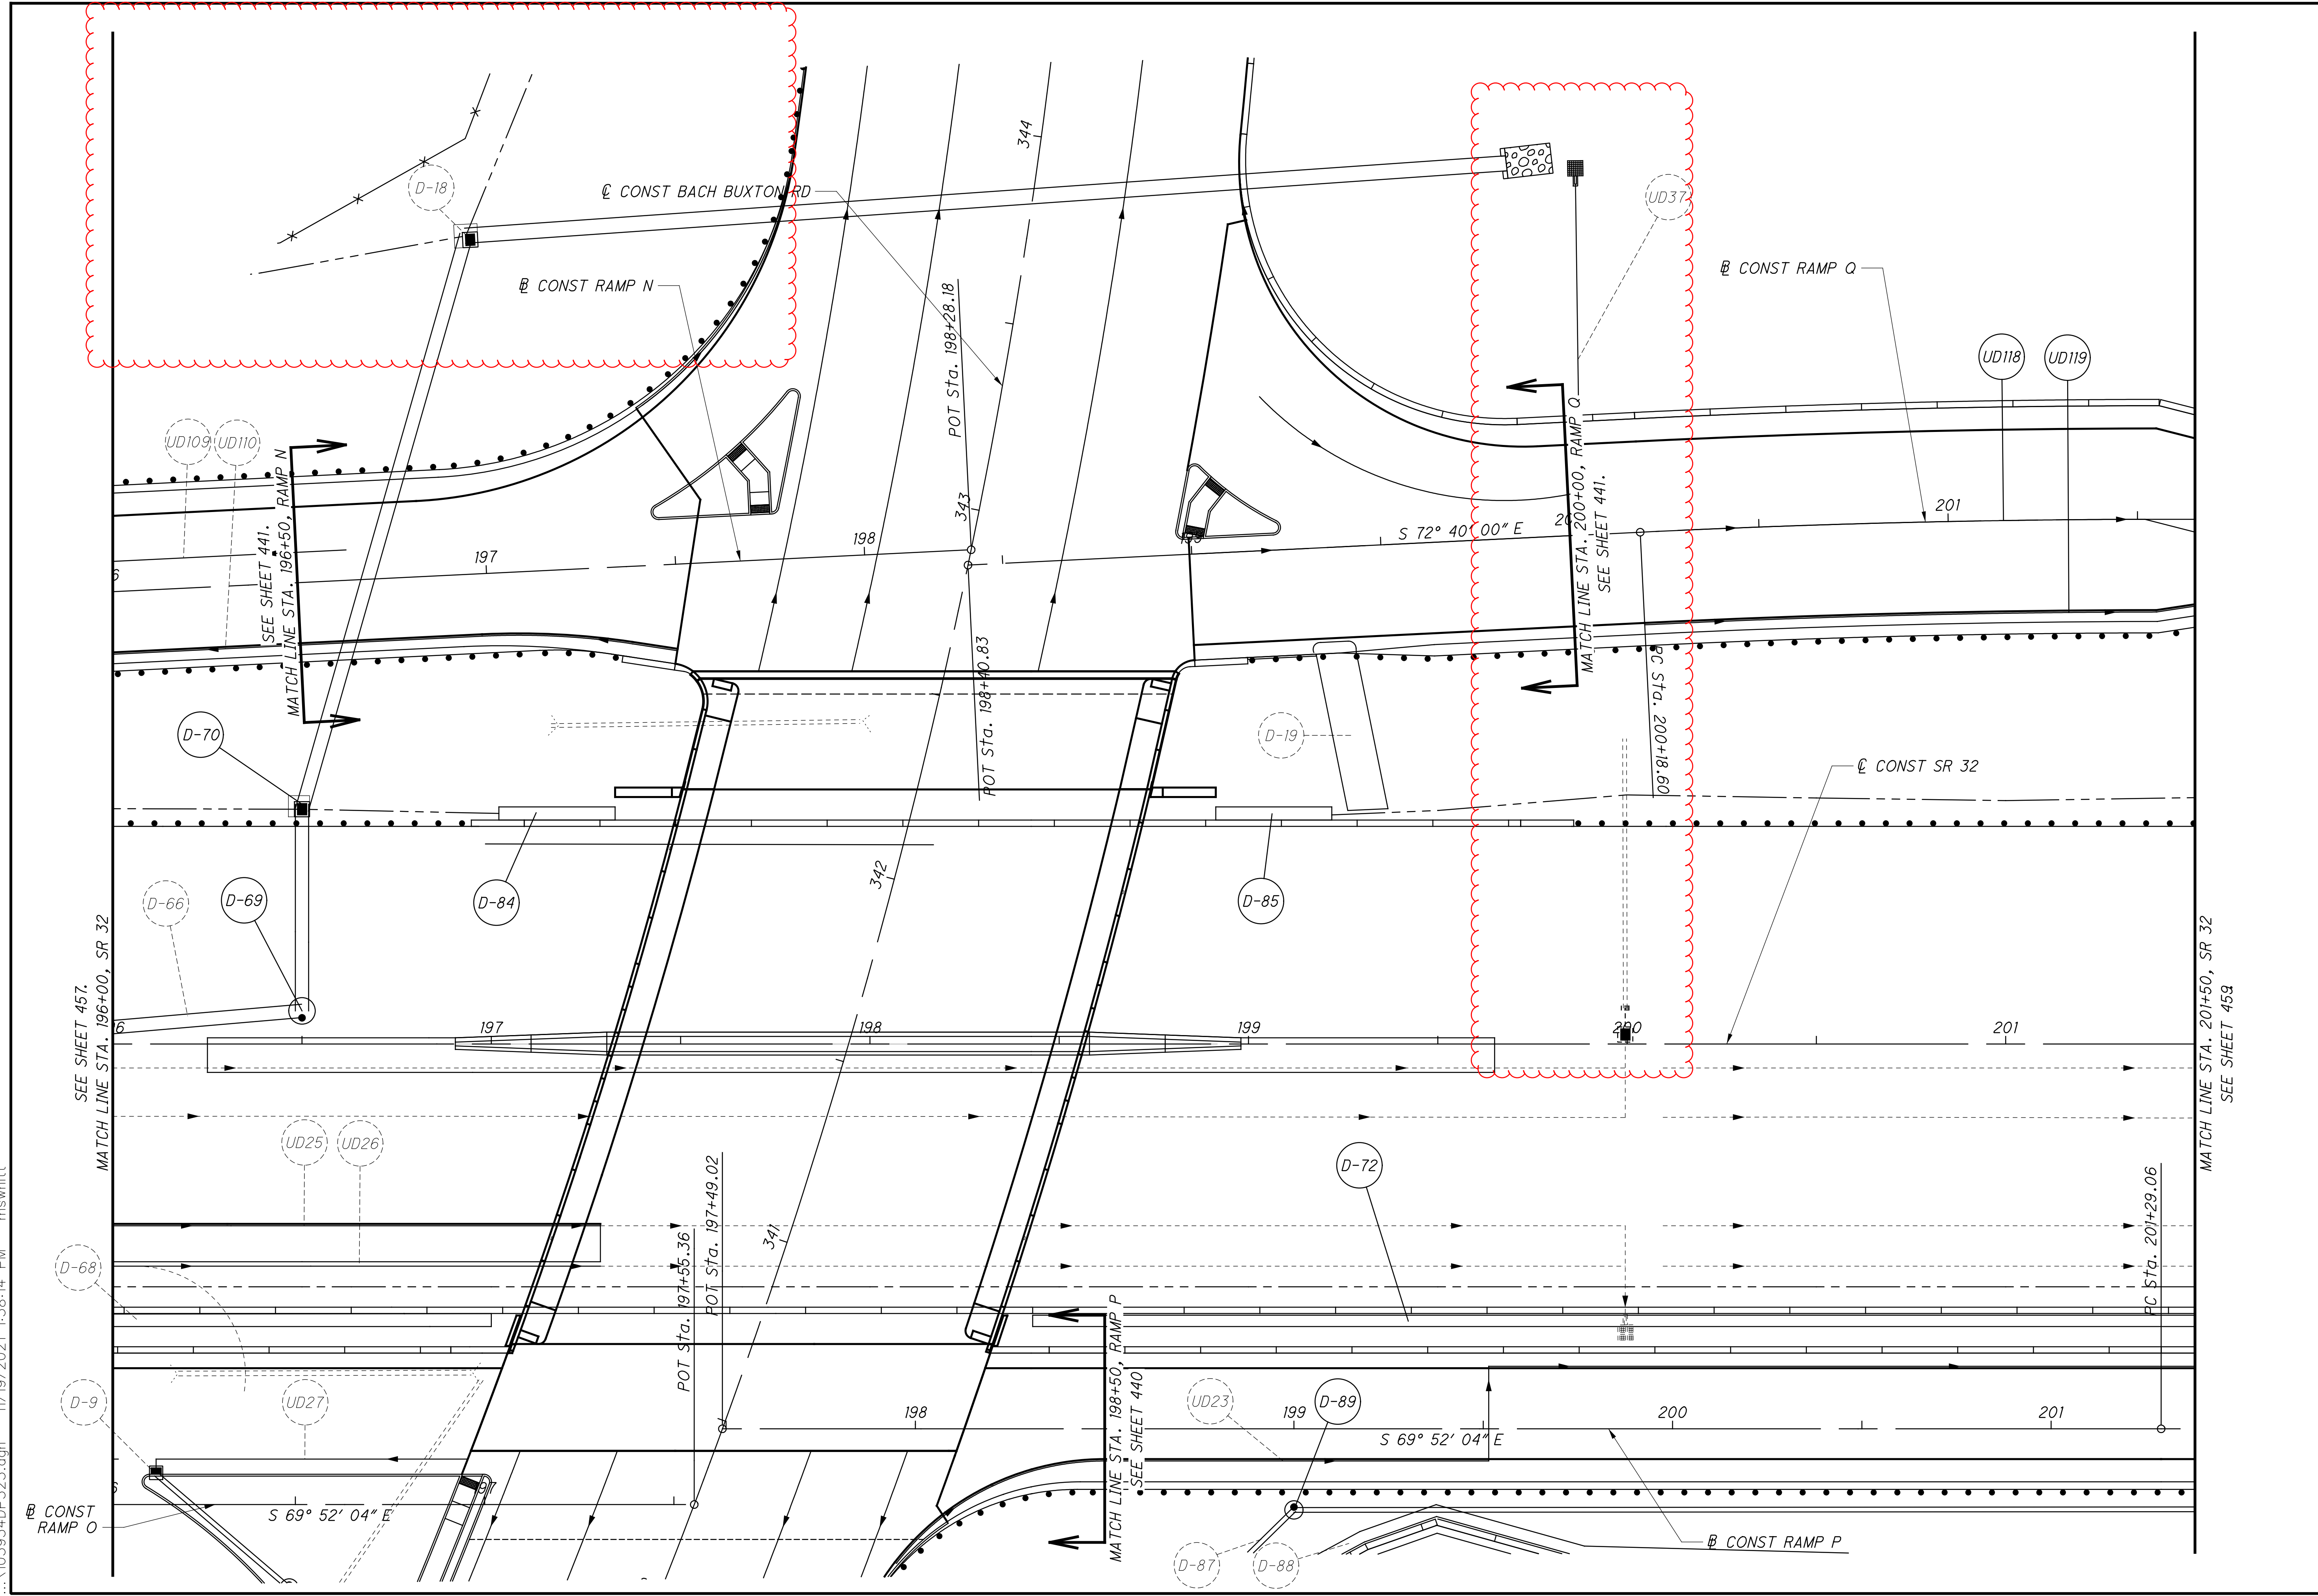

CALCULATED MHT
CHECKED WAA


0 20 40
HORIZONTAL SCALE IN FEET

DRAINAGE & UNDERDRAIN PLAN - SR 32
STA. 196+00 TO STA. 201+50

CLE-32-3.50
(PHASE 5)

458
736

...\\103954DP524.dgn 11/19/2021 1:58:18 PM mswntt

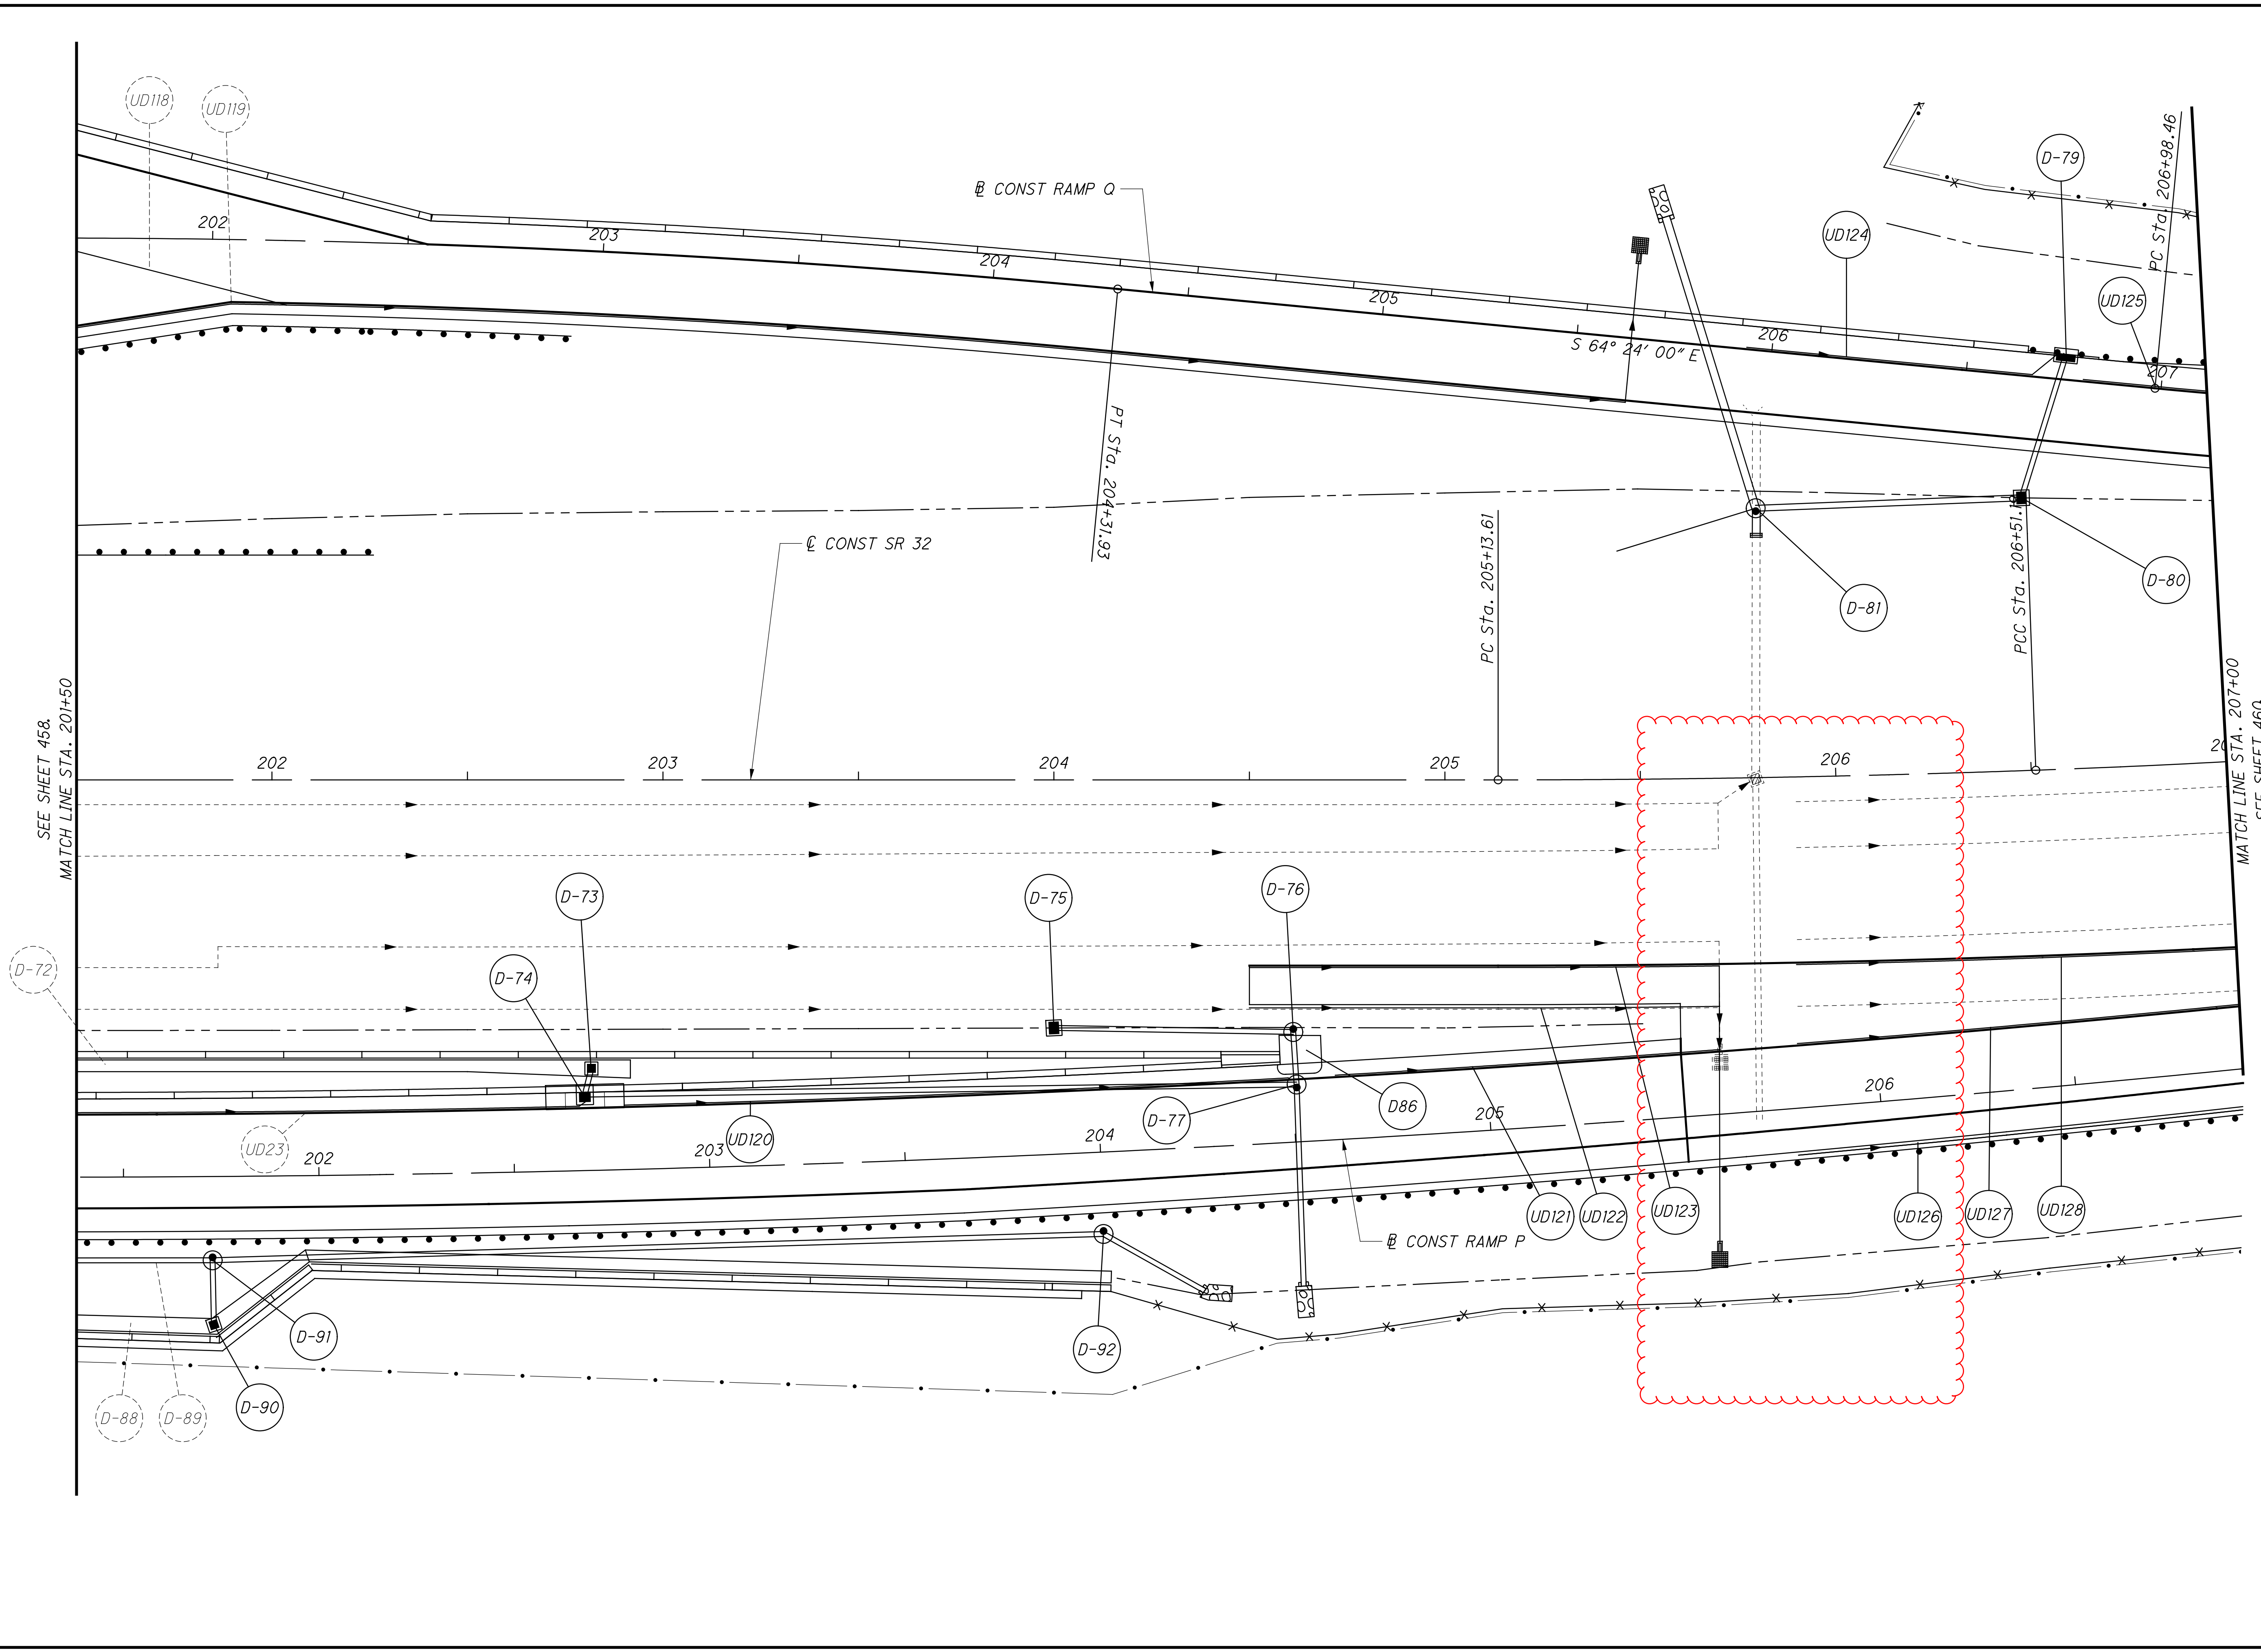

SEE SHEET 458.
MATCH LINE STA. 201+50


MATCH LINE STA. 207+00
SEE SHEET 460

CALCULATED MHT
CHECKED WAA

0 20 40
HORIZONTAL SCALE IN FEET

DRAINAGE & UNDERDRAIN PLAN - SR 32
STA. 201+50 TO STA. 207+00

CLE-32-3.50
(PHASE 5)

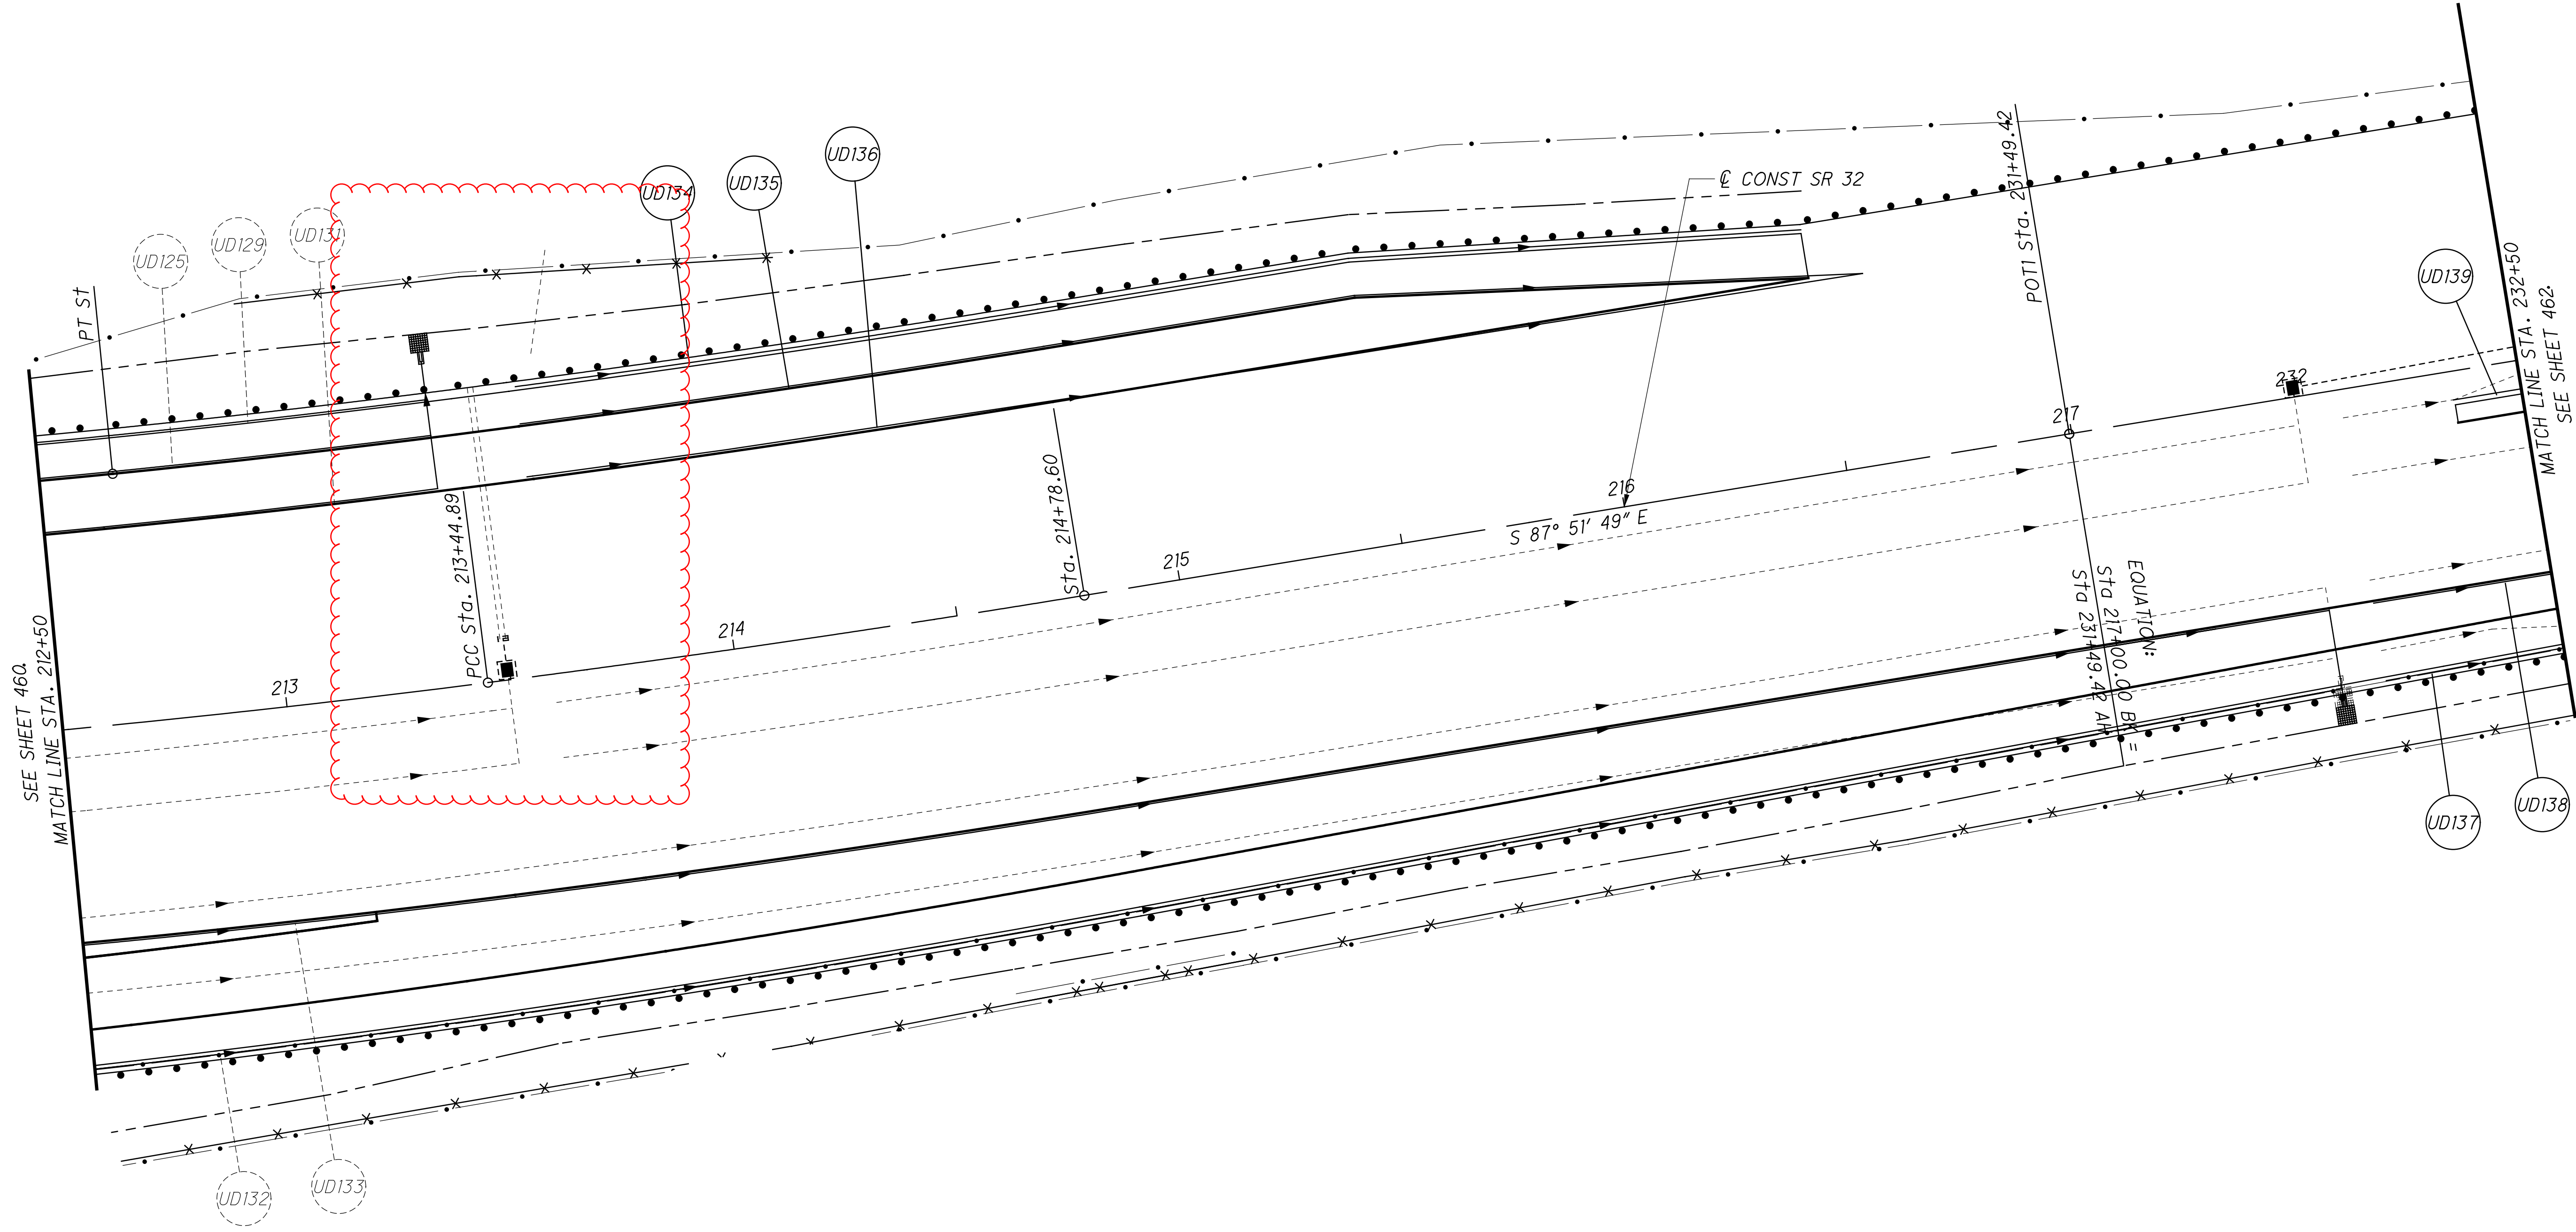

...310.20\310.205\103954\TS502.dgn 11/18/2021 4:25:26 PM ssopraseuth

| SHEET NO. | REFERENCE NO. | LOCATION | STATION | | SIDE | 626 | 626 | 642 | 644 | 644 | 807 / 850 | 807 / 850 | 644 | 807 / 850 | 644 | 644 | 644 | 807 / 850 | 644 | 644 | 644 | 644 | 644 |
|------------------------------------|---------------|--------------------|---------|--------|-------|----------------------------------|----------------------------------|---------------------------|-----------------------|------------------------|---|--|---------------|---|-----------------------------|----------------------------|-----------------------|---|-----------|----------------|----------------------------|-----------------|----------------|
| | | | FROM | TO | | BARRIER REFLECTOR, TYPE 1, INWAY | BARRIER REFLECTOR, TYPE 2, INWAY | PARKING LOT STALL MARKING | EDGE LINE, 4" (WHITE) | EDGE LINE, 4" (YELLOW) | WET REFLECTIVE THERMOPLASTIC PAVEMENT MARKING, EDGE LINE, 6" (WHITE) / GROOVING FOR 6" RECESSED PAVEMENT MARKING, (ASPHALT) | WET REFLECTIVE THERMOPLASTIC PAVEMENT MARKING, EDGE LINE, 6" (YELLOW) / GROOVING FOR 6" RECESSED PAVEMENT MARKING, (ASPHALT) | LANE LINE, 4" | WET REFLECTIVE THERMOPLASTIC PAVEMENT MARKING, LANE LINE, 6" / GROOVING FOR 6" RECESSED PAVEMENT MARKING, (ASPHALT) | CENTER LINE (DOUBLE YELLOW) | CENTER LINE (DASHED/SOLID) | CHANNELIZING LINE, 8" | WET REFLECTIVE THERMOPLASTIC PAVEMENT MARKING, CHANNELIZING LINE, 12" / GROOVING FOR 12" RECESSED PAVEMENT MARKING, (ASPHALT) | STOP LINE | CROSSWALK LINE | TRANSVERSE / DIAGONAL LINE | CHEVRON MARKING | ISLAND MARKING |
| | | | | | | EACH | EACH | FT | MILE | MILE | MILE | MILE | MILE | MILE | MILE | FT | FT | FT | FT | FT | FT | FT | SF |
| 507 | BRB2 | BACH BUXTON/RMP Q | 346+16 | 206+65 | RT/LT | 10 | | | | | | | | | | | | | | | | | |
| | BRA4 | BACH BUXTON | 346+21 | 346+70 | RT | | 1 | | | | | | | | | | | | | | | | |
| | LA32 | BACH BUXTON | 346+26 | | RT | | | | | | | | | | | | | | | | | | |
| | LA33 | BACH BUXTON | 346+55 | | LT | | | | | | | | | | | | | | | | | | |
| | LA34 | BACH BUXTON | 346+92 | | RT | | | | | | | | | | | | | | | | | | |
| | LA35 | BACH BUXTON | 347+21 | | LT | | | | | | | | | | | | | | | | | | |
| | LA36 | BACH BUXTON | 347+58 | | RT | | | | | | | | | | | | | | | | | | |
| | LA37 | BACH BUXTON | 347+80 | | LT | | | | | | | | | | | | | | | | | | |
| | WP10 | BACH BUXTON | 348+24 | | RT | | | | | | | | | | | | | | | | | | |
| | LA38 | BACH BUXTON | 348+90 | | RT | | | | | | | | | | | | | | | | | | |
| | SL12 | BACH BUXTON | 349+00 | | RT | | | | | | | | | | | | | | | | | | |
| | DTW7 | BACH BUXTON/OLD 74 | 349+00 | 211+64 | RT/LT | | | | | | | | | | | | | | | | | | |
| | | | | | | | | | | | | | | | | | | | | | | | |
| 508 | ELY3 | SR 32 | 133+95 | 157+50 | RT | | | | | | 0.45 | | | | | | | | | | | | |
| | LL9 | SR 32 | 133+95 | 157+50 | RT | | | | | | | | 0.45 | | | | | | | | | | |
| | LL10 | SR 32 | 133+95 | 157+50 | RT | | | | | | | | 0.45 | | | | | | | | | | |
| | | | | | | | | | | | | | | | | | | | | | | | |
| | DTD1 | SR 32 | 133+95 | 139+39 | RT | | | | | | | | | | | | | | | | | | |
| | ELW9 | SR 32 | 133+95 | 157+50 | RT | | | | | 0.45 | | | | | | | | | | | | | |
| 509 | BRA5 | SR 32 | 129+02 | 130+64 | RT | | 2 | | | | | | | | | | | | | | | | |
| 510 | | NO NEW QUANTITIES | | | | | | | | | | | | | | | | | | | | | |
| 511 | CHI9 | SR 32 | 139+39 | 143+22 | RT | | | | | | | | | | | | | | | | | 383 | |
| | LA39 | SR 32 | 139+58 | | RT | | | | | | | | | | | | | | | | | | |
| | | | | | | | | | | | | | | | | | | | | | | | |
| | WP11 | SR 32 | 140+24 | | RT | | | | | | | | | | | | | | | | | | |
| | LA40 | SR 32 | 140+90 | | RT | | | | | | | | | | | | | | | | | | |
| 512 | LA41 | SR 32 | 141+55 | | RT | | | | | | | | | | | | | | | | | | |
| | WP12 | SR 32 | 142+21 | | RT | | | | | | | | | | | | | | | | | | |
| | LA42 | SR 32 | 142+87 | | RT | | | | | | | | | | | | | | | | | | |
| | REM2 | SR 32 | 142+90 | 143+00 | RT | | | | | | | | | | | | | | | | | | |
| | | | | | | | | | | | | | | | | | | | | | | | |
| | BRA6 | SR 32 | 144+08 | 144+58 | RT | | | | | | | | | | | | | | | | | | |
| 513 | | NO NEW QUANTITIES | | | | | | | | | | | | | | | | | | | | | |
| 514 | | NO NEW QUANTITIES | | | | | | | | | | | | | | | | | | | | | |
| SUBTOTALS THIS SHEET | | | | | | 10 | 4 | 0 | 0 | 0 | 0.45 | 0.45 | 0 | 0.9 | 0 | 0 | 0 | 383 | 36 | 0 | 0 | 0 | 0 |
| SUBTOTALS FROM SHEET 491 | | | | | | 6 | 40 | 0 | 0.52 | 0 | 1.08 | 0.31 | 0.41 | 0.1 | 0.5 | 0 | 3241 | 973 | 223 | 0 | 909 | 0 | 490 |
| TOTALS CARRIED TO SHEET 495 | | | | | | 16 | 44 | 0 | 0.52 | 0 | 1.53 | 0.76 | 0.41 | 1 | 0.5 | 0 | 3,241 | 1,356 | 259 | 0 | 909 | 0 | 490 |

PAVEMENT MARKING SUBSUMMARY

CLE-32-3.50 (PHASE 5)

CALCULATED
ACW
CHECKED
WAA

493
736

...310.20\310.205\103954\TS502.dgn 11/18/2021 4:25:27 PM ssopraseuth

| SHEET NO. | REFERENCE NO. | LOCATION | STATION | | SIDE | 644 | 644 | 644 | 644 | 644 | 807 / 850 | 807 / 850 | 807 / 850 | 644 | 644 | 644 | 807 / 850 | 807 / 850 | 646 | 646 | 646 | 646 | 646 | |
|------------------------------------|-------------------|--------------------|------------|----------------------|-------|-----------------|-----------------------|-----------------|--|--|--|--|---|---|-----------------------------|-----------------------------|-----------------------------|--|--|-----------------------------|-----------------------|-----------|------------|-----------------------|
| | | | LANE ARROW | LANE REDUCTION ARROW | | WRONG WAY ARROW | WORD ON PAVEMENT, 72" | DOTTED LINE, 4" | WET REFLECTIVE THERMOPLASTIC PAVEMENT MARKING, DOTTED LINE, 6" / | GROOVING FOR 6" RECESSED PAVEMENT MARKING, (ASPHALT) | WET REFLECTIVE THERMOPLASTIC PAVEMENT MARKING, DOTTED LINE, 8" / | GROOVING FOR 8" RECESSED PAVEMENT MARKING, (ASPHALT) | WET REFLECTIVE THERMOPLASTIC PAVEMENT MARKING, DOTTED LINE, 12" / | GROOVING FOR 12" RECESSED PAVEMENT MARKING, (ASPHALT) | REMOVAL OF PAVEMENT MARKING | REMOVAL OF PAVEMENT MARKING | REMOVAL OF PAVEMENT MARKING | WET REFLECTIVE EPOXY PAVEMENT MARKING, EDGE LINE, 4" (WHITE) / GROOVING FOR 4" RECESSED PAVEMENT MARKING, (CONCRETE) | WET REFLECTIVE EPOXY PAVEMENT MARKING, LANE LINE, 4" / GROOVING FOR 4" RECESSED PAVEMENT MARKING, (CONCRETE) | CENTER LINE (DOUBLE YELLOW) | CHANNELIZING LINE, 8" | STOP LINE | LANE ARROW | WORD ON PAVEMENT, 72" |
| | | | FROM | TO | | EACH | EACH | EACH | EACH | FT | FT | FT | FT | FT | EACH | MILE | MILE | MILE | MILE | FT | FT | EACH | EACH | FT |
| 507 | BRB2 | BACH BUXTON/RMP Q | 346+16 | 206+65 | RT/LT | | | | | | | | | | | | | | | | | | | |
| | BRA4 | BACH BUXTON | 346+21 | 346+70 | RT | | | | | | | | | | | | | | | | | | | |
| | LA32 | BACH BUXTON | 346+26 | | RT | 3 | | | | | | | | | | | | | | | | | | |
| | LA33 | BACH BUXTON | 346+55 | | LT | 2 | | | | | | | | | | | | | | | | | | |
| | LA34 | BACH BUXTON | 346+92 | | RT | 3 | | | | | | | | | | | | | | | | | | |
| | LA35 | BACH BUXTON | 347+21 | | LT | 1 | | | | | | | | | | | | | | | | | | |
| | LA36 | BACH BUXTON | 347+58 | | RT | 3 | | | | | | | | | | | | | | | | | | |
| | LA37 | BACH BUXTON | 347+80 | | LT | 1 | | | | | | | | | | | | | | | | | | |
| | WP10 | BACH BUXTON | 348+24 | | RT | | | | 3 | | | | | | | | | | | | | | | |
| | LA38 | BACH BUXTON | 348+90 | | RT | 3 | | | | | | | | | | | | | | | | | | |
| | SL12 | BACH BUXTON | 349+00 | | RT | | | | | | | | | | | | | | | | | | | |
| | DTW7 | BACH BUXTON/OLD 74 | 349+00 | 211+64 | RT/LT | | | | | 176 | | | | | | | | | | | | | | |
| 508 | ELY3 | SR 32 | 133+95 | 157+50 | RT | | | | | | | | | | | | | | | | | | | |
| | LL9 | SR 32 | 133+95 | 157+50 | RT | | | | | | | | | | | | | | | | | | | |
| | LL10 | SR 32 | 133+95 | 157+50 | RT | | | | | | | | | | | | | | | | | | | |
| | DTD1 | SR 32 | 133+95 | 139+39 | RT | | | | | | | | 544 | | | | | | | | | | | |
| | ELW8 | SR 32 | 133+95 | 157+50 | RT | | | | | | | | | | | | | | | | | | | |
| 509 | BRA5 | SR 32 | 129+02 | 130+64 | RT | | | | | | | | | | | | | | | | | | | |
| 510 | NO NEW QUANTITIES | | | | | | | | | | | | | | | | | | | | | | | |
| 511 | CHI9 | SR 32 | 139+39 | 143+22 | RT | | | | | | | | | | | | | | | | | | | |
| | LA39 | SR 32 | 139+58 | | RT | 1 | | | | | | | | | | | | | | | | | | |
| | WP11 | SR 32 | 140+24 | | RT | | | | 1 | | | | | | | | | | | | | | | |
| | LA40 | SR 32 | 140+90 | | RT | 1 | | | | | | | | | | | | | | | | | | |
| 512 | LA41 | SR 32 | 141+55 | | RT | 1 | | | | | | | | | | | | | | | | | | |
| | WP12 | SR 32 | 142+21 | | RT | | | | 1 | | | | | | | | | | | | | | | |
| | LA42 | SR 32 | 142+87 | | RT | 1 | | | | | | | | | | | | | | | | | | |
| | REM2 | SR 32 | 142+90 | 143+00 | RT | | | | | | | | 48 | | | | | | | | | | | |
| | BRA6 | SR 32 | 144+08 | 144+58 | RT | | | | | | | | | | | | | | | | | | | |
| 513 | NO NEW QUANTITIES | | | | | | | | | | | | | | | | | | | | | | | |
| 514 | NO NEW QUANTITIES | | | | | | | | | | | | | | | | | | | | | | | |
| SUBTOTALS THIS SHEET | | | | | | 20 | 0 | 0 | 5 | 176 | 0 | 0 | 544 | 48 | 0 | 0 | 0 | 0 | 0 | 0 | 0 | 0 | 0 | 0 |
| SUBTOTALS FROM SHEET 492 | | | | | | 48 | 1 | 0 | 12 | 153 | 0 | 0 | 0 | 0 | 0 | 0 | 0.06 | 0.04 | 0.01 | 401 | 96 | 4 | 4 | 527 |
| TOTALS CARRIED TO SHEET 496 | | | | | | 68 | 1 | 0 | 17 | 329 | 0 | 0 | 544 | 48 | 0 | 0 | 0.06 | 0.04 | 0.01 | 401 | 96 | 4 | 4 | 527 |

PAVEMENT MARKING SUBSUMMARY

CLE-32-3.50 (PHASE 5)

CALCULATED
ACW
CHECKED
WAA

494
736

...310.20\310.205\103954\TS502.dgn 11/18/2021 4:25:27 PM ssopraseuth

| SHEET NO. | REFERENCE NO. | LOCATION | STATION | | SIDE | 626 | 626 | 642 | 644 | 644 | 807 / 850 | 807 / 850 | 644 | 807 / 850 | 644 | 644 | 644 | 807 / 850 | 644 | 644 | 644 | 644 | 644 |
|------------------------------------|-------------------|--------------------|---------|--------|-------|----------------------------------|----------------------------------|---------------------------|-----------------------|------------------------|---|--|---------------|---|-----------------------------|----------------------------|-----------------------|---|------------|----------------|---------------------------|-----------------|----------------|
| | | | FROM | TO | | BARRIER REFLECTOR, TYPE 1, INWAY | BARRIER REFLECTOR, TYPE 2, INWAY | PARKING LOT STALL MARKING | EDGE LINE, 4" (WHITE) | EDGE LINE, 4" (YELLOW) | WET REFLECTIVE THERMOPLASTIC PAVEMENT MARKING, EDGE LINE, 6" (WHITE) / GROOVING FOR 6" RECESSED PAVEMENT MARKING, (ASPHALT) | WET REFLECTIVE THERMOPLASTIC PAVEMENT MARKING, EDGE LINE, 6" (YELLOW) / GROOVING FOR 6" RECESSED PAVEMENT MARKING, (ASPHALT) | LANE LINE, 4" | WET REFLECTIVE THERMOPLASTIC PAVEMENT MARKING, LANE LINE, 6" / GROOVING FOR 6" RECESSED PAVEMENT MARKING, (ASPHALT) | CENTER LINE (DOUBLE YELLOW) | CENTER LINE (DASHED/SOLID) | CHANNELIZING LINE, 8" | WET REFLECTIVE THERMOPLASTIC PAVEMENT MARKING, CHANNELIZING LINE, 12" / GROOVING FOR 12" RECESSED PAVEMENT MARKING, (ASPHALT) | STOP LINE | CROSSWALK LINE | TRANSVERSE/ DIAGONAL LINE | CHEVRON MARKING | ISLAND MARKING |
| | | | | | | EACH | EACH | FT | MILE | MILE | MILE | MILE | MILE | MILE | MILE | FT | FT | FT | FT | FT | FT | FT | SF |
| 515 | BRA7 | SR 32 | 157+28 | 158+77 | RT | | 2 | | | | | | | | | | | | | | | | |
| | BRB3 | SR 32 | 158+77 | 159+90 | RT | 1 | | | | | | | | | | | | | | | | | |
| | BRA8 | SR 32 | 159+90 | 160+38 | RT | | 1 | | | | | | | | | | | | | | | | |
| 516 | NO NEW QUANTITIES | | | | | | | | | | | | | | | | | | | | | | |
| 517 | BRA9 | SR 32 | 170+77 | 174+11 | RT | | 3 | | | | | | | | | | | | | | | | |
| 518 | NO NEW QUANTITIES | | | | | | | | | | | | | | | | | | | | | | |
| 519 | DTW9 | SR 32 | 180+01 | 184+04 | RT | | | | | | | | | | | | | | | | | | |
| | BRA10 | SR 32 | 180+27 | 182+25 | LT | | 3 | | | | | | | | | | | | | | | | |
| | BRA11 | RAMP O | 182+38 | 188+50 | RT | | 6 | | | | | | | | | | | | | | | | |
| | BRB4 | RAMP N | 182+25 | 189+03 | LT | 7 | | | | | | | | | | | | | | | | | |
| | CH23 | SR 32 | 184+04 | 188+88 | RT | | | | | | | | | | | | 484 | | | | | | |
| | CM1 | SR 32 | 184+04 | 188+88 | RT | | | | | | | | | | | | | | | | | 144 | |
| | CH24 | RAMP O | 184+04 | 188+88 | LT | | | | | | | | | | | | 484 | | | | | | |
| 520 | ELY5 | RMP N/BACH BUXTON | 191+37 | 342+31 | RT/LT | | | | | | 0.12 | | | | | | | | | | | | |
| | BRB5 | RAMP O | 188+50 | 191+50 | RT | 3 | | | | | | | | | | | | | | | | | |
| | ELW12 | SR 32 | 188+88 | 205+51 | RT | | | | | 0.31 | | | | | | | | | | | | | |
| | ELY6 | RAMP O | 188+88 | 197+18 | LT | | | | | | 0.16 | | | | | | | | | | | | |
| | BRA12 | RMP N/BACH BUXTON | 189+03 | 349+28 | LT | | 15 | | | | | | | | | | | | | | | | |
| | BRA13 | SR 32 | 190+22 | 196+95 | LT | | 7 | | | | | | | | | | | | | | | | |
| | BRA14 | RAMP N | 190+25 | 197+35 | RT | | 7 | | | | | | | | | | | | | | | | |
| | LA46 | RAMP N | 190+40 | | CL | | | | | | | | | | | | | | | | | | |
| 521 | LL12 | RAMP N | 190+40 | 197+49 | RT | | | | | | | | 0.13 | | | | | | | | | | |
| | BRA15 | SR 32 | 190+53 | 192+89 | RT | | 3 | | | | | | | | | | | | | | | | |
| | BRA16 | RAMP O | 190+52 | 192+64 | LT | | 3 | | | | | | | | | | | | | | | | |
| | BRA17 | NOT USED | | | | | | | | | | | | | | | | | | | | | |
| | LA47 | RAMP N | 191+40 | | CL | | | | | | | | | | | | | | | | | | |
| | BRB6 | RAMP N | 192+64 | 197+06 | LT | 5 | | | | | | | | | | | | | | | | | |
| | BRB7 | SR 32 | 192+89 | 204+58 | RT | 12 | | | | | | | | | | | | | | | | | |
| | LA48 | RAMP O | 192+92 | | LT | | | | | | | | | | | | | | | | | | |
| | CH25 | RAMP O | 193+48 | 197+09 | LT | | | | | | | | | | | | | | | | | | |
| | CH26 | RAMP O/BACH BUXTON | 193+48 | 339+12 | CL | | | | | | | | | | | | | | | | | | |
| | LA49 | RAMP O | 193+59 | | LT/RT | | | | | | | | | | | | | | | | | | |
| | CH27 | RAMP O | 193+89 | 196+94 | LT | | | | | | | | | | | | | | | | | | |
| | LA50 | RAMP O | 194+20 | | LT/RT | | | | | | | | | | | | | | | | | | |
| | LA51 | RAMP O | 194+86 | | LT/RT | | | | | | | | | | | | | | | | | | |
| | CH28 | RAMP N | 195+86 | 197+86 | LT | | | | | | | | | | | | | | | | | | |
| | LA52 | RAMP N | 195+86 | | LT | | | | | | | | | | | | | | | | | | |
| | ELW10 | RAMP N | 195+86 | 196+89 | LT | | | | | 0.02 | | | | | | | | | | | | | |
| SUBTOTALS THIS SHEET | | | | | | 28 | 50 | 0 | 0 | 0 | 0.33 | 0.28 | 0 | 0.13 | 0 | 0 | 0 | 2294 | 0 | 0 | 0 | 144 | 0 |
| SUBTOTALS FROM SHEET 493 | | | | | | 16 | 44 | 0 | 0.52 | 0 | 1.53 | 0.76 | 0.41 | 1 | 0.5 | 0 | 3241 | 1356 | 259 | 0 | 909 | 0 | 490 |
| TOTALS CARRIED TO SHEET 497 | | | | | | 44 | 94 | 0 | 0.52 | 0 | 1.86 | 1.04 | 0.41 | 1.13 | 0.5 | 0 | 3,241 | 3,650 | 259 | 0 | 909 | 144 | 490 |

PAVEMENT MARKING SUBSUMMARY

CLE-32-3.50 (PHASE 5)

CALCULATED
ACW
CHECKED
WAA

495
736

...310.20\310.205\103954TS502.dgn 11/18/2021 4:25:27 PM ssopraseuth

| SHEET NO. | REFERENCE NO. | LOCATION | STATION | | SIDE | 644 | 644 | 644 | 644 | 644 | 807 / 850 | 807 / 850 | 807 / 850 | 644 | 644 | 644 | 807 / 850 | 807 / 850 | 646 | 646 | 646 | 646 | 646 | 646 | |
|------------------------------------|-------------------|--------------------|------------|----------------------|-------|-----------------|-----------------------|-----------------|--|--|--|--|---|---|-----------------------------|-----------------------------|-----------------------------|--|--|-----------------------------|-----------------------|-----------|------------|-----------------------|-----------------|
| | | | LANE ARROW | LANE REDUCTION ARROW | | WRONG WAY ARROW | WORD ON PAVEMENT, 72" | DOTTED LINE, 4" | WET REFLECTIVE THERMOPLASTIC PAVEMENT MARKING, DOTTED LINE, 6" / | GROOVING FOR 6" RECESSED PAVEMENT MARKING, (ASPHALT) | WET REFLECTIVE THERMOPLASTIC PAVEMENT MARKING, DOTTED LINE, 8" / | GROOVING FOR 8" RECESSED PAVEMENT MARKING, (ASPHALT) | WET REFLECTIVE THERMOPLASTIC PAVEMENT MARKING, DOTTED LINE, 12" / | GROOVING FOR 12" RECESSED PAVEMENT MARKING, (ASPHALT) | REMOVAL OF PAVEMENT MARKING | REMOVAL OF PAVEMENT MARKING | REMOVAL OF PAVEMENT MARKING | WET REFLECTIVE EPOXY PAVEMENT MARKING, EDGE LINE, 4" (WHITE) / GROOVING FOR 4" RECESSED PAVEMENT MARKING, (CONCRETE) | WET REFLECTIVE EPOXY PAVEMENT MARKING, LANE LINE, 4" / GROOVING FOR 4" RECESSED PAVEMENT MARKING, (CONCRETE) | CENTER LINE (DOUBLE YELLOW) | CHANNELIZING LINE, 8" | STOP LINE | LANE ARROW | WORD ON PAVEMENT, 72" | DOTTED LINE, 4" |
| | | | FROM | TO | | EACH | EACH | EACH | EACH | FT | FT | FT | FT | FT | EACH | MILE | MILE | MILE | MILE | FT | FT | EACH | EACH | FT | |
| 515 | BRA7 | SR 32 | 157+28 | 158+77 | RT | | | | | | | | | | | | | | | | | | | | |
| | BRB3 | SR 32 | 158+77 | 159+90 | RT | | | | | | | | | | | | | | | | | | | | |
| | BRA8 | SR 32 | 159+90 | 160+38 | RT | | | | | | | | | | | | | | | | | | | | |
| 516 | NO NEW QUANTITIES | | | | | | | | | | | | | | | | | | | | | | | | |
| 517 | BRB9 | SR 32 | 170+77 | 174+11 | RT | | | | | | | | | | | | | | | | | | | | |
| 518 | NO NEW QUANTITIES | | | | | | | | | | | | | | | | | | | | | | | | |
| 519 | DTW9 | SR 32 | 180+01 | 184+04 | RT | | | | | | 403 | | | | | | | | | | | | | | |
| | BRA10 | SR 32 | 180+27 | 182+25 | LT | | | | | | | | | | | | | | | | | | | | |
| | BRA11 | RAMP O | 182+38 | 188+50 | RT | | | | | | | | | | | | | | | | | | | | |
| | BRB4 | RAMP N | 182+25 | 189+03 | LT | | | | | | | | | | | | | | | | | | | | |
| | CH23 | SR 32 | 184+04 | 188+88 | RT | | | | | | | | | | | | | | | | | | | | |
| | CM1 | SR 32 | 184+04 | 188+88 | RT | | | | | | | | | | | | | | | | | | | | |
| | CH24 | RAMP O | 184+04 | 188+88 | LT | | | | | | | | | | | | | | | | | | | | |
| 520 | EL Y5 | RMP N/BACH BUXTON | 191+37 | 342+31 | RT/LT | | | | | | | | | | | | | | | | | | | | |
| | BRB5 | RAMP O | 188+50 | 191+50 | RT | | | | | | | | | | | | | | | | | | | | |
| | ELW12 | SR 32 | 188+88 | 205+51 | RT | | | | | | | | | | | | | | | | | | | | |
| | ELY6 | RAMP O | 188+88 | 197+18 | LT | | | | | | | | | | | | | | | | | | | | |
| | BRA12 | RMP N/BACH BUXTON | 189+03 | 349+28 | LT | | | | | | | | | | | | | | | | | | | | |
| | BRA13 | SR 32 | 190+22 | 196+95 | LT | | | | | | | | | | | | | | | | | | | | |
| | BRA14 | RAMP N | 190+25 | 197+35 | RT | | | | | | | | | | | | | | | | | | | | |
| | LA46 | RAMP N | 190+40 | | CL | | 1 | | | | | | | | | | | | | | | | | | |
| 521 | LL12 | RAMP N | 190+40 | 197+49 | RT | | | | | | | | | | | | | | | | | | | | |
| | BRA15 | SR 32 | 190+53 | 192+89 | RT | | | | | | | | | | | | | | | | | | | | |
| | BRA16 | RAMP O | 190+52 | 192+64 | LT | | | | | | | | | | | | | | | | | | | | |
| | BRA17 | NOT USED | | | | | | | | | | | | | | | | | | | | | | | |
| | LA47 | RAMP N | 191+40 | | CL | | 1 | | | | | | | | | | | | | | | | | | |
| | BRB6 | RAMP N | 192+64 | 197+06 | LT | | | | | | | | | | | | | | | | | | | | |
| | BRB7 | SR 32 | 192+89 | 204+58 | RT | | | | | | | | | | | | | | | | | | | | |
| | LA48 | RAMP O | 192+92 | | LT | | | 1 | | | | | | | | | | | | | | | | | |
| | CH25 | RAMP O | 193+48 | 197+09 | LT | | | | | | | | | | | | | | | | | | | | |
| | CH26 | RAMP O/BACH BUXTON | 193+48 | 339+12 | CL | | | | | | | | | | | | | | | | | | | | |
| | LA49 | RAMP O | 193+59 | | LT/RT | 3 | | | | | | | | | | | | | | | | | | | |
| | CH27 | RAMP O | 193+89 | 196+94 | LT | | | | | | | | | | | | | | | | | | | | |
| | LA50 | RAMP O | 194+20 | | LT/RT | 4 | | | | | | | | | | | | | | | | | | | |
| | LA51 | RAMP O | 194+86 | | LT/RT | 4 | | | | | | | | | | | | | | | | | | | |
| | CH28 | RAMP N | 195+86 | 197+86 | LT | | | | | | | | | | | | | | | | | | | | |
| | LA52 | RAMP N | 195+86 | | LT | | 1 | | | | | | | | | | | | | | | | | | |
| | ELW10 | RAMP N | 195+86 | 196+89 | LT | | | | | | | | | | | | | | | | | | | | |
| SUBTOTALS THIS SHEET | | | | | | ik | 3 | 1 | 0 | 0 | 403 | 0 | 0 | 0 | 0 | 0 | 0 | 0 | 0 | 0 | 0 | 0 | 0 | 0 | |
| SUBTOTALS FROM SHEET 494 | | | | | | 68 | 1 | 0 | 17 | 329 | 0 | 0 | 544 | 48 | 0 | 0 | 0.06 | 0.04 | 0.01 | 401 | 96 | 4 | 4 | 527 | |
| TOTALS CARRIED TO SHEET 498 | | | | | | 79 | 4 | 1 | 17 | 329 | 403 | 0 | 544 | 48 | 0 | 0 | 0.06 | 0.04 | 0.01 | 401 | 96 | 4 | 4 | 527 | |

PAVEMENT MARKING SUBSUMMARY

CALCULATED
ACW
CHECKED
WAA

CLE-32-3.50
(PHASE 5)

496
736

...310.20\310.205\103954\TS502.dgn 11/18/2021 4:25:28 PM ssopraseuth

| SHEET NO. | REFERENCE NO. | LOCATION | STATION | | SIDE | 626 | 626 | 642 | 644 | 644 | 807 / 850 | 807 / 850 | 644 | 644 | 644 | 807 / 850 | 644 | 644 | 644 | 644 | 644 | 644 | |
|------------------------------------|---------------|-------------------|----------|--------|-------|----------------------------------|----------------------------------|---------------------------|-----------------------|------------------------|---|--|---------------|---|-----------------------------|----------------------------|-----------------------|---|-----------|----------------|---------------------------|-----------------|----------------|
| | | | FROM | TO | | BARRIER REFLECTOR, TYPE 1, INWAY | BARRIER REFLECTOR, TYPE 2, INWAY | PARKING LOT STALL MARKING | EDGE LINE, 4" (WHITE) | EDGE LINE, 4" (YELLOW) | WET REFLECTIVE THERMOPLASTIC PAVEMENT MARKING, EDGE LINE, 6" (WHITE) / GROOVING FOR 6" RECESSED PAVEMENT MARKING, (ASPHALT) | WET REFLECTIVE THERMOPLASTIC PAVEMENT MARKING, EDGE LINE, 6" (YELLOW) / GROOVING FOR 6" RECESSED PAVEMENT MARKING, (ASPHALT) | LANE LINE, 4" | WET REFLECTIVE THERMOPLASTIC PAVEMENT MARKING, LANE LINE, 6" / GROOVING FOR 6" RECESSED PAVEMENT MARKING, (ASPHALT) | CENTER LINE (DOUBLE YELLOW) | CENTER LINE (DASHED/SOLID) | CHANNELIZING LINE, 8" | WET REFLECTIVE THERMOPLASTIC PAVEMENT MARKING, CHANNELIZING LINE, 12" / GROOVING FOR 12" RECESSED PAVEMENT MARKING, (ASPHALT) | STOP LINE | CROSSWALK LINE | TRANSVERSE/ DIAGONAL LINE | CHEVRON MARKING | ISLAND MARKING |
| | | | | | | EACH | EACH | FT | MILE | MILE | MILE | MILE | MILE | MILE | FT | FT | FT | FT | FT | FT | FT | SF | |
| 522 | BRB8 | | NOT USED | | | | | | | | | | | | | | | | | | | | |
| | BRB9 | SR 32 | 196+60 | 199+28 | RT | 3 | | | | | | | | | | | | | | | | | |
| | BRB10 | SR 32 | 196+95 | 199+86 | LT | 3 | | | | | | | | | | | | | | | | | |
| | LA53 | RAMP P | 199+00 | | CL | | | | | | | | | | | | | | | | | | |
| | BRA18 | SR 32 | 199+86 | 202+23 | LT | | 3 | | | | | | | | | | | | | | | | |
| | LA54 | RAMP Q | 200+43 | | LT/RT | | | | | | | | | | | | | | | | | | |
| | LA55 | RAMP Q | 201+09 | | LT/RT | | | | | | | | | | | | | | | | | | |
| 523 | LA56 | RAMP Q | 201+75 | | LT/RT | | | | | | | | | | | | | | | | | | |
| | LA57 | RAMP Q | 202+41 | | RT | | | | | | | | | | | | | | | | | | |
| | LA58 | RAMP P | 202+65 | | CL | | | | | | | | | | | | | | | | | | |
| | DTD4 | RAMP P/SR 32 | 203+65 | 216+15 | LT/RT | | | | | | | | | | | | | | | | | | |
| | CH29 | RAMP P/SR 32 | 205+50 | 211+00 | LT/RT | | | | | | | | | | | 552 | | | | | | | |
| | CH30 | SR 32 | 205+51 | 211+00 | RT | | | | | | | | | | 549 | | | | | | | | |
| | BRA19 | RAMP Q/SR 32 | 206+65 | 234+83 | LT | | 14 | | | | | | | | | | | | | | | | |
| 524 | CH31 | RAMP Q | 208+06 | 210+89 | RT | | | | | | | | | | 286 | | | | | | | | |
| | DTW11 | SR 32 | 211+00 | 236+64 | RT | | | | | | | | | | | | | | | | | | |
| 525 | | NO NEW QUANTITIES | | | | | | | | | | | | | | | | | | | | | |
| 526 | | NO NEW QUANTITIES | | | | | | | | | | | | | | | | | | | | | |
| 527 | | NO NEW QUANTITIES | | | | | | | | | | | | | | | | | | | | | |
| 528 | | NO NEW QUANTITIES | | | | | | | | | | | | | | | | | | | | | |
| 529 | | NO NEW QUANTITIES | | | | | | | | | | | | | | | | | | | | | |
| 530 | | NO NEW QUANTITIES | | | | | | | | | | | | | | | | | | | | | |
| 531 | REM3 | GEW | 12+17 | 15+50 | RT | | | | | | | | | | | | | | | | | | |
| | DTW12 | GEW | 12+17 | 14+80 | RT | | | | | | | | | | | | | | | | | | |
| | REM4 | GEW | 13+15 | 15+42 | LT | | | | | | | | | | | | | | | | | | |
| | DYL6 | GEW | 13+65 | 14+80 | LT | | | | | | | | 0.02 | | | | | | | | | | |
| 532 | ELW13 | GEW/SR 32 | 15+50 | 143+00 | LT/RT | | | | 0.09 | | | | | | | | | | | | | | |
| | TLW1 | GEW | 15+50 | 16+40 | LT | | | | | | | | | | | | | | | | 85 | | |
| | CH33 | GEW | 15+50 | 15+50 | LT | | | | | | | | | | 189 | | | | | | | | |
| | CM3 | GEW | 15+50 | 16+44 | LT | | | | | | | | | | | | | | | | 67 | | |
| | DLY7 | GEW | 15+50 | 16+44 | CL | | | | | | | | 0.02 | | | | | | | | | | |
| | CH34 | GEW | 15+50 | 16+57 | RT | | | | | | | | | | 153 | | | | | | | | |
| | ELW14 | GEW | 15+40 | 16+40 | RT | | | | 0.02 | | | | | | | | | | | | | | |
| | TLW2 | GEW | 15+40 | 16+40 | RT | | | | | | | | | | | | | | | | 108 | | |
| SUBTOTALS THIS SHEET | | | | | | 6 | 17 | 0 | 0.11 | 0 | 0 | 0 | 0 | 0.04 | 0 | 342 | 1387 | 0 | 0 | 193 | 67 | 0 | |
| SUBTOTALS FROM SHEET 495 | | | | | | 44 | 94 | 0 | 0.52 | 0 | 1.86 | 1.04 | 0.41 | 1.13 | 0.5 | 0 | 3241 | 3650 | 259 | 0 | 909 | 144 | 490 |
| TOTALS CARRIED TO SHEET 499 | | | | | | 50 | 111 | 0 | 0.63 | 0 | 1.86 | 1.04 | 0.41 | 1.13 | 0.54 | 0 | 3,583 | 5,037 | 259 | 0 | 1102 | 211 | 490 |

PAVEMENT MARKING SUBSUMMARY

CLE-32-3.50 (PHASE 5)

CALCULATED
ACW
CHECKED
WAA

497
736

...310.20\310.205\103954\TS502.dgn 11/18/2021 4:25:28 PM ssopraseuth

| SHEET NO. | REFERENCE NO. | LOCATION | STATION | | SIDE | 644 | 644 | 644 | 644 | 644 | 807 / 850 | 807 / 850 | 807 / 850 | 644 | 644 | 644 | 807 / 850 | 807 / 850 | 646 | 646 | 646 | 646 | 646 | |
|------------------------------------|---------------|-------------------|------------|----------------------|-------|-----------------|-----------------------|-----------------|--|--|--|--|---|---|-----------------------------|-----------------------------|-----------------------------|--|--|-----------------------------|-----------------------|-----------|------------|-----------------------|
| | | | LANE ARROW | LANE REDUCTION ARROW | | WRONG WAY ARROW | WORD ON PAVEMENT, 72" | DOTTED LINE, 4" | WET REFLECTIVE THERMOPLASTIC PAVEMENT MARKING, DOTTED LINE, 6" / | GROOVING FOR 6" RECESSED PAVEMENT MARKING, (ASPHALT) | WET REFLECTIVE THERMOPLASTIC PAVEMENT MARKING, DOTTED LINE, 8" / | GROOVING FOR 8" RECESSED PAVEMENT MARKING, (ASPHALT) | WET REFLECTIVE THERMOPLASTIC PAVEMENT MARKING, DOTTED LINE, 12" / | GROOVING FOR 12" RECESSED PAVEMENT MARKING, (ASPHALT) | REMOVAL OF PAVEMENT MARKING | REMOVAL OF PAVEMENT MARKING | REMOVAL OF PAVEMENT MARKING | WET REFLECTIVE EPOXY PAVEMENT MARKING, EDGE LINE, 4" (WHITE) / GROOVING FOR 4" RECESSED PAVEMENT MARKING, (CONCRETE) | WET REFLECTIVE EPOXY PAVEMENT MARKING, LANE LINE, 4" / GROOVING FOR 4" RECESSED PAVEMENT MARKING, (CONCRETE) | CENTER LINE (DOUBLE YELLOW) | CHANNELIZING LINE, 8" | STOP LINE | LANE ARROW | WORD ON PAVEMENT, 72" |
| | | | FROM | TO | | EACH | EACH | EACH | EACH | FT | FT | FT | FT | FT | EACH | MILE | MILE | MILE | MILE | FT | FT | EACH | EACH | FT |
| 522 | BRB8 | | NOT USED | | | | | | | | | | | | | | | | | | | | | |
| | BRB9 | SR 32 | 196+60 | 199+28 | RT | | | | | | | | | | | | | | | | | | | |
| | BRB10 | SR 32 | 196+95 | 199+86 | LT | | | | | | | | | | | | | | | | | | | |
| | LA53 | RAMP P | 199+00 | | CL | | 1 | | | | | | | | | | | | | | | | | |
| | BRA18 | SR 32 | 199+86 | 202+23 | LT | | | | | | | | | | | | | | | | | | | |
| | LA54 | RAMP Q | 200+43 | | LT/RT | 4 | | | | | | | | | | | | | | | | | | |
| | LA55 | RAMP Q | 201+09 | | LT/RT | 4 | | | | | | | | | | | | | | | | | | |
| 523 | LA56 | RAMP Q | 201+75 | | LT/RT | 2 | | | | | | | | | | | | | | | | | | |
| | LA57 | RAMP Q | 202+41 | | RT | | | 1 | | | | | | | | | | | | | | | | |
| | LA58 | RAMP P | 202+65 | | CL | | 1 | | | | | | | | | | | | | | | | | |
| | DTD4 | RAMP P/SR 32 | 203+65 | 216+15 | LT/RT | | | | | | | | | | | | | | | | | | | |
| | CH29 | RAMP P/SR 32 | 205+50 | 211+00 | LT/RT | | | | | | 1260 | | | | | | | | | | | | | |
| | CH30 | SR 32 | 205+51 | 211+00 | RT | | | | | | | | | | | | | | | | | | | |
| | BRA19 | RAMP Q/SR 32 | 206+65 | 234+83 | LT | | | | | | | | | | | | | | | | | | | |
| 524 | CH31 | RAMP Q | 208+06 | 210+89 | RT | | | | | | | | | | | | | | | | | | | |
| | DTW11 | SR 32 | 211+00 | 236+64 | RT | | | | | | 1120 | | | | | | | | | | | | | |
| 525 | | NO NEW QUANTITIES | | | | | | | | | | | | | | | | | | | | | | |
| 526 | | NO NEW QUANTITIES | | | | | | | | | | | | | | | | | | | | | | |
| 527 | | NO NEW QUANTITIES | | | | | | | | | | | | | | | | | | | | | | |
| 528 | | NO NEW QUANTITIES | | | | | | | | | | | | | | | | | | | | | | |
| 529 | | NO NEW QUANTITIES | | | | | | | | | | | | | | | | | | | | | | |
| 530 | | NO NEW QUANTITIES | | | | | | | | | | | | | | | | | | | | | | |
| 531 | REM3 | GEW | 12+17 | 15+50 | RT | | | | | | | | | | | 0.06 | | | | | | | | |
| | DTW12 | GEW | 12+17 | 14+80 | RT | | | | | 263 | | | | | | | | | | | | | | |
| | REM4 | GEW | 13+15 | 15+42 | LT | | | | | | | | 227 | | | | | | | | | | | |
| | DYL6 | GEW | 13+65 | 14+80 | LT | | | | | | | | | | | | | | | | | | | |
| 532 | ELW13 | GEW/SR 32 | 15+50 | 143+00 | LT/RT | | | | | | | | | | | | | | | | | | | |
| | TLW1 | GEW | 15+50 | 16+40 | LT | | | | | | | | | | | | | | | | | | | |
| | CH33 | GEW | 15+50 | 15+50 | LT | | | | | | | | | | | | | | | | | | | |
| | CM3 | GEW | 15+50 | 16+44 | LT | | | | | | | | | | | | | | | | | | | |
| | DLY7 | GEW | 15+50 | 16+44 | CL | | | | | | | | | | | | | | | | | | | |
| | CH34 | GEW | 15+50 | 16+57 | RT | | | | | | | | | | | | | | | | | | | |
| | ELW14 | GEW | 15+40 | 16+40 | RT | | | | | | | | | | | | | | | | | | | |
| | TLW2 | GEW | 15+40 | 16+40 | RT | | | | | | | | | | | | | | | | | | | |
| SUBTOTALS THIS SHEET | | | | | | 10 | 2 | 1 | 0 | 263 | 1120 | 1260 | 0 | 227 | 0 | 0.06 | 0 | 0 | 0 | 0 | 0 | 0 | 0 | 0 |
| SUBTOTALS FROM SHEET 496 | | | | | | 79 | 4 | 1 | 17 | 329 | 403 | 0 | 544 | 48 | 0 | 0 | 0.06 | 0.04 | 0.01 | 401 | 96 | 4 | 4 | 527 |
| TOTALS CARRIED TO SHEET 500 | | | | | | 89 | 6 | 2 | 17 | 592 | 1523 | 1260 | 544 | 275 | 0 | 0.06 | 0.06 | 0.04 | 0.01 | 401 | 96 | 4 | 4 | 527 |

PAVEMENT MARKING SUBSUMMARY

CLE-32-3.50 (PHASE 5)

CALCULATED
ACW
CHECKED
WAA

498
736

...310.20\310.205\103954TS502.dgn 11/18/2021 4:25:29 PM ssopraseuth

| SHEET NO. | REFERENCE NO. | LOCATION | STATION | | SIDE | 626 | 626 | 642 | 644 | 644 | 807 / 850 | 807 / 850 | 644 | 644 | 644 | 807 / 850 | 644 | 644 | 644 | 644 | 644 | 644 | |
|------------------------------------|---------------|--------------|---------|--------|-------|----------------------------------|----------------------------------|---------------------------|-----------------------|------------------------|---|--|---------------|---|-----------------------------|----------------------------|-----------------------|---|-----------|----------------|----------------------------|-----------------|----------------|
| | | | FROM | TO | | BARRIER REFLECTOR, TYPE 1, INWAY | BARRIER REFLECTOR, TYPE 2, INWAY | PARKING LOT STALL MARKING | EDGE LINE, 4" (WHITE) | EDGE LINE, 4" (YELLOW) | WET REFLECTIVE THERMOPLASTIC PAVEMENT MARKING, EDGE LINE, 6" (WHITE) / GROOVING FOR 6" RECESSED PAVEMENT MARKING, (ASPHALT) | WET REFLECTIVE THERMOPLASTIC PAVEMENT MARKING, EDGE LINE, 6" (YELLOW) / GROOVING FOR 6" RECESSED PAVEMENT MARKING, (ASPHALT) | LANE LINE, 4" | WET REFLECTIVE THERMOPLASTIC PAVEMENT MARKING, LANE LINE, 6" / GROOVING FOR 6" RECESSED PAVEMENT MARKING, (ASPHALT) | CENTER LINE (DOUBLE YELLOW) | CENTER LINE (DASHED/SOLID) | CHANNELIZING LINE, 8" | WET REFLECTIVE THERMOPLASTIC PAVEMENT MARKING, CHANNELIZING LINE, 12" / GROOVING FOR 12" RECESSED PAVEMENT MARKING, (ASPHALT) | STOP LINE | CROSSWALK LINE | TRANSVERSE / DIAGONAL LINE | CHEVRON MARKING | ISLAND MARKING |
| | | | | | | EACH | EACH | FT | MILE | MILE | MILE | MILE | MILE | MILE | MILE | MILE | MILE | FT | FT | FT | FT | FT | SF |
| 532 | LA59 | GEW | 15+60 | | LT | | | | | | | | | | | | | | | | | | |
| | WP14 | GEW | 15+68 | | RT | | | | | | | | | | | | | | | | | | |
| | LA60 | GEW | 15+68 | | RT | | | | | | | | | | | | | | | | | | |
| | ELY7 | GEW | 16+24 | 16+42 | LT | | | | | 0.01 | | | | | | | | | | | | | |
| | WP15 | GEW | 16+26 | | LT | | | | | | | | | | | | | | | | | | |
| | LA61 | GEW | 16+34 | | RT | | | | | | | | | | | | | | | | | | |
| | ELY8 | GEW | 16+59 | 16+60 | LT | | | | | 0.01 | | | | | | | | | | | | | |
| | DLY8 | GEW | 15+57 | 15+57 | RT | | | | | | | | | 0.01 | | | | | | | | | |
| | LA62 | GEW | 16+67 | | RT | | | | | | | | | | | | | | | | | | |
| | TLW3 | GEW/SR 32 | 16+72 | 143+08 | LT/RT | | | | | | | | | | | | | | | | 156 | | |
| | CH35 | GEW | 16+74 | 17+46 | LT | | | | | | | | | | | | | 72 | | | | | |
| | CH36 | GEW | 16+74 | 17+46 | LT | | | | | | | | | | | | | 72 | | | | | |
| | ELY9 | GEW/SR 32 | 16+74 | 143+22 | CL/RT | | | | | | | | | | | | | | | | | | |
| | ELW15 | GEW | 16+74 | 16+74 | RT | | | | 0.01 | 0.06 | | | | | | | | | | | | | |
| | LA63 | GEW | 16+84 | | LT | | | | | | | | | | | | | | | | | | |
| | LA64 | GEW | 17+36 | | LT | | | | | | | | | | | | | | | | | | |
| | TLY4 | GEW/SR 32 | 17+56 | 143+22 | CL/RT | | | | | | | | | | | | | | | | 202 | | |
| 533 | CH37 | GEW | 22+60 | 26+08 | RT | | | | | | | | | | | | | | | | | | |
| | LA65 | GEW | 22+70 | | RT | | | | | | | | | | | | | | | | | | |
| | LL13 | GEW | 23+19 | 26+08 | RT | | | | | | | 0.05 | | | | | | | | | | | |
| | LA66 | GEW | 23+34 | | RT | | | | | | | | | | | | | | | | | | |
| | LA67 | GEW | 24+00 | | RT | | | | | | | | | | | | | | | | | | |
| | ELW16 | GEW | 24+01 | 24+12 | LT | | | | 0.01 | | | | | | | | | | | | | | |
| | LA68 | GEW | 24+09 | | LT | | | | | | | | | | | | | | | | | | |
| | WP16 | GEW | 24+17 | | LT | | | | | | | | | | | | | | | | | | |
| | DYL9 | GEW | 24+24 | 26+08 | LT | | | | | | | | | 0.05 | | | | | | | | | |
| | TYL5 | GEW | 24+24 | 26+08 | LT | | | | | | | | | | | | | | | | | 463 | |
| | DYL10 | GEW | 24+24 | 26+08 | LT | | | | | | | | | 0.04 | | | | | | | | | |
| | LA69 | GEW | 24+33 | | LT | | | | | | | | | | | | | | | | | | |
| | ELW17 | GEW/EASTGATE | 24+38 | 46+57 | LT/RT | | | | 0.06 | | | | | | | | | | | | | | |
| | TLW4 | GEW/EASTGATE | 24+38 | 46+57 | LT/RT | | | | | | | | | | | | | | | | | 358 | |
| | LA70 | GEW | 24+66 | | RT | | | | | | | | | | | | | | | | | | |
| | WP17 | GEW | 24+86 | | LT | | | | | | | | | | | | | | | | | | |
| | WP18 | GEW | 25+32 | | RT | | | | | | | | | | | | | | | | | | |
| | LA71 | GEW | 25+52 | | LT | | | | | | | | | | | | | | | | | | |
| | LA72 | GEW | 25+68 | | RT | | | | | | | | | | | | | | | | | | |
| | SL13 | GEW | 26+08 | | RT | | | | | | | | | | | | | | | | 43 | | |
| | XW1 | GEW | 26+17 | 26+90 | LT | | | | | | | | | | | | | | | | 134 | | |
| 534 | DYL11 | EASTGATE | 46+57 | 46+94 | LT | | | | | | | | | 0.01 | | | | | | | | | |
| | CH38 | EASTGATE | 46+57 | 46+94 | RT | | | | | | | | | | | | | | | | | | |
| | ELW18 | EASTGATE/GEW | 46+78 | 28+81 | LT | | | | 0.04 | | | | | | | | | | | | | | |
| | TLW5 | EASTGATE/GEW | 46+78 | 28+81 | LT | | | | | | | | | | | | | | | | | | |
| | LA73 | EASTGATE | 46+84 | | CL | | | | | | | | | | | | | | | | | | |
| | SL14 | EASTGATE | 46+94 | | RT | | | | | | | | | | | | | | | | | | |
| | XW2 | EASTGATE | 47+07 | 48+06 | LT | | | | | | | | | | | | | | | | 25 | | |
| | SL15 | GEW | 27+30 | | LT | | | | | | | | | | | | | | | | 24 | | |
| | CH39 | GEW | 27+30 | 28+81 | LT | | | | | | | | | | | | | | | | | 198 | |
| | LA74 | GEW | 27+40 | | LT | | | | | | | | | | | | | | | | | | |
| | WP19 | GEW | 28+06 | | LT | | | | | | | | | | | | | | | | | | |
| | LA75 | GEW | 28+72 | | LT | | | | | | | | | | | | | | | | | | |
| SUBTOTALS THIS SHEET | | | | | | 0 | 0 | 0 | 0.12 | 0.08 | 0 | 0 | 0.05 | 0 | 0.1 | 0.01 | 679 | 0 | 92 | 332 | 1353 | 0 | 0 |
| SUBTOTALS FROM SHEET 497 | | | | | | 50 | 111 | 0 | 0.63 | 0 | 1.86 | 1.04 | 0.41 | 1.13 | 0.54 | 0 | 3583 | 5037 | 259 | 0 | 1102 | 211 | 490 |
| TOTALS CARRIED TO SHEET 501 | | | | | | 50 | 111 | 0 | 0.75 | 0.08 | 1.86 | 1.04 | 0.46 | 1.13 | 0.64 | 0.01 | 4,262 | 5,037 | 351 | 332 | 2455 | 211 | 490 |

PAVEMENT MARKING SUBSUMMARY

CLE-32-3.50 (PHASE 5)

CALCULATED
ACW
CHECKED
WAA

499
736

...310.20\310.205\103954TS502.dgn 11/18/2021 4:25:30 PM ssopraseuth

| SHEET NO. | REFERENCE NO. | LOCATION | STATION | | SIDE | 644 | 644 | 644 | 644 | 644 | 807 / 850 | 807 / 850 | 807 / 850 | 644 | 644 | 644 | 807 / 850 | 807 / 850 | 646 | 646 | 646 | 646 | 646 | |
|------------------------------------|---------------|--------------|------------|----------------------|-------|-----------------|-----------------------|-----------------|--|--|--|--|---|---|-----------------------------|-----------------------------|-----------------------------|--|--|-----------------------------|-----------------------|-----------|------------|-----------------------|
| | | | LANE ARROW | LANE REDUCTION ARROW | | WRONG WAY ARROW | WORD ON PAVEMENT, 72" | DOTTED LINE, 4" | WET REFLECTIVE THERMOPLASTIC PAVEMENT MARKING, DOTTED LINE, 6" / | GROOVING FOR 6" RECESSED PAVEMENT MARKING, (ASPHALT) | WET REFLECTIVE THERMOPLASTIC PAVEMENT MARKING, DOTTED LINE, 8" / | GROOVING FOR 8" RECESSED PAVEMENT MARKING, (ASPHALT) | WET REFLECTIVE THERMOPLASTIC PAVEMENT MARKING, DOTTED LINE, 12" / | GROOVING FOR 12" RECESSED PAVEMENT MARKING, (ASPHALT) | REMOVAL OF PAVEMENT MARKING | REMOVAL OF PAVEMENT MARKING | REMOVAL OF PAVEMENT MARKING | WET REFLECTIVE EPOXY PAVEMENT MARKING, EDGE LINE, 4" (WHITE) / GROOVING FOR 4" RECESSED PAVEMENT MARKING, (CONCRETE) | WET REFLECTIVE EPOXY PAVEMENT MARKING, LANE LINE, 4" / GROOVING FOR 4" RECESSED PAVEMENT MARKING, (CONCRETE) | CENTER LINE (DOUBLE YELLOW) | CHANNELIZING LINE, 8" | STOP LINE | LANE ARROW | WORD ON PAVEMENT, 72" |
| | | | FROM | TO | | EACH | EACH | EACH | EACH | FT | FT | FT | FT | FT | EACH | MILE | MILE | MILE | MILE | FT | FT | EACH | EACH | FT |
| 532 | LA59 | GEW | 15+60 | | LT | 1 | | | | | | | | | | | | | | | | | | |
| | WP14 | GEW | 15+68 | | RT | | | | 1 | | | | | | | | | | | | | | | |
| | LA60 | GEW | 15+68 | | RT | 1 | | | | | | | | | | | | | | | | | | |
| | ELY7 | GEW | 16+24 | 16+42 | LT | | | | | | | | | | | | | | | | | | | |
| | WP15 | GEW | 16+26 | | LT | | | | 1 | | | | | | | | | | | | | | | |
| | LA61 | GEW | 16+34 | | RT | 2 | | | | | | | | | | | | | | | | | | |
| | ELY8 | GEW | 16+59 | 16+60 | LT | | | | | | | | | | | | | | | | | | | |
| | DLY8 | GEW | 15+57 | 15+57 | RT | | | | | | | | | | | | | | | | | | | |
| | LA62 | GEW | 16+67 | | RT | 1 | | | | | | | | | | | | | | | | | | |
| | TLW3 | GEW/SR 32 | 16+72 | 143+08 | LT/RT | | | | | | | | | | | | | | | | | | | |
| | CH35 | GEW | 16+74 | 17+46 | LT | | | | | | | | | | | | | | | | | | | |
| | CH36 | GEW | 16+74 | 17+46 | LT | | | | | | | | | | | | | | | | | | | |
| | ELY9 | GEW/SR 32 | 16+74 | 143+22 | CL/RT | | | | | | | | | | | | | | | | | | | |
| | ELW15 | GEW | 16+74 | 16+74 | RT | | | | | | | | | | | | | | | | | | | |
| | LA63 | GEW | 16+84 | | LT | 1 | | | | | | | | | | | | | | | | | | |
| | LA64 | GEW | 17+36 | | LT | 1 | | | | | | | | | | | | | | | | | | |
| | TLY4 | GEW/SR 32 | 17+56 | 143+22 | CL/RT | | | | | | | | | | | | | | | | | | | |
| 533 | CH37 | GEW | 22+60 | 26+08 | RT | | | | | | | | | | | | | | | | | | | |
| | LA65 | GEW | 22+70 | | RT | 1 | | | | | | | | | | | | | | | | | | |
| | LL13 | GEW | 23+19 | 26+08 | RT | | | | | | | | | | | | | | | | | | | |
| | LA66 | GEW | 23+34 | | RT | 1 | | | | | | | | | | | | | | | | | | |
| | LA67 | GEW | 24+00 | | RT | 1 | | | | | | | | | | | | | | | | | | |
| | ELW16 | GEW | 24+01 | 24+12 | LT | | | | | | | | | | | | | | | | | | | |
| | LA68 | GEW | 24+09 | | LT | 1 | | | | | | | | | | | | | | | | | | |
| | WP16 | GEW | 24+17 | | LT | | | | 1 | | | | | | | | | | | | | | | |
| | DYL9 | GEW | 24+24 | 26+08 | LT | | | | | | | | | | | | | | | | | | | |
| | TYL5 | GEW | 24+24 | 26+08 | LT | | | | | | | | | | | | | | | | | | | |
| | DYL10 | GEW | 24+24 | 26+08 | LT | | | | | | | | | | | | | | | | | | | |
| | LA69 | GEW | 24+33 | | LT | 1 | | | | | | | | | | | | | | | | | | |
| | ELW17 | GEW/EASTGATE | 24+38 | 46+57 | LT/RT | | | | | | | | | | | | | | | | | | | |
| | TLW4 | GEW/EASTGATE | 24+38 | 46+57 | LT/RT | | | | | | | | | | | | | | | | | | | |
| | LA70 | GEW | 24+66 | | RT | 1 | | | | | | | | | | | | | | | | | | |
| | WP17 | GEW | 24+86 | | LT | | | | 1 | | | | | | | | | | | | | | | |
| | WP18 | GEW | 25+32 | | RT | | | | 1 | | | | | | | | | | | | | | | |
| | LA71 | GEW | 25+52 | | LT | 1 | | | | | | | | | | | | | | | | | | |
| | LA72 | GEW | 25+68 | | RT | 1 | | | | | | | | | | | | | | | | | | |
| | SL13 | GEW | 26+08 | | RT | | | | | | | | | | | | | | | | | | | |
| | XW1 | GEW | 26+17 | 26+90 | LT | | | | | | | | | | | | | | | | | | | |
| 534 | DYL11 | EASTGATE | 46+57 | 46+94 | LT | | | | | | | | | | | | | | | | | | | |
| | CH38 | EASTGATE | 46+57 | 46+94 | RT | | | | | | | | | | | | | | | | | | | |
| | ELW18 | EASTGATE/GEW | 46+78 | 28+81 | LT | | | | | | | | | | | | | | | | | | | |
| | TLW5 | EASTGATE/GEW | 46+78 | 28+81 | LT | | | | | | | | | | | | | | | | | | | |
| | LA73 | EASTGATE | 46+84 | | CL | 1 | | | | | | | | | | | | | | | | | | |
| | SL14 | EASTGATE | 46+94 | | RT | | | | | | | | | | | | | | | | | | | |
| | XW2 | EASTGATE | 47+07 | 48+06 | LT | | | | | | | | | | | | | | | | | | | |
| | SL15 | GEW | 27+30 | | LT | | | | | | | | | | | | | | | | | | | |
| | CH39 | GEW | 27+30 | 28+81 | LT | | | | | | | | | | | | | | | | | | | |
| | LA74 | GEW | 27+40 | | LT | 1 | | | | | | | | | | | | | | | | | | |
| | WP19 | GEW | 28+06 | | LT | | | | 1 | | | | | | | | | | | | | | | |
| | LA75 | GEW | 28+72 | | LT | 1 | | | | | | | | | | | | | | | | | | |
| SUBTOTALS THIS SHEET | | | | | | 18 | 0 | 0 | 6 | 0 | 0 | 0 | 0 | 0 | 0 | 0 | 0 | 0 | 0 | 0 | 0 | 0 | 0 | 0 |
| SUBTOTALS FROM SHEET 498 | | | | | | 89 | 6 | 2 | 17 | 592 | 1523 | 1260 | 544 | 275 | 0 | 0.06 | 0.06 | 0.04 | 0.01 | 401 | 96 | 4 | 4 | 527 |
| TOTALS CARRIED TO SHEET 502 | | | | | | 107 | 6 | 2 | 23 | 592 | 1523 | 1260 | 544 | 275 | 0 | 0.06 | 0.06 | 0.04 | 0.01 | 401 | 96 | 4 | 4 | 527 |

PAVEMENT MARKING SUBSUMMARY

CLE-32-3.50 (PHASE 5)

CALCULATED
ACW
CHECKED
WAA

500
736

...310.20\310.205\103954\TS502.dgn 11/18/2021 4:25:31 PM ssopraseuth

| SHEET NO. | REFERENCE NO. | LOCATION | STATION | | SIDE | 626 | 626 | 642 | 644 | 644 | 807 / 850 | 807 / 850 | 644 | 807 / 850 | 644 | 644 | 644 | 807 / 850 | 644 | 644 | 644 | 644 | 644 |
|--|-------------------|----------------|---------|--------|-------|---------------------------------|---------------------------------|---------------------------|-----------------------|------------------------|---|--|---------------|---|-----------------------------|----------------------------|-----------------------|---|-----------|----------------|----------------------------|-----------------|----------------|
| | | | FROM | TO | | BARRIER REFLECTOR, TYPE 1, 1WAY | BARRIER REFLECTOR, TYPE 2, 1WAY | PARKING LOT STALL MARKING | EDGE LINE, 4" (WHITE) | EDGE LINE, 4" (YELLOW) | WET REFLECTIVE THERMOPLASTIC PAVEMENT MARKING, EDGE LINE, 6" (WHITE) / GROOVING FOR 6" RECESSED PAVEMENT MARKING, (ASPHALT) | WET REFLECTIVE THERMOPLASTIC PAVEMENT MARKING, EDGE LINE, 6" (YELLOW) / GROOVING FOR 6" RECESSED PAVEMENT MARKING, (ASPHALT) | LANE LINE, 4" | WET REFLECTIVE THERMOPLASTIC PAVEMENT MARKING, LANE LINE, 6" / GROOVING FOR 6" RECESSED PAVEMENT MARKING, (ASPHALT) | CENTER LINE (DOUBLE YELLOW) | CENTER LINE (DASHED/SOLID) | CHANNELIZING LINE, 8" | WET REFLECTIVE THERMOPLASTIC PAVEMENT MARKING, CHANNELIZING LINE, 12" / GROOVING FOR 12" RECESSED PAVEMENT MARKING, (ASPHALT) | STOP LINE | CROSSWALK LINE | TRANSVERSE / DIAGONAL LINE | CHEVRON MARKING | ISLAND MARKING |
| | | | | | | EACH | EACH | FT | MILE | MILE | MILE | MILE | MILE | MILE | MILE | FT | FT | FT | FT | FT | FT | FT | SF |
| 535 | ELW19 | ELICK/MARIAN | 48+39 | 46+44 | LT | | | | 0.12 | | | | | | | | | | | | | | |
| | CH40 | ELICK | 48+39 | 49+50 | LT | | | | | | | | | | | III | | | | | | | |
| | DYL12 | ELICK | 48+39 | 49+50 | CL | | | | | | | | | | 0.02 | | | | | | | | |
| | LA76 | ELICK | 48+49 | | LT | | | | | | | | | | | | | | | | | | |
| | WP20 | ELICK | 49+15 | | LT | | | | | | | | | | | | | | | | | | |
| 536 | IM3 | ELICK | 60+72 | 60+78 | LT | | | | | | | | | | | | | | | | | | 57 |
| | DSL1 | ELICK | 60+78 | 62+00 | LT | | | | | | | | | | | 0.02 | | | | | | | |
| | DSL2 | ELICK | 60+78 | 62+00 | CL | | | | | | | | | | | 0.02 | | | | | | | |
| | ELW20 | ELICK | 62+00 | 63+59 | RT/LT | | | | 0.11 | | | | | | | | | | | | | | |
| 537 | NO NEW QUANTITIES | | | | | | | | | | | | | | | | | | | | | | |
| 538 | ELW21 | OLD 74 | 199+20 | 201+94 | LT | | | | 0.05 | | | | | | | | | | | | | | |
| | DYL13 | OLD 74 | 199+20 | 201+60 | CL | | | | | | | | | | 0.05 | | | | | | | | |
| | ELW22 | OLD 74 | 199+20 | 202+17 | RT/LT | | | | 0.08 | | | | | | | | | | | | | | |
| 539 | DYL14 | OLD 74 | 205+15 | 207+76 | CL | | | | | | | | | | 0.05 | | | | | | | | |
| | ELW23 | OLD 74 | 205+50 | 205+50 | LT/RT | | | | 0.04 | | | | | | | | | | | | | | |
| | REM5 | OLD 74 | 205+50 | 205+83 | LT | | | | | | | | | | | | | | | | | | |
| | REM6 | OLD 74 | 205+50 | 207+76 | RT/CL | | | | | | | | | | | | | | | | | | |
| | REM7 | OLD 74 | 205+70 | | LT | | | | | | | | | | | | | | | | | | |
| | REM8 | OLD 74 | 205+74 | | CL | | | | | | | | | | | | | | | | | | |
| 540 | PLS1 | EASTGATE WOODS | | | | | | 173 | | | | | | | | | | | | | | | |
| | PLS2 | EASTGATE WOODS | | | | | | 380 | | | | | | | | | | | | | | | |
| SUBTOTALS THIS SHEET | | | | | | 0 | 0 | 553 | 0.4 | 0 | 0 | 0 | 0 | 0 | 0.12 | 0.04 | III | 0 | 0 | 0 | 0 | 0 | 57 |
| SUBTOTALS FROM SHEET 499 | | | | | | 50 | III | 0 | 0.75 | 0.08 | 1.86 | 1.04 | 0.46 | 1.13 | 0.64 | 0.01 | 4262 | 5037 | 351 | 332 | 2455 | 211 | 490 |
| TOTALS CARRIED TO GENERAL SUMMARY | | | | | | 50 | III | 553 | 1.23 | | 2.9 | 0.46 | 1.13 | 0.81 | | 4,373 | 5,037 | 351 | 332 | 2,455 | 211 | 547 | |

PAVEMENT MARKING SUBSUMMARY

CALCULATED
ACW
CHECKED
WAA

CLE-32-3.50 (PHASE 5)

501
736

...310.20\310.205\103954\TS502.dgn 11/18/2021 4:25:31 PM ssopraseuth

| SHEET NO. | REFERENCE NO. | LOCATION | STATION | | SIDE | 644 | 644 | 644 | 644 | 644 | 807 / 850 | 807 / 850 | 807 / 850 | 644 | 644 | 644 | 807 / 850 | 807 / 850 | 646 | 646 | 646 | 646 | 646 | |
|--|-------------------|----------------|------------|----------------------|-------|-----------------|-----------------------|-----------------|--|--|--|--|---|---|-----------------------------|-----------------------------|-----------------------------|--|--|-----------------------------|-----------------------|-----------|------------|-----------------------|
| | | | LANE ARROW | LANE REDUCTION ARROW | | WRONG WAY ARROW | WORD ON PAVEMENT, 72" | DOTTED LINE, 4" | WET REFLECTIVE THERMOPLASTIC PAVEMENT MARKING, DOTTED LINE, 6" / | GROOVING FOR 6" RECESSED PAVEMENT MARKING, (ASPHALT) | WET REFLECTIVE THERMOPLASTIC PAVEMENT MARKING, DOTTED LINE, 8" / | GROOVING FOR 8" RECESSED PAVEMENT MARKING, (ASPHALT) | WET REFLECTIVE THERMOPLASTIC PAVEMENT MARKING, DOTTED LINE, 12" / | GROOVING FOR 12" RECESSED PAVEMENT MARKING, (ASPHALT) | REMOVAL OF PAVEMENT MARKING | REMOVAL OF PAVEMENT MARKING | REMOVAL OF PAVEMENT MARKING | WET REFLECTIVE EPOXY PAVEMENT MARKING, EDGE LINE, 4" (WHITE) / GROOVING FOR 4" RECESSED PAVEMENT MARKING, (CONCRETE) | WET REFLECTIVE EPOXY PAVEMENT MARKING, LANE LINE, 4" / GROOVING FOR 4" RECESSED PAVEMENT MARKING, (CONCRETE) | CENTER LINE (DOUBLE YELLOW) | CHANNELIZING LINE, 8" | STOP LINE | LANE ARROW | WORD ON PAVEMENT, 72" |
| | | | FROM | TO | | EACH | EACH | EACH | EACH | FT | FT | FT | FT | FT | EACH | MILE | MILE | MILE | MILE | FT | FT | EACH | EACH | FT |
| 535 | ELW19 | ELICK/MARIAN | 48+39 | 46+44 | LT | | | | | | | | | | | | | | | | | | | |
| | CH40 | ELICK | 48+39 | 49+50 | LT | | | | | | | | | | | | | | | | | | | |
| | DYL12 | ELICK | 48+39 | 49+50 | CL | | | | | | | | | | | | | | | | | | | |
| | LA76 | ELICK | 48+49 | | LT | 1 | | | | | | | | | | | | | | | | | | |
| | WP20 | ELICK | 49+15 | | LT | | | | 1 | | | | | | | | | | | | | | | |
| 536 | IM3 | ELICK | 60+72 | 60+78 | LT | | | | | | | | | | | | | | | | | | | |
| | DSL1 | ELICK | 60+78 | 62+00 | LT | | | | | | | | | | | | | | | | | | | |
| | DSL2 | ELICK | 60+78 | 62+00 | CL | | | | | | | | | | | | | | | | | | | |
| | ELW20 | ELICK | 62+00 | 63+59 | RT/LT | | | | | | | | | | | | | | | | | | | |
| 537 | NO NEW QUANTITIES | | | | | | | | | | | | | | | | | | | | | | | |
| 538 | ELW21 | OLD 74 | 199+20 | 201+94 | LT | | | | | | | | | | | | | | | | | | | |
| | DYL13 | OLD 74 | 199+20 | 201+60 | CL | | | | | | | | | | | | | | | | | | | |
| | ELW22 | OLD 74 | 199+20 | 202+17 | RT/LT | | | | | | | | | | | | | | | | | | | |
| 539 | DYL14 | OLD 74 | 205+15 | 207+76 | CL | | | | | | | | | | | | | | | | | | | |
| | ELW23 | OLD 74 | 205+50 | 205+50 | LT/RT | | | | | | | | | 33 | | | | | | | | | | |
| | REM5 | OLD 74 | 205+50 | 205+83 | LT | | | | | | | | | | | | | | | | | | | |
| | REM6 | OLD 74 | 205+50 | 207+76 | RT/CL | | | | | | | | | | | 0.04 | | | | | | | | |
| | REM7 | OLD 74 | 205+70 | | LT | | | | | | | | | | 1 | | | | | | | | | |
| | REM8 | OLD 74 | 205+74 | | CL | | | | | | | | | | 1 | | | | | | | | | |
| 540 | PLS1 | EASTGATE WOODS | | | | | | | | | | | | | | | | | | | | | | |
| | PLS2 | EASTGATE WOODS | | | | | | | | | | | | | | | | | | | | | | |
| SUBTOTALS THIS SHEET | | | | | | 1 | 0 | 0 | 1 | 0 | 0 | 0 | 0 | 33 | 2 | 0.04 | 0 | 0 | 0 | 0 | 0 | 0 | 0 | 0 |
| SUBTOTALS FROM SHEET 500 | | | | | | 107 | 6 | 2 | 23 | 592 | 1523 | 1260 | 544 | 275 | 0 | 0.06 | 0.06 | 0.04 | 0.01 | 401 | 96 | 4 | 4 | 527 |
| TOTALS CARRIED TO GENERAL SUMMARY | | | | | | 108 | 6 | 2 | 24 | 592 | 1,523 | 1,260 | 544 | 308 | 2 | 0.1 | 0.06 | 0.04 | 0.01 | 401 | 96 | 4 | 4 | 527 |

PAVEMENT MARKING SUBSUMMARY

CLE-32-3.50 (PHASE 5)

CALCULATED
ACW
CHECKED
WAA

502
736

...310.20\310.205\103954\TS503.dgn 11/18/2021 4:25:37 PM

| SHEET NO. | REFERENCE NO. | LOCATION | STATION | | SIDE | 621 | | | |
|---------------------------------|---------------|-------------------|---------|--------|-------|-------------------------|-----------------------------|--------------------------|--|
| | | | FROM | TO | | RPM (WHITE/RED TWO-WAY) | RPM (YELLOW/YELLOW TWO-WAY) | RPM (YELLOW/RED TWO-WAY) | |
| | | | | | | EACH | EACH | EACH | |
| 504 | RPM1 | BACH BUXTON | 332+41 | 339+80 | LT | 9 | | | |
| | RPM2 | BACH BUXTON | 332+41 | 334+65 | LT | 6 | | | |
| | RPM3 | BACH BUXTON | 332+41 | 339+80 | LT | | 9 | | |
| | RPM4 | BACH BUXTON | 332+41 | 339+80 | CL | | 9 | | |
| | RPM5 | BACH BUXTON | 332+43 | 335+60 | RT | 4 | | | |
| | RPM6 | BACH BUXTON | 335+60 | 339+80 | RT | 10 | | | |
| | RPM7 | BACH BUXTON | 335+60 | 339+80 | RT | 10 | | | |
| | RPM8 | BACH BUXTON | 335+60 | 339+80 | RT | 5 | | | |
| 505 | RPM9 | BACH BUXTON/RMP O | 339+21 | 195+91 | LT/RT | 3 | | | |
| | RPM10 | NOT USED | | | | | | | |
| | RPM11 | NOT USED | | | | | | | |
| | RPM12 | RAMP P | 198+14 | 203+65 | LT | 6 | | | |
| 506 | RPM13 | NOT USED | | | | | | | |
| | RPM14 | NOT USED | | | | | | | |
| | RPM15 | NOT USED | | | | | | | |
| | RPM16 | NOT USED | | | | | | | |
| | RPM17 | NOT USED | | | | | | | |
| | RPM18 | BACH BUXTON | 342+85 | 346+05 | LT | 8 | | | |
| | RPM19 | BACH BUXTON | 343+15 | 349+04 | LT | 7 | | | |
| | RPM20 | BACH BUXTON | 343+15 | 347+90 | LT | 12 | | | |
| | RPM21 | BACH BUXTON | 343+15 | 346+90 | LT | 9 | | | |
| | RPM22 | BACH BUXTON | 343+15 | 349+00 | CL | | 7 | | |
| | RPM23 | BACH BUXTON | 343+15 | 349+00 | RT | | 7 | | |
| | RPM24 | BACH BUXTON | 343+15 | 344+10 | RT | 2 | | | |
| | RPM25 | BACH BUXTON | 344+10 | 349+00 | RT | 12 | | | |
| | RPM26 | BACH BUXTON | 344+70 | 349+00 | RT | 10 | | | |
| | RPM27 | RMP N/BACH BUXTON | 196+89 | 343+46 | LT | 3 | | | |
| | RPM28 | RAMP Q | 198+90 | 201+85 | CL | 7 | | | |
| | RPM29 | RAMP Q | 199+01 | 201+45 | RT | 6 | | | |
| | RPM30 | BACH BUXTON/RMP Q | 343+30 | 199+60 | RT/CL | 3 | | | |
| | RPM31 | BACH BUXTON/RMP Q | 343+45 | 201+45 | LT | 6 | | | |
| 507 | | NO NEW QUANTITIES | | | | | | | |
| 509 | | NO NEW QUANTITIES | | | | | | | |
| 510 | | NO NEW QUANTITIES | | | | | | | |
| 511 | RPM35 | SR 32 | 139+39 | 143+22 | RT | 10 | | | |
| 512 | | NO NEW QUANTITIES | | | | | | | |
| 513 | | NO NEW QUANTITIES | | | | | | | |
| 514 | | NO NEW QUANTITIES | | | | | | | |
| 515 | | NO NEW QUANTITIES | | | | | | | |
| 516 | | NO NEW QUANTITIES | | | | | | | |
| 517 | | NO NEW QUANTITIES | | | | | | | |
| 518 | | NO NEW QUANTITIES | | | | | | | |
| 519 | | NO NEW QUANTITIES | | | | | | | |
| SUBTOTALS CARRIED TO RIGHT PAGE | | | | | | 148 | 32 | 0 | |

| SHEET NO. | REFERENCE NO. | LOCATION | STATION | | SIDE | 621 | | | |
|----------------------------------|---------------|-------------------|---------|--------|-------|-------------------------|-----------------------------|--------------------------|--------------------------------|
| | | | FROM | TO | | RPM (WHITE/RED TWO-WAY) | RPM (YELLOW/YELLOW TWO-WAY) | RPM (YELLOW/RED TWO-WAY) | RAISED PAVEMENT MARKER REMOVED |
| | | | | | | EACH | EACH | EACH | EACH |
| 519 | RPM41 | SR 32 | 184+04 | 188+88 | RT | 12 | | | |
| | RPM42 | RAMP O | 184+04 | 188+88 | LT | 12 | | | |
| 520 | RPM42A | RAMP O | 188+88 | 197+18 | LT | | | 10 | |
| 521 | RPM43 | RAMP N | 190+40 | 197+49 | RT | 8 | | | |
| | RPM45 | RAMP O | 193+48 | 197+09 | LT | 9 | | | |
| | RPM46 | RMP O/BACH BUXTON | 193+48 | 339+12 | CL | 11 | | | |
| | RPM47 | RAMP O | 193+89 | 196+94 | LT | 7 | | | |
| | RPM48 | RAMP N | 195+86 | 197+86 | LT | 5 | | | |
| 522 | RPM48A | RAMP Q | 198+84 | 208+06 | RT | | | 12 | |
| 523 | RPM49 | RAMP P/SR 32 | 203+65 | 216+15 | LT/RT | 15 | | | |
| | RPM50 | RAMP P/SR 32 | 205+50 | 211+00 | LT/RT | 13 | | | |
| | RPM51 | SR 32 | 205+51 | 211+00 | RT | 13 | | | |
| 524 | RPM52 | RAMP Q | 208+06 | 210+89 | RT | 7 | | | |
| 525 | | NO NEW QUANTITIES | | | | | | | |
| 526 | | NO NEW QUANTITIES | | | | | | | |
| 527 | | NO NEW QUANTITIES | | | | | | | |
| 528 | | NO NEW QUANTITIES | | | | | | | |
| 529 | | NO NEW QUANTITIES | | | | | | | |
| 530 | | NO NEW QUANTITIES | | | | | | | |
| 531 | RPM54 | GEW | 12+17 | 14+80 | RT | 3 | | | |
| | RPM55 | GEW | 13+65 | 14+80 | LT | | 2 | | |
| 532 | RPM56 | GEW | 15+50 | 15+50 | LT | 5 | | | |
| | RPM57 | GEW | 15+50 | 16+44 | CL | | 2 | | |
| | RPM58 | GEW | 15+50 | 16+57 | RT | 4 | | | |
| | RPM59 | GEW | 16+74 | 17+46 | LT | 3 | | | |
| 533 | RPM60 | GEW | 22+60 | 26+08 | RT | 8 | | | |
| | RPM61 | GEW | 23+19 | 26+08 | RT | 3 | | | |
| | RPM62 | GEW | 24+24 | 26+08 | LT | | 3 | | |
| | RPM63 | GEW | 24+24 | 26+08 | LT | | 3 | | |
| 534 | RPM64 | EASTGATE | 46+57 | 46+94 | LT | | 2 | | |
| | RPM65 | EASTGATE | 46+57 | 46+94 | RT | 3 | | | |
| | RPM66 | GEW | 27+30 | 28+81 | LT | 4 | | | |
| 535 | RPM67 | ELICK | 48+39 | 49+50 | LT | 3 | | | |
| | RPM68 | ELICK | 48+39 | 49+50 | CL | | 2 | | |
| 536 | RPM69 | ELICK | 60+78 | 62+00 | LT | | 2 | | |
| | RPM70 | ELICK | 60+78 | 62+00 | CL | | 2 | | |
| 537 | | NO NEW QUANTITIES | | | | | | | |
| 538 | RPM71 | OLD 74 | 199+20 | 201+60 | CL | | 3 | | |
| 539 | RPM72 | OLD 74 | 205+15 | 207+76 | CL | | 3 | | |
| ESTIMATED RPM REMOVALS | | | | | | | | | 450 |
| SUBTOTALS THIS PAGE | | | | | | 148 | 24 | 22 | 450 |
| SUBTOTALS FROM LEFT PAGE | | | | | | 148 | 32 | 0 | |
| TOTALS THIS PAGE | | | | | | 296 | 56 | 22 | 450 |
| TOTAL CARRIED TO GENERAL SUMMARY | | | | | | | 374 | | 450 |

CALCULATED ACW CHECKED WAA

RPM SUBSUMMARY

CLE-32-3.50 (PHASE 5)

503
736

...310.20\310.205\103954TP509.dgn 11/18/2021 4:21:06 PM ssopraseuth



NOTES:

- 1. FOR TRAFFIC CONTROL LEGEND, SEE SHEET 504
- 2. INSTALL RAISED PAVEMENT MARKERS PER ODOT SCD TC-65.10 AND TC-65.11.

CALLOUT "REMI" NOT USED

MATCH LINE STA. 119+00
SEE ABOVE RIGHT, THIS SHEET

MATCH LINE STA. 124+50
SEE SHEET 509

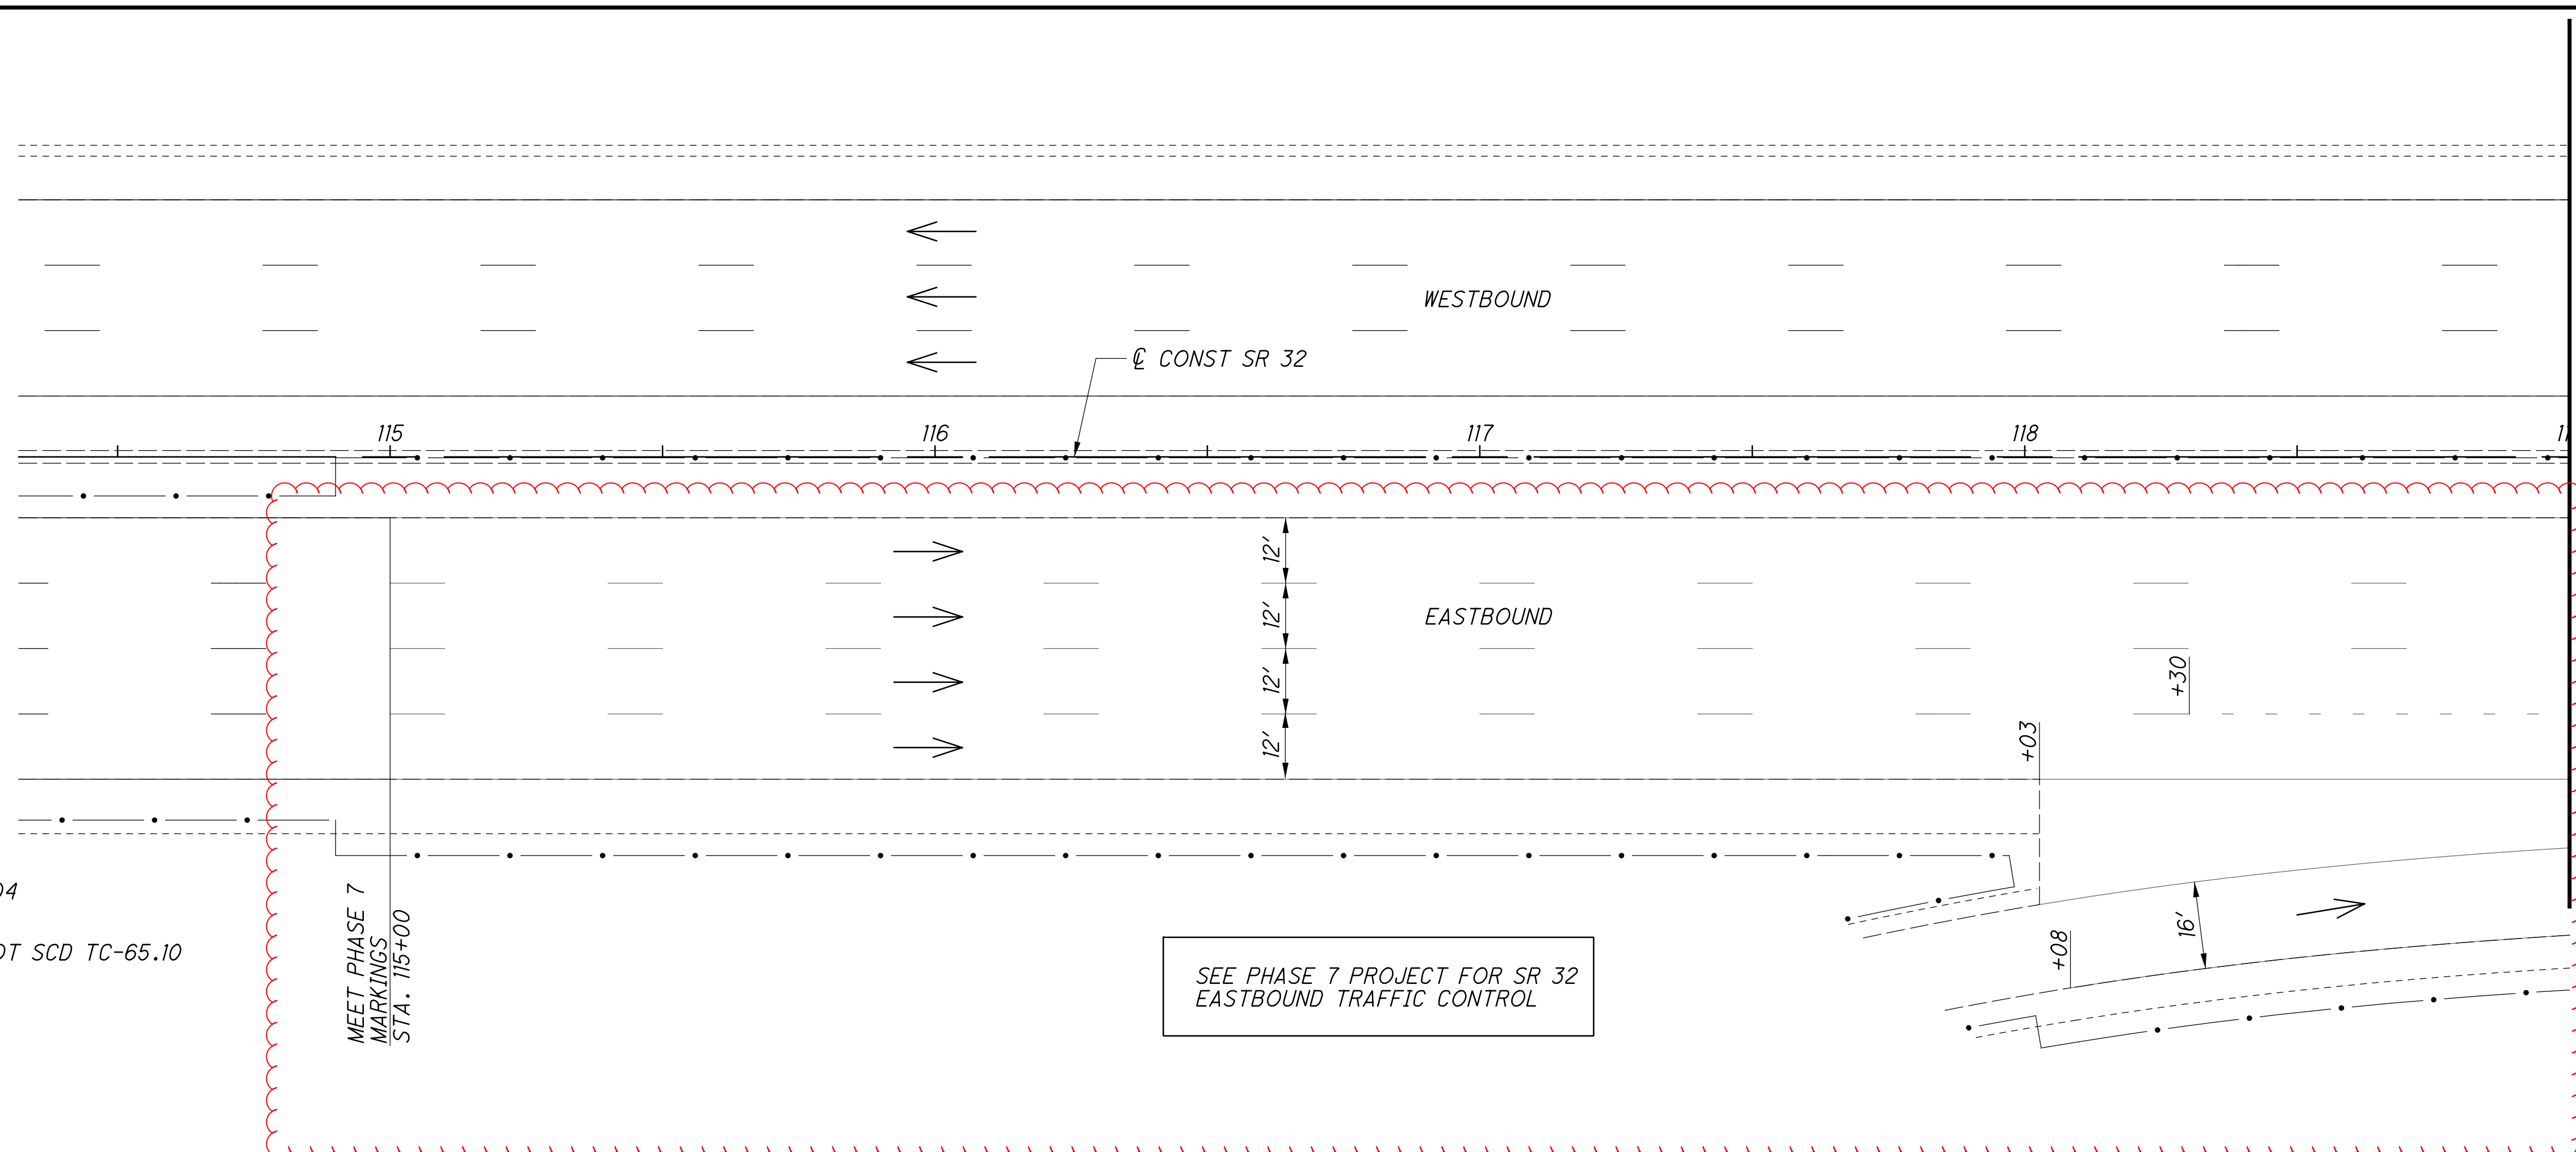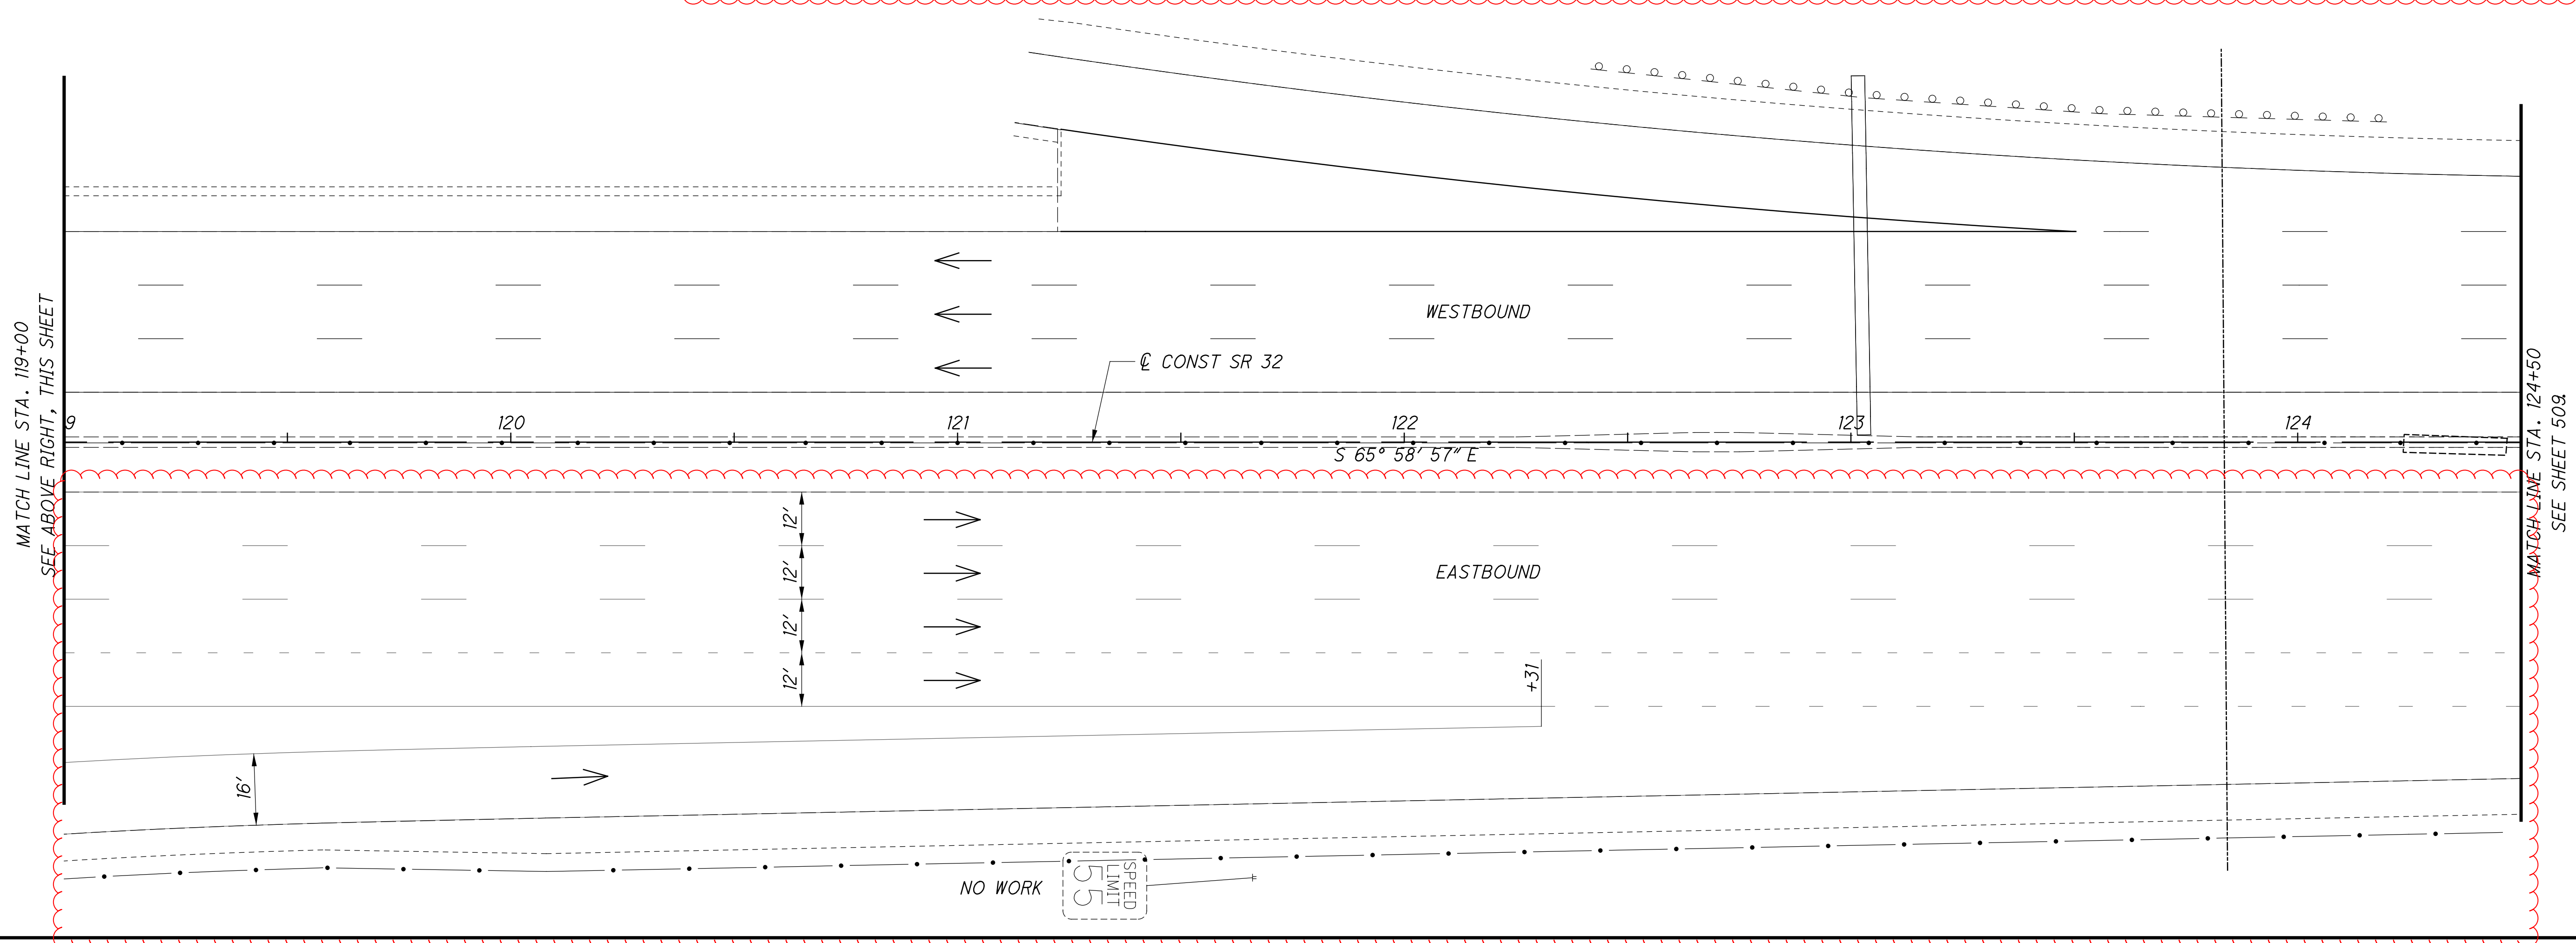

CALCULATED ACW
CHECKED WAA

HORIZONTAL SCALE IN FEET


TRAFFIC CONTROL PLAN - SR 32
STA. 115+00 TO STA. 124+50

CLE-32-3.50
(PHASE 5)

508
736

NOTE:

- 1. FOR TRAFFIC CONTROL LEGEND, SEE SHEET 504
- 2. INSTALL RAISED PAVEMENT MARKERS PER ODOT SCD TC-65.10 AND TC-65.11.

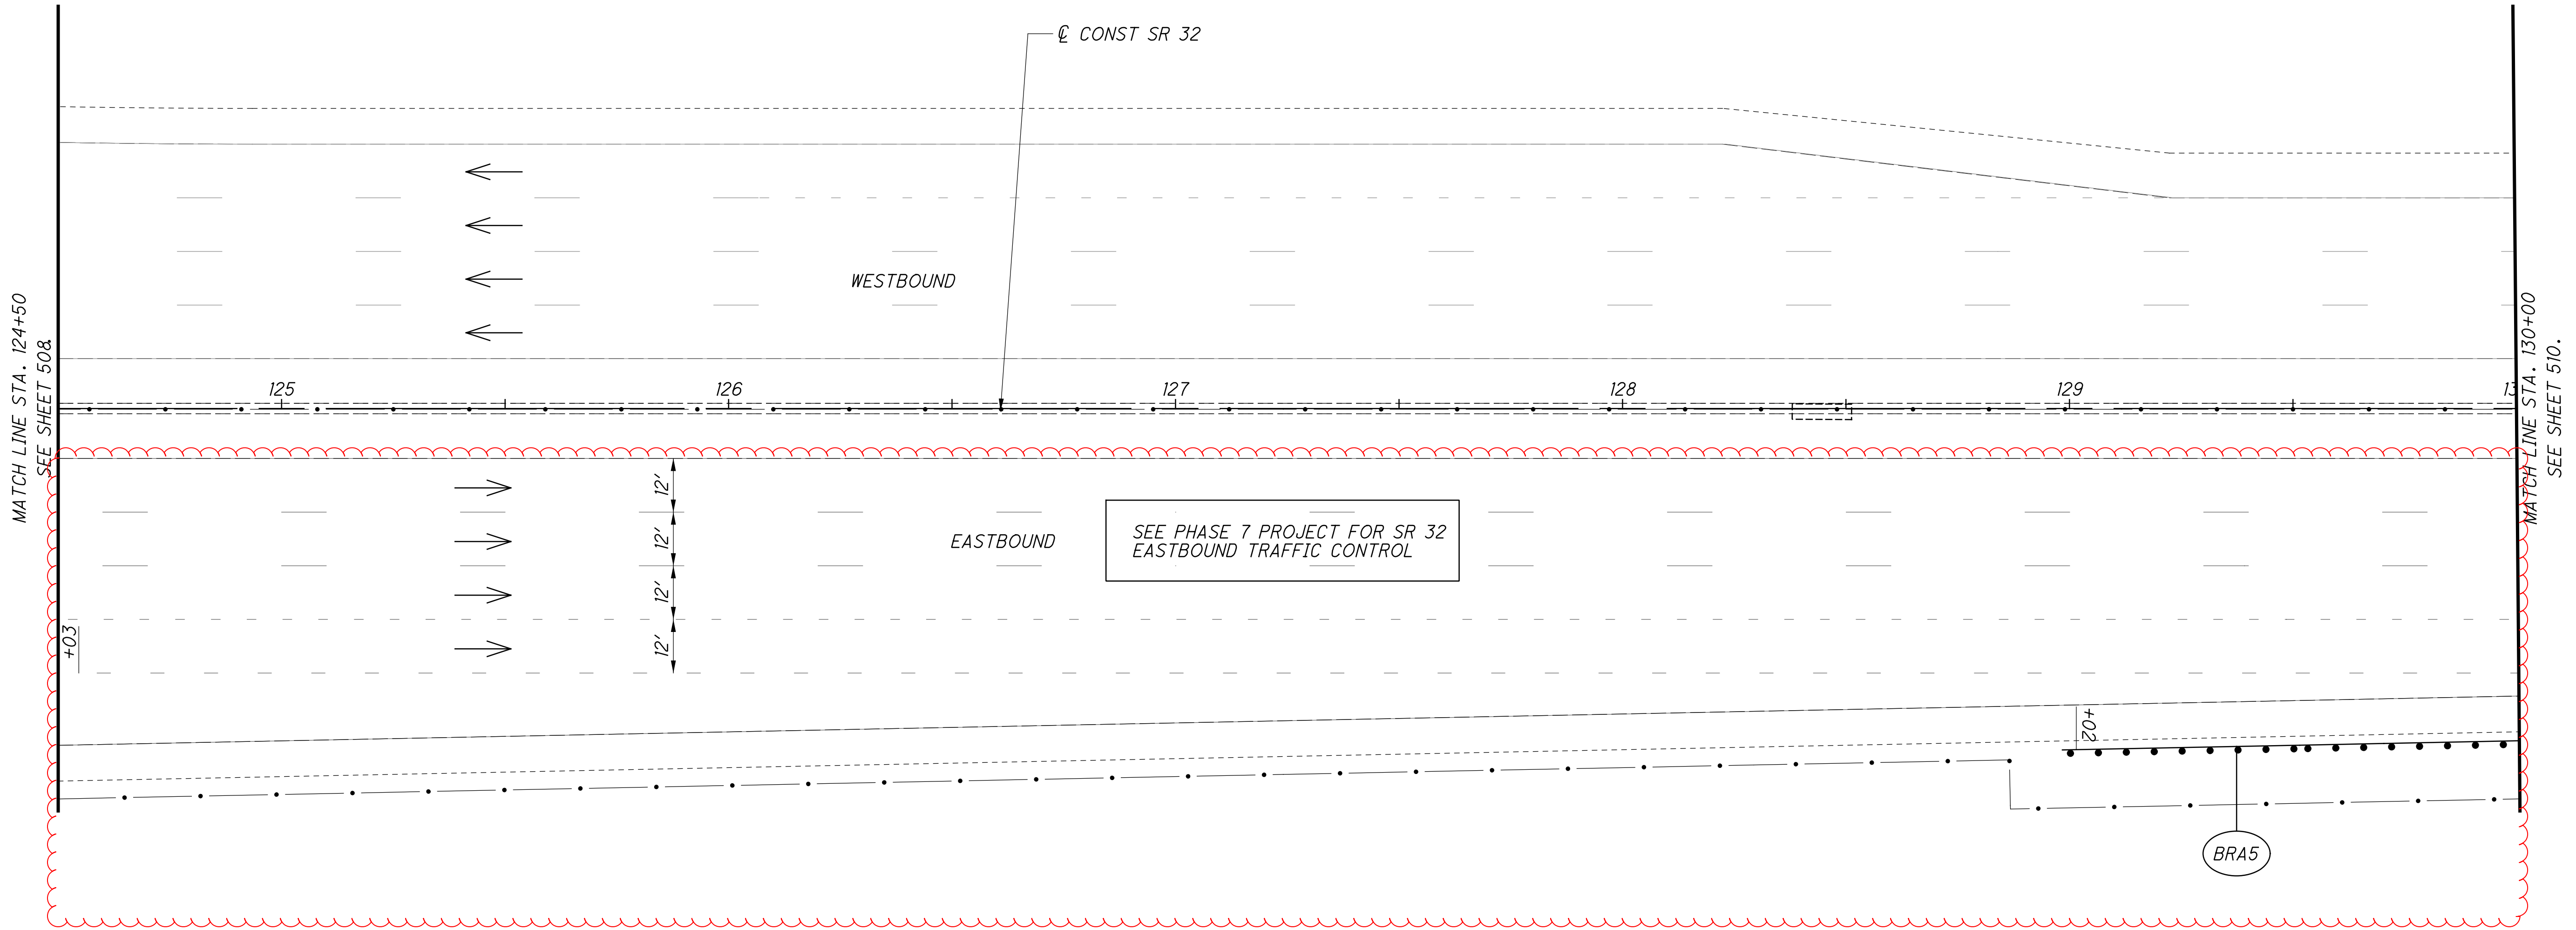

CALCULATED
ACW
CHECKED
WAA

0 10 20 40
HORIZONTAL
SCALE IN FEET


TRAFFIC CONTROL PLAN - SR 32
STA. 124+50 TO STA. 130+00

CLE-32-3.50
(PHASE 5)

NOTES:

1. FOR TRAFFIC CONTROL LEGEND, SEE SHEET 504
2. INSTALL RAISED PAVEMENT MARKERS PER ODOT SCD TC-65.10 AND TC-65.11.

...310.20\310.205\103954TP512.dgn 11/18/2021 4:21:27 PM ssopraseuth

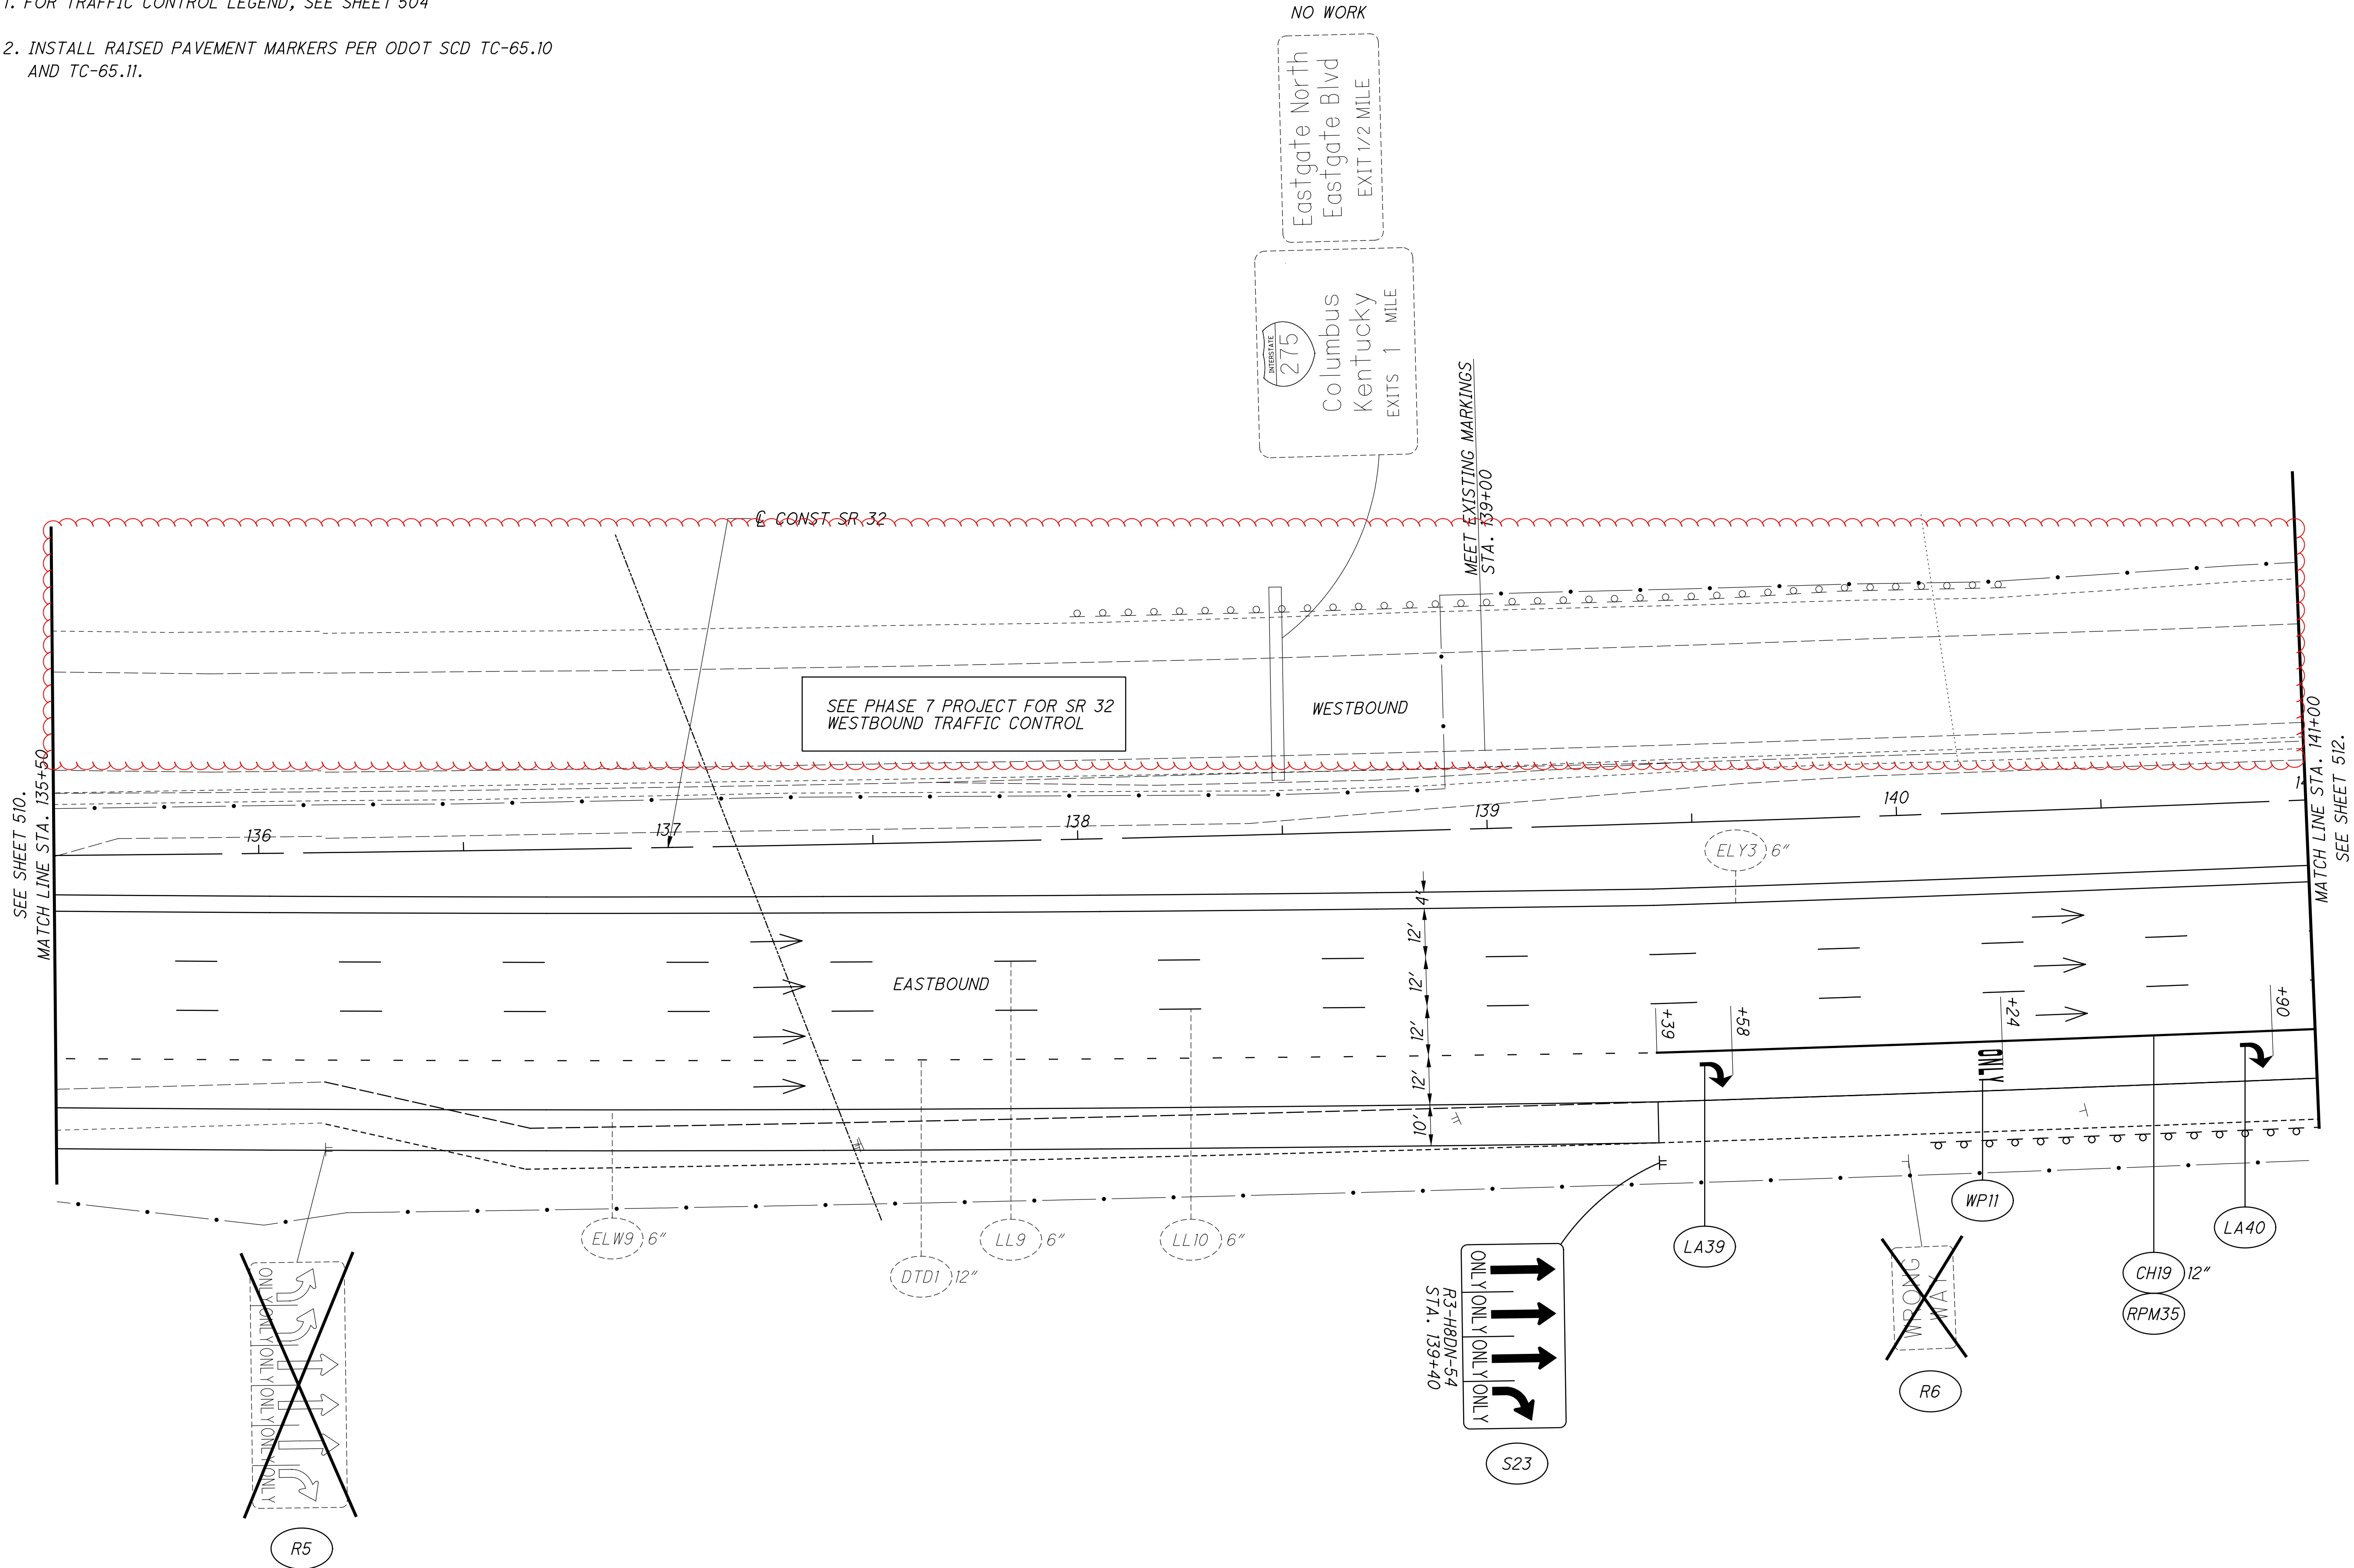

CALCULATED
ACW
CHECKED
WAA


0 10 20 40
HORIZONTAL
SCALE IN FEET

TRAFFIC CONTROL PLAN - SR 32
STA. 135+50 TO STA. 141+00

CLE-32-3.50
(PHASE 5)

...310.20\310.205\103954TP513.dgn 11/18/2021 4:21:33 PM ssopraseuth

- NOTES:
- FOR TRAFFIC CONTROL LEGEND, SEE SHEET 504
 - INSTALL RAISED PAVEMENT MARKERS PER ODOT SCD TC-65.10 AND TC-65.11.

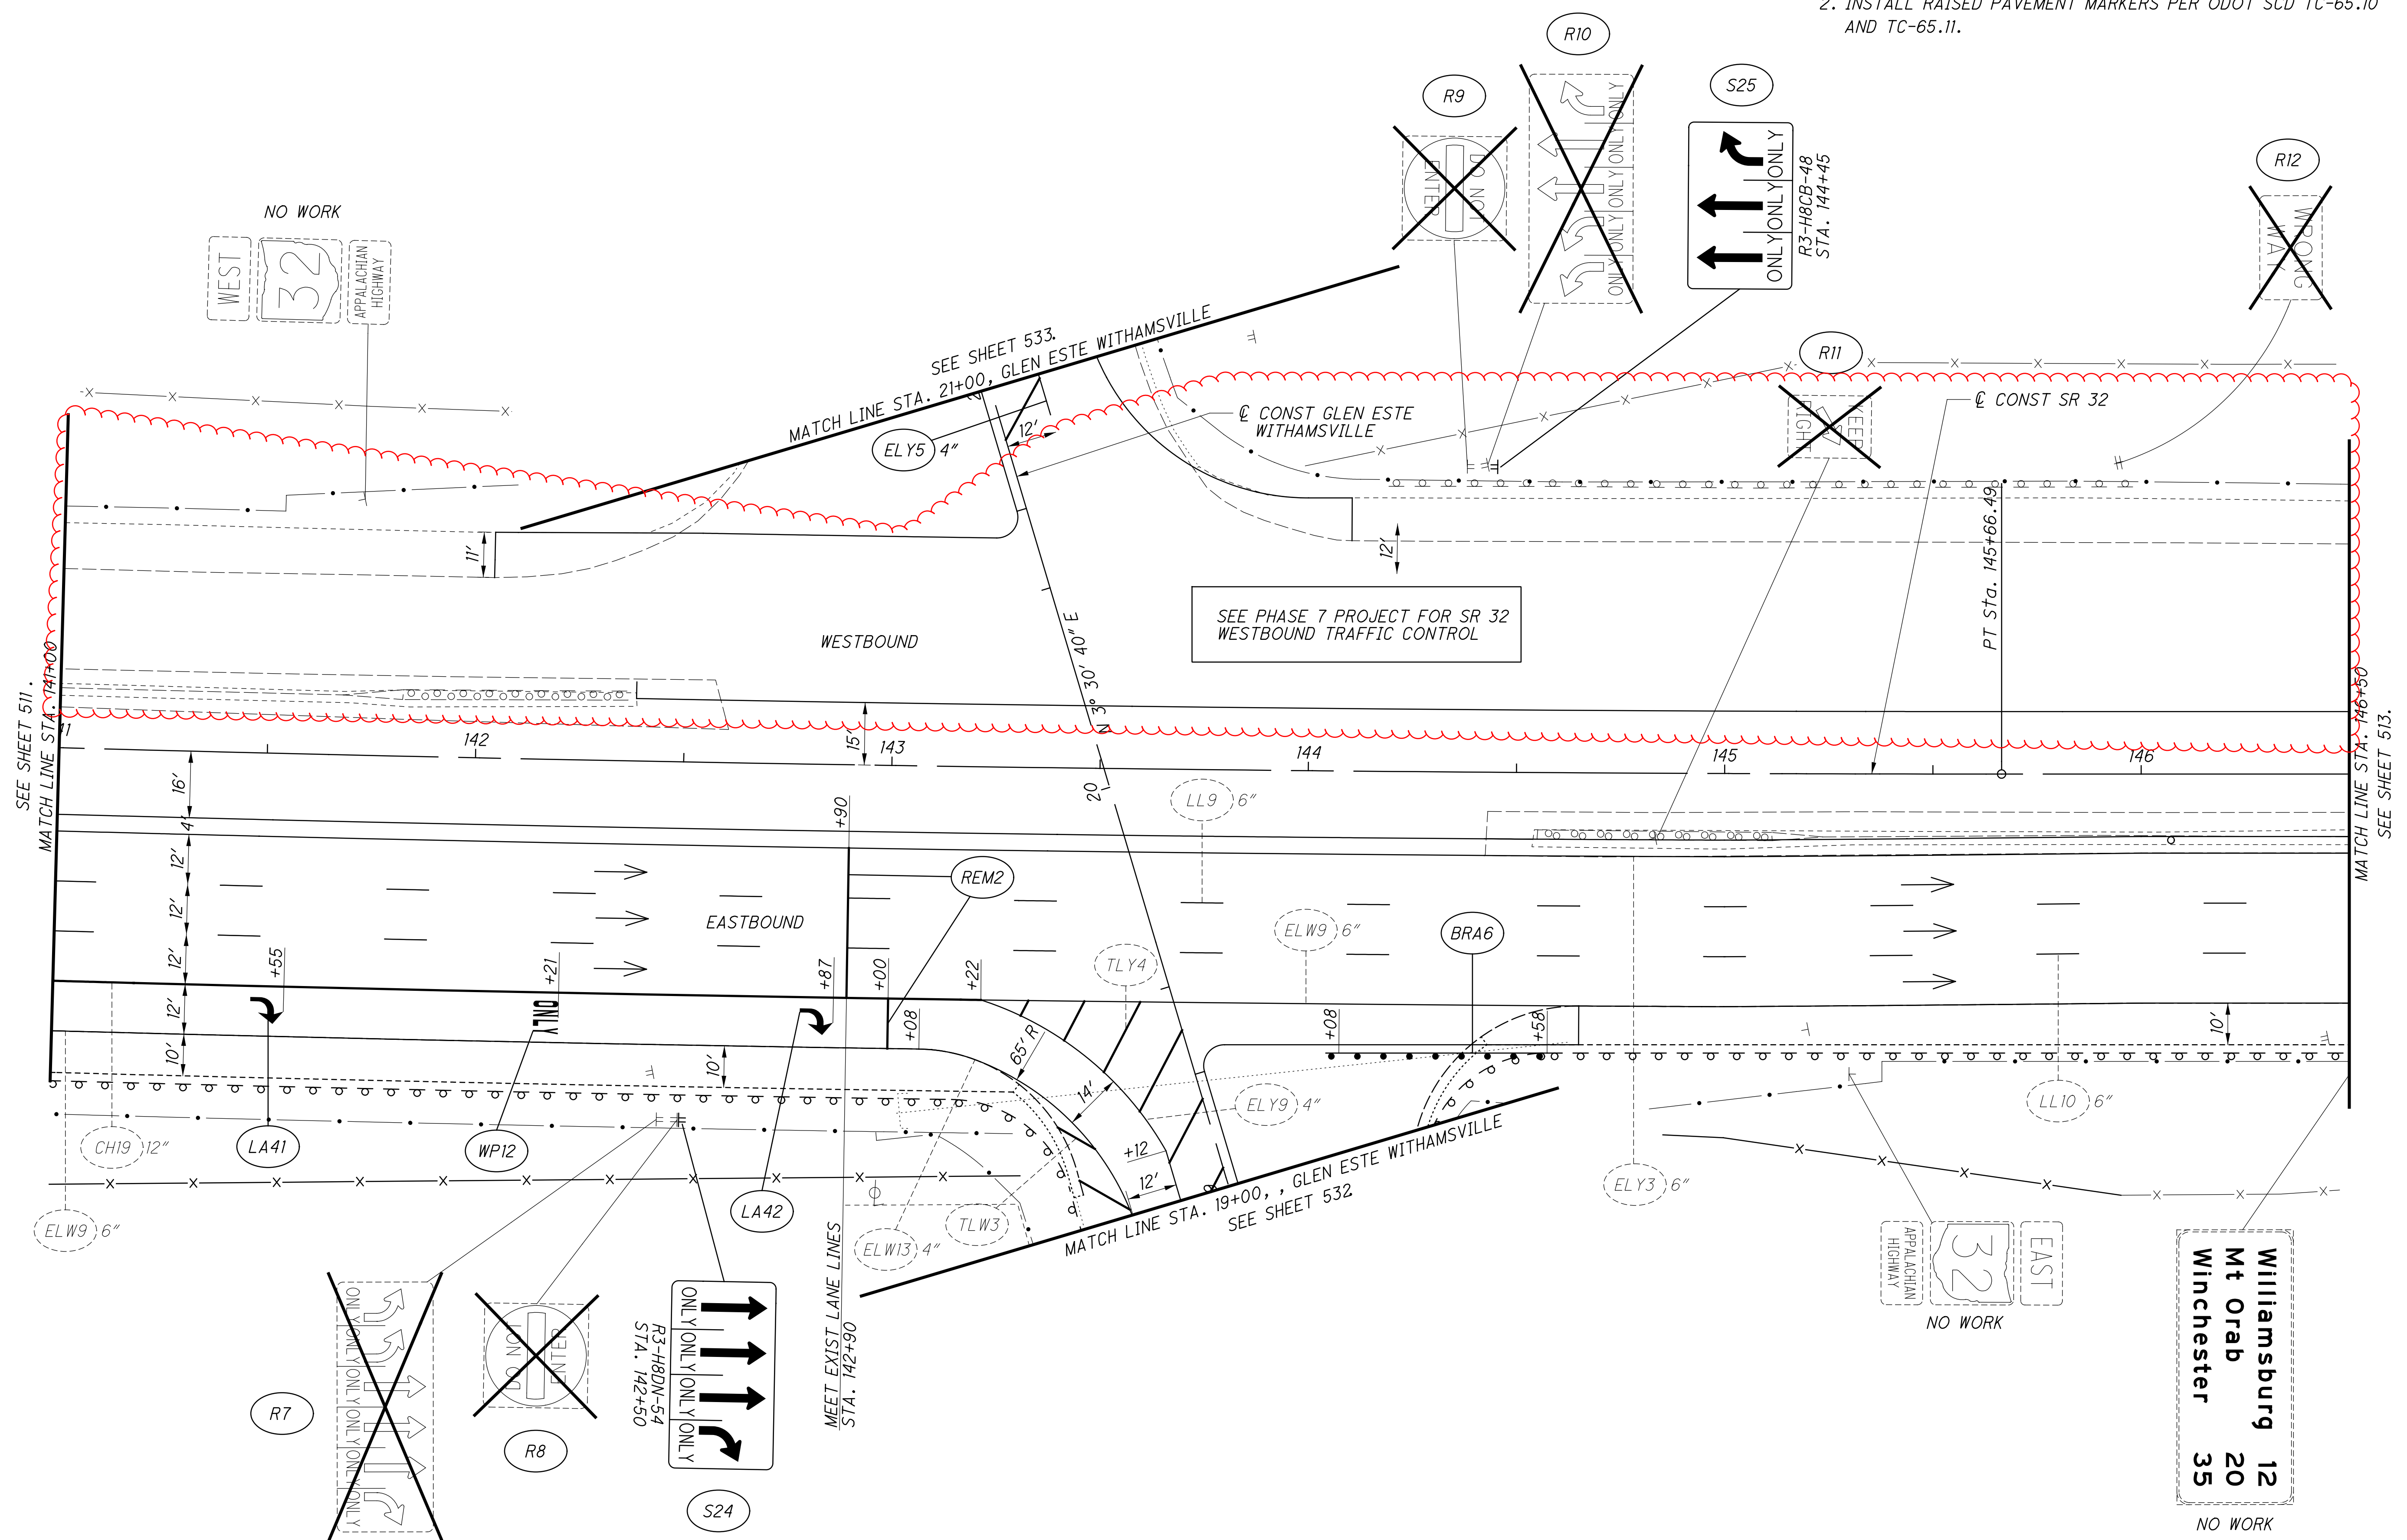

CALCULATED
ACW
CHECKED
WAA

0 10 20 40
HORIZONTAL
SCALE IN FEET

**TRAFFIC CONTROL PLAN - SR 32
STA. 141+00 TO STA. 146+50**

**CLE-32-3.50
(PHASE 5)**

512
736

**Williamsburg 12
Mt Orab 20
Winchester 35**

NO WORK

NOTES:

1. FOR TRAFFIC CONTROL LEGEND, SEE SHEET 504


CALCULATED ACW
CHECKED WAA

0 10 20 40
HORIZONTAL SCALE IN FEET


TRAFFIC CONTROL PLAN - SR 32
STA. 146+50 TO STA. 152+00

CLE-32-3.50
(PHASE 5)

513
736

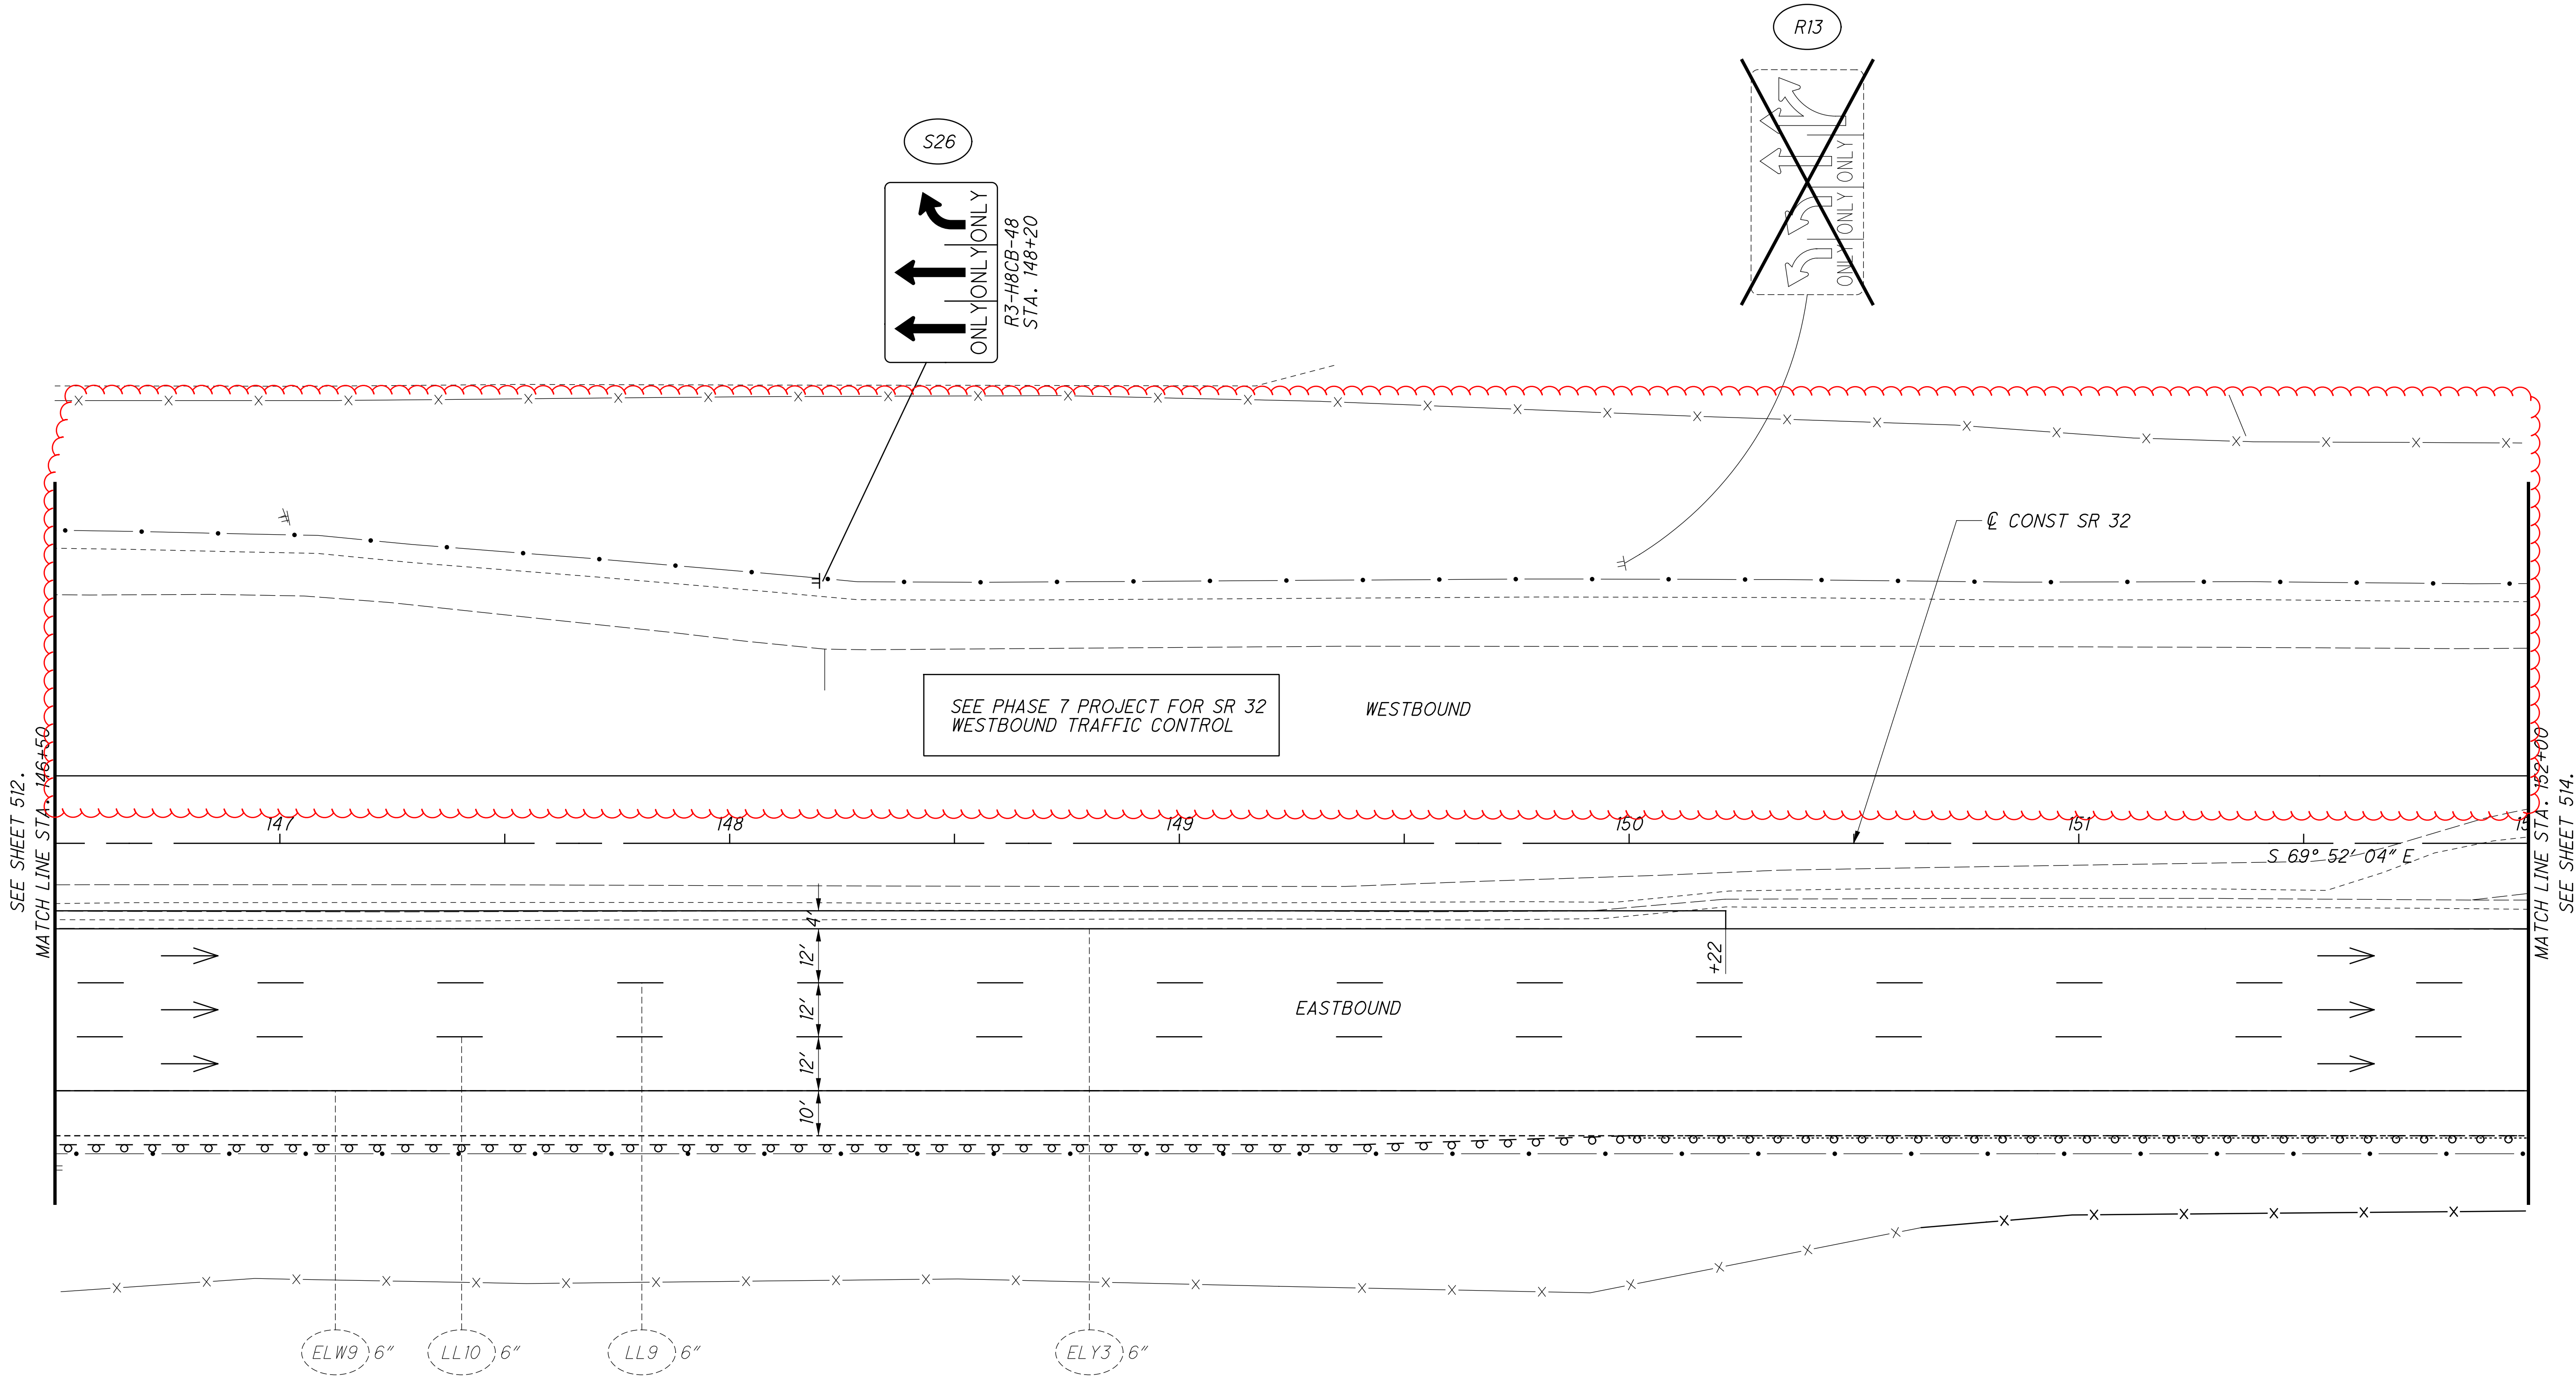

...310.20\310.205\103954TP515.dgn 11/18/2021 4:21:47 PM ssopraseuth

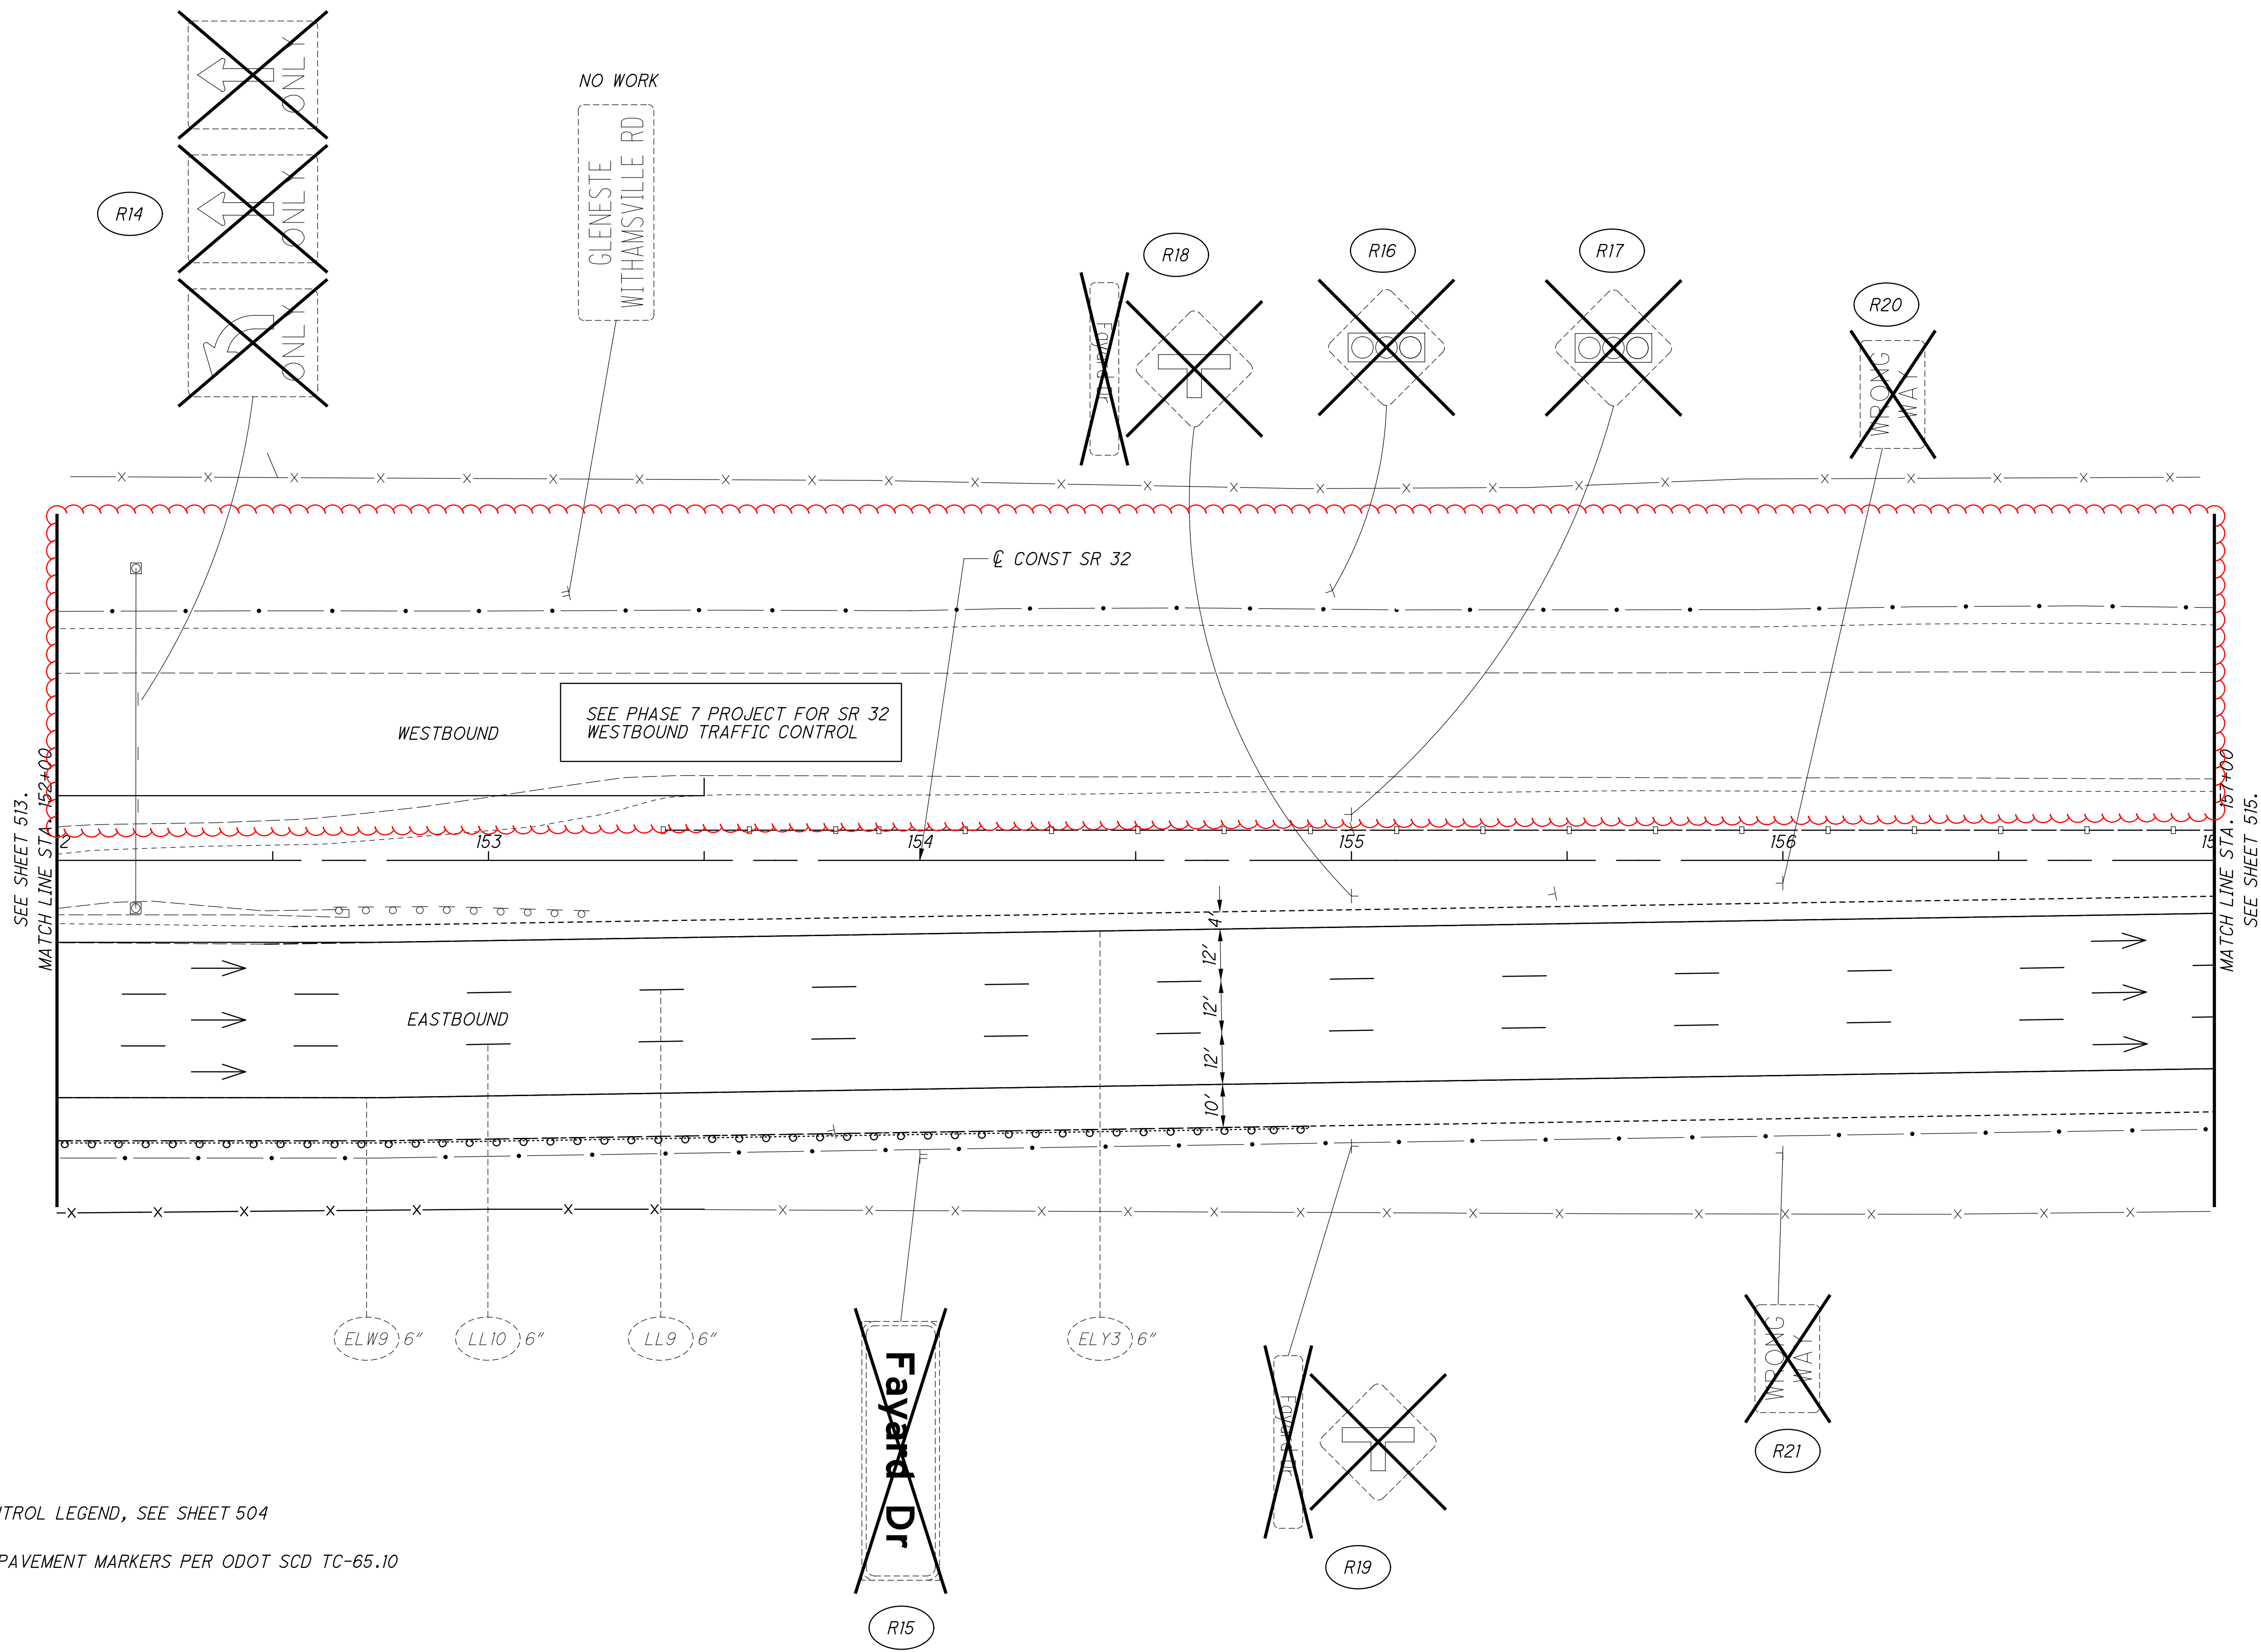


- NOTES:
1. FOR TRAFFIC CONTROL LEGEND, SEE SHEET 504
 2. INSTALL RAISED PAVEMENT MARKERS PER ODOT SCD TC-65.10 AND TC-65.11.

CALCULATED ACW
CHECKED WAA

0 10 20 40
HORIZONTAL SCALE IN FEET

TRAFFIC CONTROL PLAN - SR 32
STA. 152+00 TO STA. 157+00

CLE-32-3.50
(PHASE 5)

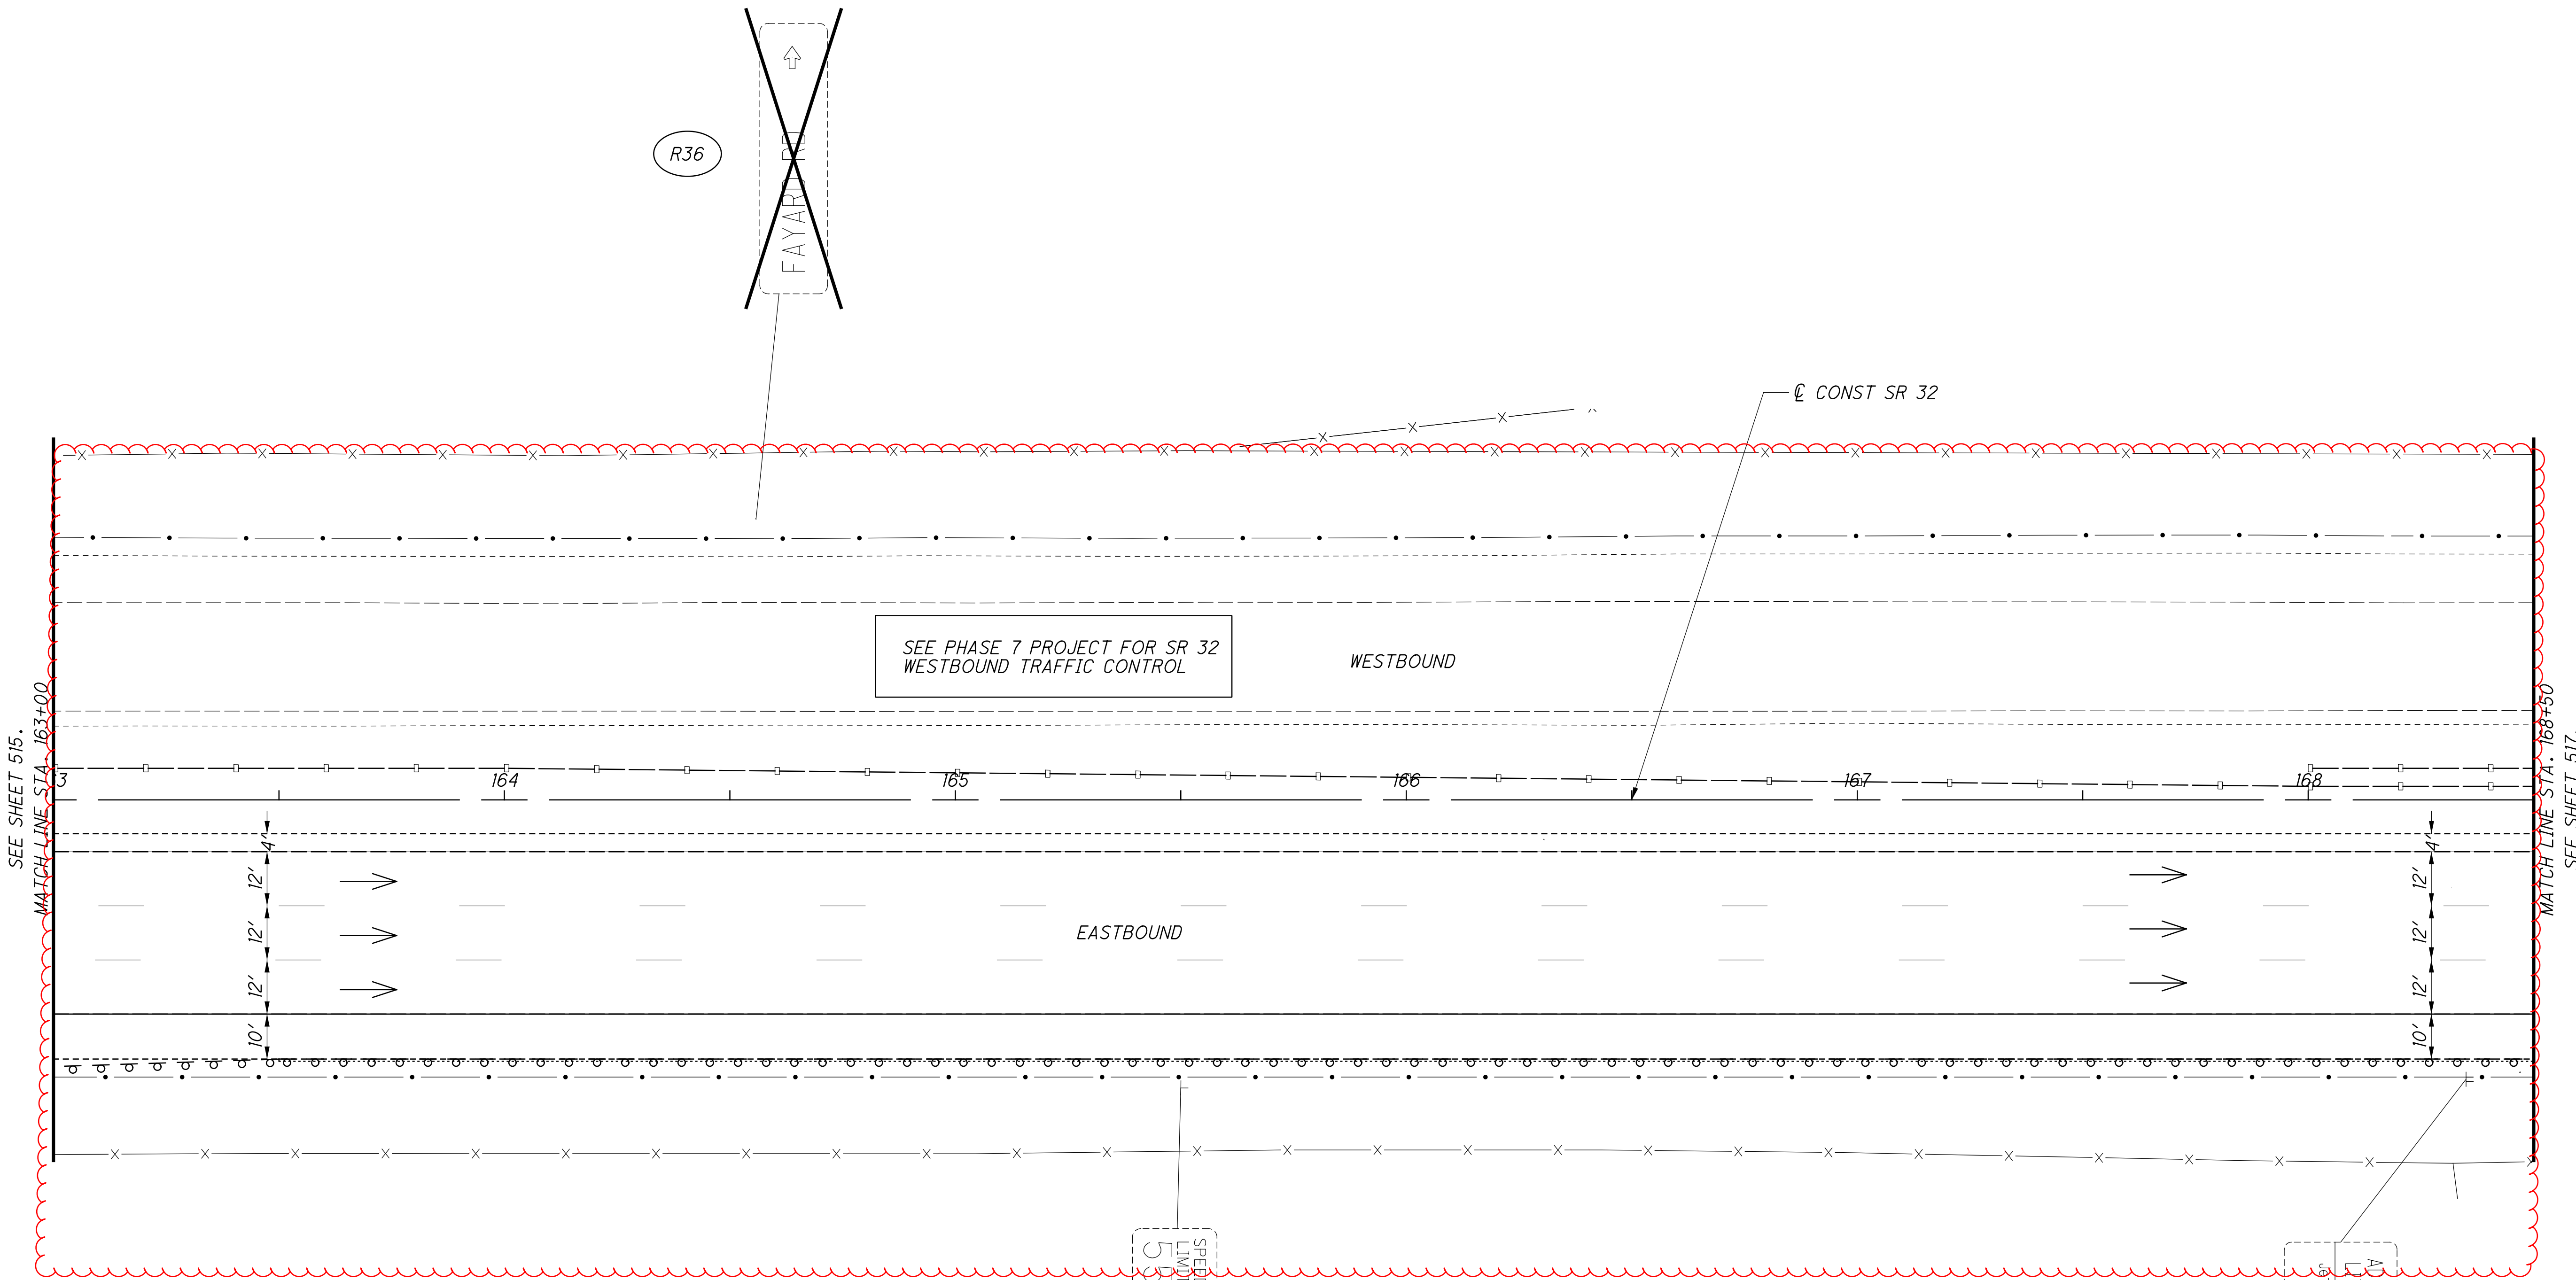

NOTES:

1. FOR TRAFFIC CONTROL LEGEND, SEE SHEET 504

CALCULATED ACW
CHECKED WAA


0 10 20 40
HORIZONTAL SCALE IN FEET

TRAFFIC CONTROL PLAN - SR 32
STA. 163+00 TO STA. 168+50

CLE-32-3.50
(PHASE 5)

SEE SHEET 516.
MATCH LINE STA. 168+50

MATCH LINE STA. 174+00
SEE SHEET 518.

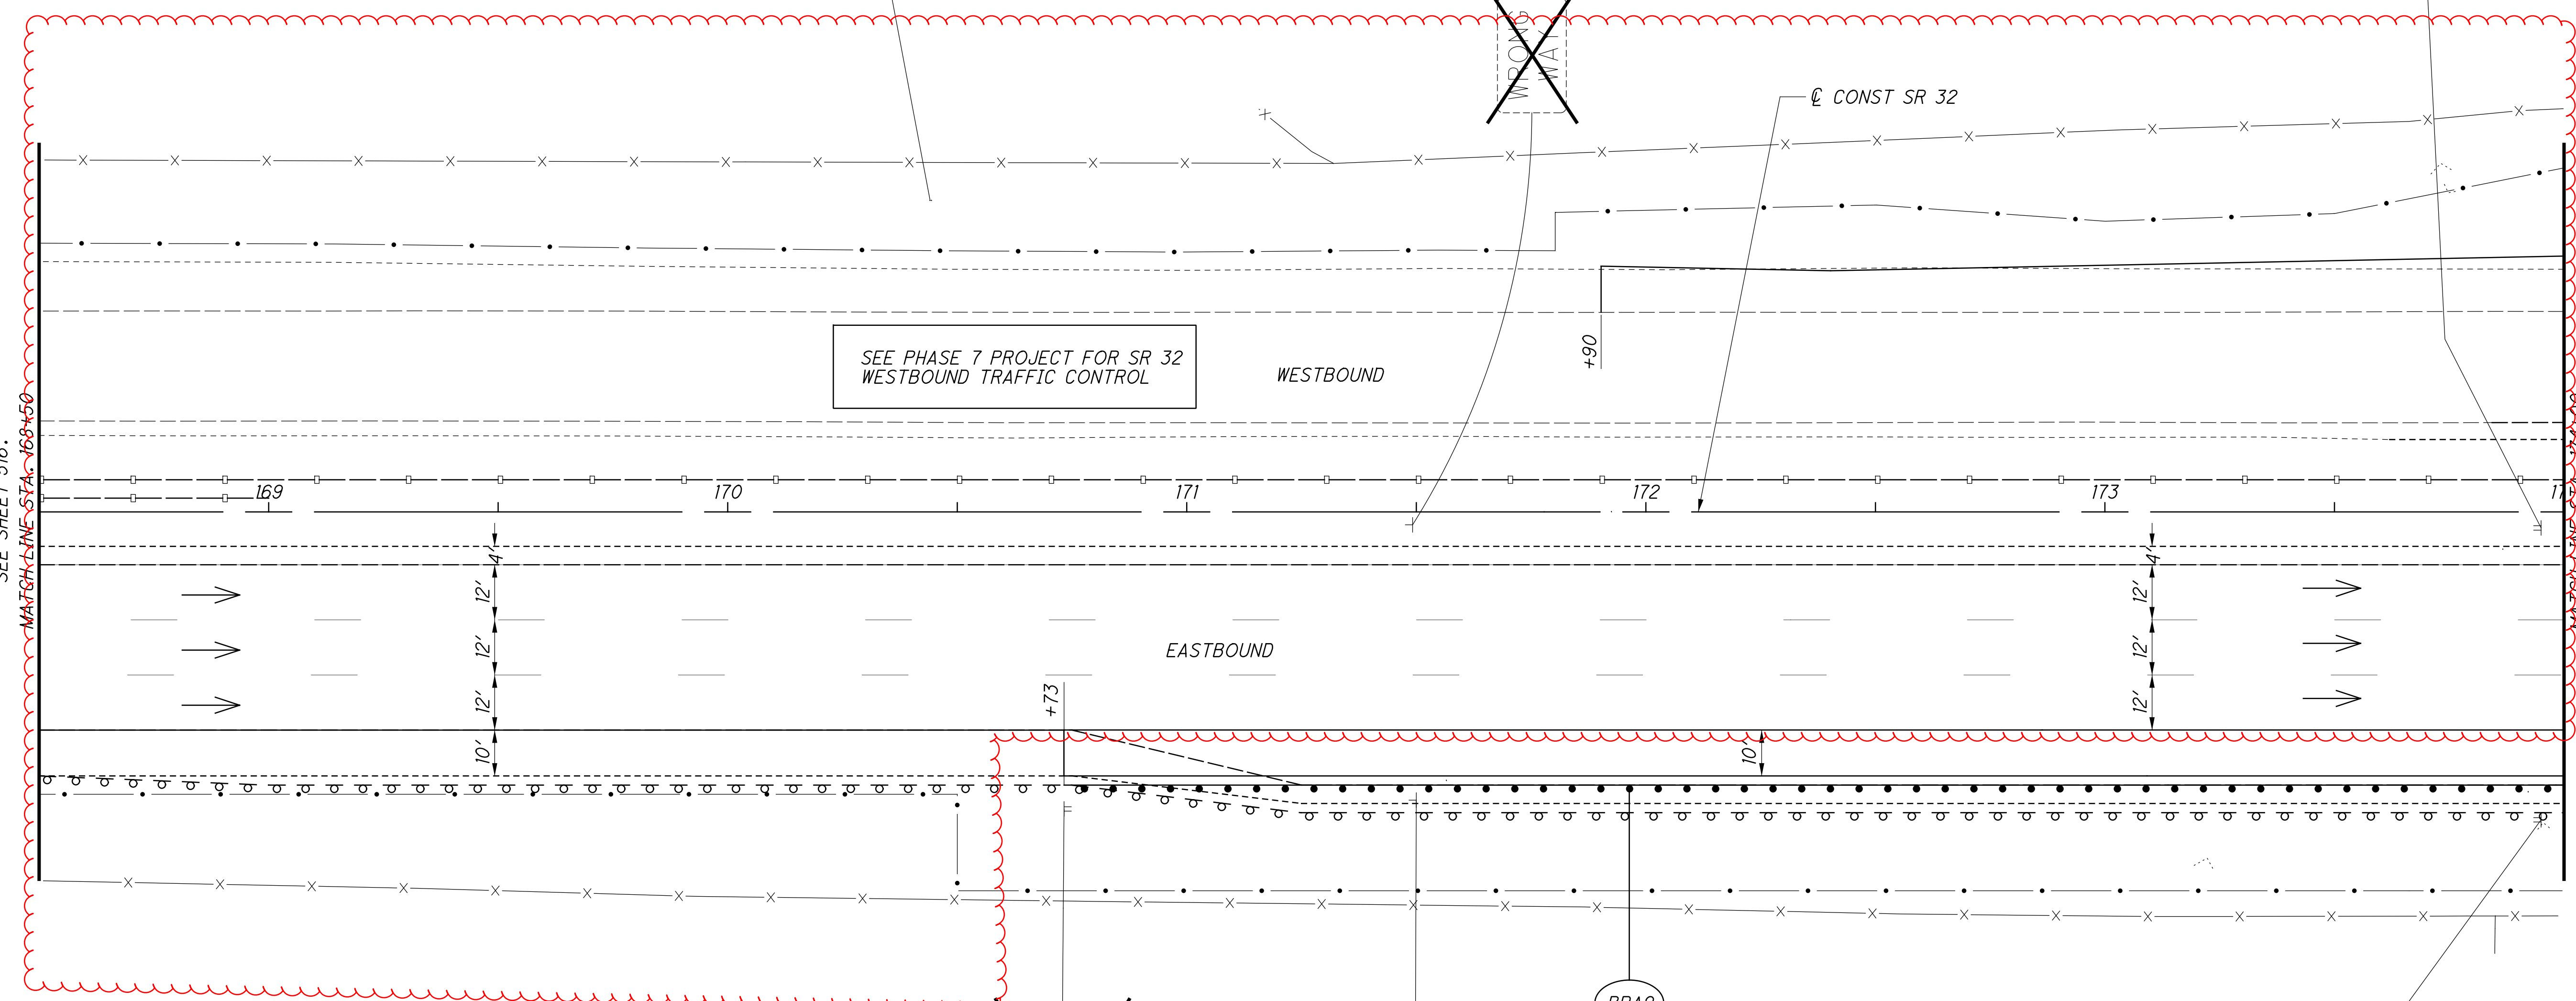

NOTES:


1. FOR TRAFFIC CONTROL LEGEND, SEE SHEET 504
2. INSTALL RAISED PAVEMENT MARKERS PER ODOT SCD TC-65.10 AND TC-65.11.

CALCULATED ACW
CHECKED WAA

0 20 40
HORIZONTAL SCALE IN FEET

TRAFFIC CONTROL PLAN - SR 32
STA. 168+50 TO STA. 174+00

CLE-32-3.50
(PHASE 5)

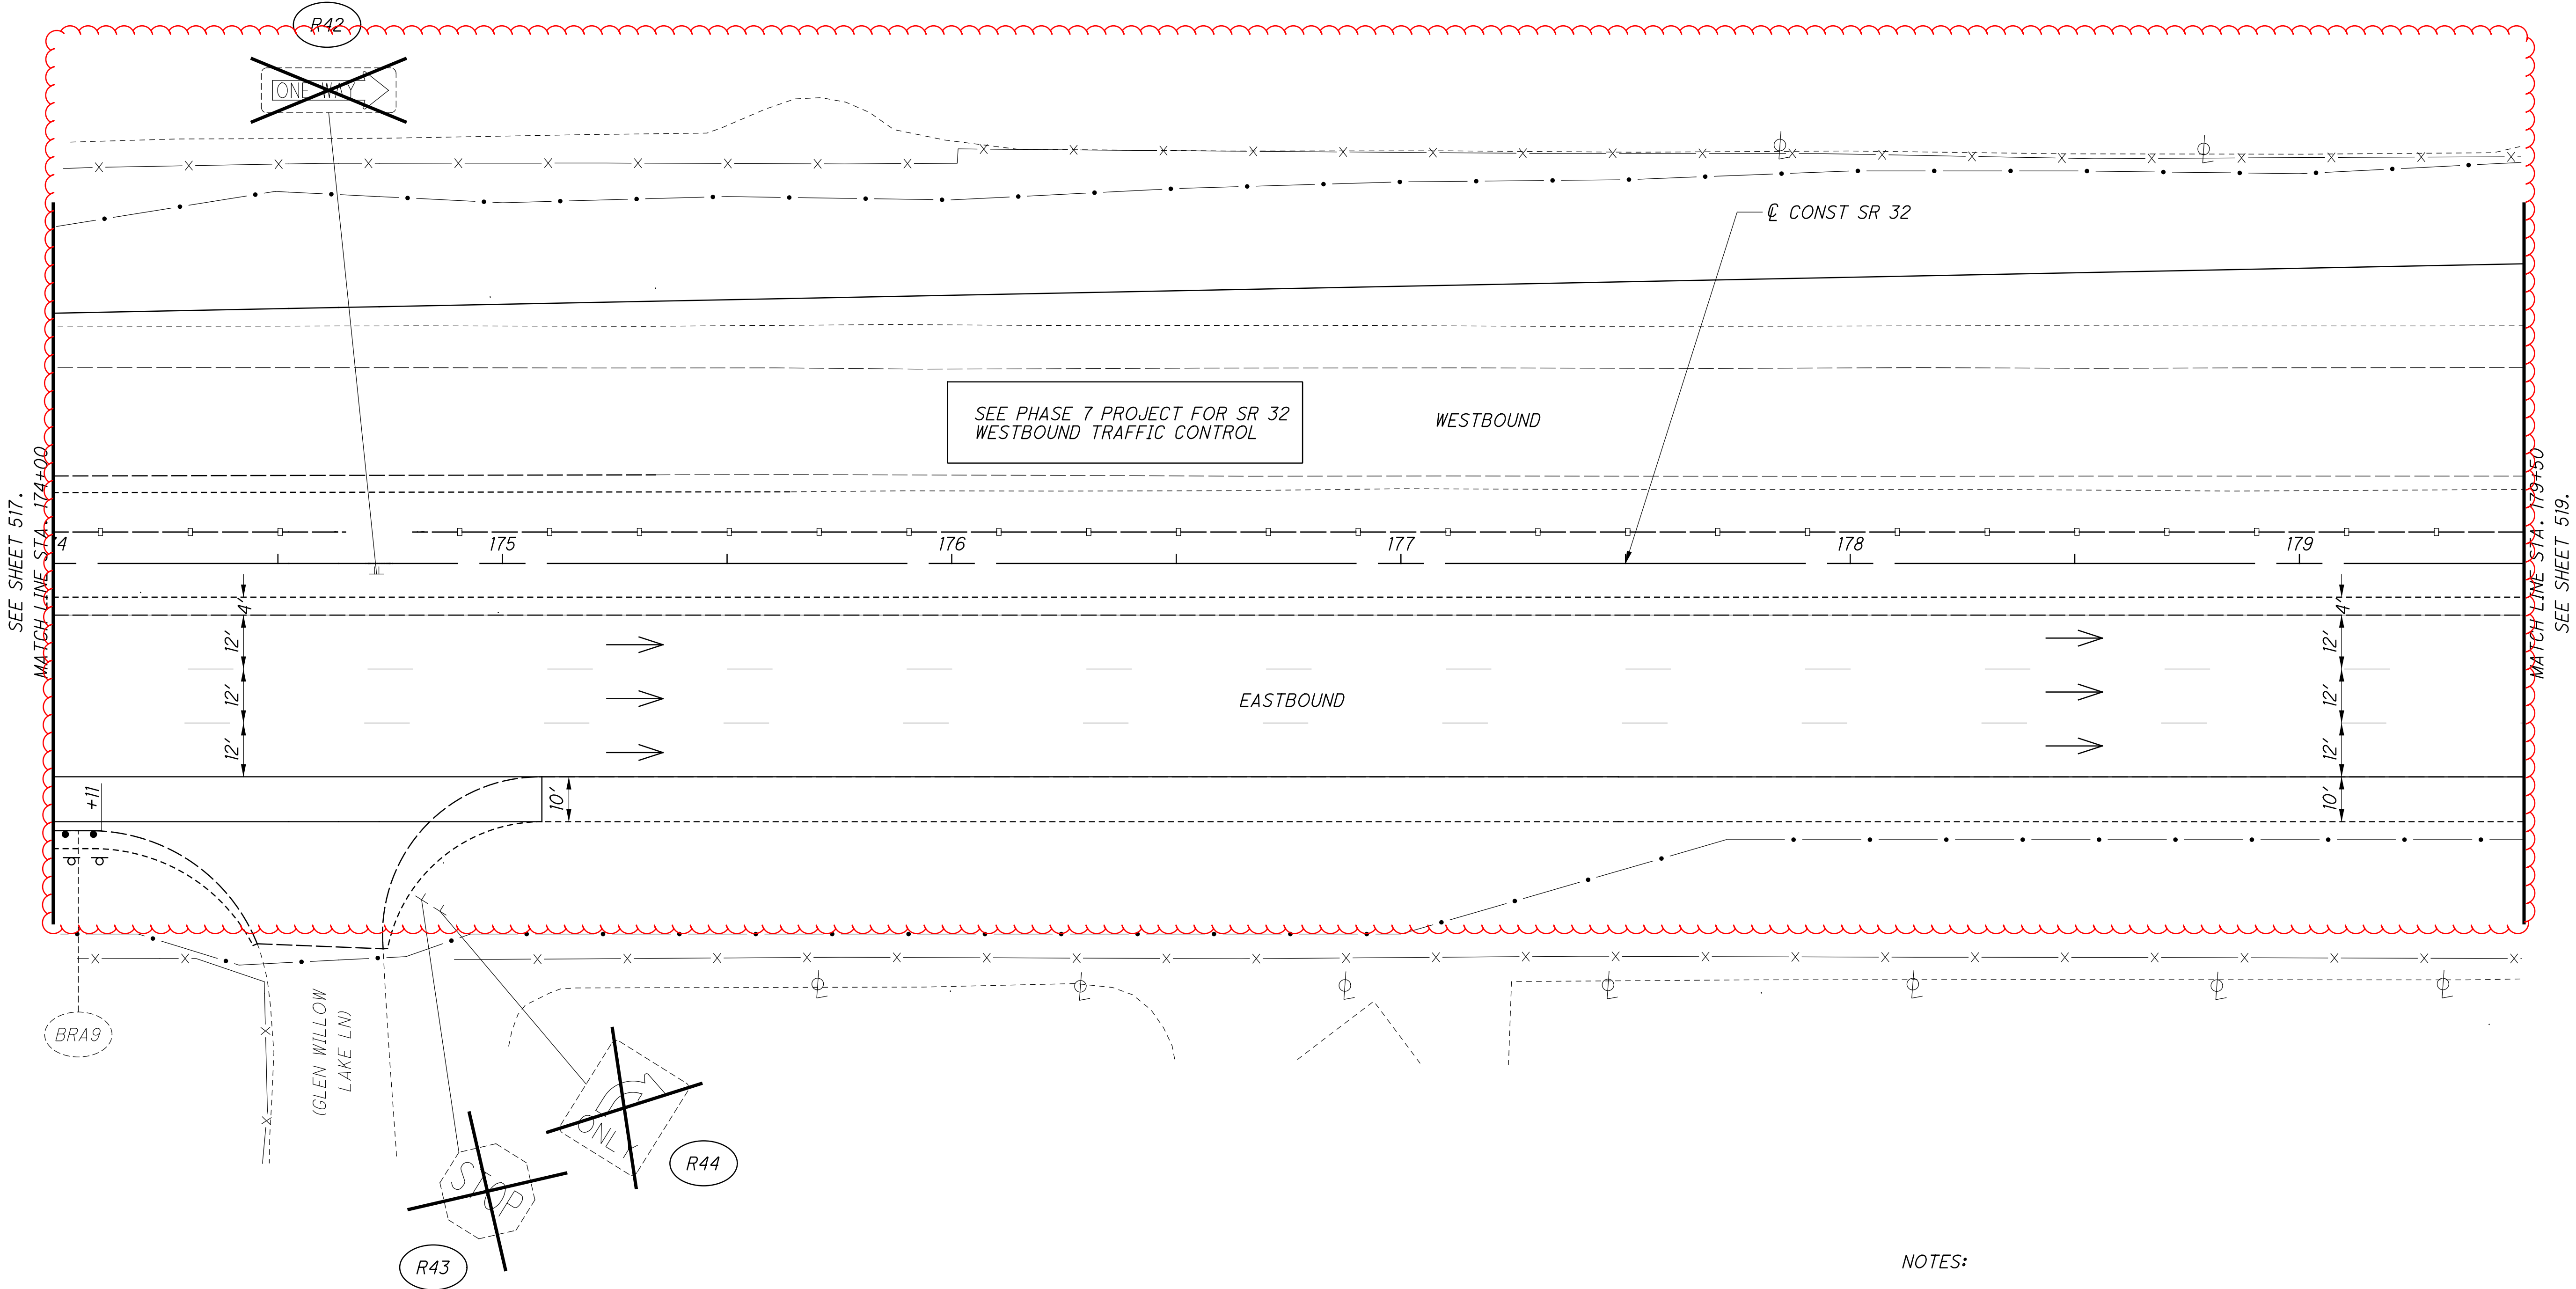

SEE SHEET 517.

SEE SHEET 519.

SEE PHASE 7 PROJECT FOR SR 32 WESTBOUND TRAFFIC CONTROL

WESTBOUND

EASTBOUND

C CONST SR 32

NOTES:


- 1. FOR TRAFFIC CONTROL LEGEND, SEE SHEET 504
- 2. INSTALL RAISED PAVEMENT MARKERS PER ODOT SCD TC-65.10 AND TC-65.11.

CALCULATED ACW
CHECKED WAA

0 10 20 40
HORIZONTAL SCALE IN FEET

TRAFFIC CONTROL PLAN - SR 32
STA. 174+00 TO STA. 179+50

CLE-32-3.50
(PHASE 5)

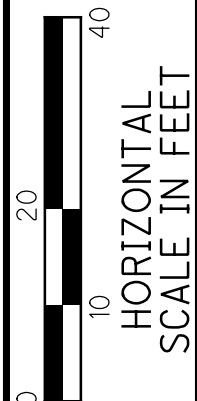


CALCULATED
ACW
CHECKED
WAA

TRAFFIC CONTROL PLAN - SR 32
STA. 179+50 TO STA. 185+00

CLE-32-3.50
(PHASE 5)

519
736

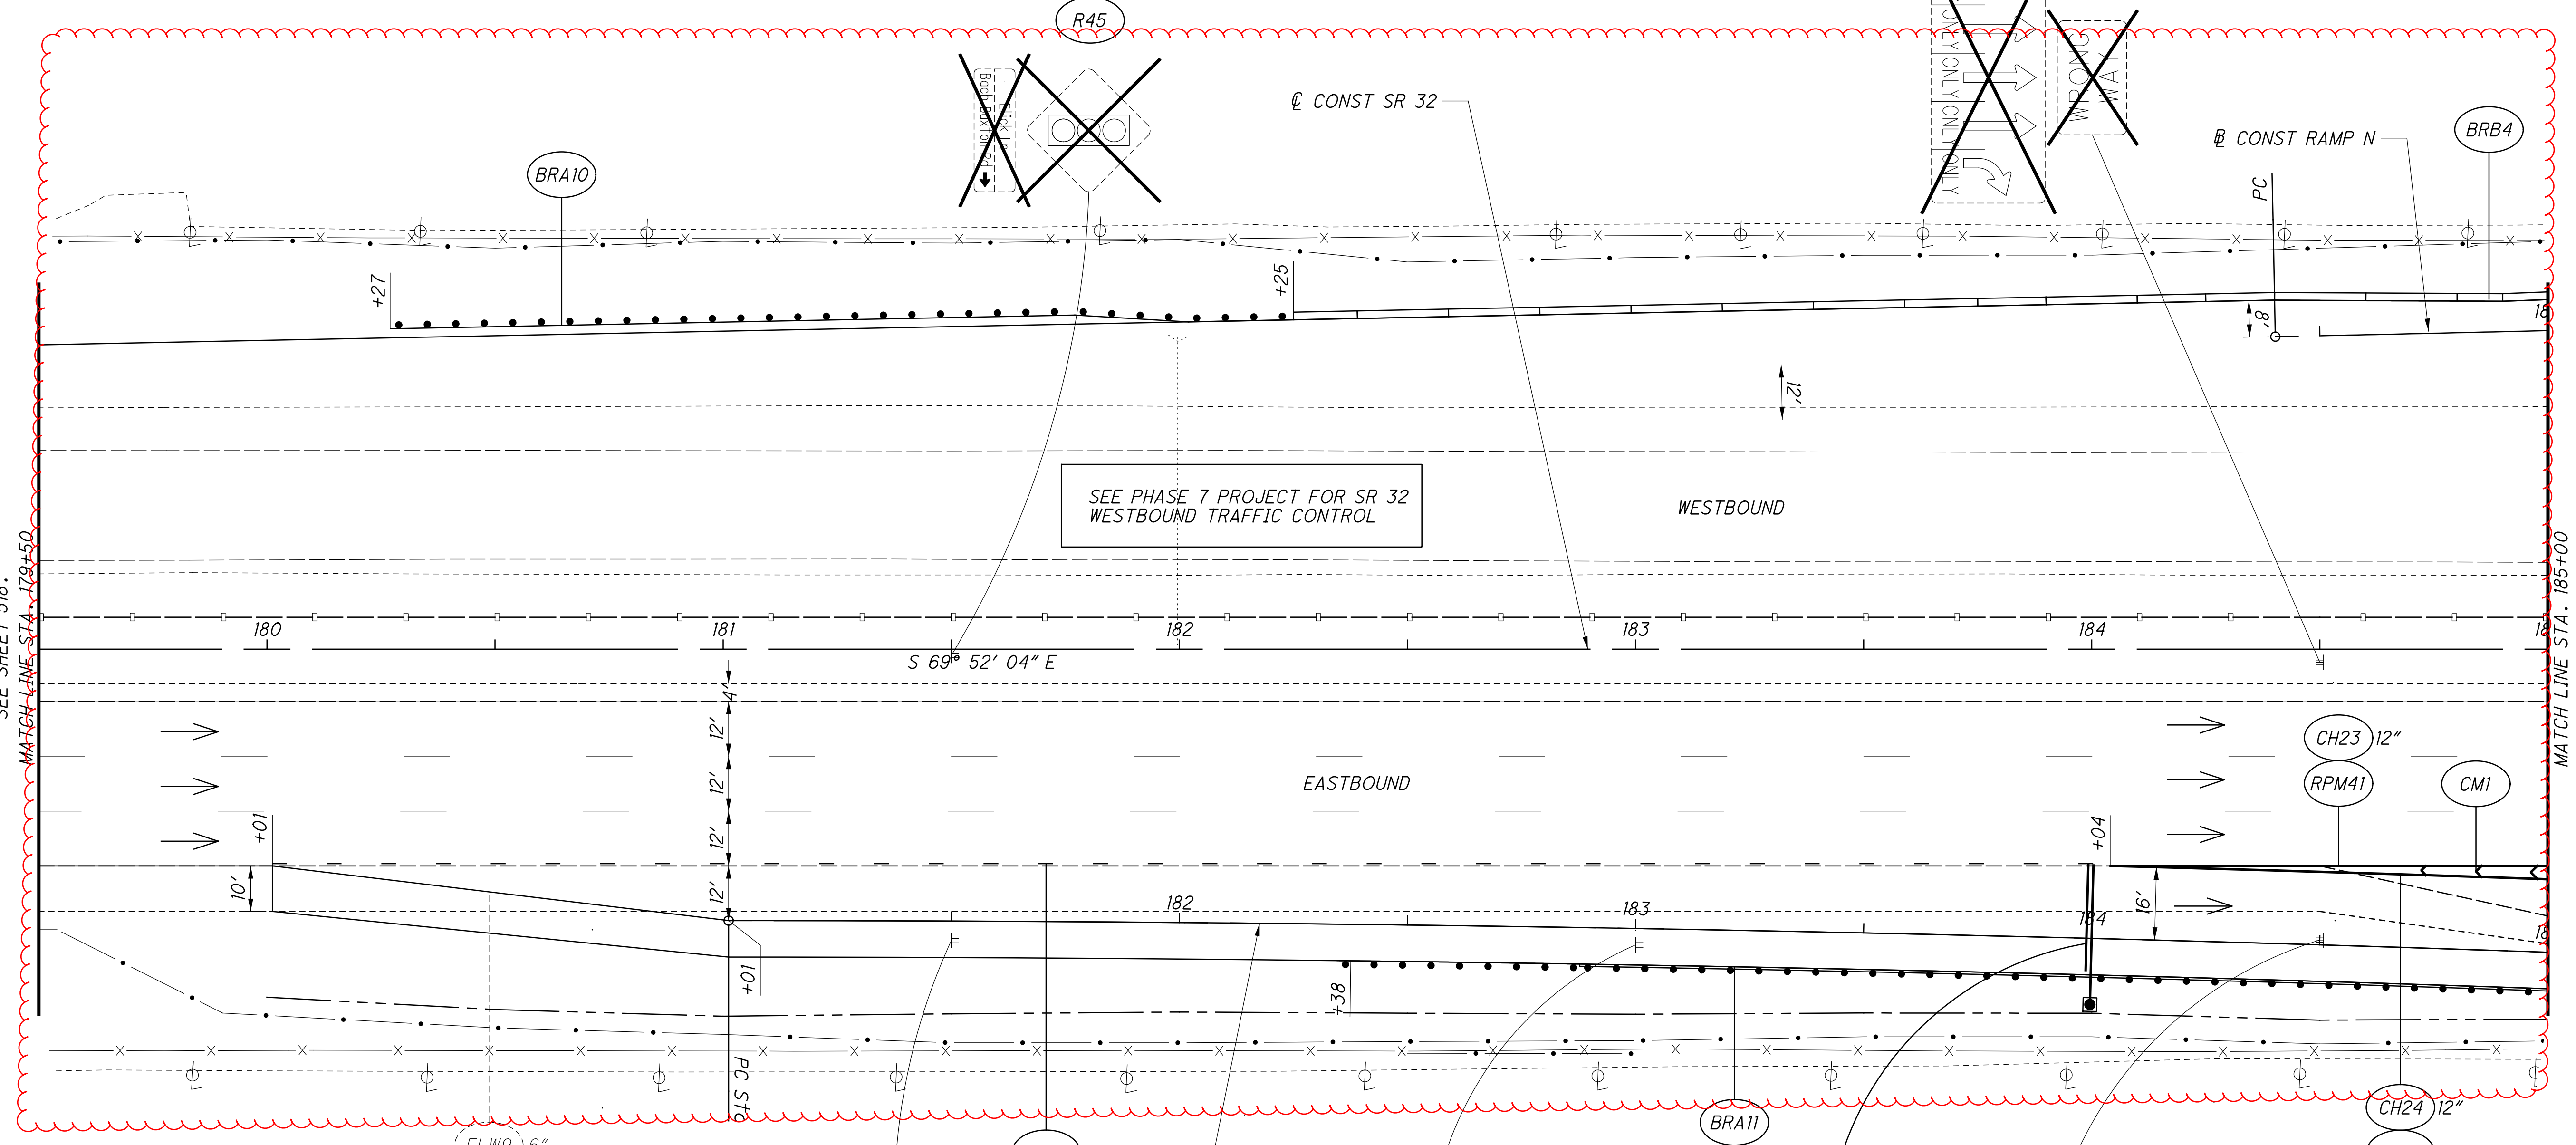


NOTES:

1. FOR TRAFFIC CONTROL LEGEND, SEE SHEET 504
2. INSTALL RAISED PAVEMENT MARKERS PER ODOT SCD TC-65.10 AND TC-65.11.
3. INSTALL LANE REDUCTION MARKINGS PER ODOT SCD TC-71.10.
4. INSTALL RAMP MARKINGS PER ODOT SCD TC-72.20.
5. EXISTING PAVEMENT MARKINGS FROM CLE-32-2.25 (PID 103755).
6. FOR SIGN ELEVATION VIEW, SEE SHEET 545

...310.20\310.205\103954\TP520.dgn 11/18/2021 4:22:22 PM ssopraseuth

...310.20\310.205\103954TP521.dgn 11/18/2021 4:22:28 PM ssopraseuth

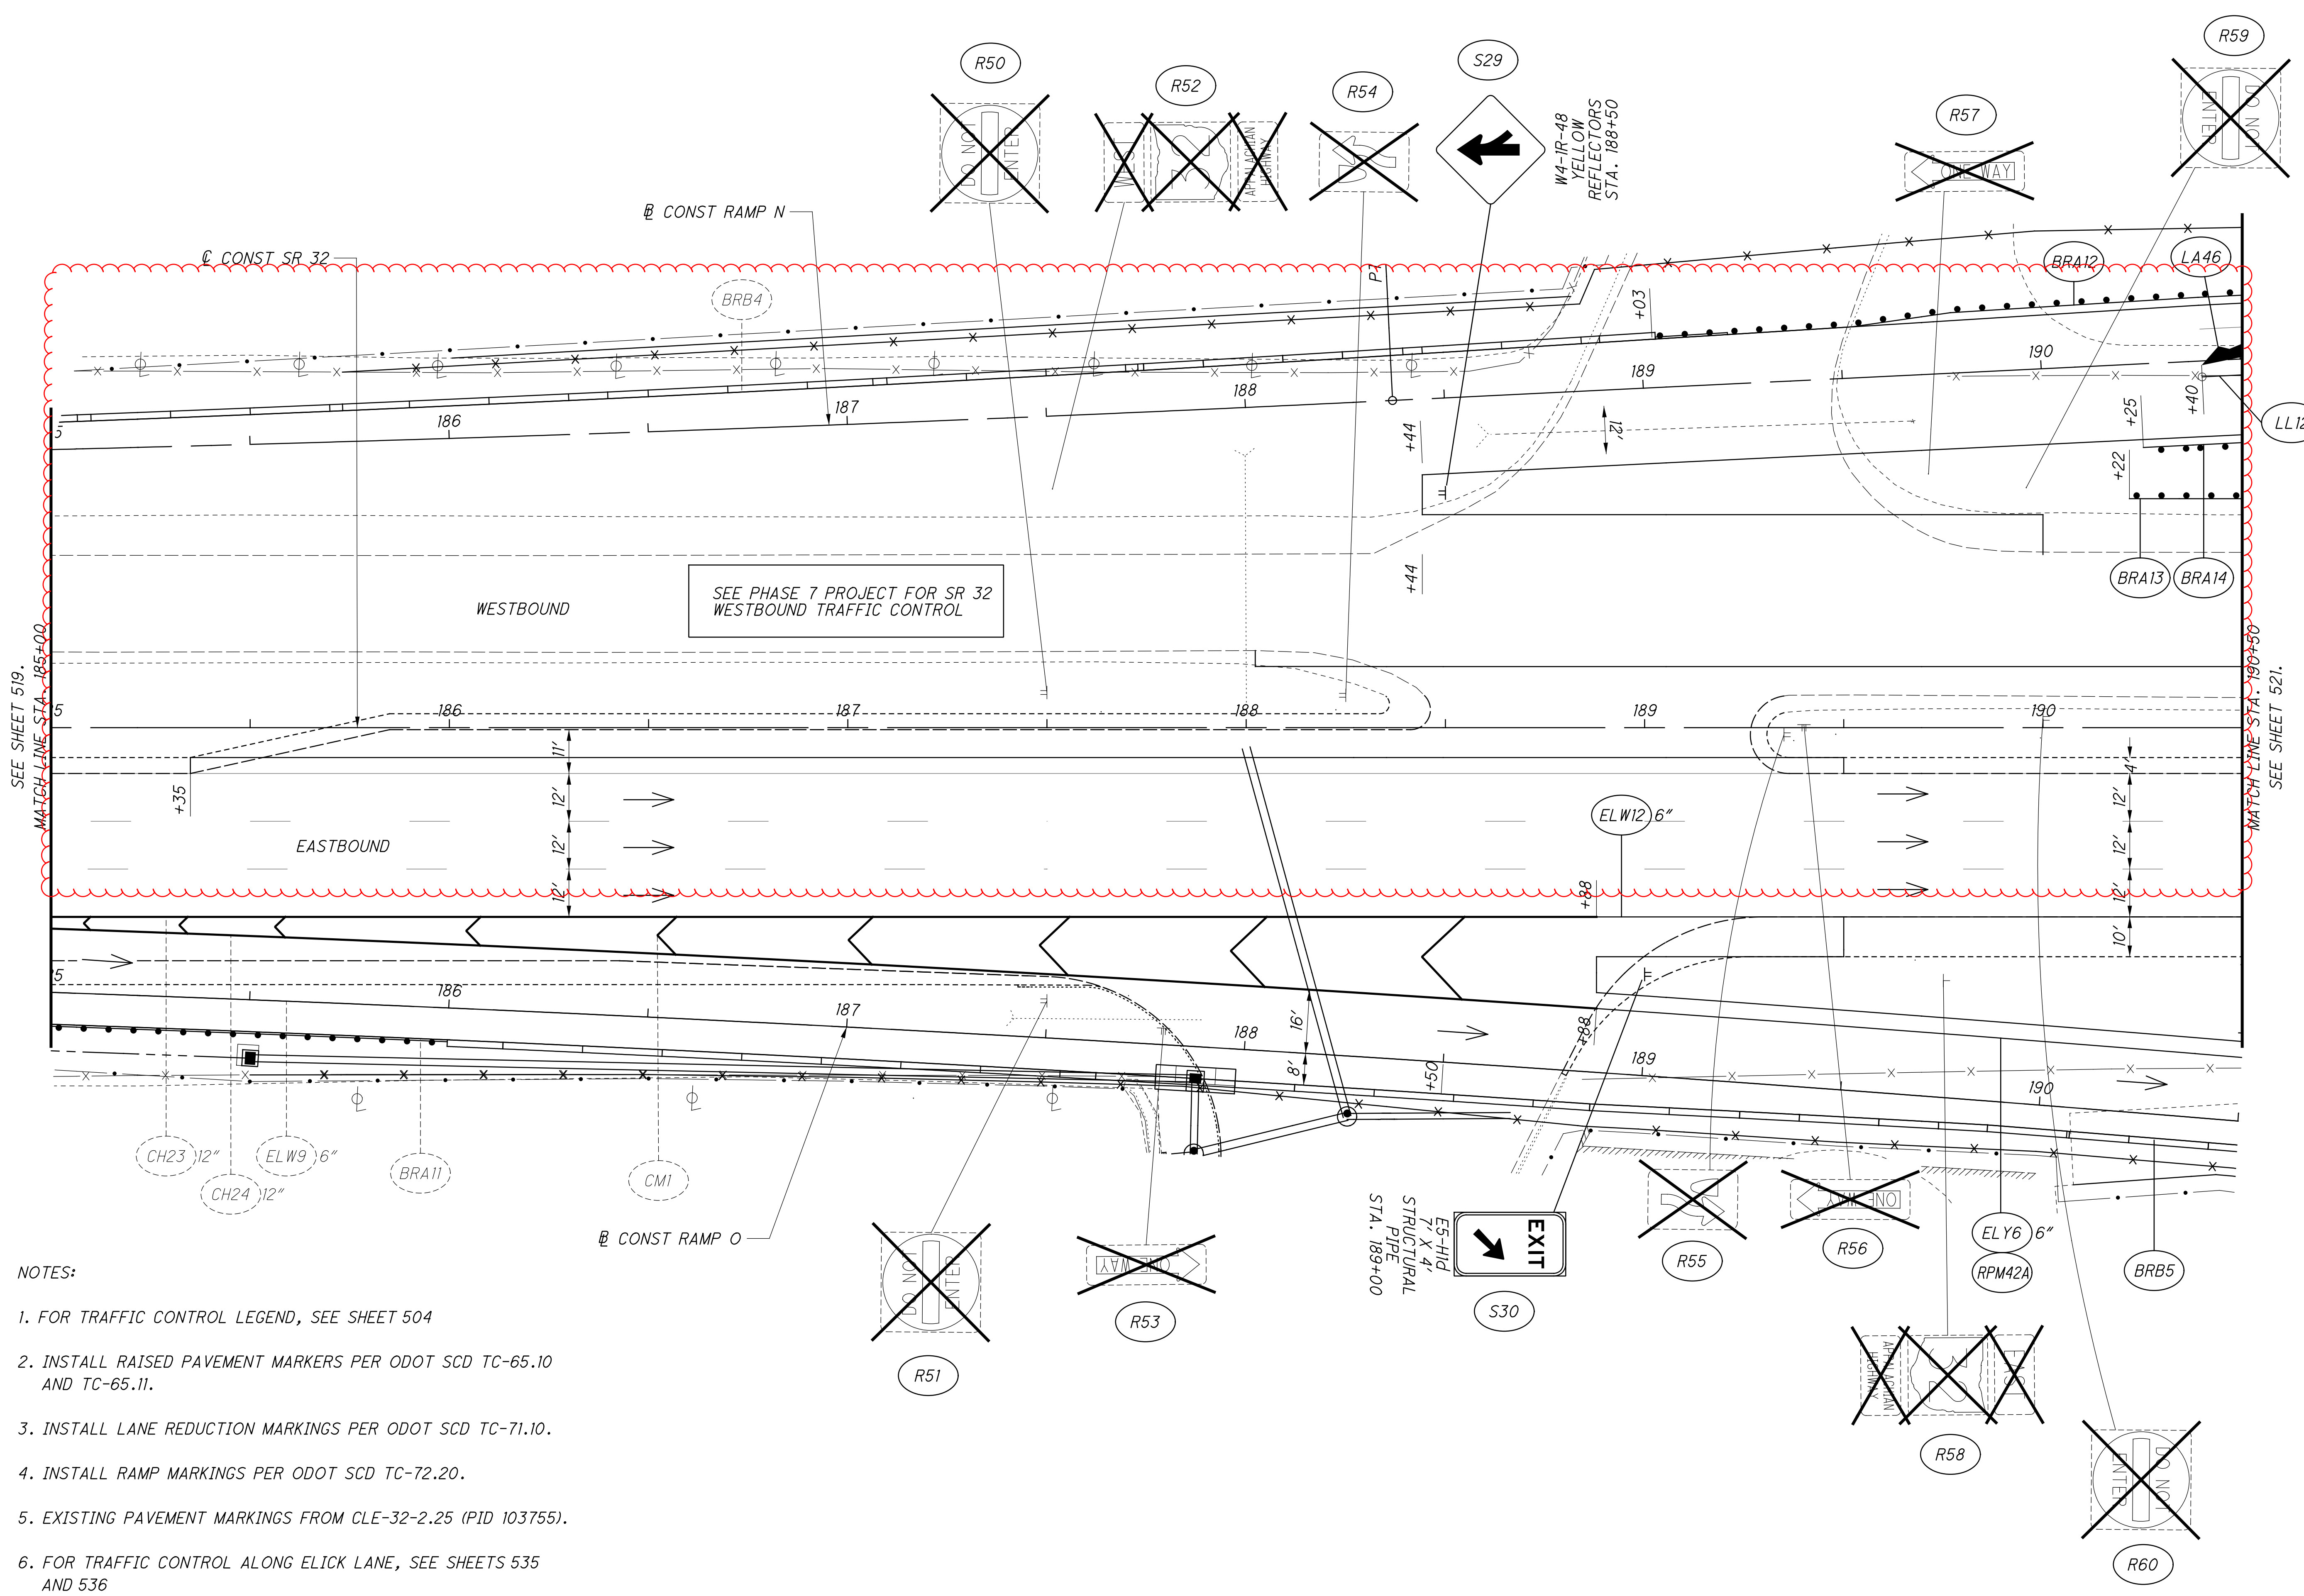

NOTES:

1. FOR TRAFFIC CONTROL LEGEND, SEE SHEET 504
2. INSTALL RAISED PAVEMENT MARKERS PER ODOT SCD TC-65.10 AND TC-65.11.
3. INSTALL LANE REDUCTION MARKINGS PER ODOT SCD TC-71.10.
4. INSTALL RAMP MARKINGS PER ODOT SCD TC-72.20.
5. EXISTING PAVEMENT MARKINGS FROM CLE-32-2.25 (PID 103755).
6. FOR TRAFFIC CONTROL ALONG ELICK LANE, SEE SHEETS 535 AND 536

CALCULATED ACW CHECKED WAA

0 20 40
HORIZONTAL SCALE IN FEET


↑
N

TRAFFIC CONTROL PLAN - SR 32
STA. 185+00 TO STA. 190+50

CLE-32-3.50
(PHASE 5)


520
736

...310.20\310.205\103954\TP522.dgn 11/18/2021 4:22:35 PM ssopraseuth

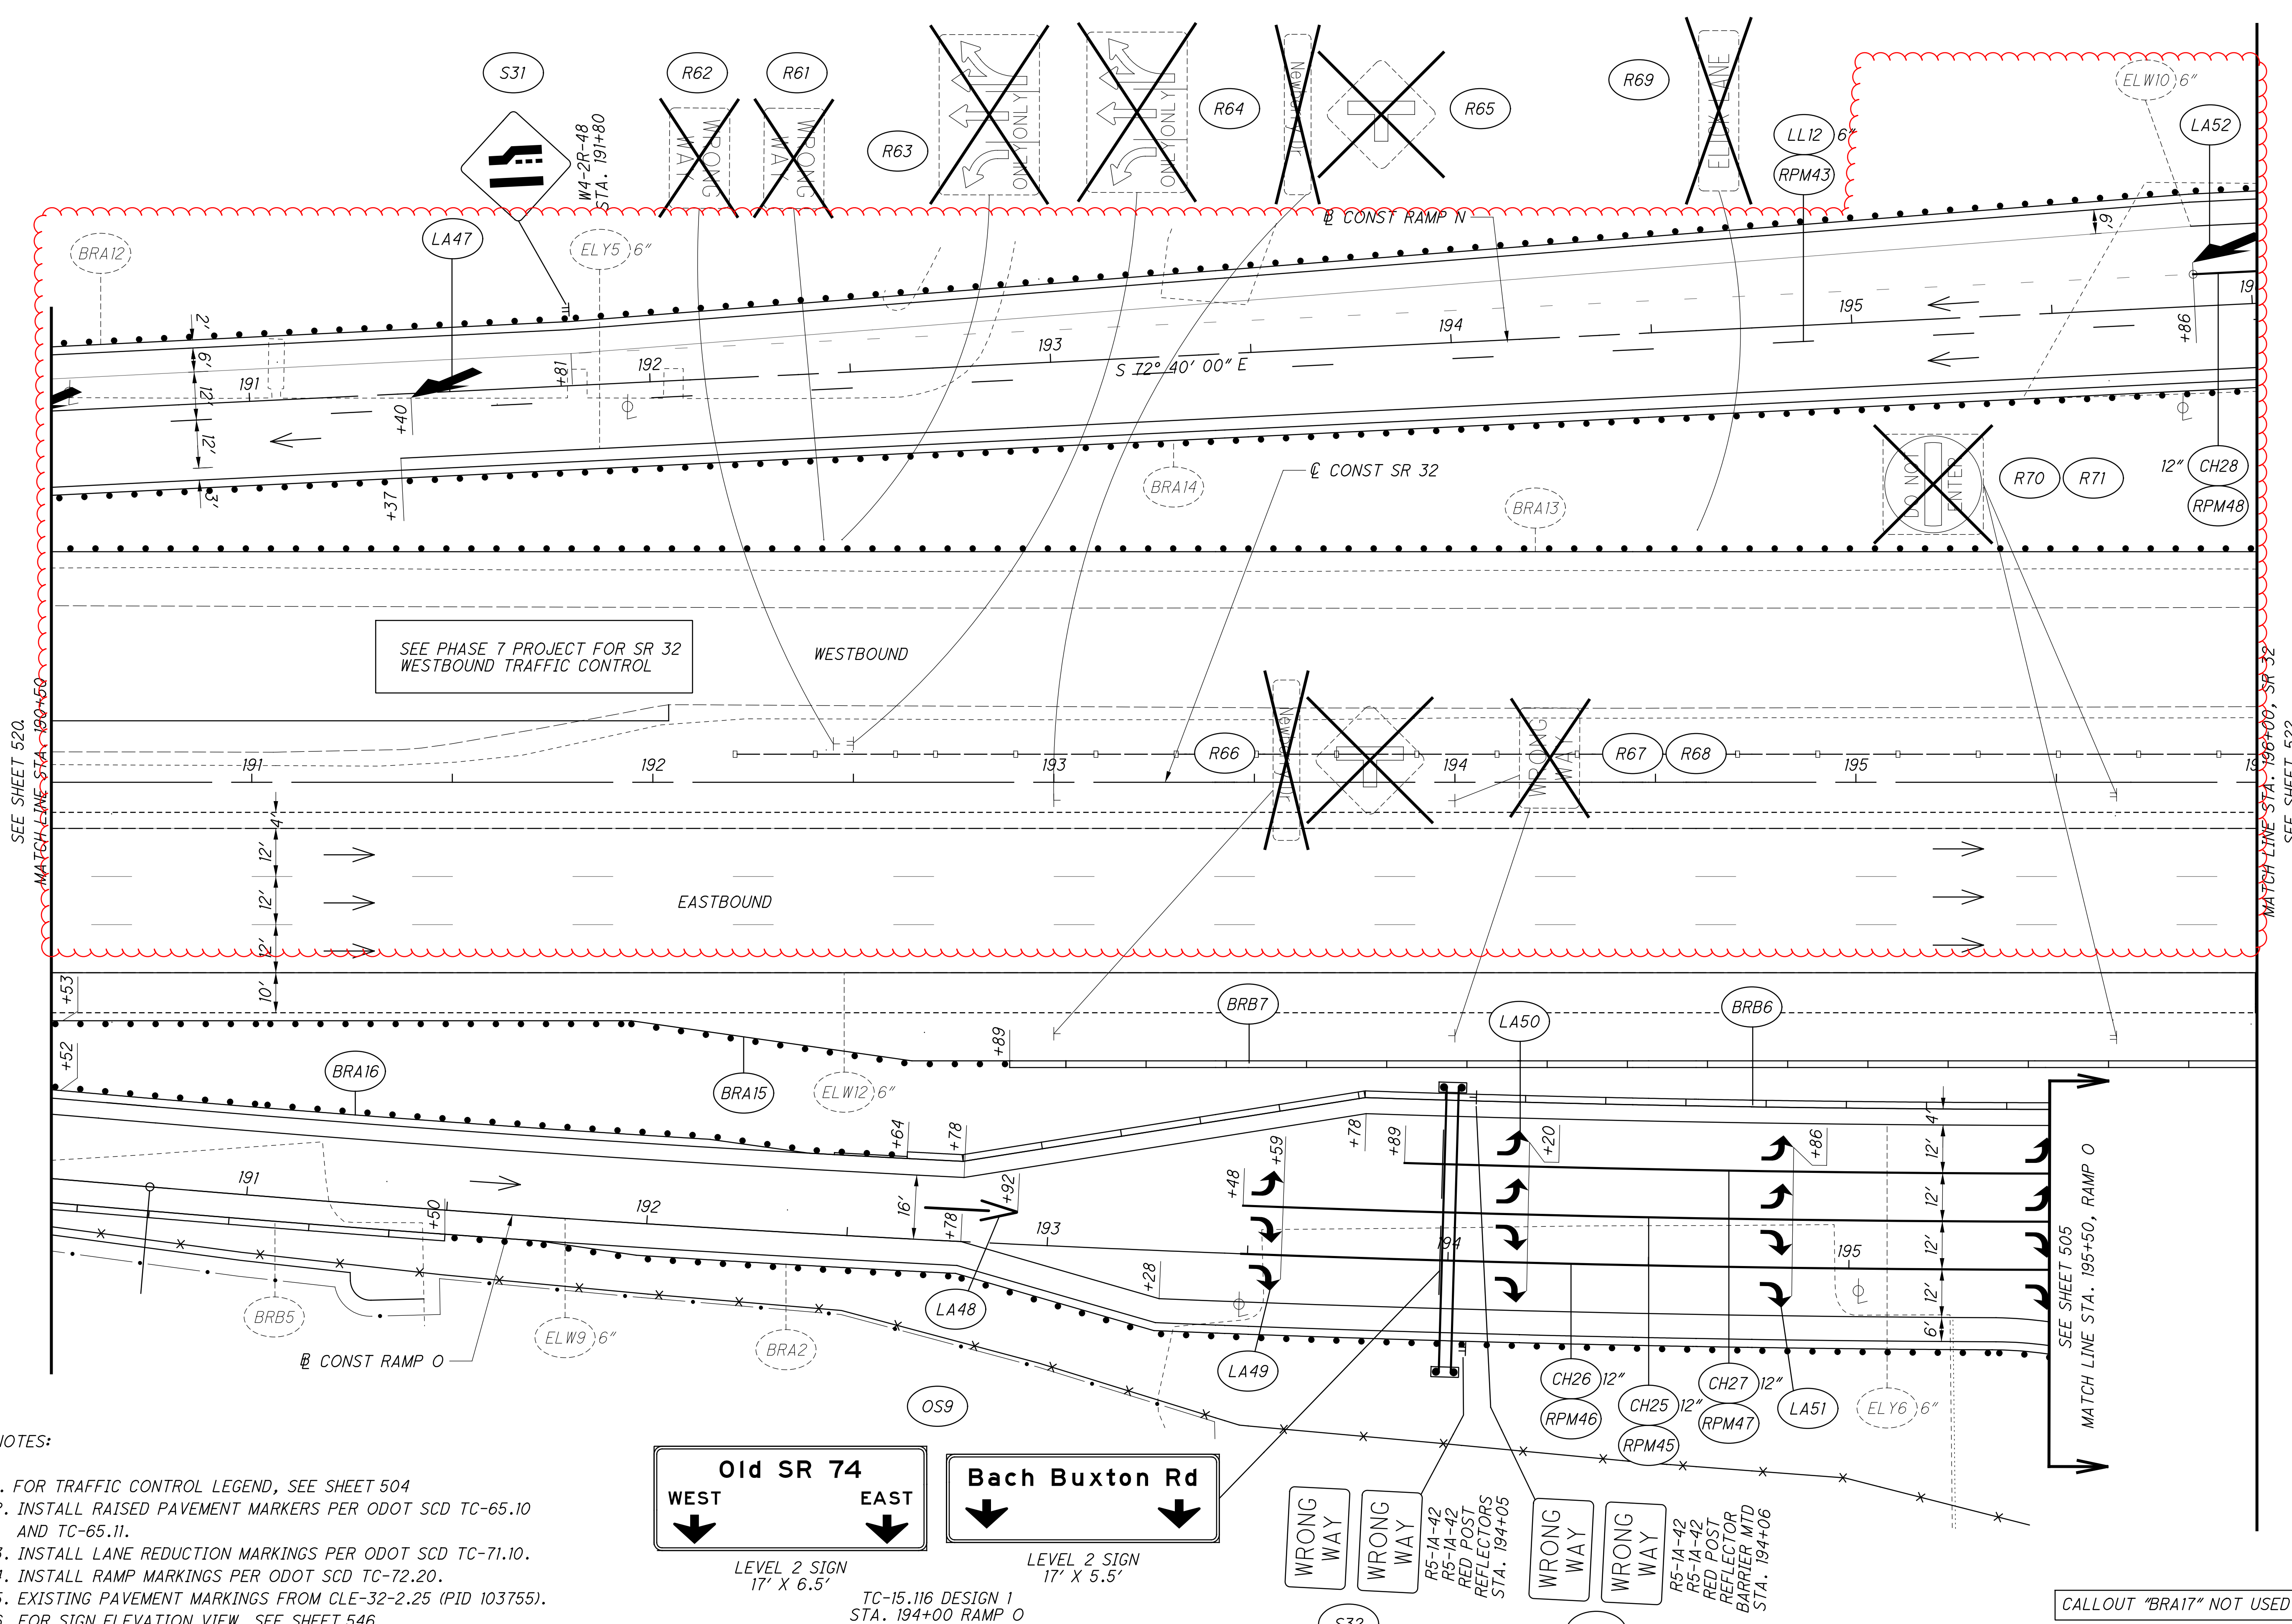

NOTES:


1. FOR TRAFFIC CONTROL LEGEND, SEE SHEET 504
2. INSTALL RAISED PAVEMENT MARKERS PER ODOT SCD TC-65.10 AND TC-65.11.
3. INSTALL LANE REDUCTION MARKINGS PER ODOT SCD TC-71.10.
4. INSTALL RAMP MARKINGS PER ODOT SCD TC-72.20.
5. EXISTING PAVEMENT MARKINGS FROM CLE-32-2.25 (PID 103755).
6. FOR SIGN ELEVATION VIEW, SEE SHEET 546

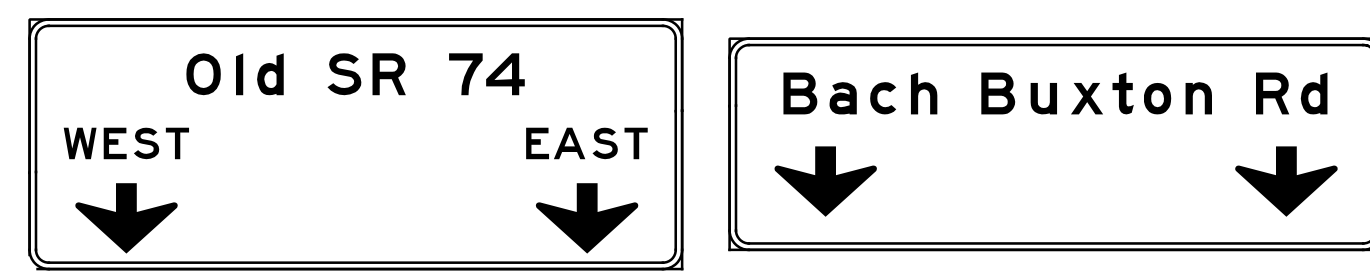

TC-15.116 DESIGN 1
STA. 194+00 RAMP O



CALLOUT "BRA17" NOT USED

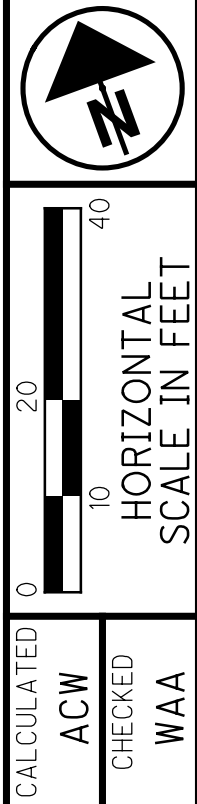

TRAFFIC CONTROL PLAN - SR 32
STA. 190+50 TO STA. 196+00

CLE-32-3.50
(PHASE 5)



521
736

CALCULATED
ACW
CHECKED
WAA

CALLOUT "BRB8" NOT USED

NOTES:


1. FOR TRAFFIC CONTROL LEGEND, SEE SHEET 504
2. INSTALL RAISED PAVEMENT MARKERS PER ODOT SCD TC-65.10 AND TC-65.11.
3. INSTALL LANE REDUCTION MARKINGS PER ODOT SCD TC-71.10.
4. INSTALL RAMP MARKINGS PER ODOT SCD TC-72.20.
5. EXISTING PAVEMENT MARKINGS FROM CLE-32-2.25 (PID 103755).
6. FOR SIGN ELEVATION VIEW, SEE SHEET 547

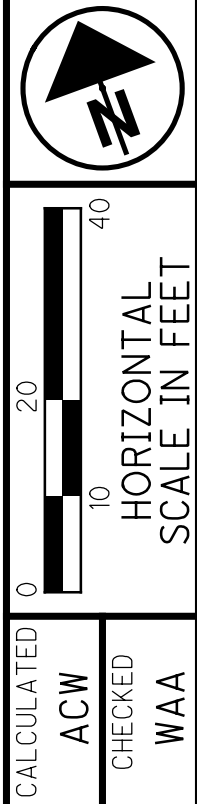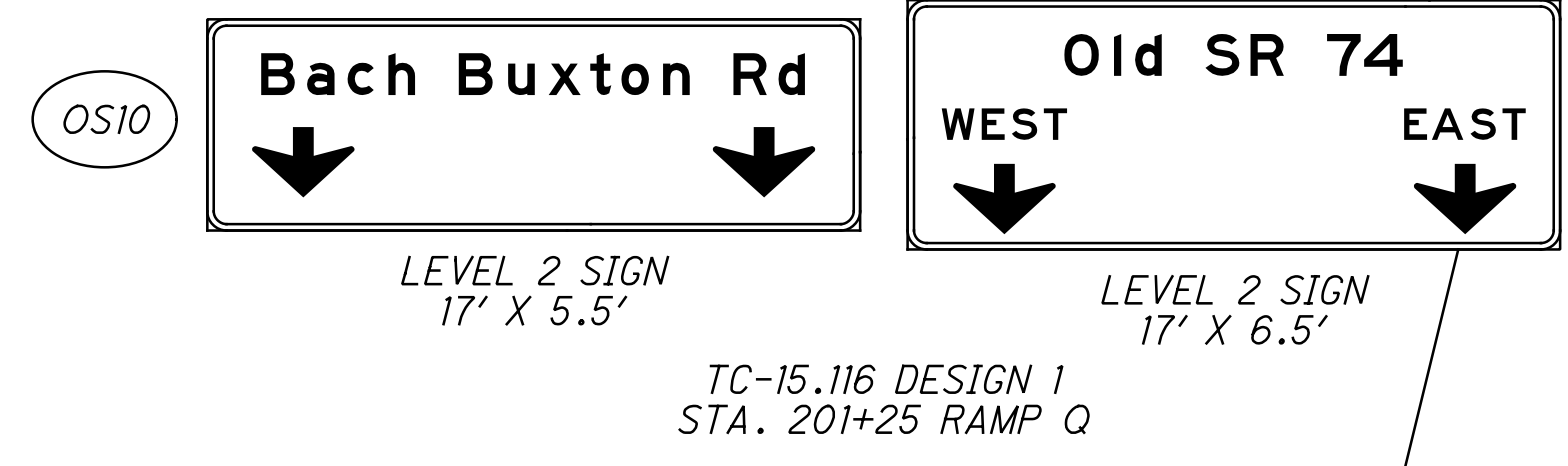

TRAFFIC CONTROL PLAN - SR 32
 STA. 196+00 TO STA. 201+50


CLE-32-3.50
 (PHASE 5)

522
 736

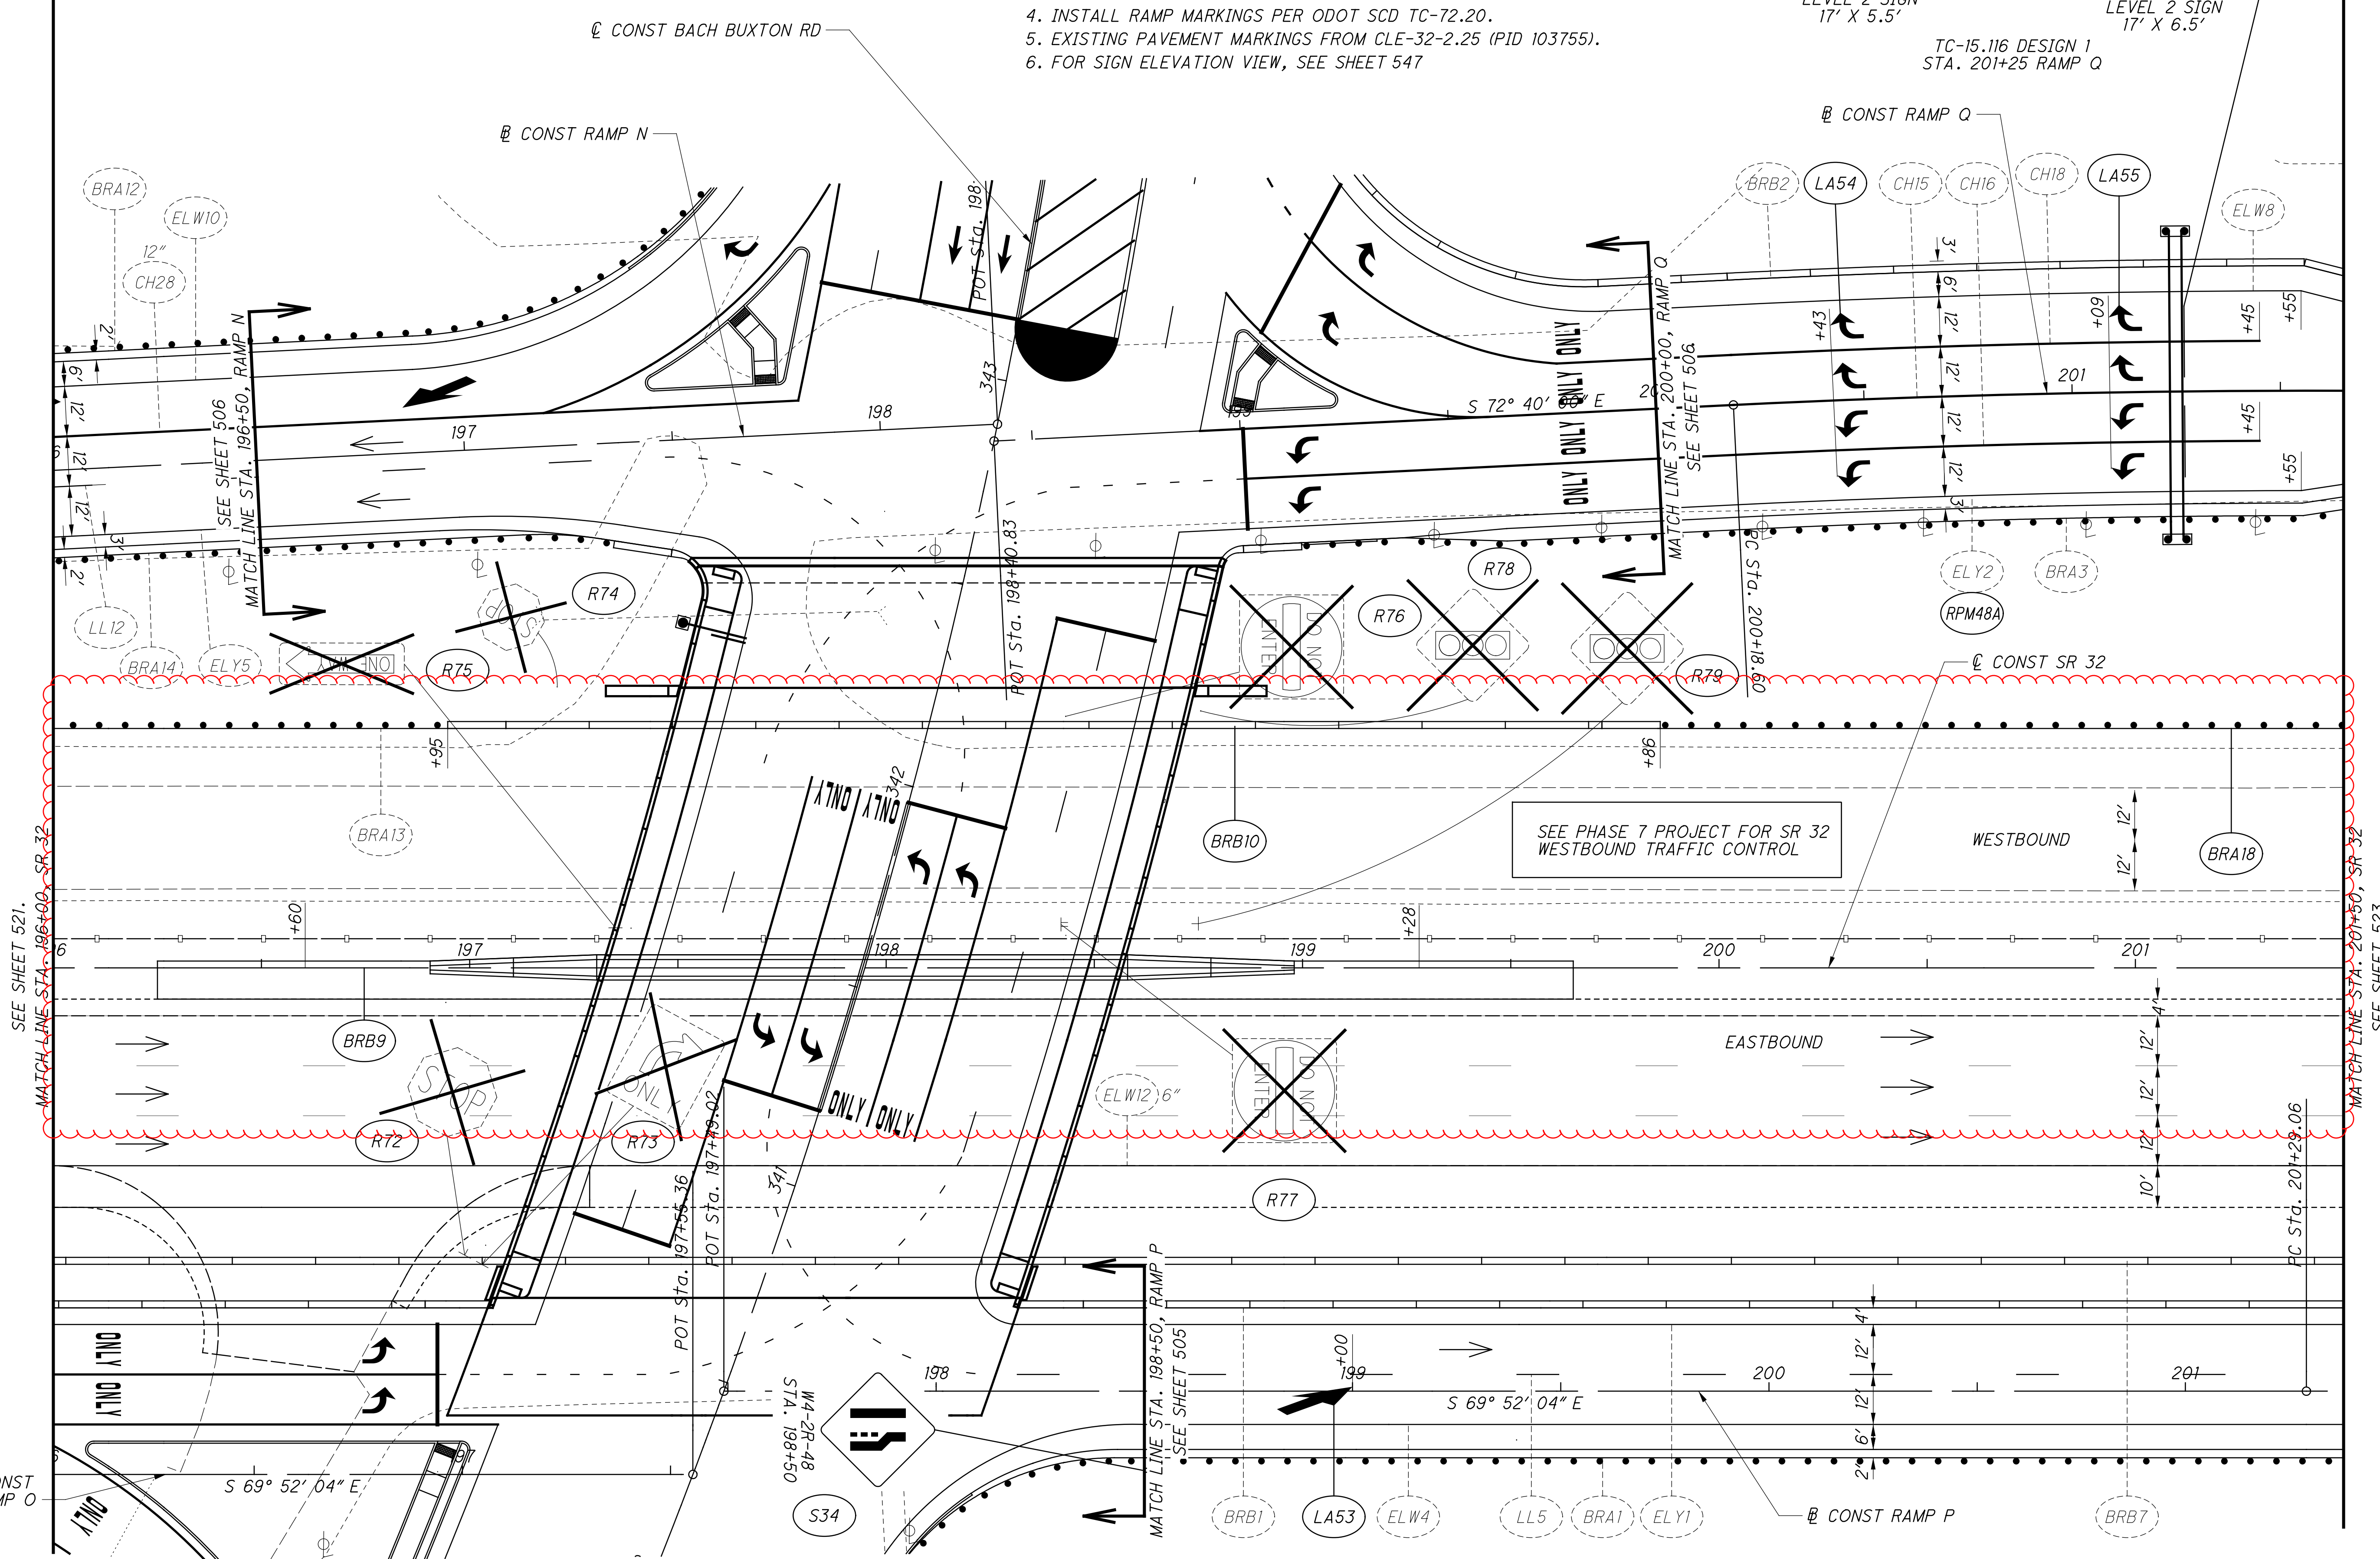

...310.20\310.205\103954TP523.dgn 11/18/2021 4:22:43 PM ssopraseuth

...310.20\310.205\103954TP524.dgn 11/18/2021 4:22:52 PM ssopraseuth

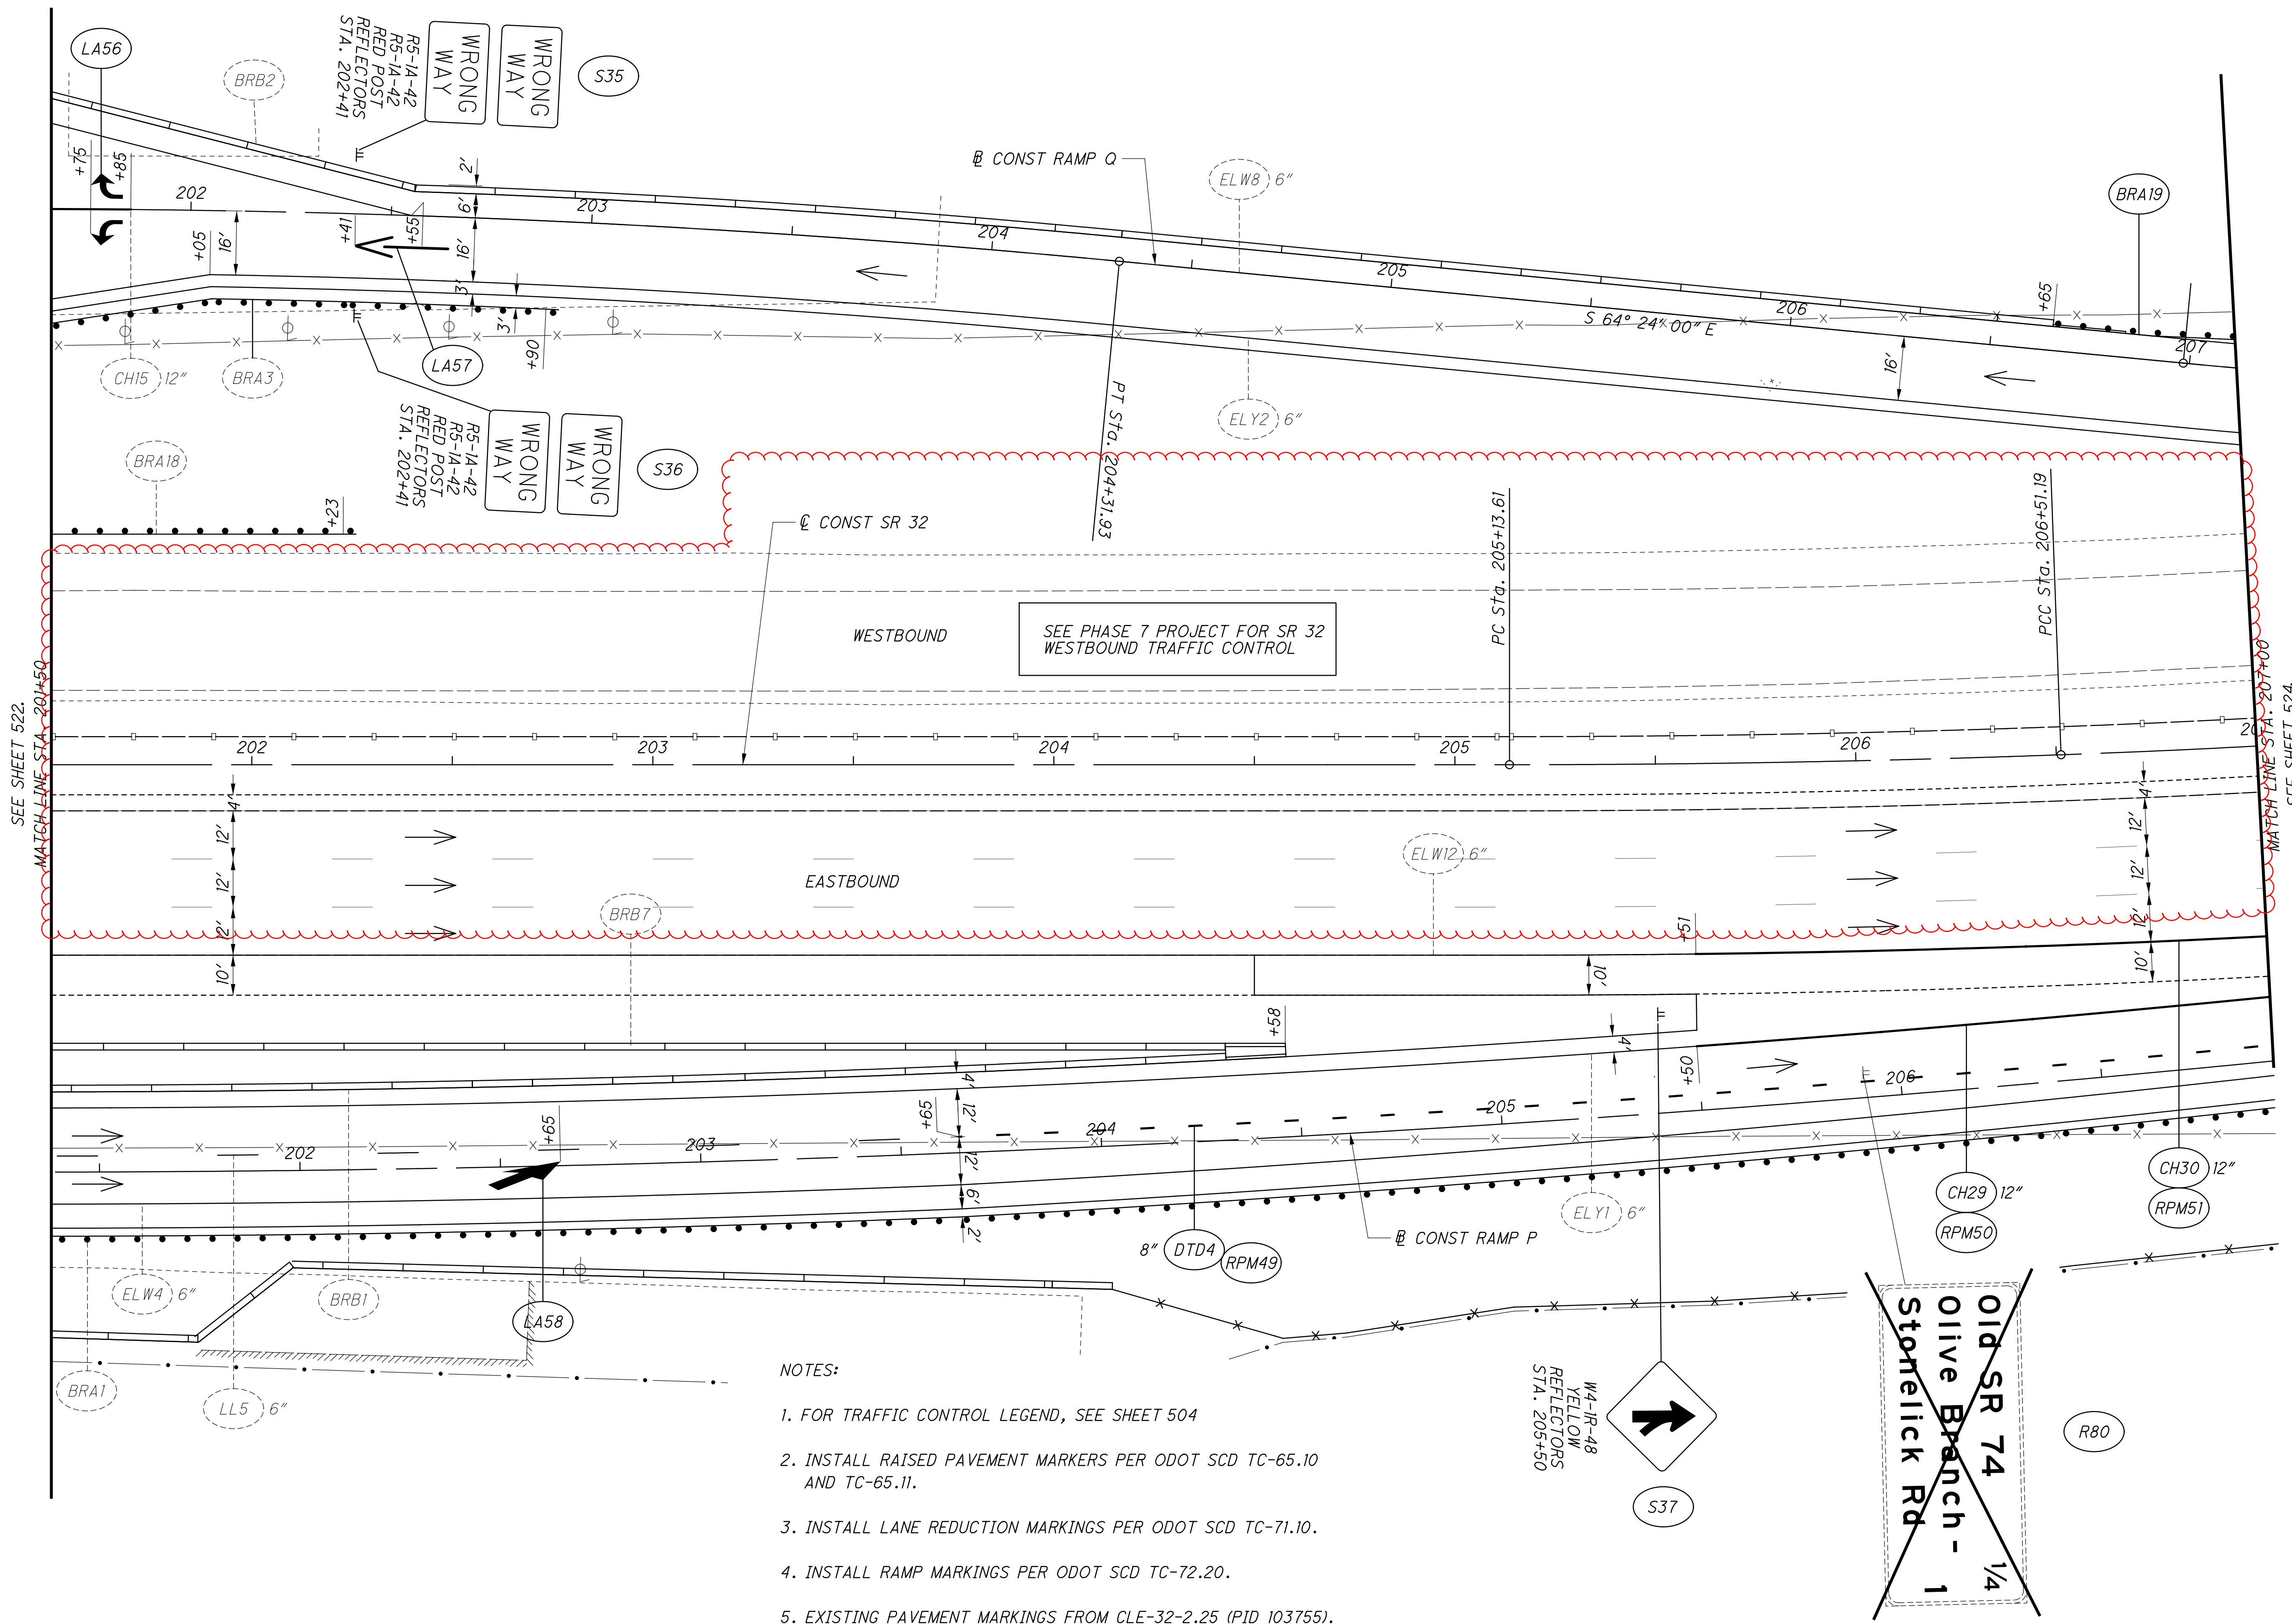

- NOTES:
1. FOR TRAFFIC CONTROL LEGEND, SEE SHEET 504
 2. INSTALL RAISED PAVEMENT MARKERS PER ODOT SCD TC-65.10 AND TC-65.11.
 3. INSTALL LANE REDUCTION MARKINGS PER ODOT SCD TC-71.10.
 4. INSTALL RAMP MARKINGS PER ODOT SCD TC-72.20.
 5. EXISTING PAVEMENT MARKINGS FROM CLE-32-2.25 (PID 103755).

~~OLD SR 74
 Olive Branch - 1/4
 Storelick Rd~~


CALCULATED ACW
 CHECKED WAA

0 10 20 40
 HORIZONTAL SCALE IN FEET

TRAFFIC CONTROL PLAN - SR 32
 STA. 201+50 TO STA. 207+00

NOTES:

1. FOR TRAFFIC CONTROL LEGEND, SEE SHEET 504
2. INSTALL RAISED PAVEMENT MARKERS PER ODOT SCD TC-65.10 AND TC-65.11.
3. INSTALL LANE REDUCTION MARKINGS PER ODOT SCD TC-71.10.
4. INSTALL RAMP MARKINGS PER ODOT SCD TC-72.20.
5. EXISTING PAVEMENT MARKINGS FROM CLE-32-2.25 (PID 103755).
6. FOR ELEVATION VIEW OF CANTILEVER SIGN, SEE SHEET 545

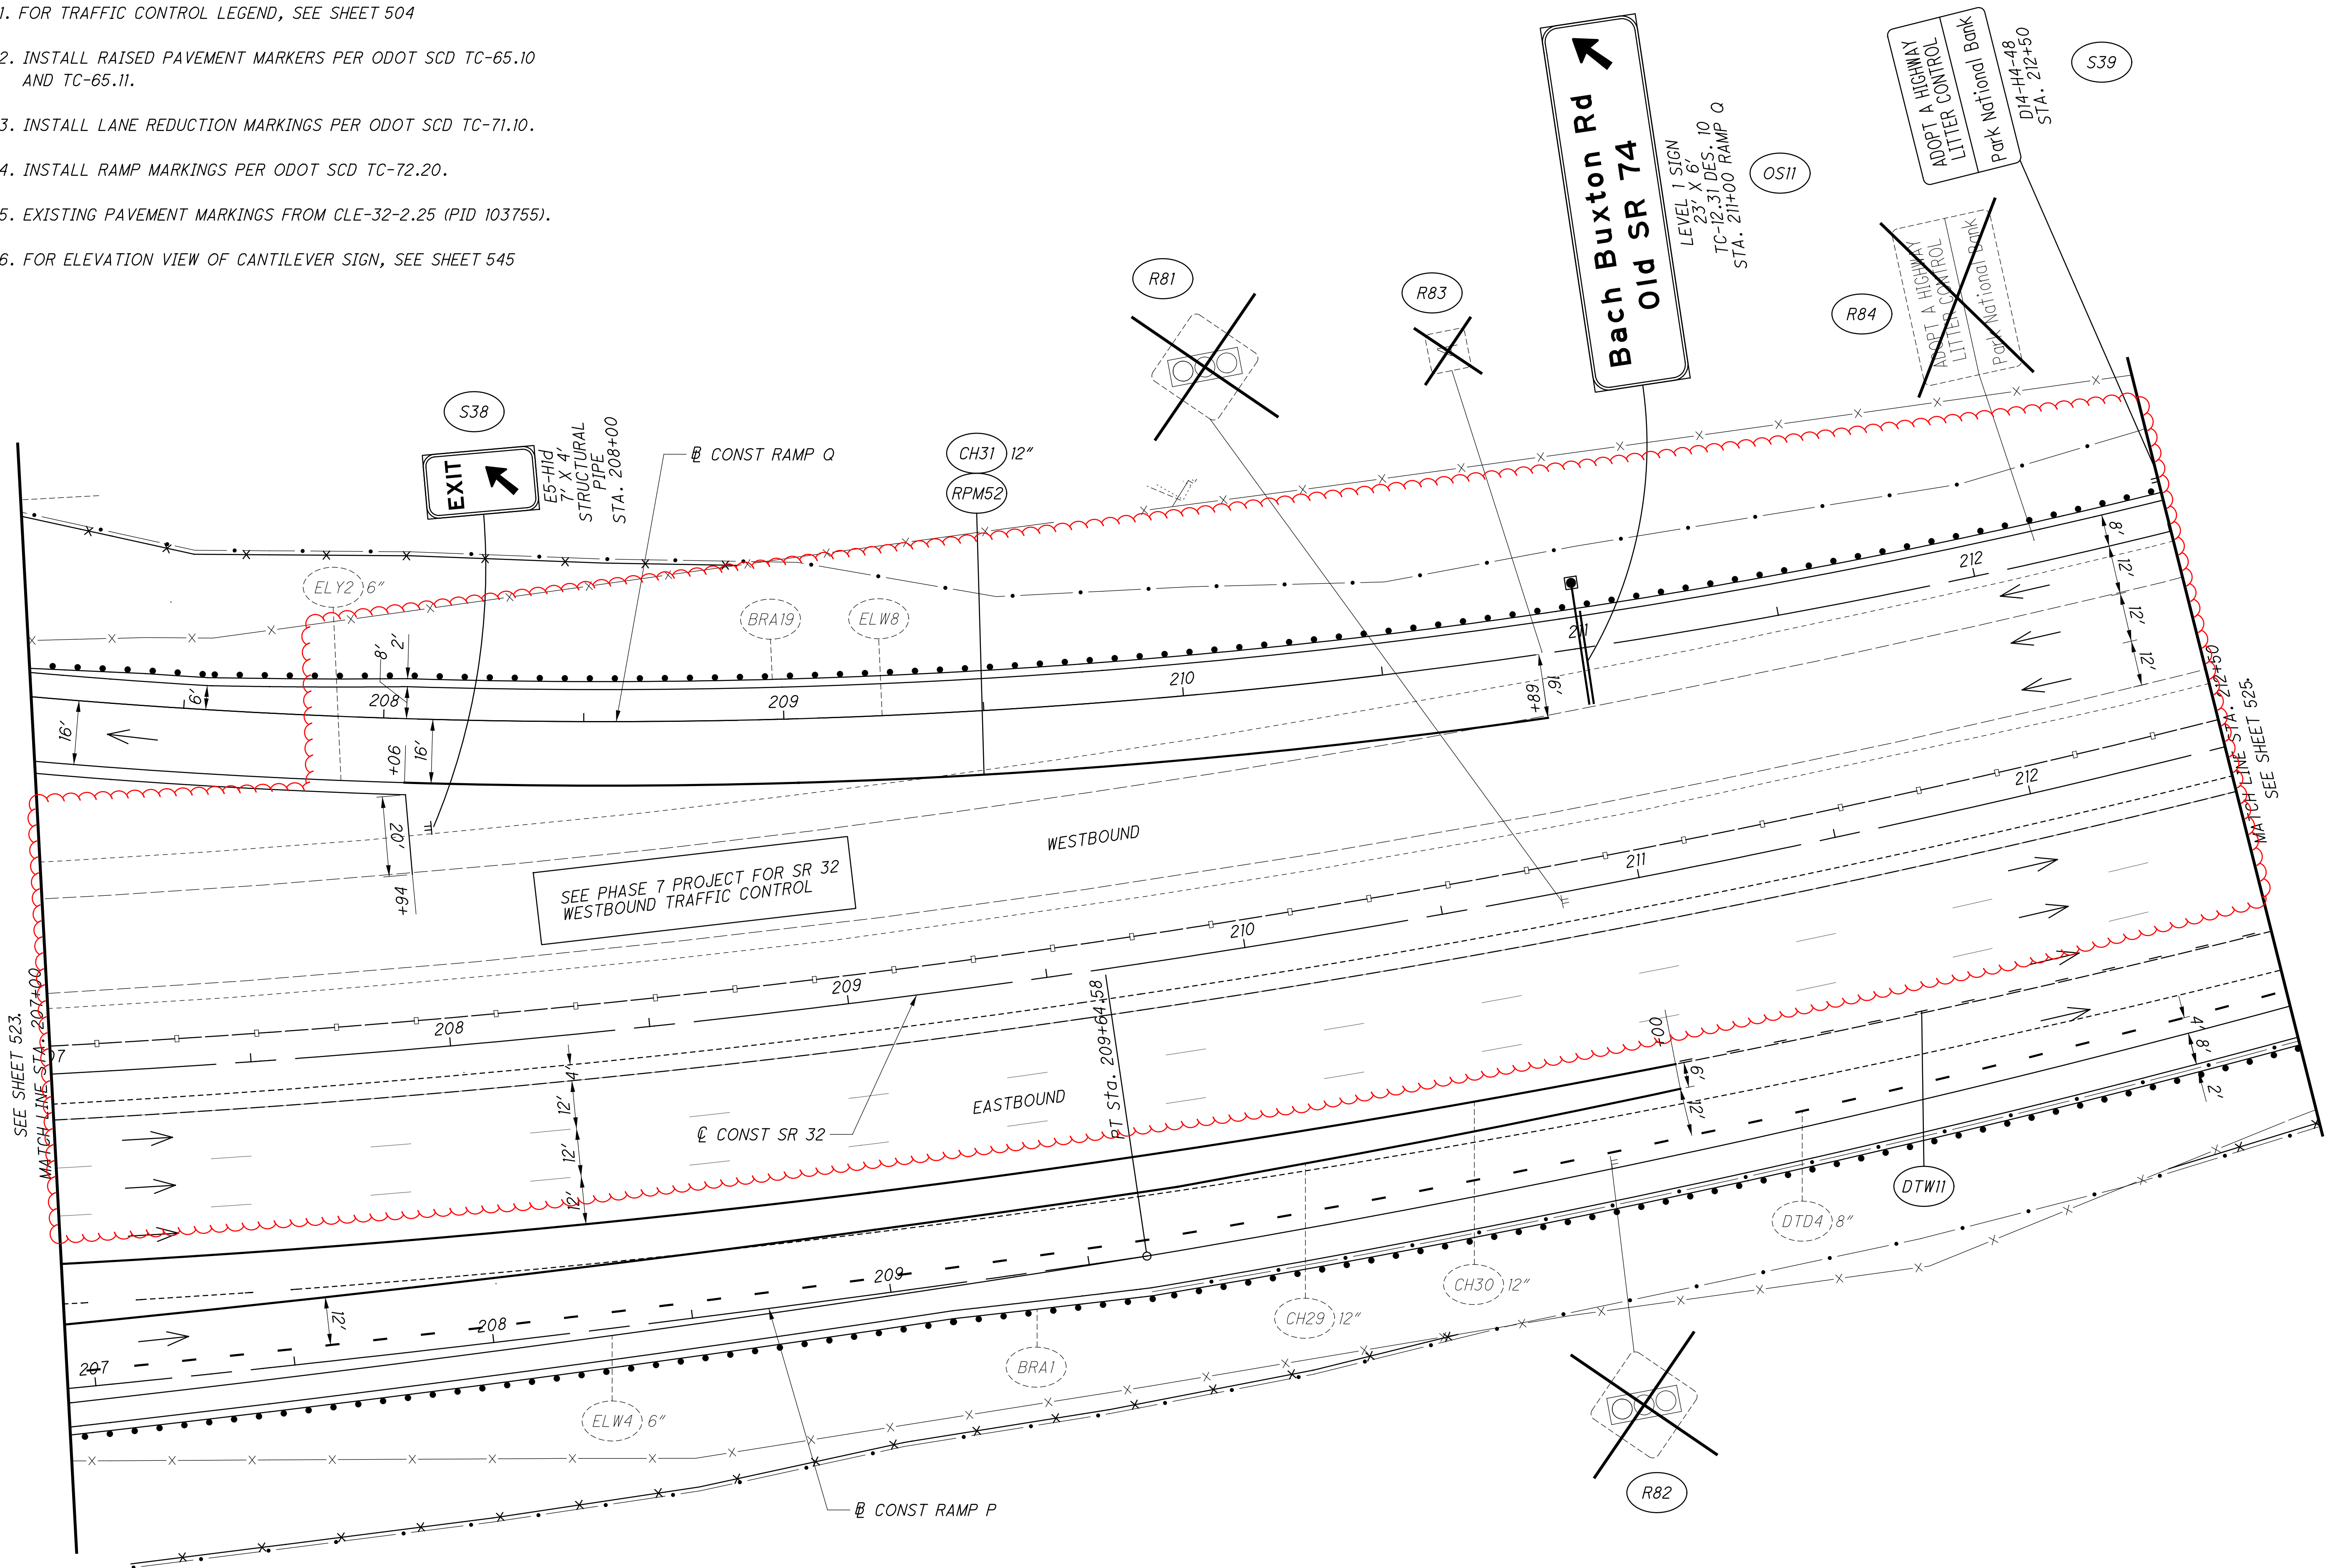

CALCULATED ACW
CHECKED WAA

0 20 40
10 HORIZONTAL
SCALE IN FEET

TRAFFIC CONTROL PLAN - SR 32
STA. 207+00 TO STA. 212+50

CLE-32-3.50
(PHASE 5)

...310.20\310.205\103954TP525.dgn 11/18/2021 4:23:01 PM ssopraseuth

NOTES:


1. FOR TRAFFIC CONTROL LEGEND, SEE SHEET 504
2. FOR REMOVAL OF EXISTING SIGN FLASHER ASSEMBLY WITH FLASHING WARNING BEACON, SEE SIGNAL REMOVAL PLANS.
3. INSTALL RAISED PAVEMENT MARKERS PER ODOT SCD TC-65.10 AND TC-65.11.

CALCULATED
ACW
CHECKED
WAA

0 10 20 40
HORIZONTAL
SCALE IN FEET

TRAFFIC CONTROL PLAN - SR 32
STA. 212+50 (BK) TO STA. 232+50 (AH)

CLE-32-3.50
(PHASE 5)

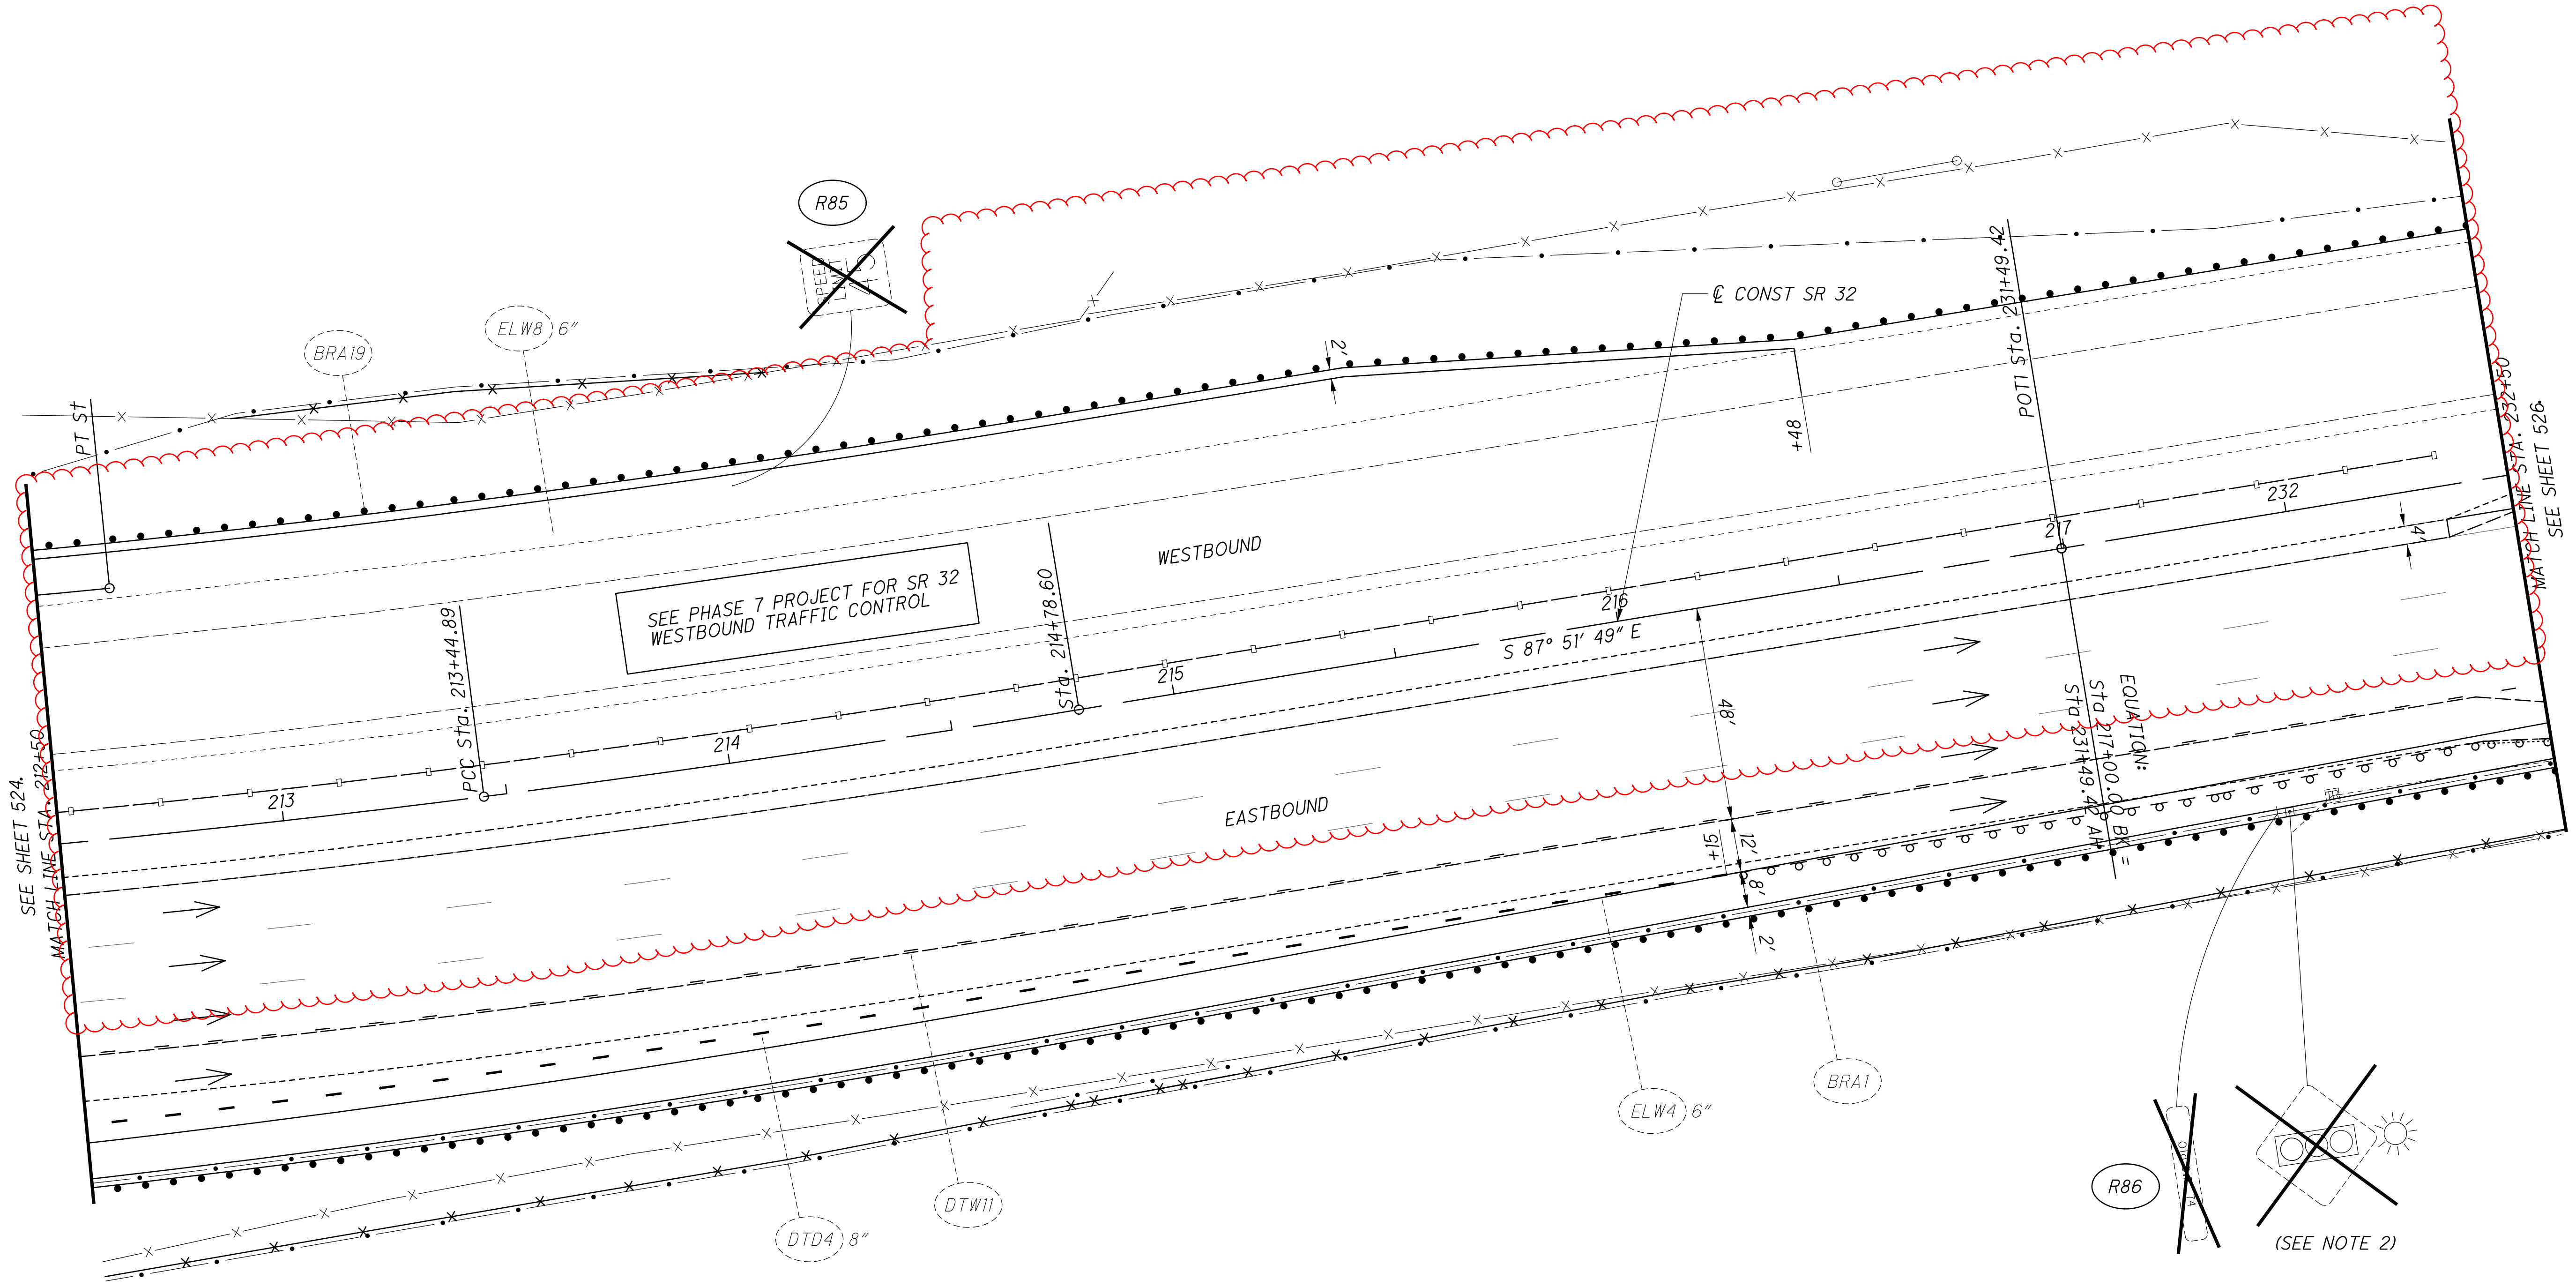


...310.20\310.205\103954TP526.dgn 11/18/2021 4:23:12 PM ssopraseuth

...310.20\310.205\103954TP527.dgn 11/18/2021 4:23:21 PM ssopraseuth

NOTES:

- 1. FOR TRAFFIC CONTROL LEGEND, SEE SHEET 504
- 2. INSTALL RAISED PAVEMENT MARKERS PER ODOT SCD TC-65.10 AND TC-65.11.
- 3. FOR TRAFFIC CONTROL ALONG OLD SR 74 NORTH OF SR 32, SEE SHEET 538
- 4. FOR TRAFFIC CONTROL ALONG OLD SR 74 SOUTH OF SR 32, SEE SHEET 539

CALCULATED ACW
CHECKED WAA

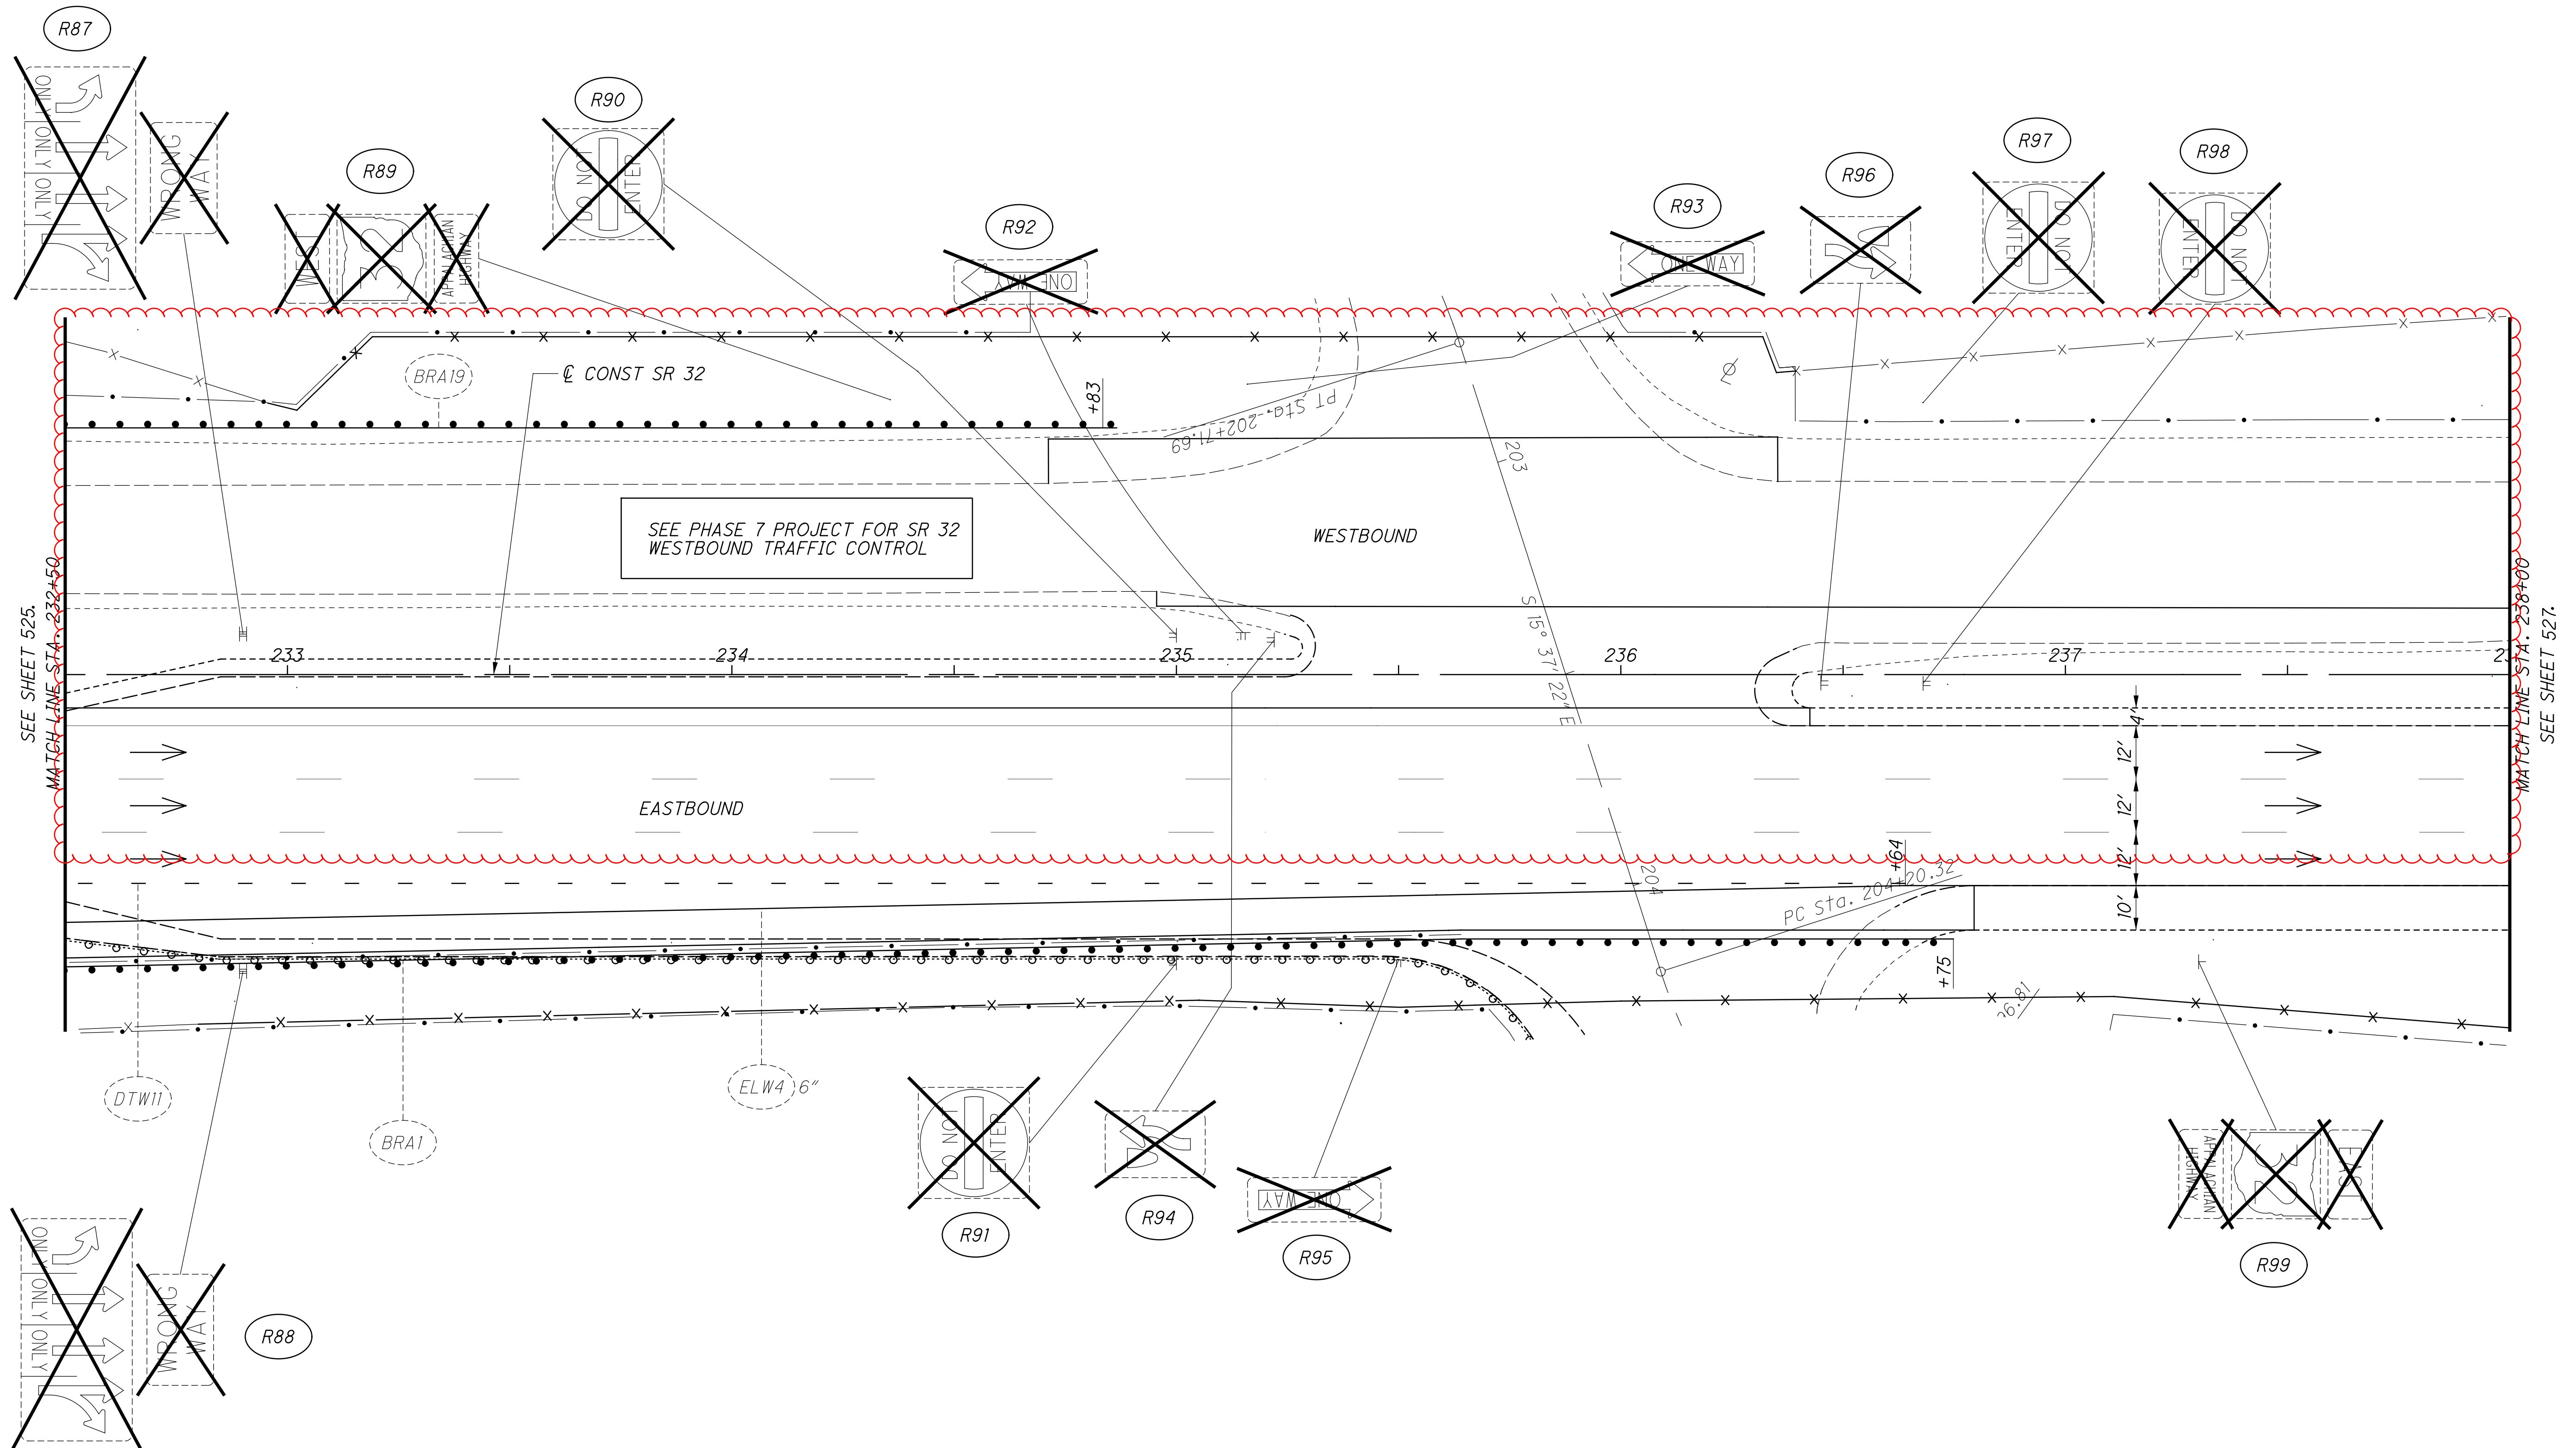


TRAFFIC CONTROL PLAN - SR 32
STA. 232+50 TO STA. 238+00

CLE-32-3.50
(PHASE 5)

NOTES:

1. FOR TRAFFIC CONTROL LEGEND, SEE SHEET 504

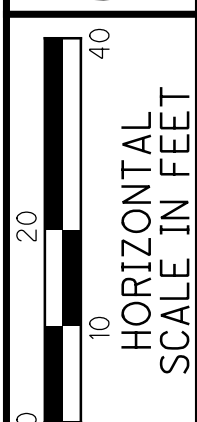


CALCULATED
ACW
CHECKED
WAA

TRAFFIC CONTROL PLAN - SR 32
STA. 243+50 TO STA. 249+00

CLE-32-3.50
(PHASE 5)


528
736

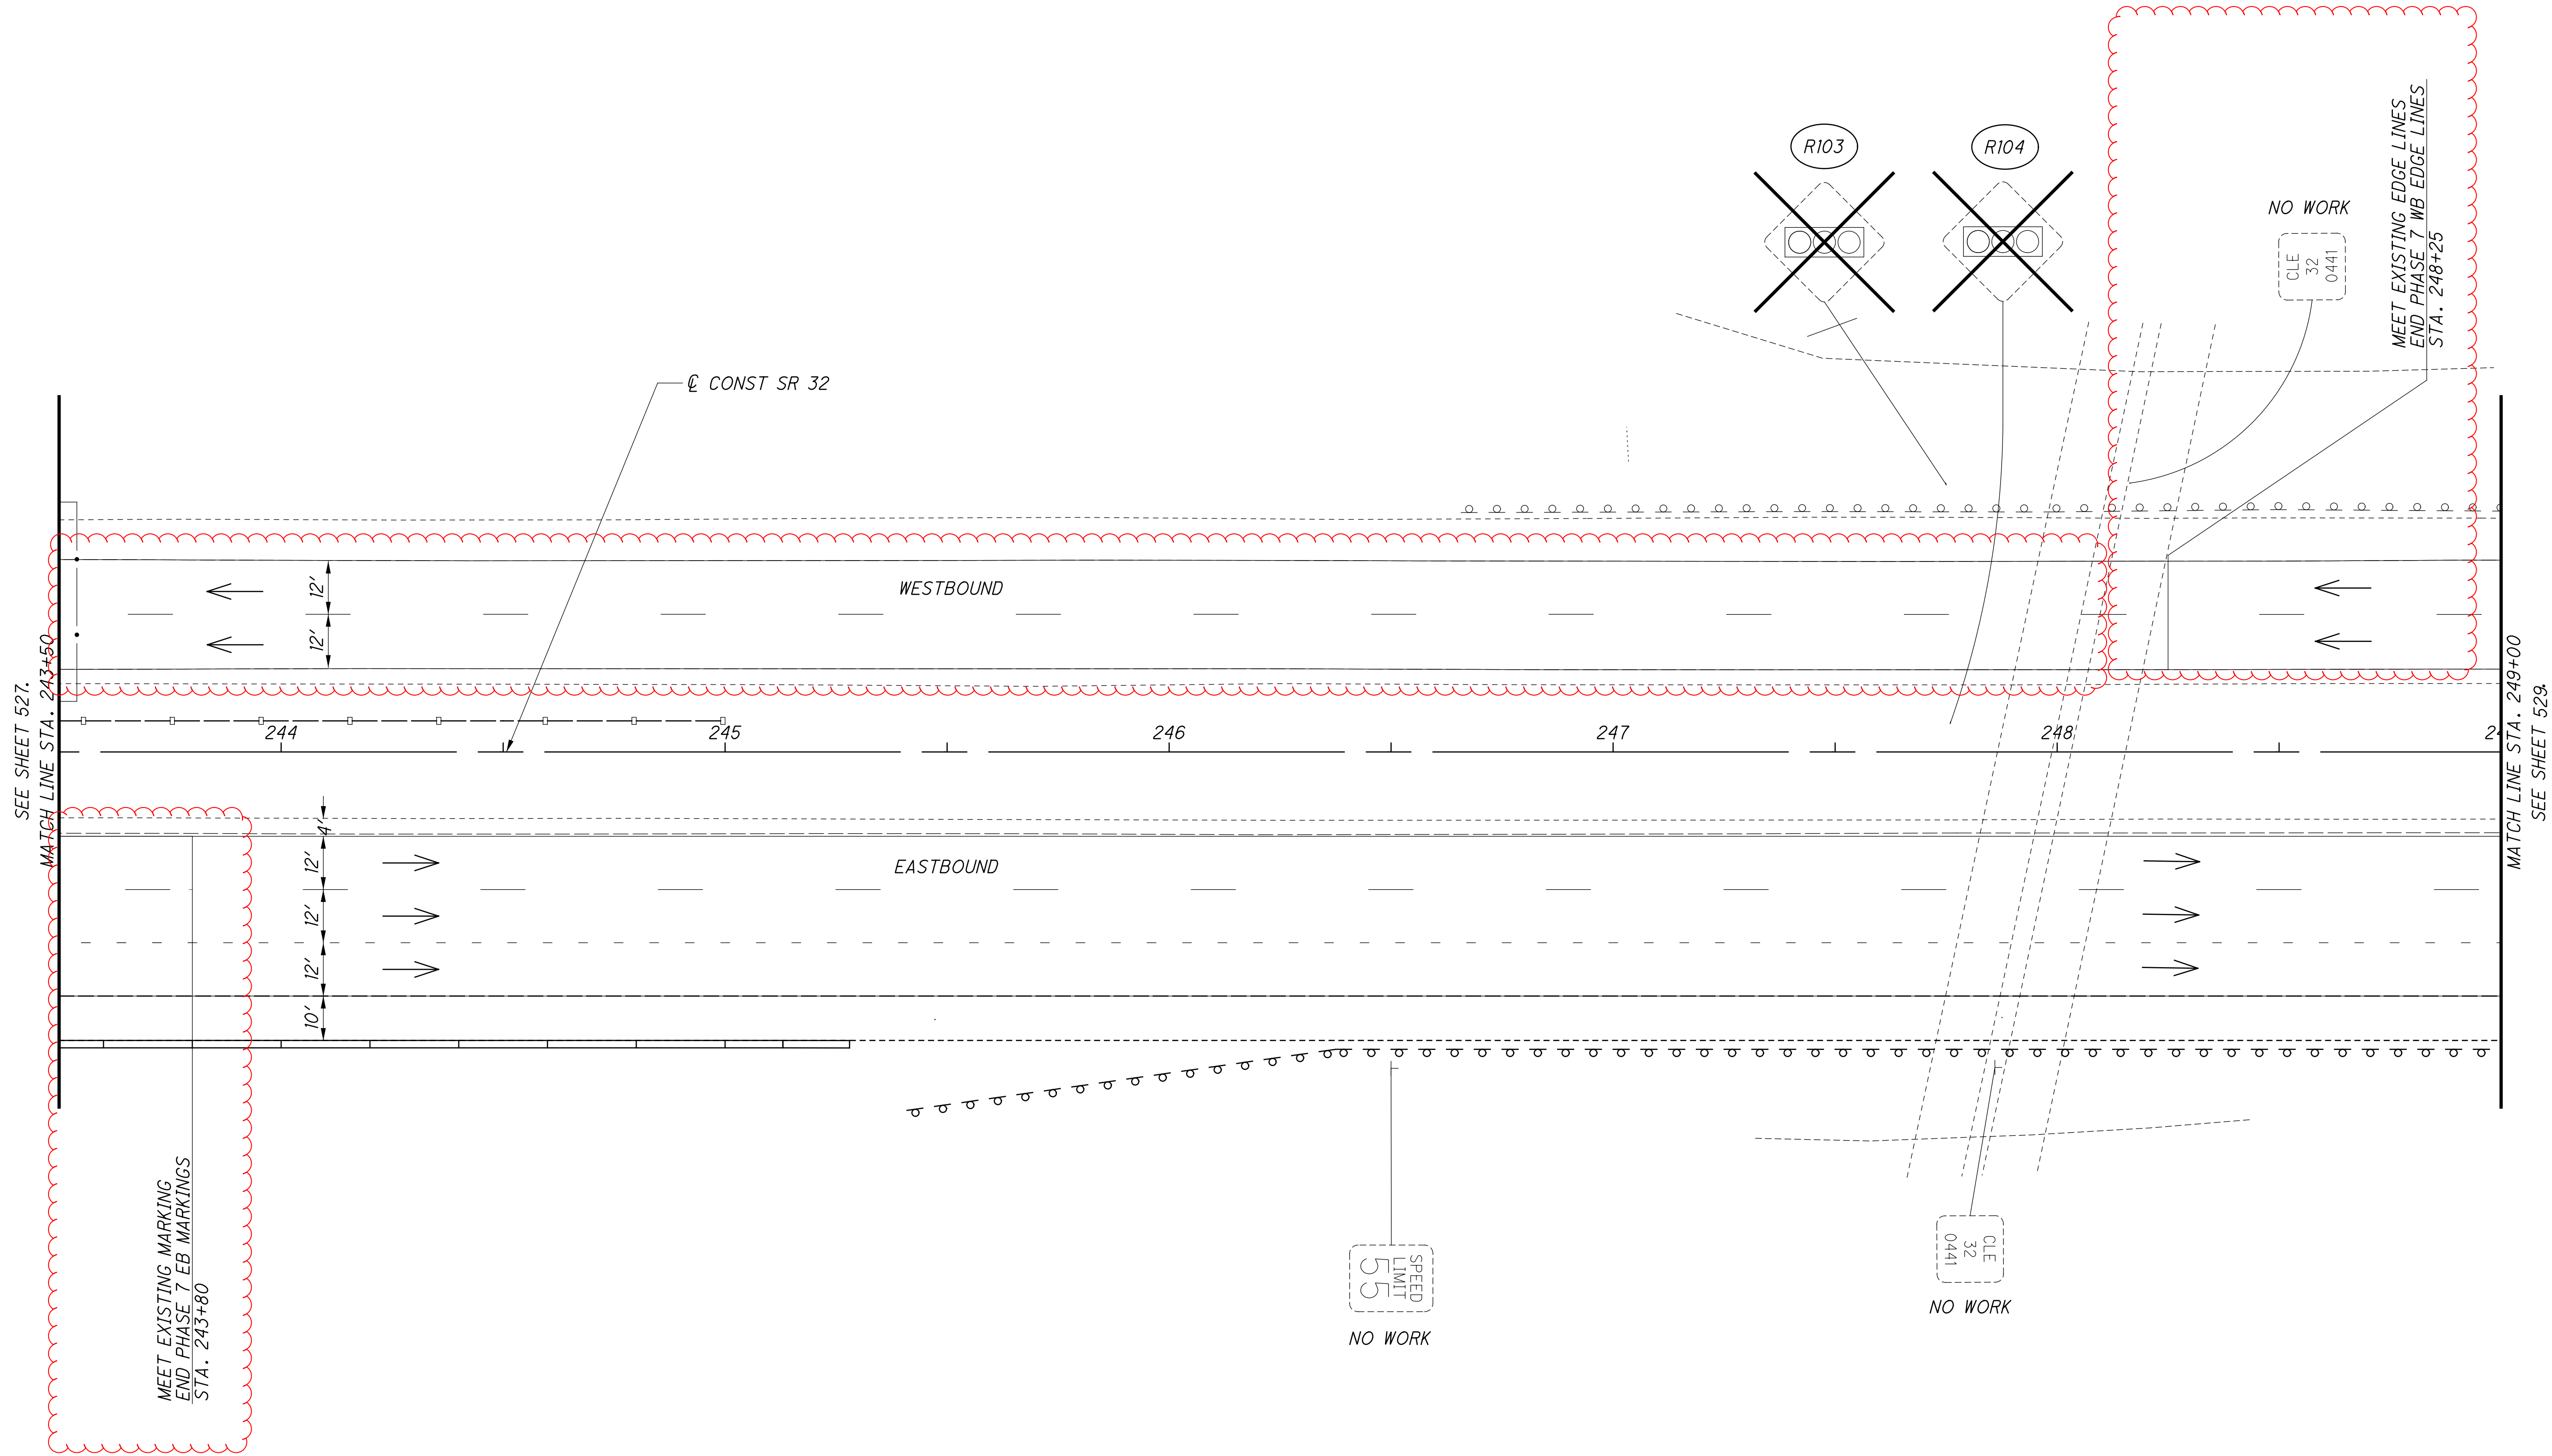

NOTES:

1. FOR TRAFFIC CONTROL LEGEND, SEE SHEET 504

2. FOR SIGN ELEVATION VIEW, SEE SHEET 548

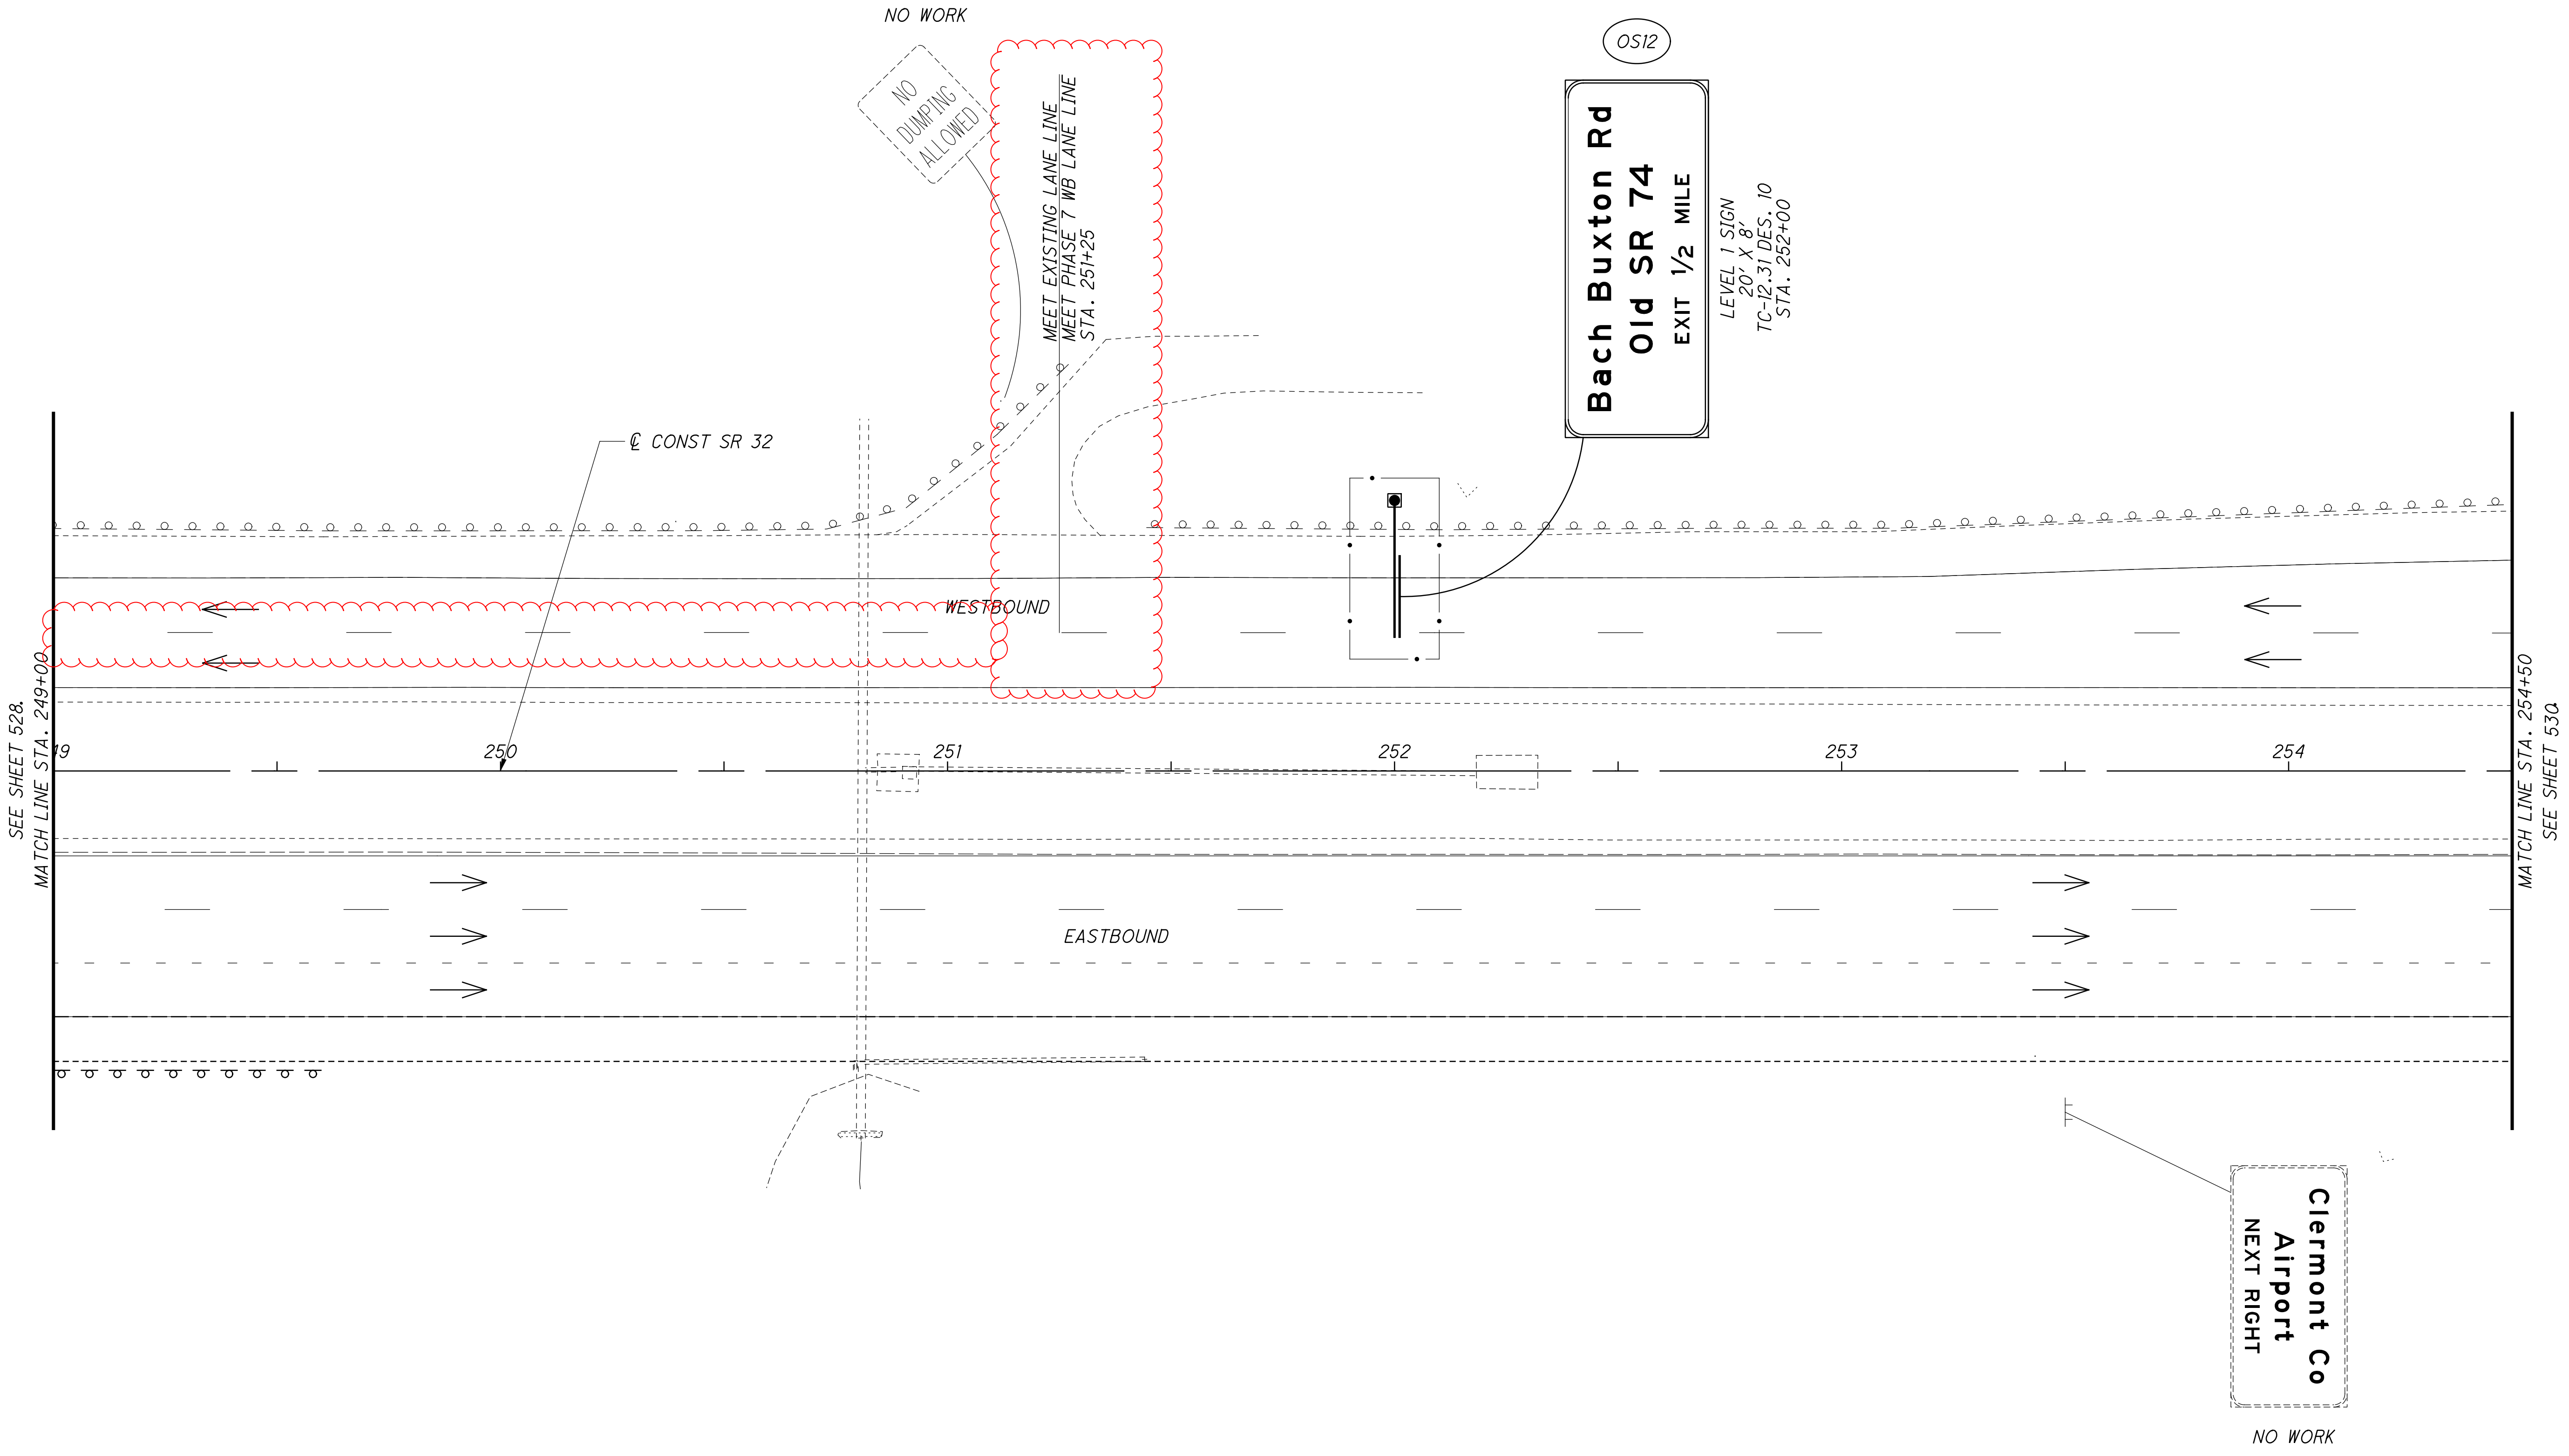

CALCULATED ACW
 CHECKED WAA

0 10 20 40
 HORIZONTAL SCALE IN FEET

TRAFFIC CONTROL PLAN - SR 32
STA. 249+00 TO STA. 254+50

CLE-32-3.50
(PHASE 5)

ITEM 632, REMOVAL OF TRAFFIC SIGNAL INSTALLATION FOR STORAGE, AS PER PLAN

TRAFFIC SIGNAL INSTALLATIONS, INCLUDING VEHICULAR SIGNAL HEADS, CABLE, MESSENGER WIRE, STRAIN POLES, CABINET, CONTROLLER, CONDUIT, PULL BOXES, ETC., SHALL BE REMOVED IN ACCORDANCE WITH CMS 632.26 AND AS INDICATED ON THE PLANS. REMOVED ITEMS SHALL BE REUSED AS PART OF A NEW INSTALLATION ON THE PROJECT OR STORED ON THE PROJECT FOR SALVAGE BY ODOT DISTRICT 8 IN ACCORDANCE WITH THE LISTING GIVEN HEREIN.

FOR ODOT MAINTAINED TRAFFIC SIGNALS, STORE 2070 CONTROLLER UNITS AND CABINETS, UPS UNITS, INTERCONNECTION/COMMUNICATION EQUIPMENT, EMERGENCY VEHICLE PREEMPTION, GPS AND VEHICLE DETECTION EQUIPMENT ON THE PROJECT FOR SALVAGE BY ODOT. STORE WITH CARE ANY ITEMS TO BE RE-USED ON THE PROJECT UNDER SEPERATE PAY ITEMS AS DIRECTED BY THE ENGINEER. ANY STORED ITEMS DAMAGED BY THE CONTRACTOR SHALL BE REPLACED AT NO ADDITIONAL COST TO THE PROJECT.

ANY ITEMS NOT SALVAGED BY ODOT OR REUSED IN THE PROJECT SHALL BE DISPOSED OF BY THE CONTRACTOR AT NO ADDITIONAL COST TO THE PROJECT. PAYMENT WILL BE MADE AT THE CONTRACT UNIT PRICE BID PER EACH OF ITEM 632, REMOVAL OF TRAFFIC SIGNAL INSTALLATION FOR STORAGE, AS PER PLAN.

ITEM 633, CONTROLLER UNIT, TYPE 2070E WITH 2070-1C CPU AND ASC/3 SOFTWARE, AS PER PLAN

THE CONTROLLER UNIT SHALL BE EQUIPMENT MANUFACTURED IN CONFORMANCE TO THE CALIFORNIA DEPARTMENT OF TRANSPORTATION (CALTRANS) SPECIFICATIONS TITLES "TRANSPORTATION ELECTRICAL EQUIPMENT SPECIFICATIONS (TEES)." THE CONTROLLER UNIT AND SOFTWARE VERSIONS SHALL BE COMPLIANT WITH THE TRAFFIC AUTHORIZED PRODUCTS (TAP) LIST.

THE CONTROLLER UNIT SHALL INCLUDE THE FOLLOWING:

1. UNIT CHASSIS
2. 2070-1C CPU MODULE (LINUX)
3. 2070-2E FIELD I/O MODULE
4. 2070-3B FRONT PANEL
5. 2070-4A POWER SUPPLY
6. 2070-7A SERIAL COMMUNICATION MODULE

THE CONTROLLER SHALL INCLUDE A TYPE 332 CABINET. THE CONTRACTOR SHALL NOT REASSIGN THE CABINET DETECTOR INPUTS IN ORDER TO REDUCE THE NUMBER OF 2-CHANNEL DETECTOR UNITS SUPPLIED, BUT SHALL USE THE STANDARD CALTRANS INPUT FILE DESIGNATIONS.

ITEM 633, CONTROLLER ITEM, MISC.: CDMA MODEM, FURNISH ONLY

FURNISH A CDMA MODEM, ANTENNA, CABLES, AND ETHERNET CABLE FOR REMOTE WIRELESS CELLULAR COMMUNICATION. FOR NETWORK CONSISTENCY CDMA MODEMS SHALL BE SIERRA WIRELESS (RAVEN X) OR GETWIRELESS (AIRLINK GX400).

THE CDMA MODEM EQUIPMENT SHALL BE DELIVERED TO THE ODOT ITS LAB FOR PROGRAMMING AND INSTALLATION.

ODOT ITS LAB
ATTN: PAUL LUNDSTROM
1605 W. BROAD STREET
COLUMBUS, OH 43223

THE CONTRACTOR SHALL PROVIDE THE MODEM SERIAL NUMBERS AND NECESSARY ESN NUMBERS FOR ODOT TO ESTABLISH WIRELESS SERVICE.

THE DEPARTMENT WILL MEASURE "CONTROLLER ITEM, MISC.: CDMA MODEM, FURNISH ONLY" BY THE NUMBER OF COMPLETE UNITS FURNISHED AND RECEIVED BY THE ODOT ITS LAB.


ITEM 633, UNINTERRUPTIBLE POWER SUPPLY (UPS), 1000 WATT, AS PER PLAN

IN ADDITION TO ITEM 633.18 AND 733.09, THE SEPARATE VENTILATED ENCLOSURE SHALL BE FOUNDATION MOUNTED NEXT TO THE PROPOSED CONTROLLER CABINET. THE CABINET SHALL BE BRUSHED ALUMINUM. PAYMENT WILL BE MADE AT THE CONTRACT UNIT PRICE BID PER EACH OF ITEM 633, UNINTERRUPTIBLE POWER SUPPLY (UPS), 1000 WATT, AS PER PLAN IN PLACE INCLUDING ALL CONNECTIONS, TESTED AND ACCEPTED.

ITEM 633, CONTROLLER WORK PAD, AS PER PLAN

CONTROLLER WORK PAD SHALL BE SIZED TO ACCOMMODATE THE UPS CABINET ON THE SAME WORK PAD. CHANGES TO THE DIMENSIONS OF THE UPS CABINET AND TO THE WORK PAD SHALL REQUIRE THE APPROVAL OF ODOT.

THE TOP OF WORK PADS INSTALLED ADJACENT TO PEDESTRIAN PATHWAYS SHALL BE FLUSH WITH THE PATHWAY. PAYMENT FOR ITEM 633, CONTROLLER WORK PAD, AS PER PLAN, WILL BE AT THE CONTRACT UNIT PRICE AND WILL BE FULL COMPENSATION FOR ALL LABOR, MATERIAL, TOOLS, EQUIPMENT AND OTHER INCIDENTALS NECESSARY FOR EACH WORK PAD IN PLACE, COMPLETE AND ACCEPTED.

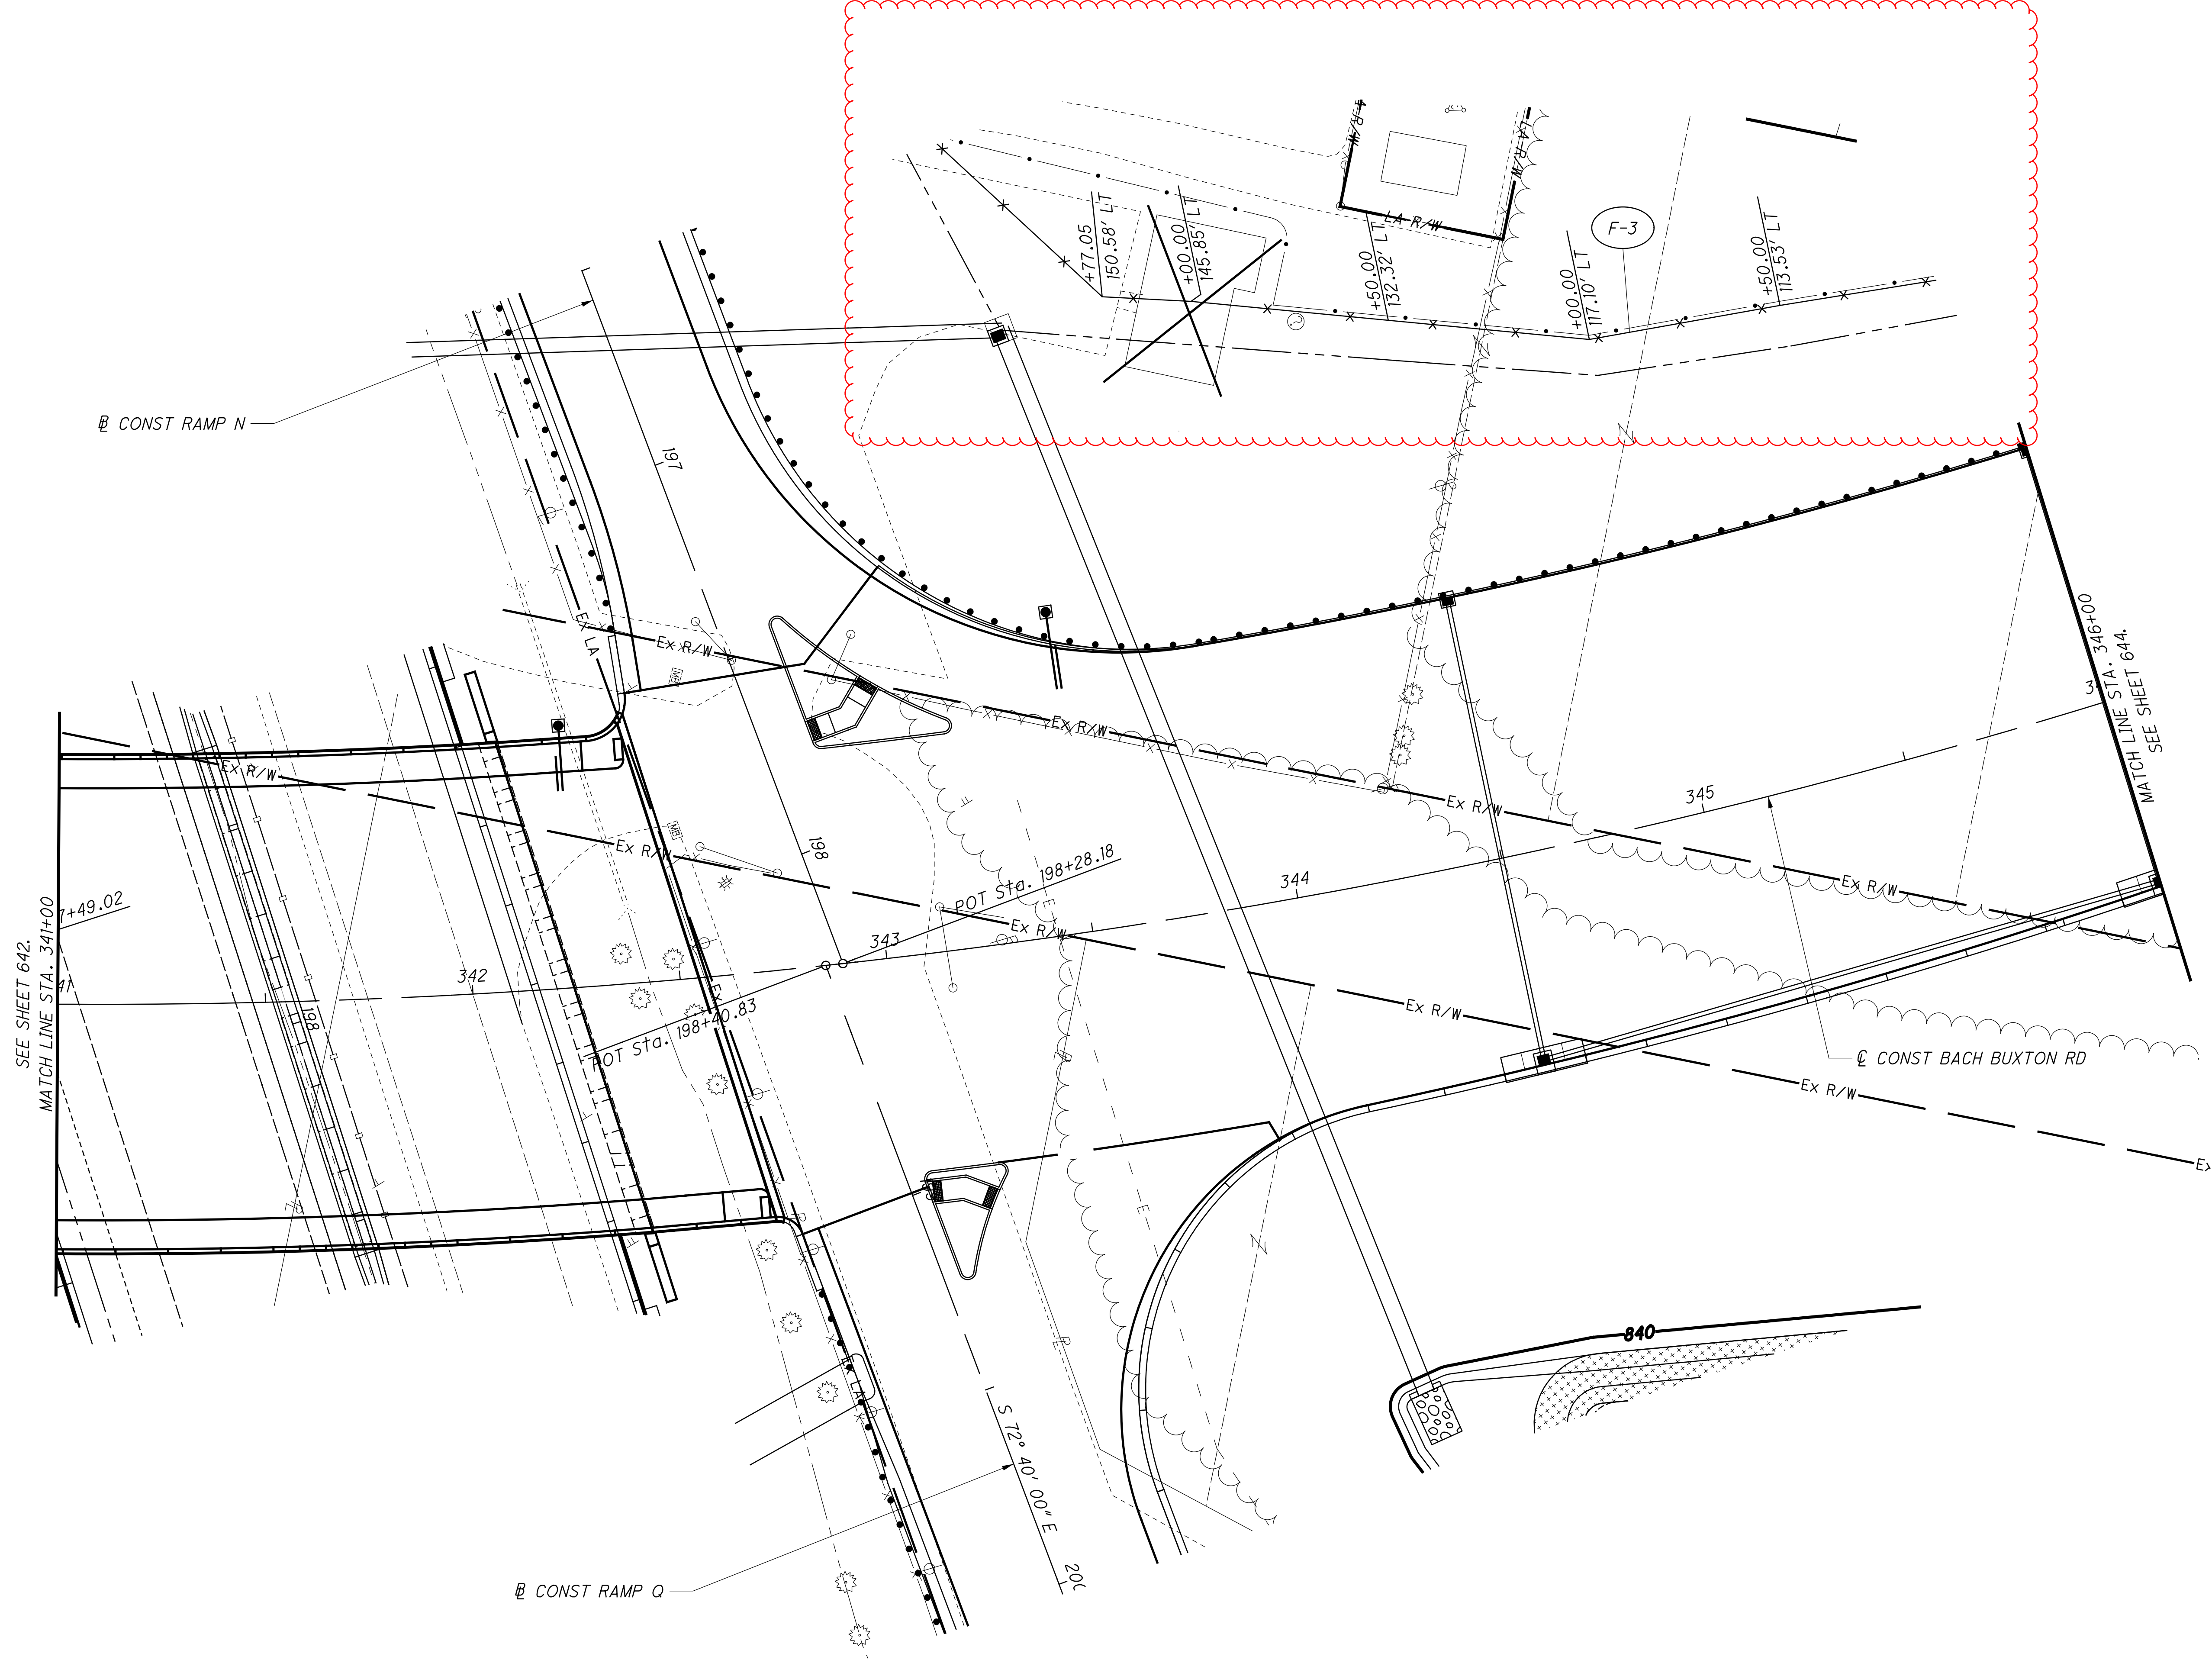


| | |
|------------|-----|
| CALCULATED | MSW |
| CHECKED | WAA |

0 20 40
HORIZONTAL SCALE IN FEET

FENCE PLAN
BACH BUXTON RD STA. 341+00 TO STA. 346+00

CLE-32-3.50
(PHASE 5)

643
736

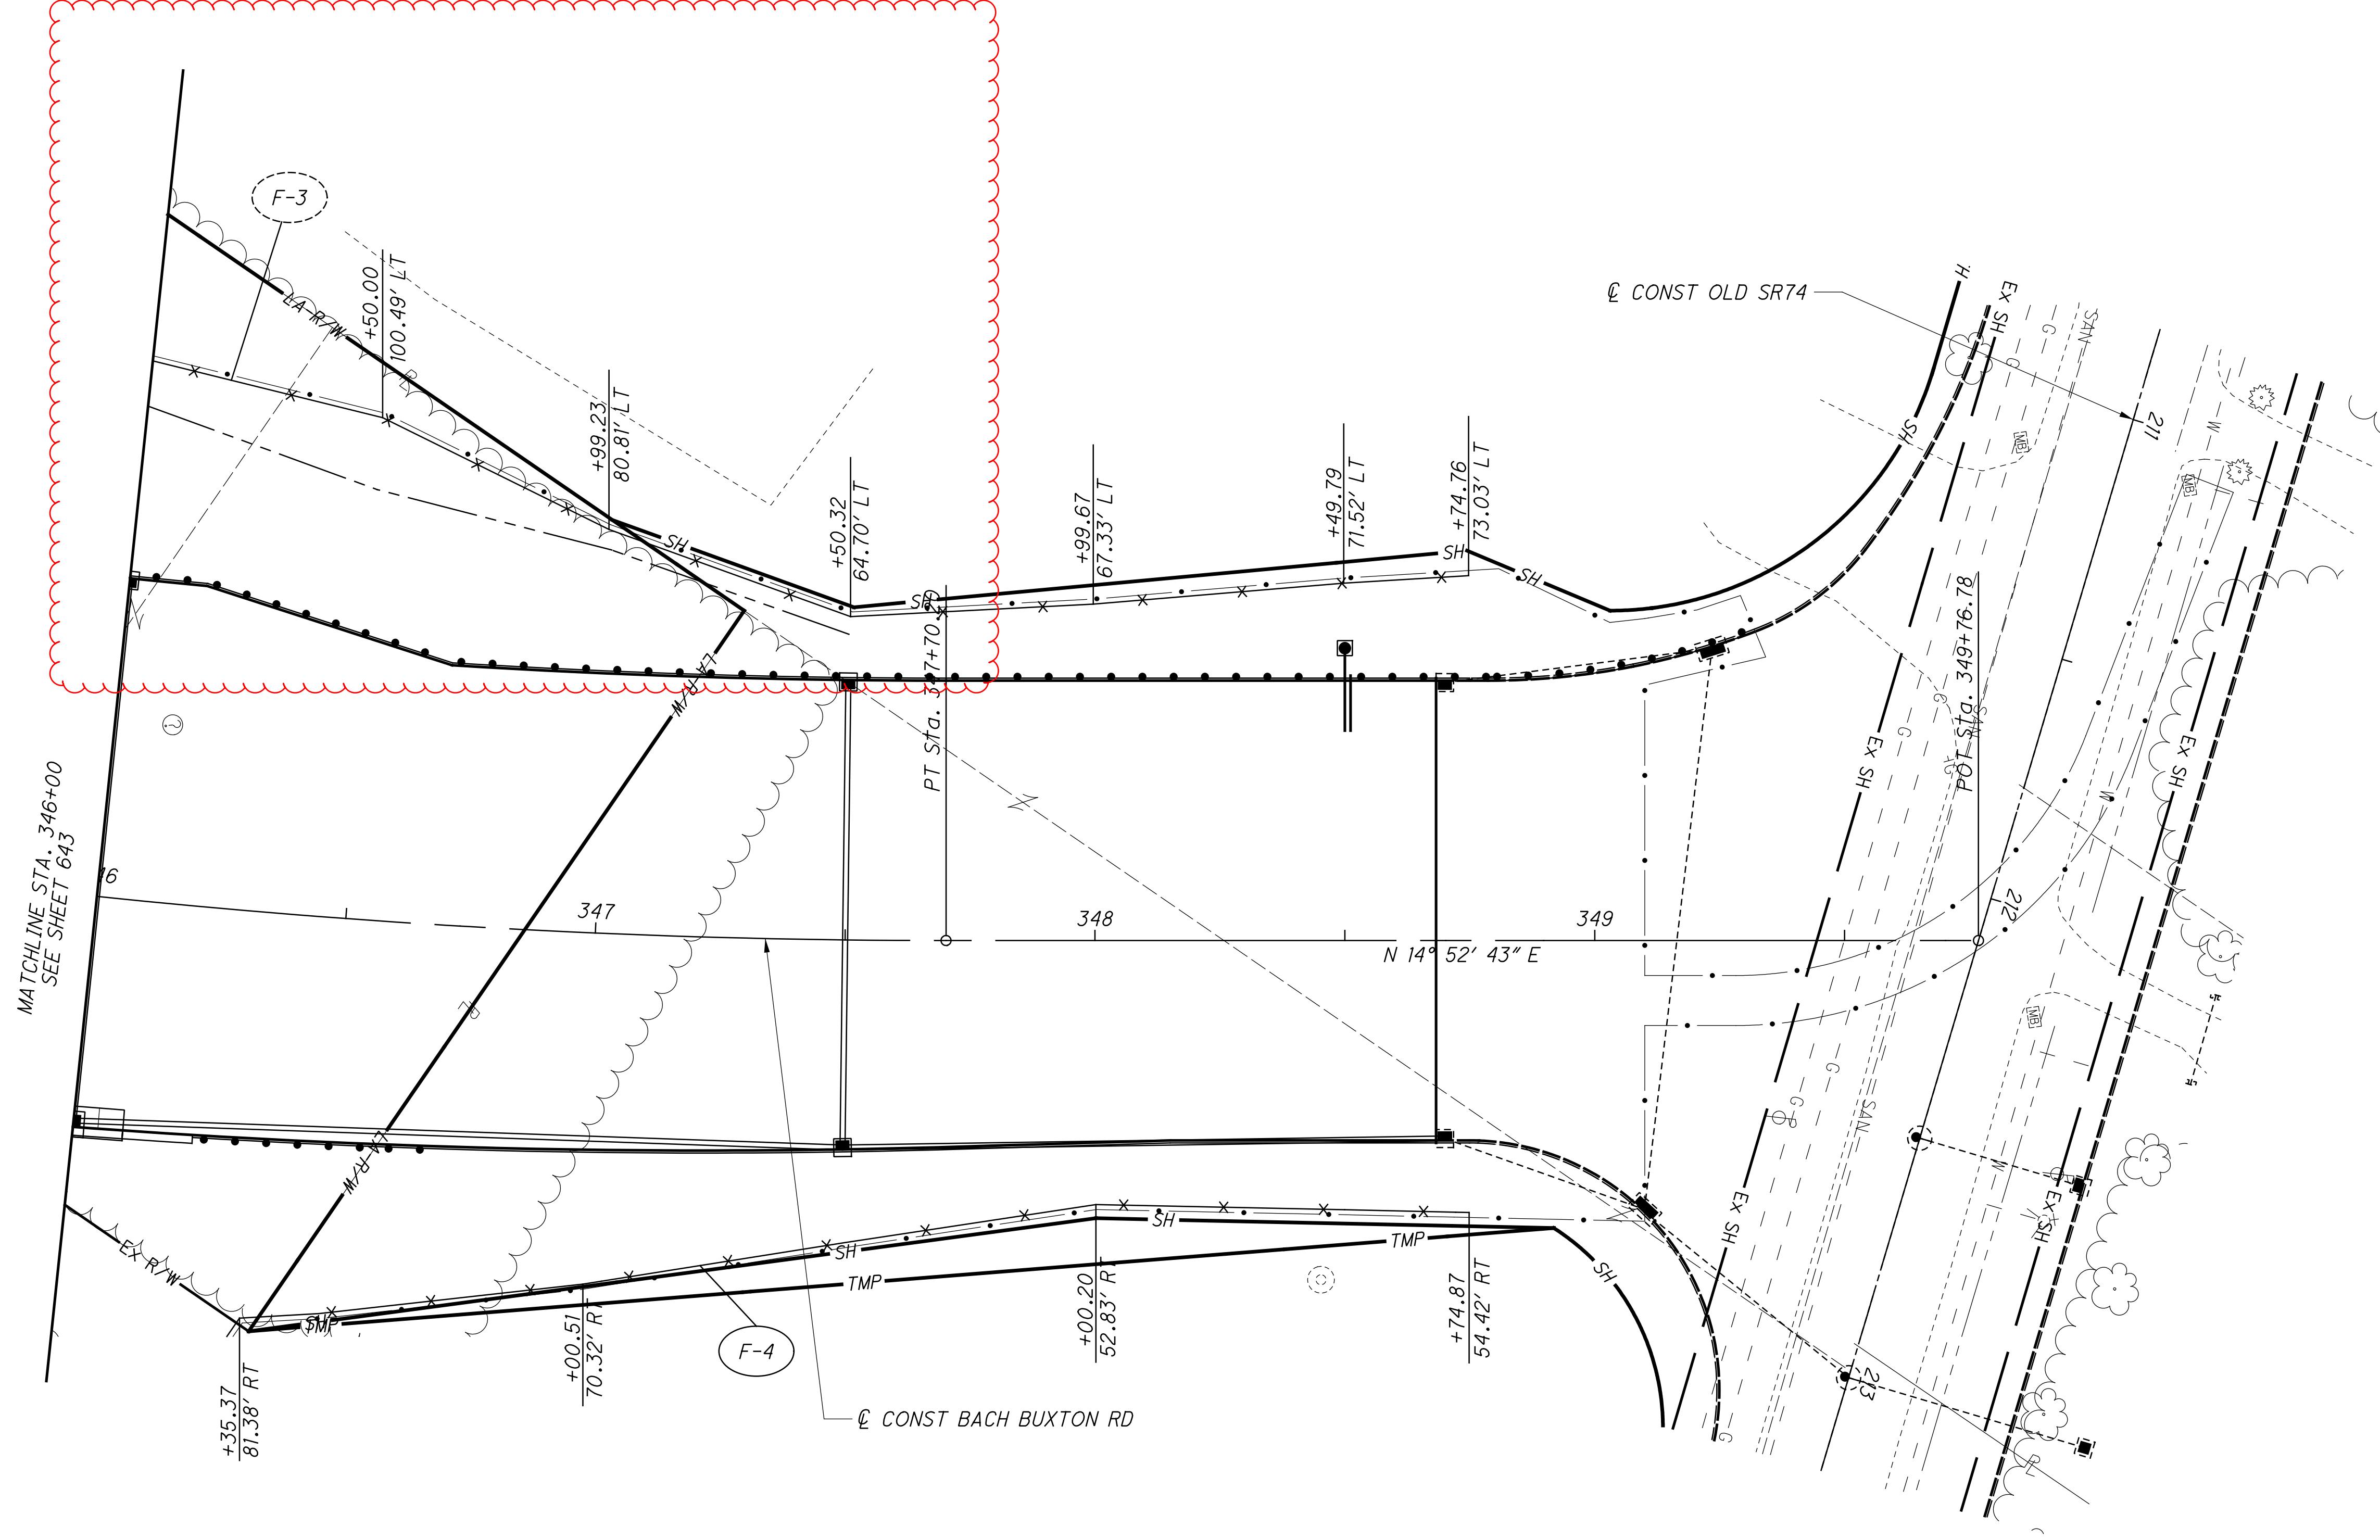



CALCULATED MSW
CHECKED WAA

0 10 20 40
HORIZONTAL SCALE IN FEET

FENCE PLAN
BACH BUXTON RD STA. 346+00 TO STA. 346+00

CLE-32-3.50
(PHASE 5)

644
736

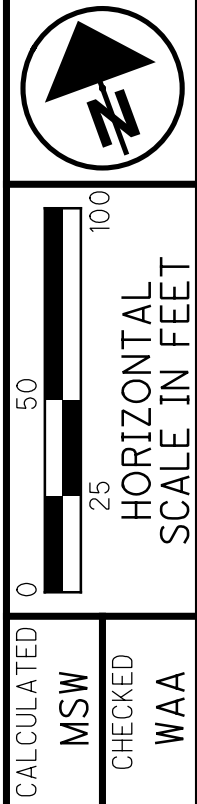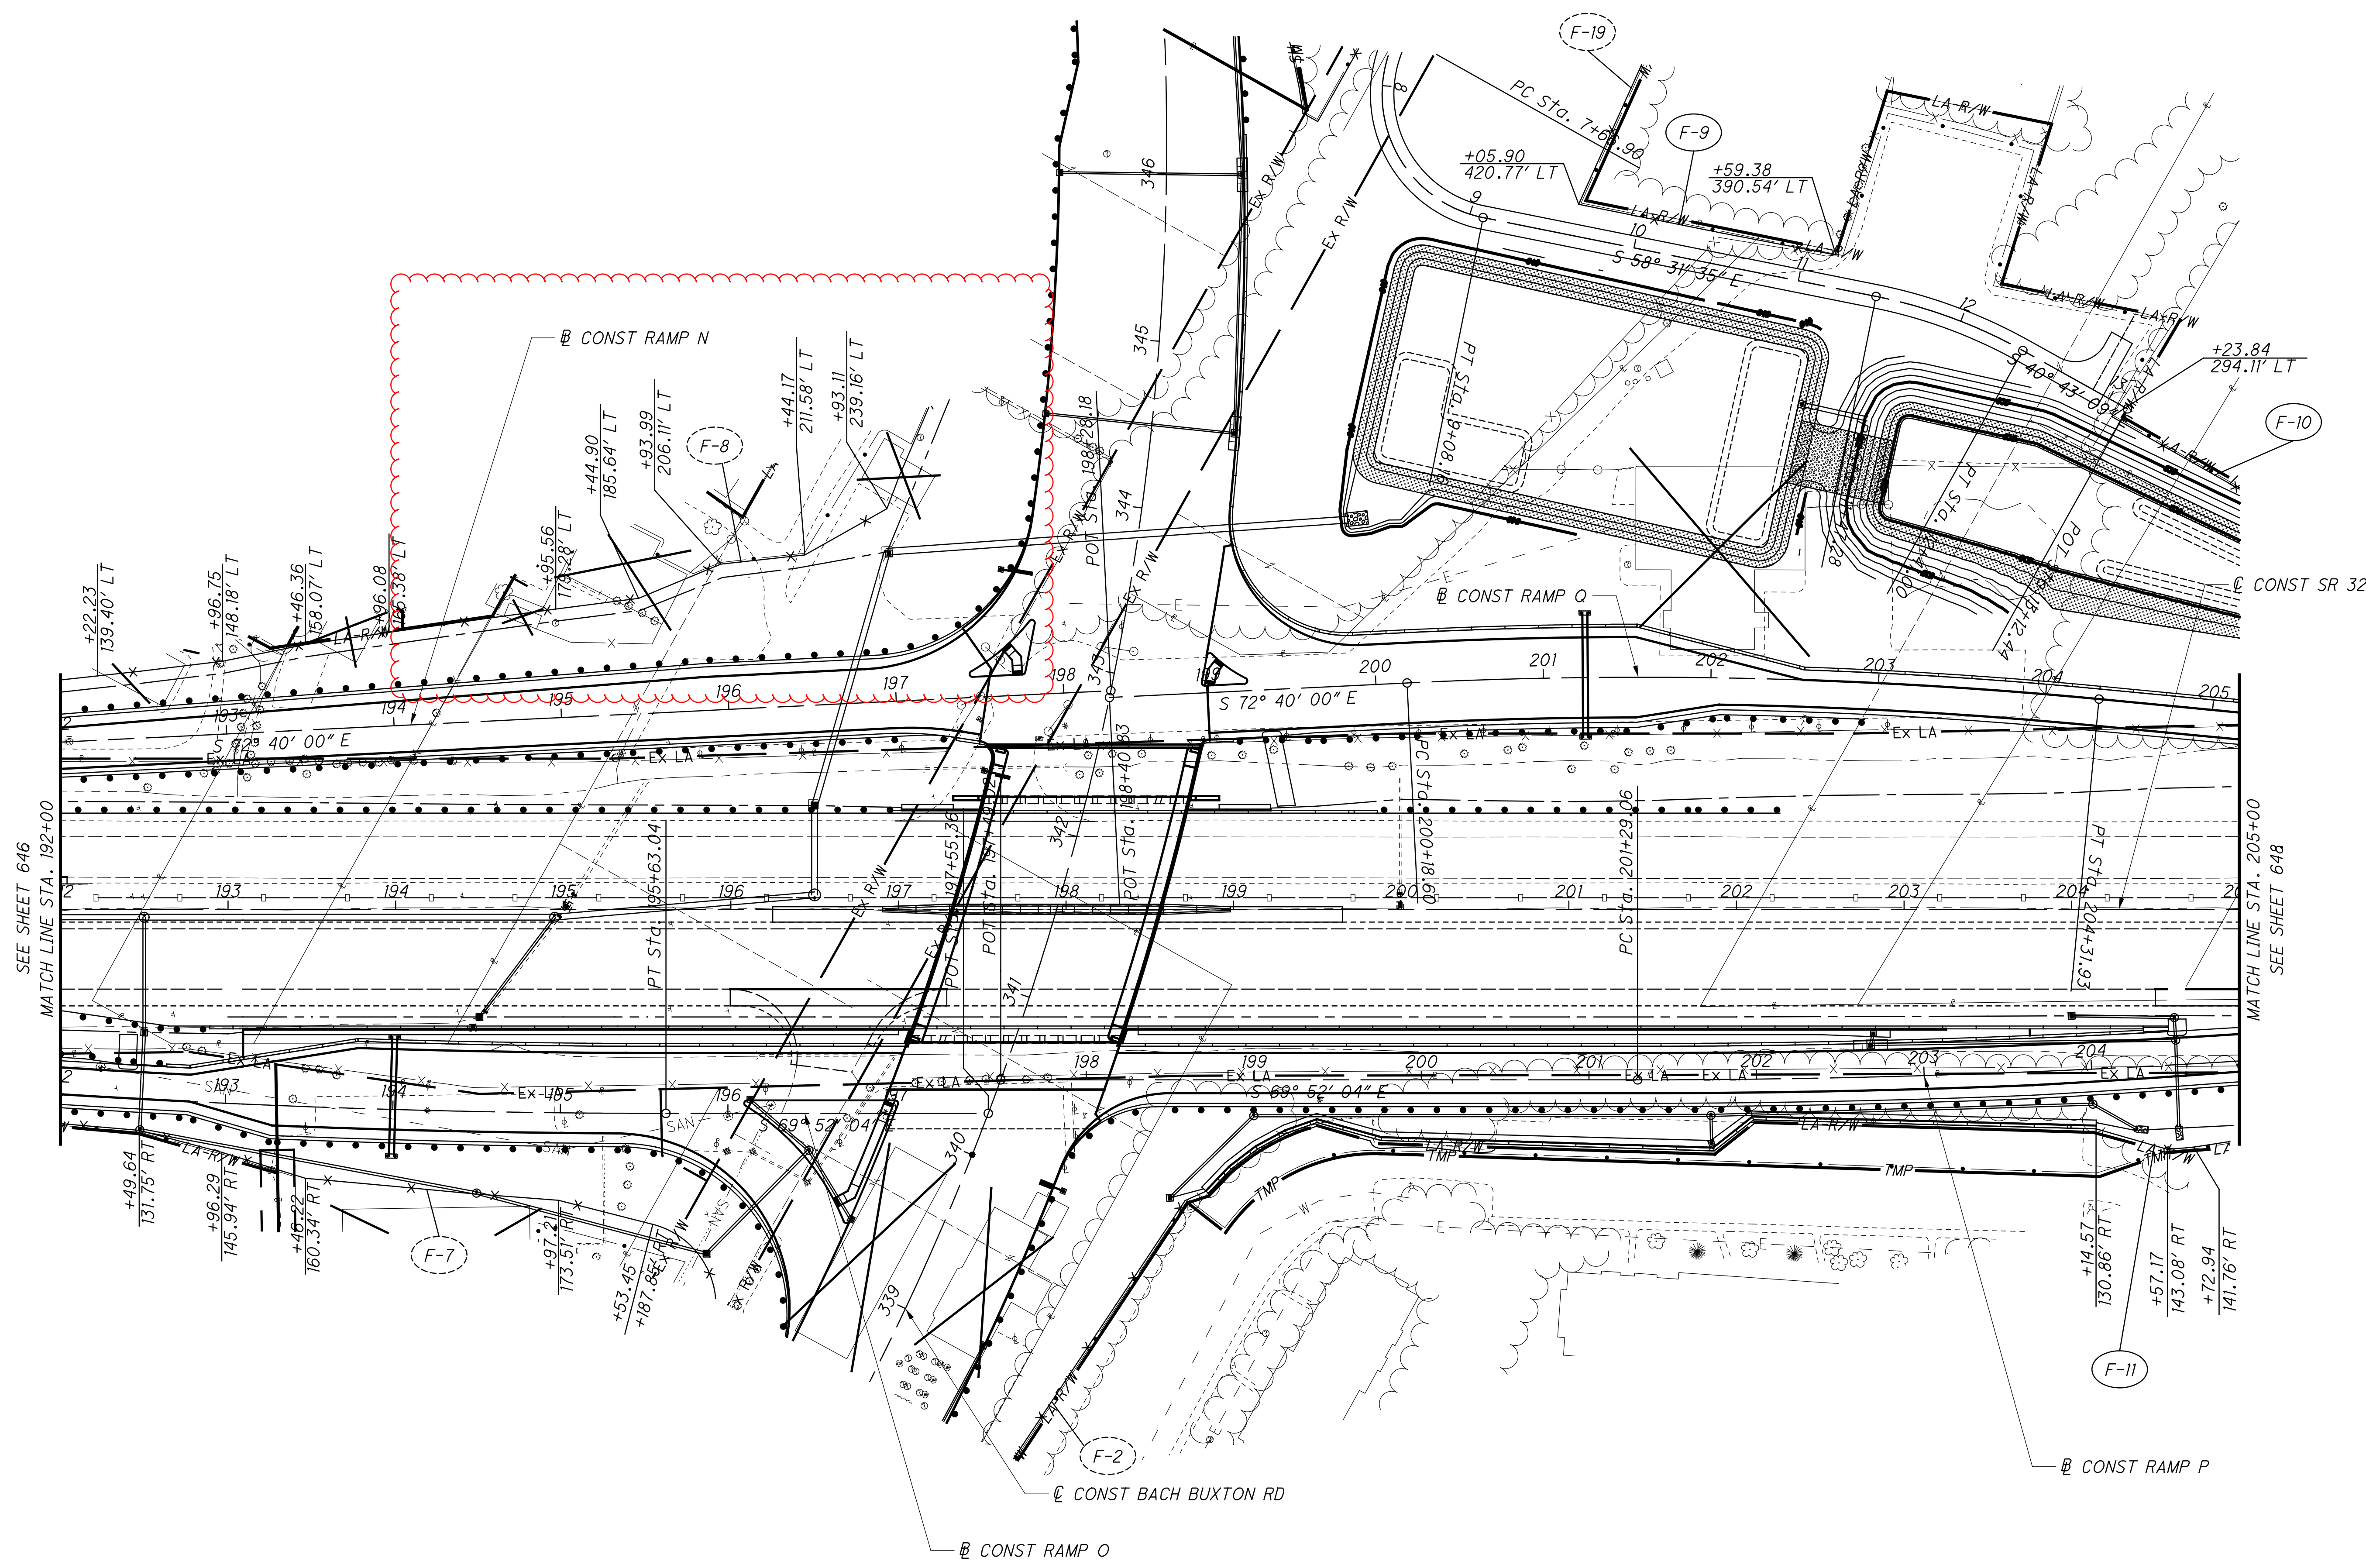

| | | | |
|------------|-----|---------|-----|
| CALCULATED | MSW | CHECKED | WAA |
|------------|-----|---------|-----|


**FENCE PLAN - SR 32
STA. 192+00 TO STA. 205+00**

**CLE-32-3.50
(PHASE 5)**


LEGEND

- ① ITEM 442 - 1½" ASPHALT CONCRETE (SC), 12.5MM, TYPE A (446)
- ② ITEM 407 - NON-TRACKING TACK COAT
- ③ ITEM 442 - 1¾" ASPHALT CONCRETE (IC), 19MM, TYPE A (446)
- ④ ITEM 659 - SEEDING AND MULCHING
- ⑤ ITEM 302 - 10" ASPHALT CONCRETE BASE, PG64-22
- ⑥ ITEM 206 - LIME STABILIZED SUBGRADE, 14" DEEP
- ⑦ ITEM 304 - 8" AGGREGATE BASE
- ⑧ ITEM 606 - GUARDRAIL, TYPE MGS
- ⑨ ITEM 605 - 6" BASE PIPE UNDERDRAINS WITH GEOTEXTILE FABRIC
- ⑩ ITEM 605 - 6" SHALLOW PIPE UNDERDRAINS WITH GEOTEXTILE FABRIC (EX PIPE PLACED IN PREVIOUS PHASES TO REMAIN IN SOME PLACES, SEE UD PLAN VIEW FOR LOCATIONS)
- ⑪ ITEM 442 - ASPHALT CONCRETE (IC), 19MM, TYPE A (446) (DEPTH AS SHOWN)
- ⑫ ITEM 622 - CONCRETE BARRIER, SINGLE SLOPE, TYPE C1
- ⑬ ITEM 254 - PAVEMENT PLANING, ASPHALT CONCRETE (DEPTH AS SHOWN)
- ⑭ ITEM 204 - EMBANKMENT
- ⑮ ITEM 204 - PROOF ROLLING
- ⑯ ITEM 302 - 4" ASPHALT CONCRETE BASE, PG64-22
- ⑰ ITEM 206 - CURING COAT

- (A) 3.25" ASPHALT CONCRETE
- (B) 9" REINFORCED CONCRETE
- (C) 6" AGGREGATE BASE
- (D) CONCRETE BARRIER
- (E) EX UNDERDRAIN TO REMAIN (SEE UNDERDRAIN PLAN FOR DETAILS)
- (F) 10" ASPHALT CONCRETE BASE

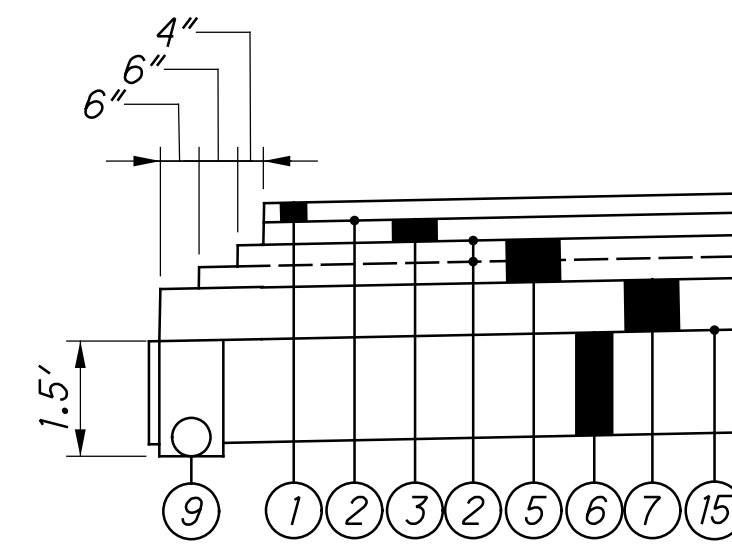

▽
**ASPHALT PAVEMENT
EDGE STEP DETAIL**

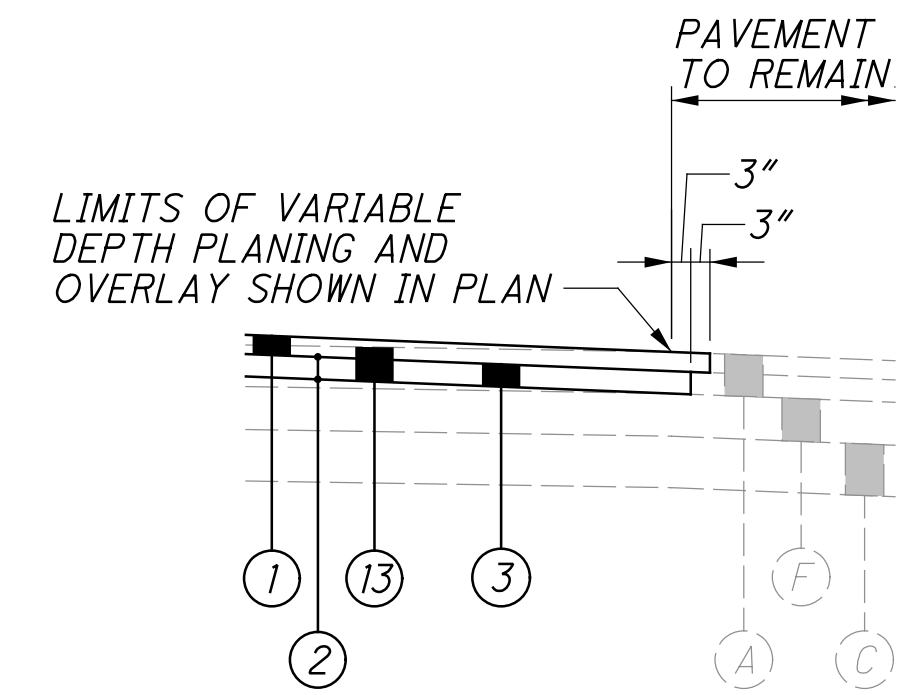


▽
**ASPHALT OVERLAY
LONGITUDINAL JOINT DETAIL**

NOTE "A"

THE EXISTING PAVEMENT EDGES SHALL BE SAW CUT TO LOCATE A SOUND PAVEMENT EDGE PER SEC. 203.04(E) OF THE CMS. FOR ESTIMATING PURPOSES, PAVEMENT CALCULATIONS INCLUDED IN THE PLAN INDICATE THE SAW CUT LOCATION AS SHOWN WHICH IS BASED ON MATERIAL LIFT THICKNESS AND PROPOSED CROSS SLOPE REQUIREMENTS.


NOTE "B"

THE EXISTING PAVEMENT EDGES SHALL BE SAW CUT TO LOCATE A SOUND PAVEMENT EDGE PER SEC. 203.04(E) OF THE CMS. FOR ESTIMATING PURPOSES, PAVEMENT CALCULATIONS INCLUDED IN THE PLAN INDICATE THE SAW CUT LOCATION ALONG THE EXISTING EDGE OF PAVEMENT LINE OR SHOULDER BREAK POINT AND AVOID ANY UNNECESSARY REMOVAL OF EXISTING REINFORCED CONCRETE PAVEMENT IN THE TRAVEL LANES.

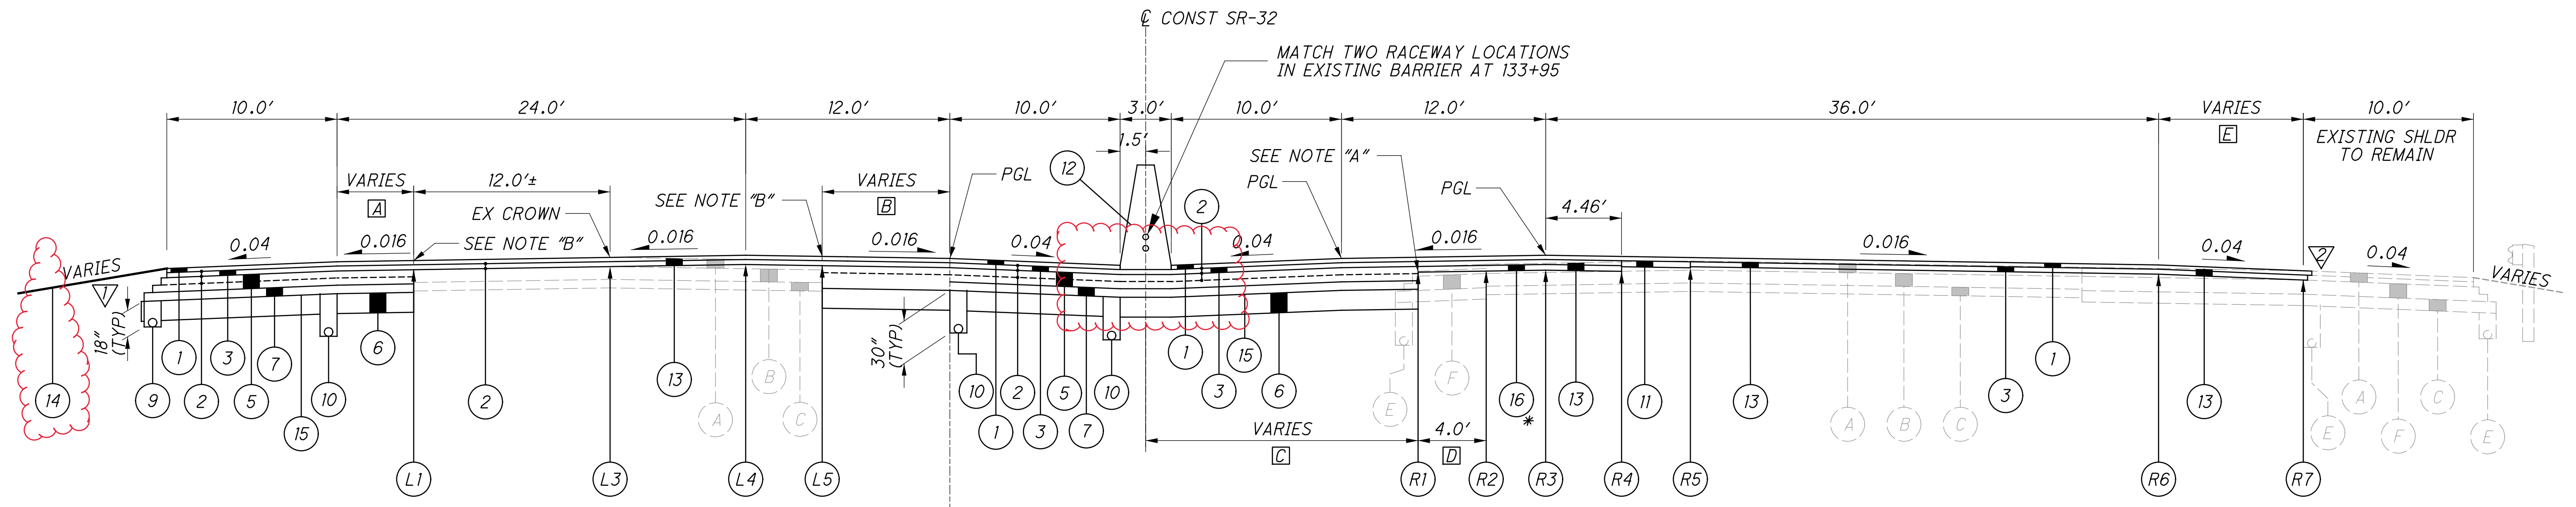

SR-32 NORMAL SECTION
STA. 133+95.00 TO STA. 143+50.93

* SEE DEPTH CHART FOR LOCATIONS & DIMENSIONS

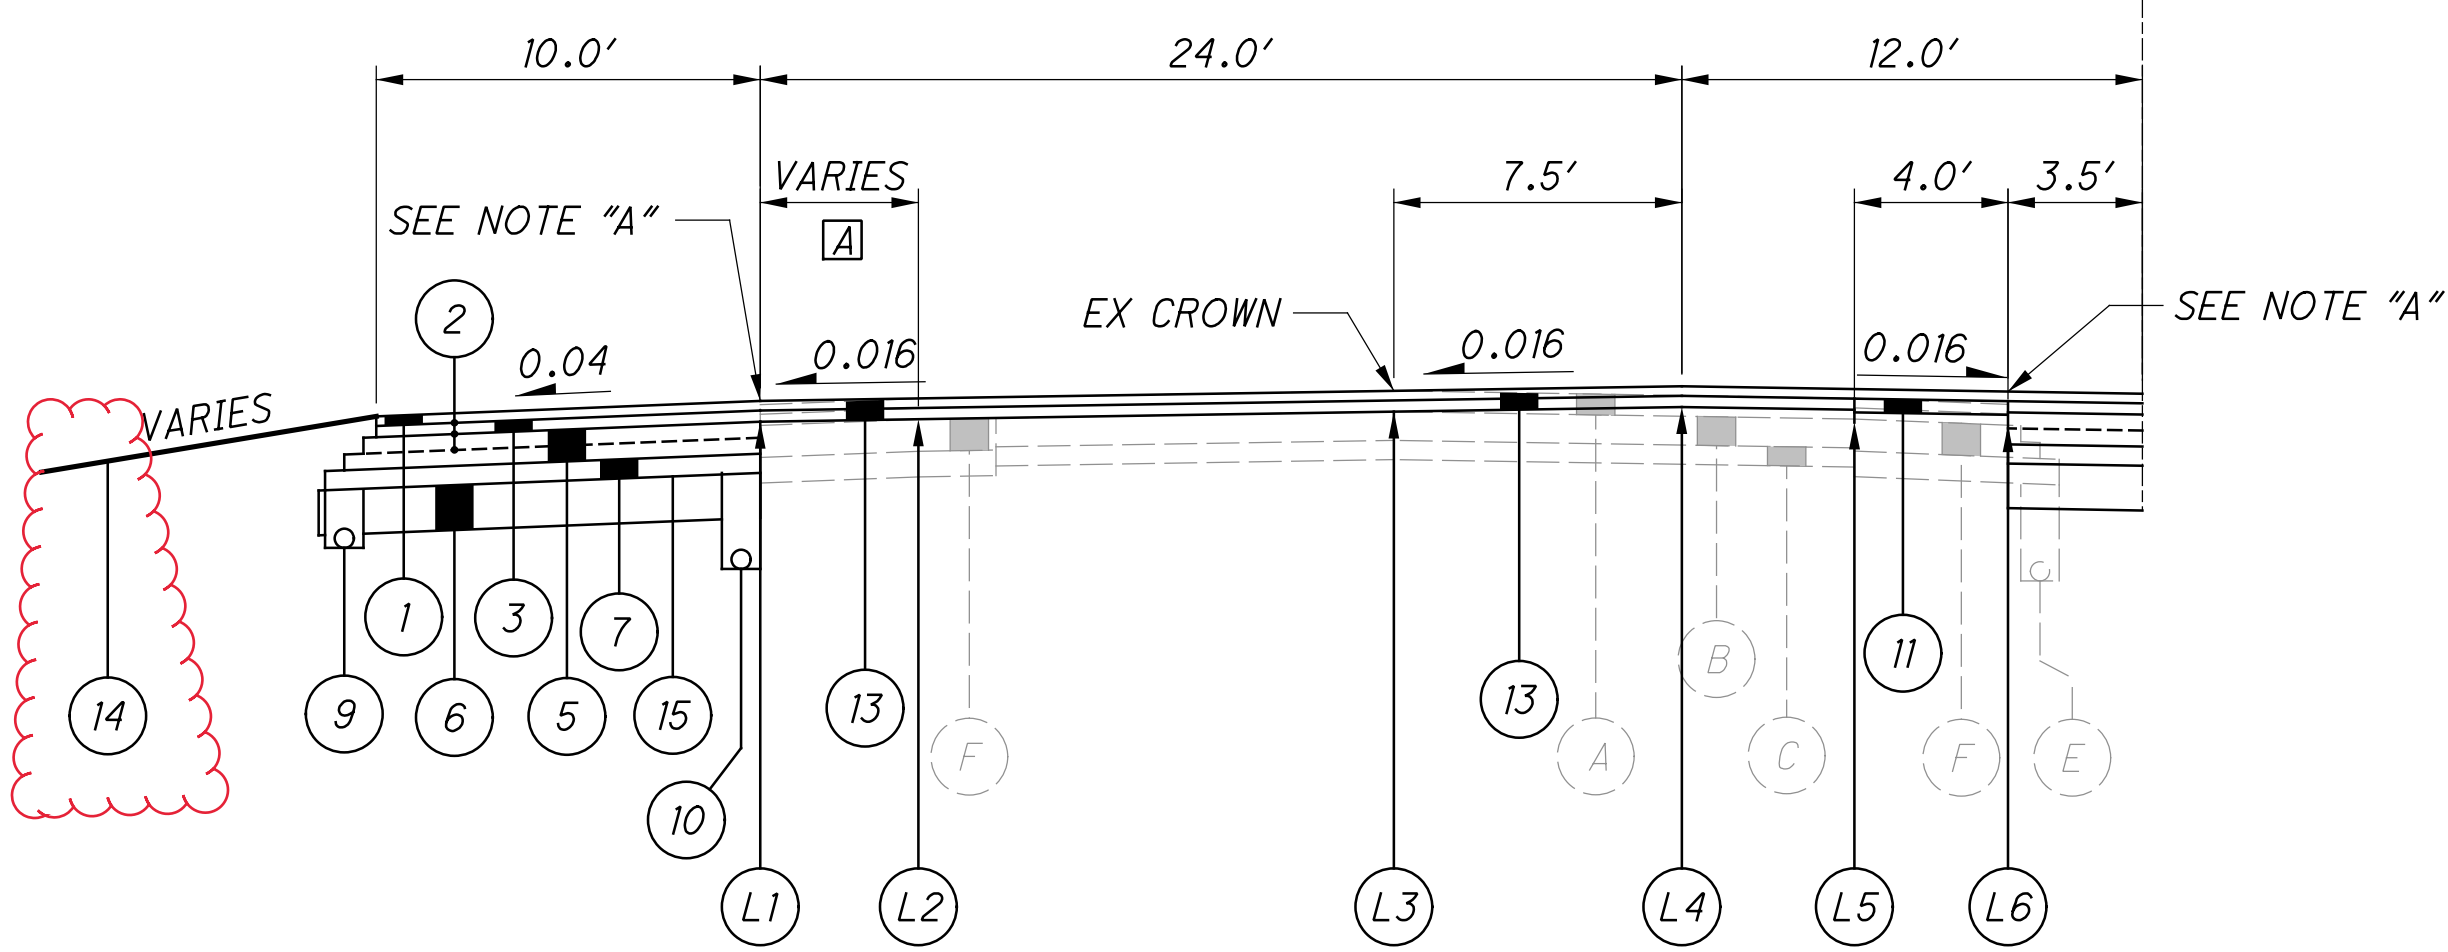

OUTSIDE EDGE APPLIES:
STA. 142+03.69 TO STA. 143+50.93

INSIDE EDGE APPLIES:
STA. 142+38.41 TO STA. 143+50.93


PAVEMENT PLANING & OVERLAY MATERIAL ESTIMATED DEPTH CHART

| POINT | STATION | OFFSET (FT) | PLANING DEPTH | | NEW LAYER THICKNESS | | POINT | STATION | OFFSET (FT) | PLANING DEPTH | | NEW LAYER THICKNESS | |
|-------|-----------|-------------|---------------|------------|---------------------|---------------|-------|-----------|-------------|---------------|------------|---------------------|---------------|
| | | | LEFT (IN) | RIGHT (IN) | ITEM 442 (IN) | ITEM 302 (IN) | | | | LEFT (IN) | RIGHT (IN) | ITEM 442 (IN) | ITEM 302 (IN) |
| L1 | 133+95.00 | -47.17 | FULL | 3.25 | 1.75 | 0.00 | R1 | 133+95.00 | 1.50 | FULL | 3.25 | 1.75 | 0.00 |
| | 134+50.54 | -46.53 | FULL | 2.88 | 1.75 | 0.00 | | 135+50.00 | 9.61 | FULL | 1.21 | 1.75 | 0.00 |
| | 136+15.43 | -44.00 | FULL | 3.25 | 1.75 | 0.00 | | 136+75.00 | 11.66 | FULL | 0.05 | 2.50 | 0.00 |
| | 137+00.00 | -43.38 | FULL | 3.25 | 1.75 | 0.00 | | 137+85.00 | 13.46 | FULL | 2.10 | 1.75 | 4.00 |
| | 142+03.69 | -47.50 | FULL | 2.06 | 1.75 | 0.00 | | 139+40.03 | 16.00 | FULL | 0.39 | 1.75 | 4.00 |
| | 143+50.93 | -47.50 | FULL | 2.06 | 1.75 | 0.00 | | 143+50.93 | 16.00 | FULL | 0.39 | 1.75 | 4.00 |
| L2 | 142+03.69 | -43.36 | 7.25 | 3.25 | 1.75 | 0.00 | R2 | 135+50.00 | 11.50 | FULL | 1.21 | 1.75 | 0.00 |
| | 143+50.93 | -43.36 | 7.25 | 3.25 | 1.75 | 0.00 | | 137+85.00 | 17.46 | 3.25 | 3.25 | 1.75 | 4.00 |
| | 133+95.00 | -23.17 | 3.25 | 3.25 | 1.75 | 0.00 | | 139+40.03 | 20.00 | 1.54 | 1.54 | 1.75 | 4.00 |
| L3 | 136+15.43 | -31.78 | 3.25 | 3.25 | 1.75 | 0.00 | R3 | 143+50.93 | 20.00 | 1.54 | 1.54 | 1.75 | 4.00 |
| | 137+00.00 | -31.52 | 3.25 | 3.25 | 1.75 | 0.00 | | 135+50.00 | 13.62 | 1.83 | 1.83 | 1.75 | 0.00 |
| | 142+38.41 | -31.00 | 3.25 | 3.25 | 1.75 | 0.00 | | 136+75.00 | 15.66 | 1.20 | 0.45 | 1.75 | 0.00 |
| | 143+50.93 | -31.00 | 3.25 | 3.25 | 1.75 | 0.00 | | 137+85.00 | 23.50 | 3.25 | 0.10 | 2.50 | 0.00 |
| L4 | 134+50.54 | -23.50 | 2.88 | 2.88 | 1.75 | 0.00 | R4 | 139+40.03 | 23.50 | 1.54 | 1.54 | 2.50 | 0.00 |
| | 136+15.43 | -23.50 | 0.07 | 0.07 | 1.75 | 0.00 | | 143+50.93 | 23.50 | 1.54 | 1.54 | 2.50 | 0.00 |
| | 137+00.00 | -23.50 | 0.17 | 0.17 | 1.75 | 0.00 | | 135+50.00 | 23.50 | 1.83 | 1.83 | 1.75 | 0.00 |
| | 142+38.41 | -23.50 | 0.37 | 0.37 | 1.75 | 0.00 | | 136+75.00 | 23.50 | 0.45 | 0.45 | 1.75 | 0.00 |
| L5 | 143+50.93 | -23.50 | 0.37 | 0.37 | 1.75 | 0.00 | R5 | 137+85.00 | 25.47 | 0.86 | 0.00 | 1.75 | 0.00 |
| | 133+95.00 | -11.17 | 3.25 | 3.25 | 1.75 | 0.00 | | 139+40.03 | 27.96 | 3.25 | 0.00 | 1.75 | 0.00 |
| | 134+50.54 | -22.53 | 3.25 | FULL | 1.75 | 0.00 | | 143+50.93 | 27.96 | 3.25 | 0.00 | 1.75 | 0.00 |
| | 136+15.43 | -20.00 | 0.07 | 0.07 | 1.75 | 0.00 | | 135+50.00 | 25.62 | 2.64 | 2.64 | 1.75 | 0.00 |
| | 137+00.00 | -19.52 | 0.17 | 0.17 | 1.75 | 0.00 | | 136+75.00 | 27.66 | 2.05 | 2.05 | 1.75 | 0.00 |
| L6 | 142+38.41 | -19.00 | 0.37 | 4.37 | 2.53 | 0.00 | R6 | 137+85.00 | 29.46 | 1.53 | 1.53 | 1.75 | 0.00 |
| | 143+50.93 | -19.00 | 0.37 | 4.37 | 2.53 | 0.00 | | 139+40.03 | 32.00 | 1.55 | 0.80 | 1.75 | 0.00 |
| | 142+38.41 | -15.00 | 3.22 | FULL | 2.53 | 0.00 | | 143+50.93 | 32.00 | 1.55 | 0.80 | 1.75 | 0.00 |
| R7 | 143+50.93 | -15.00 | 3.22 | FULL | 2.53 | 0.00 | R7 | 135+50.00 | 59.50 | 2.64 | 2.64 | 1.75 | 0.00 |
| | 133+95.00 | -11.17 | 3.25 | 3.25 | 1.75 | 0.00 | | 136+75.00 | 59.50 | 2.05 | 2.05 | 1.75 | 0.00 |
| | 134+50.54 | -22.53 | 3.25 | FULL | 1.75 | 0.00 | | 137+85.00 | 59.50 | 1.53 | 1.53 | 1.75 | 0.00 |
| | 136+15.43 | -20.00 | 0.07 | 0.07 | 1.75 | 0.00 | | 139+40.03 | 59.50 | 0.80 | 0.80 | 1.75 | 0.00 |
| | 137+00.00 | -19.52 | 0.17 | 0.17 | 1.75 | 0.00 | | 143+50.93 | 59.50 | 0.80 | 0.80 | 1.75 | 0.00 |
| | 142+38.41 | -19.00 | 0.37 | 4.37 | 2.53 | 0.00 | | 133+95.00 | 59.17 | 3.25 | 0.00 | 1.75 | 0.00 |

- A** VARIES 0.0' TO 3.5'
STA. 133+95.00 TO STA. 135+88.47
VARIES 3.5'± MIN TO 4.5'± MAX
STA. 135+88.47 TO STA. 142+03.69
0.0'
- B** 0.0'
STA. 133+95.00 TO STA. 134+00.00
VARIES 0.0' TO 11.0'±
STA. 134+00.00 TO STA. 134+50.54
VARIES 11.0'± TO 8.5'±
STA. 134+50.54 TO STA. 135+88.20
VARIES 8.5'± MAX TO 7.4'± MIN
STA. 135+88.20 TO STA. 142+38.41
- C** 1.5'
STA. 133+95.00 TO STA. 134+01.15
VARIES 1.5' TO 9.61'±
STA. 134+01.15 TO STA. 135+50.00
VARIES 9.61'± TO 16.0'±
STA. 135+50.00 TO STA. 139+40.03
16.0'±
STA. 139+40.03 TO STA. 143+50.93
- D** 10.0'
STA. 133+95.00 TO STA. 134+01.15
VARIES 10.0' TO 4.0'±
STA. 134+01.15 TO STA. 135+50.00
4.0'±
STA. 135+50.00 TO STA. 143+50.93
- E** VARIES 0.0' TO 8.5'
STA. 133+95.00 TO STA. 139+39.62
8.5'
STA. 139+39.62 TO STA. 143+50.93

▽ FOR PAVEMENT EDGE DETAILS, SEE SHEET 4

FOR PROPOSED LEGEND AND NOTES, SEE SHEET 4

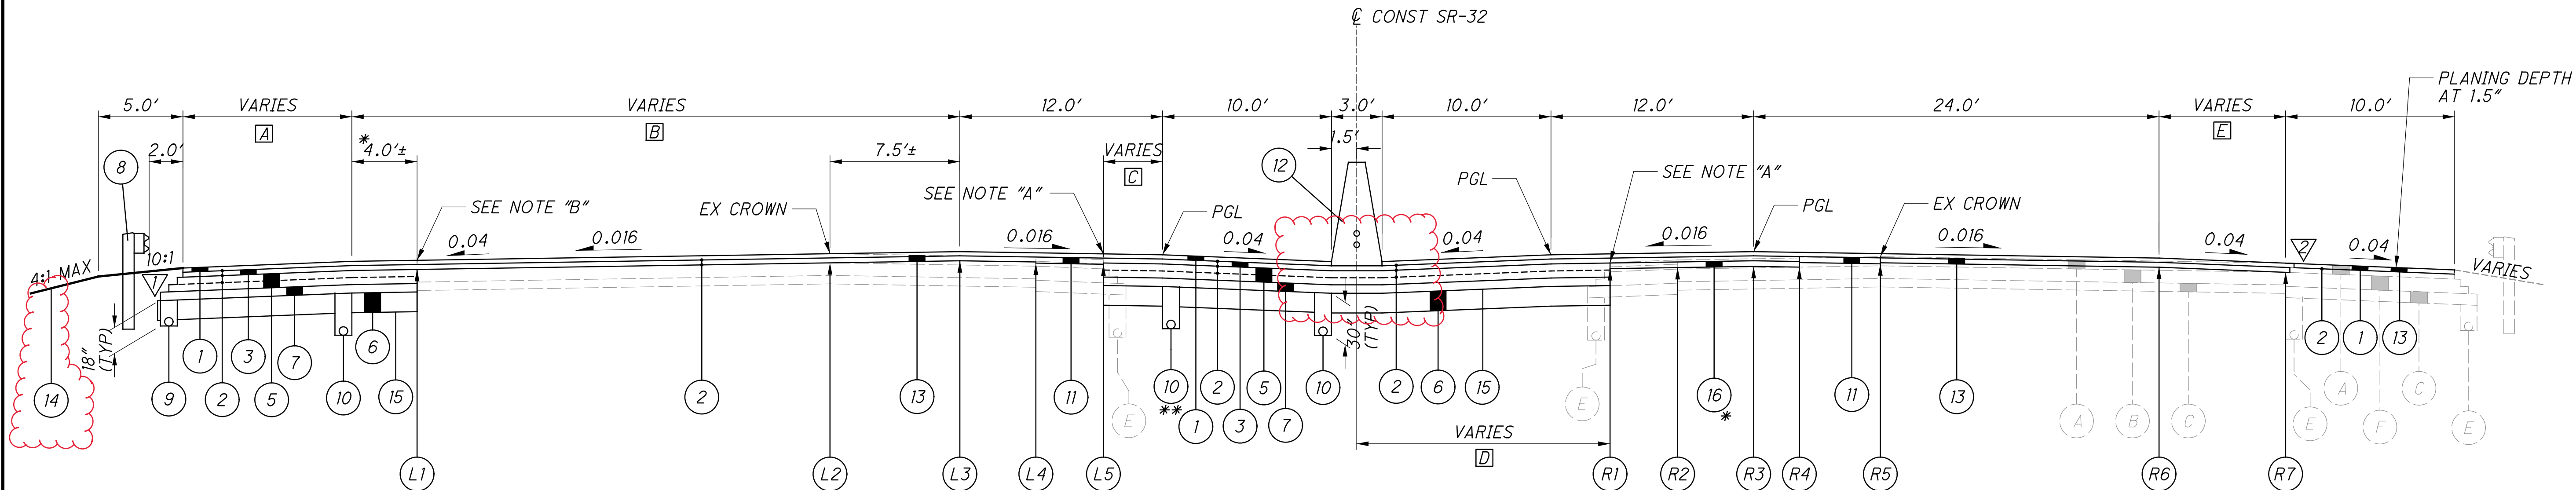

SR-32 NORMAL SECTION
 STA. 143+50.93 TO STA. 158+00.00

* SEE DEPTH CHART FOR LOCATIONS AND DIMENSIONS
 ** SEE UNDERDRAIN PLAN FOR LOCATIONS




- A** VARIES ±6.12' TO 4.0'
 STA. 144+09.97 TO STA. 144+20.75
 4.0'
 STA. 144+20.75 TO STA. 147+00.00
 VARIES 4.0' TO 10.0'
 STA. 147+00.00 TO STA. 148+00.00
 10.0'
 STA. 148+00.00 TO STA. 158+00.00
- B** 36.0'
 STA. 143+50.93 TO STA. 147+00.00
 VARIES 36.0' TO 24.0'
 STA. 147+00.00 TO STA. 148+00.00
 24.0'
 STA. 148+00.00 TO STA. 158+00.00
- C** 4.5'
 STA. 143+50.93 TO STA. 145+00.00
 VARIES 4.5' TO 3.5'
 STA. 145+00.00 TO STA. 146+00.00
 3.5'
 STA. 146+00.00 TO STA. 150+21.50
 7.5'
 STA. 150+21.50 TO STA. 152+75.00
- D** 16.0'
 STA. 143+50.93 TO STA. 145+00.00
 VARIES 16.0' TO 15.0'
 STA. 145+00.00 TO STA. 146+00.00
 15.0'
 STA. 146+00.00 TO STA. 150+21.50
 19.0'
 STA. 150+21.50 TO STA. 152+75.00
 VARIES 15.0' TO 7.5'
 STA. 152+75.00 TO STA. 158+00.00
- E** 8.5'
 STA. 143+50.93 TO STA. 145+00.00
 VARIES 8.5' TO 7.5'
 STA. 145+00.00 TO STA. 146+00.00
 7.5'
 STA. 146+00.00 TO STA. 152+75.00
 VARIES 7.5' TO 0.0'
 STA. 152+75.00 TO STA. 158+00.00

PAVEMENT PLANING & OVERLAY MATERIAL ESTIMATED DEPTH CHART

| POINT | STATION | OFFSET (FT) | PLANING DEPTH | | NEW LAYER THICKNESS | | POINT | STATION | OFFSET (FT) | PLANING DEPTH | | NEW LAYER THICKNESS | | |
|-----------|-----------|-------------|---------------|------------|---------------------|---------------|-----------|-----------|-------------|---------------|------------|---------------------|---------------|------|
| | | | LEFT (IN) | RIGHT (IN) | ITEM 442 (IN) | ITEM 302 (IN) | | | | LEFT (IN) | RIGHT (IN) | ITEM 442 (IN) | ITEM 302 (IN) | |
| L1 | 143+50.93 | -55.32 | FULL | 3.25 | 1.75 | 0.00 | R1 | 143+50.93 | 16.00 | FULL | 0.38 | 1.75 | 4.00 | |
| | 145+25.00 | -55.69 | FULL | 3.25 | 1.75 | 0.00 | | 145+00.00 | 16.00 | FULL | 0.38 | 1.75 | 4.00 | |
| | 147+00.00 | -55.07 | FULL | 3.25 | 1.75 | 0.00 | | 146+00.00 | 15.00 | FULL | 1.06 | 1.75 | 4.00 | |
| | 148+21.14 | -43.18 | FULL | 3.25 | 1.75 | 0.00 | | 155+35.59 | 10.88 | FULL | 0.00 | 1.75 | 0.00 | |
| | 153+50.00 | -43.40 | FULL | 3.25 | 1.75 | 0.00 | | 158+00.00 | 7.50 | FULL | 3.25 | 1.75 | 0.00 | |
| L2 | 143+50.93 | -31.00 | 3.25 | 3.25 | 1.75 | 0.00 | R2 | 143+50.93 | 20.00 | 1.54 | 1.54 | 1.75 | 4.00 | |
| | 145+25.00 | -31.00 | 3.25 | 3.25 | 1.75 | 0.00 | | 145+00.00 | 20.00 | 1.54 | 1.54 | 1.75 | 4.00 | |
| | 147+00.00 | -31.00 | 3.25 | 3.25 | 1.75 | 0.00 | | 146+00.00 | 19.00 | 2.21 | 2.21 | 1.75 | 4.00 | |
| | 148+21.14 | -31.07 | 3.25 | 3.25 | 1.75 | 0.00 | | 150+21.50 | 19.00 | FULL | 2.21 | 1.75 | 4.00 | |
| | 153+50.00 | -31.30 | 3.25 | 3.25 | 1.75 | 0.00 | | 152+75.00 | 19.00 | FULL | 2.21 | 1.75 | 4.00 | |
| L3 | 143+50.93 | -23.50 | 0.30 | 0.30 | 1.75 | 0.00 | R3 | 155+35.59 | 14.88 | 0.98 | 0.98 | 1.75 | 0.00 | |
| | 145+25.00 | -23.50 | 0.30 | 0.30 | 1.75 | 0.00 | | 158+00.00 | 11.50 | 3.25 | 3.25 | 1.75 | 0.00 | |
| | 147+00.00 | -23.50 | 0.30 | 0.30 | 1.75 | 0.00 | | R4 | 143+50.93 | 23.50 | 1.54 | 1.54 | 1.75 | 4.00 |
| | 148+21.14 | -23.50 | 0.30 | 0.30 | 1.75 | 0.00 | | | 145+00.00 | 23.50 | 1.54 | 1.54 | 1.75 | 4.00 |
| | 153+50.00 | -23.50 | 0.25 | 0.25 | 1.75 | 0.00 | | | 146+00.00 | 23.50 | 2.21 | 2.21 | 1.75 | 4.00 |
| 158+00.00 | -23.50 | 0.39 | 0.39 | 1.75 | 0.00 | 150+21.50 | 23.50 | | FULL | 2.21 | 1.75 | 4.00 | | |
| L4 | 143+50.93 | -19.00 | 0.30 | 1.15 | 2.60 | 0.00 | 152+75.00 | | 23.50 | FULL | 2.21 | 1.75 | 4.00 | |
| | 145+25.00 | -19.00 | 0.30 | 1.15 | 2.60 | 0.00 | 155+35.59 | 23.50 | 0.98 | 0.98 | 1.75 | 0.00 | | |
| | 147+00.00 | -19.11 | 0.30 | 1.15 | 2.60 | 0.00 | 158+00.00 | 23.50 | 3.25 | 3.25 | 1.75 | 0.00 | | |
| | 148+21.14 | -19.00 | 0.30 | 1.15 | 2.60 | 0.00 | R5 | 143+50.93 | 27.96 | 3.25 | 0.00 | 2.50 | 0.00 | |
| | 153+50.00 | -19.66 | 0.25 | FULL | 1.75 | 0.00 | | 145+00.00 | 27.96 | 3.25 | 0.00 | 2.50 | 0.00 | |
| 158+00.00 | -18.87 | 0.39 | FULL | 1.75 | 0.00 | 146+00.00 | | 26.21 | 3.25 | 0.00 | 2.50 | 0.00 | | |
| L5 | 143+50.93 | -15.00 | 0.00 | FULL | 2.60 | 0.00 | | 150+21.50 | 26.21 | 3.25 | 0.00 | 2.50 | 0.00 | |
| | 145+25.00 | -15.00 | 0.00 | FULL | 2.60 | 0.00 | | 152+75.00 | 26.21 | 3.25 | 0.00 | 2.50 | 0.00 | |
| | 147+00.00 | -15.00 | 0.00 | FULL | 2.60 | 0.00 | R6 | 143+50.93 | 32.00 | 1.55 | 0.80 | 1.75 | 0.00 | |
| | 148+21.14 | -15.00 | 0.00 | FULL | 2.60 | 0.00 | | 145+00.00 | 32.00 | 1.55 | 0.80 | 1.75 | 0.00 | |
| | R7 | 143+50.93 | 56.00 | 3.25 | 0.00 | 1.75 | | 0.00 | 146+00.00 | 31.00 | 1.84 | 1.09 | 1.75 | 0.00 |
| 145+25.00 | | 56.00 | 3.25 | 0.00 | 1.75 | 0.00 | | 150+21.50 | 31.00 | 1.84 | 1.09 | 1.75 | 0.00 | |
| 146+00.00 | | 55.00 | 3.25 | 0.00 | 1.75 | 0.00 | | 152+75.00 | 31.00 | 1.84 | 1.09 | 1.75 | 0.00 | |
| 147+00.00 | | 55.00 | 3.25 | 0.00 | 1.75 | 0.00 | 155+35.59 | 26.88 | 2.28 | 2.28 | 1.75 | 0.00 | | |
| 148+21.14 | | 55.00 | 3.25 | 0.00 | 1.75 | 0.00 | R7 | 143+50.93 | 47.50 | 0.80 | 0.80 | 1.75 | 0.00 | |
| 149+00.00 | 55.00 | 3.25 | 0.00 | 1.75 | 0.00 | 145+00.00 | | 47.50 | 0.80 | 0.80 | 1.75 | 0.00 | | |
| 150+00.00 | 55.00 | 3.25 | 0.00 | 1.75 | 0.00 | 146+00.00 | | 47.50 | 1.09 | 1.09 | 1.75 | 0.00 | | |
| 151+00.00 | 55.00 | 3.25 | 0.00 | 1.75 | 0.00 | 150+21.50 | | 47.50 | 1.09 | 1.09 | 1.75 | 0.00 | | |
| 152+00.00 | 55.00 | 3.25 | 0.00 | 1.75 | 0.00 | 152+75.00 | | 47.50 | 1.09 | 1.09 | 1.75 | 0.00 | | |

▽ FOR PAVEMENT EDGE DETAILS, SEE SHEET 4
 FOR PROPOSED LEGEND AND NOTES, SEE SHEET 4

- A** 24.0'
 STA. 158+00.00 TO STA. 173+90.25
 VARIES 24.0' TO 26.0'±
 STA. 173+90.25 TO STA. 174+90.17
 VARIES 26.0'± TO 64.4'±
 STA. 174+90.17 TO STA. 188+44.21
 12.0'
 STA. 188+44.21 TO STA. 190+00.00
- B** ±4.0'
 STA. 158+00.00 TO STA. 158+12.08
 STA. 159+32.74 TO STA. 171+90.25
 0.0'
 STA. 158+12.08 TO STA. 159+32.74
 STA. 171+90.25 TO STA. 174+90.17
- C** ±7.3'
 STA. 158+00.00 TO STA. 158+52.28
 ±4.3'
 STA. 158+52.28 TO STA. 159+66.43
 STA. 173+62.03 TO STA. 175+64.35
 ±8.0'
 STA. 159+66.43 TO STA. 173+62.03
 STA. 175+64.35 TO STA. 188+02.27
 ±3.8'
 STA. 188+02.27 TO STA. 192+03.94
 VARIES ±7.8' MAX TO ±6.8' MIN
 STA. 192+03.94 TO STA. 202+96.96
- D** 6.0'
 STA. 158+00.00 TO STA. 196+25.00
 STA. 199+65.00 TO STA. 202+96.96
 2.0'
 STA. 196+25.00 TO STA. 196+90.50
 STA. 198+98.00 TO STA. 199+65.00
 0.0'
 STA. 196+90.50 TO STA. 198+98.00
- E** 50.0'
 STA. 158+00.00 TO STA. 167+44.00
 VARIES 34.7' TO 34.2'
 STA. 167+44.00 TO STA. 184+35.77
 VARIES 34.2' TO 40.0'
 STA. 184+35.77 TO STA. 184+60.18
 40.0'
 STA. 184+60.18 TO STA. 189+13.54
 VARIES 40.0' TO 34.7'
 STA. 189+13.54 TO STA. 202+96.96
- F** 14.0' TO 50.3'
 STA. 174+90.17 TO STA. 188+44.20
 10.0'
 STA. 188+44.20 TO STA. 190+00.00

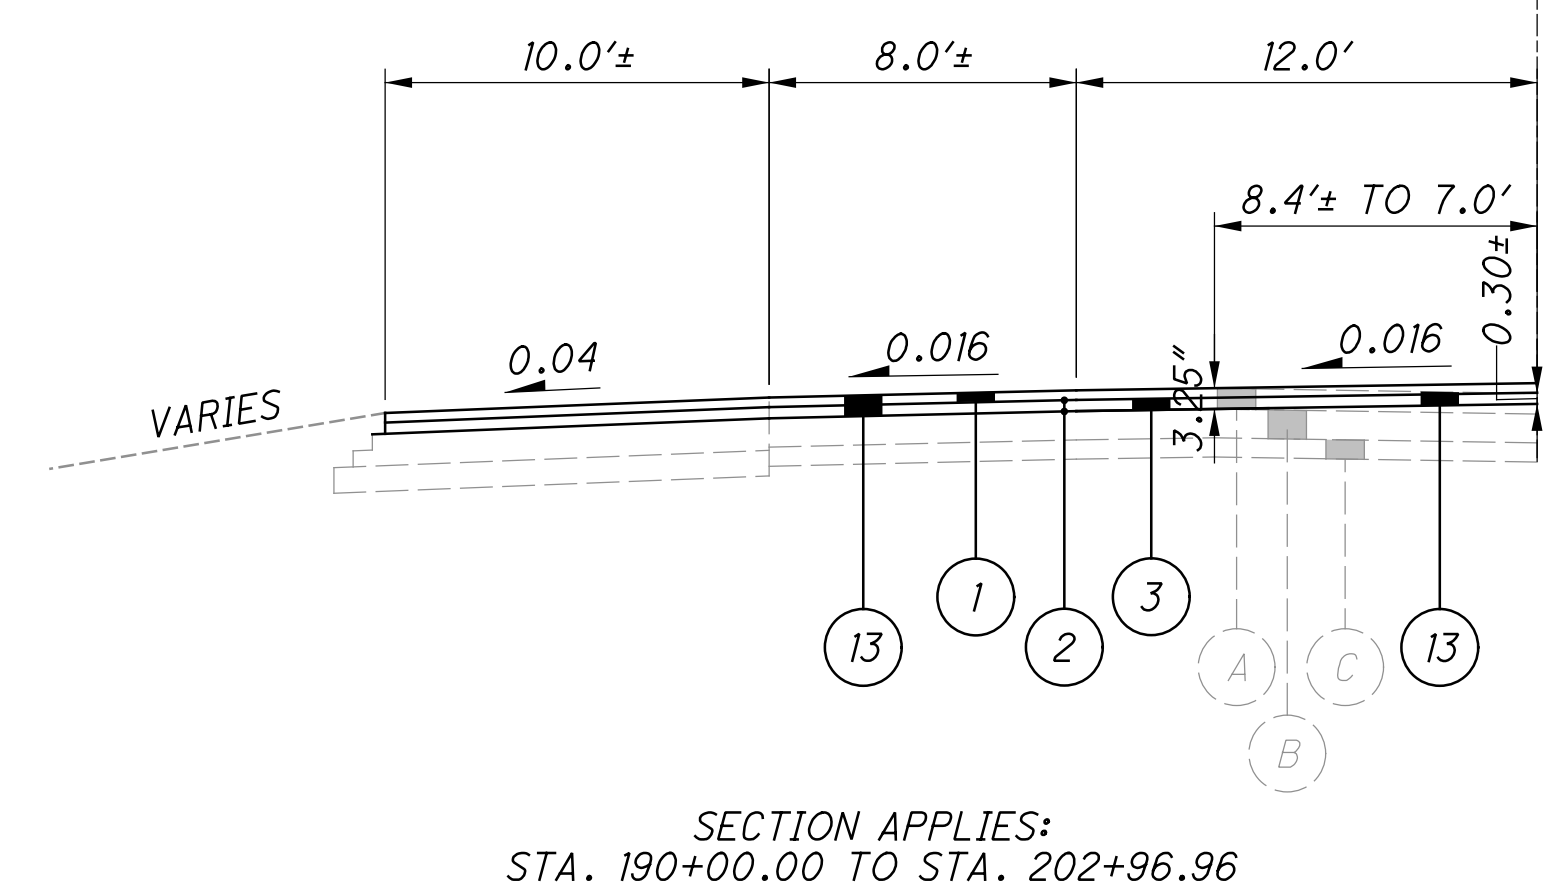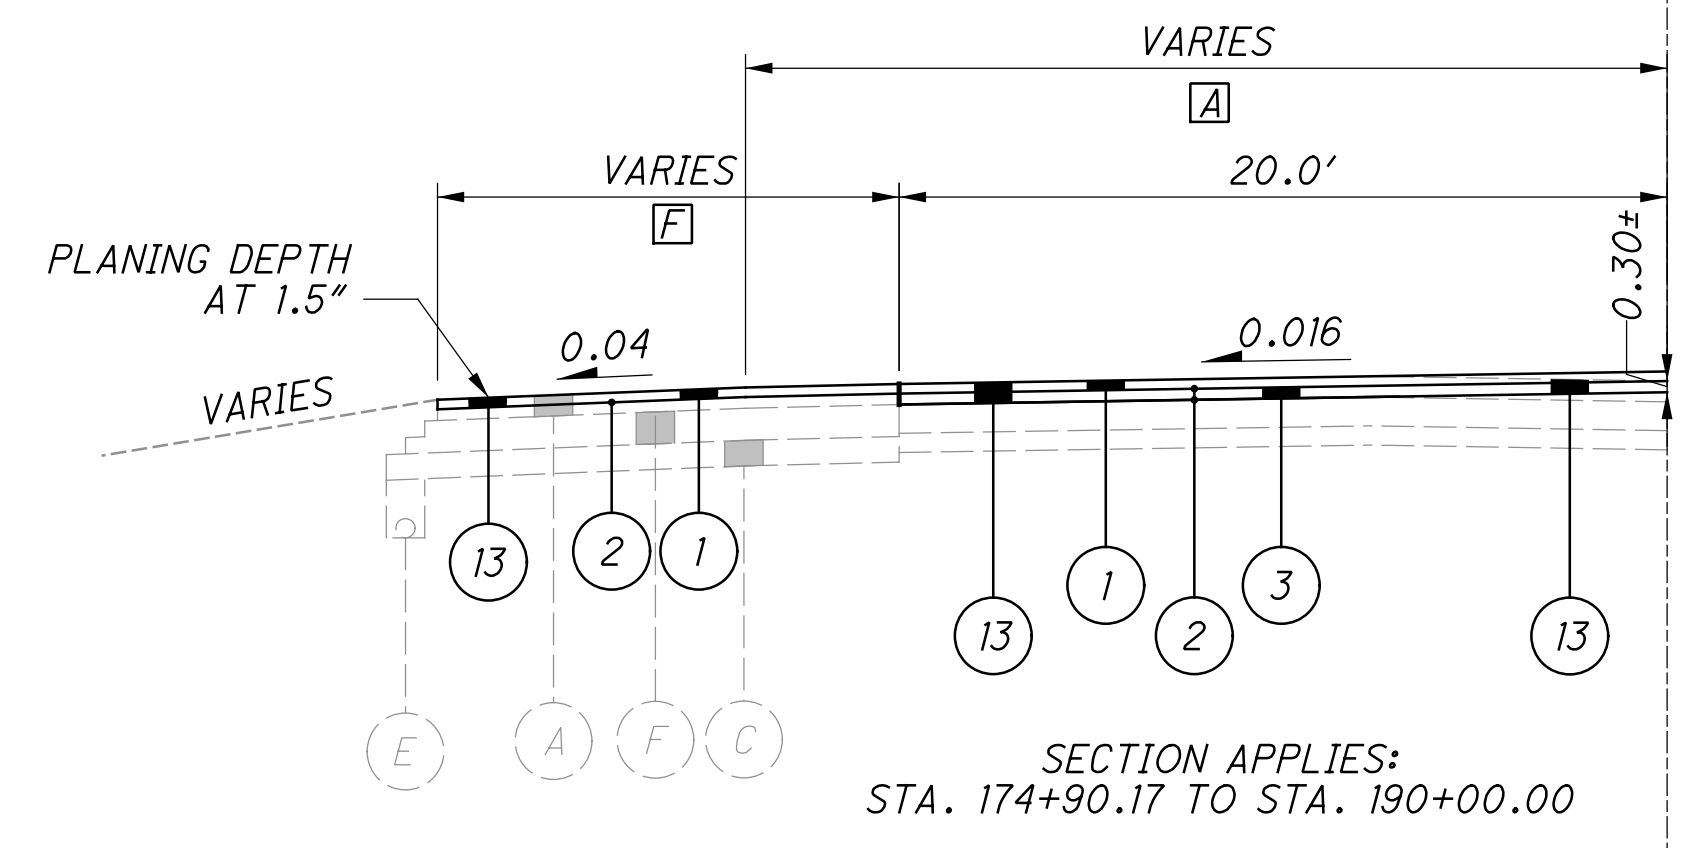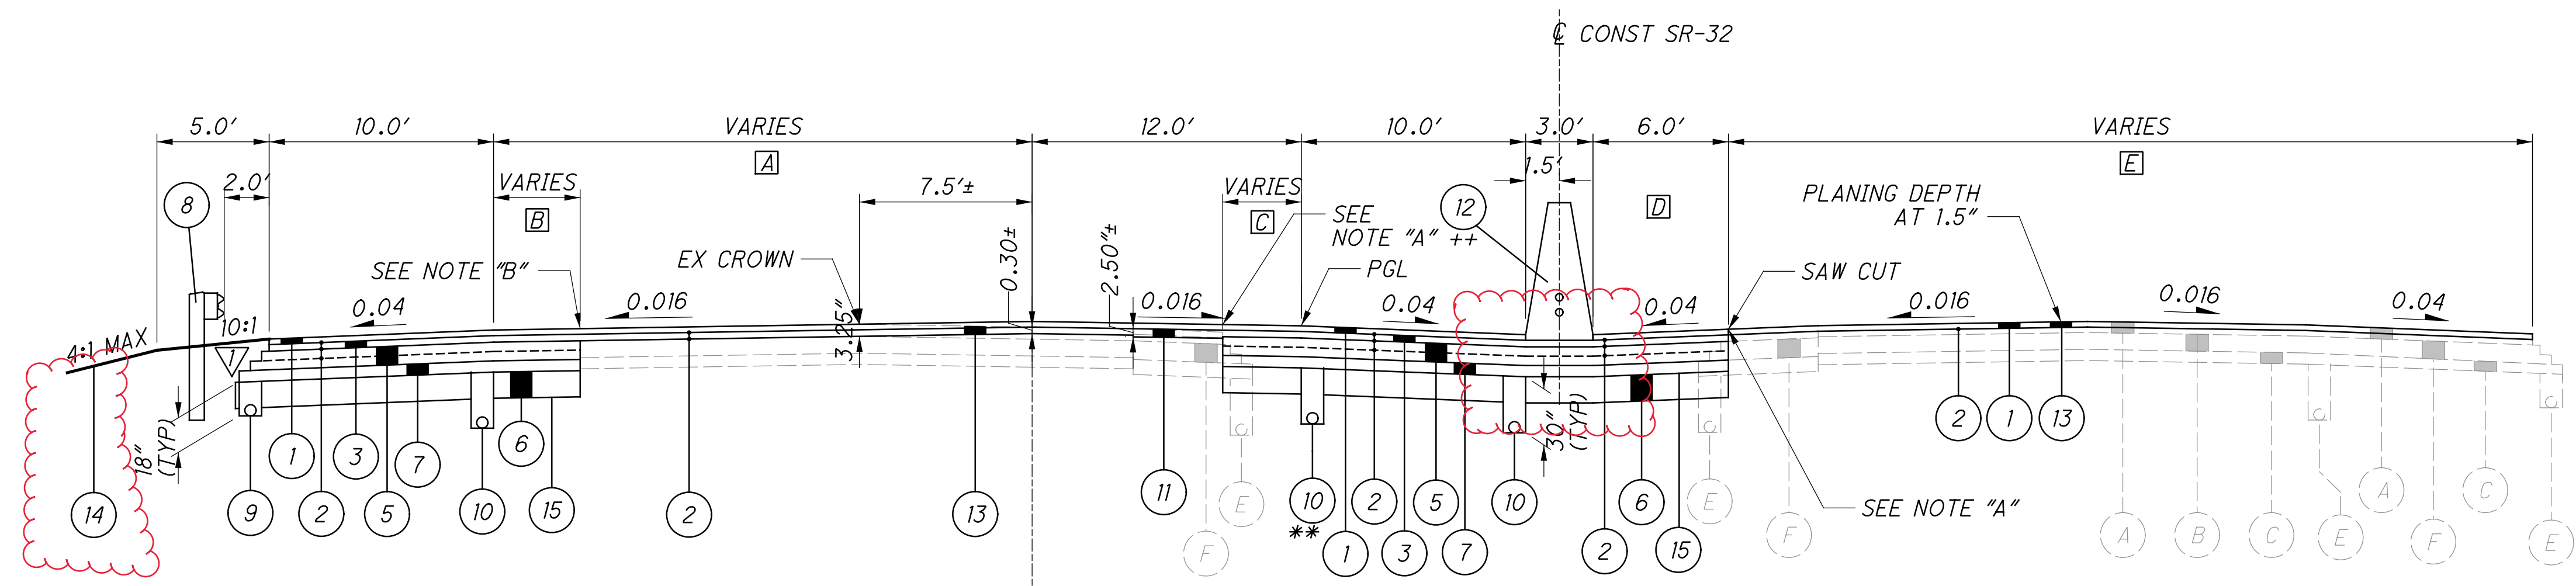

SR-32 NORMAL SECTION
 STA. 158+00.00 TO STA. 202+96.96


++ EXISTING MEDIAN BARRIER TO REMAIN SR-32:
 STA. 196+90.50 TO STA. 198+98.00
 ** SEE UNDERDRAIN PLAN FOR LOCATIONS

▽ FOR PAVEMENT EDGE DETAILS, SEE SHEET 4
 FOR PROPOSED LEGEND AND NOTES, SEE SHEET 4


...303.207\103956_GY700.dgn 11/19/2021 3:30:49 PM mswwhitt

Ⓐ VARIES 34.7' TO 34.9'
 STA. 202+96.96 TO STA. 217+00.00 BK/231+49.42 AH


Ⓑ VARIES 47.1' TO 20.0'
 STA. 207+94.20 TO STA. 212+66.69
 20.0'
 STA. 212+66.69 TO STA. 215+48.49
 VARIES 20.0' TO 10.0'
 STA. 215+48.49 TO STA. 216+48.49

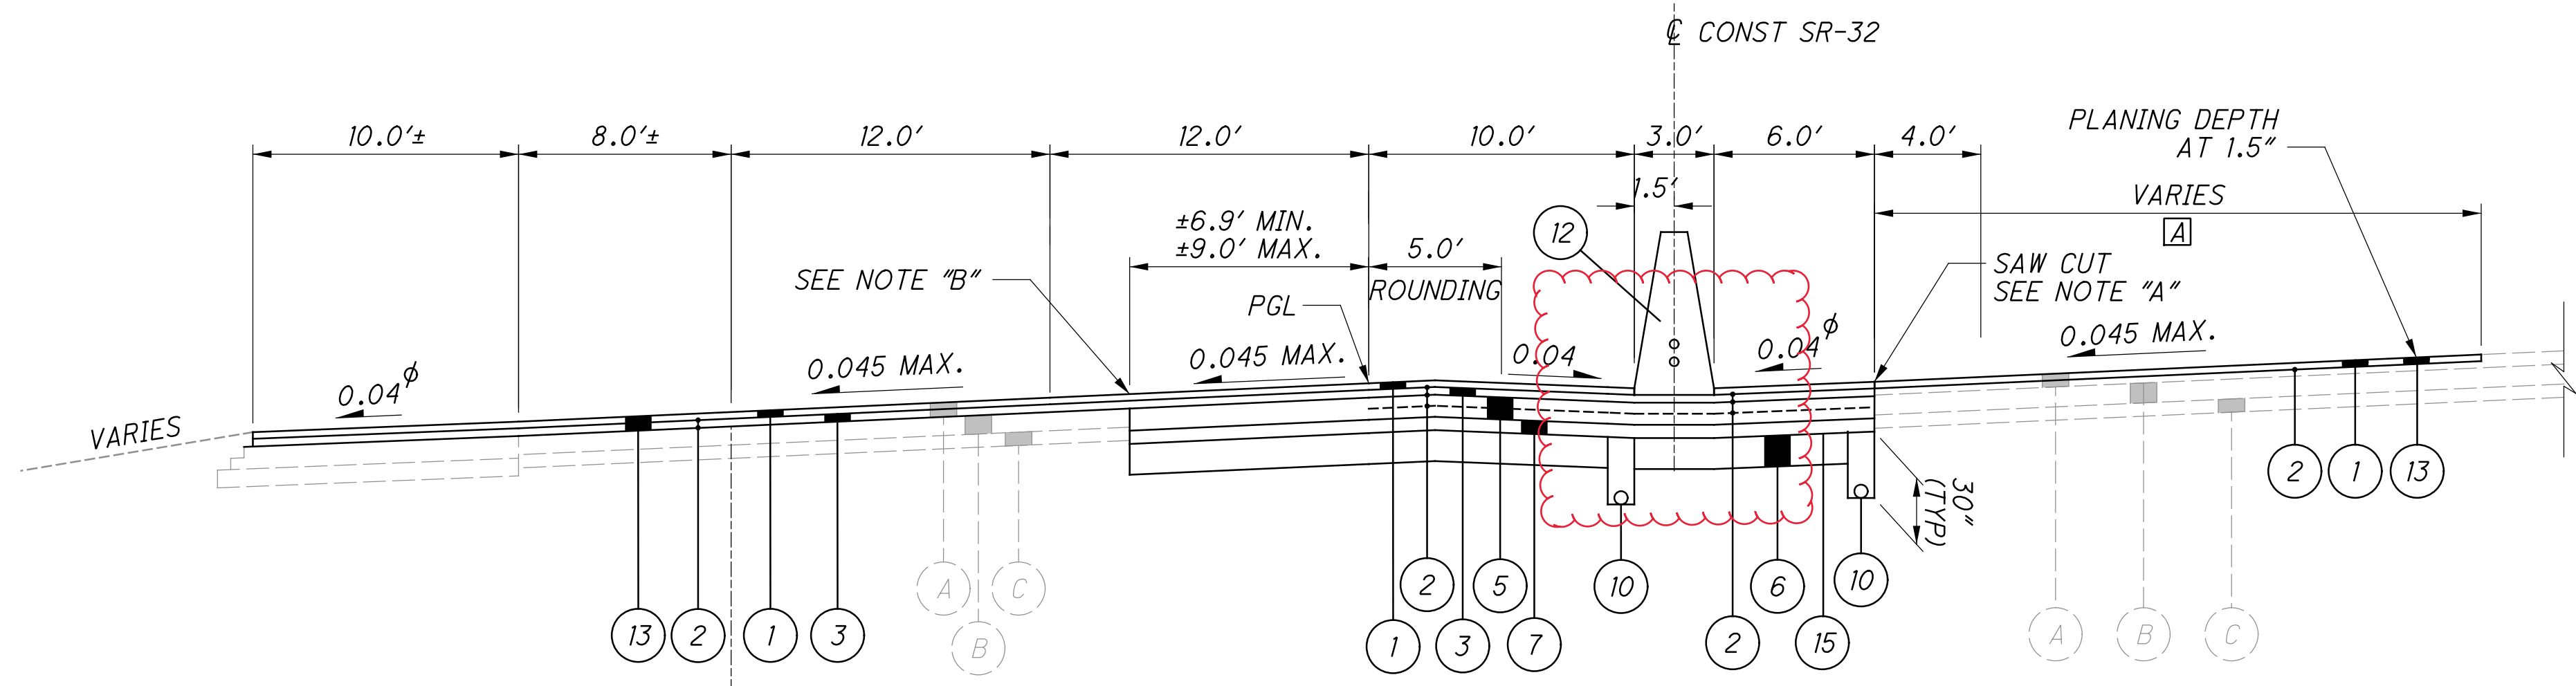

SR-32 SUPERELEVATED SECTION
 STA. 202+96.96 TO STA. 217+00.00 BK/231+49.42 AH

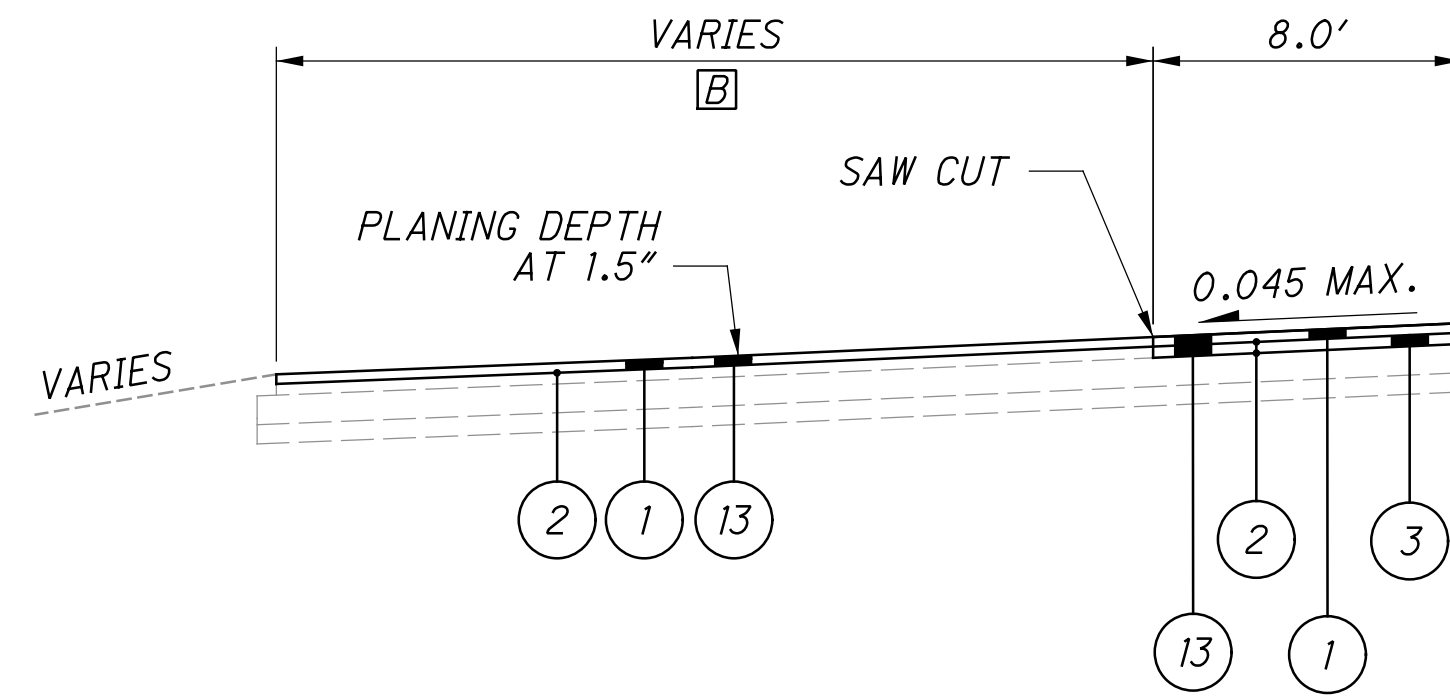

SECTION APPLIES:
 STA. 207+94.20 TO STA. 216+48.49

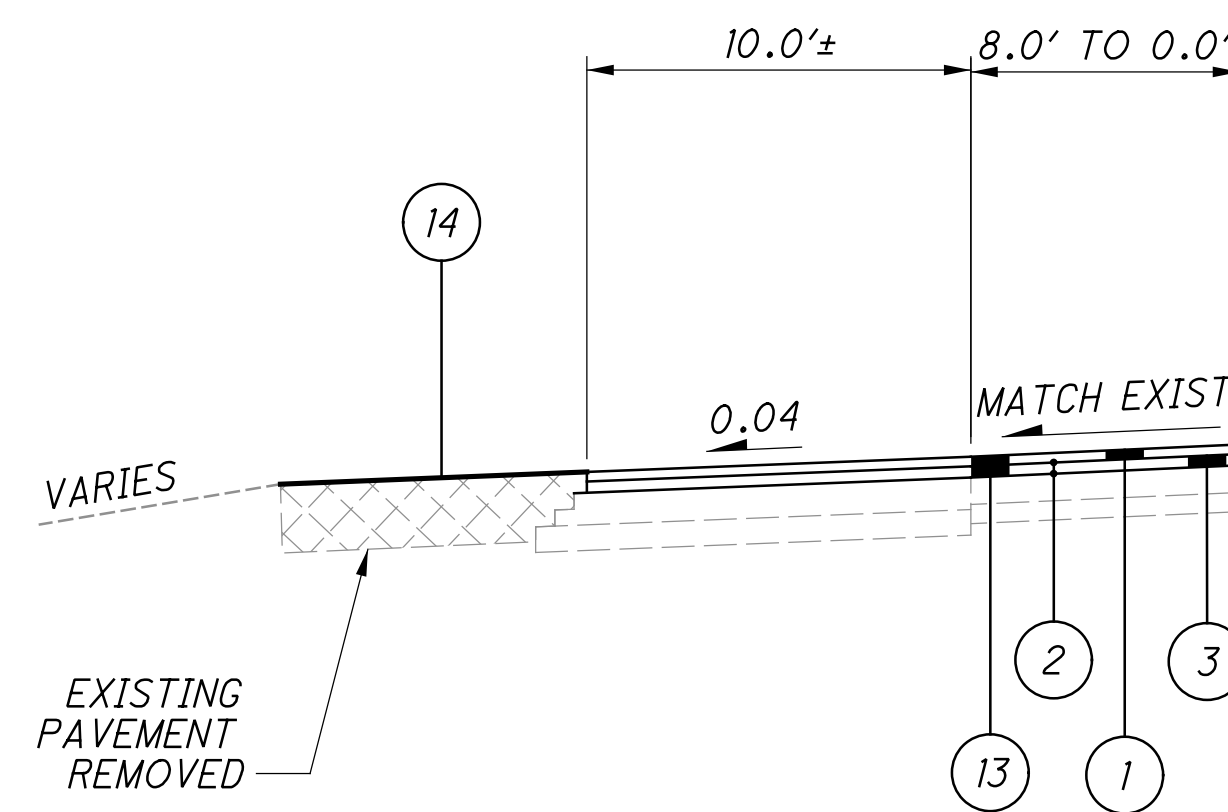

SECTION APPLIES:
 STA. 216+48.49 TO STA. 231+64.57

▽ FOR PAVEMENT EDGE DETAILS, SEE SHEET 4

λ 7.00% MAX BREAK

φ 0.040 OR RATE OF SUPER IF GREATER

FOR PROPOSED LEGEND AND NOTES, SEE SHEET 4


A VARIES 0.0' TO 7.4'±
 STA. 216+53.87 TO STA. 231+64.57
 7.5'±
 STA. 231+64.57 TO STA. 236+20.00
 VARIES 7.5'± TO 0.0'
 STA. 236+20.00 TO STA. 240+47.17
 0.0'
 STA. 240+47.17 TO STA. 241+00.00

E VARIES 34.0' TO 34.1'
 STA. 241+00.00 TO STA. 251+24.20

B ±7.0'
 STA. 231+49.42 TO STA. 234+95.58
 ±3.8'
 STA. 234+95.58 TO STA. 236+20.00
 VARIES ±3.7' TO 0.0'
 STA. 236+20.00 TO STA. 238+47.77
 0.0'
 STA. 238+47.77 TO STA. 239+21.68
 VARIES ±3.1' TO 0.0'
 STA. 239+21.68 TO STA. 241+00.00

C 6.0'
 STA. 231+49.42 TO STA. 238+00.00
 VARIES 6.0' TO 10.5'
 STA. 238+00.00 TO STA. 241+00.00

D VARIES 34.9' TO 40.0'
 STA. 231+49.42 TO STA. 235+59.43
 40.0'
 STA. 235+59.43 TO STA. 236+68.79
 VARIES 40.0' TO 30.1'
 STA. 236+68.79 TO STA. 243+80.00

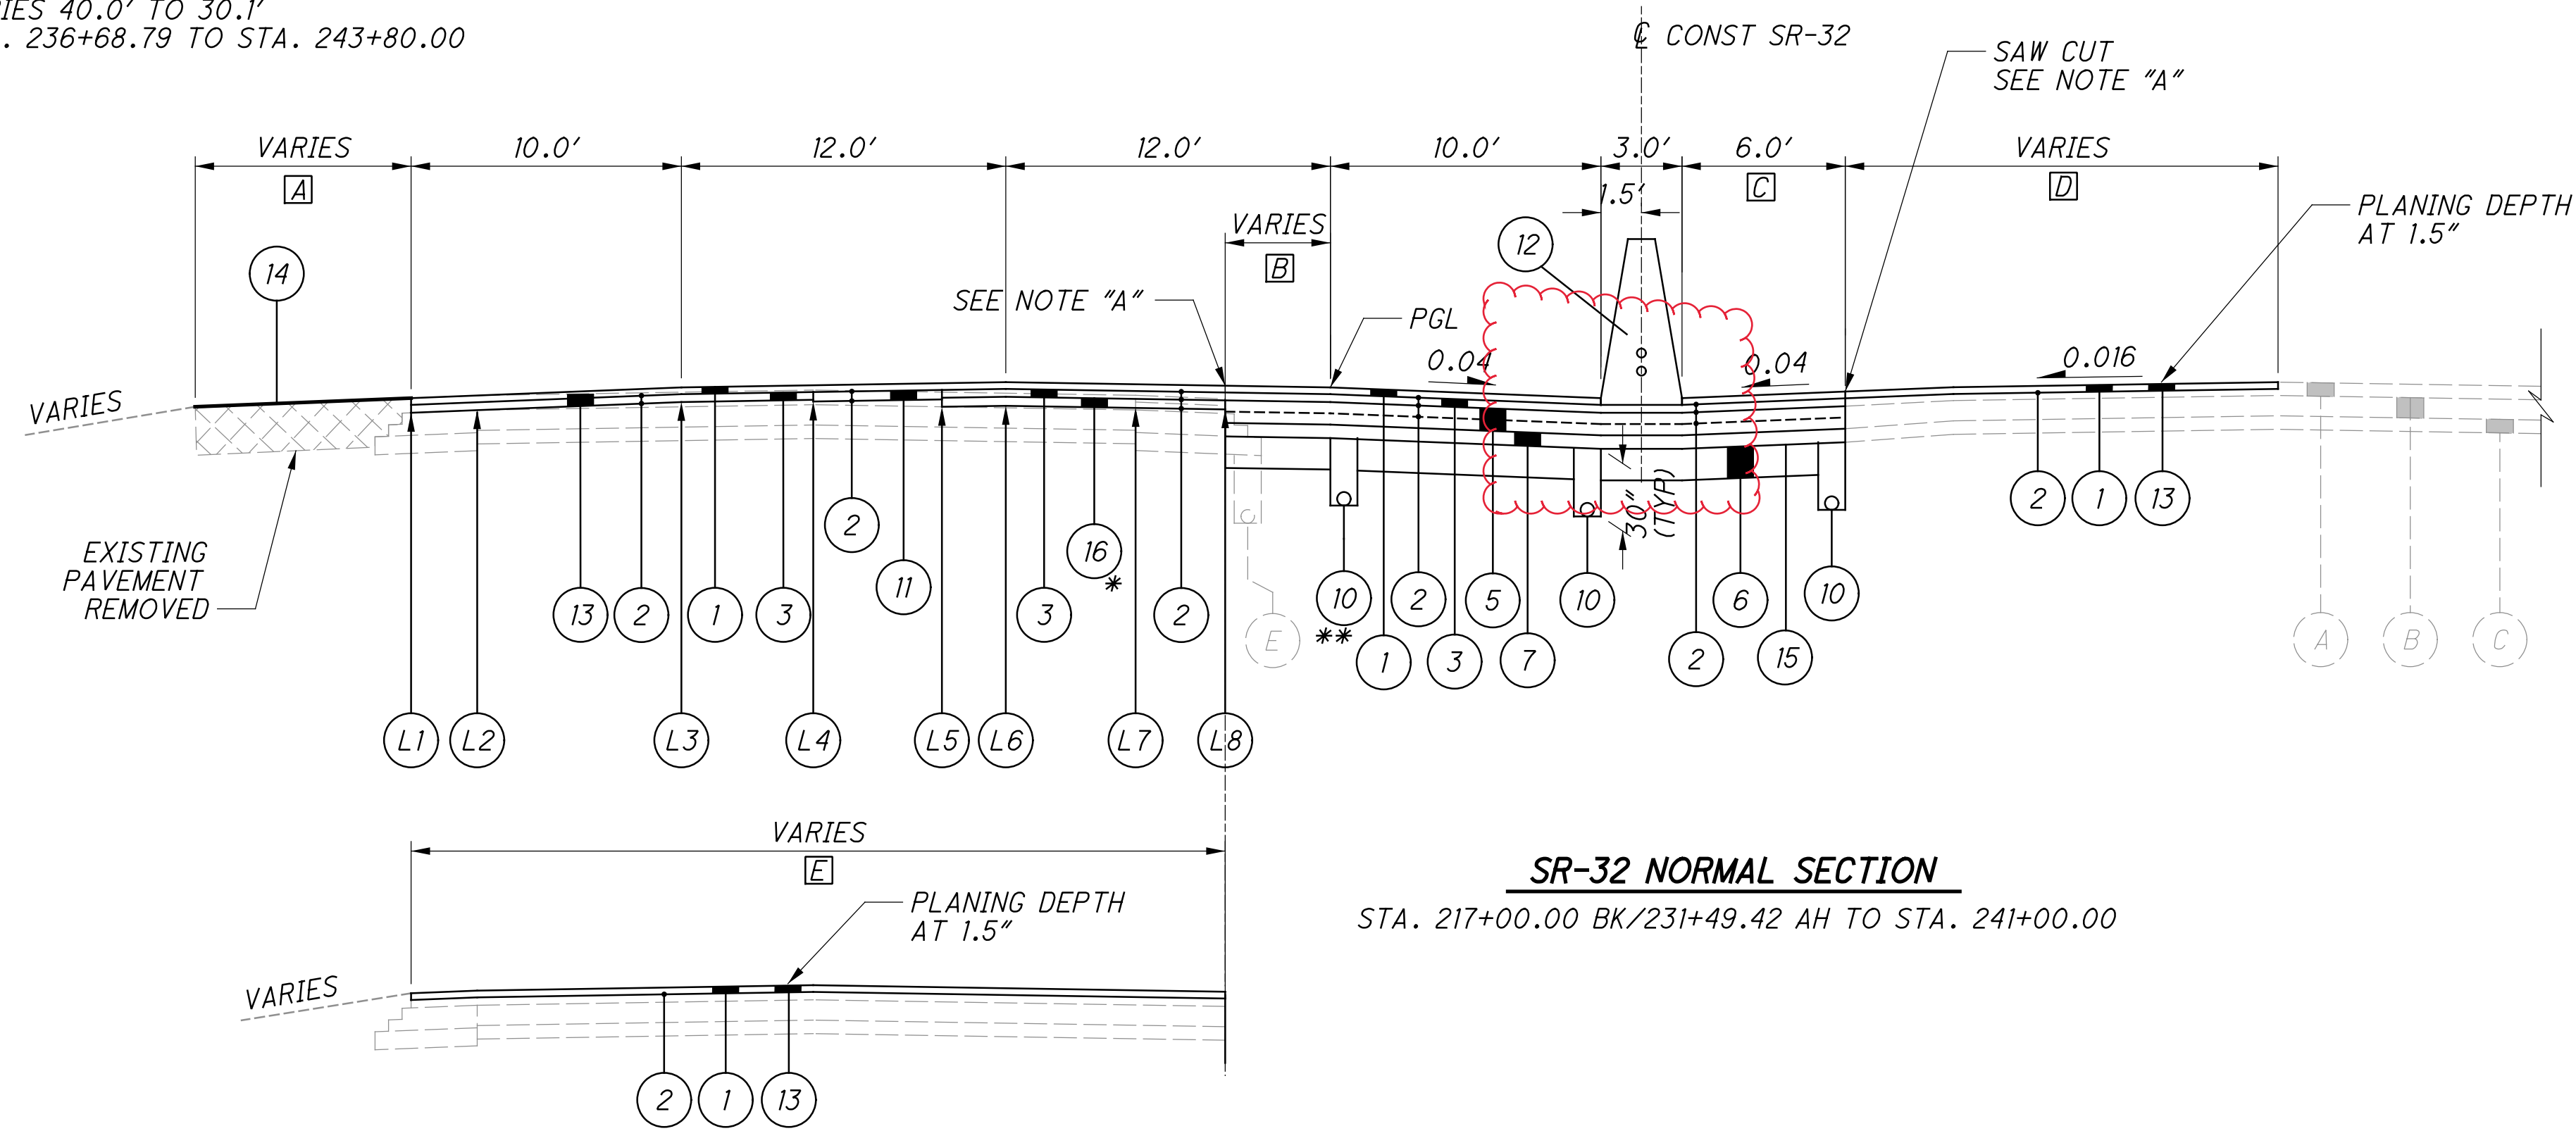

SR-32 NORMAL SECTION
 STA. 217+00.00 BK/231+49.42 AH TO STA. 241+00.00

SECTION APPLIES:
 STA. 241+00.00 TO STA. 251+24.20

* SEE DEPTH CHART FOR LOCATIONS AND DIMENSIONS
 ** SEE UNDERDRAIN PLAN FOR LOCATIONS

PAVEMENT PLANING & OVERLAY MATERIAL ESTIMATED DEPTH CHART

| POINT | STATION | OFFSET (FT) | PLANING DEPTH | | NEW LAYER THICKNESS | |
|-----------|-----------|-------------|---------------|------------|---------------------|---------------|
| | | | LEFT (IN) | RIGHT (IN) | ITEM 442 (IN) | ITEM 302 (IN) |
| L1 | 231+49.42 | -45.50 | FULL | 3.25 | 1.75 | 0.00 |
| | 234+95.57 | -45.50 | FULL | 3.25 | 1.75 | 0.00 |
| | 236+20.00 | -45.50 | FULL | 3.25 | 1.75 | 0.00 |
| | 237+17.28 | -47.07 | FULL | 3.25 | 1.75 | 0.00 |
| | 238+06.26 | -48.50 | FULL | 3.25 | 1.75 | 0.00 |
| | 239+21.68 | -50.37 | FULL | 3.25 | 1.75 | 0.00 |
| 241+00.00 | -52.54 | 0.00 | 3.25 | 1.75 | 0.00 | |
| L2 | 231+49.42 | -42.52 | 3.25 | 3.25 | 1.75 | 0.00 |
| | 234+95.57 | -43.05 | 3.25 | 3.25 | 1.75 | 0.00 |
| | 236+20.00 | -43.05 | 3.25 | 3.25 | 1.75 | 0.00 |
| | 237+17.28 | -43.33 | 3.25 | 3.25 | 1.75 | 0.00 |
| | 238+06.26 | -43.31 | 3.25 | 3.25 | 1.75 | 0.00 |
| | 239+21.68 | -43.34 | 3.25 | 3.25 | 1.75 | 0.00 |
| 241+00.00 | -43.24 | 3.25 | 3.25 | 1.75 | 0.00 | |
| L3 | 231+49.42 | -35.50 | 1.23 | 1.23 | 1.75 | 0.00 |
| | 234+95.57 | -35.50 | 1.08 | 1.08 | 1.75 | 0.00 |
| | 236+20.00 | -35.50 | 1.08 | 1.08 | 1.75 | 0.00 |
| | 237+17.28 | -36.93 | 1.41 | 1.41 | 1.75 | 0.00 |
| | 238+06.26 | -38.24 | 1.79 | 1.79 | 1.75 | 0.00 |
| | 239+21.68 | -39.94 | 2.27 | 2.27 | 1.75 | 0.00 |
| L4 | 231+49.42 | -30.00 | 1.23 | 1.98 | 2.50 | 0.00 |
| | 234+95.57 | -30.62 | 1.08 | 1.83 | 2.50 | 0.00 |
| | 236+20.00 | -30.62 | 1.08 | 1.83 | 2.50 | 0.00 |
| | 237+17.28 | -30.96 | 1.41 | 1.41 | 1.75 | 0.00 |
| | 238+06.26 | -31.00 | 1.79 | 1.79 | 1.75 | 0.00 |
| | 239+21.68 | -31.04 | 2.27 | 2.27 | 1.75 | 0.00 |
| L5 | 231+49.42 | -24.86 | 0.00 | 3.25 | 1.75 | 4.00 |
| | 234+95.57 | -25.87 | 0.00 | 3.25 | 1.75 | 4.00 |
| | 236+20.00 | -25.87 | 0.00 | 3.25 | 1.75 | 4.00 |
| | 237+17.28 | -27.30 | 0.00 | 0.91 | 2.66 | 0.00 |
| | 238+06.26 | -26.24 | 0.00 | 0.00 | 1.75 | 4.00 |
| | 239+21.68 | -27.94 | 1.08 | 1.08 | 1.75 | 0.00 |
| 241+00.00 | -31.00 | 3.25 | 3.25 | 1.75 | 0.00 | |
| L6 | 231+49.42 | -23.50 | 2.73 | 2.73 | 1.75 | 4.00 |
| | 234+95.57 | -23.50 | 2.34 | 2.34 | 1.75 | 4.00 |
| | 236+20.00 | -23.50 | 2.34 | 2.34 | 1.75 | 4.00 |
| | 237+17.28 | -24.93 | 0.00 | 3.25 | 1.75 | 4.00 |
| | 238+06.26 | -26.24 | 0.00 | 0.00 | 1.75 | 0.00 |
| | 239+21.68 | -27.94 | 1.08 | 1.08 | 1.75 | 0.00 |
| 241+00.00 | -31.00 | 3.25 | 3.25 | 1.75 | 0.00 | |
| L7 | 231+49.42 | -18.40 | 2.73 | 0.00 | 1.75 | 4.00 |
| | 234+95.57 | -18.70 | 2.34 | 2.34 | 1.75 | 4.00 |
| | 236+20.00 | -18.70 | 2.34 | 2.34 | 1.75 | 4.00 |
| | 237+17.28 | -18.88 | 3.25 | 3.25 | 1.75 | 4.00 |
| | 238+06.26 | -18.95 | 0.00 | 1.16 | 2.95 | 0.00 |
| | 239+21.68 | -19.05 | 1.08 | 1.08 | 1.75 | 0.00 |
| 241+00.00 | -18.56 | 3.25 | 3.25 | 1.75 | 0.00 | |
| L8 | 234+95.57 | -15.39 | 1.39 | FULL | 1.75 | 4.00 |
| | 236+20.00 | -15.39 | 1.39 | FULL | 1.75 | 4.00 |
| | 237+17.28 | -15.05 | 1.99 | FULL | 1.75 | 4.00 |
| | 238+06.26 | -14.92 | 0.00 | FULL | 2.95 | 0.00 |

▽ FOR PAVEMENT EDGE DETAILS, SEE SHEET 4
 FOR PROPOSED LEGEND AND NOTES, SEE SHEET 4

11/19/2021 3:31:10 PM mswwhitt

SEEDING AND MULCHING

THE FOLLOWING QUANTITIES ARE PROVIDED TO PROMOTE GROWTH AND CARE OF PERMANENT SEEDED AREAS:

| | |
|----------------------------------|----------------|
| 659, SOIL ANALYSIS TEST | 2 EACH |
| 659, TOPSOIL | 1,194 CU. YD. |
| 659, SEEDING AND MULCHING | 10,753 SQ. YD. |
| 659, REPAIR SEEDING AND MULCHING | 538 SQ. YD. |
| 659, INTER-SEEDING | 538 SQ. YD. |
| 659, COMMERCIAL FERTILIZER | 1.50 TON |
| 659, LIME | 2.22 ACRES |
| 659, WATER | 60 M GALS |
| 659, MOWING | 24 SQ. FT. |

SEEDING AND MULCHING SHALL BE APPLIED TO ALL AREAS OF EXPOSED SOIL BETWEEN THE RIGHT-OF-WAY LINES, AND WITHIN THE CONSTRUCTION LIMITS FOR AREAS OUTSIDE THE RIGHT-OF-WAY LINES COVERED BY WORK AGREEMENT OR SLOPE EASEMENT. QUANTITY CALCULATIONS FOR SEEDING AND MULCHING ARE BASED ON THESE LIMITS.

ITEM 606 - ANCHOR ASSEMBLY, MGS TYPE E (MASH 2016)

THIS ITEM SHALL CONSIST OF FURNISHING AND INSTALLING ANY OF THE GUARDRAIL END TERMINALS FOR TYPE MGS GUARDRAIL AS LISTED ON ROADWAY ENGINEERING'S WEB PAGE UNDER ROADSIDE SAFETY DEVICES FOR APPROVED GUARDRAIL END TREATMENTS. INSTALLATION SHALL BE AT THE LOCATIONS SPECIFIED IN THE PLANS, IN ACCORDANCE WITH THE MANUFACTURER'S SPECIFICATIONS.

THE FACE OF THE TYPE E IMPACT HEAD SHALL BE COVERED WITH A SHEET OF TYPE G REFLECTIVE SHEETING, PER CMS 730.19.

REFER TO THE MANUFACTURER'S INSTRUCTIONS REGARDING THE INSTALLATION OF, AND THE GRADING AROUND THE FOUNDATION TUBES AND GROUND STRUT. THE TOP OF ANY FOUNDATION TUBE SHOULD BE LESS THAN 4 INCHES ABOVE THE GROUND. THE PLACEMENT OF THE FOUNDATION TUBES SHOULD BE AN APPROPRIATE DEPTH BELOW THE LEVEL LINE IN ORDER TO MAINTAIN THE FINISHED GUARDRAIL HEIGHT OF 31 INCHES FROM THE EDGE OF THE SHOULDER.

ON-SITE GRADING IS REQUIRED IF THE TOP OF THE FOUNDATION TUBES OR TOP OF THE GROUND STRUT DOES PROJECT MORE THAN 4 INCHES ABOVE THE GROUND LINE.

PAYMENT FOR THE ABOVE WORK SHALL BE MADE AT THE UNIT PRICE BID FOR ITEM 606, ANCHOR ASSEMBLY, MGS TYPE E, EACH, AND SHALL INCLUDE ALL LABOR, TOOLS, EQUIPMENT AND MATERIALS NECESSARY TO CONSTRUCT A COMPLETE AND FUNCTIONAL ANCHOR ASSEMBLY SYSTEM, INCLUDING ALL RELATED TRANSITIONS, REFLECTIVE SHEETING, HARDWARE, GRADING, EMBANKMENT AND EXCAVATION NOT SEPARATELY SPECIFIED, AS REQUIRED BY THE MANUFACTURER.

CONNECTION BETWEEN EXISTING AND PROPOSED GUARDRAIL

WHEN IT IS NECESSARY TO SPLICE PROPOSED GUARDRAIL TO EXISTING GUARDRAIL, ONLY THE EXISTING GUARDRAIL SHALL BE CUT, DRILLED, OR PUNCHED. THE CONNECTION SHALL BE MADE USING A "W-BEAM RAIL SPLICE" AS SHOWN IN AASHTO M 180. PAYMENT SHALL BE INCLUDED IN THE CONTRACT PRICE FOR THE RESPECTIVE GUARDRAIL ITEMS.

PART WIDTH CONSTRUCTION

BECAUSE OF THE NECESSITY TO BUILD THIS PROJECT UNDER TRAFFIC AND TO CONSTRUCT THE FULL PAVEMENT WIDTH IN STAGES, EXERCISE CARE TO PREVENT THE CONSTRUCTION OF A BUTT JOINT IN THE BASE COURSES. LAP LONGITUDINAL JOINTS AS SHOWN ON STANDARD DRAWING BP-3.1.

ITEM 204 - PROOF ROLLING

THE FOLLOWING QUANTITY IS PROVIDED IN THE GENERAL SUMMARY TO ADDRESS LOCATIONS REQUIRING PROOF ROLLING. SEE PLAN SHEET 80 FOR ADDITIONAL INFORMATION.

ITEM 204 - PROOF ROLLING 17 HOURS.

PROTECTION OF RIGHT-OF-WAY LANDSCAPING

PRIOR TO BEGINNING WORK, THE CONTRACTOR, THE PROJECT ENGINEER, AND A REPRESENTATIVE OF THE MAINTAINING AGENCY WILL REVIEW AND RECORD ALL LANDSCAPING ITEMS WITHIN THE RIGHT OF WAY (BOTH WITHIN AND OUTSIDE THE CONSTRUCTION LIMITS) A RECORD OF THIS REVIEW WILL BE KEPT IN THE PROJECT ENGINEER'S FILES. PRIOR TO FINAL ACCEPTANCE, A FINAL REVIEW OF LANDSCAPING ITEMS WILL BE MADE.

CONSTRUCT ALL ACTIVITIES, EQUIPMENT STORAGE, AND STAGING TO WITHIN THE CONSTRUCTION LIMITS. UNLESS OTHERWISE IDENTIFIED IN THE PLANS OR PROPOSAL, THE CONSTRUCTION LIMITS ARE IDENTIFIED AS 30 FEET FROM THE EDGE OF PAVEMENT.

SUBMIT A WRITTEN REQUEST TO THE PROJECT ENGINEER TO USE ANY AREA OUTSIDE THESE LIMITS. THE DOCUMENT SUBMITTED MUST CLEARLY IDENTIFY THE AREA AND EXPLAIN THE PROPOSED USE AND RESTORATION OF THE AREA. EXCEPT AS INDICATED ON SHEET --- USE OF THESE AREAS FOR DISPOSAL OF WASTE MATERIAL AND CONSTRUCTION DEBRIS, EXCAVATION OF BORROW MATERIAL AND PLACEMENT OF PORTABLE PLANTS IS PROHIBITED. THE REQUEST MUST BE APPROVED, IN WRITING, BEFORE THE CONTRACTOR HAS PERMISSION TO USE THE AREA.

ANY ITEMS DAMAGED BEYOND THE CONSTRUCTION LIMITS AS DEFINED ABOVE WILL BE REPLACED IN KIND OR AS APPROVED BY THE PROJECT ENGINEER.

ITEM 253 - PAVEMENT REPAIR

THE FOLLOWING QUANTITY IS PROVIDED IN THE GENERAL SUMMARY TO ACCOUNT FOR FULL DEPTH PAVEMENT REPAIR NEEDS IN AREAS OF PAVEMENT PLANING AND RESURFACING FOR USE AS DIRECTED BY THE ENGINEER. FULL DEPTH ASPHALT PAVEMENT IS ASSUMED TO BE 19.25" DEEP.

ITEM 253 - PAVEMENT REPAIR 5,670 CY

ITEM 254 - PATCHING PLANED SURFACE

THE FOLLOWING QUANTITY IS PROVIDED IN THE GENERAL SUMMARY TO ACCOUNT FOR PATCHING AREAS OF THE PLANED SURFACE THAT THE ENGINEER DESIGNATES AS HAVING SPALLING OR DISLODGED UNSOUND PAVEMENT.

ITEM 254 - PATCHING PLANED SURFACE 10,600 SY

BENCHING OF FOUNDATION SLOPES

ALTHOUGH CROSS-SECTIONS INDICATE SPECIFIC DIMENSIONS FOR PROPOSED BENCHING OF THE EMBANKMENT FOUNDATIONS IN CERTAIN AREAS, NO WAIVER OF THE SPECIFICATIONS IS INTENDED. BENCH ALL OTHER SLOPED EMBANKMENT AREAS AS SET FORTH IN 203.05. NO ADDITIONAL PAYMENT WILL BE MADE FOR BENCHING REQUIRED UNDER THE PROVISIONS OF 203.05.

ITEM 606 - IMPACT ATTENUATOR, TYPE 2 (BIDIRECTIONAL)

THIS ITEM SHALL CONSIST OF FURNISHING AND INSTALLING ANY OF THE TYPE 2 IMPACT ATTENUATORS AS LISTED ON THE OFFICE OF ROADWAY ENGINEERING'S WEB PAGE (REFER TO THE POSTED SHOP DRAWINGS FOR THE MOST CURRENT APPROVED PRODUCT MODELS). WHEN BI-DIRECTIONAL DESIGNS ARE SPECIFIED, THE CONTRACTOR SHALL SUPPLY APPROPRIATE TRANSITIONS. THE FACE OF THE IMPACT HEAD SHALL BE COVERED WITH TYPE G REFLECTIVE SHEETING, PER CMS 730.19.

PAYMENT FOR THE ABOVE WORK SHALL BE MADE AT THE UNIT PRICE BID FOR ITEM 606, IMPACT ATTENUATOR, TYPE 2 ((BIDIRECTIONAL) 60 MPH, 34 IN), EACH, AND SHALL INCLUDE ALL LABOR, TOOLS, EQUIPMENT AND MATERIALS NECESSARY TO CONSTRUCT A COMPLETE AND FUNCTIONAL IMPACT ATTENUATOR SYSTEM, INCLUDING ALL RELATED BACKUPS/BACKSTOPS, TRANSITIONS, HARDWARE AND GRADING, NOT SEPARATELY SPECIFIED, AS REQUIRED BY THE MANUFACTURER. INSTALLATION SHALL BE AT THE LOCATIONS SPECIFIED IN THE PLANS, IN ACCORDANCE WITH THE MANUFACTURER'S SPECIFICATIONS.

ITEM SPECIAL - FILL AND PLUG EXISTING CONDUIT

THIS ITEM SHALL CONSIST OF THE CONSTRUCTION OF BULKHEADS IN EXISTING 12 AND 15 IN DIAMETER CONDUIT AND FILLING THE AREA THUS SEALED OFF WITH ITEM 613, SAND OR OTHER MATERIAL APPROVED BY THE ENGINEER.

BULKHEADS SHALL BE LOCATED AT THE LIMITS OF THE AREA TO BE FILLED AS INDICATED ON THE PLANS. THE BULKHEADS SHALL CONSIST OF BRICK OR CONCRETE MASONRY WITH A MINIMUM THICKNESS OF 12 INCHES.

THE FILL MATERIAL SHALL BE PUMPED INTO PLACE, OR PLACED BY OTHER MEANS APPROVED BY THE ENGINEER, SO THAT, AFTER SETTLEMENT, AT LEAST 90 PERCENT OF THE CROSS-SECTIONAL AREA OF THE CONDUIT, FOR ITS ENTIRE LENGTH, SHALL BE FILLED. THE LENGTH OF FILLED AND PLUGGED CONDUIT TO BE PAID FOR SHALL BE THE ACTUAL NUMBER OF FEET (MEASURED ALONG THE CENTERLINE OF EACH CONDUIT FROM OUTER FACE TO OUTER FACE OF BULKHEADS) FILLED AND PLUGGED AS DESCRIBED ABOVE.

IN LIEU OF FILLING AND PLUGGING THE EXISTING CONDUIT, THE PIPE MAY BE CRUSHED AND BACKFILLED IN ACCORDANCE WITH THE PROVISIONS OF 203, OR IT MAY BE REMOVED. THE LENGTH, MEASURED AS PROVIDED ABOVE, SHALL BE PAID FOR AT THE CONTRACT PRICE PER FOOT FOR, ITEM SPECIAL, FILL AND PLUG EXISTING CONDUIT.



CALCULATED
MSW
CHECKED
WAA

GENERAL NOTES

CLE-32-2.65
(PHASE 7)

...303.207\103956_GN701.dgn 11/19/2021 3:31:50 PM mswhtt

...303.207\103956_cg701.dgn 11/19/2021 3:32:34 PM mshitt

| SHEET NUM. | | | | | | | | | | | | PART. | ITEM | ITEM | GRAND | UNIT | DESCRIPTION | SEE |
|------------|-----|----|----|----|----|--------|-----|---------|----|--------|--|---------------|------|-------|---------|-------|---|-----|
| 12 | 13 | 14 | 15 | 19 | 74 | 76 | 77 | 81 | 82 | 251 | | 02/NHS/ PV | EXT | TOTAL | | SHEET | | |
| | | | | | | 2.5 | | | | | | 2.5 | 602 | 20000 | 2.5 | CY | DRAINAGE | |
| | | | | | | 17,348 | | | | | | 17,348 | 605 | 1110 | 17,348 | FT | CONCRETE MASONRY | |
| | 200 | | | | | | | | | | | 200 | 605 | 13300 | 200 | FT | 6" SHALLOW PIPE UNDERDRAINS WITH GEOTEXTILE FABRIC | |
| | | | | | | | | | | | | 3,743 | 605 | 14020 | 3,743 | FT | 6" UNCLASSIFIED PIPE UNDERDRAINS | |
| | 200 | | | | | | | | | | | 200 | 611 | 00406 | 200 | FT | 6" BASE PIPE UNDERDRAINS WITH GEOTEXTILE FABRIC | |
| | | | | | | | | | | | | | | | | | 4" CONDUIT, TYPE F | |
| | | | | | | | 704 | | | | | 704 | 611 | 00510 | 704 | FT | 6" CONDUIT, TYPE F FOR UNDERDRAIN OUTLETS | |
| | | | | | | 313 | | | | | | 313 | 611 | 05900 | 313 | FT | 15" CONDUIT, TYPE B | |
| | | | | | | 10 | | | | | | 10 | 611 | 05901 | 10 | FT | 15" CONDUIT, TYPE B, AS PER PLAN | |
| | | | | | | 30 | | | | | | 30 | 611 | 07400 | 30 | FT | 18" CONDUIT, TYPE B, 706.02 | |
| | | | | | | 122 | | | | | | 122 | 611 | 10400 | 122 | FT | 24" CONDUIT, TYPE B | |
| | | | | | | 15 | | | | | | 15 | 611 | 10400 | 15 | FT | 24" CONDUIT, TYPE B, 706.02 | |
| | | | | | | 10 | | | | | | 10 | 611 | 19400 | 10 | FT | 42" CONDUIT, TYPE B | |
| | | | | | | 320 | | | | | | | 611 | 96600 | 320 | FT | CONDUIT, BORED OR JACKED: 15" TYPE B | |
| | | | | | | 84 | | | | | | | 611 | 96600 | 84 | FT | CONDUIT, BORED OR JACKED: 24" TYPE B | |
| | | | | 2 | | | | | | | | 2 | 611 | 98631 | 2 | EACH | CATCH BASIN ADJUSTED TO GRADE, AS PER PLAN | |
| | | | | | | 12 | | | | | | 12 | 611 | 99110 | 12 | EACH | INLET, NO. 3 FOR SINGLE SLOPE BARRIER, TYPE C1 | |
| | | | | | | 1 | | | | | | 1 | 611 | 99574 | 1 | EACH | MANHOLE, NO. 3 | |
| | | | | | | 7 | | | | | | 7 | 611 | 99654 | 7 | EACH | MANHOLE ADJUSTED TO GRADE | |
| | | | | | | | | | | | | 1 | 611 | 99660 | 1 | EACH | MANHOLE RECONSTRUCTED TO GRADE | |
| | 4 | | | | | | 2 | | | | | 6 | 611 | 99710 | 6 | EACH | PRECAST REINFORCED CONCRETE OUTLET | |
| | | | | | | | | | | | | | | | | | PAVEMENT | |
| 5,670 | | | | | | | | | | | | 5,670 | 253 | 02000 | 5,670 | CY | PAVEMENT REPAIR | |
| | | | | | | | | 105,877 | | | | 105,877 | 254 | 01000 | 105,877 | SY | PAVEMENT PLANING, ASPHALT CONCRETE (DEPTH AS SHOWN) | |
| 10,600 | | | | | | | | | | | | 10,600 | 254 | 01600 | 10,600 | SY | PATCHING PLANED SURFACE | |
| | | | 5 | | | | | | | | | 5 | 301 | 46000 | 5 | CY | ASPHALT CONCRETE BASE, PG64-22 | |
| | | | | | | | | 9,619 | | | | 9,619 | 302 | 46000 | 9,619 | CY | ASPHALT CONCRETE BASE, PG64-22 | |
| | | | | | | | | | | | | 7,594 | 304 | 20000 | 7,594 | CY | AGGREGATE BASE | |
| | | | | | | | | 7,590 | | | | 18,069 | 407 | 20000 | 18,069 | GAL | NON-TRACKING TACK COAT | |
| | | | | | | | | 18,067 | | | | 28 | 410 | 12000 | 28 | CY | TRAFFIC COMPACTED SURFACE, TYPE A OR B | |
| | | | 28 | | | | | | | | | 1 | 441 | 50000 | 1 | CY | ASPHALT CONCRETE SURFACE COURSE, TYPE 1, (448), PG64-22 | |
| | | | | | | | | | | | | 6,122 | 442 | 00100 | 6,122 | CY | ANTI-SEGREGATION EQUIPMENT | |
| | | | | | | | | | | | | 5,684 | 442 | 10000 | 5,684 | CY | ASPHALT CONCRETE SURFACE COURSE, 12.5 MM, TYPE A (446) | |
| | | | | | | | | | | | | 3,622 | 442 | 10100 | 3,622 | CY | ASPHALT CONCRETE INTERMEDIATE COURSE, 19 MM, TYPE A (446) | |
| | | | | | | | | | | | | | | | | | WATER WORK | |
| | | | | | | | | | 2 | | | 2 | 638 | 08704 | 2 | EACH | 6" CUTTING-IN SLEEVE | |
| | | | | | | | | | 20 | | | 20 | 638 | 98600 | 20 | FT | WATER WORK, MISC.: 6" DUCTILE IRON WATER MAIN AND DUCTILE IRON FITTINGS (CCWRD ITEM 2110) | |
| | | | | | | | | | | | | | | | | | SANITARY SEWER | |
| | | | | | 1 | | | | | | | 1 | 611 | 99900 | 1 | EACH | DRAINAGE STRUCTURE, MISC.: MANHOLE ADJUSTED TO GRADE | |
| | | | | | | | | | | | | | | | | | LIGHTING | |
| | | | | | | | | | | 74 | | 74 | 625 | 00450 | 74 | EACH | CONNECTION, FUSED PULL APART | |
| | | | | | | | | | | 15 | | 15 | 625 | 00470 | 15 | EACH | CONNECTION, UNFUSED BOLTED | |
| | | | | | | | | | | 9 | | 9 | 625 | 00480 | 9 | EACH | CONNECTION, UNFUSED PERMANENT | |
| | | | | | | | | | | 37 | | 37 | 625 | 10494 | 37 | EACH | LIGHT POLE, LOW MAST, ALM50 | |
| | | | | | | | | | | 37 | | 37 | 625 | 14306 | 37 | EACH | MEDIAN LIGHT POLE FOUNDATION, 10' DEEP | |
| | | | | | | | | | | 24,881 | | 24,881 | 625 | 23300 | 24,881 | FT | NO. 2 AWG 2400 VOLT DISTRIBUTION CABLE | |
| | | | | | | | | | | 4,366 | | 4,366 | 625 | 23400 | 4,366 | FT | NO. 10 AWG POLE AND BRACKET CABLE | |
| | | | | | | | | | | 24 | | 24 | 625 | 25504 | 24 | FT | CONDUIT, 3", 725.051 | |
| | | | | | | | | | | 140 | | 140 | 625 | 25902 | 140 | FT | CONDUIT, JACKED OR DRILLED, 725.04, 3" | |
| | | | | | | | | | | 37 | | 37 | 625 | 26273 | 37 | EACH | LUMINAIRE, LOW MAST, SOLID STATE (LED), AS PER PLAN, SYMMETRIC, 480 VOLT | |
| | | | | | | | | | | 12 | | 12 | 625 | 29000 | 12 | FT | TRENCH | |
| | | | | | | | | | | 4 | | 4 | 625 | 29930 | 4 | EACH | MEDIAN JUNCTION BOX | |
| | | | | | | | | | | 2 | | 2 | 625 | 30706 | 2 | EACH | PULL BOX, 725.08, 24" | |
| | | | | | | | | | | 41 | | 41 | 625 | 32000 | 41 | EACH | GROUND ROD | |
| | | | | | | | | | | 2 | | 2 | 625 | 34001 | 2 | EACH | POWER SERVICE, AS PER PLAN | |
| | | | | | | | | | | 12 | | 12 | 625 | 36010 | 12 | FT | UNDERGROUND WARNING/MARKING TAPE | |
| | | | | | | | | | | 1 | | 1 | 625 | 75800 | 1 | EACH | DISCONNECT CIRCUIT | |

GENERAL SUMMARY

CLE-32-2.65
(PHASE 7)

...303.207\103956_CS701.dgn 11/19/2021 3:33:25 PM mswbitt

| SHEET NO. | REFERENCE NO. | STATION | | SIDE | 202 | 202 | 202 | 202 | 202 | 202 | 202 | 202 | 202 | 202 | 202 | 202 | 202 | 202 |
|--|---------------|-----------|-----------|-------|--------------------------|------------------------|-----------------------------------|--------------------------------------|-------------------------|--|--------------------------------------|--------------------------------|-------------------------|-----------------------------|--|---------------------|---------|-----|
| | | FROM | TO | | HEADWALL REMOVED EACH | PAVEMENT REMOVED SY | CONCRETE BARRIER REMOVED FT | PIPE REMOVED, 24" AND UNDER FT | GUARDRAIL REMOVED FT | GUARDRAIL REMOVED, BARRIER DESIGN FT | IMPACT ATTENUATOR REMOVED EACH | CABLE BARRIER REMOVED FT | MANHOLE REMOVED EACH | CATCH BASIN REMOVED EACH | SPECIAL - FILL AND PLUG EXISTING CONDUIT (12"-15") FT | FENCE REMOVED FT | | |
| 86 | R-1 | 133+95.00 | 143+34.25 | LT | | 1,008.2 | | | | | | | | | | | | |
| 86 | R-2 | 133+95.00 | 142+38.41 | LT | | 402.1 | | | | | | | | | | | | |
| 86 | R-3 | 133+95.00 | 141+82.28 | LT | | | 789.0 | | | | | | | | | | | |
| 86 | R-4 | 137+99.33 | 140+28.89 | LT | | | | | 229 | | | | | | | | | |
| 86 | R-5 | 141+82.28 | 142+36.58 | LT | | | | | 54 | | | | | | | | | |
| 86 | R-7 | 136+36.79 | 136+46.80 | LT | | | | | | | | | 1 | | | | | |
| 86 | R-8 | 138+39.45 | 142+00.00 | LT | | | | 349.0 | | | | | 3 | | | | | |
| 86 | R-9 | 142+31.70 | | LT | | | | | | | | | 1 | | | | | |
| 87 | R-11 | 153+40.00 | 169+00.00 | LT | | | | | | | | | 1,510 | | | | | |
| 87 | R-12 | 144+10.00 | 174+90.33 | LT | | 3,359.2 | | | | | | | | | | | | |
| 87 | R-16 | 150+21.50 | 152+75.00 | RT | | 131.9 | | | | | | | | | | | | |
| 87 | R-17 | 153+50.00 | 158+52.30 | LT | | 515.1 | | | | | | | | | | | | |
| 88 | R-20 | 158+14.44 | | LT | 1 | | | 6.0 | | | | | | | | | | |
| 88 | R-21 | 158+29.60 | 159+17.67 | LT | 2 | | | 88.0 | | | | | | | | | | |
| 88 | R-22 | 159+05.50 | 159+08.87 | LT | | | | 5.2 | | | | | | | | | | |
| 88 | R-23 | 159+73.04 | 160+50.00 | LT/RT | 1 | | | 117.6 | | | | | 1 | 1 | | 24.6 | | |
| 88 | R-24 | 160+15.36 | 160+22.12 | LT | 1 | | | 9.2 | | | | | | | | | | |
| 88 | R-25 | 159+66.43 | 173+62.03 | LT | | 495.1 | | | | | | | | | | | | |
| 88 | R-26 | 168+00.00 | 185+00.00 | LT | | | | | | | | 1,700 | | | | | | |
| 88 | R-27 | 160+95.45 | 174+11.77 | LT | | | | | | | | | | | | | 1,419.0 | |
| 89 | R-30 | 175+64.35 | 188+02.27 | LT | | 414.2 | | | | | | | | | | | | |
| 89 | R-31 | 173+46.30 | 173+74.06 | LT | 1 | | | 81.5 | | | | | | | 1 | | | |
| 89 | R-32 | 173+71.39 | 173+72.19 | LT | 1 | | | 9.7 | | | | | | | | | | |
| 90 | R-36 | 192+20.00 | 232+35.00 | LT | | | | | | | | | 2,624 | | | | | |
| 90 | R-38 | 192+03.94 | 234+95.57 | LT | | 1,036.8 | | | | | | | | | | | | |
| 91 | R-43 | 196+25.00 | 196+90.50 | CL | | | 30.0 | | | 1 | | | | | | | | |
| 91 | R-44 | 198+98.00 | 199+65.00 | CL | | | 30.0 | | | 1 | | | | | | | | |
| 92 | R-50 | 216+48.58 | 234+83.45 | LT | | | | | | | | | | | | | | |
| 92 | R-51 | 216+53.87 | 216+53.87 | LT | | 586.5 | | | | | | | | | | | | |
| 92 | R-52 | 232+00.00 | 235+34.91 | LT | | | | 335.1 | | | | | 1 | 2 | | | | |
| 93 | R-54 | 235+34.91 | | LT | | | | 45.4 | | | | | | | | | 26.8 | |
| 93 | R-55 | 239+25.00 | 245+00.00 | LT | | | | | | | | 575 | | | | | | |
| 93 | R-56 | 239+21.68 | 241+00.00 | LT | | 80.0 | | | | | | | | | | | | |
| TOTALS CARRIED TO GENERAL SUMMARY | | | | | 7 | 8,029 | 849 | 1,047 | 615 | 54 | 2 | 6,409 | 3 | 8 | 51 | 1,419 | | |

REMOVAL ESTIMATED QUANTITIES

**CLE-32-2.65
(PHASE 7)**

CALCULATED
MSW
CHECKED
WAA

...303.207\103956_CS701.dgn 11/19/2021 3:33:25 PM mswhtt

| SHEET NO. | REFERENCE NO. | STATION | | SIDE | 606 | 606 | 606 | | 606 | 607 | 607 | | 611 | | 622 | 622 | 622 | 622 | | | | |
|--|---------------|-----------|-----------|------|---------------------------|---|--|---|---|-----------------------|---|--|--|--|--|--|--|--|--|--|--|--|
| | | FROM | TO | | GUARDRAIL, TYPE MGS FT | ANCHOR ASSEMBLY, MGS TYPE E (MASH 2016) EACH | ANCHOR ASSEMBLY, MGS TYPE T EACH | | IMPACT ATTENUATOR, TYPE 2 (BIDIRECTIONAL) EACH | FENCE, TYPE CLT FT | FENCELINE SEEDING AND MULCHING FT | | DRAINAGE STRUCTURE, MISC.: MANHOLE ADJUSTED TO GRADE EACH | | CONCRETE BARRIER, SINGLE SLOPE, TYPE C1 FT | CONCRETE BARRIER END SECTION, TYPE C1 EACH | CONCRETE BARRIER, END ANCHORAGE, REINFORCED, TYPE C1 EACH | CONCRETE BARRIER, END ANCHORAGE, REINFORCED, TYPE C1, AS PER PLAN EACH | | | | |
| 86 | B-1 | 133+95.00 | 143+00.00 | CL | | | | | | | | | | | 804.0 | | 2 | 1 | | | | |
| 86 | G-1 | 138+85.95 | 140+39.61 | LT | 87.5 | 1 | 1 | | | | | | | | | | | | | | | |
| 87 | B-2 | 143+00.00 | 155+50.00 | CL | | | | | | | | | | | 1,080.0 | | 6 | | | | | |
| 87 | G-2 | 149+87.50 | 160+03.13 | LT | 900.0 | 1 | 1 | | | | | | | | | | | | | | | |
| 88 | B-3 | 155+50.00 | 168+50.00 | CL | 150.0 | 1 | 1 | | | | | | | | 1,096.0 | | 6 | | | | | |
| 88 | F-1 | 160+95.45 | 174+11.77 | LT | | | | | 1,317 | 1,317 | | | | | | | | | | | | |
| 89 | B-4 | 168+50.00 | 181+00.00 | CL | | | | | | | | | | | 1,100.0 | | 6 | | | | | |
| 89 | G-3 | 173+37.50 | 175+58.11 | LT | | | | | | | | | | | | | | | | | | |
| 90 | B-5 | 181+00.00 | 193+50.00 | CL | | | | | | | | | | | 1,130.0 | | 4 | | | | | |
| 91 | B-6 | 193+50.00 | 196+90.50 | CL | | | | | | | | | | | 259.5 | | 3 | | | | | |
| 91 | B-7 | 198+98.00 | 206+04.56 | CL | | | | | | | | | | | 567.6 | | 5 | | | | | |
| 92 | B-8 | 206+04.56 | 233+00.00 | CL | | | | | | | | | | | 1,038.0 | | 8 | | | | | |
| 92 | G-4 | 216+48.59 | 239+63.10 | LT | 812.5 | 1 | | | | | | | | | | | | | | | | |
| 93 | B-9 | 233+00.00 | 241+00.00 | CL | | | | | | | | | | | 696.0 | 1 | 2 | | | | | |
| 93 | I-1 | 241+00.00 | | CL | | | | 1 | | | | | | | | | | | | | | |
| 94 | SA-1 | 20+90.28 | | RT | | | | | | | | | 1 | | | | | | | | | |
| TOTALS CARRIED TO GENERAL SUMMARY | | | | | 1,950.0 | 4 | 3 | | 1 | 1317 | 1317 | | 1 | | 7,771 | 1 | 42 | 1 | | | | |

SR-32
 CURVE DATA NO. 1
 P.I. Sta. 139+83.95
 $\Delta = 3^\circ 53' 06''$ (LT)
 $D_c = 0^\circ 20' 00''$
 $R = 17,188.74'$
 $T = 582.99'$
 $L = 1,165.53'$
 $E = 9.88'$
 $e_{max} = NC$
 PC Sta. 134+00.97
 PT Sta. 145+66.49

FULL DEPTH ASPHALT PAVEMENT PLACED WITH PHASE 3 OR 5. (PID 103755/103954)

EXISTING ASPHALT PAVEMENT REMOVED.

STA 143+50.93 @ CONST SR-32 =
 STA 20+04.74 @ CONST GLEN ESTE-WITHAMSVILLE RD

FOR UNDERDRAIN DETAILS SEE SHEETS 196 - 213 .

VARIABLE DEPTH PLANING AND OVERLAY. SEE TYPICAL SECTIONS.

+34.02
54.00' LT
R-1

+10.00
55.32' LT

+05.41
54.98' LT

+21.14
43.18' LT

+00.00
END PAV'T TAPER

+87.50

+50.00
19.66' LT

+50.00
15.00' LT

+21.50
15.00' RT

+75.00
15.00' RT

+75.00
19.00' RT

+21.50
19.00' RT

+75.00

+75.00

+75.00


+75.00

+75.00


+75.00

+75.00

+75.00

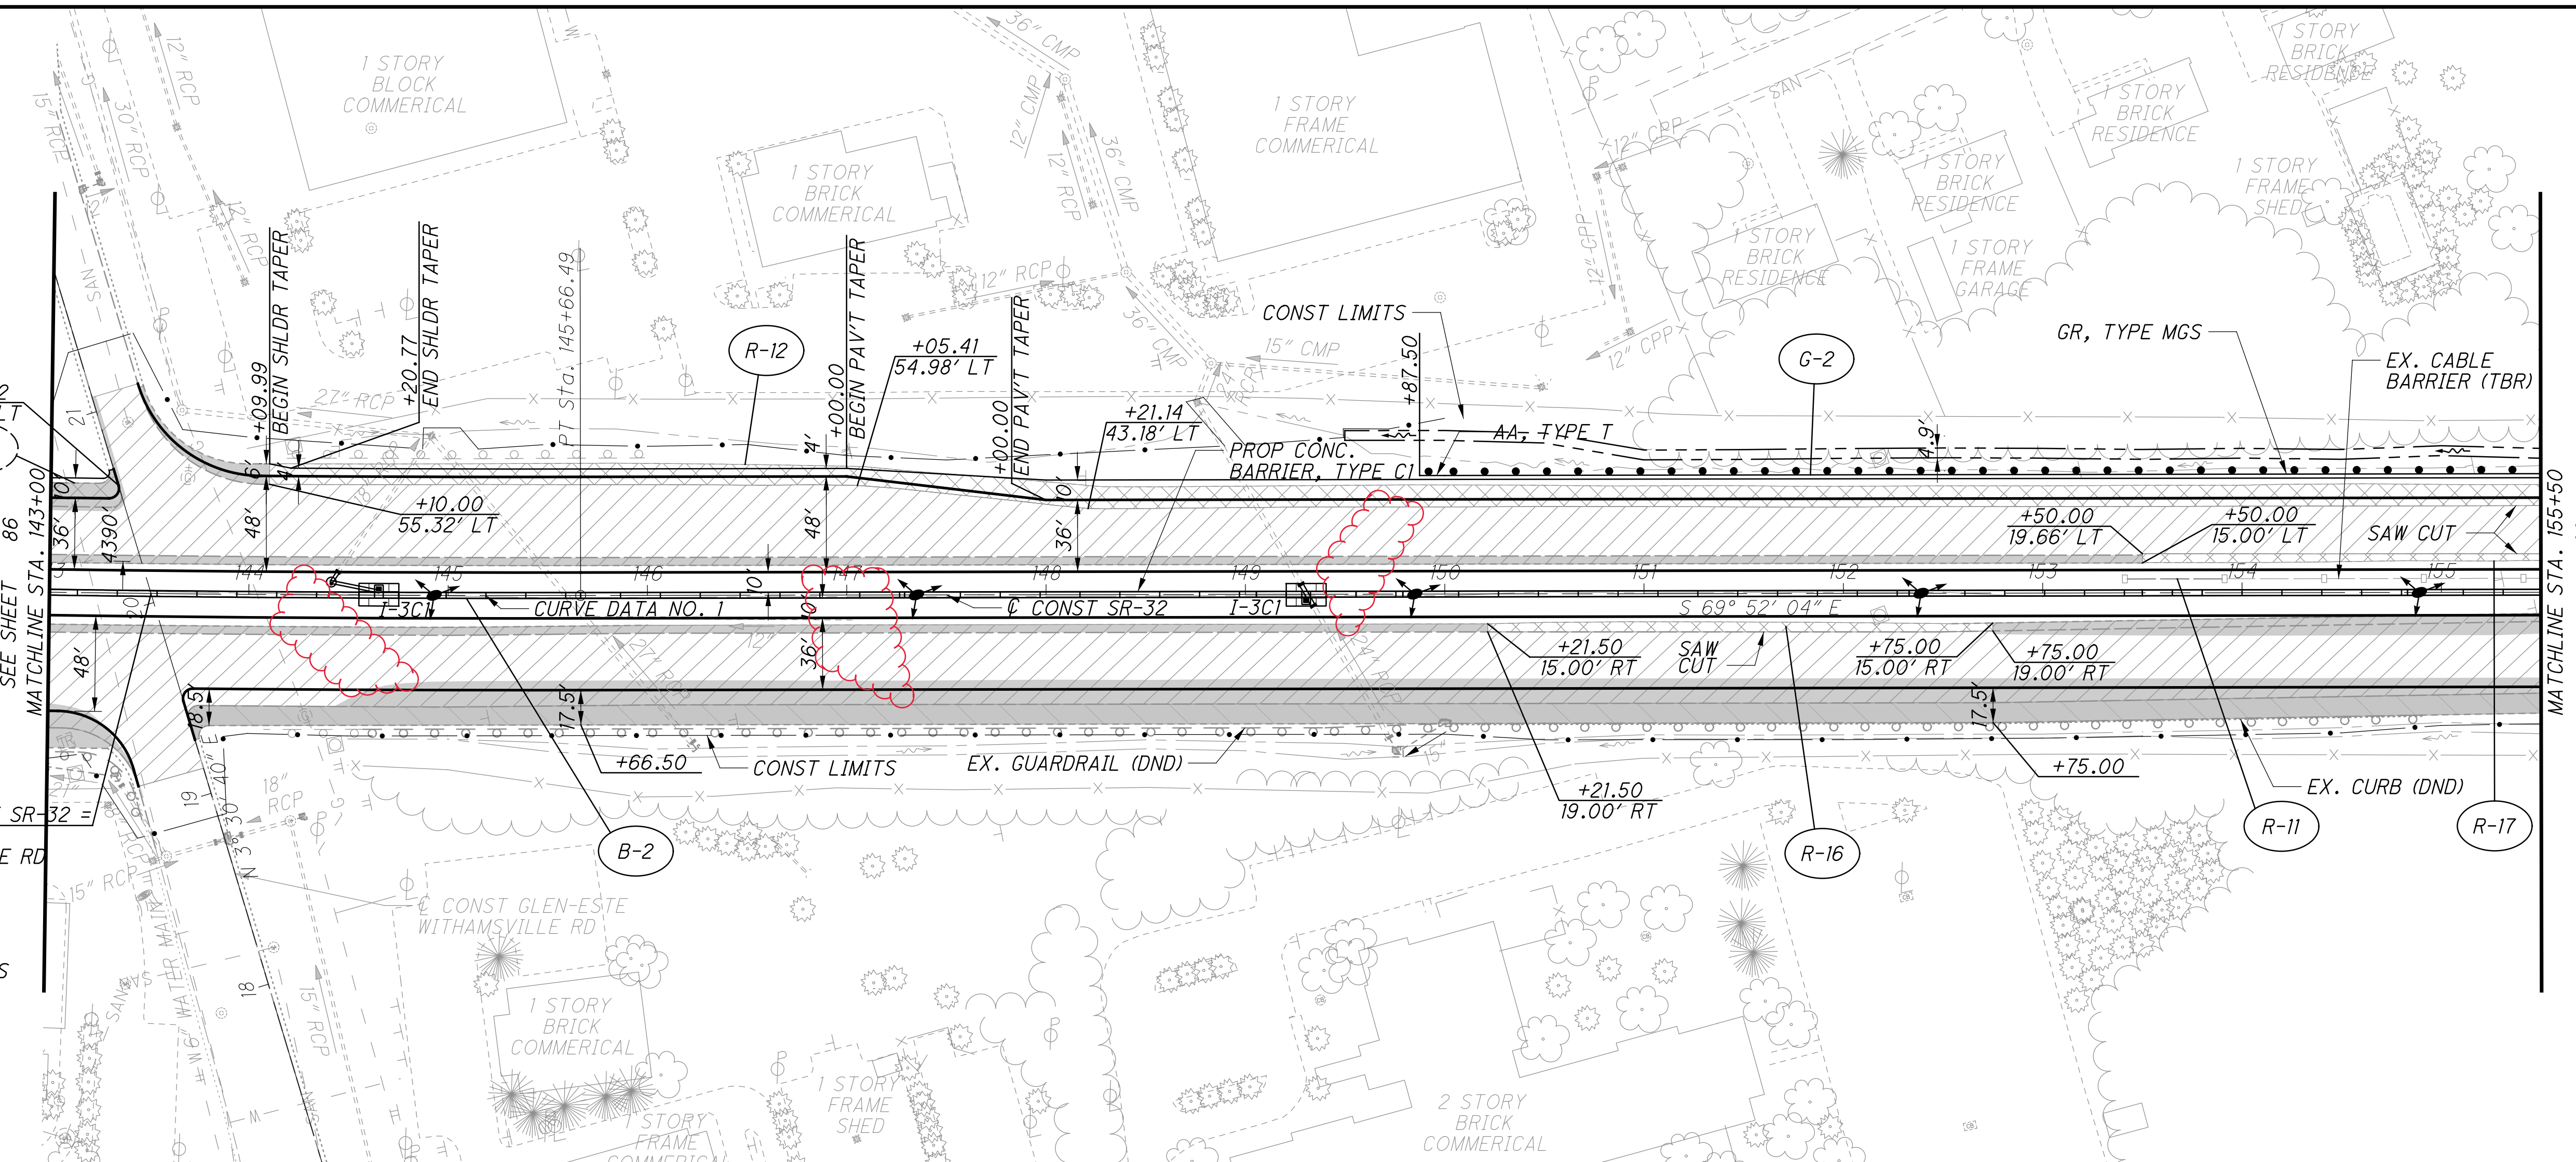




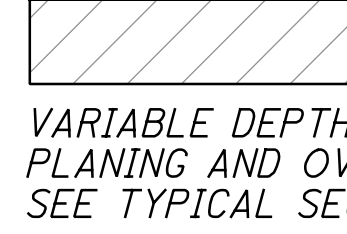
| | | | | | | | | | | | | | | | | | | | | | | | | | | | | | |
|-----|--------|--------|--------|--------|--------|--------|--------|--------|--------|--------|--------|--------|--------|--------|--------|--------|--------|--------|--------|--------|--------|--------|--------|--------|--------|--------|----------|--------|----------|
| | 860.78 | 861.52 | 862.07 | 862.57 | 862.88 | 863.32 | 863.78 | 864.28 | 864.87 | 865.43 | 865.94 | 866.50 | 867.04 | 867.50 | 868.13 | 868.67 | 869.02 | 869.68 | 870.18 | 870.12 | 869.94 | 870.57 | 870.96 | 871.61 | 872.03 | 872.62 | PROP. WB | | |
| | 861.81 | 862.07 | 862.33 | 862.58 | 862.82 | 863.00 | 863.18 | 863.38 | 863.58 | 863.78 | 863.98 | 864.18 | 864.38 | 864.58 | 864.78 | 864.98 | 865.18 | 865.38 | 865.58 | 865.78 | 865.98 | 866.18 | 866.38 | 866.58 | 866.78 | 866.98 | 867.18 | 867.38 | PROP. EB |
| 875 | | | | | | | | | | | | | | | | | | | | | | | | | | | | 875 | |
| 870 | | | | | | | | | | | | | | | | | | | | | | | | | | | | 870 | |
| 865 | | | | | | | | | | | | | | | | | | | | | | | | | | | | 865 | |
| 860 | | | | | | | | | | | | | | | | | | | | | | | | | | | | 860 | |
| 855 | | | | | | | | | | | | | | | | | | | | | | | | | | | | 855 | |
| 850 | | | | | | | | | | | | | | | | | | | | | | | | | | | | 850 | |
| 845 | | | | | | | | | | | | | | | | | | | | | | | | | | | | 845 | |
| | 143+00 | 144+00 | 145+00 | 146+00 | 147+00 | 148+00 | 149+00 | 150+00 | 151+00 | 152+00 | 153+00 | 154+00 | 155+00 | | | | | | | | | | | | | | | | |



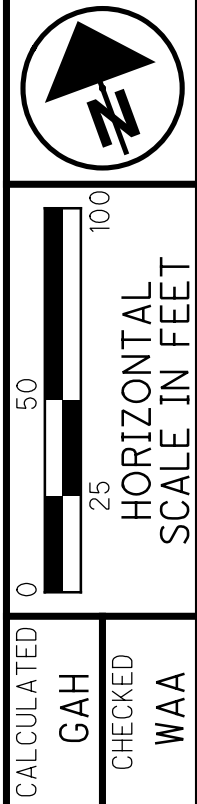


PLAN AND PROFILE - SR-32
 STA. 143+00 TO STA. 155+50

CLE-32.265
 (PHASE 7)

RAMP N
 CURVE DATA NO. 5
 P.I. Sta. 186+38.63
 $\Delta = 1^\circ 39' 11''$ (LT)
 $D_c = 0^\circ 25' 00''$
 $R = 13,750.99'$
 $T = 198.38'$
 $L = 396.74'$
 $E = 1.43'$
 $e_{max} = 0.016$
 PC Sta. 184+40.25
 PT Sta. 188+36.99

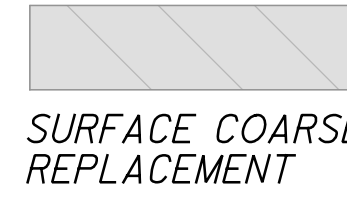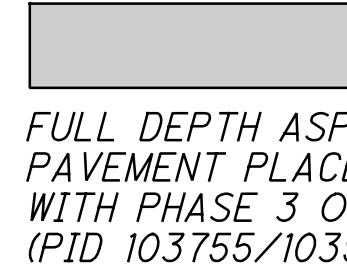-  SURFACE COARSE REPLACEMENT
-  FULL DEPTH ASPHALT PAVEMENT PLACED WITH PHASE 3 OR 5. (PID 103755/103954)
-  EXISTING ASPHALT PAVEMENT REMOVED.
-  VARIABLE DEPTH PLANING AND OVERLAY. SEE TYPICAL SECTIONS.
- FOR UNDERDRAIN DETAILS SEE SHEETS 196 - 213 .

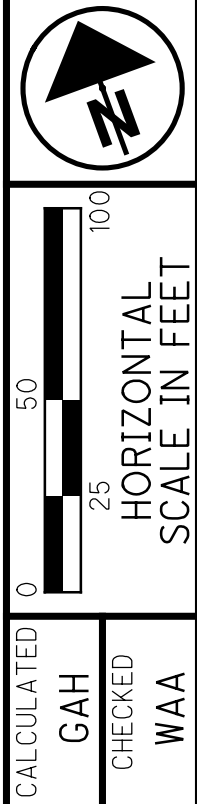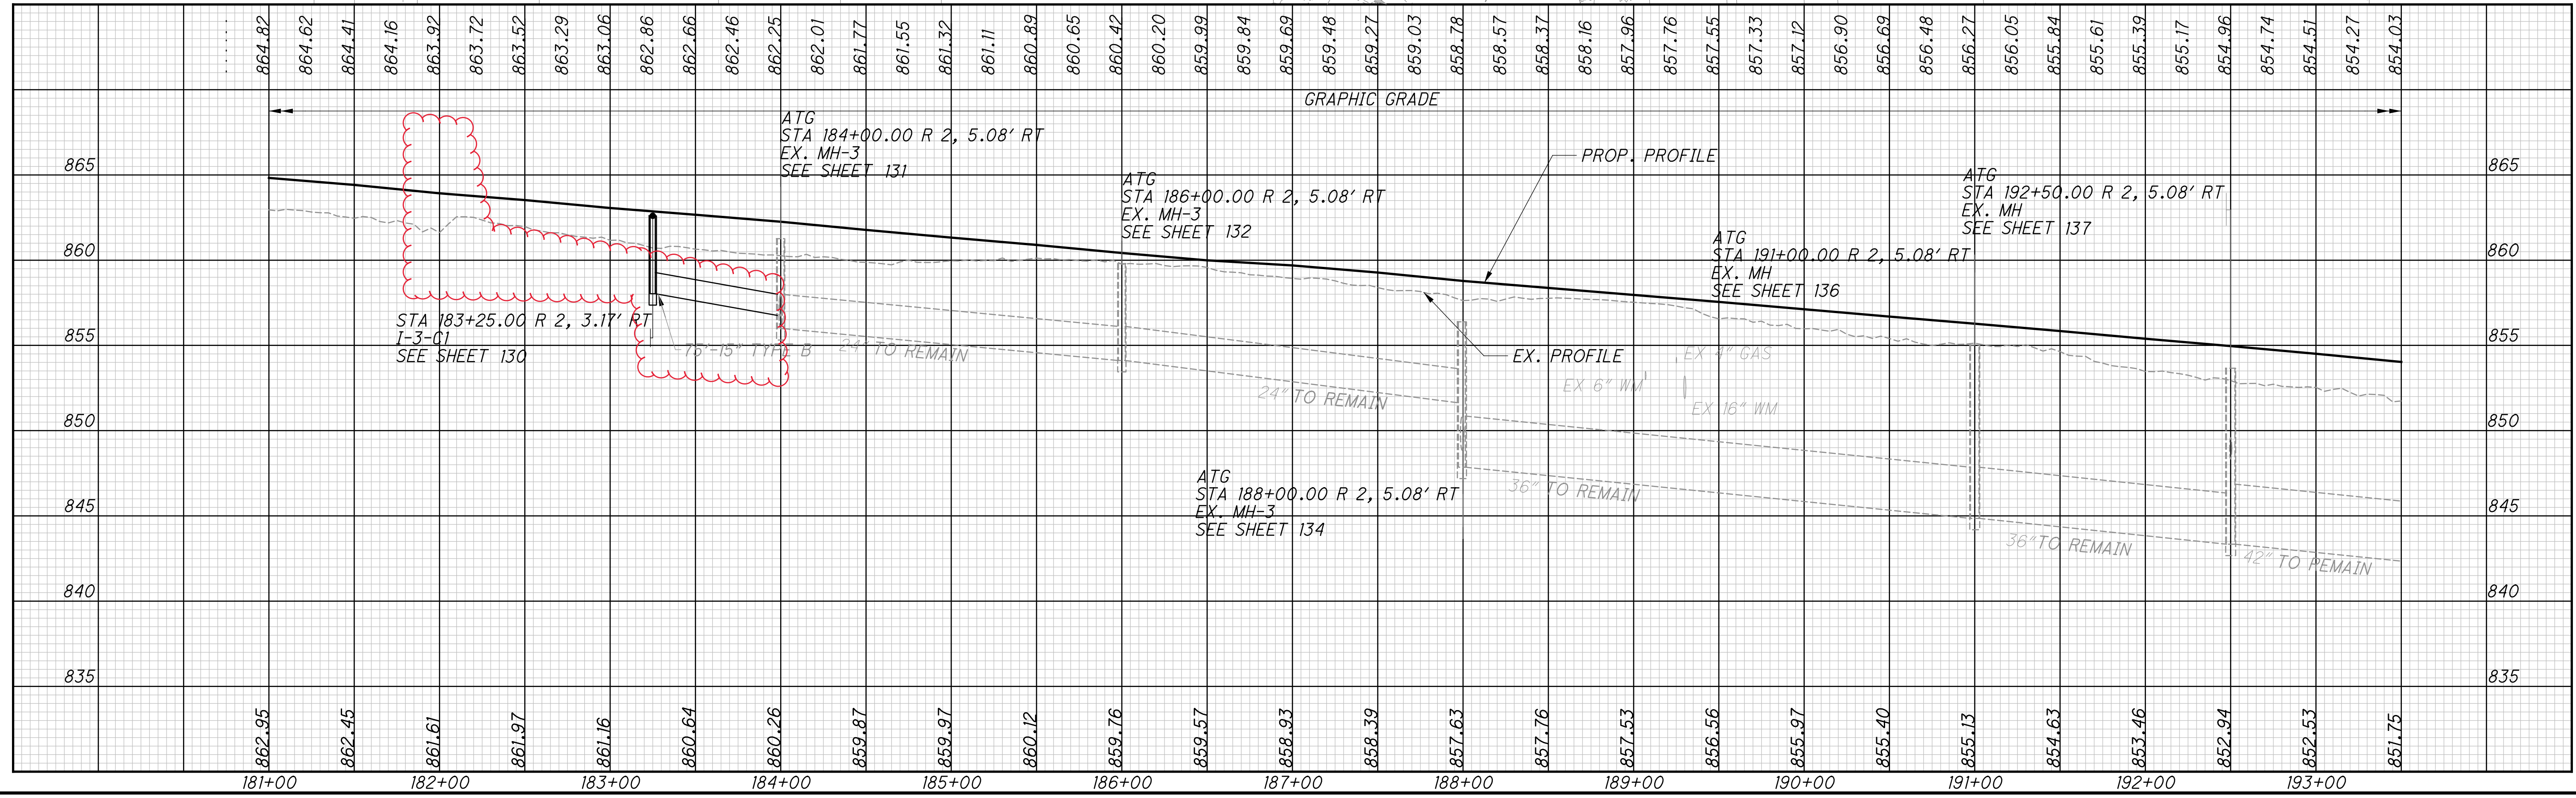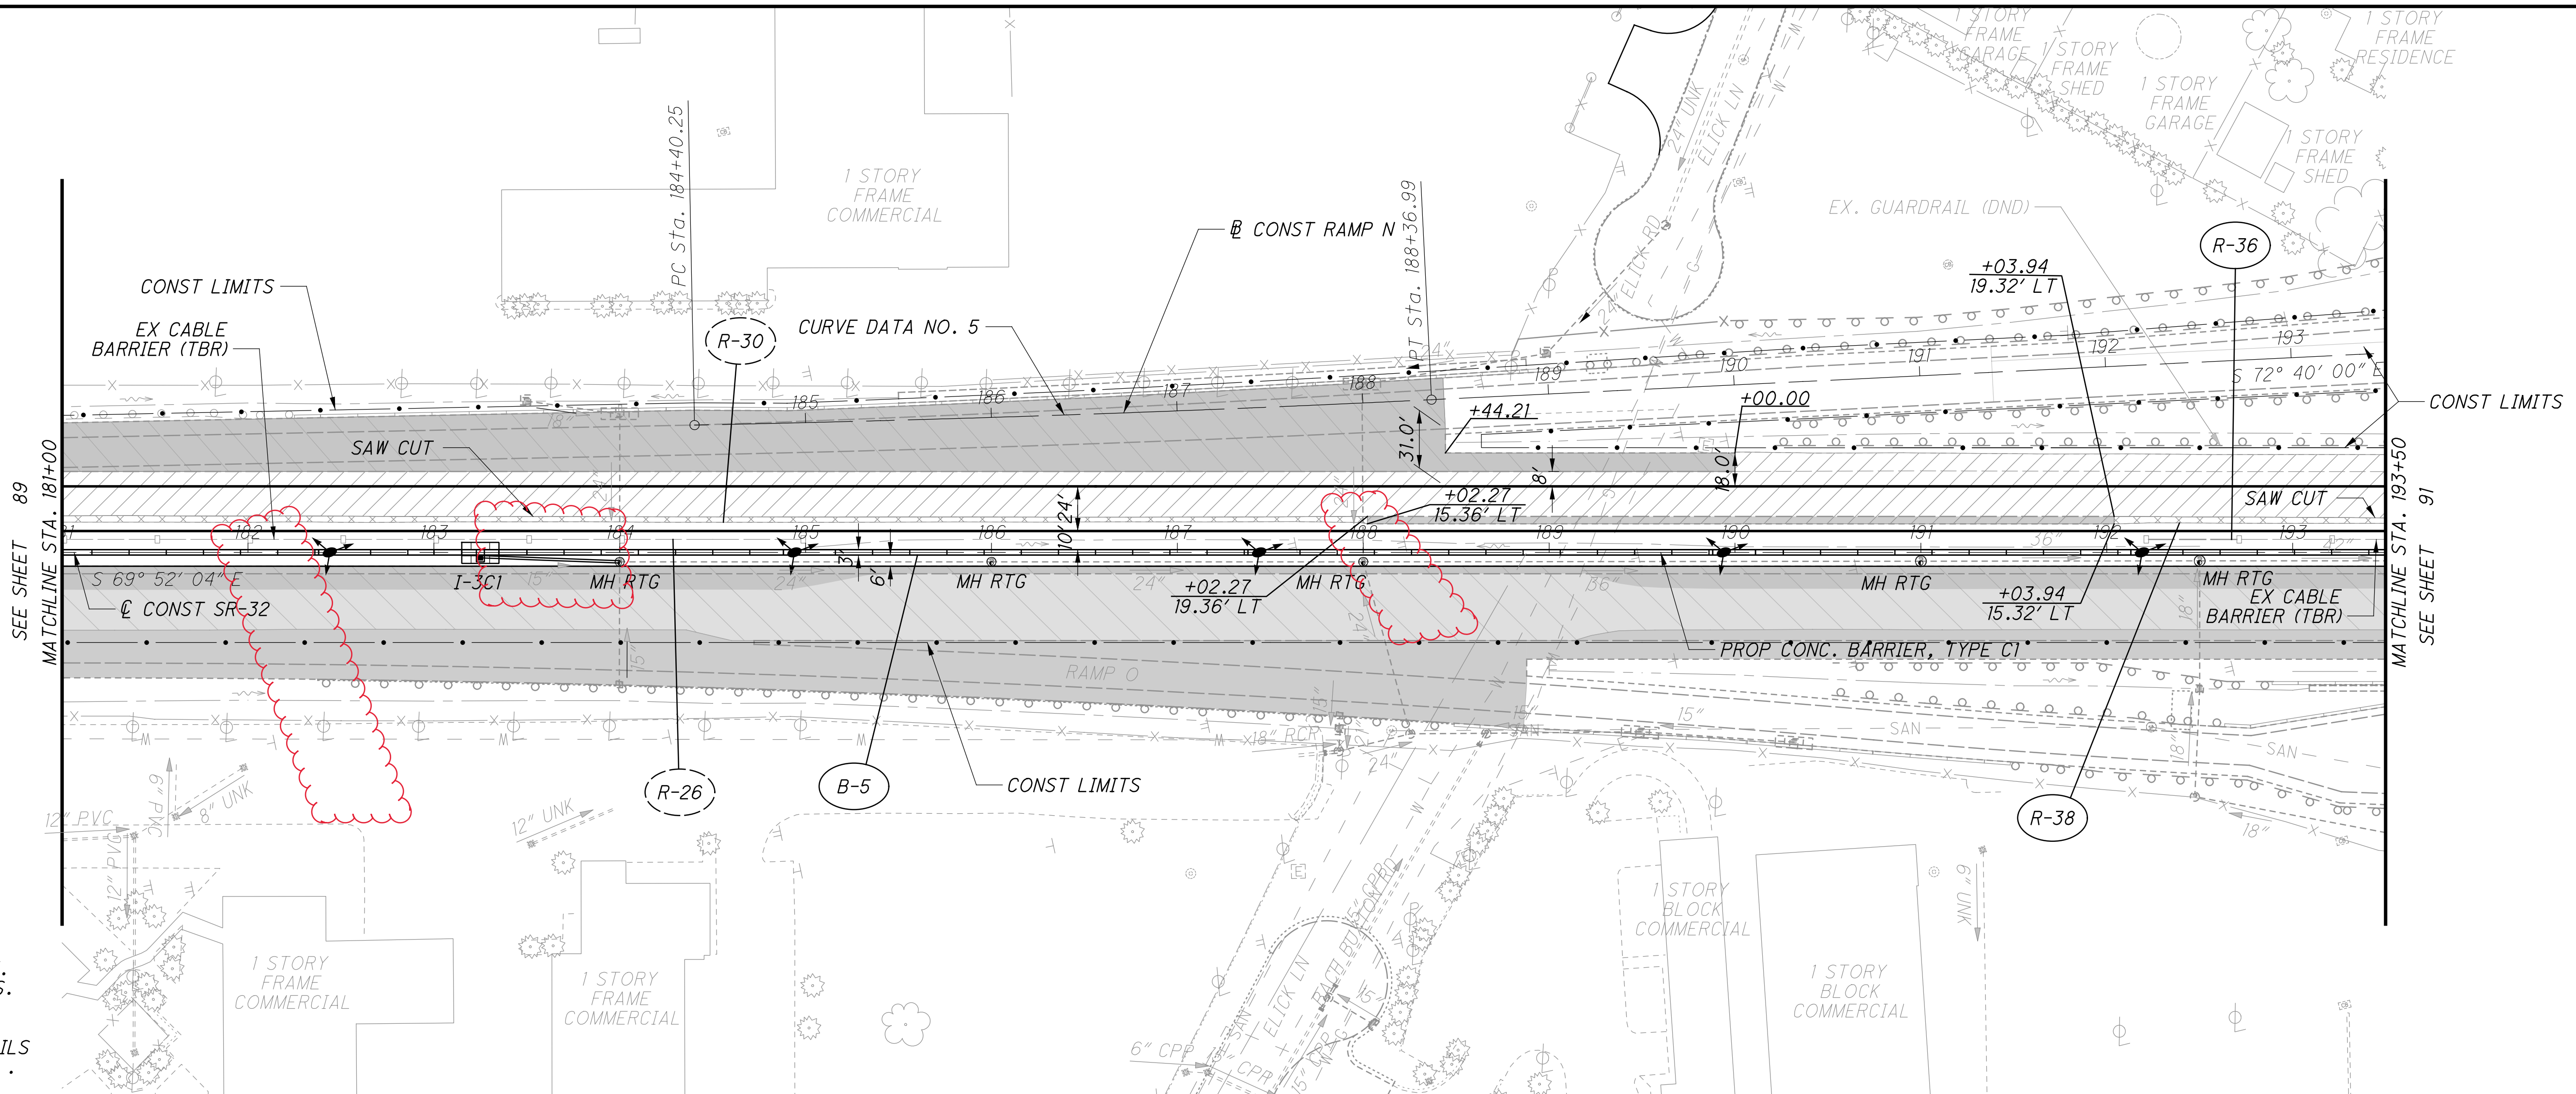

PLAN AND PROFILE - SR-32
 STA. 181+00 TO STA. 193+50





CLE-32-2.65
 (PHASE 7)




90
 316

...303.207\103956_GP706.dgn 11/19/2021 3:35:26 PM mswhatt

RAMP Q
 CURVE DATA NO. 6
 P.I. Sta. 202+25.62
 $\Delta = 8^\circ 16' 00''$ (RT)
 $D_c = 2^\circ 00' 00''$
 $R = 2,864.79'$
 $T = 207.03'$
 $L = 413.33'$
 $E = 7.47'$
 $e_{max} = 0.016$
 PC Sta. 200+18.60
 PT Sta. 204+31.93

SR-32
 CURVE DATA NO. 2
 P.I. Sta. 205+82.41
 $\Delta = 2^\circ 03' 49''$ (LT)
 $D_c = 1^\circ 30' 00''$
 $R = 3,819.74'$
 $T = 68.80'$
 $L = 137.58'$
 $E = 0.62'$
 $e_{max} = 0.037$
 PC Sta. 205+13.61
 PCC Sta. 206+51.19

-  FULL DEPTH ASPHALT PAVEMENT PLACED WITH PHASE 3 OR 5. (PID 103755/103954)
-  EXISTING ASPHALT PAVEMENT REMOVED.
-  VARIABLE DEPTH PLANING AND OVERLAY. SEE TYPICAL SECTIONS.
-  SURFACE COARSE REPLACEMENT

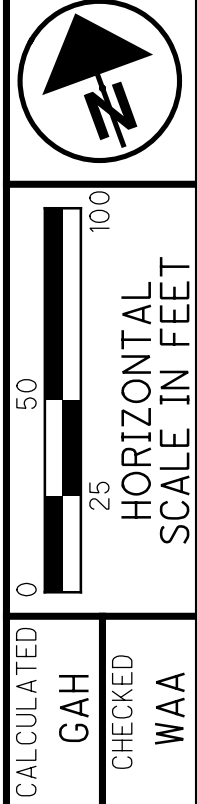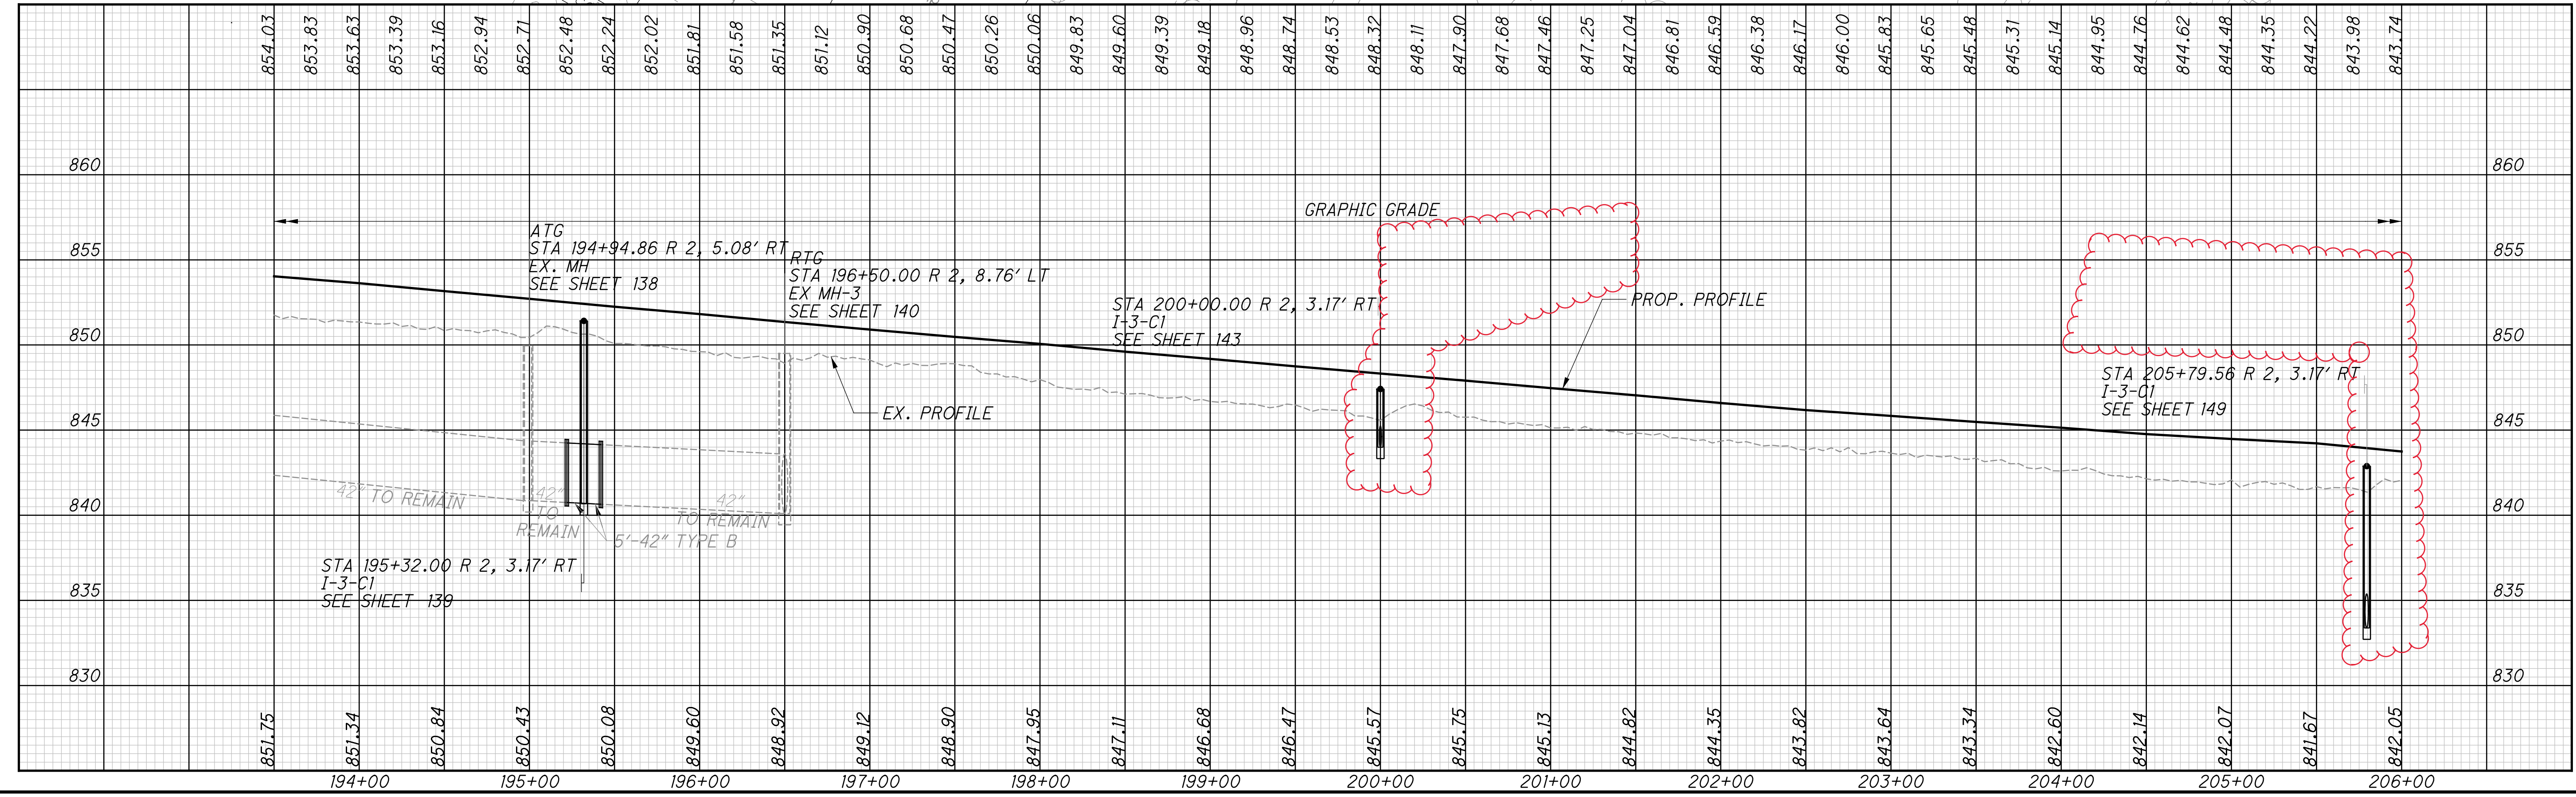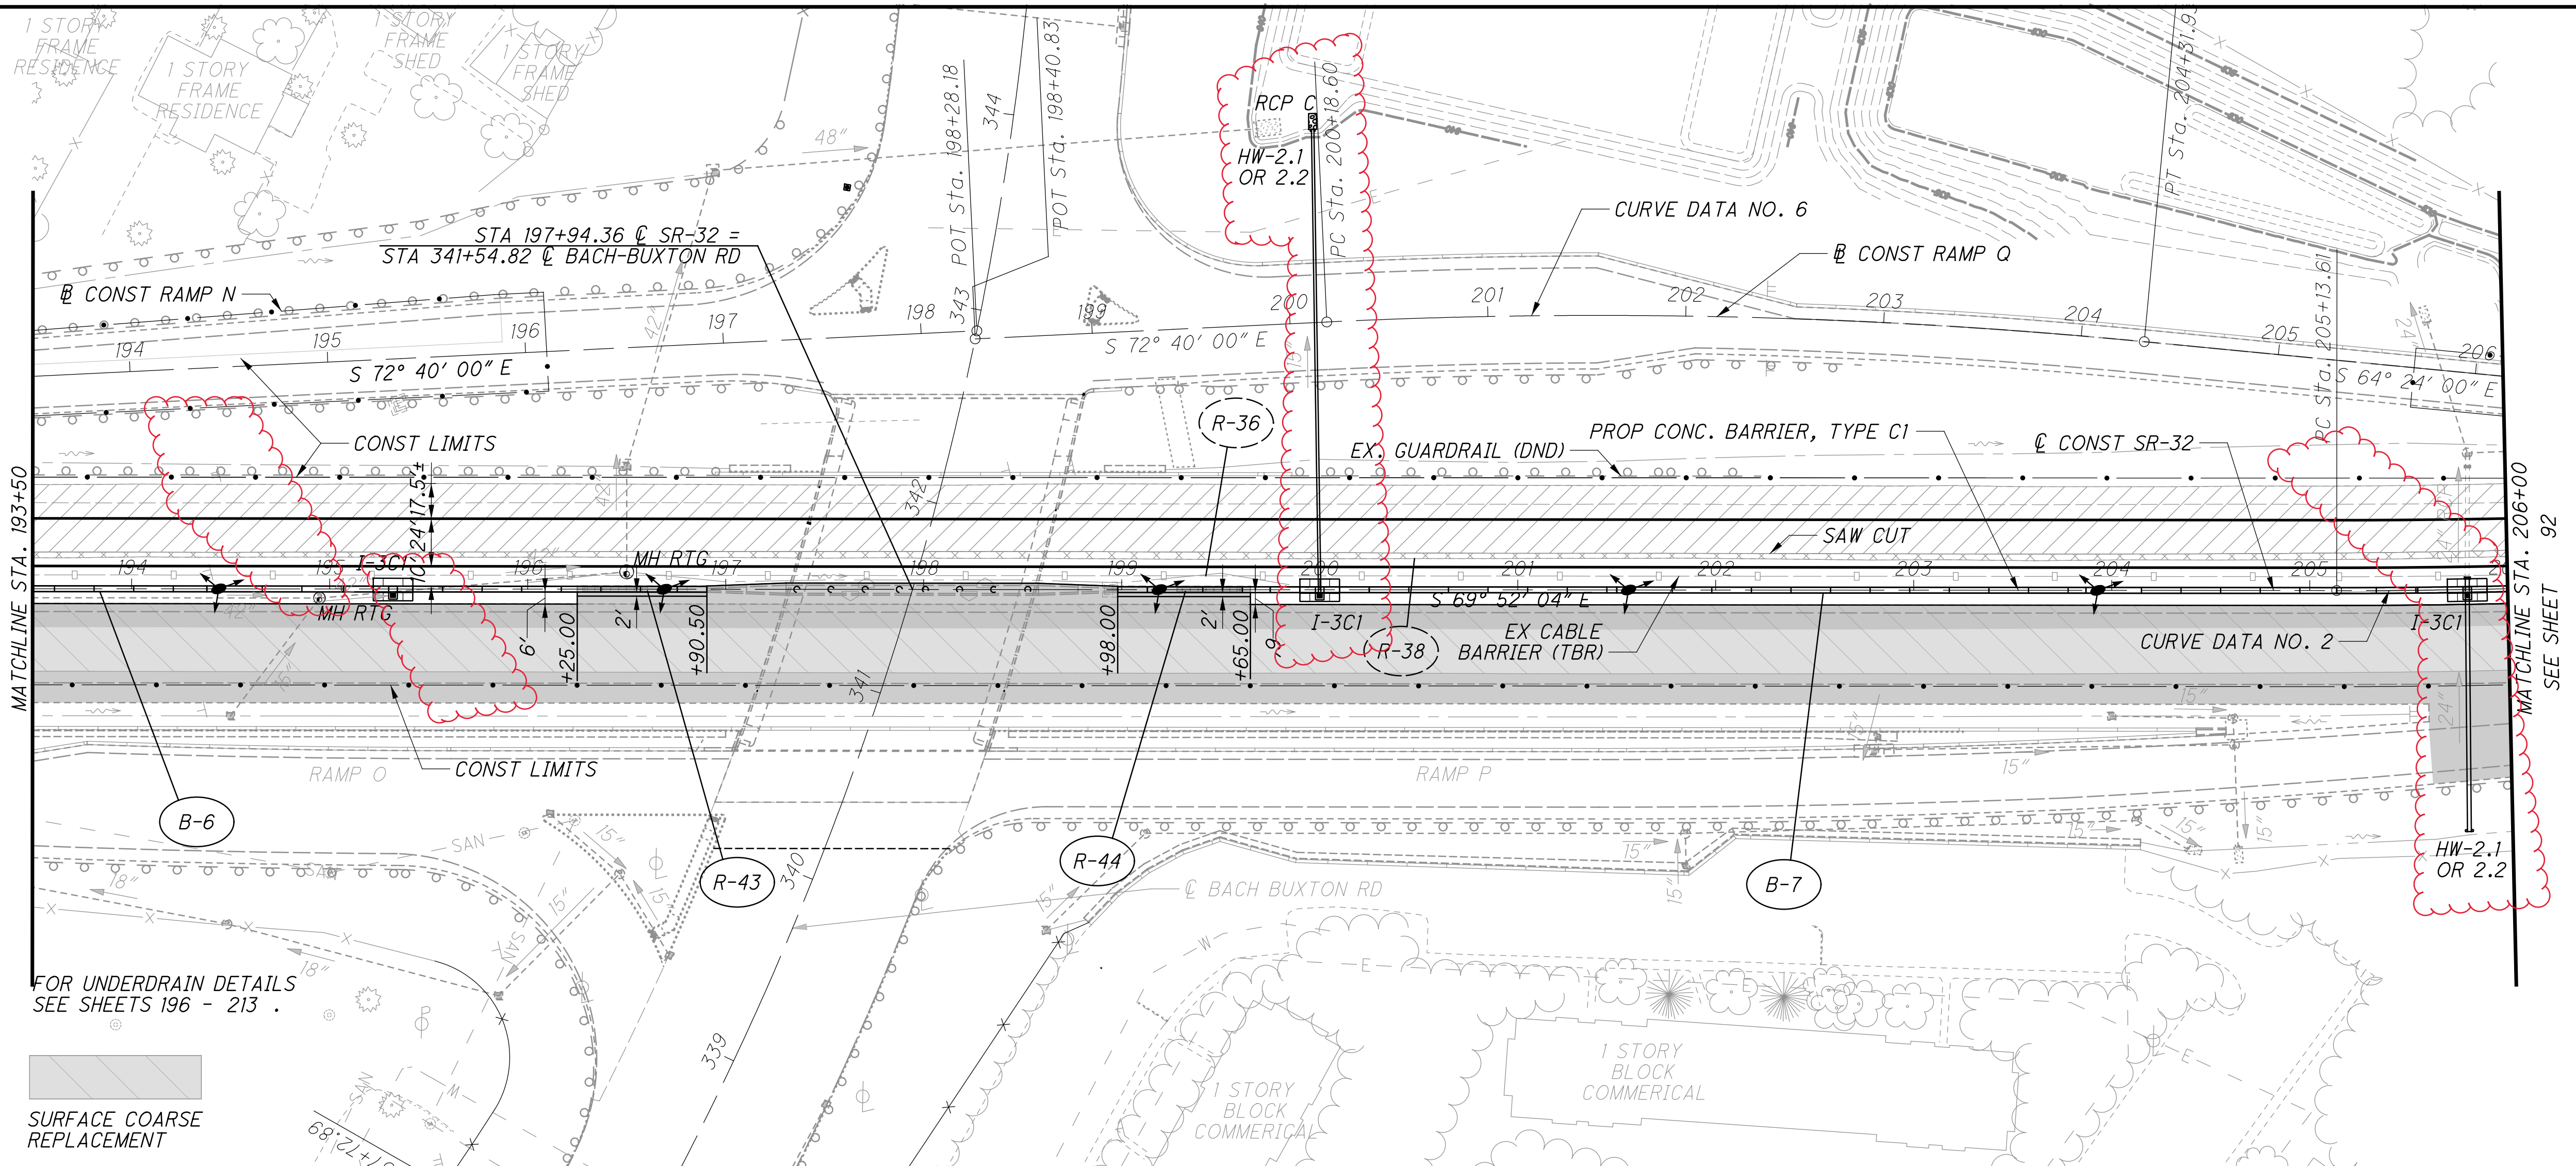

CALCULATED
 GAAH
 CHECKED
 WAA

**PLAN AND PROFILE - SR-32
 STA 193+50 TO STA 206+00**


**CLE-32-2.65
 (PHASE 7)**

...303.207\103956_GP707.dgn 11/19/2021 3:35:31 PM mshwhitt

SR-32
 CURVE DATA NO. 2
 P.I. Sta. 205+82.41
 $\Delta = 2^\circ 03' 49''$ (LT)
 $Dc = 1^\circ 30' 00''$
 $R = 3,819.74'$
 $T = 68.80'$
 $L = 137.58'$
 $E = 0.62'$
 $e_{max} = 0.037$
 PC Sta. 205+13.61
 PCC Sta. 206+51.19

SR-32
 CURVE DATA NO. 3
 P.I. Sta. 209+99.75
 $\Delta = 13^\circ 55' 35''$ (LT)
 $Dc = 2^\circ 00' 27''$
 $R = 2,854.00'$
 $T = 348.57'$
 $L = 693.70'$
 $E = 21.21'$
 $e_{max} = 0.045$
 PCC Sta. 206+51.19
 PCC Sta. 213+44.89

SR-32
 CURVE DATA NO. 4
 P.I. Sta. 214+11.75
 $\Delta = 2^\circ 00' 21''$ (LT)
 $Dc = 1^\circ 30' 00''$
 $R = 3,819.74'$
 $T = 66.86'$
 $L = 133.72'$
 $E = 0.59'$
 $e_{max} = 0.037$
 PCC Sta. 213+44.89
 PT Sta. 214+78.60
 $e_{max} = 0.060$
 PC Sta. 206+98.46
 PT Sta. 212+66.69

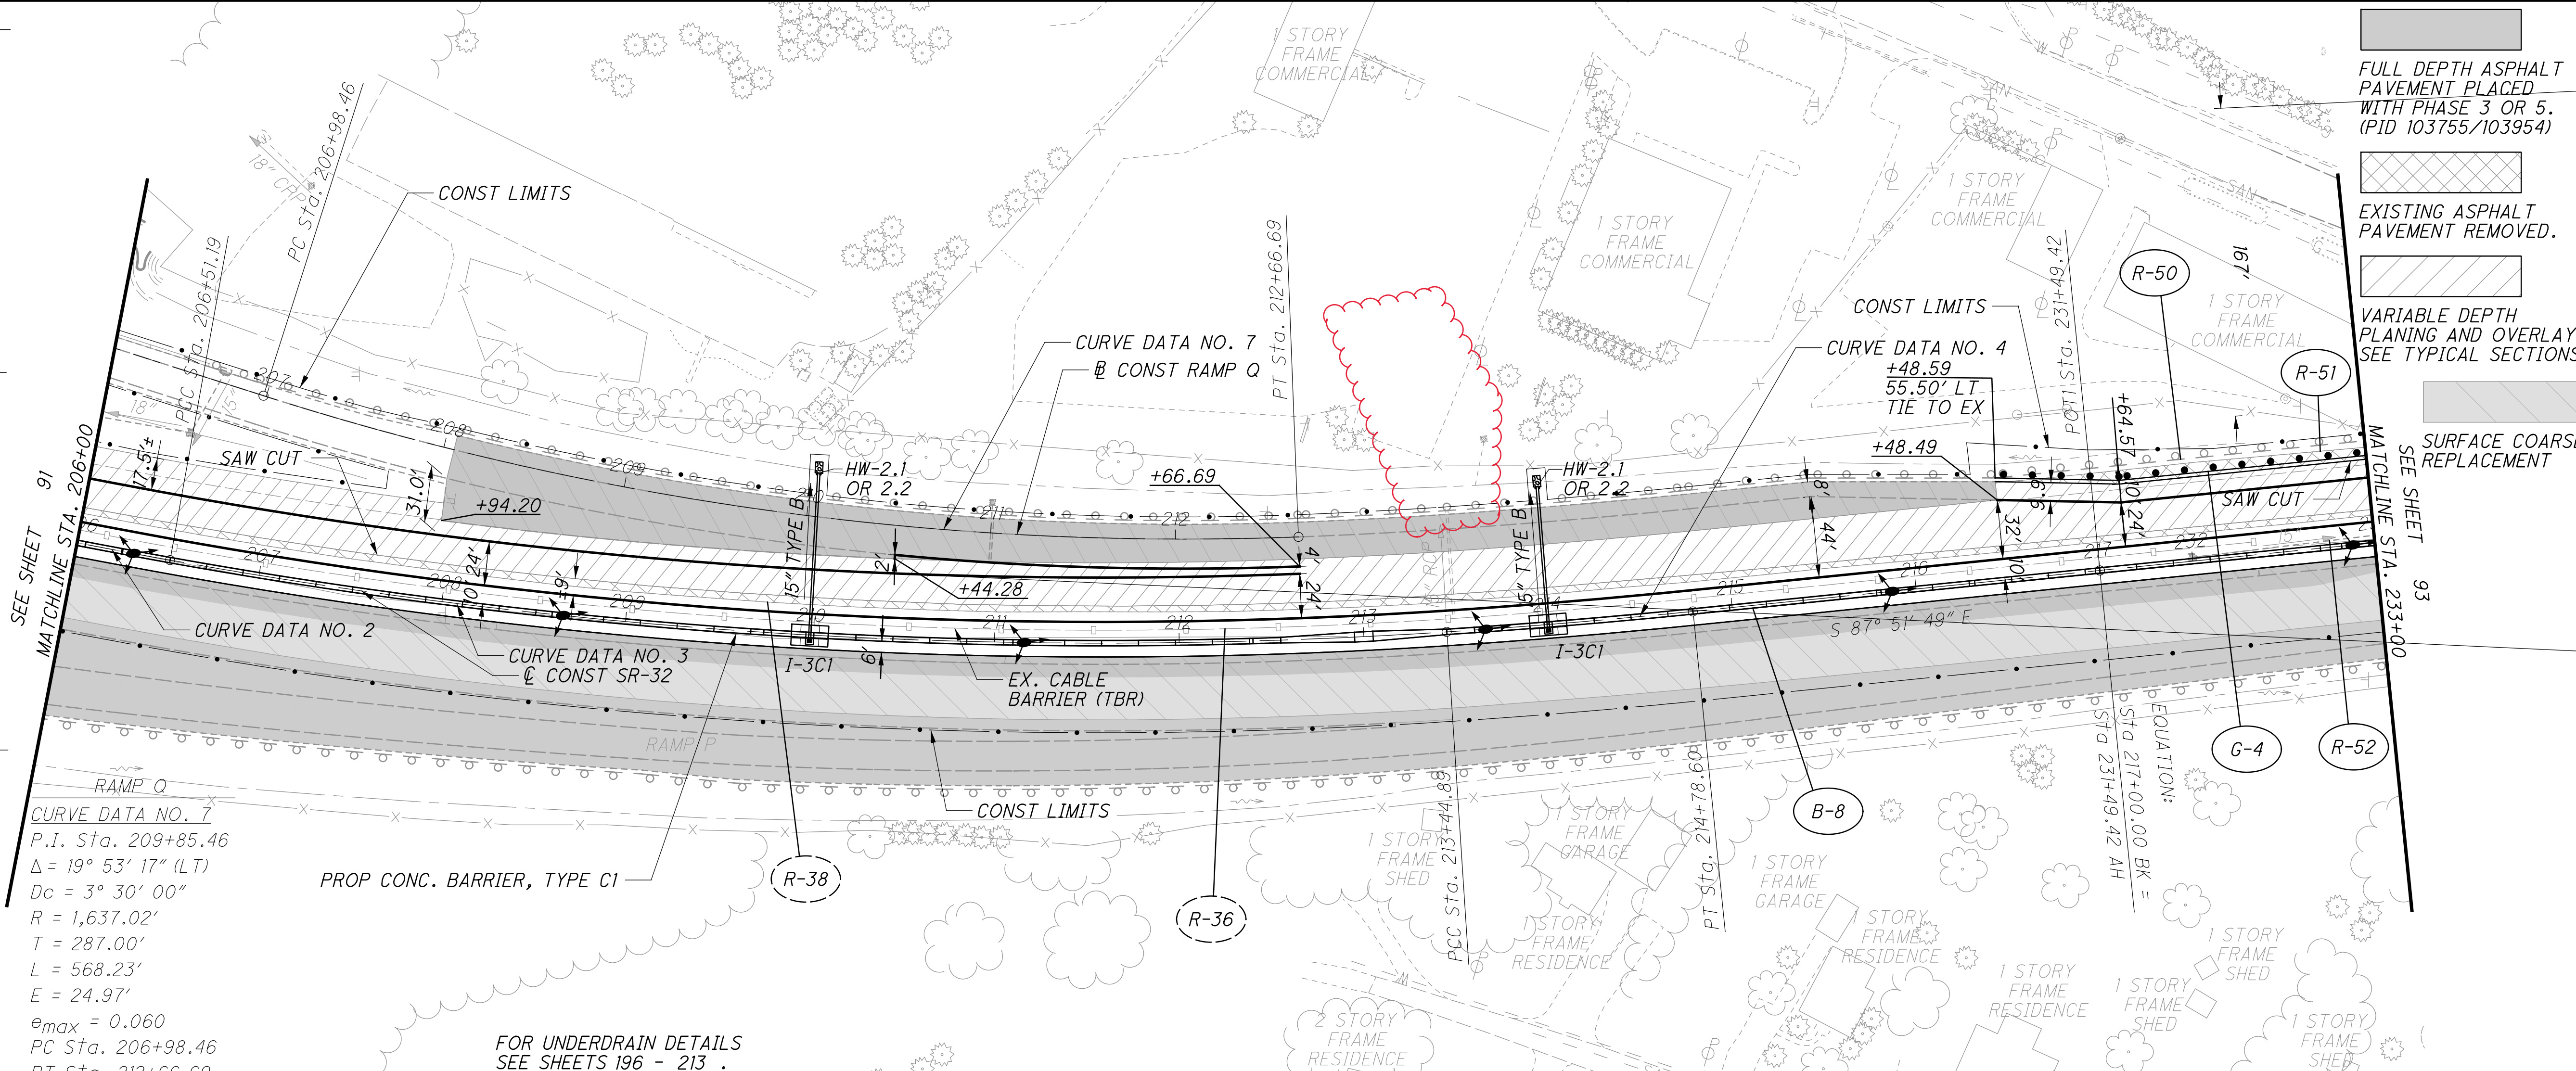


FULL DEPTH ASPHALT PAVEMENT PLACED WITH PHASE 3 OR 5. (PID 103755/103954)


EXISTING ASPHALT PAVEMENT REMOVED.

VARIABLE DEPTH PLANING AND OVERLAY. SEE TYPICAL SECTIONS.

SURFACE COARSE REPLACEMENT

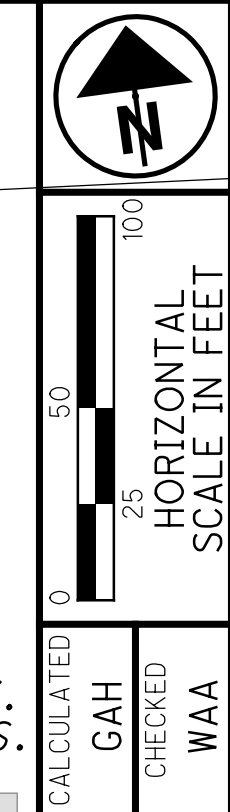

FOR UNDERDRAIN DETAILS SEE SHEETS 196 - 213

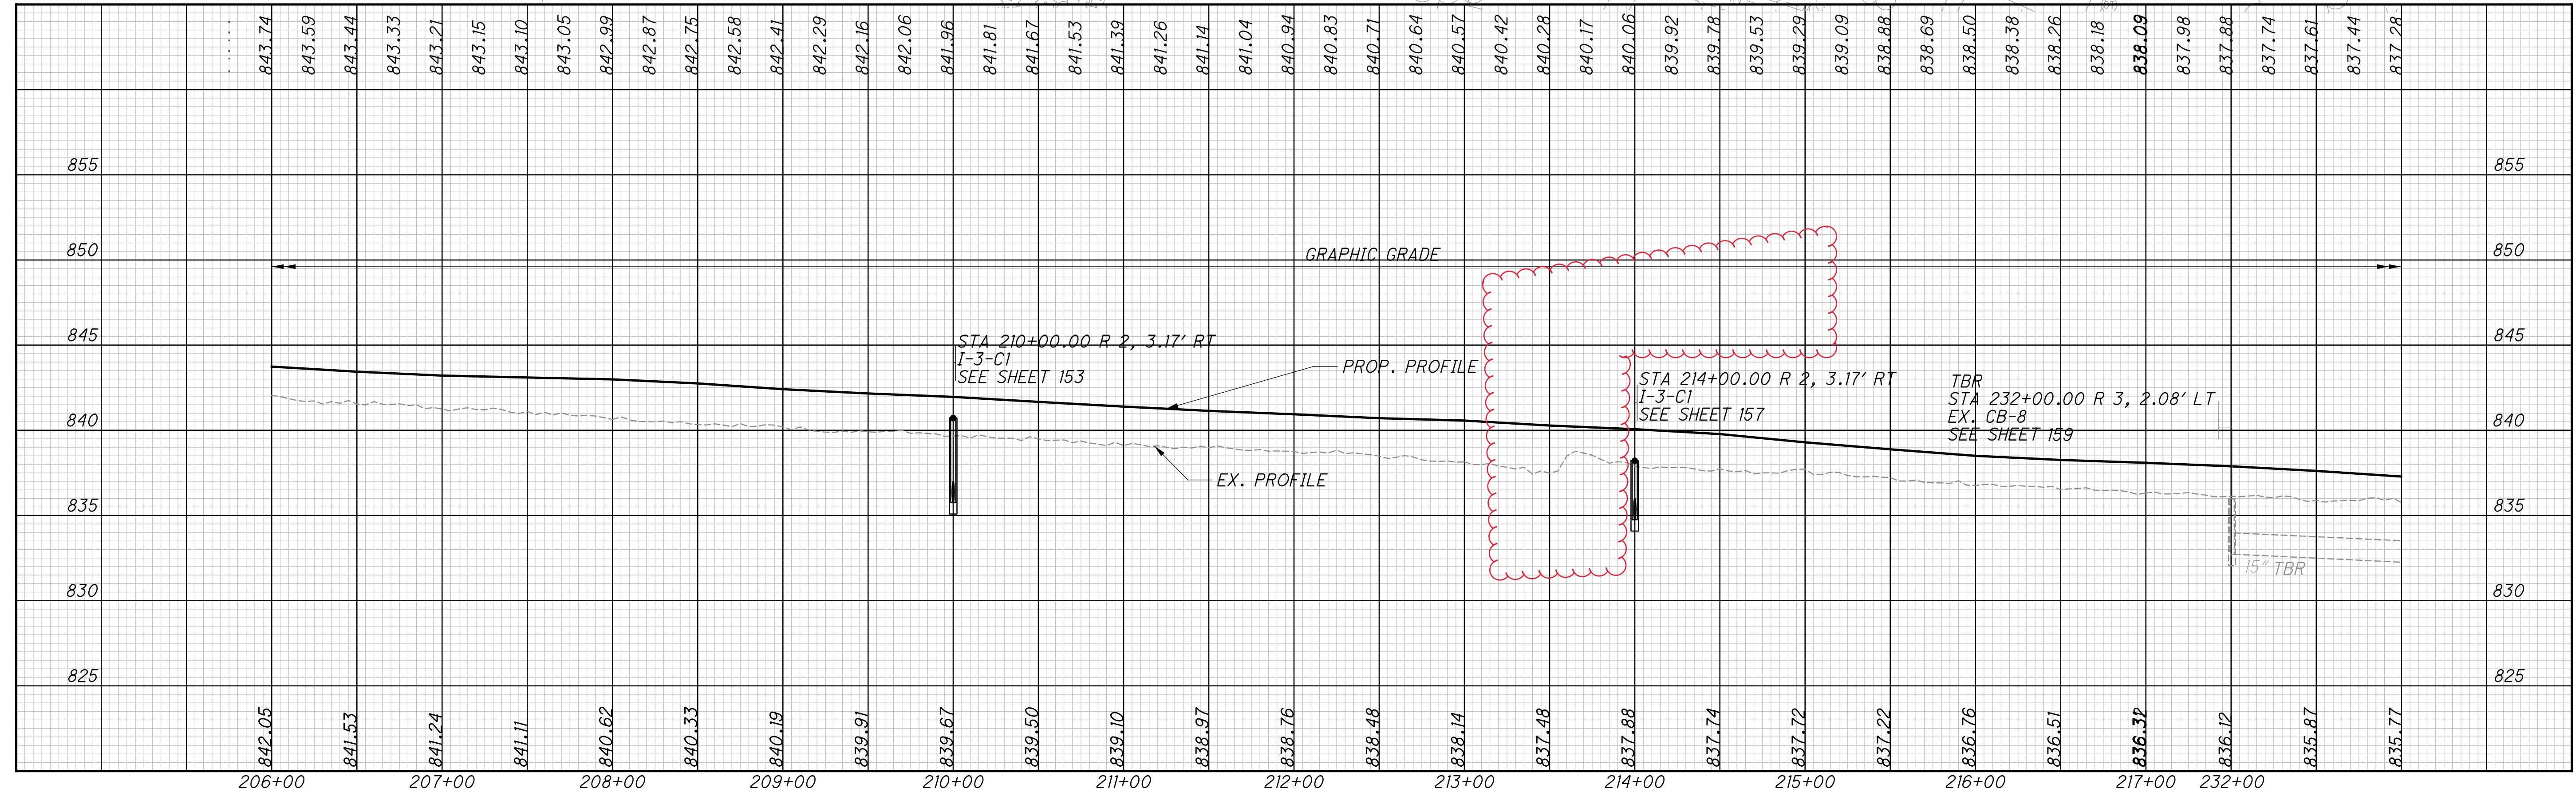


PLAN AND PROFILE - SR-32
 STA. 206+00 TO STA 233+00

CLE-32-2.65
 (PHASE 7)

...303.207\103956_XS701L_1.dgn 11/19/2021 3:40:21 PM mswwhitt

| SEEDING | |
|-----------|----------|
| END WIDTH | SO. YDS. |
| 26 | 110 |
| 101 | 100 |
| 10 | 90 |
| 50 | 80 |
| 8 | 70 |
| 44 | 60 |
| 8 | 50 |
| 195 | 40 |
| | 30 |
| | 20 |
| | 10 |
| | 0 |
| | 10 |
| | 20 |
| | 30 |
| | 40 |
| | 50 |
| | 60 |
| | 70 |
| | 80 |
| | 90 |
| | 100 |
| | 110 |

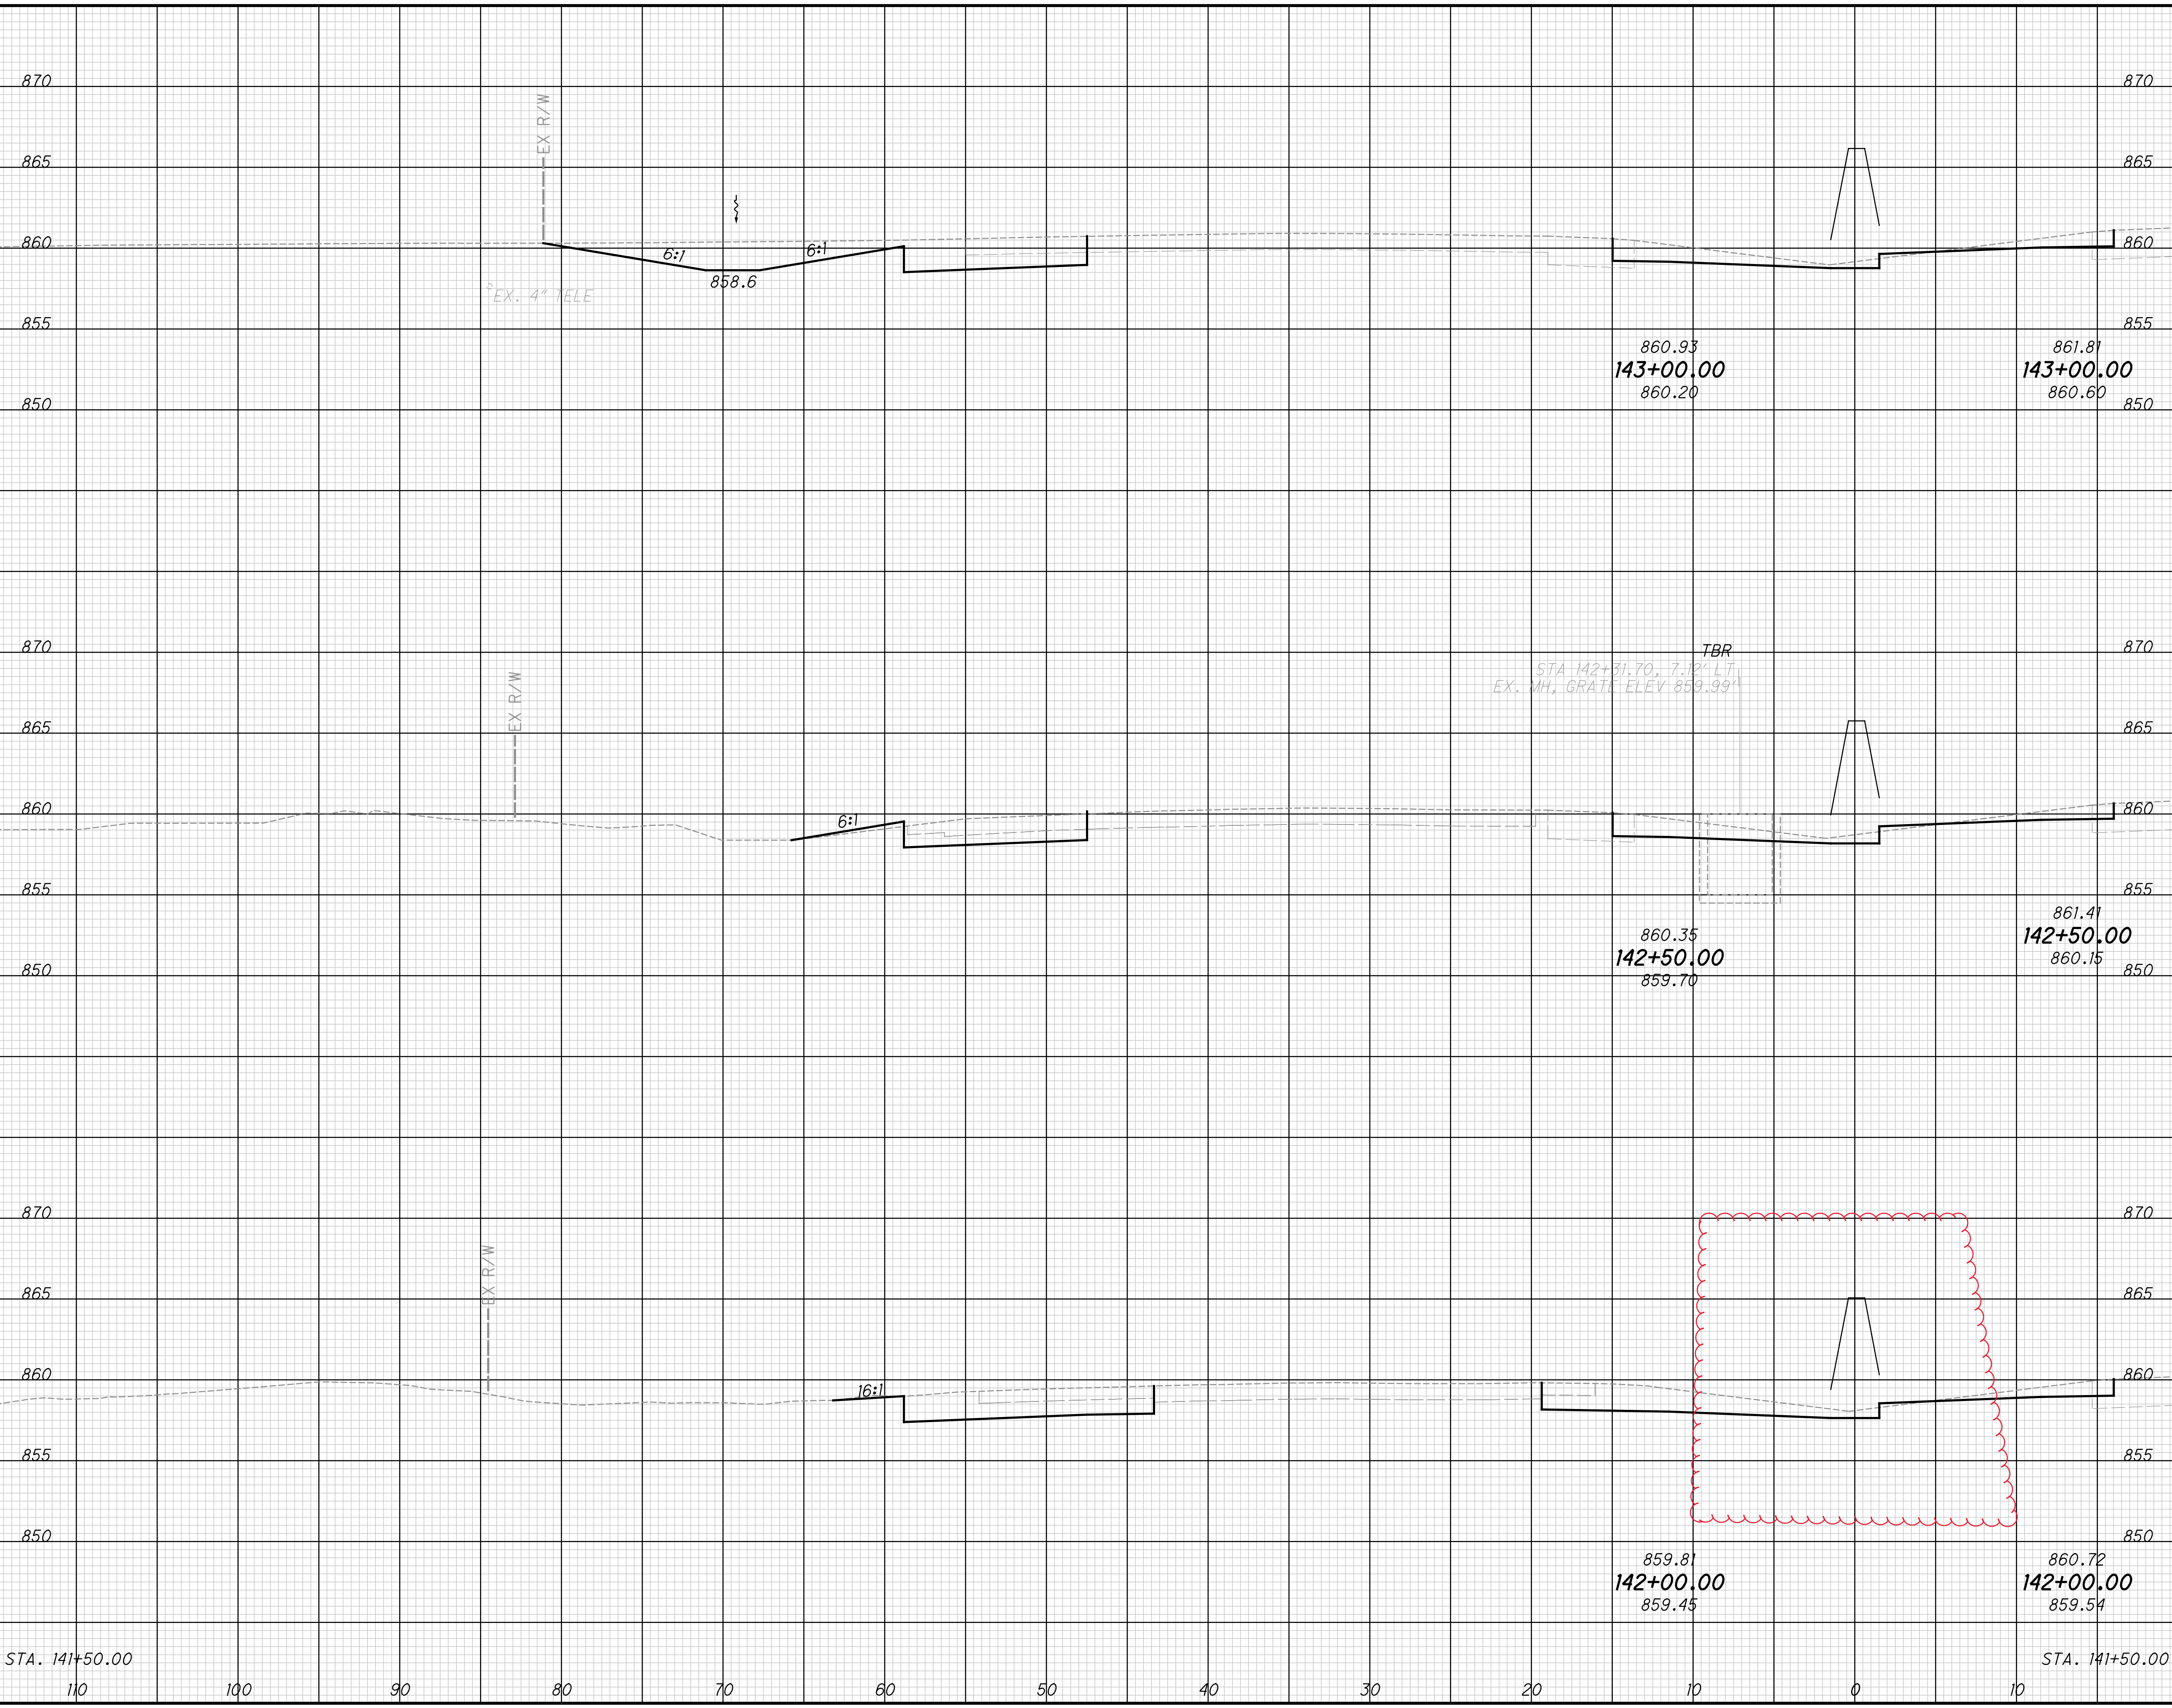


| END AREA | | VOLUME | |
|----------|------|--------|------|
| CUT | FILL | CUT | FILL |
| 52 | 2 | 69 | 5 |
| 23 | 3 | 62 | 4 |
| 44 | 1 | 99 | 2 |
| 63 | 1 | 230 | 11 |

CROSS SECTIONS SR-32 LT
STA. 142+00.00 TO STA. 143+00.00
CLE-32-2.65
(PHASE 7)

CALCULATED
 GAH
 CHECKED
 WAA

102
 316

...303.207\103956_XS701L_1.dgn 11/19/2021 3:40:22 PM mswhtt

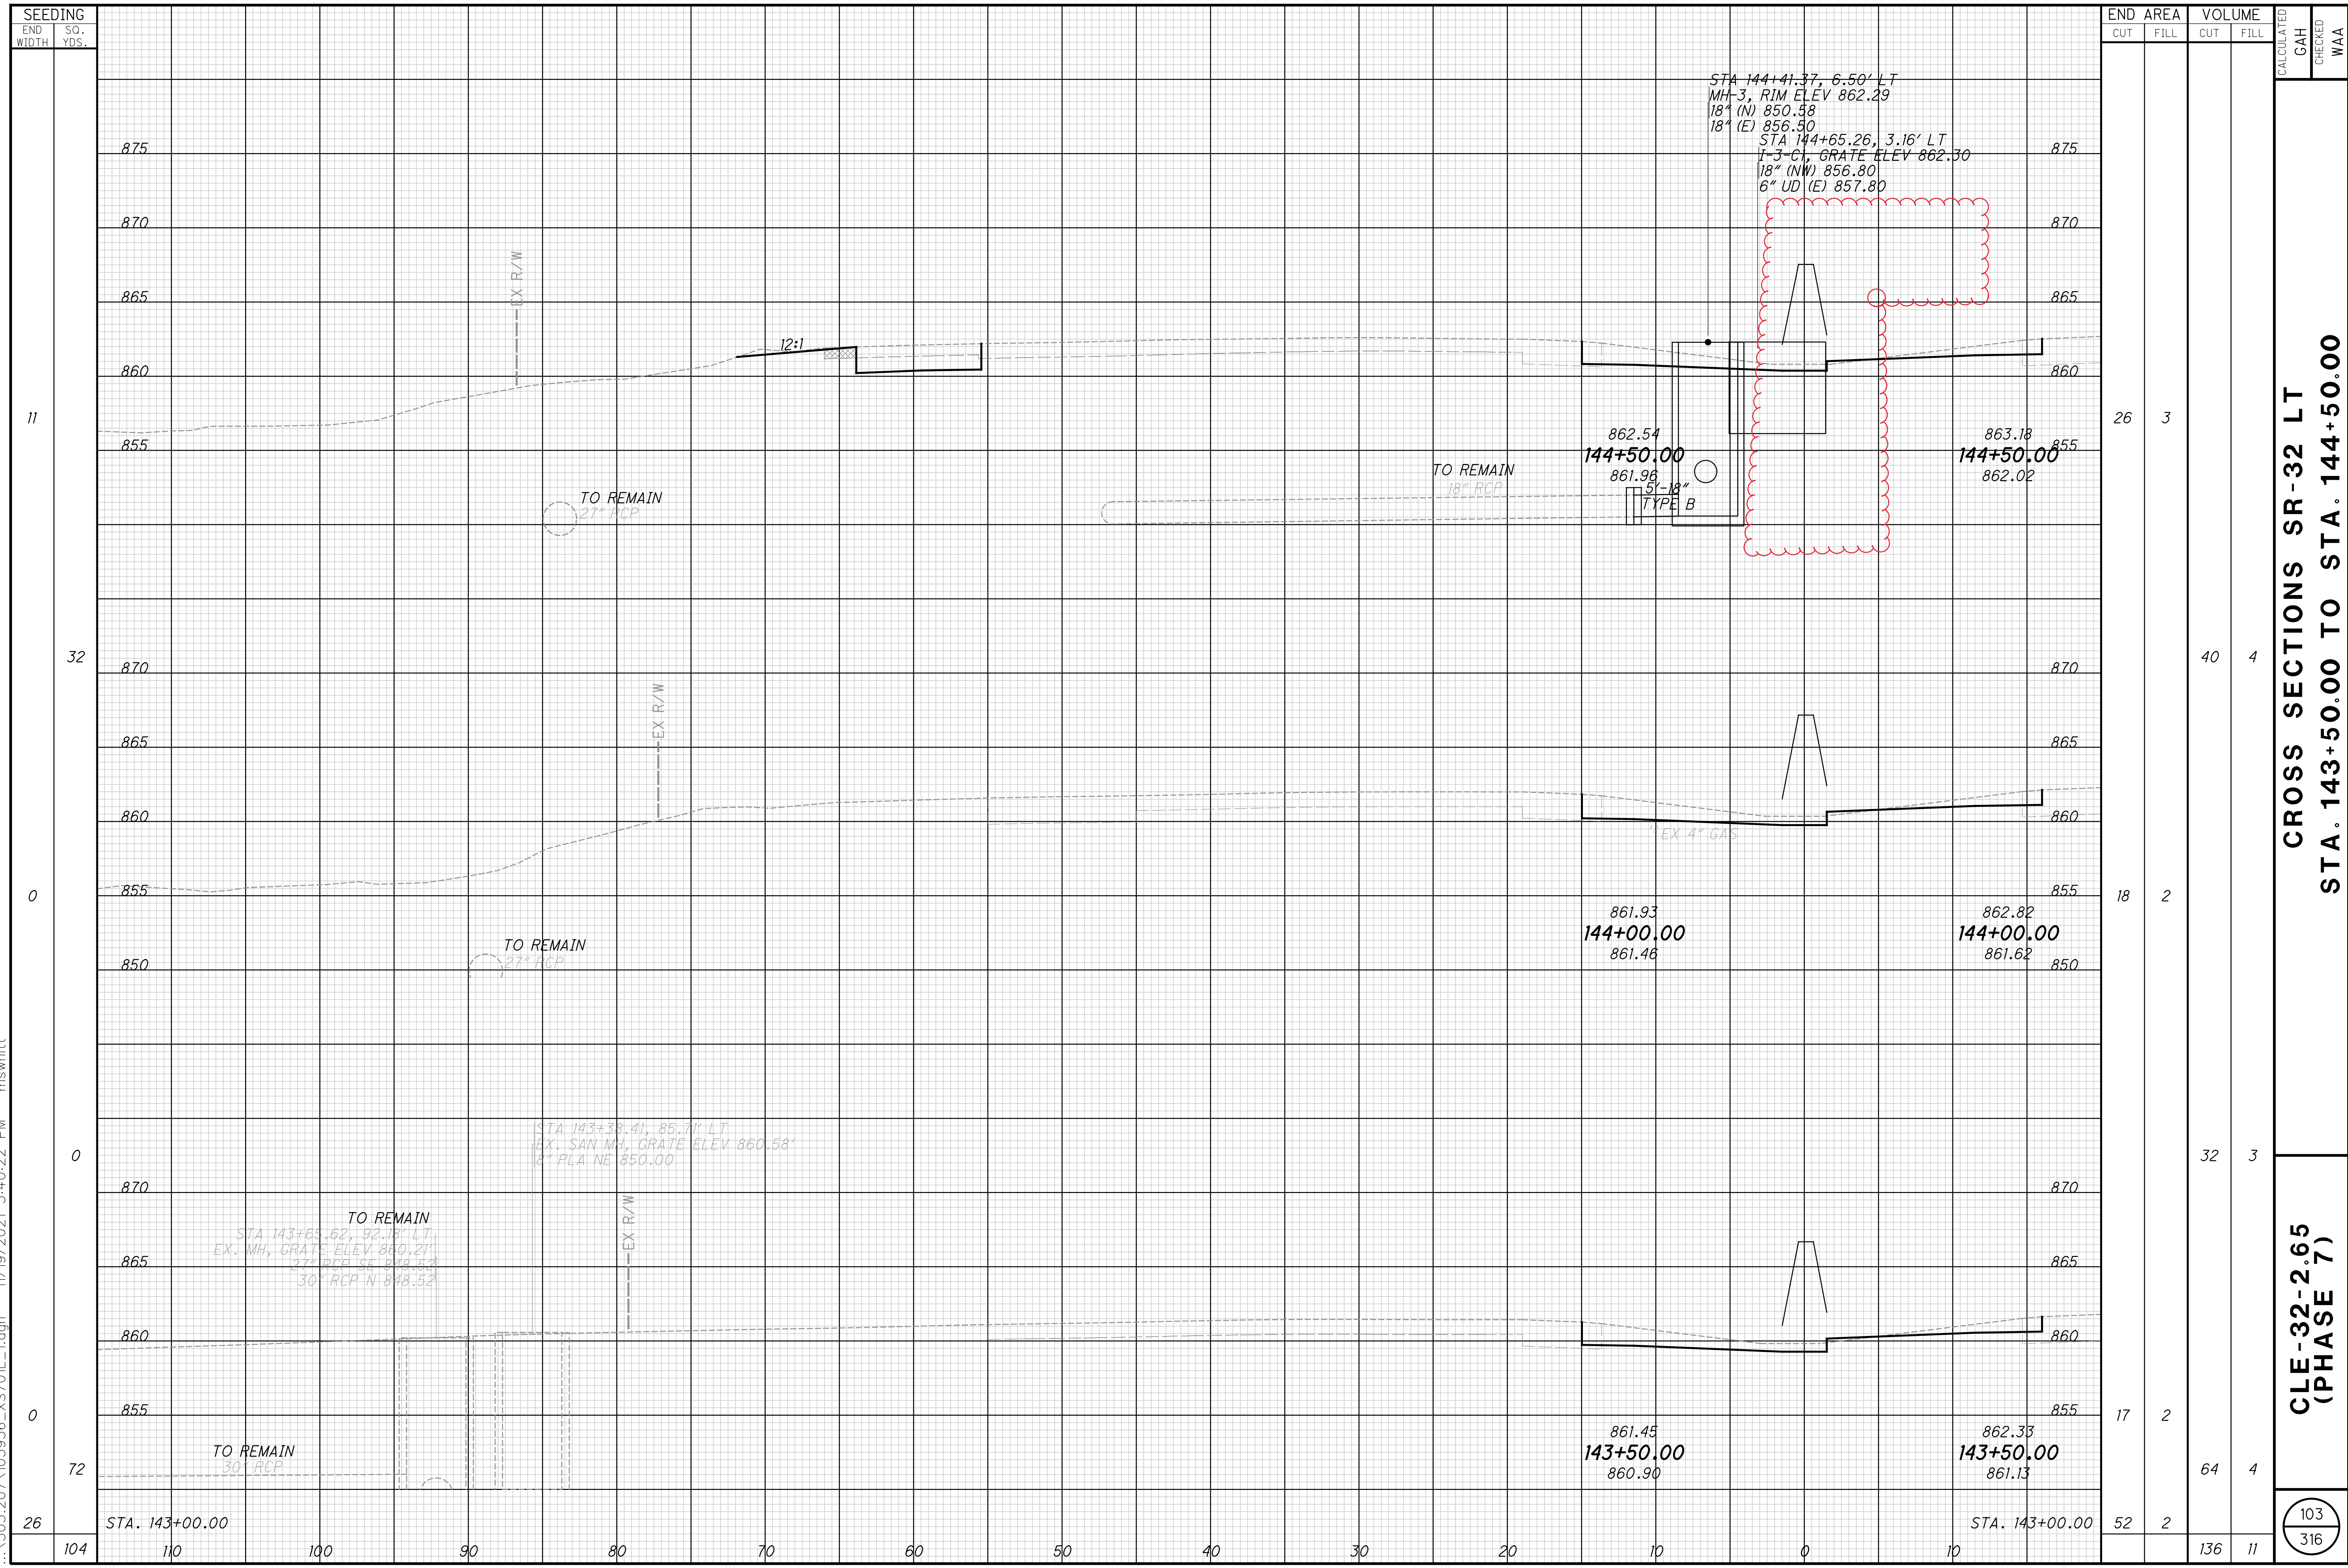

| SEEDING | END AREA | | VOLUME | | CALCULATED | CHECKED |
|---------|-----------|----------|--------|------|------------|---------|
| | END WIDTH | SO. YDS. | CUT | FILL | | |
| 11 | | | 26 | 3 | | |
| 32 | | | 40 | 4 | | |
| 0 | | | 18 | 2 | | |
| 0 | | | 32 | 3 | | |
| 0 | | | 17 | 2 | | |
| 72 | | | 64 | 4 | | |
| 26 | | | 52 | 2 | | |
| 104 | 110 | 100 | 136 | 11 | | |


CROSS SECTIONS SR-32 LT
STA. 143+50.00 TO STA. 144+50.00

CLE-32-2.65
(PHASE 7)

103
316

...303.207\103956_XS701L_1.dgn 11/19/2021 3:40:58 PM mswhtt

| SEEDING | |
|-----------|----------|
| END WIDTH | SO. YDS. |
| 149 | 100 |
| 10 | 54 |
| 9 | 54 |
| 54 | 9 |
| 10 | 54 |
| 54 | 9 |
| 10 | 54 |
| 9 | 54 |
| 54 | 9 |
| 10 | 54 |

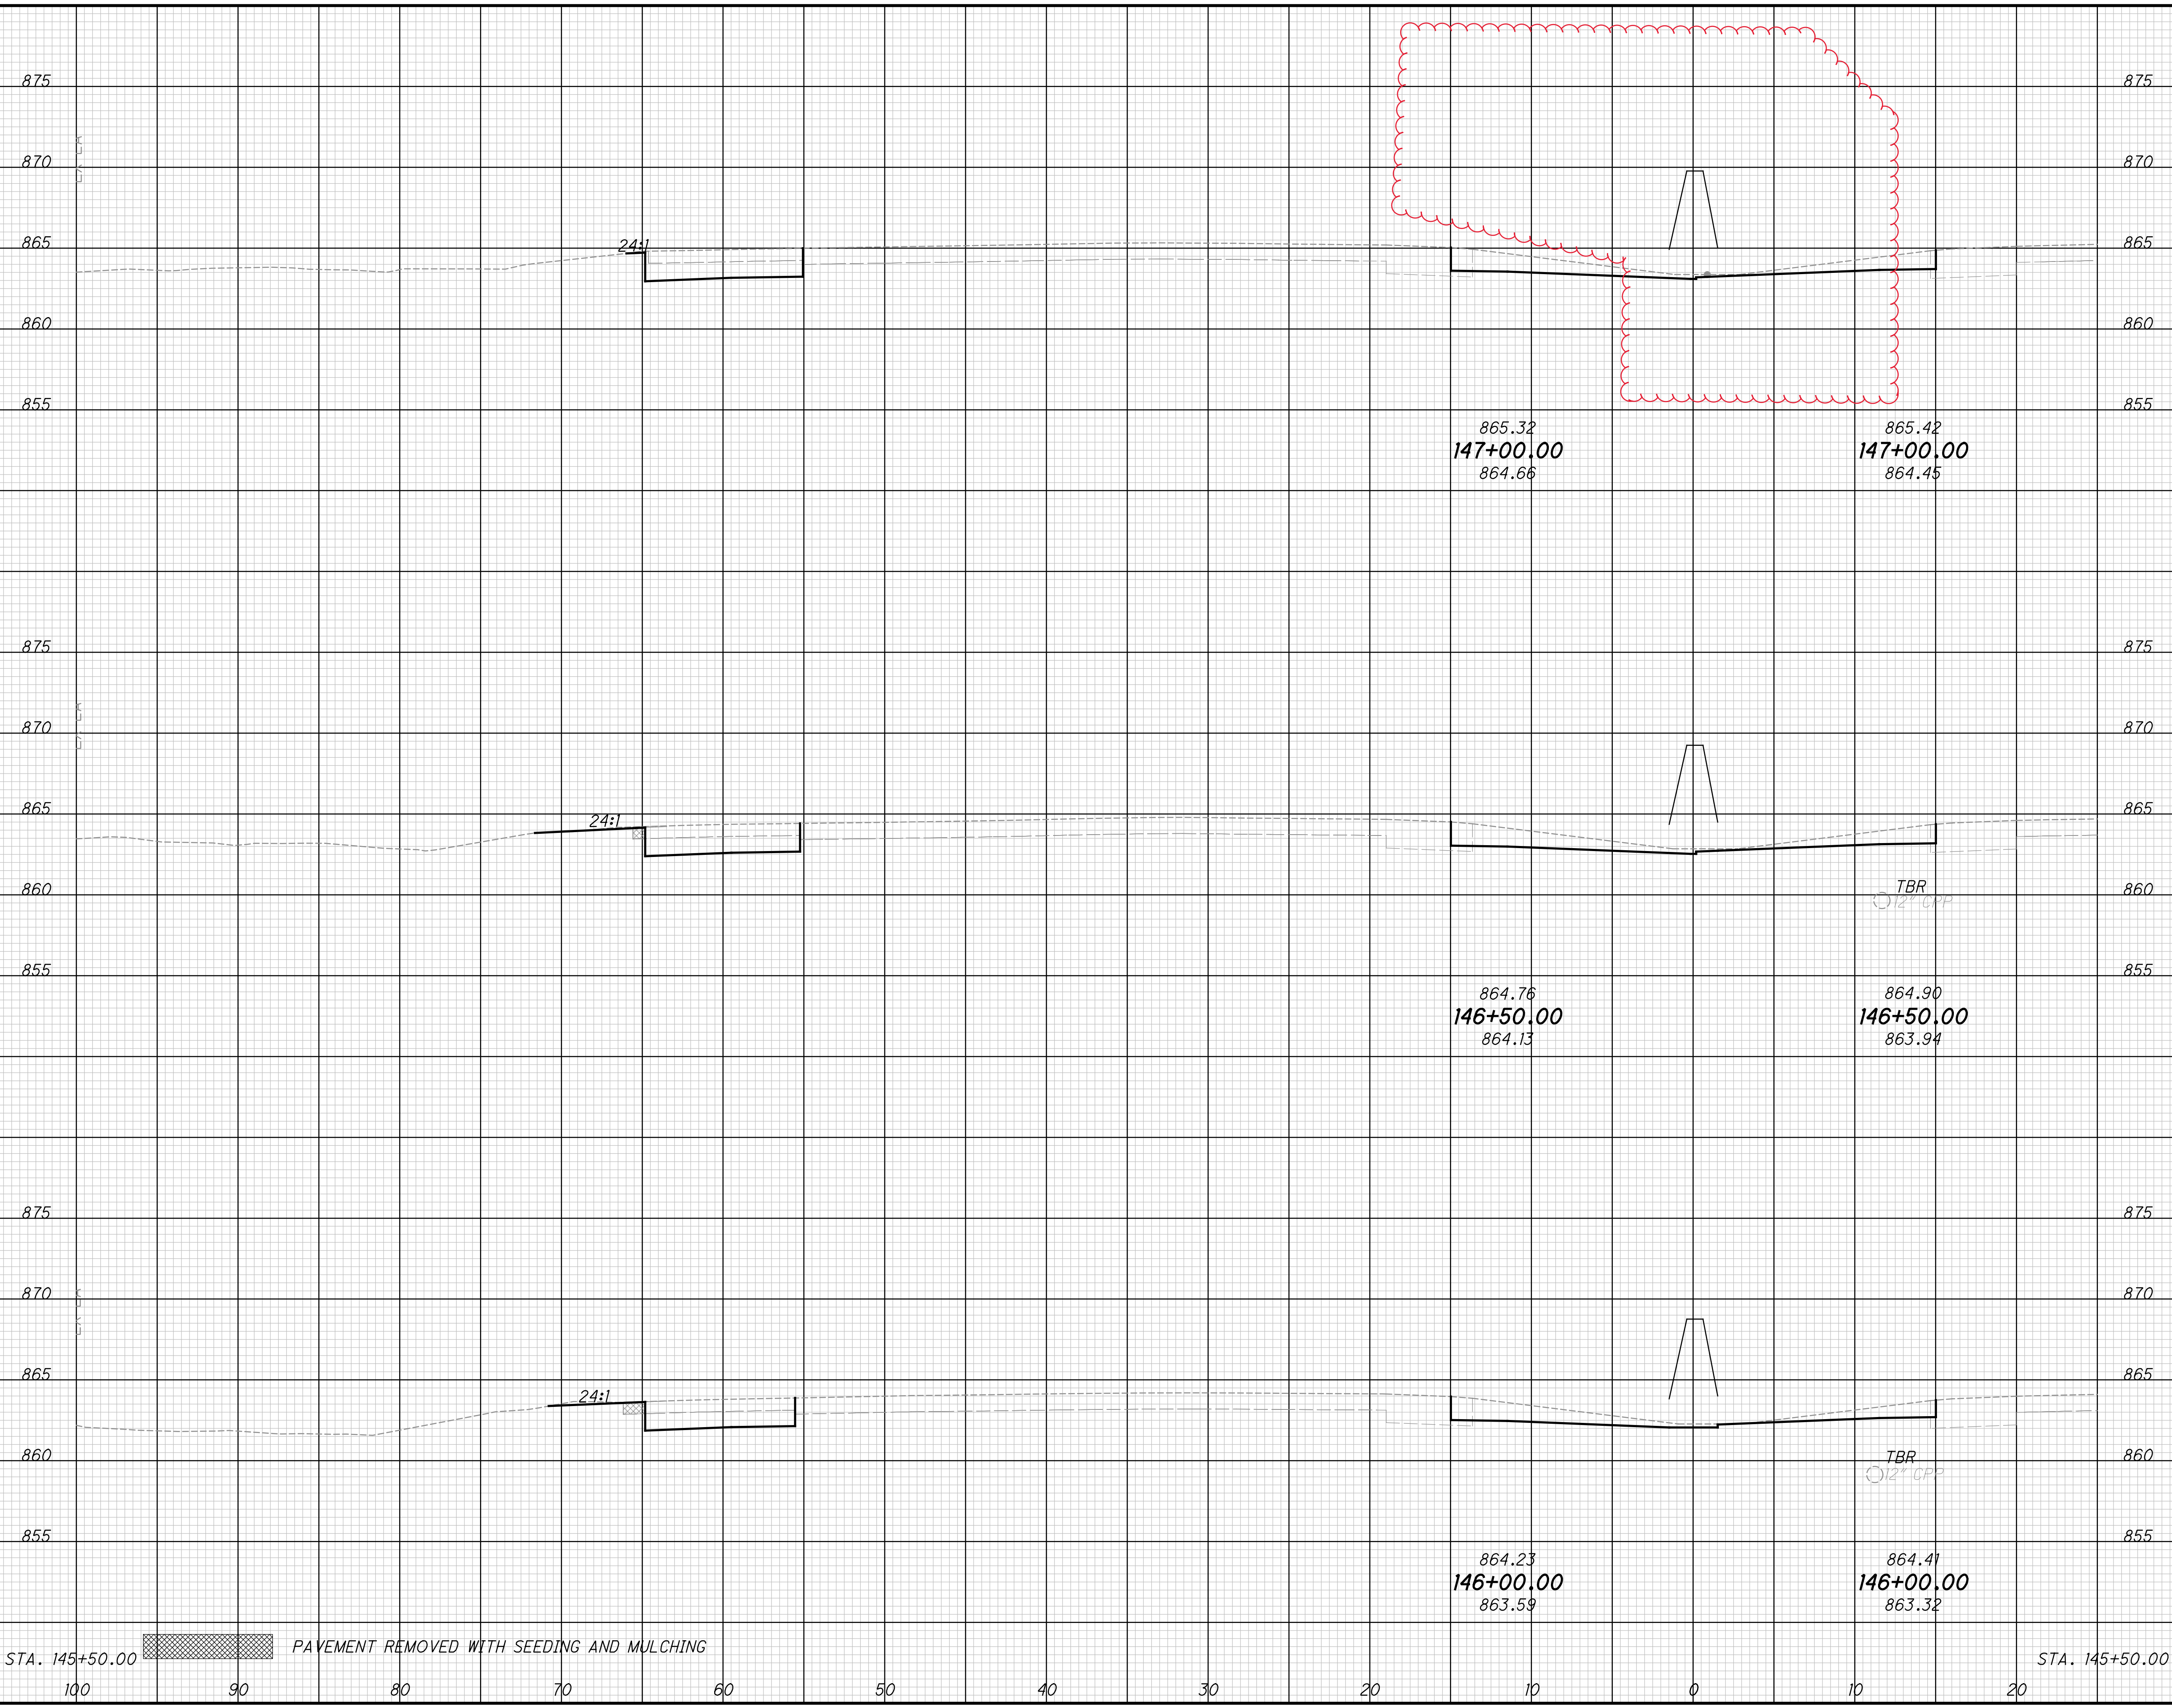

| END AREA | | VOLUME | |
|----------|------|--------|------|
| CUT | FILL | CUT | FILL |
| 27 | 1 | 51 | 2 |
| 28 | 1 | 50 | 3 |
| 26 | 2 | 39 | 4 |
| 17 | 2 | 140 | 9 |


CALCULATED
 GAH
 CHECKED
 WAA

**CROSS SECTIONS SR-32 LT
 STA. 146+00.00 TO STA. 147+00.00**

**CLE-32-2.65
 (PHASE 7)**

105
 316

...303.207\103956_XS701L_1.dgn 11/19/2021 3:44:53 PM mswhtt

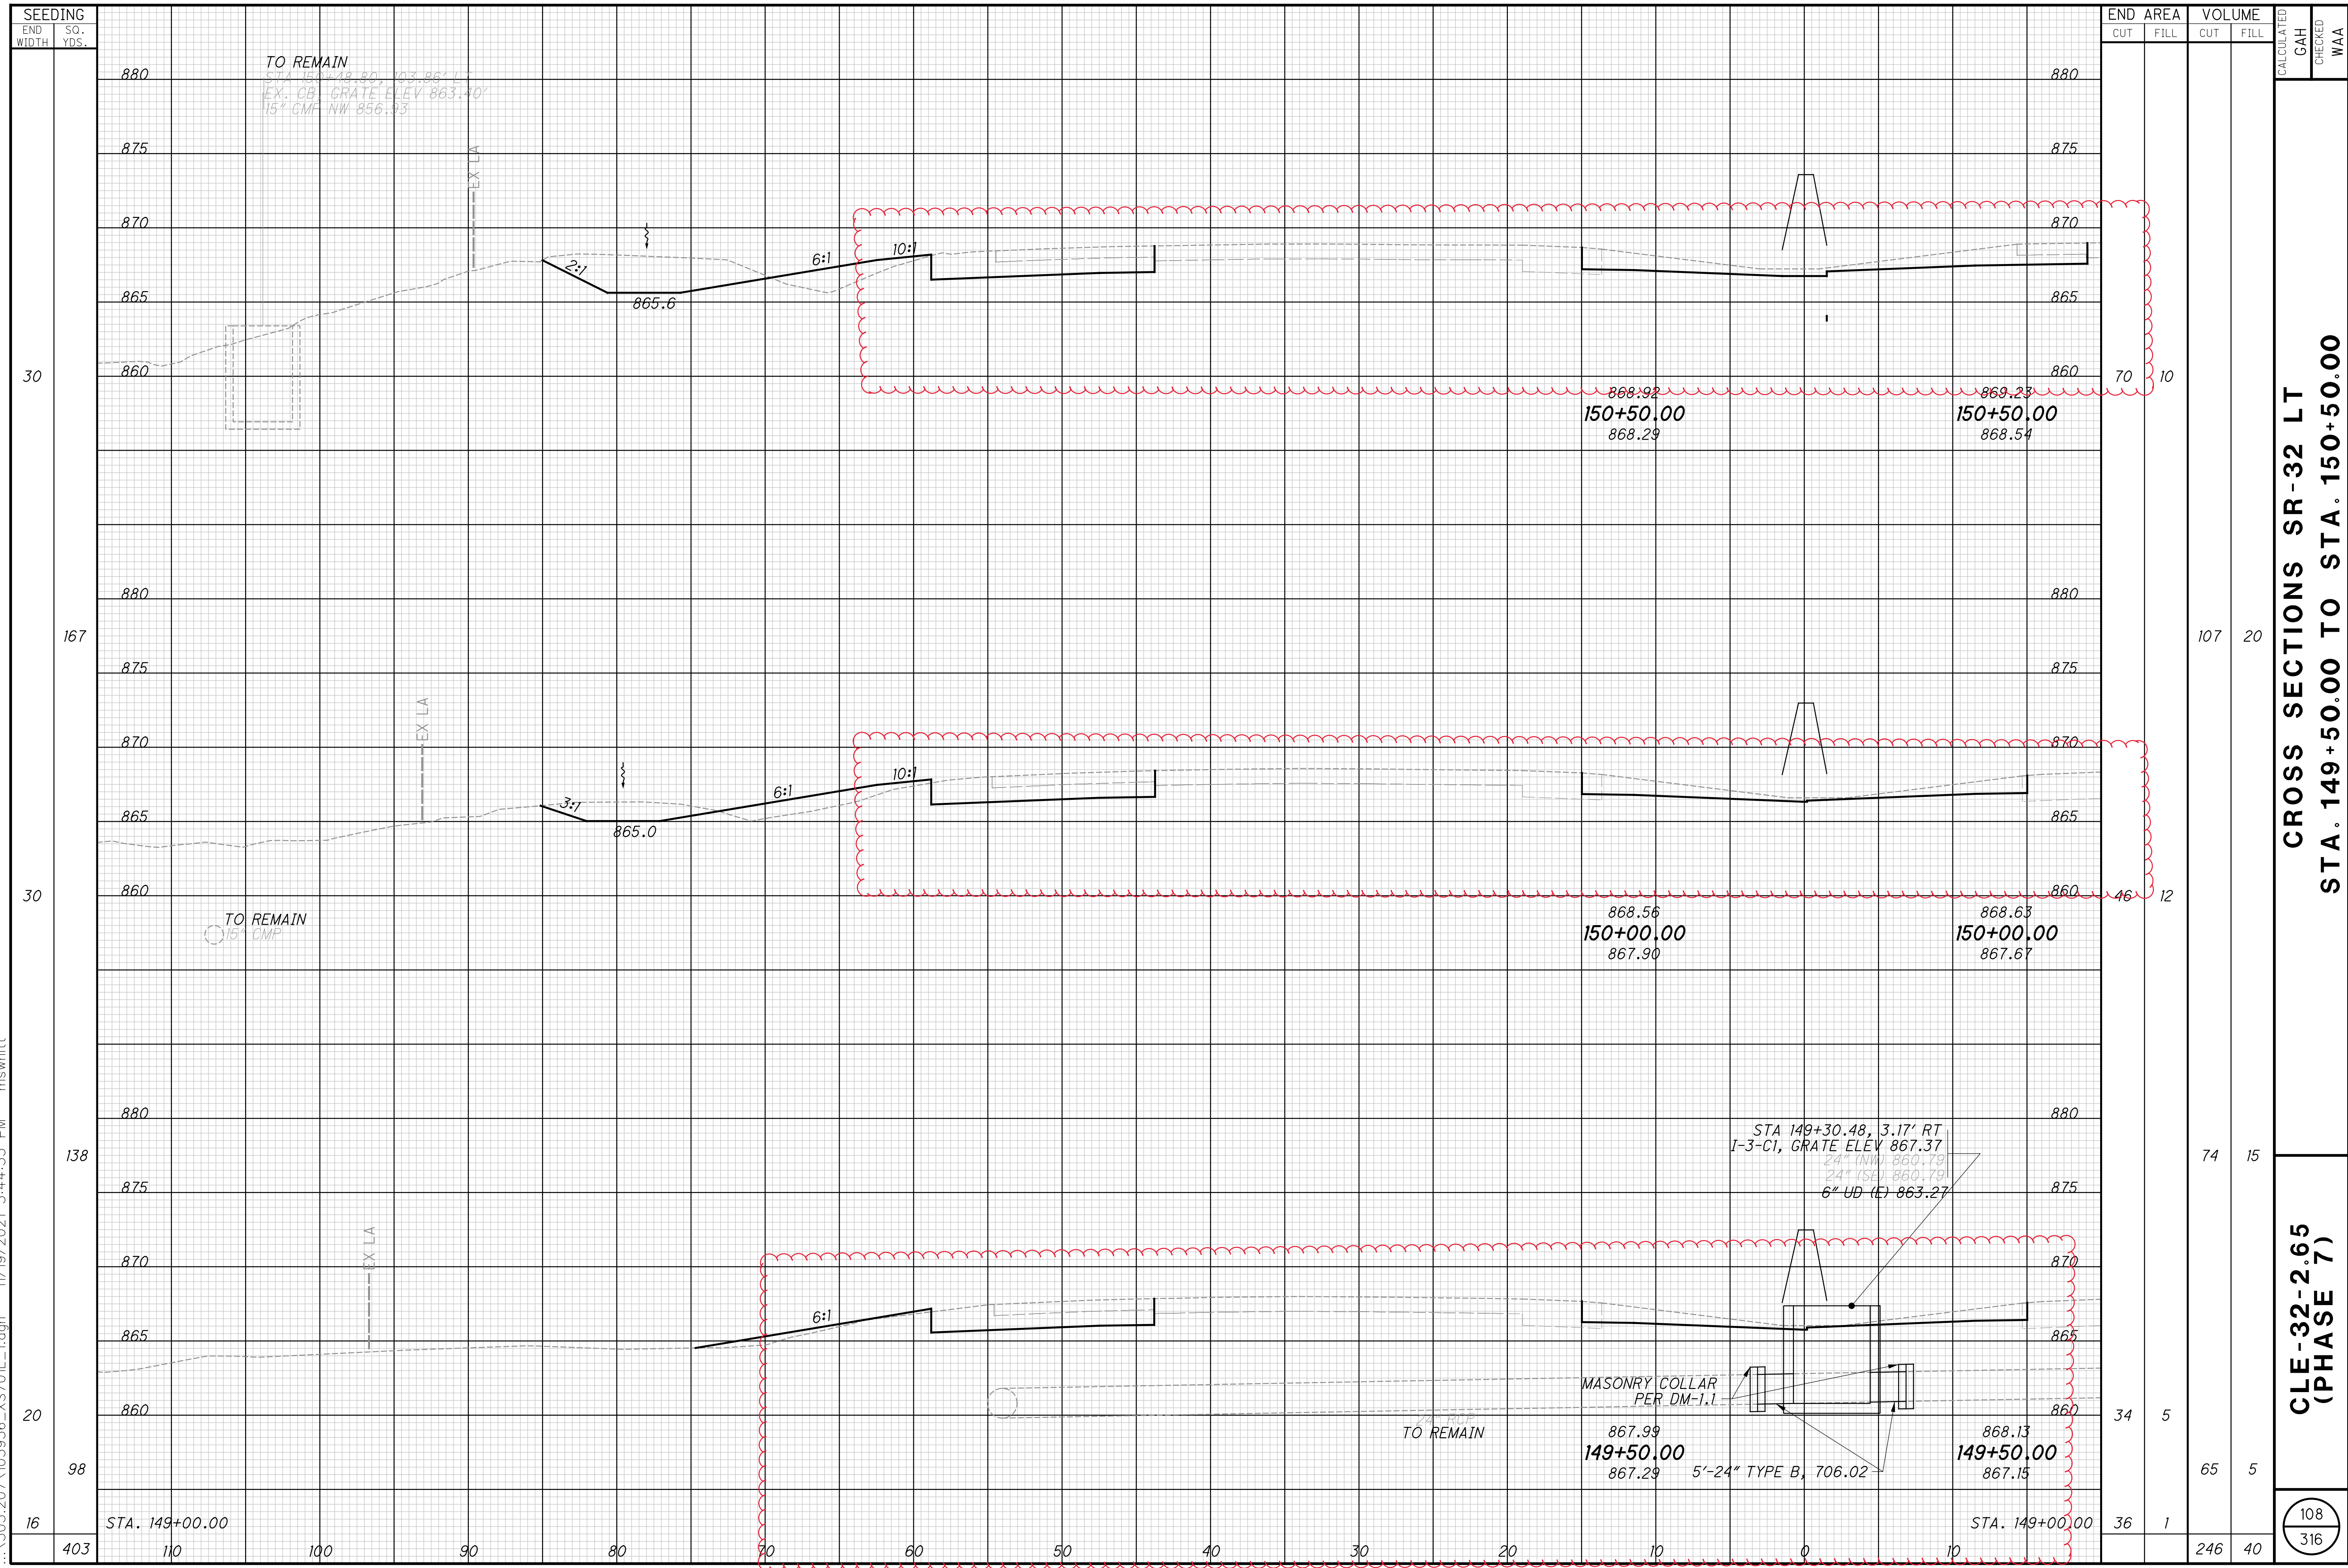

TO REMAIN
 STA. 149+30.48, 3.17' RT
 I-3-CI, GRATE ELEV 863.40'
 15" CMP NW 856.93

TO REMAIN
 15" CMP

STA 149+30.48, 3.17' RT
 I-3-CI, GRATE ELEV 867.37
 24" (NW) 860.79
 24" (SE) 860.79
 6" UD (E) 863.27

MASONRY COLLAR
 PER DM-1.1

TO REMAIN


5'-24" TYPE B, 706.02

CROSS SECTIONS SR-32 LT
 STA. 149+50.00 TO STA. 150+50.00

CLE-32-2.65
 (PHASE 7)

108
 316

...303.207\103956_XS701L_1.dgn 11/19/2021 3:44:53 PM mswhtt

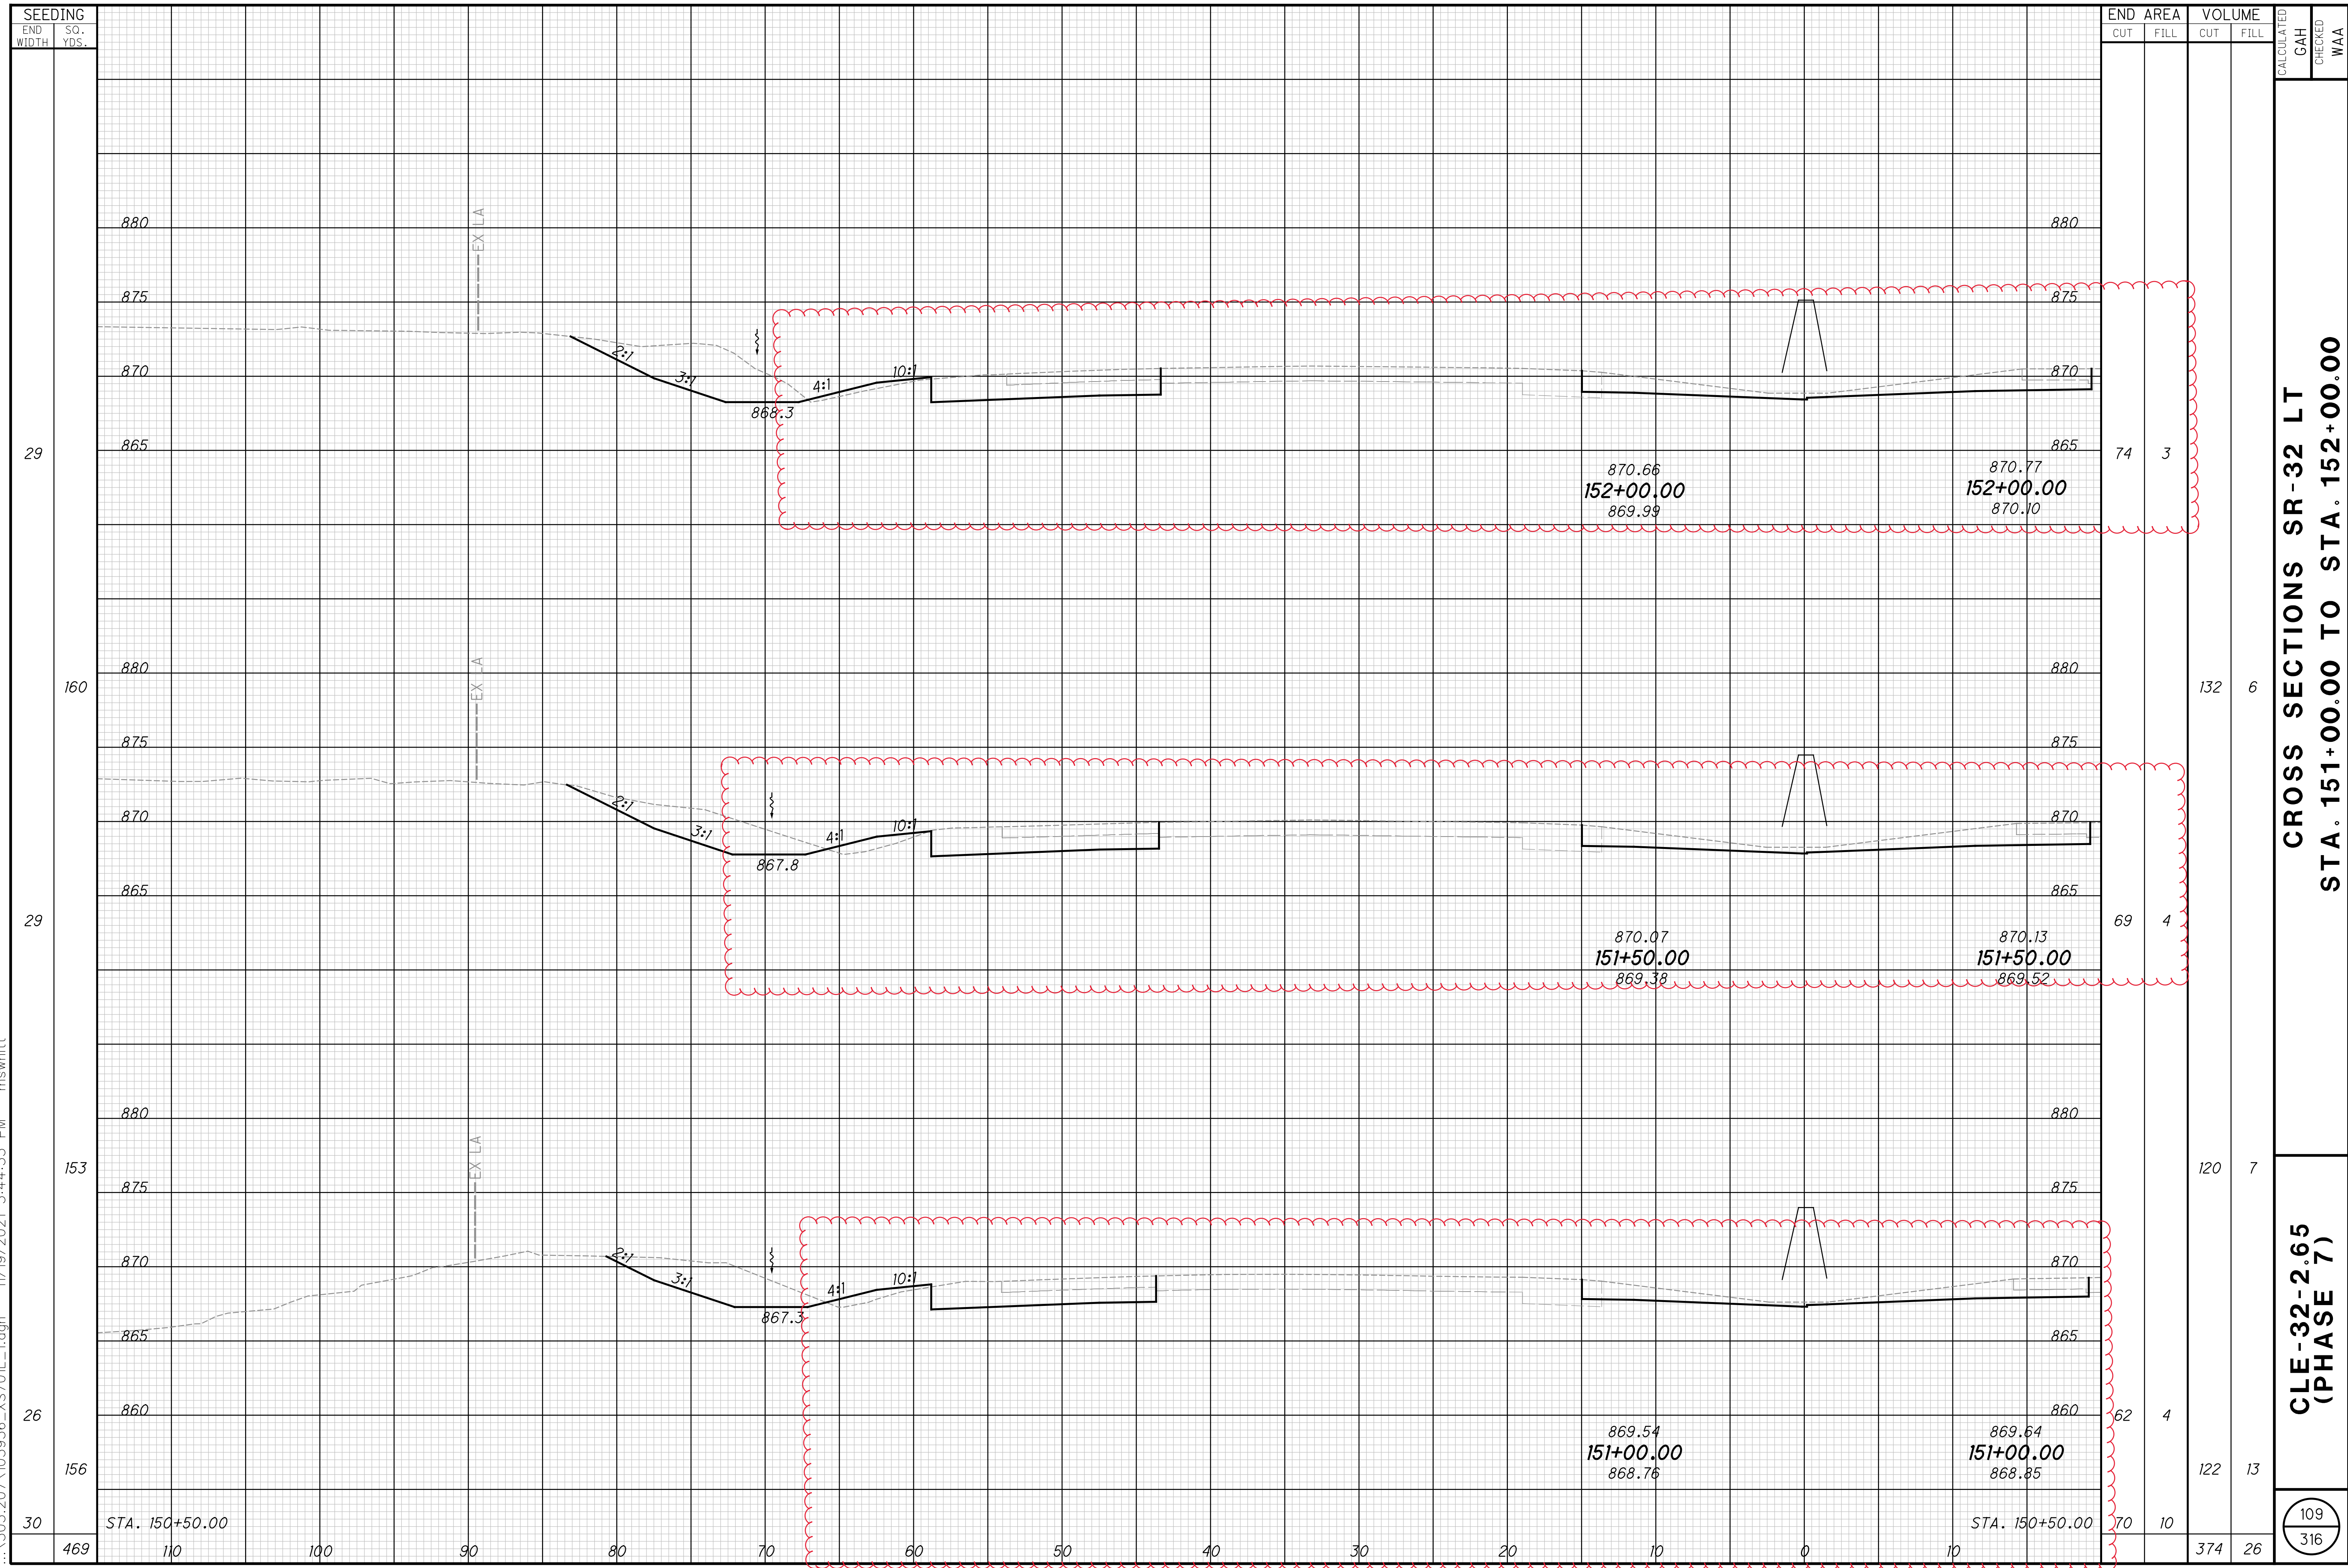


**CROSS SECTIONS SR-32 LT
STA. 151+00.00 TO STA. 152+00.00**

**CLE-32-2.65
(PHASE 7)**

109
316



...303.207\103956_XS701L_1.dgn 11/19/2021 3:44:53 PM mswwhitt


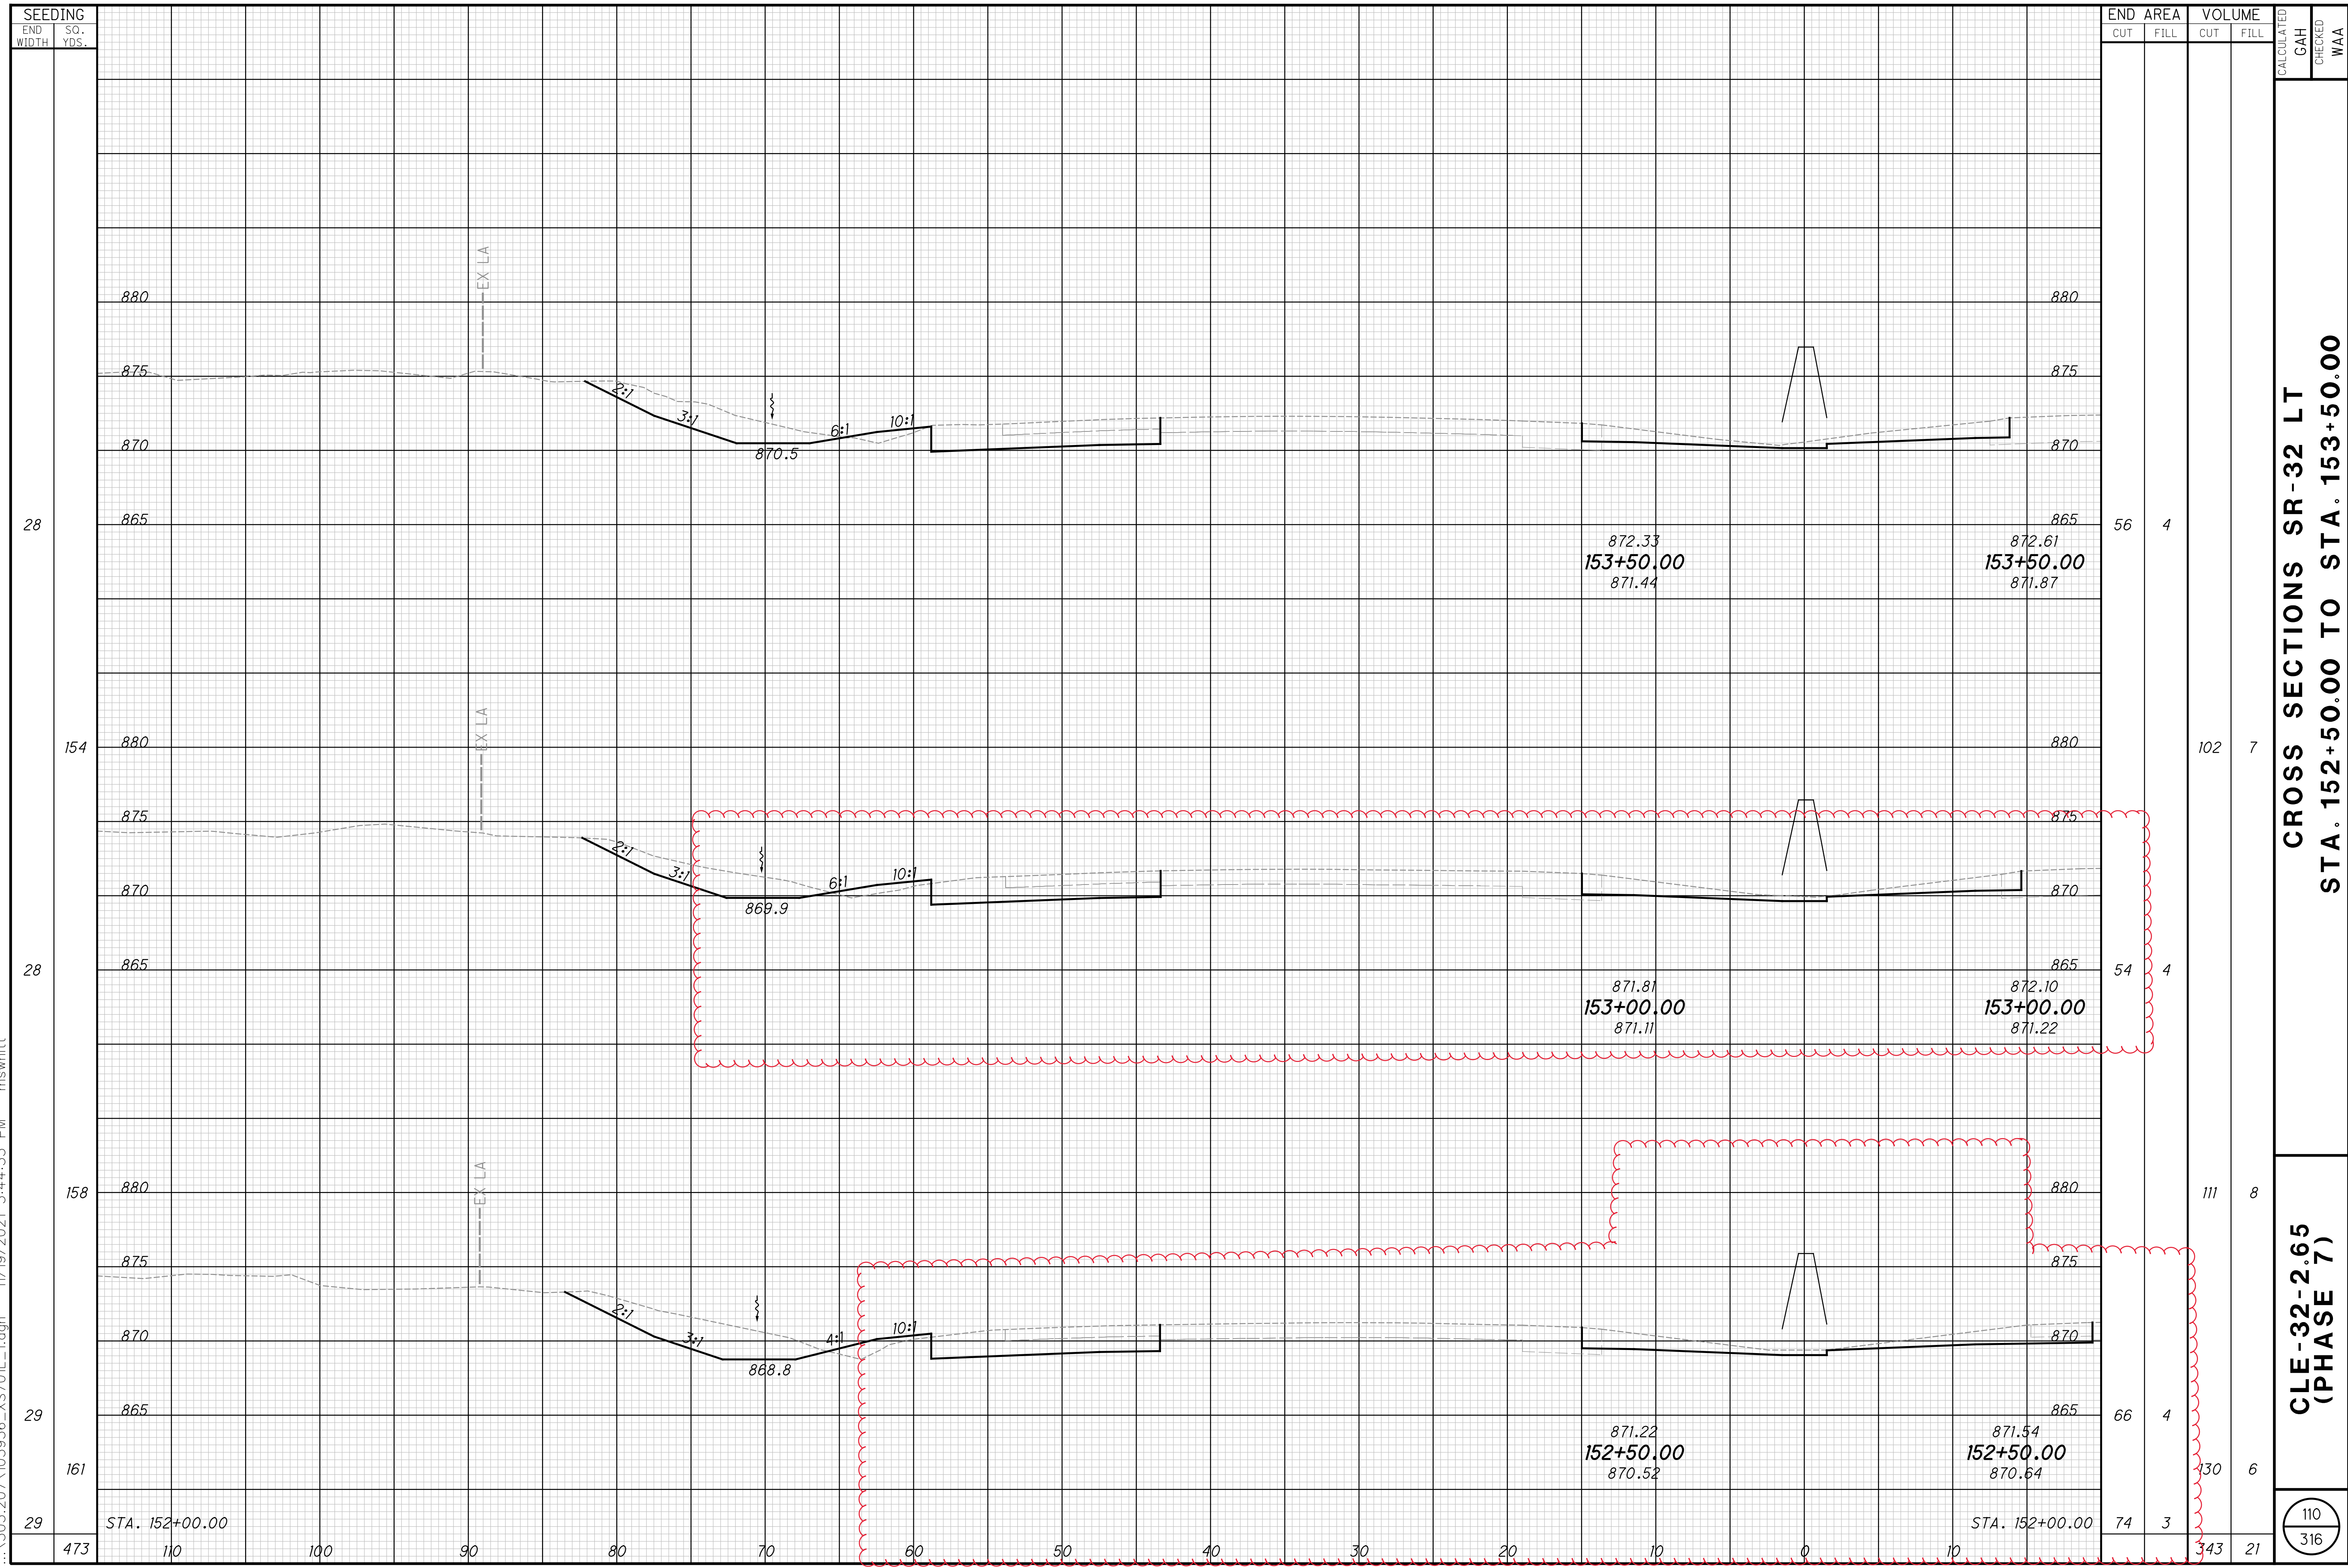



**CROSS SECTIONS SR-32 LT
STA. 152+50.00 TO STA. 153+50.00**



**CLE-32-2.65
(PHASE 7)**


110
316

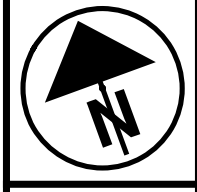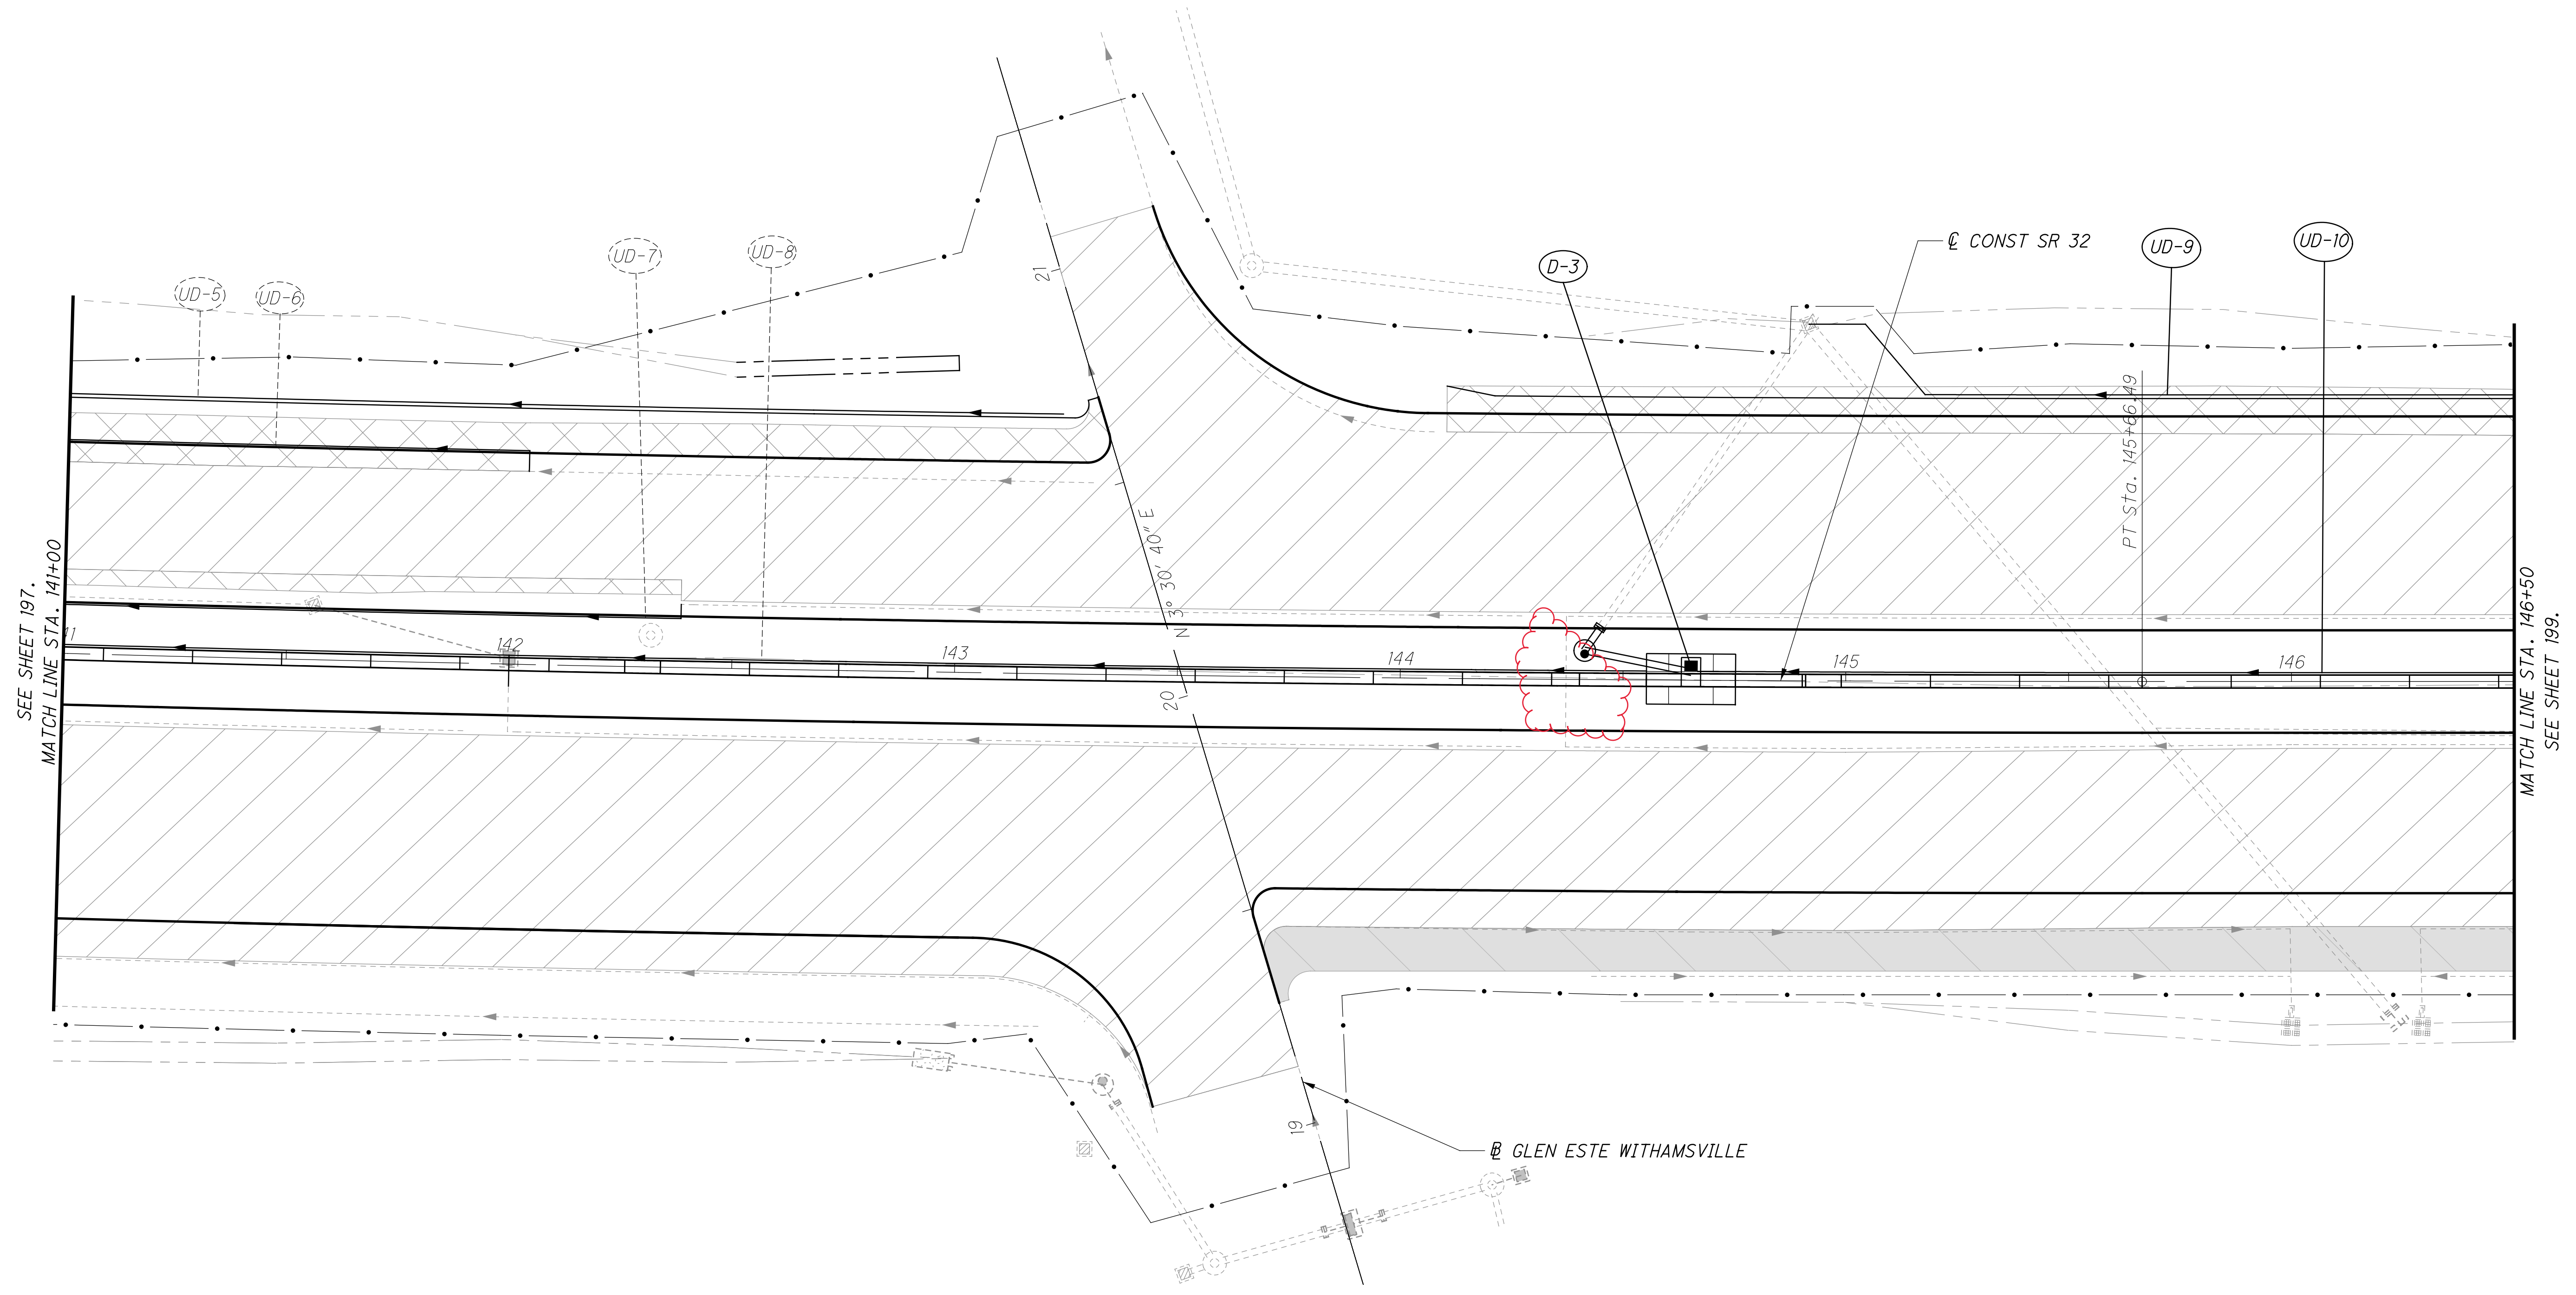

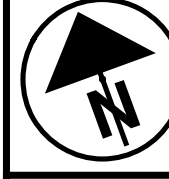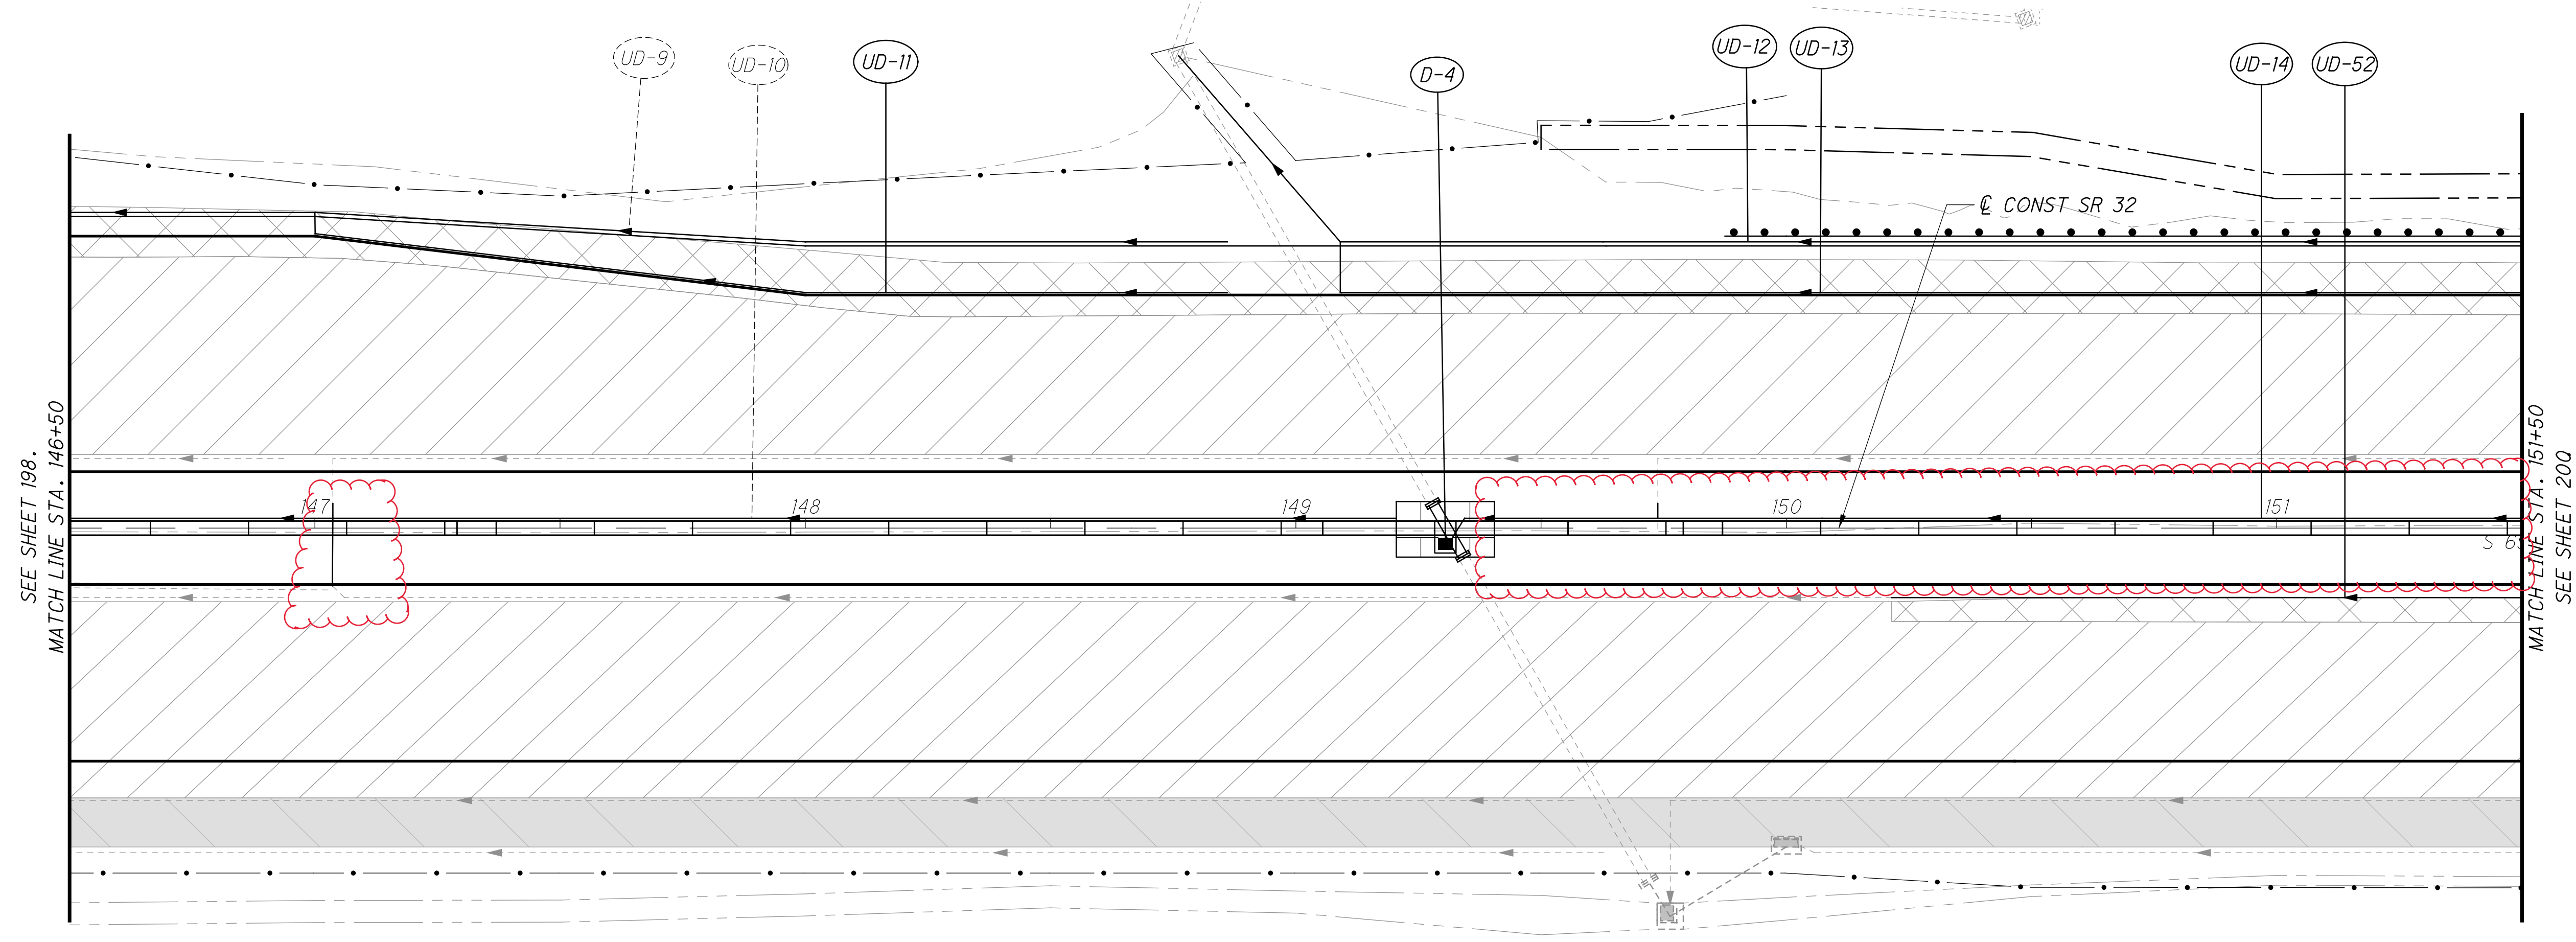

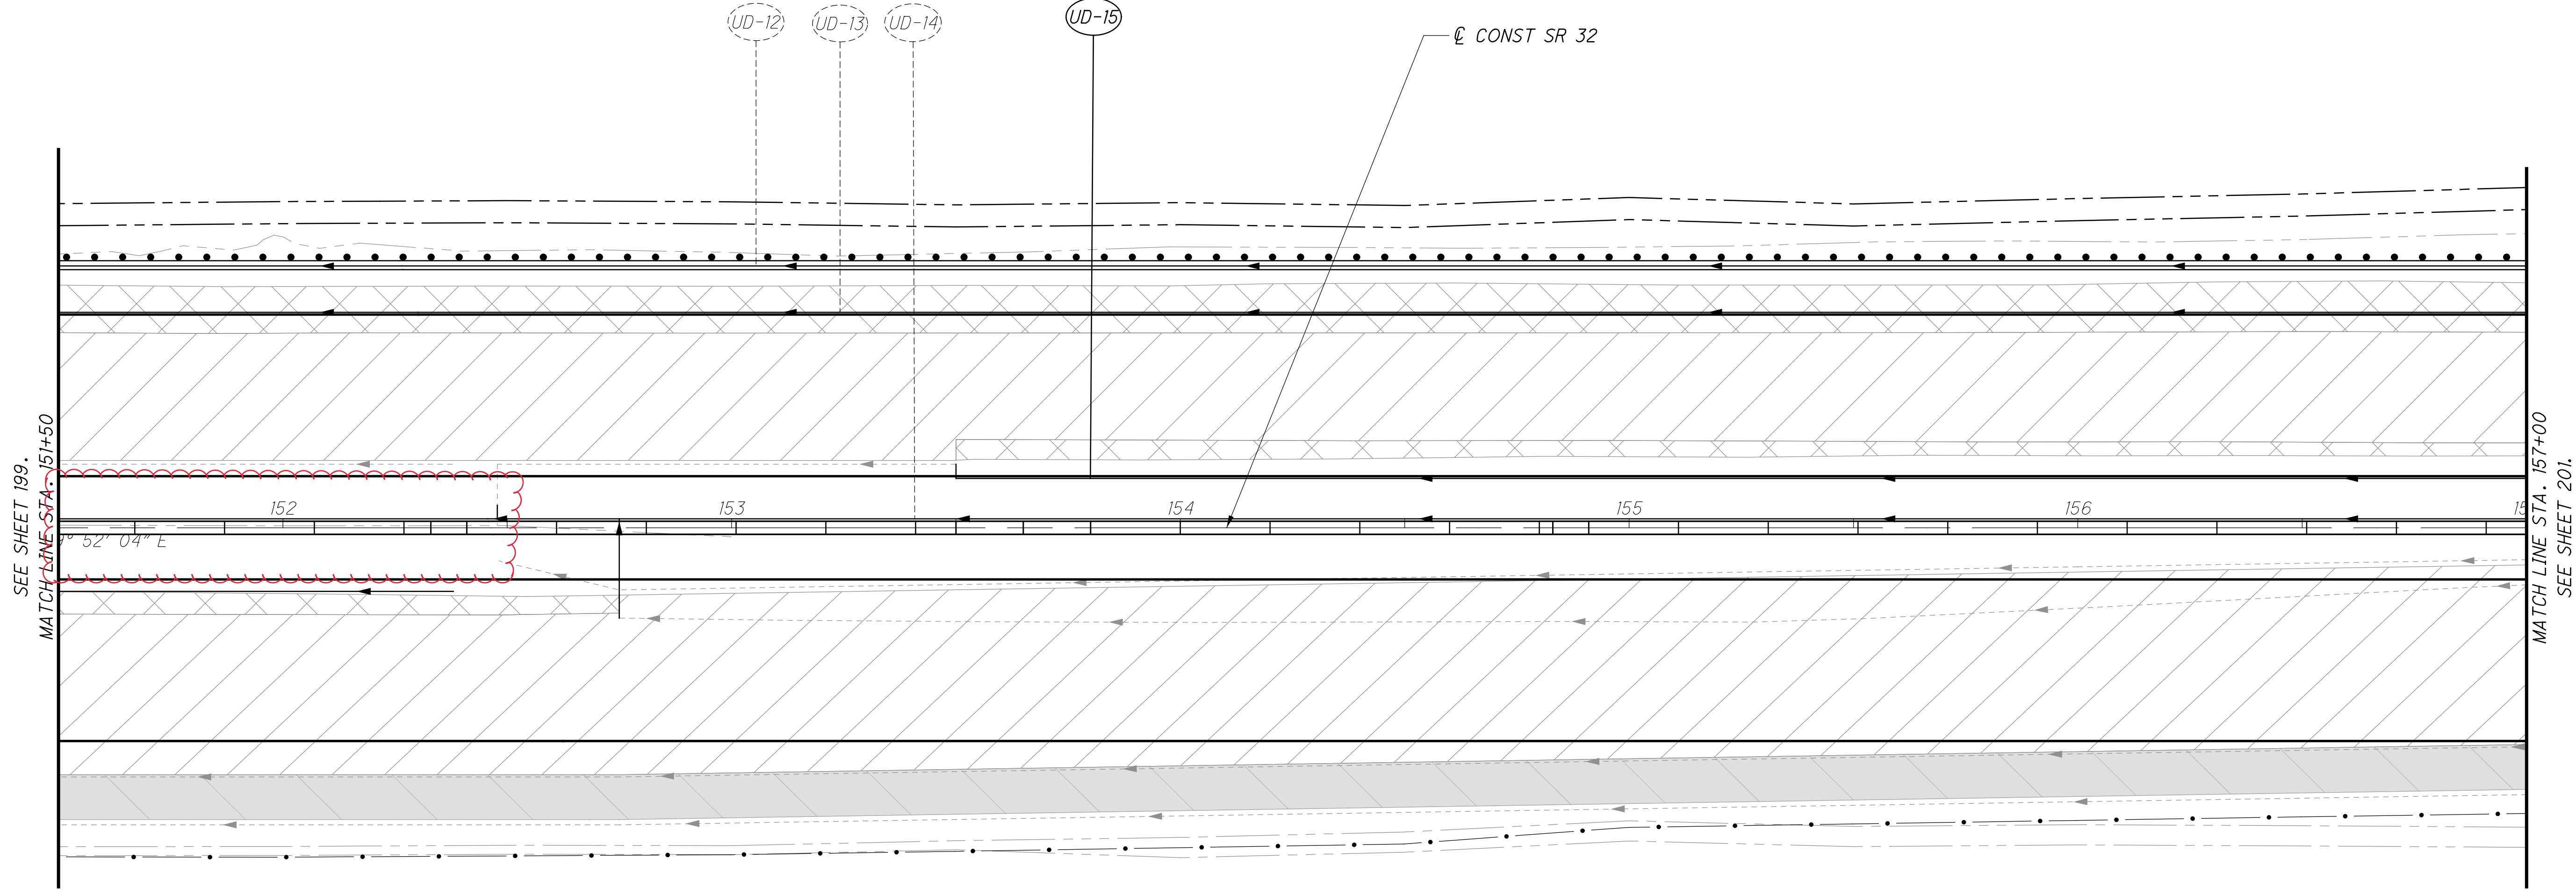

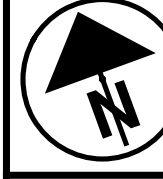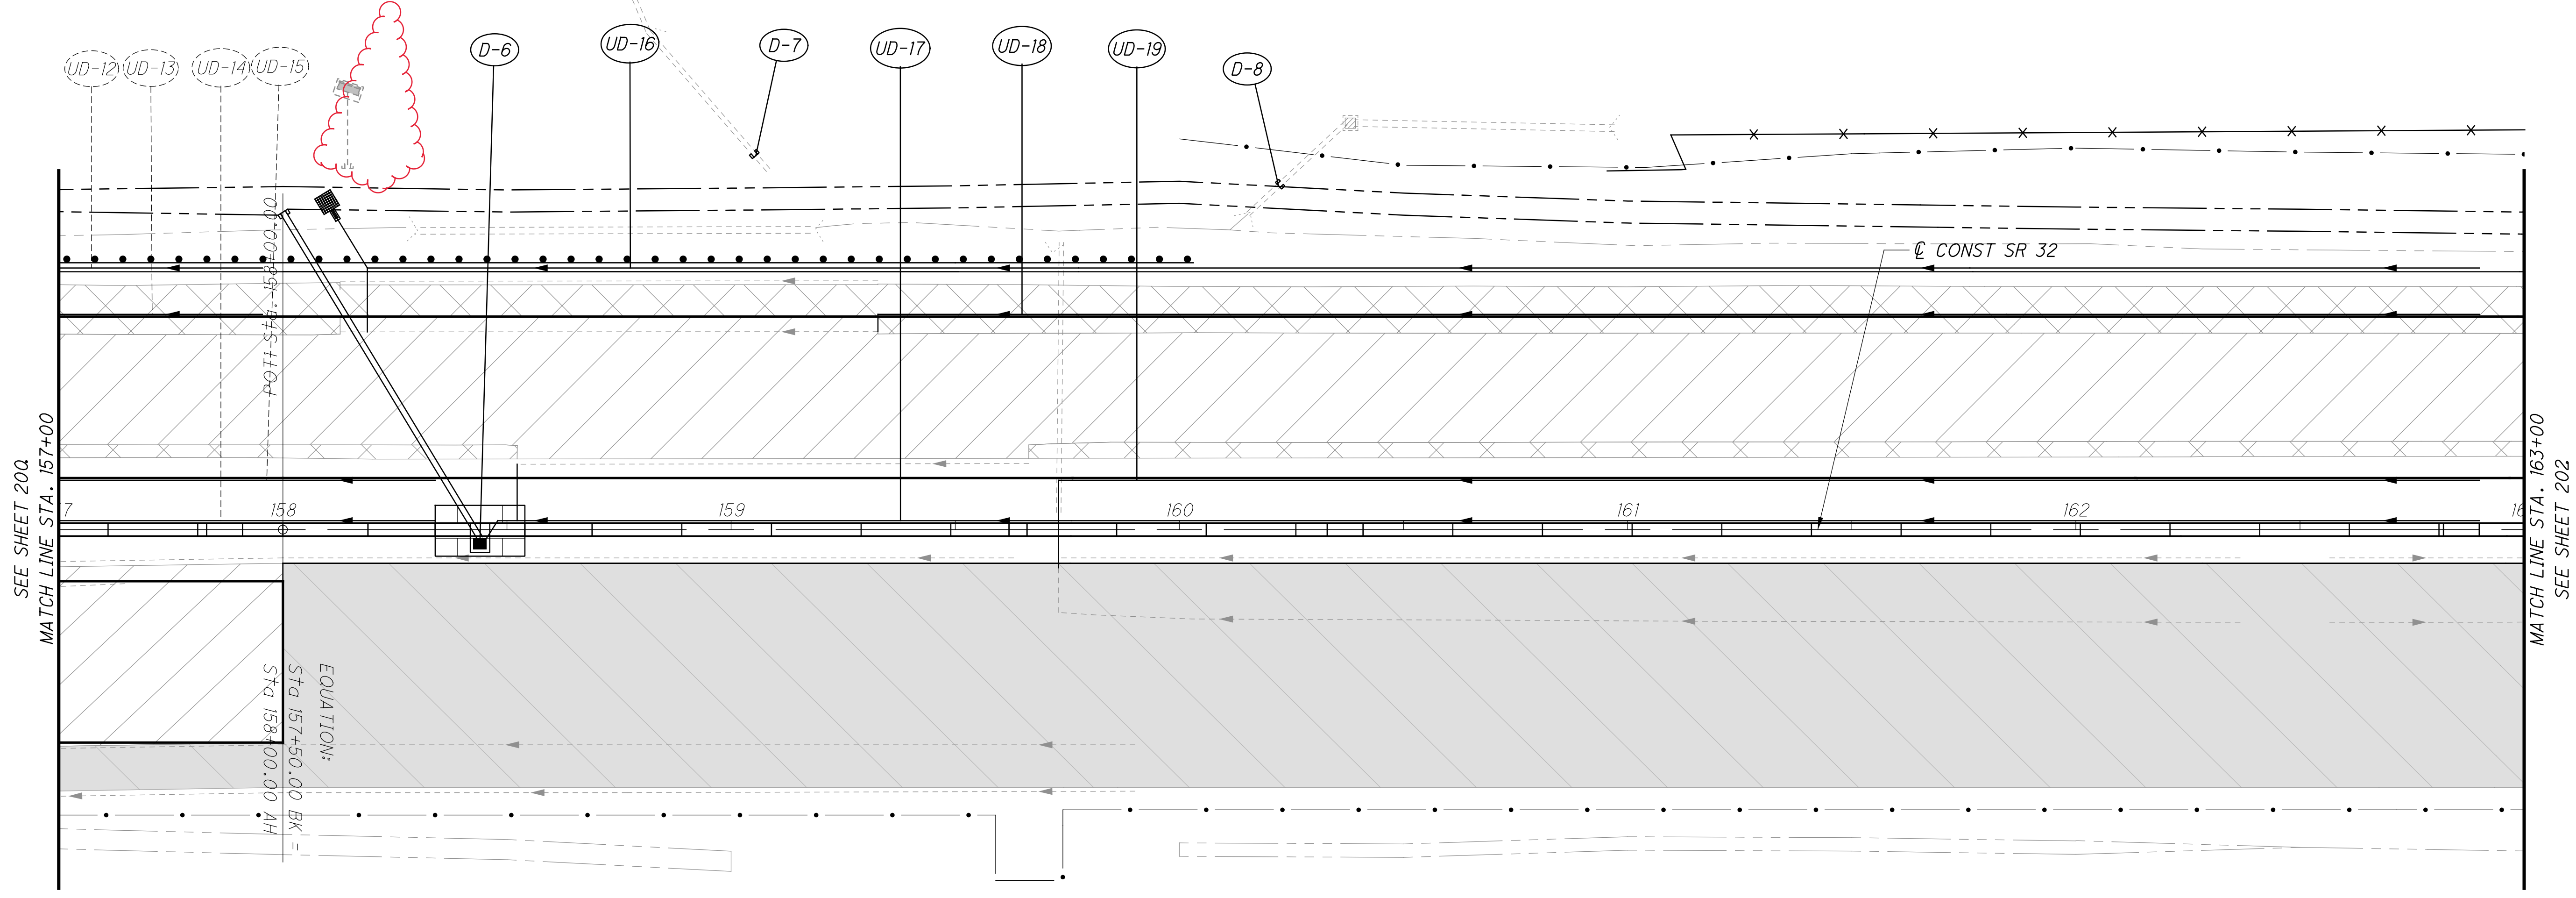

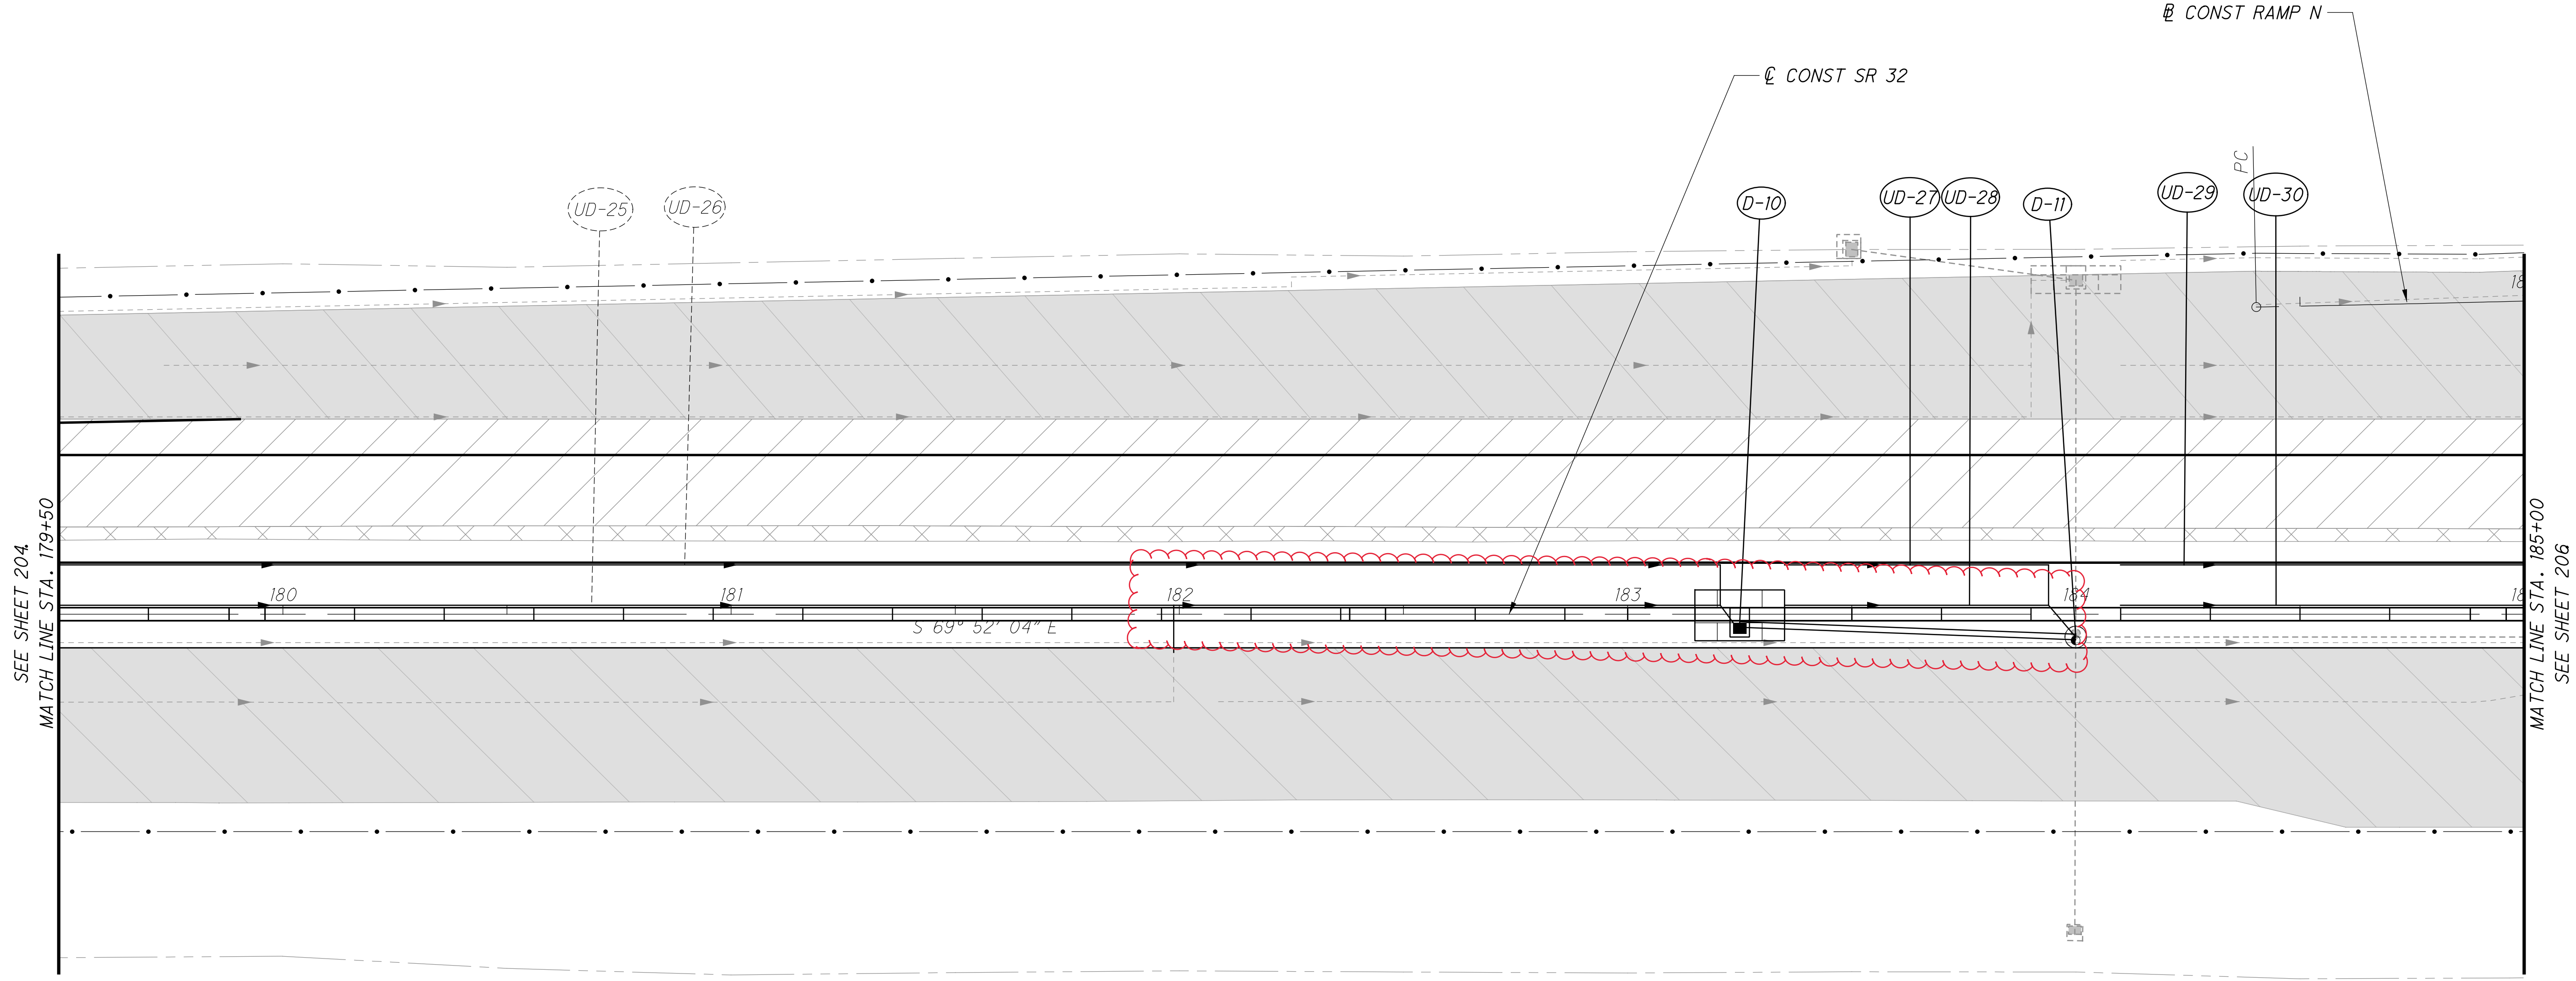

SEE SHEET 204.
MATCH LINE STA. 179+50


MATCH LINE STA. 185+00
SEE SHEET 206

| | |
|------------|-----|
| CALCULATED | MHT |
| CHECKED | WAA |

0 10 20 40
HORIZONTAL
SCALE IN FEET

DRAINAGE AND UNDERDRAIN PLAN - SR-32
STA. 179+50 TO STA. 185+00

CLE-32-2.65
(PHASE 7)

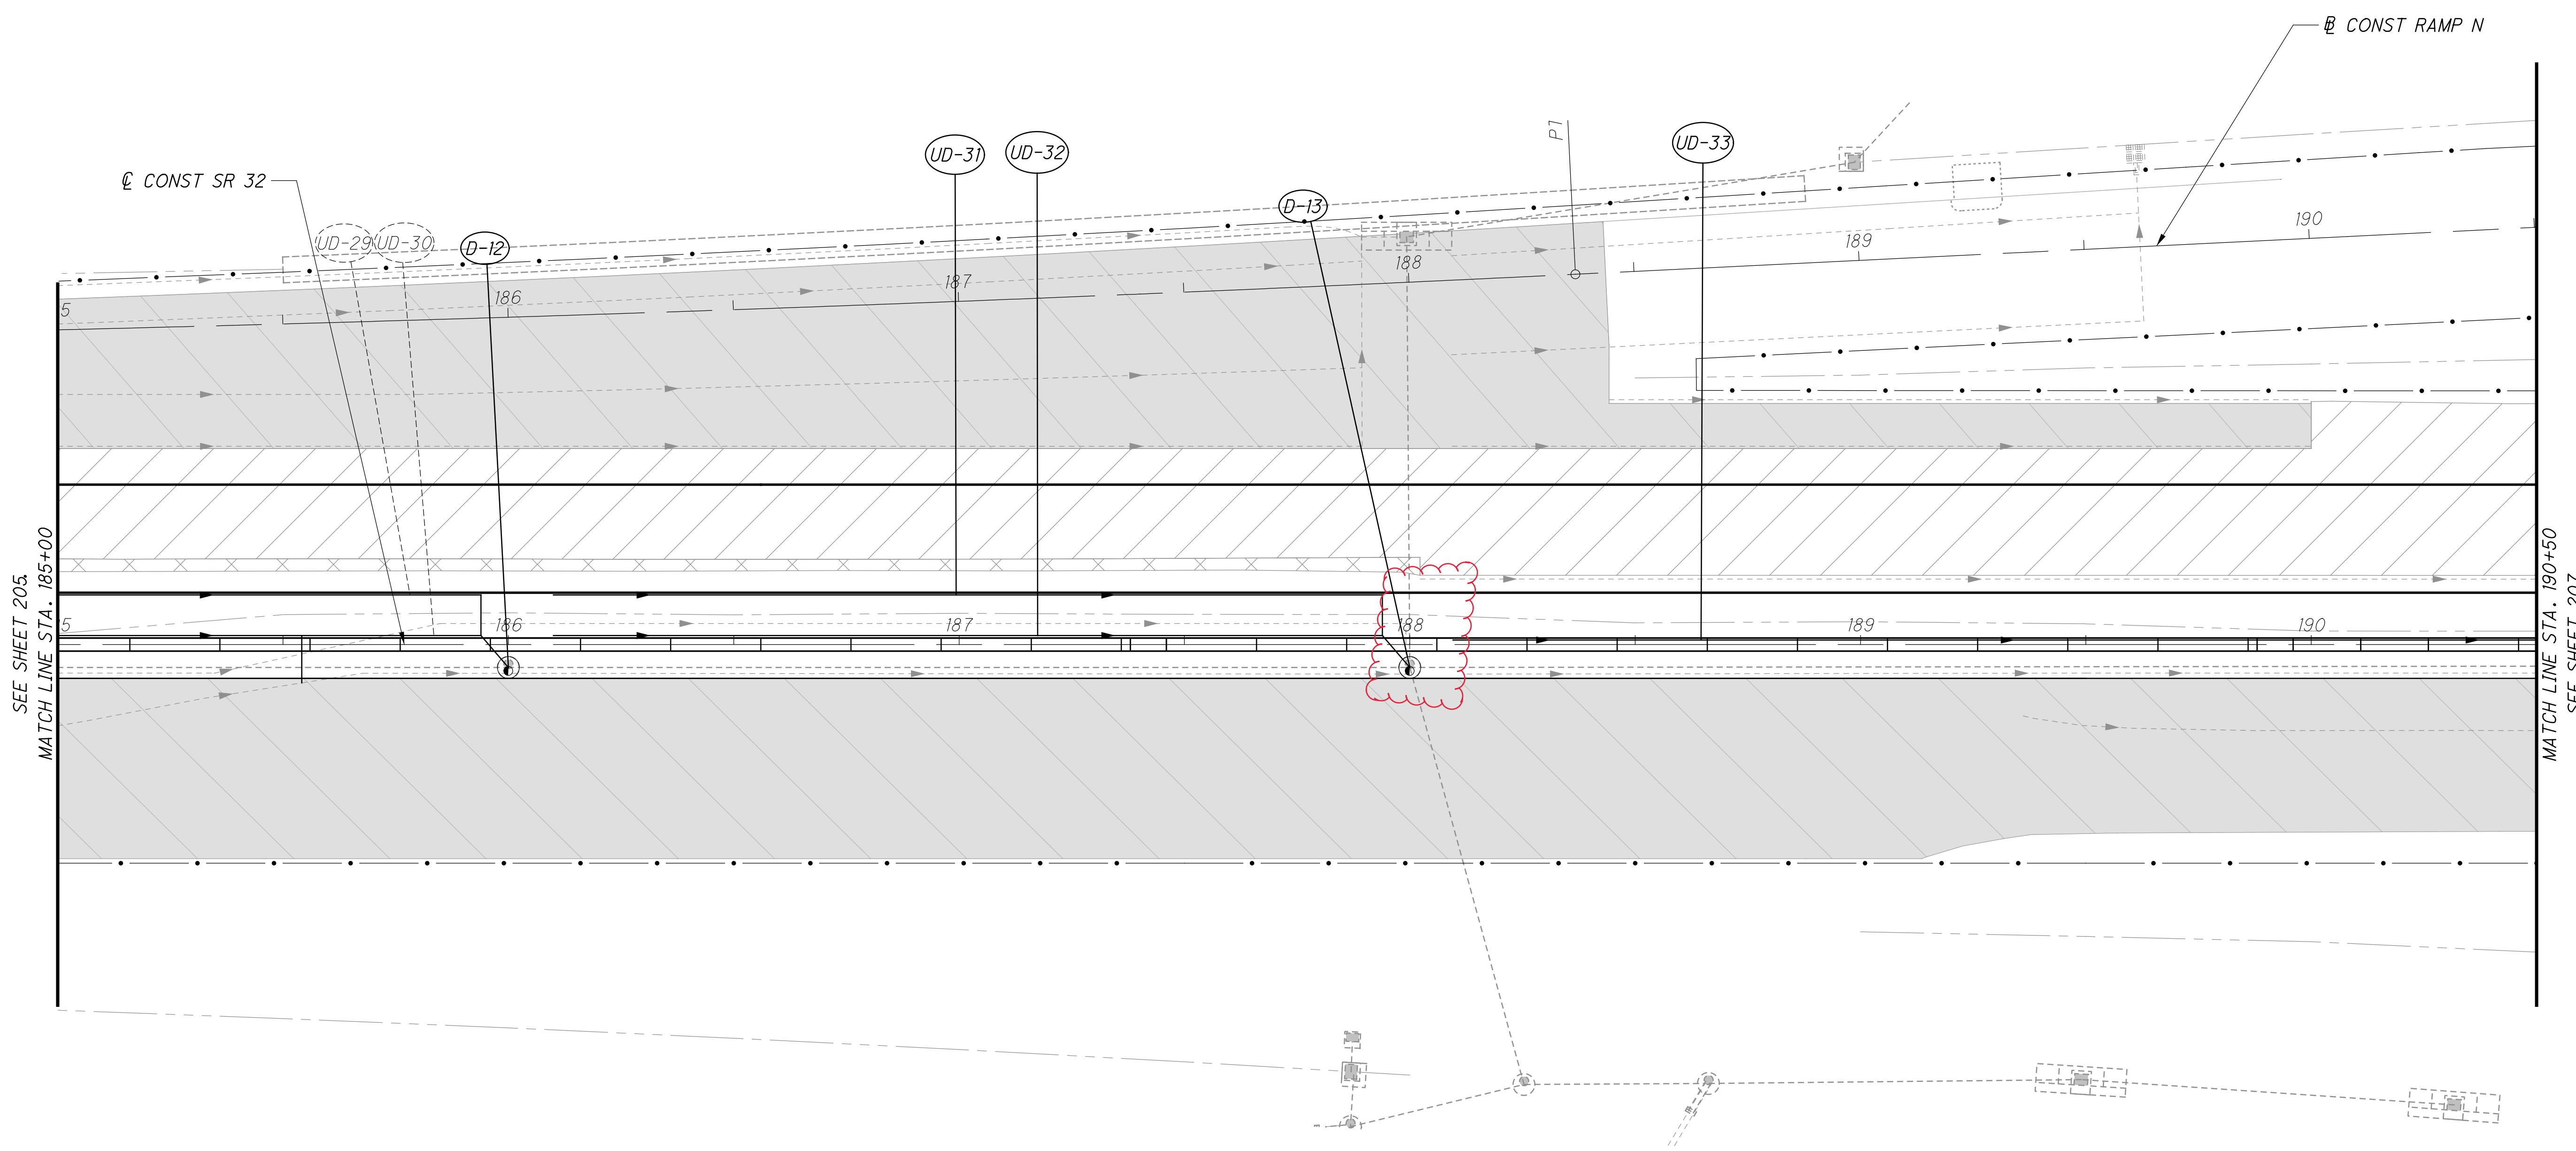


CALCULATED MHT
CHECKED WAA

0 20 40
HORIZONTAL SCALE IN FEET

DRAINAGE AND UNDERDRAIN PLAN - SR-32
STA. 185+00 TO STA. 190+50

CLE-32-2.65
(PHASE 7)


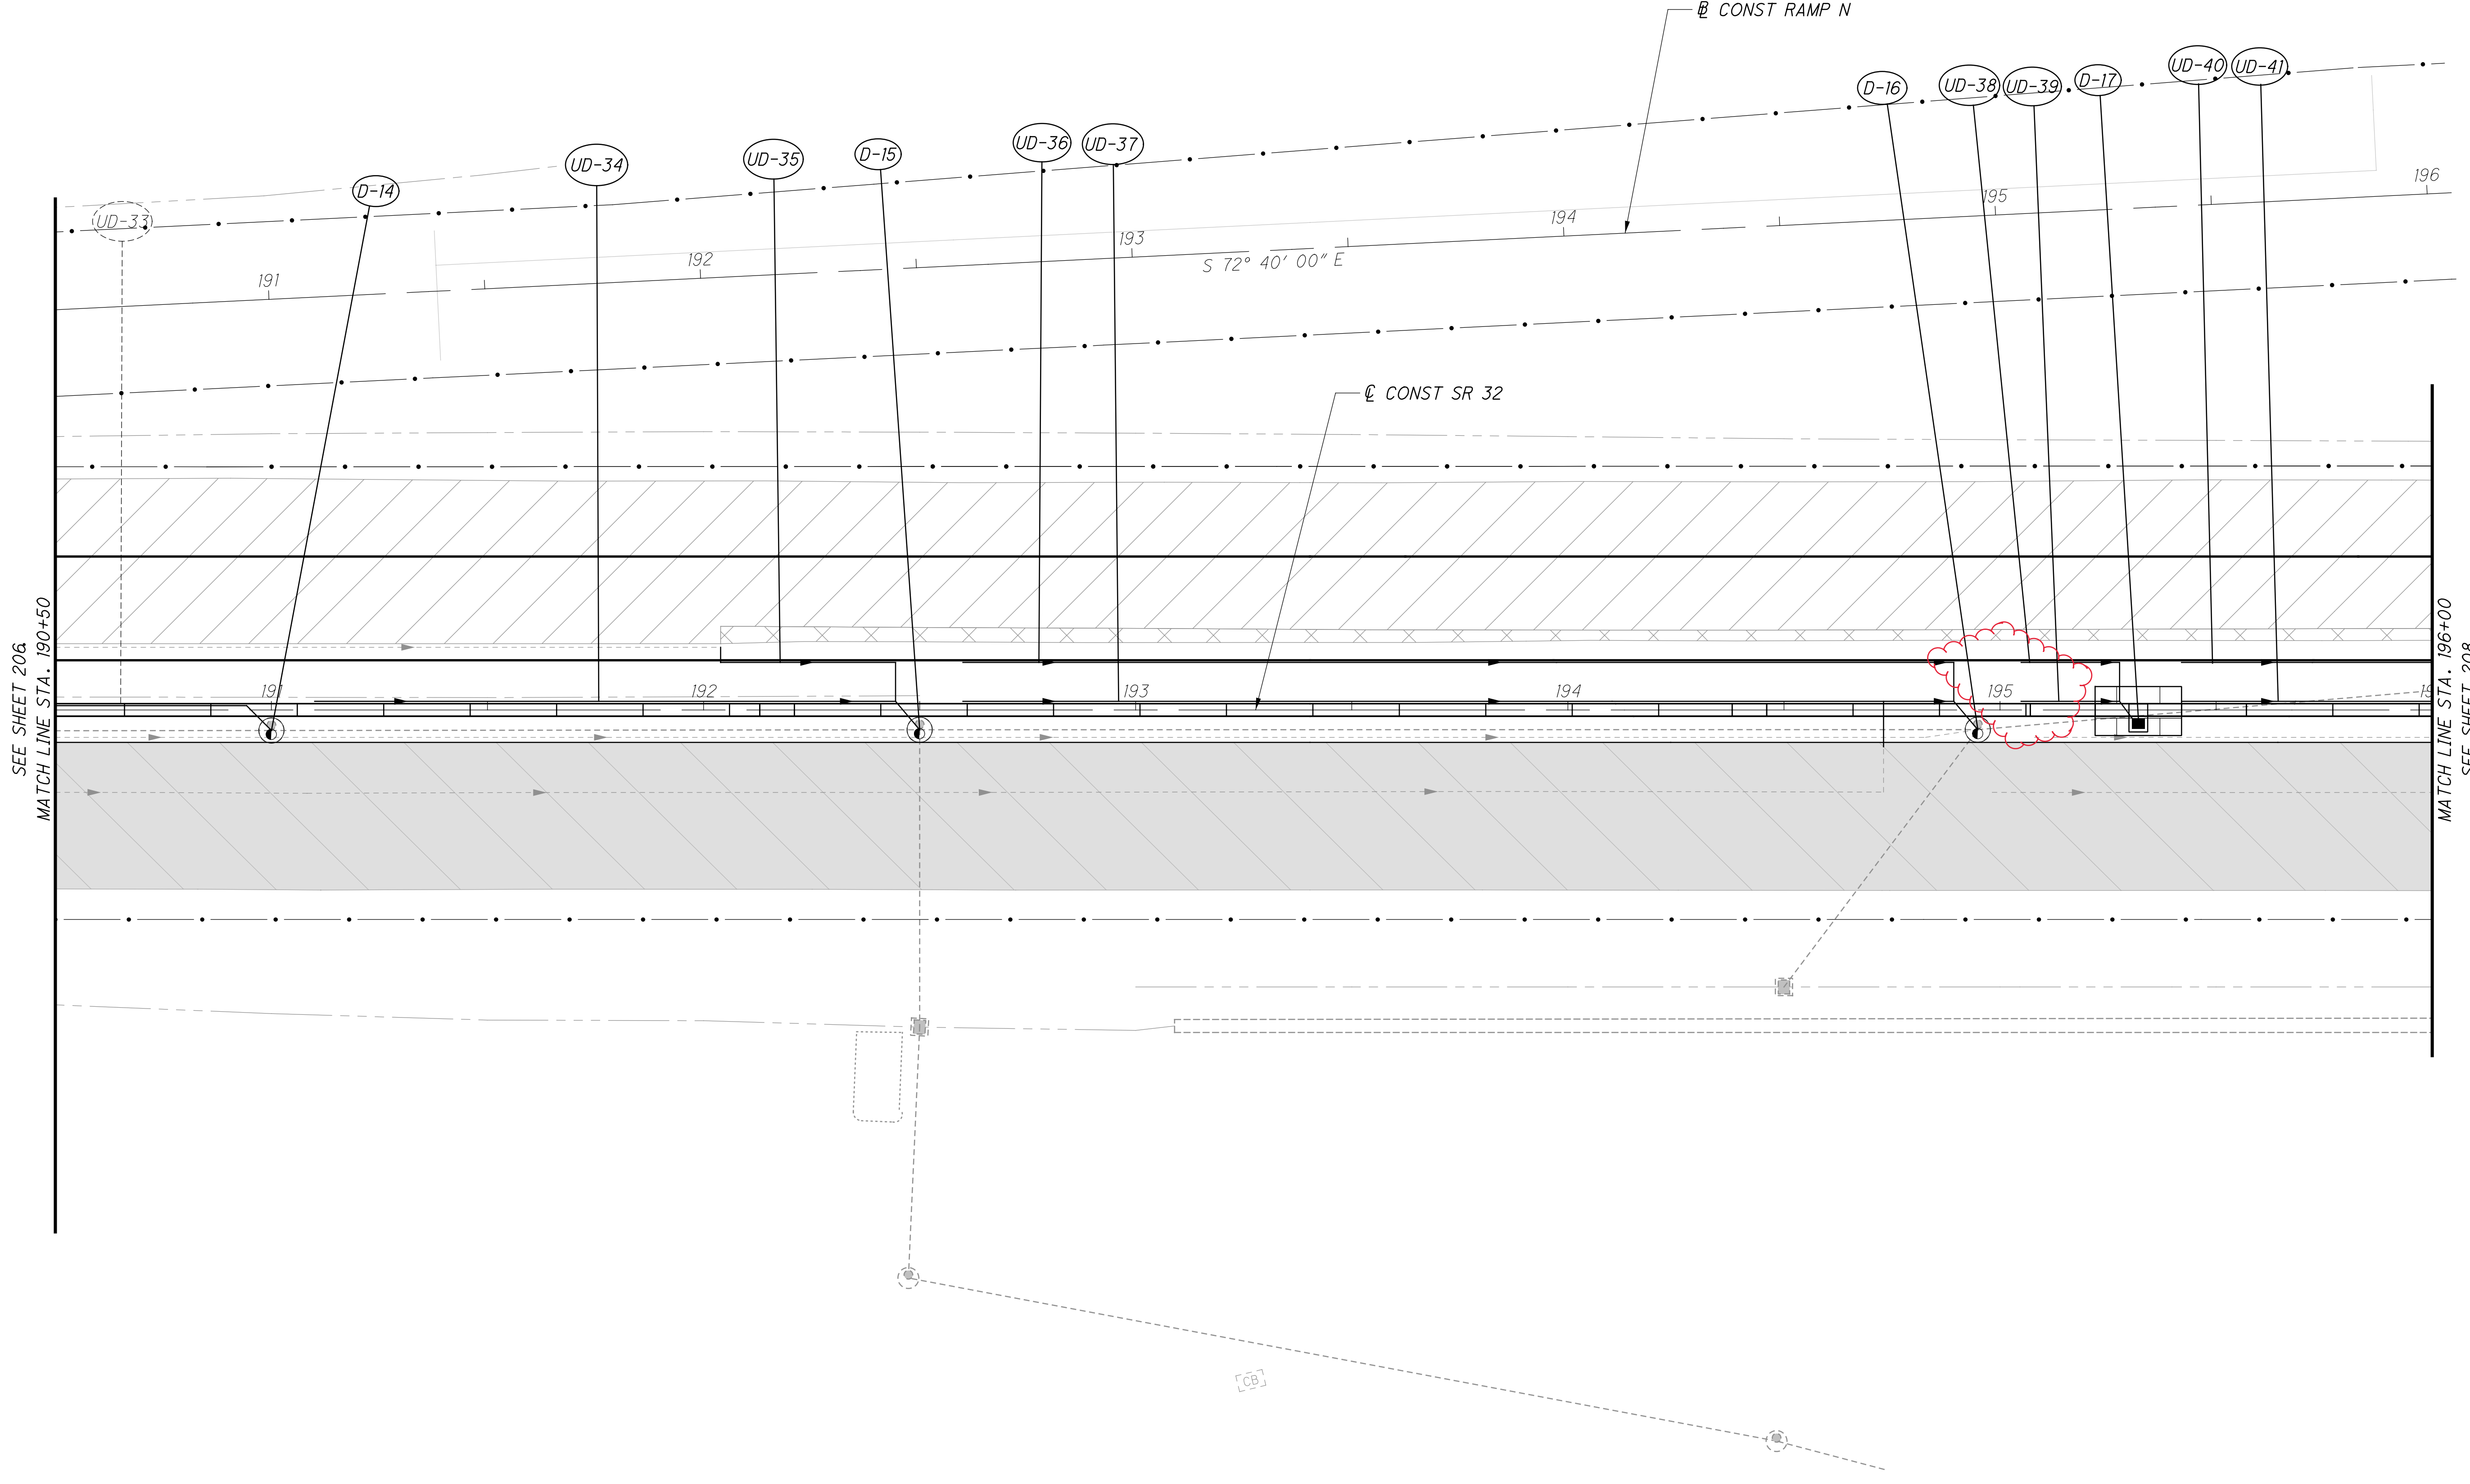



CALCULATED MHT
CHECKED WAA

0 20 40
HORIZONTAL SCALE IN FEET

DRAINAGE AND UNDERDRAIN PLAN - SR-32
STA. 190+50 TO STA. 196+00

CLE-32-2.65
(PHASE 7)

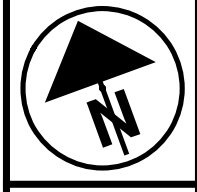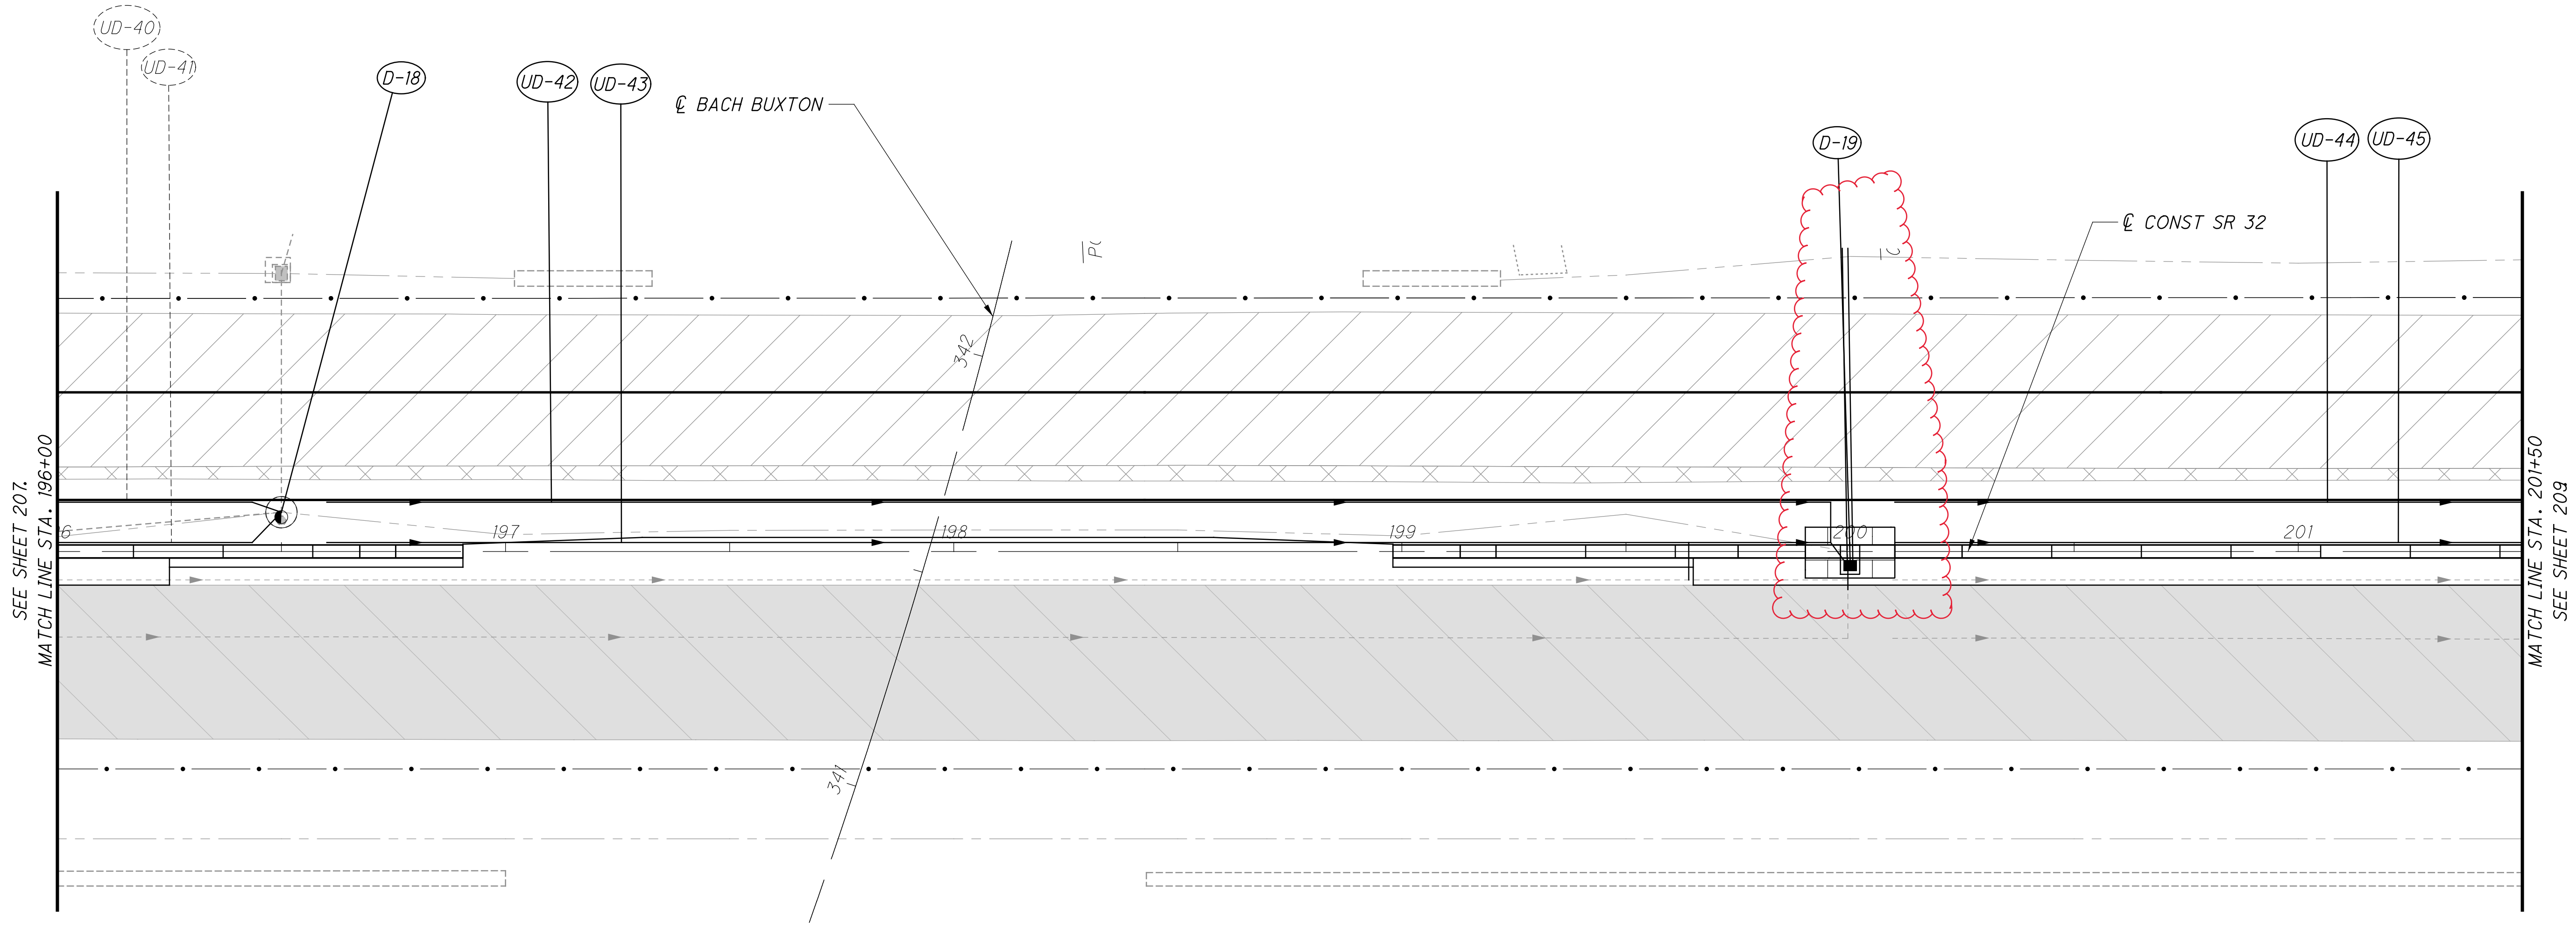

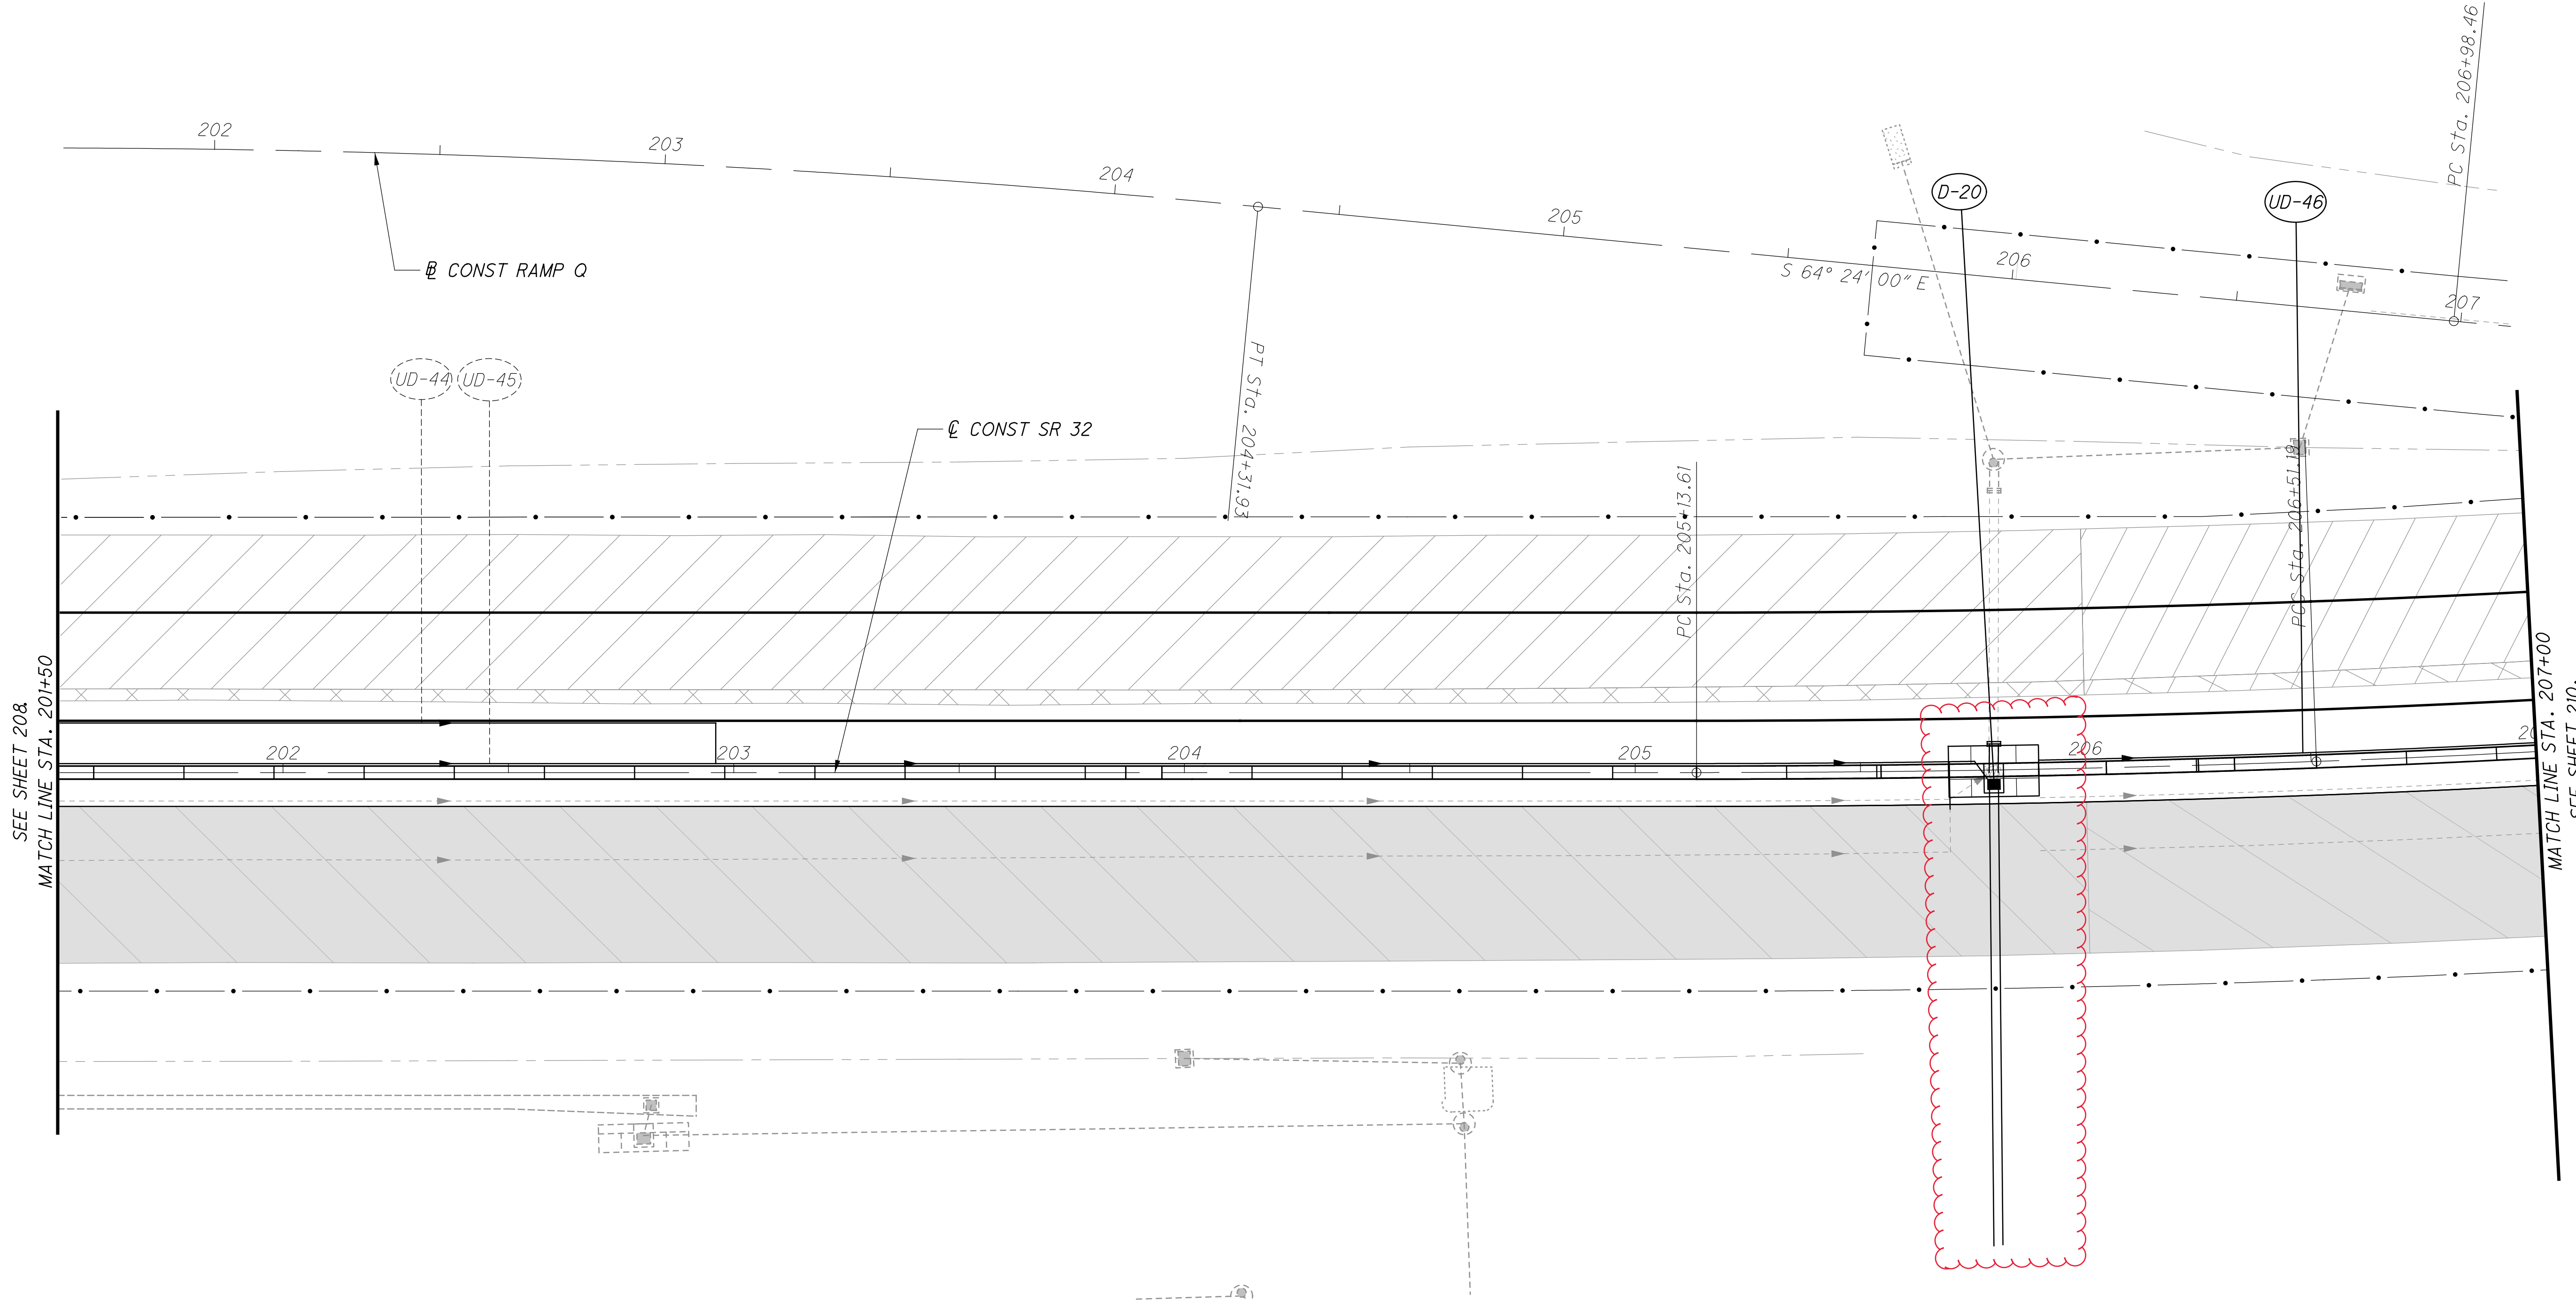



CALCULATED
MHT
CHECKED
WAA

0 20 40
HORIZONTAL
SCALE IN FEET

DRAINAGE AND UNDERDRAIN PLAN - SR-32
STA. 201+50 TO STA. 207+00

CLE-32-2.65
(PHASE 7)

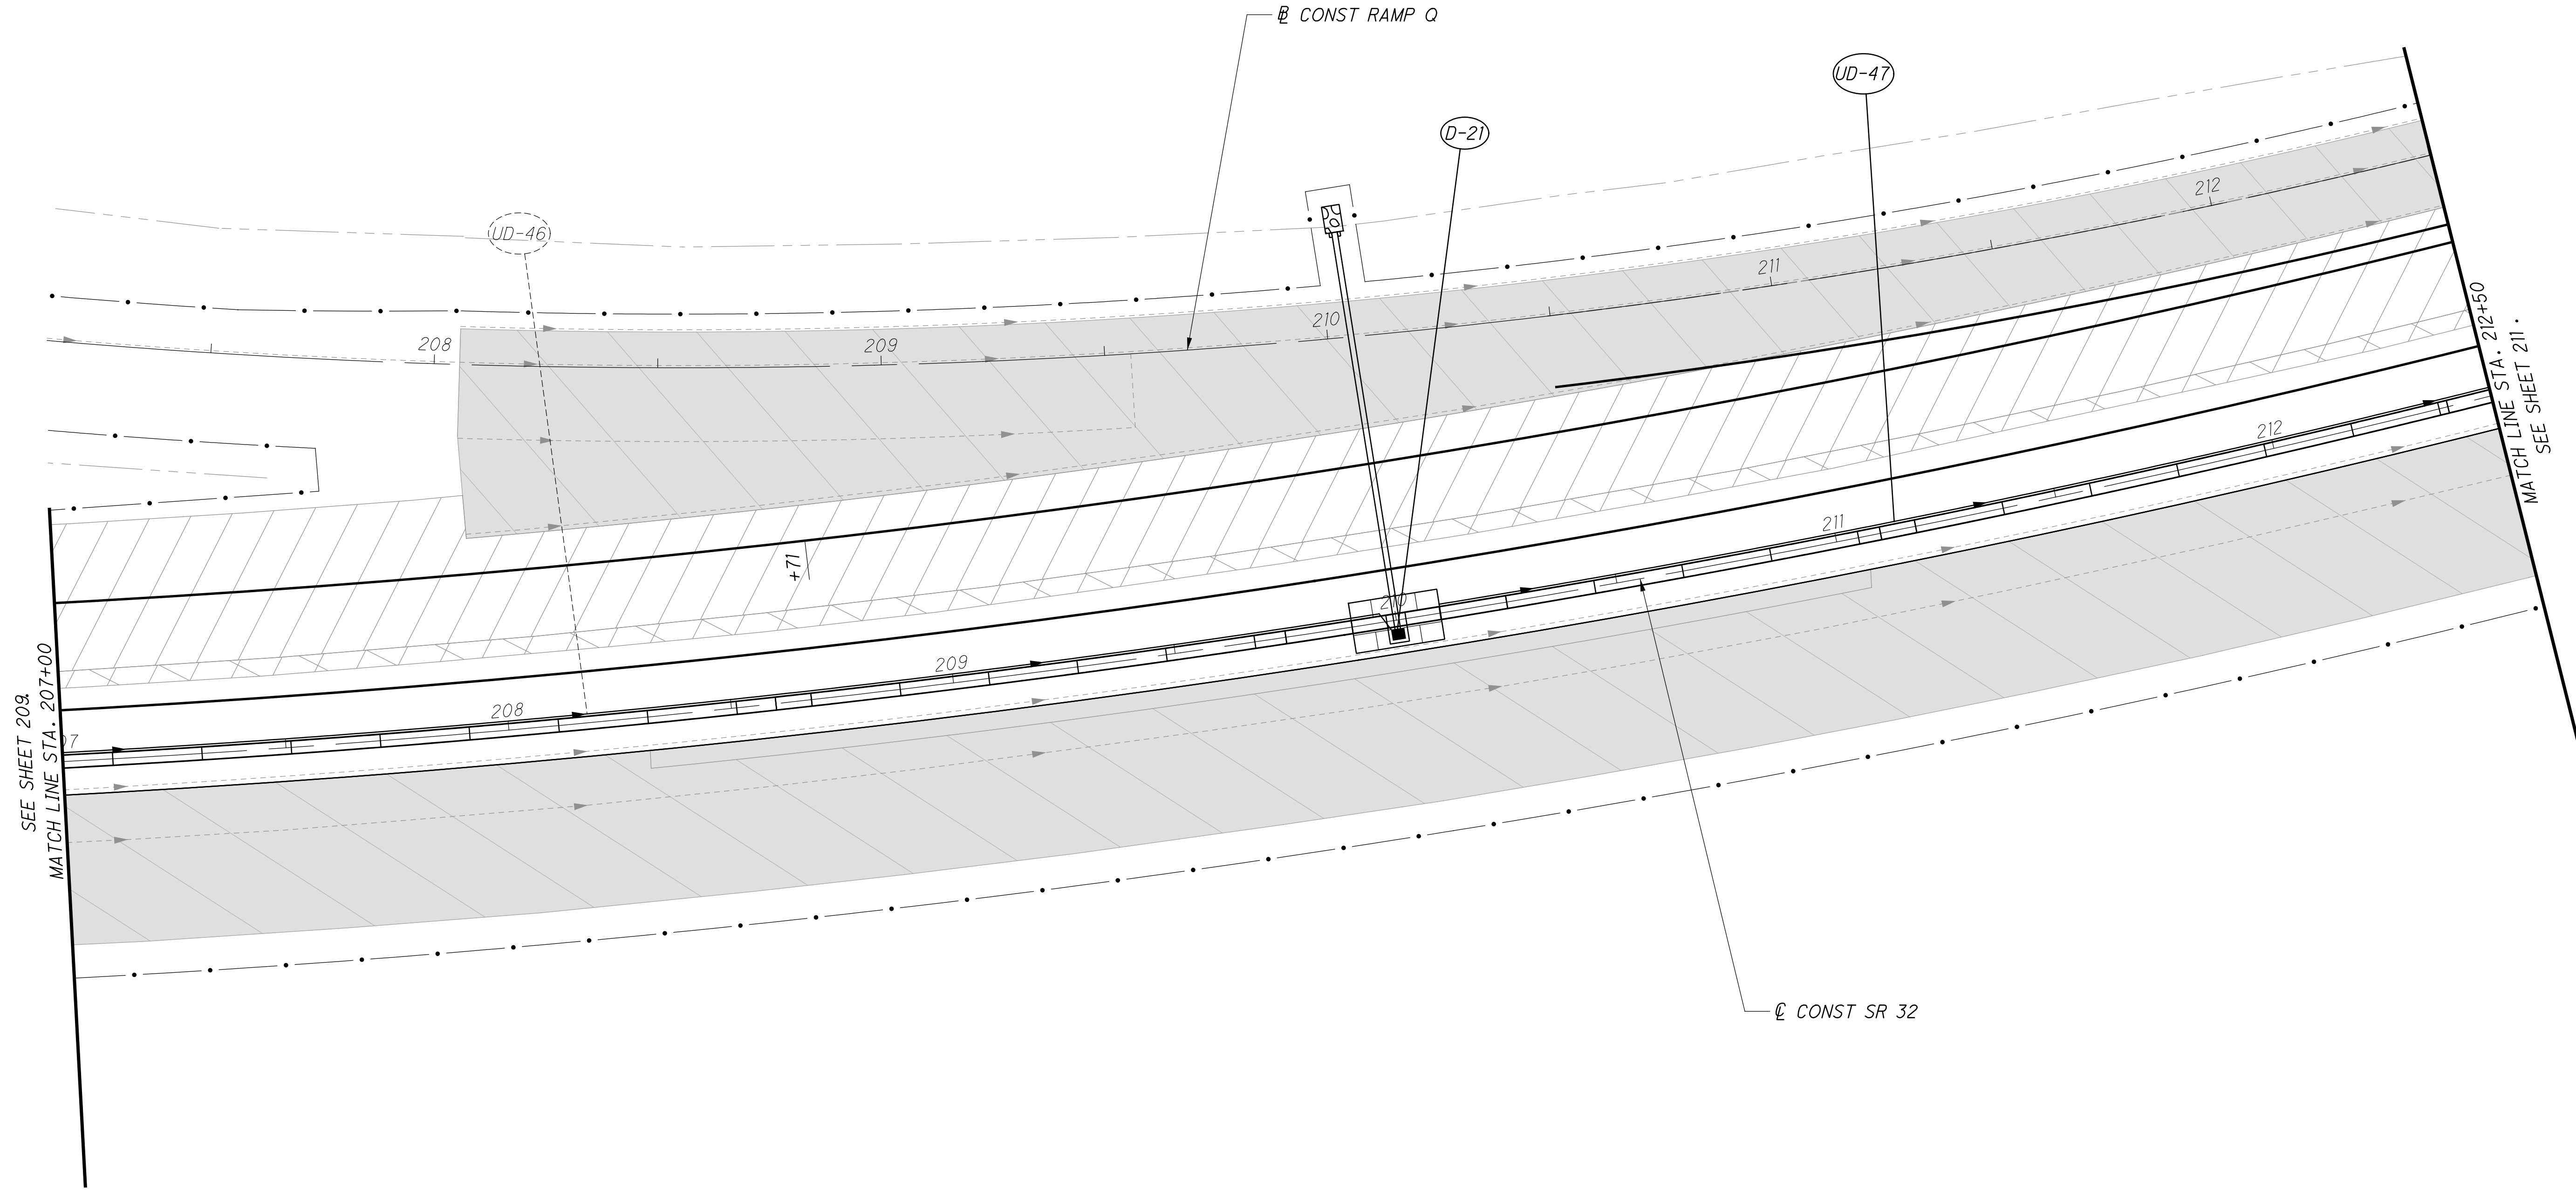

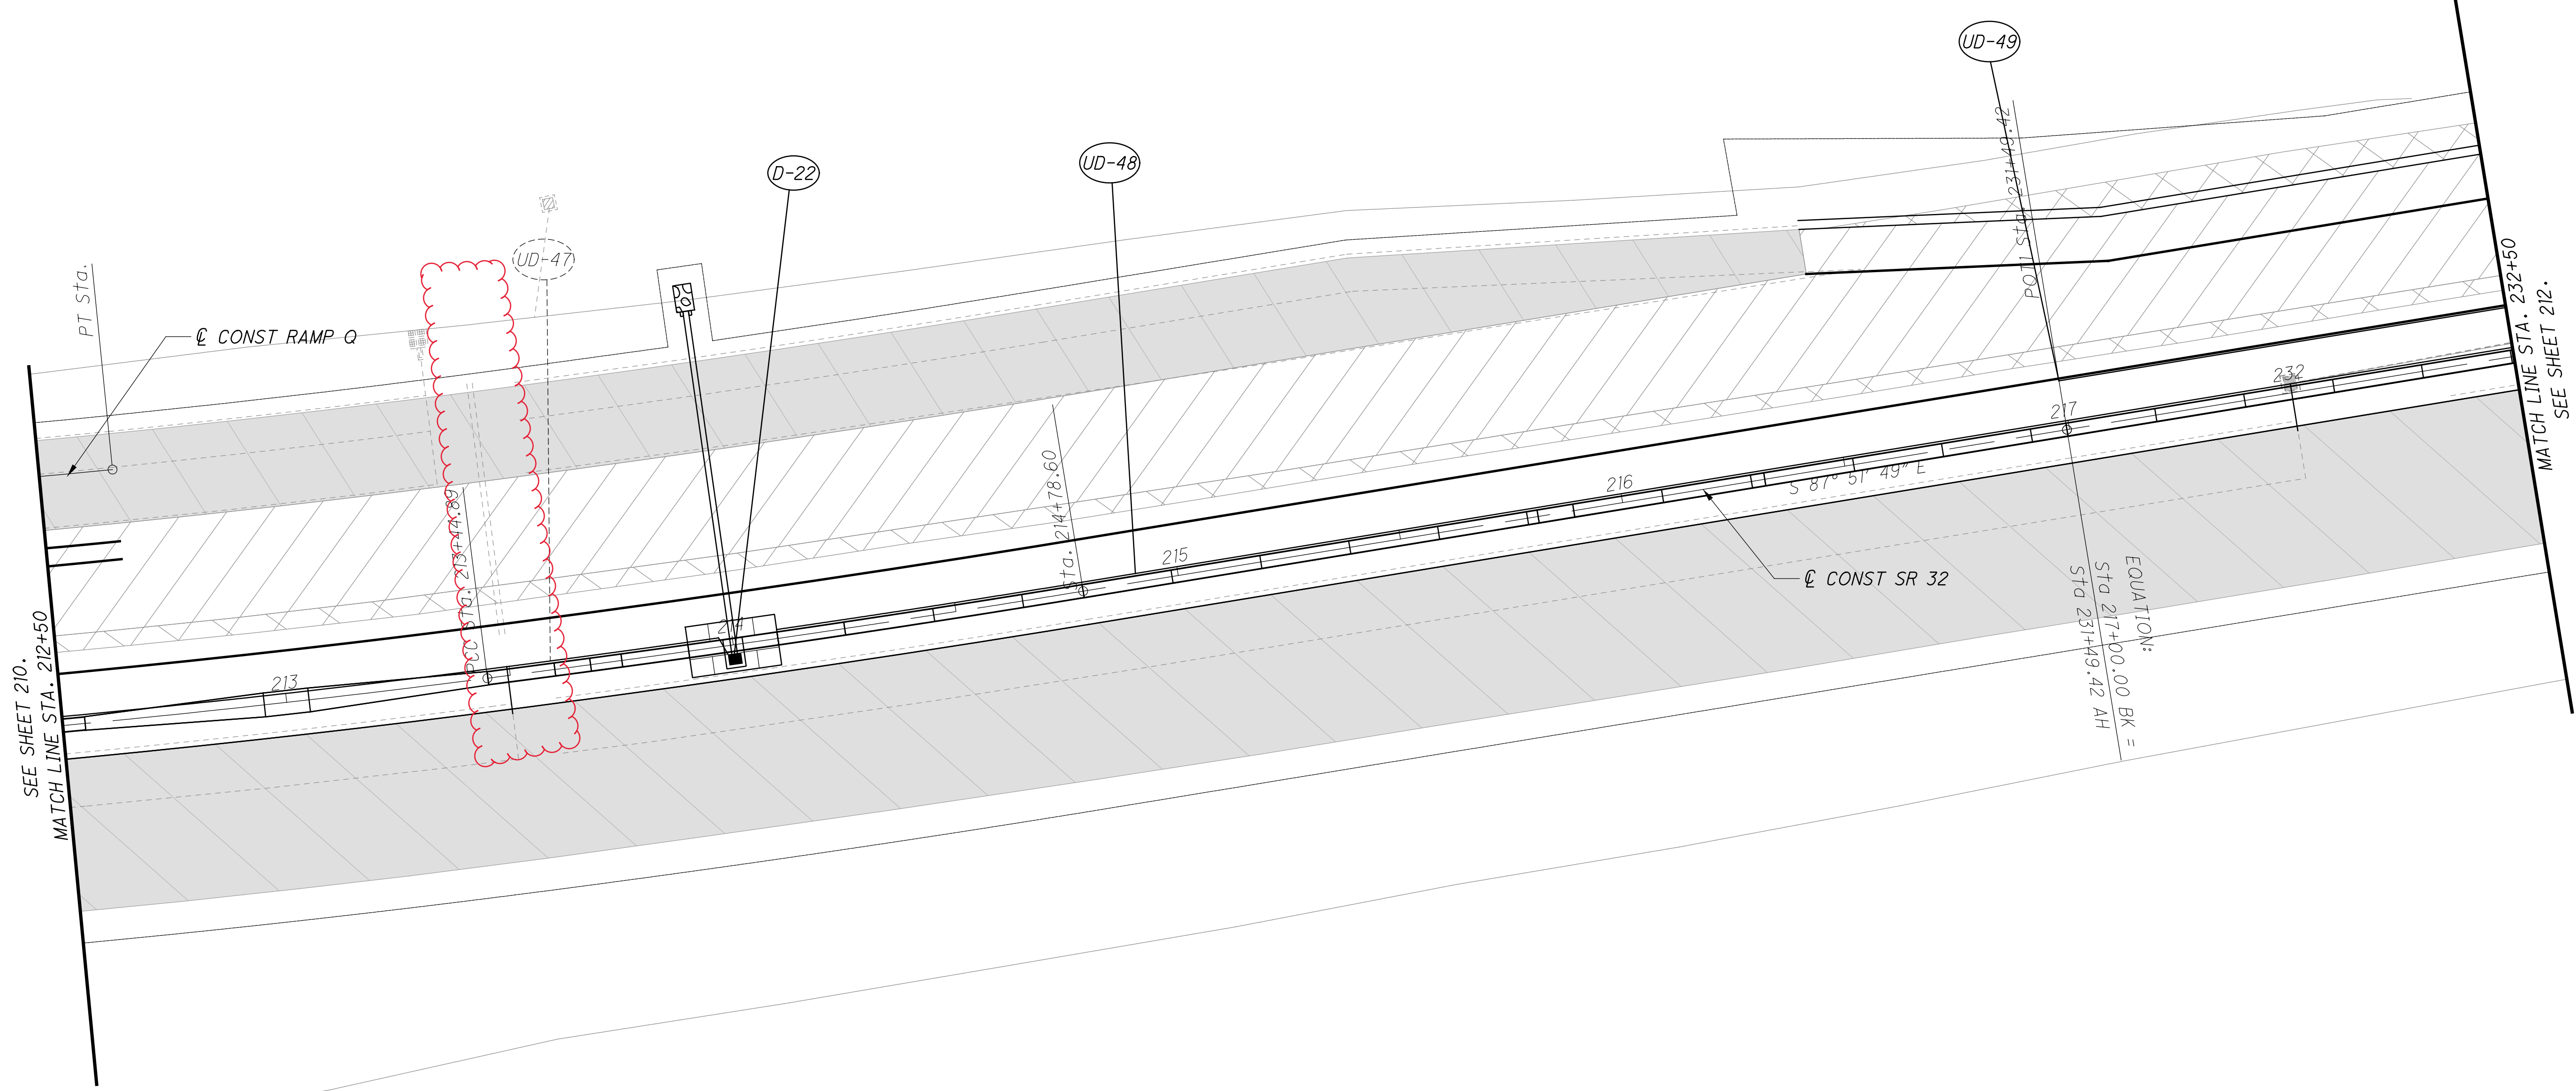

SEE SHEET 210.
MATCH LINE STA. 212+50

MATCH LINE STA. 232+50
SEE SHEET 212.

EQUATION:
STA 217+00.00 BK =
STA 231+49.42 AH

| | |
|------------|-----|
| CALCULATED | MHT |
| CHECKED | WAA |

0 20 40
HORIZONTAL
SCALE IN FEET

DRAINAGE AND UNDERDRAIN PLAN - SR-32
STA. 212+50 TO STA. 232+50


CLE-32-2.65
(PHASE 7)

...311.20\311.204\103953mg500.dgn 8/26/2021 11:59:19 AM mswitt

| SHEET NUM. | | | | | | | | | | | | | PART. | ITEM | ITEM | GRAND | UNIT | DESCRIPTION | SEE SHEET NO. | |
|------------|----|----|-----|-------|-------|-------|--|--|--|--|--|--|-----------|---------|----------|-------|------|--|------------------------|--|
| 14 | 15 | 16 | 17 | 18 | 89 | 90 | | | | | | | 03/S>2/PV | | EXT | TOTAL | | | | |
| | | | | | | | | | | | | | | | | | | | MAINTENANCE OF TRAFFIC | |
| | | | | 1 | | | | | | | | | 1 | 202 | 20010 | 1 | EACH | HEADWALL REMOVED | | |
| | | | | | 106 | | | | | | | | 106 | 202 | 23000 | 106 | SY | PAVEMENT REMOVED | | |
| | | | | 231 | | | | | | | | | 231 | 202 | 35100 | 231 | FT | PIPE REMOVED, 24" AND UNDER | | |
| | | | | 88 | | | | | | | | | 88 | 202 | 35200 | 88 | FT | PIPE REMOVED, OVER 24" | | |
| | | | | 1 | | | | | | | | | 1 | 202 | 58100 | 1 | EACH | CATCH BASIN REMOVED | | |
| | | | | 1,328 | | | | | | | | | 1,328 | SPECIAL | 20302000 | 1,328 | CY | ENGINEERED FILL | 64 | |
| | | | 60 | | | | | | | | | | 60 | 301 | 46000 | 60 | CY | ASPHALT CONCRETE BASE, PG64-22 | | |
| | | | 40 | | | | | | | | | | 50 | 304 | 20000 | 40 | CY | AGGREGATE BASE | | |
| | | | 20 | | | | | | | | | | 20 | 407 | 10000 | 20 | GAL | TACK COAT | | |
| 86 | | | | | | | | | | | | | 86 | 410 | 12000 | 86 | CY | TRAFFIC COMPACTED SURFACE, TYPE A OR B | | |
| | | | 10 | | | | | | | | | | 10 | 441 | 50000 | 10 | CY | ASPHALT CONCRETE SURFACE COURSE, TYPE 1, (448), PG64-22 | | |
| | | | | 0.2 | | | | | | | | | 0.2 | 602 | 20000 | 0.2 | CY | CONCRETE MASONRY | | |
| | | | | | 25 | | | | | | | | 25 | 609 | 10000 | 25 | FT | ASPHALT CONCRETE CURB, TYPE 1 | | |
| | | | | 27 | | | | | | | | | 27 | 611 | 04600 | 27 | FT | 12" CONDUIT, TYPE C | | |
| | | | | 204 | | | | | | | | | 204 | 611 | 10600 | 204 | FT | 24" CONDUIT, TYPE C | | |
| | | | | 88 | | | | | | | | | 88 | 611 | 26000 | 88 | FT | 72" CONDUIT, TYPE A | | |
| | | | | 1 | | | | | | | | | 1 | 611 | 98470 | 1 | EACH | CATCH BASIN, NO. 2-2B | | |
| | | | | 3 | | | | | | | | | 3 | 611 | 98631 | 3 | EACH | CATCH BASIN ADJUSTED TO GRADE, AS PER PLAN | 18 | |
| | 48 | | | | | | | | | | | | 48 | 614 | 11110 | 48 | hour | LAW ENFORCEMENT OFFICER WITH PATROL CAR FOR ASSISTANCE | | |
| | | | | | | | | | | | | | LUMP | 614 | 18002 | LS | | MAINTAINING TRAFFIC, MISC.: WORK ZONE TRAFFIC SIGNAL (SPECIAL 61411300) | 15 | |
| | | | | | 8 | | | | | | | | 8 | 614 | 12384 | 8 | EACH | WORK ZONE IMPACT ATTENUATOR, 24" WIDE HAZARDS, (BIDIRECTIONAL) | | |
| | | | | | | | | | | | | | LUMP | 614 | 12420 | LS | | DETOUR SIGNING (MARIAN DR CLOSED - PHASE 1) | | |
| | | | | | 425 | | | | | | | | 425 | 614 | 12801 | 425 | EACH | WORK ZONE RAISED PAVEMENT MARKER, AS PER PLAN | 16 | |
| 18 | | | | | | | | | | | | | 18 | 614 | 13000 | 18 | CY | ASPHALT CONCRETE FOR MAINTAINING TRAFFIC | | |
| | | | | | 151 | | | | | | | | 151 | 614 | 13310 | 151 | EACH | BARRIER REFLECTOR, TYPE 1, ONE WAY | | |
| | | | | | 151 | | | | | | | | 151 | 614 | 13350 | 151 | EACH | OBJECT MARKER, ONE WAY | | |
| | | | | 3,200 | | | | | | | | | 3,200 | 614 | 18030 | 3,200 | FT | MAINTAINING TRAFFIC, MISC.:PROVIDING POSITIVE DRAINAGE DURING CONSTRUCTION | 18 | |
| | | | | | 180 | | | | | | | | 180 | 614 | 18030 | 180 | FT | MAINTAINING TRAFFIC, MISC.:TEMPORARY SHEET PILING | 64 | |
| | | | | | 0.03 | | | | | | | | 0.03 | 614 | 20100 | 0.03 | MILE | WORK ZONE LANE LINE, CLASS I, 4", 642 PAINT | | |
| | | | | | | 0.62 | | | | | | | 0.62 | 614 | 20550 | 0.62 | MILE | WORK ZONE LANE LINE, CLASS III, 4", 642 PAINT | | |
| | | | | | 1.97 | | | | | | | | 1.97 | 614 | 21100 | 1.97 | MILE | WORK ZONE CENTER LINE, CLASS I, 642 PAINT | | |
| | | | | | | 0.95 | | | | | | | 0.95 | 614 | 21550 | 0.95 | MILE | WORK ZONE CENTER LINE, CLASS III, 642 PAINT | | |
| | | | | | 4.42 | | | | | | | | 4.42 | 614 | 22100 | 4.42 | MILE | WORK ZONE EDGE LINE, CLASS I, 4", 642 PAINT | | |
| | | | | | | 1.27 | | | | | | | 1.27 | 614 | 22350 | 1.27 | MILE | WORK ZONE EDGE LINE, CLASS III, 4", 642 PAINT | | |
| | | | | | 108 | | | | | | | | 108 | 614 | 23200 | 108 | FT | WORK ZONE CHANNELIZING LINE, CLASS I, 8", 642 PAINT | | |
| | | | | | | 2,220 | | | | | | | 2,220 | 614 | 23680 | 2,220 | FT | WORK ZONE CHANNELIZING LINE, CLASS III, 8", 642 PAINT | | |
| | | | | | 770 | | | | | | | | 770 | 614 | 24200 | 770 | FT | WORK ZONE DOTTED LINE, CLASS I, 4", 642 PAINT | | |
| | | | | | | 771 | | | | | | | 771 | 614 | 24610 | 771 | FT | WORK ZONE DOTTED LINE, CLASS III, 4", 642 PAINT | | |
| | | | | | 95 | | | | | | | | 95 | 614 | 25200 | 95 | FT | WORK ZONE TRANSVERSE/DIAGONAL LINE, CLASS I, 642 PAINT | | |
| | | | | | | 301 | | | | | | | 301 | 614 | 25620 | 301 | FT | WORK ZONE TRANSVERSE/DIAGONAL LINE, CLASS III, 642 PAINT | | |
| | | | | | 259 | | | | | | | | 259 | 614 | 26200 | 259 | FT | WORK ZONE STOP LINE, CLASS I, 642 PAINT | | |
| | | | | | | 216 | | | | | | | 216 | 614 | 26610 | 216 | FT | WORK ZONE STOP LINE, CLASS III, 642 PAINT | | |
| | | | | | | 34 | | | | | | | 34 | 614 | 30650 | 34 | EACH | WORK ZONE ARROW, CLASS III, 642 PAINT | | |
| | | | | | | 8 | | | | | | | 8 | 614 | 31620 | 8 | EACH | WORK ZONE WORD ON PAVEMENT, 72", CLASS III, 642 PAINT | | |
| LS | | 5 | | | | | | | | | | | 5 | 614 | 40051 | 5 | EACH | BUSINESS ENTRANCE SIGN, AS PER PLAN | 15 | |
| | | | | | | | | | | | | | LS | 615 | 10000 | LS | | ROADS FOR MAINTAINING TRAFFIC | | |
| | | | | | 1,424 | | | | | | | | 1,424 | 615 | 25000 | 1,424 | SY | PAVEMENT FOR MAINTAINING TRAFFIC, CLASS B | | |
| | | | | | 294 | | | | | | | | 294 | 615 | 25001 | 294 | SY | PAVEMENT FOR MAINTAINING TRAFFIC, CLASS B, AS PER PLAN | 64 | |
| 63 | | | | | | | | | | | | | 63 | 616 | 10000 | 63 | MGAL | WATER | | |
| | | | | | 7,080 | | | | | | | | 7,080 | 622 | 41100 | 7,080 | FT | PORTABLE BARRIER, UNANCHORED | | |
| | | | 0.2 | | | | | | | | | | 0.2 | 642 | 00100 | 0.2 | MILE | EDGE LINE, 4", TYPE 1 | | |
| | | | 0.1 | | | | | | | | | | 0.1 | 642 | 00300 | 0.1 | MILE | CENTER LINE, TYPE 1 | | |
| | | | | | | | | | | | | | | | | | | INCIDENTALS | | |
| | | | | | | | | | | | | | LS | 108 | 10000 | LS | | CPM PROGRESS SCHEDULE | | |
| | | | | | | | | | | | | | LS | 614 | 11000 | LS | | MAINTAINING TRAFFIC | | |
| | | | | | | | | | | | | | LS | 623 | 10000 | LS | | CONSTRUCTION LAYOUT STAKES AND SURVEYING | | |
| | | | | | | | | | | | | | LS | 624 | 10000 | LS | | MOBILIZATION | | |


GENERAL SUMMARY

CLE-CR 388 (PHASE 4)

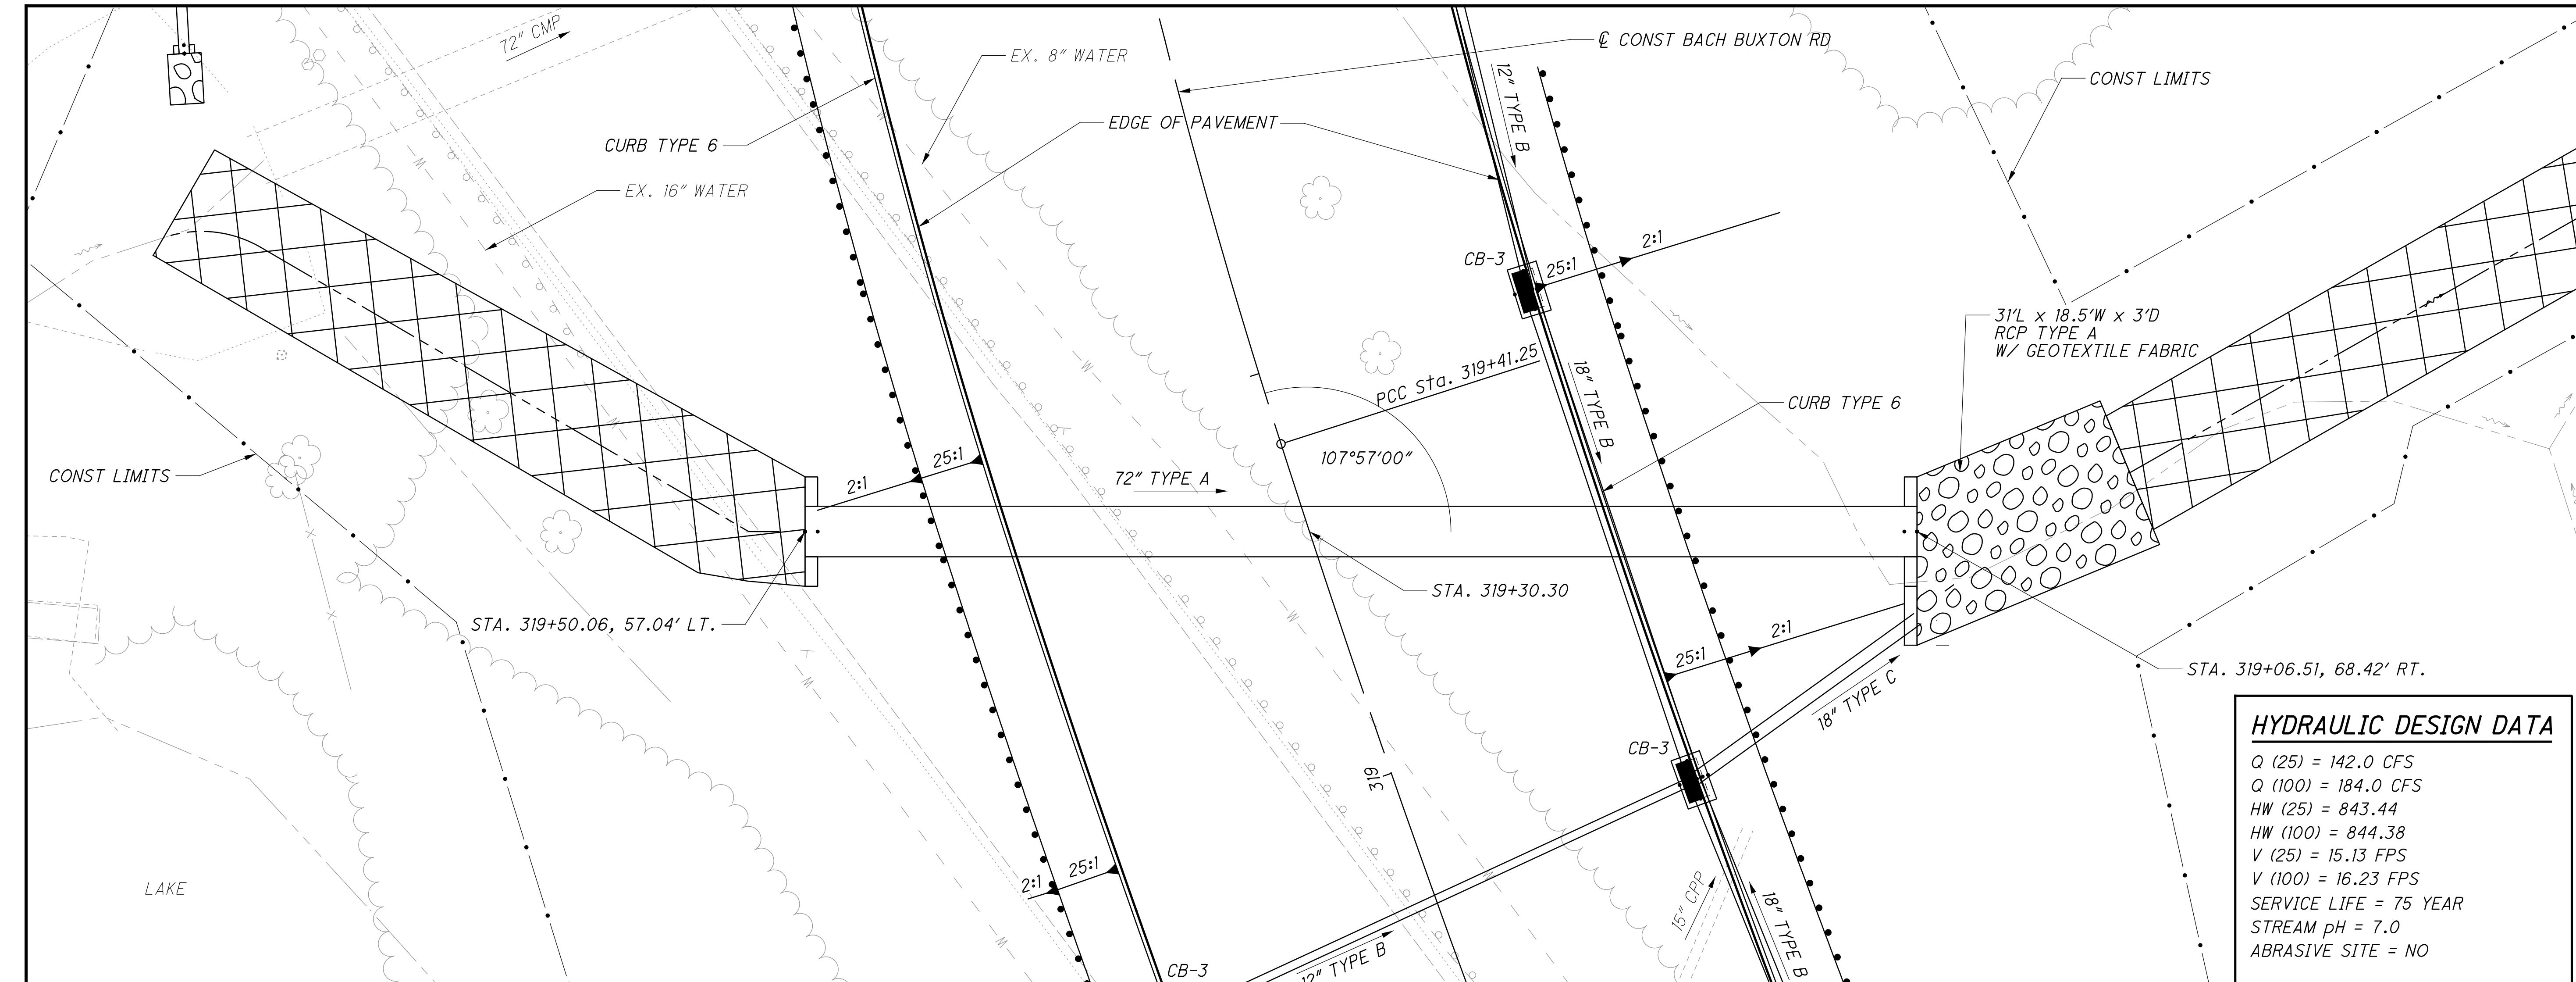

HYDRAULIC DESIGN DATA

| |
|------------------------|
| Q (25) = 142.0 CFS |
| Q (100) = 184.0 CFS |
| HW (25) = 843.44 |
| HW (100) = 844.38 |
| V (25) = 15.13 FPS |
| V (100) = 16.23 FPS |
| SERVICE LIFE = 75 YEAR |
| STREAM pH = 7.0 |
| ABRASIVE SITE = NO |

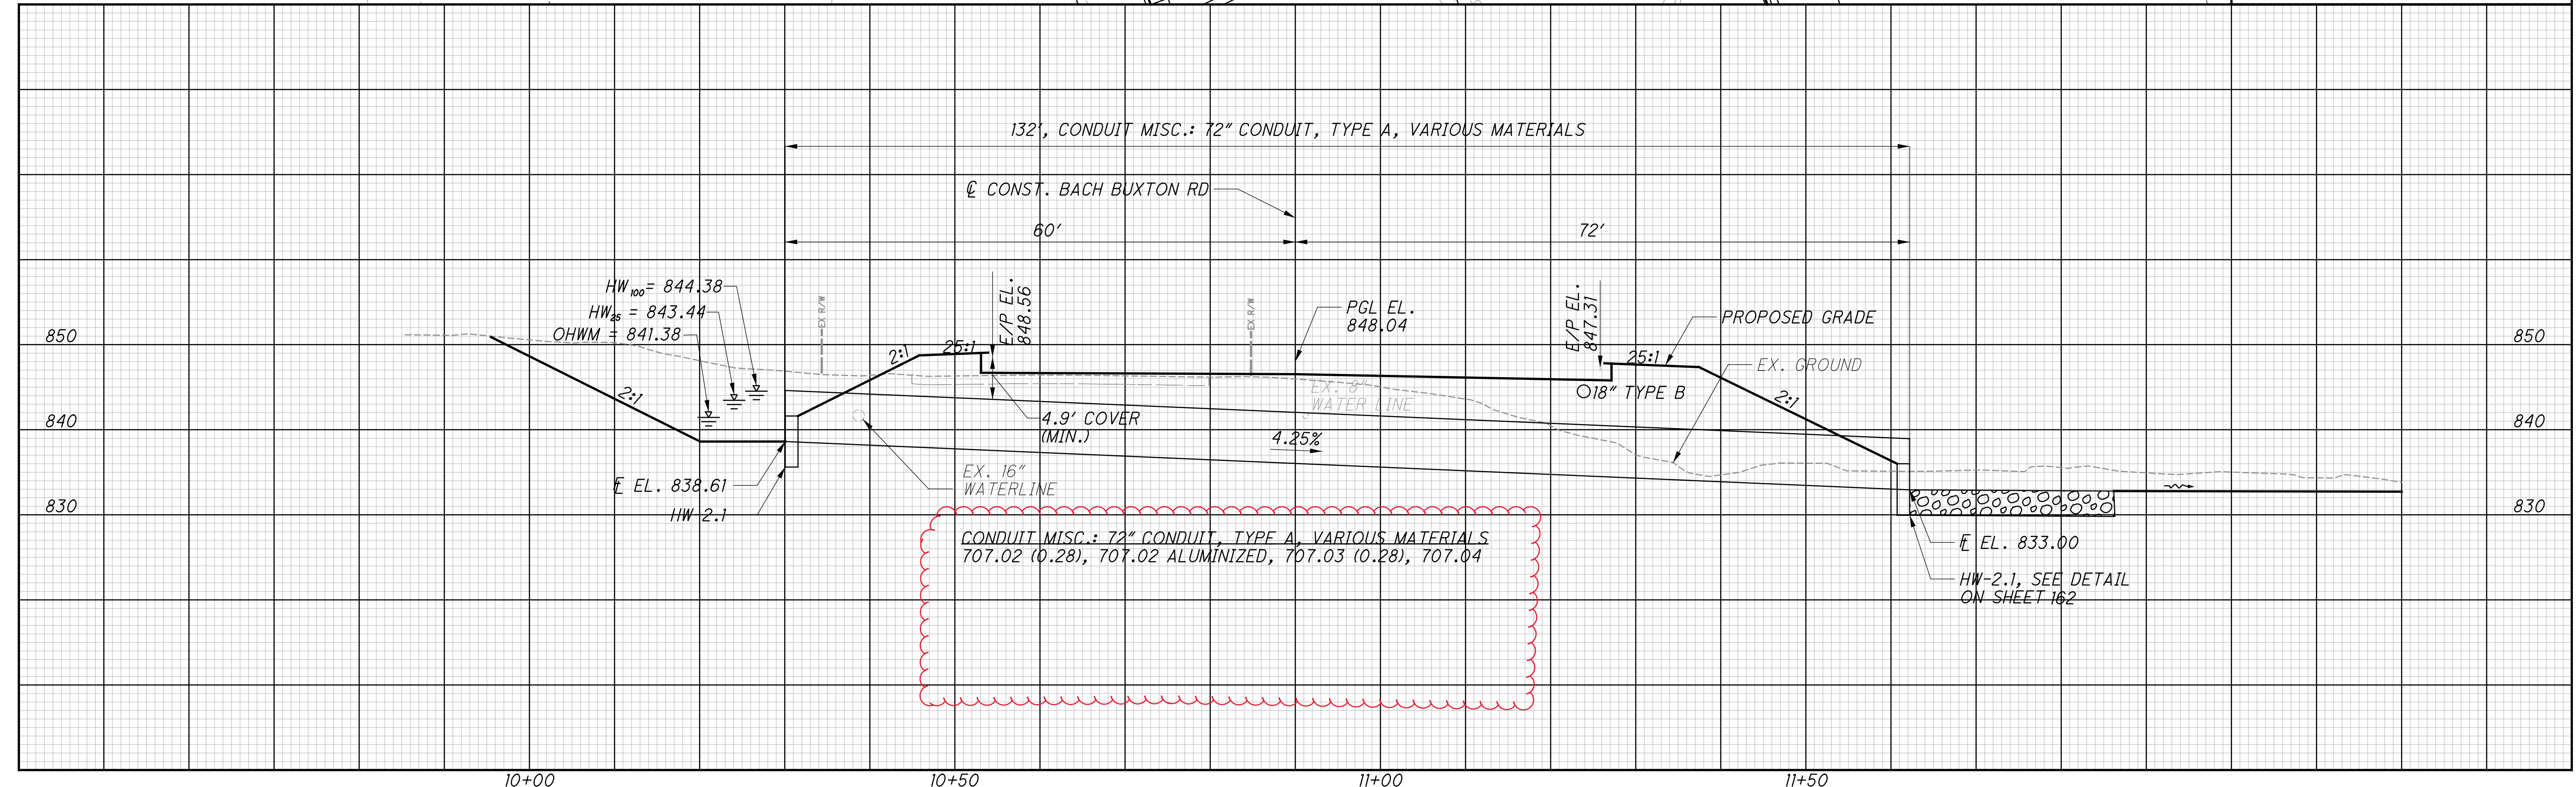

CULVERT DETAILS
BACH BUXTON RD - STA. 319+30.30

CLE-CR388
(PHASE 4)

...CULVERT SHEET 11/18/2021 10:30:06 AM mhnterrell

10:39:53ms500.dgn 7/17/2021 12:13:01 PM hyatt

| SHEET NO. | MOT PHASE | 202 | 304 | 609 | 614 | | 614 | 614 | 614 | 614 | 614 | 614 | 614 | 614 | 614 | 614 | 614 | 614 | 615 | 615 | 622 | | |
|-----------------------------------|-----------------|------------------------|----------------------|-------------------------------------|--|--|---|--|-----------------------------------|--------------------------------|--|---|---|---|---|---|---|---|-------|---|--|------------------------------------|------|
| | | PAVEMENT REMOVED SY | AGGREGATE BASE CY | ASPHALT CONCRETE CURB, TYPE 1 FT | WORK ZONE IMPACT ATTENUATOR, 24" WIDE HAZARDS, (BIDIRECTIONAL) EACH | | WORK ZONE RAISED PAVEMENT MARKER, AS PER PLAN (ONE WAY WHITE) EACH | WORK ZONE RAISED PAVEMENT MARKER, AS PER PLAN (TWO WAY YELLOW) EACH | BARRIER REFLECTOR, TYPE 1 EACH | OBJECT MARKER, ONE WAY EACH | MAINTAINING TRAFFIC, MISC.: TEMPORARY SHEET PILING FT | WORK ZONE LANE LINE, CLASS I, 4", 642 PAINT (WHITE) MILE | WORK ZONE CENTER LINE, CLASS I, 642 PAINT (SOLID, DOUBLE) MILE | WORK ZONE EDGE LINE, CLASS I, 4", 642 PAINT (WHITE) MILE | WORK ZONE CHANNELIZING LINE, CLASS I, 642 PAINT FT | WORK ZONE DOTTED LINE, CLASS I, 642 PAINT FT | WORK ZONE TRANSVERSE LINE, CLASS I, 642 PAINT FT | WORK ZONE STOP LINE, CLASS I, 642 PAINT FT | | PAVEMENT FOR MAINTAINING TRAFFIC, CLASS B SY | PAVEMENT FOR MAINTAINING TRAFFIC, CLASS B, AS PER PLAN SY | PORTABLE BARRIER, UNANCHORED FT | |
| 31 - 34 | PRE-PHASE 1 | | 10 | | 1 | | 26 | 13 | 8 | 8 | 70 | 1265 | 1272 | | | | 62 | 37 | 2952 | | 350 | | |
| 35 - 38 | PHASE 1 STEP 1 | 58 | | | | | 68 | 34 | | | 110 | 1875 | 3870 | | | | 33 | 43 | 9860 | 2644 | | | |
| 40 | PHASE 1 STEP 2 | | | 25 | | | | | | | | 703 | 950 | | | | | | | | | | |
| 42 - 45 | PHASE 2 | 48 | | | 3 | | 54 | 54 | 44 | 44 | | 178 | 1832 | 7127 | | 108 | | | | | | 2110 | |
| 47 - 50 | PHASE 3 STEP 1 | | | | 1 | | | | 13 | 13 | | 1342 | 1733 | | 114 | | | | | | | 570 | |
| 52 - 34 | PHASE 3 STEP 2 | | | | | | | | | | | 346 | 320 | | | | | | | | | 11 | |
| 53 - 56 | PHASE 4 STEP 1A | | | | 2 | | 41 | 41 | 51 | 51 | | 1333 | 5007 | 108 | 548 | | | | | | | 21 | 2490 |
| 58 | PHASE 4 STEP 1B | | | | | | | | 9 | 9 | | | | | | | | | | | | | 370 |
| 60 - 61 | PHASE 4 STEP 2A | | | | | | 47 | 47 | 22 | 22 | | 1120 | 1842 | | | | | | | | | 22 | 1050 |
| 63 | PHASE 4 STEP 2B | | | | 1 | | | | 4 | 4 | | 609 | 1218 | | | | | | | | | | 140 |
| SUBTOTALS ALL PHASES | | 106 | 10 | 25 | 8 | | 236 | 189 | 151 | 151 | 180 | 178 | 10425 | 23339 | 108 | 770 | 95 | 259 | 12812 | 2644 | 7080 | | |
| TOTALS CARRIED TO GENERAL SUMMARY | | 106 | 10 | 25 | 8 | | 425 | | 151 | 151 | 180 | 0.03 | 1.97 | 4.42 | 108 | 770 | 95 | 259 | 1424 | 294 | 7080 | | |

NOTES: 1) THE PAVEMENT MARKINGS SHALL MATCH THE FINAL PAVEMENT MARKING LAYOUT. SEE TRAFFIC PLANS FOR DETAILS. SEE GENERAL NOTES - WORK ZONE MARKINGS AND SIGNS.

MAINTENANCE OF TRAFFIC SUBSUMMARY 1 / 2

CLE-CR 388 (PHASE 4)

CALCULATED
KSC
CHECKED
JLG

89
245