



**Matthew G. Bevin**  
Governor

**COMMONWEALTH OF KENTUCKY  
TRANSPORTATION CABINET  
Frankfort, Kentucky 40622  
www.transportation.ky.gov/**

**Greg Thomas**  
Secretary

July 23, 2018

CALL NO. 103  
CONTRACT ID NO. 181025  
ADDENDUM # 2

Subject: BOONE COUNTY, STP 8200(017)  
Letting July 27, 2018

- (1)Revised - Utilities and Rail Certification Note - Pages 35-40 of 243
- (2)Revised - Proposal Bid Items - Pages 237-243 of 243
- (3)Revised - Plan Sheets - R2, R2d, R2f, R2g, R2h, R2i, R214, and R215

Proposal revisions are available at <http://transportation.ky.gov/Construction-Procurement/>.

If you have any questions, please contact us at 502-564-3500.

Sincerely,

A handwritten signature in black ink that reads "Rachel Mills".

Rachel Mills, P.E.  
Director  
Division of Construction Procurement

RM:mr  
Enclosures



An Equal Opportunity Employer M/F/D

## UTILITIES AND RAIL CERTIFICATION NOTE

Boone County

00STP8200016

FD52 008 6979203U

Mile point: 2.251 TO 5.370

RECONSTRUCT AND WIDEN KY 237 FROM VALLEY VIEW DRIVE TO ROGERS LANE. (14CCR)

ITEM NUMBER: 06-8001.21

### PROJECT NOTES ON UTILITIES

#### Damage to Utilities

Any intentional or accidental disruption of service due to damage to gas, sewer, or water mains caused by any of the contractor's operations without three days advance notice to the utility owner shall be cause for the Cabinet to charge liquidated damages in the amount of five thousand dollars per day (\$5,000/day) per occurrence against the contractor until such a time as the utility main is restored.

Any intentional or accidental disruption of any individual gas, water, or sewer service caused by any of the contractor's operations without three days advance notice to the utility owner shall be cause for the Cabinet to charge liquidated damages in the amount of five hundred dollars per day (\$500/day) per occurrence against the contractor until such time as service is restored.

In the case of a main disruption, liquidated damages shall be charged at the main disruption rate only. Liquidated damages shall not be charged in addition for service disruptions when a main disruption is involved.

#### Flowable Fill Requirement

The Contractor shall use flowable fill as the backfill media any place water lines cross under the existing or proposed roadway surfaces. It should also be noted that the cost of the flowable fill shall be incidental to the cost of the water line being installed.

#### External Utility Permits

Kentucky Division of Water permits for water relocation construction were not available before bidding. These items will be distributed at the preconstruction meeting.

#### Abandoned Utilities

The Contractor shall safeload the entire length of all abandoned pipes 6 inches in diameter and larger under proposed pavement and under any existing pavement that is to remain. The Contractor shall safeload the entire length of all abandoned pipes 15 inches and larger which will be located outside of proposed pavement but within project limits. Appropriate bid items have been included in the road contract. The safeloading criteria above shall be observed unless otherwise directed by the Section Engineer or his representative.

## UTILITIES AND RAIL CERTIFICATION NOTE

Boone County

00STP8200016

FD52 008 6979203U

Mile point: 2.251 TO 5.370

RECONSTRUCT AND WIDEN KY 237 FROM VALLEY VIEW DRIVE TO ROGERS LANE. (14CCR)

ITEM NUMBER: 06-8001.21

Please Note: The information presented in this Utility Note is informational in nature and the information contained herein is not guaranteed.

The Contractor will be responsible for contacting all utility facility owners on the subject project to coordinate activities. The Contractor will coordinate activities to minimize and, where possible, avoid conflicts with utility facilities. Where conflicts with utility facilities are unavoidable, the contractor will coordinate any necessary relocation work with the facility owner and Resident Engineer. The Kentucky Transportation Cabinet maintains the right to remove or alter portions of this contract if a utility conflict occurs. The utility facilities as noted in the previous section(s) have been determined using data garnered by varied means and with varying degrees of accuracy: from the facility owners, a result of S.U.E., field inspections, and/or reviews of record drawings. The facilities defined may not be inclusive of all utilities in the project scope and are not Level A quality, unless specified as such. It is the Contractor's responsibility to verify all utilities and their respective locations before excavating.

The Contractor shall make every effort to protect underground facilities from damage as prescribed in the Underground Facility Damage Protection Act of 1994, Kentucky Revised Statute KRS 367.4901 to 367.4917. It is the Contractor's responsibility to determine and take steps necessary to be in compliance with federal and state damage prevention directives. The Contractor is instructed to contact KY 811 for the location of existing underground utilities. Contact shall be made a minimum of two (2) and no more than ten (10) business days prior to excavation. The Contractor shall submit Excavation Locate Requests to the Kentucky Contact Center (KY 811) via web ticket entry. The submission of this request does not relieve the contractor from the responsibility of contacting non-member facility owners, whom are to be contacted through their individual Protection Notification Center. It may be necessary for the contractor to contact the County Court Clerk to determine what utility companies have facilities in the area. Non-compliance with these directives can result in the enforcement of penalties.

### NOTE: DO NOT DISTURB THE FOLLOWING FACILITIES LOCATED WITHIN THE PROJECT DISTURB LIMITS

**Mid-Valley Pipeline** crude oil transmission facilities shall not be disturbed by the Contractor as part of this project. This facility crosses the project at Station 213+10.08. The Contractor should proceed with caution in the vicinity of this facility. Test excavations to date indicate a minimum existing cover of 3.17 feet. After construction, minimum proposed cover should be 3.52 feet. Existing depths of the pipeline vary and should be verified by the Contractor prior to construction. Investigation to date has not indicated relocation of the pipeline is required.

## UTILITIES AND RAIL CERTIFICATION NOTE

Boone County

00STP8200016

FD52 008 6979203U

Mile point: 2.251 TO 5.370

RECONSTRUCT AND WIDEN KY 237 FROM VALLEY VIEW DRIVE TO ROGERS LANE. (14CCR)

ITEM NUMBER: 06-8001.21

Mid-Valley Pipeline will require timber mat cover/loading protection at a minimum but preference is an "air bridge" to protect pipeline crossing location. Refer to the bid documents for maximum allowable loading stresses on the pipeline. It is the responsibility of the Contractor to coordinate with Mid-Valley Pipeline inspectors while working in the vicinity of the pipeline crossing.

**Boone-Florence Water Commission** has a 16" water distribution facility that crosses the project near Station 86+70. This is only the Boone-Florence Water Commission facility within project limits and shall not be disturbed by the Contractor.

**\*The Contractor is fully responsible for protection of all utilities listed above\***

### THE FOLLOWING FACILITY OWNERS ARE RELOCATING/ADJUSTING THEIR FACILITIES WITHIN THE PROJECT LIMITS AND WILL BE COMPLETE PRIOR TO CONSTRUCTION

**Duke Energy (Gas)** distribution facilities should be relocated prior to roadway construction. Duke began this relocation work on May 14, 2018. The company began work at the Oakbrook Dr./Carters Mill Ln. intersection and then proceeded to the Gunpowder Creek crossing in order to avoid all potential roadway construction conflicts. Work then began at the start of the roadway project and is progressing towards the end of the roadway project. This work is expected to be complete prior to the start of roadway construction.

There is an existing 12-inch high pressure transmission facility that crosses the project between Stations 188+00 – 195+00. This facility will not be relocated prior to construction. The Contractor will need to coordinate with Duke Energy on the relocation schedule of this facility in order to avoid conflicts.

Duke Energy's proposed gas main locations are marked in the plan set in the Utility Reference Sheets (Sheets R197 – R215), as provided as part of the bid documents. Locations in the Utility Reference Sheets are approximate and final as-built gas mains shall be verified with Duke Energy by the Contractor.

### THE FOLLOWING FACILITY OWNERS HAVE FACILITIES TO BE RELOCATED/ADJUSTED BY THE OWNER OR THEIR SUBCONTRACTOR AND IS TO BE COORDINATED WITH THE ROAD CONTRACT

**Owen Electric Cooperative, Cincinnati Bell Telephone, Charter Communications, and Duke Energy (Gas)** have overhead and/or underground facilities that will be relocated by the utility owners concurrently with the road construction. **These companies estimate relocation of their facilities will be complete by August 31, 2019. This date is an estimation. The successful contractor should be aware that relocations by these**

## UTILITIES AND RAIL CERTIFICATION NOTE

Boone County

00STP8200016

FD52 008 6979203U

Mile point: 2.251 TO 5.370

RECONSTRUCT AND WIDEN KY 237 FROM VALLEY VIEW DRIVE TO ROGERS LANE. (14CCR)

ITEM NUMBER: 06-8001.21

**companies may not be complete by this date.** The road contractor will be required to coordinate with these utility companies and their contractors until completion of their work.

While the aforementioned Duke Energy (Gas) distribution project is expected to be complete prior to roadway construction, there will be a pressure improvement project which will provide a connection for two separate distribution networks. This connection will be installed between roadway STA. 219+00 and 231+00. This project is expected to begin 9/1/18 and expected completion date is 10/31/18. Duke can be flexible in this timeline and is willing to work within the timeline agreed upon by the roadway contractor.

Additionally, a Duke Energy (Gas) high-pressure transmission line exists between Stations 188+00 – 195+00 which is to be relocated concurrently with road construction. The road contractor shall coordinate schedules with Duke Energy (Gas) in order to avoid conflicts with this relocation. Duke Energy (Gas) requires the existing earth between the above stations to remain undisturbed until the completion of the new gas transmission facilities.

It will be the responsibility of the Contractor to remove any abandoned portions of the existing gas transmission line in conflict with the construction of the roadway project. Any pipe removed will become property of the road contractor. Duke Energy (gas) tested the pipe for hazardous materials and none were detected.

**The Cabinet will consider submission of a bid as the Contractor's agreement to not make any claims for additional monetary compensation due to delays or other conditions created by the operations of Owen Electric Cooperative, Cincinnati Bell Telephone, Charter Communications, and Duke Energy (Gas).**

**Monetary claims will not be considered for any delays incurred before or after August 31, 2019. Any costs (including delay costs) related to the coordination and cooperation with these utility companies shall be included in the bid item for "General Utility Coordination". After August 31, 2019, when the Contractor cannot perform work on the controlling operation due to conflicting work, or incomplete infrastructure relocations, being performed by Owen Electric Cooperative, Cincinnati Bell Telephone, Charter Communications, or Duke Energy (Gas) calendar days will be added to the fixed completion date on a day for day basis. No days will be added for delays prior to August 31, 2019. Should a difference of opinion arise as to the rights of the Contractor and others working within the limits of – or adjacent to – the project, the KYTC Section Engineer will decide as to the respective rights of the various parties involved in order to assure the completion of the Cabinet's work in general harmony and in a satisfactory manner, and his decision shall be final and binding upon the Contractor.**

## UTILITIES AND RAIL CERTIFICATION NOTE

Boone County

00STP8200016

FD52 008 6979203U

Mile point: 2.251 TO 5.370

RECONSTRUCT AND WIDEN KY 237 FROM VALLEY VIEW DRIVE TO ROGERS LANE. (14CCR)

ITEM NUMBER: 06-8001.21

**THE FOLLOWING FACILITY OWNERS HAVE FACILITIES TO BE RELOCATED/ADJUSTED BY THE ROAD CONTRACTOR AS INCLUDED IN THIS CONTRACT**

**City of Florence Water, Boone County Water District, and Sanitation District No. 1** have facilities to be adjusted by the roadway contractor using plans inserted into the road construction plans and specifications inserted into the project proposal. Appropriate utility bid items have been included in the contract bid documents.

### Utility Phasing:

The Contractor should be aware that some utilities will need to be relocated to accommodate the relocation of other utilities or construction of the roadway. Portions of utility relocations may need to be conducted outside of the MOT plan to allow the project to move forward. The Contractor should review the plans and draw his own conclusions as to the phasing of the various utilities. Utility work that needs to be conducted outside of the MOT phasing should be coordinated with the section engineer. The Contractor should pay close attention to the proximity of construction of new facilities when working in the vicinity of existing water mains to prevent blow-outs.

### Notes:

- Utility pipeline fittings are not bid as separate pay items in new utility main installations in this contract. Fittings are considered incidental to pipe and other items.
- Utility service laterals included in this contract are not paid on a linear basis. Service laterals are bid in lump sum as short side and long side.
- Bidding contractors should note that several other items of pay have been modified from previous road contracts. The contractor should thoroughly review the Standard Bid Item Descriptions for each utility discipline included in the contract. These bid item descriptions are included elsewhere in the project proposal.

Impacts to Sanitation District No. 1 facilities are minimal. There are seven manhole rim adjustments and one new manhole installation. There is not a separate set of SD1 plans provided. All SD1 bid items are included in the roadway plan set. Notes have also been added to the roadway plan set identifying adjustment locations.

**RAIL COMPANIES HAVE FACILITIES IN CONJUNCTION WITH THIS PROJECT AS NOTED**

**No Rail Involvement**    **Rail Involved**    **Rail Adjacent**

## UTILITIES AND RAIL CERTIFICATION NOTE

Boone County

00STP8200016

FD52 008 6979203U

Mile point: 2.251 TO 5.370

RECONSTRUCT AND WIDEN KY 237 FROM VALLEY VIEW DRIVE TO ROGERS LANE. (14CCR)

ITEM NUMBER: 06-8001.21

### AREA FACILITY OWNER CONTACT LIST

Facility Owner	Address	Contact Name	Phone	Email
----------------	---------	--------------	-------	-------

\*UTILITY FACILITY OWNER CONTACT INFORMATION TO BE PROVIDED AT PRECONSTRUCTION  
MEETING\*

181025

## PROPOSAL BID ITEMS

REVISED ADDENDUM #2: 7-23-18

Report Date 7/23/18

Page 1 of 7

## Section: 0001 - PAVING-ALT #1

LINE	BID CODE	ALT	DESCRIPTION	QUANTITY	UNIT	UNIT PRIC	FP	AMOUNT
0010	00003		CRUSHED STONE BASE	51,649.00	TON	\$		
0020	00008		CEMENT STABILIZED ROADBED	120,196.00	SQYD	\$		
0030	00020		TRAFFIC BOUND BASE	152.00	TON	\$		
0040	00100		ASPHALT SEAL AGGREGATE	24.60	TON	\$		
0050	00103		ASPHALT SEAL COAT	3.00	TON	\$		
0060	00214		CL3 ASPH BASE 1.00D PG64-22	70,136.00	TON	\$		
0070	00356		ASPHALT MATERIAL FOR TACK	68.00	TON	\$		
0080	00358		ASPHALT CURING SEAL	120.00	TON	\$		
0090	00388		CL3 ASPH SURF 0.38B PG64-22	11,851.00	TON	\$		
0100	01810		STANDARD CURB AND GUTTER	30,100.00	LF	\$		
0110	02084		JPC PAVEMENT-8 IN	1,455.00	SQYD	\$		
0120	02101		CEM CONC ENT PAVEMENT-8 IN	963.00	SQYD	\$		
0130	02542		CEMENT	2,294.00	TON	\$		
0140	02677		ASPHALT PAVE MILLING & TEXTURING	138.00	TON	\$		
0150	02702		SAND FOR BLOTTER	301.00	TON	\$		
0160	10020NS		FUEL ADJUSTMENT	205,212.00	DOLL \$1.00	\$	\$	\$205,212.00
0170	10030NS		ASPHALT ADJUSTMENT	320,611.00	DOLL \$1.00	\$	\$	\$320,611.00
0180	23379EC		STAMPED CONCRETE	425.00	SQYD	\$		
0190	24779EC		INTELLIGENT COMPACTION FOR SOIL	242,795.00	CUYD	\$		
			INTELLIGENT COMPACTION FOR AGGREGATE	51,183.00	TON	\$		
0200	24780EC		INTELLIGENT COMPACTION FOR ASPHALT	81,631.00	TON	\$		
0220	24891EC		PAVE MOUNT INFRARED TEMP EQUIPMENT	1,857,132.00	SF	\$		
			INTELLIGENT COMP SUBGRADE STABILIZATION	120,196.00	SQYD	\$		
0230	24990EC							

## Section: 0002 - PAVING- ALT #2

LINE	BID CODE	ALT	DESCRIPTION	QUANTITY	UNIT	UNIT PRIC	FP	AMOUNT
0240	00003		CRUSHED STONE BASE	93,072.00	TON	\$		
0250	00008		CEMENT STABILIZED ROADBED	120,145.00	SQYD	\$		
0260	00020		TRAFFIC BOUND BASE	152.00	TON	\$		
0270	00100		ASPHALT SEAL AGGREGATE	24.60	TON	\$		
0280	00103		ASPHALT SEAL COAT	3.00	TON	\$		
0290	00214		CL3 ASPH BASE 1.00D PG64-22	35,984.00	TON	\$		
0300	00356		ASPHALT MATERIAL FOR TACK	44.00	TON	\$		
0310	00358		ASPHALT CURING SEAL	120.00	TON	\$		
0320	00388		CL3 ASPH SURF 0.38B PG64-22	11,851.00	TON	\$		
0330	01810		STANDARD CURB AND GUTTER	30,100.00	LF	\$		
0340	02084		JPC PAVEMENT-8 IN	1,455.00	SQYD	\$		
0350	02101		CEM CONC ENT PAVEMENT-8 IN	963.00	SQYD	\$		
0360	02542		CEMENT	2,293.00	TON	\$		
0370	02677		ASPHALT PAVE MILLING & TEXTURING	138.00	TON	\$		
0380	02702		SAND FOR BLOTTER	301.00	TON	\$		
0390	10020NS		FUEL ADJUSTMENT	166,800.00	DOLL \$1.00	\$	\$	\$166,800.00
0400	10030NS		ASPHALT ADJUSTMENT	187,090.00	DOLL \$1.00	\$	\$	\$187,090.00

181025

## PROPOSAL BID ITEMS

REVISED ADDENDUM #2: 7-23-18

Page 2 of 7

Report Date 7/23/18

LINE	BID CODE	ALT DESCRIPTION	QUANTITY	UNIT	UNIT PRIC	FP	AMOUNT
0410	20263ED	GEOGRID REINFORCEMENT	120,145.00	SQYD	\$		
0420	23379EC	STAMPED CONCRETE	425.00	SQYD	\$		
0430	24779EC	INTELLIGENT COMPACTION FOR SOIL	242,795.00	CUYD	\$		
		INTELLIGENT COMPACTION FOR AGGREGATE	92,616.00	TON	\$		
0440	24780EC	INTELLIGENT COMPACTION FOR ASPHALT	47,479.00	TON	\$		
0450	24781EC	PAVE MOUNT INFRARED TEMP EQUIPMENT	1,857,132.00	SF	\$		
		INTELLIGENT COMP SUBGRADE STABILIZATION	120,145.00	SQYD	\$		
0470	24990EC						

## Section: 0003 - ROADWAY

LINE	BID CODE	ALT DESCRIPTION	QUANTITY	UNIT	UNIT PRIC	FP	AMOUNT
0480	00021	DRAINAGE BLANKET-EMBANKMENT	3,137.00	CUYD	\$		
0490	00078	CRUSHED AGGREGATE SIZE NO 2	2,287.00	TON	\$		
		PERFORATED PIPE-4 IN (REVISED: 7-16-18)	33,722.00	LF	\$		
0500	01000	NON-PERFORATED PIPE-4 IN	96.00	LF	\$		
0520	01020	PERF PIPE HEADWALL TY 1-4 IN	1.00	EACH	\$		
0530	01024	PERF PIPE HEADWALL TY 2-4 IN	2.00	EACH	\$		
0540	01028	PERF PIPE HEADWALL TY 3-4 IN	4.00	EACH	\$		
0550	01875	STANDARD HEADER CURB	1,852.00	LF	\$		
0560	01890	ISLAND HEADER CURB TYPE 1	438.00	LF	\$		
0570	02091	REMOVE PAVEMENT	1,346.00	SQYD	\$		
0580	02159	TEMP DITCH	8,554.00	LF	\$		
0590	02160	CLEAN TEMP DITCH	4,279.00	LF	\$		
0600	02230	EMBANKMENT IN PLACE	273,799.00	CUYD	\$		
0610	02242	WATER	648.00	MGAL	\$		
0620	02274	FENCE-6 FT CHAIN LINK	842.00	LF	\$		
0630	02287	DOUBLE VEHICULAR CHAIN LINK GATE	1.00	EACH	\$		
0640	02351	GUARDRAIL-STEEL W BEAM-S FACE	5,412.50	LF	\$		
0650	02360	GUARDRAIL TERMINAL SECTION NO 1	2.00	EACH	\$		
		GUARDRAIL CONNECTOR TO BRIDGE END TY A	4.00	EACH	\$		
0660	02363	GUARDRAIL END TREATMENT TYPE 1	5.00	EACH	\$		
0670	02367	REMOVE GUARDRAIL	50.00	LF	\$		
0680	02381	GUARDRAIL END TREATMENT TYPE 4A	19.00	EACH	\$		
0690	02391	RIGHT-OF-WAY MONUMENT TYPE 1	126.00	EACH	\$		
0700	02429	WITNESS POST	3.00	EACH	\$		
0720	02484	CHANNEL LINING CLASS III	1,315.00	TON	\$		
		CLEARING AND GRUBBING 72.39 ACRES	1.00	LS	\$		
0730	02545	TEMPORARY SIGNS	1,013.00	SQFT	\$		
0740	02562	EDGE KEY	210.00	LF	\$		
0760	02599	FABRIC-GEOTEXTILE TYPE IV	51,561.00	SQYD	\$		
0770	02650	MAINTAIN & CONTROL TRAFFIC	1.00	LS	\$		
0780	02651	DIVERSIONS (BY-PASS DETOURS)	1.00	LS	\$		
0790	02671	PORTABLE CHANGEABLE MESSAGE SIGN	4.00	EACH	\$		
0800	02676	MOBILIZATION FOR MILL & TEXT	1.00	LS	\$		
0810	02690	SAFELOADING	60.00	CUYD	\$		

181025

## PROPOSAL BID ITEMS

REVISED ADDENDUM #2: 7-23-18

Page 3 of 7

Report Date 7/23/18

LINE	BID CODE	ALT DESCRIPTION	QUANTITY	UNIT	UNIT PRIC	FP	AMOUNT
0820	02703	SILT TRAP TYPE A	72.00	EACH	\$		
0830	02704	SILT TRAP TYPE B	72.00	EACH	\$		
0840	02705	SILT TRAP TYPE C	72.00	EACH	\$		
0850	02706	CLEAN SILT TRAP TYPE A	72.00	EACH	\$		
0860	02707	CLEAN SILT TRAP TYPE B	72.00	EACH	\$		
0870	02708	CLEAN SILT TRAP TYPE C	72.00	EACH	\$		
0880	02720	SIDEWALK-4 IN CONCRETE	1,404.00	SQYD	\$		
		SIDEWALK-4 IN CONCRETE SPECIAL SIDEWALK (@ ROUNDABOUT SPLITTER ISLANDS)	526.00	SQYD	\$		
0900	02726	STAKING	1.00	LS	\$		
		REMOVE STRUCTURE (EX. TRIPLE 14'X7' RCBC @ STA 183.00) (ADDED: 7-23-18)	1.00	LS	\$		
0905	02731	ARROW PANEL	2.00	EACH	\$		
0910	02775	CONCRETE BARRIER WALL TYPE 9T	1,944.00	LF	\$		
0930	05950	EROSION CONTROL BLANKET	6,158.00	SQYD	\$		
0940	05952	TEMP MULCH	233,578.00	SQYD	\$		
0950	05953	TEMP SEEDING AND PROTECTION	175,184.00	SQYD	\$		
0960	05963	INITIAL FERTILIZER	6.90	TON	\$		
0970	05964	20-10-10 FERTILIZER	11.50	TON	\$		
0980	05985	SEEDING AND PROTECTION	198,270.00	SQYD	\$		
0990	05990	SODDING	17,930.00	SQYD	\$		
1000	05992	AGRICULTURAL LIMESTONE	138.00	TON	\$		
1010	06410	STEEL POST TYPE 1	1,137.00	LF	\$		
1020	06510	PAVE STRIPING-TEMP PAINT-4 IN	101,460.00	LF	\$		
1030	06514	PAVE STRIPING-PERM PAINT-4 IN	82,777.00	LF	\$		
1040	06516	PAVE STRIPING-PERM PAINT-8 IN	3,268.00	LF	\$		
1050	06565	PAVE MARKING-THERMO X-WALK-6 IN	1,722.00	LF	\$		
1060	06568	PAVE MARKING-THERMO STOP BAR-24IN	544.00	LF	\$		
1070	06570	PAVE MARKING-PAINT CROSS-HATCH	2,972.00	SQFT	\$		
1080	06572	PAVE MARKING-DOTTED LANE EXTN	440.00	LF	\$		
1090	06573	PAVE MARKING-THERMO STR ARROW	1.00	EACH	\$		
1100	06574	PAVE MARKING-THERMO CURV ARROW	45.00	EACH	\$		
1110	06575	PAVE MARKING-THERMO COMB ARROW	7.00	EACH	\$		
1120	06589	PAVEMENT MARKER TYPE V-MW	431.00	EACH	\$		
1130	06591	PAVEMENT MARKER TYPE V-BY	783.00	EACH	\$		
1140	08900	CRASH CUSHION TY VI CLASS B TL2	6.00	EACH	\$		
1150	15092	S MANHOLE	1.00	EACH	\$		
1160	15094	S MANHOLE ADJUST TO GRADE	7.00	EACH	\$		
1170	23158ES505	DETECTABLE WARNINGS	939.00	SQFT	\$		
1180	23274EN11F	TURF REINFORCEMENT MAT 1	5,246.00	SQYD	\$		
1190	23275EN11F	TURF REINFORCEMENT MAT 2	795.00	SQYD	\$		
1200	23276EN11F	TURF REINFORCEMENT MAT 3	351.00	SQYD	\$		
		DETENTION BASIN (STA 101+56.57) (REVISED: 7-23-18)	1.00	LS	\$		
1210	23626EC	DETENTION BASIN (STA 194+55.35) (ADDED: 7-23-18)	1.00	LS	\$		
1220	23649EC	DRAIN POND	1.00	LS	\$		
1230	23791EC	PAVE STRIPING-CHEVRON MARKINGS	1,298.00	SQFT	\$		

181025

## PROPOSAL BID ITEMS

REVISED ADDENDUM #2: 7-23-18

Page 4 of 7

Report Date 7/23/18

LINE	BID CODE	ALT DESCRIPTION	QUANTITY	UNIT	UNIT PRIC	FP	AMOUNT
1240	24845EC	UTILITY COORDINATION	1.00	LS	\$		

## Section: 0004 - DRAINAGE

LINE	BID CODE	ALT DESCRIPTION	QUANTITY	UNIT	UNIT PRIC	FP	AMOUNT
1250	00440	ENTRANCE PIPE-15 IN	199.00	LF	\$		
1260	00466	CULVERT PIPE-30 IN	8.00	LF	\$		
1270	00470	CULVERT PIPE-48 IN	236.00	LF	\$		
1280	00472	CULVERT PIPE-60 IN	201.00	LF	\$		
1290	00521	STORM SEWER PIPE-15 IN	8,149.00	LF	\$		
1300	00522	STORM SEWER PIPE-18 IN	4,495.00	LF	\$		
1310	00524	STORM SEWER PIPE-24 IN	1,424.00	LF	\$		
1320	00528	STORM SEWER PIPE-36 IN	239.00	LF	\$		
1330	01202	PIPE CULVERT HEADWALL-15 IN	4.00	EACH	\$		
1340	01204	PIPE CULVERT HEADWALL-18 IN	9.00	EACH	\$		
1350	01208	PIPE CULVERT HEADWALL-24 IN	5.00	EACH	\$		
1360	01210	PIPE CULVERT HEADWALL-30 IN	1.00	EACH	\$		
1370	01212	PIPE CULVERT HEADWALL-36 IN	1.00	EACH	\$		
1380	01216	PIPE CULVERT HEADWALL-48 IN	2.00	EACH	\$		
1390	01220	PIPE CULVERT HEADWALL-60 IN	1.00	EACH	\$		
1400	01456	CURB BOX INLET TYPE A	79.00	EACH	\$		
1410	01480	CURB BOX INLET TYPE B	1.00	EACH	\$		
1420	01544	DROP BOX INLET TYPE 11	5.00	EACH	\$		
1430	01559	DROP BOX INLET TYPE 13G	7.00	EACH	\$		
1440	01581	DROP BOX INLET TYPE 16G	1.00	EACH	\$		
1450	02484	CHANNEL LINING CLASS III	410.00	TON	\$		
1460	02600	FABRIC GEOTEXTILE TY IV FOR PIPE	52,525.00	SQYD	\$2.00	\$	\$ 105,050.00
1470	22766ED	TRENCH DRAIN	16.00	LF	\$		
		HYDRAULIC CONTROL STRUCTURE (STA 101+56.57) (REVISED: 7-23-18)					
1480	23609ED	HYDRAULIC CONTROL STRUCTURE (STA 194+55.35) (ADDED: 7-23-18)	1.00	LS	\$		
1481	23609ED	DRAINAGE JUNCTION BOX TY B	1.00	LS	\$		
1490	23952EC	PIPELINE INSPECTION	5.00	EACH	\$		
1500	24814EC		7,376.00	LF	\$		

## Section: 0005 - BRIDGE-27648

LINE	BID CODE	ALT DESCRIPTION	QUANTITY	UNIT	UNIT PRIC	FP	AMOUNT
1510	02231	STRUCTURE GRANULAR BACKFILL	1,056.20	CUYD	\$		
1520	02998	MASONRY COATING	1,054.00	SQYD	\$		
1530	08001	STRUCTURE EXCAVATION-COMMON	4,926.00	CUYD	\$		
1540	08002	STRUCTURE EXCAV-SOLID ROCK	145.00	CUYD	\$		
1550	08019	CYCLOPEAN STONE RIP RAP	3,698.00	TON	\$		
1560	08033	TEST PILES	78.00	LF	\$		
1570	08046	PILES-STEEL HP12X53	972.00	LF	\$		
1580	08094	PILE POINTS-12 IN	32.00	EACH	\$		

181025

**PROPOSAL BID ITEMS**

REVISED ADDENDUM #2: 7-23-18

Page 5 of 7

Report Date 7/23/18

LINE	BID CODE	ALT DESCRIPTION	QUANTITY	UNIT	UNIT PRIC	FP	AMOUNT
1590	08100	CONCRETE-CLASS A	603.30	CUYD	\$		
1600	08104	CONCRETE-CLASS AA	1,009.30	CUYD	\$		
1610	08135	MECHANICAL REINF COUPLER #10	43.00	EACH	\$		
1620	08150	STEEL REINFORCEMENT	67,877.00	LB	\$		
1630	08151	STEEL REINFORCEMENT-EPOXY COATED	249,355.00	LB	\$		
1640	08634	PRECAST PC I BEAM TYPE 4	1,612.30	LF	\$		
1650	23630EC	ARMORED EDGE FOR CONCRETE	1.00	LS	\$		
1660	23813EC	DECK DRAIN	24.00	EACH	\$		

**Section: 0006 - BRIDGE-CULVERT 27646**

LINE	BID CODE	ALT DESCRIPTION	QUANTITY	UNIT	UNIT PRIC	FP	AMOUNT
1670	08002	STRUCTURE EXCAV-SOLID ROCK	13.00	CUYD	\$		
1680	08003	FOUNDATION PREPARATION	1.00	LS	\$		
1690	08100	CONCRETE-CLASS A	511.20	CUYD	\$		
1700	08150	STEEL REINFORCEMENT	69,192.00	LB	\$		

**Section: 0007 - BRIDGE-RETAINING WALL 27647**

LINE	BID CODE	ALT DESCRIPTION	QUANTITY	UNIT	UNIT PRIC	FP	AMOUNT
1710	08001	STRUCTURE EXCAVATION-COMMON	37.00	CUYD	\$		
1720	08002	STRUCTURE EXCAV-SOLID ROCK	51.00	CUYD	\$		
1730	08039	PRE-DRILLING FOR PILES	60.00	LF	\$		
1740	08051	PILES-STEEL HP14X89	165.00	LF	\$		
1750	08100	CONCRETE-CLASS A	17.10	CUYD	\$		
1760	08150	STEEL REINFORCEMENT	2,354.00	LB	\$		
1770	21119ED	CONCRETE FORM LINER	42.00	SQYD	\$		

**Section: 0008 - SIGNING**

LINE	BID CODE	ALT DESCRIPTION	QUANTITY	UNIT	UNIT PRIC	FP	AMOUNT
1780	06406	SBM ALUM SHEET SIGNS .080 IN	350.00	SQFT	\$		
1790	06407	SBM ALUM SHEET SIGNS .125 IN	80.00	SQFT	\$		
1800	06410	STEEL POST TYPE 1	300.00	LF	\$		
1810	06411	STEEL POST TYPE 2	900.00	LF	\$		
1820	06490	CLASS A CONCRETE FOR SIGNS	65.00	CUYD	\$		
1830	21373ND	REMOVE SIGN	5.00	EACH	\$		
1840	21596ND	GMSS TYPE D	10.00	EACH	\$		
1850	24631EC	BARCODE SIGN INVENTORY	81.00	EACH	\$		

**Section: 0009 - SIGNALIZATION**

LINE	BID CODE	ALT DESCRIPTION	QUANTITY	UNIT	UNIT PRIC	FP	AMOUNT
1860	04795	CONDUIT-2 IN	1,100.00	LF	\$		
1870	04811	ELECTRICAL JUNCTION BOX TYPE B	6.00	EACH	\$		

181025

## PROPOSAL BID ITEMS

REVISED ADDENDUM #2: 7-23-18

Page 6 of 7

Report Date 7/23/18

LINE	BID CODE	ALT DESCRIPTION	QUANTITY	UNIT	UNIT PRIC	FP	AMOUNT
1880	04820	TRENCHING AND BACKFILLING	1,100.00	LF	\$		
1890	04830	LOOP WIRE	4,000.00	LF	\$		
1900	04844	CABLE-NO. 14/5C	2,200.00	LF	\$		
1910	04850	CABLE-NO. 14/1 PAIR	4,000.00	LF	\$		
1920	04885	MESSENGER-10800 LB	450.00	LF	\$		
1930	04895	LOOP SAW SLOT AND FILL	1,100.00	LF	\$		
1940	04931	INSTALL CONTROLLER TYPE 170	1.00	EACH	\$		
1950	04932	INSTALL STEEL STRAIN POLE	4.00	EACH	\$		
1960	20093NS835	INSTALL PEDESTRIAN HEAD-LED	8.00	EACH	\$		
1970	20188NS835	INSTALL LED SIGNAL-3 SECTION	8.00	EACH	\$		
1980	20456NS835	INSTALL TEMP VIDEO CAMERA	5.00	EACH	\$		
1990	21743NN	INSTALL PEDESTRIAN DETECTOR	8.00	EACH	\$		
2000	23157EN	TRAFFIC SIGNAL POLE BASE	18.00	CUYD	\$		
2010	24955ED	REMOVE SIGNAL EQUIPMENT	1.00	EACH	\$		

## Section: 0010 - LIGHTING

LINE	BID CODE	ALT DESCRIPTION	QUANTITY	UNIT	UNIT PRIC	FP	AMOUNT
2020	04701	POLE 40 FT MTG HT	18.00	EACH	\$		
2030	04722	BRACKET 8 FT	3.00	EACH	\$		
2040	04725	BRACKET 15 FT	15.00	EACH	\$		
2050	04740	POLE BASE	18.00	EACH	\$		
2060	04750	TRANSFORMER BASE	18.00	EACH	\$		
2070	04761	LIGHTING CONTROL EQUIPMENT	1.00	EACH	\$		
2080	04780	FUSED CONNECTOR KIT	18.00	EACH	\$		
2090	04793	CONDUIT-1 1/4 IN	3,600.00	LF	\$		
2100	04795	CONDUIT-2 IN	375.00	LF	\$		
2110	04820	TRENCHING AND BACKFILLING	4,000.00	LF	\$		
2120	04832	WIRE-NO. 12	1,836.00	LF	\$		
2130	04833	WIRE-NO. 8	10,800.00	LF	\$		
2140	20391NS835	ELECTRICAL JUNCTION BOX TYPE A	4.00	EACH	\$		
2150	24589ED	LED LUMINAIRE	18.00	EACH	\$		

## Section: 0011 - WATERLINE-BOONE COUNTY WATER DISTRICT

LINE	BID CODE	ALT DESCRIPTION	QUANTITY	UNIT	UNIT PRIC	FP	AMOUNT
2160	14004	W DIRECTIONAL BORE	200.00	LF	\$		
2170	14009	W ENCASEMENT STEEL BORED RANGE 4	77.00	LF	\$		
2180	14011	W ENCASEMENT STEEL BORED RANGE 6	64.00	LF	\$		
2190	14018	W FIRE HYDRANT ADJUST	3.00	EACH	\$		
2200	14019	W FIRE HYDRANT ASSEMBLY	11.00	EACH	\$		
2210	14020	W FIRE HYDRANT RELOCATE	15.00	EACH	\$		
2220	14029	W METER ADJUST	3.00	EACH	\$		
2230	14030	W METER RELOCATE	28.00	EACH	\$		
2240	14037	W PIPE DUCTILE IRON 08 INCH	1,044.00	LF	\$		
2250	14039	W PIPE DUCTILE IRON 12 INCH	130.00	LF	\$		
2260	14040	W PIPE DUCTILE IRON 16 INCH	9,088.00	LF	\$		

181025

**PROPOSAL BID ITEMS**

REVISED ADDENDUM #2: 7-23-18

Page 7 of 7

Report Date 7/23/18

LINE	BID CODE	ALT DESCRIPTION	QUANTITY	UNIT	UNIT PRIC	FP	AMOUNT
2270	14048	W PIPE DCTL IRON RSTRND JOINT 08 IN	93.00	LF	\$		
2280	14050	W PIPE DCTL IRON RSTRND JOINT 12 IN	100.00	LF	\$		
2290	14051	W PIPE DCTL IRON RSTRND JOINT 16 IN	281.00	LF	\$		
2300	14074	W PLUG EXISTING MAIN	2.00	EACH	\$		
2310	14090	W TAPPING SLEEVE AND VALVE SIZE 2	1.00	EACH	\$		
2320	14095	W TIE-IN 08 INCH	5.00	EACH	\$		
2330	14097	W TIE-IN 12 INCH	2.00	EACH	\$		
2340	14098	W TIE-IN 16 INCH	3.00	EACH	\$		
2350	14106	W VALVE 08 INCH	6.00	EACH	\$		
2360	14108	W VALVE 12 INCH	3.00	EACH	\$		
2370	14109	W VALVE 16 INCH	14.00	EACH	\$		
2380	14113	W VALVE BOX ADJUST	11.00	EACH	\$		
2390	14118	W VALVE CUT-IN 08 INCH	4.00	EACH	\$		
2400	14121	W VALVE CUT-IN 16 INCH	2.00	EACH	\$		
2410	14145	W SERV COPPER LONG SIDE 1 IN	1.00	EACH	\$		
2420	14147	W SERV COPPER LONG SIDE 2 IN	1.00	EACH	\$		
2430	14148	W SERV COPPER LONG SIDE 3/4 IN	15.00	EACH	\$		
2440	14152	W SERV COPPER SHORT SIDE 3/4 IN	20.00	EACH	\$		

**Section: 0012 - WATERLINE-CITY OF FLORENCE**

LINE	BID CODE	ALT DESCRIPTION	QUANTITY	UNIT	UNIT PRIC	FP	AMOUNT
2450	14001	W AIR RELEASE VALVE 3/4 INCH	1.00	EACH	\$		
2460	14019	W FIRE HYDRANT ASSEMBLY	1.00	EACH	\$		
2470	14037	W PIPE DUCTILE IRON 08 INCH	250.00	LF	\$		
2480	14095	W TIE-IN 08 INCH	2.00	EACH	\$		
2490	14113	W VALVE BOX ADJUST	7.00	EACH	\$		

**Section: 0013 - DEMOBILIZATION &/OR MOBILIZATION**

LINE	BID CODE	ALT DESCRIPTION	QUANTITY	UNIT	UNIT PRIC	FP	AMOUNT
2500	02568	MOBILIZATION	1.00	LS	\$		
2510	02569	DEMOBILIZATION	1.00	LS	\$		





# TYPICAL SECTION

PAVEMENT DESIGN ALTERNATE NO. 1


CAMP ERNST ROAD  
ROADBED PREPARATION  
8" CEMENT STABILIZED ROADBED  
6% CEMENT (106 LBS/CF)  
ASPHALT CURING SEAL (2.0 LB/SY)  
SAND FOR BLOTTER (5.0 LB/SY)

TRAFFIC LANES  
6" CRUSHED STONE BASE  
4.5" CL3 ASPHALT BASE 1.00D PG64-22  
3.75" CL3 ASPHALT BASE 1.00D PG64-22  
3" CL3 ASPHALT BASE 1.00D PG64-22  
1.25" CL3 ASPHALT SURFACE 0.38B PG64-22  
RURAL SHOULDER

PAVEMENT DESIGN ALTERNATE NO. 2  
CAMP ERNST ROAD  
ROADBED PREPARATION  
8" CEMENT STABILIZED ROADBED  
6% CEMENT (106 LBS/CF)  
ASPHALT CURING SEAL (2.0 LB/SY)  
SAND FOR BLOTTER (5.0 LB/SY)

TRAFFIC LANES  
12" GEOGRID REINFORCEMENT  
CRUSHED STONE BASE  
3" CL3 ASPHALT BASE 1.00D PG64-22  
3" CL3 ASPHALT BASE 1.00D PG64-22  
1.25" CL3 ASPHALT SURFACE 0.38B PG64-22  
RURAL SHOULDER

① SEE CROSS-SECTIONS FOR SLOPES  
OUTSIDE THE LIMITS OF THE SHOULDER

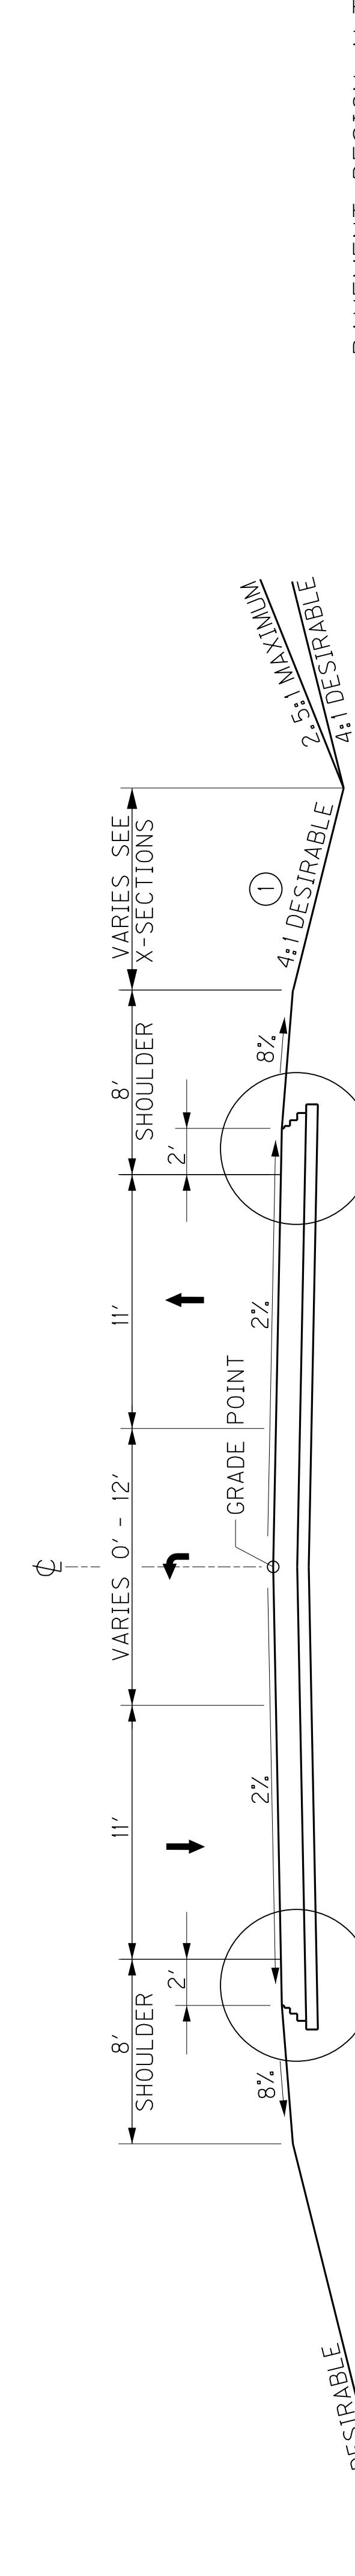

**CAMP ERNST ROAD  
NORMAL 3-LANE SECTION  
STA. 43+90 TO STA. 50+00**

SEE DETAIL "C"

PAVEMENT DESIGN ALTERNATE NO. 1  
CUL-DE-SAC

ROADBED PREPARATION  
8" CEMENT STABILIZED ROADBED  
6% CEMENT (106 LBS/CF)  
ASPHALT CURING SEAL (2.0 LB/SY)  
SAND FOR BLOTTER (5.0 LB/SY)

TRAFFIC LANES  
6" CRUSHED STONE BASE  
4.5" CL3 ASPHALT BASE 1.00D PG64-22  
3.75" CL3 ASPHALT BASE 1.00D PG64-22  
3" CL3 ASPHALT BASE 1.00D PG64-22  
1.25" CL3 ASPHALT SURFACE 0.38B PG64-22  
EARTH SHOULDERS

PAVEMENT DESIGN ALTERNATE NO. 2  
CUL-DE-SAC

ROADBED PREPARATION  
8" CEMENT STABILIZED ROADBED  
6% CEMENT (106 LBS/CF)  
ASPHALT CURING SEAL (2.0 LB/SY)  
SAND FOR BLOTTER (5.0 LB/SY)

TRAFFIC LANES  
6" CRUSHED STONE BASE  
4.5" CL3 ASPHALT BASE 1.00D PG64-22  
3.75" CL3 ASPHALT BASE 1.00D PG64-22  
3" CL3 ASPHALT BASE 1.00D PG64-22  
1.25" CL3 ASPHALT SURFACE 0.38B PG64-22  
EARTH SHOULDERS

SEE DETAIL "D"

**CUL-DE-SAC DETAIL**

SEE DETAIL "D"

PAVEMENT DESIGN ALTERNATE NO. 2  
CUL-DE-SAC

ROADBED PREPARATION  
8" CEMENT STABILIZED ROADBED  
6% CEMENT (106 LBS/CF)  
ASPHALT CURING SEAL (2.0 LB/SY)  
SAND FOR BLOTTER (5.0 LB/SY)

TRAFFIC LANES  
6" CRUSHED STONE BASE  
4.5" CL3 ASPHALT BASE 1.00D PG64-22  
3.75" CL3 ASPHALT BASE 1.00D PG64-22  
3" CL3 ASPHALT BASE 1.00D PG64-22  
1.25" CL3 ASPHALT SURFACE 0.38B PG64-22  
EARTH SHOULDERS

SEE DETAIL "D"

**DETAIL "C"  
FULL DEPTH PAVED RURAL SHOULDER  
N.T.S.**


SEE DETAIL "D"

PAVEMENT DESIGN ALTERNATE NO. 2  
CUL-DE-SAC

ROADBED PREPARATION  
8" CEMENT STABILIZED ROADBED  
6% CEMENT (106 LBS/CF)  
ASPHALT CURING SEAL (2.0 LB/SY)  
SAND FOR BLOTTER (5.0 LB/SY)

TRAFFIC LANES  
6" CRUSHED STONE BASE  
4.5" CL3 ASPHALT BASE 1.00D PG64-22  
3.75" CL3 ASPHALT BASE 1.00D PG64-22  
3" CL3 ASPHALT BASE 1.00D PG64-22  
1.25" CL3 ASPHALT SURFACE 0.38B PG64-22  
EARTH SHOULDERS

**DETAIL "D"  
EARTH SHOULDER  
N.T.S.**

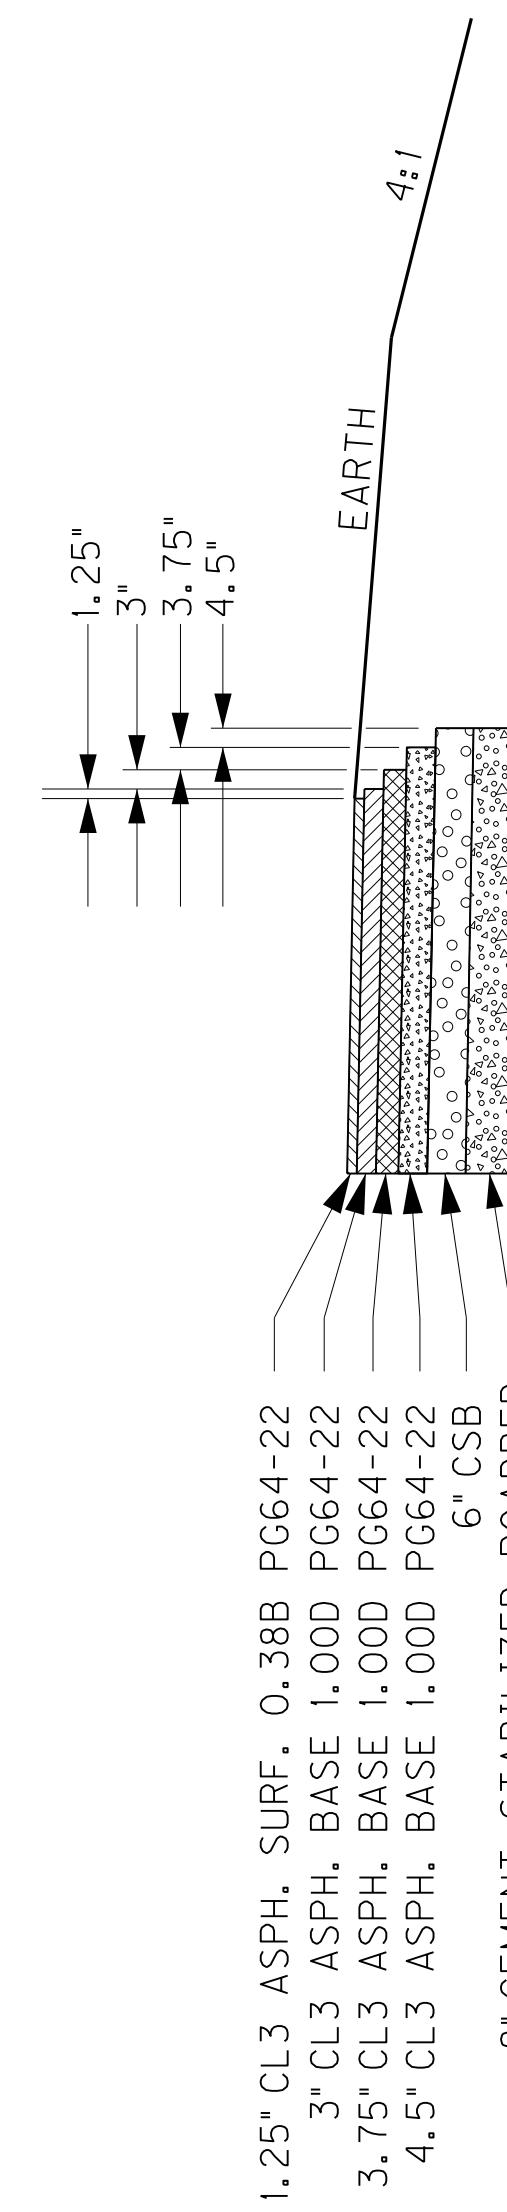

FILE NAME: P:\2144\T\SHETS\SEC2\6-8001.ZIP\CONTRACT PLANS AND PROPOSAL CONTRACT PLAN SET\ROADWAY\ROADBEDS.DGN  
DATE PLOTTED: July 19, 2018  
E-SHEET NAME: ROADBEDS  
USER: DStili  
SOME DETAILS ON THESE TYPICAL SECTIONS MAY INDICATE THE USE OF  
PAVEMENT ALT. NO. 1 ONLY. SHOULD PAVEMENT ALT. NO. 2 BE CHOSEN, THE  
CONTRACTOR SHALL SUBSTITUTE THE APPLICABLE DEPTHS AND DIMENSIONS.

CAMP ERNST ROAD AND CUL-DE-SAC  
TYPICAL SECTIONS



0'  
20'

MicroStation V8.11.9.714

# TYPICAL SECTION

PAVEMENT DESIGN ALTERNATE NO. 1

CAMP ERNST ROAD

ROADBED PREPARATION  
8" CEMENT STABILIZED ROADBED  
6% CEMENT (106 LBS/CF)  
ASPHALT CURING SEAL (2.0 LB/SY)  
SAND FOR BLOTTER (5.0 LB/SY)

TRAFFIC LANES  
6" CRUSHED STONE BASE  
4.5" CL3 ASPHALT BASE 1.00D PG64-22  
3.75" CL3 ASPHALT BASE 1.00D PG64-22  
3" CL3 ASPHALT BASE 1.00D PG64-22  
1.25" CL3 ASPHALT SURFACE 0.38B PG64-22  
RURAL SHOULDER


PAVEMENT DESIGN ALTERNATE NO. 2  
CAMP ERNST ROAD

ROADBED PREPARATION  
8" CEMENT STABILIZED ROADBED  
6% CEMENT (106 LBS/CF)  
ASPHALT CURING SEAL (2.0 LB/SY)  
SAND FOR BLOTTER (5.0 LB/SY)


TRAFFIC LANES  
12" GEORGRID REINFORCEMENT  
12" CRUSHED STONE BASE  
3" CL3 ASPHALT BASE 1.00D PG64-22  
1.25" CL3 ASPHALT BASE 1.00D PG64-22  
1.25" CL3 ASPHALT SURFACE 0.38B PG64-22  
RURAL SHOULDER

## CAMP ERNST ROAD NORMAL 3-LANE SECTION STA. 43+90 TO STA. 50+00

SEE DETAIL "C"

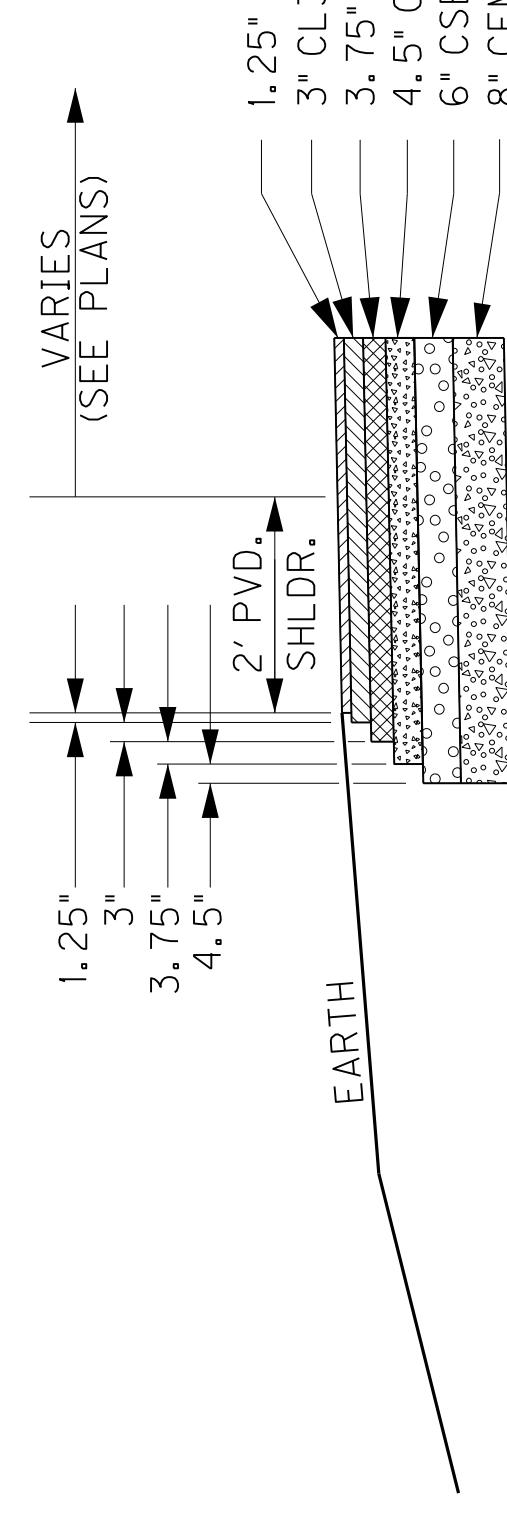


## DETAIL "C" FULL DEPTH PAVED RURAL SHOULDER N.T.S.

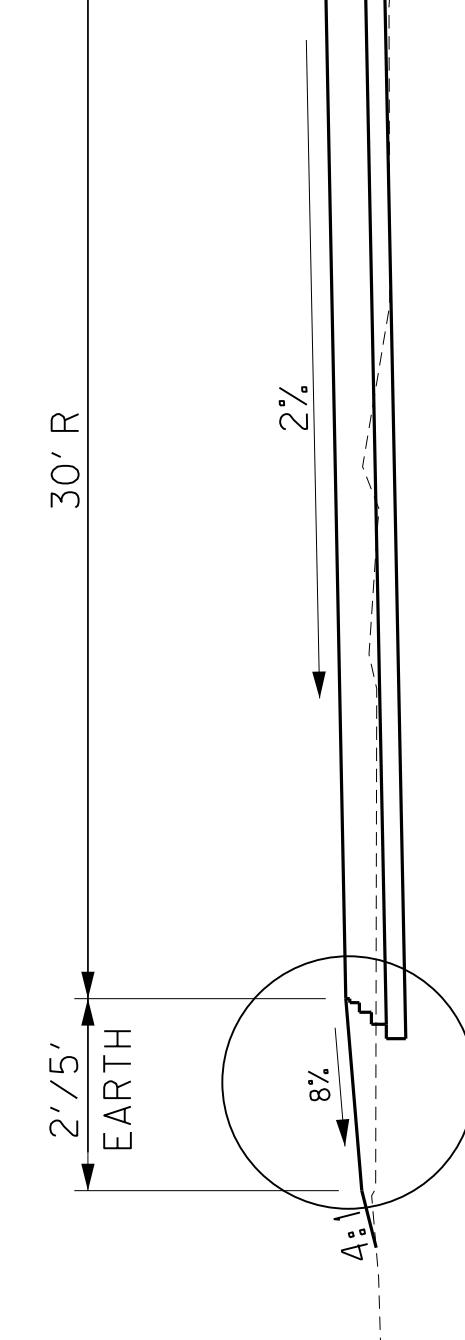

SEE DETAIL "D"

## CUL-DE-SAC DETAIL

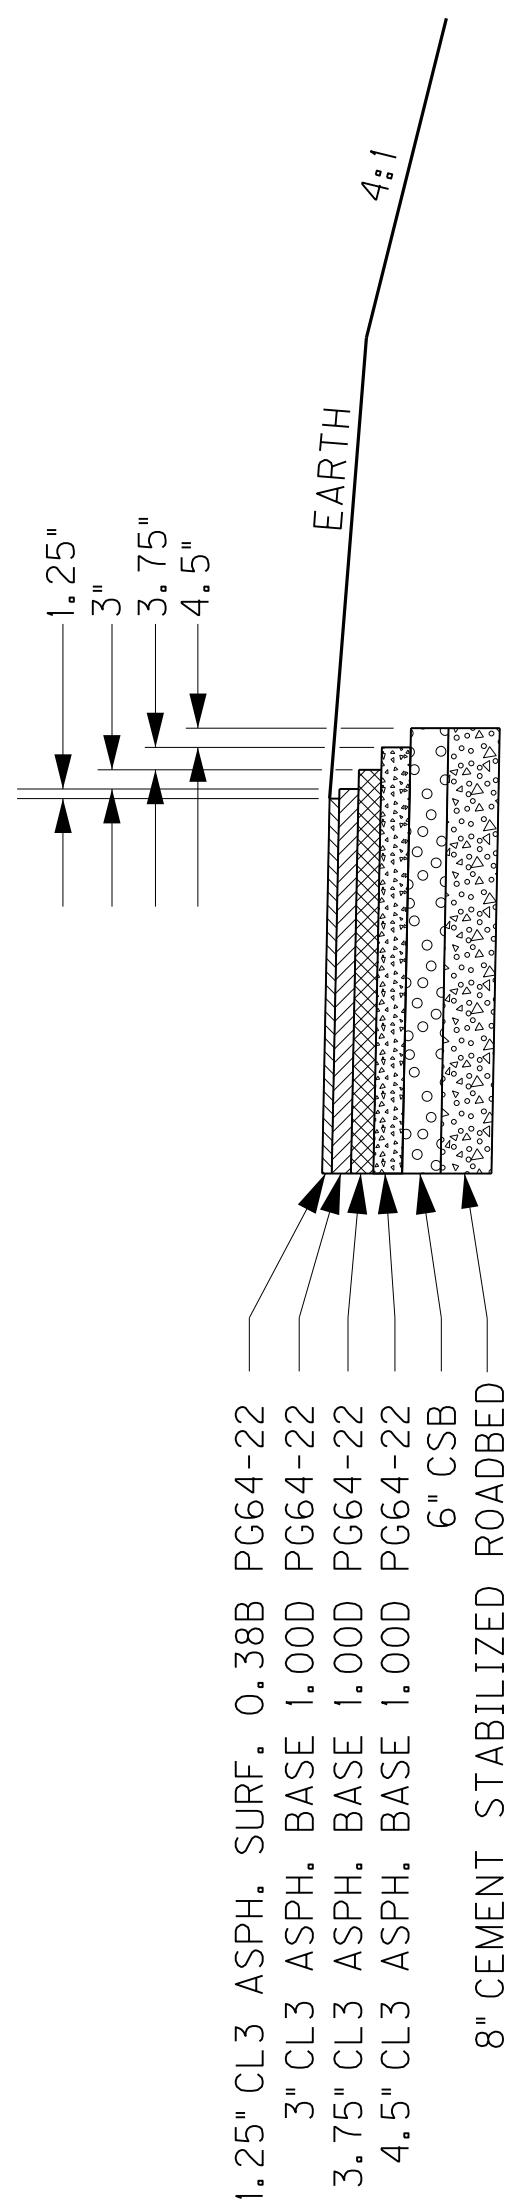

SEE DETAIL "D"

① SEE CROSS-SECTIONS FOR SLOPES  
OUTSIDE THE LIMITS OF THE SHOULDER

REVISED 7-19-18

COUNTY OF	ITEM NO.	SHEET NO.
BOONE	6-8001.21	R2d

FILE NAME: P:\Z144\T\SHETS\SEC2\6-8001.ZIP\CONTRACT PLANS AND PROPOSAL CONTRACT PLAN SET\ROADWAY\ROADBEDS.DGN  
E-SHEET NAME: ROADBEDS  
DATE PLOTTED: July 19, 2018  
USER: Dstii

MicroStation V8.11.9.714

20'

PAVEMENT DESIGN ALTERNATE NO. 1  
CUL-DE-SAC

ROADBED PREPARATION  
8" CEMENT STABILIZED ROADBED  
6% CEMENT (106 LBS/CF)  
ASPHALT CURING SEAL (2.0 LB/SY)  
SAND FOR BLOTTER (5.0 LB/SY)

TRAFFIC LANES  
6" CRUSHED STONE BASE  
4.5" CL3 ASPHALT BASE 1.00D PG64-22  
3.75" CL3 ASPHALT BASE 1.00D PG64-22  
3" CL3 ASPHALT BASE 1.00D PG64-22  
1.25" CL3 ASPHALT SURFACE 0.38B PG64-22  
EARTH SHOULDER

PAVEMENT DESIGN ALTERNATE NO. 2  
CUL-DE-SAC

ROADBED PREPARATION  
8" CEMENT STABILIZED ROADBED  
6% CEMENT (106 LBS/CF)  
ASPHALT CURING SEAL (2.0 LB/SY)  
SAND FOR BLOTTER (5.0 LB/SY)

TRAFFIC LANES  
6" CRUSHED STONE BASE  
4.5" CL3 ASPHALT BASE 1.00D PG64-22  
3.75" CL3 ASPHALT BASE 1.00D PG64-22  
3" CL3 ASPHALT BASE 1.00D PG64-22  
1.25" CL3 ASPHALT SURFACE 0.38B PG64-22  
EARTH SHOULDER

① SEE CROSS-SECTIONS FOR SLOPES  
OUTSIDE THE LIMITS OF THE SHOULDER

REVISED 7-19-18

FILE NAME: P:\Z144\T\SHETS\SEC2\6-8001.ZIP\CONTRACT PLANS AND PROPOSAL CONTRACT PLAN SET\ROADWAY\ROADBEDS.DGN  
E-SHEET NAME: ROADBEDS  
DATE PLOTTED: July 19, 2018  
USER: Dstii

20'

CAMP ERNST ROAD AND CUL-DE-SAC  
TYPICAL SECTIONS



Some details on these typical sections may indicate the use of  
pavement alt. No. 1 only. Should pavement alt. No. 2 be chosen, the  
contractor shall substitute the applicable depths and dimensions.

## GENERAL SUMMARY

ITEM	DESCRIPTION	UNIT	KY 237	THUNDER RIDGE DRIVE	CAMP MILL / OAKBROOK	EXTENSION SYSTEM	MOT	TOTALS	NOTES:
21	DRAINAGE BLANKET - EMBANKMENT	CY	3,137	0	0	0	0	0	① APPROXIMATELY 72.39 ACRES ② FOR CONTROLLING DUST CAUSED BY MAINTAINING TRAFFIC ONLY (200 MGAL/MILE)
1000	PERFORATED PIPE - 4 INCH	LF	33,722	0	0	0	0	0	③ EARTHWORK EXCAVATION
1010	NON-PERFORATED PIPE - 4 INCH	LF	96	0	0	0	0	0	④
1020	PERFORATED PIPE HEADWALL TYPE 1-4"	EACH	1	0	0	0	0	0	⑤
1024	PERFORATED PIPE HEADWALL TYPE 2-4"	EACH	2	0	0	0	0	0	⑤
1028	PERFORATED PIPE HEADWALL TYPE 3-4"	EACH	4	0	0	0	0	0	⑤
1875	STANDARD HEADER CURB	LF	1,584	0	0	268	0	0	⑥
1890	ISLAND HEADER CURB TYPE 1	LF	438	0	0	0	0	0	⑦
2091	REMOVE PAVEMENT	SOYD	1,346	0	0	0	0	0	⑧
2159	TEMPORARY DITCH	LF	7,887	75	160	305	127	8,554	⑨
2160	CLEAN TEMPORARY DITCH	LF	3,944	38	80	153	64	4,279	⑩
78	CRUSHED AGGREGATE SIZE NO. 2	TON	2,287	0	0	0	0	2,287	⑪
23649EC	DRAIN POND	EACH	3	0	0	0	0	0	⑫
2230	EMBANKMENT IN PLACE	CLUYD	242,795	289	0	1,050	41	273,799	⑬
2242	WATER	MGAL	598	5	12	23	10	648	⑭
2274	FENCE-6 FT CHAIN LINK	LF	842	0	0	0	0	842	⑮
2287	DBL. VEHICULAR CHAIN LINK GATE (10' WIDE)	EACH	1	0	0	0	0	0	⑯
2351	GUARDRAIL -STEEL W BEAM-S FACE	LF	5,412.5	0	0	0	0	5,412.5	⑰
2360	GUARDRAIL TERMINAL SECTION NO 1	EACH	2	0	0	0	0	0	⑱
2363	GUARDRAIL CONNECTOR TO BRIDGE END TY A	EACH	4	0	0	0	0	0	⑲
2367	GUARDRAIL END TREATMENT TYPE 1	EACH	5	0	0	0	0	0	⑳
2381	REMOVE GUARDRAIL	LF	0	0	0	50	0	50	⑳
2391	GUARDRAIL END TREATMENT TYPE 4A	EACH	19	0	0	0	0	0	⑳
2429	RIGHT-OF-WAY MONUMENT TYPE 1	EACH	114	0	0	6	6	126	⑳
2432	WITNESS POST	EACH	3	0	0	0	0	3	⑳
2484	CHANNEL LINING CLASS III	TON	933	0	0	0	0	1,315	⑳
2327EN1IF	TURF REINFORCEMENT MAT 1	SOYD	5,78	0	0	68	0	5,246	⑳
2327EN1IF	TURF REINFORCEMENT MAT 2	TON	795	0	0	0	0	795	⑳
2327EN1IF	TURF REINFORCEMENT MAT 3	SOYD	351	0	0	0	0	351	⑳
2545	CLEARING AND GRUBBING	LS							⑳
2568	MOBILIZATION	LS							⑳
2569	DEMOLIBILIZATION	LS							⑳
2585	EDGE KEY	LF	96	30	64	20	0	210	⑳
2599	FABRIC-GEOTEXTILE TYPE IV	SOYD	51,561	0	0	0	0	51,561	⑳
2650	MAINTAIN & CONTROL TRAFFIC	LS							⑳
2671	PORTABLE CHANGEABLE MESSAGE SIGN	EACH							⑳
2703	SILT TRAP TYPE A	EACH							⑳
2704	SILT TRAP TYPE B	EACH							⑳
2705	SILT TRAP TYPE C	EACH							⑳
2706	CLEAN SILT TRAP TYPE A	EACH							⑳
2707	CLEAN SILT TRAP TYPE B	EACH							⑳
2708	CLEAN SILT TRAP TYPE C	EACH							⑳
2726	STAKING	LS							⑳
2775	FLASHING ARROW	EACH	2	0	0	0	0	2	⑳
5950	EROSION CONTROL BLANKET	SOYD	5,480	0	0	678	-	6,158	⑳
5952	TEMPORARY MULCH	SOYD						233,578	⑳
5953	TEMP SEEDING AND PROTECTION	SOYD							⑳
5963	INITIAL FERTILIZER	TON							⑳
5964	20-TON FERTILIZER	TON							⑳
5985	SEEDING AND PROTECTION	SOYD							⑳
5990	SODDING	SOYD	17,457	118	145	0	210	175,184	⑳
5992	AGRICULTURAL LIMESTONE	TON							⑳
23629EC	DETENTION BASIN - STA. 101+56.57	LS	1	0	0	0	0	1	⑳
23628EC	DETENTION BASIN - STA. 191+55.35	LS	1	0	0	0	0	1	⑳
2676	MOBILIZATION FOR MILL & TEXT	LS							⑳

FILE NAME: P:\2144\T\VSHEETS\SEC2\6-8001.ZIVCONTRACT PLANS AND PROPOSAL CONTRACT PLANS SET\ROADWAY\R0020FSU.DGN  
USER: DStili DATE PLOTTED: July 20, 2018

KY 237 SECTION 2  
GENERAL SUMMARY  
SHEET 1 OF 2

Microsoft Office 2010  
Version: 14.0.7140.5032  
File Type: Document

FILE NAME: P:\2144\T\VSHEETS\SEC2\6-8001.ZIVCONTRACT PLANS AND PROPOSAL CONTRACT PLANS SET\ROADWAY\R0020FSU.DGN  
USER: DStili DATE PLOTTED: July 20, 2018

KY 237 SECTION 2  
GENERAL SUMMARY  
SHEET 1 OF 2

FILE NAME: P:\2144\T\VSHEETS\SEC2\6-8001.ZIVCONTRACT PLANS AND PROPOSAL CONTRACT PLANS SET\ROADWAY\R0020FSU.DGN  
USER: DStili DATE PLOTTED: July 20, 2018

KY 237 SECTION 2  
GENERAL SUMMARY  
SHEET 1 OF 2

FILE NAME: P:\2144\T\VSHEETS\SEC2\6-8001.ZIVCONTRACT PLANS AND

## GENERAL SUMMARY

ITEM	DESCRIPTION	UNIT	KY 237	THUNDER RIDGE DRIVE	CAMP MILL / OAKBROOK	BLUE STEM EXTENSION	MOT	TOTALS	NOTES:
									NOTES:
21	DRAINAGE BLANKET - EMBANKMENT	CY	3,137	0	0	0	0	0	① APPROXIMATELY 72.39 ACRES ② FOR CONTROLLING DUST CAUSED BY MAINTAINING TRAFFIC ONLY (200 MGAL/MILE)
1000	PERFORATED PIPE - 4 INCH	LF	33,722	0	0	0	0	0	③ EARTHWORK EXCAVATION
1010	NON-PERFORATED PIPE - 4 INCH	LF	96	0	0	0	0	0	④
1020	PERFORATED PIPE HEADWALL TYPE 1-4"	EACH	1	0	0	0	0	0	⑤
1024	PERFORATED PIPE HEADWALL TYPE 2-4"	EACH	2	0	0	0	0	0	⑤
1028	PERFORATED PIPE HEADWALL TYPE 3-4"	EACH	4	0	0	0	0	0	⑤
1875	STANDARD HEADER CURB	LF	1,584	0	0	268	0	0	⑥
1890	ISLAND HEADER CURB TYPE 1	LF	438	0	0	0	0	0	⑦
2091	REMOVE PAVEMENT	SOYD	1,346	0	0	0	0	0	⑧
2159	TEMPORARY DITCH	LF	7,887	75	160	305	127	8,554	⑨
2160	CLEAN TEMPORARY DITCH	LF	3,944	38	80	153	64	4,279	⑩
78	CRUSHED AGGREGATE SIZE NO. 2	TON	2,287	0	0	0	0	2,287	⑪
23649EC	DRAIN POND	EACH	3	0	0	0	0	0	⑫
2230	EMBANKMENT IN PLACE	CUYD	242,795	289	0	1,050	41	273,799	⑬
2242	WATER	MGAL	598	5	12	23	10	648	⑭
2274	FENCE-6 FT CHAIN LINK	LF	842	0	0	0	0	842	⑮
2287	DBL. VEHICULAR CHAIN LINK GATE (10' WIDE)	EACH	1	0	0	0	0	0	⑯
2351	GUARDRAIL -STEEL W BEAM-S FACE	LF	5,412.5	0	0	0	0	5,412.5	⑰
2360	GUARDRAIL TERMINAL SECTION NO 1	EACH	2	0	0	0	0	0	⑱
2363	GUARDRAIL CONNECTOR TO BRIDGE END TY A	EACH	4	0	0	0	0	0	⑲
2367	GUARDRAIL END TREATMENT TYPE 1	EACH	5	0	0	0	0	0	⑳
2381	REMOVE GUARDRAIL	LF	0	0	0	50	0	50	⑳
2391	GUARDRAIL END TREATMENT TYPE 4A	EACH	19	0	0	0	0	0	⑳
2429	RIGHT-OF-WAY MONUMENT TYPE 1	EACH	114	0	0	6	6	126	⑳
2432	WITNESS POST	EACH	3	0	0	0	0	3	⑳
2484	CHANNEL LINING CLASS III	TON	933	0	0	0	0	1,315	⑳
2327EN1F	TURF REINFORCEMENT MAT 1	SOYD	5,78	0	0	68	0	5,246	⑳
2327EN1F	TURF REINFORCEMENT MAT 2	TON	795	0	0	0	0	795	⑳
2327EN1F	TURF REINFORCEMENT MAT 3	SOYD	351	0	0	0	0	351	⑳
2545	CLEARING AND GRUBBING	LS							⑳
2568	MOBILIZATION	LS							⑳
2569	DEMOLIBILIZATION	LS							⑳
2585	EDGE KEY	LF	96	30	64	20	0	210	⑳
2599	FABRIC-GEOTEXTILE TYPE IV	SOYD	51,561	0	0	0	0	51,561	⑳
2650	MAINTAIN & CONTROL TRAFFIC	LS							⑳
2671	PORTABLE CHANGEABLE MESSAGE SIGN	EACH							⑳
2703	SILT TRAP TYPE A	EACH							⑳
2704	SILT TRAP TYPE B	EACH							⑳
2705	SILT TRAP TYPE C	EACH							⑳
2706	CLEAN SILT TRAP TYPE A	EACH							⑳
2707	CLEAN SILT TRAP TYPE B	EACH							⑳
2708	CLEAN SILT TRAP TYPE C	EACH							⑳
2726	STAKING	LS							⑳
2775	FLASHING ARROW	EACH	2	0	0	0	0	2	⑳
5950	EROSION CONTROL BLANKET	SOYD	5,480	0	0	678	-	6,158	⑳
5952	TEMPORARY MULCH	SOYD						233,578	⑳
5953	TEMP SEEDING AND PROTECTION	SOYD						17,930	⑳
5963	INITIAL FERTILIZER	TON						175,184	⑳
5964	20-10-10 FERTILIZER	TON						6,9	⑳
5985	SEEDING AND PROTECTION	SOYD						11.5	⑳
5990	SODDING	SOYD	17,457	118	145	0	210	198,270	⑳
5992	AGGREGATE & STONE	TON						13,800	⑳
2362EC	DETENTION BASIN - STA. 101+56.57	LS	1	0	0	0	0	1	⑳
2363EC	DETENTION BASIN - STA. 101+55.35	LS	1	0	0	0	0	1	⑳
2676	MOBILIZATION FOR MILL & TEXT	LS						8,730	⑳

FILE NAME: P:\2144\T\VSHEETS\SEC2\6-8001.ZIVCONTRACT PLANS AND PROPOSAL CONTRACT PLANS SET\ROADWAY\R0020FSU.DGN  
USER: DStii DATE PLOTTED: July 20, 2018

KY 237 SECTION 2  
GENERAL SUMMARY  
SHEET 1 OF 2

MicroStation V8.11.9.714 E-SHEET NAME: R0020FSU SHEET NO. SHEET NO.  
BOONE ITEM NO. 6-8001.21 R2f

① APPROXIMATELY 72.39 ACRES  
② FOR CONTROLLING DUST CAUSED BY MAINTAINING TRAFFIC ONLY  
(200 MGAL/MILE)  
③ EARTHWORK  
EXCAVATION

178,121 C.Y. COM FROM CROSS SECTIONS ⑤  
7,599 C.Y. RDZ ④  
18,233 C.Y. TRANSVERSE BENCHING ④  
10,222 C.Y. EMB. FOUND. BENCHING ④  
214,175 C.Y. TOTAL

④ EMBANKMENT

244,175 C.Y. EMB FROM CROSS SECTIONS  
1,169 C.Y. REFILL ⑫  
18,233 C.Y. TRANSVERSE BENCHING ④  
10,222 C.Y. EMB. FOUND. BENCHING ④  
273,799 C.Y. TOTAL

ESTIMATE FOR EARTHWORK CALCULATIONS FOR DESIGN ONLY. COMMON IS CONSIDERED THE AREA ABOVE THE RDZ LINE AS SHOWN ON THE CROSS-SECTIONS. THE CONTRACTOR IS ADVISED THAT THE EARTHWORK CALCULATIONS SHOWN ARE FOR INFORMATION ONLY. ASSUMPTIONS FOR SHRINKAGE FACTORS ARE THE CONTRACTOR'S RESPONSIBILITY.

④ SEE GEOTECHNICAL REPORT FOR LOCATIONS.

⑤ INCLUDES 7 TONS FROM PERFORATED PIPE DRAINAGE SUMMARY SHEET. SEE GEOTECHNICAL REPORT NOTE 16 FOR LOCATION.

⑥ TOTAL INCLUDES 382 TONS FROM PIPE DRAINAGE SUMMARY SHEET.

⑦ FOR FOUNDATION EMBANKMENT BENCHES. SEE GEOTECHNICAL REPORT NOTE 15 FOR LOCATION.

ESTIMATED QUANTITIES:  
3,137 CY DRAINAGE BLANKET - EMB  
18,182 SY FABRIC - GEOTEXTILE TYPE IV

⑧ FOR EMBANKMENT STABILITY AT STRUCTURE LOCATION. ESTIMATED QUANTITIES: 874 TONS CRUSHED AGGREGATE SIZE NO. 2  
7,276 SY FABRIC - GEOTEXTILE TYPE IV

⑨ ASSUME CONSTRUCTION PERIOD OF 2 SEASONS. REPORT NOTE 20 FOR LOCATION.

⑩ THIS VALUE PROVIDES FOR 1' OF UNDERCUT IN SHALE AREAS.

⑪ FOR POND STABILIZATION. SEE GEOTECHNICAL REPORT NOTE 20 FOR LOCATION.

⑫ THIS VALUE PROVIDES FOR 1' OF UNDERCUT IN SHALE AREAS.

⑬ INCLUDES 295 TONS FOR SPILL-THRU STABILITY SEE GEOTECHNICAL REPORT NOTE II FOR LOCATION.

⑭ SEE GEOTECHNICAL REPORT NOTE 21 FOR LOCATIONS.

⑮ INCLUDES 668 CY COM FROM CUL-DE-SACS

⑯ FOR SOFT AND/OR SATURATED SOILS. SEE GEOTECHNICAL NOTE NO. 12. ESTIMATED QUANTITIES:  
256 TONS CRUSHED AGGREGATE SIZE NO. 2

5,375 SY FABRIC - GEOTEXTILE TYPE IV

⑰ FOR SOFT-OVERS, TIE-INS, ENTRANCES, ETC. SEE GEOTECHNICAL NOTE NO. 7. ESTIMATED QUANTITIES:  
250 TONS CRUSHED AGGREGATE SIZE NO. 2

8,730 SY FABRIC - GEOTEXTILE TYPE IV

## GENERAL SUMMARY

ITEM	DESCRIPTION	UNIT	KY 237	BLUE STEM EXTENSION	MOT	PROJECT TOTALS	NOTES:	
							CAMP ERNST ROAD	CARROLL MILL / OAKBROOK
6510	PAVE STRIPING-TEMP PAINT 4 IN	LF	99,660	0	0	1,800	0	
6514	PAVE STRIPING-PERM PAINT 4 IN	LF	78,933	0	557	2,540	747	
6516	PAVE STRIPING-PERM PAINT 8 IN	LF	3,067	0	0	201	0	
2379EC	PAVE STRIPING-CHEVRON MARKINGS	SQFT	1,298	0	0	0	0	
6565	PAVE MARKING-THERMO X-WALK-6 INCH	LF	1,248	95	226	83	70	
6568	PAVE MARKING-THERMO STOP BAR-24IN	LF	392	12	40	89	11	
6570	PAVE MARKING-THERMO CROSS-HATCH	SQFT	2,291	0	0	681	0	
6572	PAVE MARKING-DOTTED LANE EXTEIN	LF	440	0	0	0	0	
6573	PAVE MARKING-THERMO STR ARROW	EACH	1	0	0	0	0	
6574	PAVE MARKING-THERMO CURV ARROW	EACH	45	0	0	0	0	
6575	PAVE MARKING-THERMO COMB ARROW	EACH	7	0	0	0	0	
6589	PAVEMENT MARKER TYPE V-MW	EACH	431	0	0	0	0	
6591	PAVEMENT MARKER TYPE V-EY	EACH	783	0	0	0	0	
2484SEC	UTILITY COORDINATION	LS				1		
2720	SIDEWALK-4 INCH CONCRETE	SOYD	877	90	166	21	250	
23158E505	DETECTABLE WARNINGS (YELLOW)	SQFT	754	21	41	40	83	
2720	SPECIAL SIDEWALK (@ ROUNDABOUT SPLITTER ISLANDS)	SOYD	440	0	0	86	0	
2690	SAFELADING	CY	60					
15094	S MANHOLE ADJUST TO GRADE	EACH	7					
15092	S MANHOLE	EACH	1					
2562	TEMPORARY SIGNS	SQFT				1,013	1,013	
6410	STEEL POST TYPE 1	LF				1,137	1,137	
8900	CRASH CUSHION TY VI CLASS B TL2	EACH				8	6	
3171	CONCRETE BARRIER WALL TYPE 9T	LF				1,944	1,944	
2651	DIVERSSIONS (BY-PASS DETOURS)	LS				1	1	
2731	REMOVE STRUCTURE - EX. TRIPLE 14X7' RCBC @ STA. 183+00	LS	1					

## GENERAL SUMMARY

ITEM	DESCRIPTION	UNIT	KY 237	THUNDER RIDGE DRIVE	CAMP MILL / OAKBROOK	CARTERS MILLS	BLUE STEM EXTENSION	MOT	PROJECT TOTALS	NOTES:
										(8) SEE GENERAL NOTES SHEET R2m (9) FOR UTILITY ABANDONMENT
6510	PAVE STRIPING-TEMP PAINT 4 IN	LF	99,660	0	0	0	1,800	0	101,460	
6514	PAVE STRIPING-PERM PAINT 4 IN	LF	78,933	0	557	2,540	747	0	82,777	
6516	PAVE STRIPING-PERM PAINT 8 IN	LF	3,067	0	0	201	0	0	3,268	
2379EC	PAVE STRIPING-CHEVRON MARKINGS	SQFT	1,298	0	0	0	0	0	1,298	
6565	PAVE MARKING-THERMO X-WALK-6 INCH	LF	1,248	95	226	83	70	1,722	1,722	
6568	PAVE MARKING-THERMO STOP BAR-24IN	LF	392	12	40	89	11	544	544	
6570	PAVE MARKING-THERMO CROSS-HATCH	SQFT	2,291	0	0	681	0	0	2,972	
6572	PAVE MARKING-DOTTED LANE EXTEIN	LF	440	0	0	0	0	0	440	
6573	PAVE MARKING-THERMO STR ARROW	EACH	1	0	0	0	0	0	1	
6574	PAVE MARKING-THERMO CURV ARROW	EACH	45	0	0	0	0	0	45	
6575	PAVE MARKING-THERMO COMB ARROW	EACH	7	0	0	0	0	0	7	
6589	PAVEMENT MARKER TYPE V-MW	EACH	431	0	0	0	0	0	431	
6591	PAVEMENT MARKER TYPE V-EY	EACH	783	0	0	0	0	0	783	
2484SEC	UTILITY COORDINATION	LS							1	
2720	SIDEWALK-4 INCH CONCRETE	SQYD	877	90	166	21	250		1,404	
23158E505	DETECTABLE WARNINGS (YELLOW)	SQFT	754	21	41	40	83		939	
2720	SPECIAL SIDEWALK (@ ROUNDABOUT SPLITTER ISLANDS)	SQYD	440	0	0	86	0		526	
2690	SAFELADING	CY	60						60	
15094	S MANHOLE ADJUST TO GRADE	EACH	7						7	
15092	S MANHOLE	EACH	1						1	
2562	TEMPORARY SIGNS	SQFT							1,013	
6410	STEEL POST TYPE 1	LF							1,137	
8900	CRASH CUSHION TY VI CLASS B TL2	EACH							6	
3171	CONCRETE BARRIER WALL TYPE 9T	LF							1,944	
2651	DIVERSECTIONS (BY-PASS DETOURS)	LS							1	
2731	REMOVE STRUCTURE - EX. TRIPLE 14X7' RCBC @ STA. 183+00	LS							1	

# PIPE DRAINAGE SUMMARY

KY 237 SECTION 2  
PIPE DRAINAGE SUMMARY  
SHEET 1 OF 2

# PIPE DRAINAGE SUMMARY

SHEET NO.	SKEW	COVER HEIGHT	DESIGN DH LEVEL	ENTRANCE PIPE 15"	TRENCH DRAIN	STORM SEWER PIPE 18"	STORM SEWER PIPE 24"	STORM SEWER PIPE 36"	CULVERT PIPE 48"	CULVERT PIPE 30"	CULVERT PIPE 60"	DROP BOX INLET TYPE 13G	DROP BOX INLET TYPE 11	CURB BOX INLET TYPE A	CULVERT HEADWALL 48" PIPE	CULVERT HEADWALL 36" PIPE	CULVERT HEADWALL 30" PIPE	CULVERT HEADWALL 24" PIPE	CULVERT HEADWALL 18" PIPE	CULVERT HEADWALL 15" PIPE	CULVERT HEADWALL 12" PIPE	CULVERT HEADWALL 10" PIPE	CULVERT HEADWALL 8" PIPE	CULVERT HEADWALL 6" PIPE	CULVERT HEADWALL 4" PIPE	CULVERT HEADWALL 2" PIPE	CULVERT HEADWALL 1" PIPE	CULVERT HEADWALL 1/2" PIPE	CULVERT HEADWALL 1/4" PIPE	CULVERT HEADWALL 1/8" PIPE	CULVERT HEADWALL 1/16" PIPE	CULVERT HEADWALL 1/32" PIPE	CULVERT HEADWALL 1/64" PIPE	CULVERT HEADWALL 1/128" PIPE	CULVERT HEADWALL 1/256" PIPE	CULVERT HEADWALL 1/512" PIPE	CULVERT HEADWALL 1/1024" PIPE	CULVERT HEADWALL 1/2048" PIPE	CULVERT HEADWALL 1/4096" PIPE	CULVERT HEADWALL 1/8192" PIPE	CULVERT HEADWALL 1/16384" PIPE	CULVERT HEADWALL 1/32768" PIPE	CULVERT HEADWALL 1/65536" PIPE	CULVERT HEADWALL 1/131072" PIPE	CULVERT HEADWALL 1/262144" PIPE	CULVERT HEADWALL 1/524288" PIPE	CULVERT HEADWALL 1/1048576" PIPE	CULVERT HEADWALL 1/2097152" PIPE	CULVERT HEADWALL 1/4194304" PIPE	CULVERT HEADWALL 1/8388608" PIPE	CULVERT HEADWALL 1/16777216" PIPE	CULVERT HEADWALL 1/33554432" PIPE	CULVERT HEADWALL 1/67108864" PIPE	CULVERT HEADWALL 1/134217728" PIPE	CULVERT HEADWALL 1/268435456" PIPE	CULVERT HEADWALL 1/536870912" PIPE	CULVERT HEADWALL 1/107374184" PIPE	CULVERT HEADWALL 1/214748368" PIPE	CULVERT HEADWALL 1/429496736" PIPE	CULVERT HEADWALL 1/858993472" PIPE	CULVERT HEADWALL 1/171798694" PIPE	CULVERT HEADWALL 1/343597388" PIPE	CULVERT HEADWALL 1/687194776" PIPE	CULVERT HEADWALL 1/137438952" PIPE	CULVERT HEADWALL 1/274877884" PIPE	CULVERT HEADWALL 1/549755768" PIPE	CULVERT HEADWALL 1/109951152" PIPE	CULVERT HEADWALL 1/219902288" PIPE	CULVERT HEADWALL 1/439804576" PIPE	CULVERT HEADWALL 1/879609152" PIPE	CULVERT HEADWALL 1/175921830" PIPE	CULVERT HEADWALL 1/351843660" PIPE	CULVERT HEADWALL 1/703687320" PIPE	CULVERT HEADWALL 1/140737464" PIPE	CULVERT HEADWALL 1/281474928" PIPE	CULVERT HEADWALL 1/562949856" PIPE	CULVERT HEADWALL 1/112589912" PIPE	CULVERT HEADWALL 1/225179824" PIPE	CULVERT HEADWALL 1/450359648" PIPE	CULVERT HEADWALL 1/900719296" PIPE	CULVERT HEADWALL 1/180143858" PIPE	CULVERT HEADWALL 1/360287716" PIPE	CULVERT HEADWALL 1/720575432" PIPE	CULVERT HEADWALL 1/144115086" PIPE	CULVERT HEADWALL 1/288230172" PIPE	CULVERT HEADWALL 1/576460344" PIPE	CULVERT HEADWALL 1/115292068" PIPE	CULVERT HEADWALL 1/230584136" PIPE	CULVERT HEADWALL 1/461168272" PIPE	CULVERT HEADWALL 1/922336544" PIPE	CULVERT HEADWALL 1/184467308" PIPE	CULVERT HEADWALL 1/368934616" PIPE	CULVERT HEADWALL 1/737869232" PIPE	CULVERT HEADWALL 1/147573846" PIPE	CULVERT HEADWALL 1/295147692" PIPE	CULVERT HEADWALL 1/590295384" PIPE	CULVERT HEADWALL 1/118059076" PIPE	CULVERT HEADWALL 1/236118152" PIPE	CULVERT HEADWALL 1/472236304" PIPE	CULVERT HEADWALL 1/944472608" PIPE	CULVERT HEADWALL 1/188894416" PIPE	CULVERT HEADWALL 1/377788832" PIPE	CULVERT HEADWALL 1/755577664" PIPE	CULVERT HEADWALL 1/151115532" PIPE	CULVERT HEADWALL 1/302231064" PIPE	CULVERT HEADWALL 1/604462128" PIPE	CULVERT HEADWALL 1/120892456" PIPE	CULVERT HEADWALL 1/241784912" PIPE	CULVERT HEADWALL 1/483569824" PIPE	CULVERT HEADWALL 1/967139648" PIPE	CULVERT HEADWALL 1/1934279296" PIPE	CULVERT HEADWALL 1/3868558592" PIPE	CULVERT HEADWALL 1/7737117184" PIPE	CULVERT HEADWALL 1/1547423432" PIPE	CULVERT HEADWALL 1/3094846864" PIPE	CULVERT HEADWALL 1/6189693728" PIPE	CULVERT HEADWALL 1/1237938756" PIPE	CULVERT HEADWALL 1/2475877512" PIPE	CULVERT HEADWALL 1/4951755024" PIPE	CULVERT HEADWALL 1/9903510048" PIPE	CULVERT HEADWALL 1/19807020096" PIPE	CULVERT HEADWALL 1/39614040192" PIPE	CULVERT HEADWALL 1/79228080384" PIPE	CULVERT HEADWALL 1/15845616072" PIPE	CULVERT HEADWALL 1/31691232144" PIPE	CULVERT HEADWALL 1/63382464288" PIPE	CULVERT HEADWALL 1/12676492856" PIPE	CULVERT HEADWALL 1/25352985712" PIPE	CULVERT HEADWALL 1/50705971424" PIPE	CULVERT HEADWALL 1/10141194288" PIPE	CULVERT HEADWALL 1/20282388576" PIPE	CULVERT HEADWALL 1/40564777152" PIPE	CULVERT HEADWALL 1/81129554304" PIPE	CULVERT HEADWALL 1/16225910856" PIPE	CULVERT HEADWALL 1/32451821712" PIPE	CULVERT HEADWALL 1/64903643424" PIPE	CULVERT HEADWALL 1/12980728688" PIPE	CULVERT HEADWALL 1/25961457376" PIPE	CULVERT HEADWALL 1/51922914752" PIPE	CULVERT HEADWALL 1/10384582904" PIPE	CULVERT HEADWALL 1/20769165808" PIPE	CULVERT HEADWALL 1/41538331616" PIPE	CULVERT HEADWALL 1/83076663232" PIPE	CULVERT HEADWALL 1/16615332640" PIPE	CULVERT HEADWALL 1/33230665280" PIPE	CULVERT HEADWALL 1/66461330560" PIPE	CULVERT HEADWALL 1/132922661120" PIPE	CULVERT HEADWALL 1/265845322240" PIPE	CULVERT HEADWALL 1/531690644480" PIPE	CULVERT HEADWALL 1/106338128880" PIPE	CULVERT HEADWALL 1/212676257760" PIPE	CULVERT HEADWALL 1/425352515520" PIPE	CULVERT HEADWALL 1/850705031040" PIPE	CULVERT HEADWALL 1/1701410062080" PIPE	CULVERT HEADWALL 1/3402820124160" PIPE	CULVERT HEADWALL 1/6805640248320" PIPE	CULVERT HEADWALL 1/1361128049664" PIPE	CULVERT HEADWALL 1/2722256099328" PIPE	CULVERT HEADWALL 1/5444512198656" PIPE	CULVERT HEADWALL 1/1088902439312" PIPE	CULVERT HEADWALL 1/2177804878624" PIPE	CULVERT HEADWALL 1/4355609757248" PIPE	CULVERT HEADWALL 1/8711219514496" PIPE	CULVERT HEADWALL 1/17422438728992" PIPE	CULVERT HEADWALL 1/34844877457984" PIPE	CULVERT HEADWALL 1/69689754915968" PIPE	CULVERT HEADWALL 1/13937950983936" PIPE	CULVERT HEADWALL 1/27875901967872" PIPE	CULVERT HEADWALL 1/55751803935744" PIPE	CULVERT HEADWALL 1/11150360787148" PIPE	CULVERT HEADWALL 1/22300721574296" PIPE	CULVERT HEADWALL 1/44601443148592" PIPE	CULVERT HEADWALL 1/89202886297184" PIPE	CULVERT HEADWALL 1/17840577259432" PIPE	CULVERT HEADWALL 1/35681154518864" PIPE	CULVERT HEADWALL 1/71362309037728" PIPE	CULVERT HEADWALL 1/14272461815552" PIPE	CULVERT HEADWALL 1/28544923631104" PIPE	CULVERT HEADWALL 1/57089847262208" PIPE	CULVERT HEADWALL 1/114179694524416" PIPE	CULVERT HEADWALL 1/228359389048832" PIPE	CULVERT HEADWALL 1/456719698097664" PIPE	CULVERT HEADWALL 1/913439376195328" PIPE	CULVERT HEADWALL 1/182687875230664" PIPE	CULVERT HEADWALL 1/365375750461328" PIPE	CULVERT HEADWALL 1/730751500922656" PIPE	CULVERT HEADWALL 1/146150301844512" PIPE	CULVERT HEADWALL 1/292300603689024" PIPE	CULVERT HEADWALL 1/584600307378048" PIPE	CULVERT HEADWALL 1/1169200614756096" PIPE	CULVERT HEADWALL 1/2338400129512192" PIPE	CULVERT HEADWALL 1/4676800259024384" PIPE	CULVERT HEADWALL 1/9353600518048768" PIPE	CULVERT HEADWALL 1/1870720103609736" PIPE	CULVERT HEADWALL 1/3741440207219472" PIPE	CULVERT HEADWALL 1/7482880414438944" PIPE	CULVERT HEADWALL 1/14965760828877888" PIPE	CULVERT HEADWALL 1/29931521657755776" PIPE	CULVERT HEADWALL 1/59863043315511552" PIPE	CULVERT HEADWALL 1/11972608663023008" PIPE	CULVERT HEADWALL 1/23945217326046016" PIPE	CULVERT HEADWALL 1/47890423452092032" PIPE	CULVERT HEADWALL 1/95780846904184064" PIPE	CULVERT HEADWALL 1/191561693808368128" PIPE	CULVERT HEADWALL 1/383123387616736256" PIPE	CULVERT HEADWALL 1/766246775233472512" PIPE	CULVERT HEADWALL 1/153249355046694528" PIPE	CULVERT HEADWALL 1/306498710093389056" PIPE	CULVERT HEADWALL 1/612997420186778112" PIPE	CULVERT HEADWALL 1/122599484037355624" PIPE	CULVERT HEADWALL 1/245198968074711248" PIPE	CULVERT HEADWALL 1/490397936149422496" PIPE	CULVERT HEADWALL 1/980795872298844992" PIPE	CULVERT HEADWALL 1/196159174597788984" PIPE	CULVERT HEADWALL 1/392318349195577976" PIPE	CULVERT HEADWALL 1/784636698391155952" PIPE	CULVERT HEADWALL 1/156927339678231144" PIPE	CULVERT HEADWALL 1/313854679356462288" PIPE	CULVERT HEADWALL 1/627709358712924576" PIPE	CULVERT HEADWALL 1/125541871742584952" PIPE	CULVERT HEADWALL 1/251083743485169904" PIPE	CULVERT HEADWALL 1/502167486970339808" PIPE	CULVERT HEADWALL 1/100433497394069760" PIPE	CULVERT HEADWALL 1/200866994788139520" PIPE	CULVERT HEADWALL 1/401733989576278512" PIPE	CULVERT HEADWALL 1/803467979152557024" PIPE	CULVERT HEADWALL 1/160693559230511448" PIPE	CULVERT HEADWALL 1/321387118461022896" PIPE	CULVERT HEADWALL 1/642774236922045792" PIPE	CULVERT HEADWALL 1/128554847384409184" PIPE	CULVERT HEADWALL 1/257109694768818368" PIPE	CULVERT HEADWALL 1/514219389537636736" PIPE	CULVERT HEADWALL 1/102843877907527352" PIPE	CULVERT HEADWALL 1/205687755815054704" PIPE	CULVERT HEADWALL 1/411375511630109408" PIPE	CULVERT HEADWALL 1/822751023260218816" PIPE	CULVERT HEADWALL 1/164550204650437760" PIPE	CULVERT HEADWALL 1/329100409300875520" PIPE	CULVERT HEADWALL 1/658200818601751040" PIPE	CULVERT HEADWALL 1/131640163720350240" PIPE	CULVERT HEADWALL 1/263280327440700480" PIPE	CULVERT HEADWALL 1/526560654881400960" PIPE	CULVERT HEADWALL 1/105312130976280192" PIPE	CULVERT HEADWALL 1/210624261952560384" PIPE	CULVERT HEADWALL 1/421248523805120768" PIPE	CULVERT HEADWALL 1/842496047610241536" PIPE	CULVERT HEADWALL 1/168498095220048312" PIPE	CULVERT HEADWALL 1/336996190440096624" PIPE	CULVERT HEADWALL 1/673992380880193248" PIPE	CULVERT HEADWALL 1/134798476176038648" PIPE	CULVERT HEADWALL 1/269596952352077296" PIPE	CULVERT HEADWALL 1/539193904704154592" PIPE	CULVERT HEADWALL 1/107838780940308592" PIPE	CULVERT HEADWALL 1/215677561880617184" PIPE	CULVERT HEADWALL 1/431355123761234368" PIPE	CULVERT HEADWALL 1/862710247522468736" PIPE	CULVERT HEADWALL 1/172542049504493520" PIPE	CULVERT HEADWALL 1/345084099008987040" PIPE	CULVERT HEADW

# PIPE DRAINAGE SUMMARY

① QUANTITIES CARRIED OVER TO THE GENERAL SUMMARY SHEET.

KY 237 SECTION 2  
PIPE DRAINAGE SUMMARY  
SHEET 2 OF 2

## PIPE DRAINAGE SUMMARY

QUANTITIES CARRIED OVER TO THE GENERAL SUMMARY SHEET.

COUNTY OF	ITEM NO.	SHEET NO.
BOONE	06-8001.21	R214

228+00

227+00

226+00

225+00

224+00


223+00

00+222

221+00

220+00

219+00

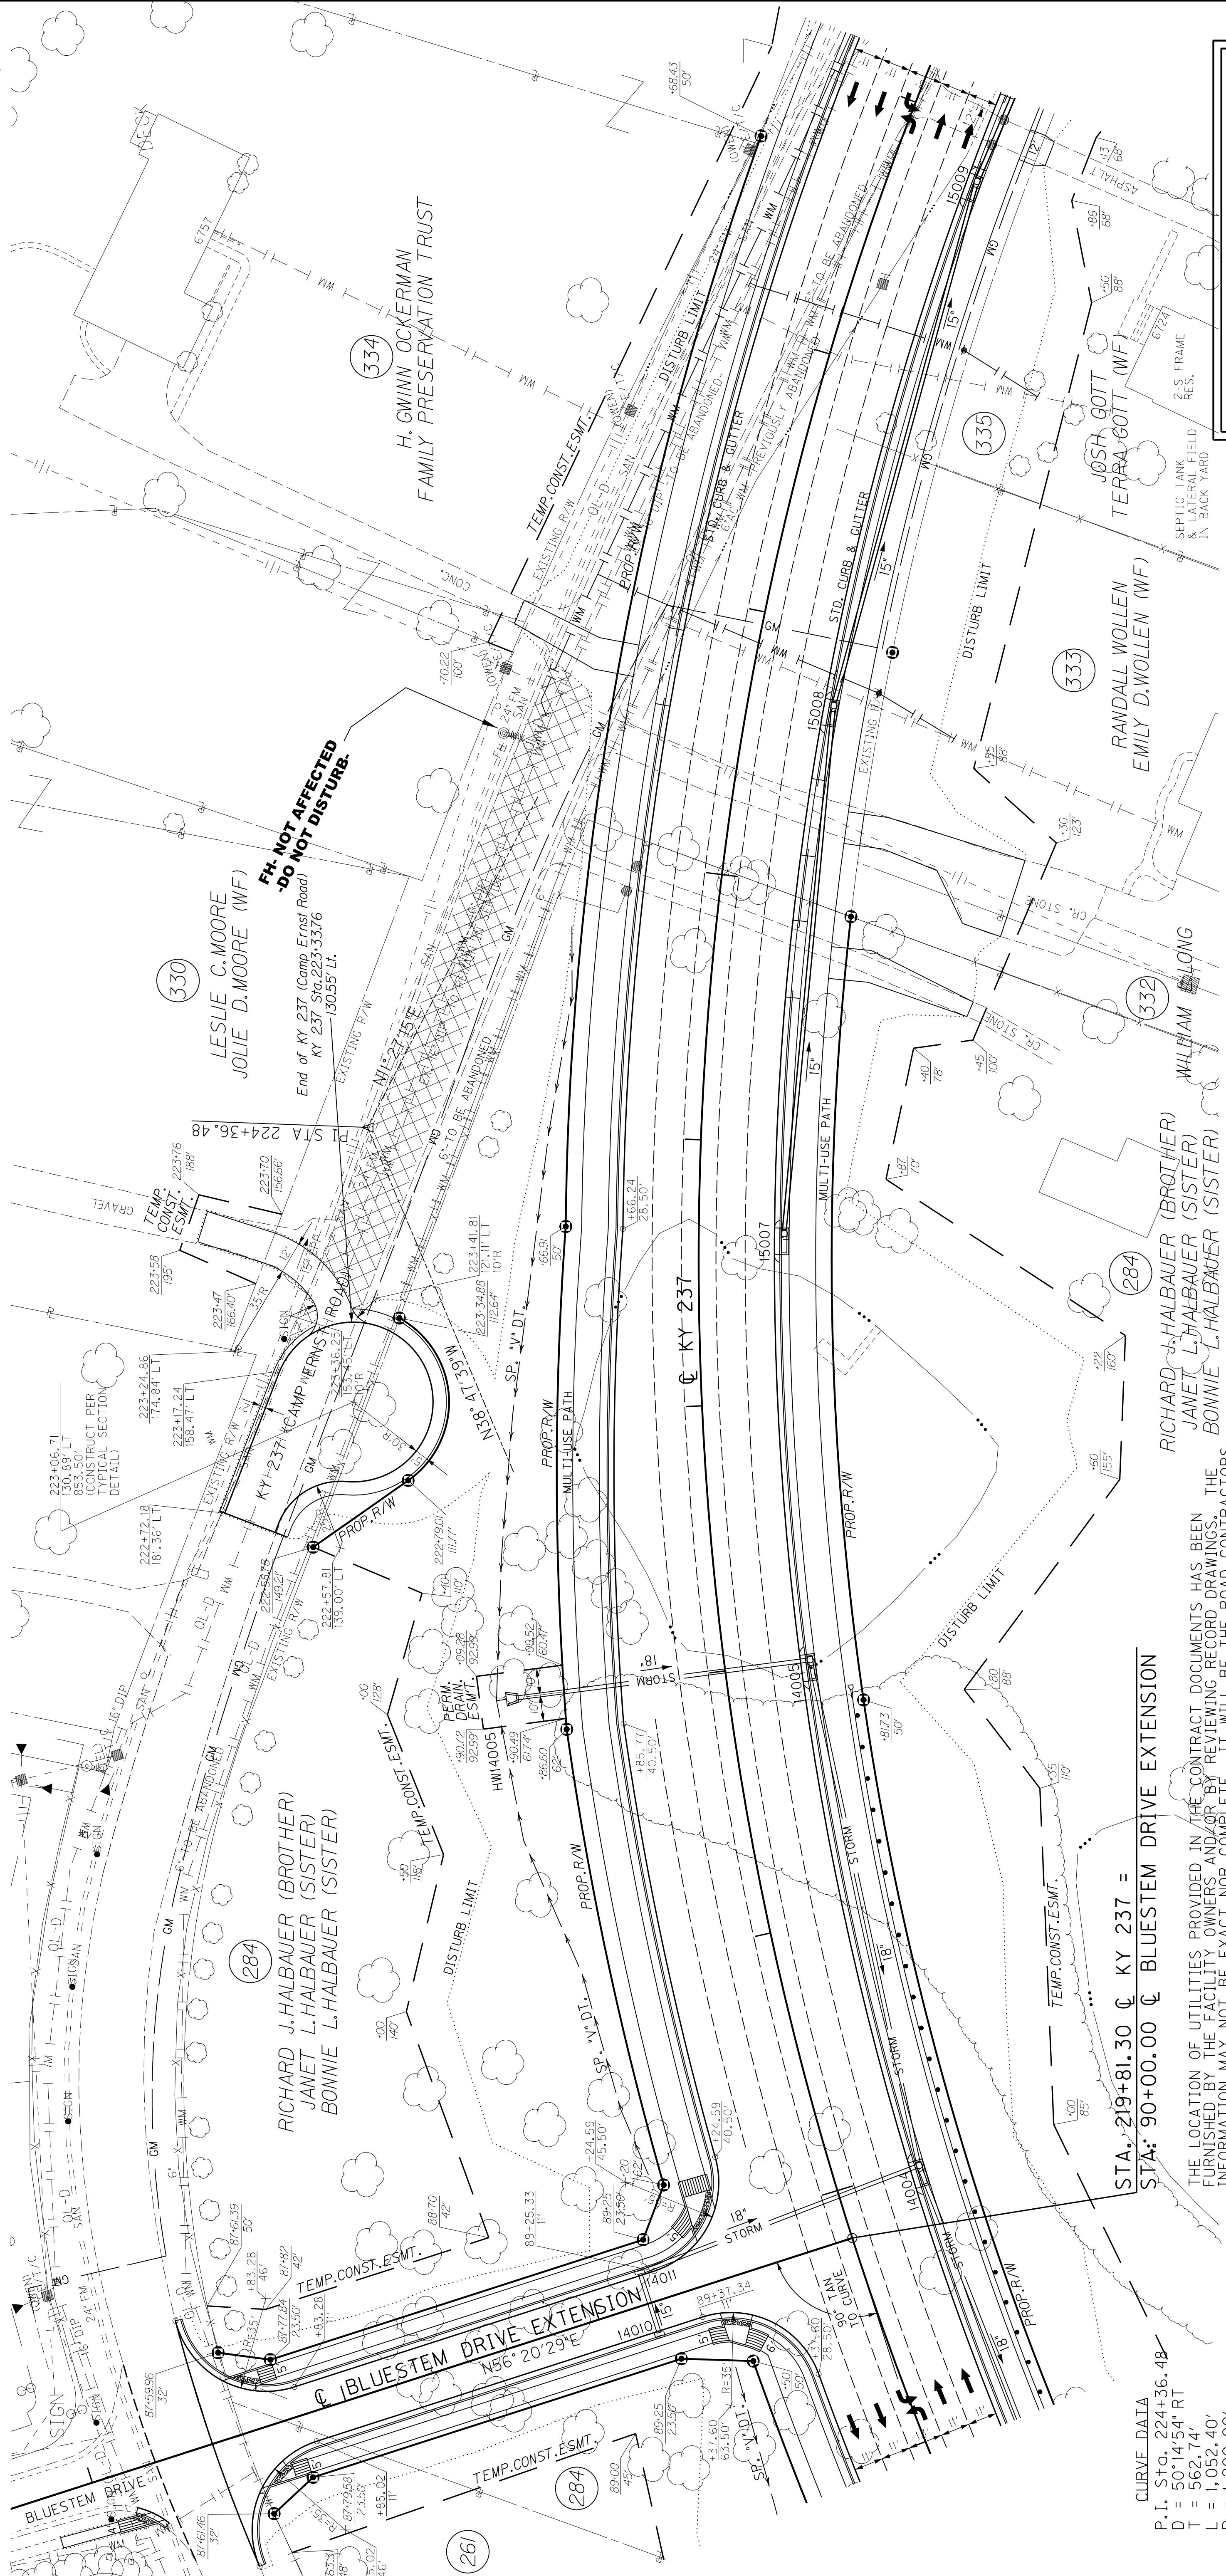

# UTILITY PLANS

NOTE: SPECTRUM FIBER FOLLOWS OWEN ELECTRIC TELEPHONE LINE INFORMATION NOT ON PLANS

/ 237 STA. 219+00 TO STA. 228  
BLUE STEM EXTENSION

THE CONTRACTOR IS ADVISED TO CONTACT THE B.U.D. ONE-CALL SYSTEM; HOWEVER, THE CONTRACTOR SHOULD BE AWARE THAT THE OWNERS OF THE UNDERGROUND FACILITIES ARE NOT REQUIRED TO BE MEMBERS OF THE B.U.D. ONE-CALL SYSTEM. IT MAY BE NECESSARY FOR THE CONTRACTOR TO CONTACT THE COUNTY COURT CLERK TO DETERMINE WHAT UTILITY COMPANIES HAVE FACILITIES IN THE PROJECT AREA.

<u>CURVE DATA</u>	<u>VAL NOTE</u>
P.I. S+a. 224+36.	CONTRACTOR SHALL REMOVE
D = 50°14'54" RT	DRAINAGE STRUCTURES
T = 562.74'	OR OTHERWISE NOTED
L = 1,052.40'	INCIDENT
R = 1,200.00'	
E = 125.40'	
e = 5.00%	
Runoff = See X-S	
Runout = See X-S	

FINAL NOTE CONTRACTOR SHALL REMOVE ALL PIPE AND DRAINAGE STRUCTURES UNLESS REMAINING IN PLACE OR OTHERWISE NOTED ON THE PLANS. REMNANT SHALL BE INCIDENTAL TO ROADWAY.



COUNTY OF	ITEM NO.	SHEET NO.
BOONE	06-8001.21	R215

231+00

230+00

229+00

228+00

END PROJECT  
SECTION 2 KY 237

---

STA. 230+34.60 =  
STA. 230+40.00 AH.  
(KY 237 SECTION 3)

H. GWYNN OCKERMAN  
FAMILY PRESERVATION TRUST  


**EXISTING R/W**

**TEMP.CONST.ESMT.**

**DISTURB LIMIT**

**SAN Q-D**

**MULTI-USE PATH**

**SDI CURB & CUTTER**

**Ex. 16" DIP - PREVIOUS ABANDON**

**6"-TO BE ABANDONED**

**PT STA 229 26.14'**

**N1°27'15"E**

**G-KY-237**

**Top Phase Only**

**SD. CURB & CUTTER**

**15010**

**18"**

**12'**

**GM**

**TEMP.CONST.ESMT.**

**TANK**

**ASPHALT**

**\*13' 68"**

**\*61'17" 80'**

**\*50' 85'**

**20'**

**EXISTING CROW**

**DISTURB LIMIT**

**QLD**

**ASPH.**

**HOLBROOK LANE**

**30' ACCESS ESMT.**

**CR. STONE**

**336**

**335**

**THE FIRST PRESIDING  
OVERSEER, AND HIS HER  
SUCCESSORS, A CORPORATION  
UNINCORPORATED SPIRITUAL  
AND EDUCATIONAL MINISTRY,  
FELLOWSHIP OF GOD'S  
COVENANT PEOPLE, INC.**

**URVE DATA**

**Sta. 224+36.48**

**50' 14" 54" RT**

**562.74'**

**1,052.40'**

**1,200.00'**

**125.40'**

**5.00%**

**ff = See X-Sec.**

CURVE DATA

P.I. S+Q. 224+36.48  
 D = 50° 14' 54" RT  
 T = 562.74'  
 = 1,052.40'  
 R = 1,200.00'  
 E = 125.40'  
 S = 5.00%  
 Runoff = See X-Sec.

REMOVAL NOTE THE CONTRACTOR SHALL REMOVE ALL PIPE AND  
DRAINAGE STRUCTURES UNLESS REMAINING  
IN USE OR OTHERWISE NOTED ON THE PLANS.  
REMOVAL SHALL BE INCIDENTAL TO ROADWAY

**NOTE:** SPECTRUM FIBER FOLLOWS OWEN ELECTRIC,  
TELEPHONE INFORMATION NOT ON PLANS.

# UTILITY PLANS

KY 237 STA. 228+00 TO STA. 230+34.60

THE LOCATION OF UTILITIES PROVIDED IN THE CONTRACT DOCUMENTS HAS BEEN FURNISHED BY THE FACILITY OWNERS AND/OR BY REVIEWING RECORD DRAWINGS. THIS INFORMATION MAY NOT BE EXACT NOR COMPLETE. IT WILL BE THE ROAD CONTRACTOR'S RESPONSIBILITY TO LOCATE UTILITIES BEFORE EXCAVATING BY CALLING THE VARIOUS UTILITY OWNERS AND BY EXAMINING ANY SUPPLEMENTAL INFORMATION PROVIDED BY THE CABINET AND/OR UTILITY OWNER. THE ROAD CONTRACTOR SHALL DETERMINE THE EXACT LOCATION AND ELEVATION OF UTILITIES BY HAND DIGGING TO EXPOSE UTILITIES BEFORE HE EXCAVATES IN THE AREA OF A UTILITY. THE COST FOR REPAIRS AND ANY OTHER ASSOCIATED COSTS FOR ANY DAMAGE TO UTILITIES CAUSED BY THE ROAD CONTRACTORS OPERATIONS SHALL BE BORNE BY THE ROAD CONTRACTOR.

KY 237 STA. 228+00 TO STA. 230+34.60  
120'

