

**WPPSS
NUCLEAR PROJECT
NO. 2**

**PRESERVICE INSPECTION
PROGRAM PLAN**

VOLUME 1


PROGRAM PLAN


COPY NO. 13

**WASHINGTON PUBLIC POWER
SUPPLY SYSTEM**

Desk # 38-397
Control # 7905070453
Date 3/28/79 of Document
REGULATORY DOCUMENT FILE

7905070456

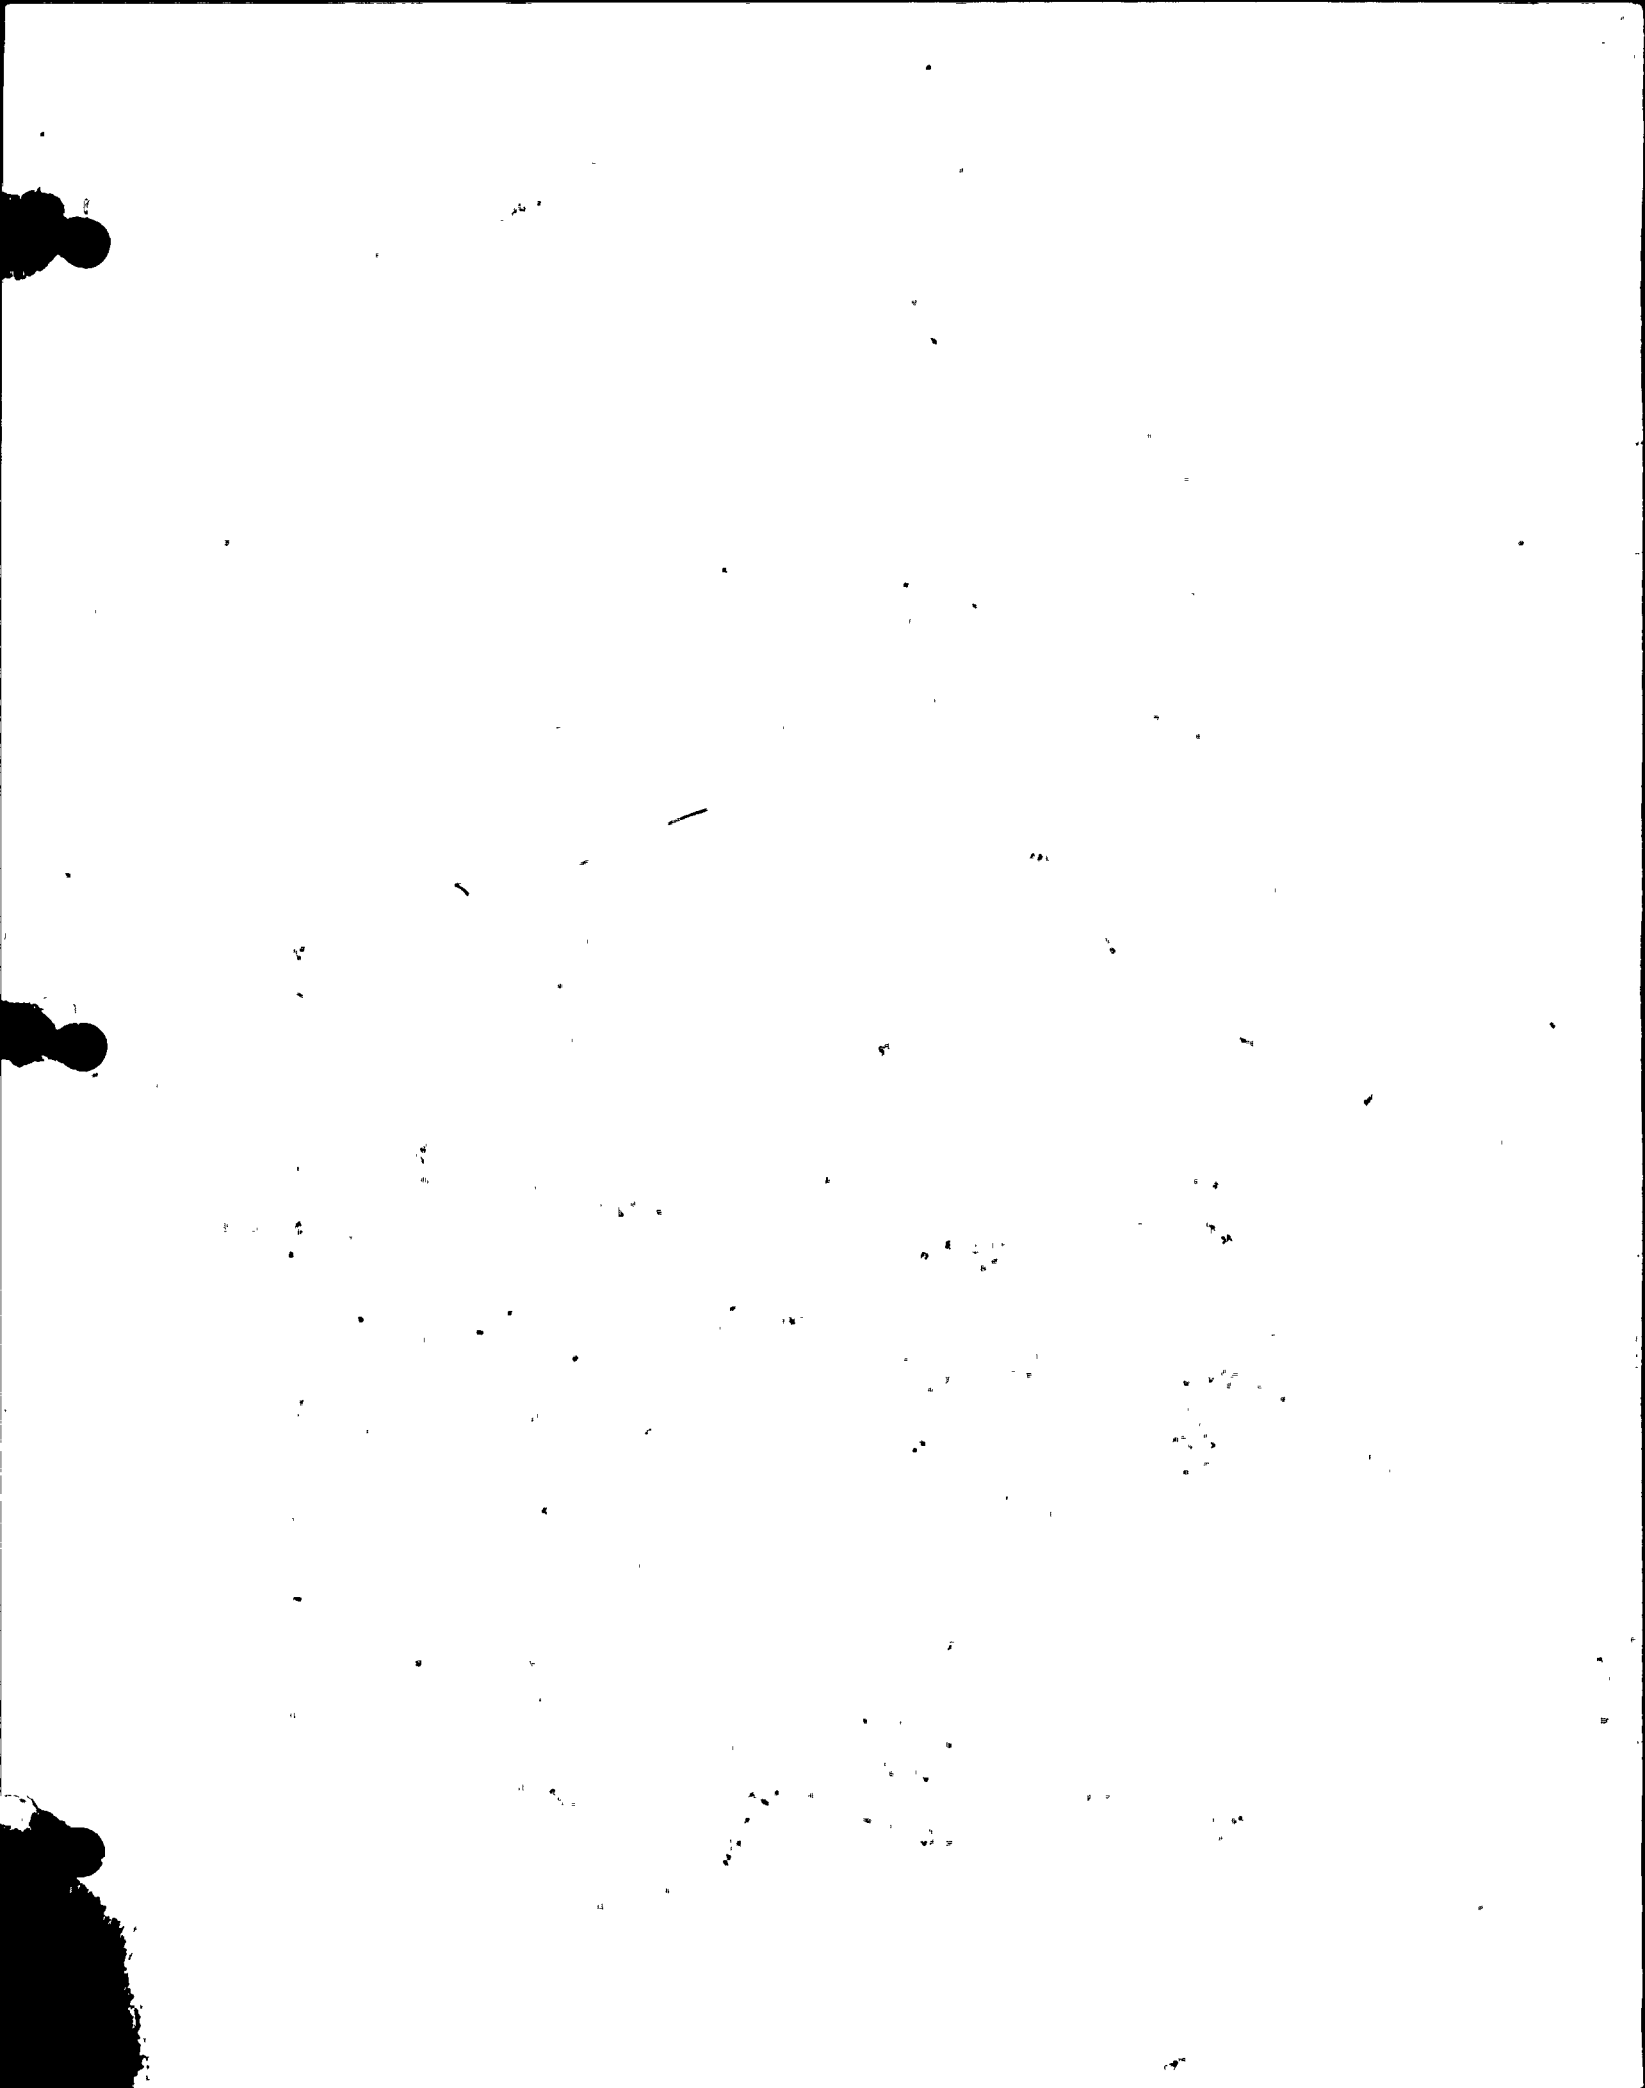

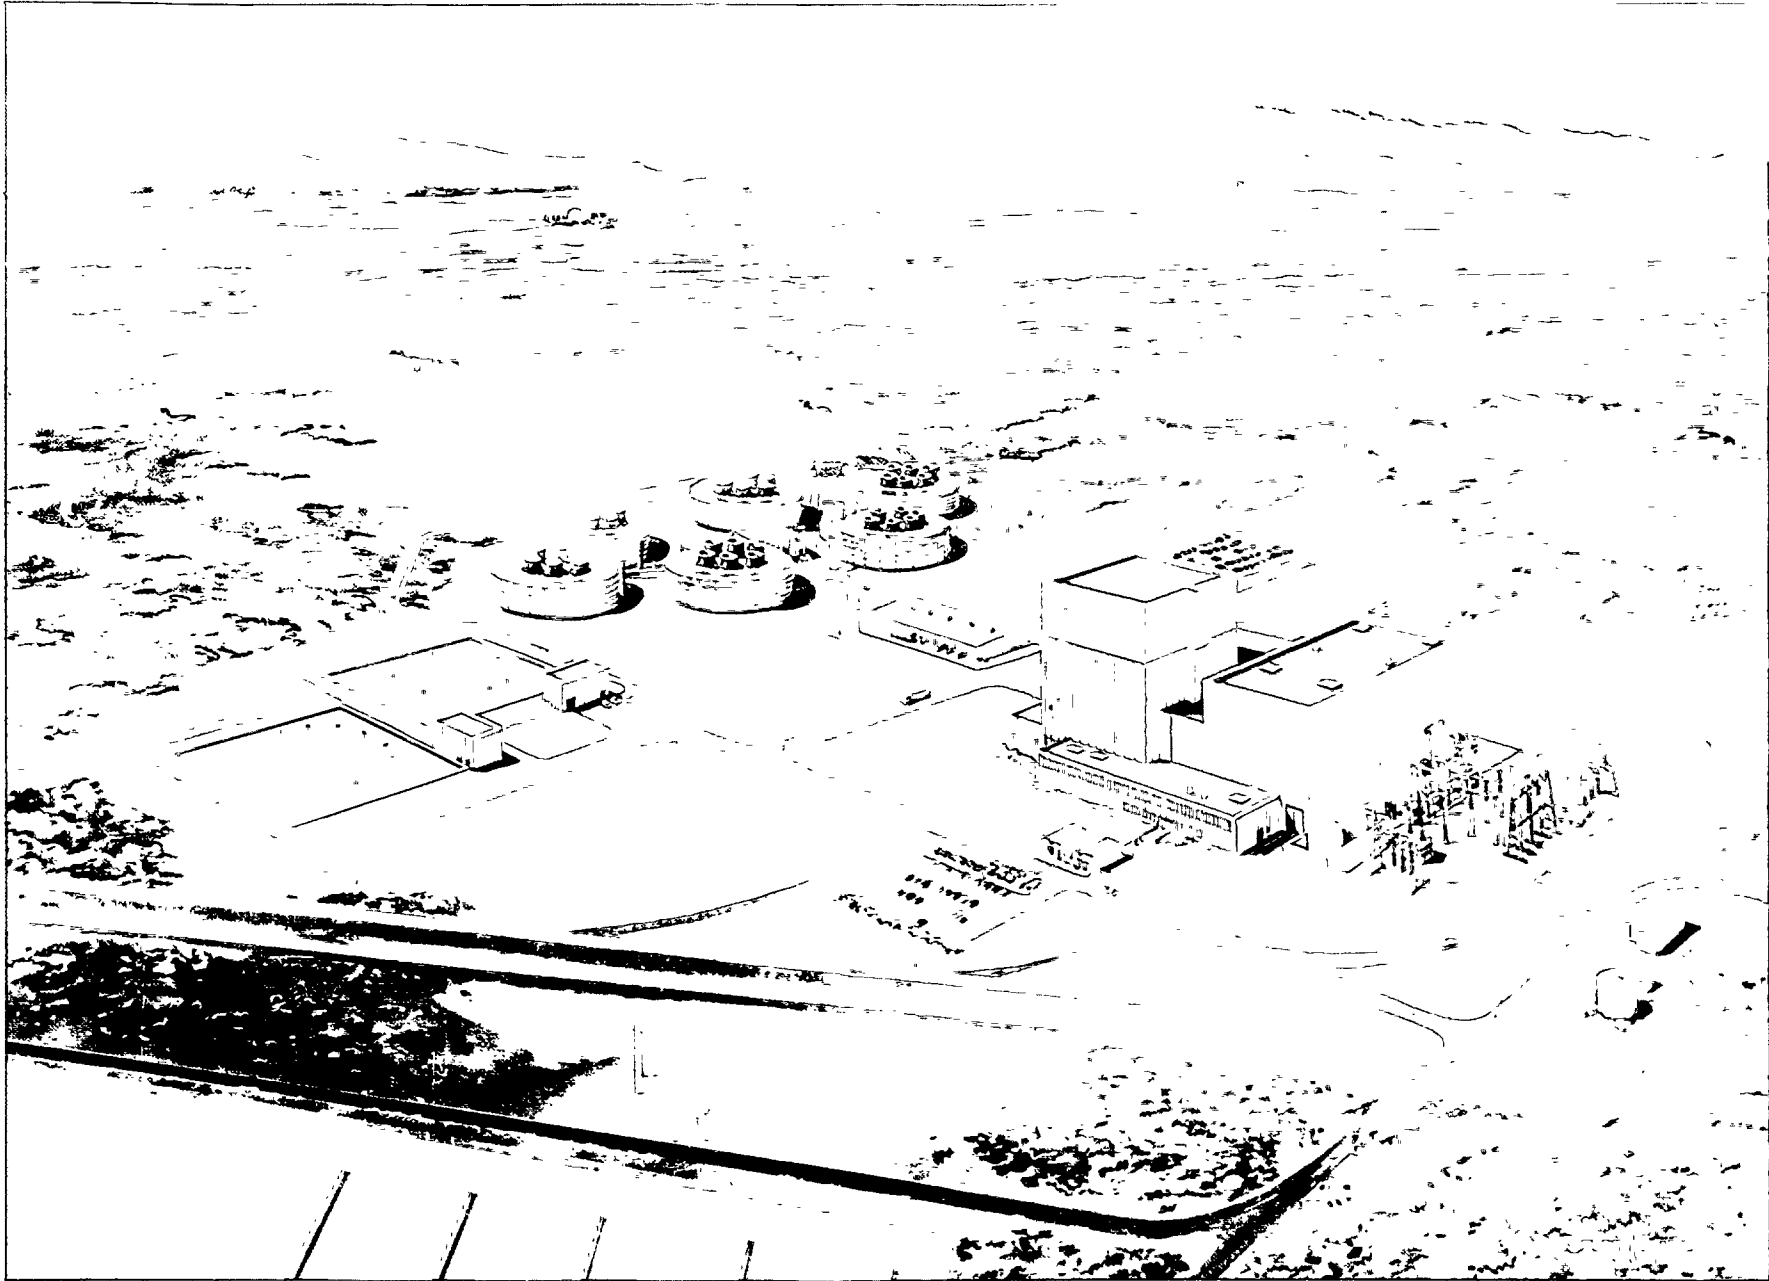

WASHINGTON PUBLIC POWER SUPPLY SYSTEM NUCLEAR PROJECT NO. 2

Revision 1
Date: 1/1/70

THE PROGRAM FOR THE
UNION

1. The program is designed to provide a comprehensive system of training and development for the union members.

2. The program will be implemented in a phased manner, with the first phase beginning in the first quarter of 1970.

3. The program will be evaluated on a regular basis to ensure its effectiveness.

4. The program will be subject to periodic review and revision.

5. The program will be subject to periodic review and revision.
Date 1/8/79

Revision 0

PRESERVICE INSPECTION PROGRAM PLAN
FOR THE
WPPSS NUCLEAR PROJECT NO. 2

OWNER: Washington Public Power Supply System
3000 George Washington Way
Richland, Washington 99352

PLANT: WNP-2, located 11 miles north of Richland, Washington, on the
U.S. Department of Energy Hanford Reservation

COMMERCIAL SERVICE DATE: June 1981 (projected)

CAPACITY: 1,094 MWe; 3,440 MWT

REACTOR PRESSURE VESSEL: Manufacturer: CBIN Serial No.: T-45
State No.: N/A Nat'l. Bd. No.: CBIN-8

PREPARED BY: Thomas J. Hark Daniel W. Porter 2/13/79 2/13/79
ISI Engineering Date

PLAN APPROVALS:

Leonard J. Blumberg 2-14-79
Supervisor, ISI & Operations Support Engineering Date

DCJ 40C 2/21/79 ADKokke, J. 2-23-79
2/14/79 WNP-2 Project Manager Date

2/16/79 RY Cockrell 2-16-79
2/14/79 Engineering Division Manager Date

ASSISTANT DIRECTORS:

D L Remberger 2/27/79
Assistant Director, Technology Date

K. J. Rubinis 2/26/79
Assistant Director, Generation Date

CONCURRENCE: 2/20/79 W. E. Vintkeeyoon 2/26/79
Manager, Quality Assurance Division Date

J. M. Frantz 2/28/79
Authorized Nuclear Inspector Date

1956

1956

Date 7/27/79

Revision 1

PRESERVICE INSPECTION PROGRAM PLAN

FOR THE

WPPSS NUCLEAR PROJECT NO. 2

Amendment No. 1

Prepared by: J.F. Linder R.W. Porter 9/24/79
ISI Engineering Date

Plan Approvals:

L.F. Blankenship 10-1-79
Supervisor, ISI & Operations Support Date
Engineering

L.T. Harold 10-3-79
Chief, Mechanical/Nuclear Engineering Date

Concurrence Keri J. Harwell 10-3-79
Supervisor, Quality Control Services Date
and Inspection

WDC K.D. Cowan 10/10/79
10/10/79 WNP-2 Project Engineering Manager Date

David G. Whitcomb 10-4-79
WNP-2 Plant Technical Supervisor Date

RPK W.E. Wittke 10-11-79
10/11/79 Manager, Quality Assurance Division Date

D.M. Fust 10/23/79
Authorized Nuclear Inspector Date

1954
1955
1956

1957

1958

1959

1960

1961

1962

1963

1964

1965

1966

PRESERVICE INSPECTION PROGRAM PLAN
FOR THE
WPPSS NUCLEAR PROJECT NO. 2

Amendment No. 2

Prepared by: Thomas F. Hoyle 12-4-80
ISI Engineering Date

Plans Approvals: D. W. Porter 12-4-80
Supervisor, ISI & Operations Support Date
Engineering

J. J. Cochran for LTH 12-4-80
Chief, Mechanical/Nuclear Engineering Date

Concurrence: Ken J. Hammond 12-4-80
Supervisor, Nondestructive Examination & Date
Inspection

WJ Conn 12/8/80
WNP-2 Project Engineering Manager Date

D. L. Whitcomb 12/5/80
WNP-2 Plant Technical Supervisor Date

[Signature] 12/4/80 12-4-80
Manager, Quality Assurance Division Date
DEPARTMENT

[Signature] 12-16-80
Authorized Nuclear Inspector Date

18/11/81

Revision 3

18/11/81

REV 03

18/11/81

Revision No. 3

18/11/81
Date

18/11/81
Date

Date 12/14/81

Revision 3

PRESERVICE INSPECTION PROGRAM PLAN

FOR THE

SUPPLY SYSTEM NUCLEAR PROJECT NO. 2

Amendment No. 3

Prepared by: D.P. Ramey 12/14/81
ISI Engineer Date

Plan Approvals: Thomas F. Hoyle 12/17/81
Lead, Plant Engineering & Surveillance Date

D.W. Porter 12/17/81
Manager, Plant Engineering & Construction Date

Concurrence: Ken J. Hannah 12/18/81
Supervisor, NDE&I Date

Douglas C. Semmes for 12/18/81
WNP-2 Project Engineering Manager Date

PSI PROGRAM PLAN

Date 12/14/81

Amendment No. 3

Revision 3

D. L. Whitcomb for KDC
WNP-2 Plant Technical Manager

12/18/81
Date

William M. Meyol
Manager, Operational Quality Assurance

12/18/81
Date

[Signature]
Authorized Nuclear Inspector

12-21-81
Date

11/18/81
Date

11/18/81
Date

11/22/81
Date

11/22/81
Date

PRESERVICE INSPECTION PROGRAM PLAN

FOR THE

SUPPLY SYSTEM NUCLEAR PLANT NO. 2

Amendment No. 4

Prepared by: *Douglas P. Roman* 1/18/85
ISI Engineer Date

Reviewed by: *Thomas D. Hoyt* 1/18/85
ISI Lead Engineer Date

Ken J. Hannich 1/22/85
Manager, ISI/NDE Date

D. W. Patten 1/22/85
Manager, Engineering Systems Support Date

A. Cowan 2/13/85
Manager, Plant Technical Date

D. B. B. 2-13-85
Manager, Plant QA Date

Approved by: *CM Powers* 2/13/85
WNP-2 Plant Manager Date

A. M. Felt 2/14/85
Authorized Nuclear Inspector Date

1.0--INTRODUCTION

This Preservice Inspection Program Plan is applicable to the WPPSS Nuclear Project No. 2, hereinafter referred to as WNP-2, a single unit Boiling Water Reactor (BWR) power plant located 11 miles north of Richland, Washington, on the Hanford Reservation. The plant employs a General Electric (GE) supplied nuclear steam supply system designated as BWR/5. The reactor is contained within an over-under drywell/wetwell containment vessel designated Mark II. The plant net rated electrical output is 1,145 MWe. The reactor vessel is surrounded by metallic reflective insulation which is attached to a sacrificial shield wall. The annulus between the insulation and reactor vessel is nominally 10 inches. The reactor bottom head area is insulated using metallic reflective insulation on the skirt inside surfaces.

The owner, Washington Public Power Supply System, hereinafter referred to as the Supply System, has installed permanent pole tracks for remote examination equipment mounted on the reflective insulation as an optional aid in achieving remote external examination of the vessel barrel and bottom head areas. Details of those devices are given in Section 14.0, "EXAMINATION EQUIPMENT".

This Program Plan has been prepared as the controlling document governing the preservice examination activities at WNP-2. The requirements for preservice examinations are outlined in the ASME Boiler and Pressure Vessel Code, Section XI, entitled "Rules for Inservice Inspection of Nuclear Power Plant Components". The scope of this plan is limited to nondestructive examinations of the reactor pressure vessel and appurtenances, and Nuclear Class 1, 2 and 3 piping systems and components. Preservice Testing of Pumps and Valves, also required by subsections IWP and IWV of ASME Section XI, are not included in this plan, and are the subject of a separate document.

This Program Plan is prepared in accordance with the 1974 Edition of ASME Section XI with addenda through Summer 1975. Also included are certain nonmandatory augmented examinations which are identified as such and performed voluntarily by, and at the discretion of, the Supply System.

Inservice Inspection of Nuclear Power Plant Components is required by federal law as stated in the Code of Federal Regulations, Title 10, Part 50 (10CFR50), Paragraph 50.55a. According to that document, the applicable edition of ASME Section XI for the WNP-2 RPV Preservice Examinations (manufactured to ASME Section III, 1968 Edition with addenda through Summer 1970) is the 1971 Edition with addenda through Winter 1971. Similarly, the WNP-2 piping systems (manufactured to ASME Section III, 1971 Edition with addenda through Summer 1973) are subject to the 1971 Edition with addenda through Winter 1971.

The Supply System has, on a voluntary basis, upgraded the WNP-2 Preservice Inspection Program to the extent practical to comply with 1974 Edition, Summer 1975 addenda, to ensure a maximum practical degree of compliance with future code addenda. Where strict compliance with that code edition and addenda is not practical, the degree of compliance is stated and the exception justified. Exceptions to code requirements which affect examination areas are listed in Section 7.0, "BOUNDARY DIAGRAMS". Exception to code requirements which affect examination and evaluation techniques (procedures) are listed in Section 10.0, "PROCEDURES".

A more complete description of the contents of the Program Plan is given on a section-by-section basis in Section 6.0, "PROGRAM DESCRIPTION". Also included in Subsection 6.6 is a definition of terms and abbreviations used herein.

The Supply System has contracted with the firm of Lambert, McGill, Thomas, Incorporated, located in Santa Clara, California, for the performance of the manual volumetric and surface NDE examinations, and the mechanical RPV examinations. A limited scope external examination of the RPV was done using remote examination devices. These devices operated from permanently installed pole tracks which are mounted on the RPV reflective insulation. The remote equipment was supplied by Southwest Research Institute.

Visual examinations will be performed by WPPSS personnel as described in Section 9.0, "VISUAL PROGRAM".

2.0--TABLE OF CONTENTS

VOLUME I - PROGRAM PLAN

- 1.0 INTRODUCTION
- 2.0 TABLE OF CONTENTS
- 3.0 RECORD OF REVISIONS
- 4.0 CODE COMMITMENTS
- 5.0 FSAR/NRC COMMITMENTS
- 6.0 PROGRAM DESCRIPTION
 - 6.1 Program Philosophy
 - 6.2 Program Scope
 - 6.3 RPV Examination
 - 6.4 Program Summary
 - 6.5 Schedule
 - 6.6 Definitions of Terms and Abbreviations
- 7.0 BOUNDARY DIAGRAMS
 - 7.1 ISI Boundary Diagrams
 - 7.2 ISI Boundary Exemptions and Exceptions
- 8.0 WELD IDENTIFICATION DIAGRAMS
- 9.0 VISUAL EXAMINATION PROGRAM
 - 9.1 Introduction
 - 9.2 Visual Examination Categories
 - 9.3 Program Description

VOLUME II - PROCEDURES

- 10.0 PROCEDURES
 - 10.1 Procedure List
 - 10.2 Code Exceptions
 - Tab 1 thru Tab 31 - Procedures

VOLUME III - PROCEDURES

- Tab 32 thru tab 45 - Procedures
- 11.0 ULTRASONIC CALIBRATION STANDARDS
 - 11.1 Vessel Standards
 - 11.2 Piping Standards

2.0--TABLE OF CONTENTS (Continued)

12.0 MANAGEMENT PLAN

12.1 Introduction

12.2 Site Organization

12.3 Planning and Scheduling

12.4 PSI Program Plan Revisions

12.5 Field Support Services

12.6 Reporting and Disposition of Indications

12.7 Technical Surveillance

13.0 QUALITY ASSURANCE

14.0 EXAMINATION EQUIPMENT

14.1 RPV Pole, Bottom Head and Nozzle Tracks


14.2 Remote Examination System

15.0 PSI REPORT SUBMITTAL

VOLUME IV

PSI SUMMARY REPORT AND NIS-1 FORM

RECORD OF PROGRAM PLAN REVISIONS

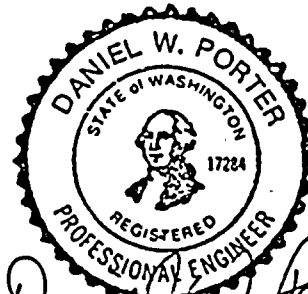

Daniel W. Porter
2/13/79

NO.	DATE	REVISIONS	BY	CHK'D	APP'D
4	1/18/85	Issued Amendment 4	<i>DPR</i>	<i>TFH</i>	<i>TFH</i>
3	12/14/81	Issued Amendment 3	<i>DPR</i>	<i>TFH</i>	<i>TFH</i>
2	11/14/80	Issued Amendment 2	<i>TFH</i>	<i>D.W. Porter</i>	<i>TFH</i>
1	9/14/79	Issued Amendment 1	<i>TFH</i>	<i>D.W. Porter</i>	<i>TFH</i>
0	1/29/79	Issued for Use	<i>TFH</i>		<i>TFH</i>
NO.	DATE	REVISIONS	BY	CHK'D	APP'D

1
2
1	
2	
3	
TITLE	SHEET	DATE/REV	TITLE	SHEET	DATE/REV
Title Sheet	1	N/A		3-13	4
Sign. Orig.	1	0		3-14	4
Sign. Amd. 1	1	1		3-15	4
Sign. Amd. 2	1	2		3-16	4
Sign. Amd. 3	1	3		3-17	4
Sign. Amd. 4	1	4		3-18	4
1.0 Intro	1-1	1			
	1-2	1			
2.0 Table of	2-1	4			
Contents	2-2	4	4.0 Code	4-1	0
			Commitments		
			Table 4-1	1	0
3.0 Record of	3-1	4		2	1
Revisions	3-2	4		3	0
	3-3	4		4	0
	3-4	4		5	0
	3-5	4		6	0
	3-6	4		7	0
	3-7	4		8	0
	3-8	4			
	3-9	4			
	3-10	4			
	3-11	4			
	3-12	4			

14-00000-10
14-00000-10
TITLE	SHEET	DATE/REV	TITLE	SHEET	DATE/REV
5.0 FSAR	5-1	1		5-24	1
Commitments	5-2	1		5-25	1
	5-2a	1		5-25a	0
	5-2b	1		5-26	1
	5-3	1		5-26a	1
1	5-4	1		5-26b	1
	5-5	2		5-27	2
	5-6	2		5-28	2
	5-7	1		5-29	2
	5-7a	1		5-30	1
	5-7b	1		5-31	1
	5-8	2		5-32	1
	5-8a	0		5-33	1
	5-9	1		5-34	1
	5-10	1		5-35	1
	5-11	1		5-36	1
	5-12	1		5-37	1
	5-13	1		5-38	1
	5-14	1		5-39	1
	5-15	1		5-40	1
	5-16	1		5-40a	0
	5-17	1		5-41	0
	5-18	1		5-42	1
	5-19	1		5-43	1
	5-20	1		5-44	0
	5-21	1		5-45	0
	5-22	1		5-46	0
	5-23	1		5-47	0

SECRET

10

SECRET

Faint, mostly illegible text fragments scattered on the left side of the page.



TITLE	SHEET	DATE/REV	TITLE	SHEET	DATE/REV
5.0 FSAR	5-48	0		6-7	0
Continued	5-49	0		6-8	0
	5-50	2		6-9	0
	5-51	0		6-10	0
	5-52	0		6-11	4
	5-53	0			
	5-54	0			
	5-55	2			
	5-56	1	7.0 Boundary	7-1	0
	5-57	1	Diagrams	7-2	0
	5-58	0		7-3	2
	5-59	0		7-4	0
	5-60	deleted		7-5	0
				7-6	2
				7-6a	1
				7-6b	0
6.0 Program	6-1	1		7-7	1
Description	6-2	1		7-8	1
	6-2a	1		7-9	2
	6-2aa	0		7-10	0
	6-2ab	0		7-11	0
	6-2b	0		7-12	1
	6-2c	0		7-12a	0
	6-2d	0		7-12b	0
	6-3	1		7-12c	1
	6-4	0		7-13	3
	6-5	0		7-13a	1
	6-6	1		7-13b	1

SECRET



1. The first part of the document discusses the importance of maintaining accurate records of all activities. It emphasizes that these records are essential for ensuring transparency and accountability in the organization's operations.

2. The second part of the document outlines the specific procedures for collecting and organizing data. It details the steps involved in identifying relevant information, gathering it from various sources, and then categorizing it into a structured format for easy access and analysis.

3. The third part of the document describes the methods used for analyzing the collected data. It highlights the use of statistical techniques and other analytical tools to identify trends, patterns, and correlations within the data set.

4. The fourth part of the document discusses the importance of interpreting the results of the analysis. It stresses that the data must be carefully examined and contextualized to draw meaningful conclusions and inform decision-making processes.

5. The fifth part of the document provides a summary of the key findings and recommendations. It outlines the main insights gained from the analysis and offers practical suggestions for how these findings can be applied to improve organizational performance and efficiency.

6. The final part of the document concludes with a statement on the overall value of the data analysis process. It reiterates that this process is a critical component of any data-driven organization and that it should be continuously refined and updated to meet the changing needs of the business.

TITLE	SHEET	DATE/REV	TITLE	SHEET	DATE/REV.
7.0 Boundary	7-14	1		2.....	1
Continued	7-15	0		7-25. . .	1
	7-16	0			
ISI-200	1	1	ISI-224	1	2
				1A	2
ISI-217	1	2		2	2
	7-19	2		2A	2
				3	2
ISI-219	1	1		3A	2
	2	1		4	2
	7-20	1		4A	2
				5	2
ISI-220	1	1		6	2
	2	1		7	0
	7-21	1		7A	0
				7-26	0
ISI-221	1	2	ISI-275	1	0
	1A	2			
	2	1	ISI-225	1	1
	2A	1		2	1
	3	2		3	1
	7-22	3		4	0
	7-23	1		7-27	0
ISI-222	1	1	ISI-226	1	2
	7-24	0		1A	2
				2	3
ISI-223	1	1		7-28	1



Faint, mostly illegible text on the left side of the page, possibly representing a list or form fields.

TITLE	SHEET	DATE/REV	TITLE	SHEET	DATE/REV
7.0 Boundary			Tables	1-2	12/14/84
Continued					
ISI-228	1	1	RPV-105	1	0
	7-29	1			
	7-30	1	RPV-106	1	0
ISI-229	1	2	RPV-107	1	0
	1A	2			
	2	2	RPV-108	1	0
	2A	2			
	3	0	RPV-109	1	0
	4	0			
	7-31	1	RPV-110	1	0
ISI-230	1	2	RPV-111	1	0
	2	2			
	3	2	RPV-112	1	0
	7-32	1			
			RPV-113	1	0
8.0 Weld ID	8-1	2	RPV-114	1	0
Diagrams	8-2	1			
	8-2a	1	RPV-115	1	0
RPV-101	1	3	RCIC-101	1	4
Tables	1-53	12/14/84		2	3
				3	2
RPV-102	1	2	Tables	1-11	12/14/84

TITLE	SHEET	DATE/REV	TITLE	SHEET	DATE/REV
8.0 Continued			RCIG-205	1	1
RCIC-102	1	3		2	1
	2	3		3	1
	3	4		4	1
Tables	1-11	12/14/84		5	1
				6	1
RCIC-201	1	2		7	0
	2	0	Tables	1-3	12/14/84
Tables	1-2	12/14/84			
			HPCS-101	1	2
RCIC-202	1	1		2	4
	2	1	Tables	1-7	12/14/84
	3	1			
	4	1	HPCS-201	1	1
	5	1		2	1
Tables	1-4	12/14/84	Tables	1	12/14/84
			HPCS-202	1	1
RCIC-203	1	1		2	1
	2	1		3	1
	3	0		4	1
Tables	1-2	12/14/84		5	1
				6	1
RCIC-204	1	1	Tables	1-3	12/14/84
	2	1			
	3	1	LPCS-101	1	2
	4	2		2	3
Tables	1	12/14/84	Tables	1-6	12/14/84

TITLE	SHEET	DATE/REV	TITLE	SHEET	DATE/REV
8.0 Continued			Tables	1-5	12/14/84
LPCS-201	1	1			
	2	1	RHR-201	1	2
Tables	1	12/14/84		2	2
				3	2
LPCS-202	1	1		4	1
	2	1		5	3
	3	1		6	1
	4	1		7	2
	5	1		8	2
	1-2	12/14/84		9	2
				10	2
RHR-101	1	5		11	3
Tables	1-6	12/14/84	Tables	1-17	12/14/84
RHR-102	1	5	RHR-202	1	1
Tables	1-6	12/14/84		2	2
			Tables	1-2	12/14/84
RHR-103	1	5			
Tables	1-6	12/14/84	RHR-203	1	2
				2	2
RHR-104	1	3		3	2
Tables	1-5	12/14/84	Tables	1-6	12/14/84
RHR-105	1	3	RHR-204	1	1
Tables	1-6	12/14/84		2	2
				3	1
RHR-106	1	3		4	1



TITLE	SHEET	DATE/REV	TITLE	SHEET	DATE/REV
8.0 Continued				15.....3...
Tables	1-3	12/14/84		16. ...	2
				17 ..	1
RHR-205	1	2	Tables	1-24	12/14/84
	2	2			
	3	2	RHR-208	1	1
	4	2		2	2
Tables	1-7	12/14/84		3	1
				4	1
RHR-206	1	2		5	1
	2	2	Tables	1-4	12/14/84
	3	3			
Tables	1-3	12/14/84	RHR-209	1	3
				2	2
RHR-207	1	2	Tables	1-3	12/14/84
	2	1			
	3	2	RHR-210	1	1
	4	2		2	1
	5	2		3	1
	6	2		4	2
	7	2		5	1
	8	2	Tables	1-3	12/14/84
	9	2			
	10	2	RHR-211	1	1
	11	2		2	1
	12	2	Tables	1-2	12/14/84
	13	3			
	14	2	RHR-212	1	1

TITLE	SHEET	DATE/REV	TITLE	SHEET	DATE/REV
8.0 Continued			Tables	1-2	12/14/84
Tables	1	12/14/84			
			MS-106	1	2
RHR-213	1	2		2	1
Tables	1-2	12/14/84		3	1
				4	1
RHR-214	1	1	Tables	1-4	12/14/84
Tables	1	12/14/84			
			MS-201	1	3
MS-101	1	4		2	3
	2	3		3	4
Tables	1-10	12/14/84		4	3
				5	0
MS-102	1	4	Tables	1-19	12/14/84
	2	2			
Tables	1-10	12/14/84	MS-202	1	4
				2	3
MS-103	1	4		3	4
	2	2		4	2
Tables	1-10	12/14/84		5	0
			Tables	1-19	12/14/84
MS-104	1	3			
	2	3	MS-203	1	3
	1-9	12/14/84		2	3
				3	4
MS-105	1	2		4	2
	2	2		5	1
	3	2	Tables	1-18	12/14/84



TITLE	SHEET	DATE/REV	TITLE	SHEET	DATE/REV
800 Continued			RFW-103	1	3
MS-204	1	3	Tables	1-4	12/14/84
	2	3			
	3	4	RRC-101	1	3
	4	2		2	2
	5	0		3	2
Tables	1-18	12/14/84		4	2
				5	2
MS-205	1	2		6	2
Tables	1	12/14/84		7	2
				8	2
MS-206	1	1	Tables	1-25	12/14/84
Tables	1	12/14/84			
			RRC-102	1	2
RFW-101	1	3		2	3
	2	2		3	2
	3	4		4	2
	4	4		5	2
	5	4		6	2
Tables	1-12	12/14/84		7	2
				8	2
RFW-102	1	3	Tables	1-24	12/14/84
	2	2			
	3	4	RRC-103	1	1
	4	4	Tables	1-4	12/14/84
	5	4			
Tables	1-12	12/14/84	RRC-104	1	2
			Tables	1-3	12/14/84

TITLE	SHEET	DATE/REV	TITLE	SHEET	DATE/REV
8.0 Continued					
RRC-105	1	2	RWCU-301	1	1
Tables	1-5	12/14/84	Tables	1-2	12/14/84
RRC-106	1	1	RWCU-302	1	1
Tables	1-3	12/14/84		1	12/14/84
RRC-107	1	1	RWCU-303	1	1
Tables	1-3	12/14/84		2	1
				3	1
RRC-108	1	1		1-2	12/14/84
Tables	1-3	12/14/84			
			RWCU-304	1	1
RRC-109	1	1		2	1
Tables	1-3	12/14/84		3	1
				1	12/14/84
RRC-110	1	2			
Tables	1	12/14/84	RWCU-305	1	1
				1	12/14/84
RRC-111	1	1			
Tables	1	12/14/84	CRD-201	1	0
				2	0
RWCU-101	1	3		3	0
	2	3		1	12/14/84
	3	3			
	4	4	CRD-202	1	0
	5	3		2	0
Tables	1-2	12/14/84		3	0



TITLE	SHEET	DATE/REV	TITLE	SHEET	DATE/REV
8.0 Continued	1	12/14/84	Tables	1-3	12/14/84
SLC-101	1	0	SW-304	1	1
	2	0	Tables	1	12/14/84
	3	0			
	4	0	SW-305	1	1
	5	0		2	1
	6	0		3	1
				4	1
SW-301	1	0	Tables	1-2	12/14/84
	2	1			
	3	1	SW-306	1	1
	4	1	Tables	1	12/14/84
	5	1			
	6	1	SW-307	1	1
Tables	1-3	12/14/84		2	1
				3	1
SW-302	1	1		4	1
Tables	1	12/14/84		5	0
			Tables	1-2	12/14/84
SW-303	1	0			
	2	1	SW-308	1	1
	3	1	Tables	1	12/14/84
	4	1			
	5	1	SW-309	1	1
	6	1	Tables	1	12/14/84
	7	1			
	8	1	SW-310	1	1



TITLE	SHEET	DATE/REV	TITLE	SHEET	DATE/REV
8.0 Continued				4	1
Tables	1	12/14/84		5	1
				6	1
SW-311	1	1		7	1
Tables	1	12/14/84		8	1
			Tables	1-3	12/14/84
SW-312	1	0			
	2	0	FPC-302	1	1
Tables	1	12/14/84		2	0
				3	1
SW-313	1	0		4	0
Tables	1	12/14/84	Tables	1	12/14/84
SW-314	1	0	FPC-303	1	1
	2	0		2	1
Tables	1	12/14/84		2 ³	0
				4	0
SW-315	1	0	Tables	1	12/14/84
Tables	1	12/14/84			
			FPC-304	1	1
FPC-201	1	1		2	1
Tables	1	12/14/84		3	1
				4	0
FPC-202	1	0		5	0
			Tables	1	12/14/84
FPC-301	1	1			
	2	1	FPC-305	1	1
	3	1		2	1



TITLE	SHEET	DATE/REV	TITLE	SHEET	DATE/REV
8.0 Continued	3	1	RCC-301	1	1
	4	1		2	1
	5	1		3	1
	6	1	Tables	1-3	12/14/84
	7	1			
	8	1	RCC-302	1	1
	9	1		2	1
	10	1	Tables	1-2	12/14/84
	11	0			
Tables	1-4	12/14/84	RCC-303	1	0
				2	0
FPC-306	1	1	Tables	1	12/14/84
Tables	1	12/14/84			
			RCC-304	1	0
FPC-307	1	1		2	0
Tables	1	12/14/84	Tables	1	12/14/84
FPC-308	1	1	DW	1	1
	2	1			
	3	1	EDR-201	1	1
	4	1			
Tables	1-2	12/14/84	FDR-201	1	0
RCC-201	1	0	MSLC	1	1
Tables	1	12/14/84			
			MISC	1	0
RCC-202	1	1	Tables	1-26	12/14/84
Tables	1	12/14/84			



TITLE	SHEET	DATE/REV	TITLE	SHEET	DATE/REV
9.0 Visual	9-1	2	UTCB-106	1	1
Exam. Progs	9-2	2	UTCB-107	1	1
	9-3	2	UTCB-108	1	1
	9-4	3	UTCB-109	1	1
	9-5	3	UTCB-110	1	1
	9-6	0	UTCB-111	1	1
Table 9-1	1-20	0	UTCB-112	1	0
Comp. Support	9-7	0	UTCB-203	1	1
Prog. Plan			UTCB-204	1	1
			UTCB-205	1	1
10.0 Procedures	10-1	3	UTCB-206	1	1
	10-2	1	UTCB-207	1	1
	10-3	2	UTCB-208	1	1
	10-4	3	UTCB-209	1	1
	10-5	3	UTCB-210	1	3
	10-6	0	UTCB-211	1	3
	10-7	0	UTCB-212	1	0
	10-8	0		11-5	0
	10-9	0		11-6	1
				11-7	2
11.0 UT	11-1	3		11-8	1
Cal. Std.	11-2	0		11-9	2
	11-3	1		11-10	0
	11-4	3			
UTCB-101	1	1	UTCB-220	1	5
UTCB-102	1	1	UTCB-221	1	5
UTCB-104	1	1	UTCB-222	1	1
UTCB-105	1	1	UTCB-223	1	2



TITLE	SHEET	DATE/REV	TITLE	SHEET	DATE/REV
11.0 Continued			LMT Mgmt	Cover Sht.	1
UTCB-224	1	2	Plan	1	1
UTCB-225	1	1		2	1
UTCB-226	1	1		3	1
UTCB-227	1	0		4	1
UTCB-228	1	0		5	1
UTCB-250	1	0		6	1
UTCB-251	1	1		7	1
UTCB-229	1	0		8	1
UTCB-230	1	0		9	1
UTCB-231	1	0		10	1
				11	1
12.0 Management	12-1	1		F	1
Plan	12-2	2			
	12-3	2	LMT Company	1	0
	12-4	2	Policy	2	0
	12-5	3		3	0
	12-6	1		4	0
	12-7	2		5	0
	12-8	2		6	0
	12-9	3		7	0
	12-10	2		8	0
	12-11	2			
	12-12	2	13.0 QA	13-1	1
	12-13	2			
	12-14	1	14.0 Exam	14-1	1
	12-15	1	Equipment	14-2	1
				14A-1	0



TITLE	SHEET	DATE/REV	TITLE	SHEET	DATE/REV
14.0 Continued	14A-2	A			
	14A-3	0			
RPV-103	1	1			
RPV-104	1	A			
Appendix B	14B-1				
	thru				
	14B-43	0			
15.0 PSI	15-1	1			
Report	15-2	0			
Submittal	15-3	1			
	15-3a	0			
	15-3b	0			
	15-4	1			
	15-4a	0			
	15-4b	0			
	15-4c	0			
	15-4d	0			

4.0--CODE COMMITMENTS

This program is prepared in accordance with the requirements of ASME Section XI, 1974 edition with addenda through Summer 1975. That code and addenda are hereinafter referred to as the reference code. There are some exceptions to the reference code, as well as certain nonmandatory augmented examinations, which are to be distinguished from NRC augmented ISI requirements, and which are performed voluntarily by the Supply System, and are implemented by this program. Table 4.1 summarizes the code applicability for the various plant components and WPPSS augmented requirements in tabular form for ease of reference. Details regarding exceptions to the reference code affecting the definition of ISI examination boundaries can be found in Section 7.0 of this Program Plan entitled "BOUNDARY DIAGRAMS" and those exceptions which affect the conduct of examinations can be found in Section 10.0 entitled "PROCEDURES". A summary of the examinations to be performed on each category of component is included in the FSAR section found in Section 5.0, "FSAR/NRC COMMITMENTS".

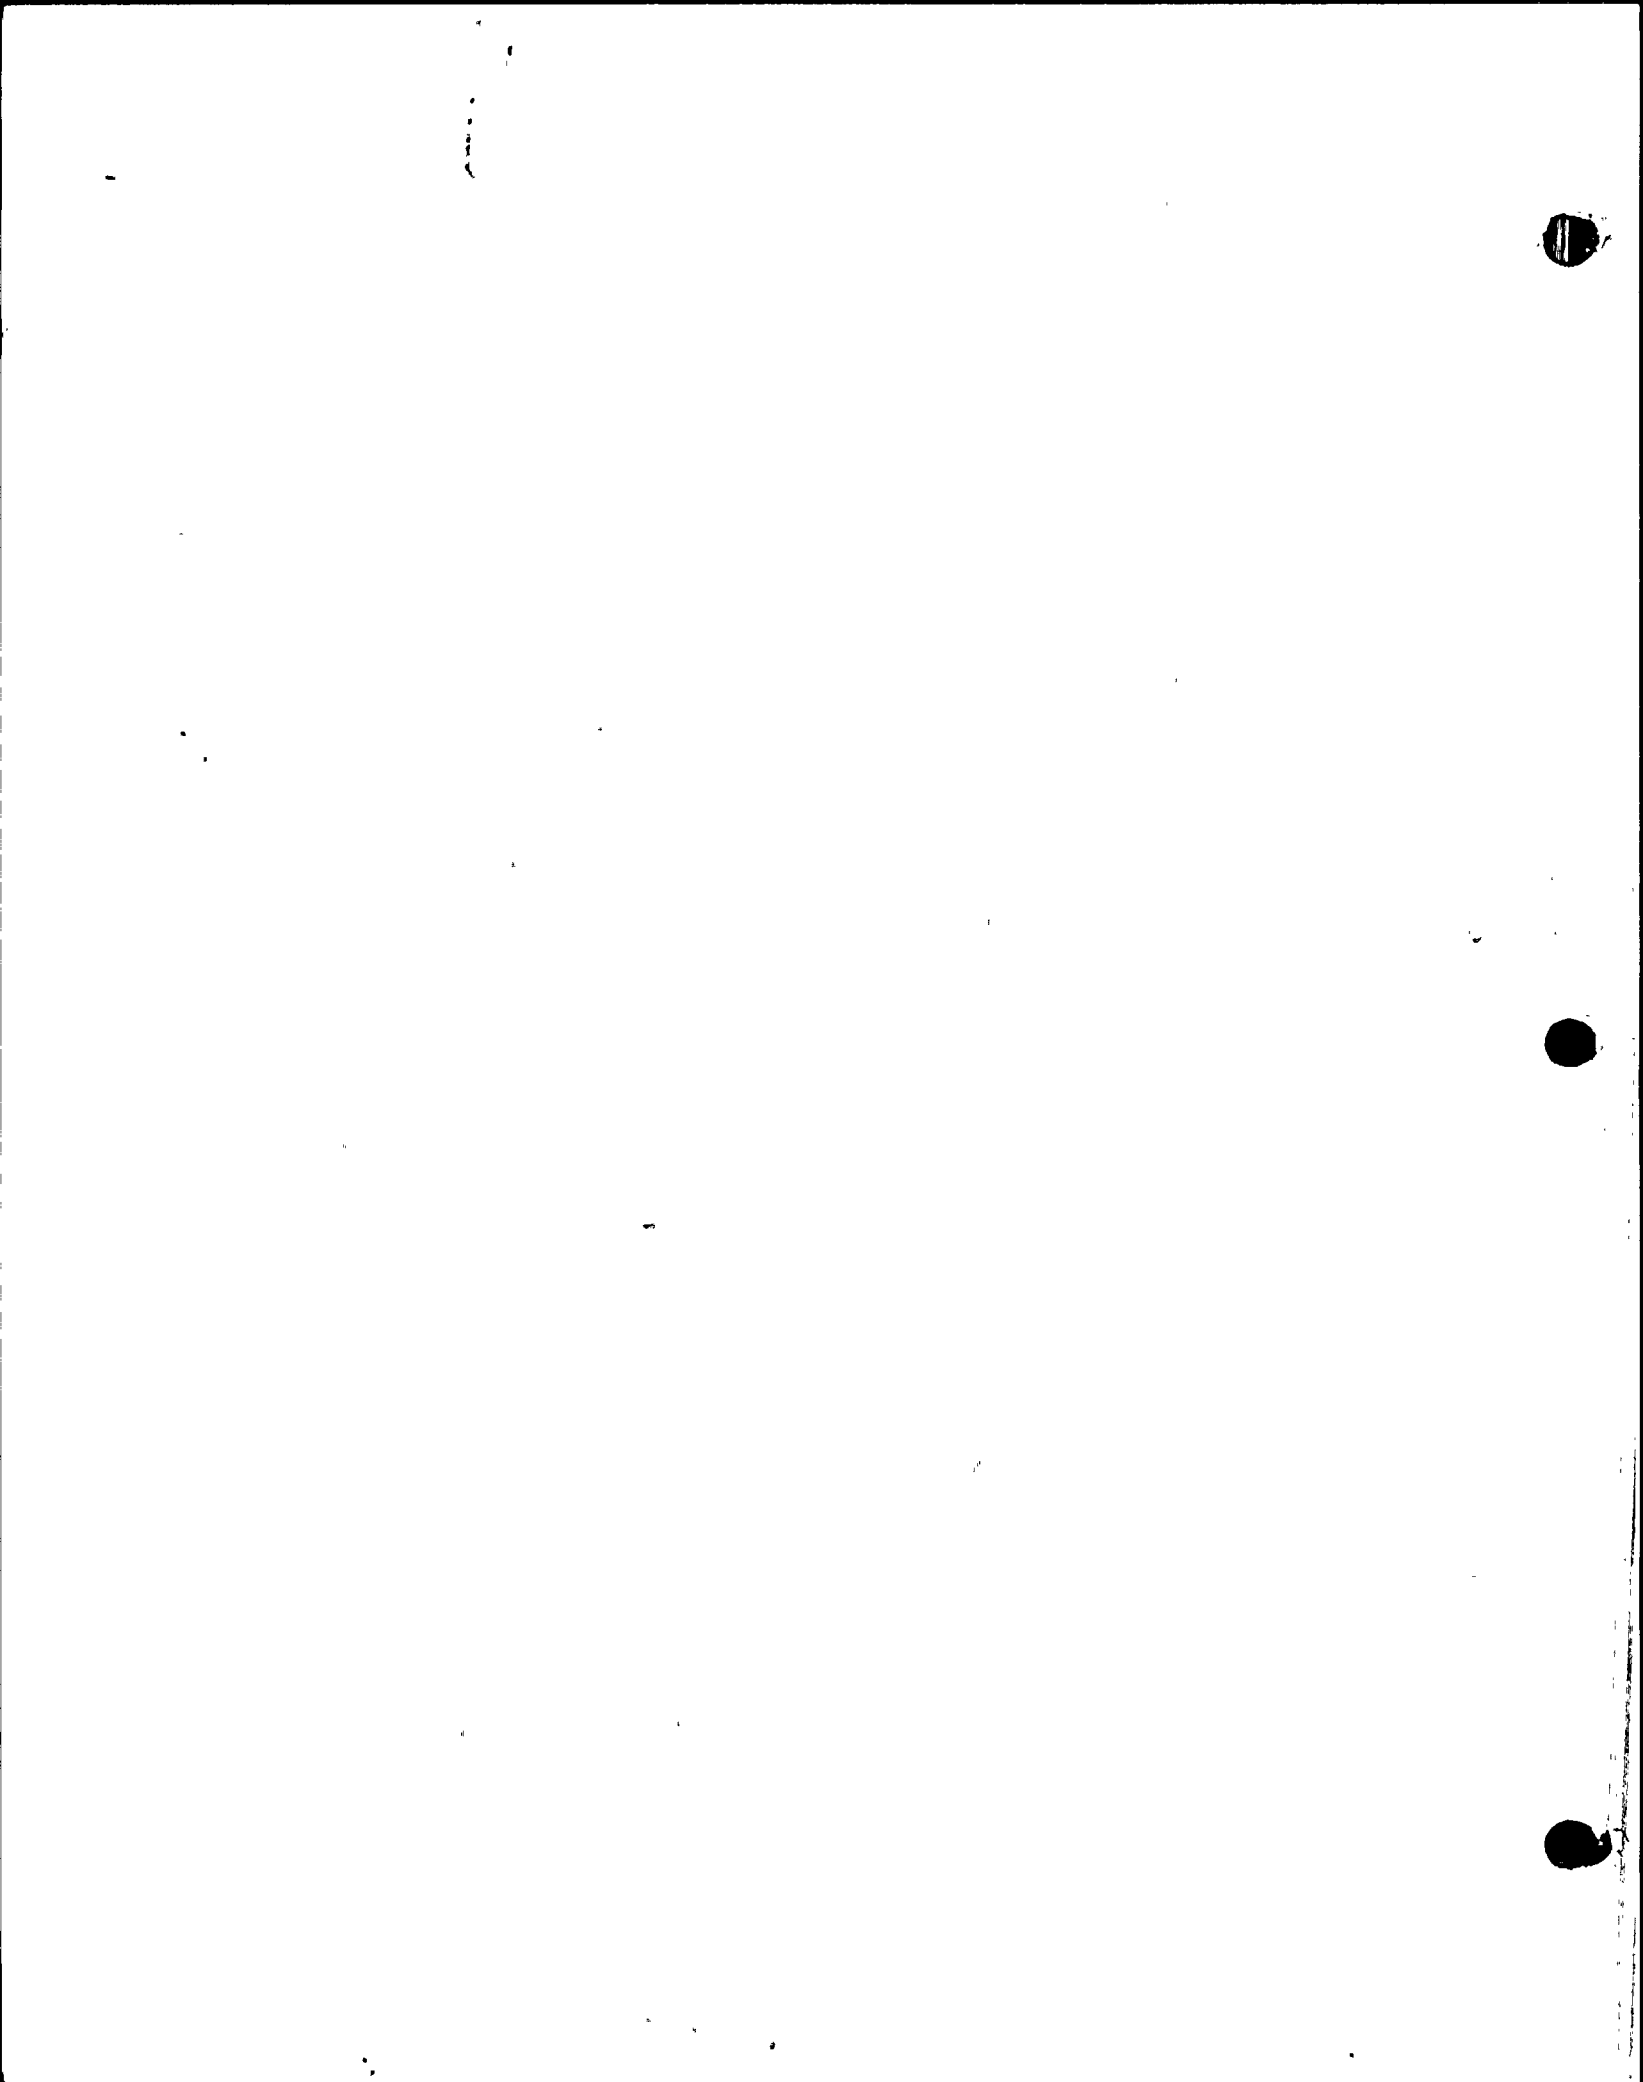


Table 4.1

Itemized Code Applicability and WPPSS Augmented Requirements

Page 1 of 8Date 1/16/79Revision 0

Sect. XI Item	Exam Category	Description	Applicable Code		WPPSS Augmented Requirements	Program Plan Preference	Remarks
			Sect. III	Sect. XI			
<u>VESSELS</u>							
B1.1	B-A	Longitudinal and circumferential shell welds in core region	1968,S'70	1974,S'75	1) Record UT data at 20% reference level, mechanized examinations only. 2) Contractor to notify Omer of all indications >80% Code Acceptance Standards	10.0	1) Partial baseline data taken manually prior to vessel installation.
B1.2	B-B	Longitudinal and circumferential welds in shell (other than those of Category B-A and B-C) and meridional and circumferential seam welds in bottom head and closure head (other than those of Category B-C)	1968,S'70	1974,S'75		12.0	
B1.3	B-C	Vessel-to-flange and head-to-flange circumferential welds	1968,S'70	1974,S'75		10.0	
B1.4	B-D	Primary nozzle-to-vessel welds and nozzle inside radiused section	1968,S'70	1974,S'75	3) Preservice mechanized to preservice manual data comparison, mechanized examinations only. (See Remark 1, this page) I&E ITEM		
B1.5	B-E	Vessel penetrations, including CRD and instrument penetrations	1968,S'70	1974,S'75			
B1.6	B-F	Nozzle-to-safe end welds	1968,S'70	1974,S'75			
B1.7	B-G-1	Closure studs, in place	1968,S'70	1974,S'75			
B1.8	B-G-1	Closure studs and nuts, when removed	1968,S'70	1974,S'75			
B1.9	B-G-1	Ligaments between threaded stud holes	1968,S'70	1974,S'75			
B1.10	B-G-1	Closure washers, bushings	1968,S'70	1974,S'75			
B1.11	B-G-2	Pressure-retaining bolting	1968,S'70	1974,S'75			
B1.12	B-H	Integrally-welded vessel supports	1968,S'70	1974,S'75			
B1.14	B-I-1	Vessel Cladding	1968,S'70	1974,S'75			
B1.15	B-H-1	Vessel Interior	1968,S'70	1974,S'75			
B1.16	B-H-2	Interior attachments and core support structures	1968,S'70	1974,S'75			
B1.17	B-H-3	Core support structures	1968,S'70	1974,S'75			
B1.18	B-O	Control rod drive housings	1968,S'70	1974,S'75			
B1.19	B-P	Exempted components	1968,S'70	1974,S'75			

Table 4.1

Itemized Code Applicability and WPPSS Augmented Requirements

 Page 2 of 8
 Date 7/27/79
 Revision 1

Sect XI Exam		Description	Applicable Code		WPPSS Augmented Requirements	Program Plan Reference	Remarks
Item	Categ		Sect. III	Sect. XI			
<u>PIPING</u>							
B4.1	B-F	Safe-end to piping welds and safe-end in branch piping welds	1971,S'73	1974,S'75	1) ASME Section XI, Appendix III 1974, W'75	10.0	<i>why 4" N.P.S.</i> 1) No UT on welds in piping <4" nominal pipe size 2) Visual examinations by Owner 3) Scope and details of examinations requirements given in Section 8.0.
B4.2	B-G-1	Pressure-retaining bolting, removed	1971,S'73	1974,S'75	2) Record UT data at 20% of reference level, mechanized examinations only.	10.0	
B4.3	B-G-1	Pressure-retaining bolting, in place	1971,S'73	1974,S'75	3) Owner notification of all indications >80% Code Acceptance Standards.	9.0	
B4.4	B-G-1	Pressure-retaining bolting	1971,S'73	1974,S'75	4) 0 ^o UT exam of plate (welded) pipe.	10.0	
B4.5	B-J	Circumferential and longitudinal pipe welds	1971,S'73	1974,S'75	5) 100% in lieu of 1 foot of longitudinal welds in pipe and fittings shall be examined during PSI.	10.0	
B4.6	B-J	Branch pipe connections welds exceeding six in. diameter	1971,S'73	1974,S'75	6) Record UT data at 50% of reference level, manual examinations.	10.0	
B4.7	B-J	Branch pipe connection welds six in. diameter and smaller	1971,S'73	1974,S'75	7) Perform surface examinations in addition to volumetric on Class I pipe welds.	8.0	
B4.8	B-J	Socket welds	1971,S'73	1974,S'75			
B4.9	B-K-1	Integrally welded supports	1971,S'73	1974,S'75			
B4.10	B-K-2	Support components	1971,S'73	1974,S'75			
B4.11	B-P	Exempted Components	1971,S'73	1974,S'75			
B4.12	B-G-2	Pressure-retaining bolting	1971,S'73	1974,S'75			

Table 4.1

Itemized Code Applicability and WPPSS Augmented Requirements

Page 3 of 8
 Date 1/8/79
 Revision 0

Sect XI Item	Exam Categ	Description	Applicable Code		WPPSS Augmented Requirements	Program Plan Reference	Remarks
			Sect. III	Sect. XI			
<u>PUMP PRESSURE BOUNDARY</u>							
B5.1	B-G-1	Pressure-retaining bolts and studs, in place	1968,S'70	1974,S'75	1) Owner notification if indications on bolts >80% Code Acceptance Standards.	9.0	1) Reactor Recirculation Pumps cast stainless, no pressure boundary welds. Bolting exceeds 2" OD. 2) Visual examinations, other than those associated with pump bolting to be performed by Owner. 3) The reactor recirculation pump casings have integrally cast support lugs. There are no "integrally welded" supports.
B5.2	B-G-1	Pressure-retaining bolts and studs, when removed	1968,S'70	1974,S'75			
B5.3	B-G-1	Pressure-retaining bolting	1968,S'70	1974,S'75			
B5.4	B-K-1	Integrally welded supports (See remark 3)	1968,S'70	1974,S'75			
B5.5	B-K-2	Support components	1968,S'70	1974,S'75			
B5.6	B-L-1	Pump Casing Welds (See remark 1)	1968,S'70	1974,S'75			
B5.7	B-L-2	Pump casings					
B5.8	B-P	Exempted components	1968,S'70	1974,S'75			
B5.9	B-G-2	Pressure-retaining bolting	1968,S'70	1974,S'75			

Table 4.1

Itemized Code Applicability and WPPSS Augmented Requirements

 Page 4 of 8
 Date 1/8/79
 Revision 0

Sect XI Exam		Description	Applicable Code		WPPSS Augmented Requirements	Program Plan Reference	Remarks
Item	Code		Sect. III	Sect. XI			
<u>VALVES</u>							
B6.1	B-G-1	Pressure-retaining bolts and studs, in place	1971,S'73	1974,S'75	1) Owner notification of all indications >80% Code Acceptance Standards.	9.0	1) There are no valve bodies containing pressure boundary welds. 2) There are no integrally welded valve supports.
B6.2	B-G-1	Pressure-retaining bolts and studs, removed	1971,S'73	1974,S'75			
B6.3	B-G-1	Pressure-retaining bolting	1971,S'73	1974,S'75			
B6.4	B-K-1	Integrally welded supports (See remark 2)	1971,S'73	1974,S'75			
B6.5	B-K-2	Support components	1971,S'73	1974,S'75			
B6.6	B-M-1	Valve body welds (See remark 1)	1971,S'73	1974,S'75			
B6.7	B-M-2	Valve bodies	1971,S'73	1974,S'75			
B6.8	B-P	Exempted components	1971,S'73	1974,S'75			
B6.9	B-G-2	Pressure retaining bolting	1971,S'73	1974,S'75			

Table 4.1

Itemized Code Applicability and WPPSS Augmented Requirements

Page 5 of 8
 Date 1/8/79
 Revision 0

Sect XI Exam		Description	Applicable Code		WPPSS Augmented Requirements	Program Plan Reference	Remarks
Item	Categ		Sect. III	Sect. XI			
		<u>PRESSURE VESSELS</u>					
C1.1	C-A	Circumferential butt welds	1968,S'70	1974,S'75	1) ASME Section XI, Appendix III, 1974,H'75	10.0	1) The RHR Heat Exchanger is the only class 2 pressure vessel subject to inservice inspection.
C1.2	C-B	Nozzle to vessel welds	1968,S'70	1974,S'75	2) Record UT data at 50% of reference level	10.0	
C1.3	C-C	Integrally welded supports	1968,S'70	1974,S'75	3) Owner notification of all indications >80% Code Acceptance Standards	9.0	
C1.4	C-D	Pressure-retaining bolting	1968,S'70	1974,S'75	4) 0° UT exam for plate (welded) Pipe.	10.0	

Table 4.1

Itemized Code Applicability and WPPSS Augmented Requirements

Page 6 of 8Date 1/8/79Revision 0

Sect XI Item	Exam Categ	Description	Applicable Code		WPPSS Augmented Requirements	Program Plan Reference	Remarks
			Sect. III	Sect. XI			
<u>PIPING</u>							
C2.1	C-F,C-G	Circumferential butt welds	1971,S'73	1974,S'75	1) ASME Section XI, Appendix III, 1974,H'75	10.0	1) No UT where pipe wall thickness $\frac{1}{2}$ inch or less.
C2.2	C-F,C-G	Longitudinal weld joints in fittings	1971,S'73	1974,S'75	2) Record UT data at 50% of reference level	10.0	
C2.3	C-F,C-G	Branch pipe-to-pipe weld joints	1971,S'73	1974,S'75	3) Owner notification of all in- dications >80% Code Accep- tance Standards	9.0	
C2.4	C-D	Pressure-retaining bolting	1971,S'73	1974,S'75	4) 0° UT exam for plate (welded) Pipe.	10.0	
C2.5	C-E-1	Integrally-welded supports	1971,S'73	1974,S'75			

Table 4.1

Itemized Code Applicability and WPPSS Augmented Requirements

Page 7 of 8Date 1/8/79Revision 0

Sect XI Exam		Description	Applicable Code		WPPSS Augmented Requirements	Program Plan Reference	Remarks
Item	Categ		Sect. III	Sect. XI			
		<u>PUMPS</u>					
C3.1	C-F,C-6	Pump casing welds (See remark 1)	1968,S'70	1974,S'75			1) The RHR pump welds are inaccessible. See section 7.0 for justification. 2) There are no integrally welded pump supports or support components for class 2 pumps.
C3.2	C-D	Pressure-retaining bolting	1968,S'70	1974,S'75			
C3.3	C-E-1	Integrally welded supports (See remark 2)	1968,S'70	1974,S'75			
C3.4	C-E-2	Support components (See remark 2)	1968,S'70	1974,S'75			

Table 4.1

Itemized Code Applicability and WPPSS Augmented Requirements

Page 8 of 8Date 1/8/79Revision 0

Sect XI Item	Exam Categ	Description	Applicable Code		WPPSS Augmented Requirements	Program Plan Reference	Remarks
			Sect. III	Sect. XI			
		<u>VALVES</u>					
C4.1	C-F,C-G	Valve body welds (See remark 1)	1971,S'73	1974,S'75			1) There are no class 2 valves with welded valve bodies. 2) There are no integrally welded valve supports or support components.
C4.2	C-D	Pressure-retaining bolting	1971,S'73	1974,S'75			
C4.3	C-E-1	Integrally welded supports (See remark 2)	1971,S'73	1974,S'75			
C4.4	C-E-2	Support components (See remark 2)	1971,S'73	1974,S'75			

5.0--FSAR/NRC COMMITMENTS

5.1 FSAR COMMITMENTS

The Supply System has committed in the WNP-2 FSAR to comply with the rules of the ASME Section XI, 1974 Edition with addenda through Summer 1975 for piping pumps and valves. This Code Edition and addenda has been approved for use by 10CFR50.55a(b). This section includes pages from the FSAR reflecting the Preservice Inspection Program commitment. The Inservice Inspection Programs will be updated in accordance with the requirements of 10CFR50.55a.

Note: The above represents a voluntary upgrade of the RPV and piping examinations from the 1971 Edition of ASME Section XI with addenda through Winter 1971 to the 1974 Edition with addenda through Summer 1975.

WNP-2

Below is a copy of the FSAR pages which apply to the WNP-2 Preservice Inspection Program Plan.

5.2.4 INSERVICE INSPECTION AND TESTING OF THE REACTOR COOLANT PRESSURE BOUNDARY

5.2.4.1 System Boundary Subject to Inspection

The system boundary subject to inspection includes all piping and components in quality Group A (ASME Boiler and Pressure Vessel Code, Section III, Class I). The WNP-2 reactor pressure vessel (RPV) will be examined prior to service in accordance with the requirements of the 1974 Edition of the ASME Boiler and Pressure Vessel Code, Section XI, including the Summer 1975 Addenda. All Class 1 piping, pumps and valves will be examined prior to service in accordance with the requirements of the 1974 Edition of the ASME Boiler and Pressure Vessel Code, Section XI, with Addenda through Summer 1975, including Appendix III from the Winter 1975 Addenda. Subsequent inservice inspections will be performed in accordance with the requirements of 10 CFR 50.55a subparagraph (g) to the extent practical.

The design of the RPV shield wall and external inservice inspection system was completed prior to the promulgation of amendments to 10 CFR 50.55a which require the upgrading of the utility's inservice inspection code commitment for examinations subsequent to the baseline examination. The design has allowed some additional access for inspections and coverages anticipated to be required by later codes, where possible. The result of this effort has increased the areas on the RPV available to inservice inspection (approximately 35% of shell circumferential and 90% of vessel longitudinal welds are accessible) and has allowed the piping examination to be upgraded to conform to the requirements of the Summer 1975 Addenda to Section XI as far as practical. The owner has developed an inservice inspection program coordinated with plant design, which complies with the intent of 10 CFR 50.55a to the maximum extent possible.

Date 12/14/81

Revision 1

WNP-2

AMENDMENT NO. -7
~~November-1979~~

The preservice examination to be performed on Class 1 components and piping pursuant to the requirements of the 1974 Edition of the ASME Boiler and Pressure Vessel Code, Section XI, including the Summer 1975 Addenda for both the RPV and associated piping, pumps, and valves are detailed in the WNP-2 Preservice Inspection Program Plan (Ref. 5.2-6).

5-2a

~~5-2-19a~~

Date 12/14/81

Revision 1

WNP-2

BLANK

5-2b

WNP-2

AMENDMENT-NO--7-
November-1979

The inservice inspections to be performed on Class 1 components and piping pursuant to the requirements of 10 CFR 50.55a (g) will be included in the WNP-2 Inservice Inspection Program Plan which will be submitted in accordance with that regulation.

5.2.4.2 Arrangement of Systems and Components to Provide Accessibility

Access for the purpose of inservice inspection is defined as the design of the plant with the proper clearances for examination personnel and/or equipment to perform inservice examinations during nuclear unit shut down. The reactor coolant pressure boundary for the WNP-2 RPV is designed to provide compliance with the provisions for access as required by Subarticle IWA-1500 of the 1974 Edition of the ASME Boiler and Pressure Vessel Code, Section XI, including the Summer 1975 Addenda. The reactor coolant pressure boundary for WNP-2 piping, pumps, and valves is designed to provide compliance with the provisions for access as required by Subarticle IWA-1500 of the 1974 Edition of the ASME Boiler and Pressure Vessel Code, Section XI, with Addenda through Summer 1975.

Access is provided for volumetric examination of the pressure containing welds from the external surfaces of components and piping by means of removable insulation, removable shielding, and permanent tracks for remote inspection devices in areas where personnel access is restricted. The provisions for suitable access for inservice inspection examinations will minimize the time required for these inspections to be performed and, hence, will reduce the amount of radiation exposure to both plant and examination personnel. Working platforms have been provided at most strategic locations in the plant which permit ready access to those areas of the reactor coolant pressure boundary which are designated as inspection points in the inservice inspection program. Temporary scaffolding will be used as required to gain access for examination.

WPPSS has retained Southwest Research Institute to provide an independent assessment as to the suitability of plant access provisions for inservice inspection. This overview provided for identification of design modification or inspection technique development needs to ensure maximum practical compliance with code requirements.

WNP-2

AMENDMENT NO. 7
November 1979

5.2.4.2.1 Reactor Pressure Vessel

Access for inspection of the reactor pressure vessel will be as follows:

- a. Access to the exterior surface of the reactor pressure vessel for inservice inspection is provided by removable insulation and shield plugs. Hinged shield wall plugs around nozzles are used to gain access for remote nozzle inspection devices. A minimum annular space of 8 1/4 inches is provided between the vessel exterior surface and the insulation interior surface to permit the insertion of remotely operated inspection devices between the insulation and the reactor vessel. The reactor pressure vessel nozzle insulation is removable. This design allows sufficient clearances for the mounting of a nozzle-to-shell examination device from tracks located either at the nozzle safe-end or at the pipe area. Examinations that can be performed from these tracks include the required coverage of the nozzle-to-shell welds and depending on technique, could provide examination coverage of the nozzle inner radius section and nozzle-to-safe-end weld. Access, geometry and radiation level considerations will determine those nozzles scheduled for manual examination.
- b. The vessel flange area and vessel closure head can be examined during refueling outages using manual ultrasonic techniques. With the closure head removed, access is afforded to the upper interior clad surface of the vessel by removal of a steam dryer and steam separator assembly. Removal of these components also enables the examination of remaining internal components by remote visual techniques. The volumetric examination of the vessel-to-flange weld and closure head-to-flange weld can be performed by applying the search units directly to the seal surface areas. The vessel-to-flange weld will also be examined from vessel shell surface.
- c. The closure head is dry stored during refueling which will facilitate direct manual examination. Removable insulation will allow examination of the head welds from the outside surface. Reactor vessel nuts and washers are removed to dry storage for examination during refueling.

selected studs will be examined during refueling so that all the studs will be examined during the inspection interval.

- b. Openings in the RPV support skirt are provided to permit access to the RPV bottom head for purposes of inservice examination. The examinations to be performed will include volumetric examinations of circumferential welds, portions of the meridional welds, portions of the dollar plate longitudinal welds, and visual examination of accessible penetration welds.

5.2.4.2.2 Piping, Pumps, and Valves

The physical arrangement of piping, pumps, and valves has been designed to allow personnel access to welds requiring inservice inspection. Modifications to the initial plant design have been incorporated where practicable to provide inspection access on Class 1 piping systems. Removable insulation has been provided on those piping systems requiring inspection. In addition, the placement of pipe hangers and supports with respect to those welds requiring inspection have been reviewed and modified where necessary to reduce the amount of plant support required in these areas during inspection. Working platforms have been provided to facilitate servicing of pumps and valves. Temporary platforms, scaffolding, and ladders will be provided to gain additional access for piping and some pump and valve examinations. An effort has been made to minimize the number of fitting-to-fitting welds within the inspection boundary. Welds requiring inspection have been located to permit ultrasonic examinations from at least one side, but where component geometries permit, access from both sides of the weld is provided. The surface of welds within the inspection boundary have been prepared to permit effective ultrasonic examination.

5.2.4.3 Examination Techniques and Procedures

Examination techniques and procedures for the preservice examination, including any special technique and procedure, have met the requirements of Table IWB-2600 of the 1974 Edition of the ASME Boiler and Pressure Vessel Code, Section XI, including the Summer 1975 Addenda for both the reactor pressure vessel and the associated piping, pump, and valve examinations. Examination techniques and procedures for inservice inspections will be upgraded to meet the requirements of the Edition and Addenda of the Code in effect to the extent practical. During plant design, an effort has been made to upgrade the requirement for calibration standards.

Where upgrading was not feasible, material of the same P series with similar acoustic characteristics will be used.

5.2.4.3.1 Equipment for Inservice Inspection

The equipment for inservice inspection of the reactor pressure vessel seam welds consists of remotely operated devices which travel over the vessel shell on permanently installed tracks between the vessel surface and the insulation. An electronic system with a receiver or data channel for each ultrasonic transducer will be used for acquiring and storing data when using remote automated examination equipment.

Tracks are located such that the devices are capable of moving ultrasonic transducers over the lengths of shell welds that are required to be examined inservice in the 1974 Edition of ASME B&PV Code, Section XI. This design does not preclude the use of remote examination devices that do not require tracks. Remote ultrasonic scanning equipment for examination of the nozzle-to-vessel welds will be supported and guided from tracks temporarily mounted on the pipe connected to the nozzle. The examination equipment will provide radial and circumferential motion to the ultrasonic transducer while rotating about the nozzle. Installation of the equipment will be accomplished through the access openings in the sacrificial shield which are provided at each nozzle location.

Mechanized surface examination techniques, if utilized, will provide results which are at least equivalent to those obtainable by manual surface techniques.

Remote visual examination techniques will provide a resolution capability which is at least equivalent to that required for direct visual observation.

Procedures governing such examinations were qualified prior to examinations in the WNP-2 plant.

5.2.4.3.2 Coordination of Inspection Equipment With Access Provisions

Access to areas of the plant requiring inservice inspection is provided to allow use of standard equipment wherever practicable. Design in general provides for free space envelopes both radially and axially from welds to be examined so standard manual examination equipment may be utilized. Any special equipment or techniques used will achieve the sensitivities required by the Codes.

Access is provided for the installation of remote examination

WNP-2

AMENDMENT NO. --7
November-1979

devices on the vessel tracks by means of hinged nozzle shield doors, removable hatches and panels, or personnel access hatches in the sacrificial shield.

5.2.4.3.3 Manual Examination

In areas where manual ultrasonic examination is performed, all reportable indications will be recorded on a strip chart or other type recorder or will be mapped and records made of maximum signal amplitude, depth below the scanning surface, and length of reflector. The data compilation format will be such as to provide for comparison of data from subsequent examinations. Radiographic techniques may be used where ultrasonic techniques are not practical. In areas where manual surface or direct visual examinations are performed, all recordable indications will either be removed by grinding or mapped with respect to size and location in a manner to allow comparison of data from subsequent examinations.

5.2.4.4 Inspection Intervals

Inspection Program B, which contains ten year inspection intervals, as defined in Section XI, will be used. These inspection intervals represent calendar years after the reactor facility has been placed into commercial service. The interval may be extended by as much as one year to permit inspections to be concurrent with plant outages. The frequency of examinations within each inspection interval will be contained in the WNP-2 Inservice Inspection Program Plan for each category. All examinations will be conducted prior to plant start-up except that examinations will be extended to include essentially 100% of the pressure containing welds.

5.2.4.5 Examination Categories and Requirements

Examination categories and requirements for the Preservice Inspection are defined in the WNP-2 Preservice Inspection Program Plan and closely follow the categories and requirements specified in Tables IWB-2500 and IWB-2600 of the 1974 Edition with Addenda through Summer 1975 of the ASME Boiler and Pressure Vessel Code, Section XI for the reactor pressure vessel and the associated piping, pumps and valves.

Examination categories and requirements for inservice inspections will be in accordance with the requirements of Section XI and will be contained in the WNP-2 Inservice Inspection Program Plan.

Date 12/14/81

Revision 1

WNP-2

AMENDMENT-NO--7

November-1979

5.2.4.6 Evaluation of Examination Results

Evaluation of examination results for the reactor pressure vessel, pump, and valve baseline examinations will be conducted in accordance with Article IWB-3000 of the 1974 Edition of the ASME Boiler and Pressure Vessel Code, Section XI, including the Summer 1975 Addenda. Evaluation of examination results for piping examinations will be conducted in accordance with

WNP-2

BLANK

Article IWB-3000 of the 1974 Edition of the ASME Boiler and Pressure Vessel Code, Section IX, with Addenda through Winter 1975. The Owner recognizes that Section XI has been promulgated as an effective code by 10CFR50.55a only through the Summer 1975 Addenda. However, the Owner also recognizes that even though the Code through Summer 1975 Addenda included evaluation criteria which could be interpreted to apply to piping (Category B-J) welds, the evaluation criteria found in the Winter 1975 Addenda clearly provides evaluation criteria which are applicable to these welds. The Owner is unaware that the NRC staff is opposed to these evaluation criteria and anticipates that the criteria which will appear in the future codes will be consistent therewith.

5.2.4.7 System Leakage and Hydrostatic Pressure Tests

The requirement for baseline hydrostatic test for the reactor pressure vessel will be satisfied by the hydrostatic test performed in accordance with the requirements of ASME Section III. Similarly, the requirements for the baseline piping system leakage and hydrostatic tests will be satisfied by reference to the Section III hydrostatic test report as permitted by ASME Section XI, IWA-5210(b). Subsequent system leak tests will be conducted prior to startup following each reactor refueling outage. A system hydrostatic test will be conducted at or near the end of each inspection interval. Examinations performed during these tests may be conducted without the removal of insulation as permitted by Code.

5.2.4.8 Inservice Inspection Commitment

All quality Group A components will be examined once prior to start-up in accordance with the above requirements. This preoperational examination will serve to satisfy the requirements of IWB-2100 of the 1974 Edition of the ASME Boiler and Pressure Vessel Code, Section XI, including the Summer 1975 Addenda for the reactor pressure vessel and associated piping, pumps, and valves. (See 3.9.6 for program for pumps and valves.) Subsequent inservice inspection of the WNP-2 plant will be performed in accordance with the requirements of 10CFR50.55a, subparagraph (g) to the extent practical.

5.2.4.9 Augmented Inservice Inspection to Protect Against Postulated Piping Failures

An augmented Inservice Inspection Program will be implemented for WNP-2, on high energy* Class 1 piping systems which penetrate containment for which the effects of postulated pipe breaks would be unacceptable. This program will entail a volumetric examination of all circumferential butt welds (surface examination for socket welds) between the first pipe whip restraint beyond the inside containment isolation valve, and first pipe whip restraint beyond the outside containment isolation valve on high-energy Class 1 lines greater than one (1) inch which penetrate the containment.

In those cases where the piping beyond the containment isolation valve is not pressurized (i.e., low energy), the augmented inservice inspection boundary will stop at the containment isolation valve.

This program will include branch lines which fall within the augmented inservice inspection boundary to the first pipe whip restraint beyond the branch line isolation valve or the first normally closed valve, whichever comes first.

*High-energy lines include those systems that, during normal plant conditions, are either in operation or maintained pressurized and where either the maximum operating pressure exceeds 275 psig or maximum operating temperature exceeds 200°F. If, for a particular line, the above pressure and temperature limits are not exceeded more than 2% of the time that the system is in operation, then that line is considered moderate energy and is exempt from the requirement for augmented inservice inspection.

WNP-2 PRESERVICE
INSPECTION PROGRAM PLAN

This page purposely left blank

WNP-2

AMENDMENT-NO--7
~~November-1979~~TABLE 5.2-12
DELETED

NOTE: The itemized examinations to be conducted in accordance with the commitments herein are delineated in the WNP-2 Preservice Inspection Program Plan (Ref. 5.2-6) for all preservice inspection commitments, and will subsequently be delineated in the WNP-2 Inservice Inspection Program Plan applicable to each inspection interval.

WNP-2

~~-AMENDMENT-NO.--7~~
~~November-1979~~

(DELETED)

5-10

5-2-61

Date 12/14/81

Revision 1

WNP-2

AMENDMENT--NO.--7
November--1979

(DELETED)

5-11

5-2-62

Date 12/14/81

Revision 1

WNP-2

~~AMENDMENT-NO.--7~~
~~November-1979~~

(DELETED)

5-12

5-2-63

Date 12/14/81

Revision 1

WNP-2

AMENDMENT NO. ~~7~~
November ~~1979~~

(DELETED)

5-13

5-2-64

Date 12/14/81

Revision 1

WNP-2

~~AMENDMENT--NO. 7~~
~~November-1979~~

(DELETED)

5-14

5-2-65

Date 12/14/81

Revision 1

WNP-2

AMENDMENT-NO. --7
November-1979

(DELETED)

5-15

5-2-66-

Date 12/14/81

Revision 1

WNP-2

~~AMENDMENT NO. -7~~
~~November - 1979~~

(DELETED)

5-16

~~5-2-67~~

Date 12/14/81

Revision 1

WNP-2

~~AMENDMENT NO. 7~~
~~November 1979~~

(DELETED)

5-17

~~5-2-68~~

Date 12/14/81

Revision 1

WNP-2

~~AMENDMENT-NO 7~~
~~November-1979~~

(DELETED)

5-18

5.2-69

Date 12/14/81

Revision 1

WNP-2

AMENDMENT NO. 7
November 1979

(DELETED)

5-19

5-2-70

Date 12/14/81

Revision 1

WNP-2

~~AMENDMENT NO. 7~~
November-1979

(DELETED)

5-20

~~5-2-71~~

Date 12/14/81

Revision 1

WNP-2

~~AMENDMENT NO. -7-~~
~~November-1979~~

(DELETED)

5-21

~~5-2-72~~

Date 12/14/81

Revision 1

WNP-2

AMENDMENT-NO--7-
November-1979

(DELETED)

5-22

~~5-2-73~~

Date 12/14/81

WNP--2

AMENDMENT-NO. 7 Revision 1
~~November-1979~~

(DELETED)

5-23

5-2-74

Date 12/14/81

Revision 1

WNP-2

~~AMENDMENT-NO.-7~~
~~November-1979~~

(DELETED)

5-24

5-2-75-

Date 12/14/81

Revision 1

WNP-2

~~AMENDMENT NO. 7~~
~~November 1979~~

(DELETED)

5-25

5-2-76

Date 12/14/81

Revision 0

WNP-2 PSI PROGRAM PLAN

N O T U S E D

(Purposely left blank)

6.6 INSERVICE INSPECTION OF ASME CODE CLASS 2 AND CLASS 3 COMPONENTS

This section addresses the preservice and inservice inspections of quality Group B and C (ASME Boiler and Pressure Vessel Code, Section III, Class 2 and 3) components as required by Section XI of the ASME Boiler and Pressure Vessel Code.

6.6.1 COMPONENTS SUBJECT TO EXAMINATION

The preservice inspection of Class 2 components will be performed in accordance with the requirements of the 1974 Edition of the ASME Boiler and Pressure Vessel Code, Section XI, with Addenda through Summer 1975 including Appendix III from the Winter 1975 Addenda. The components subject to examination are listed in the WNP-2 PSI Program Plan. These components are essentially those defined in Subarticle IWC-1200 and will be examined in accordance with that plan. Subsequent inservice inspections of Class 2 components will be performed in accordance with the requirements of 10 CFR 50.55a Subparagraph (g) to the extent practical.

All Class 3 components will be tested preservice in accordance with the requirements of Subarticle IWD-1200 of the 1974 Edition of the ASME Boiler and Pressure Vessel Code, Section XI, with Addenda through Summer 1975. Subsequent inservice inspection and testing of Class 3 components will be performed in accordance with the requirements of 10 CFR 50.55a, subparagraph (g) to the extent practical.

Components voluntarily upgraded to higher Code classes than required by their performance function will be subject to the requirements of Section XI applicable to the function related Code Class identified within the context of Regulatory Guide 1.26 (Rev. 1). The radwaste systems and off-gas system, excluding piping and valves forming part of the containment boundary, are not subject to preservice or inservice inspections.

6.6.2 ACCESSIBILITY

Access for inspection incorporated into the WNP-2 design of Class 2 and 3 piping, pumps and valves, exceeds the access requirements of ASME B&PV Code, Section XI mandatory by date of issuance of the Construction Permit. To the extent practical, access is provided in design for compliance with Subarticle IWA-1500 of the 1974 Edition of the ASME B&PV Code, Section XI, with Addenda through Summer 1975. The status of design and manufacture of individual components such

Date 12/14/81

Revision 1

WNP-2

AMENDMENT-NO--7
~~November-1979~~

as RHR pumps and RHR heat exchangers precluded compliance with all subsequent Section XI Editions and Addenda issued. WPPSS has retained Southwest Research Institute to provide an independent assessment as to the suitability of plant

5-26a

6-6-1A

Date 12/14/81

WHP-2

Revision 1

BLANK



access provisions for inservice inspection. This overview provided for identification of design modifications or inspection technique development and ensures maximum practical compliance with Code requirements. Access is provided for volumetric and surface examination of the pressure-containing welds, when required, from the external surfaces of Class 2 components and piping. Consideration has been given to the inspectability of the Class 2 and 3 systems in the design of components in the equipment layout, and in the support structures to permit access for the purpose of inservice inspection.

Access for the purpose of inservice inspection is defined as plant design with the proper clearances for examination personnel and/or equipment to perform inservice examinations during plant shutdown. Access requirements have been considered in the design of components, weld joint configuration, and system arrangements to facilitate inspection. Access to welds requiring volumetric or surface examination has been provided by means of removable insulation and/or removable structures. The provisions for suitable access for inservice inspection examinations will minimize the time required for these inspections to be performed and, hence, will reduce the amount of radiation exposure to both plant and examination personnel. Working platforms have been provided to facilitate servicing of some pumps and valves. Temporary platforms, scaffolding, and ladders will be provided to gain additional access to piping, pumps, and valves. A conscientious effort has been made to minimize the number of fitting-to-fitting welds within the inspection boundary. Welds requiring volumetric inspection have been located to permit ultrasonic examinations from at least one side, but where component geometries permit, access from both sides of the weld is provided. The surface of welds within the inspection boundary have been prepared to permit effective ultrasonic examination.

6.6.3 EXAMINATION TECHNIQUES AND PROCEDURES

Inspection categories, inspection techniques, and inspection frequencies for Class 2 components are in accordance with the ASME Boiler and Pressure Vessel Code, Section XI. Manual ultrasonic examination techniques were used for all volumetric examinations of Class 2 components. All recordable indications were recorded on a strip chart and were mapped. Records were made of the maximum signal amplitude.

depth below the scanning surface, and length of reflector. The data compilation format is such as to provide for comparison of data from subsequent examinations. Radiographic techniques may be used where ultrasonic techniques are not applicable. For areas where manual surface examinations or direct visual examinations are to be performed, all reportable indications were either removed by grinding or mapped with respect to size and location in a manner to allow comparison of data to subsequent examinations.

Class 3 components may be examined during hydrostatic testing or during operations without removing insulation as permitted by Code.

During plant design, a conscientious effort has been made to upgrade the requirements for calibration standards. Where upgrading was not permitted, materials of the same P series with similar acoustic characteristics were used.

6.6.4 INSPECTION INTERVALS

The inservice inspection schedule for Class 2 and 3 system components will be developed in accordance with the requirements of the ASME Boiler and Pressure Vessel Code, Section XI, Article IWC-2400 and IWD-2400, respectively, as required by 10CFR50.55(a), Subparagraph (g) to the extent practical. Inspection Program B which contains four 10-year intervals as described in Article IWA-2420 of Section XI will be used.

6.6.5 EXAMINATION CATEGORIES AND REQUIREMENTS

Inservice inspection categories and requirements for Class 2 components and piping are in agreement with Table IWC-2600 of the 1974 Edition of the ASME Boiler and Pressure Vessel Code, Section XI, with Addenda through Summer 1975.

WNP-2

AMENDMENT NO--7
November 1979--

6.6.6 EVALUATION OF EXAMINATION RESULTS

Evaluation of preservice examination results of Class 2 and 3 components will be in accordance with the evaluation criteria specified in 5.2.4.6 for Class I components.

6.6.7 SYSTEM PRESSURE TEST

Class 2 systems subject to hydrostatic tests will be tested in accordance with Article IWC-5000 of the ASME Boiler and Pressure Vessel Code, Section XI.

Class 3 systems subject to hydrostatic tests will be tested in accordance with the requirements of Article IWD-5000 of the ASME Boiler and Pressure Vessel Code, Section XI.

6.6.8 AUGMENTED INSERVICE INSPECTION TO PROTECT AGAINST POSTULATED PIPING FAILURES

An augmented inservice inspection program is not applicable to WNP-2 as there is no Class 2 or 3 piping greater than 1-inch penetrating the containment, classified as high energy during normal operation. Criteria used to classify high and moderate energy piping are found in Chapter 6.

WNP-2

AMENDMENT-NO.--7
November-1979

TABLE 6.6-1 DELETED

NOTE: The itemized examinations to be conducted in accordance with the commitments herein are delineated in the WNP-2 Preservice Inspection Program Plan (Reference 5.2-6) for all preservice inspection commitments, and will subsequently be delineated in the WNP-2 Inservice Inspection Program Plan applicable to each inspection interval.

Date 12/14/81

Revision 1

WNP-2

~~AMENDMENT NO. 7~~
~~November 1979~~

(DELETED)

5-31

6-6-6-

Date 12/14/81

Revision 1

WNP-2

AMENDMENT-NO:--7
November-1979

(DELETED)

5-32

~~6-6-7~~

Date 12/14/81

Revision 1

WNP-2

AMENDMENT NO. 7
November, 1979

(DELETED)

5-33

6-6-8

WNP-2

AMENDMENT-NO.--7
November-1979

Date 12/14/81

Revision 1

(DELETED)

5-34

6-6-9

WNP-2

AMENDMENT-NO--7
November-1979

Date 12/14/81

Revision 1

(DELETED)

5-35

6-6-10

WNP--2

AMENDMENT NO. 7
NOVEMBER 1979

Date 12/14/81

Revision 1

(DELETED)

5-36

~~6-6-11~~

WNP-2

~~AMENDMENT NO: 7~~
~~November 1979~~

(DELETED)

Date 12/14/81

Revision 1

WNP-2

AMENDMENT-NO--7
November-1979

(DELETED)

5-38

~~6-6-13~~

Date 12/14/81

Revision 1

WNP-2

AMENDMENT--NO--7
November-1979

(DELETED)

5-39

6-6-14

Date 12/14/81
Revision 1

WNP-2

AMENDMENT--NO. 7--
November-1979

(DELETED)

5-40

6-6-15

Date 12/14/81

Revision 0

WNP-2 PSI PROGRAM PLAN

N O T U S E D

(Purposey left blank)

5.2 NRC REGULATORY GUIDES

The Supply System has reviewed the augmented inservice inspection requirements found in the NRC Regulatory Guides listed below. Following careful review and consideration of those augmented requirements, the WNP-2 Preservice Inspection Program Plan has been found to not be subject to the augmented (i.e., above and beyond the ISI requirements of ASME Section XI) inspection requirements of those Regulatory Guides (with the possible exception of Turbine Disk Integrity Verification, Reg. Guide 1.70). This is generally due to the implementation criteria of the Guides, or the nature of the plant design which does not incorporate the design configuration addressed in the Guide. A brief statement of the reasons for nonapplicability is given for each Guide.

NRC REGULATORY GUIDE REVIEW
 FOR
 APPLICABILITY TO WNP-2 PSI PROGRAM PLAN

<u>Reg. Guide No.</u>	<u>Title</u>	<u>Applicability to WNP-2 PSI Program Plan</u>
1.14, Rev. 1	Reactor Coolant Pump	Not applicable; WNP-2 is a BWR plant which does not utilize reactor coolant pumps.
1.26, Rev. 3	Quality Group Classifications and Standard for Water, Steam, and Radioactive Waste Containing Components in Nuclear Power Plants	Applicable; used to establish WNP-2 ISI boundaries.
1.33 (Safety Guide 33)	Quality Assurance Program Requirements (Operation)	Applicable; Supply System Operational QA Program addresses compliance
1.35, Rev. 2	Inservice Inspection of UngROUTED Tendons in Prestressed Concrete Containment Structures	Not applicable; WNP-2 does <u>not</u> have a prestressed concrete containment structure.
1.58	Qualification of Nuclear Power Plant Inspection, Examination, and Testing Personnel	Applicable; Supply System Operational QA Program addresses compliance.
1.65	Materials and Inspections for Reactor Pressure Vessel Closure Studs	Applicable; WNP-2 PSI Program complies through incorporation of ASME Section XI examination requirements.
1.66	NDE of Tubular Products	Not applicable; withdrawn 9/28/77.
1.70, Rev. 2	Standard Format and Content for SAR's	The Supply System voluntarily used the subject format. <u>6.6.8--Augmented Inservice Inspection to Protect Against Postulated Piping Failures</u> This is <u>not</u> applicable to WNP-2 as there are no Class 2 or 3 piping greater than 1" penetrating containment and classified as high energy during normal operation.

Reg.
Guide
No.

Title

Applicability to WNP-2
PSI Program Plan

10.2.3--Turbine Disk Integrity

Inspections will be performed in accordance with the following Westinghouse documents:

"Report Covering the Effects of a High Pressure Turbine Rotor Fracture and Low Pressure Disk Fracture at Design Overspeed" (296/281 A, April 1975).

"Report Covering the Effects of a Turbine Accelerating to Destructive Overspeed" (296/281 B, April 1975).

- | | | |
|--------------|---|--|
| 1.83, Rev. 1 | ISI of PWR Steam Generator Tubes | Not applicable; WNP-2 is a BWR without steam generators. |
| 1.90 | ISI of Prestressed Concrete Containment Vessels With UngROUTED Tendons | Not applicable; WNP-2 does <u>not</u> have a prestressed concrete containment. |
| 1.96 | Design of Main Steam Isolation Valve Leakage Control Systems | Applicable; does <u>not</u> include augmented ISI requirements beyond that required by ASME Section XI. |
| 1.137 | Fuel Oil Systems for Standby Diesel Generators | Not applicable; Regulatory Position C.1 will <u>not</u> be used as a basis for evaluation of WNP-2 since the construction permit precedes the 9/1/78 cutoff date. (See copy of Reg. Guide 1.137 transmittal on following pages for clarification). |
| 1.150 | Ultrasonic Testing of Reactor Vessel Welds During Preservice and Inservice Examinations | Not applicable; most of the WNP-2 reactor vessel baseline examinations were done before the January 15, 1982 implementation date. The WNP-2 baseline examinations of the reactor vessel are expected to be completed in early 1982. These examinations will be done to the same requirements applied to the rest of the LMT performed reactor vessel examinations. |



Date 1/8/79
Revision 0

UNITED STATES
NUCLEAR REGULATORY COMMISSION
WASHINGTON, D. C. 20555

RECEIVED
JAN 27 1978

January 13, 1978

REGULATORY GUIDE DISTRIBUTION LIST (DIVISION 1)

Regulatory Guide 1.137, "Fuel-Oil Systems for Standby Diesel Generators," transmitted herewith, describes a method acceptable to the NRC staff for complying with the Commission's regulations regarding fuel-oil systems for standby diesel generators and assurance of adequate fuel-oil quality.

In addition to the provisions of Section D, "Implementation," of the guide, the NRC intends to implement portions of this guide for all nuclear power plants in the following manner:

1. Regulatory Position C.1 will be evaluated, on a case-by-case basis, for application to all construction permit cases under review whose Safety Evaluation Report has not been issued as of the implementation date shown in the published guide.
2. Regulatory Position C.2 will be evaluated, on a case-by-case basis, for application to all operating reactors, operating license reviews, and construction permit cases under review whose Safety Evaluation Reports are completed as of the implementation date shown in the published guide (including Preliminary Design Authorizations).
3. Regulatory Position C.2 will be applied to all construction permit cases under review whose Safety Evaluation Report has not been issued as of the implementation date shown in the published guide.

Robert B. Minogoue

Robert B. Minogue, Director
Office of Standards Development



REGULATORY GUIDE

OFFICE OF STANDARDS DEVELOPMENT

Date 1/8/79

Revision 0

REGULATORY GUIDE 1.137 FUEL-OIL SYSTEMS FOR STANDBY DIESEL GENERATORS

A. INTRODUCTION

General Design Criterion 17, "Electric Power Systems," of Appendix A, "General Design Criteria for Nuclear Power Plants," to 10 CFR Part 50, "Licensing of Production and Utilization Facilities," requires that an onsite electric power system and an offsite electric power system be provided to permit functioning of structures, systems, and components important to safety. In addition, Criterion 17 contains requirements concerning system capacity, capability, independence, redundancy, availability, testability, and reliability. Appendix B, "Quality Assurance Criteria for Nuclear Power Plants," to 10 CFR Part 50 establishes overall quality assurance requirements for the design, construction, and operation of structures, systems, and components important to safety. This regulatory guide describes a method acceptable to the NRC staff for complying with the Commission's regulations regarding fuel-oil systems for standby diesel generators and assurance of adequate fuel-oil quality.

B. DISCUSSION

Working Group ANS 59:51 of Subcommittee ANS-50, Nuclear Power Plant Systems Engineering, of the American National Standards Committee N18, Nuclear Design Criteria, has prepared a standard that provides design requirements for the fuel-oil systems for standby diesel generators. This standard was approved by the American National Standards Committee N18 and its Secretariat, and it was subsequently approved and designated ANSI N195-1976 by the American National Standards Institute on April 12, 1976.

For proper operation of the standby diesel generators, it is necessary to ensure the proper qual-

ity of the fuel oil. Appendix B to ANSI N195-1976 addresses the recommended fuel-oil practices. Although not a mandatory part of the standard, the staff believes Appendix B can serve as an acceptable basis for a program to maintain the quality of fuel oil, as supplemented by Regulatory Position C.2 of this guide.

C. REGULATORY POSITION

1. The requirements for the design of fuel-oil systems for diesel generators that provide standby electrical power for a nuclear power plant that are included in ANSI N195-1976, "Fuel Oil Systems for Standby Diesel Generators,"¹ provide a method acceptable to the NRC staff for complying with the pertinent requirements of General Design Criterion 17 of Appendix A to 10 CFR Part 50, subject to the following:

a. Throughout ANSI N195-1976, other documents required to be included as part of the standard are either identified at the point of reference or described in Section 7.4, "Applicable Codes, Standards, and Regulations," or Section 11, "References," of the standard. The specific acceptability of these listed documents has been or will be addressed separately in other regulatory guides or in Commission regulations, where appropriate.

b. Section 1, "Scope," of ANSI N195-1976 states that the standard provides the design requirements for the fuel-oil system for standby diesel generators and that it sets forth other specific design requirements such as safety class, materials, physical arrangement, and applicable codes and regulations. The standard does not specifically address quality assurance, and

¹ Copies may be obtained from the American Nuclear Society, 555 North Kensington Avenue, La Grange Park, Illinois 60525.

USNRC REGULATORY GUIDES

Regulatory Guides are issued to describe and make available to the public methods acceptable to the NRC staff of implementing specific parts of the Commission's regulations, to delineate techniques used by the staff in evaluating specific problems or postulated accidents, or to provide guidance to applicants. Regulatory Guides are not substitutes for regulations, and compliance with them is not required. Methods and solutions different from those set out in the guides will be acceptable if they provide a basis for the findings requisite to the issuance or continuance of a license or license by the Commission.

Comments and suggestions for improvements in these guides are encouraged at all times and guides will be revised, as appropriate, to accommodate comments and to reflect new information or experience. However, comments on this guide, if received within about two months after its issuance, will be particularly useful in evaluating the need for an early revision.

Comments should be sent to the Secretary of the Commission, U.S. Nuclear Regulatory Commission, Washington, D.C. 20555, Attention: Docketing and Service Branch.

The guides are issued in the following ten broad divisions:

- | | |
|-----------------------------------|------------------------|
| 1. Power Reactors | 6. Products |
| 2. Research and Test Reactors | 7. Transmutation |
| 3. Fuels and Materials Facilities | 8. Occupational Health |
| 4. Environmental and Siting | 9. Antitrust Review |
| 5. Materials and Plant Protection | 10. General |

Requests for single copies of issued guides (which may be reproduced) or for placement on an automatic distribution list for single copies of future guides in specific divisions should be made in writing to the U.S. Nuclear Regulatory Commission, Washington, D.C. 20555, Attention: Director, Division of Document Control.

in this regard ANSI N195-1976 should be used in conjunction with Regulatory Guide 1.28, "Quality Assurance Program Requirements (Design and Construction)," which endorses ANSI N45.2-1971, "Quality Assurance Program Requirements for Nuclear Power Plants," for the design, construction, and maintenance of the fuel-oil system.

c. Section 5.4, "Calculation of Fuel Oil Storage Requirements," of the standard sets forth two methods for the calculation of fuel-oil storage requirements. These two methods are (1) calculations based on assuming the diesel generator operates continuously for 7 days at its rate capacity, and (2) calculations based on the time-dependent loads of the diesel generator. For the time-dependent load method, the minimum required capacity should include the capacity to power the engineered safety features. Applications that use the time-dependent load method to calculate fuel-oil storage requirements will be reviewed on a case-by-case basis along with the calculations.

d. Section 7.3, "Physical Arrangement," of ANSI N195-1976 states that "the location of the day tanks of standby diesel generators shall be as required by the diesel-engine manufacturer." In addition to this requirement, the day tanks should be located at an elevation to ensure adequate net positive suction head at the engine fuel pumps at all times.

e. Section 7.3 of ANSI N195-1976 states that the arrangement of the fuel-oil system "shall provide for inservice inspection and testing in accordance with ASME Boiler and Pressure Vessel Code, Section XI, 'Rules for In-Service Inspection of Nuclear Power Plant Components.'" Although Section XI of the ASME Boiler and Pressure Vessel Code ~~does not specify whether its provisions apply to fuel-oil systems, they should be applied for the inservice inspection and testing program for those portions of the fuel-oil systems for standby diesel generators that are designed to Section III, Subsection ND of the Code.~~

f. Section 7.3 of ANSI N195-1976 states that adequate heating shall be provided for the fuel-oil system. Assurance should be provided that fuel oil can be supplied and ignited at all times under the most severe environmental conditions expected at the facility. This may be accomplished by use of an oil with a "Cloud Point" lower than the 3-hour minimum soak temperature (Ref. 1) expected at the site during the seasonal periods in which the oil is to be used, and/or by maintenance of the onsite fuel oil above the "Cloud Point" temperature.

g. Section 7.5, "Other Requirements," of the standard states that "protection against external and internal corrosion shall be provided" for the fuel-oil system. To amplify this requirement for buried supply tanks not located within a vault and other buried

portions of the system, a waterproof protective coating and an impressed current-type cathodic protection system should be provided in accordance with NACE Standard RP-01-69 (1972 Revision), "Recommended Practice—Control of External Corrosion on Underground or Submerged Metallic Piping Systems." In addition, the impressed current-type cathodic protection system should be designed to prevent the ignition of combustible vapors or fuel oil present in the fuel-oil systems for standby diesel generators.

h. Section 7.5 of the standard includes requirements for fire protection for the diesel-generator fuel-oil system. The requirements of Section 7.5 are not considered a part of this regulatory guide since this subject is addressed separately in more detail in other NRC documents. Thus a commitment to follow this regulatory guide does not imply a commitment to follow the requirements of Section 7.5 concerning fire protection.

2. Appendix B to ANSI N195-1976 should be used as a basis for a program to ensure the initial and continuing quality of fuel oil as supplemented by the following:

a. The oil stored in the fuel-oil supply tank, and the oil to be used for filling and refilling the supply tank, should meet the requirements of ASTM D975-74, "Standard Specification for Diesel Fuel Oils," or the requirements of the diesel-generator manufacturer, if they are more restrictive, as well as the fuel-oil total insolubles level specified in Appendix B of the standard and the "Cloud Point" requirements given in Regulatory Position C.2.b. Fuel oil contained in the supply tank not meeting these requirements should be replaced in a short period of time (about a week).

b. Prior to adding new fuel oil to the supply tanks, tests for the following properties should be conducted:

- (1) Specific or API gravity
- (2) Cloud Point
- (3) Water and Sediment
- (4) 90% Distillation Temperature

The fuel oil should meet the requirements of ASTM D975-74 for the latter two analyses. The "Cloud Point" should be less than or equal to the 3-hour minimum soak temperature, or the minimum temperature at which the fuel oil will be maintained during the period of time that it will be in storage. Analysis of the other properties of the fuel oil listed in ASTM D975-74 should be completed within 2 weeks of the transfer.

c. The periodic sampling procedure for the fuel oil

¹ Copies may be obtained from the American Society of Mechanical Engineers, United Engineering Center, 345 East 47th Street, New York, N.Y. 10017.

² Copies may be obtained from the National Association of Corrosion Engineers, 2400 West Loop South, Houston, Texas 77027.

³ Also designated ANSI Z11.205-1975. Copies may be obtained from the American National Standards Institute, 1430 Broadway, New York, N.Y. 10018.

should be in accordance with ASTM D270-1975, "Standard Method of Sampling Petroleum and Petroleum Products."³

d. Accumulated condensate should be removed from storage tanks on:

(1) a quarterly basis;

(2) a monthly basis when it is suspected or known that the ground-water table is equal to or higher than the bottom of buried storage tanks; and

(3) one day after the addition of new fuel.

e. Day tanks and integral tanks should be checked for water monthly, as a minimum, and after each operation of the diesel where the period of operation was 1 hour or longer. Any accumulated water should be removed immediately. If it is suspected that water has entered the suction piping from the day or integral tank, the entire fuel-oil system between the day or integral tank and the injectors should be flushed.

f. As a minimum, the fuel oil stored in the supply tanks should be removed, the accumulated sediment removed, and the tanks cleaned in order to perform the ASME Section XI, Article IWD-2000, "Examination Requirements," at the required 10-year intervals. To preclude the introduction of surfactants in the fuel system, this cleaning should be accomplished using sodium hypochlorite solutions or its equivalent rather than soap or detergents.

g. Assuming an unlikely event should occur that would require replenishment of fuel oil without the interruption of operation of the diesel generators, the method of adding additional fuel oil should be such as to minimize the creation of turbulence of the accumulated residual sediment in the bottom of the supply tank since stirring up this sediment during the addition of acceptable new incoming fuel has the potential of causing the overall quality of the fuel oil in the storage tank to become unacceptable.

h. Cathodic protection surveillance should be conducted according to the following procedures:

(1) At intervals not exceeding 12 months, tests should be conducted on each underground cathodic

protection system to determine whether the protection is adequate.

(2) The test leads required for cathodic protection should be maintained in such a condition that electrical measurements can be obtained to ensure the system is adequately protected.

(3) At intervals not exceeding 2 months, each of the cathodic protection rectifiers should be inspected.

(4) Records of each inspection and test should be maintained over the life of the facility, to assist in evaluating the extent of degradation of the corrosion protection systems.

D. IMPLEMENTATION

The purpose of this section is to provide information to applicants regarding the NRC staff's plans for using this regulatory guide.

Except in those cases in which the applicant proposes an acceptable alternative method for complying with specified portions of the Commission's regulations, the method described herein will be used in the evaluation of submittals for construction permit applications docketed after September 15, 1978, unless this guide is revised as a result of suggestions from the public or additional staff review.

If an applicant wishes to use this regulatory guide in developing submittals for applications docketed on or before September 15, 1978, the pertinent portions of the application will be evaluated on the basis of this guide.

REFERENCE

1. J.P. Doner, "A Predictive Study for Defining Limiting Temperatures and their Application in Petroleum Product Specifications," U.S. Army, Mobility Equipment Research and Development Center, Coating and Chemical Laboratory, Aberdeen Proving Ground, Maryland, CCL Report No. 316.

³ Also designated ANSI Z11.33-1976. Copies may be obtained from the American National Standards Institute, 1430 Broadway, New York, N.Y. 10018.

WNP-2

~~AMENDMENT NO. 5~~~~August 1979~~

Sheet 1 of 10

Q. 121.8

(In response to this item, refer to the responses to Items 121.15 and 121.18 on the Hatch-2 docket.) Additional information is required to demonstrate that: (1) the thermal sleeve/sparger design of the feedwater inlet nozzle has been evaluated with respect to potential nozzle cracking resulting from thermal cycling; and (2) a program of scheduled augmented inservice inspection has been developed.

These inservice inspections should be conducted with a method sufficiently sensitive to provide assurance that small cracks can be detected. Accordingly, we require you to supply the following information:

- a. That technical basis to assure the structural integrity of both the feedwater inlet nozzle and the sparger.
- b. An evaluation of the feasibility of installing automated ultrasonic testing (UT) fixtures on all feedwater inlet nozzles with particular attention focused on the examination of the nozzle bore region.
- c. An evaluation of the feasibility of performing the internal surface examination by magnetic particle methods.

Your response should contain: (1) a description of the nozzle and sparger design including the significant dimensions, the materials of construction and the weld locations; (2) a description of the analyses and test data, referencing appropriate data previously submitted to the NRC staff if it is applicable for the WNP-2 facility; (3) the detailed projected crack growth rates, stress levels and usage factors for both the nozzle and the sparger; (4) any plant modifications that are planned to reduce the temperature differential between the feedwater and the water in the reactor pressure vessel during low power operation; and (5) a description of any instrumentation that will be installed in the reactor pressure vessel to verify the conclusions of your design analysis.

Several ultrasonic testing concepts and procedures have been used to examine the feedwater inlet nozzle regions in operating plants. Identify which of these ultrasonic testing procedures will be used in the WNP-2 facility. Discuss the influence on crack detection, using your ultrasonic testing method in the WNP-2 facility, of local grindouts.

Sheet 2 of 10

In addition, provide a description of the augmented inservice inspection (ISI) program to be implemented including scheduled surface examination, ultrasonic testing and verification of the leak tight integrity of the joint between the thermal sleeve and the safe end on all nozzles. The essential elements of an acceptable program are given in the Appendix attached to this set of questions.

Response:

A description of the WNP-2 feedwater nozzle and sparger is presented on Figures 121.8-1 and 121.8-2.

The mechanisms which have caused a cracking in operating BWRs are understood. A summary discussion of problems and the solutions incorporated in the WNP-2 design is presented in the following.

A detailed evaluation of the problems of the feedwater nozzle and sparger is presented in NEDE-21821 "BWR Feedwater Nozzle/Sparger Final Report" March 1978. The solution of the feedwater nozzle and sparger cracking problems involves several elements, including material selection and processing, nozzle clad elimination, and thermal sleeve and sparger redesign. The following summarizes the problems and solutions that have been implemented in the WNP-2 design.

<u>PROBLEM</u>	<u>CAUSE</u>	<u>FIX</u>
Sparger Arm Cracks	Vibration	Eliminate clearance between thermal sleeve and safe end.
RPV Feedwater Nozzle	Thermal Fatigue	Eliminate clad, eliminate leakage with a welded joint between the sparger and safe end.

The sparger vibration has been attributed to a self-excitation caused by instability of leakage flow through the annular clearance between the thermal sleeve and safe end. Tests have shown that the vibration is eliminated if the clearance is reduced sufficiently or sealed. The solution which has been selected for WNP-2 uses a welded joint to assure no leakage. This feature is also an essential part of the solution of the nozzle cracking problem. Freedom from vibration over a range of conditions has been demonstrated by the tests reported in NEDE-23604.

Sheet 3 of 10

The cracking of the feedwater nozzles is a two-part process. The crack initiation mechanism as discussed above is the result of self-initiated thermal cycling. If this were the only mechanism present, the cracks would initiate, grow to a depth of approximately 0.25 inch, and arrest. This degree of cracking could be tolerated, but unfortunately there is another mechanism which supports crack growth. This mechanism is the system induced transients, primarily the startup/shutdown transients. The welded thermal sleeve arrangement also assists in this area because without leakage, the heat transfer coefficient between the feedwater and the nozzle are reduced to the point where the thermal stresses in the nozzle are not high enough to cause a significant crack growth. Analyses presented in NEDE-21821, Section 4.7, demonstrates the benefits of the welded thermal sleeve and of using unclad nozzles. With these demonstrated benefits, WNP-2 does not believe it necessary to install instrumentation for design verification.

WNP-2 has installed an automatic feedwater low flow control valve, RFW-FCV-10. This valve has the capability to control flow down to 362 gpm, or about 1.25% of total flow. This valve will substantially reduce the temperature in the RPV during low power operation.

The following paragraphs address RPV feedwater nozzle examination questions other than Appendix A to Section 121.

Feasibility of Installing Mechanized Ultrasonic Scanners

All feedwater nozzle inner radii, safe-end, and bore regions are capable of automated ultrasonic examination. Preservice inspection of the safe-end welds will be performed manually. The mechanized equipment will be demonstrated capable of examining the safe-end welds in service. The nozzle inner radii weld examinations will be performed manually. The mechanized equipment will be demonstrated capable of examining the inner radii weld. Tooling has been contracted from the baseline examination agency that will allow nozzle inner radius scanning by contacting an angle beam transducer to the vessel plate surface adjacent to the nozzle to vessel weld. The scanner mechanism is removable and would be compatible with any of the six (6) feedwater nozzles. Based on the experience of performing the baseline examination of nozzle to vessel welds, the Supply System has concluded that the radiation exposure examining the bore region manually would be less than if the examination was done with mechanized equipment. The technique providing the best balance of those two factors will be chosen. Adequate access exists for either technique.

WNP-2

~~AMENDMENT NO. 5~~
~~August 1979~~

Sheet 4 of 10

Scanning of the nozzle bore region can be accomplished from the cylindrical section of the nozzle forging. A manual examination of this region is possible to accomplish in less than ten minutes of scanning time per nozzle by one operator supported inside the biological shield cut-out. Data recording, should it be necessary, can be accomplished by a second examiner positioned outside the shield using redundant electronic instrumentation and analog recorders. Assuming ten minutes examination time per nozzle and a radiation field of 150 mr/hr, the examiner would receive 25 mr per nozzle.

The automated examination devices would be mounted on temporary tracks, would be installed just prior to the examination and removed following the examination. It is not considered feasible to leave the equipment installed during plant operation as installation and removal time is minimal and would be quickly offset by equipment recalibration and maintenance costs considering the adverse environment such equipment would be subjected to during plant operation.

Feasibility of Magnetic Particle Examination

Handheld magnetic yokes will not readily fit in the envelope between the sparger body and the nozzle radius, and yet make good contact with the low alloy steel surface. Poor contact could result in arc-strikes below the electrodes, these surface defects are localized heat affected zones of higher hardness than the surrounding metal. If the arc-strike was accompanied by localized cracking, then surface grinding would be necessary to restore the nozzle to its original surface condition. Considering the above, magnetic particle examination methods are not considered feasible inside the reactor vessel with the present sparger configuration.

Ultrasonic Examination Methods

The nozzle inner radius examination will be made by pulse-echo ultrasonic techniques from the exterior of the reactor pressure vessel by contacting the vessel plate surface. This technique is similar to that used by the General Electric Company and the firm of Lambert MacGill and Thomas. Procedures for the examination will be in a format consistent with others used by the Supply System, but the technical content will be comparable to procedures previously qualified by the above referenced testing organizations.

Sheet 5 of 10

Examination of the nozzle bore region will be performed by pulse-echo ultrasonic techniques from the cylindrical section of the nozzle forging using sound beam geometry similar to that used by the General Electric Company. The Supply System plans to extend the coverage of this technique toward the inner radius by added sound beam refraction. Prior to use on the WNP-2 feedwater nozzles, a qualification check is intended to be made on a mock-up to demonstrate the techniques validity.

Should local grind outs be made in the examination surface creating a depression with definable sides, depth, and length, the ultrasonic techniques being used would obtain reflections from these cavities. Such reflections can be minimized by blending the grind cavity into the surrounding base metal. This would result in improved detection sensitivity to postulated thermal fatigue cracks propagating from the grind cavity.

The Supply System will implement the reactor feedwater (RFW) RPV nozzle inspection program described below, which addresses Appendix A to this question on an item-by-item basis. Justification for any deviations from the Appendix A requirements is presented following the response.

I. AUGMENTED INSERVICE INSPECTION PROGRAM

A. Preservice Examination

The Supply System will perform a PSI ultrasonic examination of RFW nozzle inner radii, bore and safe end regions as described in the WNP-2 PSI Program Plan. The personnel and UT procedures used will be qualified as described in II.C below.

In addition, a preservice liquid penetrant examination will be performed on the accessible areas of all RFW nozzle inner radius surfaces.

B. Inservice Examination

- B.1 The Supply System will perform an ultrasonic examination of 1 of 6 reactor feedwater nozzle inner radii, bore and safe end regions each refueling outage using procedures and personnel subject to the same qualifications used during the PSI examinations. A different nozzle will be examined each outage. No surface examinations will be performed on the nozzle inner radii unless such a test is required to verify

the nature of an indication discovered using the ultrasonic technique when the indication is suspected to result from service induced cracks on the nozzle inner surfaces. In the event an indication is discovered and found to result from service induced cracks propagating from the nozzle inner surfaces, the following actions will be taken:

- a. All remaining feedwater nozzles will be examined using both ultrasonic (from the OD) and penetrant techniques during the refueling outage in which the cracking is verified.
- b. All surface indications determined to be service induced cracks will be removed by local grinding.
- c. An inspection method, such as a leak test, will be used to determine the integrity of each of the RFW thermal sleeve to safe end joints.
- d. Appropriate corrective action will be taken as required and as practical to prevent recurrence of crack initiation. A program and schedule for implementing such corrective action will be prepared and submitted to the Commission prior to its implementation.
- e. A RFW nozzle examination program for subsequent refueling outages will be modified to include an external ultrasonic examination of all feedwater nozzle inner radii, bore and safe end regions for each scheduled refueling outage for 3 consecutive outages. If no new indications are discovered, or if new indications are determined to not result from service induced cracks at the nozzle inner surfaces, the original Supply System program will be resumed. If after 3 additional outages no new indications resulting from surface induced cracks are detected, subsequent examinations will be performed in accordance with normal ASME Section XI requirements.
- f. The conduct of surface examinations of accessible nozzle inner radius surfaces will continue to be used throughout plant life only to confirm or characterize new ultrasonic indications which are suspected to result from service induced cracks at the nozzle inner surfaces.

Sheet 7 of 10

B.2 As stated in B.1 above, the Supply System will perform a surface (penetrant) examination of accessible inner surfaces on all RFW nozzles during the pre-service examination program. Subsequent surface examinations of those surfaces will be performed only to verify the nature of an indication discovered using the ultrasonic technique when the ultrasonic indication provides evidence of previously unidentified service induced cracks.

B.3 See response to B.2 above.

If after the sixth planned refueling outage following commercial operation no indications resulting from service induced cracks are found, the subsequent inservice examinations will be performed in accordance with the normal ASME Section XI requirements. Any indications resulting from service induce cracks which are subsequently found will result in the corrective action described above.

C. Thermal Sleeve to Safe End Joint

As stated in B.1 above, the Supply System will perform an inspection of the thermal-sleeve-to-safe-end weld joint, such as a leak test, only if service induced cracks or some other anomaly is discovered which would bring the integrity of the joint into question. In that case, the feedwater piping will be filled with water and the area of the thermal-sleeve-to-safe-end joint will be inspected for indications of leakage.

II. ACCEPTANCE CRITERIA

- A. The Supply System will comply with this criteria as stated in B.1 above.
- B. The Supply System will comply with this criteria as stated in B.1 above.
- C. The Supply System will comply with option (b), in that both the examination personnel and the procedures to be used on the nozzles will be qualified on a full size nozzle mock-up. Supply System examiners will be trained by individual NDE specialists having previous experience with the General Electric Company procedures and their nozzle test program. These examiners will undergo further training, practice, and qualifications on a full size

nozzle mockup. The Supply System has secured a feedwater nozzle from the scrapped Douglas Point Unit I reactor. The Supply System will use this nozzle to qualify the procedures and personnel for feedwater nozzle inner radii examinations. Following the qualification process, the examinations will be conducted under the direct supervision of the experienced NDE specialists responsible for ultrasonic technique and procedure development for the Supply System.

III. RECORDING AND REPORTING STANDARDS

The Supply System will record crack indications and report inspection results in compliance with the requirements stated in NUREG-0312.

121.8 JUSTIFICATION OF DEVIATION FROM APPENDIX A

I.B.1 Ultrasonic Examinations Frequency

The Supply System will examine only one RFW nozzle per refueling outage rather than all nozzles using an ultrasonic technique from the outside of the vessel. This is justified for the following reasons, which reflects a significant advance in the WNP-2 design and operating procedures towards the long-term solution of the BWR nozzle cracking problems per NUREG-0312, Section 8.0, Part 1.

- a. Improved Design: The WNP-2 RFW welded thermal-sleeve-to-safe-end joint provides a "zero leakage" design. This design essentially eliminates the primary historical initiating source of nozzle cracking in BWRs.
- b. No Nozzle Cladding: The WNP-2 RFW nozzle surfaces are not clad. The likelihood of crack initiation in unclad nozzles is more than a factor of 5, less than for clad nozzles. All cracks in BWR feedwater nozzles have initiated in the clad metal.
- c. Proven Examination Technique: The ultrasonic examination equipment and personnel to be used in performing both baseline and inservice ultrasonic examinations will be qualified on a full scale mockup of the nozzle, simulating the nozzle geometry and anticipated fatigue crack defects. Since the WNP-2 reactor feedwater nozzles are

unclad as stated in (b) above, a more sensitive examination is possible due to lack of clad/basemetal interface.

- d. Augmented Examination Frequency: The above stated program provides RFW nozzle examination coverage at nearly twice the frequency of the ASME Section XI requirements, i.e., all RFW nozzles will be examined within six years (approximately) rather than within ten years.
- e. Feedwater Temperature Controls: As previously stated, WNP-2 has incorporated a feedwater, low flow control valve. The advantages gained from low flow control are identified in Section 4.7 of NEDE-21821.
- f. Projected Crack Growth Rates: As presented in Section 4.7 of NEDE-21821, the WNP-2 design should have greater than 35 years of operation, considering our low flow control, prior to an initiated crack reaching one inch in depth. This provides for a minimum of four examinations per nozzle before reaching a point requiring repair. Even if the extremely conservative (factor of 5) upper bound crack growth curve is applied, each RFW nozzle would be examined by the Supply System program prior to a crack becoming one inch in depth. It is clear that ample conservatism exists in the Supply System examination frequency of the RFW nozzles.

The above factors, when combined, provide a great deal of assurance that the factors which have led historically to BWR RFW nozzle cracking have been virtually eliminated. Furthermore, any cracking which might occur from unanticipated sources will be discovered before propagating to a significant depth due to low flow controls and an augmented examination schedule with state-of-the-art qualified ultrasonic examination techniques.

I.B.2&3 Surface Examinations

The Supply System will perform surface (penetrant) examinations of the accessible internal surfaces of RFW nozzles during the preservice inspection program. Inservice surface examinations will be performed only when indications of service induced cracking are found using the ultrasonic examination technique. This is justified as follows:

- a. Reduced probability of crack initiation and growth as stated in the justification under I.B.1.a through f above.
- b. Access: In order to obtain access to perform a penetrant surface examination of the RFW nozzle surfaces during a refueling outage, the vessel water level would have to be lowered below the level of the spargers and hydrolaser decontamination performed. A special shielded work platform would have to be devised to minimize radiation exposure. This technique was performed at Vermont Yankee resulting in about 15 mrem.

I.C Leak Test


Thermal-Sleeve-to-Safe-End Joint: The Supply System will perform inservice inspection to determine the integrity of the thermal-sleeve-to-safe-end joint only when indications of service induced cracking are detected using the ultrasonic examination technique. The justification for this exception is similar to the justification for not performing inservice surface examinations cited above, with the following additional justification:

- a. Test Effectiveness: The maximum pressure which could practically be placed on the subject weld joint would be that available from the static head of a filled sparger, or approximately 6" of water. The effectiveness of this test to reveal throughwall cracks in the weld joint is questionable, since the weld experiences significantly higher differential pressure and temperature during operation. Furthermore, this test would not provide evidence of other than gross throughwall cracks which, if and when detected via such a test, will in all likelihood have been resulting in some degree of leaking for a significant period of time. As was previously demonstrated, any cracks developing as a result of such leakage will be detected prior to the crack propagating to a depth which would jeopardize the nozzle integrity. There is, therefore, no appreciable benefit from performing the leakage test of the spargers other than to determine the status of their integrity in the event service induced cracks are confirmed. Since there is no appreciable benefit, and the cost in dollars and mrem exposure for such a test is quite high, the performance of this test on a routine basis is not justified.

5-58

FEEDWATER NOZZLE

FIGURE
121.8-1

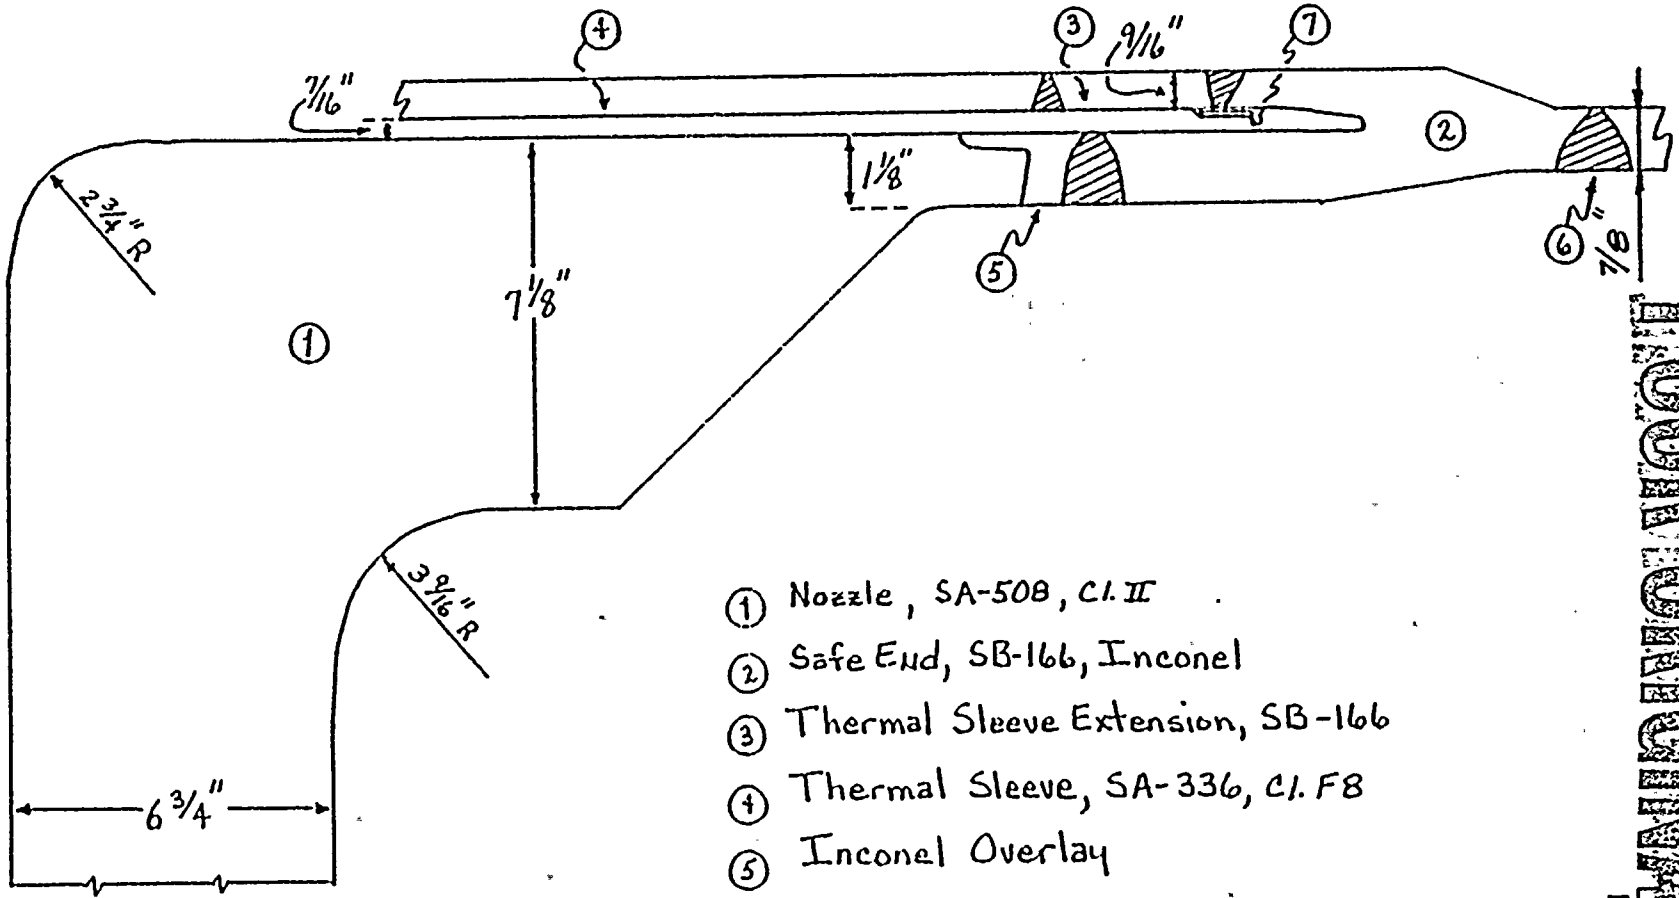


- ① Nozzle, SA-508, C.I. II
- ② Safe End, SB-166, Inconel
- ③ Thermal Sleeve Extension, SB-166
- ④ Thermal Sleeve, SA-336, C.I. F8
- ⑤ Inconel Overlay
- ⑥ Weld Illustration
- ⑦ Back-up Ring, SB-168

POOR ORIGINAL

Amendment No. 5
August 1979
Date 11/14/80
Revision 0

POOR ORIGINAL

- ① NOZZLE, SA-508, CI.II
- ② FORGED TEE, 304 S.S.
- ③ SPARGER HEADER, 304 S.S.

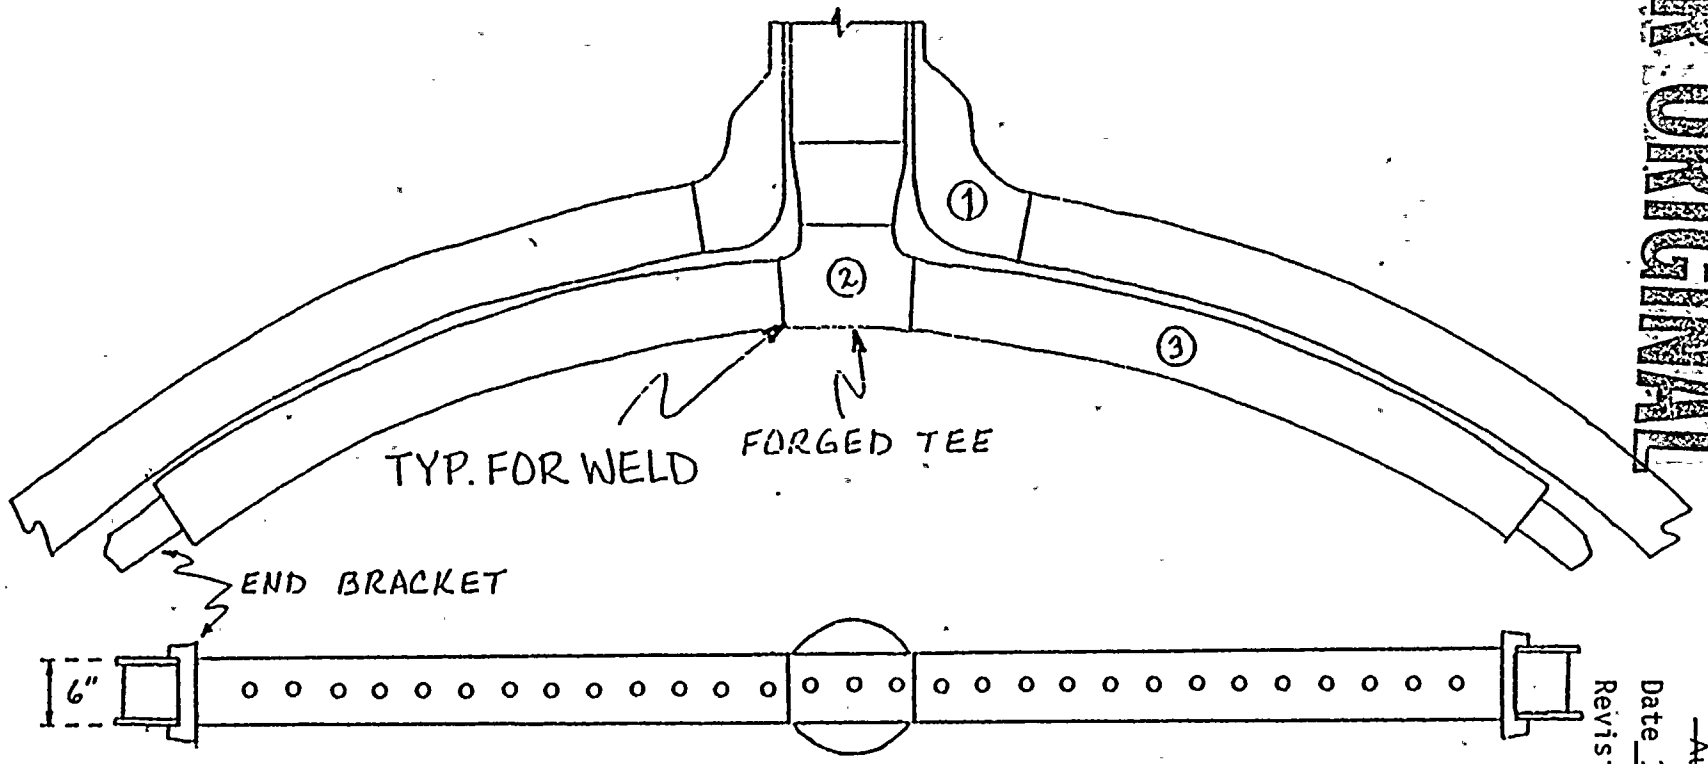

Amendment No-5
August-1979
Date 11/14/80
Revision 0

Date 12/14/81

Revision 0

NOTES

1. Preservice inspection of the safe end welds will be done manually. The mechanized equipment will be demonstrated capable of examining the safe end welds inservice. The inner radii weld examinations will be done using mechanized equipment.
2. Based on the experience of performing the baseline exam of nozzle to vessel welds, the Supply System has concluded that the radiation exposure examining the bore region manually would be less than if the exam was done mechanized.
3. The Supply System has secured a feedwater nozzle from the scrapped Douglas Point Unit I reactor. The Supply System will use this nozzle to qualify the procedures and personnel for feedwater inner radii examinations.

6.1 INTRODUCTION

The Preservice Inspection (PSI) Program Plan was prepared in accordance with ASME Section XI 1974 Edition Summer 1975 Addenda. This represents a voluntary upgrade from the applicable 1971 Edition, Winter 1971 Addenda. It should be noted that at the time this Plan was prepared, the 1977 Edition Summer 1978 Addenda had not been approved and therefore could not be used as a referenced code. The overall intent of the Supply System in preparing the Plan was to develop a program which reflects a good balance of the following objectives and constraints:

- a. To the maximum extent practical, comply with the latest approved codes and regulations governing inservice inspection of nuclear power plant components.
- b. Provide a smooth transition of the PSI Program into the Inservice Inspection (ISI) phase of plant life. In this regard, the Supply System considered the latest "unapproved" (1977 Code) ASME Section XI code editions and addenda in order to assess the changes in examination coverage and examination techniques; and then incorporated, wherever practical, these code changes into the PSI Program Plan provided the overall program effectiveness was not compromised. For any change of examination coverage or technique not allowed by the referenced code, detailed justification is provided. Such changes are held to a minimum and are applied only when there is significant benefit; such as eliminating the taking of baseline data which will never be used inservice, or substituting an examination technique which is superior in effectiveness relative to the code required technique for the particular application and, in many cases, is the same change made in later code addenda. In some cases, a voluntary increase in examination is incorporated to ensure baseline data will be available when the program is updated inservice to a later code which will require increased examination coverage.

By applying the above philosophy, the Supply System has baseline data which will be useful inservice. For example, if the letter of the law were strictly followed, Appendix III of ASME Section XI would not have been used. This would mean that the Supply System could not (1) have data comparable to that taken during the ISI or (2) use the latter approved and required code technique for piping examinations. Appendix III has subsequently been approved.

The Supply System believes that the WNP-2 Preservice Inspection Program Plan reflects the above philosophy and, as such, will result in a program of inspections which is in the best interests of the health and safety of the general public. The intent of 10CFR50.55a(g) and ASME Section XI have been met. All deviations from the specified requirements are contained herein. Again, these deviations are necessary because of conflicting requirements of a changing code.

This Program Plan governs all manual and automated non-destructive examinations, visual examinations, evaluations, and reporting activities required by ASME Section XI as invoked by 10CFR50.55a(g), and applicable augmented examination requirements from NRC regulatory guides. Pump and valve testing required by Sub-articles IWP and IWV of ASME Section XI are the subject of a separate document and are not included herein.

6.2 REFERENCED CODE

At the time when the program was developed, the latest approved ASME Section XI Code was the 1974 Edition, Summer 1975 Addenda. This is the referenced Code. However, in keeping with our program philosophy, as outlined in the preceding section, several exceptions have been taken to this Code.

The exceptions to the referenced Code are listed below. Detailed descriptions and justifications can be found in Chapter 7.0 of the Program Plan.

1. Control rod drive housings will be subjected to a visual examination for evidence of leakage in lieu of a volumetric examination. A break in the CRD housing weld will be within the makeup requirements of the normal reactor makeup systems (IWB-1220(b)(1), even though they exceed 3" nominal pipe size.
2. Pressure retaining bolting exceeding 2" diameter will be examined using a volumetric method when examined in place, and using volumetric, surface, and visual methods when examined after removal. Pressure retaining bolting less than or equal to 2" nominal diameter will be examined using a visual method.

The bolting will be examined to ASME Section XI, 1977 Edition, Summer 1978 Addenda. See Note 1 and Note 3.

3. RPV closure studs and nuts will be examined to the 1977 Edition, Summer 1978 Addenda. See Note 1, Note 3, and Note 4.
4. Class 2 piping branch connection welds will be examined to 1977 Edition, Summer 1978 Addenda. See Note 1 and Note 2.
5. Class 2 piping with wall thickness $\leq \frac{1}{2}$ " will be examined to 1977 Edition, Summer 1978 Addenda. See Note 1 and Note 2.
6. WNP-2 is applying the pressure/temperature exemption of 275 psi and 200°F, respectively, to RHR and ECCS lines where the actual design temperature is 212°F. The design pressure is less than 275 psi in all cases. The Supply System feels this meets the intent of the Code, that is in exempting low energy lines. Later Code rules allow the use of operating temperature which, in the case of WNP-2, is much lower than 200°F for the lines exempted.

7. RHR pump casing welds will be examined with a surface examination from the I.D. in lieu of a volumetric examination. This is allowed by 1977 Edition, Summer 1978 Addenda. See Note 1 and Note 2.
8. Class 1 piping less than 4" nominal pipe size will be examined by a surface in lieu of a volumetric method. This is allowed by 1977 Edition, Summer 1978 Addenda. See Note 1 and Note 2.
9. The ultrasonic examination procedure governing the examination of piping welds, UTP-10, reflects the guidelines of ASME Section XI, Appendix III, entitled "Ultrasonic Examination Method for Class 1 and 2 Piping Systems Made From Ferritic Steels", which was introduced with the Winter 1975 Addenda to 1974 Edition. This Appendix is acceptable to the NRC based on the acceptance of the Summer 1978 Addenda to the 1977 Edition. The Winter 1975 Addenda and the Summer 1978 Addenda of Appendix III are essentially the same. The Supply System has met all of the requirements of the 1978 Addenda. The use of this Appendix has also been approved at a number of other nuclear power plants.

The use of Appendix III for piping welds is considered by the Supply System to be more appropriate than the use of Article 5 of Section V, which is applicable per the 1974 Edition of Section XI through the Summer 1975 Addenda. Appendix III is written to be specifically applicable to piping welds, whereas Article 5 of Section V is intended for all types of welds, including thick-walled components such as pressure vessels, and was not intended for use with piping welds. Furthermore, Appendix III will be applicable for subsequent inservice examinations, so its use during the preservice examinations will provide for a better data comparison in the future.

10. Class 1 and 2 integral attachments will be examined to 1977 Edition, Summer 1978 Addenda. See Note 1 and Note 2.

The following examinations which are in addition to the reference code requirements will also be done:

1. Augmented ISI - An augmented Inservice Inspection Program will be implemented for WNP-2 on high-energy Class 1 piping systems which penetrate containment for which the effects of postulated pipe breaks would be unacceptable.
2. Class 1 piping will be examined by a surface method along with the volumetric examination required by the reference code.
3. Class 2 piping greater than 1/2" will be examined by a surface method in addition to the referenced code volumetric method.
4. Ten percent of the ASME Class 2 ECCS welds will receive either a volumetric (HPCS) or surface (RHR Loop C and LPCS) exam.

5. All angle beam examination results are recorded on a strip chart recorder for future comparisons with ISI results.
6. Reactor Feed Water Nozzle Augmented PSI - An examination of the RFW nozzle inner radius will be done by special UT technique qualified by the Supply System on a full size RFW nozzle mock-up. A PT examination of accessible areas of the RFW nozzle inner radius surfaces will also be performed.

Date 1/18/85

Revision 0

WNP-2 PSI PROGRAM PLAN

N O T U S E D

(Purposey left blank)

6.3 SUMMARY RPV EXAMINATIONS

Manual preservice ultrasonic examinations were completed on essentially 100% of the WNP-2 Reactor Pressure Vessel (RPV) circumferential, longitudinal, nozzle-to-vessel, vessel support welds, and nozzle inner radii, in February 1977. Those examinations were performed prior to the installation of the vessel while it was resting in its shipping cradle (horizontal) in storage at the plant site. Examinations were performed by Nuclear Energy Services (NES) to a program plan prepared by NES and approved by the Supply System. The program was prepared in accordance with the 1971 Edition of ASME Section XI with Addenda through Winter 1971, with additional evaluations performed per the requirements of the 1974 Edition of ASME Section XI with Addenda through Summer 1975. The top and bottom heads and the nozzle safe end welds were examined manually by LMT in 1981. No examinations are done on those portions of the bottom head welds which are inaccessible due to the CRD penetrations. The manual exam of the RPV revealed a very "clean" vessel. There were no angle beam reflectors greater than 50% DAC. The only reflectors found were mid-plate segregates by 0° beam in seven locations. With this information, the Supply System decided it would serve no purpose to perform another complete baseline using mechanized techniques. Instead, the Supply System decided to perform a limited examination to demonstrate that the equipment was usable and that the mechanized technique produced results equivalent in sensitivity and repeatability to the manual technique. As of October 1981, this has essentially been completed.

Before examinations were begun, a fit and function was done of all mechanized equipment that would be used inservice.

The following mechanized exams were conducted:

- a) all nozzle-to-vessel welds.
- b) all areas (except the top portion of weld BD) where NES found indications during the manual examination.
- c) major repair area in the beltline region.
- d) portion of one longitudinal weld including the vessel diameter transition.
- e) portion of one circumferential weld.

The results of these mechanized exams compared favorably with the manual examination results in that they did not reveal any angle beam reflectors greater than 50% DAC. The exams found the mid-plate segregates (by 0°) in the same general areas as NES found them.

- NOTE 1: The scope and method of examinations are defined in the 1977 Edition, 1978 Addenda of Section XI. The acceptance criteria and procedure requirements applied are from the 1974 Edition, Winter 1975 Addenda.
- NOTE 2: The acceptance criteria for surface examinations used (Winter 1975 Addenda) is more strict than the Summer 1978 Addenda (Table IWB-3514-2).
- NOTE 3: The acceptance criteria used for surface and volumetric examination (Winter 1975 Addenda) is identical to the acceptance criteria of the Summer 1978 Addenda.
- NOTE 4: The RPV closure nuts will receive a Supply System augmented ultrasonic examination. The examination will be an L-wave from the end and shear wave from four directions (two parallel to axis and two perpendicular to axis).

Date 1/18/85

Revision 0

WNP-2 PSI PROGRAM PLAN

N O T U S E D

(Purposely left blank)

Date 12/14/81

Revision 1

6.4 PROGRAM SUMMARY

Following is a listing of the Program Plan Sections with brief summaries of the purpose and content of certain sections. This summary is intended to orient the reader with the organization of the program plan. Details regarding the use of a given section are found in the introduction to that section.

1.0 INTRODUCTION

2.0 TABLE OF CONTENTS

3.0 RECORD OF REVISIONS

Identifies latest revision of each page of the program.

4.0 CODE COMMITMENTS

Identifies applicable code commitments and owner augmented requirements.

5.0 FSAR/NRC COMMITMENTS

Identifies FSAR commitments and applicable augmented NRC inspection requirements.

6.0 PROGRAM DESCRIPTION

7.0 BOUNDARY DIAGRAMS

Illustrates on system P&ID type drawings the boundaries of in-service inspection and the types of examinations performed on each portion of each system. Also found in this section is a detailed account of each exemption (based on code allowed exemption criteria) and exception (alternative to a code requirement) reflected by each system boundary diagram.

8.0 WELD ID DIAGRAMS

Illustrate on piping isometric type drawings each pipe spool and associated welds and components which require examination per the ISI Boundary Diagrams in Section 7.0. Each weld and component requiring volumetric or surface examination is assigned a unique ISI identification number which is used exclusively in referring to that weld on all examination drawings, tables, data records, and reports.

Following each weld ID drawing involving surface and volumetric examinations are a series of tables which list each examination area on the drawing, the examination requirements for examination area, and the procedure that will be used to perform the examination.

9.0 VISUAL PROGRAM

Describes the visual examination program, how it is managed, and how it will be documented. Visual examination procedures are included in Section 10.0.

10.0 PROCEDURES

Lists the procedures which govern the preservice inspection program examination and evaluation activities, as well as any exceptions to the reference code that are reflected in the procedures. The actual procedures are located in Volume 2.

11.0 UT CALIBRATION STANDARDS

Tabulates the various ultrasonic calibration standards, their material, their applicability, and their identification numbers. Also included are design drawings for each standard.

12.0 MANAGEMENT PLAN

Describes the responsibilities and interfaces between all participants in the preservice inspection program activities.

13.0 QUALITY ASSURANCE

A brief statement of conformance to Supply System Quality Assurance commitments.

14.0 EXAMINATION EQUIPMENT

Identifies the examination equipment to be used during the PSI, including diagrams, performance parameters, and functional descriptions.

15.0 PSI SUMMARY REPORT

Contains the PSI Summary Report and its supplement.

6.5 SCHEDULE

The examination schedule at the end of this section will be adhered to to the extent practical.

6.6 DEFINITION OF TERMS AND ABBREVIATIONS

The following terms and abbreviations are defined below as they are used in this document.

Access - The ability to perform non-destructive examinations (NDE) on a weld or component in accordance with applicable codes, standards, and regulatory requirements. Access may include ability to physically reach the point of examination; proper weld contouring and surface finish; proper weld geometry; adequate clearances from a weld to adjacent structures, fittings, restraints; removability of insulation; adequate radiation protection; and lighting.

Accuracy - With regard to mechanized examination "positioning" devices; the extent that the remote position readout mechanism reflects the true position of the examination device with respect to the item being examined at each point throughout the device's range of travel.

Alternative Examination - Examination performed in lieu of the minimum code requirements which are the closest practical approach to code compliance.

Analysis - Process of determining the pertinent characteristics of an indication, such as its origin (crack, porosity, laminations, etc.), location, orientation, and may include sizing.

Calibration Block (Standard) - An NDE calibration device used to simulate defects in a weld or component, the purpose of which is to calibrate ultrasonic or other NDE equipment.

Code Acceptance Standards - Acceptance standards for flaw indications as defined in ASME Section XI, IWB-3000 and IWC-3000.

Defect - A flaw in a weld or component material which exceeds code acceptance standards. Only by direct observation of the flaw, usually following excavation of covering material, is the presence of a defect confirmed. Prior to such confirmation, the term "Reportable Indication" shall be used.

Evaluation - As used pertaining to indications, the process of applying code acceptance criteria to determine the acceptability or rejectability of an indication.

Examination - A performance of a non-destructive examination (NDE) method, such as visual observation, radiography, ultrasonic, liquid penetrant, and magnetic particle.

Examination Equipment - Instruments, mechanical devices, data acquisition systems, tracks, film, sources, etc., used to accomplish a non-destructive examination.

Examiner - Person performing any non-destructive examination.

Date 1/8/79

Revision 0

Fail-Safe Provisions - With regard to mechanical examination devices; design features which prevent damage to the equipment or loss of position accuracy, or prevent the examination equipment from becoming irretrievable from a remote location, upon loss of power or equipment failure, slippage, or other abnormal occurrence.

Fit and Function - Shop or field functional testing of examination equipment under conditions anticipated during actual examinations to verify access, equipment accuracy, position repeatability, and other operating parameters.

Flaw - An indication which is determined to be other than geometric, which may be a crack, slag, inclusion or segregates, aligned or clustered rounded indications, lack of weld penetration, lack of weld fusion, lamination, or combinations thereof.

Inaccessible - An examination area which is within the scope of this document which cannot be fully examined in compliance with the applicable codes, standards, and regulations due to insufficient access.

Indication - Evidence or signal obtained by application of an examination technique, that may reveal the presence of a flaw or surface degradation, or may be caused by geometry or material properties.

Inspection - Performance of examinations verified by an Inspector representing a state or municipality of the United States, Authorized Inspection Agency, or other enforcement authorities having jurisdiction over the nuclear power components at the WNP-2 site.

Inspector - "Authorized Nuclear Inspector" as defined in ASME Section XI, 1974 Edition, Subarticle IWA-2130, as applicable.

Inservice Inspection (ISI) - Inspection activities performed in accordance with ASME Section XI, which include preservice inspection (PSI) activities.

Positioning Repeatability - With regard to mechanized examination equipment; the precision in which the equipment can move to and duplicate a known and verifiable position on subsequent and independent calibrations, i.e., the device is installed, calibrated, positioned, removed, reinstalled, recalibrated, and repositioned.

Preservice Examination - Examinations performed by the Owner or Contractor in accordance with the requirements of the Codes, Standards, and Regulations specified in Paragraph 2.4 of this specification before the plant enters service.

Preservice Inspection (PSI) - Inspection activities performed before the plant enters service.

RPV - Reactor Pressure Vessel.

Readout Sensitivity - With regard to mechanized examination equipment; the ability of the equipment's position encoders or similar instrumentation to register subtle movements of the examination device, i.e., the minimum detectible movement of the device.

Recordable Indication - An indication which equals or exceeds Owner recording criteria. The Owner recording criteria may be more restrictive than the code requirements.

Reportable Indication - Any indication which equals or exceeds code reporting criteria.

Sizing of Indications - Application of the sizing criteria given in ASME Section XI, IWB-3000 and IWC-3000, to determine the size of a flaw indication - part of the evaluation process.

Surface Examination - Liquid penetrant or magnetic particle examinations performed in accordance with the applicable codes, standards, and regulations.

Date 1/8/79

Revision 0

Visual Examinations - Examinations using visual techniques, either using the eye through direct observation or by the use of remote equipment such as mirrors, boroscopes, television, etc.

Volumetric Examinations - Radiographic or ultrasonic examinations performed in accordance with applicable codes, standards, and regulations.

WNP-2 PRESERVICE INSPECTION SCHEDULE

Commercial Operation	12/84
Fuel Load	12/83
RPV Hydro	9/82
Begin Manual Exams	3/79
Begin Mechanized Exams	1/81
Complete Preservice Inspection	11/84
File Summary Report	3/83
File Summary Report Supplement	2/85

7.0--BOUNDARY DIAGRAMS

7.1 ISI BOUNDARY DIAGRAMS

The ISI Boundary Diagrams on the following pages provide a schematic view of the examination requirements for each system which contains welds which are subject to examination within the scope of the applicable codes, standards, and regulations listed in Section 4.0, "CODE COMMITMENTS", and Section 5.0, "FSAR/NRC COMMITMENTS". The key to the symbolism used on these drawings is found on ISI-200, the first in the series of drawings.

These drawings illustrate the overall piping system examination requirements, distinguishing between systems requiring volumetric and surface examinations (dashed lines), those requiring surface examinations but not volumetric (dash-dot-lines), and those requiring only a visual examination during hydro (solid lines). Examination items such as hangers, instruments, thermal wells and leak-off connections are not typically shown on the ISI Boundary Diagrams in order to maintain drawing clarity. Detailed item-by-item examination requirements for all examination items in each of these piping systems is given in the Weld Identification Drawings and Program Plan and Schedule Tables found in Section 8.0, "WELD IDENTIFICATION DIAGRAMS".

7.2 ISI BOUNDARY EXEMPTIONS AND EXCEPTIONS

The Supply System will, on a continuing basis, make every effort to assure, to the extent practical, full compliance with the code and regulatory commitments applicable to preservice and inservice examinations of the WNP-2 power plant. However, recognizing that our reference code commitment (1974 Edition of ASME Section XI with addenda through Summer 1975) represents a voluntary upgrade as discussed in the introduction, and with full knowledge of the progress of that code in subsequent addenda, there are several exceptions to those code requirements which have been implemented in this program. It should be noted that the Supply System is aware at the time of this program's

preparation of the NRC posture on the contents of the Section XI Edition and addenda subsequent to Summer 1975, and has factored those considerations into this program.

It is the Supply System's intent to implement a preservice inspection program which incorporates, to the extent practical, the requirements of the reference code commitment, with further consideration given to NRC concerns with later code addenda, while attempting to provide for a smooth transition into the future inservice inspection program requirements, and at no time compromising the safety of operation of the plant.

In addition to the exceptions to code requirements discussed above, ASME Section XI allows certain exemptions from volumetric and surface examinations, with only visual examinations for leakage during system hydro test being required for exempted components. (Reference subarticles IWB-1220 and IWC-1220 for Class 1 and Class 2 exemptions, respectively).

Both code exceptions and exemptions for each system are summarized following each ISI Boundary Diagram. In addition, the exceptions and exemptions listed below are general in nature and are applied, as applicable, to each system.

7.2.1. Exceptions

a. ASME Section III, Class 1 Systems

- 1) Subarticle IWB-2600, Table IWB-2600, examination item B4.5, Circumferential and Longitudinal Piping Welds:

*Some are
ISI requirements*

Q-5
REVIEW

Code Requirement - Examine all nonexempt circumferential and longitudinal piping welds using a volumetric method.

Exception/Alternate Examination - Circumferential and longitudinal welds in nonexempt piping less than 4-inch nominal pipe size will be examined using a surface in lieu of volumetric method.

Justification - This exception applies primarily to the following welds in the stated piping systems:

Carbon Steel Piping

3" CRD Nozzle N-10, safe-end-to-cap weld

3" RRC (51)-4, vessel drain, 5 welds (RRC-104)

2" RRC (51)-4, vessel drain, 11 welds (RRC-104)

Stainless Steel Piping

2" RRC (6)-4S, loop A and B drains, 15 welds (RRC-110 and 111)

This exception is consistent with the 1977 edition of ASME Section XI with addenda through Summer 1978 and later addenda to which WNP-2 Inservice Inspection Programs will be subject to. There are no apparent objections to this criteria expressed by the NRC in their revision to 10CFR50, dated October 1979, which accepts editions and addenda of ASME Section XI through the Summer 1978 addenda with specific augmented examination requirements stated in the regulation.

Note that there are other Class 1, 2- and 3-inch pipes (e.g., mainstream drains, head vent) in the

WNP-2 primary system. However, they are exempt based on makeup capability of the normal reactor makeup systems as explained later in this section. Note also that WPPSS, on a voluntary basis, will perform surface examinations on all circumferential and longitudinal welds in nonexempt Class 1 piping 4 inches in diameter and greater in anticipation of the later code editions and addenda which will govern the WNP-2 Inservice Programs.

- 2) Subarticle IWB-2600, Table IWB-2600, examination item B1.18, Control Rod Drive Housing to Stub Welds:

Code Requirement - Examine 100% of the welds in 10% of the peripheral control rod drive housings using a volumetric examination method. Note that subarticle IWB-1220; paragraph (b)(1), a component may be exempted from volumetric examination if, under postulated conditions of loss of coolant from the component during normal reactor operation, the reactor can be shutdown and cooled down by the reactor coolant makeup systems only. This exemption is limited to 3" nominal pipe size components only.

Exception/Alternative Examination - Control rod drive housings will be subjected to a visual examination for evidence of leakage in lieu of a volumetric examination, even though they exceed 3" nominal pipe size.

Justification - The difference between the 6.000" outside diameter CRD housing and the 6.020" inside diameter stub tube provides an annulus between the two parts of 0.010" with CRD housing supports in

Reviews During ISI
 ISI / ISI
 Surface Exam during construction
 S78 (Method either surface or volumetric)
 ISI Issue

place (these meet NRC rod ejection criteria) and assuming that the stub tube to CRD housing weld experiences a 360° break, there would result an effective leak area of 0.189 sq. in. The CRD housing supports would prevent ejection of the housing.

Assuming saturated conditions at 1,000 psi in the RPV at the time of the break, and assuming no friction losses, the maximum flow rate of reactor water out of the break described above would be 8,000 lbm/sec ft²⁽¹⁾.

$$\text{Leakage} = 8,000 \text{ lbm/sec ft}^2 \times 0.189 \text{ in}^2 \times$$

$$\frac{\text{ft}^2}{144 \text{ in}^2} \times 0.021 \frac{\text{ft}^3}{\text{lbm}} \times 7.48 \frac{\text{gal}}{\text{ft}^3} \times 60 \text{ min/sec} = 99 \text{ gpm}$$

This is clearly within the makeup requirements of the normal reactor makeup systems (see 7.2.2.a.1).

- 3) Subarticle IWB-2600, Table IWB-2600, examination category B-G-1, Pressure Retaining Bolting 2" and Larger in Diameter:

Code Requirement - Examine pressure retaining bolting 2" and larger in diameter using visual and surface and/or volumetric methods.

Exception/Alternative Examination - Pressure retaining bolting exceeding 2" diameter will be examined using a volumetric method when examined in place, and using volumetric, surface and visual methods when examined after removal. Pressure retaining bolting less than or equal to 2" nominal diameter will be examined using a visual method.

Justification - This exception is consistent with the 1977 edition of ASME Section XI with addenda through Summer 1978. There are no apparent objections to this criteria expressed by the NRC in their October 1979 revision to 10CFR50 which accepts editions and addenda of ASME Section XI through the Summer 1978 addenda with specific augmented examination requirements stated in the regulation.

- 4) Subarticle IWV-1220(c), Visual Examination of Exempted Components:

Clarification - Components exempted from examination in accordance with IWB-1220(a) and (b) will be examined subject to the requirements of category B-P of Table IWB-2500 with the following clarification. Instrument lines which penetrate primary containment will be examined for evidence of leakage through the containment penetrations, though the excess flow check valves up to the point at which there is a transition to instrument tubing. Instrument tubing is not subject to ASME Section XI.

- 5) Subarticle IWB-2600, Table IWB-2600, examination item B 1.8, Closure Studs and Nuts, When Removed:

Code Requirement - Examine 100% of the RPV closure nuts by a volumetric and surface method.

Exception/Alternative Examination - RPV closure nuts will be examined using a surface method except for the thread area. The thread area will be examined by a volumetric method.

Justification - As stated in the Program Philosophy (Section 6.1), the Supply System is developing a program which takes into consideration examination requirements found in the latest codes and which will provide a smooth transition from the preservice inspection phase to the inservice inspection phase. The latest NRC approved Section XI Code (Summer 1978) requires only a surface examination for the RPV closure nuts. The Supply System will be using the latest approved code for the inservice inspection program. (This will be a Summer 1978 or later code.) A volumetric (ultrasonic) examination of the nut will be performed to augment the surface exam. A meaningful surface exam of the thread area cannot be achieved with the protective phosphate coating. The ultrasonic examination will consist of a L-wave from the end and shear wave in four directions (two parallel to axis and two perpendicular to axis). A spare RPV nut will be used for the calibration standard.

These nuts have received all of the Section III required non-destructive examinations and are acceptable for service.

Date 12/14/81
Revision 1

b. ASME Section III, Class 2 Systems

- 1) Subarticle IWC-2600, Table IWC-2600, examination item C2.3,
Piping Branch Connection Welds:

Code Requirement - Examine branch pipe connection welds in
nonexempt systems using a volumetric method.

Date 12/14/81

Revision 0

WNP-2 PSI PROGRAM PLAN

NOT USED

(Purposely left blank)

Exception/Alternative Examination - Pipe branch connection welds in nonexempt systems will be examined using a surface method.

Justification - This exception is consistent with ASME Section XI, 1977 edition Summer 1978 addenda. The Supply System is performing surface examinations of pipe branch connection welds because it is impractical to perform meaningful ultrasonic examinations of those welds due to their geometry. This difficulty was recognized by the ASME in the Summer 1976 and later addenda to Section XI, in which surface in lieu of volumetric methods for those items was adopted.

- 2) Subarticle IWC-2600, Table IWC-2600, examination items C2.1 and C2.2, Circumferential and Longitudinal Piping Welds:

Code Requirement - Examine circumferential and longitudinal welds in nonexempt piping systems using a volumetric method.

Exception/Alternative Examination - Circumferential and Longitudinal welds in nonexempt piping systems with piping wall thickness exceeding 1/2" nominal will be examined using a volumetric method in accordance with the reference code. In addition, all nonexempt piping welds will be examined using a surface method regardless of wall thickness. Welds in nonexempt piping systems with wall thicknesses of 1/2" nominal or less will not be examined using a volumetric method.

Date 12/14/81
Revision 1

Justification - Examining welds in nonexempt piping systems with piping wall thickness less than or equal to 1/2" by surface methods is consistent with the later (1977 edition Summer 1978 addenda) NRC approved ASME Section XI Code.

- 3) Subarticle IWC-2600, Table IWC-2600, examination category C-D, Pressure Retaining Bolting Exceeding 1" Nominal Diameter:

Code Requirement - Examine all pressure retaining bolting exceeding 1" diameter using visual and either surface or volumetric methods.

Exception/Alternative Examination - Pressure retaining bolting exceeding 2" nominal diameter will be examined using a volumetric method when examined in place, and using volumetric and surface methods when examined after removal. All bolted connections will receive a visual examination for evidence of leakage during hydrostatic/pressure test (VT-2) regardless of bolting size.

Justification - This is consistent with the ASME Section XI examination requirements for Class 2 pressure retaining bolting of the 1977 edition Summer 1978 addenda which the NRC has approved in the October 1979 revision to 10CFR50.

7.2.2 Exemptions

- a. ASME Section III, Class 1 Systems

- 1) Subarticle IWB-1220

The exemptions of this subarticle were applied to each system as explained following each ISI

Boundary Diagram. The following calculation is provided to support the exemption allowed by IWB-1220(b)(1), exemption based on leakage from the component not exceeding the normal reactor makeup system capacity.

Assumptions:

- 1) The normal reactor makeup systems have the ability to maintain reactor coolant inventory during startup, hot standby, operation or cooldown using on-site power. For WNP-2, the following normal reactor makeup systems are available for reactor water makeup with their respective nominal capacities:

<u>SYSTEM</u>	<u>CAPACITY (GPM)</u>
RCIC Pump	600
CRD Pump	<u>170</u>
TOTAL	<u><u>770</u></u>

- 2) The break is assumed to result in a high dry well pressure condition within a few seconds with a resulting scram. The CRD system capacity is based on 0.92 gpm bypass flow per each of 185 drives.⁽³⁾
- 3) The reactor is operating at 1,000 psi under saturated conditions at the time of the postulated break.

- 4) The leak rates at 1,000 psi, assuming no friction losses, are:

$$\begin{array}{ll} 8,000 \text{ lbm/sec ft}^2 & \text{water}^{(1)} \\ 2,000 \text{ lbm/sec ft}^2 & \text{steam}^{(1)} \end{array}$$

- 5) Makeup water is injected @ 100°F, 0.0162 ft³/lbm

Calculation:

$$\text{Makeup capacity} = 770 \text{ gal/min} \times \frac{1 \text{ ft}^3}{7.48 \text{ gal}} \times$$

$$\frac{1 \text{ lbm}}{0.0162 \text{ ft}^3} \times \frac{1 \text{ min}}{60 \text{ sec}} = 106 \text{ lbm/sec}$$

$$\text{Max. break area} = \frac{106 \text{ lbm/sec}}{8,000 \text{ lbm/sec ft}^2} = 0.0132 \text{ ft}^2 \text{ (water)}$$

$$= \frac{106}{2,000} = 0.053 \text{ ft}^2 \text{ (steam)}$$

This corresponds to 1.56" ID pipe (water)
3.12" ID pipe (steam)

Didn't
Affect May
Welds -
RPV drains

The above is applied to the WNP-2 ISI boundaries as follows. Class 1 piping penetrating the RPV below the normal water level and 1.5" nominal pipe size or less, and piping penetrating above the normal water level and 3" nominal pipe size or less, may be exempted from volumetric and surface

Less than
10 welds

Some
of these
lines
went
back in
under augmented
requirements.

examination and are subject only to a visual examination for evidence of leakage in accordance with IWB-1220(c).

b. ASME Section III, Class 2 Systems

1) Subarticle IWC-1210, footnote 2:

The provisions of this footnote allow the inspection rules of IWD to be applied to a component or chamber of a component which has been optionally upgraded from Class 3 to Class 2.


(a) Main Steam Relief Valve (MSRV) Discharge Piping

The portion of the subject piping within the wetwell, as illustrated on the following figure, was optionally upgraded from ASME Code Class 3 to Class 2 rules. Therefore, the inspection rules of Subsection IWD are applied.

The MSRV discharge lines connect the MSRV discharge to the wetwell quencher submerged in the suppression pool. Their purpose is to ensure that steam passed by the MSRV's is channelled to the suppression pool to prevent overpressurization of the containment.

GENERIC
RESOLUTION AS } DEFER
ISSUE

DATE 11/16/80
REVISION 0

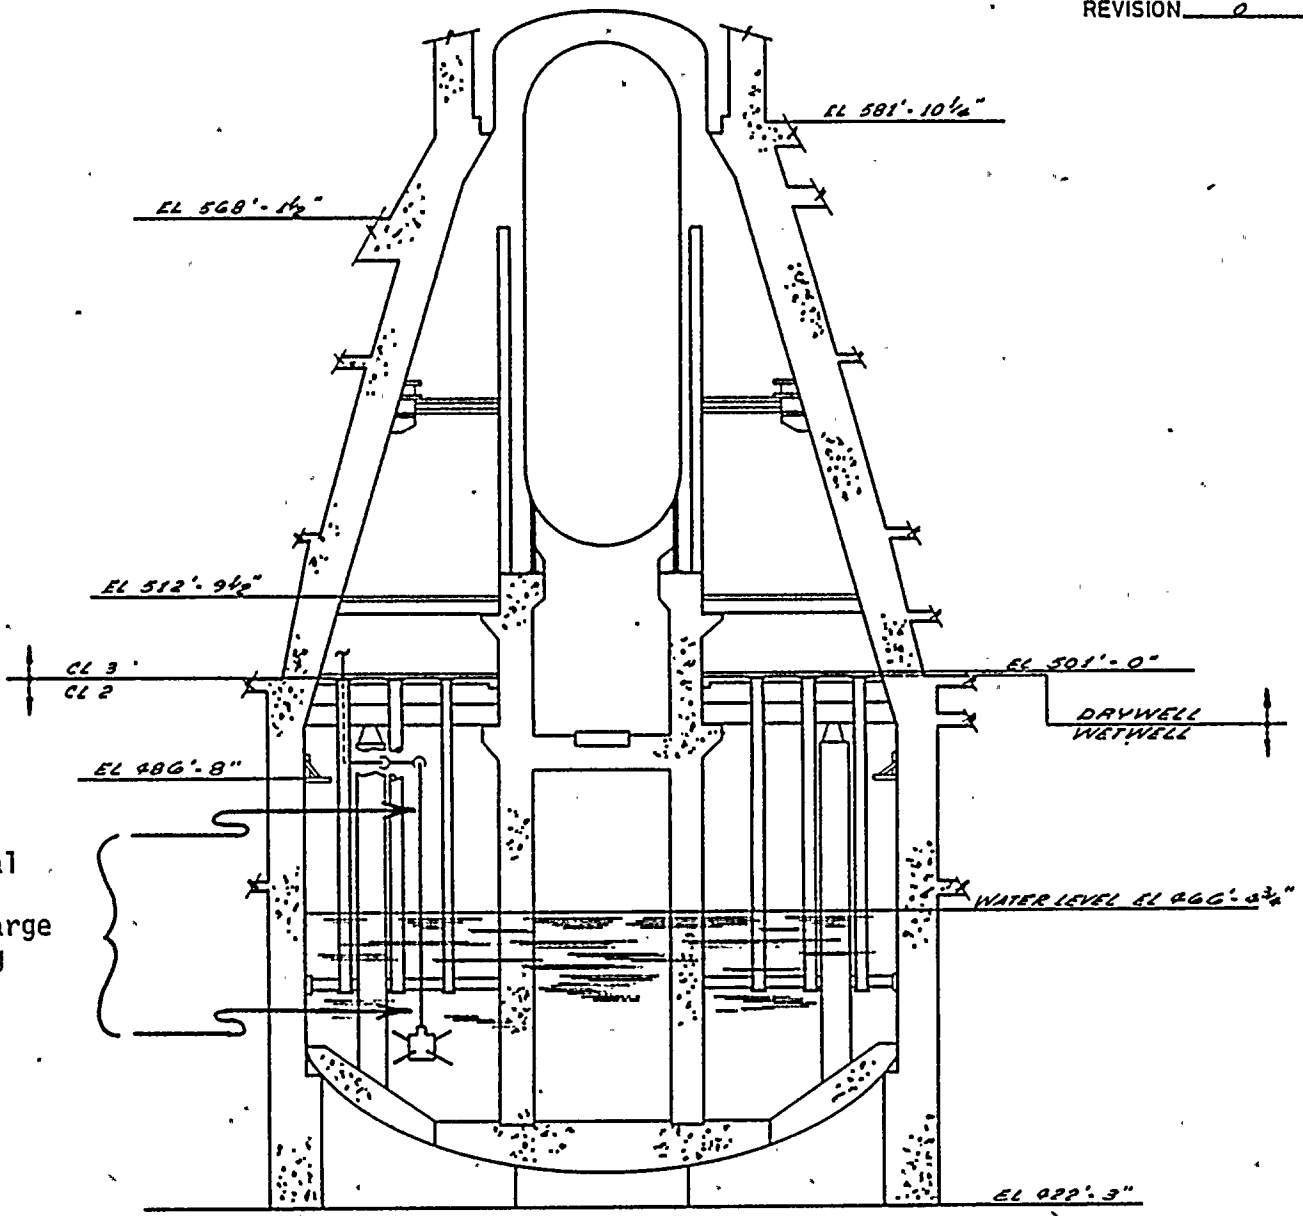

Typical
MSRV
Discharge
Piping

WNP-2 DRYWELL/WETWELL

7-12a

POOR ORIGINAL

11



FOOTNOTES

During the WNP-2 design process, the subject lines were optionally upgraded from ASME Code Class 3 to Class 2, and the schedule was increased from Schedule 40 to Schedule 80.

These changes were made by the Supply System on an optional upgrade basis for the following reasons:

- o The dynamic operational loads which these lines may be subject to were becoming better understood, but not yet finally determined.
- o The importance of the integrity of these lines to ensure the maintenance of containment integrity was recognized.
- o The inability to hydrostatically test these lines due to restricted access to the wetwell and open ended design of the discharge piping was recognized.

The quality group classification of these lines exceeds the minimum classification requirements of Regulatory Guide 1.26. This is evidenced by the precedent in the industry on other plants with similar (Mark II) design. These plants classify the MSRV discharge lines as quality group "C" (Code Class "3").

In summary, the Supply System has provided upgraded design for the subject piping in recognition of its importance and because of the restricted access for inspection or testing. Therefore, the provisions of the Code which allow the application of the inspection rules of Subsection IWD have been applied.

2. Subarticle IWC-1220

The exemptions of this subarticle were applied to each system as explained following each ISI Boundary Diagram. The following clarification is provided as a basis for applying the exemption criteria of IWC-1220(b) and IWC-1220(c).

IWC-1220(b) - Allows the exemption from volumetric and surface examinations for those components in systems or portions of systems, other than ECCS, which do not function during normal reactor operation.

Clarification - The steam condensing mode of the RHR system has been de-energized and will not be used.

The piping systems and components used solely for abnormal steam condensing, which involve portions of the RHR system and the portion of the RCIC system which supplies steam to the RHR heat exchangers, are shown as exempt on their respective Boundary Diagrams based on the exemption allowed by IWC-1220(b) as interpreted above.

IWC-1220(c) - Since the NRC will not allow components of the ECCS system to be exempted based on this exemption criteria, WNP-2 will perform the following examinations:

- HPCS - A representative sample of ten percent of the HPCS welds exempted by IWC-1220(c) will be examined by a volumetric method.
- LPCS - A representative sample of ten percent of the LPCS welds exempted by IWC-1220(c) will be examined by a surface method.
- RHR Loop C - A representative sample of ten percent of the RHR Loop C welds exempted by IWC-1220(c) will be examined by a surface method.

c. ASME Section III, Class 3 Systems

1) Subarticle IWD:

The exemptions of this subarticle were applied to each system as explained following each ISI Boundary Diagram. In addition, the following generic exemptions are applied.

- a) Deleted.

Date 12/14/81

Revision 1

This Page Purposely
Left Blank


This Page Purposely
Left Blank

- b) Systems other Than Water, Steam, or Radioactive Waste Systems - These systems, such as the containment air systems and the diesel oil transfer system, are exempt from the requirements of Article IWD since the ASME Code is applicable only to water, steam and radioactive waste systems.

Following is a letter of clarification from the ASME which substantiates this exclusion.

Footnotes:

- 1) Maximum Flow Rate of a Single Component, Two Phase Mixture, F. J. Moody, ASME 64-HT-35.
- 2) WNP-2 FSAR, Section 6.2, Figure 6.2-14.
- 3) General Electric Process Flow Diagram, GE Drawing No. 112 D1448, Mode D, Point 23.

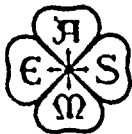

The American Society of Mechanical Engineers

United Engineering Center / 345 E. 47th St., New York, N.Y. 10017 / 212 644-7815

THE BOILER AND
PRESSURE VESSEL
COMMITTEE

February 16, 1978

Date 1/8/79

Revision 0

Chairman
L.P. Zick

L.T. Harrold, Supervisor, ISI Programs
Washington Public Power Supply System
PO Box 968
3000 George Washington Way
Richland, WA 99352

Vice-Chairman
W.L. HARDING

Secretary
W.B. HOYT

Subject: Section XI, Division 1, IWD-1200
Optionally Upgrading of Classification

C.W. ALLISON
B.W. BACE
R.D. BONNER
R.J. BOSNAK
P.M. BRISTER
H.M. CANAVAN
R.J. CEPLUCH
L.J. CHOCKIE
W.E. COOPER
W.D. DOTY
G.E. FRATCHER
R.C. GRIFFIN
S.F. HARRISON
E.J. HEMZY
W.P. JOHNSON
E.L. KEMMLER
E.L. KIME
J.E. LATTAN
J. LeCOFF
J.R. MACKAY
R.H. MOELLER
T.E. NORTHUP
C.E. RAWLINS
W.R. SMITH, SR.
W.E. SOMERS

Reference: Your letter of September 19, 1977 (APO 77-58)
ASME File #: BC 77-665
NI 77-372

Dear Mr. Harrold:

Your inquiry and our response are as stated below:

QUESTION;

Is it the intent of Subarticle IWD-1200 that when a component or a chamber of a component has been optionally upgraded by reclassification from non-nuclear to nuclear Class 3, that the rules and requirements of Subsection IWD need not be applied to that component or chamber of a component?

REPLY:

Non-nuclear safety class components are not within the scope of Section XI; therefore, there are no requirements in Section XI which addresses these components regardless of whether or not they have been optionally upgraded to Class 3. Article IWA-1000 on Scope and Responsibility, specifically Paragraph IWA-1400, requires the Owner of the nuclear plant to determine the appropriate Code, Class or Classes for each component of the nuclear power plant to be examined according to Section XI rules.

Very truly yours,

Kenneth I. Baron
Kenneth I. Baron,
Assistant Secretary

/fs



The American Society of Mechanical Engineers

United Engineering Center / 345 E. 47th St., New York, N.Y. 10017 / 212 644-7815

February 16, 1978

Date 1/8/79

Revision 0

THE BOILER AND
PRESSURE VESSEL
COMMITTEE

Chairman
L.P. Zick

Vice-Chairman
W.L. HARDING

Secretary
W.B. HOYT

C.W. ALLISON
B.W. BACE
R.D. BONNER
R.J. BOSNAK
P.M. BRISTER
H.M. CANAVAN
R.J. CEPLUCH
L.J. CHOCKIE
W.E. COOPER
W.D. DOTY
G.E. FRATCHER
R.C. GRIFFIN
S.F. HARRISON
E.J. HEMZY
W.P. JOHNSON
E.L. KEMMLER
E.L. KIME
J.E. LATTAN
J. LeCOFF
J.R. MACKAY
R.H. MOELLER
T.E. NORTHUP
C.E. RAWLINS
W.R. SMITH, SR.
W.E. SOMERS

L. T. Harrold, Supervisor, ISI Programs
Washington Public Power Supply System
PO Box 968
3000 George Washington Way
Richland, WA 99352

Subject: Section XI, Division 1, IWA-1100
Scope of Section XI, Division 1

Reference: Your letter of September 19, 1977 (APO 77-59)
ASME File #: BC 77-666
NI 77-371

Dear Mr. Harrold:

Your inquiry and our response are as stated below:

QUESTION:

Is it the intent of Subarticle IWA-1100 that the rules and requirements of Section XI, Division 1 for inservice inspection of Class 1, 2 & 3 pressure retaining components (and their supports) be applied only to water and steam systems in light water cooled nuclear power plants?

REPLY:






Systems containing other than steam or water were not originally considered by the Committee in formulating the rules in Section XI; they may, however, be included for further consideration and for revisions to future editions of Section XI. The requirements shown in Section XI, Article IWA-1000 on Scope and Responsibility, specifically Paragraph IWA-1400, requires the Owner of the nuclear plant to determine the appropriate Code, Class or Classes for each component of the nuclear power plant to be examined according to Section XI rules.

Very truly yours,

Kenneth I. Baron

Kenneth I. Baron,
Assistant Secretary

/fs

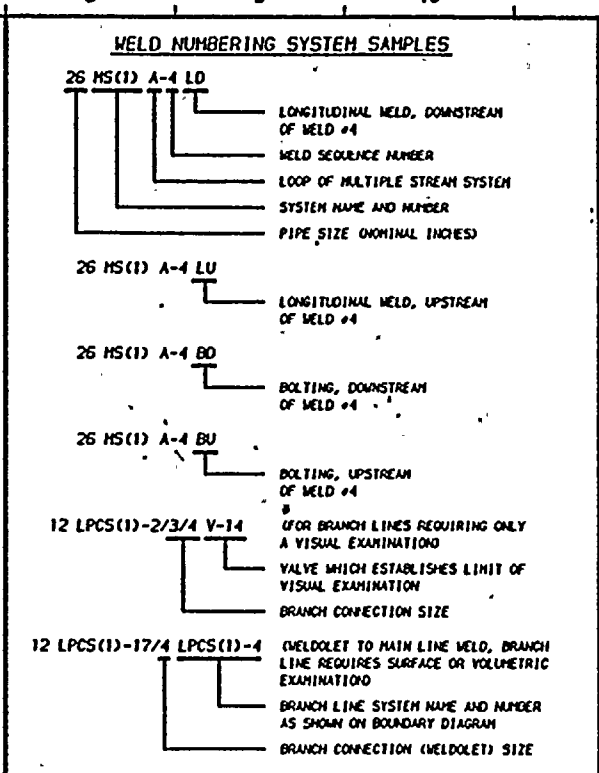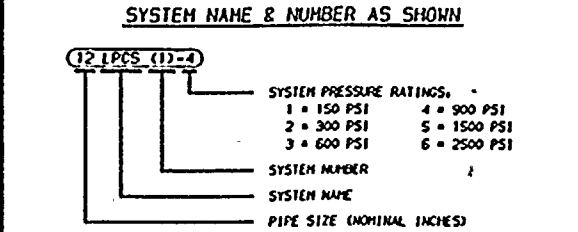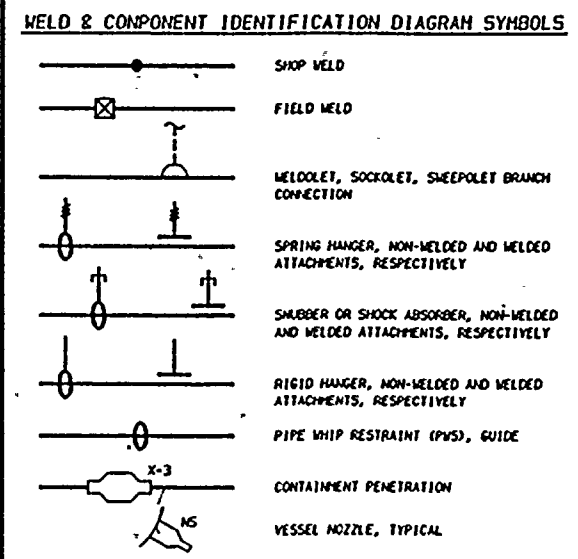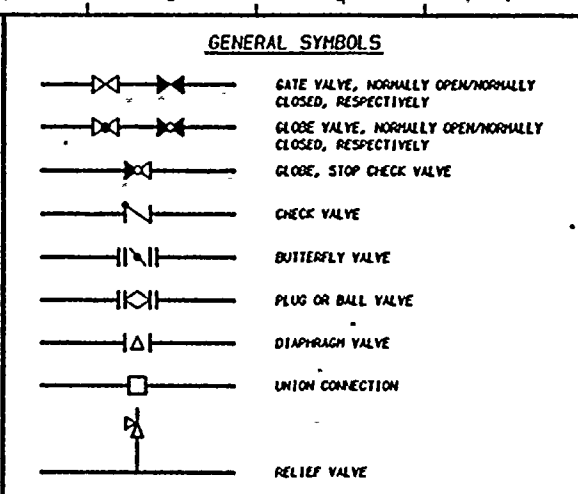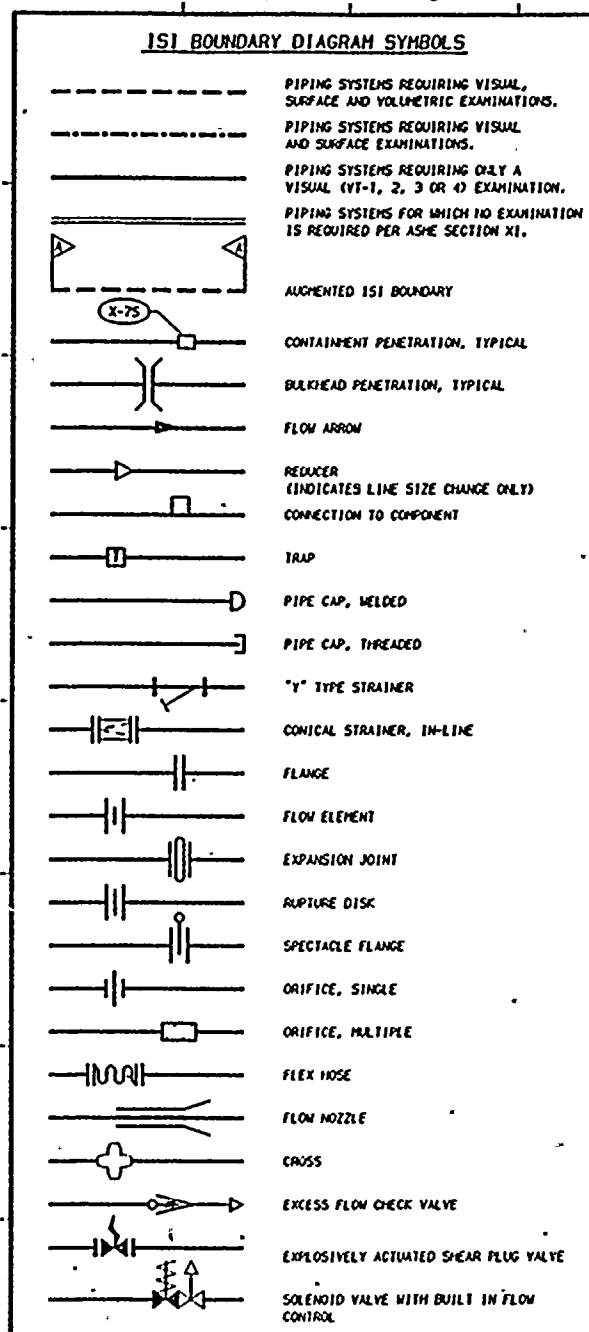

INDEX TO BOUNDARY DIAGRAMS

151-200	LEGEND
151-217	DEMINERALIZED WATER (DW), EQUIPMENT DRAIN, RADIOACTIVE (EDR), FLOOR DRAIN, RADIOACTIVE (FDR), MISCELLANEOUS WASTE, RADIOACTIVE (MWR)
151-219	REACTOR CORE ISOLATION COOLING (RCIC)
151-220	HIGH PRESSURE CORE SPRAY (HPCS), LOW PRESSURE CORE SPRAY (LPCS)
151-221	RESIDUAL HEAT REMOVAL (RHR)
151-222	STANDBY LIQUID CONTROL (SLC)
151-223	REACTOR WATER CLEANUP (RWCU)
151-224	STANDBY SERVICE WATER (SSW)
151-225	REACTOR CLOSED COOLING (RCC)
151-226	FUEL POOL COOLING (FPC)
151-228	CONTROL ROD DRIVE (CRD)
151-229	MAIN STEAM (MS), REACTOR FEED WATER (RFW)
151-230	REACTOR RECIRCULATION COOLING (RRC)

THIS DRAWING IS INTENDED FOR USE IN PRESERVICE AND INSERVICE INSPECTION PROGRAMS ONLY


WASHINGTON PUBLIC POWER SUPPLY SYSTEM
RICHLAND, WASHINGTON 99352

WNP-2
INSERVICE INSPECTION BOUNDARY DIAGRAM
LEGEND

ENGINEER	K-McANDREW
DRAWN	K-McANDREW
DATE	5-10-78
DWG NO	151-200
REV	1

NO	DATE	REVISION	BY	CHKD	APVD
1	12-28-81	GENERAL UPDATE REDRAWN			
0	1-9-79	ISSUED FOR USE			
A	5-10-78	ISSUED FOR INFORMATION ONLY			

NO	DATE	REVISION	BY	CHKD	APVD
1	12-28-81	GENERAL UPDATE REDRAWN			
0	1-9-79	ISSUED FOR USE			
A	5-10-78	ISSUED FOR INFORMATION ONLY			

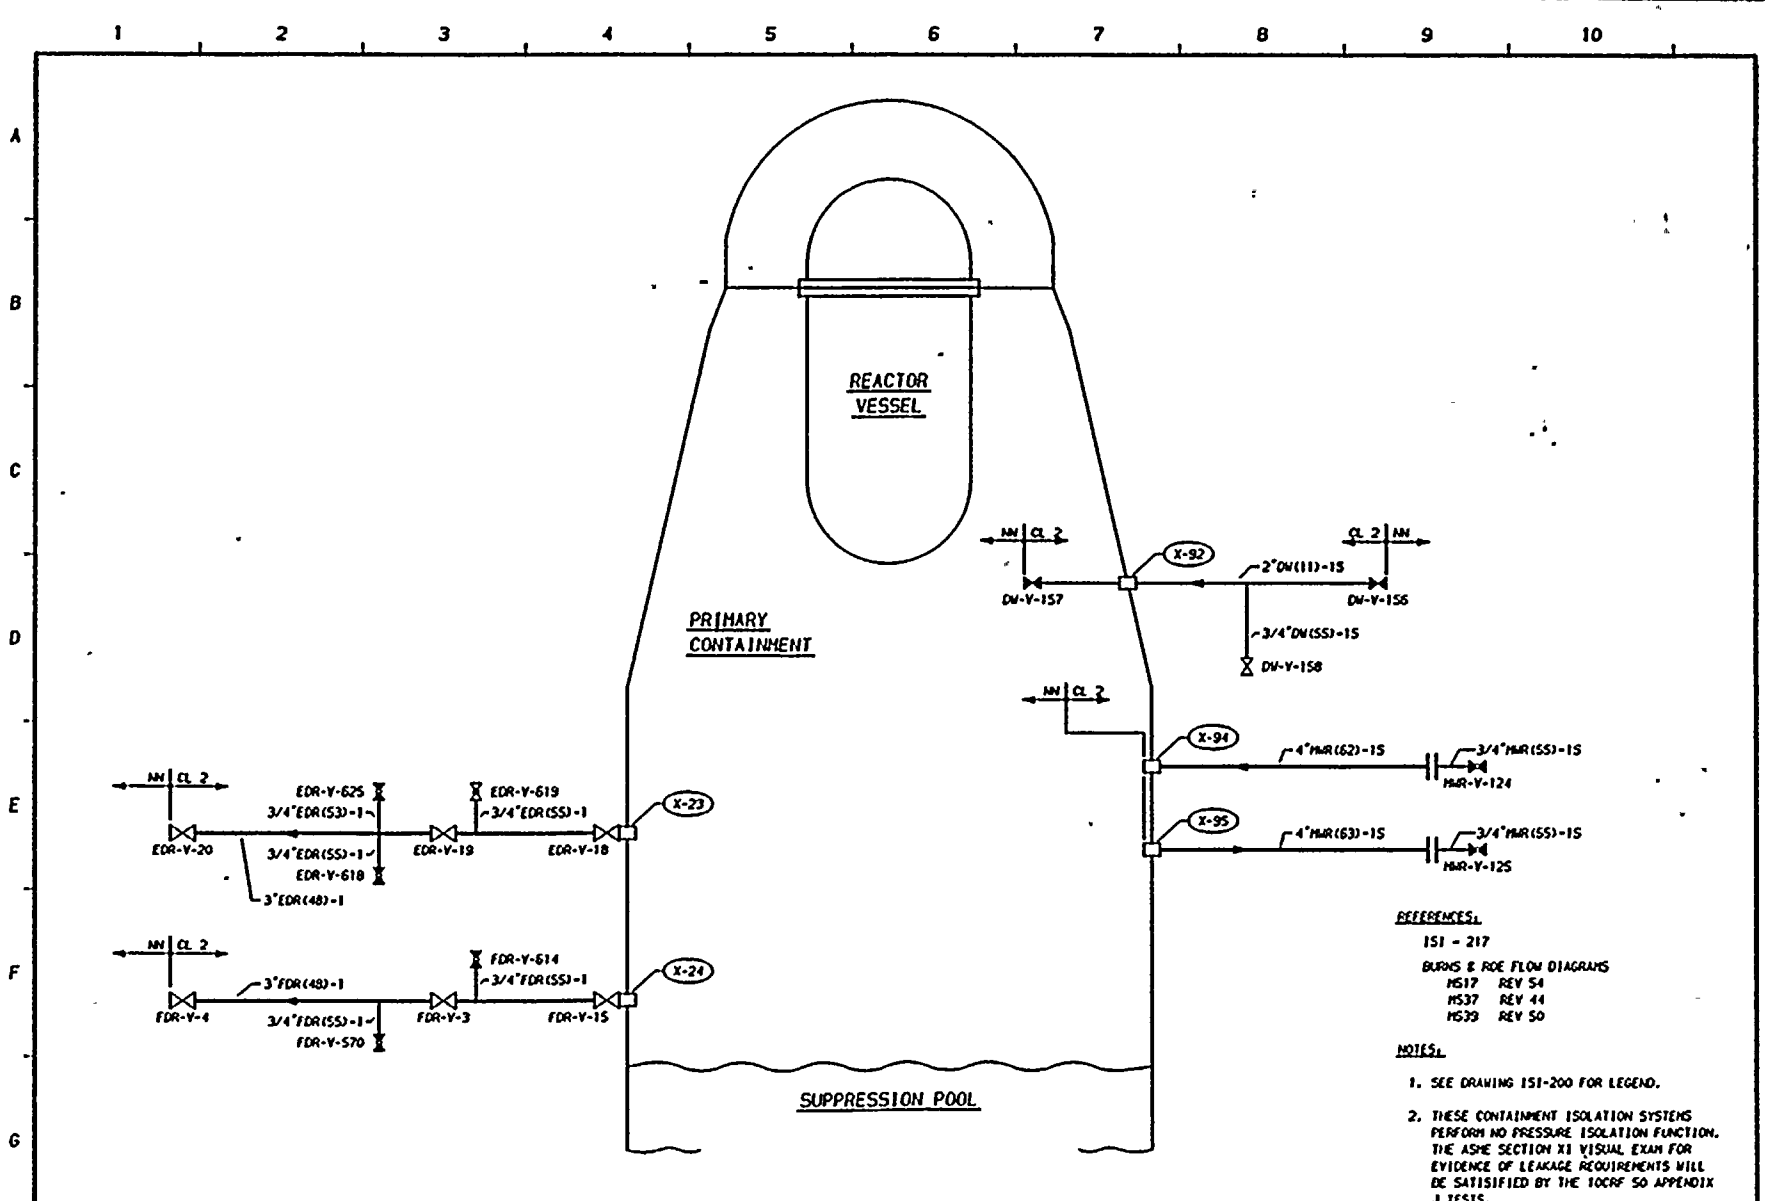

- REFERENCES:**
- 151 - 217
 - BURNS & ROE FLOW DIAGRAMS
 - MS17 REV 54
 - MS37 REV 44
 - MS39 REV 50

- NOTES:**
1. SEE DRAWING 151-200 FOR LEGEND.
 2. THESE CONTAINMENT ISOLATION SYSTEMS PERFORM NO PRESSURE ISOLATION FUNCTION. THE ASME SECTION XI VISUAL EXAM FOR EVIDENCE OF LEAKAGE REQUIREMENTS WILL BE SATISFIED BY THE 10CRF 50 APPENDIX J TESTS.

THIS DRAWING IS INTENDED FOR USE IN PRESERVICE AND INSERVICE INSPECTION PROGRAMS ONLY

WASHINGTON PUBLIC POWER SUPPLY SYSTEM RICHLAND, WASHINGTON 99352	
WPP-2	INSERVICE INSPECTION BOUNDARY DIAGRAM
MISCELLANEOUS CONTAINMENT PENETRATIONS	REV 2

NO	DATE	REVISION	BY	CHKD	APVD	NO	DATE	REVISION	BY	CHKD	APVD	DATE
1	2-2-79	DELETED PIPE AND CAPS IN E-8	K-MCA	DMP	LFB	0	12-22-78	ISSUED FOR USE	K-MCA	TH	LFB	10-12-78
0	12-22-78	ISSUED FOR USE	K-MCA	TH	LFB	A	10-18-78	ISSUED FOR INFORMATION ONLY	K-MCA	MCH	DMP	10-12-78
2	11-16-78	GENERAL UP-DATE REDRAWN	K-MCA	DR	TFH							



WNP-2 ISI BOUNDARY DIAGRAM

Date 11/14/80

Revision 2

EXCEPTIONS AND EXEMPTIONS

ISI - 217

SYSTEM Miscellaneous Containment Penetrations

EXCEPTIONS:

Class 1 Piping and Components

- ° Not applicable; all penetrations on this drawing are Class 2, associated with Class 3 piping systems.

Class 2 Piping and Components

- ° No exceptions.

EXEMPTIONS APPLIED:

IWB-1220(a)(1) No

(2) No

(3) No

(4) No

* (b)(1) No

(2) No

(3) No

IWC-1220(a) No

* (b) No

(c) No


(d) Yes, all piping

IWC-5220(d) No

IWD-5200(c) Yes, open ended drains inside dry well.

* See general exemption discussion for details.



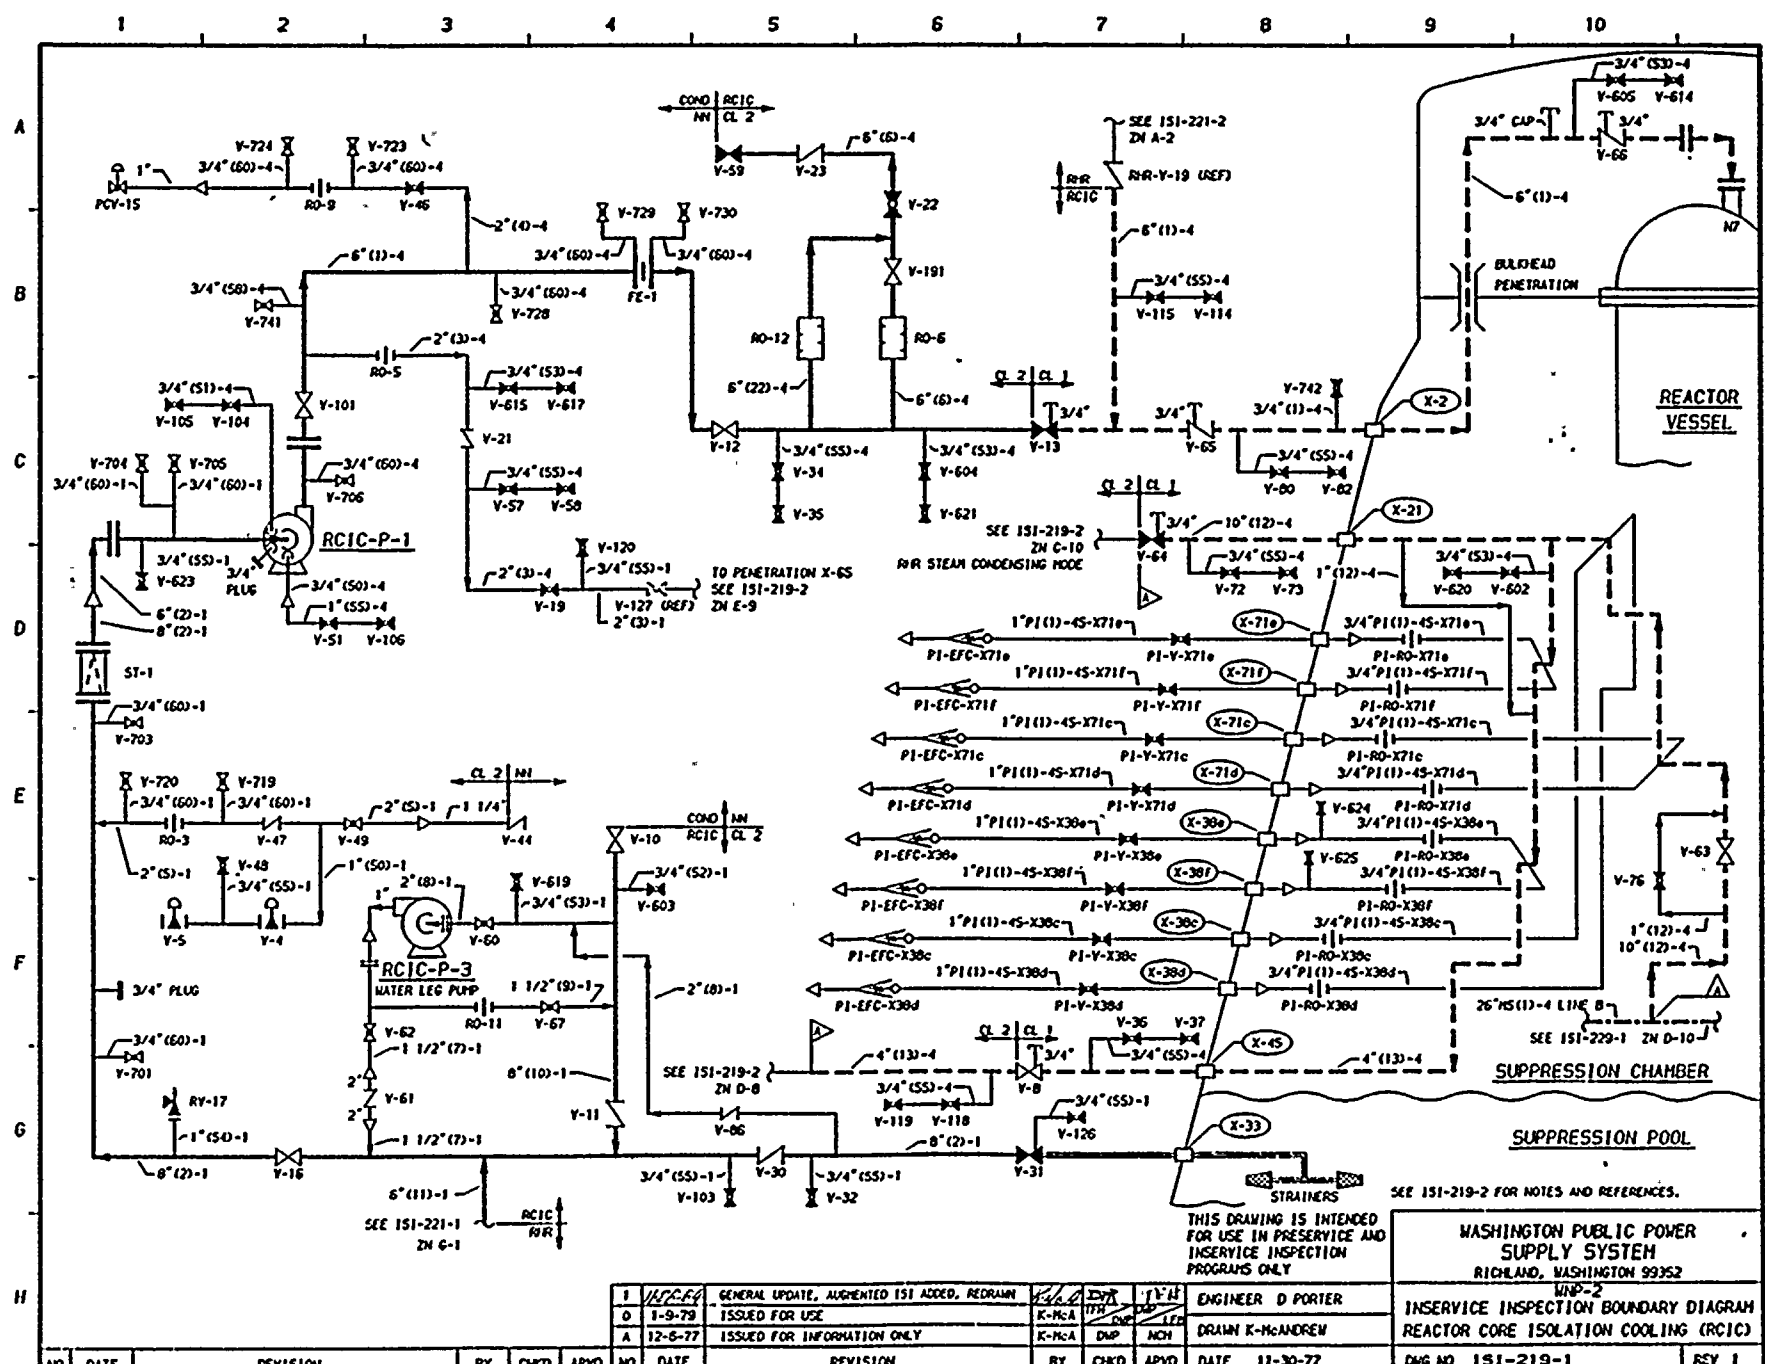

1	ISSUED FOR USE	GENERAL UPDATE, AUGMENTED ISI ADDED, REDRAWN	K-MCA	DMP	TPH	11-30-77	ENGINEER D PORTER	
0	ISSUED FOR USE		K-MCA	DMP	TPH			
A	ISSUED FOR INFORMATION ONLY		K-MCA	DMP	NCH		DRAM K-McANDREW	
NO	DATE	REVISION	BY	CHKD	APYD	NO	DATE	REVISION
							11-30-77	

THIS DRAWING IS INTENDED FOR USE IN PRESERVICE AND INSERVICE INSPECTION PROGRAMS ONLY


SEE 151-219-2 FOR NOTES AND REFERENCES.

WASHINGTON PUBLIC POWER SUPPLY SYSTEM
 RICHLAND, WASHINGTON 99352

WPP-2
 INSERVICE INSPECTION BOUNDARY DIAGRAM
 REACTOR CORE ISOLATION COOLING (RCIC)

Dwg No 151-219-1 RSV 1



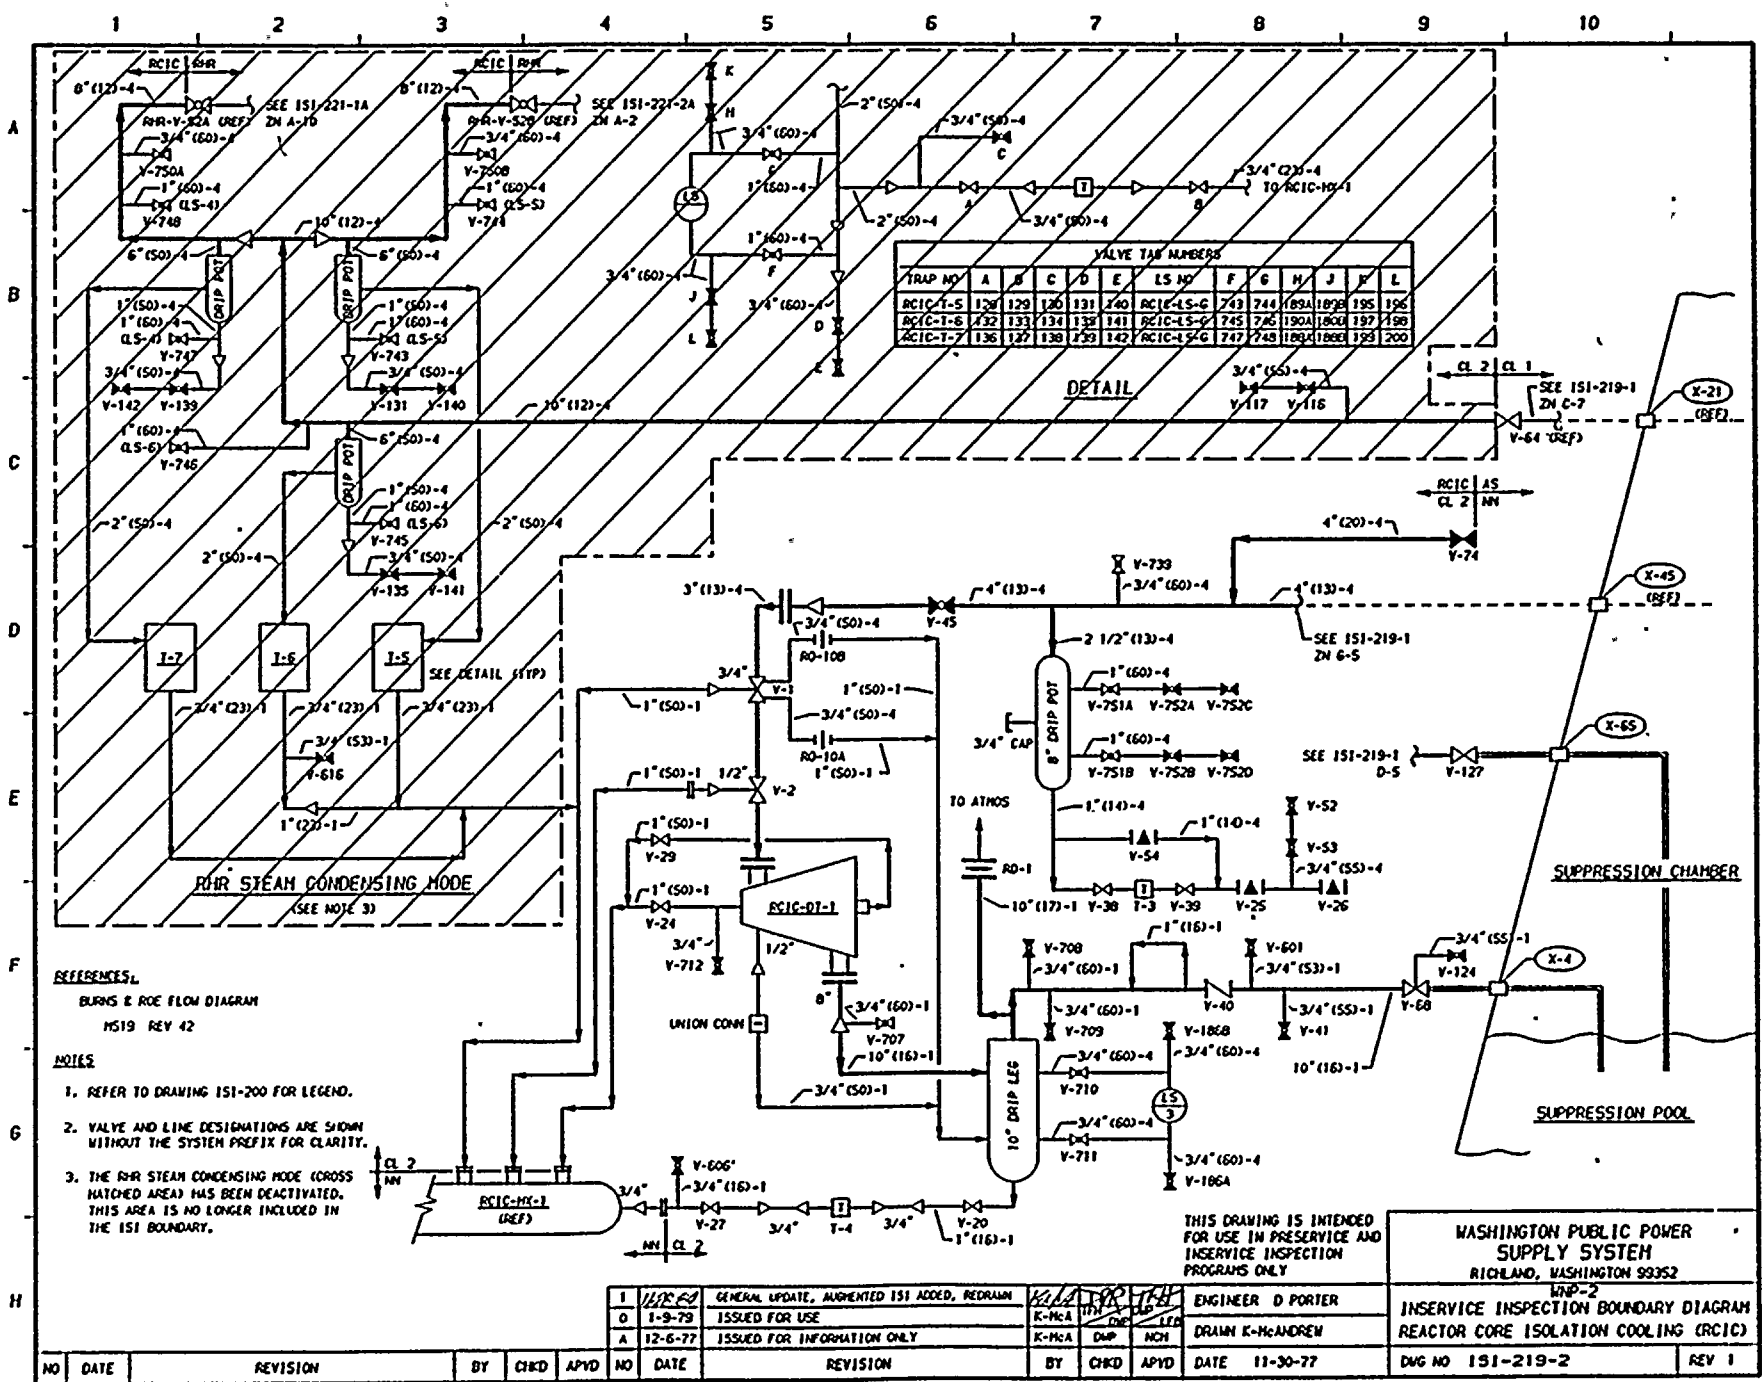

TRAP NO	A	B	C	D	E	LS NO	F	G	H	J	K	L
RCIC-T-5	120	129	130	131	140	RCIC-LS-C	743	744	189A	189B	195	196
RCIC-T-6	132	133	134	135	141	RCIC-LS-D	745	746	190A	180A	197	198
RCIC-T-7	136	127	138	139	142	RCIC-LS-E	747	748	180B	180C	199	200

REFERENCES:
 BURNS & ROE FLOW DIAGRAM
 MS19 REV 42

- NOTES:**
1. REFER TO DRAWING 151-200 FOR LEGEND.
 2. VALVE AND LINE DESIGNATIONS ARE SHOWN WITHOUT THE SYSTEM PREFIX FOR CLARITY.
 3. THE RHR STEAM CONDENSING MODE (CROSS HATCHED AREA) HAS BEEN DEACTIVATED. THIS AREA IS NO LONGER INCLUDED IN THE 151 BOUNDARY.


THIS DRAWING IS INTENDED FOR USE IN PRESERVICE AND INSERVICE INSPECTION PROGRAMS ONLY

WASHINGTON PUBLIC POWER SUPPLY SYSTEM
 RICHLAND, WASHINGTON 99352

WNP-2
 INSERVICE INSPECTION BOUNDARY DIAGRAM
 REACTOR CORE ISOLATION COOLING (RCIC)

DWG NO 151-219-2 REV 1

NO	DATE	REVISION	BY	CHKD	APVD	NO	DATE	REVISION	BY	CHKD	APVD	DATE
1	11-30-77	GENERAL UPDATE, AUGMENTED 151 ADDED, REDRAWN	K-MCA	DMP	MCN							11-30-77
0	1-9-79	ISSUED FOR USE	K-MCA	DMP	MCN							
A	12-6-77	ISSUED FOR INFORMATION ONLY	K-MCA	DMP	MCN							

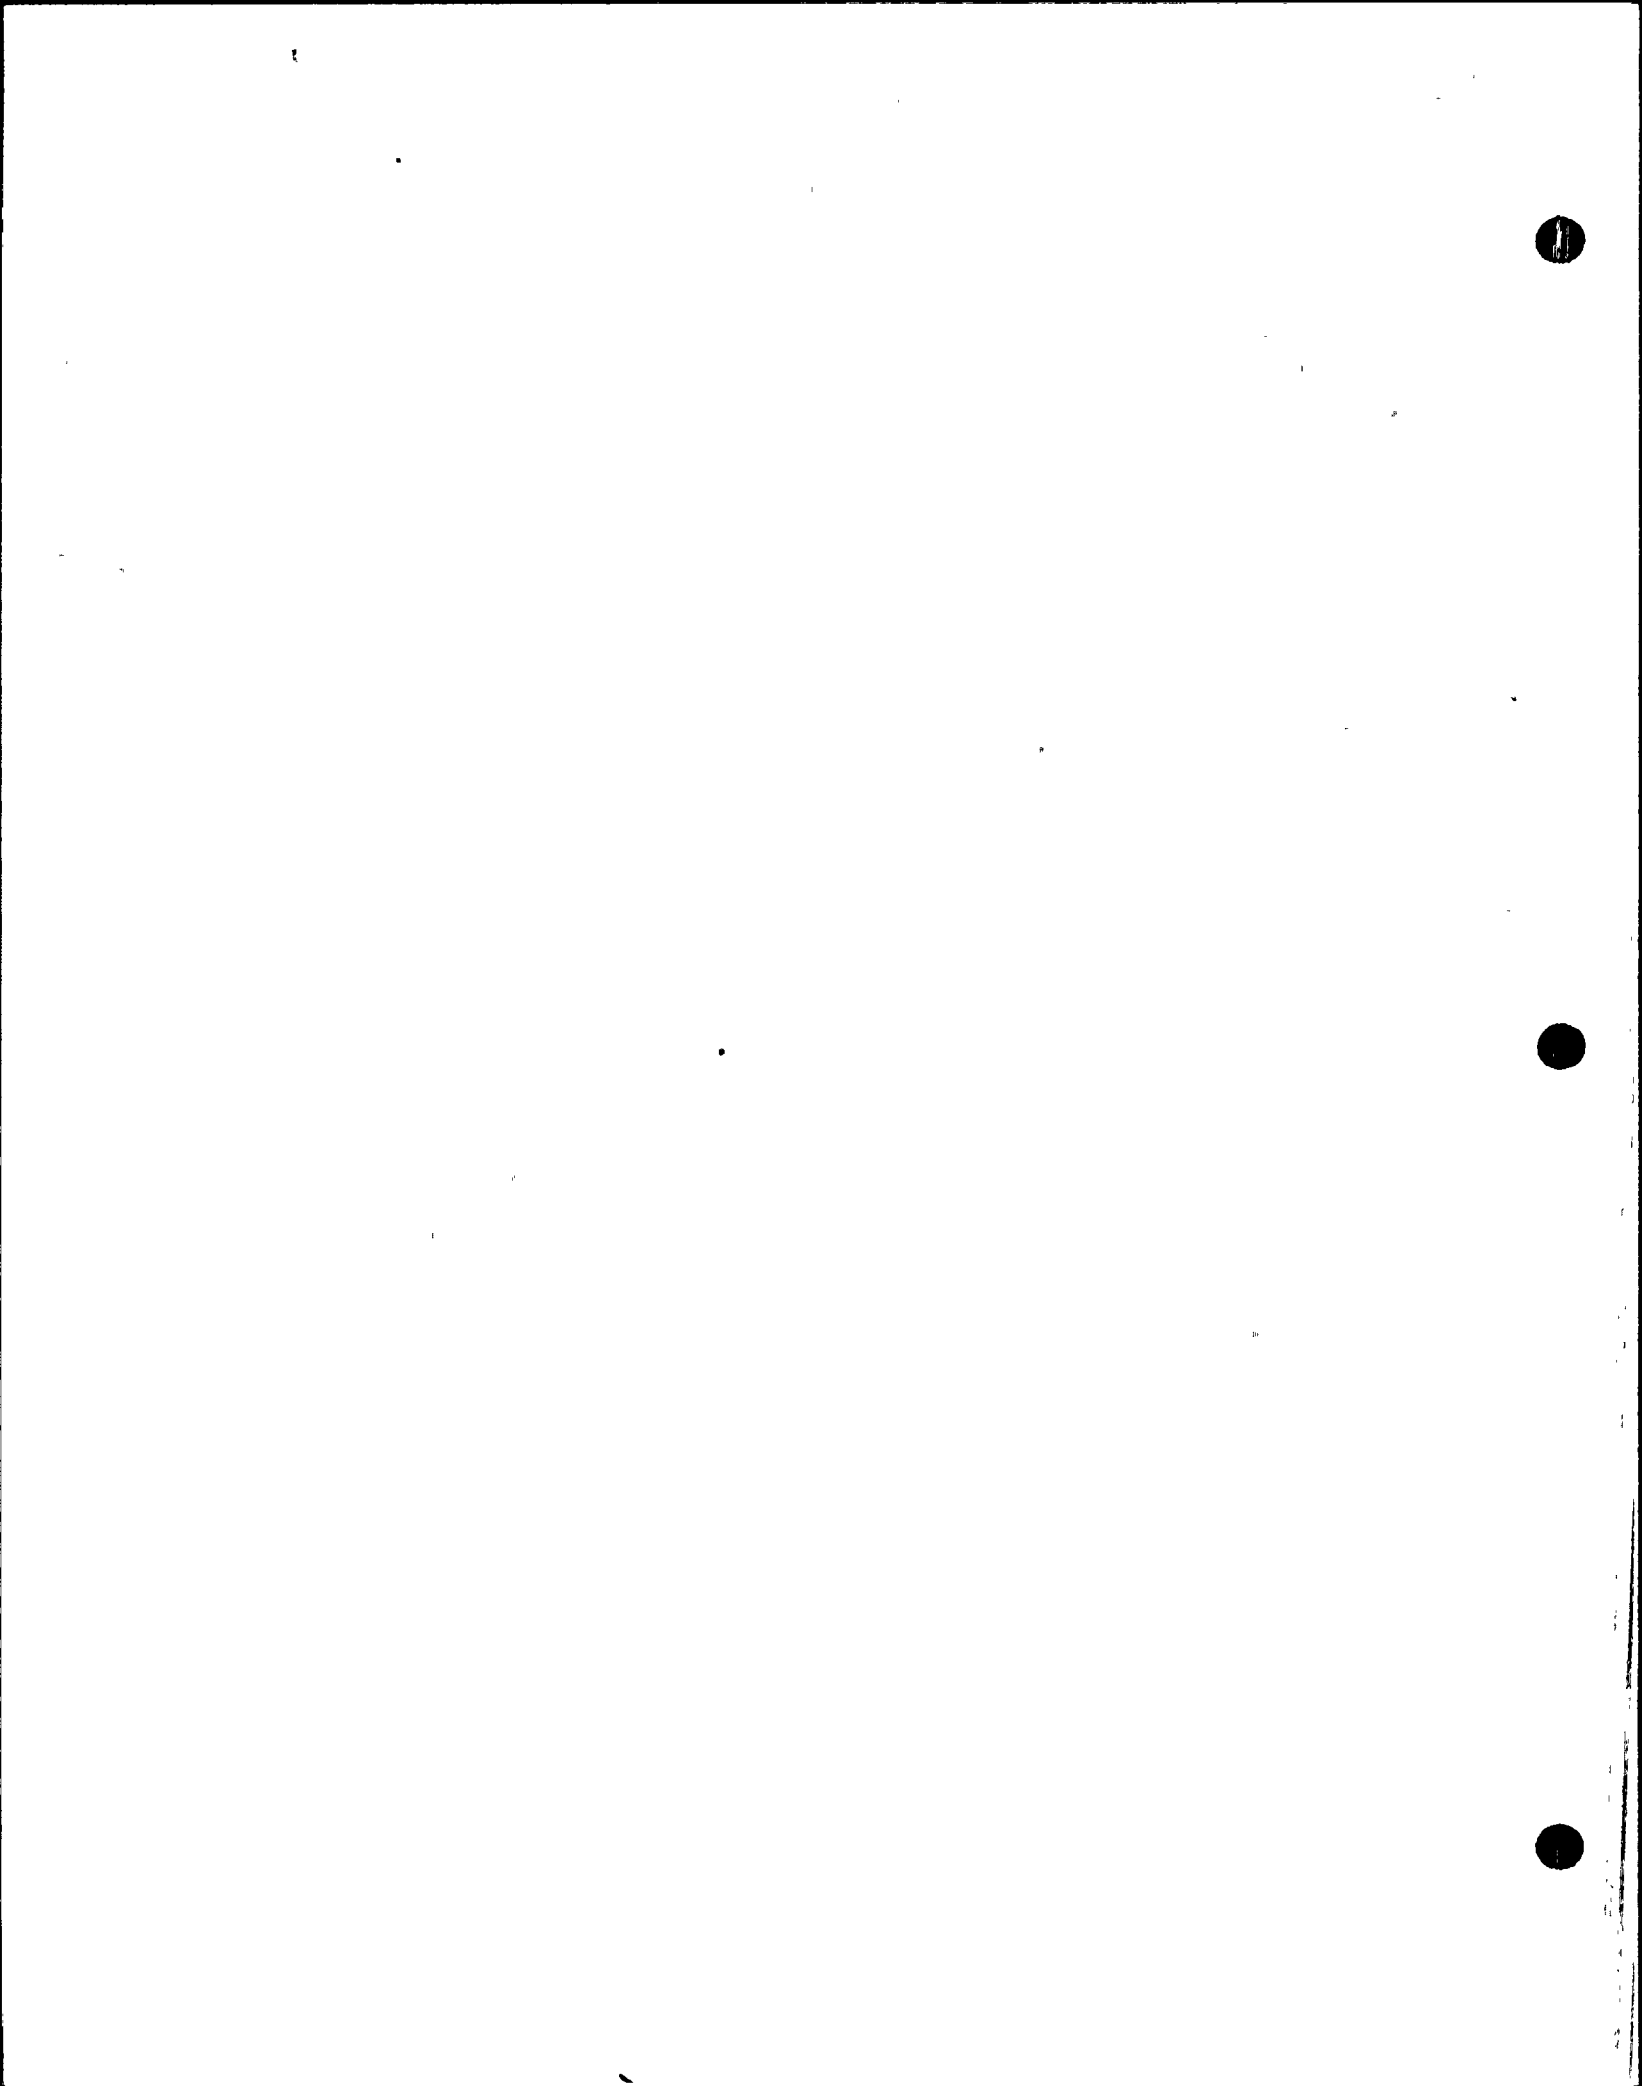

EXCEPTIONS AND EXEMPTIONSISI - 219SYSTEM Reactor Core Isolation Cooling (RCIC) SystemEXCEPTIONS:Class 1 Piping and Components

- o See general exceptions
- o No additional exceptions

Class 2 Piping and Components

- o See general exceptions.
- o No additional exceptions.

EXEMPTIONS APPLIED:

IWB-1220(a)(1) Yes, per code class boundary

(2) No

(3) No

(4) No

*(b)(1) No

(2) No

(3) Yes, all piping ≤ 1 " NPS.

IWC-1220(a) Yes, pump suction lines.

*(b) Yes, all piping > 4 ". RCIC system is non-ECCS and not "normal use" system.

(c) No

(d) Yes, all piping ≤ 4 " NPS.

IWC-5220(d) Yes, all lines open ended to suppression pool.

IWD-5200(c) No

* See general exemption discussion for details.



WNP-2 ISI BOUNDARY DIAGRAM

EXCEPTIONS AND EXEMPTIONS

ISI - 220

SYSTEM High Pressure Core Spray (HPCS)/Low Pressure Core Spray (LPCS) Systems

EXCEPTIONS:

Class 1 Piping and Components

- o See general exceptions.
- o No additional exceptions.

Class 2 Piping and Components

- o See general exceptions.
- o No additional exceptions.

EXEMPTIONS APPLIED:

IWB-1220(a)(1) Yes, per code class boundary.

(2) No

(3) No

(4) No

*(b)(1) No

(2) No

(3) Yes, all piping \leq 1" NPS.

IWC-1220(a) Yes, pump suction lines.

*(b) No

(c) 10% of all piping >4" NPS not exempted by (a), (b), or (d) will be examined by a volumetric method for HPCS and a surface method for LPCS.


(d) Yes, all piping \leq 4" NPS.

IWC-5220(d) Yes, all open ended piping to suppression pool.

IWC-5200(c) No

*See general exemption discussion for details.



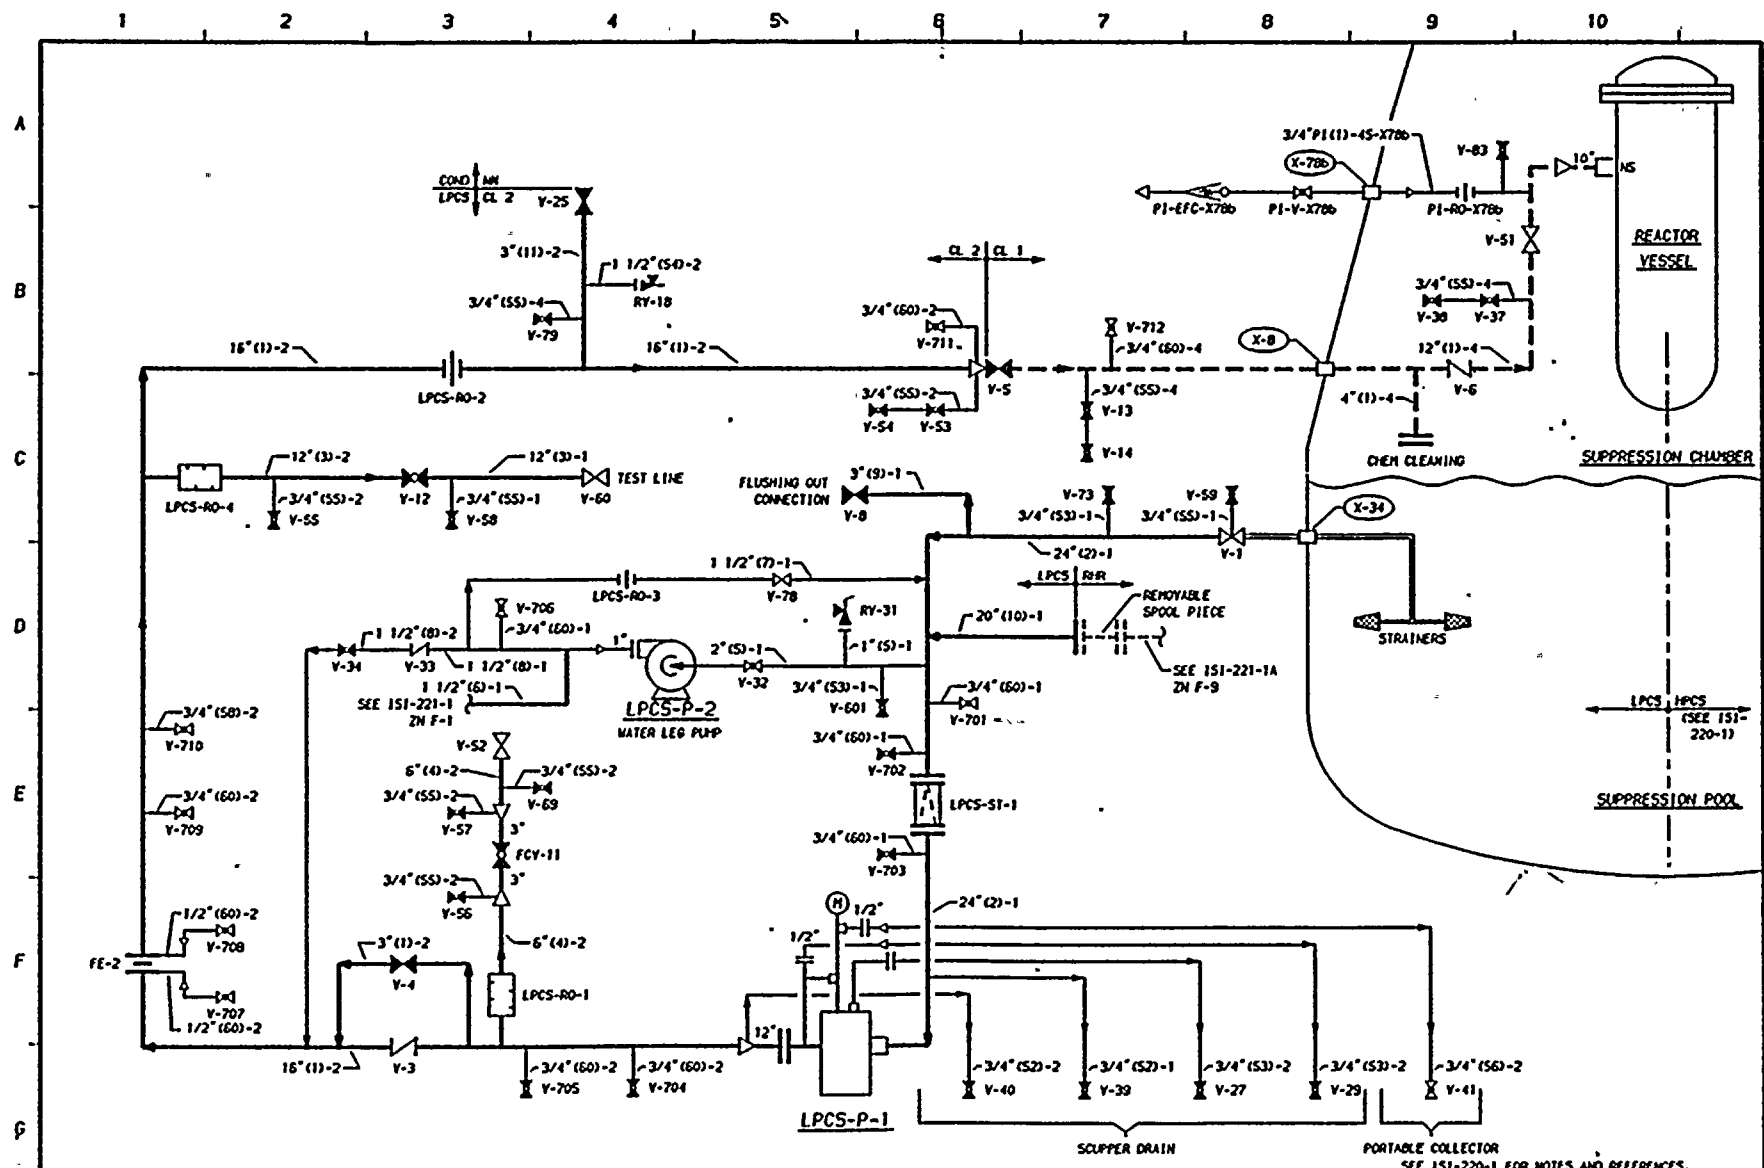

SEE 151-220-1 FOR NOTES AND REFERENCES.

WASHINGTON PUBLIC POWER
SUPPLY SYSTEM
RICHLAND, WASHINGTON 99352

MNP-2
INSERVICE INSPECTION BOUNDARY DIAGRAM
HIGH PRESSURE CORE SPRAY (HPCS)
LOW PRESSURE CORE SPRAY (LPCS)


DWG NO 151-220-2 REV 1

THIS DRAWING IS INTENDED
FOR USE IN PRESERVICE AND
INSERVICE INSPECTION
PROGRAMS ONLY

NO	DATE	REVISION	BY	CHKD	APVD	NO	DATE	REVISION	BY	CHKD	APVD	DATE	NO	REV
1	11-16-77	GENERAL UPDATE, SPLIT, (REDRAWN)	ALLA	TRP	TLG	0	11-22-76	ISSUED FOR USE (REDRAWN)	K-MCA	TRP	LFB	11-16-77	151-220-2	1
A	12-6-77	ISSUED FOR INFORMATION ONLY	K-MCA	DWP	DWP									

NO	DATE	REVISION	BY	CHKD	APVD



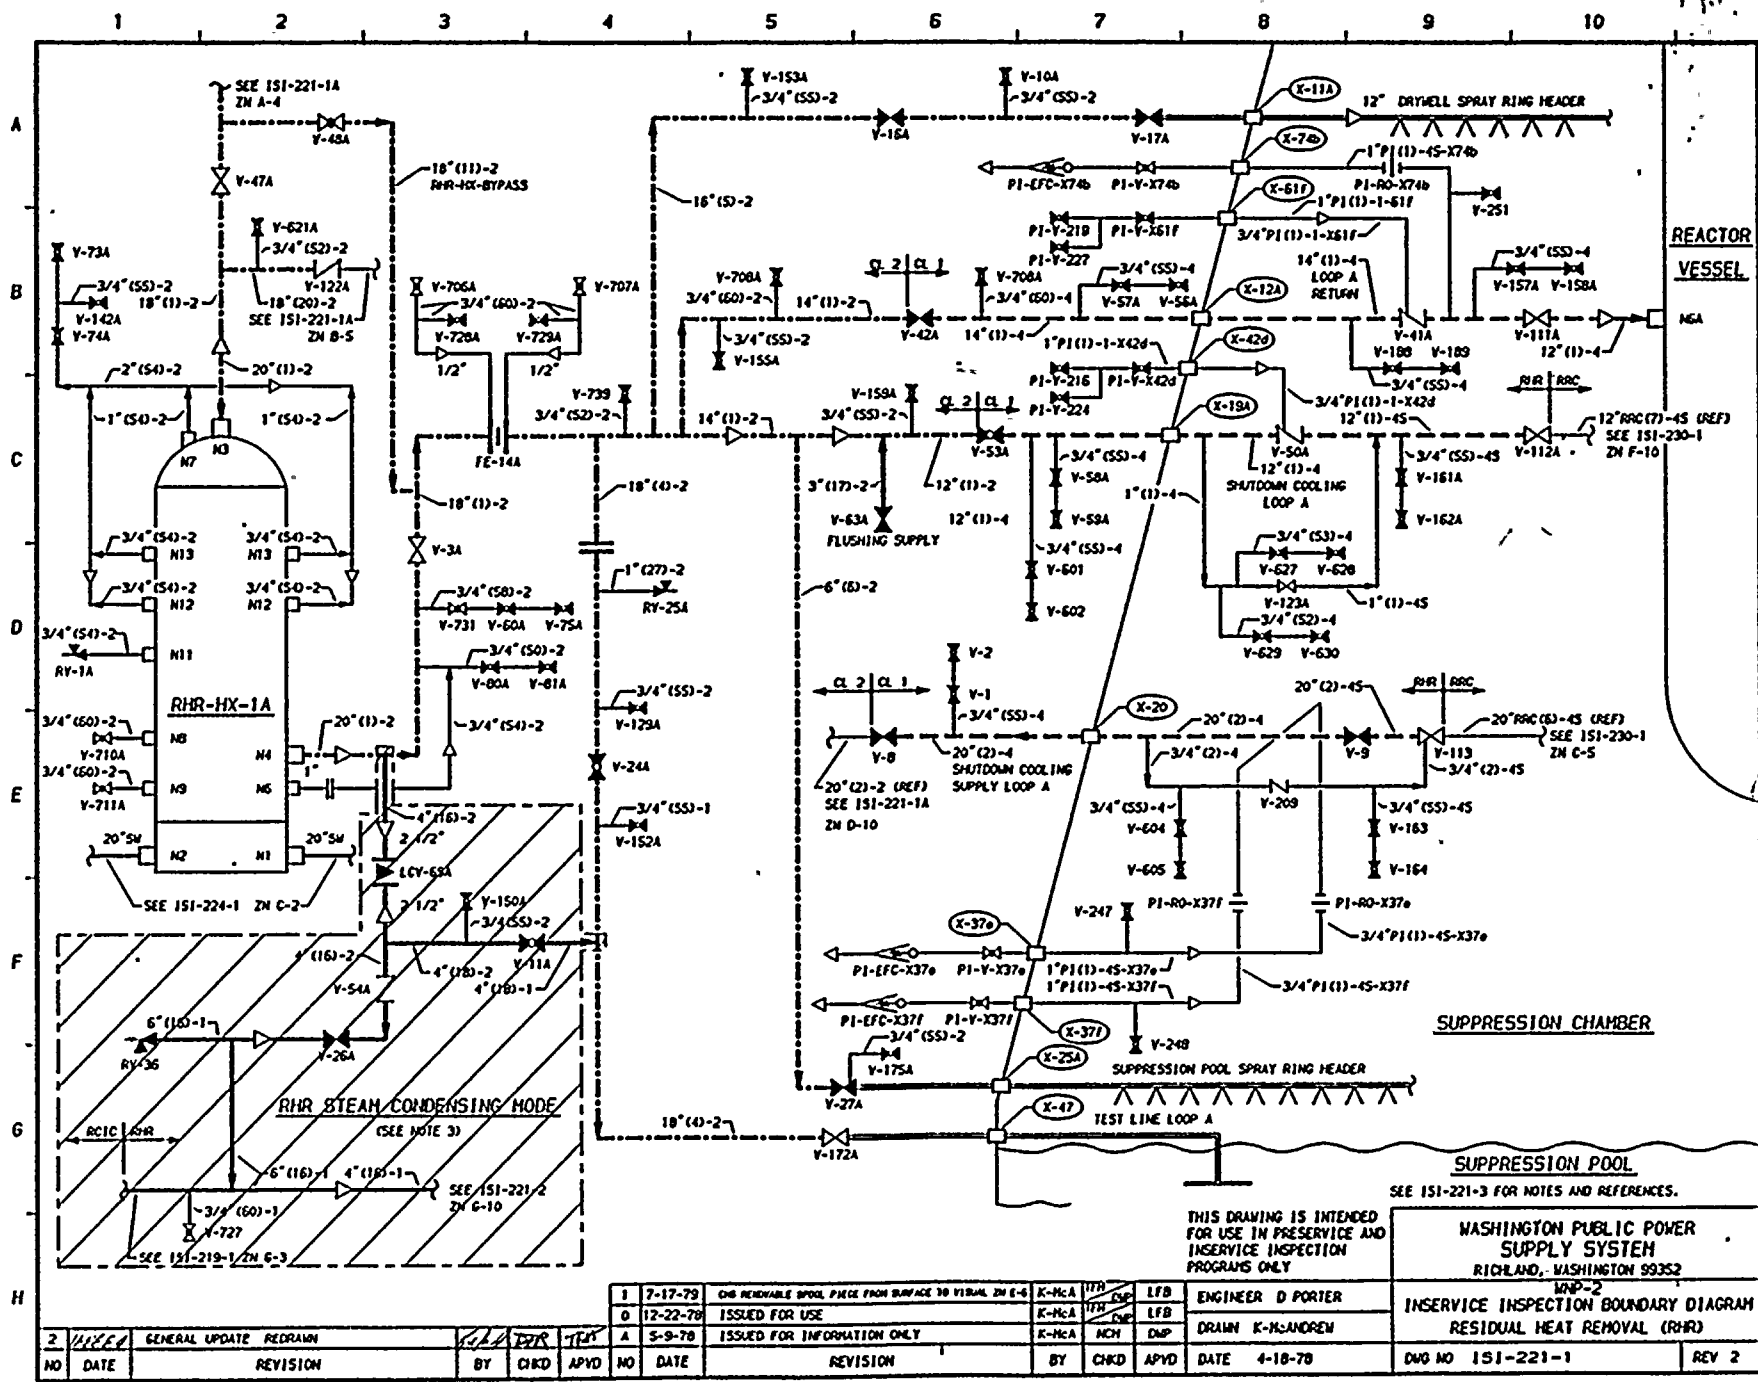

THIS DRAWING IS INTENDED FOR USE IN PRESERVICE AND INSERVICE INSPECTION PROGRAMS ONLY

SEE 151-221-3 FOR NOTES AND REFERENCES.


WASHINGTON PUBLIC POWER SUPPLY SYSTEM RICHLAND, WASHINGTON 99352			
INSERVICE INSPECTION BOUNDARY DIAGRAM RESIDUAL HEAT REMOVAL (RHR)			
DWG NO 151-221-1			
REV 2			

NO	DATE	REVISION	BY	CHKD	APVD
2	11/88	GENERAL UPDATE REDRAWN			

NO	DATE	REVISION	BY	CHKD	APVD
1	7-17-79	DRY WELL POOL PIPING FROM SURFACE TO VIBRAL ZN 6-4	K-MCA	TH	LFB
0	12-22-78	ISSUED FOR USE	K-MCA	TH	LFB
A	5-9-78	ISSUED FOR INFORMATION ONLY	K-MCA	MCH	DNP

DATE	ENGINEER	DATE	ENGINEER
4-18-78	D PORTER		K-MANDREW



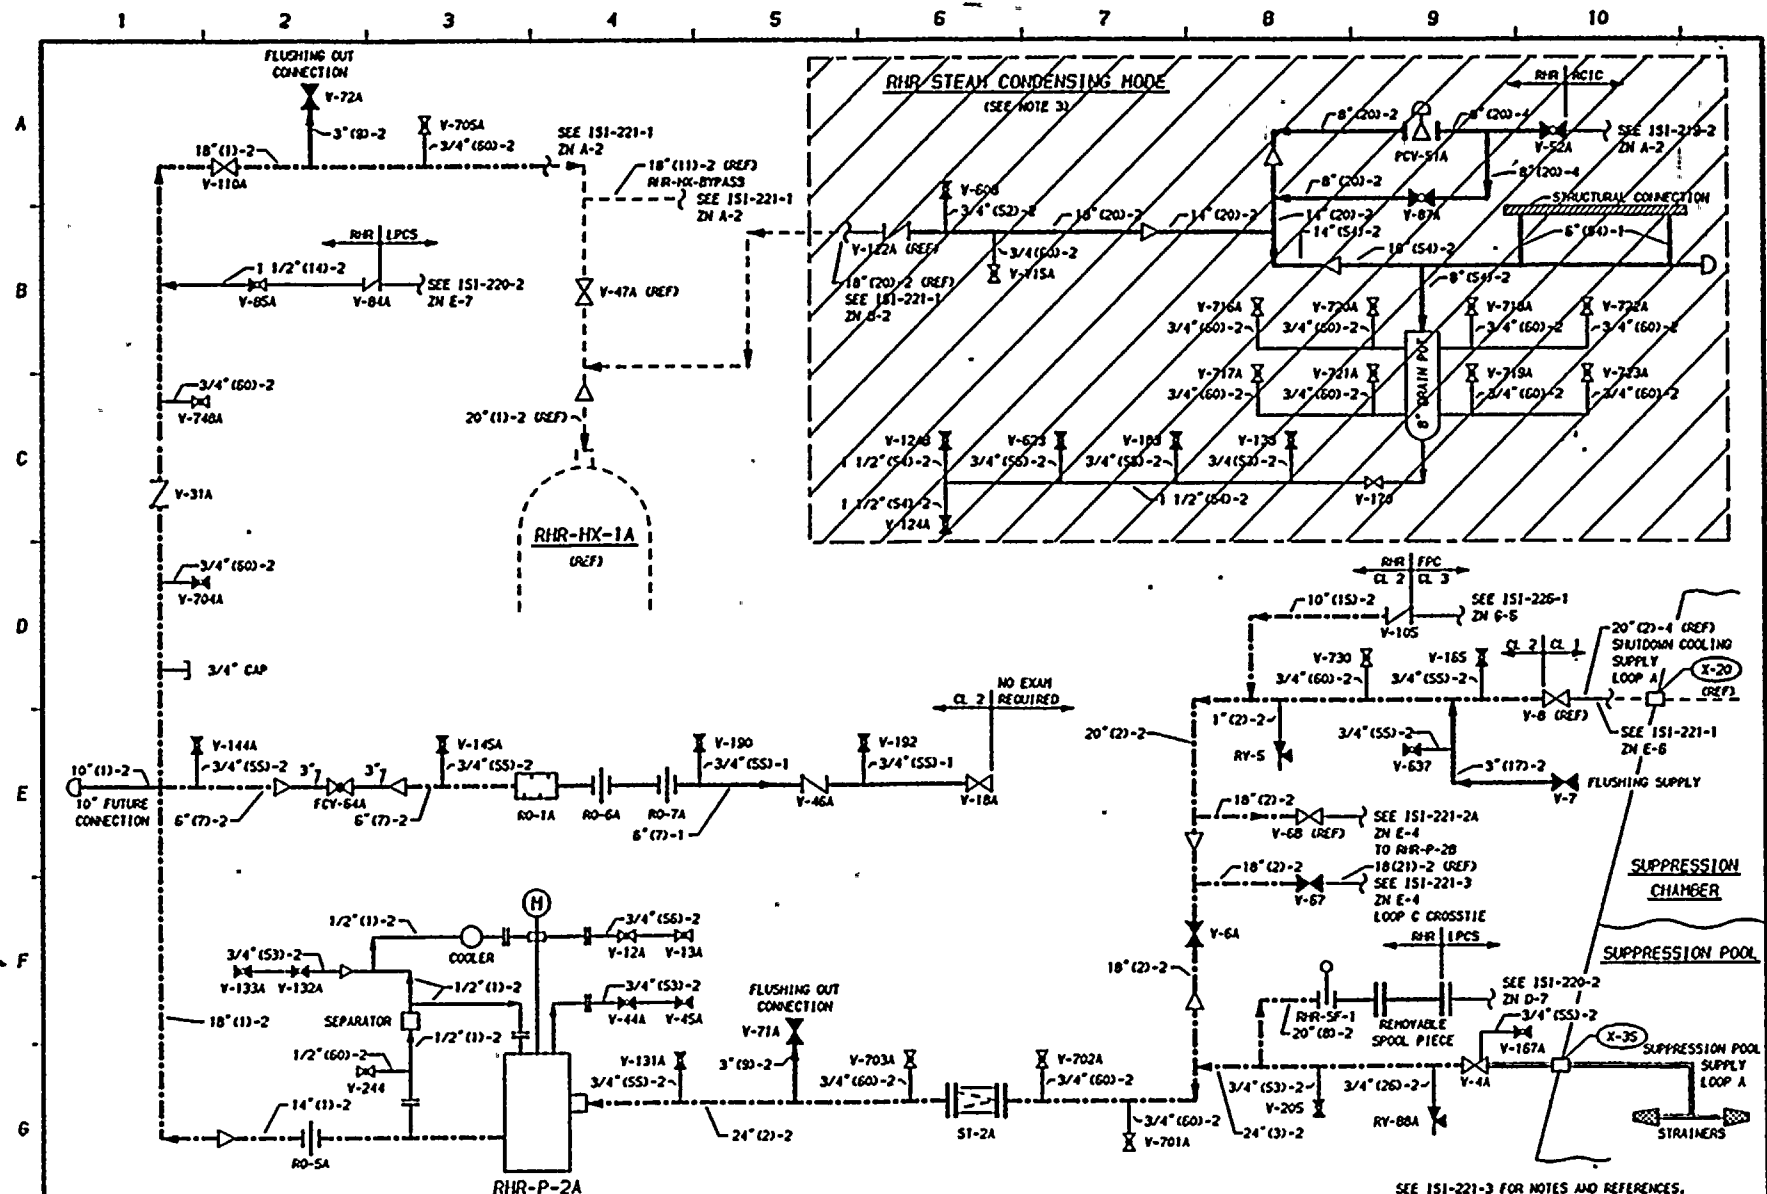

SEE 151-221-3 FOR NOTES AND REFERENCES.


THIS DRAWING IS INTENDED FOR USE IN PRESERVICE AND INSERVICE INSPECTION PROGRAMS ONLY

WASHINGTON PUBLIC POWER SUPPLY SYSTEM
 RICHLAND, WASHINGTON 99352

NO	DATE	REVISION	BY	CHKD	APVD	NO	DATE	REVISION	BY	CHKD	APVD	DATE	NO	DATE	REVISION
1	7-17-79	ENG REMOVABLE SPOOL PIECE FROM SURFACE TO VISUAL IN E-6	K-McA	MCH	LFB	1	7-17-79	ENG REMOVABLE SPOOL PIECE FROM SURFACE TO VISUAL IN E-6	K-McA	MCH	LFB	7-17-79	1	7-17-79	ENG REMOVABLE SPOOL PIECE FROM SURFACE TO VISUAL IN E-6
2	12-22-78	ISSUED FOR USE	K-McA	MCH	LFB	2	12-22-78	ISSUED FOR USE	K-McA	MCH	LFB	12-22-78	2	12-22-78	ISSUED FOR USE
3	5-9-78	ISSUED FOR INFORMATION ONLY	K-McA	MCH	DAP	3	5-9-78	ISSUED FOR INFORMATION ONLY	K-McA	MCH	DAP	5-9-78	3	5-9-78	ISSUED FOR INFORMATION ONLY
4						4							4		
5						5							5		
6						6							6		
7						7							7		
8						8							8		
9						9							9		
10						10							10		

INSERVICE INSPECTION BOUNDARY DIAGRAM
 RESIDUAL HEAT REMOVAL (RHR)
 WRP-2
 Dwg NO 151-221-1A REV 2



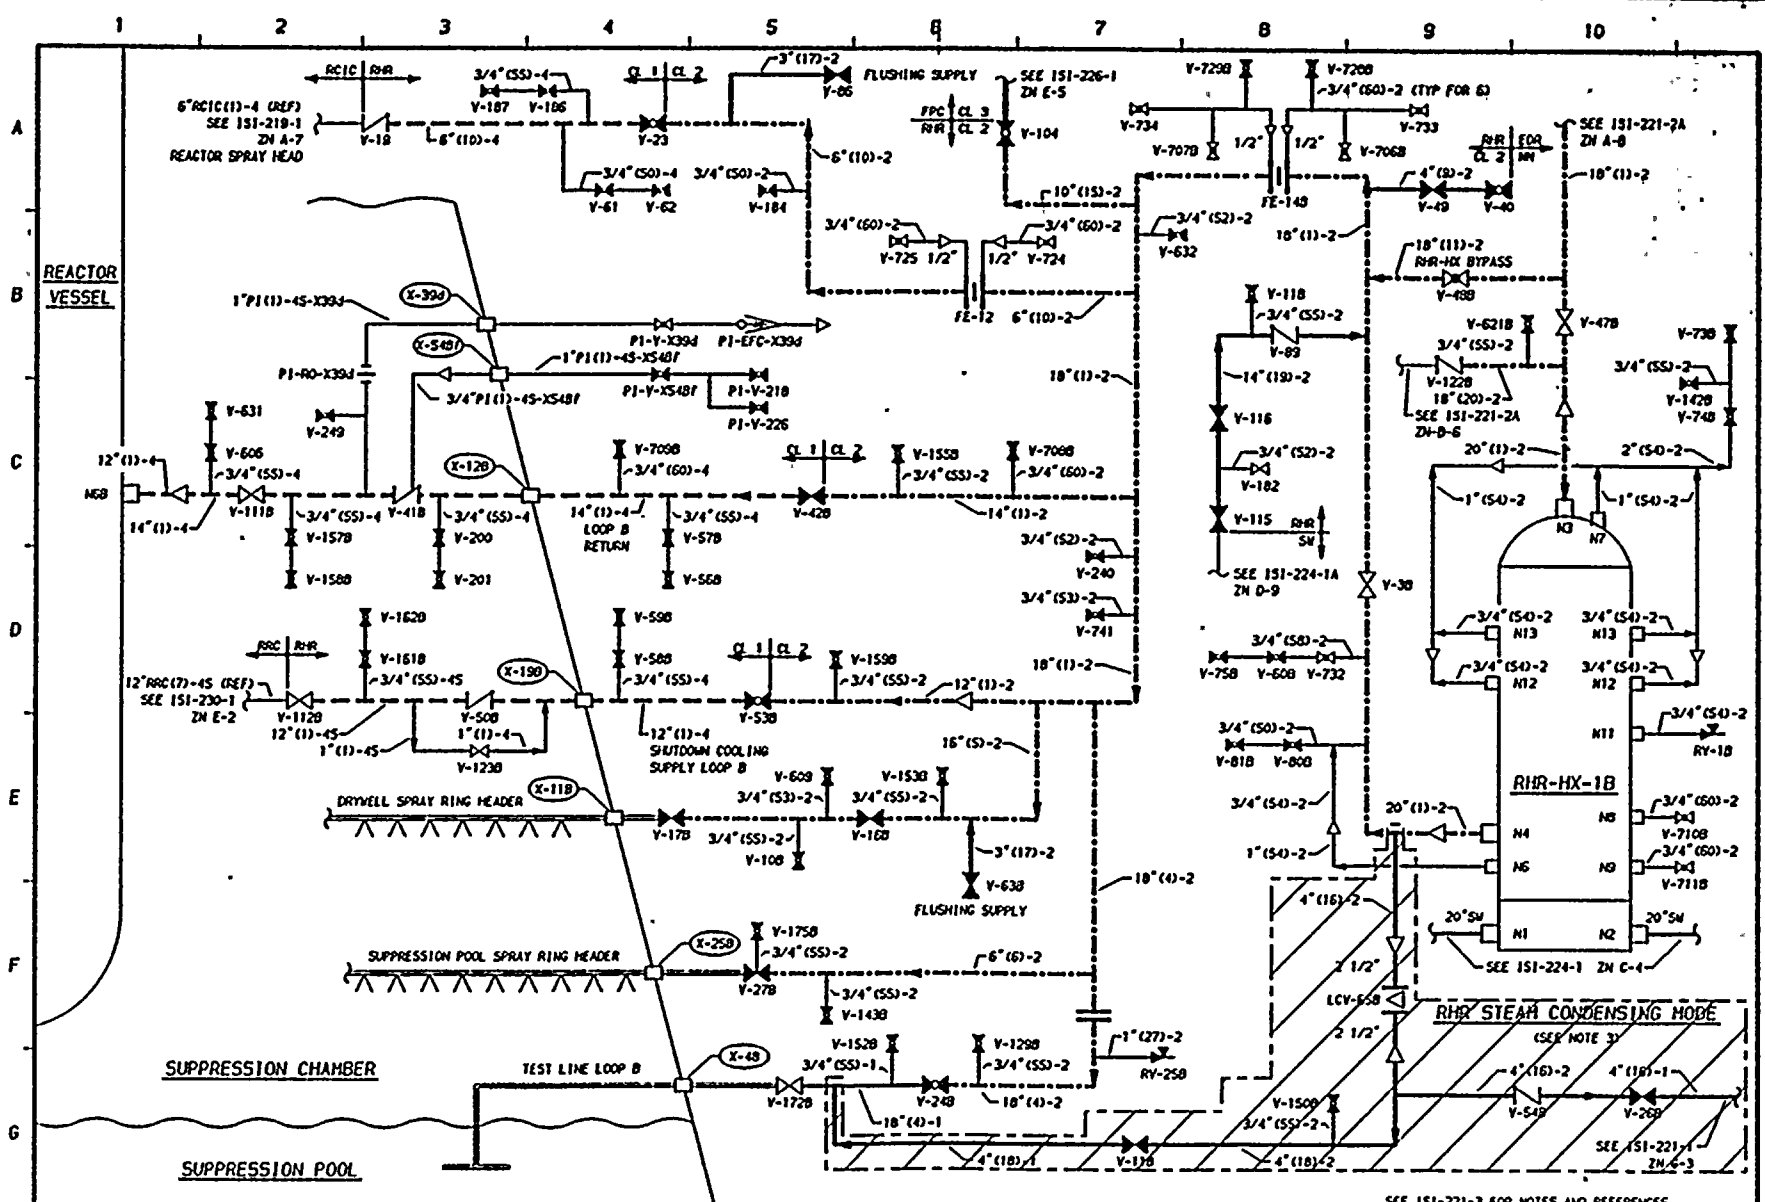

THIS DRAWING IS INTENDED FOR USE IN PRESERVICE AND INSERVICE INSPECTION PROGRAMS ONLY

SEE 151-221-3 FOR NOTES AND REFERENCES.


WASHINGTON PUBLIC POWER SUPPLY SYSTEM
 RICHLAND, WASHINGTON 99352


INSERVICE INSPECTION BOUNDARY DIAGRAM
 RESIDUAL HEAT REMOVAL (RHR)

NO	DATE	REVISION	BY	CHKD	APVD	NO	DATE	REVISION	BY	CHKD	APVD	DATE
1	11-22-78	GENERAL UPDATE REDRAWN	K-MCA	MCH	DWP	1	4-19-78	ENGINEER D PORTER	K-MCA	MCH	LFB	4-19-78
0	12-22-78	ISSUED FOR USE	K-MCA	MCH	DWP			DRAIN K-MCA	K-MCA	MCH	DWP	
A	5-9-78	ISSUED FOR INFORMATION ONLY	K-MCA	MCH	DWP							

NO	DATE	REVISION	BY	CHKD	APVD	NO	DATE	REVISION	BY	CHKD	APVD	DATE

DWG NO 151-221-2 REV 1

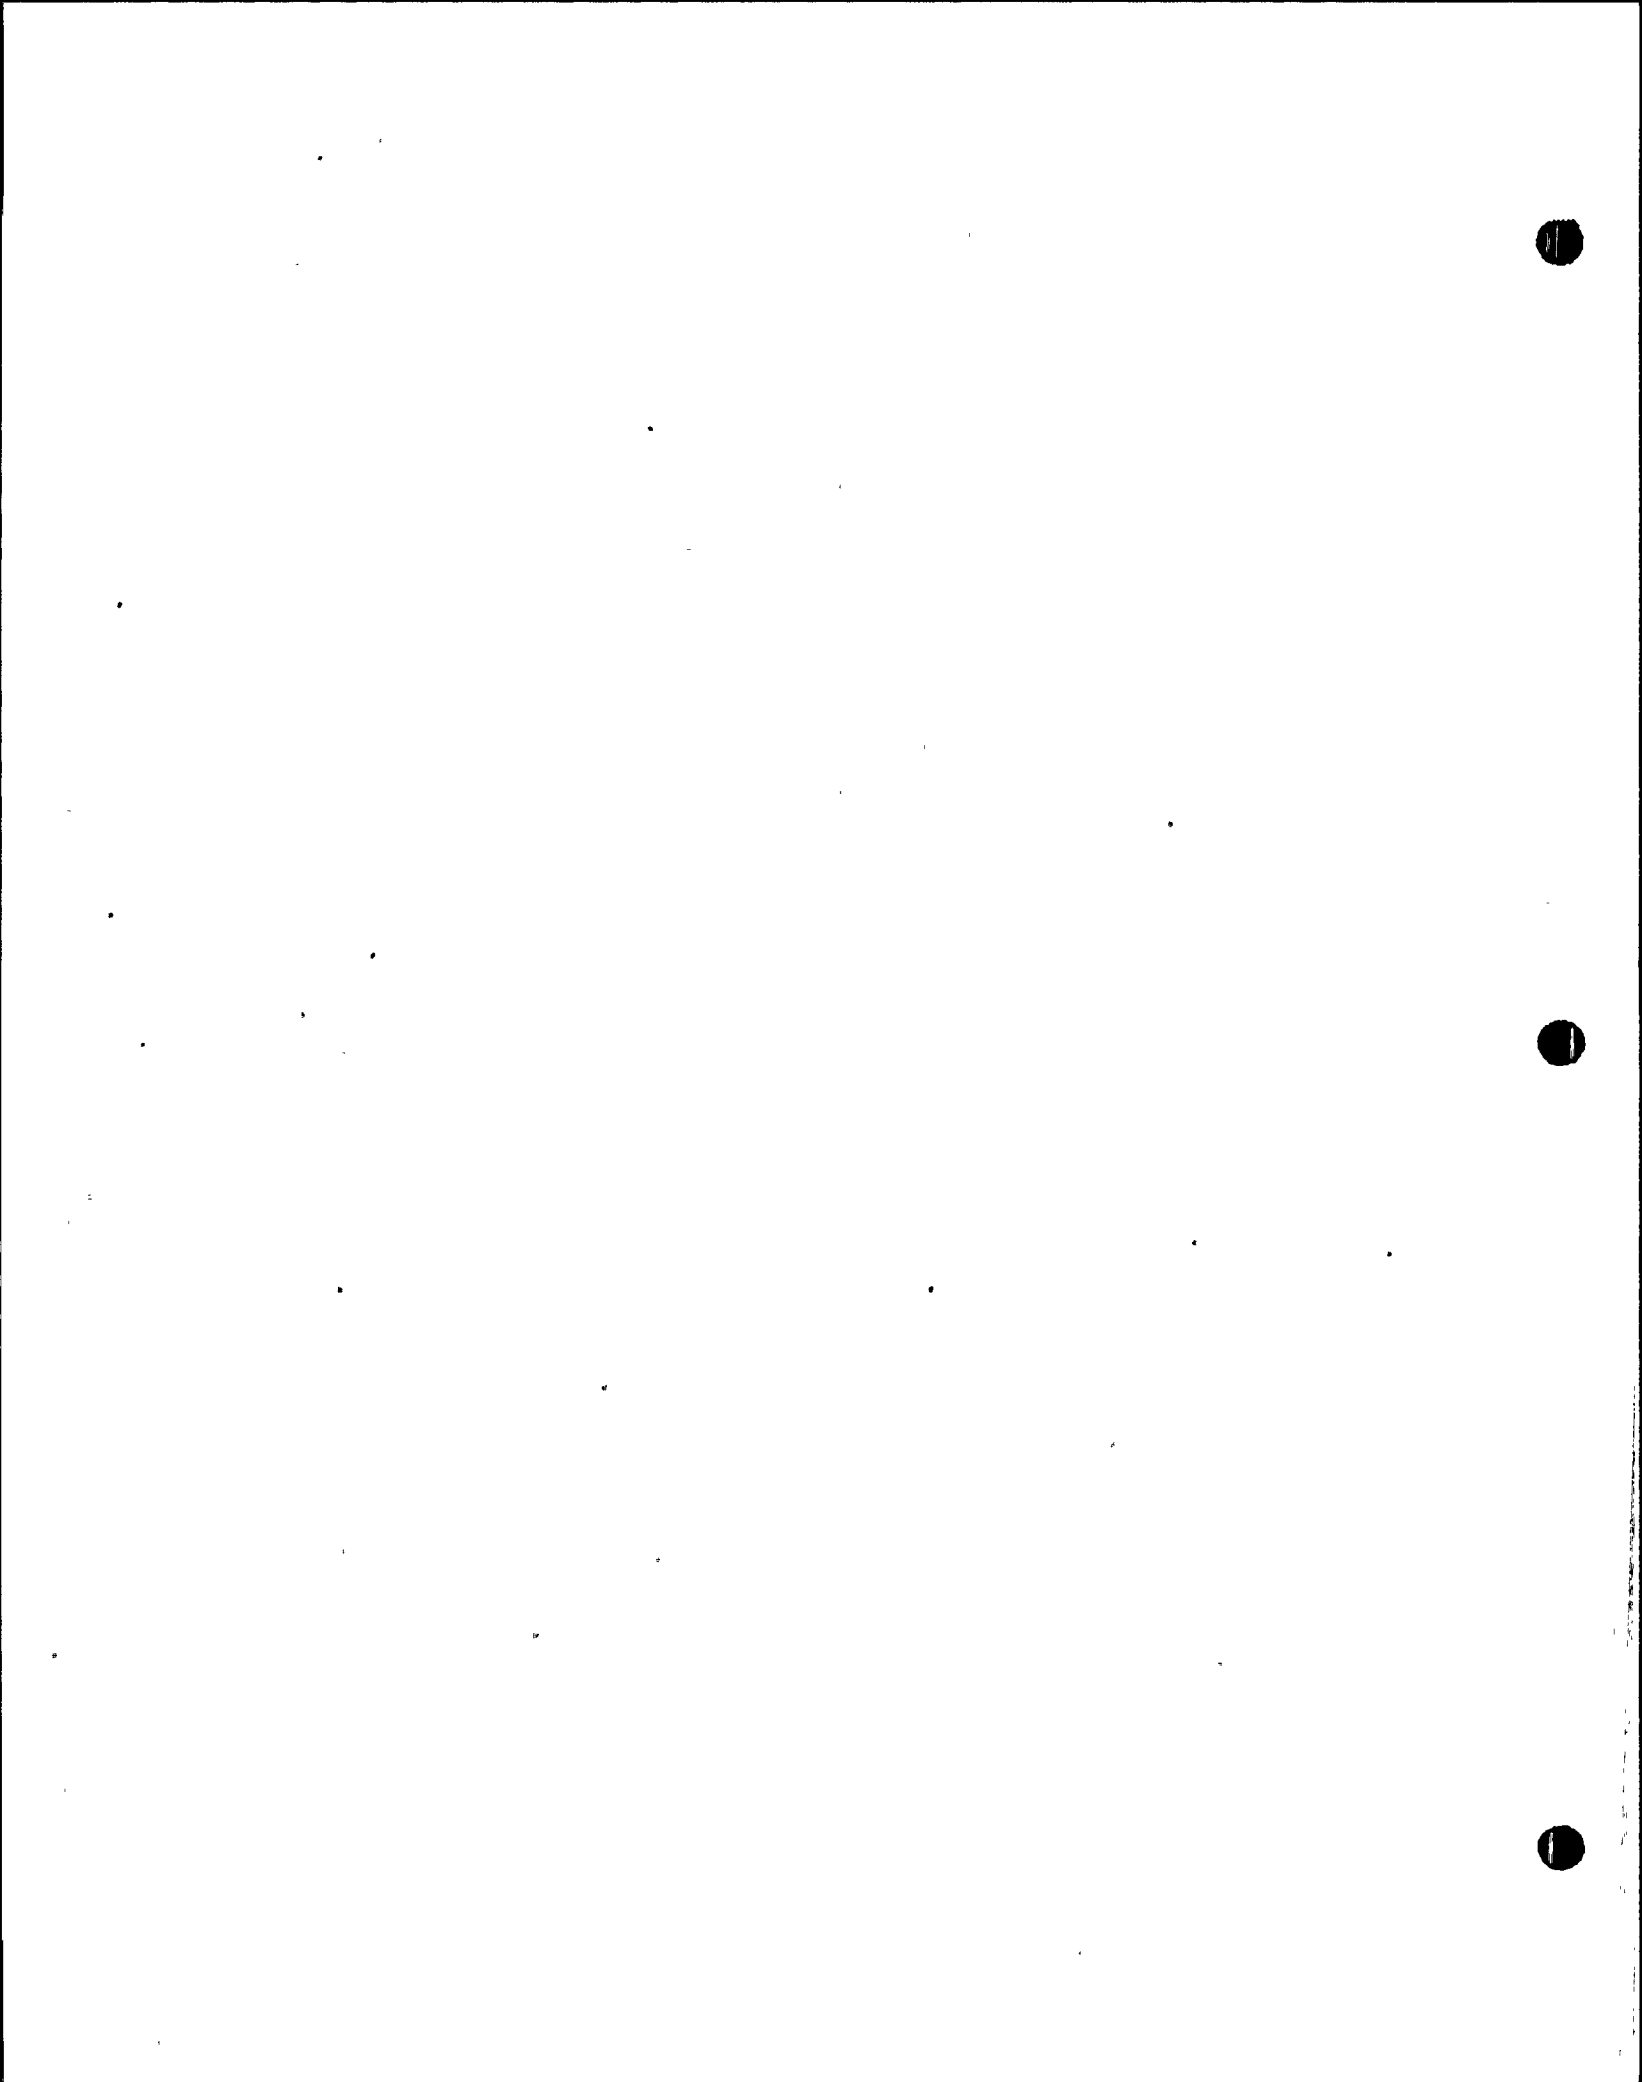

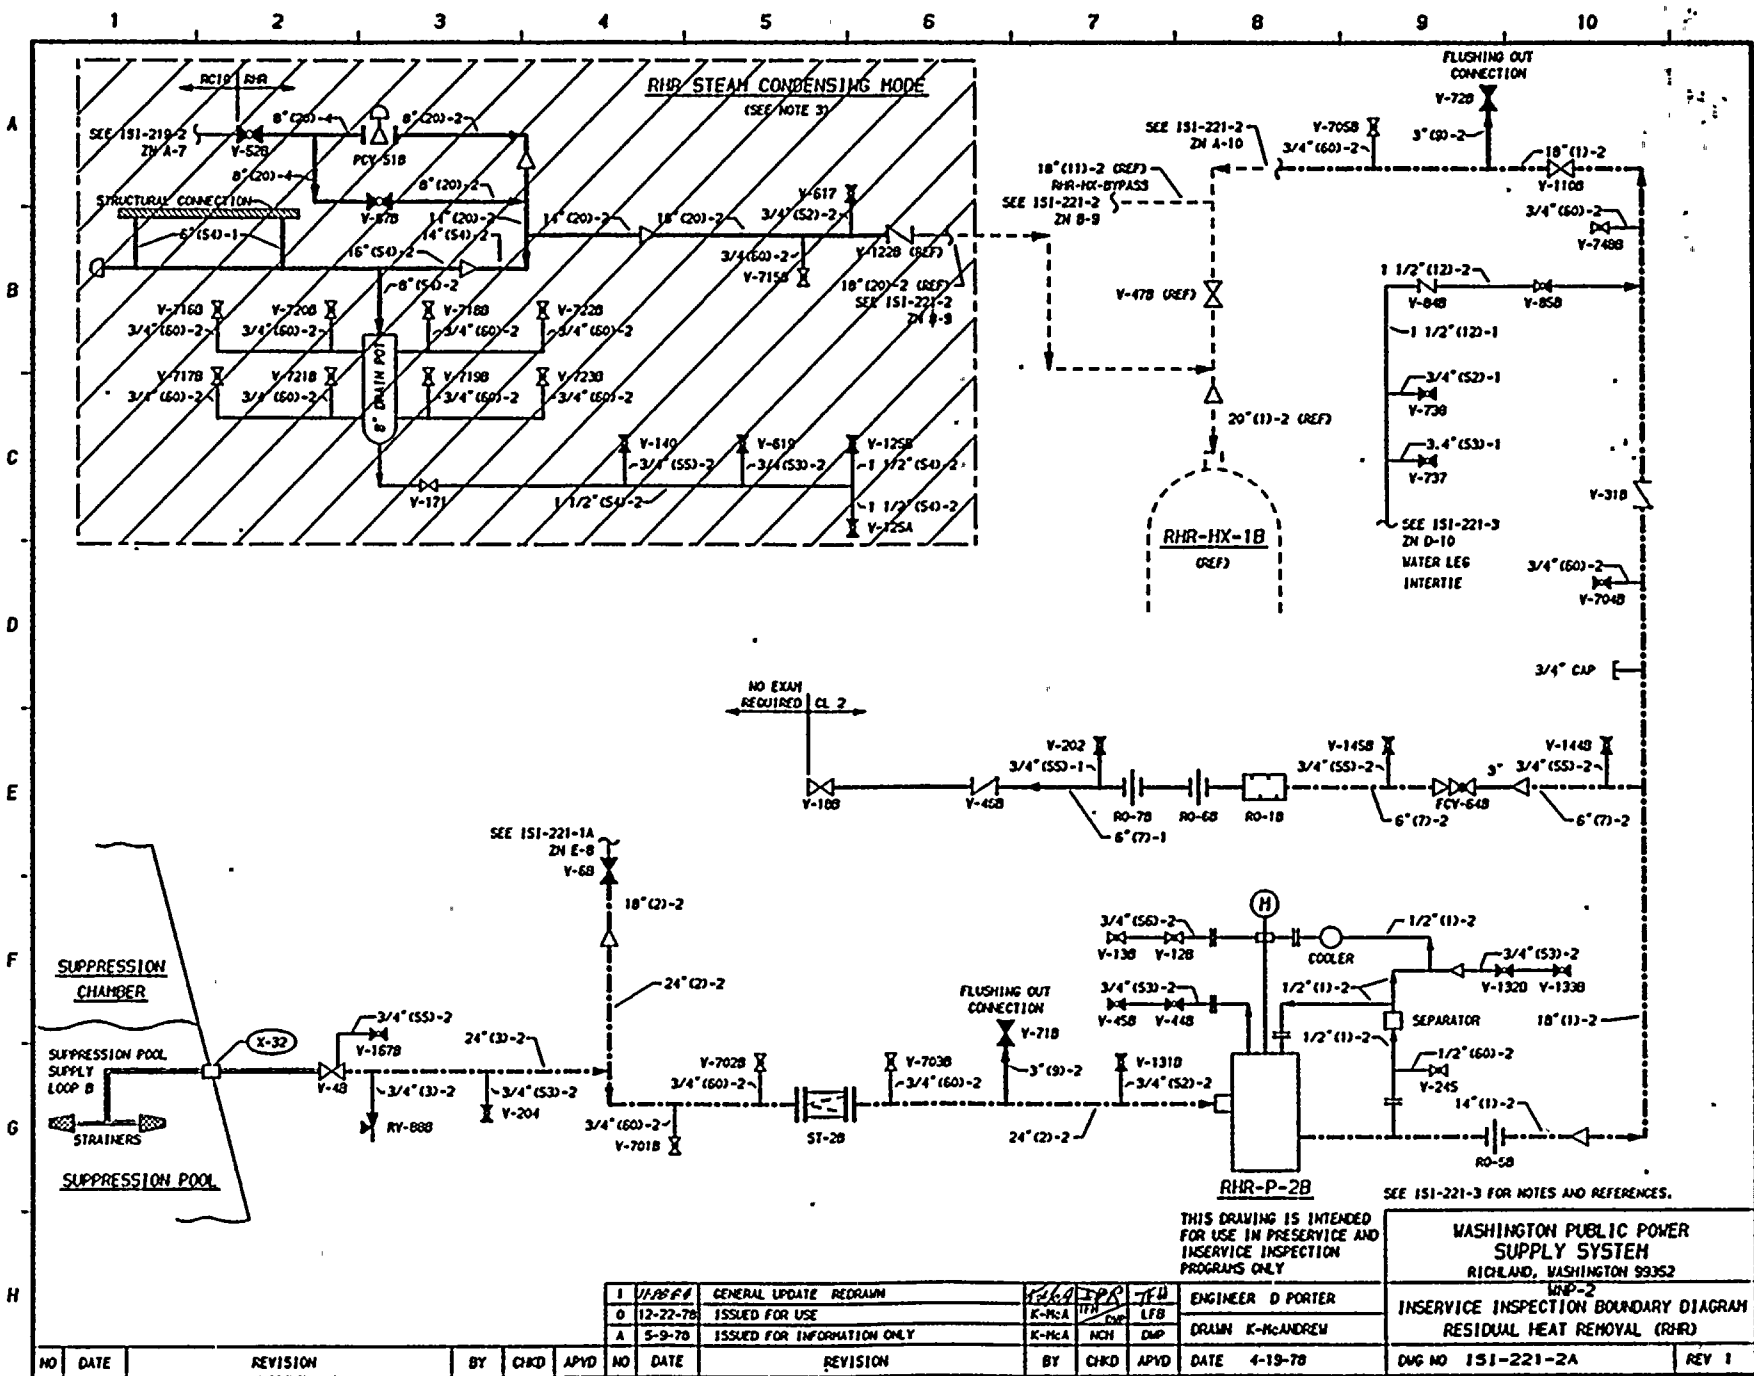

NO	DATE	REVISION	BY	CHKD	APYD	NO	DATE	REVISION	BY	CHKD	APYD	DATE
1	11-28-77	GENERAL UPDATE REDRAWN				1	4-19-78					4-19-78
0	12-22-76	ISSUED FOR USE										
A	5-9-76	ISSUED FOR INFORMATION ONLY										


THIS DRAWING IS INTENDED FOR USE IN PRESERVICE AND INSERVICE INSPECTION PROGRAMS ONLY

WASHINGTON PUBLIC POWER SUPPLY SYSTEM
 RICHLAND, WASHINGTON 99352

INSERVICE INSPECTION BOUNDARY DIAGRAM
 RESIDUAL HEAT REMOVAL (RHR)

DWG NO 151-221-2A REV 1



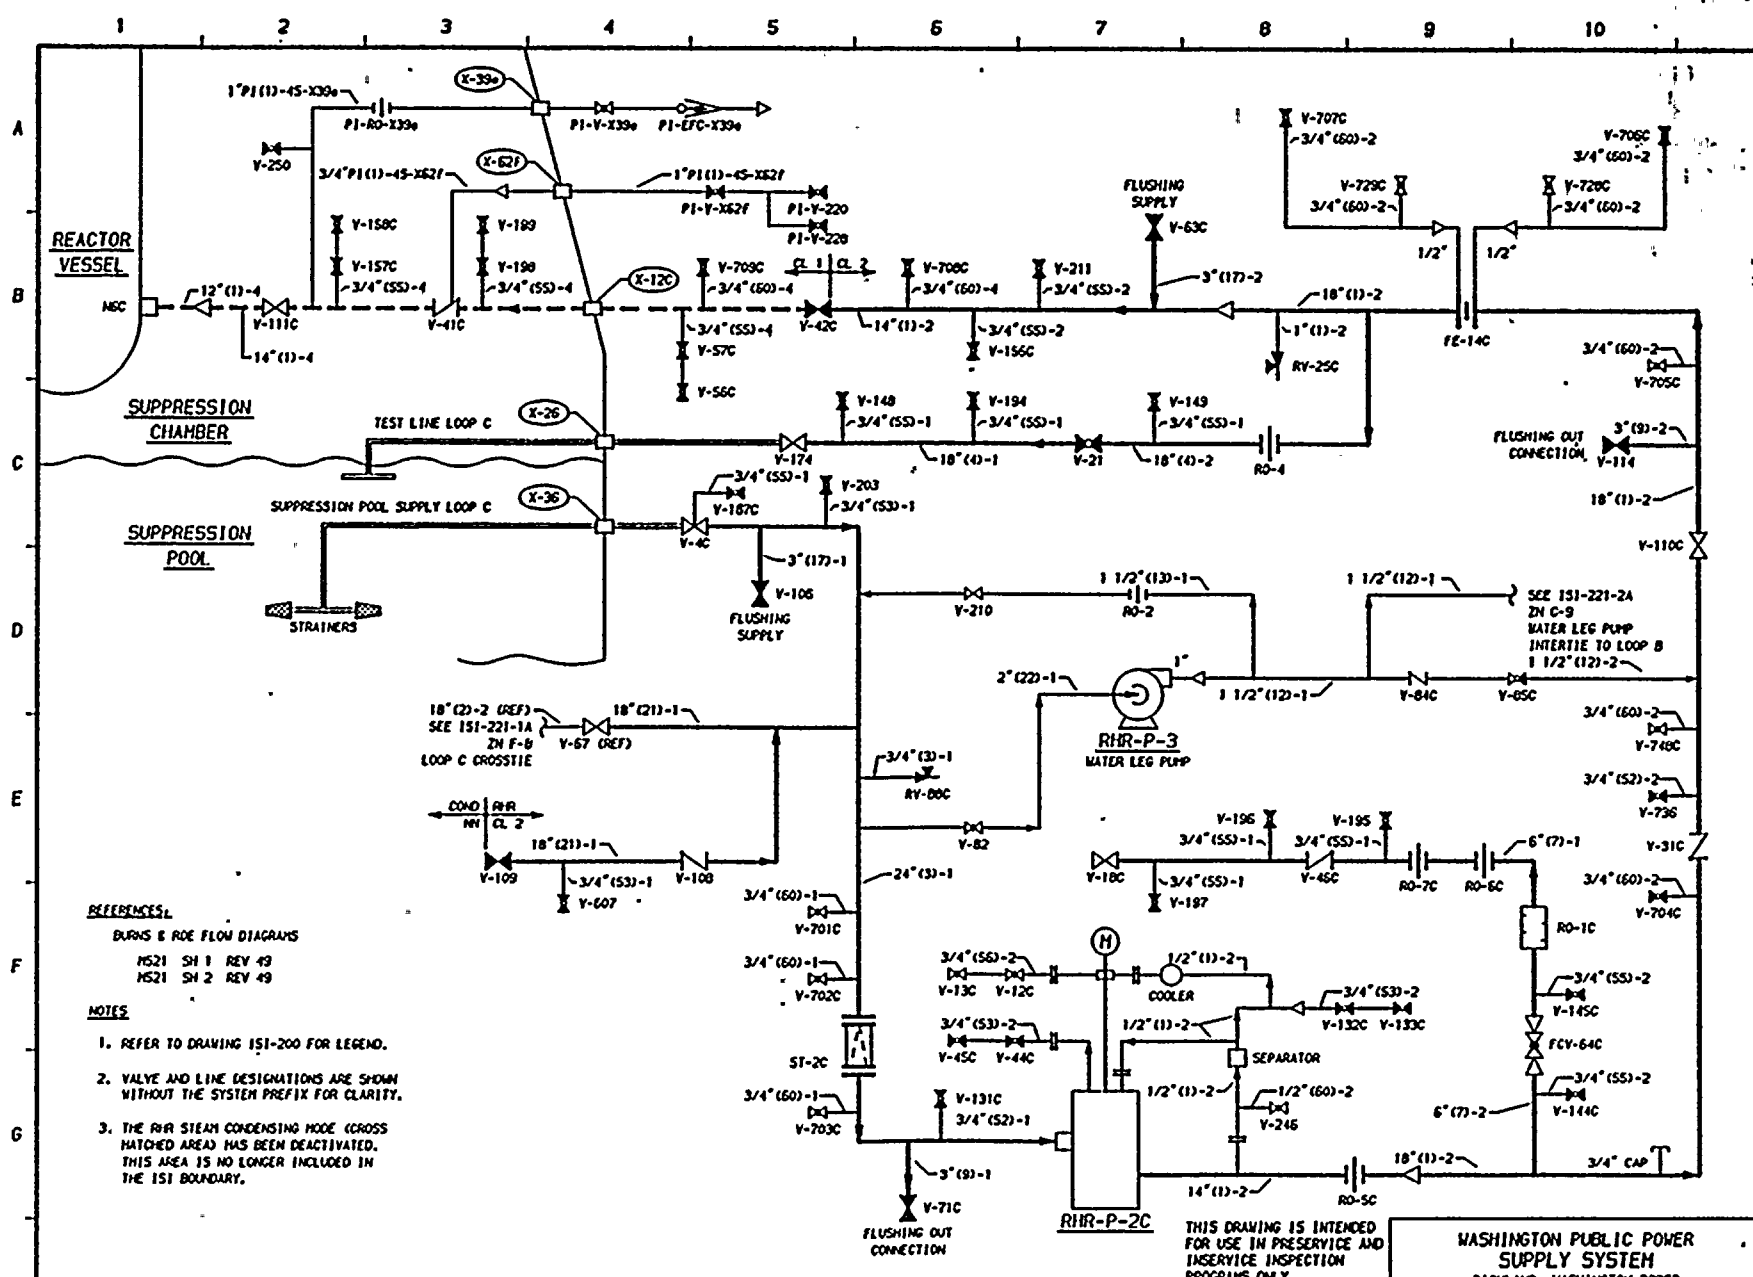

REFERENCES:
 BURNS & ROE FLOW DIAGRAMS
 MS21 SH 1 REV 49
 MS21 SH 2 REV 49

NOTES:

- REFER TO DRAWING 151-200 FOR LEGEND.
- VALVE AND LINE DESIGNATIONS ARE SHOWN WITHOUT THE SYSTEM PREFIX FOR CLARITY.
- THE RHR STEAM CONDENSING MODE (CROSS HATCHED AREA) HAS BEEN DEACTIVATED. THIS AREA IS NO LONGER INCLUDED IN THE 151 BOUNDARY.

1	7-17-79	DNB REMOVABLE STOP PIECE FROM SURFACE TO VISUAL DN E-6	K-McA	MCH	DWP	LFB	ENGINEER D PORTER
0	12-22-78	ISSUED FOR USE	K-McA	MCH	DWP	LFB	INSERVICE INSPECTION BOUNDARY DIAGRAM
A	5-9-78	ISSUED FOR INFORMATION ONLY	K-McA	MCH	DWP	DMP	DRAWN K-McANDREW
NO	DATE	REVISION	BY	CHKD	APVD	DATE	4-18-78

THIS DRAWING IS INTENDED FOR USE IN PRESERVICE AND INSERVICE INSPECTION PROGRAMS ONLY

WASHINGTON PUBLIC POWER SUPPLY SYSTEM RICHLAND, WASHINGTON 99352	
WPP-2	INSERVICE INSPECTION BOUNDARY DIAGRAM RESIDUAL HEAT REMOVAL (RHR)
DWG NO 151-221-3	REV 2

H



WNP-2 ISI BOUNDARY DIAGRAM
EXCEPTIONS AND EXEMPTIONS

ISI - 221

SYSTEM Residual Heat Removal (RHR) System

EXCEPTIONS:

Class 1 Piping and Components

- o See general exceptions.
- o No additional exceptions.

Class 2 Piping and Components

- o See general exceptions.
- o Additional exception as follows: the RHR pump P-2A and P-2B will not be examined using a volumetric method due to inaccessibility. See justification on following page. A surface examination on the pump casing welds from the I.D. when the pumps are disassembled will be performed in lieu of a volumetric examination. Accessible portions of the discharge nozzle longitudinal weld and the shell weld will be examined using a surface method.

EXEMPTIONS APPLIED:

- IWB-1220(a)(1) Yes, per code class boundary.
- (2) No
- (3) No
- (4) No
- *(b)(1) Yes, 3" RHR (17)-2 (Sheet 2, Zone A-5/6)
- (2) No
- (3) Yes, all piping ≤ 1 " NPS.
- IWC-1220(a) Yes, pump suction lines.
- *(b) Yes
- (c) 10% of all piping > 4 " NPS not exempted by (a), (b), or (d) will be examined by a volumetric method.
- (d) Yes, all piping ≤ 4 " NPS.
- IWC-5220(d) Yes, all open ended piping to suppression pool.
- IWC-5200(c) No


*See general exemption discussion for details.



JUSTIFICATION FOR SURFACE EXAMINATION OF
THE RHR PUMPS P-2A AND P-2B

The RHR pumps were designed prior to the requirement to perform Class 2 component examinations for preservice and inservice inspections. The pump casings are embedded in a pump pit which allows no access from the outside surface. The upper flange is at floor level. The welds are accessible when the pump impeller is removed. The pump casing welds will be examined with a surface method from the I.D. This meets the requirements of the 1977 Edition of ASME Section XI with Addenda through Summer 1978. Drawing RHR-213 in Section 8.0, "Weld Identification Diagrams", illustrates the pump installation details.

The 1974 Edition of ASME Section XI with Addenda through Summer 1975 requires a volumetric examination.

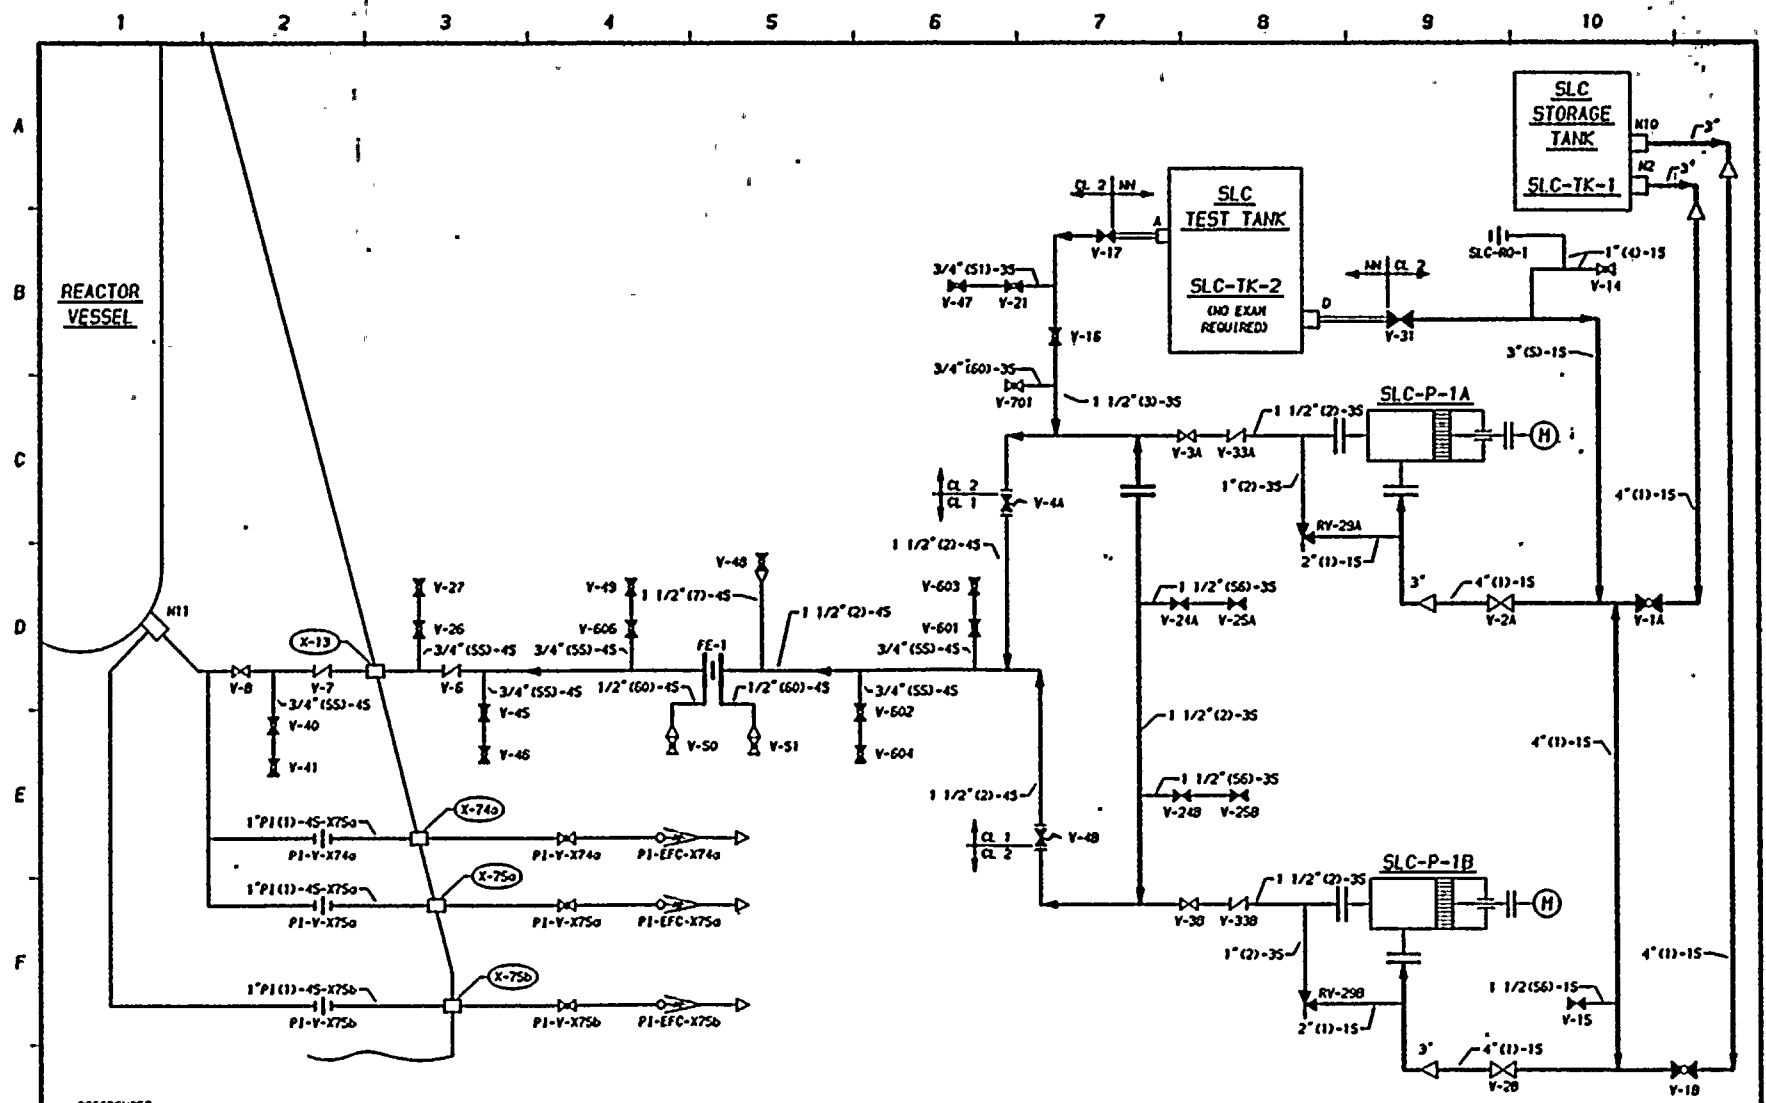

REFERENCES:
 BURNS & ROE FLOW DIAGRAM
 MS22 REV 20

- NOTES**
1. REFER TO DRAWING 151-200 FOR LEGEND.
 2. VALVE AND LINE DESIGNATIONS ARE SHOWN WITHOUT THE SYSTEM PREFIX FOR CLARITY.

THIS DRAWING IS INTENDED FOR USE IN PRESERVICE AND INSERVICE INSPECTION PROGRAMS ONLY

WASHINGTON PUBLIC POWER SUPPLY SYSTEM RICHLAND, WASHINGTON 99352 KRP-2	
INSERVICE INSPECTION BOUNDARY DIAGRAM STANDBY LIQUID CONTROL (SLC)	
DWG NO 151-222	REV 1

1	11/22/78	GENERAL UPDATE REDRAWN	K-MCA	TPH	ENGINEER D PORTER
0	12-22-78	ISSUED FOR USE	K-MCA	LFB	
A	10-18-78	ISSUED FOR INFORMATION ONLY	K-MCA	MCH	DRAWN K-MCA

NO	DATE	REVISION	BY	CHKD	APVD	NO	DATE	REVISION	BY	CHKD	APVD	DATE	8-23-78	DWG NO 151-222	REV 1
----	------	----------	----	------	------	----	------	----------	----	------	------	------	---------	----------------	-------



WNP-2 ISI BOUNDARY DIAGRAM

EXCEPTIONS AND EXEMPTIONSISI - 222SYSTEM Standby Liquid Control (SLC) SystemEXCEPTIONS:Class 1 Piping and Components

- See general exceptions
- No additional exceptions

Class 2 Piping and Components

- See general exceptions
- No additional exceptions

EXEMPTIONS APPLIED:

IWB-1220(a)(1) Yes, per code class boundary

(2) No

(3) No

(4) No

*(b)(1) Yes, 1 1/2" SLC(2)-4S (zone C/D-2-4)

(2) No

(3) Yes, all piping \leq 1" NPS

IWC-1220(a) No

*(b) No

(c) No


(d) Yes, entire Class 2 system

IWC-5220(d) No

IWD-5200(c) No

* See general exemption discussion for details.

SECRET

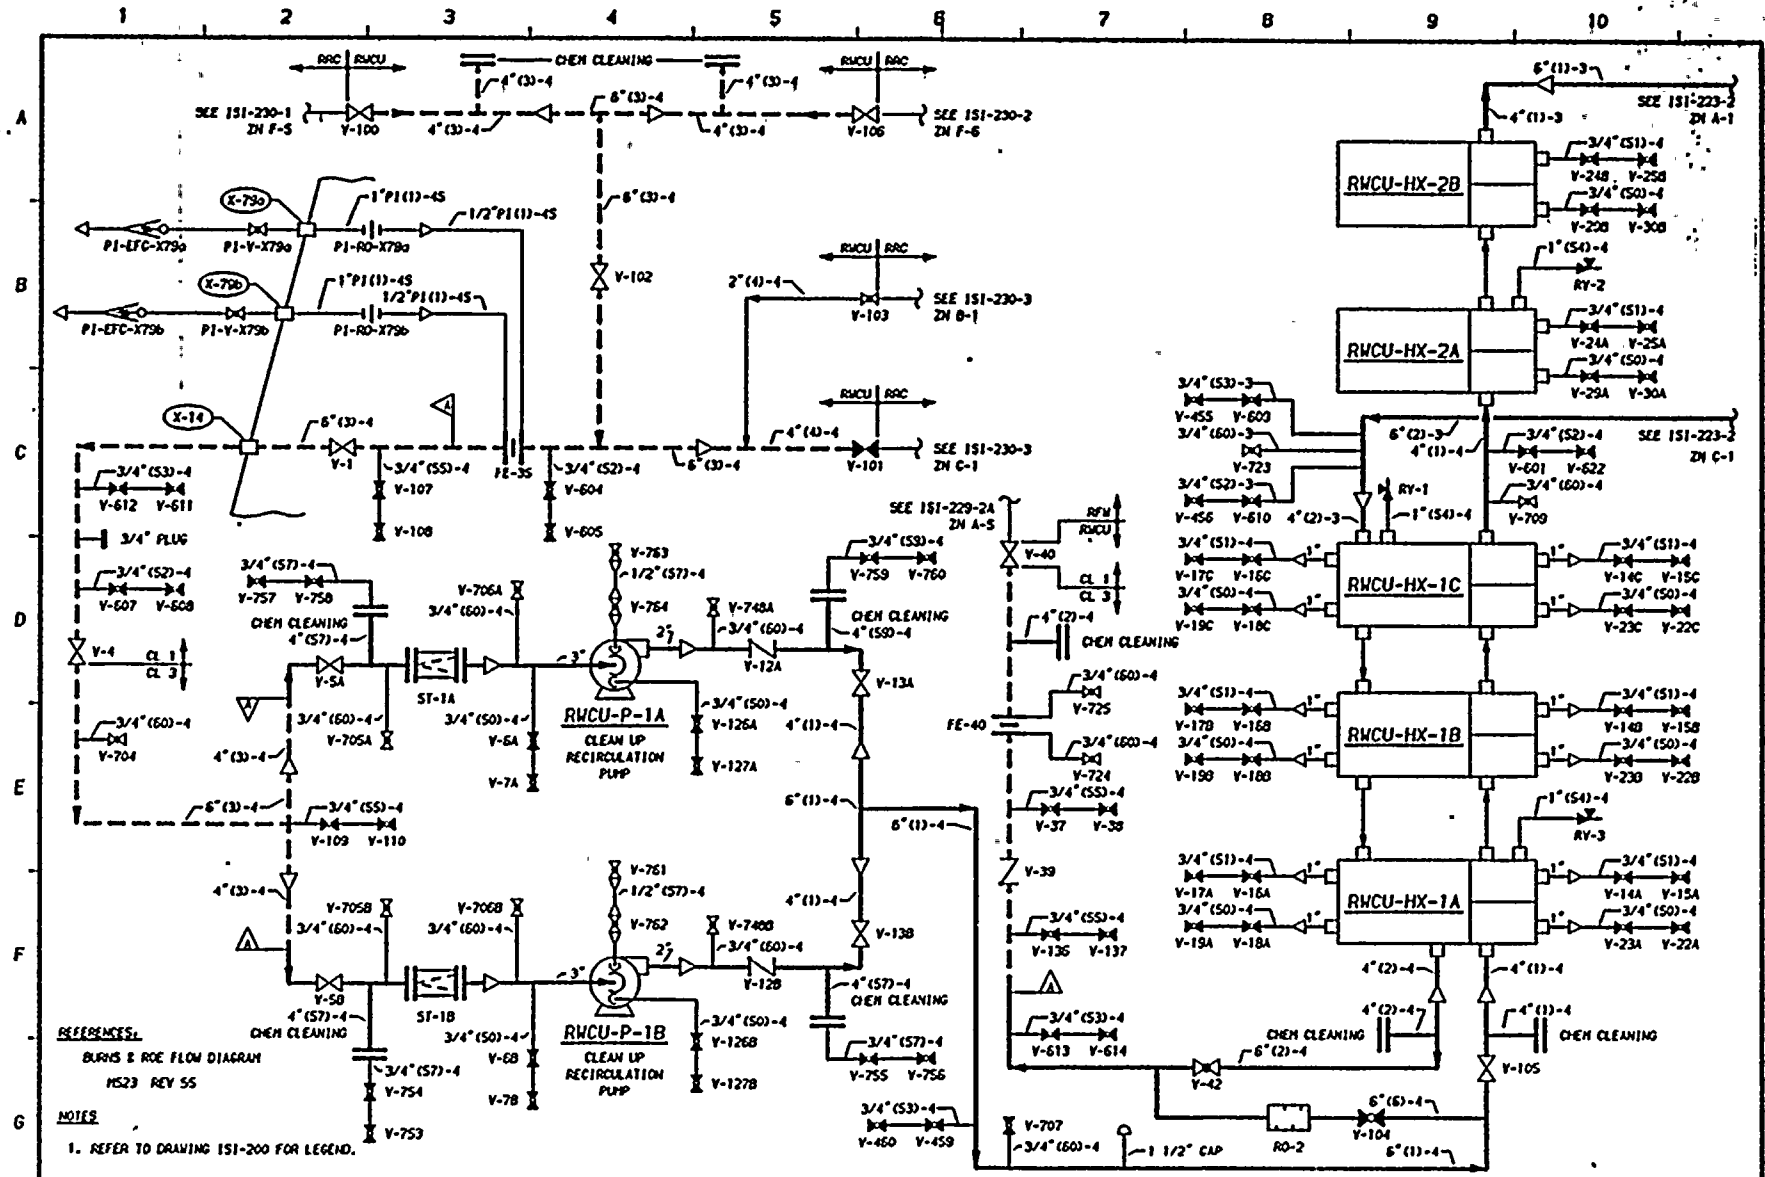

REFERENCES:
 BURNS & ROE FLOW DIAGRAM
 MS23 REV 55

NOTES

1. REFER TO DRAWING ISI-200 FOR LEGEND.
2. VALVE AND LINE DESIGNATIONS ARE SHOWN WITHOUT THE SYSTEM PREFIX FOR CLARITY.
3. PRESSURE TEST NOT REQUIRED ON CLASS 3 RWCU DURING ISI.


THIS DRAWING IS INTENDED FOR USE IN PRESERVICE AND INSERVICE INSPECTION PROGRAMS ONLY

WASHINGTON PUBLIC POWER SUPPLY SYSTEM
 RICHLAND, WASHINGTON 99352

NO	DATE	REVISION	BY	CHKD	APVD	NO	DATE	REVISION	BY	CHKD	APVD	DATE	DWG NO	REV
1	1-9-78	AUGMENTED ISI ADDED, GENERAL UPDATE, REDRAWN	K-MCA	JF-11		1	1-9-78	ISSUED FOR USE	K-MCA	JF-11		9-6-78	151-223-1	1
0	1-9-78	ISSUED FOR USE	K-MCA	JF-11		0	1-9-78	ISSUED FOR INFORMATION ONLY	K-MCA	JF-11				
A	10-18-78	ISSUED FOR INFORMATION ONLY	K-MCA	JF-11		A	10-18-78	ISSUED FOR INFORMATION ONLY	K-MCA	JF-11				

ENGINEER D PORTER
 INSERVICE INSPECTION BOUNDARY DIAGRAM
 REACTOR WATER CLEAN UP (RWCU)
 DWN K-McANDREW
 DATE 9-6-78
 DVG NO 151-223-1
 REV 1



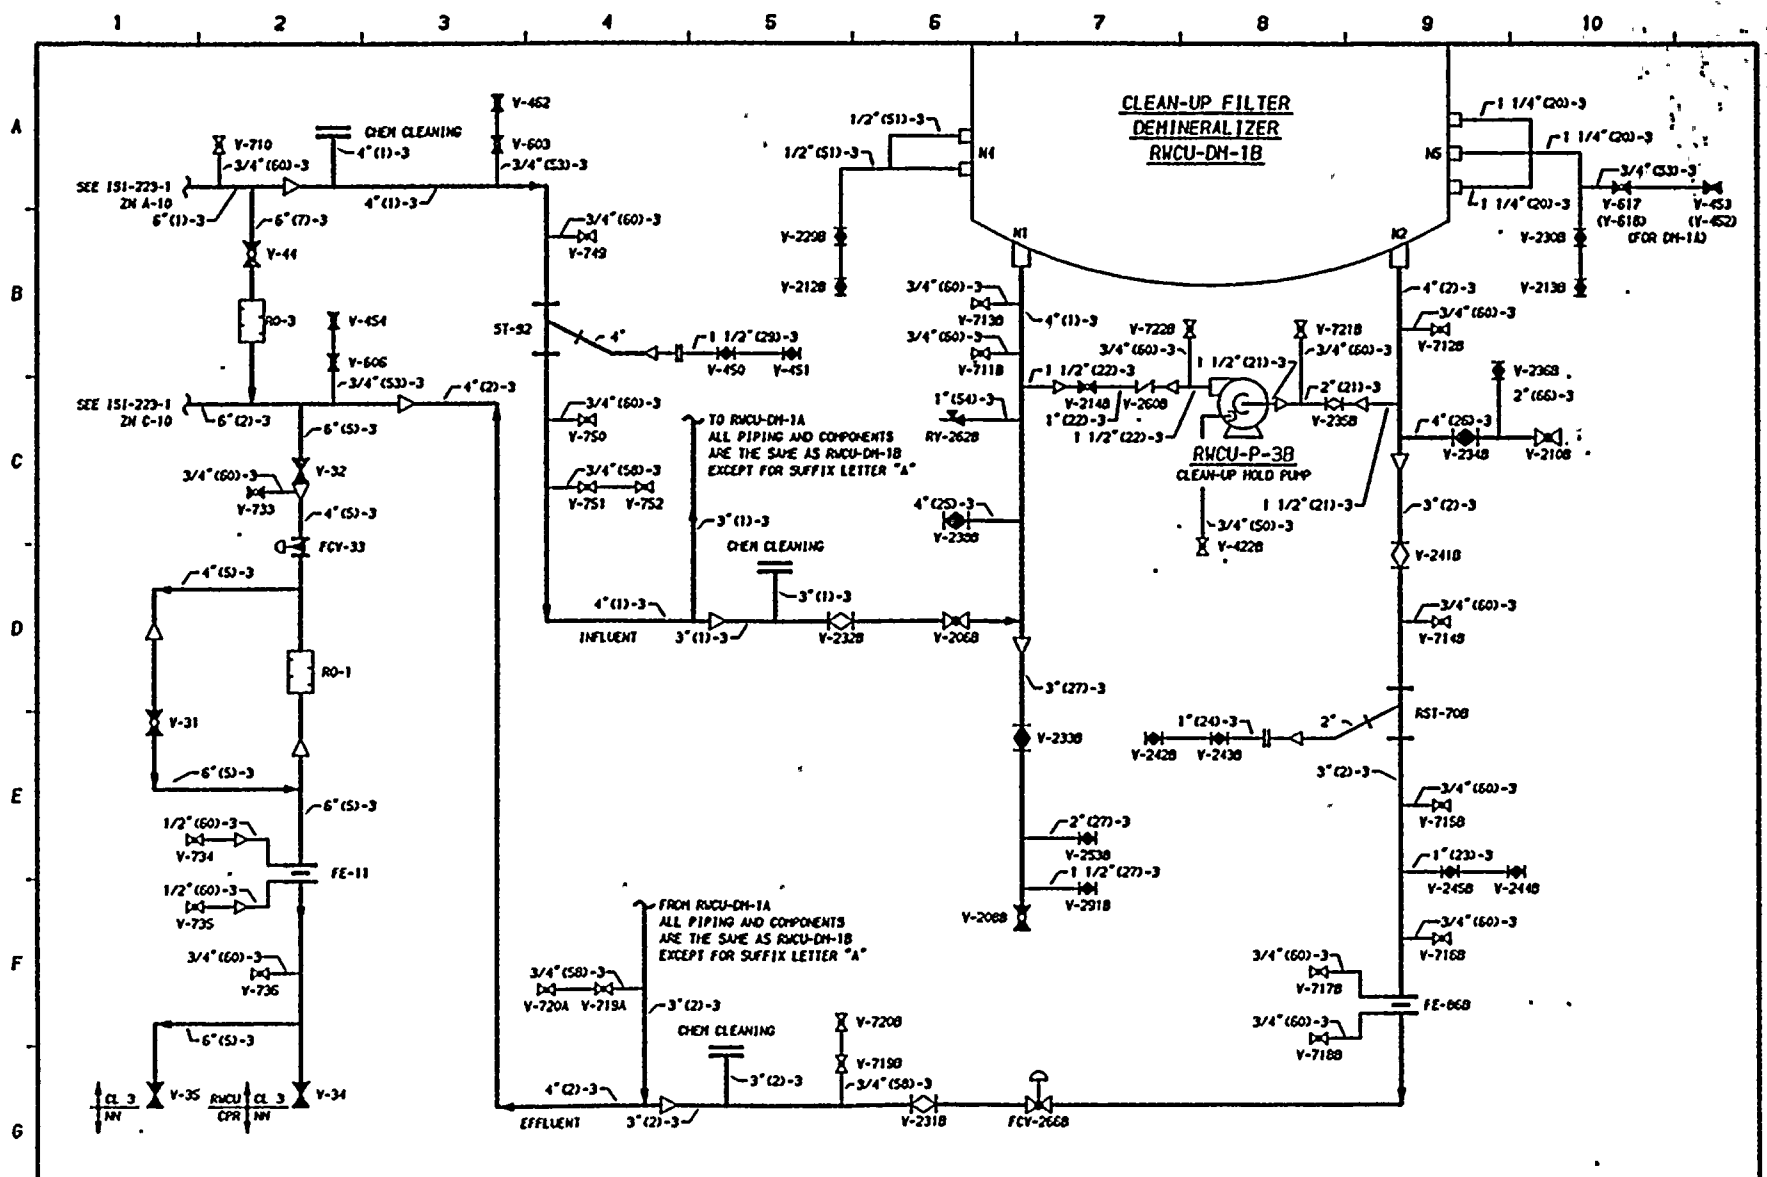

SEE 151-223-1 FOR NOTES AND REFERENCES.

THIS DRAWING IS INTENDED FOR USE IN PRESERVICE AND INSERVICE INSPECTION PROGRAMS ONLY

WASHINGTON PUBLIC POWER SUPPLY SYSTEM RICHLAND, WASHINGTON 99352	
INSERVICE INSPECTION BOUNDARY DIAGRAM REACTOR WATER CLEAN UP (RWCU)	WPP-2
DWG NO 151-223-2	REV 1

NO	DATE	REVISION	BY	CHKD	APVD
1	11-28-74	AUGMENTED IS1 ADDED, GENERAL UPDATE, REDRAWN	K-MCA	DMP	LEG
0	1-9-79	ISSUED FOR USE	K-MCA	DMP	LEG
A	10-18-78	ISSUED FOR INFORMATION ONLY	K-MCA	DMP	LEG

NO	DATE	REVISION	BY	CHKD	APVD
	9-8-78				

EXCEPTIONS AND EXEMPTIONSISI - 223SYSTEM Reactor Water Cleanup (RWCU)EXCEPTIONS:Class 1 Piping and Components

- ° See general exceptions
- ° No additional exceptions

Class 2 Piping and Components

- ° Not applicable; entire system is Class 1 or Class 3

EXEMPTIONS APPLIED:

IWB-1220(a)(1) Yes, per code class boundary

(2) No

(3) No

(4) No

*(b)(1) No

(2) No

(3) Yes, all piping \leq 1" NPS

IWC-1220(a) No

*(b) No

(c) No


(d) No

IWC-5220(d) No

IWD-5200(c) No

* See general exemption discussion for details.



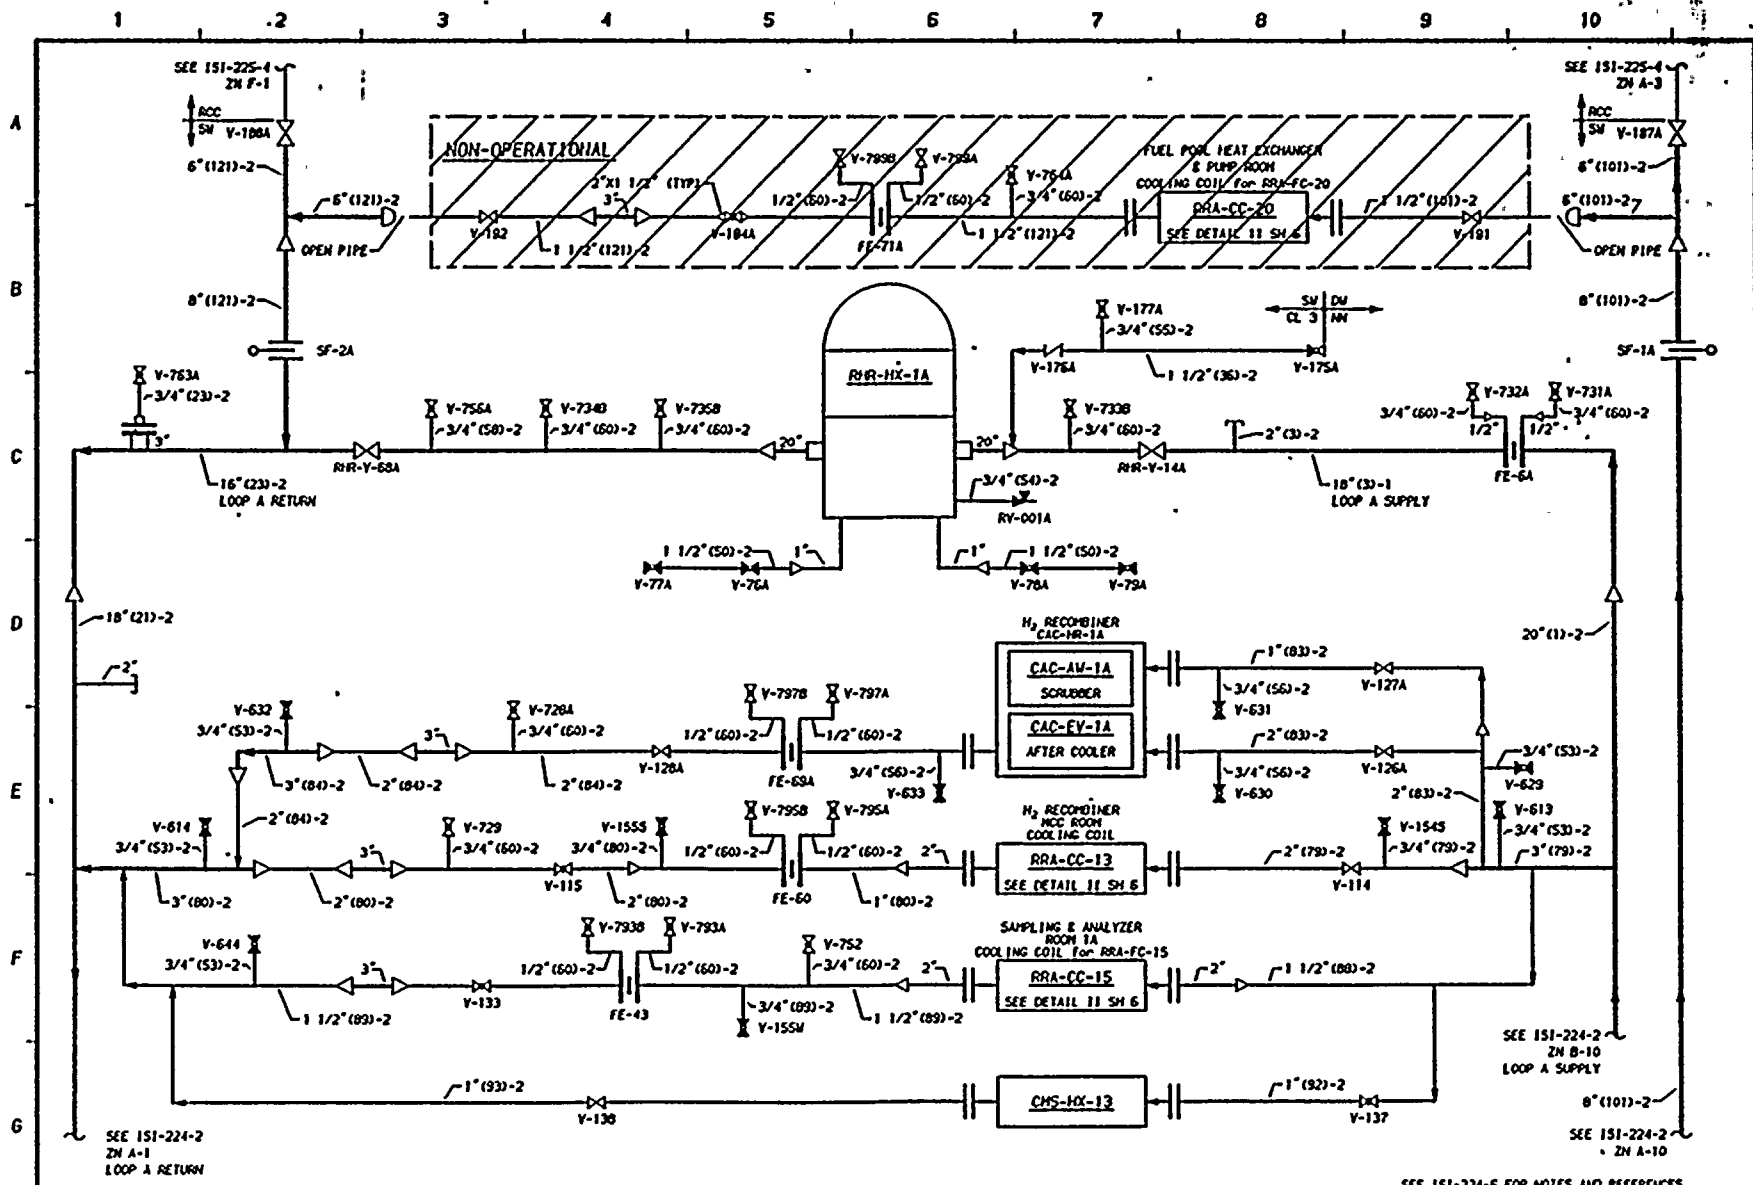

SEE 151-224-6 FOR NOTES AND REFERENCES.


THIS DRAWING IS INTENDED FOR USE IN PRESERVICE AND INSERVICE INSPECTION PROGRAMS ONLY

WASHINGTON PUBLIC POWER SUPPLY SYSTEM
 RICHLAND, WASHINGTON 99352

NO	DATE	REVISION	BY	CHKD	APVD	NO	DATE	REVISION	BY	CHKD	APVD	DATE	DWG NO	REV
1	11-5-80	GENERAL UPDATE (SEQUENCE OF CONN TO MAIN LINE)	K-MCA	TFH	DAP	1	11-5-80	GENERAL UPDATE (SEQUENCE OF CONN TO MAIN LINE)	K-MCA	TFH	DAP	10-4-78	151-224-1	2
0	1-9-79	ISSUED FOR USE	K-MCA	TFH	DAP	0	1-9-79	ISSUED FOR USE	K-MCA	TFH	DAP			
A	10-18-78	ISSUED FOR INFORMATION ONLY	K-MCA	MCH	DAP	A	10-18-78	ISSUED FOR INFORMATION ONLY	K-MCA	MCH	DAP			
2	11-22-81	GENERAL UPDATE (REDRAM)	K-MCA	TFH	DAP	2	11-22-81	GENERAL UPDATE (REDRAM)	K-MCA	TFH	DAP			

WHP-2
 INSERVICE INSPECTION BOUNDARY DIAGRAM
 STANDBY SERVICE WATER (SSW)
 DATE 10-4-78
 ENG. D PORTER
 DR. K-MANDREW
 Dwg No 151-224-1
 Rev 2



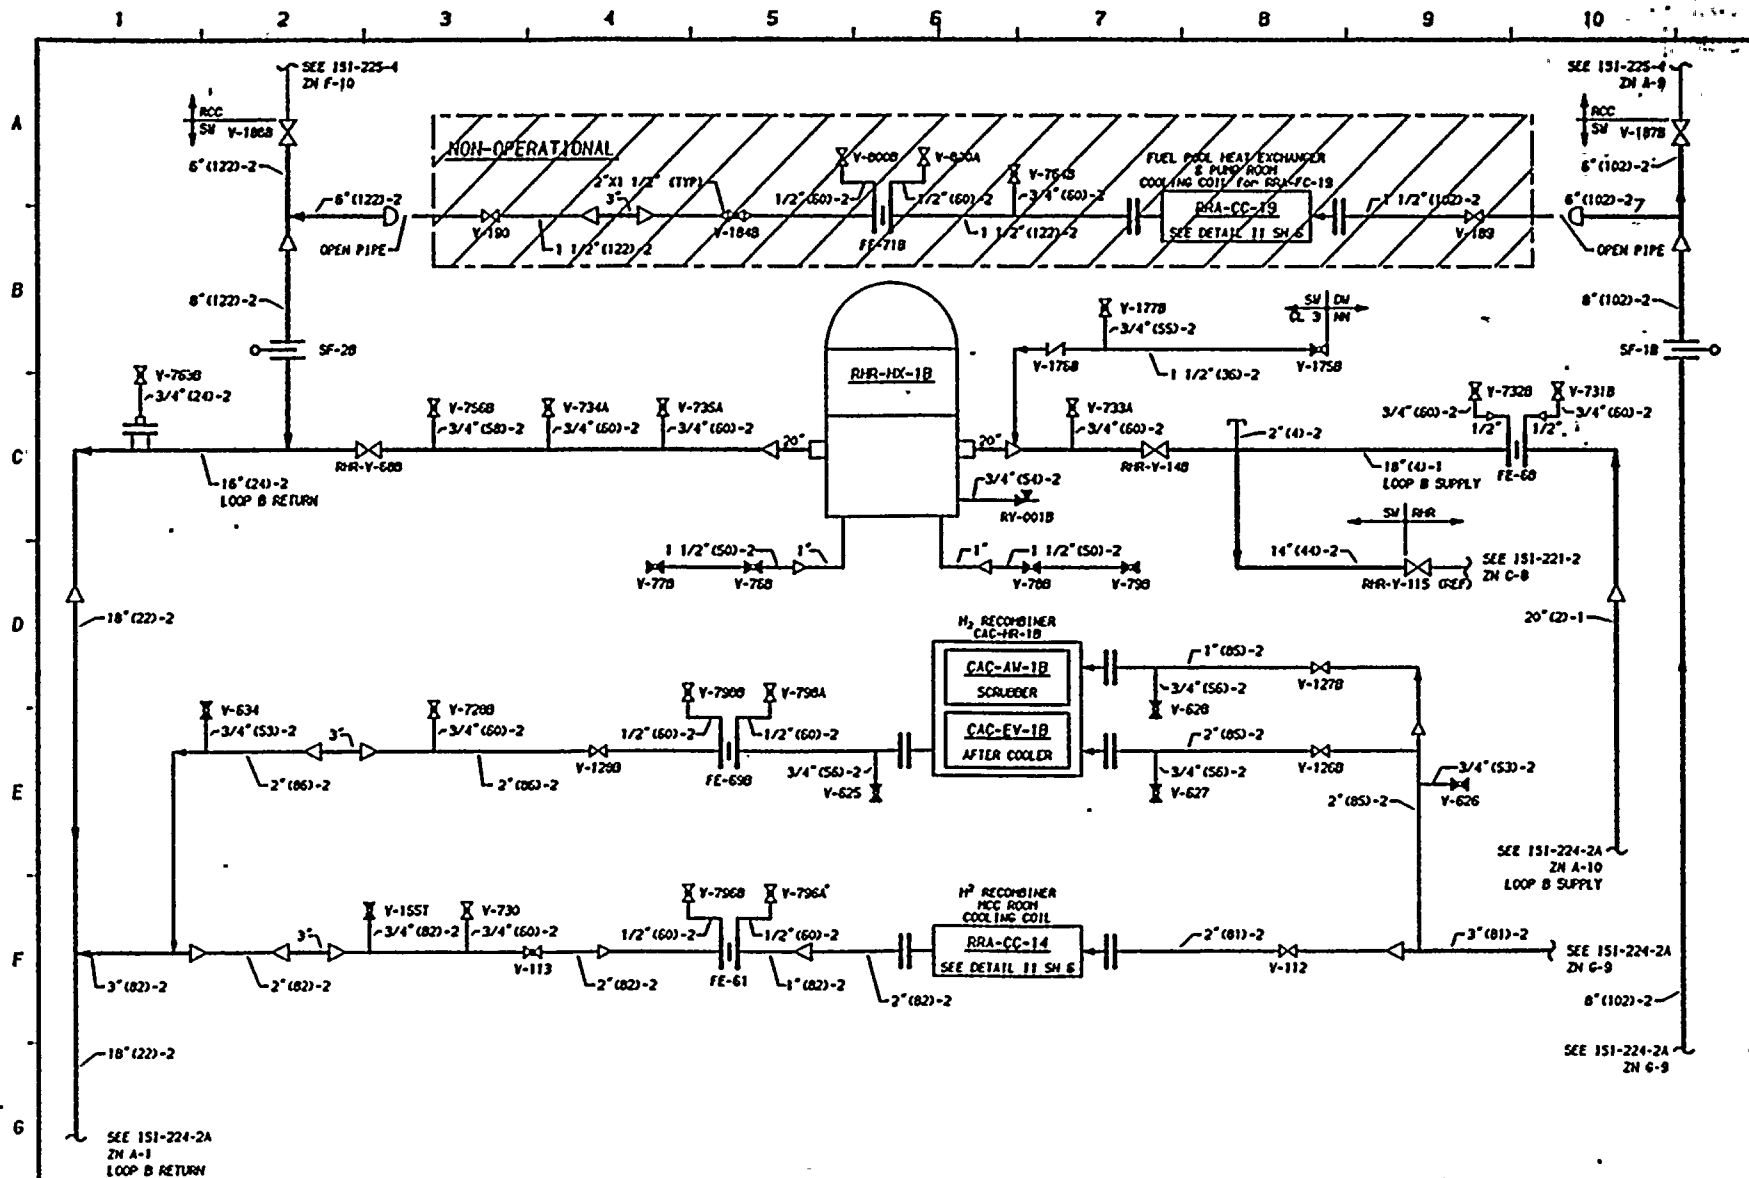


SEE 151-224-6 FOR NOTES AND REFERENCES.

THIS DRAWING IS INTENDED FOR USE IN PRESERVICE AND INSERVICE INSPECTION PROGRAMS ONLY

WASHINGTON PUBLIC POWER SUPPLY SYSTEM
 RICHLAND, WASHINGTON 99352
 WPP-2
 INSERVICE INSPECTION BOUNDARY DIAGRAM
 STANDBY SERVICE WATER (SW)
 Dwg No 151-224-1A
 REV 2

NO	DATE	REVISION	BY	CHKD	APVD	NO	DATE	REVISION	BY	CHKD	APVD	DATE
1	11-5-80	GENERAL UPDATE (SEQUENCE OF CONN TO MAIN LINE)	K-McA	TFH	DWP				K-McA	TFH	DWP	
0	1-9-79	ISSUED FOR USE							K-McA	NCH	DWP	
A	10-18-78	ISSUED FOR INFORMATION ONLY							K-McA	NCH	DWP	
2	11-28-81	GENERAL UPDATE REDRAWN	K-McA	TFH	DWP				K-McA	TFH	DWP	10-4-78

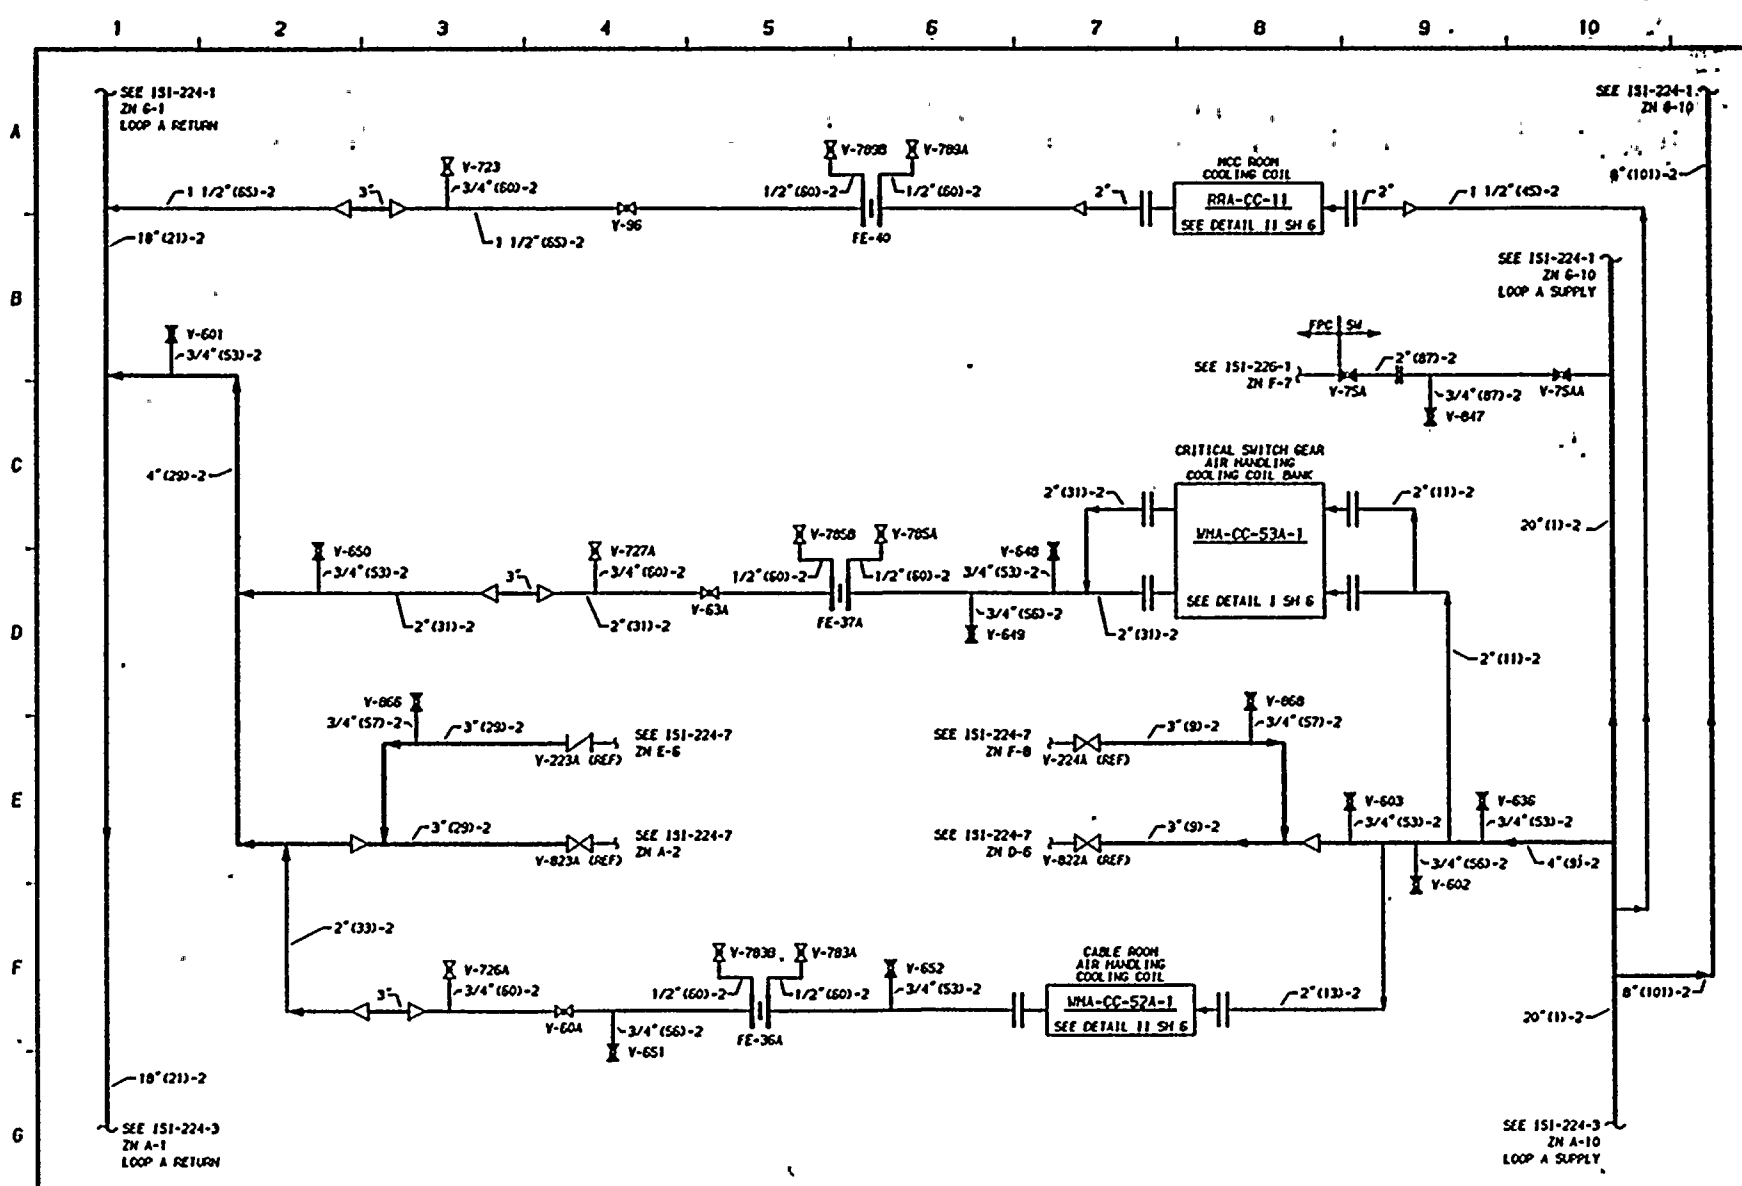


THIS DRAWING IS INTENDED FOR USE IN PRESERVICE AND INSERVICE INSPECTION PROGRAMS ONLY

WASHINGTON PUBLIC POWER SUPPLY SYSTEM
 RICHLAND, WASHINGTON 99352

NO	DATE	REVISION	BY	CHKD	APYD	NO	DATE	REVISION	BY	CHKD	APYD	DATE	DWG NO	REV
1	11-5-80	GENERAL UPDATE (SEQUENCE OF CONN TO MAIN LINE)	K-MCA	TFH	DMP	1	11-5-80	GENERAL UPDATE (SEQUENCE OF CONN TO MAIN LINE)	K-MCA	TFH	DMP	10-4-78	151-224-2	2
0	1-9-79	ISSUED FOR USE	K-MCA	TFH	DMP	0	1-9-79	ISSUED FOR USE	K-MCA	TFH	DMP			
A	10-18-78	ISSUED FOR INFORMATION ONLY	K-MCA	NCH	DMP	A	10-18-78	ISSUED FOR INFORMATION ONLY	K-MCA	NCH	DMP			
2	11-5-80	GENERAL UPDATE REDRAWN	K-MCA	TFH	DMP	2	11-5-80	GENERAL UPDATE REDRAWN	K-MCA	TFH	DMP			

ENGINEER D PORTER
 DRAWN K-MANDREW


INSERVICE INSPECTION BOUNDARY DIAGRAM
 STANDBY SERVICE WATER (SW)
 DATE 10-4-78
 DWG NO 151-224-2
 REV 2

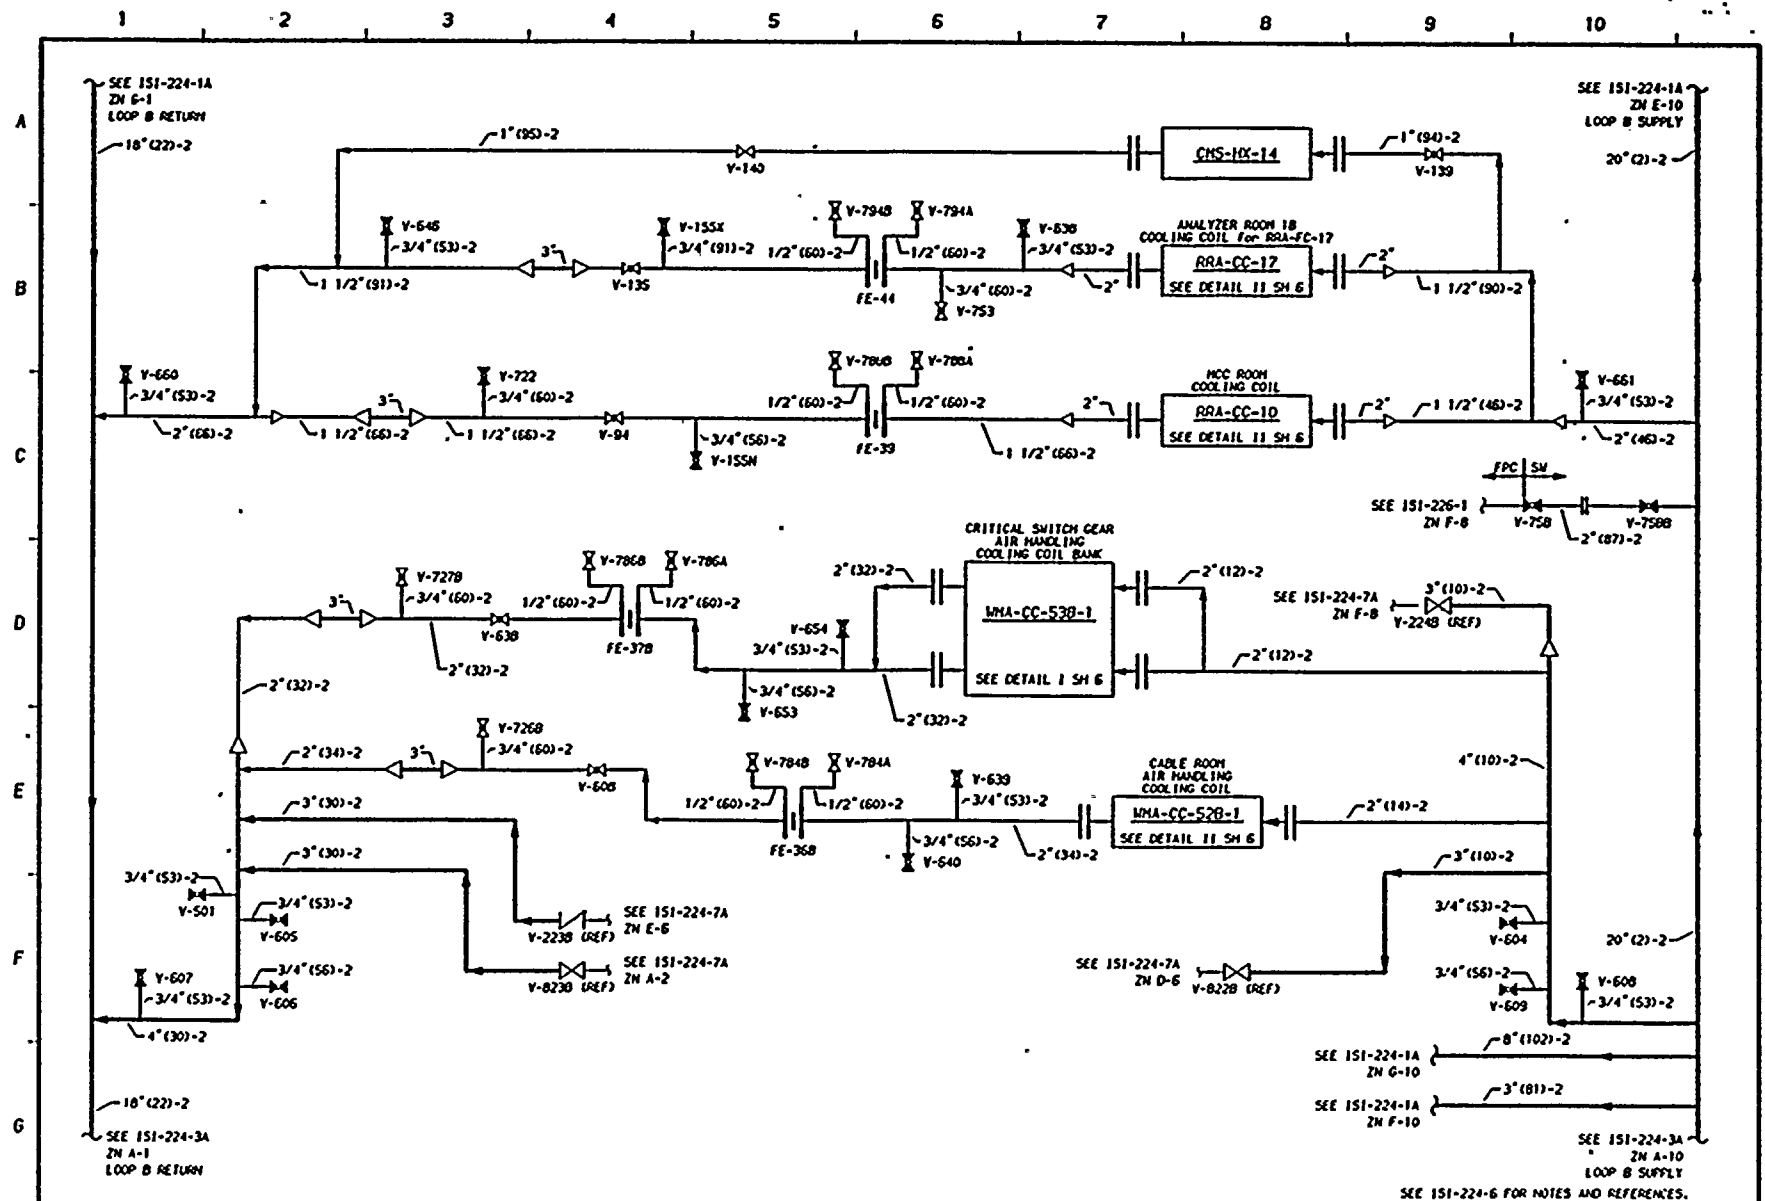

THIS DRAWING IS INTENDED FOR USE IN PRESERVICE AND INSERVICE INSPECTION PROGRAMS ONLY

WASHINGTON PUBLIC POWER SUPPLY SYSTEM RICHLAND, WASHINGTON 99352		WPP-2 INSERVICE INSPECTION BOUNDARY DIAGRAM STANDBY SERVICE WATER (SW)	
		ENGINEER D PORTER DRAWN K-McANDREW	DATE 10-4-78 Dwg NO 151-224-2A REV 2

NO	DATE	REVISION	BY	CHKD	APVD	NO	DATE	REVISION	BY	CHKD	APVD	DATE
1	11-5-80	GENERAL UPDATE (SEQUENCE OF COM TO MAIN LINE)	K-MCA	TFM	DMP							
0	1-9-79	ISSUED FOR USE	K-MCA	TFM	DMP							
A	10-18-78	ISSUED FOR INFORMATION ONLY	K-MCA	NCH	DMP							
2	10-27-78	GENERAL UPDATE REDRAWN	K-MCA	TFM	TFM							

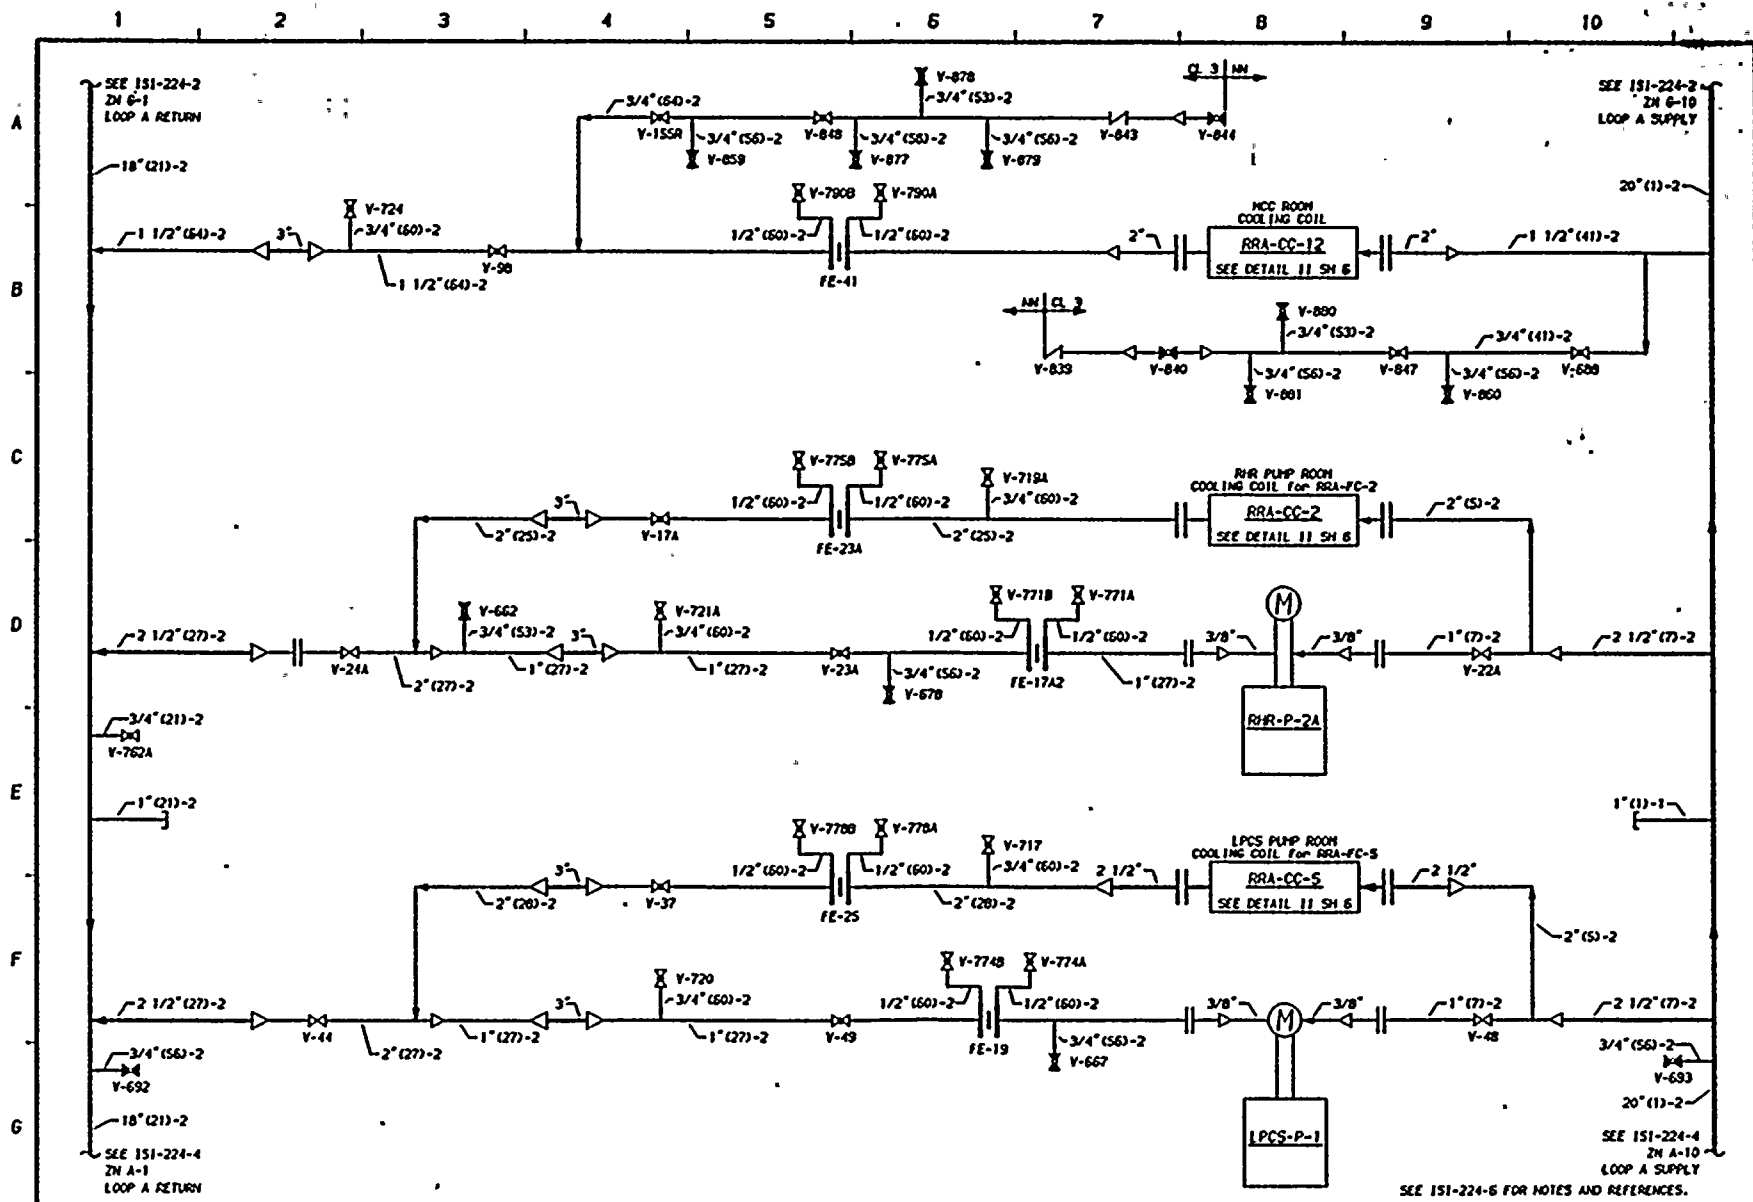


THIS DRAWING IS INTENDED FOR USE IN PRESERVICE AND INSERVICE INSPECTION PROGRAMS ONLY

SEE 151-224-6 FOR NOTES AND REFERENCES.

WASHINGTON PUBLIC POWER SUPPLY SYSTEM
 RICHLAND, WASHINGTON 99352
 INSERVICE INSPECTION BOUNDARY DIAGRAM
 STANDBY SERVICE WATER (SW)
 DWG NO 151-224-3
 REV 2

NO	DATE	REVISION	BY	CHKD	APVD	NO	DATE	REVISION	BY	CHKD	APVD	DATE
1	11-5-80	GENERAL UPDATE (SEQUENCE OF CONN TO MAIN LINE)	K-McA	TFH	DAP				K-McA	TFH	DAP	ENGINEER D PORTER
0	1-9-79	ISSUED FOR USE	K-McA	TFH	DAP				K-McA	TFH	DAP	INSERVICE INSPECTION PROGRAMS ONLY
		ISSUED FOR INFORMATION ONLY							K-McA	MCH	DAP	DRAWN K-McANDREW
2	10-18-79	GENERAL UPDATE REDRAWN	K-McA	TFH	TFB				K-McA	MCH	DAP	DATE 10-4-78



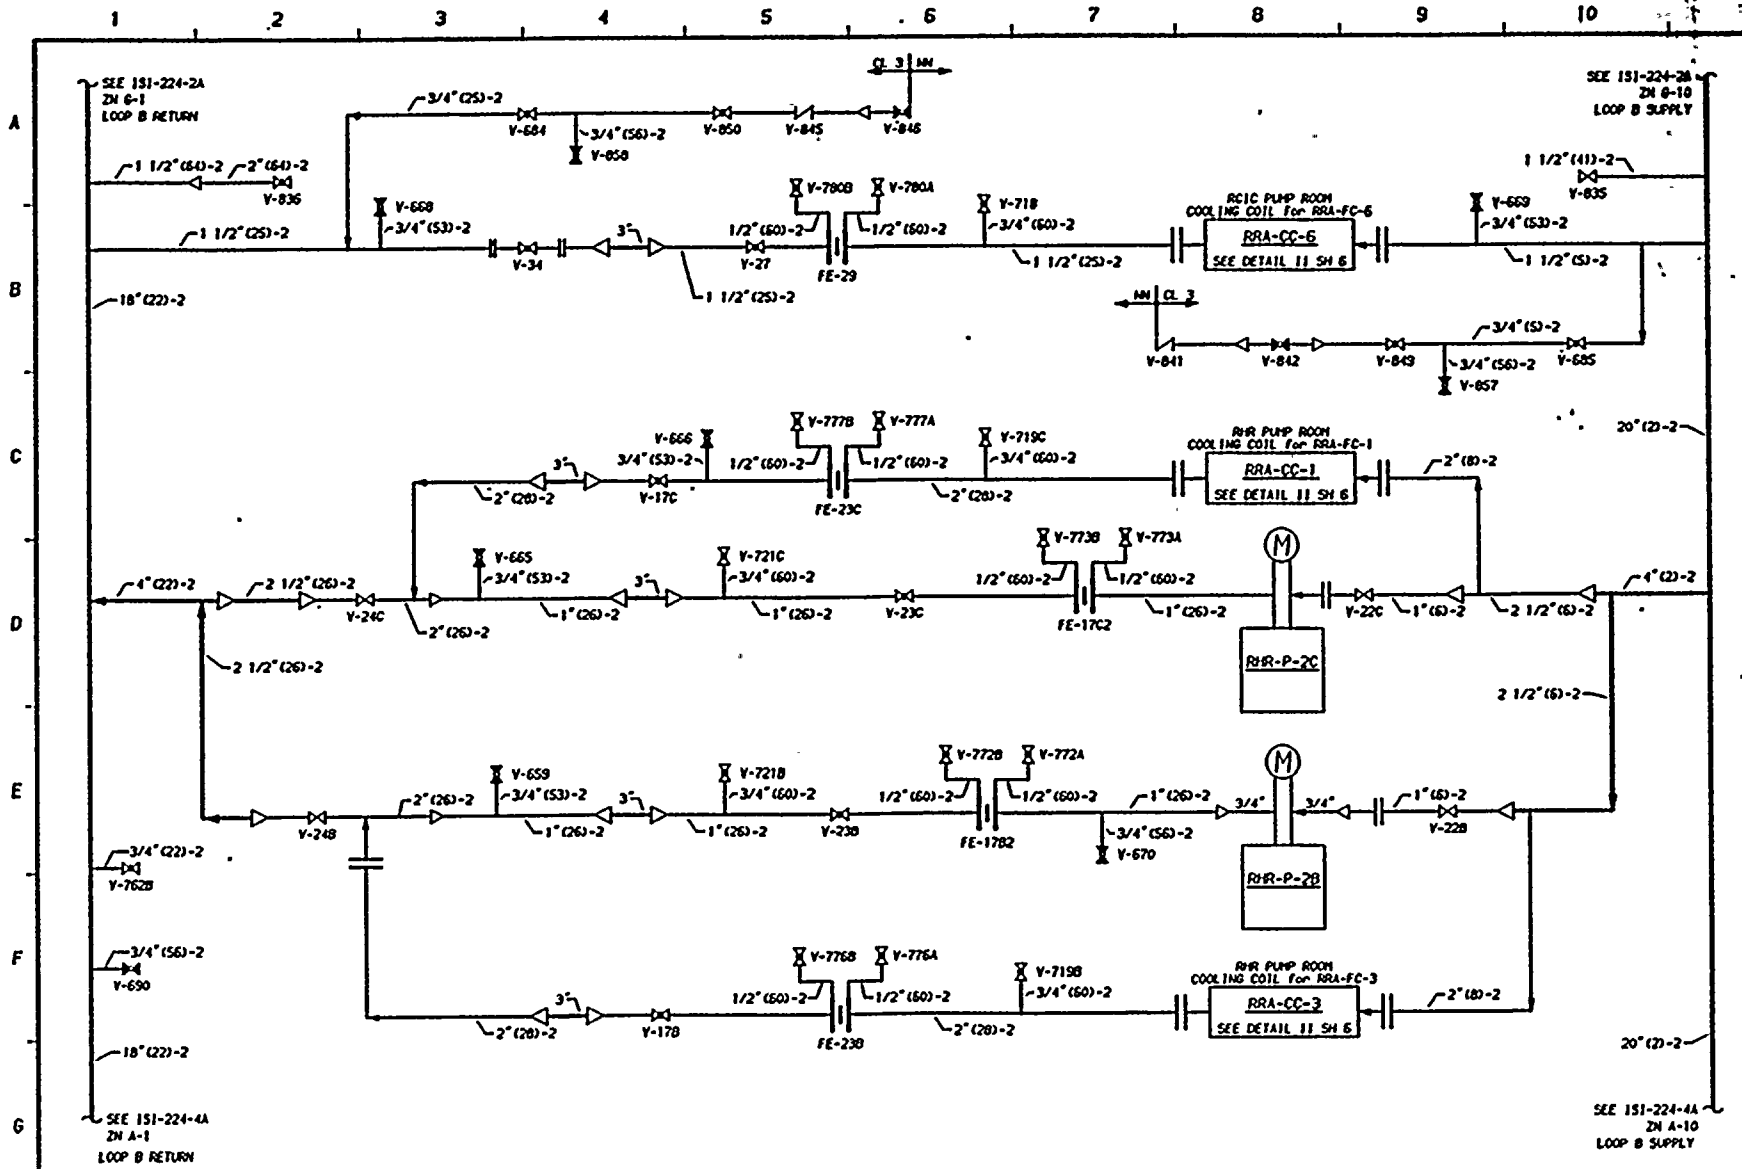

SEE 151-224-6 FOR NOTES AND REFERENCES.

THIS DRAWING IS INTENDED FOR USE IN PRESERVICE AND INSERVICE INSPECTION PROGRAMS ONLY


WASHINGTON PUBLIC POWER SUPPLY SYSTEM
 RICHLAND, WASHINGTON 99352

NO	DATE	REVISION	BY	CHKD	APVD	NO	DATE	REVISION	BY	CHKD	APVD	DATE	NO	DATE	REVISION
1	11-5-80	GENERAL UPDATE (SEQUENCE OF DOWN TO MAIN LINES)	K-McA	TFH	DMP	1	11-5-80	GENERAL UPDATE (SEQUENCE OF DOWN TO MAIN LINES)	K-McA	TFH	DMP	10-4-78	1	10-4-78	GENERAL UPDATE (SEQUENCE OF DOWN TO MAIN LINES)
0	1-9-79	ISSUED FOR USE	K-McA	TFH	DMP	0	1-9-79	ISSUED FOR USE	K-McA	TFH	DMP	10-4-78	0	1-9-79	ISSUED FOR USE
A	10-18-78	ISSUED FOR INFORMATION ONLY	K-McA	MCH	DMP	A	10-18-78	ISSUED FOR INFORMATION ONLY	K-McA	MCH	DMP	10-4-78	A	10-18-78	ISSUED FOR INFORMATION ONLY
2	11-9-80	GENERAL UPDATE REDRAWN	AS/A	TPR		2	11-9-80	GENERAL UPDATE REDRAWN	AS/A	TPR		10-4-78	2	11-9-80	GENERAL UPDATE REDRAWN

ENGINEER D PORTER
 DRAWN K-McANDREW

INSERVICE INSPECTION BOUNDARY DIAGRAM
 STANDBY SERVICE WATER (SW)
 Dwg NO 151-224-3A
 REV 2



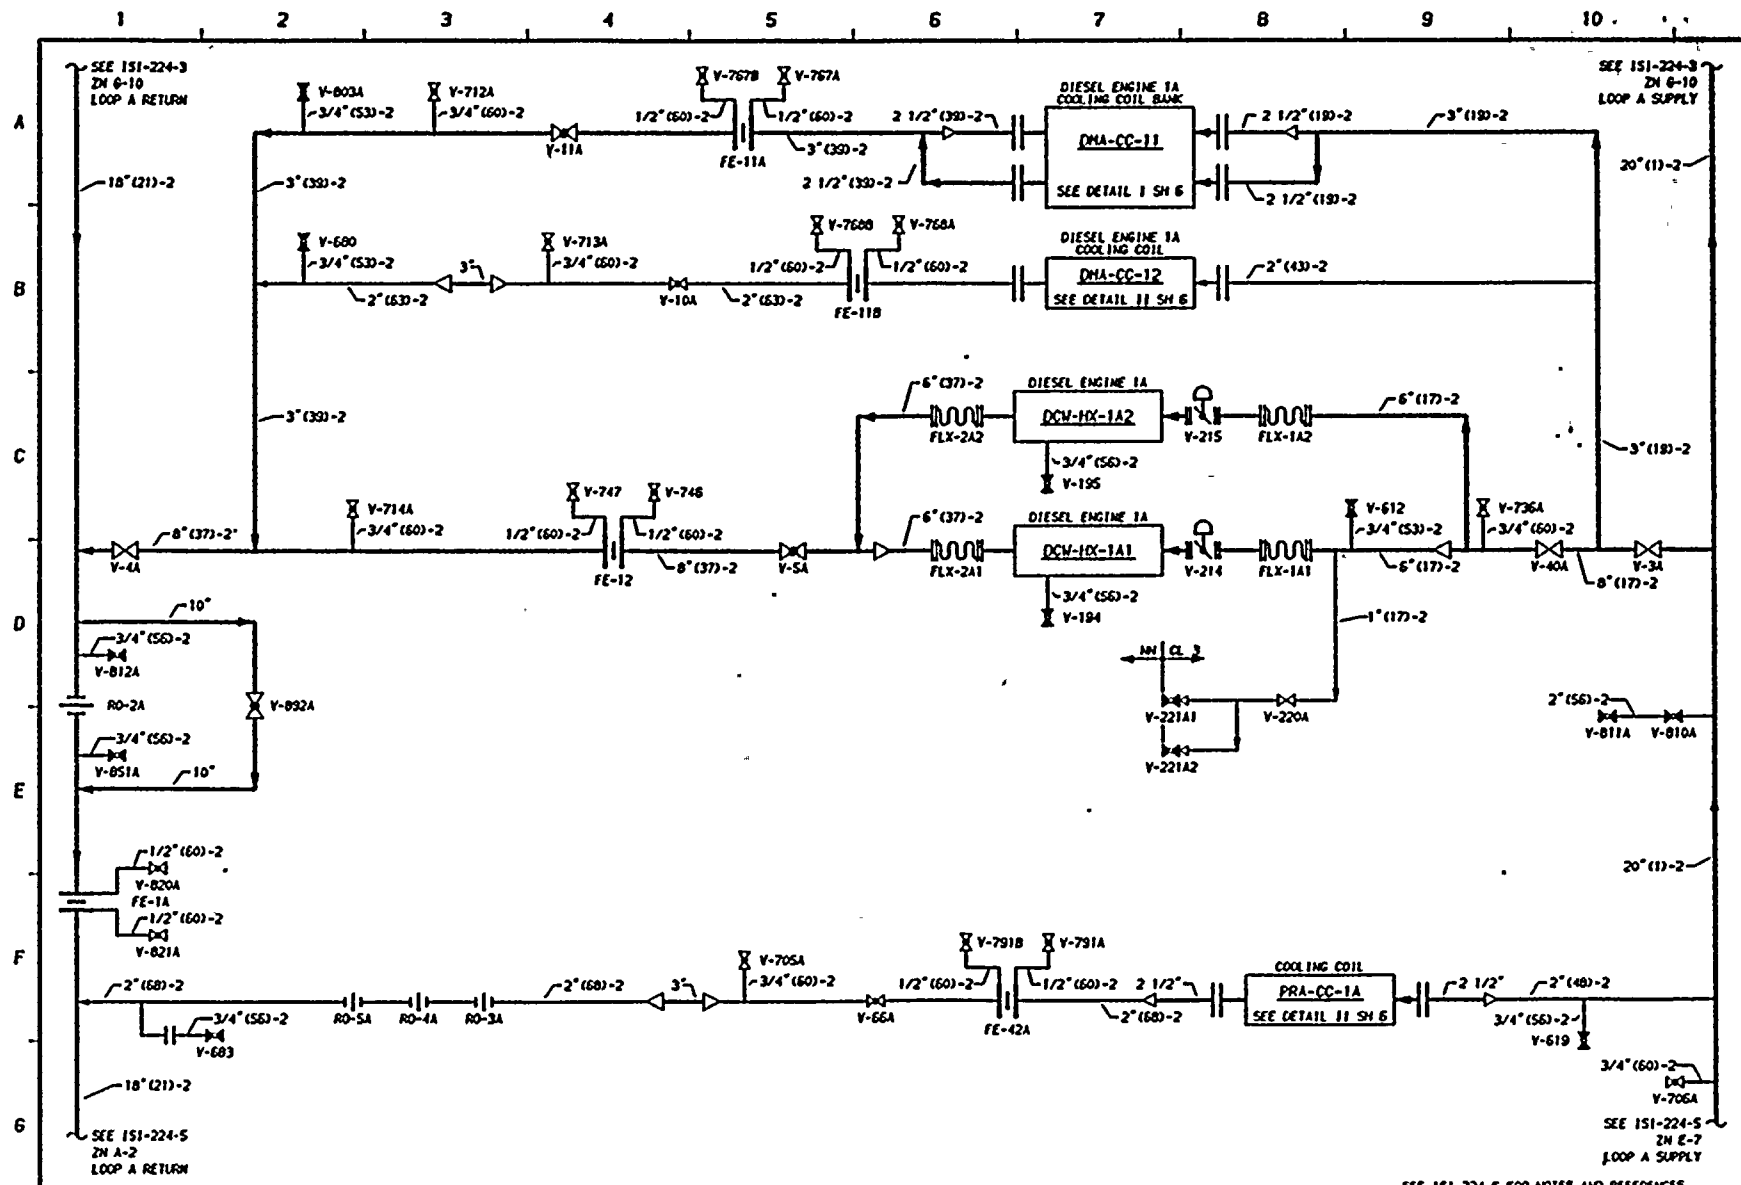

SEE 151-224-6 FOR NOTES AND REFERENCES.


THIS DRAWING IS INTENDED FOR USE IN PRESERVICE AND INSERVICE INSPECTION PROGRAMS ONLY

WASHINGTON PUBLIC POWER SUPPLY SYSTEM
RICHLAND, WASHINGTON 99352

NO	DATE	REVISION	BY	CHKD	APVD	NO	DATE	REVISION	BY	CHKD	APVD	DATE
1	11-5-60	GENERAL UPDATE (SEQUENCE OF DOWN TO MAIN LINE)	K-McA	TJH	DWP				K-McA	TJH	DWP	10-4-78
0	1-9-79	ISSUED FOR USE	K-McA	TJH	DWP				K-McA	TJH	DWP	
A	10-18-78	ISSUED FOR INFORMATION ONLY	K-McA	NCH	DWP				K-McA	NCH	DWP	

ENGINEER D PORTER
DRAWN K-McANDREW

151-224-4
INSERVICE INSPECTION BOUNDARY DIAGRAM
STANDBY SERVICE WATER (SSW)
DWG NO 151-224-4
REV 2

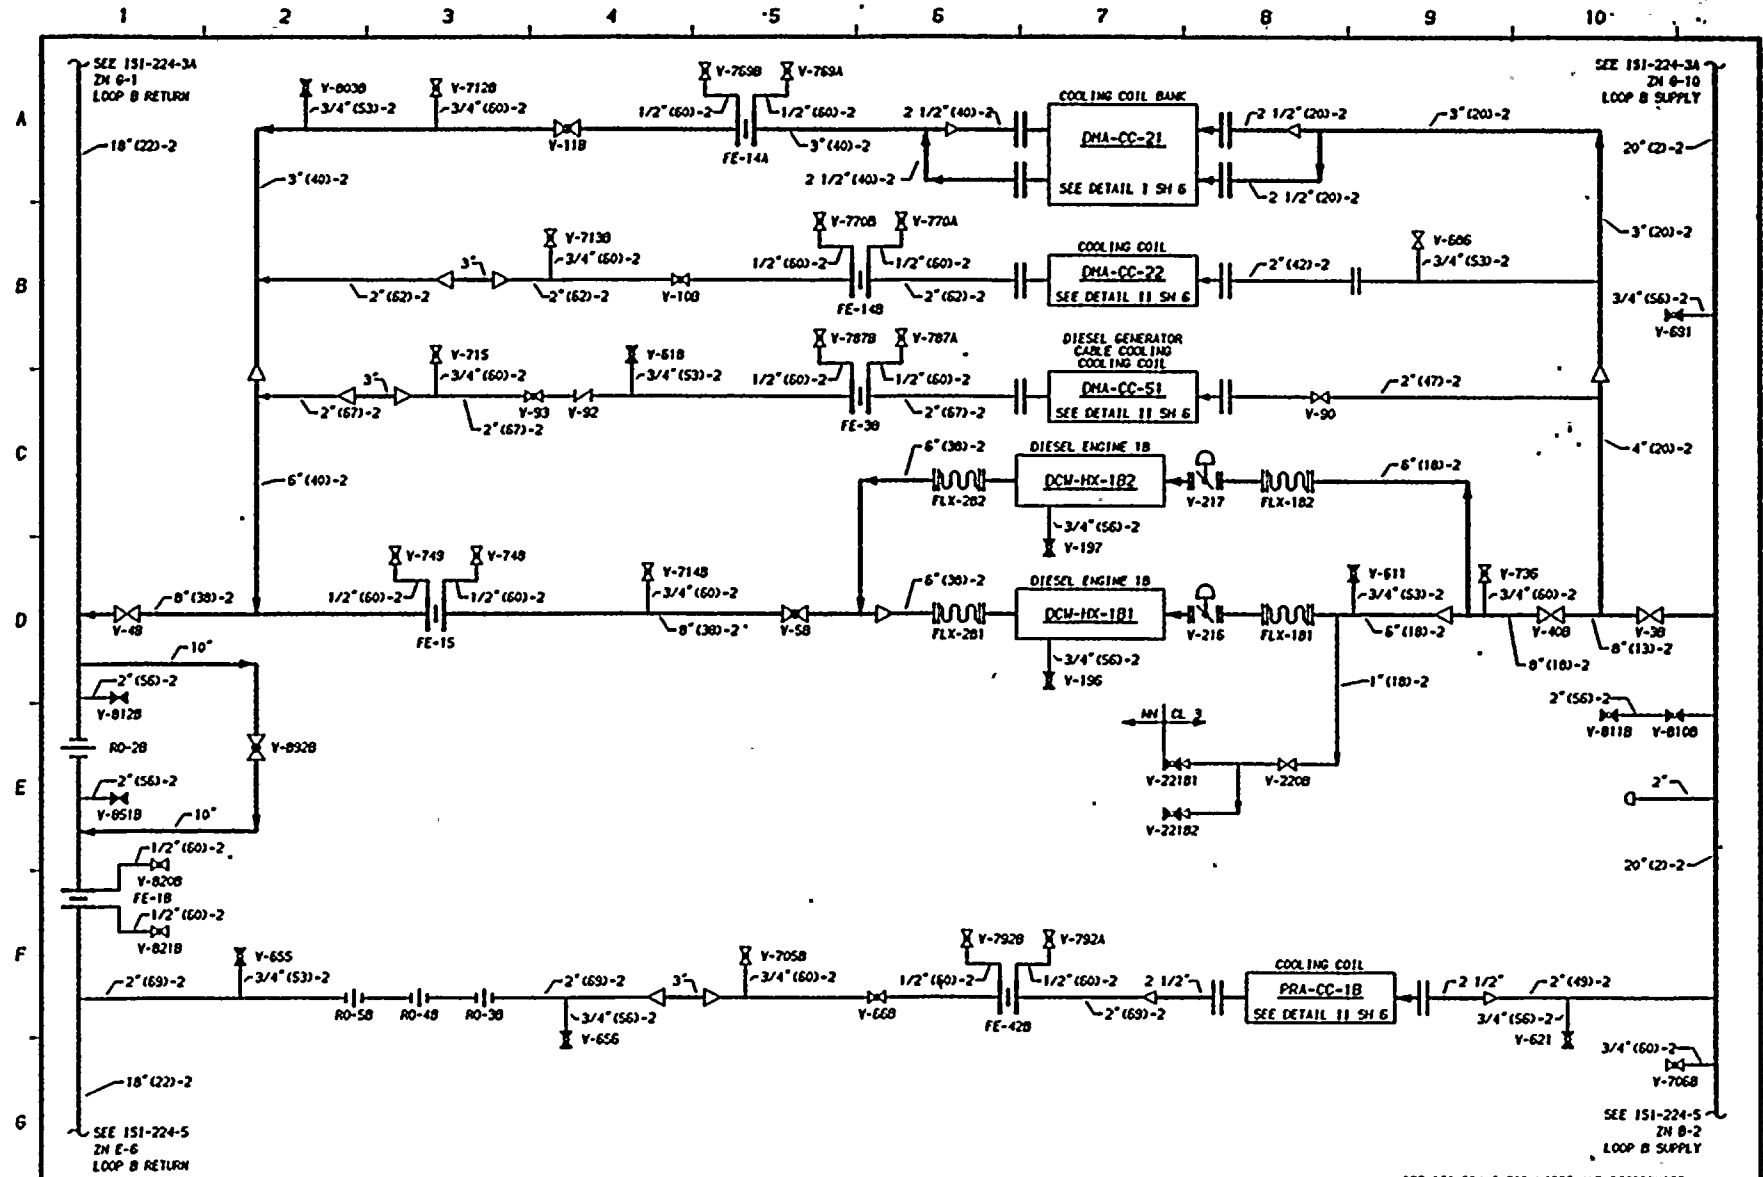


SEE 151-224-6 FOR NOTES AND REFERENCES.

THIS DRAWING IS INTENDED FOR USE IN PRESERVICE AND INSERVICE INSPECTION PROGRAMS ONLY

WASHINGTON PUBLIC POWER SUPPLY SYSTEM	
RICHLAND, WASHINGTON 99352	
WPP-2	INSERVICE INSPECTION BOUNDARY DIAGRAM
STANDBY SERVICE WATER (SW)	
DWG NO 151-224-4A	REV 2

NO	DATE	REVISION	BY	CHKD	APVD	NO	DATE	REVISION	BY	CHKD	APVD	DATE	NO
1	11-5-80	GENERAL UPDATE (SEQUENCE OF CONN TO MAIN LINE)	K-MCA	TFH	DWP	1	11-5-80	GENERAL UPDATE (SEQUENCE OF CONN TO MAIN LINE)	K-MCA	TFH	DWP	10-4-78	1
0	1-9-79	ISSUED FOR USE	K-MCA	TFH	DWP	0	1-9-79	ISSUED FOR USE	K-MCA	TFH	DWP	10-4-78	0
A	10-18-78	ISSUED FOR INFORMATION ONLY	K-MCA	NCH	DWP	A	10-18-78	ISSUED FOR INFORMATION ONLY	K-MCA	NCH	DWP	10-4-78	A
2	11-20-80	GENERAL UPDATE REDRAWN	K-MCA	TFH	DWP	2	11-20-80	GENERAL UPDATE REDRAWN	K-MCA	TFH	DWP	10-4-78	2


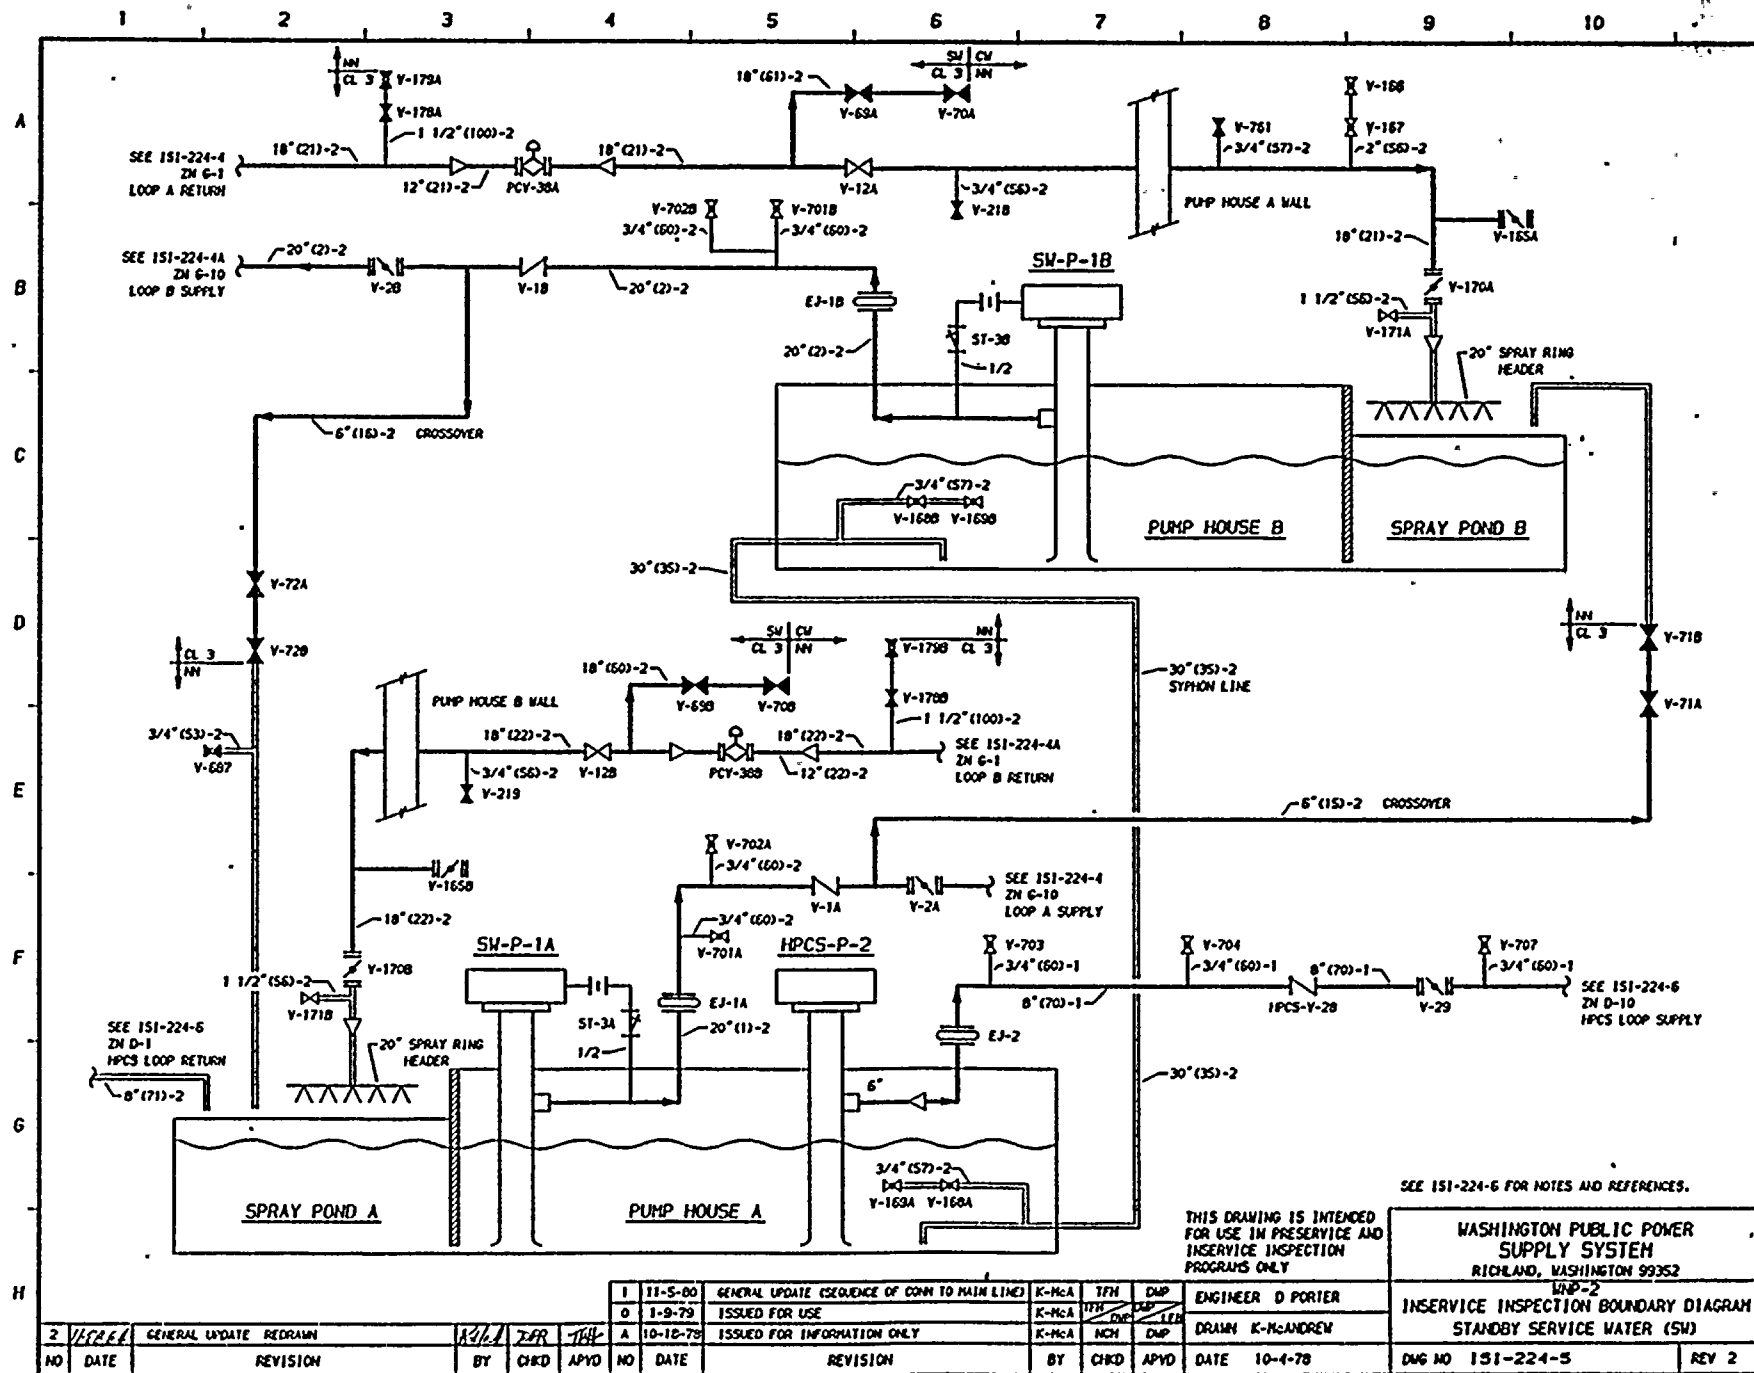


THIS DRAWING IS INTENDED FOR USE IN PRESERVICE AND INSERVICE INSPECTION PROGRAMS ONLY

SEE 151-224-6 FOR NOTES AND REFERENCES.


WASHINGTON PUBLIC POWER SUPPLY SYSTEM RICHLAND, WASHINGTON 99352		LWP-2 INSERVICE INSPECTION BOUNDARY DIAGRAM STANDBY SERVICE WATER (SW)	
		ENGINEER D PORTER	DATE 10-4-78
DRAWN K-McANDREW		DWG NO 151-224-5	

NO	DATE	REVISION	BY	CHKD	APVD	NO	DATE	REVISION	BY	CHKD	APVD	DATE
1	11-5-80	GENERAL UPDATE (SEQUENCE OF CONN TO MAIN LINE)							K-McA	TFH	DMP	10-4-78
0	1-9-79	ISSUED FOR USE							K-McA	TFH	DMP	
A	10-12-78	ISSUED FOR INFORMATION ONLY							K-McA	NCH	DMP	

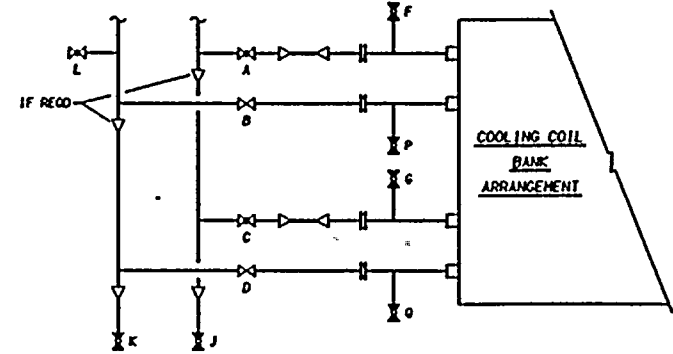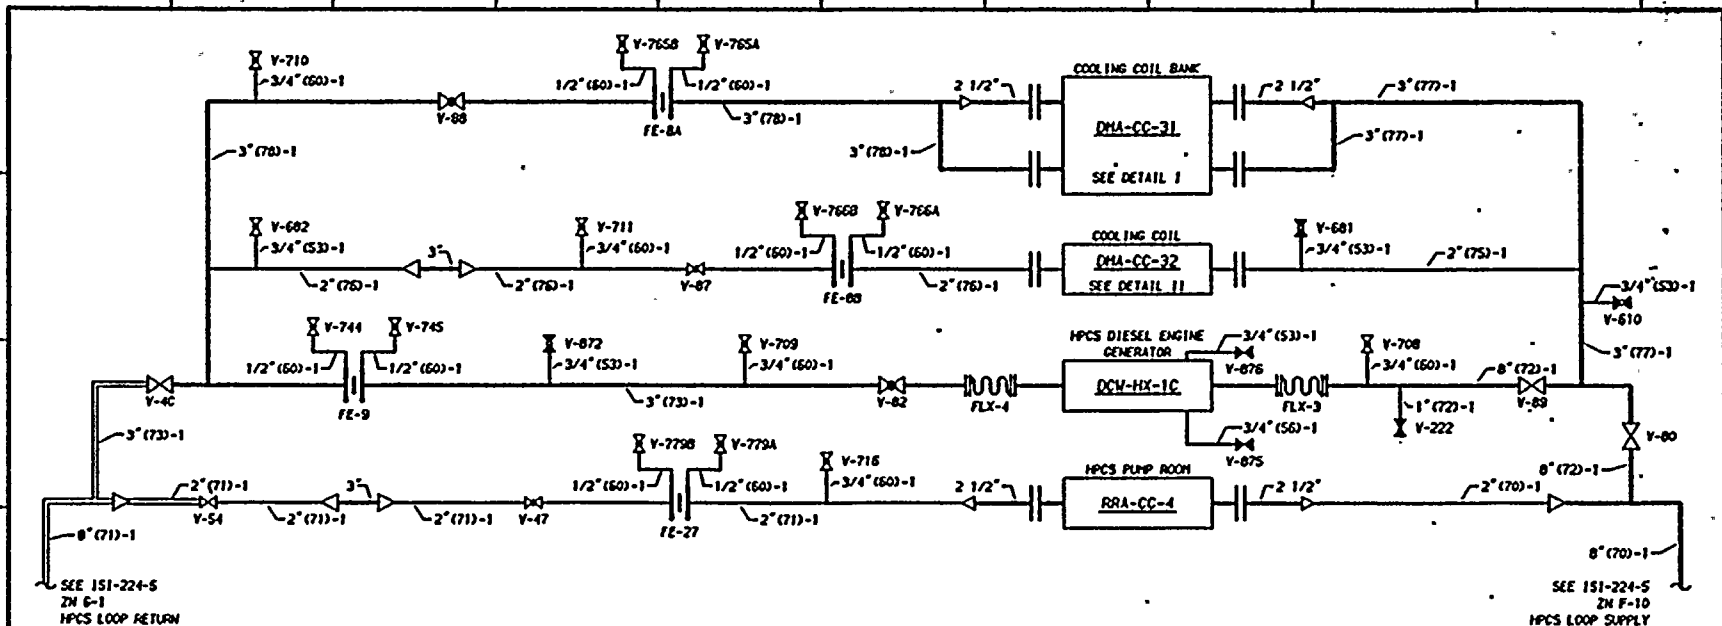

COOLING COIL BANK NUMBER	A	B	C	D	SIZE	F 3/8"	G 3/8"	K 3/4"	J 3/4"	L 3/4"	P 3/8"	Q 3/8"
DMA-CC-31	100	101	102	103	2 1/2"	141	142	143	144	737A	157	158
DMA-CC-11	104A	105A	106A	107A	2 1/2"	145A	146A	147A	148A	737B	159A	160A
DMA-CC-21	104B	105B	106B	107B	2 1/2"	145B	146B	147B	148B	737C	159B	160B
HMA-CC-52A-1	108B	109B	110B	111B	2"	149B	150B	151B	152B	737D	161B	162B
HMA-CC-52A-1	108A	109A	110A	111A	2"	149A	150A	151A	152A	737E	161A	162A

VALVE LIST										
COOLING COIL NUMBER	E	SIZE	N 3/8"	N 3/4"	N 3/4"	R 3/8"	S 3/4"	T	U	
DMA-CC-12	8A	2"	153A	154A	155A					679
DMA-CC-22	8B	2"	153B	154B	155B					156B
DMA-CC-32	8C	2"	153C	154C	155C					156C
DMA-CC-51	90	2"		154D	155D					
RRA-CC-1	16C	2"		154E	155E					664
RRA-CC-1A	65A	2"	153F	154F	155F					620
RRA-CC-1B	65B	2"	153G	154G	155G					622
RRA-CC-2	16A	2"		154I	155I					663
RRA-CC-3	16B	2"		154J	155J					658
RRA-CC-4	46	2"	153K	154K	155K					873
RRA-CC-5	36	2"	153L	154L	155L					
RRA-CC-6	26	1 1/2"	153M	154M	155M					
RRA-CC-10	91	1 1/2"	153N	154N	155N					156N
RRA-CC-11	95	1 1/2"	153P	154P	155P					819
RRA-CC-12	97	1 1/2"	153R	154R						156R
RRA-CC-13	114	2"	153S	154S	155S					3/4" 3/4"
RRA-CC-14	112	2"	153T	154T	155T					3/4" 3/4"
HMA-CC-52A-1	59A	2"	153V	154V	155V					156V
HMA-CC-52B-1	59B	2"	153V	154V	155V					156V
RRA-CC-15	132	1 1/2"	153W	154W	155W					642 3/4" 3/4"
RRA-CC-17	134	1 1/2"	153X	154X	155X					645 3/4" 3/4"
RRA-CC-19	185	1 1/2"	153Y	154Y	155Y					3/8" 3/8"
RRA-CC-20	193	1 1/2"	153Z	154Z	155Z					3/8" 3/8"

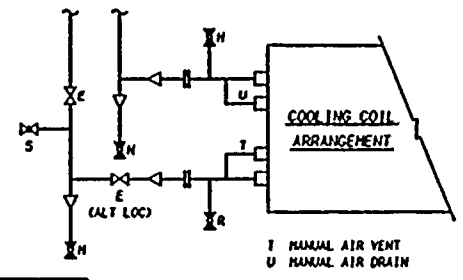

REFERENCES:

- BURNS & ROE FLOW DIAGRAMS
- MS24 SH 1 REV 50
- MS24 SH 2 REV 49
- M775 REV 4

NOTES:

- REFER TO DRAWING 151-200 FOR LEGEND.
- VALVE AND LINE DESIGNATIONS ARE SHOWN WITHOUT THE SYSTEM PREFIX FOR CLARITY.

DETAIL I


DETAIL II

THIS DRAWING IS INTENDED FOR USE IN PRESERVICE AND INSERVICE INSPECTION PROGRAMS ONLY

WASHINGTON PUBLIC POWER SUPPLY SYSTEM
RICHLAND, WASHINGTON 99352

NO	DATE	REVISION	BY	CHKD	APYD	NO	DATE	REVISION	BY	CHKD	APYD	DATE	10-4-78	ENGINEER D PORTER	DRAWN K-MCANDREW	DVG NO 151-224-6	REV 2
0	1-9-79	ISSUED FOR USE															
2	11-28-78	GENERAL UPDATE REDRAWN															

WPP-2
INSERVICE INSPECTION BOUNDARY DIAGRAM
STANDBY SERVICE WATER (SSW)
DVG NO 151-224-6 REV 2

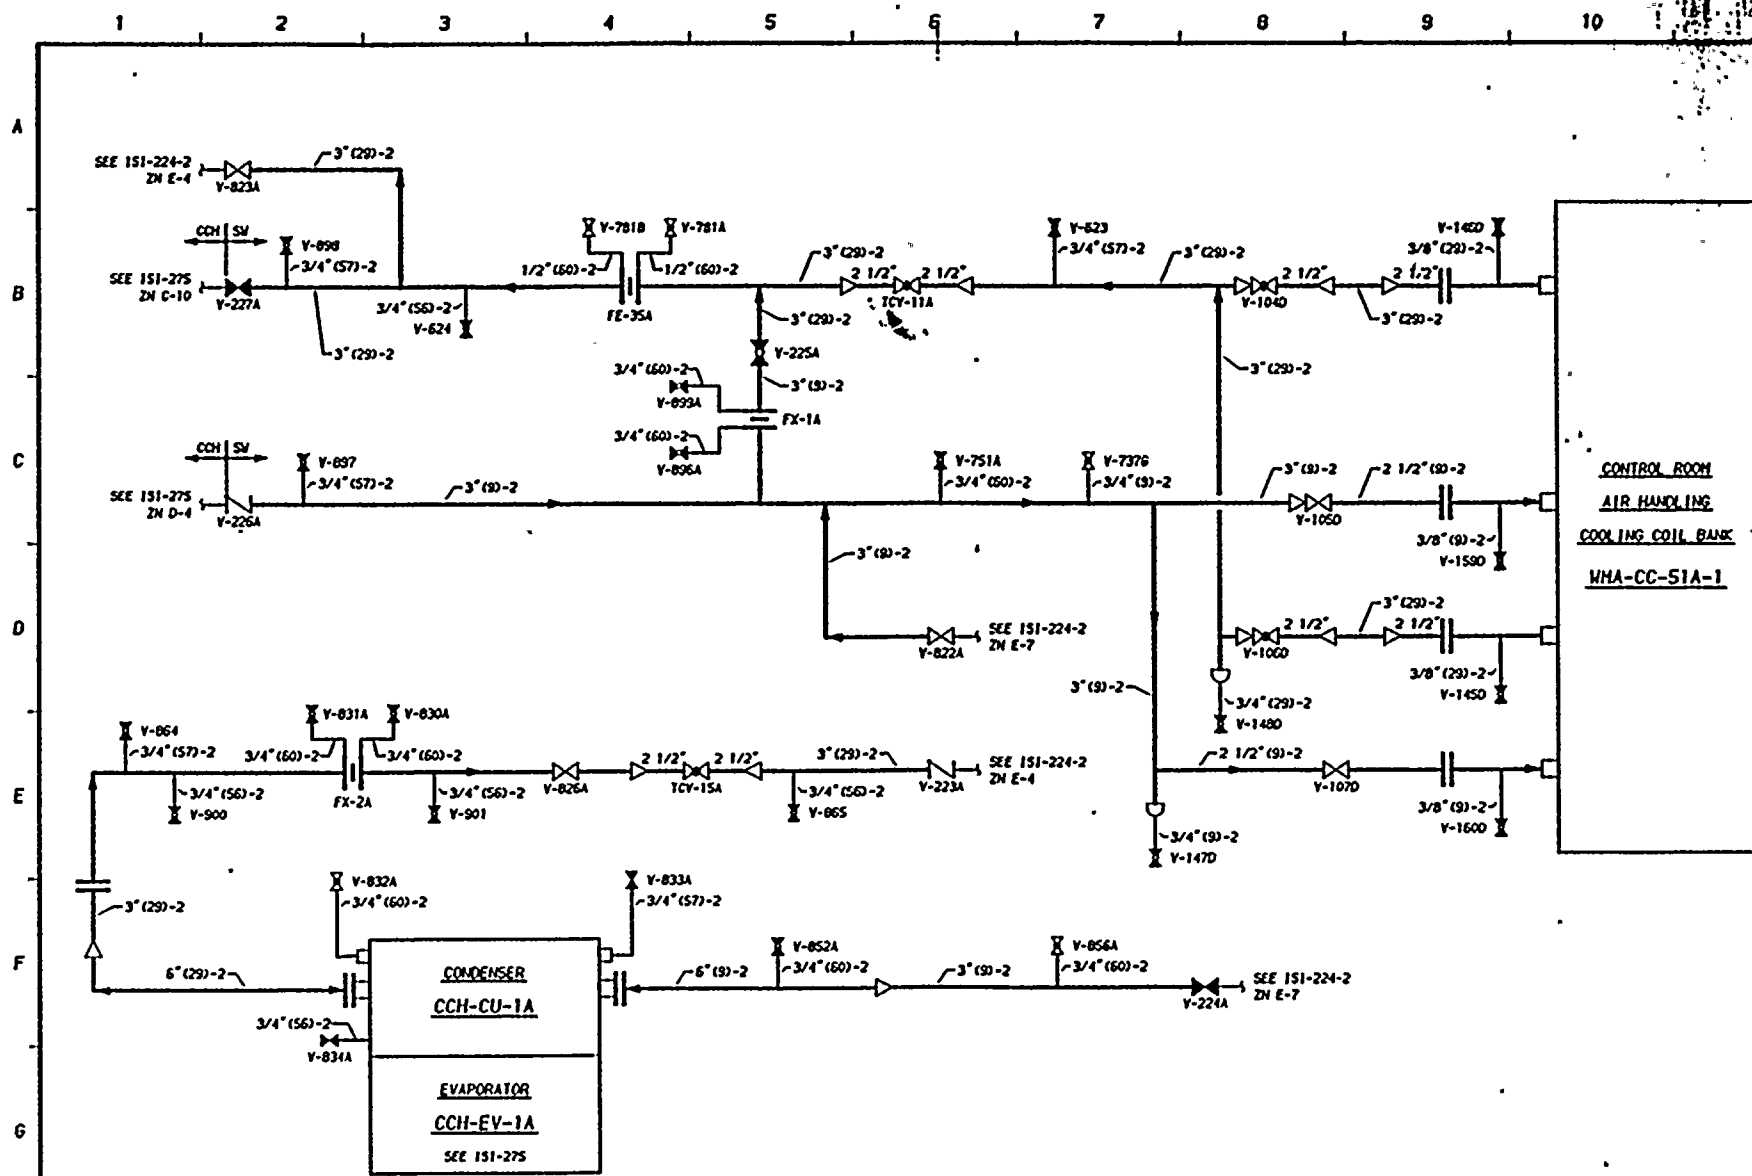

CONTROL ROOM
 AIR HANDLING
 COOLING COIL BANK
 WMA-CC-51A-1

SEE 151-224-6 FOR NOTES AND REFERENCES

THIS DRAWING IS INTENDED FOR USE IN PRESERVICE AND INSERVICE INSPECTION PROGRAMS ONLY


WASHINGTON PUBLIC POWER SUPPLY SYSTEM
 RICHLAND, WASHINGTON 99352

ENGINEER K-McANDREW
 DRAWN K-McANDREW

INSERVICE INSPECTION BOUNDARY DIAGRAM
 STANDBY SERVICE WATER (SSW)

NO	DATE	REVISION	BY	CHKD	APYD	NO	DATE	REVISION	BY	CHKD	APYD	DATE	DWG NO	REV
0	11-28-84	ISSUED FOR USE										7-23-84	151-224-7	0



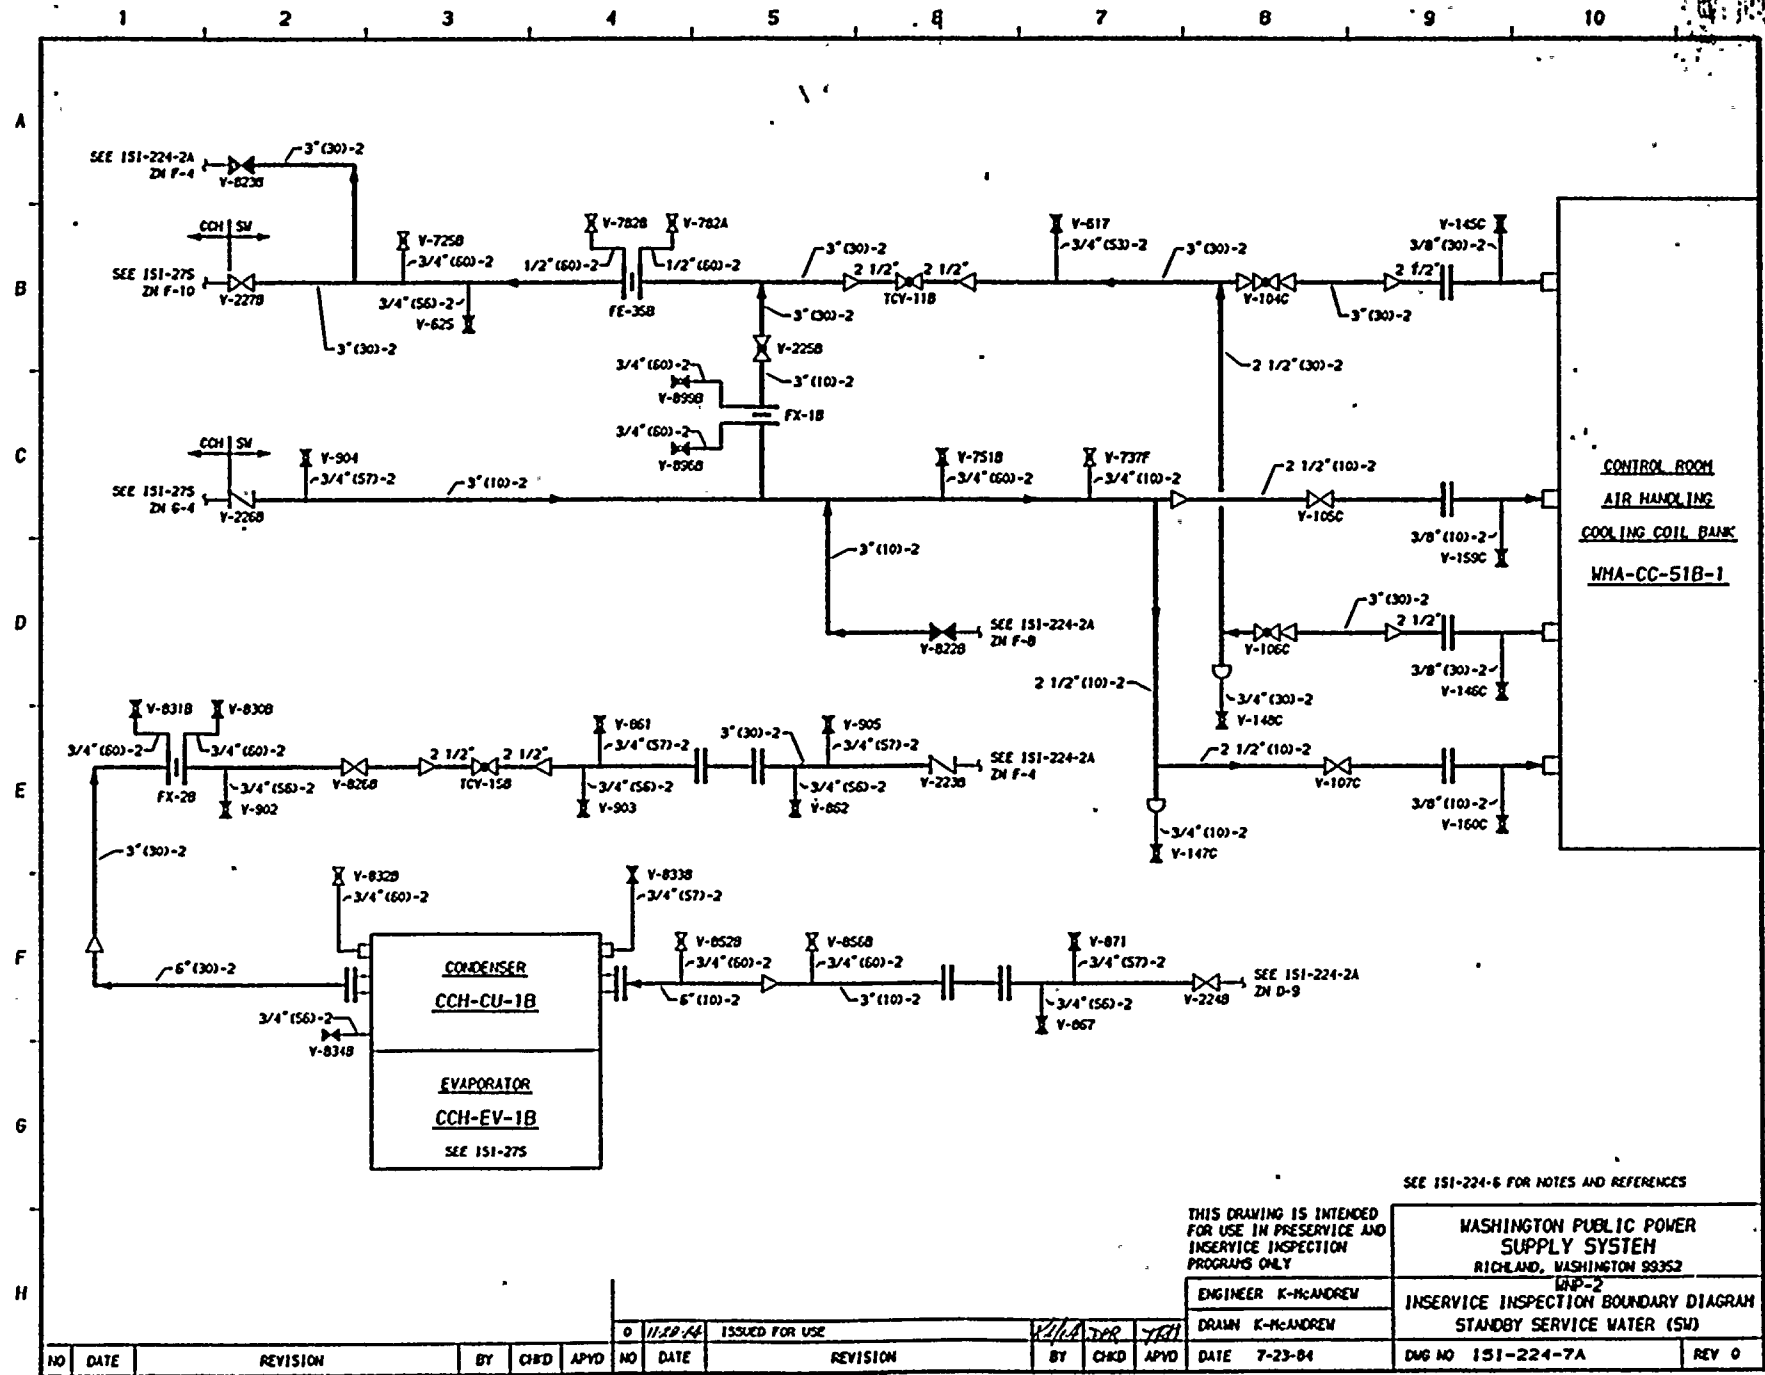

SEE 151-224-6 FOR NOTES AND REFERENCES

THIS DRAWING IS INTENDED FOR USE IN PRESERVICE AND INSERVICE INSPECTION PROGRAMS ONLY

WASHINGTON PUBLIC POWER SUPPLY SYSTEM
 RICHLAND, WASHINGTON 99352

ENGINEER K-McANDREW
 DRAWN K-McANDREW

WPP-2
 INSERVICE INSPECTION BOUNDARY DIAGRAM
 STANDBY SERVICE WATER (SW)

NO	DATE	REVISION	BY	CHKD	APVD	NO	DATE	REVISION	BY	CHKD	APVD	DATE	DWG NO	REV
						0	11/20/64	ISSUED FOR USE				7-23-64	151-224-7A	0



WNP-2 ISI BOUNDARY DIAGRAM

Date 1/8/79

Revision 0

EXCEPTIONS AND EXEMPTIONS

ISI - 224

SYSTEM Standby Service Water System

EXCEPTIONS:

Class 1 Piping and Components

- ° Not applicable; entire system Class 3 or nonnuclear only.

Class 2 Piping and Components

- ° Not applicable; entire system Class 3 or nonnuclear only.

EXEMPTIONS APPLIED:

IWB-1220(a)(1) No

(2) No

(3) No

(4) No

*(b)(1) No

(2) No

(3) No

IWC-1220(a) No

*(b) No

(c) No

(d) No


IWC-5220(d) No

IWD-5200(c) Yes, spray pond headers

* See general exemption discussion for details.



100
100
100
100

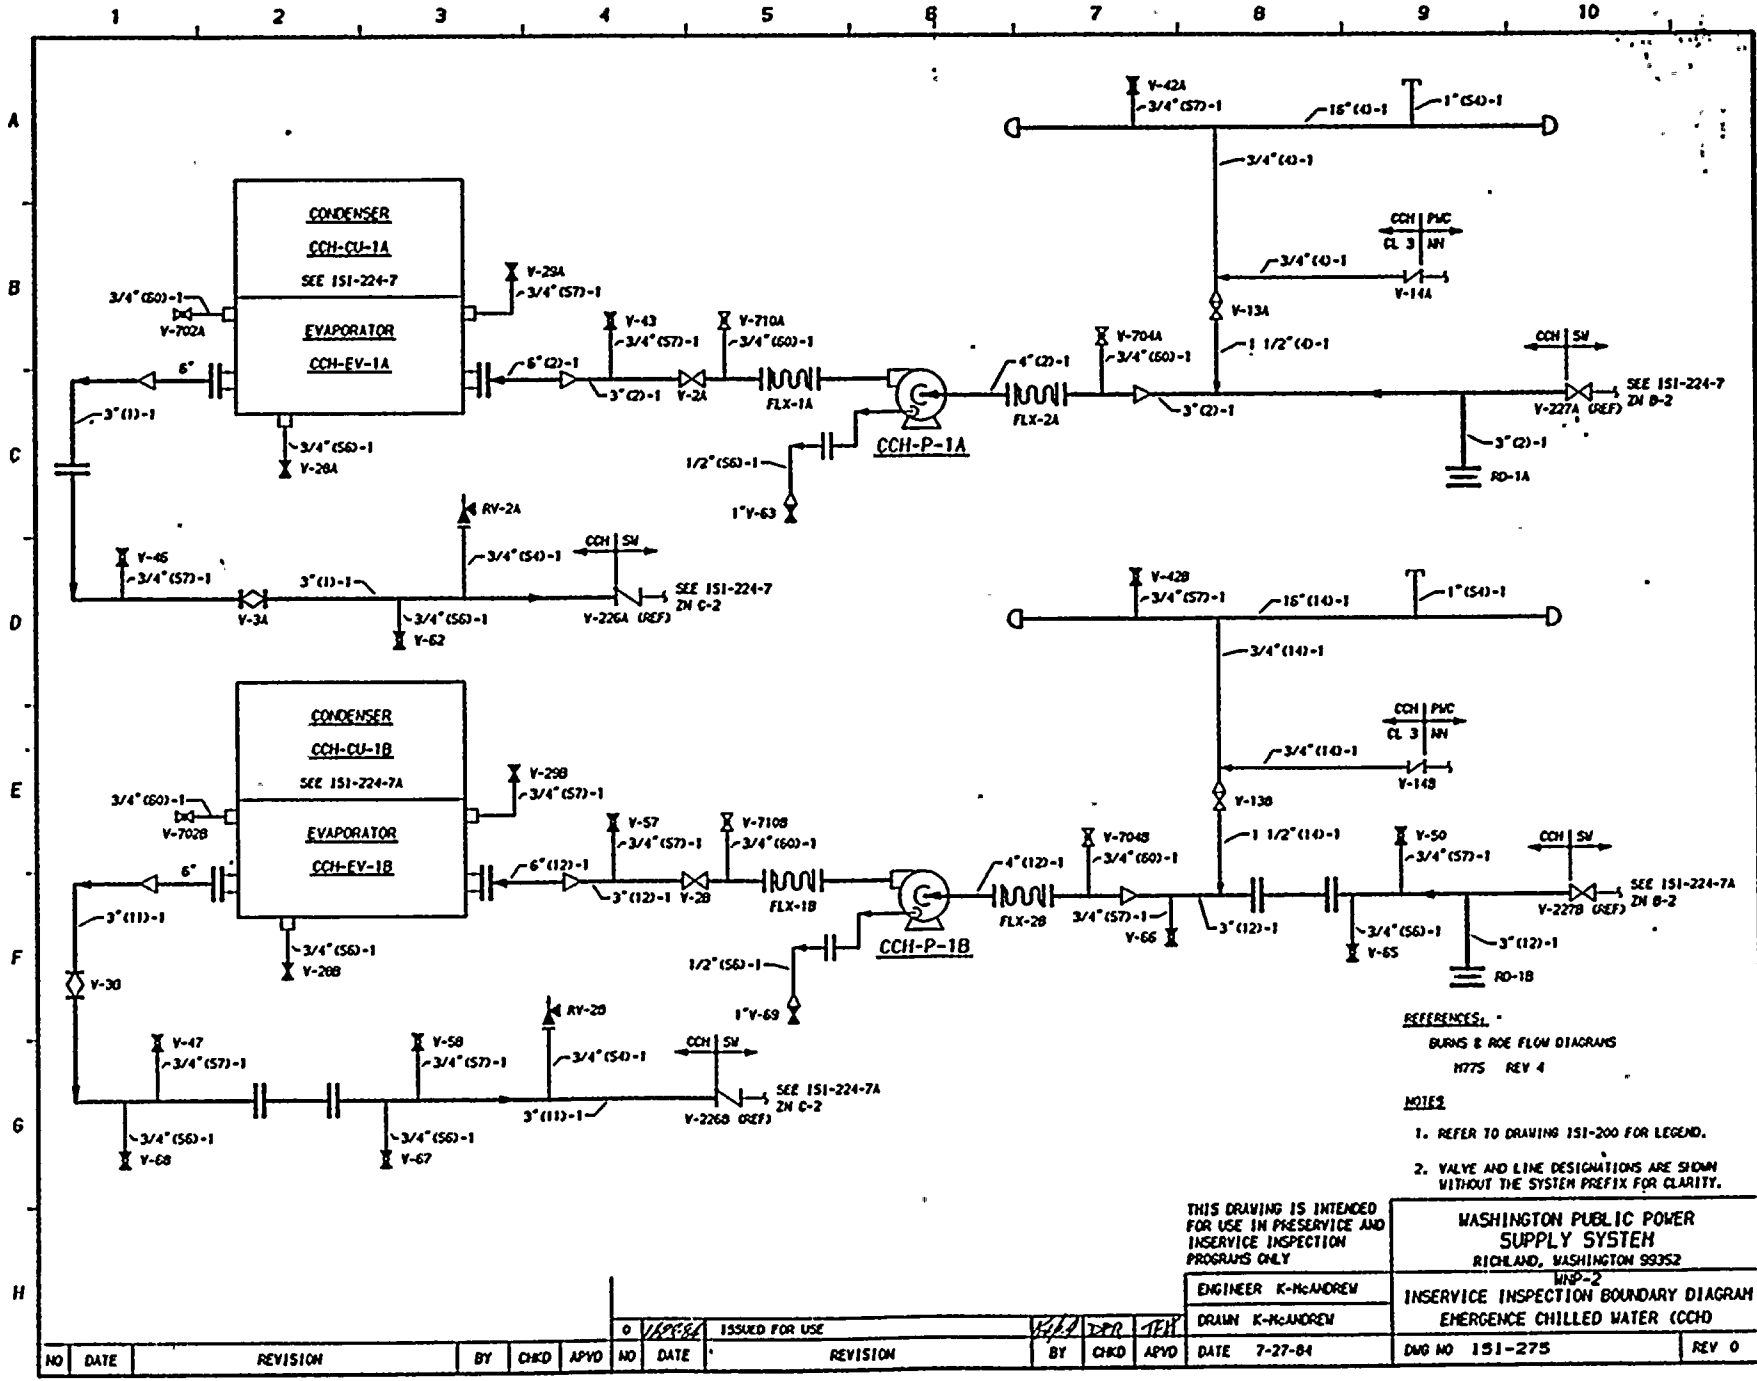


REFERENCES:
 BURNS & ROE FLOW DIAGRAMS
 1775 REV 4


- NOTES
- REFER TO DRAWING 151-200 FOR LEGEND.
 - VALVE AND LINE DESIGNATIONS ARE SHOWN WITHOUT THE SYSTEM PREFIX FOR CLARITY.

THIS DRAWING IS INTENDED FOR USE IN PRESERVICE AND INSERVICE INSPECTION PROGRAMS ONLY

WASHINGTON PUBLIC POWER SUPPLY SYSTEM
 RICHLAND, WASHINGTON 99352
 WWP-2
 INSERVICE INSPECTION BOUNDARY DIAGRAM
 EMERGENCY CHILLED WATER (CCH)
 DATE 7-27-84
 DWG NO 151-275
 REV 0

NO	DATE	REVISION	BY	CHKD	APVD	NO	DATE	REVISION	BY	CHKD	APVD	DATE
						0	7/27/84	ISSUED FOR USE	VAA	DPD	TEH	7-27-84

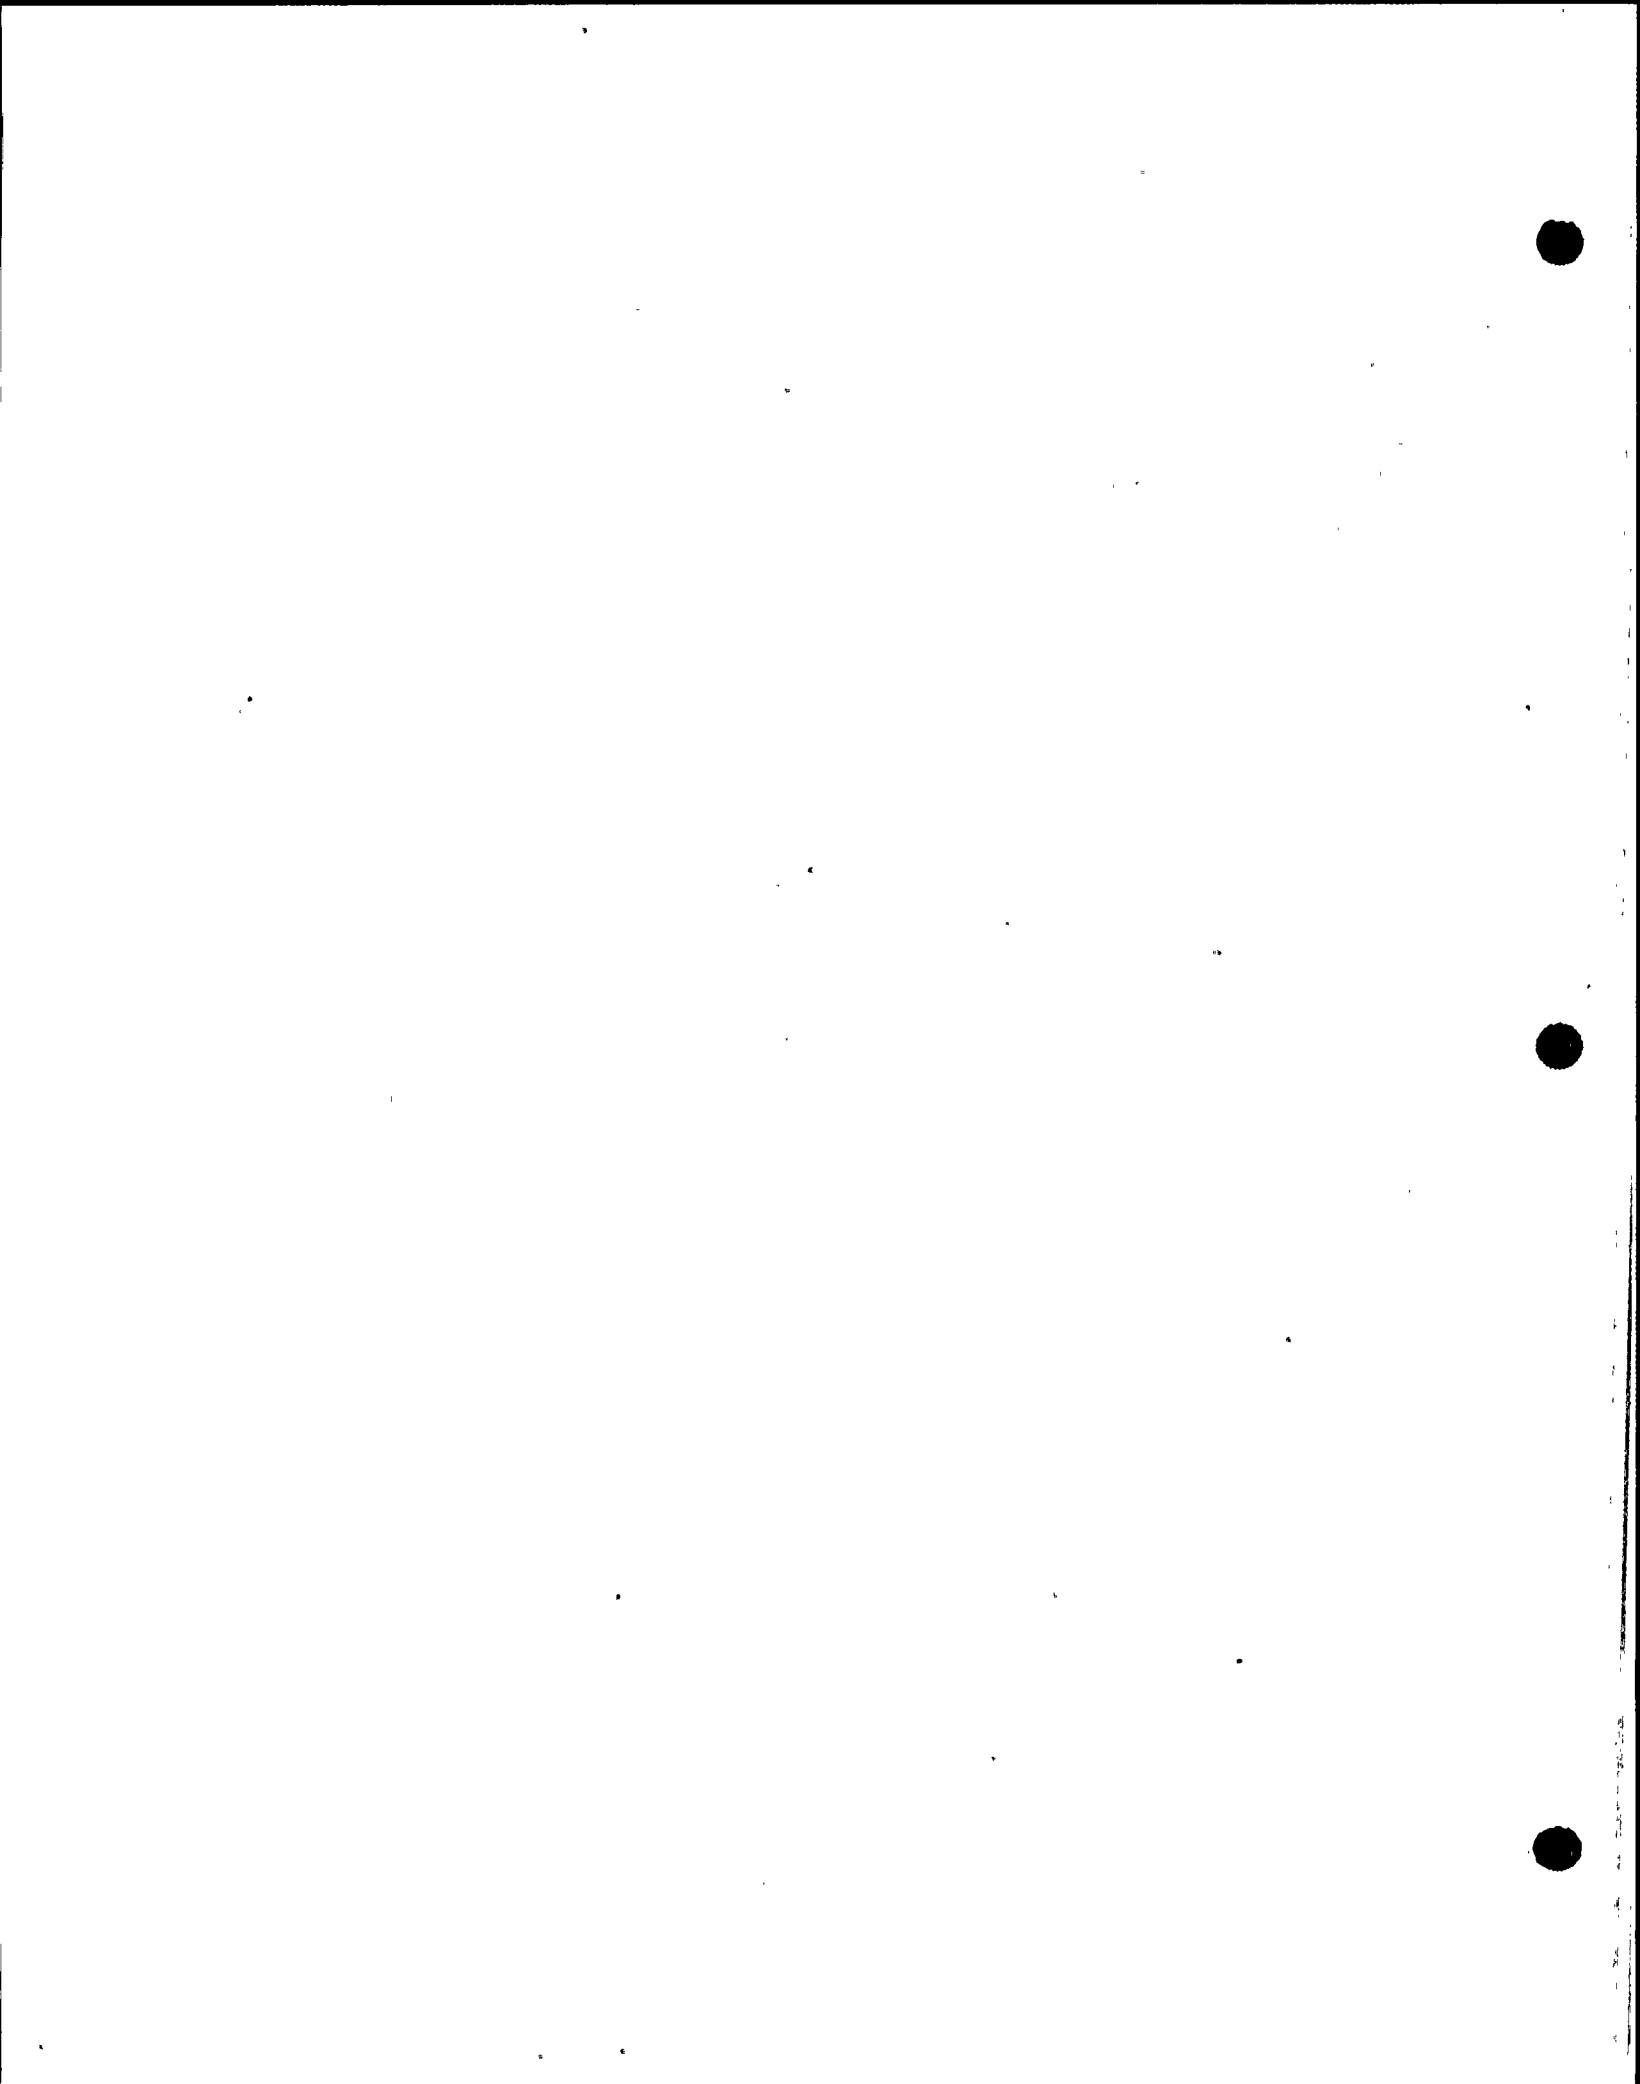

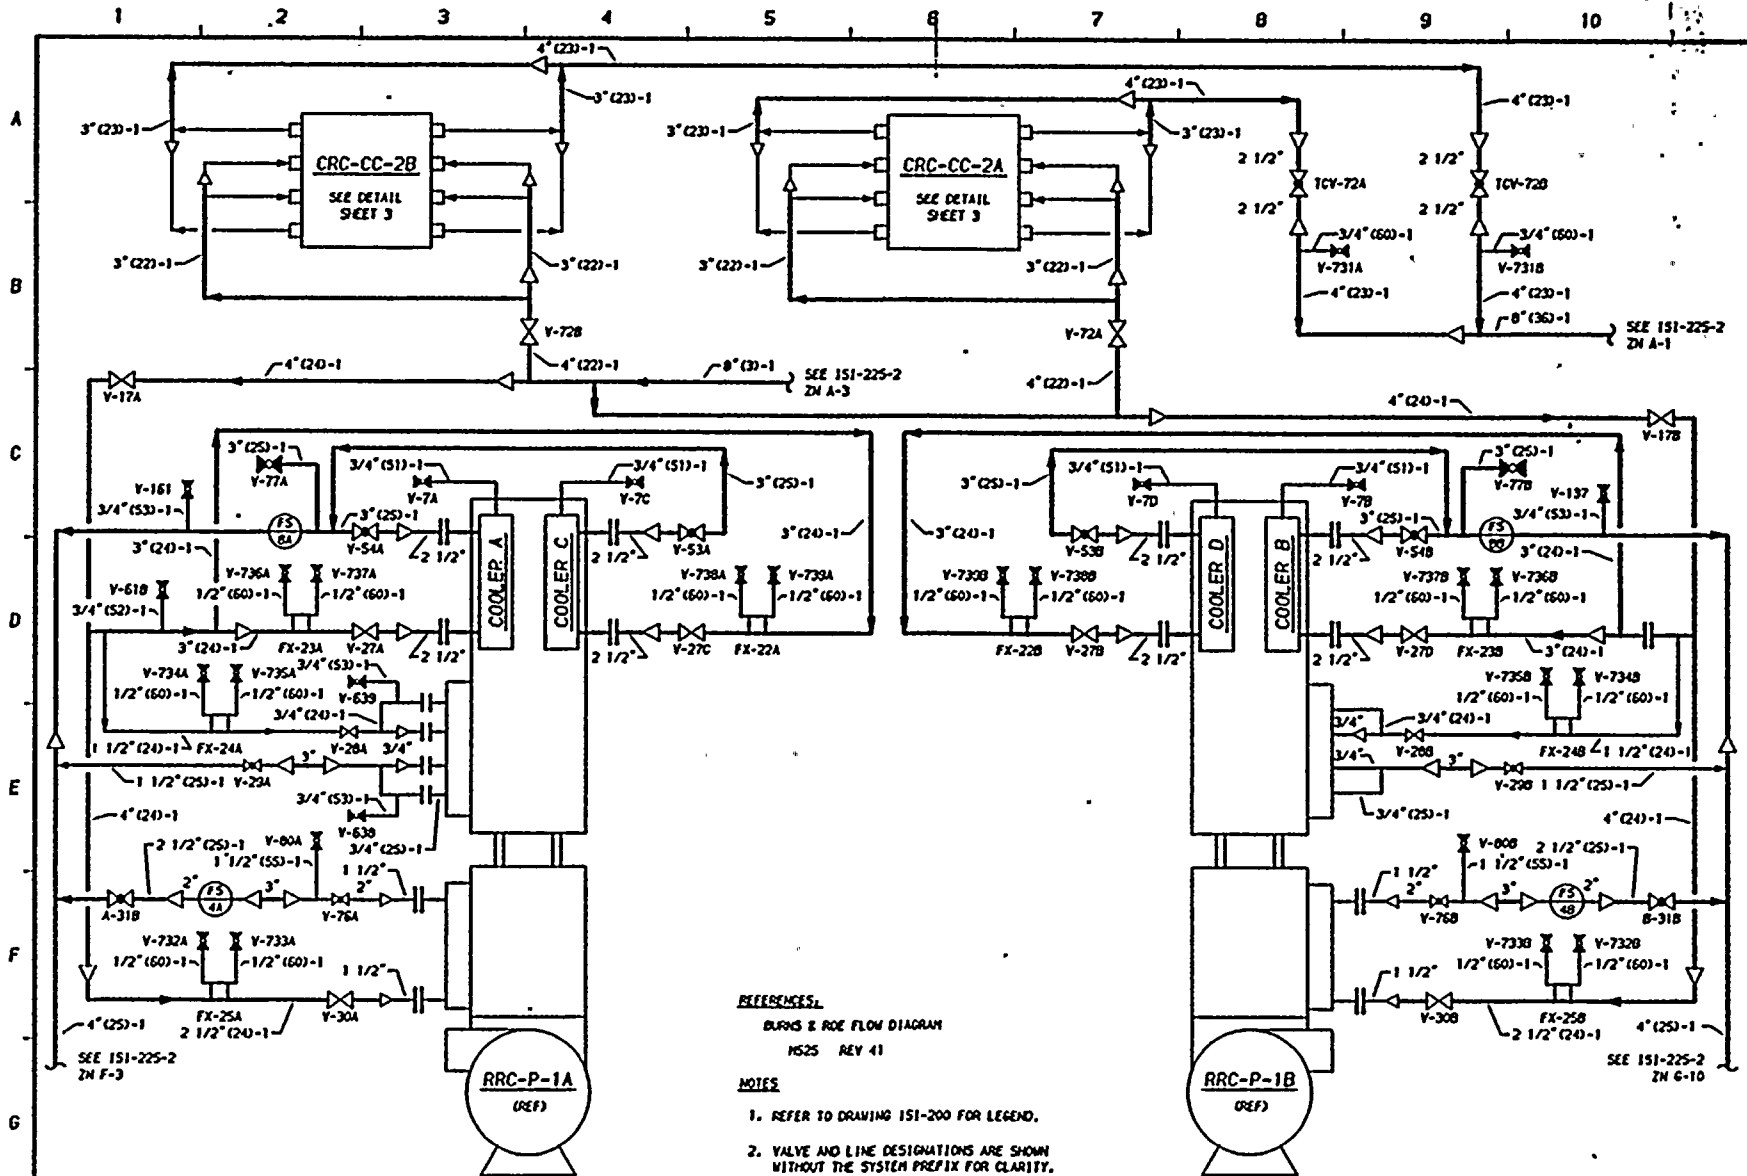

REFERENCES:
 BURNS & ROE FLOW DIAGRAM
 NS25 REV 41

- NOTES:**
1. REFER TO DRAWING 151-200 FOR LEGEND.
 2. VALVE AND LINE DESIGNATIONS ARE SHOWN WITHOUT THE SYSTEM PREFIX FOR CLARITY.
 3. ALL PIPING THIS SYSTEM, EXCEPT AS NOTED ON 151-225-2, IS CLASS 3.


THIS DRAWING IS INTENDED FOR USE IN PRESERVE AND INSERVICE INSPECTION PROGRAMS ONLY


WASHINGTON PUBLIC POWER SUPPLY SYSTEM
 RICHLAND, WASHINGTON 99352

NO	DATE	REVISION	BY	CHKD	APVD
1	11-20-74	GENERAL UPDATE REDRAWN	K-McA	MCH	DMP
0	1-9-79	ISSUED FOR USE	K-McA	MCH	DMP
A	10-18-78	ISSUED FOR INFORMATION ONLY	K-McA	MCH	DMP

ENGINEER D PORTER
 DRAWN K-McANDREW
 DATE 9-26-78
 Dwg No 151-225-1
 REV 1

NO	DATE	REVISION	BY	CHKD	APVD	NO	DATE	REVISION	BY	CHKD	APVD	DATE	DWG NO	REV
												9-26-78	151-225-1	1

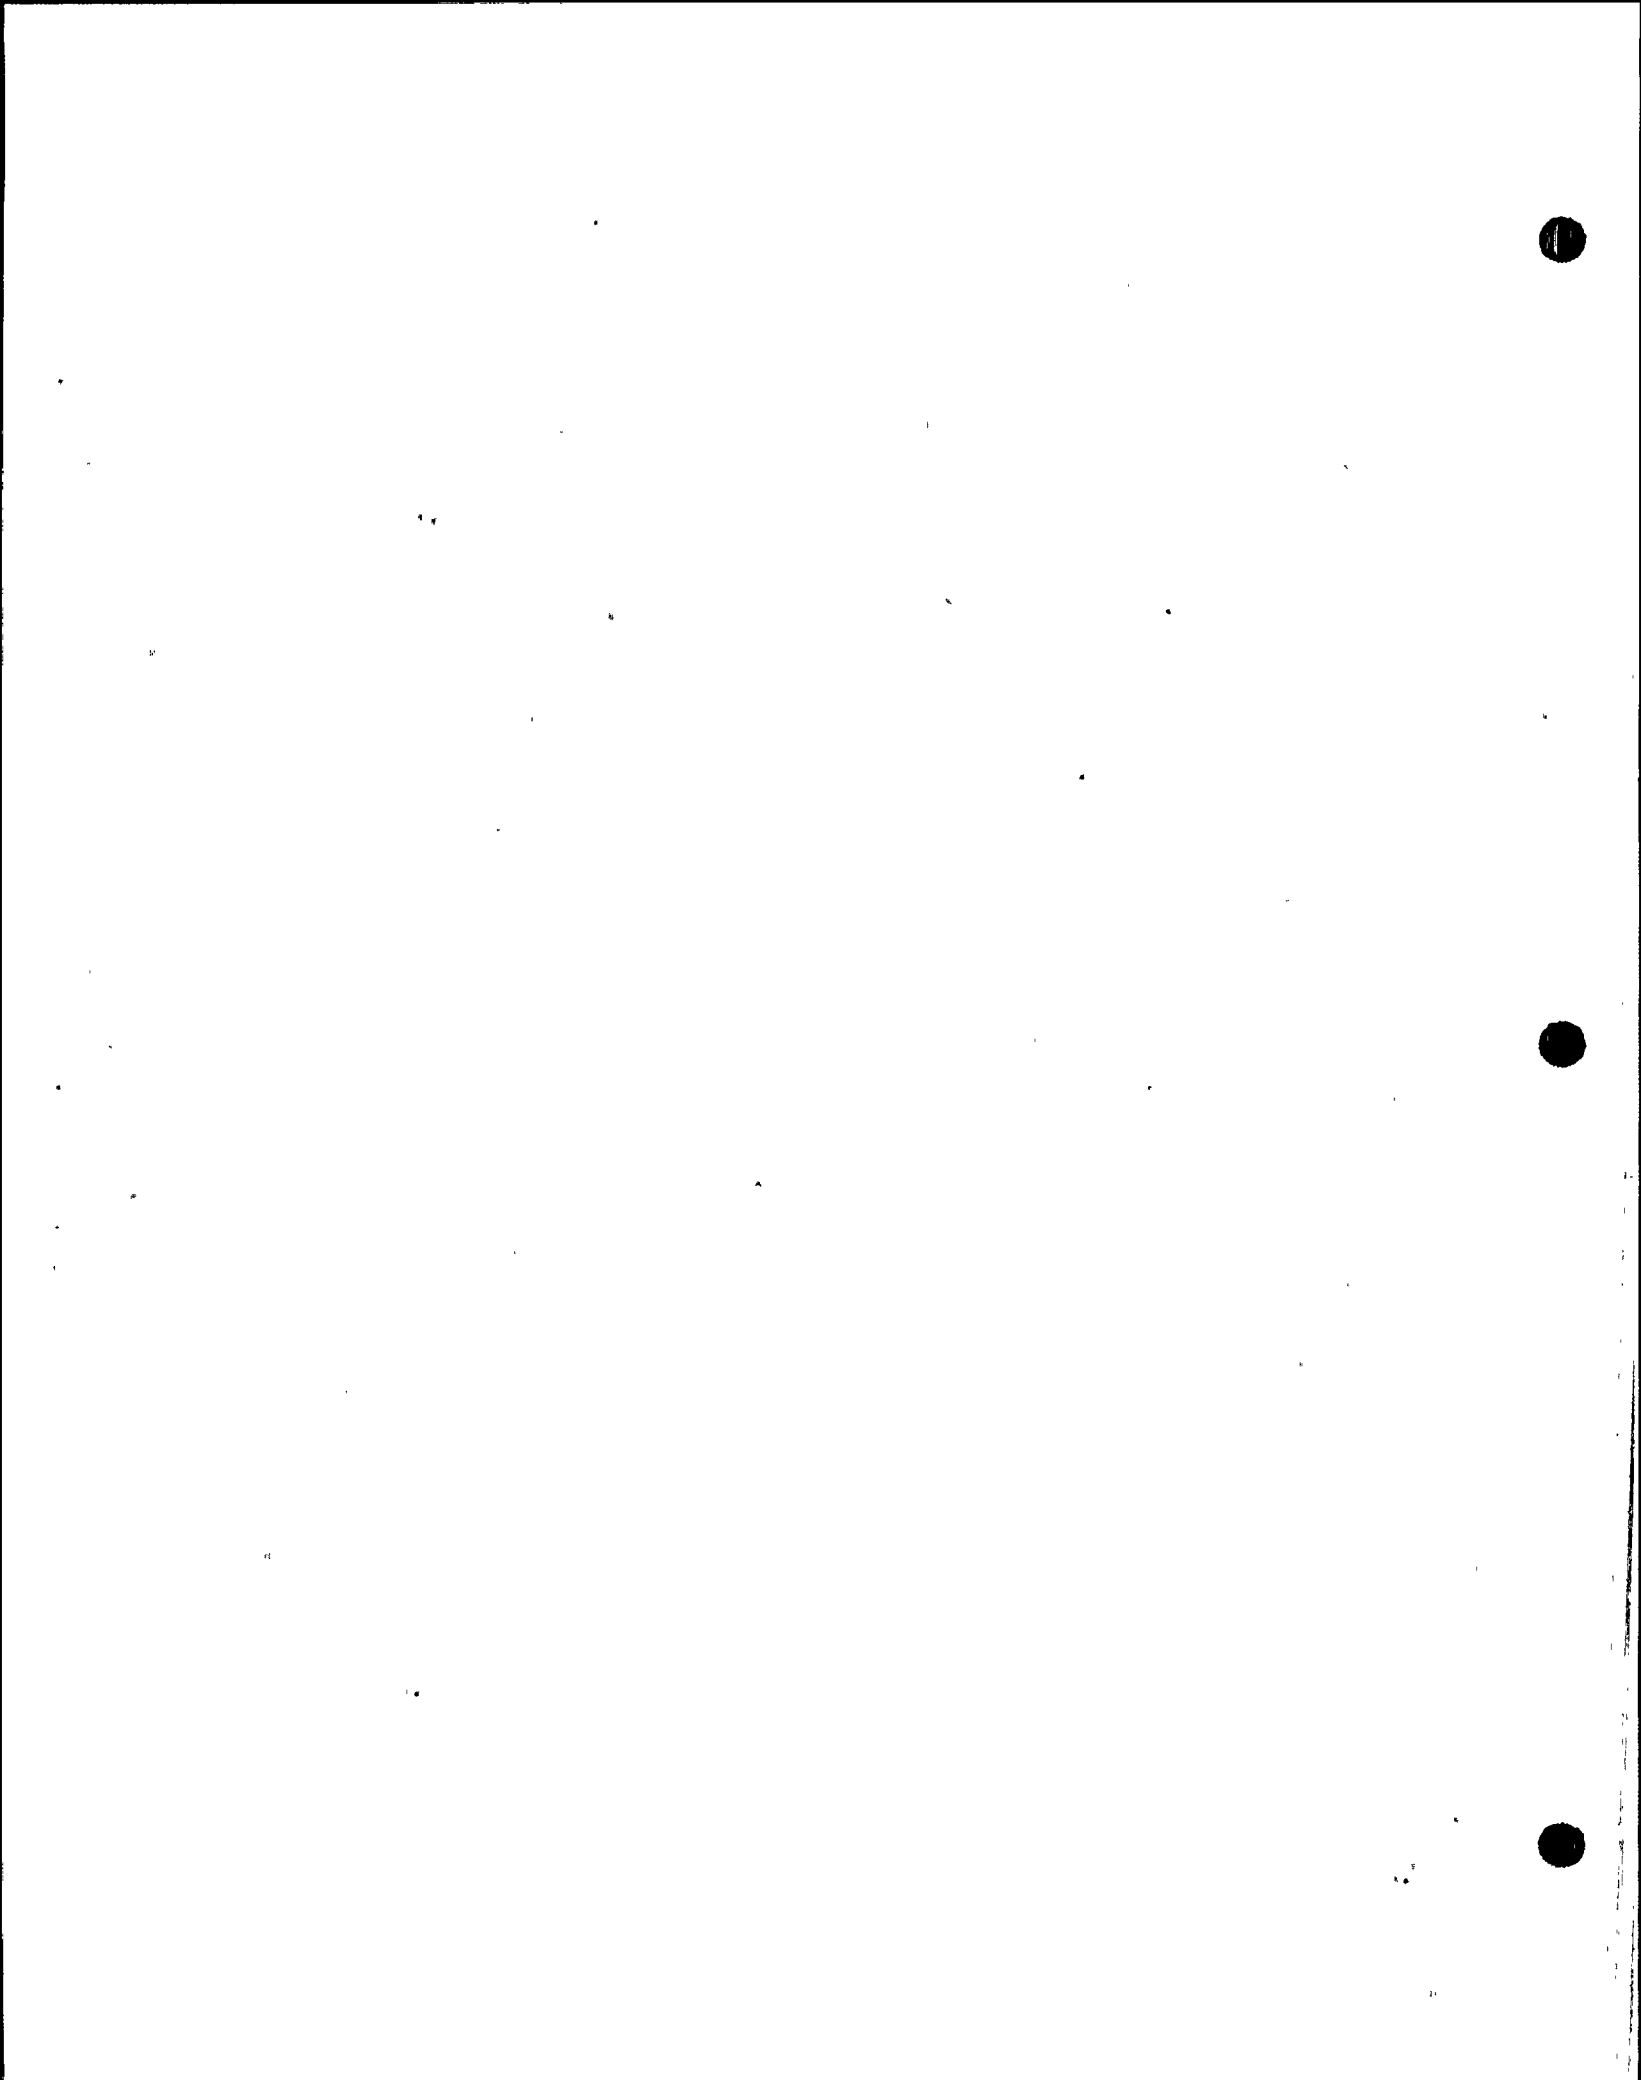

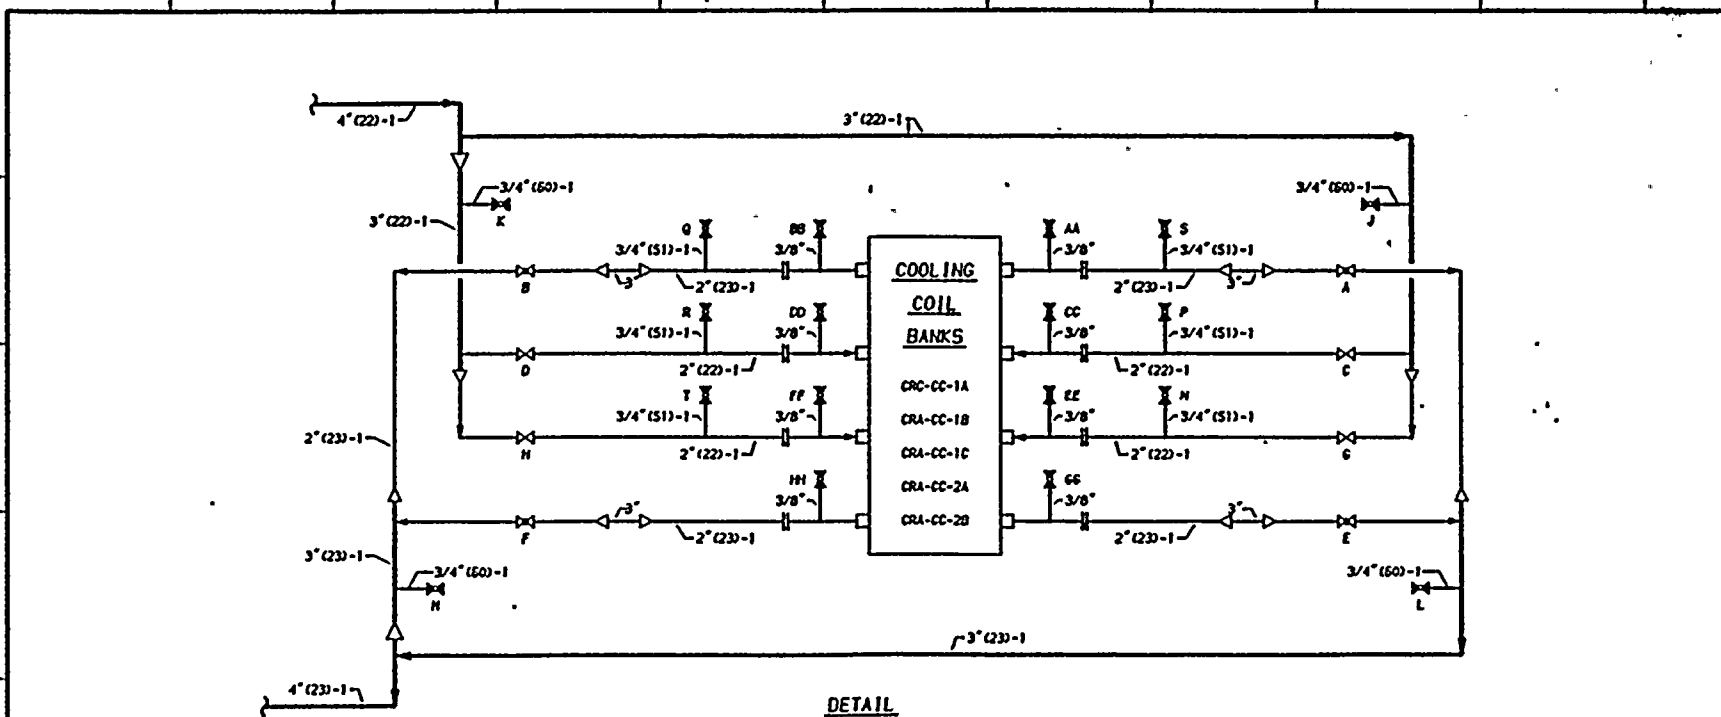

DETAIL
 TYPICAL DETAIL FOR COOLING COIL BANKS
 (SEE TABLE FOR TAG NUMBERS)

COOLING COIL BANK NUMBER	VALVE TAG NUMBERS																									
	A	B	C	D	E	F	G	H	J	K	L	M	N	P	Q	R	S	T	AA	BB	CC	DD	EE	FF	GG	HH
CRA-CC-1A	81A	82A	83A	84A	85A	86A	87A	88A	769A	770A	771A	772A	---	628	630	631	629	---	120A	121A	122A	123A	124A	125A	126A	127A
CRA-CC-1B	81B	82B	83B	84B	85B	86B	87B	88B	769B	770B	771B	772B	---	624	626	623	627	---	120B	121B	122B	123B	124B	125B	126B	127B
CRA-CC-1C	81C	82C	83C	84C	85C	86C	87C	88C	769C	770C	771C	772C	---	622	621	620	625	---	120C	121C	122C	123C	124C	125C	126C	127C
CRA-CC-2A	85D	82D	87D	86D	81D	86D	83D	84D	769D	770D	771D	772D	---	636	---	637	---	---	120D	121D	122D	123D	124D	125D	126D	127D
CRA-CC-2B	86E	85E	84E	83E	82E	81E	80E	87E	769E	770E	771E	---	---	---	---	---	---	---	120E	121E	122E	123E	124E	125E	126E	127E

TABLE

SEE 151-225-1 FOR NOTES AND REFERENCES.

THIS DRAWING IS INTENDED FOR USE IN PRESERVICE AND INSERVICE INSPECTION PROGRAMS ONLY


WASHINGTON PUBLIC POWER SUPPLY SYSTEM
 RICHLAND, WASHINGTON 99352


I	10-26-78	GENERAL UPDATE REDRAWN	K-MCA	DPH	DPH
O	1-9-79	ISSUED FOR USE	K-MCA	DPH	DPH
A	10-18-79	ISSUED FOR INFORMATION ONLY	K-MCA	MCH	DPH

ENGINEER D PORTER
 DRAWN K-McANDREW
 DATE 9-26-78

INSERVICE INSPECTION BOUNDARY DIAGRAM
 REACTOR CLOSED COOLING (RCC)

NO	DATE	REVISION	BY	CHKD	APYD	NO	DATE	REVISION	BY	CHKD	APYD	DATE	9-26-78	DWG NO 151-225-3	REV 1
----	------	----------	----	------	------	----	------	----------	----	------	------	------	---------	------------------	-------

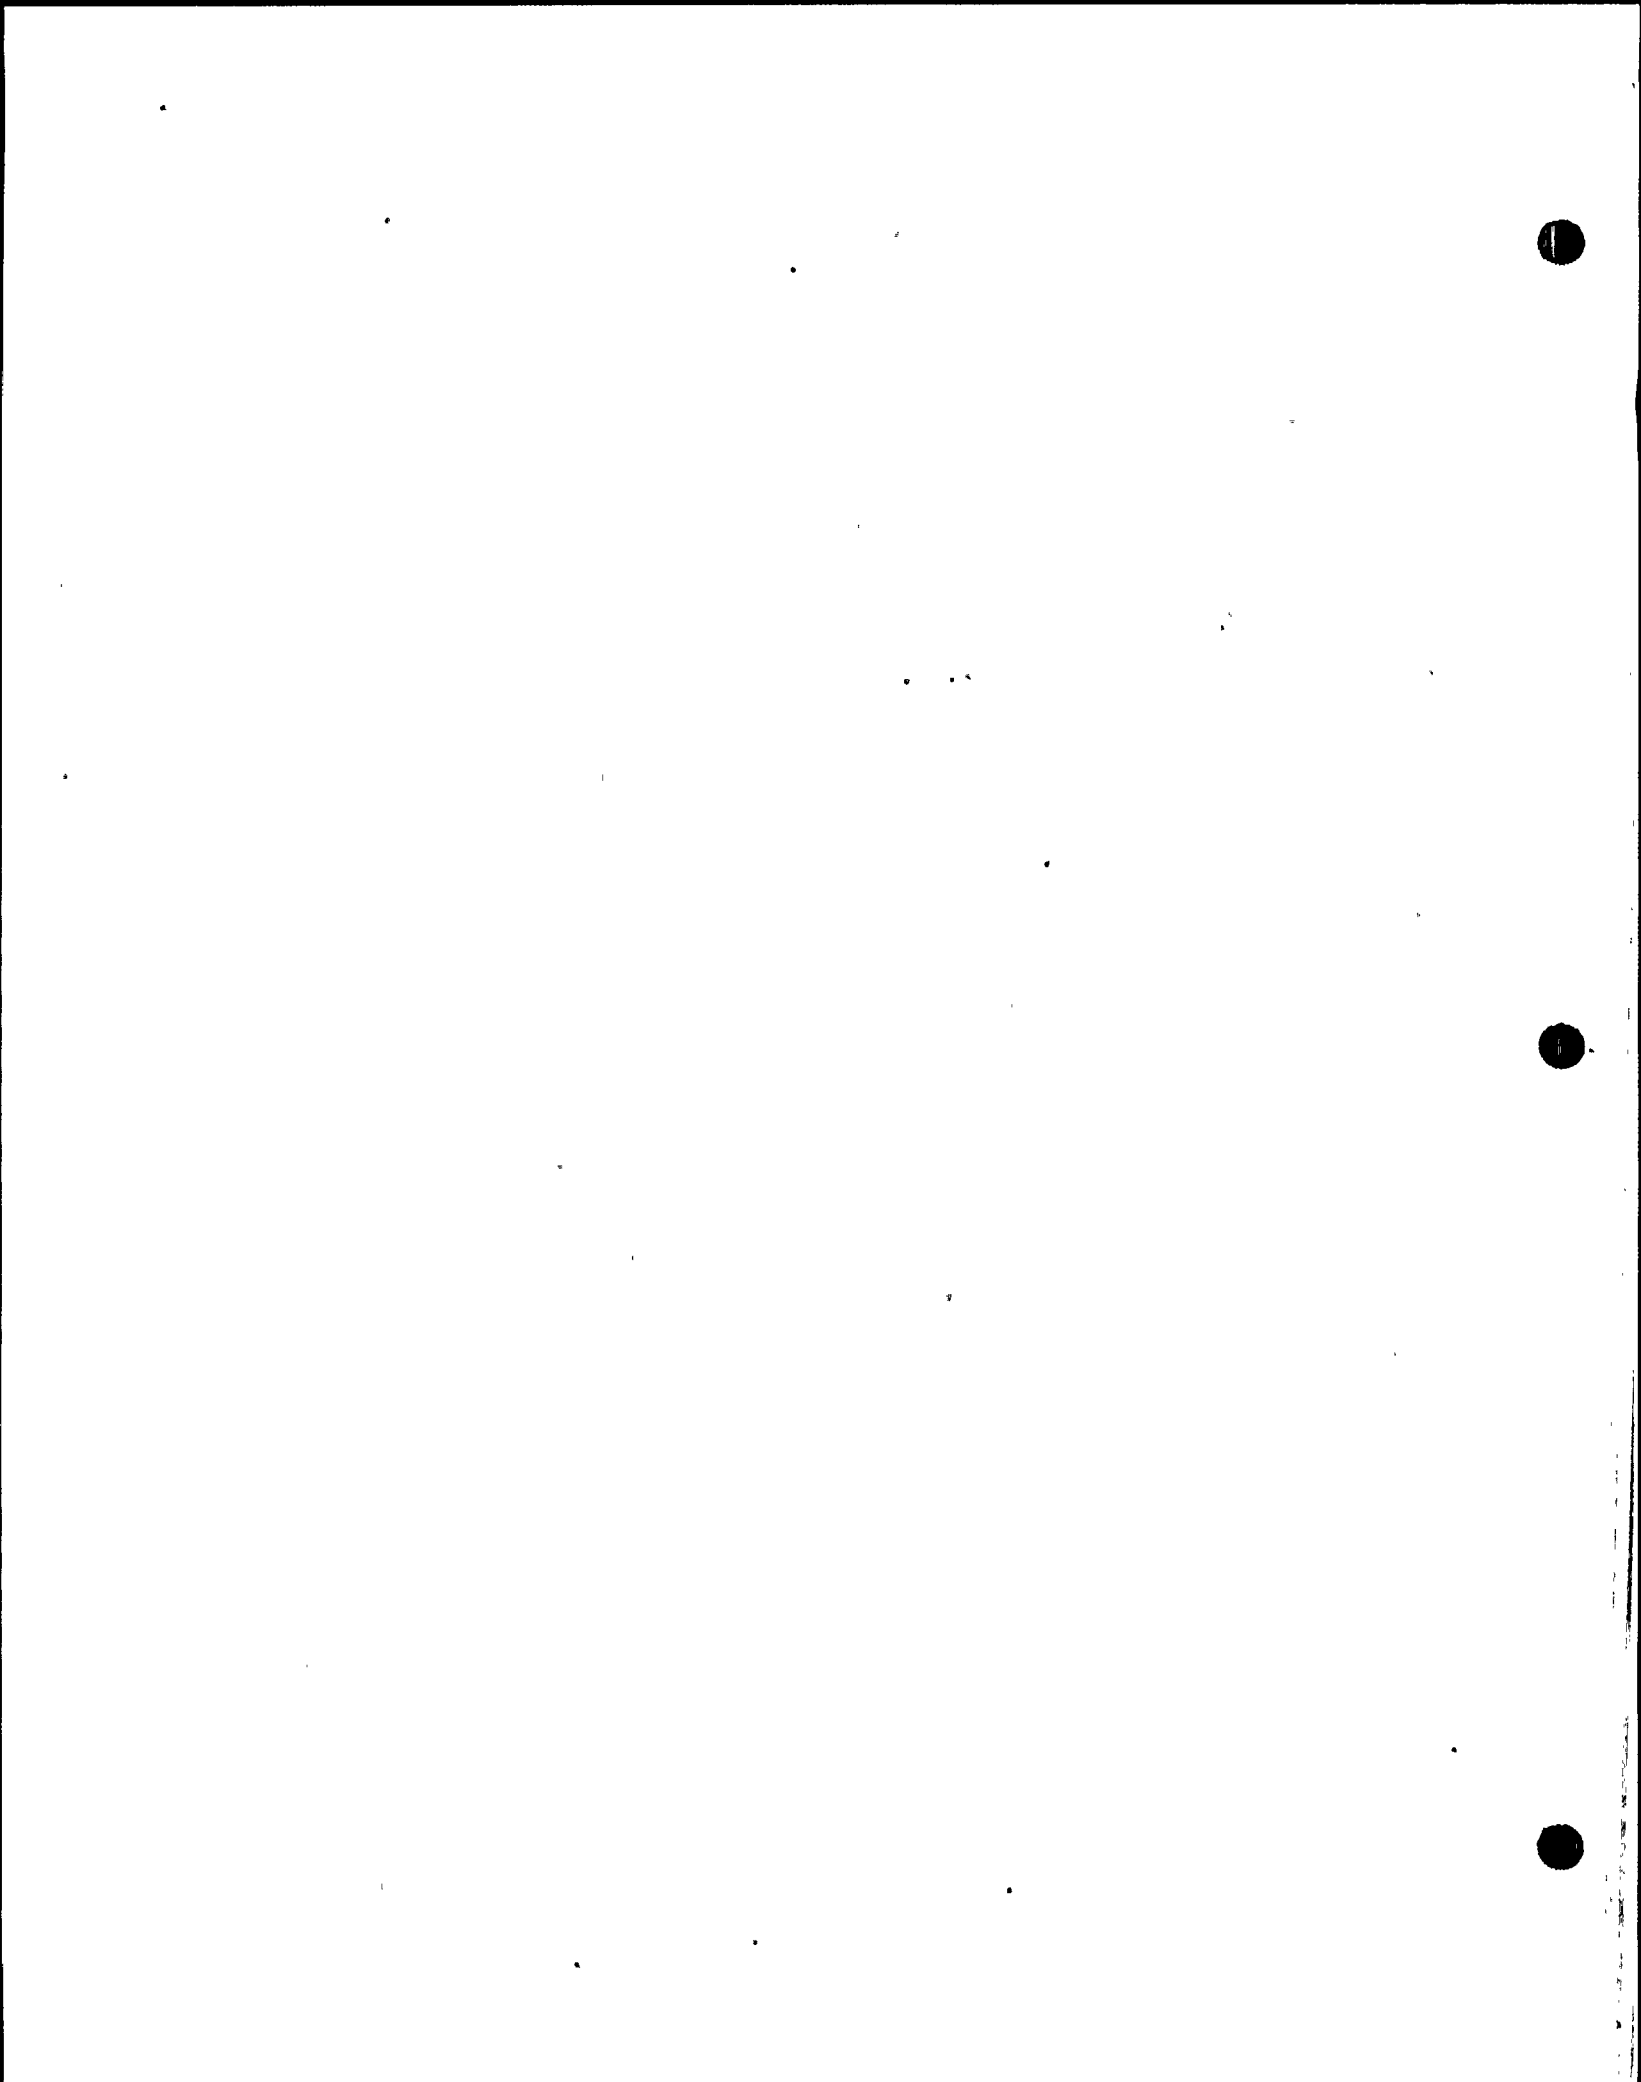

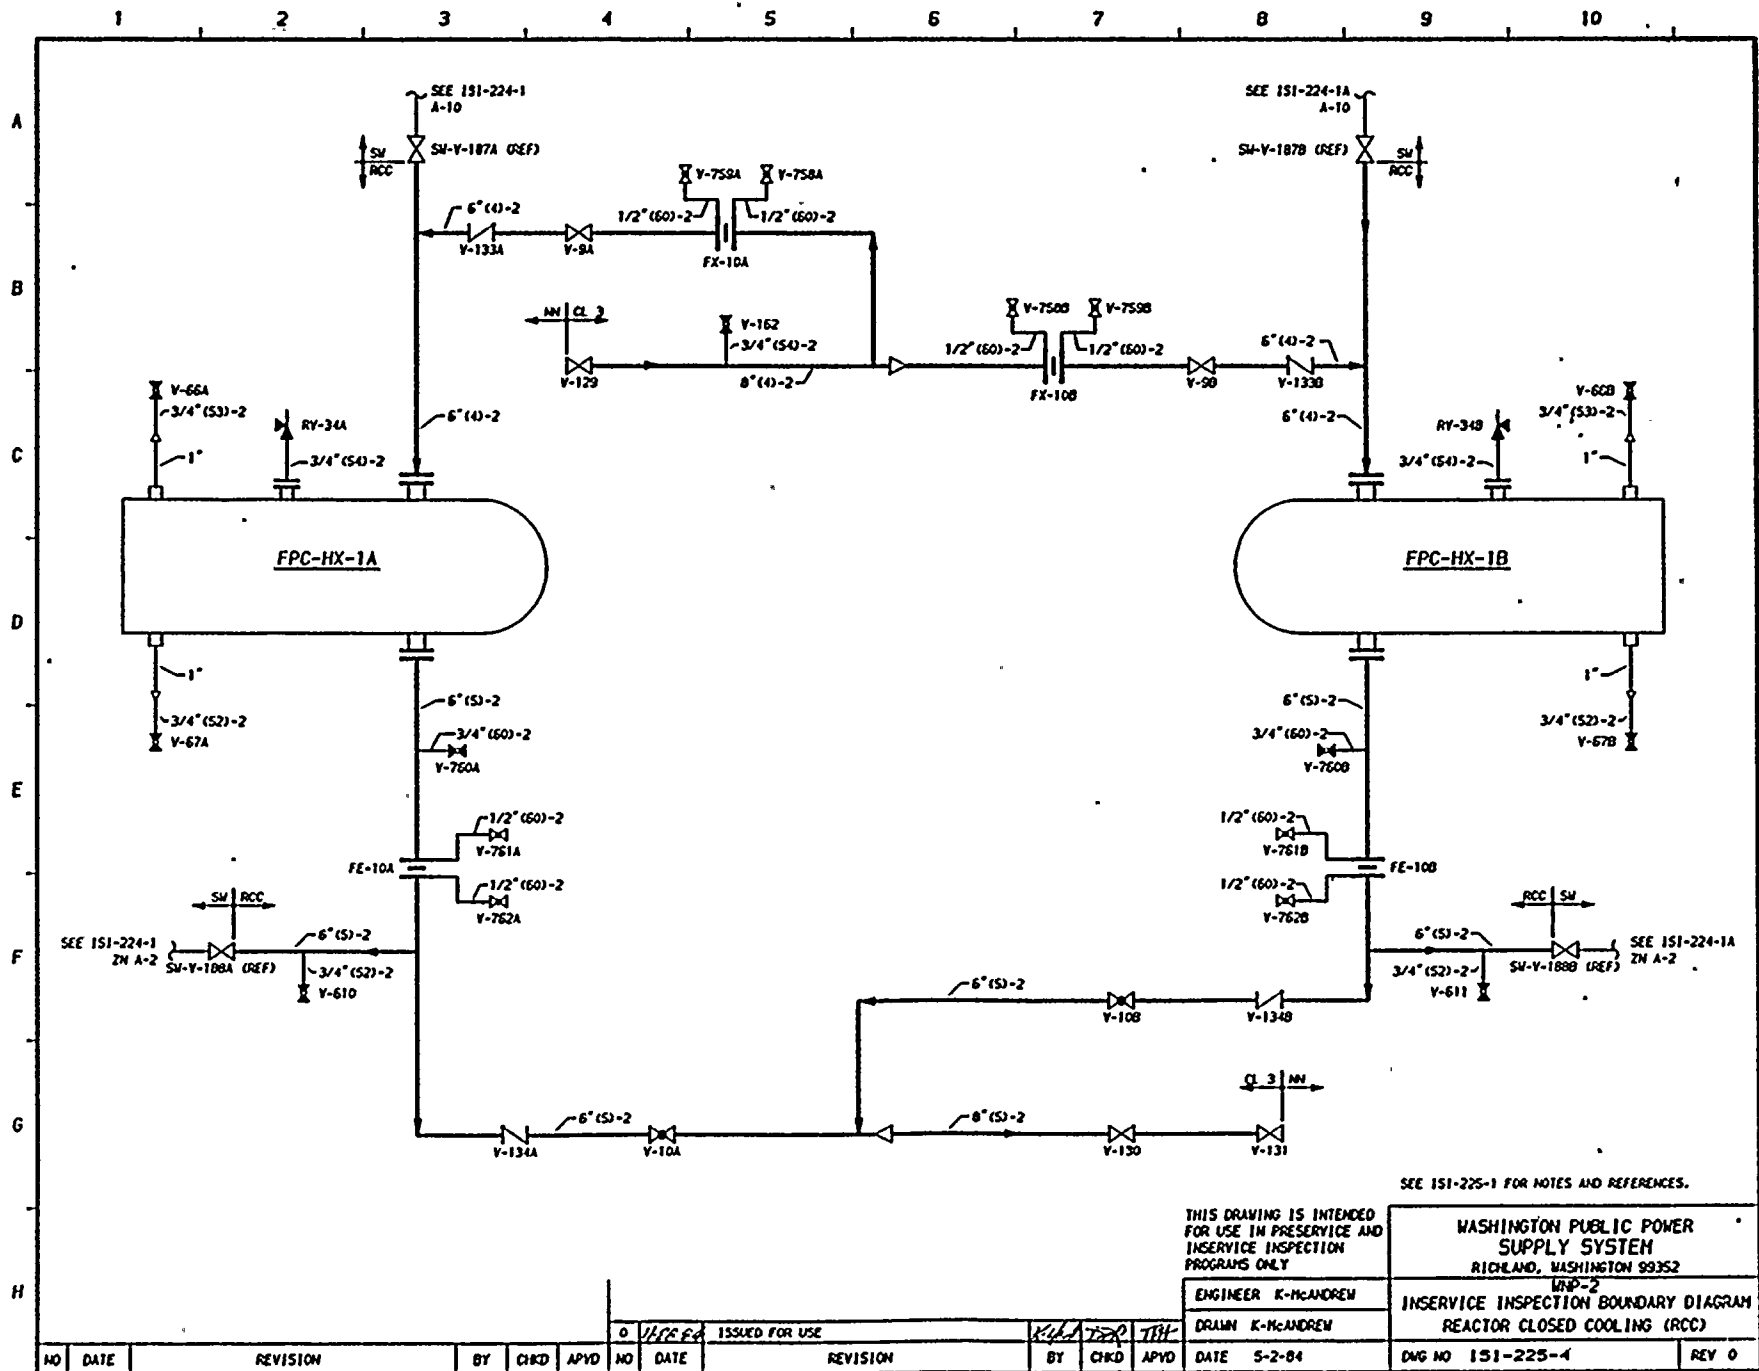

SEE 151-225-1 FOR NOTES AND REFERENCES.

THIS DRAWING IS INTENDED FOR USE IN PRESERVICE AND INSERVICE INSPECTION PROGRAMS ONLY

WASHINGTON PUBLIC POWER SUPPLY SYSTEM
RICHLAND, WASHINGTON 99352

ENGINEER K-McANDREW
DRAWN K-McANDREW

WPP-2
INSERVICE INSPECTION BOUNDARY DIAGRAM
REACTOR CLOSED COOLING (RCC)

NO	DATE	REVISION	BY	CHKD	APVD	NO	DATE	REVISION	BY	CHKD	APVD	DATE	DWG NO	REV
0	1/15/84	ISSUED FOR USE										5-2-84	151-225-4	0

EXCEPTIONS AND EXEMPTIONS

ISI - 225

SYSTEM Reactor Closed Cooling (RCC)

EXCEPTIONS:

Class 1 Piping and Components

- ° Not applicable; entire system Class 3 or nonnuclear only.

Class 2 Piping and Components

- ° Not applicable; entire system Class 3 or nonnuclear only.

EXEMPTIONS APPLIED:

IWB-1220(a)(1) No

(2) No

(3) No

(4) No

*(b)(1) No

(2) No

(3) No

IWC-1220(a) No

*(b) No

(c) No

(d) No

IWC-5220(d) No

IWD-5200(c) No

* See general exemption discussion for details.

122




122

122

122



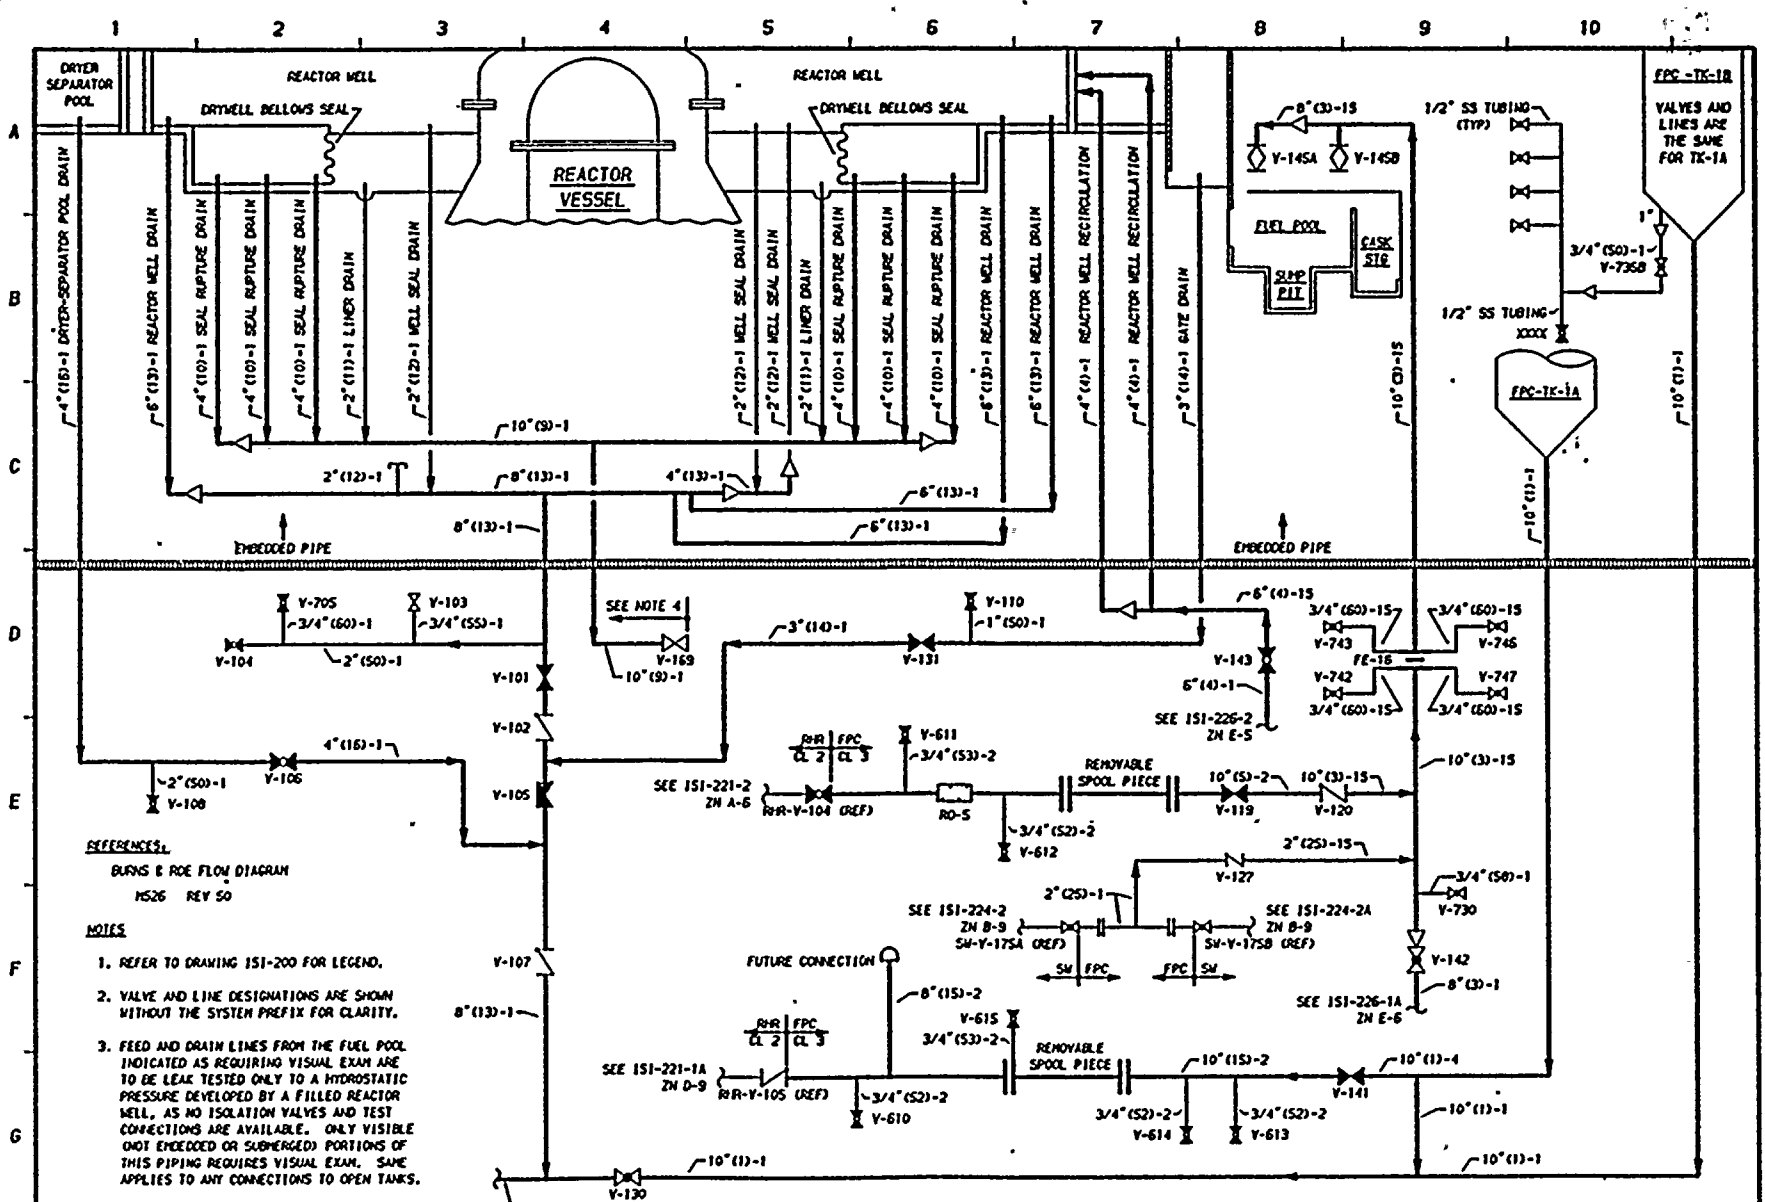

- REFERENCES:**
 BURNS & ROE FLOW DIAGRAM
 MS26 REV 50
- NOTES:**
- REFER TO DRAWING 151-200 FOR LEGEND.
 - VALVE AND LINE DESIGNATIONS ARE SHOWN WITHOUT THE SYSTEM PREFIX FOR CLARITY.
 - FEED AND DRAIN LINES FROM THE FUEL POOL INDICATED AS REQUIRING VISUAL EXAM ARE TO BE LEAK TESTED ONLY TO A HYDROSTATIC PRESSURE DEVELOPED BY A FILLED REACTOR WELL, AS NO ISOLATION VALVES AND TEST CONNECTIONS ARE AVAILABLE. ONLY VISIBLE (NOT ENCASED OR SURGERED) PORTIONS OF THIS PIPING REQUIRES VISUAL EXAM. SAME APPLIES TO ANY CONNECTIONS TO OPEN TANKS.
 - ALL PIPING FOR 10" FPC(30)-1 UPSTREAM OF FPC-V-169 IS FABRICATED TO ASME SEC III, CODE CLASS 3 BUT NOT STAMPED.


THIS DRAWING IS INTENDED FOR USE IN PRESERVICE AND INSERVICE INSPECTION PROGRAMS ONLY


WASHINGTON PUBLIC POWER SUPPLY SYSTEM
 RICHLAND, WASHINGTON 99352

NO	DATE	REVISION	BY	CHKD	APYD	NO	DATE	REVISION	BY	CHKD	APYD	DATE	DWG NO	REV
1	7-17-79	ADDED CL BRCS, CHGS ZNS B-4, D-5, E-5, 7, 8 & 9	K-MEA	11TH	DMP	LFB			K-MEA	11TH	DMP	9-20-78	151-226-1	2
0	1-9-79	ISSUED FOR USE	K-MEA	11TH	DMP	LFB			K-MEA	11TH	DMP			
A	10-18-78	ISSUED FOR INFORMATION ONLY	K-MEA	NCH	DMP	LFB			K-MEA	NCH	DMP			
2	11-2-80	GENERAL UPDATE REDRAWN	K-MEA	TJR	TJR	LFB			K-MEA	TJR	TJR			

ENGINEER D PORTER
 DRIVEN K-MANDREW
 DATE 9-20-78
 DWG NO 151-226-1
 REV 2



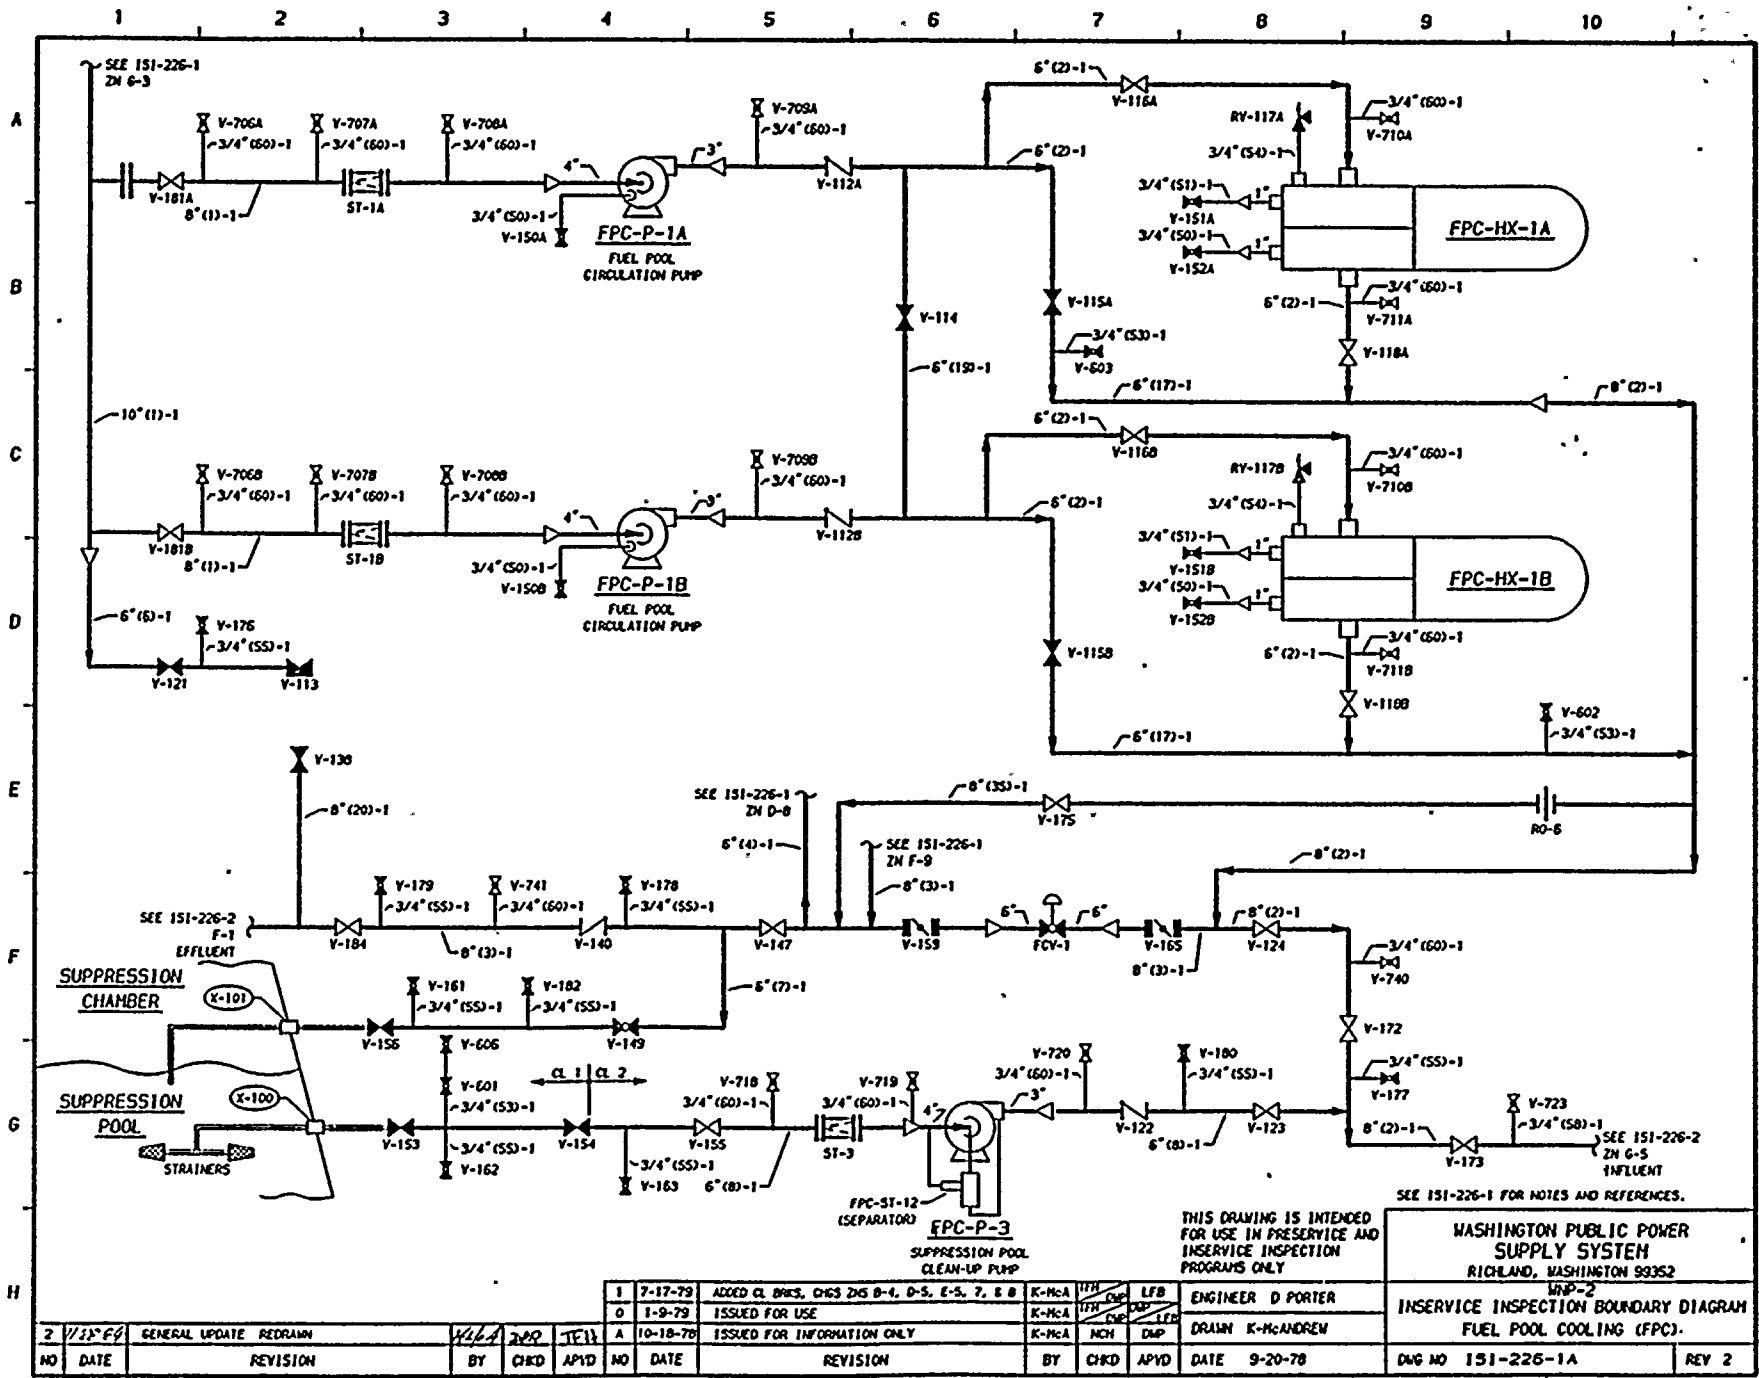

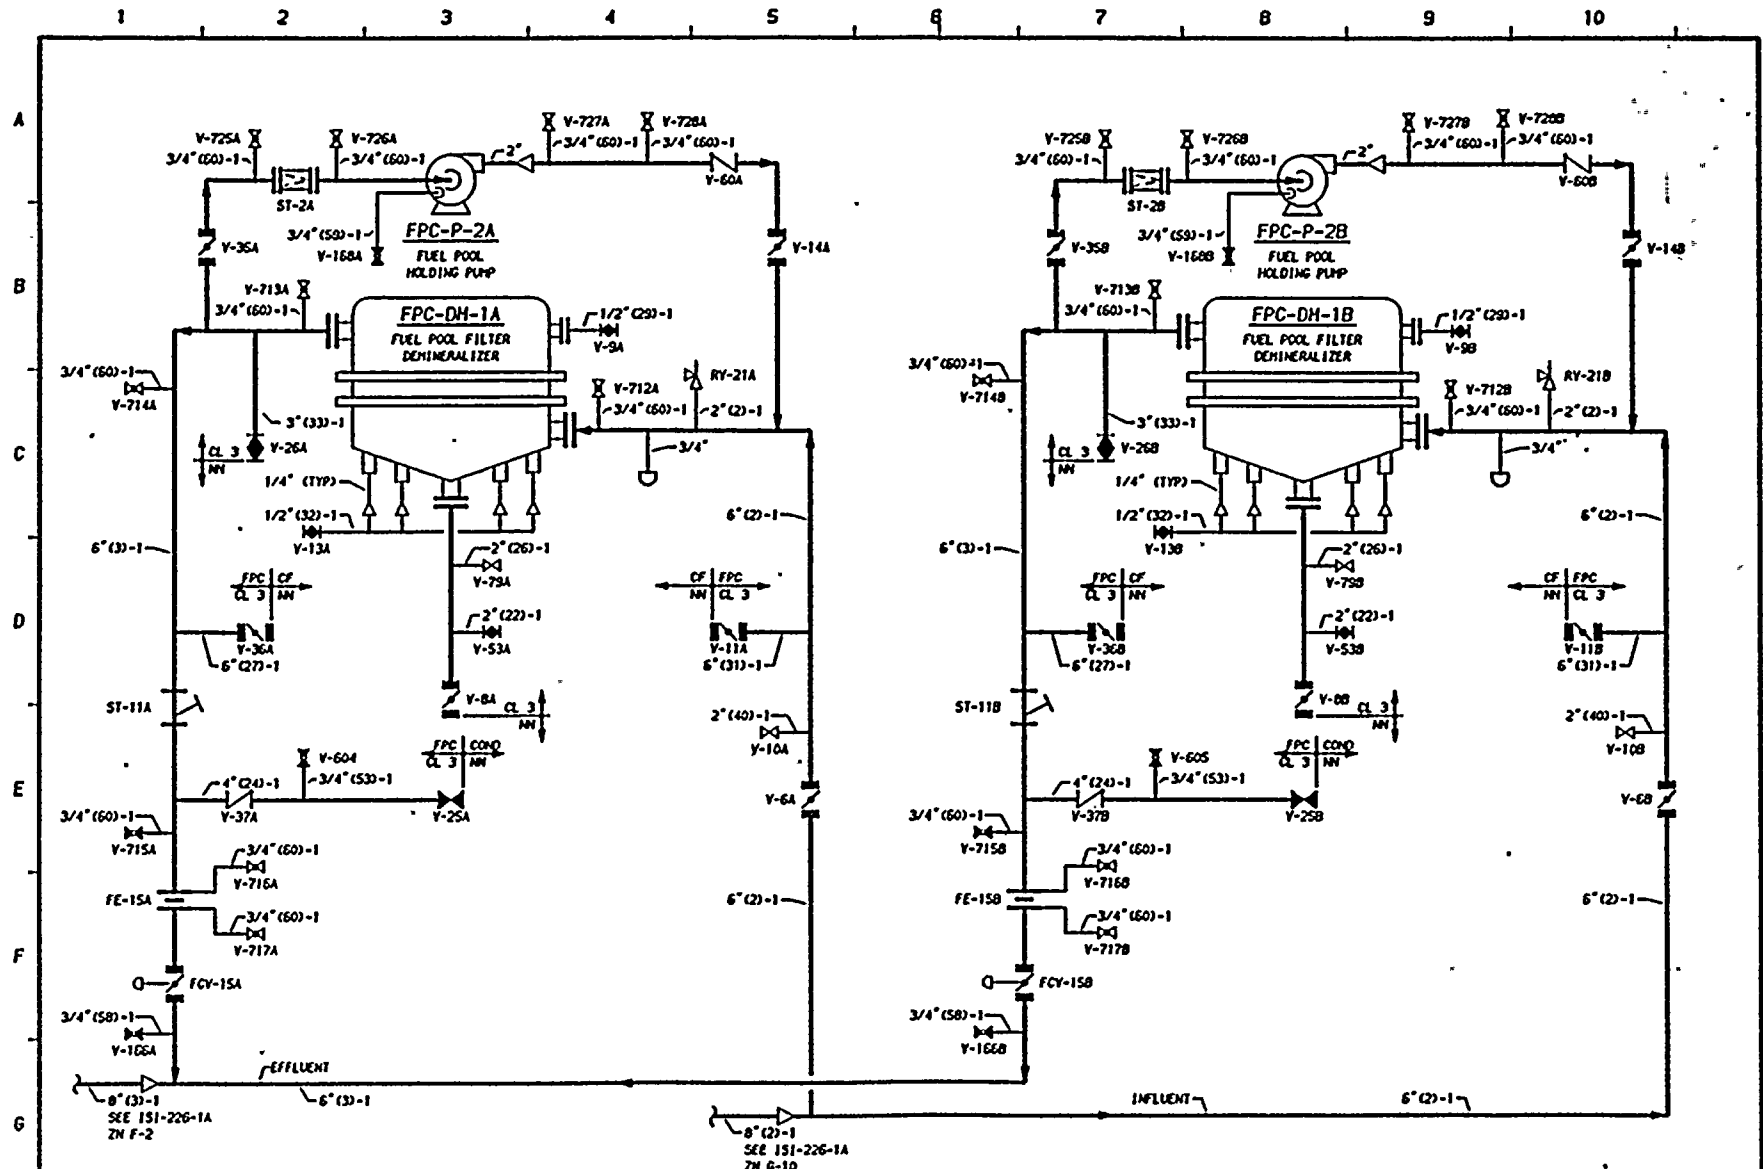

THIS DRAWING IS INTENDED FOR USE IN PRESERVICE AND INSERVICE INSPECTION PROGRAMS ONLY

SEE 151-226-1 FOR NOTES AND REFERENCES.


WASHINGTON PUBLIC POWER SUPPLY SYSTEM
RICHLAND, WASHINGTON 99352

INSERVICE INSPECTION BOUNDARY DIAGRAM
FUEL POOL COOLING (FPC)

NO	DATE	REVISION	BY	CHKD	APVD	NO	DATE	REVISION	BY	CHKD	APVD	DATE
3	11-15-80	GENERAL UPDATE REDRAWN	K-MCA	TTH	LFB	1	7-17-79	ADDED CL BRCS, CHS DSG B-4, D-5, E-5, 7, & 8	K-MCA	TTH	LFB	9-20-78
2	11-5-80	DELETED NON-NUCLEAR LINES REDRAWN	K-MCA	TTH	LFB	0	1-9-79	ISSUED FOR USE	K-MCA	TTH	LFB	9-20-78
						A	10-18-78	ISSUED FOR INFORMATION ONLY	K-MCA	MCH	DMP	9-20-78

ENGINEER D PORTER
DRAWN K-MANDREW
DATE 9-20-78
DWG NO 151-226-2
REV 3



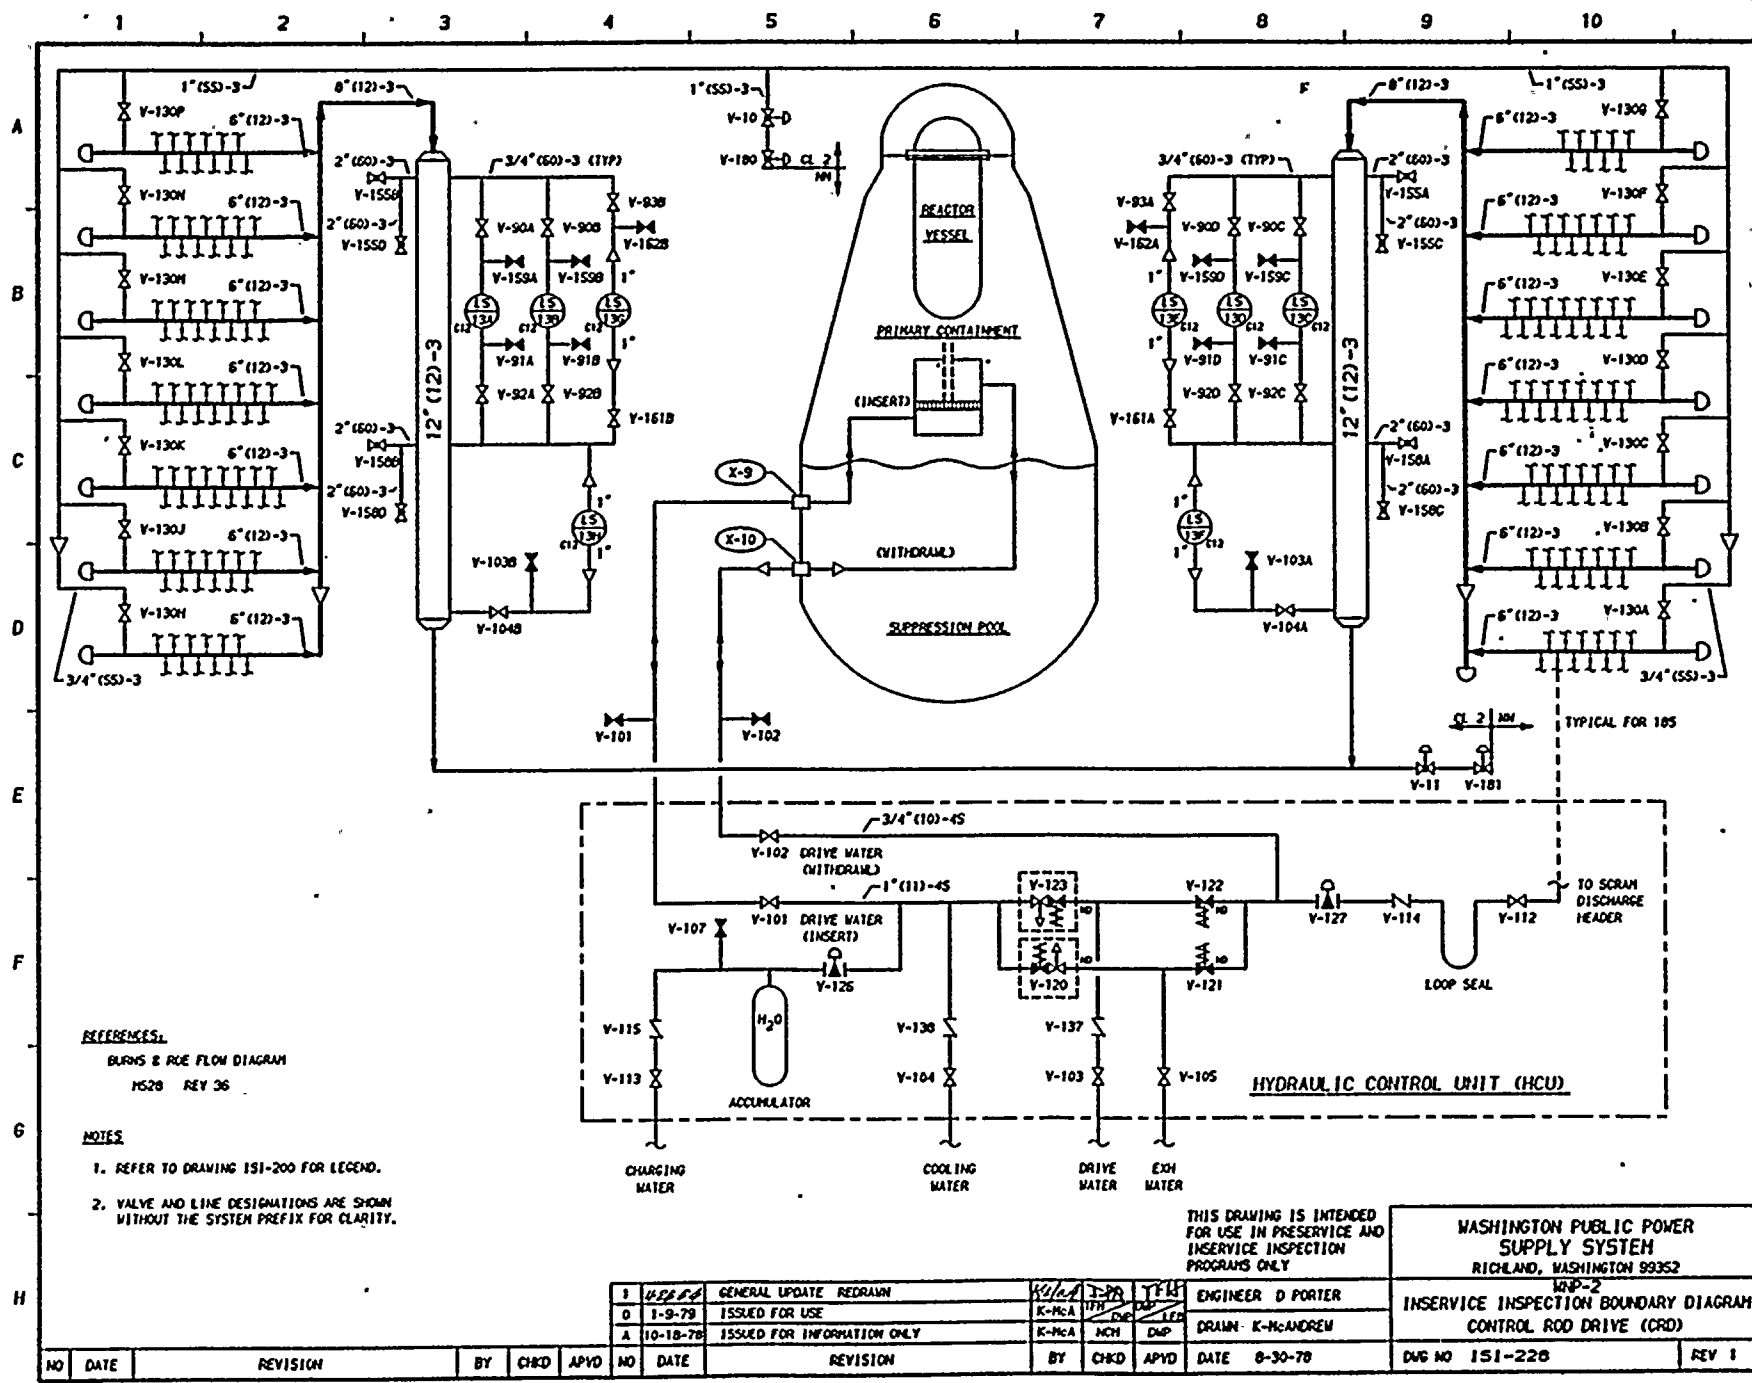

REFERENCES:
 BURNS & ROE FLOW DIAGRAM
 1528 REV 36

- NOTES:**
- REFER TO DRAWING 151-200 FOR LEGEND.
 - VALVE AND LINE DESIGNATIONS ARE SHOWN WITHOUT THE SYSTEM PREFIX FOR CLARITY.

THIS DRAWING IS INTENDED FOR USE IN PRESERVICE AND INSERVICE INSPECTION PROGRAMS ONLY


WASHINGTON PUBLIC POWER SUPPLY SYSTEM
 RICHLAND, WASHINGTON 99352

NO	DATE	REVISION	BY	CHKD	APVD
1	4-28-78	GENERAL UPDATE REDRAWN	K-MCA	MCH	DMP
D	1-9-79	ISSUED FOR USE	K-MCA	MCH	DMP
A	10-18-78	ISSUED FOR INFORMATION ONLY	K-MCA	MCH	DMP

ENGINEER D PORTER
 DRAWN K-MCANDREN
 DATE 8-30-78

INSERVICE INSPECTION BOUNDARY DIAGRAM
 CONTROL ROD DRIVE (CRD)
 DWG NO 151-228 REV 1

NO	DATE	REVISION	BY	CHKD	APVD	NO	DATE	REVISION	BY	CHKD	APVD	DATE	DWG NO	REV
												8-30-78	151-228	1

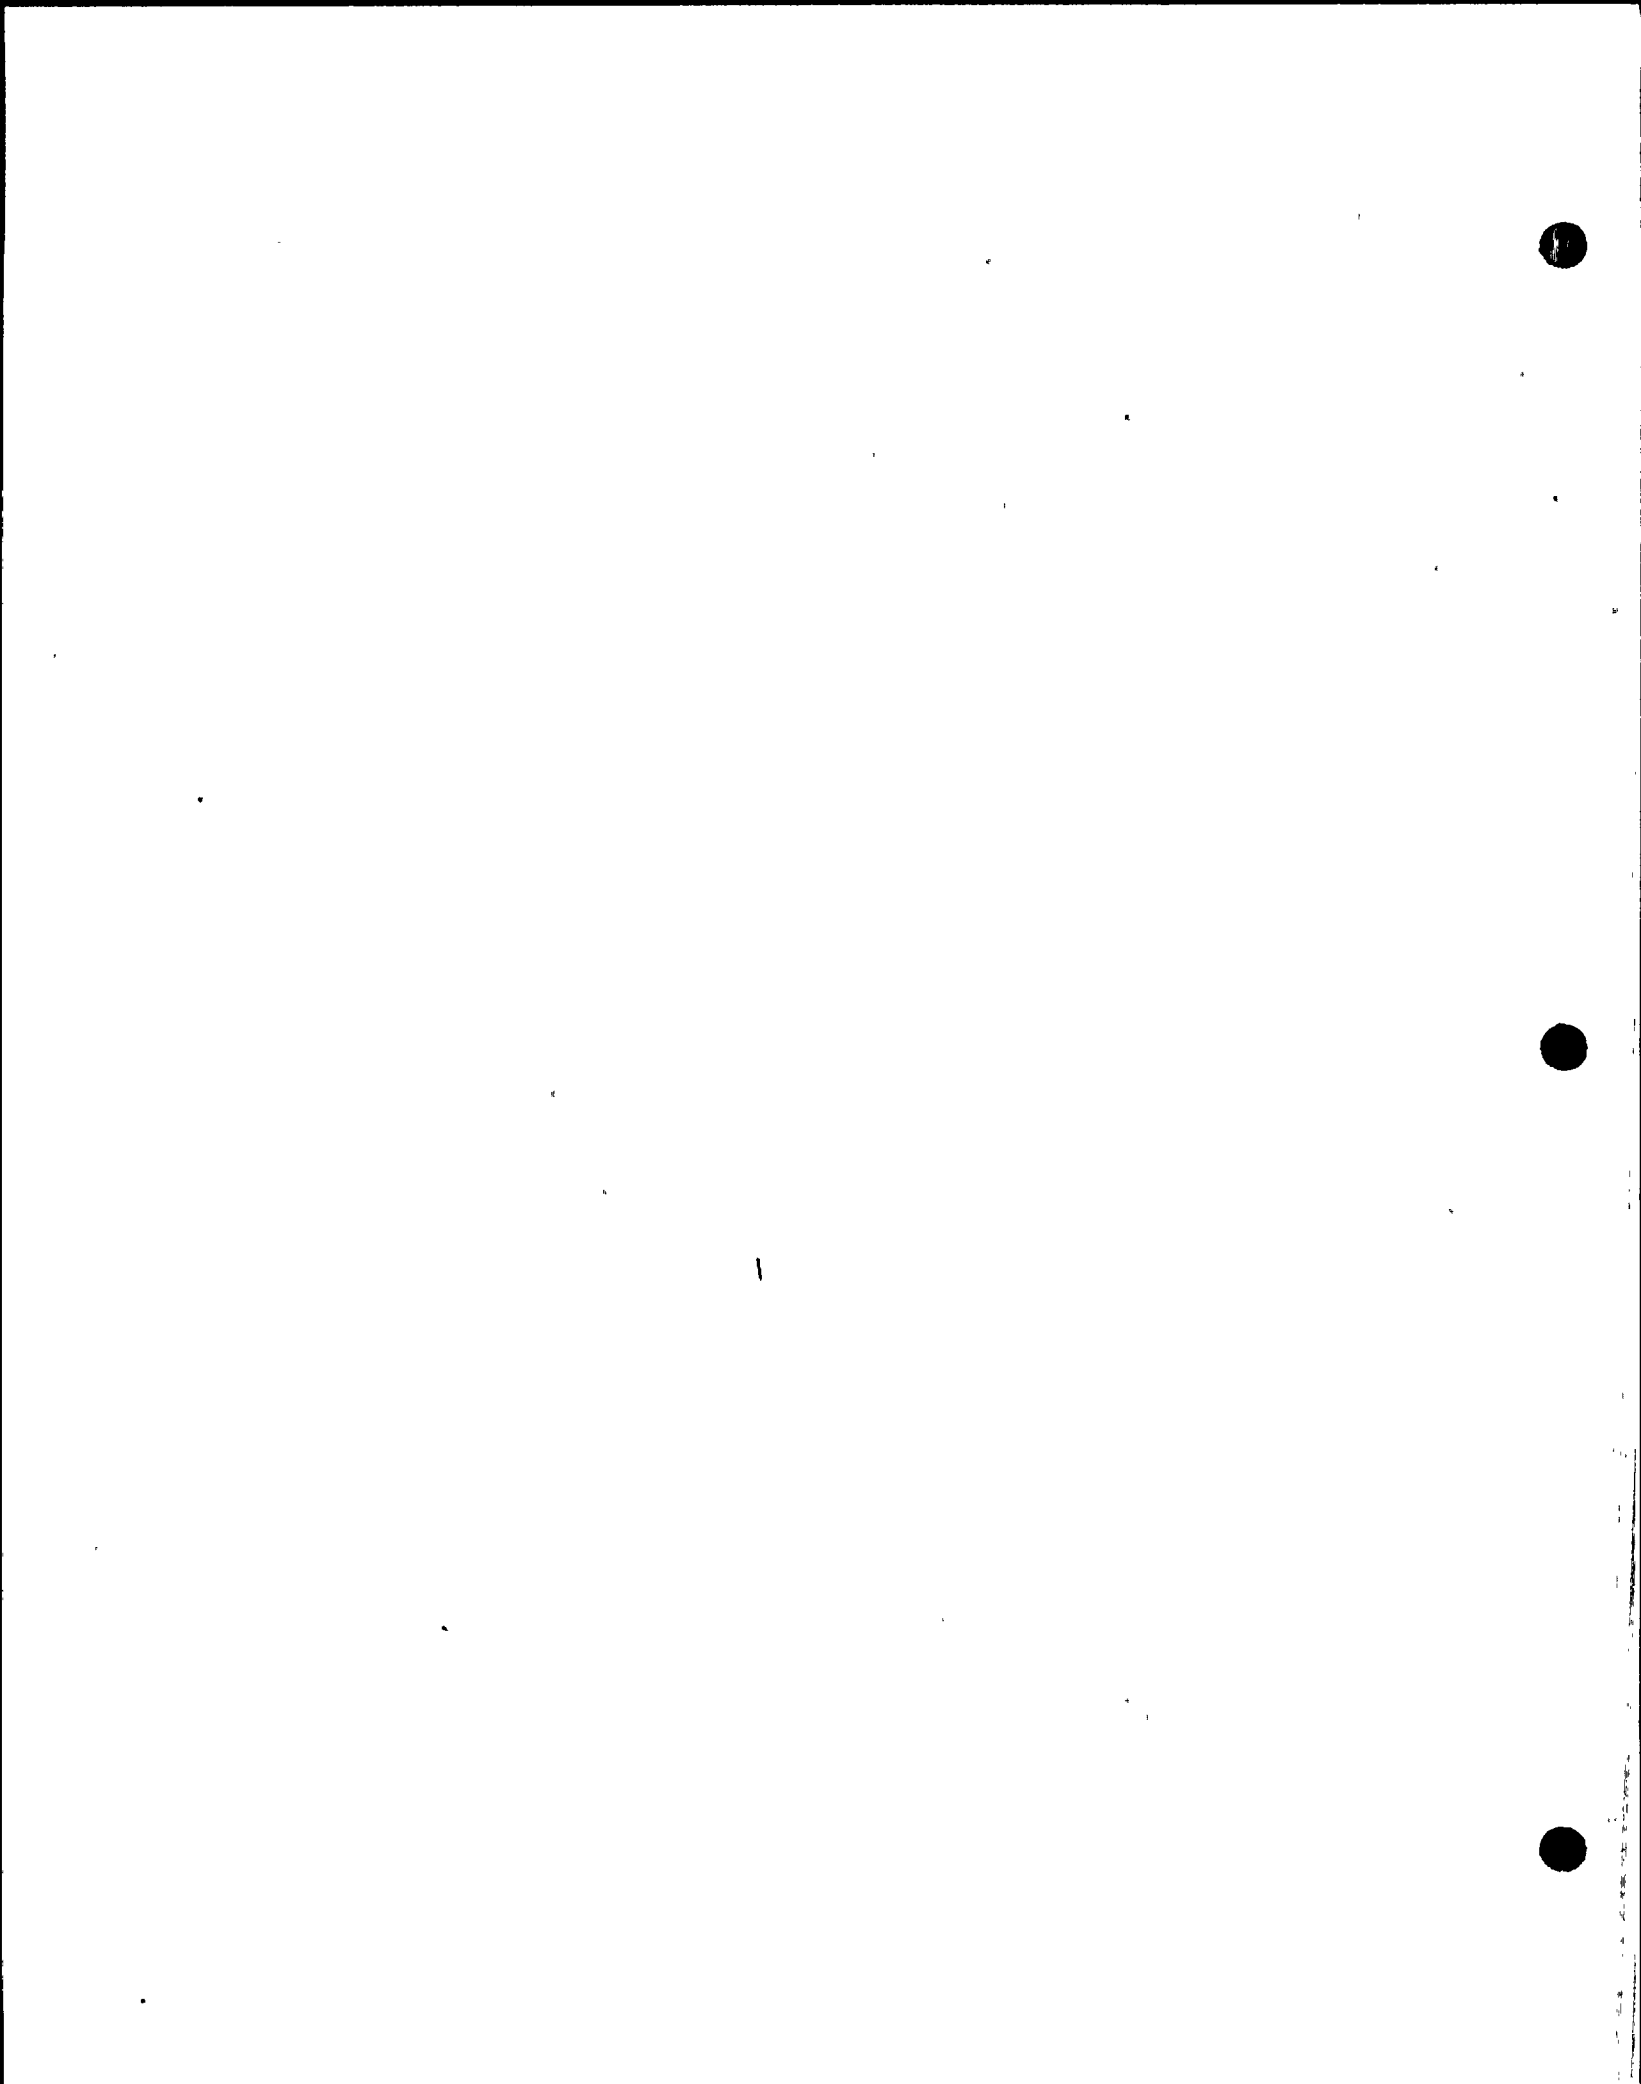

EXCEPTIONS AND EXEMPTIONS

ISI - 226

SYSTEM Fuel Pool Cooling (FPC)

EXCEPTIONS:

Class I Piping and Components

- o Not applicable; entire system Class 2 or nonnuclear only.

Class 2 Piping and Components

- o No exceptions

EXEMPTIONS APPLIED:

- IWB-1220 (a) (1) No
- (2) No
- (3) No
- (4) No
- *(b) (1) No
- (2) No
- (3) No
- IWC-1220 (a) Yes
- *(b) No
- (c) No
- (d) No
- IWC-5220 (d) Yes, open ended piping to suppression pool.
- IWD-5200 (c) No

*See general exemption discussion for details.

111111



1000



7



WNP-2 ISI BOUNDARY DIAGRAM

EXCEPTIONS AND EXEMPTIONSISI - 228SYSTEM Control Rod Drive (CRD) SystemEXCEPTIONS:Class 1 Piping and Components

- o See general exceptions.
- o No additional exceptions.


Class 2 Piping and Components

- o See general exceptions.
- o Additional exception as follows: 6" CRD(12)-3 and 8" CRD(12)-3, scram discharge headers will be examined visually for evidence of leakage. In addition 10% of the circumferential welds will be examined volumetrically. See next page for justification.

EXEMPTIONS APPLIED:

IWB-1220(a)(1)	No
(2)	No
(3)	No
(4)	No
*(b)(1)	No
(2)	No
(3)	No
IWC-1220(a)	No
*(b)	No
(c)	No
(d)	No
IWC-5220(d)	No
IWC-5200(c)	No


*See general exemption discussion for details.

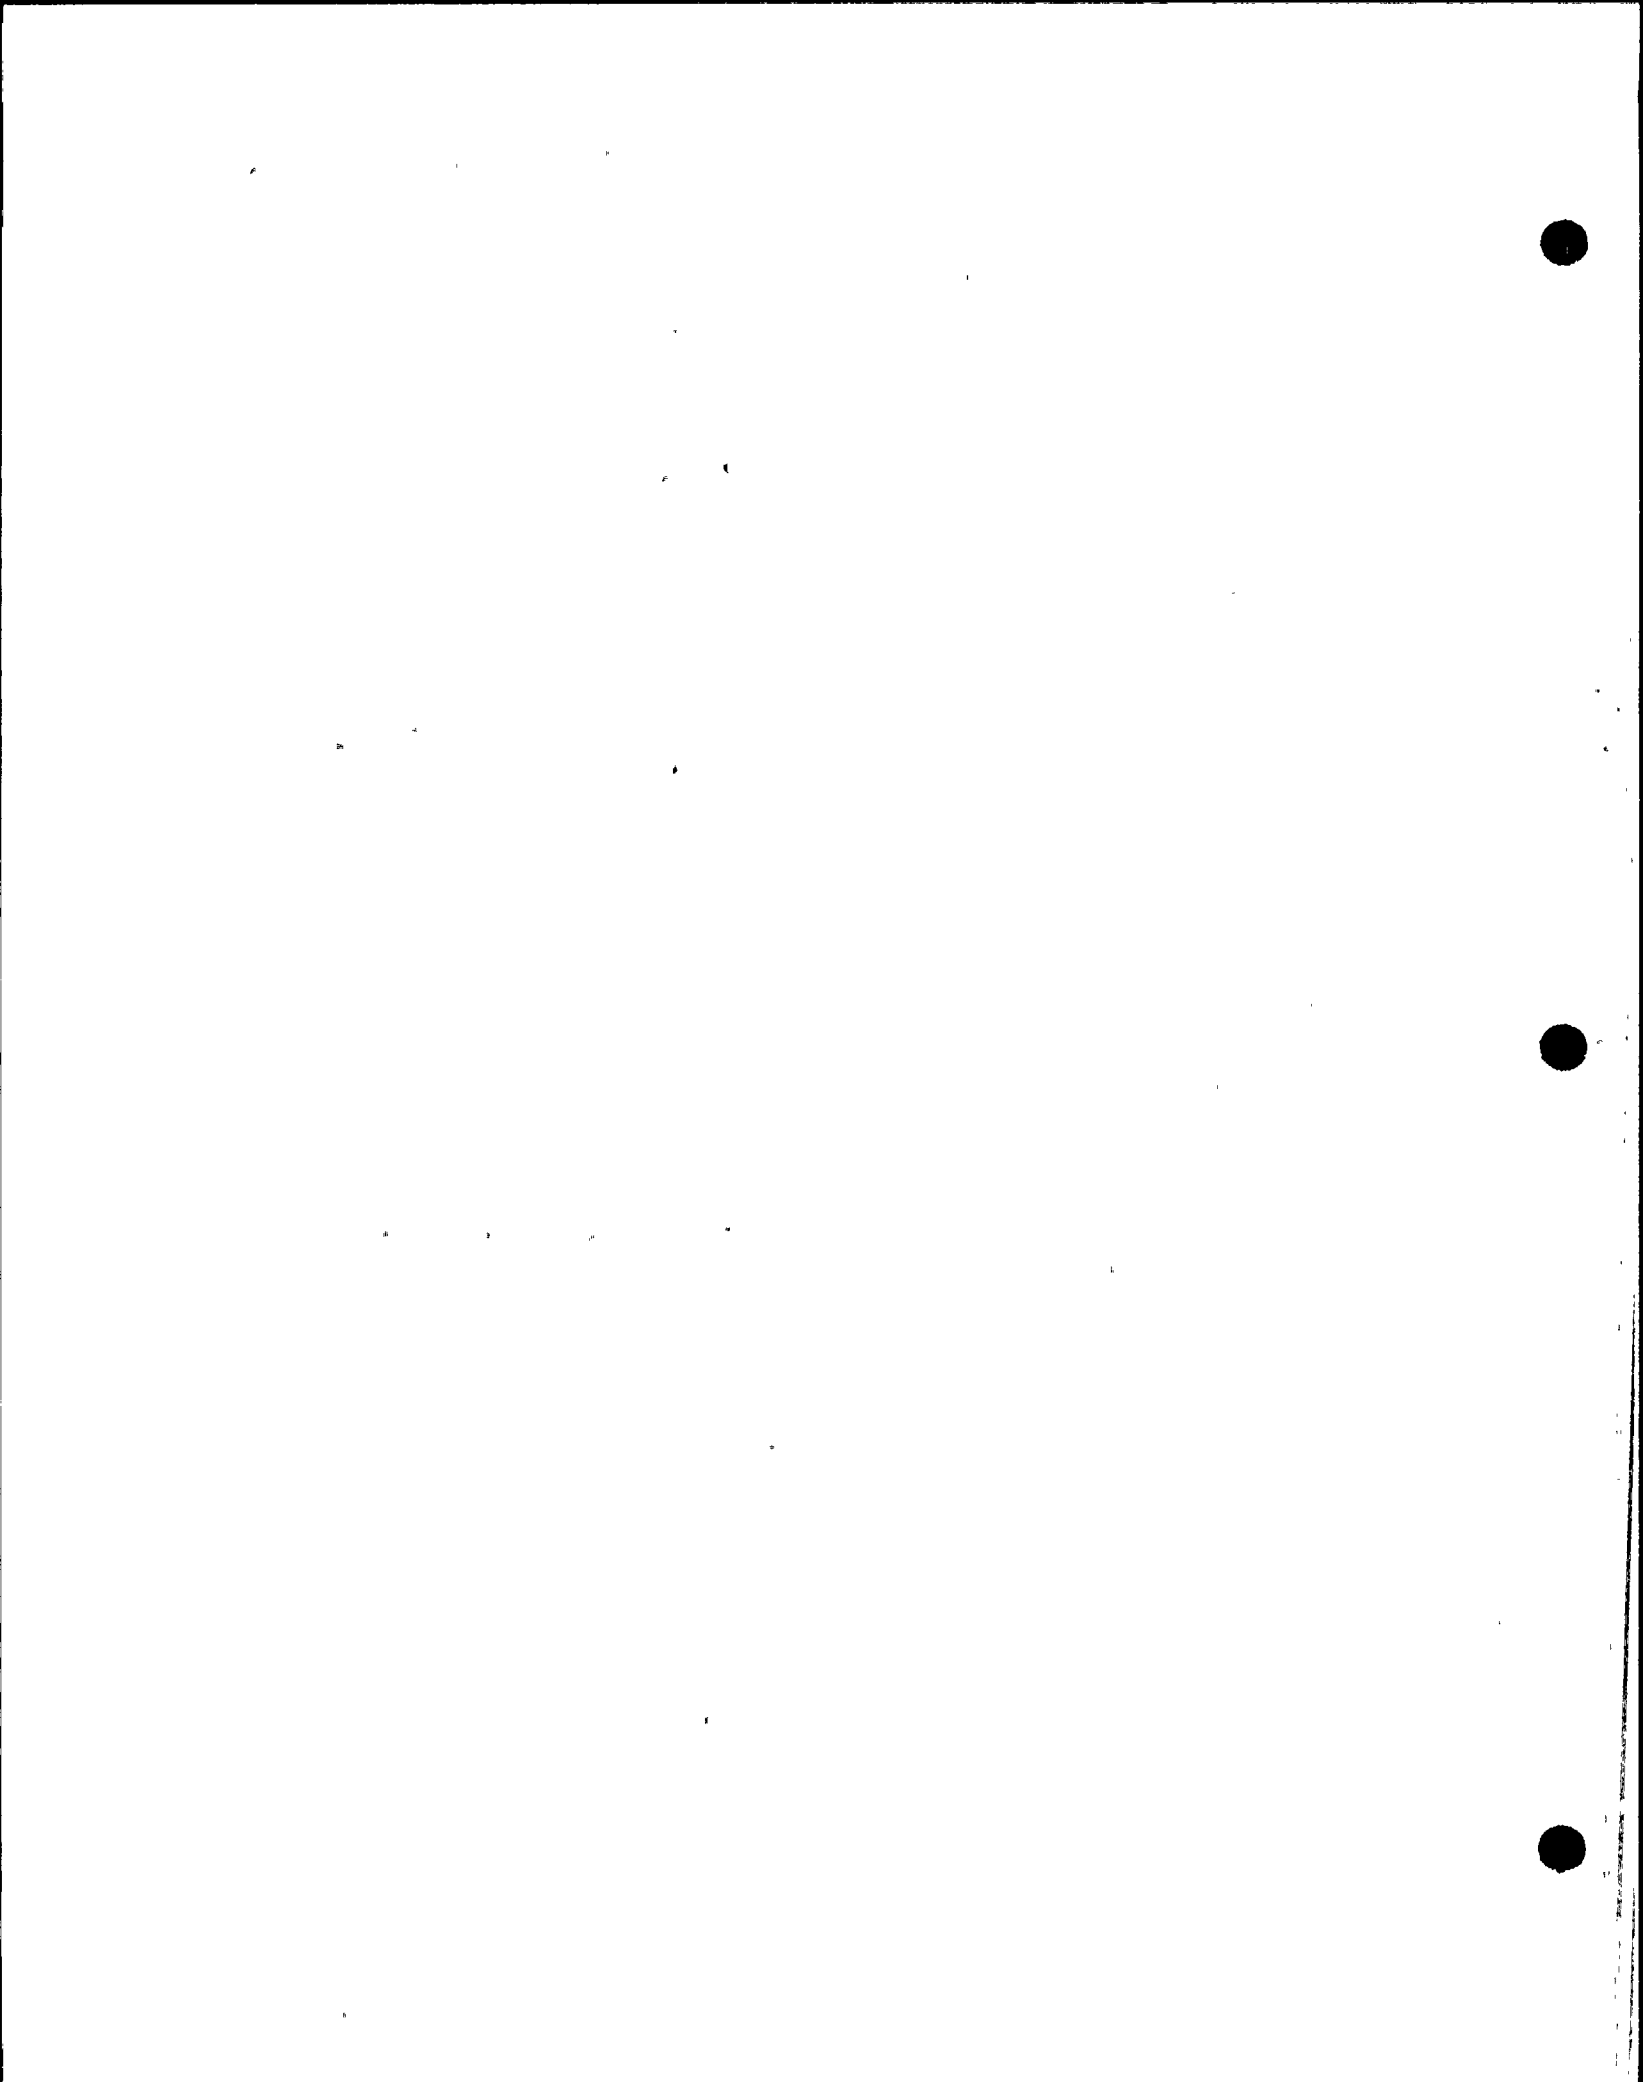

JUSTIFICATION FOR EXCEPTION FROM
SURFACE EXAMINATION OF CRD SCRAM DISCHARGE HEADERS

All piping connecting to the scram discharge headers is less than 4" nominal pipe size and subject only to a visual examination for evidence of leakage. Furthermore, the headers are on the discharge side of the scram discharge system and their failure would not prevent a scram. The only connections with the RPY are via the 3/4" CRD tubing. A minimal amount of leakage due to water bypassing the drives during scram will occur, but following scram the leakage will essentially cease upon closure of the scram valves. In any event, the sum of the bypass leakages from all drives is anticipated to be much less than the reactor makeup system capacity. Therefore, a failure of a header or any connecting piping would not impair the ability to makeup the resulting loss of reactor water using normal makeup systems. A visual examination for evidence of leakage is, therefore, adequate and commensurate with the low operability and safety implications of a loss of integrity of that pipe. In addition to the visual examination 10% of the circumferential welds on the scram discharge headers greater than 4" NPS will be examined volumetrically.



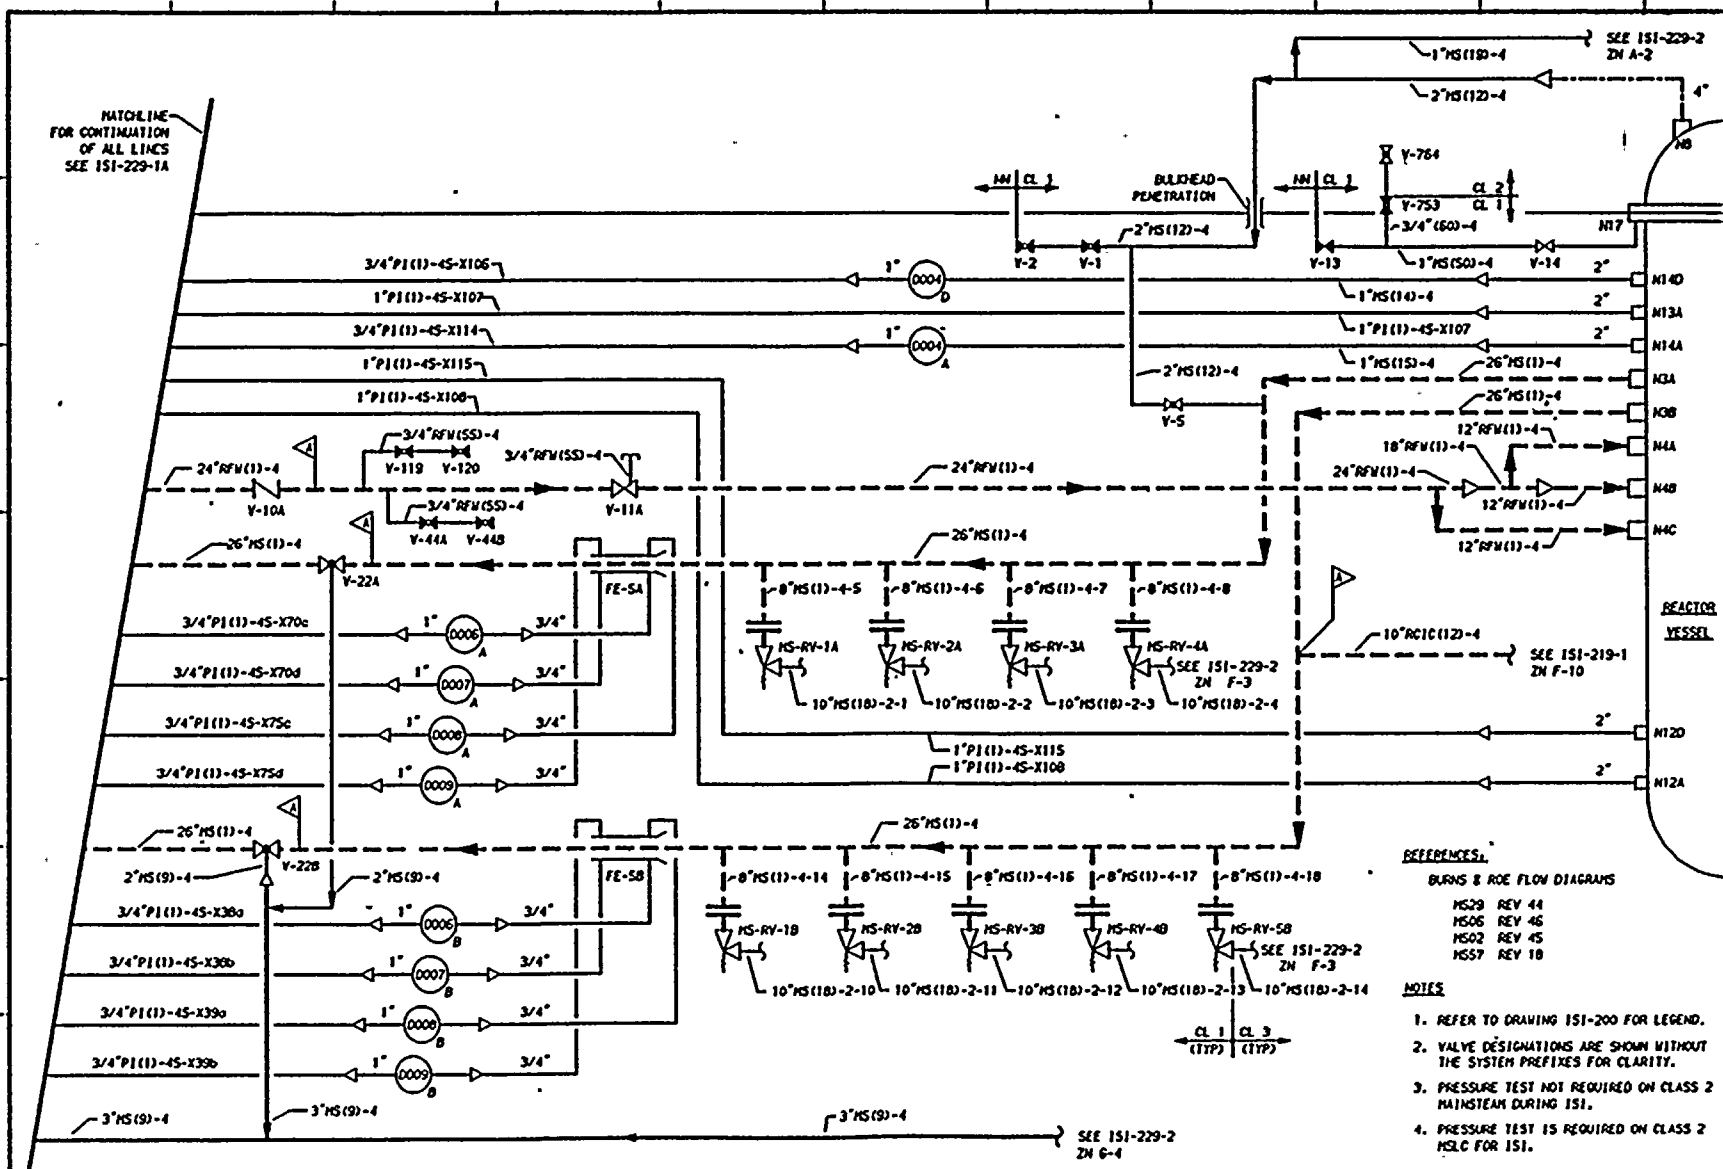

- REFERENCES:**
- BURNS & ROE FLOW DIAGRAMS
 - MS29 REV 44
 - MS06 REV 46
 - MS02 REV 45
 - MS57 REV 18
- NOTES:**
- REFER TO DRAWING ISI-200 FOR LEGEND.
 - VALVE DESIGNATIONS ARE SHOWN WITHOUT THE SYSTEM PREFIXES FOR CLARITY.
 - PRESSURE TEST NOT REQUIRED ON CLASS 2 MAINSTEAM DURING ISI.
 - PRESSURE TEST IS REQUIRED ON CLASS 2 HSLC FOR ISI.


THIS DRAWING IS INTENDED FOR USE IN PRESERVICE AND INSERVICE INSPECTION PROGRAMS ONLY


WASHINGTON PUBLIC POWER SUPPLY SYSTEM
 RICHLAND, WASHINGTON 99352

NO	DATE	REVISION	BY	CHKD	APVD	NO	DATE	REVISION	BY	CHKD	APVD	DATE
1	4-21-79	GENERAL UP-DATE										
0	10-18-78	REVISED 1/2" 2" & 3" MS-4 FROM SUPPLY TO VISUAL. MS-4 HSLC SYSTEM & ISSUED FOR USE.										
A	4-21-78	ISSUED FOR INFORMATION ONLY										

INSERVICE INSPECTION BOUNDARY DIAGRAM
 MAIN STEAM (MS) & REACTOR FEEDWATER (RFW)
 DWG NO 151-229-1
 REV 2



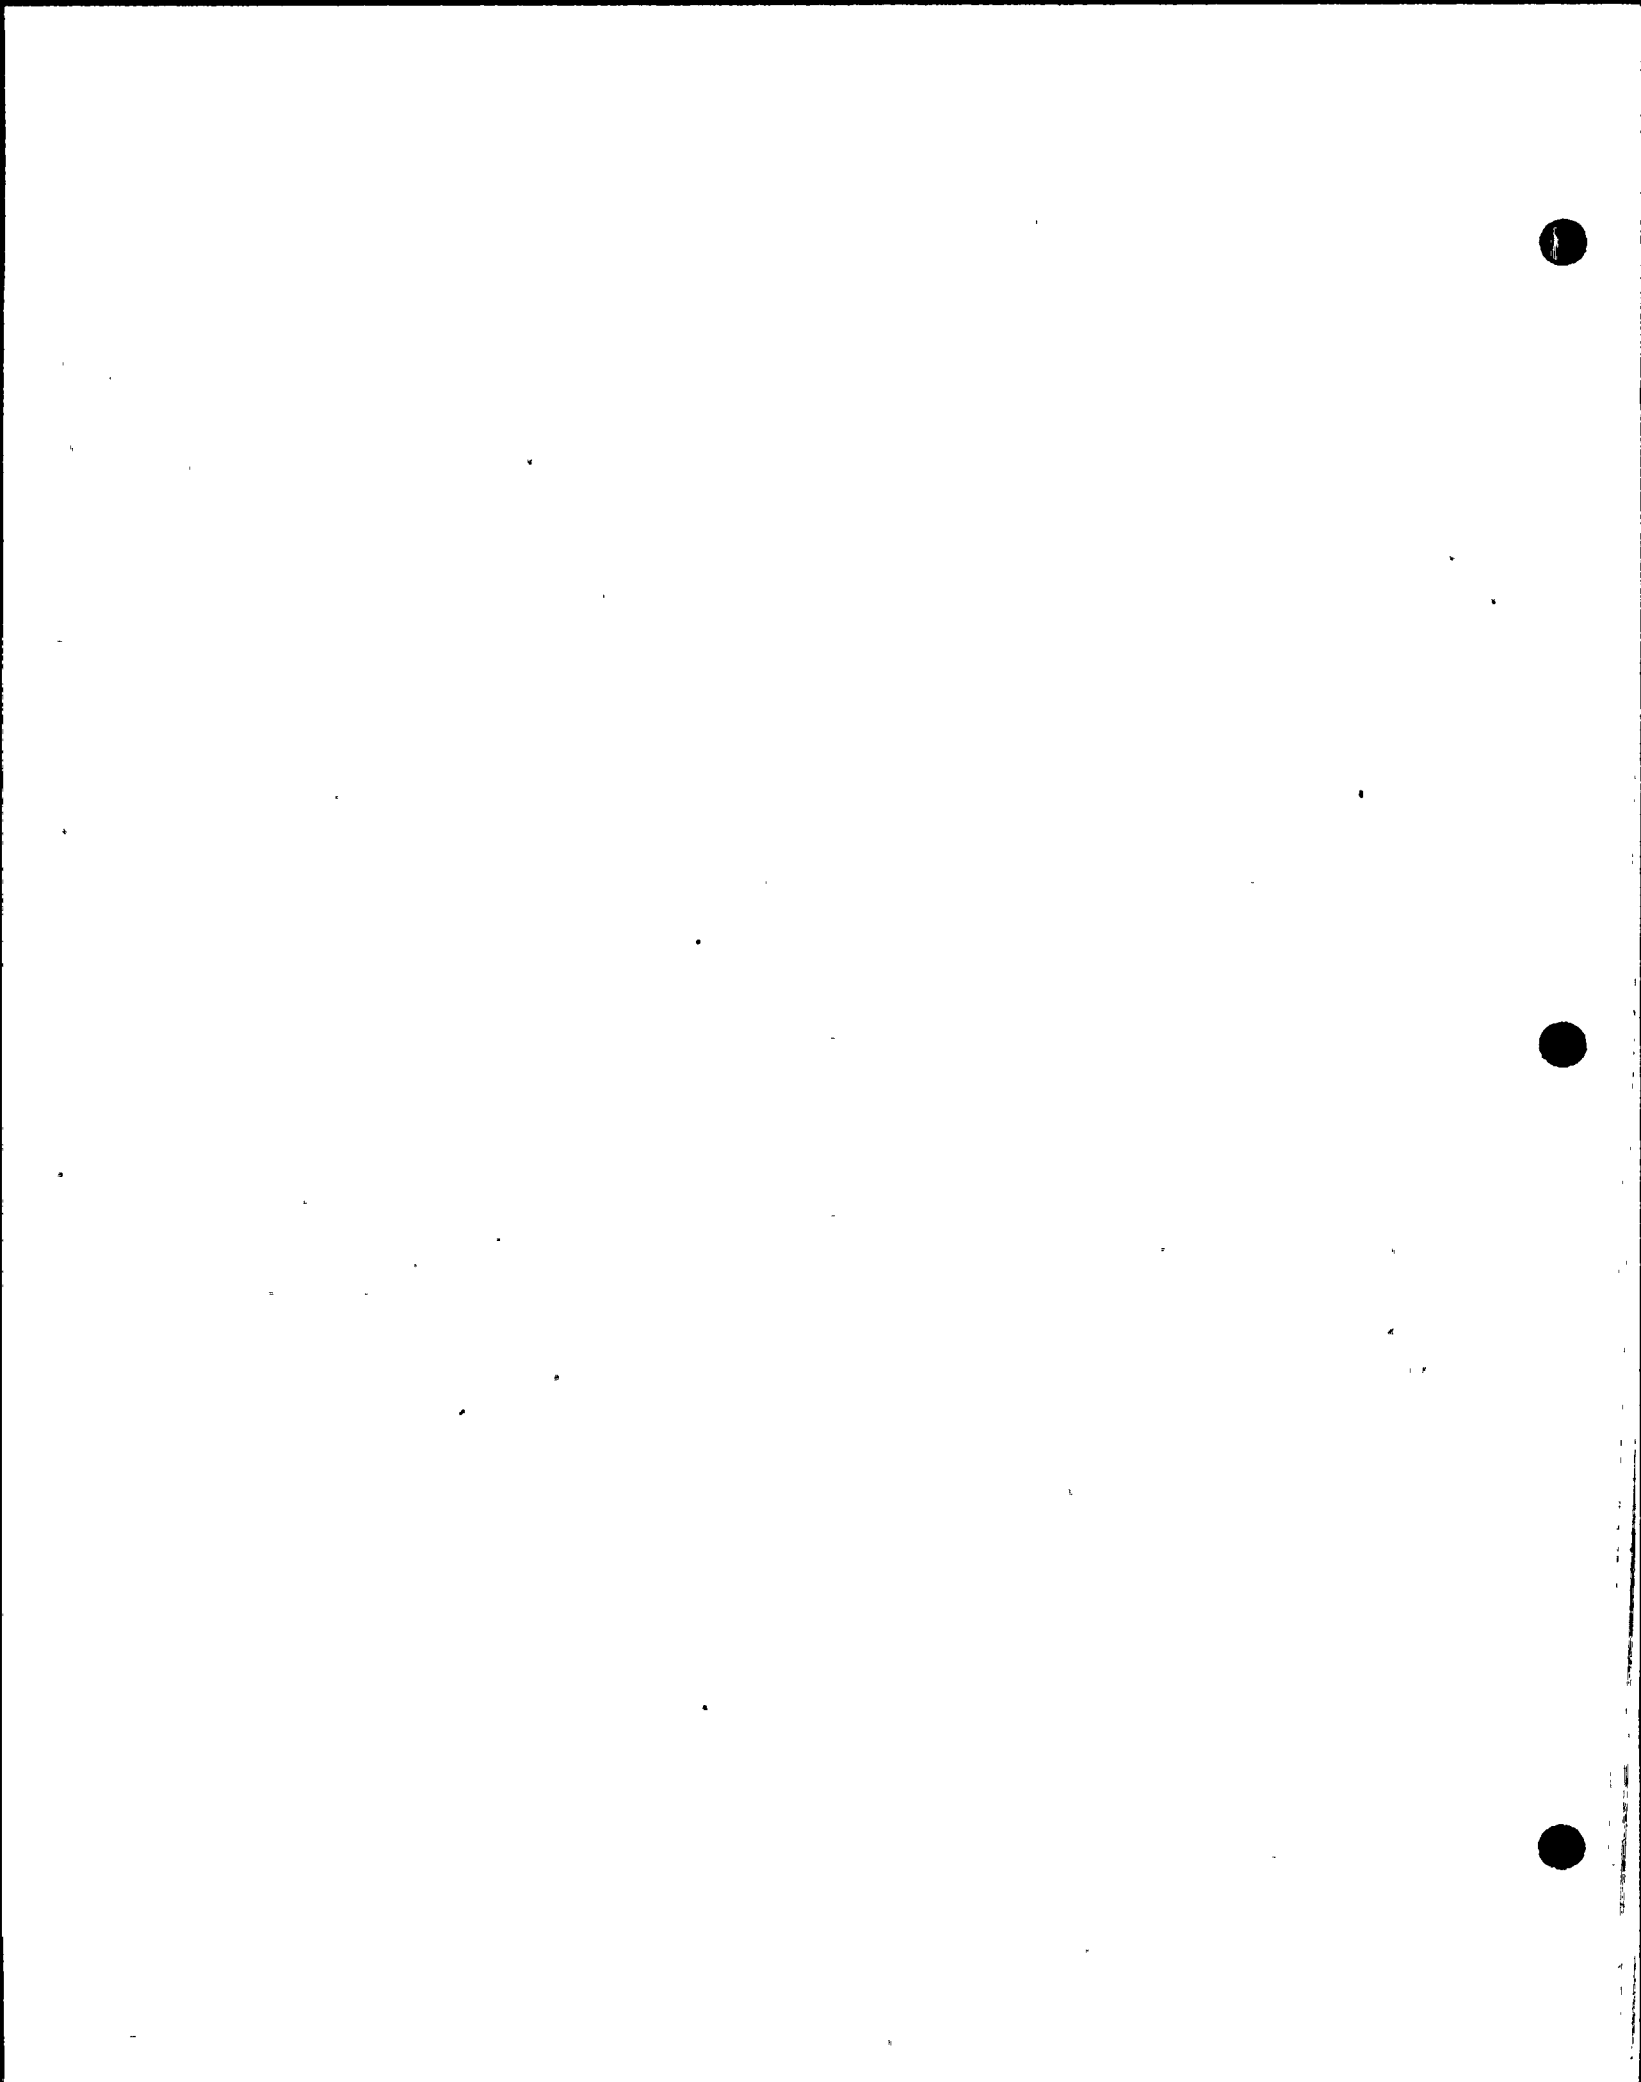

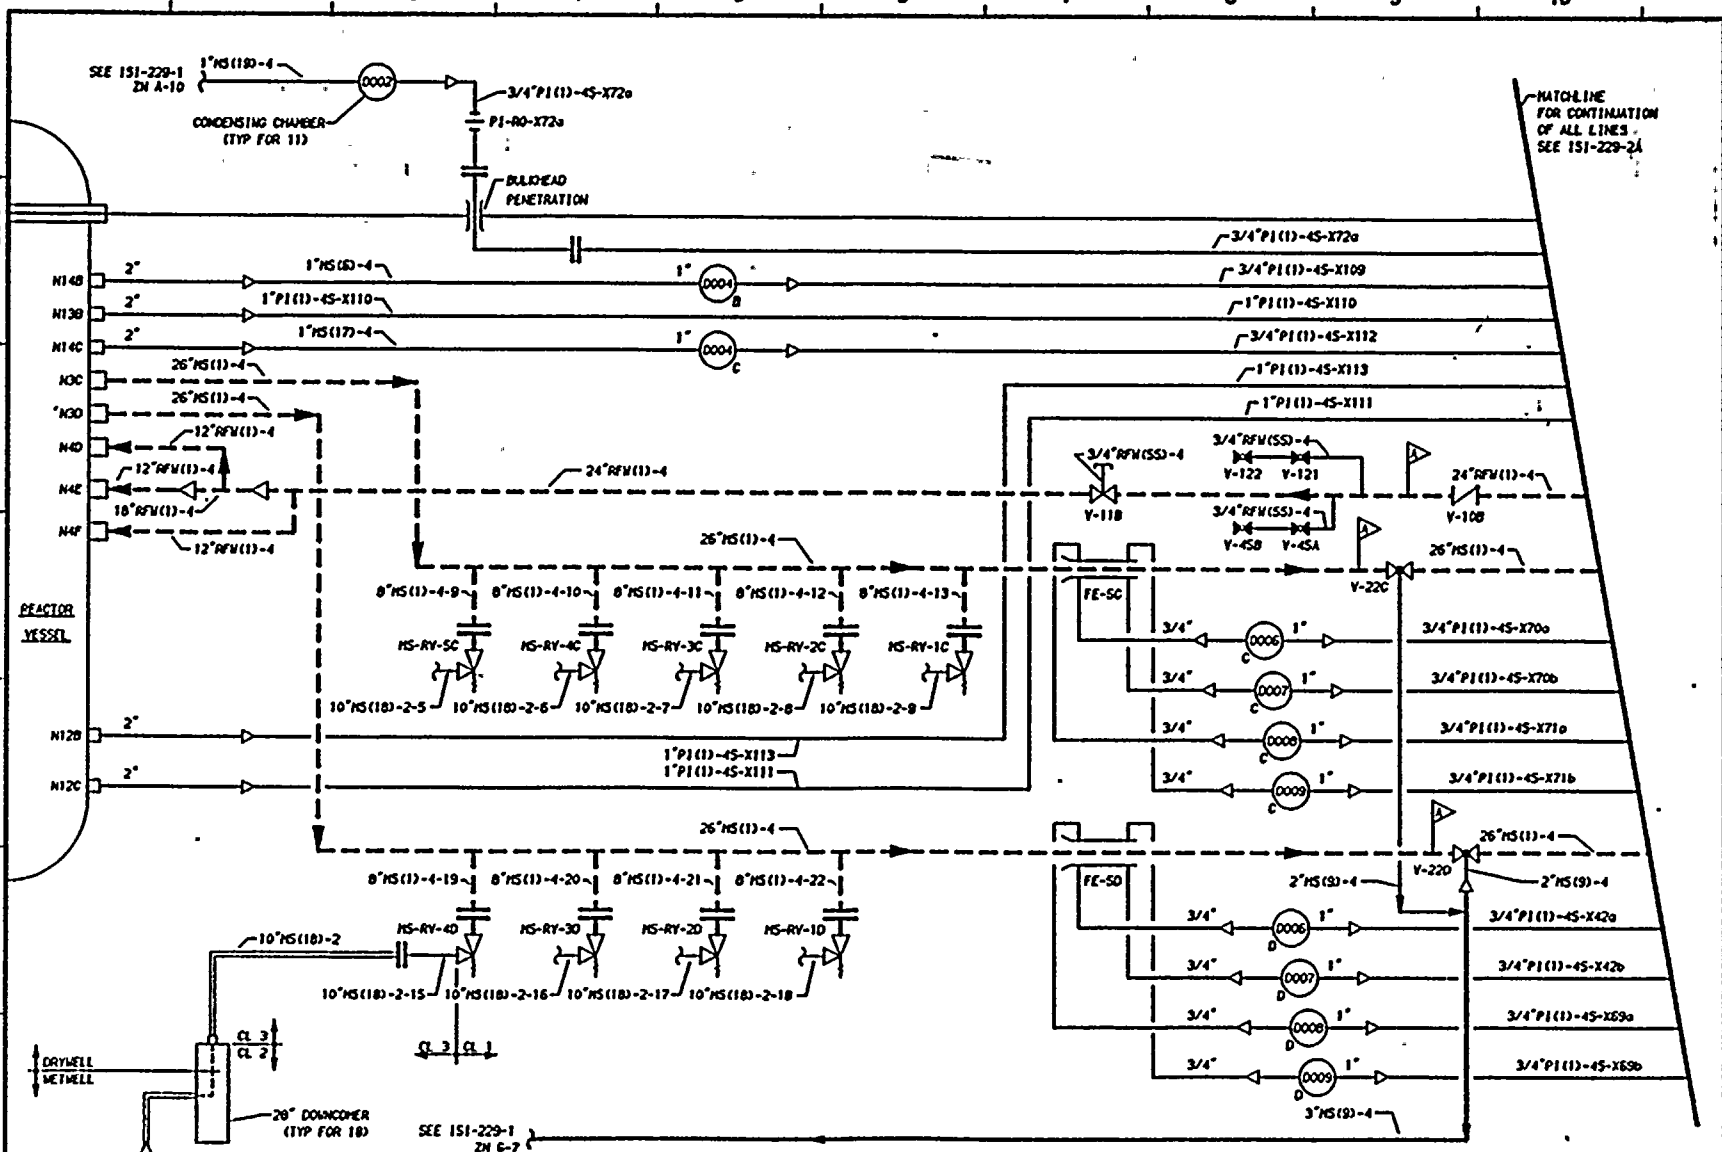

HATCHLINE FOR CONTINUATION OF ALL LINES SEE 151-229-2A

SEE 151-229-1 FOR NOTES AND REFERENCES.


THIS DRAWING IS INTENDED FOR USE IN PRESERVICE AND INSERVICE INSPECTION PROGRAMS ONLY


WASHINGTON PUBLIC POWER SUPPLY SYSTEM
 RICHLAND, WASHINGTON 99352
 LRP-2

INSERVICE INSPECTION BOUNDARY DIAGRAM
 MAIN STEAM (MS) & REACTOR FEED WATER (RFW)

NO	DATE	REVISION	BY	CHKD	APVD	NO	DATE	REVISION	BY	CHKD	APVD	ENGINEER D PORTER		
												DWP	LTH	DWP
1	11-5-80	ASCD 10\"/>												
2	10-18-78	AUGMENTED 151 ADDED. UP-DATE, SPLIT, REDRAWN												
3	4-21-78	ISSUED FOR INFORMATION ONLY												
	2-16-78													

DWG NO 151-229-2 REV 2

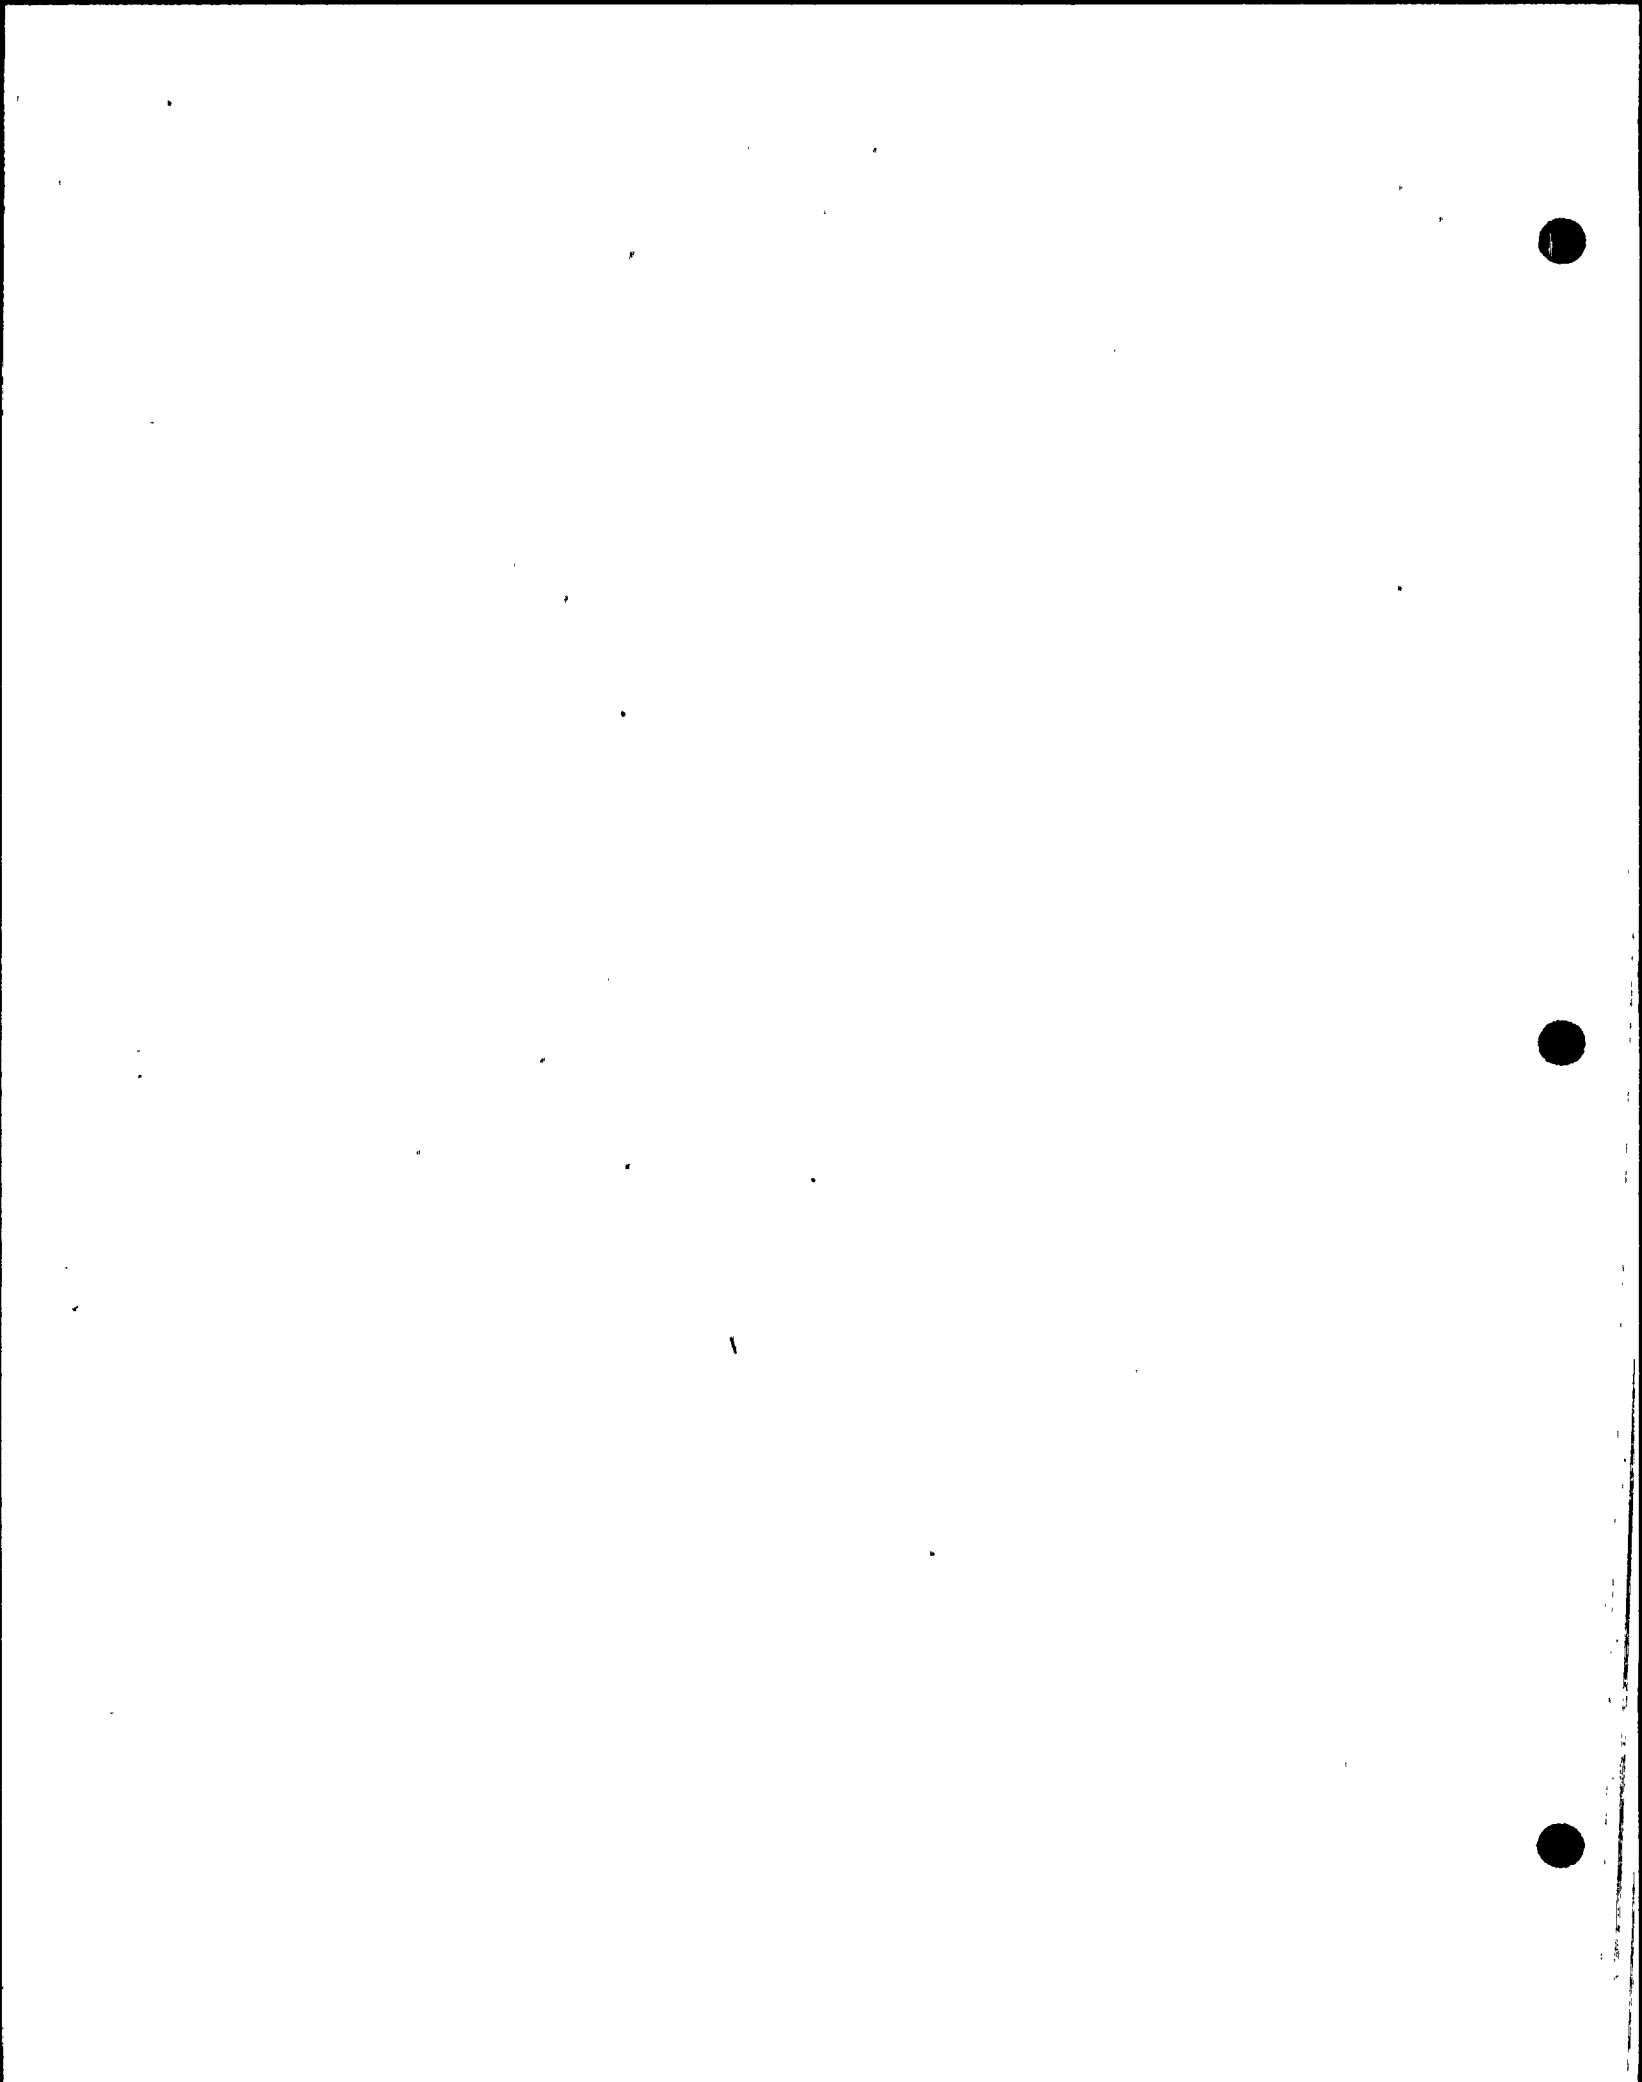

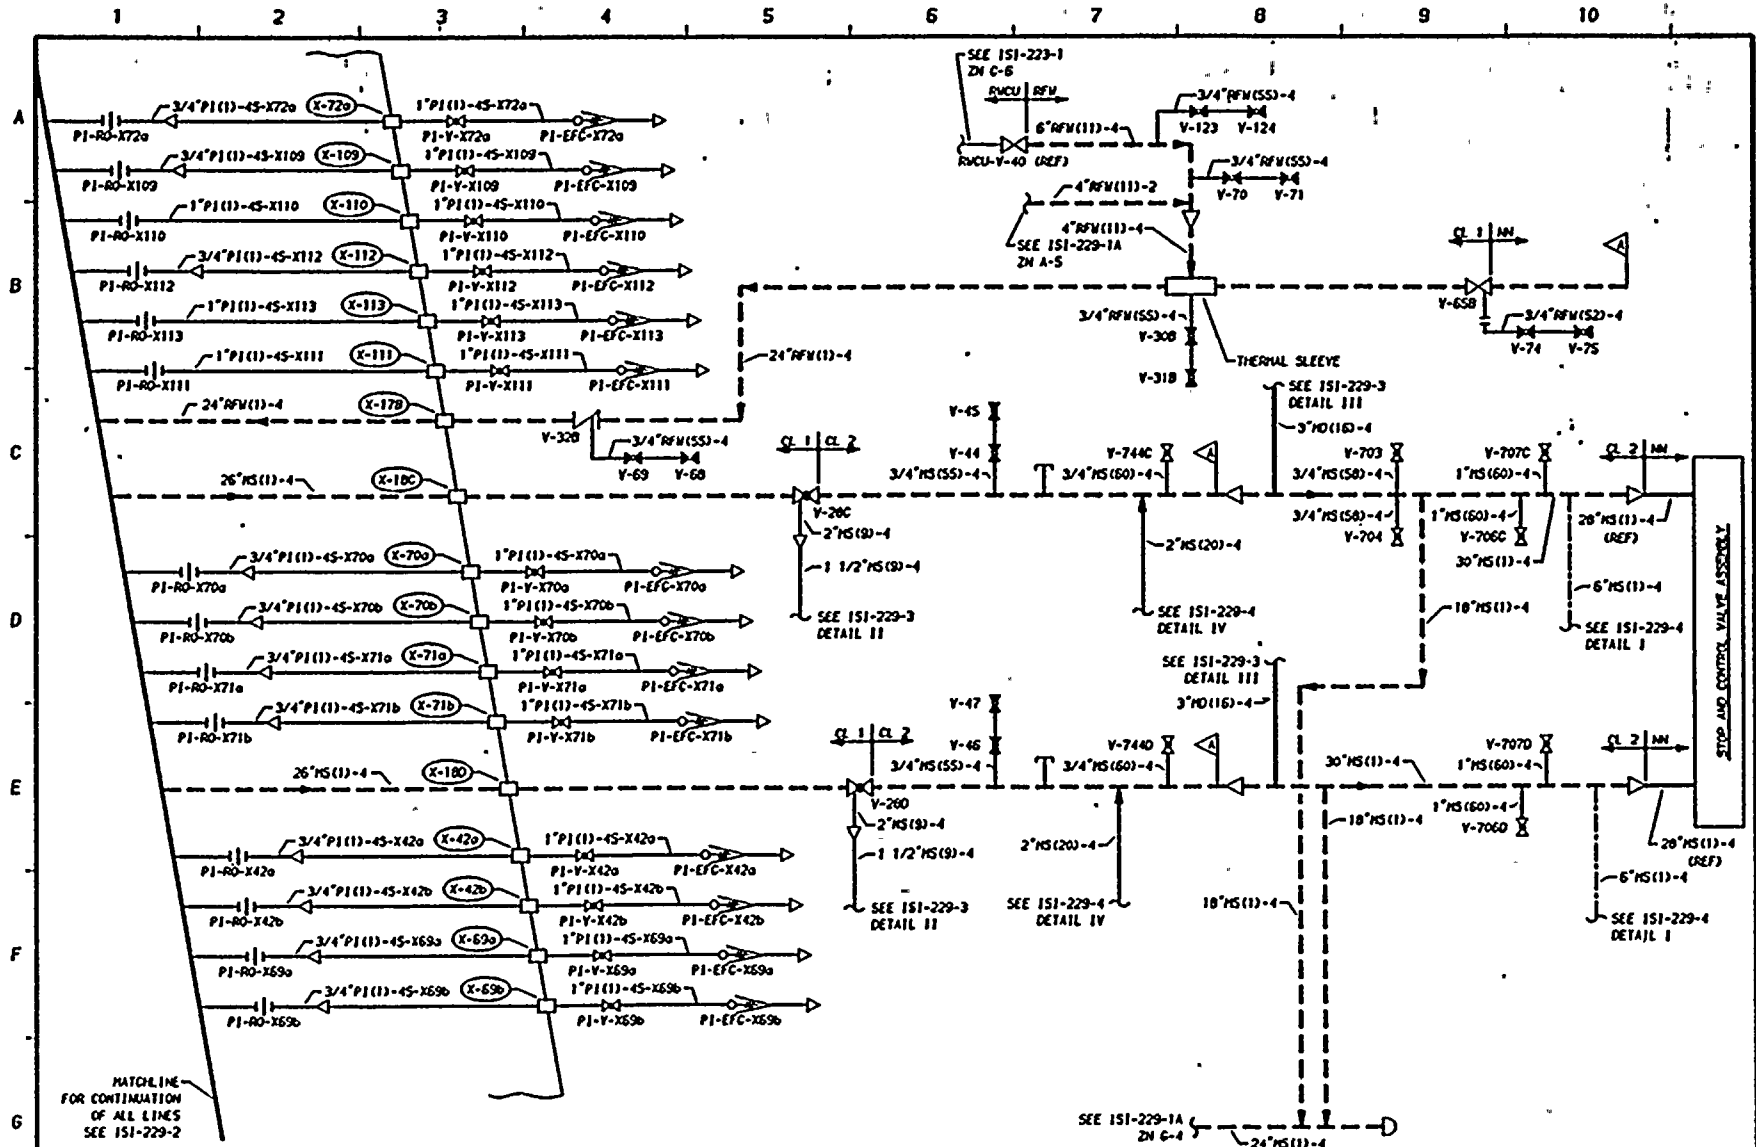

MATCHLINE
FOR CONTINUATION
OF ALL LINES
SEE ISI-229-2


SEE ISI-229-1 FOR NOTES AND REFERENCES.


THIS DRAWING IS INTENDED
FOR USE IN PRESERVICE AND
INSERVICE INSPECTION
PROGRAMS ONLY



WASHINGTON PUBLIC POWER
SUPPLY SYSTEM
RICHLAND, WASHINGTON 99352

NO	DATE	REVISION	BY	CHKD	APYD	NO	DATE	REVISION	BY	CHKD	APYD	DATE	ENGINEER D PORTER		DWP-2 INSERVICE INSPECTION BOUNDARY DIAGRAM MAIN STEAM (MS) & REACTOR FEEDWATER (RFW)
													K-MCA	DWP	
1	4-21-79	GENERAL UP-DATE							K-MCA	TFM	DWP				
0	10-18-78	REVISED TO 177.2 & 178.2 FROM SURVEY TO VISUAL APPRAISAL SYSTEM & ISSUED FOR I&I							K-MCA	DWP	LTH				
2	1/16/79	AUGMENTED ISI ACCORD. UP-DATE, SPLIT, REDRAWN	YCA	DR	TFM	A	4-21-78	ISSUED FOR INFORMATION ONLY	K-MCA	TFM	DWP				
												2-16-78			REV 2

DWG NO 151-229-2A

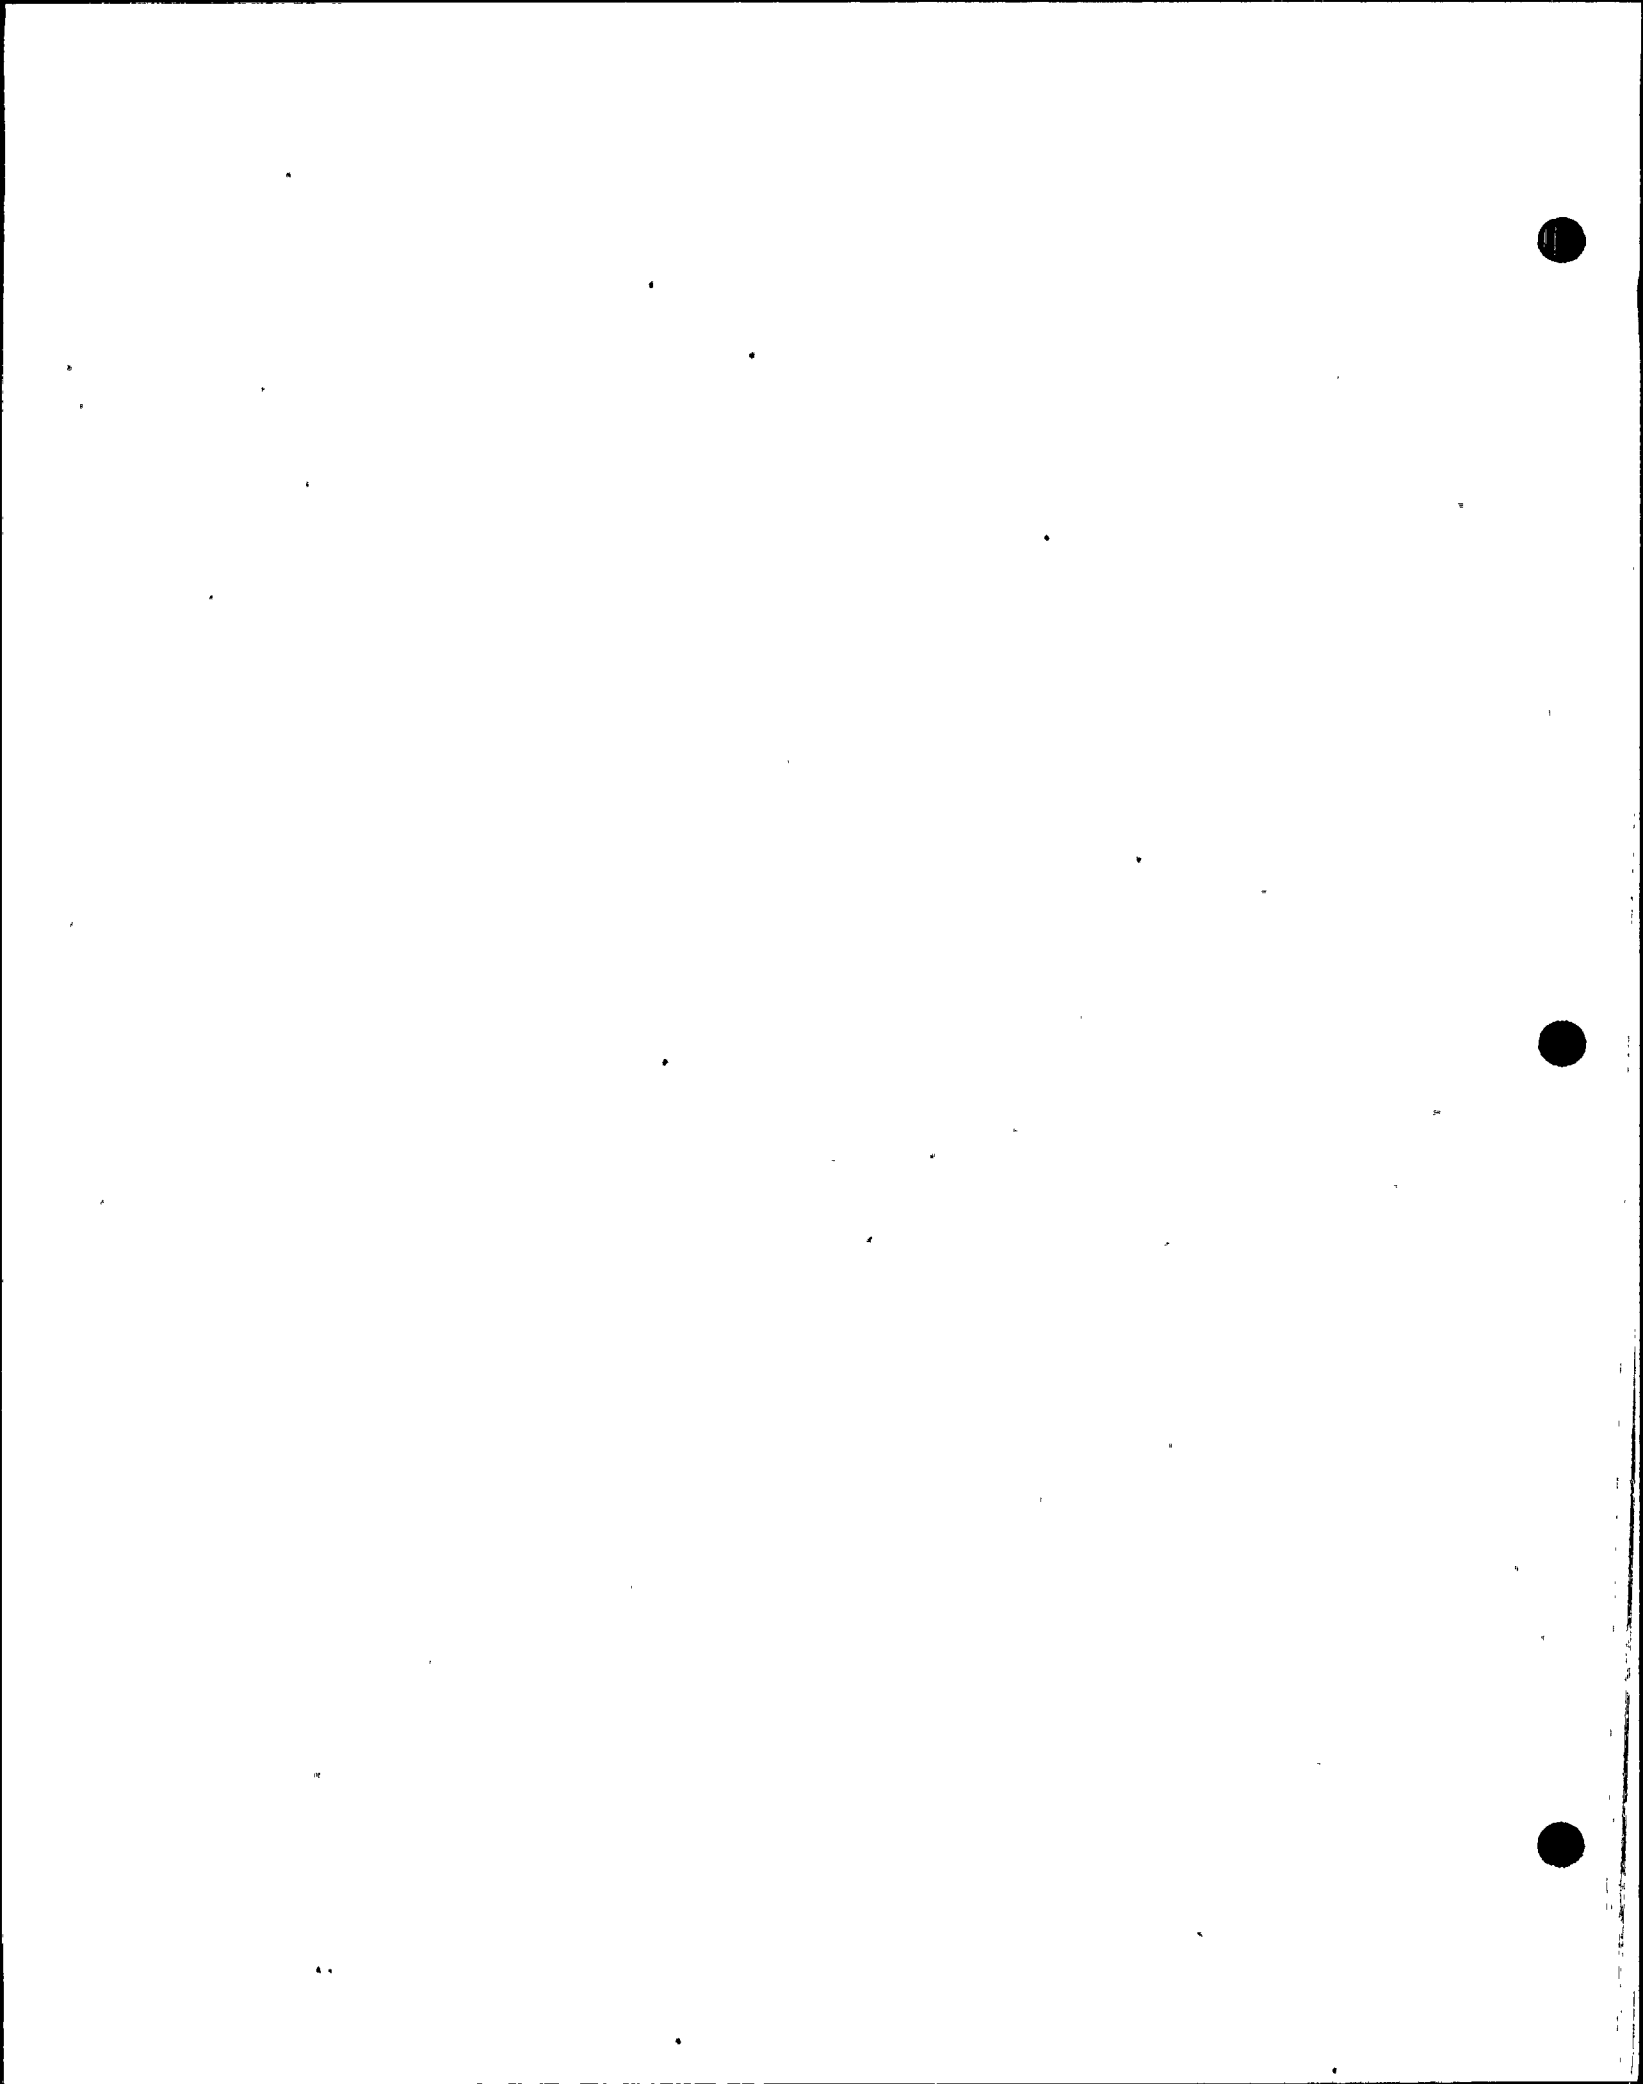

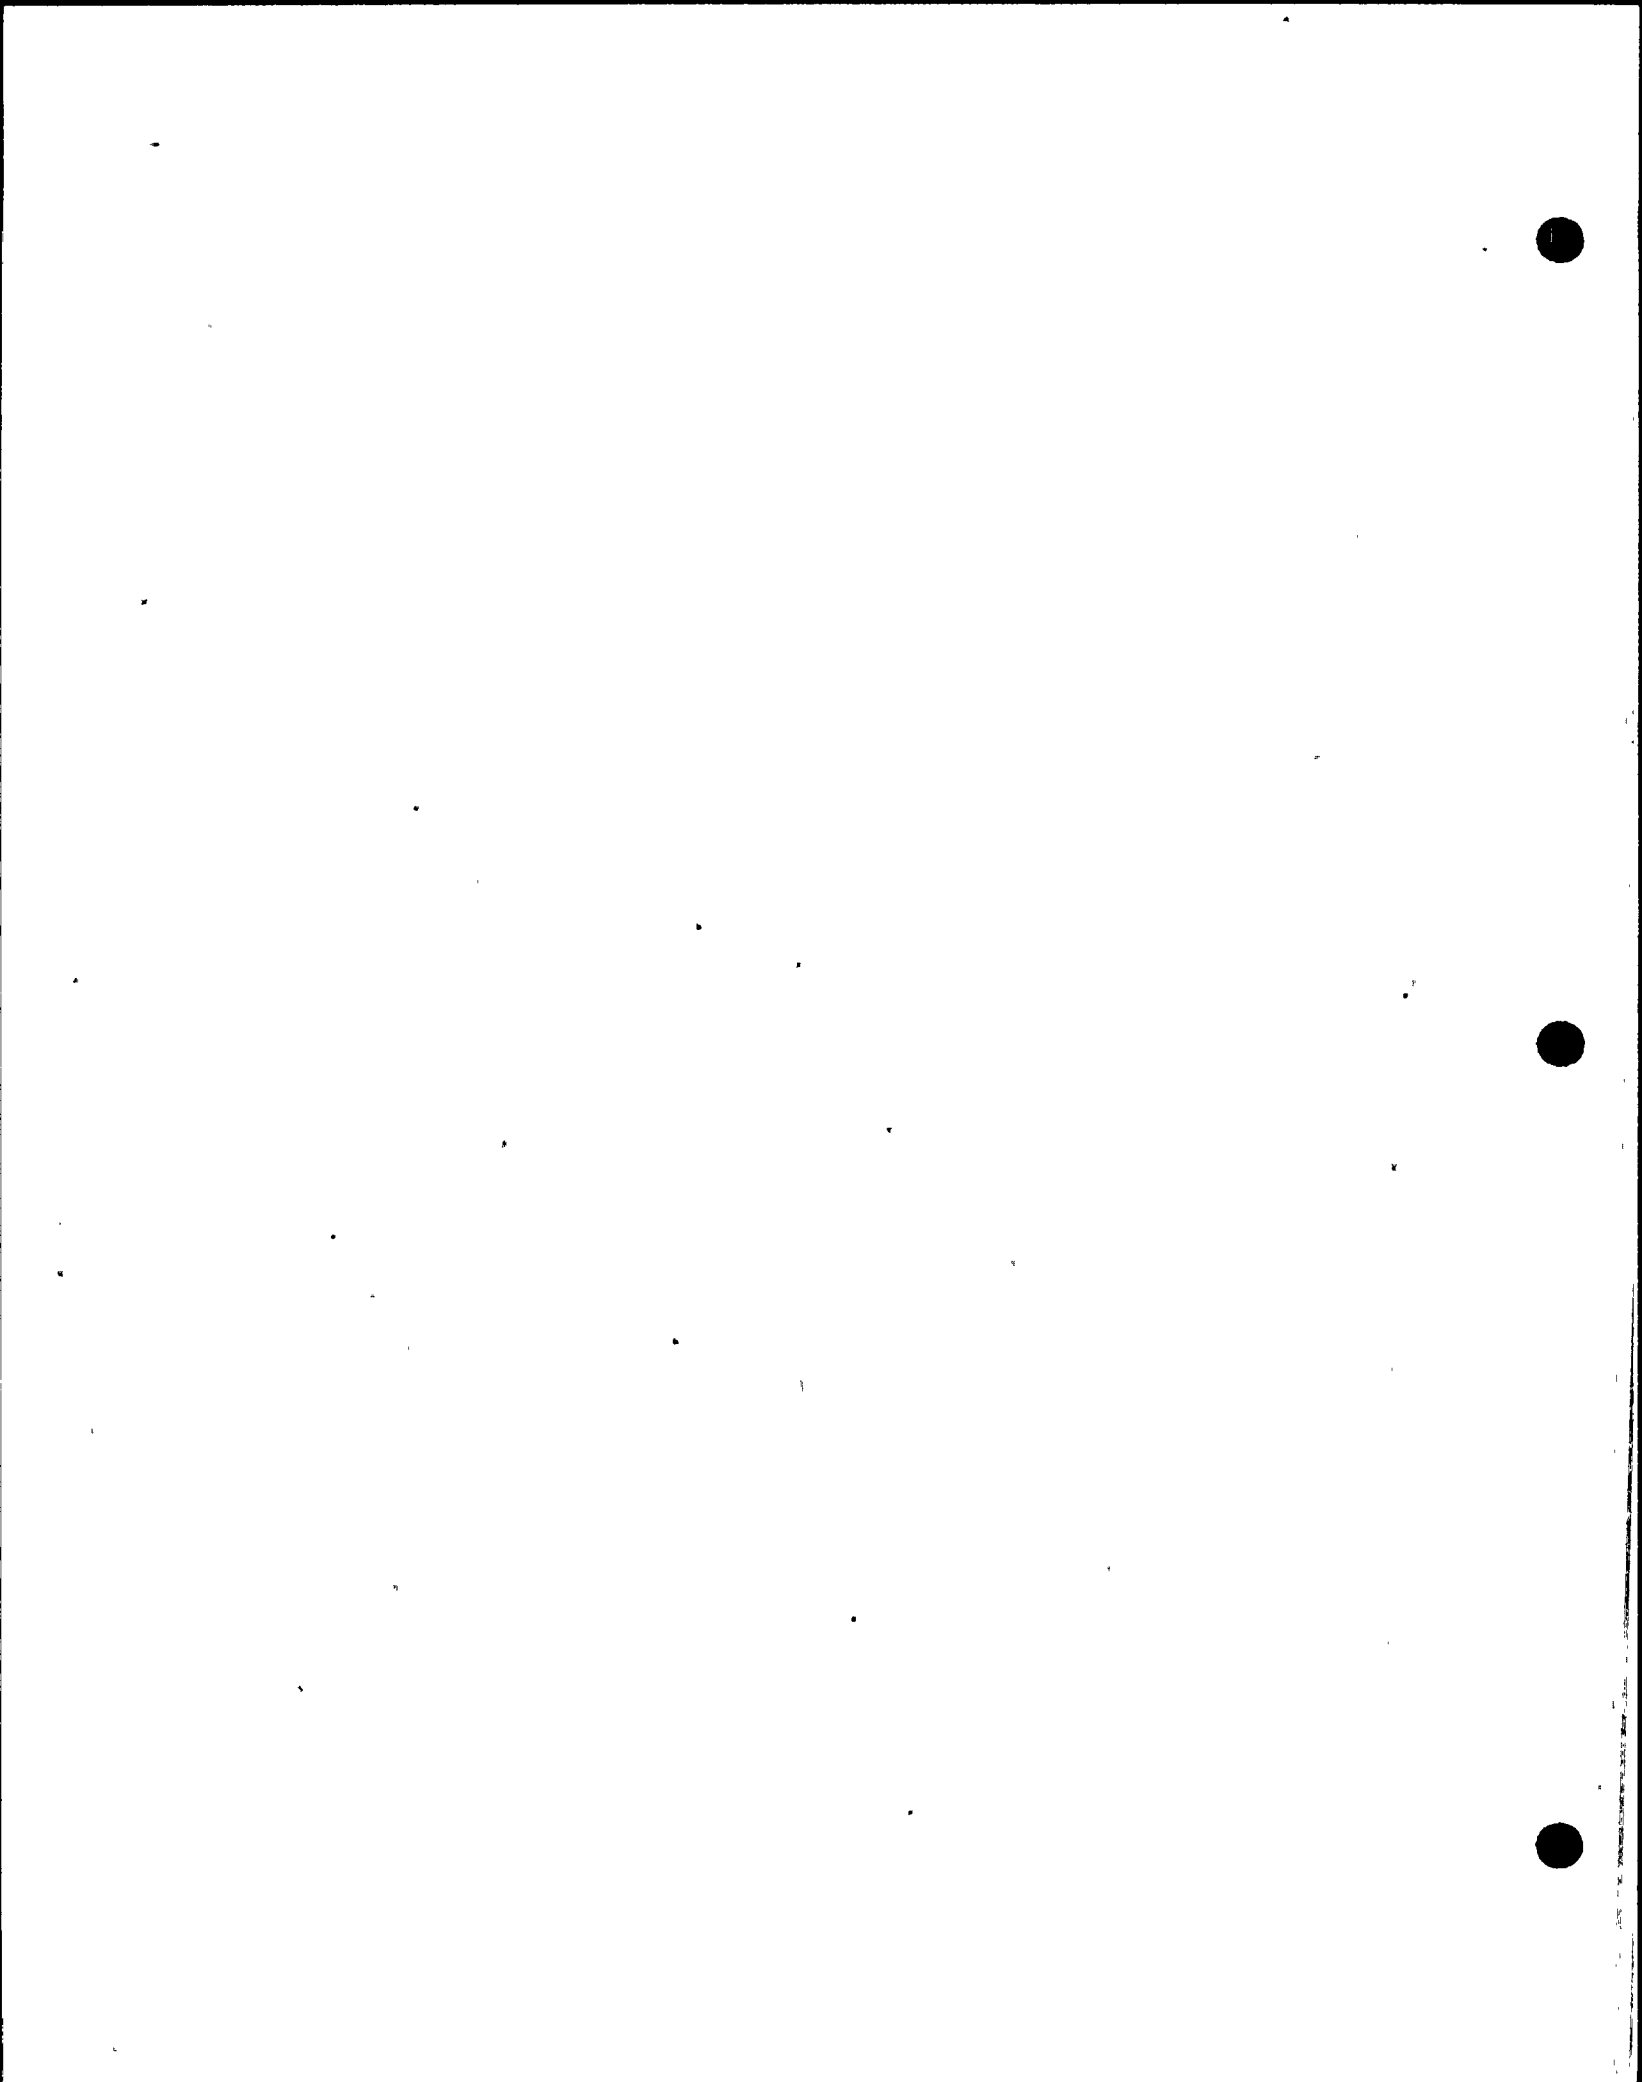

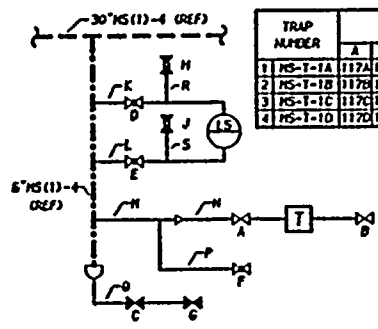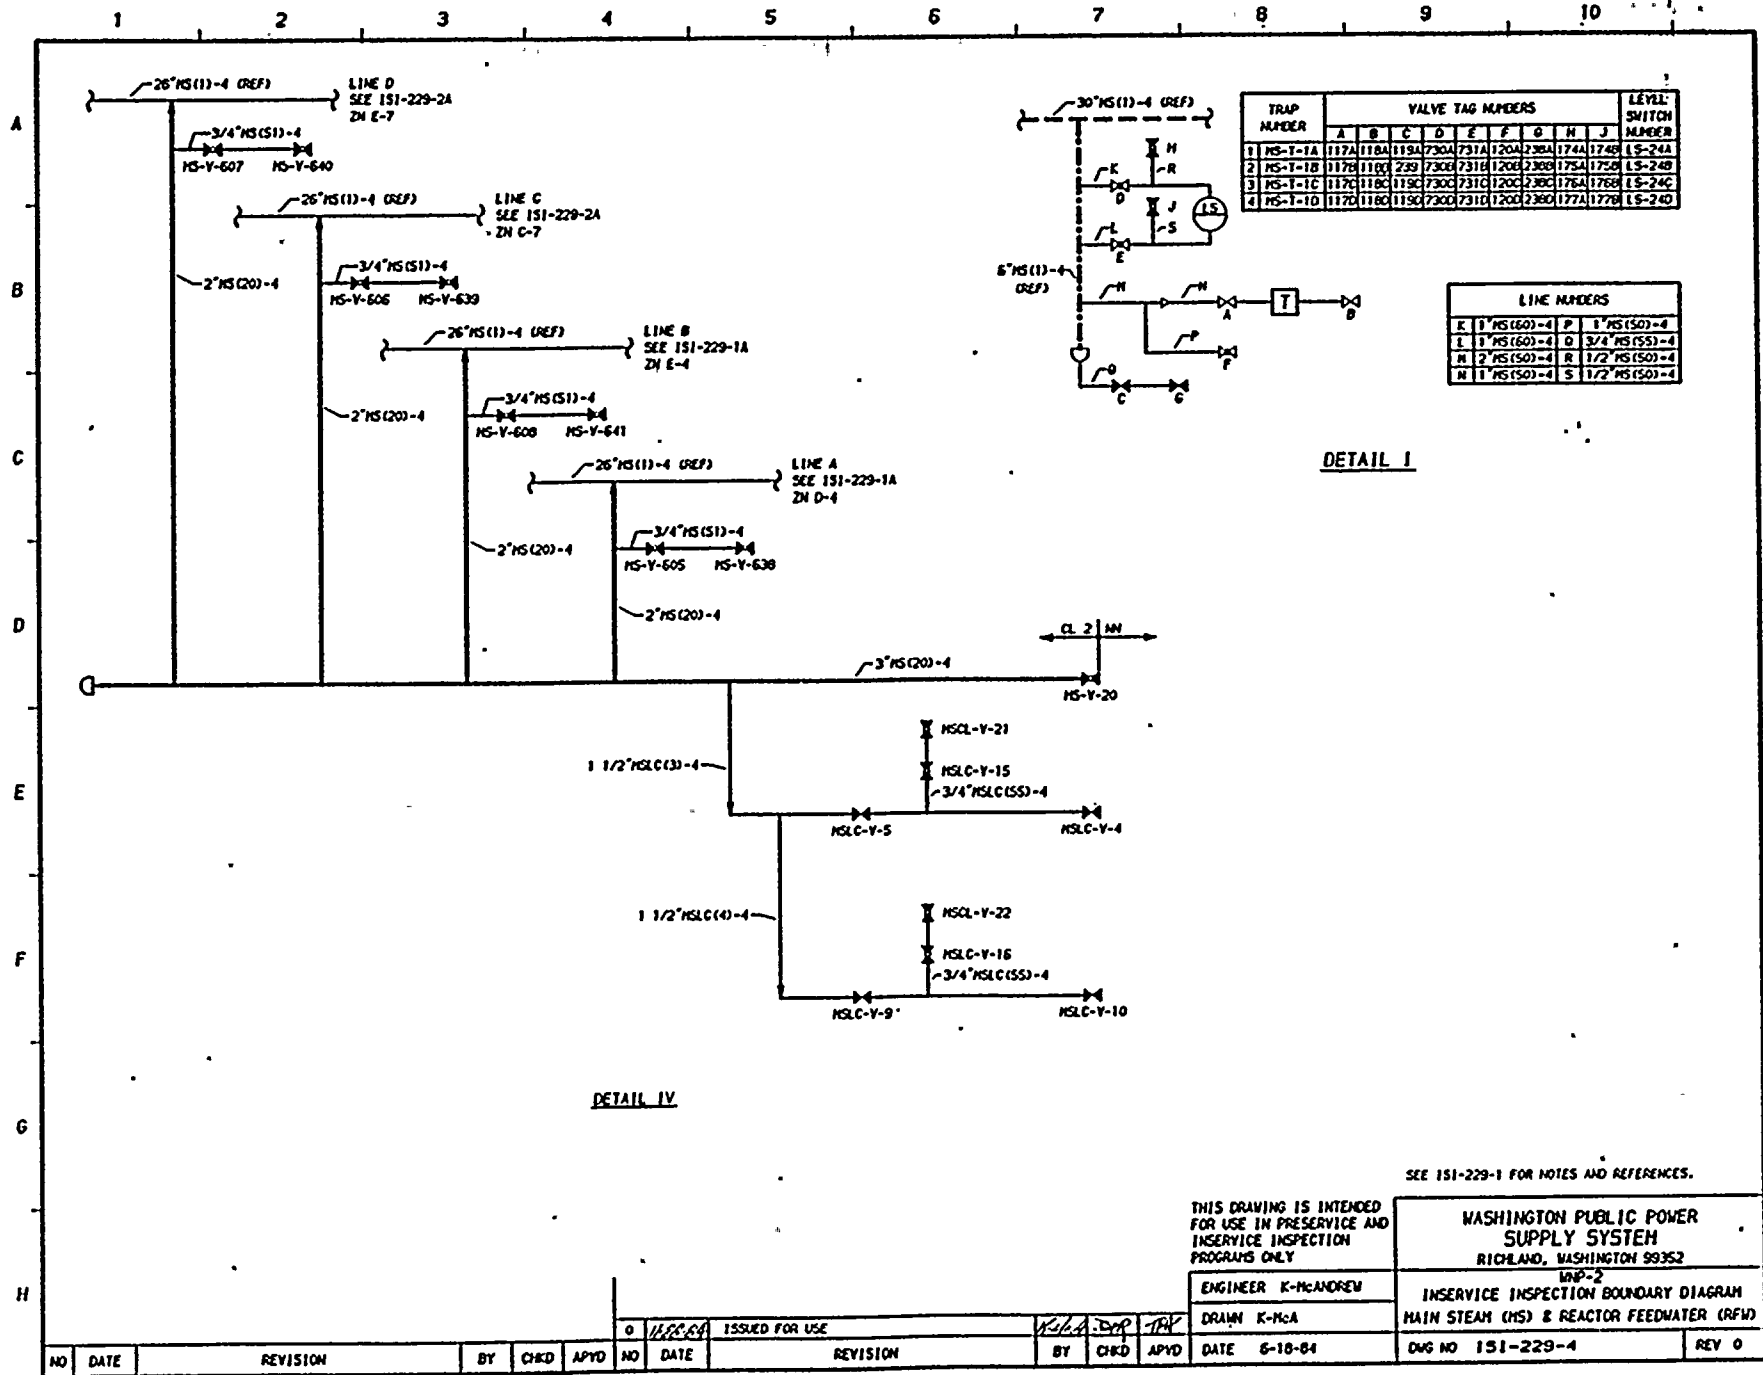

TRAP NUMBER	VALVE TAG NUMBERS										LEVEL SWITCH NUMBER
	A	B	C	D	E	F	G	H	J	J	
1 NS-Y-1A	117A	118A	119A	120A	121A	122A	123A	174A	175A	176A	LS-24A
2 NS-Y-1B	117B	118B	119B	120B	121B	122B	123B	174B	175B	176B	LS-24B
3 NS-Y-1C	117C	118C	119C	120C	121C	122C	123C	174C	175C	176C	LS-24C
4 NS-Y-1D	117D	118D	119D	120D	121D	122D	123D	174D	175D	176D	LS-24D

LINE NUMBERS				
K	1" NS(50)-4	P	1" NS(50)-4	
L	1" NS(60)-4	O	3/4" NS(55)-4	
M	2" NS(50)-4	R	1/2" NS(50)-4	
N	1" NS(50)-4	S	1/2" NS(50)-4	

DETAIL I

DETAIL IV

SEE 151-229-1 FOR NOTES AND REFERENCES.


THIS DRAWING IS INTENDED FOR USE IN PRESERVICE AND INSERVICE INSPECTION PROGRAMS ONLY

WASHINGTON PUBLIC POWER SUPPLY SYSTEM
 RICHLAND, WASHINGTON 99352

ENGINEER K-McANDREW
 DRAWN K-McA

INSERVICE INSPECTION BOUNDARY DIAGRAM
 MAIN STEAM (MS) & REACTOR FEEDWATER (RFW)
 DATE 6-18-84
 DWG NO 151-229-4
 REV 0

NO	DATE	REVISION	BY	CHKD	APVD	NO	DATE	REVISION	BY	CHKD	APVD
0	11/22/84	ISSUED FOR USE	MSLA	DMP	TBY						

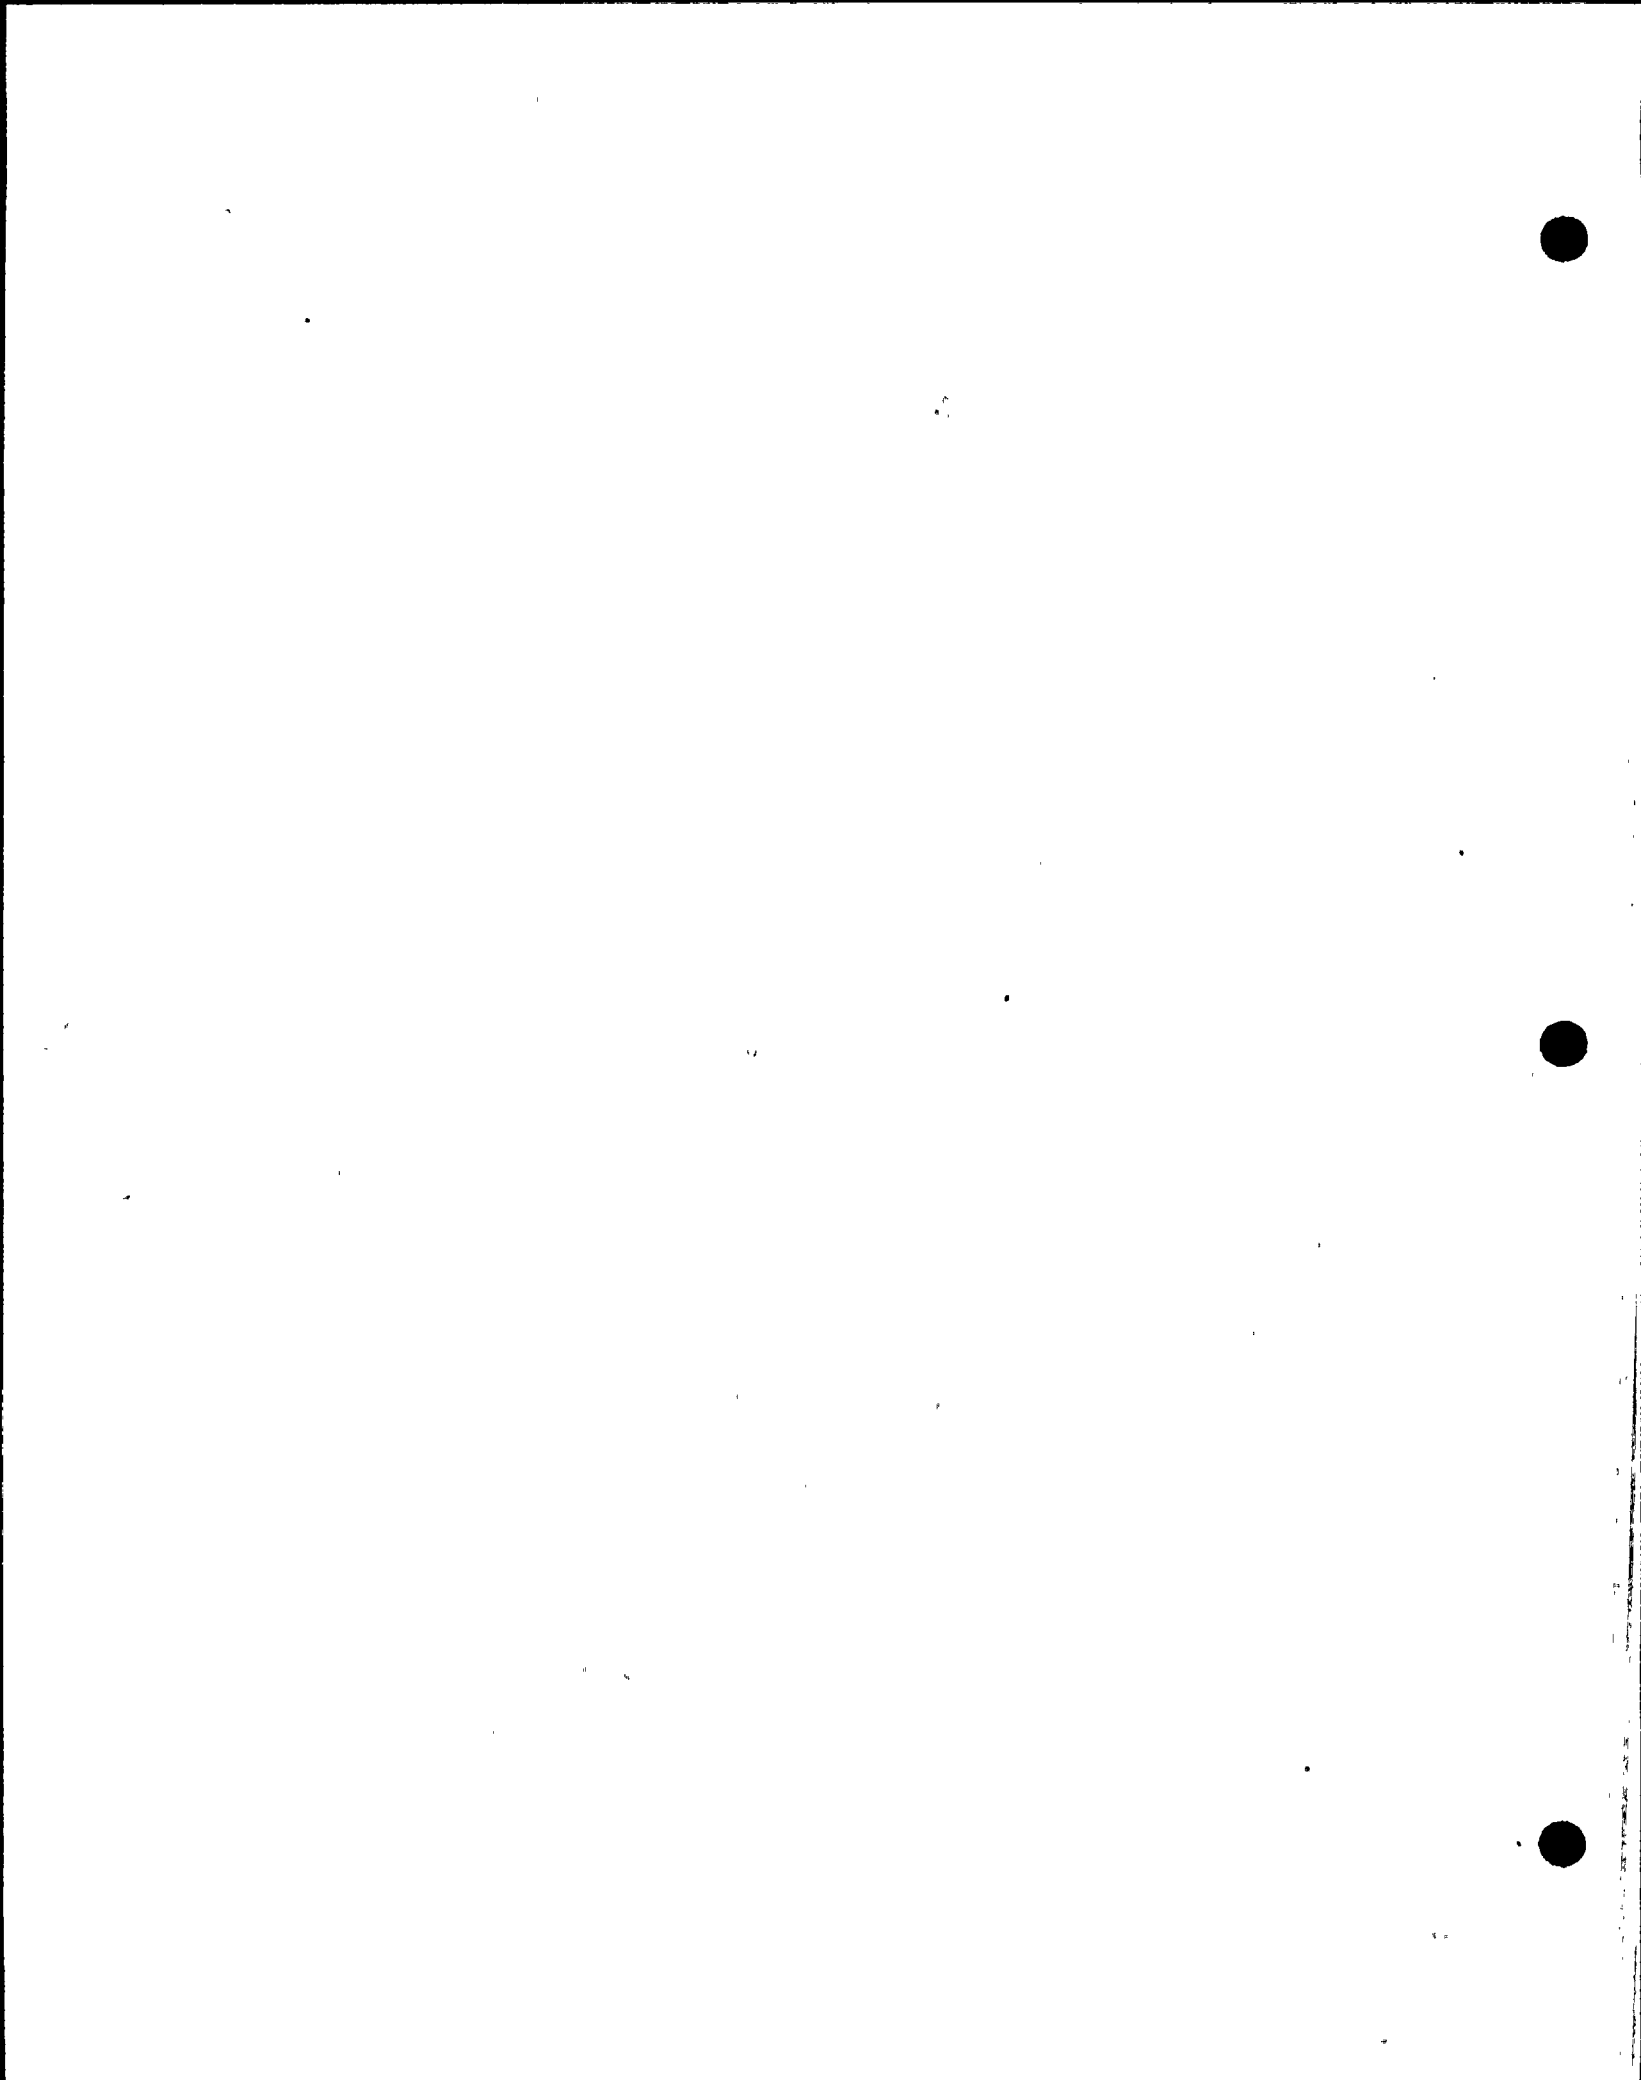

EXCEPTIONS AND EXEMPTIONSISI - 229SYSTEM Main Steam (MS) and Reactor Feedwater (RFW) SystemEXCEPTIONS:Class 1 Piping and Components

- See general exceptions.
- No additional exceptions.

Class 2 Piping and Components

- See general exceptions.
- No additional exceptions.

EXEMPTIONS APPLIED:

IWB-1220(a)(1) Yes, per code class boundary.

(2) No

(3) Yes

(4) Yes

*(b)(1) Yes, 2"MS(12)-4, 2" & 3"MS(9)-4, 2" RPV instrument lines.

(2) No

(3) Yes, all piping ≤ 1 " NPS.

IWC-1220(a) No

*(b) No


(c) No


(d) Yes, all piping ≤ 4 " NPS.


IWC-5220(d) No

IWD-5200(c) Yes, MSRV discharge piping

* See general exemption discussion for details.

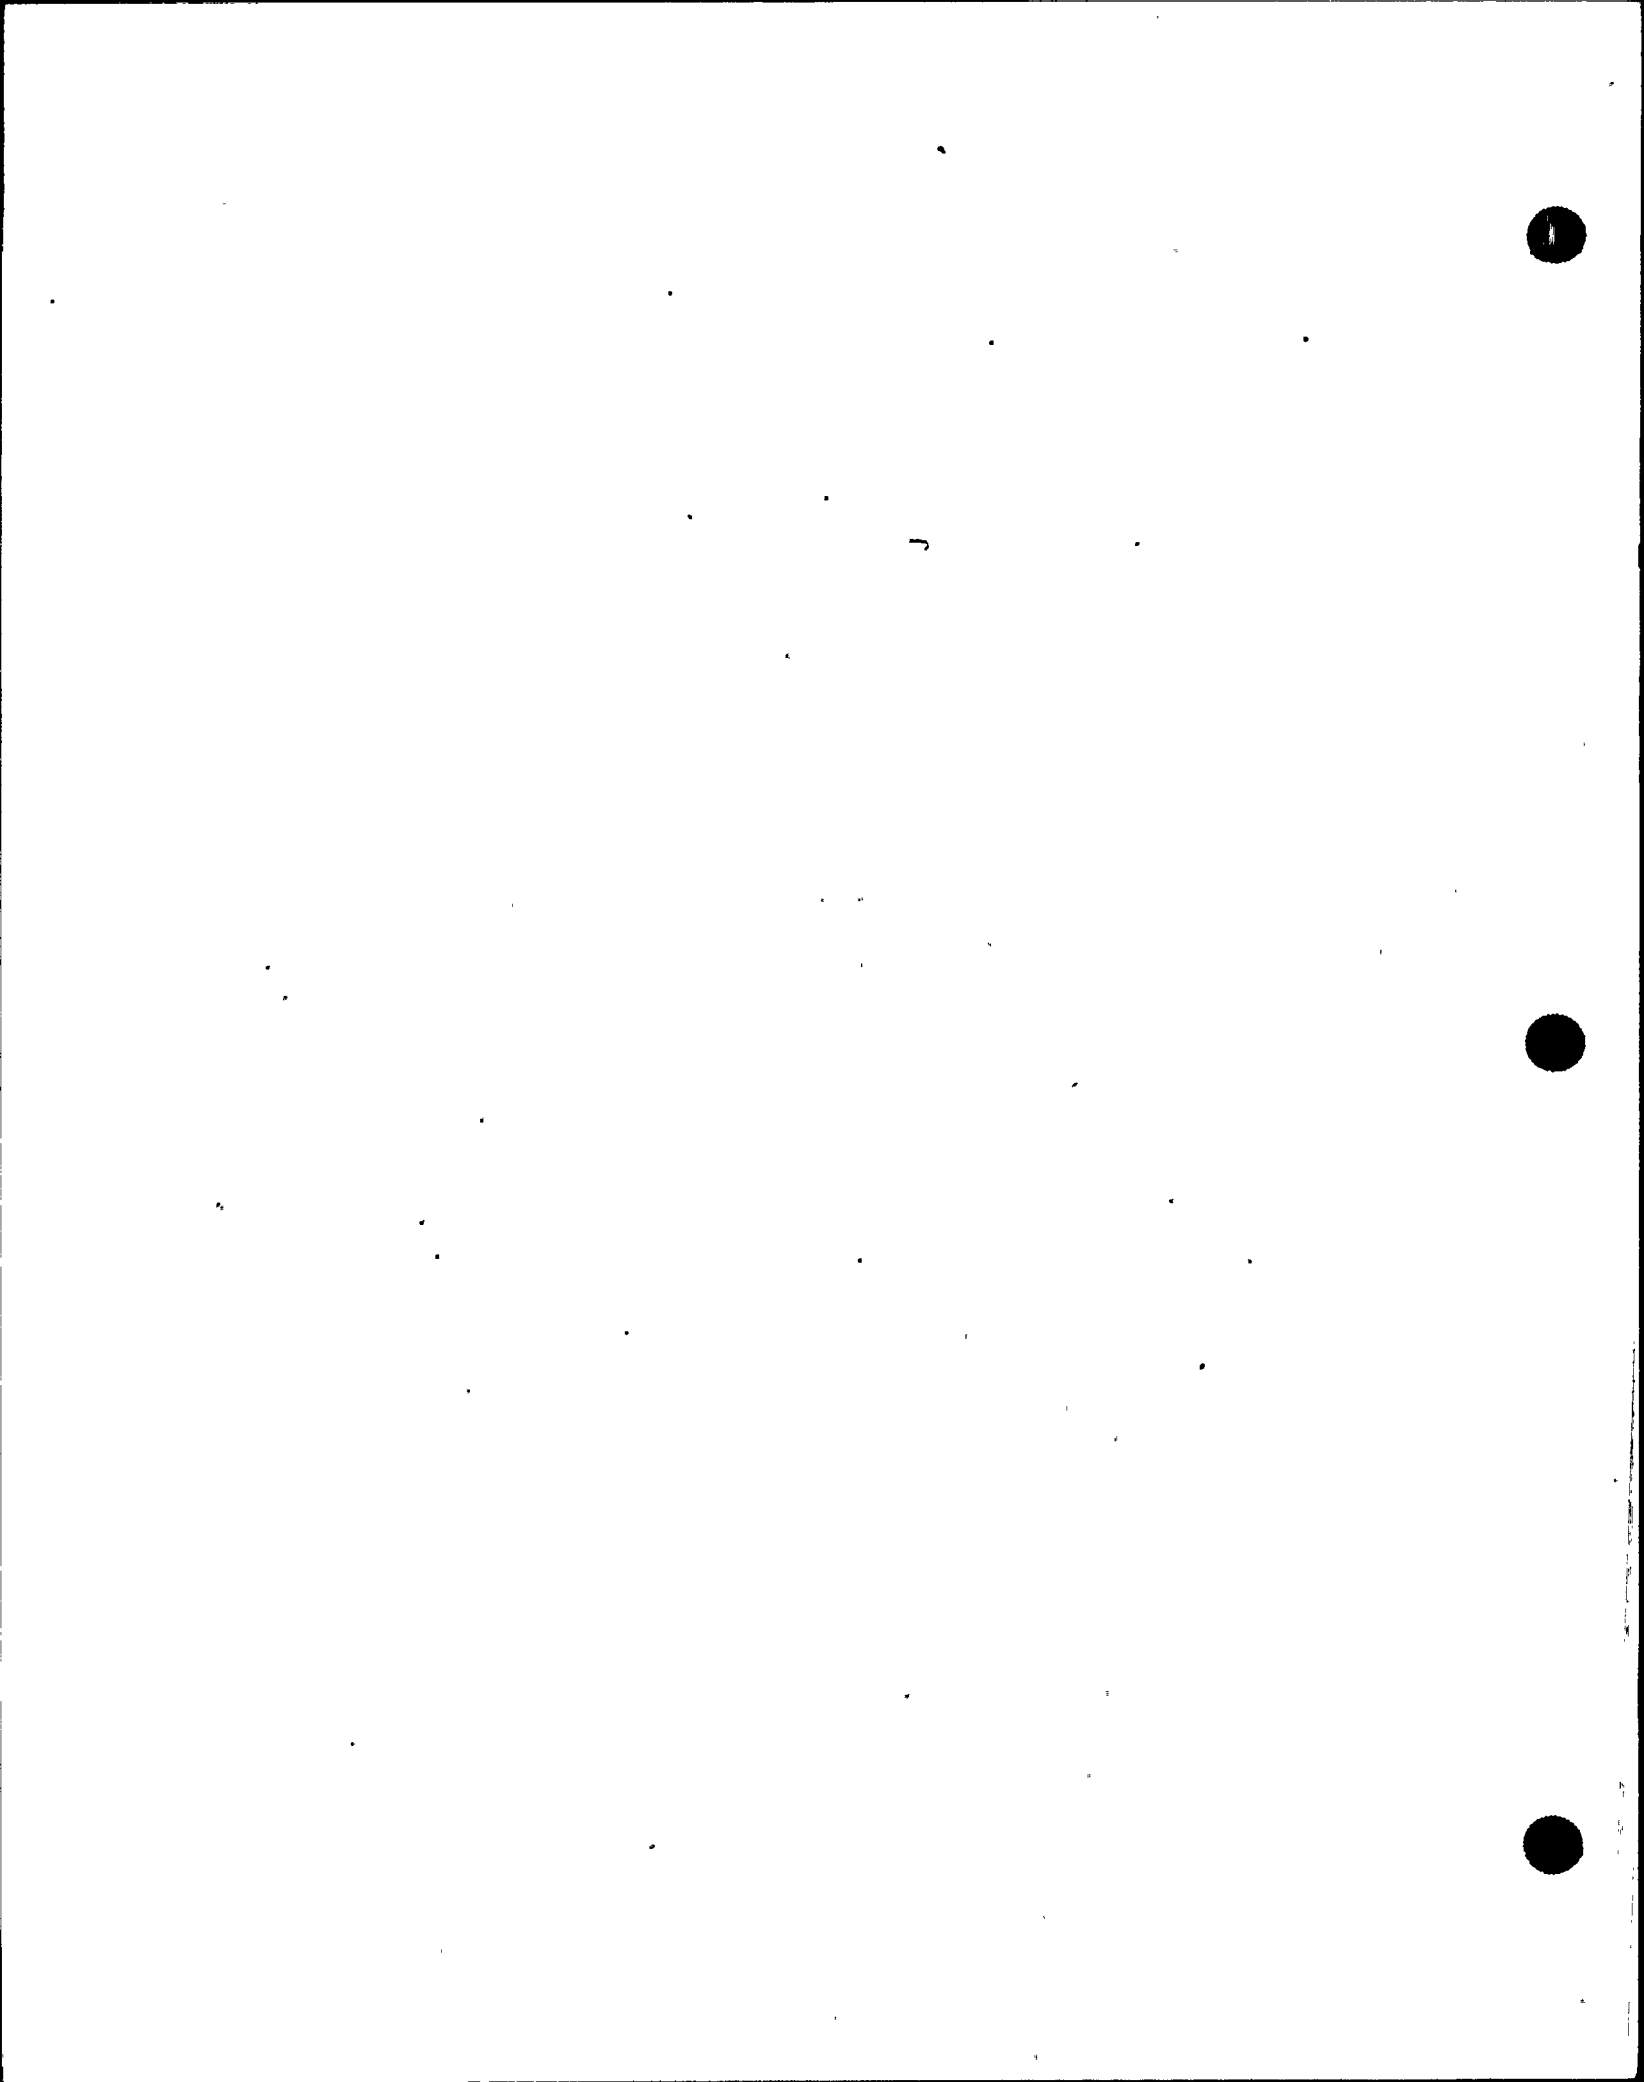

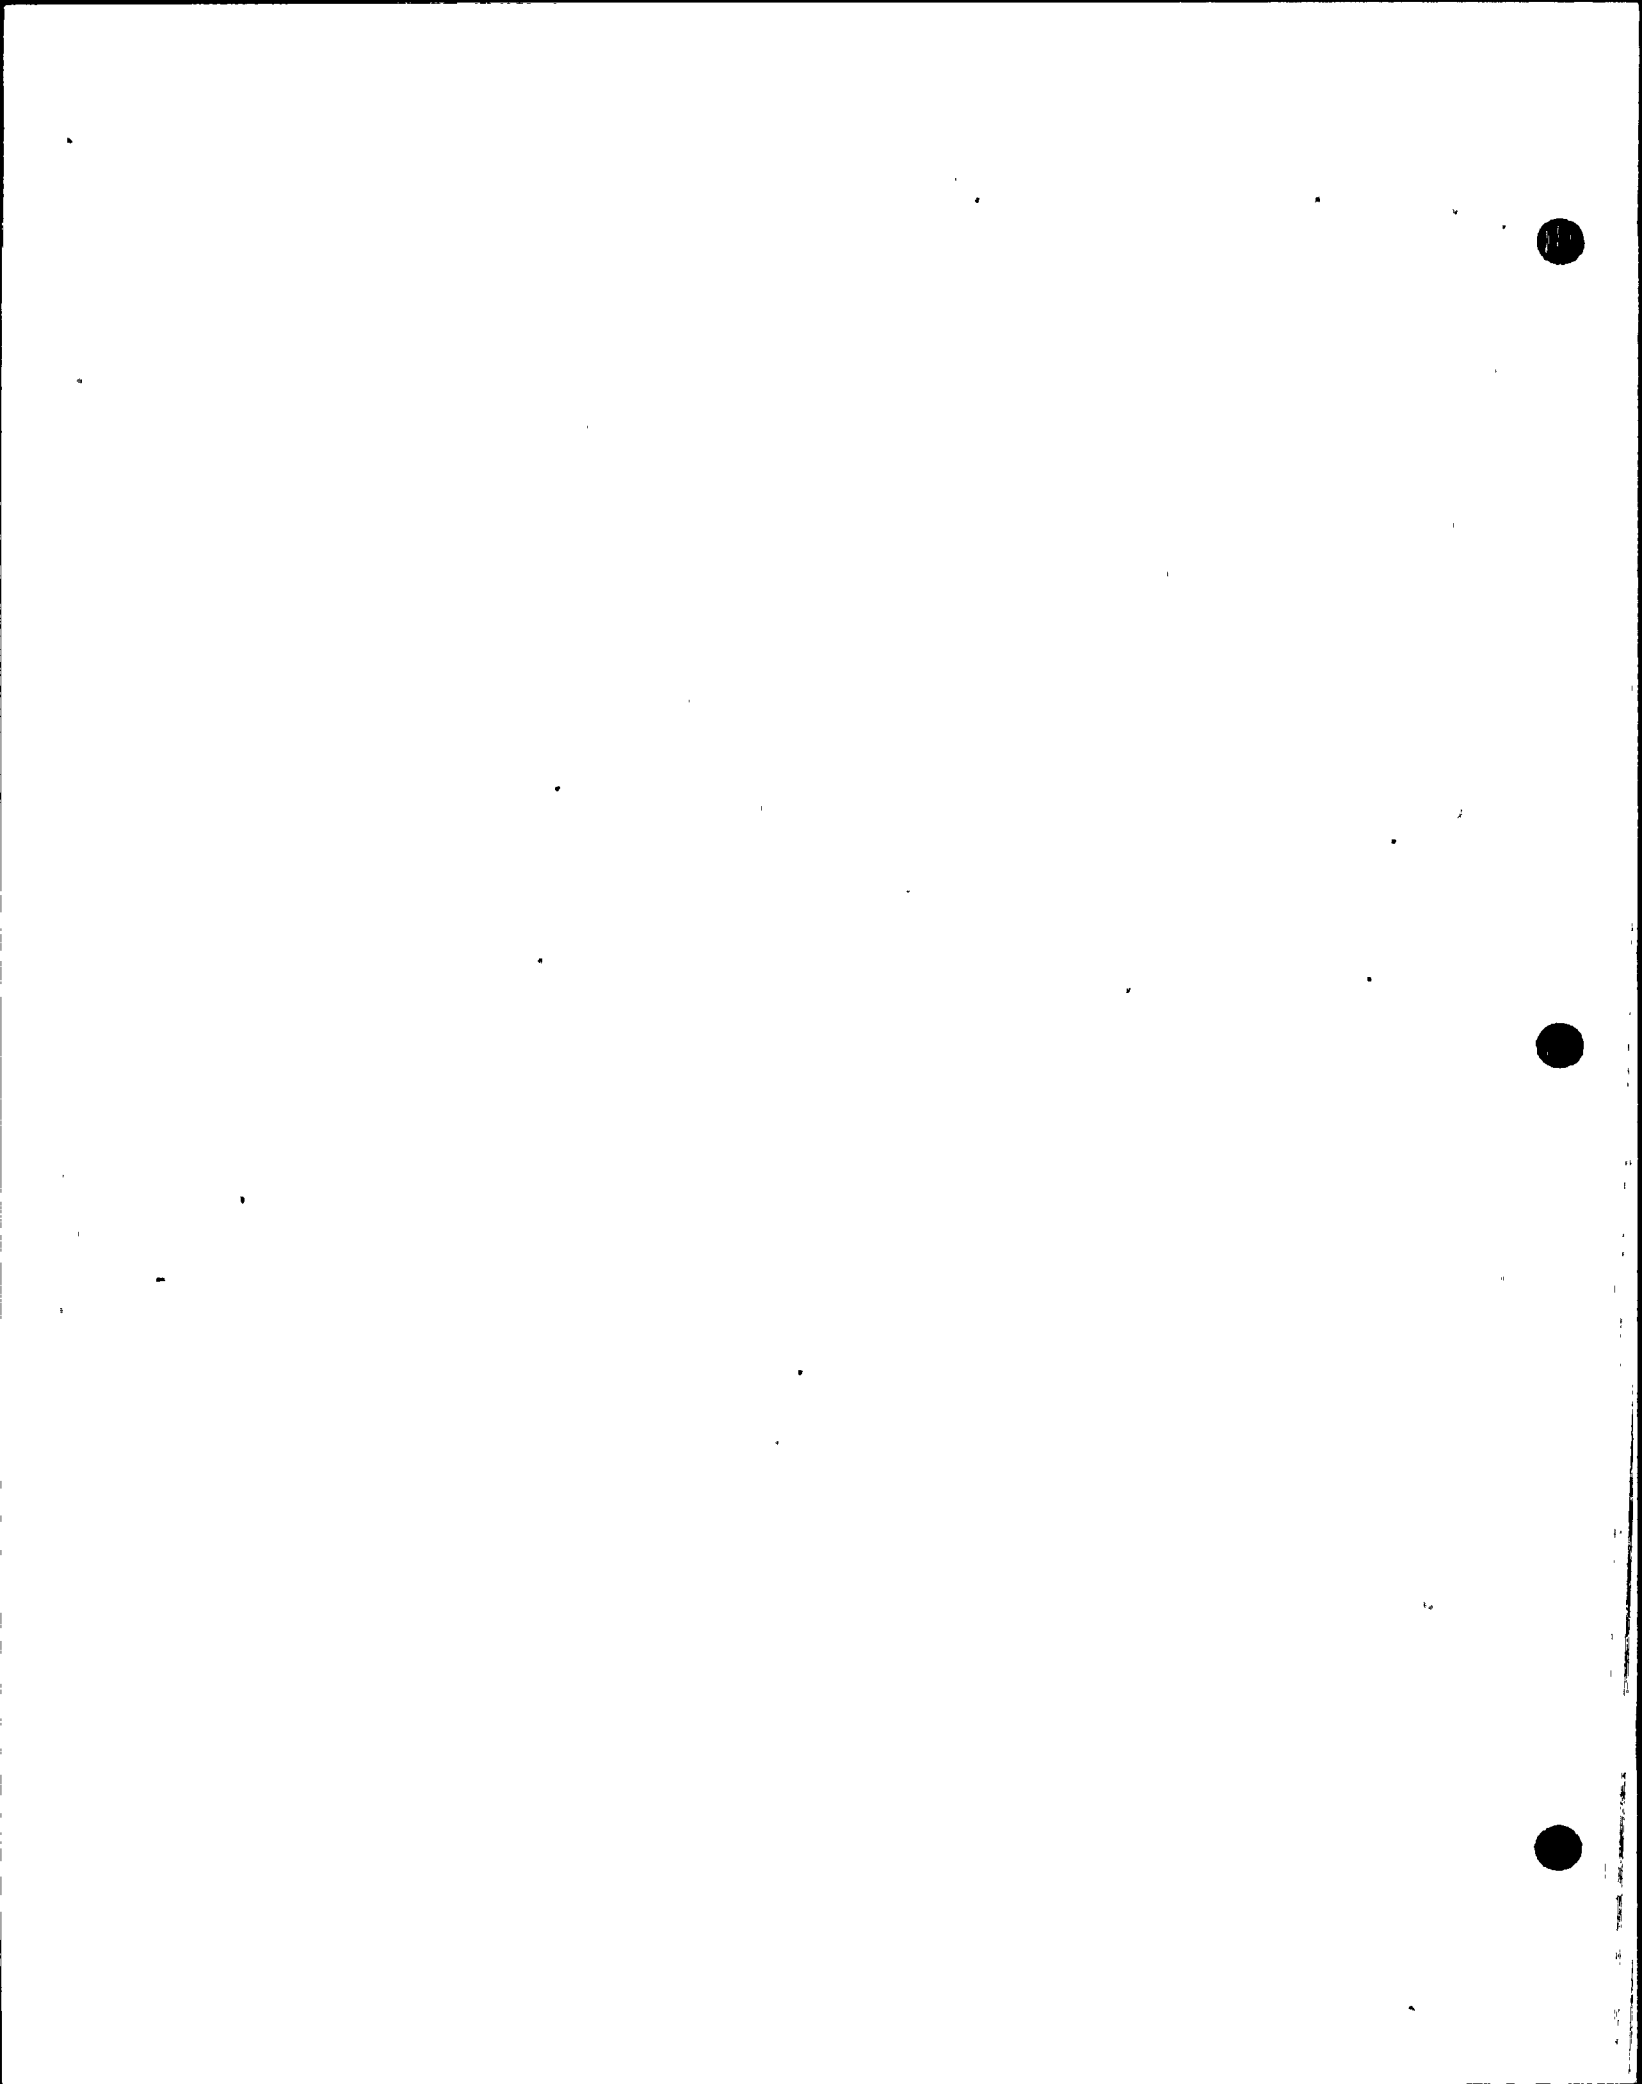

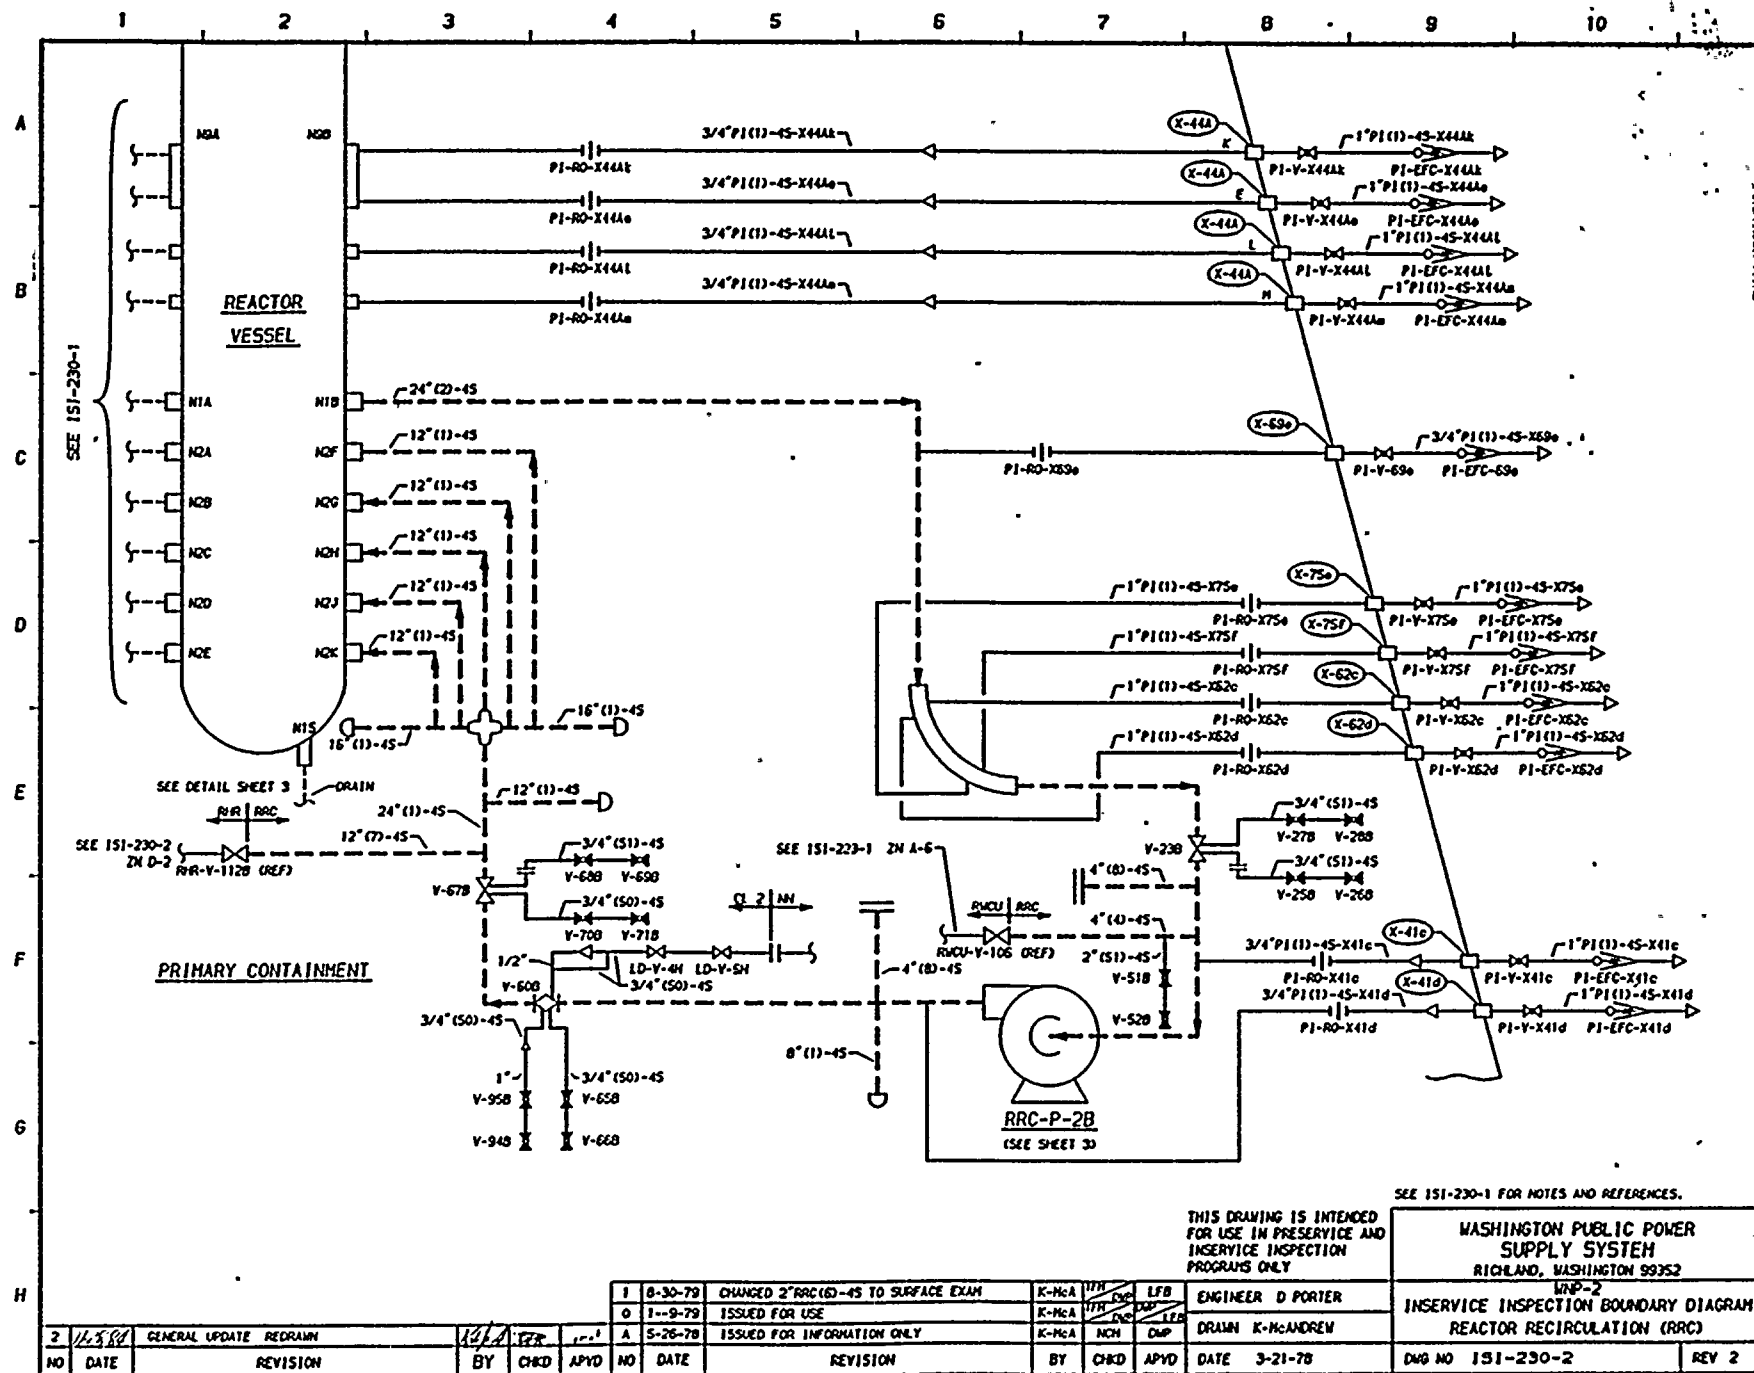


THIS DRAWING IS INTENDED FOR USE IN PRESERVICE AND INSERVICE INSPECTION PROGRAMS ONLY


SEE ISI-230-1 FOR NOTES AND REFERENCES.

WASHINGTON PUBLIC POWER SUPPLY SYSTEM
 RICHLAND, WASHINGTON 99352

WPP-2
 INSERVICE INSPECTION BOUNDARY DIAGRAM
 REACTOR RECIRCULATION (RRC)

NO	DATE	REVISION	BY	CHKD	APVD	NO	DATE	REVISION	BY	CHKD	APVD	DATE	REV
1	8-30-79	CHANGED 2" RRC(S)-45 TO SURFACE EXAM	K-McA	TH	DFB				K-McA	TH	DFB		
0	1--9-79	ISSUED FOR USE	K-McA	TH	DFB				K-McA	TH	DFB		
A	5-26-78	ISSUED FOR INFORMATION ONLY	K-McA	NCH	DFB				K-McA	NCH	DFB		
2	3-21-78	GENERAL UPDATE REDRAWN	K-McA	TH	DFB				K-McA	TH	DFB	3-21-78	2

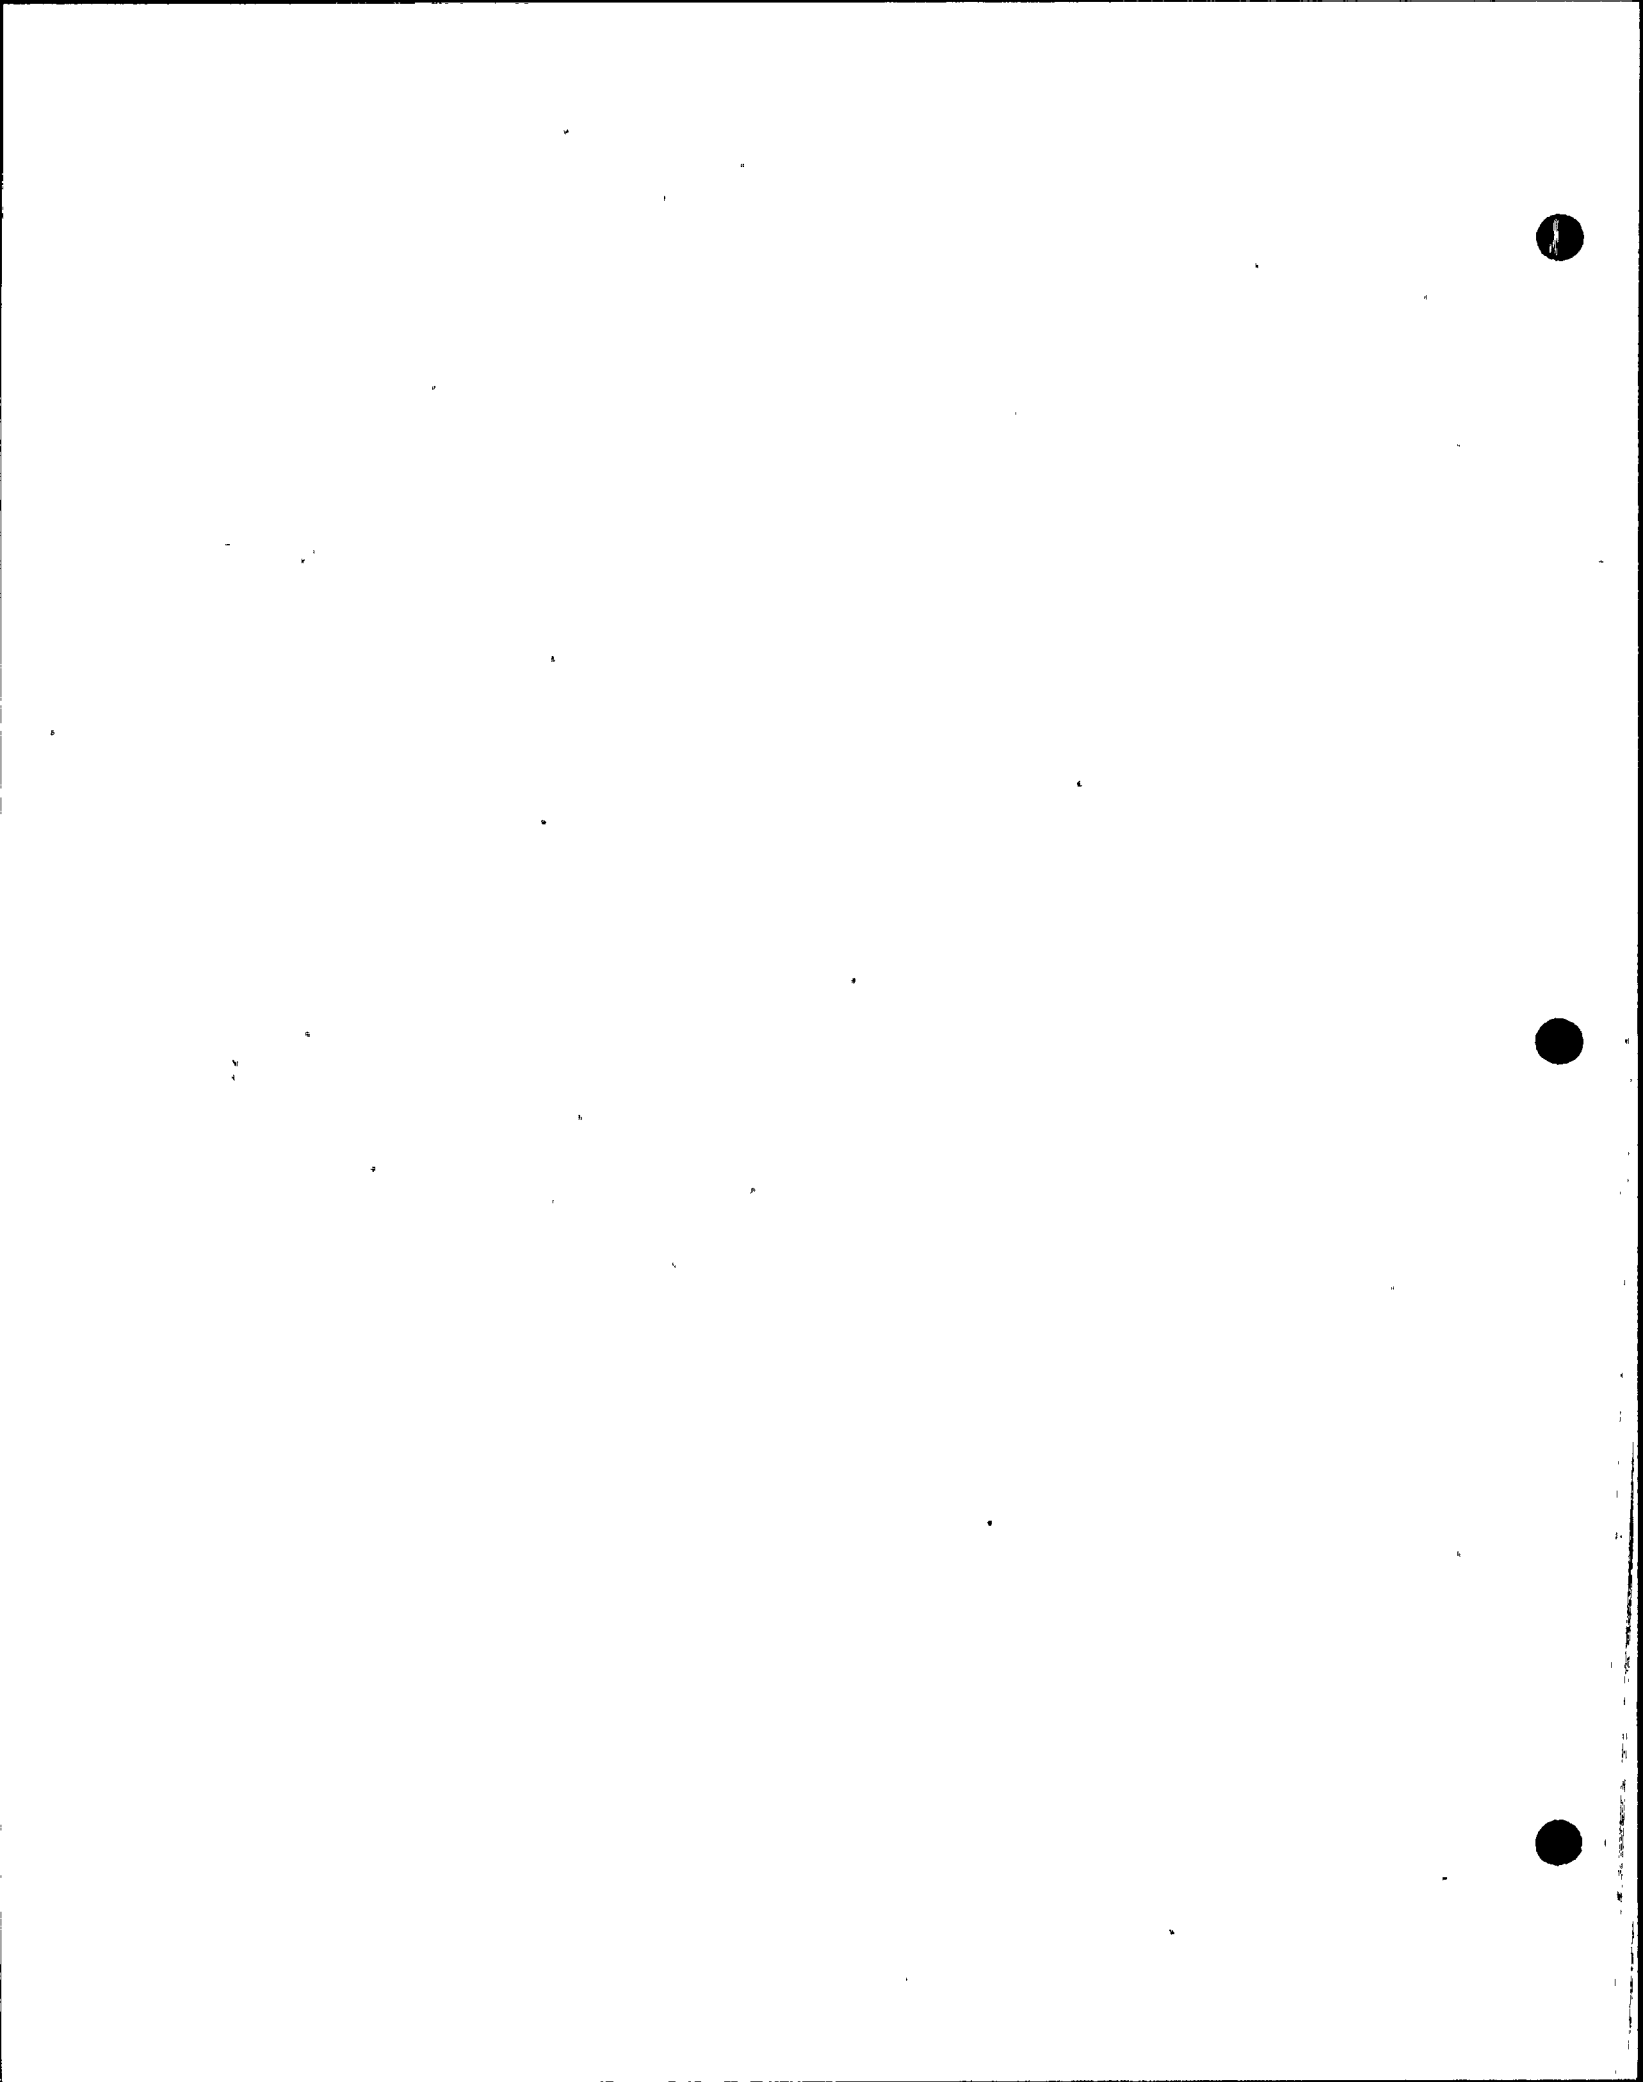

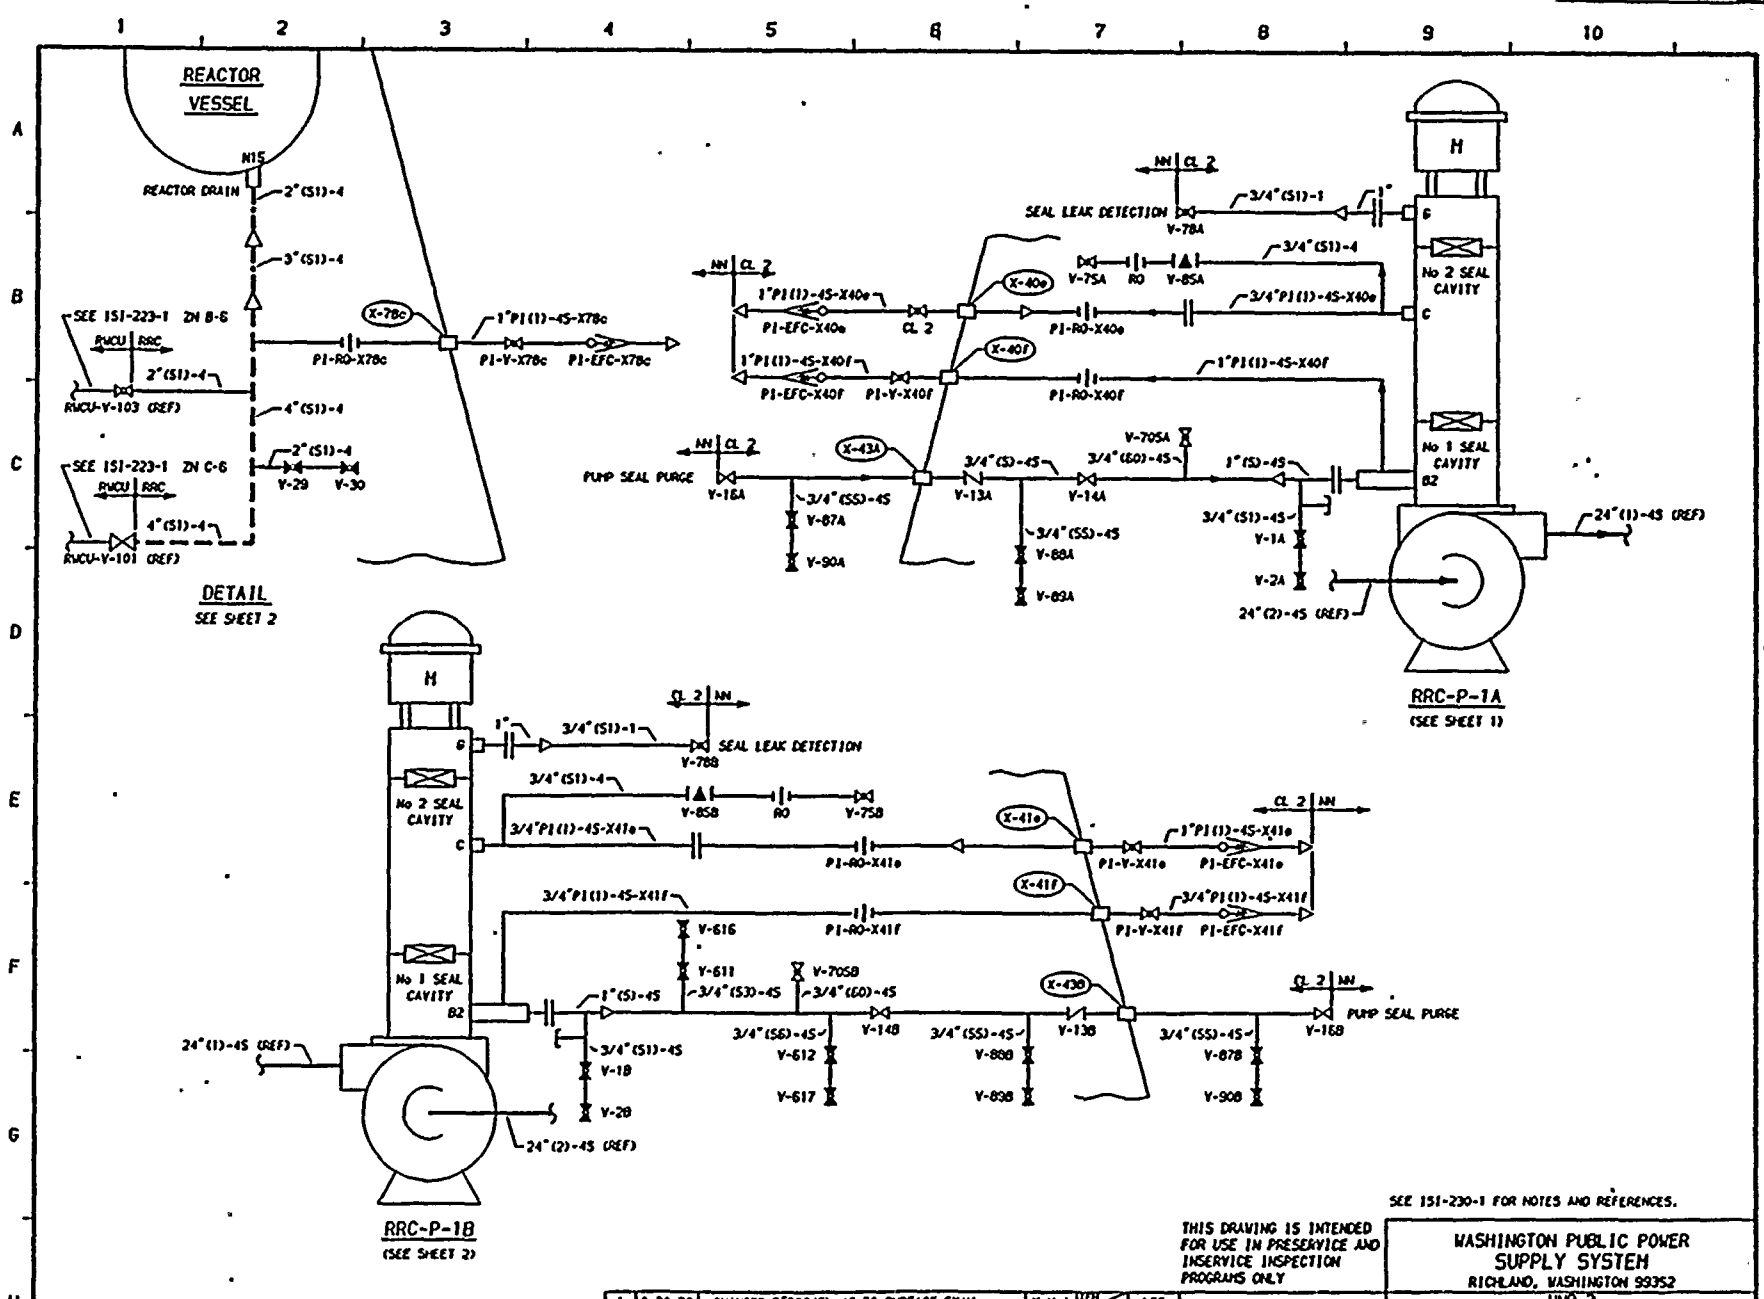

DETAIL
SEE SHEET 2

SEE 151-230-1 FOR NOTES AND REFERENCES.

THIS DRAWING IS INTENDED
FOR USE IN PRESERVICE AND
INSERVICE INSPECTION
PROGRAMS ONLY

WASHINGTON PUBLIC POWER
SUPPLY SYSTEM
RICHLAND, WASHINGTON 99352

NO	DATE	REVISION	BY	CHKD	APVD	NO	DATE	REVISION	BY	CHKD	APVD	DATE
1	8-30-79	CHANGED 2" RRC(ES)-45 TO SURFACE EXAM	K-MCA	WPH	LFB				K-MCA	WPH	LFB	
0	1--9-79	ISSUED FOR USE	K-MCA	WPH	LFB				K-MCA	WPH	LFB	
A	5-26-78	ISSUED FOR INFORMATION ONLY	K-MCA	WPH	LFB				K-MCA	WPH	LFB	

2	1/3/80	GENERAL UPDATE REDRAW	WPH	WPH	WPH				K-MCA	WPH	LFB	3-21-78
<p>ENGINEER D PORTER DRAWN K-MCA/ANDREW DATE 3-21-78</p>												

<p>INSERVICE INSPECTION BOUNDARY DIAGRAM REACTOR RECIRCULATION (RRC)</p>	
DWG NO 151-230-3	REV 2



WNP-2 ISI BOUNDARY DIAGRAM

EXCEPTIONS AND EXEMPTIONSISI - 230SYSTEM Reactor Recirculation SystemEXCEPTIONS:Class 1 Piping and Components

- See general exceptions.
- No additional exceptions.

Class 2 Piping and Components

- No applicable; entire system is Class 1, Class 3 or non-nuclear

EXEMPTIONS APPLIED:

IWB-1220(a)(1) Yes, per code class boundaries.

(2) No

(3) No

(4) No

*(b)(1) 1½ SLC(2)-45, standby liquid control injection

(2) No

(3) Yes, all piping ≤ 1 " NPS.

IWC-1220(a) No

*(b) No

(c) No

(d) No

IWC-5220(d) No

IWD-5200(c) No

* See general exemption discussion for details.



8.0--WELD IDENTIFICATION DIAGRAMS

This section of the WNP-2 PSI Program Plan contains Weld and Component Identification Diagrams for each system subject to preservice inspection. The Weld and Component Identification Diagrams identify each weld and component subject to inspection by illustrating the system in piping isometric format. For piping systems, or portions thereof, which require volumetric and/or surface examination, each weld and component is assigned an ISI identification number unique to that item, and which will be used exclusively for identification of welds and components on data sheets, reports, etc. For systems requiring only a visual examination for evidence of leakage, no ISI numbers are assigned.

Also shown on each Weld and Component Identification Diagram are such items as platforms, floors, walls, ladders, elevations and azimuths, compartment names, details, penetrations, and various notes, all of which are intended to aid the examination crew in locating and gaining access to the items to be examined, and to note potential access restrictions.

Following each set of Weld and Component Identification Diagrams applicable to a piping system which is subject to volumetric and/or surface examination, is a set of Program Plan and Schedule Tables. Those tables list and describe each weld and component shown on the diagram in order as they appear tracing the line in the direction of flow. They further define the Section XI Category, the examination method and procedures to be used, and the ultrasonic calibration block, if applicable, for each examination item. The Inservice column will not be used for the PSI Program, but will be filled in when planning the first 10-year ISI Program.

The following generic notes apply to each Program Plan and Schedule Table and is referenced from the "Remarks" column in the tables when applicable.

NOTE 1: Pipe whip restraints, abbreviated "PWS", are not designed or fabricated in accordance with ASME Section III, Article NF, and are, therefore, not subject to the rules of ASME Section XI. However, a visual examination is performed and documented on a voluntary basis by and at the discretion of the Supply System.

NOTE 2: This support has a saddle welded to the pressure boundary. The welds on the saddle are there for designer convenience and are not load bearing. Therefore, no surface and/or volumetric exam is required by Section XI.

NOTE 3: Deleted.

NOTE 4: The RHR pumps were designed prior to the requirement to perform Class 2 component examinations for preservice and inservice inspections. The pump casings are embedded in a pump pit which allows no access from the outside surface. The pump impeller was removed for pre-op maintenance. This allowed an MT examination of the inside surface of the pump's casing.

NOTE 5: Verify leakage collection system is operational.

NOTE 6: VT-2 is from later Section XI Codes. It is used in the PSI Program to provide continuity between PSI and ISI programs. All requirements for Section XI 1974 Edition, Summer 1975 Addenda for leakage examinations are being met.

NOTE 7: Satisfied by ASME Section III hydrostatic test.

NOTE 8: This weld is exempted from volumetric or surface examination by IWC-1220(c). The NRC requires that 10% of the welds exempted by IWC-1220(c) be examined by volumetric or surface methods. This weld is one of the 10%.

The following system abbreviations are used throughout this section:

COND	Main Condensate
CRD	Control Rod Drive
DW	Demineralized Water
EDR	Equipment Drains, Radioactive
FDR	Floor Drains, Radioactive
FPC	Fuel Pool Cooling
HPCS	High Pressure Core Spray
LPCI	Low Pressure Coolant Injection
LPCS	Low Pressure Core Spray
MS	Main Steam
MSLC	Main Steam Leakage Control
RCC	Reactor Closed Cooling
RFW	Reactor Feedwater
RHR	Residual Heat Removal
RCIC	Reactor Core Isolation Cooling System
RPV	Reactor Pressure Vessel
RRC	Reactor Recirculation
RWCU	Reactor Water Cleanup
SLC	Standby Liquid Control
SSW	Standby Service Water



WNP-02
 INTERVAL: PSI
 PERIOD: NA
 OUTAGE:
 DRAWING NO. RPV-101

WASHINGTON PUBLIC POWER SUPPLY SYSTEM
 PROGRAM PLAN AND SCHEDULE
 SYSTEM OR COMPONENT: RPV
 DESCRIPTION: SHL CRS & SKRT KNKL

PAGE 001
 DATE 12/14/84

<u>IDENT. NO.</u>	<u>DESCRIPTION</u>	<u>SECT.</u> <u>XI</u> <u>EXAM.</u>	<u>EXAM</u> <u>MTH.</u>	<u>PROCEDURE</u>	<u>CAL.</u> <u>BLOCK</u>	<u>INSERVICE</u>		<u>NOTES</u>
						<u>REQ.</u>	<u>SCHEDULED</u> <u>OUTAGE</u>	
AA	BTM HD-SC#1WD	B-A	VOL	UTP-40	UT-118			CAT. B-B PER S75
AB	#1-#2 SC CRC WD	B-A	VOL	UTP-40	UT-120			
AC	#2-#3 SC CRC WD	B-A	VOL	UTP-40	UT-120			CAT. B-B PER S75
AD	#3-#4 SC CRC WD	B-A	VOL	UTP-40	UT-120			CAT. B-B PER S75
AE	#4 SC-FL CRC WD	B-A	VOL	UTP-25	UT-123			CAT. B-C PER S75
CG	SKIRT KNUCKLE	B-H	VOL	UTP-27	UT-119			
EA	#1 SC VRT W0245	B-A	VOL	UTP-40	UT-119			TOP 14" CAT. B-A; REST IS CAT. B-B PER S75
BB	#1 SC VRT W0135	B-A	VOL	UTP-40	UT-119			TOP 14" CAT. B-A; REST IS CAT. B-B PER S75
BC	#1 SC VRT W0225	B-A	VOL	UTP-40	UT-119			TOP 14" CAT. B-A; REST IS CAT B-B PER S75

WNP-02
 INTERVAL: PSI
 PERIOD: NA
 OUTAGE:
 DRAWING NO. RPV-101

WASHINGTON PUBLIC POWER SUPPLY SYSTEM
 PROGRAM PLAN AND SCHEDULE
 SYSTEM OR COMPONENT: RPV
 DESCRIPTION: SHELL COURSES

PAGE 002
 DATE 12/14/84

IDENT. NO.	DESCRIPTION	SECT.		PROCEDURE	CAL. BLOCK	INSERVICE		NOTES
		XI EXAM.	EXAM. MTH.			REQ.	SCHEDULED OUTAGE	
BD	#1 SC VRT W@315	B-A	VOL	UTP-40	UT-119			TOP 14" CAT. B-A; REST IS CAT. B-B PER S75
PE	#2 SC VRT W@ 10	B-A	VGL	UTP-40	UT-120			CAT. B-B PER S75
BF	#2 SC VRT W@100	B-A	VOL	UTP-40	UT-120			CAT. B-B PER S75
EG	#2 SC VRT W@190	B-A	VOL	UTP-40	UT-120			CAT. B-B PER S75
BH	#2 SC VRT W@280	B-A	VOL	UTP-40	UT-120			CAT. B-B PER S75
BJ	#3 SC VRT W@ 50	B-A	VGL	UTP-40	UT-120			CAT. B-B PER S75
BK	#3 SC VRT W@170	B-A	VOL	UTP-40	UT-120			CAT. B-B PER S75
BM	#3 SC VRT W@290	B-A	VOL	UTP-40	UT-120			CAT. B-B PER S75
BN	#4 SC VRT W@330	B-A	VOL	UTP-40	UT-121			CAT. B-B PER S75
BP	#4 SC VRT W@ 90	B-A	VOL	UTP-40	UT-121			CAT. B-B PER S75
BR	#4 SC VRT W@210	B-A	VOL	UTP-30	UT-121			CAT. B-B PER S75

WNP-02
 INTERVAL: PSI
 PERIOD: NA
 OUTAGE:
 DRAWING NO. RPV-101

WASHINGTON PUBLIC POWER SUPPLY SYSTEM
 PROGRAM PLAN AND SCHEDULE
 SYSTEM OR COMPONENT: RPV
 DESCRIPTION: NOZZLES - SHELL

PAGE 003
 DATE 12/14/84

IDENT. NO.	DESCRIPTION	SECT. XI EXAM.	EXAM MTH.	PROCEDURE	CAL. BLOCK	INSERVICE		NOTES
						REQ.	SCHEDULED OUTAGE	
N1-0	RRC SUC NZ-V @ 0	B-D	VOL	UTP-41	UT-119			
N1-0-IR	RRC NZ-IR @ 0	B-D	VOL	QCI 6-4				INNER RADIUS
N1-180	RRC NZ-V @ 180	B-D	VOL	UTP-41	UT-119			
N1-180-IR	RRC NZ-IR @ 180	B-D	VOL	QCI 6-4				INNER RADIUS
N2-30	RRC NZ-V @ 30	B-D	VOL	UTP-41	UT-119			
N2-30-IR	RRC NZ-IR @ 30	B-D	VOL	QCI 6-4				INNER RADIUS
N2-60	RRC NZ-V @ 60	B-D	VOL	UTP-41	UT-119			
N2-60-IR	RRC NZ-IR @ 60	B-D	VOL	QCI 6-4				INNER RADIUS
N2-90	RRC NZ-V @ 90	B-D	VOL	UTP-41	UT-119			
N2-90-IR	RRC NZ-IR @ 90	B-D	VOL	QCI 6-4				INNER RADIUS
N2-120	RRC NZ-V @ 120	B-D	VOL	UTP-41	UT-119			
N2-120-IR	RRC NZ-IR @ 120	B-D	VOL	QCI 6-4				INNER RADIUS
N2-150	RRC NZ-V @ 150	B-D	VOL	UTP-41	UT-119			
N2-150-IR	RRC NZ-IR @ 150	B-D	VOL	QCI 6-4				INNER RADIUS
N2-210	RRC NZ-V @ 210	B-D	VOL	UTP-41	UT-119			
N2-210-IR	RRC NZ-IR @ 210	B-D	VOL	QCI 6-4				INNER RADIUS
N2-240	RRC NZ-V @ 240	B-D	VOL	UTP-41	UT-119			

WNP-02
 INTERVAL: PSI
 PERIOD: NA
 OUTAGE:
 DRAWING NO. RPV-101

WASHINGTON PUBLIC POWER SUPPLY SYSTEM
 PROGRAM PLAN AND SCHEDULE
 SYSTEM OR COMPONENT: RPV
 DESCRIPTION: NOZZLES - SHELL

PAGE 004
 DATE 12/14/84

IDENT. NO.	DESCRIPTION	SECT. XI EXAM	EXAM MTH.	PROCEDURE	CAL. BLOCK	INSERVICE		NOTES
						REQ.	SCHEDULED OUTAGE	
N2-240-IR	RRC NZ-IR @ 240	B-D	VOL	QCI 6-4				INNER RADIUS
N2-270	RRC NZ-V @ 270	B-D	VOL	UTP-41	UT-119			
N2-270-IR	RRC NZ-IR @ 270	B-D	VOL	QCI 6-4				INNER RADIUS
N2-300	RRC NZ-V @ 300	B-D	VOL	UTP-41	UT-119			
N2-300-IR	RRC NZ-IR @ 300	B-D	VOL	QCI 6-4				INNER RADIUS
N2-330	RRC NZ-V @ 330	B-D	VOL	UTP-41	UT-119			
N2-330-IR	RRC NZ-IR @ 330	B-D	VOL	QCI 6-4				INNER RADIUS
N3-72	MS NZ-V @ 72	B-D	VOL	UTP-41	UT-121			
N3-72-IR	MS NZ-IR @ 72	B-D	VOL	QCI 6-4				INNER RADIUS
N3-108	MS NZ-V @ 108	B-D	VOL	UTP-41	UT-121			
N3-108-IR	MS NZ-IR @ 108	B-D	VOL	QCI 6-4				INNER RADIUS
N3-252	MS NZ-V @ 252	B-D	VOL	UTP-41	UT-121			
N3-252-IR	MS NZ-IR @ 252	B-D	VOL	QCI 6-4				INNER RADIUS
N3-288	MS NZ-V @ 288	B-D	VOL	UTP-41	UT-121			
N3-288-IR	MS NZ-IR @ 288	B-D	VOL	QCI 6-4				INNER RADIUS
N4-30	FW NZ-V @ 30	B-D	VOL	UTP-41	UT-120			
N4-30-IR	FW NZ-IR @ 30	B-D	VOL	UTP-36	UT-120			INNER RADIUS

WNP-02
 INTERVAL: PSI
 PERIOD: NA
 OUTAGE:
 DRAWING NO. RPV-101

WASHINGTON PUBLIC POWER SUPPLY SYSTEM
 PROGRAM PLAN AND SCHEDULE
 SYSTEM OR COMPONENT: RPV
 DESCRIPTION: NOZZLES - SHELL

PAGE 005
 DATE 12/14/84

IDENT. NO.	DESCRIPTION	SECT. XI EXAM.	EXAM MTH.	PROCEDURE	CAL. BLOCK	INSERVICE		NOTES
						REQ.	SCHEDULED OUTAGE	
			SUR	PTP-1				NOZZLE INNER RADIUS
N4-30-NB	FW NZ BORE @ 30	B-D	VOL	QCI 6-4	UT-120			NOZZLE BORE
N4-90	FW NZ-V @ 90	B-D	VOL	UTP-41	UT-120			
N4-90-IR	FW NZ-IR @ 90	B-D	VOL	UTP-36	UT-120			INNER RADIUS
			SUR	PTP-1				NOZZLE INNER RADIUS
N4-90-NB	FW NZ BORE @ 90	B-D	VOL	QCI 6-4	UT-120			NOZZLE BORE
N4-150	FW NZ-V @ 150	B-D	VOL	UTP-41	UT-120			
N4-150-IR	FW NZ-IR @ 150	B-D	VOL	UTP-36	UT-120			INNER RADIUS
			SUR	PTP-1				INNER RADIUS
N4-150-NB	FW NZ BORE @ 150	B-D	VOL	QCI 6-4	UT-120			NOZZLE BORE
N4-210	FW NZ-V @ 210	B-D	VOL	UTP-41	UT-120			
N4-210-IR	FW NZ-IR @ 210	B-D	VOL	UTP-36	UT-120			INNER RADIUS
			SUR	PTP-1				NOZZLE INNER RADIUS
N4-210-NB	FW NZ BORE @ 210	B-D	VOL	QCI 6-4	UT-120			NOZZLE BORE
N4-270	FW NZ-V @ 270	B-D	VOL	UTP-41	UT-120			
N4-270-IR	FW NZ-IR @ 270	B-D	VOL	UTP-36	UT-120			INNER RADIUS
			SUR	PTP-1				INNER RADIUS

WNP-02
 INTERVAL: PSI
 PERIOD: NA
 OUTAGE:
 DRAWING NO. RPV-101

WASHINGTON PUBLIC POWER SUPPLY SYSTEM
 PROGRAM PLAN AND SCHEDULE
 SYSTEM OR COMPONENT: RPV
 DESCRIPTION: NOZZLES - SHELL

PAGE 006
 DATE 12/14/84

IDENT. NO.	DESCRIPTION	SECT. XI EXAM.	EXAM MTH.	PROCEDURE	CAL. BLOCK	INSERVICE		NOTES
						REQ.	SCHEDULED OUTAGE	
N4-270-NB	FW NZ BORE @270	B-D	VOL	QCI 6-4	UT-120			NOZZLE BORE
N4-330	FW NZ-V @ 330	B-D	VOL	UTP-41	UT-120			
N4-330-IR	FW NZ-IR @ 330	B-D	VOL	UTP-36	UT-120			INNER RADIUS
			SUR	PTP-1				INNER RADIUS
N4-330-NB	FW NZ BORE @330	B-D	VOL	QCI 6-4	UT-120			NOZZLE BORE
N5-120	LPCS NZ-V @ 120	B-D	VOL	UTP-41	UT-120			
N5-120-IR	LPCS NZ-IR @120	B-D	VOL	QCI 6-4				INNER RADIUS
N6-45	LPCS NZ-V @ 45	B-D	VOL	UTP-41	UT-120			
N6-45-IR	LPCS NZ-IR @ 45	B-D	VOL	QCI 6-4				INNER RADIUS
N6-135	LPCS NZ-V @ 135	B-D	VOL	UTP-41	UT-120			
N6-135-IR	LPCS NZ-IR @135	B-D	VOL	QCI 6-4				INNER RADIUS
N6-315	LPCS NZ-V @ 315	B-D	VOL	UTP-41	UT-120			
N6-315-IR	LPCS NZ-IR @315	B-D	VOL	QCI 6-4				INNER RADIUS
N9-105	JP IN-NZ-V @105	B-D	VOL	UTP-30	UT-119			
N9-105-IR	JP IN-NZ-IR@105	B-D	VOL	QCI 6-4				INNER RADIUS
N9-285	JP IN-NZ-V @285	B-D	VOL	UTP-30	UT-119			
N9-285-IR	JP IN-NZ-IR@285	B-D	VOL	QCI 6-4				INNER RADIUS

WNP-02
 INTERVAL: PSI
 PERIOD: NA
 OUTAGE:
 DRAWING NO. RPV-101

WASHINGTON PUBLIC POWER SUPPLY SYSTEM
 PROGRAM PLAN AND SCHEDULE
 SYSTEM OR COMPONENT: RPV
 DESCRIPTION: NOZZLES - SHFL

PAGE 007
 DATE 12/14/84

IDENT. NO.	DESCRIPTION	SECT. XI EXAM.	EXAM MTH.	PROCEDURE	CAL. BLOCK	INSERVICE		NOTES
						REQ.	SCHEDULED OUTAGE	
4JP(NZ)A-1	N-9 NZ-SE @ 105	B-J	VOL	UTP-10	UT-109			SHOWN ON RPV-115
			SUR	PTP-1				SHOWN ON RPV-115
4JP(NZ)A-2	N9 SE-PN SE@105	B-J	VOL	UTP-10	UT-29			SHOWN ON RPV-115
			SUR	PTP-1				SHOWN ON RPV-115
4JP(NZ)B-1	N9 NZ-SE @ 285	B-J	VOL	UTP-10	UT-109			SHOWN ON RPV-115
			SUR	PTP-1				SHOWN ON RPV-115
4JP(NZ)B-2	N9 SE-PN SE@285	B-J	VOL	UTP-10	UT-29			SHOWN ON RPV-115
			SUR	PTP-1				SHOWN ON RPV-115
N10-180	CRD NZ-V @180	B-D	VOL	UTP-30	UT-120			(CAPPED)
N10-180-IR	CRD NZ-IR@180	B-D	VOL	QCI 6-4				INNER RADIUS
5CRD(NZ)-1	CRD NZ-SE @180	B-J	VOL	UTP-10	UT-110			SHOWN ON RPV-113
			SUR	PTP-1				SHOWN ON RPV-113
3CRD(NZ)-1	CRD SE-CAP @180	B-J	SUR	PTP-1				SHOWN ON RPV-113
N16-240	HPCS N7-V @ 240	B-D	VOL	UTP-41	UT-120			
N16-240-IR	HPCS NZ-IR @240	B-D	VOL	QCI 6-4				INNER RADIUS
N12	VESS INST PENT	B-E	VT-2	QCI 7-1				N12A @20, N12B @160 N12C @200, N12D @340
N13	VESS INST PENT	B-E	VT-2	QCI 7-1				N13A @10, N13B @190

WNP-02
INTERVAL: PSI
PERIOD: NA
OUTAGE:
DRAWING NO. RPV-101

WASHINGTON PUBLIC POWER SUPPLY SYSTEM
PROGRAM PLAN AND SCHEDULE
SYSTEM OR COMPONENT: RPV
DESCRIPTION: NOZZLES - SHELL

PAGE 008
DATE 12/14/84

<u>IDENT. NO.</u>	<u>DESCRIPTION</u>	<u>SECT.</u> XI	<u>EXAM.</u> EXAM	<u>MTH.</u>	<u>PROCEDURE</u>	<u>CAL.</u> BLOCK	<u>INSERVICE</u>		<u>NOTES</u>
							<u>REQ.</u>	<u>SCHEDULED</u> OUTAGE	
N14	VESS INST PENT	B-E	VT-2	OCI 7-1					N14A @340, N14B @220 N14C @160, N14D @20
N17	FLG SEAL LK PEN	B-E	VT-2	OCI 7-1					

WNP-02
 INTERVAL: PSI
 PERIOD: NA
 OUTAGE:
 DRAWING NO. RPV-101

WASHINGTON PUBLIC POWER SUPPLY SYSTEM
 PROGRAM PLAN AND SCHEDULE
 SYSTEM OR COMPONENT: RPV
 DESCRIPTION: MAJOR REPAIR AREAS

PAGE 009
 DATE 12/14/84

IDENT. NO.	DESCRIPTION	SECT. XI EXAM.	EYAM MTH.	PROCEDURE	CAL. BLOCK	INSERVICE		NOTES
						REQ.	SCHEDULED OUTAGE	
MRP-1	REPAIR AREA	B-A	VOL	UTP-40	UT-120			MAJOR REPAIR AREA 15"X30" IN #2 SHELL & APPROX 238 DEGREES ELEVATION 545'
MRP-2	REPAIR AREA	N/A	N/A	N/A				NO EXAM REQ'D. NOT IN BELTLINE REGION; BUT WILL BE EXAM'D DURING N3-108 SHELL WELD EXAM.
MRP-3	REPAIR AREA	N/A	N/A	N/A				NO EXAM REQ'D NOT IN BELTLINE REGION. N2- 150 (RRC) REPAIR ADJACENT TO NZ-SE WELD 3X3/4X11/16 ID
MRP-4	REPAIR AREA	N/A	N/A	N/A				NO EXAM REQ'D NOT IN BELTLINE REGION; BUT WILL BE EXAM'D DURING N2-120 NZ TO SHELL WELD EXAM.

WNP-02
 INTERVAL: PSI
 PERIOD: NA
 OUTAGE:
 DRAWING NO. RPV-101

WASHINGTON PUBLIC POWER SUPPLY SYSTEM
 PROGRAM PLAN AND SCHEDULE
 SYSTEM OR COMPONENT: RPV
 DESCRIPTION: RPV STUDS, NUTS, ETC

PAGE 010
 DATE 12/14/84

<u>IDENT. NO.</u>	<u>DESCRIPTION</u>	SECT. XI	EXAM EXAM.	PROCEDURE	CAL. BLOCK	<u>INSERVICE</u>		<u>NOTES</u>
						REQ.	<u>SCHEDULED</u> OUTAGE	
RPV STUD 35-1-1A	RPV STUD	B-6-1	VOL	UTP-32	UT-130			STUD HOLE #1 IS THE 1ST CW FROM 0 DEG AZ NUMBERS CONTINUE CONSECUTIVELY IN CW DIRECTION.
			SUR	PTP-1				STUD HOLE #1 IS THE 1ST CW FROM 0 DEG AZ NUMBERS CONTINUE CONSECUTIVELY IN CW DIRECTION.
RPV STUD 35-1-2A	RPV STUD	B-6-1	VOL	UTP-32	UT-130			STUD HOLE #1 IS THE 1ST CW FROM 0 DEG AZ NUMBERS CONTINUE CONSECUTIVELY IN CW DIRECTION.
			SUR	PTP-1				STUD HOLE #1 IS THE 1ST CW FROM 0 DEG AZ NUMBERS CONTINUE CONSECUTIVELY IN CW DIRECTION.
RPV STUD 35-1-3A	RPV STUD	B-6-1	VOL	UTP-32	UT-130			STUD HOLE #1 IS THE 1ST CW FROM 0 DEG AZ NUMBERS CONTINUE CONSECUTIVELY IN CW DIRECTION.

WNP-02
 INTERVAL: PSI
 PERIOD: NA
 OUTAGE:
 DRAWING NO. RPV-101

WASHINGTON PUBLIC POWER SUPPLY SYSTEM
 PROGRAM PLAN AND SCHEDULE
 SYSTEM OR COMPONENT: RPV
 DESCRIPTION: RPV STUDS, NUTS, ETC

PAGE 011
 DATE 12/14/84

<u>IDENT. NO.</u>	<u>DESCRIPTION</u>	<u>SECT.</u> <u>XI</u> <u>EXAM.</u>	<u>EXAM</u> <u>MTH.</u>	<u>PROCEDURE</u>	<u>CAL.</u> <u>BLOCK</u>	<u>INSERVICE</u>		<u>NOTES</u>
						<u>REQ.</u>	<u>SCHEDULED</u> <u>OUTAGE</u>	
			SUR	PTP-1				STUD HOLE #1 IS THE 1ST CW FROM 0 DEG AZ NUMBERS CONTINUE CONSECUTIVELY IN CW DIRECTION.
RPV STUD 35-1-4A	RPV STUD	B-G-1	VOL	UTP-32	UT-130			STUD HOLE #1 IS THE 1ST CW FROM 0 DEG AZ NUMBERS CONTINUE CONSECUTIVELY IN CW DIRECTION.
			SUR	PTP-1				STUD HOLE #1 IS THE 1ST CW FROM 0 DEG AZ NUMBERS CONTINUE CONSECUTIVELY IN CW DIRECTION.
RPV STUD 35-1-5A	RPV STUD	B-G-1	VOL	UTP-32	UT-130			STUD HOLE #1 IS THE 1ST CW FROM 0 DEG AZ NUMBERS CONTINUE CONSECUTIVELY IN CW DIRECTION.
			SUR	PTP-1				STUD HOLE #1 IS THE 1ST CW FROM 0 DEG AZ NUMBERS CONTINUE CONSECUTIVELY IN CW DIRECTION.

WNP-02
 INTERVAL: PSI
 PERIOD: NA
 OUTAGE:
 DRAWING NO. RPV-101

WASHINGTON PUBLIC POWER SUPPLY SYSTEM
 PROGRAM PLAN AND SCHEDULE
 SYSTEM OR COMPONENT: RPV
 DESCRIPTION: RPV STUDS, NUTS, ETC

PAGE 012
 DATE 12/14/84

<u>IDENT. NO.</u>	<u>DESCRIPTION</u>	<u>SECT.</u> <u>XI</u>	<u>EXAM</u> <u>EXAM.</u>	<u>PROCEDURE</u>	<u>CAL.</u> <u>BLOCK</u>	<u>INSERVICE</u> <u>SCHEDULED</u>		<u>NOTES</u>
						<u>REQ.</u>	<u>OUTAGE</u>	
RPV STUD 35-1-6A	RPV STUD	B-G-1	VOL	UTP-32	UT-130			STUD HOLE #1 IS THE 1ST CW FROM 0 DEG AZ NUMBERS CONTINUE CONSECUTIVELY IN CW DIRECTION.
			SUR	PTP-1				STUD HOLE #1 IS THE 1ST CW FROM 0 DEG AZ NUMBERS CONTINUE CONSECUTIVELY IN CW DIRECTION.
RPV STUD 35-1-7A	RPV STUD	B-G-1	VOL	UTP-32	UT-130			STUD HOLE #1 IS THE 1ST CW FROM 0 DEG AZ NUMBERS CONTINUE CONSECUTIVELY IN CW DIRECTION.
			SUR	PTP-1				STUD HOLE #1 IS THE 1ST CW FROM 0 DEG AZ NUMBERS CONTINUE CONSECUTIVELY IN CW DIRECTION.
RPV STUD 35-1-8A	RPV STUD	B-G-1	VOL	UTP-32	UT-130			STUD HOLE #1 IS THE 1ST CW FROM 0 DEG AZ NUMBERS CONTINUE CONSECUTIVELY IN CW DIRECTION.

WNP-02
 INTERVAL: PSI
 PERIOD: NA
 OUTAGE:
 DRAWING NO. RPV-101

WASHINGTON PUBLIC POWER SUPPLY SYSTEM
 PROGRAM PLAN AND SCHEDULE
 SYSTEM OR COMPONENT: RPV
 DESCRIPTION: RPV STUDS, NUTS, ETC

PAGE 013
 DATE 12/14/84

<u>IDENT. NO.</u>	<u>DESCRIPTION</u>	SECT. XI <u>EXAM.</u>	EXAM <u>MTH.</u>	<u>PROCEDURE</u>	CAL. <u>BLOCK</u>	<u>INSERVICE</u>		<u>NOTES</u>
						<u>REQ.</u>	<u>SCHEDULED</u> <u>OUTAGE</u>	
			SUR	PTP-1				STUD HOLE #1 IS THE 1ST CW FROM 0 DEG AZ NUMBERS CONTINUE CONSECUTIVELY IN CW DIRECTION.
RPV STUD 35-1-9A	RPV STUD	B-G-1	VOL	UTP-32	UT-130			STUD HOLE #1 IS THE 1ST CW FROM 0 DEG AZ NUMBERS CONTINUE CONSECUTIVELY IN CW DIRECTION.
			SUR	PTP-1				STUD HOLE #1 IS THE 1ST CW FROM 0 DEG AZ NUMBERS CONTINUE CONSECUTIVELY IN CW DIRECTION.
RPV STUD 35-1-10A	RPV STUD	B-G-1	VOL	UTP-32	UT-130			STUD HOLE #1 IS THE 1ST CW FROM 0 DEG AZ NUMBERS CONTINUE CONSECUTIVELY IN CW DIRECTION.
			SUR	PTP-1				STUD HOLE #1 IS THE 1ST CW FROM 0 DEG AZ NUMBERS CONTINUE CONSECUTIVELY IN CW DIRECTION.

WNP-02
 INTERVAL: PSI
 PERIOD: NA
 OUTAGE:
 DRAWING NO. RPV-101

WASHINGTON PUBLIC POWER SUPPLY SYSTEM
 PROGRAM PLAN AND SCHEDULE
 SYSTEM OR COMPONENT: RPV
 DESCRIPTION: RPV STUDS, NUIS, ETC

PAGE 014
 DATE 12/14/84

<u>IDENT. NO.</u>	<u>DESCRIPTION</u>	<u>SECT.</u>		<u>EXAM</u>	<u>PROCEDURE</u>	<u>CAL.</u>	<u>INSERVICE</u>		<u>NOTES</u>
		<u>XI</u>	<u>EXAM</u>				<u>REQ.</u>	<u>SCHEDULED</u>	
<u>EXAM.</u>	<u>MTH.</u>	<u>BLOCK</u>	<u>REQ.</u>	<u>OUTAGE</u>					
RPV STUD 35-1-11A	RPV STUD	B-G-1	VOL	UTP-32	UT-130				STUD HOLE #1 IS THE 1ST CW FROM 0 DEG AZ NUMBERS CONTINUE CONSECUTIVELY IN CW DIRECTION.
			SUR	PTP-1					STUD HOLE #1 IS THE 1ST CW FROM 0 DEG AZ NUMBERS CONTINUE CONSECUTIVELY IN CW DIRECTION.
RPV STUD 35-1-12A	RPV STUD	B-G-1	VOL	UTP-32	UT-130				STUD HOLE #1 IS THE 1ST CW FROM 0 DEG AZ NUMBERS CONTINUE CONSECUTIVELY IN CW DIRECTION.
			SUR	PTP-1					STUD HOLE #1 IS THE 1ST CW FROM 0 DEG AZ NUMBERS CONTINUE CONSECUTIVELY IN CW DIRECTION.
RPV STUD 35-1-13A	RPV STUD	B-G-1	VOL	UTP-32	UT-130				STUD HOLE #1 IS THE 1ST CW FROM 0 DEG AZ NUMBERS CONTINUE CONSECUTIVELY IN CW DIPECTION.

WNP-02
 INTERVAL: PSI
 PERIOD: NA
 OUTAGE:
 DRAWING NO. RPV-101

WASHINGTON PUBLIC POWER SUPPLY SYSTEM
 PROGRAM PLAN AND SCHEDULE
 SYSTEM OR COMPONENT: RPV
 DESCRIPTION: RPV STUDS, NUTS, ETC

PAGE 015
 DATE 12/14/84

<u>IDENT. NO.</u>	<u>DESCRIPTION</u>	SECT. XI <u>EXAM.</u>	EXAM <u>MTH.</u>	<u>PROCEDURE</u>	CAL. <u>BLOCK</u>	<u>INSERVICE</u> SCHEDULED		<u>NOTES</u>
						<u>REQ.</u>	<u>OUTAGE</u>	
			SUR	PTP-1				STUD HOLE #1 IS THE 1ST CW FROM 0 DEG AZ NUMBERS CONTINUE CONSECUTIVELY IN CW DIRECTION.
RPV STUD 35-1-14A	RPV STUD	B-G-1	VOL	UTP-32	UT-130			STUD HOLE #1 IS THE 1ST CW FROM 0 DEG AZ NUMBERS CONTINUE CONSECUTIVELY IN CW DIRECTION.
			SUR	PTP-1				STUD HOLE #1 IS THE 1ST CW FROM 0 DEG AZ NUMBERS CONTINUE CONSECUTIVELY IN CW DIRECTION.
RPV STUD 35-1-15A	RPV STUD	B-G-1	VOL	UTP-32	UT-130			STUD HOLE #1 IS THE 1ST CW FROM 0 DEG AZ NUMBERS CONTINUE CONSECUTIVELY IN CW DIRECTION.
			SUR	PTP-1				STUD HOLE #1 IS THE 1ST CW FROM 0 DEG AZ NUMBERS CONTINUE CONSECUTIVELY IN CW DIRECTION.

WNP-02
 INTERVAL: PSI
 PERIOD: NA
 OUTAGE:
 DRAWING NO. RPV-101

WASHINGTON PUBLIC POWER SUPPLY SYSTEM
 PROGRAM PLAN AND SCHEDULE
 SYSTEM OR COMPONENT: RPV
 DESCRIPTION: RPV STUDS, NUTS, ETC

PAGE 016
 DATE 12/14/84

<u>IDENT. NO.</u>	<u>DESCRIPTION</u>	<u>SECT.</u>		<u>PROCEDURE</u>	<u>CAL. BLOCK</u>	<u>INSERVICE SCHEDULED</u>		<u>NOTES</u>
		<u>XI EXAM</u>	<u>EXAM</u>			<u>REQ.</u>	<u>OUTAGE</u>	
RPV STUD 35-1-16A	RPV STUD	B-G-1	VOL	UTP-32	UT-130			STUD HOLE #1 IS THE 1ST CW FROM 0 DEG AZ NUMBERS CONTINUE CONSECUTIVELY IN CW DIRECTION.
			SUR	PTP-1				STUD HOLE #1 IS THE 1ST CW FROM 0 DEG AZ NUMBERS CONTINUE CONSECUTIVELY IN CW DIRECTION.
RPV STUD 35-1-17A	RPV STUD	B-G-1	VOL	UTP-32	UT-130			STUD HOLE #1 IS THE 1ST CW FROM 0 DEG AZ NUMBERS CONTINUE CONSECUTIVELY IN CW DIRECTION.
			SUR	PTP-1				STUD HOLE #1 IS THE 1ST CW FROM 0 DEG AZ NUMBERS CONTINUE CONSECUTIVELY IN CW DIRECTION.
RPV STUD 35-1-18A	RPV STUD	B-G-1	VOL	UTP-32	UT-130			STUD HOLE #1 IS THE 1ST CW FROM 0 DEG AZ NUMBERS CONTINUE CONSECUTIVELY IN CW DIRECTION.

WNP-02
 INTERVAL: PSI
 PERIOD: NA
 OUTAGE:
 DRAWING NO. RPV-101

WASHINGTON PUBLIC POWER SUPPLY SYSTEM
 PROGRAM PLAN AND SCHEDULE
 SYSTEM OR COMPONENT: RPV
 DESCRIPTION: RPV STUDS, NUTS, ETC

PAGE 017
 DATE 12/14/84

<u>IDENT. NO.</u>	<u>DESCRIPTION</u>	<u>SECT.</u> <u>XI</u> <u>EXAM.</u>	<u>EXAM</u> <u>MTH.</u>	<u>PROCEDURE</u>	<u>CAL.</u> <u>BLOCK</u>	<u>INSERVICE</u>		<u>NOTES</u>
						<u>REQ.</u>	<u>SCHEDULED</u> <u>OUTAGE</u>	
			SUR	PTP-1				STUD HOLE #1 IS THE 1ST CW FROM 0 DEG AZ NUMBERS CONTINUE CONSECUTIVELY IN CW DIRECTION.
RPV STUD 35-1-19A	RPV STUD	B-G-1	VOL	UTP-32	UT-130			STUD.HOLE #1 IS THE 1ST CW FROM 0 DEG AZ NUMBERS CONTINUE CONSECUTIVELY IN CW DIRECTION.
			SUR	PTP-1				STUD:HOLE #1 IS THE 1ST CW FROM 0 DEG AZ NUMBERS CONTINUE CONSECUTIVELY IN CW DIRECTION.
RPV STUD 35-1-20A	RPV STUD	B-G-1	VOL	UTP-32	UT-130			STUD HOLE #1 IS THE 1ST CW FROM 0 DEG AZ NUMBERS CONTINUE CONSECUTIVELY IN CW DIRECTION.
			SUR	PTP-1				STUD.HOLE #1 IS THE 1ST CW FROM 0 DEG AZ NUMBERS CONTINUE CONSECUTIVELY IN CW DIRECTION.

WNP-02
 INTERVAL: PSI
 PERIOD: NA
 OUTAGE:
 DRAWING NO. RPV-101

WASHINGTON PUBLIC POWER SUPPLY SYSTEM
 PROGRAM PLAN AND SCHEDULE
 SYSTEM OR COMPONENT: RPV
 DESCRIPTION: RPV STUDS, NUTS, ETC

PAGE 018
 DATE 12/14/84

<u>IDENT. NO.</u>	<u>DESCRIPTION</u>	<u>SECT.</u>		<u>EXAM</u>	<u>PROCEDURE</u>	<u>CAL.</u>	<u>INSERVICE</u>		<u>NOTES</u>
		<u>XI</u>	<u>EXAM</u>				<u>REQ.</u>	<u>SCHEDULED</u>	
		<u>EYAM.</u>	<u>MTM.</u>			<u>BLOCK</u>		<u>OUTAGE</u>	
RPV STUD 35-1-21A	RPV STUD	B-G-1	VOL	UTP-32		UT-130			STUD HOLE #1 IS THE 1ST CW FROM 0 DEG AZ NUMBERS CONTINUE CONSECUTIVELY IN CW DIRECTION.
			SUR	PTP-1					STUD HOLE #1 IS THE 1ST CW FROM 0 DEG AZ NUMBERS CONTINUE CONSECUTIVELY IN CW DIRECTION.
RPV STUD 35-1-22A	RPV STUD	B-G-1	VOL	UTP-32		UT-130			STUD HOLE #1 IS THE 1ST CW FROM 0 DEG AZ NUMBERS CONTINUE CONSECUTIVELY IN CW DIRECTION.
			SUR	PTP-1					STUD HOLE #1 IS THE 1ST CW FROM 0 DEG AZ NUMBERS CONTINUE CONSECUTIVELY IN CW DIRECTION.
RPV STUD 35-1-23A	RPV STUD	B-G-1	VOL	UTP-32		UT-130			STUD HOLE #1 IS THE 1ST CW FROM 0 DEG AZ NUMBERS CONTINUE CONSECUTIVELY IN CW DIRECTION.

WNP-02
 INTERVAL: PSI
 PERIOD: NA
 OUTAGE:
 DRAWING NO. RPV-101

WASHINGTON PUBLIC POWER SUPPLY SYSTEM
 PROGRAM PLAN AND SCHEDULE
 SYSTEM OR COMPONENT: RPV
 DESCRIPTION: RPV STUDS, NUTS, ETC

PAGE 019
 DATE 12/14/84

<u>IDENT. NO.</u>	<u>DESCRIPTION</u>	SECT. XI <u>EXAM.</u>	EXAM <u>MTH.</u>	<u>PROCEDURE</u>	CAL. <u>BLOCK</u>	<u>INSERVICE</u> SCHEDULED		<u>NOTES</u>
						<u>REQ.</u>	<u>OUTAGE</u>	
			SUR	PTP-1				STUD HOLE #1 IS THE 1ST CW FROM 0 DEG AZ NUMBERS CONTINUE CONSECUTIVELY IN CW DIRECTION.
RPV STUD 35-1-24A	RPV STUD	B-G-1	VOL	UTP-32	UT-130			STUD HOLE #1 IS THE 1ST CW FROM 0 DEG AZ NUMBERS CONTINUE CONSECUTIVELY IN CW DIRECTION.
			SUR	PTP-1				STUD HOLE #1 IS THE 1ST CW FROM 0 DEG AZ NUMBERS CONTINUE CONSECUTIVELY IN CW DIRECTION.
RPV STUD 35-1-25A	RPV STUD	B-G-1	VOL	UTP-32	UT-130			STUD HOLE #1 IS THE 1ST CW FROM 0 DEG AZ NUMBERS CONTINUE CONSECUTIVELY IN CW DIRECTION.
			SUR	PTP-1				STUD HOLE #1 IS THE 1ST CW FROM 0 DEG AZ NUMBERS CONTINUE CONSECUTIVELY IN CW DIRECTION.

WNP-02
 INTERVAL: PSI
 PERIOD: NA
 OUTAGE:
 DRAWING NO. RPV-101

WASHINGTON PUBLIC POWER SUPPLY SYSTEM
 PROGRAM PLAN AND SCHEDULE
 SYSTEM OR COMPONENT: RPV
 DESCRIPTION: RPV STUDS, NUTS, ETC

PAGE 020
 DATE 12/14/84

<u>IDENT. NO.</u>	<u>DESCRIPTION</u>	<u>SECT.</u>		<u>PROCEDURE</u>	<u>CAL. BLOCK</u>	<u>INSERVICE SCHEDULED</u>		<u>NOTES</u>
		<u>XI EXAM</u>	<u>EXAM</u>			<u>REQ.</u>	<u>OUTAGE</u>	
RPV STUD 35-1-26A	RPV STUD	B-G-1	VOL	UTP-32	UT-130			STUD HOLE #1 IS THE 1ST CW FROM 0 DEG AZ NUMBERS CONTINUE CONSECUTIVELY IN CW DIRECTION.
			SUR	PTP-1				STUD HOLE #1 IS THE 1ST CW FROM 0 DEG AZ NUMBERS CONTINUE CONSECUTIVELY IN CW DIRECTION.
RPV STUD 35-1-27A	RPV STUD	B-G-1	VOL	UTP-32	UT-130			STUD HOLE #1 IS THE 1ST CW FROM 0 DEG AZ NUMBERS CONTINUE CONSECUTIVELY IN CW DIRECTION.
			SUR	PTP-1				STUD HOLE #1 IS THE 1ST CW FROM 0 DEG AZ NUMBERS CONTINUE CONSECUTIVELY IN CW DIRECTION.
RPV STUD 35-1-29A	RPV STUD	B-G-1	VOL	UTP-32	UT-130			STUD HOLE #1 IS THE 1ST CW FROM 0 DEG AZ NUMBERS CONTINUE CONSECUTIVELY IN CW DIRECTION.

WNP-02
 INTERVAL: PSI
 PERIOD: NA
 OUTAGE:
 DRAWING NO. RPV-101

WASHINGTON PUBLIC POWER SUPPLY SYSTEM
 PROGRAM PLAN AND SCHEDULE
 SYSTEM OR COMPONENT: RPV
 DESCRIPTION: RPV STUDS, NUTS, ETC

PAGE 021
 DATE 12/14/84

<u>IDENT. NO.</u>	<u>DESCRIPTION</u>	<u>SECT.</u> <u>YI</u> <u>EXAM.</u>	<u>EXAM</u> <u>MTH.</u>	<u>PROCEDURE</u>	<u>CAL.</u> <u>BLOCK</u>	<u>INSERVICE</u> <u>SCHEDULED</u>		<u>NOTES</u>
						<u>REQ.</u>	<u>OUTAGE</u>	
			SUR	PTP-1				STUD HOLE #1 IS THE 1ST CW FROM 0 DEG AZ NUMBERS CONTINUE CONSECUTIVELY IN CW DIRECTION.
RPV STUD 35-1-29A	RPV STUD	B-G-1	VOL	UTP-32	UT-130			STUD HOLE #1 IS THE 1ST CW FROM 0 DEG AZ NUMBERS CONTINUE CONSECUTIVELY IN CW DIRECTION.
			SUR	PTP-1				STUD HOLE #1 IS THE 1ST CW FROM 0 DEG AZ NUMBERS CONTINUE CONSECUTIVELY IN CW DIRECTION.
RPV STUD 35-1-30A	RPV STUD	P-G-1	VOL	UTP-32	UT-130			STUD HOLE #1 IS THE 1ST CW FROM 0 DEG AZ NUMBERS CONTINUE CONSECUTIVELY IN CW DIRECTION.
			SUR	PTP-1				STUD HOLE #1 IS THE 1ST CW FROM 0 DEG AZ NUMBERS CONTINUE CONSECUTIVELY IN CW DIRECTION.

WNP-02
 INTERVAL: PSI
 PERIOD: NA
 OUTAGE:
 DRAWING NO. RPV-101

WASHINGTON PUBLIC POWER SUPPLY SYSTEM
 PROGRAM PLAN AND SCHEDULE
 SYSTEM OR COMPONENT: RPV
 DESCRIPTION: RPV STUDS, NUTS, ETC

PAGE 022
 DATE 12/14/84

<u>IDENT. NO.</u>	<u>DESCRIPTION</u>	SECT. XI	EXAM. EXAM.	MTH. MTH.	PROCEDURE	CAL. BLOCK	<u>INSERVICE</u>		<u>NOTES</u>
							REQ.	OUTAGE	
RPV STUD 35-1-31A	RPV STUD	B-G-1	VOL	UTP-32		UT-130			STUD HOLE #1 IS THE 1ST CW FROM 0 DEG AZ NUMBERS CONTINUE CONSECUTIVELY IN CW DIRECTION.
				SUR	PTP-1				STUD HOLE #1 IS THE 1ST CW FROM 0 DEG AZ NUMBERS CONTINUE CONSECUTIVELY IN CW DIRECTION.
RPV STUD 35-1-32A	RPV STUD	B-G-1	VOL	UTP-32		UT-130			STUD HOLE #1 IS THE 1ST CW FROM 0 DEG AZ NUMBERS CONTINUE CONSECUTIVELY IN CW DIRECTION.
				SUR	PTP-1				STUD HOLE #1 IS THE 1ST CW FROM 0 DEG AZ NUMBERS CONTINUE CONSECUTIVELY IN CW DIRECTION.
RPV STUD 35-1-33A	RPV STUD	B-G-1	VOL	UTP-32		UT-130			STUD HOLE #1 IS THE 1ST CW FROM 0 DEG AZ NUMBERS CONTINUE CONSECUTIVELY IN CW DIRECTION.

WNP-02
 INTERVAL: PSI
 PERIOD: NA
 OUTAGE:
 DRAWING NO. RPV-101

WASHINGTON PUBLIC POWER SUPPLY SYSTEM
 PROGRAM PLAN AND SCHEDULE
 SYSTEM OR COMPONENT: RPV
 DESCRIPTION: RPV STUDS, NUTS, ETC

PAGE 023
 DATE 12/14/84

<u>IDENT. NO.</u>	<u>DESCRIPTION</u>	SECT. XI <u>EXAM.</u>	EXAM <u>MTN.</u>	<u>PROCEDURE</u>	CAL. <u>BLOCK</u>	<u>INSERVICE</u>		<u>NOTES</u>
						<u>REQ.</u>	<u>SCHEDULED</u> <u>OUTAGE</u>	
			SUR	PTP-1				STUD HOLE #1 IS THE 1ST CW FROM 0 DEG AZ NUMBERS CONTINUE CONSECUTIVELY IN CW DIRECTION.
RPV STUD 35-1-34A	RPV STUD	B-G-1	VOL	UTP-32	UT-130			STUD HOLE #1 IS THE 1ST CW FROM 0 DEG AZ NUMBERS CONTINUE CONSECUTIVELY IN CW DIRECTION.
			SUR	PTP-1				STUD HOLE #1 IS THE 1ST CW FROM 0 DEG AZ NUMBERS CONTINUE CONSECUTIVELY IN CW DIRECTION.
RPV STUD 35-1-35A	RPV STUD	B-G-1	VOL	UTP-32	UT-130			BUSHING INSTALLED
			SUR	PTP-1				STUD HOLE #1 IS THE 1ST CW FROM 0 DEG AZ NUMBERS CONTINUE CONSECUTIVELY IN CW DIRECTION.
RPV STUD 35-1-36A	RPV STUD	B-G-1	VOL	UTP-32	UT-130			STUD HOLE #1 IS THE 1ST CW FROM 0 DEG AZ NUMBERS CONTINUE CONSECUTIVELY IN CW DIRECTION.

WNP-02
 INTERVAL: PSI
 PERIOD: NA
 OUTAGE:
 DRAWING NO. RPV-101

WASHINGTON PUBLIC POWER SUPPLY SYSTEM
 PROGRAM PLAN AND SCHEDULE
 SYSTEM OR COMPONENT: RPV
 DESCRIPTION: RPV STUDS, NUTS, ETC

PAGE 024
 DATE 12/14/84

<u>IDENT. NO.</u>	<u>DESCRIPTION</u>	<u>SECT.</u> <u>XI</u>	<u>EXAM</u> <u>EXAM.</u>	<u>PROCEDURE</u> <u>PTH.</u>	<u>CAL.</u> <u>BLOCK</u>	<u>INSERVICE</u>		<u>NOTES</u>
						<u>REQ.</u>	<u>SCHEDULED</u> <u>OUTAGE</u>	
				SUR	PTP-1			STUD HOLE #1 IS THE 1ST CW FROM 0 DEG AZ NUMBERS CONTINUE CONSECUTIVELY IN CW DIRECTION.
RPV STUD 35-1-37A	RPV STUD	B-G-1	VOL	UTP-32	UT-130			STUD HOLE #1 IS THE 1ST CW FROM 0 DEG AZ NUMBERS CONTINUE CONSECUTIVELY IN CW DIRECTION.
			0					
				SUR	PTP-1			STUD HOLE #1 IS THE 1ST CW FROM 0 DEG AZ NUMBERS CONTINUE CONSECUTIVELY IN CW DIRECTION.
RPV STUD 35-1-38A	RPV STUD	B-G-1	VOL	UTP-32	UT-130			STUD HOLE #1 IS THE 1ST CW FROM 0 DEG AZ NUMBERS CONTINUE CONSECUTIVELY IN CW DIRECTION.
				SUR	PTP-1			STUD HOLE #1 IS THE 1ST CW FROM 0 DEG AZ NUMBERS CONTINUE CONSECUTIVELY IN CW DIRECTION.

WNP-02
 INTERVAL: PSI
 PERIOD: NA
 OUTAGE:
 DRAWING NO. RPV-101

WASHINGTON PUBLIC POWER SUPPLY SYSTEM
 PROGRAM PLAN AND SCHEDULE
 SYSTEM OR COMPONENT: RPV
 DESCRIPTION: RPV STUDS, NUTS, ETC

PAGE 025
 DATE 12/14/84

<u>IDENT. NO.</u>	<u>DESCRIPTION</u>	SECT. <u>.XI</u>	EXAM <u>EXAM.</u>	EXAM <u>MTM.</u>	PROCEDURE	CAL. <u>BLOCK</u>	<u>INSERVICE</u>		<u>NOTES</u>
							<u>REQ.</u>	<u>SCHEDULED</u> <u>OUTAGE</u>	
RPV STUD 35-1-39A	RPV STUD	B-G-1	VOL	UTP-32		UT-130			STUD HOLE #1 IS THE 1ST CW FROM 0 DEG AZ NUMBERS CONTINUE CONSECUTIVELY IN CW DIRECTION.
				SUR	PTP-1				STUD HOLE #1 IS THE 1ST CW FROM 0 DEG AZ NUMBERS CONTINUE CONSECUTIVELY IN CW DIRECTION.
RPV STUD 35-1-40A	RPV STUD	B-G-1	VOL	UTP-32		UT-130			STUD HOLE #1 IS THE 1ST CW FROM 0 DEG AZ NUMBERS CONTINUE CONSECUTIVELY IN CW DIRECTION.
				SUR	PTP-1				STUD HOLE #1 IS THE 1ST CW FROM 0 DEG AZ NUMBERS CONTINUE CONSECUTIVELY IN CW DIRECTION.
RPV STUD 35-1-41A	RPV STUD	B-G-1	VOL	UTP-32		UT-130			STUD HOLE #1 IS THE 1ST CW FROM 0 DEG AZ NUMBERS CONTINUE CONSECUTIVELY IN CW DIPECTION.

WNP-02
 INTERVAL: PSI
 PERIOD: NA
 OUTAGE:
 DRAWING NO. RPV-101

WASHINGTON PUBLIC POWER SUPPLY SYSTEM
 PROGRAM PLAN AND SCHEDULE
 SYSTEM OR COMPONENT: RPV
 DESCRIPTION: RPV STUDS, NUTS, ETC

PAGE 026
 DATE 12/14/84

<u>IDENT. NO.</u>	<u>DESCRIPTION</u>	<u>SECT.</u> XI	<u>EXAM</u> EYAM.	<u>PROCEDURE</u> MTH.	<u>CAL.</u> BLOCK	<u>INSERVICE</u>		<u>NOTES</u>
						<u>REQ.</u>	<u>SCHEDULED</u> OUTAGE	
				SUR	PTP-1			STUD HOLE #1 IS THE 1ST CW FROM 0 DEG AZ NUMBERS CONTINUE CONSECUTIVELY IN CW DIRECTION.
RPV STUD 35-1-42A	RPV STUD	B-G-1	VOL	UTP-32	UT-130			STUD HOLE #1 IS THE 1ST CW FROM 0 DEG AZ NUMBERS CONTINUE CONSECUTIVELY IN CW DIRECTION.
				SUR	PTP-1			STUD HOLE #1 IS THE 1ST CW FROM 0 DEG AZ NUMBERS CONTINUE CONSECUTIVELY IN CW DIRECTION.
RPV STUD 35-1-43A	RPV STUD	B-G-1	VOL	UTP-32	UT-130			STUD HOLE #1 IS THE 1ST CW FROM 0 DEG AZ NUMBERS CONTINUE CONSECUTIVELY IN CW DIRECTION.
				SUR	PTP-1			STUD HOLE #1 IS THE 1ST CW FROM 0 DEG AZ NUMBERS CONTINUE CONSECUTIVELY IN CW DIRECTION.

WNP-02
 INTERVAL: PSI
 PERIOD: NA
 OUTAGE:
 DRAWING NO. RPV-101

WASHINGTON PUBLIC POWER SUPPLY SYSTEM
 PROGRAM PLAN AND SCHEDULE
 SYSTEM OR COMPONENT: RPV
 DESCRIPTION: RPV STUDS, NUTS, ETC

PAGE 027
 DATE 12/14/84

<u>IDENT. NO.</u>	<u>DESCRIPTION</u>	SECT. XI <u>EYAM.</u>	EXAM <u>MTH.</u>	<u>PROCEDURE</u>	CAL. <u>BLOCK</u>	<u>INSERVICE</u> SCHEDULED		<u>NOTES</u>
						<u>REQ.</u>	<u>OUTAGE</u>	
RPV STUD 35-1-44A	RPV STUD	B-G-1	VOL	UTP-32	UT-130			STUD HOLE #1 IS THE 1ST CW FROM 0 DEG AZ NUMBERS CONTINUE CONSECUTIVELY IN CW DIRECTION.
			SUR	PTP-1				STUD HOLE #1 IS THE 1ST CW FROM 0 DEG AZ NUMBERS CONTINUE CONSECUTIVELY IN CW DIRECTION.
RPV STUD 35-1-45A	RPV STUD	B-G-1	VOL	UTP-32	UT-130			STUD HOLE #1 IS THE 1ST CW FROM 0 DEG AZ NUMBERS CONTINUE CONSECUTIVELY IN CW DIRECTION.
			SUR	PTP-1				STUD HOLE #1 IS THE 1ST CW FROM 0 DEG AZ NUMBERS CONTINUE CONSECUTIVELY IN CW DIRECTION.
RPV STUD 35-1-46A	RPV STUD	B-G-1	VOL	UTP-32	UT-130			STUD HOLE #1 IS THE 1ST CW FROM 0 DEG AZ NUMBERS CONTINUE CONSECUTIVELY IN CW DIRECTION.

WNP-02
 INTERVAL: PSI
 PERIOD: NA
 OUTAGE:
 DRAWING NO. RPV-101

WASHINGTON PUBLIC POWER SUPPLY SYSTEM
 PROGRAM PLAN AND SCHEDULE
 SYSTEM OR COMPONENT: RPV
 DESCRIPTION: RPV STUDS, NUTS, ETC

PAGE 028
 DATE 12/14/84

<u>IDENT. NO.</u>	<u>DESCRIPTION</u>	SECT. XI <u>EXAM.</u>	EXAM <u>MTM.</u>	<u>PROCEDURE</u>	CAL. <u>BLOCK</u>	<u>INSERVICE</u>		<u>NOTES</u>
						<u>REQ.</u>	<u>OUTAGE</u>	
			SUR	PTP-1				STUD HOLE #1 IS THE 1ST CW FROM 0 DEG AZ NUMBERS CONTINUE CONSECUTIVELY IN CW DIRECTION.
RPV STUD 35-1-47A	RPV STUD	B-G-1	VOL	UTP-32	UT-130			STUD HOLE #1 IS THE 1ST CW FROM 0 DEG AZ NUMBERS CONTINUE CONSECUTIVELY IN CW DIRECTION.
			SUR	PTP-1				STUD HOLE #1 IS THE 1ST CW FROM 0 DEG AZ NUMBERS CONTINUE CONSECUTIVELY IN CW DIRECTION.
RPV STUD 35-1-48A	RPV STUD	B-G-1	VOL	UTP-32	UT-130			STUD HOLE #1 IS THE 1ST CW FROM 0 DEG AZ NUMBERS CONTINUE CONSECUTIVELY IN CW DIRECTION.
			SUR	PTP-1				STUD HOLE #1 IS THE 1ST CW FROM 0 DEG AZ NUMBERS CONTINUE CONSECUTIVELY IN CW DIRECTION.

WNP-02
 INTERVAL: PSI
 PERIOD: NA
 OUTAGE:
 DRAWING NO. RPV-101

WASHINGTON PUBLIC POWER SUPPLY SYSTEM
 PROGRAM PLAN AND SCHEDULE
 SYSTEM OR COMPONENT: RPV
 DESCRIPTION: RPV STUDS, NUTS, ETC

PAGE 029
 DATE 12/14/84

<u>IDENT. NO.</u>	<u>DESCRIPTION</u>	<u>SECT.</u> <u>XI</u> <u>EXAM.</u>	<u>EXAM</u> <u>MTH.</u>	<u>PROCEDURE</u>	<u>CAL.</u> <u>BLOCK</u>	<u>INSERVICE</u> <u>SCHEDULED</u>		<u>NOTES</u>
						<u>REQ.</u>	<u>OUTAGE</u>	
RPV STUD 35-1-49A	RPV STUD	B-G-1	VOL	UTP-32	UT-130			STUD HOLE #1 IS THE 1ST CW FROM 0 DEG AZ NUMBERS CONTINUE CONSECUTIVELY IN CW DIRECTION.
			SUR	PTP-1				STUD HOLE #1 IS THE 1ST CW FROM 0 DEG AZ NUMBERS CONTINUE CONSECUTIVELY IN CW DIRECTION.
RPV STUD 35-1-50A	RPV STUD	B-G-1	VOL	UTP-32	UT-130			STUD HOLE #1 IS THE 1ST CW FROM 0 DEG AZ NUMBERS CONTINUE CONSECUTIVELY IN CW DIRECTION.
			SUR	PTP-1				STUD HOLE #1 IS THE 1ST CW FROM 0 DEG AZ NUMBERS CONTINUE CONSECUTIVELY IN CW DIRECTION.
RPV STUD 35-1-51A	RPV STUD	B-G-1	VOL	UTP-32	UT-130			STUD HOLE #1 IS THE 1ST CW FROM 0 DEG AZ NUMBERS CONTINUE CONSECUTIVELY IN CW DIRECTION.

WNP-02
 INTERVAL: PSI
 PERIOD: NA
 OUTAGE:
 DRAWING NO. RPV-191

WASHINGTON PUBLIC POWER SUPPLY SYSTEM
 PROGRAM PLAN AND SCHEDULE
 SYSTEM OR COMPONENT: RPV
 DESCRIPTION: RPV STUDS, NUTS, ETC

PAGE 030
 DATE 12/14/84

<u>IDENT. NO.</u>	<u>DESCRIPTION</u>	<u>SECT.</u>		<u>PROCEDURE</u>	<u>CAL. BLOCK</u>	<u>INSERVICE</u>		<u>NOTES</u>
		<u>XI EXAM</u>	<u>EXAM</u>			<u>REQ.</u>	<u>SCHEDULED</u>	
		<u>EXAM.</u>	<u>MTM.</u>				<u>OUTAGE</u>	
			SUR	PTP-1				STUD HOLE #1 IS THE 1ST CW FROM 0 DEG AZ NUMBERS CONTINUE CONSECUTIVELY IN CW DIRECTION.
RPV STUD 35-1-52A	RPV STUD	B-G-1	VOL	UTP-32	UT-130			STUD HOLE #1 IS THE 1ST CW FROM 0 DEG AZ NUMBERS CONTINUE CONSECUTIVELY IN CW DIRECTION.
			SUR	PTP-1				STUD HOLE #1 IS THE 1ST CW FROM 0 DEG AZ NUMBERS CONTINUE CONSECUTIVELY IN CW DIRECTION.
RPV STUD 35-1-53A	RPV STUD	B-G-1	VOL	UTP-32	UT-130			STUD HOLE #1 IS THE 1ST CW FROM 0 DEG AZ NUMBERS CONTINUE CONSECUTIVELY IN CW DIRECTION.
			SUR	PTP-1				STUD HOLE #1 IS THE 1ST CW FROM 0 DEG AZ NUMBERS CONTINUE CONSECUTIVELY IN CW DIRECTION.

WNP-02
 INTERVAL: PSI
 PERIOD: NA
 OUTAGE:
 DRAWING NO. RPV-101

WASHINGTON PUBLIC POWER SUPPLY SYSTEM
 PROGRAM PLAN AND SCHEDULE
 SYSTEM OR COMPONENT: RPV
 DESCRIPTION: RPV STUDS. NUTS. ETC

PAGE 031
 DATE 12/14/84

<u>IDENT. NO.</u>	<u>DESCRIPTION</u>	SECT. XI <u>EXAM.</u>	EXAM <u>HTH.</u>	<u>PROCEDURE</u>	CAL. <u>BLOCK</u>	<u>INSERVICE</u>		<u>NOTES</u>
						<u>REQ.</u>	<u>SCHEDULED</u> <u>OUTAGE</u>	
RPV STUD 35-1-54A	RPV STUD	B-G-1	VOL	UTP-32	UT-130			STUD HOLE #1 IS THE 1ST CW FROM 0 DEG AZ. NUMBERS CONTINUE CONSECUTIVELY IN CW DIRECTION.
			SUR	PTP-1				STUD HOLE #1 IS THE 1ST CW FROM 0 DEG AZ. NUMBERS CONTINUE CONSECUTIVELY IN CW DIRECTION.
RPV STUD 35-1-55A	RPV STUD	B-G-1	VOL	UTP-32	UT-130			STUD HOLE #1 IS THE 1ST CW FROM 0 DEG AZ. NUMBERS CONTINUE CONSECUTIVELY IN CW DIRECTION.
			SUR	PTP-1				STUD HOLE #1 IS THE 1ST CW FROM 0 DEG AZ. NUMBERS CONTINUE CONSECUTIVELY IN CW DIRECTION.
RPV STUD 35-1-56A	RPV STUD	B-G-1	VOL	UTP-32	UT-130			STUD HOLE #1 IS THE 1ST CW FROM 0 DEG AZ. NUMBERS CONTINUE CONSECUTIVELY IN CW DIRECTION.

WNP-02
 INTERVAL: PSI
 PERIOD: NA
 OUTAGE:
 DRAWING NO. RPV-101

WASHINGTON PUBLIC POWER SUPPLY SYSTEM
 PROGRAM PLAN AND SCHEDULE
 SYSTEM OR COMPONENT: RPV
 DESCRIPTION: RPV STUDS, NUIS, ETC

PAGE 032
 DATE 12/14/84

<u>IDENT. NO.</u>	<u>DESCRIPTION</u>	<u>SECT.</u>		<u>PROCEDURE</u>	<u>CAL. BLOCK</u>	<u>INSERVICE SCHEDULED</u>		<u>NOTES</u>
		<u>XI EXAM</u>	<u>EXAM</u>			<u>REQ.</u>	<u>OUTAGE</u>	
				SUR PTP-1				STUD HOLE #1 IS THE 1ST CW FROM 0 DEG AZ NUMBERS CONTINUE CONSECUTIVELY IN CW DIRECTION.
RPV STUD 35-1-57A	RPV STUD	B-G-1	VOL	UTP-32	UT-130			STUD HOLE #1 IS THE 1ST CW FROM 0 DEG AZ NUMBERS CONTINUE CONSECUTIVELY IN CW DIRECTION.
				SUR PTP-1				STUD HOLE #1 IS THE 1ST CW FROM 0 DEG AZ NUMBERS CONTINUE CONSECUTIVELY IN CW DIRECTION.
RPV STUD 35-1-58A	RPV STUD	B-G-1	VOL	UTP-32	UT-130			STUD HOLE #1 IS THE 1ST CW FROM 0 DEG AZ NUMBERS CONTINUE CONSECUTIVELY IN CW DIRECTION.
				SUR PTP-1				STUD HOLE #1 IS THE 1ST CW FROM 0 DEG AZ NUMBERS CONTINUE CONSECUTIVELY IN CW DIRECTION.

WNP-02
 INTERVAL: PSI
 PERIOD: NA
 OUTAGE:
 DRAWING NO. RPV-101

WASHINGTON PUBLIC POWER SUPPLY SYSTEM
 PROGRAM PLAN AND SCHEDULE
 SYSTEM OR COMPONENT: RPV
 DESCRIPTION: RPV STUDS, NUTS, ETC

PAGE 033
 DATE 12/14/84

<u>IDENT. NO.</u>	<u>DESCRIPTION</u>	SECT. XI <u>EXAM.</u>	EXAM <u>MTH.</u>	<u>PROCEDURE</u>	CAL. <u>BLOCK</u>	<u>INSERVICE</u> SCHEDULED		<u>NOTES</u>
						<u>REQ.</u>	<u>OUTAGE</u>	
RPV STUD 35-1-59A	RPV STUD	B-G-1	VOL	UTP-32	UT-130			STUD HOLE #1 IS THE 1ST CW FROM 0 DEG AZ NUMBERS CONTINUE CONSECUTIVELY IN CW DIRECTION.
			SUR	PTP-1				STUD HOLE #1 IS THE 1ST CW FROM 0 DEG AZ NUMBERS CONTINUE CONSECUTIVELY IN CW DIRECTION.
RPV STUD 35-1-60A	RPV STUD	B-G-1	VOL	UTP-32	UT-130			STUD HOLE #1 IS THE 1ST CW FROM 0 DEG AZ NUMBERS CONTINUE CONSECUTIVELY IN CW DIRECTION.
			Ø					
			SUR	PTP-1				STUD HOLE #1 IS THE 1ST CW FROM 0 DEG AZ NUMBERS CONTINUE CONSECUTIVELY IN CW DIRECTION.
RPV STUD 35-1-61A	RPV STUD	B-G-1	VOL	UTP-32	UT-130			STUD HOLE #1 IS THE 1ST CW FROM 0 DEG AZ NUMBERS CONTINUE CONSECUTIVELY IN CW DIRECTION.

WNP-02
 INTERVAL: PSI
 PERIOD: NA
 OUTAGE:
 DRAWING NO. RPV-101

WASHINGTON PUBLIC POWER SUPPLY SYSTEM
 PROGRAM PLAN AND SCHEDULE
 SYSTEM OR COMPONENT: RPV
 DESCRIPTION: RPV STUDS, NUTS, ETC

PAGE 034
 DATE 12/14/84

<u>IDENT. NO.</u>	<u>DESCRIPTION</u>	<u>SECT.</u> <u>XI</u> <u>EXAM.</u>	<u>EXAM</u> <u>MTH.</u>	<u>PROCEDURE</u>	<u>CAL.</u> <u>BLOCK</u>	<u>INSERVICE</u> <u>SCHEDULED</u>		<u>NOTES</u>
						<u>REQ.</u>	<u>OUTAGE</u>	
			SUR	PTP-1				STUD HOLE #1 IS THE 1ST CW FROM 0 DEG AZ NUMBERS CONTINUE CONSECUTIVELY IN CW DIRECTION.
RPV STUD 35-1-62A	RPV STUD	B-G-1	VOL	UTP-32	UT-130			STUD HOLE #1 IS THE 1ST CW FROM 0 DEG AZ NUMBERS CONTINUE CONSECUTIVELY IN CW DIRECTION.
			SUR	PTP-1				STUD HOLE #1 IS THE 1ST CW FROM 0 DEG AZ NUMBERS CONTINUE CONSECUTIVELY IN CW DIRECTION.
RPV STUD 35-1-63A	RPV STUD	B-G-1	VOL	UTP-32	UT-130			STUD HOLE #1 IS THE 1ST CW FROM 0 DEG AZ NUMBERS CONTINUE CONSECUTIVELY IN CW DIRECTION.
			SUR	PTP-1				STUD HOLE #1 IS THE 1ST CW FROM 0 DEG AZ NUMBERS CONTINUE CONSECUTIVELY IN CW DIRECTION.

WNP-02
 INTERVAL: PSI
 PERIOD: NA
 OUTAGE:
 DRAWING NO. RPV-101

WASHINGTON PUBLIC POWER SUPPLY SYSTEM
 PROGRAM PLAN AND SCHEDULE
 SYSTEM OR COMPONENT: RPV
 DESCRIPTION: RPV STUDS, NUTS, ETC

PAGE 035
 DATE 12/14/84

<u>IDENT. NO.</u>	<u>DESCRIPTION</u>	SECT. XI <u>EXAM.</u>	EXAM <u>MT'</u>	<u>PROCEDURE</u>	CAL. <u>BLOCK</u>	<u>INSERVICE</u> SCHEDULED		<u>NOTES</u>
						<u>REQ.</u>	<u>OUTAGE</u>	
RPV STUD 35-1-64A	RPV STUD	B-G-1	VOL	UTP-32	UT-130			STUD HOLE #1 IS THE 1ST CW FROM 0 DEG AZ NUMBERS CONTINUE CONSECUTIVELY IN CW DIRECTION.
			SUR	PTP-1				STUD HOLE #1 IS THE 1ST CW FROM 0 DEG AZ NUMBERS CONTINUE CONSECUTIVELY IN CW DIRECTION.
RPV STUD 35-1-65A	RPV STUD	B-G-1	VOL	UTP-32	UT-130			STUD HOLE #1 IS THE 1ST CW FROM 0 DEG AZ NUMBERS CONTINUE CONSECUTIVELY IN CW DIRECTION.
			SUR	PTP-1				STUD HOLE #1 IS THE 1ST CW FROM 0 DEG AZ NUMBERS CONTINUE CONSECUTIVELY IN CW DIRECTION.
RPV STUD 35-1-66A	RPV STUD	B-G-1	VOL	UTP-32	UT-130			STUD HOLE #1 IS THE 1ST CW FROM 0 DEG AZ NUMBERS CONTINUE CONSECUTIVELY IN CW DIRECTION.

WNP-02
 INTERVAL: PSI
 PERIOD: NA
 OUTAGE:
 DRAWING NO. RPV-101

WASHINGTON PUBLIC POWER SUPPLY SYSTEM
 PROGRAM PLAN AND SCHEDULE
 SYSTEM OR COMPONENT: RPV
 DESCRIPTION: RPV STUDS, NUTS, ETC

PAGE 036
 DATE 12/14/84

<u>IDENT. NO.</u>	<u>DESCRIPTION</u>	SECT. XI <u>EXAM.</u>	EXAM <u>MTM.</u>	<u>PROCEDURE</u>	CAL. <u>BLOCK</u>	<u>INSERVICE</u>		<u>NOTES</u>
						<u>REQ.</u>	<u>SCHEDULED</u> <u>OUTAGE</u>	
			SUR	PTP-1				STUD HOLE #1 IS THE 1ST CW FROM 0 DEG AZ NUMBERS CONTINUE CONSECUTIVELY IN CW DIRECTION.
RPV STUD 35-1-67A	RPV STUD	B-G-1	VOL	UTP-32	UT-130			STUD HOLE #1 IS THE 1ST CW FROM 0 DEG AZ NUMBERS CONTINUE CONSECUTIVELY IN CW DIRECTION.
			SUR	PTP-1				STUD HOLE #1 IS THE 1ST CW FROM 0 DEG AZ NUMBERS CONTINUE CONSECUTIVELY IN CW DIRECTION.
RPV STUD 35-1-68A	RPV STUD	B-G-1	VOL	UTP-32	UT-130			STUD HOLE #1 IS THE 1ST CW FROM 0 DEG AZ NUMBERS CONTINUE CONSECUTIVELY IN CW DIRECTION.
			SUR	PTP-1				STUD HOLE #1 IS THE 1ST CW FROM 0 DEG AZ NUMBERS CONTINUE CONSECUTIVELY IN CW DIRECTION.

WNP-02
 INTERVAL: PSI
 PERIOD: NA
 OUTAGE:
 DRAWING NO. RPV-101

WASHINGTON PUBLIC POWER SUPPLY SYSTEM
 PROGRAM PLAN AND SCHEDULE
 SYSTEM OR COMPONENT: RPV
 DESCRIPTION: RPV STUDS, NUTS, ETC

PAGE 037
 DATE 12/14/84

<u>IDENT. NO.</u>	<u>DESCRIPTION</u>	<u>SECT.</u> <u>XI</u> <u>EXAM.</u>	<u>EXAM</u> <u>MTH.</u>	<u>PROCEDURE</u>	<u>CAL.</u> <u>BLOCK</u>	<u>INSERVICE</u>		<u>NOTES</u>
						<u>REQ.</u>	<u>SCHEDULED</u> <u>OUTAGE</u>	
RPV STUD 35-1-69A	RPV STUD	B-G-1	VOL	UTP-32	UT-130			STUD HOLE #1 IS THE 1ST CW FROM 0 DEG AZ NUMBERS CONTINUE CONSECUTIVELY IN CW DIRECTION.
			SUR	PTP-1				STUD HOLE #1 IS THE 1ST CW FROM 0 DEG AZ NUMBERS CONTINUE CONSECUTIVELY IN CW DIRECTION.
RPV STUD 35-1-70A	RPV STUD	B-G-1	VOL	UTP-32	UT-130			STUD HOLE #1 IS THE 1ST CW FROM 0 DEG AZ NUMBERS CONTINUE CONSECUTIVELY IN CW DIRECTION.
			SUR	PTP-1				STUD HOLE #1 IS THE 1ST CW FROM 0 DEG AZ NUMBERS CONTINUE CONSECUTIVELY IN CW DIRECTION.
RPV STUD 35-1-71A	RPV STUD	B-G-1	VOL	UTP-32	UT-130			STUD HOLE #1 IS THE 1ST CW FROM 0 DEG AZ NUMBERS CONTINUE CONSECUTIVELY IN CW DIRECTION.

WNP-02
 INTERVAL: PSI
 PERIOD: NA
 OUTAGE:
 DRAWING NO. RPV-101

WASHINGTON PUBLIC POWER SUPPLY SYSTEM
 PROGRAM PLAN AND SCHEDULE
 SYSTEM OR COMPONENT: RPV
 DESCRIPTION: RPV STUDS, NUTS, ETC

PAGE 038
 DATE 12/14/84

<u>IDENT. NO.</u>	<u>DESCRIPTION</u>	SECT. XI <u>EXAM.</u>	EXAM <u>MTM.</u>	PROCEDURE	CAL. <u>BLOCK</u>	<u>INSERVICE</u>		<u>NOTES</u>
						<u>REQ.</u>	<u>SCHEDULED</u> <u>OUTAGE</u>	
			SUR	PTP-1				STUD HOLE #1 IS THE 1ST CW FROM 0 DEG AZ NUMBERS CONTINUE CONSECUTIVELY IN CW DIRECTION.
RPV STUD 35-1-72A	RPV STUD	B-G-1	VOL	UTP-32	UT-130			STUD HOLE #1 IS THE 1ST CW FROM 0 DEG AZ NUMBERS CONTINUE CONSECUTIVELY IN CW DIRECTION.
			SUR	PTP-1				STUD HOLE #1 IS THE 1ST CW FROM 0 DEG AZ NUMBERS CONTINUE CONSECUTIVELY IN CW DIRECTION.
RPV STUD 35-1-73A	RPV STUD	B-G-1	VOL	UTP-32	UT-130			STUD HOLE #1 IS THE 1ST CW FROM 0 DEG AZ NUMBERS CONTINUE CONSECUTIVELY IN CW DIRECTION.
			SUR	PTP-1				STUD HOLE #1 IS THE 1ST CW FROM 0 DEG AZ NUMBERS CONTINUE CONSECUTIVELY IN CW DIRECTION.

WNP-02
 INTERVAL: PSI
 PERIOD: NA
 OUTAGE:
 DRAWING NO. RPV-101

WASHINGTON PUBLIC POWER SUPPLY SYSTEM
 PROGRAM PLAN AND SCHEDULE
 SYSTEM OR COMPONENT: RPV
 DESCRIPTION: RPV STUDS. NUTS. ETC

PAGE 039
 DATE 12/14/84

<u>IDENT. NO.</u>	<u>DESCRIPTION</u>	SECT. XI <u>EXAM.</u>	EXAM <u>MTH.</u>	PROCEDURE	CAL. <u>BLOCK</u>	<u>INSERVICE</u>		<u>NOTES</u>
						<u>REQ.</u>	<u>SCHEDULED OUTAGE</u>	
RPV STUD 35-1-74A	RPV STUD	B-G-1	VOL	UTP-32	UT-130			STUD HOLE #1 IS THE 1ST CW FROM 0 DEG AZ NUMBERS CONTINUE CONSECUTIVELY IN CW DIRECTION.
			0					
			SUR	PTP-1				STUD HOLE #1 IS THE 1ST CW FROM 0 DEG AZ NUMBERS CONTINUE CONSECUTIVELY IN CW DIRECTION.
RPV STUD 35-1-75A	RPV STUD	B-G-1	VOL	UTP-32	UT-130			STUD HOLE #1 IS THE 1ST CW FROM 0 DEG AZ NUMBERS CONTINUE CONSECUTIVELY IN CW DIRECTION.
			SUR	PTP-1				STUD HOLE #1 IS THE 1ST CW FROM 0 DEG AZ NUMBERS CONTINUE CONSECUTIVELY IN CW DIRECTION.
RPV STUD 35-1-76A	RPV STUD	B-G-1	VOL	UTP-32	UT-130			STUD HOLE #1 IS THE 1ST CW FROM 0 DEG AZ NUMBERS CONTINUE CONSECUTIVELY IN CW DIRECTION.

WNP-02
 INTERVAL: PSI
 PERIOD: NA
 OUTAGE:
 DRAWING NO. RPV-101

WASHINGTON PUBLIC POWER SUPPLY SYSTEM
 PROGRAM PLAN AND SCHEDULE
 SYSTEM OR COMPONENT: RPV
 DESCRIPTION: RPV STUDS, NUTS, ETC

PAGE 040
 DATE 12/14/84

IDENT. NO.	DESCRIPTION	SECT. XI EXAM.	EXAM MTH.	PROCEDURE	CAL. BLOCK	INSERVICE		NOTES
						REQ.	SCHEDULED OUTAGE	
			SUR	PTP-1				STUD HOLE #1 IS THE 1ST CW FROM 0 DEG AZ NUMBERS CONTINUE CONSECUTIVELY IN CW DIRECTION.
RPV NUT 36-1-1A	RPV NUT	B-G-1	VOL	UTP-35	UT-132			
			SUR	MTP-1				SURFACE EXAM REQ'D ONLY WHEN NUT IS REMOVED
RPV NUT 36-1-2A	RPV NUT	B-G-1	VOL	UTP-35	UT-132			
			SUR	MTP-1				SURFACE EXAM REQ'D ONLY WHEN NUT IS REMOVED
RPV NUT 36-1-3A	RPV NUT	B-G-1	VOL	UTP-35	UT-132			
			SUR	MTP-1				SURFACE EXAM REQ'D ONLY WHEN NUT IS REMOVED
RPV NUT 36-1-4A	RPV NUT	B-G-1	VOL	UTP-35	UT-132			
			SUR	MTP-1				SURFACE EXAM REQ'D ONLY WHEN NUT IS REMOVED
RPV NUT 36-1-5A	RPV NUT	B-G-1	VOL	UTP-35	UT-132			

WNP-02
 INTERVAL: PSI
 PERIOD: NA
 OUTAGE:
 DRAWING NO. RPV-101

WASHINGTON PUBLIC POWER SUPPLY SYSTEM
 PROGRAM PLAN AND SCHEDULE
 SYSTEM OR COMPONENT: RPV
 DESCRIPTION: RPV STUDS, NUTS, ETC

PAGE 041
 DATE 12/14/84

<u>IDENT. NO.</u>	<u>DESCRIPTION</u>	SECT. XI <u>EXAM.</u>	EXAM <u>MTH.</u>	<u>PROCEDURE</u>	CAL. <u>BLOCK</u>	<u>INSERVICE</u> SCHEDULED		<u>NOTES</u>
						<u>REQ.</u>	<u>OUTAGE</u>	
			SUR	MTP-1				SURFACE EXAM REQ'D ONLY WHEN NUT IS REMOVED
RPV NUT 36-1-6A	RPV NUT	B-G-1	VOL	UTP-35	UT-132			
			SUR	MTP-1				SURFACE EXAM REQ'D ONLY WHEN NUT IS REMOVED
RPV NUT 36-1-7A	RPV NUT	B-G-1	VOL	UTP-35	UT-132			
			SUR	MTP-1				SURFACE EXAM REQ'D ONLY WHEN NUT IS REMOVED
RPV NUT 36-1-8A	RPV NUT	B-G-1	VOL	UTP-35	UT-132			
			SUR	MTP-1				SURFACE EXAM REQ'D ONLY WHEN NUT IS REMOVED
RPV NUT 36-1-9A	RPV NUT	B-G-1	VOL	UTP-35	UT-132			
			SUR	MTP-1				SURFACE EXAM REQ'D ONLY WHEN NUT IS REMOVED
RPV NUT 36-1-10A	RPV NUT	B-G-1	VOL	UTP-35	UT-132			
			SUR	MTP-1				SURFACE EXAM REQ'D ONLY WHEN NUT IS REMOVED
RPV NUT 36-1-11A	RPV NUT	B-G-1	VOL	UTP-35	UT-132			

WNP-02
 INTERVAL: PSI
 PERIOD: NA
 OUTAGE:
 DRAWING NO. RPV-101

WASHINGTON PUBLIC POWER SUPPLY SYSTEM
 PROGRAM PLAN AND SCHEDULE
 SYSTEM OR COMPONENT: RPV
 DESCRIPTION: RPV STUDS, NUTS, ETC

PAGE 042
 DATE 12/14/84

<u>IDENT. NO.</u>	<u>DESCRIPTION</u>	<u>SECT.</u> <u>XI</u>	<u>EXAM</u> <u>MTH.</u>	<u>PROCEDURE</u>	<u>CAL.</u> <u>BLOCK</u>	<u>INSERVICE</u> <u>SCHEDULED</u>		<u>NOTES</u>
						<u>REQ.</u>	<u>OUTAGE</u>	
			SUR	MTP-1				SURFACE EXAM REQ'D ONLY WHEN NUT IS REMOVED
RPV NUT 36-1-12A	RPV NUT	B-G-1	VOL	UTP-35	UT-132			
			SUR	MTP-1				SURFACE EXAM REQ'D ONLY WHEN NUT IS REMOVED
RPV NUT 36-1-13A	RPV NUT	B-G-1	VOL	UTP-35	UT-132			
			SUR	MTP-1				SURFACE EXAM REQ'D ONLY WHEN NUT IS REMOVED
RPV NUT 36-1-14A	RPV NUT	B-G-1	VOL	UTP-35	UT-132			
			SUR	MTP-1				SURFACE EXAM REQ'D ONLY WHEN NUT IS REMOVED
RPV NUT 36-1-15A	RPV NUT	B-G-1	VOL	UTP-35	UT-132			
			SUR	MTP-1				SURFACE EXAM REQ'D ONLY WHEN NUT IS REMOVED
RPV NUT 36-1-16A	RPV NUT	B-G-1	VOL	UTP-35	UT-132			
			SUR	MTP-1				SURFACE EXAM REQ'D ONLY WHEN NUT IS REMOVED
RPV NUT 36-1-17A	RPV NUT	B-G-1	VOL	UT-5	UT-132			

WNP-02
 INTERVAL: PSI
 PERIOD: NA
 OUTAGE:
 DRAWING NO. RPV-101

WASHINGTON PUBLIC POWER SUPPLY SYSTEM
 PROGRAM PLAN AND SCHEDULE
 SYSTEM OR COMPONENT: RPV
 DESCRIPTION: RPV STUDS, NUTS, ETC

PAGE 043
 DATE 12/14/84

<u>IDENT. NO.</u>	<u>DESCRIPTION</u>	<u>SECT.</u> <u>XI</u> <u>EXAM.</u>	<u>EXAM</u> <u>MTH.</u>	<u>PROCEDURE</u>	<u>CAL.</u> <u>BLOCK</u>	<u>INSERVICE</u> <u>SCHEDULED</u>		<u>NOTES</u>
						<u>REQ.</u>	<u>OUTAGE</u>	
			SUR	MTP-1				SURFACE EXAM REQ'D ONLY WHEN NUT IS REMOVED
RPV NUT 36-1-18A	RPV NUT	B-G-1	VOL	UTP-35	UT-132			
			SUR	MTP-1				SURFACE EXAM REQ'D ONLY WHEN NUT IS REMOVED
RPV NUT 36-1-19A	RPV NUT	B-G-1	VOL	UTP-35	UT-132			
			SUR	MTP-1				SURFACE EXAM REQ'D ONLY WHEN NUT IS REMOVED
RPV NUT 36-1-20A	RPV NUT	B-G-1	VOL	UTP-35	UT-132			
			SUR	MTP-1				SURFACE EXAM REQ'D ONLY WHEN NUT IS REMOVED
RPV NUT 36-1-21A	RPV NUT	B-G-1	VOL	UTP-35	UT-132			
			SUR	MTP-1				SURFACE EXAM REQ'D ONLY WHEN NUT IS REMOVED
RPV NUT 36-1-22A	RPV NUT	B-G-1	VOL	UTP-35	UT-132			
			SUR	MTP-1				SURFACE EXAM REQ'D ONLY WHEN NUT IS REMOVED
RPV NUT 36-1-23A	RPV NUT	B-G-1	VOL	UTP-35	UT-132			

WNP-02
 INTERVAL: PSI
 PERIOD: NA
 OUTAGE:
 DRAWING NO. RPV-101

WASHINGTON PUBLIC POWER SUPPLY SYSTEM
 PROGRAM PLAN AND SCHEDULE
 SYSTEM OR COMPONENT: RPV
 DESCRIPTION: RPV STUDS. NUTS. ETC

PAGE 044
 DATE 12/14/84

<u>IDENT. NO.</u>	<u>DESCRIPTION</u>	<u>SECT.</u> <u>XI</u> <u>EXAM.</u>	<u>EXAM</u> <u>MTH.</u>	<u>PROCEDURE</u>	<u>CAL.</u> <u>BLOCK</u>	<u>INSERVICE</u>		<u>NOTES</u>
						<u>REQ.</u>	<u>SCHEDULED</u> <u>OUTAGE</u>	
			SUR	MTP-1				SURFACE EXAM REQ'D ONLY WHEN NUT IS REMOVED
RPV NUT 36-1-24A	RPV NUT	B-G-1	VOL	UTP-35	UT-132			
			SUR	MTP-1				SURFACE EXAM REQ'D ONLY WHEN NUT IS REMOVED
RPV NUT 36-1-25A	RPV NUT	B-G-1	VOL	UTP-35	UT-132			
			SUR	MTP-1				SURFACE EXAM REQ'D ONLY WHEN NUT IS REMOVED
RPV NUT 36-1-26A	RPV NUT	B-G-1	VOL	UTP-35	UT-132			
			SUR	MTP-1				SURFACE EXAM REQ'D ONLY WHEN NUT IS REMOVED
RPV NUT 36-1-27A	RPV NUT	B-G-1	VOL	UTP-35	UT-132			
			SUR	MTP-1				SURFACE EXAM REQ'D ONLY WHEN NUT IS REMOVED
RPV NUT 36-1-28A	RPV NUT	B-G-1	VOL	UTP-35	UT-132			
			SUR	MTP-1				SURFACE EXAM REQ'D ONLY WHEN NUT IS REMOVED
RPV NUT 36-1-29A	RPV NUT	B-G-1	VOL	UTP-35	UT-132			

WNP-02
 INTERVAL: PSI
 PERIOD: NA
 OUTAGE:
 DRAWING NO. RPV-101

WASHINGTON PUBLIC POWER SUPPLY SYSTEM
 PROGRAM PLAN AND SCHEDULE
 SYSTEM OR COMPONENT: RPV
 DESCRIPTION: RPV STUDS, NUTS, ETC

PAGE 045
 DATE 12/14/84

<u>IDENT. NO.</u>	<u>DESCRIPTION</u>	<u>SECT.</u> <u>XI</u> <u>EXAM.</u>	<u>EXAM</u> <u>MTH.</u>	<u>PROCEDURE</u>	<u>CAL.</u> <u>BLOCK</u>	<u>INSERVICE</u>		<u>NOTES</u>
						<u>REQ.</u>	<u>SCHEDULED</u> <u>OUTAGE</u>	
			SUR	MTP-1				SURFACE EXAM REQ'D ONLY WHEN NUT IS REMOVED
RPV NUT 36-1-30A	RPV NUT	B-G-1	VOL	UTP-35	UT-132			
			SUR	MTP-1				SURFACE EXAM REQ'D ONLY WHEN NUT IS REMOVED
RPV NUT 36-1-31A	RPV NUT	B-G-1	VOL	UTP-35	UT-132			
			SUR	MTP-1				SURFACE EXAM REQ'D ONLY WHEN NUT IS REMOVED
RPV NUT 36-1-32A	RPV NUT	B-G-1	VOL	UTP-35	UT-132			
			SUR	MTP-1				SURFACE EXAM REQ'D ONLY WHEN NUT IS REMOVED
RPV NUT 36-1-33A	RPV NUT	B-G-1	VOL	UTP-35	UT-132			
			SUR	MTP-1				SURFACE EXAM REQ'D ONLY WHEN NUT IS REMOVED
RPV NUT 36-1-34A	RPV NUT	B-G-1	VOL	UTP-35	UT-132			
			SUR	MTP-1				SURFACE EXAM REQ'D ONLY WHEN NUT IS REMOVED
RPV NUT 36-1-35A	RPV NUT	B-G-1	VOL	UTP-35	UT-132			

MNP-02
 INTERVAL: PSI
 PERIOD: NA
 OUTAGE:
 DRAWING NO. RPV-101

WASHINGTON PUBLIC POWER SUPPLY SYSTEM
 PROGRAM PLAN AND SCHEDULE
 SYSTEM OR COMPONENT: RPV
 DESCRIPTION: RPV STUDS, NUTS, ETC

PAGE 046
 DATE 12/14/84

<u>IDENT. NO.</u>	<u>DESCRIPTION</u>	SECT. XI <u>EXAM.</u>	EXAM <u>MTH.</u>	<u>PROCEDURE</u>	CAL. <u>BLOCK</u>	<u>INSERVICE</u>		<u>NOTES</u>
						<u>REQ.</u>	<u>SCHEDULED</u> <u>OUTAGE</u>	
			SUR	MTP-1				SURFACE EXAM REQ'D ONLY WHEN NUT IS REMOVED
RPV NUT 36-1-36A	RPV NUT	B-G-1	VOL	UTP-35	UT-132			
			SUR	MTP-1				SURFACE EXAM REQ'D ONLY WHEN NUT IS REMOVED
RPV NUT 36-1-37A	RPV NUT	B-G-1	VOL	UTP-35	UT-132			
			SUR	MTP-1				SURFACE EXAM REQ'D ONLY WHEN NUT IS REMOVED
RPV NUT 36-1-38A	RPV NUT	B-G-1	VOL	UTP-35	UT-132			
			SUR	MTP-1				SURFACE EXAM REQ'D ONLY WHEN NUT IS REMOVED
RPV NUT 36-1-39A	RPV NUT	B-G-1	VOL	UTP-35	UT-132			
			SUR	MTP-1				SURFACE EXAM REQ'D ONLY WHEN NUT IS REMOVED
RPV NUT 36-1-40A	RPV NUT	B-G-1	VOL	UTP-35	UT-132			
			SUR	MTP-1				SURFACE EXAM REQ'D ONLY WHEN NUT IS REMOVED
RPV NUT 36-1-41A	RPV NUT	B-G-1	VOL	UTP-35	UT-132			

WNP-02
 INTERVAL: PSI
 PERIOD: NA
 OUTAGE:
 DRAWING NO. RPV-101

WASHINGTON PUBLIC POWER SUPPLY SYSTEM
 PROGRAM PLAN AND SCHEDULE
 SYSTEM OR COMPONENT: RPV
 DESCRIPTION: RPV STUDS, NUTS, ETC

PAGE 047
 DATE 12/14/84

<u>IDENT. NO.</u>	<u>DESCRIPTION</u>	<u>SECT.</u> <u>XI</u> <u>EXAM.</u>	<u>EXAM</u> <u>MTH.</u>	<u>PROCEDURE</u>	<u>CAL.</u> <u>BLOCK</u>	<u>INSERVICE</u> <u>SCHEDULED</u>		<u>NOTES</u>
						<u>REQ.</u>	<u>OUTAGE</u>	
			SUR	MTP-1				SURFACE EXAM REQ'D ONLY WHEN NUT IS REMOVED
RPV NUT 36-1-42A	RPV NUT	B-G-1	VOL	UTP-35	UT-132			
			SUR	MTP-1				SURFACE EXAM REQ'D ONLY WHEN NUT IS REMOVED
RPV NUT 36-1-43A	RPV NUT	B-G-1	VOL	UTP-35	UT-132			
			SUR	MTP-1				SURFACE EXAM REQ'D ONLY WHEN NUT IS REMOVED
RPV NUT 36-1-44A	RPV NUT	B-G-1	VOL	UTP-35	UT-132			
			SUR	MTP-1				SURFACE EXAM REQ'D ONLY WHEN NUT IS REMOVED
RPV NUT 36-1-45A	RPV NUT	B-G-1	VOL	UTP-35	UT-132			
			SUR	MTP-1				SURFACE EXAM REQ'D ONLY WHEN NUT IS REMOVED
RPV NUT 36-1-46A	RPV NUT	B-G-1	VOL	UTP-35	UT-132			
			SUR	MTP-1				SURFACE EXAM REQ'D ONLY WHEN NUT IS REMOVED
RPV NUT 36-1-47A	RPV NUT	B-G-1	VOL	UTP-35	UT-132			

WNP-02
 INTERVAL: PSI
 PERIOD: NA
 OUTAGE:
 DRAWING NO. RPV-101

WASHINGTON PUBLIC POWER SUPPLY SYSTEM
 PROGRAM PLAN AND SCHEDULE
 SYSTEM OR COMPONENT: RPV
 DESCRIPTION: RPV STUDS, NUTS, ETC

PAGE 048
 DATE 12/14/84

<u>IDENT. NO.</u>	<u>DESCRIPTION</u>	SECT. XI <u>EXAM.</u>	EXAM <u>MTM.</u>	<u>PROCEDURE</u>	CAL. <u>BLOCK</u>	<u>INSERVICE</u>		<u>NOTES</u>
						<u>REQ.</u>	<u>SCHEDULED OUTAGE</u>	
			SUR	MTP-1				SURFACE EXAM REQ'D ONLY WHEN NUT IS REMOVED
RPV NUT 36-1-48A	RPV NUT	B-G-1	VOL	UTP-35	UT-132			
			SUR	MTP-1				SURFACE EXAM REQ'D ONLY WHEN NUT IS REMOVED
RPV NUT 36-1-49A	RPV NUT	B-G-1	VOL	UTP-35	UT-132			
			SUR	MTP-1				SURFACE EXAM REQ'D ONLY WHEN NUT IS REMOVED
RPV NUT 36-1-50A	RPV NUT	B-G-1	VOL	UTP-35	UT-132			
			SUR	MTP-1				SURFACE EXAM REQ'D ONLY WHEN NUT IS REMOVED
RPV NUT 36-1-51A	RPV NUT	B-G-1	VOL	UTP-35	UT-132			
			SUR	MTP-1				SURFACE EXAM REQ'D ONLY WHEN NUT IS REMOVED
RPV NUT 36-1-52A	RPV NUT	B-G-1	VOL	UTP-35	UT-132			
			SUR	MTP-1				SURFACE EXAM REQ'D ONLY WHEN NUT IS REMOVED
RPV NUT 36-1-53A	RPV NUT	B-G-1	VOL	UTP-35	UT-132			

WNP-02
 INTERVAL: PSI
 PERIOD: NA
 OUTAGE:
 DRAWING NO. RPV-101

WASHINGTON PUBLIC POWER SUPPLY SYSTEM
 PROGRAM PLAN AND SCHEDULE
 SYSTEM OR COMPONENT: RPV
 DESCRIPTION: RPV STUDS, NUTS, ETC

PAGE 049
 DATE 12/14/84

IDENT. NO.	DESCRIPTION	SECT. XI EXAM.	EXAM MTH.	PROCEDURE	CAL. BLOCK	INSERVICE		NOTES
						REQ.	SCHEDULED OUTAGE	
			SUR	MTP-1				SURFACE EXAM REQ'D ONLY WHEN NUT IS REMOVED
RPV NUT 36-1-54A	RPV NUT	B-G-1	VOL	UTP-35	UT-132			
			SUR	MTP-1				SURFACE EXAM REQ'D ONLY WHEN NUT IS REMOVED
RPV NUT 36-1-55A	RPV NUT	B-G-1	VOL	UTP-35	UT-132			
			SUR	MTP-1				SURFACE EXAM REQ'D ONLY WHEN NUT IS REMOVED
RPV NUT 36-1-56A	RPV NUT	B-G-1	VOL	UTP-35	UT-132			
			SUR	MTP-1				SURFACE EXAM REQ'D ONLY WHEN NUT IS REMOVED
RPV NUT 36-1-57A	RPV NUT	B-G-1	VOL	UTP-35	UT-132			
			SUR	MTP-1				SURFACE EXAM REQ'D ONLY WHEN NUT IS REMOVED
RPV NUT 36-1-58A	RPV NUT	B-G-1	VOL	UTP-35	UT-132			
			SUR	MTP-1				SURFACE EXAM REQ'D ONLY WHEN NUT IS REMOVED
RPV NUT 36-1-59A	RPV NUT	B-G-1	VOL	UTP-35	UT-132			

WNP-02
 INTERVAL: PSI
 PERIOD: NA
 OUTAGE:
 DRAWING NO. RPV-101

WASHINGTON PUBLIC POWER SUPPLY SYSTEM
 PROGRAM PLAN AND SCHEDULE
 SYSTEM OR COMPONENT: RPV
 DESCRIPTION: RPV STUDS, NUTS, ETC

PAGE 050
 DATE 12/14/84

<u>IDENT. NO.</u>	<u>DESCRIPTION</u>	SECT. XI <u>EXAM.</u>	EXAM <u>MTH.</u>	<u>PROCEDURE</u>	CAL. <u>BLOCK</u>	<u>INSERVICE</u>		<u>NOTES</u>
						<u>REQ.</u>	<u>OUTAGE</u>	
			SUR	MTP-1				SURFACE EXAM REQ'D ONLY WHEN NUT IS REMOVED
RPV NUT 36-1-60A	RPV NUT	B-G-1	VOL	UTP-35	UT-132			
			SUR	HTP-1				SURFACE EXAM REQ'D ONLY WHEN NUT IS REMOVED
RPV NUT 36-1-61A	RPV NUT	B-G-1	VOL	UTP-35	UT-132			
			SUR	MTP-1				SURFACE EXAM REQ'D ONLY WHEN NUT IS REMOVED
RPV NUT 36-1-62A	RPV NUT	B-G-1	VOL	UTP-35	UT-132			
			SUR	MTP-1				SURFACE EXAM REQ'D ONLY WHEN NUT IS REMOVED
RPV NUT 36-1-63A	RPV NUT	B-G-1	VOL	UTP-35	UT-132			
			SUR	MTP-1				SURFACE EXAM REQ'D ONLY WHEN NUT IS REMOVED
RPV NUT 36-1-64A	RPV NUT	B-G-1	VOL	UTP-35	UT-132			
			SUR	HTP-1				SURFACE EXAM REQ'D ONLY WHEN NUT IS REMOVED
RPV NUT 36-1-65A	RPV NUT	B-G-1	VOL	UTP-35	UT-132			

WNP-02
 INTERVAL: PSI
 PERIOD: NA
 OUTAGE:
 DRAWING NO. RPV-101

WASHINGTON PUBLIC POWER SUPPLY SYSTEM
 PROGRAM PLAN AND SCHEDULE
 SYSTEM OR COMPONENT: RPV
 DESCRIPTION: RPV STUDS, NUTS, ETC

PAGE 051
 DATE 12/14/84

<u>IDENT. NO.</u>	<u>DESCRIPTION</u>	SECT. XI <u>EXAM.</u>	EXAM <u>MTH.</u>	<u>PROCEDURE</u>	CAL. <u>BLOCK</u>	<u>INSERVICE</u>		<u>NOTES</u>
						<u>REQ.</u>	<u>SCHEDULED OUTAGE</u>	
			SUR	MTP-1				SURFACE EXAM REQ'D ONLY WHEN NUT IS REMOVED
RPV NUT 36-1-66A	RPV NUT	B-G-1	VOL	UTP-35	UT-132			
			SUR	MTP-1				SURFACE EXAM REQ'D ONLY WHEN NUT IS REMOVED
RPV NUT 36-1-67A	RPV NUT	B-G-1	VOL	UTP-35	UT-132			
			SUR	MTP-1				SURFACE EXAM REQ'D ONLY WHEN NUT IS REMOVED
RPV NUT 36-1-68A	RPV NUT	B-G-1	VOL	UTP-35	UT-132			
			SUR	MTP-1				SURFACE EXAM REQ'D ONLY WHEN NUT IS REMOVED
RPV NUT 36-1-69A	RPV NUT	B-G-1	VOL	UTP-35	UT-132			
			SUR	MTP-1				SURFACE EXAM REQ'D ONLY WHEN NUT IS REMOVED
RPV NUT 36-1-70A	RPV NUT	B-G-1	VOL	UTP-35	UT-132			
			SUR	MTP-1				SURFACE EXAM REQ'D ONLY WHEN NUT IS REMOVED
RPV NUT 36-1-71A	RPV NUT	B-G-1	VOL	UTP-35	UT-132			

WNP-02
 INTERVAL: PSI
 PERIOD: NA
 OUTAGE:
 DRAWING NO. RPV-101

WASHINGTON PUBLIC POWER SUPPLY SYSTEM
 PROGRAM PLAN AND SCHEDULE
 SYSTEM OR COMPONENT: RPV
 DESCRIPTION: RPV STUDS, NUTS, ETC

PAGE 052
 DATE 12/14/84


IDENT. NO.	DESCRIPTION	SECT. XI EXAM.	EXAM MTH.	PROCEDURE	CAL. BLOCK	INSERVICE		NOTES
						REQ.	SCHEDULED OUTAGE	
			SUR	MTP-1				SURFACE EXAM REQ'D ONLY WHEN NUT IS REMOVED
RPV NUT 36-1-72A	RPV NUT	B-G-1	VOL	UTP-35	UT-132			
			SUR	MTP-1				SURFACE EXAM REQ'D ONLY WHEN NUT IS REMOVED
RPV NUT 36-1-73A	RPV NUT	B-G-1	VOL	UTP-35	UT-132			
			SUR	MTP-1				SURFACE EXAM REQ'D ONLY WHEN NUT IS REMOVED
RPV NUT 36-1-74A	RPV NUT	B-G-1	VOL	UTP-35	UT-132			
			SUR	MTP-1				SURFACE EXAM REQ'D ONLY WHEN NUT IS REMOVED
RPV NUT 36-1-75A	RPV NUT	B-G-1	VOL	UTP-35	UT-132			
			SUR	MTP-1				SURFACE EXAM REQ'D ONLY WHEN NUT IS REMOVED
RPV NUT 36-1-76A	RPV NUT	B-G-1	VOL	UTP-35	UT-132			
			SUR	MTP-1				SURFACE EXAM REQ'D ONLY WHEN NUT IS REMOVED
RPV WASHERS	RPV WASHER-76EA	B-G-1	VT-1	QCI 7-1				

WNP-02
 INTERVAL: PSI
 PERIOD: NA
 OUTAGE:
 DRAWING NO. RPV-101

WASHINGTON PUBLIC POWER SUPPLY SYSTEM
 PROGRAM PLAN AND SCHEDULE
 SYSTEM OR COMPONENT: RPV
 DESCRIPTION: RPV STUDS, NUTS, ETC

PAGE 053
 DATE 12/14/84

IDENT. NO.	DESCRIPTION	SECT.	EXAM	PROCEDURE	CAL. BLOCK	INSERVICE		NOTES
		XI EXAM.	MTH.			REQ.	SCHEDULED OUTAGE	
RPV BUSHING	RPV BUSHING	B-G-1	VT-1	QCI 7-1				RPV BUSHING IS LOCATED AT FLANGE HOLE #35
RPV THREADS	THREADS-RPV FLG	B-G-1	VOL	UTP-28	UT-123			
RPV LIGAMENTS	RPV FLG LIGMTS	B-G-1	VOL	UTP-15	UT-123			
RPV CLADDING	RPV CLAD PATCHS	B-I-1	VT-1	QCI 7-1				REFER TO RPV-101 FOR CLAD PATCH LOCATIONS
RPV INTERIOR	RPV INTERIOR	B-N-1	VT-3	QCI 7-1				
RPV CORE SUPPORTS	CORE SUPPORTS	B-N-2	VT-1	QCI 7-1				INTEGRALLY WELDED CORE SUPPORT STRUCTURES AND INTERIOR ATTACHMENTS TO RPV.
RPV-PB-101	RPV PRES BNDRY	B-P	VT-2	N/A				SEE NOTES #6 & #7.

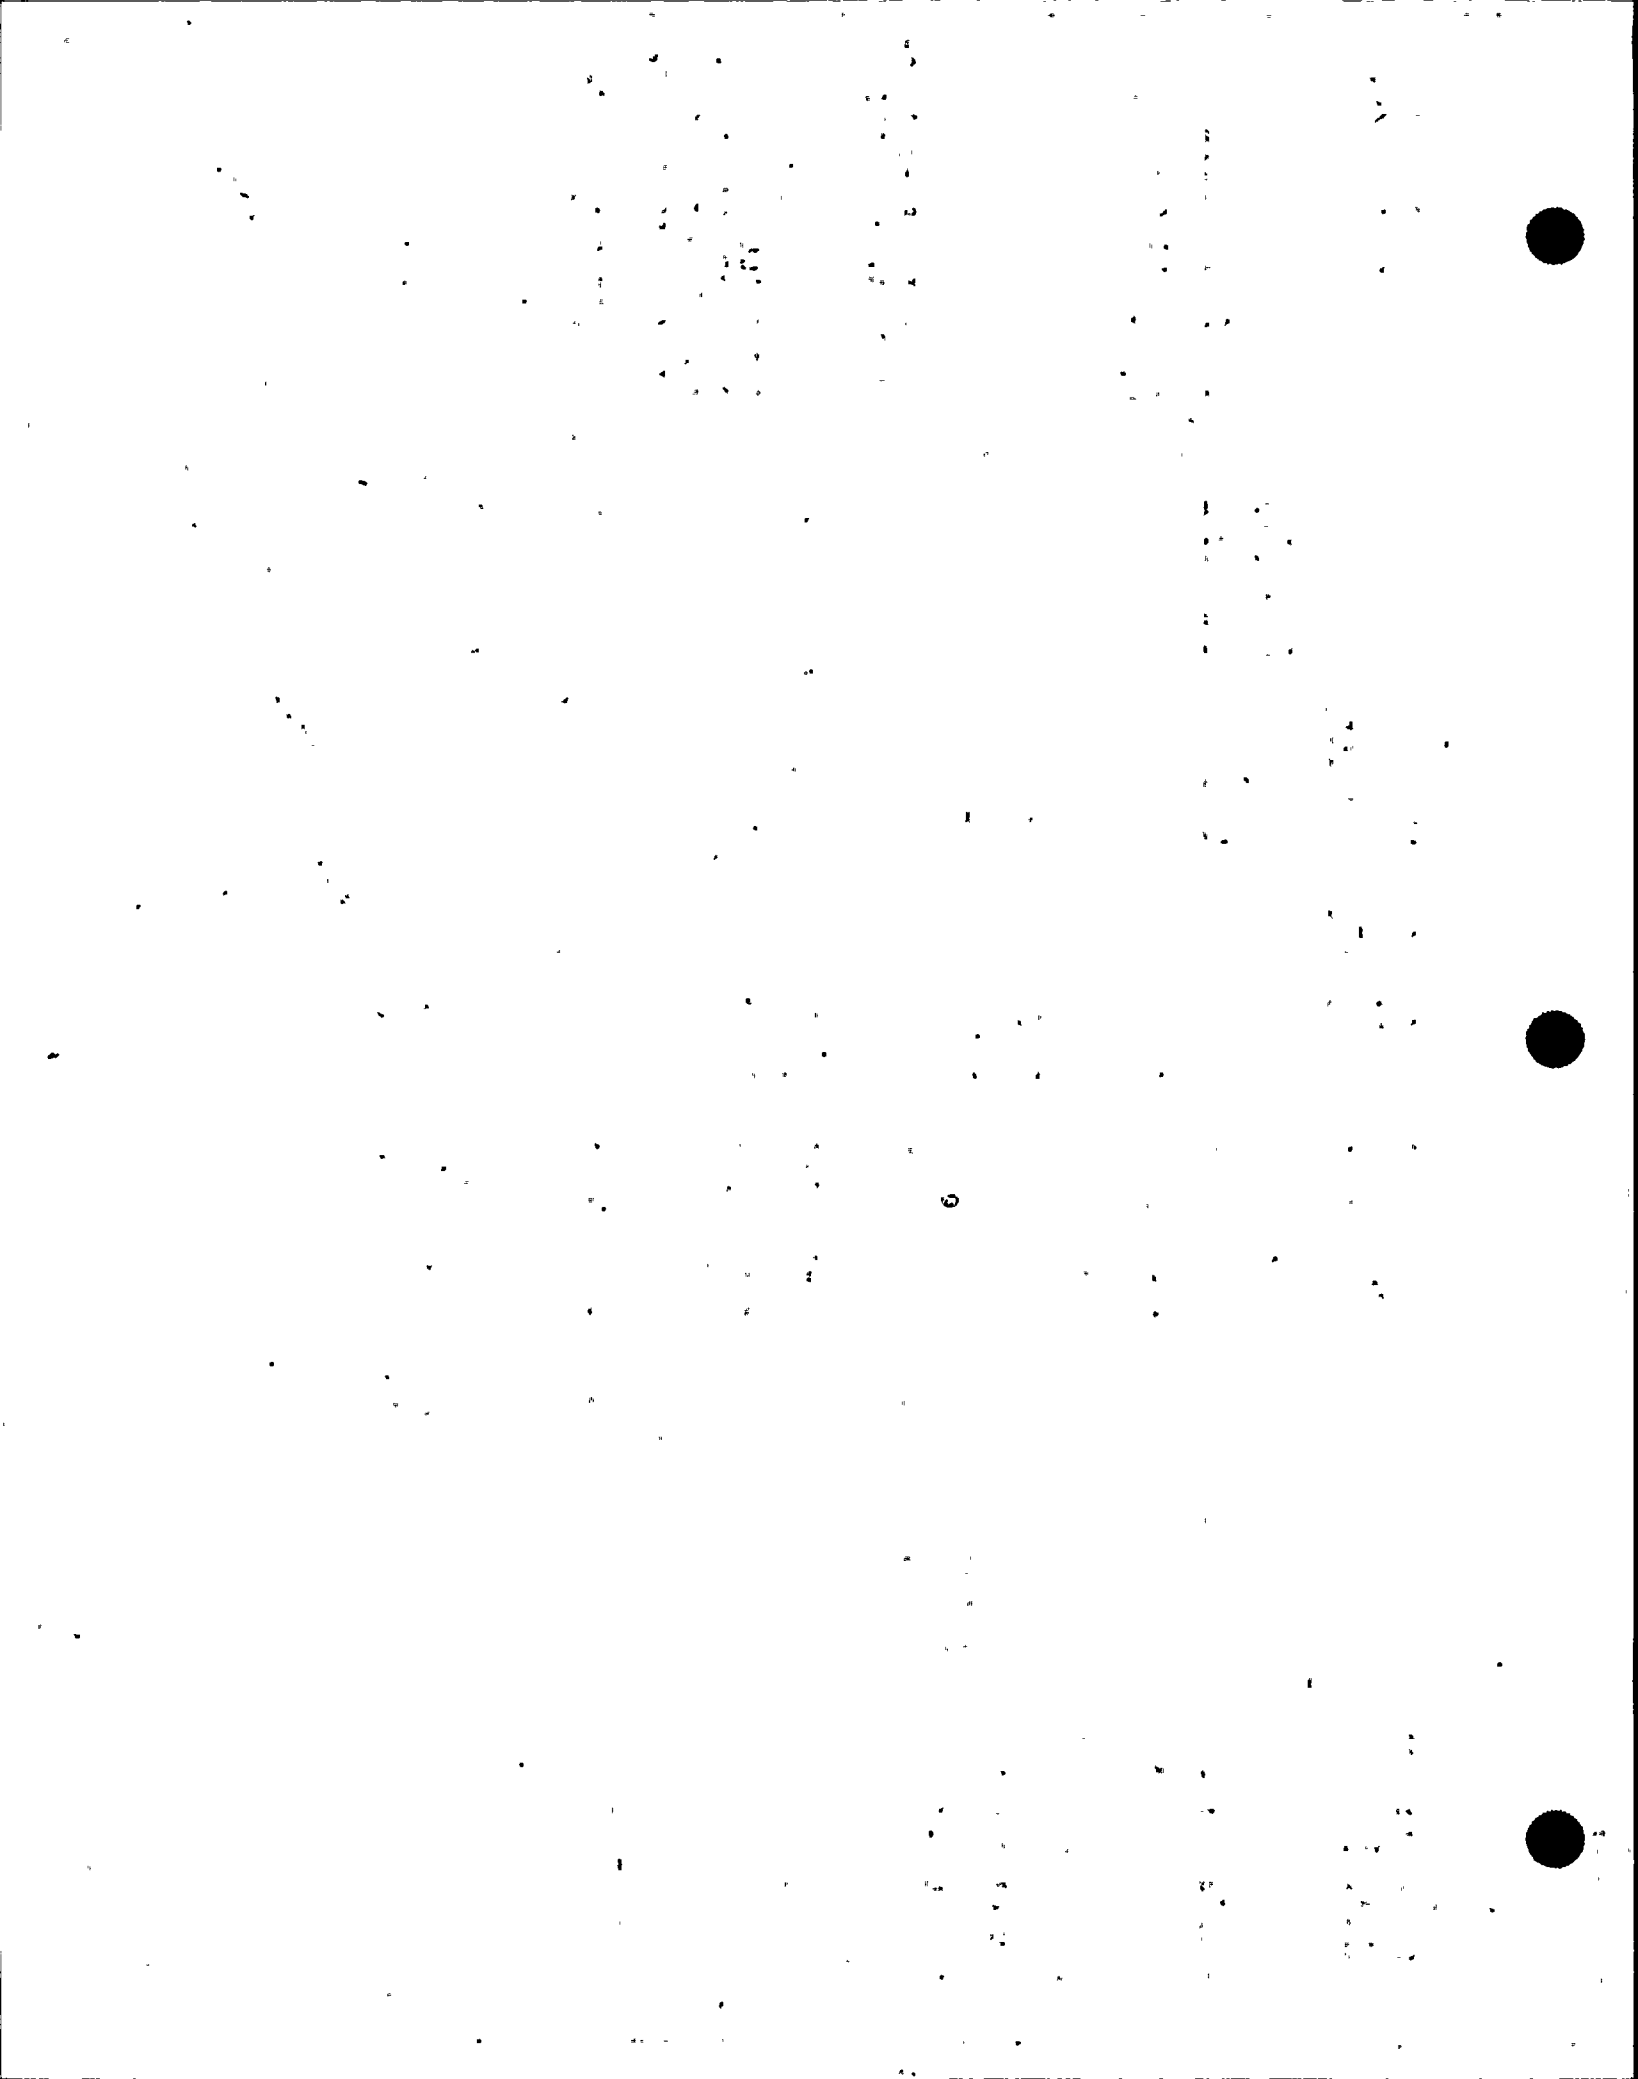

WNP-02
 INTERVAL: PSI
 PERIOD: NA
 OUTAGE:
 DRAWING NO. RPV-102

WASHINGTON PUBLIC POWER SUPPLY SYSTEM
 PROGRAM PLAN AND SCHEDULE
 SYSTEM OR COMPONENT: RPV
 DESCRIPTION: TOP & BOTTOM HEAD

PAGE 001
 DATE 12/14/84

<u>IDENT. NO.</u>	<u>DESCRIPTION</u>	<u>SECT.</u> <u>XI</u>	<u>EXAM</u> <u>EXAM.</u>	<u>MITH.</u>	<u>PROCEDURE</u>	<u>CAL.</u> <u>BLOCK</u>	<u>INSERVICE</u> <u>SCHEDULED</u>		<u>NOTES</u>
							<u>REQ.</u>	<u>OUTAGE</u>	
DA	BOT HD MRD @272	B-A	VOL	UTP-30	UT-118				
DB	BOT HD MRD @332	B-A	VOL	UTP-30	UT-118				
DC	BOT HD MRD @ 32	B-A	VOL	UTP-30	UT-118				
DD	BOT HD MRD @ 92	B-A	VOL	UTP-30	UT-118				
DE	BOT HD MRD @152	B-A	VOL	UTP-30	UT-118				
DF	BOT HD MRD @212	B-A	VOL	UTP-30	UT-118				
AJ	BGT HD DOL WELD	B-A	VOL	UTP-30	UT-117 UT-118			8" THK. TO 6 3/4 THK.	
DG	BOT HD DOL /270	B-A	VOL	UTP-30	UT-117				
DR	BOT HD DOL / 90	B-A	VOL	UTP-30	UT-117				
AG	TOP HD-FLG WELD	B-A	VOL	UTP-30	UT-116				
AH	TOP HD DOL PLT	B-A	VOL	UTP-30	UT-115 UT-116			5 1/8" TO 3 5/8" THK	
DH	TOP HD MRD @15	B-A	VOL	UTP-30	UT-116				
DJ	TOP HD MRD @75	B-A	VOL	UTP-30	UT-116				
DK	TOP HD MRD @135	B-A	VOL	UTP-30	UT-116				
DK	TOP HD MRD @195	B-A	VOL	UTP-30	UT-116				
DN	TOP HD MRD @255	B-A	VOL	UTP-30	UT-116				
DP	TOP HD MRD @315	B-A	VOL	UTP-30	UT-116				


WNP-02
 INTERVAL: PSI
 PERIOD: NA
 OUTAGE:
 DRAWING NO. RPV-102

WASHINGTON PUBLIC POWER SUPPLY SYSTEM
 PROGRAM PLAN AND SCHEDULE
 SYSTEM OR COMPONENT: RPV
 DESCRIPTION: TOP & BTM HD NOZZLES

PAGE 002
 DATE 12/14/84


<u>IDENT. NO.</u>	<u>DESCRIPTION</u>	<u>SECT.</u> XI <u>EXAM.</u>	<u>EXAM</u> <u>MTH.</u>	<u>PROCEDURE</u>	<u>CAL.</u> <u>BLOCK</u>	<u>INSERVICE</u>		<u>NOTES</u>
						<u>REQ.</u>	<u>SCHEDULED</u> <u>OUTAGE</u>	
N7	HD SP NZ-HD TOP	B-D	VOL	OCI 6-21	UT-115			
N7-IR	HD SP NZ-HD IR	B-D	VOL	OCI 6-21	UT-115			INNER RADIUS
N8	HD VN NZ-HD TOP	B-D	VOL	OCI 6-21	UT-115			
N8-IR	HD VN NZ-HD IR	B-D	VOL	OCI 6-21	UT-115			INNER RADIUS
N18-IR	SPARE NZ-TOP HD	B-D	VOL	OCI 6-21	UT-115			
N18	SPARE NZ-TOP IR	B-D	VOL	OCI 6-21	UT-115			INNER RADIUS
6SPARE-1	SPARE NZ-FLANGE	B-J	VOL	UTP-10	UT-107			SHOWN ON RPV-111
6SPARE-1BU			SUR	PTP-1				SHOWN ON RPV-111
N11	FLANGE BOLTING	B-G-2	VT-1	OCI 7-1				
N15	SLC BTM HD PEN	B-E	VT-2	OCI 7-1				
CRD	BTM HD DRAIN	B-E	VT-2	OCI 7-1				
INCORE	CRD PEN (185EA)	B-E	VT-2	OCI 7-1				
RPV-PB-102	INCOR PEN(55EA)	B-E	VT-2	OCI 7-1				
	RPV PRES BNDRY	B-P	VT-2	N/A				SEE NOTES #6 & #7.



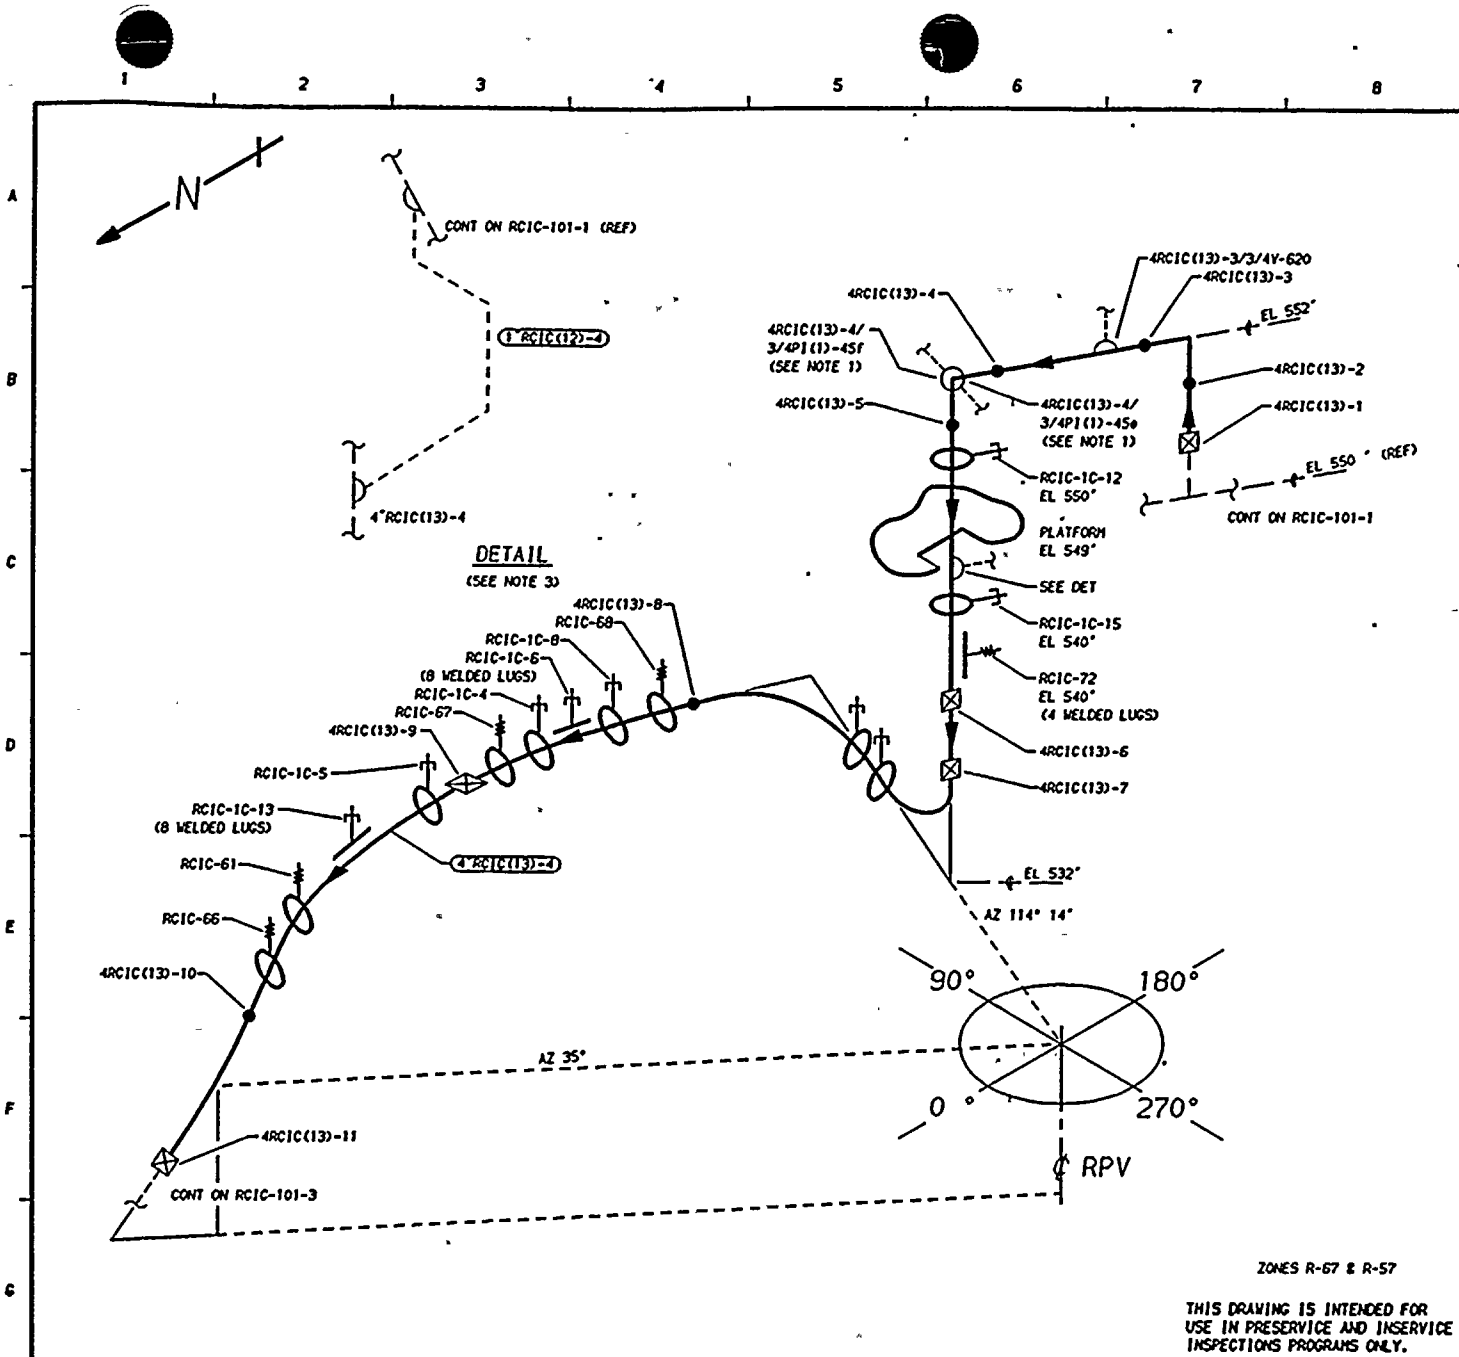

- NOTES:**
1. EXTEND LEAKAGE EXAM THROUGH COTAINMENT CX-710, X-711 THROUGH EXCESS FLOW CHECK VALVE TO INSTRUMENT TUBING CONNECTION.
 2. ALL CIRCUMFERENTIAL BUTT WELDS GREATER THAN ONE INCH RECEIVE AUGMENTED ISI.
 3. EXTEND V-2 EXAM THROUGH LINE 1 RCIC(12)-4.

- REFERENCES:**
- ISI - 219
 - BOYEE CRAIL ISIMETRICS
 - RCIC-663-1.2 REV 12
 - RCIC-662-1 REV 12
 - RCIC-662-2.4 REV 11
 - RCIC-5429-1 REV 3

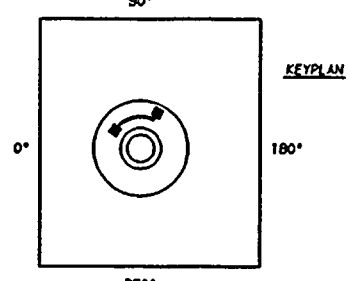

QUALITY CLASS, 1 ASME CODE CLASS, 2
ENGR, D PORTER DRAWN, K-McA DATE, 11-7-77


WASHINGTON PUBLIC POWER
SUPPLY SYSTEM
RICHLAND, WASHINGTON 99352

WNP-2
WELD & COMPONENT
IDENTIFICATION DIAGRAM

TITLE:
RCIC STEAM SUPPLY
DWG NO, RCIC-101-2 REV 3

ZONES R-67 & R-57
THIS DRAWING IS INTENDED FOR
USE IN PRESERVICE AND INSERVICE
INSPECTIONS PROGRAMS ONLY.

NO	DATE	REVISION	BY	CHKD	APVD	PIPING SYSTEM	NOM DIA (IN)	SCH	NOM WALL THK	MATERIAL SPECIFICATION	MATL TYPE	CAL BLOCK NO
3	1-11-84	GENERAL UPDATE REDRAWN	K-McA	DPR	TFH	4"RCIC(13)-4	4	80	0.337	SA 106 GR B	CS	UT-30
2	12-2-81	AUGMENTED ISI ADDED	K-McA	DPR	TFH							
1	11-5-80	REVISED AS NOTED	K-McA	TFH	DWP							
0	11-27-78	ISSUED FOR USE	K-McA	TFH	DWP							
A	3-15-78	ISSUED FOR INFORMATION ONLY	K-McA	NCH	DWP							
NO	DATE	REVISION	BY	CHKD	APVD							

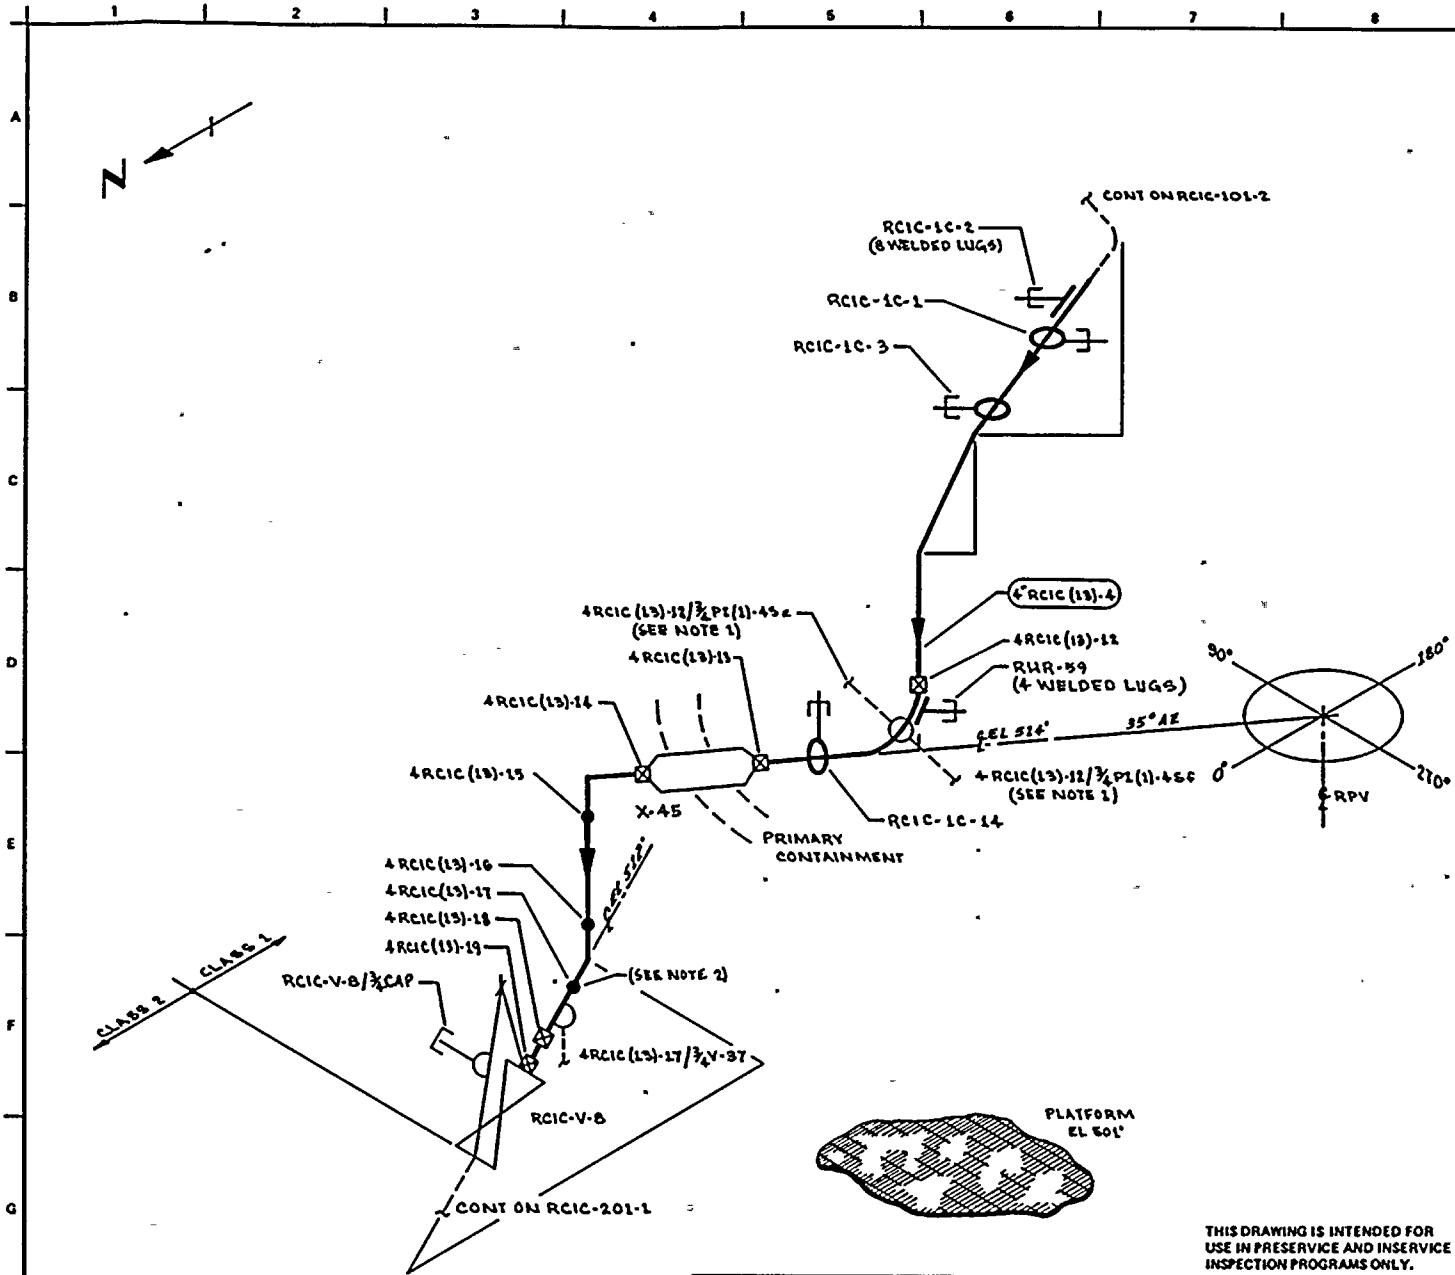


NOTES:

1. EXTEND LEAKAGE EXAM THROUGH CONTAINMENT (X-35 & 4 F) THROUGH EXCESS FLOW CHECK VALVE TO INSTRUMENT TUBING CONNECTION.
2. ACCESS TO WELD 4 RCIC (13)-17 IS RESTRICTED ON ONE SIDE BY 4 RCIC (13)-17 3/4 V-37.
3. ALL CIRCUMFERENTIAL BUTT WELDS GREATER THAN 1 INCH RECEIVE AUGMENTED ISI.

REFERENCES:

- BOVEE & CRILL ISOMETRICS
 RCIC-662-2.4 REV 11
 RCIC-662-5 REV 8

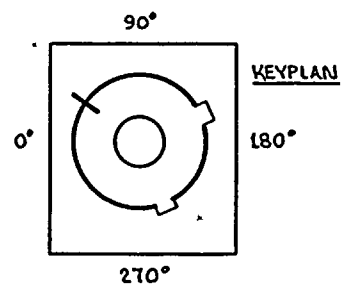

QUALITY CLASS: 1	ASME CODE CLASS: 1
ENGR: D PORTER	DRAWN: V. M. C. A. DATE: 11-7-77

WASHINGTON PUBLIC POWER SUPPLY SYSTEM
 RICHMOND, WASHINGTON 98342

THIS DRAWING IS INTENDED FOR USE IN PRESERVICE AND INSERVICE INSPECTION PROGRAMS ONLY.

PIPING SYSTEM	NOM DIA (IN)	SCH	NOM WALL THK	MATERIAL SPECIFICATION	MATL TYPE	CAL BLOCK NO
4" RCIC (13)-4	4	80	0.337	SA 106 GR B	CS	UT-30
LUGS	NA	NA	NA	SA 516 GR 70	CS	UT-46

NO	DATE	REVISION	BY	CHKD	APPVD
2	10-13-81	ADDED HANGERS, 3/4" CAP & KEYPLAN, LUGS	K.H.	EXP	T.H.
1	11-2-81	AUGMENTED ISI ADDED	K.H.	EXP	T.H.
0	11-27-78	ISSUED FOR USE	K.H.	DR	T.H.
A	2-15-78	ISSUED FOR INFORMATION ONLY	K.H.	DR	T.H.

WNP-2
 WELD & COMPONENT IDENTIFICATION DIAGRAM

TITLE:
 RCIC STEAM SUPPLY

DWG NO: RCIC-101-B REV 2

WNP-02
 INTERVAL: PSI
 PERIOD: NA
 OUTAGE:
 DRAWING NO. RCIC-101

WASHINGTON PUBLIC POWER SUPPLY SYSTEM
 PROGRAM PLAN AND SCHEDULE
 SYSTEM OR COMPONENT: RCIC(12)-4
 DESCRIPTION: RCIC STEAM SUPPLY

PAGE 001
 DATE 12/14/84

<u>IDENT. NO.</u>	<u>DESCRIPTION</u>	SECT. XI <u>EXAM.</u>	EXAM <u>MTM.</u>	<u>PROCEDURE</u>	CAL. <u>BLOCK</u>	<u>INSERVICE</u>		<u>NOTES</u>
						<u>REQ.</u>	<u>SCHEDULED</u> <u>OUTAGE</u>	
10RCIC(12)-1	SWL TO PIPE	B-J	VOL	UTP-10	UT-22			AUGMT
			SUR	PTP-1				AUGMT
10RCIC(12)-2	PIPE TO EL	B-J	VOL	UTP-10	UT-22			AUGMT
			SUR	PTP-1				AUGMT
10RCIC(12)-3	EL TO PIPE	B-J	VOL	UTP-10	UT-22			AUGMT
			SUR	PTP-1				AUGMT
10RCIC(12)-3/1V-76	BI-PASS CONN	B-P	VT-2	N/A				SEE NOTES #6 & #7.
RCIC-75	SPRING	B-K-2	VT-3	303/8.2.17				
			VT-4	303/8.2.17				
10RCIC(12)-4	PIPE TO VLV	B-J	VOL	UTP-10	UT-22			AUGMT
			SUR	PTP-1				AUGMT
RCIC-V-63-BDY	VALVE BODY	B-M-2	VT-1	OCI 7-1				
RCIC-V-63-BLT	VALVE BOLTING	B-G-2	VT-1	OCI 7-1				
RCIC-968S	PSA-1 SNUBBER	B-K-2	VT-3	303/8.2.17				S/N 575, LOCATED ON RCIC-V-63, BYPASS.
			VT-4	303/8.2.17				S/N 575, LOCATED ON RCIC-V-63, BYPASS.
RCIC-969S	PSA-1/2 SNUBBER	B-K-2	VT-3	303/8.2.17				S/N 2113, LOCATED ON RCIC-V-63, BYPASS.

WNP-02
 INTERVAL: PSI
 PERIOD: NA
 OUTAGE:
 DRAWING NO. RCIC-101

WASHINGTON PUBLIC POWER SUPPLY SYSTEM
 PROGRAM PLAN AND SCHEDULE
 SYSTEM OR COMPONENT: RCIC(12)-4
 DESCRIPTION: RCIC STEAM SUPPLY

PAGE 002
 DATE 12/14/84

<u>IDENT. NO.</u>	<u>DESCRIPTION</u>	<u>SECT.</u> <u>XI</u> <u>EXAM.</u>	<u>EXAM</u> <u>MTG.</u>	<u>PROCEDURE</u>	<u>CAL.</u> <u>BLOCK</u>	<u>INSERVICE</u> <u>SCHEDULED</u>		<u>NOTES</u>
						<u>REQ.</u>	<u>OUTAGE</u>	
			VT-4	303/8.2.17				S/N 2113, LOCATED ON RCIC-V-63, BYPASS.
RCIC-970S	PSA-1/2 SNUBBER	B-K-2	VT-3	303/8.2.17				S/N 2528, LOCATED ON RCIC-V-63, BYPASS.
			VT-4	303/8.2.17				S/N 2528, LOCATED ON RCIC-V-63, BYPASS.
RCIC-974S	PSA-1 SNUBBER	B-K-2	VT-3	303/8.2.17				S/N 573
			VT-4	303/8.2.17				S/N 573
RCIC-975S	PSA-1/4 SNUBBER	B-K-2	VT-3	303/8.2.17				S/N 28459
			VT-4	303/8.2.17				S/N 28459
RCIC-976S	SPRING	B-K-2	VT-3	303/8.2.17				
			VT-4	303/8.2.17				
RCIC-V-63/3/4CAP	LEAKOFF CAPPED	B-P	VT-2	N/A				SEE NOTES #6 & #7.
10RCIC(12)-5	VALVE TO PIPE	B-J	VOL	UTP-10		UT-22		AUGHT
			SUR	PTP-1				AUGHT
10RCIC(12)-5/1V-76	BI-PASS CONN	B-P	VT-2	N/A				SEE NOTES #6 & #7.
FWS-30-1	PIPE WHIP	N/A	N/A	N/A				SEE NOTE #1
RCIC-1C-9	PSA-10 SNUBBER	B-K-2	VT-3	303/8.2.17				S/N 7786
			VT-4	303/8.2.17				S/N 7786

WNP-02
 INTERVAL: PSI
 PERIOD: NA
 OUTAGE:
 DRAWING NO. RCIC-101

WASHINGTON PUBLIC POWER SUPPLY SYSTEM
 PROGRAM PLAN AND SCHEDULE
 SYSTEM OR COMPONENT: RCIC(12)-4
 DESCRIPTION: RCIC STEAM SUPPLY

PAGE 003
 DATE 12/14/84

IDENT. NO.	DESCRIPTION	SECT. XI EXAM.	EXAM MTH.	PROCEDURE	CAL. BLOCK	INSERVICE		NOTES
						REQ.	SCHEDULED OUTAGE	
10RCIC(12)-5A	PIPE TO PIPE	B-J	VOL	UTP-10	UT-22			AUGMT
			SUR	PTP-1				AUGMT
RCIC-1C-10	PSA-3 SNUBBER	B-K-2	VT-3	303/8.2.17				S/N 4490
			VT-4	303/8.2.17				S/N 4490
10RCIC(12)-6	PIPE TO EL	B-J	VOL	UTP-10	UT-22			AUGMT
			SUR	PTP-1				AUGMT
10RCIC(12)-6/3/4PI(1)-4D	PRESSURE TAP	B-P	VT-2	N/A				SEE NOTES #6 & #7.
10RCIC(12)-6/3/4PI(1)-4C	PRESSURE TAP	B-P	VT-2	N/A				SEE NOTES #6 & #7.
10RCIC(12)-7	EL TO PIPE	B-J	VOL	UTP-10	UT-23			AUGMT
			SUR	PTP-1				AUGMT
10RCIC(12)-8	PIPE TO PIPE	B-J	VOL	UTP-10	UT-23			AUGMT
			SUR	PTP-1				AUGMT
PWS-30-2	PIPE WHIP	N/A	N/A	N/A				SEE NOTE #1
10RCIC(12)-9	PIPE TO EL	B-J	VOL	UTP-10	UT-23			AUGMT
			SUR	PTP-1				AUGMT
10RCIC(12)-9/3/4PI(1)-4C	PRESSURE TAP	B-P	VT-2	N/A				SEE NOTES #6 & #7.
10RCIC(12)-9/3/4PI(1)-4D	PRESSURE TAP	B-P	VT-2	N/A				SEE NOTES #6 & #7.

WNP-02
 INTERVAL: PSI
 PERIOD: NA
 OUTAGE:
 DRAWING NO. RCIC-101

WASHINGTON PUBLIC POWER SUPPLY SYSTEM
 PROGRAM PLAN AND SCHEDULE
 SYSTEM OR COMPONENT: RCIC(12)-4
 DESCRIPTION: RCIC STEAM SUPPLY

PAGE 004
 DATE 12/14/84

IDENT. NO.	DESCRIPTION	SECT. XI EXAM.	EXAM MTH.	PROCEDURE	CAL. BLOCK	INSERVICE		NOTES
						REQ.	SCHEDULED OUTAGE	
10RCIC(12)-10	EL TO PIPE	B-J	VOL	UTP-10	UT-22			AUGMT
			SUR	PTP-1				AUGMT
10RCIC(12)-10A	PIPE TO PIPE	B-J	VOL	UTP-10	UT-22			AUGMT
			SUR	PTP-1				AUGMT
RCIC-74	SPRING	B-K-2	VT-3	303/8.2.17				
			VT-4	303/8.2.17				
10RCIC(12)-11	PIPE TO TEE	B-J	VOL	UTP-10	UT-22			AUGMT
			SUR	PTP-1				AUGMT
10RCIC(12)-12	TEE TO PIPE	B-J	VOL	UTP-10	UT-22			AUGMT
			SUR	PTP-1				AUGMT
PWS-30-3	PIPE WHIP	N/A	N/A	N/A				SEE NOTE #1
10RCIC(12)-13	PIPE TO EL	B-J	VOL	UTP-10	UT-22			AUGMT
			SUR	PTP-1				AUGMT
10RCIC(12)-14	EL TO PIPE	B-J	VOL	UTP-10	UT-22			AUGMT
			SUR	PTP-1				AUGMT
10RCIC(12)-15	PIPE TO PEN	B-J	VOL	UTP-10	UT-22			AUGMT
			SUR	PTP-1				AUGMT

WNP-02
 INTERVAL: PSI
 PERIOD: NA
 OUTAGE:
 DRAWING NO. RCIC-101

WASHINGTON PUBLIC POWER SUPPLY SYSTEM
 PROGRAM PLAN AND SCHEDULE
 SYSTEM OR COMPONENT: RCIC(12)-4
 DESCRIPTION: RCIC STEAM SUPPLY

PAGE 005
 DATE 12/14/84

IDENT. NO.	DESCRIPTION	SECT. XI EXAM.	EXAM MTH.	PROCEDURE	CAL. BLOCK	INSERVICE		NOTES
						REQ.	SCHEDULED OUTAGE	
10RCIC(12)-16	PEN TO EL	B-J	VOL	UTP-10	UT-22			FITTING TO FITTING, AUGMT.
			SUR	PTP-1				FITTING TO FITTING, AUGMT.
10RCIC(12)-16/3/4V-118	TEST CONN	B-P	VT-2	N/A				SEE NOTES #6 & #7.
10RCIC(12)-17	EL TO PIPE	B-J	VOL	UTP-10	UT-22			AUGMT
			SUR	FTP-1				AUGMT
10RCIC(12)-18	EL TO VALVE	B-J	VOL	UTP-10	UT-22			FITTING TO FITTING, AUGMT.
			SUR	PTP-1				FITTING TO FITTING, AUGMT.
RCIC-V-64-BDY	VALVE BODY	B-M-2	VT-1	QCI, 7-1				
RCIC-V-64-BLT	VALVE BOLTING	B-G-2	VT-1	QCI 7-1				
RCIC-V-64/3/4CAP	LEAKOFF CAPPED	B-P	VT-2	N/A				SEE NOTES #6 & #7.
4RCIC(13)-1	TEE TO PIPE	B-J	VOL	UTP-10	UT-30			AUGMT
			SUR	PTP-1				AUGMT
4RCIC(13)-2	PIPE TO EL	B-J	VOL	UTP-10	UT-30			AUGMT
			SUR	PTP-1				AUGMT
4RCIC(13)-3	EL TO PIPE	B-J	VOL	UTP-10	UT-30			AUGMT

WNP-02
 INTERVAL: PSI
 PERIOD: NA
 OUTAGE:
 DRAWING NO. RCIC-101

WASHINGTON PUBLIC POWER SUPPLY SYSTEM
 PROGRAM PLAN AND SCHEDULE
 SYSTEM OR COMPONENT: RCIC(13)-4
 DESCRIPTION: RCIC STEAM SUPPLY

PAGE 006
 DATE 12/14/84

IDENT. NO.	DESCRIPTION	SECT. XI EXAM.	EYAM MTH.	PROCEDURE	CAL. BLOCK	INSERVICE		NOTES
						REQ.	SCHEDULED OUTAGE	
4RCIC(13)-3/3/4V-620	TEST CONN	B-P	VT-2	N/A				AUGMT SEE NOTES #6 & #7.
PWS-30-6	PIPE WHIP	N/A	N/A	N/A				SEE NOTE #1
PWS-30-5	PIPE WHIP	N/A	N/A	N/A				SEE NOTE #1
4RCIC(13)-4	PIPE TO EL	B-J	VOL	UTP-10	UT-30			AUGMT
4RCIC(13)-4/3/4PI(1)-4SE	PRESSURE TAP	B-P	VT-2	N/A				SEE NOTE #6 & #7.
4RCIC(13)-4/3/4PI(1)-4SF	PRESSURE TAP	B-P	VT-2	N/A				SEE NOTES #6 & #7.
4RCIC(13)-5	EL TO PIPE	B-J	VOL	UTP-10	UT-30			AUGMT
RCIC-1C-12	PSA-3 SNUBBER	B-K-2	VT-3	303/8.2.17				S/N 4405
			VT-4	303/8.2.17				S/N 4405
PWS-30-4	PIPE WHIP	N/A	N/A	N/A				SEE NOTE #1
RCIC-1C-15	PSA-3 SN(2)	B-K-2	VI-3	303/8.2.17				S/N 3953
			VI-4	303/8.2.17				S/N 3953
RCIC-72	SPRING	B-K-2	VT-3	303/8.2.17				
			VT-4	303/8.2.17				

WNP-02
 INTERVAL: PSI
 PERIOD: NA
 OUTAGE:
 DRAWING NO. RCIC-101

WASHINGTON PUBLIC POWER SUPPLY SYSTEM
 PROGRAM PLAN AND SCHEDULE
 SYSTEM OR COMPONENT: RCIC(13)-4
 DESCRIPTION: RCIC STEAM SUPPLY

PAGE 007
 DATE 12/14/84

<u>IDENT. NO.</u>	<u>DESCRIPTION</u>	SECT. XI <u>EXAM.</u>	EXAM <u>MTH.</u>	<u>PROCEDURE</u>	CAL. <u>BLOCK</u>	<u>INSERVICE</u>		<u>NOTES</u>
						<u>REQ.</u>	<u>SCHEDULED</u> <u>OUTAGE</u>	
4RCIC(13)-6	PIPE TO PIPE	B-J	VOL	UTP-10	UT-30			AUGMT
			SUR	PTP-1				AUGMT
4RCIC(13)-7	PIPE TO PIPE	B-J	VOL	UTP-10	UT-30			AUGMT
			SUR	PTP-1				AUGMT
RCIC-1C-16	PSA-3 SNUBBER	B-K-2	VT-3	303/8.2.17				S/N 231
			VT-4	303/8.2.17				S/N 231
RCIC-1C-7	PSA-3 SNUBBER	B-K-2	VT-3	303/8.2.17				S/N 3917
			VT-4	303/8.2.17				S/N 3917
4RCIC(13)-8	PIPE TO PIPE	B-J	VOL	UTP-10	UT-30			AUGMT
			SUR	PTP-1				AUGMT
RCIC-68	SPRING	B-K-2	VT-3	303/8.2.17				
			VT-4	303/8.2.17				
RCIC-1C-8	PSA-3 SNUBBER	B-K-2	VT-3	303/8.2.17				S/N 471
			VT-4	303/8.2.17				S/N 471
RCIC-1C-6(W)	8 WELDED LUGS	B-K-1	VOL	QCI 6-15	UT-30			3/4"Wx1"Hx3"L.
RCIC-1C-6	PSA-3 SN(2)	B-K-2	VT-3	303/8.2.17				S/N 4491/4424
			VT-4	303/8.2.17				S/N 4491/4424

WNP-02
 INTERVAL: PSI
 PERIOD: NA
 OUTAGE:
 DRAWING NO. RCIC-101

WASHINGTON PUBLIC POWER SUPPLY SYSTEM
 PROGRAM PLAN AND SCHEDULE
 SYSTEM OR COMPONENT: RCIC(13)-4
 DESCRIPTION: RCIC STEAM SUPPLY

PAGE 008
 DATE 12/14/84

IDENT. NO.	DESCRIPTION	SECT. XI EXAM.	EXAM MTH.	PROCEDURE	CAL. BLOCK	INSERVICE		NOTES
						REQ.	SCHEDULED OUTAGE	
RCIC-1C-4	PSA-1 SNUBBER	B-K-2	VT-3	303/8.2.17				S/N 618
			VT-4	303/8.2.17				S/N 618
RCIC-67	SPRING	B-K-2	VT-3	303/8.2.17				
			VT-4	303/9.2.17				
4RCIC(13)-9	PIPE TO PIPE	B-J	VOL	UTP-10	UT-30			AUGMT
			SUR	QCI 3-3				AUGMT
RCIC-1C-5	PSA-10 SNUBBER	B-K-2	VT-3	303/8.2.17				S/N 13029
			VT-4	303/8.2.17				S/N 13029
RCIC-1C-13(W)	8 WELDED LUGS	B-K-1	VOL	UTP-26	UT-30			3/4"Wx1-1/16"Hx4"L.
RCIC-1C-13	PSA-3 SN(2)	B-K-2	VT-3	303/8.2.17				S/N 4461/4450
			VT-4	303/8.2.17				S/N 4461/4450
RCIC-61	SPRING	B-K-2	VT-3	303/8.2.17				
			VT-4	303/8.2.17				
RCIC-66	SPRING	B-K-2	VT-3	303/8.2.17				
			VT-4	303/8.2.17				
4RCIC(13)-10	PIPE TO PIPE	B-J	VOL	UTP-10	UT-30			AUGMT
			SUR	PTP-1				AUGMT

WNP-02
 INTERVAL: PSI
 PERIOD: NA
 OUTAGE:
 DRAWING NO. RCIC-101

WASHINGTON PUBLIC POWER SUPPLY SYSTEM
 PROGRAM PLAN AND SCHEDULE
 SYSTEM OR COMPONENT: RCIC(13)-4
 DESCRIPTION: RCIC STEAM SUPPLY

PAGE 009
 DATE 12/14/84

<u>IDENT. NO.</u>	<u>DESCRIPTION</u>	<u>SECT.</u> <u>XI</u> <u>EXAM.</u>	<u>EXAM</u> <u>MTH.</u>	<u>PROCEDURE</u>	<u>CAL.</u> <u>BLOCK</u>	<u>INSERVICE</u>		<u>NOTES</u>
						<u>REQ.</u>	<u>SCHEDULED</u> <u>OUTAGE</u>	
4RCIC(13)-11	PIPE TO PIPE	B-J	VOL	UTP-10	UT-30			AUGMT
			SUR	OCI 3-3				AUGMT
RCIC-1C-2(W)	8 WELDED LUGS	B-K-1	VOL	OCI 6-15	UT-30			3/4"W x1"H x2"L.
RCIC-1C-2	PSA-3 SN(2)	B-K-2	VT-3	303/8.2.17				S/N 482/631
			VT-4	303/8.2.17				S/N 482/631
RCIC-1C-1	PSA-1 SNUBBER	B-K-2	VT-3	303/8.2.17				S/N 359
			VT-4	303/8.2.17				S/N 359
RCIC-1C-3	PSA-1 SNUBBER	B-K-2	VT-3	303/8.2.17				S/N 346
			VT-4	303/8.2.17				S/N 346
4RCIC(13)-12	PIPE TO PIPE	B-J	VOL	UTP-10	UT-30			AUGMT
			SUR	PTP-1				AUGMT
RCIC-59	SPRING (2)	B-K-2	VT-3	303/8.2.17				
			VT-4	303/8.2.17				
4RCIC(13)-12/3/4PI(1)-4E	PRESSURE TAP	B-P	VT-2	N/A				SEE NOTES #6 & #7.
4RCIC(13)-12/3/4PI(1)-4F	PRESSURE TAP	B-P	VT-2	N/A				SEE NOTES #6 & #7.
RCIC-1C-14	PSA-1 SNUBBER	B-K-2	VT-3	303/8.2.17				S/N 22371
			VT-4	303/8.2.17				S/N 22371

WNP-02
 INTERVAL: PSI
 PERIOD: NA
 OUTAGE:
 DRAWING NO. RCIC-101

WASHINGTON PUBLIC POWER SUPPLY SYSTEM
 PROGRAM PLAN AND SCHEDULE
 SYSTEM OR COMPONENT: RCIC(13)-4
 DESCRIPTION: RCIC STEAM SUPPLY

PAGE 010
 DATE 12/14/84


<u>IDENT. NO.</u>	<u>DESCRIPTION</u>	SECT. XI <u>EXAM.</u>	<u>EXAM</u> MTH.	<u>PROCEDURE</u>	<u>CAL.</u> BLOCK	<u>INSERVICE</u>		<u>NOTES</u>
						<u>REQ.</u>	<u>SCHEDULED</u> OUTAGE	
4RCIC(13)-13	PIPE TO PEN	B-J	VOL	UTP-10	UT-30			AUGMT
			SUR	PTP-1				AUGMT
4RCIC(13)-14	PEN TO EL	B-J	VOL	UTP-10	UT-30			FITTING TO FITTING, AUGMT.
			SUR	PTP-1				FITTING TO FITTING, AUGMT.
4RCIC(13)-15	EL TO PIPE	B-J	VOL	UTP-30	UT-30			AUGMT
			SUR	PTP-1				AUGMT
4RCIC(13)-16	PIPE TO EL	B-J	VOL	UTP-10	UT-30			AUGMT
			SUR	PTP-1				AUGMT
4RCIC(13)-17	EL TO PIPE	B-J	VOL	UTP-10	UT-30			AUGMT
			SUR	PTP-1				AUGMT
4RCIC(13)-17/3/4V-37	TEST CONN	B-P	VT-2	N/A				SEE NOTES #6 & #7.
4RCIC(13)-18	PIPE TO PIPE	B-J	VOL	QCI 6-13	UT-30			AUGMT
			SUR	QCI 3-3				AUGMT
4RCIC(13)-19	PIPE TO VLV	B-J	VOL	QCI 6-13	UT-30			AUGMT
			SUR	QCI 3-3				AUGMT
RCIC-V-8-BDY	VALVE BODY	B-M-2	VT-1	QCI 7-1				
RCIC-V-8-BLT	VALVE BOLTING	B-G-2	VT-1	QCI 7-1				


WNP-02
 INTERVAL: PSI
 PERIOD: NA
 OUTAGE:
 DRAWING NO. RCIC-101

WASHINGTON PUBLIC POWER SUPPLY SYSTEM
 PROGRAM PLAN AND SCHEDULE
 SYSTEM OR COMPONENT: RCIC(13)-4
 DESCRIPTION: RCIC STEAM SUPPLY

PAGE 011
 DATE 12/14/84

<u>IDENT. NO.</u>	<u>DESCRIPTION</u>	<u>SECT.</u> XI	<u>EXAM</u> EXAM.	<u>MTH.</u>	<u>PROCEDURE</u>	<u>CAL.</u> BLOCK	<u>INSERVICE</u>		<u>NOTES</u>
							<u>REQ.</u>	<u>SCHEDULED</u> OUTAGE	
RCIC-V-8/3/4CAP	LEAKOFF CAPPED	B-P	VT-2	N/A					SEE NOTES #6 & #7.
RCIC-PB-101	RCIC PRES BNDRY	B-P	VT-2	N/A					SEE NOTES #6 & #7.

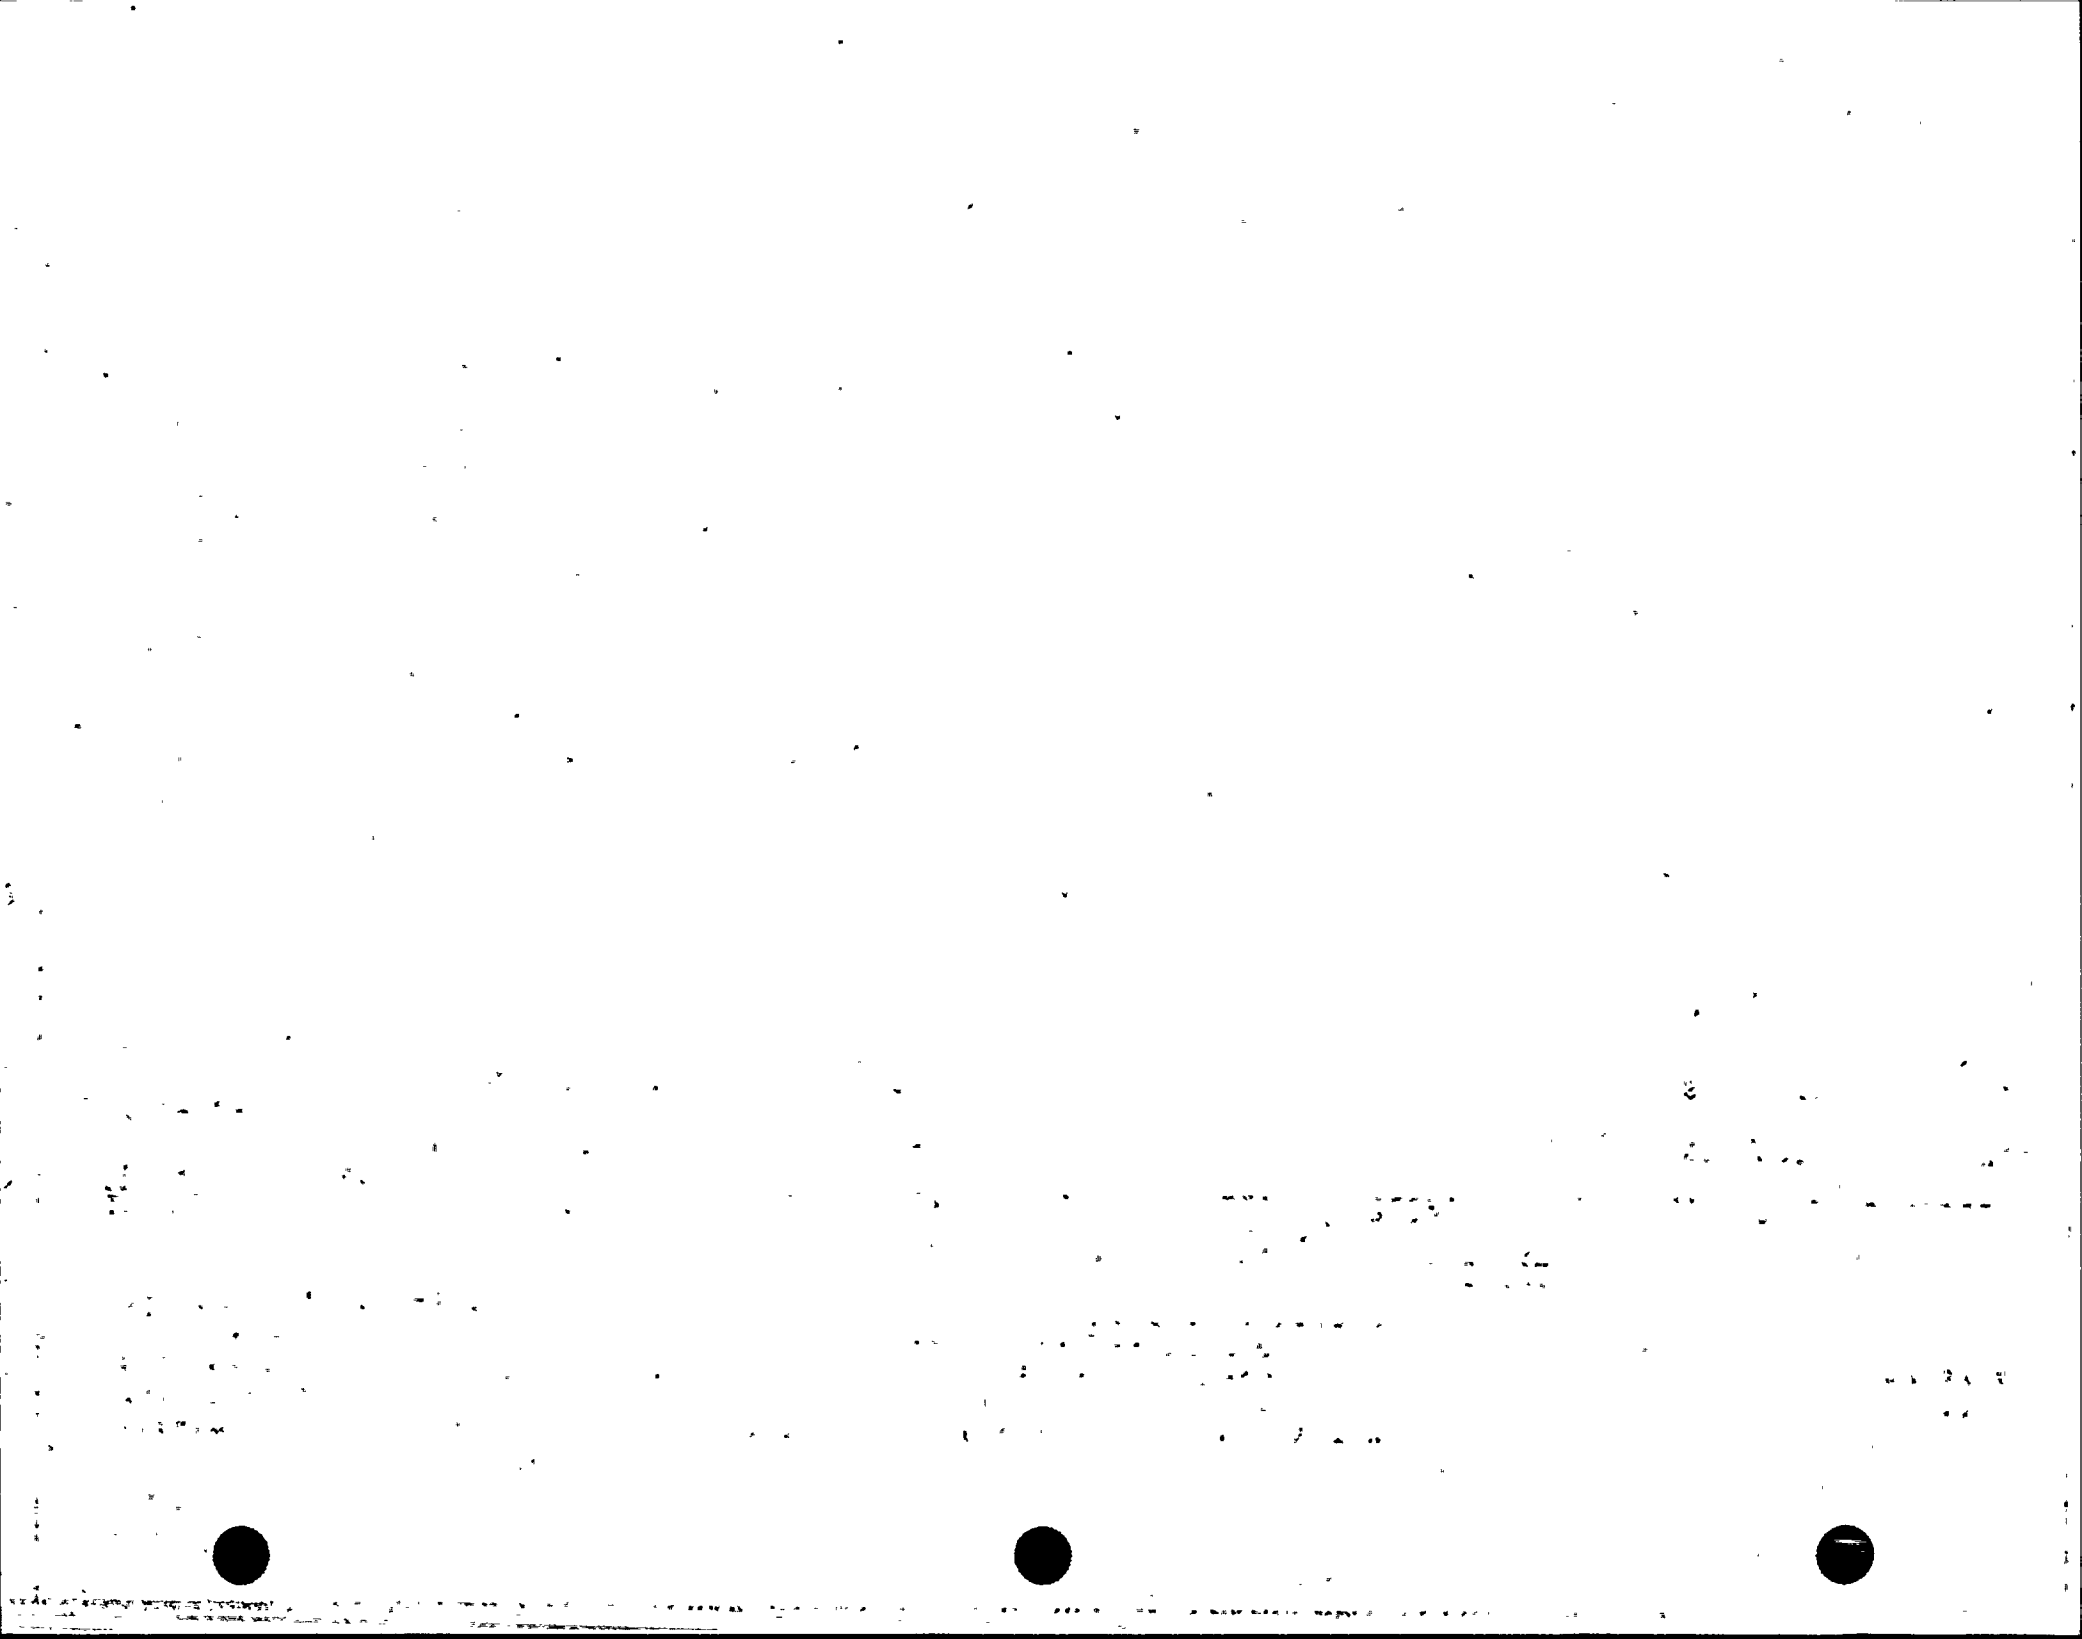

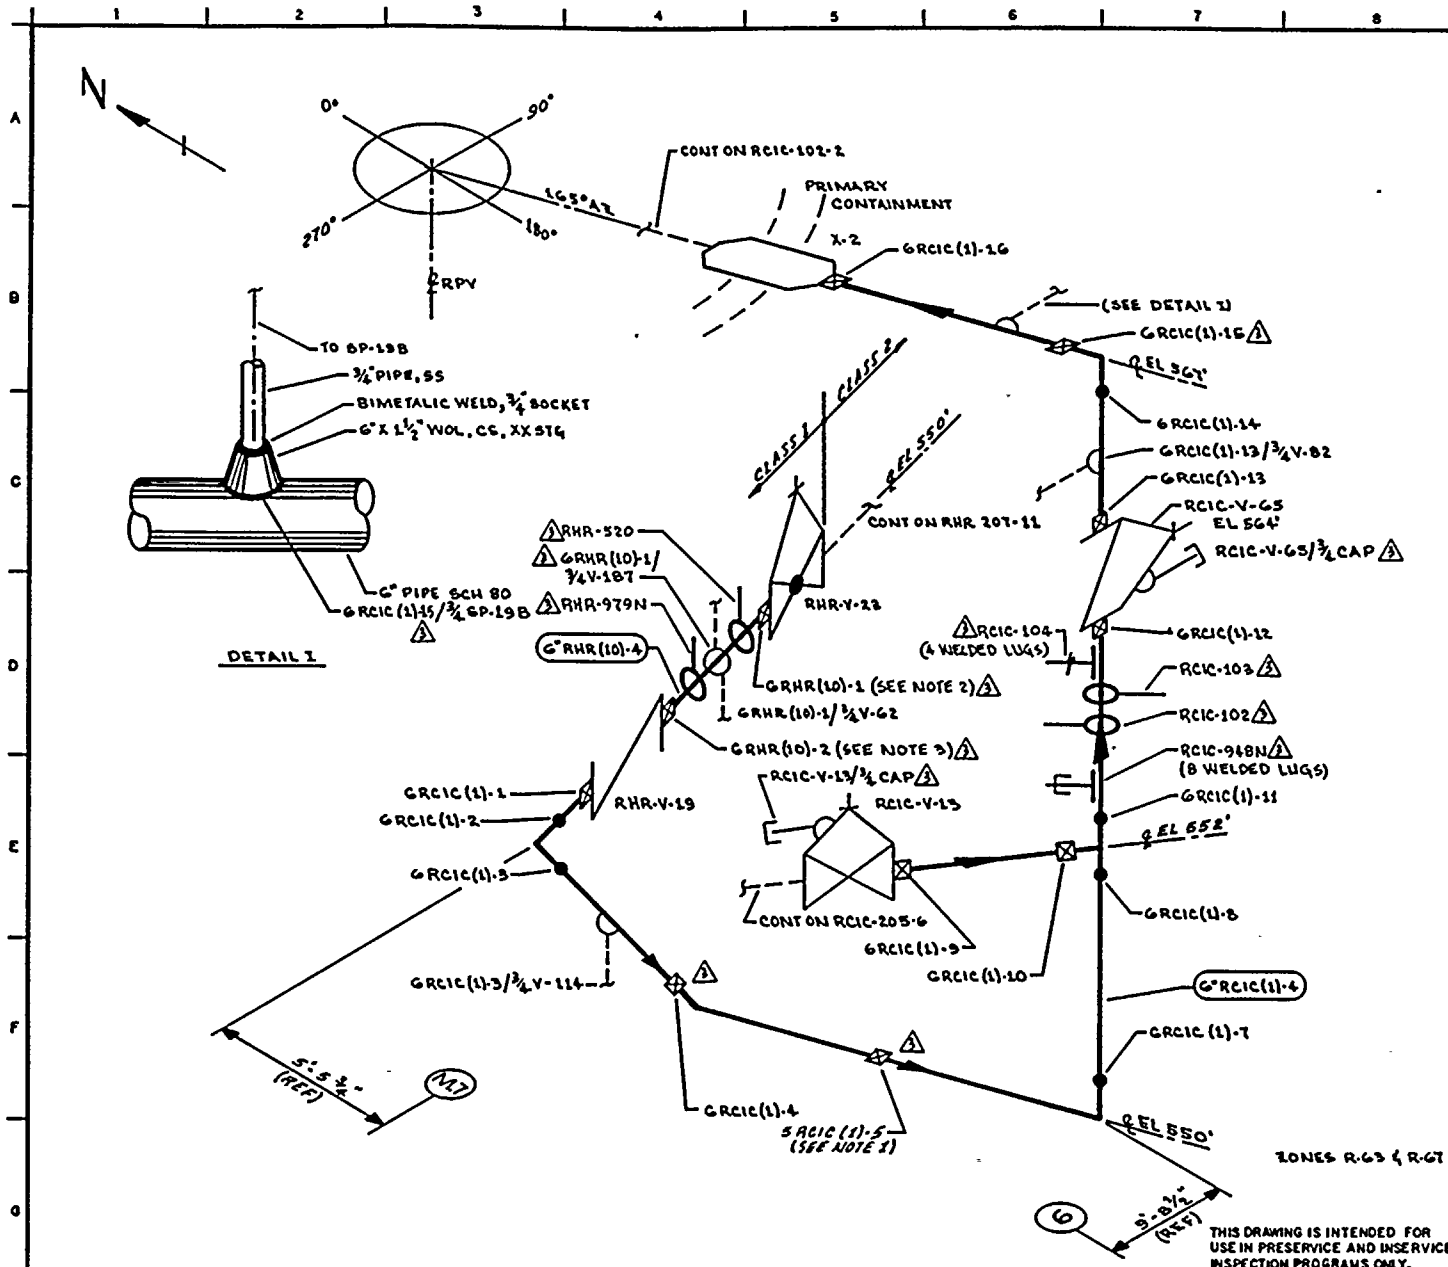


NOTES:

1. WELD GRCIC(1)-5 IS FITTING TO FITTING.
2. ACCESS TO WELD GRHR(10)-1 REQUIRES REMOVAL OF RHR-520.
3. ACCESS TO WELD GRHR(10)-2 REQUIRES REMOVAL OF RHR-979N.

REFERENCES:

- DOVER & CRAIL ISOMETRICS
- | | |
|----------------|--------|
| RHR-748-1 | REV 9 |
| RCIC-659-22-23 | REV 7 |
| RCIC-659-24 | REV 12 |
| RCIC-659-25 | REV 10 |

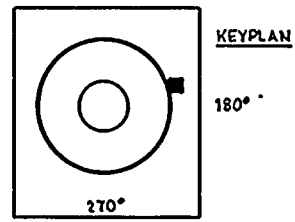

QUALITY CLASS: 1 ASME CODE CLASS: 1
 ENGR: D PORTER DRAWN: MCLA DATE: 4-26-78

WASHINGTON PUBLIC POWER SUPPLY SYSTEM
 RICHLAND, WASHINGTON 99352

WNP-2
 WELD & COMPONENT IDENTIFICATION DIAGRAM

TITLE: RESIDUAL HEAT REMOVAL/ REACTOR CORE ISOLATION COOLANT HEAD SPRAY


DWG NO: RCIC-102-1 REV 3

NO	DATE	REVISION	BY	CHKD	APPVD	PIPING SYSTEM	NOM DIA (IN)	SCH	NOM WALL THK	MATERIAL SPECIFICATION	MATL TYPE	CAL BLOCK NO
3	10-13-83	REVISED AS NOTED ADDED KEYPLAN, LUGS	KMA	MM	TP	G RHR (10)-4	6	80	0.432	SA 106 GR B	CS	UT-28
2	11-5-80	DELETED GRCIC(1)-6 ADDED NOTE 1	KMA	MM	TP	G RCIC (1)-4	6	80	0.432	SA 106 GR B	CS	UT-28
1	1-10-79	CAL BLOCK REFERENCE CHANGED	KMA	MM	TP	LUGS	NA	NA	NA	SA 516 GR 70	CS	UT-46
0	11-21-78	ISSUED FOR USE	KMA	MM	TP							
A	5-19-78	ISSUED FOR INFORMATION ONLY	KMA	MM	TP							

THIS DRAWING IS INTENDED FOR USE IN PRESERVICE AND INSERVICE INSPECTION PROGRAMS ONLY.


ZONES R-63 & R-67



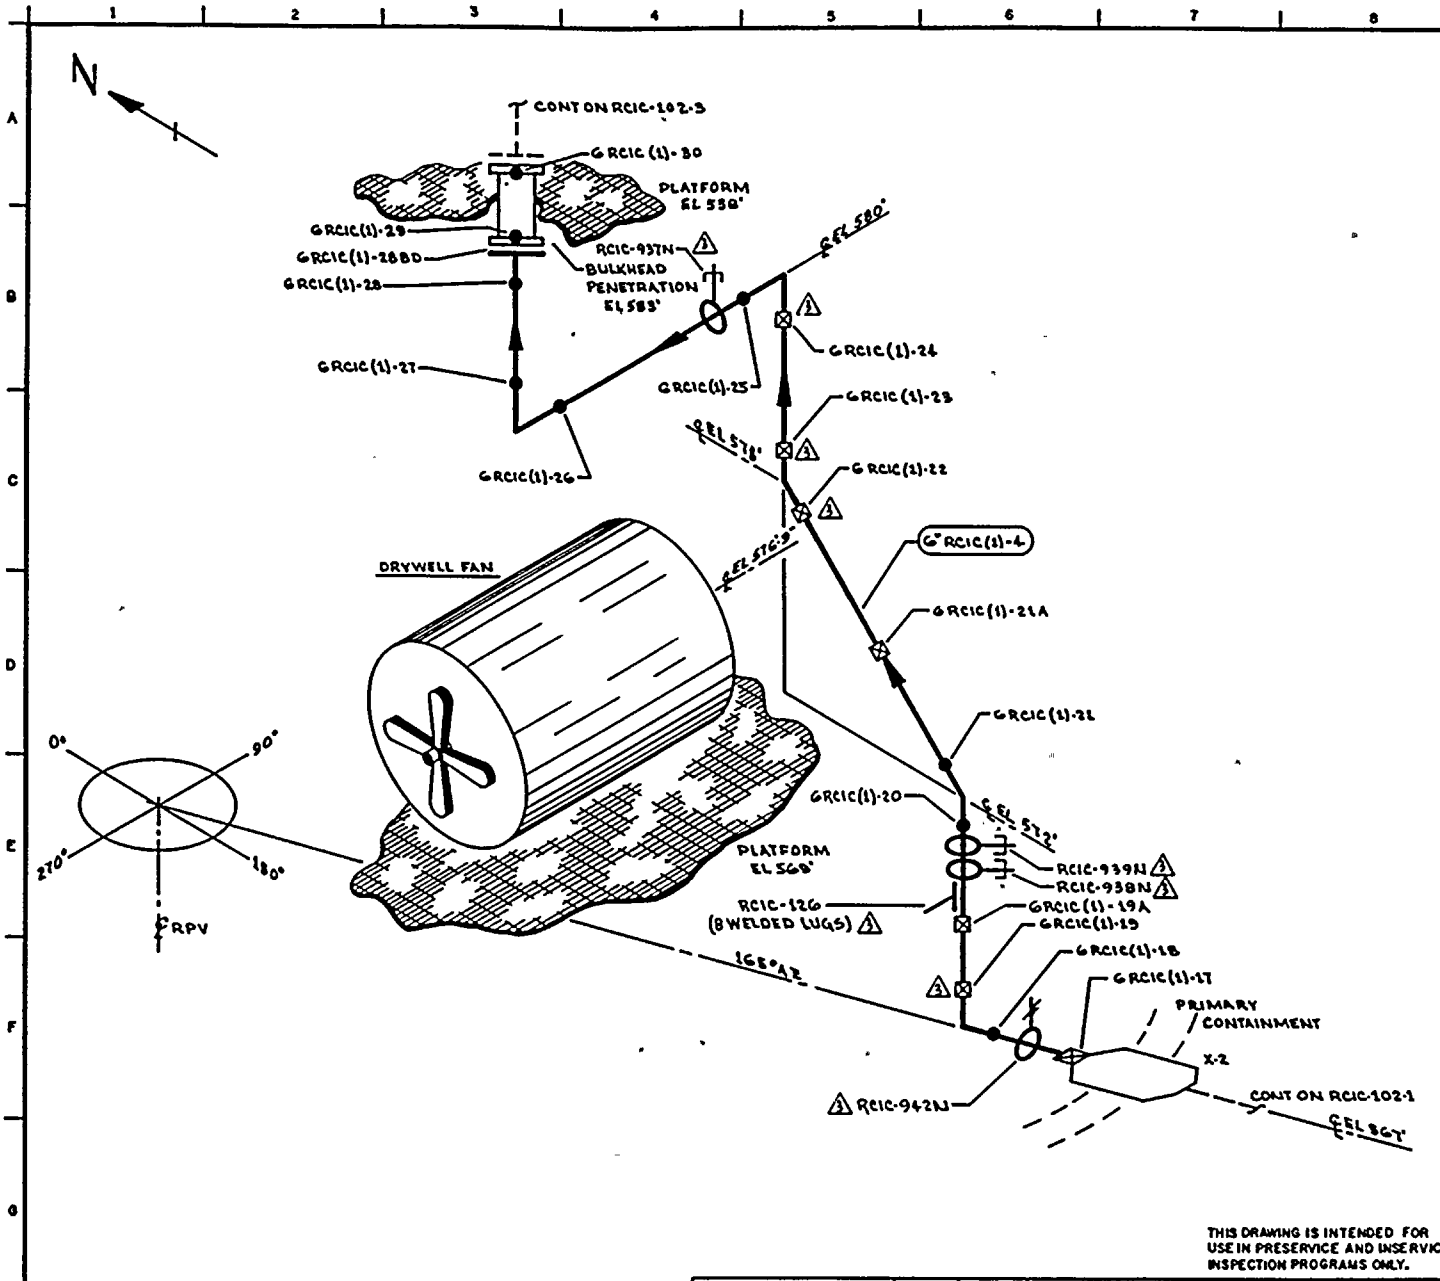

NOTES:
 1. ACCESS TO WELDS GRCIC(1)-22 THRU GRCIC(1)-27 REQUIRES TEMPORARY SCAFFOLDING.

REFERENCE:
 BOVEE & CRAIG ISOMETRIC
 RCIC-659-28 REV 7

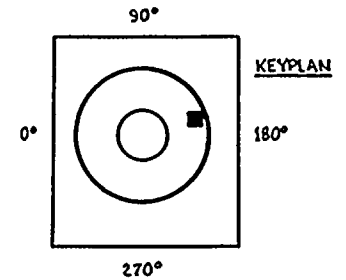

THIS DRAWING IS INTENDED FOR USE IN PRESERVE AND INSERVICE INSPECTION PROGRAMS ONLY.

QUALITY CLASS: 1 ASME CODE CLASS: 1
 ENGR: D PORTER DRAWN: K. M. A. DATE: 4-25-78

 WASHINGTON PUBLIC POWER SUPPLY SYSTEM
 RICHLAND, WASHINGTON 99362


NO	DATE	REVISION	BY	CHKD	APPVD	PIPING SYSTEM	NOM DIA (IN)	SCH	NOM WALL THK	MATERIAL SPECIFICATION	MATL TYPE	CAL BLOCK NO
3	9-26-83	REVISED AS NOTED ADDED KEYPLAN	K.M.A.	D.P.R.	T.P.A.	GRCIC (1)-4	6	80	0.432	SA 106 GR B	CS	UT-28
2	11-5-80	ADDED FW 19A & 21A, HNGR RCIC-12	K.M.A.	T.P.R.	D.P.V.	LUGS	NA	NA	NA	SA 516 GR 70	CS	UT-46
1	1-16-79	CAL BLOCK REFERENCE CHANGED	K.M.A.	T.P.R.	D.P.V.							
0	11-27-78	ISSUED FOR USE	K.M.A.	T.P.R.	D.P.V.							
A	5-19-78	ISSUED FOR INFORMATION ONLY	K.M.A.	T.P.R.	D.P.V.							

WNP-2
 WELD & COMPONENT IDENTIFICATION DIAGRAM

TITLE:
 RESIDUAL HEAT REMOVAL / REACTOR CORE ISOLATION COOLANT HEAD SPRAY


DWG NO: RCIC-102-2 REV 3



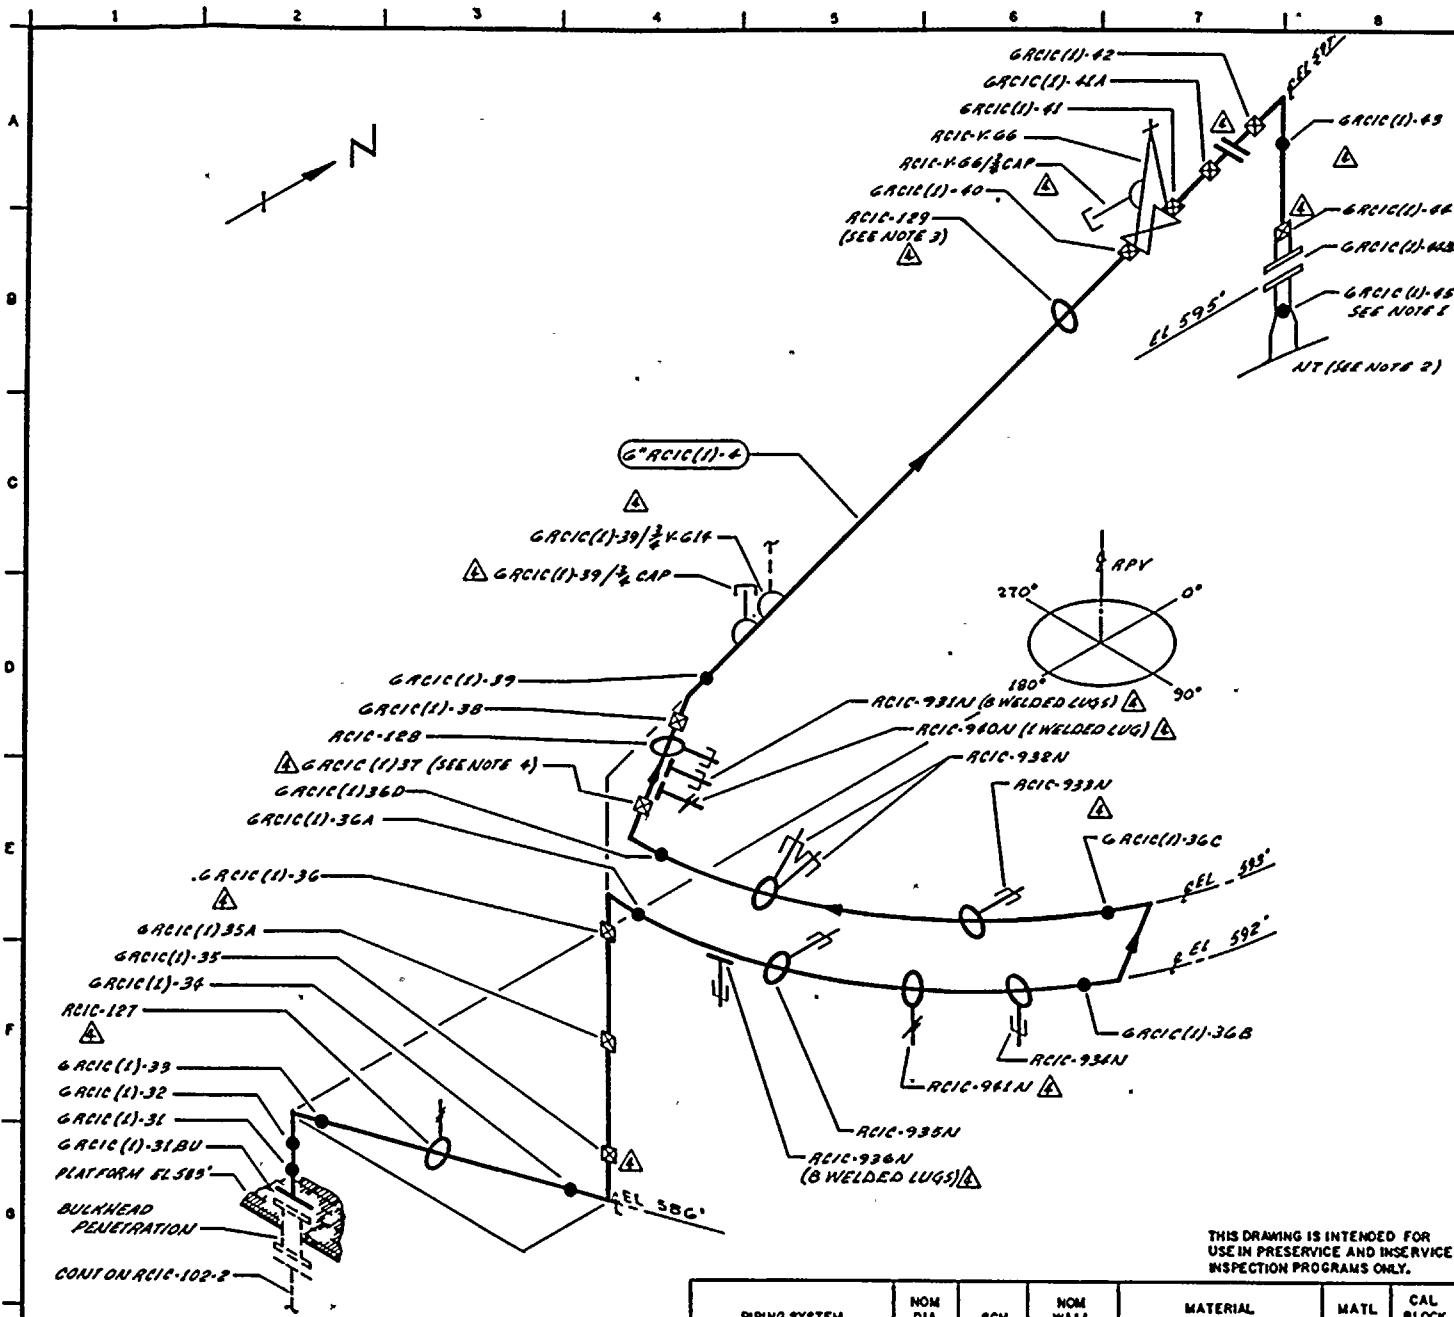

- NOTES:**
1. WELD 6\"/>

REFERENCES:
 BOYKE & CHAIL ISOMETRIC
 RCIC-G59-27.29 REV 12

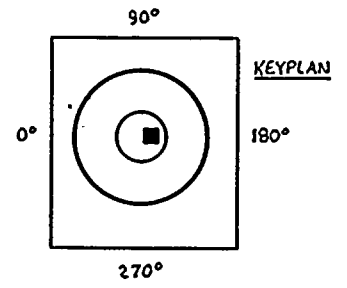

QUALITY CLASS: 1	ASME CODE CLASS: 1
ENGR: D PORTER	DATE: 6-26-78
DRAWN: K.A.H.	

WASHINGTON PUBLIC POWER SUPPLY SYSTEM
 RICHLAND, WASHINGTON 98362

THIS DRAWING IS INTENDED FOR USE IN PRESERVE AND INSERVICE INSPECTION PROGRAMS ONLY.

PIPING SYSTEM	NOM DIA (IN)	SCH	NOM WALL THK	MATERIAL SPECIFICATION	MATL TYPE	CAL BLOCK NO
6\"/>	6	80	0.482	SA 106 GR B	CS	UN28
LUGS	NA	NA	NA	SA 516 GR 70	CS	UT-46

NO	DATE	REVISION	BY	CHKD	APPVD
4	6-26-78	REVISED AS NOTED ADDED KEYPLAN & LUGS	K.A.H.	SP	TD
3	11-1-78	REDRAWN - CONFIGURATION CHG-ADDED ANGLES	K.A.H.	SP	DUL
2	8-30-78	ADDED NOTE 2	K.A.H.	SP	RIB
1	1-18-78	CAL BLOCK REFERENCE CHANGE	K.A.H.	SP	SP
0	11-27-78	ISSUED FOR USE	K.A.H.	SP	SP
A	5-19-78	ISSUED FOR INFORMATION ONLY	K.A.H.	SP	SP

WNP-2
 WELD 8 COMPONENT
 IDENTIFICATION DIAGRAM

TITLE:
 RESIDUAL HEAT REMOVAL/ REACTOR CORE ISOLATION COOLANT HEAD SPRAY

DWG NO: RCIC-108-3 REV 4

DRAWN BY K.A.H.

WNP-02
 INTERVAL: PSI
 PERIOD: NA
 OUTAGE:
 DRAWING NO. RCIC-102

WASHINGTON PUBLIC POWER SUPPLY SYSTEM
 PROGRAM PLAN AND SCHEDULE
 SYSTEM OR COMPONENT: RHR(10)-4
 DESCRIPTION: RPV HEAD SPRAY

PAGE 001
 DATE 12/14/84

<u>IDENT. NO.</u>	<u>DESCRIPTION</u>	<u>SECT.</u> <u>XI</u> <u>EXAM.</u>	<u>EXAM</u> <u>MTM.</u>	<u>PROCEDURE</u>	<u>CAL.</u> <u>BLOCK</u>	<u>INSERVICE</u>		<u>NOTES</u>
						<u>REQ.</u>	<u>SCHEDULED</u> <u>OUTAGE</u>	
RHR-V-23-BDY	VALVE BODY	B-M-2	VT-1	QCI 7-1				
6RHR(10)-1	VLV TO PIPE	B-J	VOL	UTP-10	UT-28			
			SUR	PTP-1				
RHR-520	SPRING	B-K-2	VT-3	303/8.2.17				
			VT-4	303/8.2.17				
6RHR(10)-1/3/4V-187	TEST CONN	B-P	VT-2	N/A				SEE NOTES #6 & #7.
6RHR(10)-1/3/4V-62	TEST CONN	B-P	VT-2	N/A				SEE NOTES #6 & #7.
RHR-979N	RIGID HANGER	B-K-2	VT-3	303/8.2.17				
6RHR(10)-2	PIPE TO VLV	B-J	VOL	UTP-10	UT-28			FITTING TO FITTING < 6"
			SUR	PTP-1				FITTING TO FITTING < 6"
RHR-V-19-BDY	VALVE BODY	B-M-2	VT-1	QCI 7-1				
6RCIC(1)-1	VALVE TO PIPE	B-J	VOL	UTP-10	UT-28			
			SUR	PTP-1				
6RCIC(1)-2	PIPE TO EL	B-J	VOL	UTP-10	UT-28			
			SUR	PTP-1				
6RCIC(1)-3	EL TO PIPE	B-J	VOL	UTP-10	UT-28			
			SUR	PTP-1				

WNP-02
 INTERVAL: PSI
 PERIOD: NA
 OUTAGE:
 DRAWING NO. RCIC-102

WASHINGTON PUBLIC POWER SUPPLY SYSTEM
 PROGRAM PLAN AND SCHEDULE
 SYSTEM OR COMPONENT: RCIC(1)-4
 DESCRIPTION: RPV HEAD SPRAY

PAGE 002
 DATE 12/14/84

IDENT. NO.	DESCRIPTION	SECT. XI EXAM.	EXAM MTH.	PROCEDURE	CAL. BLOCK	INSERVICE		NOTES
						REQ.	SCHEDULED OUTAGE	
6RCIC(1)-3/3/4V-11 ⁴	TEST CONN	B-P	VT-2	N/A				SEE NOTES #6 & #7.
6RCIC(1)-4	PIPE TO EL	B-J	VOL	UTP-10	UT-28			
			SUR	PTP-1				
6RCIC(1)-5	EL TO EL	B-J	VOL	UTP-1	UT-28			FITTING TO FITTING.
			SUR	PTP-1				FITTING TO FITTING.
6RCIC(1)-7	EL TO PIPE	B-J	VOL	UTP-10	UT-28			
			SUR	PTP-1				
6RCIC(1)-8	PIPE TO TEE	B-J	VOL	UTP-10	UT-28			
			SUR	PTP-1				
RCIC-V-13-BDY	VALVE BODY	B-M-2	VT-1	OCI 7-1				
RCIC-V-13-BLT	VALVE BOLTING	B-G-2	VT-1	OCI 7-1				
RCIC-V-13/3/4CAP	LEAKOFF CAPPED	B-P	VT-2	N/A				SEE NOTES #6 & #7.
6RCIC(1)-9	VLV TO PIPE	B-J	VOL	UTP-10	UT-28			
			SUR	PTP-1				
6RCIC(1)-10	PIPE TO TEE	B-J	VOL	UTP-10	UT-28			
			SUR	PTP-1				
6RCIC(1)-11	TEE TO PIPE	B-J	VOL	UTP-10	UT-28			
			SUR	PTP-1				

WNP-02
 INTERVAL: PSI
 PERIOD: NA
 OUTAGE:
 DRAWING NO. RCIC-102

WASHINGTON PUBLIC POWER SUPPLY SYSTEM
 PROGRAM PLAN AND SCHEDULE
 SYSTEM OR COMPONENT: RCIC(1)-4
 DESCRIPTION: RPV HEAD SPRAY

PAGE 003
 DATE 12/14/84

<u>IDENT. NO.</u>	<u>DESCRIPTION</u>	<u>SECT.</u> <u>XI</u> <u>EXAM.</u>	<u>EXAM</u> <u>MTH.</u>	<u>PROCEDURE</u>	<u>CAL.</u> <u>BLOCK</u>	<u>INSERVICE</u>		<u>NOTES</u>
						<u>REQ.</u>	<u>SCHEDULED</u> <u>OUTAGE</u>	
RCIC-948N	PSA-1 SN(2)	B-K-2	VT-3	303/8.2.17				S/N
			VT-4	303/8.2.17				S/N
RCIC-102	STRUT	B-K-2	VT-3	303/8.2.17				
RCIC-103	STRUT	B-K-2	VT-3	303/8.2.17				
RCIC-104	SPRING	B-K-2	VT-3	303/8.2.17				
			VT-4	303/8.2.17				
6RCIC(1)-12	PIPE TO VLV	B-J	VOL	QCI 6-13	UT-28			
			SUR	QCI 3-3				
RCIC-V-65-BDY	VALVE BODY	B-M-2	VT-1	QCI 7-1				
RCIC-V-65-BLT	VALVE BOLTING	B-G-2	VT-1	QCI 7-1				
RCIC-V-65/3/4CAP	LEAKOFF CAPPED	B-P	VT-2	N/A				SEE NOTES #6 & #7.
6RCIC(1)-13	VLV TO PIPE	B-J	VOL	QCI 6-13	UT-28			
			SUR	QCI 3-3				
6RCIC(1)-13/3/4V-82	TEST CONN	B-P	VT-2	N/A				SEE NOTES #6 & #7.
6RCIC(1)-14	PIPE TO EL	B-J	VOL	UTP-10	UT-28			
			SUR	QCI 3-3				
6RCIC(1)-15	EL TO PIPE	B-J	VOL	QCI 6-13	UT-28			
			SUR	QCI 3-3				

WNP-02
 INTERVAL: PSI
 PERIOD: NA
 OUTAGE:
 DRAWING NO. RCIC-102

WASHINGTON PUBLIC POWER SUPPLY SYSTEM
 PROGRAM PLAN AND SCHEDULE
 SYSTEM OR COMPONENT: RCIC(1)-4
 DESCRIPTION: RPV HEAD SPRAY

PAGE 004
 DATE 12/14/84

IDENT. NO.	DESCRIPTION	SECT. XI	EXAM EXAM.	PROCEDURE	CAL. BLOCK	INSERVICE		NOTES
						REQ.	SCHEDULED OUTAGE	
6RCIC(1)-15/3/4SP-19B	PIPE TO VOL	B-J	SUR	PTP-1				
6RCIC(1)-16	PIPE TO PEN	B-J	VOL	QCI 6-13	UT-28			PEN. X-2
			SUR	QCI 3-3				
6RCIC(1)-17	PEN TO PIPE	B-J	VOL	UTP-10	UT-28			
			SUR	PTP-1				
RCIC-942N	SPRING	B-K-2	VT-3	303/8.2.17				
			VT-4	303/8.2.17				
6RCIC(1)-18	PIPE TO EL	B-J	VOL	UTP-10	UT-28			
			SUR	PTP-1				
6RCIC(1)-19	EL TO PIPE	B-J	VOL	UTP-10	UT-28			
			SUR	PTP-1				
6RCIC(1)-19A	PIPE TO PIPE	B-J	VOL	UTP-10	UT-28			
			SUR	PTP-1				
RCIC-126	PSA-1 SN(2)	B-K-2	VT-3	303/8.2.17				S/N 585/586
			VT-4	303/8.2.17				S/N 585/586
RCIC-938N	PSA-3 SNUBBER	B-K-2	VT-3	303/8.2.17				S/N 2378
			VT-4	303/8.2.17				S/N 2378

WNP-02
 INTERVAL: PSI
 PERIOD: NA
 OUTAGE:
 DRAWING NO. RCIC-102

WASHINGTON PUBLIC POWER SUPPLY SYSTEM
 PROGRAM PLAN AND SCHEDULE
 SYSTEM OR COMPONENT: RCIC(1)-4
 DESCRIPTION: RPV HEAD SPRAY

PAGE 005
 DATE 12/14/84

IDENT. NO.	DESCRIPTION	SECT. XI EXAM.	EXAM MTH.	PROCEDURE	CAL. BLOCK	INSERVICE		NOTES
						REQ.	SCHEDULED OUTAGE	
RCIC-939N	PSA-3 SNUBBER	B-K-2	VT-3	303/8.2.17				S/N 4476
			VT-4	303/8.2.17				S/N 4476
6RCIC(1)-20	PIPE TO EL	B-J	VOL	UTP-10	UT-28			
			SUR	PTP-1				
6RCIC(1)-21	EL TO PIPE	B-J	VOL	UTP-10	UT-28			
			SUR	PTP-1				
6RCIC(1)-21A	PIPE TO PIPE	B-J	VOL	UTP-10	UT-28			
			SUR	PTP-1				
6RCIC(1)-22	PIPE TO EL	B-J	VOL	UTP-10	UT-28			
			SUR	PTP-1				
6RCIC(1)-23	EL TO PIPE	B-J	VOL	UTP-10	UT-28			
			SUR	PTP-1				
6RCIC(1)-24	PIPE TO EL	B-J	VOL	UTP-10	UT-28			
			SUR	PTP-1				
6RCIC(1)-25	EL TO PIPE	B-J	VOL	UTP-10	UT-28			
			SUR	PTP-1				
RCIC-937N	PSA-3 SNUBBER	B-K-2	VT-3	303/8.2.17				S/N 2571

WNP-02
 INTERVAL: PSI
 PERIOD: NA
 OUTAGE:
 DRAWING NO. RCIC-102

WASHINGTON PUBLIC POWER SUPPLY SYSTEM
 PROGRAM PLAN AND SCHEDULE
 SYSTEM OR COMPONENT: RCIC(1)-4
 DESCRIPTION: RPV HEAD SPRAY

PAGE 006
 DATE 12/14/84

<u>IDENT. NO.</u>	<u>DESCRIPTION</u>	SECT. XI <u>EXAM.</u>	EXAM <u>MTM.</u>	<u>PROCEDURE</u>	CAL. <u>BLOCK</u>	<u>INSERVICE</u>		<u>NOTES</u>
						<u>REQ.</u>	<u>SCHEDULED OUTAGE</u>	
6RCIC(1)-26	PIPE TO EL	B-J	VT-4	303/8.2.17	UT-28			S/N 2571
6RCIC(1)-27	EL TO PIPE	B-J	SUR	PTP-1	UT-28			
6RCIC(1)-28	PIPE TO FLANGE	B-J	SUR	PTP-1	UT-28			
6RCIC(1)-28BD	FLANGE BOLTING	B-G-2	VT-1	QCI 7-1				
6RCIC(1)-29	FLANGE TO PIPE	B-J	SUR	PTP-1	UT-28			
6RCIC(1)-30	PIPE TO FLANGE	B-J	SUR	PTP-1	UT-28			
6RCIC(1)-31BD	FLANGE BOLTING	B-G-2	VT-1	QCI 7-1				
6RCIC(1)-31	FLANGE TO PIPE	B-J	SUR	PTP-1	UT-28			
6RCIC(1)-32	PIPE TO EL	B-J	SUR	PTP-1	UT-28			
6RCIC(1)-33	EL TO PIPE	B-J	SUR	PTP-1	UT-28			

WNP-02
 INTERVAL: PSI
 PERIOD: NA
 OUTAGE:
 DRAWING NO. RCIC-102

WASHINGTON PUBLIC POWER SUPPLY SYSTEM
 PROGRAM PLAN AND SCHEDULE
 SYSTEM OR COMPONENT: RCIC(1)-4
 DESCRIPTION: RPV HEAD SPRAY

PAGE 007
 DATE 12/14/84

<u>IDENT. NO.</u>	<u>DESCRIPTION</u>	<u>SECT.</u> <u>XI</u> <u>EXAM.</u>	<u>EXAM</u> <u>MTM.</u>	<u>PROCEDURE</u>	<u>CAL.</u> <u>BLOCK</u>	<u>INSERVICE</u>		<u>NOTES</u>
						<u>REQ.</u>	<u>SCHEDULED</u> <u>OUTAGE</u>	
RCIC-127			SUR	PTP-1				
	SPRING	B-K-2	VT-3	303/8.2.17				
			VT-4	303/8.2.17				
6RCIC(1)-34	PIPE TO EL	B-J	VOL	UTP-10	UT-28			
			SUR	PTP-1				
6RCIC(1)-35	EL TO PIPE	B-J	VOL	UTP-10	UT-28			
			SUR	PTP-1				
6RCIC(1)-35A	PIPE TO PIPE	B-J	VOL	UTP-10	UT-28			
			SUR	PTP-1				
6RCIC(1)-36	PIPE TO EL	B-J	VOL	UTP-10	UT-28			
			SUR	PTP-1				
6RCIC(1)-36A	EL TO PIPE	B-J	VOL	UTP-10	UT-28			
			SUR	PTP-1				
RCIC-936N	PSA-1 SN(2)	B-K-2	VT-3	303/8.2.17				S/N 22373/223
			VT-4	303/8.2.17				S/N 22373/223
RCIC-935N	PSA-1 SNUBBER	B-K-2	VT-3	303/8.2.17				S/N 627
			VT-4	303/8.2.17				S/N 627
RCIC-941N	SPRING	B-K-2	VT-3	303/8.2.17				

WNP-02
 INTERVAL: PSI
 PERIOD: NA
 OUTAGE:
 DRAWING NO. RCIC-102

WASHINGTON PUBLIC POWER SUPPLY SYSTEM
 PROGRAM PLAN AND SCHEDULE
 SYSTEM OR COMPONENT: RCIC(1)-4
 DESCRIPTION: RPV HEAD SPRAY

PAGE 008
 DATE 12/14/84

<u>IDENT. NO.</u>	<u>DESCRIPTION</u>	<u>SECT.</u> <u>XI</u>	<u>EXAM</u> <u>EXAM.</u>	<u>VT-4</u> <u>MTM.</u>	<u>PROCEDURE</u>	<u>CAL.</u> <u>BLOCK</u>	<u>INSERVICE</u>		<u>NOTES</u>
							<u>REQ.</u>	<u>SCHEDULED</u> <u>OUTAGE</u>	
RCIC-941N(S)	WELDED SADDLE	B-K-1	VOL	UTP-26	UT-30				5/8" PLATE WELDED TO PIPE TUBE STEEL, WELDED TO PLATE.
RCIC-934N	PSA-1 SNUBBER	B-K-2	VT-3	303/8.2.17					S/N 3912
6RCIC(1)-36B	PIPE TO U-TURN	B-J	VOL	UTP-10	UT-28				S/N 3912
6RCIC(1)-36C	U-TURN TO PIPE	B-J	VOL	UTP-10	UT-28				
RCIC-933N	PSA-1 SNUBBER	B-K-2	VT-3	303/8.2.17					S/N 3903
RCIC-932N	PSA-1 SN(2)	B-K-2	VT-3	303/8.2.17					S/N 3903
6RCIC(1)-36D	PIPE TO EL	B-J	VOL	UTP-10	UT-28				S/N 664/643
6RCIC(1)-37	EL TO PIPE	B-J	VOL	UTP-10	UT-28				

WNP-02
 INTERVAL: PSI
 PERIOD: NA
 OUTAGE:
 DRAWING NO. RCIC-102

WASHINGTON PUBLIC POWER SUPPLY SYSTEM
 PROGRAM PLAN AND SCHEDULE
 SYSTEM OR COMPONENT: RCIC(1)-4
 DESCRIPTION: RPV HEAD SPRAY

PAGE 009
 DATE 12/14/84

<u>IDENT. NO.</u>	<u>DESCRIPTION</u>	SECT. XI <u>EXAM.</u>	<u>EXAM</u> MTH.	<u>PROCEDURE</u>	<u>CAL.</u> BLOCK	<u>INSERVICE</u>		<u>NOTES</u>
						<u>REQ.</u>	<u>SCHEDULED</u> OUTAGE	
RCIC-940N(W)	1 WELDED LUG	B-K-1	VOL	UTP-26	UT-28			3/4"Wx1 1/2"Hx3"L.
RCIC-940N	SPRING	B-K-2	VT-3	303/8.2.17				
			VT-4	303/8.2.17				
RCIC-931N(W)	8 WELDED LUGS	B-K-1	VOL	UTP-26	UT-28			3/4"Wx1 1/2"Hx3"L.
RCIC-931N	PSA-3 SNUBBER	B-K-2	VT-3	303/8.2.17				S/N 4422
			VT-4	303/8.2.17				S/N 4422
RCIC-128	PSA-3 SNUBBER	B-K-2	VT-3	303/8.2.17				S/N 4492
			VT-4	303/8.2.17				S/N 4492
6RCIC(1)-38	PIPE TO EL	B-J	VOL	UTP-10	UT-28			
			SUR	PTP-1				
6RCIC(1)-39	EL TO PIPE	B-J	VOL	UTP-10	UT-28			
			SUR	PTP-1				
6RCIC(1)-39/3/4CAP	VENT CAPPED	B-P	VT-2	N/A				SEE NOTES #6 & #7.
6RCIC(1)-39/3/4V-614	VENT CONN	B-P	VT-2	N/A				SEE NOTES #6 & #7.
RCIC-129	SPRING	B-K-2	VT-3	303/8.2.17				DOUBLE CONSTANT SPRING HANGER
			VT-4	303/8.2.17				DOUBLE CONSTANT SPRING HANGER
6RCIC(1)-40	PIPE TO VLV	B-J	VOL	UTP-10	UT-28			

WNP-02
 INTERVAL: PSI
 PERIOD: NA
 OUTAGE:
 DRAWING NO. RCIC-102

WASHINGTON PUBLIC POWER SUPPLY SYSTEM
 PROGRAM PLAN AND SCHEDULE
 SYSTEM OR COMPONENT: RCIC(1)-4
 DESCRIPTION: RPV HEAD SPRAY

PAGE 010
 DATE 12/14/84


IDENT. NO.	DESCRIPTION	SECT. XI EXAM.	EXAM MIP.	PROCEDURE	CAL. BLOCK	INSERVICE		NOTES
						REQ.	SCHEDULED OUTAGE	
			SUR	PTP-1				
RCIC-V-66-BDY	VALVE BODY	B-M-2	VT-1	GCI 7-1				
RCIC-V-66/3/4CAP	LEAKOFF CAPPED	B-P	VT-2	N/A				SEE NOTES #6 & #7.
6RCIC(1)-41	VLV TO PIPE	B-J	VOL	UTP-10	UT-28			
			SUR	PTP-1				
6RCIC(1)-41A	PIPE TO FLANGE	B-J	VOL	UTP-10	UT-28			
			SUR	PTP-1				
6RCIC(1)-41ABD	FLANGE BOLTING	B-G-2	VT-1	GCI 7-1				
6RCIC(1)-42	FLANGE TO EL	B-J	VOL	UTP-10	UT-28			
			SUR	PTP-1				
6RCIC(1)-43	EL TO PIPE	B-J	VOL	UTP-10	UT-28			
			SUR	PTP-1				
6RCIC(1)-44	PIPE TO FLANGE	B-J	VOL	UTP-10	UT-28			
			SUR	PTP-1				
6RCIC(1)-44BD	FLANGE BOLTING	B-G-2	VT-1	GCI 7-1				12 1-1/8" DIA. BOLTS
6RCIC(1)-45	FLG TO NOZZLE	B-J	VOL	UTP-10	UT-107			
			SUR	PTP-1				


WNP-02
INTERVAL: PSI
PERIOD: NA
OUTAGE:
DRAWING NO. RCIC-102

WASHINGTON PUBLIC POWER SUPPLY SYSTEM
PROGRAM PLAN AND SCHEDULE
SYSTEM OR COMPONENT: RCIC(1)-4
DESCRIPTION: RPV HEAD SPRAY

PAGE 011
DATE 12/14/84

<u>IDENT. NO.</u>	<u>DESCRIPTION</u>	<u>.SECT.</u> XI	<u>EXAM</u> EXAM.	<u>MTH.</u>	<u>PROCEDURE</u>	<u>CAL.</u> BLOCK	<u>INSERVICE</u>		<u>NOTES</u>
							<u>REQ.</u>	<u>SCHEDULED</u> OUTAGE	
RCIC-PB-102	RCIC PRES BNDRY	B-P	VT-2	N/A					SEE NOTES #6 & #7.

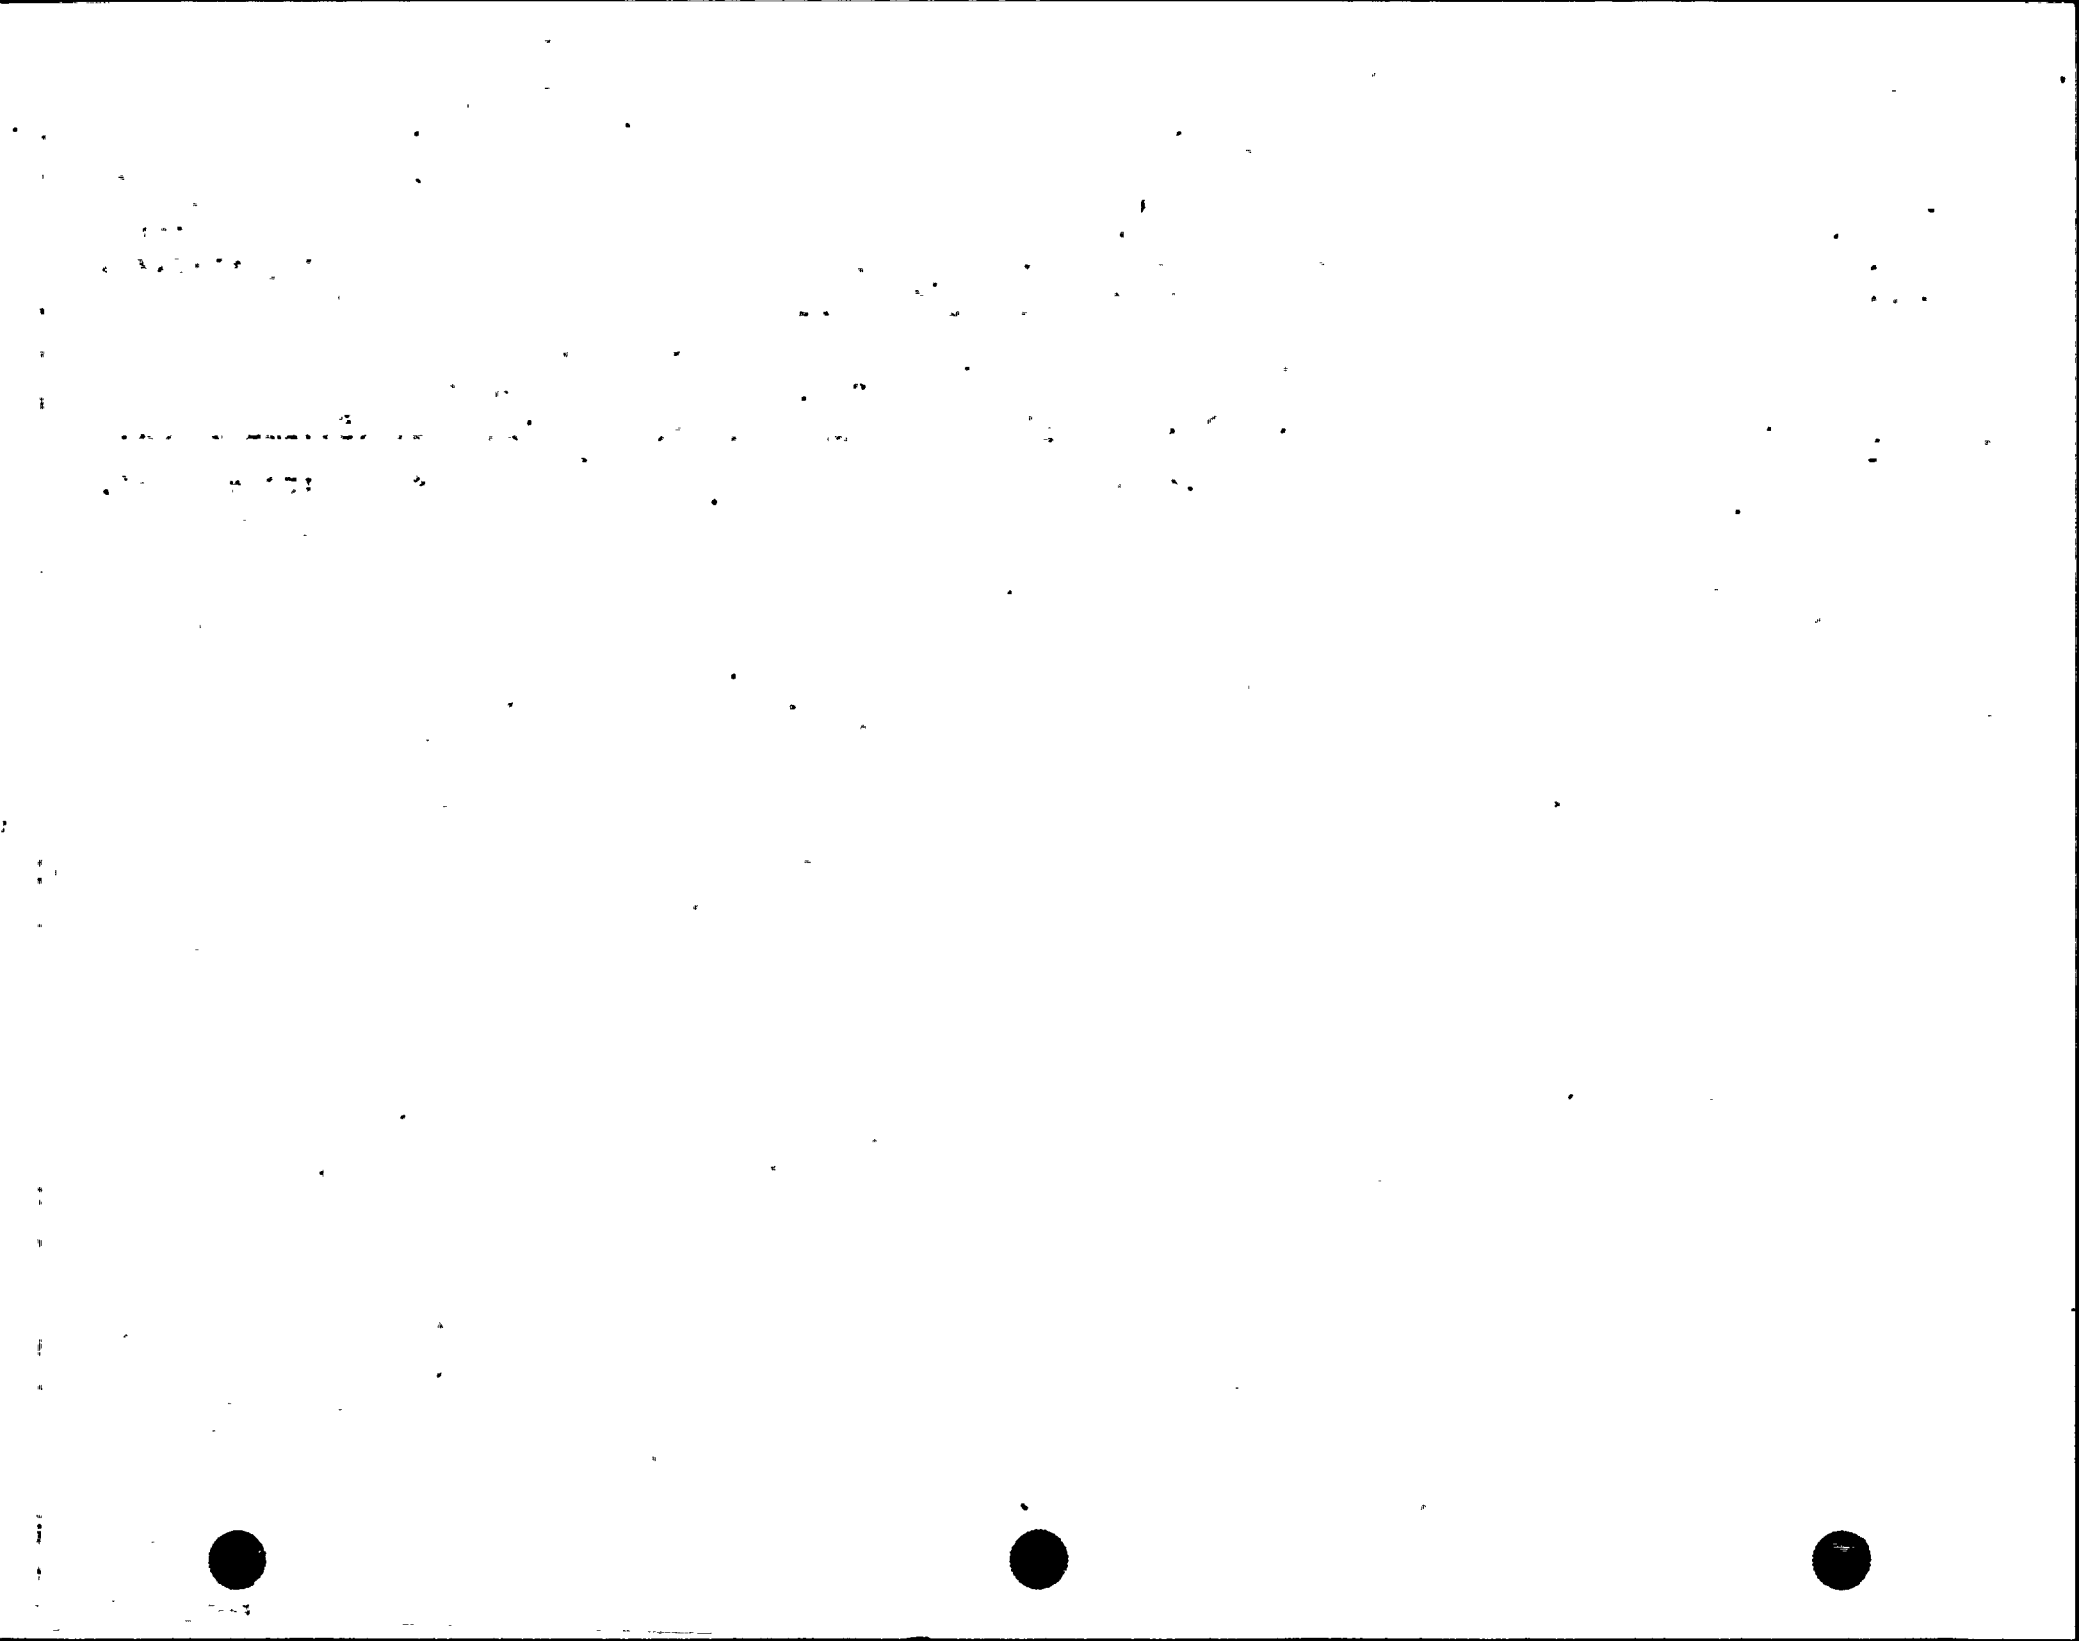

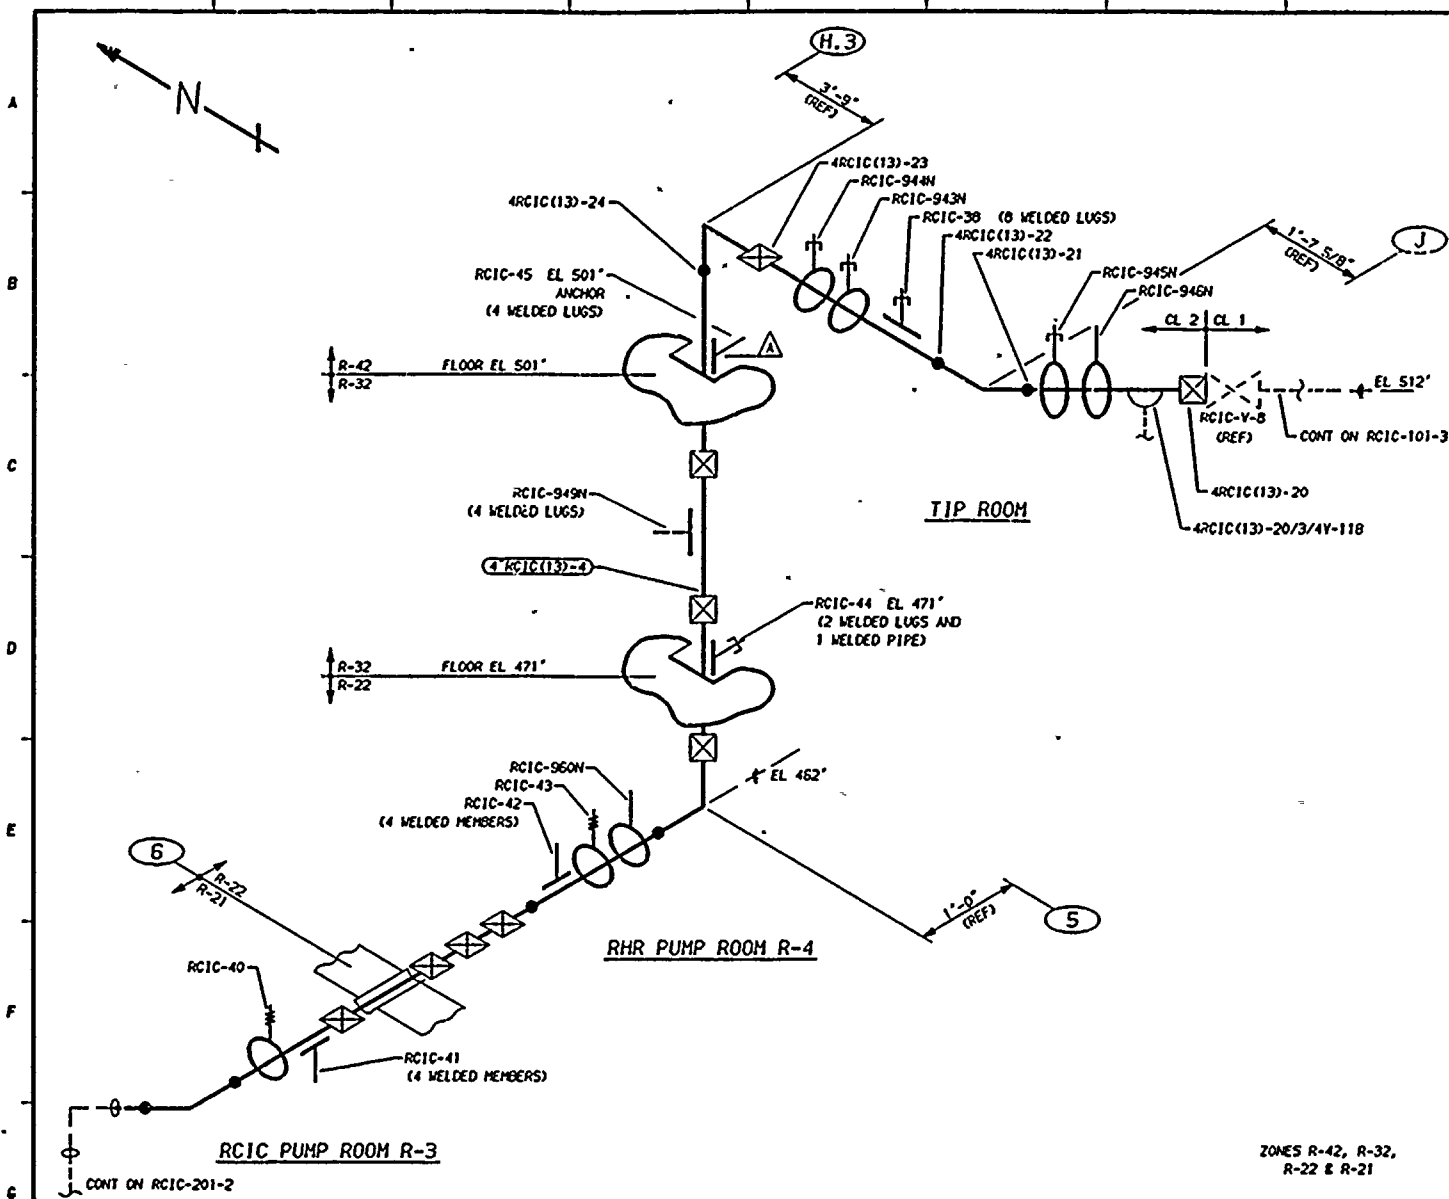


NOTES:

1. THIS DRAWING IDENTIFIES PIPING AND COMPONENTS SUBJECT TO A VISUAL EXAM FOR EVIDENCE OF LEAKAGE DURING SYSTEM HYDRO OR OPERABILITY TESTS. TESTS ARE TO BE CONDUCTED PER THE REQUIREMENTS OF ASME SECTION XI, PARAGRAPH IWA-5000.
2. FOR BRANCH PIPING 4" NOM. OR LESS (CONNECTION SHOWN IN DASHED LINES) EXTEND VISUAL LEAKAGE EXAM THROUGH THE OUTERMOST NORMALLY CLOSED NUCLEAR CLASS VALVE, OR UNTIL TRANSITION TO INSTRUMENT TUBING, UNLESS OTHERWISE NOTED.

REFERENCES:

- 151 - 219
- BOYCE CRAIL ISOMETRICS
- RCIC-662-6 REV 6
- RCIC-662-7.10 REV 4

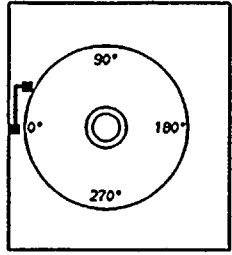

QUALITY CLASS, 1	ASME CODE CLASS, 2
ENGR, GA KUGLER	DRAWN, K-McA DATE, 7-6-78

WASHINGTON PUBLIC POWER
SUPPLY SYSTEM
RICHLAND, WASHINGTON 99352

**WNP-2
WELD & COMPONENT
IDENTIFICATION DIAGRAM**

TITLE:
RCIC STEAM SUPPLY TO RCIC-DT-1

DWG NO, RCIC-201-1 REV 2


ZONES R-42, R-32,
R-22 & R-21

THIS DRAWING IS INTENDED FOR
USE IN PRESERVICE AND INSERVICE
INSPECTIONS PROGRAMS ONLY.

PIPING SYSTEM	NOM DIA (IN)	SCH	NOM WALL THK	MATERIAL SPECIFICATION	MATL TYPE	CAL BLOCK NO
4" RCIC(13)-4	4	80	0.337	SA 106 GR B	CS	UT-30

NO	DATE	REVISION	BY	CHKD	APVD
2	12-2-83	GENERAL UP-DATE REDRAWN	TFH	DPR	TFH
1	12-2-81	AUGMENTED ISI ADDED	K-McA	DPR	TFH
0	12-22-78	ISSUED FOR USE	K-McA	DPR	LFB
A	10-3-78	ISSUED FOR INFORMATION ONLY	K-McA	GAK	DWP



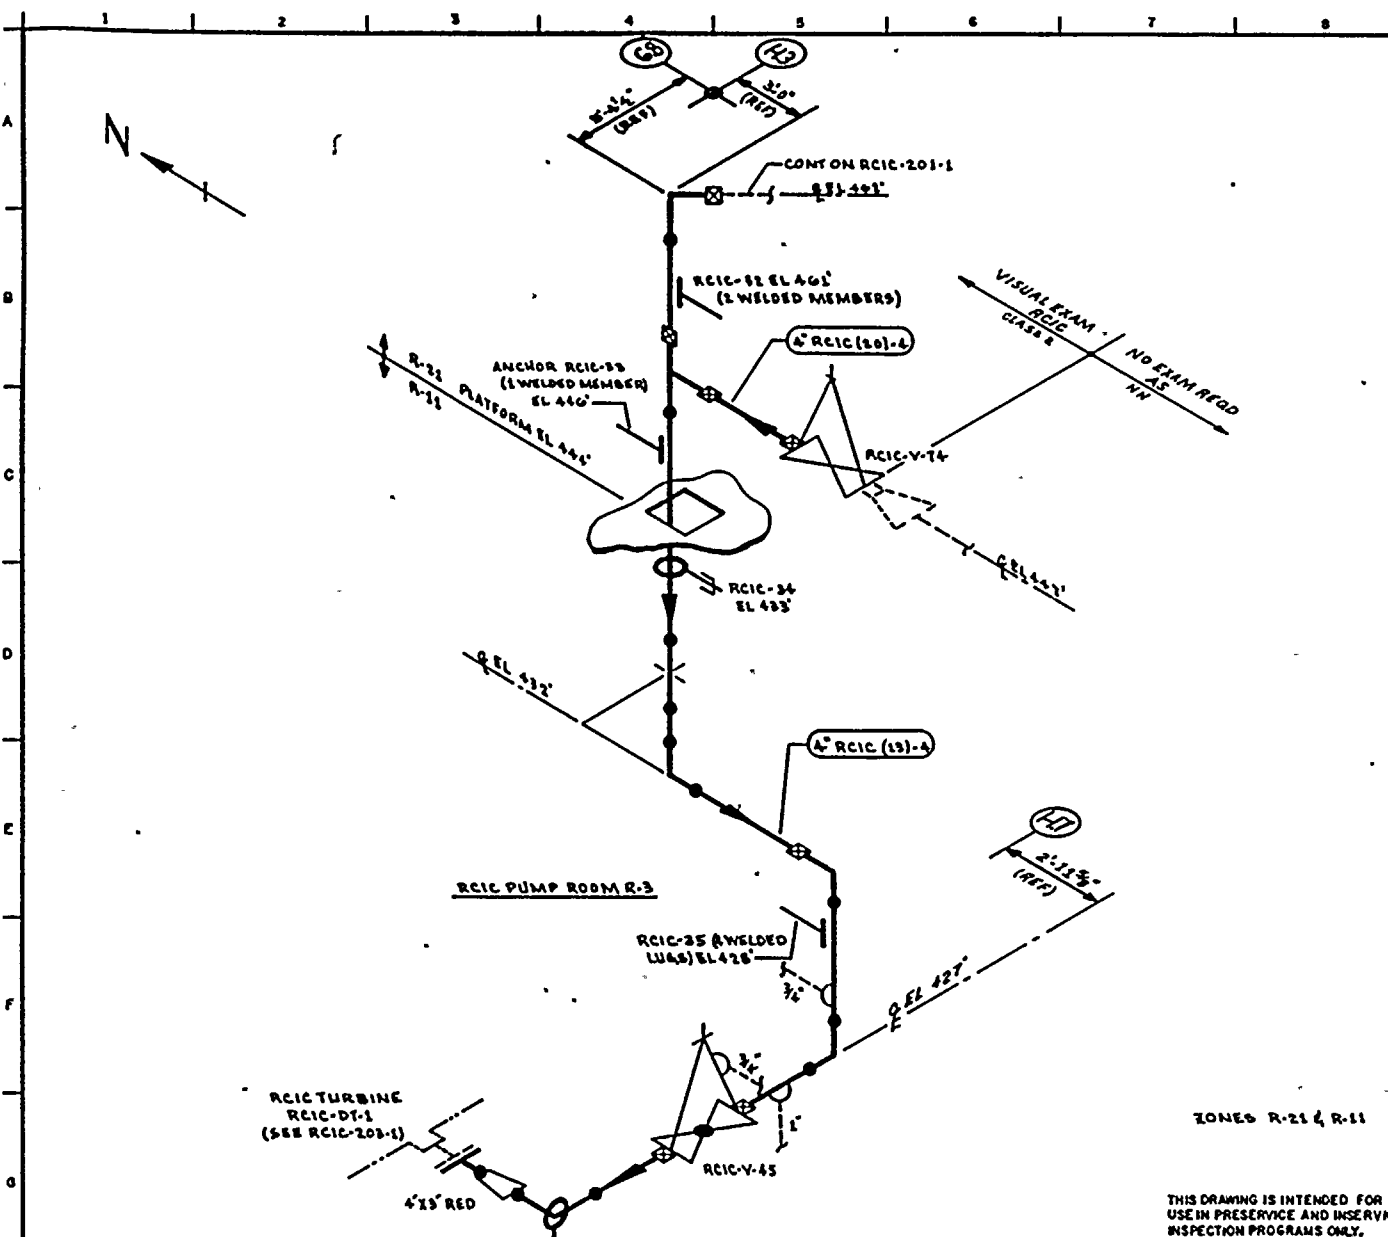

- NOTES:
1. THIS DRAWING IDENTIFIES PIPING & COMPONENTS SUBJECT TO A VISUAL EXAM FOR EVIDENCE OF LEAKAGE DURING SYSTEM HYDRO OR OPERABILITY TESTS. TESTS ARE TO BE CONDUCTED PER THE REQUIREMENTS OF ASME SECTION XI, PARAGRAPH IWA-5000.
 2. FOR BRANCH PIPING 4" DIA OR LESS (CONN SHOWN IN DASHED LINES) EXTEND VISUAL LEAKAGE EXAM THROUGH THE OUTERMOST NORMALLY CLOSED NUCLEAR CLASS VALVE OR UNTIL TRANSITION TO INSTRUMENT TUBING UNLESS OTHERWISE NOTED.
 3. AT LOCATIONS WHERE LEAKAGE IS NORMALLY EXPECTED (EG, VALVE STEM & PUMP SEAL LEAKOFF CONN) VERIFY LEAKAGE COLLECTION SYSTEM OPERABILITY ONLY. NO HYDRO TEST OF COLLECTION SYSTEM IS REQUIRED.

- REFERENCES:
- BOVEE & CRAIG ISOMETRICS
- | | |
|-----------------|-------|
| RCIC-602-11.15 | REV 2 |
| RCIC-698-1 | REV 0 |
| RCIC-602-11.15H | REV 1 |
| RCIC-698-1H | REV 0 |

QUALITY CLASS: 1	ASME CODE CLASS: 2
ENGR: G.A. KUGLER	DRAWN: K.M.C.A. DATE: 7-17-78

 WASHINGTON PUBLIC POWER SUPPLY SYSTEM
RICHLAND, WASHINGTON 99352

THIS DRAWING IS INTENDED FOR USE IN PRESERVE AND INSERVICE INSPECTION PROGRAMS ONLY.

PIPING SYSTEM	NOM DIA (IN)	SCH	NOM WALL THK	MATERIAL SPECIFICATION	MATL TYPE	CAL BLOCK NO
4" RCIC (13)-4	4"	80	0.337	SA 106 GR B	CS	NA
4" RCIC (10)-4	4"	80	0.337	SA 106 GR B	CS	NA

WNP-2
WELD & COMPONENT IDENTIFICATION DIAGRAM

TITLE:
RCIC STEAM SUPPLY TO RCIC-DT-1

DWG NO: RCIC-201-2 REV 0

NO	DATE	REVISION	BY	CHKD	APPVD
0	12-22-77	ISSUED FOR USE	K.M.C.A.	K.M.C.A.	[Signature]
1	10-3-78	ISSUED FOR INFORMATION ONLY	[Signature]	[Signature]	[Signature]

WNP-02
 INTERVAL: PSI
 PERIOD: NA
 OUTAGE:
 DRAWING NO. RCIC-201

WASHINGTON PUBLIC POWER SUPPLY SYSTEM
 PROGRAM PLAN AND SCHEDULE
 SYSTEM OR COMPONENT: RCIC(13)-4
 DESCRIPTION: RCIC STEAM SUPPLY

PAGE 601
 DATE 12/14/84


<u>IDENT. NO.</u>	<u>DESCRIPTION</u>	<u>SECT.</u> <u>XI</u> <u>EXAM</u>	<u>EXAM</u> <u>MTH.</u>	<u>PROCEDURE</u>	<u>CAL.</u> <u>BLOCK</u>	<u>INSERVICE</u> <u>SCHEDULED</u>		<u>NOTES</u>
						<u>REQ.</u>	<u>OUTAGE</u>	
4RCIC(13)-20	VLV TO PIPE	AUGMT	VOL	QCI 6-13	UT-30			
4RCIC(13)-20/3/4V-118	TEST CONN	N/A	VT-2	N/A				SEE NOTES #6 & #7.
RCIC-945N	PSA-10 SNUBBER	C-E-2	VT-3	303/8.2.17				S/N 9924, +QC I SN.
			VT-4	303/8.2.17				S/N 9924, +QC I SN.
4RCIC(13)-21	PIPE TO EL	AUGMT	VOL	QCI 6-13	UT-30			
4RCIC(13)-22	EL TO PIPE	AUGMT	VOL	QCI 6-13	UT-30			
RCIC-38	PSA-1 SN(2)	C-E-2	VT-3	303/8.2.17				S/N E214/W599, +QC I SN.
			VT-4	303/8.2.17				S/N E214/W599, +QC I SN.
RCIC-943N	PSA-10 SNUBBER	C-E-2	VT-3	303/8.2.17				S/N 577, +QC I SN.
			VT-4	303/8.2.17				S/N 577, +QC I SN.
RCIC-944N	PSA-3 SN(2)	C-E-2	VT-3	303/8.2.17				S/N T4437/B390, +QC I SN.
			VT-4	303/8.2.17				S/N T4437/B390, +QC I SN.
4RCIC(13)-23	PIPE TO EL	AUGMT	VOL	QCI 6-13	UT-30			
4RCIC(13)-24	EL TO PIPE	AUGMT	VOL	QCI 6-13	UT-30			
RCIC-44	PSA-1/4 SNUBBER	N/A	VT-3	303/8.2.17				S/N 432, +QC I SN.

WNP-02
 INTERVAL: PSI
 PERIOD: NA
 OUTAGE:
 DRAWING NO. RCIC-201

WASHINGTON PUBLIC POWER SUPPLY SYSTEM
 PROGRAM PLAN AND SCHEDULE
 SYSTEM OR COMPONENT: RCIC(13)-4
 DESCRIPTION: RCIC STEAM SUPPLY


PAGE 002
 DATE 12/14/84

<u>IDENT. NO.</u>	<u>DESCRIPTION</u>	SECT. XI <u>EXAM.</u>	<u>EXAM</u> MTH.	<u>PROCEDURE</u>	CAL. <u>BLOCK</u>	<u>INSERVICE</u> SCHEDULED		<u>NOTES</u>
						<u>REQ.</u>	<u>OUTAGE</u>	
RCIC-34			VT-4	303/8.2.17				S/N 432, +QC I SN.
	PSA-1/2 SNUBBER	N/A	VT-3	303/8.2.17				S/N 4008, +QC I SN.
			VT-4	303/8.2.17				S/N 4008, +QC I SN.
RCIC-962N			VT-3	303/8.2.17				S/N 2115, +QC I SN.
	PSA-1/2 SNUBBER	N/A	VT-3	303/8.2.17				S/N 2115, +QC I SN.
			VT-4	303/8.2.17				S/N 2115, +QC I SN.
RCIC-961N			VT-3	303/8.2.17				S/N 6229, +QC I SN, THIS SN IS ON DRIP- LEG NEAR VALVE RCIC- V-45.
	PSA-1/4 SNUBBER	N/A	VT-3	303/8.2.17				S/N 6229, +QC I SN, THIS SN IS ON DRIP- LEG NEAR VALVE RCIC- V-45.
			VT-4	303/8.2.17				S/N 6229, +QC I SN, THIS SN IS ON DRIP- LEG NEAR VALVE RCIC- V-45.
RCIC-PB-201	RCIC PRES BNDRY	N/A	VT-2	N/A				SEE NOTES #6 & #7.

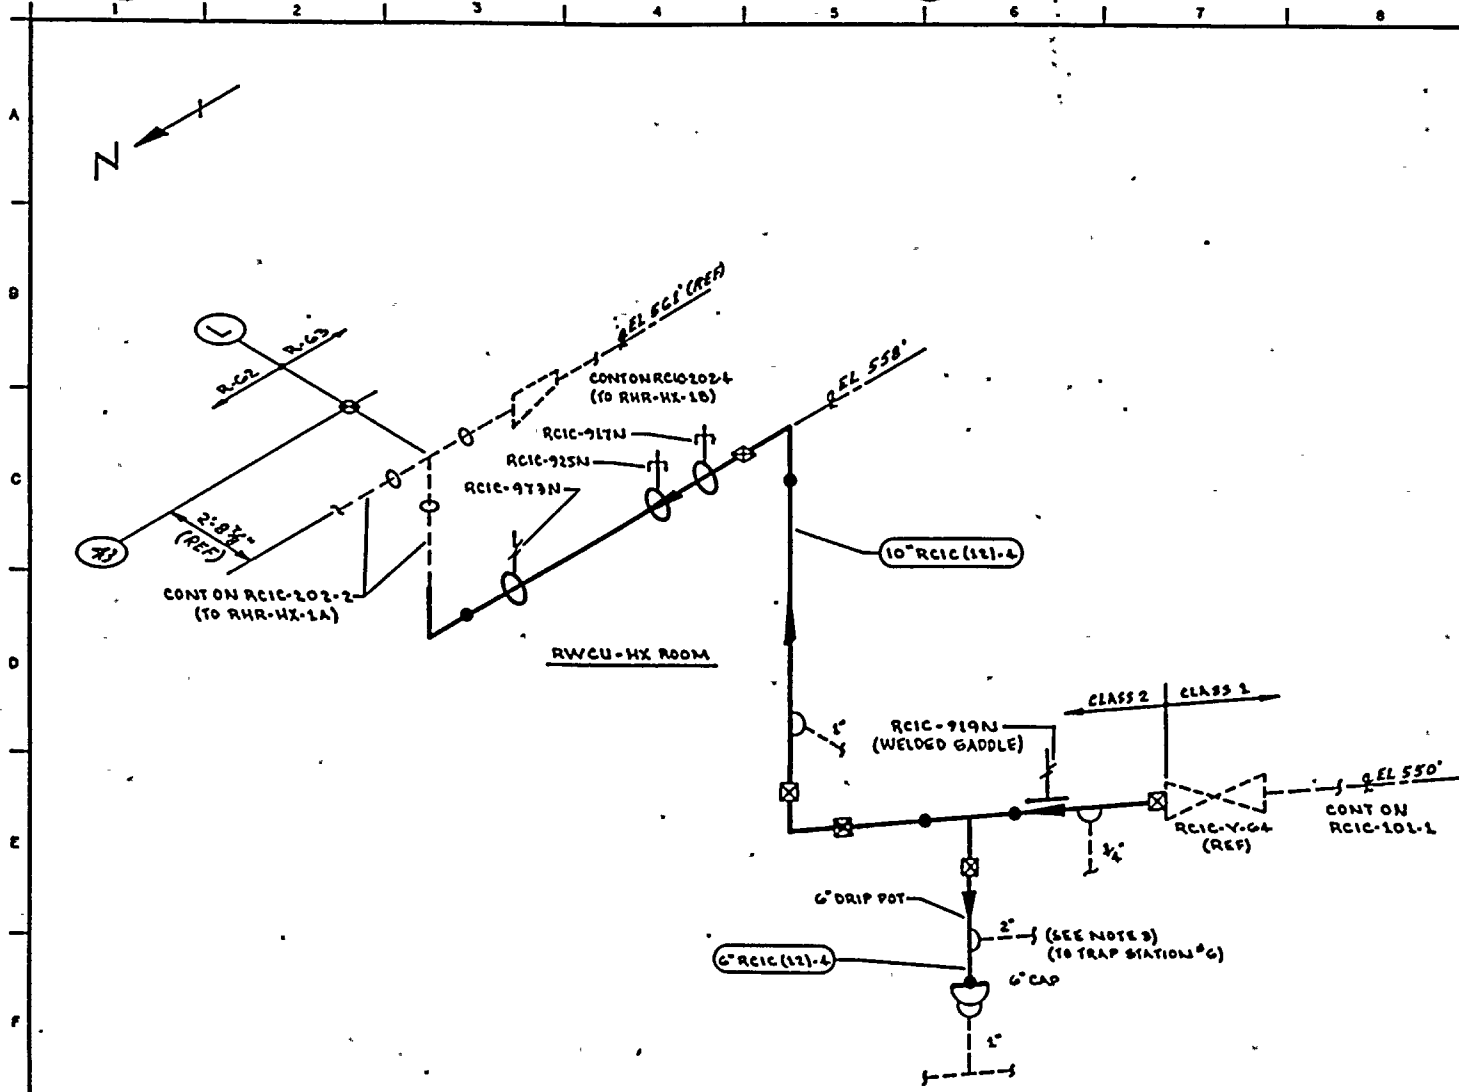

- NOTES:**
1. THIS DRAWING IDENTIFIES PIPING & COMPONENTS SUBJECT TO A VISUAL EXAM FOR EVIDENCE OF LEAKAGE DURING SYSTEM HYDRO OR OPERABILITY TESTS. TESTS ARE TO BE CONDUCTED PER THE REQUIREMENTS OF ASME SECTION XI, PARAGRAPH IWA-5000.
 2. FOR BRANCH PIPING 4" DIA OR LESS (CONN SHOWN IN DASHED LINES) EXTEND VISUAL LEAKAGE EXAM THROUGH THE OUTERMOST NORMALLY CLOSED NUCLEAR CLASS VALVE OR UNTIL TRANSITION TO INSTRUMENT TUBING UNLESS OTHERWISE NOTED.
 3. EXTEND VISUAL LEAKAGE EXAM THROUGH TRAP STATION. FROM TRAP STATION TO BAROMETRIC CONDENSER, VERIFY THAT DRAINAGE SYSTEM IS OPERATIVE.

REFERENCES:
 BOVSE & CRAIG ISOMETRICS
 RCIC-663-B.3 REV C
 RCIC-663-C REV A

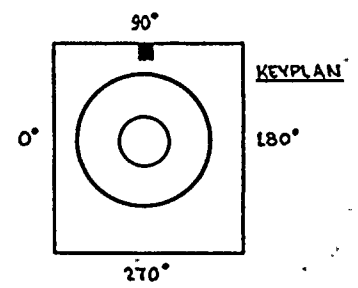

ZONES R-62 & R-63

THIS DRAWING IS INTENDED FOR USE IN PRESERVICE AND INSERVICE INSPECTION PROGRAMS ONLY.

QUALITY CLASS: 1 ASME CODE CLASS: 2
 ENGR: GA KUHLER | DRAWN: V. McLA | DATE: 7-17-78

WASHINGTON PUBLIC POWER SUPPLY SYSTEM
 RICHLAND, WASHINGTON 99352

PIPING SYSTEM	NOM DIA (IN)	SCH	NOM WALL THK	MATERIAL SPECIFICATION	MATL TYPE	CAL BLOCK NO
10" RCIC (12)-4	10	100	0.718	SA 106 GR B	CS	NA
6" RCIC (12)-4	6	120	0.362	SA 106 GR B	CS	NA


NO	DATE	REVISION	BY	CHKD	APPVD
1	9-26-83	ADDED HANGERS RHR-917N, 919N, 920N & 925N	KJA	DPK	TJK
0	12-22-78	ISSUED FOR USE	KJA	DPK	TJK
1	10-3-78	ISSUED FOR INFORMATION ONLY	KJA	DPK	OUT

WNP-2
 WELD & COMPONENT IDENTIFICATION DIAGRAM

TITLE:
 CONDENSING MODE STEAM SUPPLY TO RHR-HX-1A & 1B


DWG NO: RCIC-202-1 REV 1



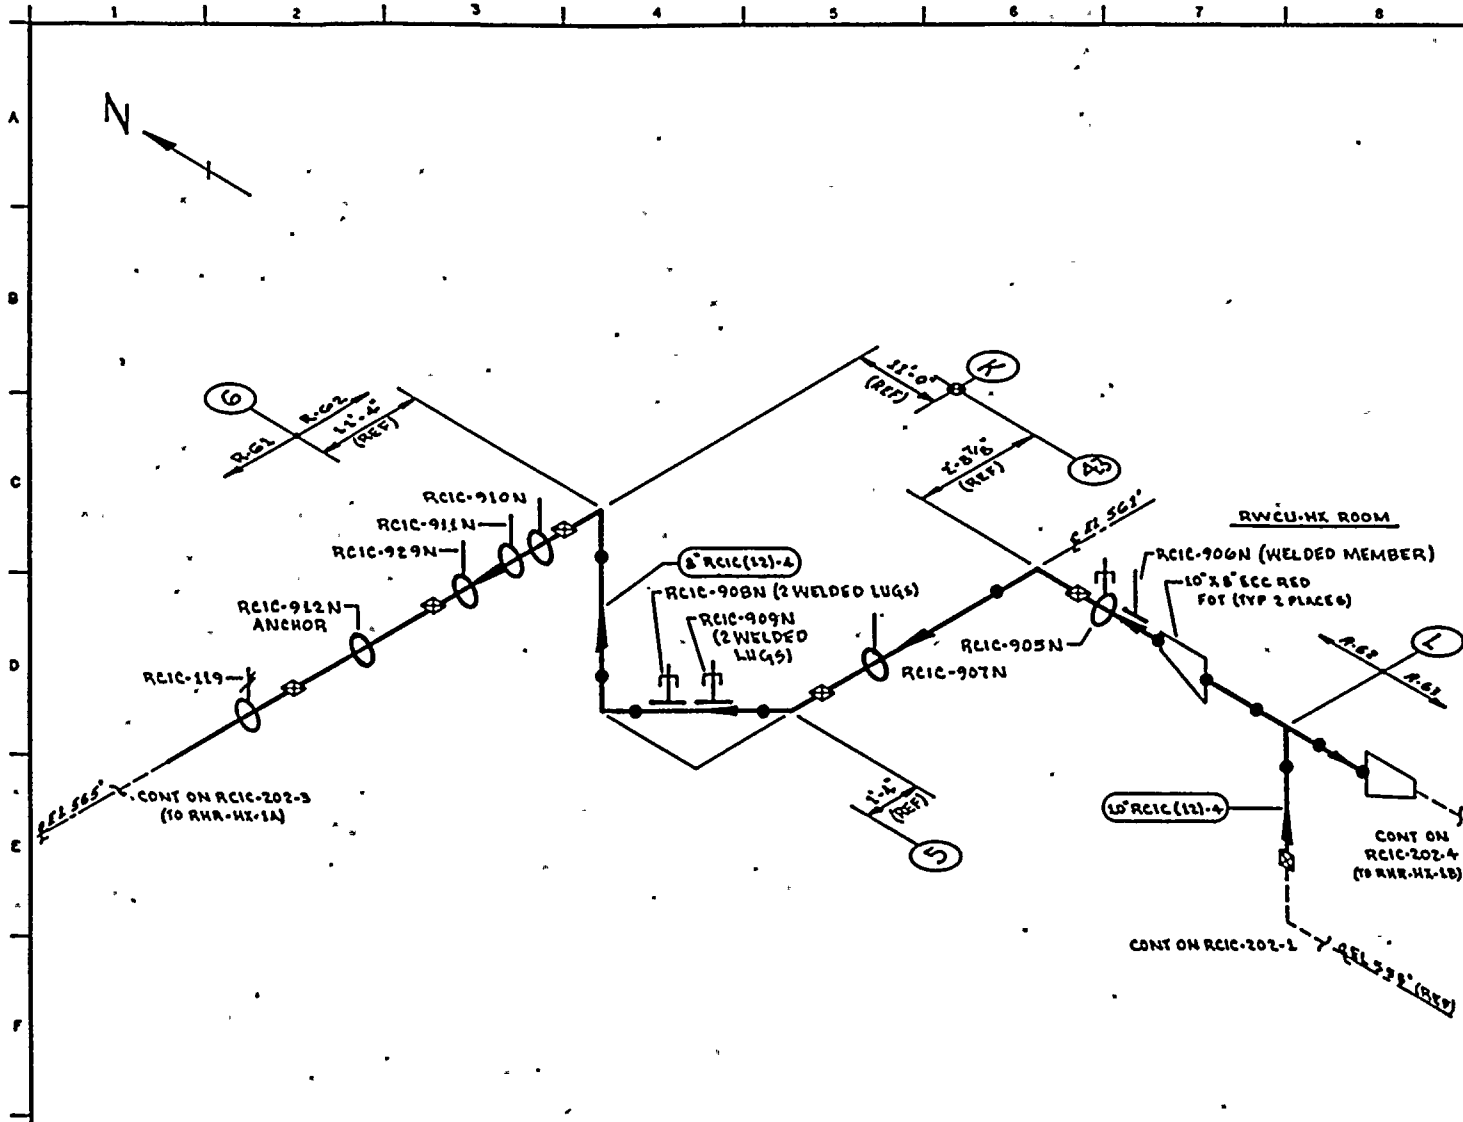

NOTES:
 1. THIS DRAWING IDENTIFIES PIPING & COMPONENTS SUBJECT TO A VISUAL EXAM FOR EVIDENCE OF LEAKAGE DURING SYSTEM HYDRO OR OPERABILITY TESTS. TESTS ARE TO BE CONDUCTED PER THE REQUIREMENTS OF ASME SECTION XI, PARAGRAPH IWA-5000.

REFERENCES:
 BOVEE & CRAIG ISOMETRICS
 RCIC-665-1.3 REV B
 RCIC-665-4.9 REV 9

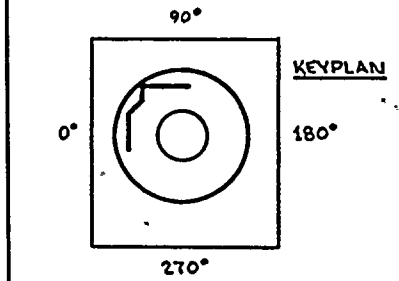

ZONES R-61, R-62 (R-61)

THIS DRAWING IS INTENDED FOR USE IN PRESERVICE AND INSERVICE INSPECTION PROGRAMS ONLY.

QUALITY CLASS: 1 ASME CODE CLASS: 2
 ENGR: GA KUGLER DRAWN: K-McA DATE: 1-18-78


WASHINGTON PUBLIC POWER SUPPLY SYSTEM
 RICHLAND, WASHINGTON 99302

PIPING SYSTEM	NOM DIA (IN)	SCH	NOM WALL THK	MATERIAL SPECIFICATION	MATL TYPE	CAL BLOCK NO
10" RCIC (12)-4	10	100	0.718	SA 106 GR B	C5	NA
8" RCIC (12)-4	8	100	0.593	SA 106 GR B	C5	NA

NO	DATE	REVISION	BY	CHKD	APPVD
1	12-2-83	ADDED HANGERS & KEYPLAN	KMK/A	EPK	TTR
0	12-18-78	ISSUED FOR USE	KMK/A	EPK	TTR
A	10-3-78	ISSUED FOR INFORMATION ONLY	KMK/A	EPK	TTR


WHP-2
 WELD & COMPONENT IDENTIFICATION DIAGRAM
 TITLE: CONDENSING MODE STEAM SUPPLY TO RHR-HX-1A
 DWG NO: RCIC-202-2 REV 2



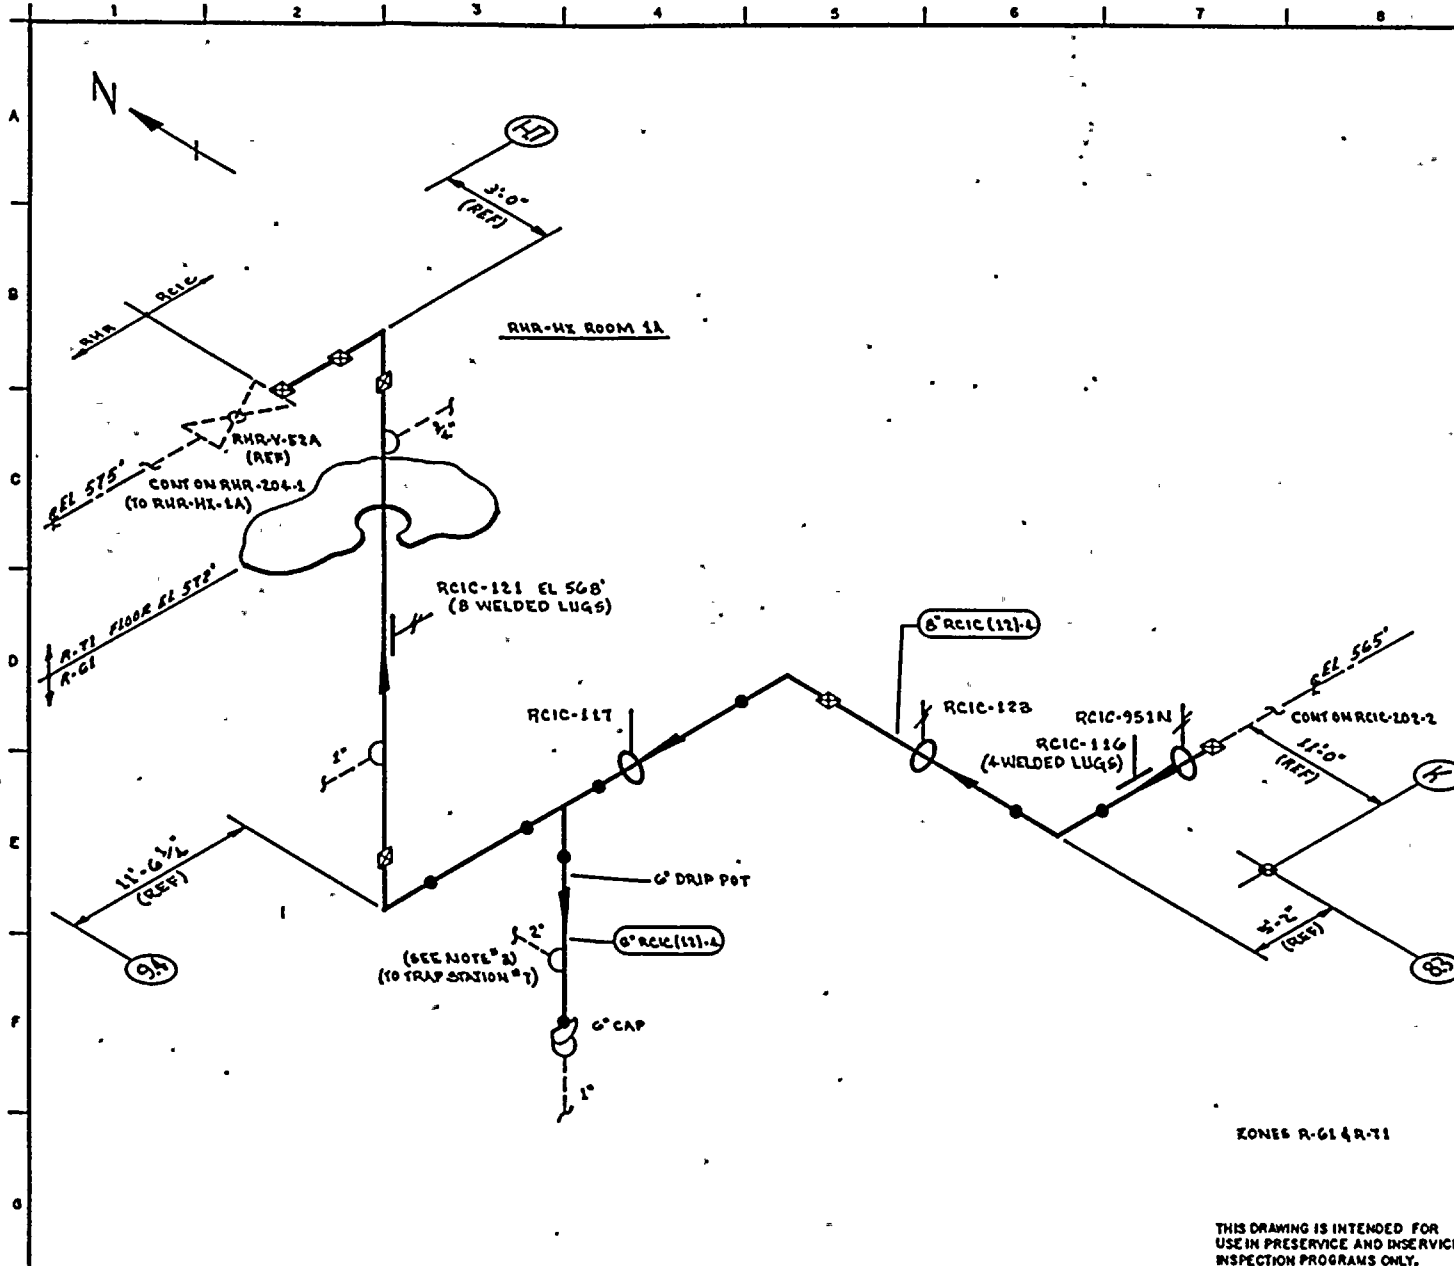

- NOTES:
1. THIS DRAWING IDENTIFIES PIPING & COMPONENTS SUBJECT TO A VISUAL EXAM FOR EVIDENCE OF LEAKAGE DURING SYSTEM HYDRO OR OPERABILITY TESTS. TESTS ARE TO BE CONDUCTED PER THE REQUIREMENTS OF ASME SECTION XI, PARAGRAPH 5WA-5000.
 2. FOR BRANCH PIPING 4" DIA OR LESS (CONN SHOWN IN DASHED LINES) EXTEND VISUAL LEAKAGE EXAM THROUGH THE OUTERMOST NORMALLY CLOSED NUCLEAR CLASS VALVE OR UNTIL TRANSITION TO INSTRUMENT TUBING UNLESS OTHERWISE NOTED.
 3. EXTEND VISUAL LEAKAGE EXAM THROUGH TRAP STATION. FROM TRAP STATION TO BAROMETRIC CONDENSER, VERIFY THAT DRAINAGE SYSTEM IS OPERATIVE.

REFERENCES:
 BOVEE & CRAIG ISOMETRIC
 RCIC-065-4.9 REV 9

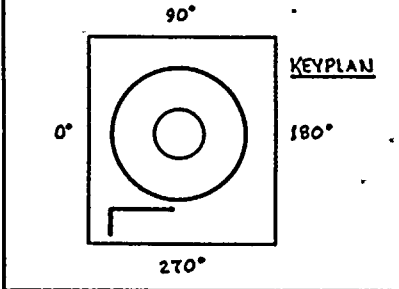

ZONES R-61 & R-71

THIS DRAWING IS INTENDED FOR USE IN PRESERVE AND INSERVICE INSPECTION PROGRAMS ONLY.

QUALITY CLASS: 1	ASME CODE CLASS: 2
ENGR: CA KUGLER	DRAWN: V. M. L. DATE: 7-16-76


WASHINGTON PUBLIC POWER SUPPLY SYSTEM
 PONGLAND, WASHINGTON 99302

PIPING SYSTEM	NOM DIA (IN)	SCH	NOM WALL THK	MATERIAL SPECIFICATION	MATL TYPE	CAL BLOCK NO
8" RCIC (121)-4	8"	100	0.343	SA 106 GR B	CS	NA
6" RCIC (121)-4	6"	120	0.362	SA 106 GR B	CS	NA


NO	DATE	REVISION	BY	CHKD	APPVD
1	12-8-83	ADDED HANGERS & KEYPLAN	KRA	DPR	TYM
0	12-22-76	ISSUED FOR USE	KRA	APP	TYM
1	11-3-76	ISSUED FOR INFORMATION ONLY	KRA	APP	TYM

WNP-2
 WELD 8 COMPONENT
 IDENTIFICATION DIAGRAM

TITLE:
 CONDENSING MODE
 STEAM SUPPLY TO RHR-HX-1A


DWG NO: RCIC-202-3 REV 1



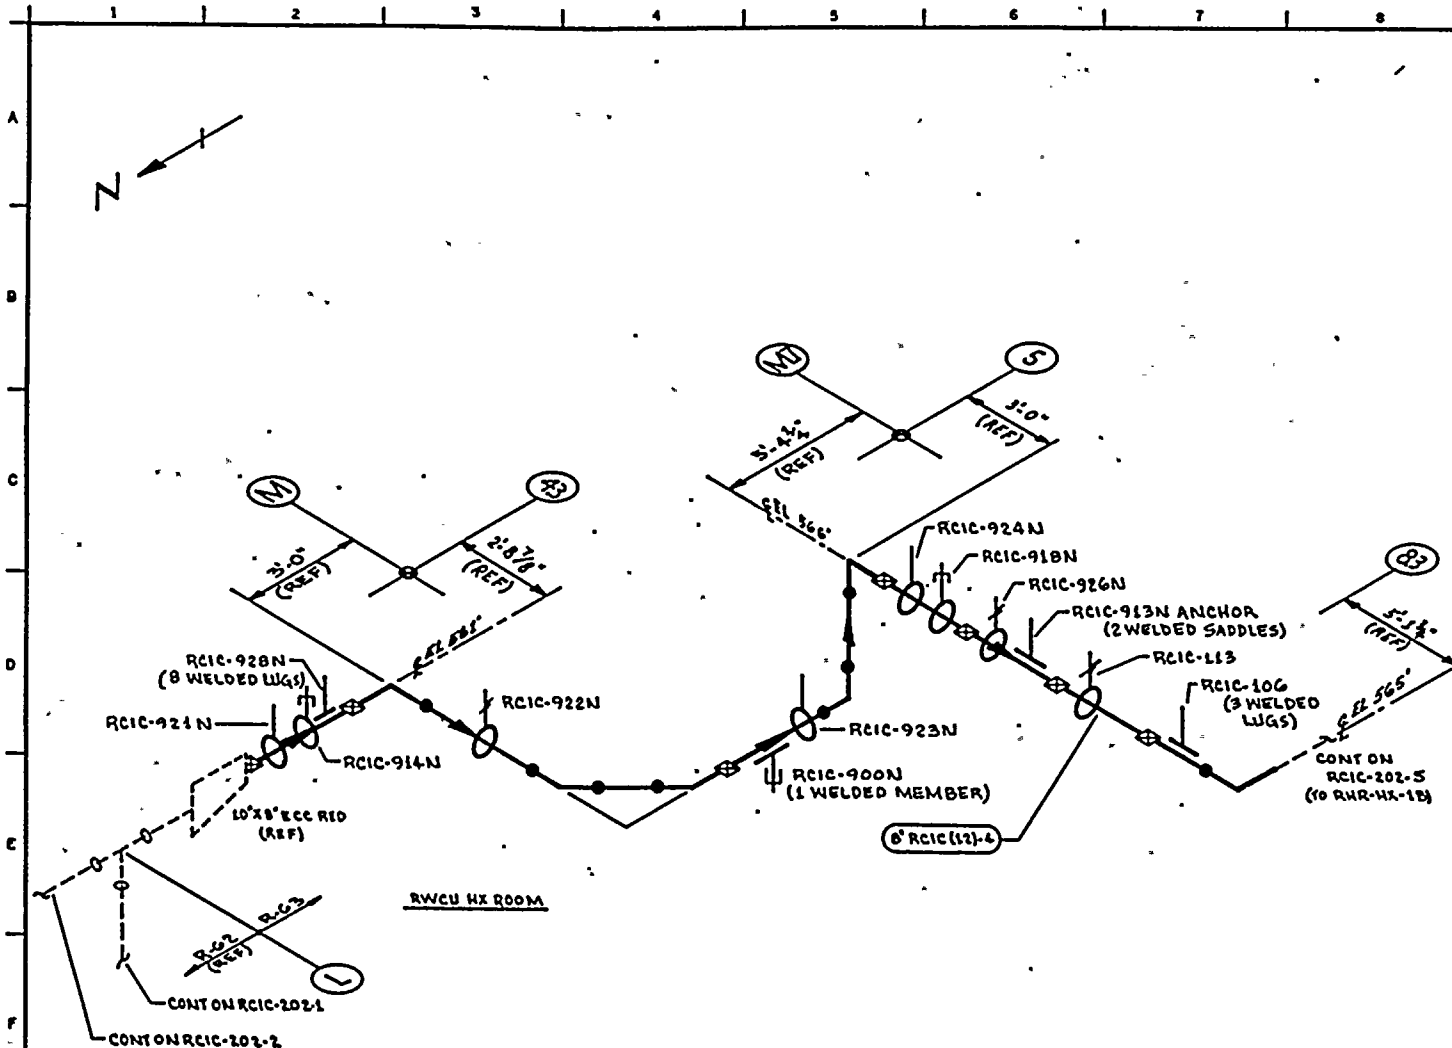

NOTES:
 1. THIS DRAWING IDENTIFIES PIPING & COMPONENTS SUBJECT TO A VISUAL EXAM FOR EVIDENCE OF LEAKAGE DURING SYSTEM HYDRO OR OPERABILITY TESTS. TESTS ARE TO BE CONDUCTED PER THE REQUIREMENTS OF ASME SECTION XI, PARAGRAPH IWA-5000.

REFERENCES:
 BOVEE & CRAIG ISOMETRIC
 RCIC-664-LT REV B

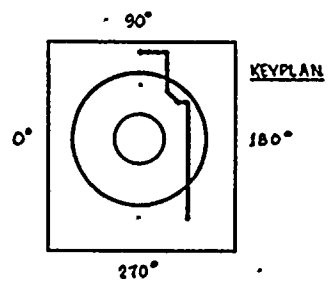

ZONE R-63

THIS DRAWING IS INTENDED FOR USE IN PRESERVICE AND INSERVICE INSPECTION PROGRAMS ONLY.

QUALITY CLASS: 1	ASME CODE CLASS: 2
ENGR: G.A. KUGLER	DRAWN: V.M.C.A. DATE: 7-19-78


 WASHINGTON PUBLIC POWER SUPPLY SYSTEM
 RICHLAND, WASHINGTON 99352

PIPING SYSTEM	NOM DIA (N)	SCH	NOM WALL THK	MATERIAL SPECIFICATION	MATL TYPE	CAL BLOCK NO
8° RCIC (12)-4	8	100	0.393	SA 106 GR B	CS	NA

NO	DATE	REVISION	BY	CHKD	APPVD
1	12-283	ADDED HANGERS & KEYPLAN	KKA	DKR	TFH
0	12-11-78	ISSUED FOR USE	KKA	DKR	TFH
1	11-11-78	ISSUED FOR INFORMATION ONLY	KKA	DKR	DKS

WHP-2
 WELD & COMPONENT IDENTIFICATION DIAGRAM
 TITLE:
 CONDENSING MODE STEAM SUPPLY TO RHR-HX-1B
 DWG NO: RCIC-202-4
 REV 1



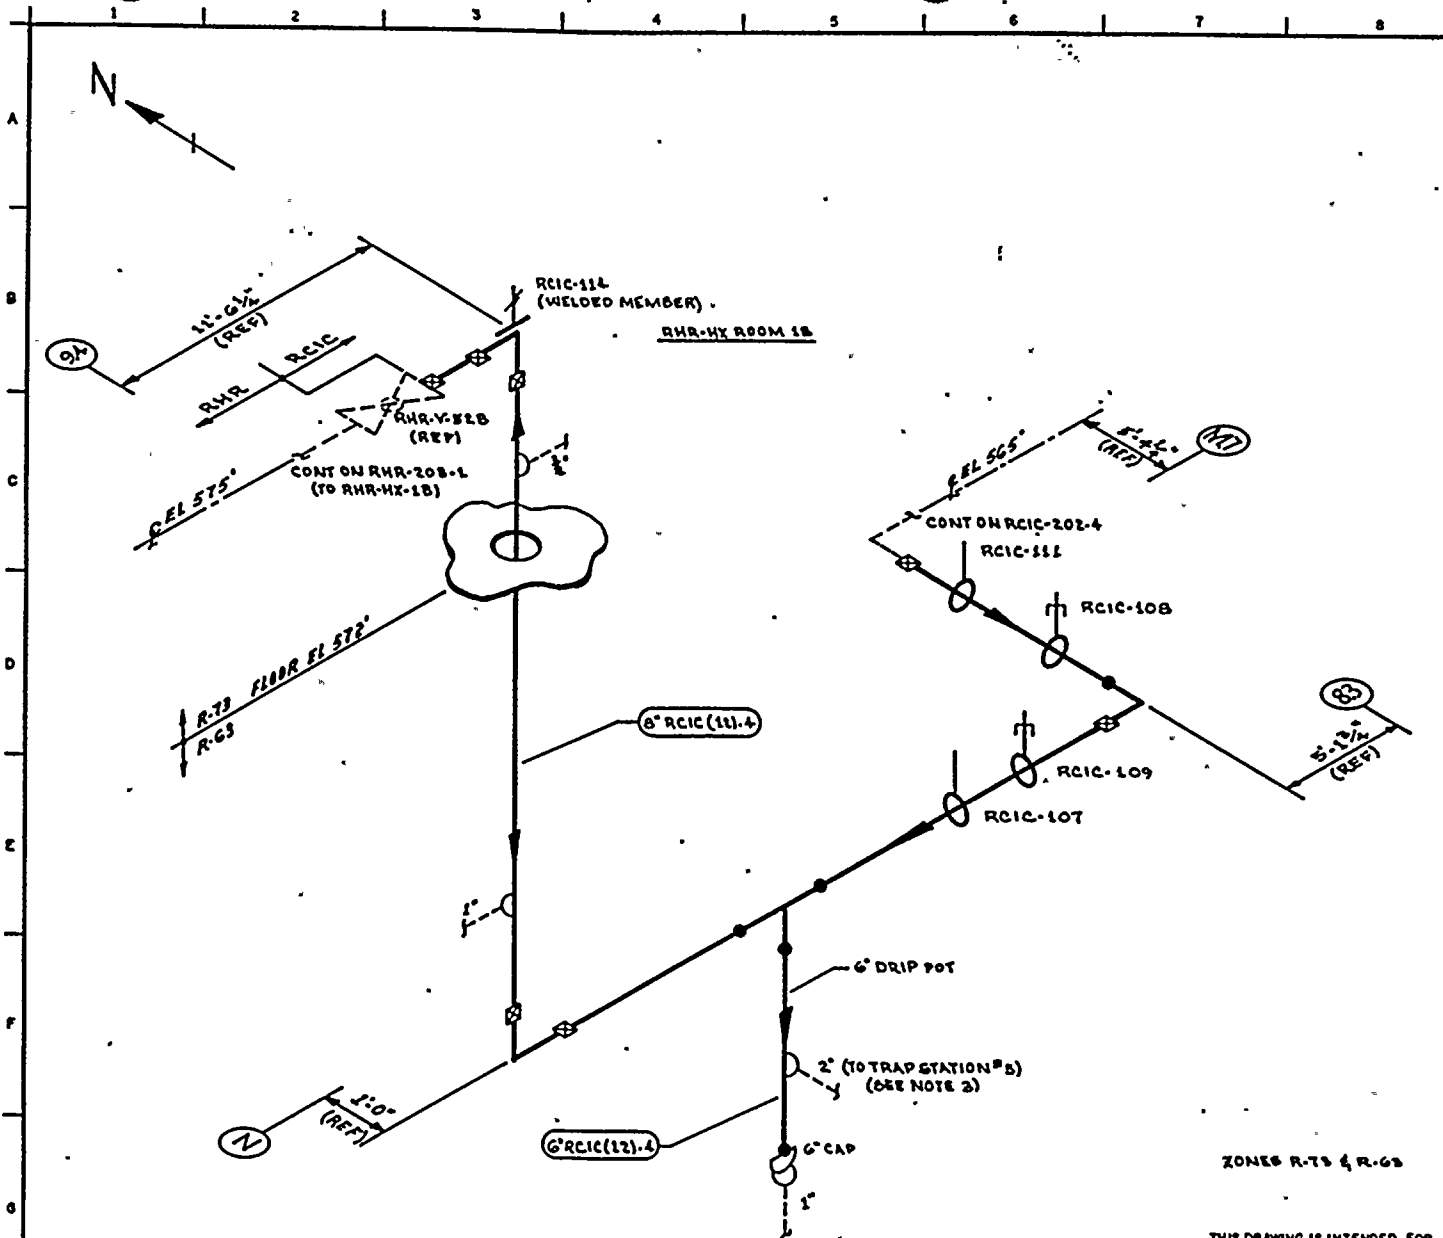


NOTES:

1. THIS DRAWING IDENTIFIED PIPING & COMPONENTS SUBJECT TO A VISUAL EXAM FOR EVIDENCE OF LEAKAGE DURING SYSTEM HYDRO OR OPERABILITY TESTS. TESTS ARE TO BE CONDUCTED PER THE REQUIREMENTS OF ASME SECTION XI, PARAGRAPH IWA-5000.
2. FOR BRANCH PIPING 4" DIA OR LESS (CONN SHOWN IN DASHED LINES) EXTEND VISUAL LEAKAGE EXAM THROUGH THE OUTERMOST NORMALLY CLOSED NUCLEAR CLASS VALVE OR UNTIL TRANSITION TO INSTRUMENT TUBING UNLESS OTHERWISE NOTED.
3. EXTEND VISUAL LEAKAGE EXAM THROUGH TRAP STATION TO BAROMETRIC CONDENSER. VERIFY THAT DRAINAGE SYSTEM IS OPERATIVE.

REFERENCES:

BOVEE & CRAIG ISOMETRIC
RCIC-664-B.10 REV 10

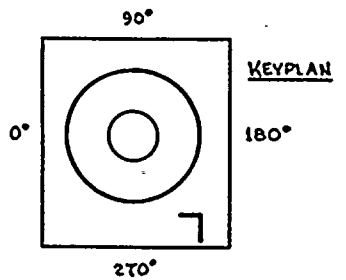

QUALITY CLASS: 1	ASME CODE CLASS: 2
ENGR: QA KUGLER	DRAWN: V.M.C.A. DATE: 7-21-76



**WASHINGTON PUBLIC POWER
SUPPLY SYSTEM**
RICHLAND, WASHINGTON 99352

THIS DRAWING IS INTENDED FOR
USE IN PRESERVICE AND INSERVICE
INSPECTION PROGRAMS ONLY.

PIPING SYSTEM	NOM DIA (IN)	SCH	NOM WALL THK	MATERIAL SPECIFICATION	MATL TYPE	CAL BLOCK NO
8" RCIC (11)-4	8"	100	0.598	SA 106 GR B	CS	NA
6" RCIC (12)-4	6"	120	0.562	SA 106 GR B	CS	NA

NO	DATE	REVISION	BY	CHKD	APPVD
1	12-2-83	ADDED HANGERS & KEYPLAN	KWA	ZFR	tk
0	12-2-78	ISSUED FOR USE	KWA	ALB	tk
A	10-3-75	ISSUED FOR INFORMATION ONLY	W.L.	SW	DWP

WNP-2
WELD 8 COMPONENT
IDENTIFICATION DIAGRAM

TITLE:
CONDENSING MODE
STEAM SUPPLY TO RHR-HX 1B

DWG NO: RCIC-202.5
REV 1



WNP-02
 INTERVAL: PSI
 PERIOD: NA
 OUTAGE:
 DRAWING NO. RCIC-202

WASHINGTON PUBLIC POWER SUPPLY SYSTEM
 PROGRAM PLAN AND SCHEDULE
 SYSTEM OR COMPONENT: RCIC(12)-4
 DESCRIPTION: COND MODE STM SUPPLY

PAGE 001
 DATE 12/14/84

<u>IDENT. NO.</u>	<u>DESCRIPTION</u>	<u>SECT.</u>		<u>PROCEDURE</u>	<u>CAL. BLOCK</u>	<u>INSERVICE SCHEDULED</u>		<u>NOTES</u>
		<u>EXAM.</u>	<u>EXAM MTH.</u>			<u>REQ.</u>	<u>OUTAGE</u>	
RCIC-919N	SPRING	C-E-2	VT-3	303/8.2.17				
			VT-4	303/8.2.17				
RCIC-917N	PSA-3 SNUBBER	C-E-2	VT-3	303/8.2.17				S/N
			VT-4	303/8.2.17				S/N
RCIC-925N	PSA-3 SNUBBER	C-E-2	VT-3	303/8.2.17				S/N
RCIC-920N	SPRING	C-E-2	VT-3	303/8.2.17				
			VT-4	303/8.2.17				
RCIC-906N	STRUT	C-E-2	VT-3	303/8.2.17				
RCIC-905N	PSA-10 SNUBBER	C-E-2	VT-3	303/8.2.17				S/N
			VT-4	303/8.2.17				S/N
RCIC-907N	STRUT	C-E-2	VT-3	303/8.2.17				
RCIC-909N	PSA-3 SNUBBER	C-E-2	VT-3	303/8.2.17				S/N
			VT-4	303/8.2.17				S/N
RCIC-908N	PSA-3 SNUBBER	C-E-2	VT-3	303/8.2.17				S/N
			VT-4	303/8.2.17				S/N
RCIC-910N	STRUT	C-E-2	VT-3	303/8.2.17				
RCIC-911N	STRUT	C-E-2	VT-3	303/8.2.17				
RCIC-929N	STRUT	C-E-2	VT-3	303/8.2.17				

WNP-02
 INTERVAL: PSI
 PERIOD: NA
 OUTAGE:
 DRAWING NO. RCIC-202

WASHINGTON PUBLIC POWER SUPPLY SYSTEM
 PROGRAM PLAN AND SCHEDULE
 SYSTEM OR COMPONENT: RCIC(12)-4
 DESCRIPTION: COND MODE STM SUPPLY

PAGE 002
 DATE 12/14/84

<u>IDENT. NO.</u>	<u>DESCRIPTION</u>	<u>SECT.</u> <u>XI</u> <u>EXAM.</u>	<u>EXAM</u> <u>MTM.</u>	<u>PROCEDURE</u>	<u>CAL.</u> <u>BLOCK</u>	<u>INSERVICE</u>		<u>NOTES</u>
						<u>REQ.</u>	<u>SCHEDULED</u> <u>OUTAGE</u>	
RCIC-912N	ANCHOR	C-E-2	VT-3	303/8.2.17				
RCIC-119	SPRING	C-E-2	VT-3	303/8.2.17				
			VT-4	303/8.2.17				
RCIC-951N	SPRING	C-E-2	VT-3	303/8.2.17				
			VT-4	303/8.2.17				
RCIC-116	STRUT	C-E-2	VT-3	303/8.2.17				
RCIC-123	SPRING	C-E-2	VT-3	303/8.2.17				
			VT-4	303/8.2.17				
RCIC-117	STRUT	C-E-2	VT-3	303/8.2.17				
RCIC-121	SPRING	C-E-2	VT-3	303/8.2.17				
			VT-4	303/8.2.17				
RCIC-921N	STRUT	C-E-2	VT-3	303/8.2.17				
RCIC-914N	PSA-3 SNUBBER	C-E-2	VT-3	303/8.2.17				S/N
			VT-4	303/8.2.17				S/N
RCIC-928N	STRUT	C-E-2	VT-3	303/8.2.17				
RCIC-922N	SPRING	C-E-2	VT-3	303/8.2.17				
			VT-4	303/8.2.17				

WNP-02
 INTERVAL: PSI
 PERIOD: NA
 OUTAGE:
 DRAWING NO. RCIC-202

WASHINGTON PUBLIC POWER SUPPLY SYSTEM
 PROGRAM PLAN AND SCHEDULE
 SYSTEM OR COMPONENT: RCIC(12)-4
 DESCRIPTION: COND MODE STM SUPPLY

PAGE 003
 DATE 12/14/84


IDENT. NO.	DESCRIPTION	SECT. XI EXAM.	EXAM MTH.	PROCEDURE	CAL. BLOCK	INSERVICE		NOTES
						REQ.	SCHEDULED OUTAGE	
RCIC-900N	PSA-3 SNUBBER	C-E-2	VT-3	303/8.2.17				S/N
			VT-4	303/8.2.17				S/N
RCIC-923N	STRUT	C-E-2	VT-3	303/8.2.17				
RCIC-924N	STRUT	C-E-2	VT-3	303/8.2.17				
RCIC-918N	PSA-3 SNUBBER	C-E-2	VT-3	303/8.2.17				S/N
			VT-4	303/8.2.17				S/N
RCIC-926N	SPRING	C-E-2	VT-3	303/8.2.17				
			VT-4	303/8.2.17				
RCIC-913N	ANCHOR	C-E-2	VT-3	303/8.2.17				
RCIC-113	SPRING	C-E-2	VT-3	303/8.2.17				
			VT-4	303/8.2.17				
RCIC-106	BOX	C-E-2	VT-3	303/8.2.17				
RCIC-111	BOX	C-E-2	VT-3	303/8.2.17				
RCIC-108	PSA-1/2 SNUBBER	C-E-2	VT-3	303/8.2.17				S/N
			VT-4	303/8.2.17				S/N
RCIC-109	PSA-3 SNUBBER	C-E-2	VT-3	303/8.2.17				S/N
			VT-4	303/8.2.17				S/N
RCIC-107	BOX	C-E-2	VT-3	303/8.2.17				

WNP-02
INTERVAL: PSI
PERIOD: NA
OUTAGE:
DRAWING NO. RCIC-202

WASHINGTON PUBLIC POWER SUPPLY SYSTEM
PROGRAM PLAN AND SCHEDULE
SYSTEM OR COMPONENT: RCIC(12)-4
DESCRIPTION: COND MODE SIM SUPPLY


PAGE 004
DATE 12/14/84

<u>IDENT. NO.</u>	<u>DESCRIPTION</u>	<u>SECT.</u>		<u>PROCEDURE</u>	<u>CAL. BLOCK</u>	<u>INSERVICE SCHEDULED</u>		<u>NOTES</u>
		<u>XI</u>	<u>EXAM</u>			<u>REQ.</u>	<u>OUTAGE</u>	
RCIC-114	SPRING	C-E-2	VT-3	303/8.2.17				
			VT-4	303/8.2.17				
RCIC-PB-202	RCIC PRES BNDRY	N/A	VT-2	N/A				SEE NOTES #6 & #7.

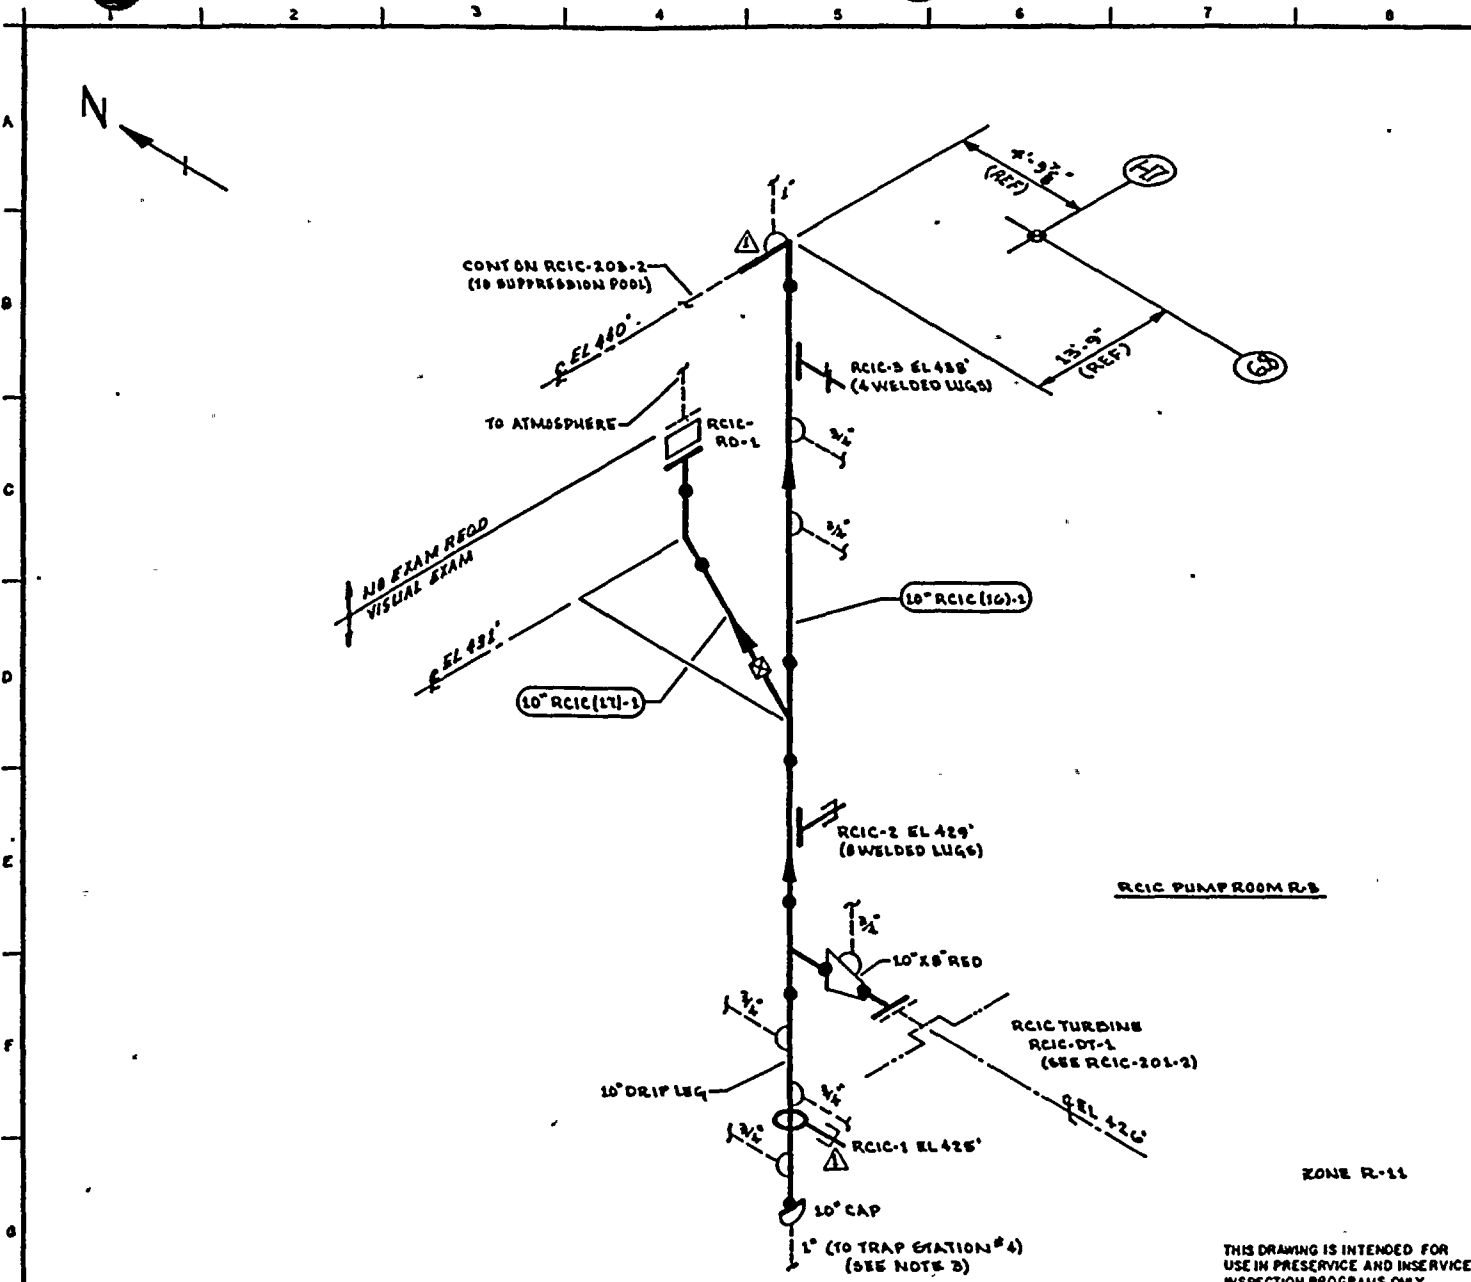

- NOTES:**
1. THIS DRAWING IDENTIFIES PIPING & COMPONENTS SUBJECT TO A VISUAL EXAM FOR EVIDENCE OF LEAKAGE DURING SYSTEM HYDRO OR OPERABILITY TESTS. TESTS ARE TO BE CONDUCTED PER THE REQUIREMENTS OF ASME SECTION XI, PARAGRAPH IWA-5000.
 2. FOR BRANCH PIPING 4" DIA OR LESS (CONN SHOWN IN DASHED LINES) EXTEND VISUAL LEAKAGE EXAM THROUGH THE OUTERMOST NORMALLY CLOSED NUCLEAR VALVE OR UNTIL TRANSITION TO INSTRUMENT TUBING, UNLESS OTHERWISE NOTED.
 3. EXTEND VISUAL LEAKAGE EXAM THROUGH TRAP STATION TO BAROMETRIC CONDENSER. VERIFY THAT DRAINAGE SYSTEM IS OPERATIVE.

- REFERENCES:**
- BOYER & CRAIG ISOMETRICS
 - RCIC-660-1 REV B
 - RCIC-661-1.R REV G

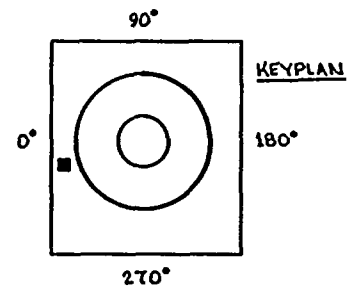

QUALITY CLASS: 1 ASME CODE CLASS: 2
 ENGR: G.A. KUGLER DRAWN: K.M.A. DATE: 7-21-78

WASHINGTON PUBLIC POWER SUPPLY SYSTEM
 RICHLAND, WASHINGTON 99352

WNP-2
 WELD COMPONENT IDENTIFICATION DIAGRAM


TITLE:
RCIC TURBINE EXHAUST

DWG NO: RCIC-203-1 REV 1

THIS DRAWING IS INTENDED FOR USE IN PRESERVICE AND INSERVICE INSPECTION PROGRAMS ONLY.


PIPING SYSTEM	NOM DIA (IN)	SCH	NOM WALL THK	MATERIAL SPECIFICATION	MATL TYPE	CAL BLOCK NO
10" RCIC (16)-3	10	STD	0.365	SA 106 GR B	CG	NA
10" RCIC (17)-3	10	STD	0.365	SA 106 GR B	CG	NA

NO	DATE	REVISION	BY	CHKD	APPVD
1	12-2-83	REVISED AS NOTED ADDED KEYPLAN	K.A.A.	E.P.R.	T.P.H.
0	12-2-78	ISSUED FOR USE	K.M.A.	A.P.S.	S.P.O.
1	10-3-78	ISSUED FOR INFORMATION ONLY	K.M.A.	A.P.S.	Q.M.L.

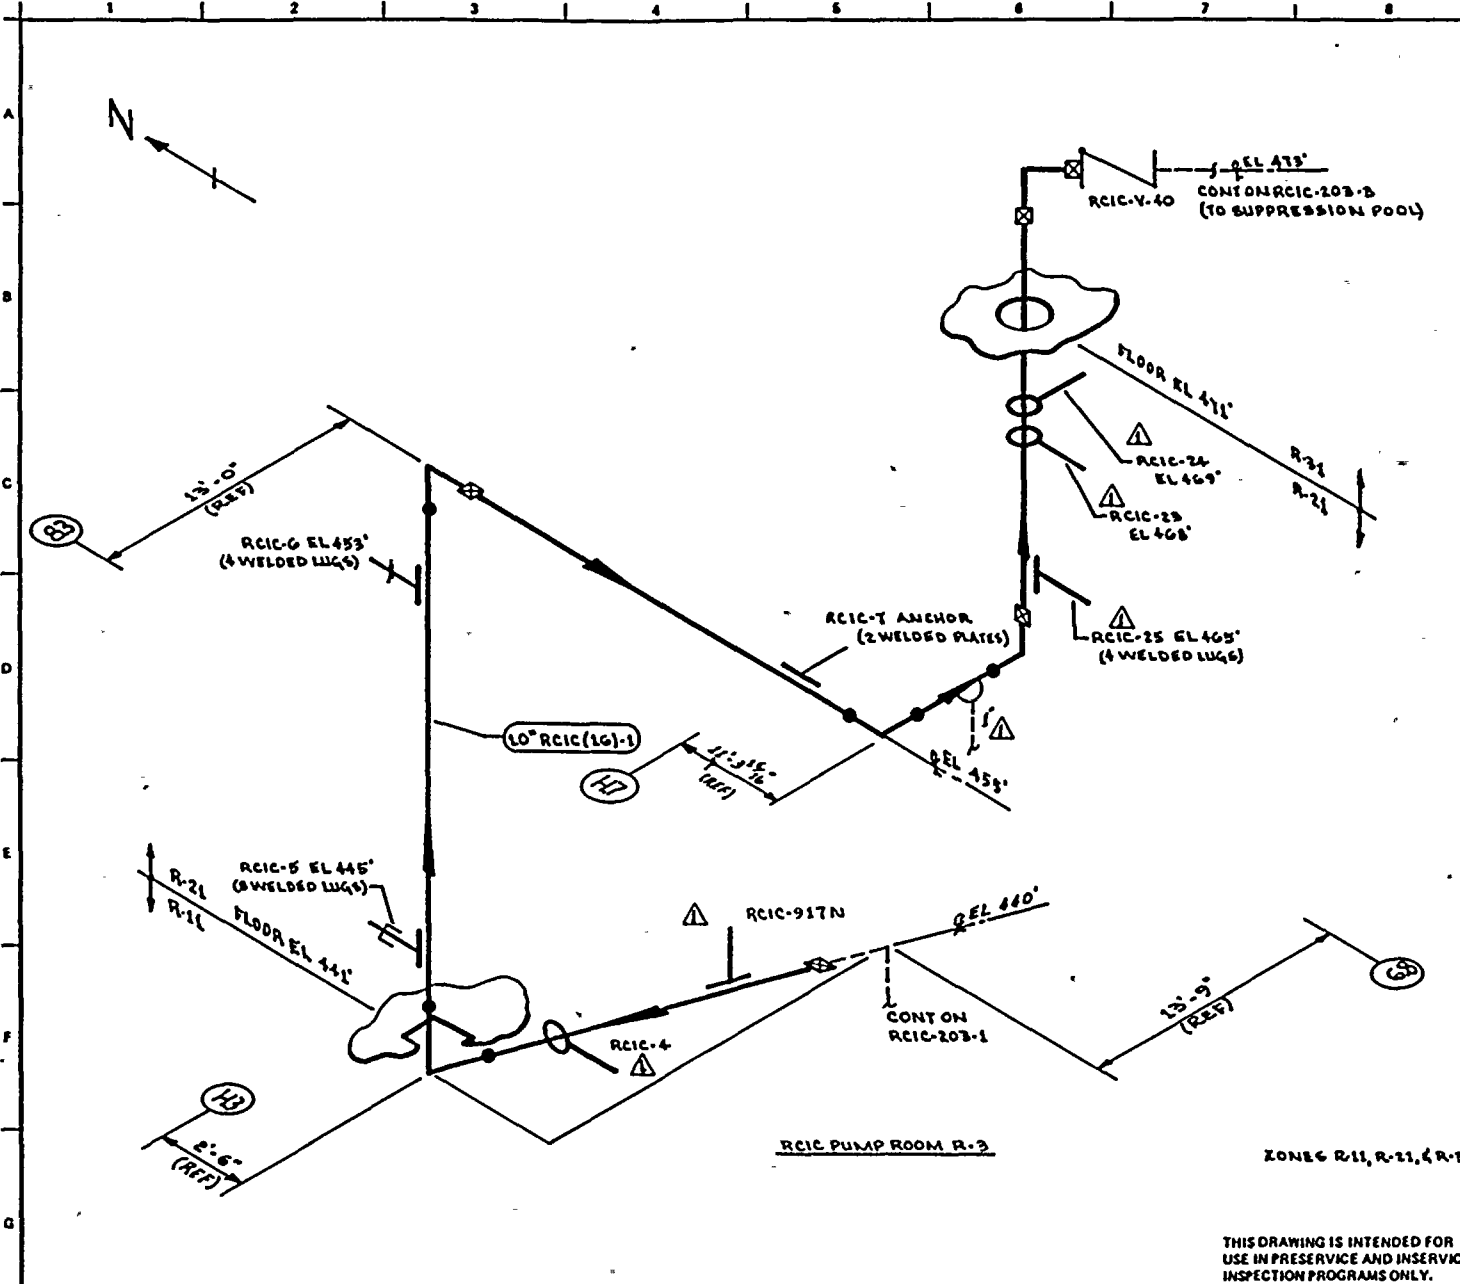

- NOTES:
1. THIS DRAWING IDENTIFIES PIPING & COMPONENTS SUBJECT TO A VISUAL EXAM FOR EVIDENCE OF LEAKAGE DURING SYSTEM HYDRO OR OPERABILITY TESTS. TESTS ARE TO BE CONDUCTED PER THE REQUIREMENTS OF ASME SECTION XI, PARAGRAPH 5WA-5000.
 2. For branch piping, 4" or less (conn. shown in dashed lines), extend visual leakage exam through the outermost normally closed nuclear class valve, or until transition to instrument tubing, unless otherwise noted.

REFERENCE:
 BOVE & CRAIG ISOMETRICS
 RCIC-660-24 REV 11

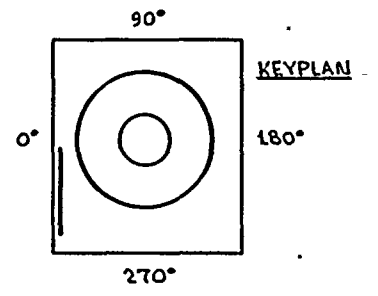

QUALITY CLASS: 1 ASME CODE CLASS: 2
 ENGR: QA KUGLER DRAWN: V-MeA DATE: 7-21-78
WASHINGTON PUBLIC POWER SUPPLY SYSTEM
 RICHMOND, WASHINGTON 98342

THIS DRAWING IS INTENDED FOR USE IN PRESERVICE AND INSERVICE INSPECTION PROGRAMS ONLY.

PIPING SYSTEM	NOM DIA (IN)	SCH	NOM WALL THK	MATERIAL SPECIFICATION	MATL TYPE	CAL BLOCK NO
10" RCIC (16)-1	10	STD	0.365	SA 106 GR B	CG	NA


NO	DATE	REVISION	BY	CHK	APPV'D
1	12-28-73	REVISED AS NOTED ADDED KEYPLAN	KUG	ZPC	JKP
0	11-22-73	ISSUED FOR USE	KUG	APP	JKP
A	11-1-73	ISSUED FOR INFORMATION ONLY	KUG	ZPC	JKP

WNP-2
 WELD & COMPONENT IDENTIFICATION DIAGRAM

TITLE:
 RCIC TURBINE EXHAUST


DWG NO: RCIC-203-2 REV 1



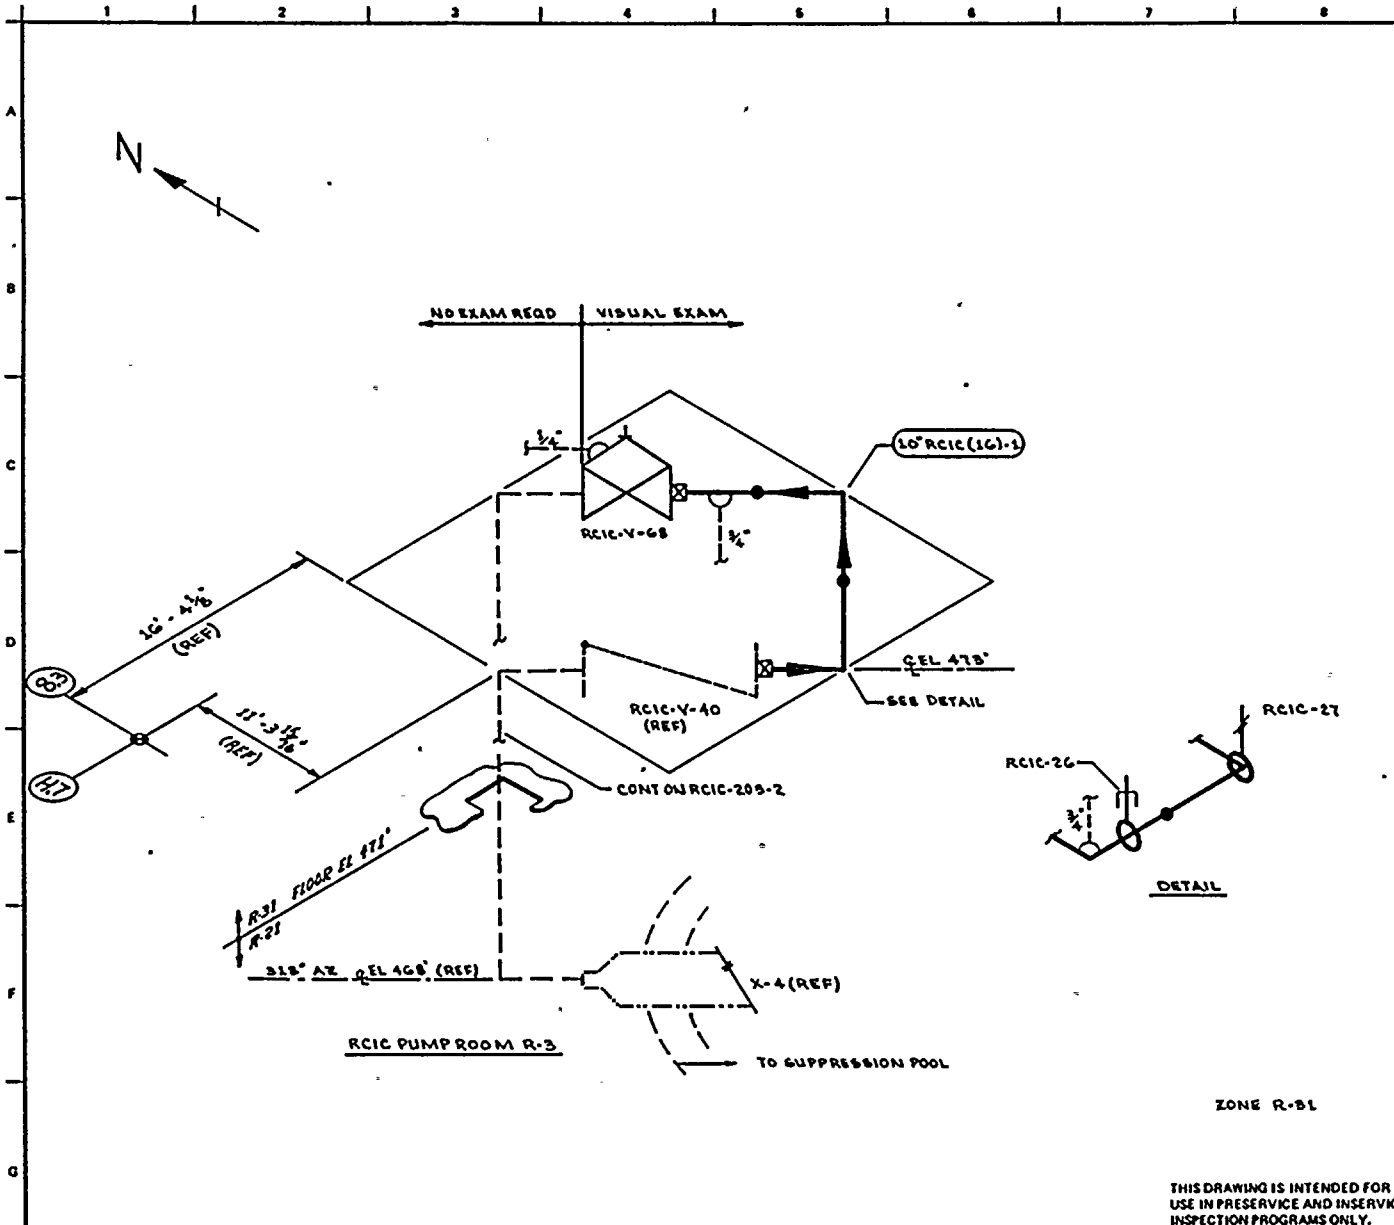

- NOTES:
1. THIS DRAWING IDENTIFIES PIPING & COMPONENTS SUBJECT TO A VISUAL EXAM FOR EVIDENCE OF LEAKAGE DURING SYSTEM HYDRO OR OPERABILITY TESTS. TESTS ARE TO BE CONDUCTED PER THE REQUIREMENTS OF ASME SECTION XI, PARAGRAPH IWA-5000.
 2. FOR BRANCH PIPING 4" DIA OR LESS (CONN SHOWN IN DASHED LINES) EXTEND VISUAL LEAKAGE EXAM THROUGH THE OUTER MOST NORMALLY CLOSED NUCLEAR CLASS VALVE OR UNTIL TRANSITION TO INSTRUMENT TUBING UNLESS OTHERWISE NOTED.
 3. AT LOCATIONS WHERE LEAKAGE IS NORMALLY EXPECTED (EG VALVE STEM & PUMP SEAL LEAKOFF CONN) VERIFY LEAKAGE COLLECTION SYSTEM OPERABILITY ONLY. NO HYDRO TEST OF COLLECTION SYSTEM IS REQUIRED.

- REFERENCES:
- DOVE & CRAIL ISOMETRIC
 - RCIC-660-5 REV T
 - RCIC-660-5H REV O

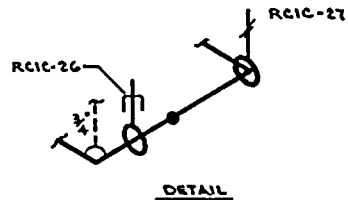

QUALITY CLASS: 1 ASME CODE CLASS: 2
 ENGR: G.A. KUGLER DRAWN: K.M.C.A. DATE: 7-24-78

WASHINGTON PUBLIC POWER SUPPLY SYSTEM
 RICHLAND, WASHINGTON 99362

THIS DRAWING IS INTENDED FOR USE IN PRESERVICE AND INSERVICE INSPECTION PROGRAMS ONLY.

PIPING SYSTEM	NOM DIA (IN)	SCH	NOM WALL THK	MATERIAL SPECIFICATION	MATL TYPE	CAL BLOCK NO
10" RCIC(16)-1	10	STD	0.365	SA 106 GR B	CS	NA

WNP-2
 WELD & COMPONENT IDENTIFICATION DIAGRAM

TITLE:
 RCIC TURBINE EXHAUST

DWG NO: RCIC-203-B REV O

NO	DATE	REVISION	BY	CHKD	APPVD
0	12-28-78	ISSUED FOR USE	K.A.	J.P.	J.P.
1	10-1-78	ISSUED FOR INFORMATION ONLY	K.A.	J.P.	J.P.

WNP-02
 INTERVAL: PSI
 PERIOD: NA
 OUTAGE:
 DRAWING NO. RCIC-203

WASHINGTON PUBLIC POWER SUPPLY SYSTEM
 PROGRAM PLAN AND SCHEDULE
 SYSTEM OR COMPONENT: RCIC(16)-1
 DESCRIPTION: RCIC TURBINE EXHAUST

PAGE 001
 DATE 12/14/84


<u>IDENT. NO.</u>	<u>DESCRIPTION</u>	SECT. XI <u>EXAM.</u>	EXAM <u>MTH.</u>	<u>PROCEDURE</u>	CAL. <u>BLOCK</u>	<u>INSERVICE</u>		<u>NOTES</u>
						<u>REQ.</u>	<u>SCHEDULED</u> <u>OUTAGE</u>	
RCIC-1	PSA-1 SNUBBER	C-E-2	VT-3	303/8.2.17				S/N 587
			VT-4	303/8.2.17				S/N 587
RCIC-2	PSA-1 SNUBBER	C-E-2	VT-3	303/8.2.17				S/N 572
			VT-4	303/8.2.17				S/N 572
RCIC-3	SPRING (2)	C-E-2	VT-3	303/8.2.17				
			VT-4	303/8.2.17				
RCIC-971N	PSA-1 SNUBBER	C-E-2	VT-3	303/8.2.17				S/N 603
			VT-4	303/8.2.17				S/N 603
RCIC-4	PSA-1 SNUBBER	C-E-2	VT-3	303/8.2.17				S/N
			VT-4	303/8.2.17				S/N
RCIC-5	PSA-1/2 SN(2)	C-E-2	VT-3	303/8.2.17				S/N E2139/W388
			VT-4	303/8.2.17				S/N E2139/W388
RCIC-6	SPRING	C-E-2	VT-3	303/8.2.17				
			VT-4	303/8.2.17				
RCIC-7	ANCHOR	C-E-2	VT-3	303/8.2.17				
RCIC-25	STRUT	C-E-2	VT-3	303/8.2.17				
RCIC-23	STRUT	C-E-2	VT-3	303/8.2.17				
RCIC-24	STRUT	C-E-2	VT-3	303/8.2.17				

WNP-02
 INTERVAL: PSI
 PERIOD: NA
 OUTAGE:
 DRAWING NO. RCIC-203

WASHINGTON PUBLIC POWER SUPPLY SYSTEM
 PROGRAM PLAN AND SCHEDULE
 SYSTEM OR COMPONENT: RCIC(16)-1
 DESCRIPTION: RCIC TURBINE EXHAUST


PAGE 002
 DATE 12/14/84

<u>IDENT. NO.</u>	<u>DESCRIPTION</u>	<u>SECT.</u> <u>XI</u>	<u>EXAM</u> <u>EXAM.</u>	<u>PROCEDURE</u> <u>MTH.</u>	<u>CAL.</u> <u>BLOCK</u>	<u>INSERVICE</u>		<u>NOTES</u>
						<u>REQ.</u>	<u>SCHEDULED</u> <u>OUTAGE</u>	
RCIC-26	PSA-3 SNUBBER	C-E-2	VT-3	303/8.2.17				S/N 4415
			VT-4	303/8.2.17				S/N 4415
RCIC-27	SPRING	C-E-2	VT-3	303/8.2.17				
			VT-4	303/8.2.17				
RCIC-PB-203	RCIC PRES BNDRY	N/A	VT-2	N/A				SEE NOTES #6 & #7.

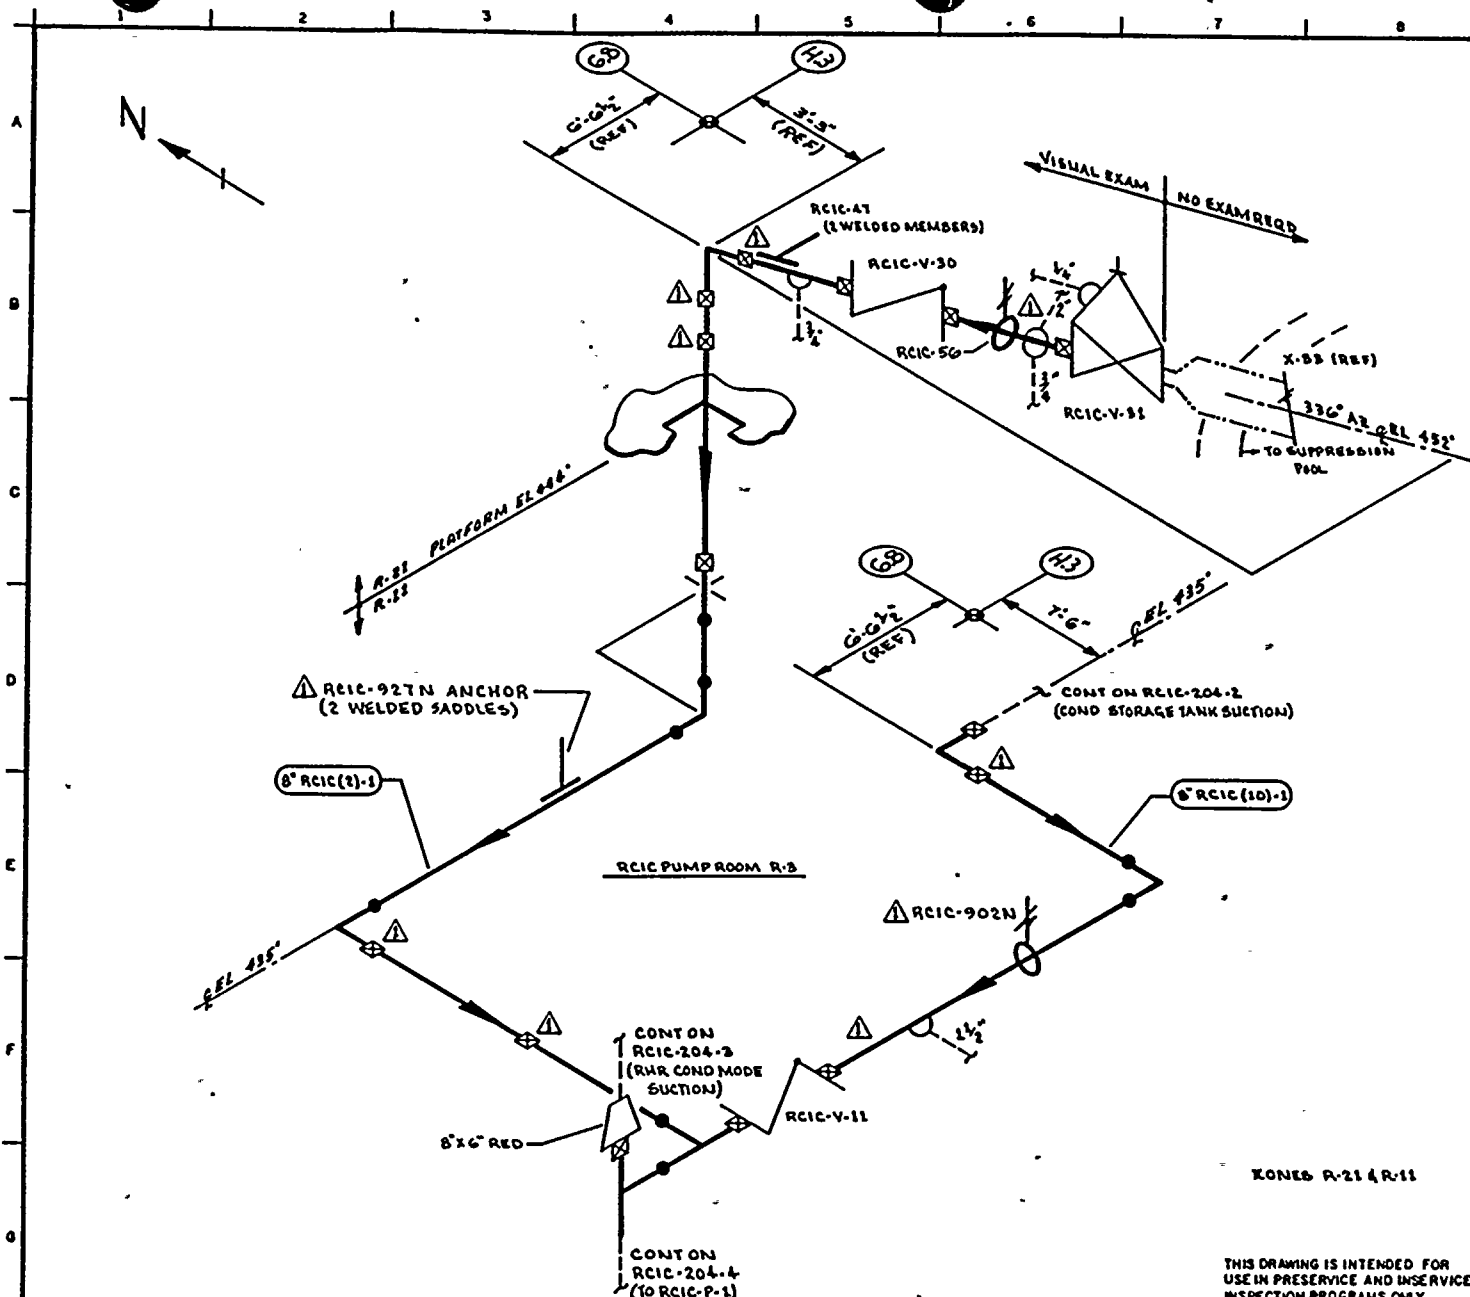

- NOTES:**
1. THIS DRAWING IDENTIFIES PIPING & COMPONENTS SUBJECT TO A VISUAL EXAM FOR EVIDENCE OF LEAKAGE DURING SYSTEM HYDRO OR OPERABILITY TESTS. TESTS ARE TO BE CONDUCTED PER THE REQUIREMENTS OF ASME SECTION XI, PARAGRAPH IWA-5000.
 2. FOR PIPING 4" DIA OR LESS (CONN SHOWN IN DASHED LINES) EXTEND VISUAL LEAKAGE EXAM THROUGH THE OUTERMOST NORMALLY CLOSED NUCLEAR CLASS VALVE OR UNTIL TRANSITION TO INSTRUMENT TUBING UNLESS OTHERWISE NOTED.
 3. AT LOCATIONS WHERE LEAKAGE IS NORMALLY EXPECTED (EG VALVE STEM & PUMP SEAL LEAKOFF CONN) VERIFY LEAKAGE COLLECTION SYSTEM OPERABILITY ONLY. NO HYDRO TEST OF COLLECTION SYSTEM IS REQUIRED.

REFERENCES:
 BOVES & CRAL ISOMETRICS
 RCIC-656-L-3 REV 6

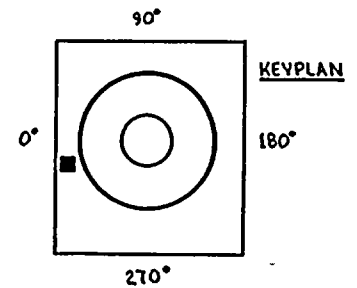

QUALITY CLASS: 1 ASME CODE CLASS: 2
 ENGR: G.A. KUGLER DRAWN: K.McA DATE: 7-24-78

WASHINGTON PUBLIC POWER SUPPLY SYSTEM
 RICHLAND, WASHINGTON 99352

THIS DRAWING IS INTENDED FOR USE IN PRESERVICE AND INSERVICE INSPECTION PROGRAMS ONLY.


PIPING SYSTEM	NOM DIA (IN)	SCH	NOM WALL THK	MATERIAL SPECIFICATION	MATL TYPE	CAL BLOCK NO
8" RCIC(2)-1	8"	STD	0.322	SA 106 GR B	CS	NA
8" RCIC(10)-1	8"	STD	0.322	SA 106 GR B	CS	NA

NO	DATE	REVISION	BY	CHKD	APPVD
1	12-28-83	REVISED AS NOTED ADDED KEYPLAN	KMcA	ZPK	JFH
0	12-22-78	ISSUED FOR USE	KMcA	JFH	JFH
1	10-9-78	ISSUED FOR INFORMATION ONLY	KMcA	JFH	JFH

WNP-2
 WELD COMPONENT IDENTIFICATION DIAGRAM


TITLE:
 RCIC PUMP SUCTION LINES

DWG NO: RCIC-204-1 REV 1

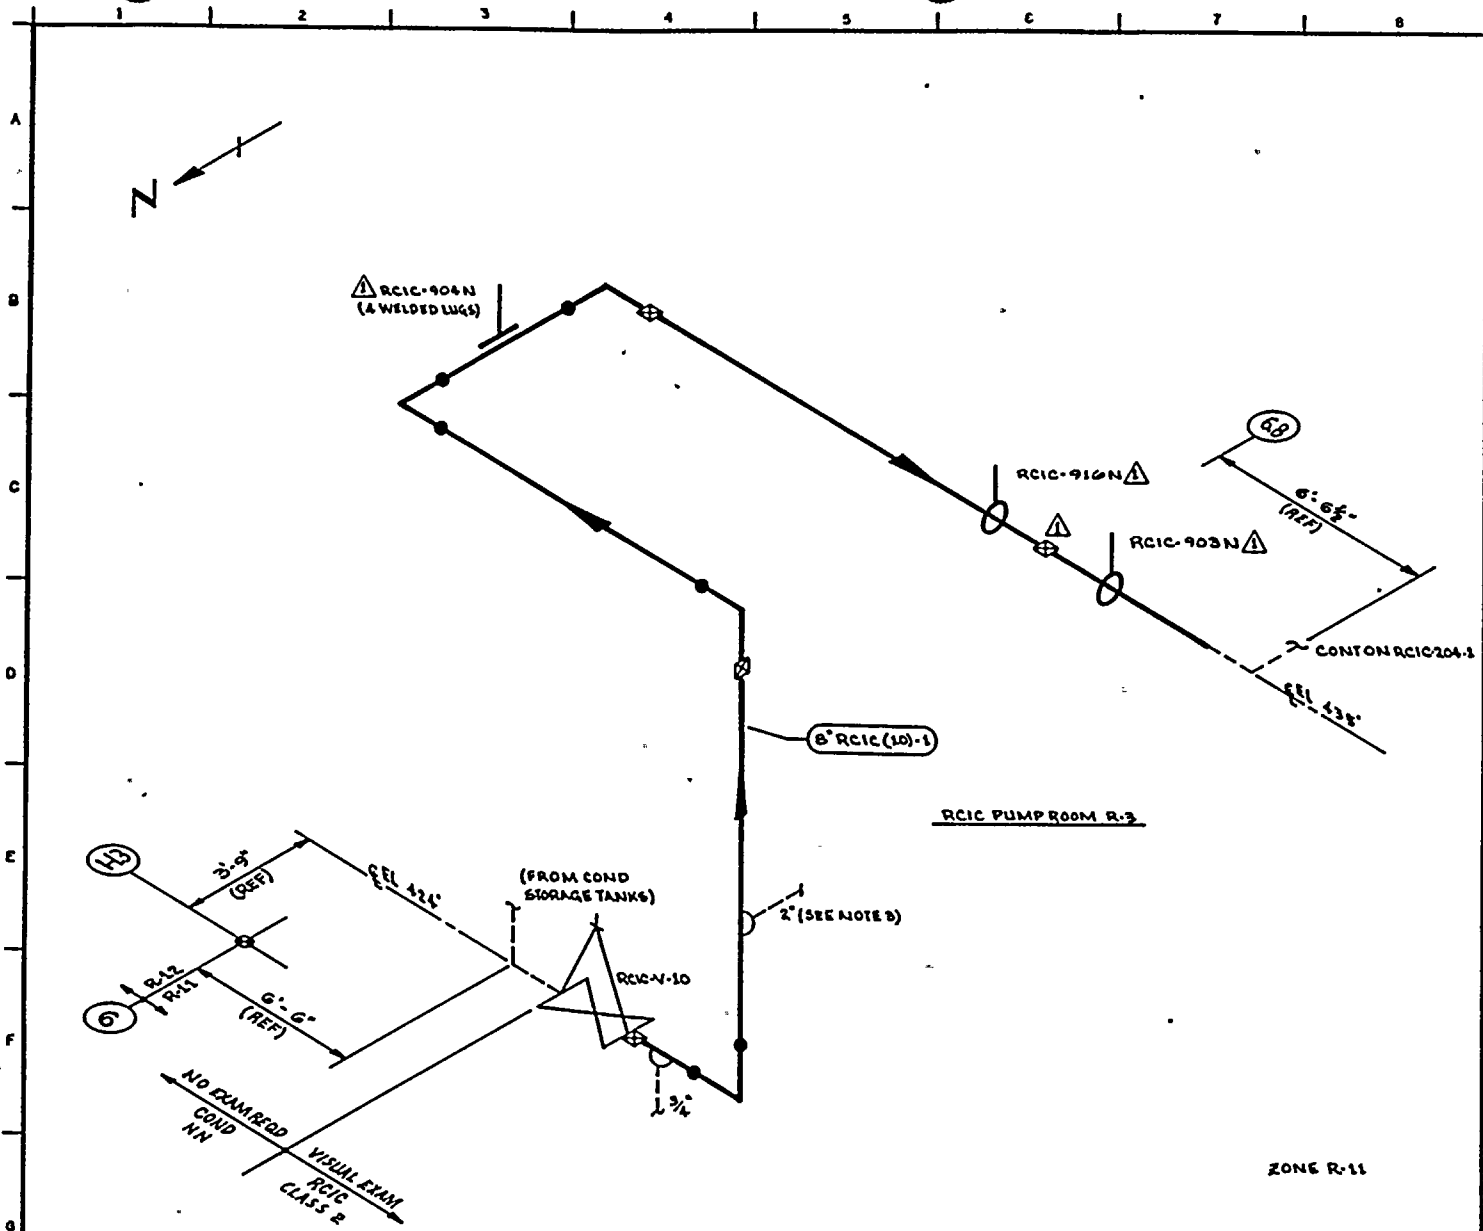

- NOTES:
1. THIS DRAWING IDENTIFIES PIPING & COMPONENTS SUBJECT TO A VISUAL EXAM FOR EVIDENCE OF LEAKAGE DURING SYSTEM HYDRO OR OPERABILITY TESTS. TESTS ARE TO BE CONDUCTED PER THE REQUIREMENTS OF ASME SECTION XI, PARAGRAPH IWA-5000.
 2. FOR BRANCH PIPING 4" DIA OR LESS (CONN SHOWN IN DASHED LINES) EXTEND VISUAL LEAKAGE EXAM THROUGH THE OUTERMOST NORMALLY CLOSED NUCLEAR CLASS VALVE OR UNTIL TRANSITION TO INSTRUMENT TUBING UNLESS OTHERWISE NOTED.
 3. EXTEND VISUAL LEAKAGE EXAM THROUGH PUMP RCIC-P-3.

REFERENCES:
BOVEE & CRAIG ISOMETRICS
RCIC-657-1.2 REV B

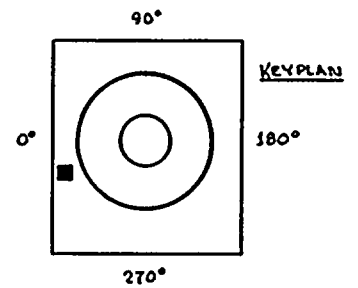

ZONE R-11

THIS DRAWING IS INTENDED FOR USE IN PRESERVICE AND INSERVICE INSPECTION PROGRAMS ONLY.

QUALITY CLASS: 1 ASME CODE CLASS: 2
ENGR G.A. KLIJNER DRAWN K.M.C.A DATE: 7-25-78

WASHINGTON PUBLIC POWER SUPPLY SYSTEM
RICHLAND WASHINGTON 99352


PIPING SYSTEM	NOM DIA (IN)	SCH	NOM WALL THK	MATERIAL SPECIFICATION	MATL TYPE	CAL BLOCK NO
8" RCIC (10)-1	8	STD	0.322	SA 106 GR B	CB	NA

NO	DATE	REVISION	BY	CHKD	APPVD
1	12-2-83	REVISED AS NOTED ADDED KEYPLAN	K.A.	E.P.R.	J.P.R.
0	12-23-78	ISSUED FOR USE	K.A.	A.P.R.	J.P.R.
1	10-3-78	ISSUED FOR INFORMATION ONLY	K.A.	L.A.K.	R.D.S.

WHP-2
WELD & COMPONENT IDENTIFICATION DIAGRAM


TITLE:
RCIC COND STORAGE TANK SUCTION
OWG NO: RCIC-204-2 REV 1



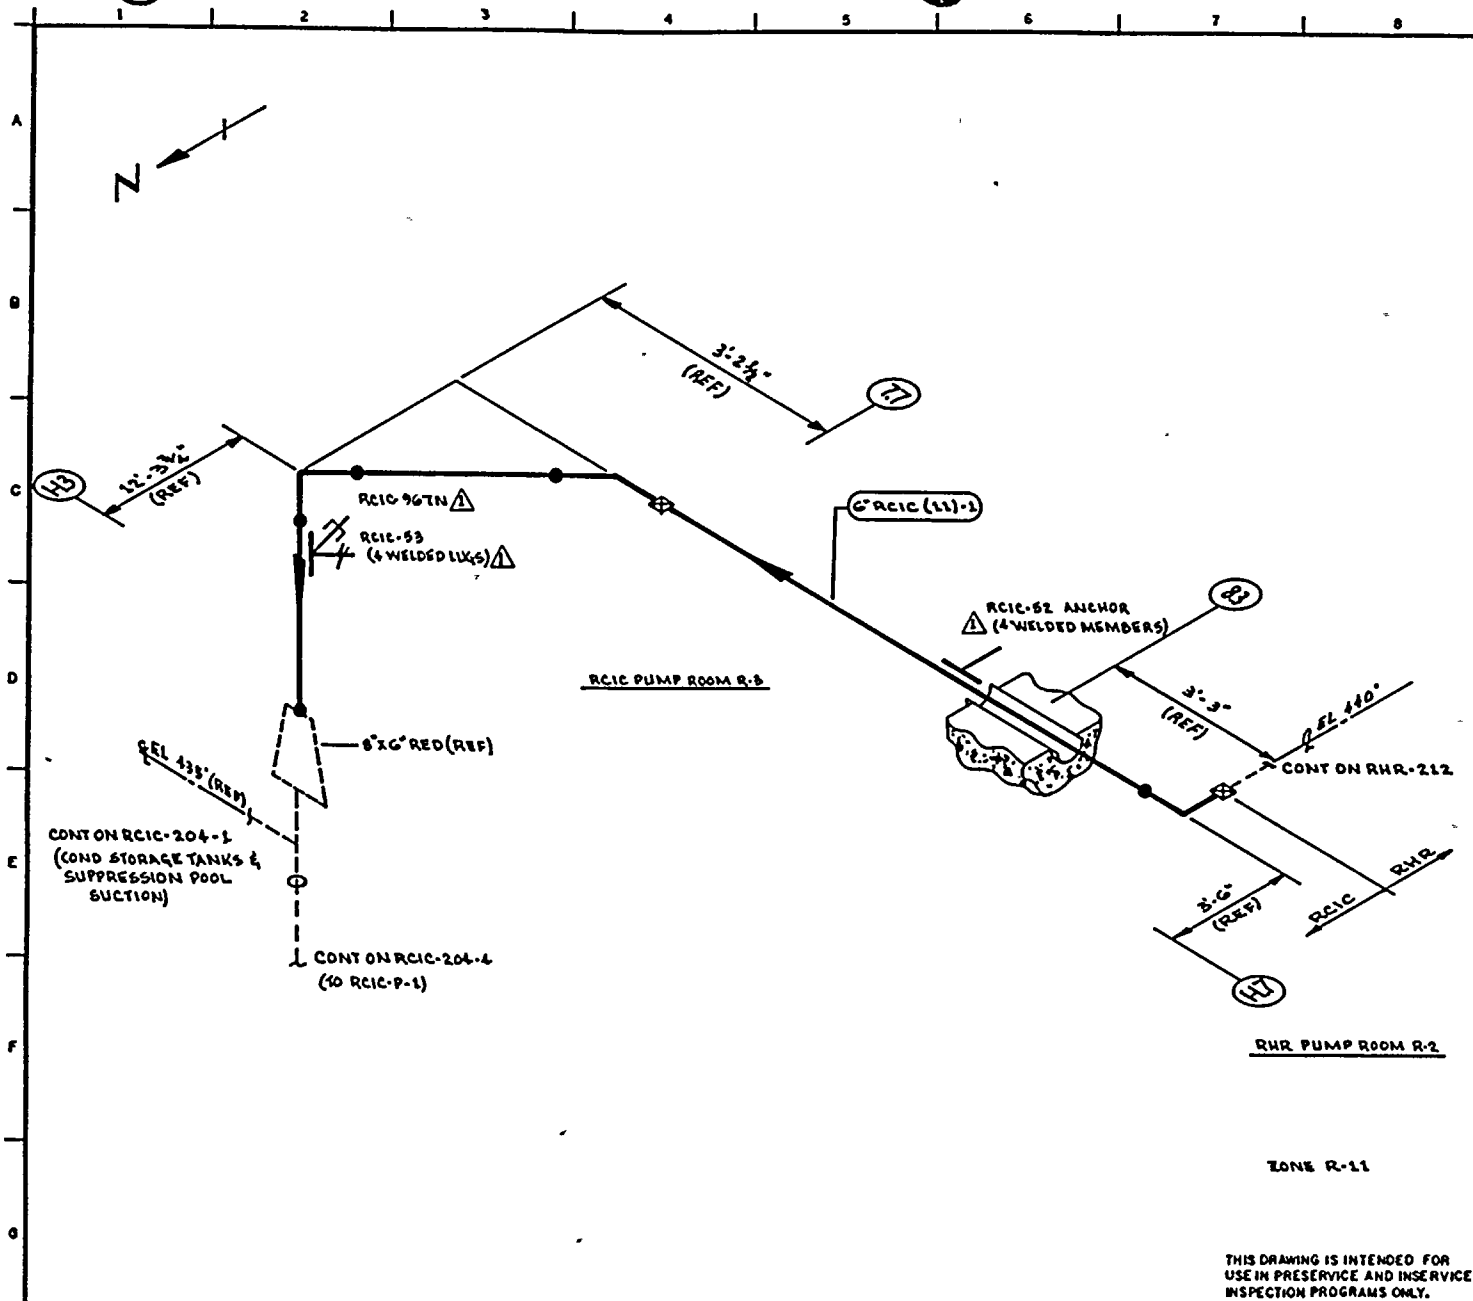

NOTES:
 1. THIS DRAWING IDENTIFIES PIPING & COMPONENTS SUBJECT TO A VISUAL EXAM FOR EVIDENCE OF LEAKAGE DURING SYSTEM HYDRO OR OPERABILITY TESTS. TESTS ARE TO BE CONDUCTED PER THE REQUIREMENTS OF ASME SECTION II, PARAGRAPH IWA-5000.

REFERENCED:
 BOVES & CRAIG ISOMETRIC
 RCIC-659-1.2 REV 8

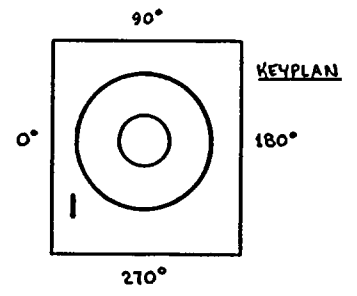

THIS DRAWING IS INTENDED FOR USE IN PRESERVICE AND INSERVICE INSPECTION PROGRAMS ONLY.

QUALITY CLASS: 1 ASME CODE CLASS: 2
 ENGR: G.A. KUGLER DRAWN: K.M.C.A. DATE: 7-25-78

 **WASHINGTON PUBLIC POWER SUPPLY SYSTEM**
 RICHLAND, WASHINGTON 99352


PIPING SYSTEM	NOM DIA (IN)	SCH	NOM WALL THK	MATERIAL SPECIFICATION	MATL TYPE	CAL BLOCK NO
6" RCIC (11)-1	6	40	0.280	SA 106 GR B	CS	N/A


NO	DATE	REVISION	BY	CHKD	APPVD
1	11-2-83	REVISED AS NOTED ADDED KEYPLAN	KUPA	LPR	TEX
0	12-12-78	ISSUED FOR USE	K.M.C.A.	KUPA	TEX
1	10-1-78	ISSUED FOR INFORMATION ONLY	K.M.C.A.	MA	TEX

WHP-2
 WELD & COMPONENT IDENTIFICATION DIAGRAM

TITLE:
 RHR CONDENSING MODE SUPPLY TO RCIC-P-1


DWG NO: RCIC-204-3 REV 1

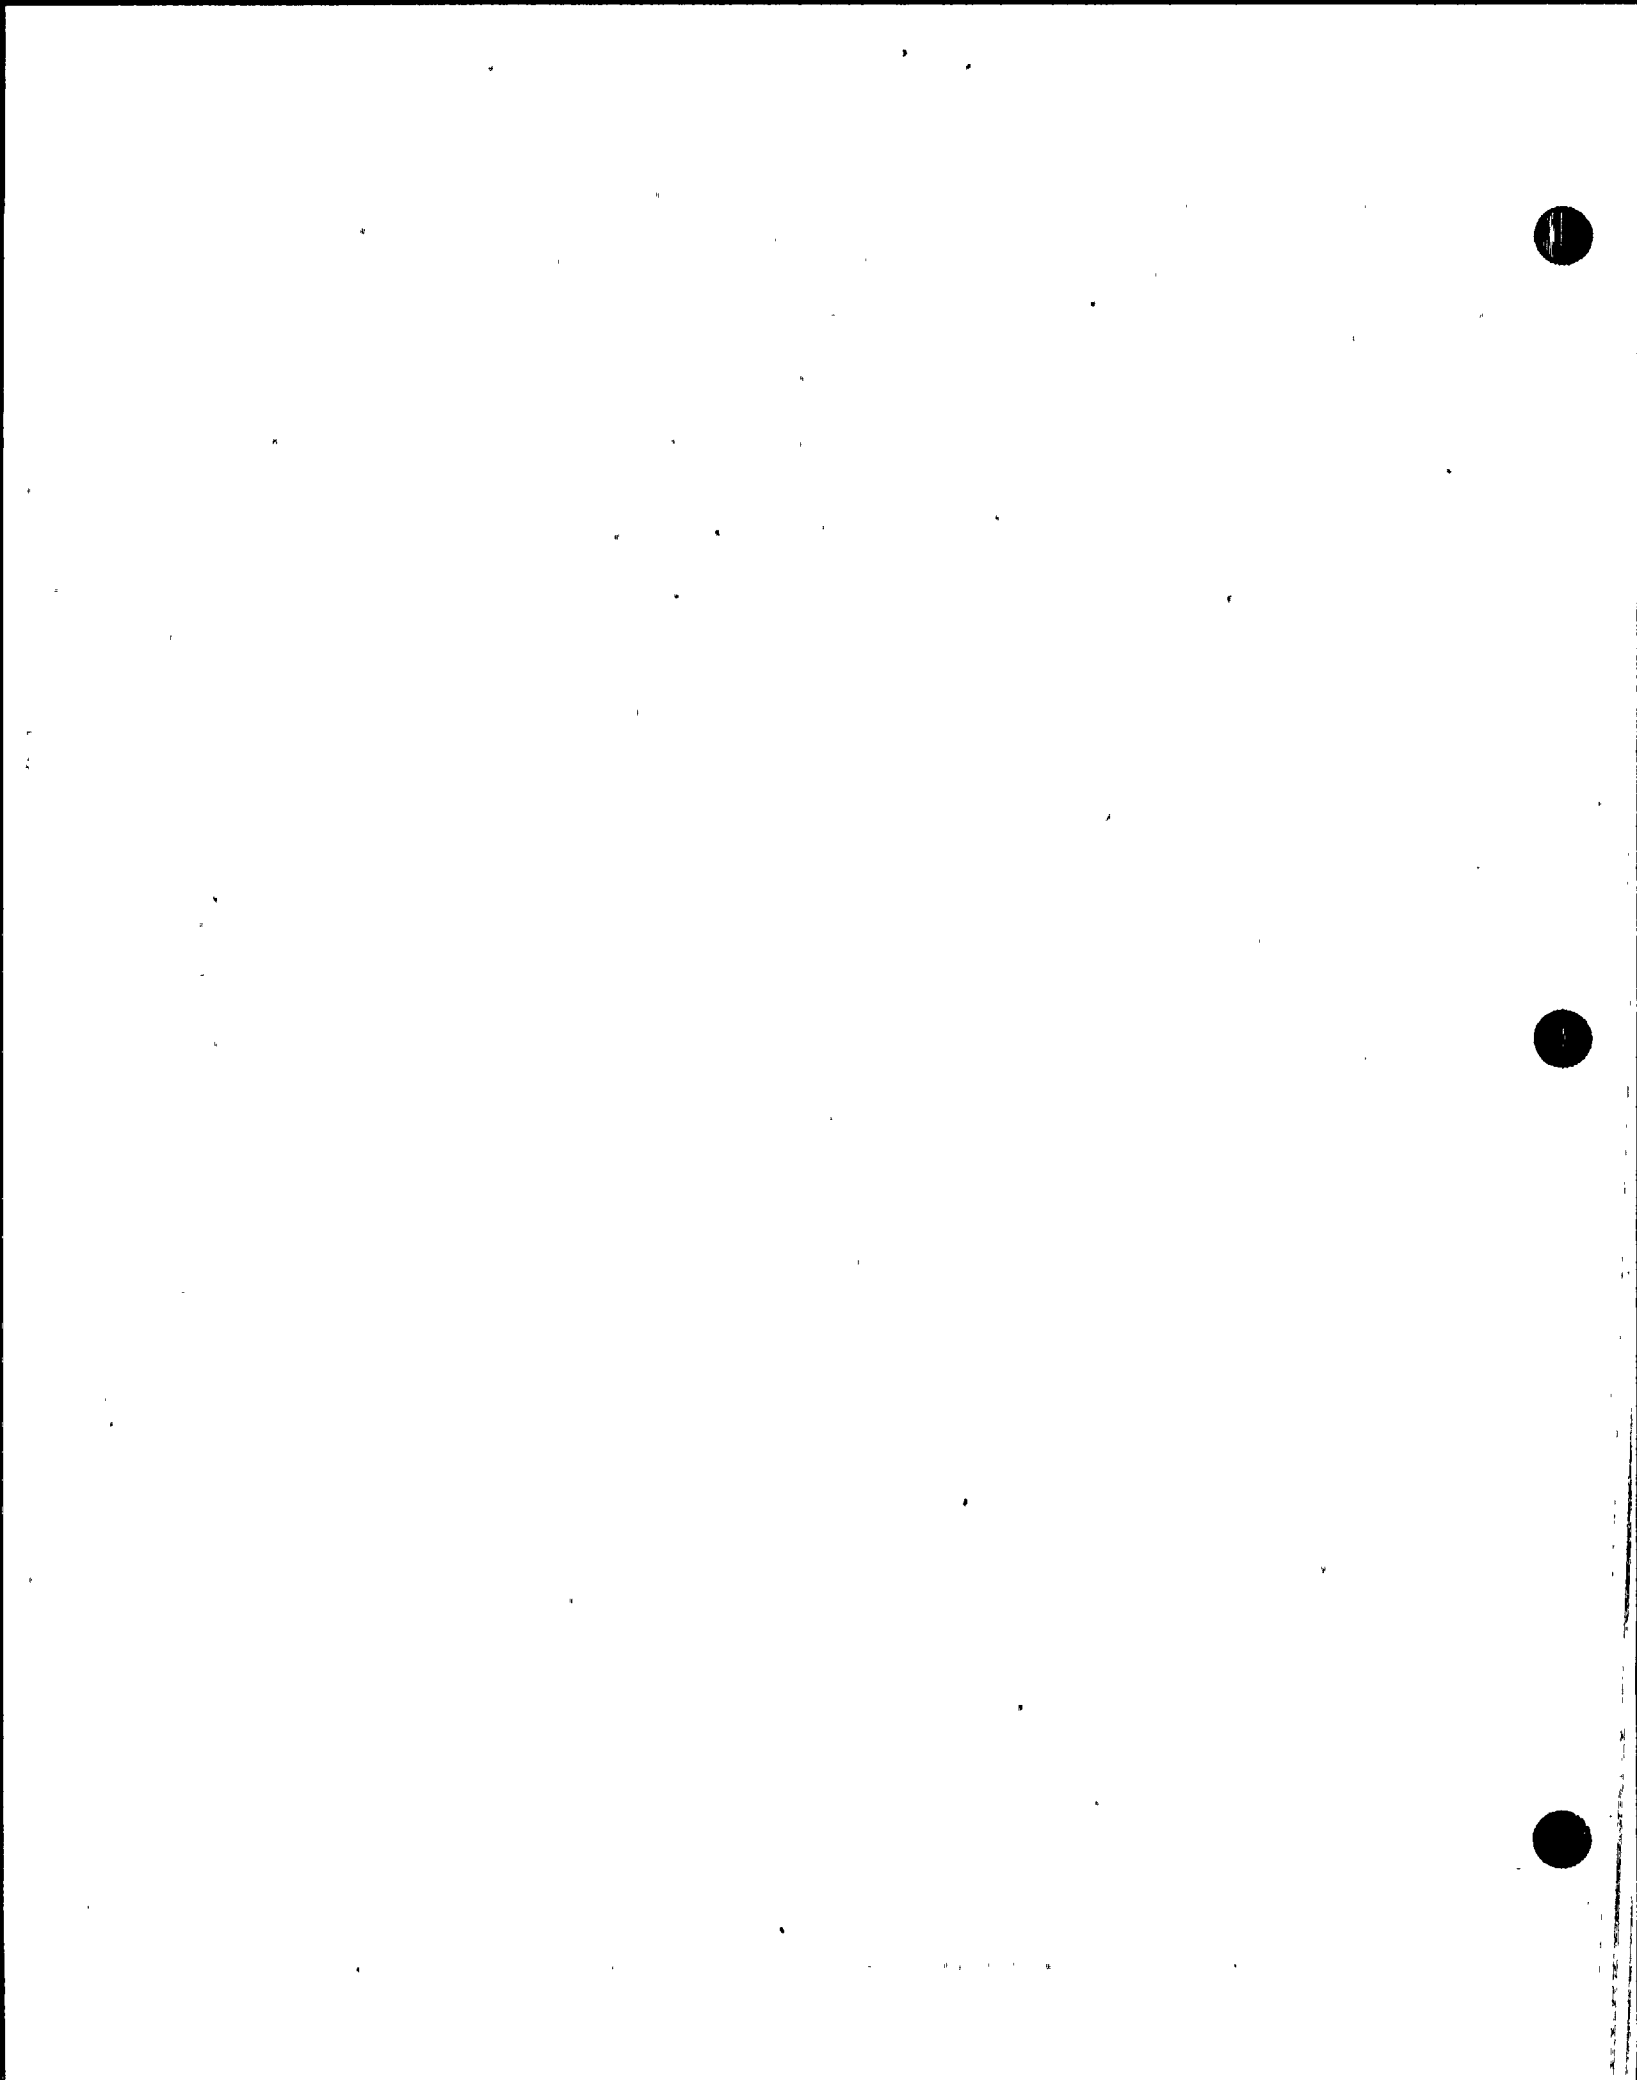

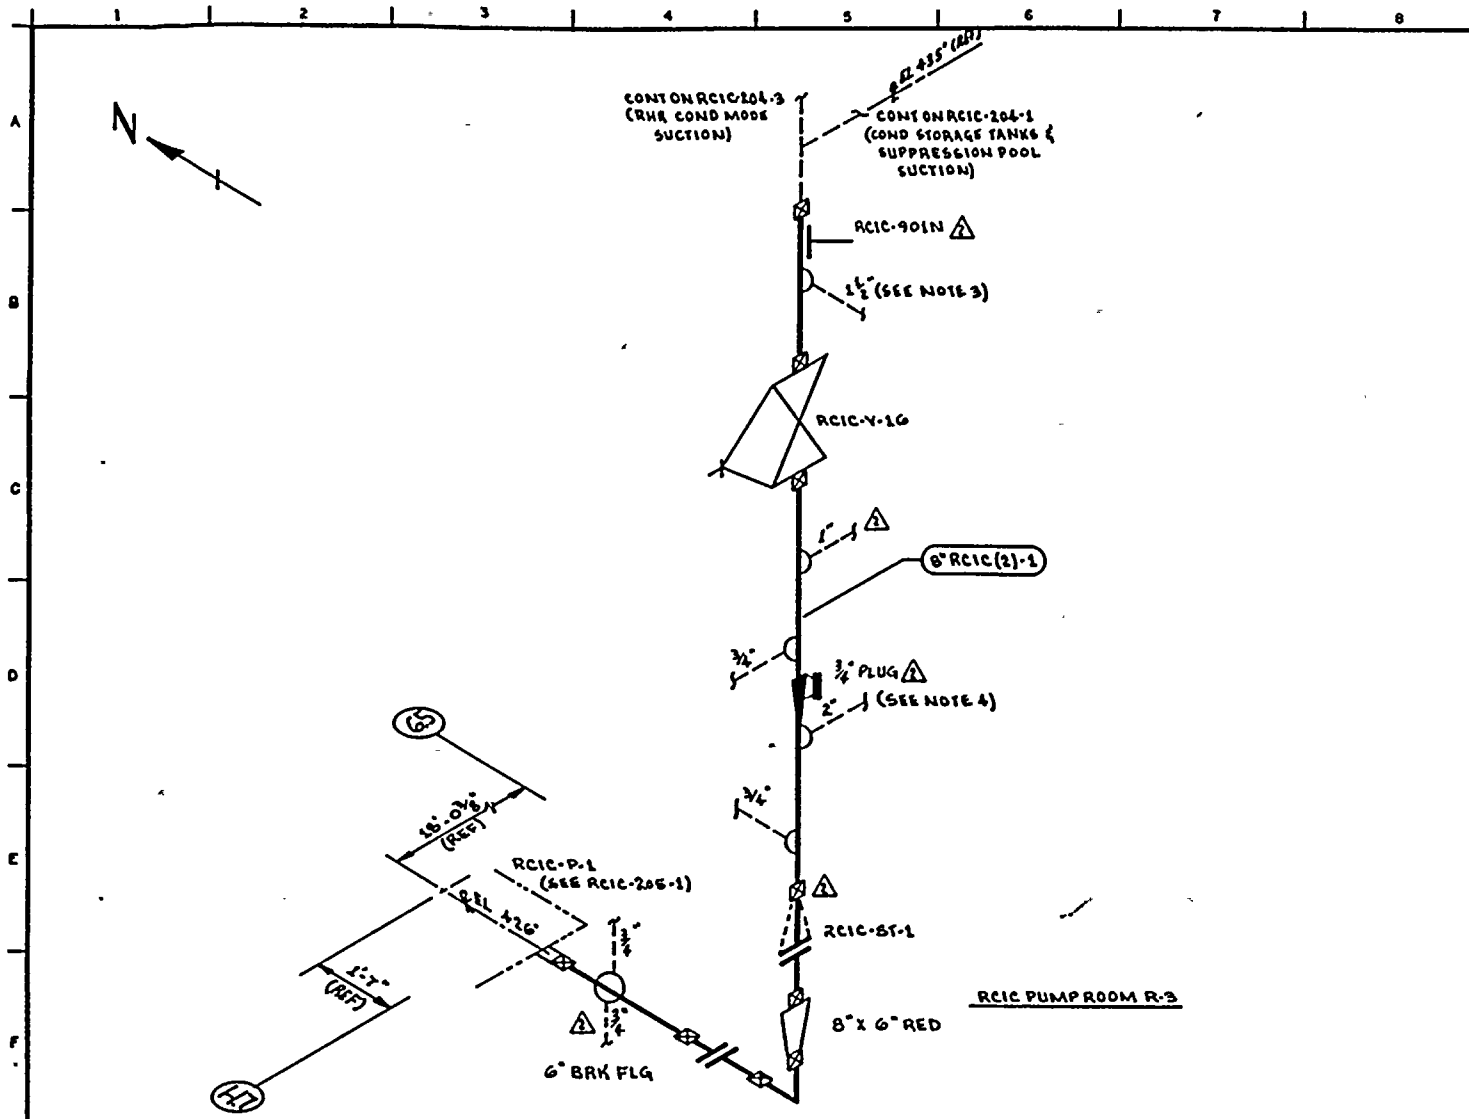

- NOTES**
1. THIS DRAWING IDENTIFIES PIPING & COMPONENTS SUBJECT TO A VISUAL EXAM FOR EVIDENCE OF LEAKAGE DURING SYSTEM HYDRO OR OPERABILITY TESTS. TESTS ARE TO BE CONDUCTED PER THE REQUIREMENTS OF ASME SECTION XI, PARAGRAPH IWA-5000.
 2. FOR BRANCH PIPING 4" DIA OR LESS (CONN SHOWN IN DASHED LINES) EXTEND VISUAL LEAKAGE THROUGH THE OUTERMOST NORMALLY CLOSED NUCLEAR CLASS VALVE OR UNTIL TRANSITION TO INSTRUMENT TUBING UNLESS OTHERWISE NOTED.
 3. EXTEND VISUAL LEAKAGE EXAM THROUGH VALVE RCIC-V-67 & PUMP RCIC-P-3.
 4. EXTEND VISUAL LEAKAGE EXAM THROUGH VALVE RCIC-V-47, VACUUM TANK RCIC-TK-1, PUMP RCIC-P-4 & CONNECTING PIPE SHOULD BE EXAMINED FOR LEAKAGE WITH TANK WATER HEAD ONLY.

REFERENCES:
BOYER & CRAIG ISOMETRICS
RCIC-656-B-B REV 11

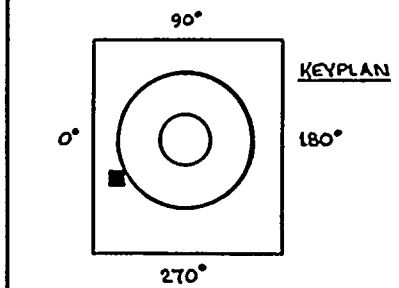

ZONE R-11

THIS DRAWING IS INTENDED FOR
USE IN PRESERVICE AND INSERVICE
INSPECTION PROGRAMS ONLY.

QUALITY CLASS: 1 ASME CODE CLASS: 2
ENGR G.A. KUGLER DRAWN: V. M. A. DATE: 2-28-78

**WASHINGTON PUBLIC POWER
SUPPLY SYSTEM**
RICHLAND, WASHINGTON 99352

PIPING SYSTEM	NOM DIA (IN)	SCH	NOM WALL THK	MATERIAL SPECIFICATION	MATL TYPE	CAL BLOCK NO
8" RCIC (2)-1	8	STD	0.322	SA 106 GR B	CS	NA

NO	DATE	REVISION	BY	CHKD	APPVD
2	12-28-78	REVISED AS NOTED ADDED KEYPLAN	K.A.A.	Z.P.R.	J.F.H.
1	12-28-78	UP-DATED DWG IN F-445	K.A.A.	Z.P.R.	J.F.H.
0	11-22-78	ISSUED FOR USE	K.A.A.	Z.P.R.	J.F.H.
A	10-3-78	ISSUED FOR INFORMATION ONLY	K.A.A.	Z.P.R.	J.F.H.

WNP-2
WELD & COMPONENT
IDENTIFICATION DIAGRAM

TITLE:
RCIC-P-1 SUCTION


DWG NO: RCIC-204-4 REV 2

WNP-02
 INTERVAL: PSI
 PERIOD: NA
 OUTAGE:
 DRAWING NO. RCIC-204

WASHINGTON PUBLIC POWER SUPPLY SYSTEM
 PROGRAM PLAN AND SCHEDULE
 SYSTEM OR COMPONENT: RCIC(10)-1
 DESCRIPTION: PUMP SUCTION LINES


PAGE 001
 DATE 12/14/84

<u>IDENT. NO.</u>	<u>DESCRIPTION</u>	SECT. XI <u>EXAM.</u>	EXAM <u>MTM.</u>	<u>PROCEDURE</u>	CAL. <u>BLOCK</u>	<u>INSERVICE</u>		<u>NOTES</u>
						<u>REQ.</u>	<u>SCHEDULED</u> <u>OUTAGE</u>	
RCIC-56	SPRING	C-E-2	VT-3	303/8.2.17				
			VT-4	303/8.2.17				
RCIC-47								
RCIC-927N	BOX	C-E-2	VT-3	303/8.2.17				
RCIC-902N	ANCHOR	C-E-2	VT-3	303/8.2.17				
	SPRING	C-E-2	VT-3	303/8.2.17				
			VT-4	303/8.2.17				
RCIC-903N	STRUT	C-E-2	VT-3	303/8.2.17				
RCIC-916N								
RCIC-904N	STRUT	C-E-2	VT-3	303/8.2.17				
RCIC-52	BOX	C-E-2	VT-3	303/8.2.17				
	ANCHOR	C-E-2	VT-3	303/8.2.17				
RCIC-967N	PSA-1/4 SN(2)	C-E-2	VT-3	303/8.2.17				S/N
			VT-4	303/8.2.17				S/N
RCIC-53	SPRING	C-E-2	VT-3	303/8.2.17				
			VT-4	303/8.2.17				
RCIC-901N	STRUT	C-E-2	VT-3	303/8.2.17				
RCIC-PB-204	RCIC PRES BNDRY	N/A	VT-2	N/A				SEE NOTES #6 & #7.

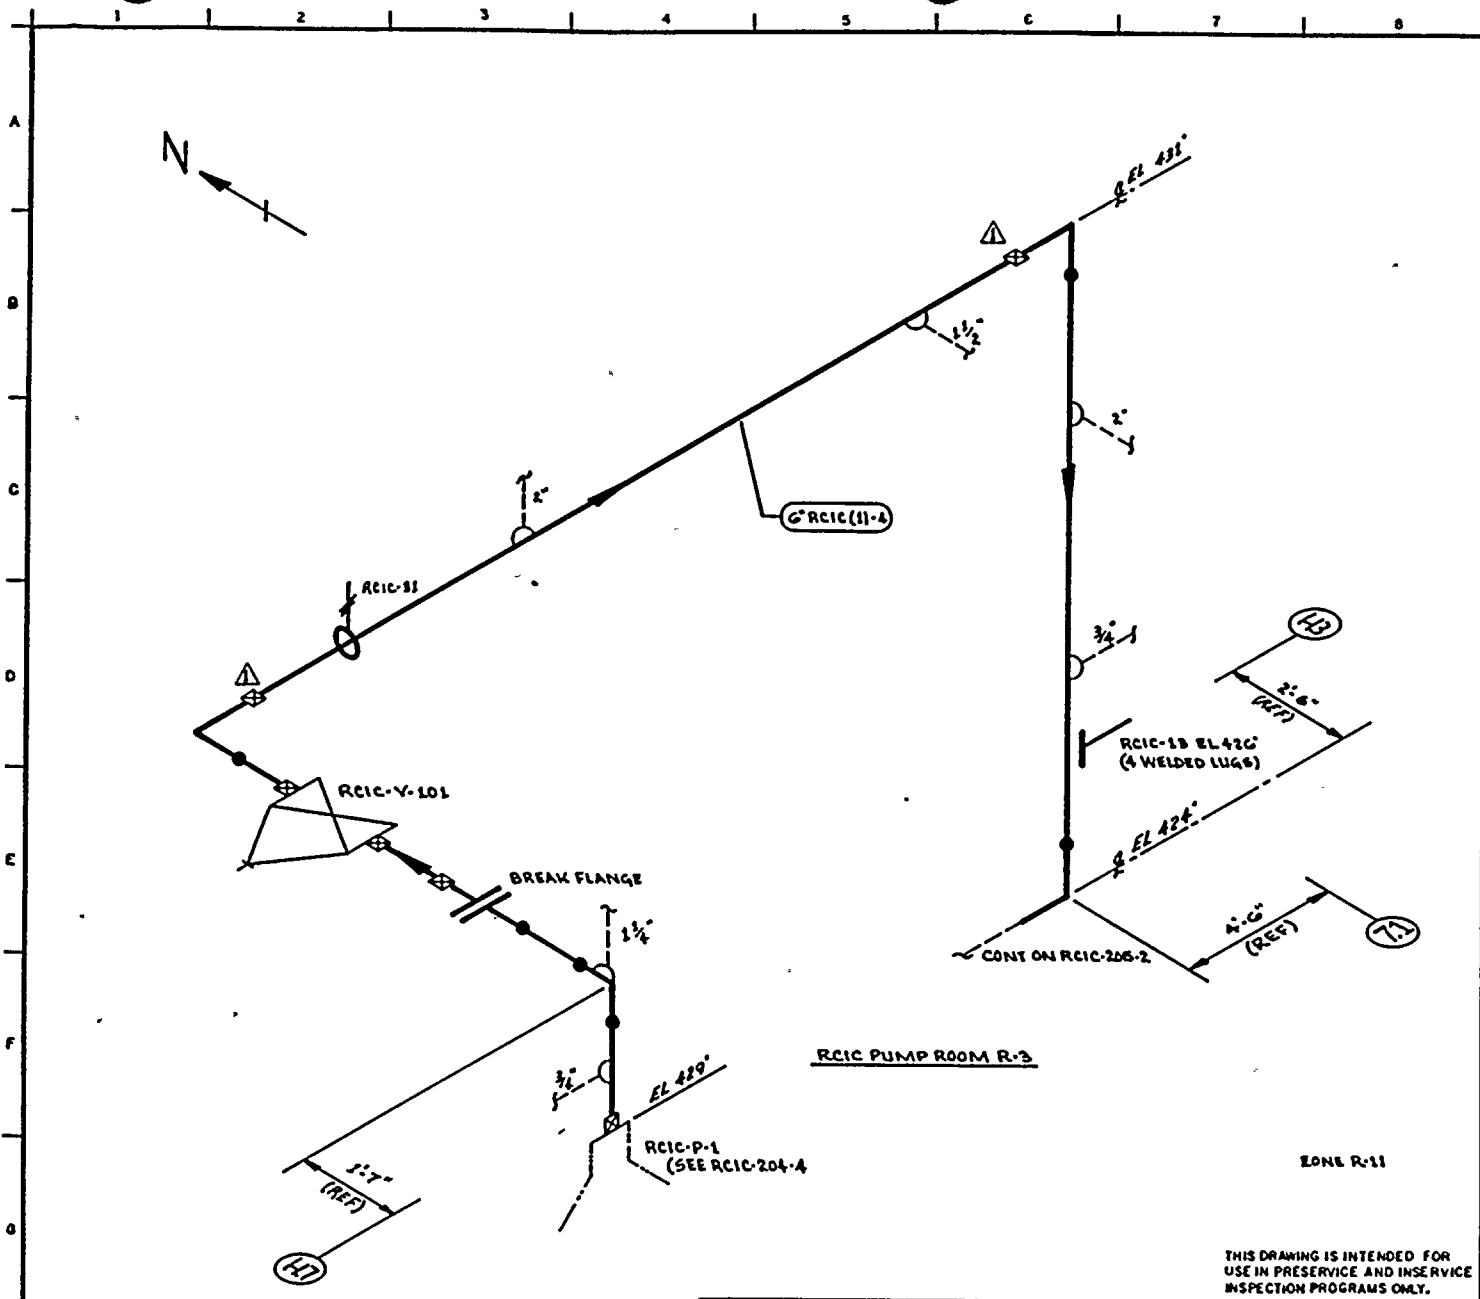

- NOTES:
1. THIS DRAWING IDENTIFIES PIPING & COMPONENTS SUBJECT TO A VISUAL EXAM FOR EVIDENCE OF LEAKAGE DURING SYSTEM HYDRO OR OPERABILITY TESTS. TESTS ARE TO BE CONDUCTED PER THE REQUIREMENTS OF ASME SECTION XI, PARAGRAPH IWA-5000.
 2. FOR BRANCH PIPING 4" DIA OR LESS (CONN SHOWN IN DASHED LINES) EXTEND VISUAL LEAKAGE EXAM THROUGH THE OUTERMOST NORMALLY CLOSED NUCLEAR CLASS VALVE OR UNTIL TRANSITION TO INSTRUMENT TUBING UNLESS OTHERWISE NOTED.

REFERENCES:
BOVEE & CRAIG ISOMETRICS
RCIC-659-1.2 REV B

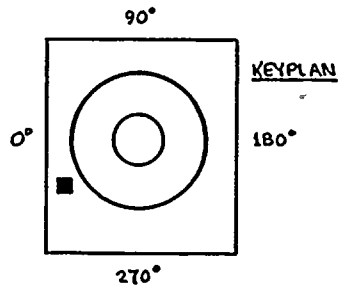

QUALITY CLASS: 1 ASME CODE CLASS: 2
ENGR. GA KUHLER DRAWN: K.M.A. DATE: 8-1-78

WASHINGTON PUBLIC POWER SUPPLY SYSTEM
RICHLAND WASHINGTON 99352

THIS DRAWING IS INTENDED FOR USE IN PRESERVICE AND INSERVICE INSPECTION PROGRAMS ONLY.

PIPING SYSTEM	NOM DIA (DN)	SCH	NOM WALL THK	MATERIAL SPECIFICATION	MATL TYPE	CAL BLOCK NO
6" RCIC (11-A)	6	120	0.562	SA 106 GR B	CB	NA


NO	DATE	REVISION	BY	CHKD	APPVD
1	12-28-83	REVISED AS NOTED ADDED KEYPLAN	K.M.A.	R.P.	T.H.
0	8-1-78	ISSUED FOR USE	K.M.A.	R.P.	T.H.
1	10-3-78	ISSUED FOR INFORMATION ONLY	K.M.A.	B.A.C.	S.H.P.

WNP-2
WELD & COMPONENT IDENTIFICATION DIAGRAM

TITLE:
RCIC-PUMP-1 DISCHARGE


DWG NO: RCIC-205-1 REV 1



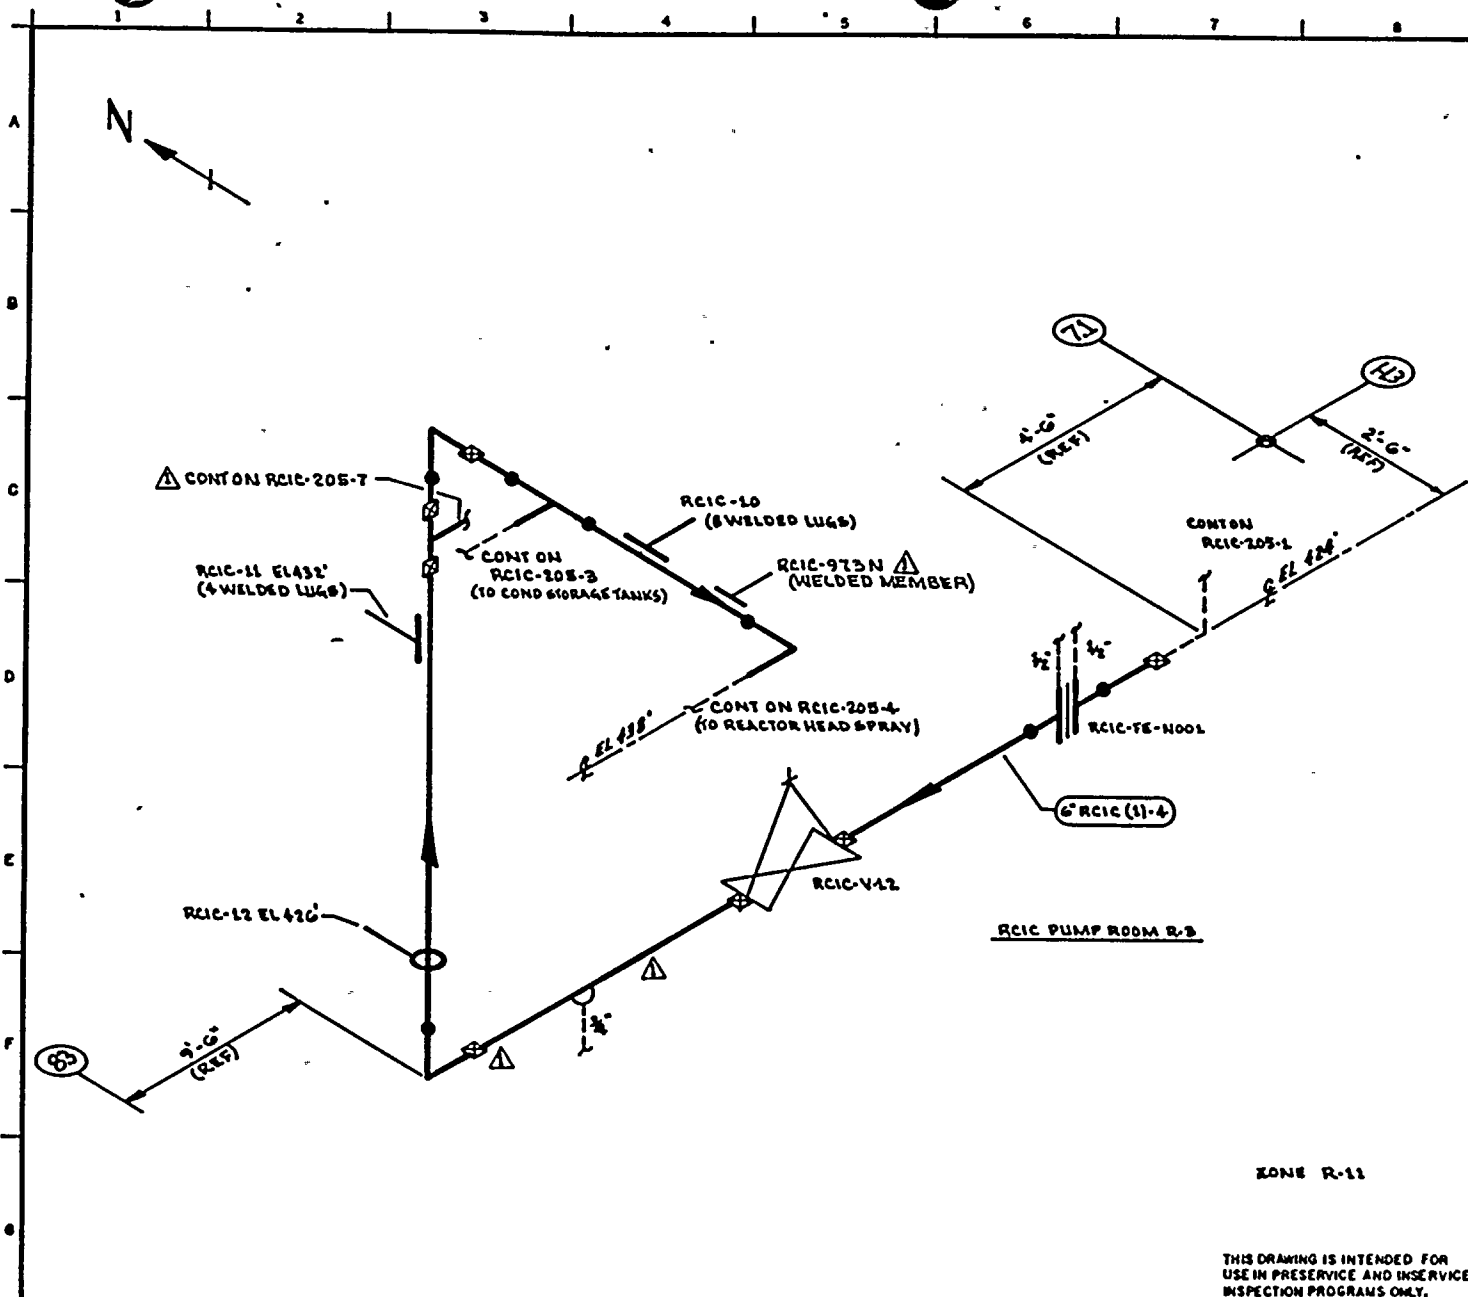

- NOTES:
1. THIS DRAWING IDENTIFIES PIPING & COMPONENTS SUBJECT TO A VISUAL EXAM FOR EVIDENCE OF LEAKAGE DURING SYSTEM HYDRO OR OPERABILITY TESTS. TESTS ARE TO BE CONDUCTED PER THE REQUIREMENTS OF ASME SECTION XI, PARAGRAPH IWA-5000.
 2. FOR BRANCH PIPING 4" DIA OR LESS (CONN SHOWN IN DASHED LINES) EXTEND VISUAL LEAKAGE EXAM THROUGH THE OUTERMOST NORMALLY CLOSED NUCLEAR CLASS VALVE OR UNTIL TRANSITION TO INSTRUMENT TUBING UNLESS OTHERWISE NOTED.

REFERENCES:
 BOVEE & CRAIG ISOMETRICS
 RCIC-689-3.6 REV 10

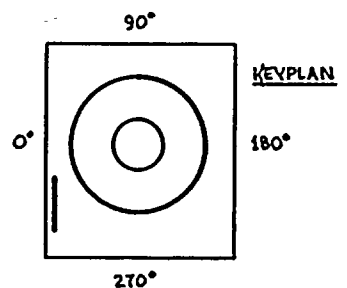


QUALITY CLASS: 1 ASME CODE CLASS: 2
 ENGR GA KUGLER DRAWN: KMcL DATE: 8-2-78
 WASHINGTON PUBLIC POWER SUPPLY SYSTEM
 RICHLAND, WASHINGTON 98932


THIS DRAWING IS INTENDED FOR USE IN PRESERVICE AND INSERVICE INSPECTION PROGRAMS ONLY.

PIPING SYSTEM	NOM DIA (IN)	SCH	NOM WALL THK	MATERIAL SPECIFICATION	MATL TYPE	CAL BLOCK NO
6" RCIC (1)-4	6	110	0.562	SA 106 GR B	CS	NA

NO	DATE	REVISION	BY	CHKD	APPVD
1	1/22/83	REVISED AS NOTED	KMcL	EPR	TFH
0	8/22/78	ISSUED FOR USE	KMcL	ERB	LSB
1	12/78	ISSUED FOR INFORMATION ONLY	KMcL	EAK	ROD


WNP-2
 WELD & COMPONENT IDENTIFICATION DIAGRAM
 TITLE:
 RCIC-PUMP-1 DISCHARGE LINES
 DWG NO: RCIC-205-2 REV 1

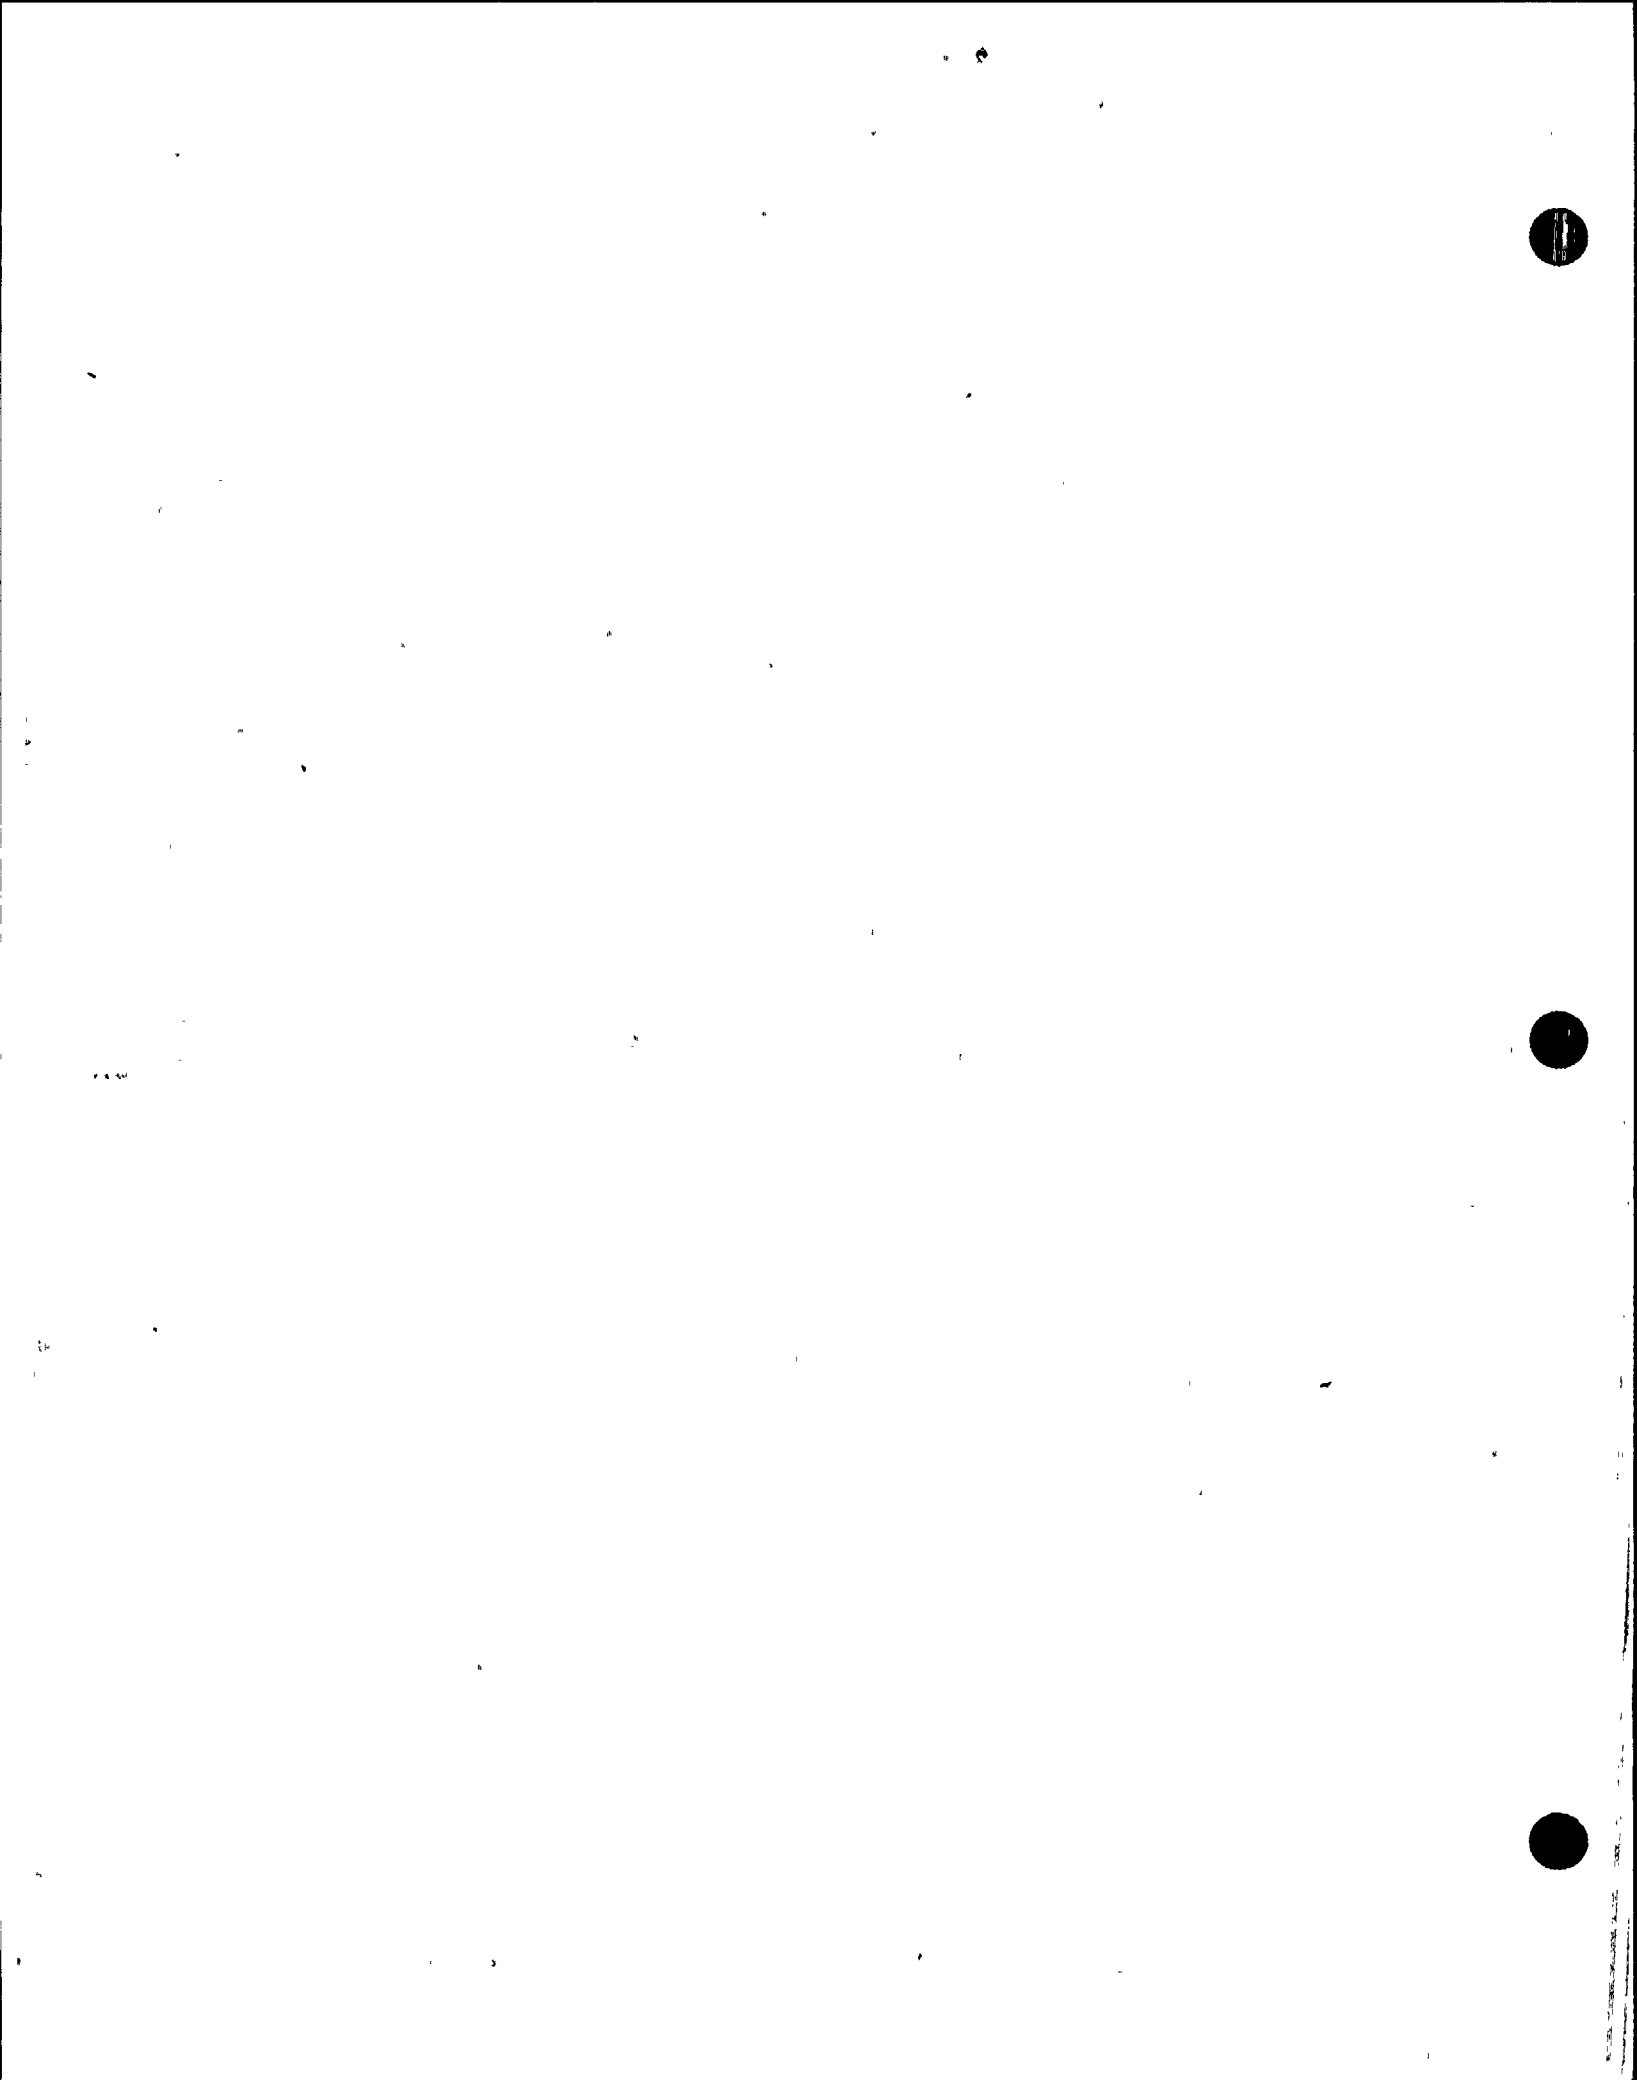

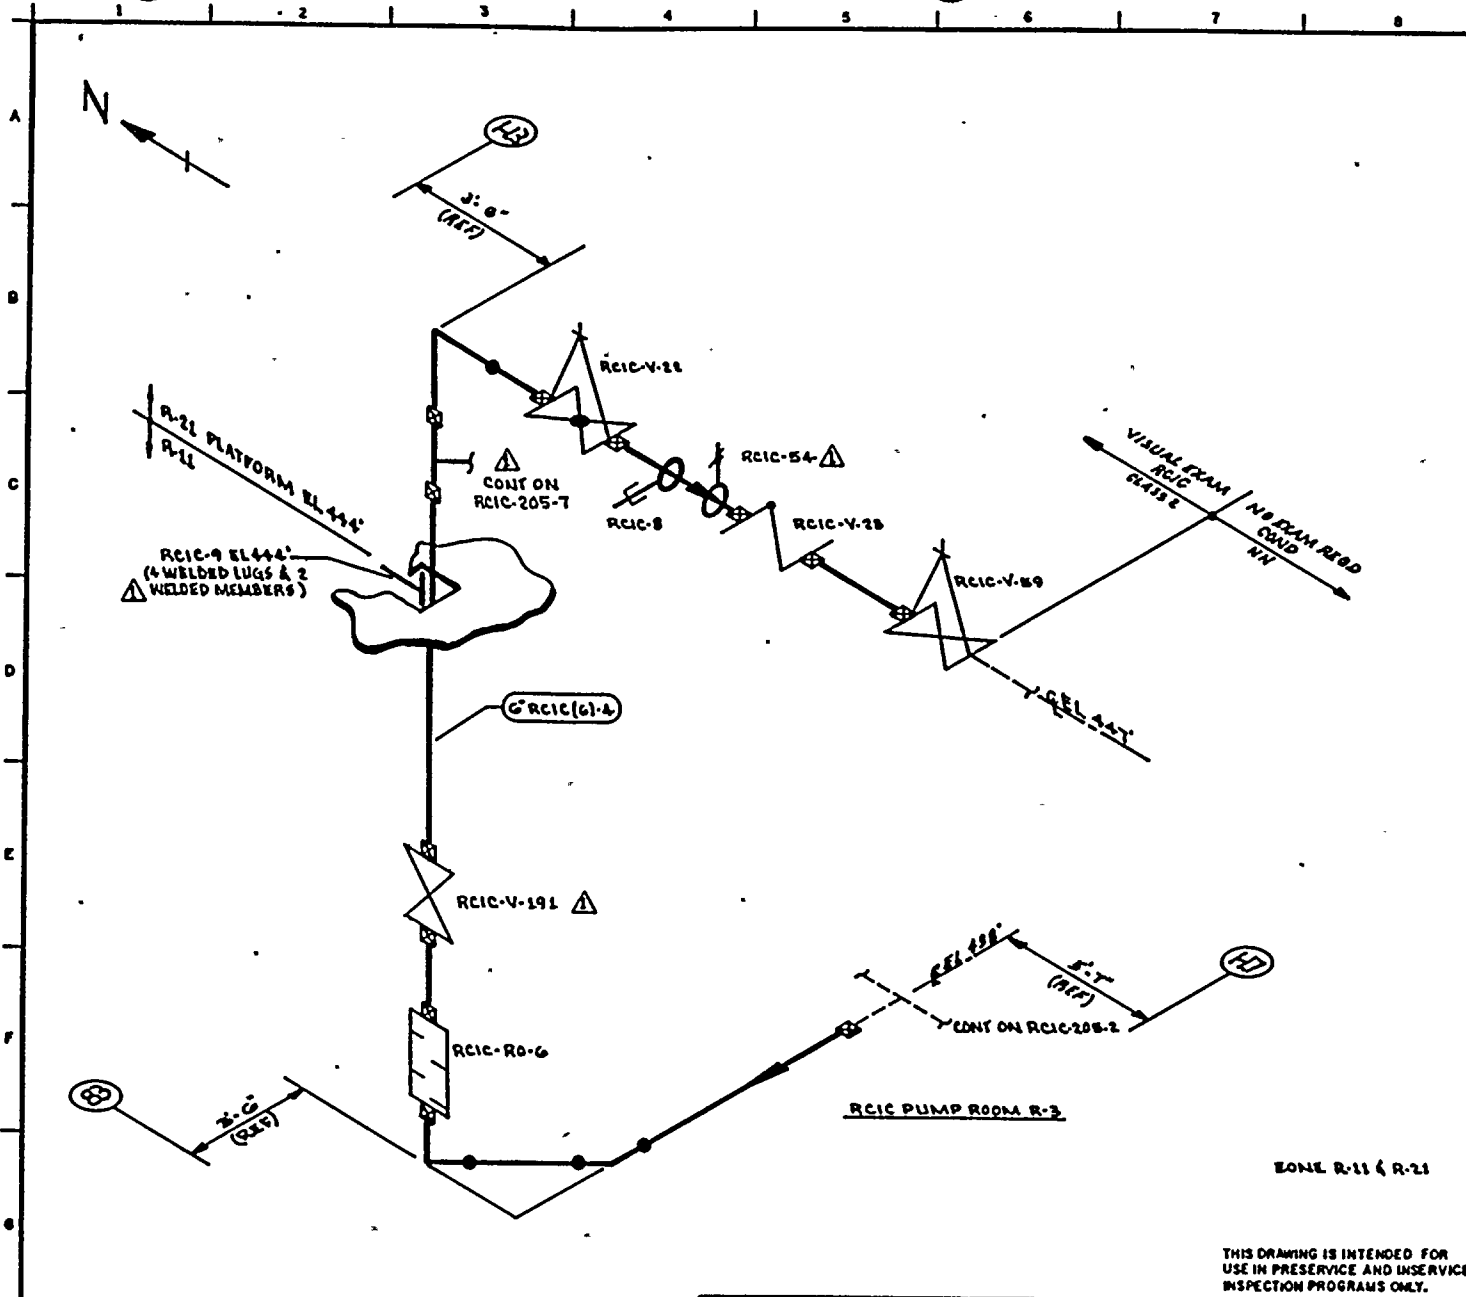

NOTES:
 1. THIS DRAWING IDENTIFIES PIPING & COMPONENTS SUBJECT TO A VISUAL EXAM FOR EVIDENCE OF LEAKAGE DURING SYSTEM HYDRO OR OPERABILITY TESTS. TESTS ARE TO BE CONDUCTED PER THE REQUIREMENTS OF ASME SECTION XI, PARAGRAPH IWA-5000.

REFERENCED:
 BOVEE & CRAIG ISOMETRICS
 RCIC-642-1.5 REV 11

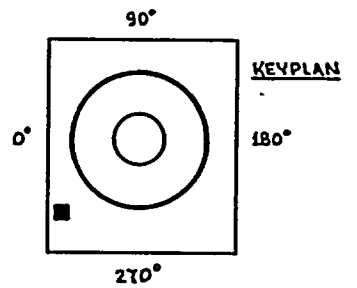

QUALITY CLASS: 1 | ASME CODE CLASS: 2
 ENGR: G.A. KUGLER | DRAWN: K.M.C.A. | DATE: 8-2-78


WASHINGTON PUBLIC POWER SUPPLY SYSTEM
 RICHLAND, WASHINGTON 99352


THIS DRAWING IS INTENDED FOR USE IN PRESERVICE AND INSERVICE INSPECTION PROGRAMS ONLY.

PIPING SYSTEM	NOM DIA (IN)	SCH	NOM WALL THK	MATERIAL SPECIFICATION	MATL TYPE	CAL BLOCK NO
G ^o RCIC(6)-4	6	12D	0.362	SA 106 GR B	CS	NA

NO	DATE	REVISION	BY	CHKD	APPVD
1	12-2-78	REVISED AS NOTED ADDED KEYPLAN	K.M.C.A.	EPR	T.M.H.
0	12-28-78	ISSUED FOR USE	K.M.C.A.	T.M.H.	T.M.H.
1	1-3-79	ISSUED FOR INFORMATION ONLY	K.M.C.A.	T.M.H.	Q.W.D.


WNP-2
 WELD COMPONENT IDENTIFICATION DIAGRAM
 TITLE:
 RCIC SUPPLY TO COND STORAGE TANKS
 DWG NO: RCIC-205-3 | REV 1

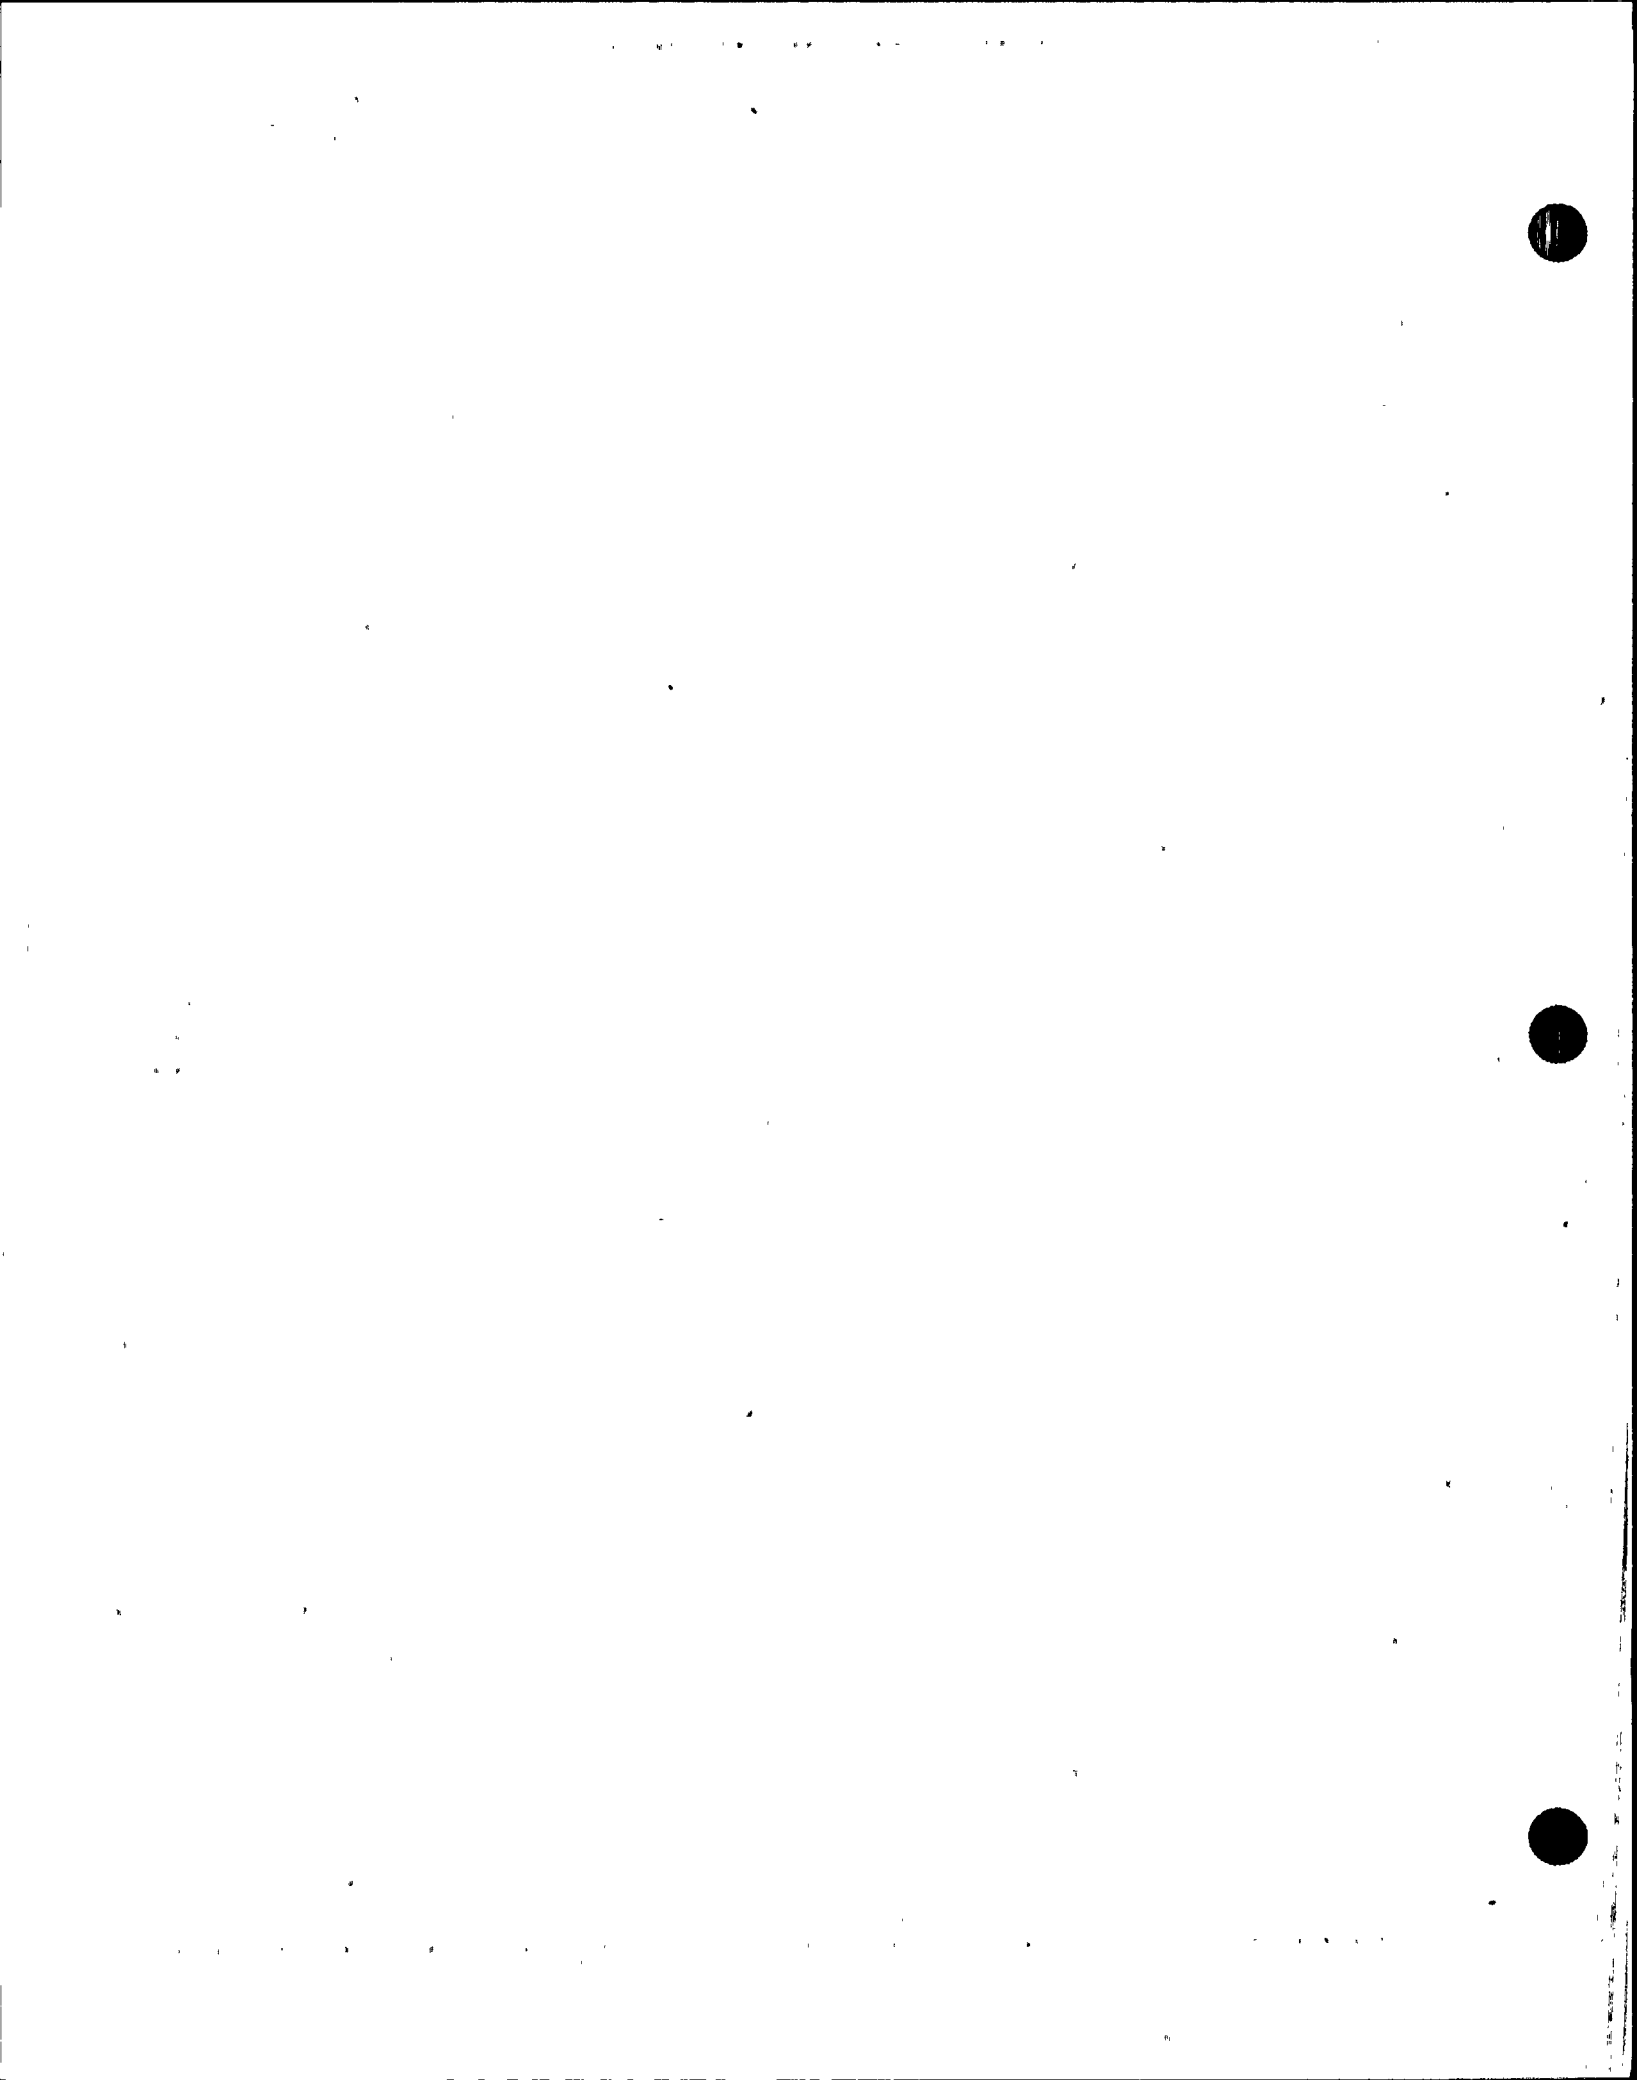

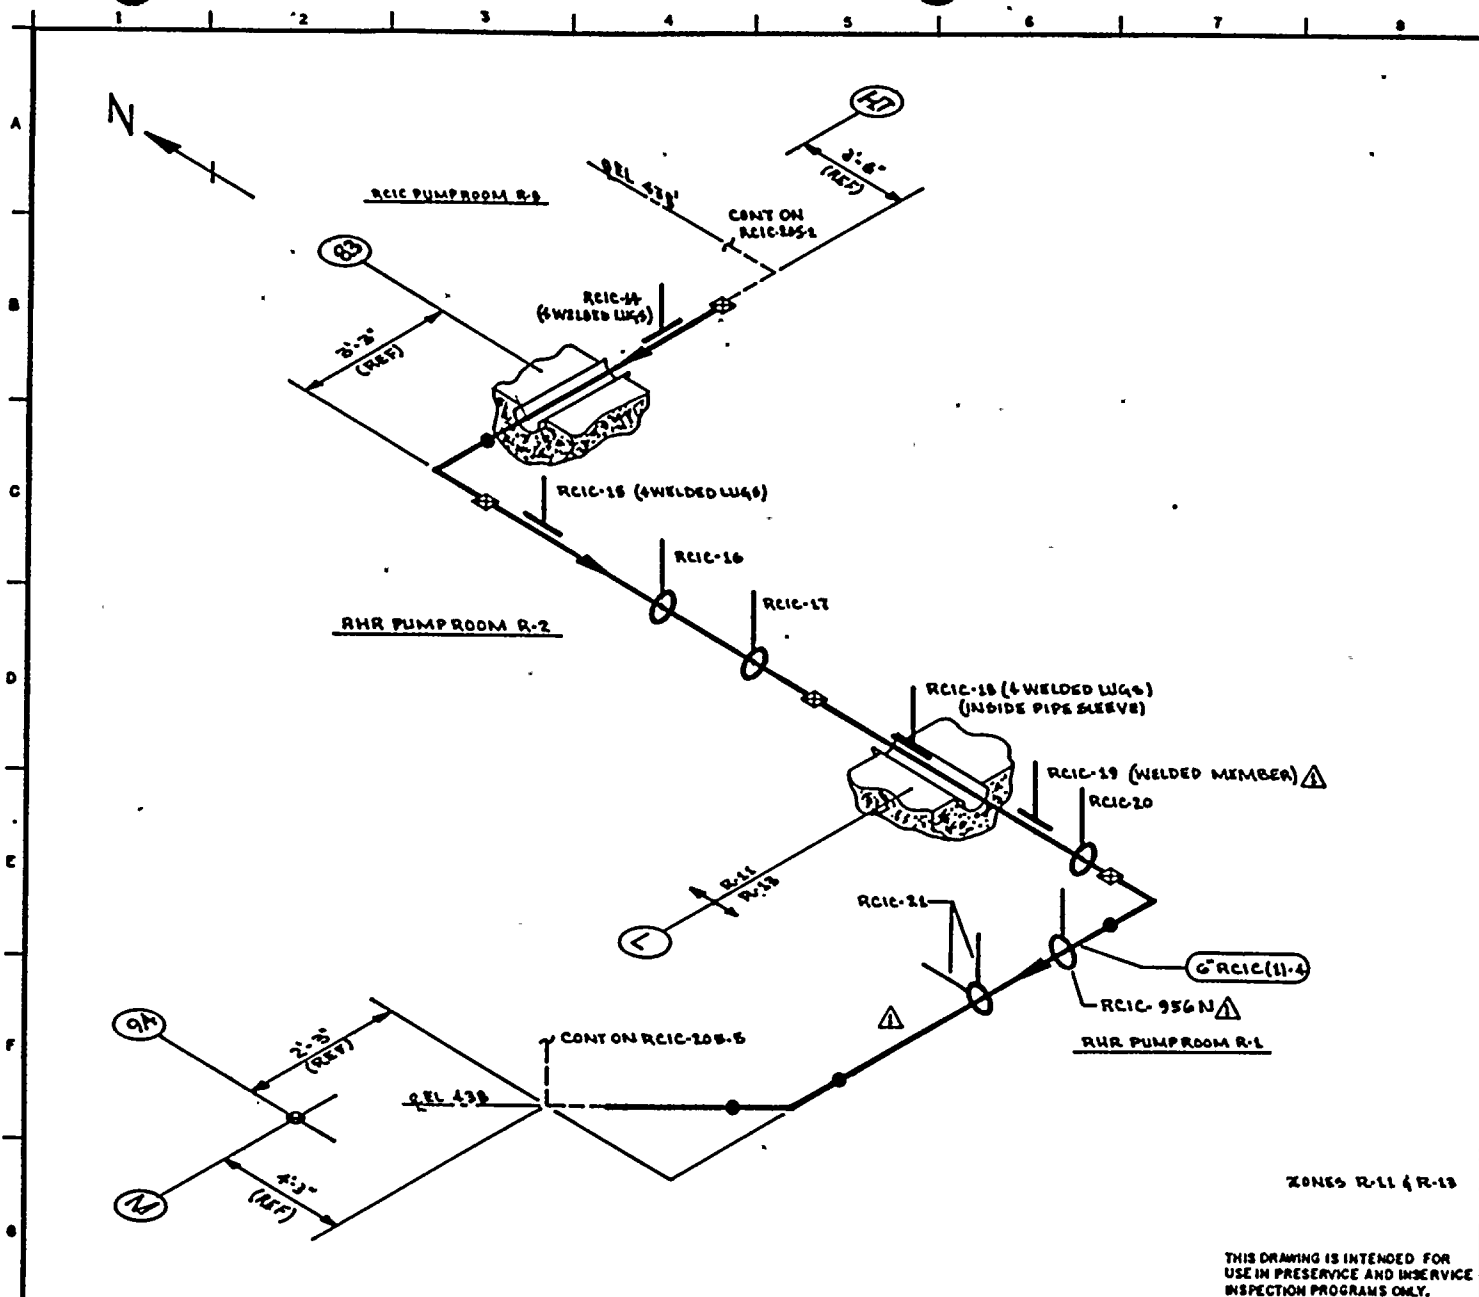

NOTES:
 1. THIS DRAWING IDENTIFIES PIPING & COMPONENTS SUBJECT TO A VISUAL EXAM FOR EVIDENCE OF LEAKAGE DURING SYSTEM HYDRO OR OPERABILITY TESTS. TESTS ARE TO BE CONDUCTED PER THE REQUIREMENTS OF ASME SECTION XI, PARAGRAPH IWA-5000.

REFERENCES:
 BOVBE & CRAIL ISOMETRICS
 RCIC-669-T-10 REV 7

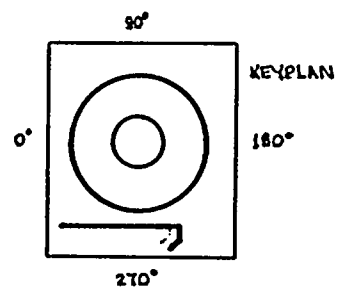

ZONES R-11 & R-13

THIS DRAWING IS INTENDED FOR USE IN PRESERVICE AND INSERVICE INSPECTION PROGRAMS ONLY.

QUALITY CLASS: 1 ASME CODE CLASS: 2
 ENGR: G.A. WIGLICKI DRAWN: K.M.C.A. DATE: 8-2-78

WASHINGTON PUBLIC POWER SUPPLY SYSTEM
 RICHLAND, WASHINGTON 99352

WHP-2
 WELD & COMPONENT IDENTIFICATION DIAGRAM



PIPING SYSTEM	NOM DIA (IN)	SCH	NOM WALL THK	MATERIAL SPECIFICATION	MATL TYPE	CAL BLOCK NO
0" RCIC (11-4)	6	120	0.362	SA 106 GR B	CD	NA

NO	DATE	REVISION	BY	CHKD	APPVD
1	12-2-78	REVISED AS NOTED ADDED KEYPLAN	K.M.C.A.	ZMK	TJK
2	12-12-78	ISSUED FOR USE	K.M.C.A.	ZMK	TJK
3	10-1-79	ISSUED FOR INFORMATION ONLY	K.M.C.A.	ZMK	CLM

TITLE:
 RCIC SUPPLY TO REACTOR HEAD SPRAY
 DWG NO: RCIC-205-A REV 1



A
B
C
D
E
F
G

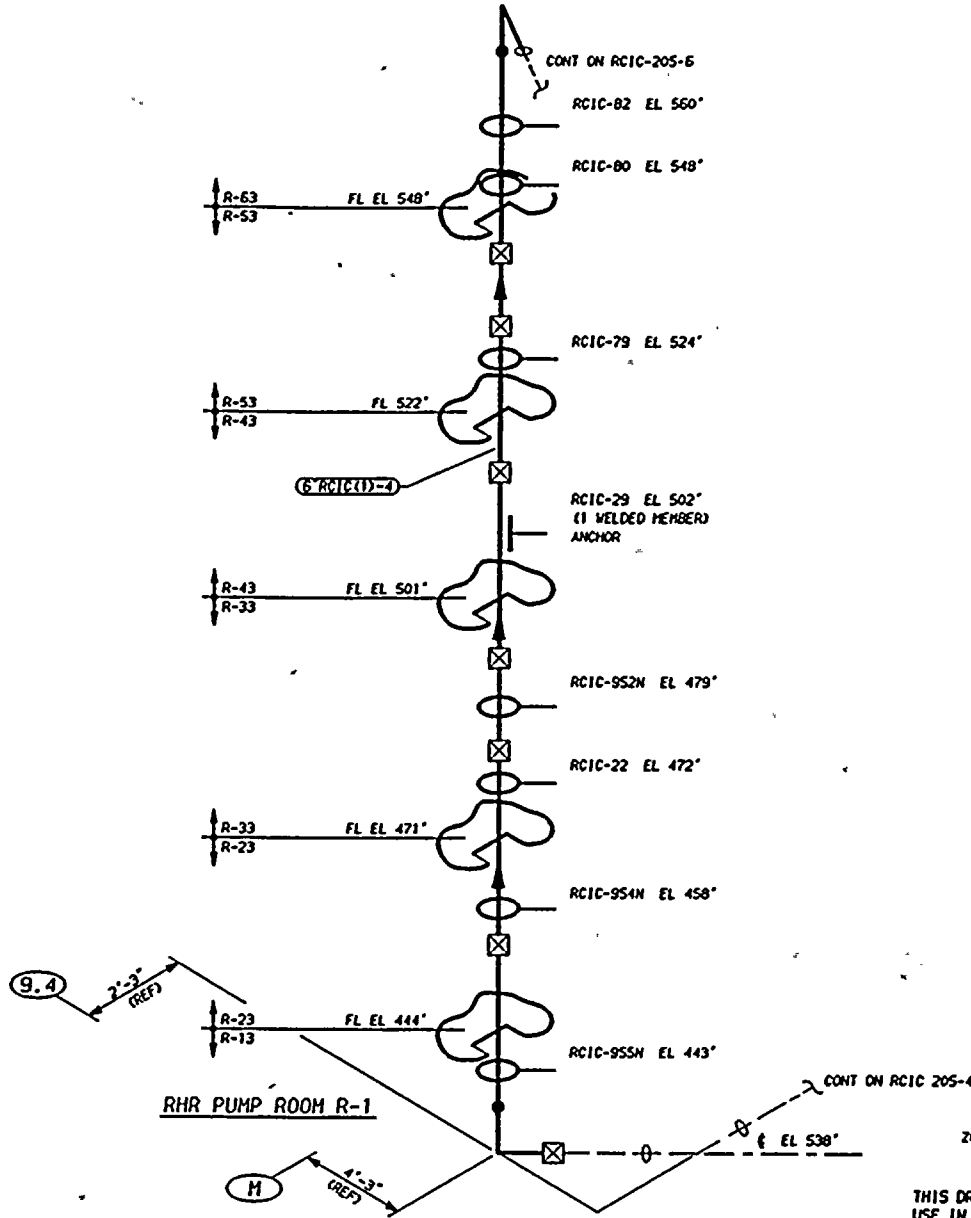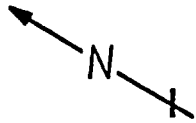


ZONES R-13, R-23, R-33, R-43, R-53 & R-63

THIS DRAWING IS INTENDED FOR USE IN PRESERVICE AND INSERVICE INSPECTIONS PROGRAMS ONLY.

NOTES:
1. THIS DRAWING IDENTIFIES PIPING AND COMPONENTS SUBJECT TO A VISUAL EXAM FOR EVIDENCE OF LEAKAGE DURING SYSTEM HYDRO OR OPERABILITY TESTS. TESTS ARE TO BE CONDUCTED PER THE REQUIREMENTS OF ASME SECTION XI, PARAGRAPH IMA-5000.

REFERENCES:
151 - 219
BOYEE CRAIL ISOMETRICS
RCIC-659-11.17 REV 6

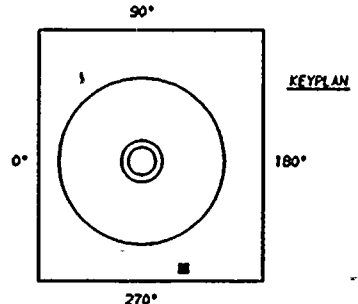

QUALITY CLASS, 1 ASME CODE CLASS, 2
ENGR, GA KUGLER | DRAWN, K-McA | DATE, 8-3-78

WASHINGTON PUBLIC POWER
SUPPLY SYSTEM
RICHLAND, WASHINGTON 99352


WNP-2
WELD & COMPONENT
IDENTIFICATION DIAGRAM


TITLE:
RCIC SUPPLY TO REACTOR HEAD SPRAY

DWG NO, RCIC-205-5 REV 1

PIPING SYSTEM	NOM DIA (IN)	SCH	NOM WALL THK	MATERIAL SPECIFICATION	MATL TYPE	CAL BLOCK NO
6"RCIC(1)-4	6	120	0.562	SA 106 GR B	CS	NA


NO	DATE	REVISION	BY	CHKD	APVD
1	12-8-83	GENERAL UP-DATE REDRAWN	K-McA	DMP	TFH
0	12-22-78	ISSUED FOR USE	K-McA	DMP	LFB
A	10-3-78	ISSUED FOR INFORMATION ONLY	K-McA	GAK	DMP

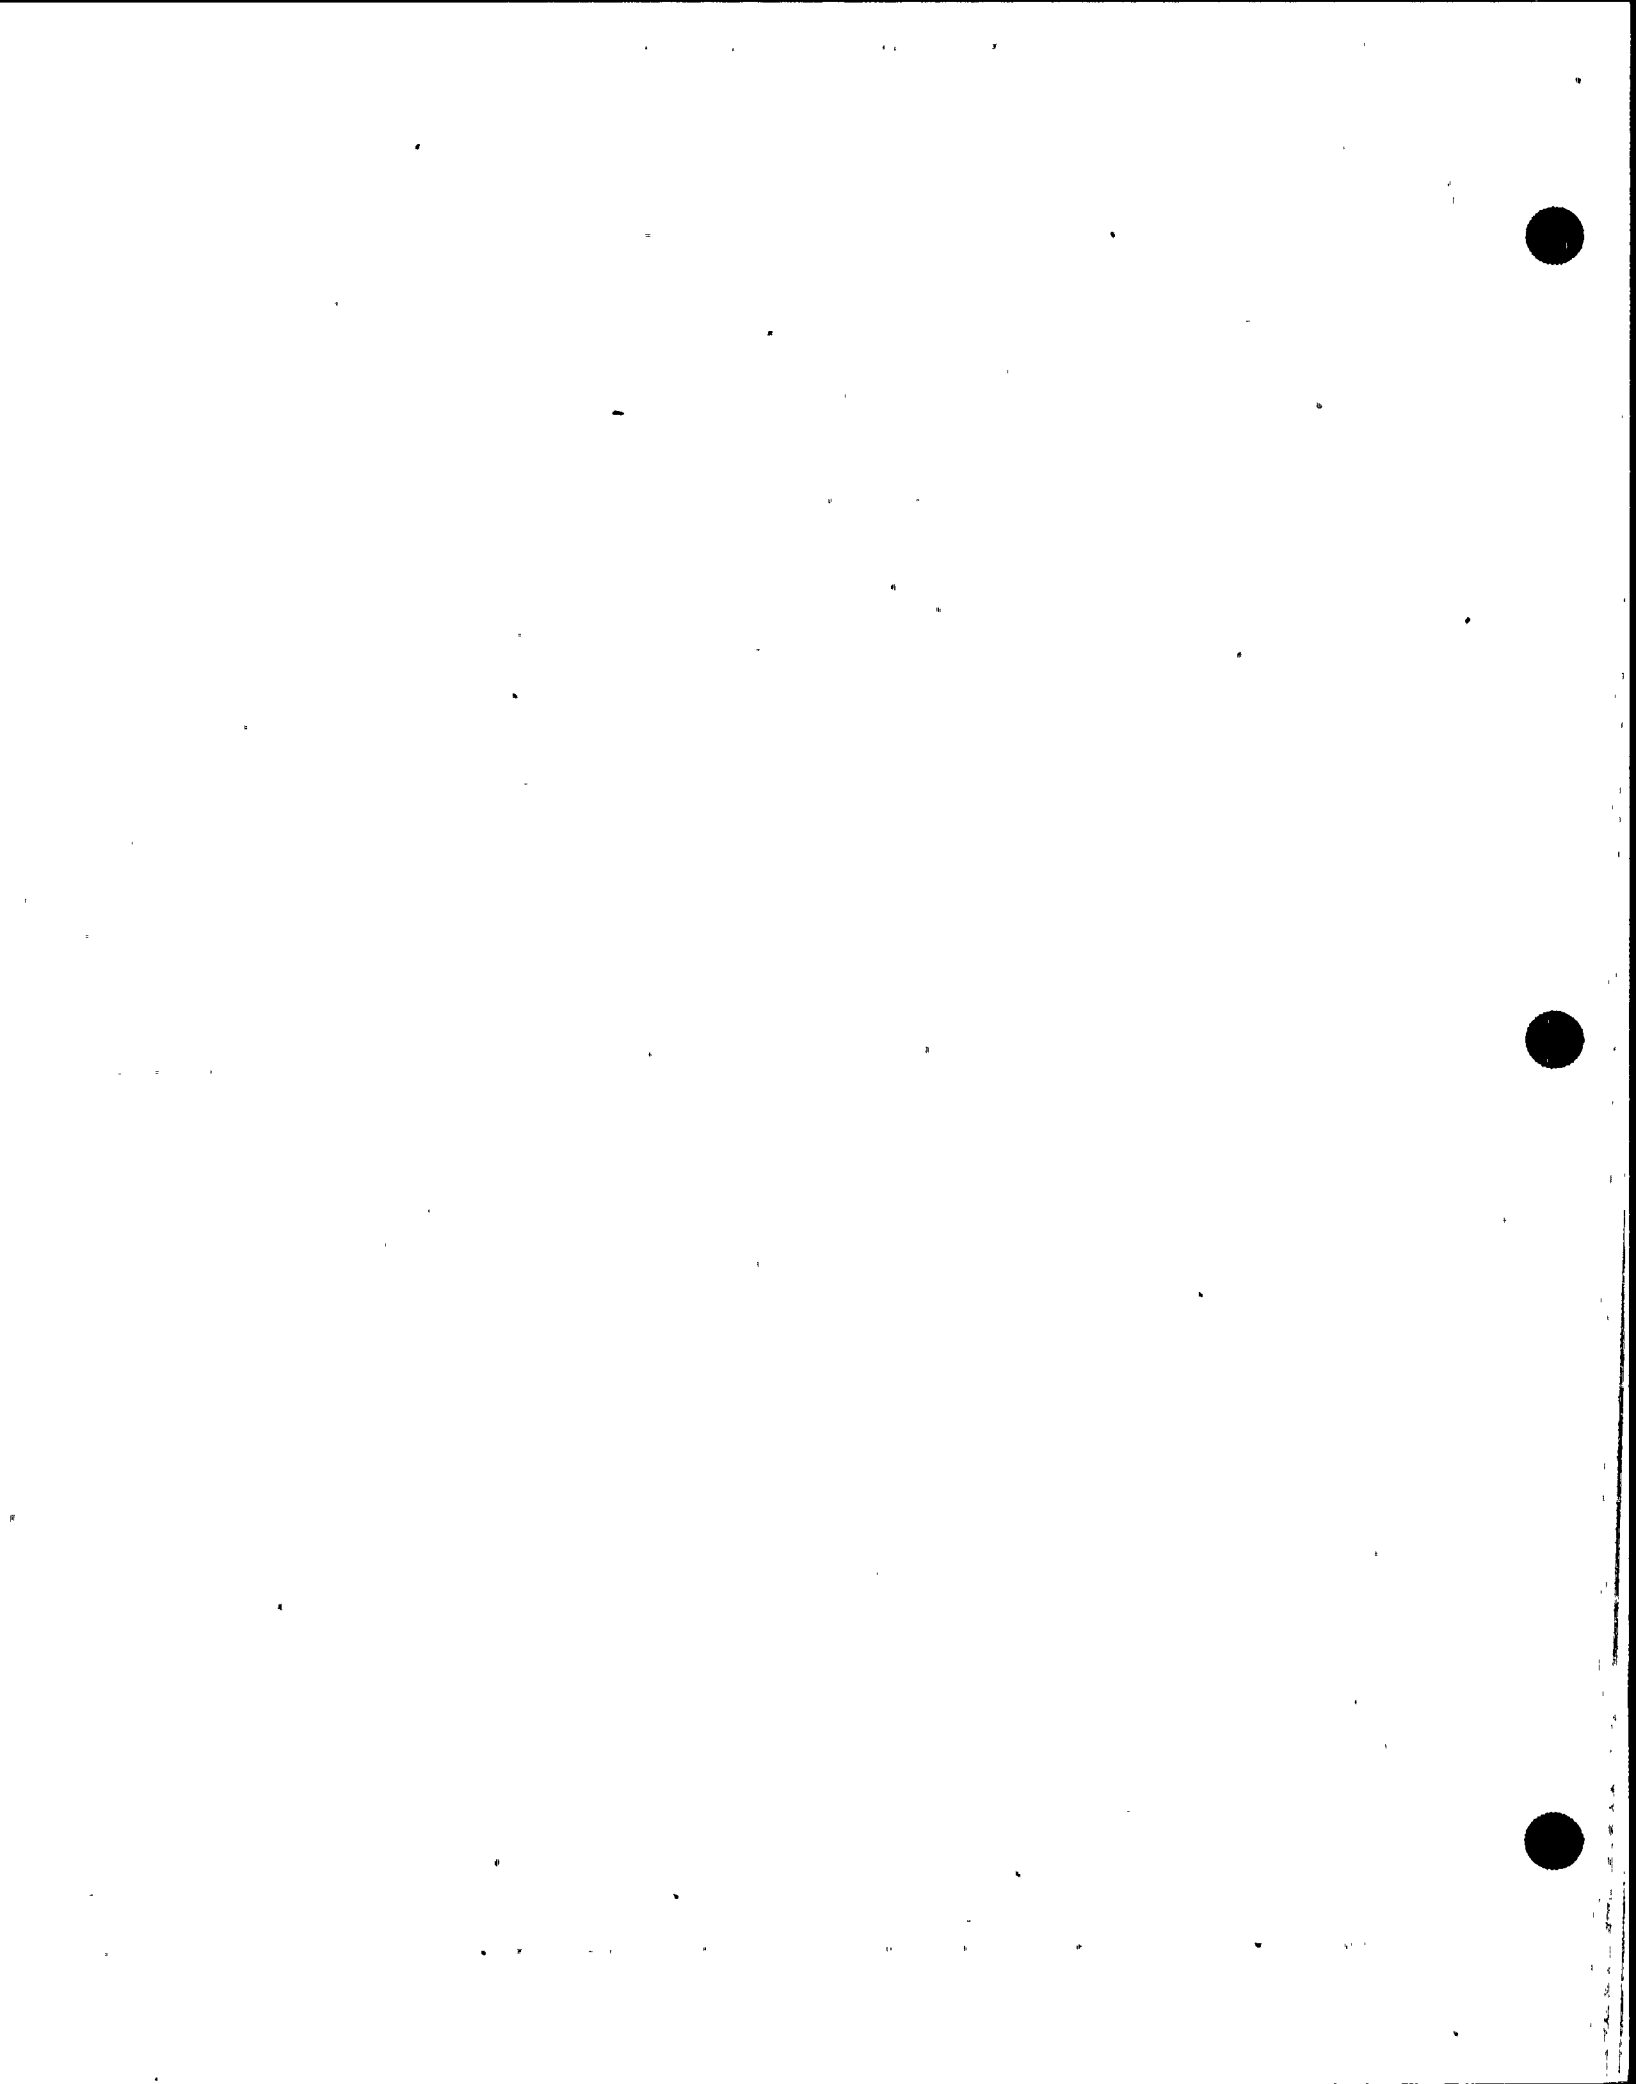

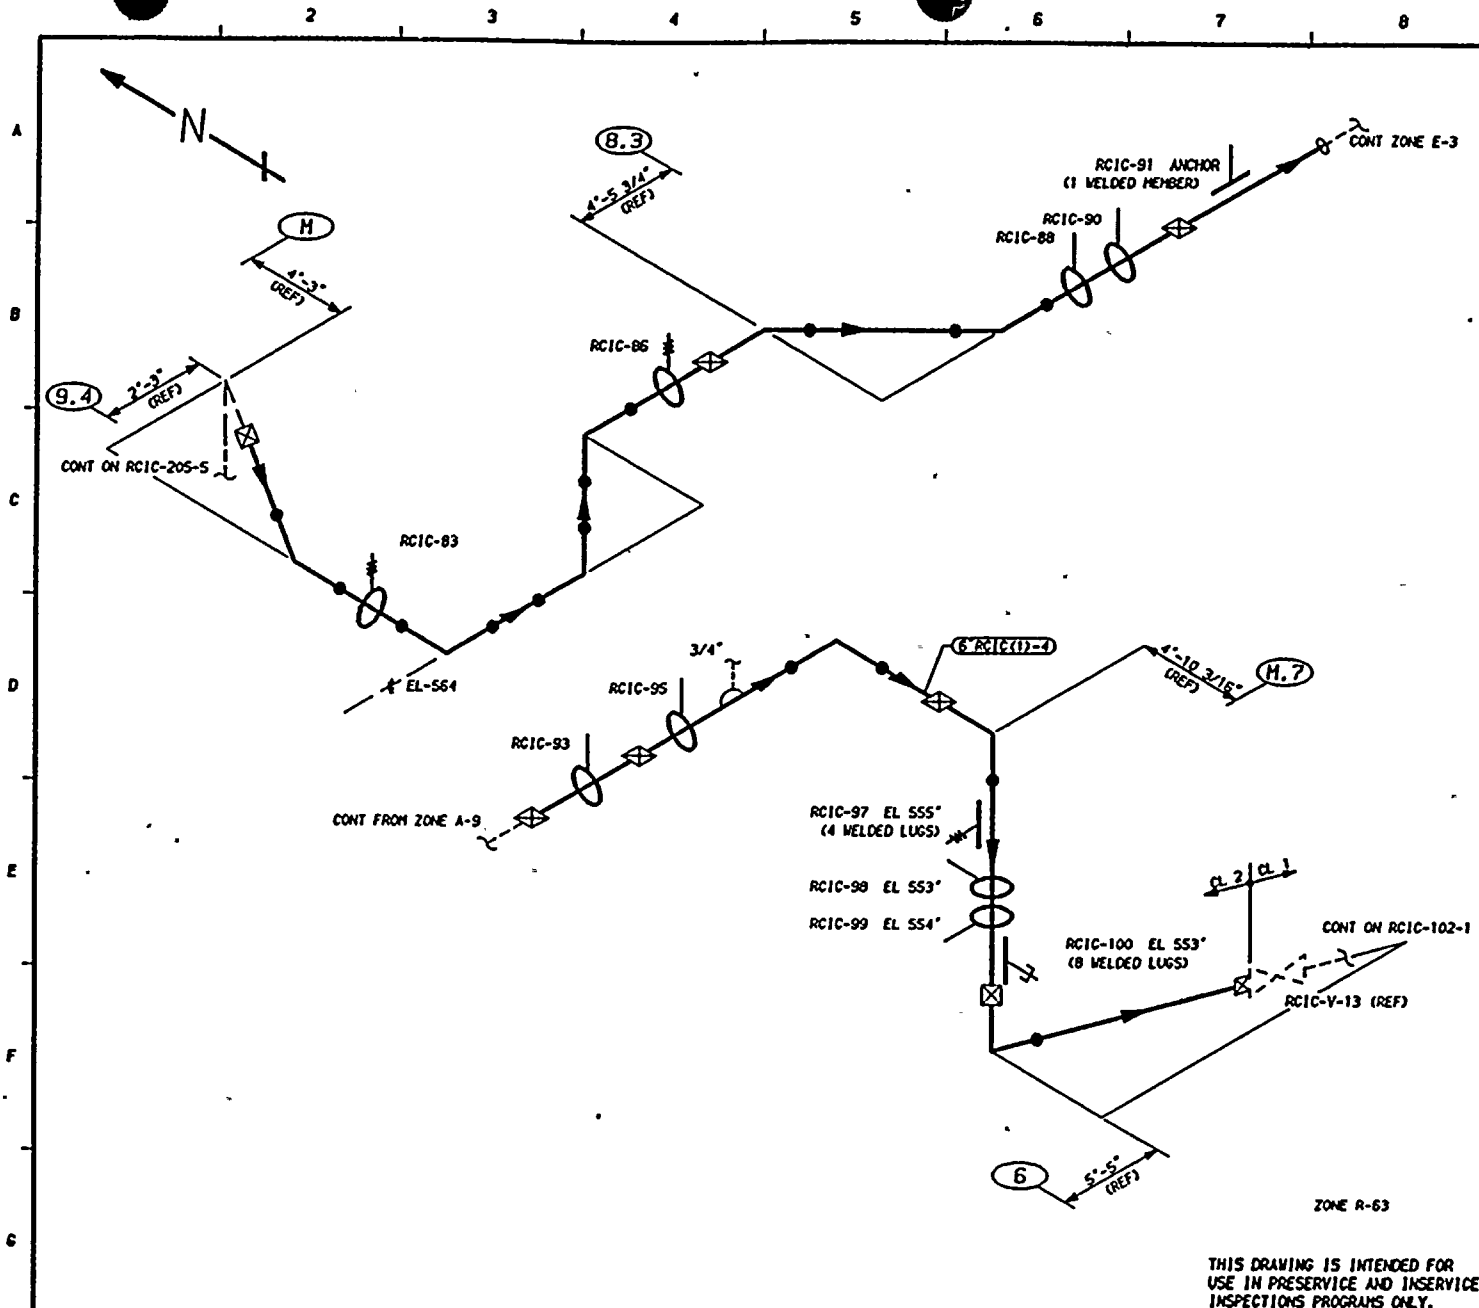

- NOTES:**
1. THIS DRAWING IDENTIFIES PIPING AND COMPONENTS SUBJECT TO A VISUAL EXAM FOR EVIDENCE OF LEAKAGE DURING SYSTEM HYDRO OR OPERABILITY TESTS. TESTS ARE TO BE CONDUCTED PER THE REQUIREMENTS OF ASME SECTION XI, PARAGRAPH IMA-5000.
 2. FOR BRANCH PIPING 4" NOM. OR LESS (CONNECTION SHOWN IN DASHED LINES) EXTEND VISUAL LEAKAGE EXAM THROUGH THE OUTERMOST NORMALLY CLOSED NUCLEAR CLASS VALVE, OR UNTIL TRANSITION TO INSTRUMENT TUBING, UNLESS OTHERWISE NOTED.

- REFERENCES:**
- 151 - 219
 - BOYEE CRAIL ISOMETRICS
 - RCIC-659-18.21 REV 10
 - RCIC-659-22.23 REV 7

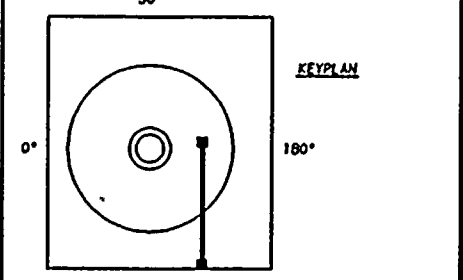

QUALITY CLASS, 1	ASME CODE CLASS, 2
ENGR, GA KUGLER	DRAWN, K-McA DATE, 8-3-78

WASHINGTON PUBLIC POWER
SUPPLY SYSTEM
 RICHLAND, WASHINGTON 99352

WNP-2
 WELD & COMPONENT
IDENTIFICATION DIAGRAM

TITLE:
 RCIC SUPPLY TO REACTOR HEAD SPRAY


DWG NO, RCIC-205-6 REV 1

THIS DRAWING IS INTENDED FOR
 USE IN PRESERVICE AND INSERVICE
 INSPECTIONS PROGRAMS ONLY.

PIPING SYSTEM	NOM DIA (IN)	SCH	NOM WALL THK	MATERIAL SPECIFICATION	MATL TYPE	CAL BLOCK NO
6"RCIC(1)-4	6	80	0.562	SA 106 GR B	CS	NA

NO	DATE	REVISION	BY	CHKD	APVD
1	12-2-83	GENERAL UPDATE REDRAWN	K-McA	DWP	TJB
0	12-22-78	ISSUED FOR USE	K-McA	DWP	LFB
A	10-3-78	ISSUED FOR INFORMATION ONLY	K-McA	GAR	DWP



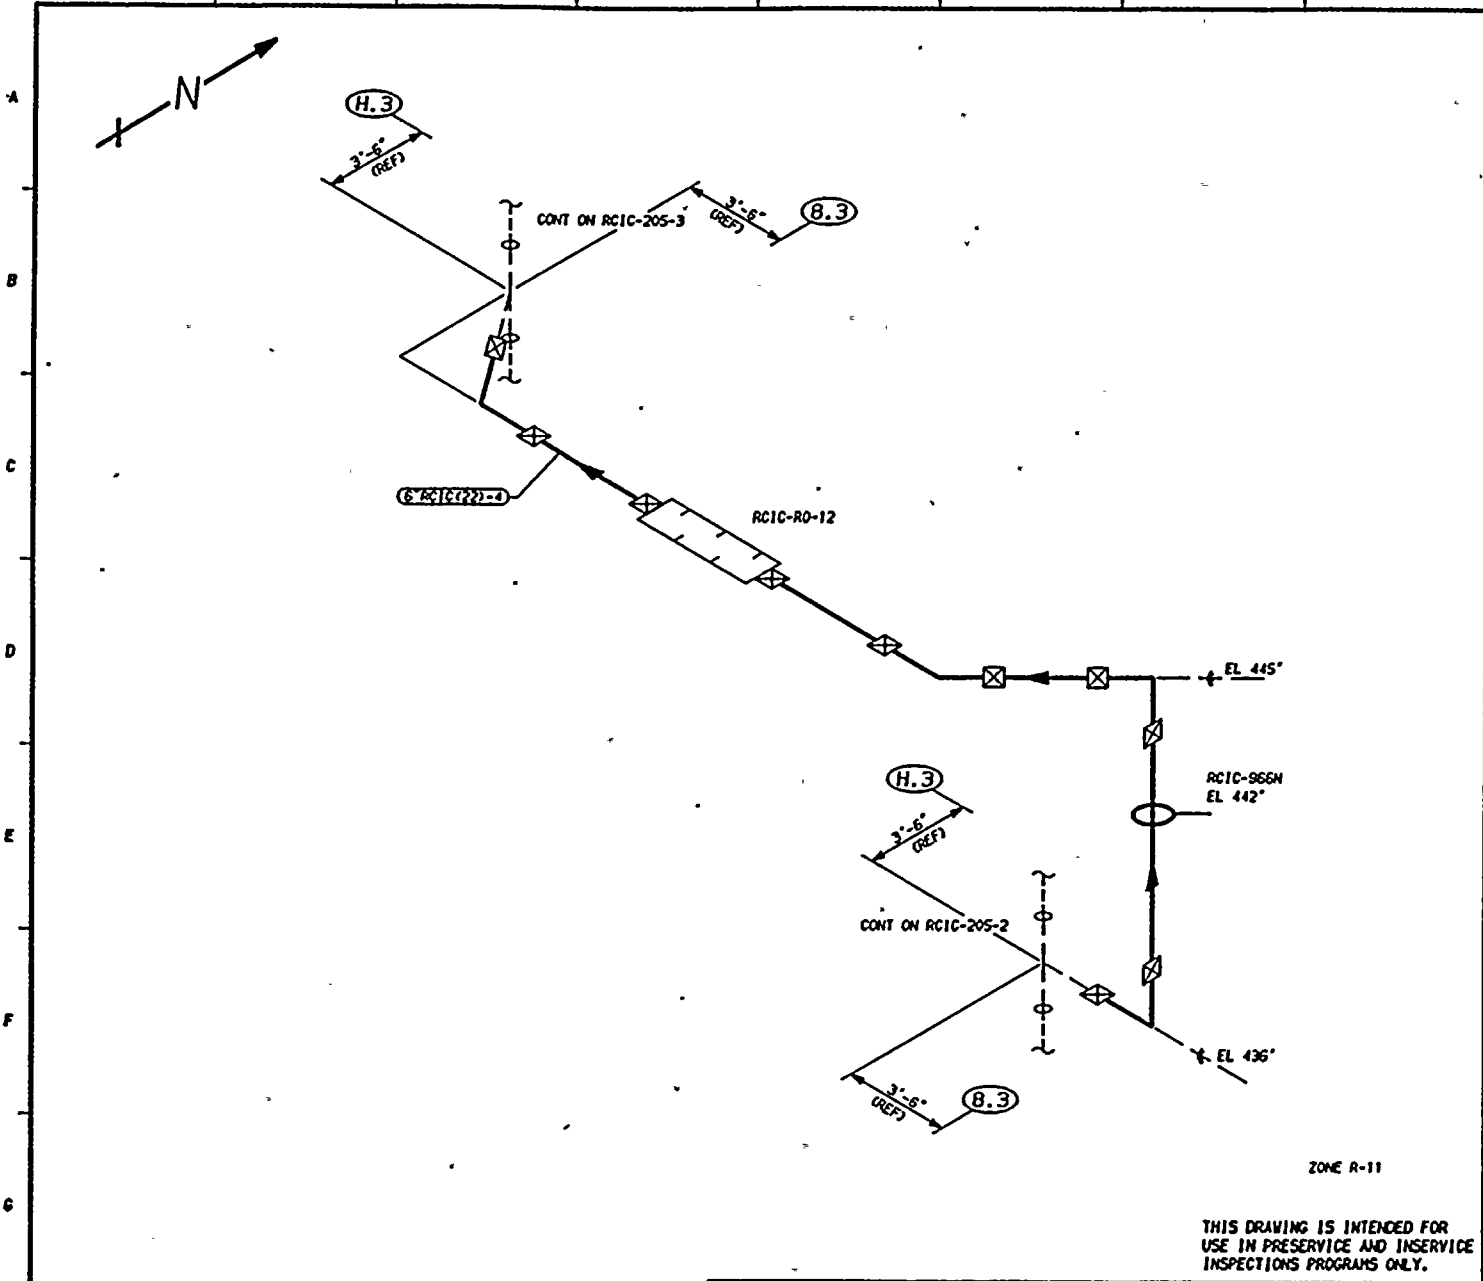

ZONE R-11

THIS DRAWING IS INTENDED FOR USE IN PRESERVICE AND INSERVICE INSPECTIONS PROGRAMS ONLY.


PIPING SYSTEM	NOM DIA (IN)	SCH	NOM WALL THK	MATERIAL SPECIFICATION	MATL TYPE	CAL BLOCK NO
6"RCIC(22)-4	6	120	0.562	SA 106 GR B	CS	NA

NOTES:

1. THIS DRAWING IDENTIFIES PIPING AND COMPONENTS SUBJECT TO A VISUAL EXAM FOR EVIDENCE OF LEAKAGE DURING SYSTEM HYDRO OR OPERABILITY TESTS. TESTS ARE TO BE CONDUCTED PER THE REQUIREMENTS OF ASME SECTION XI, PARAGRAPH IMA-5000.

REFERENCES:

ISI - 219
 BOYCE CRAIL ISOMETRICS
 RCIC-659-3.6 REV 10
 RCIC-642-1.5 REV 11

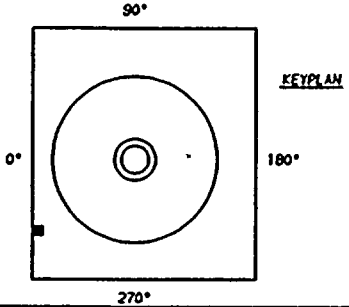

QUALITY CLASS, 1	ASME CODE CLASS, 2
ENGR, K-McANDREW	DRW, K-McA DATE, 10-12-83

WASHINGTON PUBLIC POWER
 SUPPLY SYSTEM
 RICHLAND, WASHINGTON 99352

WNP-2
 WELD & COMPONENT
 IDENTIFICATION DIAGRAM

TITLE:
 RCIC-R0-12 BY-PASS LINE

DWG NO, RCIC-205-7 REV 0

NO	DATE	REVISION	BY	CHKD	APVD
0	10-12-83	ISSUED FOR USE	tkk	DPK	tkk



WMP-02
 INTERVAL: PSI
 PERIOD: NA
 OUTAGE:
 DRAWING NO. RCIC-205

WASHINGTON PUBLIC POWER SUPPLY SYSTEM
 PROGRAM PLAN AND SCHEDULE
 SYSTEM OR COMPONENT: RCIC(1)-4
 DESCRIPTION: RCIC PUMP DISCHARGE

PAGE 001
 DATE 12/14/84

<u>IDENT. NO.</u>	<u>DESCRIPTION</u>	<u>SECT.</u> <u>YI</u> <u>EXAM.</u>	<u>EXAM</u> <u>MTH.</u>	<u>PROCEDURE</u>	<u>CAL.</u> <u>BLOCK</u>	<u>INSERVICE</u>		<u>NOTES</u>
						<u>REQ.</u>	<u>SCHEDULED</u> <u>OUTAGE</u>	
RCIC-13								
	BOX	C-E-2	VT-3	303/8.2.17				
RCIC-31								
	SPRING	C-E-2	VT-3	303/8.2.17				
			VT-4	303/8.2.17				
RCIC-12								
	BOX	C-E-2	VT-3	303/8.2.17				
RCIC-11								
	BOX	C-E-2	VT-3	303/8.2.17				
RCIC-10								
	STRUT	C-E-2	VT-3	303/8.2.17				
RCIC-973N								
	STRUT	C-E-2	VT-3	303/8.2.17				
RCIC-9								
	BOX	C-E-2	VT-3	303/8.2.17				
RCIC-8								
	STRUT	C-E-2	VT-3	303/8.2.17				
RCIC-54								
	SPRING	C-E-2	VT-3	303/8.2.17				
			VT-4	303/8.2.17				
RCIC-14								
	BOX	C-E-2	VT-3	303/8.2.17				
RCIC-15								
	BOX	C-E-2	VT-3	303/8.2.17				
RCIC-16								
	BOX	C-E-2	VT-3	303/8.2.17				
RCIC-17								
	BOX	C-E-2	VT-3	303/8.2.17				
RCIC-18								
	BOX	C-E-2	VT-3	303/8.2.17				
RCIC-19								
	OTHER	C-E-2	VT-3	303/8.2.17				
RCIC-19								
	BOX	C-E-2	VT-3	303/8.2.17				
RCIC-20								
	BOX	C-E-2	VT-3	303/8.2.17				

WNP-02
 INTERVAL: PSI
 PERIOD: NA
 OUTAGE:
 DRAWING NO. RCIC-205

WASHINGTON PUBLIC POWER SUPPLY SYSTEM
 PROGRAM PLAN AND SCHEDULE
 SYSTEM OR COMPONENT: RCIC(1)-4
 DESCRIPTION: RCIC PUMP DISCHARGE

PAGE 002
 DATE 12/14/84

<u>IDENT. NO.</u>	<u>DESCRIPTION</u>	<u>SECT.</u> XI <u>EXAM.</u>	<u>EXAM</u> MTH.	<u>PROCEDURE</u>	<u>CAL.</u> BLOCK	<u>INSERVICE</u>		<u>NOTES</u>
						<u>REQ.</u>	<u>SCHEDULED</u> OUTAGE	
RCIC-956N	STRUT	C-E-2	VT-3	303/8.2.17				
RCIC-21	STRUT	C-E-2	VT-3	303/8.2.17				
RCIC-955N	BOX	C-E-2	VT-3	303/8.2.17				
RCIC-954N	BOX	C-E-2	VT-3	303/8.2.17				
RCIC-22	BOX	C-E-2	VT-3	303/8.2.17				
RCIC-952N	BOX	C-E-2	VT-3	303/8.2.17				
RCIC-29	ANCHOR	C-E-2	VT-3	303/8.2.17				
RCIC-79	BOX	C-E-2	VT-3	303/8.2.17				
RCIC-80	STRUT	C-E-2	VT-3	303/8.2.17				
RCIC-82	BOX	C-E-2	VT-3	303/8.2.17				
RCIC-83	SPRING	C-E-2	VT-3	303/8.2.17				
RCIC-86	SPRING	C-E-2	VT-3	303/8.2.17				
RCIC-88			VT-4	303/8.2.17				
RCIC-90	BOX	C-E-2	VT-3	303/8.2.17				
RCIC-91	STRUT	C-E-2	VT-3	303/8.2.17				
RCIC-93	ANCHOR	C-E-2	VT-3	303/8.2.17				
	BOX	C-E-2	VT-3	303/8.2.17				


WNP-02
 INTERVAL: PSI
 PERIOD: NA
 OUTAGE:
 DRAWING NO. RCIC-205

WASHINGTON PUBLIC POWER SUPPLY SYSTEM
 PROGRAM PLAN AND SCHEDULE
 SYSTEM OR COMPONENT: RCIC(1)-4
 DESCRIPTION: RCIC PUMP DISCHARGE

PAGE 003
 DATE 12/14/84

<u>IDENT. NO.</u>	<u>DESCRIPTION</u>	<u>SECT.</u> <u>XI</u>	<u>EXAM</u> <u>MTH.</u>	<u>PROCEDURE</u>	<u>CAL.</u> <u>BLOCK</u>	<u>INSERVICE</u>		<u>NOTES</u>
						<u>REQ.</u>	<u>SCHEDULED</u> <u>OUTAGE</u>	
RCIC-95								
	BOX	C-E-2	VT-3	303/8.2.17				
RCIC-97								
	SPRING	C-E-2	VT-3	303/8.2.17				
			VT-4	303/8.2.17				
RCIC-98								
	STRUT	C-E-2	VT-3	303/8.2.17				
RCIC-99								
	STRUT	C-E-2	VT-3	303/8.2.17				
RCIC-100								
	PSA-1 SNUBBER	C-E-2	VT-3	303/8.2.17				S/N
			VT-4	303/8.2.17				S/N
RCIC-966N								
	STRUT	C-E-2	VT-3	303/8.2.17				
RCIC-PB-205								
	RCIC PRES BNDRY	N/A	VT-2	N/A				SEE NOTES #6 & #7.



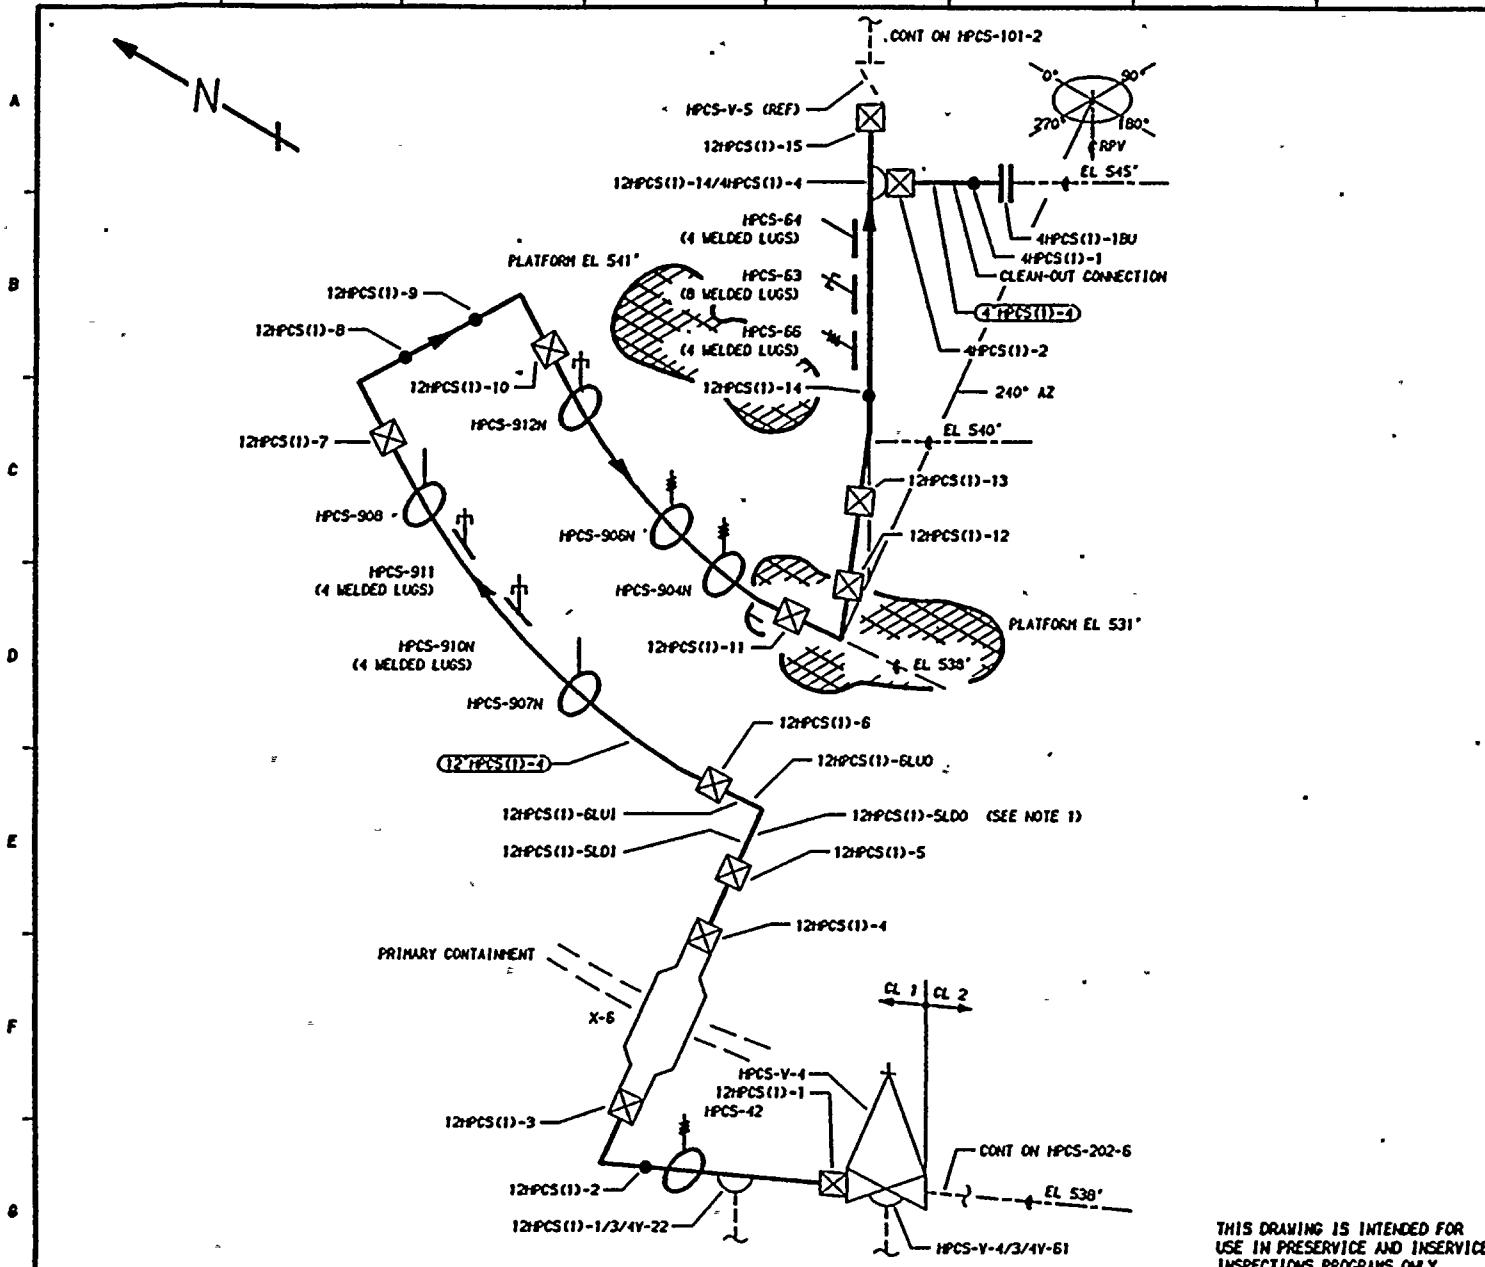


NOTES

1. PIPING SYSTEM 12"HPCS(1)-4 IS CONSTRUCTED OF SEAMLESS SCH 80 PIPE AND FITTINGS EXCEPT FOR THE SR ELL ASSOCIATED WITH WELDS 12"HPCS(1)-5 & 6 WHICH IS WELDED SCH 100. USE THE CAL BLOCKS SHOWN BELOW ACCORDINGLY.

REFERENCES:

151 - 220
 BOYEE AND CRAIL ISOMETRICS
 HPCS-630-26-28 REV 8
 HPCS-630-29-30 REV 7

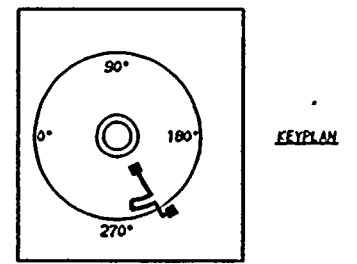

THIS DRAWING IS INTENDED FOR USE IN PRESERVICE AND INSERVICE INSPECTIONS PROGRAMS ONLY.

QUALITY CLASS, 1	ASME CODE CLASS, 1
ENGR, GA KUGLER	DRAWN, K-HcA DATE, 2-11-83

WASHINGTON PUBLIC POWER
 SUPPLY SYSTEM
 RICHLAND, WASHINGTON 99352

PIPING SYSTEM	NOM DIA (IN)	SCH	NOM WALL THK	MATERIAL SPECIFICATION	MATL TYPE	CAL BLOCK NO
12"HPCS(1)-4	12	80	0.688	SA 106 GR B	CS	UT-17
12"HPCS(1)-4	12	100	0.844	SA 106 GR B	CS	UT-16
4"HPCS(1)-4	4	80	0.337	SA 106 GR B	CS	UT-30
LUGS	N/A	N/A	N/A	SA 515 GR 70	CS	UT-46


NO	DATE	REVISION	BY	CHKD	APVD
2	5-26-83	ADDED SUPPORT RESTRICTIONS, ADDED LUGS & UT-46 DELETED 3/4" LUGS (SEEDRAWN)	K-HcA	DPR	JFH
1	12-2-81	CORRECTED VALVE TAG NO. IN A-4	K-HcA	DPR	JFH
0	11-27-78	ISSUED FOR USE (REDRAWN)	K-HcA	DWP	LFB
A	11-28-77	ISSUED FOR INFORMATION ONLY	K-HcA	DWP	DWP

WNP-2
 WELD & COMPONENT
 IDENTIFICATION DRAWING

TITLE: HPCS DISCHARGE TO VESSEL


DWG NO, HPCS-101-1 REV 2



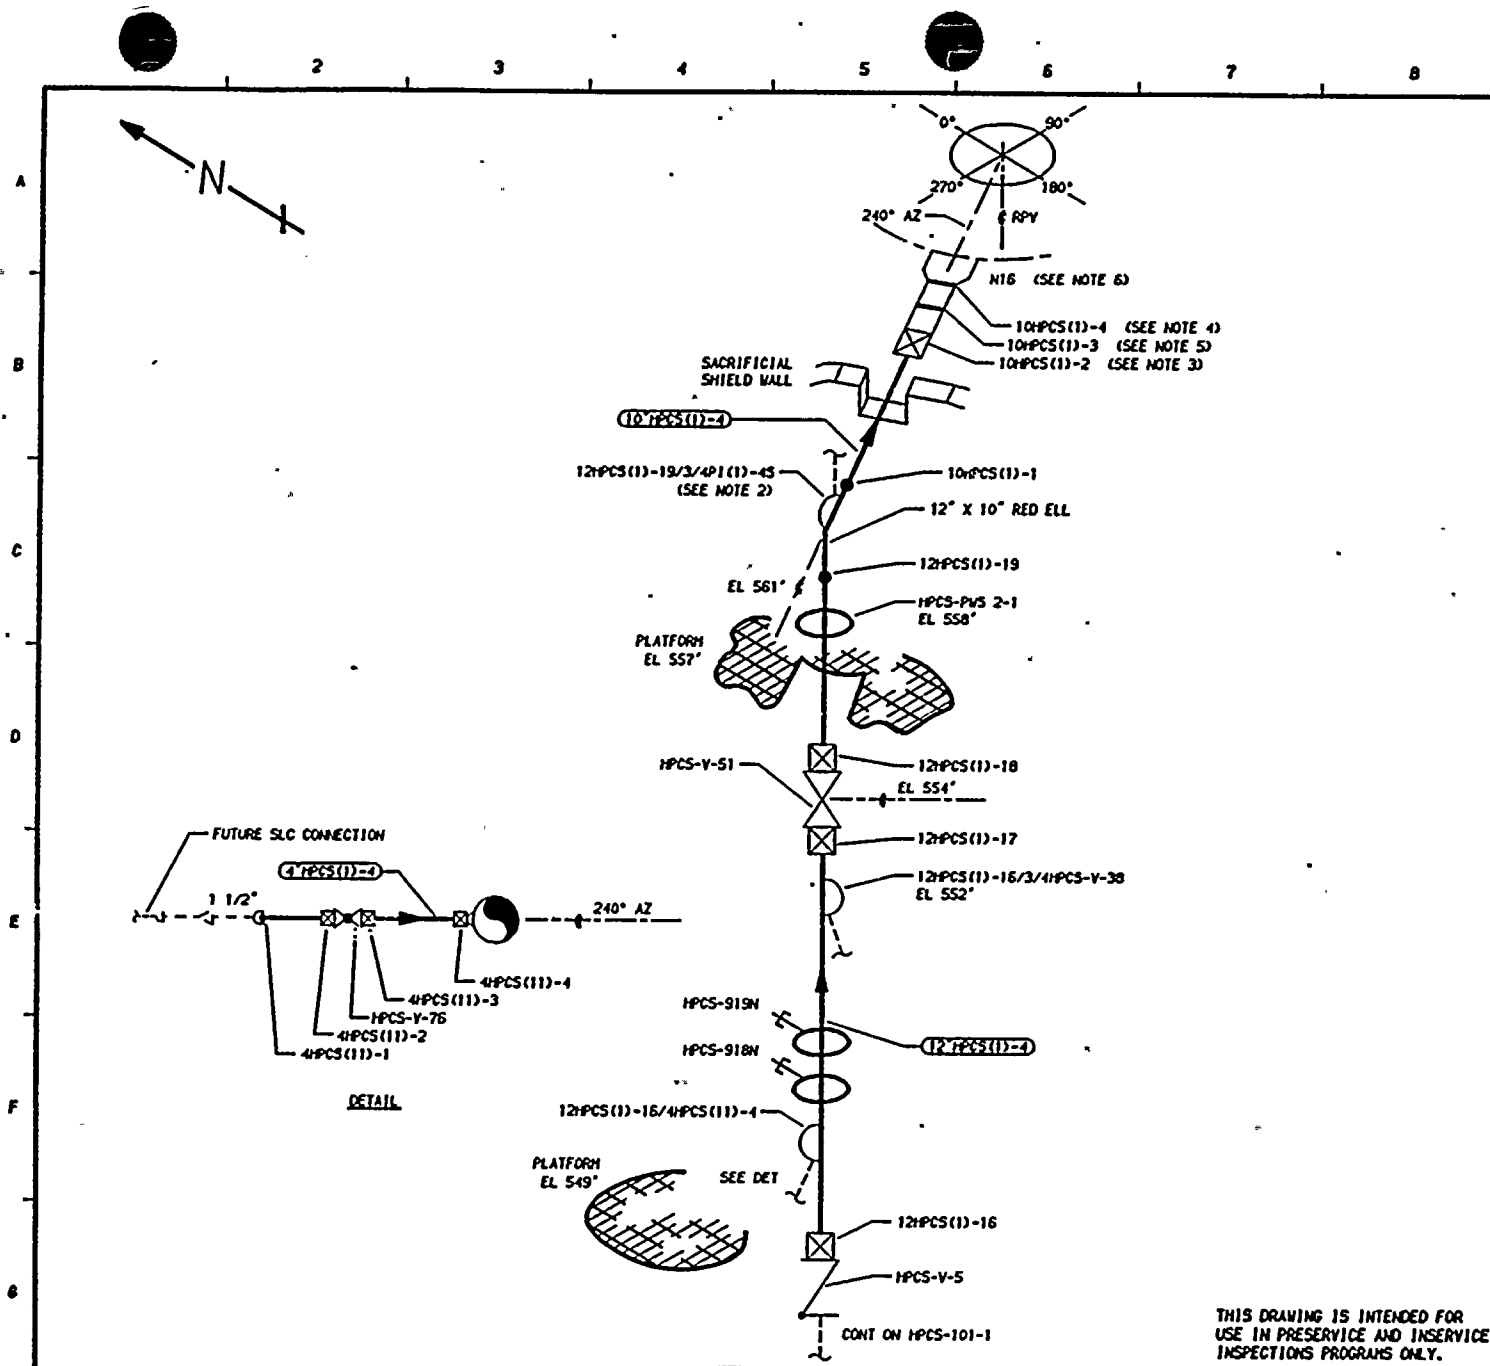

- NOTES**
1. DELETED
 2. EXTEND VISUAL LEAKAGE EXAM THROUGH CONTAINMENT PENETRATION (X-73a) THROUGH EXCESS FLOW CHECK VALVE TO INSTRUMENT TUBING CONNECTION.
 3. DISTANCE BETWEEN WELDS 10HPCS(1)-2 AND 10HPCS(1)-3 IS LESS THAN 6".
 4. DISSIMILAR METAL WELD, CS TO INCO, USE CAL BLOCK UT-102.
 5. DISSIMILAR METAL WELD, CS TO INCO, USE CAL BLOCK UT-106.
 6. FOR NOZZLE ASSEMBLY DETAILS SEE RPV-109.

- REFERENCES**
- 151 - 220
 - BOYCE AND CRILL ISOMETRICS
 - HPCS-630-29-30 REV 7
 - HPCS-530-31.33 REV 9

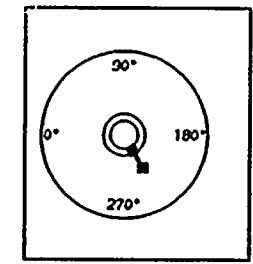


QUALITY CLASS, 1	ASME CODE CLASS, 1
ENGR, GA KUGLER	DRAWN, K-MCA DATE, 11-2-77

WASHINGTON PUBLIC POWER
SUPPLY SYSTEM
 RICHLAND, WASHINGTON 99352

WNP-2 WELD & COMPONENT IDENTIFICATION DRAWING	
TITLE: HPCS DISCHARGE TO VESSEL	
DWG NO, HPCS-101-2	REV 4

THIS DRAWING IS INTENDED FOR
 USE IN PRESERVICE AND INSERVICE
 INSPECTIONS PROGRAMS ONLY.

NO	DATE	REVISION	BY	CHKD	APVD	PIPING SYSTEM	MON DIA (110)	SCH	MON WALL THK	MATERIAL SPECIFICATION	MATL TYPE	CAL BLOCK NO
4	5-21-83	ADDED SADDLES STUB & BUSH, REMOVED 3/4" O/C, ADDED 4" HPCS(1)-3, ADDED 101-32, CSD10130	K-MCA	DPR	TFH	12" HPCS(1)-4	12	80	0.688	SA 106 BR B	CS	UT-17
3	12-2-81	REVISED AS NOTED	K-MCA	TFH	DWP	10" HPCS(1)-4	10	80	0.594	SA 106 BR B	CS	UT-22
2	7-17-79	DELETED NOTE 1 AND REF TO WELDS IN REDUCING ELBOW AS BUILT ELBOW IS SEAMLESS. IN P-5	K-MCA	TFH	DWP	4" HPCS(1)-4	4	80	0.377	SA 106 BR B	CS	UT-30
1	1-10-79	REVISED REFERENCE TO NOTES 4 AND 5	K-MCA	TFH	DWP							
0	11-27-78	ISSUED FOR USE (REDRAWN)	K-MCA	DWP	LFB							
A	11-28-77	ISSUED FOR INFORMATION ONLY	K-MCA	DWP	GAK							

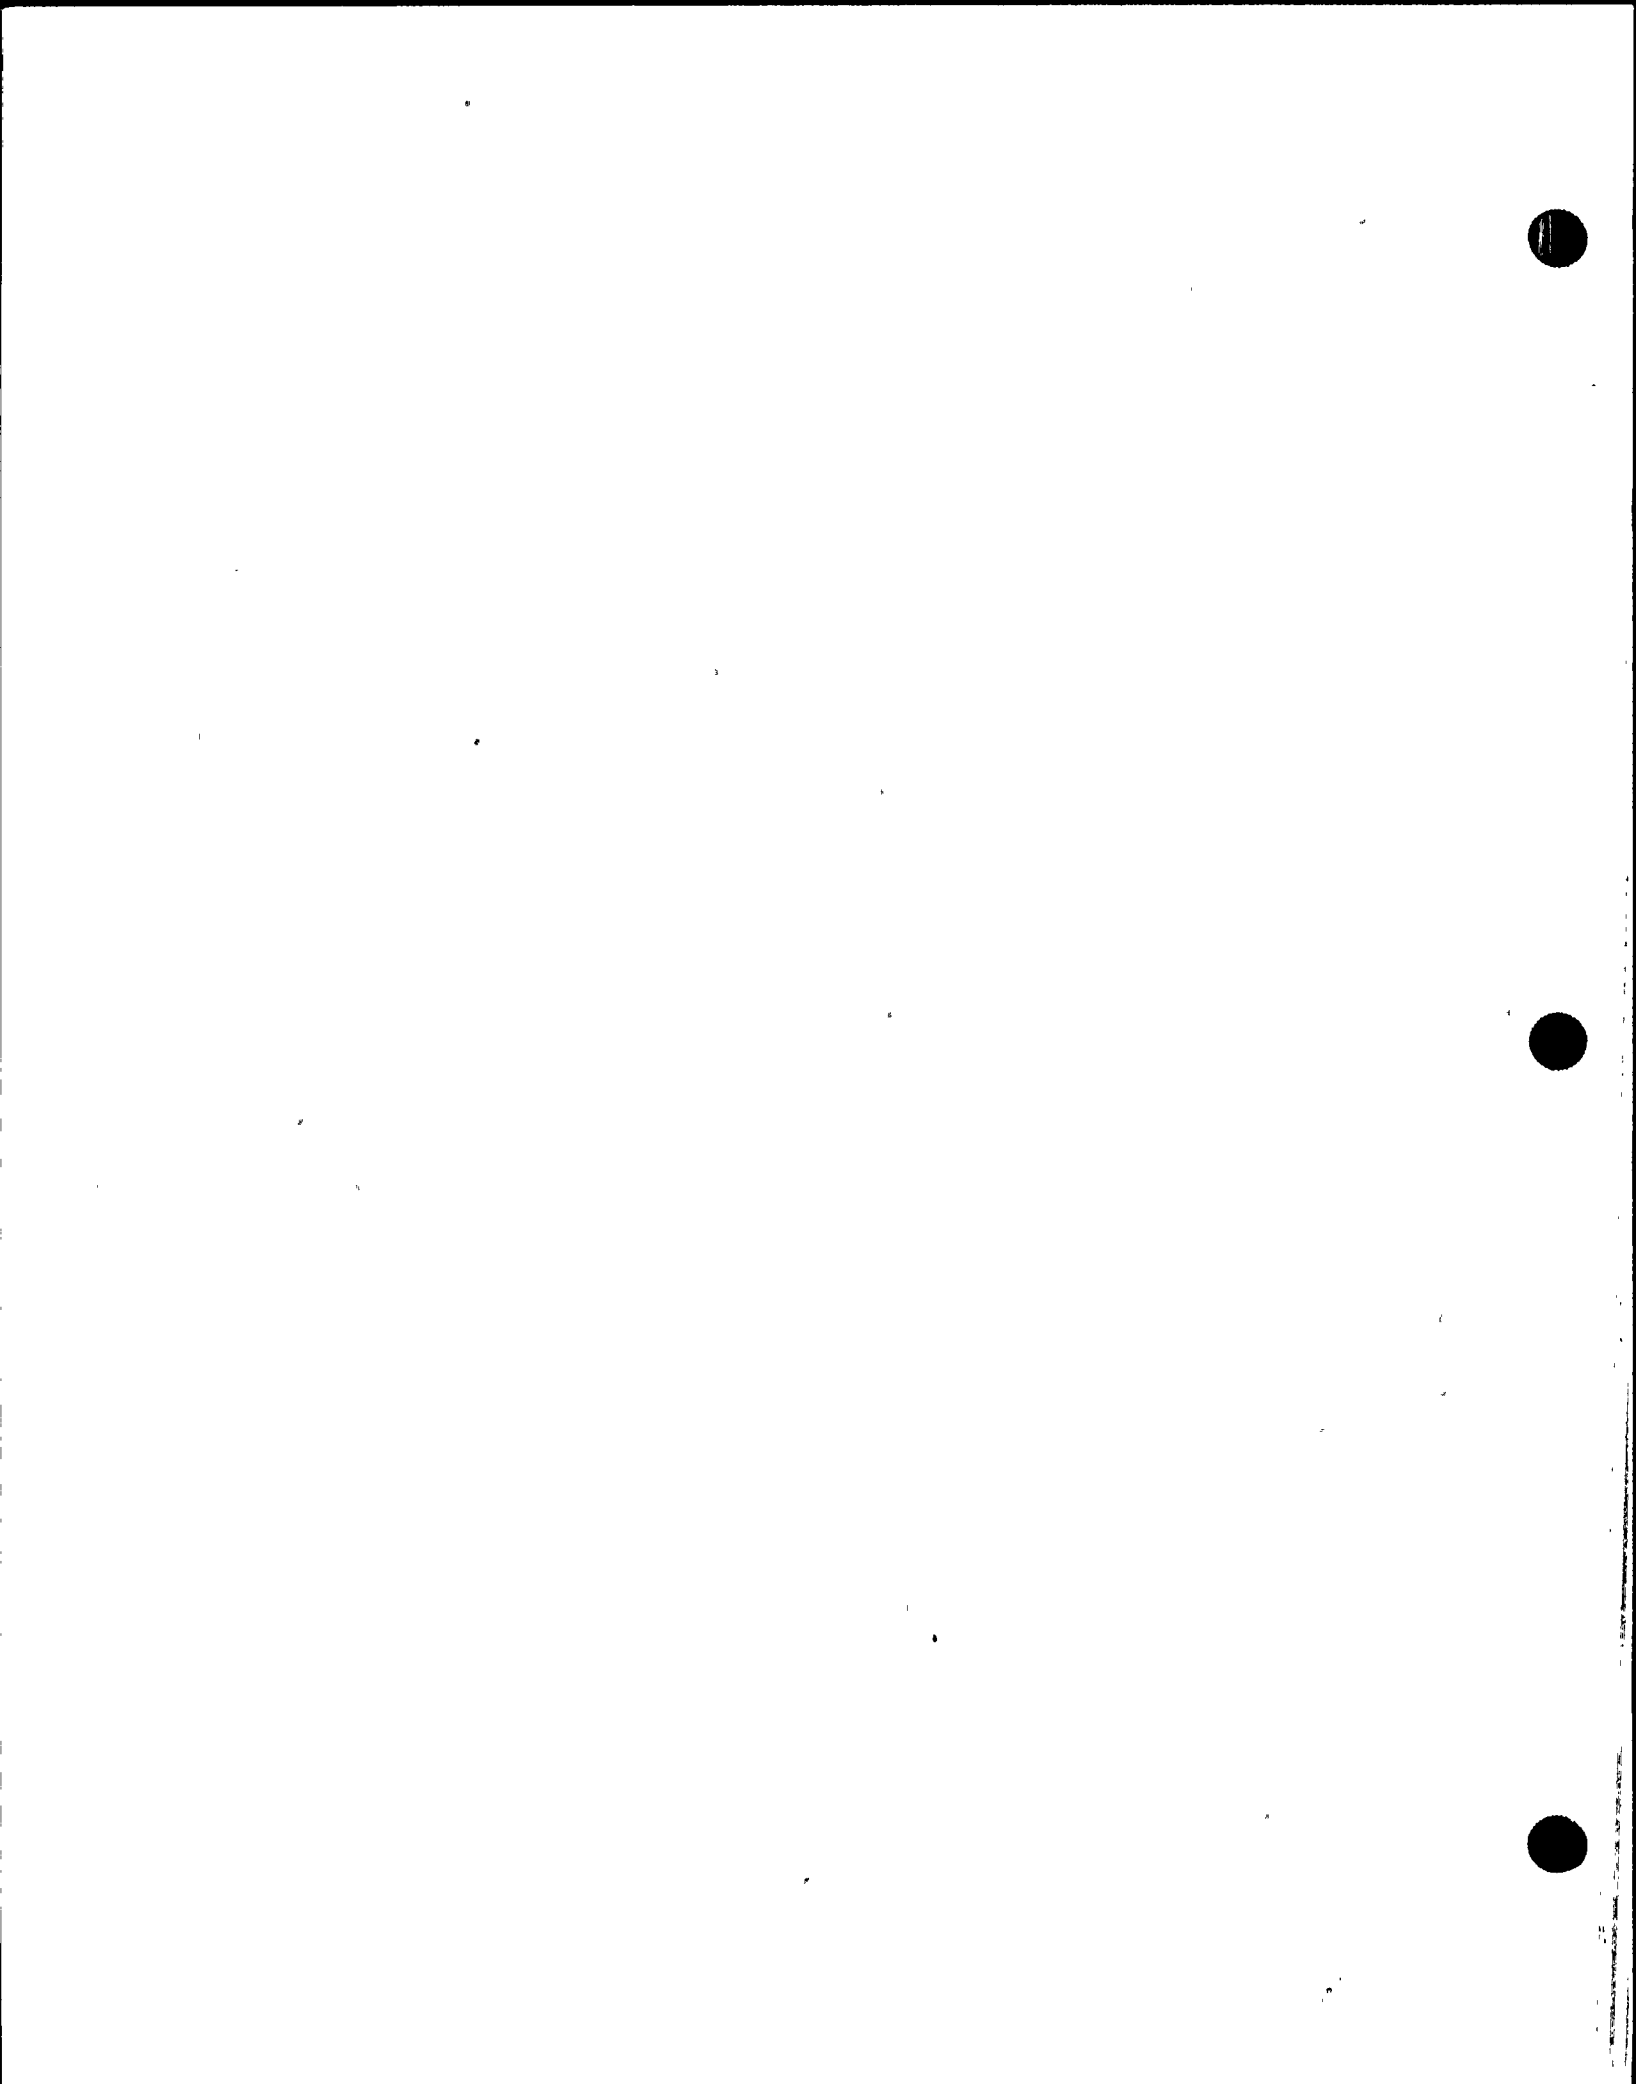

WNP-02
 INTERVAL: PSI
 PERIOD: NA
 OUTAGE:
 DRAWING NO. HPCS-101

WASHINGTON PUBLIC POWER SUPPLY SYSTEM
 PROGRAM PLAN AND SCHEDULE
 SYSTEM OR COMPONENT: HPCS(1)-4
 DESCRIPTION: HIGH PRES CORE SPRAY

PAGE 001
 DATE 12/14/84

IDENT. NO.	DESCRIPTION	SECT. XI EXAM	EXAM MTH.	PROCEDURE	CAL. BLOCK	INSERVICE		NOTES
						REQ.	SCHEDULED OUTAGE	
HPCS-V-4-BDY	VALVE BODY	B-M-2	VT-1	QCI 7-1				
HPCS-V-4-BLT	VALVE BOLTING	B-G-2	VT-1	QCI 7-1				
HPCS-V-4/3/4CAP	LEAKOFF CAPPED	B-P	VT-2	N/A				SEE NOTES #6 & #7.
HPCS-V-4/3/4V-61	DRAIN CONN	B-P	VT-2	N/A				SEE NOTES #6 & #7.
12HPCS(1)-1	VALVE TO PIPE	B-J	VOL	UTP-10	UT-17			
			SUR	PTP-1				
12HPCS(1)-1/3/4V-22	TEST CONN	B-P	VT-2	N/A				SEE NOTES #6 & #7.
HPCS-42	SPRING	B-K-2	VT-3	303/8.2.17				
			VT-4	303/8.2.17				
12HPCS(1)-2	PIPE TO EL	B-J	VOL	UTP-10	UT-17			
			SUR	PTP-1				
12HPCS(1)-3	EL TO PEN	B-J	VOL	QCI 6-13	UT-17			FITTING TO FITTING
			SUR	QCI 3-3				FITTING TO FITTING
12HPCS(1)-4	PEN TO PIPE	B-J	VOL	UTP-10	UT-17			
			SUR	PTP-1				
12HPCS(1)-5	PIPE TO EL	B-J	VOL	UTP-10	UT-17			
			SUR	PTP-1				
12HPCS(1)-5L00	EL SEAM	B-J	VOL	UTP-10	UT-16			

WNP-02
 INTERVAL: PSI
 PERIOD: NA
 OUTAGE:
 DRAWING NO. HPCS-101

WASHINGTON PUBLIC POWER SUPPLY SYSTEM
 PROGRAM PLAN AND SCHEDULE
 SYSTEM OR COMPONENT: HPCS(1)-4
 DESCRIPTION: HIGH PRES CORE SPRAY

PAGE 002
 DATE 12/14/84

<u>IDENT. NO.</u>	<u>DESCRIPTION</u>	SECT. XI <u>EXAM.</u>	EXAM <u>MTM.</u>	<u>PROCEDURE</u>	CAL. <u>BLOCK</u>	<u>INSERVICE</u>		<u>NOTES</u>
						<u>REQ.</u>	<u>SCHEDULED OUTAGE</u>	
			SUR	PTP-1				
12HPCS(1)-5LDI	EL SEAM	B-J	VOL	UTP-10	UT-16			
			SUR	PTP-1				
12HPCS(1)-6LU0	EL SEAM	B-J	VOL	UTP-10	UT-16			
			SUR	PTP-1				
-12HPCS(1)-6LUI	EL SEAM	B-J	VOL	UTP-10	UT-16			
			SUR	PTP-1				
12HPCS(1)-6	EL TO PIPE	B-J	VOL	UTP-10	UT-17			
			SUR	PTP-1				
HPCS-907N	STRUT	B-K-2	VT-3	303/8.2.17				
HPCS-910N(W)	4 WELDED LUGS	B-K-1	VOL	UTP-26	UT-17			
HPCS-910N	PSA-3 SN(2)	B-K-2	VT-3	303/8.2.17				S/N 2579/2691
			VT-4	303/8.2.17				S/N 2579/2691
HPCS-911N	PSA-10 SNUBBER	B-K-2	VT-3	303/8.2.17				S/N
			VT-4	303/8.2.17				S/N
HPCS-908N	STRUT	B-K-2	VT-3	303/8.2.17				
12HPCS(1)-7	PIPE TO EL	B-J	VOL	UTP-10	UT-17			
			SUR	PTP-1				

WNP-02.
 INTERVAL: PSI
 PERIOD: NA
 OUTAGE:
 DRAWING NO. HPCS-101

WASHINGTON PUBLIC POWER SUPPLY SYSTEM
 PROGRAM PLAN AND SCHEDULE
 SYSTEM OR COMPONENT: HPCS(1)-4
 DESCRIPTION: HIGH PRES CORE SPRAY

PAGE 003
 DATE 12/14/84

<u>IDENT. NO.</u>	<u>DESCRIPTION</u>	<u>SECT.</u> XI <u>EXAM.</u>	<u>EXAM</u> MTH.	<u>PROCEDURE</u>	<u>CAL.</u> BLOCK	<u>INSERVICE</u> SCHEDULED		<u>NOTES</u>
						<u>REQ.</u>	<u>OUTAGE</u>	
12HPCS(1)-8	EL TO PIPE	B-J	VOL	UTP-10	UT-17			
			SUR	PTP-1				
12HPCS(1)-9	PIPE TO EL	B-J	VOL	UTP-10	UT-17			
			SUR	PTP-1				
12HPCS(1)-10	EL TO PIPE	B-J	VOL	UTP-10	UT-17			
			SUR	PTP-1				
HPCS-912N	PSA-3 SNUBBER	B-K-2	VT-3	303/8.2.17				S/N 2790
			VT-4	303/8.2.17				S/N 2790
HPCS-906N	SPRING	B-K-2	VT-3	303/8.2.17				
			VT-4	303/8.2.17				
HPCS-904N	SPRING	B-K-2	VT-3	303/8.2.17				
			VT-4	303/8.2.17				
12HPCS(1)-11	PIPF TO EL	B-J	VOL	UTP-10	UT-17			
			SUR	PTP-1				
12HPCS(1)-12	EL TO PIPE	B-J	VOL	UTP-10	UT-17			
			SUR	PTP-1				
12HPCS(1)-13	PIPE TO EL	B-J	VOL	UTP-10	UT-17			
			SUR	PTP-1				

WNP-02
 INTERVAL: PSI
 PERIOD: NA
 OUTAGE:
 DRAWING NO. HPCS-101

WASHINGTON PUBLIC POWER SUPPLY SYSTEM
 PROGRAM PLAN AND SCHEDULE
 SYSTEM OR COMPONENT: HPCS(1)-4
 DESCRIPTION: HIGH PRES CORE SPRAY

PAGE 004
 DATE 12/14/84

IDENT. NO.	DESCRIPTION	SECT. XI EXAM. EXAM.	EXAM MTH.	PROCEDURE	CAL. BLOCK	INSERVICE		NOTES
						REQ.	SCHEDULED OUTAGE	
12HPCS(1)-14	EL TO PIPE	B-J	VOL	UTP-10	UT-17			
			SUR	PTP-1				
HPCS-66(W) HPCS-66	4 WELDED LUGS	B-K-1	VOL	UTP-26	UT-17			3/4"Wx1 1/8"Hx3"L.
	SPRING	B-K-2	VT-3	303/8.2.17				
			VT-4	303/8.2.17				
-HPCS-63(W) HPCS-63	8 WELDED LUGS	B-K-1	VOL	QCI 6-15	UT-17			
	PSA-10 SN(2)	B-K-2	VT-3	303/8.2.17				S/N 1470/1474
			VT-4	303/8.2.17				S/N 1470/1474
HPCS-64(W) HPCS-64	4 WELDED LUGS	B-K-1	VOL	UTP-26	UT-17			3/4"W x 2"H x 3"L.
	BOX HANGER	B-K-2	VT-3	303/8.2.17				
12HPCS(1)-14/4HPCS(1)-4	WOL TO PIPE	B-J	SUR	QCI 3-3				
4HPCS(1)-1BD	FLANGE BOLTING	B-G-2	VT-1	QCI 7-1				
4HPCS(1)-1	FLANGE TO PIPE	B-J	VOL	UTP-10	UT-30			
			SUR	PTP-1				
4HPCS(1)-2	PIPE TO WOL	B-J	VOL	UTP-10	UT-30			
			SUR	PTP-1				
12HPCS(1)-15	PIPE TO VLV	B-J	VOL	UTP-10	UT-17			
			SUR	PTP-1				

WNP-02
 INTERVAL: PSI
 PERIOD: NA
 OUTAGE:
 DRAWING NO. HPCS-101

WASHINGTON PUBLIC POWER SUPPLY SYSTEM
 PROGRAM PLAN AND SCHEDULE
 SYSTEM OR COMPONENT: HPCS(1)-4
 DESCRIPTION: HIGH PRES CORE SPRAY

PAGE 005
 DATE 12/14/84

<u>IDENT. NO.</u>	<u>DESCRIPTION</u>	<u>SECT.</u>		<u>PROCEDURE</u>	<u>CAL. BLOCK</u>	<u>INSERVICE SCHEDULED</u>		<u>NOTES</u>
		<u>EXAM.</u>	<u>EXAM</u>			<u>REQ.</u>	<u>OUTAGE</u>	
HPCS-V-5-BDY	VALVE BODY	B-M-2	VT-1	QCI 7-1				
HPCS-V-5-BLT	VALVE BOLTING	B-G-2	VT-1	QCI 7-1				
HPCS-V-5/3/4CAP	LEAKOFF CAPPED	B-P	VT-2	N/A				SEE NOTES #6 & #7.
12HPCS(1)-16	VLV TO PIPE	B-J	VOL	UTP-10	UT-17			
			SUR	PTP-1				
4HPCS(11)-1	CAP TO PIPE	B-J	VOL	UTP-10	UT-30			
			SUR	PTP-1				
4HPCS(11)-2	PIPE TO VALVE	B-J	VOL	UTP-10	UT-30			
			SUR	PTP-1				
4HPCS(11)-3	VALVE TO PIPE	B-J	VOL	UTP-10	UT-30			
			SUR	PTP-1				
4HPCS(11)-4	PIPE TO WOL	B-J	VOL	UTP-10	UT-30			
			SUR	PTP-1				
12HPCS(1)-16/4HPCS(11)-4	PIPE TO WOL	B-J	SUR	PTP-1				
HPCS-918N	PSA-10 SNUBBER	B-K-2	VT-3	303/8.2.17				S/N 298
			VT-4	303/8.2.17				S/N 298
HPCS-919N	PSA-10 SNUBBER	B-K-2	VT-3	303/8.2.17				S/N 300

WNP-02
 INTERVAL: PSI
 PERIOD: NA
 OUTAGE:
 DRAWING NO. HPCS-101

WASHINGTON PUBLIC POWER SUPPLY SYSTEM
 PROGRAM PLAN AND SCHEDULE
 SYSTEM OR COMPONENT: HPCS(1)-4
 DESCRIPTION: HIGH PRES CORE SPRAY

PAGE 006
 DATE 12/14/84


<u>IDENT. NO.</u>	<u>DESCRIPTION</u>	<u>SECT.</u> <u>XI</u>	<u>EXAM</u> <u>EXAM.</u>	<u>PROCEDURE</u> <u>MTH.</u>	<u>CAL.</u> <u>BLOCK</u>	<u>INSERVICE</u>		<u>NOTES</u>
						<u>REQ.</u>	<u>SCHEDULED</u> <u>OUTAGE</u>	
				VT-4	303/8.2.17			S/N 300
12HPCS(1)-16/3/4V-38	TEST CONN	B-P	VT-2	N/A				SEE NOTES #6 & #7.
12HPCS(1)-17	PIPE TO VLV	B-J	VOL	UTP-10	UT-17			
			SUR	PTP-1				
HPCS-V-51-BDY	VALVE BODY	B-M-2	VT-1	OCI 7-1				
HPCS-V-51-BLT	VALVE BOLTING	B-G-2	VT-1	QCI 7-1				
12HPCS(1)-18	VLV TO PIPE	B-J	VOL	UTP-10	UT-17			
			SUR	PTP-1				
PWS-2-1	B&R WHIP SUP	N/A	N/A	N/A				SEE NOTE #1
12HPCS(1)-19	PIPE TO EL	B-J	VOL	UTP-10	UT-17			
			SUR	PTP-1				
12HPCS(1)-19/3/4PI(1)-4S	PRESSURE TAP	B-P	VT-2	N/A				SEE NOTES #6 & #7.
10HPCS(1)-1	EL TO PIPE	B-J	VOL	UTP-10	UT-22			
			SUR	PTP-1				
10HPCS(1)-2	PIPE TO SE EXT	B-J	VOL	UTP-10	UT-22			SEE RPV-109, NOZZLE N16
			SUR	PTP-1				SEE RPV-109, NOZZLE N16


WNP-02
 INTERVAL: PSI
 PERIOD: NA
 OUTAGE:
 DRAWING NO. HPCS-101

WASHINGTON PUBLIC POWER SUPPLY SYSTEM
 PROGRAM PLAN AND SCHEDULE
 SYSTEM OR COMPONENT: HPCS(1)-4
 DESCRIPTION: HIGH PRES CORE SPRAY

PAGE 007
 DATE 12/14/84


<u>IDENT. NO.</u>	<u>DESCRIPTION</u>	SECT. XI <u>EXAM.</u>	EXAM <u>MIN.</u>	PROCEDURE	CAL. <u>BLOCK</u>	<u>INSERVICE</u>		<u>NOTES</u>
						<u>REQ.</u>	<u>SCHEDULED</u> <u>OUTAGE</u>	
10HPCS(1)-3	SE EXT TO SE	B-F	VOL	UTP-10	UT-106			SEE RPV-105, NOZZLE N16
			SUR	PTP-1				SEE RPV-105, NOZZLE N16
10HPCS(1)-4	SE TO NOZZLE	B-F	VOL	UTP-10	UT-102			SEE RPV-105, NOZZLE N16
			SUR	PTP-1				SEE RPV-105, NOZZLE N16
HPCS-PB-101	HPCS PRES BNDRY	B-P	VT-2	N/A				SEE NOTES #6 & #7.

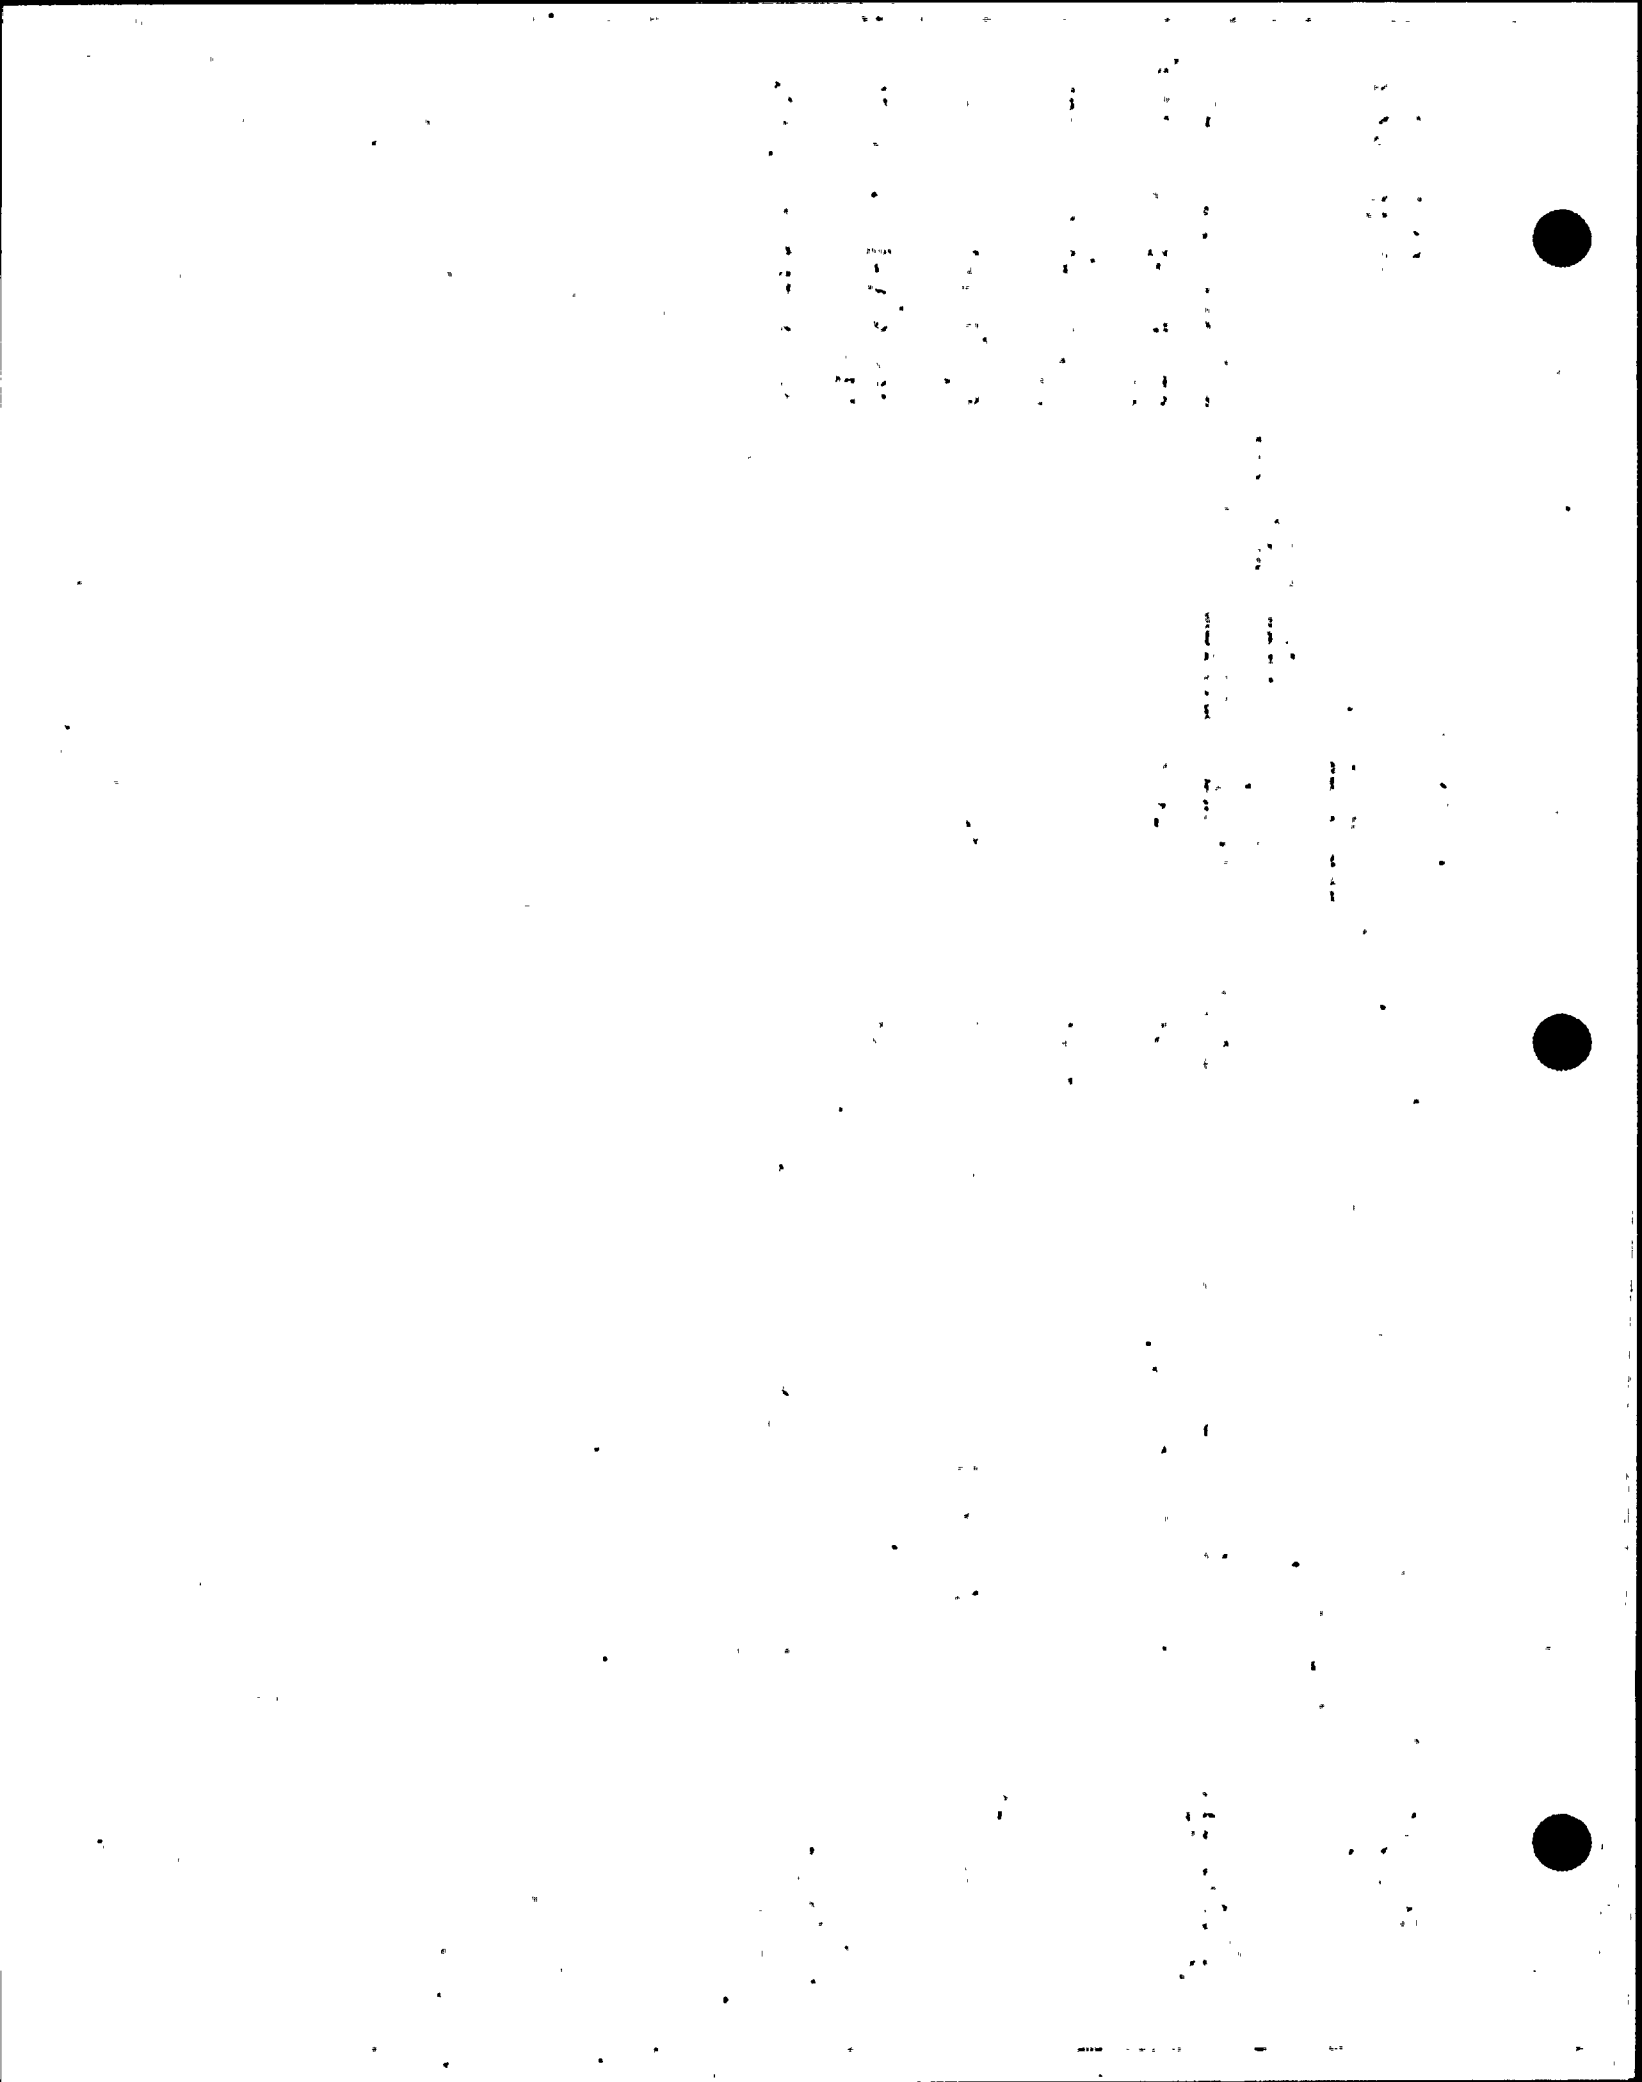

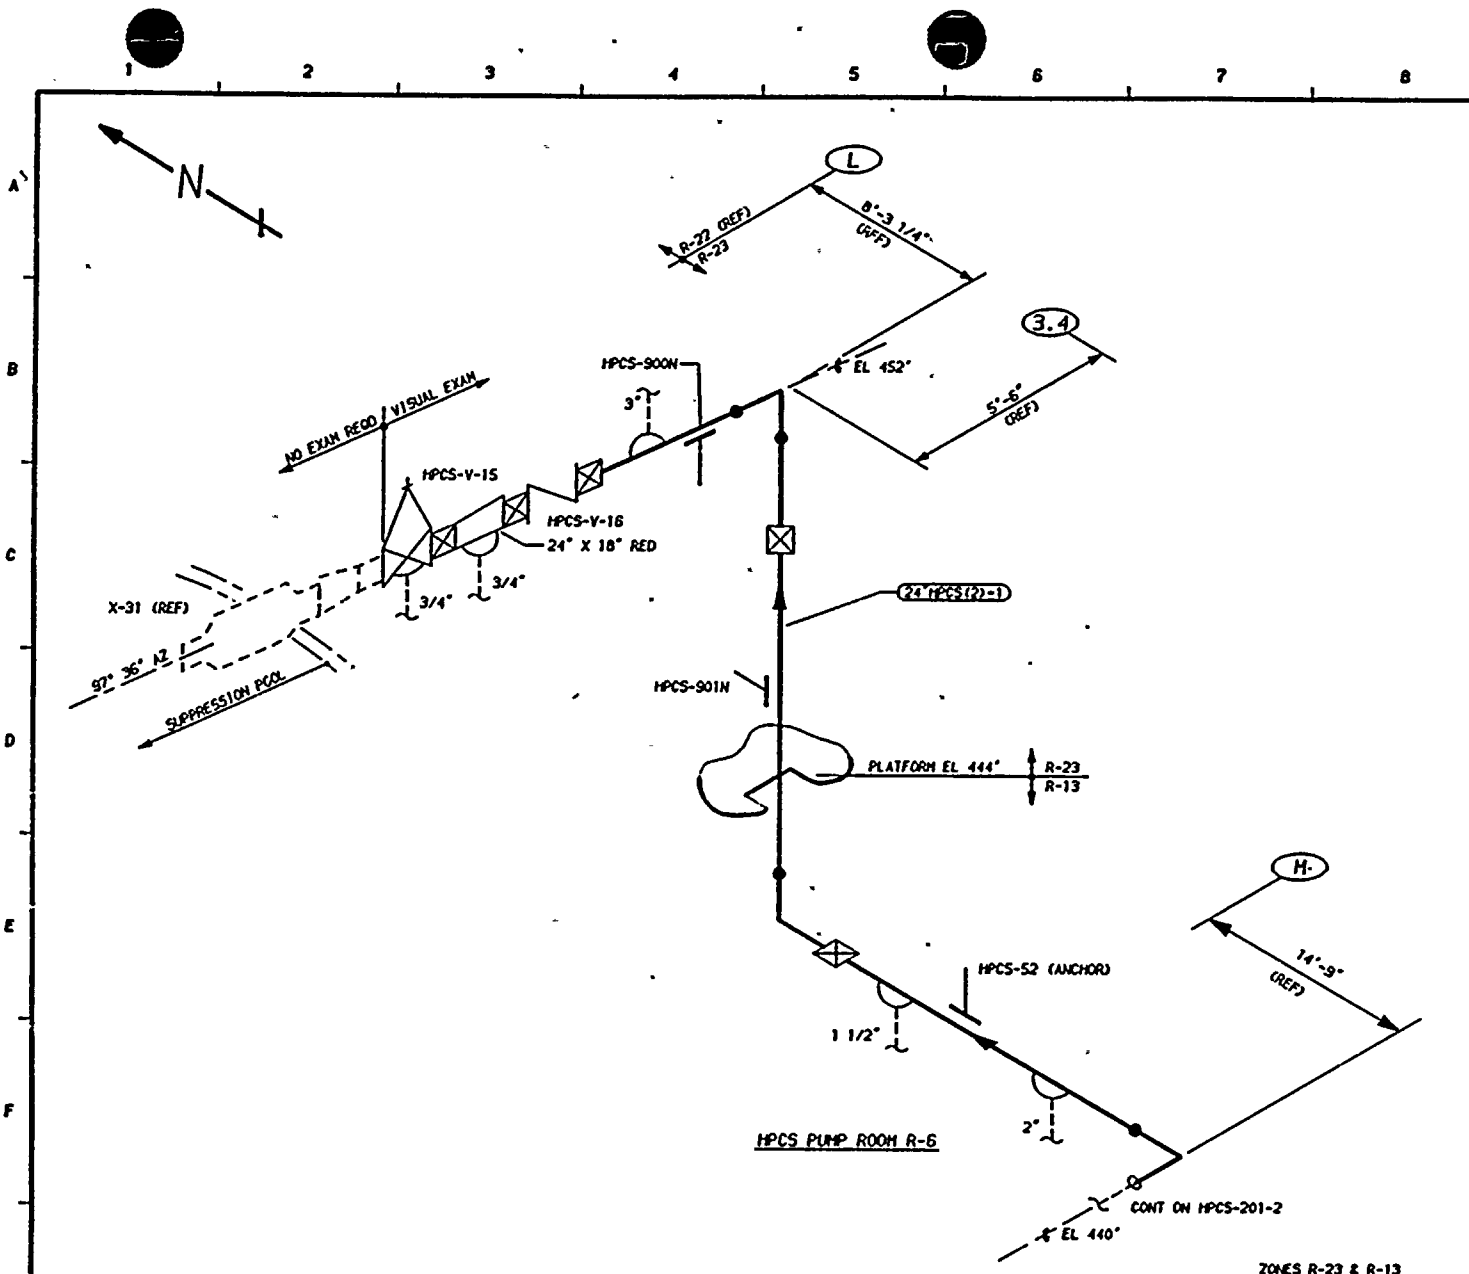

- NOTES:**
1. THIS DRAWING IDENTIFIES PIPING AND COMPONENTS SUBJECT TO A VISUAL EXAM FOR EVIDENCE OF LEAKAGE DURING SYSTEM HYDRO OR OPERABILITY TESTS. TESTS ARE TO BE CONDUCTED PER THE REQUIREMENTS OF ASME SECTION XI, PARAGRAPH IMA-5000.
 2. FOR BRANCH PIPING 4" NOM. OR LESS (CONNECTION SHOWN IN DASHED LINES) EXTEND VISUAL LEAKAGE EXAM THROUGH THE OUTERMOST CLOSED NUCLEAR CLASS VALVE, OR UNTIL TRANSITION TO INSTRUMENT TUBING, UNLESS OTHERWISE NOTED.

- REFERENCES:**
- 151 - 220
 - BOYEE AND CRAIL ISOMETRICS
 - HPSC-629-1.4 REV 8

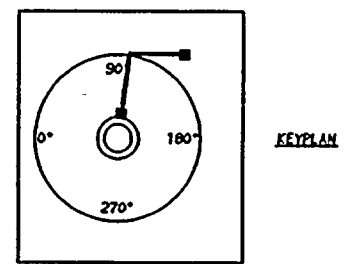

QUALITY CLASS: 1	ASME CODE CLASS: 2
ENGR: GA KUGLER	DRAWN: K-McA DATE: 8-4-78

WASHINGTON PUBLIC POWER
SUPPLY SYSTEM
 RICHLAND, WASHINGTON 99352

WNP-2
WELD & COMPONENT
IDENTIFICATION DRAWING


TITLE:
 HPCS PUMP SUPPRESSION POOL SUCTION LINE

DWG NO: HPCS-201-1 REV 1

THIS DRAWING IS INTENDED FOR
 USE IN PRESERVICE AND INSERVICE
 INSPECTIONS PROGRAMS ONLY.


PIPING SYSTEM	NOM DIA (IN)	SCH	NOM WALL THK	MATERIAL SPECIFICATION	MATL TYPE	CAL BLOCK NO
24" HPCS(2)-1	24	STD	0.375	SA 106 GR B	CS	NA

NO	DATE	REVISION	BY	CHKD	APVD
1	5-24-83	ADDED HPCS-900N EXAM; DELETED HPCS-50, 51, 54, 55 & 56 ADDED FIELD WELD, ADDED 2" SOL (REFERENCE)	K-McA	DFP	TPA
0	12-22-78	ISSUED FOR USE	K-McA	DFP	LFB
A	10-3-78	ISSUED FOR INFORMATION ONLY	K-McA	GAK	DMP
NO					

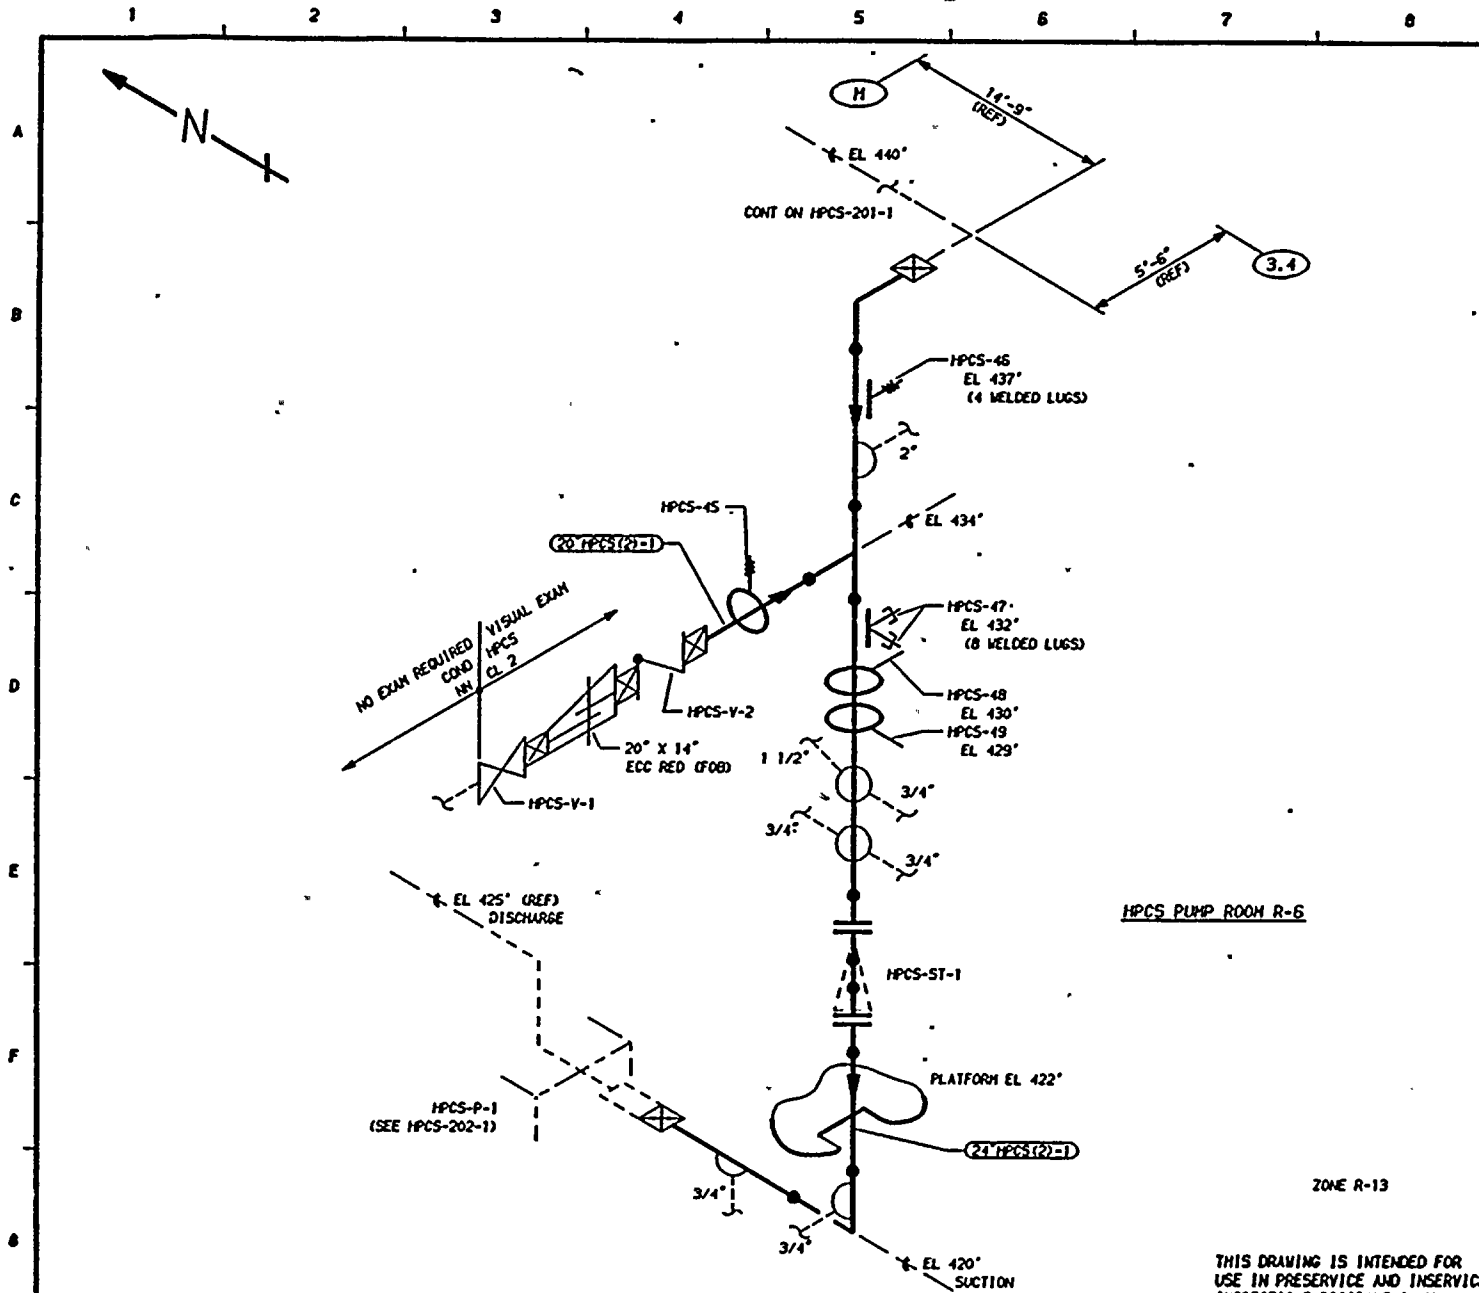

- NOTES:**
1. THIS DRAWING IDENTIFIES PIPING AND COMPONENTS SUBJECT TO A VISUAL EXAM FOR EVIDENCE OF LEAKAGE DURING SYSTEM HYDRO OR OPERABILITY TESTS. TESTS ARE TO BE CONDUCTED PER THE REQUIREMENTS OF ASME SECTION XI, PARAGRAPH IWA-5000.
 2. FOR BRANCH PIPING 4" NOM. OR LESS (CONNECTION SHOWN IN DASHED LINES) EXTEND VISUAL EXAM THROUGH THE OUTERMOST NORMALLY CLOSED NUCLEAR CLASS VALVE, OR UNTIL TRANSITION TO INSTRUMENT TUBING, UNLESS OTHERWISE NOTED.

REFERENCES:
 ISI - 220
 BOYEE AND CRAIL ISOMETRICS
 HPCS-629-5.7 REV 7

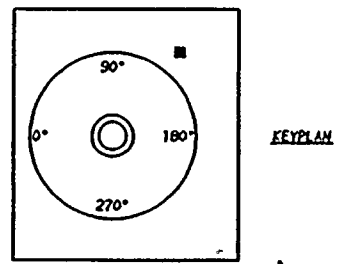

QUALITY CLASS, 1	ASME CODE CLASS, 2
ENGR, GA KUGLER	DRAWN, K-McA DATE, 8-9-78

WASHINGTON PUBLIC POWER
 SUPPLY SYSTEM
 RICHLAND, WASHINGTON 99352

WNP-2
 WELD & COMPONENT
 IDENTIFICATION DRAWING

TITLE:
 HPCS PUMP SUPPRESSION POOL SUCTION LINE

DWG NO, HPCS-201-2 REV 1

PIPING SYSTEM	NOM DIA (IN)	SCH	NOM WALL THK	MATERIAL SPECIFICATION	MATL TYPE	CAL BLOCK NO
24" HPCS(2)-1	24	STD	0.375	SA 106 GR B	CS	NA
20" HPCS(2)-1	20	STD	0.375	SA 106 GR B	CS	NA

NO	DATE	REVISION	BY	CHKD	APVD
1	5-27-83	ADDED 3/4" SOL, HPCS-48 NOW RIGID, (REDRAWN)	K-McA	IFP	IFP
0	12-22-78	ISSUED FOR USE	K-McA	IFP	LFB
A	10-3-78	ISSUED FOR INFORMATION ONLY	K-McA	GAK	DMP

THIS DRAWING IS INTENDED FOR
 USE IN PRESERVICE AND INSERVICE
 INSPECTIONS PROGRAMS ONLY.

ZONE R-13

HPCS PUMP ROOM R-6

HPCS-ST-1

PLATFORM EL 422'

HPCS-P-1
 (SEE HPCS-202-1)

NO EXAM REQUIRED
 COND. IN
 VISUAL EXAM
 HPCS
 CL 2

CONT ON HPCS-201-1

14'-9" (REF)
 EL 440'

5'-6" (REF)
 3.4

HPCS-45
 EL 437'
 (4 WELDED LUGS)

EL 434'

HPCS-47
 EL 432'
 (8 WELDED LUGS)

HPCS-48
 EL 430'

HPCS-49
 EL 429'

20" HPCS(2)-1

20" X 14"
 ECC RED (FOB)

HPCS-V-2

HPCS-V-1

EL 425' (REF)
 DISCHARGE

1 1/2"

3/4"

3/4"

24" HPCS(2)-1

3/4"

3/4"

EL 420'
 SUCTION


WNP-02
 INTERVAL: PSI
 PERIOD: NA
 OUTAGE:
 DRAWING NO. HPCS-201

WASHINGTON PUBLIC POWER SUPPLY SYSTEM
 PROGRAM PLAN AND SCHEDULE
 SYSTEM OR COMPONENT: HPCS(2)-1
 DESCRIPTION: HPCS-P-1 SUCTION

PAGE 001
 DATE 12/14/84


<u>IDENT. NO.</u>	<u>DESCRIPTION</u>	<u>SECT.</u> <u>XI</u> <u>EXAM.</u>	<u>EXAM</u> <u>MTH.</u>	<u>PROCEDURE</u>	<u>CAL.</u> <u>BLOCK</u>	<u>INSERVICE</u>		<u>NOTES</u>
						<u>REQ.</u>	<u>SCHEDULED</u> <u>OUTAGE</u>	
HPCS-900N	STRUT	C-E-2	VT-3	303/8.2.17				
HPCS-901N	BOX	C-E-2	VT-3	303/8.2.17				
HPCS-52	ANCHOR	C-E-2	VT-3	303/8.2.17				
HPCS-46	SPRING	C-E-2	VT-3	303/8.2.17				
			VT-4	303/8.2.17				
HPCS-45	SPRING	C-E-2	VT-3	303/8.2.17				
			VT-4	303/8.2.17				
HPCS-47	PSA-3 SN(2)	C-E-2	VT-3	303/8.2.17				S/N 470/485
			VT-4	303/8.2.17				S/N 470/485
HPCS-48	STRUT	C-E-2	VT-3	303/8.2.17				
HPCS-49	STRUT	C-E-2	VT-3	303/8.2.17				
HPCS-PB-201	HPCS PRES BNDRY	N/A	VT-2	N/A				



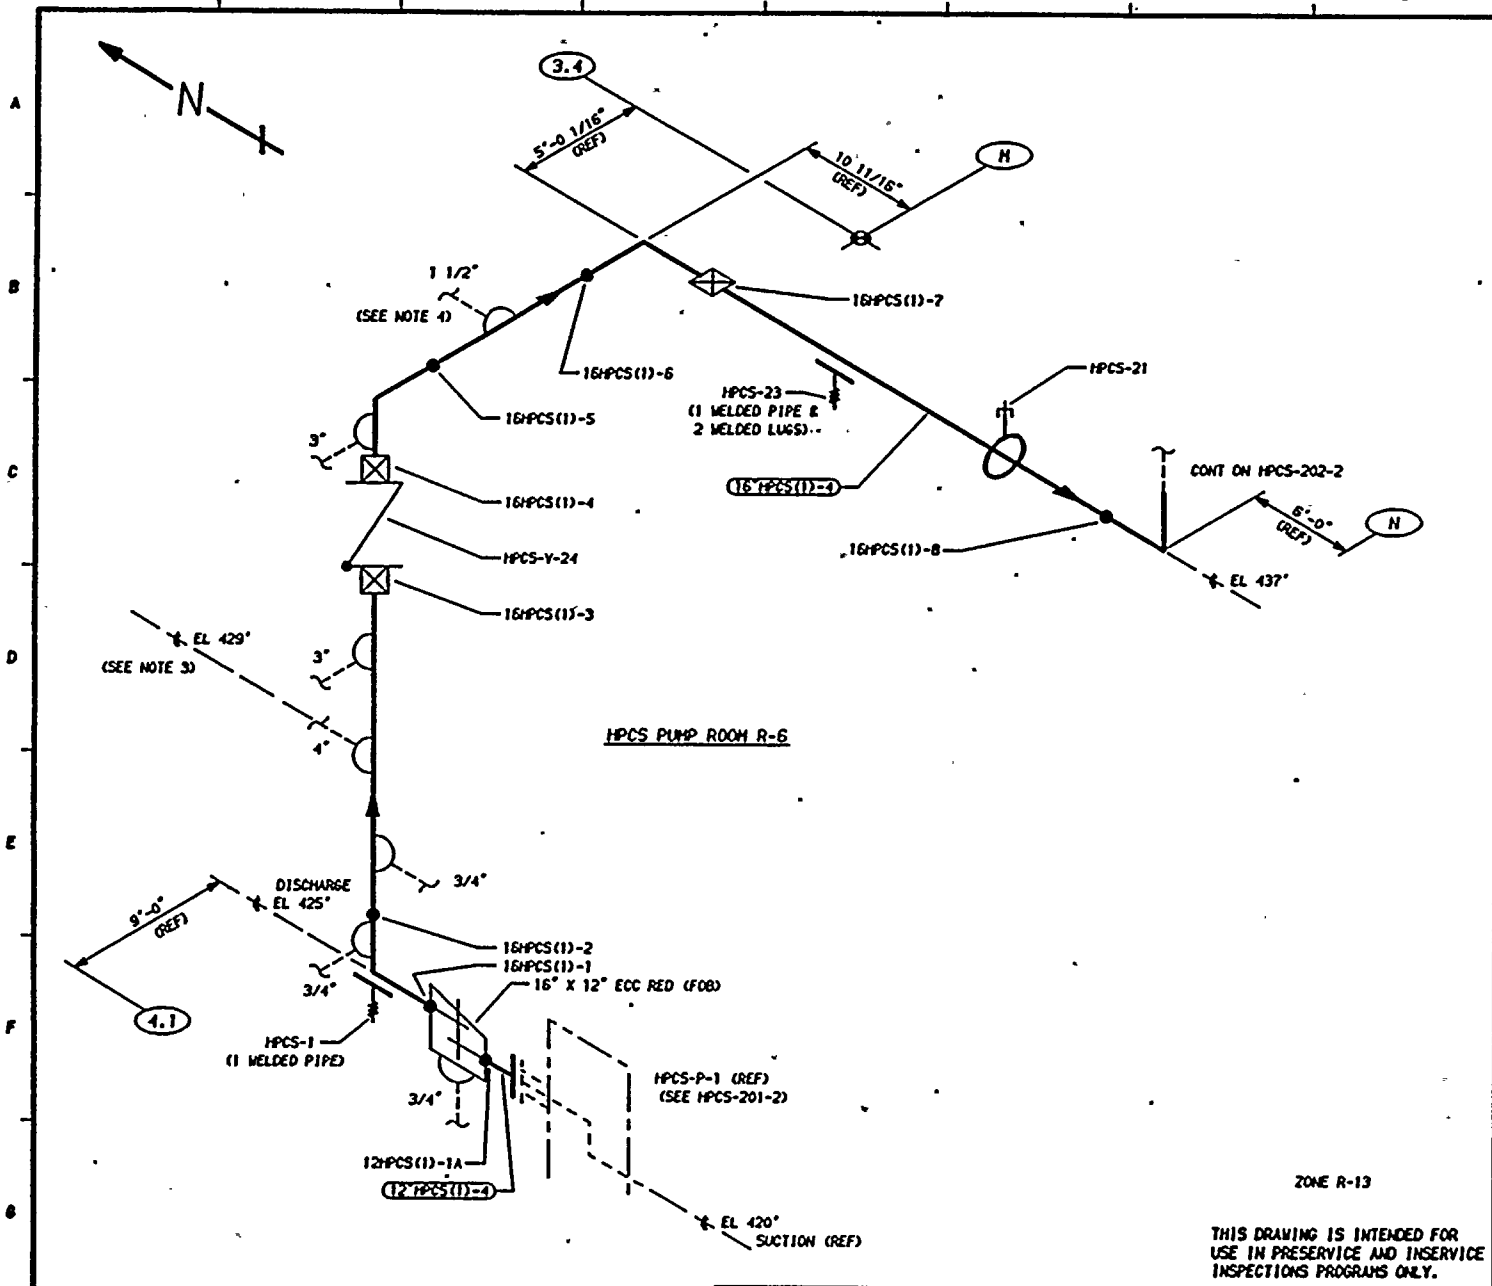

- NOTES:**
1. THIS DRAWING IDENTIFIES PIPING AND COMPONENTS SUBJECT TO A VISUAL EXAM FOR EVIDENCE OF LEAKAGE DURING SYSTEM HYDRO OR OPERABILITY TESTS. TESTS ARE TO BE CONDUCTED PER THE REQUIREMENTS OF ASME SECTION XI, PARAGRAPH IWA-5000.
 2. FOR BRANCH PIPING 4" NOM. OR LESS (CONNECTION SHOWN IN DASHED LINES) EXTEND VISUAL LEAKAGE EXAM THROUGH THE OUTERMOST NORMALLY CLOSED NUCLEAR CLASS VALVE, OR UNTIL TRANSITION TO INSTRUMENT TUBING, UNLESS OTHERWISE NOTED.
 3. EXTEND VISUAL LEAKAGE EXAM THROUGH VALVES HPCS-V-53, HPCS-V-62 AND HPCS-V-63.
 4. EXTEND VISUAL LEAKAGE EXAM THROUGH PUMP HPCS-P-3.

- REFERENCES:**
- 151 - 220
 - BOYEE & CRAIL ISOMETRICS
 - HPCS-630-1.4 REV 12
 - HPCS-630-7.10 REV 8

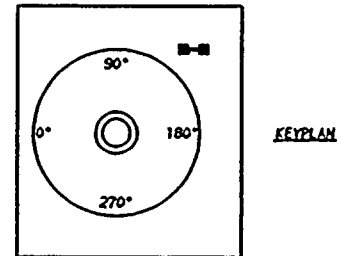

QUALITY CLASS: 1	ASME CODE CLASS: 2
ENGR: GA KUGLER	DRAWN: K-McA DATE: 8-9-78

WASHINGTON PUBLIC POWER
SUPPLY SYSTEM
RICHLAND, WASHINGTON 99352

WNP-2
WELD & COMPONENT
IDENTIFICATION DRAWING


TITLE: HPCS-PUMP-1 DISCHARGE

DWG NO: HPCS-202-1 REV 1

THIS DRAWING IS INTENDED FOR
USE IN PRESERVICE AND INSERVICE
INSPECTIONS PROGRAMS ONLY.

PIPING SYSTEM	NOM DIA (IN)	SCH	NOM WALL THK	MATERIAL SPECIFICATION	MATL TYPE	CAL BLOCK NO
16" HPCS(1)-4	16	100	1.031	SA 106 GR B	CS	UT-15
12" HPCS(1)-4	12	100	0.844	SA 106 GR B	CS	NA

NO	DATE	REVISION	BY	CHKD	APVD
1	5-21-83	ISSUED TO WELD DELIVERED HPCS-2 & 23 AS PER UT-15 (DRAWING)	K-McA	GAK	LFB
0	12-22-78	ISSUED FOR USE	K-McA	GAK	LFB
A	10-3-78	ISSUED FOR INFORMATION ONLY	K-McA	GAK	DWP

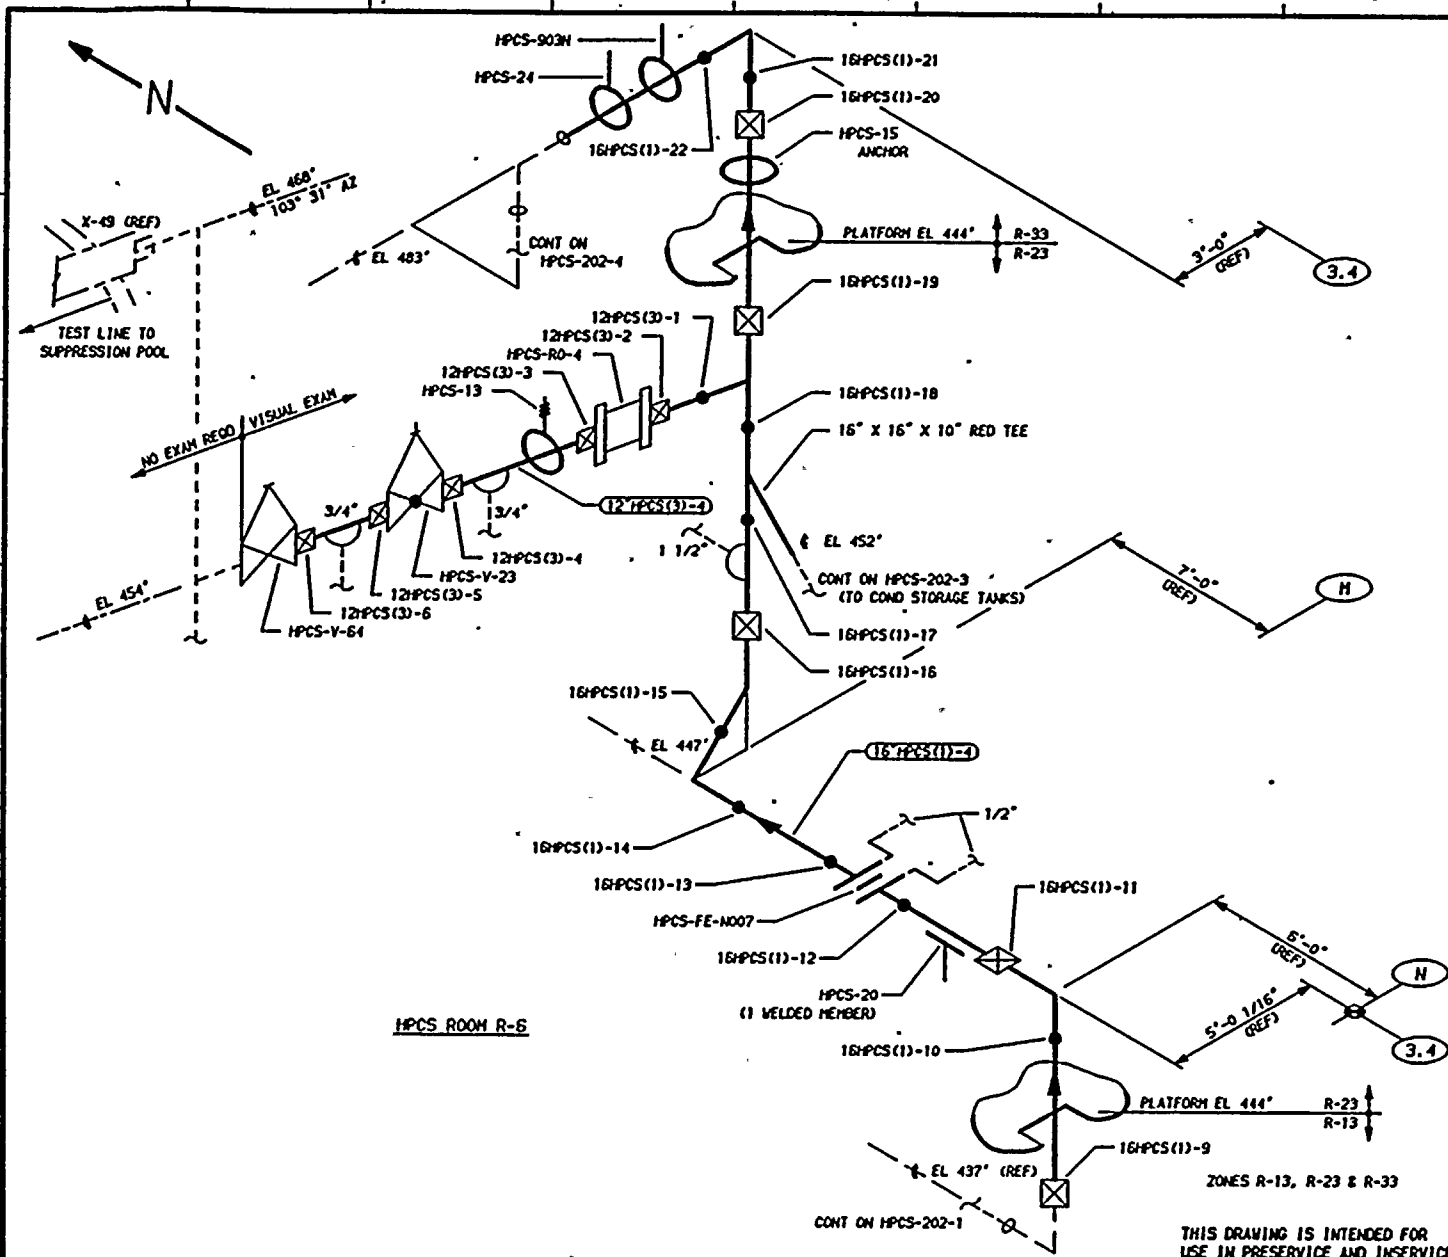


NOTES:

1. THIS DRAWING IDENTIFIES PIPING AND COMPONENTS SUBJECT TO A VISUAL EXAM FOR EVIDENCE OF LEAKAGE DURING SYSTEM HYDRO OR OPERABILITY TESTS. TESTS ARE TO BE CONDUCTED PER THE REQUIREMENTS OF ASME SECTION XI, PARAGRAPH IMA-5000.
2. FOR BRANCH PIPING 4" NOM. OR LESS (CONNECTION SHOWN IN DASHED LINES) EXTEND VISUAL LEAKAGE EXAM THROUGH THE OUTERMOST NORMALLY CLOSED NUCLEAR CLASS VALVE, OR UNTIL TRANSITION TO INSTRUMENT TUBING, UNLESS OTHERWISE NOTED.

REFERENCES:

- 151 - 220
- BOUYEE & GRILL ISOMETRICS
- HPCS-630-7.10 REV 8
- HPCS-630-11.12 REV 8
- HPCS-630-13.19 REV 6
- HPCS-632-1.3 REV 10

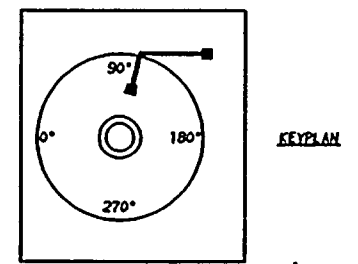

QUALITY CLASS: 1	ASME CODE CLASS: 2
ENGR: GA KUGLER	DRAWN: K-McA DATE: 8-10-78

WASHINGTON PUBLIC POWER
SUPPLY SYSTEM
RICHLAND, WASHINGTON 99352

WNP-2
WELD & COMPONENT
IDENTIFICATION DRAWING

TITLE: HPCS-PUMP-1 DISCHARGE

DWG NO: HPCS-202-2 REV 1

PIPING SYSTEM	NOM DIA (IN)	SCH	NOM WALL THK	MATERIAL SPECIFICATION	MATL TYPE	CAL BLOCK NO
16" HPCS(1)-4	16	100	1.031	SA 106 GR B	CS	NA
12" HPCS(3)-4	12	100	0.844	SA 106 GR B	CS	NA

NO	DATE	REVISION	BY	CHKD	APVD
1	5-27-83	ADDED WELDS, ADDED NO-4, DELETED HPCS-10 & 14 AND HPCS-903N, RELOCATED HPCS-15 (REDRAWN)	K-McA	DWP	LFB
0	12-22-78	ISSUED FOR USE	K-McA	DWP	LFB
A	10-3-78	ISSUED FOR INFORMATION ONLY	K-McA	GAK	DWP


THIS DRAWING IS INTENDED FOR USE IN PRESERVICE AND INSERVICE INSPECTIONS PROGRAMS ONLY.

ZONES R-13, R-23 & R-33

HPCS ROOM R-6


A
B
C
D
E
F
G

1 2 3 4 5 6 7 8

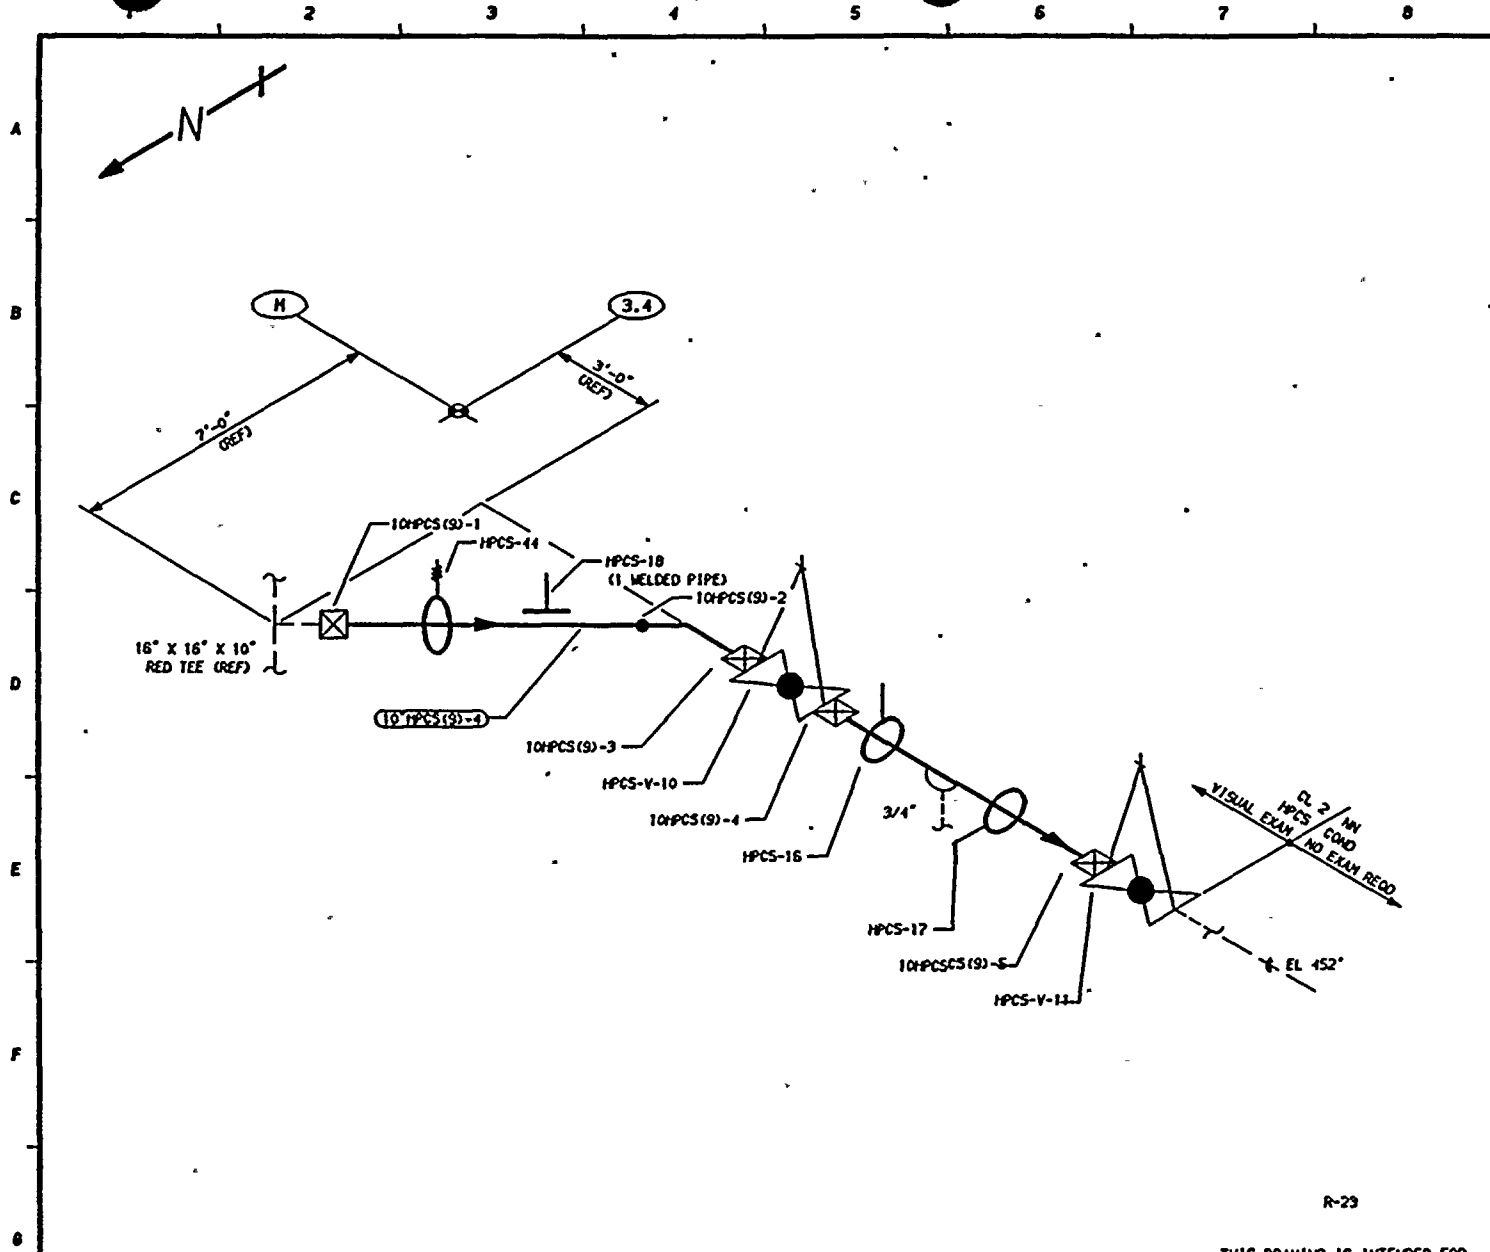

- NOTES:**
1. THIS DRAWING IDENTIFIES PIPING AND COMPONENTS SUBJECT TO A VISUAL EXAM FOR EVIDENCE OF LEAKAGE DURING SYSTEM HYDRO OR OPERABILITY TESTS. TESTS ARE TO BE CONDUCTED PER THE REQUIREMENTS OF ASME SECTION XI, PARAGRAPH IWA-5000.
 2. FOR BRANCH PIPING 4" NOM. OR LESS (CONNECTION SHOWN IN DASHED LINES) EXTEND VISUAL LEAKAGE EXAM THROUGH THE OUTERMOST NORMALLY CLOSED NUCLEAR CLASS VALVE, OR UNTIL TRANSITION TO INSTRUMENT TUBING, UNLESS OTHERWISE NOTED.

REFERENCES:
 ISI - 220
 BOYEE & CRILL ISOMETRICS
 HPCS-633-1.2 REV 8

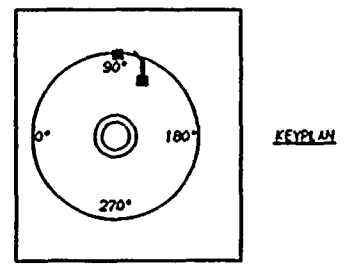

QUALITY CLASS: 1	ASME CODE CLASS: 2
ENGR: GA KUGLER	DRAWN: K-McA DATE: 8-11-78

WASHINGTON PUBLIC POWER
 SUPPLY SYSTEM
 RICHLAND, WASHINGTON 99352

WNP-2
 WELD & COMPONENT
 IDENTIFICATION DRAWING

TITLE:
 HPCS SUPPLY TO COND STORAGE TANKS


DWG NO: HPCS-202-3 REV 1

R-23

THIS DRAWING IS INTENDED FOR
 USE IN PRESERVICE AND INSERVICE
 INSPECTIONS PROGRAMS ONLY.

PIPING SYSTEM	NOM DIA (IN)	SCH	NOM WALL THK	MATERIAL SPECIFICATION	MATL TYPE	CAL BLOCK NO
10" HPCS(9)-4	10	100	0.719	SA 106 GR B	CS	NA

NO	DATE	REVISION	BY	CHKD	APVD
1	8-21-83	NUMBERED WELDS, HPCS-17, 10 RIGID, (REDRAWN)	WKA	DPK	TRK
0	12-22-78	ISSUED FOR USE	K-McA	DPK	LFB
A	10-3-78	ISSUED FOR INFORMATION ONLY	K-McA	GAK	DWP

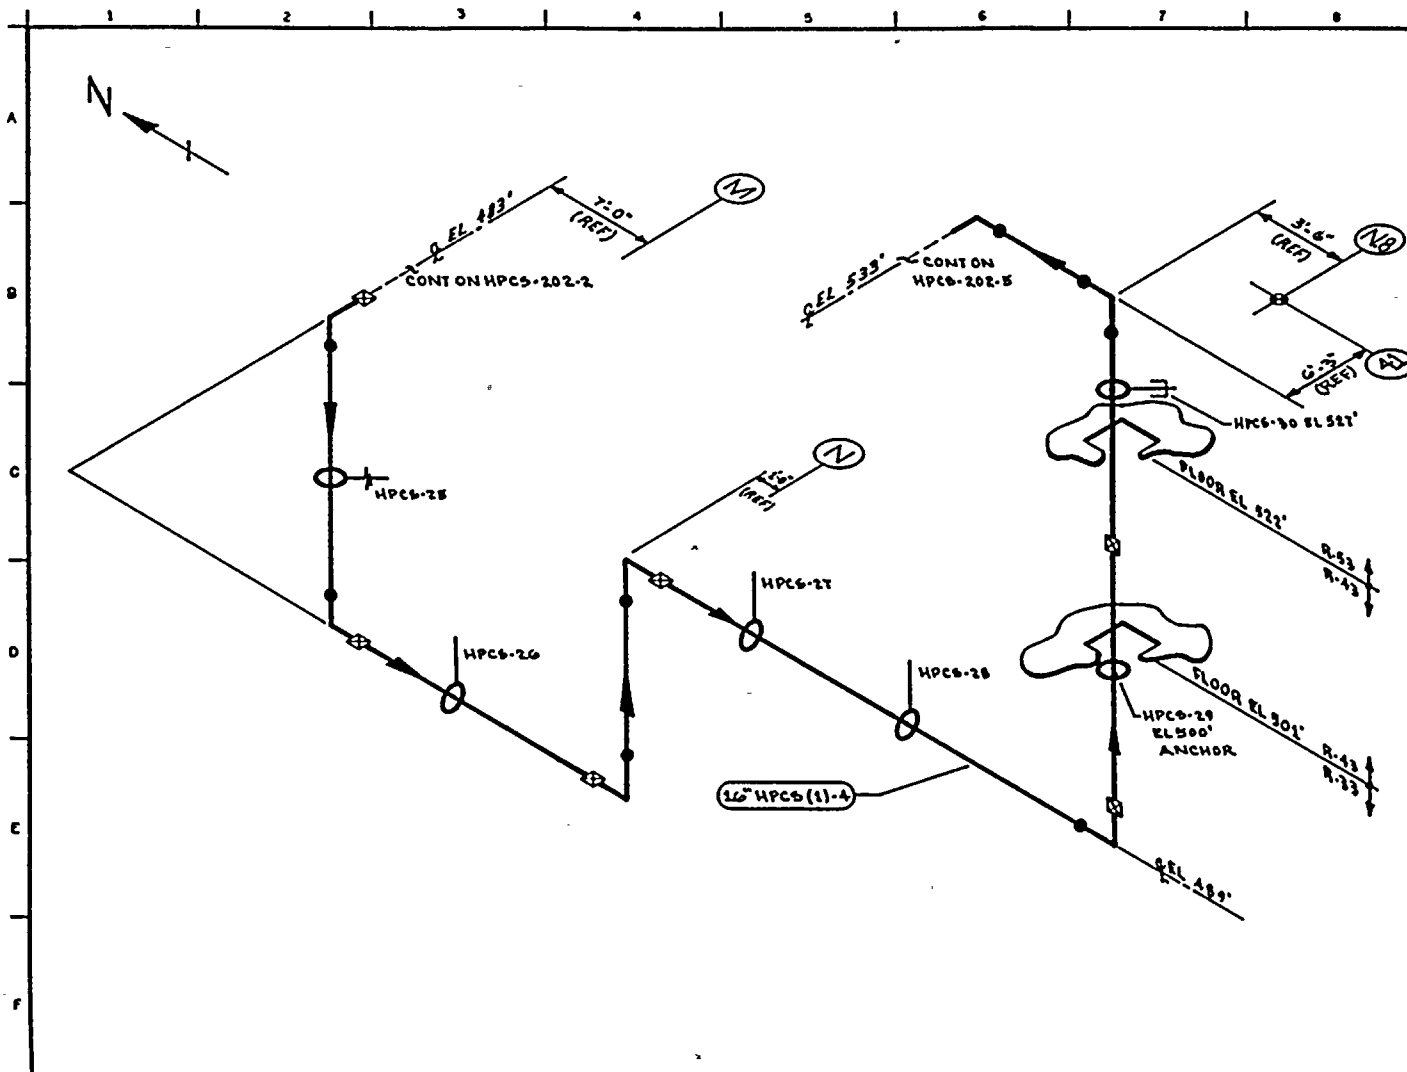

NOTES:

1. THIS DRAWING IDENTIFIES PIPING & COMPONENTS SUBJECT TO A VISUAL EXAM FOR EVIDENCE OF LEAKAGE DURING SYSTEM HYDRO OR OPERABILITY TESTS. TESTS ARE TO BE CONDUCTED PER THE REQUIREMENTS OF ASME SECTION XI, PARAGRAPH SVA-5000.

REFERENCES:

BOVEE & CRAIG ISOMETRICS
 HPCS-630-19.19 REV 2
 HPCS-630-19.19H REV 0

ZONES R-33, R-43 & R-53

THIS DRAWING IS INTENDED FOR USE IN PRESERVE AND INSERVICE INSPECTION PROGRAMS ONLY.

QUALITY CLASS: 1 ASME CODE CLASS: 2
 ENGR: G.A. KUGLER DRAWN: V.M.C.A. DATE: 8-11-78

 **WASHINGTON PUBLIC POWER SUPPLY SYSTEM**
 RICHLAND, WASHINGTON 99352


WNP-2
 WELD & COMPONENT IDENTIFICATION DIAGRAM



TITLE:
 HPCS-PUMP-1 DISCHARGE

DWG NO: HPCS-202-4 REV 0

PIPING SYSTEM	NOM DIA (IN)	SCH	NOM WALL THK	MATERIAL SPECIFICATION	MATL TYPE	CAL BLOCK NO
16" HPCS (1)-4	16	100	1.031	SA 106 GR B	CS	NA


NO	DATE	REVISION	BY	CHKD	APPVD
0	12-22-78	ISSUED FOR USE	KWA	AKK	SKS
1	10-9-78	ISSUED FOR INFORMATION ONLY	KWA	AKK	SKS

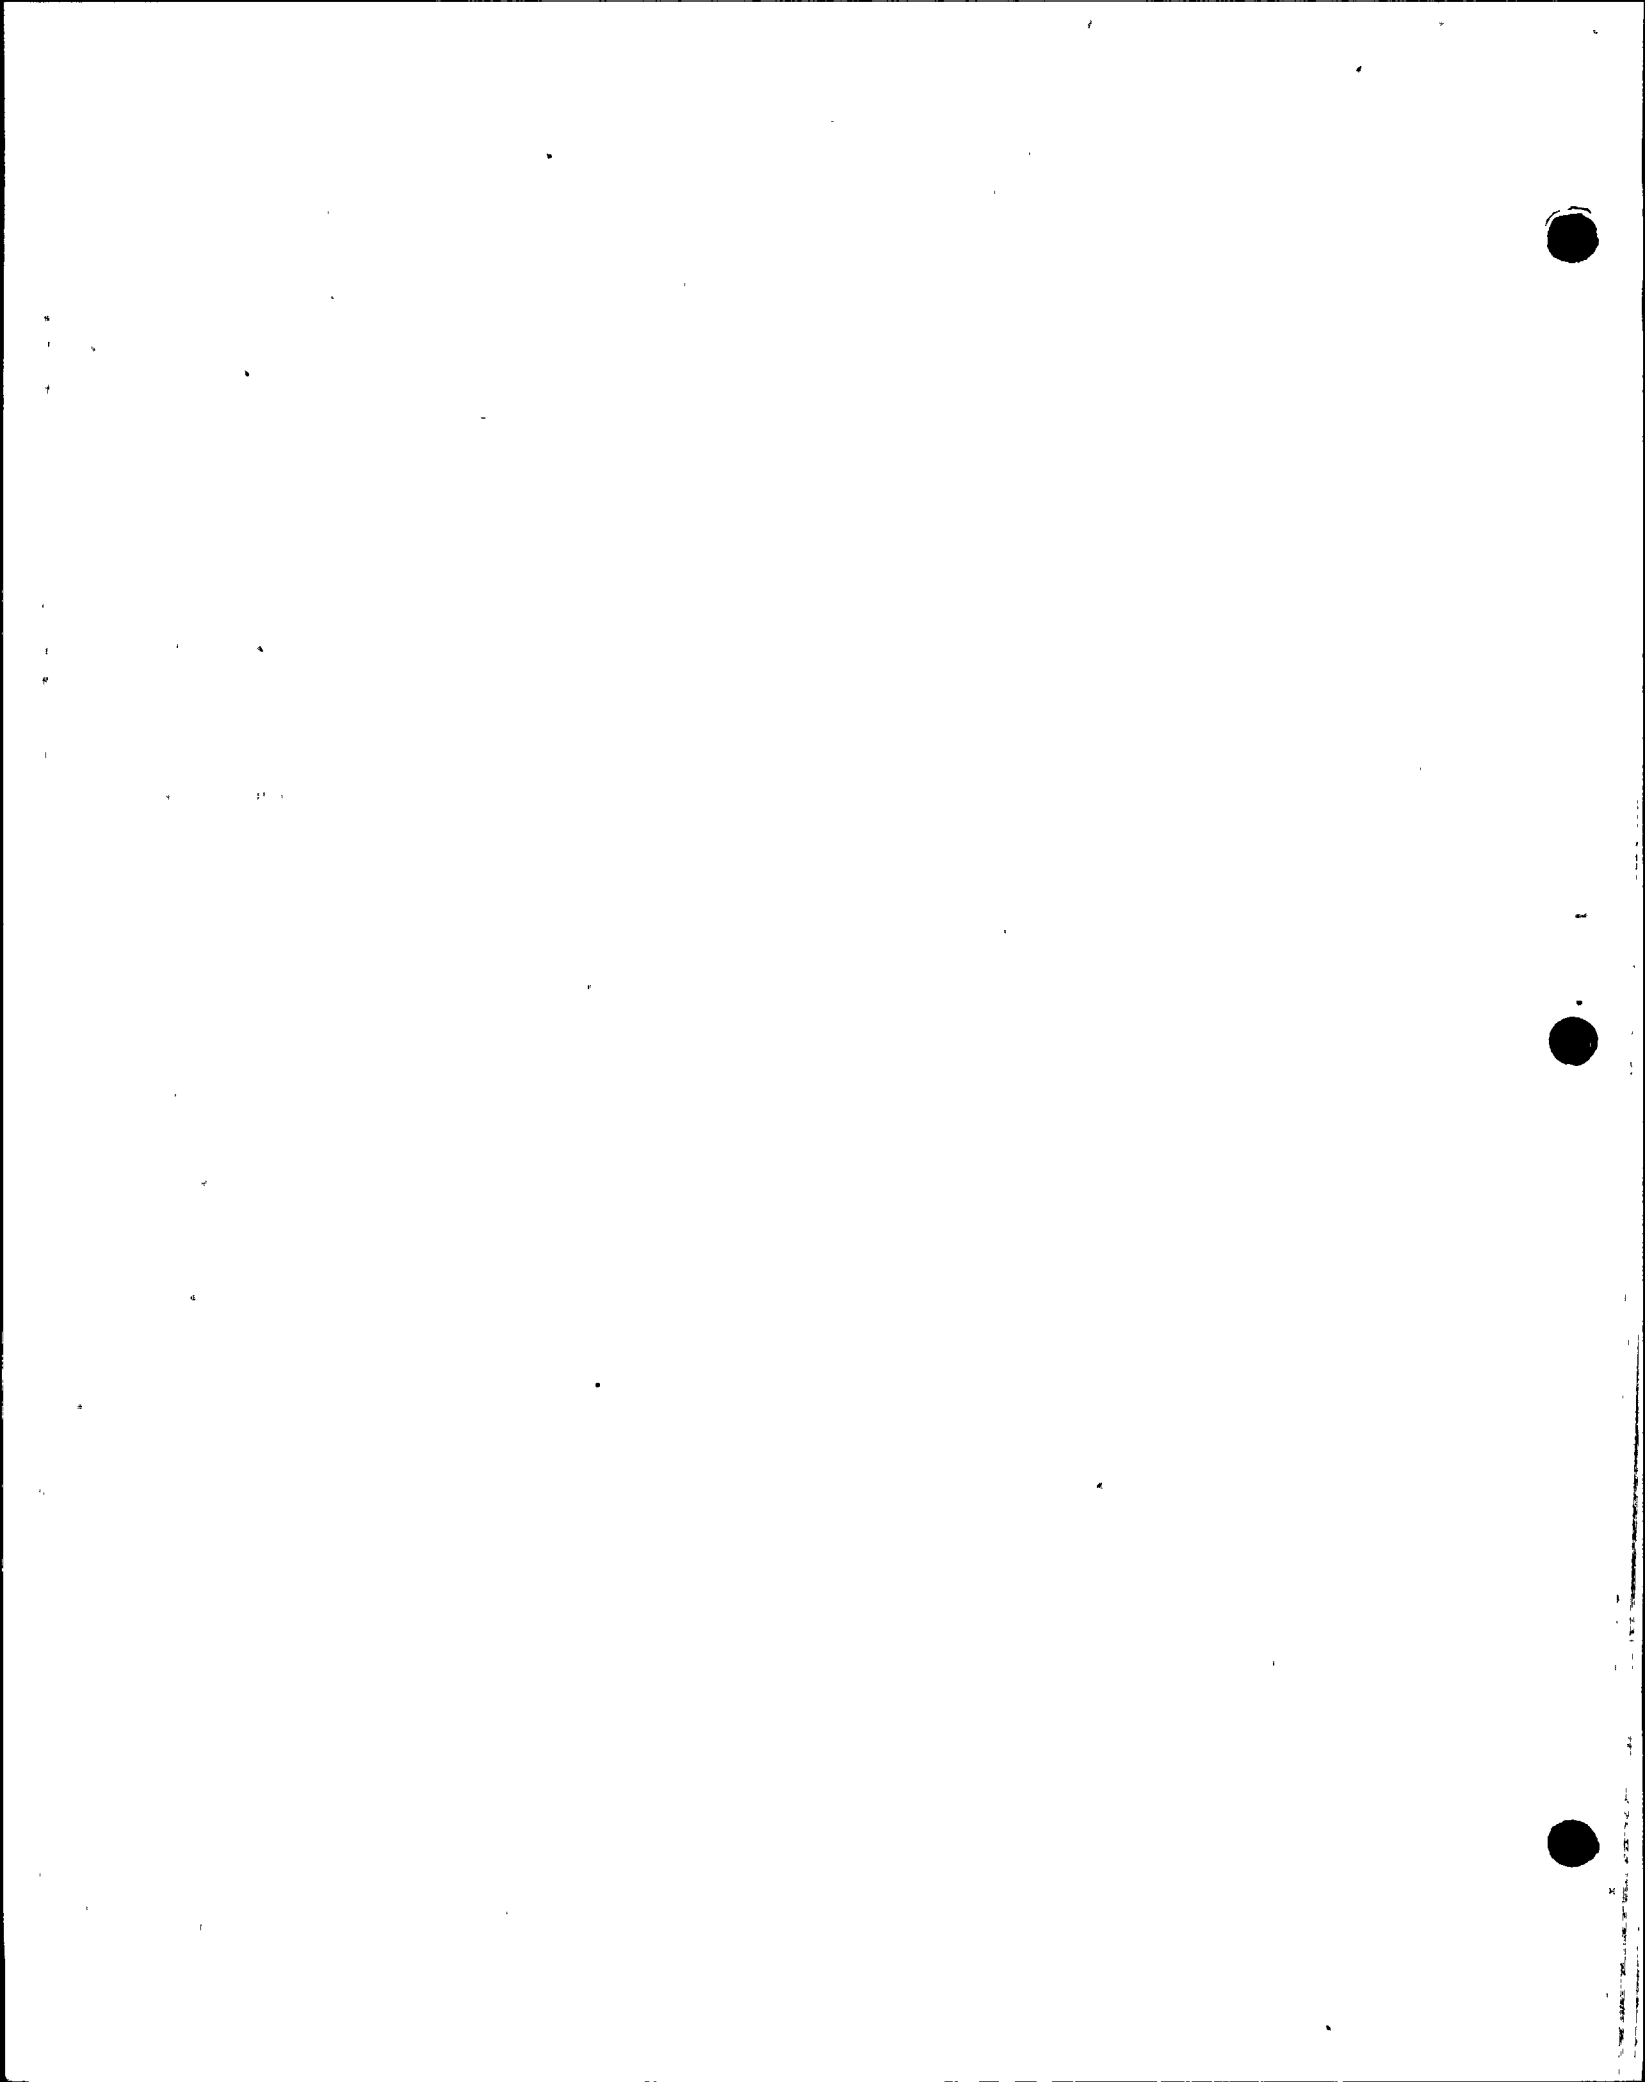

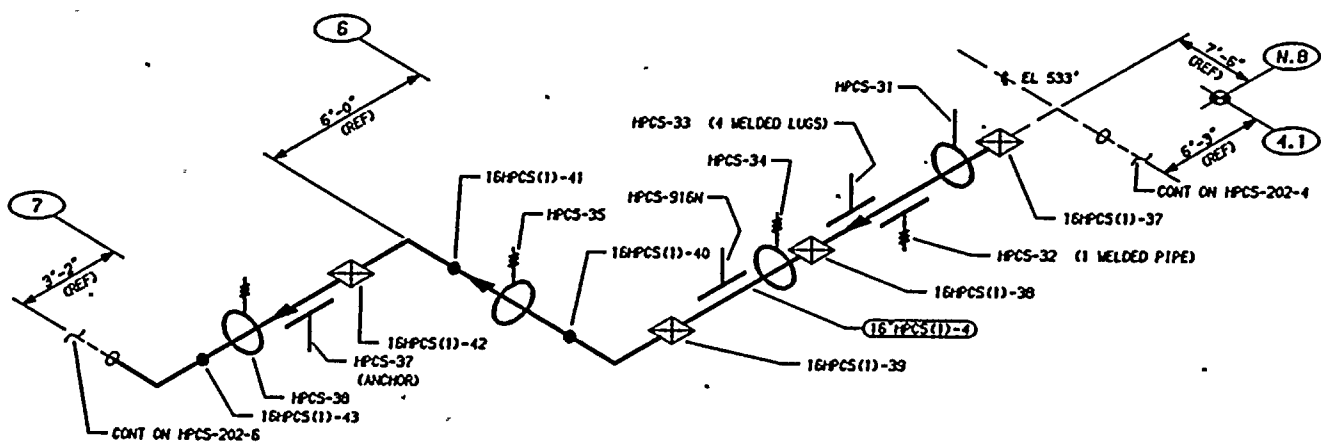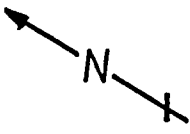

- NOTES:**
1. THIS DRAWING IDENTIFIES PIPING AND COMPONENTS SUBJECT TO A VISUAL EXAM FOR EVIDENCE OF LEAKAGE DURING SYSTEM HYDRO OR OPERABILITY TESTS. TESTS ARE TO BE CONDUCTED PER THE REQUIREMENTS OF ASME SECTION XI, PARAGRAPH IMA-5000.
 2. THE FOLLOWING WELD RECEIVES A VOLUMETRIC EXAM. IT REPRESENTS 10% OF THE WELDS EXEMPTED BY IWC-1220(C).
- 16HPCS(1)-37

- REFERENCES:**
- 151 - 220
 - BOYCE & CRAIL ISOMETRIC
 - HPCS-630-20.23 REV 4

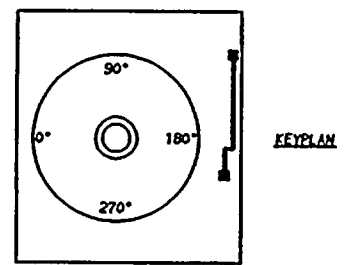

ZONE R-53

THIS DRAWING IS INTENDED FOR USE IN PRESERVICE AND INSERVICE INSPECTIONS PROGRAMS ONLY.



PIPING SYSTEM	NOM DIA (IN)	SCH	NOM WALL THK	MATERIAL SPECIFICATION	MATL TYPE	CAL BLOCK NO
16HPCS(1)-4	16	100	1.031	SA 106 GR B	CS	UT-15

NO	DATE	REVISION	BY	CHKD	APVD
1	5-20-83	NUMBERED WELDS, HPCS-37, 38 MODIFIED, ADDED HPCS-916W, DELETED HPCS-36, ADDED 10-15, ADDED NOTE 2, (RETRAW)	V. H. A.	D. J. P.	K. P.
0	12-22-78	ISSUED FOR USE	K-MCA	LFB	
A	10-3-78	ISSUED FOR INFORMATION ONLY	K-MCA	GAK	DWP

QUALITY CLASS, 1	ASME CODE CLASS, 2
ENGR, GA KUSLER	DRAWN, K-MCA DATE, 8-11-78
WASHINGTON PUBLIC POWER SUPPLY SYSTEM RICHLAND, WASHINGTON 99352	
WNP-2 WELD & COMPONENT IDENTIFICATION DRAWING	
TITLE, HPCS-PUMP-1 DISCHARGE	
DWG NO, HPCS-202-5	REV 1



A
B
C
D
E
F
G

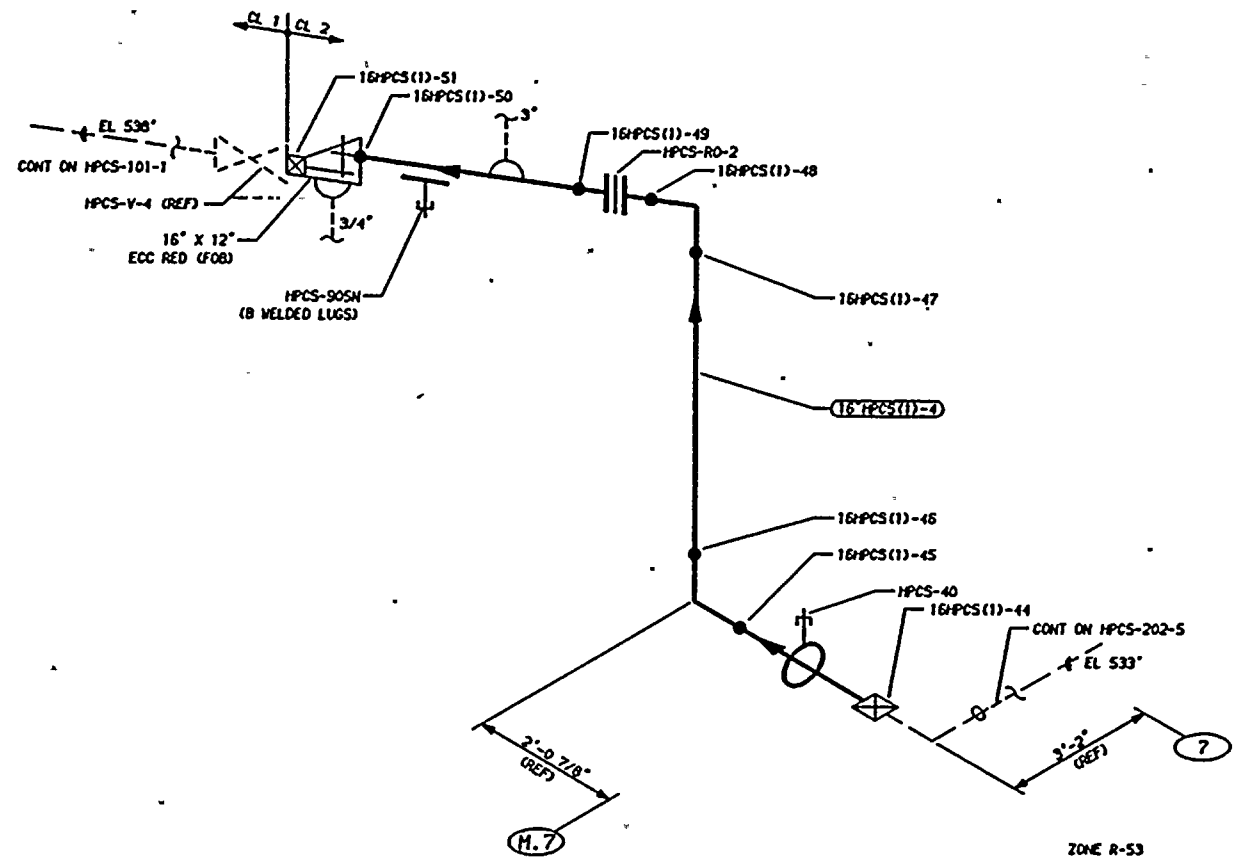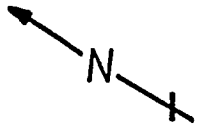


NOTES:

1. THIS DRAWING IDENTIFIES PIPING AND COMPONENTS SUBJECT TO A VISUAL EXAM FOR EVIDENCE OF LEAKAGE DURING SYSTEM HYDRO OR OPERABILITY TESTS. TESTS ARE TO BE CONDUCTED PER THE REQUIREMENTS OF ASME SECTION XI, PARAGRAPH 1WA-5000.
2. FOR BRANCH PIPING 4" NOM. OR LESS (CONNECTIONS SHOWN IN DASHED LINES) EXTEND VISUAL LEAKAGE EXAM THROUGH THE OUTERMOST NORMALLY CLOSED NUCLEAR CLASS VALVE, OR UNTIL TRANSITION TO INSTRUMENT TUBING, UNLESS OTHERWISE NOTED.
3. THE FOLLOWING WELD RECEIVES A VOLUMETRIC EXAM. IT REPRESENTS 10% OF THE WELDS EXEMPTED BY 1WC-1220(C).

16\"/>

REFERENCES:

- ISI - 220
- BOYEE & CRAIL ISOMETRIC
HPCS-630-24.25 REV 4

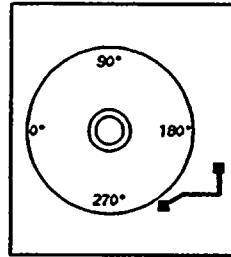

KEYPLAN

THIS DRAWING IS INTENDED FOR USE IN PRESERVICE AND INSERVICE INSPECTIONS PROGRAMS ONLY.

QUALITY CLASS: 1	ASME CODE CLASS: 2
ENGR, GA KUGLER	DRAWN, K-MCA DATE: 8-11-78

WASHINGTON PUBLIC POWER
SUPPLY SYSTEM
RICHLAND, WASHINGTON 99352

WNP-2
WELD & COMPONENT
IDENTIFICATION DRAWING

TITLE: HPCS-PUMP-1 DISCHARGE

DWG NO, HPCS-202-6 REV 1

PIPING SYSTEM	NOM DIA (IN)	SCH	NOM WALL THK	MATERIAL SPECIFICATION	MATL TYPE	CAL BLOCK NO
16\"/>						

NO	DATE	REVISION	BY	CHKD	APVD
1	5-21-83	NUMBERED WELDS, ADDED HPCS-905W, UT-15, NOTE 3, DELETED HPCS-41, HPCS-52 (REDLINED)	K-MCA	JDP	TLB
0	12-22-78	ISSUED FOR USE	K-MCA	TLP	LFB
A	10-3-78	ISSUED FOR INFORMATION ONLY	K-MCA	GAK	DMP



WHP-02
 INTERVAL: PSI
 PERIOD: NA
 OUTAGE:
 DRAWING NO. HPCS-202

WASHINGTON PUBLIC POWER SUPPLY SYSTEM
 PROGRAM PLAN AND SCHEDULE
 SYSTEM OR COMPONENT: HPCS(1)-4
 DESCRIPTION: HPCS-P-1 DISCHARGE

PAGE 001
 DATE 12/14/84

IDENT. NO.	DESCRIPTION	SECT.	EXAM MTH.	PROCEDURE	CAL. BLOCK	INSERVICE		NOTES
		XI EXAM.				REQ.	SCHEDULED OUTAGE	
HPCS-1	SPRING	C-E-2	VT-3	303/8.2.17				
			VT-4	303/8.2.17				
HPCS-23	SPRING	C-E-2	VT-3	303/8.2.17				
			VT-4	303/8.2.17				
HPCS-21	RIGID	C-E-2	VT-3	303/8.2.17				
HPCS-20	RIGID	C-E-2	VT-3	303/8.2.17				
HPCS-17	STRUT	C-E-2	VT-3	303/8.2.17				
HPCS-16	STRUT	C-E-2	VT-3	303/8.2.17				
HPCS-18	STRUT	C-E-2	VT-3	303/8.2.17				
HPCS-44	SPRING	C-E-2	VT-3	303/8.2.17				
			VT-4	303/8.2.17				
HPCS-13	ANCHOR	C-E-2	VT-3	303/8.2.17				
HPCS-15	ANCHOR	C-E-2	VT-3	303/8.2.17				
HPCS-903N	STRUT	C-E-2	VT-3	303/8.2.17				
HPCS-24	STRUT	C-E-2	VT-3	303/8.2.17				
HPCS-25	SPRING	C-E-2	VT-3	303/8.2.17				
			VT-4	303/8.2.17				
HPCS-26	STRUT	C-E-2	VT-3	303/8.2.17				

WNP-02
 INTERVAL: PSI
 PERIOD: NA
 OUTAGE:
 DRAWING NO. HPCS-202

WASHINGTON PUBLIC POWER SUPPLY SYSTEM
 PROGRAM PLAN AND SCHEDULE
 SYSTEM OR COMPONENT: HPCS(1)-4
 DESCRIPTION: HPCS-P-1 DISCHARGE

<u>IDENT. NO.</u>	<u>DESCRIPTION</u>	SECT. XI <u>EXAM.</u>	EXAM MTH.	PROCEDURE	CAL. BLOCK	<u>INSERVICE</u>		<u>NOTES</u>
						REQ.	SCHEDULED OUTAGE	
16HPCS(1)-27	PIPE TO EL	N/A	VOL	QCI 6-13	UT-15			SEE NOTE #8.
HPCS-27	STRUT	C-E-2	VT-3	303/8.2.17				
HPCS-28	BOX	C-E-2	VT-3	303/8.2.17				
HPCS-917N	STRUT	C-E-2	VT-3	303/8.2.17				
HPCS-915N	STRUT	C-E-2	VT-3	303/8.2.17				
16HPCS(1)-31	PIPE TO EL	N/A	VOL	OCI 6-13	UT-15			SEE NOTE #8.
HPCS-909N	STRUT	C-E-2	VT-3	303/8.2.17				
16HPCS(1)-35	EL TO PIPE	N/A	VOL	OCI 6-13	UT-15			SEE NOTE #8.
16HPCS(1)-36	PIPE TO EL	N/A	VOL	QCI 6-13	UT-15			SEE NOTE #8.
16HPCS(1)-37	EL TO PIPE	N/A	VOL	QCI 6-13	UT-15			SEE NOTE #8.
HPCS-31	STRUT	C-E-2	VT-3	303/8.2.17				
HPCS-32	SPRING	C-E-2	VT-3	303/8.2.17				
			VT-4	303/8.2.17				
HPCS-33	BOX	C-E-2	VT-3	303/8.2.17				
HPCS-34	SPRING	C-E-2	VT-3	303/8.2.17				
			VT-4	303/8.2.17				
HPCS-916N	BOX	C-E-2	VT-3	303/8.2.17				
HPCS-35	SPRING	C-E-2	VT-3	303/8.2.17				


WNP-02
 INTERVAL: PSI
 PERIOD: NA
 OUTAGE:
 DRAWING NO. HPCS-202

WASHINGTON PUBLIC POWER SUPPLY SYSTEM
 PROGRAM PLAN AND SCHEDULE
 SYSTEM OR COMPONENT: HPCS(1)-4
 DESCRIPTION: HPCS-P-1 DISCHARGE

PAGE 003
 DATE 12/14/84


<u>IDENT. NO.</u>	<u>DESCRIPTION</u>	SECT. XI <u>EXAM.</u>	EXAM <u>MT.</u>	<u>PROCEDURE</u>	CAL. <u>BLOCK</u>	<u>INSERVICE</u>		<u>NOTES</u>
						<u>REQ.</u>	<u>SCHEDULED</u> <u>OUTAGE</u>	
HPCS-37			VT-4	303/8.2.17				
HPCS-38	ANCHOR	C-E-2	VT-3	303/8.2.17				
	SPRING	C-E-2	VT-3	303/8.2.17				
HPCS-40			VT-4	303/8.2.17				
HPCS-925N	STRUT	C-E-2	VT-3	303/8.2.17				
	PSA-3 SNUBBER	C-E-2	VT-3	303/8.2.17				S/N 4421
HPCS-905N			VT-4	303/8.2.17				S/N 4421
	PSA-10 SNUBBER	C-E-2	VT-3	303/8.2.17				S/N
HPCS-924N			VT-4	303/8.2.17				S/N
	PSA-3 SN(2)	C-E-2	VT-3	303/8.2.17				S/N 3924/3883
16HPCS(1)-50			VT-4	303/8.2.17				S/N 3924/3883
HPCS-PB-202	PIPE TO RED	N/A	VOL	OCI 6-13	UT-15			SEE NOTE #8.
	HPCS PRES BNDRY	N/A	VT-2	N/A				SEE NOTES #6 & #7.



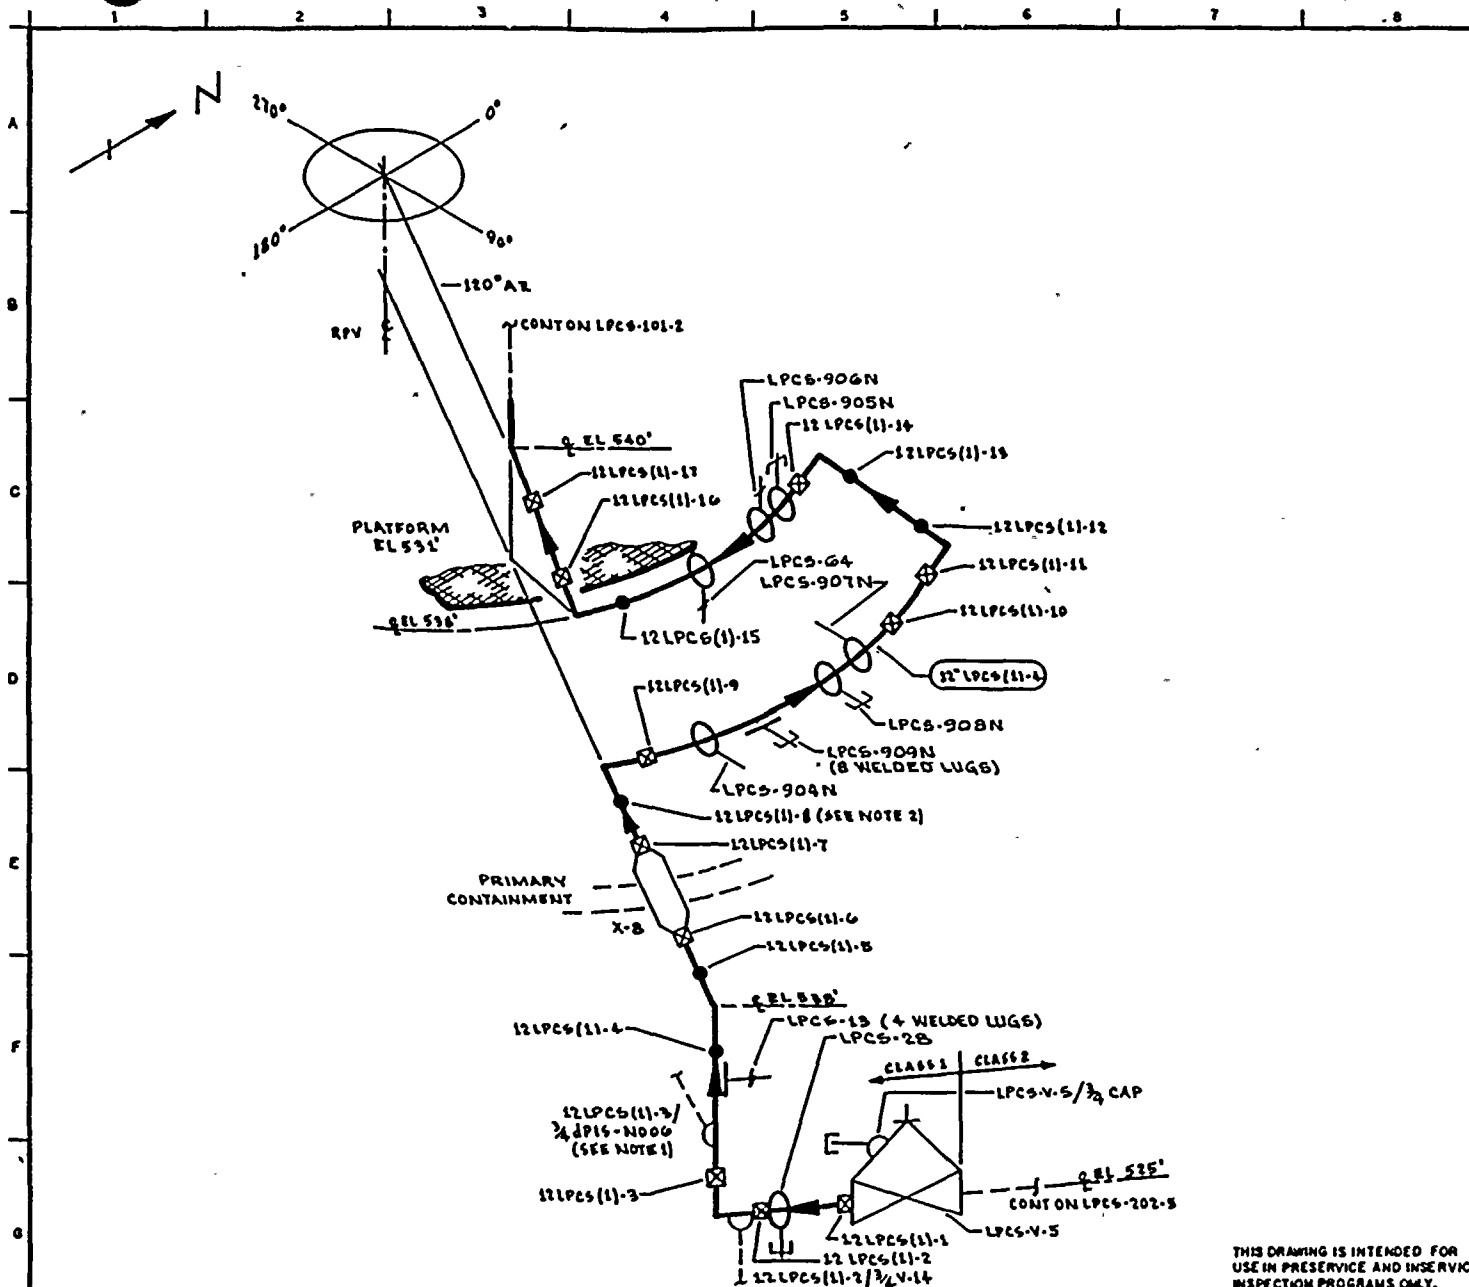

- NOTES:**
1. EXTEND VISUAL LEAKAGE EXAM THROUGH EXCESS FLOW CHECK VALVE TO INSTRUMENT TUBING CONNECTION.
 2. PIPING SYSTEM 12" LPCS (1)-4 IS CONSTRUCTED OF SEAMLESS SCH 80 PIPE & FITTINGS EXCEPT FOR THE SR ELL ASSOCIATED WITH WELDS 12LPCS(1)-8 & 9 WHICH IS SEAMLESS SCH 100. USE CAL BLOCKS SHOWN BELOW ACCORDINGLY.
 3. ACCESS TO 12LPCS(1)-5 & 12LPCS(1)-6 REQUIRES USE OF A LADDER.
 4. ACCESS TO 12LPCS(1)-1 REQUIRES REMOVAL OF LPCS-2B.

- REFERENCES:**
- BOYD & CRAIG ISOMETRICS
 - LPCS-756-19.21 REV B
 - LPCS-756-22.24 REV 9

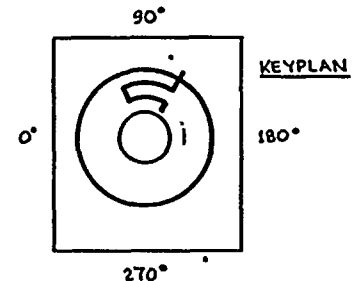

QUALITY CLASS: 1 ASME CODE CLASS: 1
 ENGR: G.A. WUGLER DRAWN: K.McA DATE: 10-28-78

WASHINGTON PUBLIC POWER SUPPLY SYSTEM
 RICHLAND, WASHINGTON 99352

THIS DRAWING IS INTENDED FOR USE IN PRESERVICE AND INSERVICE INSPECTION PROGRAMS ONLY.


PIPING SYSTEM	NOM DIA (IN)	SCH	NOM WALL THK	MATERIAL SPECIFICATION	MATL TYPE	CAL BLOCK NO
12" LPCS (1)-4	12	80	0.688	SA 106 GR B	CS	UT-17
12" LPCS (1)-4	12	100	0.844	SA 106 GR B	CS	UT-16
LUGS	NA	NA	NA	SA 515 GR 70	CB	UT-46


NO	DATE	REVISION	BY	CHKD	APPVD
2	9-26-83	ADDED SUPPORTS, NOTES 3 & 4, LUGS. DELETED 3/4 LOC.	K.McA	DKP	TK
1	7-17-79	FLOW CHANGED TO BEAMERS DOWNSTREAM OF 12LPCS(1)-2. PRR AS BUILT. IN D-5.	K.McA	DKP	TK
0	51-2778	ISSUED FOR USE (REDRAWN)	K.McA	DKP	TK
A	11-13-71	ISSUED FOR INFORMATION ONLY	K.McA	DKP	TK

WNP-2
 WELD & COMPONENT IDENTIFICATION DIAGRAM

TITLE:
LPCS DISCHARGE TO VESSEL

DWG NO: LPCS-101-1 REV 2

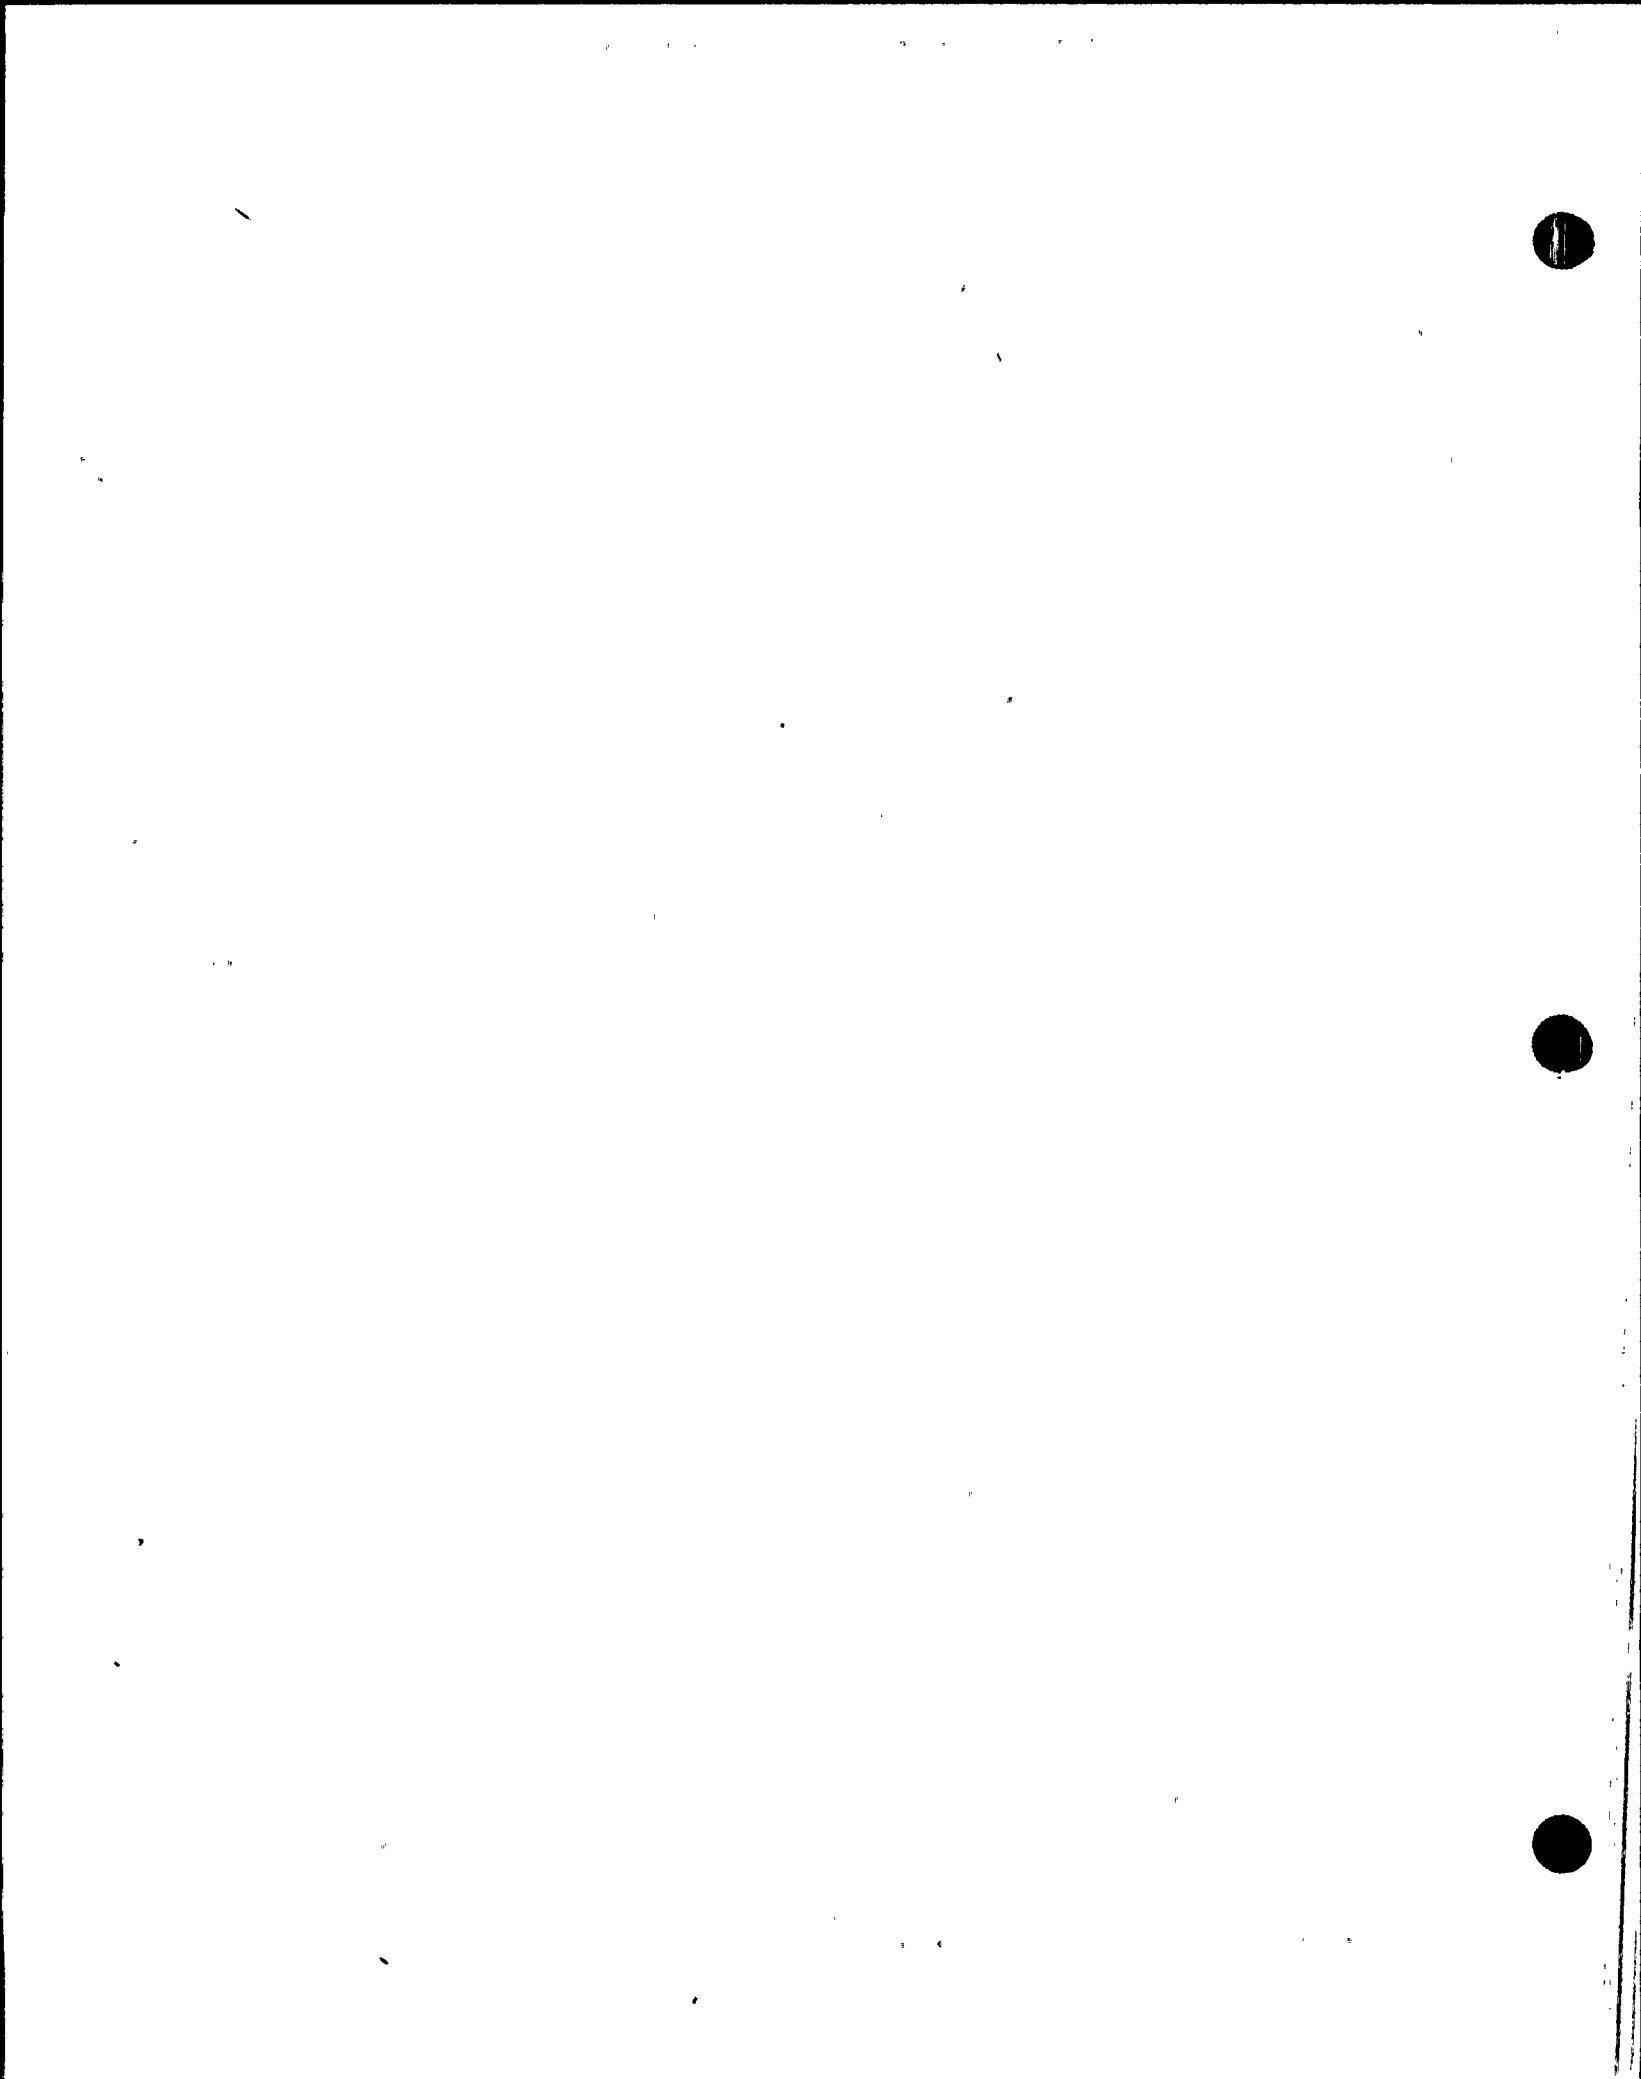

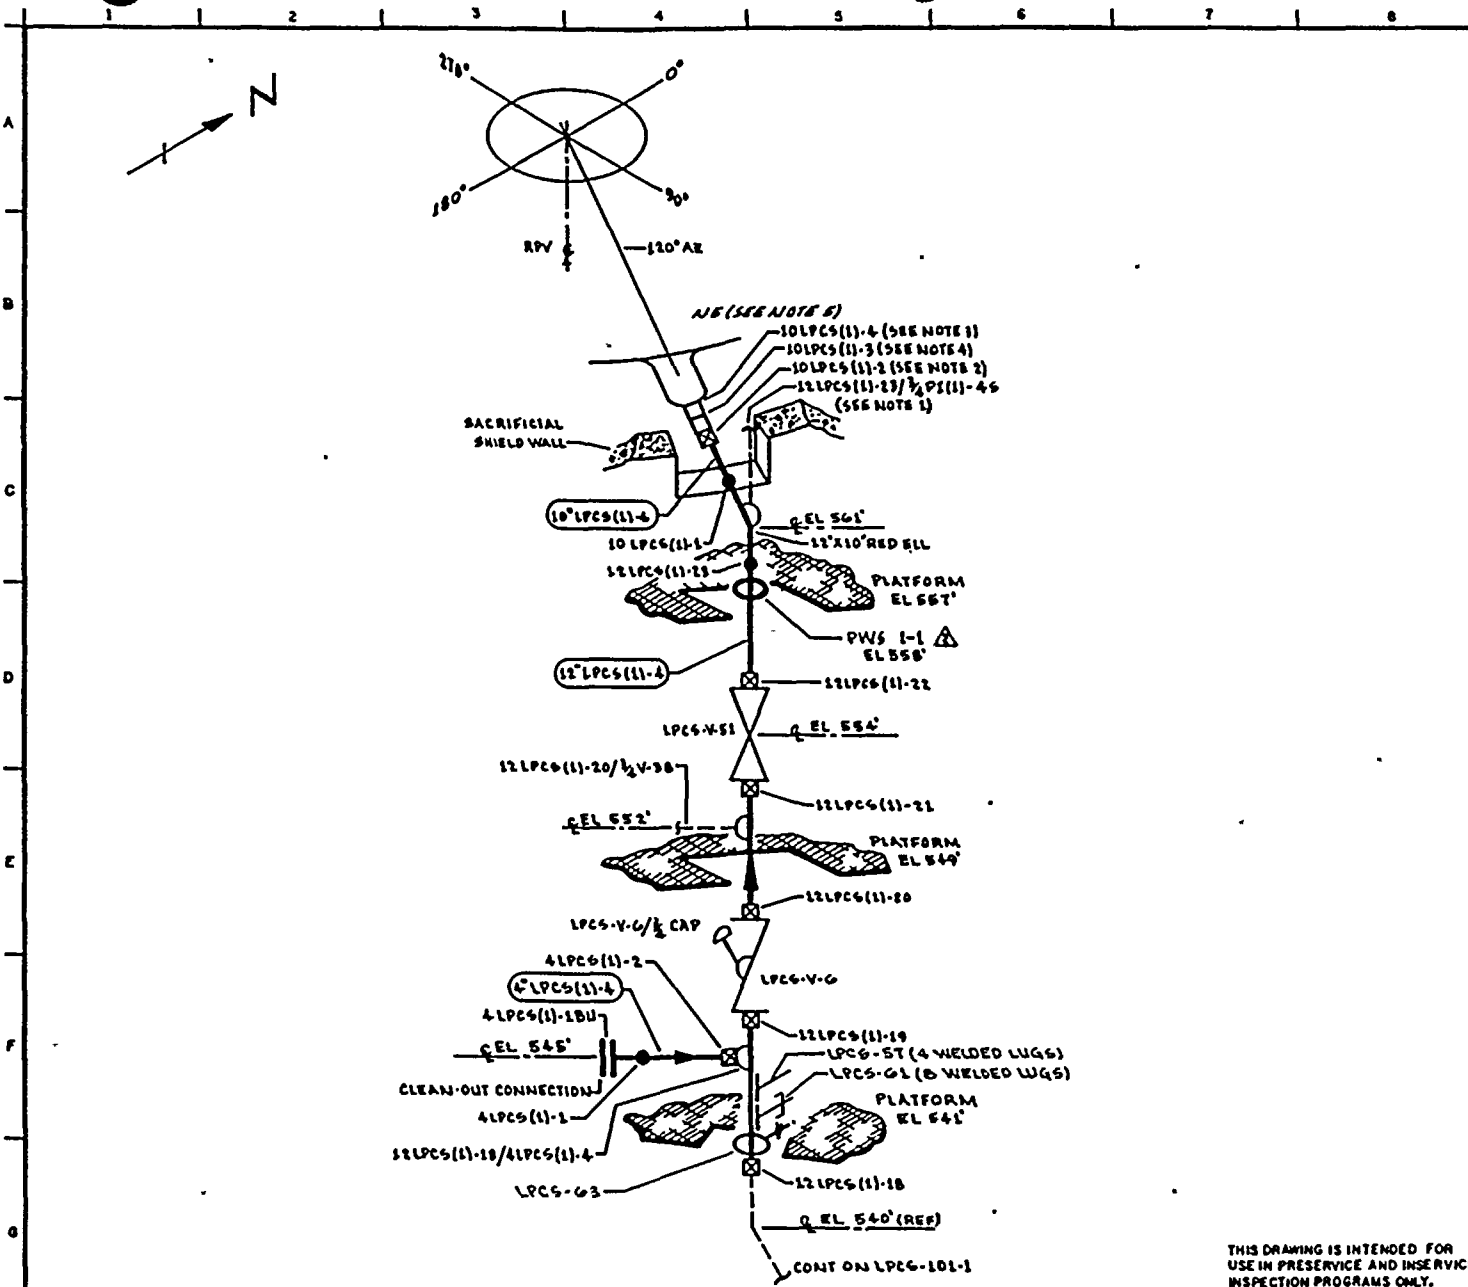

- NOTES:
1. EXTEND VISUAL LEAKAGE EXAM THROUGH CONTAINMENT PENETRATION (X-75b) THROUGH EXCESS FLOW CHECK VALVE TO INSTRUMENT TUBING CONNECTION.
 2. DISTANCE BETWEEN WELDS 10LPCS(1)-2 & 10LPCS(1)-3 IS LESS THAN Ø.
 3. DISSIMILAR METAL WELD, CS TO INCO, USE CAL BLOCK UT-102.
 4. DISSIMILAR METAL WELD, INCO TO CS, USE CAL BLOCK UT-106.
 5. FOR NOZZLE ASSEMBLY DETAILS SEE RPV-109.

- REFERENCES:
- BOYSE & CRAIG ISOMETRICS
 LPCS-756-22.24 REV 3
 LPCS-756-25.26 REV 1

QUALITY CLASS: 1 ASME CODE CLASS: 1
 ENGR: GA KUGLER DRAWN: K-McA DATE: 10-31-77

 WASHINGTON PUBLIC POWER SUPPLY SYSTEM
 RICHLAND, WASHINGTON 99352

THIS DRAWING IS INTENDED FOR USE IN PRESERVICE AND INSERVICE INSPECTION PROGRAMS ONLY.

NO	DATE	REVISION	BY	CHKD	APPVD	PIPING SYSTEM	NOM DIA (IN)	SCH	NOM WALL THK	MATERIAL SPECIFICATION	MATL TYPE	CAL BLOCK NO
3	9-26-73	ADDED SUPPORTS, LUGS 1/2 LOC CAPPED	KML	DP	TEJ	12" LPCS(1)-4	12	80	0.688	SA 106 GR B	CS	UT-17
2	11-5-70	ADDED NOTE E AS NOTED	KML	DP	TEJ	4" LPCS(1)-4	4	80	0.307	SA 106 GR B	CS	UT-30
1	1-18-75	REVISED REFERENCE TO NOTES 3 & 4	KML	DP	TEJ	10" LPCS(1)-4	10	80	0.594	SA 106 GR B	CS	UT-22
0	11-22-76	ISSUED FOR USE (REDRAWN)	KML	DP	TEJ	LUGS	NA	NA	NA	SA 515 GR 70	CS	UT-46
A	11-22-77	ISSUED FOR INFORMATION ONLY	KML	DP	TEJ							
NO	DATE	REVISION	BY	CHKD	APPVD							

WNP-2
 WELD & COMPONENT IDENTIFICATION DIAGRAM

TITLE:
 LPCS DISCHARGE TO VESSEL

DWG NO: LPCS-101-2 REV 3



WNP-02
 INTERVAL: PSI
 PERIOD: NA
 OUTAGE:
 DRAWING NO. LPCS-101

WASHINGTON PUBLIC POWER SUPPLY SYSTEM
 PROGRAM PLAN AND SCHEDULE
 SYSTEM OR COMPONENT: LPCS(1)-4
 DESCRIPTION: LOW PRES CORE SPRAY

PAGE 001
 DATE 12/14/84

<u>IDENT. NO.</u>	<u>DESCRIPTION</u>	<u>SECT.</u> <u>XI</u>	<u>EXAM</u>	<u>EXAM.</u>	<u>MTN.</u>	<u>PROCEDURE</u>	<u>CAL.</u> <u>BLOCK</u>	<u>INSERVICE</u>		<u>NOTES</u>
								<u>REQ.</u>	<u>SCHEDULED</u> <u>OUTAGE</u>	
LPCS-V-5-BDY	VALVE BODY	B-M-2	VT-1	QCI	7-1					
LPCS-V-5-BLT	VALVE BOLTING	B-G-2	VT-1	QCI	7-1					
LPCS-V-5/3/4CAP	LEAKOFF CAPPED	B-P	VT-2	N/A						SEE NOTES #6 & #7.
12LPCS(1)-1	VLV TO PIPE	B-J	VOL	UTP-10		UT-17				
			SUR	PTP-1						
LPCS-28	PSA-3 SNUBBER	B-K-2	VT-3	303/8.2.17						S/N
			VT-4	303/8.2.17						S/N
12LPCS(1)-2	PIPE TO EL	B-J	VOL	UTP-10		UT-17				
			SUR	PTP-1						
12LPCS(1)-2/3/4V-14	TEST CONN	B-P	VT-2	N/A						SEE NOTES #6 & #7.
12LPCS(1)-3	EL TO PIPE	B-J	VOL	UTP-10		UT-17				
			SUR	PTP-1						
12LPCS(1)-3/3/4DPIS-N006	INSTR CONN	B-P	VT-2	N/A						SEE NOTES #6 & #7.
LPCS-13(W)	4 WELDED LUGS	B-K-1	VOL	UTP-26		UT-17				
LPCS-13	SPRING	B-K-2	VT-3	303/8.2.17						
			VT-4	303/8.2.17						
12LPCS(1)-4	PIPE TO EL	B-J	VOL	UTP-10		UT-17				
			SUR	PTP-1						

WNP-02
 INTERVAL: PSI
 PERIOD: NA
 OUTAGE:
 DRAWING NO. LPCS-101

WASHINGTON PUBLIC POWER SUPPLY SYSTEM
 PROGRAM PLAN AND SCHEDULE
 SYSTEM OR COMPONENT: LPCS(1)-4
 DESCRIPTION: LOW PRES CORE SPRAY

PAGE 002
 DATE 12/14/84

<u>IDENT. NO.</u>	<u>DESCRIPTION</u>	SECT. XI <u>EXAM.</u>	EXAM <u>MTG.</u>	<u>PROCEDURE</u>	CAL. <u>BLOCK</u>	<u>INSERVICE</u>		<u>NOTES</u>
						<u>REQ.</u>	<u>SCHEDULED OUTAGE</u>	
12LPCS(1)-5	EL TO PIPE	B-J	VOL	UTP-10	UT-17			
			SUR	PTP-1				
12LPCS(1)-6	PIPE TO PEN	B-J	VOL	UTP-10	UT-17			
			SUR	PTP-1				
12LPCS(1)-7	PEN TO PIPE	B-J	VOL	UTP-10	UT-17			
			SUR	PTP-1				
12LPCS(1)-8	PIPE TO EL	B-J	VOL	UTP-10	UT-17			
			SUR	PTP-1				
12LPCS(1)-9	EL TO PIPE	B-J	VOL	QCI 6-13	UT-17			
			SUR	QCI 3-3				
LPCS-904N	STRUT	B-K-2	VT-3	303/8.2.17				
LPCS-909N(W)	8 WELDED LUGS	B-K-1	VOL	UTP-26	UT-17			
LPCS-909N	PSA-3 SN(2)	B-K-2	VT-3	303/8.2.17				S/N 1066/3921
			VT-4	303/8.2.17				S/N 1066/3921
LPCS-908N	PSA-10 SNUBBER	B-K-2	VT-3	303/8.2.17				S/N 1485
			VT-4	303/8.2.17				S/N 1485
LPCS-907N	STRUT	B-K-2	VT-3	303/8.2.17				
12LPCS(1)-10	PIPE TO PIPE	B-J	VOL	UTP-10	UT-17			

WNP-02
 INTERVAL: PSI
 PERIOD: NA
 OUTAGE:
 DRAWING NO. LPCS-101

WASHINGTON PUBLIC POWER SUPPLY SYSTEM
 PROGRAM PLAN AND SCHEDULE
 SYSTEM OR COMPONENT: LPCS(1)-4
 DESCRIPTION: LOW PRES CORE SPRAY

PAGE 003
 DATE 12/14/84

IDENT. NO.	DESCRIPTION	SECT. XI EXAM.	EXAM MTH.	PROCEDURE	CAL. BLOCK	INSERVICE		NOTES
						REQ.	SCHEDULED OUTAGE	
12LPCS(1)-11	PIPE TO EL	B-J	VOL	PTP-1 UTP-10	UT-17			
12LPCS(1)-12	EL TO PIPE	B-J	VOL	PTP-1 UTP-10	UT-17			
12LPCS(1)-13	PIPE TO EL	B-J	VOL	PTP-1 UTP-10	UT-17			
12LPCS(1)-14	EL TO PIPE	B-J	VOL	PTP-1 UTP-10	UT-17			
LPCS-905N	PSA-3 SNUBBER	B-K-2	VT-3	PTP-1 303/8.2.17				S/N 4469
LPCS-906N	SPRING	B-K-2	VT-3	VT-4 303/8.2.17				S/N 4469
LPCS-64	SPRING	B-K-2	VT-3	VT-4 303/8.2.17				
12LPCS(1)-15	PIPE TO EL	B-J	VOL	PTP-1 UTP-10	UT-17			
12LPCS(1)-16	EL TO PIPE	B-J	VOL	SUR OCT 3-3 QCI 6-13	UT-17			

WNP-02
 INTERVAL: PSI
 PERIOD: NA
 OUTAGE:
 DRAWING NO. LPCS-101

WASHINGTON PUBLIC POWER SUPPLY SYSTEM
 PROGRAM PLAN AND SCHEDULE
 SYSTEM OR COMPONENT: LPCS(1)-4
 DESCRIPTION: LOW PRFS CORE SPRAY

PAGE 004
 DATE 12/14/84

IDENT. NO.	DESCRIPTION	SECT. XI EXAM.	EXAM MTH.	PROCEDURE	CAL. BLOCK	INSERVICE		NOTES
						REQ.	SCHEDULED OUTAGE	
12LPCS(1)-17	PIPE TO EL	B-J	VOL	UTP-10	UT-17			
12LPCS(1)-18	EL TO PIPE	B-J	VOL	UTP-10	UT-17			
LPCS-63	SPRING	B-K-2	VT-3	303/8.2.17				
LPCS-61(W)	8 WELDED LUGS	B-K-1	VOL	QCI 6-15	UT-17			
LPCS-61	PSA-10 SN(2)	B-K-2	VT-3	303/8.2.17				S/N 327/291
LPCS-57(W)	4 WELDED LUGS	B-K-1	VOL	UTP-26	UT-17			S/N 327/291
LPCS-57	BOX	B-K-2	VT-3	303/8.2.17				3/4"W x 2"H x 3"L.
12LPCS(1)-18/4LPCS(1)-4	WOL TO PIPE	B-J	SUR	PTP-1				
4LPCS(1)-1BU	FLANGE BOLTING	B-G-2	VT-1	QCI 7-1				
4LPCS(1)-1	FLANGE TO PIPE	B-J	VOL	UTP-10	UT-30			
4LPCS(1)-2	PIPE TO WOL	B-J	VOL	UTP-10	UT-30			
			SUR	PTP-1				

WNP-02
 INTERVAL: PSI
 PERIOD: NA
 OUTAGE:
 DRAWING NO. LPCS-101

WASHINGTON PUBLIC POWER SUPPLY SYSTEM
 PROGRAM PLAN AND SCHEDULE
 SYSTEM OR COMPONENT: LPCS(1)-4
 DESCRIPTION: LOW PRES CORE SPRAY

PAGE 005
 DATE 12/14/84


IDENT. NO.	DESCRIPTION	SECT. XI EXAM.	EXAM MTH.	PROCEDURE	CAL. BLOCK	INSERVICE		NOTES
						REG.	SCHEDULED OUTAGE	
12LPCS(1)-19	PIPE TO VLV	B-J	VOL	UTP-10	UT-17			
			SUR	PTP-1				
LPCS-V-6-BDY	VALVE BODY	B-M-2	VT-1	OCI 7-1				
LPCS-V-6-BLT	VALVE BOLTING	B-G-2	VT-1	OCI 7-1				
LPCS-V-6/3/4CAP	LEADOFF CAPPED	B-P	VT-2	N/A				SEE NOTES #6 & #7.
12LPCS(1)-20	VLV TO PIPE	B-J	VOL	UTP-10	UT-17			
			SUR	PTP-1				
12LPCS(1)-20/3/4V-38	TEST CONN	B-P	VT-2	OCI 7-1				
12LPCS(1)-21	PIPE TO VLV	B-J	VOL	UTP-10	UT-17			
			SUR	PTP-1				
LPCS-V-51-BDY	VALVE BODY	B-M-2	VT-1	OCI 7-1				
LPCS-V-51-BLT	VALVE BOLTING	B-G-2	VT-1	OCI 7-1				
12LPCS(1)-22	VLV TO PIPE	B-J	VOL	UTP-10	UT-17			
			SUR	PTP-1				
PWS-1-1	PIPE WHIP	N/A	N/A	N/A				SEE NOTE #1
12LPCS(1)-23	PIPE TO EL	B-J	VOL	UTP-10	UT-17			
			SUR	PTP-1				

WNP-02
 INTERVAL: PSI
 PERIOD: NA
 OUTAGE:
 DRAWING NO. LPCS-101

WASHINGTON PUBLIC POWER SUPPLY SYSTEM
 PROGRAM PLAN AND SCHEDULE
 SYSTEM OR COMPONENT: LPCS(1)-4
 DESCRIPTION: LOW PRES CORE SPRAY

PAGE 006
 DATE 12/14/84

IDENT. NO.	DESCRIPTION	SECT.		EXAM MTH.	PROCEDURE	CAL. BLOCK	INSERVICE		NOTES
		XI EXAM.					REG.	SCHEDULED OUTAGE	
12LPCS(1)-23/3/4	PI(1)-4S PRESSURE TAP	B-P		VT-2	N/A				SEE NOTES #6 & #7.
10LPCS(1)-1	EL TO PIPE	B-J		VOL	UTP-10	UT-22			
				SUR	PTP-1				
10LPCS(1)-2	PIPE TO SE EXT	B-J		VOL	UTP-10	UT-22			SEE RPV-105,NOZ N5
				SUR	PTP-1				SEE RPV-105,NOZ N5
10LPCS(1)-3	SE EXT TO SE	B-F		VOL	UTP-10	UT-106			SEE RPV-105,NOZ N5
				SUR	PTP-1				SEE RPV-105,NOZ N5
10LPCS(1)-4	SE TO NOZZLE	B-F		VOL	UTP-10	UT-102			SEE RPV-105,NOZ N5
				SUR	PTP-1				SEE RPV-105,NOZ N5
LPCS-PB-101	LPCS PRES BNDRY	B-P		VT-2	N/A				SEE NOTES #6 & #7.

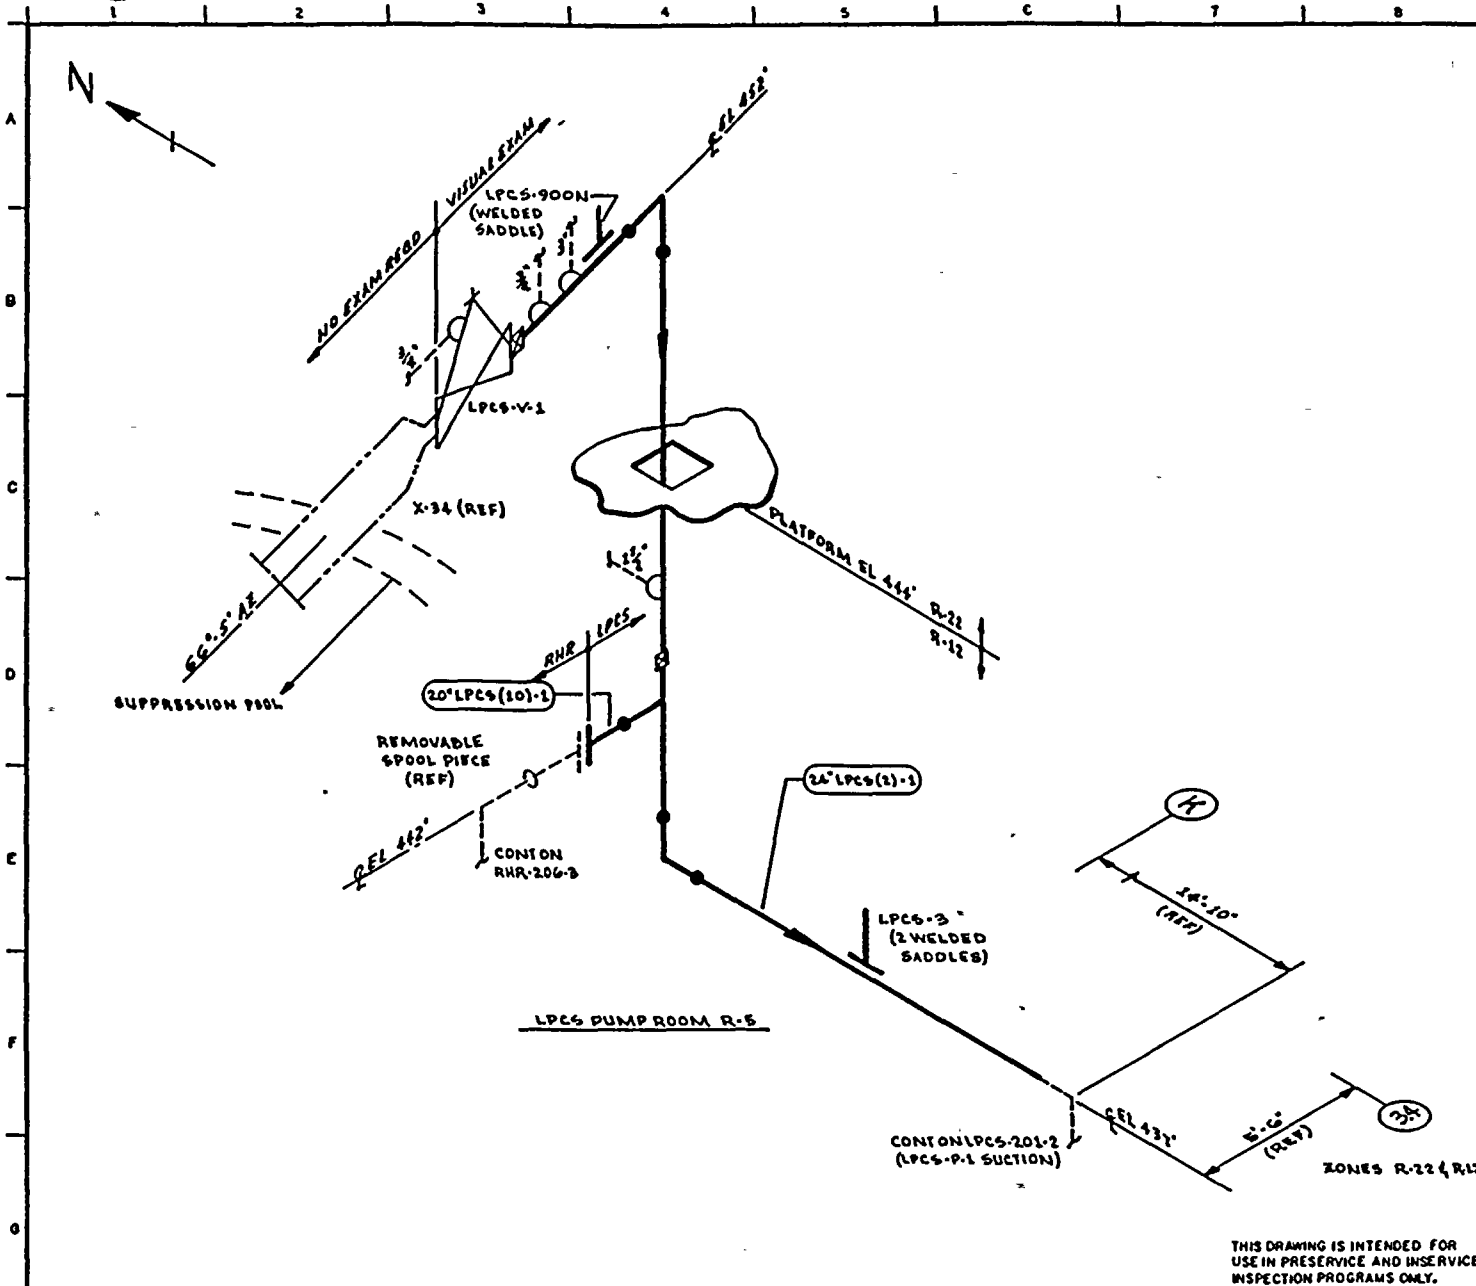

- NOTES:**
1. THIS DRAWING IDENTIFIES PIPING & COMPONENTS SUBJECT TO A VISUAL EXAM FOR EVIDENCE OF LEAKAGE DURING SYSTEM HYDRO OR OPERABILITY TESTS. TESTS ARE TO BE CONDUCTED PER THE REQUIREMENTS OF ASME SECTION XI, PARAGRAPH IWA-3000.
 2. FOR BRANCH PIPING 4" DIA OR LESS (CONN SHOWN IN DASHED LINES) EXTEND VISUAL LEAKAGE EXAM THROUGH THE OUTERMOST NORMALLY CLOSED NUCLEAR CLASS VALVE OR UNTIL TRANSITION TO INSTRUMENT TUBING, UNLESS OTHERWISE NOTED.
 3. AT LOCATIONS WHERE LEAKAGE IS NORMALLY EXPECTED (EG, VALVE STEM & PUMP SEAL LEAK-OFF CONN) VERIFY LEAKAGE COLLECTION SYSTEM OPERABILITY ONLY. NO HYDRO TEST OF COLLECTION SYSTEM IS REQUIRED.

REFERENCES:
 BOVEE & CRAIL ISOMETRICS
 LPCS-788-1.2 REV 13

QUALITY CLASS: 1 ASME CODE CLASS: 2
 ENGR: G.A. KUGLER DRAWN: K.M.C.A. DATE: 8-16-78



WASHINGTON PUBLIC POWER SUPPLY SYSTEM
 RICHMOND WASHINGTON 99122

THIS DRAWING IS INTENDED FOR USE IN PRESERVICE AND INSERVICE INSPECTION PROGRAMS ONLY.


PIPING SYSTEM	NOM DIA (DN)	SCH	NOM WALL THK	MATERIAL SPECIFICATION	MATL TYPE	CAL BLOCK NO
24" LPCS (2)-1	24	STD	0.375	SA 106 GR B	CS	NA
20" LPCS (10)-1	20	STD	0.375	SA 106 GR B	CS	NA


NO	DATE	REVISION	BY	CHKD	APPVD
1	10-18-78	ADDED 3" CONN, LPCS-900N DELETED LPCS-4, 5, 6 & T	K.M.C.A.	J.P.R.	T.H.H.
0	11-29-78	ISSUED FOR USE	K.M.C.A.	J.P.R.	T.H.H.
1	12-3-78	ISSUED FOR INFORMATION ONLY	K.M.C.A.	J.P.R.	J.W.V.

WNP-2
 WELD & COMPONENT IDENTIFICATION DIAGRAM

TITLE:
 LPCS SUPPRESSION POOL SUCTION


DWG NO: LPCS-201-1 REV 1

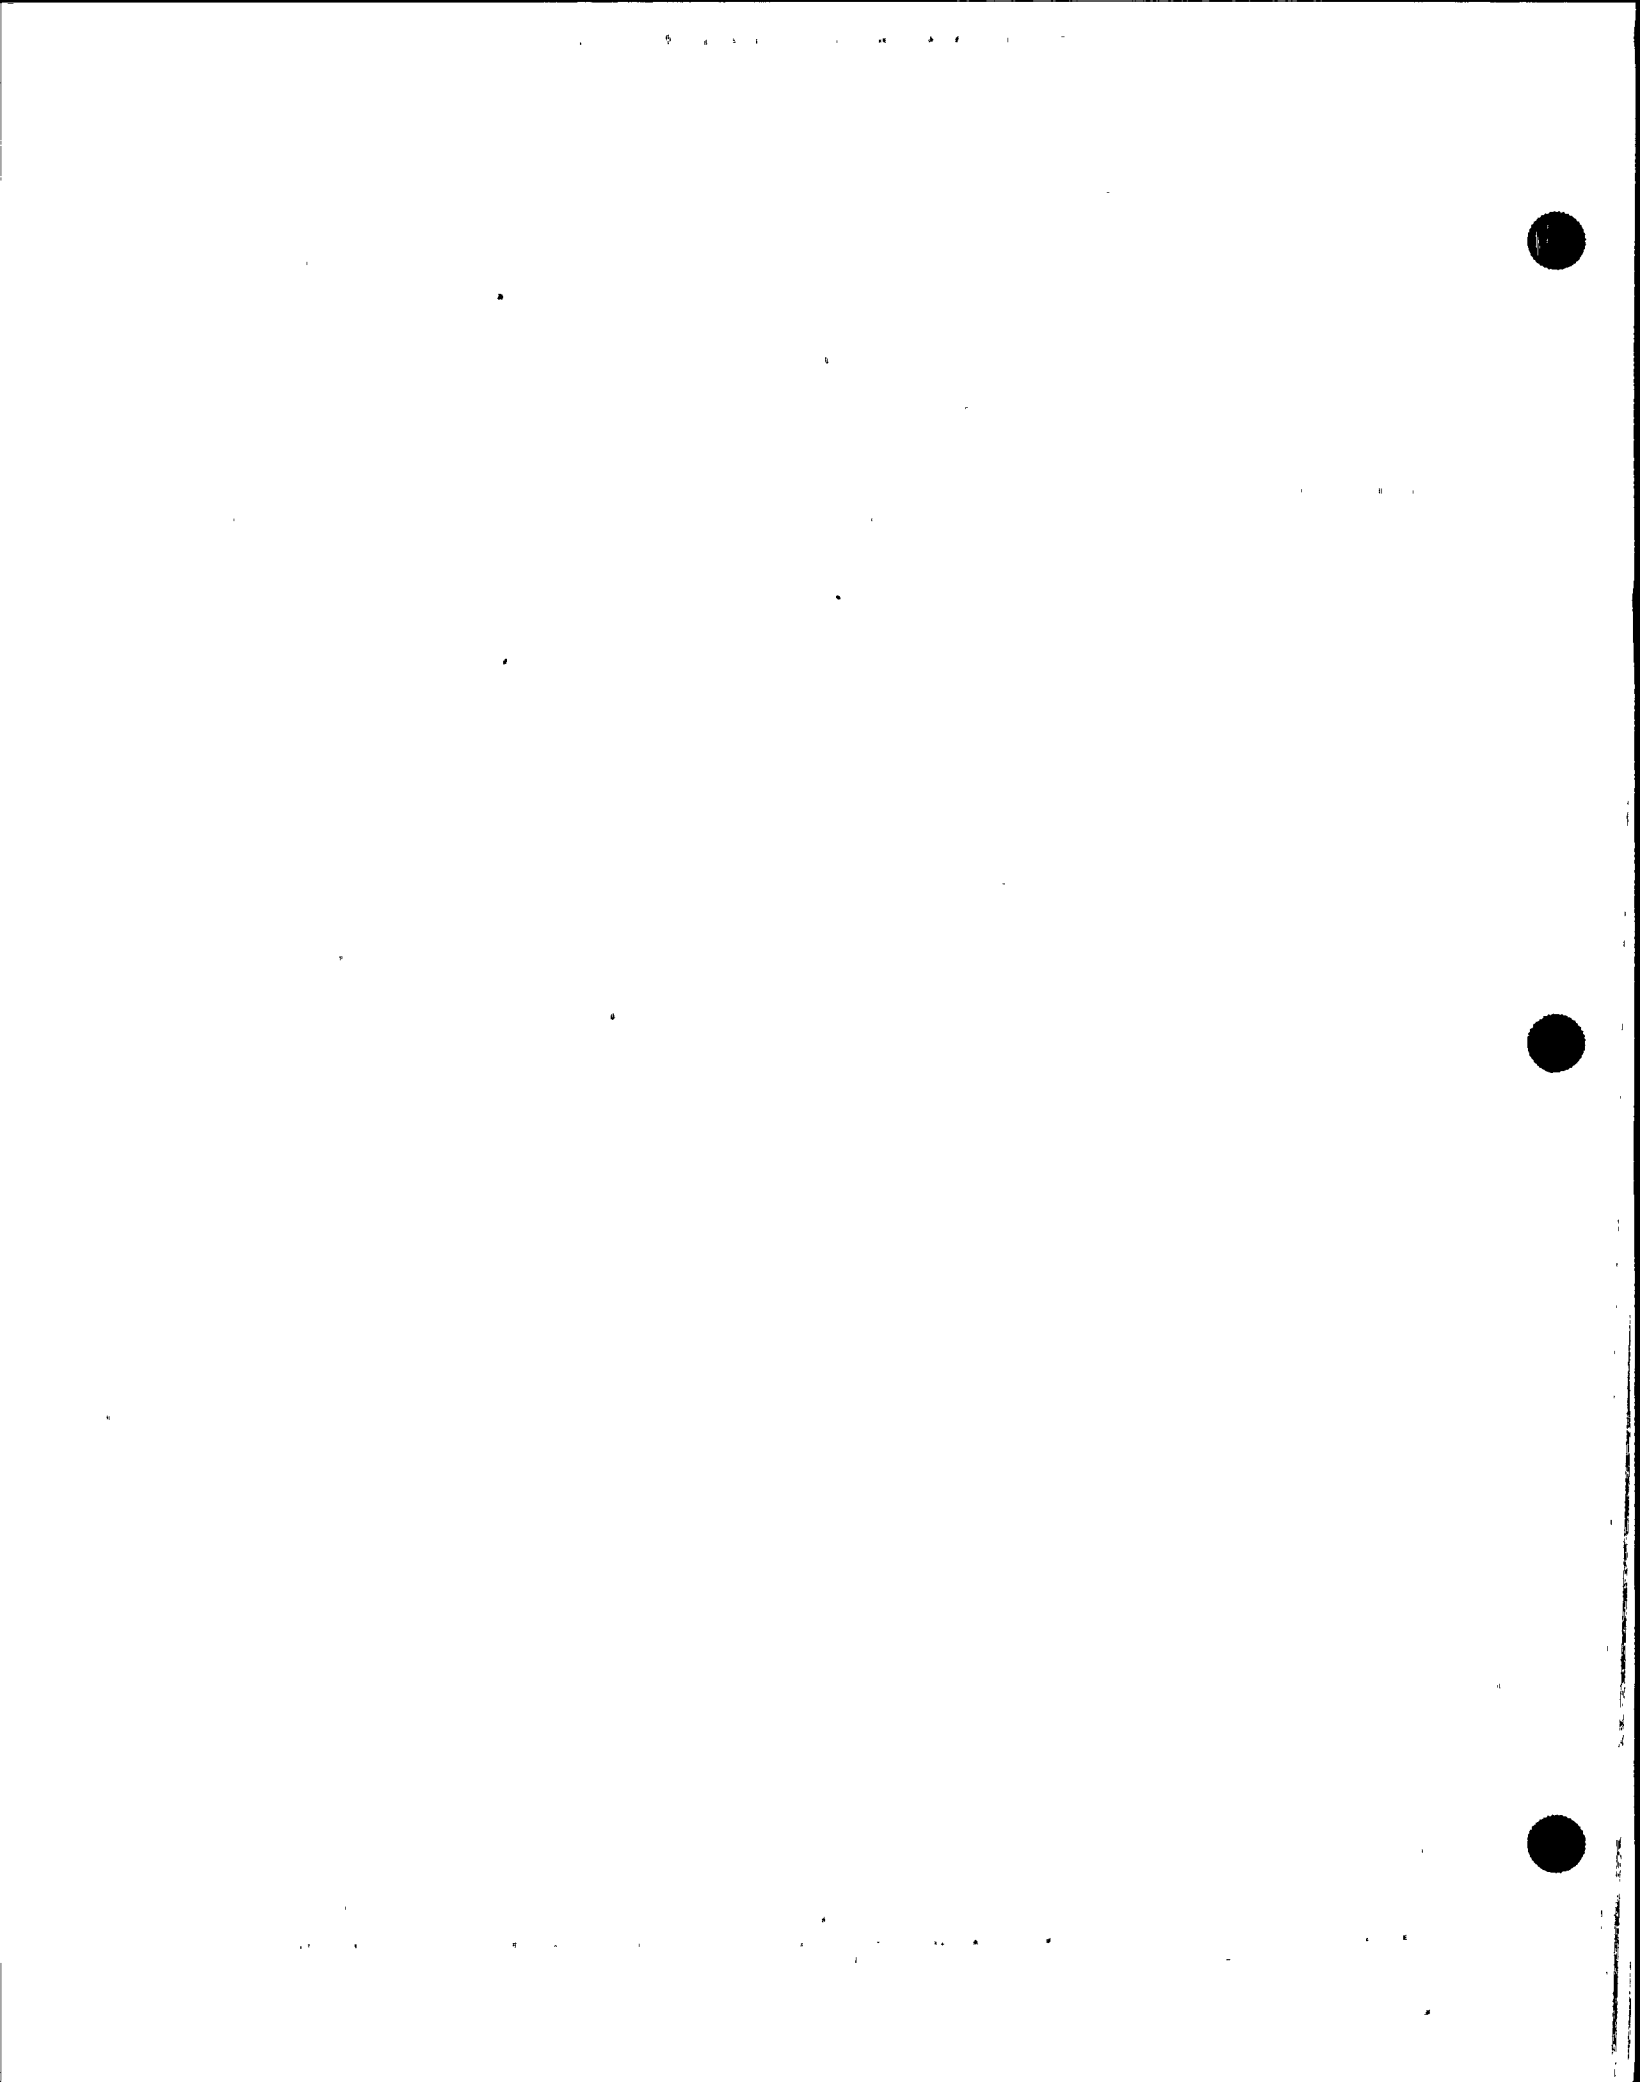

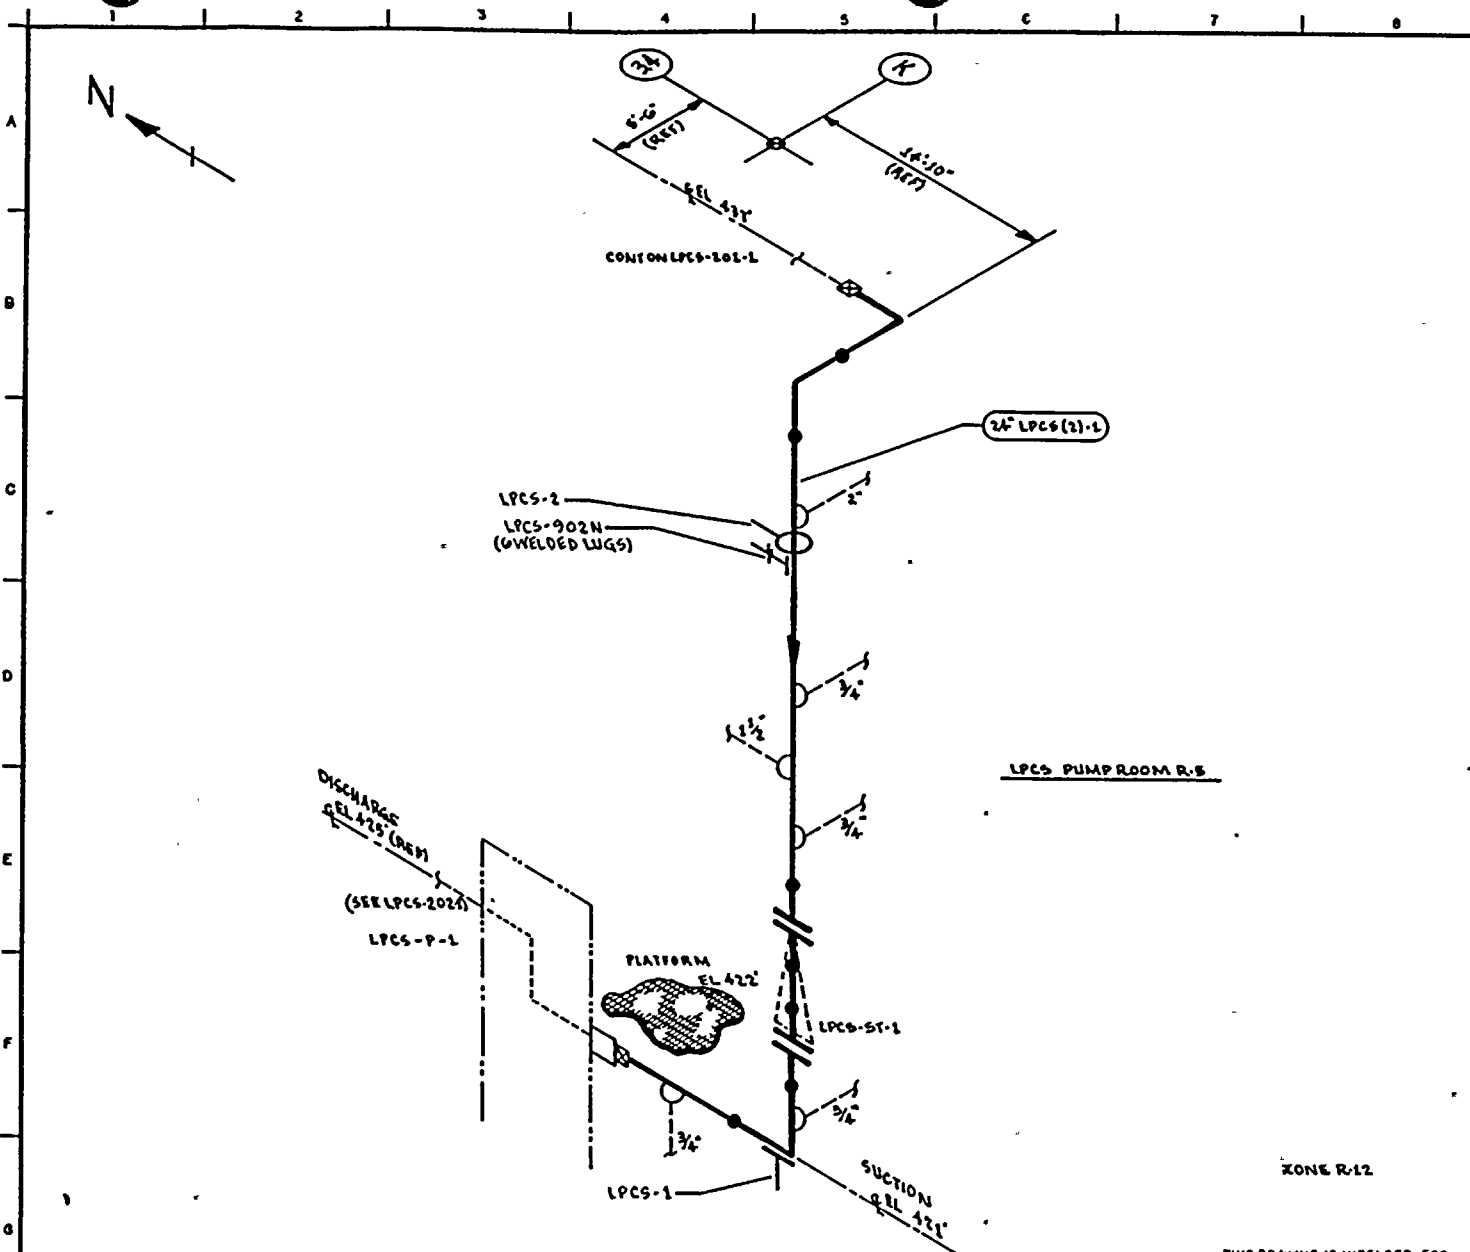

- NOTES:
1. THIS DRAWING IDENTIFIES PIPING & COMPONENTS SUBJECT TO A VISUAL EXAM FOR EVIDENCE OF LEAKAGE DURING SYSTEM HYDRO OR OPERABILITY TESTS. TESTS ARE TO BE CONDUCTED PER THE REQUIREMENTS OF ASME SECTION XI, PARAGRAPH IWA-5000.
 2. FOR BRANCH PIPING 4" DIA OR LESS (CONN SHOWN IN DASHED LINES) EXTEND VISUAL LEAKAGE EXAM THROUGH THE OUTERMOST NORMALLY CLOSED NUCLEAR CLASS VALVE OR UNTIL TRANSITION TO INSTRUMENT TUBING, UNLESS OTHERWISE NOTED.

REFERENCES:
 BOVER & CRILL ISOMETRICS
 LPCS-758-3-5 REV 7

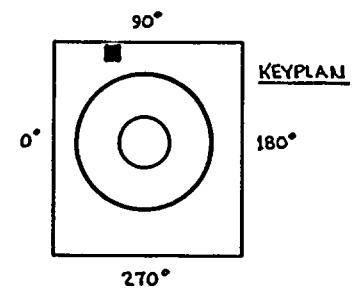

QUALITY CLASS: 1 ASME CODE CLASS: 2
 ENGR: G.A. KUGLER | DRAWN: K.McA | DATE: 8-17-78
 WASHINGTON PUBLIC POWER SUPPLY SYSTEM
 RICHLAND WASHINGTON 99352

THIS DRAWING IS INTENDED FOR USE IN PRESERVICE AND INSERVICE INSPECTION PROGRAMS ONLY.

PIPING SYSTEM	NOM DIA (DN)	SCH	NOM WALL THK	MATERIAL SPECIFICATION	MATL TYPE	CAL BLOCK NO
24" LPCS (2)-L	24	STD	0.375	SA 106 GR B	CB	NA

NO	DATE	REVISION	BY	CHKD	APPVD
1	9-26-78	ADDED LPCS-1, 2 & 902N & KEYPLAN	KMcA	DKR	JPH
0	11-22-78	ISSUED FOR USE	KMcA	DKR	JPH
1	12-3-78	ISSUED FOR INFORMATION ONLY	KMcA	DKR	JPH

WNP-2
 WELD & COMPONENT IDENTIFICATION DIAGRAM
 TITLE:
 LPCS-PUMP-1 SUCTION
 DWG NO: LPCS-201-2
 REV 1




WNP-02
 INTERVAL: PSI
 PERIOD: NA
 OUTAGE:
 DRAWING NO. LPCS-201

WASHINGTON PUBLIC POWER SUPPLY SYSTEM
 PROGRAM PLAN AND SCHEDULE
 SYSTEM OR COMPONENT: LPCS(2)-1
 DESCRIPTION: LPCS-P-1 SUCTION


PAGE 001
 DATE 12/14/84

<u>IDENT. NO.</u>	<u>DESCRIPTION</u>	<u>SECT.</u> <u>XI</u>	<u>EXAM</u> <u>EXAM.</u>	<u>PROCEDURE</u>	<u>CAL.</u> <u>BLOCK</u>	<u>INSERVICE</u>		<u>NOTES</u>
						<u>REQ.</u>	<u>SCHEDULED</u> <u>OUTAGE</u>	
LPCS-900N	BOX	C-E-2	VT-3	303/8.2.17				
LPCS-3	ANCHOR	C-E-2	VT-3	303/8.2.17				
LPCS-2	RIGID	C-E-2	VT-3	303/8.2.17				
LPCS-902N	SPRING	C-E-2	VT-3	303/8.2.17				
LPCS-1			VT-4	303/8.2.17				
LPCS-PB-201	RIGID	C-E-2	VT-3	303/8.2.17				
	LPCS PRES BNDRY	N/A	VT-2	N/A				SEE NOTES #6 & #7.

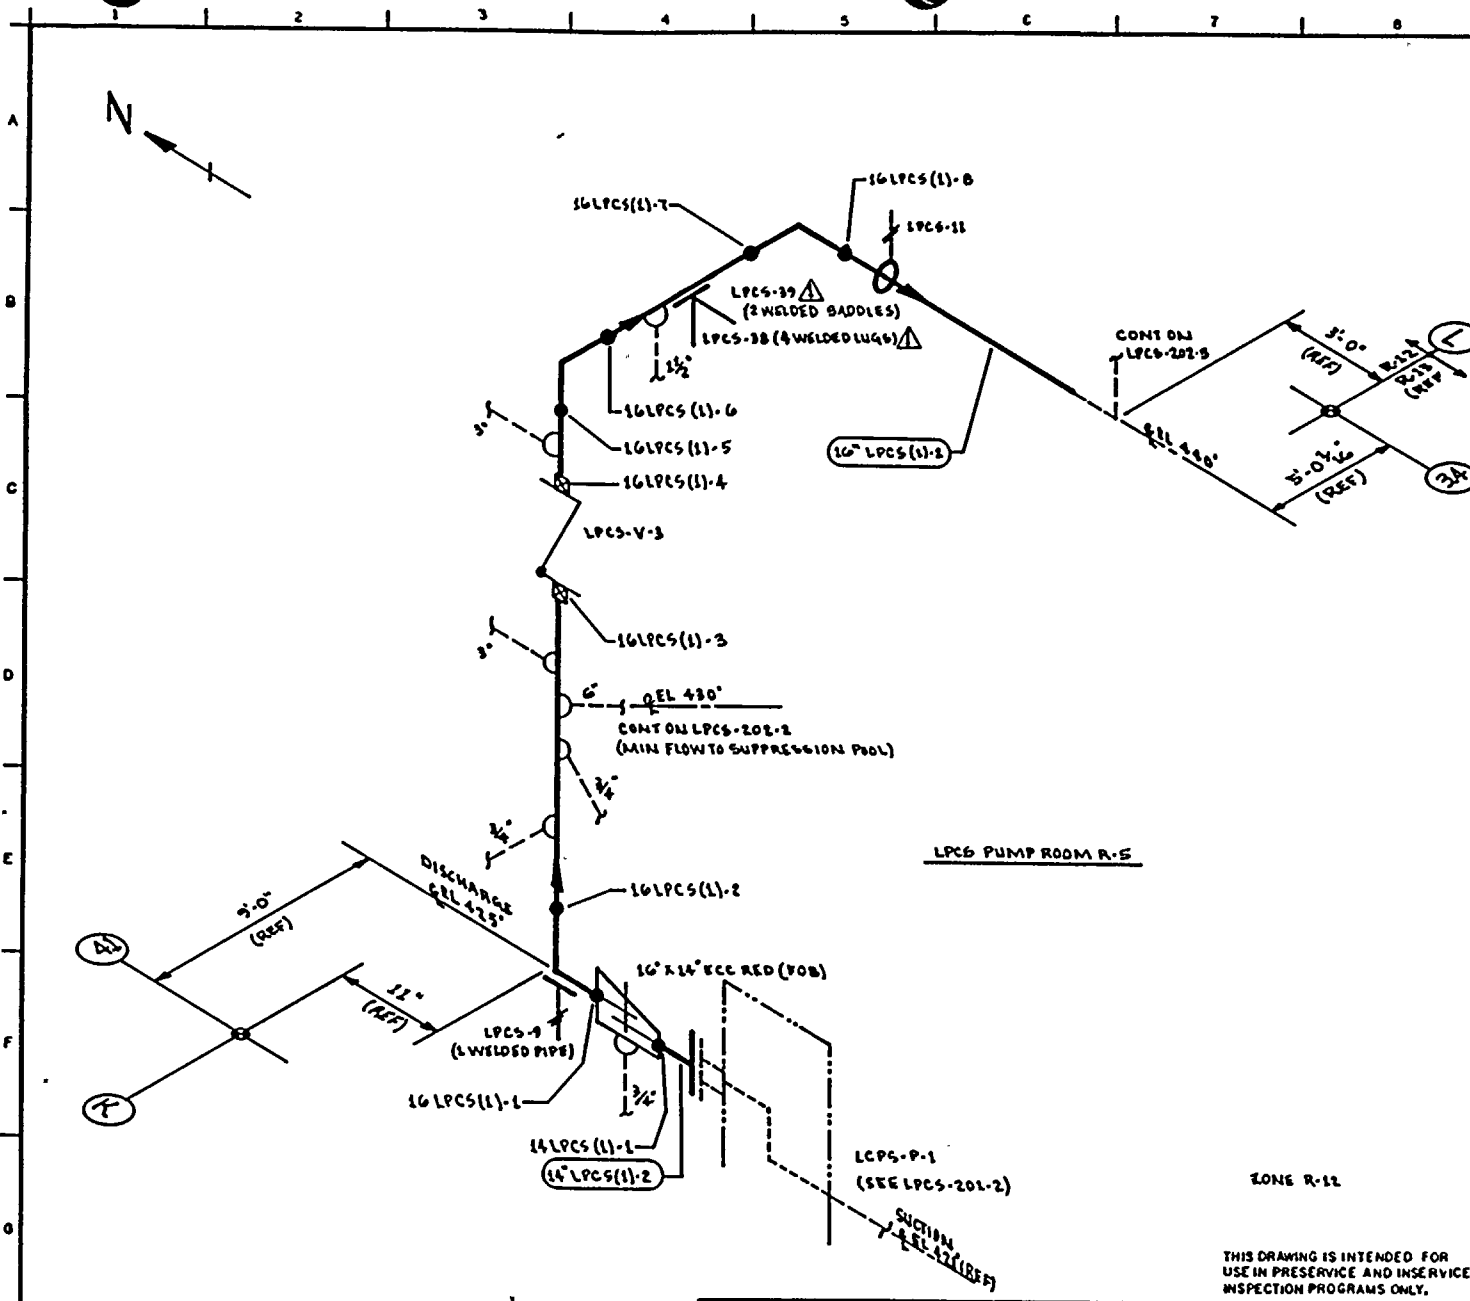

- NOTES:**
1. THIS DRAWING IDENTIFIES PIPING & COMPONENTS SUBJECT TO A VISUAL EXAM FOR EVIDENCE OF LEAKAGE DURING SYSTEM HYDRO OR OPERABILITY TESTS. TESTS ARE TO BE CONDUCTED PER THE REQUIREMENTS OF ASME SECTION XI, PARAGRAPH IWA-5000.
 2. FOR BRANCH PIPING 4" DIA OR LESS (CONN SHOWN IN DASHED LINES) EXTEND VISUAL LEAKAGE EXAM THROUGH THE OUTERMOST NORMALLY CLOSED NUCLEAR CLASS VALVE OR UNTIL TRANSITION TO INSTRUMENT TUBING, UNLESS OTHERWISE NOTED.
 3. THE FOLLOWING WELD REQUIRES A SURFACE EXAM. THIS REPRESENTS 10% OF THE WELDS EXEMPTED BY IWC-1220 (C).
16 LPCS (1)-5

REFERENCES:
BOVEE & CRANLISOMETRIC
LPCS-TSG-1.4 REV 10

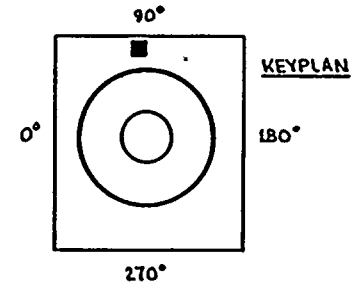

QUALITY CLASS: 1 ASME CODE CLASS: 2
ENGRGA KUGLER | DRAWN: W.M.E.A. | DATE: 8-17-78

WASHINGTON PUBLIC POWER SUPPLY SYSTEM
RICHMOND AND WASHINGTON 99352

WNP-2
WELD & COMPONENT IDENTIFICATION DIAGRAM

TITLE:
LPCS-PUMP-1 DISCHARGE


THIS DRAWING IS INTENDED FOR USE IN PRESERVICE AND INSERVICE INSPECTION PROGRAMS ONLY.

PIPING SYSTEM	NOM DIA (IN)	SCH	NOM WALL THK	MATERIAL SPECIFICATION	MATL TYPE	CAL BLOCK NO
16" LPCS (1)-2	16	S1D	0.375	SA 106 GR B	CS	NA
14" LPCS (1)-2	14	STD	0.375	SA 106 GR B	CS	NA

NO	DATE	REVISION	BY	CHKD	APPVD
1	9-27-78	NUMBERED WELDS ADDED NOTE 3, 16" LPCS(1)-2 DEL (P)S	W.M.E.A.	W.M.E.A.	W.M.E.A.
0	11-13-78	ISSUED FOR USE	W.M.E.A.	W.M.E.A.	W.M.E.A.
A	10-3-78	ISSUED FOR INFORMATION ONLY	W.M.E.A.	W.M.E.A.	W.M.E.A.


DWG NO: LPCS-202-1 REV 1



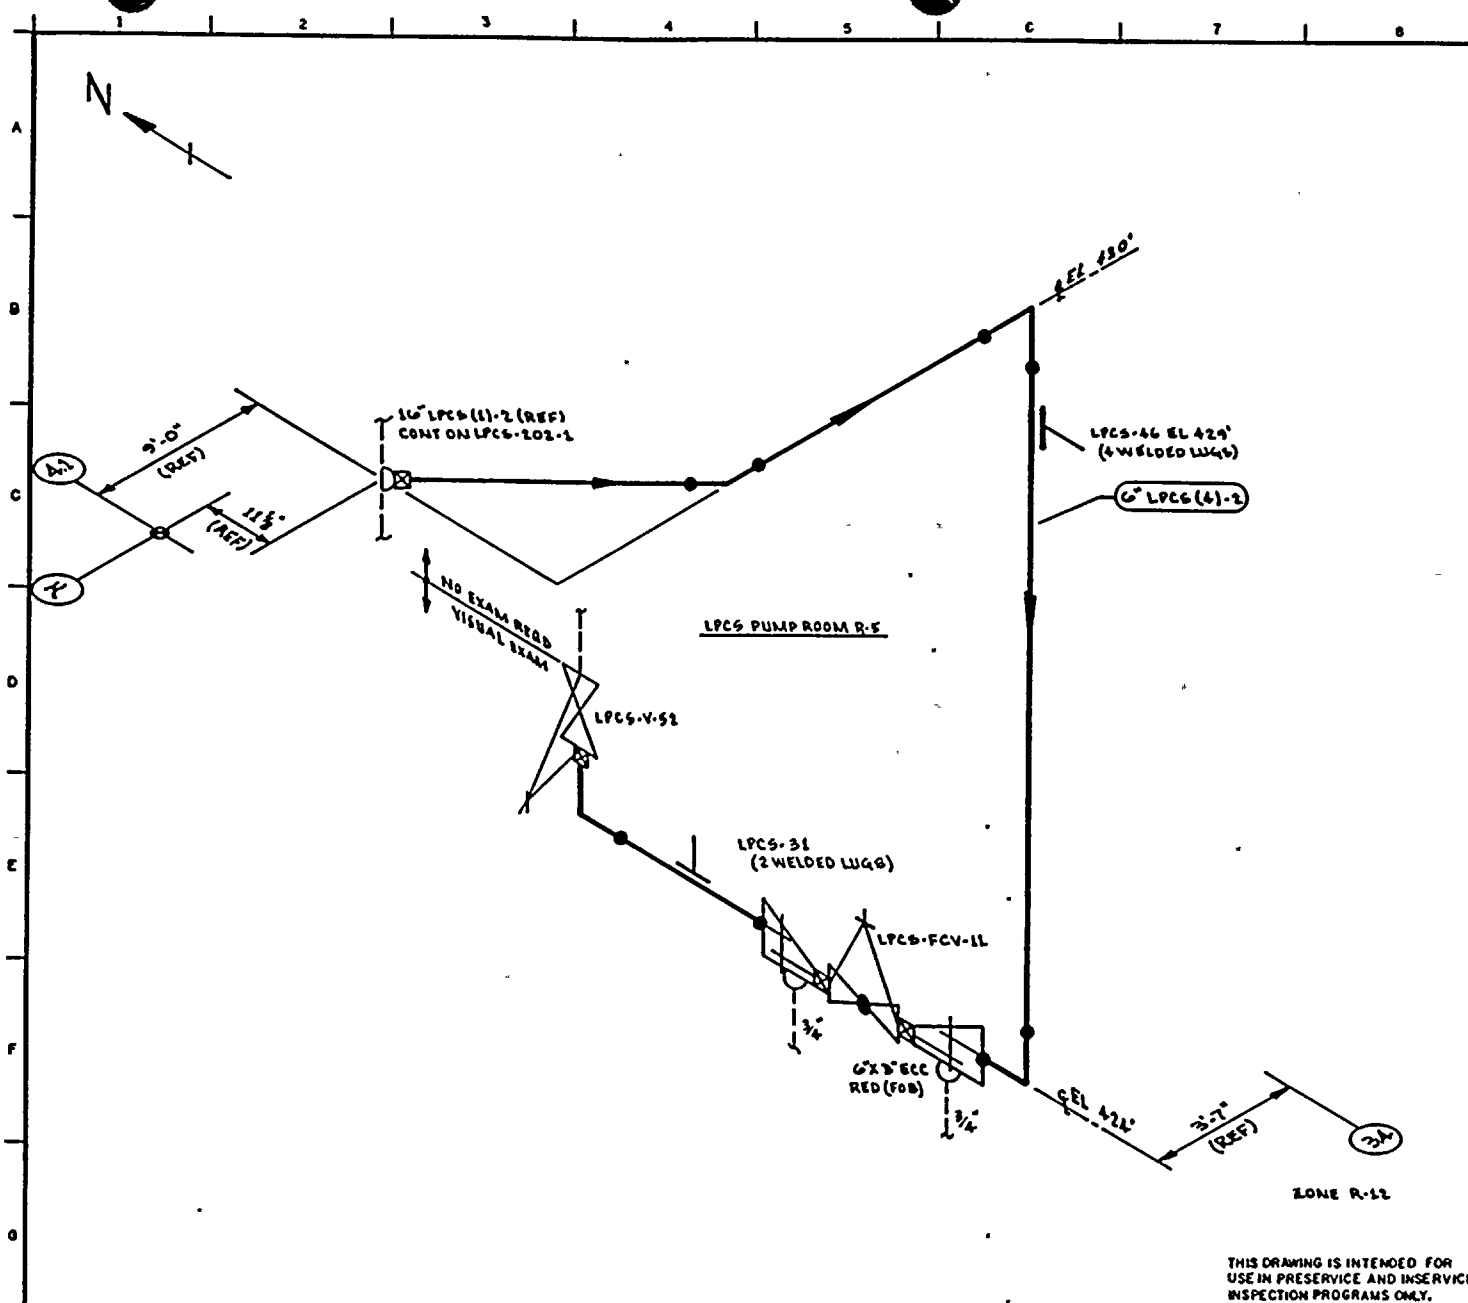

- NOTES:
1. THIS DRAWING IDENTIFIES PIPING & COMPONENTS SUBJECT TO A VISUAL EXAM FOR EVIDENCE OF LEAKAGE DURING SYSTEM HYDRO OR OPERABILITY TESTS. TESTS ARE TO BE CONDUCTED PER THE REQUIREMENTS OF ASME SECTION XI, PARAGRAPH SQA-5000.
 2. FOR BRANCH PIPING 4" DIA OR LESS (CONN SHOWN IN DASHED LINES) EXTEND VISUAL LEAKAGE EXAM THROUGH THE OUTERMOST NORMALLY CLOSED NUCLEAR CLASS VALVE OR UNTIL TRANSITION TO INSTRUMENT TUBING, UNLESS OTHERWISE NOTED.

REFERENCES:
 DOME & CRAIL ISOMETRIC
 LPCS-TSC-5-7 REV 11

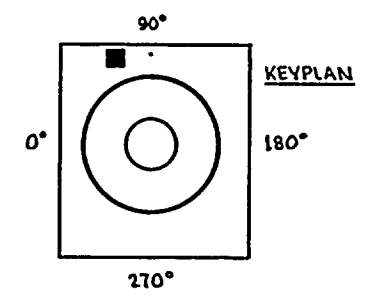

THIS DRAWING IS INTENDED FOR USE IN PRESERVICE AND INSERVICE INSPECTION PROGRAMS ONLY.

QUALITY CLASS: 1	ASME CODE CLASS: 2
ENGR G.A. WICKLER	DATE: 8-17-78
 WASHINGTON PUBLIC POWER SUPPLY SYSTEM RICHARD WASHINGTON 9932	

PIPING SYSTEM	NOM DIA (IN)	SCH	NOM WALL THK	MATERIAL SPECIFICATION	MATL TYPE	CAL BLOCK NO
6" LPCS (4)-2	6	STD	0.280	SA 106 GR B	CS	NA


NO	DATE	REVISION	BY	CHKD	APPVD
1	9-24-78	ADDED LPCS-31 ADDED KEYPLAN	KWA	JWT	TRP
0	12-12-78	ISSUED FOR USE	KWA	AKW	LSB
1	12-19	ISSUED FOR INFORMATION ONLY	KWA	AKW	DDR

WNP-2
 WELD & COMPONENT IDENTIFICATION DIAGRAM

TITLE:
 LPCS MINIMUM FLOW LINE TO SUPPRESSION POOL


DWG NO: LPCS-202-2 REV 1



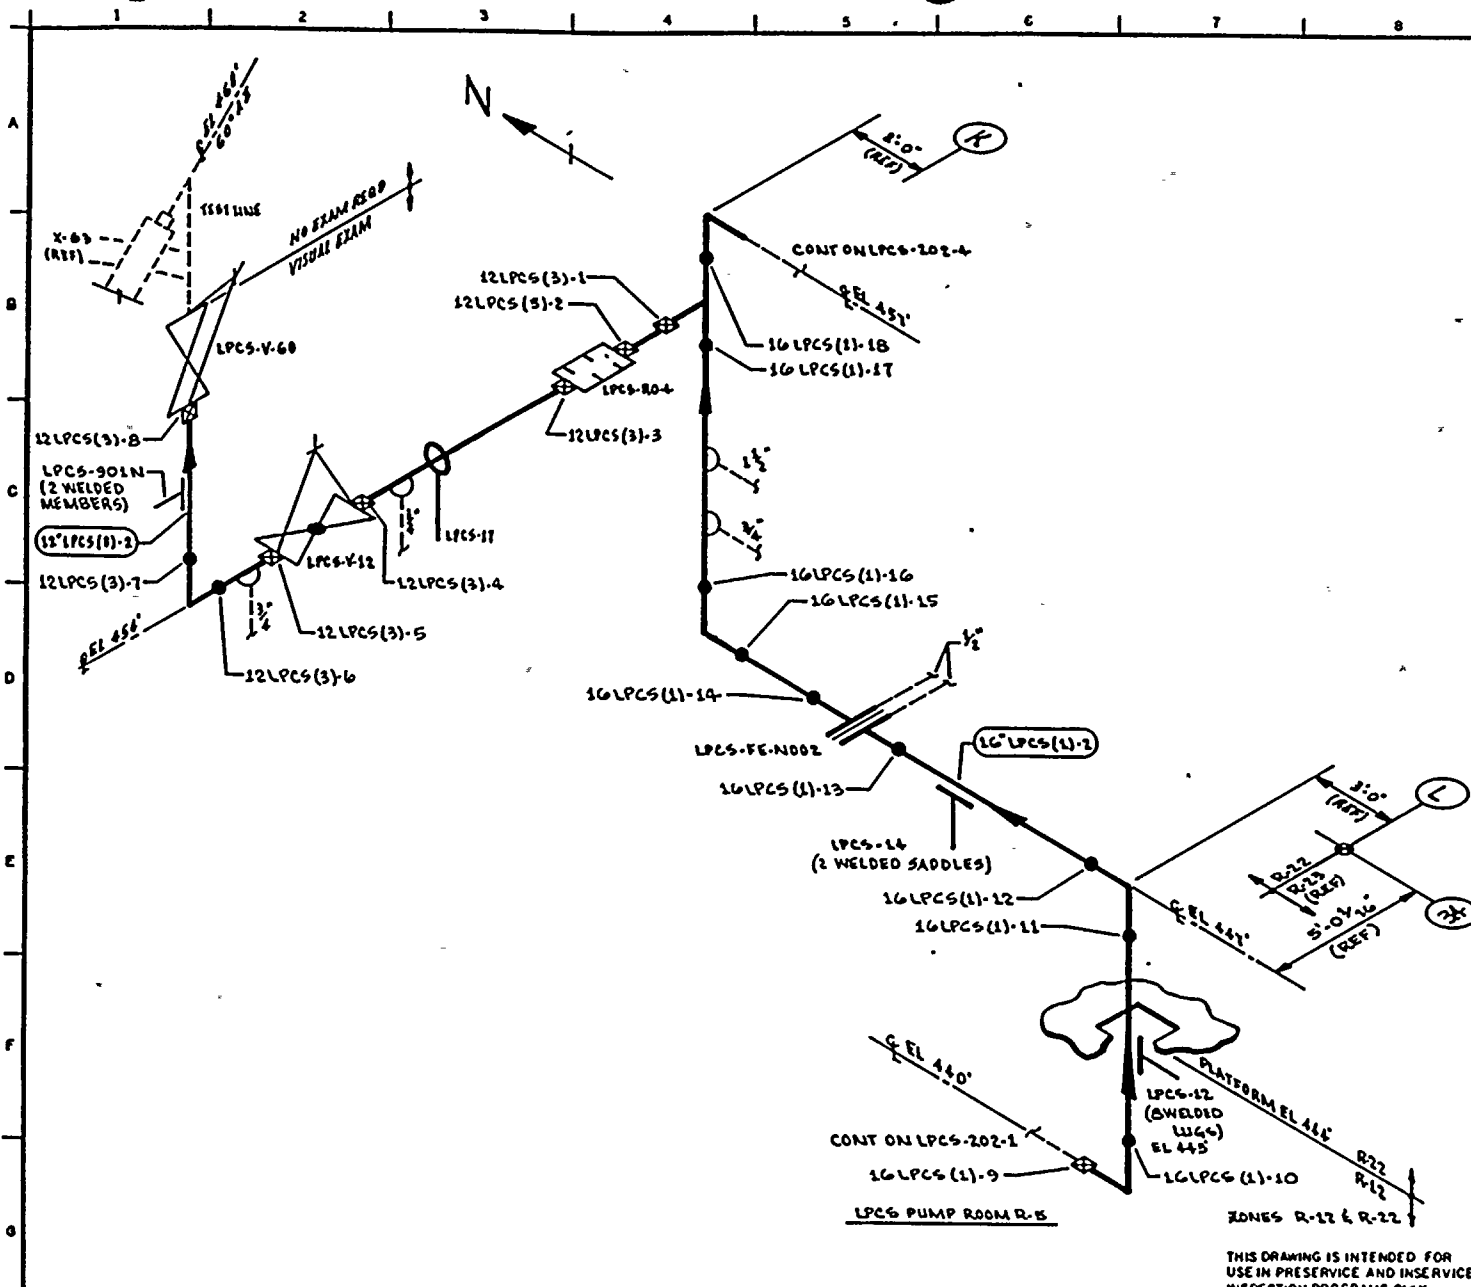

- NOTES:**
1. THIS DRAWING IDENTIFIES PIPING & COMPONENTS SUBJECT TO A VISUAL EXAM FOR EVIDENCE OF LEAKAGE DURING SYSTEM HYDRO OR OPERABILITY TESTS. TESTS ARE TO BE CONDUCTED PER THE REQUIREMENTS OF ASME SECTION XI, PARAGRAPH SVA-5000.
 2. FOR BRANCH PIPING 4" DIA OR LESS (CONN SHOWN IN DASHED LINES) EXTEND VISUAL LEAKAGE EXAM THROUGH THE OUTER MOST NORMALLY CLOSED NUCLEAR CLASS VALVE OR UNTIL TRANSITION TO INSTRUMENT TUBING, UNLESS OTHERWISE NOTED.

- REFERENCES:**
- BOVEE & CRAIG ISOMETRICS
 - LPCS-756-8.10 REV 8
 - LPCS-759-1 REV 9

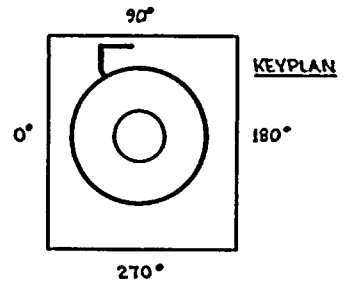

QUALITY CLASS: 1 ASME CODE CLASS: 2
 ENGR G.A. KUGLER, DRAWN: K.M.C.A. DATE: 8-18-78

WASHINGTON PUBLIC POWER SUPPLY SYSTEM
 RICHLAND WASHINGTON 99322

THIS DRAWING IS INTENDED FOR USE IN PRESERVICE AND INSERVICE INSPECTION PROGRAMS ONLY.


PIPING SYSTEM	NOM DIA (IN)	SCH	NOM WALL THK	MATERIAL SPECIFICATION	MATL TYPE	CAL BLOCK NO
12" LPCS(3)-2	12	STD	0.375	SA 106 GR B	C5	NA
16" LPCS(1)-2	16	STD	0.375	SA 106 GR B	C6	NA

NO	DATE	REVISION	BY	CHKD	APPVD
1	8-26-83	NUMBERED WELDS, ADDED LPCS-901N, DELETED LPCS-10, 19, 12 & 40, CHANGED LPCS-12 & 17	KMA	AK	TR
0	8-18-78	ISSUED FOR USE	KMA	AK	TR
A	8-3-78	ISSUED FOR INFORMATION ONLY	KMA	AK	TR
		REVISION			

WHP-2
 WELD & COMPONENT IDENTIFICATION DIAGRAM


TITLE:
 LPCS-PUMP-1 DISCHARGE & TEST LINES

DWG NO: LPCS-202-3 REV 1

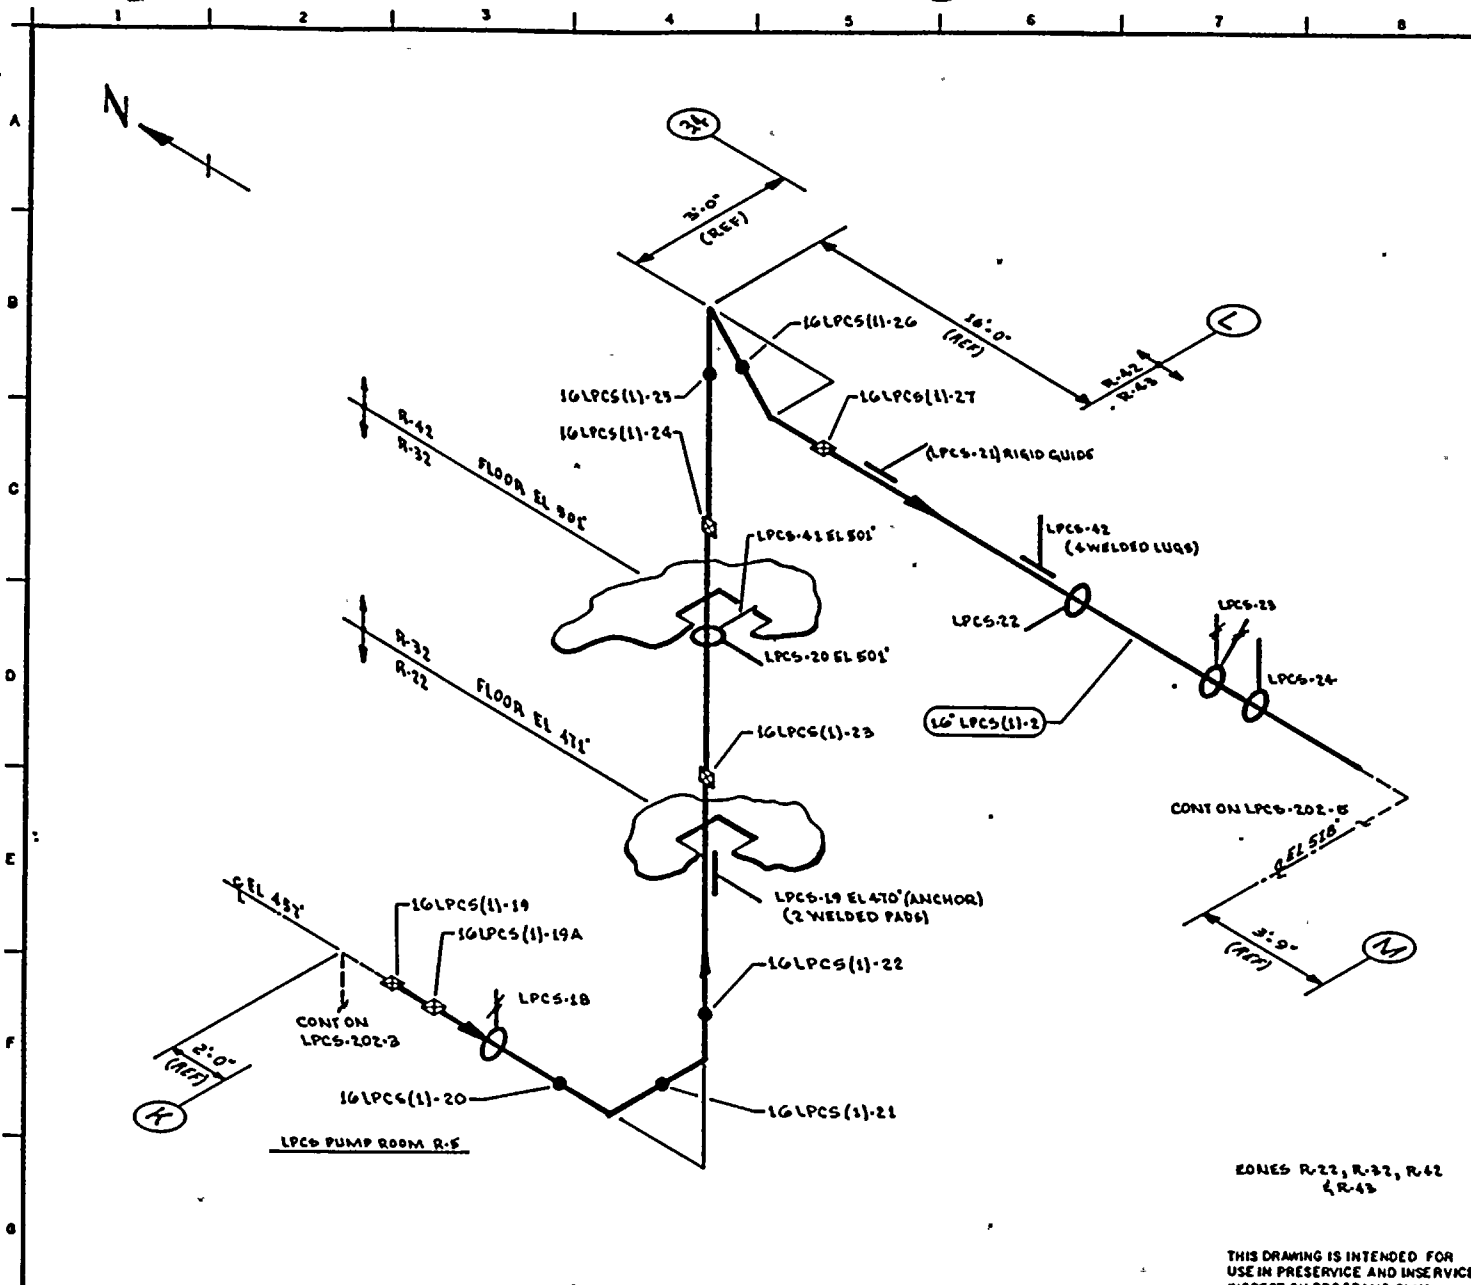

NOTES:
 1. THIS DRAWING IDENTIFIES PIPING & COMPONENTS SUBJECT TO A VISUAL FLAM FOR EVIDENCE OF LEAKAGE DURING SYSTEM HYDRO OR OPERABILITY TESTS. TESTS ARE TO BE CONDUCTED PER THE REQUIREMENTS OF ASME SECTION XI, PARAGRAPH SVA-5000.

REFERENCES:
 BOYCE & CRALL ISOMETRICS:
 LPCS-TSL-11.15 REV 5

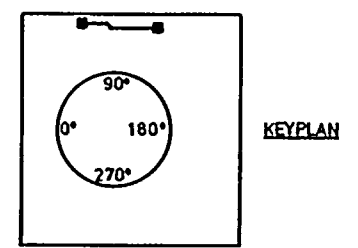

EDGES R-22, R-32, R-42 & R-43

THIS DRAWING IS INTENDED FOR USE IN PRESERVICE AND INSERVICE INSPECTION PROGRAMS ONLY.

QUALITY CLASS: 1 ASME CODE CLASS: 2
 ENGR GA KUGLER DRAWN: KMcA DATE: 8-21-78

WASHINGTON PUBLIC POWER SUPPLY SYSTEM
 RICHLAND, WASHINGTON 99352

PIPING SYSTEM	NOM DIA (IN)	SCH	NOM WALL THK	MATERIAL SPECIFICATION	MATL TYPE	CAL BLOCK NO
16" LPCS(1)-2	16	STD	0.375	SA 106 GR B	CG	NA


NO	DATE	REVISION	BY	CHKD	APPVD
1	9-26-83	NUMBERED WELDS. LPCS-20, 22 & 24 NOW RIGID	KMcA	DKP	TTS
0	12-22-78	ISSUED FOR USE	KMcA	DKP	TTS
A	10-31-78	ISSUED FOR INFORMATION ONLY	KMcA	DKP	TTS

WNP-2
 WELD & COMPONENT IDENTIFICATION DIAGRAM

TITLE:
 LPCS-PUMP 1 DISCHARGE


DWG NO: LPCS-202-4 REV 1



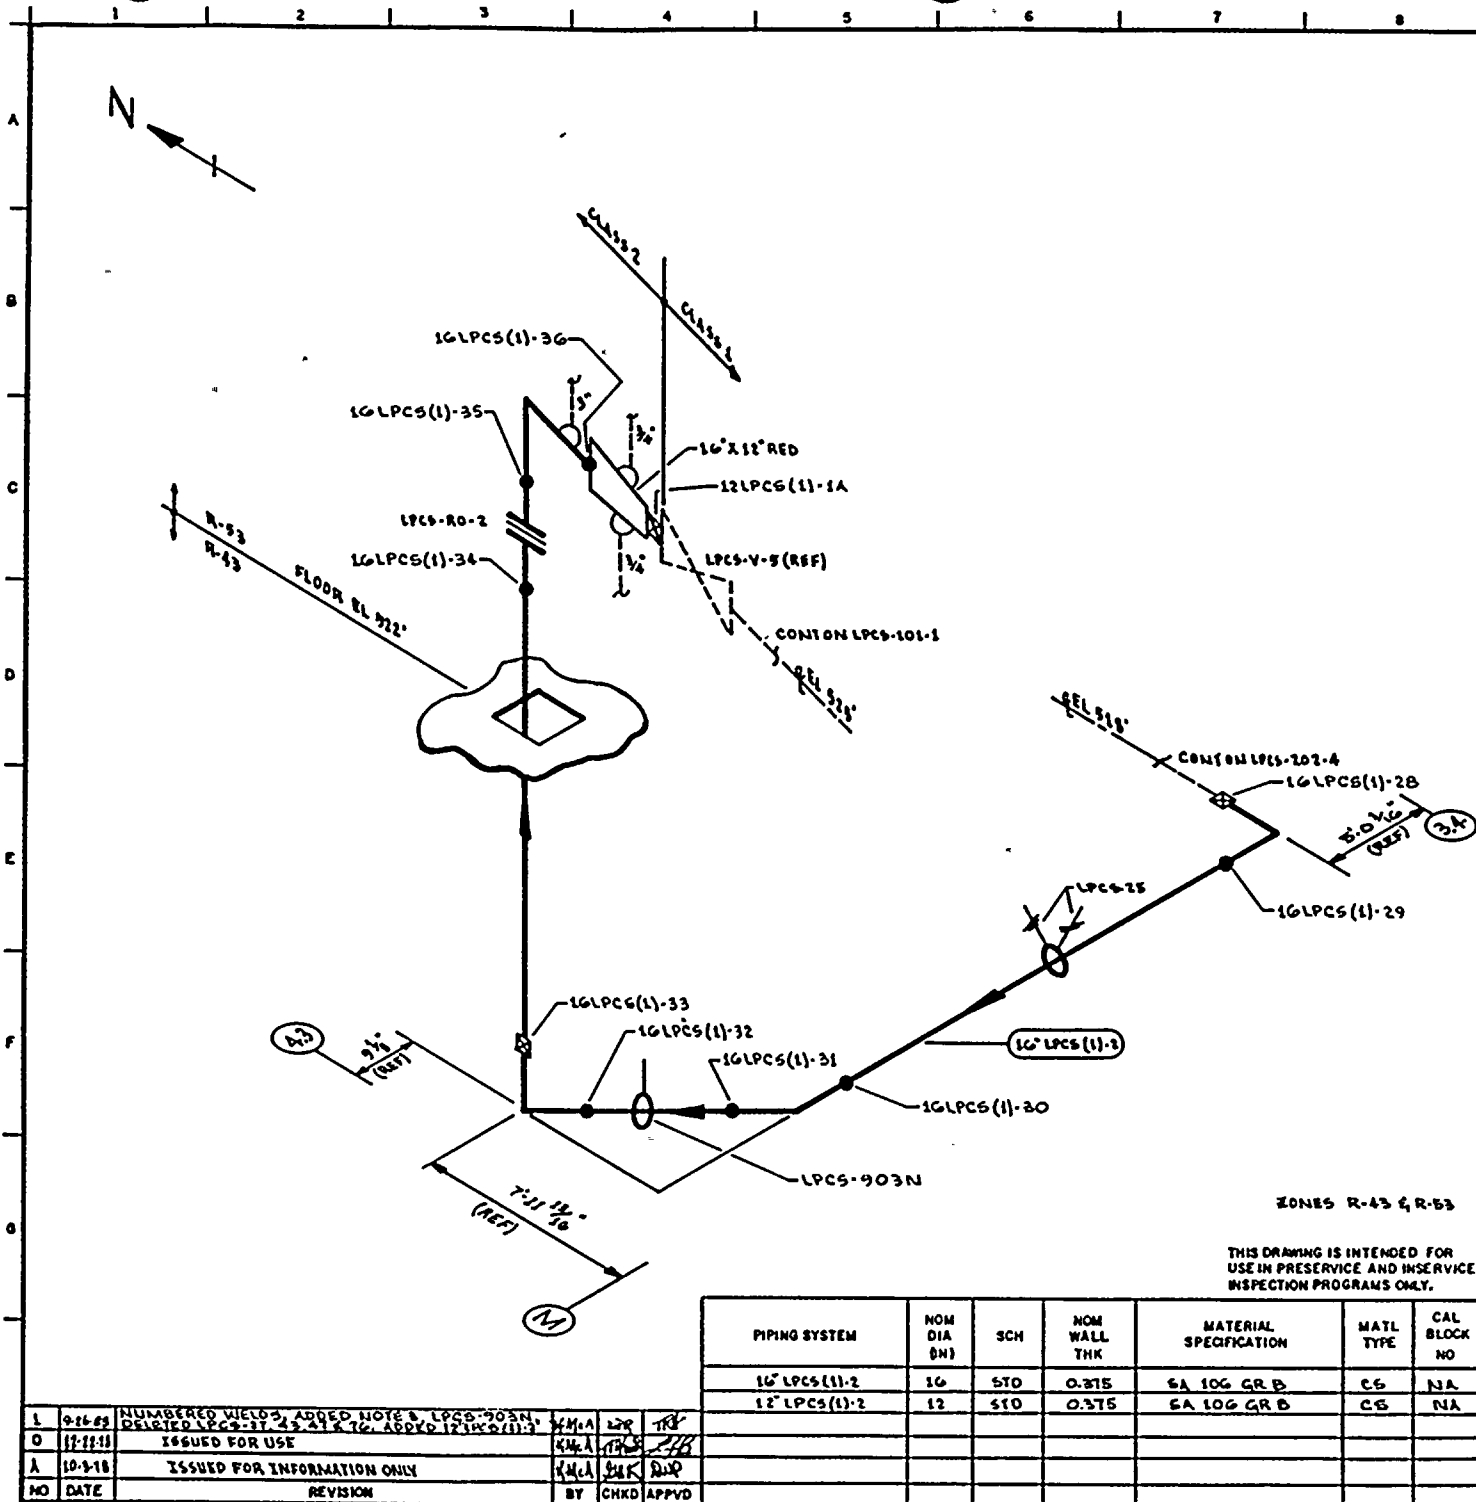

- NOTES:**
1. THIS DRAWING IDENTIFIES PIPING & COMPONENTS SUBJECT TO A VISUAL EXAM FOR EVIDENCE OF LEAKAGE DURING SYSTEM HYDRO OR OPERABILITY TESTS. TESTS ARE TO BE CONDUCTED PER THE REQUIREMENTS OF ASME SECTION XI, PARAGRAPH IWA-5000.
 2. FOR BRANCH PIPING 4" DIA OR LESS (CONN SHOWN IN DASHED LINES) EXTEND VISUAL LEAKAGE EXAM THROUGH THE OUTERMOST NORMALLY CLOSED NUCLEAR CLASS VALVE OR UNTIL TRANSITION TO INSTRUMENT TUBING, UNLESS OTHERWISE NOTED.
 3. THE FOLLOWING WELDS REQUIRE A SURFACE EXAM. THEY REPRESENT 10% OF THE WELDS EXEMPTED BY IWC-1200 (C):
 - 12 LPCS (1)-1A
 - 16 LPCS (1)-2B
 - 16 LPCS (1)-30
 - 16 LPCS (1)-31
 - 16 LPCS (1)-32
 - 16 LPCS (1)-33
 - 16 LPCS (1)-35

- REFERENCES:**
- BOYCE & CRAIG ISOMETRICS
 - LPCS-756-11.15 REV 5
 - LPCS-756-16.18 REV 3

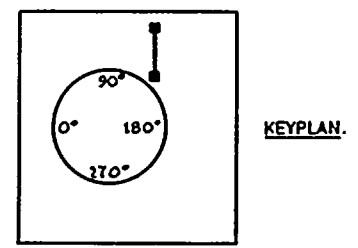

QUALITY CLASS: L ASME CODE CLASS: 2
 ENGR G.A. KUGLER DRAWN: K.M.C.L DATE: 8-21-78
WASHINGTON PUBLIC POWER SUPPLY SYSTEM
 RICHMOND, WASHINGTON 98382

ZONES R-43 & R-53
 THIS DRAWING IS INTENDED FOR USE IN PRESERVICE AND INSERVICE INSPECTION PROGRAMS ONLY.

PIPING SYSTEM	NOM DIA (DN)	SCH	NOM WALL THK	MATERIAL SPECIFICATION	MATL TYPE	CAL BLOCK NO
16" LPCS (1)-2	16	STD	0.375	SA 106 GR B	C6	NA
12" LPCS (1)-2	12	STD	0.375	SA 106 GR B	C6	NA

NO	DATE	REVISION	BY	CHKD	APPVD
1	8-26-78	NUMBERED WELDS ADDED NOTE 3, LPCS-903N DELETED LPCS-31, 33, 34 & 35. APPROV 12/1/80 (11)	K.M.C.L.	L.P.R.	T.P.B.
0	11-11-78	ISSUED FOR USE	K.M.C.L.	T.P.B.	T.P.B.
A	10-3-78	ISSUED FOR INFORMATION ONLY	K.M.C.L.	T.P.B.	T.P.B.

WNP-2
 WELD & COMPONENT IDENTIFICATION DIAGRAM
 TITLE:
 LPCS-PUMP-1 DISCHARGE
 DWG NO: LPCS-202-5 REV 1



WNP-02
 INTERVAL: PSI
 PERIOD: NA
 OUTAGE:
 DRAWING NO. LPCS-202

WASHINGTON PUBLIC POWER SUPPLY SYSTEM
 PROGRAM PLAN AND SCHEDULE
 SYSTEM OR COMPONENT: LPCS(1)-2
 DESCRIPTION: LPCS-P-1 DISCHARGE

PAGE 001
 DATE 12/14/84


IDENT. NO.	DESCRIPTION	SECT. XI EXAM.	EXAM MTH.	PROCEDURE	CAL. BLOCK	INSERVICE		NOTES
						REQ.	SCHEDULED OUTAGE	
LPCS-9	SPRING	C-E-2	VT-3	303/8.2.17				
			VT-4	303/8.2.17				
LPCS-46	BOX	C-E-2	VT-3	303/8.2.17				
LPCS-31	BOX	C-E-2	VT-3	303/8.2.17				
16LPCS(1)-5	PIPE TO EL	N/A	SUR	OCT 3-3				SEE NOTE #8.
LPCS-38	BOX	C-E-2	VT-3	303/8.2.17				
LPCS-39	BOX	C-E-2	VT-3	303/8.2.17				
LPCS-11	SPRING	C-E-2	VT-3	303/8.2.17				
			VT-4	303/8.2.17				
LPCS-12	BOX	C-E-2	VT-3	303/8.2.17				
LPCS-14	ANCHOR	C-E-2	VT-3	303/8.2.17				
LPCS-17	BOX	C-E-2	VT-3	303/8.2.17				
LPCS-901N	ANCHOR	C-E-2	VT-3	303/8.2.17				
LPCS-18	SPRING	C-E-2	VT-3	303/8.2.17				
			VT-4	303/8.2.17				
LPCS-19	ANCHOR	C-E-2	VT-3	303/8.2.17				
LPCS-20	STRUT	C-E-2	VT-3	303/8.2.17				
LPCS-41	STRUT	C-E-2	VT-3	303/8.2.17				

WNP-02
 INTERVAL: PSI
 PERIOD: NA
 OUTAGE:
 DRAWING NO. LPCS-202

WASHINGTON PUBLIC POWER SUPPLY SYSTEM
 PROGRAM PLAN AND SCHEDULE
 SYSTEM OR COMPONENT: LPCS(1)-2
 DESCRIPTION: LPCS-P-1 DISCHARGE


PAGE 002
 DATE 12/14/84

<u>IDENT. NO.</u>	<u>DESCRIPTION</u>	<u>SECT.</u> <u>XI</u> <u>EXAM.</u>	<u>EXAM</u> <u>MTH.</u>	<u>PROCEDURE</u>	<u>CAL.</u> <u>BLOCK</u>	<u>INSERVICE</u> <u>SCHEDULED</u>		<u>NOTES</u>
						<u>REQ.</u>	<u>OUTAGE</u>	
LPCS-21	BOX	C-E-2	VT-3	303/8.2.17				
LPCS-42	BOX	C-E-2	VT-3	303/8.2.17				
LPCS-22	RIGID	C-E-2	VT-3	303/8.2.17				
LPCS-23	SPRING	C-E-2	VT-3	303/8.2.17				
			VT-4	303/8.2.17				
LPCS-24	BOX	C-E-2	VT-3	303/8.2.17				
LPCS-25	SPRING	C-E-2	VT-3	303/8.2.17				
			VT-4	303/8.2.17				
16LPCS(1)-30	PIPE TO EL	N/A	SUR	OCI 3-3				SEE NOTE #8.
LPCS-903N	ANCHOR	C-E-2	VT-3	303/8.2.17				
16LPCS(1)-32	PIPE TO EL	N/A	SUR	PTP-1				SEE NOTE #8.
16LPCS(1)-33	EL TO PIPE	N/A	SUR	PTP-1				SEE NOTE #8.
16LPCS(1)-35	FLANGE TO EL	N/A	SUR	OCI 3-3				SEE NOTE #8.
12LPCS(1)-1A	RED TO VALVE	N/A	SUR	OCI 3-3				SEE NOTE #8.
LPCS-PB-202	LPCS PRES BNDRY	N/A	VT-2	N/A				SEE NOTES #6 & #7.

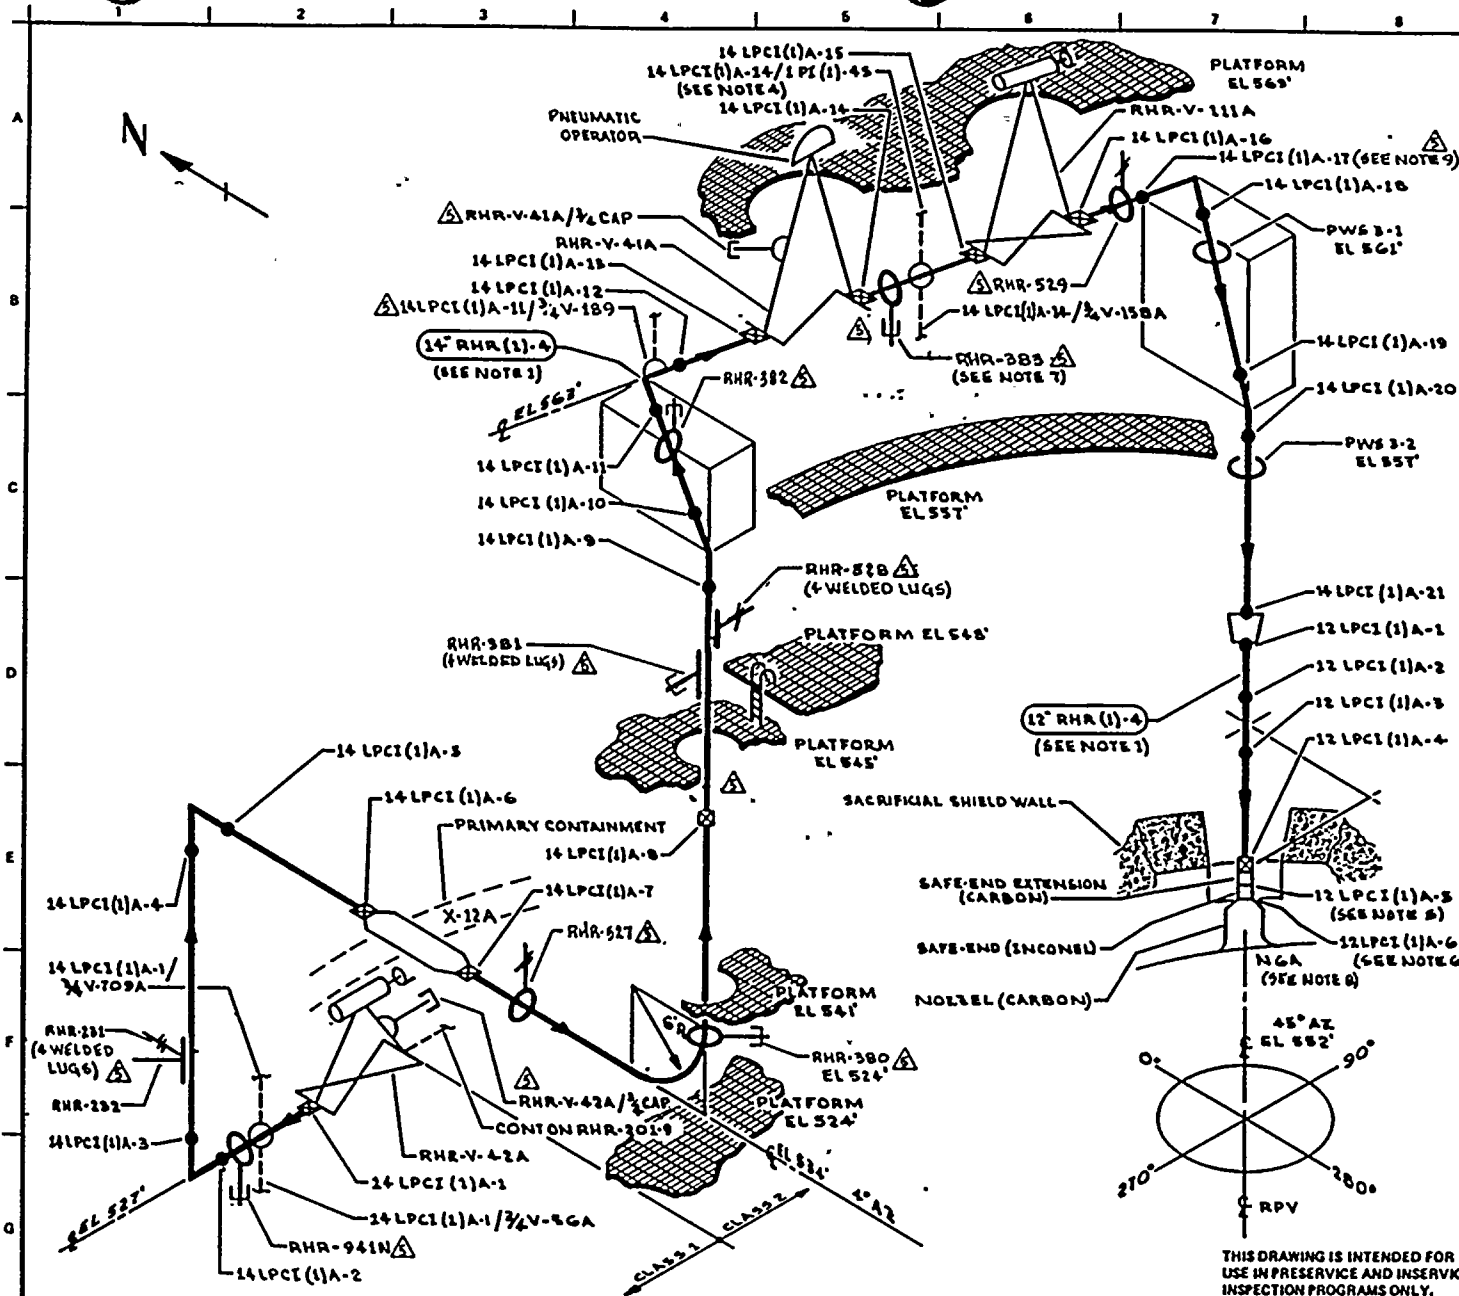

- NOTES:
- WELD NUMBERING UTILIZES "LPCI" RATHER THAN "RHR" FOR SYSTEM DESIGNATION FOR CLARITY.
 - ACCESS TO WELDS AT NOZZEL NGA REQUIRE TEMPORARY SCAFFOLDING.
 - PWS 10 PR 15 WITHIN $\sim 4^\circ$ OF WELD 14 LPCI (1)A-18
 - EXTEND LEAKAGE EXAM THROUGH CONTAINMENT (X-74b) THROUGH EXCESS FLOW CHECK VALVE TO INSTRUMENT TUBING CONNECTION.
 - DISSIMILAR METAL WELD, CS TO INCO, - USE CAL BLOCK UT-100.
 - DISSIMILAR METAL WELD, INCO TO CS, - USE CAL BLOCK UT-102.
 - ACCESS TO WELD 14 LPCI (1)A-15 \triangle REQUIRES REMOVAL OF RHR-13B3.
 - FOR DETAILS OF NOZZLE ASSEMBLY SEE RPV-110.
 - ACCESS TO WELD 14 LPCI (1)A-17 REQUIRES REMOVAL OF RHR-529.

- REFERENCES:
- BOVEE & CRAIL ISOMETRICS:
 - RHR-851-20 REV 7
 - RHR-851-21.24 REV 6

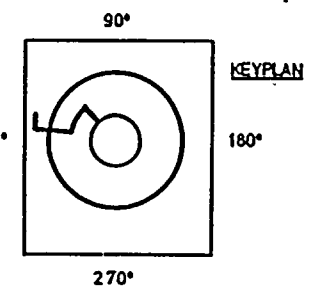

QUALITY CLASS: 1	ASME CODE CLASS: 1
ENGR: D PORTER	DRAWN: K.M.A. DATE: 12-1-77


WASHINGTON PUBLIC POWER SUPPLY SYSTEM
 RICHMOND, WASHINGTON 98362

THIS DRAWING IS INTENDED FOR USE IN PRESERVE AND INSERVICE INSPECTION PROGRAMS ONLY.

NO	DATE	REVISION	BY	CHKD	APPVD	PIPING SYSTEM	NOM DIA (IN)	SCH	NOM WALL THK	MATERIAL SPECIFICATION	MATL TYPE	CAL BLOCK NO
5	8-21-83	ADDED KEYPLAN & AS NOTED ADDED LUGS	W.M.A.	M.R.	T.H.P.							
4	8-21-83	REVISED AS NOTED	W.M.A.	M.R.	T.H.P.							
3	11-15-80	CORRECTED SCH (WALL THK FOR 12" RHR 11-6)	W.M.A.	M.R.	T.H.P.	12" RHR (1)A-4	14	80	0.750	SA 106 GR B	CS	UT-14
2	8-20-79	ADDED NOTED. ADDED CALLOUT IN A-4	W.M.A.	M.R.	T.H.P.	12" RHR (1)A-4	12	80	0.688	SA 106 GR B	CS	UT-17
1	1-18-78	CAL BLOCK REFERENCE CHANGED (NOTE 3)	W.M.A.	M.R.	T.H.P.	LUGS	NA	NA	NA	SA 516 GR 70	CS	UT-46
0	11-17-78	ISSUED FOR USE	W.M.A.	M.R.	T.H.P.							
A	3-15-78	ISSUED FOR INFORMATION ONLY	W.M.A.	M.R.	T.H.P.							

WNP-2 WELD & COMPONENT IDENTIFICATION DIAGRAM	
TITLE: RHR/LPCI LOOP "A"	
DWG NO: RHR-101	REV 5



WNP-02
 INTERVAL: PSI
 PERIOD: NA
 OUTAGE:
 DRAWING NO. RHR-101

WASHINGTON PUBLIC POWER SUPPLY SYSTEM
 PROGRAM PLAN AND SCHEDULE
 SYSTEM OR COMPONENT: RHR(1)-4
 DESCRIPTION: RHR/LPCI LOOP "A"

PAGE 001
 DATE 12/14/84

IDENT. NO.	DESCRIPTION	SECT. XI EXAM.	EXAM MTH.	PROCEDURE	CAL. BLOCK	INSERVICE		NOTES
						REQ.	SCHEDULED OUTAGE	
RHR-V-42A-BDY	VALVE BODY	B-M-2	VT-1	QCI 7-1				
RHR-V-42A-BLT	VALVE BOLTING	B-G-2	VT-1	QCI 7-1				
RHR-V-42A/3/4CAP	LEAKOFF CAPPED	B-P	VT-2	N/A				SEE NOTES #6 & #7.
14LPCI(1)A-1	VLV TO PIPE	B-J	VOL	UTP-10	UT-14			
			SUR	PTP-1				
14LPCI(1)A-1/3/4V-709A	PRESSURE TAP	B-P	VT-2	N/A				SEE NOTES #6 & #7.
14LPCI(1)A-1/3/4V-56A	TEST CONN	B-P	VT-2	N/A				SEE NOTES #6 & #7.
RHR-941N	PSA-3 SNUBBER	B-K-2	VT-3	303/8.2.17				S/N 110
			VT-4	303/8.2.17				S/N 110
14LPCI(1)A-2	PIPE TO EL	B-J	VOL	UTP-10	UT-14			
			SUR	PTP-1				
14LPCI(1)A-3	EL TO PIPE	B-J	VOL	UTP-10	UT-14			
			SUR	PTP-1				
RHR-231(W)	4 WELDED LUGS	B-K-1	VOL	QCI 6-15	UT-14			
RHR-231	SPRING	B-K-2	VT-3	303/8.2.17				
			VT-4	303/8.2.17				
14LPCI(1)A-4	PIPE TO EL	B-J	VOL	UTP-10	UT-14			
			SUR	PTP-1				

WNP-02
 INTERVAL: PSI
 PERIOD: NA
 OUTAGE:
 DRAWING NO. RHR-101

WASHINGTON PUBLIC POWER SUPPLY SYSTEM
 PROGRAM PLAN AND SCHEDULE
 SYSTEM OR COMPONENT: RHR(1)-4
 DESCRIPTION: RHR/LPCI LOOP "A"

PAGE 002
 DATE 12/14/84

<u>IDENT. NO.</u>	<u>DESCRIPTION</u>	SECT. XI <u>EXAM.</u>	EXAM <u>MTM.</u>	<u>PROCEDURE</u>	CAL. <u>BLOCK</u>	<u>INSERVICE</u>		<u>NOTES</u>
						<u>REQ.</u>	<u>SCHEDULED</u> <u>OUTAGE</u>	
14LPCI(1)A-5	EL TO PIPE	B-J	VOL	UTP-10	UT-14			
			SUR	PTP-1				
14LPCI(1)A-6	PIPE TO PEN	B-J	VOL	UTP-10	UT-14			
			SUR	PTP-1				
14LPCI(1)A-7	PEN TO PIPE	B-J	VOL	UTP-10	UT-14			
			SUR	PTP-1				
RHR-527	SPRING	B-K-2	VT-3	303/8.2.17				
			VT-4	303/8.2.17				
RHR-380	PSA-10 SNUBBER	B-K-2	VT-3	303/8.2.17				S/N 692
			VT-4	303/8.2.17				S/N 692
14LPCI(1)A-8	PIPE TO PIPE	B-J	VOL	UTP-10	UT-14			
			SUR	PTP-1				
RHR-381	PSA-10 SN(2)	B-K-2	VT-3	303/8.2.17				S/N E695/W683
			VT-4	303/8.2.17				S/N E695/W683
RHR-528(W)	4 WELDED LUGS	B-K-1	VOL	UTP-26	UT-14			
RHR-528	SPRING	B-K-2	VT-3	303/8.2.17				
			VT-4	303/8.2.17				
14LPCI(1)A-9	PIPE TO EL	B-J	VOL	UTP-10	UT-14			

WNP-02
 INTERVAL: PSI
 PERIOD: NA
 OUTAGE:
 DRAWING NO. RHR-101

WASHINGTON PUBLIC POWER SUPPLY SYSTEM
 PROGRAM PLAN AND SCHEDULE
 SYSTEM OR COMPONENT: RHR(1)-4
 DESCRIPTION: RHR/LPCI LOOP "A"

PAGE 003
 DATE 12/14/84

IDENT. NO.	DESCRIPTION	SECT. XI EXAM.	EXAM MTH.	PROCEDURE	CAL. BLOCK	INSERVICE		NOTES
						REQ.	SCHEDULED OUTAGE	
14LPCI(1)A-10	EL TO PIPE	B-J	VOL	PTP-1	UT-14			
RHR-382	PSA-35 SNUBBER	B-K-2	VT-3	303/8.2.17				SN 6126
14LPCI(1)A-11	PIPE TO EL	B-J	VOL	PTP-1	UT-14			SN 6126
14LPCI(1)A-11/3/4V-189	PRESSURE TAP	B-P	VT-2	N/A				SEE NOTES #6 & #7.
14LPCI(1)A-12	EL TO PIPE	B-J	VOL	PTP-1	UT-14			
14LPCI(1)A-13	PIPE TO VLV	B-J	VOL	QCI 3-3	UT-14			
RHR-V-41A-BDY	VALVE BODY	B-M-2	VT-1	QCI 7-1				
RHR-V-41A-BLT	VALVE BOLTING	B-G-2	VT-1	QCI 7-1				
RHR-V-41A/3/4CAP	LEAKOFF CAPPED	B-P	VT-2	N/A				SEE NOTES #6 & #7.
14LPCI(1)A-14	VLV TO PIPE	B-J	VOL	PTP-1	UT-14			

WNP-02
 INTERVAL: PSI
 PERIOD: NA
 OUTAGE:
 DRAWING NO. RHR-101

WASHINGTON PUBLIC POWER SUPPLY SYSTEM
 PROGRAM PLAN AND SCHEDULE
 SYSTEM OR COMPONENT: RHR(1)-4
 DESCRIPTION: RHR/LPCI LOOP "A"

PAGE 004
 DATE 12/14/84

IDENT. NO.	DESCRIPTION	SECT. XI EXAM.	EXAM MTH.	PROCEDURE	CAL. BLOCK	INSERVICE		NOTES
						REQ.	SCHEDULED OUTAGE	
RHR-383	PSA-35 SNUBBER	B-K-2	VT-3	303/8.2.17				S/N 10568
			VT-4	303/8.2.17				S/N 10568
14LPCI(1)A-14/1PI(1)-4S	PRESSURE TAP	B-P	VT-2	N/A				SEE NOTES #6 & #7.
14LPCI(1)A-14/3/4V-158A	PRESSURE TAP	B-P	VT-2	N/A				SEE NOTES #6 & #7.
14LPCI(1)A-15	PIPE TO VALVE	B-J	VOL	UTP-10	UT-14			
			SUR	PTP-1				
RHR-V-111A-BDY	VALVE BODY	B-M-2	VT-1	OCI 7-1				
RHR-V-111A-BLT	VALVE BOLTING	B-G-2	VT-1	OCI 7-1				
14LPCI(1)A-16	VLV TO PIPE	B-J	VOL	UTP-10	UT-14			
			SUR	PTP-1				
RHR-529	SPRING	B-K-2	VT-3	303/8.2.17				
			VT-4	303/8.2.17				
14LPCI(1)A-17	EL TO PIPE	B-J	VOL	UTP-10	UT-14			
			SUR	PTP-1				
14LPCI(1)A-18	EL TO PIPE	B-J	VOL	UTP-10	UT-14			
			SUR	PTP-1				
PWS-3-1	PIPE WHIP	N/A	N/A	N/A				SEE NOTE #1
14LPCI(1)A-19	PIPE TO EL	B-J	VOL	UTP-10	UT-14			

WNP-02
 INTERVAL: PSI
 PERIOD: NA
 OUTAGE:
 DRAWING NO. RHR-101

WASHINGTON PUBLIC POWER SUPPLY SYSTEM
 PROGRAM PLAN AND SCHEDULE
 SYSTEM OR COMPONENT: RHR(1)-4
 DESCRIPTION: RHR/LPCI LOOP "A"

PAGE 005
 DATE 12/14/84


IDENT. NO.	DESCRIPTION	SECT. XI EXAM.	EXAM MTH.	PROCEDURE	CAL. BLOCK	INSERVICE		NOTES
						REQ.	SCHEDULED OUTAGE	
14LPCI(1)A-20	EL TO PIPE	B-J	VOL	PTP-1 UTP-10	UT-14			
PWS-3-2	PIPE WHIP	N/A	N/A	N/A				SEE NOTE #1
14LPCI(1)A-21	PIPE TO REDUCER	B-J	VOL	PTP-1 UTP-10	UT-14			
12LPCI(1)A-1	REDUCER TO PIPE	B-J	VOL	PTP-1 UTP-10	UT-17			
12LPCI(1)A-2	PIPE TO EL	B-J	VOL	PTP-1 UTP-10	UT-17			
12LPCI(1)A-3	EL TO PIPE	B-J	VOL	PTP-1 UTP-10	UT-17			
12LPCI(1)A-4	PIPE TO SE	B-J	VOL	PTP-1 UTP-10	UT-17			
12LPCI(1)A-5	SE EXT TO SE	B-F	VOL	PTP-1 UTP-10	UT-106			DISSIMILAR METAL (CS-INCO)
			SUR	PTP-1				DISSIMILAR METAL (CS-INCO)

WNP-02
 INTERVAL: PSI
 PERIOD: NA
 OUTAGE:
 DRAWING NO. RHR-101

WASHINGTON PUBLIC POWER SUPPLY SYSTEM
 PROGRAM PLAN AND SCHEDULE
 SYSTEM OR COMPONENT: RHR(1)-4
 DESCRIPTION: RHR/LPCI LOOP "A"

PAGE 006
 DATE 12/14/84

<u>IDENT. NO.</u>	<u>DESCRIPTION</u>	<u>SECT.</u> XI	<u>EXAM</u> MTH.	<u>PROCEDURE</u>	<u>CAL.</u> BLOCK	<u>INSERVICE</u>		<u>NOTES</u>
						<u>REQ.</u>	<u>SCHEDULED</u> OUTAGE	
12LPCI(1)A-6	SE TO NOZZLE	B-F	VOL	UTP-10	UT-102			DISSIMILAR METAL (CS-INCO)
			SUR	PTP-1				DISSIMILAR METAL (CS-INCO)
RHR-PB-101	RHR PRES BNDRY	B-P	VT-2	N/A				SEE NOTES #6 & #7.

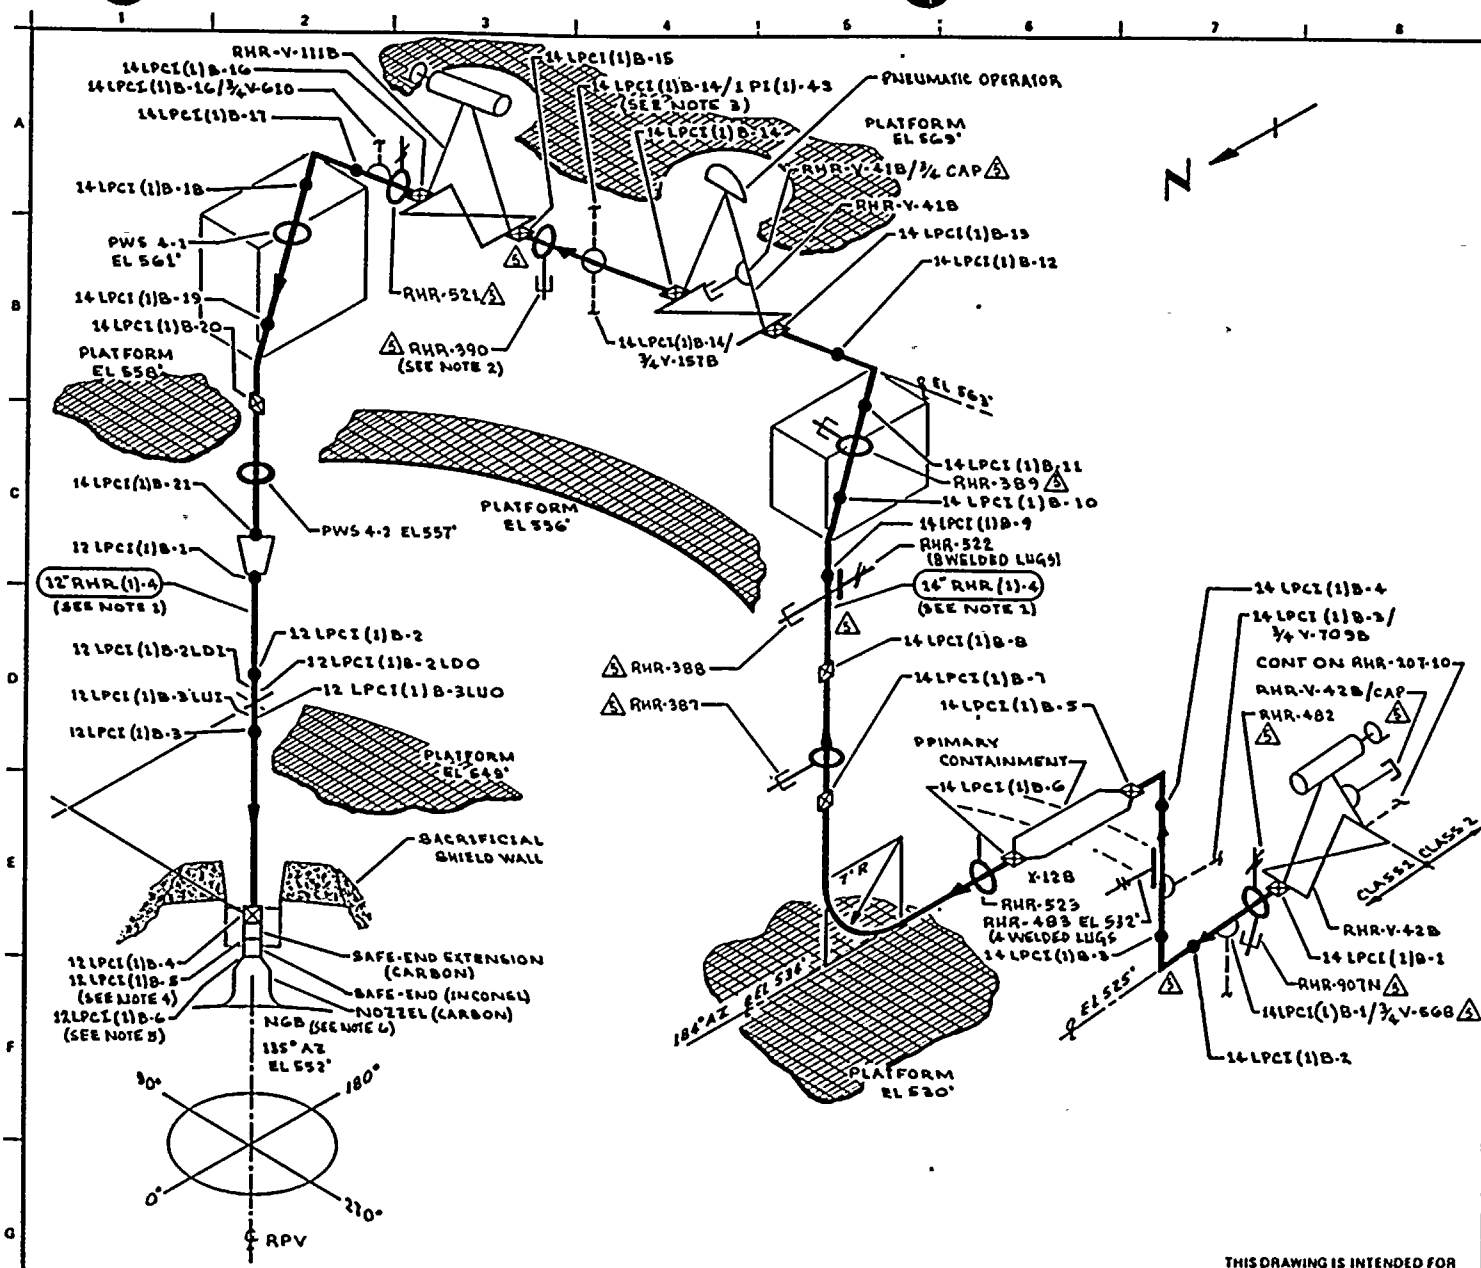

- NOTES:
1. WELD NUMBERING UTILIZES "LPCI" RATHER THAN "RHR" FOR SYSTEM DESIGNATION FOR CLARITY.
 2. ACCESS TO WELD 14LPCI(1)B-15 REQUIRES REMOVAL OF RHR-390.
 3. EXTEND LEAKAGE EXAM THROUGH CONTAINMENT (X-39B) THROUGH EXCESS FLOW CHECK VALVE TO INSTRUMENT TUBING CONNECTION.
 4. DISSIMILAR METAL WELD, CS TO INCO, USE CAL BLOCK UT-106.
 5. DISSIMILAR METAL WELD, INCO TO CS, USE CAL BLOCK UT-102.
 6. FOR DETAILS OF NOZZLE ASSEMBLY SEE RPV-110.

- REFERENCES:
- BOVEE & CRAIG ISOMETRICS I,
 RHR-899-38 REV 8
 RHR-899-39-44 REV 9

QUALITY CLASS: 1 ASME CODE CLASS: 1
 ENGR: D PORTER DRAWN: X-MCA DATE: 12-9-77



THIS DRAWING IS INTENDED FOR USE IN PRESERVICE AND INSERVICE INSPECTION PROGRAMS ONLY.

NO	DATE	REVISION	BY	CHKD	APPVD	PIPING SYSTEM	NOM DIA (IN)	SCH	NOM WALL THK	MATERIAL SPECIFICATION	MATL TYPE	CAL BLOCK NO
5	9-26-83	REVISED AS NOTED. ADDED KEYPLAN & LUGS	KMA	DMR	TRK							
4	11-2-81	REVISED AS NOTED	KMA	DMR	TRK							
3	11-5-80	CORRECTED SLOPE & WALL THK FOR 12" RHR 111-6	KMA	DMR	TRK	12" RHR (1)A-4	12	80	0.688	SA-106 GR B	CS	UT-14
2	1-12-79	ADDED 12" RHR 111-6 TO 12" RHR 111-6. 12" RHR 111-6 IS 12" RHR 111-6. 12" RHR 111-6 IS 12" RHR 111-6.	KMA	DMR	TRK	LUGS	NA	NA	NA	SA 516 GR 70	CS	UT-46
1	1-10-79	CAL BLOCK REFERENCE CHANGED (NOTE 4)	KMA	DMR	TRK							
0	11-27-78	ISSUED FOR USE	KMA	DMR	TRK							
A	8-15-78	ISSUED FOR INFORMATION ONLY	KMA	DMR	TRK							

WNP-2
 WELD & COMPONENT
 IDENTIFICATION DIAGRAM

TITLE:
 RHR/LPCI LOOP "B"

DWG NO: RHR-102 REV 5



WNP-02
 INTERVAL: PSI
 PERIOD: NA
 OUTAGE:
 DRAWING NO. RHR-102

WASHINGTON PUBLIC POWER SUPPLY SYSTEM
 PROGRAM PLAN AND SCHEDULE
 SYSTEM OR COMPONENT: RHR(1)-4
 DESCRIPTION: RHR/LPCI LOOP "B"

PAGE 001
 DATE 12/14/84

IDENT. NO.	DESCRIPTION	SECT. XI EXAM.	EXAM MTH.	PROCEDURE	CAL. BLOCK	INSERVICE		NOTES
						REQ.	SCHEDULED -OUTAGE	
RHR-V-42B-BDY	VALVE BODY	B-M-2	VT-1	OCI 7-1				
RHR-V-42B-BLT	VALVE BOLTING	B-G-2	VT-1	CCI 7-1				
RHR-V-42B/3/4CAP	LEAKOFF CAPPED	B-P	VT-2	N/A				SEE NOTES #6 & #7.
14LPCI(1)B-1	VLV TO PIPE	B-J	VOL	UTP-10	UT-14			
			SUR	PTP-1				
RHR-907N	PSA-35 SNUBBER	B-K-2	VT-3	303/8.2.17				S/N 6234
			VT-4	303/8.2.17				S/N 6234
RHR-482	STRUT	B-K-2	VT-3	303/8.2.17				
14LPCI(1)B-1/3/4V-568	TEST CONN	B-P	VT-2	N/A				SEE NOTES #6 & #7.
14LPCI(1)B-2	PIPE TO EL	B-J	VOL	UTP-10	UT-14			
			SUR	PTP-1				
14LPCI(1)B-3	EL TO PIPE	B-J	VOL	UTP-10	UT-14			
			SUR	PTP-1				
14LPCI(1)B-3/3/4V-709B	PRESSURE TAP	B-P	VT-2	N/A				SEE NOTES #6 & #7.
RHR-483	SPRING	B-K-2	VT-3	303/8.2.17				
			VT-4	303/8.2.17				
RHR-483(W)	4 WELDED LUGS	B-K-1	VOL	UTP-26	UT-14			
14LPCI(1)B-4	PIPE TO EL	B-J	VOL	UTP-10	UT-14			

WNP-02
 INTERVAL: PSI
 PERIOD: NA
 OUTAGE:
 DRAWING NO. RHR-102

WASHINGTON PUBLIC POWER SUPPLY SYSTEM
 PROGRAM PLAN AND SCHEDULE
 SYSTEM OR COMPONENT: RHR(1)-4
 DESCRIPTION: RHR/LPCI LOOP "B"

PAGE 002
 DATE 12/14/84

IDENT. NO.	DESCRIPTION	SECT. XI EXAM.	EXAM MTH.	PROCEDURE	CAL. BLOCK	INSERVICE		NOTES
						REQ.	SCHEDULED OUTAGE	
14LPCI(1)B-5	EL TO PEN	B-J	VOL	UTP-10	UT-14			
14LPCI(1)B-6	PEN TO PIPE	B-J	VOL	UTP-10	UT-14			
RHR-523	SPRING	B-K-2	VT-3	303/8.2.17				
14LPCI(1)B-7	PIPE TO PIPE	B-J	VOL	UTP-10	UT-14			
RHR-387	PSA-10 SNUBBER	B-K-2	VT-3	303/8.2.17				S/N 11867
14LPCI(1)B-8	PIPE TO PIPE	B-J	VOL	UTP-10	UT-14			S/N 11867
RHR-388	PSA-10 SNUBBER	B-K-2	VT-3	303/8.2.17				S/N W1486/E1489
RHR-522	SPRING	B-K-2	VT-3	303/8.2.17				S/N W1486/E1489
14LPCI(1)B-9	PIPE TO EL	B-J	VOL	UTP-10	UT-14			

WNP-02
 INTERVAL: PSI
 PERIOD: NA
 OUTAGE:
 DRAWING NO. RHR-102

WASHINGTON PUBLIC POWER SUPPLY SYSTEM
 PROGRAM PLAN AND SCHEDULE
 SYSTEM OR COMPONENT: RHR(1)-4
 DESCRIPTION: RHR/LPCI LOOP "B"

PAGE 003
 DATE 12/14/84

<u>IDENT. NO.</u>	<u>DESCRIPTION</u>	<u>SECT.</u> <u>XI</u>	<u>EXAM</u> <u>MTH.</u>	<u>PROCEDURE</u>	<u>CAL.</u> <u>BLOCK</u>	<u>INSERVICE</u>		<u>NOTES</u>
						<u>REQ.</u>	<u>SCHEDULED</u> <u>OUTAGE</u>	
14LPCI(1)B-10	EL TO PIPE	B-J	SUR	PTP-1	UT-14			
RHR-389	PSA-35 SNUBBER	B-K-2	VT-3	303/8.2.17				S/N 7040
14LPCI(1)B-11	PIPE TO EL	B-J	VT-4	303/8.2.17	UT-14			S/N 7040
14LPCI(1)B-12	EL TO PIPE	B-J	SUR	PTP-1	UT-14			
14LPCI(1)B-13	PIPE TO VALVE	B-J	VT-1	QCI 7-1	UT-14			
RHR-V-41B-BDY	VALVE BODY	B-M-2	VT-1	QCI 7-1				
RHR-V-41B-BLT	VALVE BOLTING	B-G-2	VT-1	QCI 7-1				
RHR-V-41B/3/4CAP	LEAKOFF CAPPED	B-P	VT-2	N/A				SEE NOTES #6 & #7.
14LPCI(1)B-14	VALVE TO PIPE	B-J	SUR	PTP-1	UT-14			
14LPCI(1)B-14/1PI(1)-4S	PRESSURE TAP	B-P	VT-2	N/A				SEE NOTES #6 & #7.

WNP-02
 INTERVAL: PSI
 PERIOD: NA
 OUTAGE:
 DRAWING NO. RHR-102

WASHINGTON PUBLIC POWER SUPPLY SYSTEM
 PROGRAM PLAN AND SCHEDULE
 SYSTEM OR COMPONENT: RHR(1)-4
 DESCRIPTION: RHR/LPCI LOOP "B"

PAGE 004
 DATE 12/14/84

<u>IDENT. NO.</u>	<u>DESCRIPTION</u>	<u>SECT.</u> <u>XI</u> <u>EXAM.</u>	<u>EXAM</u> <u>MTH.</u>	<u>PROCEDURE</u>	<u>CAL.</u> <u>BLOCK</u>	<u>INSERVICE</u>		<u>NOTES</u>
						<u>REQ.</u>	<u>SCHEDULED</u> <u>OUTAGE</u>	
14LPCI(1)B-14/3/4V-157B	TEST CONN	B-P	VT-2	N/A				SEE NOTES #6 & #7.
RHR-390	PSA-35 SNUBBER	B-K-2	VT-3	303/8.2.17				S/N 2636
			VT-4	303/8.2.17				S/N 2636
14LPCI(1)B-15	PIPE TO VALVE	B-J	VOL	UTP-10	UT-14			
RHR-V-111B-BDY	VALVE BODY	B-M-2	VT-1	OCI 7-1				
RHR-V-111B-DLT	VALVE BOLTING	B-G-2	VT-1	OCI 7-1				
14LPCI(1)B-16	VALVE TO PIPE	B-J	VOL	UTP-10	UT-14			
RHR-521	SPRING	B-K-2	VT-3	303/8.2.17				
			VT-4	303/8.2.17				
14LPCI(1)B-16/3/4V-610	TEST CONN	B-P	VT-2	N/A				SEE NOTES #6 & #7.
14LPCI(1)B-17	PIPE TO EL	B-J	VOL	UTP-10	UT-14			
			SUR	PTP-1				
14LPCI(1)B-18	EL TO PIPE	B-J	VOL	UTP-10	UT-14			
			SUR	PTP-1				
FWS-4-1	PIPE WHIP	N/A	N/A	N/A				SEE NOTE #1
14LPCI(1)B-19	PIPE TO EL	B-J	VOL	UTP-10	UT-14			

WNP-02
 INTERVAL: PSI
 PERIOD: NA
 OUTAGE:
 DRAWING NO. RHR-102

WASHINGTON PUBLIC POWER SUPPLY SYSTEM
 PROGRAM PLAN AND SCHEDULE
 SYSTEM OR COMPONENT: RHR(1)-4
 DESCRIPTION: RHR/LPCI LOOP "B"

PAGE 005
 DATE 12/14/84


<u>IDENT. NO.</u>	<u>DESCRIPTION</u>	<u>SECT.</u> <u>XI</u> <u>EXAM.</u>	<u>EXAM</u> <u>MTH.</u>	<u>PROCEDURE</u>	<u>CAL.</u> <u>BLOCK</u>	<u>INSERVICE</u>		<u>NOTES</u>
						<u>REQ.</u>	<u>SCHEDULED</u> <u>OUTAGE</u>	
14LPCI(1)B-20	EL TO PIPE	B-J	VOL	PTP-1 UTP-10	UT-14			
PWS-4-2	PIPE WHIP	N/A	N/A	N/A				SEE NOTE #1
14LPCI(1)B-21	PIPE TO REDUCER	B-J	VOL	PTP-1 UTP-10	UT-14			
12LPCI(1)B-1	REDUCER TO PIPE	B-J	VOL	PTP-1 UTP-10	UT-17			
12LPCI(1)B-2	PIPE TO EL	B-J	VOL	PTP-1 UTP-10	UT-17			
12LPCI(1)B-2LDI	EL SEAM	B-J	VGL	PTP-1 UTP-10	UT-17			
12LPCI(1)B-2LDO	EL SEAM	B-J	VOL	PTP-1 UTP-10	UT-17			
12LPCI(1)B-3LUI	EL SEAM	B-J	VOL	PTP-1 UTP-10	UT-17			
12LPCI(1)B-3LUO	EL SEAM	B-J	VOL	PTP-1 UTP-10	UT-17			

WNP-02
 INTERVAL: PSI
 PERIOD: NA
 OUTAGE:
 DRAWING NO. RHR-102

WASHINGTON PUBLIC POWER SUPPLY SYSTEM
 PROGRAM PLAN AND SCHEDULE
 SYSTEM OR COMPONENT: RHR(1)-4
 DESCRIPTION: RHR/LPCI LOOP "B"


PAGE 006
 DATE 12/14/84

<u>IDENT. NO.</u>	<u>DESCRIPTION</u>	SECT. YI <u>EXAM.</u>	EYAM <u>MTH.</u>	<u>PROCEDURE</u>	CAL. <u>BLOCK</u>	<u>INSERVICE</u>		<u>NOTES</u>
						<u>REQ.</u>	<u>SCHEDULED</u> <u>OUTAGE</u>	
12LPCI(1)B-3	EL TO PIPE	B-J	VOL	UTP-10	UT-17			
			SUR	PTP-1				
12LPCI(1)B-4	PIPE TO SE EXT	B-J	VOL	UTP-10	UT-17			
			SUR	PTP-1				
12LPCI(1)B-5	SE EXT TO SE	B-F	VOL	UTP-10	UT-105			DISSIMILAR METAL (CS-INCO)
			SUR	PTP-1				DISSIMILAR METAL (CS-INCO)
12LPCI(1)B-6	SE TO NOZZLE	B-F	VOL	UTP-10	UT-102			DISSIMILAR METAL (CS-INCO)
			SUR	PTP-1				DISSIMILAR METAL (CS-INCO)
RHR-PB-102	RHR PRES BNDRY	B-P	VT-2	N/A				SEE NOTES #6 & #7.

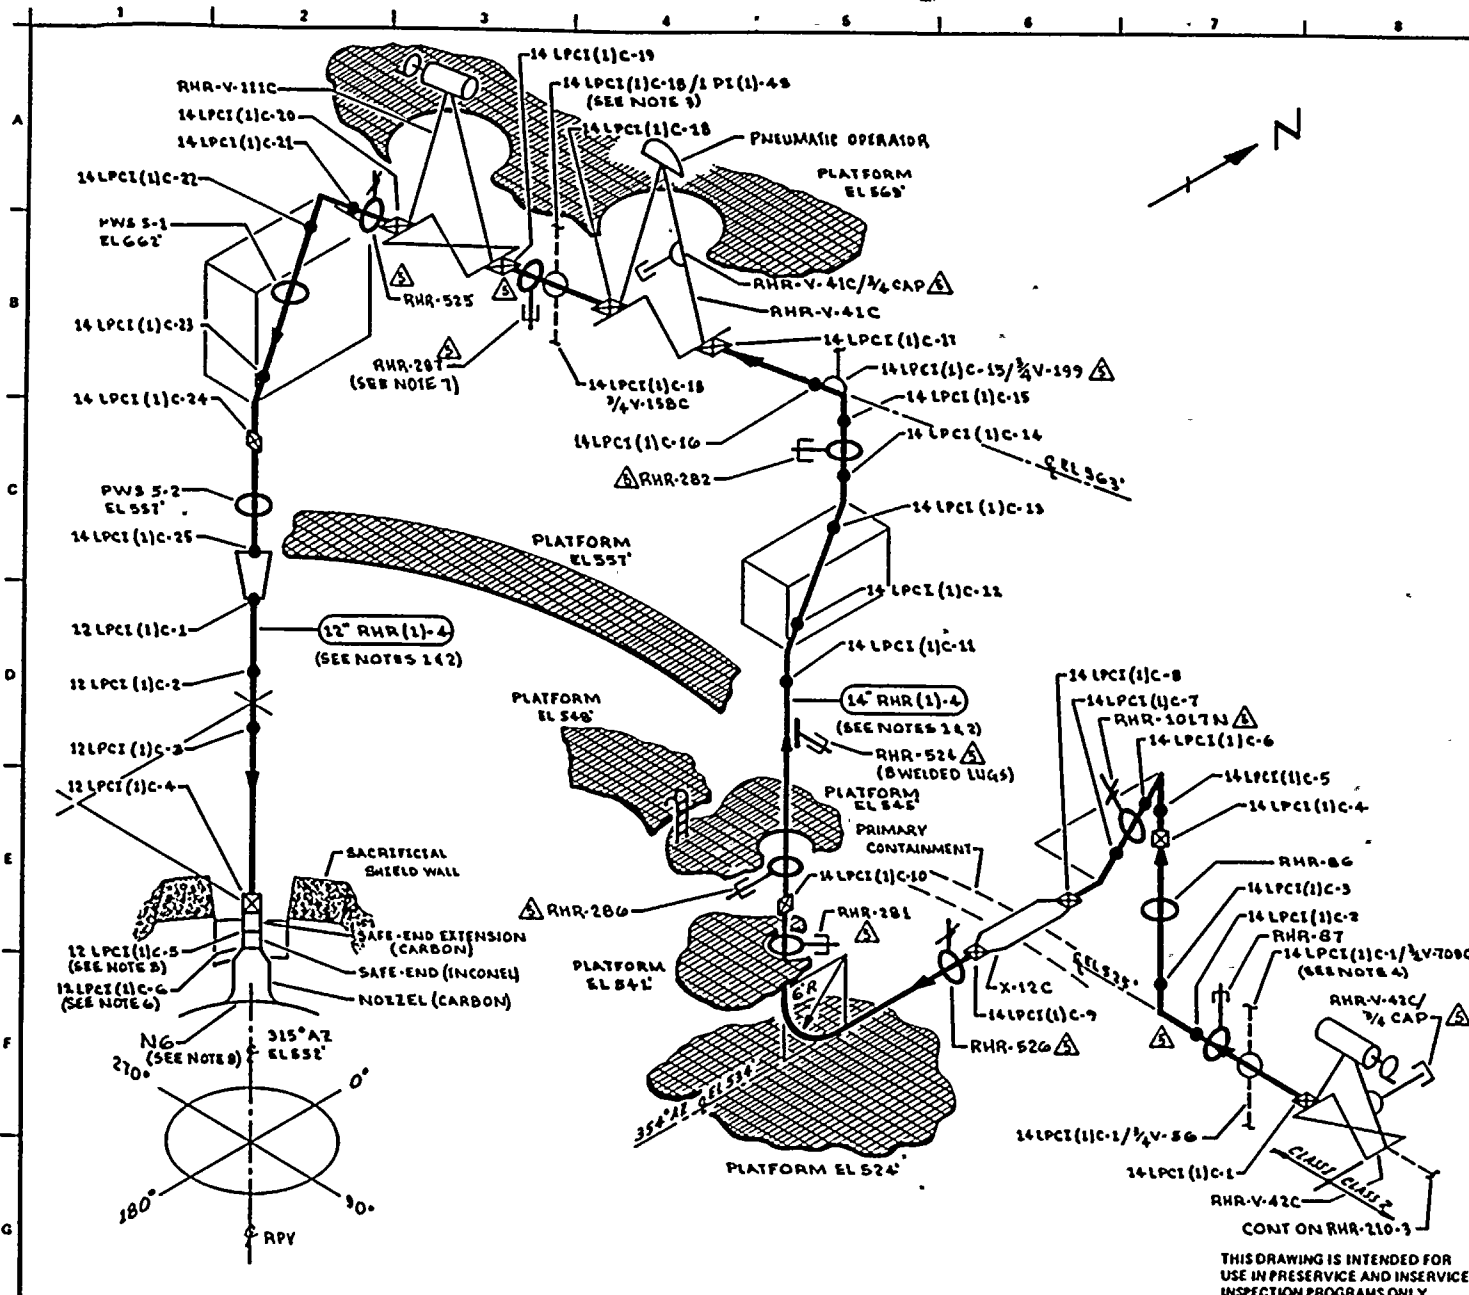

- NOTES:**
1. WELD NUMBERING UTILIZES "LPCI" RATHER THAN "RHR" FOR SYSTEM DESIGNATION FOR CLARITY.
 2. ACCESS TO WELDS 12 LPCI (1)C-1 THROUGH 12 LPCI (1)C-6 & 14 LPCI (1)C-24 REQUIRES TEMPORARY SCAFFOLDING.
 3. EXTEND VISUAL LEAKAGE EXAM THROUGH CONTAINMENT (X-39C) THROUGH EXCESS FLOW CHECK VALVE TO INSTRUMENT TUBING CONNECTION.
 4. EXTEND VISUAL LEAKAGE EXAM THROUGH EXCESS FLOW CHECK VALVE TO INSTRUMENT TUBING CONNECTION.
 5. DISSIMILAR METAL WELD, CS TO INCO, - USE CAL BLOCK UT-106.
 6. DISSIMILAR METAL WELD, INCO TO CS, - USE CAL BLOCK UT-102.
 7. ACCESS TO WELD 14 LPCI (1)C-15 REQUIRES REMOVAL RHR-287.
- B. FOR DETAILS OF NOZZLE ASSEMBLY SEE RPV-110

- REFERENCES:**
- BOYER & CRILL ISOMETRICS:
 RHR-897-19 REV B
 RHR-897-20-24 REV 9

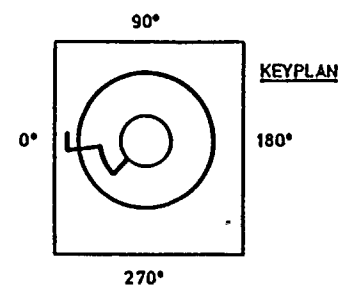

QUALITY CLASS: 1 ASME CODE CLASS: 1
 ENGR: D PORTER DRAWN: K-M-A DATE: 12-9-77

WASHINGTON PUBLIC POWER SUPPLY SYSTEM
 RICHMOND WASHINGTON 98362

THIS DRAWING IS INTENDED FOR USE IN PRESERVICE AND INSERVICE INSPECTION PROGRAMS ONLY.

NO	DATE	REVISION	BY	CHKD	APPVD
5	9-21-83	REVISED AS NOTED. ADDED KEYPLAN & LUGS	K/A	R/R	T/P
4	12-2-81	REVISED AS NOTED	K/A	R/R	T/P
3	11-6-80	CORRECTED SCH & WALL THK FOR 12" RHR (1)-4 & MILD	K/A	R/R	T/P
2	11-17-79	CORRECTED NOTE T, ADDED NOTE B & CALL-OUT ELL A-4	K/A	R/R	T/P
1	1-10-79	CAL BLOCK REFERENCE CHANGED (NOTE B)	K/A	R/R	T/P
0	11-27-78	ISSUED FOR USE	K/A	R/R	T/P
A	9-15-78	ISSUED FOR INFORMATION ONLY	K/A	R/R	T/P

PIPING SYSTEM	NOM DIA (IN)	SCH	NOM WALL THK	MATERIAL SPECIFICATION	MATL TYPE	CAL BLOCK NO
12" RHR (1)-4	12	80	0.288	SA-106 GR B	CS	UT-17
LUGS	NA	NA	NA	SA SIG GR 70	CS	UT-46

WNP-2
 WELD & COMPONENT IDENTIFICATION DIAGRAM

TITLE:
RHR/LPCI LOOP "C"

DWG NO: RHR-103 REV 5



WNP-02
 INTERVAL: PSI
 PERIOD: NA
 OUTAGE:
 DRAWING NO. RHR-103

WASHINGTON PUBLIC POWER SUPPLY SYSTEM
 PROGRAM PLAN AND SCHEDULE
 SYSTEM OR COMPONENT: RHR(1)-4
 DESCRIPTION: RHR SHUTDN COOL SUCT

PAGE 001
 DATE 12/14/84

IDENT. NO.	DESCRIPTION	SECT. XI EXAM.	EXAM MTH.	PROCEDURE	CAL. BLOCK	INSERVICE		NOTES
						REQ.	SCHEDULED OUTAGE	
RHR-V-42C-BDY	VALVE BODY	B-M-2	VT-1	QCI 7-1				
RHR-V-42C-BLT	VALVE BOLTING	B-G-2	VT-1	QCI 7-1				
RHR-V-42C/3/4CAP	LEAKOFF CAPPED	B-P	VT-2	N/A				SEE NOTES #6 & #7.
14LPCI(1)C-1	VLV TO PIPE	B-J	VOL	UTP-10	UT-14			
			SUR	PTP-1				
14LPCI(1)C-1/3/4V-56	TEST CONN	B-P	VT-2	N/A				SEE NOTES #6 & #7.
14LPCI(1)C-1/3/4V-709C	PRESSURE TAP	B-P	VT-2	N/A				SEE NOTES #6 & #7.
RHR-87	PSA-10 SHUBBER	B-K-2	VT-3	303/8.2.17				S/N 773
			VT-4	303/8.2.17				S/N 773
14LPCI(1)C-2	PIPE TO EL	B-J	VOL	UTP-10	UT-14			
			SUR	PTP-1				
14LPCI(1)C-3	EL TO PIPE	B-J	VOL	UTP-10	UT-14			
			SUR	PTP-1				
14LPCI(1)C-4	PIPE TO PIPE	B-J	VOL	UTP-10	UT-14			
			SUR	PTP-1				
14LPCI(1)C-5	PIPE TO EL	B-J	VOL	UTP-10	UT-14			
			SUR	PTP-1				
14LPCI(1)C-6	EL TO PIPE	B-J	VOL	UTP-10	UT-14			

WNP-02
 INTERVAL: PSI
 PERIOD: NA
 OUTAGE:
 DRAWING NO. RHR-103

WASHINGTON PUBLIC POWER SUPPLY SYSTEM
 PROGRAM PLAN AND SCHEDULE
 SYSTEM OR COMPONENT: RHR(1)-4
 DESCRIPTION: RHR SHUTDN COOL SUCT

PAGE 002
 DATE 12/14/84

IDENT. NO.	DESCRIPTION	SECT. XI FYAM.	EXAM MTH.	PROCEDURE	CAL. BLOCK	INSERVICE		NOTES
						REQ.	SCHEDULED OUTAGE	
RHR-1017N			SUR	PTP-1				
	SPRING	B-K-2	VT-3	303/8.2.17				
			VT-4	303/9.2.17				
14LPCI(1)C-7	PIPE TO EL	B-J	VOL	UTP-10	UT-14			
			SUR	PTP-1				
14LPCI(1)C-8	EL TO PEN	B-J	VOL	UTP-10	UT-14			
			SUR	PTP-1				
14LPCI(1)C-9	PEN TO PIPE	B-J	VOL	UTP-10	UT-14			
			SUR	PTP-1				
RHR-526	SPRING	B-K-2	VT-3	303/8.2.17				
			VT-4	303/8.2.17				
RHR-281	PSA-10 SNUBBER	B-K-2	VT-3	303/8.2.17				S/N 11868
			VT-4	303/8.2.17				S/N 11868
14LPCI(1)C-10	PIPE TO PIPE	B-J	VOL	UTP-10	UT-14			
			SUR	PTP-1				
RHR-286	PSA-10 SN(2)	B-K-2	VT-3	303/8.2.17				S/N 15466/154
			VT-4	303/8.2.17				S/N 15466/154
RHR-524	SPRING	B-K-2	VT-3	303/8.2.17				

WNP-02
 INTERVAL: PSI
 PERIOD: NA
 OUTAGE:
 DRAWING NO. RHR-103

WASHINGTON PUBLIC POWER SUPPLY SYSTEM
 PROGRAM PLAN AND SCHEDULE
 SYSTEM OR COMPONENT: RHR (1)-4
 DESCRIPTION: RHR SHUTDN COOL SUCT

PAGE 003
 DATE 12/14/84

IDENT. NO.	DESCRIPTION	SECT. XI EXAM. EXAM.	MTH.	PROCEDURE	CAL. BLOCK	INSERVICE		NOTES
						REQ.	SCHEDULED OUTAGE	
RHR-524 (W)			VT-4	303/8.2.17				
14LPCI(1)C-11	8 WELDED LUGS	B-K-1	VOL	UTP-26	UT-14			
	PIPE TO EL	B-J	VOL	UTP-10	UT-14			
14LPCI(1)C-12			SUR	PTP-1				
	EL TO PIPE	B-J	VOL	UTP-10	UT-14			
14LPCI(1)C-13			SUR	PTP-1				
	PIPE TO EL	B-J	VOL	UTP-10	UT-14			
14LPCI(1)C-14			SUR	PTP-1				
	EL TO PIPE	B-J	VOL	UTP-10	UT-14			
RHR-282			SUR	PTP-1				
	PSA-35 SNUBBER	B-K-2	VT-3	303/8.2.17				S/N 10568
14LPCI(1)C-15			VT-4	303/8.2.17				S/N 10568
	PIPE TO EL	B-J	VOL	UTP-10	UT-14			
14LPCI(1)C-15/3/4V-199			SUR	PTP-1				
	TEST CONN	B-P	VT-2	N/A				SEE NOTES #6 & #7.
14LPCI(1)C-16								
	EL TO PIPE	B-J	VOL	UTP-10	UT-14			
14LPCI(1)C-17			SUR	PTP-1				
	PIPE TO VALVE	B-J	VOL	UTP-10	UT-14			

WNP-02
 INTERVAL: PSI
 PERIOD: NA
 OUTAGE:
 DRAWING NO. RHR-103

WASHINGTON PUBLIC POWER SUPPLY SYSTEM
 PROGRAM PLAN AND SCHEDULE
 SYSTEM OR COMPONENT: RHR(1)-4
 DESCRIPTION: RHR SHUTDN COOL SUCT

PAGE 004
 DATE 12/14/84

IDENT. NO.	DESCRIPTION	SECT.		PROCEDURE	CAL. BLOCK	INSERVICE		NOTES
		XI EXAM EXAM. MTH.				SCHEDULED SEQ. OUTAGE		
				SUR				
RHR-V-41C-BDY	VALVE BODY	B-M-2	VT-1	QCI 7-1				
RHR-V-41C-BLT	VALVE BOLTING	B-G-2	VT-1	QCI 7-1				
RHR-V-41C/3/4CAP	LEAKOFF CAPPED	B-P	VT-2	N/A				SEE NOTES #6 & #7.
14LPCI(1)C-18	VLV TO PIPE	B-J	VOL	UTP-10	UT-14			
				SUR				
14LPCI(1)C-18/1PI(1)-4S	PRESSURE TAP	B-P	VT-2	N/A				SEE NOTES #6 & #7.
14LPCI(1)C-18/3/4V-158C	TEST CGNN	B-P	VT-2	N/A				SEE NOTES #6 & #7.
RHR-287	PSA-35 SNUBBER	B-K-2	VT-3	303/8.2.17				S/N 10567
			VT-4	303/8.2.17				S/N 10567
14LPCI(1)C-19	PIPE TO VALVE	B-J	VOL	UTP-10	UT-14			
				SUR				
RHR-V-111C-BDY	VALVE BODY	B-M-2	VT-1	QCI 7-1				
RHR-V-111C-BLT	VALVE BOLTING	B-G-2	VT-1	QCI 7-1				
14LPCI(1)C-20	VALVE TO PIPE	B-J	VOL	UTP-10	UT-14			
				SUR				
PHR-525	SPRING	B-K-2	VT-3	303/8.2.17				
			VT-4	303/8.2.17				

WNP-02
 INTERVAL: PSI
 PERIOD: NA
 OUTAGE:
 DRAWING NO. RHR-103

WASHINGTON PUBLIC POWER SUPPLY SYSTEM
 PROGRAM PLAN AND SCHEDULE
 SYSTEM OR COMPONENT: PHR(1)-4
 DESCRIPTION: RHR SHUTDN COOL SUCT

PAGE 005
 DATE 12/14/84


IDENT. NO.	DESCRIPTION	SECT.	EXAM	PROCEDURE	CAL.	INSERVICE		NOTES
		XI EXAM.	MIH.		BLOCK	REQ.	SCHEDULED OUTAGE	
14LPCI(1)C-21	PIPE TO EL	B-J	VOL	UTP-10	UT-14			
			SUR	PTP-1				
14LPCI(1)C-22	EL TO PIPE	B-J	VOL	UTP-10	UT-14			
			SUR	PTP-1				
PWS-5-1	PIPE WHIP	N/A	N/A	N/A				SEE NOTE #1
14LPCI(1)C-23	PIPE TO EL	B-J	VOL	UTP-10	UT-14			
			SUR	PTP-1				
14LPCI(1)C-24	EL TO PIPE	B-J	VOL	UTP-10	UT-14			
			SUR	PTP-1				
PWS-5-2	PIPE WHIP	N/A	N/A	N/A				SEE NOTE #1
14LPCI(1)C-25	PIPE TO REDUCER	B-J	VOL	UTP-10	UT-14			
			SUR	PTP-1				
12LPCI(1)C-1	REDUCER TO PIPE	B-J	VOL	UTP-10	UT-17			
			SUR	PTP-1				
12LPCI(1)C-2	PIPE TO EL	B-J	VOL	UTP-10	UT-17			
			SUR	PTP-1				
12LPCI(1)C-3	EL TO PIPE	B-J	VOL	UTP-10	UT-17			
			SUR	PTP-1				

WNP-02
 INTERVAL: PSI
 PERIOD: NA
 OUTAGE:
 DRAWING NO. RHR-103

WASHINGTON PUBLIC POWER SUPPLY SYSTEM
 PROGRAM PLAN AND SCHEDULE
 SYSTEM OR COMPONENT: RHR(1)-4
 DESCRIPTION: RHR SHUTDN COOL SUCT


PAGE 006
 DATE 12/14/84

IDENT. NO.	DESCRIPTION	SECT. XI EXAM.	EXAM MTH.	PROCEDURE	CAL. BLOCK	INSERVICE		NOTES
						REQ.	SCHEDULED OUTAGE	
12LPCI(1)C-4	PIPE TO SE EXT	B-J	VOL	UTP-10	UT-17			
			SUR	PTP-1				
12LPCI(1)C-5	SE EXT TO SE	B-F	VOL	UTP-10	UT-106			DISSIMILAR METAL (CS-INCO)
			SUR	PTP-1				DISSIMILAR METAL (CS-INCO)
12LPCI(1)C-6	SE TO NOZZLE	B-F	VOL	UTP-10	UT-102			DISSIMILAR METAL (CS-INCO)
			SUR	PTP-1				DISSIMILAR METAL (CS-INCO)
RHR-PB-103	RHR PRES BNDRY	B-P	VT-2	N/A				SEE NOTES #6 & #7.

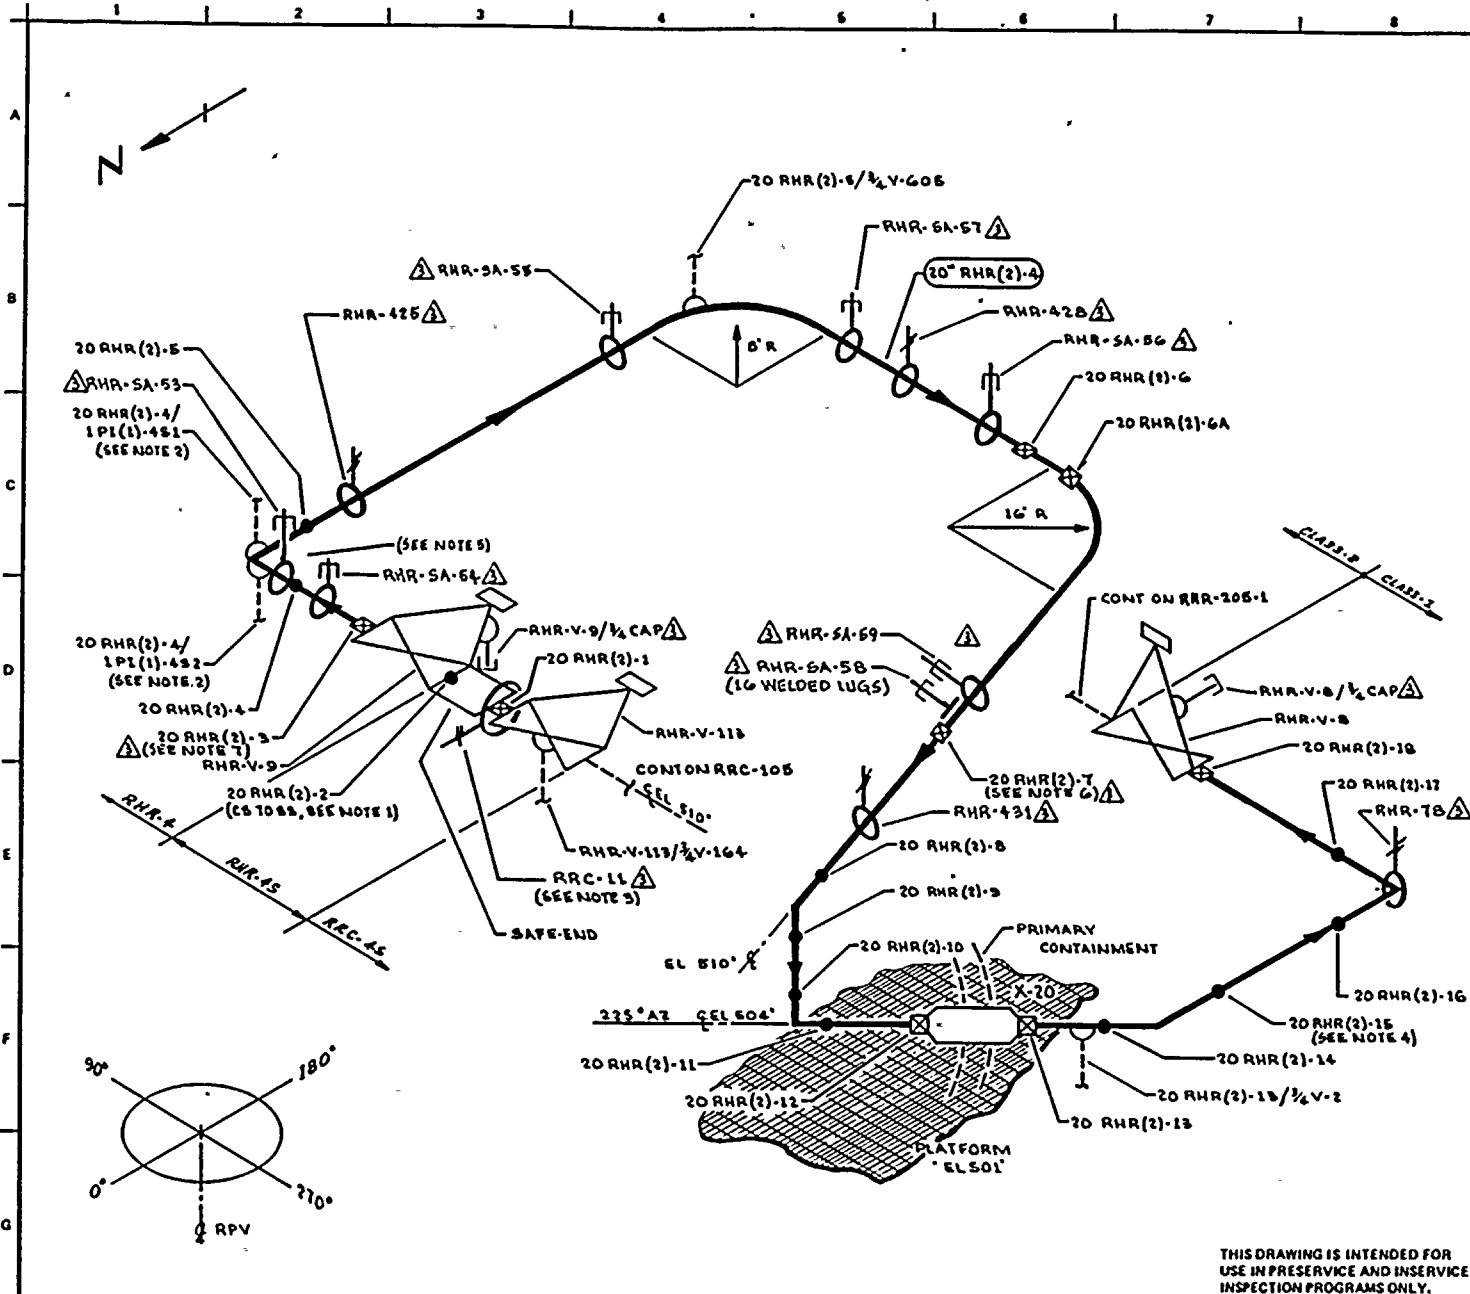

- NOTES:
1. DISSIMILAR METAL WELD, CS TO SS USE CAL BLOCK UT-9
 2. EXTEND VISUAL LEAKAGE EXAM THROUGH CONTAINMENT (X-37 & F) THROUGH EXCESS FLOW CHECK VALVE TO INSTRUMENT TUBING CONNECTION.
 3. ACCESS TO WELD 20RHR(2)-1 & 20RHR(2)-2 REQUIRES REMOVAL OF RRC-11
 4. DISTANCE BETWEEN WELDS 20RHR(2)-15 & 20RHR(2)-16 IS 4"
 5. AN ELECTRICAL JUNCTION BOX IS ABOVE PIPE WITH 4" CLEARANCE.
 6. ACCESS TO WELD 20RHR(2)-7 REQUIRES REMOVAL OF RHR-5A-58.
 7. ACCESS TO WELD 20RHR(2)-3 REQUIRES REMOVAL OF RHR-5A-54.

- REFERENCES:
- BOVEE & CRAIG ISOMETRICS:
 RHR-874-1-B REV 10
 RHR-874-6 REV 10

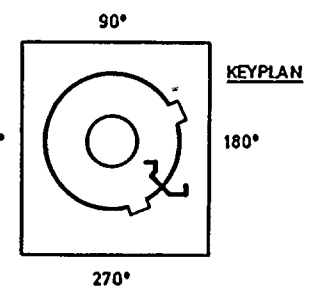

THIS DRAWING IS INTENDED FOR USE IN PRESERVICE AND INSERVICE INSPECTION PROGRAMS ONLY.

QUALITY CLASS: 1	ASME CODE CLASS: 1
ENGR: D PORTER	DATE: 12-13-77
DRAWN: K.M.C.A.	

WASHINGTON PUBLIC POWER SUPPLY SYSTEM
 RICHMOND, WASHINGTON 98042

NO	DATE	REVISION	BY	CHKD	APPVD	PIPING SYSTEM	NOM DIA (IN)	SCH	NOM WALL THK	MATERIAL SPECIFICATION	MATL TYPE	CAL BLOCK NO
3	9/2/82	REVISED AS NOTED. ADDED KEYPLAN, LUGS	K.M.C.A.	D.P.	T.P.	20" RHR(2)-4	20	80	1.031	SA 106 GR B	CS	UT-10
2	12-2-81	REVISED AS NOTED	K.M.C.A.	D.P.	T.P.	20" RHR(2)-45	20	80	1.031	SA 376 TP 304	SS	UT-9
1	2-17-79	ADDED FIELD WELD 20RHR(2)-6A PER AS BUILT. IN C-6	K.M.C.A.	D.P.	T.P.	LUGS	NA	NA	NA	SA 516 GR 70	CS	UT-46
0	11-27-78	ISSUED FOR USE	K.M.C.A.	D.P.	T.P.	LUGS	NA	NA	NA	SA 240 TP 304	SS	UT-47
A	2-15-78	ISSUED FOR INFORMATION ONLY	K.M.C.A.	D.P.	T.P.							
NO	DATE	REVISION	BY	CHKD	APPVD							

WNP-2
 WELD & COMPONENT IDENTIFICATION DIAGRAM

TITLE:
 RHR SHUTDOWN COOLING SUCTION

DWG NO: RHR-104
 REV 3

WNP-02
 INTERVAL: PSI
 PERIOD: NA
 OUTAGE:
 DRAWING NO. RHR-104

WASHINGTON PUBLIC POWER SUPPLY SYSTEM
 PROGRAM PLAN AND SCHEDULE
 SYSTEM OR COMPONENT: RHR(2)-4
 DESCRIPTION: RHR SHUTDN COOL SUCT

PAGE 001
 DATE 12/14/84

IDENT. NO.	DESCRIPTION	SECT. XI FYAM.	EXAM MTH.	PROCEDURE	CAL. BLOCK	INSERVICE		NOTES
						REQ.	SCHEDULED OUTAGE	
RHR-V-113-BDY	VALVE BODY	B-M-2	VT-1	QCI 7-1				
RHR-V-113/3/4V-164	STEM LEAKOFF	B-P	VT-2	QCI 7-1				SEE NOTES #5 & #6.
20RHR(2)-1	VLV TO SE	B-J	VOL	UTP-10	UT-9			
			SUR	PTP-1				
RRC-11	SPRING	B-K-2	VT-3	303/8.2.17				
			VT-4	303/8.2.17				
20RHR(2)-2	SE TO PIPE	B-F	VOL	UTP-10	UT-9			DISSIMILAR METAL (SS-CS)
			SUR	PTP-1				DISSIMILAR METAL (SS-CS)
RHR-V-9-BDY	VALVE BODY	B-M-2	VT-1	QCI 7-1				
RHR-V-9/3/4CAP	LEAKOFF CAPPED	B-P	VT-2	N/A				SEE NOTE #6 & #7.
20RHR(2)-3	VLV TO PIPE	B-J	VOL	UTP-10	UT-10			
			SUR	PTP-1				
RHR-SA-54	PSA-35 SNUBBER	B-K-2	VT-3	303/8.2.17				S/N 6125
			VT-4	303/8.2.17				S/N 6125
20RHR(2)-4	PIPE TO EL	B-J	VOL	UTP-10	UT-10			
			SUR	PTP-1				

WNP-02
 INTERVAL: PSI
 PERIOD: NA
 OUTAGE:
 DRAWING NO. RHR-104

WASHINGTON PUBLIC POWER SUPPLY SYSTEM
 PROGRAM PLAN AND SCHEDULE
 SYSTEM OR COMPONENT: RHR(2)-4
 DESCRIPTION: RHR SHUTDN COOL SUCT

PAGE 002
 DATE 12/14/84

IDENT. NO.	DESCRIPTION	SECT. XI EXAM.	EXAM MTH.	PROCEDURE	CAL. BLOCK	INSERVICE		NOTES
						REQ.	SCHEDULED OUTAGE	
RHR-SA-53	PSA-10 SNUBBER	B-K-2	VT-3	303/8.2.17				S/N 113
			VT-4	303/8.2.17				S/N 113
20RHR(2)-4/1PI(1)-4S1	PRESSURE TAP	B-P	VT-2	N/A				SEE NOTES #6 & #7.
20RHR(2)-4/1PI(1)-4S2	PRESSURE TAP	B-P	VT-2	N/A				SEE NOTES #6 & #7.
20RHR(2)-5	EL TO PIPE	B-J	VOL	UTP-10	UT-10			
			SUR	FTP-1				
RHR-425	SPRING	B-K-2	VT-3	303/8.2.17				
			VT-4	303/8.2.17				
RHR-SA-55	PSA-100 SNUBBER	B-K-2	VT-3	303/8.2.17				S/N 1053
			VT-4	303/8.2.17				S/N 1053
20RHR(2)-5/3/4V-605	TEST CONN	B-P	VT-2	N/A				SEE NOTES #6 & #7.
RHR-SA-57	PSA-35 SNUBBER	B-K-2	VT-3	303/8.2.17				S/N 10567
			VT-4	303/8.2.17				S/N 10567
RHR-428	SPRING	B-K-2	VT-3	303/8.2.17				
			VT-4	303/8.2.17				
RHR-SA-56	PSA-10 SNUBBER	B-K-2	VT-3	303/8.2.17				S/N 707
			VT-4	303/8.2.17				S/N 707
20RHR(2)-6	PIPE TO PIPE	B-J	VOL	UTP-10	UT-10			

WNP-02
 INTERVAL: PSI
 PERIOD: NA
 OUTAGE:
 DRAWING NO. RHR-104

WASHINGTON PUBLIC POWER SUPPLY SYSTEM
 PROGRAM PLAN AND SCHEDULE
 SYSTEM OR COMPONENT: RHR(2)-4
 DESCRIPTION: RHR SHUTDN COOL SUCT

PAGE 003
 DATE 12/14/84

<u>IDENT. NO.</u>	<u>DESCRIPTION</u>	<u>SECT.</u>		<u>PROCEDURE</u>	<u>CAL. BLOCK</u>	<u>INSERVICE SCHEDULED</u>		<u>NOTES</u>
		<u>XI EXAM.</u>	<u>EXAM HTM.</u>			<u>REQ.</u>	<u>OUTAGE</u>	
			SUR	PTP-1				
20RHR(2)-6A	PIPE TO PIPE	B-J	VOL	UTP-10	UT-10			
			SUR	PTP-1				
RHR-SA-59	PSA-35 SNUBBER	B-K-2	VT-3	303/8.2.17				S/N 6278
			VT-4	303/8.2.17				S/N 6278
RHR-SA-58(W)	16 WELDED LUGS	B-K-1	VOL	UTP-26	UT-10			.75"Wx2.125"Hx4"L.
RHR-SA-58	PSA-35 SN(2)	B-K-2	VT-3	303/8.2.17				S/N 62156/526
			VT-4	303/8.2.17				S/N 62156/526
20RHR(2)-7	PIPE TO PIPE	B-J	VOL	UTP-10	UT-10			
			SUR	PTP-1				
RHR-431	SPRING	B-K-2	VT-3	303/8.2.17				
			VT-4	303/8.2.17				
20RHR(2)-8	PIPE TO EL	B-J	VOL	UTP-10	UT-10			
			SUR	PTP-1				
20RHR(2)-9	EL TO PIPE	B-J	VOL	UTP-10	UT-10			
			SUR	PTP-1				
20RHR(2)-10	PIPE TO EL	B-J	VOL	UTP-10	UT-10			
			SUR	PTP-1				

WNP-02
 INTERVAL: PSI
 PERIOD: NA
 OUTAGE:
 DRAWING NO. RHR-104

WASHINGTON PUBLIC POWER SUPPLY SYSTEM
 PROGRAM PLAN AND SCHEDULE
 SYSTEM OR COMPONENT: RHR(2)-4
 DESCRIPTION: RHR SHUTDOWN COOL SUCT

PAGE 004
 DATE 12/14/84


IDENT. NO.	DESCRIPTION	SECT. XI EXAM. EXAM.	EXAM MTH.	PROCEDURE	CAL. BLOCK	INSERVICE		NOTES
						REQ.	SCHEDULED OUTAGE	
20RHR(2)-11	EL TO PIPE	B-J	VOL	UTP-10	UT-10			
			SUR	PTP-1				
20RHR(2)-12	PIPE TO PEN	B-J	VOL	UTP-10	UT-10			
			SUR	PTP-1				
20RHR(2)-13	PEN TO PIPE	B-J	VOL	UTP-10	UT-10			
			SUR	PTP-1				
20RHR(2)-13/3/4V-2	TEST CONN	B-P	VT-2	N/A				SEE NOTES #6 & #7.
20RHR(2)-14	PIPE TO EL	B-J	VOL	UTP-10	UT-10			
			SUR	PTP-1				
20RHR(2)-15	EL TO PIPE	B-J	VOL	UTP-10	UT-10			FITTING TO FITTING
			SUR	PTP-1				FITTING TO FITTING
20RHR(2)-16	PIPE TO EL	B-J	VOL	UTP-10	UT-10			FITTING TO FITTING
			SUR	PTP-1				FITTING TO FITTING
RHR-78	SPRING	B-K-2	VT-3	303/8.2.17				
			VT-4	303/8.2.17				
20RHR(2)-17	EL TO PIPE	B-J	VOL	UTP-10	UT-10			
			SUR	PTP-1				
20RHR(2)-18	PIPE TO VALVE	B-J	VOL	UTP-10	UT-10			


WNP-02
 INTERVAL: PSI
 PERIOD: NA
 OUTAGE:
 DRAWING NO. RHR-104

WASHINGTON PUBLIC POWER SUPPLY SYSTEM
 PROGRAM PLAN AND SCHEDULE
 SYSTEM OR COMPONENT: RHR (2)-4
 DESCRIPTION: RHR SHUTDN COOL SUCT

PAGE 005
 DATE 12/14/84


<u>IDENT. NO.</u>	<u>DESCRIPTION</u>	<u>SECT.</u> XI	<u>EXAM</u> EXAM.	<u>PROCEDURE</u>	<u>CAL.</u> BLOCK	<u>INSERVICE</u>		<u>NOTES</u>
						<u>REQ.</u>	<u>SCHEDULED</u> OUTAGE	
RHR-V-8-BDY	VALVE BODY	B-M-2	VT-1	RCI 7-1				
RHR-V-8/3/4CAP	LEAKOFF CAPPED	B-P	VT-2	N/A				SEE NOTES #6 & #7.
RHR-PB-104	RHR PRES BNDRY	B-P	VT-2	N/A				SEE NOTES #6 & #7.

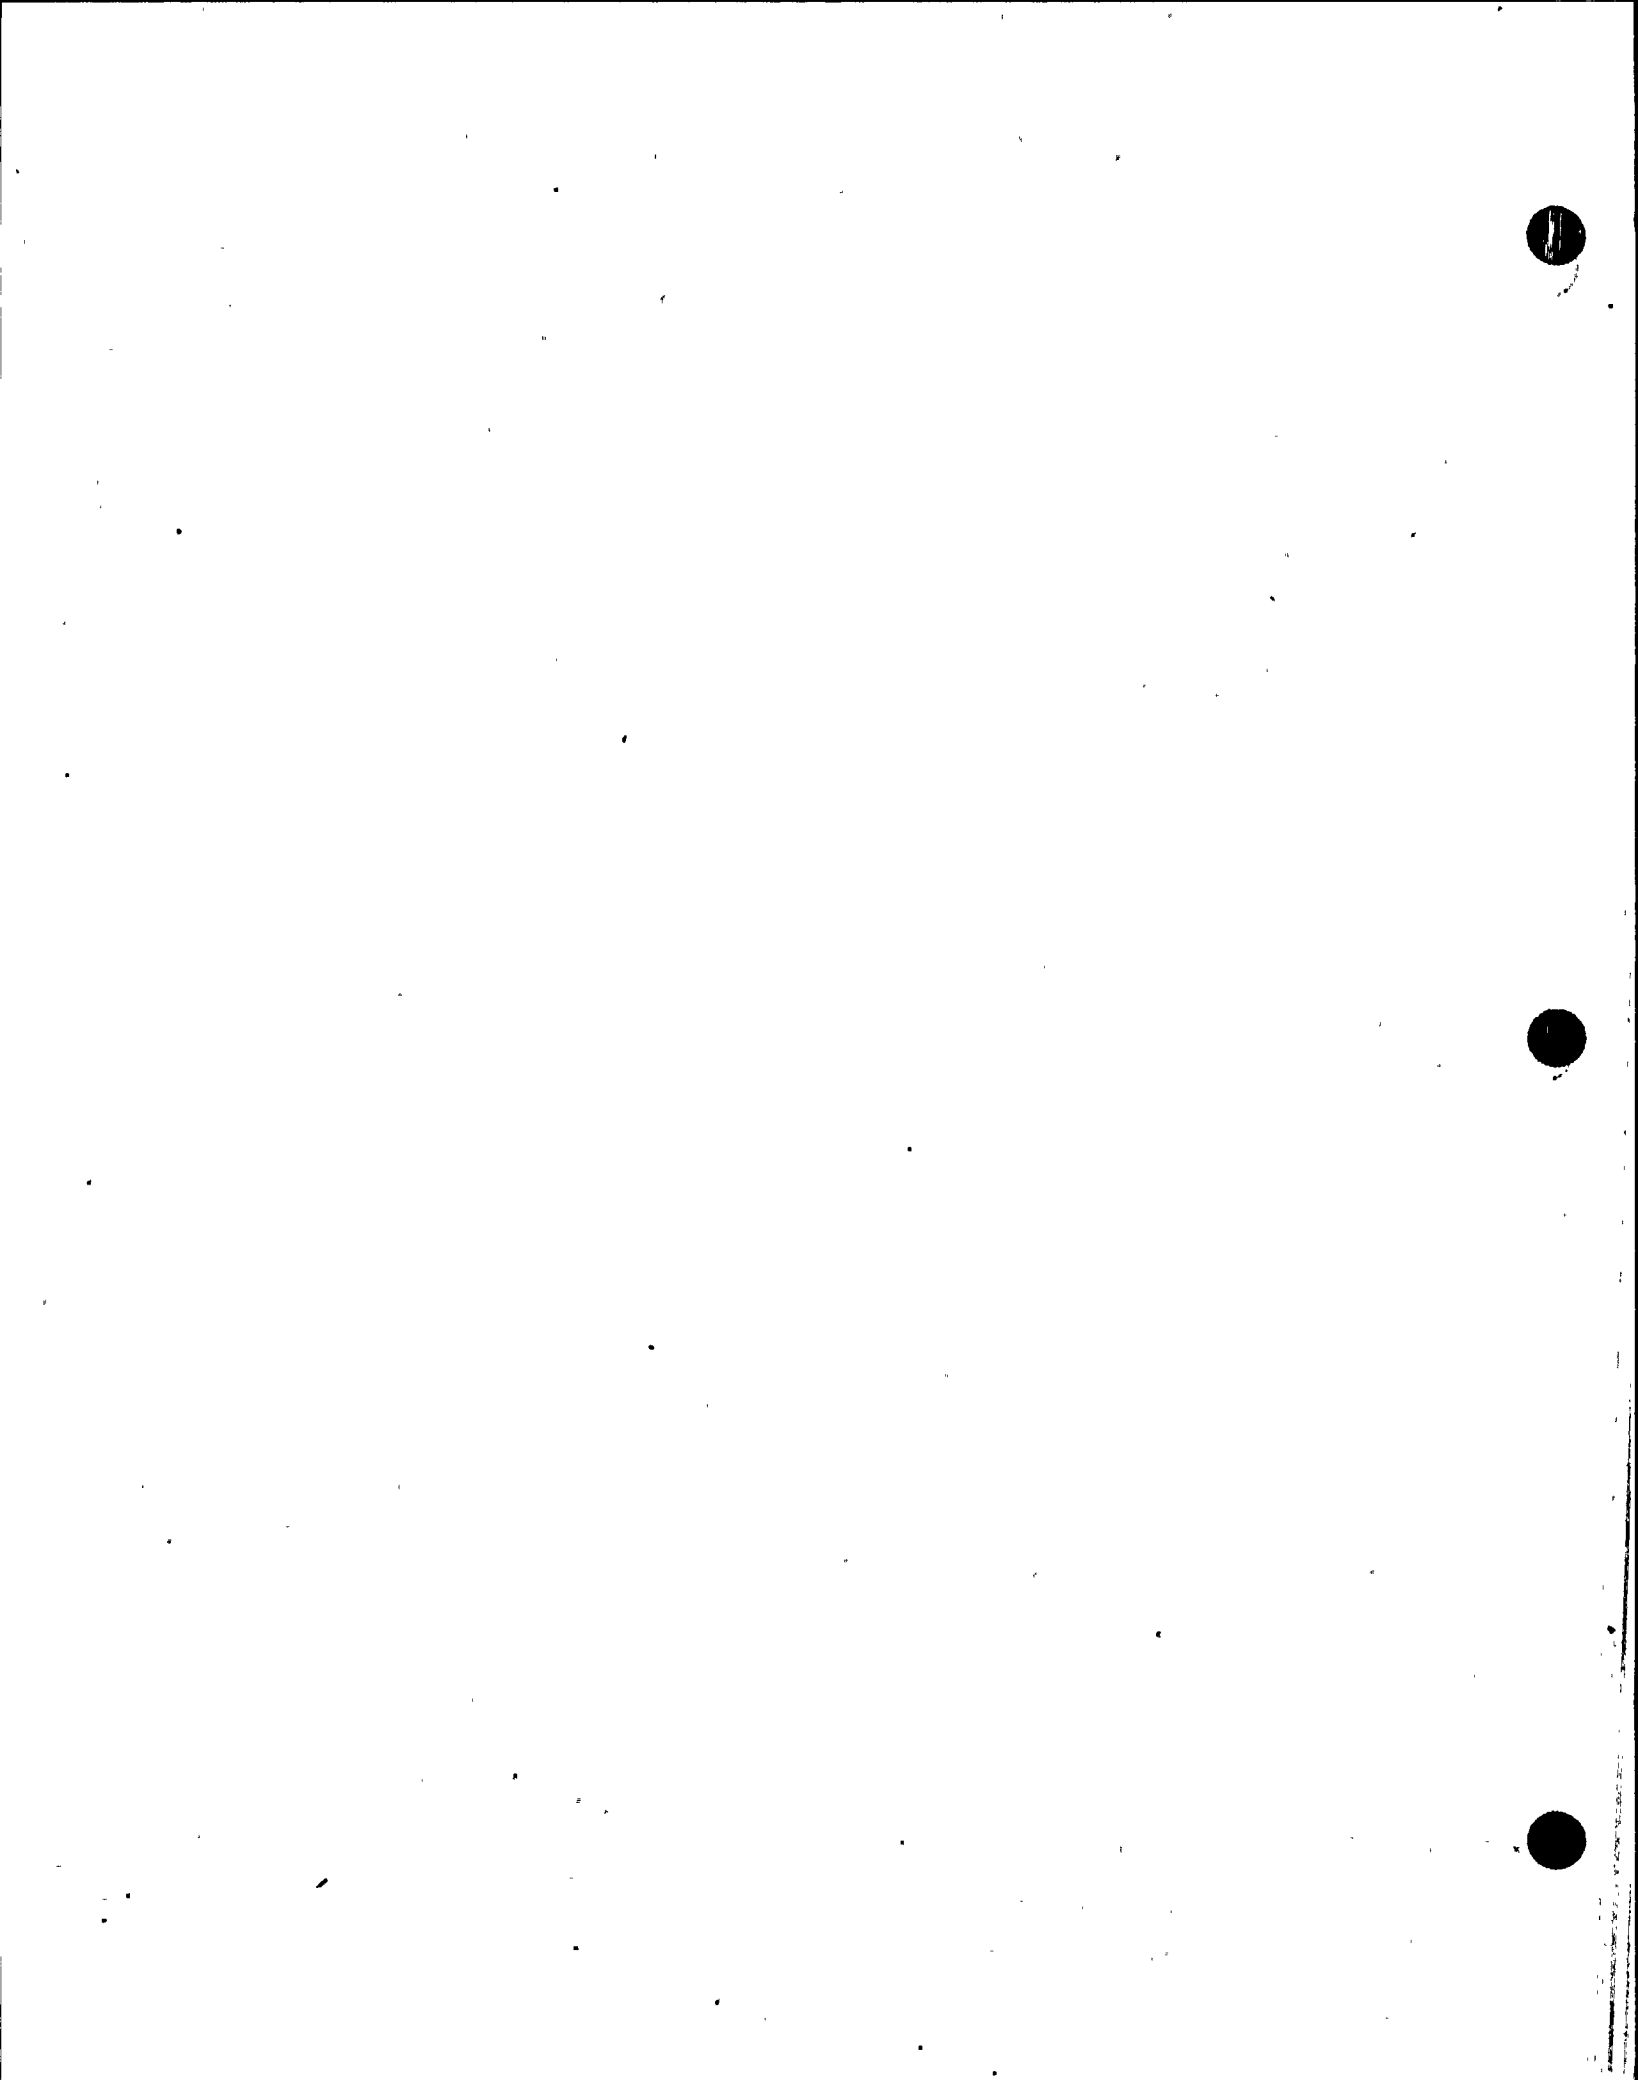

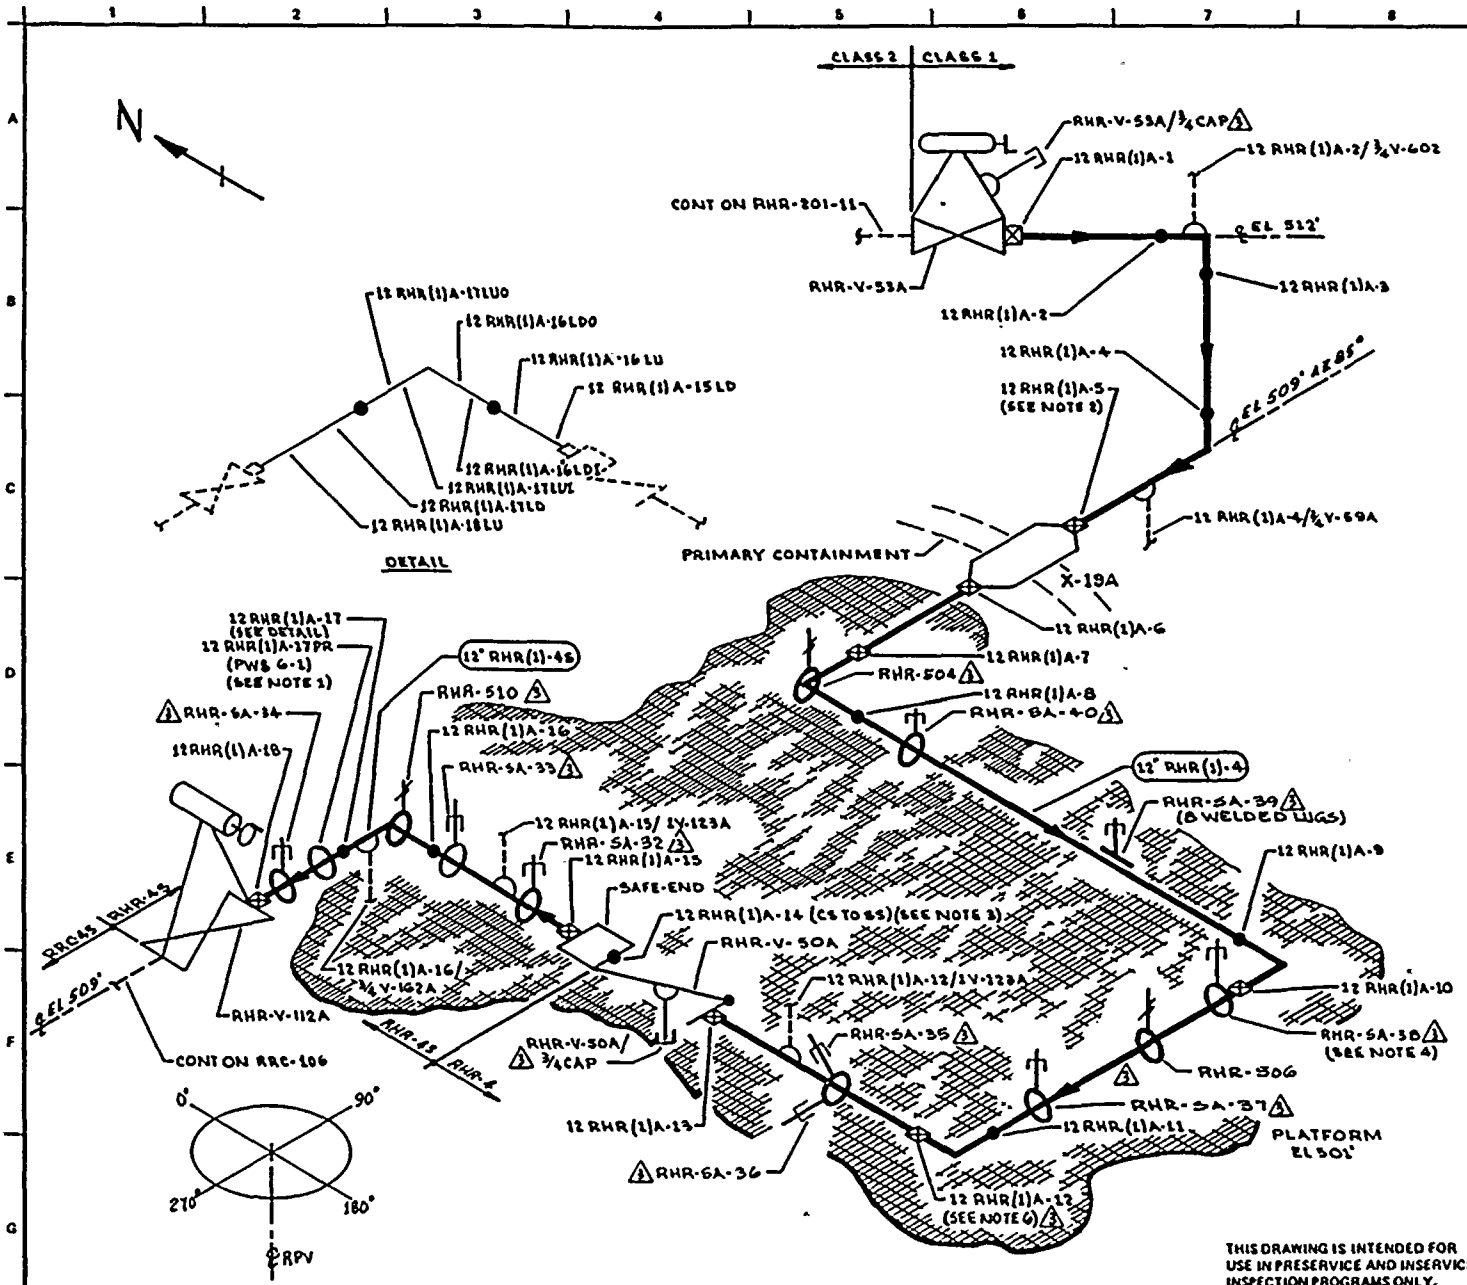

- NOTES:**
1. ACCESS TO WELD 12 RHR(1)A-1B REQUIRES REMOVAL OF 12 RHR(1)A-17PR.
 2. WELD 12 RHR(1)A-5 IS FITTING TO FITTING.
 3. DISSIMILAR METAL WELD, C6 TO C5, - USE CAL BLOCK
 4. ACCESS TO WELD 12 RHR(1)A-10 REQUIRES REMOVAL OF RHR-5A-3B.
 5. DELETED
 6. CONDUIT 2 1/2" ABOVE WELD 12 RHR(1)A-12.

- REFERENCES:**
- BOVEE & CRAIG ISOMETRICS:
- RHR-851-14 REV 8
 - RHR-851-15.16 REV 7
 - RHR-851-17 REV 8

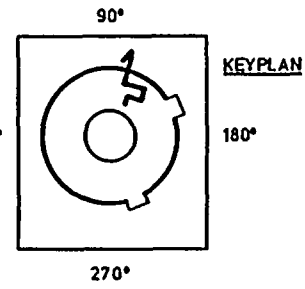

QUALITY CLASS: 1 ASME CODE CLASS: 1
 ENGR: D PORTER DRAWN: K M C A DATE: 12-14-77

WASHINGTON PUBLIC POWER SUPPLY SYSTEM
 RACINE AND WASHINGTON SEALS

THIS DRAWING IS INTENDED FOR USE IN PRESERVICE AND INSERVICE INSPECTION PROGRAMS ONLY.

NO	DATE	REVISION	BY	CHKD	APPVD	PIPING SYSTEM	NOM DIA (IN)	SCH	NOM WALL THK	MATERIAL SPECIFICATION	MATL TYPE	CAL BLOCK NO
3	9-22-73	REVISED AS NOTED. ADDED KEYPLAN	K.M.C.A.	D.P.	T.H.W.	12" RHR(1)-4	12	100	0.844	SA 106 GR B	C5	UT-16
2	12-2-81	REVISED AS NOTED	K.M.C.A.	D.P.	T.H.W.	12" RHR(1)-4S	12	80	0.688	SA 312 GR B	S5	UT-19
1	8-30-77	ADDED LONG SEAM DOWNSTREAM FROM WELD 12 RHR(1)A-5 & 12 RHR(1)A-15. ADDED DETAIL FOR CLARITY. 121 C-5	K.M.C.A.	D.P.	T.H.W.							
0	11-2-77	ISSUED FOR USE	K.M.C.A.	D.P.	T.H.W.							
A	3-15-78	ISSUED FOR INFORMATION ONLY	K.M.C.A.	D.P.	T.H.W.							

WNP-2
 WELD & COMPONENT
 IDENTIFICATION DIAGRAM

TITLE:
 SHUTDOWN COOLING RETURN LOOP "A"

DWG NO: RHR-105 REV 3



WNP-02
 INTERVAL: PSI
 PERIOD: NA
 OUTAGE:
 DRAWING NO. RHR-105

WASHINGTON PUBLIC POWER SUPPLY SYSTEM
 PROGRAM PLAN AND SCHEDULE
 SYSTEM OR COMPONENT: RHR(1)-4
 DESCRIPTION: SHUTDN COOL RET-LP-A

PAGE 001
 DATE 12/14/84

IDENT. NO.	DESCRIPTION	SECT. XI EXAM. EXAM.	MTH.	PROCEDURE	CAL. BLOCK	INSERVICE		NOTES
						REQ.	SCHEDULED OUTAGE	
RHR-V-53A-BDY	VALVE BODY	B-M-2	VT-1	OCI 7-1				
RHR-V-53A/3/4CAP	LEAKOFF CAPPED	B-P	VT-2	N/A				SEE NOTES #6 & #7.
12RHR(1)A-1	VLV TO PIPE	B-J	VOL	UTP-10	UT-16			
			SUR	PTP-1				
12RHR(1)A-2	PIPE TO EL	B-J	VOL	UTP-10	UT-16			
			SUR	PTP-1				
12RHR(1)A-2/3/4V-602	VENT CONN	B-P	VT-2	N/A				SEE NOTES #6 & #7.
12RHR(1)A-3	EL TO PIPE	B-J	VOL	UTP-10	UT-16			
			SUR	PTP-1				
12RHR(1)A-4	PIPE TO EL	B-J	VOL	UTP-10	UT-16			
			SUR	PTP-1				
12RHR(1)A-4/3/4V-59A	TEST CONN	B-P	VT-2	N/A				SEE NOTES #6 & #7.
12RHR(1)A-5	EL TO PEN	B-J	VOL	UTP-10	UT-16			
			SUR	PTP-1				
12RHR(1)A-6	PEN TO PIPE	B-J	VOL	UTP-10	UT-16			
			SUR	PTP-1				
12RHR(1)A-7	PIPE TO EL	B-J	VOL	UTP-10	UT-16			
			SUR	PTP-1				

WNP-02
 INTERVAL: PSI
 PERIOD: NA
 OUTAGE:
 DRAWING NO. RHR-105.

WASHINGTON PUBLIC POWER SUPPLY SYSTEM
 PROGRAM PLAN AND SCHEDULE
 SYSTEM OR COMPONENT: FHR(1)-4
 DESCRIPTION: SHUTDOWN COOL RET LP-A

PAGE 002
 DATE 12/14/84

<u>IDENT. NO.</u>	<u>DESCRIPTION</u>	<u>SECT.</u> <u>XI</u> <u>EXAM.</u>	<u>EYAN</u> <u>HTH.</u>	<u>PROCEDURE</u>	<u>CAL.</u> <u>BLOCK</u>	<u>INSERVICE</u>		<u>NOTES</u>
						<u>REQ.</u>	<u>SCHEDULED</u> <u>OUTAGE</u>	
RHR-504	SPRING	B-K-2	VT-3	303/8.2.17				
			VT-4	303/8.2.17				
12RHR(1)A-8	EL TO PIPE	B-J	VOL	UTP-10	UT-16			
			SUR	PTP-1				
RHR-SA-40	PSA-10 SNUBBER	B-K-2	VT-3	303/8.2.17				S/N 296
			VT-4	303/8.2.17				S/N 296
RHR-SA-39(W)	8 WELDED LUGS	B-K-1	VOL	UTP-26	UT-16			
RHR-SA-39	PSA-10 SN(2)	B-K-2	VT-3	303/8.2.17				S/N 4856/4857
			VT-4	303/8.2.17				S/N 4856/4857
12RHR(1)A-9	PIPE TO EL	B-J	VOL	UTP-10	UT-16			
			SUR	PTP-1				
12RHR(1)A-10	EL TO PIPE	B-J	VOL	UTP-10	UT-16			
			SUR	PTP-1				
RHR-SA-38	PSA-10 SNUBBER	B-K-2	VT-3	303/8.2.17				S/N 1449
			VT-4	303/8.2.17				S/N 1449
RHR-506	SPRING	B-K-2	VT-3	303/8.2.17				
			VT-4	303/8.2.17				

WNP-02
 INTERVAL: PSI
 PERIOD: NA
 OUTAGE:
 DRAWING NO. RHR-105

WASHINGTON PUBLIC POWER SUPPLY SYSTEM
 PROGRAM PLAN AND SCHEDULE
 SYSTEM OR COMPONENT: RHR(1)-4
 DESCRIPTION: SHUTDOWN COOL RET LP-A

PAGE 003
 DATE 12/14/84

IDENT. NO.	DESCRIPTION	SECT. XI EXAM.	EXAM MTH.	PROCEDURE	CAL. BLOCK	INSERVICE		NOTES
						REQ.	SCHEDULED OUTAGE	
RHR-SA-37	PSA-10 SNUBBER	B-K-2	VT-3	303/8.2.17				S/N 10734
			VT-4	303/8.2.17				S/N 10734
12RHR(1)A-11	PIPE TO EL	B-J	VOL	UTP-10	UT-10			
			SUR	PTP-1				
12RHR(1)A-12	EL TO PIPE	B-J	VOL	UTP-10	UT-16			
			SUR	PTP-1				
RHR-SA-36	PSA-10 SNUBBER	B-K-2	VT-3	303/8.2.17				S/N 10735
			VT-4	303/8.2.17				S/N 10735
RHR-SA-35	PSA-10 SNUBBER	B-K-2	VT-3	303/8.2.17				S/N 4855
			VT-4	303/8.2.17				S/N 4855
12RHR(1)A-12/1V-123A	BYPASS CONN	B-P	VT-2	N/A				SEE NOTES #6 & #7.
12RHR(1)A-13	PIPE TO VALVE	B-J	VOL	UTP-10	UT-16			
			SUR	PTP-1				
RHR-V-50A-BDY	VALVE BODY	B-M-2	VT-1	CCI 7-1				
RHR-V-50A-BLT	VALVE BOLTING	B-G-2	VT-1	CCI 7-1				
RHR-V-50A/3/4CAP	LEAKOFF CAPPED	B-P	VT-2	N/A				SEE NOTES #6 & #7.
12RHR(1)A-14	VALVE TO SE	B-F	VOL	UTP-10	UT-19			DISSIMILAR METAL (CS-SS)

WNP-02
 INTERVAL: PSI
 PERIOD: NA
 OUTAGE:
 DRAWING NO. RHR-105

WASHINGTON PUBLIC POWER SUPPLY SYSTEM
 PROGRAM PLAN AND SCHEDULE
 SYSTEM OR COMPONENT: RHR(1)-AS
 DESCRIPTION: SHUTDN COOL RET LP-A

PAGE 004
 DATE 12/14/84

IDENT. NO.	DESCRIPTION	SECT. XI EXAM.	EXAM MTH.	PROCEDURE	CAL. BLOCK	INSERVICE		NOTES
						REQ.	SCHEDULED OUTAGE	
			SUR	PTP-1				DISSIMILAR METAL (CS-SS)
12RHR(1)A-15	SE TO PIPE	B-J	VOL	UTP-10	UT-19			
12RHR(1)A-15LD	PIPE SEAM	B-J	VOL	UTP-10	UT-19			
RHR-SA-32	PSA-10 SN(2)	B-K-2	VT-3	303/8.2.17				S/N 13031/993
12RHR(1)A-15/1V-123A	BYPASS CONN	B-P	VT-2	N/A				S/N 13031/993
RHR-SA-33	PSA-10 SNUBBER	B-K-2	VT-3	303/8.2.17				SEE NOTES #6 & #7.
12RHR(1)A-16LU	PIPE SEAM	B-J	VOL	UTP-10	UT-19			S/N 11849
12RHR(1)A-16	PIPE TO EL	B-J	VOL	UTP-10	UT-19			
12RHR(1)A-16LDI	EL SEAM	B-J	VOL	UTP-10	UT-19			
12RHR(1)A-16LDO	EL SEAM	B-J	VOL	UTP-10	UT-19			

WNP-02
 INTERVAL: PSI
 PERIOD: NA
 OUTAGE:
 DRAWING NO. RHR-105

WASHINGTON PUBLIC POWER SUPPLY SYSTEM
 PROGRAM PLAN AND SCHEDULE
 SYSTEM OR COMPONENT: RHR(1)-4S
 DESCRIPTION: SHUTDN COGL RET LP-A

PAGE 005
 DATE 12/14/84


IDENT. NO.	DESCRIPTION	SECT. XI EXAM.	EXAM MTH.	PROCEDURE	CAL. BLOCK	INSERVICE		NOTES
						REQ.	SCHEDULED OUTAGE	
RHR-510			SUR	PTP-1				
	SPRING	B-K-2	VT-3	303/8.2.17				
			VT-4	303/8.2.17				
12RHR(1)A-16/3/4V-162A	TEST CONN	B-P	VT-2	N/A				SEE NOTES #6 & #7.
12RHR(1)A-17LUI	EL SEAM	B-J	VOL	UTP-10	UT-19			
			SUR	PTP-1				
12RHR(1)A-17LUO	EL SEAM	B-J	VOL	UTP-10	UT-19			
			SUR	PTP-1				
12RHR(1)A-17	EL TO PIPE	B-J	VOL	UTP-10	UT-19			
			SUR	PTP-1				
12RHR(1)A-17LD	PIPE SEAM	B-J	VOL	UTP-10	UT-19			
			SUR	PTP-1				
FWS-6-1	PIPE WHIP	N/A	N/A	N/A				SEE NOTE #1
RHR-SA-34	PSA-35 SN(2)	B-K-2	VT-3	303/8.2.17				S/N 9949/9261
			VT-4	303/8.2.17				S/N 9949/9261
12RHR(1)A-18LU	PIPE SEAM	B-J	VOL	UTP-10	UT-19			
			SUR	PTP-1				
12RHR(1)A-18	PIPE TO VLV	B-J	VOL	UTP-10	UT-19			

WNP-02
 INTERVAL: PSI
 PERIOD: NA
 OUTAGE:
 DRAWING NO. RHR-105

WASHINGTON PUBLIC POWER SUPPLY SYSTEM
 PROGRAM PLAN AND SCHEDULE
 SYSTEM OR COMPONENT: RHR(1)-4S
 DESCRIPTION: SHUTDOWN COOL REF LP-A


PAGE 006
 DATE 12/14/84

<u>IDENT. NO.</u>	<u>DESCRIPTION</u>	<u>SECT.</u>		<u>PROCEDURE</u>	<u>CAL. BLOCK</u>	<u>INSERVICE</u>		<u>NOTES</u>
		<u>XI EXAM.</u>	<u>EXAM. MTH.</u>			<u>REQ.</u>	<u>SCHEDULED OUTAGE</u>	
			SUR	PTP-1				
RHR-V-112A-BOY	VALVE BODY	B-M-2	VT-1	QCI 7-1				
RHR-V-112A-BLT	VALVE BOLTING	B-G-2	VT-1	QCI 7-1				
RHR-PB-105	RHR PRES BNDRY	B-P	VT-2	N/A				SEE NOTES #6 & #7.

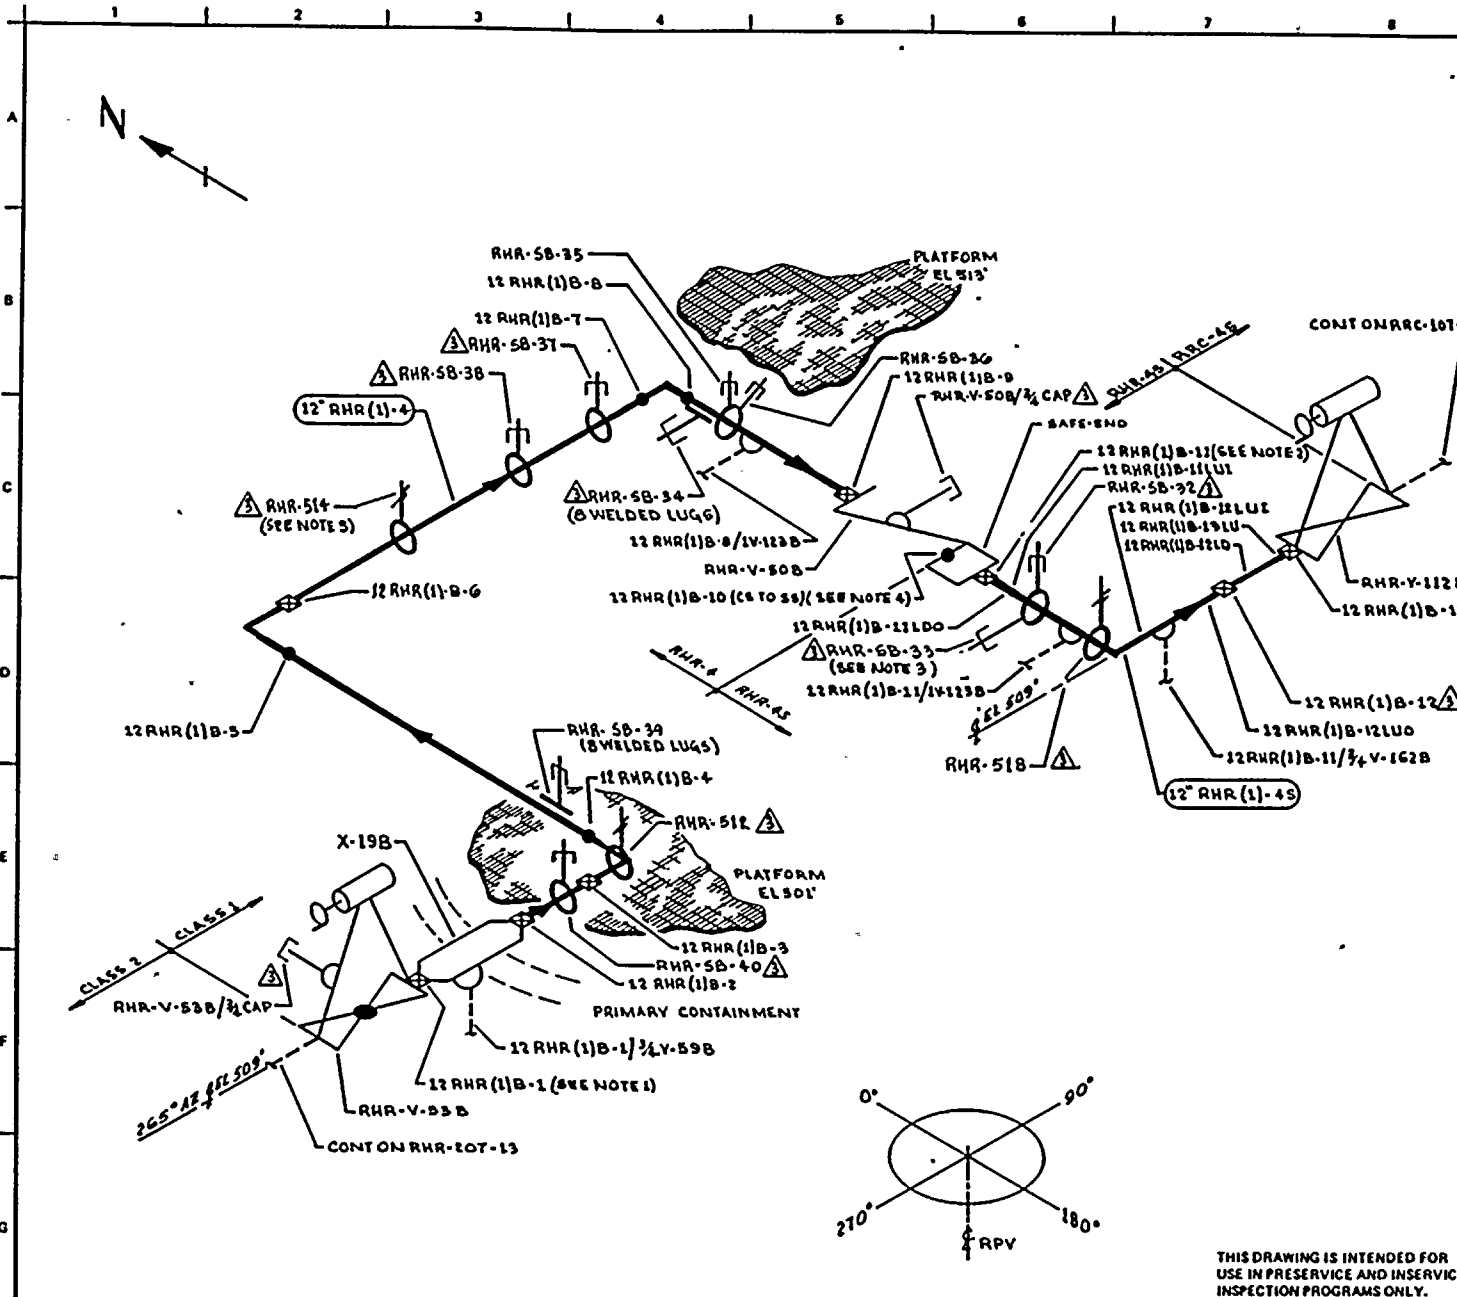

- NOTES:
1. WELD N° 12 RHR(1)B-1 IS FITTING TO FITTING.
 2. WELD N° 12 RHR(1)B-11 IS FITTING TO FITTING.
 3. ACCESS TO WELD N° 12 RHR(1)B-11 REQUIRES REMOVAL OF RHR-5B-32 & RHR-5B-33.
 4. DISSIMILAR METAL WELD, CS TO CS, USE CAL BLOCK UT-19.
 5. ACCESS TO WELD N° 12 RHR(1)B-6 REQUIRES REMOVAL OF RHR-514.

REFERENCES:
 BOVEN & CRILL ISOMETRICS:
 RHR-899-46-47 REV B
 RHR-899-48 REV B

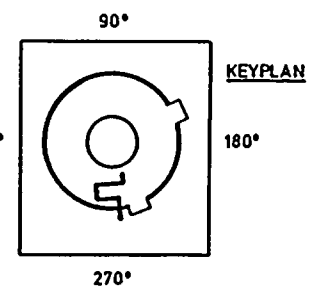

QUALITY CLASS: 1 ASME CODE CLASS: 1
 ENGR: D PORTER DRAWN: V.M.A. DATE: 12-15-77

WASHINGTON PUBLIC POWER SUPPLY SYSTEM
 RICHMOND, WASHINGTON 98042

THIS DRAWING IS INTENDED FOR USE IN PRESERVE AND INSERVICE INSPECTION PROGRAMS ONLY.

NO	DATE	REVISION	BY	CHKD	APPVD	PIPING SYSTEM	NOM DIA (IN)	SCH	NOM WALL THK	MATERIAL SPECIFICATION	MATL TYPE	CAL BLOCK NO
3	9-26-83	REVISED AS NOTED. ADDED KEYPLAN, LUGS	V.M.A.	DRP	IFH	12" RHR(1)B-4	12	100	0.844	SA 106 GR B	CS	UT-16
2	12-2-81	REVISED AS NOTED	V.M.A.	DRP	IFH	12" RHR(1)B-4S	12	80	0.680	SA 312 TP 304	SS	UT-19
1	1-17-79	ADDED LONG BEAM DOWN STREAM FROM WELD	V.M.A.	DRP	IFH	LUGS	NA	NA	NA	SA 516 GR 70	CS	UT-46
0	11-11-78	ISSUED FOR USE	V.M.A.	DRP	IFH	LUGS	NA	NA	NA	SA 240 TP 304	CS	UT-47
A	2-15-78	ISSUED FOR INFORMATION ONLY	V.M.A.	DRP	IFH							

WNP-2
 WELD & COMPONENT IDENTIFICATION DIAGRAM

TITLE:
 SHUTDOWN COOLING RETURN LOOP "B"

DWG NO: RHR-106 REV 3



WNP-02
 INTERVAL: PSI
 PERIOD: NA
 OUTAGE:
 DRAWING NO. RHR-106

WASHINGTON PUBLIC POWER SUPPLY SYSTEM
 PROGRAM PLAN AND SCHEDULE
 SYSTEM OR COMPONENT: RHR(1)-4
 DESCRIPTION: SHUTDN COOL RET LP-B

PAGE 001
 DATE 12/14/84

IDENT. NO.	DESCRIPTION	SECT.		PROCEDURE	CAL. BLOCK	INSERVICE SCHEDULED		NOTES
		EXAM.	EXAM			REQ.	OUTAGE	
RHR-V-53B-BDY	VALVE BODY	B-M-2	VT-1	OCI 7-1				
RHR-V-53B/3/4CAP	LEAKOFF CAPPED	B-P	VT-2	N/A				SEE NOTES #6 & #7.
12RHR(1)B-1	VLV TO PEN	B-J	VOL	UTP-10	UT-16			
			SUR	PTP-1				
12RHR(1)B-1/3/4V-598	TEST CGNN	B-P	VT-2	N/A				SEE NOTES #6 & #7.
12RHR(1)B-2	PEN TO PIPE	B-J	VOL	UTP-10	UT-16			
			SUR	PTP-1				
RHR-SB-40	PSA-10 SNUBBER	B-K-2	VT-3	303/8.2.17				S/N 4873
			VT-4	303/8.2.17				S/N 4873
12RHR(1)B-3	PIPE TO EL	B-J	VOL	UTP-10	UT-16			
			SUR	PTP-1				
RHR-512	SPRING	B-K-2	VT-3	303/8.2.17				
			VT-4	303/8.2.17				
12RHR(1)B-4	EL TO PIPE	B-J	VOL	UTP-10	UT-16			
			SUR	PTP-1				
RHR-SB-39(W)	8 WELDED LUGS	B-K-1	VOL	UTP-26	UT-16			
RHR-SB-39	PSA-10 SN(2)	B-K-2	VT-3	303/8.2.17				S/N 4863

WNP-02
 INTERVAL: PSI
 PERIOD: NA
 OUTAGE:
 DRAWING NO. RHR-106

WASHINGTON PUBLIC POWER SUPPLY SYSTEM
 PROGRAM PLAN AND SCHEDULE
 SYSTEM OR COMPONENT: RHR(1)-4
 DESCRIPTION: SHUTDOWN COOL RFT LP-B

PAGE 002
 DATE 12/14/84

IDENT. NO.	DESCRIPTION	SECT. XI EXAM.	EXAM MTH.	PROCEDURE	CAL. BLOCK	INSERVICE		NOTES
						REQ.	SCHEDULED OUTAGE	
12RHR(1)B-5	PIPE TO EL	B-J	VT-4	303/8.2.17	UT-16			S/N 4863
12RHR(1)B-6	EL TO PIPE	B-J	VT-4	UTP-10	UT-16			
RHR-514	SPRING	B-K-2	VT-3	303/8.2.17				
RHR-SB-38	PSA-10 SNUBBER	B-K-2	VT-3	303/8.2.17				S/N 705
RHR-SB-37	PSA-10 SNUBBER	B-K-2	VT-3	303/8.2.17				S/N 705
12RHR(1)B-7	PIPE TO EL	B-J	VT-4	303/8.2.17	UT-16			S/N 114
12RHR(1)B-8	EL TO PIPE	B-J	VT-4	UTP-10	UT-16			
RHR-SB-34(W)	8 WELDED LUGS	B-K-1	VT-3	303/8.2.17				
RHR-SB-34	PSA-10 SN(2)	B-K-2	VT-3	303/8.2.17	UT-16			S/N 13060/130

WNP-02
 INTERVAL: PSI
 PERIOD: NA
 OUTAGE:
 DRAWING NO. RHR-106

WASHINGTON PUBLIC POWER SUPPLY SYSTEM
 PROGRAM PLAN AND SCHEDULE
 SYSTEM OR COMPONENT: RHR(1)-4
 DESCRIPTION: SHUTDOWN COOL RET LP-B

PAGE 003
 DATE 12/14/84

IDENT. NO.	DESCRIPTION	SECT. XI EXAM.	EXAM MTH.	PROCEDURE	CAL. BLOCK	INSERVICE		NOTES
						REQ.	SCHEDULED OUTAGE	
RHR-SB-35			VT-4	303/8.2.17				S/N 13060/130
	PSA-10 SNUBBER	B-K-2	VT-3	303/8.2.17				S/N 11869
			VT-4	303/8.2.17				S/N 11869
RHR-SB-36	PSA-10 SNUBBER	B-K-2	VT-3	303/8.2.17				S/N 691
			VT-4	303/8.2.17				S/N 691
12RHR(1)B-8/1V-123B	BYPASS CONN	B-P	VT-2	N/A				SEE NOTES #6 & #7.
12RHR(1)B-9	PIPE TO VLV	B-J	VOL	UTP-10	UT-16			
			SUR	PTP-1				
RHR-V-508-BDY	VALVE BODY	B-M-2	VT-1	OCI 7-1				
RHR-V-508-BLT	VALVE BOLTING	B-G-2	VT-1	OCI 7-1				
RHR-V-508/3/4CAP	LEAKOFF CAPPED	B-P	VT-2	N/A				SEE NOTES #6 & #7.
12RHR(1)B-10	VLV TO SE	B-F	VOL	UTP-10	UT-19			
			SUR	PTP-1				
12RHR(1)B-11	SE TO PIPE	B-J	VOL	UTP-10	UT-19			
			SUR	PTP-1				
12RHR(1)B-11LDI	EL SEAM	B-J	VOL	UTP-10	UT-19			
			SUR	PTP-1				
12RHR(1)B-11LDO	EL SEAM	B-J	VOL	UTP-10	UT-19			

WNP-02-
 INTERVAL: PSI
 PERIOD: NA
 OUTAGE:
 DRAWING NO. RHR-106

WASHINGTON PUBLIC POWER SUPPLY SYSTEM
 PROGRAM PLAN AND SCHEDULE
 SYSTEM OR COMPONENT: RHR(1)-4S
 DESCRIPTION: SHUTDN COOL RET LP-B

PAGE 004
 DATE 12/14/84

IDENT. NO.	DESCRIPTION	SECT. YI EXAM.	EYAM MTH.	PROCEDURE	CAL. BLOCK	INSERVICE		NOTES
						REQ.	SCHEDULED OUTAGE	
RHR-SB-32			SUR	PTP-1				
	PSA-10 SNUBBER	B-K-2	VT-3	303/8.2.17				S/N 11862
			VT-4	303/8.2.17				S/N 11862
RHR-SB-33								
	PSA-10 SNUBBER	B-K-2	VT-3	303/8.2.17				S/N 11851
			VT-4	303/8.2.17				S/N 11851
12RHR(1)B-11/1V-123B								
	BYPASS CONN	B-P	VT-2	N/A				SEE NOTES #6 & #7.
RHR-518								
	SPRING	B-K-2	VT-3	303/8.2.17				
			VT-4	303/8.2.17				
12RHR(1)B-11/3/4V-162B								
	TEST CONN	B-P	VT-2	N/A				SEE NOTES #6 & #7.
12RHR(1)B-12LUI								
	EL SEAM	B-J	VOL	UTP-10	UT-19			
			SUR	PTP-1				
12RHR(1)B-12LUO								
	EL SEAM	B-J	VOL	UTP-10	UT-19			
			SUR	PTP-1				
12RHR(1)B-12								
	EL TO PIPE	B-J	VOL	OCI 6-13	UT-19			
			SUR	OCI 3-3				
12RHR(1)B-12LD								
	PIPE SEAM	B-J	VOL	UTP-10	UT-19			
			SUR	PTP-1				


WNP-02
 INTERVAL: PSI
 PERIOD: NA
 OUTAGE:
 DRAWING NO. RHR-106

WASHINGTON PUBLIC POWER SUPPLY SYSTEM
 PROGRAM PLAN AND SCHEDULE
 SYSTEM OR COMPONENT: RHR(1)-4S
 DESCRIPTION: SHUTDN COOL RFT LP-B

PAGE 005
 DATE 12/14/84


IDENT. NO.	DESCRIPTION	SECT. XI EXAM.	EXAM MTH.	PROCEDURE	CAL. BLOCK	INSERVICE		NOTES
						REQ.	SCHEDULED OUTAGE	
PWS-7-1								
12RHR(1)R-13LU	PIPE WHIP	N/A	N/A	N/A				SEE NOTE #1
	PIPE SEAM	B-J	VOL	UTP-10	UT-19			
			SUR	PTP-1				
12RHR(1)B-13	PIPE TO VLV	B-J	VOL	UTP-10	UT-19			
			SUR	PTP-1				
RHR-V-112B-BDY	VALVE BODY	B-M-2	VT-1	QCI 7-1				
RHR-V-112B-BLT	VALVE BOLTING	B-G-2	VT-1	QCI 7-1				
RHR-PB-106	RHR PRES BNDRY	B-P	VT-2	N/A				SEE NOTES #6 & #7.



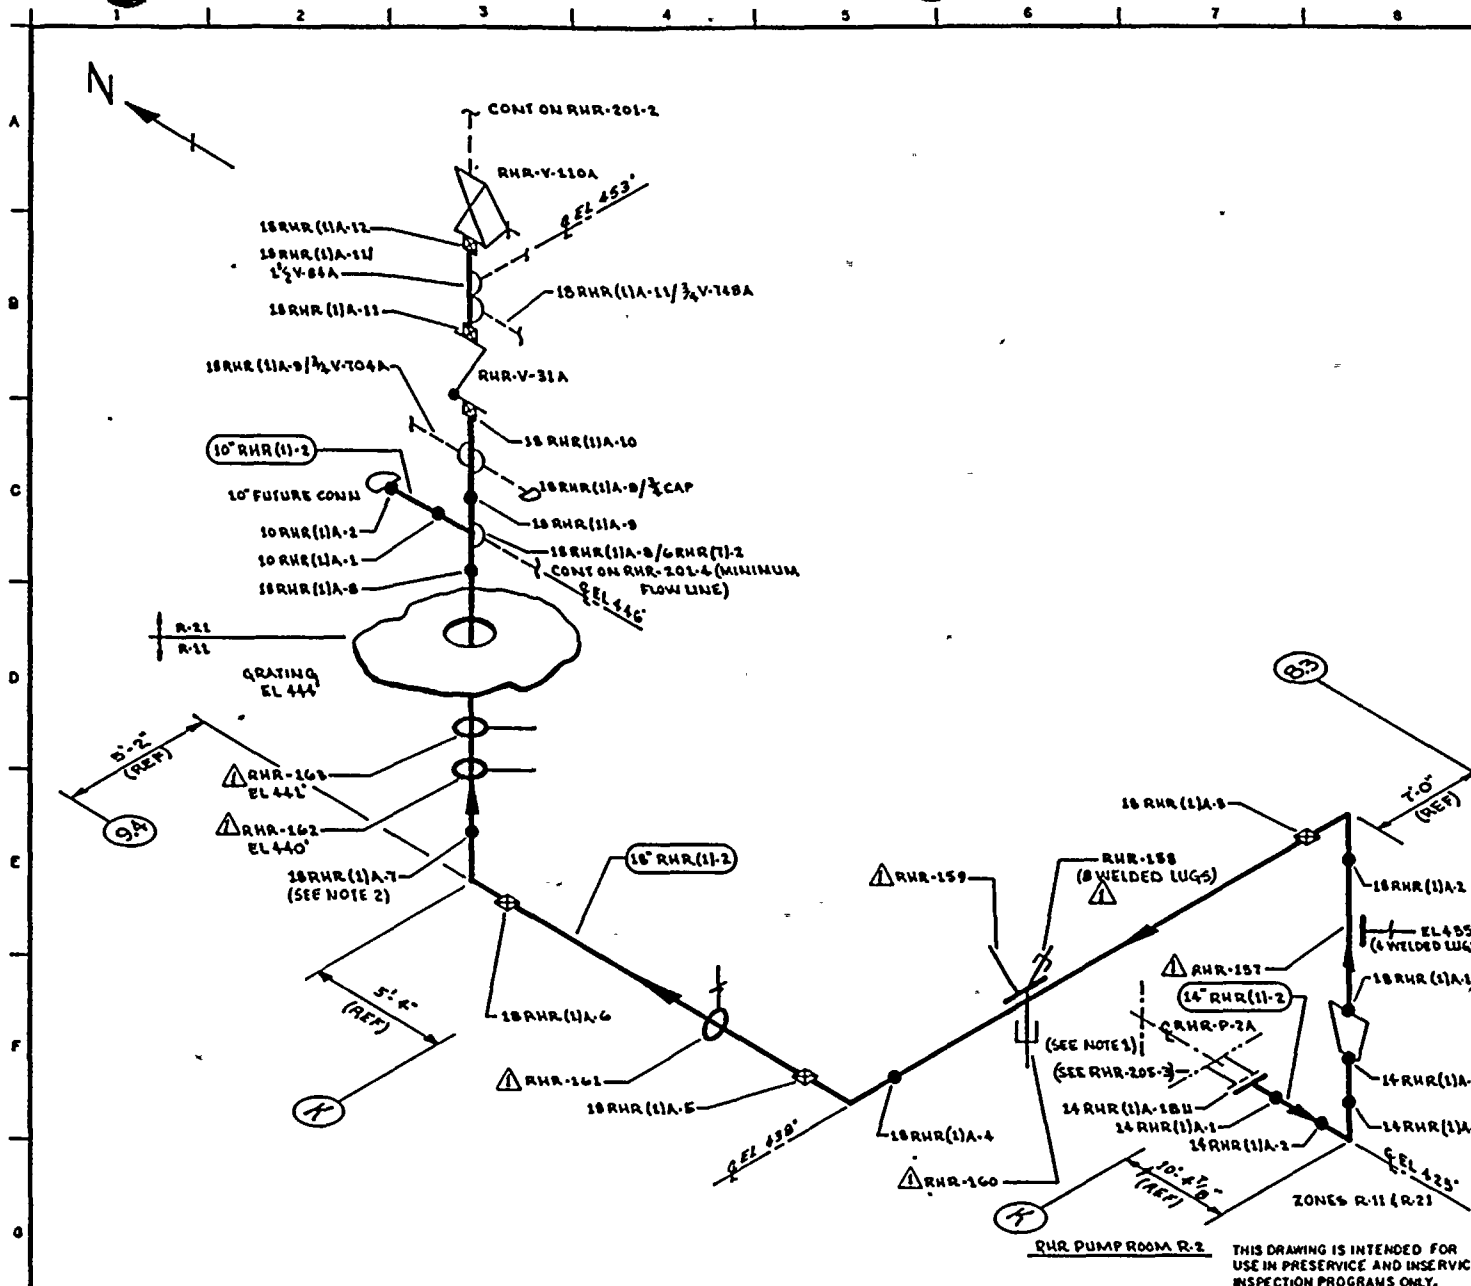

- NOTES:
1. EXTEND VISUAL LEAKAGE EXAM OF RHR-PUMP-2A YENTS & DRAINS TO OUTERMOST NORMALLY CLOSED VALVE.
 2. ACCESS TO 18RHR(11A-7) REQUIRES REMOVAL OF RHR-162.
 3. SCAFFOLDING IS REQUIRED.

- REFERENCES:
- BOOKS & CRAIL ISOMETRICS
 - RHR-867-1.4 REV 7
 - RHR-867-5.7 REV 6

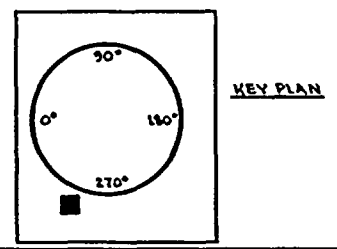

QUALITY CLASS: 1 ASME CODE CLASS: 2
 ENGR: GA KUGLER DRAWN: K.M.A. DATE: 5-1-78

WASHINGTON PUBLIC POWER SUPPLY SYSTEM
 RICHMOND WASHINGTON 99352

WNP-2
 WELD & COMPONENT IDENTIFICATION DIAGRAM

TITLE:
 RHR LOOP A
 SUPPLY TO RHR-HX-1A


DWG NO: RHR-201-1 REV 2

PIPING SYSTEM	NOM DIA (IN)	SCH	NOM WALL THK	MATERIAL SPECIFICATION	MATL TYPE	CAL BLOCK NO
14" RHR (11-2)	14	STD	0.375	SA 106 GR B	CB	NA
18" RHR (11-2)	18	30	0.418	SA 106 GR B	CB	NA
10" RHR (11-2)	10	40	0.365	SA 106 GR B	CB	NA

NO	DATE	REVISION	BY	CHKD	APPVD
2	9-26-83	ADDED 3/4 SOL. NOTES 2 & 3. RHR-162 LUGS NOW RIGID.	K.M.A.	WPT	J.H.
1	11-2-81	REVISED AS NOTED	K.M.A.	WPT	J.H.
0	12-21-77	ISSUED FOR USE	K.M.A.	WPT	J.H.
A	5-1-78	ISSUED FOR INFORMATION ONLY	K.M.A.	WPT	J.H.
		REVISION			


THIS DRAWING IS INTENDED FOR USE IN PRESERVICE AND INSERVICE INSPECTION PROGRAMS ONLY.



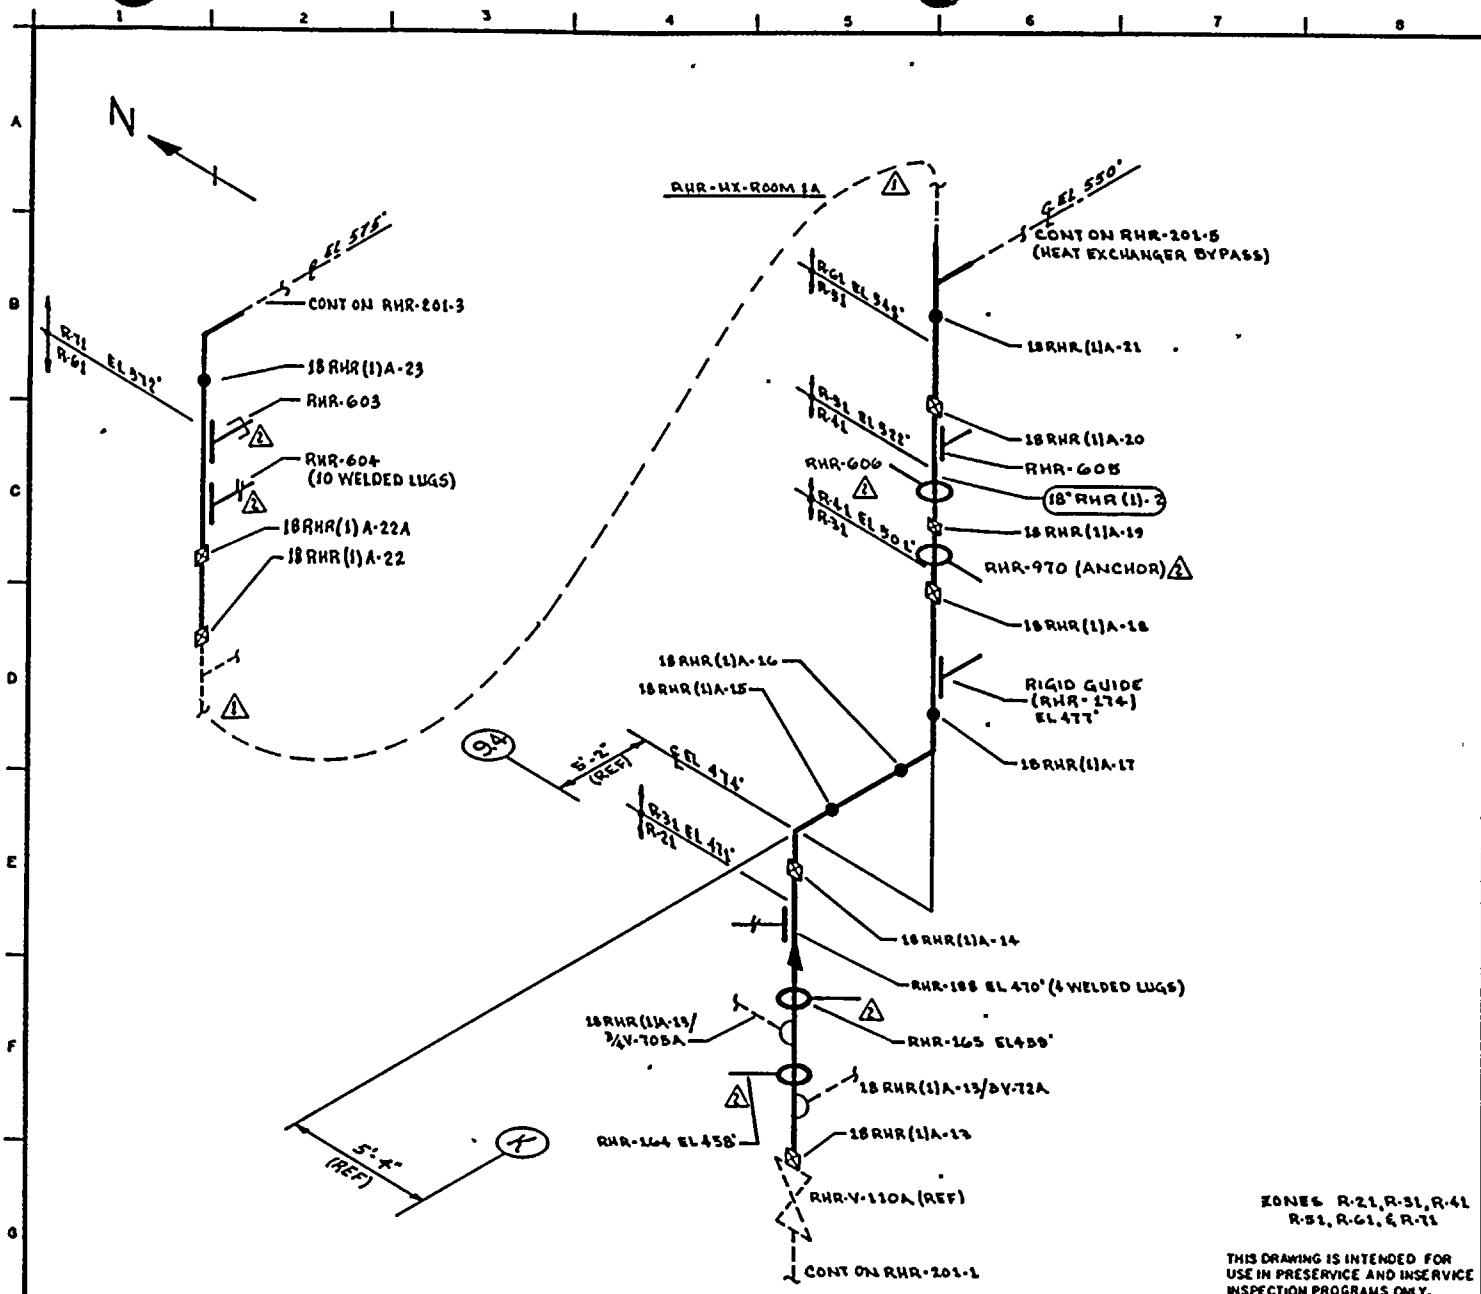

NOTES:

REFERENCES:
 BOVEE & CRAIG ISOMETRICS
 RHR-867-B.7 REV 6
 RHR-867-B.12 REV 5

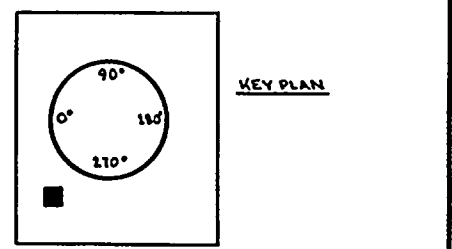

QUALITY CLASS: 1 ASME CODE CLASS: 2
 ENGR: GA KUGLER DRAWN: X-M-A DATE: 5-1-78

WASHINGTON PUBLIC POWER SUPPLY SYSTEM
 RICHMOND, WASHINGTON 98352

ZONES R-21, R-31, R-41
 R-51, R-61, & R-71

THIS DRAWING IS INTENDED FOR
 USE IN PRESERVICE AND INSERVICE
 INSPECTION PROGRAMS ONLY.

PIPING SYSTEM	NOM DIA (DN)	SCH	NOM WALL THK	MATERIAL SPECIFICATION	MATL TYPE	CAL BLOCK NO
18" RHR (1)-2	18	30	0.438	SA 106 GR B	CS	NA


NO	DATE	REVISION	BY	CHKD	APPVD
2	9-26-83	REVISED AS NOTED	KUL/A	JWR	TTH
1	12-28-81	REVISED AS NOTED	KUL/A	200	TTH
0	12-22-78	ISSUED FOR USE	KUL/A	GAK	TTH
A	5-26-78	ISSUED FOR INFORMATION ONLY	KUL/A	GAK	OLP

WNP-2
 WELD & COMPONENT
 IDENTIFICATION DIAGRAM

TITLE:
 RHR LOOP A
 SUPPLY TO RHR-HX-1A


DWG NO: RHR-201-2 REV 2



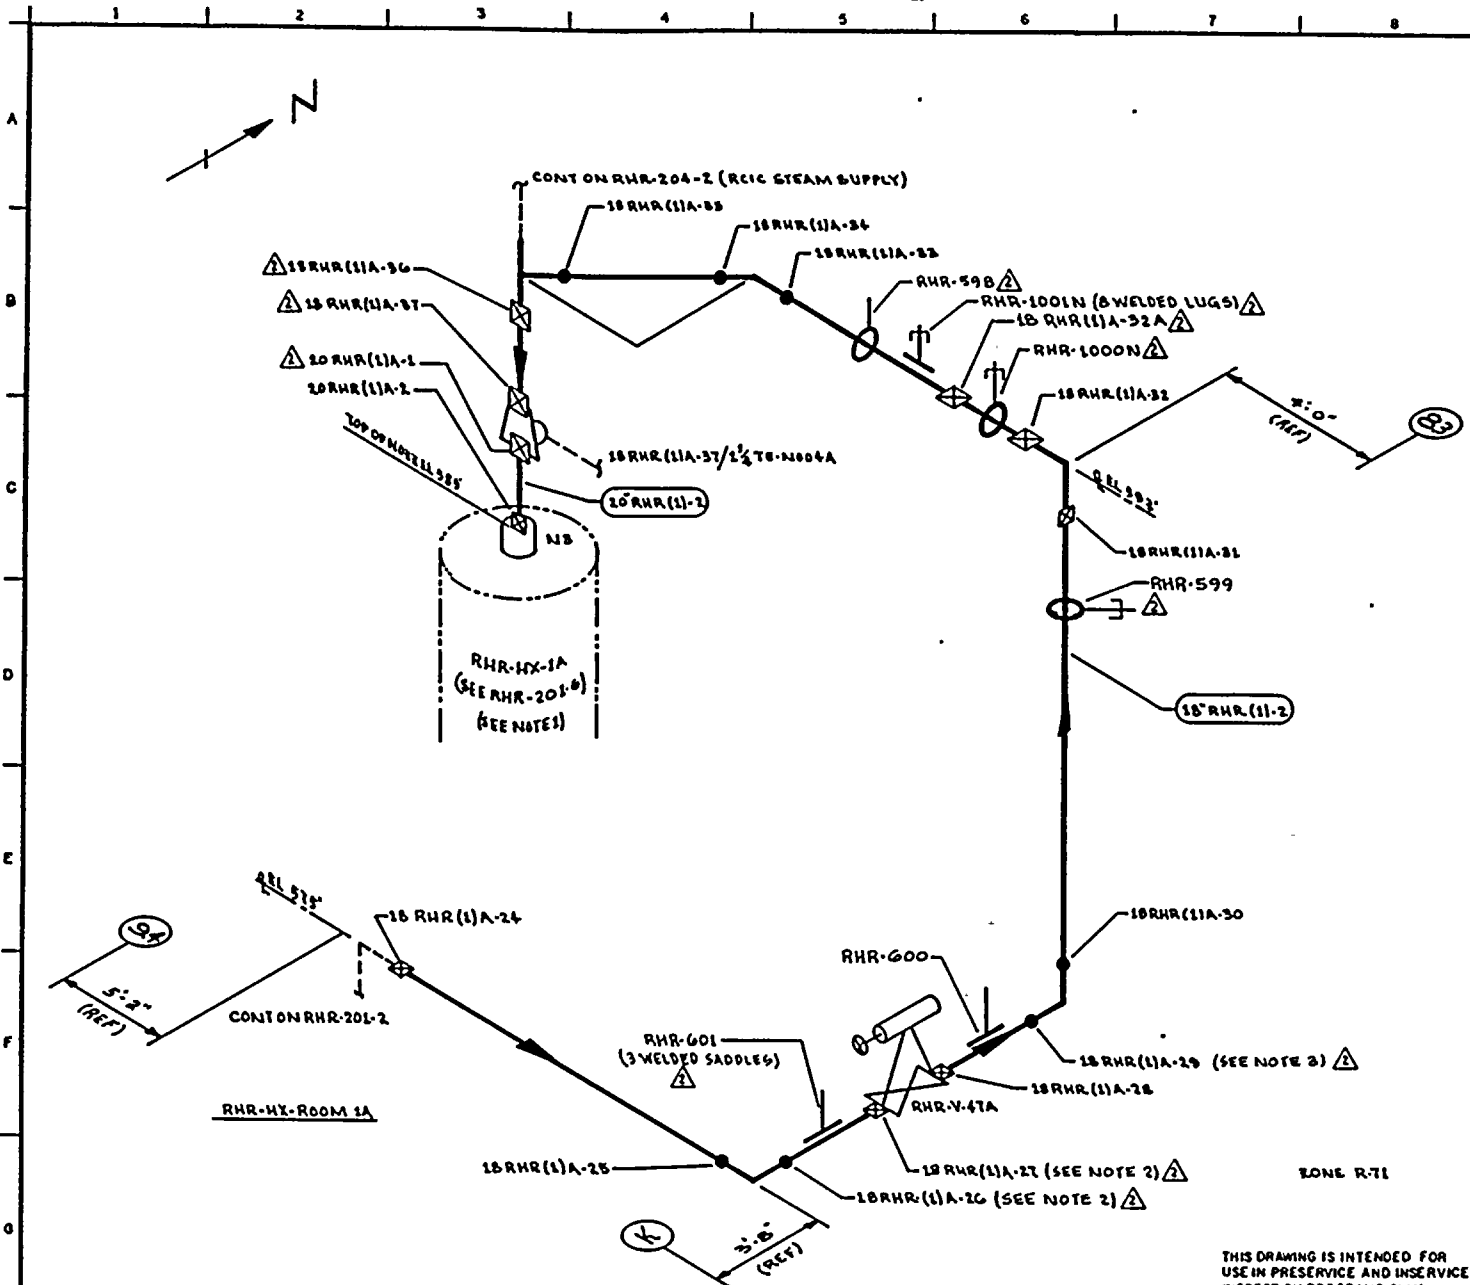

- NOTES:
1. EXTEND VISUAL LEAKAGE EXAM OF RHR-HX-1A VENTS & DRAINS THROUGH OUTERMOST NORMALLY CLOSED ISOLATION VALVE, RELIEF VALVE OR TRANSITION TO INSTRUMENT TUBING.
 2. RHR-601 - WELDED SADDLE 1" FROM WELD 18RHR(1)A-26 CENTERLINE & 2" FROM WELD 18RHR(1)A-27 CENTERLINE.
 3. RHR-600 - 4" DIA PIPE WELDED TO LINE, 1 1/2" FROM WELD 18RHR(1)A-29 CENTERLINE AT 90° & 270°.

REFERENCES:
 BOYER (CRAIL ISOMETRIC
 RHR-86T-13.15 REV 3

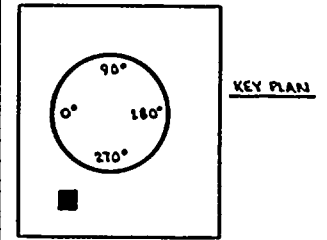

QUALITY CLASS: 1 ASME CODE CLASS: 2
 ENGR: GA KUGLER DRAWN: K-McA DATE: 6-2-76

WASHINGTON PUBLIC POWER SUPPLY SYSTEM
 RICHLAND, WASHINGTON 99352

THIS DRAWING IS INTENDED FOR USE IN PRESERVICE AND INSERVICE INSPECTION PROGRAMS ONLY.

PIPING SYSTEM	NOM DIA (IN)	SCH	NOM WALL THK	MATERIAL SPECIFICATION	MATL TYPE	CAL BLOCK NO
18" RHR (1)A-2	18	30	0.438	SA 106 GR B	CC	NA
20" RHR (1)A-2	20	20	0.500	SA 106 GR B	CC	NA


NO	DATE	REVISION	BY	CHKD	APPVD
2	9-25-83	REVISED AS NOTED	K.M.A	J.P.R	J.F.S
1	12-2-81	REVISED AS NOTED	K.M.A	L.W.S	T.F.H
0	12-17-79	ISSUED FOR USE	K.M.A	J.P.R	J.F.S
A	5-16-78	ISSUED FOR INFORMATION ONLY	K.M.A	C.A.K	D.W.R

WHP-2
 WELD & COMPONENT IDENTIFICATION DIAGRAM

TITLE:
 RHR LOOP A SUPPLY TO RHR-HX-1A

DWG NO: RHR-201-3 REV 2



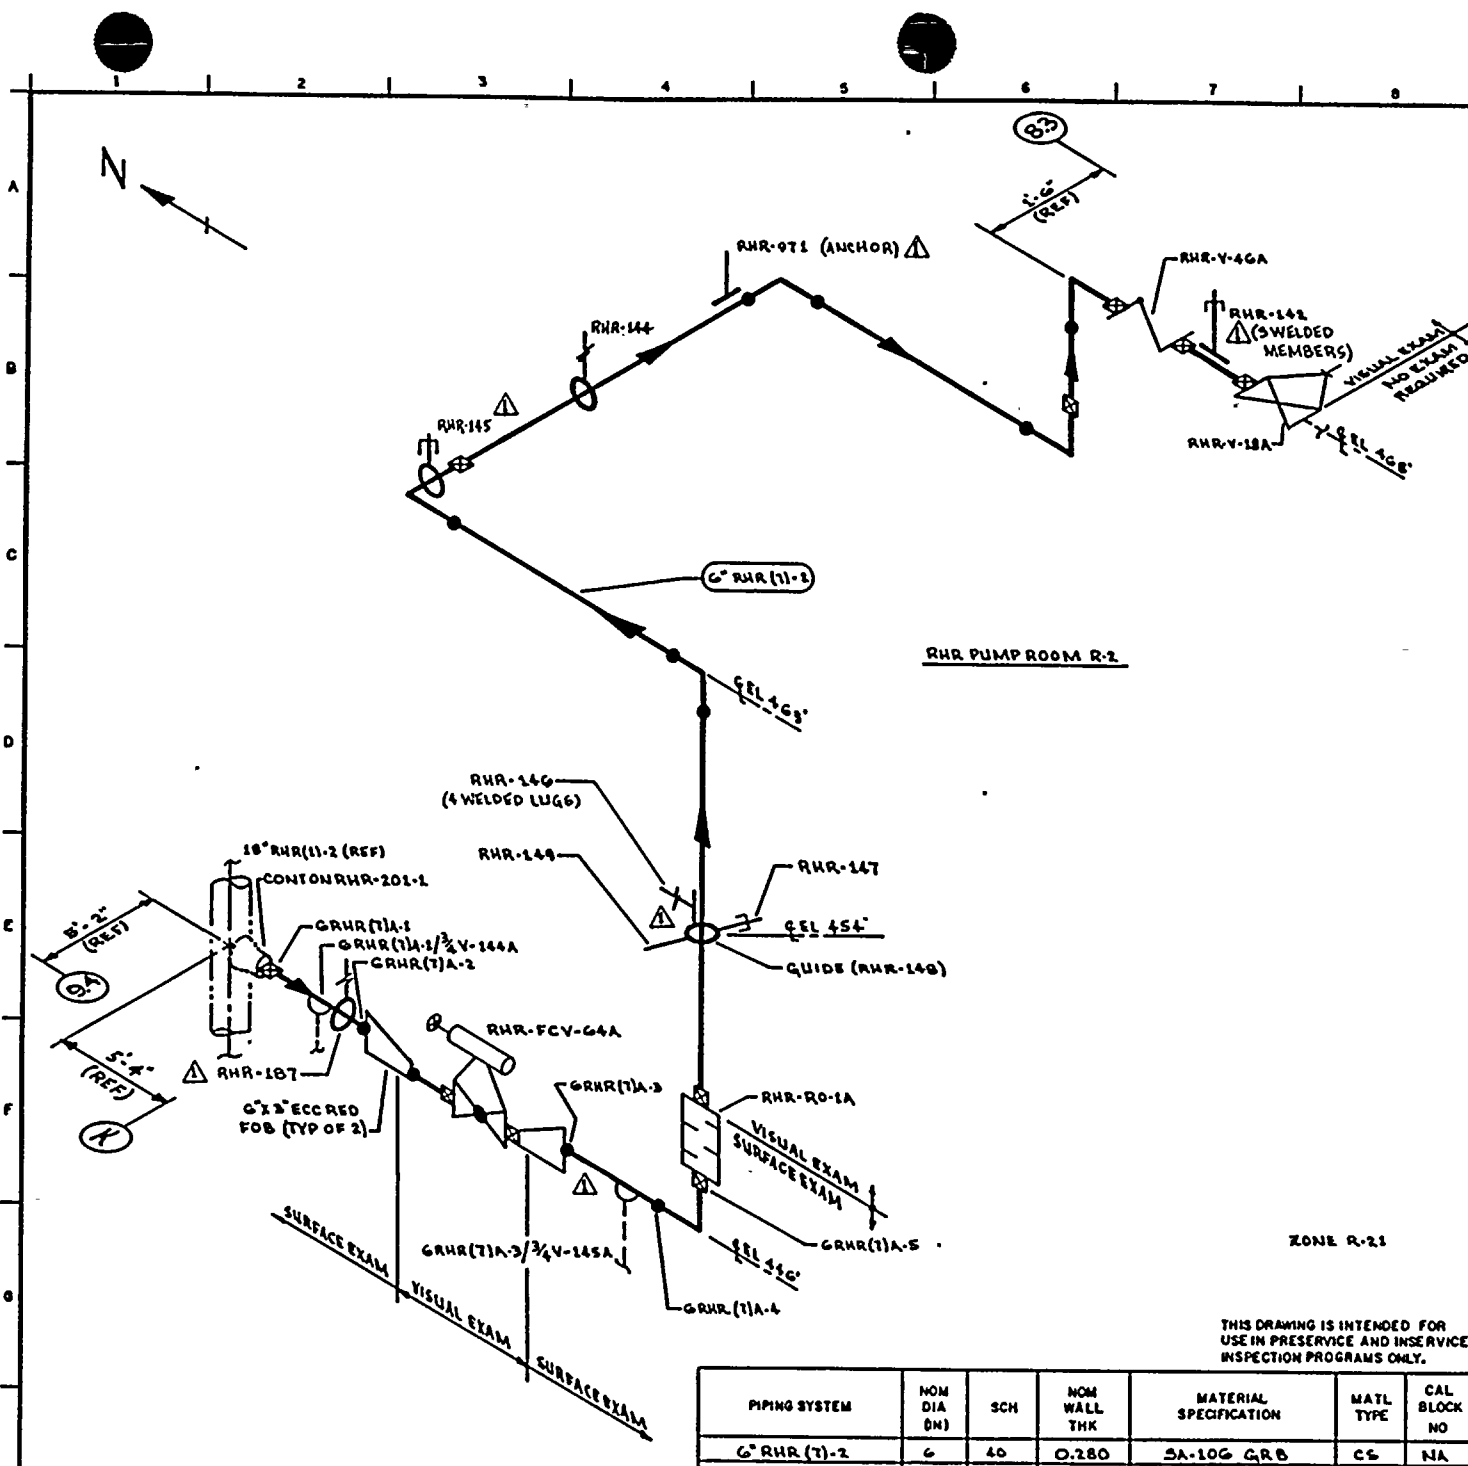


NOTES:

1. PORTIONS OF THIS DRAWING IDENTIFY PIPING & COMPONENTS SUBJECT ONLY TO A VISUAL EXAM FOR EVIDENCE OF LEAKAGE DURING SYSTEM HYDRO OR OPERABILITY TESTS. TESTS ARE TO BE CONDUCTED PER THE REQUIREMENTS OF ASME SECTION XI, PARAGRAPH IWA-5000.
2. SCAFFOLDING IS REQUIRED.

REFERENCES:

BOVER & CRILL ISOMETRICS
 RHR-867-16-19 REV 5
 RHR-867-10-12 REV 6

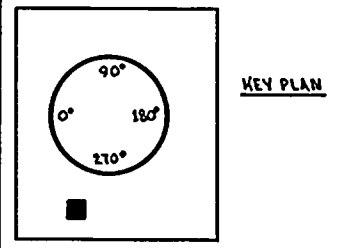

QUALITY CLASS: 1 | ASME CODE CLASS: 2
 ENGR: GA WJGLER | DRAWN: J. M. A. | DATE: 5-2-78

WASHINGTON PUBLIC POWER SUPPLY SYSTEM
 RICHLAND, WASHINGTON 98352

THIS DRAWING IS INTENDED FOR USE IN PRESERVICE AND INSERVICE INSPECTION PROGRAMS ONLY.

PIPING SYSTEM	NOM DIA (DN)	SCH	NOM WALL THK	MATERIAL SPECIFICATION	MATL TYPE	CAL BLOCK NO
6" RHR (7)-2	6	40	0.280	SA-106 GRB	CS	NA


NO	DATE	REVISION	BY	CHKD	APPVD
1	10-28-83	REVISED AS NOTED	AKA	DPF	TTH
0	11-18-78	ISSUED FOR USE	AKA	DPF	TTH
A	5-26-78	ISSUED FOR INFORMATION ONLY	AKA	DPF	TTH

WNP-2
 WELD COMPONENT
 IDENTIFICATION DIAGRAM

TITLE:
 RHR LOOP A
 MINIMUM FLOW LINE TO SUPPRESSION POOL


DWG NO: RHR-201-4 | REV 1



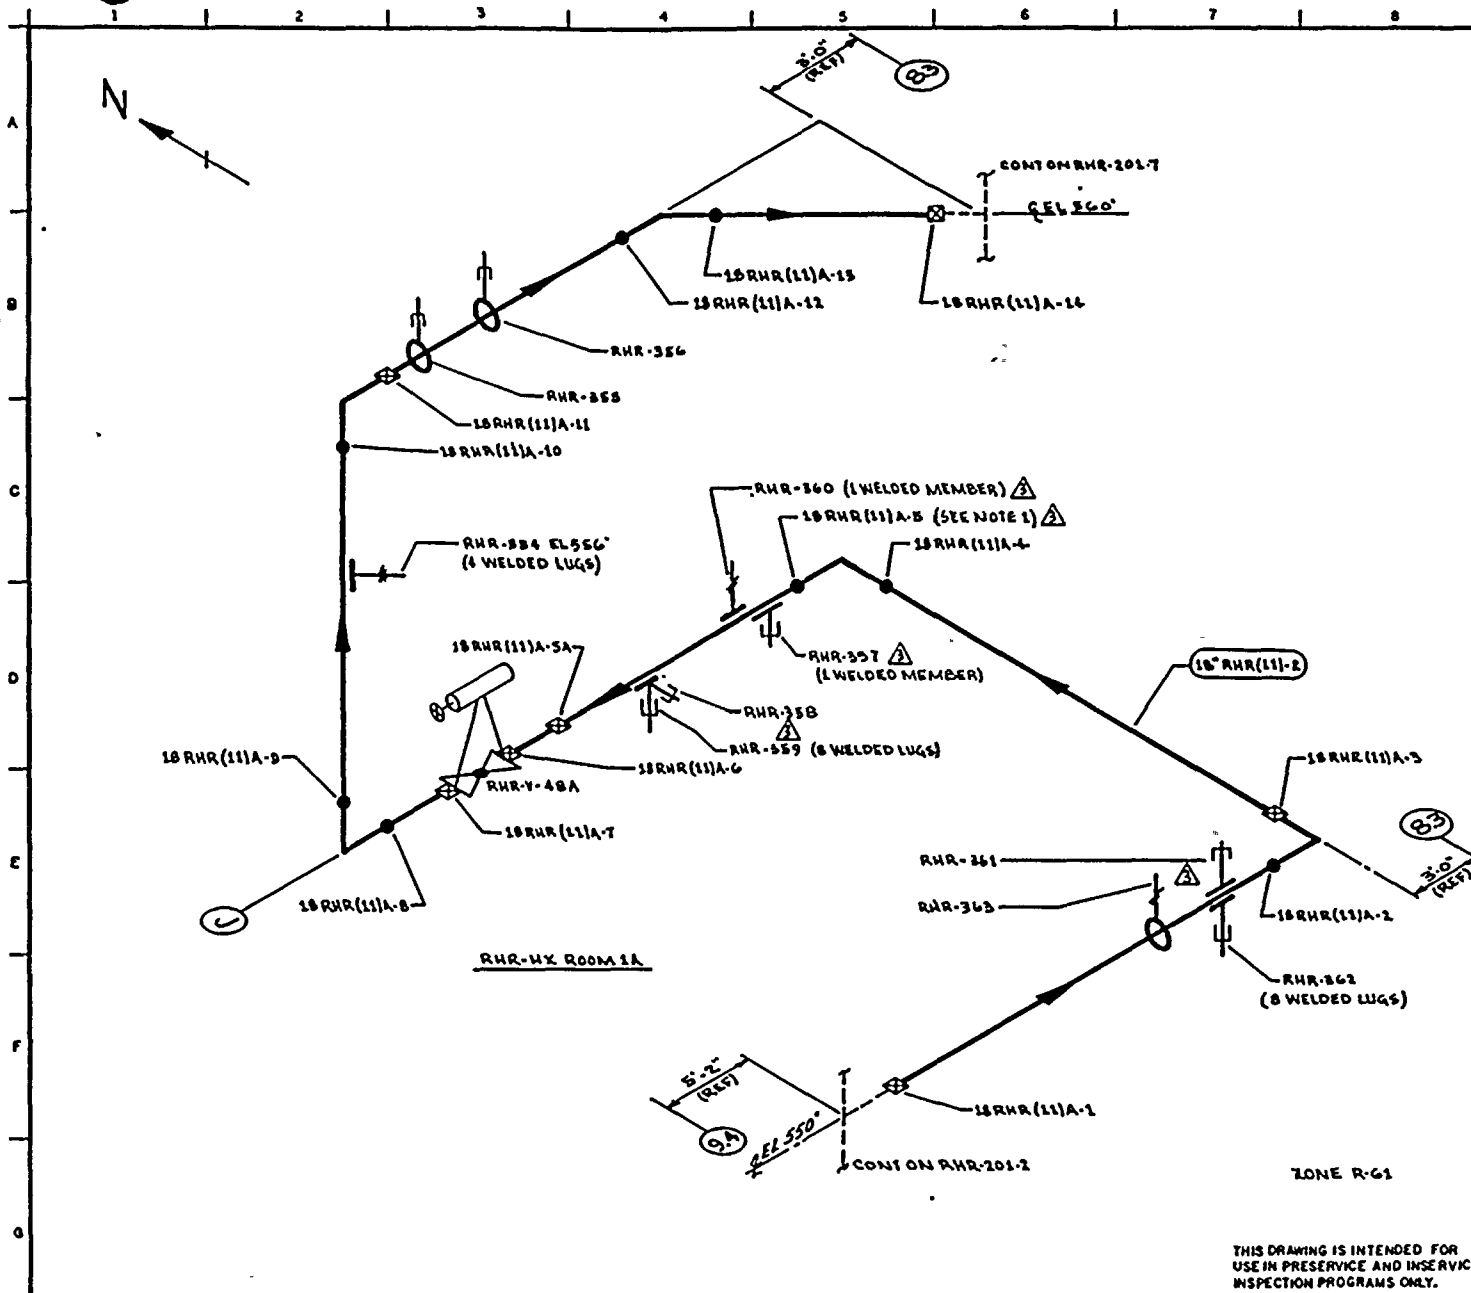

- NOTES:
1. RHR-357 WELDED MEMBER IS 1 1/2" FROM WELD 18RHR(11)A-5 CENTERLINE AT 0°.
 2. SCAFFOLDING IS REQUIRED.

REFERENCE:
BOVEE & CRILL ISOMETRICS
RHR-852-1.4 REV 5

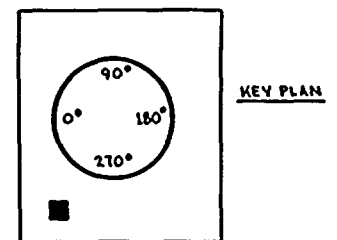

QUALITY CLASS: 1 ASME CODE CLASS: 2
ENGR: GA KUGLER DRAWN: V.M.L.A DATE: 5-8-78

WASHINGTON PUBLIC POWER SUPPLY SYSTEM
RICHLAND, WASHINGTON 99022


THIS DRAWING IS INTENDED FOR USE IN PRESERVICE AND INSERVICE INSPECTION PROGRAMS ONLY.


NO	DATE	REVISION	BY	CHKD	APPVD	PIPING SYSTEM	NOM DIA (IN)	SCH	NOM WALL THK	MATERIAL SPECIFICATION	MATL TYPE	CAL BLOCK NO
3	9-7-73	REVISED AS NOTED	KWA	JFR	TFR	18" RHR (11)-2	16	30	0.438	SA 106 GR B	CB	N.A.
2	12-2-81	REVISED AS NOTED	KWA	JFR	TFR							
1	11-6-80	ADDED FIELD WELD 18RHR(11)A-5A EAS NOTED	KWA	JFR	QUL							
0	11-11-78	ISSUED FOR USE	KWA	JFR	TFR							
A	5-16-78	ISSUED FOR INFORMATION ONLY	KWA	GAK	QUL							

WNP-2
WELD & COMPONENT
IDENTIFICATION DIAGRAM

TITLE:
RHR LOOP A
RHR-HEAT-EXCHANGER BYPASS


DWG NO: RHR-201-5 REV 3

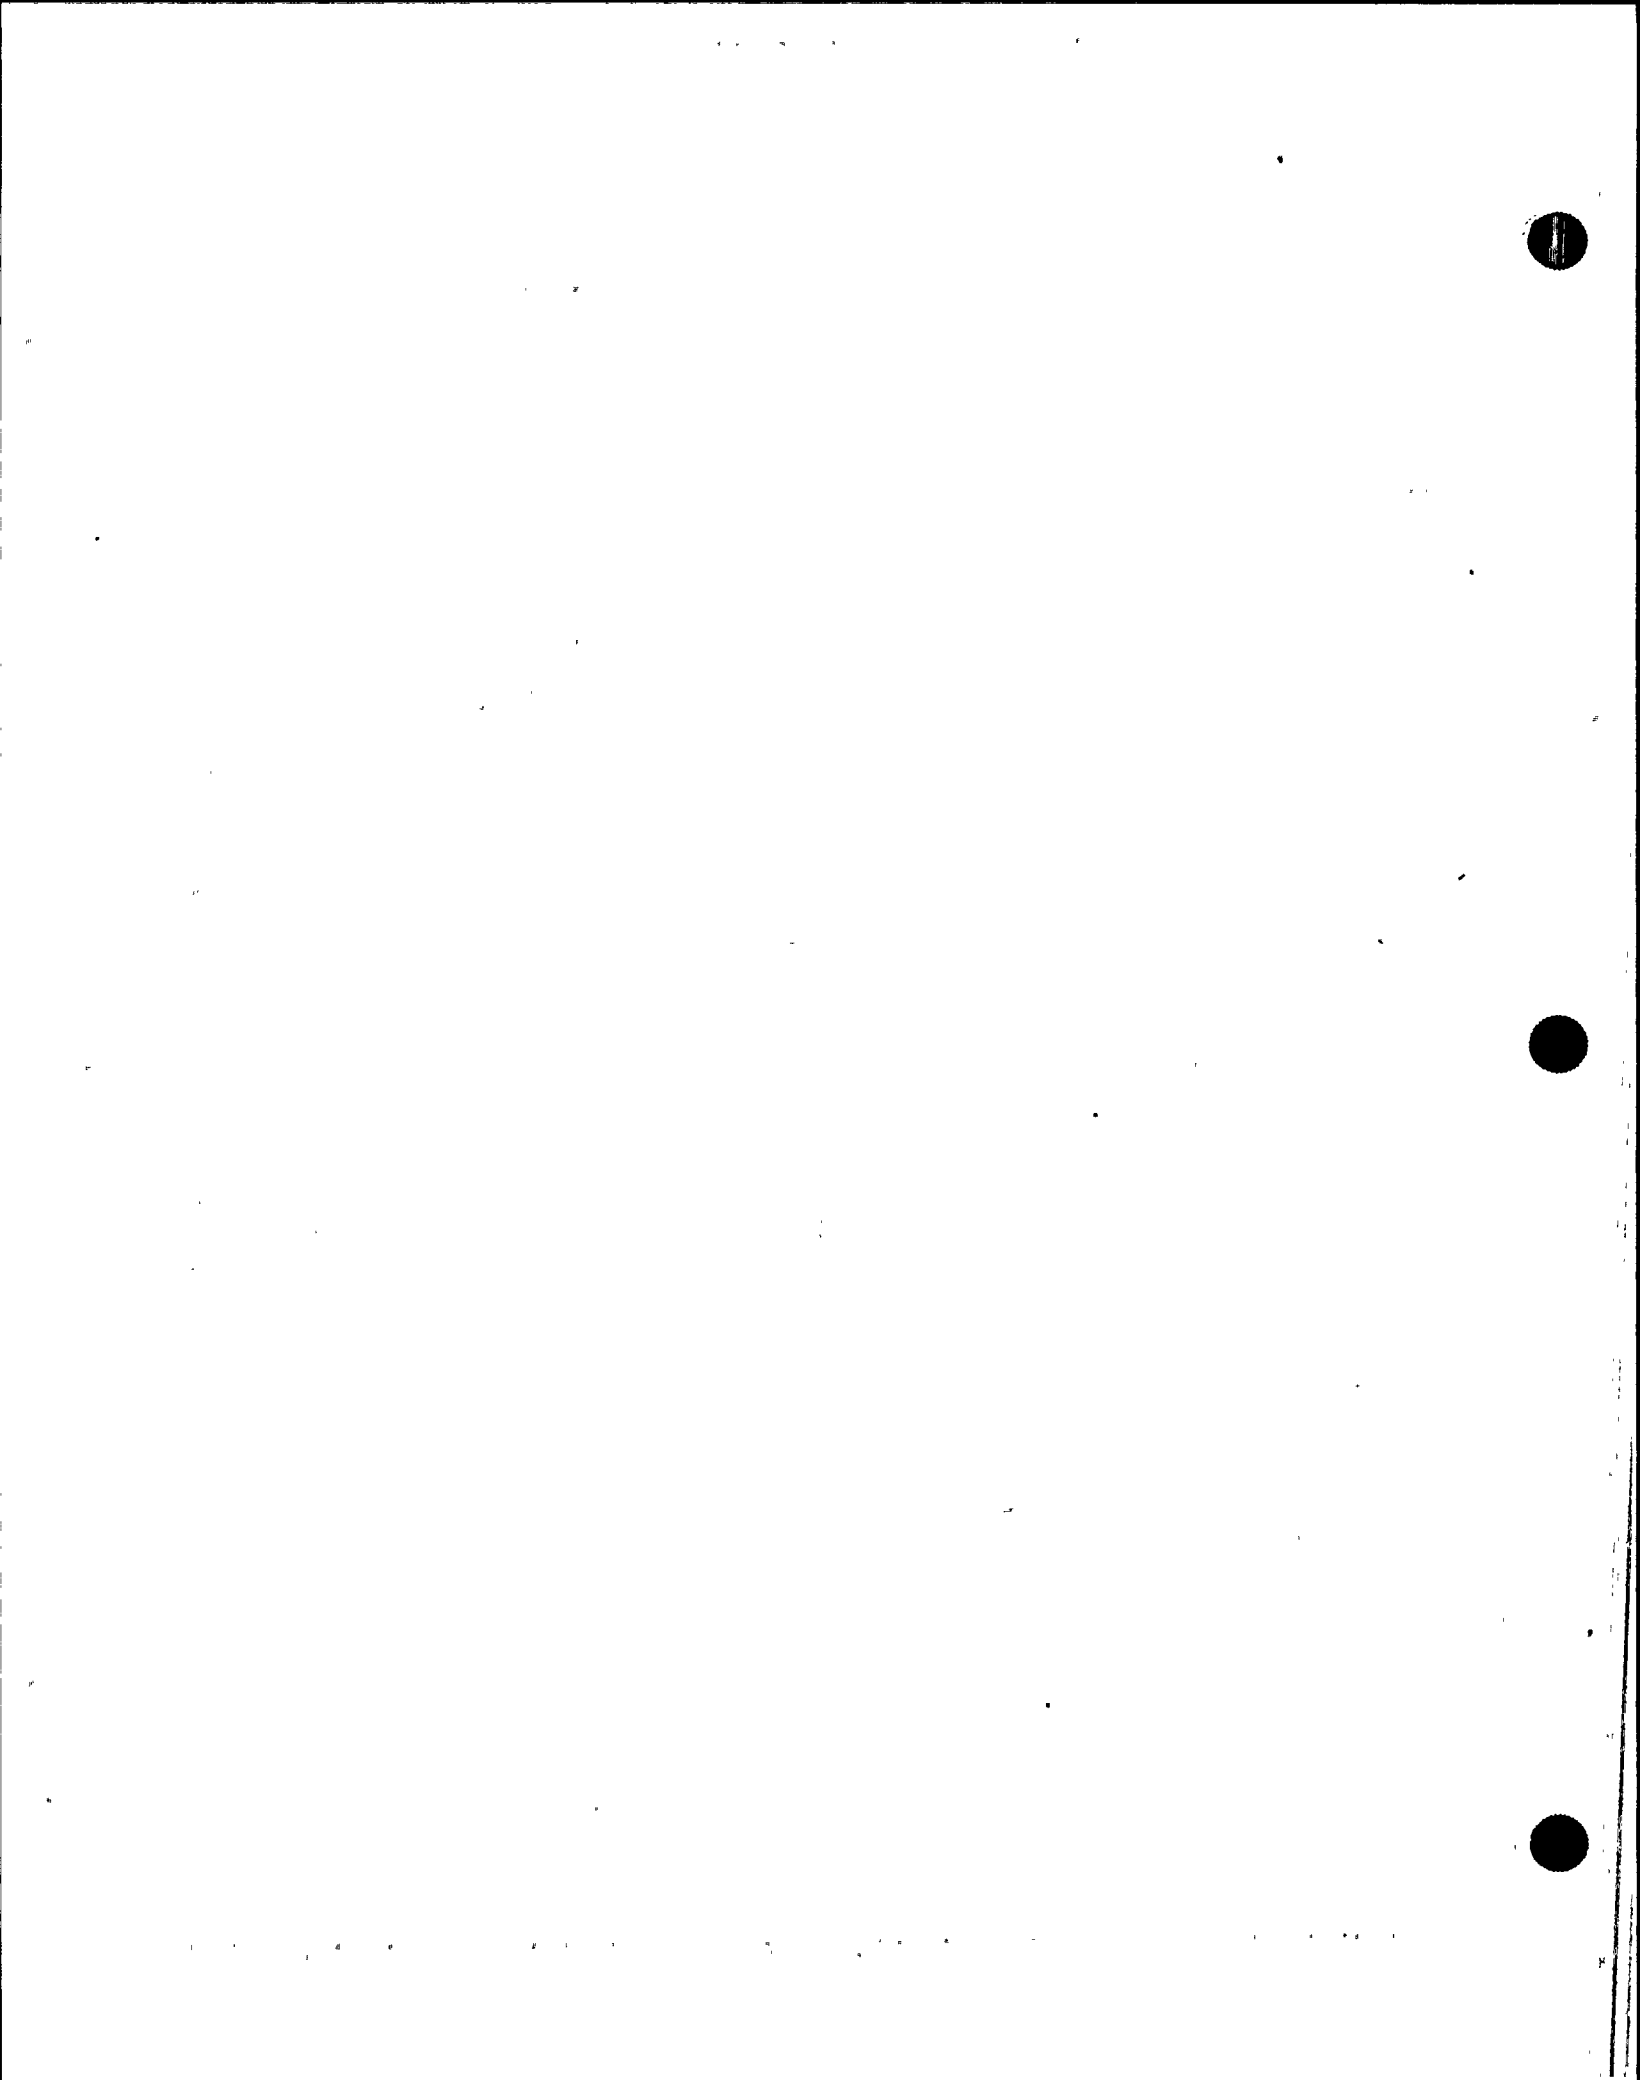

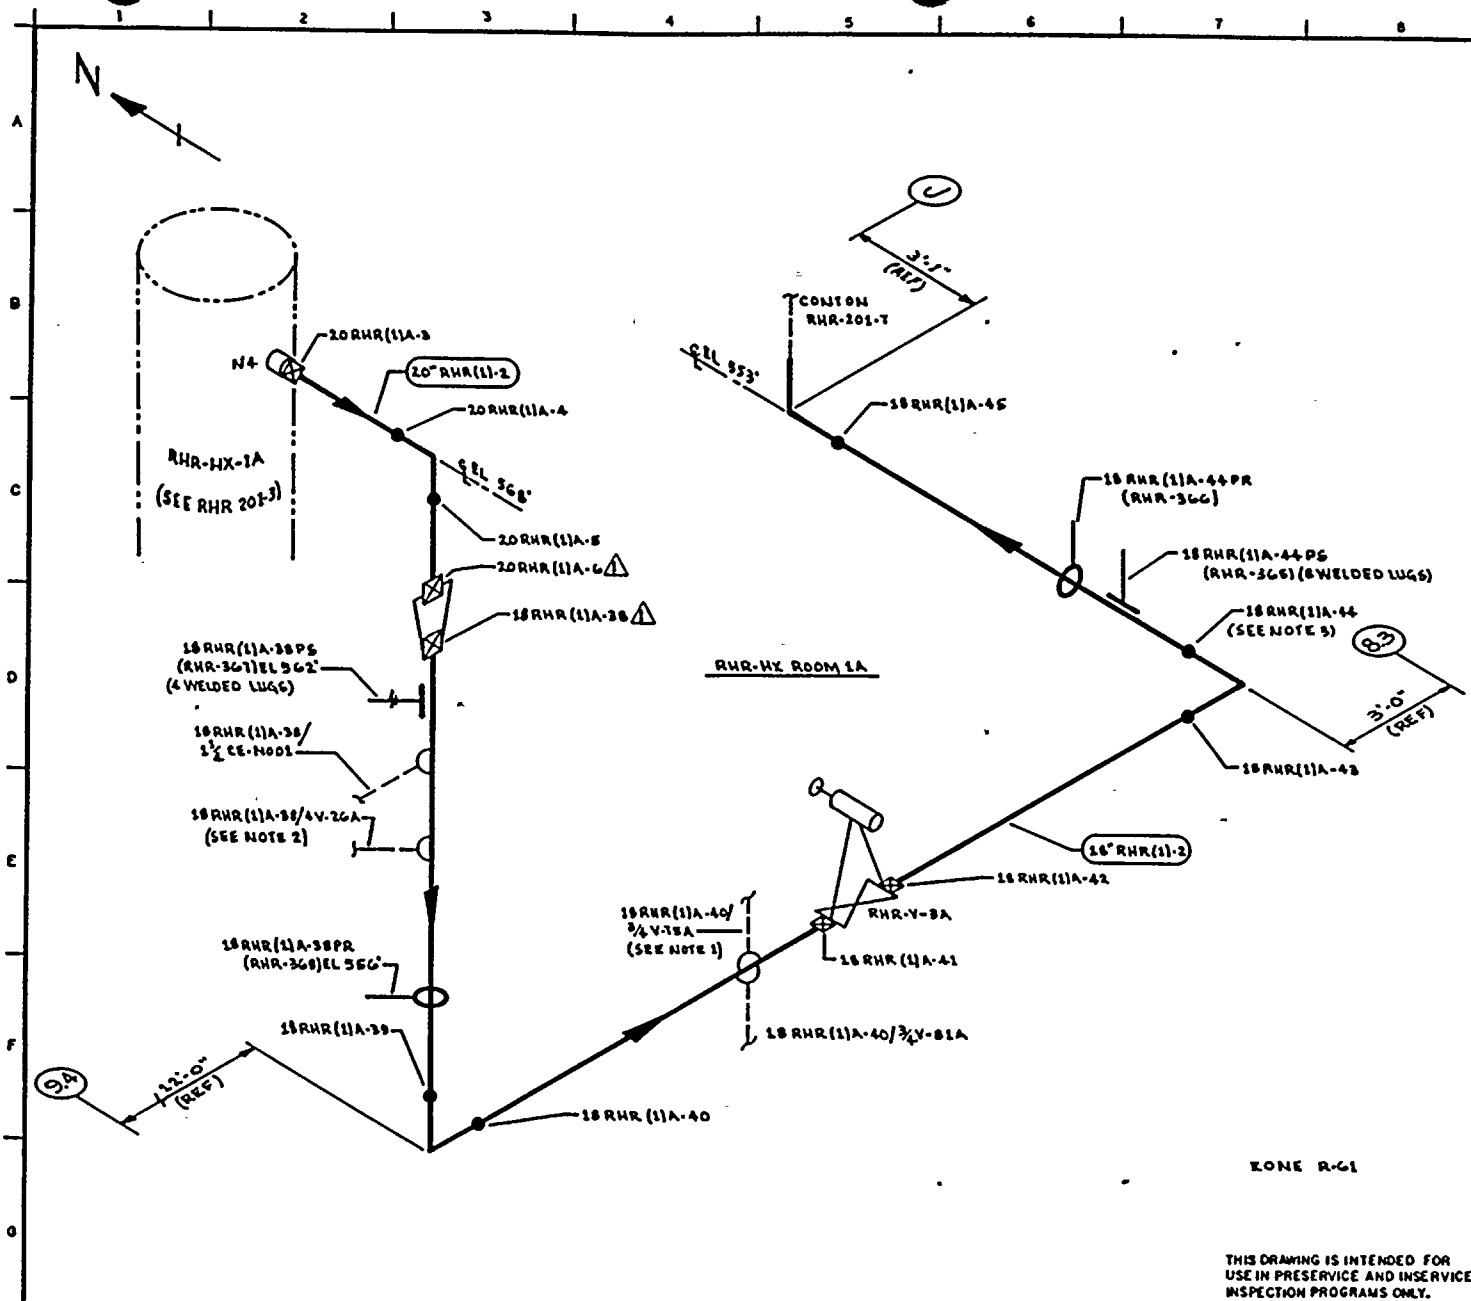

- NOTES:
1. THIS IS A 1 1/2" CONNECTION WITH VISUAL EXAM EXTENDING TO 3/4" V-75A.
 2. TERMINATE VISUAL EXAM AT V-26A, V-11A & V-150A.
 3. FOUR LUGS FROM RHR-365 ARE 1" FROM WELD 18 RHR(11A)-44 CENTERLINE.
 4. SCAFFOLDING IS REQUIRED.

REFERENCES:
 ABOVE & CRAIL ISOMETRICS
 RHR-801-1.2 REV 9

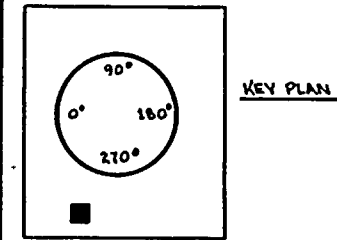

THIS DRAWING IS INTENDED FOR USE IN PRESERVICE AND INSERVICE INSPECTION PROGRAMS ONLY.

QUALITY CLASS: 1 ASME CODE CLASS: 2
 ENGR: GA KUGLER DRAWN: V. McCA DATE: 5-4-78

WASHINGTON PUBLIC POWER SUPPLY SYSTEM
 RICHMOND, WASHINGTON 98352

PIPING SYSTEM	NOM DIA (IN)	SCH	NOM WALL THK	MATERIAL SPECIFICATION	MATL TYPE	CAL BLOCK NO
18" RHR(11)-2	18	30	0.438	SA 106 GR B	CS	NA
20" RHR(11)-2	20	30	0.500	SA 106 GR B	CS	NA


NO	DATE	REVISION	BY	CHKD	APPVD
1	2-22-83	ADDED NOTES 3 & 4. CHGD 20RHR(11A)-6 & 38 TO FW	KJA	DM	TJ
0	11-18-77	ISSUED FOR USE	KJA	DM	TJ
A	5-11-78	ISSUED FOR INFORMATION ONLY	KJA	DM	TJ

WNP-2
 WELD B COMPONENT
 IDENTIFICATION DIAGRAM

TITLE: RHR LOOP A SUPPLY FROM RHR-HX-1A


DWG NO: RHR-201-G REV 1



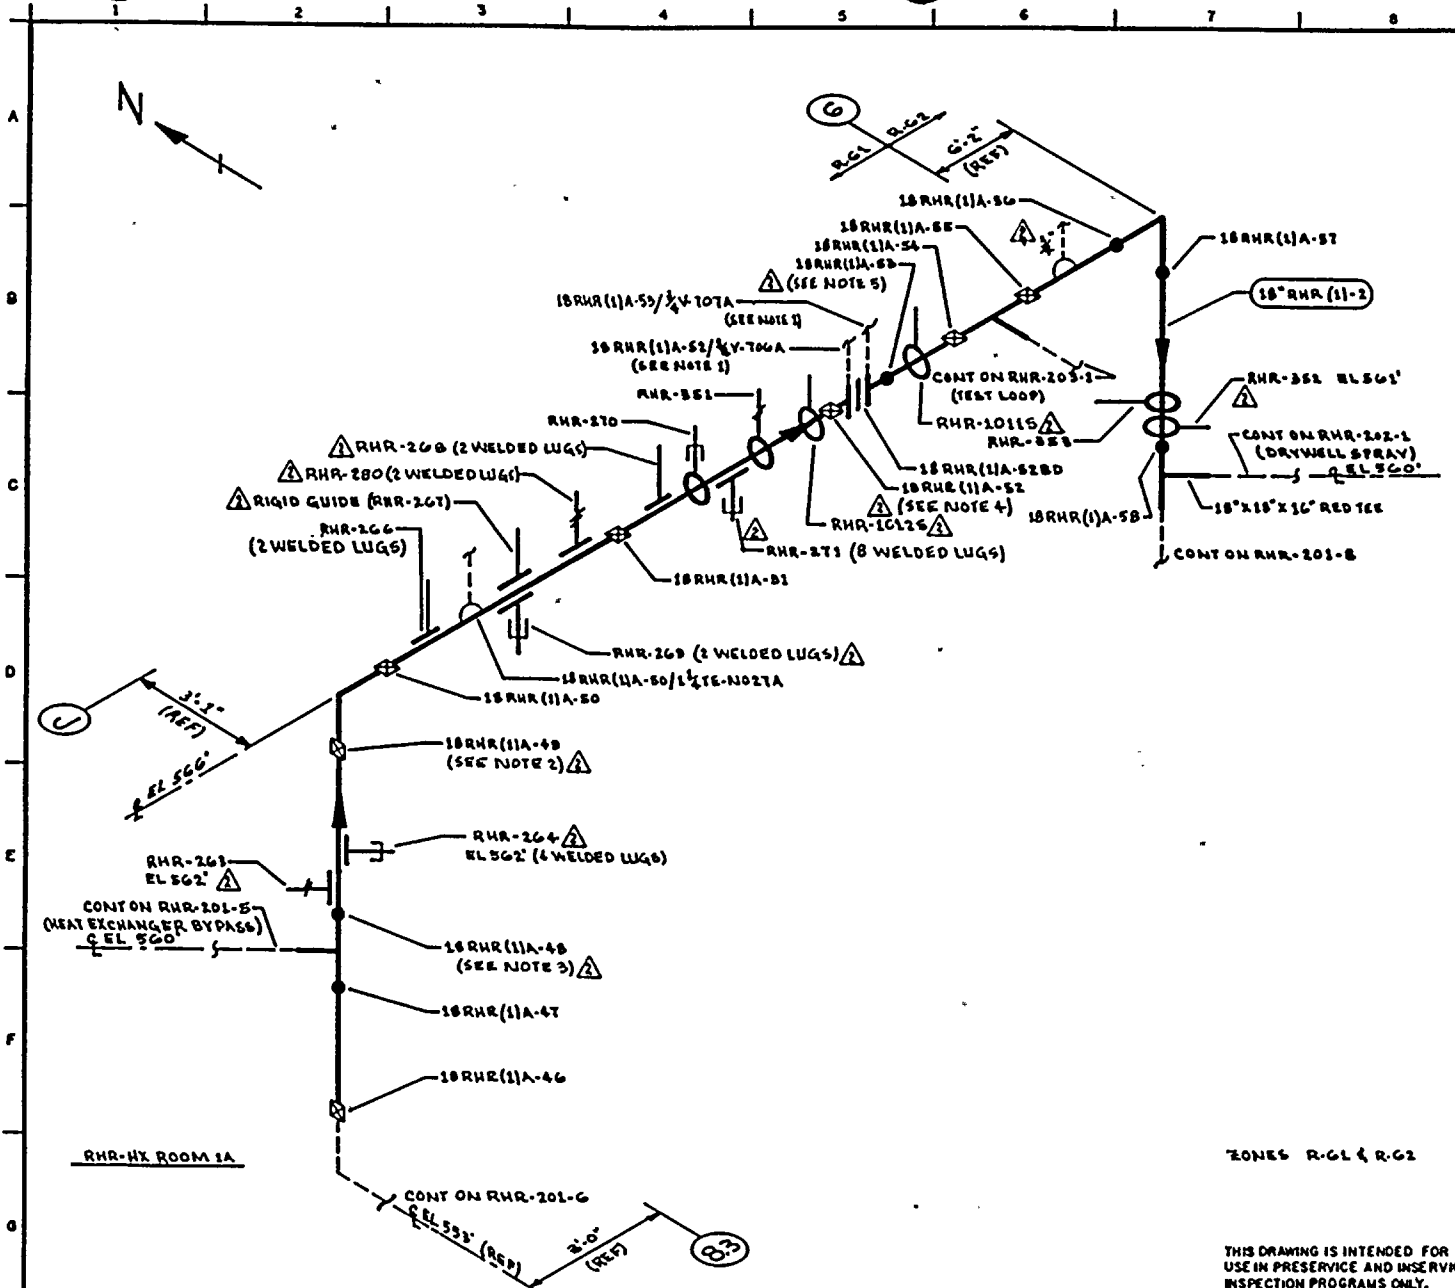

- NOTES:
1. THESE ARE 1/2" CONNECTIONS WITH VISUAL EXAM EXTEND TO 1/4V-106A, 1/4V-107A, 1/4V-128A & 1/4V-129A.
 2. RHR-264 LUGS ARE 1/4" FROM WELD 18 RHR (1)A-49 CENTERLINE.
 3. RHR-263 LUGS ARE 1/4" FROM WELD 18 RHR (1)A-48 CENTERLINE.
 4. ACCESS TO WELD 18 RHR (1)A-52 REQUIRES REMOVAL OF RHR-1012S.
 5. ACCESS TO WELD 18 RHR (1)A-53 REQUIRES REMOVAL OF RHR-1011S.

REFERENCES:
 BOVEE & CRAIG ISOMETRIC
 RHR-851-3.0 REV B

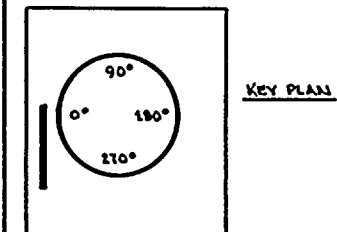

QUALITY CLASS: L ASME CODE CLASS: 2
 ENGR: DRAWN: X.M.C.A. DATE: 8-4-78
WASHINGTON PUBLIC POWER SUPPLY SYSTEM
 RICHLAND, WASHINGTON 99352


THIS DRAWING IS INTENDED FOR USE IN PRESERVICE AND INSERVICE INSPECTION PROGRAMS ONLY.

ZONES R-6L & R-62

PIPING SYSTEM	NOM DIA (IN)	SCH	NOM WALL THK	MATERIAL SPECIFICATION	MATL TYPE	CAL BLOCK NO
18" RHR (1)-2	18	30	0.438	SA 106 GR B	CB	NA


NO	DATE	REVISION	BY	CHKD	APPVD
2	10-13-83	REVISED AS NOTED	KLA	ZPR	STP
1	12-2-81	REVISED AS NOTED	KLA	ZPR	TRF
0	12-11-81	ISSUED FOR USE	KLA	ZPR	TRF
A	5-24-78	ISSUED FOR INFORMATION ONLY	KLA	GAK	STP

WNP-2
 WELD & COMPONENT
 IDENTIFICATION DIAGRAM
 TITLE: RHR LOOP A SUPPLY FROM RHR-WX-1A
 DWG NO: RHR-201-T REV 2

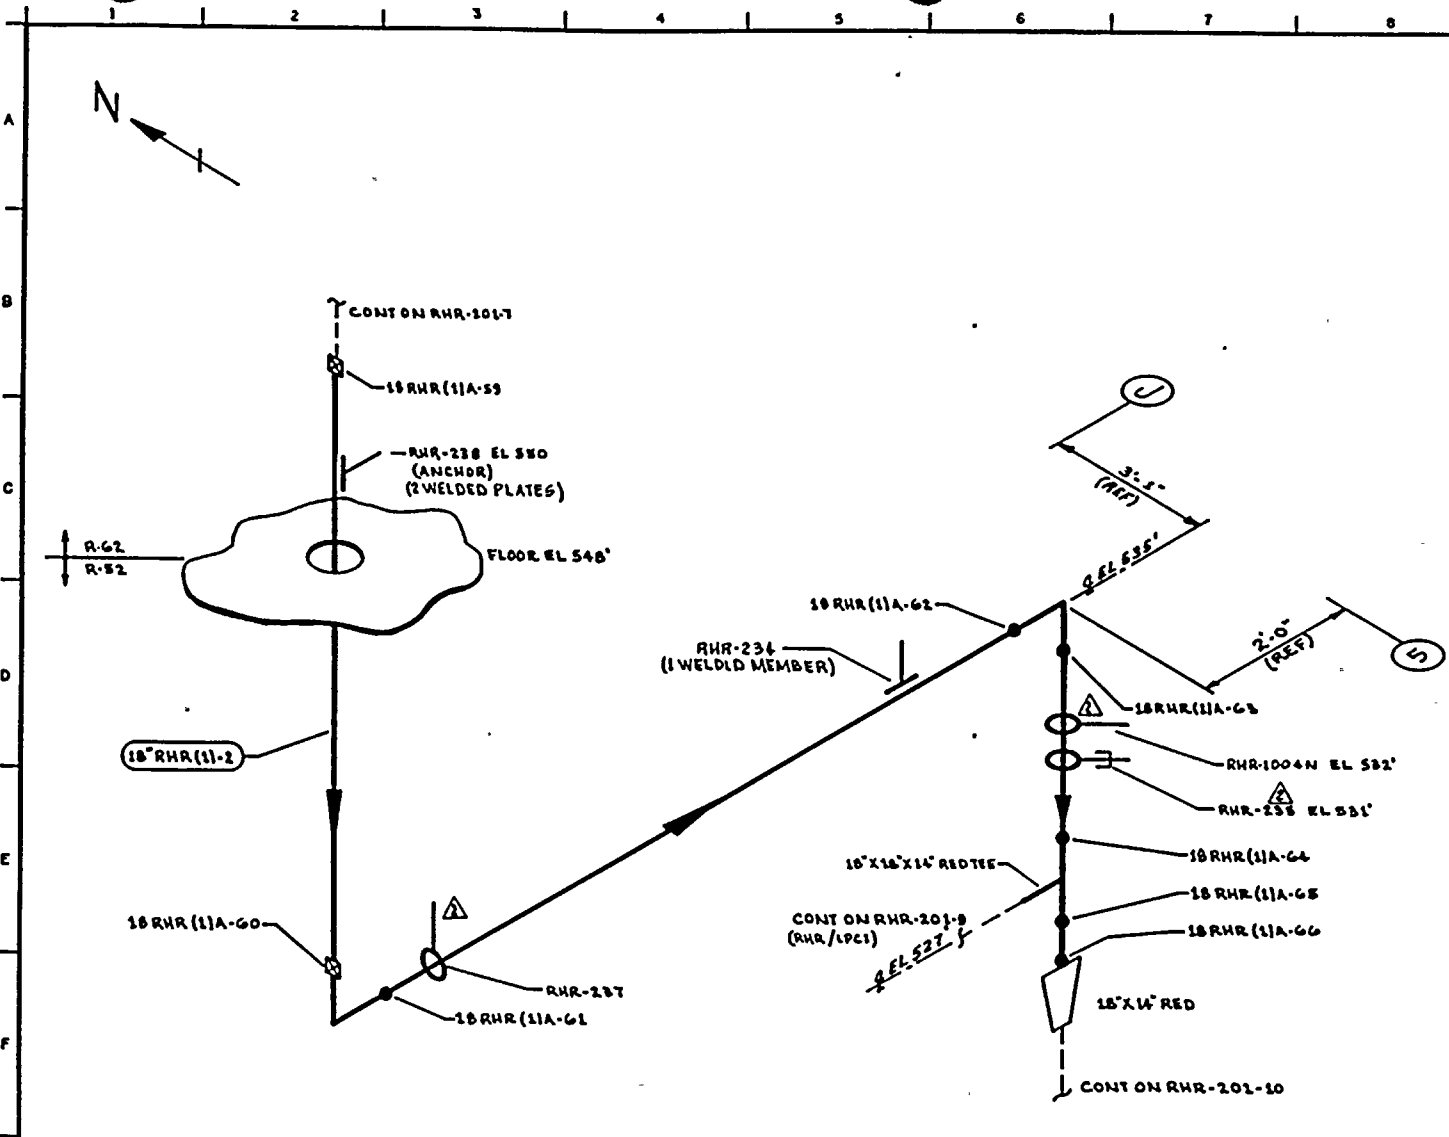

NOTES:
 1. SCAFFOLDING IS REQUIRED.

REFERENCES:
 DOVE & CRILL ISOMETRIC
 RHR-551-3.9 REV G

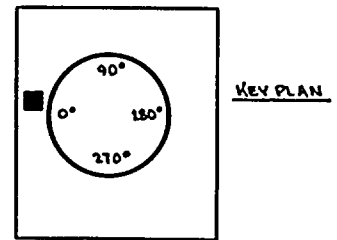

ZONES R-62 & R-52

THIS DRAWING IS INTENDED FOR
 USE IN PRESERVICE AND INSERVICE
 INSPECTION PROGRAMS ONLY.

QUALITY CLASS: 1 ASME CODE CLASS: 2
 ENGR: G.A. KUGLER DRAWN: K.M.L.A. DATE: 5-4-78

WASHINGTON PUBLIC POWER
 SUPPLY SYSTEM
 RICHLAND, WASHINGTON 99352


WNP-2
 WELD 8 COMPONENT
 IDENTIFICATION DIAGRAM

TITLE:
 RHR LOOP A SUPPLY FROM
 RHR-HX-1A

DWG NO: RHR-201-B REV 2


NO	DATE	REVISION	BY	CHKD	APPVD
2	9-16-78	REVISED AS NOTED	K.M.L.A.	229	TFW
1	12-2-81	REVISED AS NOTED	K.M.L.A.	---	TFW
D	11-22-77	ISSUED FOR USE	K.M.L.A.	---	TFW
A	5-16-78	ISSUED FOR INFORMATION ONLY	K.M.L.A.	GAK	---

PIPING SYSTEM	NOM DIA (DN)	SCH	NOM WALL THK	MATERIAL SPECIFICATION	MATL TYPE	CAL BLOCK NO
18" RHR (1)-2	18	50	0.438	SA 106 GR B	C4	N/A

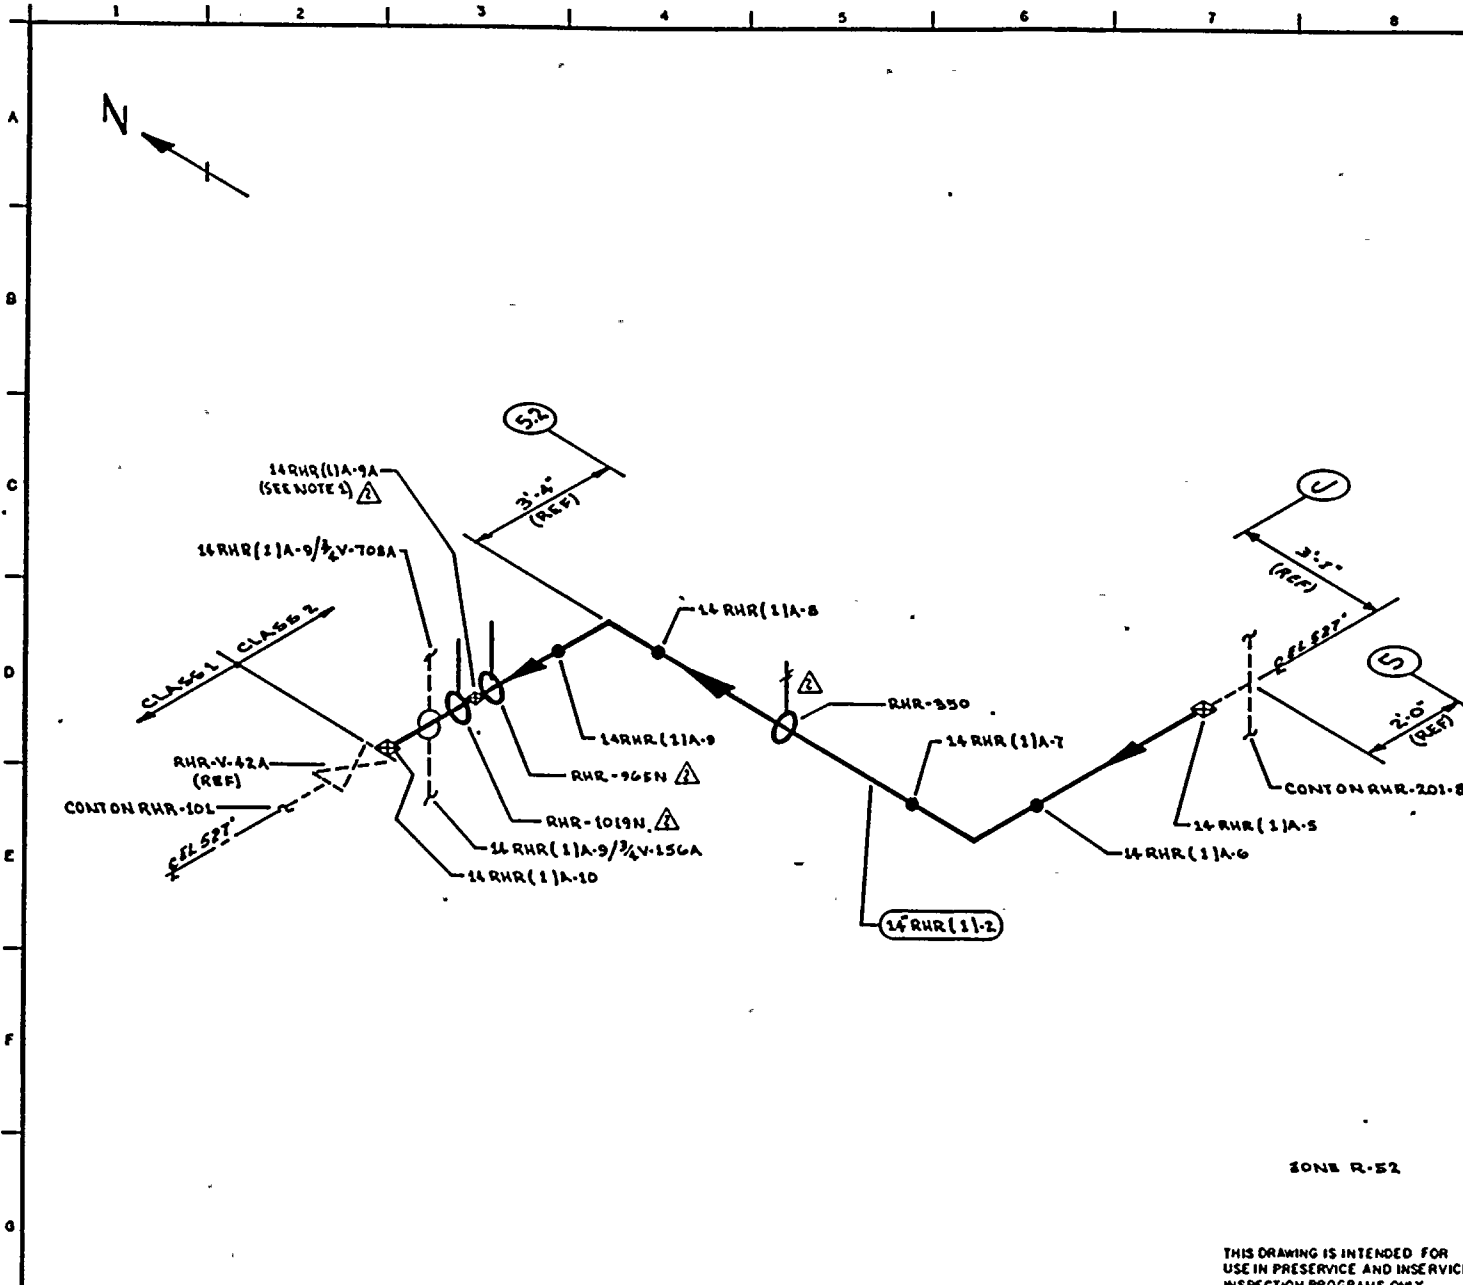

NOTES:
 1. ACCESS TO WELD 14 RHR (1)A-9A REQUIRES REMOVAL OF RHR-1019N. CLAMP IS 1 1/2" FROM WELD CENTERLINE.

REFERENCE:
 BOVEE & CRAIL ISOMETRIC
 RHR-881-18.19 REV 8

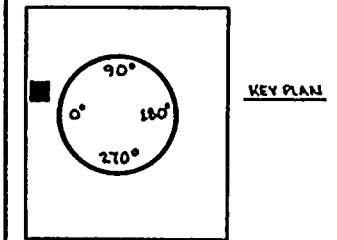

ZONE R-52

THIS DRAWING IS INTENDED FOR USE IN PRESERVICE AND INSERVICE INSPECTION PROGRAMS ONLY.

QUALITY CLASS: 1 ASME CODE CLASS: 2
 ENGR: G.A. KUGLER DRAWN: V.M.A. DATE: 5-8-78

WASHINGTON PUBLIC POWER SUPPLY SYSTEM
 RICHLAND, WASHINGTON 99352


WHP-2
 WELD 8 COMPONENT IDENTIFICATION DIAGRAM

TITLE:
 RHR LOOP A / LDCI RETURN

DWG NO: RHR-201-9 REV 2


NO	DATE	REVISION	BY	CHKD	APPVD
2	9-26-93	REVISED AS NOTED	K.L.A.	J.P.S.	T.H.R.
1	11-5-80	ADDED FIELD WELD 14 RHR (1)A-9A & AS NOTED	K.M.A.	J.P.F.	D.R.P.
0	12-11-77	ISSUED FOR USE	K.W.L.	K.H.S.	J.L.B.
A	5-26-78	ISSUED FOR INFORMATION ONLY	K.W.L.	C.H.K.	A.W.S.

PIPING SYSTEM	NOM DIA (IN)	SCH	NOM WALL THK	MATERIAL SPECIFICATION	MATL TYPE	CAL BLOCK NO
14" RHR (1)-2	14"	STD	0.375	SA 106 GR B	CS	N.A.

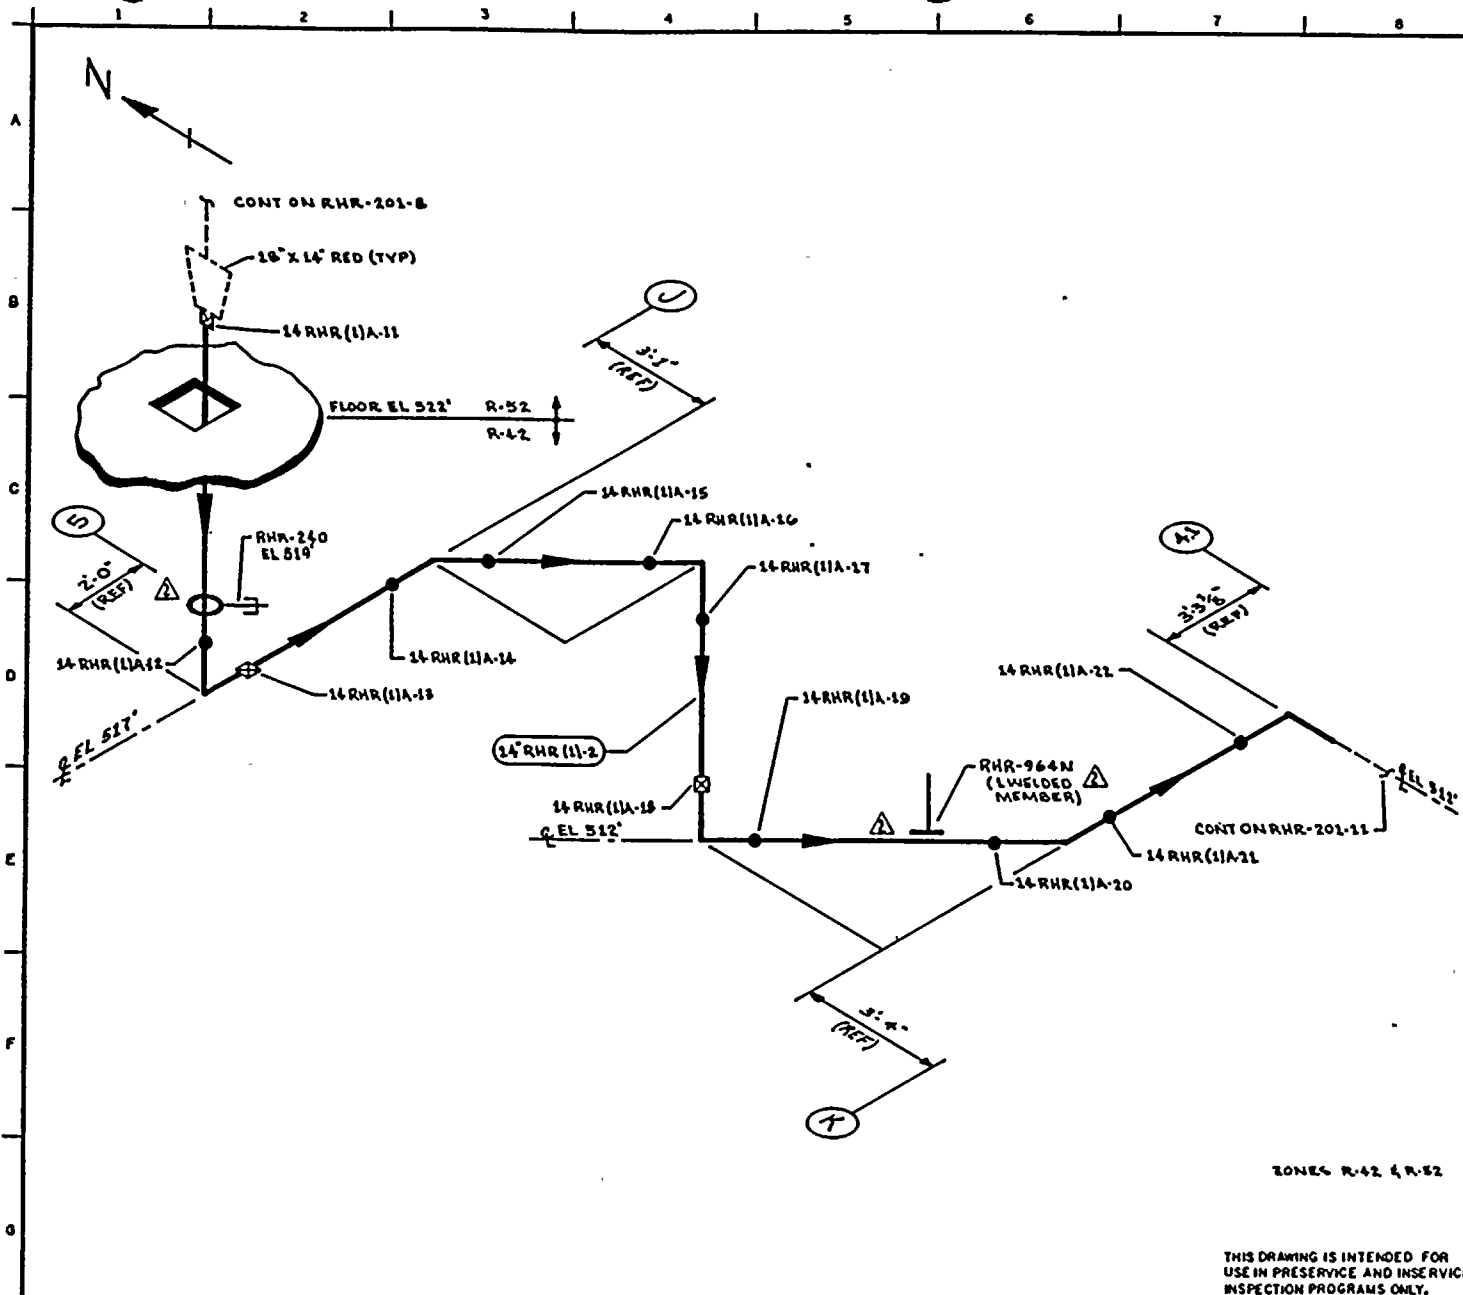

NOTES:

REFERENCES
 BOVEE & CRAIG ISOMETRICS
 RHR-051-10-12 REV 5

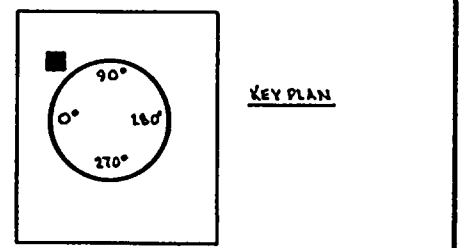

QUALITY CLASS: 1 ASME CODE CLASS: 2
 ENGR: G.A. KUGLER DRAWN: K.M.C.L. DATE: 5-8-78

WASHINGTON PUBLIC POWER SUPPLY SYSTEM
 RICHMOND, WASHINGTON 99352


THIS DRAWING IS INTENDED FOR USE IN PRESERVICE AND INSERVICE INSPECTION PROGRAMS ONLY.

PIPING SYSTEM	NOM DIA (IN)	SCH	NOM WALL THK	MATERIAL SPECIFICATION	MATL TYPE	CAL BLOCK NO
14" RHR (1)-2	14	STD	0.375	SA 106 GR B	CE	NA

NO	DATE	REVISION	BY	CHKD	APPVD
2	9-26-83	REVISED AS NOTED	KHA	SPK	JFB
1	11-2-81	REVISED AS NOTED	KHA	SPK	TFH
0	11-11-77	ISSUED FOR USE	KHA	SPK	ZLB
A	5-26-78	ISSUED FOR INFORMATION ONLY	KHA	SPK	RUR
NO					

WNP-2
 WELD B COMPONENT
 IDENTIFICATION DIAGRAM
 TITLE: RHR LOOP A
 SUPPLY FROM RHR-HX-1A
 DWG NO: RHR-201-10 REV 2



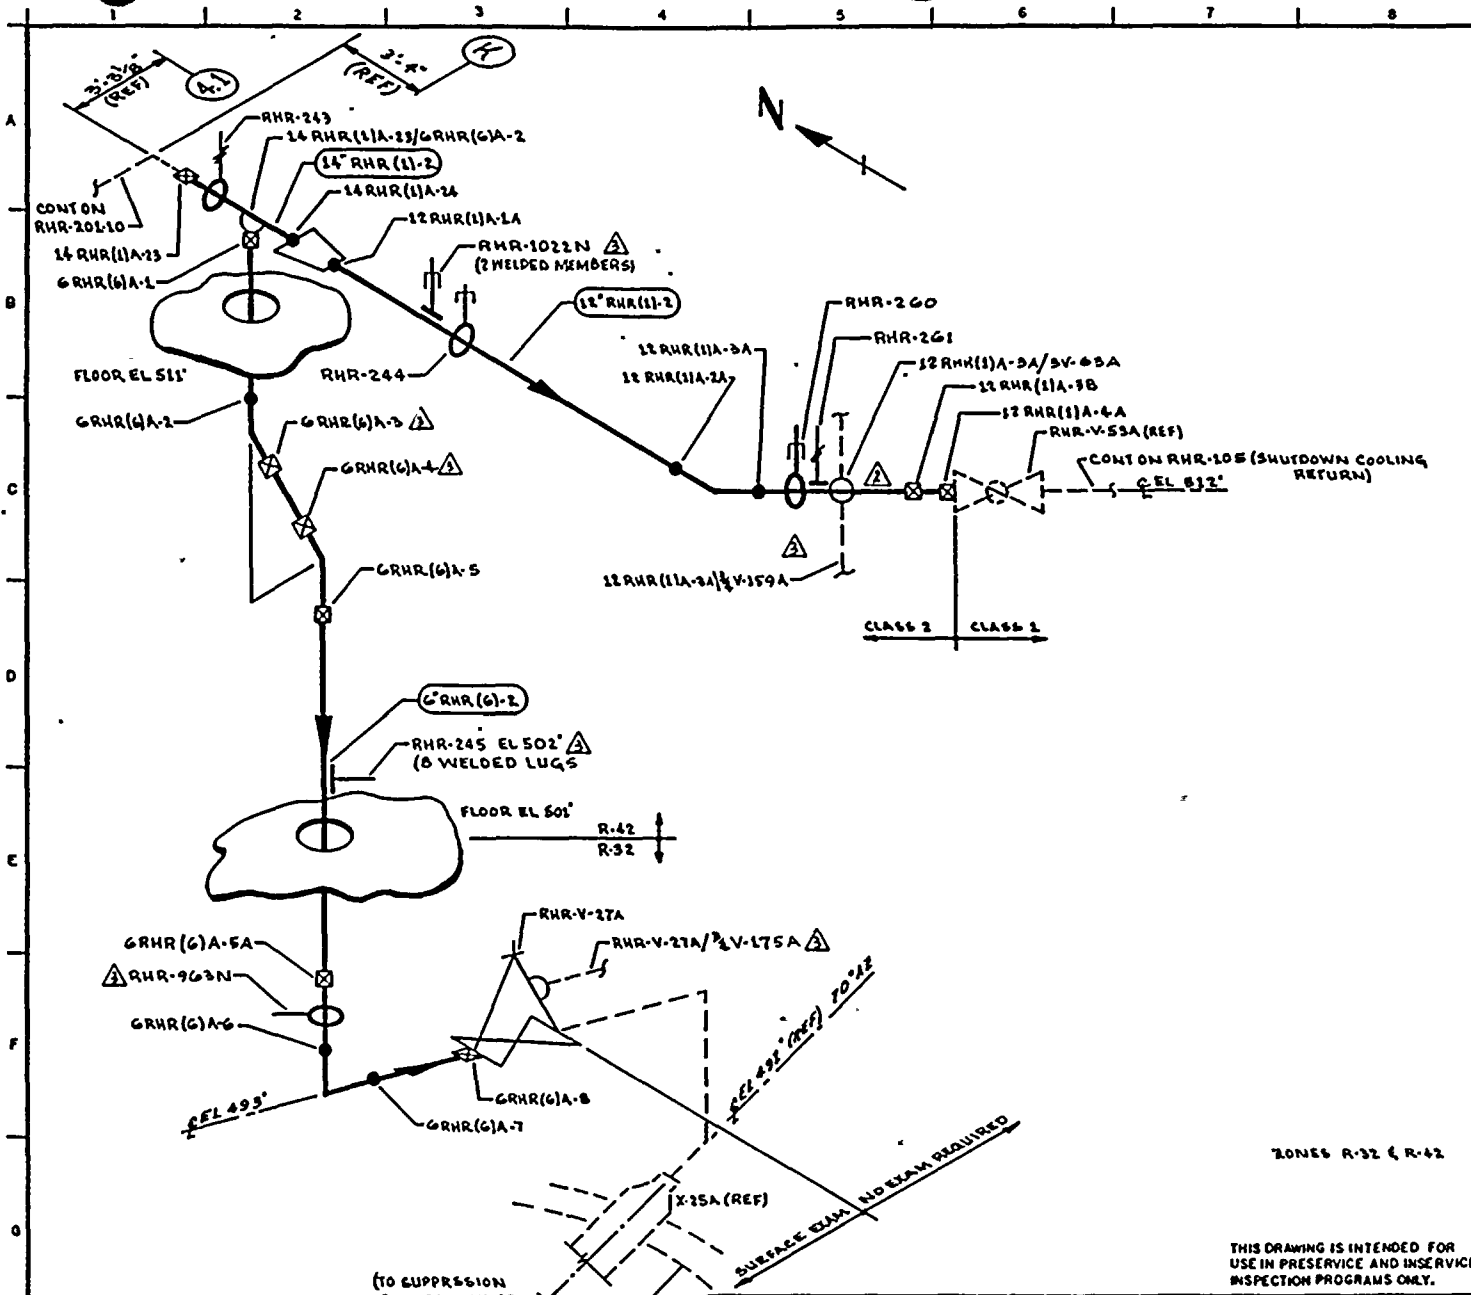


NOTES:



REFERENCES:

- DOVER & CRAIG ISOMETRICS:
- RHR-851-13 REV 6
- RHR-855-13 REV 7

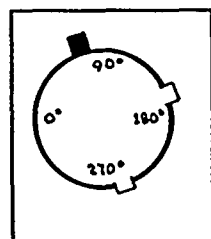

KEY PLAN

ZONES R-32 & R-42

THIS DRAWING IS INTENDED FOR USE IN PRESERVICE AND INSERVICE INSPECTION PROGRAMS ONLY.

QUALITY CLASS: 1	ASME CODE CLASS: 2
ENGR: GA KUGLER	DRAWN: K.M.C.A. DATE: 5-8-78



WASHINGTON PUBLIC POWER SUPPLY SYSTEM
 RICHMOND, WASHINGTON 99302

NO	DATE	REVISION	BY	CHKD	APPVD
3	9-26-83	REVISED AS NOTED	K.M.A.	D.M.	T.H.
2	12-2-81	REVISED AS NOTED	K.M.A.	D.M.	T.H.
1	11-6-80	REVISED AS NOTED	K.M.A.	T.H.	D.M.
0	12-11-77	ISSUED FOR USE	K.M.A.	D.M.	T.H.
A	5-26-78	ISSUED FOR INFORMATION ONLY	K.M.A.	G.A.S.	D.M.

PIPING SYSTEM	NOM DIA (IN)	SCH	NOM WALL THK	MATERIAL SPECIFICATION	MATL TYPE	CAL BLOCK NO
14" RHR(1)-2	14	STD	0.375	SA 106 GR B	CS	NA
12" RHR(1)-2	12	STD	0.375	SA 106 GR B	CS	NA
6" RHR(6)-2	6	40	0.280	SA 106 GR B	CS	NA

WNP-2 WELD & COMPONENT IDENTIFICATION DIAGRAM	
TITLE: RHR LOOP A SHUTDOWN COOLING RETURN & SUPPRESSION POOL SPRAY SUPPLY	
DWG NO: RHR-204-11	REV 3



WNP-02
 INTERVAL: PSI
 PERIOD: NA
 OUTAGE:
 DRAWING NO. RHR-201

WASHINGTON PUBLIC POWER SUPPLY SYSTEM
 PROGRAM PLAN AND SCHEDULE
 SYSTEM OR COMPONENT: RHR(1)-2
 DESCRIPTION: STM SPLY TO RHR HX1A

PAGE 001
 DATE 12/14/84

IDENT. NO.	DESCRIPTION	SECT. XI FYAM.	FYAM MTH.	PROCEDURE	CAL. CLOCK	INSERVICE		NOTES
						REQ.	SCHEDULED OUTAGE	
14RHR(1)A-1	FLANGE TO PIPE	C-F	SUR	PTP-1				
14RHR(1)A-2	PIPE TO EL	C-F	SUR	PTP-1				
14RHR(1)A-3	EL TO PIPE	C-F	SUR	PTP-1				
14RHR(1)A-4	PIPE TO REDUCER	C-F	SUR	PTP-1				
18RHR(1)A-1	REDUCER TO PIPE	C-F	SUR	PTP-1				
RHR-157(W)	4 WELDED LUGS	C-E-1	SUR	MTP-1				
RHR-157	SPRING	C-E-2	VT-3	303/8.2.17				
			VT-4	303/8.2.17				
18RHR(1)A-2	PIPE TO EL	C-F	SUR	PTP-1				
18RHR(1)A-3	EL TO PIPE	C-F	SUR	PTP-1				
RHR-159	STRUT	C-E-2	VT-3	303/8.2.17				
RHR-158(W)	8 WELDED LUGS	C-E-1	SUR	MTP-1				
RHR-158	PSA-3 SNUBBER	C-E-2	VT-3	303/8.2.17				S/N 494
			VT-4	303/8.2.17				S/N 494
RHR-160	PSA-3 SNUBBER	C-E-2	VT-3	303/8.2.17				S/N 3937
			VT-4	303/8.2.17				S/N 3937
18RHR(1)A-4	PIPE TO EL	C-F	SUR	PTP-1				
18RHR(1)A-5	EL TO PIPE	C-F	SUR	PTP-1				

WNP-02
 INTERVAL: PSI
 PERIOD: NA
 OUTAGE:
 DRAWING NO. RHR-201

WASHINGTON PUBLIC POWER SUPPLY SYSTEM
 PROGRAM PLAN AND SCHEDULE
 SYSTEM OR COMPONENT: RHR(1)-2
 DESCRIPTION: STM SPLY TO RHR HX1A

PAGE 002
 DATE 12/14/84

<u>IDENT. NO.</u>	<u>DESCRIPTION</u>	<u>SECT.</u> <u>XI</u>	<u>EYAM</u> <u>MTH.</u>	<u>PROCEDURE</u>	<u>CAL.</u> <u>BLOCK</u>	<u>INSERVICE</u>		<u>NOTES</u>
						<u>REQ.</u>	<u>SCHEDULED</u> <u>OUTAGE</u>	
RHR-161	SPRING	C-E-2	VT-3	303/8.2.17				
			VT-4	303/8.2.17				
18RHR(1)A-6	PIPE TO EL	C-F	SUR	PTP-1				
18RHR(1)A-7	EL TO PIPE	C-F	SUR	PTP-1				
RHR-162	STRUT	C-E-2	VT-3	303/8.2.17				
RHR-163	STRUT	C-E-2	VT-3	303/8.2.17				
18RHR(1)A-8	PIPE TO TEE	C-F	SUR	PTP-1				
10RHR(1)A-1	TEE TO PIPE	C-F	SUR	PTP-1				
10RHR(1)A-2	PIPE TO CAP	C-F	SUR	PTP-1				
18RHR(1)A-8/6RHR(7)-2	BRANCH CONN	C-F	SUR	PTP-1				
18RHR(1)A-9	TEE TO PIPE	C-F	SUR	PTP-1				
18RHR(1)A-9/3/4CAP	CAPPED CONN	N/A	VT-2	N/A				IWC-2510, SEE NOTES #6 & #7.
18RHR(1)A-9/3/4V-704A	INST CONN	N/A	VT-2	N/A				IWC-2510, SEE NOTES #6 & #7.
18RHR(1)A-10	PIPE TO VALVE	C-F	SUR	PTP-1				
18RHR(1)A-11	VALVE TO PIPE	C-F	SUR	PTP-1				
18RHR(1)A-11/3/4V-74RA	INSTR CONN	N/A	VT-2	N/A				

WNP-02
 INTERVAL: PSI
 PERIOD: NA
 OUTAGE:
 DRAWING NO. RHR-201

WASHINGTON PUBLIC POWER SUPPLY SYSTEM
 PROGRAM PLAN AND SCHEDULE
 SYSTEM OR COMPONENT: RHR(1)-2
 DESCRIPTION: STM SPLY TO RHR HX1A

PAGE 003
 DATE 12/14/84

IDENT. NO.	DESCRIPTION	SECT. XI EXAM.	EXAM MTH.	PROCEDURE	CAL. BLOCK	INSERVICE		NOTES
						REQ.	SCHEDULED OUTAGE	
18RHR(1)A-11/1-1/2V-84A	CROSSTIE CONN	N/A	VT-2	N/A				IWC-2510, SEE NOTES #6 & #7.
18RHR(1)A-12	PIPE TO VALVE	C-F	SUR	PTP-1				
18RHR(1)A-13	VALVE TO PIPE	C-F	SUR	PTP-1				
18RHR(1)A-13/3V-72A	FLUSH CONN	N/A	VT-2	N/A				IWC-2510, SEE NOTES #6 & #7.
RHR-164	STRUT	C-E-2	VT-3	303/8.2.17				
18RHR(1)A-13/3/4V-705A	INST CONN	N/A	VT-2	N/A				IWC-2510, SEE NOTES #6 & #7.
RHR-165	STRUT	C-E-2	VT-3	303/8.2.17				
RHR-188(W)	4 WELDED LUGS	C-E-1	SUR	MTP-1				
RHR-188	SPRING	C-E-2	VT-3	303/8.2.17				
			VT-4	303/8.2.17				
18RHR(1)A-14	PIPE TO EL	C-F	SUR	PTP-1				
18RHR(1)A-15	EL TO PIPE	C-F	SUR	PTP-1				
18RHR(1)A-16	PIPE TO EL	C-F	SUR	PTP-1				
18RHR(1)A-17	EL TO PIPE	C-F	SUR	PTP-1				
RHR-174	BOX	C-E-2	VT-3	303/8.2.17				
18RHR(1)A-18	PIPE TO PIPE	C-F	SUR	PTP-1				

WNP-02
 INTERVAL: PSI
 PERIOD: NA
 OUTAGE:
 DRAWING NO. RHR-201

WASHINGTON PUBLIC POWER SUPPLY SYSTEM
 PROGRAM PLAN AND SCHEDULE
 SYSTEM OR COMPONENT: RHR(1)-2
 DESCRIPTION: SIM SPLY TO RHR HX1A

PAGE 004
 DATE 12/14/84

IDENT. NO.	DESCRIPTION	SECT. XI EXAM.	EXAM HTH.	PROCEDURE	CAL. BLOCK	INSERVICE		NOTES
						REQ.	SCHEDULED OUTAGE	
RHR-970N								
18RHR(1)A-19	ANCHOR	C-E-2	VT-3	303/8.2.17				
RHR-606	PIPE TO PIPE	C-F	SUR	PTP-1				
RHR-605	STRUT	C-E-2	VT-3	303/8.2.17				
18RHR(1)A-20	STRUT	C-E-2	VT-3	303/8.2.17				
18RHR(1)A-21	PIPE TO PIPE	C-F	SUR	PTP-1				
18RHR(1)A-22	PIPE TO TEE	C-F	SUR	PTP-1				
18RHR(1)A-22A	TEE TO PIPE	C-F	SUR	PTP-1				
RHR-604	PIPE TO PIPE	C-F	SUR	PTP-1				
RHR-603	SPRING	C-E-2	VT-3	303/8.2.17				
			VT-4	303/8.2.17				
18RHR(1)A-23	PSA-3 SN(2)	C-E-2	VT-3	303/8.2.17				S/N 4470/4497
			VT-4	303/8.2.17				S/N 4470/4497
18RHR(1)A-24	PIPE TO EL	C-F	SUR	PTP-1				
18RHR(1)A-25	EL TO PIPE	C-F	SUR	PTP-1				
18RHR(1)A-26	PIPE TO EL	C-F	SUR	PTP-1				
RHR-601	EL TO PIPE	C-F	SUR	PTP-1				
18RHR(1)A-27	STRUT	C-E-2	VT-3	303/8.2.17				
	PIPE TO VLV	C-F	SUR	PTP-1				W/3 WELDED SADDLES.

WNP-02
 INTERVAL: PSI
 PERIOD: NA
 OUTAGE:
 DRAWING NO. RHR-201

WASHINGTON PUBLIC POWER SUPPLY SYSTEM
 PROGRAM PLAN AND SCHEDULE
 SYSTEM OR COMPONENT: RHR(1)-2
 DESCRIPTION: SIM SPLY TO RHR HX1A

PAGE 005
 DATE 12/14/84

IDENT. NO.	DESCRIPTION	SECT. XI EXAM.	EXAM MTH.	PROCEDURE	CAL. BLOCK	INSERVICE		NOTES
						REQ.	SCHEDULED OUTAGE	
18RHR(1)A-28	PIPE TO PIPE	C-F	SUR	PTP-1				
RHR-600	STRUT	C-E-2	VT-3	303/8.2.17				
18RHR(1)A-29	PIPE TO EL	C-F	SUR	PTP-1				
18RHR(1)A-30	EL TO PIPE	C-F	SUR	PTP-1				
RHR-599	PSA-3 SNUBBER	C-E-2	VT-3	303/8.2.17				S/N 3906
			VT-4	303/8.2.17				S/N 3906
18RHR(1)A-31	PIPE TO EL	C-F	SUR	PTP-1				
18RHR(1)A-32	EL TO PIPE	C-F	SUR	PTP-1				
RHR-1000N	PSA-3 SNUBBER	C-E-2	VT-3	303/8.2.17				S/N 3931
			VT-4	303/8.2.17				S/N 3931
18RHR(1)A-32A	PIPE TO PIPE	C-F	SUR	QCI 3-3				
RHR-1001N(W)	8 WELDED LUGS	C-E-1	SUR	QCI 4-3				
RHR-1001N	PSA-1 SN(2)	C-E-2	VT-3	303/8.2.17				S/N 4410/2785
			VT-4	303/8.2.17				S/N 4410/2785
RHR-598	SPRING	C-E-2	VT-3	303/8.2.17				
			VT-4	303/8.2.17				
18RHR(1)A-33	PIPE TO EL	C-F	SUR	PTP-1				
18RHR(1)A-34	EL TO PIPE	C-F	SUR	PTP-1				

WNP-02
 INTERVAL: PSI
 PERIOD: NA
 OUTAGE:
 DRAWING NO. RHR-201

WASHINGTON PUBLIC POWER SUPPLY SYSTEM
 PROGRAM PLAN AND SCHEDULE
 SYSTEM OR COMPONENT: RHR(1)-2
 DESCRIPTION: STM SPLY TO RHR HX1A

PAGE 006
 DATE 12/14/84

IDENT. NO.	DESCRIPTION	SECT. XI EXAM.	EXAM MTH.	PROCEDURE	CAL. BLOCK	INSERVICE		NOTES
						REQ.	SCHEDULED OUTAGE	
18RHR(1)A-35	PIPE TO TEE	C-F	SUR	PTP-1				
18RHR(1)A-36	TEE TO PIPE	C-F	SUR	PTP-1				
18RHR(1)A-37	PIPE TO REDUCER	C-F	SUR	PTP-1				
20RHR(1)A-1	REDUCER TO PIPE	C-F	SUR	PTP-1				
18RHR(1)A-37/5/4TE-N004A	INSTR CONN	N/A	VT-2	N/A				IWC-2510, SEE NOTES #6 & #7.
20RHR(1)A-2	PIPE TO NOZZLE	C-F	SUR	PTP-1				
6RHR(7)A-1	WOL TO PIPE	C-F	SUR	PTP-1				
6RHR(7)A-1/3/4V-144A	TEST CONN	N/A	VT-2	N/A				IWC-2510, SEE NOTES #6 & #7.
RHR-187	SPRING	C-E-2	VT-3	303/8.2.17				
			VT-4	303/8.2.17				
6RHR(7)A-2	PIPE TO REDUCER	C-F	SUR	PTP-1				
6RHR(7)A-3	REDUCER TO PIPE	C-F	SUR	PTP-1				
6RHR(7)A-3/3/4V-145A	TEST CONN	N/A	VT-2	N/A				IWC-2510, SEE NOTES #6 & #7.
6RHR(7)A-4	PIPE TO EL	C-F	SUR	PTP-1				
6RHR(7)A-5	FL TO ORIFICE	C-F	SUR	PTP-1				
RHR-149	STRUT	C-E-2	VT-3	303/8.2.17				

WNP-02
 INTERVAL: PSI
 PERIOD: NA
 OUTAGE:
 DRAWING NO. RHR-201

WASHINGTON PUBLIC POWER SUPPLY SYSTEM
 PROGRAM PLAN AND SCHEDULE
 SYSTEM OR COMPONENT: RHR(11)-2
 DESCRIPTION: SIM SPLY TO RHR HX1A

PAGE 007
 DATE 12/14/84

IDENT. NO.	DESCRIPTION	SECT.		PROCEDURE	CAL. BLOCK	INSERVICE		NOTES
		XI EXAM	EXAM MTH.			REQ.	SCHEDULED OUTAGE	
RHR-148	BOX	C-E-2	VT-3	303/8.2.17				
RHR-147	PSA-1 SN(2)	C-E-2	VT-3	303/8.2.17				S/N E628/W607.
			VT-4	303/8.2.17				S/N E628/W607
RHR-146	SPRING	C-E-2	VT-3	303/8.2.17				
			VT-4	303/8.2.17				
RHR-145	PSA-1 SNUBBER	C-E-2	VT-3	303/8.2.17				S/N 342
			VT-4	303/8.2.17				S/N 342
RHR-144	SPRING	C-E-2	VT-3	303/8.2.17				
			VT-4	303/8.2.17				
RHR-971N	ANCHOR	C-E-2	VT-3	303/8.2.17				
RHR-142	PSA-1 SN(2)	C-E-2	VT-3	303/8.2.17				S/N W354/E355
			VT-4	303/8.2.17				S/N W354/E355
18RHR(11)A-1	TEE TO PIPE	C-F	SUR	PTP-1				
RHR-363	SPRING	C-E-2	VT-3	303/8.2.17				
			VT-4	303/8.2.17				
RHR-361	PSA-3 SNUBBER	C-E-2	VT-3	303/8.2.17				S/N 2786
			VT-4	303/8.2.17				S/N 2786
RHR-362(W)	8 WELDED LUGS	C-E-1	SUR	MTP-1				

WMP-02
 INTERVAL: PSI
 PERIOD: NA
 OUTAGE:
 DRAWING NO. RHR-201

WASHINGTON PUBLIC POWER SUPPLY SYSTEM
 PROGRAM PLAN AND SCHEDULE
 SYSTEM OR COMPONENT: RHR(1)-2
 DESCRIPTION: STM SPLY TO RHR HX1A

PAGE 008
 DATE 12/14/84

IDENT. NO.	DESCRIPTION	SECT. XI EXAM.	EXAM MTH.	PROCEDURE	CAL. BLOCK	INSERVICE		NOTES
						REQ.	SCHEDULED OUTAGE	
RHR-362	PSA-3 SN(2)	C-E-2	VT-3	303/8.2.17				S/N 3927/3952
			VT-4	303/8.2.17				S/N 3927/3952
18RHR(11)A-2	PIPE TO EL	C-F	SUR	PTP-1				
18RHR(11)A-3	EL TO PIPE	C-F	SUR	PTP-1				
18RHR(11)A-4	PIPE TO EL	C-F	SUR	PTP-1				
18RHR(11)A-5	EL TO PIPE	C-F	SUR	PTP-1				
RHR-357	PSA-3 SNUBBER	C-E-2	VT-3	303/8.2.17				S/N 9951
			VT-4	303/8.2.17				S/N 9951
RHR-360	SPRING	C-E-2	VT-3	303/8.2.17				
			VT-4	303/8.2.17				
RHR-359	PSA-3 SNUBBER	C-E-2	VT-3	303/8.2.17				S/N 2346
			VT-4	303/8.2.17				S/N 2346
RHR-358	BOX	C-E-2	VT-3	303/8.2.17				
18RHR(11)A-5A	PIPE TO PIPE	C-F	SUR	PTP-1				
18RHR(11)A-6	PIPE TO VALVE	C-F	SUR	OCI 3-3				
18RHR(11)A-7	VALVE TO PIPE	C-F	SUR	PTP-1				
18RHR(11)A-8	PIPE TO EL	C-F	SUR	PTP-1				
18RHR(11)A-9	EL TO PIPE	C-F	SUR	OCI 3-3				

WNP-02
 INTERVAL: PSI
 PERIOD: NA
 OUTAGE:
 DRAWING NO. RHR-201

WASHINGTON PUBLIC POWER SUPPLY SYSTEM
 PROGRAM PLAN AND SCHEDULE
 SYSTEM OR COMPONENT: RHR(1)-2
 DESCRIPTION: SIM SPLY TO RHR HX1A

PAGE 009
 DATE 12/14/84

IDENT. NO.	DESCRIPTION	SECT. XI EXAM.	EXAM MTH.	PROCEDURE	CAL. BLOCK	INSERVICE		NOTES
						REQ.	SCHEDULED OUTAGE	
RHR-354(W)								
RHR-354	4 WELDED LUGS	C-E-1	SUR	MTP-1				
	SPRING	C-E-2	VT-3	303/8.2.17				
			VT-4	303/8.2.17				
18RHR(11)A-10	PIPE TO EL	C-F	SUR	PTP-1				
18RHR(11)A-11	EL TO PIPE	C-F	SUR	PTP-1				
RHR-355	PSA-3 SNUBBER	C-E-2	VT-3	303/8.2.17				S/N 4483
			VT-4	303/8.2.17				S/N 4483
RHR-356	PSA-3 SNUBBER	C-E-2	VT-3	303/8.2.17				S/N 13028
			VT-4	303/8.2.17				S/N 13028
18RHR(11)A-12	PIPE TO EL	C-F	SUR	PTP-1				
18RHR(11)A-13	EL TO PIPE	C-F	SUR	PTP-1				
18RHR(11)A-14	PIPE TO TEE	C-F	SUR	OCT 3-3				
20RHR(1)A-3	NOZZLE TO PIPE	C-F	SUR	PTP-1				
20RHR(1)A-4	PIPE TO EL	C-F	SUR	PTP-1				
20RHR(1)A-5	EL TO PIPE	C-F	SUR	PTP-1				
20RHR(1)A-6	PIPE TO REDUCER	C-F	SUR	OCT 3-3				
18RHR(1)A-38	REDUCER TO PIPE	C-F	SUR	PTP-1				
RHR-367(W)	4 WELDED LUGS	C-E-1	SUR	MTP-1				

WNP-02
 INTERVAL: PSI
 PERIOD: NA
 OUTAGE:
 DRAWING NO. RHR-201

WASHINGTON PUBLIC POWER SUPPLY SYSTEM
 PROGRAM PLAN AND SCHEDULE
 SYSTEM OR COMPONENT: RHR(1)-2
 DESCRIPTION: STH SPLY TO RHR HX1A

PAGE 010
 DATE 12/14/84

IDENT. NO.	DESCRIPTION	SECT. XI EXAM EYAM.	EXAM MTH.	PROCEDURE	CAL. BLOCK	INSERVICE		NOTES
						REQ.	SCHEDULED OUTAGE	
RHR-367	SPRING	C-E-2	VT-3	303/8.2.17				
			VT-4	303/8.2.17				
18RHR(1)A-38/5/4CE-N001	INSTR CONN	N/A	VT-2	N/A				IWC-2510, SEE NOTES #6 & #7.
18RHR(1)A-38/4V-26A	BRANCH CONN	N/A	VT-2	N/A				IWC-2510, SEE NOTES #6 & #7.
RHR-368	STRUT	C-E-2	VT-3	303/8.2.17				
18RHR(1)A-39	PIPE TO EL	C-F	SUR	PTP-1				
18RHR(1)A-40	EL TO PIPE	C-F	SUR	PTP-1				
18RHR(1)A-40/3/4V-81A	DRAIN CONN	N/A	VT-2	N/A				IWC-2510, SEE NOTES #6 & #7.
18RHR(1)A-40/3/4V-75A	SAMPLING CONN	N/A	VT-2	N/A				IWC-2510, SEE NOTES #6 & #7.
18RHR(1)A-41	PIPE TO VALVE	C-F	SUR	QCI 3-3				
18RHR(1)A-42	VALVE TO PIPE	C-F	SUR	PTP-1				
18RHR(1)A-43	PIPE TO EL	C-F	SUR	PTP-1				
18RHR(1)A-44	EL TO PIPE	C-F	SUR	PTP-1				
RHR-365(V)	8 WELDED LUGS	C-E-1	SUR	MTP-1				
RHR-365	STRUT	C-E-2	VT-3	303/8.2.17				
RHR-366	STRUT	C-E-2	VT-3	303/8.2.17				

WNP-02
 INTERVAL: PSI
 PERIOD: NA
 OUTAGE:
 DRAWING NO. RHR-201

WASHINGTON PUBLIC POWER SUPPLY SYSTEM
 PROGRAM PLAN AND SCHEDULE
 SYSTEM OR COMPONENT: RHR(1)-2
 DESCRIPTION: STM SPLY TO RHR HX1A

PAGE 011
 DATE 12/14/84

IDENT. NO.	DESCRIPTION	SECT. XI EXAM.	EXAM MTH.	PROCEDURE	CAL. BLOCK	INSERVICE		NOTES
						REQ.	SCHEDULED OUTAGE	
18RHR(1)A-45	PIPE TO EL	C-F	SUR	PTP-1				
18RHR(1)A-46	EL TO PIPE	C-F	SUR	PTP-1				
18RHR(1)A-47	PIPE TO TEE	C-F	SUR	PTP-1				
18RHR(1)A-48	TEE TO PIPE	C-F	SUR	PTP-1				
RHR-263	SPRING	C-E-2	VT-3	303/8.2.17				
			VT-4	303/8.2.17				
RHR-264	PSA-3 SNUBBER	C-E-2	VT-3	303/8.2.17				S/N 4428
			VT-4	303/8.2.17				S/N 4428
18RHR(1)A-49	PIPE TO EL	C-F	SUR	PTP-1				
18RHR(1)A-50	EL TO PIPE	C-F	SUR	PTP-1				
RHR-266	BOX	C-E-2	VT-3	303/8.2.17				
18RHR(1)A-50/5/4TE-N027A	INST CONN	N/A	VT-2	N/A				SEE NOTES #6 & #7.
RHR-267	BOX	C-E-2	VT-3	303/8.2.17				
RHR-269	PSA-3 SNUBBER	C-E-2	VT-3	303/8.2.17				S/N 2385
			VT-4	303/8.2.17				S/N 2385
RHR-280	SPRING	C-E-2	VT-3	303/8.2.17				
			VT-4	303/8.2.17				
18RHR(1)A-51	PIPE TO PIPE	C-F	SUR	PTP-1				

WNP-02
 INTERVAL: PSI
 PERIOD: NA
 OUTAGE:
 DRAWING NO. RHR-201

WASHINGTON PUBLIC POWER SUPPLY SYSTEM
 PROGRAM PLAN AND SCHEDULE
 SYSTEM OR COMPONENT: RHR(1)-2
 DESCRIPTION: STM SPLY TO RHR HX1A

PAGE 012
 DATE 12/14/84

IDENT. NO.	DESCRIPTION	SECT. XI EXAM.	EXAM. MTH.	PROCEDURE	CAL. BLOCK	INSERVICE		NOTES
						REQ.	SCHEDULED OUTAGE	
RHR-268								
RHR-270	BOX	C-F-2	VT-3	303/8.2.17				
	PSA-3 SNUBBER	C-E-2	VT-3	303/8.2.17				S/N 362/616
			VT-4	303/8.2.17				S/N 362/616
RHR-271	PSA-3 SN(2)	C-E-2	VT-3	303/8.2.17				S/N 3885/3941
			VT-4	303/8.2.17				S/N 3883/3941
RHR-351	SPRING	C-E-2	VT-3	303/8.2.17				
			VT-4	303/8.2.17				
RHR-1012S	PIPE CLAMP	C-E-2	VT-3	303/8.2.17				
18RHR(1)A-52	PIPE TO FLANGE	C-F	SUR	PTP-1				
18RHR(1)A-52/3/4V-706A	INST CONN	N/A	VT-2	N/A				IWC-2510, SEE NOTES #6 & #7.
18RHR(1)A-52/3/4V-707A	INST CONN	N/A	VT-2	N/A				IWC-2510, SEE NOTES #6 & #7.
18RHR(1)A-53	FLANGE TO PIPE	C-F	SUR	PTP-1				
RHR-1011S	PIPE CLAMP	C-E-2	VT-3	303/8.2.17				
18RHR(1)A-54	PIPE TO TEE	C-F	SUR	PTP-1				
18RHR(1)A-55	TEE TO PIPE	C-F	SUR	PTP-1				
18RHR(1)A-56	PIPE TO EL	C-F	SUR	DCI 3-3				
18RHR(1)A-57	EL TO PIPE	C-F	SUR	PTP-1				

WNP-02
 INTERVAL: PSI
 PERIOD: NA
 OUTAGE:
 DRAWING NO. RHR-201

WASHINGTON PUBLIC POWER SUPPLY SYSTEM
 PROGRAM PLAN AND SCHEDULE
 SYSTEM OR COMPONENT: RHR(1)-2
 DESCRIPTION: STM SPLY TO RHR HX1A

PAGE 013
 DATE 12/14/84

IDENT. NO.	DESCRIPTION	SECT. YI	EXAM EXAM.	EXAM MTH.	PROCEDURE	CAL. BLOCK	INSERVICE		NOTES
							REQ.	SCHEDULED OUTAGE	
RHR-353									
RHR-352	STRUT	C-E-2	VT-3	303/8.2.17					
18RHR(1)A-58	STRUT	C-E-2	VT-3	303/8.2.17					
18RHR(1)A-59	PIPE TO TEE	C-F	SUR	PTP-1					
RHR-238(S)	TEE TO PIPE	C-F	SUR	PTP-1					
RHR-238	2 WELDED SADDLE	C-E-1	SUR	OCT 4-3					
18RHR(1)A-60	ANCHOR	C-E-2	VT-3	303/8.2.17					
18RHR(1)A-61	PIPE TO EL	C-F	SUR	PTP-1					
RHR-237	EL TO PIPE	C-F	SUR	PTP-1					
RHR-234	STRUT	C-E-2	VT-3	303/8.2.17					
18RHR(1)A-62	BOX	C-E-2	VT-3	303/8.2.17					
18RHR(1)A-63	PIPE TO EL	C-F	SUR	PTP-1					
RHR-1004N	EL TO PIPE	C-F	SUR	PTP-1					
RHR-235	STRUT	C-E-2	VT-3	303/8.2.17					
	PSA-10 SNUBBER	C-E-2	VT-3	303/8.2.17					S/N 1462
			VT-4	303/8.2.17					S/N 1462
18RHR(1)A-64	PIPE TO TEE	C-F	SUR	PTP-1					
18RHR(1)A-65	TEE TO PIPE	C-F	SUR	PTP-1					
18RHR(1)A-66	PIPE TO REDUCER	C-F	SUR	PTP-1					

WNP-02
 INTERVAL: PSI
 PERIOD: NA
 OUTAGE:
 DRAWING NO. RHR-201

WASHINGTON PUBLIC POWER SUPPLY SYSTEM
 PROGRAM PLAN AND SCHEDULE
 SYSTEM OR COMPONENT: RHR(1)-2
 DESCRIPTION: STM SPLY TO RHR HY1A

PAGE 014
 DATE 12/14/84

IDENT. NO.	DESCRIPTION	SECT. XI EXAM.	EXAM MTH.	PROCEDURE	CAL. BLOCK	INSERVICE		NOTES
						REQ.	SCHEDULED OUTAGE	
14RHR(1)A-5	TEE TO PIPE	C-F	SUR	PTP-1				
14RHR(1)A-6	PIPE TO EL	C-F	SUR	PTP-1				
14RHR(1)A-7	EL TO PIPE	C-F	SUR	PTP-1				
RHR-350	SPRING	C-E-2	VT-3	303/8.2.17				
			VT-4	303/8.2.17				
14RHR(1)A-8	PIPE TO EL	C-F	SUR	PTP-1				
14RHR(1)A-9	EL TO PIPE	C-F	SUR	PTP-1				
RHR-965N	ANCHOR	C-E-2	VT-3	303/8.2.17				
14RHR(1)A-9A	PIPE TO PIPE	C-F	SUR	QCI 3-3				
RHR-1019N	STRUT	C-E-2	VT-3	303/8.2.17				
14RHR(1)A-9/3/4V-708	INSTR CONN	N/A	VT-2	N/A				IWC-2510, SEE NOTES #6 & #7.
14RHR(1)A-9/3/4V-156A	TEST CONN	N/A	VT-2	N/A				IWC-2510, SEE NOTES #6 & #7.
14RHR(1)A-10	PIPE TO VALVE	C-F	SUR	PTP-1				
14RHR(1)A-11	REDUCER TO PIPE	C-F	SUR	PTP-1				
RHR-240	BOX	C-E-2	VT-3	303/8.2.17				
14RHR(1)A-12	PIPE TO EL	C-F	SUR	PTP-1				
14RHR(1)A-13	EL TO PIPE	C-F	SUR	PTP-1				

WNP-02
 INTERVAL: PSI
 PERIOD: NA
 OUTAGE:
 DRAWING NO. RHR-201

WASHINGTON PUBLIC POWER SUPPLY SYSTEM
 PROGRAM PLAN AND SCHEDULE
 SYSTEM OR COMPONENT: RHR(1)-2
 DESCRIPTION: STM SPLY TO RHR HX1A

PAGE 015
 DATE 12/14/84

IDENT. NO.	DESCRIPTION	SECT. XI EXAM.	EXAM MTH.	PROCEDURE	CAL. BLOCK	INSERVICE		NOTES
						REQ.	SCHEDULED OUTAGE	
14RHR(1)A-14	PIPE TO EL	C-F	SUR	PTP-1				
14RHR(1)A-15	EL TO PIPE	C-F	SUR	PTP-1				
14RHR(1)A-16	PIPE TO EL	C-F	SUR	PTP-1				
14RHR(1)A-17	PIPE TO EL	C-F	SUR	PTP-1				
14RHR(1)A-18	PIPE TO EL	C-F	SUR	PTP-1				
14RHR(1)A-19	EL TO PIPE	C-F	SUR	PTP-1				
RHR-964N	ANCHOR	C-E-2	VT-3	303/8.2.17				W/1 WELDED SADDLE.
14RHR(1)A-20	PIPE TO EL	C-F	SUR	PTP-1				
14RHR(1)A-21	EL TO PIPE	C-F	SUR	PTP-1				
14RHR(1)A-22	PIPE TO EL	C-F	SUR	PTP-1				
14RHR(1)A-23	EL TO PIPE	C-F	SUR	PTP-1				
RHR-243	SPRING	C-E-2	VT-3	303/8.2.17				
14RHR(1)A-23/6RHR(6)A-2	BRANCH CONN	C-F	SUR	PTP-1				
14RHR(1)A-24	PIPE TO REDUCER	C-F	SUR	PTP-1				
12RHR(1)A-1A	REDUCER TO PIPE	C-F	SUR	PTP-1				
RHR-1022N	PSA-35 SN(2)	C-E-2	VT-3	303/8.2.17				S/N N3007/S3008

WNP-02
 INTERVAL: PSI
 PERIOD: NA
 OUTAGE:
 DRAWING NO. RHR-201

WASHINGTON PUBLIC POWER SUPPLY SYSTEM
 PROGRAM PLAN AND SCHEDULE
 SYSTEM OR COMPONENT: RHR(1)-2
 DESCRIPTION: STM SPLY TO RHR HX1A

PAGE 016
 DATE 12/14/84

IDENT. NO.	DESCRIPTION	SECT. XI EXAM.	EXAM MTH.	PROCEDURE	CAL. BLOCK	INSERVICE		NOTES
						REQ.	SCHEDULED OUTAGE	
			VT-4	303/8.2.17				S/N N3007/S3008
RHR-244	PSA-35 SNUBBER	C-E-2	VT-3	303/8.2.17				S/N 6239
			VT-4	303/8.2.17				S/N 6239
12RHR(1)A-2A	PIPE TO EL	C-F	SUR	PTP-1				
12RHR(1)A-3A	PIPE TO EL	C-F	SUR	PTP-1				
RHR-260	PSA-3 SNUBBER	C-E-2	VT-3	303/8.2.17				S/N 716
			VT-4	303/8.2.17				S/N 716
RHR-261	SPRING	C-E-2	VT-3	303/8.2.17				
			VT-4	303/8.2.17				
12RHR(1)A-3A/3V-63A	FLUSH CONN	N/A	VT-2	N/A				IWC-2510, SEE NOTES #6 & #7.
12RHR(1)A-3A/3/4V-159A	TEST CONN	N/A	VT-2	N/A				IWC-2510, SEE NOTES #6 & #7.
12RHR(1)A-3B	PIPE TO PIPE	C-F	SUR	PTP-1				
12RHR(1)A-4A	PIPE TO VALVE	C-F	SUR	PTP-1				
6RHR(6)A-1	WOL TO PIPE	C-F	SUR	PTP-1				
6RHR(6)A-2	PIPE TO EL	C-F	SUR	PTP-1				
6RHR(6)A-3	EL TO PIPE	C-F	SUR	PTP-1				
6RHR(6)A-4	PIPE TO EL	C-F	SUR	PTP-1				


UNP-02
 INTERVAL: PSI
 PERIOD: NA
 OUTAGE:
 DRAWING NO. RHR-201

WASHINGTON PUBLIC POWER SUPPLY SYSTEM
 PROGRAM PLAN AND SCHEDULE
 SYSTEM OR COMPONENT: RHR(1)-2
 DESCRIPTION: STM SPLY TO RHR HX1A

PAGE 017
 DATE 12/14/84


IDENT. NO.	DESCRIPTION	SECT. XI EXAM.	EXAM MTH.	PROCEDURE	CAL. BLOCK	INSERVICE		NOTES
						REQ.	SCHEDULED OUTAGE	
6RHR(6)A-5	EL TO PIPE	C-F	SUR	PTP-1				
RHR-245(W)	8 WELDED LUGS	C-E-1	SUR	MTP-1				
RHR-245	BOX	C-E-2	VT-3	303/8.2.17				
6RHR(6)A-5A	PIPE TO PIPE	C-F	SUR	PTP-1				
RHR-963N	BOX	C-E-2	VT-3	303/8.2.17				
6RHR(6)A-6	PIPE TO EL	C-F	SUR	PTP-1				
6RHR(6)A-7	EL TO PIPE	C-F	SUR	PTP-1				
6RHR(6)A-8	PIPE TO VALVE	C-F	SUR	PTP-1				
RHR-V-27A/3/4V-175A	STEM LEAKOFF	N/A	VT-2	QCI 7-1				IWC-2510, SEE NOTES #5 & #6.
RHR-PB-201	RHR PRESS BNDRY	N/A	VT-2	N/A				IWC-2510, SEE NOTES #6 & #7.



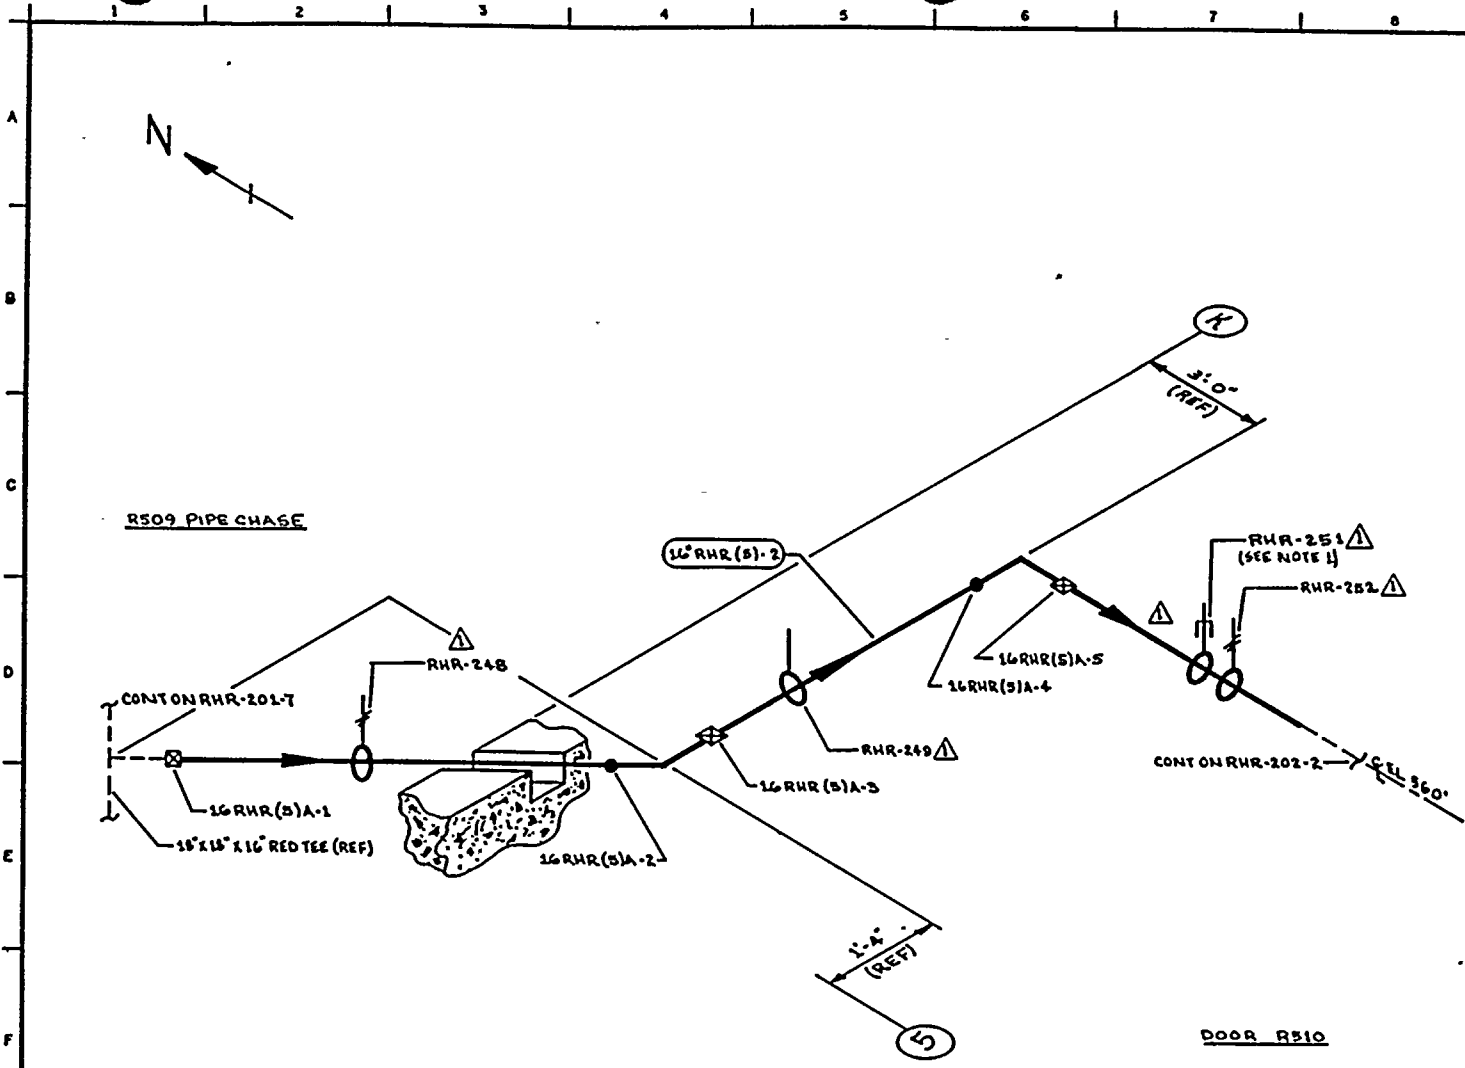

- NOTES:
- △1. STAMPING ON CLAMP IS RHR-912N.
 - △2. SCAFFOLDING IS REQUIRED.

REFERENCES:
 BOVEE & CRAIG ISOMETRICS
 RHR-853-1.4 REV 5

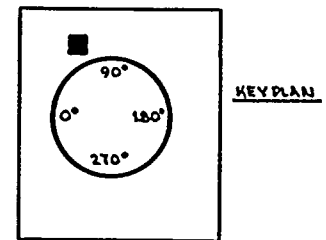

DOOR R510

ZONE R-62

THIS DRAWING IS INTENDED FOR
 USE IN PRESERVICE AND INSERVICE
 INSPECTION PROGRAMS ONLY.

QUALITY CLASS: 1	ASME CODE CLASS: 2
ENGR: GA KUGLER	DRAWN: V.M.E.A. DATE: 5-12-78

**WASHINGTON PUBLIC POWER
 SUPPLY SYSTEM**
 RICHLAND, WASHINGTON 99352


PIPING SYSTEM	NOM DIA (IN)	SCH	NOM WALL THK	MATERIAL SPECIFICATION	MATL TYPE	CAL BLOCK NO
16" RHR (S)-2	16	40	0.500	SA 106 GR B	CS	NA

NO	DATE	REVISION	BY	CHKD	APPVD
1	9-25-78	REVISED AS NOTED	K.A.A.	D.R.	J.F.W.
0	12-11-78	ISSUED FOR USE	K.A.A.	D.R.	J.F.W.
A	9-12-78	ISSUED FOR INFORMATION ONLY	K.A.A.	D.R.	D.R.

WNP-2
 WELD & COMPONENT
 IDENTIFICATION DIAGRAM


TITLE:
 RHR LOOP A
 DRYWELL SPRAY SUPPLY

DWG NO: RHR-202-1 REV 1

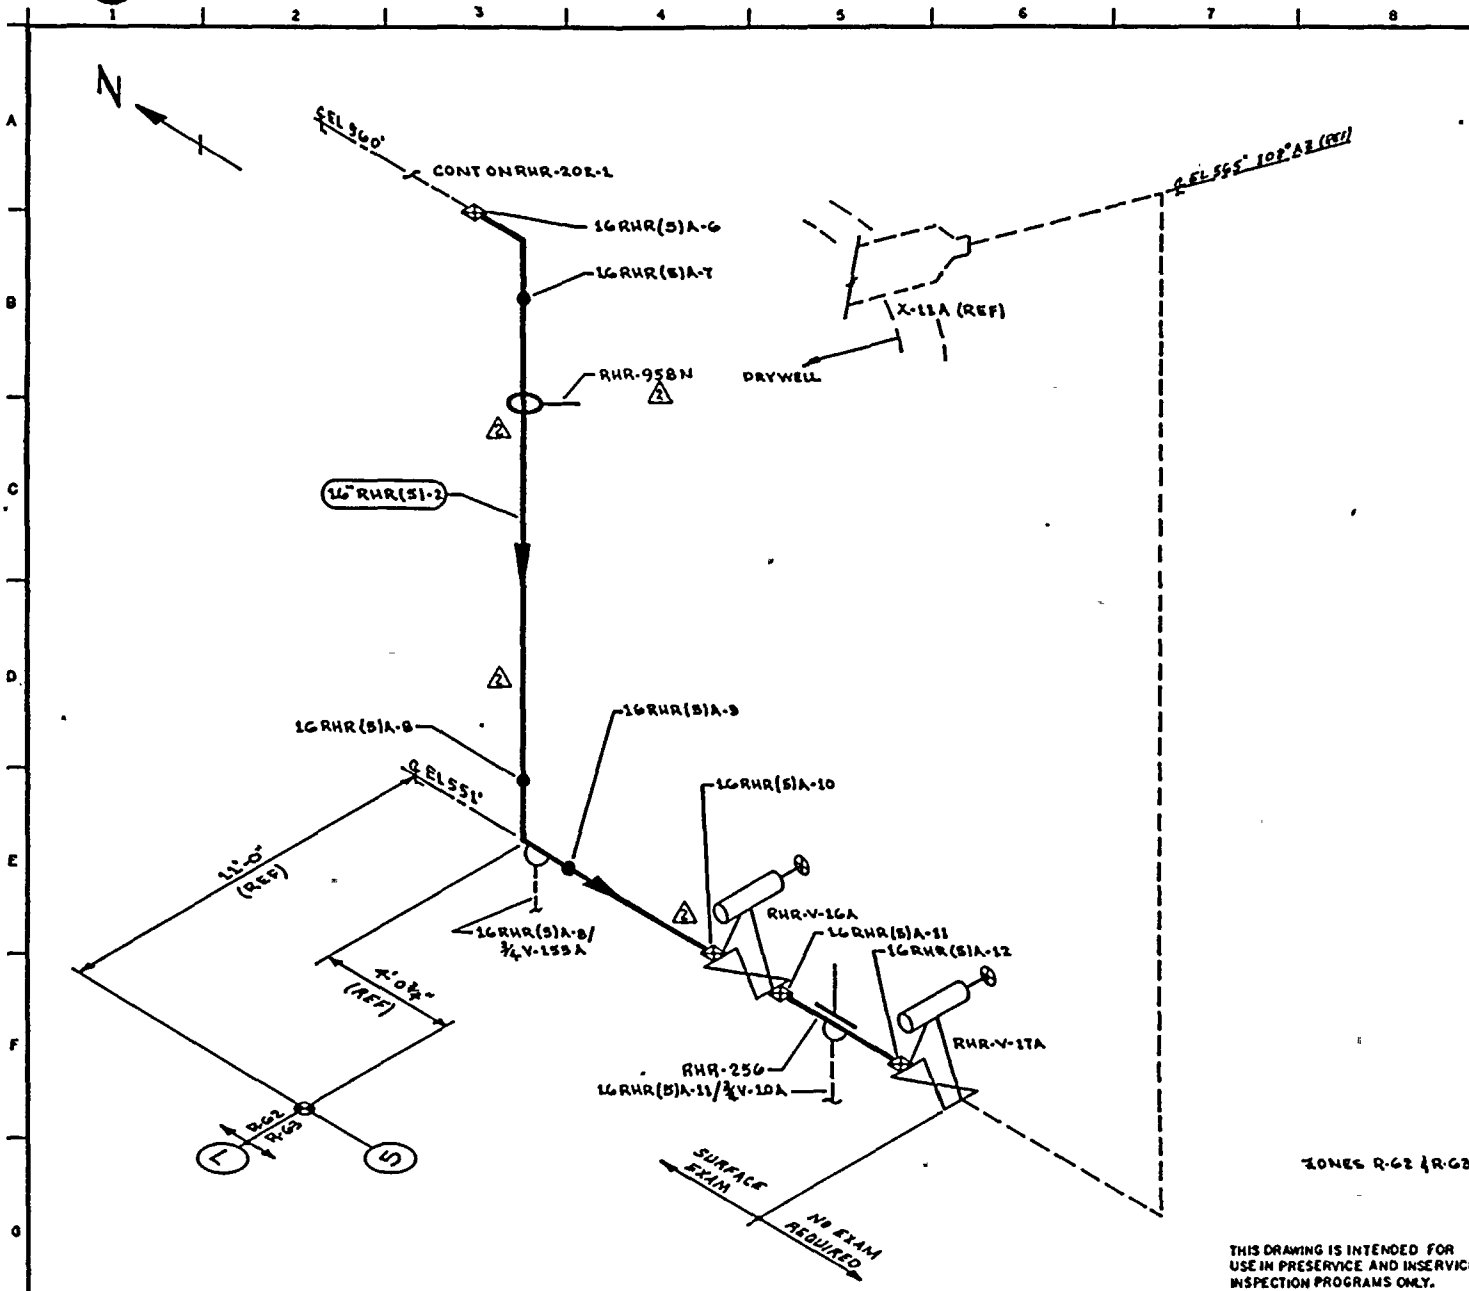

NOTES:

REFERENCES:
 BOVES & CRAIG ISOMETRICS
 RHR-853-1.4 REV 5
 RHR-853-3.6 REV 4

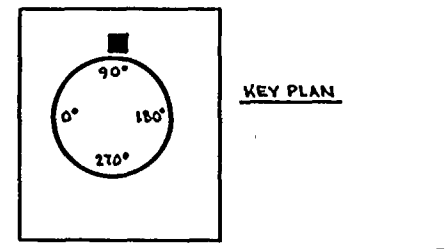

QUALITY CLASS: 1 ASME CODE CLASS: 2
 ENGR: G.A. KUGLER DRAWN: K.M.A. DATE: 6-12-78

WASHINGTON PUBLIC POWER SUPPLY SYSTEM
 RICHLAND, WASHINGTON 99352

WNP-2
 WELD COMPONENT
 IDENTIFICATION DIAGRAM

TITLE:
**RHR LOOP A
 DRYWELL SPRAY SUPPLY**
 DWG NO: RHR-202-2 REV 2

PIPING SYSTEM	NOM DIA (IN)	SCH	NOM WALL THK	MATERIAL SPECIFICATION	MATL TYPE	CAL BLOCK NO
16" RHR (B)-2	16	40	0.500	SA 106 GR B	CS	N/A

NO	DATE	REVISION	BY	CHKD	APPVD
2	9-26-78	REVISED AS NOTED	K.M.A.	207	T.H.
1	12-2-81	REVISED AS NOTED	K.M.A.	207	T.H.
0	12-12-78	ISSUED FOR USE	K.M.A.	207	T.H.
A	9-12-78	ISSUED FOR INFORMATION ONLY	K.M.A.	207	T.H.



WNP-02
 INTERVAL: PSI
 PERIOD: NA
 OUTAGE:
 DRAWING NO. RHR-202

WASHINGTON PUBLIC POWER SUPPLY SYSTEM
 PROGRAM PLAN AND SCHEDULE
 SYSTEM OR COMPONENT: 16RHR(5)-2
 DESCRIPTION: DRYWELL SPRAY SUP"A"

PAGE 001
 DATE 12/14/84

IDENT. NO.	DESCRIPTION	SECT. XI EXAM.	EXAM MTH.	PROCEDURE	CAL. BLOCK	INSERVICE		NOTES
						REQ.	SCHEDULED OUTAGE	
16RHR(5)A-1	TEE TO PIPE	C-F	SUR	PTP-1				
RHR-248	SPRING	C-E-2	VT-3	303/8.2.17				
			VT-4	303/8.2.17				
16RHR(5)A-2	PIPE TO EL	C-F	SUR	PTP-1				
16RHR(5)A-3	EL TO PIPE	C-F	SUR	PTP-1				
RHR-249	BOX	C-E-2	VT-3	303/8.2.17				
16RHR(5)A-4	PIPE TO EL	C-F	SUR	PTP-1				
16RHR(5)A-5	EL TO PIPE	C-F	SUR	PTP-1				
RHR-251	PSA-3 SNUBBER	C-E-2	VT-3	303/8.2.17				S/N 2387
			VT-4	303/8.2.17				S/N 2387
RHR-252	SPRING	C-E-2	VT-3	303/8.2.17				
			VT-4	303/8.2.17				
16RHR(5)A-6	PIPE TO EL	C-F	SUR	PTP-1				
16RHR(5)A-7	EL TO PIPE	C-F	SUR	PTP-1				
RHR-958N	ANCHOR	C-E-2	VT-3	303/8.2.17				
16RHR(5)A-8	PIPE TO EL	C-F	SUR	PTP-1				
16RHR(5)A-8/3/4V-153A	TEST CONN	N/A	VT-2	N/A				


IWC-2510, SEE NOTES
 #6 & #7.

WNP-02
 INTERVAL: PSI
 PERIOD: NA
 OUTAGE:
 DRAWING NO. RHR-202

WASHINGTON PUBLIC POWER SUPPLY SYSTEM
 PROGRAM PLAN AND SCHEDULE
 SYSTEM OR COMPONENT: 16RHR(5)-2
 DESCRIPTION: DRYWELL SPRAY SUP"A"


PAGE 002
 DATE 12/14/84

<u>IDENT. NO.</u>	<u>DESCRIPTION</u>	<u>SECT.</u> <u>XI</u> <u>EXAM.</u>	<u>EXAM</u> <u>MTH.</u>	<u>PROCEDURE</u>	<u>CAL.</u> <u>BLOCK</u>	<u>INSERVICE</u> <u>SCHEDULED</u>		<u>NOTES</u>
						<u>REQ.</u>	<u>OUTAGE</u>	
16RHR(5)A-9	EL TO PIPE	C-F	SUR	PTP-1				
16RHR(5)A-10	PIPE TO VALVE	C-F	SUR	PTP-1				
16RHR(5)A-11	VALVE TO PIPE	C-F	SUR	PTP-1				
RHR-256	PSA-35 SNUBBER	C-E-2	VT-3	303/8.2.17				S/N 10730
			VT-4	303/8.2.17				S/N 10730
16RHR(5)A-11/3/4V-10A	TEST CONN	N/A	VT-2	N/A				IWC-2510, SEE NOTES #6 & #7.
16RHR(5)A-12	PIPE TO VALVE	C-F	SUR	PTP-1				
RHR-PB-202	RHR PRESS BNDRY	N/A	VT-2	N/A				IWC-2510, SEE NOTES #6 & #7.

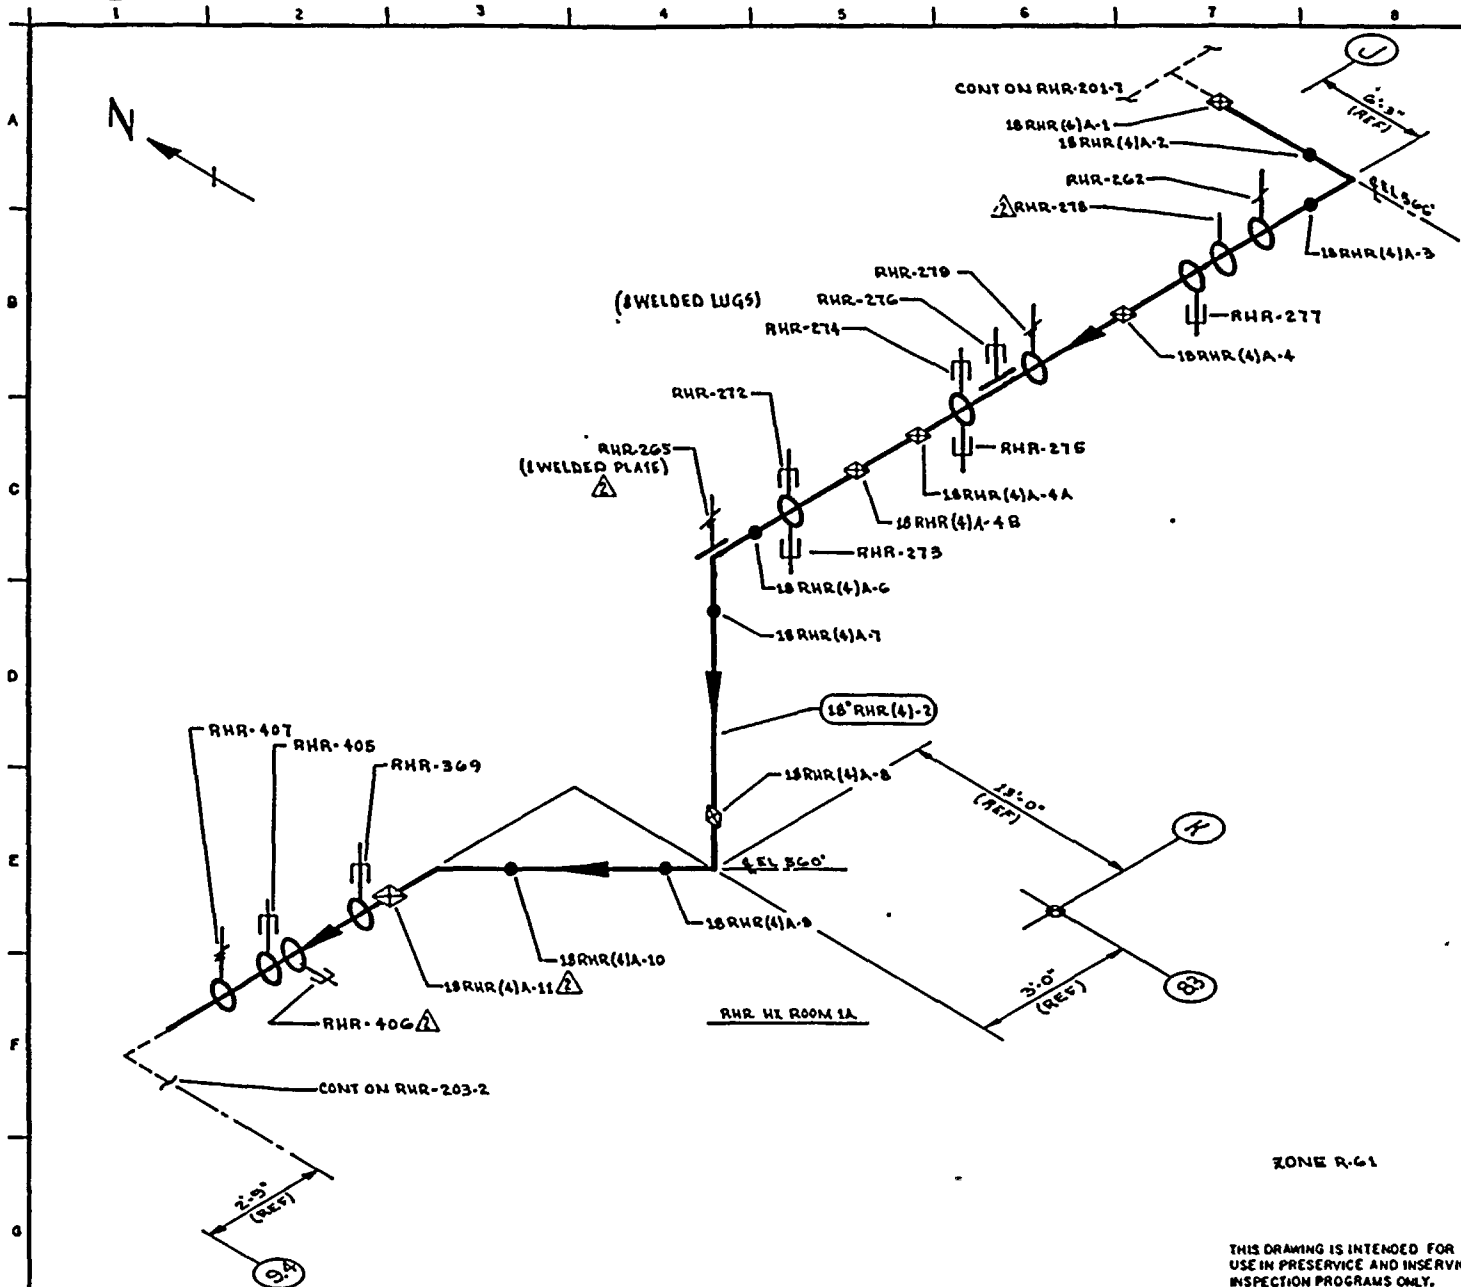

NOTES:

REFERENCES:
 BOVEE & CRAIG ISOMETRICS,
 RHR-854-LB REV 4

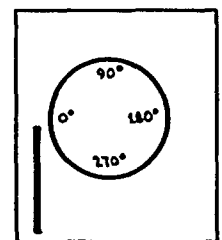

KEY PLAN

ZONE R-61

THIS DRAWING IS INTENDED FOR
 USE IN PRESERVICE AND INSERVICE
 INSPECTION PROGRAMS ONLY.

QUALITY CLASS: 1 ASME CODE CLASS: 2
 ENGR: GA. KUGLER DRAWN: R.N.C.A. DATE: 5-12-78



WASHINGTON PUBLIC POWER
 SUPPLY SYSTEM
 RICHMOND, WASHINGTON 98352


PIPING SYSTEM	NOM DIA (IN)	SCH	NOM WALL THK	MATERIAL SPECIFICATION	MATL TYPE	CAL BLOCK NO
18" RHR (4)-2	18	30	0.438	SA 106 GR B	CB	NA


NO	DATE	REVISION	BY	CHKD	APPVD
2	9-26-83	REVISED AS NOTED	K.N.A.	TRR	TRR
1	11-5-80	REVISED AS NOTED	K.N.A.	TRR	TRR
0	12-22-77	ISSUED FOR USE	K.N.A.	TRR	TRR
A	9-12-78	ISSUED FOR INFORMATION ONLY	K.N.A.	HAY	TRR

WHP-2
 WELD & COMPONENT
 IDENTIFICATION DIAGRAM

TITLE:
 RHR LOOP A TEST LINE


DWG NO: RHR-203-1 REV 2

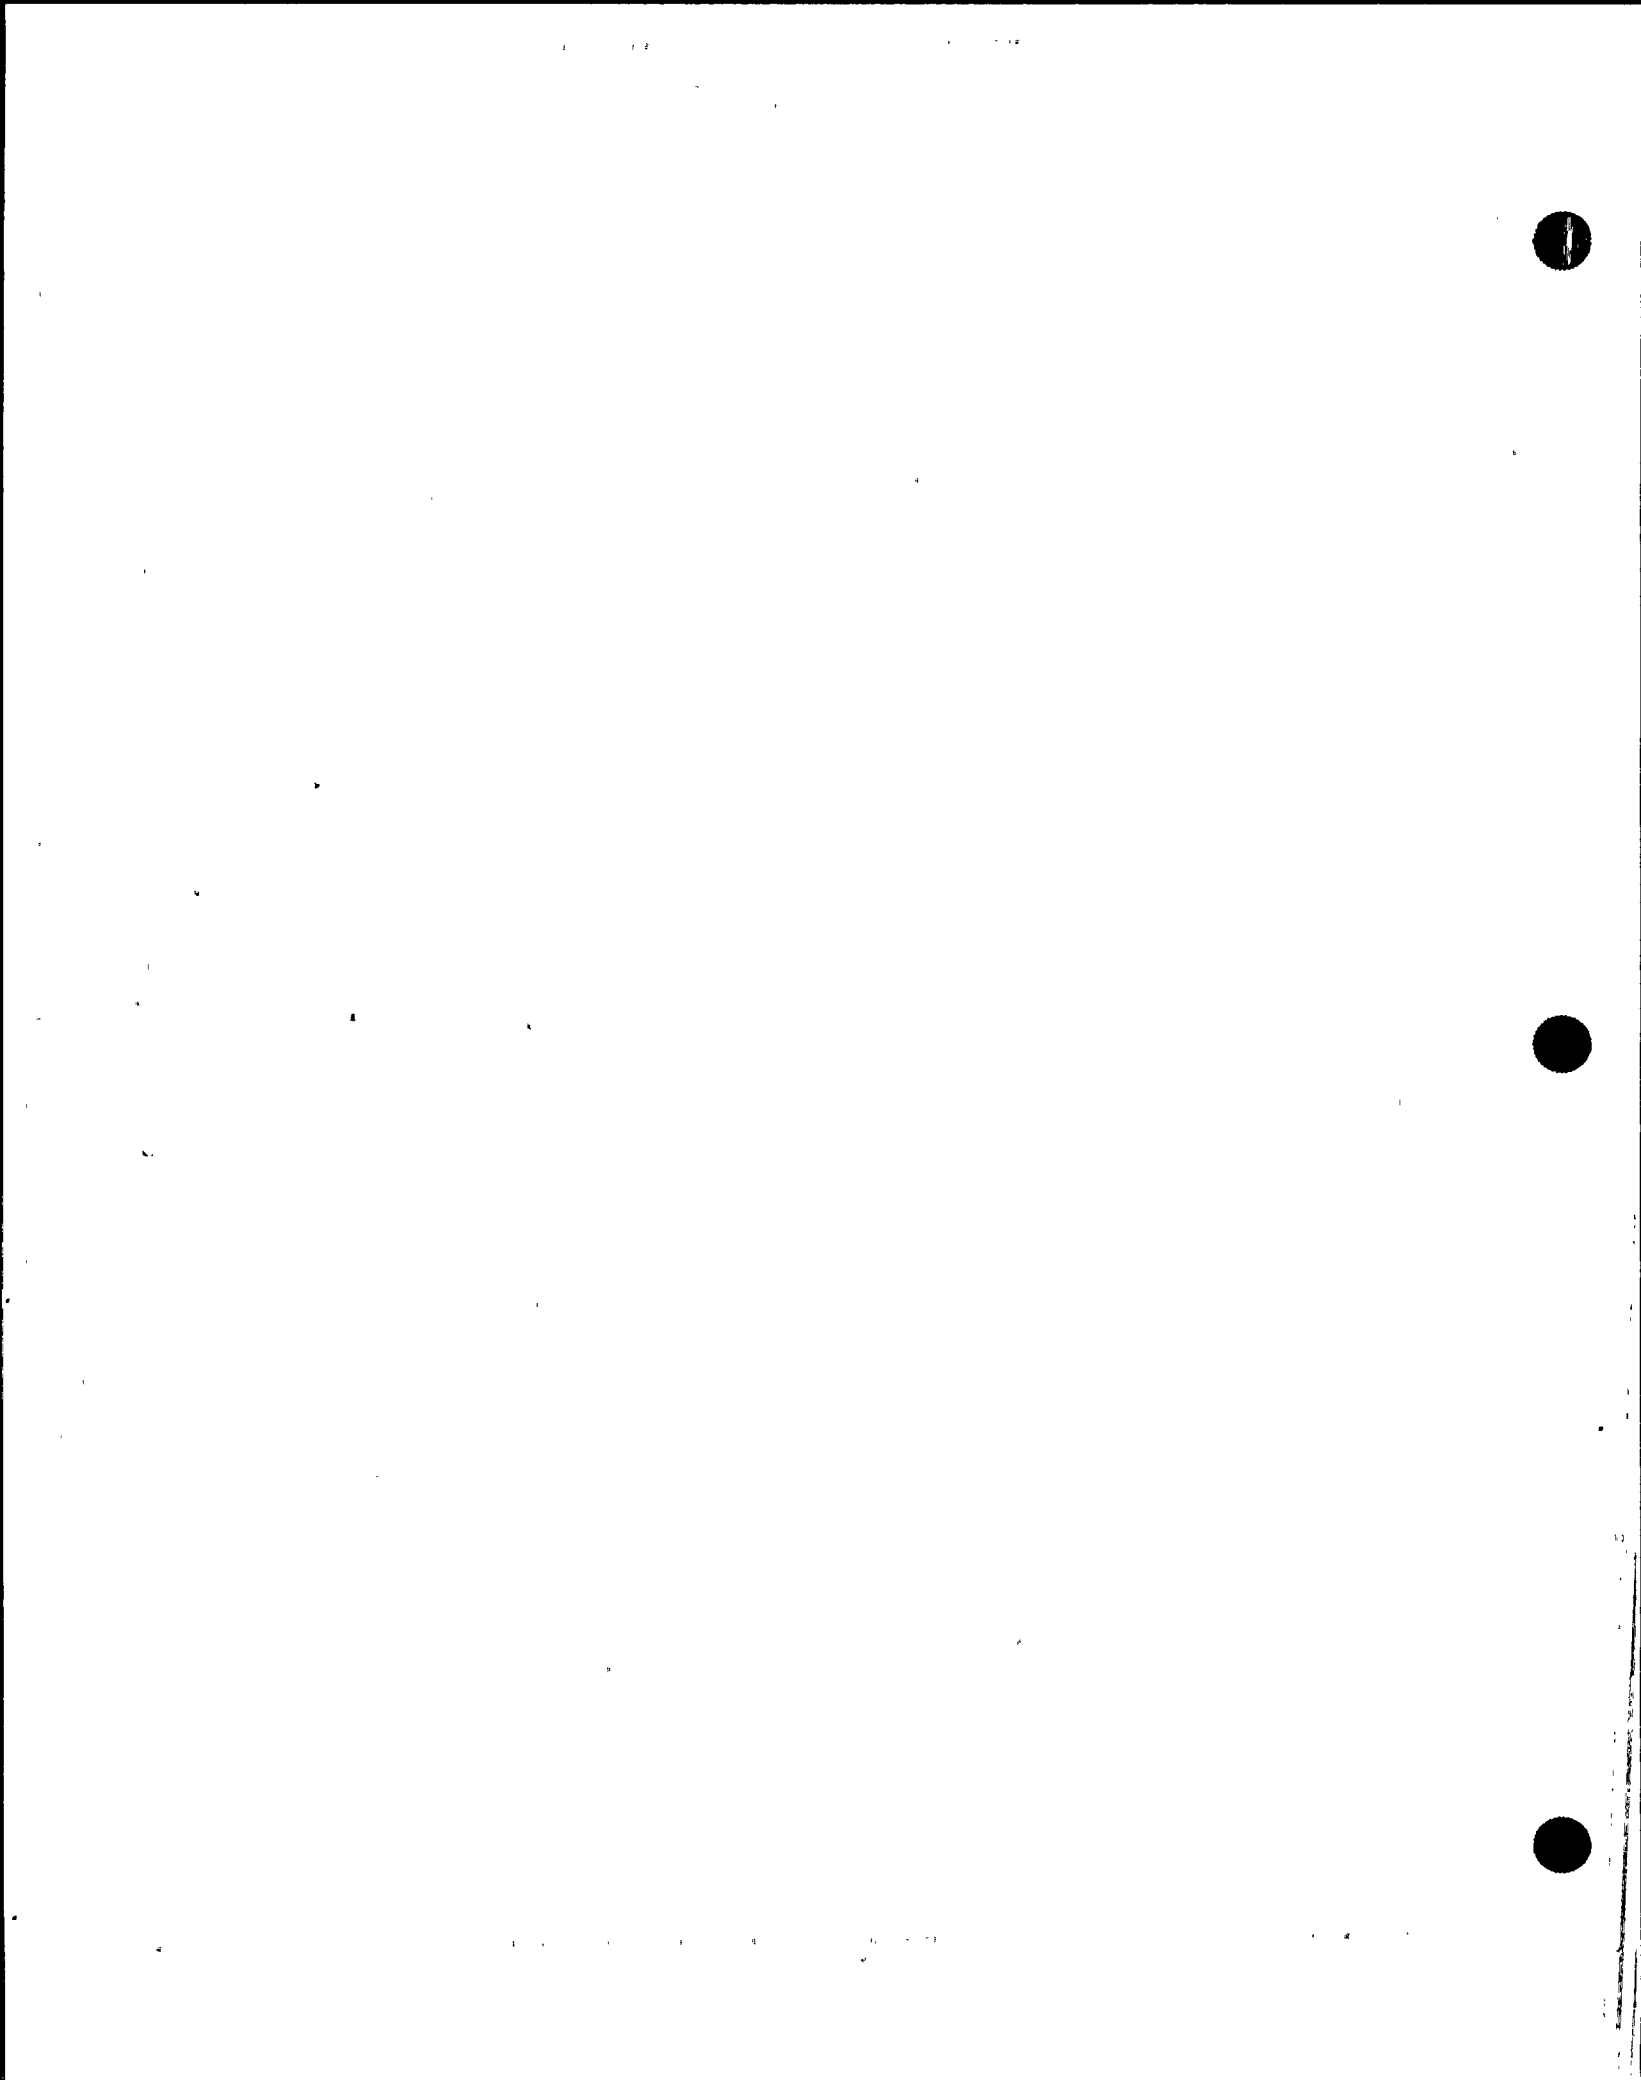

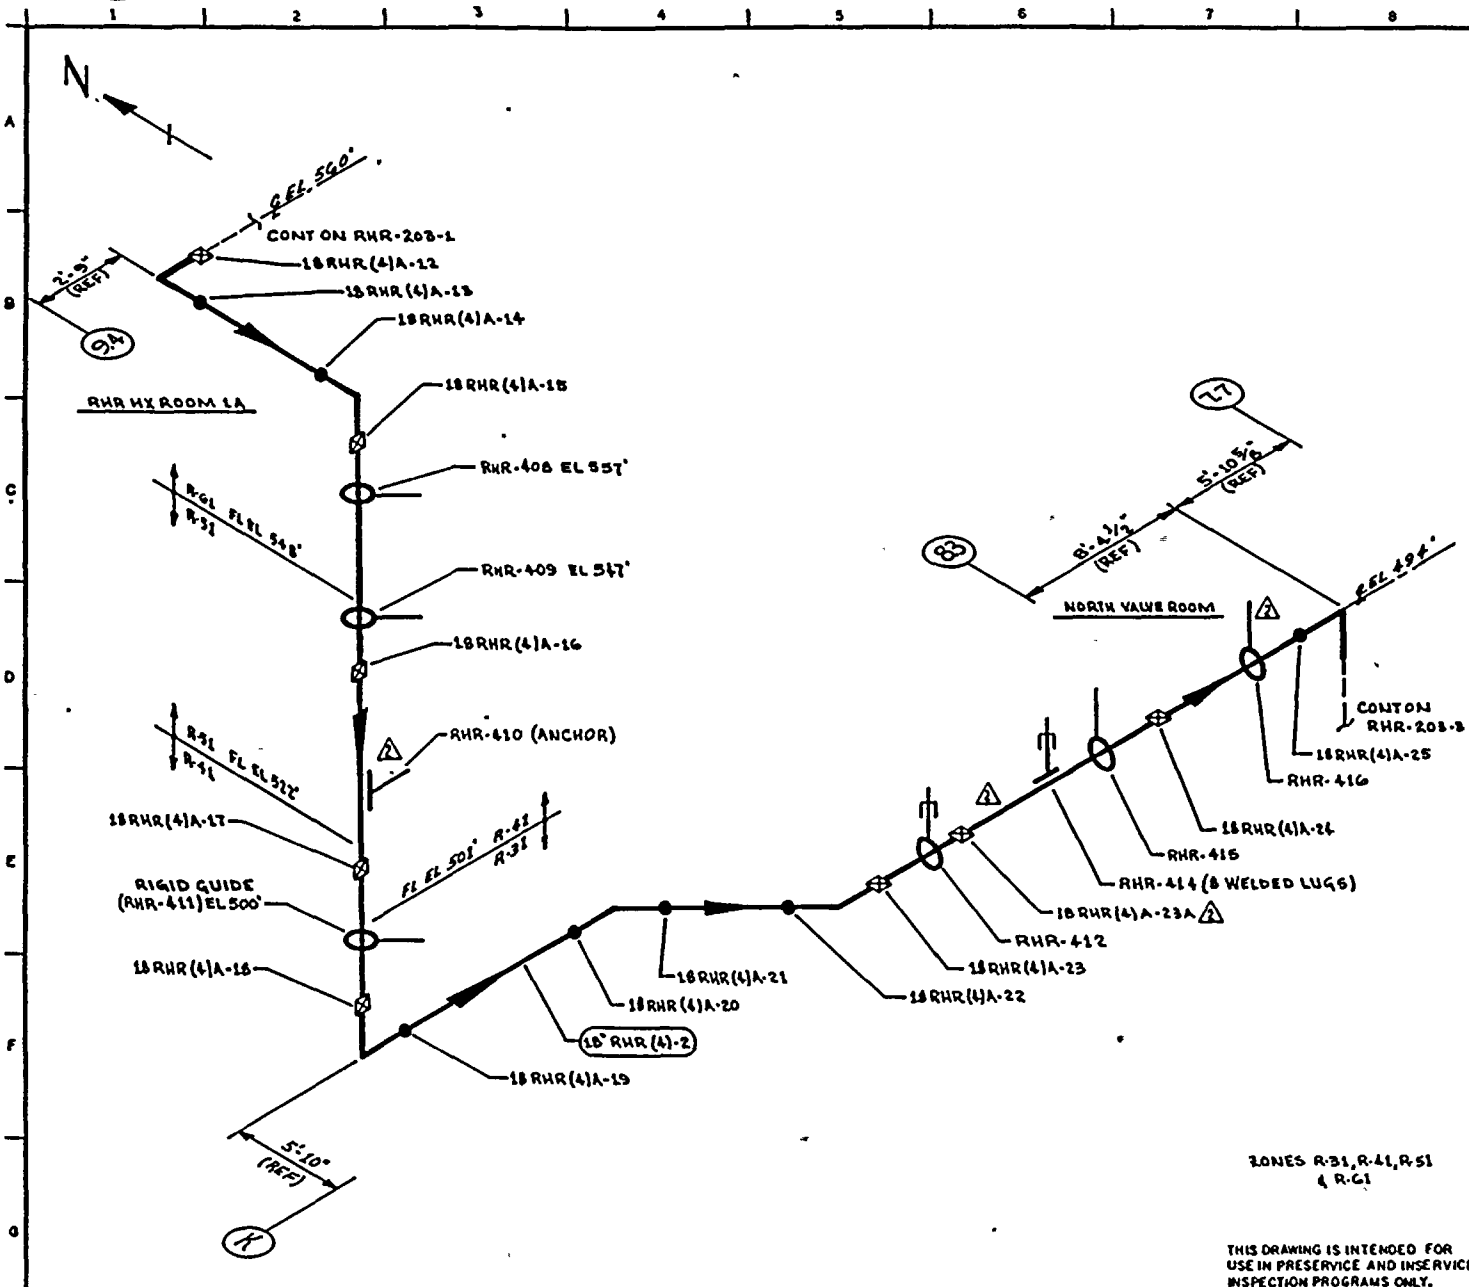

NOTES:
1. SCAFFOLDING IS REQUIRED.

REFERENCES:
BOVES & CRAIL ISOMETRICS
RHR-854-L-5 REV 4
RHR-854-G-11 REV 7

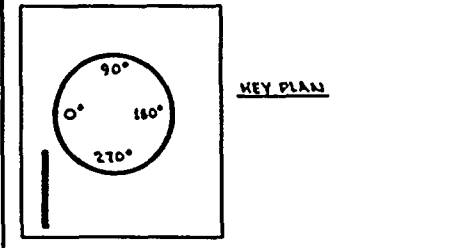

QUALITY CLASS: 1 ASME CODE CLASS: 2
ENGR: G. L. KUKLER DRAWN: V. J. C. L. DATE: 5-15-76




THIS DRAWING IS INTENDED FOR USE IN PRESERVICE AND INSERVICE INSPECTION PROGRAMS ONLY.

PIPING SYSTEM	NOM DIA (DN)	SCH	NOM WALL THK	MATERIAL SPECIFICATION	MATL TYPE	CAL BLOCK NO
18" RHR(4)-2	18	30	0.426	SA 106 GR B	CS	NA

NO	DATE	REVISION	BY	CHKD	APPVD
2	9-22-83	REVISED AS NOTED	KMA	ZOR	THH
1	12-23-81	REVISED AS NOTED	KMA	ZOR	THH
0	12-22-78	ISSUED FOR USE	KMA	ZOR	THH
A	9-12-78	ISSUED FOR INFORMATION ONLY	KMA	ZOR	THH


WHP-2
WELD & COMPONENT
IDENTIFICATION DIAGRAM
TITLE:
RHR LOOP A TEST LINE
DWG NO: RHR-203-2 REV 2



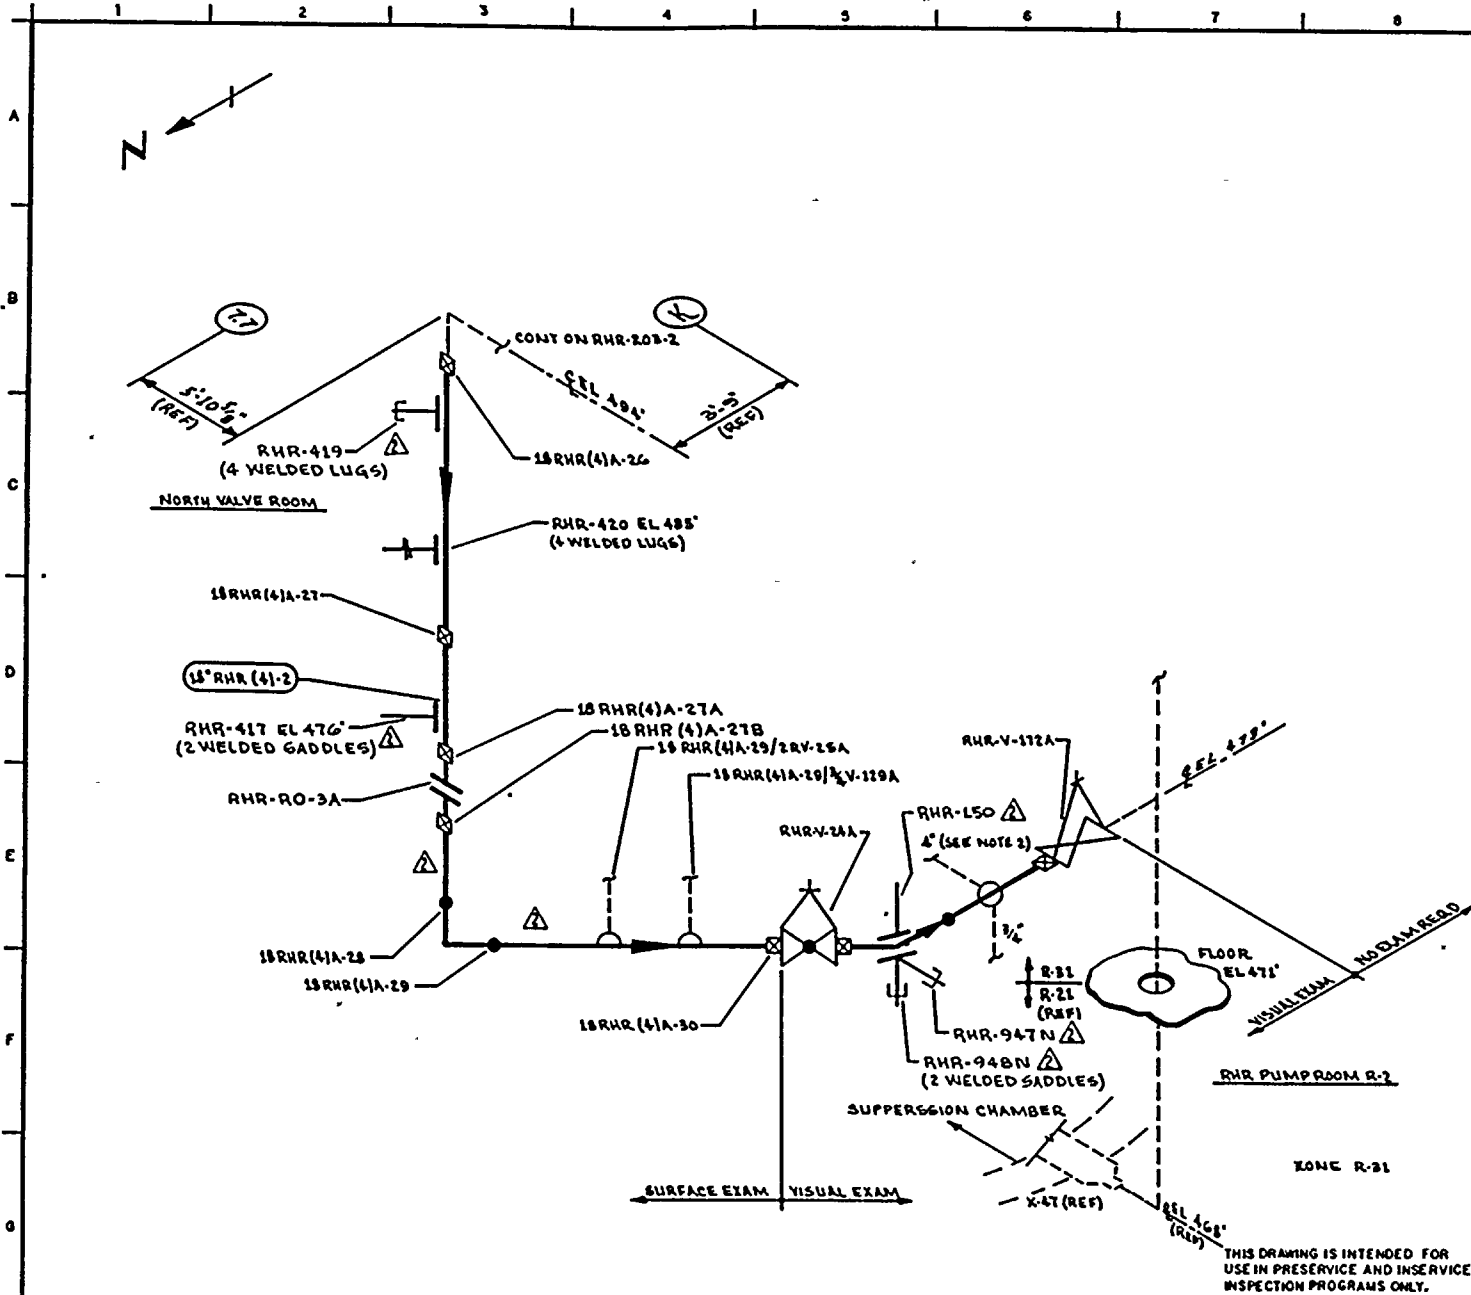

- NOTES:**
- FOR BRANCH PIPING 4" DIA OR LESS (CONN SHOWN IN DASHED LINES) EXTEND VISUAL LEAKAGE EXAM THROUGH OUTERMOST NORMALLY CLOSED NUCLEAR VALVE OR UNTIL TRANSITION TO INSTRUMENT TUBING, UNLESS OTHERWISE NOTED.
 - EXTEND VISUAL LEAKAGE EXAM THROUGH RHR-V-11A.
 - PORTIONS OF THIS DRAWING IDENTIFY PIPING & COMP THAT ARE SUBJECT ONLY TO A VISUAL EXAM FOR EVIDENCE OF LEAKAGE DURING SYSTEM HYDRO OR OPERABILITY TESTS. TESTS ARE TO BE CONDUCTED PER THE REQUIREMENTS OF ASME SECTION XI, PARAGRAPH IWA-5000.

REFERENCES:
 BOYER & CRAIG ISOMETRICS
 RHR-854-12.16 REV 9

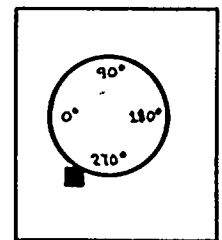

KEY PLAN

QUALITY CLASS: 1 | ASME CODE CLASS: 2
 ENGR: G.A. KUMLER | DRAWN: K.M.A. | DATE: 5-15-78



WASHINGTON PUBLIC POWER SUPPLY SYSTEM
 RICHLAND, WASHINGTON 99352

THIS DRAWING IS INTENDED FOR USE IN PRESERVICE AND INSERVICE INSPECTION PROGRAMS ONLY.

PIPING SYSTEM	NOM DIA (IN)	SCH	NOM WALL THK	MATERIAL SPECIFICATION	MATL TYPE	CAL BLOCK NO
18" RHR (4)A-2	18	30	0.438	SA 106 GR B	CS	NA

NO	DATE	REVISION	BY	CHKD	APPVD
2	9-26-81	REVISED AS NOTED	K.M.A.	TRK	TRK
1	11-5-80	REVISED AS NOTED	K.M.A.	TRK	TRK
0	11-22-78	ISSUED FOR USE	K.M.A.	TRK	TRK
1	9-18-78	ISSUED FOR INFORMATION ONLY	K.M.A.	TRK	TRK

WNP-2
 WELD & COMPONENT IDENTIFICATION DIAGRAM

TITLE:
RHR LOOP A TEST LINE

DWG NO: RHR-203-3 | REV 2



WNP-02
 INTERVAL: PSI
 PERIOD: NA
 OUTAGE:
 DRAWING NO. RHR-203

WASHINGTON PUBLIC POWER SUPPLY SYSTEM
 PROGRAM PLAN AND SCHEDULE
 SYSTEM OR COMPONENT: 18RHR(4)-2
 DESCRIPTION: RHR TEST LINE LOOP A

PAGE 001
 DATE 12/14/84

IDENT. NO.	DESCRIPTION	SECT. XI EXAM.	EXAM MTH.	PROCEDURE	CAL. BLOCK	INSERVICE		NOTES
						REQ.	SCHEDULED OUTAGE	
18RHR(4)A-1	TEE TO PIPE	C-F	SUR	PTP-1				
18RHR(4)A-2	PIPE TO EL	C-F	SUR	PTP-1				
18RHR(4)A-3	EL TO PIPE	C-F	SUR	PTP-1				
RHR-262	SPRING	C-E-2	VT-3	303/8.2.17				
			VT-4	303/8.2.17				
RHR-278	BOX	C-E-2	VT-3	303/8.2.17				
RHR-277	PSA-3 SNUBBER	C-E-2	VT-3	303/8.2.17				S/N 509
			VT-4	303/8.2.17				S/N 509
18RHR(4)A-4	PIPE TO PIPE	C-F	SUR	PTP-1				
RHR-279	SPRING	C-F-2	VT-3	303/8.2.17				
			VT-4	303/8.2.17				
RHR-276	PSA-1 SN(?)	C-E-2	VT-3	303/8.2.17				S/N S2796/N2576
			VT-4	303/8.2.17				S/N S2796/N2576
RHR-274	PSA-3 SNUBBER	C-E-2	VT-3	303/8.2.17				S/N 2590
			VT-4	303/8.2.17				S/N 2590
RHR-275	PSA-3 SNUBBER	C-E-2	VT-3	303/8.2.17				S/N 2379
			VT-4	303/8.2.17				S/N 2379
18RHR(4)A-4A	PIPE TO PIPE	C-F	SUR	PTP-1				

WNP-02
 INTERVAL: PSI
 PERIOD: NA
 OUTAGE:
 DRAWING NO. RHR-203

WASHINGTON PUBLIC POWER SUPPLY SYSTEM
 PROGRAM PLAN AND SCHEDULE
 SYSTEM OR COMPONENT: 18RHR(4)-2
 DESCRIPTION: RHR TEST LINE LOOP A

PAGE 002
 DATE 12/14/84

IDENT. NO.	DESCRIPTION	SECT. XI EXAM.	EX44 MTH.	PROCEDURE	CAL. BLOCK	INSERVICE		NOTES
						REQ.	SCHEDULED OUTAGE	
18RHR(4)A-4B RHR-272	PIPE TO PIPE	C-F	SUR	PTP-1				
RHR-273	PSA-3 SNUBBER	C-E-2	VT-3	303/8.2.17				S/N 258
			VT-4	303/8.2.17				S/N 258
18RHR(4)A-6 RHR-265	PSA-3 SNUBBER	C-E-2	VT-3	303/8.2.17				S/N 508
			VT-4	303/8.2.17				S/N 508
RHR-265	PIPE TO EL	C-F	SUR	PTP-1				
			VT-3	303/8.2.17				W/1 WELDED PLATE.
18RHR(4)A-7 RHR-369	SPRING	C-E-2	VT-4	303/8.2.17				W/1 WELDED PLATE.
			VT-3	303/8.2.17				
18RHR(4)A-8	EL TO PIPE	C-F	SUR	PTP-1				
18RHR(4)A-9	PIPE TO EL	C-F	SUR	PTP-1				
18RHR(4)A-10	EL TO PIPE	C-F	SUR	PTP-1				
18RHR(4)A-11	PIPE TO EL	C-F	SUR	PTP-1				
RHR-369	EL TO PIPE	C-F	SUR	PTP-1				
			VT-3	303/8.2.17				S/N 646
RHR-406	PSA-3 SNUBBER	C-E-2	VT-4	303/8.2.17				S/N 646
			VT-3	303/8.2.17				S/N 2588
			VT-4	303/8.2.17				S/N 2588

WNP-02
 INTERVAL: PSI
 PERIOD: NA
 OUTAGE:
 DRAWING NO. RHR-203

WASHINGTON PUBLIC POWER SUPPLY SYSTEM
 PROGRAM PLAN AND SCHEDULE
 SYSTEM OR COMPONENT: 18RHR(4)-2
 DESCRIPTION: RHR TEST LINE LOOP A

PAGE 003
 DATE 12/14/84

IDENT. NO.	DESCRIPTION	SECT. XI EXAM.	EXAM. MTH.	PROCEDURE	CAL. BLOCK	INSERVICE		NOTES
						REQ.	SCHEDULED OUTAGE	
RHR-405	PSA-3 SNUBBER	C-E-2	VT-3	303/8.2.17				S/N 4420
			VT-4	303/8.2.17				S/N 4420
RHR-407	SPRING	C-E-2	VT-3	303/8.2.17				
			VT-4	303/8.2.17				
18RHR(4)A-12	PIPE TO EL	C-F	SUR	PTP-1				
18RHR(4)A-13	EL TO PIPE	C-F	SUR	PTP-1				
18RHR(4)A-14	PIPE TO EL	C-F	SUR	PTP-1				
18RHR(4)A-15	EL TO PIPE	C-F	SUR	PTP-1				
RHR-408	STRUT	C-E-2	VT-3	303/8.2.17				
RHR-409	BOX	C-E-2	VT-3	303/8.2.17				
18RHR(4)A-16	PIPE TO PIPE	C-F	SUR	PTP-1				
RHR-410(S)	WELDED SADDLE	C-E-1	SUR	NTP-1				
RHR-410	ANCHOR	C-E-2	VT-3	303/8.2.17				
18RHR(4)A-17	PIPE TO PIPE	C-F	SUR	PTP-1				
RHR-411	BOX	C-E-2	VT-3	303/8.2.17				
18RHR(4)A-18	PIPE TO EL	C-F	SUR	PTP-1				
18RHR(4)A-19	EL TO PIPE	C-F	SUR	PTP-1				
18RHR(4)A-20	PIPE TO EL	C-F	SUR	PTP-1				

WNP-02
 INTERVAL: PSI
 PERIOD: NA
 OUTAGE:
 DRAWING NO. RHR-203

WASHINGTON PUBLIC POWER SUPPLY SYSTEM
 PROGRAM PLAN AND SCHEDULE
 SYSTEM OR COMPONENT: 18RHR(4)-2
 DESCRIPTION: RHR TEST LINE LOOP A

PAGE 004
 DATE 12/14/84

IDENT. NO.	DESCRIPTION	SECT. XI EXAN.	EXAM MTH.	PROCEDURE	CAL. BLOCK	INSERVICE		NOTES
						REQ.	SCHEDULED OUTAGE	
18RHR(4)A-21	EL TO PIPE	C-F	SUR	PTP-1				
18RHR(4)A-22	PIPE TO EL	C-F	SUR	QCI 3-3				
18RHP(4)A-23	EL TO PIPE	C-F	SUR	PTP-1				
RHR-412	STRUT	C-E-2	VT-3	303/8.2.17				
18RHR(4)A-23A	PIPE TO PIPE	C-F	SUR	QCI 3-3				
RHR-414	PSA-3 SN(2)	C-E-2	VT-3	303/8.2.17				S/N N2353/S2586
			VT-4	303/8.2.17				S/N N2353/S2586
RHR-415	STRUT	C-E-2	VT-3	303/8.2.17				
18RHP(4)A-24	PIPE TO PIPE	C-F	SUR	PTP-1				
RHR-416	PSA-10 SN(2)	C-E-2	VT-3	303/8.2.17				S/N T9906/B9934
			VT-4	303/8.2.17				S/N T9906/B9934
18RHR(4)A-25	PIPE TO EL	C-F	SUR	PTP-1				
18RHR(4)A-26	EL TO PIPE	C-F	SUR	PTP-1				
RHR-419(W)	8 WELDED LUGS	C-E-1	SUR	QCI 4-3				
RHR-419	PSA-3 SN(2)	C-E-2	VT-3	303/8.2.17				S/N E4432/W5744
			VT-4	303/8.2.17				S/N E4432/W5744
RHR-420(W)	4 WELDED LUGS	C-E-1	SUR	MTP-1				
RHR-420	SPRING	C-E-2	VT-3	303/8.2.17				

WNP-02
 INTERVAL: PSI
 PERIOD: NA
 OUTAGE:
 DRAWING NO. RHR-203

WASHINGTON PUBLIC POWER SUPPLY SYSTEM
 PROGRAM PLAN AND SCHEDULE
 SYSTEM OR COMPONENT: 18RHR(4)-2
 DESCRIPTION: RHR TEST LINE LOOP A

PAGE 005
 DATE 12/14/84


IDENT. NO.	DESCRIPTION	SECT. XI EXAM.	EXAM MTH.	PROCEDURE	CAL. BLOCK	INSERVICE		NOTES
						REQ.	SCHEDULED OUTAGE	
			VT-4	303/8.2.17				
18RHR(4)A-27	PIPE TO PIPE	C-F	SUR	PTP-1				
RHR-417	STRUT	C-E-2	VT-3	303/8.2.17				
18RHR(4)A-27A	PIPE TO FLANGE	C-F	SUR	PTP-1				
18RHR(4)A-27B	FLANGE TO PIPE	C-F	SUR	PTP-1				
18RHR(4)A-28	PIPE TO EL	C-F	SUR	PTP-1				
18RHR(4)A-29	EL TO PIPE	C-F	SUR	PTP-1				
18RHR(4)A-29/2RV-25A	THERMAL RELIEF	N/A	VT-2	N/A				IWC-2510, SEE NOTES #6 & #7.
18RHR(4)A-29/3/4V-129A	TEST CONN	N/A	VT-2	N/A				IWC-2510, SEE NOTES #6 & #7.
18RHR(4)A-30	PIPE TO VALVE	C-F	SUR	PTP-1				
RHR-150	SPRING	C-E-2	VT-3	303/8.2.17				
			VT-4	303/8.2.17				
RHR-948N(S)	2 WELDED SADDLE	C-E-1	SUR	QCI 4-3				SADDLE *T* = 1.031".
RHR-948N	PSA-3 SN(2)	C-E-2	VT-3	303/8.2.17				S/N T2789/B2580
			VT-4	303/8.2.17				S/N T2789/B2580
RHR-947N	PSA-3 SN(2)	C-E-2	VT-3	303/8.2.17				S/N 3905/3882

WNP-02
INTERVAL: PSI
PERIOD: NA
OUTAGE:
DRAWING NO. RHR-203

WASHINGTON PUBLIC POWER SUPPLY SYSTEM
PROGRAM PLAN AND SCHEDULE
SYSTEM OR COMPONENT: 19RHR(4)-2
DESCRIPTION: RHR TEST LINE LOOP_A


PAGE 006
DATE 12/14/84

<u>IDENT. NO.</u>	<u>DESCRIPTION</u>	<u>SECT.</u>		<u>PROCEDURE</u>	<u>CAL. BLOCK</u>	<u>REQ.</u>	<u>INSERVICE</u>		<u>NOTES</u>
		<u>XI</u>	<u>EXAM</u>				<u>SCHEDULED</u>	<u>OUTAGE</u>	
		<u>EXAM.</u>	<u>MTH.</u>						
			VT-4	303/8.2.17					S/N 3905/3882
RHR-PB-203	RHR PRESS BNDRY	N/A	VT-2	N/A					IWC-2510, SEE NOTES #6 & #7.

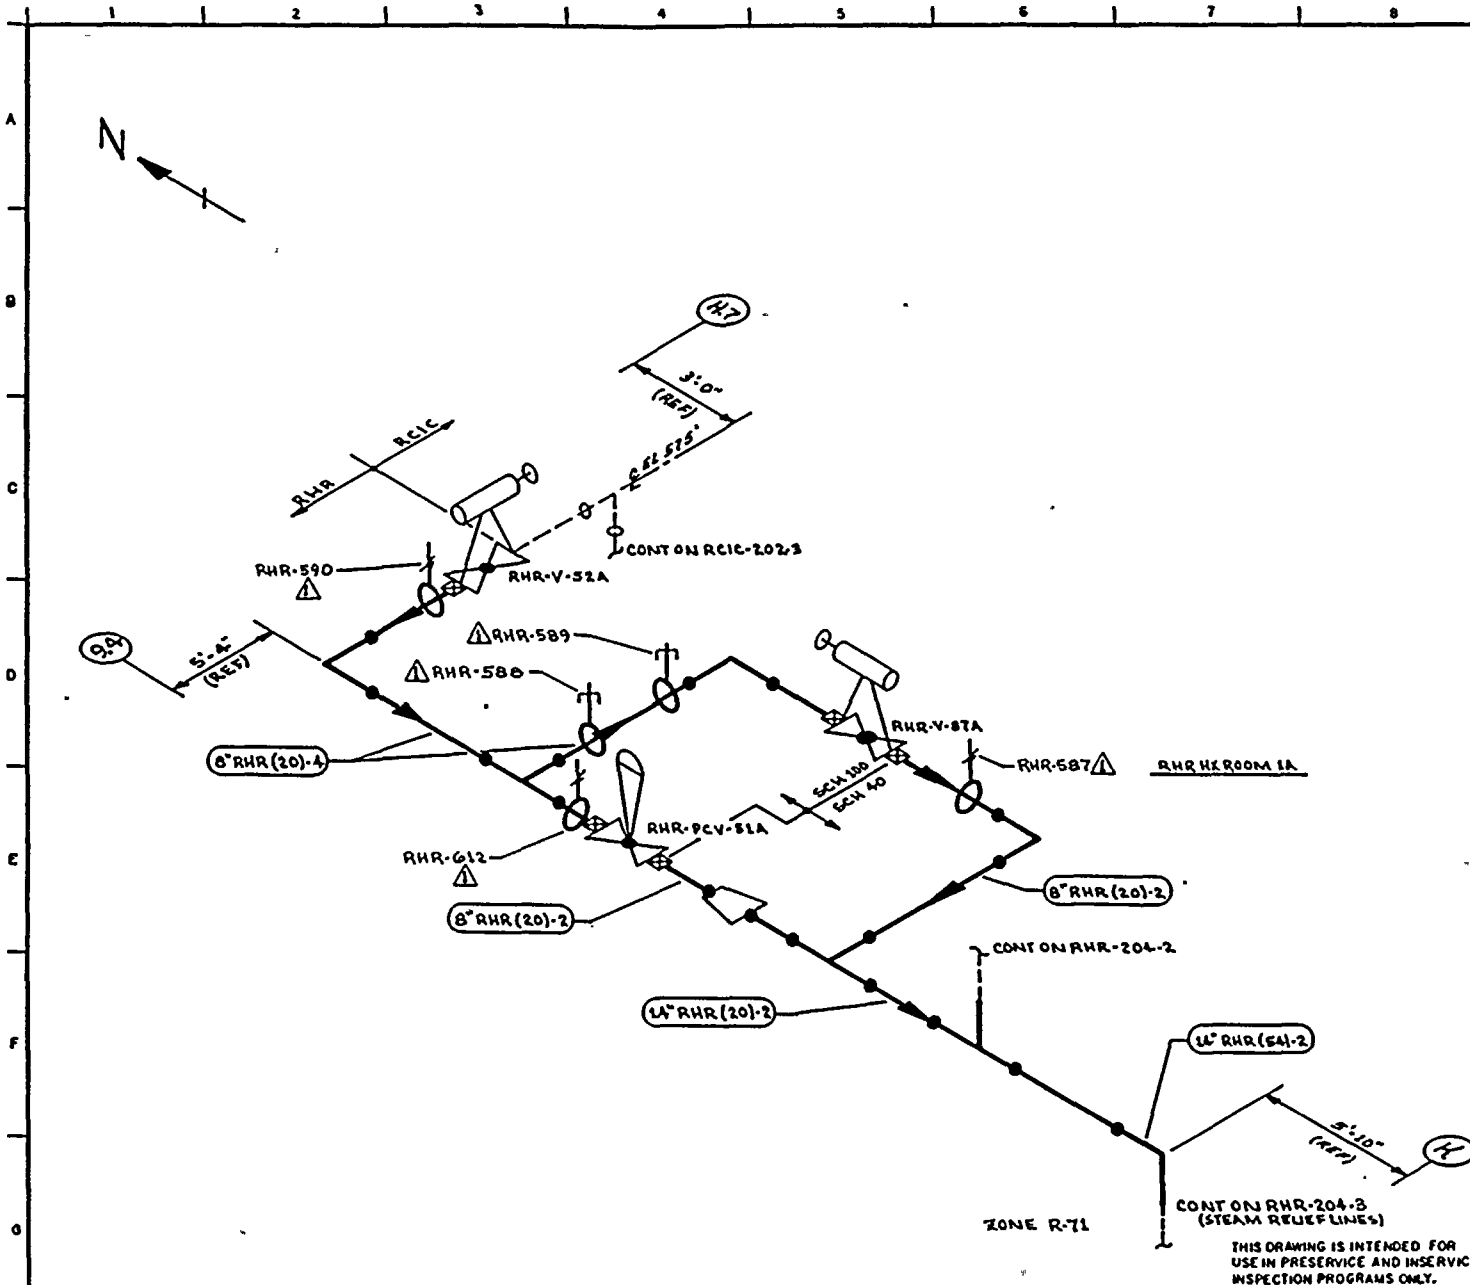

NOTES:
 1. THIS DRAWING IDENTIFIES PIPING & COMPONENTS SUBJECT TO A VISUAL EXAM FOR EVIDENCE OF LEAKAGE DURING SYSTEM HYDRO OR OPERABILITY TESTS. TESTS ARE TO BE CONDUCTED PER THE REQUIREMENTS OF ASME SECTION XI, PARAGRAPH IWA-5000.

REFERENCES:
 BOVEE & CRAIG ISOMETRIC
 RHR-807-24.25 REV7

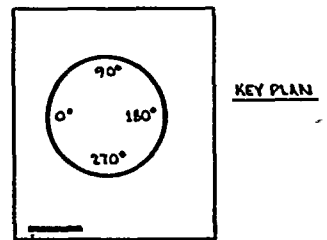

QUALITY CLASS: 1 ASME CODE CLASS: 2
 ENGR: G.A. KUCLER DRAWN: K.M.A. DATE: 8-16-78


WASHINGTON PUBLIC POWER
 SUPPLY SYSTEM
 RICHMOND, WASHINGTON 98052

PIPING SYSTEM	NOM DIA (IN)	SCH	NOM WALL THK	MATERIAL SPECIFICATION	MATL TYPE	CAL BLOCK NO
8" RHR (20)-4	8	100	0.594	SA 106 GR B	CS	NA
8" RHR (20)-2	8	40	0.322	SA 106 GR B	CS	NA
14" RHR (20)-2	14	STD	0.375	SA 106 GR B	CS	NA
16" RHR (54)-2	16	STD	0.515	SA 106 GR B	CS	NA

NO	DATE	REVISION	BY	CHKD	APPVD
1	9-26-78	REVISED AS NOTED	KMcA	SPK	SPK
0	8-17-78	ISSUED FOR USE	KMcA	SPK	SPK
A	9-12-78	ISSUED FOR INFORMATION ONLY	KMcA	SPK	SPK


WNP-2
 WELD & COMPONENT
 IDENTIFICATION DIAGRAM
 TITLE: RHR LOOP A
 RCIC STEAM SUPPLY TO RHR-HX-1A
 DWG NO: RHR-204-1 REV 1



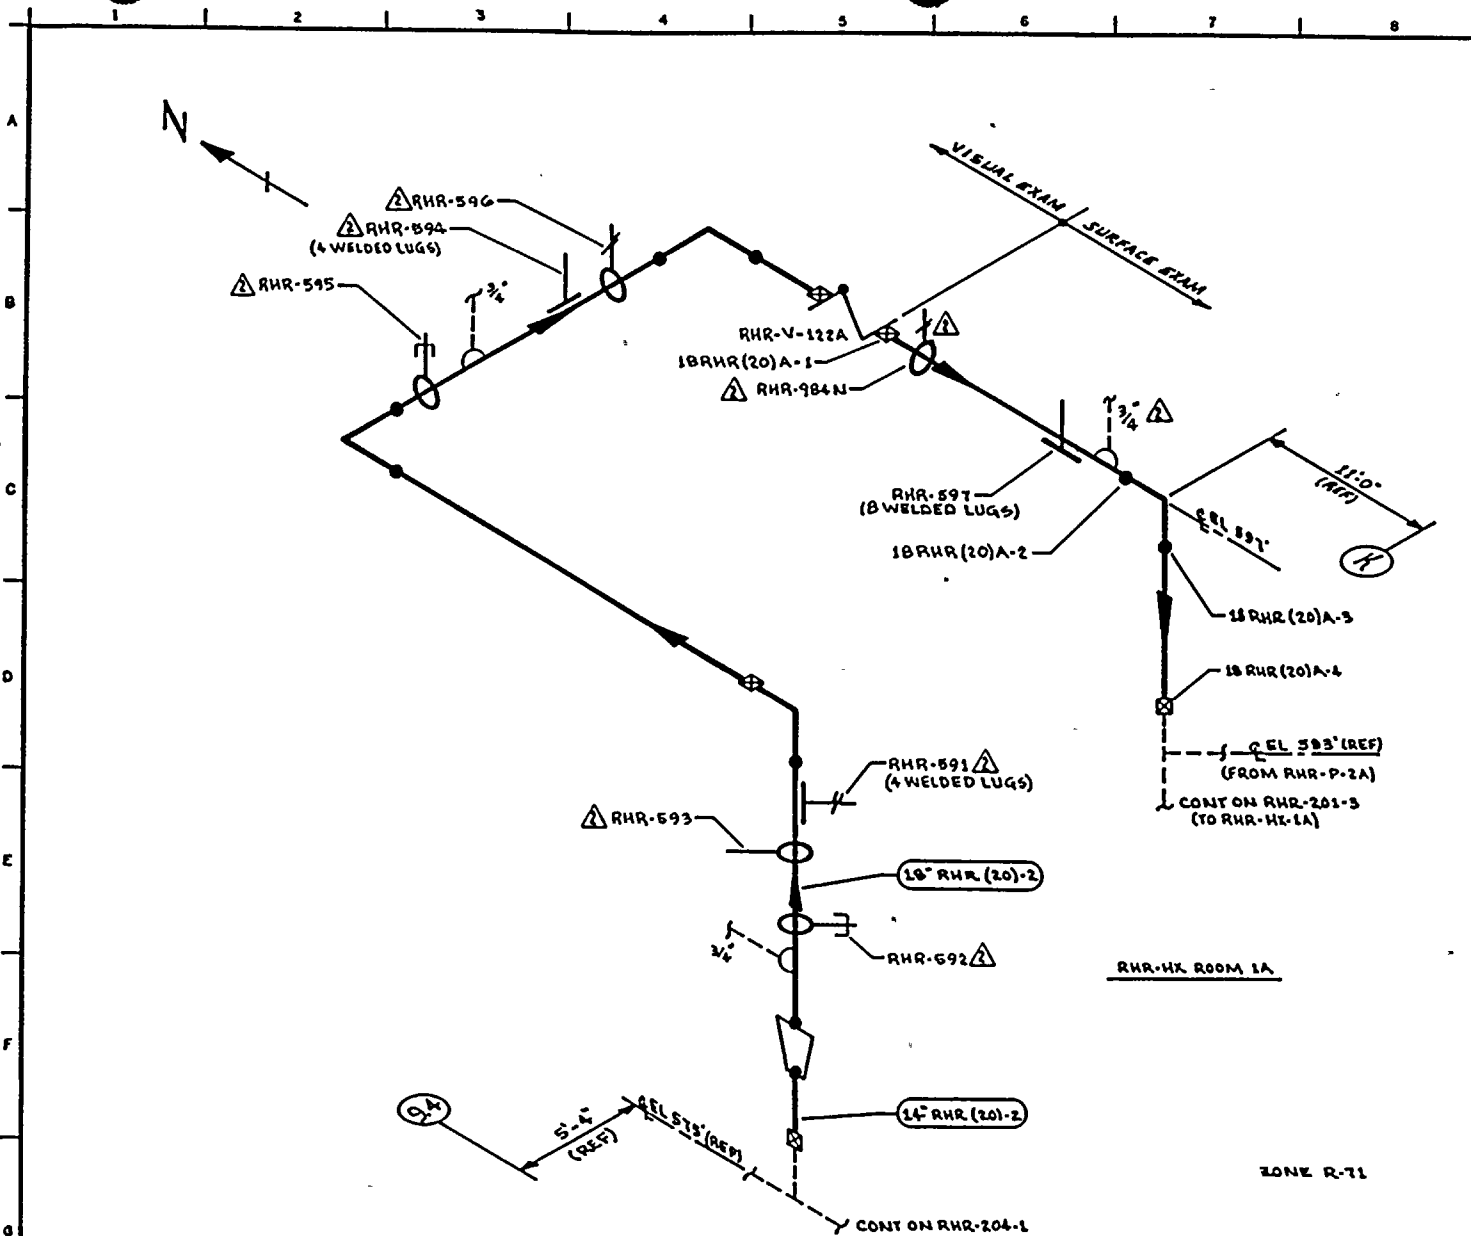

- NOTES:
1. PORTIONS OF THIS DRAWING IDENTIFY PIPING & COMPONENTS THAT ARE SUBJECT ONLY TO A VISUAL EXAM FOR EVIDENCE OF LEAKAGE DURING SYSTEM HYDRO OR OPERABILITY TESTS. TESTS ARE TO BE CONDUCTED PER THE REQUIREMENTS OF ASME SECTION XI, PARAGRAPH IWA.5000.
 2. FOR BRANCH PIPING 4" DIA OR LESS (CONN SHOWN IN DASHED LINES) EXTEND VISUAL LEAKAGE EXAM THROUGH THE OUTERMOST NORMALLY CLOSED NUCLEAR VALVE OR UNTIL TRANSITION TO INSTRUMENT TUBING, UNLESS OTHERWISE NOTED.
 3. SCAFFOLDING IS REQUIRED.

REFERENCES:
 BOVEE & CRAL ISOMETRIC
 RHR-567-25.30 REV 9

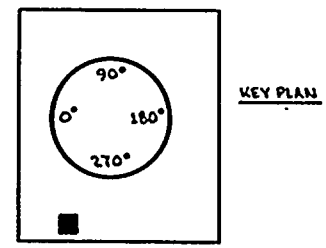

QUALITY CLASS: 1 ASME CODE CLASS: 2
 ENGR: G.A. KUGLER DRAWN: K.M.C. DATE: 5-16-78

WASHINGTON PUBLIC POWER SUPPLY SYSTEM
 RICHLAND, WASHINGTON 99352

THIS DRAWING IS INTENDED FOR USE IN PRESERVICE AND INSERVICE INSPECTION PROGRAMS ONLY.

PIPING SYSTEM	NOM DIA (IN)	SCH	NOM WALL THK	MATERIAL SPECIFICATION	MATL TYPE	CAL BLOCK NO
14" RHR (20)-2	14	STD	0.375	SA 106 GR B	CS	NA
18" RHR (20)-2	18	30	0.438	SA 106 GR B	CS	NA


NO	DATE	REVISION	BY	CHKD	APPVD
2	9-26-81	REVISED AS NOTED	W.H.A.	W.H.A.	T.P.H.
1	12-1-81	REVISED AS NOTED	W.H.A.	W.H.A.	T.P.H.
0	12-22-77	ISSUED FOR USE	W.H.A.	W.H.A.	T.P.H.
A	9-12-78	ISSUED FOR INFORMATION ONLY	W.H.A.	W.H.A.	T.P.H.

WHP-2
 WELD COMPONENT
 IDENTIFICATION DIAGRAM

TITLE:
 RHR LOOP A
 RCIC STEAM SUPPLY TO RHR-HX-1A


DWG NO: RHR-204-2 REV 2



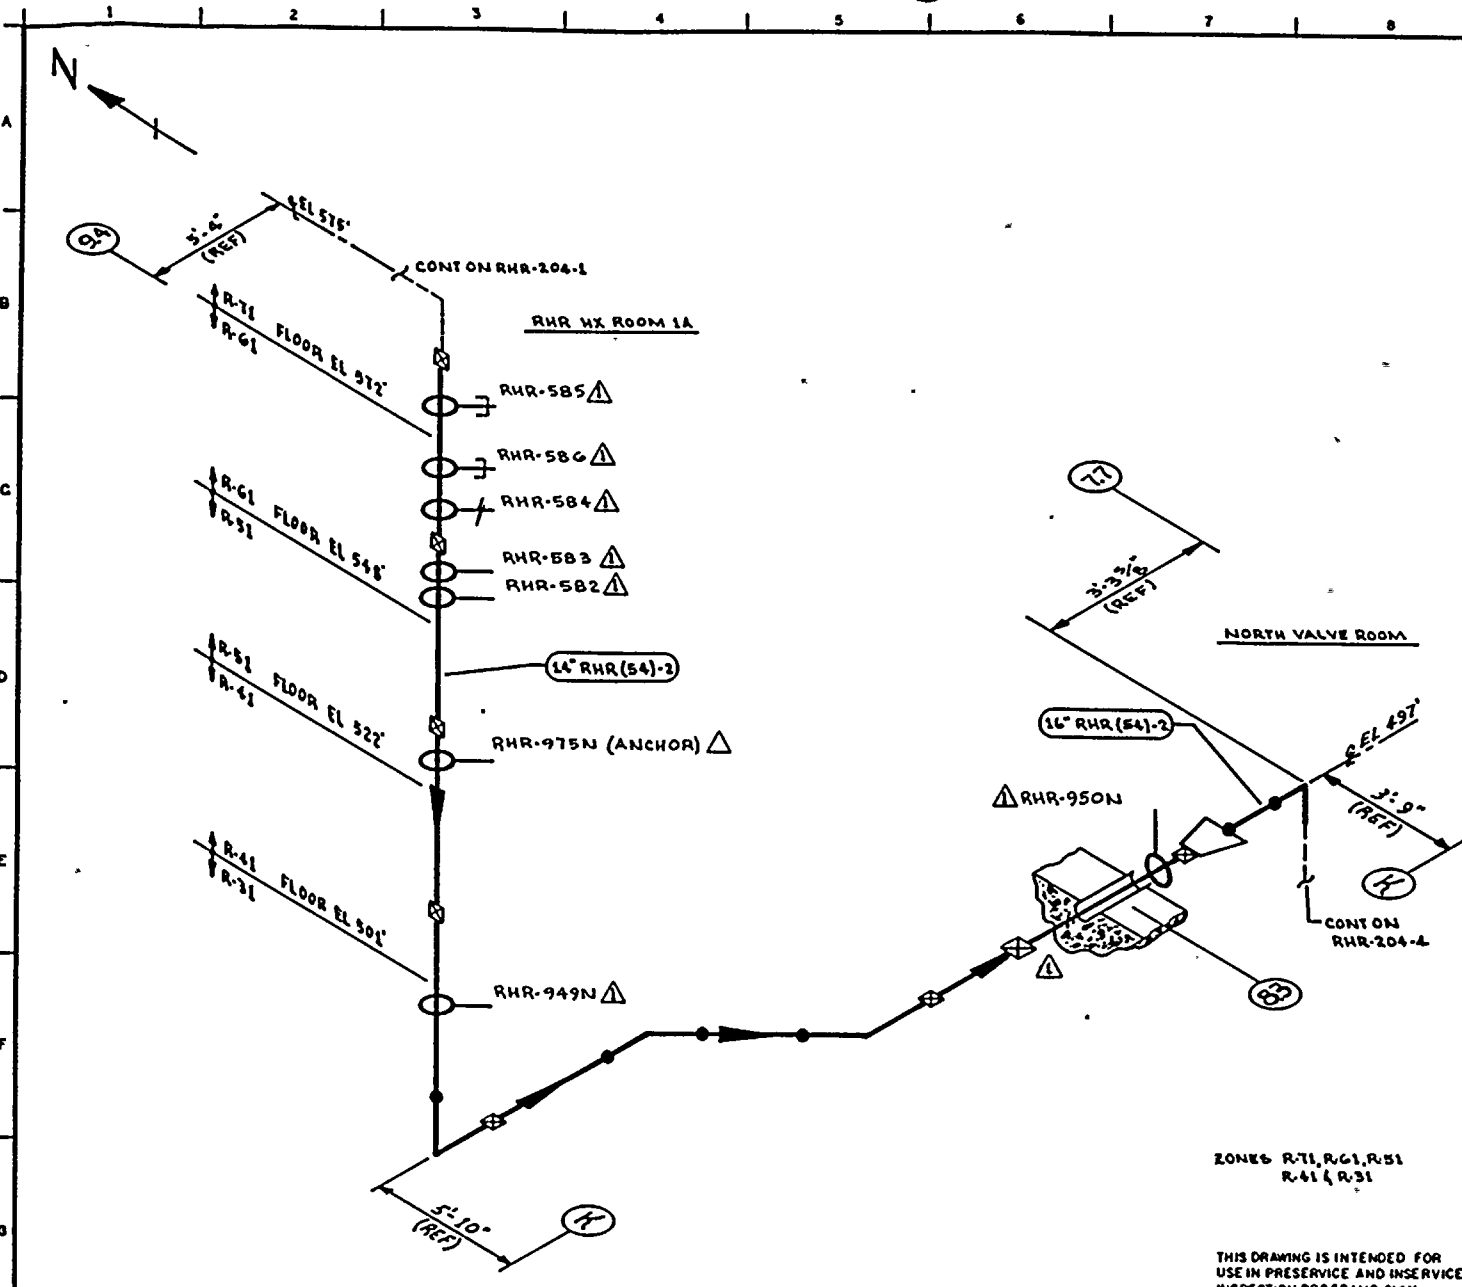

NOTES:
 1. THIS DRAWING IDENTIFIES PIPING & COMPONENTS SUBJECT TO A VISUAL EXAM FOR EVIDENCE OF LEAKAGE DURING SYSTEM HYDRO OR OPERABILITY TESTS. TESTS ARE TO BE CONDUCTED PER THE REQUIREMENTS OF ASME SECTION XI PARAGRAPH IWA-5000.

REFERENCES:
 BOVEE & CRAIG ISOMETRIC
 RHR-867-21.27 REV 4

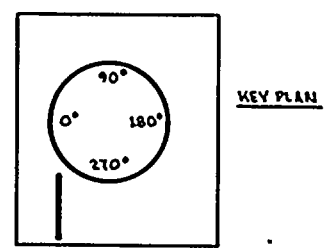

QUALITY CLASS: 1 ASME CODE CLASS: 2
 ENGR: GA KUGLER DRAWN: KMcA DATE: 5-17-76

WASHINGTON PUBLIC POWER SUPPLY SYSTEM
 RICHMOND, WASHINGTON 98122


THIS DRAWING IS INTENDED FOR USE IN PRESERVICE AND INSERVICE INSPECTION PROGRAMS ONLY.

PIPING SYSTEM	NOM DIA (DN)	SCH	NOM WALL THK	MATERIAL SPECIFICATION	MATL TYPE	CAL BLOCK NO
14" RHR (54)-2	14	STD	0.275	SA 106 GR B	CC	NA
16" RHR (54)-2	16	40	0.500	SA 106 GR B	CC	NA

NO	DATE	REVISION	BY	CHKD	APPVD
1	9-7-73	REVISED AS NOTED	KMcA	opc	JFW
0	11-22-75	ISSUED FOR USE	KMcA	AK	JFW
A	9-12-76	ISSUED FOR INFORMATION ONLY	KMcA	BAK	FWR


WNP-2
 WELD & COMPONENT IDENTIFICATION DIAGRAM
 TITLE: RHR LOOP A RCIC STEAM RELIEF LINES TO SUPPRESSION POOL
 DWG NO: RHR-204-3 REV 1



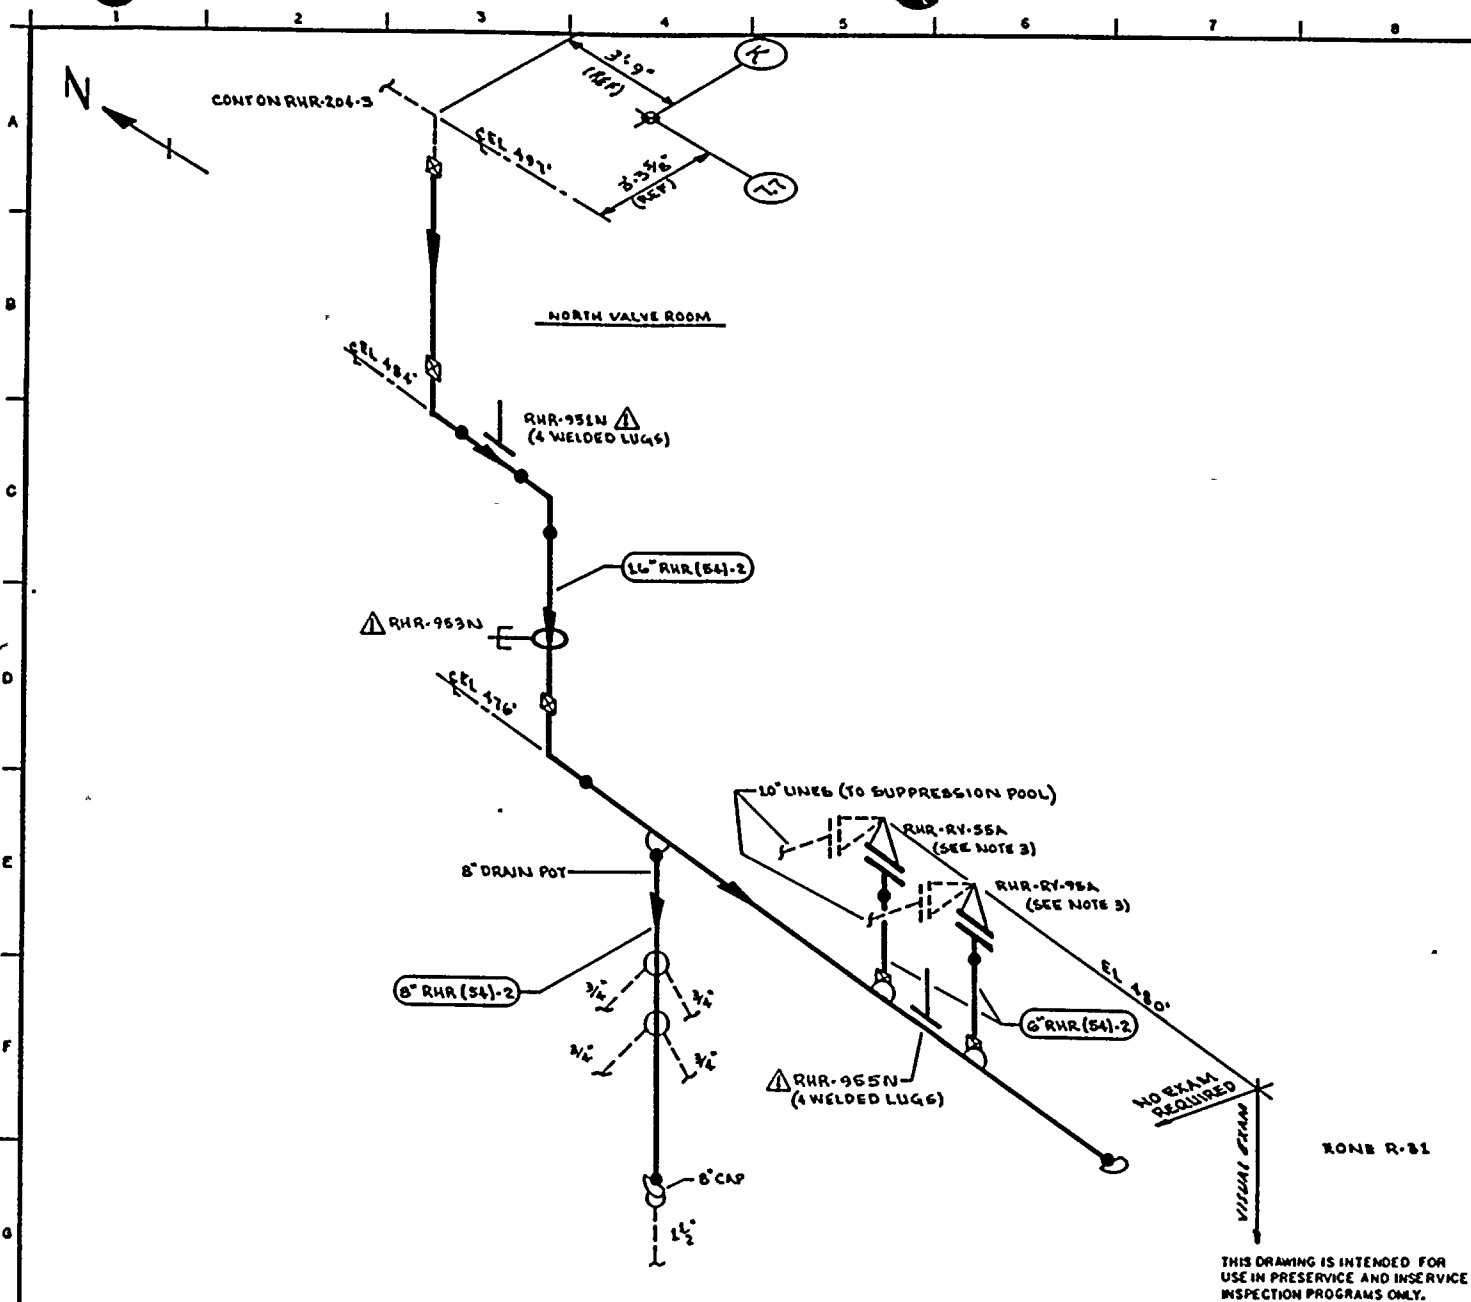

- NOTES:
1. THIS DRAWING IDENTIFIES PIPING & COMPONENTS SUBJECT TO A VISUAL EXAM FOR EVIDENCE OF LEAKAGE DURING SYSTEM HYDRO OR OPERABILITY TESTS. TESTS ARE TO BE CONDUCTED PER THE REQUIREMENTS OF ASME SECTION XI PARAGRAPH IWA-5000.
 2. FOR BRANCH PIPING 4" DIA OR LESS (CONN SHOWN IN DASHED LINES) EXTEND VISUAL LEAKAGE EXAM THROUGH THE OUTERMOST NORMALLY CLOSED NUCLEAR VALVE OR UNTIL TRANSITION TO INSTRUMENT TUBING, UNLESS OTHERWISE NOTED.
 3. THE TWO LINES TO THE SUPPRESSION POOL FROM RHR-RV-55A & RHR-RV-95A ARE OPEN ENDED & THEREFORE EXEMPT FROM EXAM.

- REFERENCES:
- BOVEE & CRAIG ISOMETRICS
 - RHR-86T-98.39 REV G
 - RHR-86T-40.44 REV G

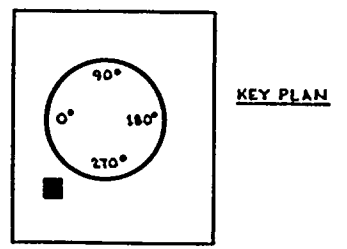

QUALITY CLASS: 1	ASME CODE CLASS: 2
ENGR: G.A. KUGLER	DATE: 5-17-76
DRAWN: K.M.C.A.	


WASHINGTON PUBLIC POWER SUPPLY SYSTEM
 RICHMOND, WASHINGTON 98352

PIPING SYSTEM	NOM DIA (IN)	SCH	NOM WALL THK	MATERIAL SPECIFICATION	MATL TYPE	CAL BLOCK NO
16" RHR (54)-2	16	40	0.500	SA 106 GRB	CS	NA
8" RHR (54)-2	8	40	0.322	SA 106 GRB	CS	NA
6" RHR (54)-2	6	40	0.280	SA 106 GRB	CS	NA

NO	DATE	REVISION	BY	CHKD	APPVD
1	9-21-73	REVISED AS NOTED	KML	DK	TBY
0	8-11-76	ISSUED FOR USE	KML	DK	TBY
A	9-12-78	ISSUED FOR INFORMATION ONLY	KML	DK	KWR

WHP-2
 WELD & COMPONENT IDENTIFICATION DIAGRAM

TITLE: RHR LOOP A RCIC STEAM RELIEF LINES TO SUPPRESSION POOL

DWG NO: RHR-204-4

REV 1



WNP-02
 INTERVAL: PSI
 PERIOD: NA
 OUTAGE:
 DRAWING NO. RHR-204

WASHINGTON PUBLIC POWER SUPPLY SYSTEM
 PROGRAM PLAN AND SCHEDULE
 SYSTEM OR COMPONENT: 18RHR(20)2
 DESCRIPTION: RCIC STM-RHR HX-1A

PAGE 001
 DATE 12/14/84

IDENT. NO.	DESCRIPTION	SECT. XI EXAM. EXAM.	EXAM MTH.	PROCEDURE	CAL. BLOCK	INSERVICE		NOTES
						REQ.	SCHEDULED OUTAGE	
RHR-590	SPRING	C-E-2	VT-3	303/8.2.17				
			VT-4	303/8.2.17				
RHR-612	SPRING	C-E-2	VT-3	303/8.2.17				
			VT-4	303/8.2.17				
RHR-588	PSA-3 SN(2)	C-E-2	VT-3	303/8.2.17				S/N T2792/B2347
			VT-4	303/8.2.17				S/N T2792/B2347
RHR-589	PSA-3 SNUBBER	C-E-2	VT-3	303/8.2.17				S/N 4493
			VT-4	303/8.2.17				S/N 4493
RHR-587	SPRING	C-E-2	VT-3	303/8.2.17				
			VT-4	303/8.2.17				
RHR-592	PSA-1/2 SNUBBER	C-E-2	VT-3	303/8.2.17				S/N 2782
			VT-4	303/8.2.17				S/N 2782
RHR-593	STRUT	C-E-2	VT-3	303/8.2.17				
RHR-591	SPRING	C-E-2	VT-3	303/8.2.17				
			VT-4	303/8.2.17				
RHR-595	PSA-1 SNUBBER	C-E-2	VT-3	303/8.2.17				S/N 3888
			VT-4	303/8.2.17				S/N 3888
RHR-594	STRUT	C-E-2	VT-3	303/8.2.17				

WNP-02
 INTERVAL: PSI
 PERIOD: NA
 OUTAGE:
 DRAWING NO. RHR-204

WASHINGTON PUBLIC POWER SUPPLY SYSTEM
 PROGRAM PLAN AND SCHEDULE
 SYSTEM OR COMPONENT: 18RHR(20)2
 DESCRIPTION: RCIC STM-RHR HY-1A

PAGE 002
 DATE 12/14/84


IDENT. NO.	DESCRIPTION	SECT. XI EXAM.	EXAM MTH.	PROCEDURE	CAL. BLOCK	INSERVICE		NOTES
						REQ.	SCHEDULED OUTAGE	
RHR-596	SPRING	C-E-2	VT-3	303/8.2.17				
			VT-4	303/8.2.17				
18RHR(20)A-1 RHR-984N	VALVE TO PIPE	C-F	SUR	PTP-1				
	SPRING	C-E-2	VT-3	303/8.2.17				
			VT-4	303/8.2.17				
RHR-597(W) RHR-597	8 WELDED LUGS	C-E-1	SUR	QCI 4-3				
18RHR(20)A-2	STRUT	C-E-2	VT-3	303/8.2.17				
18RHR(20)A-3	PIPE TO EL	C-F	SUR	PTP-1				
18RHR(20)A-4	EL TO PIPE	C-F	SUR	PTP-1				
RHR-585	PIPE TO TEE	C-F	SUR	PTP-1				
	PSA-3 SNUBBER	C-E-2	VT-3	303/8.2.17				S/N 9929
			VT-4	303/8.2.17				S/N 9929
RHR-586	PSA-3 SNUBBER	C-E-2	VT-3	303/8.2.17				S/N 3894
			VT-4	303/8.2.17				S/N 3894
RHR-584	SPRING	C-E-2	VT-3	303/8.2.17				
			VT-4	303/8.2.17				
RHR-583	STRUT	C-E-2	VT-3	303/8.2.17				
RHR-582	STRUT	C-E-2	VT-3	303/8.2.17				

WNP-02
 INTERVAL: PSI
 PERIOD: NA
 OUTAGE:
 DRAWING NO. RHR-204

WASHINGTON PUBLIC POWER SUPPLY SYSTEM
 PROGRAM PLAN AND SCHEDULE
 SYSTEM OR COMPONENT: 18RHR(20)2
 DESCRIPTION: RCIC STM-RHR HX-1A


PAGE 003
 DATE 12/14/84

<u>IDENT. NO.</u>	<u>DESCRIPTION</u>	<u>SECT.</u> <u>XI</u> <u>EXAM.</u>	<u>EXAM</u> <u>MTH.</u>	<u>PROCEDURE</u>	<u>CAL.</u> <u>PLOCK</u>	<u>INSERVICE</u>		<u>NOTES</u>
						<u>REQ.</u>	<u>SCHEDULED</u> <u>OUTAGE</u>	
RHR-975N	ANCHOR	C-E-2	VT-3	303/8.2.17				
RHR-949N	BOX	C-E-2	VT-3	303/8.2.17				
RHR-950N	BOX	C-E-2	VT-3	303/8.2.17				
RHR-951N	BOX	C-E-2	VT-3	303/8.2.17				
RHR-953N	PSA-3 SNUBBER	C-E-2	VT-3	303/8.2.17				S/N 3879
RHR-955N			VT-4	303/8.2.17				S/N 3879
RHR-PB-204	BOX	C-E-2	VT-3	303/8.2.17				
	RHR PRESS BNDRY	N/A	VT-2	N/A				IWC-2510, SEE NOTES #6 & #7.

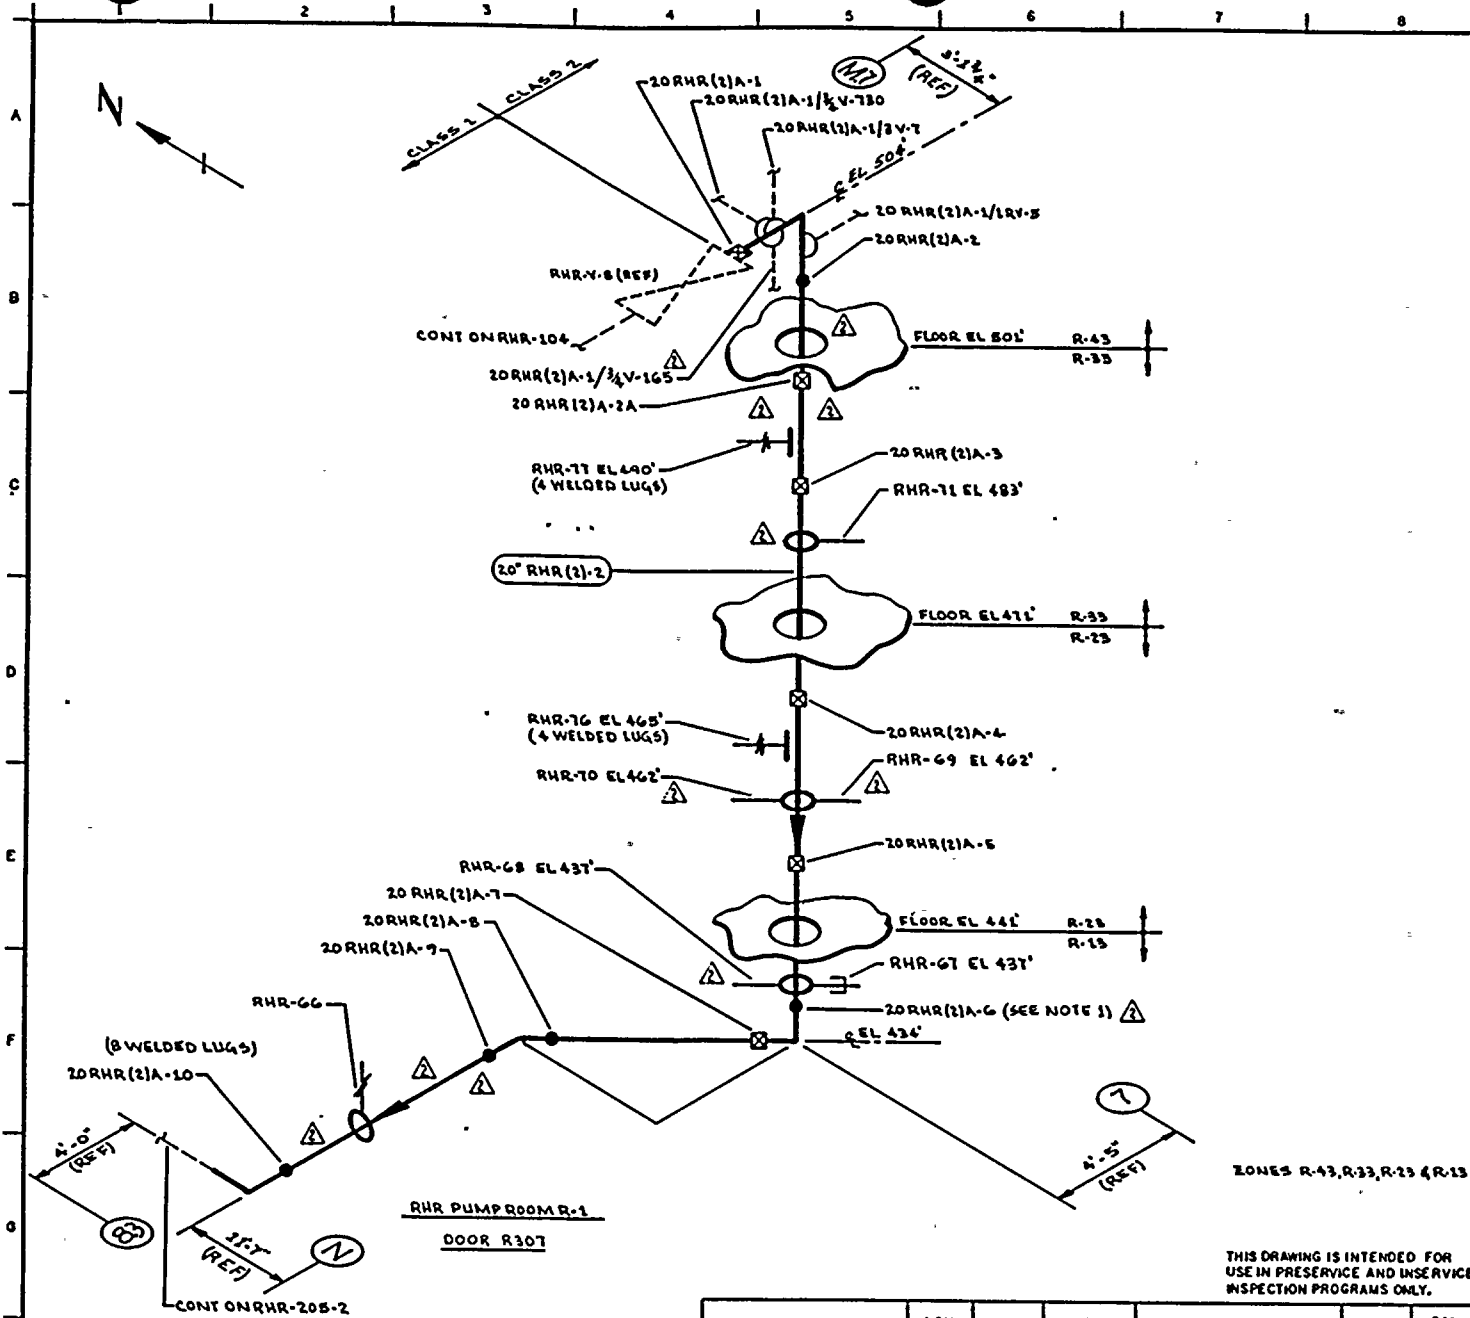

NOTES:
 1. ACCESS TO WELD 20RHR (2)A-6 REQUIRES REMOVAL OF RHR-68.
 2. SCAFFOLDING IS REQUIRED.

REFERENCES:
 BOVEE & CRAIG ISOMETRIC
 RHR-875-1.5 REV B

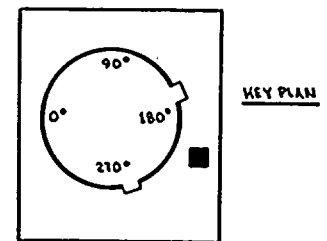

ZONES R-43, R-33, R-23 & R-13

THIS DRAWING IS INTENDED FOR USE IN PRESERVICE AND INSERVICE INSPECTION PROGRAMS ONLY.

QUALITY CLASS: 1 ASME CODE CLASS: 2
 ENGR GA KUGLER DRAWN: K-McA DATE: 5-19-78



NO	DATE	REVISION	BY	CHKD	APPVD
1	9-76-83	REVISED AS NOTED	KMcA	SPK	FOR
2	11-5-80	ADDED FIELD WELD 20 RHR (2)A-7A AS NOTED	KMcA	TFB	SPB
3	12-22-85	ISSUED FOR USE	KMcA	SPK	FOR
4	9-12-78	ISSUED FOR INFORMATION ONLY	KMcA	SPK	FOR


PIPING SYSTEM	NOM DIA (IN)	SCH	NOM WALL THK	MATERIAL SPECIFICATION	MATL TYPE	CAL BLOCK NO
20" RHR (2)A-2	20	STD	0.375	SA 106 GR B	CS	NA

WNP-2
 WELD 8 COMPONENT
 IDENTIFICATION DIAGRAM

TITLE:
 RHR
 SHUTDOWN COOLING SUCTION


DWG NO: RHR-205-1 REV 2



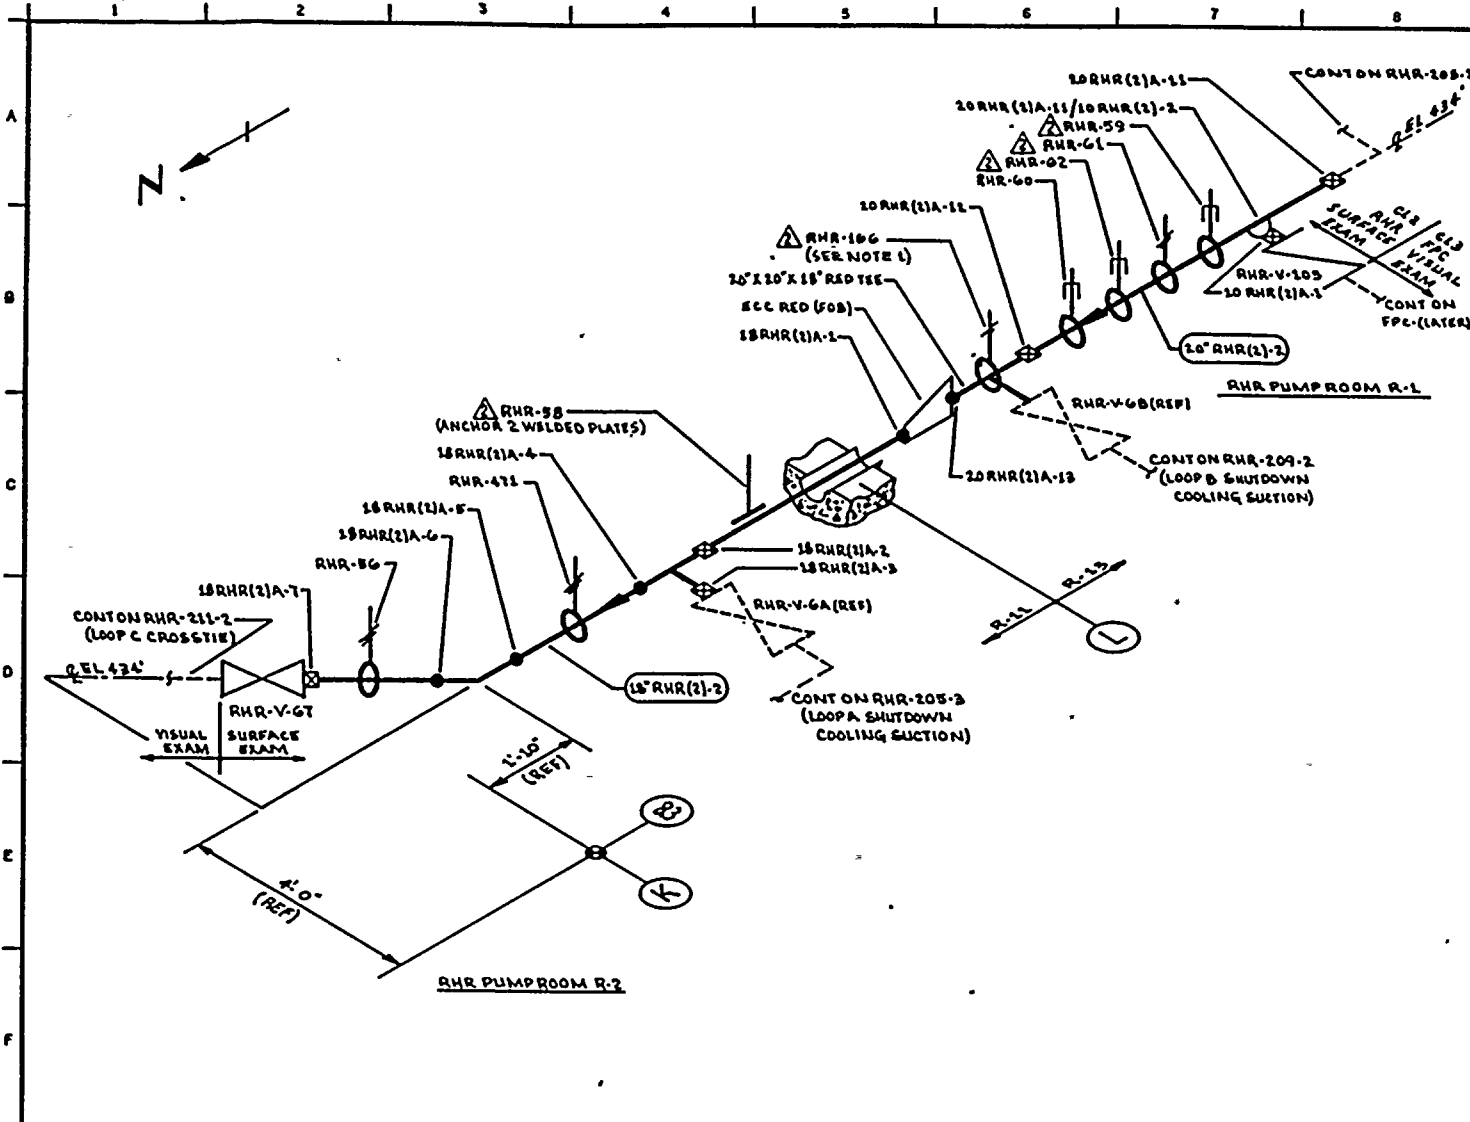

- NOTES:
1. ACCESS TO WELDS 10 RHR(2)A-12 & 13 REQUIRES REMOVAL OF RHR-166.
 2. SCAFFOLDING IS REQUIRED.

REFERENCES:
BOVEE & CRAIG ISOMETRICS
RHR-875-G-8 REV 6

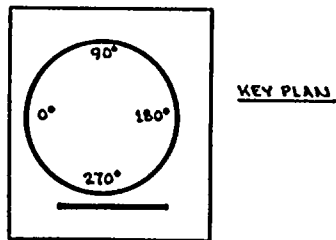

ZONES R-11 & R-13

THIS DRAWING IS INTENDED FOR USE IN PRESERVICE AND INSERVICE INSPECTION PROGRAMS ONLY.

QUALITY CLASS: 1 ASME CODE CLASS: 2
ENGR: G.A. KUGLER | DRAWN: V.M.E.A | DATE: 5-19-78

WASHINGTON PUBLIC POWER SUPPLY SYSTEM
RICHLAND, WASHINGTON 99352


WNP-2
WELD & COMPONENT IDENTIFICATION DIAGRAM

TITLE:
RHR SHUTDOWN COOLING SUCTION & FPC INTERTIE

DWG NO: RHR-205-2 REV 2


NO	DATE	REVISION	BY	CHKD	APPVD
2	9-27-83	REVISED AS NOTED	K.A.A.	E.P.R.	T.H.H.
1	12-2-81	REVISED AS NOTED	K.A.A.	E.P.R.	T.H.H.
0	12-23-78	ISSUED FOR USE	K.A.A.	E.P.R.	T.H.H.
A	9-22-78	ISSUED FOR INFORMATION ONLY	K.A.A.	E.P.R.	T.H.H.

PIPING SYSTEM	NOM DIA (IN)	SCH	NOM WALL THK	MATERIAL SPECIFICATION	MATL TYPE	CAL BLOCK NO
20" RHR(2)-2	20	STD	0.315	SA 106 GR B	CS	NA
18" RHR(2)-2	18	STD	0.315	SA 106 GR B	CS	NA
10" RHR(2)-2	10	STD	0.365	SA 234 GR WPB (WOL MATL)	CS	NA

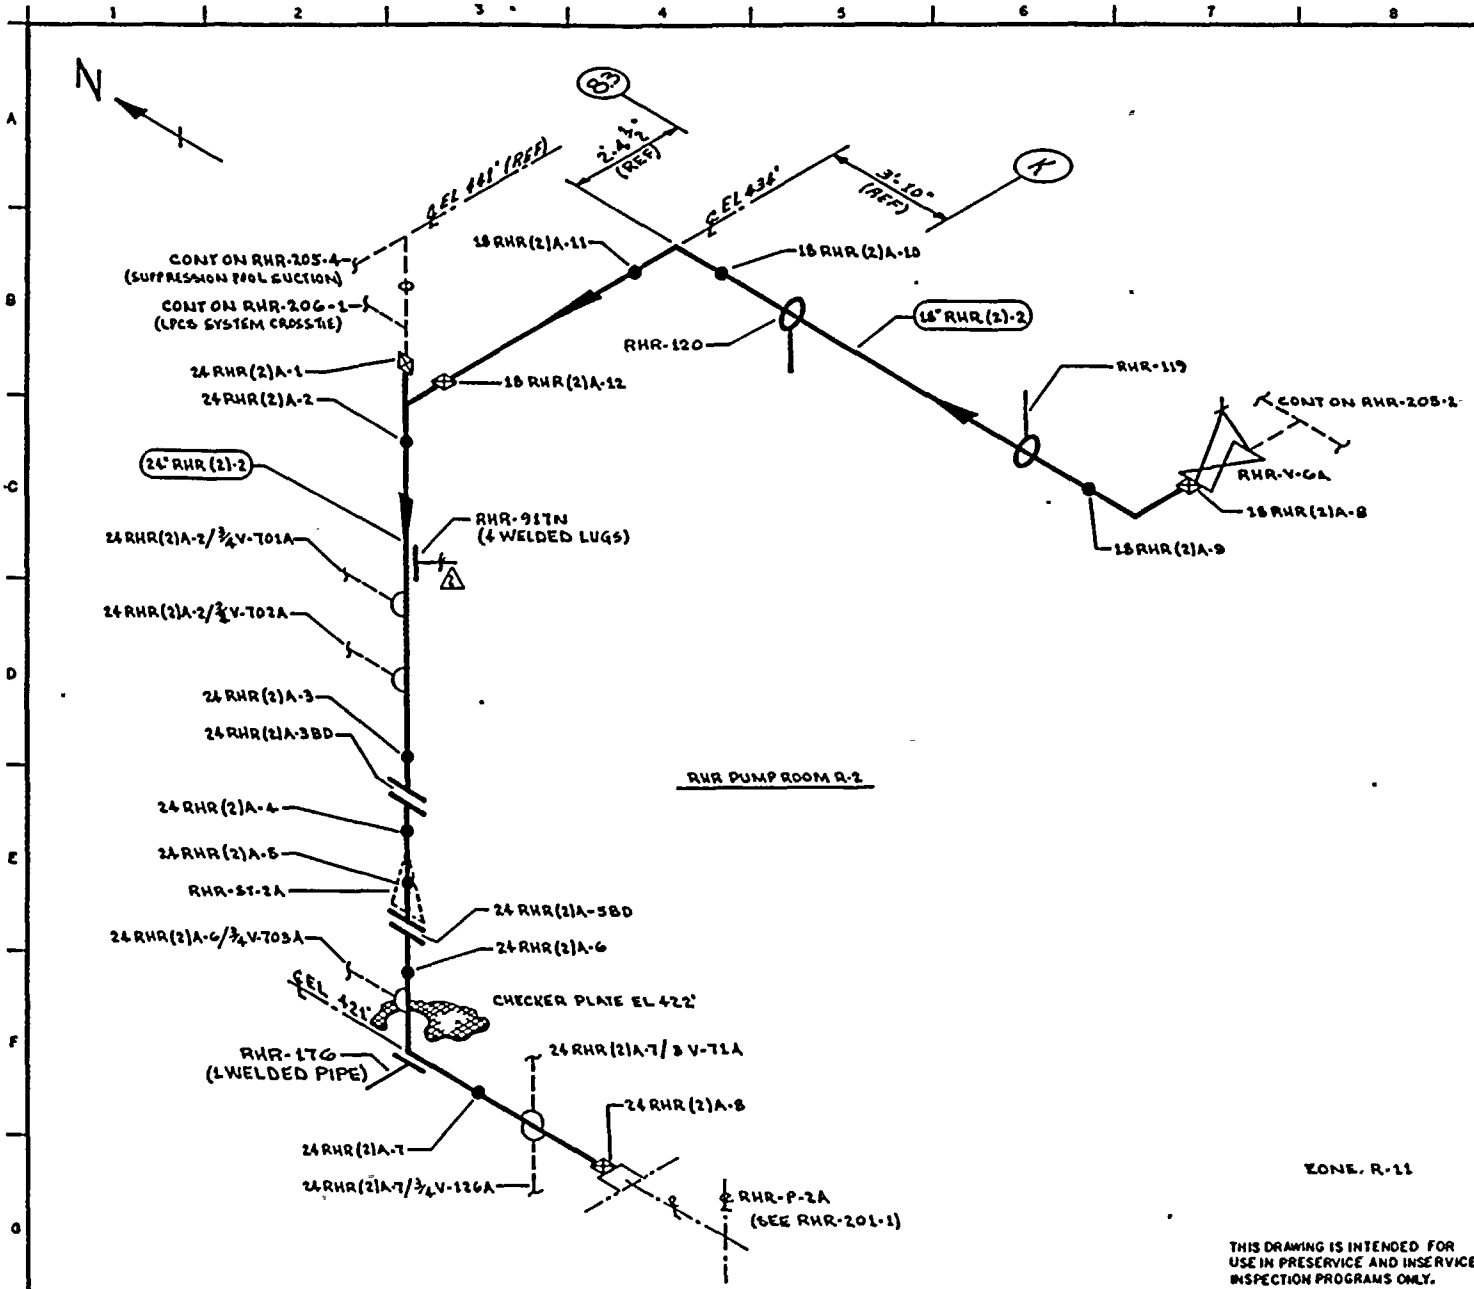

NOTES:
 1. SCAFFOLDING IS REQUIRED.

REFERENCES:
 BOVEE & CRAIG ISOMETRICS
 RHR-875-13.16 REV 4

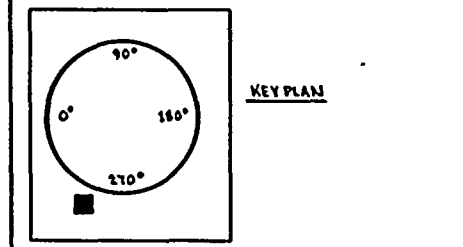

QUALITY CLASS: 1 ASME CODE CLASS: 2
 ENGR: G.A. KUGLER DRAWN: K.McA DATE: 5-19-78
 WASHINGTON PUBLIC POWER SUPPLY SYSTEM
 RICHLAND, WASHINGTON 99352

THIS DRAWING IS INTENDED FOR USE IN PRESERVICE AND INSERVICE INSPECTION PROGRAMS ONLY.

PIPING SYSTEM	NOM DIA (IN)	SCH	NOM WALL THK	MATERIAL SPECIFICATION	MATL TYPE	CAL BLOCK NO
18" RHR (2)-2	18	STD	0.375	SA 106 GR B	CS	NA
24" RHR (2)-2	24	STD	0.375	SA 106 GR B	CS	NA


NO	DATE	REVISION	BY	CHKD	APPVD
2	9-26-77	ADDED NOTE 1. RHR-917N CHANGED.	KMcA	DM	JFH
1	11-2-81	REVISED AS NOTED	KMcA	DM	JFH
0	11-18-77	ISSUED FOR USE	KMcA	DM	JFH
A	9-12-78	ISSUED FOR INFORMATION ONLY	KMcA	DM	JFH

WNP-2 WELD & COMPONENT IDENTIFICATION DIAGRAM
 TITLE: RHR LOOP A SHUTDOWN COOLING SUCTION
 DWG NO: RHR-205-2 REV 2




2 3 4 5 6 7 8

A
B
C
D
E
F
G

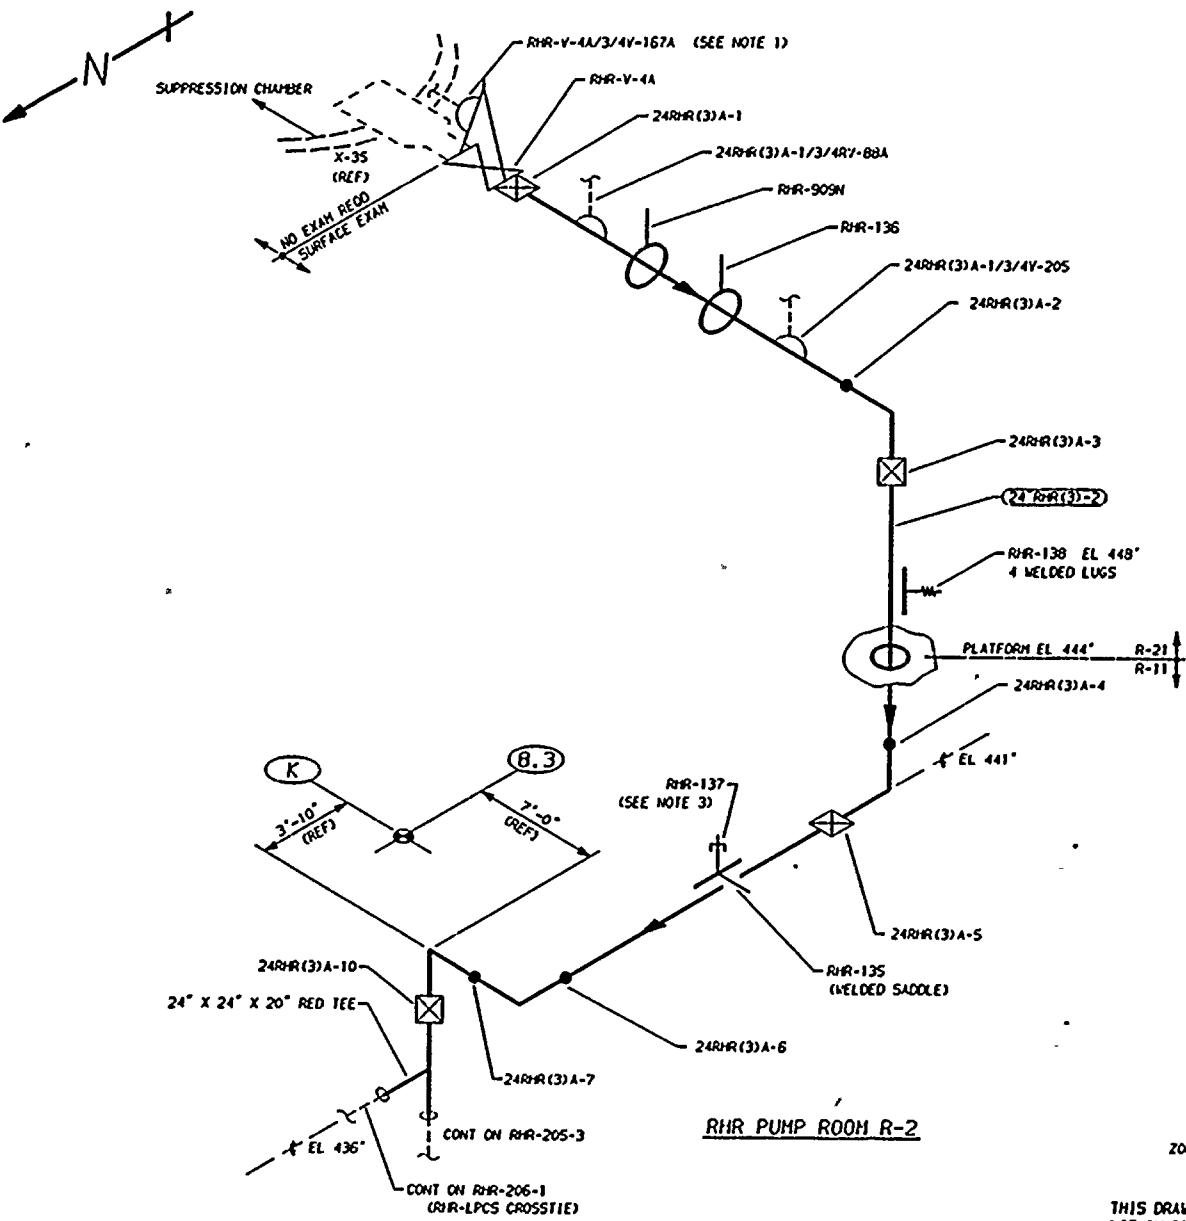

- NOTES:**
1. THIS IS A 1/4" CONNECTION WITH VISUAL EXAM EXTENDING TO 3/4"V-167A.
 2. WELD 24RHR(3)A-7 IS FITTING TO FITTING.
 3. THERE ARE EIGHT ABANDONED LUGS IN THE VICINITY OF RHR-137. NO EXAM IS REQUIRED.
 4. SCAFFOLDING IS REQUIRED.

REFERENCES:
BOYCE AND GRILL ISOMETRIC
RHR-801-1.3 REV 2

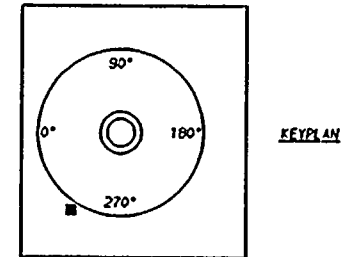

QUALITY CLASS, 1	ASME CODE CLASS, 2
ENGR, GA KUGLER	DRAWN, K-MCA DATE, 5-19-78

WASHINGTON PUBLIC POWER
SUPPLY SYSTEM
RICHLAND, WASHINGTON 99352

WNP-2
WELD & COMPONENT
IDENTIFICATION DIAGRAM

TITLE:
RHR LOOP A
SUPPRESSION POOL SUCTION

DWG NO, RHR-205-4 REV 2

THIS DRAWING IS INTENDED FOR
USE IN PRESERVICE AND INSERVICE
INSPECTIONS PROGRAMS ONLY.

ZONES R-21 & R-11

RHR PUMP ROOM R-2

PIPING SYSTEM	NOM DIA (IN)	SCH	NOM WALL THK	MATERIAL SPECIFICATION	MATL TYPE	CAL BLOCK NO
24"RHR(3)-2	24	STD	0.375	SA 106 GR B	CS	NA

NO	DATE	REVISION	BY	CHKD	APVD
2		REVISED HANGERS, REDRAWN.	K-MCA	TFH	DMP
1	11-5-80	DELETED WELDS 24RHR(3)A-8 & 9, AND AS NOTED	K-MCA	TFH	DMP
0	12-22-78	ISSUED FOR USE	K-MCA	TFH	LFB
A	9-12-78	ISSUED FOR INFORMATION ONLY	K-MCA	GAK	DMP

WNP-02
 INTERVAL: PSI
 PERIOD: NA
 OUTAGE:
 DRAWING NO. RHR-205

WASHINGTON PUBLIC POWER SUPPLY SYSTEM
 PROGRAM PLAN AND SCHEDULE
 SYSTEM OR COMPONENT: 20RHR(2)-2
 DESCRIPTION: RHR SHUTDN COOL SUCT

PAGE 001
 DATE 12/14/84

IDENT. NO.	DESCRIPTION	SECT. XI EXAM.	EXAM MTH.	PROCEDURE	CAL. BLOCK	INSERVICE		NOTES
						REQ.	SCHEDULED OUTAGE	
20RHR(2)A-1	VALVE TO EL	C-F	SUR	PTP-1				
20RHR(2)A-1/3/4V-730	INST CONN	N/A	VT-2	N/A				IWC-2510, SEE NOTES #6 & #7.
20RHR(2)A-1/3/4V-165	TEST CONN	N/A	VT-2	N/A				IWC-2510, SEE NOTES #6 & #7.
20RHR(2)A-1/3V-7	FLUSH CONN	N/A	VT-2	N/A				IWC-2510, SEE NOTES #6 & #7.
20RHR(2)A-1/1RV-5	RELIEF CONN	N/A	VT-2	N/A				IWC-2510, SEE NOTES #6 & #7.
20RHR(2)A-2	EL TO PIPE	C-F	SUR	PTP-1				
20RHR(2)A-2A	PIPE TO PIPE	C-F	SUR	PTP-1				
RHR-77(W)	4 WELDED LUGS	C-E-1	SUR	MTP-1				
RHR-77	SPRING	C-E-2	VT-3	303/8.2.17				
			VT-4	303/8.2.17				
20RHR(2)A-3	PIPE TO PIPE	C-F	SUR	PTP-1				
RHR-71	ANCHOR	C-E-2	VT-3	303/8.2.17				
20RHR(2)A-4	PIPE TO PIPE	C-F	SUR	PTP-1				
RHR-76(W)	4 WELDED LUGS	C-E-1	SUR	MTP-1				
RHR-76	SPRING	C-E-2	VT-3	303/8.2.17				
			VT-4	303/8.2.17				

WNP-02
 INTERVAL: PSI
 PERIOD: NA
 OUTAGE:
 DRAWING NO. RHR-205

WASHINGTON PUBLIC POWER SUPPLY SYSTEM
 PROGRAM PLAN AND SCHEDULE
 SYSTEM OR COMPONENT: 20RHR(2)-2
 DESCRIPTION: RHR SHUTDN COOL SUCT

PAGE 002
 DATE 12/14/84

IDENT. NO.	DESCRIPTION	SECT. XI EXAM.	EYAM HTH.	PROCEDURE	CAL. BLOCK	INSERVICE		NOTES
						REQ.	SCHEDULED OUTAGE	
RHR-69								
RHR-70	STRUT	C-E-2	VT-3	303/8.2.17				
20RHR(2)A-5	STRUT	C-E-2	VT-3	303/8.2.17				
RHR-67	PIPE TO PIPE	C-F	SUR	PTP-1				
	PSA-3 SNUBBER	C-E-2	VT-3	303/8.2.17				S/N 475
			VT-4	303/8.2.17				S/N 475
RHR-68	STRUT	C-E-2	VT-3	303/8.2.17				
20RHR(2)A-6	PIPE TO EL	C-F	SUR	PTP-1				
20RHR(2)A-7	EL TO PIPE	C-F	SUR	PTP-1				
20RHR(2)A-8	PIPE TO EL	C-F	SUR	PTP-1				
20RHR(2)A-9	EL TO PIPE	C-F	SUR	PTP-1				
RHR-66	SPRING	C-E-2	VT-3	303/8.2.17				
			VT-4	303/8.2.17				
20RHR(2)A-10	PIPE TO EL	C-F	SUR	PTP-1				
20RHR(2)A-11	EL TO PIPE	C-F	SUR	PTP-1				
20RHR(2)A-11/10RHR(2)-2	PIPE TO WOL	C-F	SUR	PTP-1				
10RHR(2)A-1	WOL TO PIPE	C-F	SUR	PTP-1				
RHR-59	PSA-19 SNUBBER	C-E-2	VT-3	303/8.2.17				S/N 9942

WNP-02
 INTERVAL: PSI
 PERIOD: NA
 OUTAGE:
 DRAWING NO. RHR-205

WASHINGTON PUBLIC POWER SUPPLY SYSTEM
 PROGRAM PLAN AND SCHEDULE
 SYSTEM OR COMPONENT: 10RHR(2)-2
 DESCRIPTION: RHR SHUTDOWN COOL SUCT

PAGE 003
 DATE 12/14/84

IDENT. NO.	DESCRIPTION	SECT. XI EXAM.	EXAM MTH.	PROCEDURE	CAL. BLOCK	INSERVICE		NOTES
						REQ.	SCHEDULED OUTAGE	
RHR-61			VT-4	303/8.2.17				S/N 9942
	PSA-10 SNUBBER	C-E-2	VT-3	303/8.2.17				S/N 680
RHR-62			VT-4	303/8.2.17				S/N 680
	SPRING	C-F-2	VT-3	303/8.2.17				
RHR-60			VT-4	303/8.2.17				
	PSA-3 SNUBBER	C-E-2	VT-3	303/8.2.17				S/N 2369
20RHR(2)A-12			VT-4	303/8.2.17				S/N 2369
RHR-166	PIPE TO TEE	C-F	SUR	PTP-1				
	SPRING	C-E-2	VT-3	303/8.2.17				
20RHR(2)A-13			VT-4	303/8.2.17				
18RHR(2)A-1	TEE TO REDUCER	C-F	SUR	PTP-1				
RHR-58	REDUCER TO PIPE	C-F	SUR	PTP-1				
18RHR(2)A-2	ANCHOR	C-E-2	VT-3	303/8.2.17				W/2 WELDED PLATES.
18RHR(2)A-3	PIPE TO TEE	C-F	SUR	PTP-1				
18RHR(2)A-4	TEE TO VALVE	C-F	SUR	PTP-1				
RHR-471	TEE TO PIPE	C-F	SUR	PTP-1				
	SPRING	C-E-2	VT-3	303/8.2.17				
			VT-4	303/8.2.17				

WNP-02
 INTERVAL: PSI
 PERIOD: NA
 OUTAGE:
 DRAWING NO. RHR-205

WASHINGTON PUBLIC POWER SUPPLY SYSTEM
 PROGRAM PLAN AND SCHEDULE
 SYSTEM OR COMPONENT: 18RHR(2)-2
 DESCRIPTION: RHR SHUTDN COOL SUCT

PAGE 004
 DATE 12/14/84

<u>IDENT. NO.</u>	<u>DESCRIPTION</u>	<u>SECT.</u> <u>XI</u>	<u>EXAM</u> <u>MTH.</u>	<u>PROCEDURE</u>	<u>CAL.</u> <u>BLOCK</u>	<u>INSERVICE</u>		<u>NOTES</u>
						<u>REQ.</u>	<u>SCHEDULED</u> <u>OUTAGE</u>	
18RHR(2)A-5	PIPE TO EL	C-F	SUR	PTP-1				
18RHR(2)A-6	EL TO PIPE	C-F	SUR	PTP-1				
RHR-56	SPRING	C-E-2	VT-3	303/8.2.17				
			VT-4	303/8.2.17				
18RHR(2)A-7	PIPE TO VALVE	C-F	SUR	PTP-1				
18RHR(2)A-8	VALVE TO EL	C-F	SUR	OCT 3-3				
18RHR(2)A-9	EL TO PIPE	C-F	SUR	PTP-1				
RHR-119	STRUT	C-E-2	VT-3	303/8.2.17				
RHR-120	STRUT	C-E-2	VT-3	303/8.2.17				
18RHR(2)A-10	PIPE TO EL	C-F	SUR	PTP-1				
18RHR(2)A-11	EL TO PIPE	C-F	SUR	PTP-1				
18RHR(2)A-12	PIPE TO TEE	C-F	SUR	PTP-1				
24RHR(2)A-1	TEE TO TEE	C-F	SUR	PTP-1				
24RHR(2)A-2	TEE TO PIPE	C-F	SUR	PTP-1				
RHR-917N(W)	4 WELDED LUGS	C-E-1	SUR	OCT 4-3				
RHR-917N	SPRING	C-E-2	VT-3	303/8.2.17				
			VT-4	303/8.2.17				

WNP-02
 INTERVAL: PSI
 PERIOD: NA
 OUTAGE:
 DRAWING NO. RHR-205

WASHINGTON PUBLIC POWER SUPPLY SYSTEM
 PROGRAM PLAN AND SCHEDULE
 SYSTEM OR COMPONENT: 24RHR(2)-2
 DESCRIPTION: RHR SHUTDN COOL SUCT.

PAGE 005
 DATE 12/14/84

IDENT. NO.	DESCRIPTION	SECT. XI EXAM.	EYAM MTH.	PROCEDURE	CAL. BLOCK	INSERVICE		NOTES
						REQ.	SCHEDULED OUTAGE	
24RHR(2)A-2/3/4V-701A	INSTR CONN	N/A	VT-2	N/A				IWC-2510, SEE NOTES #6 & #7.
24RHR(2)A-2/3/4V-702A	INSTR CONN	N/A	VT-2	N/A				IWC-2510, SEE NOTES #6 & #7.
24RHR(2)A-3	PIPE TO FLANGE	C-F	SUR	PTP-1				
24RHR(2)A-4	FLANGE TO PIPE	C-F	SUR	PTP-1				
24RHR(2)A-5	PIPE TO FLANGE	C-F	SUR	PTP-1				
24RHR(2)A-6	FLANGE TO EL	C-F	SUR	PTP-1				
24RHR(2)A-6/3/4V-703A	INSTR CONN	N/A	VT-2	N/A				IWC-2510, SEE NOTES #6 & #7.
RHR-176	STRUT	C-E-2	VT-3	303/8.2.17				
24RHR(2)A-7	FL TO PIPE	C-F	SUR	PTP-1				
24RHR(2)A-7/3V-71A	FLUSH CONN	N/A	VT-2	N/A				IWC-2510, SEE NOTES #6 & #7.
24RHR(2)A-7/3/4V-126A	DRAIN CONN	N/A	VT-2	N/A				IWC-2510, SEE NOTES #6 & #7.
24RHR(2)A-8	PIPE TO PUMP	C-F	SUR	PTP-1				
RHR-V-4A/3/4V-167A	TEST CONN	N/A	VT-2	N/A				IWC-2510, SEE NOTES #6 & #7.
24RHR(3)A-1	VALVE TO PIPE	C-F	SUR	PTP-1				

WNP-02
 INTERVAL: PSI
 PERIOD: NA
 OUTAGE:
 DRAWING NO. RHR-205

WASHINGTON PUBLIC POWER SUPPLY SYSTEM
 PROGRAM PLAN AND SCHEDULE
 SYSTEM OR COMPONENT: 24RHR(2)-2
 DESCRIPTION: RHR SHUTDN COOL SUCT

PAGE 006
 DATE 12/14/84


IDENT. NO.	DESCRIPTION	SECT. XI EXAM.	EXAM MTH.	PROCEDURE	CAL. BLOCK	INSERVICE		NOTES
						REQ.	SCHEDULED OUTAGE	
24RHR(3)A-1/3/4RV-98A	RELIEF CONN	N/A	VT-2	N/A				IWC-2510, SEE NOTES #6 & #7.
RHR-909N								
RHR-136	STRUT	C-E-2	VT-3	303/8.2.17				
24RHR(3)A-1/3/4V-205	STRUT	C-E-2	VT-3	303/8.2.17				
24RHR(3)A-2	BRANCH CONN	N/A	VT-2	N/A				
24RHR(3)A-3	PIPE TO EL	C-F	SUR	PTP-1				
RHR-138(W)	EL TO PIPE	C-F	SUR	PTP-1				
RHR-138	4 WELDED LUGS	C-E-1	SUR	MTP-1				
	SPRING	C-E-2	VT-3	303/8.2.17				
24RHR(3)A-4			VT-4	303/8.2.17				
24RHR(3)A-5	PIPE TO EL	C-F	SUR	PTP-1				
RHR-135	EL TO PIPE	C-F	SUR	PTP-1				
RHR-137	STRUT	C-E-2	VT-3	303/8.2.17				
	PSA-3 SN(2)	C-E-2	VT-3	303/8.2.17				S/N E14554/W14553
24RHR(3)A-6			VT-4	303/8.2.17				S/N E14554/W14553
24RHR(3)A-7	PIPE TO EL	C-F	SUR	PTP-1				
24RHR(3)A-10	EL TO EL	C-F	SUR	PTP-1				
	EL TO TEE	C-F	SUR	PTP-1				

WNP-02
INTERVAL: PSI
PERIOD: NA
OUTAGE:
DRAWING NO. RHR-205

WASHINGTON PUBLIC POWER SUPPLY SYSTEM
PROGRAM PLAN AND SCHEDULE
SYSTEM OR COMPONENT: 24RHR(2)-2
DESCRIPTION: RHR SHUTDN COOL SUCT


PAGE 007
DATE 12/14/84

<u>IDENT. NO.</u>	<u>DESCRIPTION</u>	<u>SECT.</u>		<u>PROCEDURE</u>	<u>CAL. BLOCK</u>	<u>INSERVICE</u>		<u>NOTES</u>
		<u>XT</u>	<u>EXAM</u>			<u>REQ.</u>	<u>SCHEDULED OUTAGE</u>	
RHR-PB-205	RHR PRESS BNDRY	N/A	VT-2	N/A				IWC-2510, SEE NOTES #6 & #7.

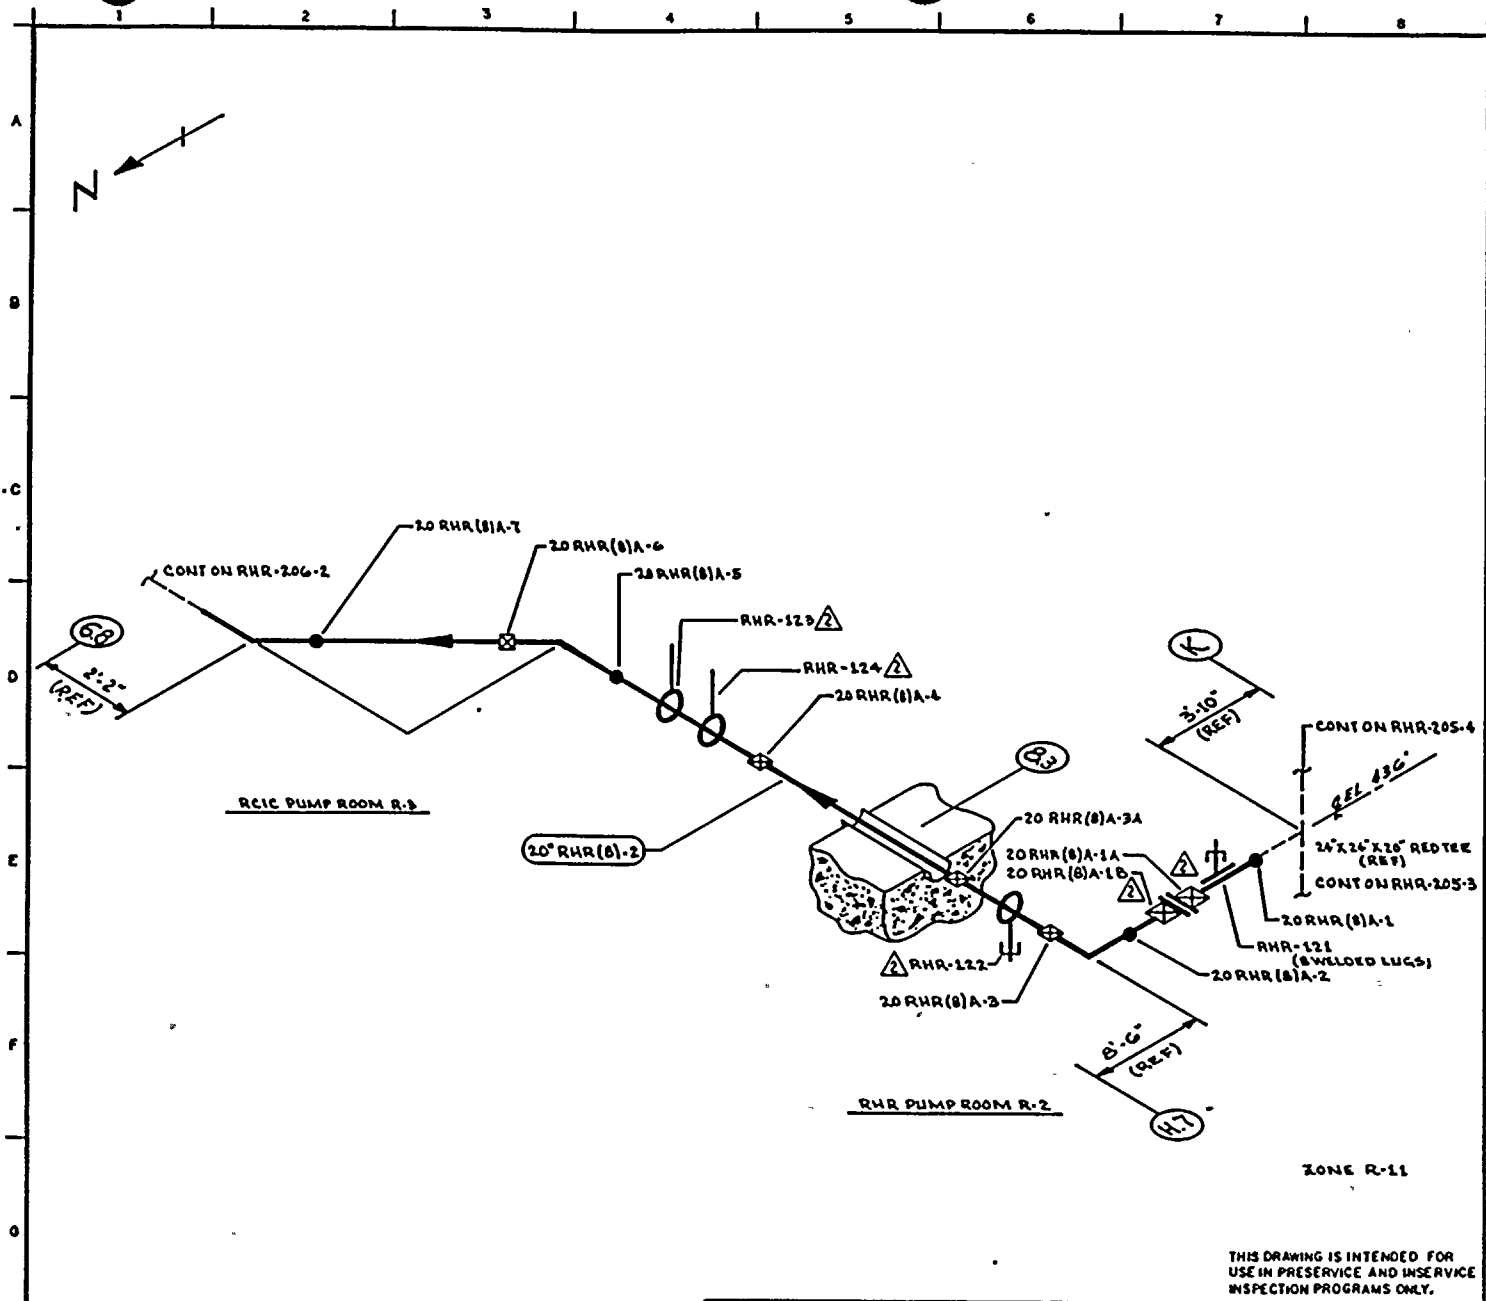

NOTES:
 1. SCAFFOLDING IS REQUIRED.

REFERENCES:
 BOYER & CRAIG ISOMETRICS
 RHR-881-4.7 REV G

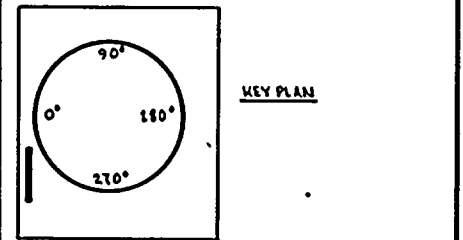


QUALITY CLASS: 1 ASME CODE CLASS: 2
 ENGR: GA KUGLER DRAWN: KMLA DATE: 5-21-78
WASHINGTON PUBLIC POWER SUPPLY SYSTEM
 RICHLAND WASHINGTON 99302

THIS DRAWING IS INTENDED FOR USE IN PRESERVICE AND INSERVICE INSPECTION PROGRAMS ONLY.

PIPING SYSTEM	NOM DIA (IN)	SCH	NOM WALL THK	MATERIAL SPECIFICATION	MATL TYPE	CAL BLOCK NO
20" RHR (8)A-2	20	STD	0.375	SA 106 GR B	CS	NA


NO	DATE	REVISION	BY	CHKD	APPVD
2	9-16-83	REVISED AS NOTED	KMLA	DKS	TKR
1	11-5-80	ADDED FIELD WELD 20 RHR (8)A-2A AS NOTED	KMLA	TKR	SKL
0	10-11-77	ISSUED FOR USE	KMLA	TKR	SKL
A	9-12-78	ISSUED FOR INFORMATION ONLY	KMLA	TKR	SKL

WNP-2
 WELD 8 COMPONENT
 IDENTIFICATION DIAGRAM
 TITLE:
 RHR-LPCS CROSSTIE
 DWG NO: RHR-206-1 REV 2

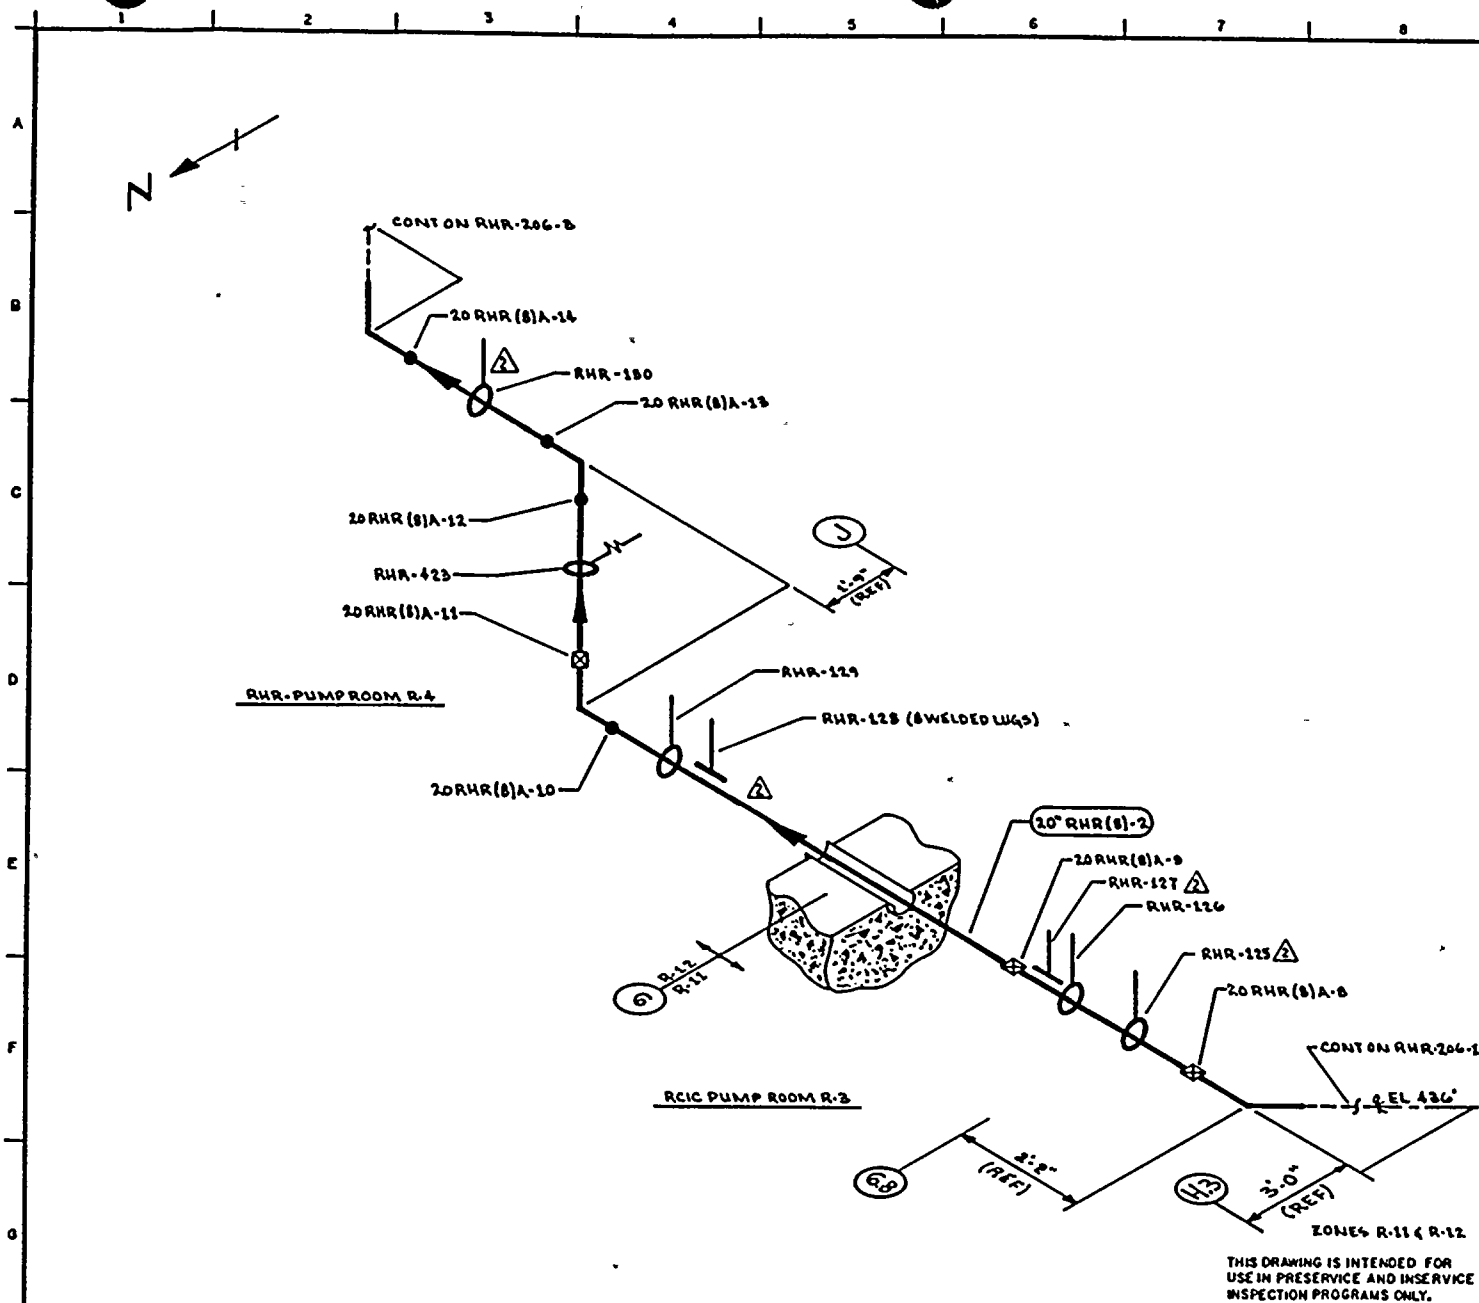

NOTES:
1. SCAFFOLDING IS REQUIRED.

REFERENCES:
BOYES (CRAIL ISOMETRIC)
RHR-881-8.13 REV 4

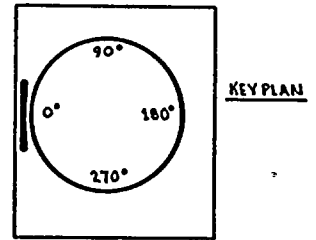

QUALITY CLASS: 1 ASME CODE CLASS: 2
ENGR: G.A. KUGLER DRAWN: V.M.C.A. DATE: 5-22-78

WASHINGTON PUBLIC POWER SUPPLY SYSTEM
RICHLAND, WASHINGTON 99352

WNP-2
WELD & COMPONENT IDENTIFICATION DIAGRAM


TITLE:
RHR-LPCS CROSS-TIE


DWG NO: RHR-206-2 REV 2

PIPING SYSTEM	NOM DIA (IN)	SCH	NOM WALL THK	MATERIAL SPECIFICATION	MATL TYPE	CAL BLOCK NO
20" RHR (8)A-2	20	STD	0.375	SA 106 GR B	CS	N/A

THIS DRAWING IS INTENDED FOR USE IN PRESERVICE AND INSERVICE INSPECTION PROGRAMS ONLY.


NO	DATE	REVISION	BY	CHKD	APPVD
2	9-26-83	REVISED AS NOTED	KUL/A	BR	JFR
1	12-2-81	REVISED AS NOTED	KUL/A	BR	JFR
0	12-11-78	ISSUED FOR USE	KUL/A	BR	Z/S
A	9-12-18	ISSUED FOR INFORMATION ONLY	KUL/A	BR	BR

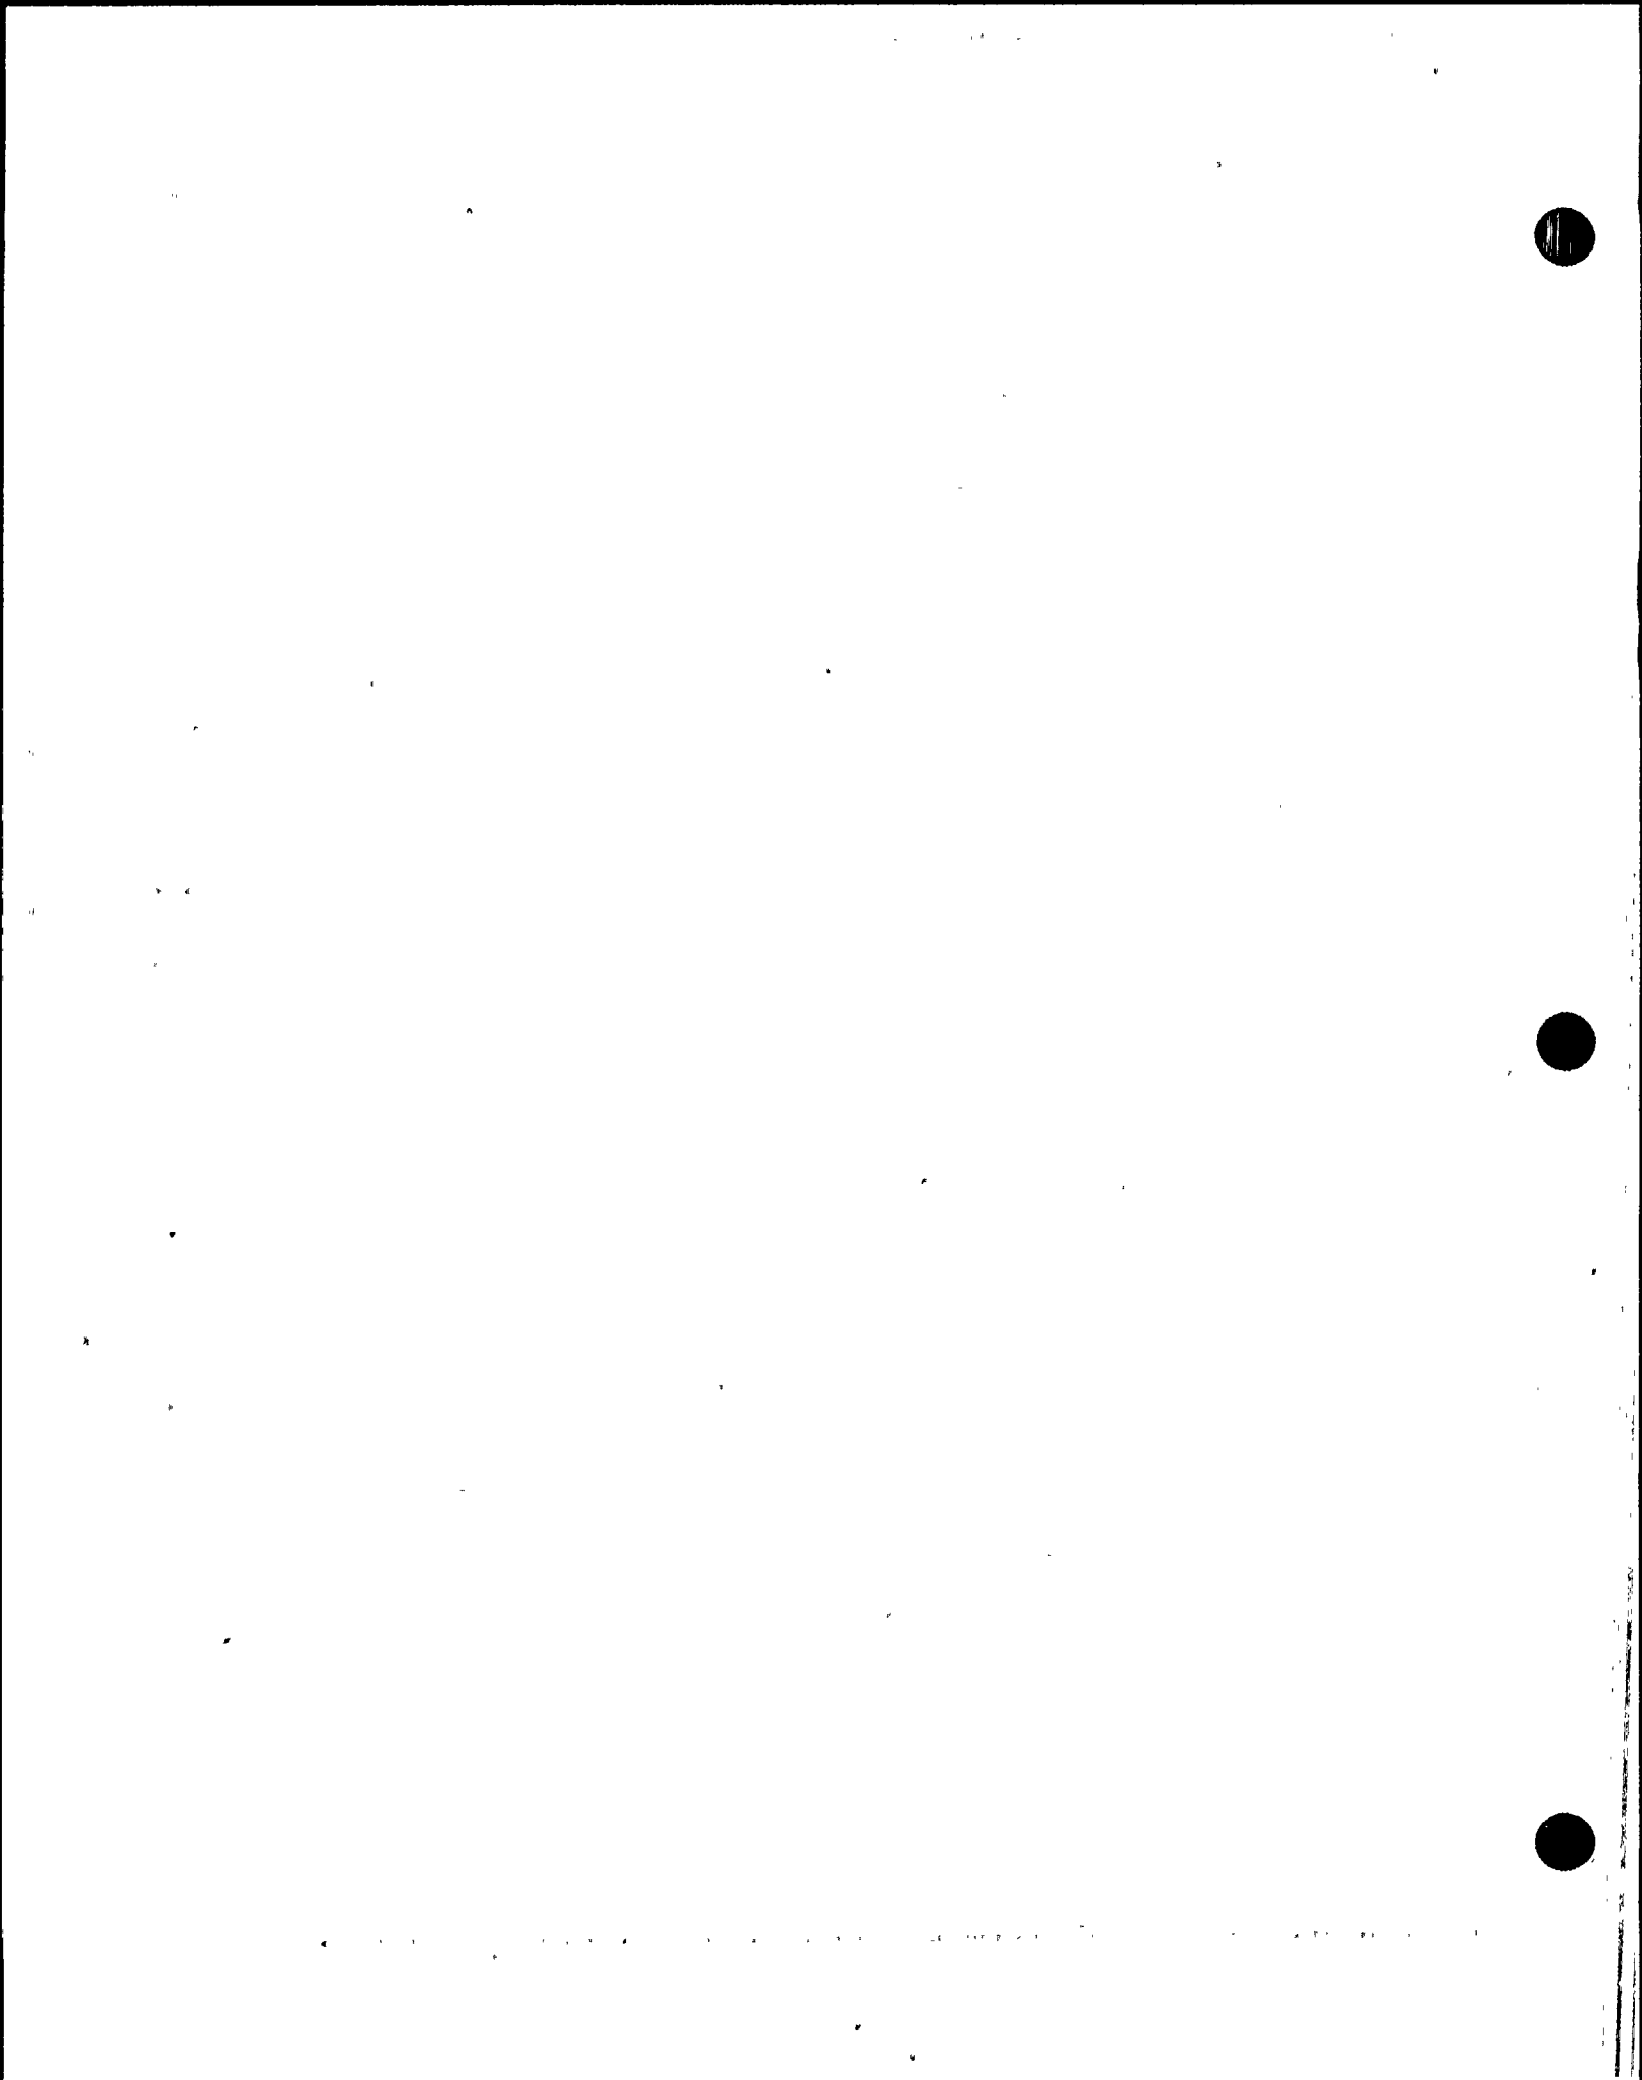

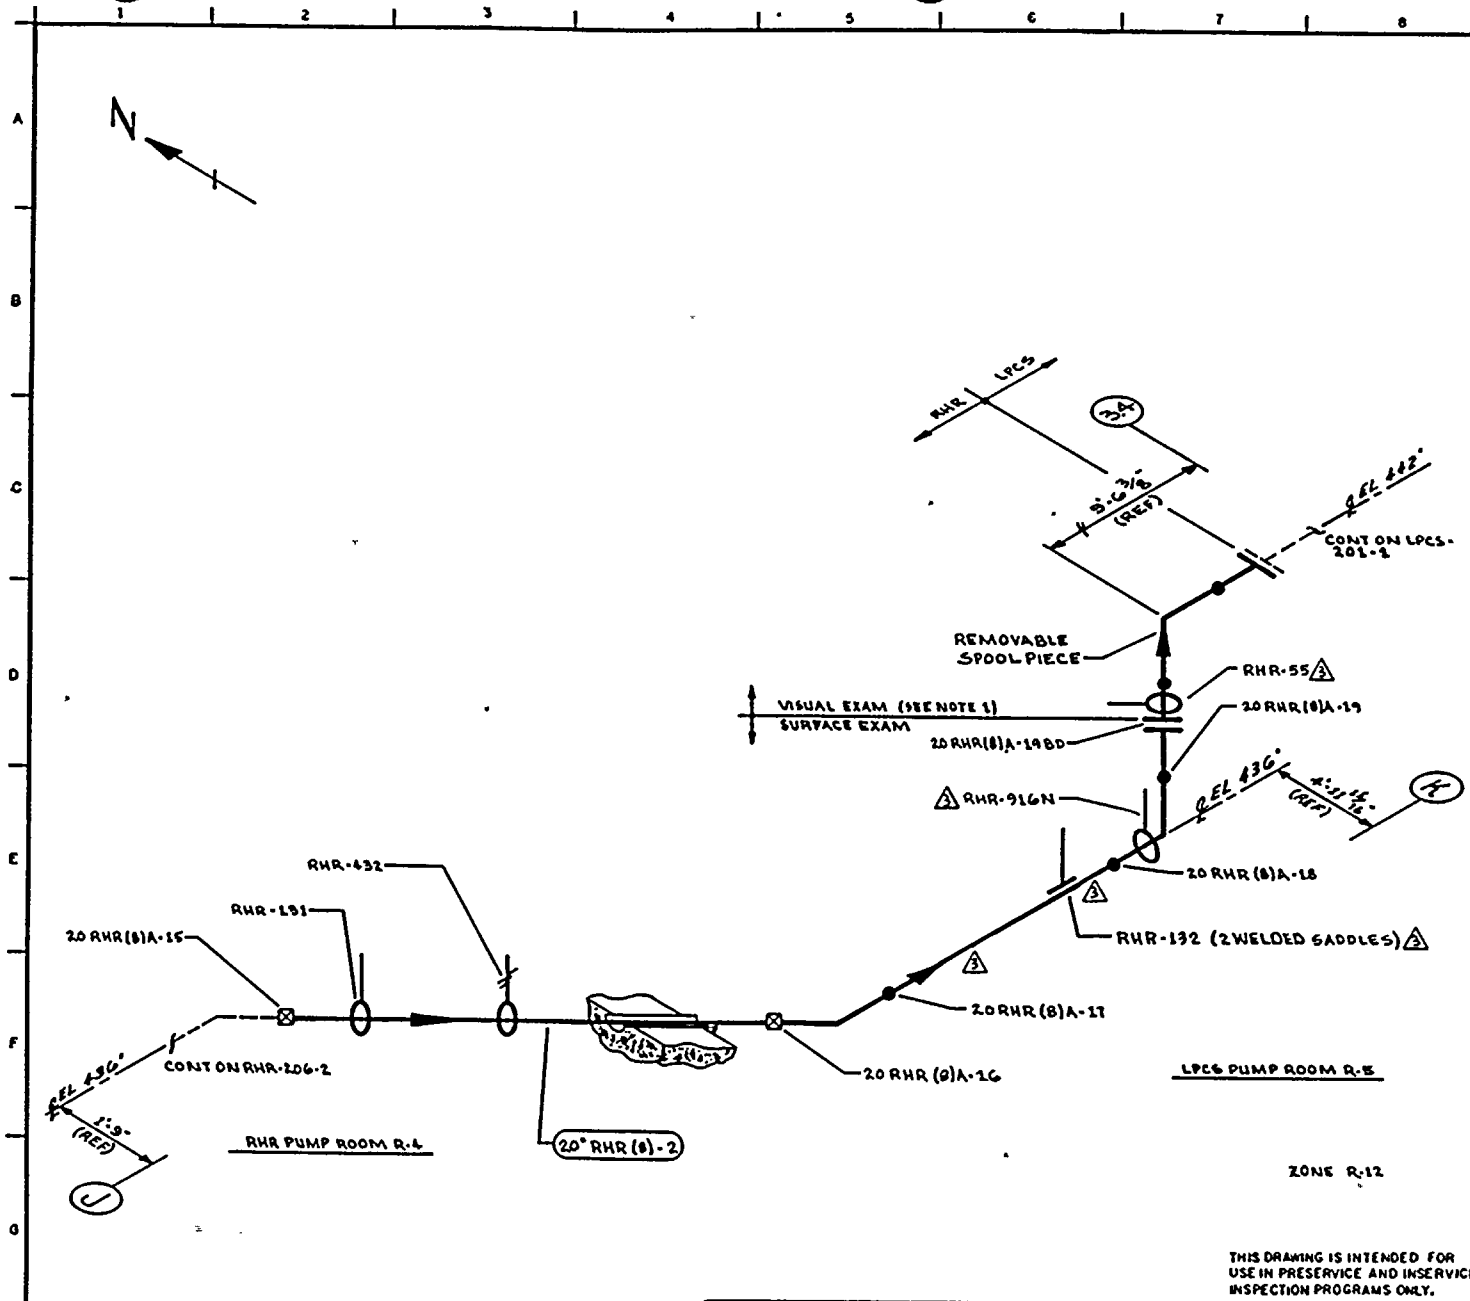

NOTES:
 1. SPOOL PIECE REMOVED DURING NORMAL OPERATION. BLANKED FLANGE IS THE LIMIT OF CLASS 2 PRESSURE BOUNDARY. NO EXAMS REQUIRED OF SPOOL PIECE ITSELF, AS IT IS USED FOR PREOPERATIONAL TESTING ONLY.

REFERENCES:
 BOVEE & CRILL ISOMETRIC
 RHR-881-8.13 REV 4

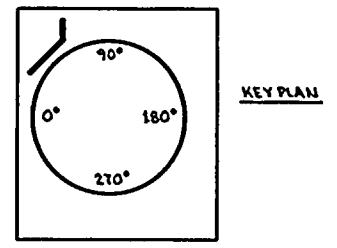

QUALITY CLASS: 1 ASME CODE CLASS: 2
 ENGR: G.A. KUGLER DRAWN: V.M.C.A. DATE: 5-22-78

WASHINGTON PUBLIC POWER SUPPLY SYSTEM
 RICHMOND WASHINGTON 99302

THIS DRAWING IS INTENDED FOR USE IN PRESERVICE AND INSERVICE INSPECTION PROGRAMS ONLY.

NO	DATE	REVISION	BY	CHKD	APPVD	PIPING SYSTEM	NOM DIA (IN)	SCH	NOM WALL THK	MATERIAL SPECIFICATION	MATL TYPE	CAL BLOCK NO
1	9-21-81	REVISED AS NOTED	K.M.A.	J.R.	J.F.	20" RHR (8) 2	20	STD	0.375	SA 106 GR B	CB	NA
2	11-2-81	REVISED AS NOTED	K.M.A.	J.R.	J.F.							
3	1-11-79	CHANGED REMOVABLE SPOOL PIECE TO VISUAL SURFACE EXAM (SEE NOTE 1)	K.M.A.	J.R.	J.F.							
4	11-22-77	ISSUED FOR USE	K.M.A.	J.R.	J.F.							
5	9-22-78	ISSUED FOR INFORMATION ONLY	K.M.A.	J.R.	J.F.							

WNP-2
 WELD COMPONENT
 IDENTIFICATION DIAGRAM
 TITLE:
 RHR-LPCS CROSSTIE
 DNG NO: RHR-206-3
 REV 3



WNP-02
 INTERVAL: PSI
 PERIOD: NA
 OUTAGE:
 DRAWING NO. RHR-206

WASHINGTON PUBLIC POWER SUPPLY SYSTEM
 PROGRAM PLAN AND SCHEDULE
 SYSTEM OR COMPONENT: 20RHR(8)-2
 DESCRIPTION: RHR-LPCS CROSSIE

PAGE 001
 DATE 12/14/84

<u>IDENT. NO.</u>	<u>DESCRIPTION</u>	<u>SECT.</u> <u>XI</u>	<u>EXAM</u> <u>MTM.</u>	<u>PROCEDURE</u>	<u>CAL.</u> <u>BLOCK</u>	<u>INSERVICE</u>		<u>NOTES</u>
						<u>REQ.</u>	<u>SCHEDULED</u> <u>OUTAGE</u>	
20RHR(8)A-1	TEE TO PIPE	C-F	SUR	PTP-1				
RHR-121(W)	8 WELDED LUGS	C-E-1	SUR	MTP-1				
RHR-121	PSA-10 SN(2)	C-E-2	VT-3	303/8.2.17				S/N W11860/E11855
			VT-4	303/8.2.17				S/N W11860/E11855
20RHR(8)A-1A	PIPE TO FLANGE	C-F	SUR	PTP-1				
20RHR(8)A-1B	FLANGE TO PIPE	C-F	SUR	PTP-1				
20RHR(8)A-2	PIPE TO EL	C-F	SUR	PTP-1				
20RHR(8)A-3	EL TO PIPE	C-F	SUR	PTP-1				
RHR-122	STRUT	C-E-2	VT-3	303/8.2.17				
20RHR(8)A-3A	PIPE TO PIPE	C-F	SUR	PTP-1				
20RHR(8)A-4	PIPE TO PIPE	C-F	SUR	PTP-1				
RHR-124	STRUT	C-E-2	VT-3	303/8.2.17				
RHR-123	BOX	C-E-2	VT-3	303/8.2.17				
20RHR(8)A-5	PIPE TO EL	C-F	SUR	PTP-1				
20RHR(8)A-6	EL TO PIPE	C-F	SUR	PTP-1				
20RHR(8)A-7	PIPE TO EL	C-F	SUR	PTP-1				
20RHR(8)A-8	EL TO PIPE	C-F	SUR	PTP-1				
RHR-125	STRUT	C-E-2	VT-3	303/8.2.17				

WNP-02
 INTERVAL: PSI
 PERIOD: NA
 OUTAGE:
 DRAWING NO. RHR-206

WASHINGTON PUBLIC POWER SUPPLY SYSTEM
 PROGRAM PLAN AND SCHEDULE
 SYSTEM OR COMPONENT: 20RHR(8)-2
 DESCRIPTION: RHR-LPCS CROSS TIE

PAGE 002
 DATE 12/14/84

IDENT. NO.	DESCRIPTION	SECT.		CAL. BLOCK	PROCEDURE	INSERVICE SCHEDULED		NOTES
		XI EXAM	EXAM. MIT.			REQ.	OUTAGE	
RHR-126								
RHR-127	STRUT	C-E-2	VT-3		303/8.2.17			
20RHR(8)A-9	BOX	C-E-2	VT-3		303/8.2.17			
RHR-128	PIPE TO PIPE	C-F	SUR		PTP-1			
RHR-129	BOX	C-E-2	VT-3		303/8.2.17			
20RHR(8)A-10	STRUT	C-E-2	VT-3		303/8.2.17			
20RHR(8)A-11	PIPE TO EL	C-F	SUR		PTP-1			
RHR-423	EL TO PIPE	C-F	SUR		PTP-1			
	SPRING	C-E-2	VT-3		303/8.2.17			
20RHR(8)A-12			VT-4		303/8.2.17			
20RHR(8)A-13	PIPE TO EL	C-F	SUR		PTP-1			
RHR-130	EL TO PIPE	C-F	SUR		PTP-1			
20RHR(8)A-14	BOX	C-E-2	VT-3		303/8.2.17			
20RHR(8)A-15	PIPE TO EL	C-F	SUR		PTP-1			
RHR-131	EL TO PIPE	C-F	SUR		PTP-1			
RHR-432	STRUT	C-E-2	VT-3		303/8.2.17			
	SPRING	C-E-2	VT-3		303/8.2.17			
20RHR(8)A-16			VT-4		303/8.2.17			
	PIPE TO EL	C-F	SUR		FTP-1			


WNP-02
 INTERVAL: PSI
 PERIOD: NA
 OUTAGE:
 DRAWING NO. RHR-206

WASHINGTON PUBLIC POWER SUPPLY SYSTEM
 PROGRAM PLAN AND SCHEDULE
 SYSTEM OR COMPONENT: 20RHR(8)-2
 DESCRIPTION: RHR-LPCS CROSSIE

PAGE 003
 DATE 12/14/84


<u>IDENT. NO.</u>	<u>DESCRIPTION</u>	SECT. XI	EXAM MTH.	PROCEDURE	CAL. BLOCK	<u>INSERVICE</u>		<u>NOTES</u>
						REQ.	SCHEDULED OUTAGE	
20RHR(8)A-17	EL TO PIPE	C-F	SUR	PTP-1				
RHR-132	ANCHOR	C-E-2	VT-3	303/8.2.17				W/2 WELDED SADDLES.
20RHR(8)A-18	PIPE TO EL	C-F	SUR	PTP-1				
RHR-916N	RIGID	C-E-2	VT-3	303/8.2.17				
20RHR(8)A-19	EL TO FLANGE	C-F	SUR	PTP-1				
RHR-55	BOX	C-E-2	VT-3	303/8.2.17				
RHR-PB-206	RHR PRESS BNDRY	N/A	VT-2	N/A				IWC-2510, SEE NOTES #6 & #7.



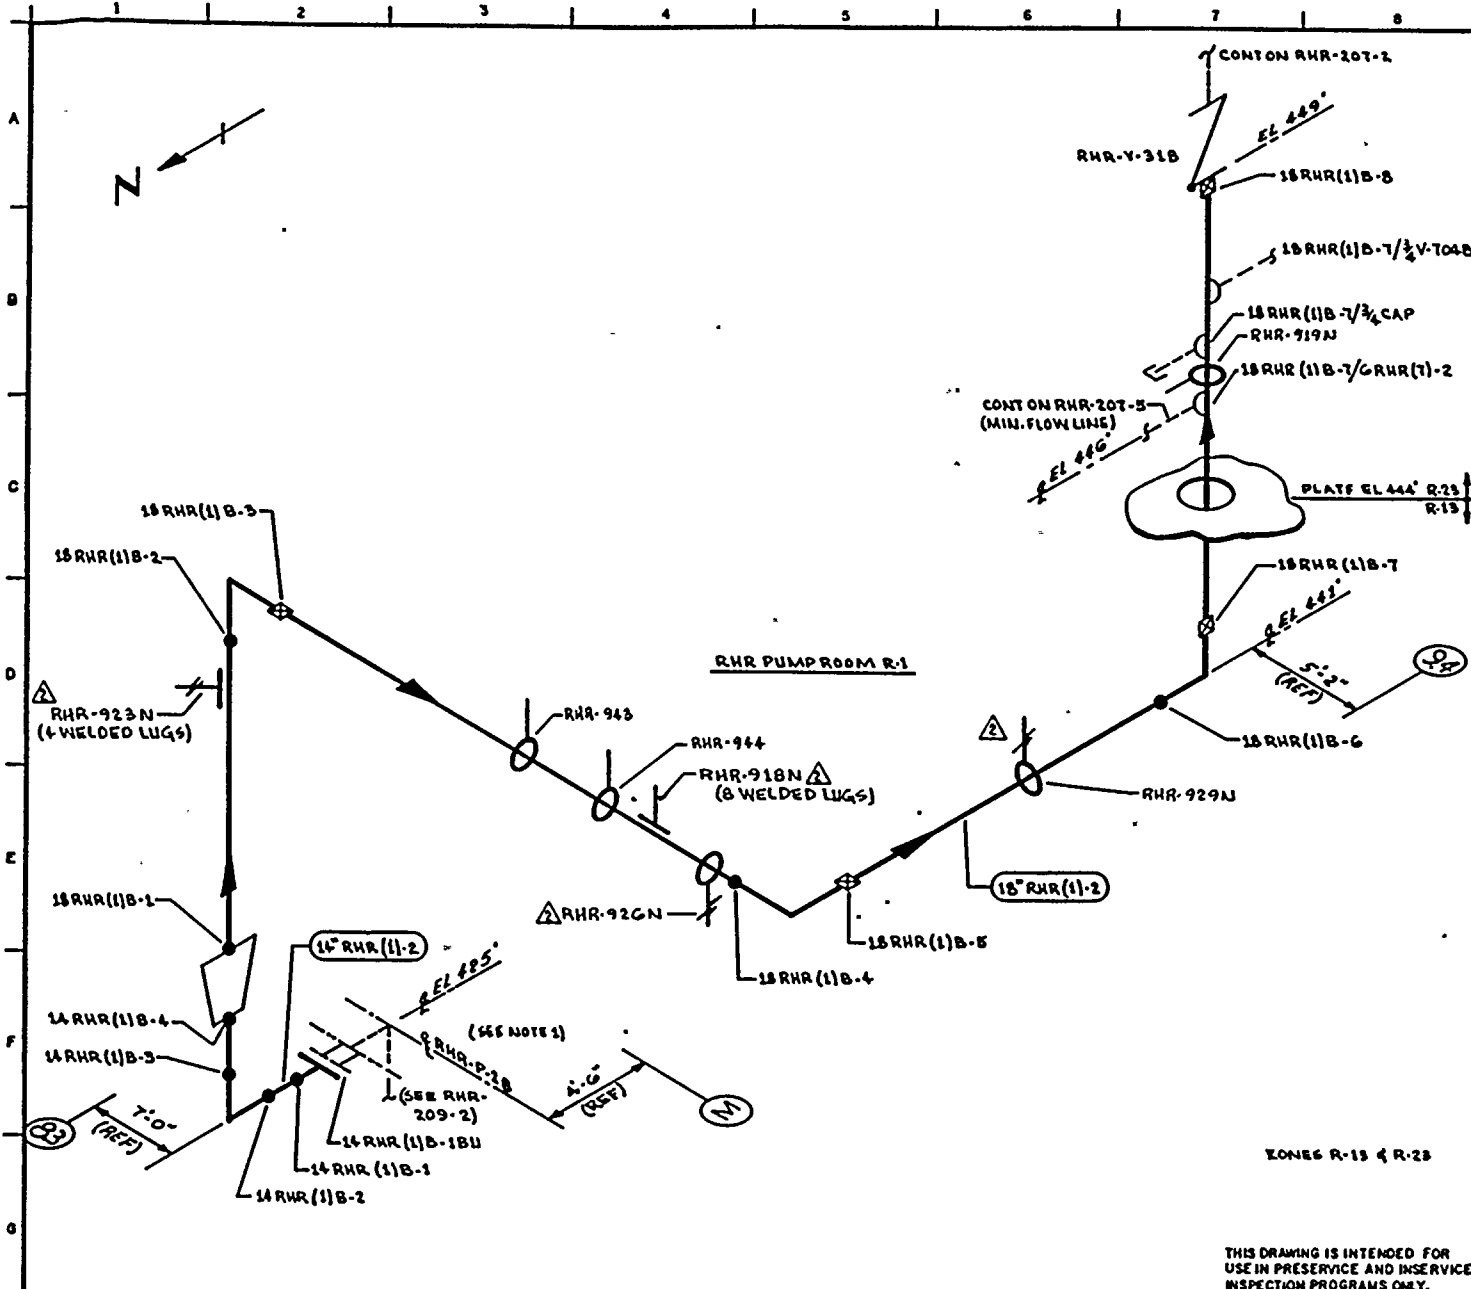

- NOTES:
1. EXTEND VISUAL LEAKAGE EXAM OF RHR-PUMP-7B VENTS & DRAINS TO OUTERMOST NORMALLY CLOSED VALVE.
 2. SCAFFOLDING IS REQUIRED.

- REFERENCES:
- BOVEE & CRAIG ISOMETRIC
RHR-898-1.4 REV 9

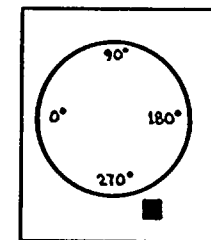

QUALITY CLASS: 1 ASME CODE CLASS: 2
ENGR: GA KUGLER DRAWN: K.McA DATE: G-5-78

WASHINGTON PUBLIC POWER SUPPLY SYSTEM
RICHLAND, WASHINGTON 99352

THIS DRAWING IS INTENDED FOR USE IN PRESERVICE AND INSERVICE INSPECTION PROGRAMS ONLY.

NO	DATE	REVISION	BY	CHKD	APPVD
2	12-2-83	REVISED AS NOTED	K.McA	WR	TFH
1	12-2-81	REVISED AS NOTED	K.McA	WR	TFH
0	12-11-77	ISSUED FOR USE	K.McA	WR	TFH
A	9-11-78	ISSUED FOR INFORMATION ONLY	K.McA	WR	TFH


PIPING SYSTEM	NOM DIA (IN)	SCH	NOM WALL THK	MATERIAL SPECIFICATION	MATL TYPE	CAL BLOCK NO
14" RHR (1)B-2	14	STD	0.375	SA 106 GR B	CS	NA
18" RHR (1)B-2	18	30	0.435	SA 106 GR B	CS	NA

WNP-2
WELD & COMPONENT IDENTIFICATION DIAGRAM

TITLE: RHR LOOP B SUPPLY TO RHR-HX-1B


DWG NO: RHR-207-1 REV 2



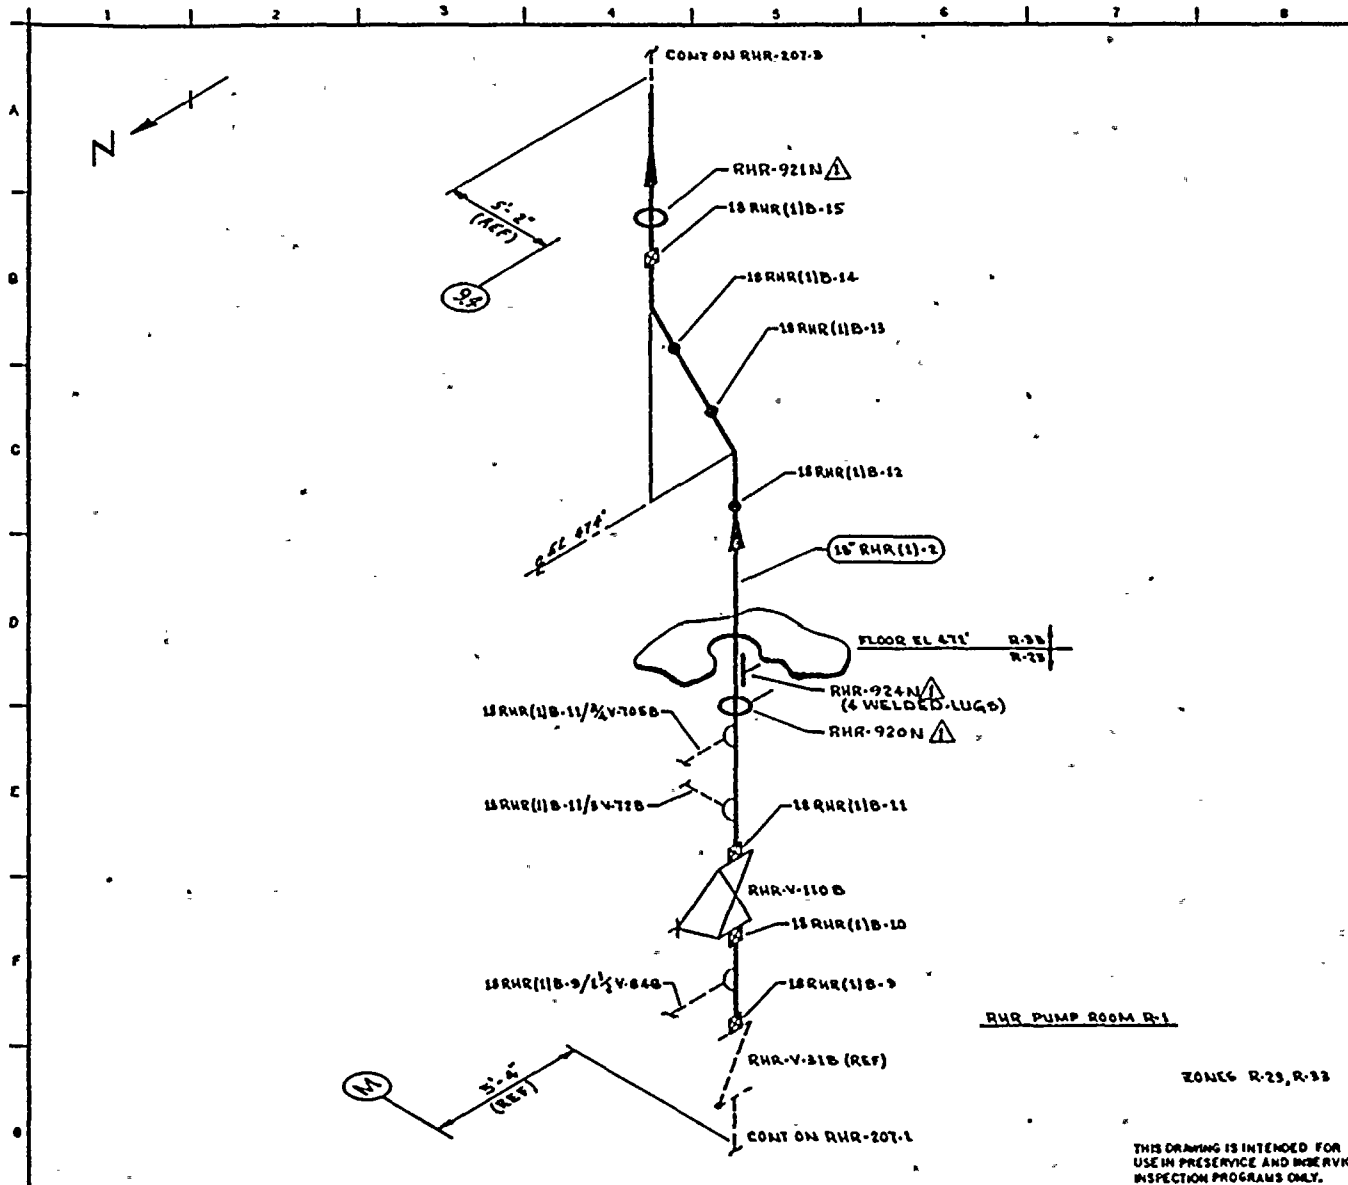

NOTES:

REFERENCES:
BOYCE & CRAIG ISOMETRIC
RHR-898-D.8 REV 0

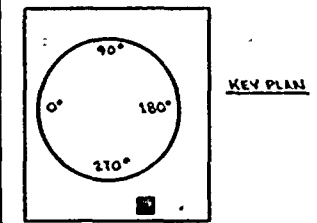

QUALITY CLASS: 1 ASME CODE CLASS: 2
ENGR. GA KUGLER DRAWN: V. M. CA. DATE: 6-5-78

WASHINGTON PUBLIC POWER
SUPPLY SYSTEM
RICHLAND, WASHINGTON 99302

THIS DRAWING IS INTENDED FOR
USE IN PRESERVICE AND INSERVICE
INSPECTION PROGRAMS ONLY.


PIPING SYSTEM	NOM DIA (IN)	SCH	NOM WALL THK	MATERIAL SPECIFICATION	MATL TYPE	CAL BLOCK NO
18" RHR (1) B	18	30	0.478	SA 106 GR B	CS	N/A

NO	DATE	REVISION	BY	CHKD	APPVD
1	11/17/78	ISSUED FOR USE	W. J. D.	D. J. D.	
1	4/11/78	ISSUED FOR INFORMATION ONLY	W. J. D.	D. J. D.	
1		REVISED AS NOTED	W. J. D.	D. J. D.	

WNP-2
WELD & COMPONENT
IDENTIFICATION DIAGRAM


TITLE:
RHR LOOP B
SUPPLY TO RHR-WX1B

OWG NO: RHR-207-2 REV 1

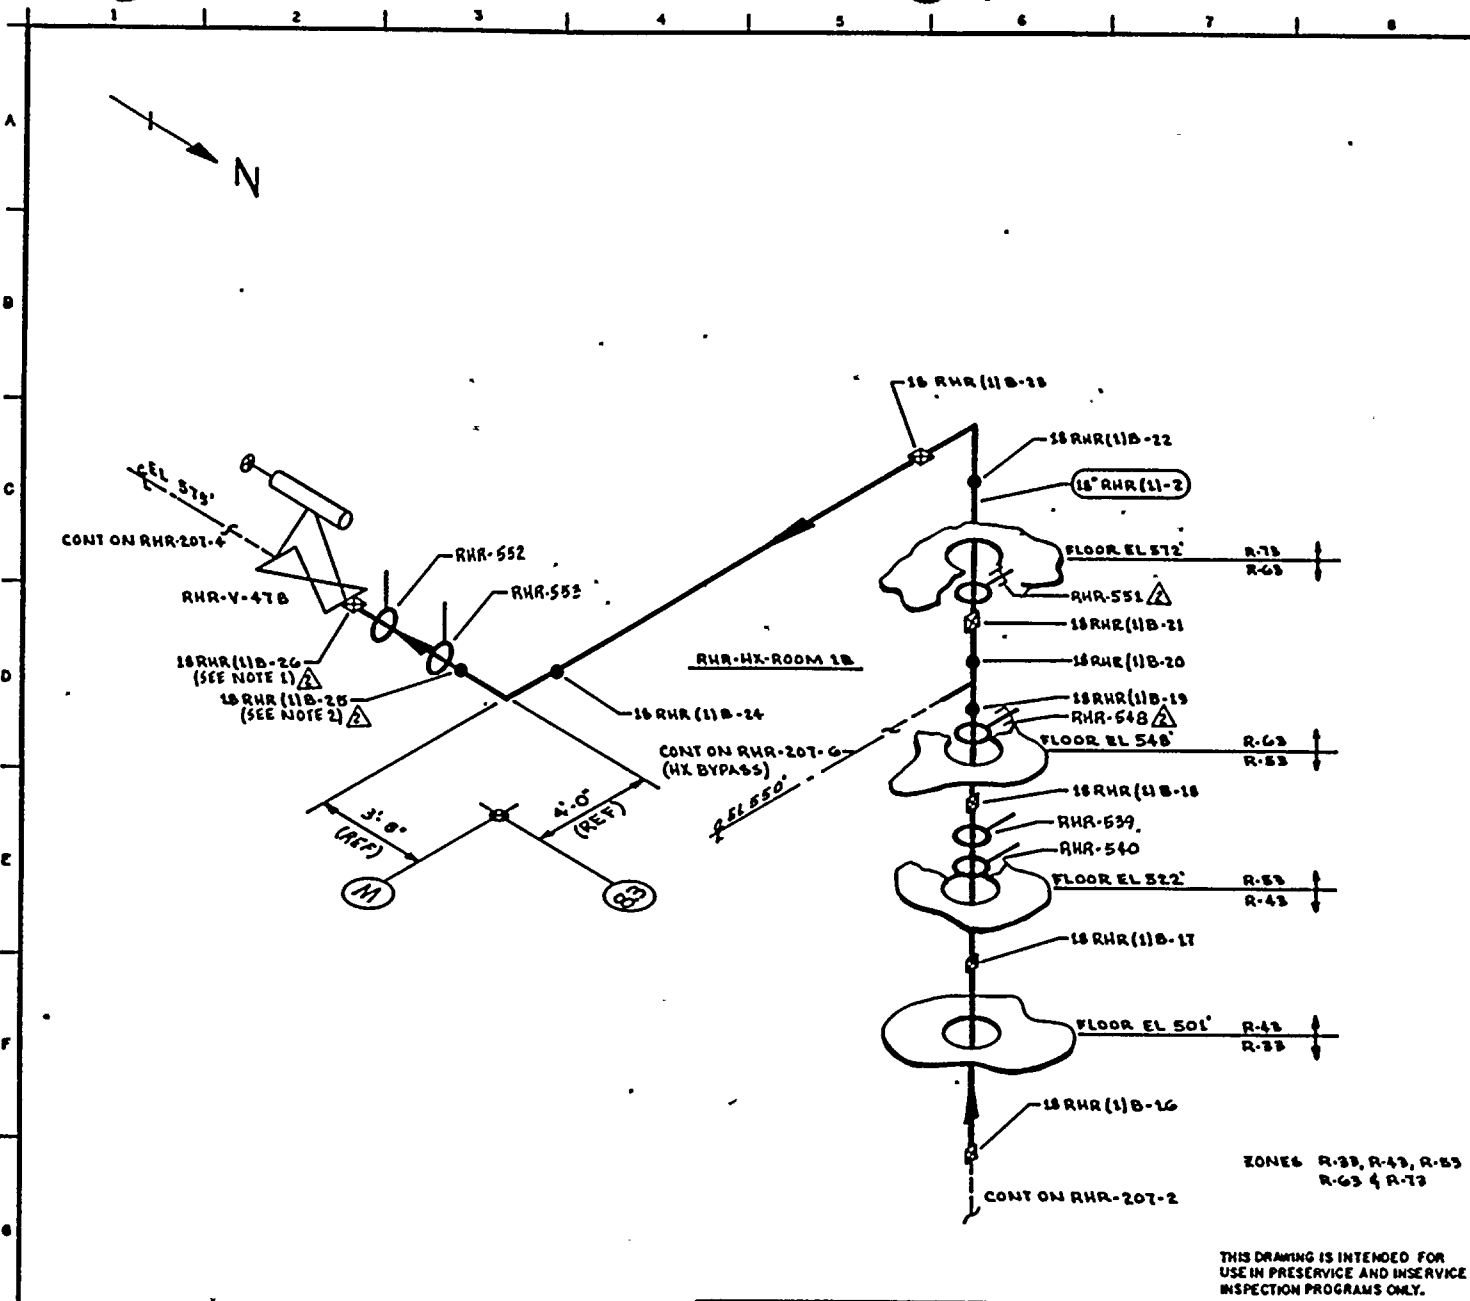


- NOTES:
- 1. ACCESS TO WELD 18RHR (1)B-26 REQUIRES REMOVAL OF RHR-552.
 - 2. ACCESS TO WELD 18RHR (1)B-25 REQUIRES REMOVAL OF RHR-553.

REFERENCES
 BOYCE & CRAIG ISOMETRICS
 RHR-898-5.8 REV 3
 RHR-898-9.14 REV 9

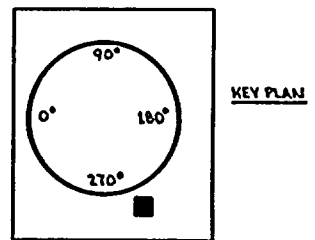

ZONEs R-33, R-43, R-53
 R-63 & R-73

THIS DRAWING IS INTENDED FOR
 USE IN PRESERVICE AND INSERVICE
 INSPECTION PROGRAMS ONLY.

QUALITY CLASS: 1	ASME CODE CLASS: 2
ENGR: GA. KUGLER	DRAWN: K. H. A.
DATE: 6-6-78	
 WASHINGTON PUBLIC POWER- SUPPLY SYSTEM RICHLAND, WASHINGTON 99352	

PIPING SYSTEM	NOM DIA (IN)	SCH	NOM WALL THK	MATERIAL SPECIFICATION	MATL TYPE	CAL BLOCK NO
18" RHR (1)B-2	18	30	0.438	SA 106 GR B	CS	NA


NO	DATE	REVISION	BY	CHKD	APPVD
2	10-13-83	REVISED AS NOTED	KMA	SP	TF
1	11-2-81	REVISED AS NOTED	KMA	DM	TF
0	11-23-78	ISSUED FOR USE	KMA	SP	TF
1	9-13-78	ISSUED FOR INFORMATION ONLY	KMA	SP	TF

WNP-2
 WELD 8 COMPONENT
 IDENTIFICATION DIAGRAM

TITLE:
 RHR LOOP B
 SUPPLY TO RHR-HX-1B


DWG NO: RHR-207-3 REV 2



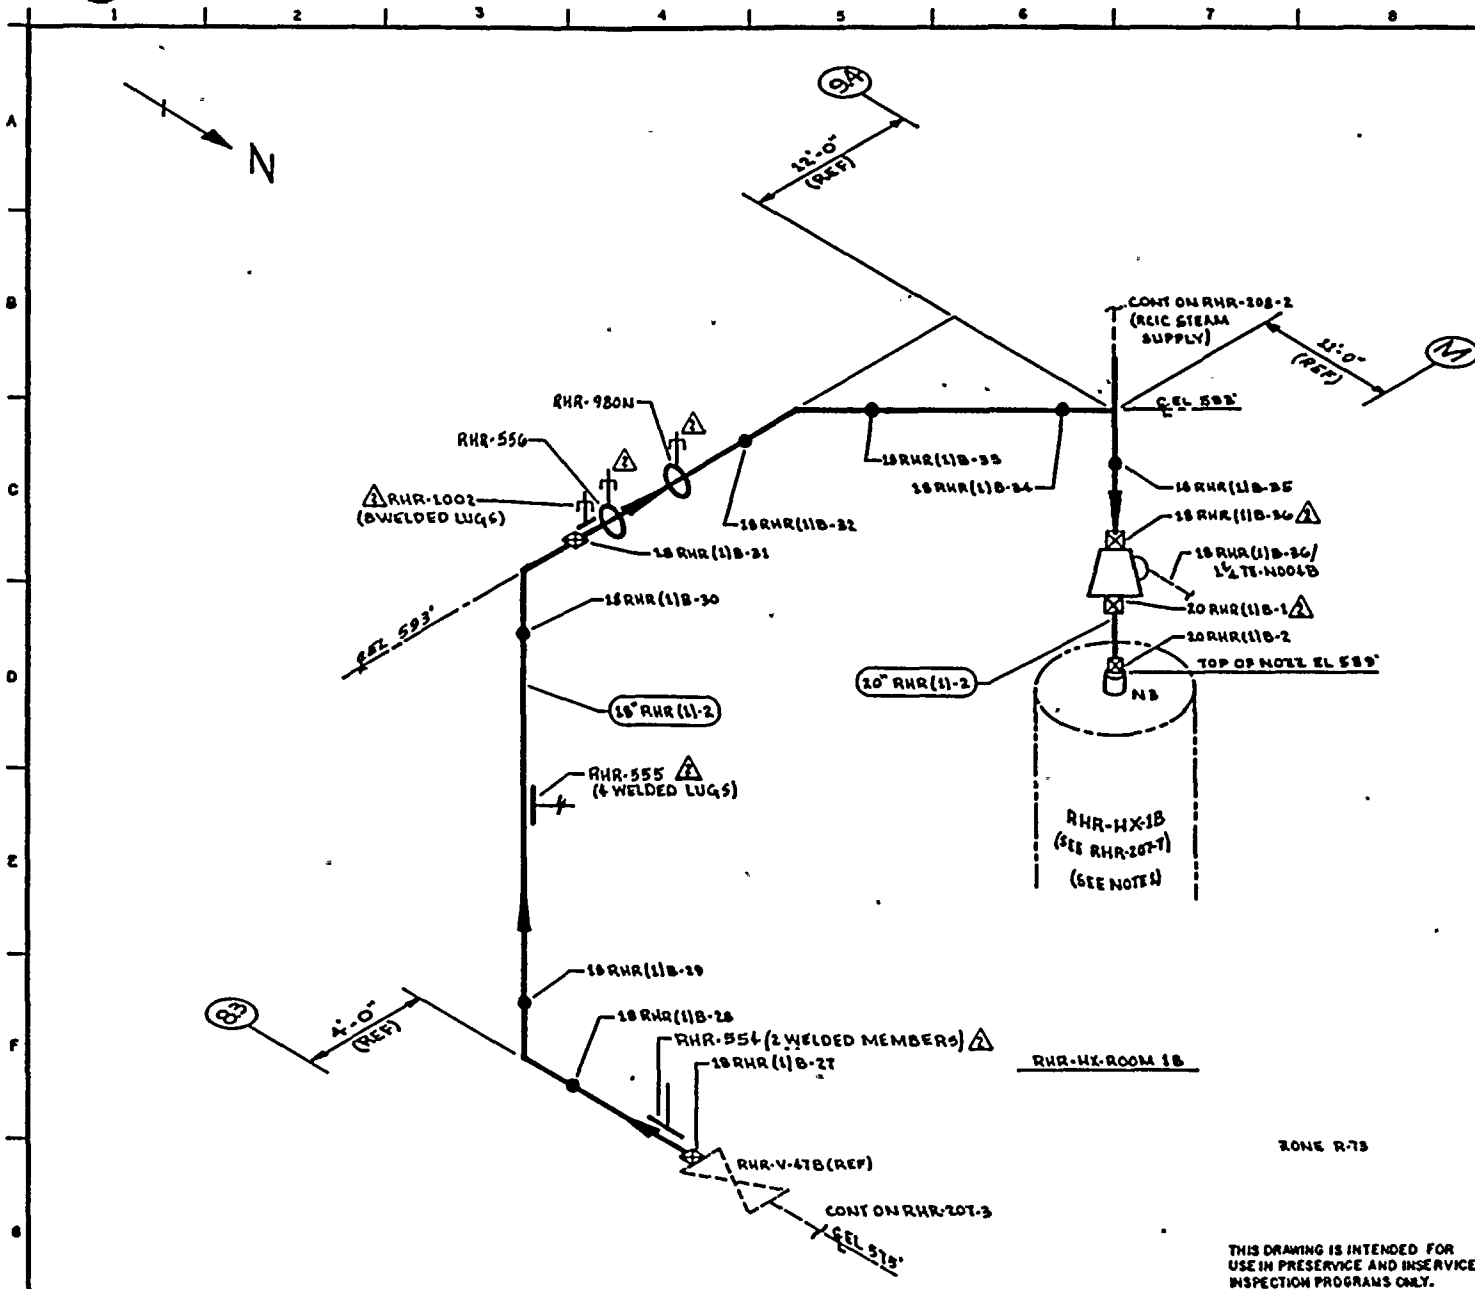

- NOTES:
1. EXTEND VISUAL LEAKAGE EXAM OF RHR-HX-1B VENTS & DRAINS THROUGH OUTERMOST NORMALLY CLOSED ISOLATION VALVE, RELIEF VALVE OR TRANSITION TO INSTRUMENT TUBING.
 2. SCAFFOLDING IS REQUIRED.

REFERENCES:
BOVEE & CRAIL ISOMETRIC
RHR-89B-9.14 REV 9

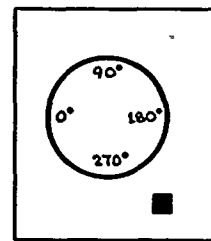

KEY PLAN

QUALITY CLASS: 1 ASME CODE CLASS: 2
ENGR: G.A. KUGLER DRAWN: K.M.A. DATE: 6-6-78



WASHINGTON PUBLIC POWER
SUPPLY SYSTEM
RICHLAND, WASHINGTON 99352

THIS DRAWING IS INTENDED FOR
USE IN PRESERVICE AND INSERVICE
INSPECTION PROGRAMS ONLY.


PIPING SYSTEM	NOM DIA (IN)	SCH	NOM WALL THK	MATERIAL SPECIFICATION	MATL TYPE	CAL BLOCK NO
18" RHR (1) 2	18	30	0.438	SA 106 GR B	CS	NA
20" RHR (1) 2	20	30	0.500	SA 106 GR B	CS	NA

WNP-2
WELD & COMPONENT
IDENTIFICATION DIAGRAM

TITLE:
RHR LOOP B
SUPPLY TO RHR-HX-1B


DWG NO: RHR-207-4 REV 2

NO	DATE	REVISION	BY	CHKD	APPVD
2	10-11-83	REVISED AS NOTED	K.M.A.	J.P.P.	T.P.
1	12-2-81	REVISED AS NOTED	K.M.A.	J.P.P.	T.P.
0	12-22-78	ISSUED FOR USE	K.M.A.	J.P.P.	T.P.
A	9-11-78	ISSUED FOR INFORMATION ONLY	K.M.A.	J.P.P.	D.W.P.

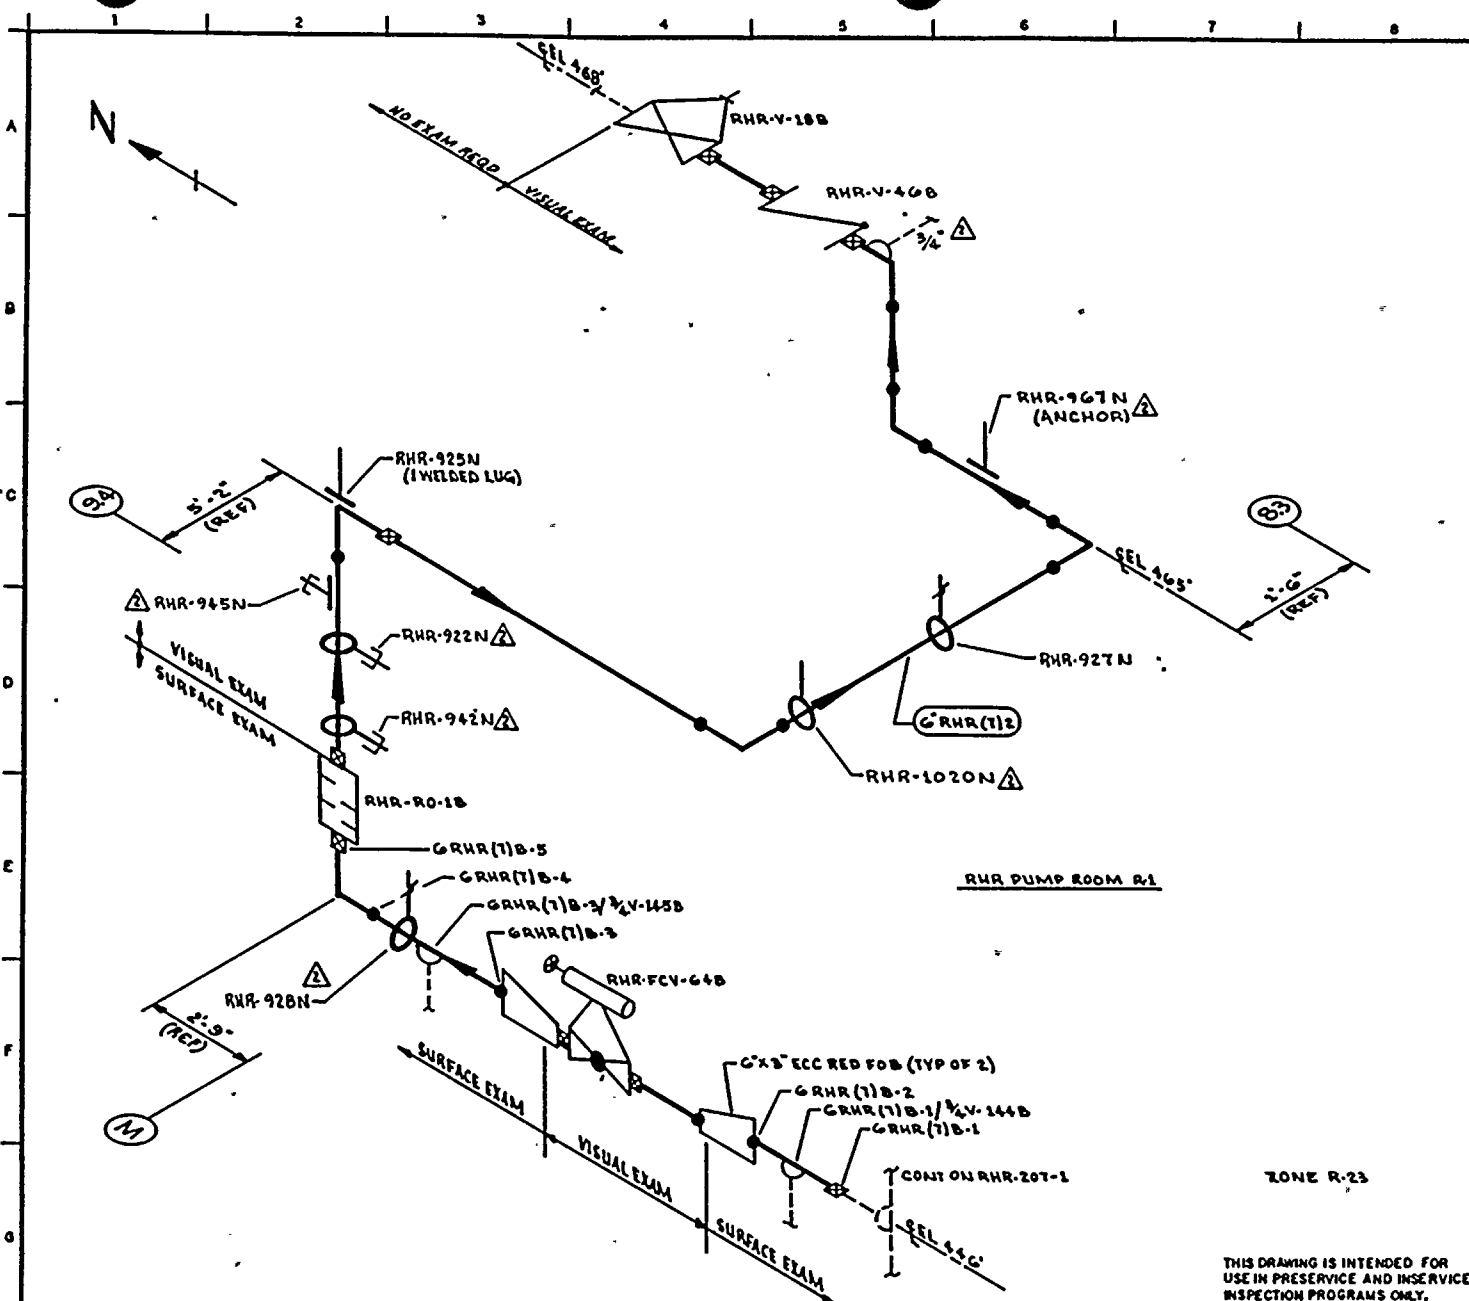

NOTES:
 1. PORTIONS OF THIS DRAWING IDENTIFY PIPING & COMPONENTS THAT ARE SUBJECT ONLY TO A VISUAL EXAM FOR EVIDENCE OF LEAKAGE DURING SYSTEM HYDRO OR OPERABILITY TESTS. TESTS ARE TO BE CONDUCTED PER THE REQUIREMENTS OF ASME SECTION XI, PARAGRAPH IWA-5000.

REFERENCES:
 BOVEE & CRAIG ISOMETRICS
 RHR-898-36.38 REV 9
 RHR-898-39.40 REV 7

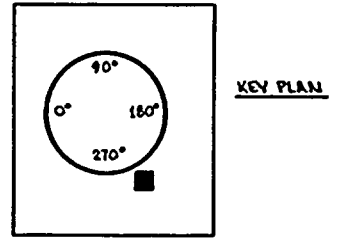

QUALITY CLASS: 1 ASME CODE CLASS: 2
 ENGR: G.A. KUGLER DRAWN: K.McA DATE: 6-6-78

WASHINGTON PUBLIC POWER SUPPLY SYSTEM
 RICHLAND, WASHINGTON 99352

THIS DRAWING IS INTENDED FOR USE IN PRESERVICE AND INSERVICE INSPECTION PROGRAMS ONLY.


PIPING SYSTEM	NOM DIA (IN)	SCH	NOM WALL THK	MATERIAL SPECIFICATION	MATL TYPE	CAL BLOCK NO
6" RHR (7) 2	6	40	0.280	SA 106 GR B	CS	NA


NO	DATE	REVISION	BY	CHKD	APPVD
2	9-26-83	REVISED AS NOTED	WKA	WKA	TFB
1	12-2-81	REVISED AS NOTED	WKA	WKA	TFB
0	12-18-79	ISSUED FOR USE	WKA	WKA	TFB
A	9-12-78	ISSUED FOR INFORMATION ONLY	WKA	WKA	TFB

WNP-2
 WELD 8 COMPONENT
 IDENTIFICATION DIAGRAM

TITLE:
 RHR LOOP B
 MINIMUM FLOW LINE TO SUPPRESSION POOL


DWG NO: RHR-207-B REV 2

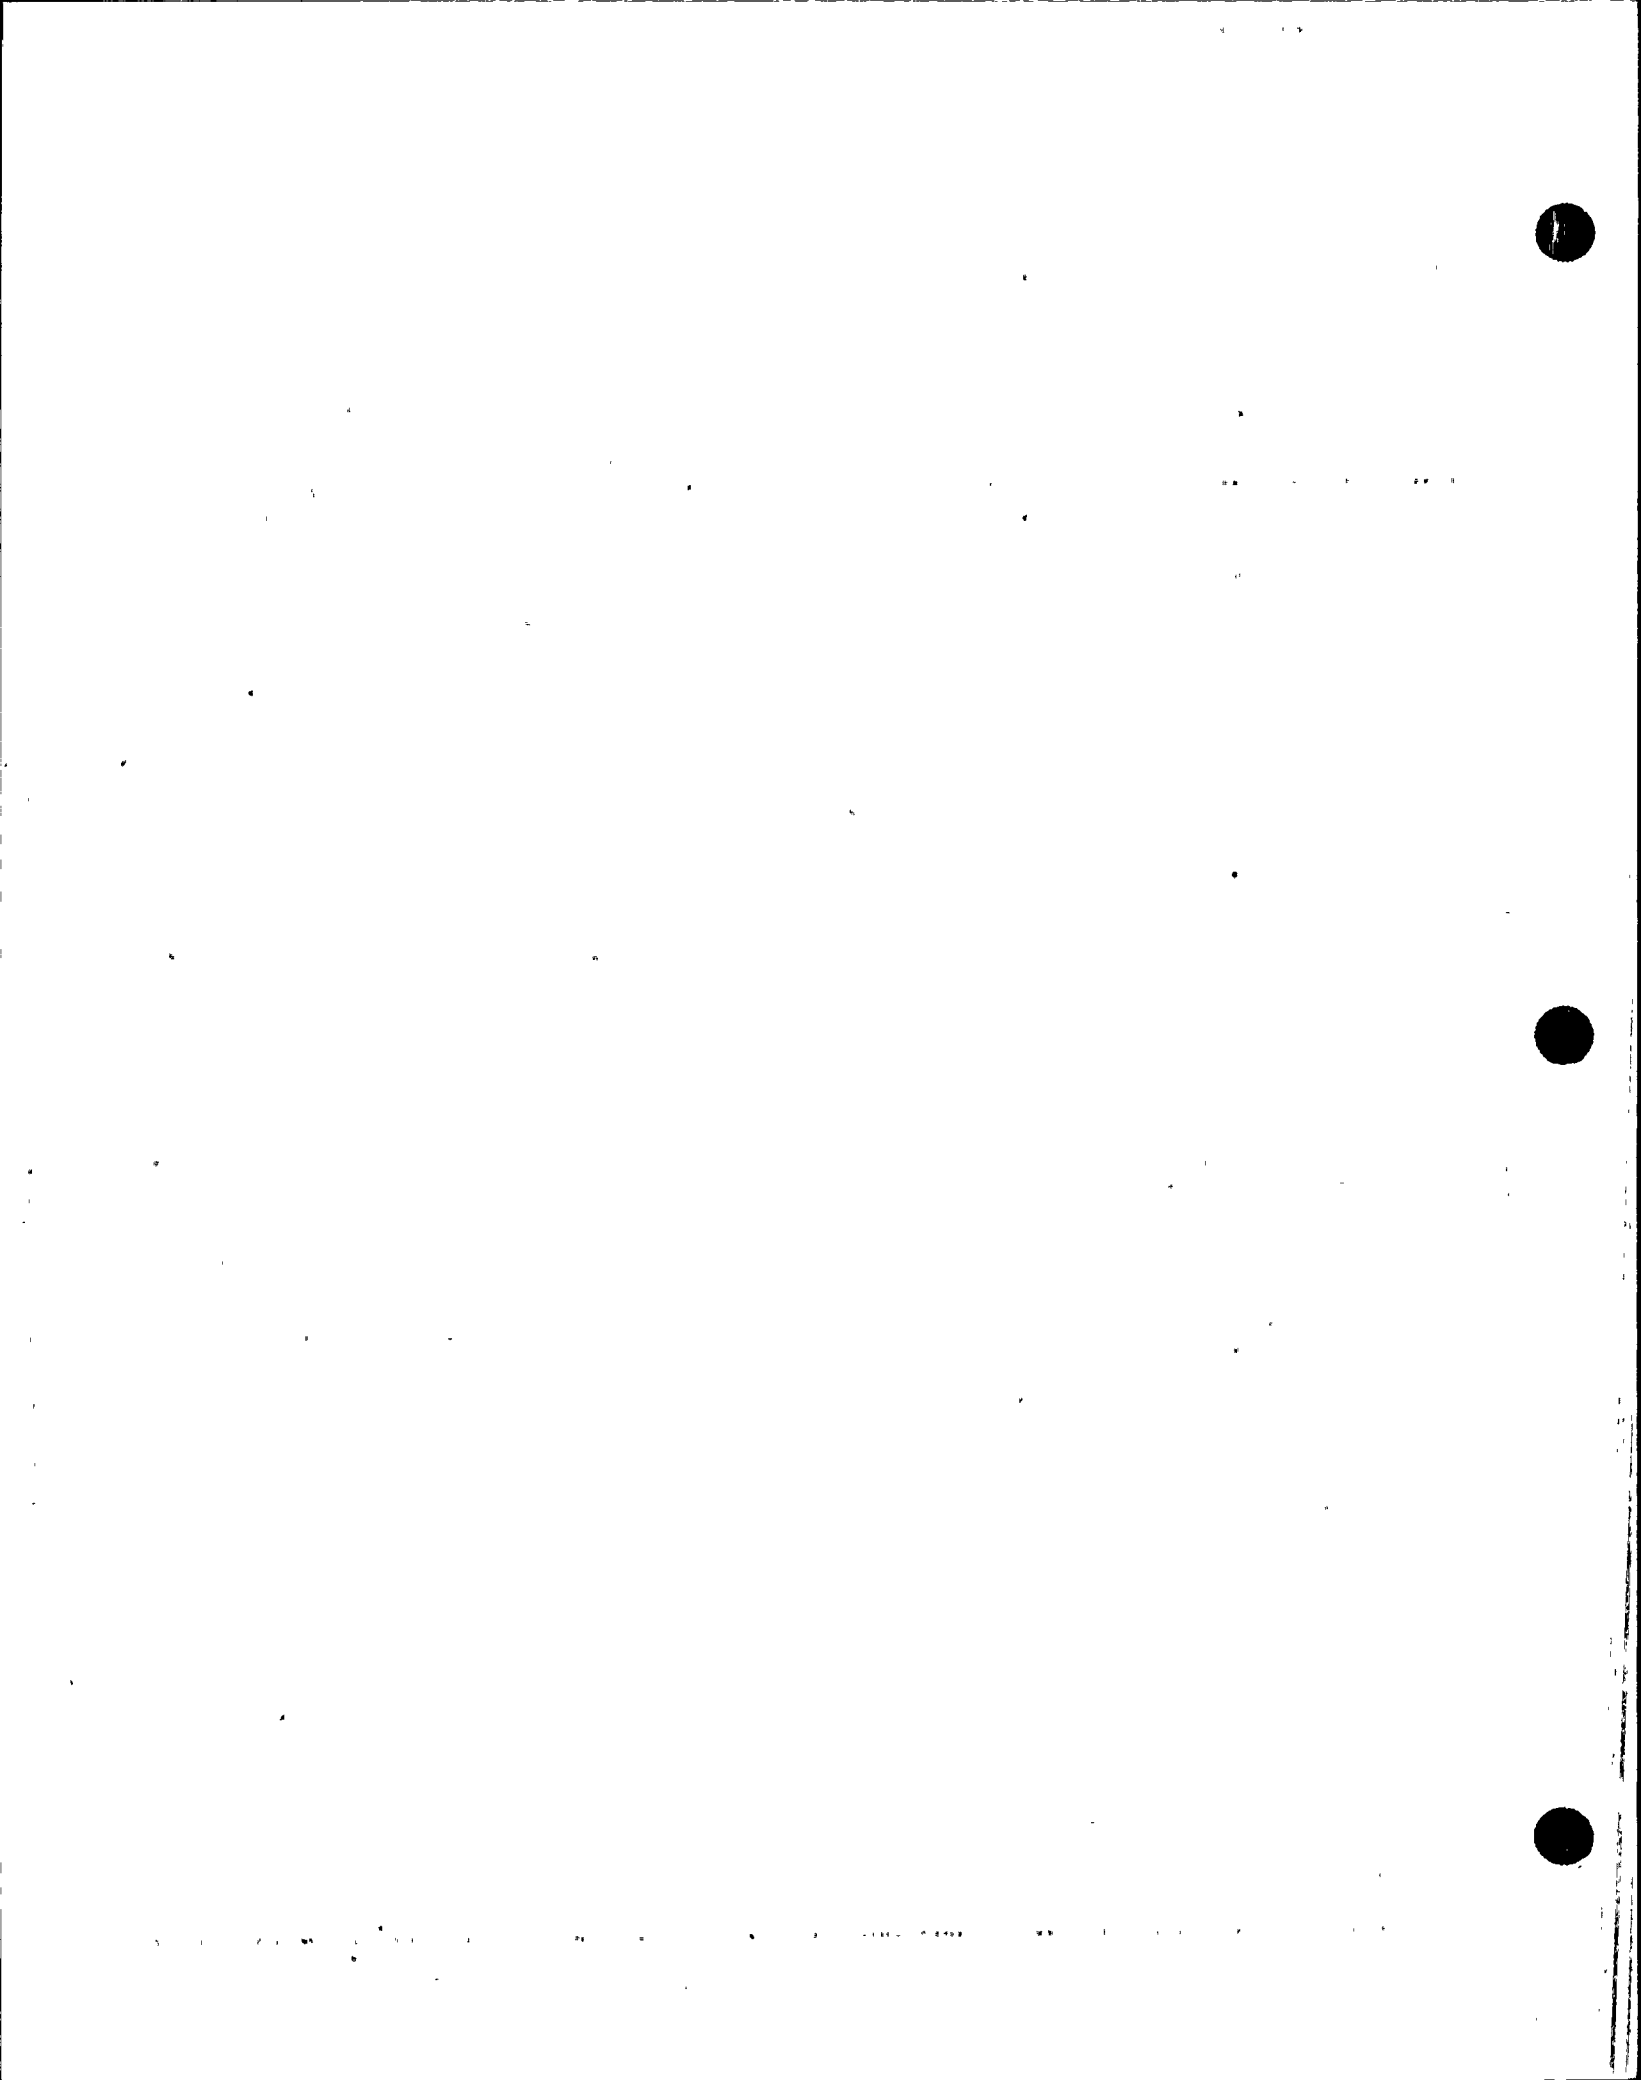

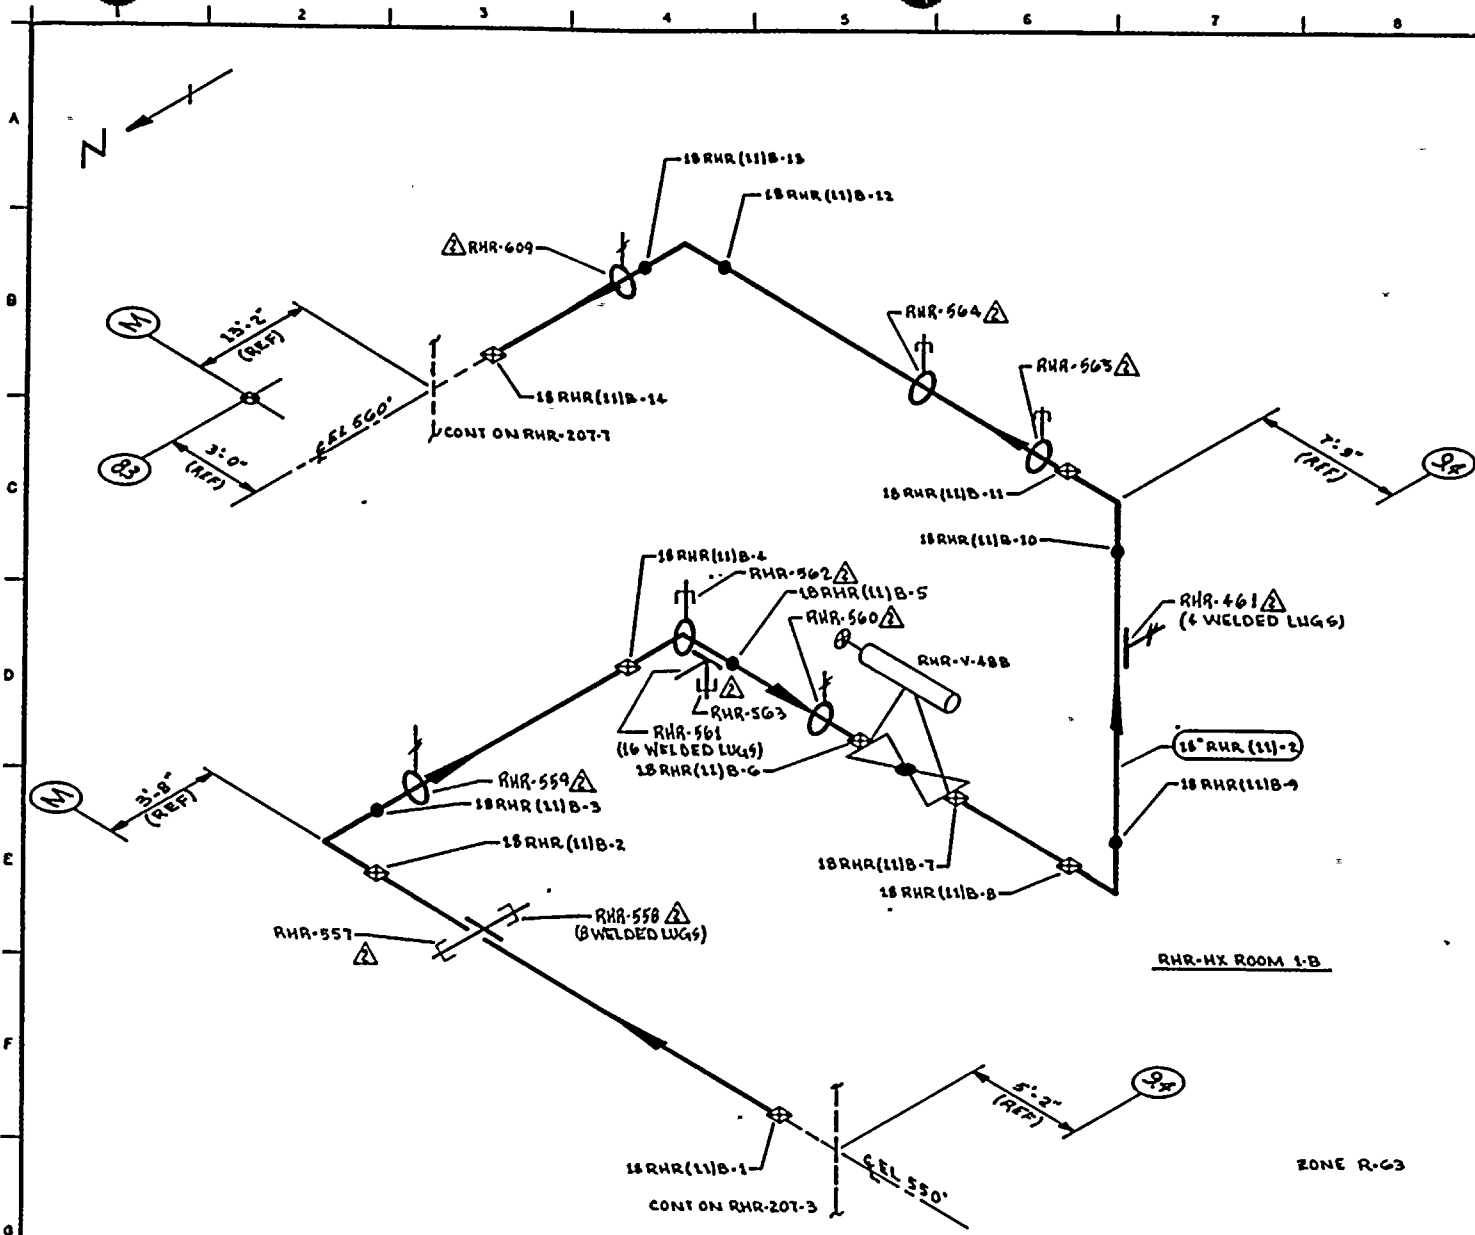

NOTES:

REFERENCES:
BOVEE & CRAIG ISOMETRIC
RHR-900-1.5 REV 5

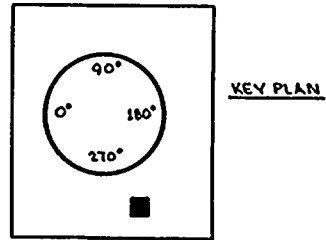

THIS DRAWING IS INTENDED FOR USE IN PRESERVICE AND INSERVICE INSPECTION PROGRAMS ONLY.

QUALITY CLASS: 1 ASME CODE CLASS: 2
ENGR: GA KUGLER DRAWN: KMcA DATE: 6-7-78

WASHINGTON PUBLIC POWER SUPPLY SYSTEM
RICHMOND, WASHINGTON 99052

PIPING SYSTEM	NOM DIA (IN)	SCH	NOM WALL THK	MATERIAL SPECIFICATION	MATL TYPE	CAL BLOCK NO
18" RHR (11)-2	18	30	0.438	SA 106 GR B	CS	NA


NO	DATE	REVISION	BY	CHKD	APPVD
2	9-26-83	REVISED AS NOTED	KMcA	DM	JFA
1	12-2-81	REVISED AS NOTED	KMcA	JMM	JFA
0	11-11-78	ISSUED FOR USE	KMcA	DM	JFA
1	9-11-78	ISSUED FOR INFORMATION ONLY	KMcA	DM	DM

WNP-2
WELD B COMPONENT
IDENTIFICATION DIAGRAM

TITLE:
RHR LOOP B
RHR HEAT EXCHANGER BYPASS


DWG NO: RHR-207-G REV 2



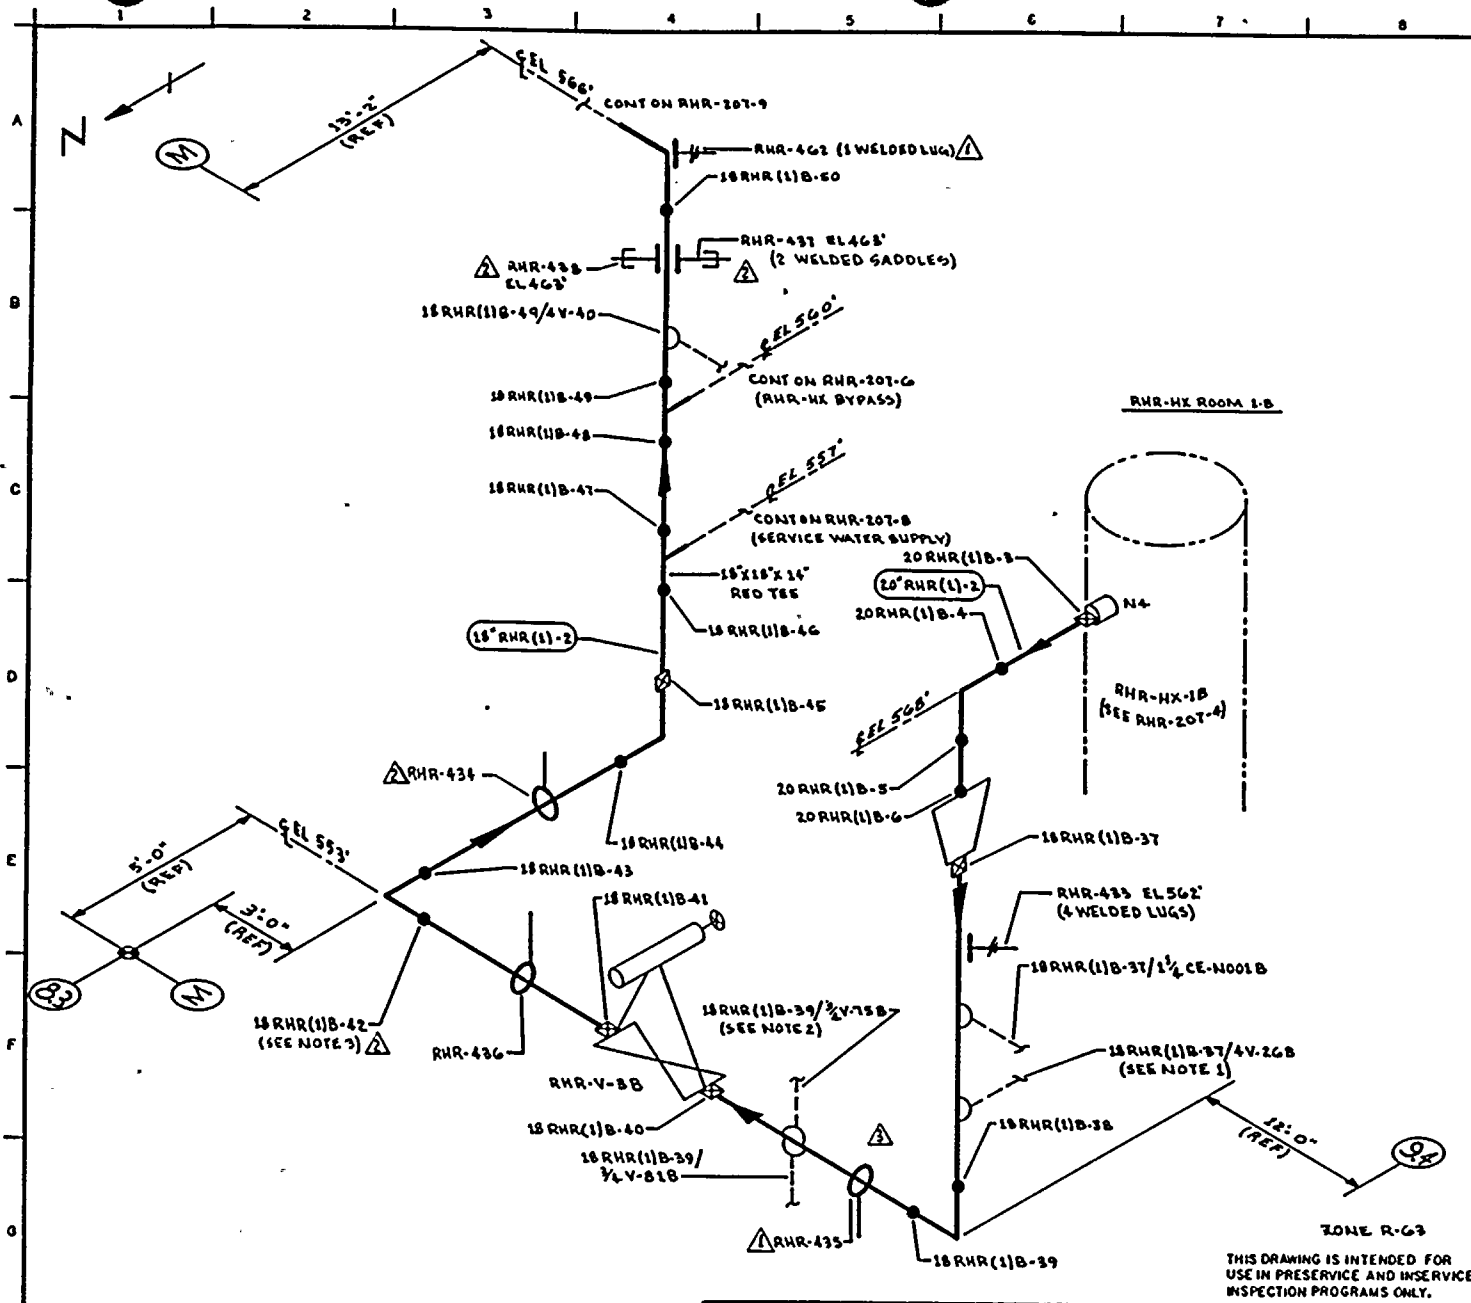

- NOTES:
1. TERMINATE VISUAL EXAM AT V-26B, V-11B & V-150 B.
 2. THIS IS A 1 1/2" WOL WITH 3/4" BRANCH PIPE. EXTEND VISUAL EXAM TO V-158.
 3. WELD 18RHR(1)B-42 IS PARTIALLY OBSTRUCTED BY TRUNION ATTACHED TO RHR-436.
 4. SCAFFOLDING IS REQUIRED.

REFERENCES:
BOYEE & CRILL ISOMETRICS
RHR-899-14 REV 9

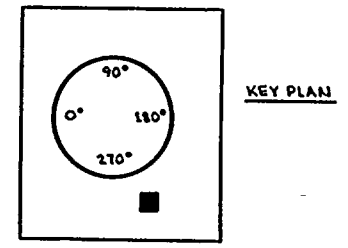

QUALITY CLASS: 1 ASME CODE CLASS: 2
ENGR: GA KUGLER DRAWN: K. McCA DATE: 6-7-78

WASHINGTON PUBLIC POWER SUPPLY SYSTEM
RICHMOND WASHINGTON 95352

THIS DRAWING IS INTENDED FOR USE IN PRESERVICE AND INSERVICE INSPECTION PROGRAMS ONLY.


PIPING SYSTEM	NOM DIA (IN)	SCH	NOM WALL THK	MATERIAL SPECIFICATION	MATE TYPE	CAL BLOCK NO
18" RHR (1)B-2	18	30	0.438	SA 106 GR B	CS	NA
20" RHR (1)B-2	20	30	0.500	SA 106 GR B	CS	NA

NO	DATE	REVISION	BY	CHKD	APPVD
2	9-26-81	REVISED AS NOTED	K. McCA	WPK	TKP
1	12-2-81	REVISED AS NOTED	K. McCA	WPK	TKP
0	11-19-81	ISSUED FOR USE	K. McCA	WPK	TKP
1	9-18-81	ISSUED FOR INFORMATION ONLY	K. McCA	WPK	TKP

WNP-2
WELD COMPONENT
IDENTIFICATION DIAGRAM


TITLE:
RHR LOOP B
SUPPLY FROM RHR-HX-1B

DWG NO: RHR-207-7 REV 2

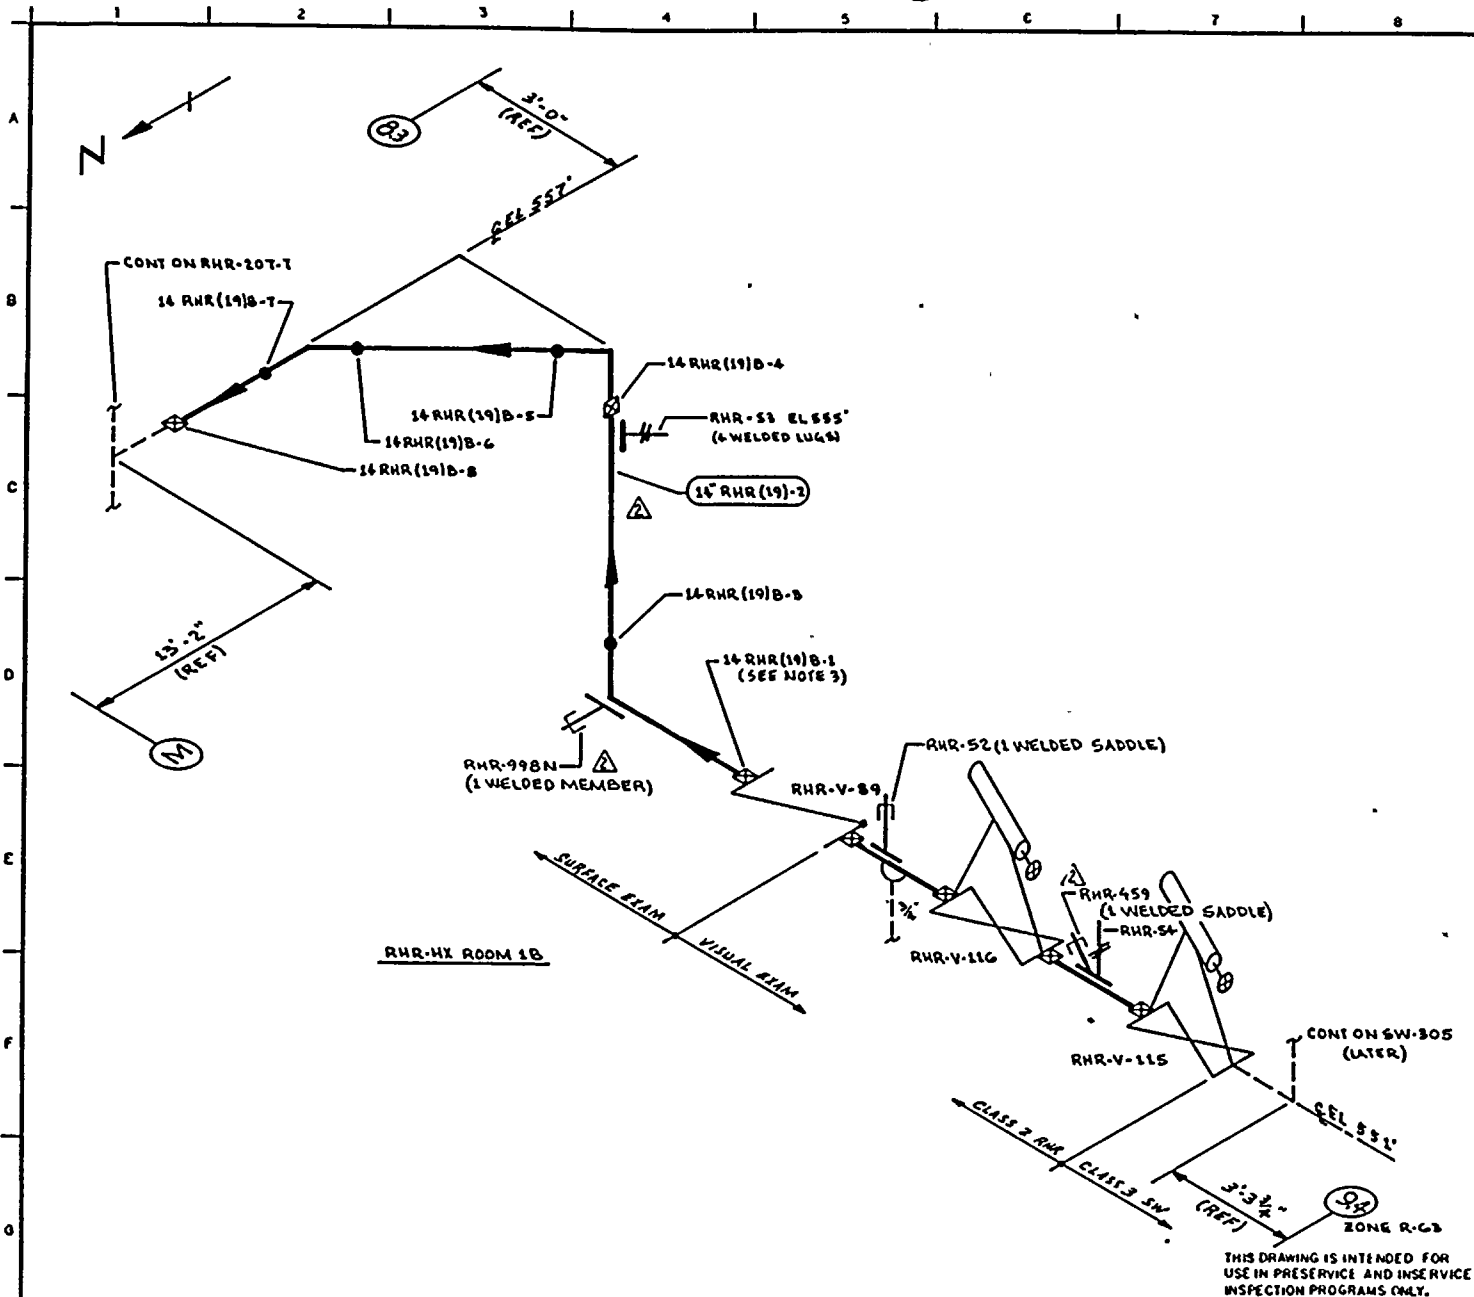

- NOTES:
1. PORTIONS OF THIS DRAWING IDENTIFY PIPING & COMPONENTS THAT ARE SUBJECT ONLY TO A VISUAL EXAM FOR EVIDENCE OF LEAKAGE DURING SYSTEM HYDRO OR OPERABILITY TESTS. TESTS ARE TO BE CONDUCTED PER THE REQUIREMENTS OF ASME SECTION XI, PARAGRAPH IWA-5000.
 2. FOR BRANCH PIPING 4" DIA OR LESS (CONN SHOWN IN DASHED LINES) EXTEND VISUAL LEAKAGE EXAM THROUGH THE OUTERMOST NORMALLY CLOSED NUCLEAR VALVE OR UNTIL TRANSITION TO INSTRUMENT TUBING, UNLESS OTHERWISE NOTED.
 3. ELBOW BETWEEN WELDS 14 RHR (19)B-1 & 3 IS FITTING TO VALVE.
 4. SCAFFOLDING IS REQUIRED DOWN-STREAM OF WELD 14 RHR (19)B-4.

REFERENCES:
BOVEE & CRAIG ISOMETRICS
RHR-978-L-4 REV 11

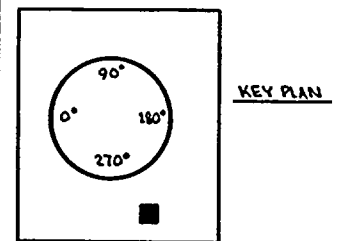

QUALITY CLASS: 1 ASME CODE CLASS: 2
ENGR G.A. KUGLER DRAWN: K.M.C.A. DATE: 6-8-78

WASHINGTON PUBLIC POWER SUPPLY SYSTEM
NORTH WASHINGTON

THIS DRAWING IS INTENDED FOR USE IN PRESERVICE AND INSERVICE INSPECTION PROGRAMS ONLY.


PIPING SYSTEM	NOM DIA (IN)	SCH	NOM WALL THK	MATERIAL SPECIFICATION	MATL TYPE	CAL BLOCK NO
14" RHR (19)-2	14	STD	0.275	SA 106 GR B	CS	NA

NO	DATE	REVISION	BY	CHKD	APPVD
2	12-2-83	REVISED AS NOTED	CMCA	TFW	TFW
1	11-6-80	DELETED WELD 14 RHR (19)B-2, ADDED NOTE 3, ENVRD	CMCA	TFW	TFW
0	12-2-77	ISSUED FOR USE	CMCA	TFW	TFW
A	9-12-78	ISSUED FOR INFORMATION ONLY	CMCA	TFW	TFW

WHP-2
WELD & COMPONENT IDENTIFICATION DIAGRAM


TITLE:
RHR LOOP B
SERVICE WATER SUPPLY TO RHR-HX-1B DISCHARGE

DWG NO: RHR-207-B REV 2

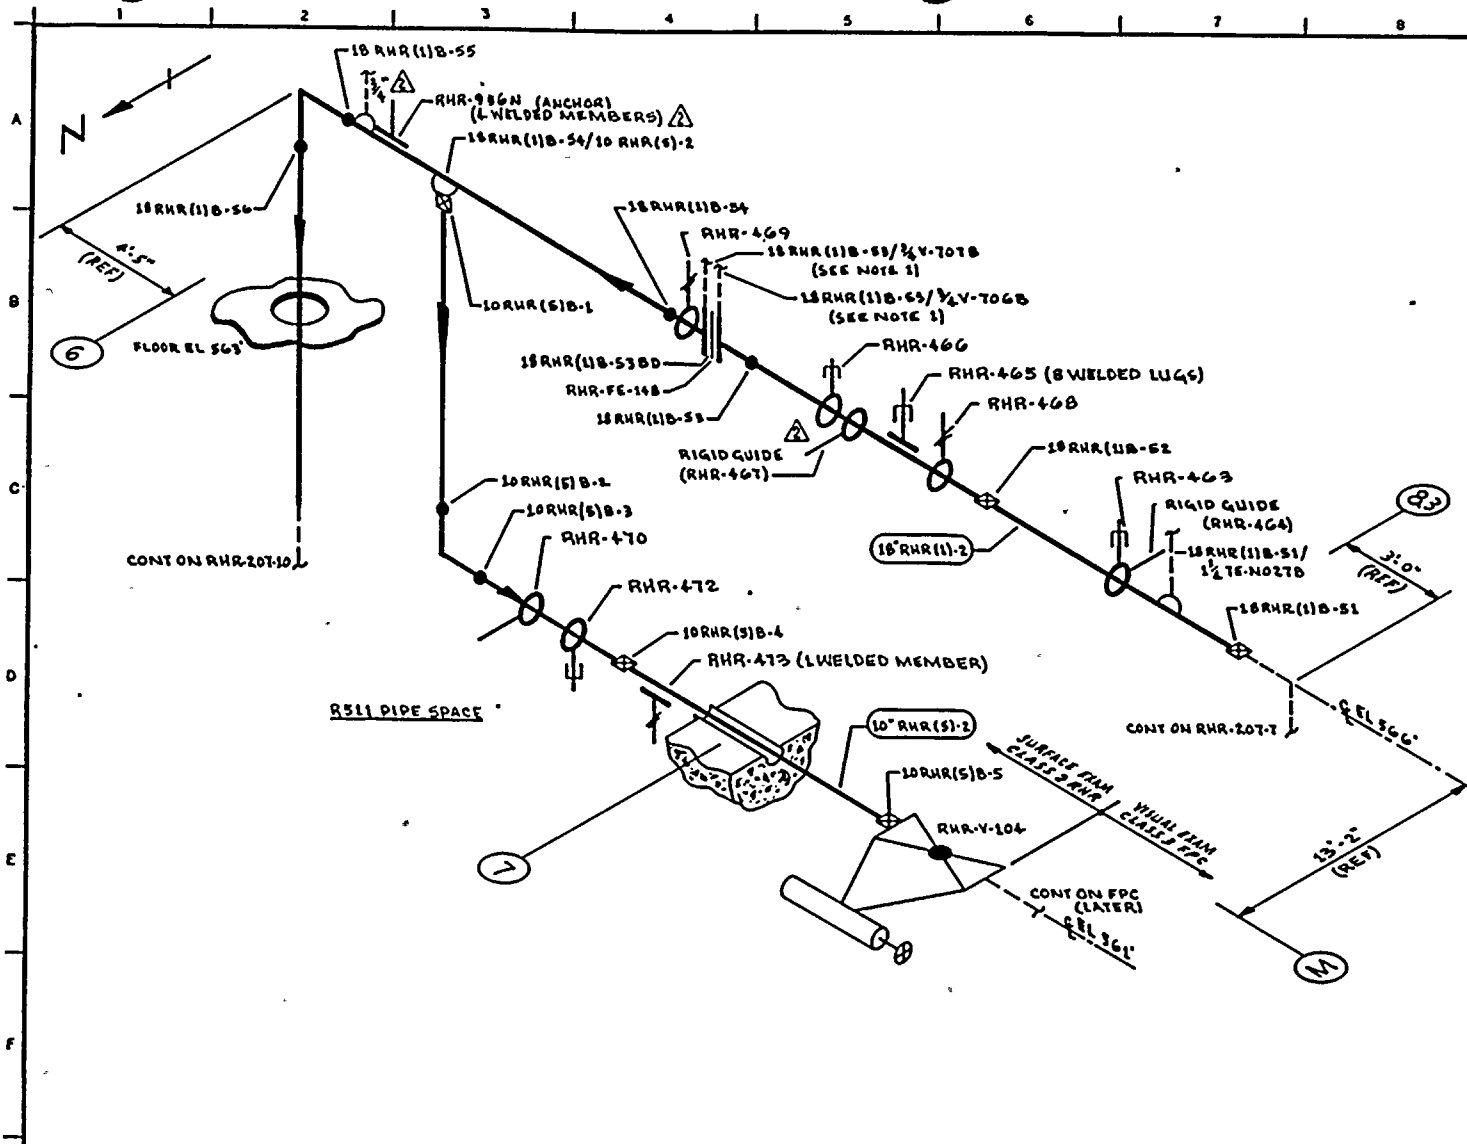

NOTES:
 1. THESE ARE 1/2" CONNECTIONS WITH VISUAL EXAM EXTENDING TO 3/4" V-706B, 3/4" V-706D, 3/4" V-728B & 3/4" V-729B.

REFERENCES:
 BOVEE & CRILL ISOMETRICS
 RHR-899-5.7 REV 7
 RHR-899-36.37 REV 4

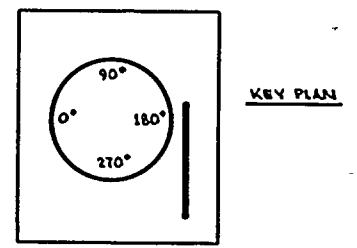

ZONES R-63

THIS DRAWING IS INTENDED FOR USE IN PRESERVICE AND INSERVICE INSPECTION PROGRAMS ONLY.

QUALITY CLASS: 1 ASME CODE CLASS: 2
 ENGR: GA KUGLER DRAWN: KMcA DATE: 6-8-78

WASHINGTON PUBLIC POWER-SUPPLY SYSTEM
 RICHMOND, WASHINGTON 99322

WNP-2
 WELD & COMPONENT IDENTIFICATION DIAGRAM


TITLE:
 RHR LOOP B SUPPLY FROM RHR-HK-1B & FPC INTERTIE

DWG NO: RHR-207-9 REV 2

PIPING SYSTEM	NOM DIA (IN)	SCH	NOM WALL THK	MATERIAL SPECIFICATION	MATL TYPE	CAL BLOCK NO
18" RHR (1)2	18	30	0.438	SA 106 GR B	C5	NA
10" RHR (5)2	10	40	0.365	SA 106 GR B	C5	NA


NO	DATE	REVISION	BY	CHKD	APPVD
2	9-16-81	REVISED AS NOTED	KMcA	DKP	APK
1	12-28-81	REVISED AS NOTED	KMcA	DKP	TPH
0	12-22-81	ISSUED FOR USE	KMcA	DKP	TPH
A	5-11-81	ISSUED FOR INFORMATION ONLY	KMcA	DKP	TPH



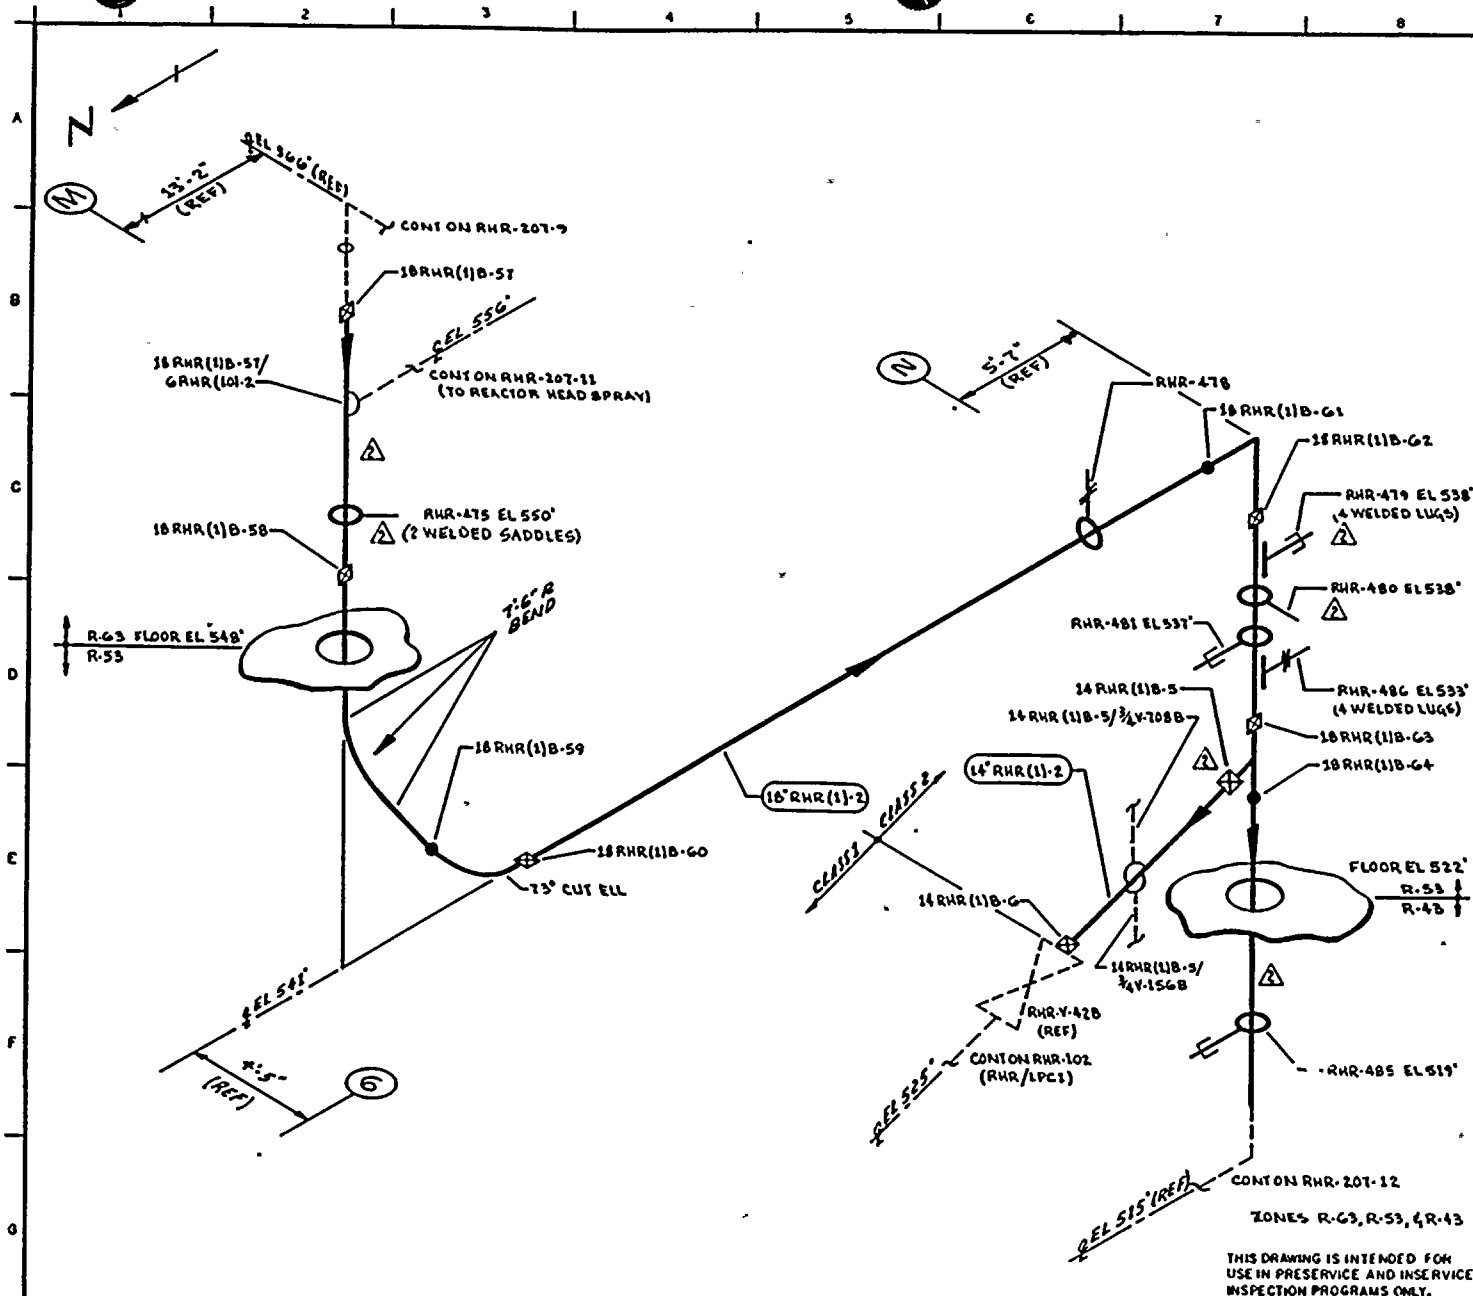

NOTES:

REFERENCES:
 DOVE & GRILL ISOMETRICS
 RHR-899-B.31 REV 6
 RHR-899-12.17 REV 9

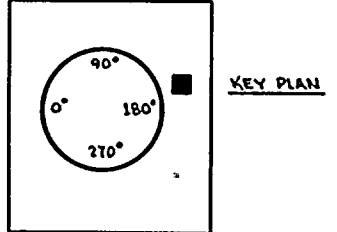

QUALITY CLASS: 1 ASME CODE CLASS: 2
 ENGR: GA KUGLER DRAWN: KMLA DATE: 6-12-78

WASHINGTON PUBLIC POWER SUPPLY SYSTEM
 RHR IN AND WASHINGTON 9927


THIS DRAWING IS INTENDED FOR USE IN PRESERVE AND INSERVICE INSPECTION PROGRAMS ONLY.

PIPING SYSTEM	NOM DIA (IN)	SCH	NOM WALL THK	MATERIAL SPECIFICATION	MATL TYPE	CAL BLOCK NO
18" RHR (1) 2	18	30	0.438	SA 106 GRB	CS	NA
14" RHR (1) 2	14	STD	0.375	SA 106 GRB	CS	NA

NO	DATE	REVISION	BY	CHKD	APPVD
2	10-11-83	REVISED AS NOTED	KMLA	IKR	TFH
1	12-2-81	REVISED AS NOTED	KMLA	IKR	TFH
0	12-28-78	ISSUED FOR USE	KMLA	IKR	TFH
A	9-11-78	ISSUED FOR INFORMATION ONLY	KMLA	IKR	TFH


WNP-2
 WELD B COMPONENT
 IDENTIFICATION DIAGRAM
 TITLE: RHR LOOP B
 SUPPLY FROM RHR-HX-1B
 DWG NO: RHR-207-10 REV 2



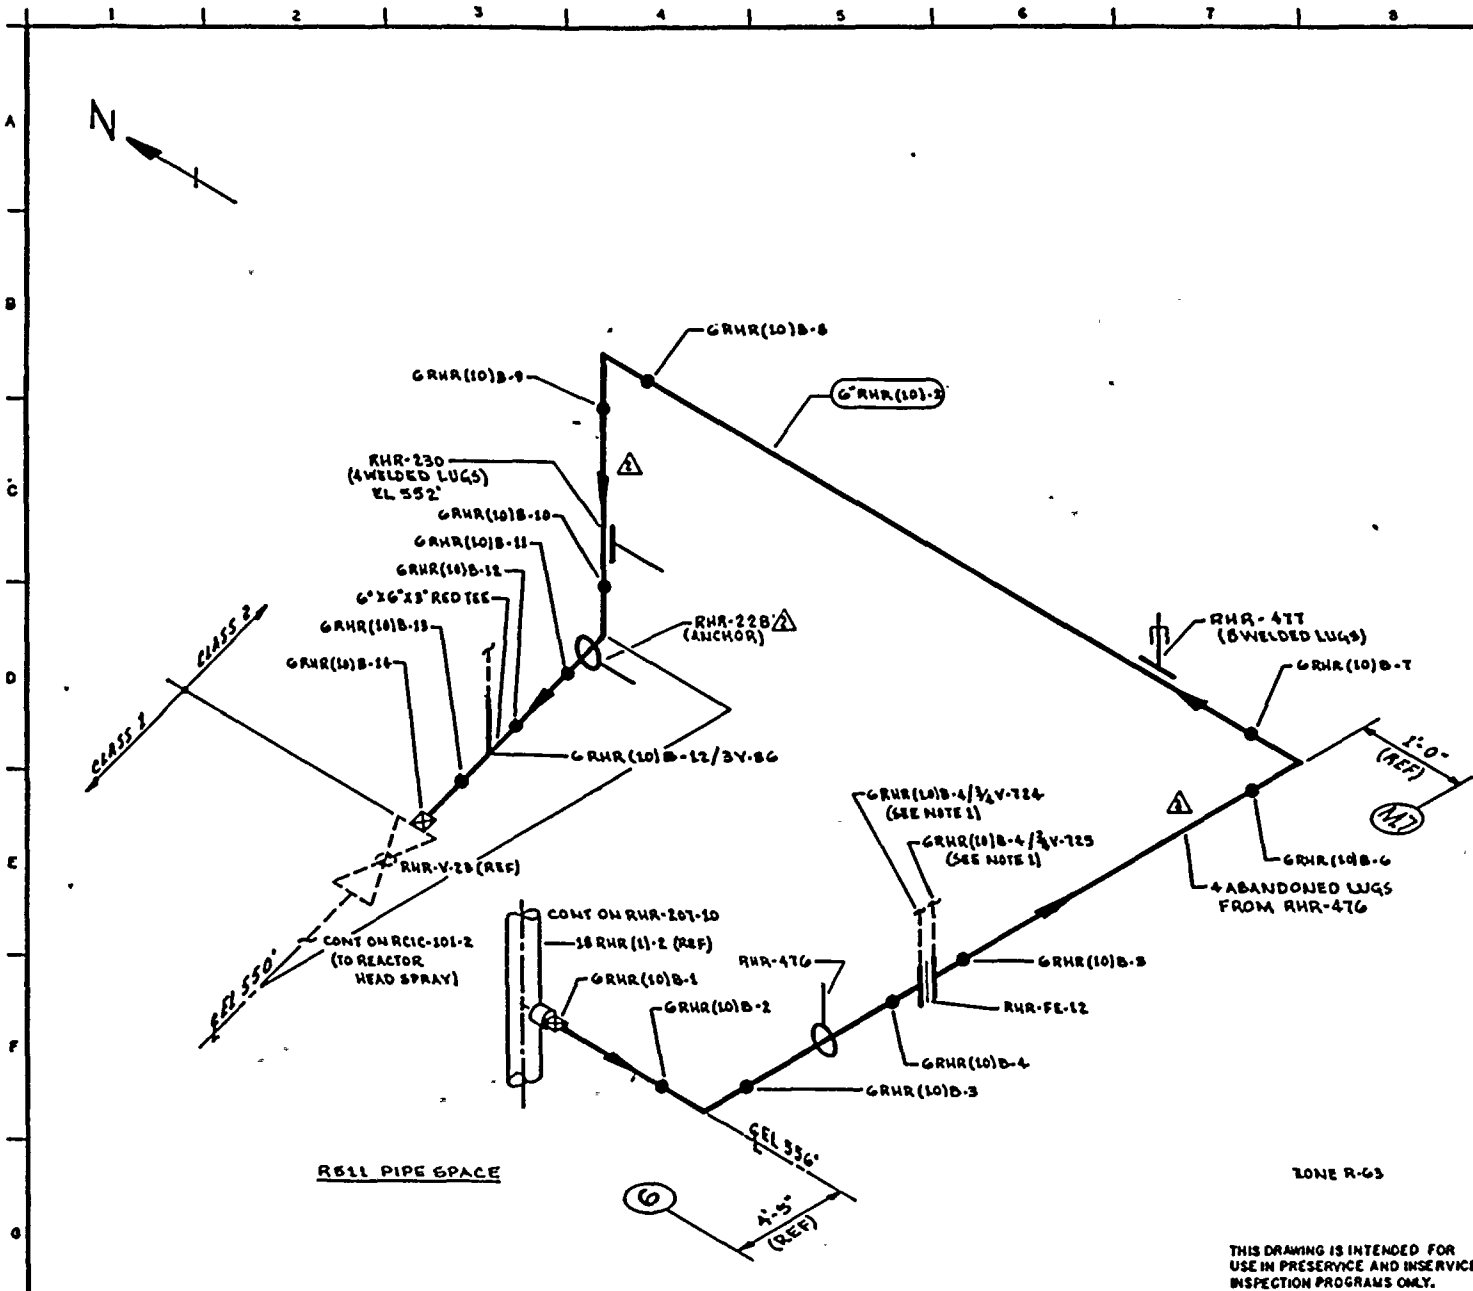

NOTES:
 1. THESE ARE 1/2" CONNECTIONS WITH VISUAL EXAM EXTENDING TO 3/4" V-724 & 3/4" V-725.

REFERENCES:
 BOVEE & CRAIL ISOMETRICS
 RHR-745-1.2 REV 7

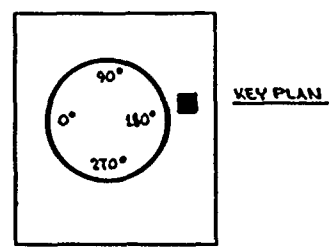

QUALITY CLASS: 1 | ASME CODE CLASS: 2
 ENGR: GA KUGLER | DRAWN: K, M, C, A | DATE: 6-12-76

WASHINGTON PUBLIC POWER SUPPLY SYSTEM
 RICHMOND, WASHINGTON 98352

THIS DRAWING IS INTENDED FOR USE IN PRESERVICE AND INSERVICE INSPECTION PROGRAMS ONLY.

PIPING SYSTEM	NOM DIA (IN)	SCH	NOM WALL THK	MATERIAL SPECIFICATION	MATL TYPE	CAL BLOCK NO
G" RHR (10) 2	6	40	0.280	SA 106 GR B	CG	NA


WNP-2
 WELD B COMPONENT
 IDENTIFICATION DIAGRAM

TITLE:
 RHR LOOP B
 REACTOR HEAD SPRAY SUPPLY

DWG NO: RHR-207-11 | REV 2


NO	DATE	REVISION	BY	CHKD	APPVD
2	9-21-81	REVISED AS NOTED	KMA	JPR	TFH
1	12-2-81	REVISED AS NOTED	KMA	JPR	TFH
0	11-18-77	ISSUED FOR USE	KMA	JPR	TFH
A	9-12-76	ISSUED FOR INFORMATION ONLY	KMA	JPR	TFH
NO					



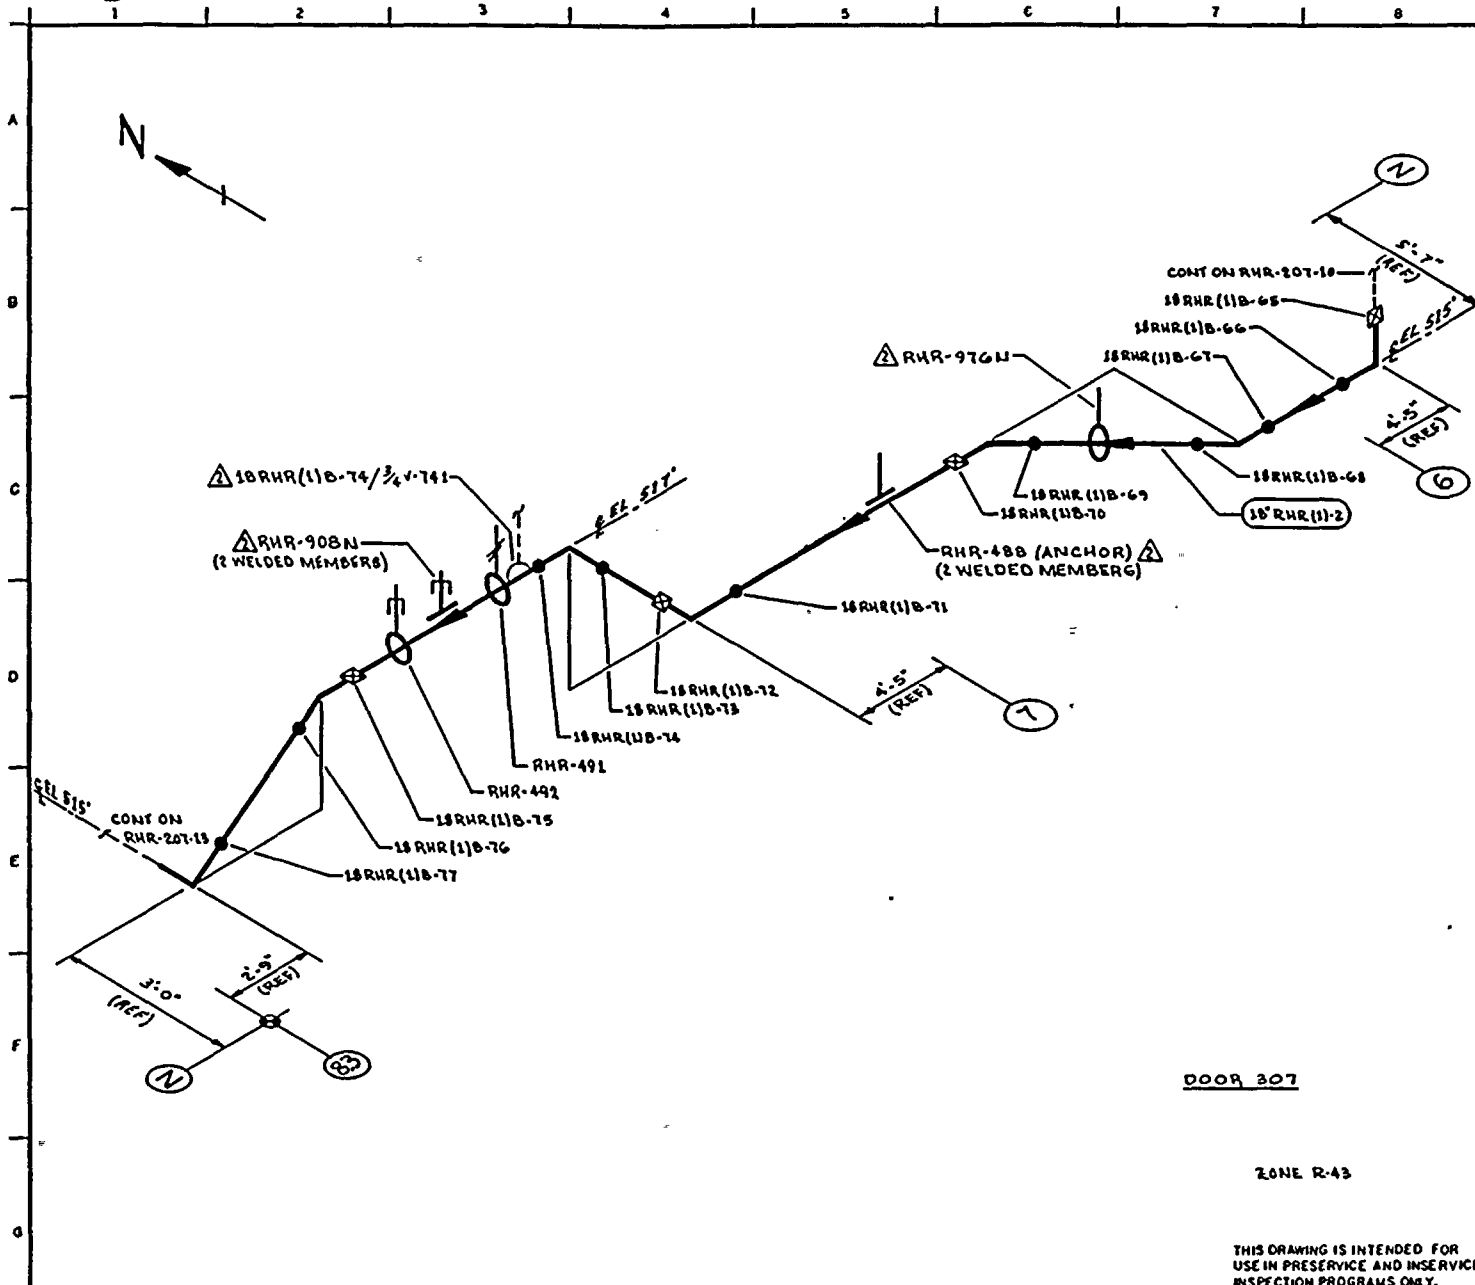

NOTES:

REFERENCES:
 BOVEE & CRAIG ISOMETRICS
 RHR-819-12.11 REV 7

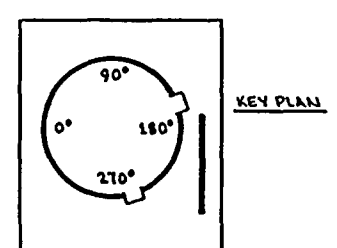

QUALITY CLASS: 1 ASME CODE CLASS: 2
 ENGR: CA KULLER DRAWN: K.M.A. DATE: 6-12-78

WASHINGTON PUBLIC POWER SUPPLY SYSTEM
 RICH AND WASHINGTON 99352

THIS DRAWING IS INTENDED FOR USE IN PRESERVICE AND INSERVICE INSPECTION PROGRAMS ONLY.

PIPING SYSTEM	NOM DIA (IN)	SCH	NOM WALL THK	MATERIAL SPECIFICATION	MATL TYPE	CAL BLOCK NO
18 RHR(1)-2	18	30	0.438	SA 106 GR B	CS	NA


NO	DATE	REVISION	BY	CHKD	APPVD
2	9-26-81	REVISED AS NOTED	K.M.A.	D.P.R.	T.H.
1	11-2-81	REVISED AS NOTED	K.M.A.	CH	T.H.
0	12-21-79	ISSUED FOR USE	K.M.A.	CH	T.H.
A	9-12-78	ISSUED FOR INFORMATION ONLY	K.M.A.	CH	T.H.

WNP-2, WELD 8 COMPONENT IDENTIFICATION DIAGRAM

TITLE:
 RHR LOOP B
 SUPPLY FROM RHR-HX-1B


DWG NO: RHR-207-12 REV 2



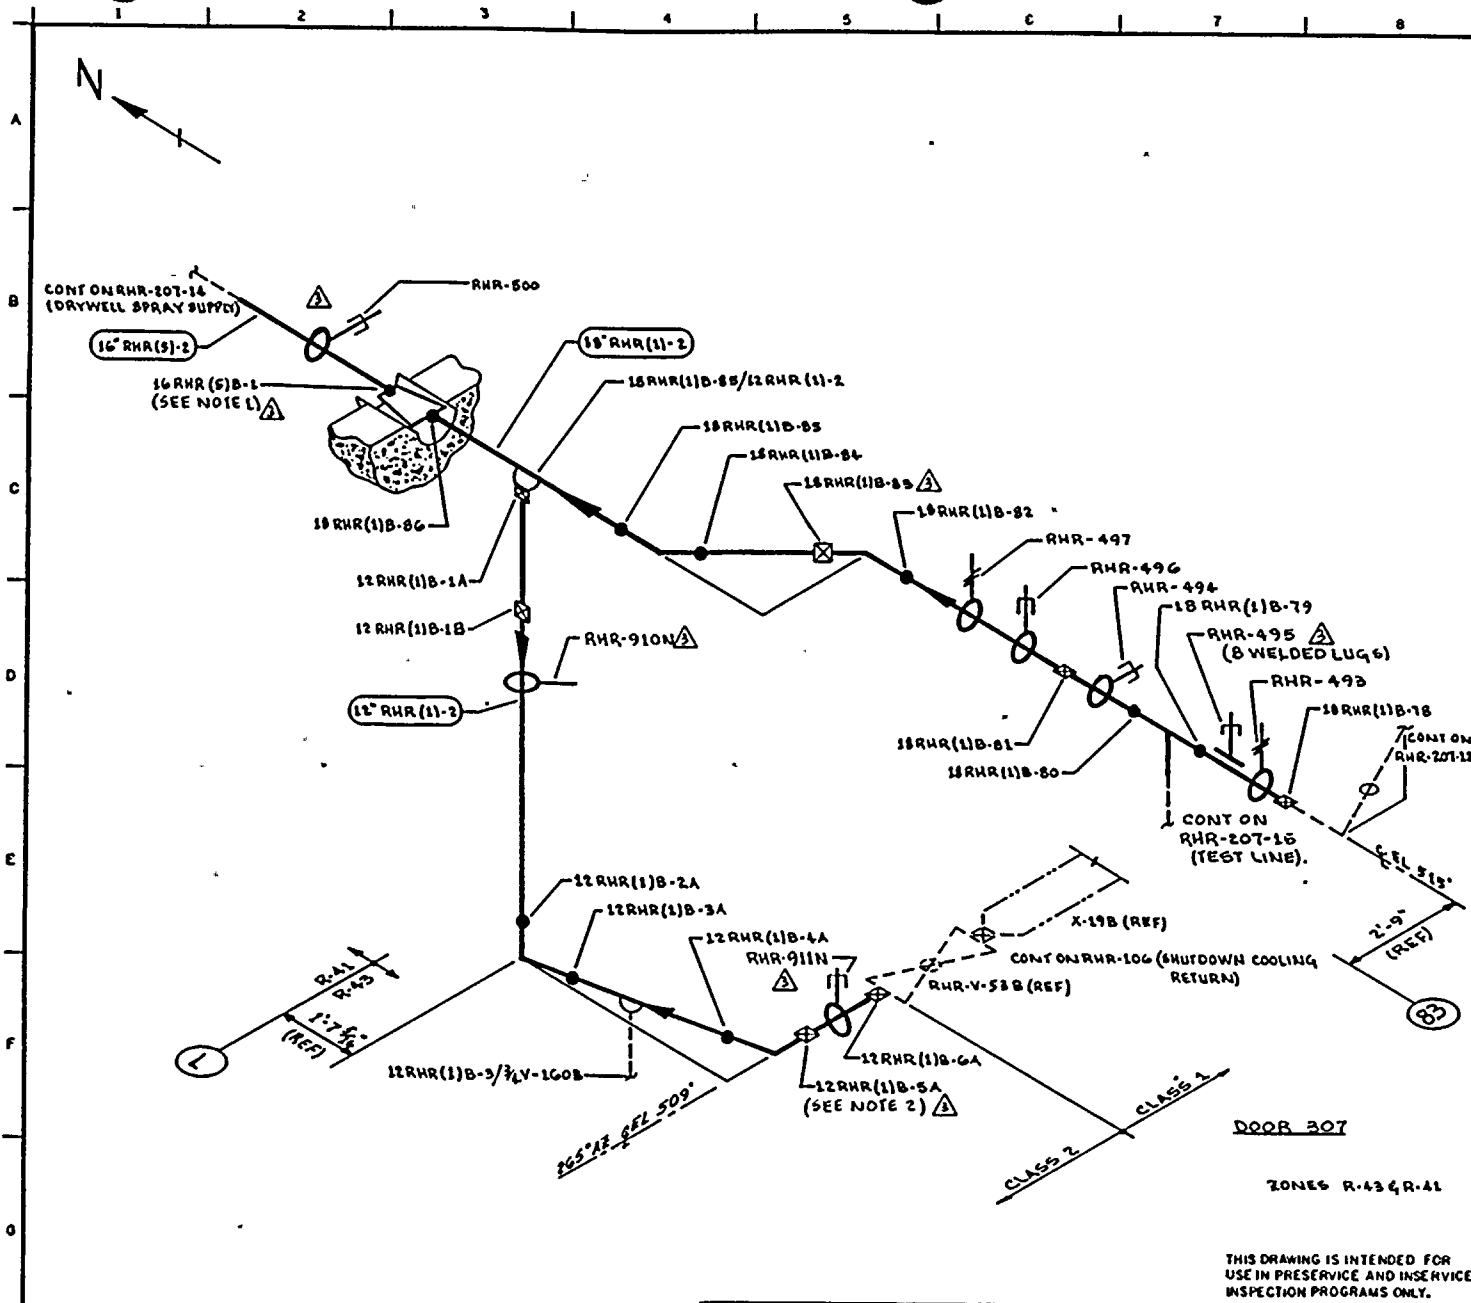

- NOTES:
- △ 1. ACCESS TO WELD 16RHR(5)B-1 REQUIRES REMOVAL OF RHR-500.
 - △ 2. ACCESS TO WELD 12RHR(1)B-6A REQUIRES REMOVAL OF RHR-911N.
 - △ 3. LADDER IS REQUIRED.

- REFERENCES:
- BOVEE & CRAIG ISOMETRICS
 - RHR-899-1B.19 REV 5
 - RHR-899-45 REV 4

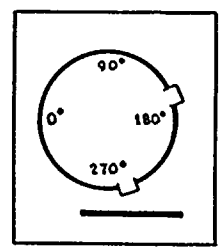

QUALITY CLASS: 1 ASME CODE CLASS: 2
 ENGR: GA KUGLER DRAWN: K-MCA DATE: 6-13-78



THIS DRAWING IS INTENDED FOR USE IN PRESERVICE AND INSERVICE INSPECTION PROGRAMS ONLY.


NO	DATE	REVISION	BY	CHKD	APPVD	PIPING SYSTEM	NOM DIA (IN)	SCH	NOM WALL THK	MATERIAL SPECIFICATION	MATL TYPE	CAL BLOCK NO
3	9-26-81	REVISED AS NOTED	K/MCA	JFK	JFK	18" RHR(1)B-2	18	30	0.478	SA 106 GR B	CS	NA
2	12-2-81	REVISED AS NOTED & WELD NITS ON 12" RHR(1)B-2	K/MCA	WJ	JFK	16" RHR(5)B-2	16	40	0.500	SA 106 GR B	CS	NA
1	11-5-80	ADDED FIELD WELD 12RHR(1)B-1A & AS NOTED	K/MCA	JFK	JFK	12" RHR(1)B-2	12	STD	0.315	SA 106 GR B	CS	NA
0	12-23-78	ISSUED FOR USE	K/MCA	JFK	JFK							
1	9-12-78	ISSUED FOR INFORMATION ONLY	K/MCA	JFK	JFK							

WNP-2
 WELD B COMPONENT
 IDENTIFICATION DIAGRAM

TITLE: RHR LOOP B
 SUPPLY FROM RHR-HX-1B
 & SHUTDOWN COOLING RETURN


DWG NO: RHR-207-13 REV 3



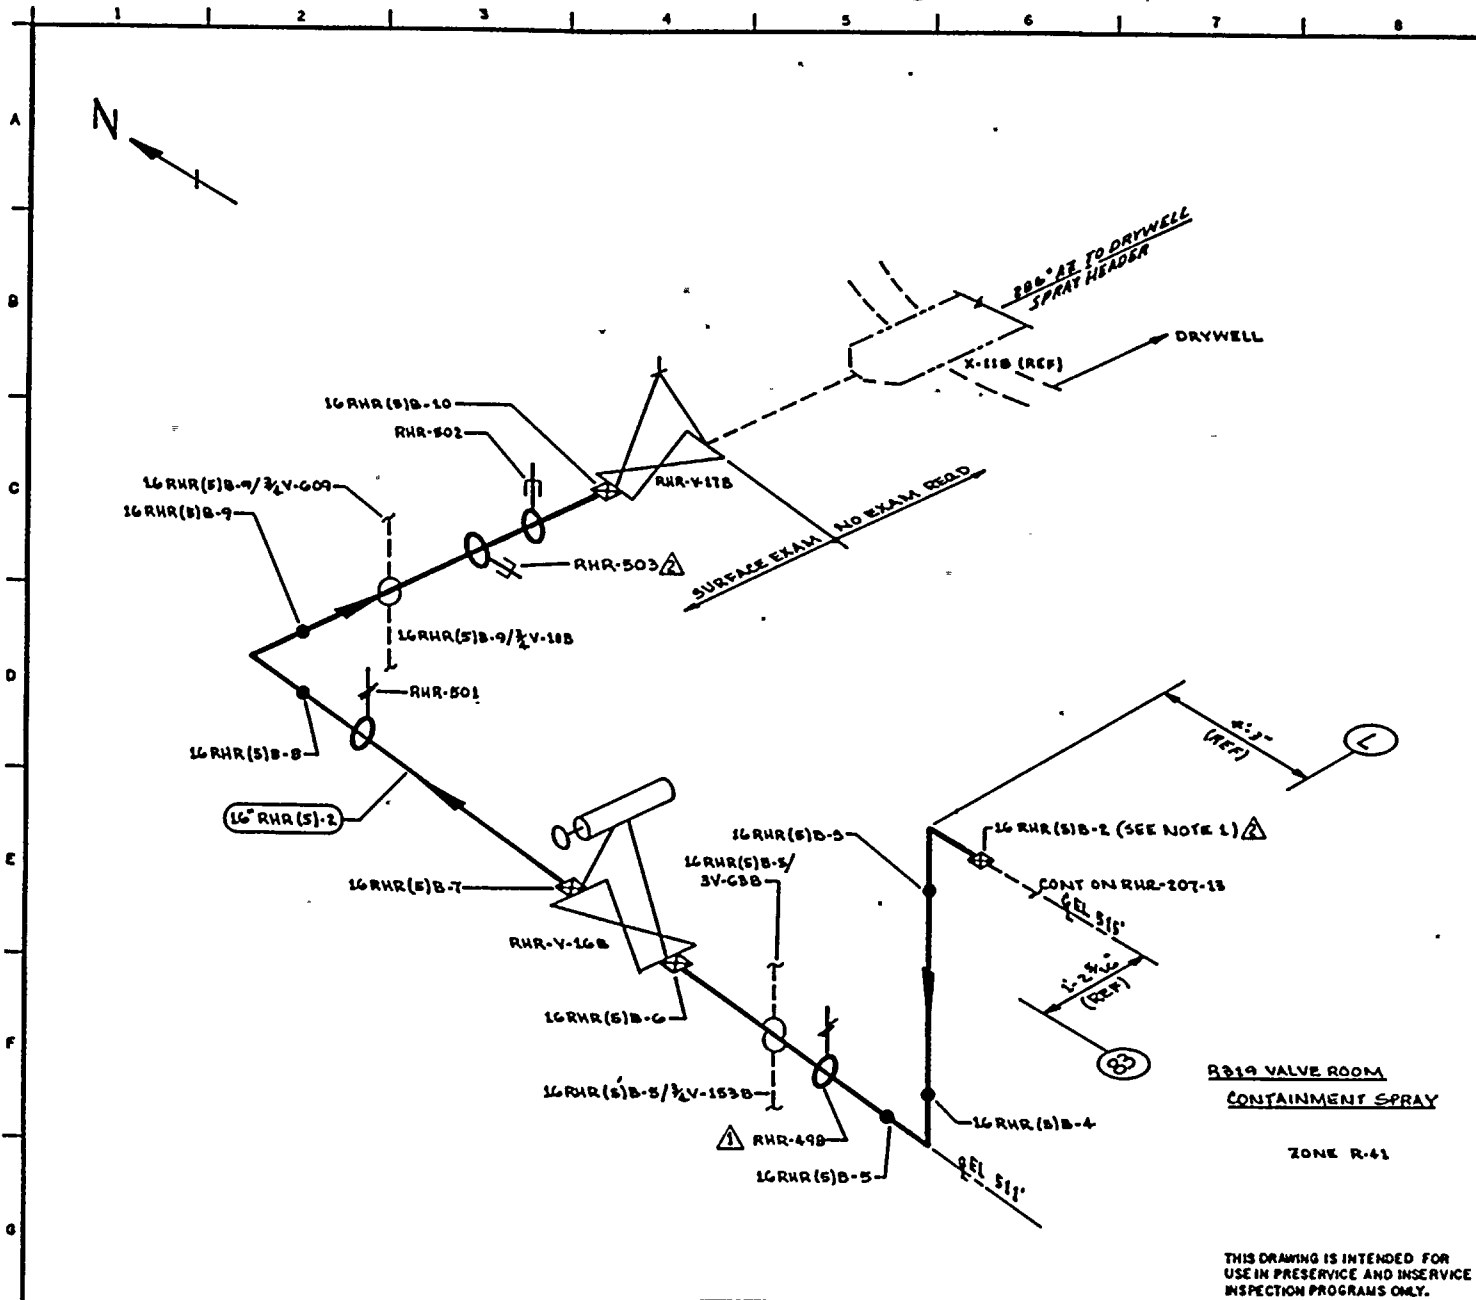

NOTES:
 1. ACCESS TO WELD 16RHR(5)B-2 REQUIRES REMOVAL OF RHR-500.
 2. LADDER IS REQUIRED.

REFERENCES:
 BOYCE & CRAIG ISOMETRICS
 RHR-899-20-22 REV 7

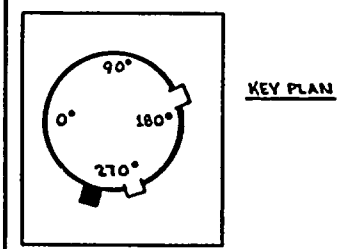

QUALITY CLASS: 1 ASME CODE CLASS: 2
 ENGR: GA KUGLER DRAWN: K-McA DATE: 6-14-78

WASHINGTON PUBLIC POWER SUPPLY SYSTEM
 RICHLAND, WASHINGTON 98362


THIS DRAWING IS INTENDED FOR USE IN PRESERVICE AND INSERVICE INSPECTION PROGRAMS ONLY.

PIPING SYSTEM	NOM DIA (DN)	SCH	NOM WALL THK	MATERIAL SPECIFICATION	MATL TYPE	CAL BLOCK NO
16RHR(5)B-2	16	40	0.500	SA 106 GRB	CS	N/A

NO	DATE	REVISION	BY	CHKD	APPVD
2	9-25-83	REVISED AS NOTED	KMcA	ZPK	TJK
1	10-20-81	REVISED AS NOTED	KMcA	ZPK	TJK
0	10-20-78	ISSUED FOR USE	KMcA	ZPK	TJK
1	9-12-78	ISSUED FOR INFORMATION ONLY	KMcA	SWK	QWP


WNP-2 WELD B COMPONENT IDENTIFICATION DIAGRAM
 TITLE: RHR LOOP B DRYWELL SPRAY SUPPLY
 DWG NO: RHR-207-14 REV 2



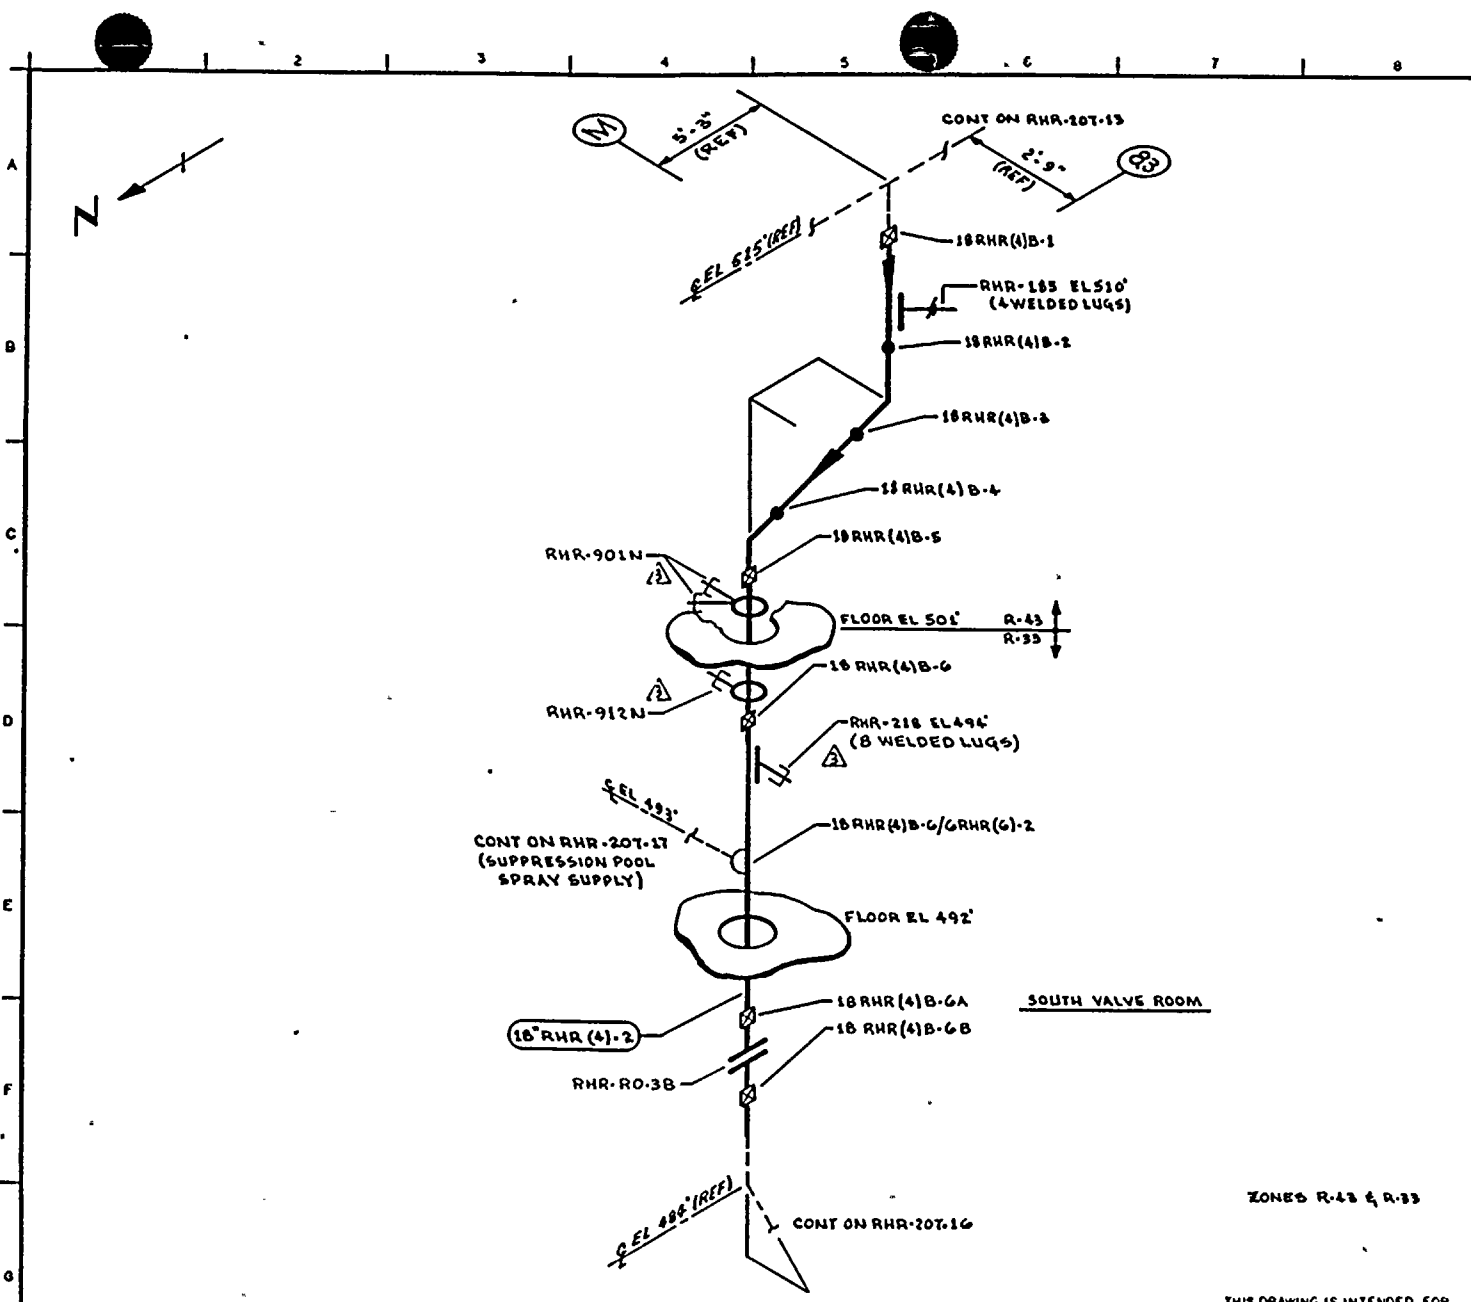

NOTES:

REFERENCE:
DOVE & CRAIL ISOMETRICS
RHR-970-1.4 REV 11

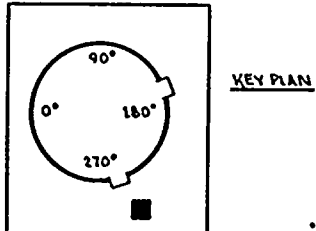

QUALITY CLASS: 1 ASME CODE CLASS: 2
ENGR G.A. KUGLER DRAWN: K.M.C.A. DATE: 6-13-78

WASHINGTON PUBLIC POWER SUPPLY SYSTEM
P.O. BOX 100 WASHINGTON, D.C. 20002


THIS DRAWING IS INTENDED FOR USE IN PRESERVICE AND INSERVICE INSPECTION PROGRAMS ONLY.


NO	DATE	REVISION	BY	CHKD	APPRD	PIPING SYSTEM	NOM DIA (DN)	SCH	NOM WALL THK	MATERIAL SPECIFICATION	MATL TYPE	CAL BLOCK NO
3	9-26-83	REVISED AS NOTED	KMcA	SPK	JFH	18" RHR(4)-2	18	30	0.438	SA 106 GR B	CS	NA
2	12-2-81	REVISED AS NOTED	KMcA	SPK	JFH							
1	11-5-80	ADDED FLG & FW 18 RHR(4)B-6A & 6B (AS NOTED)	KMcA	SPK	JFH							
0	12-22-79	ISSUED FOR USE	KMcA	SPK	JFH							
1	9-22-78	ISSUED FOR INFORMATION ONLY	KMcA	SPK	JFH							

WNP-2
WELD & COMPONENT
IDENTIFICATION DIAGRAM

TITLE: RHR LOOP B
TEST LINE

DWG NO: RHR-207-15 REV 3

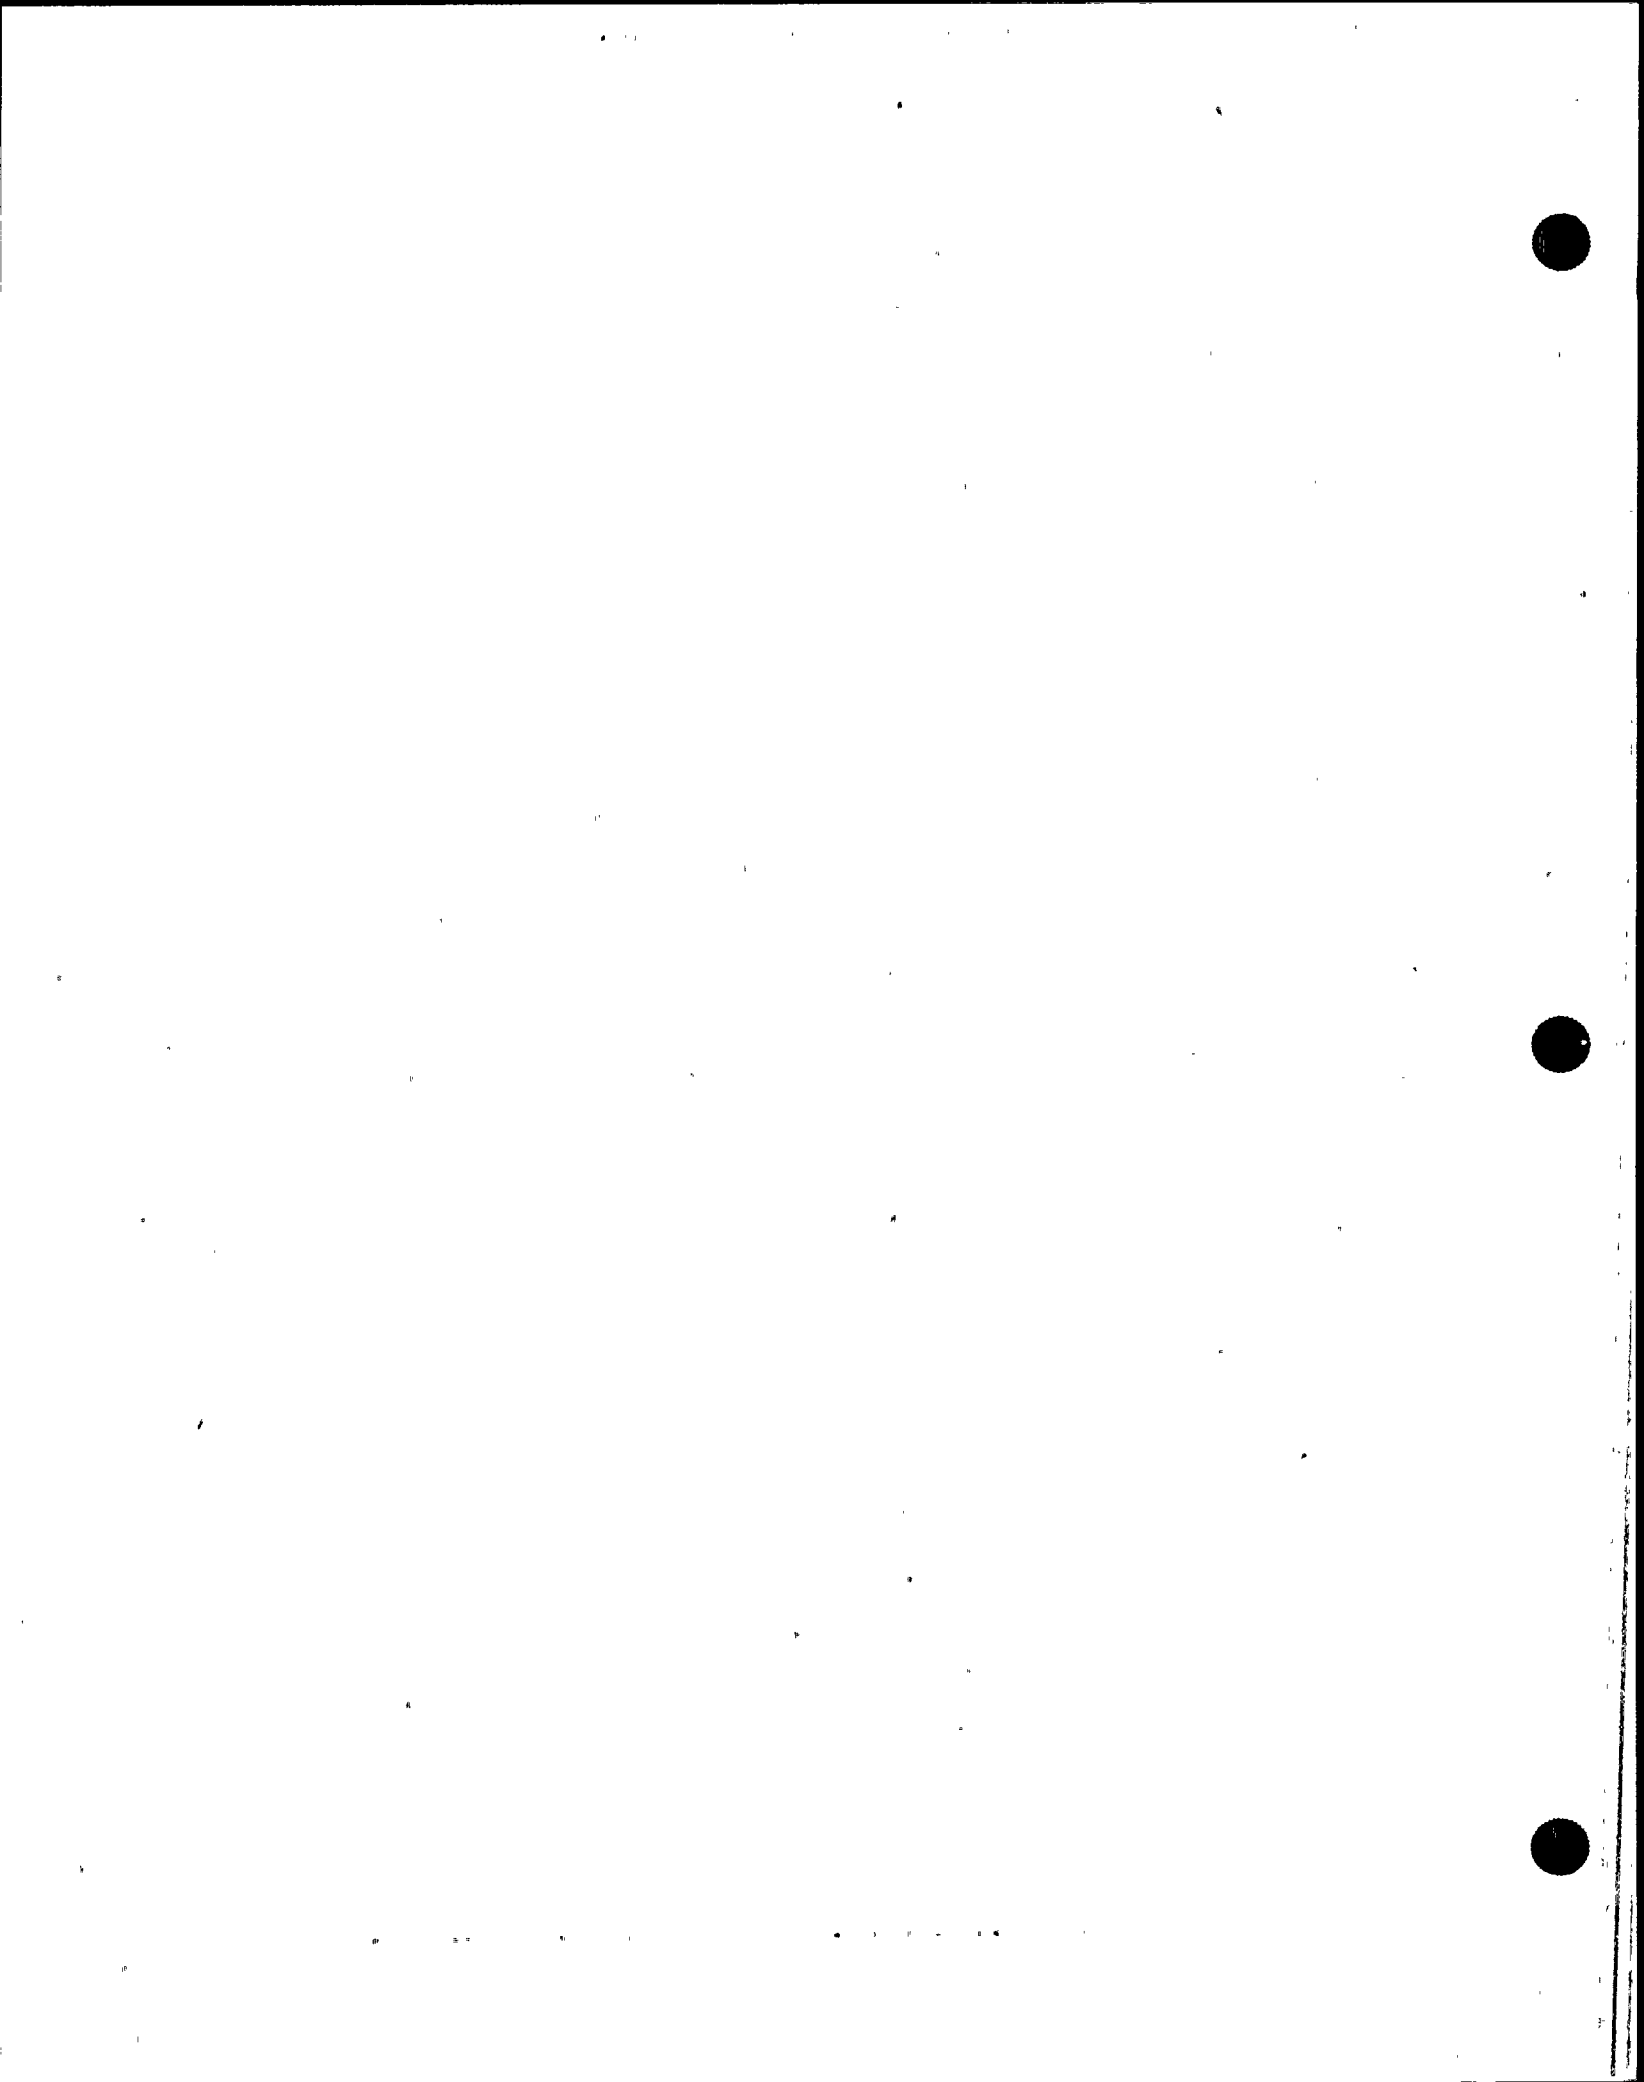


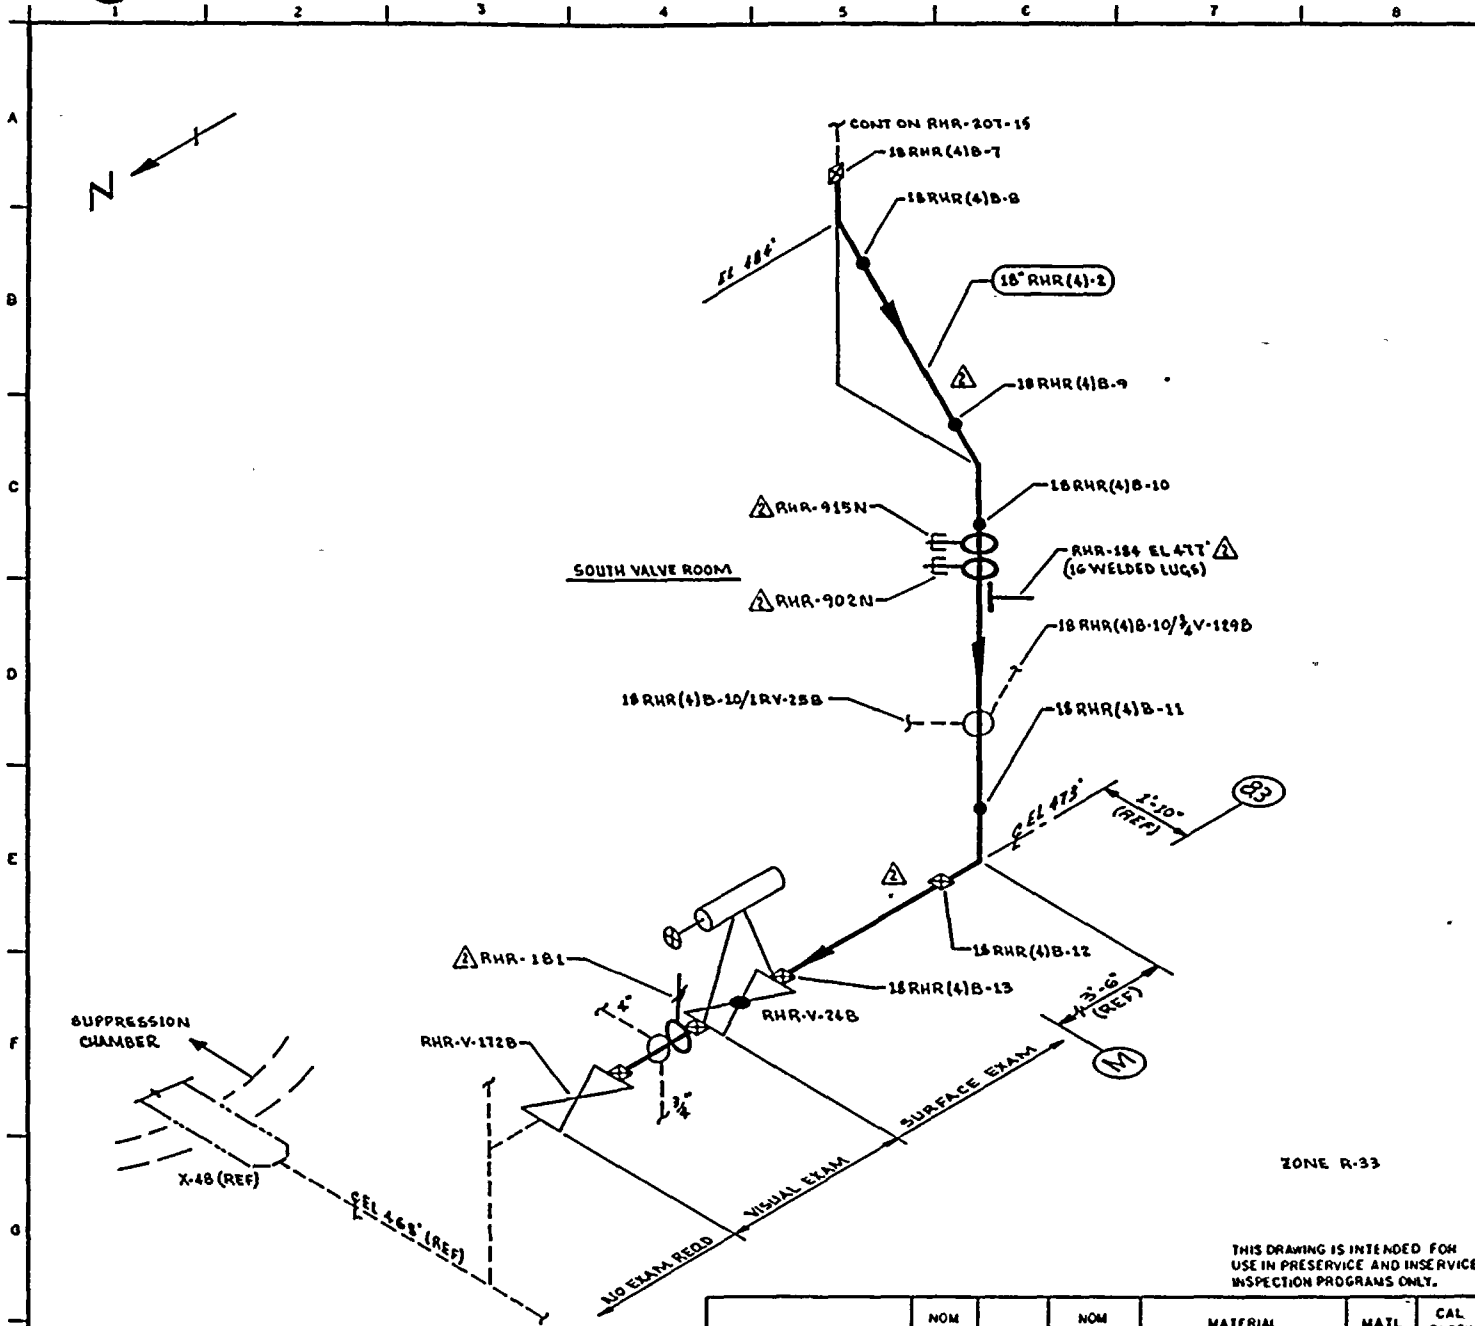

- NOTES:
1. PORTIONS OF THIS DRAWING IDENTIFY PIPING & COMPONENTS THAT ARE SUBJECT ONLY TO A VISUAL EXAM FOR EVIDENCE OF LEAKAGE DURING SYSTEM HYDRO OR OPERABILITY TESTS. TESTS ARE TO BE CONDUCTED PER THE REQUIREMENTS OF ASME SECTION XI, PARAGRAPH IWA-5000.
 2. FOR BRANCH PIPING 4" DIA OR LESS (CONNS SHOWN IN DASHED LINES) EXTEND VISUAL LEAKAGE EXAM THROUGH THE NORMALLY CLOSED NUCLEAR CLASS VALVE OR UNTIL TRANSITION TO INSTRUMENT TUBING, UNLESS OTHERWISE NOTED.
 3. SCAFFOLDING IS REQUIRED.

REFERENCES:

BOVEE & CRAIG ISOMETRICS
 RHR-976-1.4 REV 11
 RHR-976-5.6 REV 5

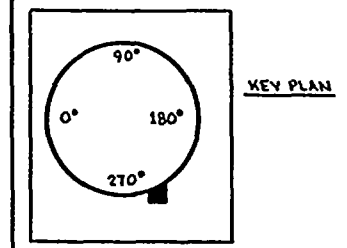

QUALITY CLASS: 1 ASME CODE CLASS: 2
 ENGR: GA KUGLER DRAWN: K. M. A DATE: 6-14-78

WASHINGTON PUBLIC POWER SUPPLY SYSTEM
 NICH AND WASHINGTON 9182

THIS DRAWING IS INTENDED FOR USE IN PRESERVICE AND INSERVICE INSPECTION PROGRAMS ONLY.


PIPING SYSTEM	NOM DIA (IN)	SCH	NOM WALL THK	MATERIAL SPECIFICATION	MATL TYPE	CAL BLOCK NO
18" RHR (4) B-2	18	30	0.438	SA-106 GR B	C6	NA

WNP-2 WELD & COMPONENT IDENTIFICATION DIAGRAM

TITLE: RHR LOOP B TEST LINE


DWG NO: RHR-207-16 REV 2

NO	DATE	REVISION	BY	CHKD	APPVD
2	9-26-83	REVISED AS NOTED	KUA	RFR	TEN
1	12-2-81	REVISED AS NOTED	KUA	DR	TEN
0	11-22-78	ISSUED FOR USE	KUA	DR	TEN
1	9-12-78	ISSUED FOR INFORMATION ONLY	KUA	DR	TEN

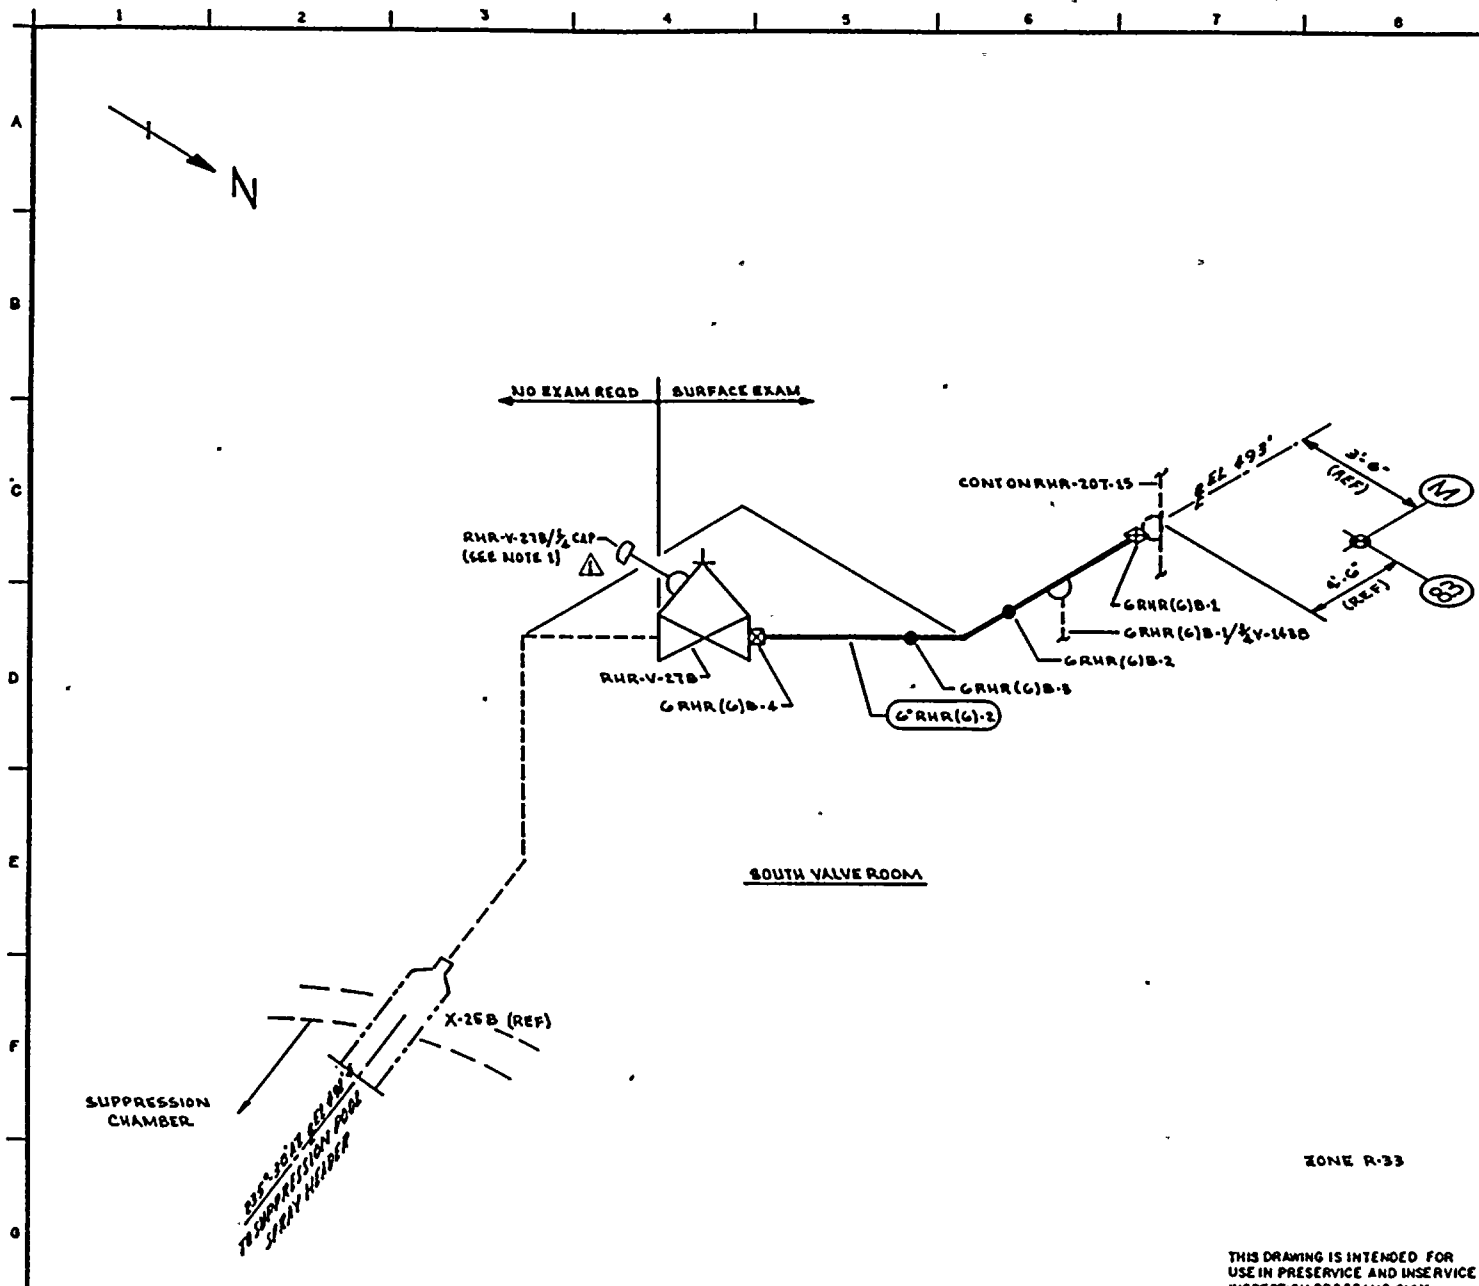

NOTES:
 1. THIS IS A 1/2" CONNECTION WITH VISUAL EXAM EXTENDING TO 1/2" CAP. Δ

REFERENCES:
 BOVES & CRAIL ISOMETRIC
 RHR-976-T.B REV 0

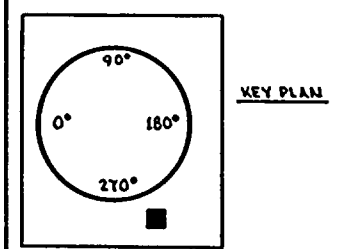

QUALITY CLASS: 1 ASME CODE CLASS: 2
 ENGR: GA KUGLER DRAWN: K-McA DATE: 6-14-78

WASHINGTON PUBLIC POWER SUPPLY SYSTEM
 RICHLAND, WASHINGTON 99302

THIS DRAWING IS INTENDED FOR USE IN PRESERVICE AND INSERVICE INSPECTION PROGRAMS ONLY.

PIPING SYSTEM	NOM DIA (IN)	SCH	NOM WALL THK	MATERIAL SPECIFICATION	MATL TYPE	CAL BLOCK NO
G ^o RHR(G)-2	6	40	0.280	SA 106 GR B	CG	NA

NO	DATE	REVISION	BY	CHKD	APPVD
1	9-22-78	CAPPED LEAK-OFF CONNECTION	KMcA	DKR	THA
0	12-11-78	ISSUED FOR USE	KMcA	DKR	ZBB
A	9-12-78	ISSUED FOR INFORMATION ONLY	KMcA	BAK	GLB

WNP-2
 WELD B COMPONENT
 IDENTIFICATION DIAGRAM

TITLE:
 RHR LOOP B
 SUPPRESSION SPRAY SUPPLY

DWG NO: RHR-207-17 REV 1



WNP-02
 INTERVAL: PSI
 PERIOD: NA
 OUTAGE:
 DRAWING NO. RHR-207

WASHINGTON PUBLIC POWER SUPPLY SYSTEM
 PROGRAM PLAN AND SCHEDULE
 SYSTEM OR COMPONENT: RHR(1)2
 DESCRIPTION: LOOP B SPLY-RHR HX1B

PAGE 001
 DATE 12/14/84

IDENT. NO.	DESCRIPTION	SECT. XI EXAM.	EXAM MTH.	PROCEDURE	CAL. BLOCK	INSERVICE		NOTES
						REQ.	SCHEDULED OUTAGE	
14RHR(1)B-1	FLANGE TO PIPE	C-F	SUR	PTP-1				
14RHR(1)B-2	PIPE TO EL	C-F	SUR	PTP-1				
14RHR(1)B-3	EL TO PIPE	C-F	SUR	PTP-1				
14RHR(1)B-4	PIPE TO REDUCER	C-F	SUR	PTP-1				
18RHR(1)B-1	REDUCER TO PIPE	C-F	SUR	PTP-1				
RHR-923N	SPRING	C-E-2	VT-3	303/8.2.17				
			VT-4	303/8.2.17				
18RHR(1)B-2	PIPE TO EL	C-F	SUR	PTP-1				
18RHR(1)B-3	EL TO PIPE	C-F	SUR	PTP-1				
PHR-943N	PSA-3 SNUBBER	C-E-2	VT-3	303/8.2.17				S/N 3900
			VT-4	303/8.2.17				S/N 3900
RHR-944N	PSA-3 SNUBBER	C-E-2	VT-3	303/8.2.17				S/N 4411
			VT-4	303/8.2.17				S/N 4411
RHR-918N(W)	8 WELDED LUGS	C-E-1	SUR	QCI 4-3				
RHR-918N	BOX	C-E-2	VT-3	303/8.2.17				
RHR-926N	SPRING	C-E-2	VT-3	303/8.2.17				
			VT-4	303/8.2.17				
18RHR(1)B-4	PIPE TO EL	C-F	SUR	PTP-1				

WNP-02
 INTERVAL: PSI
 PERIOD: NA
 OUTAGE:
 DRAWING NO. RHR-207

WASHINGTON PUBLIC POWER SUPPLY SYSTEM
 PROGRAM PLAN AND SCHEDULE
 SYSTEM OR COMPONENT: RHR(1)2
 DESCRIPTION: LOOP B SPLY-RHR HX1B

PAGE 002
 DATE 12/14/84

IDENT. NO.	DESCRIPTION	SECT. XI EXAM.	EXAM MTH.	PROCEDURE	CAL. BLOCK	INSERVICE		NOTES
						REQ.	SCHEDULED OUTAGE	
18RHR(1)B-5	EL TO PIPE	C-F	SUR	PTP-1				
RHR-929N	SPRING	C-E-2	VT-3	303/8.2.17				
			VT-4	303/8.2.17				
18RHR(1)B-6	PIPE TO EL	C-F	SUR	PTP-1				
18RHR(1)B-7	EL TO PIPE	C-F	SUR	PTP-1				
18RHR(1)B-7/6RHR(7)-2	BRANCH CONN	C-F	SUR	PTP-1				
RHR-919N	BOX	C-E-2	VT-3	303/8.2.17				
18RHR(1)B-7/3/4CAP	CAPPED CONN	N/A	VT-2	N/A				IWC-2510, SEE NOTES #6 & #7.
18RHR(1)B-7/3/4V-704B	INST CONN	N/A	VT-2	N/A				IWC-2510, SEE NOTES #6 & #7.
18RHR(1)B-8	PIPE TO VALVE	C-F	SUR	PTP-1				
18RHR(1)B-9	VALVE TO PIPE	C-F	SUR	PTP-1				
18RHR(1)B-9/1-1/2V-84B	CROSSTIE CONN	N/A	VT-2	N/A				IWC-2510, SEE NOTES #6 & #7.
18RHR(1)B-10	PIPE TO VALVE	C-F	SUR	PTP-1				
18RHR(1)B-11	VALVE TO PIPE	C-F	SUR	PTP-1				
18RHR(1)B-11/3V-72B	FLUSH CONN	N/A	VT-2	N/A				IWC-2510, SEE NOTES #6 & #7.

WNP-02
 INTERVAL: PSI
 PERIOD: NA
 OUTAGE:
 DRAWING NO. RHR-207

WASHINGTON PUBLIC POWER SUPPLY SYSTEM
 PROGRAM PLAN AND SCHEDULE
 SYSTEM OR COMPONENT: RHR(1)2
 DESCRIPTION: LOOP B SPLY-RHR HX1B

PAGE 003
 DATE 12/14/84

IDENT. NO.	DESCRIPTION	SECT. XI EXAM.	EXAM MTH.	PROCEDURE	CAL. BLOCK	INSERVICE		NOTES
						REQ.	SCHEDULED OUTAGE	
18RHR(1)B-11/3/4V-705B	INSTR CONN	N/A	VT-2	N/A				IWC-2510, SEE NOTES #6 & #7.
RHR-920N	BOX	C-E-2	VT-3	303/8.2.17				
RHR-924N	SPRING	C-E-2	VT-3	303/8.2.17				
			VT-4	303/8.2.17				
RHR-924N(W)	4 WELDED LUGS	C-E-1	SUR	MTP-1				
18RHR(1)B-12	PIPE TO EL	C-F	SUR	QCI 3-3				
18RHR(1)B-13	EL TO PIPE	C-F	SUR	PTP-1				
18RHR(1)B-14	PIPE TO EL	C-F	SUR	PTP-1				
18RHR(1)B-15	EL TO PIPE	C-F	SUR	PTP-1				
RHR-921N	BOX	C-E-2	VT-3	303/8.2.17				
RHR-968N	ANCHOR	C-E-2	VT-3	303/8.2.17				
18RHR(1)B-16	PIPE TO PIPE	C-F	SUR	PTP-1				
18RHR(1)B-17	PIPE TO PIPE	C-F	SUR	PTP-1				
RHR-540	STRUT	C-E-2	VT-3	303/8.2.17				
RHR-539	STRUT	C-E-2	VT-3	303/8.2.17				
18RHR(1)B-18	PIPE TO PIPE	C-F	SUR	PTP-1				
RHR-548	PSA-1 SN(2)	C-E-2	VT-3	303/8.2.17				S/N 630/503

WNP-02
 INTERVAL: PSI
 PERIOD: NA
 OUTAGE:
 DRAWING NO. RHR-207

WASHINGTON PUBLIC POWER SUPPLY SYSTEM
 PROGRAM PLAN AND SCHEDULE
 SYSTEM OR COMPONENT: RHR(1)2
 DESCRIPTION: LOOP B SPLY-RHR_HX1B

PAGE 004
 DATE 12/14/84

IDENT. NO.	DESCRIPTION	SECT. XI EXAM.	EXAM MTH.	PROCEDURE	CAL. BLOCK	INSERVICE		NOTES
						REQ.	SCHEDULED OUTAGE	
			VT-4	303/8.2.17				S/N 630/503
18RHR(1)B-19	PIPE TO TEE	C-F	SUR	PTP-1				
18RHR(1)B-20	TEE TO PIPE	C-F	SUR	PTP-1				
18RHR(1)B-21	PIPE TO PIPE	C-F	SUR	PTP-1				
RHR-551	PSA-3 SN(2)	C-E-2	VT-3	303/8.2.17				S/N 3914/3940
			VT-4	303/8.2.17				S/N 3914/3940
18RHR(1)B-22	PIPE TO EL	C-F	SUR	PTP-1				
18RHR(1)B-23	EL TO PIPE	C-F	SUR	PTP-1				
18RHR(1)B-24	PIPE TO EL	C-F	SUR	PTP-1				
18RHR(1)B-25	EL TO PIPE	C-F	SUR	PTP-1				
RHR-553	STRUT	C-E-2	VT-3	303/8.2.17				
RHR-552	STRUT	C-E-2	VT-3	303/8.2.17				
18RHR(1)B-26	PIPE TO VALVE	C-F	SUR	PTP-1				
18RHR(1)B-27	VALVE TO PIPE	C-F	SUR	PTP-1				
RHR-554	STRUT	C-E-2	VT-3	303/8.2.17				
18RHR(1)B-28	PIPE TO EL	C-F	SUR	PTP-1				
18RHR(1)B-29	EL TO PIPE	C-F	SUR	PTP-1				
RHR-555	SPRING	C-E-2	VT-3	303/8.2.17				

WNP-02
 INTERVAL: PSI
 PERIOD: NA
 OUTAGE:
 DRAWING NO. RHR-207

WASHINGTON PUBLIC POWER SUPPLY SYSTEM
 PROGRAM PLAN AND SCHEDULE
 SYSTEM OR COMPONENT: RHR(1)2
 DESCRIPTION: LOOP R SPLY-RHR HX1B

PAGE 005
 DATE 12/14/84

IDENT. NO.	DESCRIPTION	SECT. XI EXAM.	EXAM MTH.	PROCEDURE	CAL. BLOCK	INSERVICE		NOTES
						REQ.	SCHEDULED OUTAGE	
RHR-555(W)			VT-4	303/8.2.17				
18RHR(1)B-30	4 WELDED LUGS	C-E-1	SUR	QCI 4-3				
18RHR(1)B-31	PIPE TO EL	C-F	SUR	PTP-1				
RHR-1002N	EL TO PIPE	C-F	SUR	PTP-1				
	PSA-3 SN(2)	C-E-2	VT-3	303/8.2.17				S/N 4495/4418
RHR-556			VT-4	303/8.2.17				S/N 4495/4418
	PSA-3 SNUBBER	C-E-2	VT-3	303/8.2.17				S/N 3920
RHR-980N			VT-4	303/8.2.17				S/N 3920
	PSA-3 SNUBBER	C-E-2	VT-3	303/8.2.17				S/N 11850
18RHR(1)B-32			VT-4	303/8.2.17				S/N 11850
18RHR(1)B-33	PIPE TO EL	C-F	SUR	PTP-1				
18RHR(1)B-34	EL TO PIPE	C-F	SUR	PTP-1				
18RHR(1)B-35	PIPE TO TEE	C-F	SUR	PTP-1				
18RHR(1)B-36	TEE TO PIPE	C-F	SUR	PTP-1				
18RHR(1)B-36/5/4TE-N004R	PIPE TO REDUCER	C-F	SUR	QCI 3-3				
20RHR(1)B-1	INST CONN	N/A	VT-2	N/A				
	REDUCER TO PIPE	C-F	SUR	QCI 3-3				

IWC-2510, SEE NOTES
 #6 & #7.

WNP-02
 INTERVAL: PSI
 PERIOD: NA
 OUTAGE:
 DRAWING NO. RHR-207

WASHINGTON PUBLIC POWER SUPPLY SYSTEM
 PROGRAM PLAN AND SCHEDULE
 SYSTEM OR COMPONENT: RHR(1)2
 DESCRIPTION: LOOP B SPLY-RHR HX1R

PAGE 006
 DATE 12/14/84

IDENT. NO.	DESCRIPTION	SECT. YI EXAM.	EXAM MTH.	PROCEDURE	CAL. BLOCK	INSERVICE		NOTES
						REQ.	SCHEDULED OUTAGE	
20RHR(1)B-2	PIPE TO NOZZLE	C-F	SUR	PTP-1				
6RHR(7)B-1	WOL TO PIPE	C-F	SUR	PTP-1				
6RHR(7)B-1/3/4V-144B	TEST CONN	N/A	VT-2	N/A				IWC-2510, SEE NOTES #6 & #7.
6RHR(7)B-2	PIPE TO REDUCER	C-F	SUR	PTP-1				
6RHR(7)B-3	REDUCER TO PIPE	C-F	SUR	PTP-1				
6RHR(7)B-3/3/4V-145B	TEST CONN	N/A	VT-2	N/A				IWC-2510, SEE NOTES #6 & #7.
RHR-928N	SPRING	C-E-2	VT-3	303/8.2.17				
			VT-4	303/8.2.17				
6RHR(7)B-4	PIPE TO EL	C-F	SUR	PTP-1				
6RHR(7)B-5	EL TO RO-18	C-F	SUR	PTP-1				
RHR-942N	PSA-1 SN(2)	C-E-2	VT-3	303/8.2.17				S/N N371/S609
			VT-4	303/8.2.17				S/N N371/S609
RHR-922N	PSA-1 SNUBBER	C-E-2	VT-3	303/8.2.17				S/N 631
			VT-4	303/8.2.17				S/N 631
RHR-945N(W)	8 WELDED LUGS	C-E-1	SUR	OCI 4-3				
RHR-945N	PSA-1 SN(2)	C-E-2	VT-3	303/8.2.17				S/N E130/W134

WNP-02
 INTERVAL: PSI
 PERIOD: NA
 OUTAGE:
 DRAWING NO. RHR-207

WASHINGTON PUBLIC POWER SUPPLY SYSTEM
 PROGRAM PLAN AND SCHEDULE
 SYSTEM OR COMPONENT: RHR(1)2
 DESCRIPTION: LOOP B SPLY-RHR HX1B

PAGE 007
 DATE 12/14/84

IDENT. NO.	DESCRIPTION	SECT. XI EXAM.	EXAM MTH.	PROCEDURE	CAL. BLOCK	INSERVICE		NOTES
						REQ.	SCHEDULED OUTAGE	
RHR-925N			VT-4	303/8.2.17				S/N E130/W134
	SPRING	C-E-2	VT-3	303/8.2.17				
			VT-4	303/8.2.17				
RHR-1020N	STRUT	C-E-2	VT-3	303/8.2.17				
RHR-927N	SPRING	C-E-2	VT-3	303/8.2.17				
			VT-4	303/8.2.17				
RHR-967N	ANCHOR	C-E-2	VT-3	303/8.2.17				
RHR-967N(S)	WELDED SADDLE	C-E-1	SUR	MTP-1				
18RHR(11)B-1	TEE TO PIPE	C-F	SUR	PTP-1				
RHR-558	PSA-3 SNUBBER	C-E-2	VT-3	303/8.2.17				S/N 4414
			VT-4	303/8.2.17				S/N 4414
RHR-557(W)	8 WELDED LUGS	C-E-1	SUR	MTP-1				
RHR-557	PSA-3 SN(2)	C-E-2	VT-3	303/8.2.17				S/N 4480/3928
			VT-4	303/8.2.17				S/N 4480/3928
18RHR(11)B-2	PIPE TO EL	C-F	SUR	PTP-1				
18RHR(11)B-3	EL TO PIPE	C-F	SUR	PTP-1				
RHR-559	SPRING	C-E-2	VT-3	303/8.2.17				
			VT-4	303/8.2.17				

WMP-02
 INTERVAL: PSI
 PERIOD: NA
 OUTAGE:
 DRAWING NO. RHR-207

WASHINGTON PUBLIC POWER SUPPLY SYSTEM
 PROGRAM PLAN AND SCHEDULE
 SYSTEM OR COMPONENT: RHR(1)2
 DESCRIPTION: LOOP B SPLY-RHR HX1B

PAGE 008
 DATE 12/14/84

IDENT. NO.	DESCRIPTION	SECT. XI EXAM.	EXAM MTH.	PROCEDURE	CAL. BLOCK	INSERVICE		NOTES
						REQ.	SCHEDULED OUTAGE	
18RHR(11)B-4	PIPE TO EL	C-F	SUR	PTP-1				
RHR-562	PSA-3 SNUBBER	C-E-2	VT-3	303/8.2.17				S/N 4491
			VT-4	303/8.2.17				S/N 4491
RHR-561	STRUT	C-E-2	VT-3	303/8.2.17				
RHR-563	PSA-1 SN(2)	C-E-2	VT-3	303/8.2.17				S/N 345/361
			VT-4	303/8.2.17				S/N 345/361
18RHR(11)B-5	EL TO PIPE	C-F	SUR	PTP-1				
RHR-560	SPRING	C-E-2	VT-3	303/8.2.17				
			VT-4	303/8.2.17				
18RHR(11)B-6	PIPE TO VALVE	C-F	SUR	PTP-1				
18RHR(11)B-7	VALVE TO PIPE	C-F	SUR	QCI 3-3				
18RHR(11)B-8	PIPE TO EL	C-F	SUR	QCI 3-3				
18RHR(11)B-9	EL TO PIPE	C-F	SUR	PTP-1				
RHR-461	SPRING	C-E-2	VT-3	303/8.2.17				
			VT-4	303/8.2.17				
18RHR(11)B-10	PIPE TO EL	C-F	SUR	PTP-1				
18RHR(11)B-11	EL TO PIPE	C-F	SUR	PTP-1				

UNP-02
 INTERVAL: PSI
 PERIOD: NA
 OUTAGE:
 DRAWING NO. RHR-207

WASHINGTON PUBLIC POWER SUPPLY SYSTEM
 PROGRAM PLAN AND SCHEDULE
 SYSTEM OR COMPONENT: RHR(1)2
 DESCRIPTION: LOOP B SPLY-RHR HX1B

PAGE 009
 DATE 12/14/84

IDENT. NO.	DESCRIPTION	SECT. XI EXAM.	EXAM MTH.	PROCEDURE	CAL. BLOCK	INSERVICE		NOTES
						REQ.	SCHEDULED OUTAGE	
RHR-565	PSA-3 SNUBBER	C-E-2	VT-3	303/8.2.17				S/N 3887
			VT-4	303/8.2.17				S/N 3887
RHR-564	PSA-3 SNUBBER	C-E-2	VT-3	303/8.2.17				S/N 4500
			VT-4	303/8.2.17				S/N 4500
18RHR(11)B-12	PIPE TO EL	C-F	SUR	PTP-1				
18RHR(11)B-13	EL TO PIPE	C-F	SUR	PTP-1				
RHR-609	SPRING	C-E-2	VT-3	303/8.2.17				
			VT-4	303/8.2.17				
18RHR(11)B-14	PIPE TO TEE	C-F	SUR	PTP-1				
20RHR(1)B-3	NOZZLE TO PIPE	C-F	SUR	OCT 3-3				
20RHR(1)B-4	PIPE TO EL	C-F	SUR	PTP-1				
20RHR(1)B-5	EL TO PIPE	C-F	SUR	PTP-1				
20RHR(1)B-6	PIPE TO REDUCER	C-F	SUR	PTP-1				
18RHR(1)B-37	REDUCER TO PIPE	C-F	SUR	PTP-1				
RHR-433	SPRING	C-E-2	VT-3	303/8.2.17				
			VT-4	303/8.2.17				
18RHR(1)B-37/5/4CE-N0018	INST CONN	N/A	VT-2	N/A				

IWC-2510, SEE NOTES
 #6 & #7.

WNP-0
 INTERVAL: PSI
 PERIOD: NA
 OUTAGE:
 DRAWING NO. RHR-207

WASHINGTON PUBLIC POWER SUPPLY SYSTEM
 PROGRAM PLAN AND SCHEDULE
 SYSTEM OR COMPONENT: RHR(1)2
 DESCRIPTION: LOOP B SPLY-RHR HX1B

PAGE 010
 DATE 12/14/84

IDENT. NO.	DESCRIPTION	SECT. XI EXAM EXAM.	EXAM MTH.	PROCEDURE	CAL. BLOCK	INSERVICE		NOTES
						REQ.	SCHEDULED OUTAGE	
18RHR(1)B-37/4V-26B	BRANCH CONN	N/A	VT-2	N/A				IWC-2510, SEE NOTES #6 & #7.
18RHR(1)B-38	PIPE TO EL	C-F	SUR	PTP-1				
18RHR(1)B-39	EL TO PIPE	C-F	SUR	PTP-1				
RHR-435	STRUT	C-E-2	VT-3	303/8.2.17				
18RHR(1)B-39/3/4V-81B	DRAIN CONN	N/A	VT-2	N/A				IWC-2510, SEE NOTES #6 & #7.
18RHR(1)B-39/3/4V-75B	SAMPLE CONN	N/A	VT-2	N/A				1 1/2"WOL, 3/4"BRANCH IWC-2510, SEE NOTES #6 & #7.
18RHR(1)B-40	PIPE TO VALVE	C-F	SUR	PTP-1				
18RHR(1)B-41	VALVE TO PIPE	C-F	SUR	PTP-1				
RHR-436	BOX	C-E-2	VT-3	303/8.2.17				
18RHR(1)B-42	PIPE TO EL	C-F	SUR	QCI 3-3				
18RHR(1)B-43	EL TO PIPE	C-F	SUR	PTP-1				
RHR-434	BOX	C-E-2	VT-3	303/8.2.17				
18RHR(1)B-44	PIPE TO EL	C-F	SUR	PTP-1				
18RHR(1)B-45	EL TO PIPE	C-F	SUR	PTP-1				
18RHR(1)B-46	PIPE TO TEE	C-F	SUR	PTP-1				
18RHR(1)B-47	TEE TO PIPE	C-F	SUR	PTP-1				

WNP-02
 INTERVAL: PSI
 PERIOD: NA
 OUTAGE:
 DRAWING NO. RHR-207

WASHINGTON PUBLIC POWER SUPPLY SYSTEM
 PROGRAM PLAN AND SCHEDULE
 SYSTEM OR COMPONENT: RHR(1)2
 DESCRIPTION: LOOP R SPLY-RHR HX1R

PAGE 011
 DATE 12/14/84

IDENT. NO.	DESCRIPTION	SECT. YI EXAM.	EXAM MTH.	PROCEDURE	CAL. BLOCK	INSERVICE		NOTES
						REQ.	SCHEDULED OUTAGE	
18RHR(1)B-48	PIPE TO TEE	C-F	SUR	PTP-1				
18RHR(1)B-49	TEE TO PIPE	C-F	SUR	PTP-1				
18RHR(1)B-49/4V-40	DRAIN CONN	N/A	VT-2	N/A				IWC-2510, SEE NOTES #6 & #7.
RHR-438	STRUT	C-E-2	VT-3	303/8.2.17				
RHR-437	PSA-3 SN(2)	C-E-2	VT-3	303/8.2.17				S/N 226/4456
			VT-4	303/8.2.17				S/N 226/4456
18RHR(1)B-50	PIPE TO EL	C-F	SUR	PTP-1				
RHR-462	SPRING	C-E-2	VT-3	303/8.2.17				
			VT-4	303/8.2.17				
RHR-54	SPRING	C-E-2	VT-3	303/8.2.17				
			VT-4	303/8.2.17				
RHR-459	PSA-10 SNUBBER	C-E-2	VT-3	303/8.2.17				S/N 109
			VT-4	303/8.2.17				S/N 109
RHR-52	PSA-3 SNUBBER	C-E-2	VT-3	303/8.2.17				S/N 4463
			VT-4	303/8.2.17				S/N 4463
14RHR(19)B-1	VALVE TO EL	C-F	SUR	PTP-1				
RHR-998N	PSA-3 SNUBBER	C-E-2	VT-3	303/8.2.17				S/N 3936

WNP-02
 INTERVAL: PSI
 PERIOD: NA
 OUTAGE:
 DRAWING NO. RHR-207

WASHINGTON PUBLIC POWER SUPPLY SYSTEM
 PROGRAM PLAN AND SCHEDULE
 SYSTEM OR COMPONENT: RHR(1)2
 DESCRIPTION: LOOP B SPLY-RHR HY1B

PAGE 012
 DATE 12/14/84

IDENT. NO.	DESCRIPTION	SECT. XI EXAM.	EXAM MTH.	PROCEDURE	CAL. BLOCK	INSERVICE		NOTES
						REQ.	SCHEDULED OUTAGE	
14RHR(19)B-3			VT-4	303/8.2.17				S/N 3936
RHR-53(W)	EL TO PIPE	C-F	SUR	PTP-1				
RHR-53	4 WELDED LUGS	C-E-1	SUR	OCI 4-3				
	SPRING	C-E-2	VT-3	303/8.2.17				
14RHR(19)B-4			VT-4	303/8.2.17				
	PIPE TO EL	C-F	SUR	PTP-1				
14RHR(19)B-5								
	EL TO PIPE	C-F	SUR	PTP-1				
14RHR(19)B-6								
	PIPE TO EL	C-F	SUR	PTP-1				
14RHR(19)B-7								
	EL TO PIPE	C-F	SUR	PTP-1				
14RHR(19)B-8								
	PIPE TO TEE	C-F	SUR	PTP-1				
18RHR(1)B-51								
	EL TO PIPE	C-F	SUR	PTP-1				
18RHR(1)B-51/5/4TE	-N027B							
	INSTR CONN	N/A	VT-2	N/A				IWC-2510, SEE NOTES #6 & #7.
RHR-463								
	PSA-3 SNUBBER	C-E-2	VT-3	303/8.2.17				S/N 2391
			VT-4	303/8.2.17				S/N 2391
RHR-464								
	BOX	C-E-2	VT-3	303/8.2.17				
18RHR(1)B-52								
	PIPE TO PIPE	C-F	SUR	PTP-1				
RHR-468								
	SPRING	C-E-2	VT-3	303/8.2.17				

WNP-02
 INTERVAL: PSI
 PERIOD: NA
 OUTAGE:
 DRAWING NO. RHR-207

WASHINGTON PUBLIC POWER SUPPLY SYSTEM
 PROGRAM PLAN AND SCHEDULE
 SYSTEM OR COMPONENT: RHR(1)2
 DESCRIPTION: LOOP B SPLY-RHR HX1B

IDENT. NO.	DESCRIPTION	SECT. XI EXAM.	EXAM MTH.	PROCEDURE	CAL. BLOCK	INSERVICE		NOTES
						REQ.	SCHEDULED OUTAGE	
RHR-465(U)			VT-4	303/8.2.17				
RHR-465	8 WELDED LUGS	C-E-1	SUR	HTP-1				
	PSA-3 SN(2)	C-E-2	VT-3	303/8.2.17				S/N N1069/S2364
RHR-467			VT-4	303/8.2.17				S/N N1069/S2364
RHR-466	STRUT	C-E-2	VT-3	303/8.2.17				
	PSA-3 SNUBBER	C-E-2	VT-3	303/8.2.17				S/N 3896
18RHR(1)B-53			VT-4	303/8.2.17				S/N 3896
18RHR(1)B-53/3/4V-706B	PIPE TO FLANGE	C-F	SUR	PTP-1				
	INSTR CONN	N/A	VT-2	N/A				IWC 2510, SEE NOTES #6 & #7.
18RHR(1)B-53/3/4V-707B								
	INSTR CONN	N/A	VT-2	N/A				IWC 2510, SEE NOTES #6 & #7.
RHR-469								
	SPRING	C-E-2	VT-3	303/8.2.17				
18RHR(1)B-54			VT-4	303/8.2.17				
18RHR(1)B-54/10RHR(5)-2	FLANGE TO PIPE	C-F	SUR	PTP-1				
	BRANCH CONN	C-F	SUR	PTP-1				
RHR-956N								
	BOX	C-E-2	VT-3	303/8.2.17				
18RHR(1)B-55								
	PIPE TO EL	C-F	SUR	PTP-1				
18RHR(1)B-56								
	EL TO PIPE	C-F	SUR	PTP-1				

WNP-02
 INTERVAL: PSI
 PERIOD: NA
 OUTAGE:
 DRAWING NO. RHR-207

WASHINGTON PUBLIC POWER SUPPLY SYSTEM
 PROGRAM PLAN AND SCHEDULE
 SYSTEM OR COMPONENT: RHR(1)2
 DESCRIPTION: LOOP R SPLY-RHR HX1B

PAGE 014
 DATE 12/14/84

IDENT. NO.	DESCRIPTION	SECT. XI EXAM.	EXAM MTH.	PROCEDURE	CAL. BLOCK	INSERVICE		NOTES
						REQ.	SCHEDULED OUTAGE	
10RHR(5)B-1	WOL TO PIPE	C-F	SUR	PTP-1				
10RHR(5)B-2	PIPE TO EL	C-F	SUR	PTP-1				
10RHR(5)B-3	EL TO PIPE	C-F	SUR	PTP-1				
RHR-470	STRUT	C-E-2	VT-3	303/8.2.17				
RHR-472	PSA-1 SNUBBER	C-E-2	VT-3	303/8.2.17				S/N 2574
			VT-4	303/8.2.17				S/N 2574
10RHR(5)B-4	PIPE TO PIPE	C-F	SUR	PTP-1				
RHR-473	SPRING	C-E-2	VT-3	303/8.2.17				S/N
			VT-4	303/8.2.17				
10RHR(5)B-5	PIPE TO VALVE	C-F	SUR	PTP-1				
18RHR(1)B-57	PIPE TO PIPE	C-F	SUR	PTP-1				
18RHR(1)B-57/6RHR(10)-2	BRANCH CONN	C-F	SUR	PTP-1				
RHR-475	ANCHOR	C-E-2	VT-3	303/8.2.17				
RHR-475(S)	2 WELDED SADDLE	C-E-1	SUR	HTP-1				W/2 WELDED SADDLES.
18RHR(1)B-58	PIPE TO PIPE	C-F	SUR	PTP-1				
18RHR(1)B-59	PIPE TO EL	C-F	SUR	PTP-1				
18RHR(1)B-60	EL TO PIPE	C-F	SUR	PTP-1				
RHR-478	SPRING	C-E-2	VT-3	303/8.2.17				

WNP-02
 INTERVAL: PSI
 PERIOD: NA
 OUTAGE:
 DRAWING NO. RHR-207

WASHINGTON PUBLIC POWER SUPPLY SYSTEM
 PROGRAM PLAN AND SCHEDULE
 SYSTEM OR COMPONENT: RHR(1)2
 DESCRIPTION: LOOP B SPLY-RHR HX1B

PAGE 015
 DATE 12/14/84

IDENT. NO.	DESCRIPTION	SFCT. XI EXAM.	EXAM MTH.	PROCEDURE	CAL. BLOCK	INSERVICE		NOTES
						REQ.	SCHEDULED OUTAGE	
			VT-4	303/8.2.17				
18RHR(1)B-61	PIPE TO EL	C-F	SUR	PTP-1				
18RHR(1)B-62	EL TO PIPE	C-F	SUR	OCI 3-3				
RHR-479(W)	4 WELDED LUGS	C-E-1	SUR	OCI 4-3				
RHR-479	PSA-3 SN(2)	C-E-2	VT-3	303/8.2.17				S/N 292/620
			VT-4	303/8.2.17				S/N 292/620
RHR-480	STRUT	C-E-2	VT-3	303/8.2.17				
RHR-481	PSA-35 SNUBBER	C-E-2	VT-3	303/8.2.17				S/N 10739
			VT-4	303/8.2.17				S/N 10739
RHR-486(V)	4 WELDED LUGS	C-E-1	SUR	PTP-1				
RHR-486	SPRING	C-E-2	VT-3	303/8.2.17				
			VT-4	303/8.2.17				
18RHR(1)B-63	PIPE TO TEE	C-F	SUR	PTP-1				
14RHR(1)B-5	TEE TO PIPE	C-F	SUR	OCI 3-3				
14RHR(1)B-5/3/4V-708B	INST CONN	N/A	VT-2	N/A				IWC-2510, SEE NOTES #6 & #7.
14RHR(1)B-5/3/4V-155B	TEST CONN	N/A	VT-2	N/A				IWC-2510, SEE NOTES #6 & #7.
14RHR(1)B-6	PIPE TO VALVE	C-F	SUR	PTP-1				

WNP-02
 INTERVAL: PSI
 PERIOD: NA
 OUTAGE:
 DRAWING NO. RHR-207

WASHINGTON PUBLIC POWER SUPPLY SYSTEM
 PROGRAM PLAN AND SCHEDULE
 SYSTEM OR COMPONENT: RHR(1)2
 DESCRIPTION: LOCP B SPLY-RHR HX1B

PAGE 016
 DATE 12/14/84

IDENT. NO.	DESCRIPTION	SECT. XI EXAM.	EXAM MTH.	PROCEDURE	CAL. BLOCK	INSERVICE		NOTES
						REQ.	SCHEDULED OUTAGE	
18RHR(1)B-64	TEE TO PIPE	C-F	SUR	PTP-1				
RHR-485	PSA-10 SNUBBER	C-E-2	VT-3	303/8.2.17				S/N 11856
			VT-4	303/8.2.17				S/N 11856
6RHR(10)B-1	WOL TO PIPE	C-F	SUR	PTP-1				
6RHR(10)B-2	PIPE TO EL	C-F	SUR	PTP-1				
6RHR(10)B-3	EL TO PIPE	C-F	SUR	PTP-1				
RHR-476	BOX	C-E-2	VT-3	303/8.2.17				
6RHR(10)B-4	PIPE TO FLANGE	C-F	SUR	PTP-1				
6RHR(10)B-4/3/4V-724	INST CONN	N/A	VT-2	N/A				IWC-2510, SEE NOTES #6 & #7.
6RHR(10)B-4/3/4V-725	INST CONN	N/A	VT-2	N/A				IWC-2510, SEE NOTES #6 & #7.
6RHR(10)B-5	FLANGE TO PIPE	C-F	SUR	PTP-1				
6RHR(10)B-6	PIPE TO EL	C-F	SUR	PTP-1				
6RHR(10)B-7	EL TO PIPE	C-F	SUR	PTP-1				
6RHR(10)B-8	PIPE TO EL	C-F	SUR	PTP-1				
6RHR(10)B-9	EL TO PIPE	C-F	SUR	PTP-1				
RHR-230	BOX	C-E-2	VT-3	303/8.2.17				
RHR-230(W)	4 WELDED LUGS	C-E-1	SUR	OCT 4-3				

WNP-02
 INTERVAL: PSI
 PERIOD: NA
 OUTAGE:
 DRAWING NO. RHR-207

WASHINGTON PUBLIC POWER SUPPLY SYSTEM
 PROGRAM PLAN AND SCHEDULE
 SYSTEM OR COMPONENT: RHR(1)2
 DESCRIPTION: LOOP B SPLY-RHR HY1B

PAGE 017
 DATE 12/14/84

IDENT. NO.	DESCRIPTION	SECT. XI EXAM.	EXAM MTH.	PROCEDURE	CAL. BLOCK	INSERVICE		NOTES
						REQ.	SCHEDULED OUTAGE	
6RHR(10)B-10	PIPE TO EL	C-F	SUR	PTP-1				
RHR-228	ANCHOR	C-E-2	VT-3	303/8.2.17				
6RHR(10)B-11	EL TO PIPE	C-F	SUR	PTP-1				
6RHR(10)B-12	PIPE TO TEE	C-F	SUR	PTP-1				
6RHR(10)B-12/3V-86	FLUSH CONN	N/A	VT-2	N/A				IWC-2510, SEE NOTES #6 & #7.
6RHR(10)B-13	TEE TO PIPE	C-F	SUR	PTP-1				
6RHR(10)B-14	PIPE TO VALVE	C-F	SUR	PTP-1				
18RHR(1)B-65	PIPE TO EL	C-F	SUR	PTP-1				
18RHR(1)B-66	EL TO PIPE	C-F	SUR	PTP-1				
18RHR(1)B-67	PIPE TO EL	C-F	SUR	PTP-1				
18RHR(1)B-68	EL TO PIPE	C-F	SUR	PTP-1				
RHR-976N	STRUT	C-E-2	VT-3	303/8.2.17				
18RHR(1)B-69	PIPE TO EL	C-F	SUR	PTP-1				
18RHR(1)B-70	EL TO PIPE	C-F	SUR	OCI 3-3				
RHR-488	ANCHOR	C-E-2	VT-3	303/8.2.17				
18RHR(1)B-71	PIPE TO EL	C-F	SUR	OCI 3-3				
18RHR(1)B-72	EL TO PIPE	C-F	SUR	OCI 3-3				

WNP-02
 INTERVAL: PSI
 PERIOD: NA
 OUTAGE:
 DRAWING NO. RHR-207

WASHINGTON PUBLIC POWER SUPPLY SYSTEM
 PROGRAM PLAN AND SCHEDULE
 SYSTEM OR COMPONENT: RHR(1)2
 DESCRIPTION: LOOP B SPLY-RHR HX1B

PAGE 018
 DATE 12/14/84

IDENT. NO.	DESCRIPTION	SECT. XI EXAM.	EXAM MTH.	PROCEDURE	CAL. BLOCK	INSERVICE		NOTES
						REQ.	SCHEDULED OUTAGE	
18RHR(1)B-73	PIPE TO EL	C-F	SUR	PTP-1				
18RHR(1)B-74	EL TO PIPE	C-F	SUR	PTP-1				
18RHR(1)B-74/3/4V-741	VENT CONN	N/A	VT-2	OCI 7-1				
RHR-491	SPRING	C-E-2	VT-3	303/8.2.17				
			VT-4	303/8.2.17				
RHR-906N	PSA-3 SN(2)	C-E-2	VT-3	303/8.2.17				S/N 1068/2358
			VT-4	303/8.2.17				S/N 1068/2358
RHR-492	PSA-3 SN(2)	C-E-2	VT-3	303/8.2.17				S/N 3950/3942
			VT-4	303/8.2.17				S/N 3950/3942
18RHR(1)B-75	PIPE TO EL	C-F	SUR	PTP-1				
18RHR(1)B-76	EL TO PIPE	C-F	SUR	PTP-1				
18RHR(1)B-77	PIPE TO EL	C-F	SUR	PTP-1				
18RHR(1)B-78	EL TO PIPE	C-F	SUR	PTP-1				
RHR-493	SPRING	C-E-2	VT-3	303/8.2.17				
			VT-4	303/8.2.17				
RHR-495	PSA-3 SN(2)	C-E-2	VT-3	303/8.2.17				S/N 6175/6163
			VT-4	303/8.2.17				S/N 6175/6163
RHR-495(W)	8 WELDED LUGS	C-E-1	SUR	OCI 4-3				

WNP-02
 INTERVAL: PSI
 PERIOD: NA
 OUTAGE:
 DRAWING NO. RHR-207

WASHINGTON PUBLIC POWER SUPPLY SYSTEM
 PROGRAM PLAN AND SCHEDULE
 SYSTEM OR COMPONENT: RHR(1)2
 DESCRIPTION: LOOP B SPLY-RHR HX1B

PAGE 019
 DATE 12/14/84

IDENT. NO.	DESCRIPTION	SECT. XI EXAM.	EXAM MTH.	PROCEDURE	CAL. BLOCK	INSERVICE		NOTES
						REQ.	SCHEDULED OUTAGE	
18RHR(1)B-75	PIPE TO TEE	C-F	SUR	PTP-1				
18RHR(1)B-80	TEE TO PIPE	C-F	SUR	PTP-1				
RHR-494	PSA-3 SNUBBER	C-E-2	VT-3	303/8.2.17				S/N 13034
			VT-4	303/8.2.17				S/N 13034
18RHR(1)B-81	PIPE TO PIPE	C-F	SUR	QCI 3-3				
RHR-496	PSA-3 SNUBBER	C-E-2	VT-3	303/8.2.17				S/N 13057
			VT-4	303/8.2.17				S/N 13057
RHR-497	SPRING	C-E-2	VT-3	303/8.2.17				
			VT-4	303/8.2.17				
18RHR(1)B-82	PIPE TO EL	C-F	SUR	PTP-1				
18RHR(1)B-83	EL TO PIPE	C-F	SUR	PTP-1				
18RHR(1)B-84	PIPE TO EL	C-F	SUR	PTP-1				
18RHR(1)B-85	EL TO PIPE	C-F	SUR	PTP-1				
18RHR(1)B-85/12RHR(1)-2	BRANCH CONN	C-F	SUR	PTP-1				
18RHR(1)B-86	PIPE TO REDUCER	C-F	SUR	PTP-1				
12RHR(1)B-1A	WOL TO PIPE	C-F	SUR	PTP-1				
12RHR(1)B-1B	PIPE TO PIPE	C-F	SUR	PTP-1				
RHR-910N	STRUT	C-E-2	VT-3	303/8.2.17				

WNP-02
 INTERVAL: PSI
 PERIOD: NA
 OUTAGE:
 DRAWING NO. RHR-207

WASHINGTON PUBLIC POWER SUPPLY SYSTEM
 PROGRAM PLAN AND SCHEDULE
 SYSTEM OR COMPONENT: RHR(1)2
 DESCRIPTION: LOOP B SPLY-RHR HX1B

PAGE 020
 DATE 12/14/84

IDENT. NO.	DESCRIPTION	SECT. XI EXAM.	EXAM MTH.	PROCEDURE	CAL. BLOCK	INSERVICE		NOTES
						REQ.	SCHEDULED OUTAGE	
12RHR(1)B-2A	PIPE TO EL	C-F	SUR	PTP-1				
12RHR(1)B-3A	EL TO PIPE	C-F	SUR	PTP-1				
12RHR(1)B-3/3/4V-160B	TEST CONN	N/A	VT-2	N/A				IWC-2510, SEE NOTES #6 & #7.
12RHR(1)B-4A	PIPE TO EL	C-F	SUR	PTP-1				
12RHR(1)B-5A	EL TO PIPE	C-F	SUR	PTP-1				
RHR-911N	PSA-10 SNUBBER	C-E-2	VT-3	303/8.2.17				S/N 7039
			VT-4	303/8.2.17				S/N 7039
12RHR(1)B-6A	PIPE TO VALVE	C-F	SUR	PTP-1				
16RHR(5)B-1	REDUCER TO PIPE	C-F	SUR	PTP-1				
RHR-500	PSA-3 SNUBBER	C-E-2	VT-3	303/8.2.17				S/N 699
			VT-4	303/8.2.17				S/N 699
16RHR(5)B-2	PIPE TO EL	C-F	SUR	PTP-1				
16RHR(5)B-3	EL TO PIPE	C-F	SUR	PTP-1				
16RHR(5)B-4	PIPE TO EL	C-F	SUR	PTP-1				
16RHR(5)B-5	EL TO PIPE	C-F	SUR	PTP-1				
RHR-498	SPRING	C-E-2	VT-3	303/8.2.17				
			VT-4	303/8.2.17				

WNP-02
 INTERVAL: PSI
 PERIOD: NA
 OUTAGE:
 DRAWING NO. RHR-207

WASHINGTON PUBLIC POWER SUPPLY SYSTEM
 PROGRAM PLAN AND SCHEDULE
 SYSTEM OR COMPONENT: RHR(1)2
 DESCRIPTION: LOOP B SPLY-RHR HX1B

PAGE 021
 DATE 12/14/84

IDENT. NO.	DESCRIPTION	SECT. XI EXAM.	EXAM MTH.	PROCEDURE	CAL. BLOCK	INSERVICE		NOTES
						REQ.	SCHEDULED OUTAGE	
16RHR(5)B-5/3V-63B	FLUSH CONN	N/A	VT-2	N/A				SEE NOTES #6 & #7.
16RHR(5)B-5/3/4V-153B	TEST CONN	N/A	VT-2	N/A				SEE NOTES #6 & #7.
16RHR(5)B-6	PIPE TO VALVE	C-F	SUR	PTP-1				
16RHR(5)B-7	VALVE TO PIPE	C-F	SUR	PTP-1				
RHR-501	SPRING	C-E-2	VT-3	303/8.2.17				
			VT-4	303/8.2.17				
16RHR(5)B-8	PIPE TO EL	C-F	SUR	PTP-1				
16RHR(5)B-9	EL TO PIPE	C-F	SUR	PTP-1				
16RHR(5)B-9/3/4V-10B	TEST CONN	N/A	VT-2	N/A				IWC-2510, SEE NOTES #6 & #7.
16RHR(5)B-9/3/4V-609	TEST CONN	N/A	VT-2	N/A				IWC-2510, SEE NOTES #6 & #7.
RHR-503	PSA-10 SNUBBER	C-E-2	VT-3	303/8.2.17				S/N 8687
			VT-4	303/8.2.17				S/N 8687
RHR-502	PSA-3 SNUBBER	C-E-2	VT-3	303/8.2.17				S/N 6178
			VT-4	303/8.2.17				S/N 6178
16RHR(5)B-10	PIPE TO VALVE	C-F	SUR	PTP-1				
18RHR(4)B-1	TEE TO PIPE	C-F	SUR	OCT 3-3				
RHR-185(V)	4 WELDED LUGS	C-E-1	SUR	OCT 4-3				

WNP-02
 INTERVAL: PSI
 PERIOD: NA
 OUTAGE:
 DRAWING NO. RHR-207

WASHINGTON PUBLIC POWER SUPPLY SYSTEM
 PROGRAM PLAN AND SCHEDULE
 SYSTEM OR COMPONENT: RHR(1)2
 DESCRIPTION: LOOP R SPLY-RHR HYDR

PAGE 022
 DATE 12/14/84

IDENT. NO.	DESCRIPTION	SECT. XI EXAM.	EXAM MTH.	PROCEDURE	CAL. BLOCK	INSERVICE		NOTES
						REQ.	SCHEDULED OUTAGE	
RHR-185	SPRING	C-E-2	VT-3	303/8.2.17				
			VT-4	303/8.2.17				
18RHR(4)B-2	PIPE TO EL	C-F	SUR	PTP-1				
18RHR(4)B-3	EL TO PIPE	C-F	SUR	PTP-1				
18RHR(4)B-4	PIPE TO EL	C-F	SUR	PTP-1				
18RHR(4)B-5	EL TO PIPE	C-F	SUR	PTP-1				
RHR-901N	PSA-3 SN(2)	C-E-2	VT-3	303/8.2.17				S/N 491
			VT-4	303/8.2.17				S/N 491
RHR-912N	PSA-3 SNUBBER	C-E-2	VT-3	303/8.2.17				S/N 15469
			VT-4	303/8.2.17				S/N 15469
18RHR(4)B-6	PIPE TO PIPE	C-F	SUR	OCI 3-3				
RHR-218(W)	8 WELDED LUGS	C-E-1	SUR	OCI 4-3				
RHR-218	PSA-3 SN(2)	C-E-2	VT-3	303/8.2.17				S/N W104/E308
			VT-4	303/8.2.17				S/N W104/E308
18RHR(4)B-6/6RHR(6)-2	BRANCH CONN	C-F	SUR	PTP-1				
18RHR(4)B-6A	PIPE TO FLANGE	C-F	SUR	PTP-1				
18RHR(4)B-6B	FLANGE TO PIPE	C-F	SUR	PTP-1				
18RHR(4)B-7	PIPE TO EL	C-F	SUR	PTP-1				

WNP-02
 INTERVAL: PSI
 PERIOD: NA
 OUTAGE:
 DRAWING NO. RHR-207

WASHINGTON PUBLIC POWER SUPPLY SYSTEM
 PROGRAM PLAN AND SCHEDULE
 SYSTEM OR COMPONENT: RHR(1)2
 DESCRIPTION: LOOP P SPLY-RHR HX1R

PAGE 023
 DATE 12/14/84


IDENT. NO.	DESCRIPTION	SECT. XI	EXAM.	EXAM MTH.	PROCEDURE	CAL. BLOCK	INSERVICE		NOTES
							REQ.	SCHEDULED OUTAGE	
18RHR(4)B-8	EL TO PIPE	C-F	SUR	PTP-1					
18RHR(4)B-9	PIPE TO EL	C-F	SUR	PTP-1					
18RHR(4)B-10	EL TO PIPE	C-F	SUR	PTP-1					
RHR-915N	PSA-3 SNUBBER	C-E-2	VT-3	303/8.2.17					S/N 104
			VT-4	303/8.2.17					S/N 104
RHR-902N	PSA-3 SNUBBER	C-E-2	VT-3	303/8.2.17					S/N 303
			VT-4	303/8.2.17					S/N 303
RHR-184(W)	16 WELDED LUGS	C-E-1	SUR	QCI 4-3					
RHR-184	STRUT	C-E-2	VT-3	303/8.2.17					
18RHR(4)B-10/1RV-25B	RELIEF CONN	N/A	VT-2	N/A					IWC-2510, SEE NOTES #5 & #7.
18RHR(4)B-10/3/4V-129B	TEST CONN	N/A	VT-2	N/A					IWC-2510, SEE NOTES #5 & #7.
18RHR(4)B-11	PIPE TO EL	C-F	SUR	PTP-1					
18RHR(4)B-12	EL TO PIPE	C-F	SUR	QCI 3-3					
18RHR(4)B-13	PIPE TO VALVE	C-F	SUR	PTP-1					
RHR-181	SPRING	C-E-2	VT-3	303/8.2.17					
			VT-4	303/8.2.17					
6RHR(6)B-1	WOL TO PIPE	C-F	SUR	PTP-1					

WNP-02
 INTERVAL: PSI
 PERIOD: NA
 OUTAGE:
 DRAWING NO. RHR-207

WASHINGTON PUBLIC POWER SUPPLY SYSTEM
 PROGRAM PLAN AND SCHEDULE
 SYSTEM OR COMPONENT: RHR(1)2
 DESCRIPTION: LOOP R SPLY-RHR HX1B


PAGE 024
 DATE 12/14/84

IDENT. NO.	DESCRIPTION	SECT.		PROCEDURE	CAL. BLOCK	INSERVICE		NOTES
		XI EXAM. EXAM.	MIH. MTH.			REQ.	SCHEDULED OUTAGE	
6RHR(6)B-1/3/4V-143B	TEST CONN	N/A	VT-2	N/A				IWC-2510, SEE NOTES #6 & #7.
6RHR(6)B-2	PIPE TO EL	C-F	SUR	PTP-1				
6RHR(6)B-3	EL TO PIPE	C-F	SUR	PTP-1				
6RHR(6)B-4	PIPE TO VALVE	C-F	SUR	PTP-1				
RHR-V-27B/1/4CAP	STEM LEAKOFF	N/A	VT-2	GCI 7-1				IWC-2510, SEE NOTES #5 & #6.
RHR-PB-207	RHR PRESS BNDRY	N/A	VT-2	N/A				IWC-2510, SEE NOTES #6 & #7.

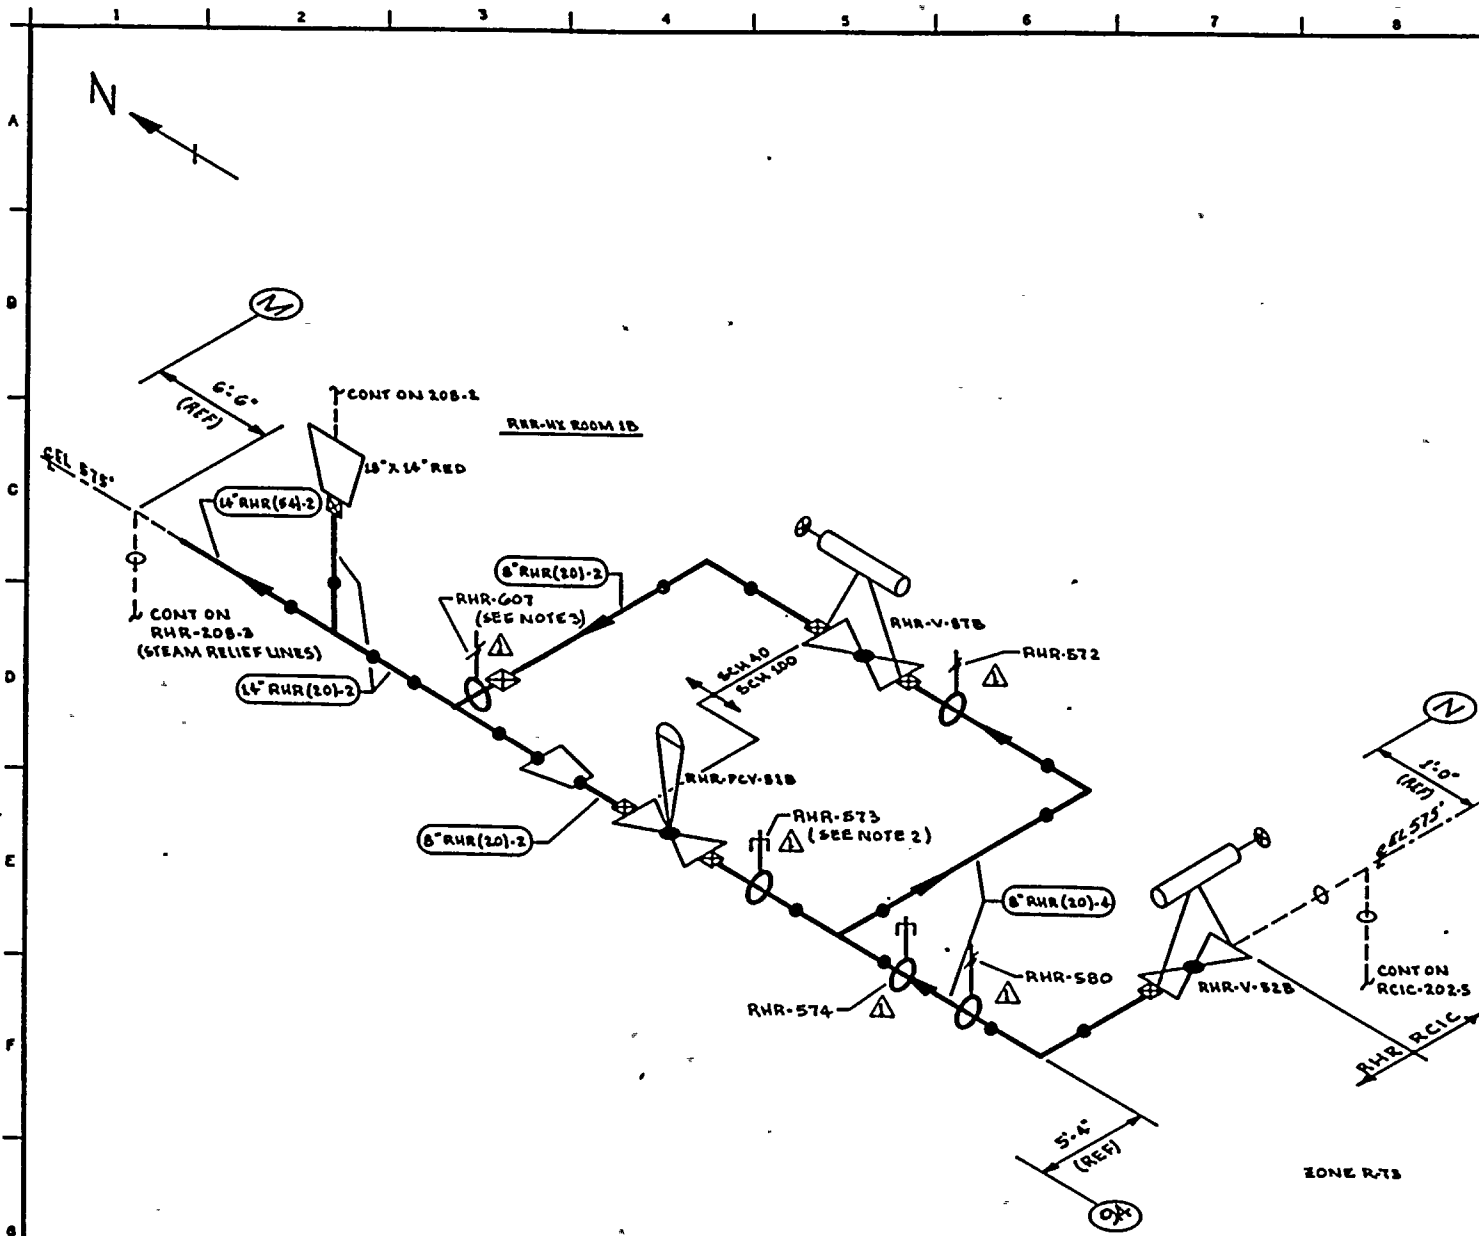

- NOTES:**
1. THIS DRAWING IDENTIFIES PIPING & COMPONENTS SUBJECT TO A VISUAL EXAMINATION FOR EVIDENCE OF LEAKAGE DURING SYSTEM HYDRO OR OPERABILITY TESTS. TESTS ARE TO BE CONDUCTED PER THE REQUIREMENTS OF ASME SECTION XI, PARAGRAPH IWA-8000.
 - △ 2. CLAMP IS STAMPED RCIC-918N.
 - △ 3. NAME PLATE IS STAMPED RHR-72. ATTACHMENT IS STAMPED RHR-707.

- REFERENCES:**
- BOYCE & CRAIG ISOMETRICS
 - RHR-898-15 REV 8
 - RHR-098-16.17 REV 9

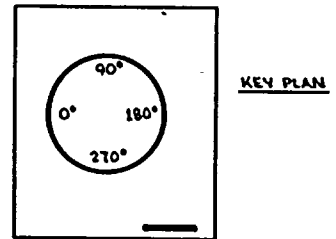

QUALITY CLASS: 1 ASME CODE CLASS: 2
 ENGR: GA WUGLER DRAWN: K.M.C.A. DATE: 6-15-78

WASHINGTON PUBLIC POWER SUPPLY SYSTEM
 RICHLAND, WASHINGTON 99352

THIS DRAWING IS INTENDED FOR USE IN PRESERVICE AND INSERVICE INSPECTION PROGRAMS ONLY.

PIPING SYSTEM	NOM DIA (IN)	SCH	NOM WALL THK	MATERIAL SPECIFICATION	MATL TYPE	CAL BLOCK NO
8" RHR(20)-4	8	100	0.594	SA 106 GR B	CS	NA
8" RHR(20)-2	8	40	0.323	SA 106 GR B	CS	NA
14" RHR(20)-2	14	STD	0.375	SA 106 GR B	CS	NA
14" RHR(54)-2	14	STD	0.375	SA 106 GR B	CS	NA


NO	DATE	REVISION	BY	CHKD	APPVD
1	9-26-73	REVISED AS NOTED	K.M.C.A.	W.P.	T.P.H.
0	11-11-71	ISSUED FOR USE	K.M.C.A.	W.P.	T.P.H.
A	9-12-78	ISSUED FOR INFORMATION ONLY	K.M.C.A.	W.P.	T.P.H.
		REVISION	BY	CHKD	APPVD

WHP-2
 WELD & COMPONENT IDENTIFICATION DIAGRAM

TITLE: RHR LOOP B
 RCIC STEAM SUPPLY TO RHR-UX-1B


DWG NO: RHR-20B-1 REV 1



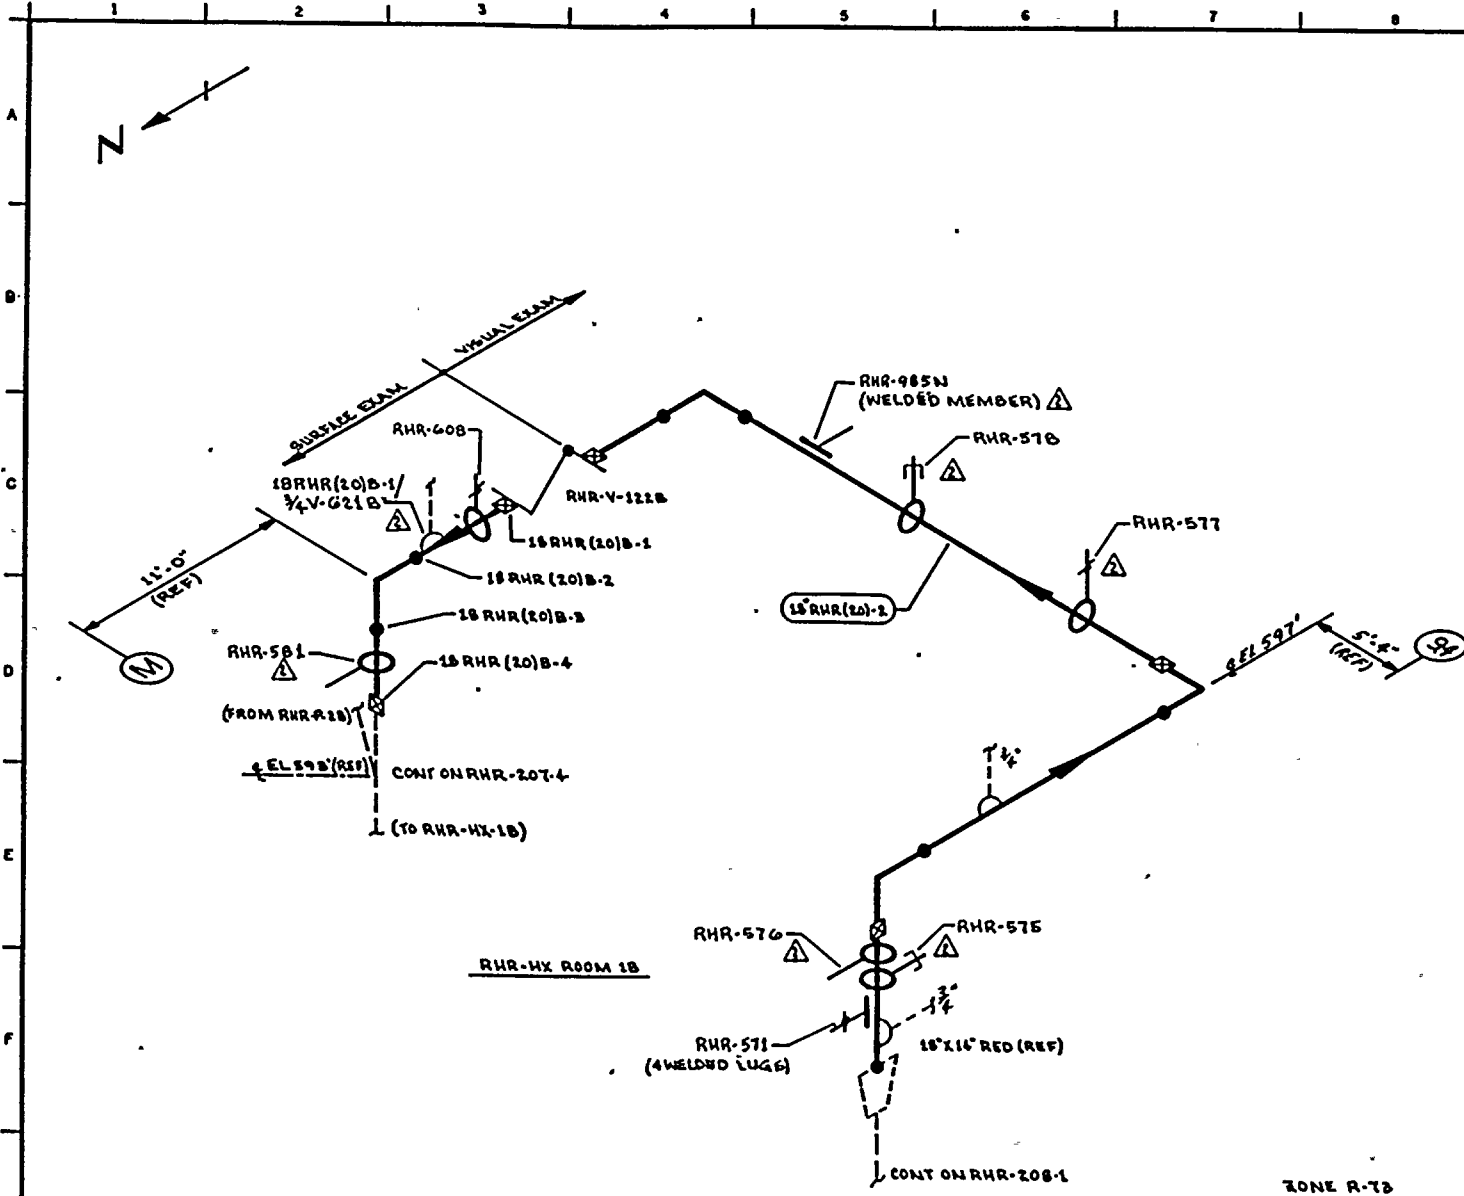

- NOTES:**
1. FOR BRANCH PIPING 4" DIA OR LESS (CONN SHOWN IN DASHED LINE) EXTEND VISUAL EXAM THROUGH THE OUTERMOST NORMALLY CLOSED NUCLEAR CLASS VALVE OR UNTIL TRANSITION TO INSTRUMENT TUBING, UNLESS OTHERWISE NOTED.
 2. PORTIONS OF THIS DRAWING IDENTIFY PIPING & COMPONENTS SUBJECT TO A VISUAL EXAM FOR EVIDENCE OF LEAKAGE DURING SYSTEM HYDRO OR OPERABILITY TESTS. TESTS ARE TO BE CONDUCTED PER THE REQUIREMENTS OF ASME SECTION XI, PARAGRAPH IWA-5000.

- REFERENCES:**
- BOVEE & CRAIG ISOMETRICS
 - RHR-898-16-17 REV 9
 - RHR-898-18-20 REV 6

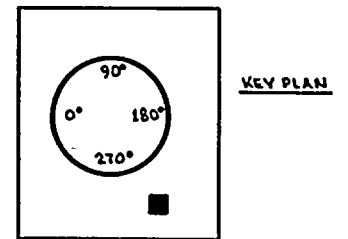

QUALITY CLASS: 1 ASME CODE CLASS: 2
 ENGR: GA KUGLER DRAWN: K. McLA DATE: 6-15-78

WASHINGTON PUBLIC POWER SUPPLY SYSTEM
 RICHLAND, WASHINGTON 98362

THIS DRAWING IS INTENDED FOR USE IN PRESERVICE AND INSERVICE INSPECTION PROGRAMS ONLY.

PIPING SYSTEM	NOM DIA (IN)	SCH	NOM WALL THK	MATERIAL SPECIFICATION	MATL TYPE	CAL BLOCK NO
18" RHR (20)-2	18	30	0.438	SA 106 GR B	CC	N/A



NO	DATE	REVISION	BY	CHKD	APPVD
2	9-26-83	REVISED AS NOTED	K.M.C.A.	SMR	TTH
1	12-2-81	REVISED AS NOTED	K.M.C.A.	SMR	TTH
0	11-18-78	ISSUED FOR USE	K.M.C.A.	SMR	TTH
A	9-11-78	ISSUED FOR INFORMATION ONLY	K.M.C.A.	SMR	TTH

WNP-2
 WELD & COMPONENT IDENTIFICATION DIAGRAM

TITLE: RHR LOOP B
 RCIC STEAM SUPPLY TO RHR-HX-1B


DWG NO: RHR-20B-2 REV 2



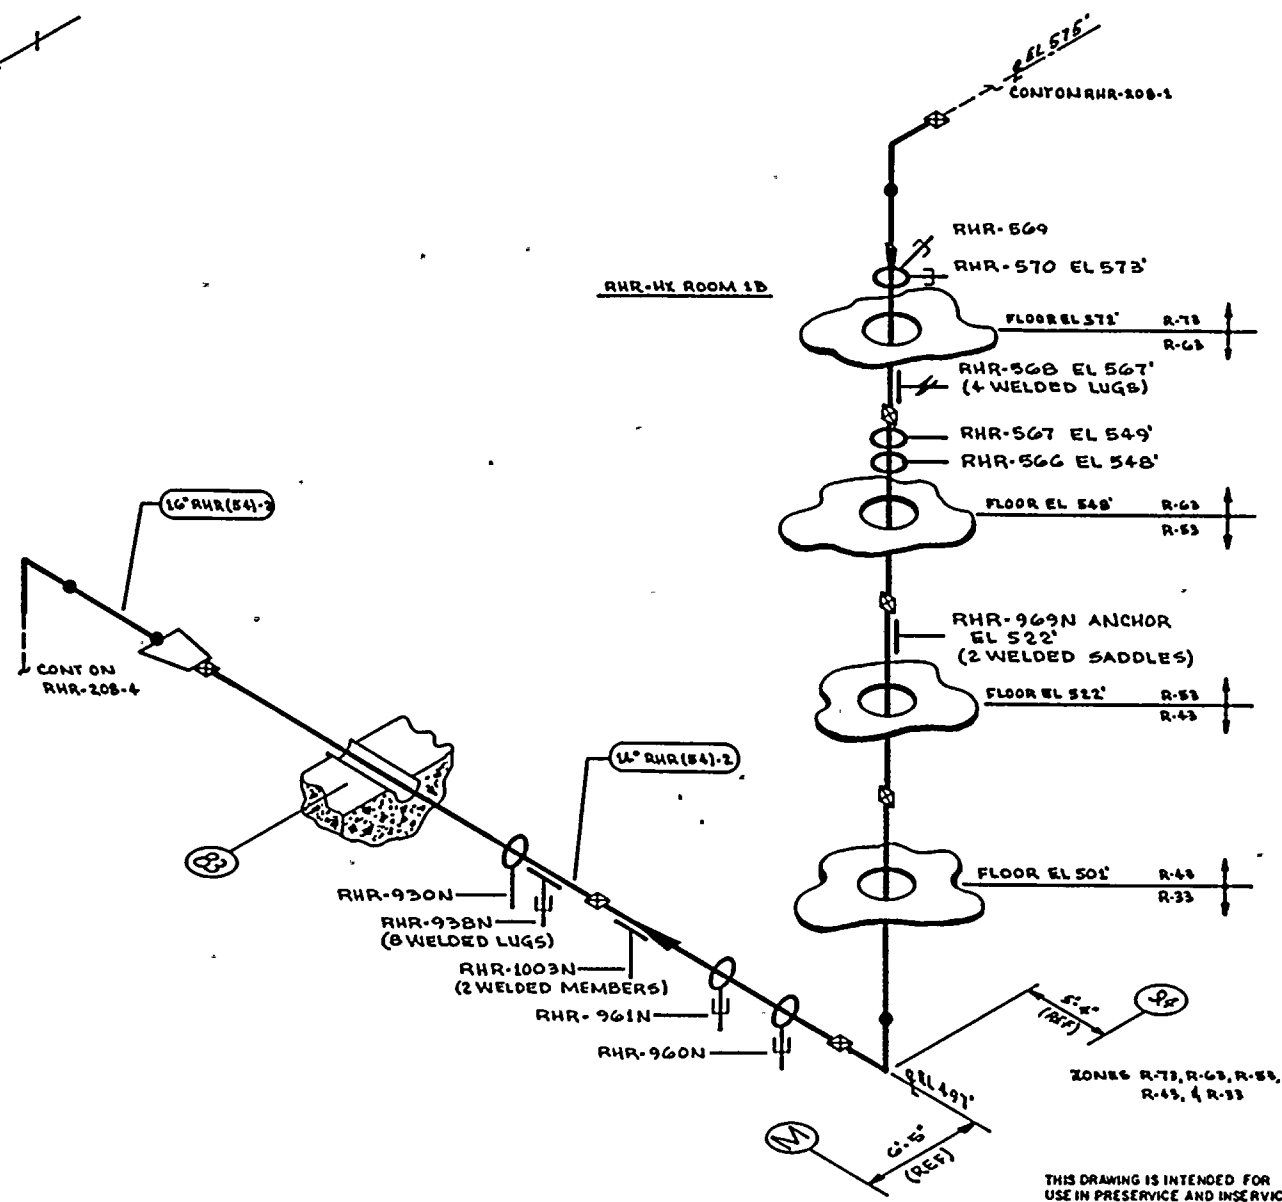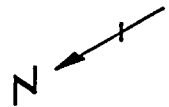

- NOTES:**
1. THIS DRAWING IDENTIFIES PIPING & COMPONENTS SUBJECT TO A VISUAL EXAM FOR EVIDENCE OF LEAKAGE DURING SYSTEM HYDRO OPERABILITY TESTS. TESTS ARE TO BE CONDUCTED PER THE REQUIREMENTS OF ASME SECTION XI, PARAGRAPH IWA-5000.
 2. THE VERTICAL RUN OF PIPE IS IN PIPE CHASE BEHIND REMOVABLE SHIELD WALLS.

REFERENCES:
 ABOVE & CRAIL ISOMETRICS
 RHR-898-21.29 REV 11

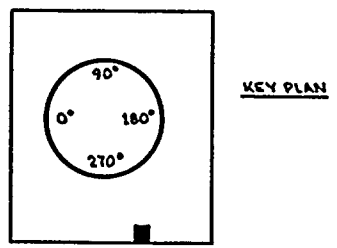

QUALITY CLASS: 1 ASME CODE CLASS: 2
 ENGR: GA. KUGLER DRAWN: V. M. C. A. DATE: 6-16-78

WASHINGTON PUBLIC POWER SUPPLY SYSTEM
 RICHLAND, WASHINGTON 99352

THIS DRAWING IS INTENDED FOR USE IN PRESERVICE AND INSERVICE INSPECTION PROGRAMS ONLY.


PIPING SYSTEM	NOM DIA (IN)	SCH	NOM WALL THK	MATERIAL SPECIFICATION	MATL TYPE	CAL BLOCK NO
14 RHR (54)-2	14	STD	0.375	SA 106 GR B	CS	NA
16 RHR (54)-2	16	40	0.500	SA 106 GR B	CS	NA

WNP-2
 WELD 8 COMPONENT
 IDENTIFICATION DIAGRAM

TITLE: **RHR LOOP B**
 RCIC STEAM RELIEF LINES TO SUPPRESSION POOL
 DWG NO: RHR-208-3 REV 1


NO	DATE	REVISION	BY	CHKD	APPVD
3	12-14-83	ADDED HANGERS & NOTE 2	VMA	DK	TRW
0	11-21-78	ISSUED FOR USE	VMA	DK	TRW
A	9-12-76	ISSUED FOR INFORMATION ONLY	VMA	DK	TRW



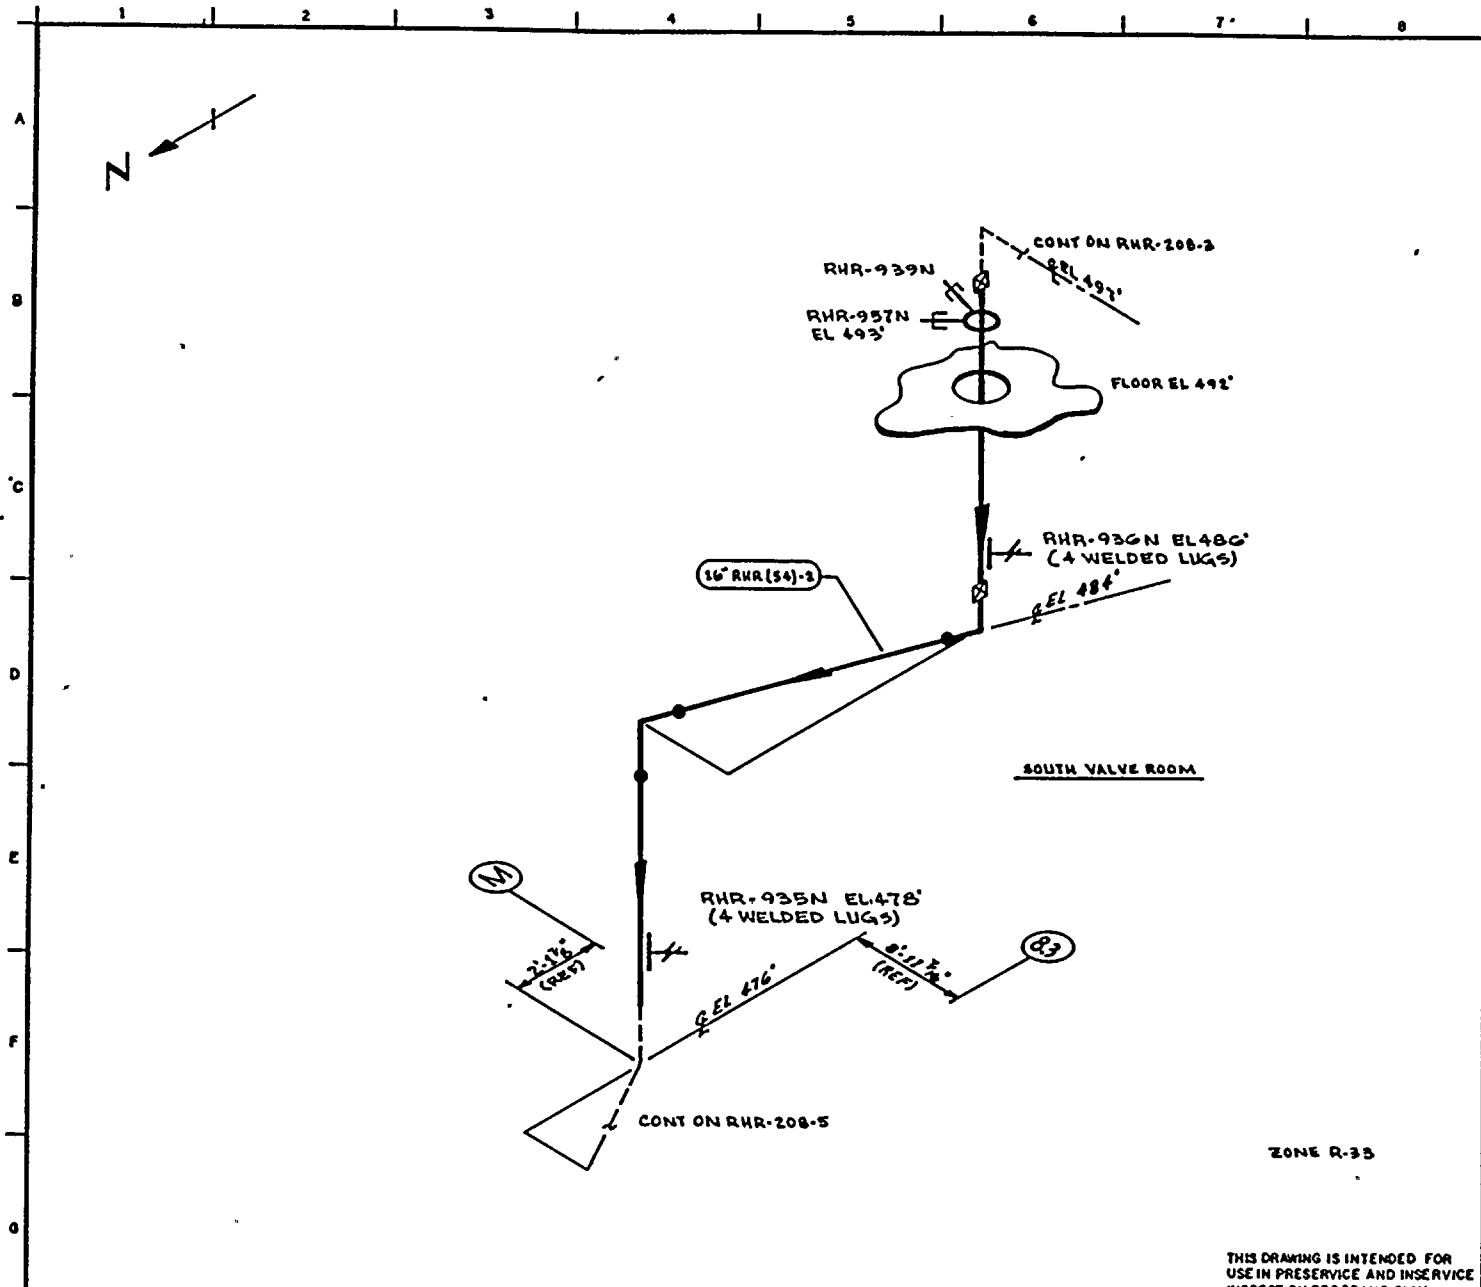

NOTES:
 1 THIS DRAWING IDENTIFIES PIPING & COMPONENTS SUBJECT TO A VISUAL EXAM FOR EVIDENCE OF LEAKAGE DURING SYSTEM HYDRO OR OPERABILITY TESTS. TESTS ARE TO BE CONDUCTED PER THE REQUIREMENTS OF ASME SECTION XI, PARA. GRAPH IWA-8000.

REFERENCES:
 BOYCE & CRAIG ISOMETRIC
 RHR-898-2L.29 REV 11

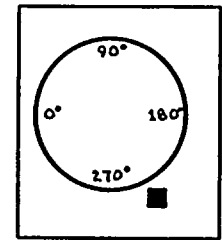

THIS DRAWING IS INTENDED FOR USE IN PRESERVICE AND INSERVICE INSPECTION PROGRAMS ONLY.

QUALITY CLASS: 1 ASME CODE CLASS: 2
 ENGR: G.A. KUGLER DRAWN: X.M.C.A. DATE: 6-16-78




WASHINGTON PUBLIC POWER SUPPLY SYSTEM
 RICHLAND, WASHINGTON 99352

PIPING SYSTEM	NOM DIA (DN)	SCH	NOM WALL THK	MATERIAL SPECIFICATION	MATL TYPE	CAL BLOCK NO
16" RHR(54)-2	16	40	0.500	SA 106 GR B	CS	NA

NO	DATE	REVISION	BY	CHKD	APPVD
1	12-11-83	ADDED HANGERS	KVA	CPE	TFH
0	11-11-81	ISSUED FOR USE	KVA	RJA	JJS
A	7-12-78	ISSUED FOR INFORMATION ONLY	KVA	WH	QJ


WNP-2
 WELD & COMPONENT IDENTIFICATION DIAGRAM
 TITLE: RHR LOOP B
 RCIC STEAM RELIEF LINES TO SUPPRESSION POOL
 DWG NO: RHR-208-4 REV 1



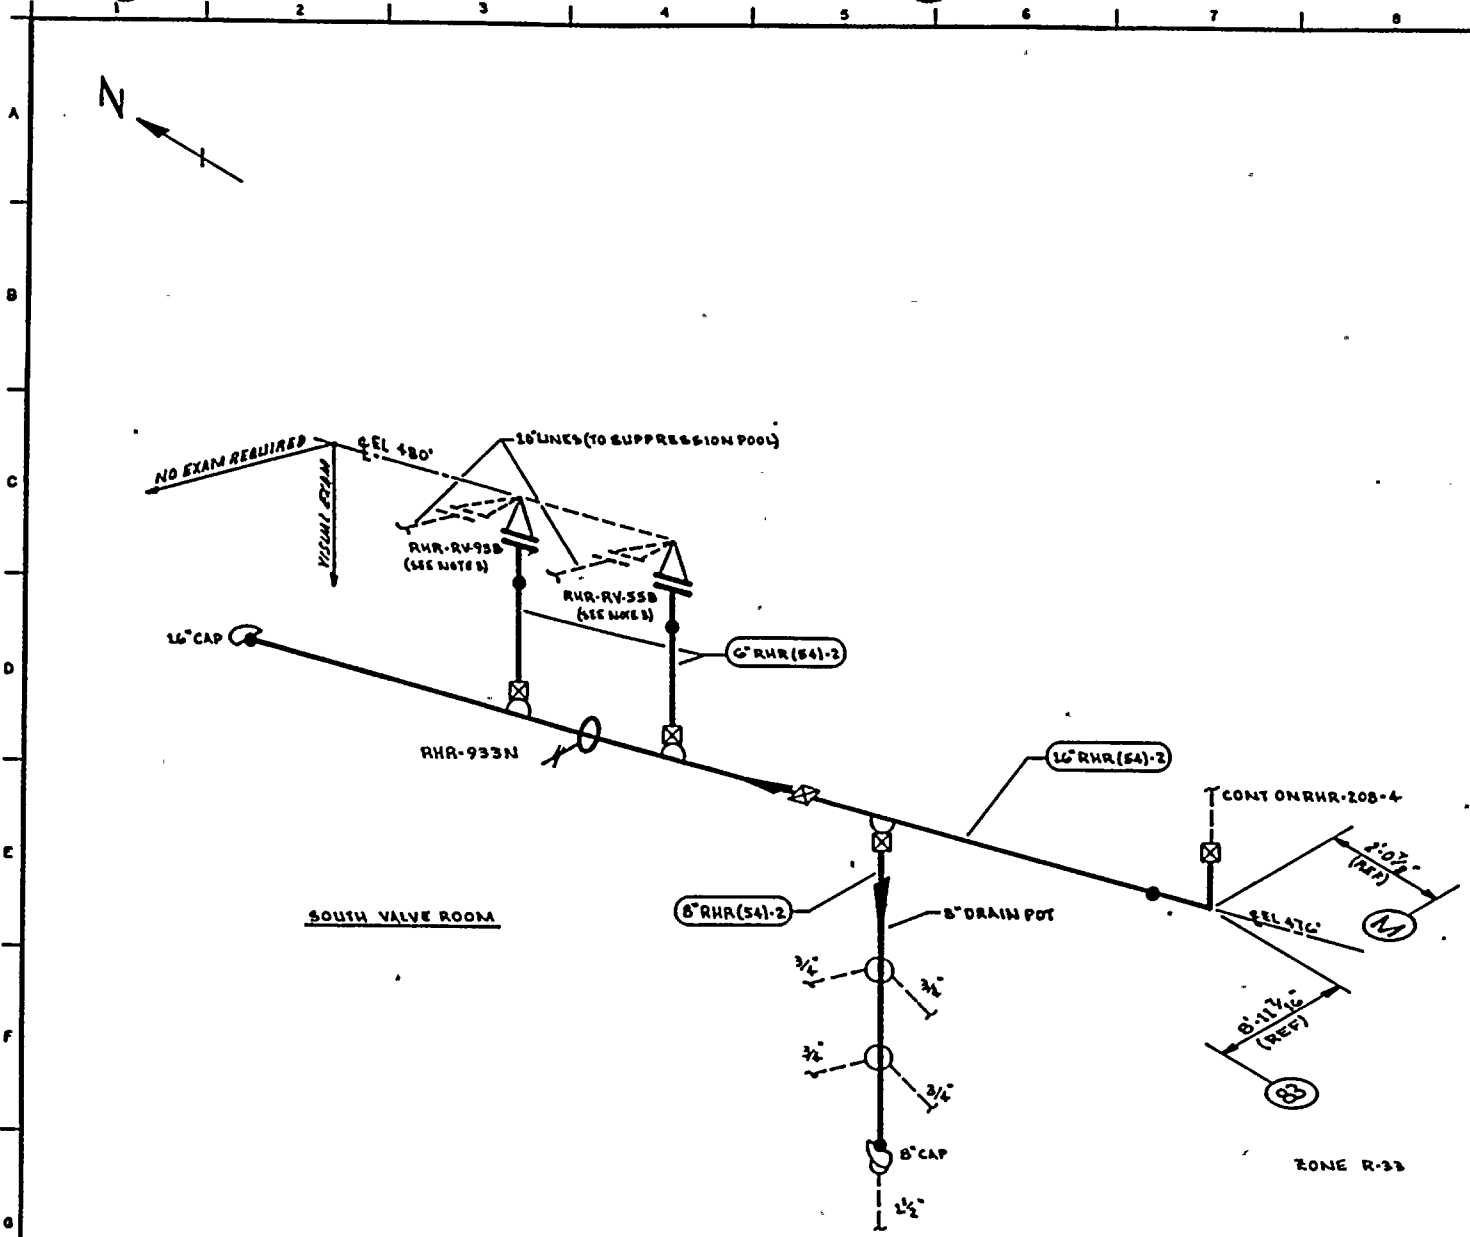

- NOTES:
- THIS DRAWING IDENTIFIES PIPING & COMPONENTS SUBJECT TO A VISUAL EXAM FOR EVIDENCE OF LEAKAGE DURING SYSTEM HYDRO OR OPERABILITY TESTS. TESTS ARE TO BE CONDUCTED PER THE REQUIREMENTS OF ASME SECTION XI, PARAGRAPH IWA-5000.
 - FOR BRANCH PIPING 4" DIA OR LESS (CONN SHOWN IN DASHED LINES) EXTEND VISUAL LEAKAGE EXAM THROUGH THE OUTER MOST NORMALLY CLOSED NUCLEAR CLASS VALVE OR UNTIL TRANSITION TO INSTRUMENT TUBING, UNLESS OTHERWISE NOTED.
 - THE TWO LINES TO THE SUPPRESSION POOL FROM RHR-RV-55B & RHR-RV-95B ARE OPEN ENDED & THEREFORE EXEMPT FROM EXAM.

REFERENCES:
BOVEE & CRAIG ISOMETRIC
RHR-898-30.32 REV 0

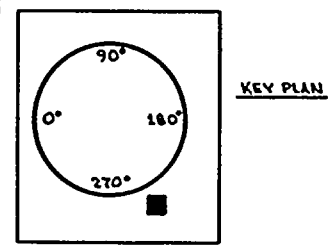

QUALITY CLASS: 1 ASME CODE CLASS: 2
ENGR: GA KUGLER DRAWN: K.M.C.A DATE: 6-16-78

WASHINGTON PUBLIC POWER SUPPLY SYSTEM
RICHLAND, WASHINGTON 98352

THIS DRAWING IS INTENDED FOR USE IN PRESERVICE AND INSERVICE INSPECTION PROGRAMS ONLY.

PIPING SYSTEM	NOM DIA (IN)	SCH	NOM WALL THK	MATERIAL SPECIFICATION	MATL TYPE	CAL BLOCK NO
16" RHR(S4)-2	16	40	0.500	SA 106 GR B	C6	NA
8" RHR(S4)-2	8	40	0.322	SA 106 GR B	C6	NA
6" RHR(S4)-2	6	40	0.280	SA 106 GR B	C5	NA

NO	DATE	REVISION	BY	CHKD	APPVD
1	12-14-83	ADDED HANGER, FIELD WELD IN E-5	KMcA	2PR	TFH
0	12-28-78	ISSUED FOR USE	KMcA	6PR	TFH
A	9-13-78	ISSUED FOR INFORMATION ONLY	KMcA	JAY	02P

WNP-2
WELD & COMPONENT IDENTIFICATION DIAGRAM

TITLE: RHR LOOP B
RHC STEAM RELIEF LINES TO SUPPRESSION POOL

DWG NO: RHR-208-5 REV 1



WNP-02
 INTERVAL: PSI
 PERIOD: NA
 OUTAGE:
 DRAWING NO. RHR-208

WASHINGTON PUBLIC POWER SUPPLY SYSTEM
 PROGRAM PLAN AND SCHEDULE
 SYSTEM OR COMPONENT: RHR(20)-2
 DESCRIPTION: LOOP B SPLY-RHR HX1B

PAGE 001
 DATE 12/14/84

<u>IDENT. NO.</u>	<u>DESCRIPTION</u>	<u>SECT.</u> <u>XI</u> <u>EXAM.</u>	<u>EXAM</u> <u>MTH.</u>	<u>PROCEDURE</u>	<u>CAL.</u> <u>BLOCK</u>	<u>INSERVICE</u>		<u>NOTES</u>
						<u>REQ.</u>	<u>SCHEDULED</u> <u>OUTAGE</u>	
RHR-580	SPRING	C-E-2	VT-3	303/8.2.17				
			VT-4	303/8.2.17				
RHR-574	PSA-3 SNUBBER	C-E-2	VT-3	303/8.2.17				S/N
			VT-4	303/8.2.17				S/N
RHR-573	PSA-3 SNUBBER	C-E-2	VT-3	303/8.2.17				S/N
			VT-4	303/8.2.17				S/N
RHR-572	SPRING	C-E-2	VT-3	303/8.2.17				
			VT-4	303/8.2.17				
RHR-607	SPRING	C-E-2	VT-3	303/8.2.17				
			VT-4	303/8.2.17				
RHR-571	SPRING	C-E-2	VT-3	303/8.2.17				
			VT-4	303/8.2.17				
RHR-575	PSA-3 SNUBBER	C-E-2	VT-3	303/8.2.17				S/N
			VT-4	303/8.2.17				S/N
RHR-576	STRUT	C-E-2	VT-3	303/8.2.17				
RHR-577	SPRING	C-E-2	VT-3	303/8.2.17				
			VT-4	303/8.2.17				

WNP-02
 INTERVAL: PSI
 PERIOD: NA
 OUTAGE:
 DRAWING NO. RHR-208

WASHINGTON PUBLIC POWER SUPPLY SYSTEM
 PROGRAM PLAN AND SCHEDULE
 SYSTEM OR COMPONENT: RHR(20)-2
 DESCRIPTION: LOOP B SPLY-RHR HX1B

PAGE 002
 DATE 12/14/84

IDENT. NO.	DESCRIPTION	SECT. XI EXAM.	EXAM MTH.	PROCEDURE	CAL. BLOCK	INSERVICE		NOTES
						REQ.	SCHEDULED OUTAGE	
RHR-578	PSA-3 SNUBBER	C-E-2	VT-3	303/8.2.17				S/N
			VT-4	303/8.2.17				S/N
RHR-985N	STRUT	C-E-2	VT-3	303/8.2.17				
18RHR(20)B-1	VALVE TO PIPE	C-F	SUR	PTP-1				
RHR-608	SPRING	C-E-2	VT-3	303/8.2.17				
			VT-4	303/8.2.17				
18RHR(20)B-1/3/4V-621B	VENT CONN	N/A	VT-2	OCI 7-1				
18RHR(20)B-2	PIPE TO EL	C-F	SUR	PTP-1				
18RHR(20)B-3	EL TO PIPE	C-F	SUR	PTP-1				
RHR-581	STRUT	C-E-2	VT-3	303/8.2.17				
18RHR(20)B-4	PIPE TO TEE	C-F	SUR	PTP-1				
RHR-569	PSA-3 SNUBBER	C-E-2	VT-3	303/8.2.17				S/N
			VT-4	303/8.2.17				S/N
RHR-570	PSA-3 SNUBBER	C-E-2	VT-3	303/8.2.17				S/N
			VT-4	303/8.2.17				S/N
RHR-568	SPRING	C-E-2	VT-3	303/8.2.17				
			VT-4	303/8.2.17				
RHR-567	STRUT	C-E-2	VT-3	303/8.2.17				

WNP-02
 INTERVAL: PSI
 PERIOD: NA
 OUTAGE:
 DRAWING NO. RHR-208

WASHINGTON PUBLIC POWER SUPPLY SYSTEM
 PROGRAM PLAN AND SCHEDULE
 SYSTEM OR COMPONENT: RHR(20)-2
 DESCRIPTION: LOOP B SPLY-RHR HX1B

PAGE 003
 DATE 12/14/84


IDENT. NO.	DESCRIPTION	SECT. XI EXAM.	EXAM MTH.	PROCEDURE	CAL: BLOCK	INSERVICE		NOTES
						REQ.	SCHEDULED OUTAGE	
RHR-566	STRUT	C-E-2	VT-3	303/8.2.17				
RHR-969N	ANCHOR	C-E-2	VT-3	303/8.2.17				
RHR-960N	PSA-1 SNUBBER	C-E-2	VT-3	303/8.2.17				S/N
			VT-4	303/8.2.17				S/N
RHR-961N	PSA-3 SNUBBER	C-E-2	VT-3	303/8.2.17				S/N
			VT-4	303/8.2.17				S/N
RHR-1003N	STRUT	C-E-2	VT-3	303/8.2.17				
RHR-938N	PSA-1 SN(2)	C-E-2	VT-3	303/8.2.17				S/N
			VT-4	303/8.2.17				S/N
RHR-930N	STRUT	C-E-2	VT-3	303/8.2.17				
RHR-939N	PSA-3 SNUBBER	C-E-2	VT-3	303/8.2.17				S/N
			VT-4	303/8.2.17				S/N
RHR-957N	PSA-3 SNUBBER	C-E-2	VT-3	303/8.2.17				S/N
			VT-4	303/8.2.17				S/N
RHR-936N	SPRING	C-E-2	VT-3	303/8.2.17				
			VT-4	303/8.2.17				
RHR-935N	SPRING	C-E-2	VT-3	303/8.2.17				
			VT-4	303/8.2.17				

WNP-02
INTERVAL: PSI
PERIOD: NA
OUTAGE:
DRAWING NO. RHR-208

WASHINGTON PUBLIC POWER SUPPLY SYSTEM
PROGRAM PLAN AND SCHEDULE
SYSTEM OR COMPONENT: RHR(20)-2
DESCRIPTION: LOOP B_SPLY-RHR_HX1B


PAGE 004
DATE 12/14/84

<u>IDENT. NO.</u>	<u>DESCRIPTION</u>	<u>SECT.</u>		<u>PROCEDURE</u>	<u>CAL.</u>	<u>INSERVICE</u>		<u>NOTES</u>
		<u>XI</u>	<u>EXAM</u>			<u>SCHEDULED</u>	<u>OUTAGE</u>	
<u>EXAM.</u>	<u>MTH.</u>	<u>BLOCK</u>	<u>REQ.</u>					
RHR-933N	SPRING	C-E-2	VT-3	303/8.2.17				
			VT-4	303/8.2.17				
RHR-PB-208	RHR PRESS BNDRY	N/A	VT-2	N/A				SEE NOTES #6 & #7.

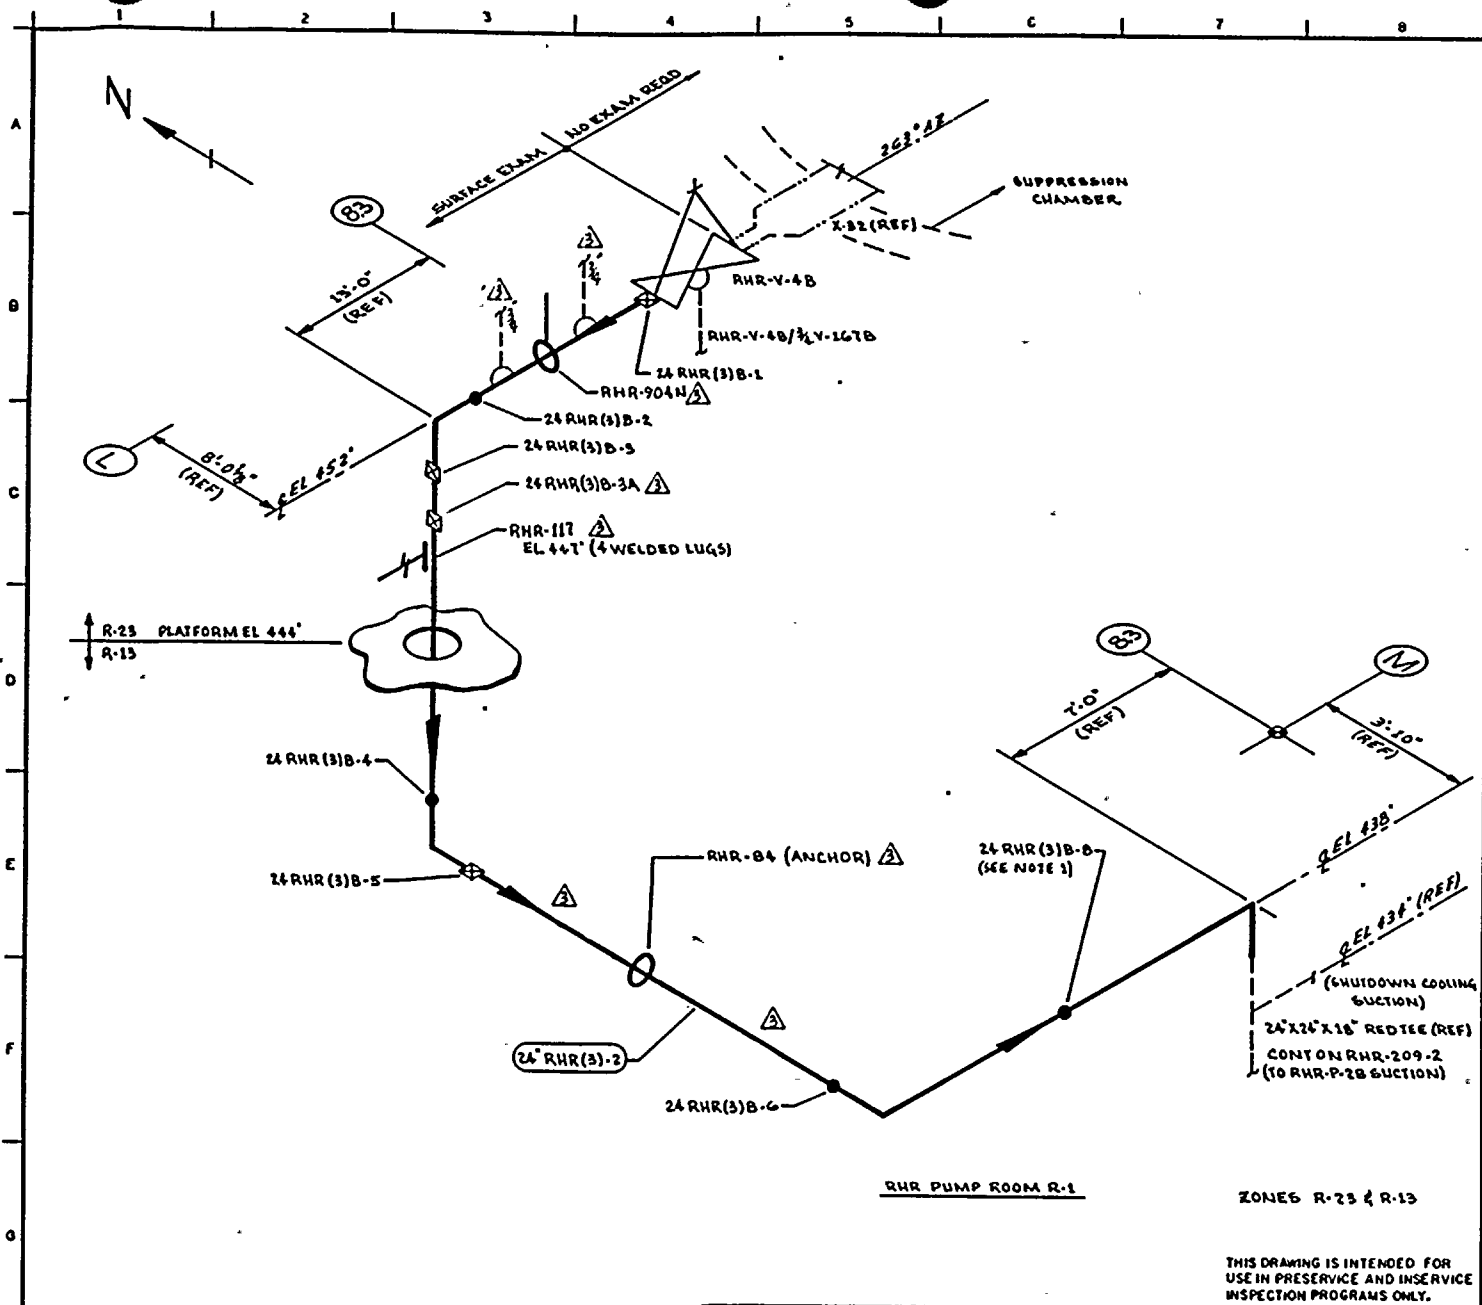

NOTES:
 1. WELD 24 RHR (3)B-6 IS FITTING TO FITTING.
 2. SCAFFOLD IS REQUIRED.

REFERENCES:
 BOWEN & CRAIG ISOMETRICS
 RHR-879-1.3 REV G

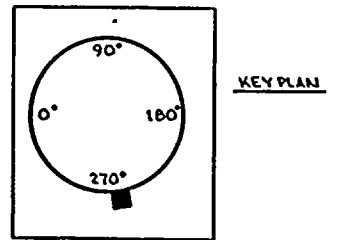


QUALITY CLASS: 1 ASME CODE CLASS: 2
 ENGR. G.A. KUGLER DRAWN. V.M.C.A. DATE: 6-19-78


WASHINGTON PUBLIC POWER SUPPLY SYSTEM
 RHR AND WASHINGTON SUB

THIS DRAWING IS INTENDED FOR USE IN PRESERVICE AND INSERVICE INSPECTION PROGRAMS ONLY.

NO	DATE	REVISION	BY	CHKD	APPVD	PIPING SYSTEM	NOM DIA (IN)	SCH	NOM WALL THK	MATERIAL SPECIFICATION	MATL TYPE	CAL BLOCK NO
3	10-13-83	REVISED AS NOTED	KUGLER	ZOK	1/19/84	24" RHR (3)B-2	24	STD	0.375	SA 106 GR B	CS	NA
2	11-2-81	REVISED AS NOTED	KUGLER	BR	1/15/82							
1	11-6-80	DELETED WELD 24 RHR (3)B-6, ADDED NOTE 1.	KUGLER	AD	1/15/82							
0	11-21-77	ISSUED FOR USE	KUGLER	AD	1/15/82							
1	9-12-77	ISSUED FOR INFORMATION ONLY	KUGLER	AD	1/15/82							


WNP-2
 WELD B COMPONENT
 IDENTIFICATION DIAGRAM
 TITLE:
 RHR LOOP B
 SUPPRESSION POOL SUCTION
 DWG NO: RHR-209-1
 REV 3

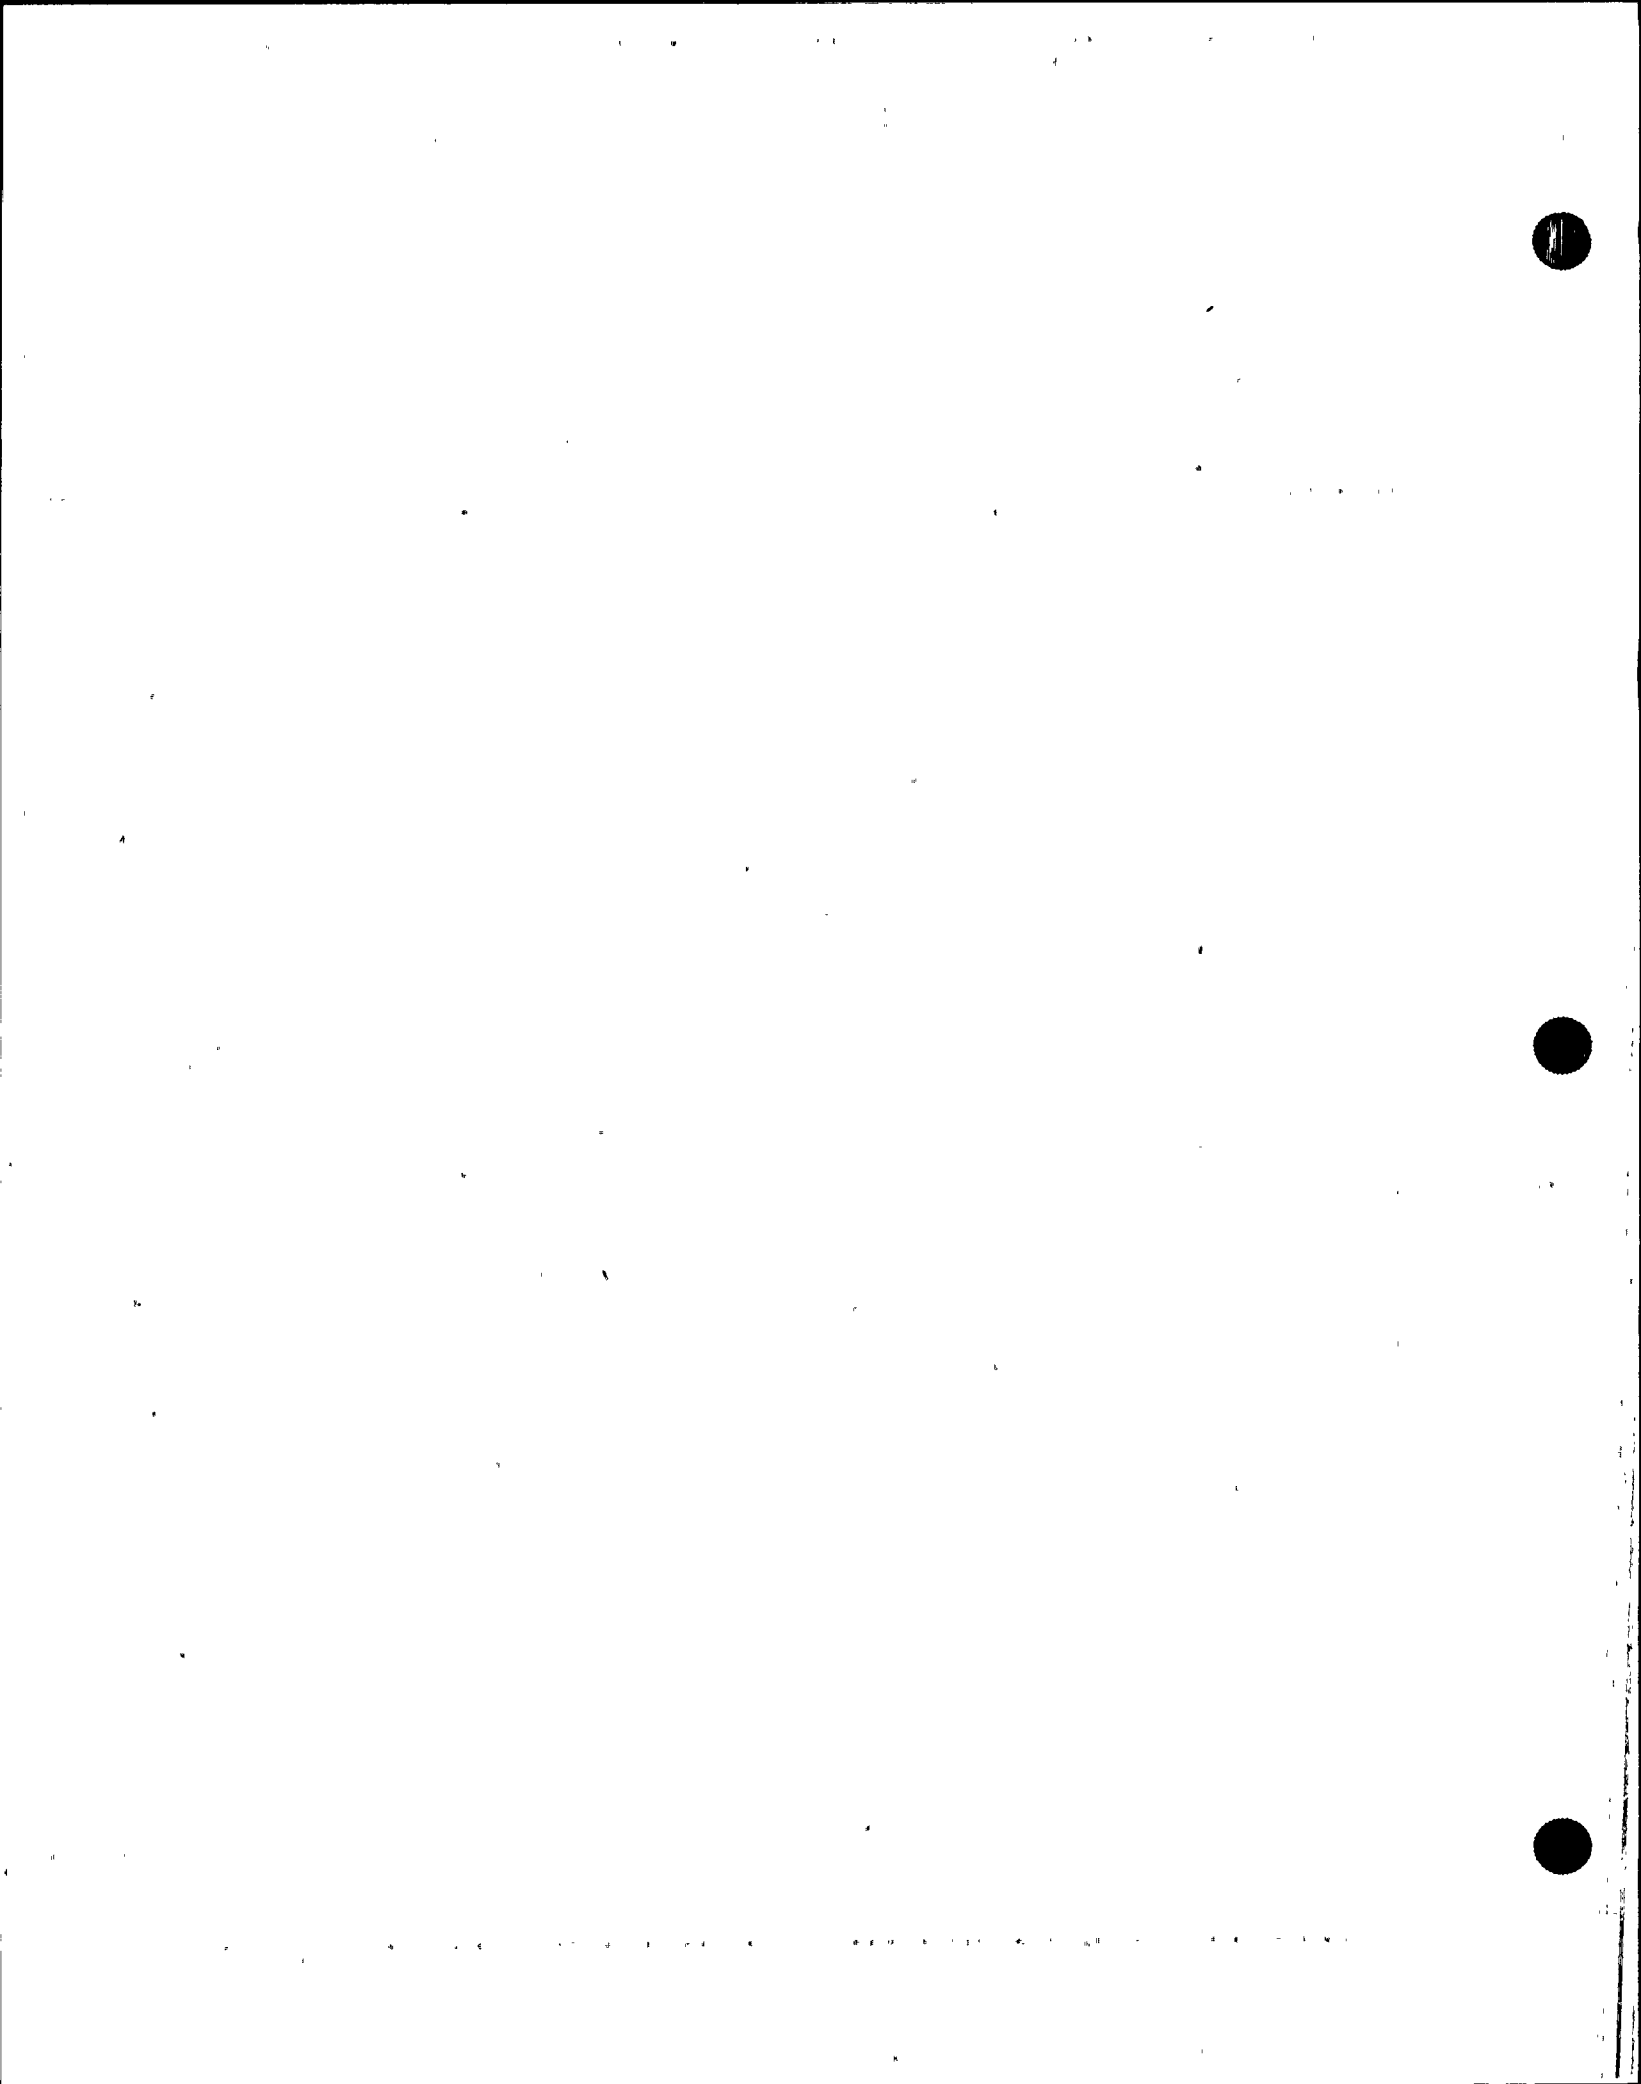

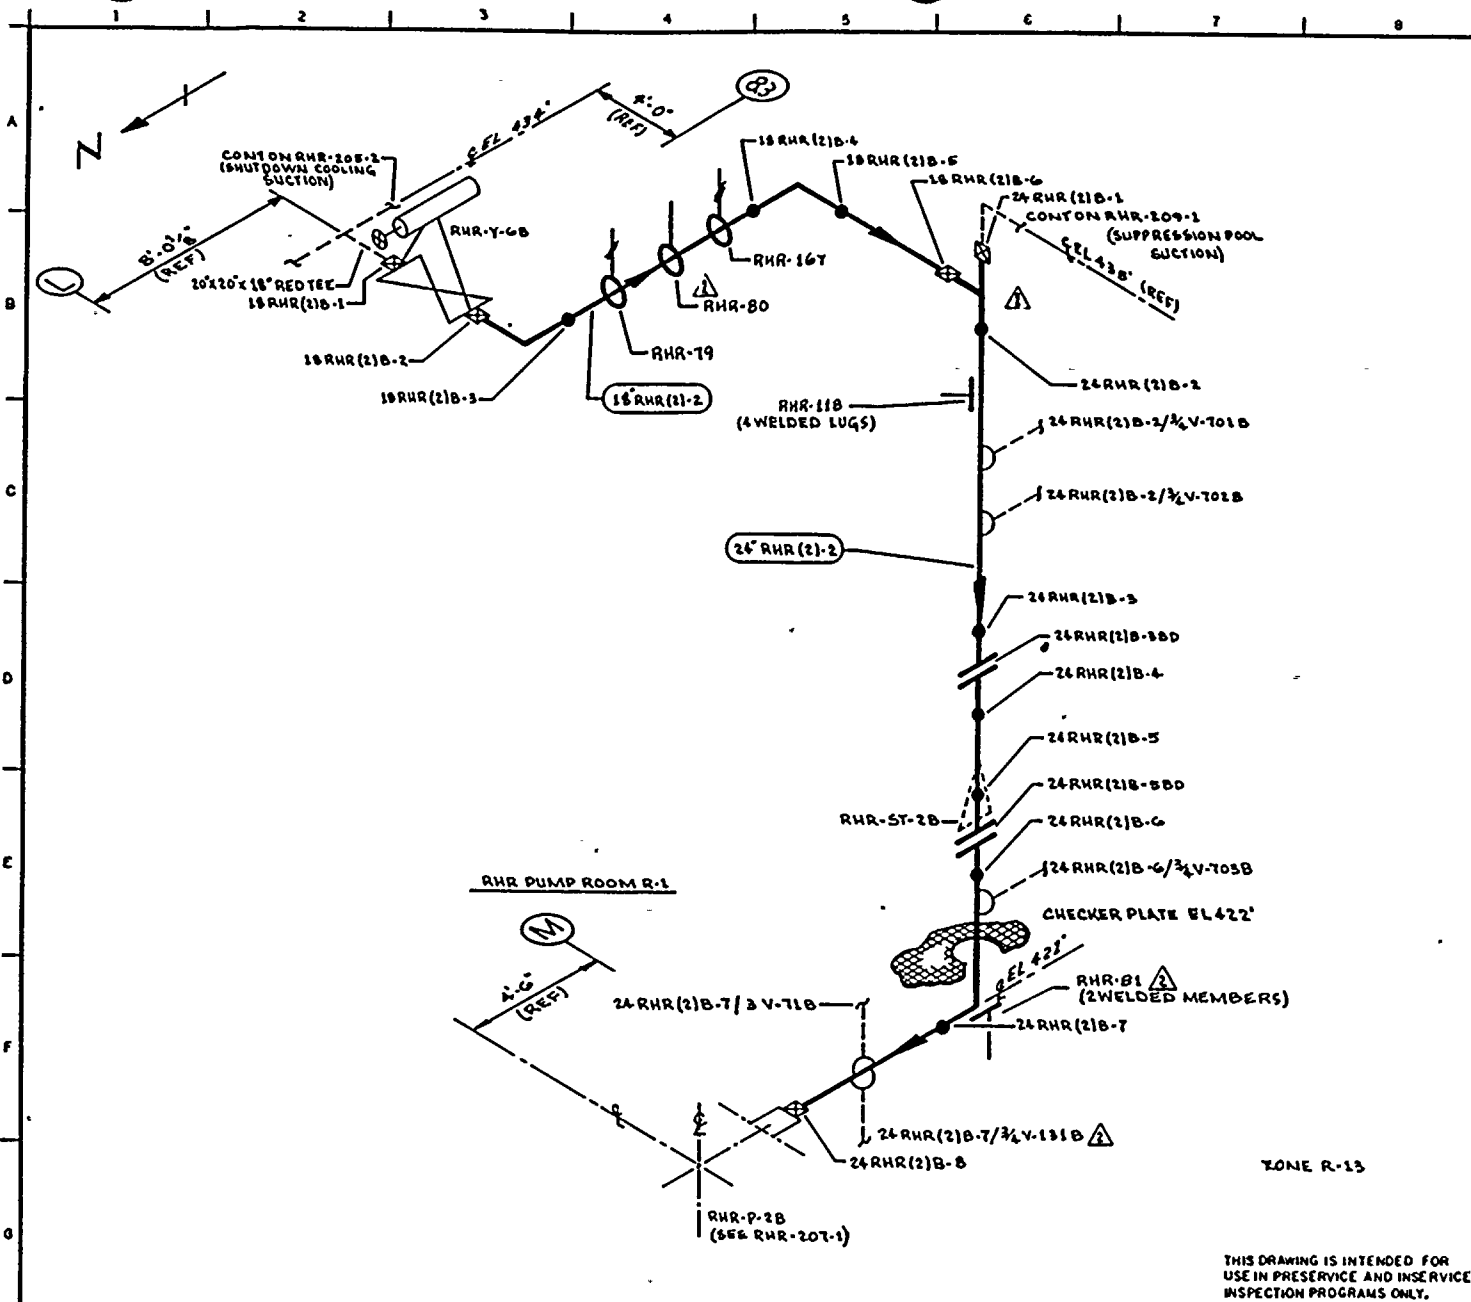

NOTES:
 ⚠ SCAFFOLDING IS REQUIRED.

REFERENCES:
 BOVEE & CRAL ISOMETRICS
 RHR-875-9.12 REV 6

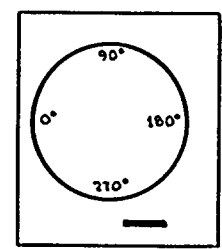

KEY PLAN

ZONE R-13

THIS DRAWING IS INTENDED FOR
 USE IN PRESERVICE AND INSERVICE
 INSPECTION PROGRAMS ONLY.

QUALITY CLASS: 1 ASME CODE CLASS: 2
 ENGR GA KUGLER DRAWN: K. Mc A DATE: 6-19-78



WASHINGTON PUBLIC POWER
 SUPPLY SYSTEM
 12TH AND WASHINGTON 99152

PIPING SYSTEM	NOM DIA (DN)	SCH	NOM WALL THK	MATERIAL SPECIFICATION	MATL TYPE	CAL BLOCK NO
18" RHR (2)-2	18	STD	0.375	SA 106 GR B	CS	NA
24" RHR (2)-2	24	STD	0.375	SA 106 GR B	CS	NA

NO	DATE	REVISION	BY	CHKD	APPVD
2	9-26-78	REVISED AS NOTED	KMcA	LPR	TFH
1	12-2-81	REVISED AS NOTED	KMcA	LPR	TFH
0	11-22-78	ISSUED FOR USE	KMcA	LPR	TFH
1	9-12-78	ISSUED FOR INFORMATION ONLY	KMcA	LPR	TFH

WNP-2
 WELD B COMPONENT
 IDENTIFICATION DIAGRAM

TITLE:
 RHR LOOP B
 SHUTDOWN COOLING SUCTION

DWG NO: RHR-209-2

MIV 2



WNP-02
 INTERVAL: PSI
 PERIOD: NA
 OUTAGE:
 DRAWING NO. RHR-209

WASHINGTON PUBLIC POWER SUPPLY SYSTEM
 PROGRAM PLAN AND SCHEDULE
 SYSTEM OR COMPONENT: RHR(1)2
 DESCRIPTION: LOOP B SPLY-RHR HX1B

PAGE 001
 DATE 12/14/84

IDENT. NO.	DESCRIPTION	SECT.	EXAM.	EXAM.	PROCEDURE	CAL. BLOCK	INSERVICE		NOTES
		MIH.					REQ.	SCHEDULED OUTAGE	
RHR-V-4B/3/4V-167B	TEST CONN	N/A	VT-2	N/A					IVC-2510, SEE NOTES #6 & #7.
24RHR(3)B-1	VALVE TO PIPE	C-F	SUR	QCI 3-3					
RHR-904N	STRUT	C-E-2	VT-3	303/8.2.17					
24RHR(3)B-2	PIPE TO EL	C-F	SUR	QCI 3-3					
24RHR(3)B-3	EL TO PIPE	C-F	SUR	PTP-1					
24RHR(3)B-3A	PIPE TO PIPE	C-F	SUR	PTP-1					
RHR-117(W)	4 WELDED LUGS	C-E-1	SUR	QCI 4-3					
RHR-117	SPRING	C-E-2	VT-3	303/8.2.17					
			VT-4	303/8.2.17					
24RHR(3)B-4	PIPE TO EL	C-F	SUR	PTP-1					
24RHR(3)B-5	EL TO PIPE	C-F	SUR	PTP-1					
RHR-84	ANCHOR	C-E-2	VT-3	303/8.2.17					
24RHR(3)B-6	PIPE TO EL	C-F	SUR	PTP-1					
24RHR(3)B-8	EL TO FL	C-F	SUR	QCI 3-3					
18RHR(2)B-1	TEE TO VALVE	C-F	SUR	PTP-1					
18RHR(2)B-2	VALVE TO EL	C-F	SUR	PTP-1					
18RHR(2)B-3	EL TO PIPE	C-F	SUR	PTP-1					

WNP-02
 INTERVAL: PSI
 PERIOD: NA
 OUTAGE:
 DRAWING NO. RHR-209

WASHINGTON PUBLIC POWER SUPPLY SYSTEM
 PROGRAM PLAN AND SCHEDULE
 SYSTEM OR COMPONENT: RHR(1)2
 DESCRIPTION: LOOP B SPLY-RHR HX1B

PAGE 002
 DATE 12/14/84


IDENT. NO.	DESCRIPTION	SECT. XI EXAM.	EXAM MTH.	PROCEDURE	CAL. BLOCK	INSERVICE		NOTES
						REQ.	SCHEDULED OUTAGE	
RHR-79	SPRING	C-E-2	VT-3	303/8.2.17				
			VT-4	303/8.2.17				
RHR-80	STRUT	C-E-2	VT-3	303/8.2.17				
RHR-167	SPRING	C-E-2	VT-3	303/8.2.17				
			VT-4	303/8.2.17				
18RHR(2)B-4	PIPE TO EL	C-F	SUR	PTP-1				
18RHR(2)B-5	EL TO PIPE	C-F	SUR	PTP-1				
18RHR(2)B-6	PIPE TO TEE	C-F	SUR	PTP-1				
24RHR(2)B-1	EL TO TEE	C-F	SUR	PTP-1				
24RHR(2)B-2	TEE TO PIPE	C-F	SUR	PTP-1				
RHR-118(W)	4 WELDED LUGS	C-E-1	SUR	MTP-1				
RHR-118	SPRING	C-E-2	VT-3	303/8.2.17				
			VT-4	303/8.2.17				
24RHR(2)B-2/3/4V-701B	INSTR CONN	N/A	VT-2	N/A				IWC-2510, SEE NOTES #6 & #7.
24RHR(2)B-2/3/4V-702B	INSTR CONN	N/A	VT-2	N/A				IWC-2510, SEE NOTES #6 & #7.
24RHR(2)B-3	PIPE TO FLANGE	C-F	SUR	PTP-1				
24RHR(2)B-4	FLANGE TO PIPE	C-F	SUR	PTP-1				

WNP-02
 INTERVAL: PSI
 PERIOD: NA
 OUTAGE:
 DRAWING NO. RHR-209

WASHINGTON PUBLIC POWER SUPPLY SYSTEM
 PROGRAM PLAN AND SCHEDULE
 SYSTEM OR COMPONENT: RHR(1)2
 DESCRIPTION: LOOP B SPLY-RHR HX1B


PAGE 003
 DATE 12/14/84

<u>IDENT. NO.</u>	<u>DESCRIPTION</u>	<u>SECT.</u>		<u>PROCEDURE</u>	<u>CAL. BLOCK</u>	<u>REQ.</u>	<u>INSERVICE SCHEDULED</u>		<u>NOTES</u>
		<u>XI EXAM.</u>	<u>EXAM. HIH.</u>				<u>OUTAGE</u>		
24RHR(2)B-5	PIPE TO FLANGE	C-F	SUR	PTP-1					
24RHR(2)B-6	FLANGE TO EL	C-F	SUR	PTP-1					
24RHR(2)B-6/3/4V-703B	INST CONN	N/A	VT-2	N/A					IWC-2510, SEE NOTES #6 & #7.
RHR-81	STRUT	C-E-2	VT-3	303/8.2.17					
24RHR(2)B-7	EL TO PIPE	C-F	SUR	PTP-1					
24RHR(2)B-7/3V-71B	FLUSH CONN	N/A	VT-2	N/A					IWC-2510, SEE NOTES #6 & #7.
24RHR(2)B-7/3/4V-131B	DRAIN CONN	N/A	VT-2	N/A					IWC-2510, SEE NOTES #6 & #7.
24RHR(2)B-8	PIPE TO PUMP	C-F	SUR	PTP-1					
RHR-PB-209	RHR PRESS BNDRY	N/A	VT-2	N/A					IWC-2510, SEE NOTES #6 & #7.

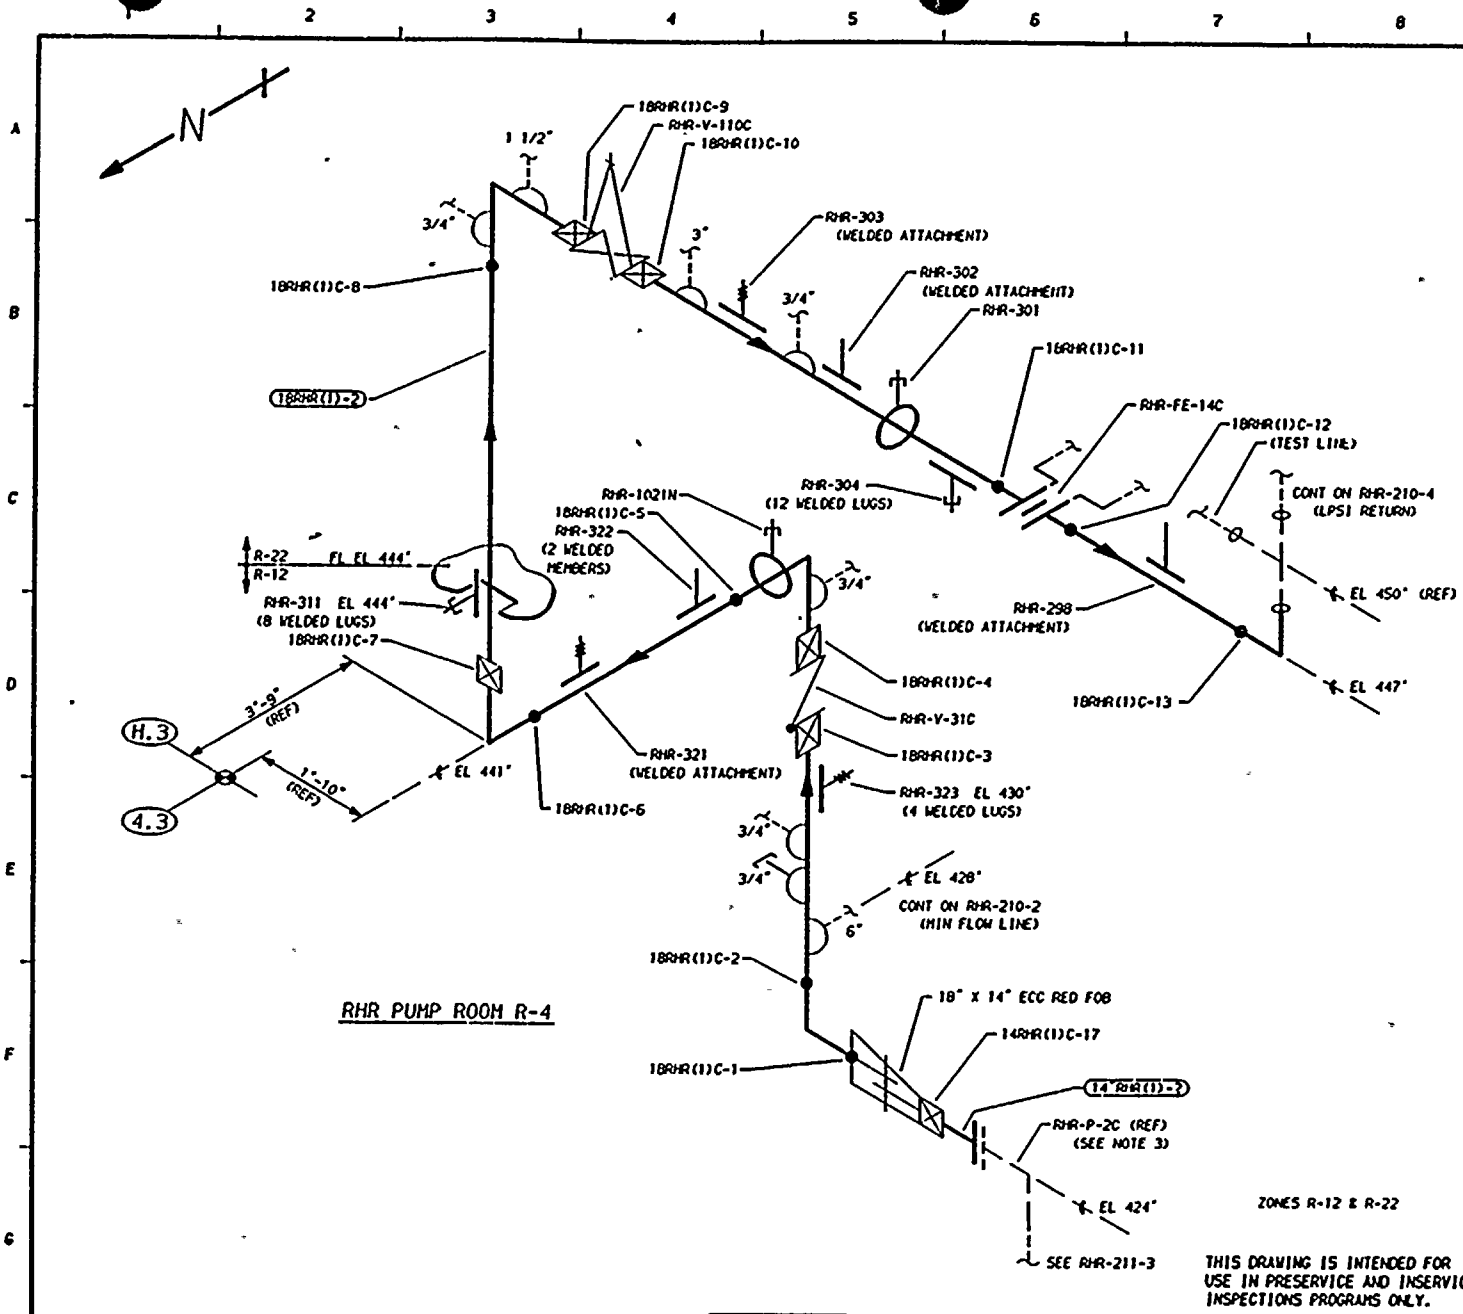

- NOTES:**
1. THIS DRAWING IDENTIFIES PIPING AND COMPONENTS SUBJECT TO A VISUAL EXAM FOR EVIDENCE OF LEAKAGE DURING SYSTEM HYDRO OR OPERABILITY TESTS. TESTS ARE TO BE CONDUCTED PER THE REQUIREMENTS OF ASME SECTION XI, PARAGRAPH IMA-5000.
 2. FOR BRANCH PIPING 4" NOM. OR LESS (CONNECTION SHOWN IN DASHED LINES) EXTEND VISUAL LEAKAGE EXAM THROUGH THE OUTERMOST NORMALLY CLOSED NUCLEAR CLASS VALVE, OR UNTIL TRANSITION TO INSTRUMENT TUBING, UNLESS OTHERWISE NOTED.
 3. EXTEND VISUAL LEAKAGE EXAM OF RHR-P-2C VENTS AND DRAINS TO OUTERMOST NORMALLY CLOSED VALVE.
 4. SCAFFOLDING IS REQUIRED.

- REFERENCES:**
- BOYEE AND CRILL ISOMETRIC
 - RHR-897-1.2 REV 7
 - RHR-897-3.5 REV 9

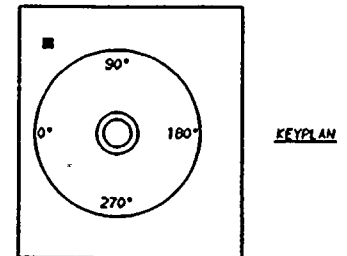

QUALITY CLASS:	1	ASME CODE CLASS:	2
ENGR:	GA KUGLER	DRAWN:	K-McA
DATE:	6-19-78		

WASHINGTON PUBLIC POWER
SUPPLY SYSTEM
RICHLAND, WASHINGTON 99352

**WHP-2
WELD & COMPONENT
IDENTIFICATION DIAGRAM**

TITLE:	RHR LOOP C SUPPRESSION POOL SUCTION	
DWG NO:	RHR-210-1	REV 1

PIPING SYSTEM	NOM DIA (IN)	SCH	NOM WALL THK	MATERIAL SPECIFICATION	MATL TYPE	CAL BLOCK NO
14" RHR(1)-2	14	STD	0.375	SA 106 GR B	CS	NA
18" RHR(1)-2	18	30	0.438	SA 106 GR B	CS	NA

NO	DATE	REVISION	BY	CHKD	APVD
1	10-18-82	REVISED HANGERS. REDRAWN	K-McA	DPP	TFK
0	12-22-78	ISSUED FOR USE	K-McA	DFC	LFB
A	9-12-78	ISSUED FOR INFORMATION ONLY	K-McA	GAK	DWP


THIS DRAWING IS INTENDED FOR USE IN PRESERVICE AND INSERVICE INSPECTIONS PROGRAMS ONLY.


ZONES R-12 & R-22


SEE RHR-211-3

18" X 14" ECC RED FOB

RHR PUMP ROOM R-4

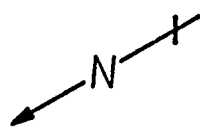


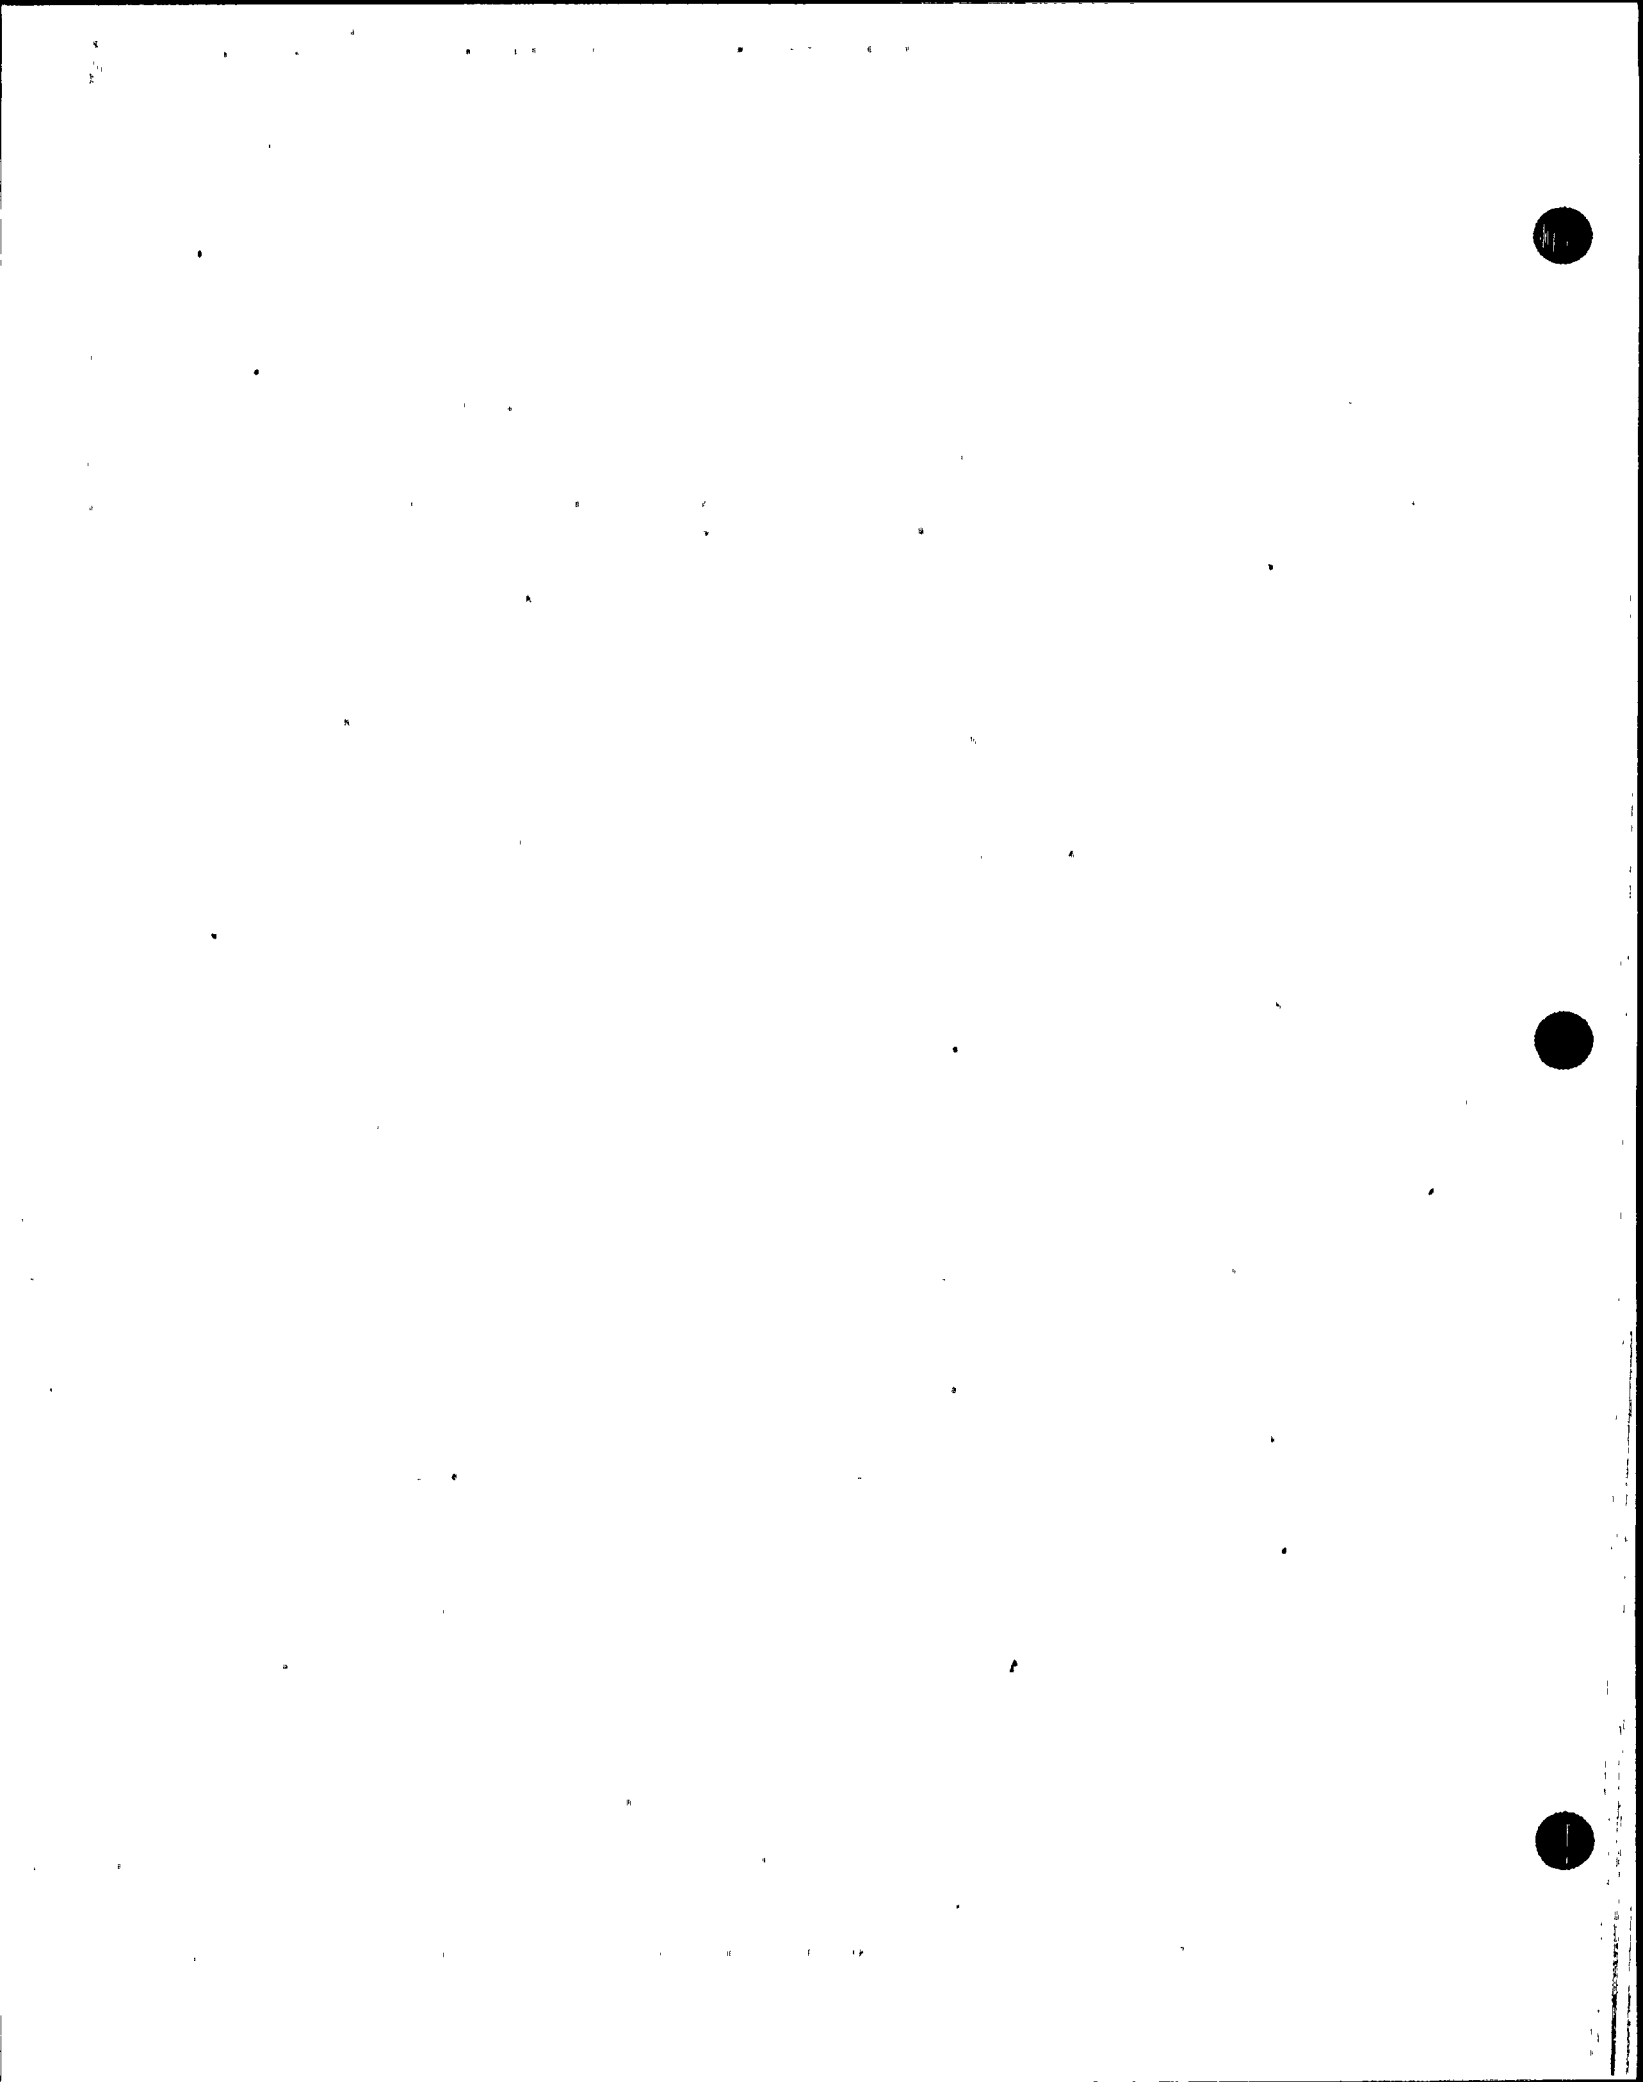

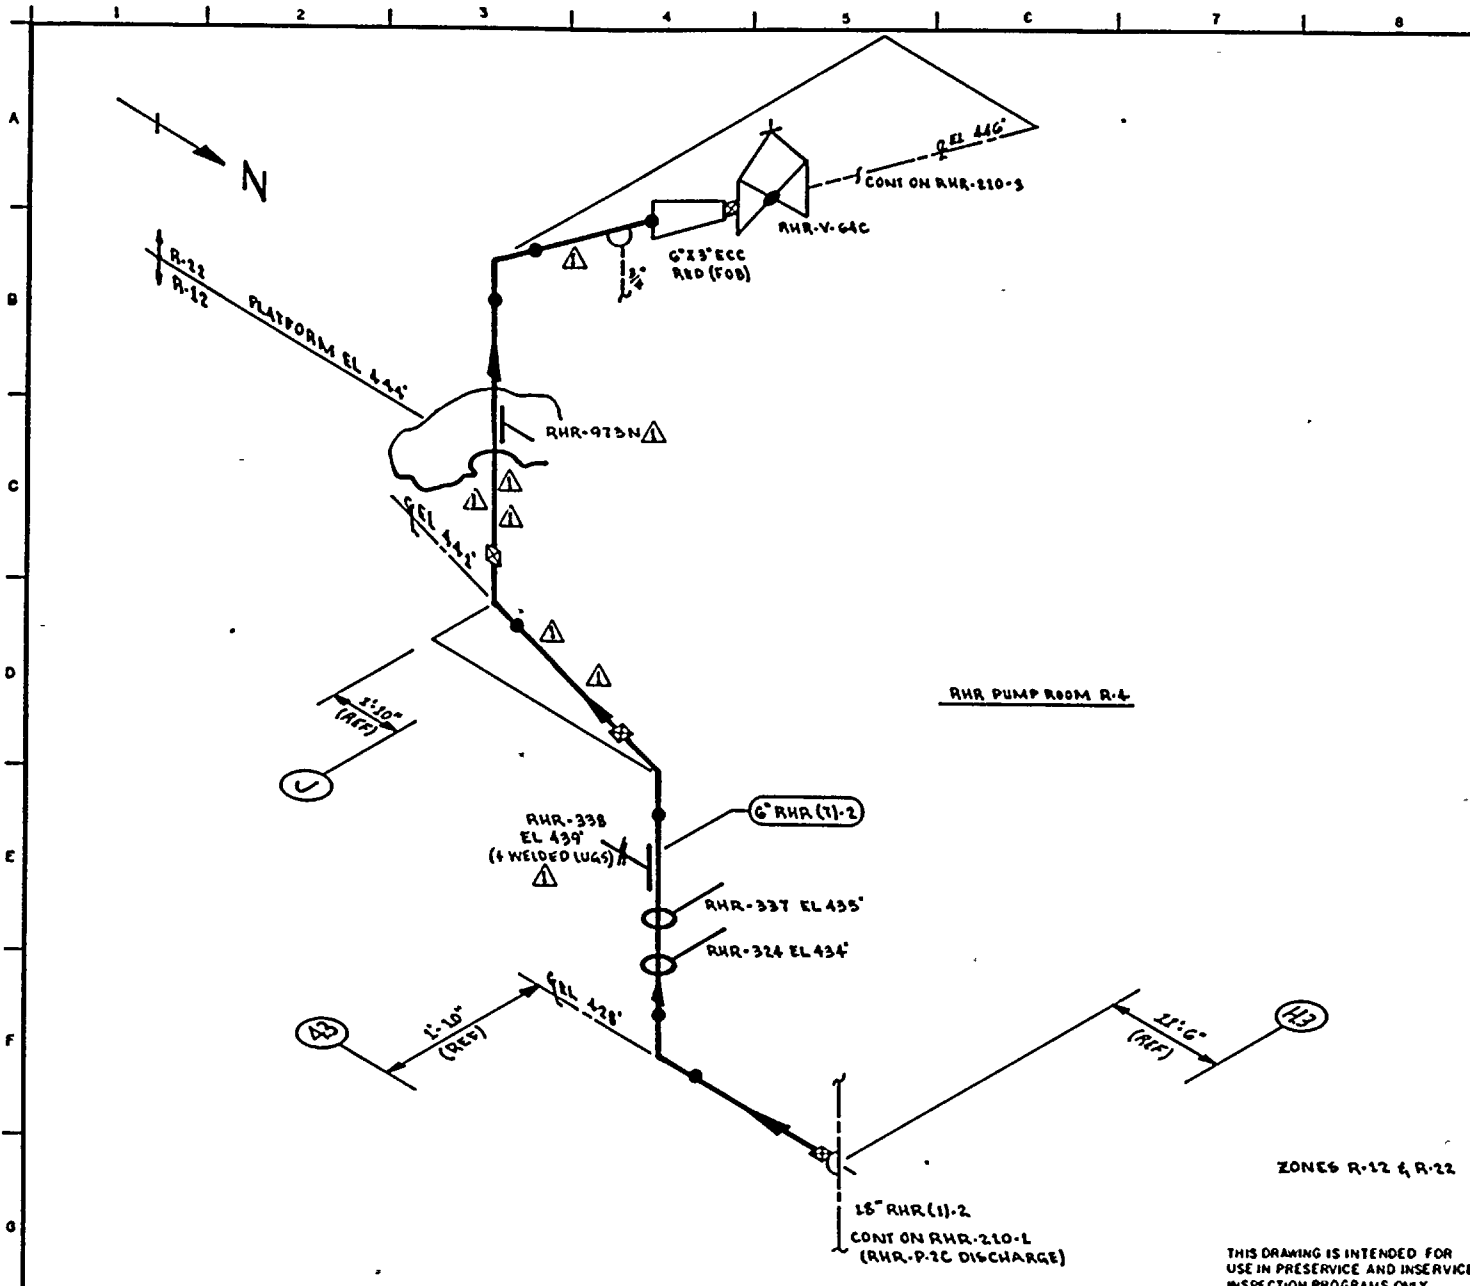

- NOTES:
1. THIS DRAWING IDENTIFIES PIPING & COMPONENTS SUBJECT TO A VISUAL EXAM FOR EVIDENCE OF LEAKAGE DURING SYSTEM HYDRO OR OPERABILITY TESTS. TESTS ARE TO BE CONDUCTED PER THE REQUIREMENTS OF ASME SECTION XI, PARAGRAPH 5WA-5000.
 2. FOR BRANCH PIPING 4" DIA OR LESS (CONN SHOWN IN DASHED LINES) EXTEND VISUAL LEAKAGE EXAM THROUGH THE OUTERMOST NORMALLY CLOSED NUCLEAR CLASS VALVE OR UNTIL TRANSITION TO INSTRUMENT TUBING, UNLESS OTHERWISE NOTED.

REFERENCES:
 BOVEE & CRAIG ISOMETRICS
 RHR-897-25.30 REV 0

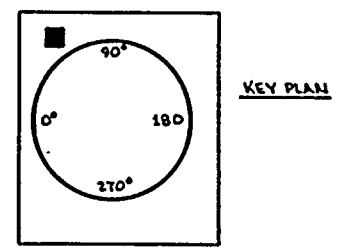

QUALITY CLASS: 1 ASME CODE CLASS: 2
 ENGR: GA KUGLER DRAWN: K.M.L.A DATE: 6-20-78

WASHINGTON PUBLIC POWER SUPPLY SYSTEM
 RICHLAND WASHINGTON 99352

THIS DRAWING IS INTENDED FOR USE IN PRESERVICE AND INSERVICE INSPECTION PROGRAMS ONLY.

PIPING SYSTEM	NOM DIA (IN)	SCH	NOM WALL THK	MATERIAL SPECIFICATION	MATL TYPE	CAL BLOCK NO
6" RHR (7)-2	6	A0	0.280	SA 106 GR B	CS	NA


NO	DATE	REVISION	BY	CHKD	APPVD
1	9-26-83	REVISED AS NOTED	K.M.L.A	LOR	JFH
0	12-11-78	ISSUED FOR USE	K.M.L.A	ROR	JFH
A	9-12-78	ISSUED FOR INFORMATION ONLY	K.M.L.A	J.M.K.	JFH

WNP-2
 WELD & COMPONENT IDENTIFICATION DIAGRAM

TITLE:
 RHR LOOP C
 MINIMUM FLOW LINE TO SUPPRESSION POOL

DWG NO: RHR-210-2 REV 1



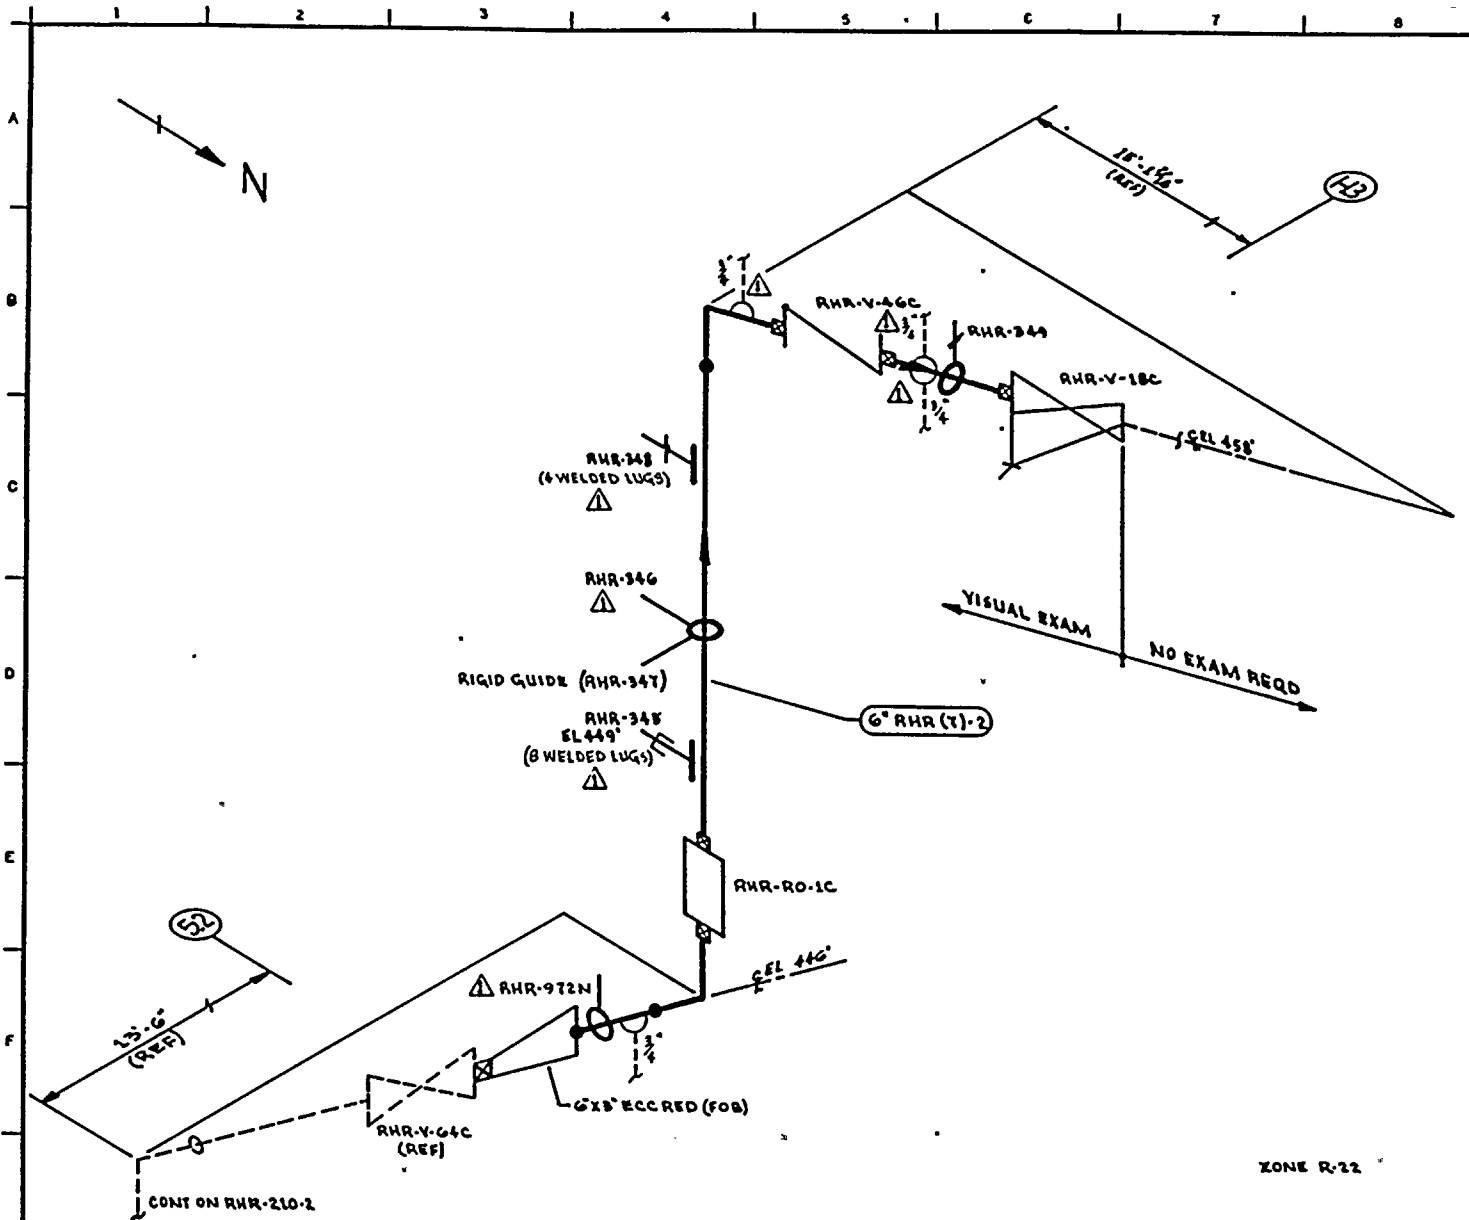


NOTES:

1. THIS DRAWING IDENTIFIES PIPING & COMPONENTS SUBJECT TO A VISUAL EXAM FOR EVIDENCE OF LEAKAGE DURING SYSTEM HYDRO OR OPERABILITY TESTS. TESTS ARE TO BE CONDUCTED PER THE REQUIREMENTS OF ASME SECTION XI, PARAGRAPH IWA-5000.
2. FOR BRANCH PIPING 4" DIA OR LESS (CONN SHOWN IN DASHED LINE) EXTEND VISUAL LEAKAGE EXAM THROUGH THE OUTERMOST NORMALLY CLOSED NUCLEAR CLASS VALVE OR UNTIL TRANSITION TO INSTRUMENT TUBING, UNLESS OTHERWISE NOTED.

REFERENCES:

BOVEE & CRAIG ISOMETRICS
RHR-897-25.30 REV B

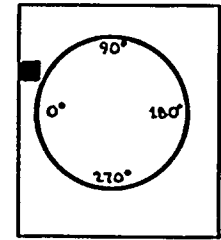

KEY PLAN

ZONE R-22

THIS DRAWING IS INTENDED FOR USE IN PRESERVICE AND INSERVICE INSPECTION PROGRAMS ONLY.

QUALITY CLASS: 1 ASME CODE CLASS: 2
ENGR G.A. KUGLER DRAWN: K.McA DATE: 6-20-78



WASHINGTON PUBLIC POWER SUPPLY SYSTEM
RICHMOND WASHINGTON 99352

PIPING SYSTEM	NOM DIA (IN)	SCH	NOM WALL THK	MATERIAL SPECIFICATION	MATL TYPE	CAL BLOCK NO
6" RHR (T)-2	6	40	0.280	SA 106 GR B	CS	NA


NO	DATE	REVISION	BY	CHKD	APPVD
1	9-21-83	REVISED AS NOTED	K.McA	DMC	TFH
0	11-22-78	ISSUED FOR USE	K.McA	R.McA	TFH
A	9-11-78	ISSUED FOR INFORMATION ONLY	K.McA	DMC	R.McA

WNP-2
WELD & COMPONENT IDENTIFICATION DIAGRAM

TITLE:
RHR LOOP C
MINIMUM FLOW LINE TO SUPPRESSION POOL

DWG NO: RHR-210-3 REV 1




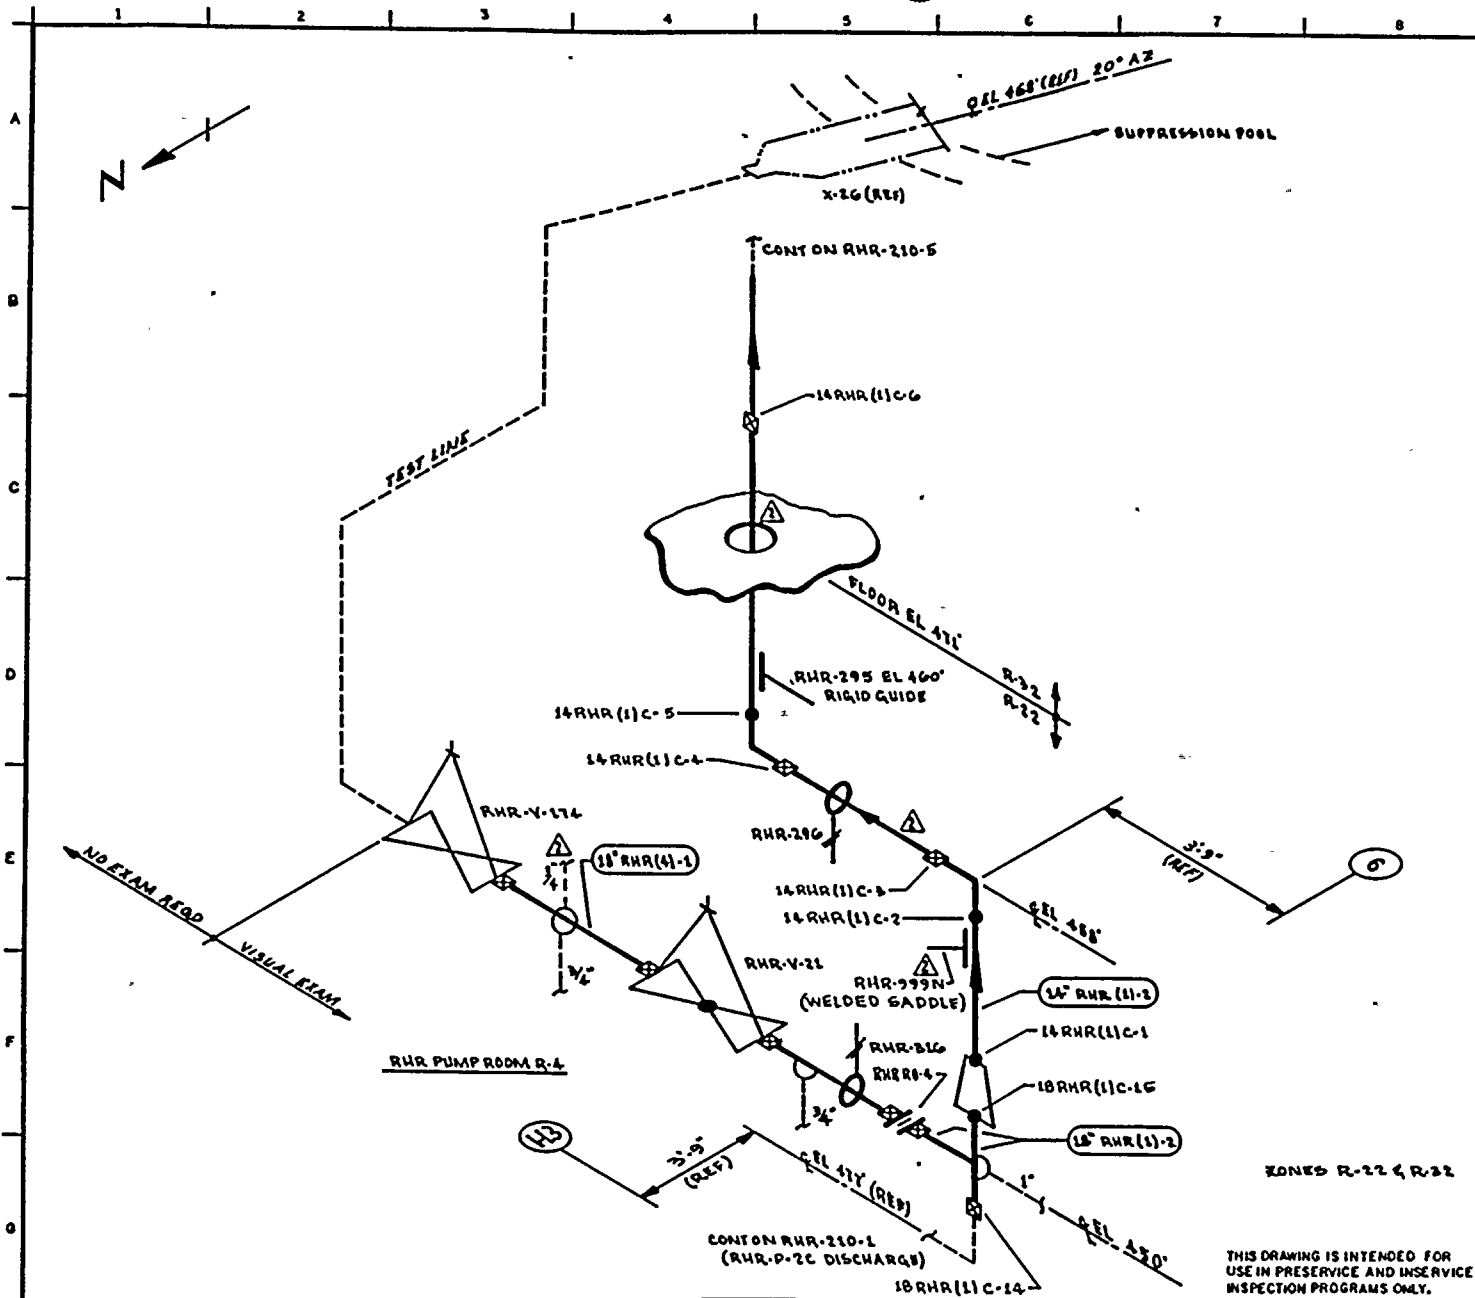

NOTES:

1. THIS DRAWING IDENTIFIES PIPING & COMPONENTS SUBJECT TO A VISUAL EXAM FOR EVIDENCE OF LEAKAGE DURING SYSTEM HYDRO OR OPERABILITY TEST. TESTS ARE TO BE CONDUCTED PER THE REQUIREMENTS OF ASME SECTION XI, PARAGRAPH SVA-5000.
2. FOR BRANCH PIPING 4" DIA OR LESS (CONN SHOWN IN DASHED LINES) EXTEND VISUAL LEAKAGE EXAM THROUGH THE OUTER MOST NORMALLY CLOSED NUCLEAR CLASS VALVE OR UNTIL TRANSITION TO INSTRUMENT TUBING, UNLESS OTHERWISE NOTED.
3. THE FOLLOWING WELDS REQUIRE A SURFACE EXAM. THEY REPRESENT 10% OF THE WELDS EXEMPTED BY SMC-1220 (C).
 10 RHR (1) C-14
 14 RHR (1) C-1

REFERENCES:
 BOVEE & CRAIG ISOMETRICS
 RHR-897-6.9 REV 12
 RHR-897-10.14 REV 5

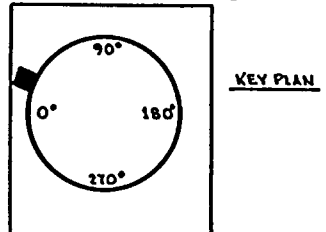

THIS DRAWING IS INTENDED FOR USE IN PRESERVICE AND INSERVICE INSPECTION PROGRAMS ONLY.

QUALITY CLASS: 1 ASME CODE CLASS: 2
 ENGR: GA KUGLER DRAWN: V. McA DATE: 6-20-78

WASHINGTON PUBLIC POWER SUPPLY SYSTEM
 RICHMOND WASHINGTON 98352

PIPING SYSTEM	NOM DIA (IN)	SCH	NOM WALL THK	MATERIAL SPECIFICATION	MATL TYPE	CAL BLOCK NO
14" RHR (1) C-2	14	SD	0.375	SA 106 GR B	C6	NA
18" RHR (1) C-2	18	SD	0.438	SA 106 GR B	C6	NA
18" RHR (4) C-1	18	SD	0.375	SA 106 GR B	C5	NA


NO	DATE	REVISION	BY	CHKD	APPVD
2	10-15-81	NUMBERED WELDS, ADDED NOTE 3, & AS NOTED	SMcA	EPK	TFW
1	12-2-81	ADDED RHR-RO-4 IN P-5	KLLA	JFP	TFW
0	12-22-78	ISSUED FOR USE	KLLA	EPK	TFW
A	9-12-78	ISSUED FOR INFORMATION ONLY	KLLA	EPK	TFW

WNP-2
 WELD & COMPONENT IDENTIFICATION DIAGRAM

TITLE:
 RHR LOOP C/LPCI RETURN & TEST LINE


DWG NO: RHR-210-4 REV 2



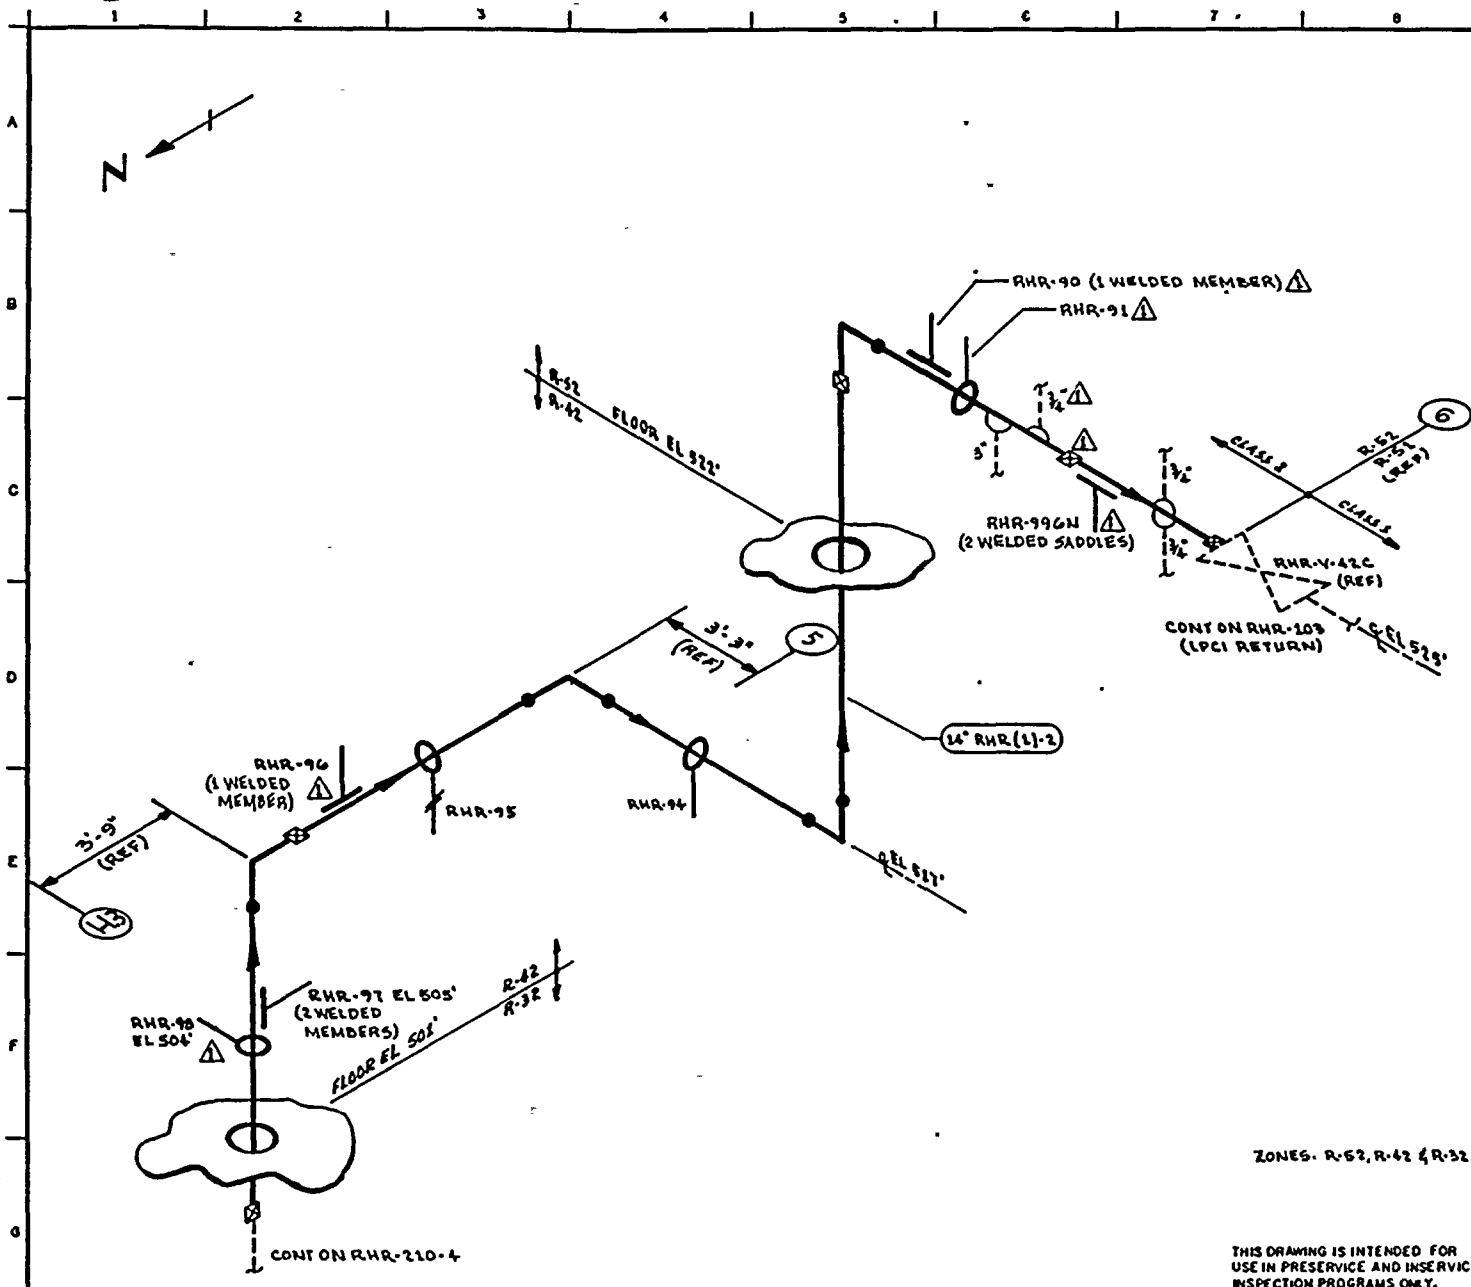

- NOTES:**
1. THIS DRAWING IDENTIFIES PIPING & COMPONENTS SUBJECT TO A VISUAL EXAM FOR EVIDENCE OF LEAKAGE DURING SYSTEM HYDRO OR OPERABILITY TESTS. TESTS ARE TO BE CONDUCTED PER THE REQUIREMENTS OF ASME SECTION XI, PARAGRAPH IWA-5000.
 2. FOR BRANCH PIPING 4" DIA OR LESS (CONN SHOWN IN DASHED LINES) EXTEND VISUAL LEAKAGE EXAM THROUGH THE OUTERMOST NORMALLY CLOSED NUCLEAR CLASS VALVE OR UNTIL TRANSITION TO INSTRUMENT TUBING, UNLESS OTHERWISE NOTED.

- REFERENCES:**
- BOYER & CRAIG ISOMETRICS
 - RHR-897-10.14 REV 7
 - RHR-897-15.18 REV 10

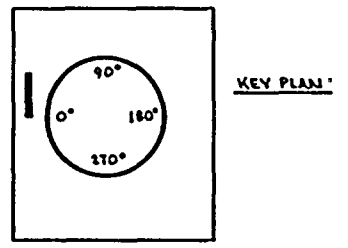

ZONES: R-52, R-42 & R-32

THIS DRAWING IS INTENDED FOR USE IN PRESERVE AND INSERVICE INSPECTION PROGRAMS ONLY.

QUALITY CLASS: 1	ASME CODE CLASS 2
ENGR GA KUGLER	DATE: 8-16-78


WASHINGTON PUBLIC POWER SUPPLY SYSTEM
 RICHMOND WASHINGTON 99182

PIPING SYSTEM	NOM DIA (IN)	SCH	NOM WALL THK	MATERIAL SPECIFICATION	MATL TYPE	CAL BLOCK NO
14" RHR (L)-2	14	STD	0.375	SA 106 GR B	CS	NA

WNP- 2
 WELD & COMPONENT IDENTIFICATION DIAGRAM

TITLE:
 RHR LOOP C / LPCI RETURN
 DWG NO: RHR-210-5 REV 1

NO	DATE	REVISION	BY	CHKD	APPVD
1	8-22-83	REVISED AS NOTED	GA	DK	TFH
0	8-11-78	ISSUED FOR USE	GA	DK	TFH
A	9-11-78	ISSUED FOR INFORMATION ONLY	GA	DK	TFH



WNP-02
 INTERVAL: PSI
 PERIOD: NA
 OUTAGE:
 DRAWING NO. RHR-210

WASHINGTON PUBLIC POWER SUPPLY SYSTEM
 PROGRAM PLAN AND SCHEDULE
 SYSTEM OR COMPONENT: RHR(1)-2
 DESCRIPTION: LOOP C/LPCI RETURN

PAGE 001
 DATE 12/14/84

IDENT. NO.	DESCRIPTION	SECT. XI EXAM.	EXAM MTH.	PROCEDURE	CAL. BLOCK	INSERVICE		NOTES
						REQ.	SCHEDULED OUTAGE	
RHR-323	SPRING	C-E-2	VT-3	303/8.2.17				
			VT-4	303/8.2.17				
RHR-1021N	PSA-3 SN(2)	C-E-2	VT-3	303/8.2.17				S/N W3947/E3930
			VT-4	303/8.2.17				S/N W3947/E3930
RHR-322	BOX	C-E-2	VT-3	303/8.2.17				
RHR-321	SPRING	C-E-2	VT-3	303/8.2.17				
			VT-4	303/8.2.17				
RHR-311	PSA-1 SN(2)	C-E-2	VT-3	303/8.2.17				S/N
			VT-4	303/8.2.17				S/N
RHR-303	SPRING	C-E-2	VT-3	303/8.2.17				
			VT-4	303/8.2.17				
RHR-302	STRUT	C-E-2	VT-3	303/8.2.17				
RHR-301	PSA-1 SNUBBER	C-E-2	VT-3	303/8.2.17				S/N 654
			VT-4	303/8.2.17				S/N 654
RHR-304	PSA-10 SNUBBER	C-E-2	VT-3	303/8.2.17				S/N
			VT-4	303/8.2.17				S/N
RHR-298	RIGID	C-E-2	VT-3	303/8.2.17				
RHR-324	STRUT	C-E-2	VT-3	303/8.2.17				

WNP-02
 INTERVAL: PSI
 PERIOD: NA
 OUTAGE:
 DRAWING NO. RHR-210

WASHINGTON PUBLIC POWER SUPPLY SYSTEM
 PROGRAM PLAN AND SCHEDULE
 SYSTEM OR COMPONENT: RHR(1)-2
 DESCRIPTION: LOOP C/LPCI RETURN

PAGE 002
 DATE 12/14/84

<u>IDENT. NO.</u>	<u>DESCRIPTION</u>	<u>SECT.</u>		<u>PROCEDURE</u>	<u>CAL. BLOCK</u>	<u>INSERVICE SCHEDULED</u>		<u>NOTES</u>
		<u>XI EXAM.</u>	<u>EXAM MTH.</u>			<u>REQ.</u>	<u>OUTAGE</u>	
RHR-337	STRUT	C-E-2	VT-3	303/8.2.17				
RHR-338	SPRING	C-E-2	VT-3	303/8.2.17				
			VT-4	303/8.2.17				
RHR-973N	ANCHOR	C-E-2	VT-3	303/8.2.17				
RHR-972N	BOX	C-E-2	VT-3	303/8.2.17				
RHR-345	PSA-1/4 SN(2)	C-E-2	VT-3	303/8.2.17				S/N
			VT-4	303/8.2.17				S/N W570/E571
RHR-347	BOX	C-E-2	VT-3	303/8.2.17				
RHR-346	STRUT	C-E-2	VT-3	303/8.2.17				
RHR-348	SPRING	C-E-2	VT-3	303/8.2.17				
			VT-3	303/8.2.17				
RHR-349	SPRING	C-E-2	VT-3	303/8.2.17				
			VT-4	303/8.2.17				
RHR-316	SPRING	C-E-2	VT-3	303/8.2.17				
			VT-4	303/8.2.17				
18RHR(1)C-15	TEE TO RED	N/A	SUR	QCI 3-3				SEE NOTE #8.
14RHR(1)C-1	RED TO PIPE	N/A	SUR	QCI 3-3				SEE NOTE #8.
RHR-999N	STRUT	C-E-2	VT-3	303/8.2.17				

WNP-02
 INTERVAL: PSI
 PERIOD: NA
 OUTAGE:
 DRAWING NO. RHR-210

WASHINGTON PUBLIC POWER SUPPLY SYSTEM
 PROGRAM PLAN AND SCHEDULE
 SYSTEM OR COMPONENT: RHR(1)-2
 DESCRIPTION: LOOP C/LPCI RETURN

PAGE 003
 DATE 12/14/84

<u>IDENT. NO.</u>	<u>DESCRIPTION</u>	<u>SECT.</u> <u>XI</u> <u>EXAM.</u>	<u>EXAM</u> <u>MTM.</u>	<u>PROCEDURE</u>	<u>CAL.</u> <u>BLOCK</u>	<u>INSERVICE</u>		<u>NOTES</u>
						<u>REQ.</u>	<u>SCHEDULED</u> <u>OUTAGE</u>	
RHR-296	SPRING	C-E-2	VT-3	303/8.2.17				
			VT-4	303/8.2.17				
14RHR(1)C-13	PIPE TO ELB	N/A	SUR	PTP-1				SEE NOTE #8.
14RHR(1)C-14	PIPE TO EL	N/A	SUR	QCI 3-3				SEE NOTE #8.
14RHR(1)C-15	EL TO PIPE	N/A	SUR	QCI 3-3				SEE NOTE #8.
RHR-295	BOX	C-E-2	VT-3	303/8.2.17				
RHR-98	STRUT	C-E-2	VT-3	303/8.2.17				
RHR-97	BOX	C-E-2	VT-3	303/8.2.17				
RHR-96	BOX	C-E-2	VT-3	303/8.2.17				
RHR-95	SPRING	C-E-2	VT-3	303/8.2.17				
			VT-4	303/8.2.17				
RHR-94	STRUT	C-E-2	VT-3	303/8.2.17				
RHR-90	BOX	C-E-2	VT-3	303/8.2.17				
RHR-91	STRUT	C-E-2	VT-3	303/8.2.17				
RHR-996N	ANCHOR	C-E-2	VT-3	303/8.2.17				
RHR-PB-210	RHR PRES BNDRY	N/A	VT-2	N/A				SEE NOTES #6 & #7.



WNP-02
 INTERVAL: PSI
 PERIOD: NA
 OUTAGE:
 DRAWING NO. RRC-101

WASHINGTON PUBLIC POWER SUPPLY SYSTEM
 PROGRAM PLAN AND SCHEDULE
 SYSTEM OR COMPONENT: RRC(2)-4S
 DESCRIPTION: REACTOR RECTR LOOP A

PAGE 001
 DATE 12/14/84

<u>IDENT. NO.</u>	<u>DESCRIPTION</u>	<u>SECT.</u> <u>XI</u> <u>EXAM.</u>	<u>EXAM</u> <u>HTH.</u>	<u>PROCEDURE</u>	<u>CAL.</u> <u>BLOCK</u>	<u>INSERVICE</u> <u>SCHEDULED</u>		<u>NOTES</u>
						<u>REQ.</u>	<u>OUTAGE</u>	
24RRC(2)A-1	NOZ TO SE	B-F	VOL	UTP-10	UT-101			
			SUR	PTP-1				
24RRC(2)A-2	SE TO PIPE	B-J	VOL	UTP-10	UT-7			
			SUR	PTP-1				
24RRC(2)A-2LD	PIPE SEAM	B-J	VOL	UTP-10	UT-7			
			SUR	PTP-1				
24RRC(2)A-3LU	PIPE SEAM	B-J	VOL	UTP-10	UT-7			
			SUR	PTP-1				
24RRC(2)A-3	PIPE TO EL	B-J	VOL	UTP-10	UT-7			
			SUR	PTP-1				
24RRC(2)A-3LDO	EL SEAM	B-J	VOL	UTP-10	UT-7			
			SUR	PTP-1				
24RRC(2)A-3LDI	EL SEAM	B-J	VOL	UTP-10	UT-7			
			SUR	PTP-1				
24RRC(2)A-4LUO	EL SEAM	B-J	VOL	UTP-10	UT-7			
			SUR	PTP-1				
24RRC(2)A-4LUI	EL SEAM	B-J	VOL	UTP-10	UT-7			
			SUR	PTP-1				

WNP-02
 INTERVAL: PSI
 PERIOD: NA
 OUTAGE:
 DRAWING NO. RRC-101

WASHINGTON PUBLIC POWER SUPPLY SYSTEM
 PROGRAM PLAN AND SCHEDULE
 SYSTEM OR COMPONENT: RRC(2)-4S
 DESCRIPTION: REACTOR RECIR LOOP A

PAGE 902
 DATE 12/14/84

IDENT. NO.	DESCRIPTION	SECT. XI EXAM.	EXAM MTH.	PROCEDURE	CAL. BLOCK	INSERVICE		NOTES
						REQ.	SCHEDULED OUTAGE	
24RRC(2)A-4	EL TO PIPE	B-J	VOL	UTP-10	UT-7			
			SUR	PTP-1				
24RRC(2)A-4LD	PIPE SEAM	B-J	VOL	UTP-10	UT-7			
			SUR	PTP-1				
RRC-1A	PIPE WHIP	N/A	N/A	N/A				SEE NOTE #1
24RRC(2)A-5LU	PIPE SEAM	B-J	VOL	UTP-10	UT-7			
			SUR	PTP-1				
24RRC(2)A-5	PIPE TO PIPE	B-J	VOL	UTP-10	UT-7			
			SUR	PTP-1				
24RRC(2)A-5LD	PIPE SEAM	B-J	VOL	UTP-10	UT-7			
			SUR	PTP-1				
RRC-HA-1(W)	4 WELDED LUGS	B-K-1	VOL	UTP-26	UT-7			
RRC-HA-1	SPRING	B-K-2	VT-3	303/R.2.17				
			VT-4	303/R.2.17				
RRC-2A	PIPE WHIP	N/A	N/A	N/A				SEE NOTE #1
RRC-SA-20	PSA-35 SNUBBER	B-K-2	VT-3	303/R.2.17				S/N 4215
			VT-4	303/R.2.17				S/N 4215

WNP-02
 INTERVAL: PSI
 PERIOD: NA
 OUTAGE:
 DRAWING NO. RRC-101

WASHINGTON PUBLIC POWER SUPPLY SYSTEM
 PROGRAM PLAN AND SCHEDULE
 SYSTEM OR COMPONENT: RRC(2)-4S
 DESCRIPTION: REACTOR RECIR LOOP A

PAGE 004
 DATE 12/14/84

IDENT. NO.	DESCRIPTION	SECT. YI EXAM.	EXAM MTH.	PROCEDURE	CAL. BLOCK	INSERVICE		NOTES
						REQ.	SCHEDULED OUTAGE	
24RRC(2)A-7/3/4PS-H018	INSTR CONN	B-P	VT-2	N/A				SEE NOTES #6 & #7.
RRC-2B	PIPE WHIP	N/A	N/A	N/A				SEE NOTE #1
RRC-SA-25	PSA-35 SNUBBER	B-K-2	VT-3	303/8.2.17				S/N 4213
			VT-4	303/8.2.17				S/N 4213
RRC-SA-2	PSA-35 SNUBBER	B-K-2	VT-3	303/8.2.17				S/N 10733
			VT-4	303/8.2.17				S/N 10733
RRC-SA-2(W)	4 WELDED LUGS	B-K-1	VOL	UTP-26	UT-7			
24RRC(2)A-7/3/4PX-1A	INSTR CONN	B-P	VT-2	N/A				SEE NOTES #6 & #7.
RRC-SA-1(W)	4 WELDED LUGS	B-K-1	VOL	UTP-26	UT-7			
RRC-SA-1	PSA-35 SNUBBER	B-K-2	VT-3	303/8.2.17				S/N 4157
			VT-4	303/8.2.17				S/N 4157
RRC-3A	PIPE WHIP	N/A	N/A	N/A				SEE NOTE #1
24RRC(2)A-8LU	PIPE SEAM	B-J	VOL	UTP-10	UT-7			
			SUR	PTP-1				
24RRC(2)A-8	PIPE TO PIPE	B-J	VOL	UTP-10	UT-7			
			SUR	PTP-1				
24RRC(2)A-8LDO	EL SEAM	B-J	VOL	UTP-10	UT-7			
			SUR	PTP-1				

WNP-02
 INTERVAL: PSI
 PERIOD: NA
 OUTAGE:
 DRAWING NO. RRC-101

WASHINGTON PUBLIC POWER SUPPLY SYSTEM
 PROGRAM PLAN AND SCHEDULE
 SYSTEM OR COMPONENT: RRC(2)-4S
 DESCRIPTION: REACTOR RECIR LOOP A

PAGE 003
 DATE 12/14/84

<u>IDENT. NO.</u>	<u>DESCRIPTION</u>	<u>SECT.</u> <u>XI</u> <u>EXAM.</u>	<u>EXAM</u> <u>MTH.</u>	<u>PROCEDURE</u>	<u>CAL.</u> <u>BLOCK</u>	<u>INSERVICE</u>		<u>NOTES</u>
						<u>REQ.</u>	<u>SCHEDULED</u> <u>OUTAGE</u>	
FRC-SA-19	PSA-35 SNUBBER	R-K-2	VT-3	303/8.2.17				S/N 4216
			VT-4	303/8.2.17				S/N 4216
24RRC(2)A-6LU	PIPE SEAM	B-J	VOL	UTP-10	UT-7			
			SUR	PTP-1				
24RRC(2)A-6	PIPE TO TEE	B-J	VOL	UTP-10	UT-7			
			SUR	PTP-1				
24RRC(2)A-6LDI	TEE SEAM	B-J	VOL	UTP-10	UT-7			
			SUR	PTP-1				
24RRC(2)A-6LDO	TEE SEAM	B-J	VOL	UTP-10	UT-7			
			SUR	PTP-1				
24RRC(2)A-7LUI	TEE SEAM	B-J	VOL	UTP-10	UT-7			
			SUR	PTP-1				
24RRC(2)A-7LUO	TEE SEAM	B-J	VOL	UTP-10	UT-7			
			SUR	PTP-1				
24RRC(2)A-7	TEE TO PIPE	B-J	VOL	UTP-10	UT-7			
			SUR	PTP-1				
24RRC(2)A-7LD	PIPE SEAM	B-J	VOL	UTP-10	UT-7			
			SUR	PTP-1				

WNP-02
 INTERVAL: PSI
 PERIOD: NA
 OUTAGE:
 DRAWING NO. RRC-101

WASHINGTON PUBLIC POWER SUPPLY SYSTEM
 PROGRAM PLAN AND SCHEDULE
 SYSTEM OR COMPONENT: RRC(2)-4S
 DESCRIPTION: REACTOR RECIR LOOP A

PAGE 006
 DATE 12/14/84

IDENT. NO.	DESCRIPTION	SECT. XI EXAM.	EXAM MTH.	PROCEDURE	CAL. BLOCK	INSERVICE		NOTES
						REQ.	SCHEDULED OUTAGE	
24RRC(2)A-10	VALVE TO PIPE	B-J	VOL	UTP-10	UT-7			
			SUR	PTP-1				
24RRC(2)A-10LD	PIPE SEAM	B-J	VOL	UTP-10	UT-7			
			SUR	PTP-1				
24RRC(2)A-10/4RRC(8)-4S	PIPE TO SWL	B-J	SUR	PTP-1				
4RRC(8)2A-1	SWL TO PIPE	B-J	VOL	UTP-10	UT-31			
			SUR	PTP-1				
4RRC(8)2A-2	PIPE TO FLANGE	B-J	VOL	UTP-10	UT-31			
			SUR	PTP-1				
4RRC(8)2A-2BD	FLANGE BOLTING	B-G-2	VT-1	QCI 7-1				
24RRC(2)A-10/3/4TE-N028	INSTR CONN.	B-P	VT-2	N/A				SEE NOTES #6 & #7.
24RRC(2)A-10/4RRC(4)-4S	PIPE TO SWL	B-J	SUR	PTP-1				
24RRC(2)A-10/3/4TE-N023	INSTR CONN	B-P	VT-2	N/A				SEE NOTES #6 & #7.
24RRC(2)A-10/3/4DPT-N015	INSTR CONN	B-P	VT-2	N/A				SEE NOTES #6 & #7.
24RRC(2)A-10/3/4TE-N035	INSTR CONN	B-P	VT-2	N/A				SEE NOTES #6 & #7.
24RRC(2)A-11LU	PIPE SEAM	B-J	VOL	UTP-10	UT-7			
			SUR	PTP-1				
24RRC(2)A-11	PIPE TO EL	B-J	VOL	UTP-10	UT-7			

WNP-02
 INTERVAL: PSI
 PERIOD: NA
 OUTAGE:
 DRAWING NO. RRC-101

WASHINGTON PUBLIC POWER SUPPLY SYSTEM
 PROGRAM PLAN AND SCHEDULE
 SYSTEM OR COMPONENT: RRC(2)-4S
 DESCRIPTION: REACTOR RECIR LOOP A

PAGE 005
 DATE 12/14/84

IDENT. NO.	DESCRIPTION	SECT. XI EXAM.	EXAM MTH.	PROCEDURE	CAL. BLOCK	INSERVICE		NOTES
						REQ.	SCHEDULED OUTAGE	
24RRC(2)A-8LDT	EL SEAM	B-J	VOL	UTP-10	UT-7			
			SUR	PTP-1				
24RRC(2)A-8/1PI(1)-4SA	INSTR CONN	B-P	VT-2	N/A				SEE NOTES #6 & #7.
24RRC(2)A-8/1PI(1)-4SB	INSTR CONN	B-P	VT-2	N/A				SEE NOTES #6 & #7.
24RRC(2)A-8/1PI(1)-4SC	INSTR CONN	B-P	VT-2	N/A				SEE NOTES #6 & #7.
24RRC(2)A-8/1PI(1)-4SD	INSTR CONN	B-P	VT-2	N/A				SEE NOTES #6 & #7.
RRC-SA-16	PSA-35 SNURDER	B-K-2	VT-3	303/8.2.17				S/N 4197
			VT-4	303/8.2.17				S/N 4197
24RRC(2)A-9LUO	EL SEAM	B-J	VOL	UTP-10	UT-7			
			SUR	PTP-1				
24RRC(2)A-9LUI	EL SEAM	B-J	VOL	UTP-10	UT-7			
			SUR	PTP-1				
24RRC(2)A-9	EL TO VALVE	B-J	VOL	UTP-10	UT-7			FITTING TO FITTING
			SUR	PTP-1				FITTING TO FITTING
RRC-V-23A/3/4V-26A	VALVE DRAIN	B-P	VT-2	N/A				SEE NOTES #6 & #7.
RRC-V-23A/3/4V-26A	VALVE VENT	B-P	VT-2	N/A				SEE NOTES #6 & #7.
RRC-V-23A-BDY	VALVE BODY	B-M-2	VT-1	OCI 7-1				
RRC-V-23A-BLT	VALVE BOLTING	B-G-2	VT-1	OCI 7-1				

WNP-02
 INTERVAL: PSI
 PERIOD: NA
 OUTAGE:
 DRAWING NO. RRC-101

WASHINGTON PUBLIC POWER SUPPLY SYSTEM
 PROGRAM PLAN AND SCHEDULE
 SYSTEM OR COMPONENT: RRC(2)-4S
 DESCRIPTION: REACTOR RECIR LOOP A

PAGE 008
 DATE 12/14/84

IDENT. NO.	DESCRIPTION	SECT. XI EXAM.	EXAM MTH.	PROCEDURE	CAL. PLOCK	INSERVICE		NOTES
						REQ.	SCHEDULED OUTAGE	
24RRC(1)A-13/8CAF-1	SWL TO PIPE	B-J	VOL	UTP-10	UT-26			FITTING TO FITTING
			SUF	PTP-1				FITTING TO FITTING
24PRC(1)A-13/4RRC(8)-4S	PIPE TO SWL	B-J	SUR	PTP-1				
4RRC(8)1A-1	SWL TO PIPE	B-J	VOL	UTP-10	UT-31			
			SUR	PTP-1				
4RRC(8)1A-2	PIPE TO FLANGE	B-J	VOL	UTP-10	UT-31			
			SUR	PTP-1				
4RRC(8)1A-2BD	FLANGE BOLTING	B-G-2	VT-1	OCI 7-1				
RRC-SA-66	PSA-35 SNUBBER	B-K-2	VT-3	303/8.2.17				S/N 4167
			VT-4	303/8.2.17				S/N 4167
24RRC(1)A-14LU	PIPE SEAM	B-J	VOL	UTP-10	UT-7			
			SUR	PTP-1				
24RRC(1)A-14	PIPE TO VALVE	B-J	VOL	UTP-10	UT-7			
			SUR	PTP-1				
RRC-V-60A-BDY	VALVE BODY	B-M-2	VT-1	OCI 7-1				
RRC-V-60A-BLT	VALVE BOLTING	B-G-1	VOL	UTP-34	UT-43			STUDS: UT ONLY IN PLACE. PT & UT WHEN REMOVED

WNP-02
 INTERVAL: PSI
 PERIOD: NA
 OUTAGE:
 DRAWING NO. RRC-101

WASHINGTON PUBLIC POWER SUPPLY SYSTEM
 PROGRAM PLAN AND SCHEDULE
 SYSTEM OR COMPONENT: RRC(2)-4S
 DESCRIPTION: REACTOR RECIR LOOP A

PAGE 007
 DATE 12/14/84

IDENT. NO.	DESCRIPTION	SECT. XI EXAM.	EXAM MTH.	PROCEDURE	CAL. BLOCK	INSERVICE		NOTES
						REQ.	SCHEDULED OUTAGE	
24RRC(2)A-11LDO	EL SEAM	B-J	VOL	UTP-10	UT-7			
24RRC(2)A-11LDI	EL SEAM	B-J	VOL	UTP-10	UT-7			
24RRC(2)A-12LUO	EL SEAM	B-J	VOL	UTP-10	UT-7			
24RRC(2)A-12LUI	EL SEAM	B-J	VOL	UTP-10	UT-7			
24RRC(2)A-12	EL TO PUMP	B-J	VOL	UTP-10	UT-7			
24RRC(1)A-13	PUMP TO PIPE	B-J	VOL	UTP-10	UT-7			
24RRC(1)A-13LO	PIPE SEAM	B-J	VOL	UTP-10	UT-7			
24RRC(1)A-13/3/4DPT-N015	INSTR CONN	B-P	VT-2	N/A				
24RRC(1)A-13/8CAP	PIPE TO SWL	B-J	VOL	UTP-10	UT-7			

SEE NOTES #6 & #7.

WNP-02
 INTERVAL: PSI
 PERIOD: NA
 OUTAGE:
 DRAWING NO. RRC-101

WASHINGTON PUBLIC POWER SUPPLY SYSTEM
 PROGRAM PLAN AND SCHEDULE
 SYSTEM OR COMPONENT: REC(2)-4S
 DESCRIPTION: REACTOR RECIR LOOP A

PAGE 009
 DATE 12/14/84.

<u>IDENT. NO.</u>	<u>DESCRIPTION</u>	SECT. XI <u>EXAM.</u>	<u>EXAM</u> MTH.	<u>PROCEDURE</u>	<u>CAL.</u> BLOCK	<u>INSERVICE</u>		<u>NOTES</u>
						<u>REQ.</u>	<u>SCHEDULED</u> OUTAGE	
			SUR	PTP-1				STUDS: UT ONLY IN PLACE. PT & UT WHEN REMOVED
			VT-1	OCI 7-1				STUDS: UT ONLY IN PLACE. PT & UT WHEN REMOVED
RRC-V-60A/3/4LOC	STFM LEAKOFF	B-P	VT-2	OCI 7-1				SEE NOTES #5 & #6.
24RRC(1)A-15	VALVE TO PIPE	B-J	VOL	UTP-10	UT-7			
24PRC(1)A-15LD	PIPE SEAM	B-J	VOL	UTP-10	UT-7			
24RRC(1)A-16LU	PIPE SEAM	B-J	VOL	UTP-10	UT-7			
24RRC(1)A-16	PIPE TO EL	B-J	VOL	UTP-10	UT-7			
24RRC(1)A-16LDO	EL SEAM	B-J	VOL	UTP-10	UT-7			
24RRC(1)A-16LDI	EL SEAM	B-J	VOL	UTP-10	UT-7			
RRC-HA-7	SPRING	B-K-2	VT-3	303/8.2.17				

WNP-02
 INTERVAL: PSI
 PERIOD: NA
 OUTAGE:
 DRAWING NO. RRC-101

WASHINGTON PUBLIC POWER SUPPLY SYSTEM
 PROGRAM PLAN AND SCHEDULE
 SYSTEM OR COMPONENT: RRC(2)-4S
 DESCRIPTION: REACTOR RECIR LOOP A

PAGE 010
 DATE 12/14/84

<u>IDENT. NO.</u>	<u>DESCRIPTION</u>	SECT. XI <u>EXAM.</u>	<u>EXAM</u> MTH.	<u>PROCEDURE</u>	CAL. <u>BLOCK</u>	<u>INSERVICE</u>		<u>NOTES</u>
						<u>REQ.</u>	<u>SCHEDULED</u> OUTAGE	
RRC-SA-65	PSA-35 SNUBBER	B-K-2	VT-4	303/8.2.17				S/N 4159
RRC-SA-7	PSA-35 SNUBBER	B-K-2	VT-4	303/8.2.17				S/N 4159
24RRC(1)A-17LU0	EL SEAM	B-J	VT-3	303/8.2.17				S/N 4209
24RRC(1)A-17LUI	EL SEAM	B-J	VT-3	303/8.2.17				S/N 4209
24RRC(1)A-17	EL TO PIPE	B-J	VOL	UTP-10	UT-7			
24RRC(1)A-17LD	PIPE SEAM	B-J	SUR	PTP-1				
24RRC(1)A-18LU	PIPE SEAM	B-J	VOL	UTP-10	UT-7			
24RRC(1)A-18	PIPE TO VALVE	B-J	SUR	PTP-1				
			VOL	UTP-10	UT-7			
			SUR	PTP-1				

WNP-02
 INTERVAL: PSI
 PERIOD: NA
 OUTAGE:
 DRAWING NO. RRC-101

WASHINGTON PUBLIC POWER SUPPLY SYSTEM
 PROGRAM PLAN AND SCHEDULE
 SYSTEM OR COMPONENT: RRC(2)-4S
 DESCRIPTION: REACTOR RECIR LOOP A

PAGE 011
 DATE 12/14/84

IDENT. NO.	DESCRIPTION	SECT. XI FYAM.	EXAM MTH.	PROCEDURE	CAL. BLOCK	INSERVICE		NOTES
						REQ.	SCHEDULED OUTAGE	
RRC-V-67A/3/4V-71A	VALVE DRAIN	B-P	VT-2	N/A				SEE NOTES #6 & #7.
RRC-V-67A-BDY	VALVE BODY	B-M-2	VT-1	OCI 7-1				
RRC-V-67A-BLT	VALVE BOLTING	B-G-2	VT-1	OCI 7-1				
RRC-V-67A/3/4V-69A	VALVE VENT	B-P	VT-2	N/A				SEE NOTES #6 & #7.
24RRC(1)A-19	VALVE TO EL	B-J	VOL	UTP-10	UT-7			
			SUR	PTP-1				
24RRC(1)A-19LDO	EL SEAM	B-J	VOL	UTP-10	UT-7			
			SUR	PTP-1				
24RRC(1)A-19LDI	EL SEAM	B-J	VOL	UTP-10	UT-7			
			SUR	PTP-1				
RRC-SA-15	PSA-35 SNUBBER	B-K-2	VT-3	303/8.2.17				S/N 4169
			VT-4	303/8.2.17				S/N 4169
24RRC(1)A-20LUO	EL SEAM	B-J	VOL	UTP-10	UT-7			
			SUR	PTP-1				
24RRC(1)A-20LUI	EL SEAM	B-J	VOL	UTP-10	UT-7			
			SUR	PTP-1				
24RRC(1)A-20	EL TO PIPE	B-J	VOL	UTP-10	UT-7			
			SUR	PTP-1				

WNP-02
 INTERVAL: PSI
 PERIOD: NA
 OUTAGE:
 DRAWING NO. RRC-101

WASHINGTON PUBLIC POWER SUPPLY SYSTEM
 PROGRAM PLAN AND SCHEDULE
 SYSTEM OR COMPONENT: RRC(2)-4S
 DESCRIPTION: REACTOR RECIR LOOP A

PAGE 012
 DATE 12/14/84

IDENT. NO.	DESCRIPTION	SECT. XI EXAM.	EXAM MTH.	PROCEDURE	CAL. BLOCK	INSERVICE		NOTES
						REQ.	SCHEDULED OUTAGE	
24RRC(1)A-20LD	PIPE SEAM	B-J	VOL	UTP-10	UT-7			
RCR-8A				SUR	PTP-1			
24RRC(1)A-20/12RRC(7)-4S	PIPE WHIP	N/A	N/A	N/A				SEE NOTE #1
	PIPE TO SWL	B-J	VOL	UTP-10	UT-7			
				SUR	PTP-1			
24RRC(1)A-20/12CAP	PIPE TO SWL	B-J	VOL	UTP-10	UT-7			
				SUR	PTP-1			
24RRC(1)A-20/12CAP-1	SWL TO CAP	B-J	VOL	UTP-10	UT-19			FITTING TO FITTING
				SUR	PTP-1			FITTING TO FITTING
RRC-SA-8	PSA-35 SNUBBER	B-K-2	VT-3	303/8.2.17				S/N 4163
			VT-4	303/8.2.17				S/N 4163
RRC-SA-9	PSA-35 SNUBBER	B-K-2	VT-3	303/8.2.17				S/N 4165
			VT-4	303/8.2.17				S/N 4165
24RRC(1)A-20/3/4DO-14	SAMPLE CONN	B-P	VT-2	N/A				SEE NOTES #6 & #7.
RCR-9A	PIPE WHIP	N/A	N/A	N/A				SEE NOTE #1
RRC-SA-17	PSA-35 SNUBBER	B-K-2	VT-3	303/8.2.17				S/N 4217
			VT-4	303/A.2.17				S/N 4217

WNP-02
 INTERVAL: PSI
 PERIOD: NA
 OUTAGE:
 DRAWING NO. RRC-101

WASHINGTON PUBLIC POWER SUPPLY SYSTEM
 PROGRAM PLAN AND SCHEDULE
 SYSTEM OF COMPONENT: RRC(2)-4S
 DESCRIPTION: REACTOR RECIR LOOP A

PAGE 013
 DATE 12/14/84

ICENT. NO.	DESCRIPTION	SECT. XI EXAM.	EXAM MTH.	PROCEDURE	CAL. BLOCK	INSERVICE		NOTES
						REQ.	SCHEDULED OUTAGE	
RRC-SA-10	PSA-35 SNUBBER	B-K-2	VT-3	303/8.2.17				S/N 4219
			VT-4	303/8.2.17				S/N 4219
24RRC(1)A-21LU	PIPE SEAM	B-J	VOL	UTP-10	UT-7			
			SUR	PTP-1				
24RRC(1)A-21	PIPE TO CROSS	B-J	VOL	UTP-10	UT-7			
			SUR	PTP-1				
24RRC(1)A-21LDI	CROSS SEAM	B-J	VOL	UTP-10	UT-7			
			SUR	PTP-1				
24RRC(1)A-21LD0	CROSS SEAM	B-J	VOL	UTP-10	UT-7			
			SUR	PTP-1				
24RRC(1)A-22LUI	CROSS SEAM	B-J	VOL	UTP-10	UT-7			
			SUR	PTP-1				
24RRC(1)A-22LU0	CROSS SEAM	B-J	VOL	UTP-10	UT-7			
			SUR	PTP-1				
24RRC(1)A-22	CROSS-REDUCER	B-J	VOL	UTP-10	UT-7			FITTING TO FITTING
			SUR	PTP-1				FITTING TO FITTING
16RRC(1)A-1	CROSS TO PIPE	B-J	VOL	UTP-10	UT-13			
			SUR	PTP-1				

WNF-02
 INTERVAL: PSI
 PERIOD: NA
 OUTAGE:
 DRAWING NO. RRC-101

WASHINGTON PUBLIC POWER SUPPLY SYSTEM
 PROGRAM PLAN AND SCHEDULE
 SYSTEM OR COMPONENT: RRC(2)-4S
 DESCRIPTION: REACTOR RECIR LOOP A

PAGE 014
 DATE 12/14/84

IDENT. NO.	DESCRIPTION	SECT. XI EXAM.	EXAM MTH.	PROCEDURE	CAL. PLOCK	INSERVICE		NOTES
						REQ.	SCHEDULED OUTAGE	
16RRC(1)A-1LD	PIPE SEAM	B-J	VOL	UTP-10	UT-13			
			SUR	PTP-1				
RCR-13A	PIPE WHIP	N/A	N/A	N/A				SEE NOTE #1
RRC-NA-9.	SPRING	B-K-2	VT-3	303/R.2.17				
			VT-4	303/P.2.17				
16RRC(1)A-1/12RRC(1)-N2D	PIPE TO SWL	B-J	VOL	UTP-10	UT-13			
			SUR	PTP-1				
RCR-14A	PIPE WHIP	N/A	N/A	N/A				SEE NOTE #1
RRC-SA-13	PSA-35 SNUBBER	B-K-2	VT-3	303/8.2.17				S/N 4193
			VT-4	303/P.2.17				S/N 4193
RRC-SA-11	PSA-35 SNUBBER	B-K-2	VT-3	303/R.2.17				S/N 4198
			VT-4	303/8.2.17				S/N 4198
RCR-15A	PIPE WHIP	N/A	N/A	N/A				SEE NOTE #1
16RRC(1)A-1/12RRC(1)-N2E	PIPE TO SWL	B-J	VOL	UTP-10	UT-13			
			SUR	PTP-1				
16RRC(1)A-2LU	PIPE SEAM	B-J	VOL	UTP-10	UT-13			
			SUR	PTP-1				
16RRC(1)A-2	PIPE TO CAP	B-J	VOL	UTP-10	UT-13			

WNP-02
 INTERVAL: PSI
 PERIOD: NA
 OUTAGE:
 DRAWING NO. RRC-101

WASHINGTON PUBLIC POWER SUPPLY SYSTEM
 PROGRAM PLAN AND SCHEDULE
 SYSTEM OR COMPONENT: RRC(2)-4S
 DESCRIPTION: REACTOR RECIR LOOP A

PAGE 015
 DATE 12/14/84

IDENT. NO.	DESCRIPTION	SECT. XI EXAM.	EXAM MTH.	PROCEDURE	CAL. BLOCK	INSERVICE		NOTES
						REQ.	SCHEDULED OUTAGE	
16RRC(1)A-3	CROSS TO PIPE	B-J	VOL	UTP-10	UT-13			
			SUR	PTP-1				
16RRC(1)A-3LD	PIPE SEAM	B-J	VOL	UTP-10	UT-13			
			SUR	PTP-1				
RCR-12A	PIPE WHIP	N/A	N/A	N/A				SEE NOTE #1
RRC-HA-8	SPRING	B-K-2	VT-3	303/8.2.17				
			VT-4	303/8.2.17				
16RRC(1)A-3/12RRC(1)-N2B	PIPE TO SWL	B-J	VOL	UTP-10	UT-13			
			SUR	PTP-1				
RCR-11A	PIPE WHIP	N/A	N/A	N/A				SEE NOTE #1
RRC-SA-12	PSA-35 SNUBBER	B-K-2	VT-3	303/8.2.17				S/N 4200
			VT-4	303/8.2.17				S/N 4200
RRC-SA-14	PSA-35 SNUBBER	B-K-2	VT-3	303/8.2.17				S/N 4195
			VT-4	303/8.2.17				S/N 4195
RCR-10A	PIPE WHIP	N/A	N/A	N/A				SEE NOTE #1
16RRC(1)A-3/12RRC(1)-N2A	PIPE TO SWL	B-J	VOL	UTP-10	UT-13			
			SUR	PTP-1				

WNP-02
 INTERVAL: PSI
 PERIOD: NA
 OUTAGE:
 DRAWING NO. RRC-101

WASHINGTON PUBLIC POWER SUPPLY SYSTEM
 PROGRAM PLAN AND SCHEDULE
 SYSTEM OR COMPONENT: RRC(2)-4S
 DESCRIPTION: REACTOR RECIR LOOP A

PAGE 016
 DATE 12/14/84

IDENT. NO.	DESCRIPTION	SECT. XI EXAM.	EXAM MTH.	PROCEDURE	CAL. BLOCK	INSERVICE		NOTES
						REQ.	SCHEDULED OUTAGE	
16RRC(1)A-4LU	PIPE SEAM	B-J	VOL	UTP-10	UT-13			
			SUR	PTP-1				
16RRC(1)A-4	PIPE TO CAP	B-J	VOL	UTP-10	UT-13			
			SUR	PTP-1				
12RRC(1)-N2A-1	SWL TO PIPE	B-J	VOL	UTP-10	UT-19			
			SUR	PTP-1				
12RRC(1)-N2A-1LD	PIPE SEAM	B-J	VOL	UTP-10	UT-19			
			SUR	PTP-1				
12RRC(1)-N2A-1ALU	PIPE SEAM	B-J	VOL	UTP-10	UT-19			
			SUR	PTP-1				
12RRC(1)-N2A-1A	PIPE TO PIPE	B-J	VOL	UTP-10	UT-19			
			SUR	PTP-1				
12RRC(1)-N2A-1ALD	PIPE SEAM	B-J	VOL	UTP-10	UT-19			
			SUR	PTP-1				
RCR-16A	PIPE WHIP	N/A	N/A	N/A				SEE NOTE #1
12RRC(1)-N2A-2LU	PIPE SEAM	B-J	VOL	UTP-10	UT-19)
			SUR	PTP-1				
12RRC(1)-N2A-2	PIPE TO EL	B-J	VOL	UTP-10	UT-19			

WNP-02
 INTERVAL: PSI
 PERIOD: NA
 OUTAGE:
 DRAWING NO. RRC-101

WASHINGTON PUBLIC POWER SUPPLY SYSTEM
 PROGRAM PLAN AND SCHEDULE
 SYSTEM OR COMPONENT: RRC(2)-4S
 DESCRIPTION: REACTOR RECIR LOOP A

PAGE 018
 DATE 12/14/84

IDENT. NO.	DESCRIPTION	SECT. XI EXAM.	EXAM MTH.	PROCEDURE	CAL. BLOCK	INSERVICE		NOTES
						REQ.	SCHEDULED OUTAGE	
12RRC(1)-N2B-1	SWL TO PIPE	B-J	VOL	UTP-10	UT-19			
12RRC(1)-N2B-1LD	PIPE SEAM	B-J	VOL	UTP-10	UT-19			
12RRC(1)-N2B-1ALU	PIPE SEAM	B-J	VOL	UTP-10	UT-19			
12RRC(1)-N2B-1A	PIPE TO PIPE	B-J	VOL	UTP-10	UT-19			
12RRC(1)-N2B-1ALD	PIPE SEAM	B-J	VOL	UTP-10	UT-19			
RCR-17A	PIPE WHIP	N/A	N/A	N/A				SEE NOTE #1
12RRC(1)-N2B-2LU	PIPE SEAM	B-J	VOL	UTP-10	UT-19			
12RRC(1)-N2B-2	PIPE TO EL	B-J	VOL	UTP-10	UT-19			
12RRC(1)-N2B-2LD9	EL SEAM	B-J	VOL	UTP-10	UT-19			

WNP-02
 INTERVAL: PSI
 PERIOD: NA
 OUTAGE:
 DRAWING NO. RRC-101

WASHINGTON PUBLIC POWER SUPPLY SYSTEM
 PROGRAM PLAN AND SCHEDULE
 SYSTEM OR COMPONENT: RRC(2)-4S
 DESCRIPTION: REACTOR RECIR LOOP A

PAGE 017
 DATE 12/14/84

<u>IDENT. NO.</u>	<u>DESCRIPTION</u>	<u>SECT.</u> <u>XI</u> <u>EXAM.</u>	<u>EXAM</u> <u>MTH.</u>	<u>PROCEDURE</u>	<u>CAL.</u> <u>BLOCK</u>	<u>INSERVICE</u>		<u>NOTES</u>
						<u>REQ.</u>	<u>SCHEDULED</u> <u>OUTAGE</u>	
12RRC(1)-N2A-2LD0	EL SEAM	B-J	VOL	PTP-1 UTP-10	UT-19			
12RRC(1)-N2A-2LDI	EL SEAM	B-J	VOL	PTP-1 UTP-10	UT-19			
12RRC(1)-N2A-3LU0	EL SEAM	B-J	VOL	PTP-1 UTP-10	UT-19			
12RRC(1)-N2A-3LUI	EL SEAM	B-J	VOL	PTP-1 UTP-10	UT-19			
12RRC(1)-N2A-3	EL SEAM	B-J	VOL	PTP-1 UTP-10	UT-19			
12RRC(1)-N2A-3LD	PIPE SEAM	B-J	VOL	PTP-1 UTP-10	UT-19			
12RRC(1)-N2A-4LU	PIPE SEAM	B-J	VOL	PTP-1 UTP-10	UT-19			
12RRC(1)-N2A-4	PIPE TO SE EXT	B-J	VOL	PTP-1 UTP-10	UT-19			
12RRC(1)-N2A-6	SE TO NOZ	B-F	VOL	PTP-1 UTP-10	UT-111			

WNP-02
 INTERVAL: PSI
 PERIOD: NA
 OUTAGE:
 DRAWING NO. RRC-101

WASHINGTON PUBLIC POWER SUPPLY SYSTEM
 PROGRAM PLAN AND SCHEDULE
 SYSTEM OR COMPONENT: RRC(2)-4S
 DESCRIPTION: REACTOR RECIR LOOP A

PAGE 019
 DATE 12/14/84

IDENT. NO.	DESCRIPTION	SECT. XI EXAM.	EXAM MTH.	PROCEDURE	CAL. BLOCK	INSERVICE		NOTES
						REQ.	SCHEDULED OUTAGE	
12RRC(1)-N2B-2L0I	EL SEAM	B-J	VOL	UTP-10	UT-19			
			SUR	PTP-1				
12RRC(1)-N2B-3LU0	EL SEAM	B-J	VOL	UTP-10	UT-19			
			SUR	PTP-1				
12RRC(1)-N2B-3LUI	EL SEAM	B-J	VOL	UTP-10	UT-19			
			SUR	PTP-1				
12RRC(1)-N2B-3	EL TO PIPE	B-J	VOL	UTP-10	UT-19			
			SUR	PTP-1				
12RRC(1)-N2B-3LD	PIPE SEAM	B-J	VOL	UTP-10	UT-19			
			SUR	PTP-1				
12RRC(1)-N2B-4LU	PIPE SEAM	B-J	VOL	UTP-10	UT-19			
			SUR	PTP-1				
12RRC(1)-N2B-4	PIPE TO SE EXT	B-J	VOL	UTP-10	UT-19			
			SUR	PTP-1				
12RRC(1)-N2B-6	SE TO NOZ	B-F	VOL	UTP-10	UT-111			
			SUR	PTP-1				
12RRC(1)-N2C-1	REDUCER TO PIPE	B-J	VOL	UTP-10	UT-19			
			SUR	PTP-1				

WNP-02
 INTERVAL: PSI
 PERIOD: NA
 OUTAGE:
 DRAWING NO. RRC-101

WASHINGTON PUBLIC POWER SUPPLY SYSTEM
 PROGRAM PLAN AND SCHEDULE
 SYSTEM OR COMPONENT: RRC(2)-4S
 DESCRIPTION: REACTOR RECIR LOOP A

PAGE 020
 DATE 12/14/84

IDENT. NO.	DESCRIPTION	SECT. XI EXAM.	EXAM MTH.	PROCEDURE	CAL. BLOCK	INSERVICE		NOTES
						REQ.	SCHEDULED OUTAGE	
12RRC(1)-N2C-1LD	PIPE SEAM	B-J	VOL	UTP-10	UT-19			
			SUR	PTP-1				
12RRC(1)-N2C-1ALU	PIPE SEAM	B-J	VOL	UTP-10	UT-19			
			SUR	PTP-1				
12RRC(1)-N2C-1A	PIPE TO PIPE	B-J	VOL	UTP-10	UT-19			
			SUR	PTP-1				
12RRC(1)-N2C-1ALD	PIPE SEAM	B-J	VOL	UTP-10	UT-19			
			SUR	PTP-1				
RCR-18A	PIPE WHIP	N/A	N/A	N/A				SEE NOTE #1
12RRC(1)-N2C-2LU	PIPE SEAM	B-J	VOL	UTP-10	UT-19			
			SUR	PTP-1				
12RRC(1)-N2C-2	PIPE TO EL	B-J	VOL	UTP-10	UT-19			
			SUR	PTP-1				
12RRC(1)-N2C-2LD0	EL SEAM	B-J	VOL	UTP-10	UT-19			
			SUR	PTP-1				
12RRC(1)-N2C-2LDI	EL SEAM	B-J	VOL	UTP-10	UT-19			
			SUR	PTP-1				
12RRC(1)-N2C-3LU0	EL SEAM	B-J	VOL	UTP-10	UT-19			

WNP-02
 INTERVAL: PSI
 PERIOD: NA
 OUTAGE:
 DRAWING NO. RRC-101

WASHINGTON PUBLIC POWER SUPPLY SYSTEM
 PROGRAM PLAN AND SCHEDULE
 SYSTEM OR COMPONENT: RRC(2)-4S
 DESCRIPTION: REACTOR RECIR LOOP A

PAGE 021
 DATE 12/14/84

<u>IDENT. NO.</u>	<u>DESCRIPTION</u>	<u>SECT.</u> <u>XI</u> <u>EXAM.</u>	<u>EXAM</u> <u>MTH.</u>	<u>PROCEDURE</u>	<u>CAL.</u> <u>BLOCK</u>	<u>INSERVICE</u>		<u>NOTES</u>
						<u>REQ.</u>	<u>SCHEDULED</u> <u>OUTAGE</u>	
12RRC(1)-N2C-3LUI	EL SEAM	B-J	VOL	UTP-10	UT-19			
12RRC(1)-N2C-3	EL TO PIPE	B-J	VOL	UTP-10	UT-19			
12RRC(1)-N2C-3LD	PIPE SEAM	B-J	VOL	UTP-10	UT-19			
12RRC(1)-N2C-4LU	PIPE SEAM	B-J	VOL	UTP-10	UT-19			
12RRC(1)-N2C-4	PIPE TO SE EXT	B-J	VOL	UTP-10	UT-19			
12RRC(1)-N2C-6	SE TO NOZ	B-J	VOL	UTP-10	UT-111			
12RRC(1)-N2D-1	SWL TO PIPE	B-J	VOL	UTP-10	UT-19			
12RRC(1)-N2D-1LD	PIPE SEAM	B-J	VOL	UTP-10	UT-19			
12RRC(1)-N2D-1ALU	PIPE SEAM	B-J	VOL	UTP-10	UT-19			

WNP-02
 INTERVAL: PSI
 PERIOD: NA
 OUTAGE:
 DRAWING NO. RRC-101

WASHINGTON PUBLIC POWER SUPPLY SYSTEM
 PROGRAM PLAN AND SCHEDULE
 SYSTEM OR COMPONENT: RRC(2)-4S
 DESCRIPTION: REACTOR RECIR LOOP A

PAGE 022
 DATE 12/14/84

IDENT. NO.	DESCRIPTION	SECT. XI EXAM.	EXAM MTH.	PROCEDURE	CAL. BLOCK	INSERVICE		NOTES
						REQ.	SCHEDULED OUTAGE	
12RRC(1)-N2D-1A	PIPE TO PIPE	B-J	VOL	PTP-1 UTP-10	UT-19			
12RRC(1)-N2D-1ALD	PIPE SEAM	B-J	VOL	PTP-1 UTP-10	UT-19			
RCR-19A	PIPE WHIP	N/A	N/A	PTP-1 N/A				SEE NOTE #1
12RRC(1)-N2D-2LU	PIPE SEAM	B-J	VOL	PTP-1 UTP-10	UT-19			
12RRC(1)-N2D-2	PIPE TO EL	B-J	VOL	PTP-1 UTP-10	UT-19			
12RRC(1)-N2D-2LDO	EL SEAM	B-J	VOL	PTP-1 UTP-10	UT-19			
12RRC(1)-N2D-2LDI	EL SEAM	B-J	VOL	PTP-1 UTP-10	UT-19			
12RRC(1)-N2D-3LUO	EL SEAM	B-J	VOL	PTP-1 UTP-10	UT-19			
12RRC(1)-N2D-3LUI	EL SEAM	B-J	VOL	PTP-1 UTP-10	UT-19			
				SUR PTP-1				

WNP-02
 INTERVAL: PSI
 PERIOD: NA
 OUTAGE:
 DRAWING NO. RRC-101

WASHINGTON PUBLIC POWER SUPPLY SYSTEM
 PROGRAM PLAN AND SCHEDULE
 SYSTEM OR COMPONENT: RRC(2)-4S
 DESCRIPTION: REACTOR RECIR LOOP A

PAGE 024
 DATE 12/14/84

IDENT. NO.	DESCRIPTION	SECT. XI EXAM.	EYAM MTH.	PROCEDURE	CAL. BLOCK	INSERVICE		NOTES
						REQ.	SCHEDULED OUTAGE	
12RRC(1)-N2E-1ALD	PIPE SEAM	B-J	VOL	UTP-10	UT-19			
			SUR	PTP-1				
RCR-20A	PIPE WHIP	N/A	N/A	N/A				SEE NOTE #1
12RRC(1)-N2E-2LU	PIPE SEAM	B-J	VOL	UTP-10	UT-19			
			SUR	PTP-1				
12RRC(1)-N2E-2	PIPE TO EL	B-J	VOL	UTP-10	UT-19			
			SUR	PTP-1				
12RRC(1)-N2E-2LDO	EL SEAM	B-J	VOL	UTP-10	UT-19			
			SUR	PTP-1				
12RRC(1)-N2E-2LDI	EL SEAM	B-J	VOL	UTP-10	UT-19			
			SUR	PTP-1				
12RRC(1)-N2E-3LUO	EL SEAM	B-J	VOL	UTP-10	UT-19			
			SUR	PTP-1				
12RRC(1)-N2E-3LUI	EL SEAM	B-J	VOL	UTP-10	UT-19			
			SUR	PTP-1				
12RRC(1)-N2E-3	EL TO PIPE	B-J	VOL	UTP-10	UT-19			
			SUR	PTP-1				
12RRC(1)-N2E-3LD	PIPE SEAM	B-J	VOL	UTP-10	UT-19			

WNP-02
 INTERVAL: PSI
 PERIOD: NA
 OUTAGE:
 DRAWING NO. RRC-101

WASHINGTON PUBLIC POWER SUPPLY SYSTEM
 PROGRAM PLAN AND SCHEDULE
 SYSTEM OR COMPONENT: RRC(2)-4S
 DESCRIPTION: REACTOR RECIR LOOP A

PAGE 023
 DATE 12/14/84

<u>IDENT. NO.</u>	<u>DESCRIPTION</u>	<u>SECT.</u> <u>XI</u> <u>EXAM.</u>	<u>EXAM</u> <u>MTN.</u>	<u>PROCEDURE</u>	<u>CAL.</u> <u>BLOCK</u>	<u>INSERVICE</u>		<u>NOTES</u>
						<u>REQ.</u>	<u>SCHEDULED</u> <u>OUTAGE</u>	
12RRC(1)-N2D-3	EL TO PIPE	B-J	VOL	UTP-10	UT-19			
			SUR	PTP-1				
12RRC(1)-N2D-3LD	PIPE SEAM	B-J	VOL	UTP-10	UT-19			
			SUR	PTP-1				
12RRC(1)-N2D-4LU	PIPE SEAM	B-J	VOL	UTP-10	UT-19			
			SUR	PTP-1				
12RRC(1)-N2D-4	PIPE TO SE EXT	B-J	VOL	UTP-10	UT-19			
			SUR	PTP-1				
12RRC(1)-N2D-6	SE TO NOZ	B-J	VOL	UTP-10	UT-111			
			SUR	PTP-1				
12RRC(1)-N2E-1	SWL TO PIPE	B-J	VOL	UTP-10	UT-19			
			SUR	PTP-1				
12RRC(1)-N2E-1LD	PIPE SEAM	B-J	VOL	UTP-10	UT-19			
			SUR	PTP-1				
12RRC(1)-N2E-1ALU	PIPE SEAM	B-J	VOL	UTP-10	UT-19			
			SUR	PTP-1				
12RRC(1)-N2E-1A	PIPE TO PIPE	B-J	VOL	UTP-10	UT-19			
			SUR	PTP-1				

WNP-02
 INTERVAL: PSI
 PERIOD: NA
 OUTAGE:
 DRAWING NO. RRC-101

WASHINGTON PUBLIC POWER SUPPLY SYSTEM
 PROGRAM PLAN AND SCHEDULE
 SYSTEM OR COMPONENT: RRC(2)-4S
 DESCRIPTION: REACTOR RECIR LOOP A

PAGE 025
 DATE 12/14/84

<u>IDENT. NO.</u>	<u>DESCRIPTION</u>	<u>SECT.</u> <u>XI</u> <u>EXAN.</u>	<u>EXAM</u> <u>MTI.</u>	<u>PROCEDURE</u>	<u>CAL.</u> <u>BLOCK</u>	<u>INSERVICE</u>		<u>NOTES</u>
						<u>REQ.</u>	<u>SCHEDULED</u> <u>OUTAGE</u>	
12RRC(1)-N2E-4LU	PIPE SEAM	B-J	VOL	UTP-10	UT-19			
12RRC(1)-N2E-4	PIPE TO SE EXT	B-J	VOL	UTP-10	UT-19			
12RRC(1)-N2E-6	SE TO NOZ	B-F	VOL	UTP-10	UT-111			
RRC-PB-101	RRC PRES BNDRY	R-P	VT-2	N/A				SEE NOTES #6 8 47.



WNP-02
 INTERVAL: PSI
 PERIOD: NA
 OUTAGE:
 DRAWING NO. RFW-103

WASHINGTON PUBLIC POWER SUPPLY SYSTEM
 PROGRAM PLAN AND SCHEDULE
 SYSTEM OR COMPONENT: RFW(11)-4
 DESCRIPTION: REACTOR FEEDWATER

PAGE 001
 DATE 12/14/84


<u>IDENT. NO.</u>	<u>DESCRIPTION</u>	<u>SECT.</u> XI	<u>EXAM</u> EXAM.	<u>PROCEDURE</u>	<u>CAL.</u> BLOCK	<u>INSERVICE</u>		<u>NOTES</u>
						<u>REQ.</u>	<u>SCHEDULED</u> OUTAGE	
RNCU-V-40-BDY	VALVE BODY	B-M-2	VT-1	GCI 7-1				
RWCU-V-40-BLT	VALVE BOLTING	B-G-2	VT-1	QCI 7-1				
6RFW(11)-1	VALVE TO PIPE	B-J	VOL	UTP-10	UT-28			AUGMT
			SUR	PTP-1				AUGMT
6RFW(11)-2	PIPE TO EL	B-J	VOL	UTP-10	UT-28			AUGMT
			SUR	PTP-1				AUGMT
6RFW(11)-2/3/4V-124	TEST CONN	B-P	VT-2	N/A				SEE NOTES #6 & #7.
6RFW(11)-2/3/4V-71	TEST CONN	B-P	VT-2	N/A				SEE NOTES #6 & #7.
6RFW(11)-3	EL TO PIPE	B-J	VOL	UTP-10	UT-28			AUGMT
			SUR	PTP-1				AUGMT
RFW-177	SPRING	B-K-2	VT-3	303/8.2.17				
			VT-4	303/8.2.17				
RFW-178	BOX	B-K-2	VT-3	303/8.2.17				
RFW-942N	PSA-1 SN(2)	B-K-2	VT-3	303/8.2.17				S/N 371
			VT-4	303/8.2.17				S/N 371
6RFW(11)-4	PIPE TO EL	B-J	VOL	UTP-10	UT-28			AUGMT
			SUR	PTP-1				AUGMT

WNP-02
 INTERVAL: PSI
 PERIOD: NA
 OUTAGE:
 DRAWING NO. RFW-103

WASHINGTON PUBLIC POWER SUPPLY SYSTEM
 PROGRAM PLAN AND SCHEDULE
 SYSTEM OR COMPONENT: RFW(11)-4
 DESCRIPTION: REACTOR FEEDWATER

PAGE 002
 DATE 12/14/84

<u>IDENT. NO.</u>	<u>DESCRIPTION</u>	SECT. XI <u>EXAM.</u>	EXAM <u>MTH.</u>	<u>PROCEDURE</u>	CAL. <u>BLOCK</u>	<u>INSERVICE</u> SCHEDULED		<u>NOTES</u>
						<u>REQ.</u>	<u>OUTAGE</u>	
6RFW(11)-5	EL TO PIPE	B-J	VOL	UTP-10	UT-28			AUGMT
			SUR	PTP-1				AUGMT
6RFW(11)-6	PIPE TO EL	B-J	VOL	UTP-10	UT-28			AUGMT
			SUR	PTP-1				AUGMT
6RFW(11)-7	EL TO PIPE	B-J	VOL	UTP-10	UT-28			AUGMT
			SUR	PTP-1				AUGMT
RFW-179	SPRING	B-K-2	VT-3	303/8.2.17				
			VT-4	303/8.2.17				
6RFW(11)-8	PIPE TO TEE	B-J	VOL	UTP-10	UT-28			AUGMT
			SUR	PTP-1				AUGMT
4RFW(11)A-1	TEE TO PIPE	B-J	VOL	QCI 6-13	UT-30			AUGMT
			SUR	QCI 3-3				AUGMT
4RFW(11)A-2	PIPE TO EL	B-J	VOL	UTP-10	UT-30			AUGMT
			SUR	PTP-1				AUGMT
4RFW(11)A-3	EL TO SLEEVE	B-J	VOL	UTP-10	UT-30			AUGMT
			SUR	PTP-1				AUGMT
6RFW(11)-9	TEE TO PIPE	B-J	VOL	UTP-10	UT-28			AUGMT

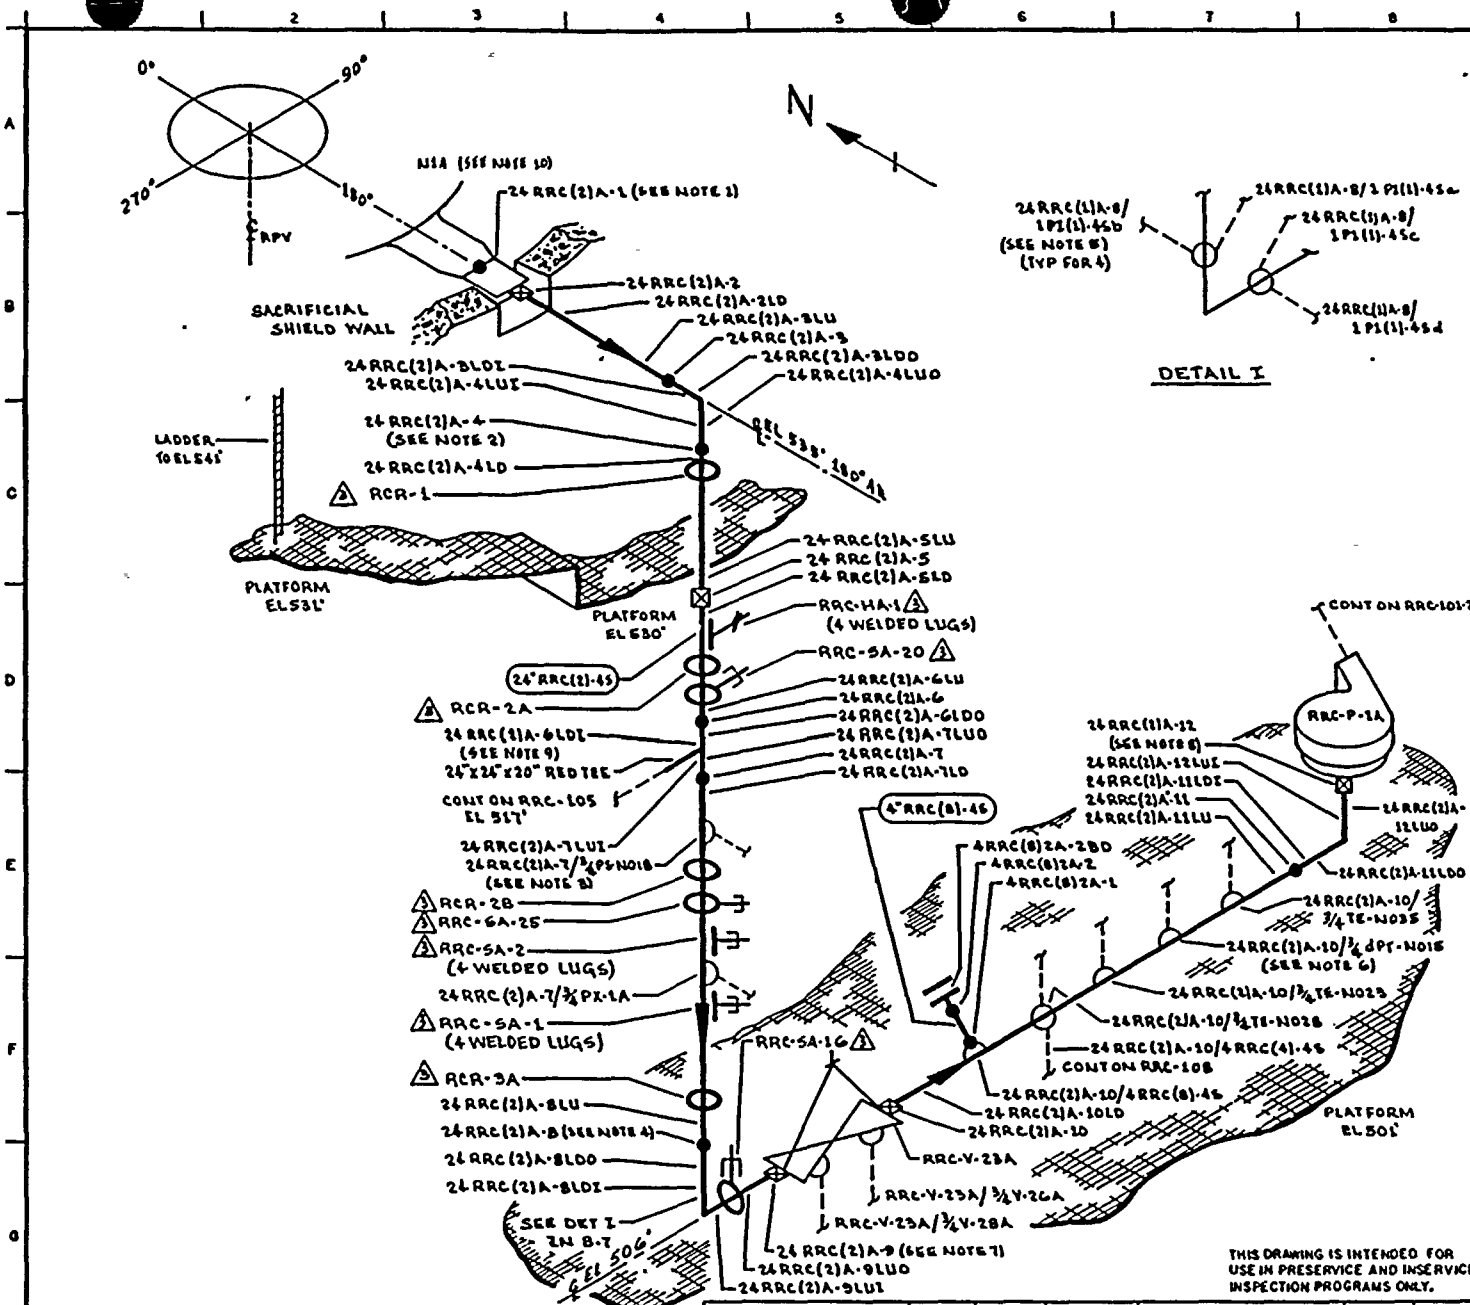


- NOTES:
- WELD 24 RRC(2)A-1 UTILIZES CAL BLOCK UT-101.
 - ACCESS TO WELD 24 RRC(2)A-4 REQUIRES REMOVAL OF RCR-1.
 - EXTEND LEAKAGE EXAM THROUGH CONTAINMENT PENETRATION [1-78F] THROUGH EXCESS FLOW CHECK VALVE TO INSTRUMENT TUBING CONNECTION.
 - ACCESS TO WELD 24 RRC(2)A-8 REQUIRES REMOVAL OF RCR-3A.
 - EXTEND LEAKAGE EXAM THROUGH CONTAINMENT PENETRATIONS (X-40C, X-40D, X-61a, & X-61b) THROUGH EXCESS FLOW CHECK VALVES TO INSTRUMENT TUBING CONNECTIONS.
 - EXTEND LEAKAGE EXAM THROUGH CONTAINMENT PENETRATION (X-70F) THROUGH EXCESS FLOW CHECK VALVE TO INSTRUMENT TUBING CONNECTION.
 - WELD 24 RRC(2)A-9 IS FITTING TO FITTING.
 - WELD 24 RRC(2)A-12 IS FITTING TO FITTING.
 - LONGITUDINAL WELDS LOCATED INBOARD & OUTBOARD ON THE RED TEE, WITH RESPECT TO THE RPV, ARE 90° FROM THE BRANCH CONNECTION.
 - FOR NOZZLE ASSY. DET SEE RPV-105.
 - PIPING PURCHASED TO MIN. WALL SPEC - C.910.

REFERENCES:

GENERAL ELECTRIC DRAWINGS

761 E 424 REV 2 761 E 735 REV 6
 162 E 538 641 REV 5 131 C 7587 REV 3
 762 E 538 642 REV 3 151 C 7586 REV 4

CB&I NUCLEAR CO.
 4B, REV 4, N1 NOZZLE ASSEMBLY
 BONEE CRAIL/GERI
 BCK-215 REV 7

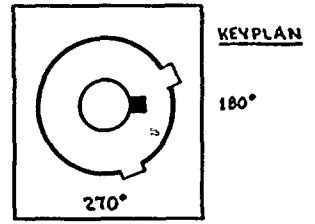

QUALITY CLASS: 1 ASME CODE CLASS: 1
 ENGR: D TIMMINS DRAWN: K MCA DATE: 4-9-78

WASHINGTON PUBLIC POWER SUPPLY SYSTEM
 RICHMOND WASHINGTON 99352

THIS DRAWING IS INTENDED FOR USE IN PRESERVICE AND INSERVICE INSPECTION PROGRAMS ONLY.


NO	DATE	REVISION	BY	CHKD	APPVD	PIPING SYSTEM	NOM DIA (IN)	SCH	NOM WALL THK	MATERIAL SPECIFICATION	MATL TYPE	CAL BLOCK NO
B	12/1/80	REVISED AS NOTED ADDED KEYPLAN & LUGS	K.M.A.	M.R.	T.P.H.	24" RRC(2)A-45	24	XXY	SEE NOTE 11	SA 358 GR 304 CL1	SS	UT-7
Z	11/5/80	ADDED NOTE 10, REVISED AS NOTED	K.M.A.	M.R.	S.D.	4" RRC(8)A-45	4	80	0.237	SA 376 TP 304	SS	UT-31
1	7-17-79	CORRECTED TEE TO WELDED TEE, EN D-4	K.M.A.	M.R.	S.D.	LUGS	N.A.	N.A.	N.A.	SA 240 TP 304	SS	UT-47
0	11/7/78	ISSUED FOR USE	K.M.A.	M.R.	S.D.							
A	5-19-78	ISSUED FOR INFORMATION ONLY	K.M.A.	M.R.	S.D.							

WNP-2
 WELD 8 COMPONENT
 IDENTIFICATION DIAGRAM

TITLE:
 REACTOR RECIRCULATION LOOP A


DWG NO: RRC-101-1 REV 3



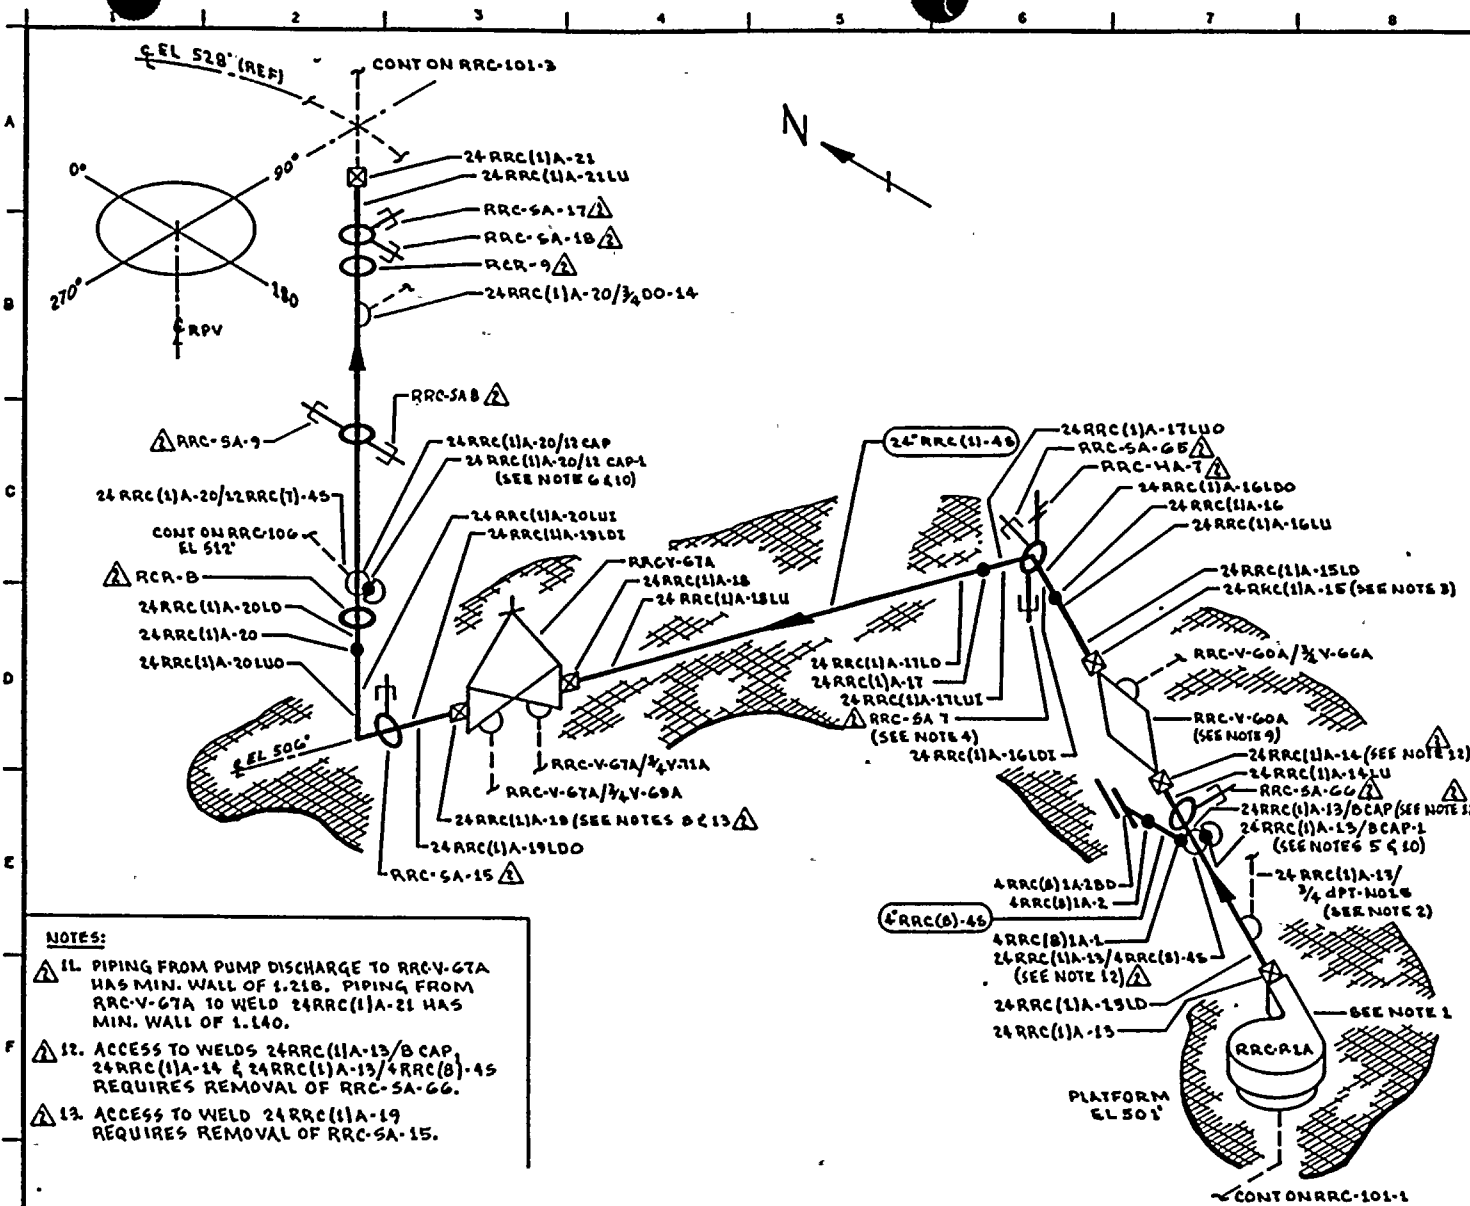

- NOTES:
1. SEE RRC-P-1A DETAIL DWG RRC-103 FOR PUMP SUPPORT DETAILS.
 2. EXTEND LEAKAGE EXAM THROUGH CONTAINMENT PENETRATION (X-704) THROUGH EXCESS FLOW CHECK VALVE TO INSTRUMENT TUBING CONNECTION.
 3. DELETED
 4. SPECIAL CLAMP WITH HAT & BAT ATTACHMENTS.
 5. WELD 24RRC(1)A-13/SCAP 1 IS FITTING TO FITTING.
 6. WELD 24RRC(1)A-20/SCAP 1 IS FITTING TO FITTING.
 7. EXTEND LEAKAGE EXAM THROUGH CONTAINMENT PENETRATION (X-694) THROUGH VALVE RRC-V-20.
 8. WELD 24RRC(1)A-19 IS FITTING TO FITTING.
 9. RRC-V-60A HAS TWELVE (12) 2 1/2" X 15" BODY TO BONNET STUDS.
 10. CAP TO NOZZLE WELDS ARE CLAD ON THE ID IN THE WELD AREAS. SEE REF. DWGS. 191 C 1588 & 191 C 1589.

- REFERENCES:
- GENERAL ELECTRIC DRAWINGS:
- | | | | |
|----------------|-------|------------|-------|
| 761 E 424 | REV 2 | 151 C 1588 | REV 3 |
| 762 E 538 SH 1 | REV 1 | 151 C 1589 | REV 5 |
| 762 E 538 SH 2 | REV 9 | 151 C 1582 | REV 3 |
| 761 E 735 | REV 6 | | |
- BOVEE CRAIL/GERI
BC/G-216 REV B

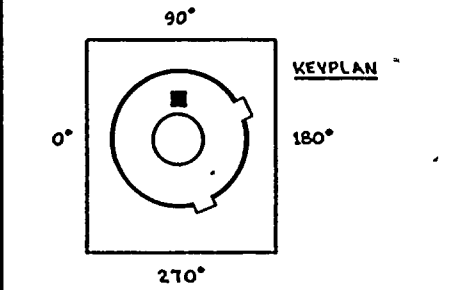

- NOTES:
11. PIPING FROM PUMP DISCHARGE TO RRC-V-67A HAS MIN. WALL OF 1.218. PIPING FROM RRC-V-67A TO WELD 24RRC(1)A-21 HAS MIN. WALL OF 1.140.
 12. ACCESS TO WELDS 24RRC(1)A-13/B CAP, 24RRC(1)A-14 & 24RRC(1)A-13/4RRC(8)-45 REQUIRES REMOVAL OF RRC-SA-66.
 13. ACCESS TO WELD 24RRC(1)A-19 REQUIRES REMOVAL OF RRC-SA-15.

THIS DRAWING IS INTENDED FOR USE IN PRESERVICE AND INSERVICE INSPECTION PROGRAMS ONLY.

QUALITY CLASS: 1 ASME CODE CLASS: 1

ENGR: D TIMMINS | DRAWN: X. M. A | DATE: 4-6-78

WASHINGTON PUBLIC POWER SUPPLY SYSTEM
RICHLAND, WASHINGTON 99352



	NO	DATE	REVISION	BY	CHKD	APPVD
2	10-15-78		REVISED AS NOTED ADDED KEYPLAN.	KMA	JTR	JH
1	11-6-80		REVISED AS NOTED	KMA	JTR	DW
0	11-27-78		ISSUED FOR USE	KMA	JTR	JH
A	5-29-78		ISSUED FOR INFORMATION ONLY	KMA	JTR	DW
NO	DATE		REVISION	BY	CHKD	APPVD

PIPING SYSTEM	NOM DIA (IN)	SCH	NOM WALL THK	MATERIAL SPECIFICATION	MATL TYPE	CAL BLOCK NO
24 RRC(1)A-45	24	XXX	SEE NOTE 11	SA 350 GR 304 CL 1	SS	UT-7
4 RRC(8)-45	4	80	0.357	SA 316 TP 304	SS	UT-31
CAP	12	80	0.688	SA 403 GR WP 804	-	UT-19
CAP	8	-	0.500	-	-	UT-26


WHP-2
WELD COMPONENT
IDENTIFICATION DIAGRAM

TITLE:
REACTOR RECIRCULATION LOOP A

DWG NO: RRC-101-2 | REV 2

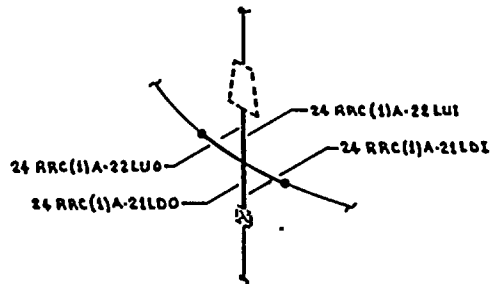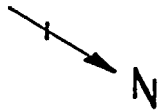

DETAIL 1
(SEE NOTE 3)

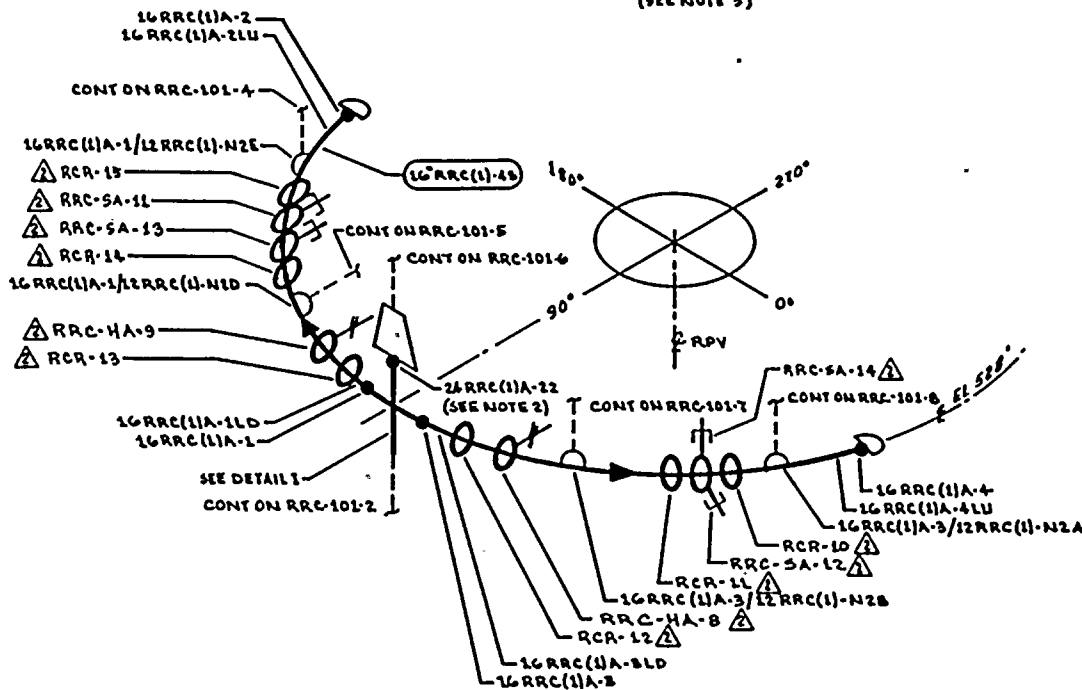

NOTES:

1. ACCESS TO WELDS 16 RRC(1)A-1 THRU 4 & 24 RRC(1)A-22 REQUIRES TEMPORARY SCAFFOLDING.
2. WELD 24 RRC(1)A-22 IS FITTING TO FITTING.
3. LONGITUDINAL WELDS ON CROSS LOCATED INBOARD & OUTBOARD, WITH RESPECT TO RPV, ARE 90° FROM THE HEADER CONN.
4. PIPING PURCHASED TO MIN WALL SPECIFICATION. MIN WALL 0.758".


REFERENCES:

GENERAL ELECTRIC DRAWINGS

- 761 E 424 REV 2
- 762 E 53B SH 1 REV 3
- 762 E 53B SH 2 REV 3
- 761 E 735 REV 6
- 131 C 7590 REV 1

BOVEE CRAIL/GERS

- BCG-216 REV B

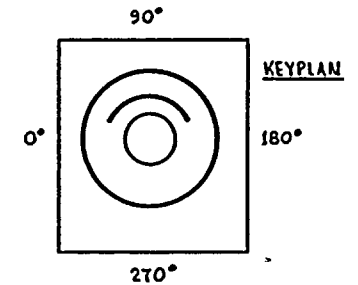

QUALITY CLASS: L ASME CODE CLASS: 1
ENGR: D TIMMINS DRAWN: K.M.A. DATE: 4-6-78



WASHINGTON PUBLIC POWER SUPPLY SYSTEM

RICHLAND, WASHINGTON 99352

THIS DRAWING IS INTENDED FOR USE IN PRESERVICE AND INSERVICE INSPECTION PROGRAMS ONLY.


PIPING SYSTEM	NOM DIA (IN)	SCH	NOM WALL THK	MATERIAL SPECIFICATION	MATL TYPE	CAL BLOCK NO
16" RRC(1)A-45	16	XXX	SEE NOTE 4	SA 358 QR 304 CLI	SS	UT-15

NO	DATE	REVISION	BY	CHKD	APPVD
2	10-13-83	REVISED AS NOTED ADDED KEYPLAN	K.M.A.	D.R.	T.H.
1	7-17-77	REVISED RISER LETTERING TO REFLECT AS BUILT, REVISED CROSS TO WELDED CROSS, ADDED DETAIL FOR CLARITY	K.M.A.	D.R.	T.H.
0	11-17-77	ISSUED FOR USE	K.M.A.	D.R.	T.H.
A	5-19-78	ISSUED FOR INFORMATION ONLY	K.M.A.	D.R.	T.H.

WNP-2
WELD & COMPONENT
IDENTIFICATION DIAGRAM

TITLE:
REACTOR RECIRCULATION LOOP A

DWG NO: RRC-101-3 REV 2

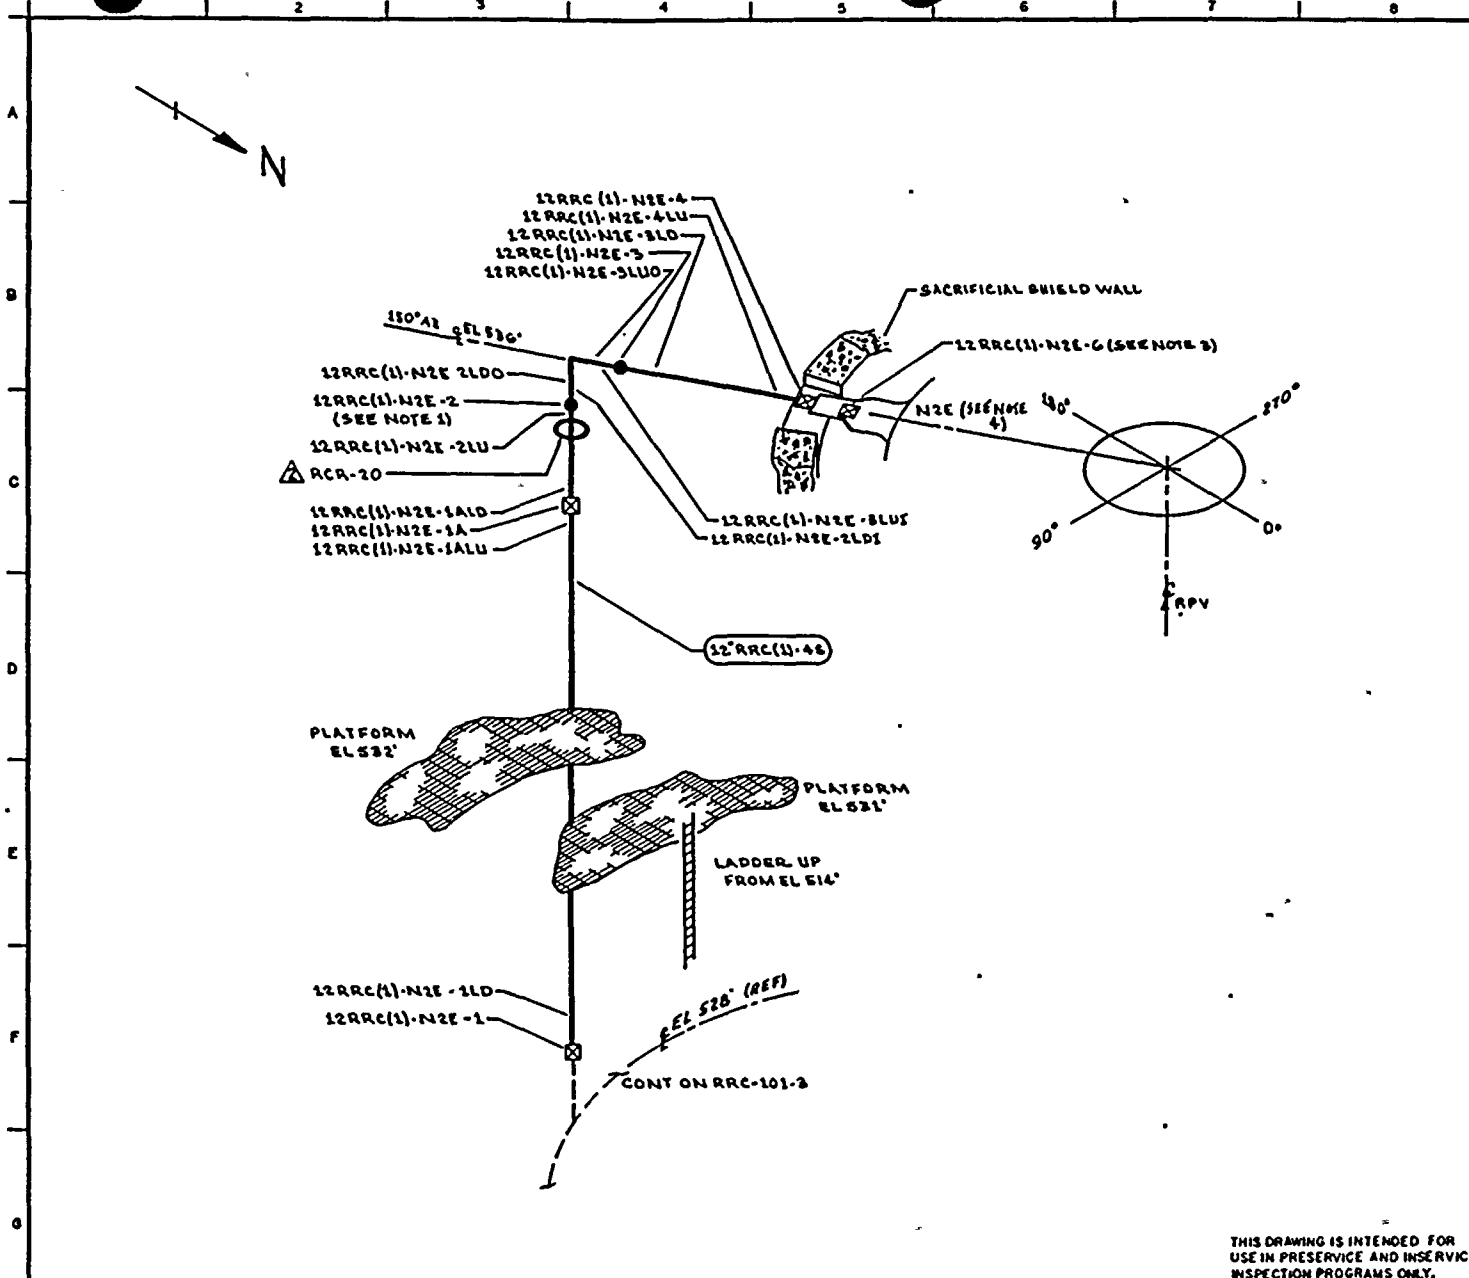

NOTES:

- 1. ACCESS TO WELD 12 RRC(1)-N2E-2 REQUIRES REMOVAL OF RCR-20.
- 2. DELETED
- 3. WELD 12 RRC(1)-N2E-6 UTILIZES CAL BLOCK UT-111.
- 4. FOR NOZZLE ASSEMBLY DETAILS SEE RPY-106.
- 5. PIPING PURCHASED TO MIN WALL SPECIFICATION. MIN WALL 0.604".

REFERENCES:


GENERAL ELECTRIC DRAWINGS

- 761 E 424 REV 2
- 762 E 938 SH 1 REV 3
- 762 E 938 SH 2 REV 3
- 761 E 735 REV 6

CB&I NUCLEAR CO.

52, REV 12, N2 NOZZLE ASSEMBLY

BOVEE CRAIG/GERI
BC/G-216 REV 8

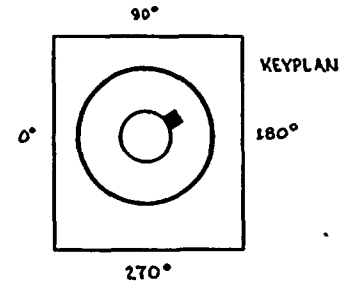

THIS DRAWING IS INTENDED FOR USE IN PRESERVICE AND INSERVICE INSPECTION PROGRAMS ONLY.

QUALITY CLASS: 1	ASME CODE CLASS: 1
ENGR: D. TIMMINGS	DRAWN: K. M. A. DATE: 4-4-78



**WASHINGTON PUBLIC POWER
SUPPLY SYSTEM**


RICHMOND, WASHINGTON 98362

PIPING SYSTEM	NOM DIA (IN)	SCH	NOM WALL THK	MATERIAL SPECIFICATION	MATL TYPE	CAL BLOCK NO
12" RRC(1)-46	12	XXX	SEE NOTE 5	SA 358 QR 304 CL I	SS	UT-19

NO	DATE	REVISION	BY	CHKD	APPVD
2	10-13-78	REVISED AS NOTED ADDED KEYPLAN	KMA	DR	TFK
1	7-12-79	REVISED OVER LETTERING FROM A TO C, CHANGED NOTE 3, WELDS 5, ADDED WELDS 1A, 1A1D & 1A1U TO PER A.E. DRILL.	KMA	PPB	ZLO
0	11-22-78	ISSUED FOR USE	KMA	DR	ZLO
A	5-14-78	ISSUED FOR INFORMATION ONLY	KMA	DR	ZLO


WNP-2 WELD & COMPONENT IDENTIFICATION DIAGRAM	
TITLE: REACTOR RECIRCULATION LOOP A	
DWG NO: RRC-101-4	REV 2



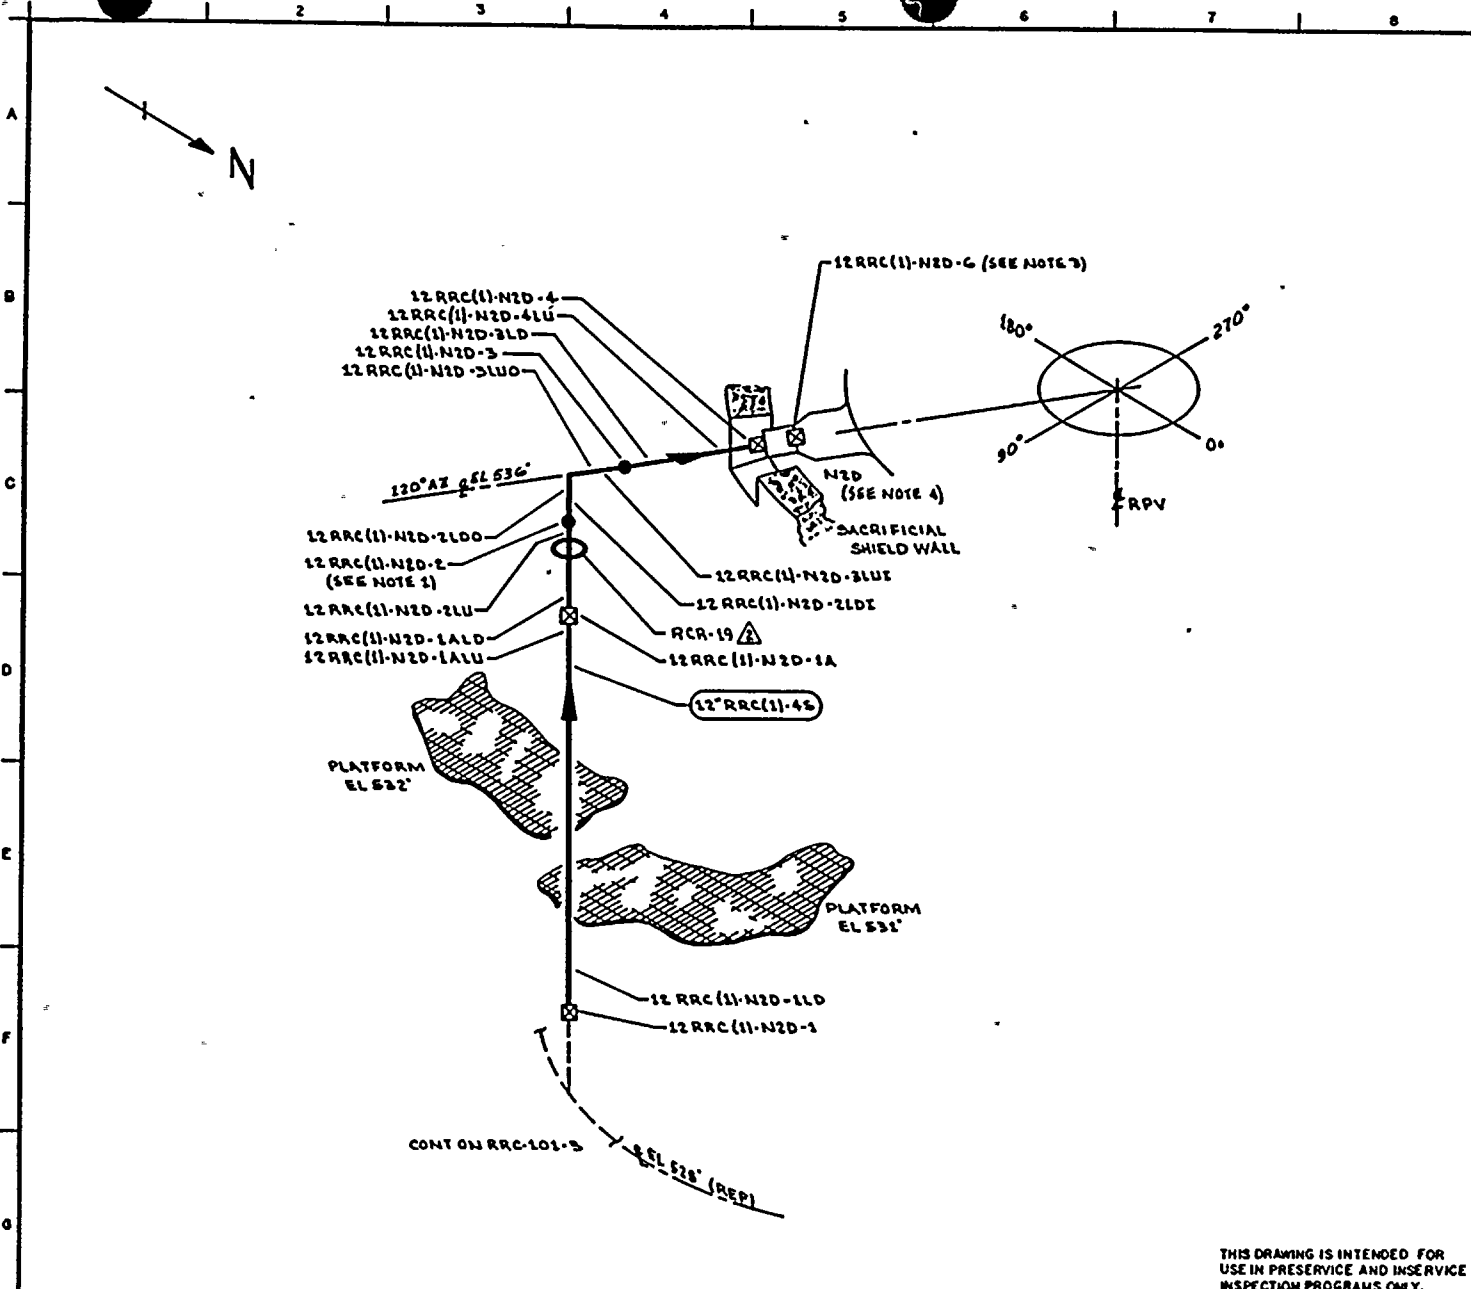

- NOTES:**
1. ACCESS TO WELD 12 RRC(11-N2D-2) REQUIRES REMOVAL OF RCR-19.
 2. DELETED
 3. WELD 12 RRC(11-N2D-6) UTILIZES CAL BLOCK UT-111.
 4. FOR NOZZLE ASSEMBLY DETAILS SEE RPV-106.
 5. PIPING PURCHASED TO MIN WALL SPECIFICATION. MIN WALL 0.604\".

- REFERENCES:**
- GENERAL ELECTRIC DRAWINGS
- 761 E REV 2
 - 762 E SH 1 REV 3
 - 762 E SH 2 REV 3
 - 761 E REV 6
- CBI NUCLEAR CO.
- 52, REV 10, N2 NOZZLE ASSEMBLY
- BOVEE CRAIG / GERI
- BC/G-216 REV 8

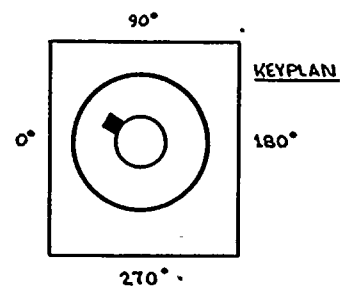

QUALITY CLASS: 1 ASME CODE CLASS: 1
 ENGR: D TIMMINS DRAWN: K MCLA DATE: 4-4-76

WASHINGTON PUBLIC POWER SUPPLY SYSTEM
 RICHLAND, WASHINGTON 99352

THIS DRAWING IS INTENDED FOR USE IN PRESERVICE AND INSERVICE INSPECTION PROGRAMS ONLY.

PIPING SYSTEM	NOM DIA (IN)	SCH	NOM WALL THK	MATERIAL SPECIFICATION	MATL TYPE	CAL BLOCK NO
12 RRC(11-46)	12	XXX	SEE NOTE 6	SA 358 GR B04 CL1	66	UT-19


NO	DATE	REVISION	BY	CHKD	APPVD
2	10-13-83	REVISED AS NOTED ADDED KEYPLAN	X/HA	EDR	TFR
1	2-11-79	REVISED WATER LITERING FROM B TO D, DELETED NOTE 2, WELD 5, ADDED FW 1A, WELD 2, 11, 14, 15, 16, 17, 18, 19, 20, 21.	X/HA	EDR	TFR
0	11-27-78	ISSUED FOR USE	X/HA	EDR	TFR
A	5-14-78	ISSUED FOR INFORMATION ONLY	X/HA	EDR	TFR

WNP-2
 WELD 8 COMPONENT
 IDENTIFICATION DIAGRAM

TITLE:
REACTOR RECIRCULATION LOOP A


DWG NO: RRC-101-5 REV 2



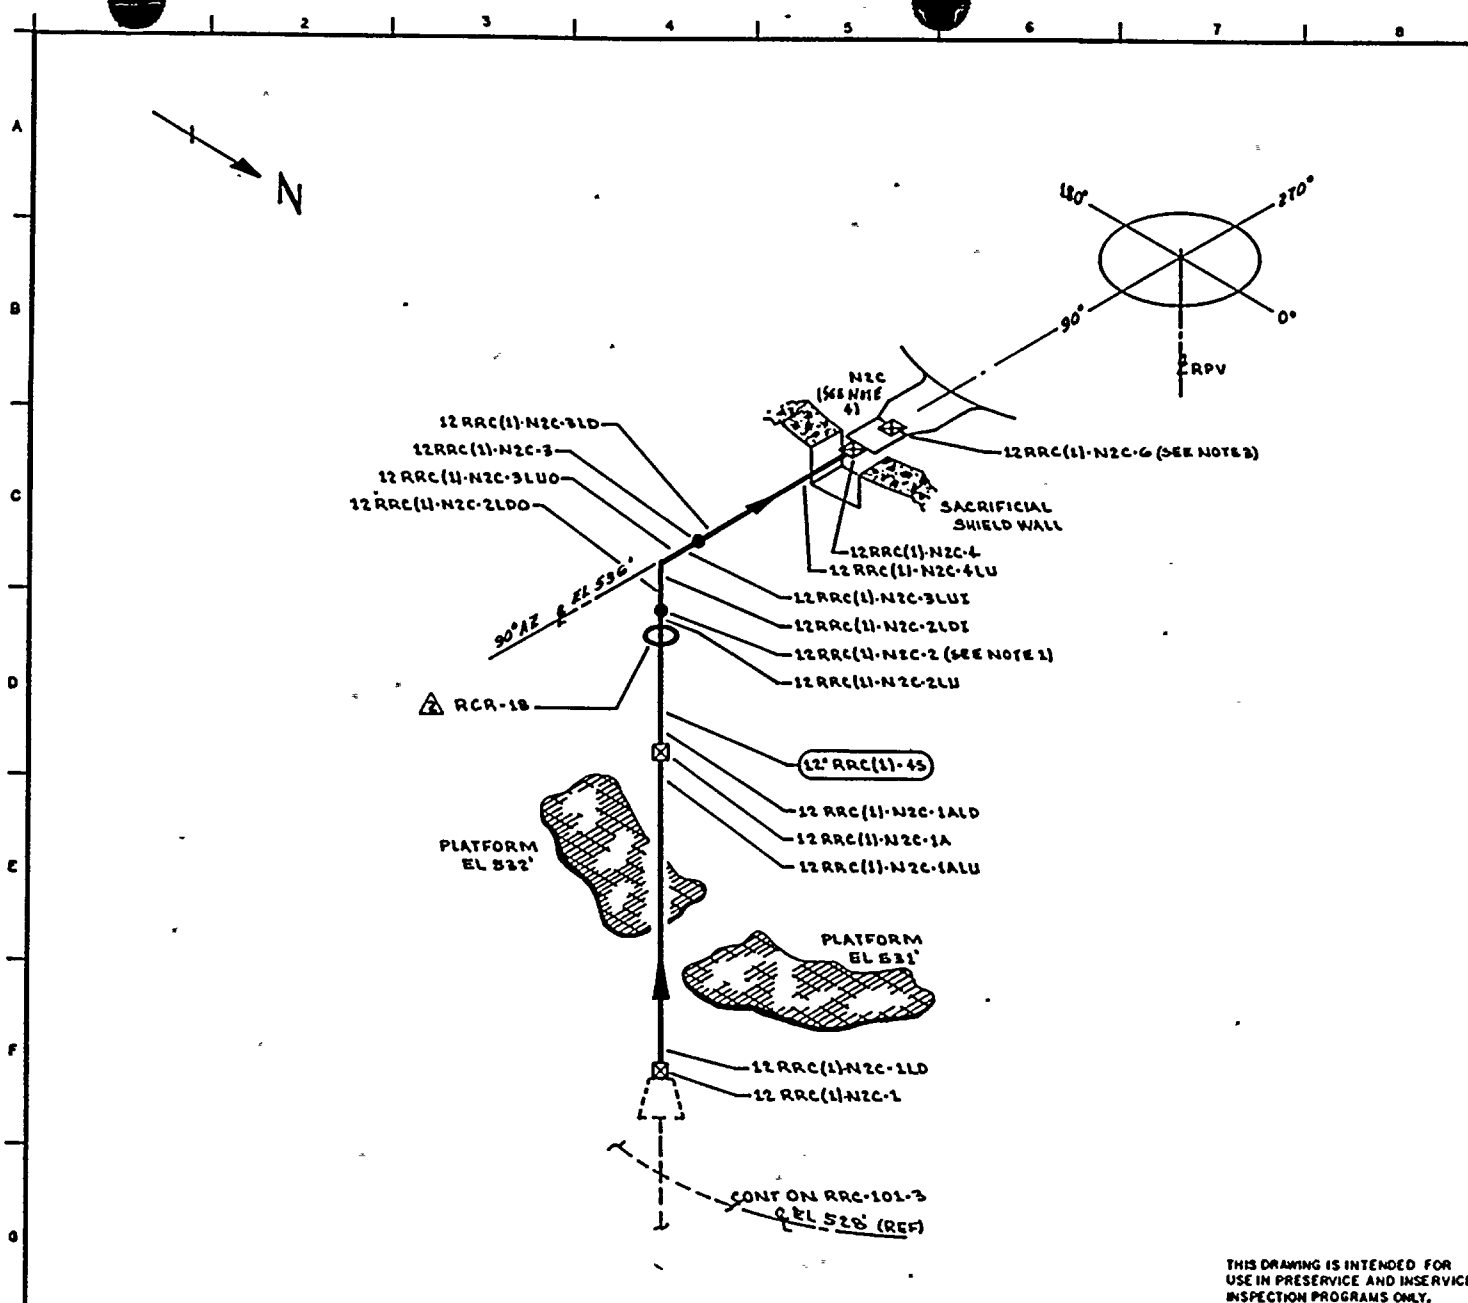

- NOTES:
1. ACCESS TO WELD 12 RRC(1)-N2C-2 REQUIRES REMOVAL OF RCR-18.
 2. DELETED
 3. WELD 12 RRC(1)-N2C-6 UTILIZES CAL BLOCK UT-111.
 4. FOR NOZZLE ASSEMBLY DETAILS SEE RPY-106.
 5. PIPING PURCHASED TO MIN WALL SPECIFICATION. MIN WALL 0.604".

- REFERENCES:
- GENERAL ELECTRIC DRAWINGS
- 761 E REV 2
 - 762 E SH1 REV 3
 - 762 E SH2 REV 3
 - 763 E REV 6
- CBT NUCLEAR CO.
- S2, REV 10, N2 NOZZLE ASSEMBLY
- BOVEE CRAIG/GERI
- BC/G-216 REV B

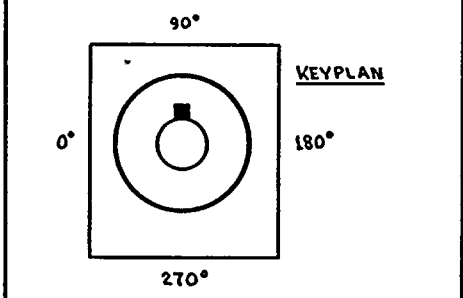

QUALITY CLASS: 1 ASME CODE CLASS: 1
 ENGR: D TIMMINS DRAWN: X.M.C.A DATE: 4-4-78

WASHINGTON PUBLIC POWER SUPPLY SYSTEM
 RICHLAND, WASHINGTON 99352

THIS DRAWING IS INTENDED FOR USE IN PRESERVICE AND INSERVICE INSPECTION PROGRAMS ONLY.


PIPING SYSTEM	NOM DIA (IN)	SCH	NOM WALL THK	MATERIAL SPECIFICATION	MATL TYPE	CAL BLOCK NO
12" RRC(1)-45	12	XXX	SEE NOTES	SA 358 GR 304-CL1	66	UT-19


NO	DATE	REVISION	BY	CHKD	APPVD
2	0893	REVISED AS NOTED ADDED KEYPLAN	W.A.A.	J.P.H.	T.H.C.
1	7-17-78	DELETED WELD 12 RRC(1)-N2C-6, ADDED WELD 12 RRC(1)-N2C-6LU0 PER AS BUILT	W.A.A.	J.P.H.	T.H.C.
0	11-22-78	ISSUED FOR USE	W.A.A.	J.P.H.	T.H.C.
A	5-1-78	ISSUED FOR INFORMATION ONLY	W.A.A.	J.P.H.	T.H.C.

WNP-2
 WELD 8 COMPONENT
 IDENTIFICATION DIAGRAM

TITLE:
REACTOR RECIRCULATION LOOP A


DWG NO: RRC-101-G REV 2

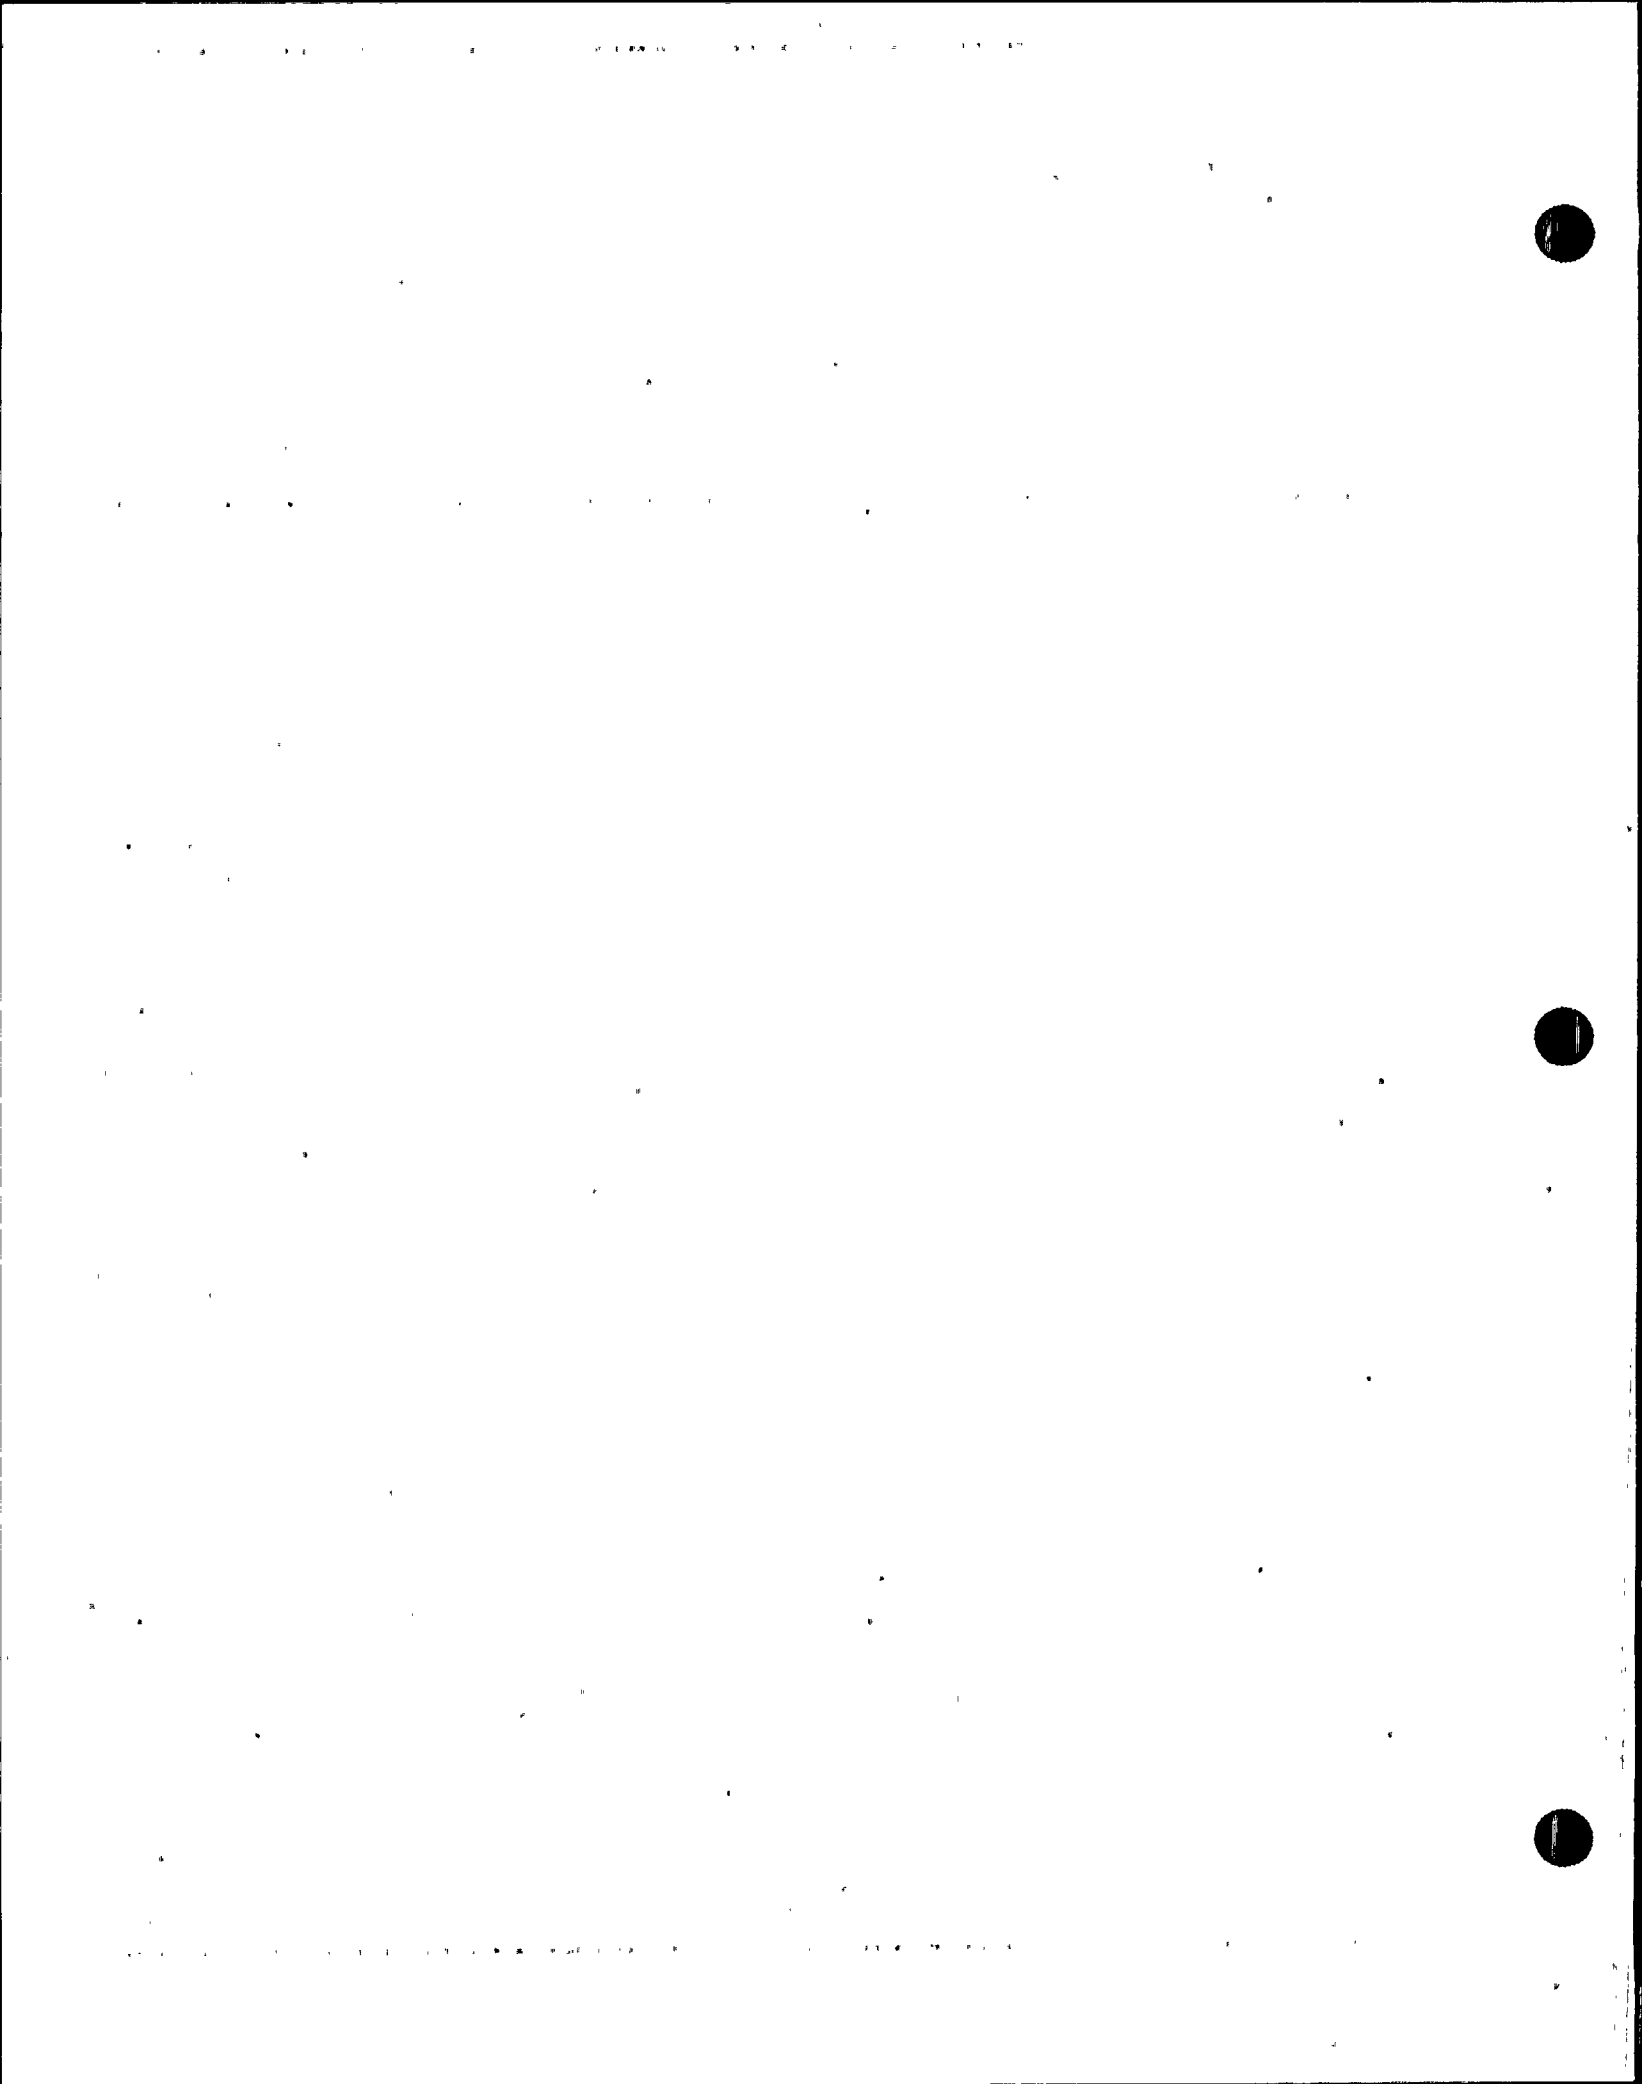

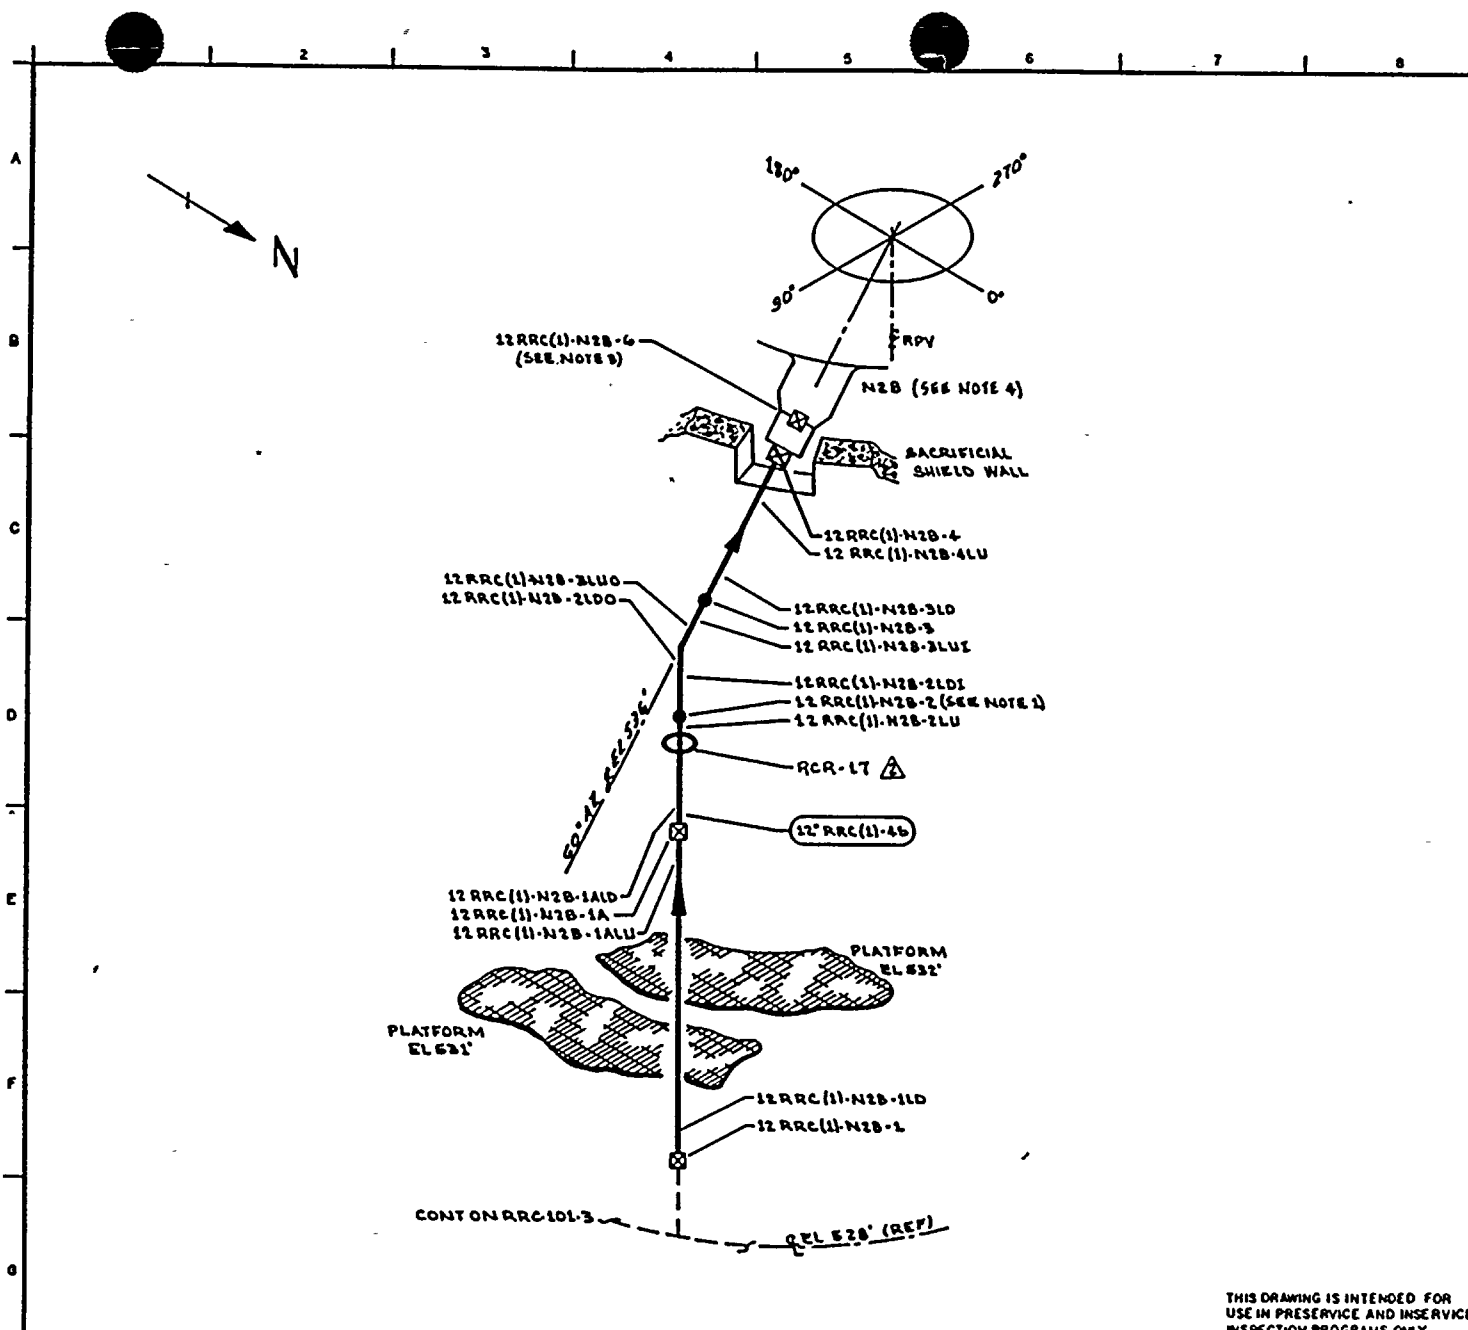

- NOTES:
1. ACCESS TO WELD 12 RRC (1)-N2B-2 REQUIRES REMOVAL OF 12 RRC (1)-N2B-1PR. DELETED
 2. WELD 12 RRC (1)-N2B-6 UTILIZES CAL BLOCK UT-111.
 4. FOR NOZZLE ASSEMBLY DETAILS SEE RPV-106.

- REFERENCES:
- GENERAL ELECTRIC DRAWINGS
- 761 E 424 REV 2
 - 762 E 538 SH1 REV 3
 - 762 E 538 SH2 REV 3
 - 761 E 735 REV 6
- CBI NUCLEAR CO.
- 52, REV 10, N2 NOZZLE ASSEMBLY
 - BOVER & CRRIL/GER1
 - BC/G-216 REV 9

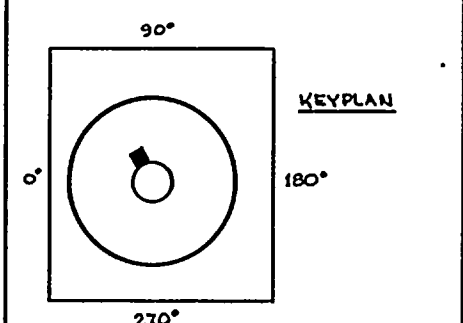

QUALITY CLASS: 1 ASME CODE CLASS: 1

ENGR: D. TIMMINS DRAWN: K. McCA DATE: 4-4-78

WASHINGTON PUBLIC POWER SUPPLY SYSTEM

RICHLAND, WASHINGTON 98322

THIS DRAWING IS INTENDED FOR USE IN PRESERVICE AND INSERVICE INSPECTION PROGRAMS ONLY.

PIPING SYSTEM	NOM DIA (IN)	SCH	NOM WALL THK	MATERIAL SPECIFICATION	MATL TYPE	CAL BLOCK NO
12 RRC (1)-45	12	XXX	0.604	SA 358 GR 304 CL1	S6	UT-19


NO	DATE	REVISION	BY	CHKD	APPVD
2	12-2-83	REVISED AS NOTED ADDED KEYPLAN	K.M.A.	L.M.R.	J.H.
1	7-17-77	REVISED RISER LIFTING FROM D10 B, DESMO N2B-2 WELD 12 RRC (1)-N2B-6 (WELD 12 RRC (1)-N2B-6) FOR AT RMT.	K.M.A.	F.P.V.	J.H.
0	11-27-78	ISSUED FOR USE	K.M.A.	J.C.S.	J.H.
A	5-19-78	ISSUED FOR INFORMATION ONLY	K.M.A.	H.M.W.	F.P.V.

WNP-2 WELD 8 COMPONENT IDENTIFICATION DIAGRAM

TITLE: REACTOR RECIRCULATION LOOP A


DWG NO: RRC-101-7 REV 2



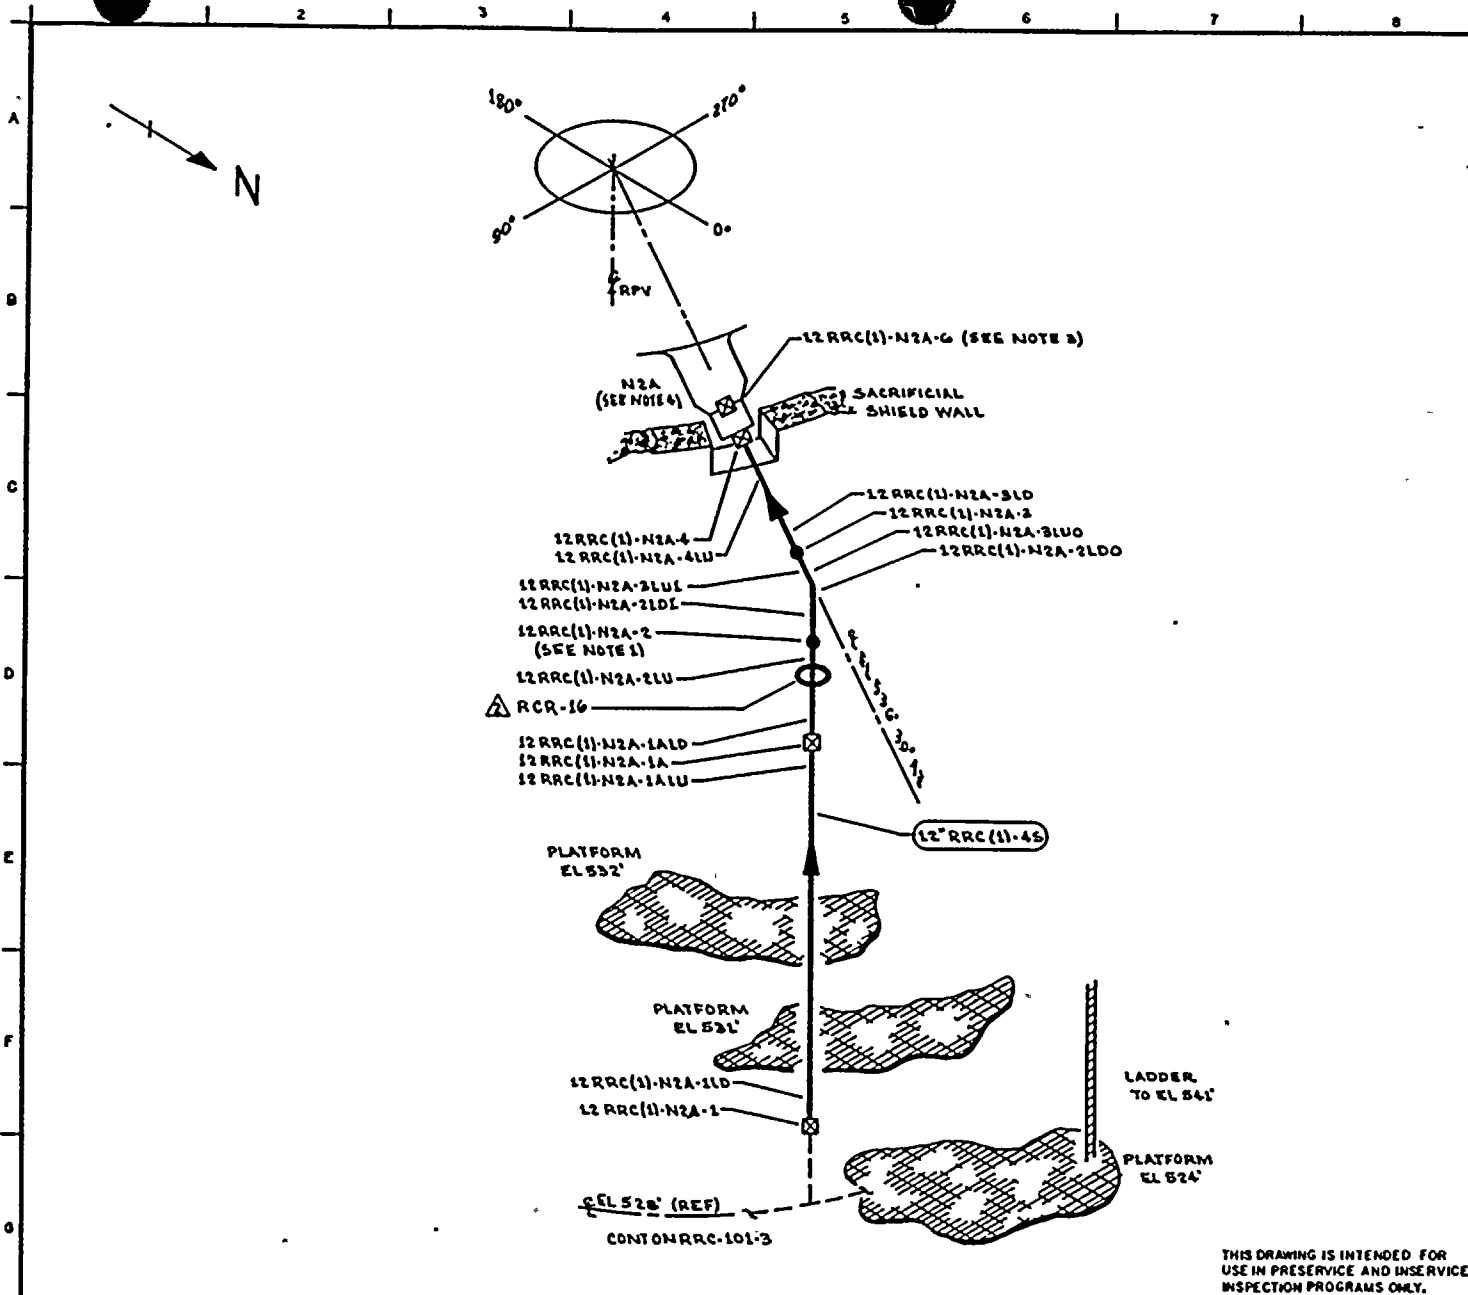

- NOTES:**
1. ACCESS TO WELD 12RRC(1)-N2A-2 REQUIRES REMOVAL OF RCR-16.
 2. DELETED
 3. WELD 12RRC(1)-N2A-6 UTILIZES CAL BLOCK UT-111.
 4. FOR NOZZLE ASSEMBLY DETAILS SEE RPV-106.
 5. PIPING PURCHASED TO MIN WALL SPECIFICATION. MIN WALL 0.604".

- REFERENCES:**
- GENERAL ELECTRIC DRAWINGS
- 721 E 424 REV 2
 - 762 E 538 SH 1 REV 3
 - 762 E 538 SH 2 REV 3
 - 761 E 735 REV 6
- CBI NUCLEAR CO.
52, REV 10, N2 NOZZLE ASSEMBLY
- BOVEE CRAIL/GERS
BC/Q-216 REV B

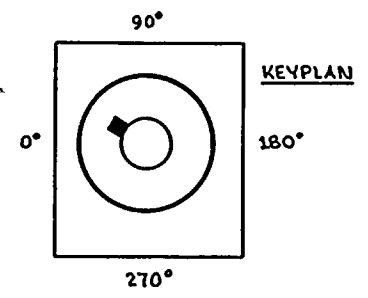

QUALITY CLASS: 1	ASME CODE CLASS: 1
ENGR'D: TIMMING	DRAWN: K. McLA
	DATE: 4-4-78

WASHINGTON PUBLIC POWER SUPPLY SYSTEM
RICHMOND, WASHINGTON 98352

THIS DRAWING IS INTENDED FOR USE IN PRESERVICE AND INSERVICE INSPECTION PROGRAMS ONLY.

PIPING SYSTEM	NOM DIA (IN)	SCH	NOM WALL THK	MATERIAL SPECIFICATION	MATL TYPE	CAL BLOCK NO
12" RRC(1)-45	12	XXX	SEE NOTES	SA 358 GR 304 CL 7	65	UT-19

NO	DATE	REVISION	BY	CHKD	APPVD
2	10-11-78	REVISED AS NOTED ADDED KEYPLAN	KMcLA	SPK	TPK
1	7-17-78	REVISED RISER LETTERING FROM E TO A DELETED NOTE # 2 & WELD # 23 ADDED FOR 12" WELDS 1 & 1A WELDS 1A AND 1B AS SHOWN	KMcLA	SPK	TPK
0	11-27-78	ISSUED FOR UGW	KMcLA	BCJ	TPK
A	5-19-78	ISSUED FOR INFORMATION ONLY	KMcLA	TPK	SPK


WNP-2
WELD & COMPONENT IDENTIFICATION DIAGRAM

TITLE:
REACTOR RECIRCULATION LOOP A

DWG NO: RRC-101-B


REV 2



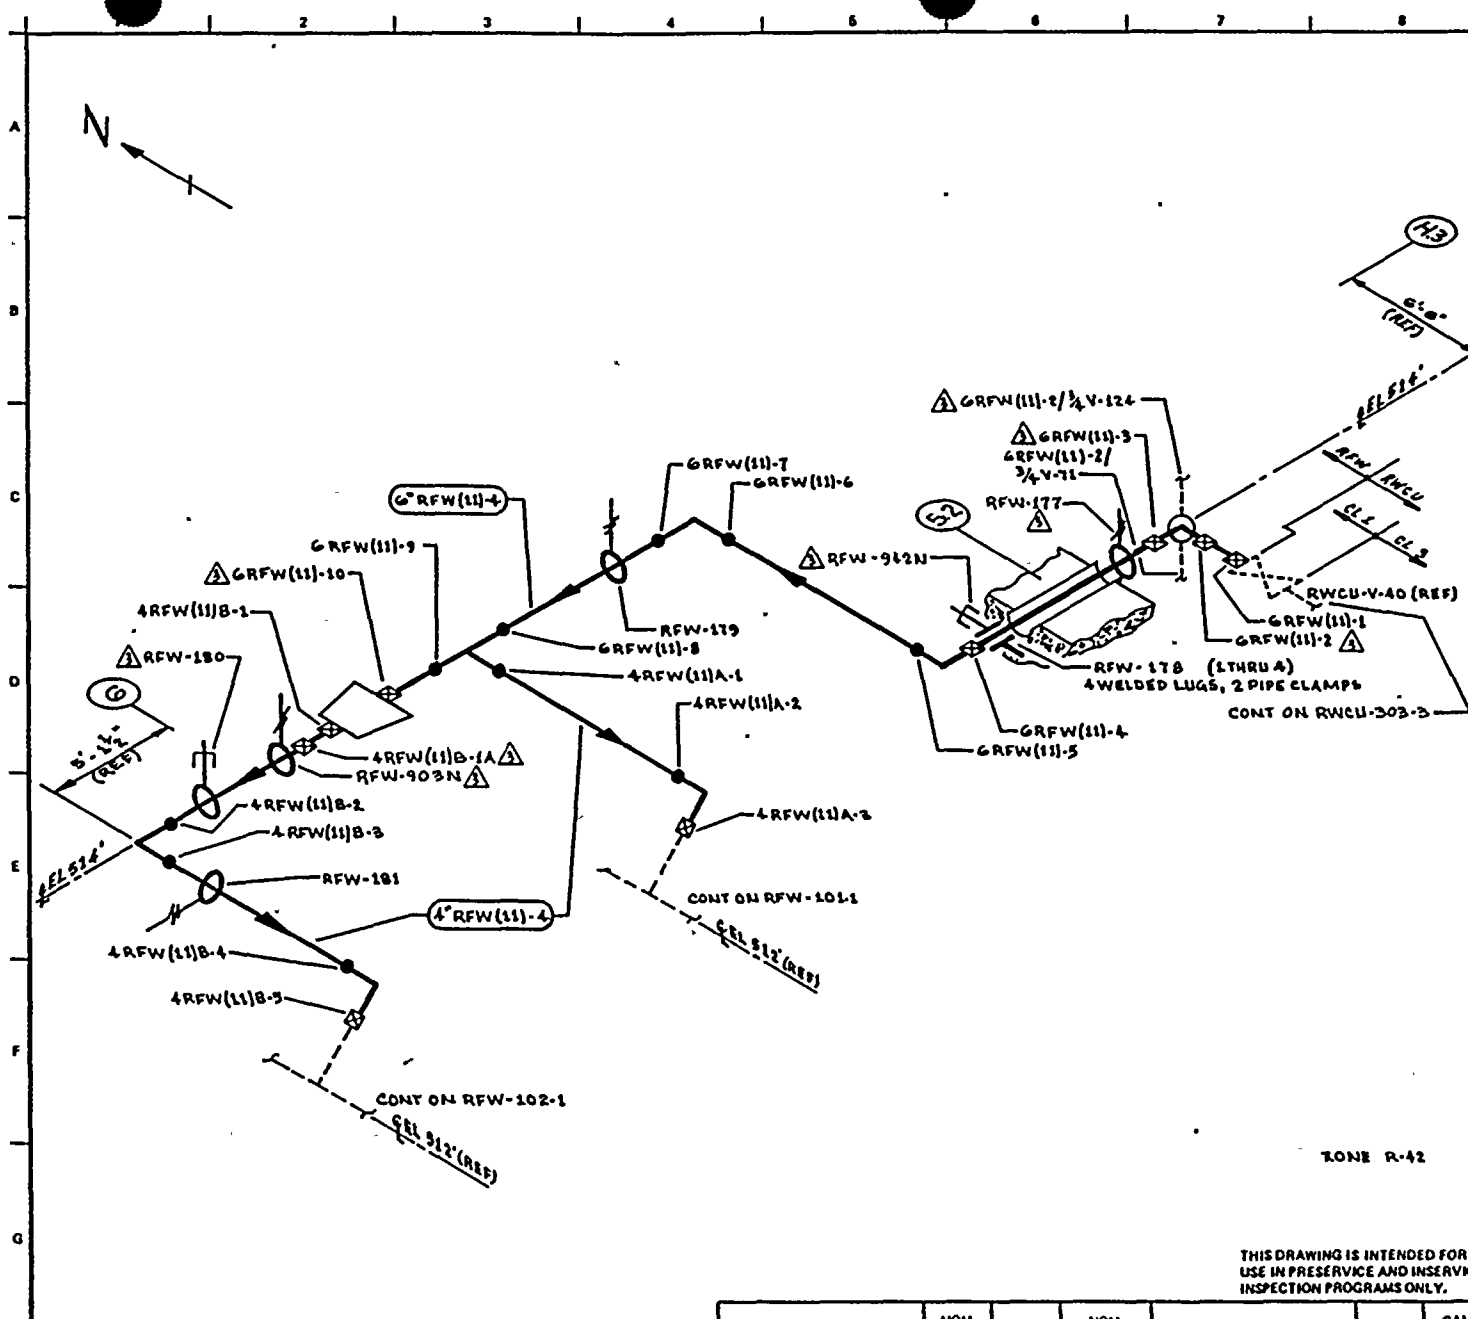

- NOTES:
1. ALL CIRCUMFERENTIAL BUTT WELDS GREATER THAN 1 INCH REQUIRE AUGMENTED ISI.
 2. AUGMENTED ISI CONTINUES ON RWCU-303-B.

- REFERENCES:
- BOVEE & CRAIG ISOMETRICS
 - RFW-428-1.2 REV 11
 - RFW-438-3 REV 5

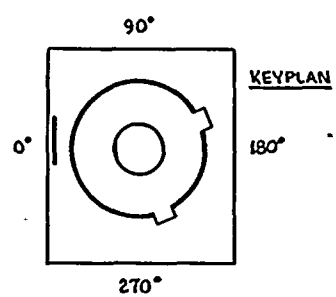

ZONE R-42

THIS DRAWING IS INTENDED FOR USE IN PRESERVICE AND INSERVICE INSPECTION PROGRAMS ONLY.

QUALITY CLASS: 1	ASME CODE CLASS: 1
ENGR: D TIMMINS	DRAWN: V.M.C.A. DATE: 3-15-78



WASHINGTON PUBLIC POWER SUPPLY SYSTEM
 RICHLAND, WASHINGTON 99352

NO	DATE	REVISION	BY	CHKD	APPVD	PIPING SYSTEM	NOM DIA (IN)	SCH	NOM WALL THK	MATERIAL SPECIFICATION	MATL TYPE	CAL BLOCK NO
3	11-13-81	REVISED AS NOTED ADDED KEYPLAN	V.M.C.A.	EPF	TFH	6" RFW(11)-4	6	80	0.432	SA 106 GR B	CG	UT-28
2	12-2-81	REVISED AS NOTED	V.M.C.A.	EPF	TFH	4" RFW(11)-4	4	80	0.227	SA 106 GR B	CG	UT-30
1	1-10-79	CAL BLOCK REFERENCE CHANGED, DELETED 3" PIPING	V.M.C.A.	EPF	TFH							
0	12-12-78	ISSUED FOR USE	V.M.C.A.	EPF	TFH							
A	1-21-78	ISSUED FOR INFORMATION ONLY	V.M.C.A.	DCJ	DUP							

WNP-2
 WELD & COMPONENT
 IDENTIFICATION DIAGRAM

TITLE:
REACTOR FEED WATER RWCU/CRO INTER-TIE

DWG NO: RFW-103 REV 2

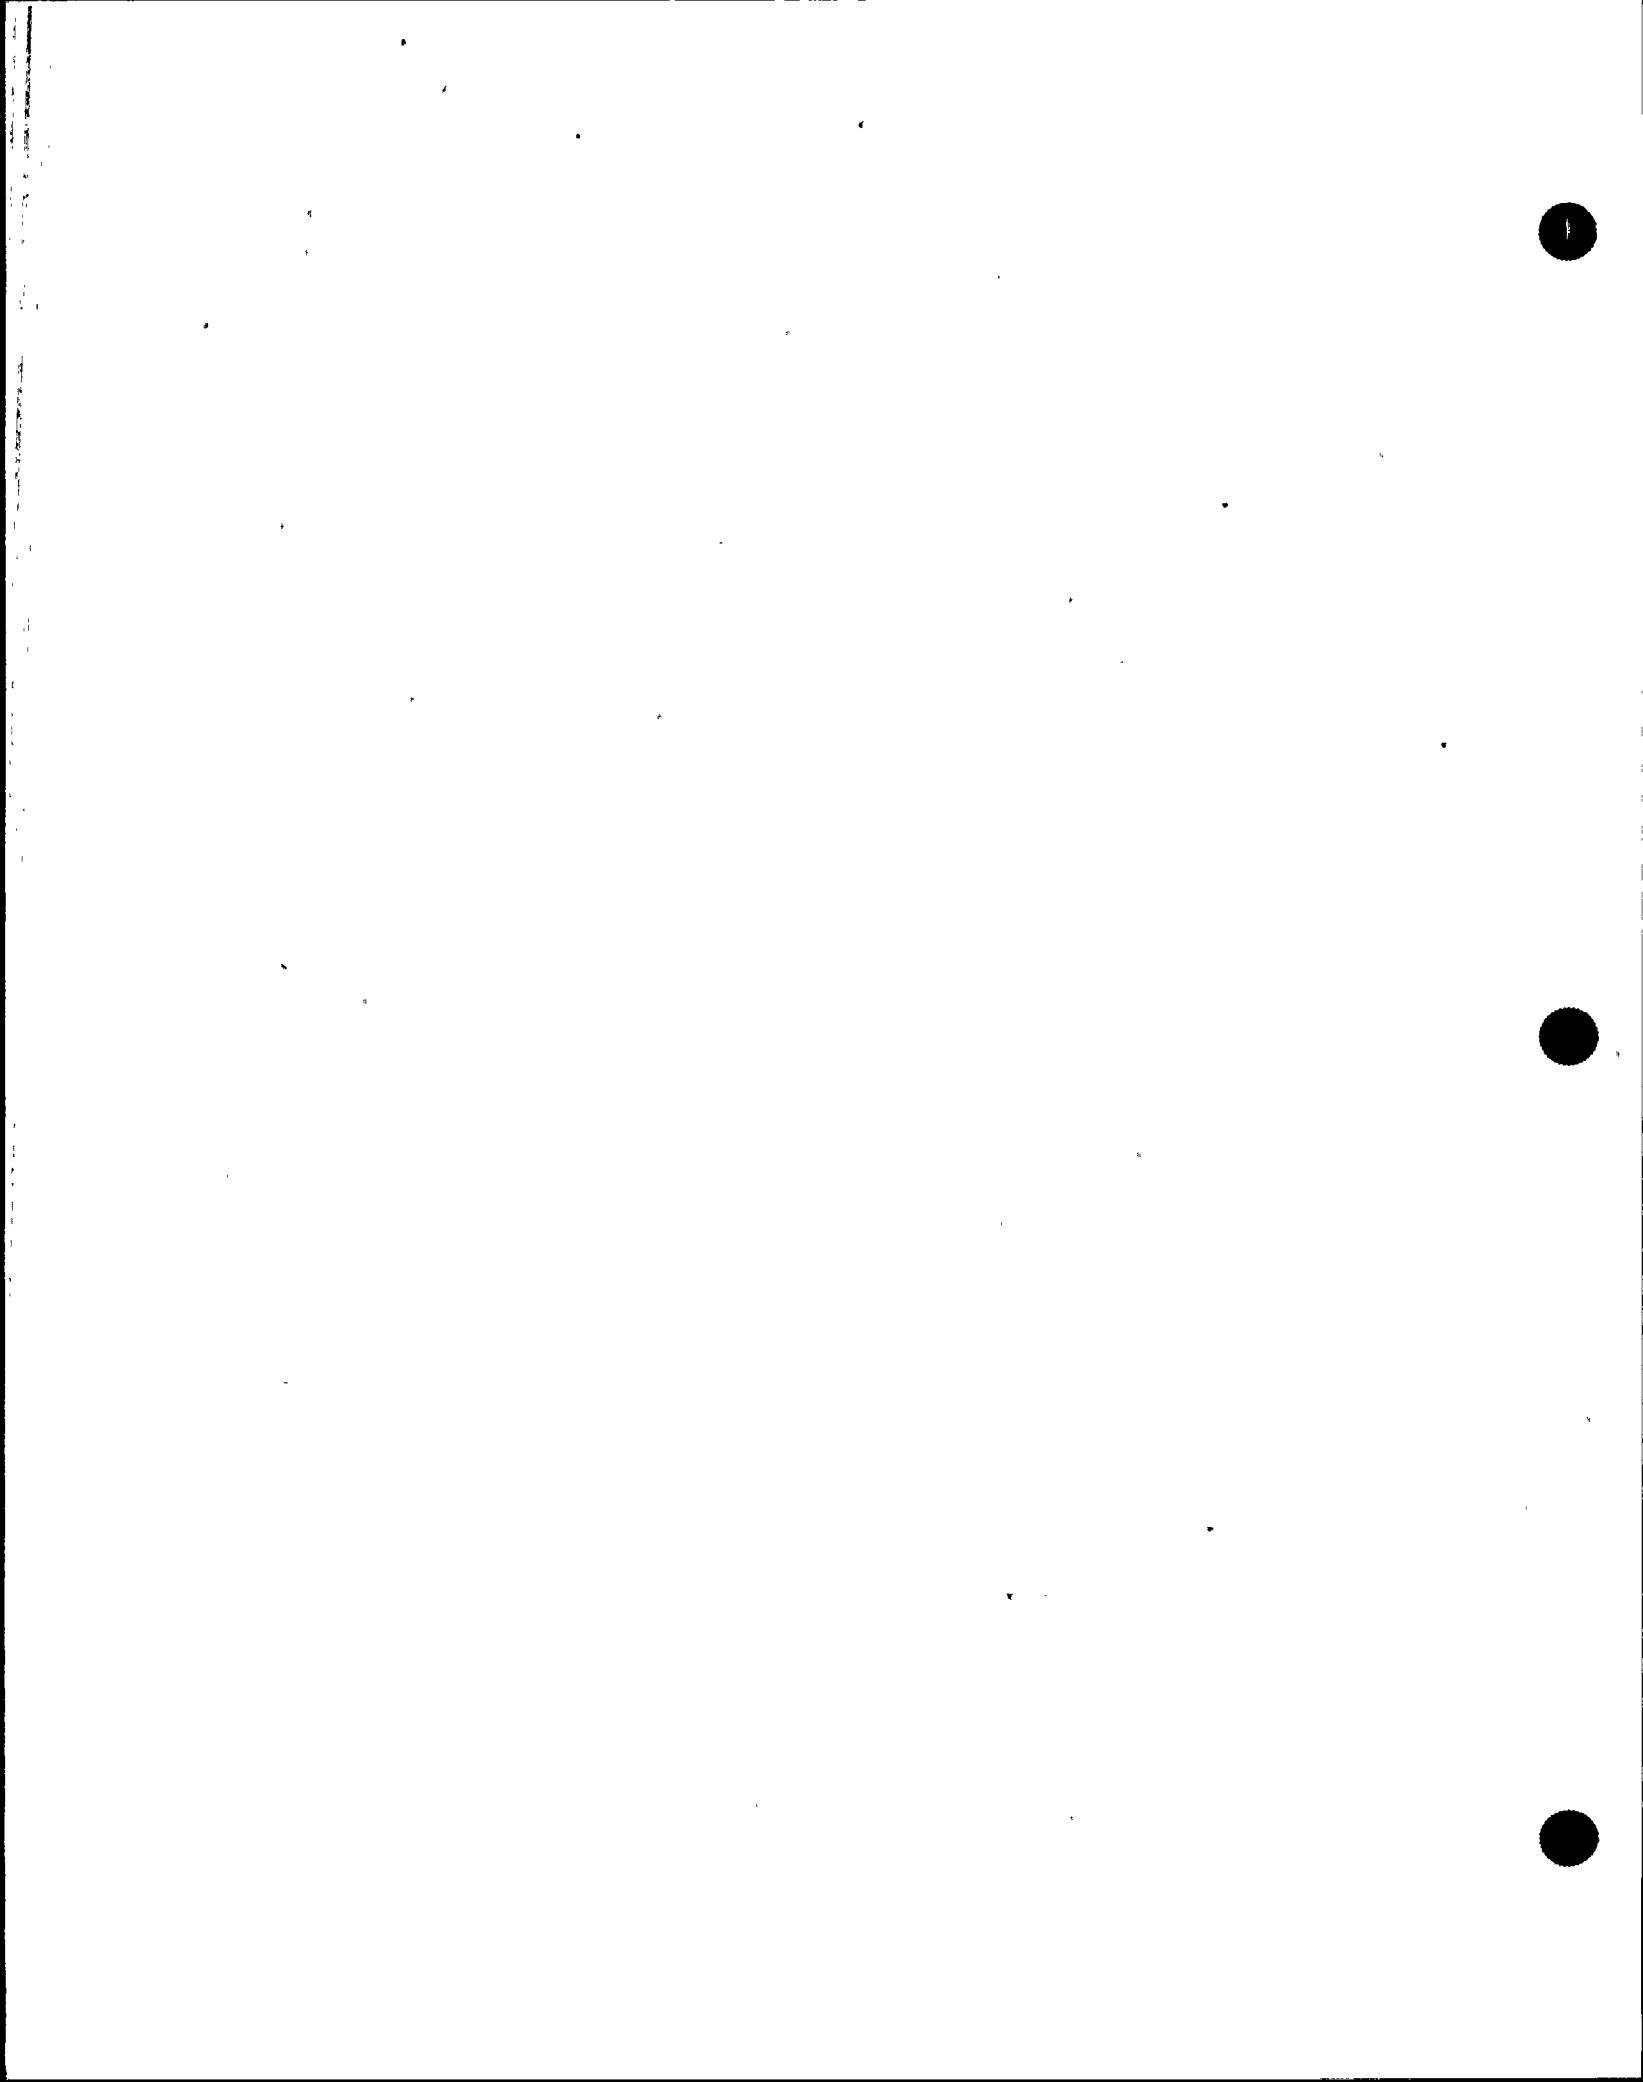

WNP-02
INTERVAL: PSI
PERIOD: NA
OUTAGE:
DRAWING NO. RFW-102

WASHINGTON PUBLIC POWER SUPPLY SYSTEM
PROGRAM PLAN AND SCHEDULE
SYSTEM OR COMPONENT: RFW(1)-4
DESCRIPTION: RX FEEDWATER LINE R

PAGE 012
DATE 12/14/84

<u>IDENT. NO.</u>	<u>DESCRIPTION</u>	<u>SECT.</u> XI	<u>EXAM</u> EXAM	<u>PROCEDURE</u>	<u>CAL.</u> CAL.	<u>INSERVICE</u> SCHEDULED	<u>OUTAGE</u>	<u>NOTES</u>
RFW-PB-102	RFW PRES BNDRY	B-P	VT-2	N/A				SEE NOTES #6 & #7.

WNP-02
 INTERVAL: PSI
 PERIOD: NA
 OUTAGE:
 DRAWING NO. RFW-102

WASHINGTON PUBLIC POWER SUPPLY SYSTEM
 PROGRAM PLAN AND SCHEDULE
 SYSTEM OR COMPONENT: RFW(1)-4
 DESCRIPTION: RX FEEDWATER LINE B

PAGE 011
 DATE 12/14/84

<u>IDENT. NO.</u>	<u>DESCRIPTION</u>	<u>SECT.</u> <u>XI</u> <u>EXAM.</u>	<u>EXAM</u> <u>MTH.</u>	<u>PROCEDURE</u>	<u>CAL.</u> <u>BLOCK</u>	<u>INSERVICE</u>		<u>NOTES</u>
						<u>REQ.</u>	<u>SCHEDULED</u> <u>OUTAGE</u>	
PWS-28-6			VT-4	303/R.2.17				S/N 1467
PWS-28-5	PIPE WHIP	N/A	N/A	N/A				SEE NOTE #1
RFW-183(W)	PIPE WHIP	N/A	N/A	N/A				SEE NOTE #1
RFW-183	4 WELDED LUGS	R-K-1	VOL	UTP-26	UT-15			
	SPRING	R-K-2	VT-3	303/R.2.17				
			VT-4	303/R.2.17				
12RFW(1)BD-6	PIPE TO EL	B-J	VOL	UTP-10	UT-15			
			SUR	PTP-1				
12RFW(1)PD-7	EL TO PIPE	B-J	VOL	UTP-10	UT-15			
			SUR	PTP-1				
12RFW(1)BD-8	PIPE TO SE EXT	B-J	VOL	UTP-10	UT-15			
			SUR	PTP-1				
12RFW(1)BD-9	SE EXT-SE STUB	B-F	VOL	UTP-10	UT-106			
			SUR	PTP-1				
12RFW(1)BD-10	SE STUB TO SE	R-J	VOL	UTP-10	UT-105			
			SUR	PTP-1				
12RFW(1)BD-11	SE TO N4	B-F	VOL	UTP-10	UT-102			
			SUR	PTP-1				

WNP-02
 INTERVAL: PSI
 PERIOD: NA
 OUTAGE:
 DRAWING NO. RFW-102

WASHINGTON PUBLIC POWER SUPPLY SYSTEM
 PROGRAM PLAN AND SCHEDULE
 SYSTEM OR COMPONENT: RFW(1)-4
 DESCRIPTION: RX FEEDWATER LINE R

PAGE 010
 DATE 12/14/84

IDENT. NO.	DESCRIPTION	SECT. XI EXAM.	EXAM MTH.	PROCEDURE	CAL. BLOCK	INSERVICE		NOTES
						REQ.	SCHEDULED OUTAGE	
			VT-4	303/8.2.17				
PWS-28-12	PIPE WHIP	N/A	N/A	N/A				SEE NOTE #1
12RFW(1)BD-2	PIPE TO EL	B-J	VOL	UTP-10	UT-15			
			SUR	PTP-1				
12RFW(1)BD-3	EL TO PIPE	B-J	VOL	UTP-10	UT-15			
			SUR	PTP-1				
PWS-28-8	PIPE WHIP	N/A	N/A	N/A				SEE NOTE #1
RFW-172	PSA-35 SNUBBER	B-K-2	VT-3	303/8.2.17				S/N 6152
			VT-4	303/8.2.17				S/N 6152
PWS-28-7	PIPE WHIP	N/A	N/A	N/A				SEE NOTE #1
12RFW(1)BD-4	PIPE TO EL	B-J	VOL	UTP-10	UT-15			
			SUR	PTP-1				
12RFW(1)BD-5	EL TO PIPE	B-J	VOL	UTP-10	UT-15			
			SUR	PTP-1				
RFW-171	PSA-10 SNUBBER	B-K-2	VT-3	303/8.2.17				S/N 579
			VT-4	303/8.2.17				S/N 579
RFW-915N	PSA-10 SNUBBER	B-K-2	VT-3	303/8.2.17				S/N 1467

WNP-02
 INTERVAL: PSI
 PERIOD: NA
 OUTAGE:
 DRAWING NO. RFW-102

WASHINGTON PUBLIC POWER SUPPLY SYSTEM
 PROGRAM PLAN AND SCHEDULE
 SYSTEM OR COMPONENT: RFW(1)-4
 DESCRIPTION: RX FEEDWATER LINE B

PAGE 009
 DATE 12/14/84

<u>IDENT. NO.</u>	<u>DESCRIPTION</u>	<u>SECT.</u> <u>XI</u> <u>EXAM.</u>	<u>EXAM</u> <u>MTH.</u>	<u>PROCEDURE</u>	<u>CAL.</u> <u>BLOCK</u>	<u>INSERVICE</u> <u>SCHEDULED</u>		<u>NOTES</u>
						<u>REQ.</u>	<u>OUTAGE</u>	
12RFW(1)BE-7	EL TO PIPE	R-J	VOL	PTP-1 UTP-10	UT-15			
12RFW(1)BE-8	PIPE TO SE EXT	B-J	VOL	PTP-1 UTP-10	UT-15			
12RFW(1)BE-9	SE EXT-SE STUB	R-F	VOL	PTP-1 UTP-10	UT-106			
12RFW(1)BE-10	SE STUB TO SE	B-J	VOL	PTP-1 UTP-10	UT-105			
12RFW(1)BE-11	SE TO N4	B-F	VOL	PTP-1 UTP-10	UT-102			
18RFW(1)B-3	TEE TO PIPE	B-J	VOL	PTP-1 UTP-10	UT-11			
18RFW(1)B-4	PIPE TO REDUCEP	B-J	VOL	PTP-1 UTP-10	UT-11			
12RFW(1)BD-1	REDUCER TO PIPE	B-J	VOL	PTP-1 UTP-10	UT-15			
RFW-173	SPRING	B-K-2	VT-3	PTP-1 303/8.2.17				

WNP-02
 INTERVAL: PSI
 PERIOD: NA
 OUTAGE:
 DRAWING NO. RFW-102

WASHINGTON PUBLIC POWER SUPPLY SYSTEM
 PROGRAM PLAN AND SCHEDULE
 SYSTEM OR COMPONENT: RFW(1)-4
 DESCRIPTION: RX FEEDWATER LINE P

PAGE 008
 DATE 12/14/84

IDENT. NO.	DESCRIPTION	SECT. XI EXAM.	EXAM MTH.	PROCEDURE	CAL. BLOCK	INSERVICE		NOTES
						REQ.	SCHEDULED OUTAGE	
FWS-28-9	PIPE WHIP	N/A	N/A	N/A				SEE NOTE #1
12RFW(1)BE-2	PIPE TO EL	B-J	VOL	UTP-10	UT-15			
12RFW(1)BE-3	EL TO PIPE	B-J	VOL	UTP-10	UT-15			
FWS-28-11	PIPE WHIP	N/A	N/A	N/A				SEE NOTE #1
12RFW(1)BE-4	PIPE TO EL	B-J	VOL	UTP-10	UT-15			
12RFW(1)BE-5	EL TO PIPE	B-J	VOL	UTP-10	UT-15			
FWS-28-4	PIPE WHIP	N/A	N/A	N/A				SEE NOTE #1
12RFW(1)BE-5A	PIPE TO PIPE	B-J	VOL	UTP-10	UT-15			
FWS-28-3	PIPE WHIP	N/A	N/A	N/A				SEE NOTE #1
RFW-184	SPRING	B-K-2	VT-3	303/R.2.17				
12RFW(1)BE-6	PIPE TO EL	B-J	VOL	UTP-10	UT-15			

WNP-02
 INTERVAL: PSI
 PERIOD: NA
 OUTAGE:
 DRAWING NO. RFW-102

WASHINGTON PUBLIC POWER SUPPLY SYSTEM
 PROGRAM PLAN AND SCHEDULE
 SYSTEM OR COMPONENT: RFW(1)-4
 DESCRIPTION: RX FEEDWATER LINE B

PAGE 007
 DATE 12/14/84

<u>IDENT. NO.</u>	<u>DESCRIPTION</u>	<u>SECT.</u> <u>XI</u> <u>EXAM.</u>	<u>EXAM</u> <u>MTH.</u>	<u>PROCEDURE</u>	<u>CAL.</u> <u>BLOCK</u>	<u>INSERVICE</u>		<u>NOTES</u>
						<u>REQ.</u>	<u>SCHEDULED</u> <u>OUTAGE</u>	
24RFW(1)B-17	PIPE TO REDUCER	B-J	VOL	PTP-1 UTP-10	UT-5			
18RFW(1)B-1	REDUCER TO PIPE	B-J	VOL	PTP-1 UTP-10	UT-11			
RFW-167	PSA-10 SN(2)	B-K-2	VT-3	PTP-1 303/8.2.17				S/N 13036/130
RFW-166	PSA-10 SN(2)	B-K-2	VT-3	VT-4 303/8.2.17				S/N 13036/130
RFW-168(W)	12 WELDED LUGS	B-K-1	VOL	VT-3 303/8.2.17	UT-11			S/N 120/687
RFW-168	PSA-10 SN(2)	B-K-2	VT-3	VT-4 303/8.2.17				S/N 120/687
PWS-28-10	PIPE WHIP	N/A	N/A	N/A				S/N 14555/145
RFW-170	PSA-10 SN(2)	B-K-2	VT-3	VT-4 303/8.2.17				SEE NOTE #1
18RFW(1)B-2	PIPE TO TEE	B-J	VOL	303/8.2.17 UTP-10	UT-11			S/N 7785/7782
12RFW(1)BE-1	TEE TO PIPE	B-J	VOL	SUR PTP-1 UTP-10	UT-15			S/N 7785/7782

WNP-02
 INTERVAL: PSI
 PERIOD: NA
 OUTAGE:
 DRAWING NO. RFW-102

WASHINGTON PUBLIC POWER SUPPLY SYSTEM
 PROGRAM PLAN AND SCHEDULE
 SYSTEM OR COMPONENT: RFW(1)-4
 DESCRIPTION: RX FEEDWATER LINE R

PAGE 006
 DATE 12/14/84

<u>IDENT. NO.</u>	<u>DESCRIPTION</u>	SECT. XI <u>EXAM.</u>	<u>EXAM.</u>	<u>MTH.</u>	<u>PROCEDURE</u>	<u>CAL.</u>	<u>INSERVICE</u>		<u>NOTES</u>
							<u>REQ.</u>	<u>SCHEDULED</u> <u>OUTAGE</u>	
PWS-28-2	PIPE WHIP	N/A	N/A	N/A					SEE NOTE #1
PWS-28-1	PIPE WHIP	N/A	N/A	N/A					SEE NOTE #1
RFW-185(W)	4 WELDED LUGS	B-K-1	VOL	UTP-26		UT-15			
RFW-185	SPRING	B-K-2	VT-3	303/8.2.17					
			VT-4	303/8.2.17					
12RFW(1)BF-9	PIPE TO EL	B-J	VOL	UTP-10		UT-15			
			SUR	PTP-1					
12RFW(1)BF-10	EL TO PIPE	B-J	VOL	UTP-10		UT-15			
			SUR	PTP-1					
12RFW(1)BF-11	PIPE TO SE EXT	B-J	VOL	UTP-10		UT-15			
			SUR	PTP-1					
12RFW(1)BF-12	SE EXT-SE STUB	B-F	VOL	UTP-10		UT-106			
			SUR	PTP-1					
12RFW(1)BF-13	SE STUB TO SE	B-J	VOL	UTP-10		UT-105			
			SUR	PTP-1					
12RFW(1)PF-14	SE TO N4	B-F	VOL	UTP-10		UT-102			
			SUR	PTP-1					
24RFW(1)B-16	TEE TO PIPE	B-J	VOL	UTP-10		UT-5			

WNP-02
 INTERVAL: PSI
 PERIOD: NA
 OUTAGE:
 DRAWING NO. RFW-102

WASHINGTON PUBLIC POWER SUPPLY SYSTEM
 PROGRAM PLAN AND SCHEDULE
 SYSTEM OR COMPONENT: RFW(1)-4
 DESCRIPTION: RX FEEDWATER LINE R

PAGE 005
 DATE 12/14/84

<u>IDENT. NO.</u>	<u>DESCRIPTION</u>	<u>SECT.</u> YI	<u>EXAM</u> EXAM.	<u>EXAM</u> MTH.	<u>PROCEDURE</u>	<u>CAL.</u> BLOCK	<u>INSERVICE</u> <u>SCHEDULED</u>		<u>NOTES</u>
							<u>REQ.</u>	<u>OUTAGE</u>	
RFW-175(W)	6 WELDED LUGS	B-K-1	VOL	UTP-26		UT-15			
RFW-175	SPRING	B-K-2	VT-3	303/8.2.17					
			VT-4	303/8.2.17					
12RFW(1)BF-2	PIPE TO EL	B-J	VOL	UTP-10		UT-15			
			SUR	PTP-1					
12RFW(1)BF-3	EL TO PIPE	B-J	VOL	UTP-10		UT-15			
			SUR	PTP-1					
PWS-28-15	PIPE WHIP	N/A	N/A	N/A					SEE NOTE #1
12RFW(1)BF-4	PIPE TO EL	B-J	VOL	UTP-10		UT-15			
			SUR	PTP-1					
12RFW(1)BF-5	EL TO PIPE	B-J	VOL	UTP-10		UT-15			
			SUR	PTP-1					
12RFW(1)BF-6	PIPE TO PIPE	B-J	VOL	UTP-10		UT-15			
			SUR	PTP-1					
12RFW(1)BF-7	PIPE TO EL	B-J	VOL	UTP-10		UT-15			
			SUR	PTP-1					
12RFW(1)BF-8	EL TO PIPE	B-J	VOL	UTP-10		UT-15			
			SUR	PTP-1					

WNP-02
 INTERVAL: PSI
 PERIOD: NA
 OUTAGE:
 DRAWING NO. RFW-102

WASHINGTON PUBLIC POWER SUPPLY SYSTEM
 PROGRAM PLAN AND SCHEDULE
 SYSTEM OR COMPONENT: RFW(1)-4
 DESCRIPTION: RX FEEDWATER LINE R

PAGE 004
 DATE 12/14/84

IDENT. NO.	DESCRIPTION	SECT.	EXAM	PROCEDURE	CAL.	INSERVICE		NOTES
		EXAM.	MTG.			REQ.	SCHEDULED OUTAGE	
24RFW(1)B-9	VALVE TO PIPE	B-J	VOL	UTP-10	UT-5			
			SUR	PTP-1				
PWS-28-18	PIPE WHIP	N/A	N/A	N/A				SEE NOTE #1
24RFW(1)B-10	PIPE TO PIPE	B-J	VOL	UTP-10	UT-5			
			SUR	PTP-1				
24RFW(1)B-11	PIPE TO EL	B-J	VOL	UTP-10	UT-33			
			SUR	PTP-1				
24RFW(1)B-12	EL TO PIPE	B-J	VOL	UTP-10	UT-33			
			SUR	PTP-1				
24RFW(1)B-13	PIPE TO EL	B-J	VOL	UTP-10	UT-33			
			SUR	PTP-1				
24RFW(1)B-14	EL TO PIPE	B-J	VOL	UTP-10	UT-5			
			SUR	PTP-1				
PWS-28-16	PIPE WHIP	N/A	N/A	N/A				SEE NOTE #1
24RFW(1)B-15	PIPE TO TEE	B-J	VOL	UTP-10	UT-5			
			SUR	PTP-1				
12RFW(1)BF-1	TEF TO PIPE	B-J	VOL	UTP-10	UT-15			
			SUR	PTP-1				

WNP-02
 INTERVAL: PSI
 PERIOD: NA
 OUTAGE:
 DRAWING NO. RFW-102

WASHINGTON PUBLIC POWER SUPPLY SYSTEM
 PROGRAM PLAN AND SCHEDULE
 SYSTEM OR COMPONENT: RFW(1)-4
 DESCRIPTION: RX FEEDWATER LINE B

PAGE 003
 DATE 12/14/84

IDENT. NO.	DESCRIPTION	SECT. XI EXAM.	EXAM MTH.	PROCEDURE	CAL. BLOCK	INSERVICE		NOTES
						REQ.	SCHEDULED OUTAGE	
24RFW(1)B-7	EL TO PIPE	B-J	VOL	UTP-10	UT-5			
			SUR	PTP-1				
RFW-182(W)	6 WELDED LUGS	B-K-1	VOL	UTP-26	UT-5			3/4"W x 2"H x 2"L.
RFW-182	SPRING	B-K-2	VT-3	303/8.2.17				
			VT-4	303/8.2.17				
RFW-162	PSA-10 SN(2)	B-K-2	VT-3	303/8.2.17				S/N 128/132
			VT-4	303/8.2.17				S/N 128/132
RFW-162(W)	6 WELDED LUGS	B-K-1	VOL	UTP-26	UT-15			3/4"W x 2"H x 4"L.
PWS-28-13	PIPE WHIP	N/A	N/A	N/A				SEE NOTE #1
RFW-163	PSA-100 SNUBBER	B-K-2	VT-3	303/8.2.17				S/N 594
			VT-4	303/8.2.17				S/N 594
RFW-164	PSA-35 SNUBBER	B-K-2	VT-3	303/8.2.17				S/N 594
			VT-4	303/8.2.17				S/N 594
PWS-28-17	PIPE WHIP	N/A	N/A	N/A				SEE NOTE #1
24RFW(1)B-7/3/4V-45B	TEST CONN	B-P	VT-2	N/A				SEE NOTES #6 & #7.
24RFW(1)B-8.	PIPE TO VALVE	B-J	VOL	UTP-10	UT-5			
			SUR	PTP-1				
RFW-V-11B-RDY	VALVE BODY	B-M-2	VT-1	OCI 7-1				

WMP-02
 INTERVAL: PSI
 PERIOD: NA
 OUTAGE:
 DRAWING NO. RFW-102

WASHINGTON PUBLIC POWER SUPPLY SYSTEM
 PROGRAM PLAN AND SCHEDULE
 SYSTEM OR COMPONENT: RFW(1)-4
 DESCRIPTION: RY FEEDWATER LINE R

PAGE 002
 DATE 12/14/84


<u>IDENT. NO.</u>	<u>DESCRIPTION</u>	SECT. XI <u>EXAM.</u>	EXAM MII.	<u>PROCEDURE</u>	CAL. <u>BLOCK</u>	<u>INSERVICE</u> SCHEDULED		<u>NOTES</u>
						<u>REG.</u>	<u>OUTAGE</u>	
24RFW(1)B-3	VALVE TO PENE	B-J	VOL	OCT 6-13	UT-5			AUGMT
			SUR	PTP-1				AUGMT
24RFW(1)B-4	PENE TO VALVE	B-J	VOL	UTP-10	UT-5			AUGMT
			SUR	PTP-1				AUGMT
RFW-V-10B-BDY	VALVE BODY	B-M-2	VT-1	OCT 7-1				
24RFW(1)B-5	VALVE TO PIPE	B-J	VOL	UTP-10	UT-5			AUGMT
			SUR	PTP-1				AUGMT
PWS-28-14	PIPE WHIP	N/A	N/A	N/A				SEE NOTE #1
24RFW(1)B-6.	PIPE TO EL	B-J	VOL	UTP-10	UT-5			
			SUR	PTP-1				
24RFW(1)B-6LDO	EL SEAM	B-J	VOL	UTP-10	UT-33			
			SUR	PTP-1				
24RFW(1)B-6LDI	EL SEAM	B-J	VOL	UTP-10	UT-33			
			SUR	PTP-1				
24RFW(1)B-7LUI	EL SEAM	B-J	VOL	UTP-10	UT-33			
			SUR	PTP-1				
24RFW(1)B-7LUO	EL SEAM	B-J	VOL	UTP-10	UT-33			
			SUR	PTP-1				

WNP-02
 INTERVAL: PSI
 PERIOD: NA
 OUTAGE:
 DRAWING NO. RFW-102.

WASHINGTON PUBLIC POWER SUPPLY SYSTEM
 PROGRAM PLAN AND SCHEDULE
 SYSTEM OR COMPONENT: RFW(1)-4
 DESCRIPTION: RY FEEDWATER LINE R


PAGE 001
 DATE 12/14/84

IDENT. NO.	DESCRIPTION	SECT. XI EXAM.	EXAM MTH.	PROCEDURE	CAL. BLOCK	INSERVICE		NOTES
						REQ.	SCHEDULED OUTAGE	
RFW-V-65B/3/4CAP	LEAKOFF CAPPED	B-P	VT-2	N/A				SEE NOTES #6 & #7.
RFW-V-65B-BDY	VALVE BODY	B-M-2	VT-1	OCI 7-1				
24RFW(1)B-1A	PIPE TO VLV	AUGMT	VOL	OCI 6-13	UT-			
24RFW(1)B-1	VALVE TO PIPE	B-J	VOL	OCI 6-13	UT-5			AUGMT
			SUR	OCI 3-3				AUGMT
24RFW(1)B-1/3/4V-31B	TEST CONN	B-P	VT-2	N/A				SEE NOTES #6 & #7.
24RFW(1)B-1/5RFW(11)-4	PIPE TO WOL	B-J	VOL	OCI 6-13	UT-5			AUGMT
			SUR	PTP-1				AUGMT
5RFW(11)B-2	SLEEVE TO WOL	B-J	VOL	UTP-10	UT-32			AUGMT
			SUR	PTP-1				AUGMT
5RFW(11)B-1	SLEEVE-SLEEVE	B-J	SUR	PTP-1				AUGMT. THIS IS SOCKET TYPE. WELD, SEE DETAIL I DRAWING RFW-102-1.
24RFW(1)B-2	PIPE TO VALVE	B-J	VOL	UTF-10	UT-5			AUGMT.
			SUR	PTP-1				AUGMT.
RFW-V-32B/3/4CAP	LEAKOFF CAPPED	B-P	VT-2	N/A				SEE NOTES #6 & #7.
RFW-V-32B-BDY	VALVE BODY	B-M-2	VT-1	OCI 7-1				
RFW-V-32B/3/4V-6B	TEST CONN	B-P	VT-2	N/A				SEE NOTES #6 & #7.

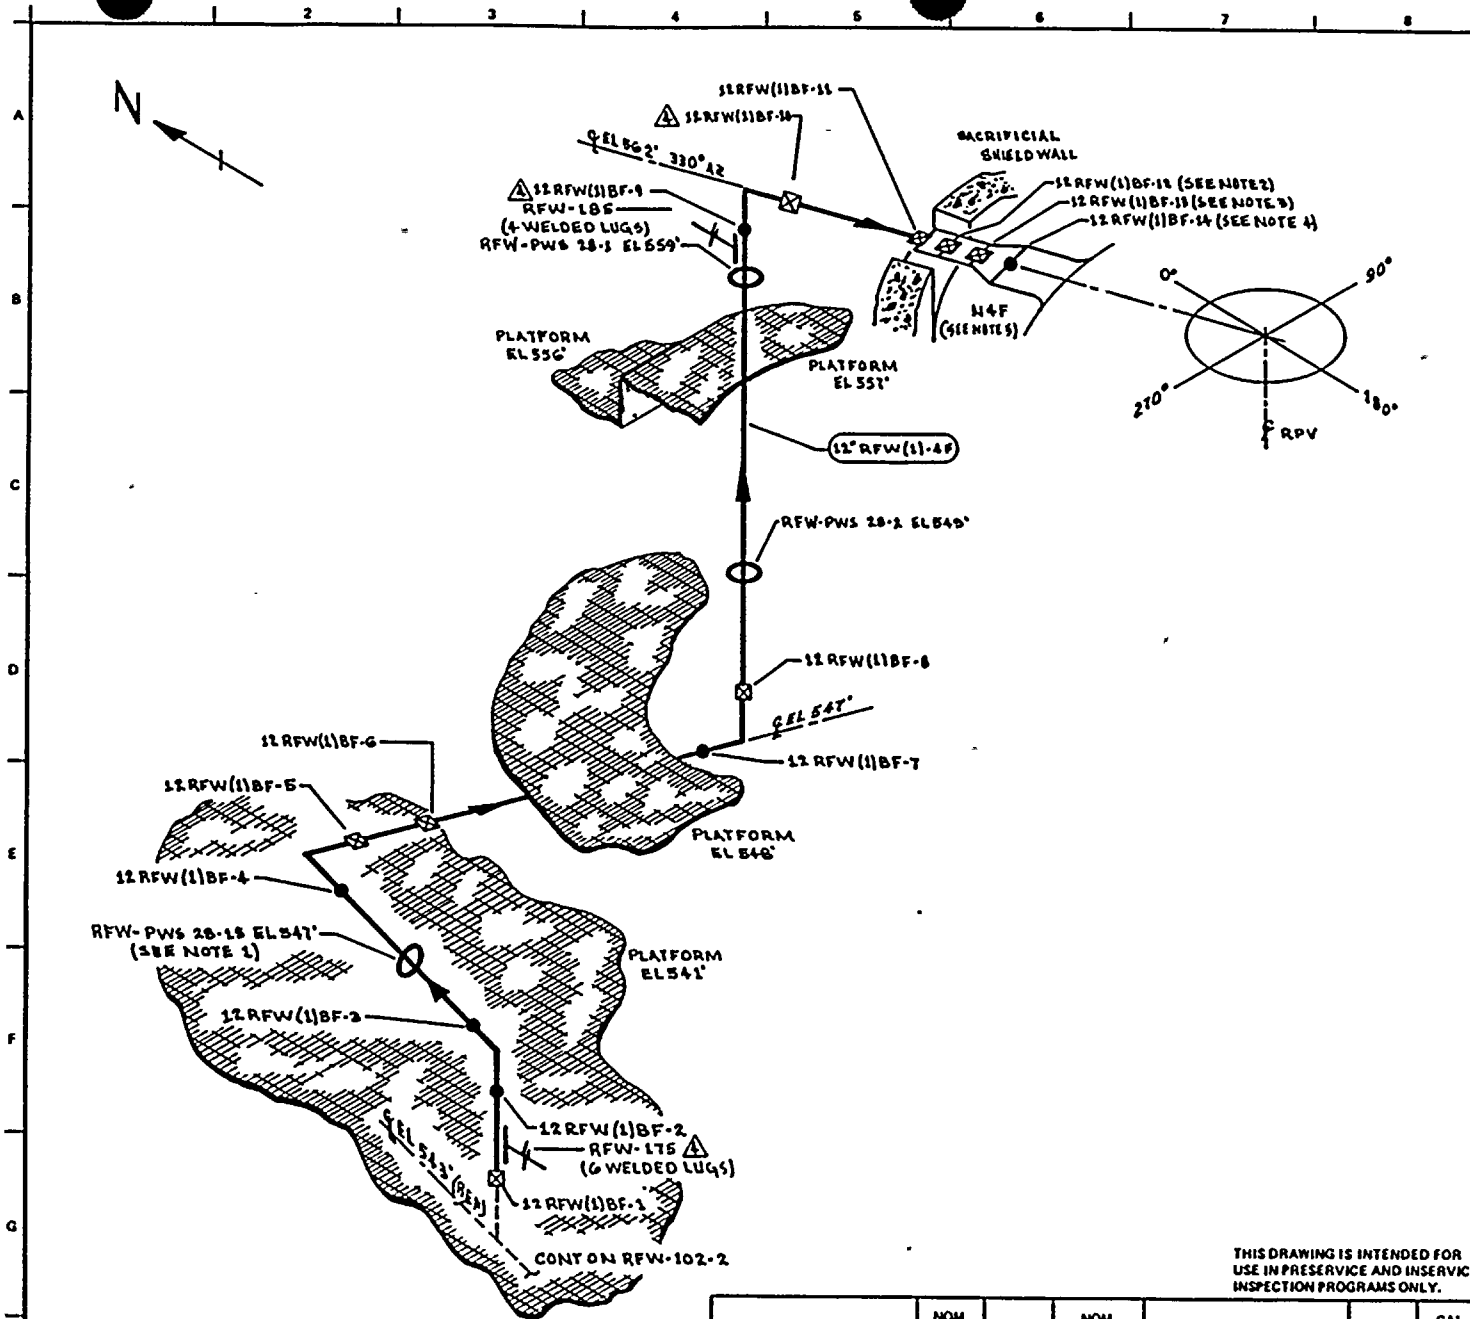

- NOTES:
1. ACCESS TO WELDS 12 RFW(1)BF-3 & 12 RFW(1)BF-4 REQUIRES REMOVAL OF RFW-PWS 28-15
 2. WELD 12 RFW(1)BF-12 UTILIZES CAL BLOCK UT-106.
 3. WELD 12 RFW(1)BF-13 UTILIZES CAL BLOCK UT-105.
 4. WELD 12 RFW(1)BF-14 UTILIZES CAL BLOCK UT-102.
 5. FOR NOZZLE ASSEMBLY DETAILS SEE RPV-108.

- REFERENCES:
- BOVEE & CRAIG ISOMETRIC RFW-419-12.13 REV B
 - CBI NUCLEAR CO. 59, REV D, N4 NOZZLE

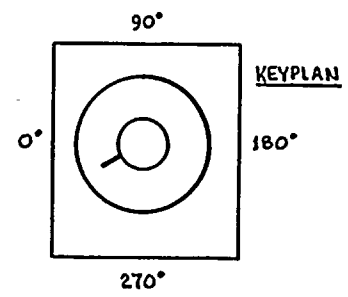

THIS DRAWING IS INTENDED FOR USE IN PRESERVICE AND INSERVICE INSPECTION PROGRAMS ONLY.

QUALITY CLASS: 1	ASME CODE CLASS: 1
ENGR: D. TIMMINS	DRAWN: K. M. C. A. DATE: 3-13-78

WASHINGTON PUBLIC POWER SUPPLY SYSTEM
 PCH&NO, WASHINGTON 98362

NO	DATE	REVISION	BY	CHKD	APPVD
4	11-17-83	REVISED AS NOTED ADDED LUGS & KEYPLAN	KMA	DR	TR
3	12-2-81	REVISED AS NOTED	KMA	DR	TR
2	7-17-79	CORRECTED AZIMUTH 350° TO 390° IN A-4 ADDED NOTE 5.	KMA	DR	TR
1	5-10-79	CAL BLOCK REFERENCE CHANGED (NOTE 2)	KMA	DR	TR
0	11-21-78	ISSUED FOR USE	KMA	DR	TR
A	4-22-78	ISSUED FOR INFORMATION ONLY	KMA	DR	TR




PIPING SYSTEM	NOM DIA (IN)	SCH	NOM WALL THK	MATERIAL SPECIFICATION	MATL TYPE	CAL BLOCK NO
12" RFW(1)-4	12	120	1.000	SA 106 GR B	CS	UT-15
LUGS	NA	NA	NA	SA B16 GR 70	CS	UT-46

WNP-2
 WELD & COMPONENT IDENTIFICATION DIAGRAM

TITLE:
 REACTOR FEED WATER LINE BF


DWG NO: RFW-102-B
 REV 4



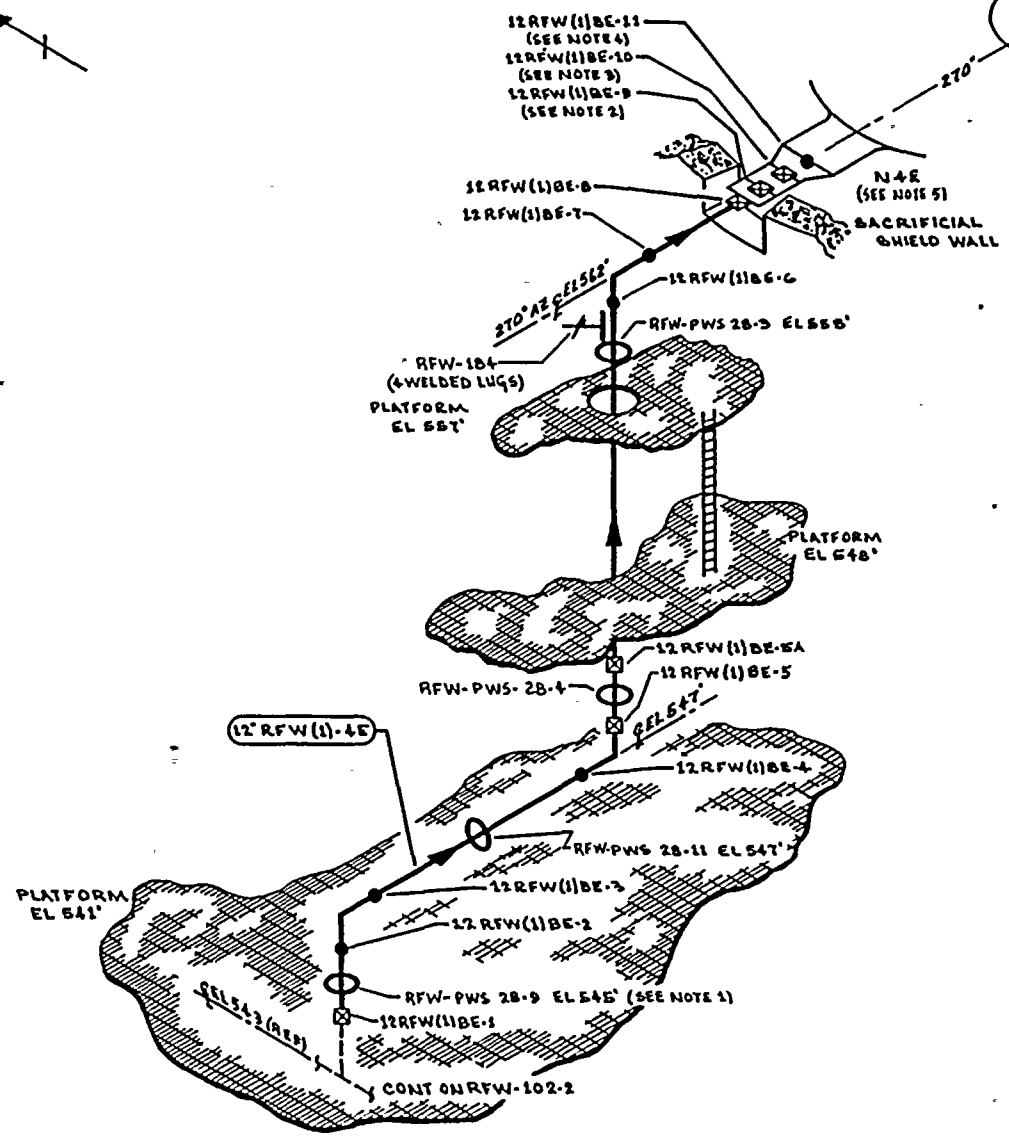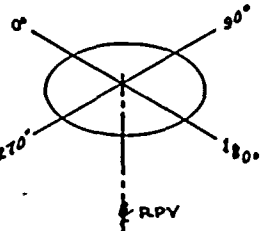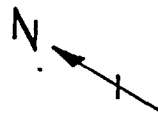

- NOTES:**
1. ACCESS TO WELD 12RFW(1)BE-2 REQUIRES REMOVAL OF RFW-PWS 28-9.
 2. WELD 12RFW(1)BE-9 UTILIZES CAL BLOCK UT-106.
 3. WELD 12RFW(1)BE-10 UTILIZES CAL BLOCK UT-105.
 4. WELD 12RFW(1)BE-11 UTILIZES CAL BLOCK UT-102.
 5. FOR NOZZLE ASSEMBLY DETAILS SEE RPV-108.

REFERENCES:
 BOYCE & CRAIL ISOMETRIC
 RFW-419-10-11 REV 6
 CBI NUCLEAR CO.
 59, REV 3, N4 NOZZLE

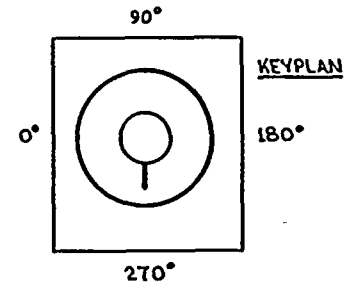

QUALITY CLASS: 1 ASME CODE CLASS: 1
 ENGR: D TIMMINS DRAWN: Y.M.A. DATE: 3-7-76
WASHINGTON PUBLIC POWER SUPPLY SYSTEM
 RICHLAND, WASHINGTON 99052



THIS DRAWING IS INTENDED FOR USE IN PRESERVICE AND INSERVICE INSPECTION PROGRAMS ONLY.

NO	DATE	REVISION	BY	CHKD	APPVD
4	10-11-83	REVISED AS NOTED ADDED KEYPLAN	KUL	JR	JR
3	11-2-81	REVISED AS NOTED	KUL	JR	JR
2	7-11-79	ADDED 12RFW(1)BE-5A PER AS BUILT, YN E-5, ADDITIONAL	KUL	JR	JR
1	1-10-78	CAL BLOCK REFERENCE CHANGED (NOTE 2)	KUL	JR	JR
0	11-27-76	ISSUED FOR USE	KUL	JR	JR
A	11-18-76	ISSUED FOR INFORMATION ONLY	KUL	JR	JR

PIPING SYSTEM	NOM DIA (IN)	SCH	NOM WALL THK	MATERIAL SPECIFICATION	MATL TYPE	CAL BLOCK NO
12" RFW(1)-4	12	120	1.000	SA 106 GR B	CS	UT-15


WNP-2
 WELD & COMPONENT IDENTIFICATION DIAGRAM
 TITLE:
REACTOR FEED WATER LINE BE
 DWG NO: RFW-102-A REV 4



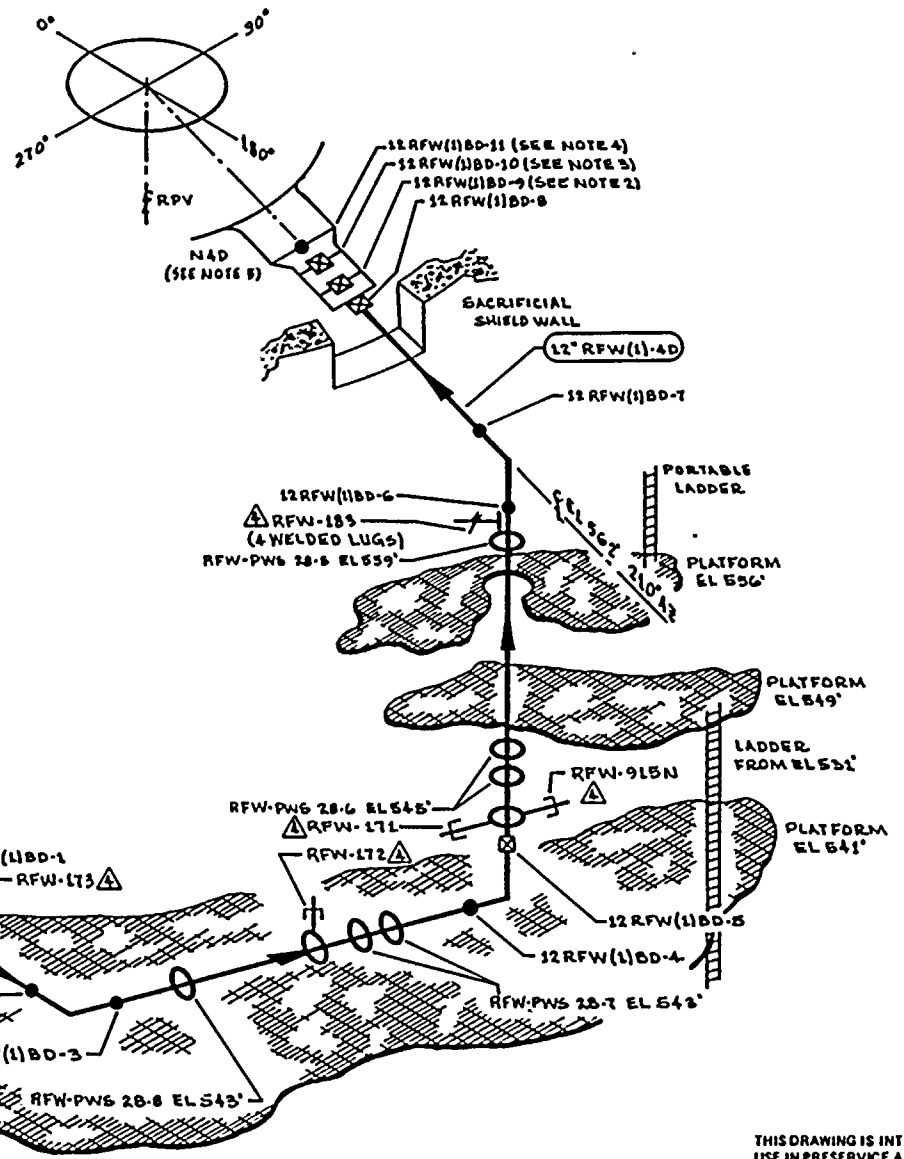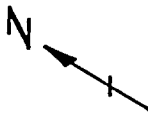

- NOTES:
1. ACCESS TO WELD 12 RFW(1)BD-2 REQUIRES REMOVAL OF RFW-PWS 28-12.
 2. WELD 12 RFW(1)BD-9 UTILIZES CAL BLOCK UT-106.
 3. WELD 12 RFW(1)BD-10 UTILIZES CAL BLOCK UT-105.
 4. WELD 12 RFW(1)BD-11 UTILIZES CAL BLOCK UT-102.
 5. FOR NOZZLE ASSEMBLY DETAILS SEE RPV-108

REFERENCES:
 BOYCE & CRAIG ISOMETRIC
 RFW-419-B.3 REV 8
 CBS NUCLEAR CO.
 59, REV 9, N4 NOZZLE

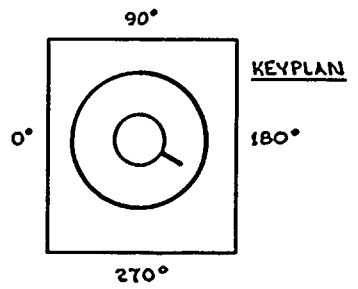

QUALITY CLASS: 1 ASME CODE CLASS: 1
 ENGR: D TIMMINS DRAWN: KMcA DATE: 2-7-78

WASHINGTON PUBLIC POWER SUPPLY SYSTEM
 RICHLAND, WASHINGTON 99352


THIS DRAWING IS INTENDED FOR USE IN PRESERVE AND INSERVICE INSPECTION PROGRAMS ONLY.

NO	DATE	REVISION	BY	CHKD	APPVD	PIPING SYSTEM	NOM DIA (IN)	SCH	NOM WALL THK	MATERIAL SPECIFICATION	MATL TYPE	CAL BLOCK NO
4	10-11-77	REVISED AS NOTED ADDED LUGS & KEYPLAN	KMcA	JMR	TRH	12" RFW(1)-L	12	120	1.000	SA 106 GR B	CC	UT-15
3	12-1-77	REVISED AS NOTED	KMcA	JMR	TRH	LUGS	NA	NA	NA	SA 516 GR 70	CS	UT-4C
2	8-30-77	ADDED NOTE 5.	KMcA	JMR	TRH							
1	1-10-78	CAL BLOCK REFERENCE CHANGED (NOTE 2)	KMcA	JMR	TRH							
0	11-27-78	ISSUED FOR USE	KMcA	JMR	TRH							
A	4-21-78	ISSUED FOR INFORMATION ONLY	KMcA	JMR	TRH							
NO	DATE	REVISION	BY	CHKD	APPVD							

WNP-2
 WELD & COMPONENT
 IDENTIFICATION DIAGRAM


TITLE:
REACTOR FEED WATER LINE BD

DWG NO: RFW-102-3 REV 4

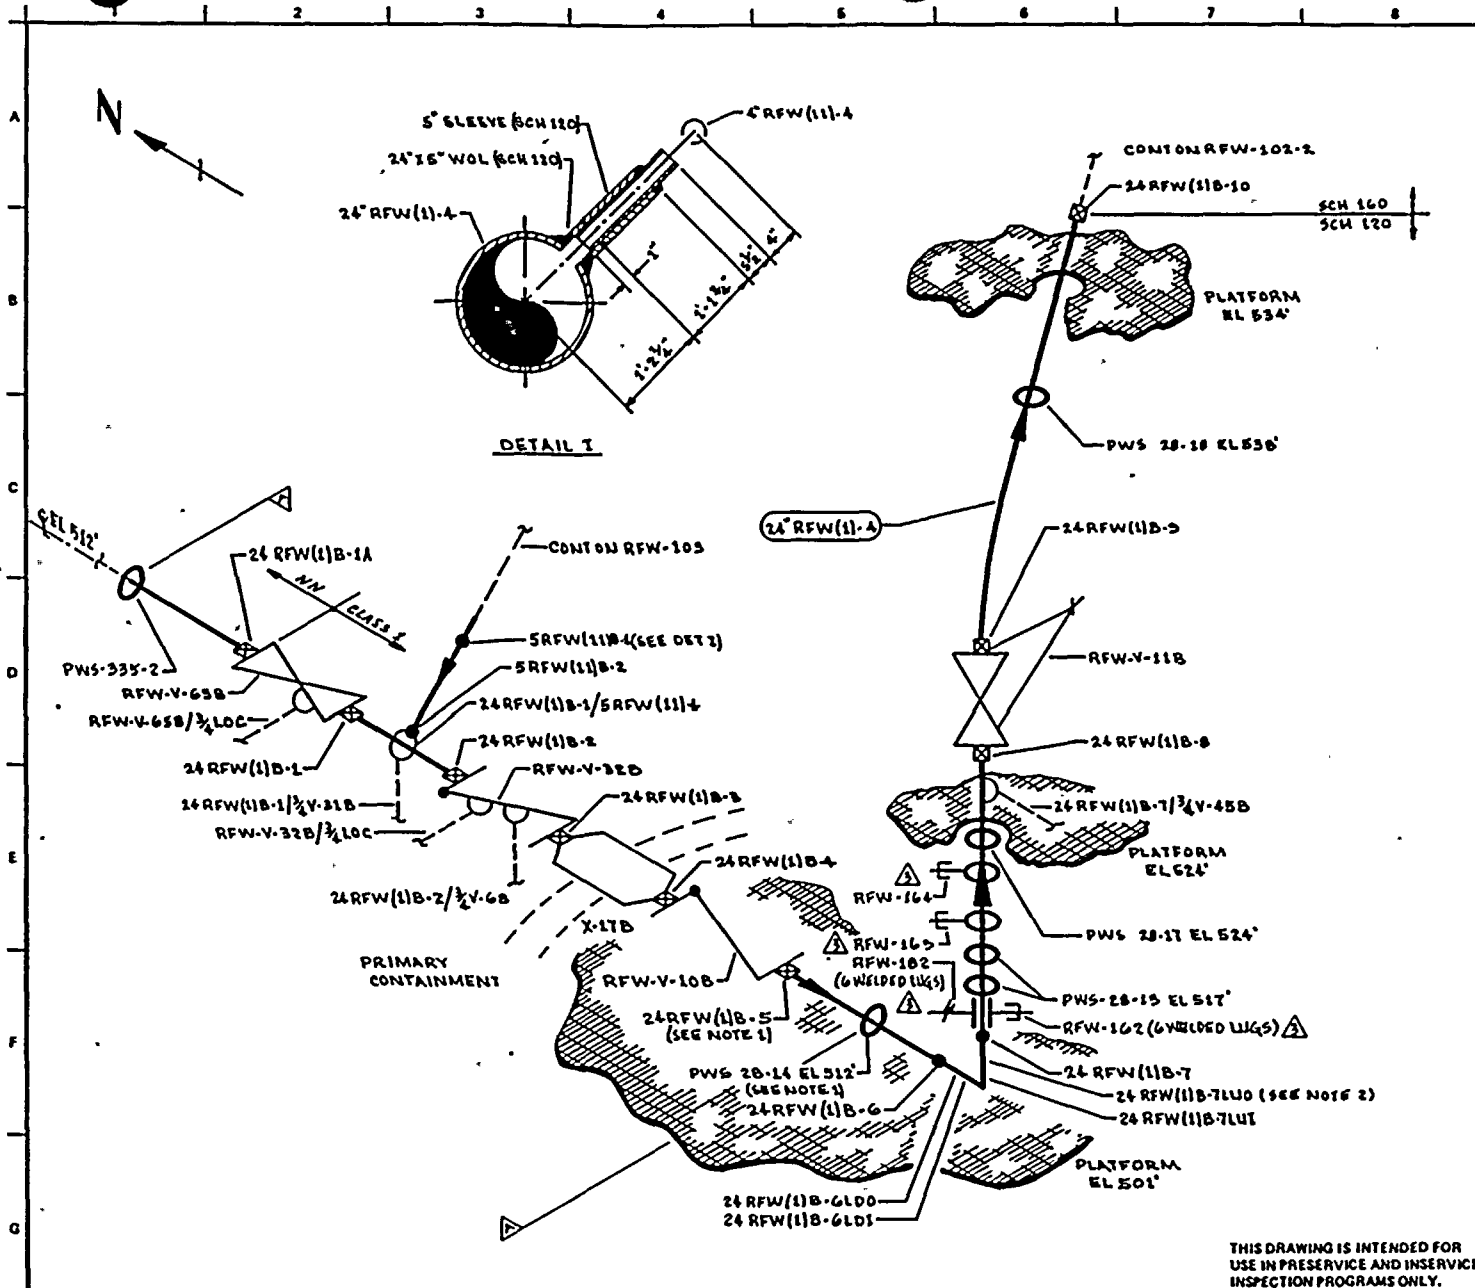

- NOTES:
1. ACCESS TO WELDS 24 RFW(1)B-5 & 24 RFW(1)B-6 REQUIRES REMOVAL OF PWS 28-14.
 2. ELBOW BETWEEN WELDS 24 RFW(1)B-6 & 7 IS SCH 140, WELDED & SHORT RADIUS.

- REFERENCES:
- BOVEE & CRAILIGOMETRICS
- | | |
|-------------|-------|
| RFW-419-3 | REV 6 |
| RFW-419-4 | REV 5 |
| RFW-419-5.7 | REV 9 |

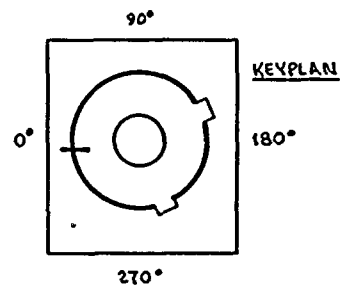

THIS DRAWING IS INTENDED FOR USE IN PRESERVICE AND INSERVICE INSPECTION PROGRAMS ONLY.

QUALITY CLASS: 1 ASME CODE CLASS: 1
 ENGR: D TIMMINS DRAWN: X/M/A DATE: 8-6-78



WASHINGTON PUBLIC POWER SUPPLY SYSTEM
 RICHLAND, WASHINGTON 99282

WNP-2
 WELD & COMPONENT IDENTIFICATION DIAGRAM

TITLE:
REACTOR FEED WATER LINE B


DWG NO: RFW-102-1 REV 3

NO	DATE	REVISION	BY	CHKD	APPVD	PIPING SYSTEM	NOM DIA (IN)	SCH	NOM WALL THK	MATERIAL SPECIFICATION	MATL TYPE	CAL BLOCK NO
3	11-2-83	REVISED AS NOTED ADDED KEYPLAN & LUGS	K/A	WR	T/F	24" RFW(1)B-4	24	120	1.812	SA 106 GR B	CS	UT-5
2	11-2-81	AUGMENTED 1ST ADDED	K/A	WR	T/F	5" RFW(1)B-4	5	120	0.500	SA 106 GR B	CS	UT-32
1	11-5-80	ADDED NOTE 2 & PIPE SCH BREAK	K/A	T/F	R/W	24" RFW(1)B-4	24	160	2.062	SA 106 GR B	CS	UT-33
0	11-7-78	ISSUED FOR USE	K/M	D/W	R/S	LUGS	NA	NA	NA	SA 516 GR 70	CS	UT-46
A	4-11-78	ISSUED FOR INFORMATION ONLY	K/A	DCJ	B/LD							

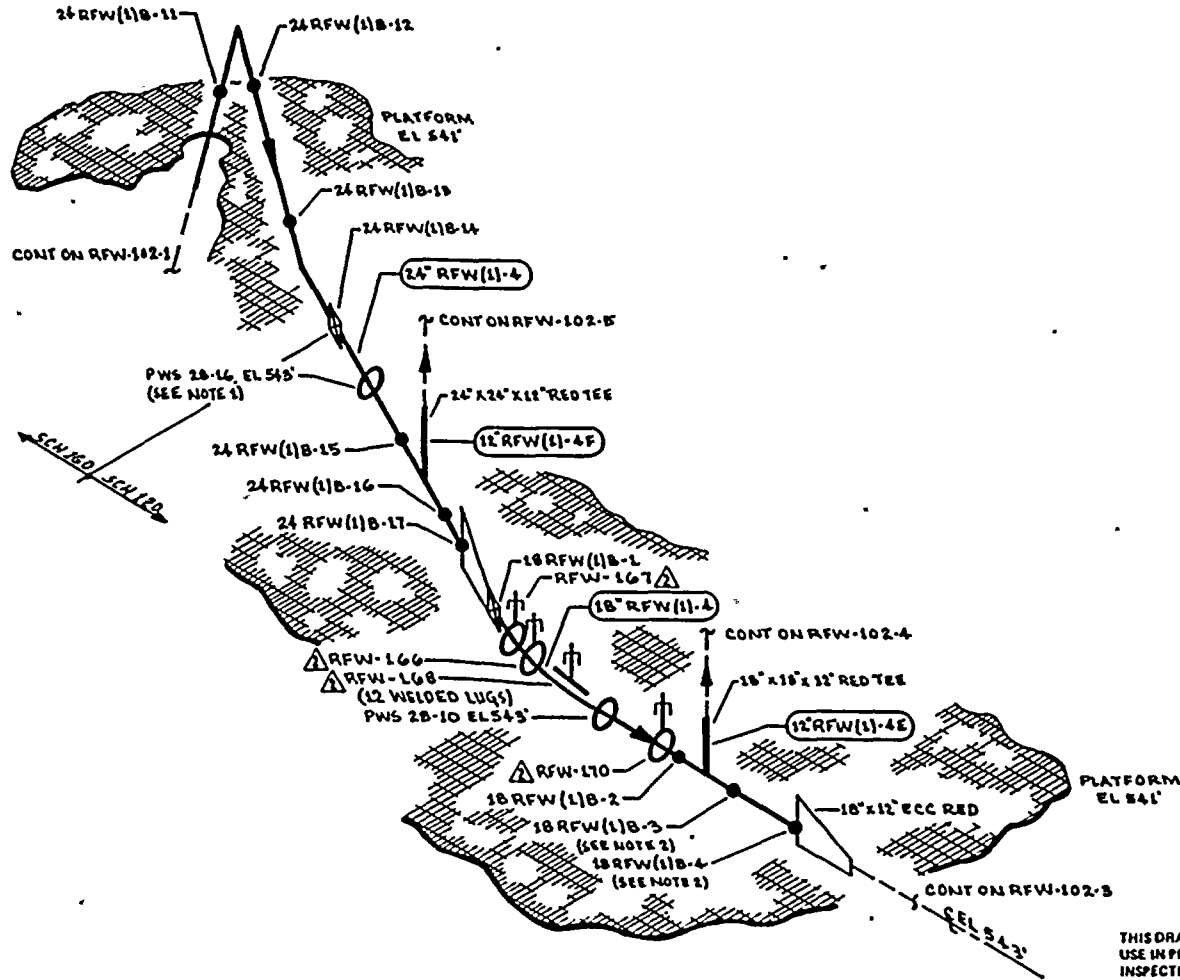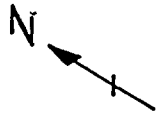

- NOTES:
1. ACCESS TO WELD 24 RFW(1)B-14 REQUIRES REMOVAL OF PWS-28-16.
 2. WELDS 18 RFW(1)B-3 & 18 RFW(1)B-4 ARE FITTING TO FITTING. SPACING IS 3 1/2\".

REFERENCES:
BOVEE & CRAIG ISOMETRIC
RFW-419-E.7 REV 9

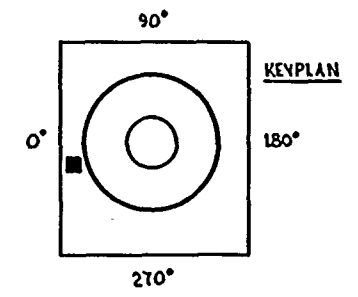


QUALITY CLASS: 1 ASME CODE CLASS: 1
ENGR: D TIMMINS DRAWN: X MCL DATE: 3-6-78
WASHINGTON PUBLIC POWER
SUPPLY SYSTEM
RICHLAND, WASHINGTON 99352

THIS DRAWING IS INTENDED FOR
USE IN PRESERVICE AND INSERVICE
INSPECTION PROGRAMS ONLY.

PIPING SYSTEM	NOM DIA (IN)	SCH	NOM WALL THK	MATERIAL SPECIFICATION	MATL TYPE	CAL BLOCK NO
24" RFW(1)A	24	120	1.812	SA 106 GR B	CS	UT-5
18" RFW(1)A	18	120	1.375	SA 106 GR B	CS	UT-11
24" RFW(1)A	24	160	2.344	SA 106 GR B	CS	UT-23
LUGS	NA	NA	NA	SA 516 GR 70	CS	UT-46


NO	DATE	REVISION	BY	CHKD	APPROV
2	11-11-78	REVISED AS NOTED ADDED LUGS & KEYPLAN	X MCL	TRR	TRR
3	11-5-80	ADDED PIPE SCH BREAK E AS NOTED	X MCL	TRR	TRR
0	11-21-78	ISSUED FOR USE	X MCL	TRR	TRR
A	4-21-78	ISSUED FOR INFORMATION ONLY	X MCL	DCJ	TRR
NO	DATE	REVISION	BY	CHKD	APPROV

WHP-2
WELD & COMPONENT
IDENTIFICATION DIAGRAM
TITLE:
REACTOR FEED WATER LINE B
DWG NO: RFW-102-2 REV 2

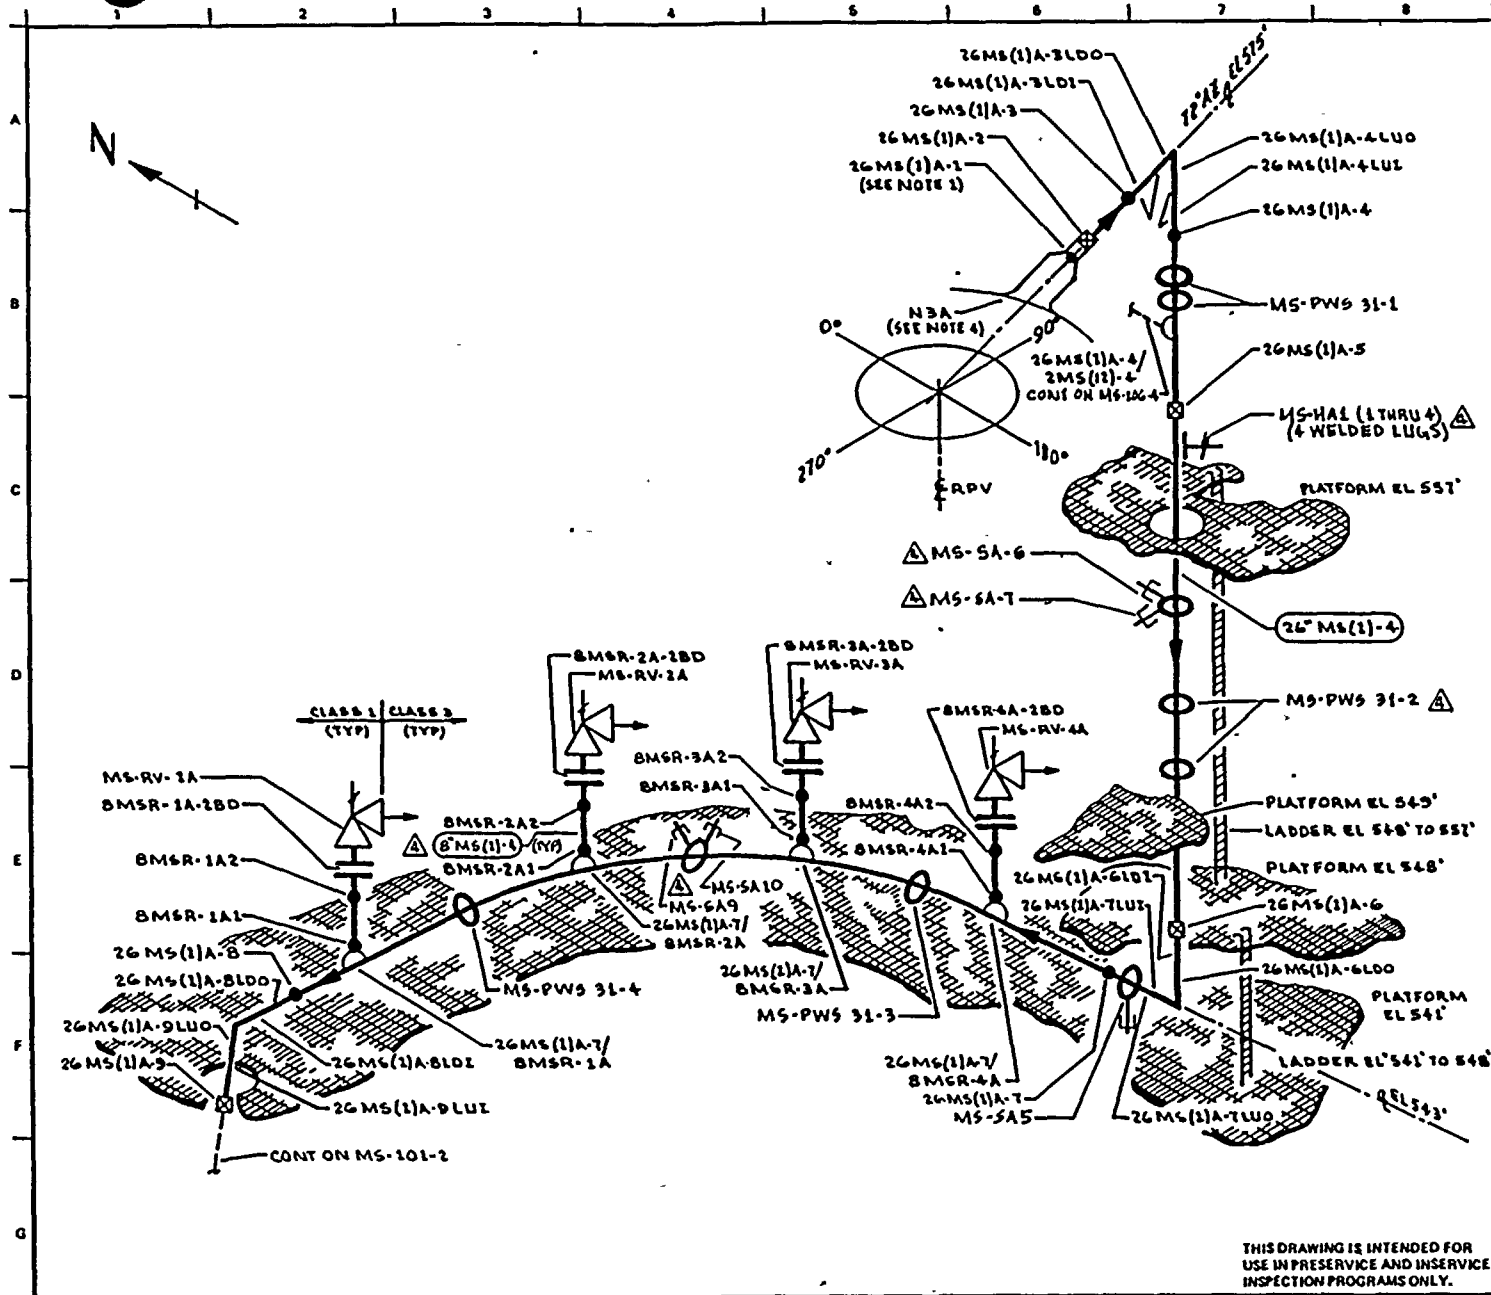

- NOTES:
1. WELD 26MS(1)A-1 UTILIZES CAL BLOCK UT-104.
 2. ACCESS TO WELDS 26MS(1)A-1 THRU 26MS(1)A-5 REQUIRES TEMPORARY SCAFFOLDING.
 3. ACCESS TO WELD 26MS(1)A-7 REQUIRES REMOVAL OF MS-5A5.
 4. FOR NOZZLE ASSEMBLY DETAILS SEE RPV-101.

- REFERENCES:
- GENERAL ELECTRIC DRAWINGS:
- | | |
|------------|------------|
| 7G1 E 992 | 131 C 8031 |
| 131 C 1131 | 131 C 8030 |
| 131 C 8403 | 131 C 8046 |
| 131 C 8501 | |
- CBI NUCLEAR CO.
55, REV 3, NB NOZZLE
BOYCE CRAIL/GERI
BC/Q - 211A REV 4

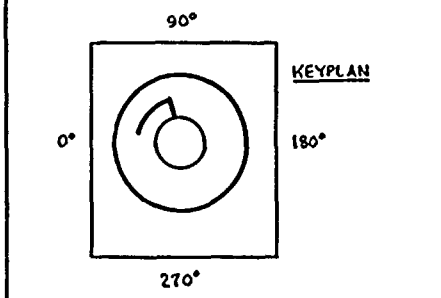

QUALITY CLASS: 1 ASME CODE CLASS: 1
ENGR: D TIMMINS DRAWN: V. M. C. A. DATE: 1-10-76

WASHINGTON PUBLIC POWER SUPPLY SYSTEM
RICHLAND, WASHINGTON 9882


WNP-2
WELD & COMPONENT IDENTIFICATION DIAGRAM

TITLE:
MAIN STEAM LINE A

DWG NO: MS-101-1 REV 4


THIS DRAWING IS INTENDED FOR USE IN PRESERVE AND INSERVICE INSPECTION PROGRAMS ONLY.

NO	DATE	REVISION	BY	CHKD	APPVD	PIPING SYSTEM	NOM DIA (IN)	SCH	NOM WALL THK	MATERIAL SPECIFICATION	MATL TYPE	CAL BLOCK NO
4	9-2-83	ADDED UT-46 LUGS & AS NOTED. ADDED KEYPLAN	KMcA	DR	JFH							
3	12-28-81	REVISED AS NOTED	KMcA	DR	JFH							
2	8-20-79	ADDED NOTE 4.	KMcA	DR	JFH	26 MS(1)A-4	26	XXX	1.125	SA 106 GR B	CS	UT-4
1	1-10-76	CAL BLOCK REFERENCE CHANGED (FOR 8" PIPING)	KMcA	DR	JFH	8" MS(1)A-4	8	160	0.906	SA 106 GR B	CS	UT-34
0	11-27-74	ISSUED FOR USE	KMcA	DR	JFH	LUGS	NA	NA	NA	6A 615 GR TO	CS	UT-46
A	4-11-75	ISSUED FOR INFORMATION ONLY	KMcA	DR	JFH							
NO	DATE	REVISION	BY	CHKD	APPVD							

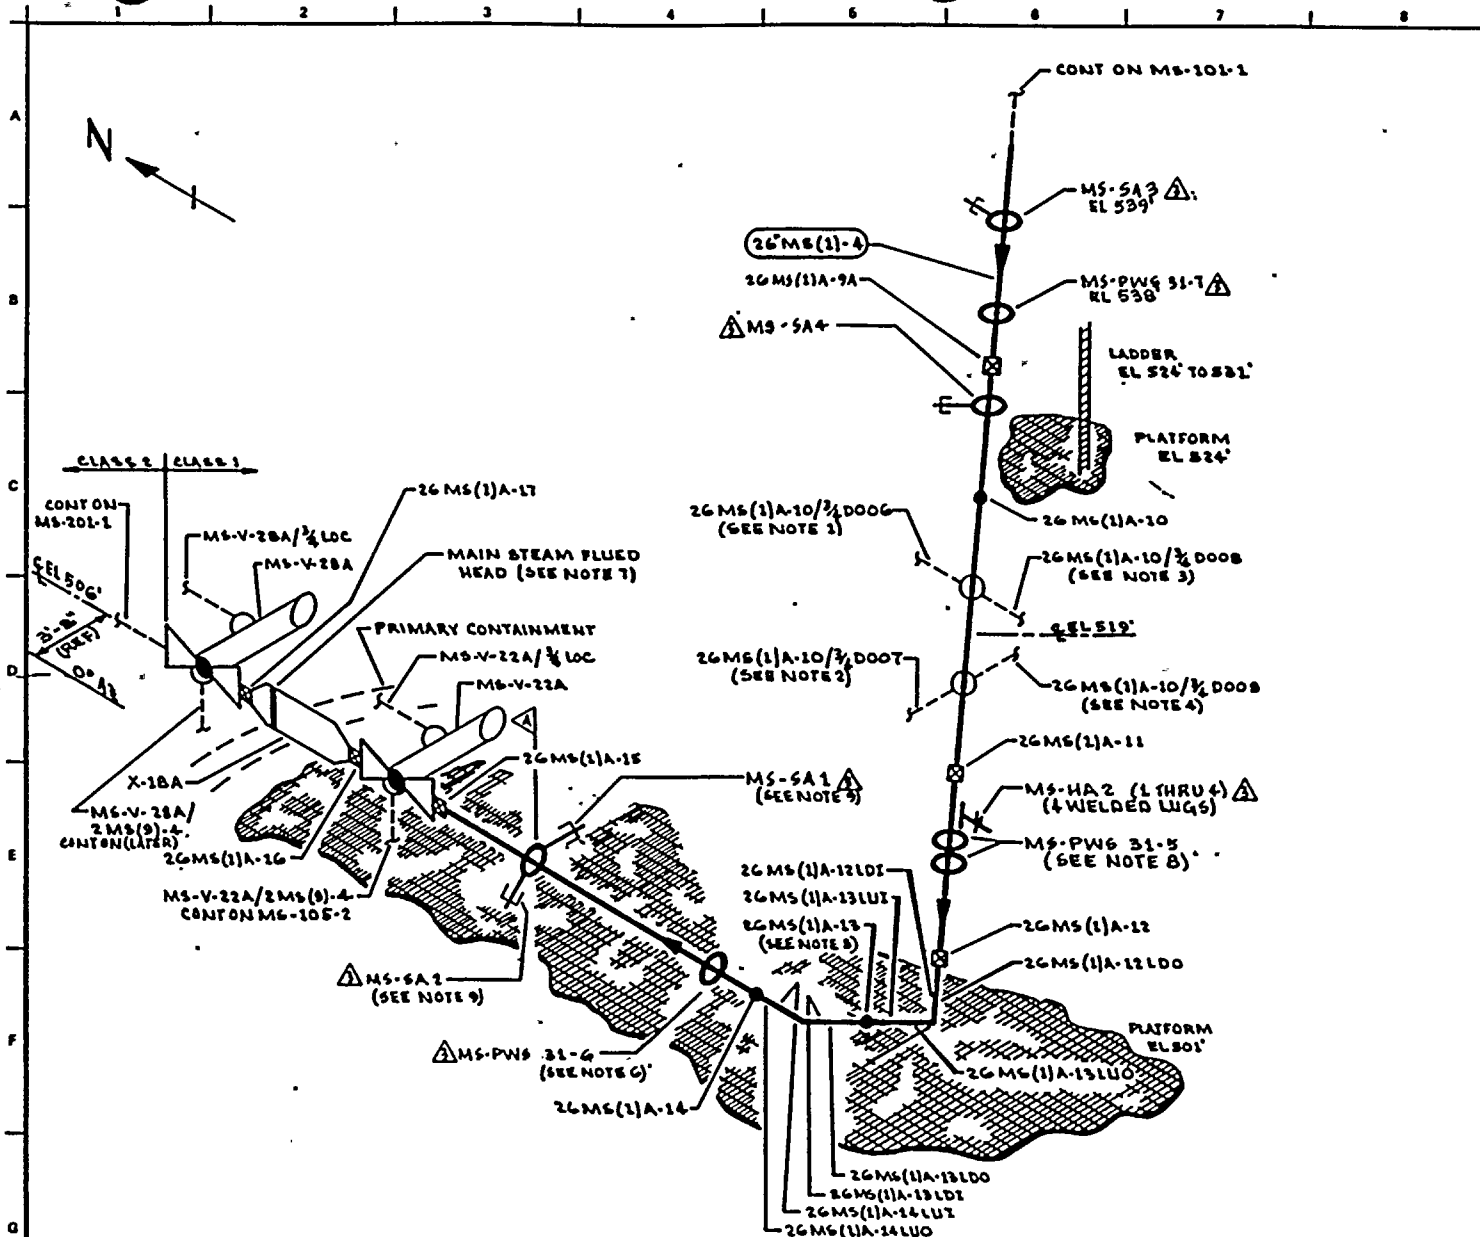

- NOTES:
1. EXTEND LEAKAGE EXAM THROUGH CONTAINMENT (X-69a) THROUGH EXCESS FLOW CHECK VALVE TO INSTRUMENT TUBING CONNECTION.
 2. EXTEND LEAKAGE EXAM THROUGH CONTAINMENT (X-69 b) THROUGH EXCESS FLOW CHECK VALVE TO INSTRUMENT TUBING CONNECTION.
 3. EXTEND LEAKAGE EXAM THROUGH CONTAINMENT (X-42 a) THROUGH EXCESS FLOW CHECK VALVE TO INSTRUMENT TUBING CONNECTION.
 4. EXTEND LEAKAGE EXAM THROUGH CONTAINMENT (X-42 b) THROUGH EXCESS FLOW CHECK VALVE TO INSTRUMENT TUBING CONNECTION.
 5. WELD 26 MS(1)A-13 IS FITTING TO FITTING.
 6. ACCESS TO WELD 26 MS(1)A-14 REQUIRES REMOVAL OF MS-PWS 31-6.
7. FOR EXAM OF MAIN STEAM FLUED HEAD SEE DWG MS-101-2.
 8. ACCESS TO WELD 26 MS(1)A-12 IS RESTRICTED BY PWS 31-5.
 9. ACCESS TO WELD 26 MS(1)A-15 IS RESTRICTED BY MS-5A1 & MS-5A2.

- REFERENCES:
- GENERAL ELECTRIC DRAWINGS
- | | |
|------------|------------|
| 761 E 992 | 131 C 8031 |
| 131 C 7731 | 131 C 8030 |
| 131 C 8403 | 131 C 8046 |
| 131 C 8501 | |
- BOVEE CRAN/ERS
- BC/G-211A REV 4
- 90°

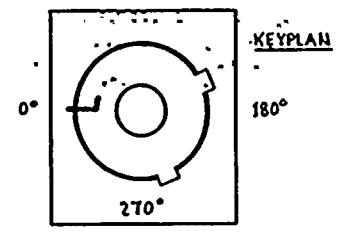

THIS DRAWING IS INTENDED FOR USE IN PRESERVE AND INSERVICE INSPECTION PROGRAMS ONLY.

NO	DATE	REVISION	BY	CHKD	APPVD	PIPING SYSTEM	NOM DIA (IN)	SCH	NOM WALL THK	MATERIAL SPECIFICATION	MATL TYPE	CAL BLOCK NO
3	9-26-81	REVISED AS NOTED. ADDED KEYPLAN & LUGS	KJA	ISK	TFW	26" MS(1)-4	26	XXX	1.125	SA 106 GR B	C5	UT-4
2	12-1-81	REVISED AS NOTED, AUGMENTED ISL ADDED	KJA	SR	TFW	LUGS	NA	NA	NA	SA 516 GR 70	C6	UT-46
1	8-30-79	ADDED FIELD WELD 26 MS(1)A-9A IN B-6	KJA	ISK	TFW							
0	11-27-78	ISSUED FOR USE	KJA	ISK	TFW							
A	4-21-78	ISSUED FOR INFORMATION ONLY	KJA	ISK	TFW							
NO	DATE	REVISION	BY	CHKD	APPVD							

QUALITY CLASS: 1 ASME CODE CLASS: 1

ENGR: D TIMMINS DRAWN: KJA DATE: 1-10-78


WASHINGTON PUBLIC POWER SUPPLY SYSTEM
RICHLAND, WASHINGTON 99352

WNP-2
WELD & COMPONENT IDENTIFICATION DIAGRAM

TITLE: MAIN STEAM LINE A


DWG NO: MS-101-2 REV 3



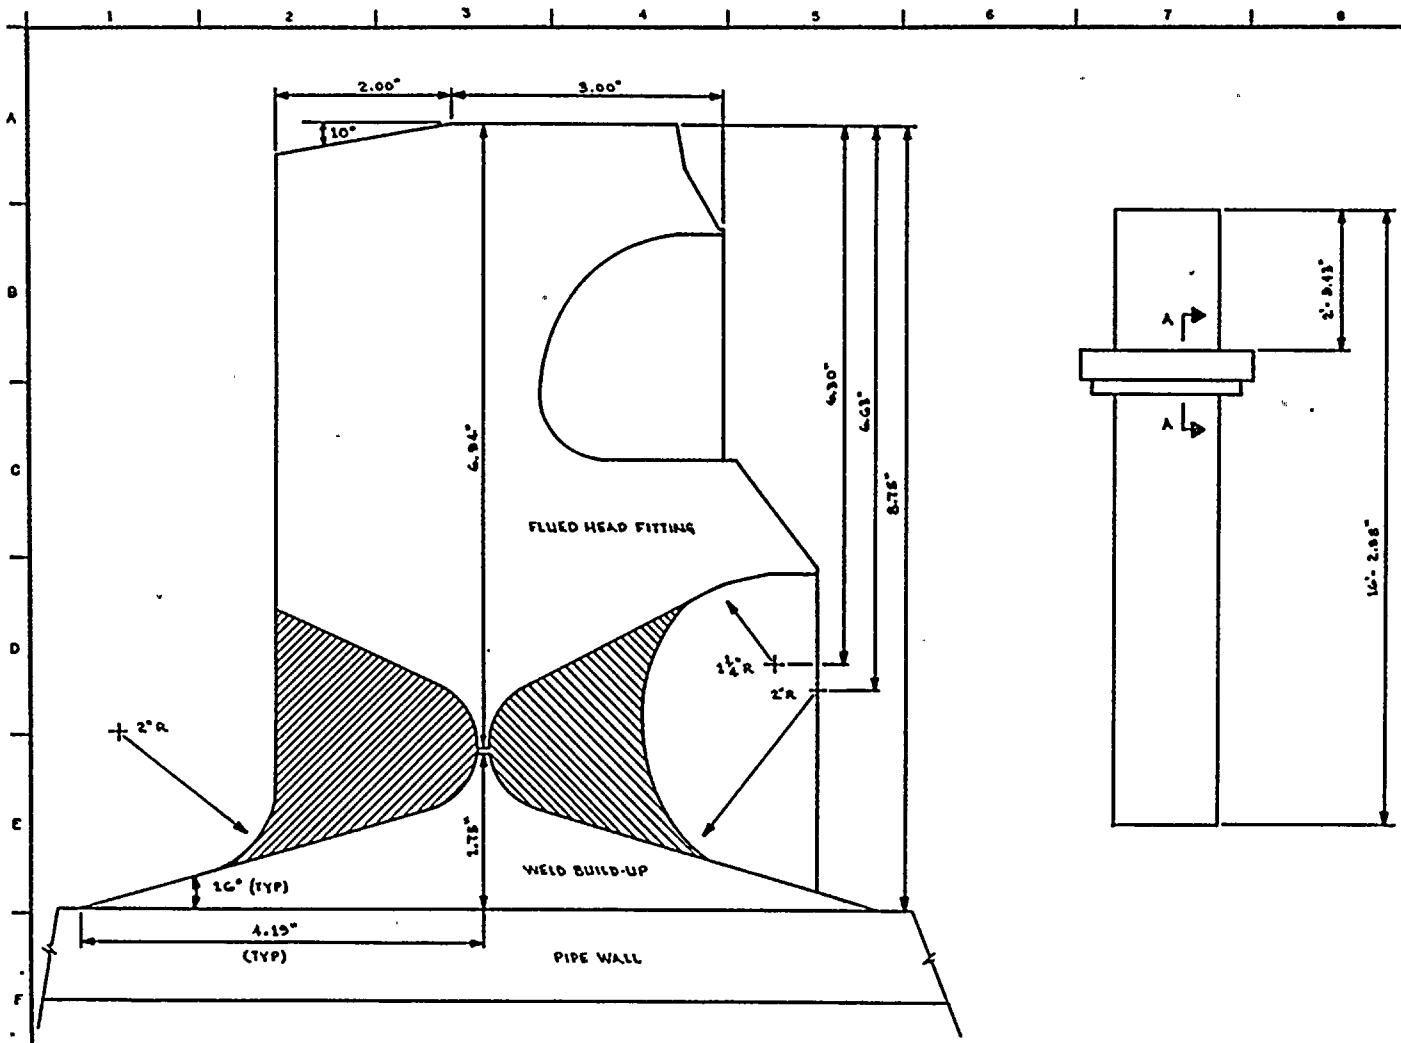

SECTION A-A

NOTES:
 1. THIS DETAIL OF THE MAIN STEAM FLUED HEAD IS ASSOCIATED WITH MS-101-2, MS-102-2, MS-103-2 & MS-104-2.

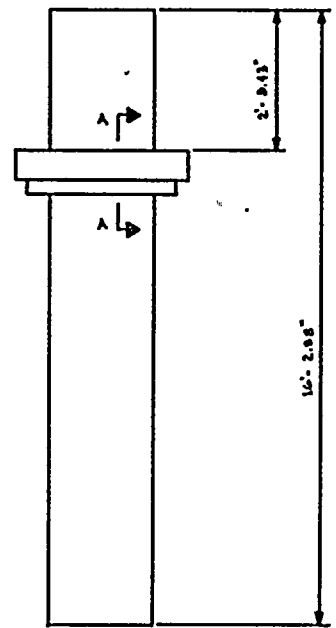

QUALITY CLASS: 1 ASME CODE CLASS: 1
 ENGR: D TIMMINS DRAWN: V.M.C.A. DATE: 4-24-78

 WASHINGTON PUBLIC POWER SUPPLY SYSTEM
 RICHLAND, WASHINGTON 99352

THIS DRAWING IS INTENDED FOR USE IN PRESERVE AND INSERVICE INSPECTION PROGRAMS ONLY.

PIPING SYSTEM	NOM DIA (IN)	SCH	NOM WALL THK	MATERIAL SPECIFICATION	MATL TYPE	CAL BLOCK NO
26" MG(1)-4	26	XXX	1.125	SA 106 GR. B	CS	UT-4
FLUED HEAD	NA	NA	NA	SA 105	CS	UT-40

WNP-2
 WELD B COMPONENT
 IDENTIFICATION DIAGRAM
 TITLE:
 MAIN STEAM FLUED HEAD
 DWG NO: MS-101-B REV 0

NO	DATE	REVISION	BY	CHKD	APPVD
0	11-22-78	ISSUED FOR USE	K.M.A.	D.W.	19/2
A	5-19-78	ISSUED FOR INFORMATION ONLY	K.M.A.	D.W.	018



WNP-G2
 INTERVAL: PSI
 PERIOD: NA
 OUTAGE:
 DRAWING NO. MS-101

WASHINGTON PUBLIC POWER SUPPLY SYSTEM
 PROGRAM PLAN AND SCHEDULE
 SYSTEM OR COMPONENT: MS(1)-4
 DESCRIPTION: MAIN STEAM LINE A

PAGE 001
 DATE 12/14/84

IDENT. NO.	DESCRIPTION	SECT. XI EXAM.	EXAM MTH.	PROCEDURE	CAL. BLOCK	INSERVICE		NOTES
						REQ.	SCHEDULED OUTAGE	
26MS(1)A-1	NZ/TRANSITION	B-J	VOL	UTP-10	UT-104			
			SUR	PTP-1				
26MS(1)A-2	TRANSITION/PIPE	B-J	VOL	UTP-10	UT-4			
			SUR	PTP-1				
26MS(1)A-3	PIPE TO EL	B-J	VOL	UTP-10	UT-4			
			SUR	PTP-1				
26MS(1)A-3LGI	EL SEAM	B-J	VOL	UTP-10	UT-4			
			SUR	PTP-1				
26MS(1)A-3LGG	EL SEAM	B-J	VOL	UTP-10	UT-4			
			SUR	PTP-1				
26MS(1)A-4LUI	EL SEAM	B-J	VOL	UTP-10	UT-4			
			SUR	PTP-1				
26MS(1)A-4LUG	EL SEAM	B-J	VOL	UTP-10	UT-4			
			SUR	PTP-1				
26MS(1)A-4	EL TO PIPE	B-J	VOL	UTP-10	UT-4			
			SUR	PTP-1				
PWS-31-1	PIPE WHIP	N/A	N/A	N/A				SEE NOTE #1
26MS(1)A-4/2MS(12)-4	HEAD VENT CONN	B-J	SUR	PTP-1				

WHP-02
 INTERVAL: PSI
 PERIOD: NA
 OUTAGE:
 DRAWING NO. MS-101

WASHINGTON PUBLIC POWER SUPPLY SYSTEM
 PROGRAM PLAN AND SCHEDULE
 SYSTEM OR COMPONENT: MS(1)-4
 DESCRIPTION: MAIN STEAM LINE A

PAGE 002
 DATE 12/14/84

IDENT. NO.	DESCRIPTION	SECT. XI EXAM.	EXAM MTH.	PROCEDURE	CAL. BLOCK	INSERVICE		NOTES
						REQ.	SCHEDULED OUTAGE	
26MS(1)A-5	PIPE TO PIPE	P-J	VOL	UTP-10	UT-4			
			SUR	PTP-1				
MS-HA-1(W)	4 WELDED LUGS	E-K-1	VOL	UTP-26	UT-4			
MS-HA-1	SPRING (2)	B-K-2	VT-3	303/8.2.17				
			VT-4	303/8.2.17				
MS-SA-6	PSA-35 SNUBBER	R-K-2	VT-3	303/8.2.17				S/N 4205
			VT-4	303/8.2.17				S/N 4205
MS-SA-7	PSA-35 SNUBBER	R-K-2	VT-3	303/8.2.17				S/N 4209
			VT-4	303/8.2.17				S/N 4209
PWS-31-2	PIPE WHIP	N/A	N/A	N/A				
26MS(1)A-6	PIPE TO EL	B-J	VOL	UTP-10	UT-4			
			SUR	PTP-1				
26MS(1)A-6LDT	EL SEAM	B-J	VOL	UTP-10	UT-4			
			SUR	PTP-1				
26MS(1)A-6LDO	EL SEAM	B-J	VOL	UTP-10	UT-4			
			SUR	PTP-1				
26MS(1)A-7LUI	EL SEAM	B-J	VOL	UTP-10	UT-1			
			SUR	PTP-1				

WMP-02
 INTERVAL: PSI
 PERIOD: NA
 OUTAGE:
 DRAWING NO. MS-101

WASHINGTON PUBLIC POWER SUPPLY SYSTEM
 PROGRAM PLAN AND SCHEDULE
 SYSTEM OR COMPONENT: MS(1)-4
 DESCRIPTION: MAIN STEAM LINE A

PAGE 003
 DATE 12/14/84

IDENT. NO.	DESCRIPTION	SECT. XI EXAM.	EXAM MTH.	PROCEDURE	CAL. BLOCK	INSERVICE		NOTES
						REQ.	SCHEDULED OUTAGE	
26MS(1)A-7LUC	EL SEAM	B-J	VOL	UTP-10	UT-4			
			SUR	PTP-1				
MS-SA-5	PSA-35 SHURBER	B-K-2	VT-3	303/8.2.17				S/N 4139
			VT-4	303/8.2.17				S/N 4139
26MS(1)A-7	EL TO PIPE	B-J	VOL	UTP-10	UT-4			
			SUR	PTP-1				
26MS(1)A-7/BMSR-4A	PIPE TO SWL	B-J	VOL	UTP-10	UT-4			
			SUR	PTP-1				
BMSR-4A1	SWL TO PIPE	B-J	VOL	UTP-10	UT-24			
			SUR	PTP-1				
BMSR-4A2	PIPE TO FLANGE	B-J	VOL	UTP-10	UT-24			
			SUR	PTP-1				
BMSR-4A-2B0	FLANGE BOLTING	B-G-2	VT-1	OCI 7-1				
HS-RV-4A-CLT	VALVE BOLTING	B-G-2	VT-1	OCI 7-1				
HS-RV-4A-BDY	VALVE BODY	B-H-2	VT-1	OCI 7-1				
PWS-31-3	PIPE WHIP	N/A	N/A	N/A				
26MS(1)A-7/BMSR-3A	PIPE TO SWL	B-J	VOL	UTP-10	UT-4			SEE NOTE #1
			SUR	PTP-1				

WNP-02
 INTERVAL: PSI
 PERIOD: NA
 OUTAGE:
 DRAWING NO. MS-101

WASHINGTON PUBLIC POWER SUPPLY SYSTEM
 PROGRAM PLAN AND SCHEDULE
 SYSTEM OR COMPONENT: MS(1)-4
 DESCRIPTION: MAIN STEAM LINE A

PAGE 004
 DATE 12/14/84

IDENT. NO.	DESCRIPTION	SECT. XI EXAM.	EXAM MTH.	PROCEDURE	CAL. BLOCK	INSERVICE		NOTES
						REQ.	SCHEDULED OUTAGE	
8MSR-3A1	SWL TO PIPE	B-J	VOL	UTP-10	UT-24			
			SUR	PTP-1				
8MSR-3A2	PIPE TO FLANGE	B-J	VOL	UTP-10	UT-24			
			SUR	PTP-1				
8MSR-3A-2BD	FLANGE BOLTING	B-G-2	VT-1	OCI 7-1				
MS-RV-3A-BLT	VALVE BOLTING	B-G-2	VT-1	OCI 7-1				
MS-RV-3A-BDY	VALVE BODY	B-M-2	VT-1	OCI 7-1				
MS-SA-9	PSA-35 SNUBBER	B-K-2	VT-3	303/8.2.17				S/N 4141
			VT-4	303/8.2.17				S/N 4141
MS-SA-10	PSA-35 SNUBBER	B-K-2	VT-3	303/8.2.17				S/N 4143
			VT-4	303/8.2.17				S/N 4143
26MS(1)A-7/8MSR-2A	PIPE TO SWL	B-J	VOL	UTP-10	UT-4			
			SUR	PTP-1				
8MSR-2A1	SWL TO PIPE	B-J	VOL	UTP-10	UT-24			
			SUR	PTP-1				
8MSR-2A2	PIPE TO FLANGE	B-J	VOL	UTP-10	UT-24			
			SUR	PTP-1				
8MSR-2A-2BD	FLANGE BOLTING	B-G-2	VT-1	OCI 7-1				

WNP-02
 INTERVAL: PSI
 PERIOD: NA
 OUTAGE:
 DRAWING NO. MS-101

WASHINGTON PUBLIC POWER SUPPLY SYSTEM
 PROGRAM PLAN AND SCHEDULE
 SYSTEM OR COMPONENT: MS(1)-4
 DESCRIPTION: MAIN STEAM LINE A

PAGE 005
 DATE 12/14/84

IDENT. NO.	DESCRIPTION	SECT. XI EXAM.	EXAM MIN.	PROCEDURE	CAL. BLOCK	INSERVICE		NOTES
						REQ.	SCHEDULED OUTAGE	
MS-RV-2A-BLT	VALVE BOLTING	B-G-2	VT-1	OCI 7-1				
MS-RV-2A-BDY	VALVE BODY	B-M-2	VT-1	OCI 7-1				
FWS-31-4	PIPE WHIP	N/A	N/A	N/A				
26MS(1)A-7/8MSR-1A	PIPE TO SWL	B-J	VOL	UTP-10	UT-4			SEE NOTE #1
EMSR-1A1			SUR	PTP-1				
	SWL TO PIPE	B-J	VOL	UTP-10	UT-24			
			SUR	PTP-1				
8MSR-1A2	PIPE TO FLANGE	B-J	VOL	UTP-10	UT-24			
			SUR	PTP-1				
8MSR-1A-2BD	FLANGE BOLTING	B-G-2	VT-1	OCI 7-1				
MS-RV-1A-BLT	VALVE BOLTING	B-G-2	VT-1	OCI 7-1				
MS-RV-1A-BDY	VALVE BODY	B-M-2	VT-1	OCI 7-1				
26MS(1)A-8	PIPE TO FL	B-J	VOL	UTP-10	UT-4			
			SUR	PTP-1				
26MS(1)A-8L01	EL SEAM	B-J	VOL	UTP-10	UT-4			
			SUR	PTP-1				
26MS(1)A-8L00	EL SEAM	B-J	VOL	UTP-10	UT-4			
			SUR	PTP-1				

WNP-02
 INTERVAL: PSI
 PERIOD: NA
 OUTAGE:
 DRAWING NO. HS-101

WASHINGTON PUBLIC POWER SUPPLY SYSTEM
 PROGRAM PLAN AND SCHEDULE
 SYSTEM OR COMPONENT: HS(1)-4
 DESCRIPTION: MAIN STEAM LINE A

PAGE 006
 DATE 12/14/84

IDENT. NO.	DESCRIPTION	SECT. XI EXAM.	EXAM MTH.	PROCEDURE	CAL. BLOCK	INSERVICE		NOTES
						REQ.	SCHEDULED OUTAGE	
26MS(1)A-9LUT	EL SEAM	B-J	VOL	UTP-10	UT-4			
			SUR	PTP-1				
26MS(1)A-9LU0	EL SEAM	B-J	VOL	UTP-10	UT-4			
			SUR	PTP-1				
26MS(1)A-9	EL TO PIPE	B-J	VOL	UTP-10	UT-4			
			SUR	PTP-1				
KS-SA-3	PSA-35 SNUBBER	B-K-2	VT-3	303/8.2.17				S/N 4145
			VT-4	303/8.2.17				S/N 4145
PWS-31-7	PIPE WHIP	N/A	N/A	N/A				SEE NOTE #1
26MS(1)A-9A	PIPE TO PIPE	B-J	VOL	UTP-10	UT-4			
			SUR	PTP-1				
MS-SA-4	PSA-35 SNUBBER	B-K-2	VT-3	303/9.2.17				S/N 4147
			VT-4	303/9.2.17				S/N 4147
26MS(1)A-10	PIPE TO PIPE	B-J	VOL	UTP-10	UT-4			
			SUR	PTP-1				
26MS(1)A-10/3/4-0006	INSTR CONN	B-P	VT-2	N/A				SEE NOTES #6 & #7.
26MS(1)A-10/3/4-0008	INSTR CONN	B-P	VT-2	N/A				SEE NOTES #6 & #7.

WNP-02
 INTERVAL: PSI
 PERIOD: NA
 OUTAGE:
 DRAWING NO. MS-101

WASHINGTON PUBLIC POWER SUPPLY SYSTEM
 PROGRAM PLAN AND SCHEDULE
 SYSTEM OR COMPONENT: MS(1)-4
 DESCRIPTION: MAIN STEAM LINE A

PAGE 007
 DATE 12/14/84

IDENT. NO.	DESCRIPTION	SECT. XI EXAM.	EXAM MTH.	PROCEDURE	CAL. BLOCK	INSERVICE		NOTES
						REQ.	SCHEDULED OUTAGE	
26MS(1)A-10/3/4-D007	INSTR CONN	B-P	VT-2	N/A				SEE NOTES #6 & #7.
26MS(1)A-10/3/4-D009	INSTR CONN	B-P	VT-2	N/A				SEE NOTES #6 & #7.
26MS(1)A-11	PIPE TO PIPE	B-J	VOL	UTP-10	UT-4			
			SUR	PTP-1				
MS-HA-2(W)	4 WELDED LUGS	B-K-1	VOL	UTP-26	UT-4			
MS-HA-2	SPRING (2)	B-K-2	VT-3	303/8.2.17				
			VT-4	303/8.2.17				
PWS-31-E	PIPE WHIP	N/A	N/A	N/A				SEE NOTE #1
26MS(1)A-12	PIPE TO EL	B-J	VOL	UTP-10	UT-4			
			SUR	PTP-1				
26MS(1)A-12LDI	EL SEAM	B-J	VOL	UTP-10	UT-4			
			SUR	PTP-1				
26MS(1)A-12LDO	EL SEAM	B-J	VOL	UTP-10	UT-4			
			SUR	PTP-1				
26MS(1)A-13LUI	EL SEAM	B-J	VOL	UTP-10	UT-4			
			SUR	PTP-1				
26MS(1)A-13LUO	EL SEAM	B-J	VOL	UTP-10	UT-4			
			SUR	PTP-1				

WNP-02
 INTERVAL: PSI
 PERIOD: NA
 OUTAGE:
 DRAWING NO. MS-101

WASHINGTON PUBLIC POWER SUPPLY SYSTEM
 PROGRAM PLAN AND SCHEDULE
 SYSTEM OR COMPONENT: MS(1)-4
 DESCRIPTION: MAIN STEAM LINE A

PAGE 608
 DATE 12/14/84

IDENT. NO.	DESCRIPTION	SECT. XI EXAM.	EXAM MTH.	PROCEDURE	CAL. BLOCK	INSERVICE		NOTES
						REQ.	SCHEDULED OUTAGE	
26MS(1)A-13	EL TO EL	B-J	VOL	UTP-10	UT-4			
			SUR	PTP-1				
26MS(1)A-13L01	EL SEAM	B-J	VOL	UTP-10	UT-4			
			SUR	PTP-1				
26MS(1)A-13L00	EL SEAM	B-J	VOL	UTP-10	UT-4			
			SUR	PTP-1				
26MS(1)A-14L01	EL SEAM	B-J	VOL	UTP-10	UT-4			
			SUR	PTP-1				
26MS(1)A-14L00	EL SEAM	B-J	VOL	UTP-10	UT-4			
			SUR	PTP-1				
26MS(1)A-14	EL TO PIPE	B-J	VOL	UTP-10	UT-4			
			SUR	PTP-1				
PWS-31-6	PIPE WHIP	N/A	N/A	N/A				SEE NOTE #1
MS-SA-1	PSA-100 SNUBBER	B-K-2	VT-3	303/8.2.17				S/N 608
			VT-4	303/8.2.17				S/N 608
MS-SA-2	PSA-100 SNUBBER	B-K-2	VT-3	303/8.2.17				S/N 610
			VT-4	303/8.2.17				S/N 610

WNP-02
 INTERVAL: PSI
 PERIOD: NA
 OUTAGE:
 DRAWING NO. MS-101

WASHINGTON PUBLIC POWER SUPPLY SYSTEM
 PROGRAM PLAN AND SCHEDULE
 SYSTEM OR COMPONENT: MS(1)-4
 DESCRIPTION: MAIN STEAM LINE A

PAGE 009
 DATE 12/14/84

IDENT. NO.	DESCRIPTION	SECT. XI EXAM. EXAM.	MTH.	PROCEDURE	CAL. BLOCK	INSERVICE		NOTES
						REQ.	SCHEDULED OUTAGE	
26MS(1)A-15	PIPE TO VALVE	B-J	VOL	UTP-10	UT-4			AUGMT
			SUR	PTP-1				AUGMT
MS-V-22A/2MS(9)-4	DRAIN CONN	B-J	SUR	FTP-1				
MS-V-22A-BLT	VALVE BOLTING	B-G-2	VT-1	GCI 7-1				
MS-V-22A-BDY	VALVE BODY	B-G-2	VT-1	GCI 7-1				
MS-V-22A/3/4CAP	LEAKOFF CAPPED	B-P	VT-2	N/A				
26MS(1)A-16	VALVE TO PENE	B-J	VOL	UTP-10	UT-4			AUGMT
			SUR	PTP-1				AUGMT
MS FLUED HEAD A	FLUED HEAD WELD	B-K-1	VOL	UTP-33	UT-40			SEE DWG. #MS-101-3, AUGMT.
			SUR	HTP-1				SEE DWG. #MS-101-3, AUGMT.
26MS(1)A-17	PENE TO VALVE	B-J	VOL	UTP-10	UT-4			AUGMT
			SUR	PTP-1				AUGMT
MS-V-28A/2MS(9)-4	DRAIN CONN	B-J	SUR	FTP-1				AUGMT
MS-V-28A-BLT	VALVE BOLTING	B-G-2	VT-1	GCI 7-1				
MS-V-28A-BDY	VALVE BODY	B-N-2	VT-1	GCI 7-1				
MS-V-28A/3/4CAP	LEAKOFF CAPPED	B-P	VT-2	N/A				

WNP-02
INTERVAL: PSI
PERIOD: NA
OUTAGE:
DRAWING NO. MS-101

WASHINGTON PUBLIC POWER SUPPLY SYSTEM
PROGRAM PLAN AND SCHEDULE
SYSTEM OR COMPONENT: MS(1)-4
DESCRIPTION: MAIN STEAM LINE A

PAGE 010
DATE 12/14/84

<u>IDENT. NO.</u>	<u>DESCRIPTION</u>	<u>SECT.</u> XI	<u>EXAM</u> EXAM	<u>PROCEDURE</u>	<u>CAL.</u> BLOCK	<u>INSERVICE</u>		<u>NOTES</u>
						<u>REQ.</u>	<u>SCHEDULED</u> OUTAGE	
MS-PB-101	MS PRESS BNDRY	B-P	VT-2	N/A				SEE NOTES #6 & #7.

WNP-02
 INTERVAL: PSI
 PERIOD: NA
 OUTAGE:
 DRAWING NO. RFW-103

WASHINGTON PUBLIC POWER SUPPLY SYSTEM
 PROGRAM PLAN AND SCHEDULE
 SYSTEM OR COMPONENT: RFW(11)-4
 DESCRIPTION: REACTOR FEEDWATER

PAGE 003
 DATE 12/14/84

<u>IDENT. NO.</u>	<u>DESCRIPTION</u>	<u>SECT.</u> <u>XI</u> <u>EXAM.</u>	<u>EXAM</u> <u>MTM.</u>	<u>PROCEDURE</u>	<u>CAL.</u> <u>BLOCK</u>	<u>INSERVICE</u> <u>SCHEDULED.</u>		<u>NOTES</u>
						<u>REQ.</u>	<u>OUTAGE</u>	
6RFW(11)-10	PIPE TO REDUCER	B-J	SUR	PTP-1	UT-28			AUGMT
4RFW(11)B-1	REDUCER TO PIPE	B-J	SUR	OCI 3-3				AUGMT
4RFW(11)B-1A	PIPE TO PIPE	B-J	SUR	OCI 3-3	UT-30			AUGMT
RFW-903N	SPRING	B-K-2	VT-3	303/8.2.17				AUGMT
RFW-180	PSA-1 SNUBBER	B-K-2	VT-3	303/8.2.17				S/N 22345
4RFW(11)B-2	PIPE TO EL	B-J	VT-4	303/8.2.17				S/N 22345
4RFW(11)B-3	EL TO PIPE	B-J	SUR	PTP-1	UT-30			AUGMT
RFW-181	SPRING	B-K-2	SUR	PTP-1				AUGMT
			VT-3	303/8.2.17				
			VT-4	303/8.2.17				

WMP-02
 INTERVAL: PSI
 PERIOD: NA
 OUTAGE:
 DRAWING NO. RFW-103

WASHINGTON PUBLIC POWER SUPPLY SYSTEM
 PROGRAM PLAN AND SCHEDULE
 SYSTEM OR COMPONENT: RFW(11)-4
 DESCRIPTION: REACTOR FEEDWATER

PAGE 004
 DATE 12/14/84

<u>IDENT. NO.</u>	<u>DESCRIPTION</u>	SECT. XI EXAM.	EXAM MTH.	PROCEDURE	CAL. BLOCK	<u>INSERVICE</u>		<u>NOTES</u>
						<u>REQ.</u>	<u>SCHEDULED</u> OUTAGE	
4RFW(11)B-4	PIPE TO EL	B-J	VOL	UTP-10	UT-30			AUGMT
			SUR	PTP-1				AUGMT
4RFW(11)B-5	EL TO SLEEVE	B-J	VOL	UTP-10	UT-30			AUGMT
			SUR	PTP-1				AUGMT
RFW-PB-103	RFW PRES BNDRY	B-P	VT-2	N/A				SEE NOTES #6 & #7.

WNP-02
INTERVAL: PSI
PERIOD: NA
OUTAGE:
DRAWING NO. RFW-101

WASHINGTON PUBLIC POWER SUPPLY SYSTEM
PROGRAM PLAN AND SCHEDULE
SYSTEM OR COMPONENT: RFW(1)-4
DESCRIPTION: RX FEEDWATER LINE A

PAGE 012
DATE 12/14/84

<u>IDENT. NO.</u>	<u>DESCRIPTION</u>	<u>SECT.</u> <u>XI</u>	<u>EXAM</u> <u>EXAM.</u>	<u>PROCEDURE</u>	<u>CAL.</u> <u>BLOCK</u>	<u>INSERVICE</u> <u>SCHEDULED</u> <u>REQ.</u>	<u>OUTAGE</u>	<u>NOTES</u>
RFW-PG-101	RFW PRES BNDRY	B-P	VT-2	N/A				SEE NOTES #6 & #7.

WNP-02
 INTERVAL: PSI
 PERIOD: NA
 OUTAGE:
 DRAWING NO. RFW-101

WASHINGTON PUBLIC POWER SUPPLY SYSTEM
 PROGRAM PLAN AND SCHEDULE
 SYSTEM OR COMPONENT: RFW(1)-4
 DESCRIPTION: RY FEEDWATER LINE A

PAGE 011
 DATE 12/14/84

IDENT. NO.	DESCRIPTION	SECT. XI EXAM.	EXAM MIN.	PROCEDURE	CAL. BLOCK	INSERVICE		NOTES
						REQ.	SCHEDULED OUTAGE	
			VT-4	303/8.2.17				S/N 278/279
FWS-27-6	PIPE WHIP	N/A	N/A	N/A				SEE NOTE #1
PWS-27-5	PIPE WHIP	N/A	N/A	N/A				SEE NOTE #1
RFW-159(W)	4 WELDED LUGS	B-K-1	VCL	UTP-26	UT-15			SEE NOTE #1
RFW-159	SPRING	B-K-2	VT-3	303/8.2.17				
			VT-4	303/8.2.17				
12RFW(1)AA-6	PIPE TO EL	B-J	VCL	UTP-10	UT-15			
			SUR	PTP-1				
12RFW(1)AA-7	EL TO PIPE	B-J	VCL	UTP-10	UT-15			
			SUR	PTP-1				
12RFW(1)AA-8	PIPE TO SE EXT	B-J	VCL	UTP-10	UT-15			
			SUR	PTP-1				
12RFW(1)AA-9	SE EXT-SE STUB	B-F	VCL	UTP-10	UT-106			
			SUR	PTP-1				
12RFW(1)AA-10	SE STUB-SE EXT	B-J	VCL	UTP-10	UT-105			
			SUR	PTP-1				
12RFW(1)AA-11	SE TO N4	B-F	VCL	UTP-10	UT-102			
			SUR	PTP-1				

WNP-02
 INTERVAL: PSI
 PERIOD: NA
 OUTAGE:
 DRAWING NO. RFW-101

WASHINGTON PUBLIC POWER SUPPLY SYSTEM
 PROGRAM PLAN AND SCHEDULE
 SYSTEM OR COMPONENT: RFW(1)-4
 DESCRIPTION: RX FEEDWATER LINE A

PAGE 010
 DATE 12/14/84

IDENT. NO.	DESCRIPTION	SECT. XI EXAM.	EXAM MTH.	PROCEDURE	CAL. BLOCK	INSERVICE		NOTES
						REQ.	SCHEDULED OUTAGE	
			VT-4	303/8.2.17				
PWS-27-12	PIPE WHIP	N/A	N/A	N/A				SEE NOTE #1
12RFW(1)AA-2	PIPE TO EL	B-J	VOL	UTP-10	UT-15			
			SUR	PTP-1				
12RFW(1)AA-3	EL TO PIPE	B-J	VOL	UTP-10	UT-15			
			SUR	PTP-1				
PWS-27-8	PIPE WHIP	N/A	N/A	N/A				SEE NOTE #1
PWS-27-7	PIPE WHIP	N/A	N/A	N/A				SEE NOTE #1
RFW-151	PSA-10 SNURBER	B-K-2	VT-3	303/8.2.17				S/N 10732
			VT-4	303/8.2.17				S/N 10732
RFW-153	PSA-10 SNURBER	B-K-2	VT-3	303/8.2.17				S/N 9931
			VT-4	303/8.2.17				S/N 9931
12RFW(1)AA-4	PIPE TO EL	B-J	VOL	UTP-10	UT-15			
			SUR	PTP-1				
12RFW(1)AA-5	EL TO PIPE	B-J	VOL	UTP-10	UT-15			
			SUR	PTP-1				
RFW-929N	PSA-10 SN(2)	B-K-2	VT-3	303/8.2.17				S/N 278/279

WNP-02
 INTERVAL: PSI
 PERIOD: NA
 OUTAGE:
 DRAWING NO. RFW-101

WASHINGTON PUBLIC POWER SUPPLY SYSTEM
 PROGRAM PLAN AND SCHEDULE
 SYSTEM OR COMPONENT: RFW(1)-4
 DESCRIPTION: RX FEEDWATER LINE A

PAGE 009
 DATE 12/14/84

<u>IDENT. NO.</u>	<u>DESCRIPTION</u>	<u>SECT.</u> <u>YI</u> <u>EXAM.</u>	<u>EXAM</u> <u>MTH.</u>	<u>PROCEDURE</u>	<u>CAL.</u> <u>BLOCK</u>	<u>INSERVICE</u>		<u>NOTES</u>
						<u>REQ.</u>	<u>SCHEDULED</u> <u>OUTAGE</u>	
12RFW(1)AB-7	EL TO PIPE	B-J	VOL	PTP-1 UTP-10	UT-15			
12RFW(1)AB-8	PIPE-SE EXT	B-J	VOL	PTP-1 UTP-10	UT-15			
12RFW(1)AB-9	SE EXT-SE STUB	B-F	VOL	PTP-1 UTP-10	UT-106			
12RFW(1)AB-10	SE STUB TO SF	B-J	VOL	PTP-1 UTP-10	UT-105			
12RFW(1)AB-11	SE TO H4	B-F	VOL	PTP-1 UTP-10	UT-102			
18RFW(1)A-3	TEE TO PIPE	B-J	VOL	PTP-1 UTP-10	UT-11			
18RFW(1)A-4	PIPE TO REDUCER	B-J	VOL	PTP-1 UTP-10	UT-11			
12RFW(1)AA-1	REDUCER TO PIPE	B-J	VOL	PTP-1 UTP-10	UT-15			
RFW-152	SPRING	B-K-2	VT-3	PTP-1 303/8.2.17				

WNP-02
 INTERVAL: PSI
 PERIOD: NA
 OUTAGE:
 DRAWING NO. RFW-101

WASHINGTON PUBLIC POWER SUPPLY SYSTEM
 PROGRAM PLAN AND SCHEDULE
 SYSTEM OR COMPONENT: RFW(1)-4
 DESCRIPTION: RX FEEDWATER LINE A

PAGE 008
 DATE 12/14/84

<u>IDENT. NO.</u>	<u>DESCRIPTION</u>	<u>SECT.</u> <u>XI</u>	<u>EXAM</u> <u>EXAM.</u>	<u>PROCEDURE</u>	<u>CAL.</u> <u>BLOCK</u>	<u>INSERVICE</u>		<u>NOTES</u>
						<u>REQ.</u>	<u>SCHEDULED</u> <u>OUTAGE</u>	
12RFW(1)AB-1	TEE TO PIPE	B-J	VOL	UTP-10	UT-11			
PWS-27-9	PIPE WHIP	N/A	N/A	N/A				SEE NOTE #1
12RFW(1)AB-2	PIPE TO EL	B-J	VOL	UTP-10	UT-15			
12RFW(1)AB-3	EL TO PIPE	B-J	VOL	UTP-10	UT-15			
PWS-27-11	PIPE WHIP	N/A	N/A	N/A				SEE NOTE #1
12RFW(1)AB-4	PIPE TO EL	B-J	VOL	UTP-10	UT-15			
12RFW(1)AB-5	EL TO PIPE	B-J	VOL	UTP-10	UT-15			
PWS-27-4	PIPE WHIP	N/A	N/A	N/A				SEE NOTE #1
PWS-27-3	PIPE WHIP	N/A	N/A	N/A				SEE NOTE #1
RFW-158	SPRING	B-K-2	VT-3	303/8.2.17				
12RFW(1)AB-6	PIPE TO EL	B-J	VOL	UTP-10	UT-15			

WNP-02
 INTERVAL: PSI
 PERIOD: NA
 OUTAGE:
 DRAWING NO. RFW-101

WASHINGTON PUBLIC POWER SUPPLY SYSTEM
 PROGRAM PLAN AND SCHEDULE
 SYSTEM OR COMPONENT: RFW(1)-4
 DESCRIPTION: RX FEEDWATER LINE A

PAGE 007
 DATE 12/14/84

IDENT. NO.	DESCRIPTION	SECT. XI EXAM.	EXAM MTH.	PROCEDURE	CAL. BLOCK	INSERVICE		NOTES
						REQ.	SCHEDULED OUTAGE	
24RFW(1)A-16	TEE TO PIPE	B-J	VOL	PTP-1 UTP-10	UT-5			
24RFW(1)A-17	PIPE TO REDUCER	B-J	VOL	PTP-1 UTP-10	UT-5			
18RFW(1)A-1	REDUCER TO PIPE	B-J	VOL	PTP-1 UTP-10	UT-11			
RFW-160	PSA-10 SN(?)	B-K-2	VT-3	PTP-1 303/8.2.17				S/N 288/1475
RFW-154	PSA-10 SN(?)	B-K-2	VT-3	PTP-1 303/8.2.17				S/N 288/1475
RFW-155	PSA-10 SN(?)	B-K-2	VT-3	PTP-1 303/8.2.17				S/N 9958/9939
RFW-155(W)	PSA-10 SN(?)	B-K-2	VT-3	PTP-1 303/8.2.17				S/N 9958/9939
RFW-156	8 WELDED LUGS	B-K-1	VOL	UTP-26	UT-15			3/4"W x 2"H x 4"L.
PWS-27-10	PSA-10 SN(?)	B-K-2	VT-3	303/8.2.17				S/N 581/ 136
18RFW(1)A-2	PIPE WHIP	N/A	N/A	N/A				S/N 581/ 136
	PIPE TO TEE	B-J	VOL	UTP-10	UT-11			SEE NOTE #1

WNP-02
 INTERVAL: PSI
 PERIOD: NA
 OUTAGE:
 DRAWING NO. RFW-101

WASHINGTON PUBLIC POWER SUPPLY SYSTEM
 PROGRAM PLAN AND SCHEDULE
 SYSTEM OR COMPONENT: RFW(1)-4
 DESCRIPTION: RX FEEDWATER LINE A

PAGE 006
 DATE 12/14/84

IDENT. NO.	DESCRIPTION	SECT. XI EXAM.	EXAM MTH.	PROCEDURE	CAL. BLOCK	INSERVICE		NOTES
						REQ.	SCHEDULED OUTAGE	
PWS-27-2			SUR	PTP-1				
PWS-27-1	PIPE WHIP	N/A	N/A	N/A				SEE NOTE #1
RFW-157(W)	PIPE WHIP	N/A	N/A	N/A				SEE NOTE #1
RFW-157	4 WELDED LUGS	B-K-1	VOL	UTP-26	UT-15			3/4"W x 2 1/8"H x 2"L.
12RFW(1)AC-8	SPRING	B-K-2	VT-3	303/8.2.17				
			VT-4	303/9.2.17				
12RFW(1)AC-9	PIPE TO EL	B-J	VOL	UTP-10	UT-15			
			SUR	PTP-1				
12RFW(1)AC-10	EL TO PIPE	B-J	VOL	UTP-10	UT-15			
			SUR	PTP-1				
12RFW(1)AC-11	PIPE-SE EXT	B-J	VOL	UTP-10	UT-15			
			SUR	PTP-1				
12RFW(1)AC-12	SE/EX-SE/STUB	B-F	VOL	UTP-10	UT-105			
			SUR	PTP-1				
12RFW(1)AC-13	SE/STUB TO SE	B-J	VOL	UTP-10	UT-105			
			SUR	PTP-1				
12RFW(1)AC-13	SE / N4	B-F	VOL	UTP-10	UT-102			

WNP-02
 INTERVAL: PSI
 PERIOD: NA
 OUTAGE:
 DRAWING NO. RFW-101

WASHINGTON PUBLIC POWER SUPPLY SYSTEM
 PROGRAM PLAN AND SCHEDULE
 SYSTEM OR COMPONENT: RFW(1)-4
 DESCRIPTION: RX FEEDWATER LINE A

PAGE 005
 DATE 12/14/84

IDENT. NO.	DESCRIPTION	SECT. YI EXAM.	EXAM MTH.	PROCEDURE	CAL. BLOCK	INSERVICE		NOTES
						REQ.	SCHEDULED OUTAGE	
RFW-156	SPRING	B-K-2	VT-3	PTP-1				
			VT-4	303/8.2.17				
RFW-156(W)	6 WELDED LUGS	B-K-1	VOL	UTP-26	UT-15			5/8"W x 2"H x 4"L.
12RFW(1)AC-2	PIPE TO EL	B-J	VOL	UTP-10	UT-15			
12RFW(1)AC-3	EL TO PIPE	B-J	VOL	UTP-10	UT-15			
FWS-27-15	PIPE WHIP	N/A	N/A	N/A				SEE NOTE #1
12RFW(1)AC-4	PIPE TO EL	B-J	VOL	UTP-10	UT-15			
12RFW(1)AC-5	EL TO PIPE	B-J	VOL	UTP-10	UT-15			
12RFW(1)AC-6	PIPE TO EL	B-J	VOL	UTP-10	UT-15			
12RFW(1)AC-7	EL TO PIPE	B-J	VOL	UTP-10	UT-15			
12RFW(1)AC-7A	PIPE TO PIPE	B-J	VOL	UTP-10	UT-15			

WNP-02
 INTERVAL: PSI
 PERIOD: NA
 OUTAGE:
 DRAWING NO. RFW-101

WASHINGTON PUBLIC POWER SUPPLY SYSTEM
 PROGRAM PLAN AND SCHEDULE
 SYSTEM OR COMPONENT: RFW(1)-4
 DESCRIPTION: RX FEEDWATER LINE A

PAGE 004
 DATE 12/14/84

<u>IDENT. NO.</u>	<u>DESCRIPTION</u>	<u>SECT.</u>		<u>PROCEDURE</u>	<u>CAL. BLOCK</u>	<u>INSERVICE SCHEDULED</u>		<u>NOTES</u>
		<u>XI EXAM.</u>	<u>EXAM MTH.</u>			<u>REQ.</u>	<u>OUTAGE</u>	
RFW-V-11A-00Y	VALVE BODY	B-M-2	VT-1	OCI 7-1				
24RFW(1)A-9	VALVE TO PIPE	B-J	VOL	UTP-10	UT-5			
			SUR	PTP-1				
PWS-27-18	PIPE WHIP	N/A	N/A	N/A				SEE NOTE #1
24RFW(1)A-10	PIPE TO PIPE	B-J	VOL	UTP-10	UT-5			
			SUR	PTP-1				
24RFW(1)A-11	PIPE TO EL	B-J	VOL	UTP-10	UT-33			
			SUR	PTP-1				
24RFW(1)A-12	EL TO PIPE	B-J	VOL	UTP-10	UT-33			
			SUR	PTP-1				
24RFW(1)A-13	PIPE TO EL	B-J	VOL	UTP-10	UT-33			
			SUR	PTP-1				
24RFW(1)A-14	EL TO PIPE	B-J	VOL	UTP-10	UT-5			
			SUR	PTP-1				
PWS-27-16	PIPE WHIP	N/A	N/A	N/A				SEE NOTE #1
24RFW(1)A-15	PIPE TO TEE	B-J	VOL	UTP-10	UT-5			
			SUR	PTP-1				
12RFW(1)AC-1	TEE TO PIPE	B-J	VOL	UTP-10	UT-15			

WNP-02
 INTERVAL: PSI
 PERIOD: NA
 OUTAGE:
 DRAWING NO. RFW-101

WASHINGTON PUBLIC POWER SUPPLY SYSTEM
 PROGRAM PLAN AND SCHEDULE
 SYSTEM OR COMPONENT: RFW(1)-4
 DESCRIPTION: RX FEEDWATER LINE A

PAGE 003
 DATE 12/14/84

IDENT. NO.	DESCRIPTION	SECT. XI EXAM.	EXAM MTH.	PROCEDURE	CAL. BLOCK	INSERVICE		NOTES
						REQ.	SCHEDULED OUTAGE	
24RFW(1)A-7	EL TO PIPE	B-J	VOL	UTP-10	UT-5			
PWS-27-13			SUR	PTP-1				
RFW-186(W)	PIPE WHIP	N/A	N/A	N/A				SEE NOTE #1
RFW-186	6 WELDED LUGS	B-K-1	VOL	UTP-26	UT-5			3/4"W x 2"H x 2"L.
	SPRING	B-K-2	VT-3	303/8.2.17				
RFW-146			VT-4	303/8.2.17				
	PSA-10 SN(2)	B-K-2	VT-3	303/8.2.17				S/N 131/13044
			VT-4	303/8.2.17				S/N 131/13044
RFW-146(W)	6 WELDED LUGS	B-K-1	VOL	UTP-26	UT-5			3/4"W x 2"H x 4"L.
RFW-147	PSA-100 SNUBBER	B-K-2	VT-3	303/8.2.17				S/N 500
			VT-4	303/8.2.17				S/N 500
PWS-27-17	PIPE WHIP	N/A	N/A	N/A				SEE NOTE #1
RFW-148	PSA-35 SNUBBER	B-K-2	VT-3	303/8.2.17				S/N 8930
			VT-4	303/8.2.17				S/N 8930
24RFW(1)A-7/3/4V-44R	TEST CONN	B-P	VT-2	N/A				SEE NOTES #6 & #7.
24RFW(1)A-8	PIPE TO VALVE	B-J	VOL	UTP-10	UT-5			
			SUR	PTP-1				

WMP-02
 INTERVAL: PSI
 PERIOD: NA
 OUTAGE:
 DRAWING NO. RFW-101

WASHINGTON PUBLIC POWER SUPPLY SYSTEM
 PROGRAM PLAN AND SCHEDULE
 SYSTEM OR COMPONENT: RFW(1)-4
 DESCRIPTION: PX FEEDWATER LINE A

PAGE 002
 DATE 12/14/84


IDENT. NO.	DESCRIPTION	SECT. XI EXAM.	EXAM MTH.	PROCEDURE	CAL. BLOCK	INSERVICE		NOTES
						REQ.	SCHEDULED OUTAGE	
24RFW(1)A-3	VALVE TO PENE	B-J	VOL	UTP-10	UT-5			AUGMT
			SUR	PTP-1				AUGMT
24RFW(1)A-4	PENE TO VALVE	B-J	VOL	UTP-10	UT-5			AUGMT
			SUR	PTP-1				AUGMT
RFW-V-10A-BDY	VALVE BODY	B-M-2	VT-1	OCT 7-1				
24RFW(1)A-5	VALVE TO PIPE	B-J	VOL	UTP-10	UT-5			AUGMT
			SUR	PTP-1				AUGMT
PWS-27-14	PIPE WHIP	N/A	N/A	N/A				SEE NOTE #1
24RFW(1)A-6	PIPE TO EL	B-J	VOL	UTP-10	UT-5			
			SUR	PTP-1				
24RFW(1)A-6/3/4V-120	VENT CONN	B-P	VT-2	N/A				SEE NOTES #6 & #7.
24RFW(1)A-6LDO	EL PIPE	B-J	VOL	UTP-10	UT-33			
			SUR	PTP-1				
24RFW(1)A-6LDI	EL PIPE	B-J	VOL	UTP-10	UT-33			
			SUR	PTP-1				
24RFW(1)A-7LUI	EL PIPE	B-J	VOL	UTP-10	UT-33			
			SUR	PTP-1				
24RFW(1)A-7LUO	EL PIPE	B-J	VOL	UTP-10	UT-33			

WNP-02
 INTERVAL: PSI
 PERIOD: NA
 OUTAGE:
 DRAWING NO. RFW-101

WASHINGTON PUBLIC POWER SUPPLY SYSTEM
 PROGRAM PLAN AND SCHEDULE
 SYSTEM OR COMPONENT: RFW(1)-4
 DESCRIPTION: RY FEEDWATER LINE A


PAGE 001
 DATE 12/14/84

<u>IDENT. NO.</u>	<u>DESCRIPTION</u>	<u>SECT.</u> <u>XI</u> <u>EXAM.</u>	<u>EXAM</u> <u>MTH.</u>	<u>PROCEDURE</u>	<u>CAL.</u> <u>BLOCK</u>	<u>INSERVICE</u>		<u>NOTES</u>
						<u>REQ.</u>	<u>SCHEDULED</u> <u>OUTAGE</u>	
RFW-V-65A/3/4CAP	LEAKOFF CAPPED	B-P	VT-2	N/A				SEE NOTES #6 & #7.
RFW-V-65A-BDY	VALVE BODY	G-M-2	VT-1	OCI 7-1				
24RFW(1)A-1A	PIPE TO VALVE	AUGMT	VOL	UTP-10	UT-5			
24RFW(1)A-1	VALVE TO PIPE	B-J	VOL	UTP-10	UT-5			AUGMT
			SUR	PTP-1				AUGMT
24RFW(1)A-1/3/4V-31A	TEST CGNN	B-P	VT-2	N/A				SEE NOTES #6 & #7.
24RFW(1)A-1/5RFW(11)-4	PIPE TO WOL	B-J	VOL	OCI 6-13	UT-5			AUGMT
			SUR	OCI 3-3				AUGMT
5RFW(11)A-2	SLEEVE TO WOL	B-J	VOL	UTP-10	UT-32			AUGMT
			SUR	PTP-1				AUGMT
5RFW(11)A-1	SLEEVE-SLEEVE	B-J	SUR	PTP-1				AUGMT. THIS IS SOCKET TYPE WELD, SEE DETAIL I DRAWING RFW-101-1.
24RFW(1)A-2	PIPE TO VALVE	B-J	VOL	UTP-10	UT-5			AUGMT
			SUR	PTP-1				AUGMT
RFW-V-32A/3/4CAP	LEAKOFF CAPPED	B-P	VT-2	N/A				SEE NOTES #6 & #7.
RFW-V-32A-BDY	VALVE BODY	B-M-2	VT-1	OCI 7-1				
RFW-V-32A/3/4V-67	TEST CONN	B-P	VT-2	N/A				SEE NOTES #6 & #7.

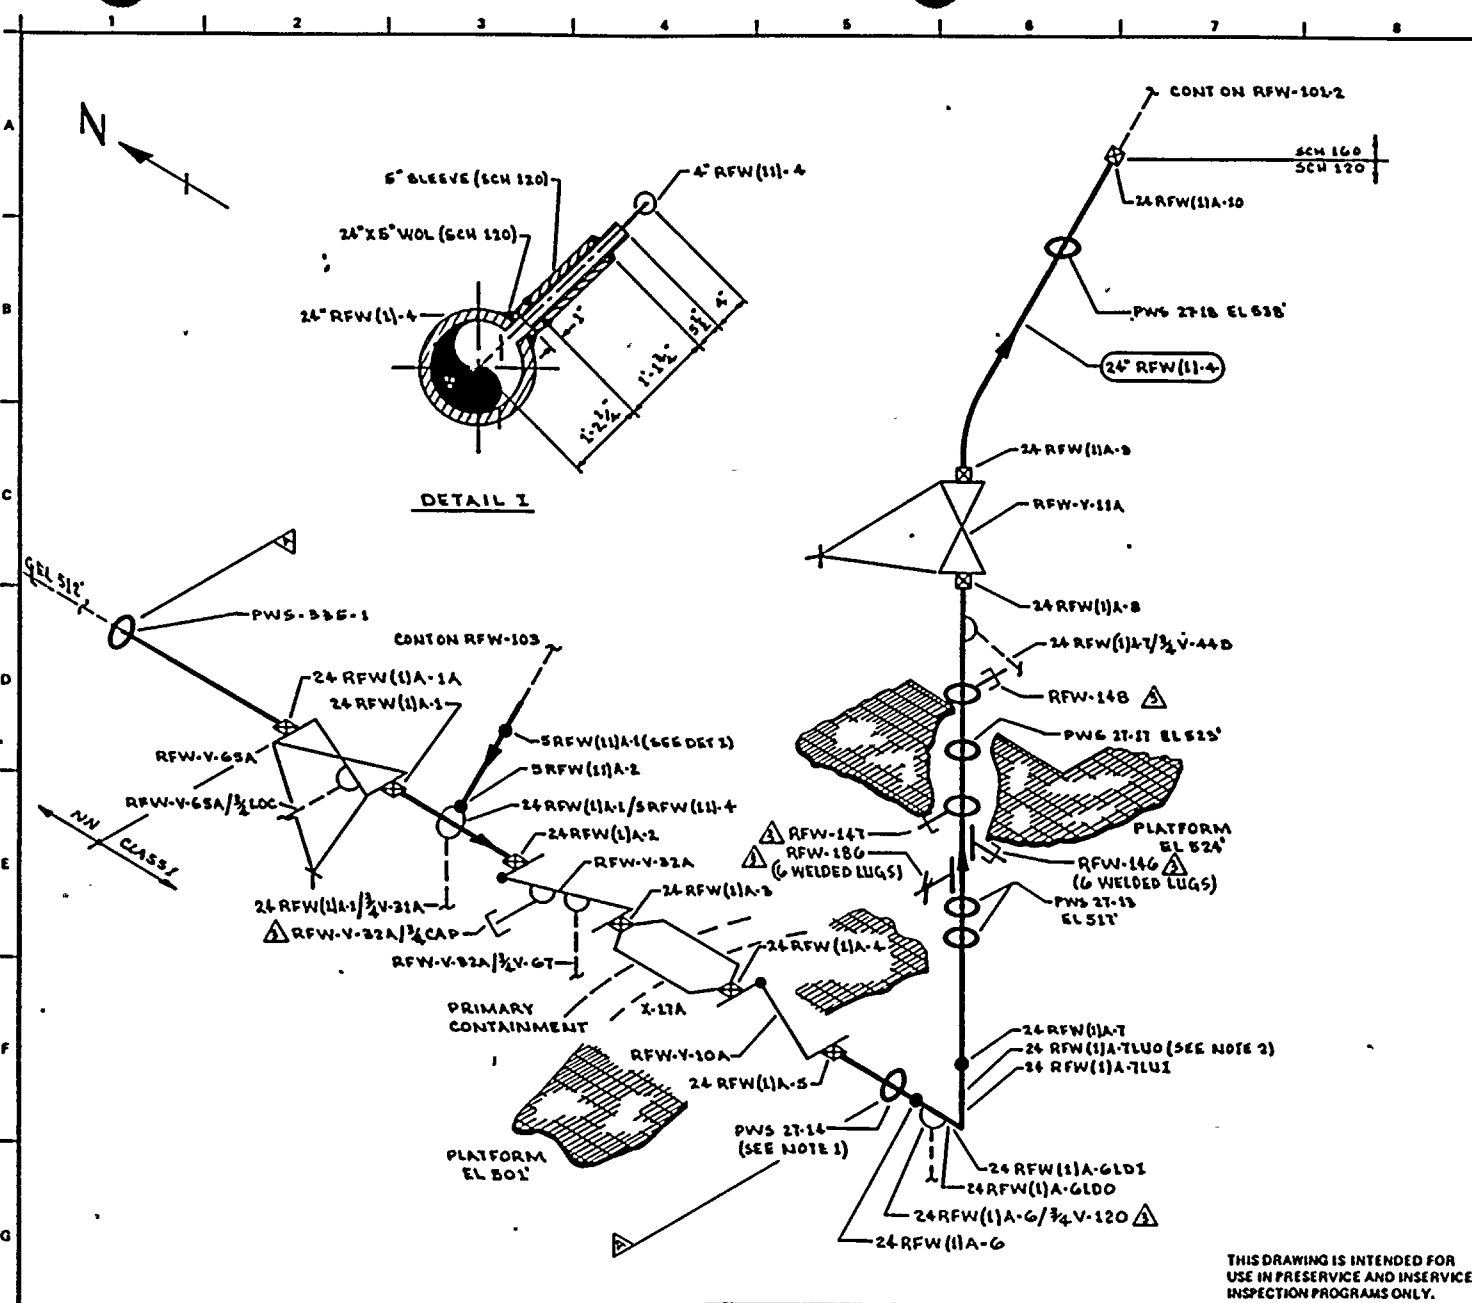

- NOTES:
1. ACCESS TO WELDS 24 RFW(1)A-5 & 24 RFW(1)A-6 REQUIRES REMOVAL OF PWS 27-14.
 2. ELBOW BETWEEN WELDS 24 RFW(1)A-6 & 7 IS SCH 140, WELDED & SHORT RADIUS.

- REFERENCES:
- DOVES & CRAIL ISOMETRICS
 - RFW-418-3 REV C
 - RFW-418-4 REV D
 - RFW-418-5-6 REV B

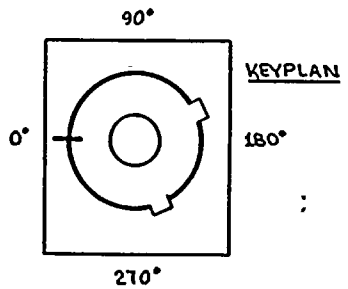

QUALITY CLASS: 1 ASME CODE CLASS: 1
 ENGR: D TIMMINS DRAWN: K M A DATE: 5-3-78

WASHINGTON PUBLIC POWER SUPPLY SYSTEM
 RICHLAND, WASHINGTON 99352

THIS DRAWING IS INTENDED FOR USE IN PRESERVE AND INSERVICE INSPECTION PROGRAMS ONLY.


NO	DATE	REVISION	BY	CHKD	APPVD	PIPING SYSTEM	NOM DIA (IN)	SCH	NOM WALL THK	MATERIAL SPECIFICATION	MATL TYPE	CAL BLOCK NO
3	10-13-83	REVISED AS NOTED ADDED LUGS & KEYPLAN	KML	DJL	TFB	24" RFW(1)A-4	24	120	1.812	SA 106 GR B	CS	UT-5
2	11-2-81	AUGMENTED 1ST ADDED	KML	DJL	TFB	5" RFW(1)A-4	5	120	0.500	SA 106 GR B	CS	UT-22
1	1-15-80	ADDED NOTE 2 & PIPE SCH BREAK & AS NOTED	KML	DJL	TFB	24" RFW(1)A-4	24	140	2.062	SA 106 GR B	CS	UT-33
0	11-27-78	ISSUED FOR USE	KML	DJL	TFB	LUGS	NA	NA	NA	SA 516 GR 70	CS	UT-46
A	4-11-78	ISSUED FOR INFORMATION ONLY	KML	DJL	TFB							
NO	DATE	REVISION	BY	CHKD	APPVD							

WNP-2
 WELD & COMPONENT IDENTIFICATION DIAGRAM

TITLE:
REACTOR FEED WATER LINE A


DWG NO: RFW-101-1 REV 3



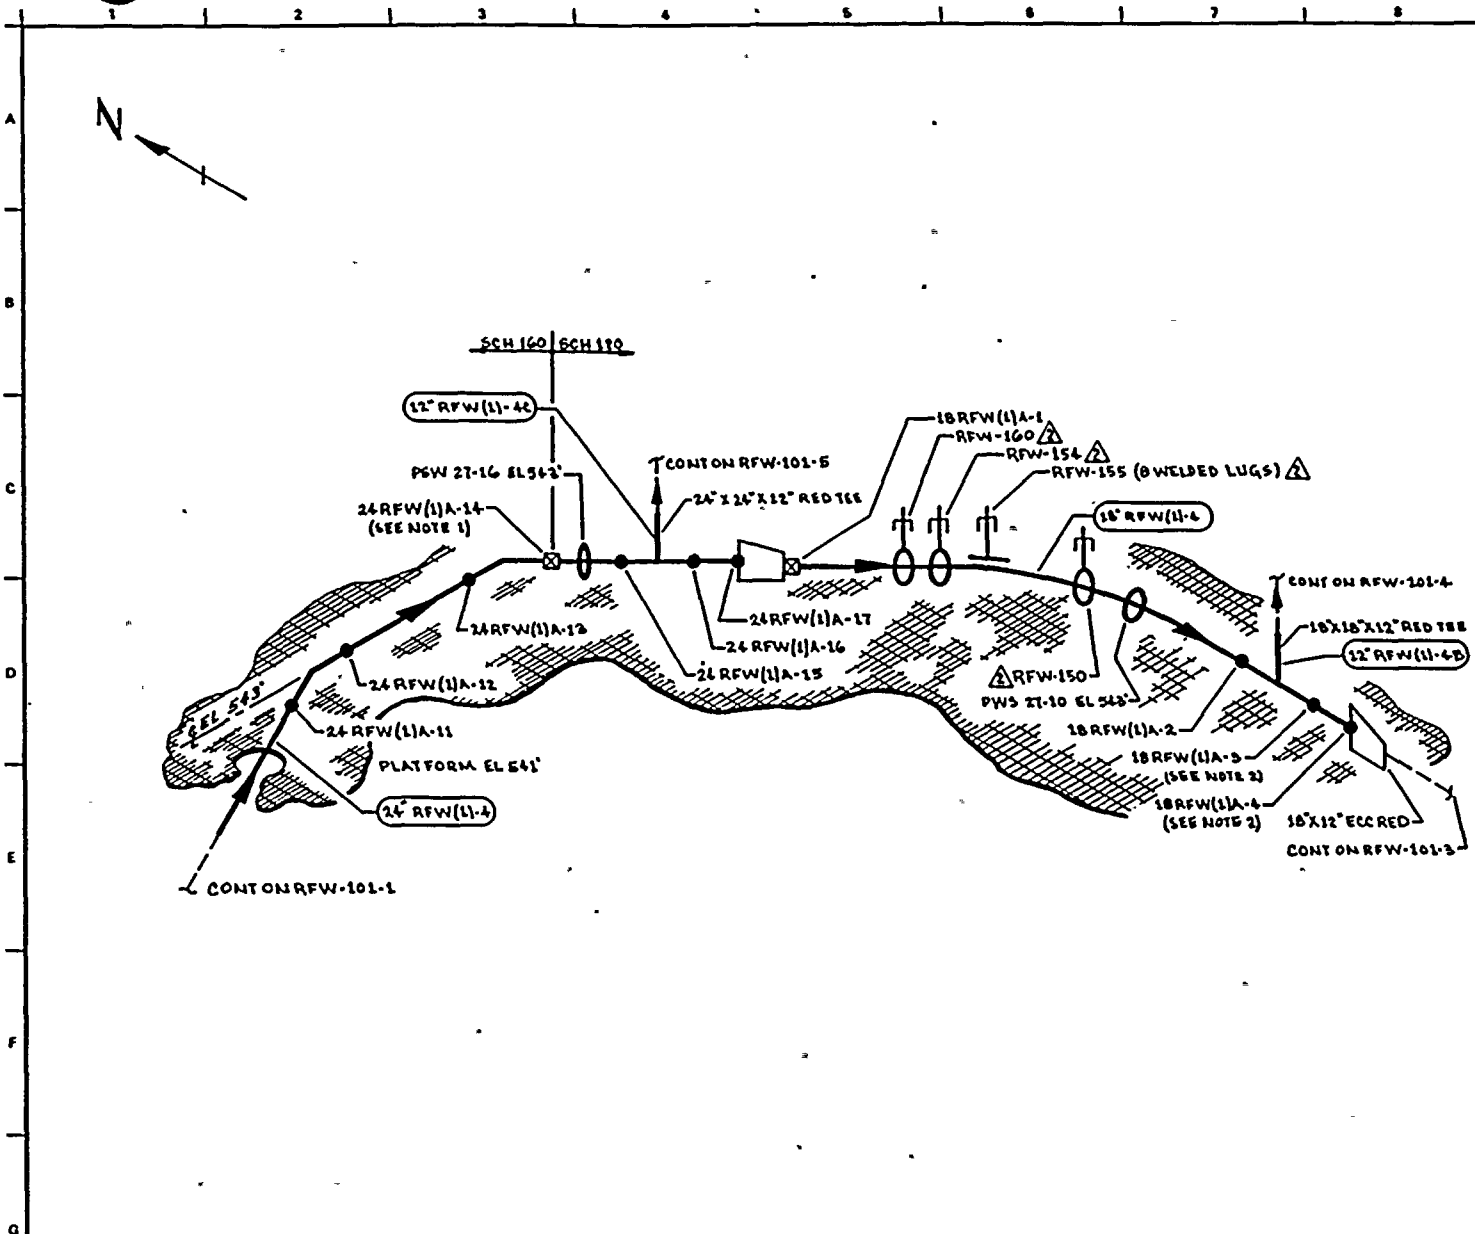

- NOTES:
1. ACCESS TO WELD 24 RFW(1)A-14 REQUIRES REMOVAL OF PWG-27-16.
 2. WELDS 18 RFW(1)A-3 & 18 RFW(1)A-4 ARE FITTING TO FITTING. SPACING IS 3 1/2\".

- REFERENCES:
- BOVEE & CRAIG ISOMETRICS
 - RFW-418-S.6 REV 8
 - RFW-418-T.8 REV 7

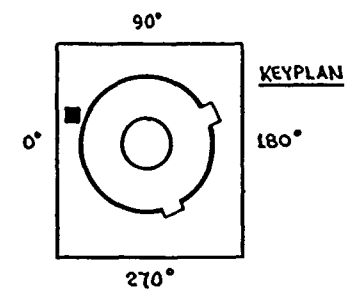

QUALITY CLASS: 1 | ASME CODE CLASS: 1
 ENGR: D TIMMINGS | DRAWN: K M C A | DATE: 3-2-78

WASHINGTON PUBLIC POWER SUPPLY SYSTEM
 RICHMOND, WASHINGTON 98122

THIS DRAWING IS INTENDED FOR USE IN PRESERVICE AND INSERVICE INSPECTION PROGRAMS ONLY.


WNP-2
 WELD & COMPONENT IDENTIFICATION DIAGRAM

TITLE:
REACTOR FEED WATER LINE A

DWG NO: RFW-101-2 | REV 2


NO	DATE	REVISION	BY	CHKD	APPVD	PIPING SYSTEM	NOM DIA (IN)	SCH	NOM WALL THK	MATERIAL SPECIFICATION	MATL TYPE	CAL BLOCK NO
2	10-15-80	REVISED AS NOTED ADDED LUGS & KEYPLAN	KMA	DK	DK	18" RFW(1)A-4	18	120	1.315	SA 106 GR B	CS	UT-11
1	11-5-80	ADDED PIPE SCH BREAK & AS NOTED	KMA	DK	DK	24" RFW(1)A-4	24	160	2.344	SA 106 GR B	CS	UT-33
0	11-27-78	ISSUED FOR USE	KMA	DK	DK	LUGS	NA	NA	NA	SA 516 GR 70	CS	UT-46
A	4-11-78	ISSUED FOR INFORMATION ONLY	KMA	DCJ	DJP							
NO	DATE	REVISION	BY	CHKD	APPVD							



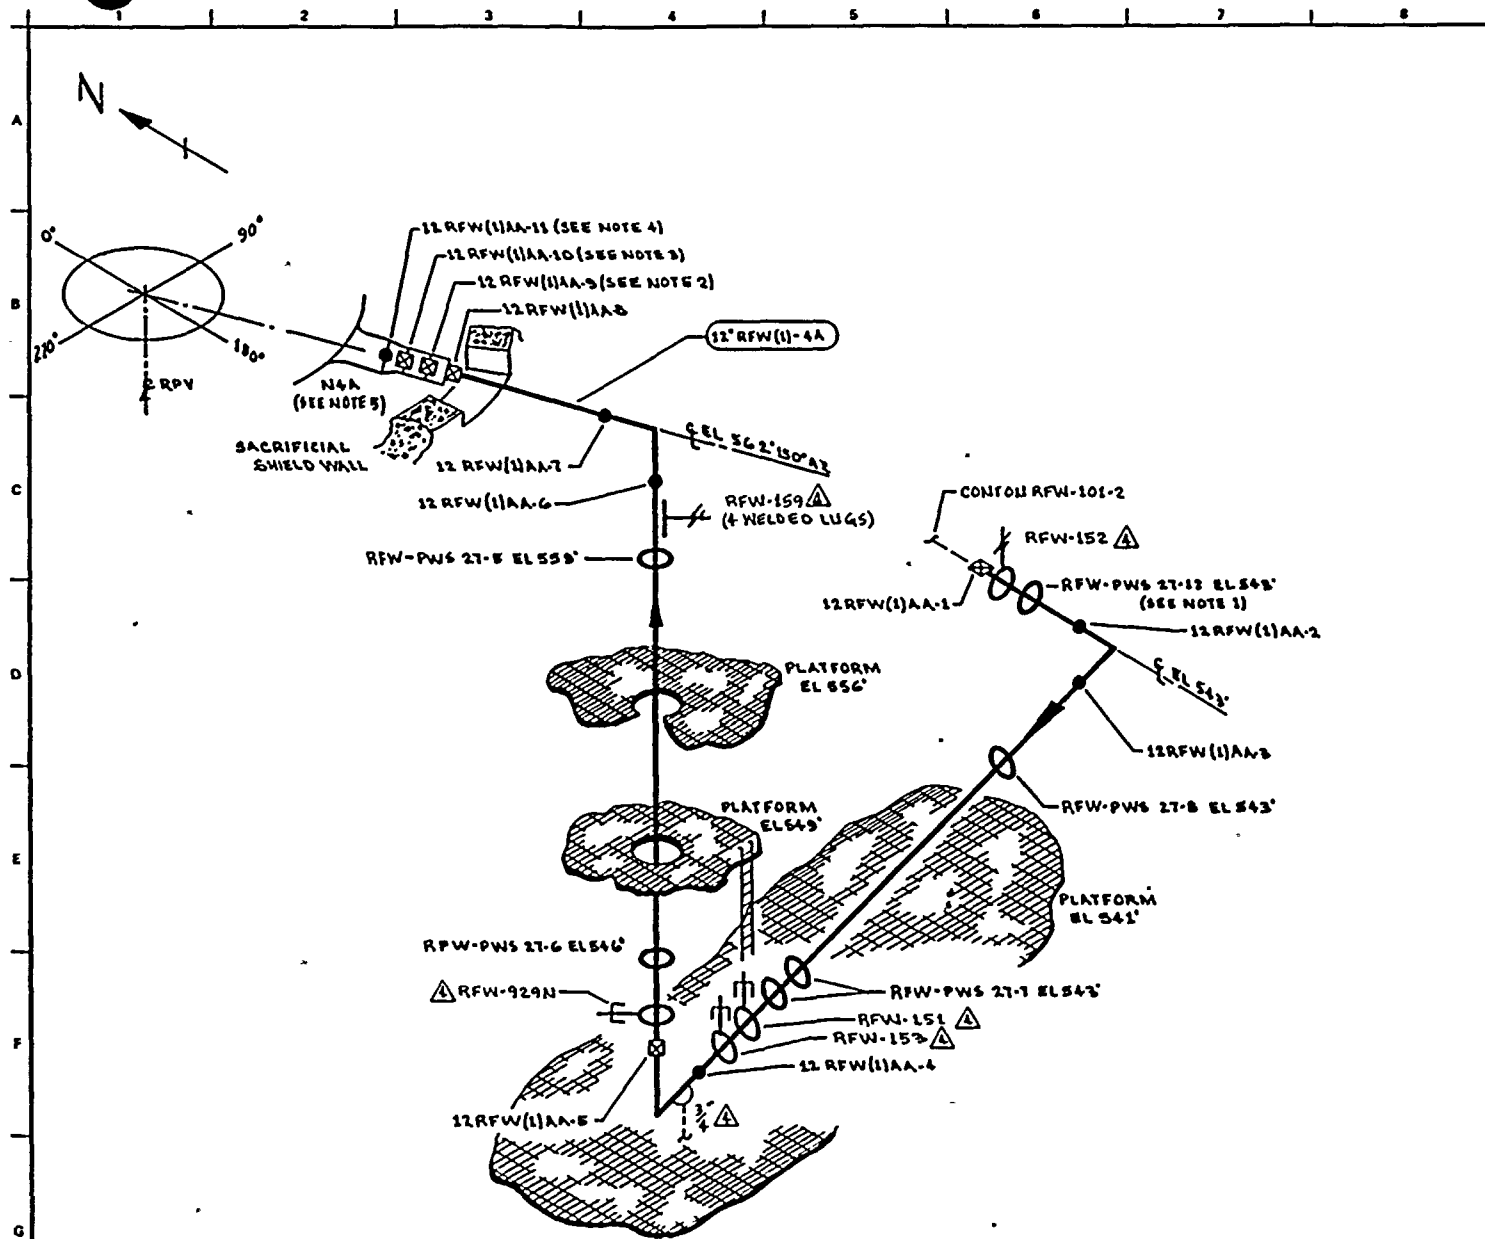

- NOTES:**
1. ACCESS TO WELD 12 RFW(1)AA-2 REQUIRES REMOVAL OF RFW-PWS 27-12.
 2. WELD 12 RFW(1)AA-9 UTILIZES CAL BLOCK UT-100.
 3. WELD 12 RFW(1)AA-10 UTILIZES CAL BLOCK UT-105.
 4. WELD 12 RFW(1)AA-11 UTILIZES CAL BLOCK UT-102.
 5. FOR NOZZLE ASSEMBLY DETAILS SEE RFW-108.

- REFERENCES:**
- BOVEE & CRAIG ISOMETRICS
RFW-41B-T8 REV 7
RFW-41B-13 REV 8
 - CBI NUCLEAR CO.
59, REV 3, N4 NOZZLE

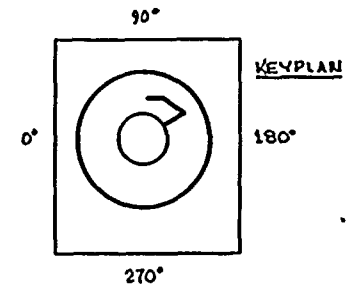

THIS DRAWING IS INTENDED FOR USE IN PRESERVE AND INSERVICE INSPECTION PROGRAMS ONLY.

QUALITY CLASS: 1 ASME CODE CLASS: 1
ENGR: D TIMMINS DRAWN: V MCLA DATE: 3-2-78


WASHINGTON PUBLIC POWER SUPPLY SYSTEM
ACME AND WASHINGTON 9032

NO	DATE	REVISION	BY	CHKD	APPVD	PIPING SYSTEM	NOM DIA (IN)	SCH	NOM WALL THK	MATERIAL SPECIFICATION	MATL TYPE	CAL BLOCK NO
4	12-2-85	REVISED AS NOTED ADDED KEYPLAN & LUGS	KJA	DR	JFH	12" RFW(1)-4	12	120	1.000	SA 106 GR B	CS	UT-15
3	12-2-81	REVISED AS NOTED	KJA	DR	JFH	LUGS	NA	NA	NA	SA 516 GR 70	CS	UT-46
2	8-30-79	ADDED NOTE 5.	KJA	DR	JFH							
1	1-10-79	CAL BLOCK REFERENCE CHANGED (NOTE 2)	KJA	DR	JFH							
0	11-27-78	ISSUED FOR USE	KJA	DR	JFH							
A	12-1-78	ISSUED FOR INFORMATION ONLY	KJA	DCS	DR							
NO	DATE	REVISION	BY	CHKD	APPVD							

WNP-2
WELD & COMPONENT
IDENTIFICATION DIAGRAM


TITLE:
REACTOR FEED WATER LINE AA

DWG NO: RFW-101-3 REV 4

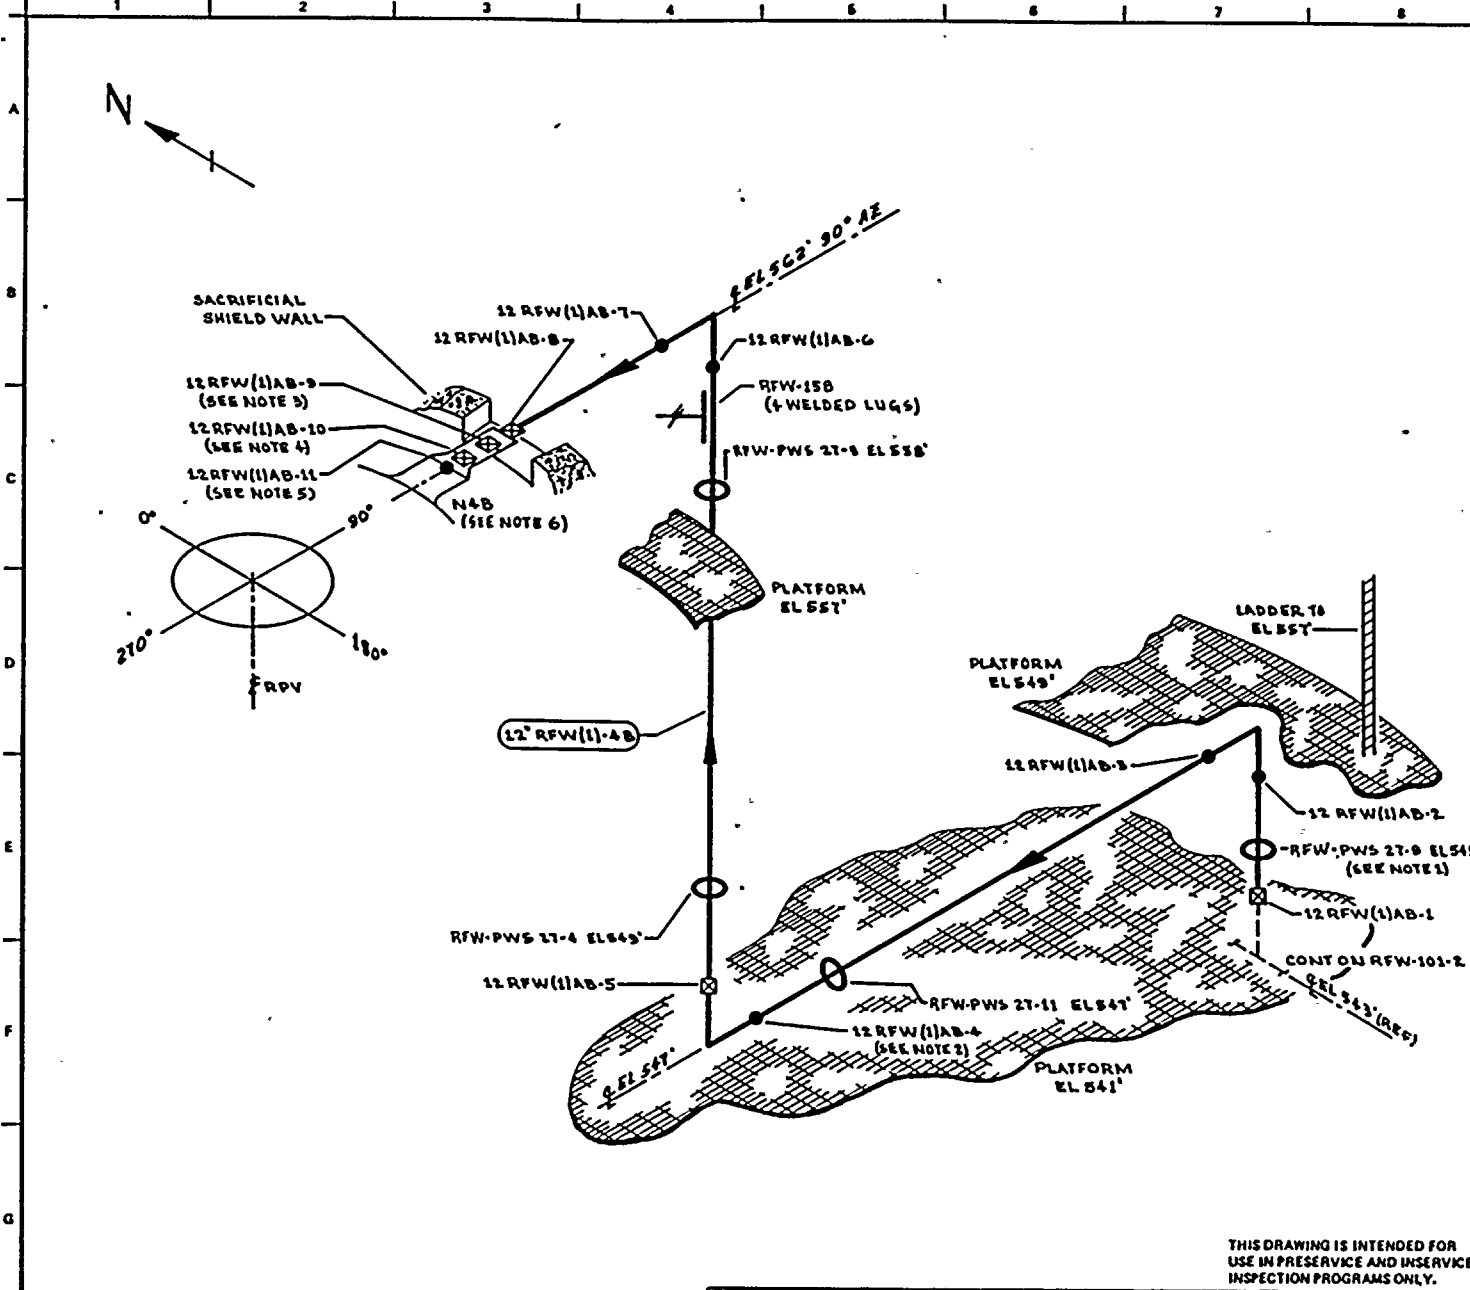

- NOTES:
1. ACCESS TO WELD 12 RFW(1)AB-2 REQUIRES REMOVAL OF RFW-PWS 27-9.
 2. ACCESS TO WELD 12 RFW(1)AB-4 REQUIRES REMOVAL OF RFW-PWS 27-11.
 3. WELD 12 RFW(1)AB-9 UTILIZES CAL BLOCK UT-106.
 4. WELD 12 RFW(1)AB-10 UTILIZES CAL BLOCK UT-105.
 5. WELD 12 RFW(1)AB-11 UTILIZES CAL BLOCK UT-102.
 6. FOR NOZZLE ASSEMBLY DETAILS SEE RPV-108.

REFERENCES:
 BOWER & CRAIG ISOMETRICS
 RFW-418-11.12 REV 7
 CBS NUCLEAR CO.
 59, REV 9, N4 NOZZLE

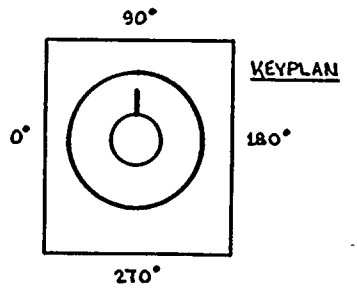

THIS DRAWING IS INTENDED FOR USE IN PRESERVICE AND INSERVICE INSPECTION PROGRAMS ONLY.


QUALITY CLASS: 1 ASME CODE CLASS: 1
 ENGR: D TIMMING DRAWN: K.M.C.A. DATE: 3-2-78


WASHINGTON PUBLIC POWER SUPPLY SYSTEM
 RICHLAND, WASHINGTON 98921

NO	DATE	REVISION	BY	CHKD	APPVD
4	10-17-78	ADDED RFW-15B & KEYPLAN	K.M.A.	DVT	RPV
3	12-2-81	REVISED AS NOTED	K.M.A.	DR	TRF
2	8-30-79	ADDED NOTE 6.	K.M.A.	DR	TRF
1	1-10-79	CAL BLOCK REFERENCE CHANGED (NOTE 3)	K.M.A.	DR	TRF
0	11-27-78	ISSUED FOR USE	K.M.A.	DR	TRF
A	4-21-78	ISSUED FOR INFORMATION ONLY	K.M.A.	DR	TRF

PIPING SYSTEM	NOM DIA (IN)	SCH	NOM WALL THK	MATERIAL SPECIFICATION	MATL TYPE	CAL BLOCK NO
12" RFW(1)-4	12	120	1.000	SA 106 GR B	CB	UT-15


WNP-2
 WELD & COMPONENT IDENTIFICATION DIAGRAM
 TITLE:
 REACTOR FEED WATER LINE AB-
 DWG NO: RFW-101-4 REV 4

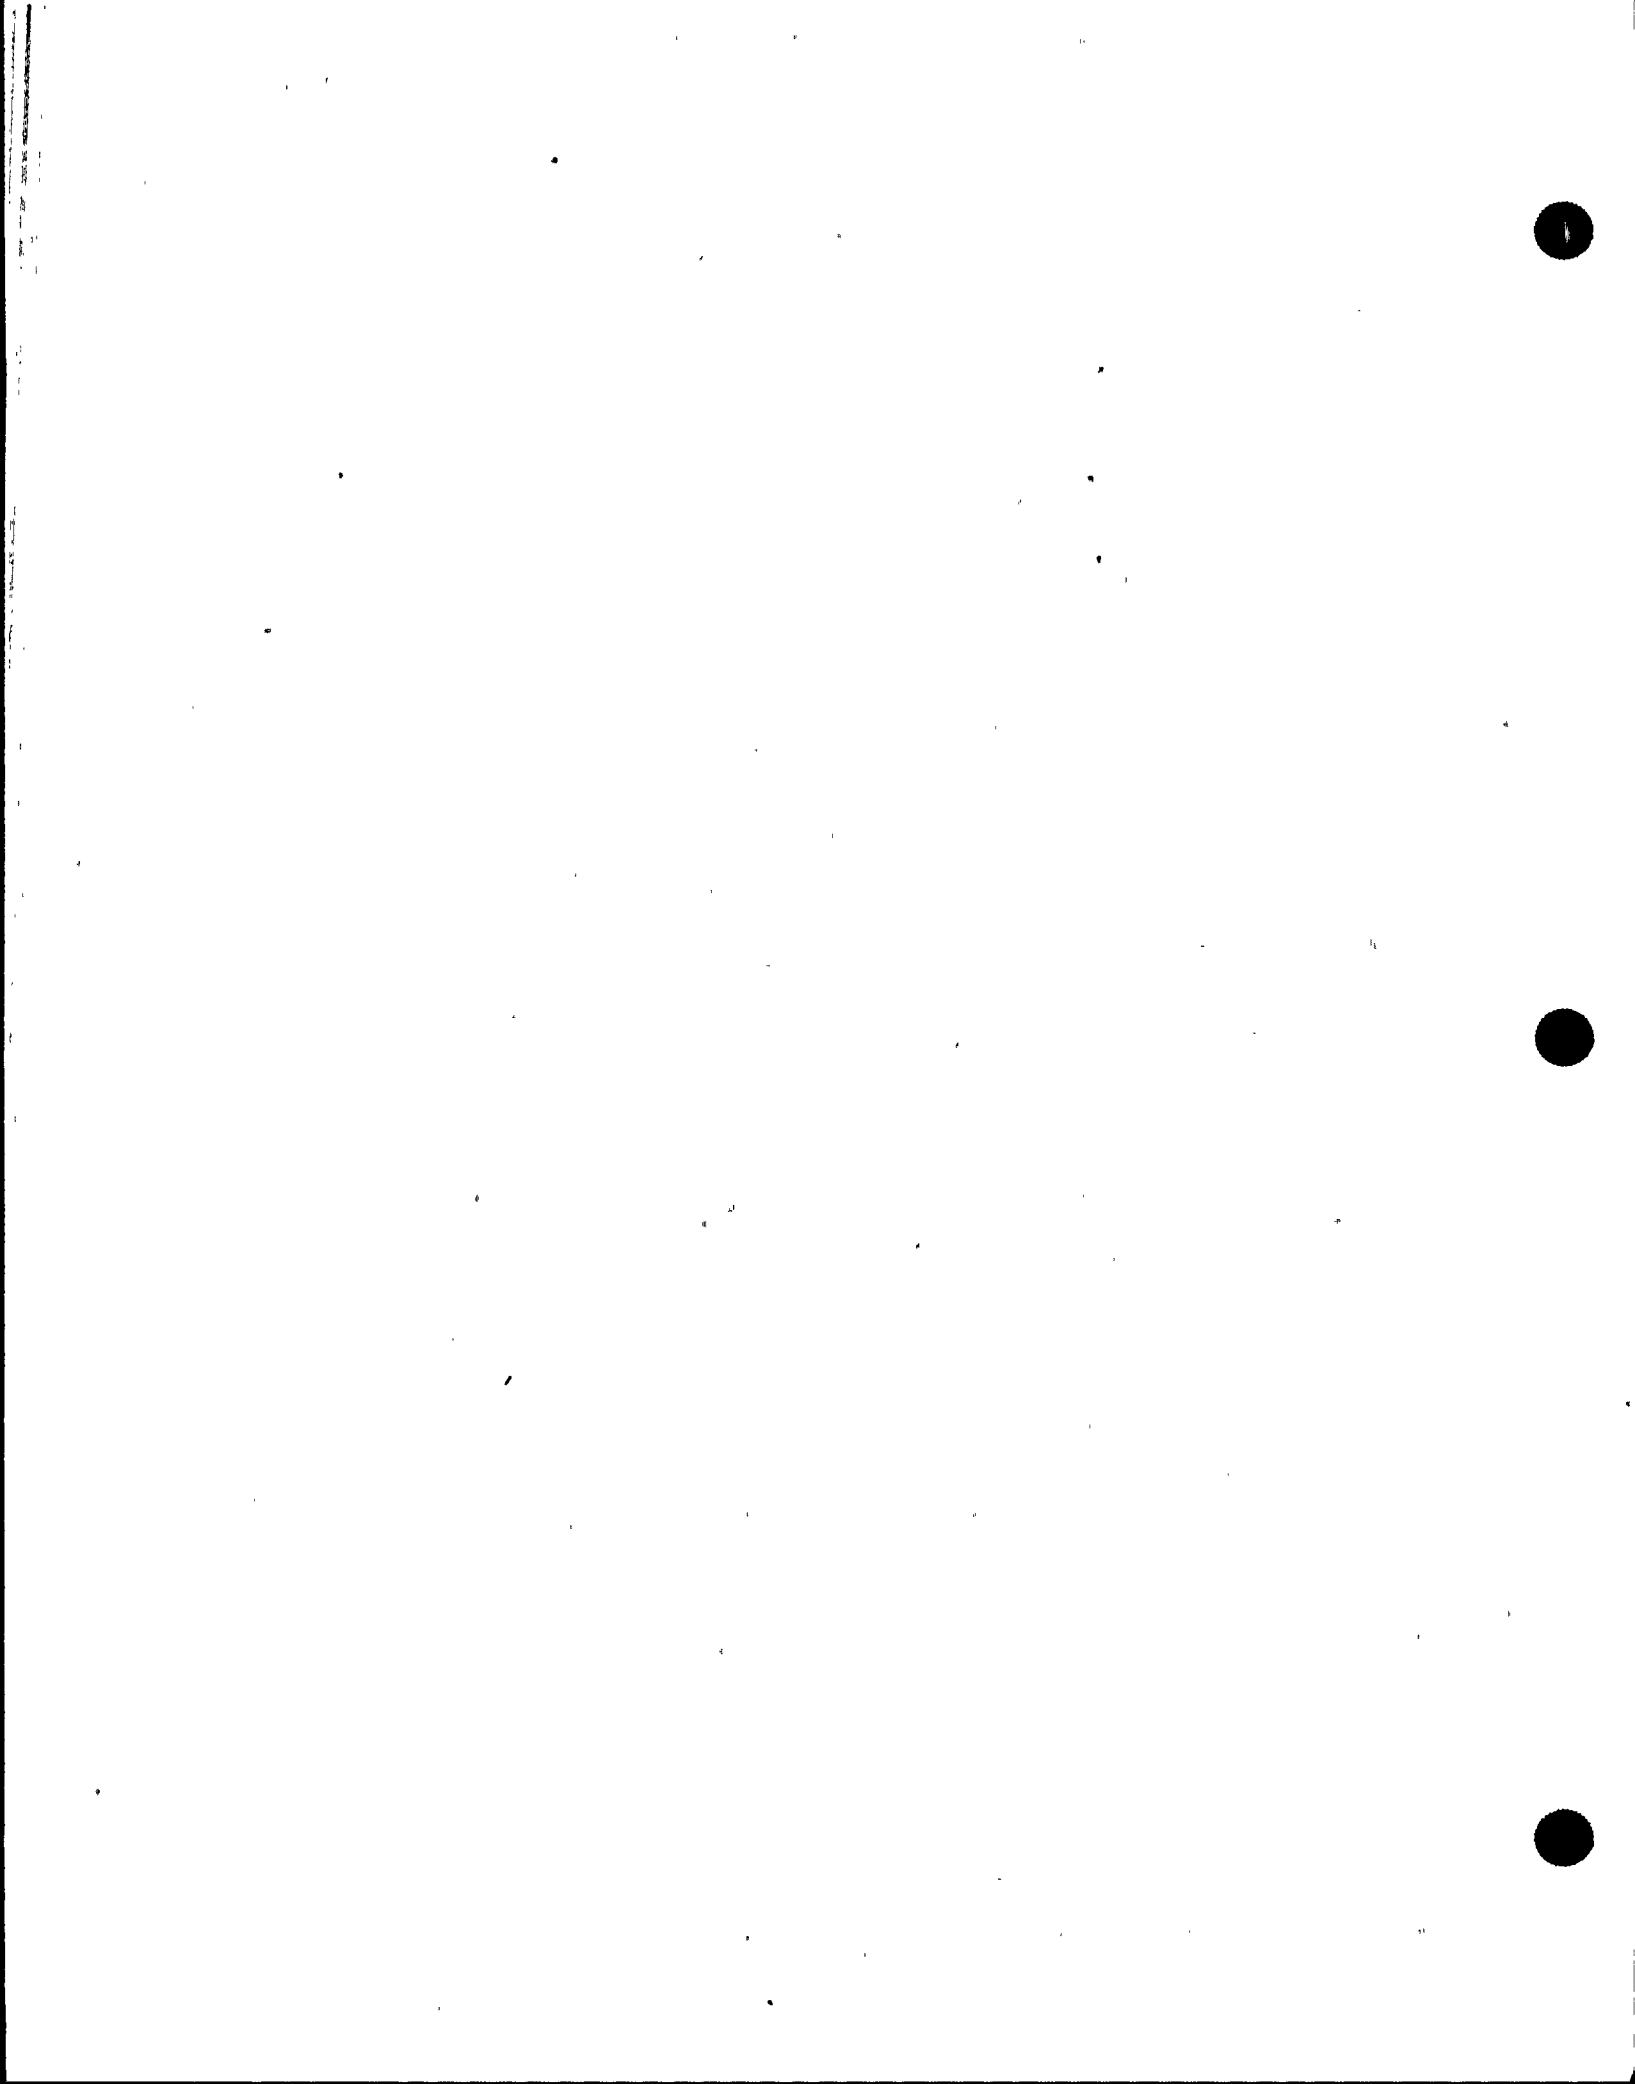

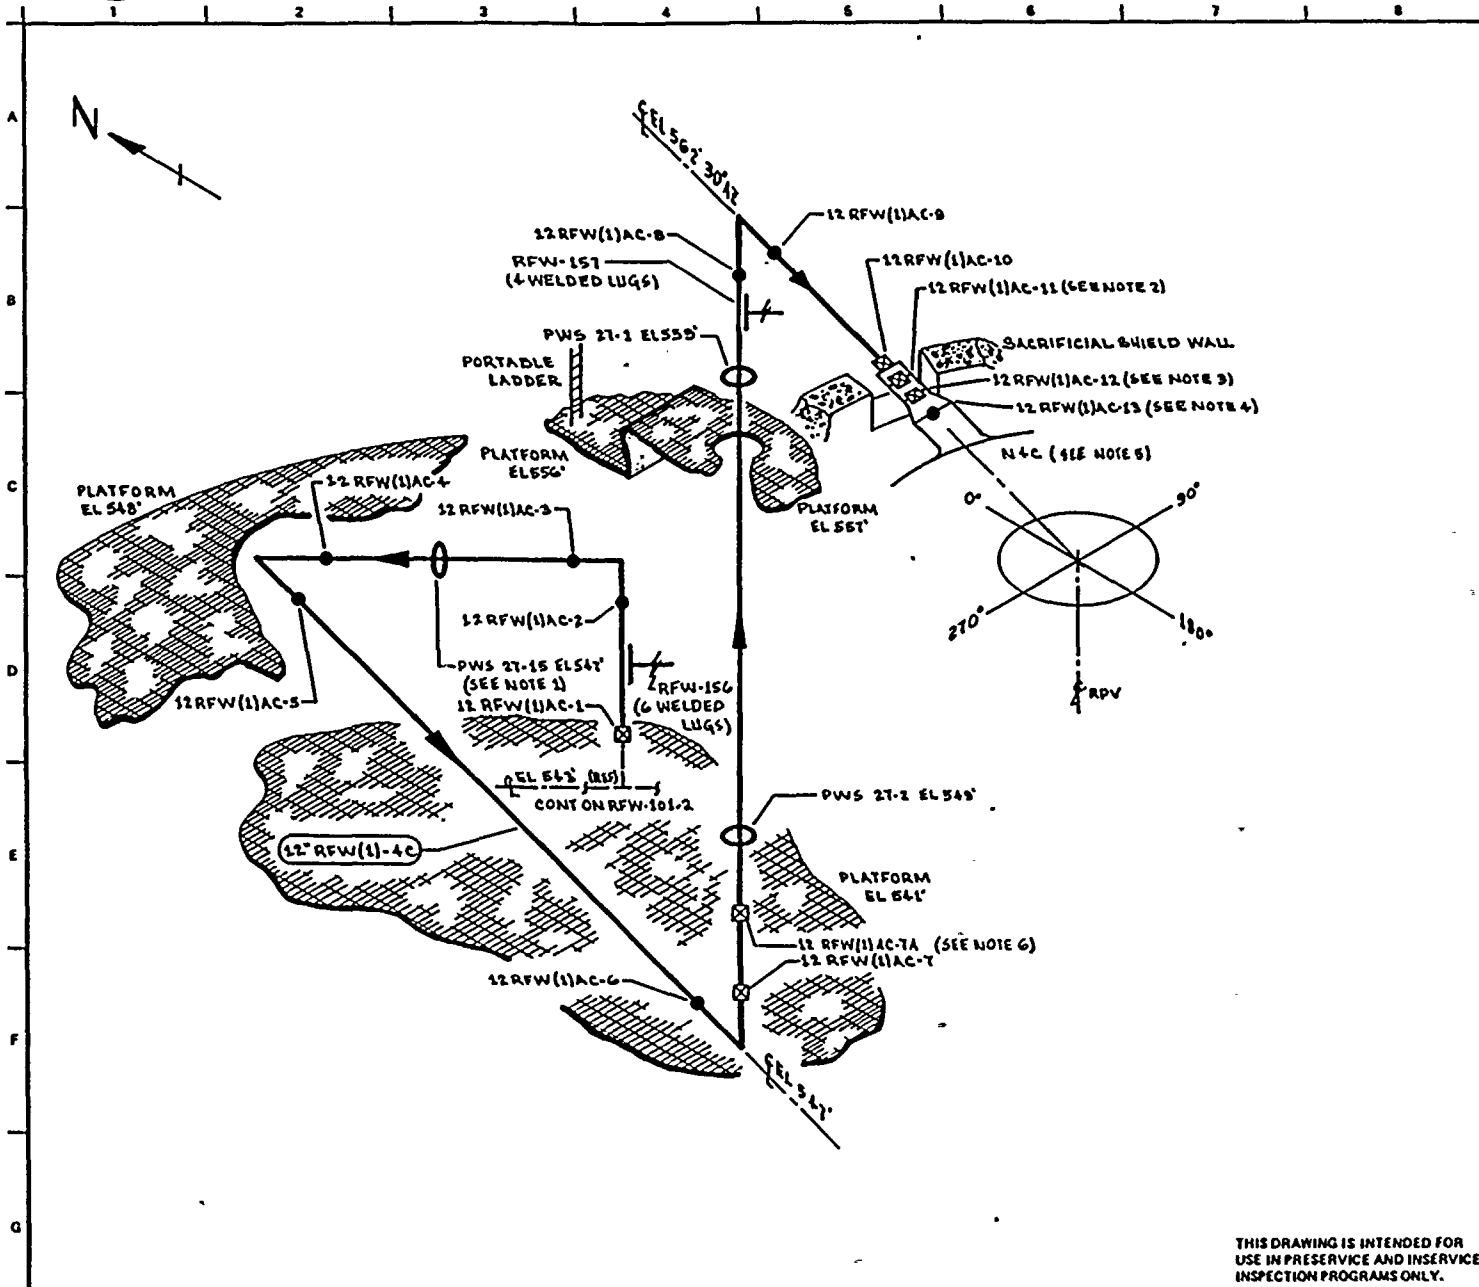

- NOTES:
1. ACCESS TO WELDS 12 RFW(1)AC-3 & 12 RFW(1)AC-4 REQUIRES REMOVAL OF PWS 27-15.
 2. WELD 12 RFW(1)AC-11 UTILIZES CAL BLOCK UT-106.
 3. WELD 12 RFW(1)AC-12 UTILIZES CAL BLOCK UT-105.
 4. WELD 12 RFW(1)AC-13 UTILIZES CAL BLOCK UT-102.
 5. FOR NOZZLE ASSEMBLY DETAILS SEE RPV-30B.
 6. ACCESS TO 12 RFW(1)AC-7A IS LIMITED BY PWS 27-2.

- REFERENCES:
- BOVEE & CRAIG ISOMETRIC
RFW-4-10-B.10 REV B
- CBI NUCLEAR CO.
59, REV D, N4 NOZZLE

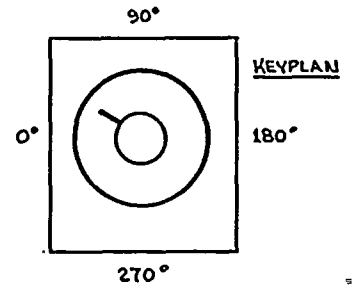

QUALITY CLASS: 1 ASME CODE CLASS: 1
ENGR: D TIMMINS DRAWN: V. M. A. DATE: 5-3-78



WASHINGTON PUBLIC POWER
SUPPLY SYSTEM

RICHLAND, WASHINGTON 99352


THIS DRAWING IS INTENDED FOR
USE IN PRESERVICE AND INSERVICE
INSPECTION PROGRAMS ONLY.

NO	DATE	REVISION	BY	CHKD	APPVD	PIPING SYSTEM	NOM DIA (IN)	SCH	NOM WALL THK	MATERIAL SPECIFICATION	MATL TYPE	CAL BLOCK NO
4	10-11-83	ADDED RFW-156, RFW-157, LUGS & KEYPLAN	K.M.A.	D.J.	R.P.	12" RFW(1)-4	12	120	1.000	SA 106 GR B	CS	UT-15
3	11-5-80	REVISED AS NOTED	K.M.A.	R.H.	D.W.	LUGS	NA	NA	NA	SA 516 GR 70	CS	UT-16
2	8-30-77	ADDED NOTE 5.	K.M.A.	R.H.	R.S.							
1	1-10-78	CAL BLOCK REFERENCE CHANGED (NOTE 2)	K.M.A.	R.H.	D.W.							
0	11-27-78	ISSUED FOR USE	K.M.A.	R.H.	D.W.							
A	4-21-75	ISSUED FOR INFORMATION ONLY	K.M.A.	D.J.	R.P.							
NO	DATE	REVISION	BY	CHKD	APPVD							

WNP-2
WELD & COMPONENT
IDENTIFICATION DIAGRAM


TITLE:
REACTOR FEED WATER LINE AC

DWG NO: RFW-101-B REV 4

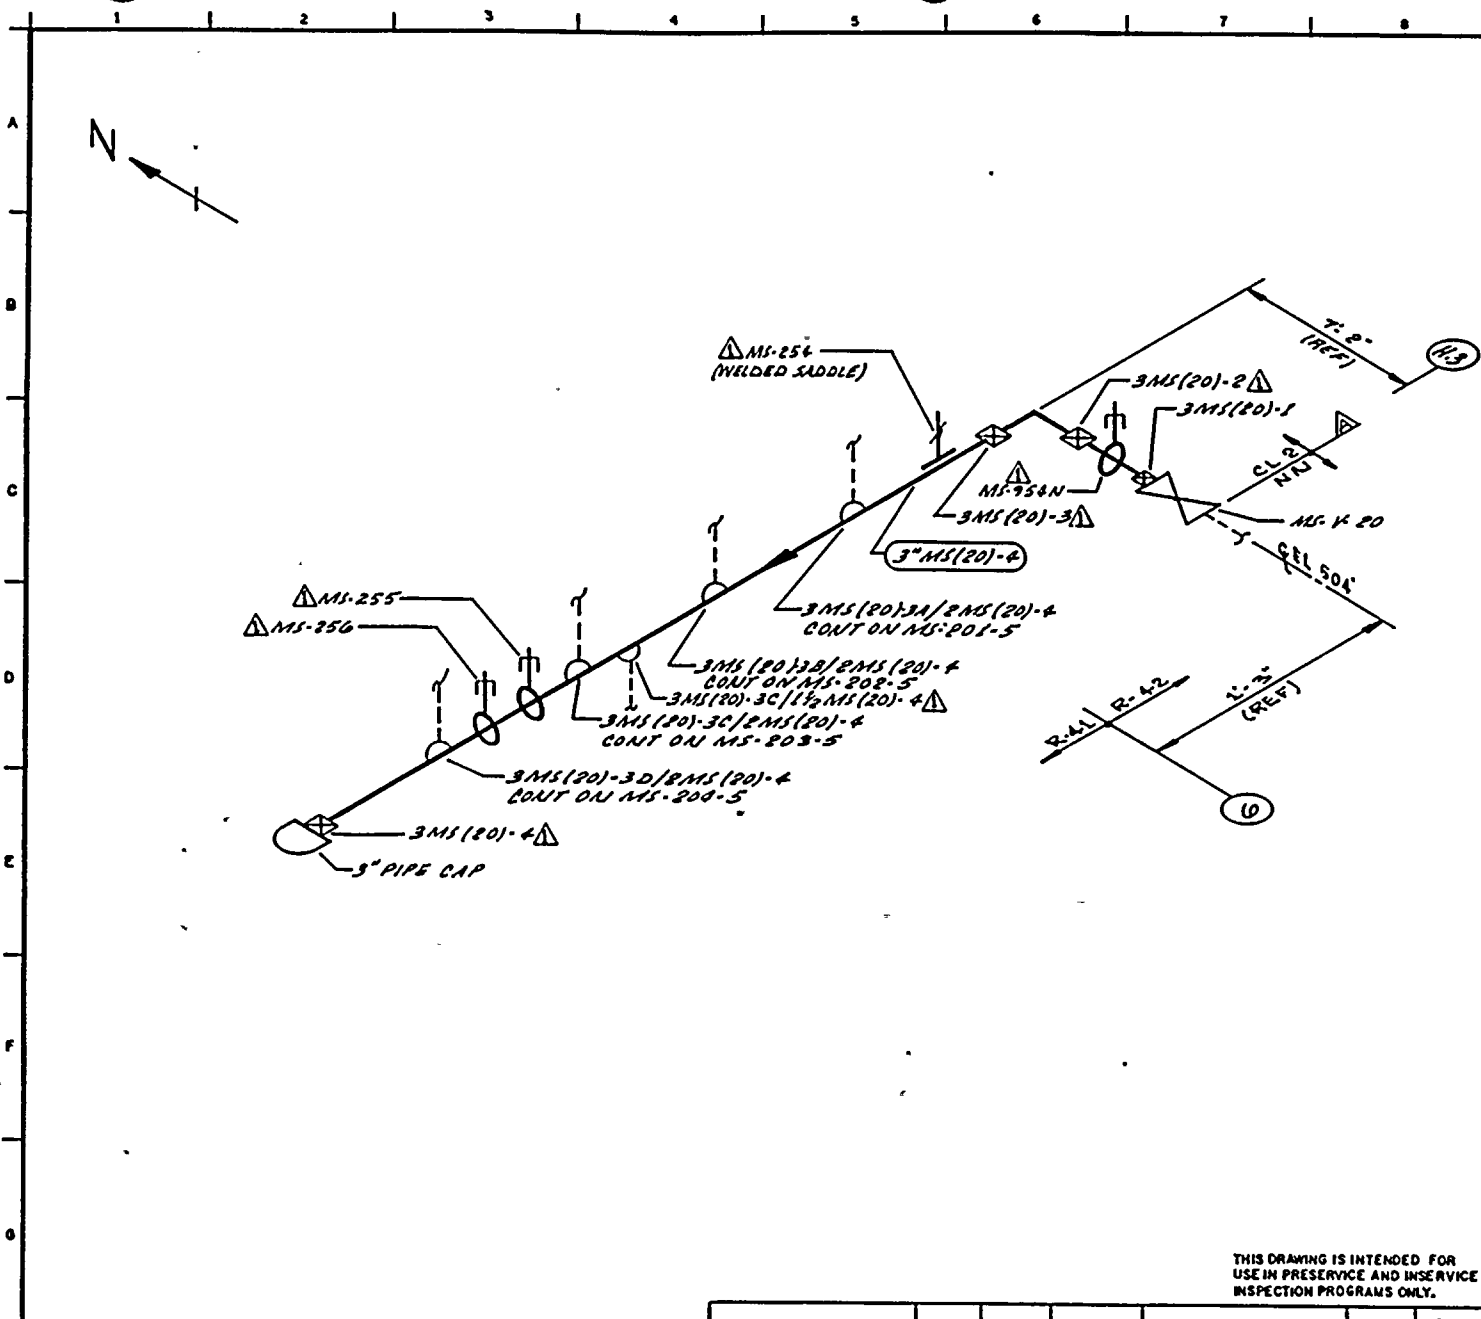

NOTES:
 1. THIS DWG. IDENTIFIES PIPING WELDS THAT REQUIRE AUGMENTED ISI.

REFERENCES:
 BOYCE CRAIG ISOMETRIC
 MS-582-5 REV 4

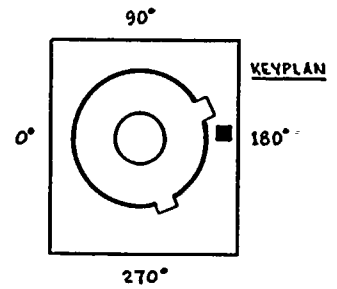

QUALITY CLASS: 1 ASME CODE CLASS: 2
 ENGR: *[Signature]* DRAWN: *[Signature]* DATE: 12-7-81

WASHINGTON PUBLIC POWER SUPPLY SYSTEM
 RICHLAND, WASHINGTON 99352

THIS DRAWING IS INTENDED FOR USE IN PRESERVICE AND INSERVICE INSPECTION PROGRAMS ONLY.

PIPING SYSTEM	NOM DIA (DN)	SCH	NOM WALL THK	MATERIAL SPECIFICATION	MATL TYPE	CAL BLOCK NO
3" MS(20)-4	3	160	0.438	SA 106 GR B	CS	42

WNP-2
 WELD & COMPONENT
 IDENTIFICATION DIAGRAM

TITLE:
 MAIN STREAM
 PRESSURE STABILIZATION LINE

DWG NO: MS-206 REV 1

NO	DATE	REVISION	BY	CHKD	APPVD
1	9-26-81	REVISED AS NOTED ADDED KEYPLAN	<i>[Signature]</i>	<i>[Signature]</i>	TFB
0	1/18/81	ISSUED FOR USE	<i>[Signature]</i>	<i>[Signature]</i>	TFB

WNP-02
 INTERVAL: PSI
 PERIOD: NA
 OUTAGE:
 DRAWING NO. MS-206

WASHINGTON PUBLIC POWER SUPPLY SYSTEM
 PROGRAM PLAN AND SCHEDULE
 SYSTEM OR COMPONENT: 3MS(20)-4
 DESCRIPTION: MS PRESS STAB. LINE

PAGE 001
 DATE 12/14/84

<u>IDENT. NO.</u>	<u>DESCRIPTION</u>	<u>SECT.</u> <u>XI</u>	<u>EXAM</u> <u>MTH.</u>	<u>PROCEDURE</u>	<u>CAL.</u> <u>BLOCK</u>	<u>INSERVICE</u>		<u>NOTES</u>
						<u>REQ.</u>	<u>SCHEDULED</u> <u>OUTAGE</u>	
3MS(20)-1	VALVE TO PIPE	N/A	VOL	UTP-10	UT-44			AUGMT
3MS(20)-2	PIPE TO EL	N/A	VOL	UTP-10	UT-44			AUGMT
3MS(20)-3	EL TO PIPE	N/A	VOL	UTP-10	UT-44			AUGMT
3MS(20)-4	PIPE TO CAP	N/A	VOL	UTP-10	UT-44			AUGMT



WNP-02
 INTERVAL: PSI
 PERIOD: NA
 OUTAGE:
 DRAWING NO. MS-205


WASHINGTON PUBLIC POWER SUPPLY SYSTEM
 PROGRAM PLAN AND SCHEDULE
 SYSTEM OR COMPONENT: MS(1)-4
 DESCRIPTION: MS HDR / BYPASS VLV

PAGE .001
 DATE 12/14/84

IDENT. NO.	DESCRIPTION	SECT. XI EXAM.	EXAM MTH.	PROCEDURE	CAL. BLOCK	INSERVICE		NOTES
						REQ.	SCHEDULED OUTAGE	
24MS(1)-1	CAP TO PIPE	C-F	VOL	UTP-10	UT-6			
			SUR	PTP-1				
MS-180	ROD	C-E-2	VT-3	303/8.2.17				
MS-180(S)	1 WELDED SADDLE	C-E-1	SUR	QCI 4-3				
24MS(1)-1/18MS(1)-4D	WOL TO PIPE	C-F	SUR	PTP-1				
24MS(1)-1/18MS(1)-4C	WOL TO PIPE	C-F	SUR	PTP-1				
MS-181	ROD	C-E-2	VT-3	303/8.2.17				
MS-181(S)	3 WELDED SADDLE	C-E-1	SUR	QCI 4-3				
24MS(1)-1/18MS(1)-4A	WOL TO PIPE	C-F	SUR	PTP-1				
24MS(1)-1/18MS(1)-4B	WOL TO PIPE	C-F	SUR	PTP-1				
MS-182	ROD	C-E-2	VT-3	303/8.2.17				
MS-182(S)	1 WELDED SADDLE	C-E-1	SUR	QCI 4-3				
24MS(1)-2	PIPE TO VALVE	C-F	VOL	UTP-10	UT-6			
			SUR	PTP-1				
MS-PB-205	MS PRES BNDRY	N/A	VT-2	N/A				

IWC-2510, SEE NOTES
 #6 & #7.



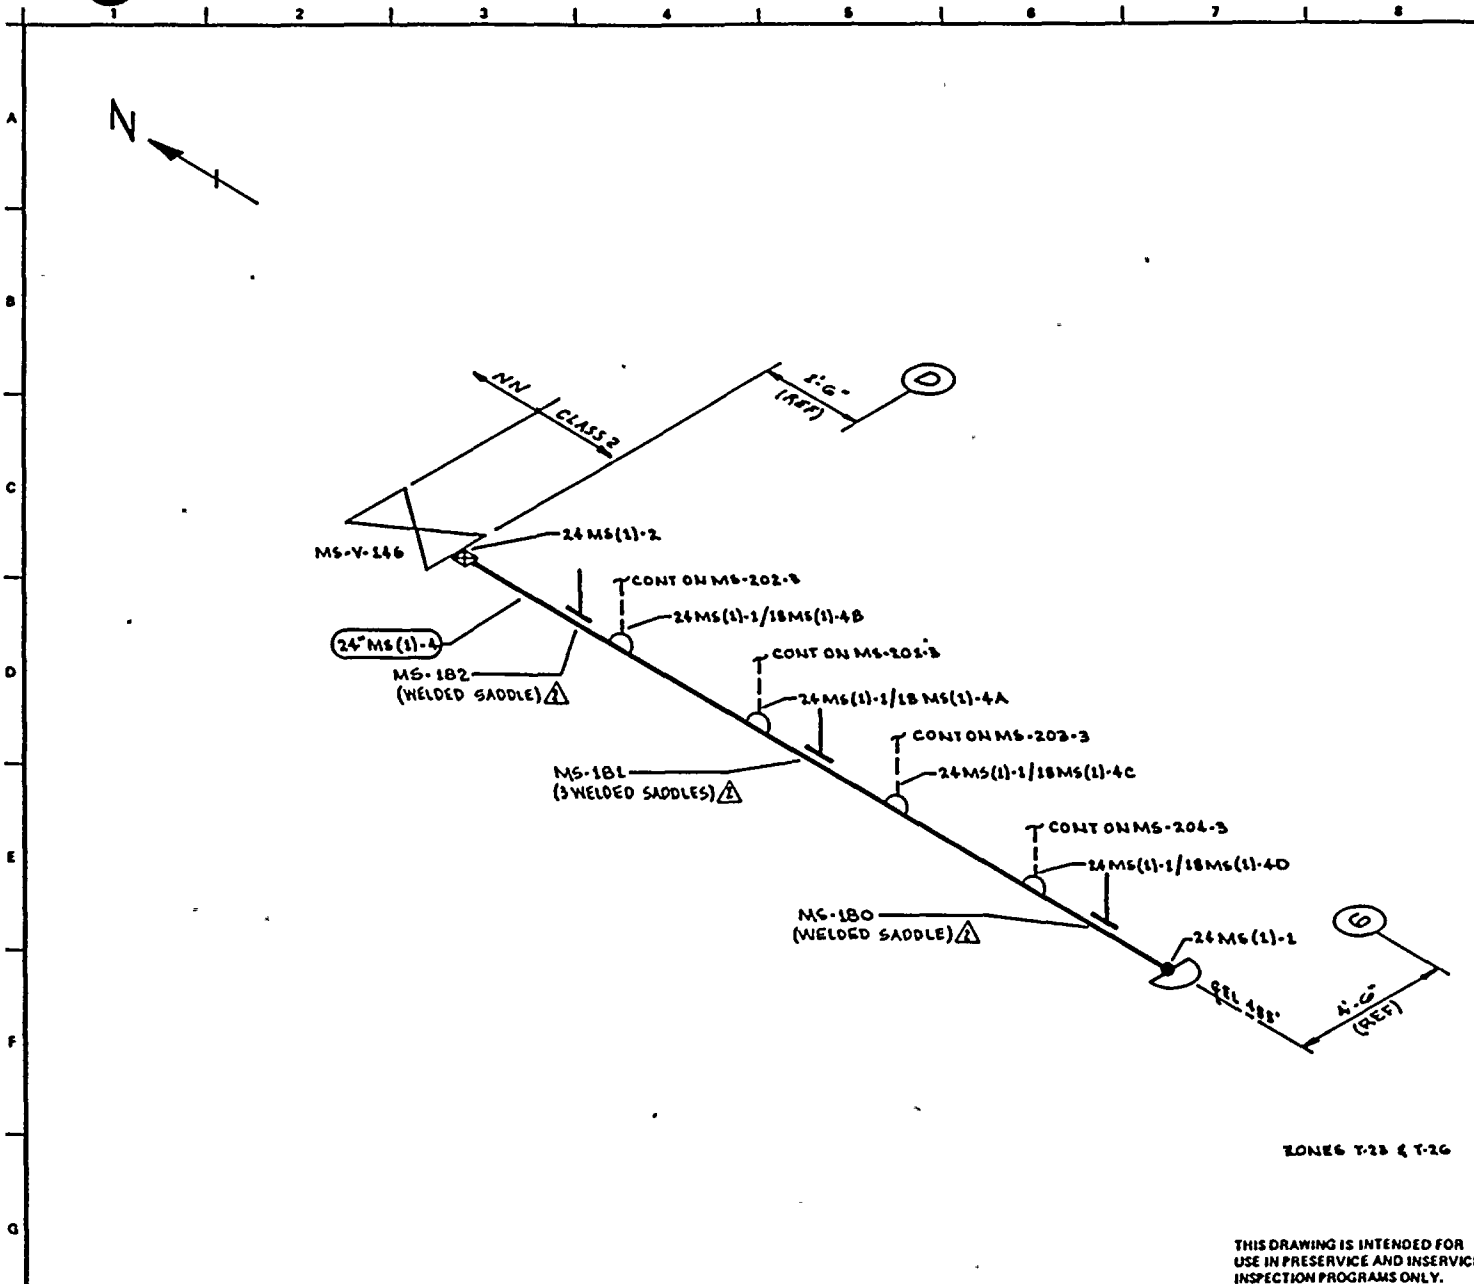


NOTES:

1. SCAFFOLDING IS REQUIRED.

REFERENCES:

BOVEE & CRAIG ISOMETRIC
MS-584-1 REV 4

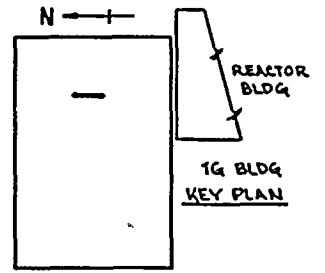

ZONES T-23 & T-26

THIS DRAWING IS INTENDED FOR
USE IN PRESERVICE AND INSERVICE
INSPECTION PROGRAMS ONLY.

QUALITY CLASS: 1	ASME CODE CLASS: 2
ENGR: D TIMMINS	DRAWN: V. M. A. DATE: 3-23-78


**WASHINGTON PUBLIC POWER
SUPPLY SYSTEM**
 RICHLAND, WASHINGTON 99352

WNP-2
 WELD & COMPONENT
 IDENTIFICATION DIAGRAM

TITLE:
MAIN STEAM HEADER

DWG NO: MS-205 REV 2

NO	DATE	REVISION	BY	CHKD	APPVD	PIPING SYSTEM	NOM DIA (IN)	SCH	NOM WALL THK	MATERIAL SPECIFICATION	MATL TYPE	CAL BLOCK NO
2	9-22-81	REVISED AS NOTED.	CMC	EPK	YFH	24" MS(1)-4	24	BO	1.218	SA 106 GR B	CS	UT-6
1	12-2-81	REVISED AS NOTED	CMC	EPK	YFH							
0	1-9-78	ISSUED FOR USE	CMC	EPK	YFH							
A	5-14-78	ISSUED FOR INFORMATION ONLY	CMC	EPK	YFH							



WNP-02
 INTERVAL: PSI
 PERIOD: NA
 OUTAGE:
 DRAWING NO. HS-204

WASHINGTON PUBLIC POWER SUPPLY SYSTEM
 PROGRAM PLAN AND SCHEDULE
 SYSTEM OR COMPONENT: 2MS(20)-4
 DESCRIPTION: MS PRESS STAR. LINE

PAGE 018
 DATE 12/14/84

<u>IDENT. NO.</u>	<u>DESCRIPTION</u>	<u>SECT.</u> <u>XI</u>	<u>EXAM</u> <u>MTH.</u>	<u>PROCEDURE</u>	<u>CAL.</u> <u>BLOCK</u>	<u>INSERVICE</u>		<u>NOTES</u>
						<u>REQ.</u>	<u>SCHEDULED</u> <u>OUTAGE</u>	
2MS(20)D-1	SOL TO PIPE	N/A	SUR	PTP-1				AUGMT
2MS(20)D-2	PIPE TO EL	N/A	SUR	PTP-1				AUGMT
2MS(20)D-3	EL TO PIPE	N/A	SUR	PTP-1				AUGMT
2MS(20)D-4	PIPE TO TEE	N/A	SUR	PTP-1				AUGMT
2MS(20)D-5	TEE TO RED	N/A	SUR	PTP-1				AUGMT
2MS(20)D-6	TEE TO PIPE	N/A	SUR	PTP-1				AUGMT
2MS(20)D-7	PIPE TO SOL	N/A	SUR	PTP-1				AUGMT

WNP-02
 INTERVAL: PSI
 PERIOD: NA
 OUTAGE:
 DRAWING NO. MS-204

WASHINGTON PUBLIC POWER SUPPLY SYSTEM
 PROGRAM PLAN AND SCHEDULE
 SYSTEM OR COMPONENT: MS(1)-4
 DESCRIPTION: MAIN STEAM LINE D

PAGE 017
 DATE 12/14/84

IDENT. NO.	DESCRIPTION	SECT. XI EXAM.	EXAM MTH.	PROCEDURE	CAL. BLOCK	INSERVICE		NOTES
						REQ.	SCHEDULED OUTAGE	
30MS(1)D-26LU	PIPE LONG SEAM	C-F	VOL	UTP-10	UT-1			
30MS(1)D-26	PIPE TO REDUCER	C-F	VOL	UTP-10	UT-1			
28MS(1)D-1	REDUCER TO PIPE	C-F	VOL	UTP-10	UT-2			
MS-PB-204	MS PRES BNDRY	N/A	VT-2	N/A				

IUC-2510, SEE NOTES
 #6 & #7.

WNP-02
 INTERVAL: PSI
 PERIOD: NA
 OUTAGE:
 DRAWING NO. MS-204

WASHINGTON PUBLIC POWER SUPPLY SYSTEM
 PROGRAM PLAN AND SCHEDULE
 SYSTEM OR COMPONENT: MS(1)-4
 DESCRIPTION: MAIN STEAM LINE D

PAGE 016
 DATE 12/14/84

IDENT. NO.	DESCRIPTION	SECT. XI EXAM.	EXAM MTH.	PROCEDURE	CAL. BLOCK	INSERVICE		NOTES
						REQ.	SCHEDULED OUTAGE	
6MS(1)D-1/2ND(1)-2	DRAIN CONN	N/A	VT-2	N/A				IWC-2510, SEE NOTES #6 & #7.
6MS(1)D-2	CAP TO PIPE	C-F	SUR	PTP-1				
MS-1012S	PSA-1/4 SNUBBER	C-E-2	VT-3	303/8.2.17				S/N 314, LOCATED BY MS-V-119D.
			VT-4	303/8.2.17				S/N 314, LOCATED BY MS-V-119D.
-6MS(1)D-2/3/4V-119D	DRAIN CONN	N/A	VT-2	N/A				IWC-2510, SEE NOTES #6 & #7.
30MS(1)D-24LU	PIPE LONG SEAM	C-F	VOL	UTP-10	UT-1			
			SUR	PTP-1				
30MS(1)D-24	PIPE TO EL	C-F	VOL	UTP-10	UT-1			
			SUR	PTP-1				
30MS(1)D-24LD0	EL SEAM	C-F	VOL	UTP-10	UT-1			
			SUR	PTP-1				
30MS(1)D-25LU0	EL SEAM	C-F	VOL	UTP-10	UT-1			
			SUR	PTP-1				
30MS(1)D-25	EL TO PIPE	C-F	VOL	UTP-10	UT-1			
			SUR	PTP-1				
30MS(1)D-25LD	PIPE LONG SEAM	C-F	VOL	UTP-10	UT-1			

WNF-02
 INTERVAL: PSI
 PERIOD: NA
 OUTAGE:
 DRAWING NO. MS-204

WASHINGTON PUBLIC POWER SUPPLY SYSTEM
 PROGRAM PLAN AND SCHEDULE
 SYSTEM OR COMPONENT: MS(1)-4
 DESCRIPTION: MAIN STEAM LINE D

PAGE 015
 DATE 12/14/84

IDENT. NO.	DESCRIPTION	SECT. XI EXAM.	EXAM MTH.	PROCEDURE	CAL. DLGCK	INSERVICE		NOTES
						REQ.	SCHEDULED OUTAGE	
30MS(1)D-23LD	PIPE LONG SEAM	C-F	VOL	UTP-10	UT-1			
			SUR	PTP-1				
30MS(1)D-23/3/4V-707D	INSTR CONN	N/A	VT-2	N/A				IWC-2510, SEE NOTES #6 & #7.
30MS(1)D-23/1TX-10	INSTR CONN	N/A	VT-2	N/A				IWC-2510, SEE NOTES #6 & #7.
30MS(1)D-23/1TE-10	INSTR CONN	N/A	VT-2	N/A				IWC-2510, SEE NOTES #6 & #7.
MS-50	SPRING	C-E-2	VT-3	303/8.2.17				
			VT-4	303/8.2.17				
30MS(1)D-23/6MS(1)-4	WOL TO PIPE	C-F	SUR	PTP-1				
6MS(1)D-1	PIPE TO WOL	C-F	SUR	PTP-1				
MS-1011S	PSA-1/4 SNURBER	C-E-2	VT-3	303/8.2.17				S/N 277, LOCATED ON LS-24D.
			VT-4	303/8.2.17				S/N 277, LOCATED ON LS-24D.
6MS(1)D-1/1LS-24DD	INSTR CONN	N/A	VT-2	N/A				IWC-2510, SEE NOTES #6 & #7.
6MS(1)D-2/1LS-24DU	INSTR CONN	N/A	VT-2	N/A				IWC-2510, SEE NOTES #6 & #7.

WNP-02
 INTERVAL: PSI
 PERIOD: NA
 OUTAGE:
 DRAWING NO. MS-204

WASHINGTON PUBLIC POWER SUPPLY SYSTEM
 PROGRAM PLAN AND SCHEDULE
 SYSTEM OR COMPONENT: MS(1)-4
 DESCRIPTION: MAIN STEAM LINE D

IDENT. NO.	DESCRIPTION	SECT. XI EXAM.	EXAM MTH.	PROCEDURE	CAL. BLOCK	INSERVICE		NOTES
						REQ.	SCHEDULED OUTAGE	
30MS(1)D-21LD	PIPE LONG SEAM	C-F	VOL	UTP-10	UT-1			
MS-51(W)	4 WELDED LUGS	C-E-1	SUR	PTP-1				
MS-51	SPRING (?)	C-E-2	VT-3	303/8.2.17				
MS-1005N	PSA-35 SNUBBER	C-E-2	VT-3	303/8.2.17				S/N 9257
30MS(1)D-22LU	PIPE LONG SEAM	C-F	VOL	UTP-10	UT-1			S/N 9257
30MS(1)D-22	PIPE TO EL	C-F	VOL	UTP-10	UT-1			
30MS(1)D-22LD0	EL SEAM	C-F	VOL	UTP-10	UT-1			
30MS(1)D-23LU0	EL SEAM	C-F	VOL	UTP-10	UT-1			
30MS(1)D-23	EL TO PIPE	C-F	VOL	UTP-10	UT-1			

WNP-02
 INTERVAL: PSI
 PERIOD: NA
 OUTAGE:
 DRAWING NO. MS-204

WASHINGTON PUBLIC POWER SUPPLY SYSTEM
 PROGRAM PLAN AND SCHEDULE
 SYSTEM OR COMPONENT: MS(1)-4
 DESCRIPTION: MAIN STEAM LINE D

PAGE 013
 DATE 12/14/84

<u>IDENT. NO.</u>	<u>DESCRIPTION</u>	<u>SECT.</u> <u>XI</u> <u>EXAM.</u>	<u>EXAM</u> <u>MTW.</u>	<u>PROCEDURE</u>	<u>CAL.</u> <u>BLOCK</u>	<u>INSERVICE</u>		<u>NOTES</u>
						<u>REQ.</u>	<u>SCHEDULED</u> <u>OUTAGE</u>	
30MS(1)D-19LD	PIPE LONG SEAM	C-F	VOL	UTP-10	UT-1			
			SUR	PTP-1				
30MS(1)D-19/1V-706D	INSTR CONN	N/A	VT-2	N/A				IWC-2510, SEE NOTES #6 & #7.
MS-53	PSA-35 SN(2)	C-E-2	VT-3	303/8.2.17				S/N E3010/W2
			VT-4	303/8.2.17				S/N E3010/W2
MS-54	PSA-10 SNURBER	C-E-2	VT-3	303/8.2.17				S/N 1494
			VT-4	303/8.2.17				S/N 1494
30MS(1)D-20LU	PIPE LONG SEAM	C-F	VOL	UTP-10	UT-1			
			SUR	PTP-1				
30MS(1)D-20	PIPE TO EL	C-F	VOL	UTP-10	UT-1			
			SUR	PTP-1				
30MS(1)D-20LDO	EL SEAM	C-F	VOL	UTP-10	UT-1			
			SUR	PTP-1				
30MS(1)D-21LUO	EL SEAM	C-F	VOL	UTP-10	UT-1			
			SUR	PTP-1				
30MS(1)D-21	EL TO PIPE	C-F	VOL	UTP-10	UT-1			

WPP-02
 INTERVAL: PSI
 PERIOD: NA
 OUTAGE:
 DRAWING NO. MS-204

WASHINGTON PUBLIC POWER SUPPLY SYSTEM
 PROGRAM PLAN AND SCHEDULE
 SYSTEM OR COMPONENT: MS(1)-4
 DESCRIPTION: MAIN STEAM LINE D

PAGE 012
 DATE 12/14/84

IDENT. NO.	DESCRIPTION	SECT. XI EXAM.	EXAM MTH.	PROCEDURE	CAL. BLOCK	INSERVICE		NOTES
						REQ.	OUTAGE	
18MS(1)D-6	PIPE TO EL	C-F	VT-4 VOL	303/8.2.17 UTP-10	UT-12			
18MS(1)D-7	EL TO PIPE	C-F	SUR VOL	PTP-1 UTP-10	UT-12			
18MS(1)D-8	PIPE TO VOL	C-F	SUR VOL	PTP-1 UTP-10	UT-12			
30MS(1)D-18LU	PIPE SEAM	C-F	SUR VOL	PTP-1 UTP-10	UT-1			
30MS(1)D-18	PIPE TO PIPE	C-F	SUR VOL	PTP-1 UTP-10	UT-1			
30MS(1)D-18LD	PIPE LONG SEAM	C-F	SUR VOL	PTP-1 UTP-10	UT-1			
MS-55	SPRING (2)	C-E-2	VT-3 VT-4	303/8.2.17 303/8.2.17				
30MS(1)D-19LU	PIPE LONG SEAM	C-F	SUR VOL	PTP-1 UTP-10	UT-1			
30MS(1)D-19	PIPE TO PIPE	C-F	SUR VOL	PTP-1 UTP-10	UT-1			

WNP-02
 INTERVAL: PSI
 PERIOD: NA
 OUTAGE:
 DRAWING NO. MS-204

WASHINGTON PUBLIC POWER SUPPLY SYSTEM
 PROGRAM PLAN AND SCHEDULE
 SYSTEM OR COMPONENT: MS(1)-4
 DESCRIPTION: MAIN STEAM LINE D

PAGE 011
 DATE 12/14/84

IDENT. NO.	DESCRIPTION	SECT. XI EXAM.	EXAM MIN.	PROCEDURE	CAL. BLOCK	INSERVICE		NOTES
						REQ.	SCHEDULED OUTAGE	
MS-56	PSA-10 SN(2)	C-E-2	VT-3	303/8.2.17				S/N 9896/9907
			VT-4	303/8.2.17				S/N 9896/9907
30MS(1)D-16/18MS(1)-4	PIPE TO WOL	C-F	SUR	PTP-1				
18MS(1)D-1	WOL TO PIPE	C-F	VOL	UTP-10	UT-12			
			SUR	PTP-1				
18MS(1)D-2	PIPE TO EL	C-F	VOL	UTP-10	UT-12			
			SUR	PTP-1				
18MS(1)D-3	EL TO PIPE	C-F	VOL	UTP-10	UT-12			
			SUR	PTP-1				
18MS(1)D-4	PIPE TO EL	C-F	VOL	UTP-10	UT-12			
			SUR	PTP-1				
18MS(1)D-4A	EL TO EL	C-F	VOL	UTP-10	UT-12			
			SUR	PTP-1				
MS-86	PSA-3 SNUBBER	C-E-2	VT-3	303/8.2.17				S/N 625
			VT-4	303/8.2.17				S/N 625
18MS(1)D-5	EL TO PIPE	C-F	VOL	UTP-10	UT-12			
			SUR	PTP-1				
MS-87	SPRING	C-E-2	VT-3	303/8.2.17				

WNP-02
 INTERVAL: PSI
 PERIOD: NA
 OUTAGE:
 DRAWING NO. MS-204

WASHINGTON PUBLIC POWER SUPPLY SYSTEM
 PROGRAM PLAN AND SCHEDULE
 SYSTEM OR COMPONENT: MS(1)-4
 DESCRIPTION: MAIN STEAM LINE D

PAGE 010
 DATE 12/14/84

IDENT. NO.	DESCRIPTION	SECT.	EXAM	PROCEDURE	CAL.	INSERVICE		NOTES
		XI	MIH.		BLOCK	REQ.	SCHEDULED	
MS-59(S)		EXAM.				OUTAGE		
30MS(1)D-15LU	1 WELDED SADDLE	C-E-1	SUR	MTP-1				
	PIPE LONG SEAM	C-F	VOL	UTP-10	UT-1			
			SUR	PTP-1				
30MS(1)D-15	PIPE TO EL	C-F	VOL	UTP-10	UT-1			
			SUR	PTP-1				
30MS(1)D-15LDO	EL SEAM	C-F	VOL	UTP-10	UT-1			
			SUR	PTP-1				
30MS(1)D-16LUO	EL SEAM	C-F	VOL	UTP-10	UT-1			
			SUR	PTP-1				
30MS(1)D-16	EL TO PIPE	C-F	VOL	UTP-10	UT-1			
			SUR	PTP-1				
30MS(1)D-16LD	PIPE LONG SEAM	C-F	VOL	UTP-10	UT-1			
			SUR	PTP-1				
MS-58	SPRING (2)	C-E-2	VT-3	303/8.2.17				
			VT-4	303/8.2.17				
MS-57	PSA-3 SN(2)	C-E-2	VT-3	303/8.2.17				S/N 284/294
			VT-4	303/8.2.17				S/N 284/294

WNP-02
 INTERVAL: PSI
 PERIOD: NA
 OUTAGE:
 DRAWING NO. MS-204

WASHINGTON PUBLIC POWER SUPPLY SYSTEM
 PROGRAM PLAN AND SCHEDULE
 SYSTEM OR COMPONENT: MS(1)-4
 DESCRIPTION: MAIN STEAM LINE D

PAGE 009
 DATE 12/14/84

<u>IDENT. NO.</u>	<u>DESCRIPTION</u>	<u>SECT.</u> <u>YI</u> <u>EXAM.</u>	<u>EXAM</u> <u>MIN.</u>	<u>PROCEDURE</u>	<u>CAL.</u> <u>BLOCK</u>	<u>INSERVICE</u> <u>SCHEDULED</u>		<u>NOTES</u>
						<u>REQ.</u>	<u>OUTAGE</u>	
30MS(1)D-12LDO	EL SEAM	C-F	VOL	UTP-10	UT-1			
			SUR	PTP-1				
30MS(1)D-13LUO	EL SEAM	C-F	VOL	UTP-10	UT-1			
			SUR	PTP-1				
30MS(1)D-13	EL TO PIPE	C-F	VOL	UTP-10	UT-1			
			SUR	PTP-1				
30MS(1)D-13LD	PIPE LONG SEAM	C-F	VOL	UTP-10	UT-1			
			SUR	PTP-1				
MS-61	STRUT	C-E-2	VT-3	303/8.2.17				
MS-61(S)	1 WELDED SADDLE	C-E-1	SUR	MTP-1				
30MS(1)D-14LU	PIPE LONG SEAM	C-F	VOL	UTP-10	UT-1			
			SUR	PTP-1				
30MS(1)D-14	PIPE TO PIPE	C-F	VOL	UTP-10	UT-1			
			SUR	PTP-1				
30MS(1)D-14LD	PIPE LONG SEAM	C-F	VOL	UTP-10	UT-1			
			SUR	PTP-1				
MS-1009N	RIGID	C-E-2	VT-3	303/8.2.17				
MS-59	STRUT	C-E-2	VT-3	303/8.2.17				

WNP-02
 INTERVAL: PSI
 PERIOD: NA
 OUTAGE:
 DRAWING NO. MS-204

WASHINGTON PUBLIC POWER SUPPLY SYSTEM
 PROGRAM PLAN AND SCHEDULE
 SYSTEM OR COMPONENT: MS(1)-4
 DESCRIPTION: MAIN STEAM LINE D

PAGE 002
 DATE 12/14/84

IDENT. NO.	DESCRIPTION	SECT. XI EXAM.	EXAM MTH.	PROCEDURE	CAL. BLOCK	INSERVICE		NOTES
						REQ.	SCHEDULED OUTAGE	
30MS(1)D-1CLO	PIPE LONG SEAM	C-F	VOL	UTP-10	UT-1			
			SUR	PTP-1				
MS-63	SPRING (2)	C-E-2	VT-3	303/8.2.17				
			VT-4	303/8.2.17				
MS-906N	PSA-3 SN(2)	C-E-2	VT-3	303/8.2.17				S/N E4486/W450
			VT-4	303/8.2.17				S/N E4486/W450
30MS(1)D-11LU	PIPE LONG SEAM	C-F	VOL	UTP-10	UT-1			
			SUR	PTP-1				
30MS(1)D-11	PIPE TO PIPE	C-F	VOL	UTP-10	UT-1			
			SUR	PTP-1				
30MS(1)D-11LD	PIPE LONG SEAM	C-F	VOL	UTP-10	UT-1			
			SUR	PTP-1				
MS-62	SPRING (2)	C-E-2	VT-3	303/8.2.17				
			VT-4	303/8.2.17				
30MS(1)D-12LU	PIPE LONG SEAM	C-F	VOL	UTP-10	UT-1			
			SUR	PTP-1				
30MS(1)D-12	PIPE TO EL	C-F	VOL	UTP-10	UT-1			
			SUR	PTP-1				

WNP-02
 INTERVAL: PSI
 PERIOD: NA
 OUTAGE:
 DRAWING NO. MS-204

WASHINGTON PUBLIC POWER SUPPLY SYSTEM
 PROGRAM PLAN AND SCHEDULE
 SYSTEM OR COMPONENT: MS(1)-4
 DESCRIPTION: MAIN STEAM LINE D

PAGE 007
 DATE 12/14/84

IDENT. NO.	DESCRIPTION	SECT. XI EXAM.	EXAM MTH.	PROCEDURE	CAL. BLOCK	INSERVICE		NOTES
						REQ.	SCHEDULED OUTAGE	
30MS(1)D-9LD	PIPE LONG SEAM	C-F	VOL	UTP-10	UT-1			
			SUR	PTP-1				
30MS(1)D-9ALU	PIPE LONG SEAM	C-F	VOL	UTP-10	UT-1			
			SUR	PTP-1				
30MS(1)D-9A	PIPE TO PIPE	C-F	VOL	UTP-10	UT-1			
			SUR	PTP-1				
30MS(1)D-9ALD	PIPE LONG SEAM	C-F	VOL	UTP-10	UT-1			
			SUR	PTP-1				
MS-1010N(W)	8 WFLDED LUGS	C-E-1	SUR	MTP-1				
MS-1010N	PSA-10 SN(2)	C-E-2	VT-3	303/8.2.17				S/N 693/1454
			VT-4	303/8.2.17				S/N 693/1454
MS-65	STRUT	C-E-2	VT-3	303/8.2.17				
MS-1006N	PSA-3 SN(2)	C-E-2	VT-3	303/8.2.17				S/N 4462/4440
			VT-4	303/8.2.17				S/N 4462/4440
30MS(1)D-10LU	PIPE LONG SEAM	C-F	VOL	UTP-10	UT-1			
			SUR	PTP-1				
30MS(1)D-10	PIPE TO PIPE	C-F	VOL	UTP-10	UT-1			
			SUR	PTP-1				

WHP-02
 INTERVAL: PSI
 PERIOD: NA
 OUTAGE:
 DRAWING NO. MS-204

WASHINGTON PUBLIC POWER SUPPLY SYSTEM
 PROGRAM PLAN AND SCHEDULE
 SYSTEM OR COMPONENT: MS(1)-4
 DESCRIPTION: MAIN STEAM LINE D

PAGE 006
 DATE 12/14/84

<u>IDENT. NO.</u>	<u>DESCRIPTION</u>	<u>SECT.</u> <u>XI</u>	<u>EYAM</u> <u>EYAM.</u>	<u>PROCEDURE</u>	<u>CAL.</u> <u>BLOCK</u>	<u>INSERVICE</u>		<u>NOTES</u>
						<u>REQ.</u>	<u>SCHEDULED</u> <u>OUTAGE</u>	
MS-66	SPRING (2)	C-E-2	VT-3	303/8.2.17				
			VT-4	303/8.2.17				
30MS(1)D-7LU	PIPE LONG SEAM	C-F	VOL	UTP-10	UT-1			
			SUR	PTP-1				
30MS(1)D-7	PIPE TO EL	C-F	VOL	UTP-10	UT-1			
			SUR	PTP-1				
30MS(1)D-7L00	EL SEAM	C-F	VOL	UTP-10	UT-1			
			SUR	PTP-1				
30MS(1)D-8LU0	EL SEAM	C-F	VOL	UTP-10	UT-1			
			SUR	PTP-1				
30MS(1)D-8	EL TO PIPE	C-F	VOL	UTP-10	UT-1			
			SUR	PTP-1				
30MS(1)D-8LD	PIPE LONG SEAM	C-F	VOL	UTP-10	UT-1			
			SUR	PTP-1				
30MS(1)D-9LU	PIPE LONG SEAM	C-F	VOL	UTP-10	UT-1			
			SUR	PTP-1				
30MS(1)D-9	PIPE TO PIPE	C-F	VOL	UTP-10	UT-1			
			SUR	PTP-1				

WNP-02
 INTERVAL: PSI
 PERIOD: NA
 OUTAGE:
 DRAWING NO. MS-204

WASHINGTON PUBLIC POWER SUPPLY SYSTEM
 PROGRAM PLAN AND SCHEDULE
 SYSTEM OR COMPONENT: MS(1)-4
 DESCRIPTION: MAIN STEAM LINE D

PAGE 005
 DATE 12/14/84

IDENT. NO.	DESCRIPTION	SECT. XI EXAM.	EXAM MTH.	PROCEDURE	CAL. BLOCK	INSERVICE		NOTES
						REQ.	SCHEDULED OUTAGE	
30MS(1)D-5LD	PIPE LONG SEAM	C-F	VOL	UTP-10	UT-1			
			SUR	PTP-1				
30MS(1)D-5/3MD(16)-4	DRAIN CONN	N/A	VT-2	N/A				SEE NOTES #6 & #7.
MS-69	SPRING	C-E-2	VT-3	303/8.2.17				
			VT-4	303/8.2.17				
MS-908N	PSA-35 SN(2)	C-E-2	VT-3	303/8.2.17				S/N 6092/6094
			VT-4	303/8.2.17				S/N 6092/6094
MS-908N(S)	1 WELDED SADDLE	C-E-1	SUR	MTP-1				
30MS(1)D-6LU	PIPE LONG SEAM	C-F	VOL	UTP-10	UT-1			
			SUR	PTP-1				
30MS(1)D-6	PIPE TO PIPE	C-F	VOL	UTP-10	UT-1			
			SUR	PTP-1				
30MS(1)D-6LD	PIPE LONG SEAM	C-F	VOL	UTP-10	UT-1			
			SUR	PTP-1				
MS-1007N	PSA-10 SN(2)	C-E-2	VT-3	303/8.2.17				S/N 708/289
			VT-4	303/8.2.17				S/N 708/289
MS-1007N(W)	8 WELDED LUGS	C-E-1	SUR	MTP-1				
MS-68	STRUT	C-F-2	VT-3	303/8.2.17				

WMP-02
 INTERVAL: PSI
 PERIOD: NA
 OUTAGE:
 DRAWING NO. MS-204

WASHINGTON PUBLIC POWER SUPPLY SYSTEM
 PROGRAM PLAN AND SCHEDULE
 SYSTEM OR COMPONENT: MS(1)-4
 DESCRIPTION: MAIN STEAM LINE D

PAGE 004
 DATE 12/14/84

IDENT. NO.	DESCRIPTION	SECT. XI EXAM.	EXAM MTH.	PROCEDURE	CAL. BLOCK	INSERVICE		NOTES
						REG.	SCHEDULED OUTAGE	
30MS(1)D-3LU0	EL SEAM	C-F	VOL	UTP-10	UT-1			
30MS(1)D-3	EL TO PIPE	C-F	VOL	UTP-10	UT-1			
30MS(1)D-3LD	PIPE LONG SEAM	C-F	VOL	UTP-10	UT-1			
FWS-315-10	PIPE WHIP	N/A	N/A	N/A				
30MS(1)D-4LU	PIPE LONG SEAM	C-F	VOL	UTP-10	UT-1			
30MS(1)D-4	PIPE TO EL	C-F	VOL	UTP-10	UT-1			
30MS(1)D-4LD0	EL SEAM	C-F	VOL	UTP-10	UT-1			
30MS(1)D-5LU0	EL SEAM	C-F	VOL	UTP-10	UT-1			
30MS(1)D-5	EL TO PIPE	C-F	VOL	UTP-10	UT-1			

WNP-02
 INTERVAL: PSI
 PERIOD: NA
 OUTAGE:
 DRAWING NO. MS-204

WASHINGTON PUBLIC POWER SUPPLY SYSTEM
 PROGRAM PLAN AND SCHEDULE
 SYSTEM OR COMPONENT: MS(1)-4
 DESCRIPTION: MAIN STEAM LINE D

PAGE 003
 DATE 12/14/84

<u>IDENT. NO.</u>	<u>DESCRIPTION</u>	<u>SECT.</u> <u>XI</u> <u>EXAM.</u>	<u>EYAM</u> <u>MTH.</u>	<u>PROCEDURE</u>	<u>CAL.</u> <u>BLOCK</u>	<u>INSERVICE</u>		<u>NOTES</u>
						<u>REQ.</u>	<u>SCHEDULED</u> <u>OUTAGE</u>	
MS-71	SPRING	C-E-2	VT-3	303/8.2.17				
			VT-4	303/8.2.17				
MS-71(H)	2 WELDED LUGS	C-E-1	SUR	MTP-1				
26MS(1)D-22LU	PIPE LONG SEAM	C-F	VOL	UTP-10	UT-3			
			SUR	PTP-1				
26MS(1)D-22	PIPE TO REDUCER	C-F	VOL	UTP-10	UT-3			
			SUR	PTP-1				
30MS(1)D-1	REDUCER TO PIPE	C-F	VOL	UTP-10	UT-1			
			SUR	PTP-1				
30MS(1)D-1LD	PIPE LONG SEAM	C-F	VOL	UTP-10	UT-1			
			SUR	PTP-1				
PWS-315-8	PIPE WHIP	N/A	N/A	N/A				
30MS(1)D-2LU	PIPE LONG SEAM	C-F	VOL	UTP-10	UT-1			
			SUR	PTP-1				
30MS(1)D-2	PIPE TO EL	C-F	VOL	UTP-10	UT-1			
			SUR	PTP-1				
30MS(1)D-2LD0	EL SEAM	C-F	VOL	UTP-10	UT-1			

WNP-02
 INTERVAL: PSI
 PERIOD: MA
 OUTAGE:
 DRAWING NO. MS-204

WASHINGTON PUBLIC POWER SUPPLY SYSTEM
 PROGRAM PLAN AND SCHEDULE
 SYSTEM OR COMPONENT: MS(1)-4
 DESCRIPTION: MAIN STEAM LINE D

PAGE 002
 DATE 12/14/84


IDENT. NO.	DESCRIPTION	SECT. XI EXAM.	EXAM MTH.	PROCEDURE	CAL. BLOCK	INSERVICE		NOTES
						REQ.	SCHEDULED OUTAGE	
MS-72	PSA-35 SNURBER	C-E-2	VT-3	303/8.2.17				S/N 8691
			VT-4	303/8.2.17				S/N 8691
PWS-315-4	PIPE WHIP	N/A	N/A	N/A				
26MS(1)D-20LU	PIPE LONG SEAM	C-F	VOL	UTP-10	UT-3			
			SUR	PTP-1				
26MS(1)D-20	PIPE TO EL	C-F	VOL	UTP-10	UT-3			
			SUR	PTP-1				
26MS(1)D-20LDI	EL SEAM	C-F	VOL	UTP-10	UT-3			
			SUR	PTP-1				
26MS(1)D-20LDO	EL SEAM	C-F	VOL	UTP-10	UT-3			
			SUR	PTP-1				
26MS(1)D-21LUI	EL SEAM	C-F	VOL	UTP-10	UT-3			
			SUR	PTP-1				
26MS(1)D-21LUO	EL SEAM	C-F	VOL	UTP-10	UT-3			
			SUR	PTP-1				
26MS(1)D-21	EL TO PIPE	C-F	VOL	UTP-10	UT-3			
			SUR	PTP-1				
26MS(1)D-21LD	PIPE LONG SEAM	C-F	VOL	UTP-10	UT-3			

WNP-02
 INTERVAL: PSI
 PERIOD: NA
 OUTAGE:
 DRAWING NO. MS-204

WASHINGTON PUBLIC POWER SUPPLY SYSTEM
 PROGRAM PLAN AND SCHEDULE
 SYSTEM OR COMPONENT: MS(1)-4
 DESCRIPTION: MAIN STEAM LINE D


PAGE 001
 DATE 12/14/84

<u>IDENT. NO.</u>	<u>DESCRIPTION</u>	<u>SECT.</u> <u>XI</u> <u>EXAM.</u>	<u>CXAM</u> <u>HTH.</u>	<u>PROCEDURE</u>	<u>CAL.</u> <u>BLOCK</u>	<u>INSERVICE</u>		<u>NOTES</u>
						<u>REQ.</u>	<u>SCHEDULED</u> <u>OUTAGE</u>	
26MS(1)D-18	VALVE TO PIPE	C-F	VOL	UTP-10	UT-3			AUGMT
			SUR	PTP-1				AUGMT
26MS(1)D-18LD	PIPE LONG SEAM	C-F	VOL	UTP-10	UT-3			
			SUR	PTP-1				
26MS(1)D-18/3/4CAP	CAPPED CONN	N/A	VT-2	N/A				IWC-2510, SEE NOTES #6 & #7.
26MS(1)D-18/3/4V-47	TEST CONN	N/A	VT-2	N/A				IWC-2510, SEE NOTES #6 & #7.
MS-74	SPRING	C-E-2	VT-3	303/R.2.17				
			VT-4	303/R.2.17				
26MS(1)D-19LU	PIPE LONG SEAM	C-F	VOL	UTP-10	UT-3			
			SUR	PTP-1				
26MS(1)D-19	PIPE TO PIPE	C-F	VOL	UTP-10	UT-3			AUGMT
			SUR	PTP-1				AUGMT
26MS(1)D-19LD	PIPE LONG SEAM	C-F	VOL	UTP-10	UT-3			
			SUR	PTP-1				
26MS(1)D-19/3V-20	DRAIN CONN	N/A	SUR	PTP-1				IWC-2510, AUGMT.
26MS(1)D-19/3/4V-744D	INSTR CONN	N/A	VT-2	N/A				IWC-2510, SEE NOTES #6 & #7.

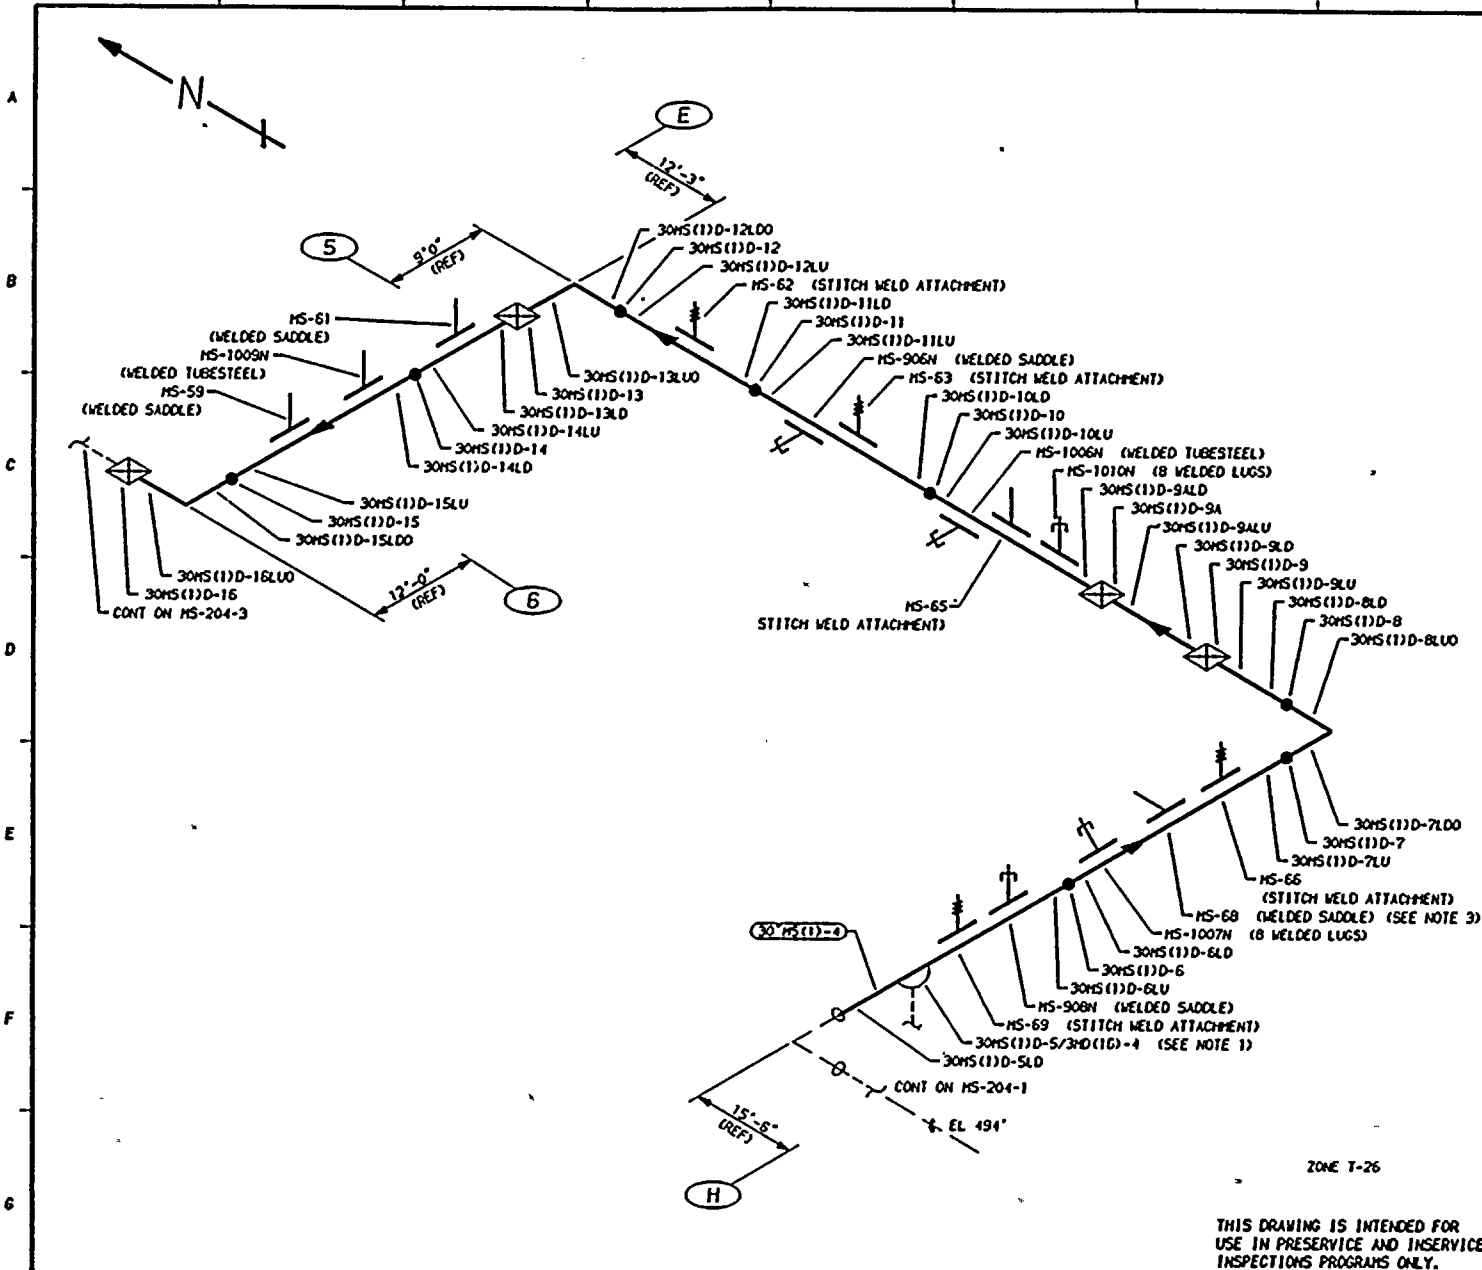

- NOTES**
1. EXTEND LEAKAGE EXAM THROUGH DRAINAGE SYSTEM TO VALVES MS-V-72 & MS-V-73.
 2. SCAFFOLDING IS REQUIRED.
 3. THERE ARE FOUR ABANDONED LUGS BETWEEN MS-68 AND MS-1007N THAT DO NOT REQUIRE EXAMINATION.

REFERENCES:
BOYCE AND CRAIL ISOMETRIC
MS-531-4.6 REV 5

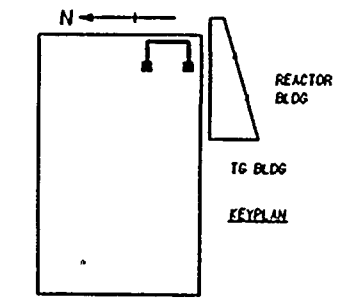

QUALITY CLASS: 1 ASME CODE CLASS: 2
ENGR: D TIMMINS DRAWN: K-MCA DATE: 2-17-78

WASHINGTON PUBLIC POWER
SUPPLY SYSTEM
RICHLAND, WASHINGTON 99352


WNP-2
WELD & COMPONENT
IDENTIFICATION DIAGRAM

TITLE: MAIN STEAM LINE D


DWG NO. MS-204-2 REV 3

THIS DRAWING IS INTENDED FOR
USE IN PRESERVICE AND INSERVICE
INSPECTIONS PROGRAMS ONLY.

NO	DATE	REVISION	BY	CHKD	APVD	PIPING SYSTEM	NOM DIA (IN)	SCH	NOM WALL THK	MATERIAL SPECIFICATION	MATL TYPE	CAL BLOCK NO
3	11-13-83	GENERAL UP-DATE REDRAWN	K-MCA	DPK	TFH	30"MS(1)-4	30	XXX	1.25	SA 155 CL 1 KCF 70	CS	UT-1
2	12-2-81	REVISED AS NOTED	K-MCA	DPR	TFH							
1	11-5-80	REVISED AS NOTED	K-MCA	TFH	D&P							
0	1-9-79	ISSUED FOR USE	K-MCA	TFH	D&P							
A	4-20-78	ISSUED FOR INFORMATION ONLY	K-MCA	DC1	D&P							

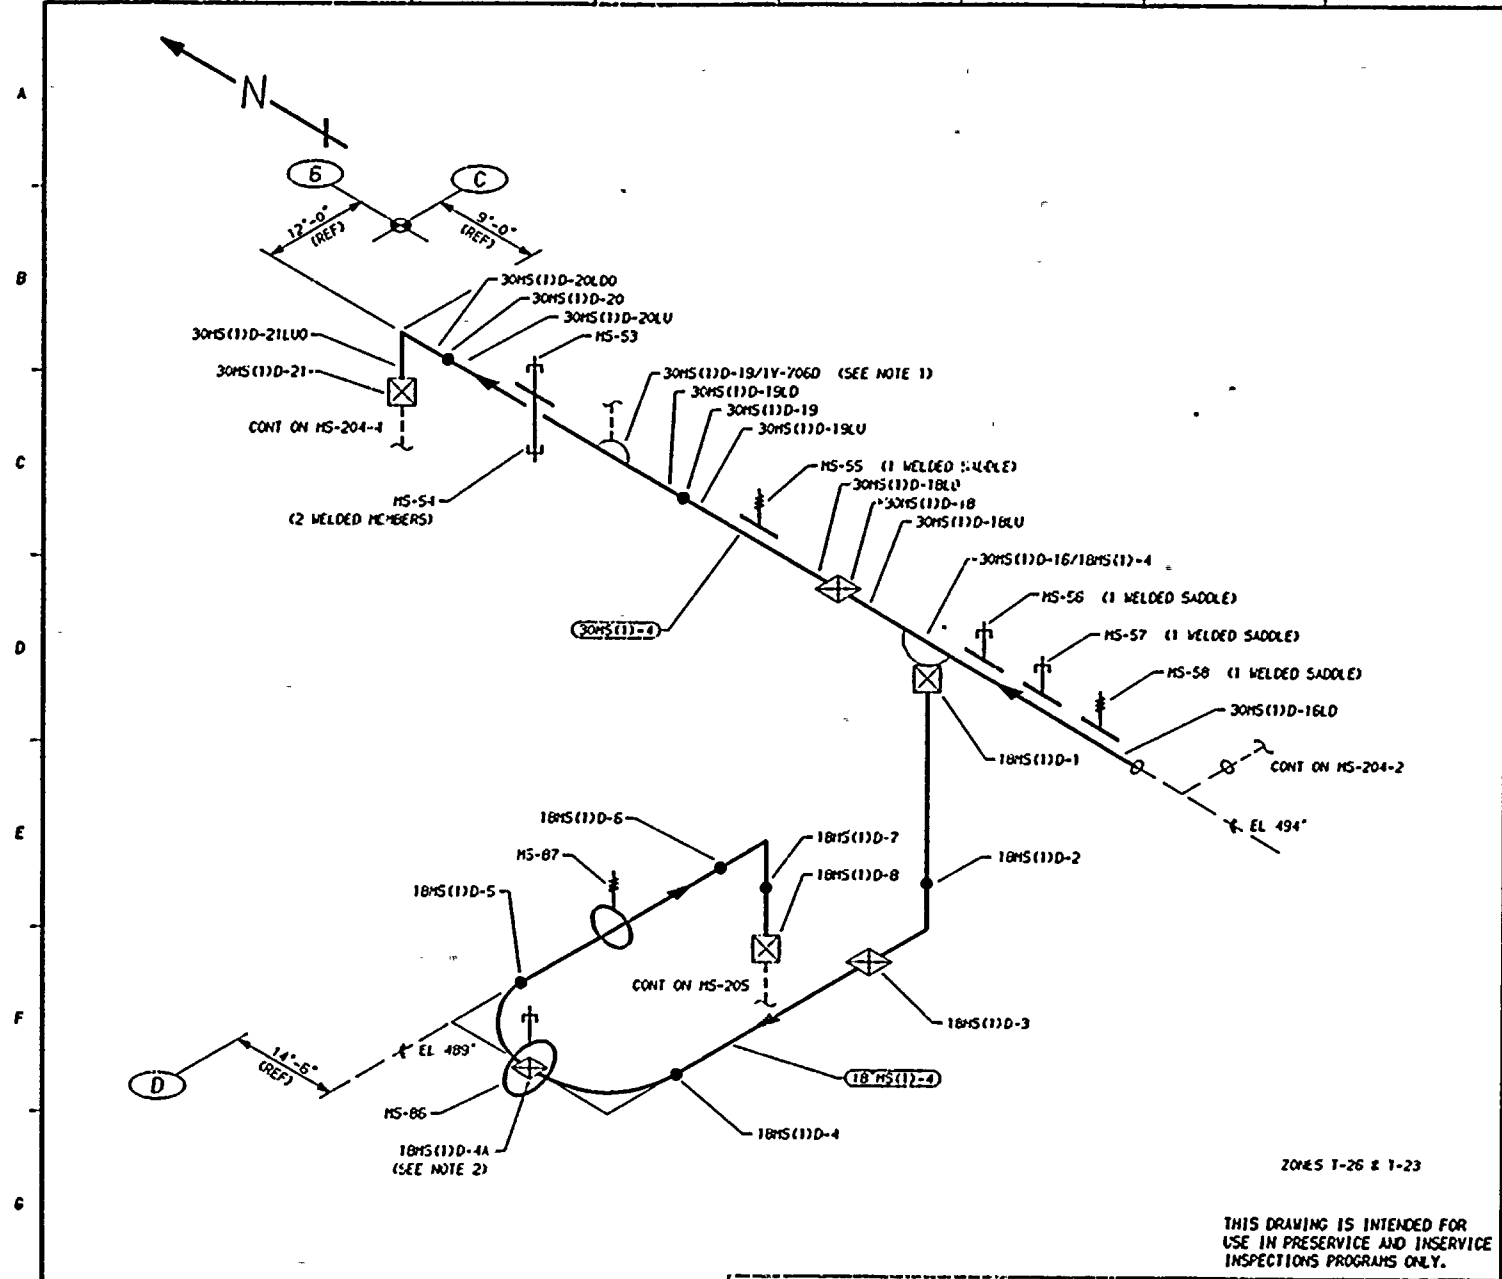

- NOTES**
1. EXTEND LEAKAGE EXAM THROUGH VALVE MS-V-706D TO MAIN STEAM PRESSURE AVERAGING MANIFOLD.
 2. WELD 18MS(1)D-4A IS FITTING. ACCESS TO WELD 18MS(1)D-4A REQUIRES REMOVAL OF MS-86.

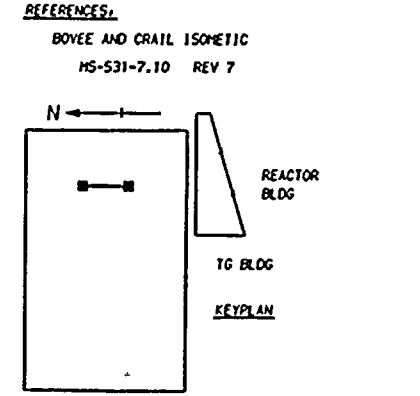

QUALITY CLASS: 1 ASME CODE CLASS: 2
ENGR: D TIMMINS DRAWN: K-McA DATE: 2-21-78

WASHINGTON PUBLIC POWER
SUPPLY SYSTEM
RICHLAND, WASHINGTON 99352

WIP-2
WELD & COMPONENT
IDENTIFICATION DIAGRAM


TITLE:
MAIN STEAM LINE D

DWG NO. MS-204-3 REV 4

THIS DRAWING IS INTENDED FOR
USE IN PRESERVICE AND INSERVICE
INSPECTIONS PROGRAMS ONLY.


20x5 1-26 & 1-23

NO	DATE	REVISION	BY	CHKD	APVD	PIPING SYSTEM	NOM DIA (IN)	SCH	NOM WALL THK	MATERIAL SPECIFICATION	MATL TYPE	CAL BLOCK NO
4	12-2-83	REVISED HANGERS REDRAWN	K-McA	DPF	TFH	30" MS(1)-4	30	XXX	1.25	SA 155 CL 1 KCF 70	CS	UT-1
3	12-2-81	REVISED AS NOTED	K-McA	DPF	TFH	30" MS(1)-4	30	XXX	1.25	SA 155 CL 1 KCF 70	CS	UT-1
2	11-5-80	REDRAWN ADDED FM 4A, NOTE 2, AND MODIFIED SUPPORT NOS.	K-McA	TFH	DMP	18" MS(1)-4	18	80	0.938	SA 106 GR B	CS	UT-12
1	9-13-79	DELETED TIE AND CORRESPONDING WELDS. ADDED WELD IN D-5	K-McA	TFH	ENT							
0	1-9-79	ISSUED FOR USE	K-McA	TFH	DMP							
A	4-20-78	ISSUED FOR INFORMATION ONLY	K-McA	TFH	DMP							

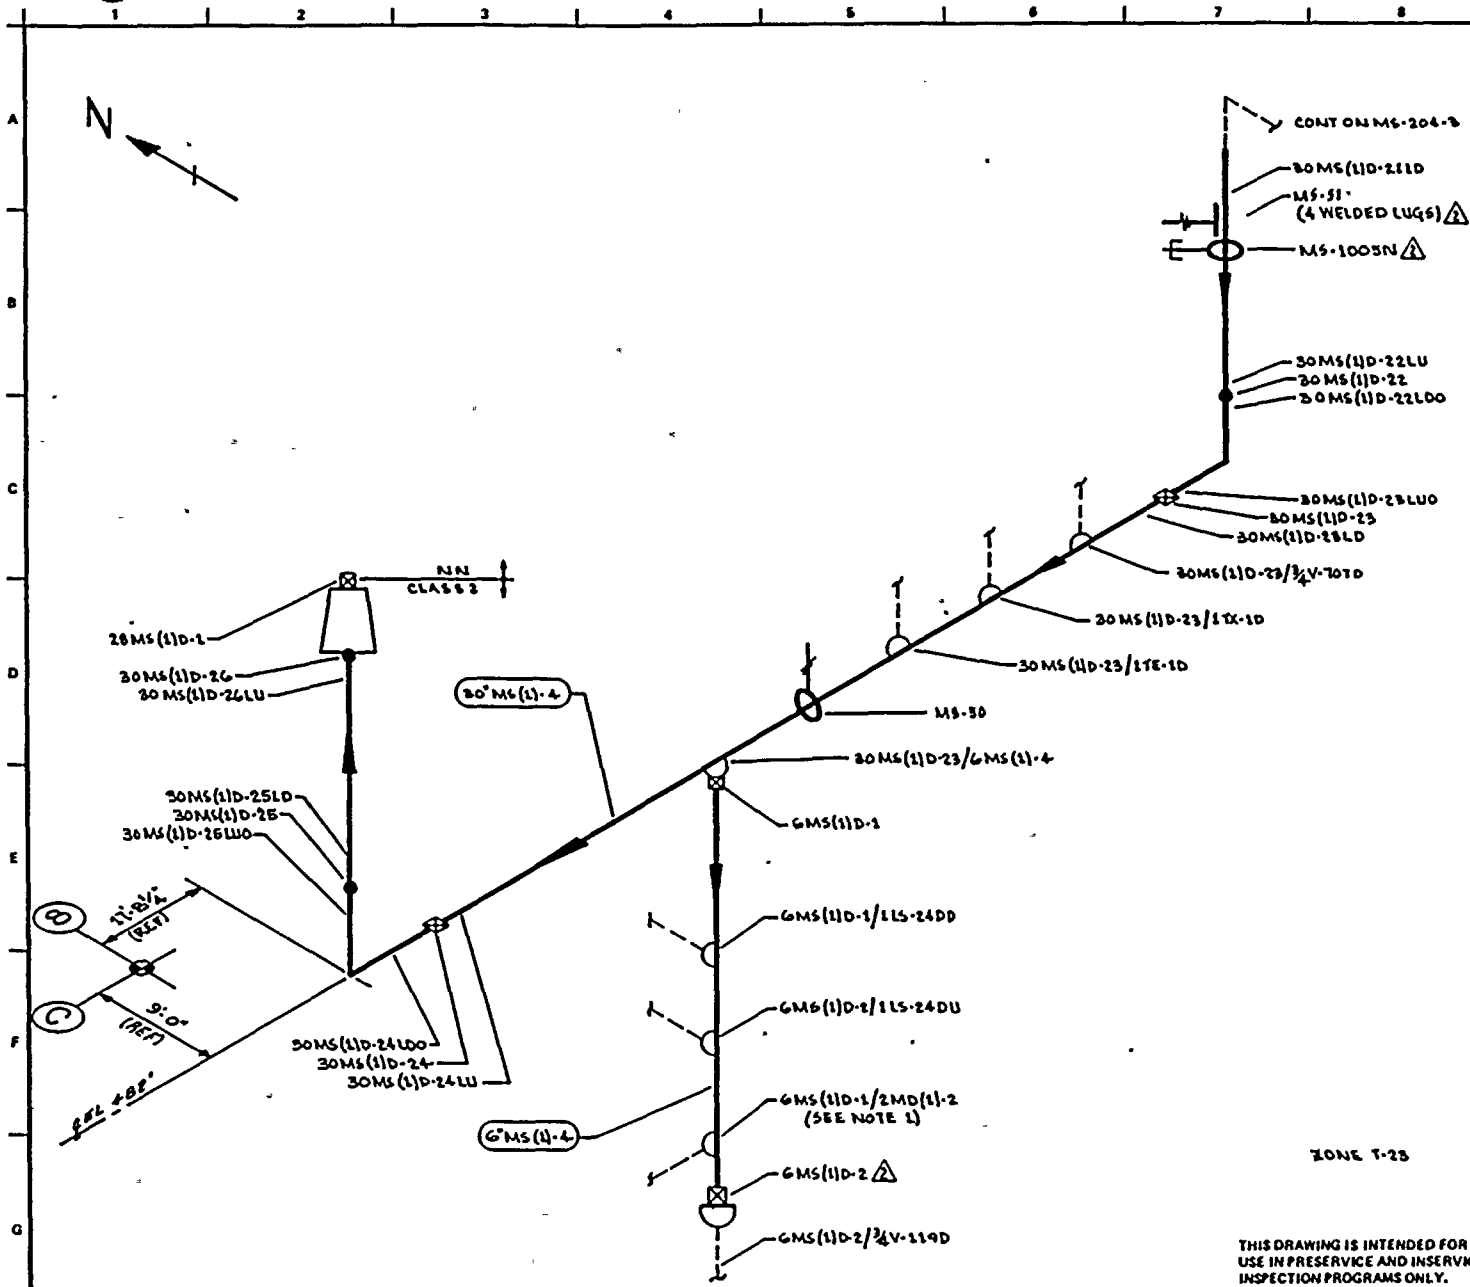

- NOTES:
1. EXTEND LEAKAGE BEAM THROUGH VALVES MD-V-120D & MD-V117D.
 2. SCAFFOLDING IS REQUIRED.

- REFERENCES:
- DOYER & CRAIG ISOMETRICS
- | | |
|-------------|-------|
| MS-531-11 | REV 7 |
| MS-531-12 | REV 8 |
| MS-531-7.10 | REV 8 |

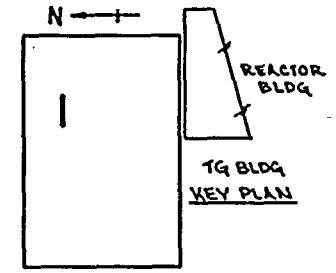

QUALITY CLASS: 1 ASME CODE CLASS: 2
 ENGR: D TIMMINS DRAWN: V. McA DATE: 2-21-78



THIS DRAWING IS INTENDED FOR USE IN PRESERVE AND INSERVICE INSPECTION PROGRAMS ONLY.

WNP-2
 WELD & COMPONENT IDENTIFICATION DIAGRAM


TITLE:
 MAIN STEAM LINE D

DWG NO: MS-204-4 REV 2

PIPING SYSTEM	NOM DIA (IN)	SCH	NOM WALL THK	MATERIAL SPECIFICATION	MATL TYPE	CAL BLOCK NO
30" MS (11-4)	30	XXX	1.25	SA 155 CL 1 KCF T0	C6	UT-1
6" MS (11-4)	6	80	0.432	SA 106 GR B	C5	N/A
28" MS (11-4)	28	XXX	1.410	SA 155 CL 1 KCF T0	C5	UT-2

NO	DATE	REVISION	BY	CHKD	APPVD
2	2-21-78	REVISED AS NOTED	KJA	DC	TAV
1	11-6-80	DELETED WELDS 22101, 231LU, 24101 & 251LU & AS NOTED	KJA	DC	TAV
0	1-9-78	ISSUED FOR USE	KJA	DC	TAV
A	4-26-78	ISSUED FOR INFORMATION ONLY	KJA	DC	TAV
NO	DATE	REVISION	BY	CHKD	APPVD



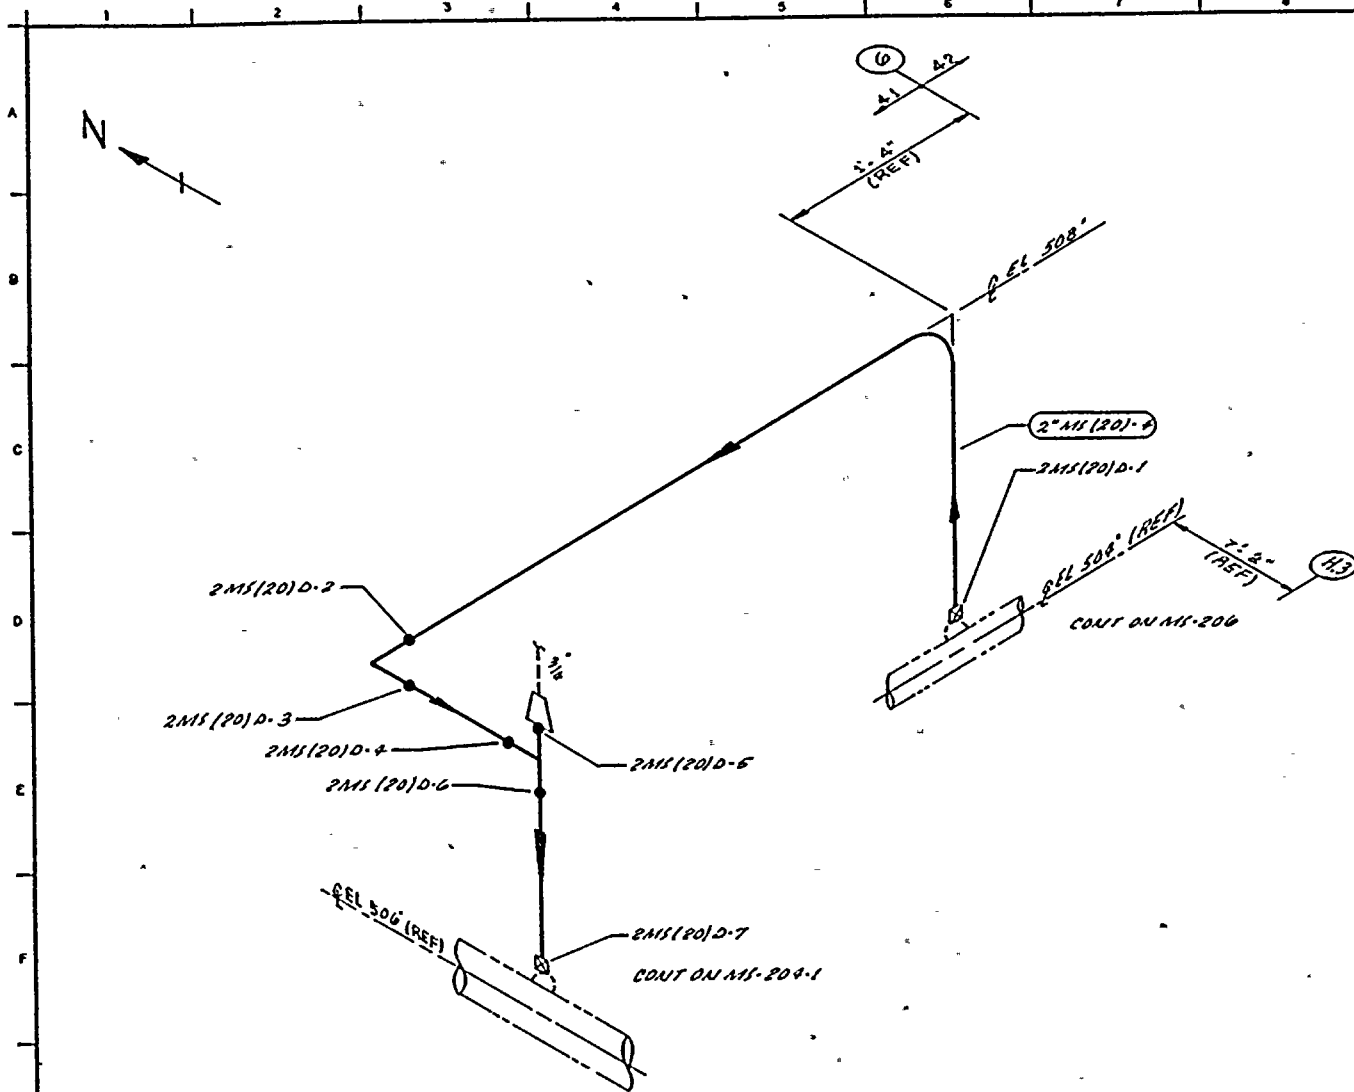

- NOTES:**
1. For branch piping, 1" or less (conn. shown in dashed lines), extend visual leakage exam through the outermost normally closed nuclear class valve, or until transition to instrument tubing, unless otherwise noted.
 2. THIS DWG IDENTIFIES PIPING WELDS THAT REQUIRE AUGMENTED ISI.

REFERENCES:
 BAYSB GRAIL ISOMETRIC
 MS-1292-1 REV 1

QUALITY CLASS: 1 ASME CODE CLASS: 2
 ENGR: *Schaden* DRAWN: *KAL* DATE: *12/81*

WASHINGTON PUBLIC POWER SUPPLY SYSTEM
 RICHMOND, WASHINGTON 98122

THIS DRAWING IS INTENDED FOR USE IN PRESERVICE AND INSERVICE INSPECTION PROGRAMS ONLY.

PIPING SYSTEM	NOM DIA (IN)	SCH	NOM WALL THK	MATERIAL SPECIFICATION	MATL TYPE	CAL BLOCK NO
2MS(20)D-4	2	160	0.033	SA 106 GR B	CS	NA

WNP-2
 WELD & COMPONENT IDENTIFICATION DIAGRAM

TITLE:
 MAIN STEAM PRESSURE STABILIZATION LINE

DWG NO: MS-204-5 REV 0

ISSUED FOR USE	BY	CHKD	APPVD
0	MMH		
NO	DATE	REVISION	

SCALE: AS SHOWN UNLESS OTHERWISE NOTED



WNP-02
 INTERVAL: PSI
 PERIOD: NA
 OUTAGE:
 DRAWING NO. MS-203

WASHINGTON PUBLIC POWER SUPPLY SYSTEM
 PROGRAM PLAN AND SCHEDULE
 SYSTEM OR COMPONENT: 2MS(20)-4
 DESCRIPTION: MS PRESS STAR. LINE

PAGE 018
 DATE 12/14/84

<u>IDENT. NO.</u>	<u>DESCRIPTION</u>	<u>SECT.</u> <u>XI</u> <u>EXAM.</u>	<u>EXAM</u> <u>MTG.</u>	<u>PROCEDURE</u>	<u>CAL.</u> <u>BLOCK</u>	<u>INSERVICE</u>		<u>NOTES</u>
						<u>REQ.</u>	<u>SCHEDULED</u> <u>OUTAGE</u>	
2MS(20)C-1	SOL TO PIPE	N/A	SUR	PTP-1				AUGMT
2MS(20)C-2	PIPE TO EL	N/A	SUR	PTP-1				AUGMT
2MS(20)C-3	EL TO PIPE	N/A	SUR	PTP-1				AUGMT
2MS(20)C-4	PIPE TO EL	N/A	SUR	PTP-1				AUGMT
2MS(20)C-5	EL TO PIPE	N/A	SUR	PTP-1				AUGMT
2MS(20)C-6	PIPE TO TEE	N/A	SUR	PTP-1				AUGMT
2MS(20)C-7	TEE TO RED	N/A	SUR	PTP-1				AUGMT
2MS(20)C-8	TEE TO PIPE	N/A	SUR	PTP-1				AUGMT
2MS(20)C-9	PIPE TO SOL	N/A	SUR	PTP-1				AUGMT

WNP-02
INTERVAL: PSI
PERIOD: NA
OUTAGE:
DRAWING NO. MS-203

WASHINGTON PUBLIC POWER SUPPLY SYSTEM
PROGRAM PLAN AND SCHEDULE
SYSTEM OR COMPONENT: MS(1)-4
DESCRIPTION: MAIN STEAM LINE C

PAGE 017
DATE 12/14/84

<u>IDENT. NO.</u>	<u>DESCRIPTION</u>	<u>SECT.</u>		<u>PROCEDURE</u>	<u>CAL. BLOCK</u>	<u>INSERVICE SCHEDULED</u>		<u>NOTES</u>
		<u>XI EXAM.</u>	<u>EXAM. MTH.</u>			<u>REQ.</u>	<u>OUTAGE</u>	
MS-PB-203	MS PRESS BNDRY	N/A	VT-2	N/A				IWC-2510, SEE NOTES #6 & #7.

WNP-02
 INTERVAL: PSI
 PERIOD: NA
 OUTAGE:
 DRAWING NO. MS-203

WASHINGTON PUBLIC POWER SUPPLY SYSTEM
 PROGRAM PLAN AND SCHEDULE
 SYSTEM OR COMPONENT: MS(1)-4
 DESCRIPTION: MAIN STEAM LINE C

PAGE 016
 DATE 12/14/84

IDENT. NO.	DESCRIPTION	SECT. XI EXAM.	EXAM MTH.	PROCEDURE	CAL. BLOCK	INSERVICE		NOTES
						REQ.	SCHEDULED OUTAGE	
30MS(1)C-24LU	PIPE LONG SEAM	C-F	VOL	UTP-10	UT-1			
			SUR	PTP-1				
30MS(1)C-24	PIPE TO EL	C-F	VOL	UTP-10	UT-1			
			SUR	OCI 3-3				
30MS(1)C-24LDO	EL SEAM	C-F	VOL	UTP-10	UT-1			
			SUR	FTP-1				
30MS(1)C-25LUO	EL SEAM	C-F	VOL	UTP-10	UT-1			
			SUR	PTP-1				
30MS(1)C-25	EL TO PIPE	C-F	VOL	UTP-10	UT-1			
			SUR	PTP-1				
30MS(1)C-25LD	PIPE LONG SEAM	C-F	VOL	UTP-10	UT-1			
			SUR	PTP-1				
30MS(1)C-26LU	PIPE LONG SEAM	C-F	VOL	UTP-10	UT-1			
			SUR	PTP-1				
30MS(1)C-26	PIPE TO REDUCER	C-F	VOL	UTP-10	UT-1			
			SUR	PTP-1				
28MS(1)C-1	REDUCER TO PIPE	C-F	VOL	UTP-10	UT-2			
			SUR	PTP-1				

WNP-02
 INTERVAL: PSI
 PERIOD: NA
 OUTAGE:
 DRAWING NO. MS-203

WASHINGTON PUBLIC POWER SUPPLY SYSTEM
 PROGRAM PLAN AND SCHEDULE
 SYSTEM OR COMPONENT: MS(1)-4
 DESCRIPTION: MAIN STEAM LINE C

PAGE 015
 DATE 12/14/84

<u>IDENT. NO.</u>	<u>DESCRIPTION</u>	<u>SECT.</u> <u>XI</u> <u>EXAM.</u>	<u>EXAM.</u> <u>MTM.</u>	<u>PROCEDURE</u>	<u>CAL.</u> <u>BLOCK</u>	<u>INSERVICE</u>		<u>NOTES</u>
						<u>REQ.</u>	<u>SCHEDULED</u> <u>OUTAGE</u>	
6MS(1)C-2/3/4V-119C	INSTR CONN	N/A	VT-2	N/A				IWC-2510, SEE NOTES #6 & #7.
30MS(1)C-22LU	PIPE LONG SEAM	C-F	VOL	UTP-10	UT-1			
			SUR	PTP-1				
30MS(1)C-22	PIPE TO EL	C-F	VOL	UTP-10	UT-1			
			SUR	PTP-1				
30MS(1)C-22LDI	EL SEAM	C-F	VOL	UTP-10	UT-1			
			SUR	PTP-1				
30MS(1)C-22LDO	EL SEAM	C-F	VOL	UTP-10	UT-1			
			SUR	PTP-1				
30MS(1)C-23LUI	EL SEAM	C-F	VOL	UTP-10	UT-1			
			SUR	PTP-1				
30MS(1)C-23LUO	EL SEAM	C-F	VOL	UTP-10	UT-1			
			SUR	PTP-1				
30MS(1)C-23	EL TO PIPE	C-F	VOL	OCI 6-13	UT-1			
			SUR	OCI 3-3				
30MS(1)C-23LD	PIPE LONG SEAM	C-F	VOL	UTP-10	UT-1			
			SUR	PTP-1				

WNP-02
 INTERVAL: PSI
 PERIOD: NA
 OUTAGE:
 DRAWING NO. HS-203

WASHINGTON PUBLIC POWER SUPPLY SYSTEM
 PROGRAM PLAN AND SCHEDULE
 SYSTEM OR COMPONENT: MS(1)-4
 DESCRIPTION: MAIN STEAM LINE C

PAGE 014
 DATE 12/14/84

IDENT. NO.	DESCRIPTION	SECT. XI EXAM.	EXAM MTH.	PROCEDURE	CAL. BLOCK	INSERVICE		NOTES
						REQ.	SCHEDULED OUTAGE	
30MS(1)C-21/1TX-1C	INSTR CONN	N/A	VT-2	N/A				IWC-2510, SEE NOTES #6 & #7.
MS-141	SPRING	C-E-2	VT-3	303/8.2.17				
			VT-4	303/8.2.17				
30MS(1)C-21/1TE-1C	INSTR CONN	N/A	VT-2	N/A				IWC-2510, SEE NOTES #6 & #7.
MS-24	SPRING	C-E-2	VT-3	303/8.2.17				
			VT-4	303/8.2.17				
30MS(1)C-21/6MS(1)-4	WOL TO PIPE	C-F	SUR	PTP-1				
6MS(1)C-1	PIPE TO WOL	C-F	SUR	PTP-1				
MS-1015S	PSA-1/4 SHUBBER	C-E-2	VT-3	303/8.2.17				S/N 386, LOCATED ON LS-24C.
			VT-4	303/8.2.17				S/N 386, LOCATED ON LS-24C.
6MS(1)C-1/2LS-24CD	INSTR CONN	N/A	VT-2	N/A				IWC-2510, SEE NOTES #6 & #7.
6MS(1)C-2/2LS-24CU	INSTR CONN	N/A	VT-2	N/A				IWC-2510, SEE NOTES #6 & #7.
6MS(1)C-1/2MD(1)-2	DRAIN CONN	N/A	VT-2	N/A				IWC-2510, SEE NOTES #6 & #7.
6MS(1)C-2	CAP TO PIPE	C-F	SUR	PTP-1				

WNP-02
 INTERVAL: PSI
 PERIOD: NA
 OUTAGE:
 DRAWING NO. MS-203

WASHINGTON PUBLIC POWER SUPPLY SYSTEM
 PROGRAM PLAN AND SCHEDULE
 SYSTEM OR COMPONENT: MS(1)-4
 DESCRIPTION: MAIN STEAM LINE C

PAGE 013
 DATE 12/14/84

IDENT. NO.	DESCRIPTION	SECT. XI EXAM.	EXAM MTH.	PROCEDURE	CAL. BLOCK	INSERVICE		NOTES
						REQ.	SCHEDULED OUTAGE	
30MS(1)C-19LD	PIPE LONG SEAM	C-F	VOL	UTP-10	UT-1			
			SUR	PTP-1				
MS-26(W)	8 WELDED LUGS	C-E-1	SUR	PTP-1				
MS-26	STRUT	C-E-2	VT-3	303/8.2.17				
30MS(1)C-20LU	PIPE LONG SEAM	C-F	VOL	UTP-10	UT-1			
			SUR	PTP-1				
30MS(1)C-20	PIPE TO EL	C-F	VOL	UTP-10	UT-1			
			SUR	PTP-1				
30MS(1)C-20LDC	EL SEAM	C-F	VOL	UTP-10	UT-1			
			SUR	PTP-1				
30MS(1)C-21LU0	EL SEAM	C-F	VOL	UTP-10	UT-1			
			SUR	PTP-1				
30MS(1)C-21	EL TO PIPE	C-F	VOL	UTP-10	UT-1			
			SUR	PTP-1				
30MS(1)C-21LD	PIPE LONG SEAM	C-F	VOL	UTP-10	UT-1			
			SUR	PTP-1				
30MS(1)C-21/3/4V-707C	INSTR COMM	N/A	VT-2	N/A				

IWC-2510, SEE NOTES
 #6 & #7.

WMP-02
 INTERVAL: PSI
 PERIOD: NA
 OUTAGE:
 DRAWING NO. NS-203

WASHINGTON PUBLIC POWER SUPPLY SYSTEM
 PROGRAM PLAN AND SCHEDULE
 SYSTEM OR COMPONENT: MS(1)-4
 DESCRIPTION: MAIN STEAM LINE C

PAGE 012
 DATE 12/14/84

IDENT. NO.	DESCRIPTION	SECT. XI EXAM.	EXAM MTH.	PROCEDURE	CAL. BLOCK	INSERVICE		NOTES
						REQ.	SCHEDULED OUTAGE	
30MS(1)C-17LD	PIPE LONG SEAM	C-F	VOL	UTP-10	UT-1			
MS-28	SPRING	C-E-2	VT-3	303/8.2.17				
30MS(1)C-17/1V-706C	INSTR CONN	N/A	VT-2	N/A				SEE NOTES #6 & #7.
MS-27	PSA-10 SH(2)	C-E-2	VT-3	303/8.2.17				S/N T121/B124
30MS(1)C-18LU	PIPE LONG SEAM	C-F	VOL	UTP-10	UT-1			S/N T121/B124
30MS(1)C-18	PIPE TO EL	C-F	VOL	UTP-10	UT-1			
30MS(1)C-18L00	EL SEAM	C-F	VOL	UTP-10	UT-1			
30MS(1)C-19LU0	EL SEAM	C-F	VOL	UTP-10	UT-1			
30MS(1)C-19	EL TO PIPE	C-F	VOL	UTP-10	UT-1			

WNP-02
 INTERVAL: PSI
 PERIOD: WA
 OUTAGE:
 DRAWING NO. MS-203

WASHINGTON PUBLIC POWER SUPPLY SYSTEM
 PROGRAM PLAN AND SCHEDULE
 SYSTEM OR COMPONENT: MS(1)-4
 DESCRIPTION: MAIN STEAM LINE C

PAGE 011
 DATE 12/14/84

IDENT. NO.	DESCRIPTION	SECT. XI EXAM.	EXAM MTH.	PROCEDURE	CAL. BLOCK	INSERVICE		NOTES
						REQ.	SCHEDULED OUTAGE	
18MS(1)C-7	EL TO PIPE	C-F	VOL	UTP-10	UT-12			
			SUR	PTP-1				
18MS(1)C-8	PIPE TO EL	C-F	VOL	UTP-10	UT-12			
			SUR	PTP-1				
18MS(1)C-9	EL TO PIPE	C-F	VOL	UTP-10	UT-12			
			SUR	PTP-1				
18MS(1)C-10	PIPE TO WOL	C-F	VOL	UTP-10	UT-12			
			SUR	PTP-1				
30MS(1)C-16LU	PIPE SEAM	C-F	VOL	UTP-10	UT-1			
			SUR	PTP-1				
30MS(1)C-16	PIPE TO PIPE	C-F	VOL	UTP-10	UT-1			
			SUR	PTP-1				
30MS(1)C-16LD	PIPE LONG SEAM	C-F	VOL	UTP-10	UT-1			
			SUR	PTP-1				
MS-994H	BOX	C-E-2	VT-3	303/8.2.17				
30MS(1)C-17LU	PIPE LONG SEAM	C-F	VOL	UTP-10	UT-1			
			SUR	PTP-1				
30MS(1)C-17	PIPE TO PIPE	C-F	VOL	UTP-10	UT-1			

WHP-02
 INTERVAL: PSI
 PERIOD: NA
 OUTAGE:
 DRAWING NO: MS-203

WASHINGTON PUBLIC POWER SUPPLY SYSTEM
 PROGRAM PLAN AND SCHEDULE
 SYSTEM OR COMPONENT: MS(1)-4
 DESCRIPTION: MAIN STEAM LINE C

PAGE 010
 DATE 12/14/84

IDENT. NO.	DESCRIPTION	SECT. XI EXAM.	EXAM MTH.	PROCEDURE	CAL. BLOCK	INSERVICE		NOTES
						REQ.	SCHEDULED OUTAGE	
MS-30(S)	1 WELDED SADDLE	C-E-1	SUR	OCI 4-3				
30MS(1)C-14/18MS(1)-4	PIPE TO WOL	C-F	SUR	PTP-1				
18MS(1)C-1	WOL TO PIPE	C-F	VOL	UTP-10	UT-12			
18MS(1)C-2	PIPE TO EL	C-F	VOL	UTP-10	UT-12			
18MS(1)C-3	EL TO PIPE	C-F	VOL	UTP-10	UT-12			
18MS(1)C-4	PIPE TO EL	C-F	VOL	UTP-10	UT-12			
18MS(1)C-5	EL TO PIPE	C-F	VOL	UTP-10	UT-12			
MS-48	PSA-3 SNUBBER	C-E-2	VT-3	303/8.2.17				S/N 296
MS-49	SPRING	C-E-2	VT-3	303/8.2.17				S/N 296
18MS(1)C-6	PIPE TO EL	C-F	VOL	UTP-10	UT-12			
			SUR	PTP-1				

WNP-C2
 INTERVAL: PSI
 PERIOD: NA
 OUTAGE:
 DRAWING NO. MS-203

WASHINGTON PUBLIC POWER SUPPLY SYSTEM
 PROGRAM PLAN AND SCHEDULE
 SYSTEM OR COMPONENT: MS(1)-4
 DESCRIPTION: MAIN STEAM LINE C

PAGE 009
 DATE 12/14/84

IDENT. NO.	DESCRIPTION	SECT. XI EXAM. FYAN.	EXAM MTH.	PROCEDURE	CAL. BLOCK	INSERVICE		NOTES
						REQ.	SCHEDULED OUTAGE	
30MS(1)C-13LU	PIPE LONG SEAM	C-F	VOL	UTP-10	UT-1			
			SUR	PTP-1				
30MS(1)C-13	PIPE TO EL	C-F	VOL	UTP-10	UT-1			
			SUR	PTP-1				
30MS(1)C-13L00	EL SEAM	C-F	VOL	UTP-10	UT-1			
			SUR	PTP-1				
30MS(1)C-14LU0	EL SEAM	C-F	VOL	UTP-10	UT-1			
			SUR	PTP-1				
30MS(1)C-14	EL TO PIPE	C-F	VOL	UTP-10	UT-1			
			SUR	PTP-1				
30MS(1)C-14LD	PIPE LONG SEAM	C-F	VOL	UTP-10	UT-1			
			SUR	PTP-1				
MS-31	PSA-3 SN(2)	C-E-2	VT-3	303/8.2.17				S/N 4417/2587
			VT-4	303/8.2.17				S/N 4417/2587
MS-999N	PSA-10 SNURBER	C-E-2	VT-3	303/8.2.17				S/N 328
			VT-4	303/8.2.17				S/N 328
MS-30	SPRINGS (2)	C-E-2	VT-3	303/8.2.17				
			VT-4	303/8.2.17				

WNP-02
 INTERVAL: PSI
 PERIOD: NA
 OUTAGE:
 DRAWING NO. MS-203

WASHINGTON PUBLIC POWER SUPPLY SYSTEM
 PROGRAM PLAN AND SCHEDULE
 SYSTEM OR COMPONENT: MS(1)-4
 DESCRIPTION: MAIN STEAM LINE C

PAGE 008
 DATE 12/14/84

IDENT. NO.	DESCRIPTION	SECT. XI EXAM.	EXAM MTH.	PROCEDURE	CAL. BLOCK	INSERVICE		NOTES
						REQ.	SCHEDULED OUTAGE	
30MS(1)C-11	EL TO PIPE	C-F	VOL	PTP-1 UTP-10	UT-1			
30MS(1)C-11LD	PIPE LONG SEAM	C-F	VOL	PTP-1 UTP-10	UT-1			
MS-1C01N	PSA-35 SNUBBER	C-E-2	VT-3	PTP-1 303/8.2.17				S/N 8686
MS-36	STRUT	C-E-2	VT-3	VT-4 303/8.2.17				S/N 8686
MS-1000N	BOX	C-E-2	VT-3	303/8.2.17				
30MS(1)C-12LU	PIPE LONG SEAM	C-F	VOL	PTP-1 UTP-10	UT-1			
30MS(1)C-12	PIPE TO PIPE	C-F	VOL	PTP-1 UTP-10	UT-1			
30MS(1)C-12LD	PIPE LONG SEAM	C-F	VOL	PTP-1 UTP-10	UT-1			
MS-34	STRUT	C-E-2	VT-3	PTP-1 303/8.2.17				
MS-33	SPRING (2)	C-E-2	VT-3	VT-4 303/8.2.17				

WNP-02
 INTERVAL: PSI
 PERIOD: NA
 OUTAGE:
 DRAWING NO. MS-203

WASHINGTON PUBLIC POWER SUPPLY SYSTEM
 PROGRAM PLAN AND SCHEDULE
 SYSTEM OR COMPONENT: MS(1)-4
 DESCRIPTION: MAIN STEAM LINE C

PAGE 007
 DATE 12/14/84

IDENT. NO.	DESCRIPTION	SECT. XT EXAM.	EXAM MTH.	PROCEDURE	CAL. BLOCK	INSERVICE		NOTES
						REQ.	SCHEDULED OUTAGE	
30MS(1)C-9LU	PIPE LONG SEAM	C-F	VOL	UTP-10	UT-1			
			SUR	PTP-1				
30MS(1)C-9	PIPE TO PIPE	C-F	VOL	UTP-10	UT-1			
			SUR	PTP-1				
30MS(1)C-9LO	PIPE LONG SEAM	C-F	VOL	UTP-10	UT-1			
			SUR	PTP-1				
MS-921N	STRUT	C-E-2	VT-3	303/8.2.17				
MS-38	PSA-10 SN(2)	C-E-2	VT-3	303/8.2.17				S/N 117/127
			VT-4	303/8.2.17				S/N 117/127
MS-37	SPRING (2)	C-E-2	VT-3	303/8.2.17				
			VT-4	303/8.2.17				
30MS(1)C-10LU	PIPE LONG SEAM	C-F	VOL	UTP-10	UT-1			
			SUR	PTP-1				
30MS(1)C-10	PIPE TO EL	C-F	VOL	UTP-10	UT-1			
			SUR	PTP-1				
30MS(1)C-10LDO	EL SEAM	C-F	VOL	UTP-10	UT-1			
			SUR	PTP-1				
30MS(1)C-11LUO	EL SEAM	C-F	VOL	UTP-10	UT-1			

WNP-02
 INTERVAL: PSI
 PERIOD: NA
 OUTAGE:
 DRAWING NO. MS-203

WASHINGTON PUBLIC POWER SUPPLY SYSTEM
 PROGRAM PLAN AND SCHEDULE
 SYSTEM OR COMPONENT: MS(1)-4
 DESCRIPTION: MAIN STEAM LINE C

PAGE 006
 DATE 12/14/84

IDENT. NO.	DESCRIPTION	SECT.	EXAM	PROCEDURE	CAL. BLOCK	INSERVICE		NOTES
		XI EXAM	HTH.			REQ.	SCHEDULED OUTAGE	
			SUR	PTP-1				
MS-1602N	PSA-10 SN(2)	C-E-2	VT-3	303/8.2.17				S/N 9900/9960
			VT-4	303/8.2.17				S/N 9900/9960
MS-40	STRUT	C-E-2	VT-3	303/8.2.17				
30MS(1)C-7LU	PIPE LONG SEAM	C-F	VOL	UTP-10	UT-1			
			SUR	PTP-1				
30MS(1)C-7	PIPE TO EL	C-F	VOL	UTP-10	UT-1			
			SUR	PTP-1				
30MS(1)C-7LDO	EL SEAM	C-F	VOL	UTP-10	UT-1			
			SUR	PTP-1				
30MS(1)C-8LUG	EL SEAM	C-F	VOL	UTP-10	UT-1			
			SUR	PTP-1				
30MS(1)C-8	EL TO PIPE	C-F	VOL	UTP-10	UT-1			
			SUR	PTP-1				
30MS(1)C-8LD	PIPE LONG SEAM	C-F	VOL	UTP-10	UT-1			
			SUR	PTP-1				
MS-39	STRUT	C-E-2	VT-3	303/8.2.17				
MS-39(S)	1 WELDED SADDLE	C-E-1	SUR	OCT 4-3				

WNP-02
 INTERVAL: PSI
 PERIOD: NA
 OUTAGE:
 DRAWING NO. MS-203

WASHINGTON PUBLIC POWER SUPPLY SYSTEM
 PROGRAM PLAN AND SCHEDULE
 SYSTEM OR COMPONENT: MS(1)-4
 DESCRIPTION: MAIN STEAM LINE C

PAGE 005
 DATE 12/14/84

<u>IDENT. NO.</u>	<u>DESCRIPTION</u>	<u>SECT.</u> <u>XI</u> <u>EXAM.</u>	<u>EXAM</u> <u>MTH.</u>	<u>PROCEDURE</u>	<u>CAL.</u> <u>BLOCK</u>	<u>INSERVICE</u> <u>SCHEDULED</u>		<u>NOTES</u>
						<u>REQ.</u>	<u>OUTAGE</u>	
			SUR	PTP-1				
30MS(1)C-4	PIPE TO EL	C-F	VOL	UTP-10	UT-1			
			SUR	PTP-1				
30MS(1)C-4LD0	EL SEAM	C-F	VOL	UTP-10	UT-1			
			SUR	PTP-1				
30MS(1)C-5LU0	EL SEAM	C-F	VOL	UTP-10	UT-1			
			SUR	PTP-1				
30MS(1)C-5	EL TO PIPE	C-F	VOL	UTP-10	UT-1			
			SUR	PTP-1				
30MS(1)C-5LD	PIPE LONG SEAM	C-F	VOL	UTP-10	UT-1			
			SUR	PTP-1				
MS-42	SPRING (2)	C-E-2	VT-3	303/8.2.17				
			VT-4	303/8.2.17				
30MS(1)C-6LU	PIPE LONG SEAM	C-F	VOL	UTP-10	UT-1			
			SUR	PTP-1				
30MS(1)C-6	PIPE TO PIPE	C-F	VOL	UTP-10	UT-1			
			SUR	PTP-1				
30MS(1)C-6LD	PIPE LONG SEAM	C-F	VOL	UTP-10	UT-1			

WMP-02
 INTERVAL: PSI
 PERIOD: NA
 OUTAGE:
 DRAWING NO. MS-203

WASHINGTON PUBLIC POWER SUPPLY SYSTEM
 PROGRAM PLAN AND SCHEDULE
 SYSTEM OR COMPONENT: MS(1)-4
 DESCRIPTION: MAIN STEAM LINE C

PAGE 004
 DATE 12/14/84

IDENT. NO.	DESCRIPTION	SECT. XI EXAM.	EYAM MTH.	PROCEDURE	CAL. BLOCK	INSERVICE		NOTES
						REQ.	SCHEDULED OUTAGE	
30MS(1)C-2L00	EL SEAM	C-F	VOL	UTP-10	UT-1			
			SUR	PTP-1				
30MS(1)C-3LUC	EL SEAM	C-F	VOL	UTP-10	UT-1			
			SUR	PTP-1				
30MS(1)C-3	EL TO PIPE	C-F	VOL	UTP-10	UT-1			
			SUR	PTP-1				
30MS(1)C-3LD	PIPE LONG SEAM	C-F	VOL	UTP-10	UT-1			
			SUR	PTP-1				
30MS(1)C-3/3MD(16)-4	DRAIN CONN	N/A	VT-2	N/A				IWC-2510, SEE NOTES #6 & #7.
MS-1003N	PSA-10 SN(2)	C-E-2	VT-3	303/8.2.17				S/N 689/322
			VT-4	303/8.2.17				S/N 689/322
MS-1003N(S)	1 WELDED SADDLE	C-E-1	SUR	OCI 4-3				
30MS(1)C-3/3/4V-703	INSTR CONN	N/A	VT-2	N/A				IWC-2510, SEE NOTES #6 & #7.
30MS(1)C-3/3/4V-704	INSTR CONN	N/A	VT-2	N/A				IWC-2510, SEE NOTES #6 & #7.
PWS-315-9	PIPE WHIP	N/A	N/A	N/A				
30MS(1)C-4LU	PIPE LONG SEAM	C-F	VOL	UTP-10	UT-1			

WNP-02
 INTERVAL: PSI
 PERIOD: NA
 OUTAGE:
 DRAWING NO. MS-203

WASHINGTON PUBLIC POWER SUPPLY SYSTEM
 PROGRAM PLAN AND SCHEDULE
 SYSTEM OR COMPONENT: MS(1)-4
 DESCRIPTION: MAIN STEAM LINE C

PAGE 003
 DATE 12/14/84

<u>IDENT. NO.</u>	<u>DESCRIPTION</u>	<u>SECT.</u> <u>XI</u>	<u>EXAM</u> <u>MIN.</u>	<u>PROCEDURE</u>	<u>CAL.</u> <u>BLOCK</u>	<u>INSERVICE</u> <u>SCHEDULED</u>		<u>NOTES</u>
						<u>REQ.</u>	<u>OUTAGE</u>	
			SUR	PTP-1				
26MS(1)C-22	EL TO PIPE	C-F	VOL	UTP-10	UT-3			
			SUR	PTP-1				
26MS(1)C-22LD	PIPE LONG SEAM	C-F	VOL	UTP-10	UT-3			
			SUR	PTP-1				
26MS(1)C-23LU	PIPE LONG SEAM	C-F	VOL	UTP-10	UT-3			
			SUR	PTP-1				
26MS(1)C-23	PIPE TO REDUCER	C-F	VOL	UTP-10	UT-3			
			SUR	PTP-1				
30MS(1)C-1	REDUCER TO PIPE	C-F	VOL	UTP-10	UT-1			
			SUR	PTP-1				
30MS(1)C-1LD	PIPE LONG SEAM	C-F	VOL	UTP-10	UT-1			
			SUR	PTP-1				
FWS-315-7	PIPE WHIP	N/A	N/A	N/A				
30MS(1)C-2LU	PIPE LONG SEAM	C-F	VOL	UTP-10	UT-1			
			SUR	PTP-1				
30MS(1)C-2	PIPE TO EL	C-F	VOL	UTP-10	UT-1			
			SUR	PTP-1				

WNP-02
 INTERVAL: PSI
 PERIOD: NA
 OUTAGE:
 DRAWING NO. MS-203

WASHINGTON PUBLIC POWER SUPPLY SYSTEM
 PROGRAM PLAN AND SCHEDULE
 SYSTEM OR COMPONENT: MS(1)-4
 DESCRIPTION: MAIN STEAM LINE C

PAGE 002
 DATE 12/14/84


IDENT. NO.	DESCRIPTION	SECT. YI EXAM.	EXAM MTH.	PROCEDURE	CAL. BLOCK	INSERVICE		NOTES
						REQ.	SCHEDULED OUTAGE	
26MS(1)C-20/3/4V-744C	INSTR CONN	N/A	VT-2	N/A				IWC-2510, SEE NOTES #6 & #7.
MS-44	SPRING	C-E-2	VT-3	303/8.2.17				
			VT-4	303/8.2.17				
MS-45	PSA-35 SNUBBER	C-E-2	VT-3	303/8.2.17				S/N 8689
			VT-4	303/8.2.17				S/N 8689
PWS-315-3	PIPE WHIP	N/A	N/A	N/A				
26MS(1)C-21LU	PIPE LONG SEAM	C-F	VOL	UTP-10	UT-3			
			SUR	PTP-1				
26MS(1)C-21	PIPE TO EL	C-F	VOL	UTP-10	UT-3			
			SUR	PTP-1				
26MS(1)C-21LDI	EL SEAM	C-F	VOL	UTP-10	UT-3			
			SUR	PTP-1				
26MS(1)C-21LD0	EL SEAM	C-F	VOL	UTP-10	UT-3			
			SUR	PTP-1				
26MS(1)C-22LUT	EL SEAM	C-F	VOL	UTP-10	UT-3			
			SUR	PTP-1				
26MS(1)C-22LU0	EL SEAM	C-F	VOL	UTP-10	UT-3			

WHP-02
 INTERVAL: PSI
 PERIOD: HA
 OUTAGE:
 DRAWING NO. MS-203

WASHINGTON PUBLIC POWER SUPPLY SYSTEM
 PROGRAM PLAN AND SCHEDULE
 SYSTEM OR COMPONENT: MS(1)-4
 DESCRIPTION: MAIN STEAM LINE C


PAGE 001
 DATE 12/14/84

<u>IDENT. NO.</u>	<u>DESCRIPTION</u>	SECT. XI <u>EXAM.</u>	EYAM MTH.	PROCEDURE	CAL. BLOCK	<u>INSERVICE</u>		<u>NOTES</u>
						<u>REQ.</u>	<u>SCHEDULED</u> OUTAGE	
26MS(1)C-19	VALVE TO PIPE	C-F	VOL	UTP-10	UT-3			AUGMT
			SUR	PTP-1				AUGMT
26MS(1)C-19LD	PIPE LONG SEAM	C-F	VOL	UTP-10	UT-3			
			SUR	PTP-1				
26MS(1)C-19/3/4CAP	CAPPED CONN	N/A	VT-2	N/A				IWC-2510, SEE NOTE #6 & #7.
26MS(1)C-19/3/4V-45	TEST CONN	N/A	VT-2	N/A				IWC-2510, SEE NOTES #6 & #7.
26MS(1)C-19/1-1/2PLUG	PLUG CONN	N/A	VT-2	N/A				IWC-2510, SEE NOTES #6 & #7.
MS-47	SPRING	C-E-2	VT-3	303/R.2.17				
			VT-4	303/R.2.17				
26MS(1)C-20LU	PIPE LONG SEAM	C-F	VOL	UTP-10	UT-3			
			SUR	PTP-1				
26MS(1)C-20	PIPE TO PIPE	C-F	VOL	UTP-10	UT-3			AUGMT
			SUR	PTP-1				AUGMT
26MS(1)C-20LD	PIPE LONG SEAM	C-F	VOL	UTP-10	UT-3			
			SUR	PTP-1				
26MS(1)C-20/3V-20	DRAIN CONN	N/A	SUR	PTP-1				IWC-2510, AUGMT.

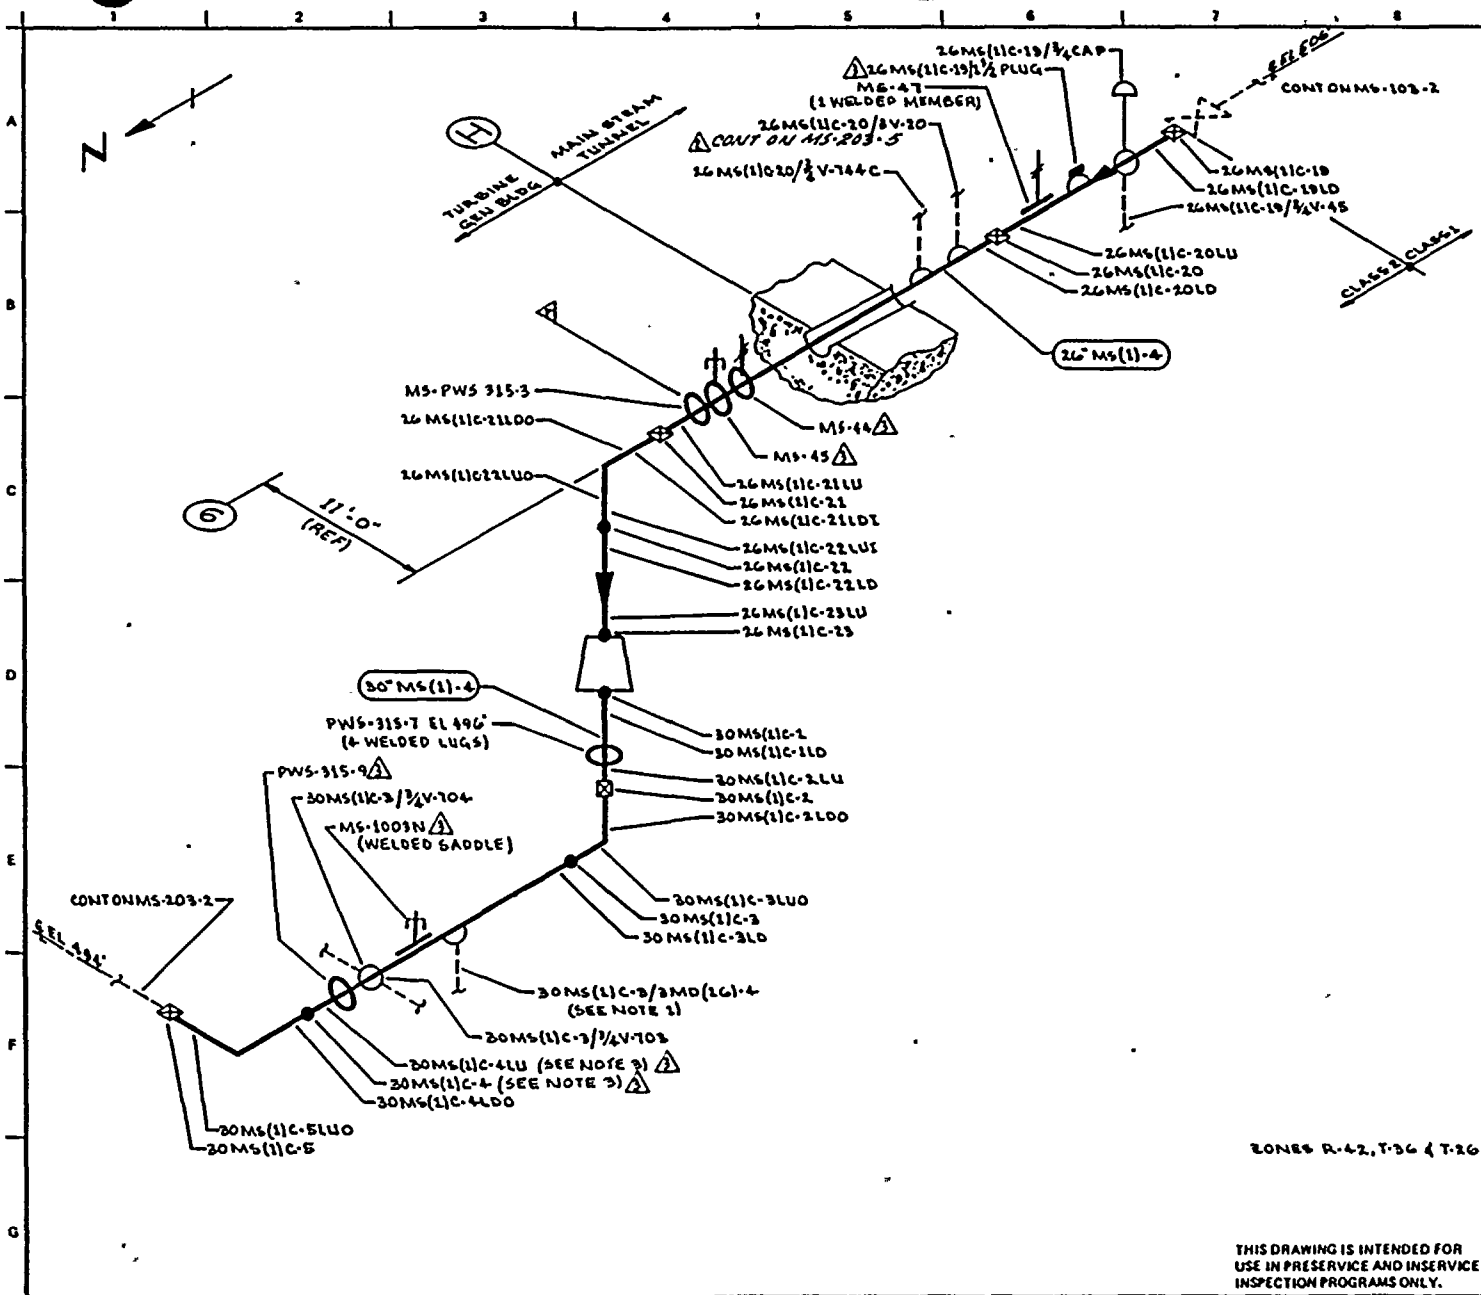

- NOTES:
1. EXTEND LEAKAGE EXAM THROUGH DRAINAGE SYSTEM TO VALVES MS-V-12 & MS-V-13.
 2. SCAFFOLDING IS REQUIRED.
 3. ACCESS TO WELDS 30MS(11C-4LU & 30MS(11C-4) REQUIRES REMOVAL OF PWS-315-9.

REFERENCES:
BOVVE & CRAL ISOMETRIC
MS-850-1.3 REV 9

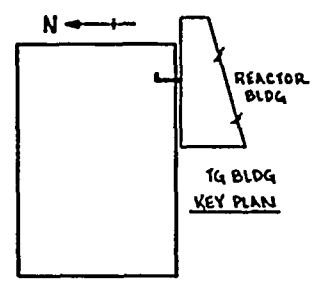

ZONES R-42, T-36 & T-26

THIS DRAWING IS INTENDED FOR USE IN PRESERVICE AND INSERVICE INSPECTION PROGRAMS ONLY.

QUALITY CLASS: 1 ASME CODE CLASS: 2
ENGR: D TIMMING DRAWN: K.M.C.A DATE: 2-3-78



WASHINGTON PUBLIC POWER SUPPLY SYSTEM
RICHMOND, WASHINGTON 98362


NO	DATE	REVISION	BY	CHKD	APPVD	PIPING SYSTEM	NOM DIA (IN)	SCH	NOM WALL THK	MATERIAL SPECIFICATION	MATL TYPE	CAL BLOCK NO
3	9-26-83	REVISED AS NOTED	K.M.C.A	D.P.R	T.P.H.	26 MS(11)-4	26	XXX	1.125	SA 155 CL1 KCF 70	C6	UT-3
2	12-28-81	REVISED AS NOTED, AUGMENTED (SI ADDED)	K.M.C.A	D.P.R	T.P.H.	30 MS(11)-4	30"	XXX	1.25	SA 155 CL1 KCF 70	C6	UT-1
1	11-18-80	DELETED WELDS 2LDI, 3LUI, 4LDI & 5LUI.	K.M.C.A	T.P.H.	D.P.R							
0	1-9-79	ISSUED FOR USE	K.M.C.A	D.P.R	T.P.H.							
A	6-24-78	ISSUED FOR INFORMATION ONLY	K.M.C.A	D.P.R	T.P.H.							
NO	DATE	REVISION	BY	CHKD	APPVD							

WNP-2
WELD & COMPONENT IDENTIFICATION DIAGRAM

TITLE:
MAIN STEAM LINE C

DWG NO: MS-203-1 REV 3



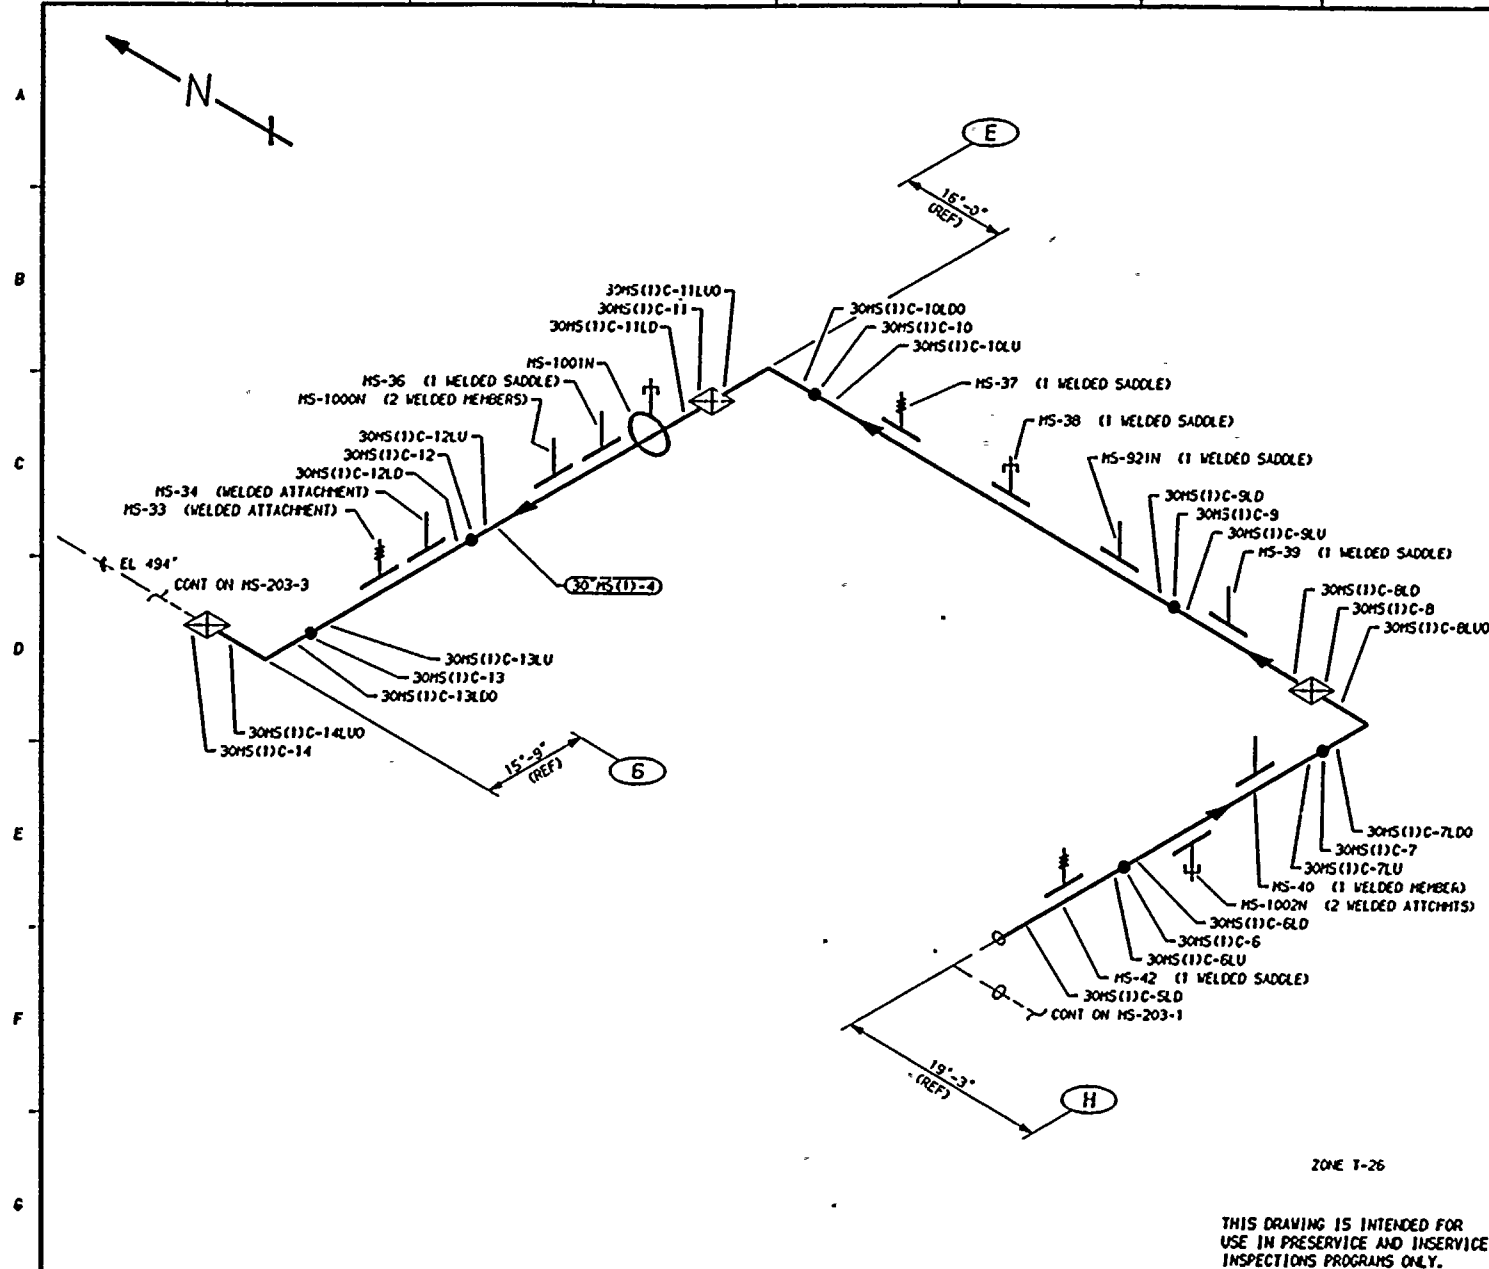


NOTES:

- 1. SCAFFOLDING IS REQUIRED.

REFERENCES:

BOYEE AND CRAIL ISOMETRIC
MS-530-4.6 REV 5

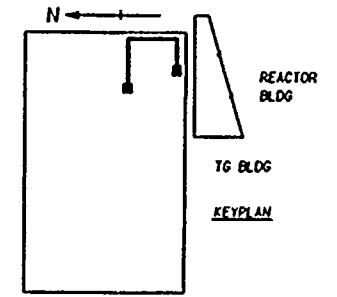

ZONE T-26

THIS DRAWING IS INTENDED FOR
USE IN PRESERVICE AND INSERVICE
INSPECTIONS PROGRAMS ONLY.

QUALITY CLASS, 1	ASME CODE CLASS, 2
ENGR, D TIMMINS	DRAWN, K-MCA DATE, 2-6-78


WASHINGTON PUBLIC POWER
SUPPLY SYSTEM
RICHLAND, WASHINGTON 99352

WNP-2
WELD & COMPONENT
IDENTIFICATION DIAGRAM

TITLE:
MAIN STEAM LINE C

DWG NO, MS-203-2 REV 3

NO	DATE	REVISION	BY	CHKD	APVD	PIPING SYSTEM	NOM DIA (IN)	SCH	NOM WALL THK	MATERIAL SPECIFICATION	MATL TYPE	CAL BLOCK NO
3	11-2-83	REVISED HANGERS REDRAWN	K-MCA	DPR	TFH	30"MS(1)-4	30	XXX	1.25	SA 155 CL 1 KCF 70	CS	UT-1
2	12-2-81	REVISED AS NOTED	K-MCA	DPR	TFH							
1	11-5-80	CHANGED WELDS TO 1/2", 3/4", 1 1/4", 1 1/2" & 1 3/4". CHANGED WELD 13LD TO 13LU, AS NOTED	K-MCA	TFH	DMP							
0	1-9-79	ISSUED FOR USE	K-MCA	TFH	DMP							
A	4-20-78	ISSUED FOR INFORMATION ONLY	K-MCA	OC	DMP							

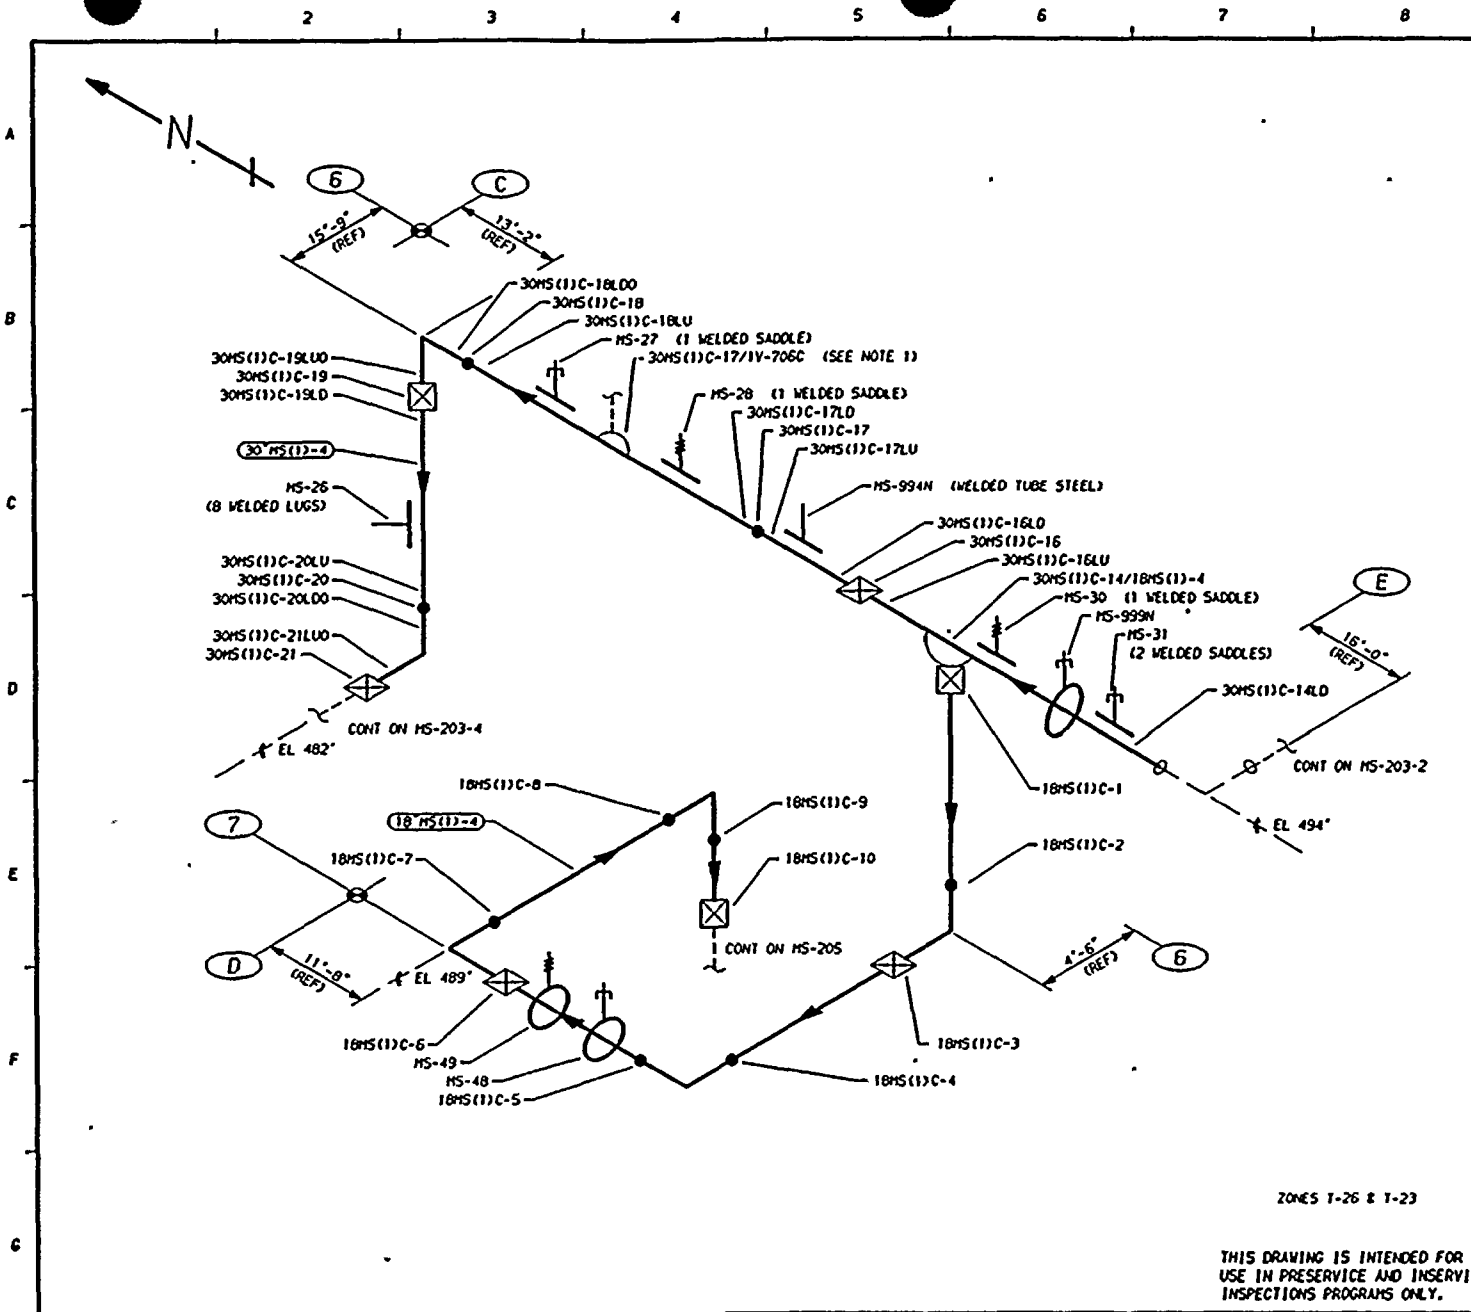


NOTES

1. EXTEND LEAKAGE EXAM THROUGH VALVE MS-V-706C TO MAIN STEAM PRESSURE AVERAGING MANIFOLD.

REFERENCES:

BOYEE AND CRAIL ISOMETRIC
MS-530-7.10 REV 6

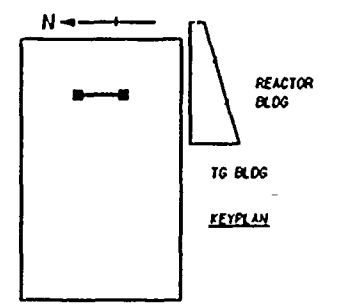


ZONES T-26 & T-23

THIS DRAWING IS INTENDED FOR USE IN PRESERVICE AND INSERVICE INSPECTIONS PROGRAMS ONLY.

NO	DATE	REVISION	BY	CHKD	APVD
4	12-2-83	REVISED HANGERS REDRAWN	K-MCA	DPR	TFH
3	12-2-81	REVISED AS NOTED	K-MCA	DPR	TFH
2	11-5-80	DELETED WELDS 18LD1, 19LU1, 20LD1 & 21LU1 & AS NOTED	K-MCA	TFH	DMP
1	9-13-79	DELETED TEE AND CORRESPONDING WELDS. ADDED WELDS IN C-5	K-MCA	TFH	DMP
0	1-9-79	ISSUED FOR USE	K-MCA	TFH	DMP
A	4-20-78	ISSUED FOR INFORMATION ONLY	K-MCA	TFH	DMP


PIPING SYSTEM	NOM DIA (IND)	SCH	NOM WALL THK	MATERIAL SPECIFICATION	MATL TYPE	CAL BLOCK NO
30"MS(1)-4	30	XXX	1.25	SA 155 CL 1 KCF 70	CS	UT-1
18"MS(1)-4	18	80	0.938	SA 106 GR B	CS	UT-12

QUALITY CLASS, 1	ASME CODE CLASS, 2
ENGR, D TIMMINS	DATE, 2-6-78
WASHINGTON PUBLIC POWER SUPPLY SYSTEM RICHLAND, WASHINGTON 99352	
WNP-2 WELD & COMPONENT IDENTIFICATION DIAGRAM	
TITLE: MAIN STEAM LINE C	
DWG NO, MS-203-3	REV 4

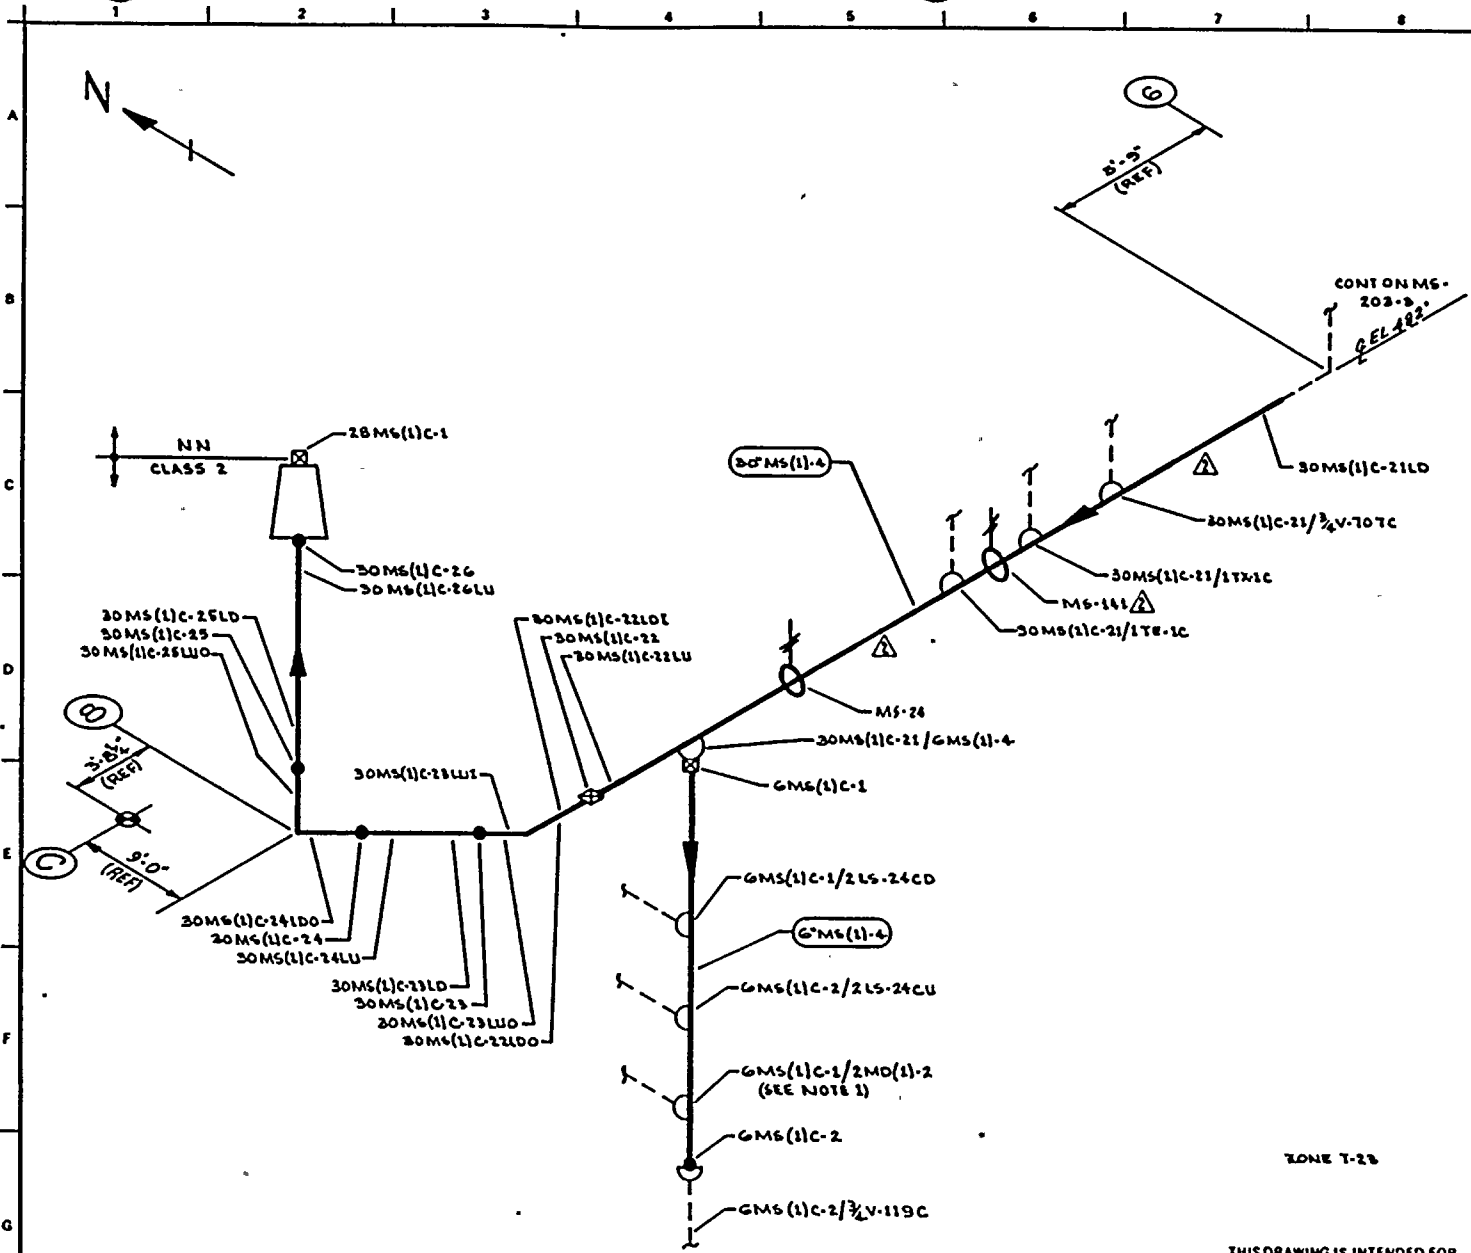

NOTES:
 1. EXTEND LEAKAGE EXAM THROUGH VALVES MD-V-120C & MD-V-117C.
 2. SCAFFOLDING IS REQUIRED.

REFERENCES:
 BOVEE & CRAIG ISOMETRICS
 MG-530-11 REV 6
 MG-530-12 REV 7

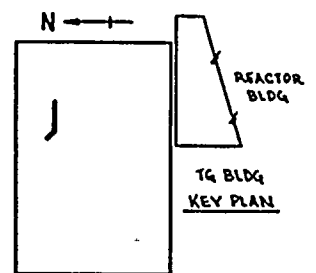

ZONE T-28

THIS DRAWING IS INTENDED FOR USE IN PRESERVE AND INSERVICE INSPECTION PROGRAMS ONLY.

QUALITY CLASS: 1 ASME CODE CLASS: 2
 ENGR: D TIMMING DRAWN: K MCLA DATE: 2/1/80

WASHINGTON PUBLIC POWER SUPPLY SYSTEM
 RICHMOND WASHINGTON 98502


WNP-2 WELD & COMPONENT IDENTIFICATION DIAGRAM

TITLE: MAIN STEAM LINE C

DWG NO: MG-203-4 REV 2

PIPING SYSTEM	NOM DIA (IN)	SCH	NOM WALL THK	MATERIAL SPECIFICATION	MATL TYPE	CAL BLOCK NO
30" MS (1) - 4	30	XXX	1.25	SA 155 CL 1 KCF 70	CS	UT-1
6" MS (1) - 4	6	80	0.432	SA 106 GR B	CS	NA
28" MS (1) - 4	28	XXX	1.420	SA 155 CL 1 KCF 70	CS	UT-2

NO	DATE	REVISION	BY	CHKD	APPVD
2	9-21-83	REVISED AS NOTED	KMCLA	DPF	TEH
1	11-5-80	DELETED WELDS 24LDI & 26LUI & AS NOTED	KMCLA	DPF	TEH
0	1-9-79	ISSUED FOR USE	KMCLA	DPF	TEH
A	4-24-78	ISSUED FOR INFORMATION ONLY	KMCLA	DPF	TEH

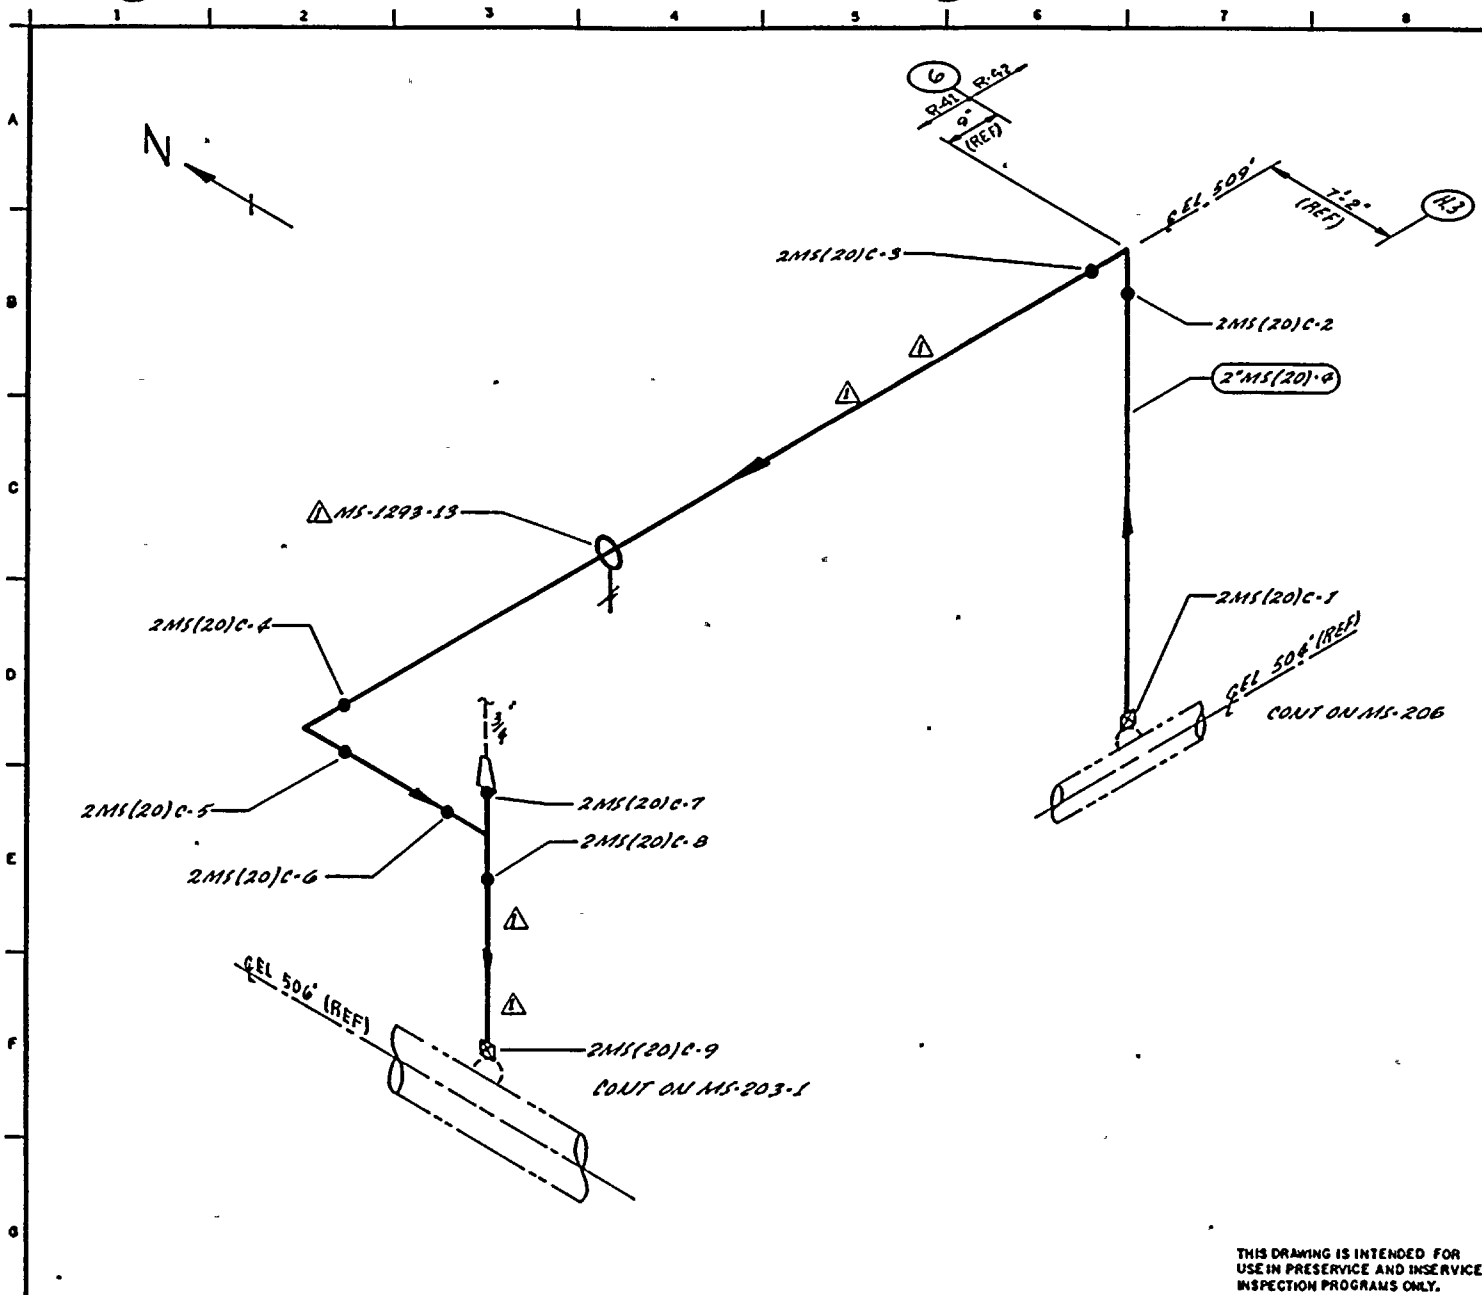

- NOTES:**
1. For branch piping, 1" or less (conn. shown in dashed lines), extend visual leakage exam through the outermost normally closed nuclear class valve, or until transition to instrument tubing, unless otherwise noted.
 2. THIS DWG. IDENTIFIES PIPING WELDS THAT REQUIRE AUGMENTED ISI.
 3. SCAFFOLDING IS REQUIRED.

REFERENCE
 BOYER CRAIL ISOMETRIC
 MS-1293-1 REV G

QUALITY CLASS: 1 ASME CODE CLASS: 2
 ENGR: *[Signature]* DRAWN: *[Signature]* DATE: 12.7.81

WASHINGTON PUBLIC POWER SUPPLY SYSTEM
 RICHLAND, WASHINGTON 99352

THIS DRAWING IS INTENDED FOR USE IN PRESERVICE AND INSERVICE INSPECTION PROGRAMS ONLY.


PIPING SYSTEM	NOM DIA (IN)	SCH	NOM WALL THK	MATERIAL SPECIFICATION	MATL TYPE	CAL BLOCK NO
2"MS(20)-4	2	160	0.344	SA 106 GR B	CS	NA

WNP- 2
 WELD & COMPONENT IDENTIFICATION DIAGRAM

TITLE:
MAIN STEAM PRESSURE STABILIZATION LINE

DWG NO: MS-203-5 REV 1

NO	DATE	REVISION	BY	CHKD	APPVD
1	9/26/81	REVISED AS NOTED	<i>[Signature]</i>	DPE	TFH
0	12/8/81	ISSUED FOR USE	<i>[Signature]</i>	ZHR	TFH

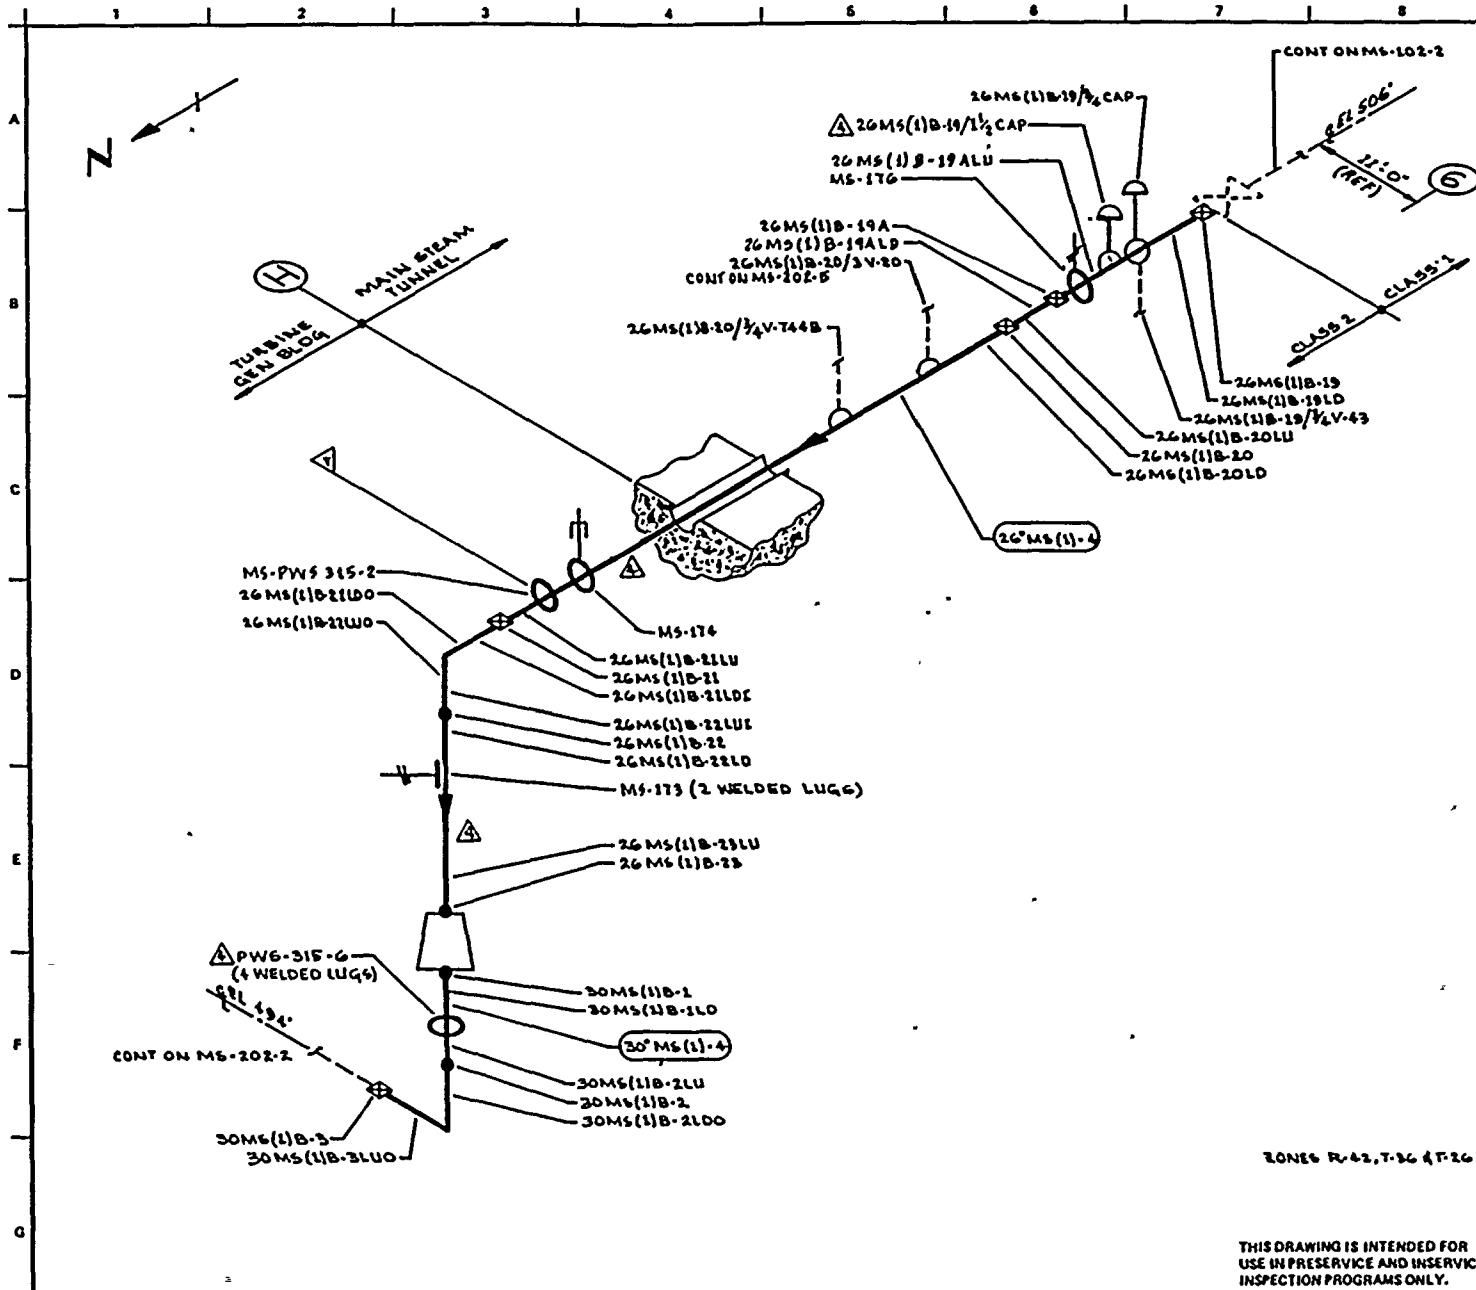


NOTES:

1. SCAFFOLDING IS REQUIRED.

REFERENCES:

BOVER & CRAIG ISOMETRIC
MS-529-1.3 REV B

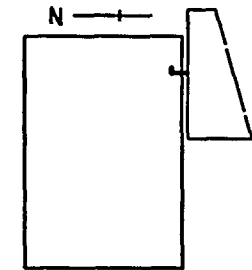

ZONES R-42, T-26 & T-26

THIS DRAWING IS INTENDED FOR
USE IN PRESERVICE AND INSERVICE
INSPECTION PROGRAMS ONLY.

QUALITY CLASS: 1 ASME CODE CLASS: 2
ENGR: D TIMMING DRAWN: K. M. A. DATE: 2-2-78



WASHINGTON PUBLIC POWER
SUPPLY SYSTEM


RICHLAND, WASHINGTON 99352

NO	DATE	REVISION	BY	CHKD	APPVD	PIPING SYSTEM	NOM DIA (IN)	SCH	NOM WALL THK	MATERIAL SPECIFICATION	MATL TYPE	CAL BLOCK NO
4	4-26-83	REVISED AS NOTED	K.M.A.	D.P.R.	T.R.							
3	11-28-81	REVISED AS NOTED, AUGMENTED IGT ADDED	K.M.A.	T.R.	T.R.	26MS(1)-4	26	XXX	1.125	SA 155 CL I KCF 70	CS	UT-3
2	11-6-80	ADDED WELDS 19ALU & 19ALD. DELETED WELDS 210T & 31U1	K.M.A.	T.R.	T.R.	30MS(1)-4	30	XXX	1.25	SA 155 CL I KCF 70	CS	UT-1
1	8-30-77	ADDED FIELD WELD 26MS(1)B-19A ZN B-6.	K.M.A.	T.R.	T.R.							
0	1-9-79	ISSUED FOR USE	K.M.A.	T.R.	T.R.							
A	4-24-78	ISSUED FOR INFORMATION ONLY	K.M.A.	T.R.	T.R.							

WNP-1
WELD & COMPONENT
IDENTIFICATION DIAGRAM

TITLE:
MAIN STEAM LINE B

DWG NO: MS-202-1 REV 4

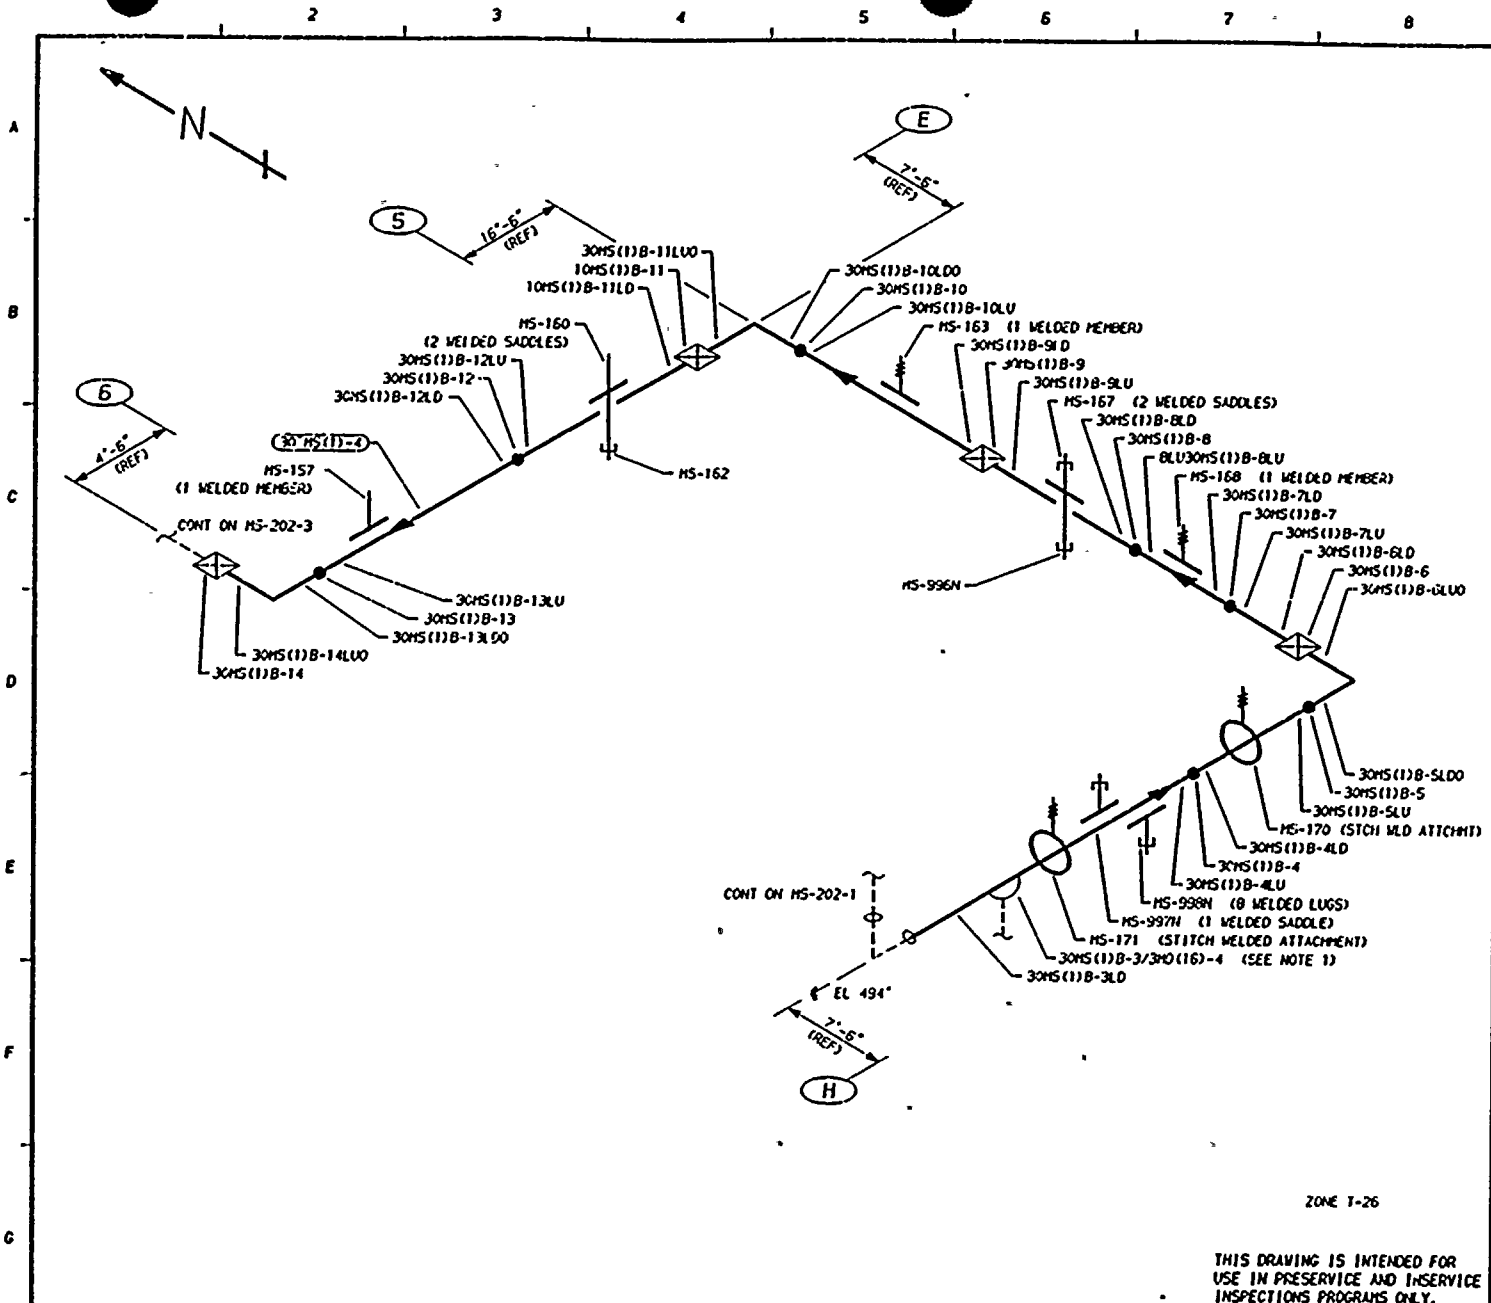


NOTES

1. EXTEND LEAKAGE EXAM THROUGH DRAINAGE SYSTEM TO VALVES MS-V-72 & MS-V-73.
2. SCAFFOLDING IS REQUIRED.

REFERENCES:

BOYCE AND CRAIG ISOMETRIC
MS-529-4.7 REV 5

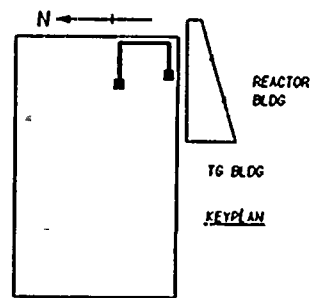

ZONE 1-26

THIS DRAWING IS INTENDED FOR
USE IN PRESERVICE AND INSERVICE
INSPECTIONS PROGRAMS ONLY.

NO	DATE	REVISION	BY	CHKD	APVD	PIPING SYSTEM	NOM DIA (IN)	SCH	NOM WALL THK	MATERIAL SPECIFICATION	MATL TYPE	CAL BLOCK NO
3	10-13-83	REVISED HANGERS REDRAWN	K-McA	DPR	TFH	30" MS(1)-4	30	XXX	1.25	SA 155 CL 1 KCF.70	CS	UT-1
2	12-2-81	REVISED AS NOTED	K-McA	DPR	TFH							
1	11-5-80	DELETE WELDS SLOI, BLUI, 10LDI, 11LUI, 13LDI & 14LUI	K-McA	TFH	DWP							
0	1-9-79	ISSUED FOR USE	K-McA	TFH	DWP							
A	4-20-78	ISSUED FOR INFORMATION ONLY	K-McA	TFH	DWP							

QUALITY CLASS, 1	ASME CODE CLASS, 2
ENGR, D TIMMINS	DRAWN, K-McA DATE, 2-2-78


WASHINGTON PUBLIC POWER
SUPPLY SYSTEM
RICHLAND, WASHINGTON 99352

WNP-2
WELD & COMPONENT
IDENTIFICATION DIAGRAM

TITLE: MAIN STEAM LINE B


DWG NO, MS-202-2 REV 3



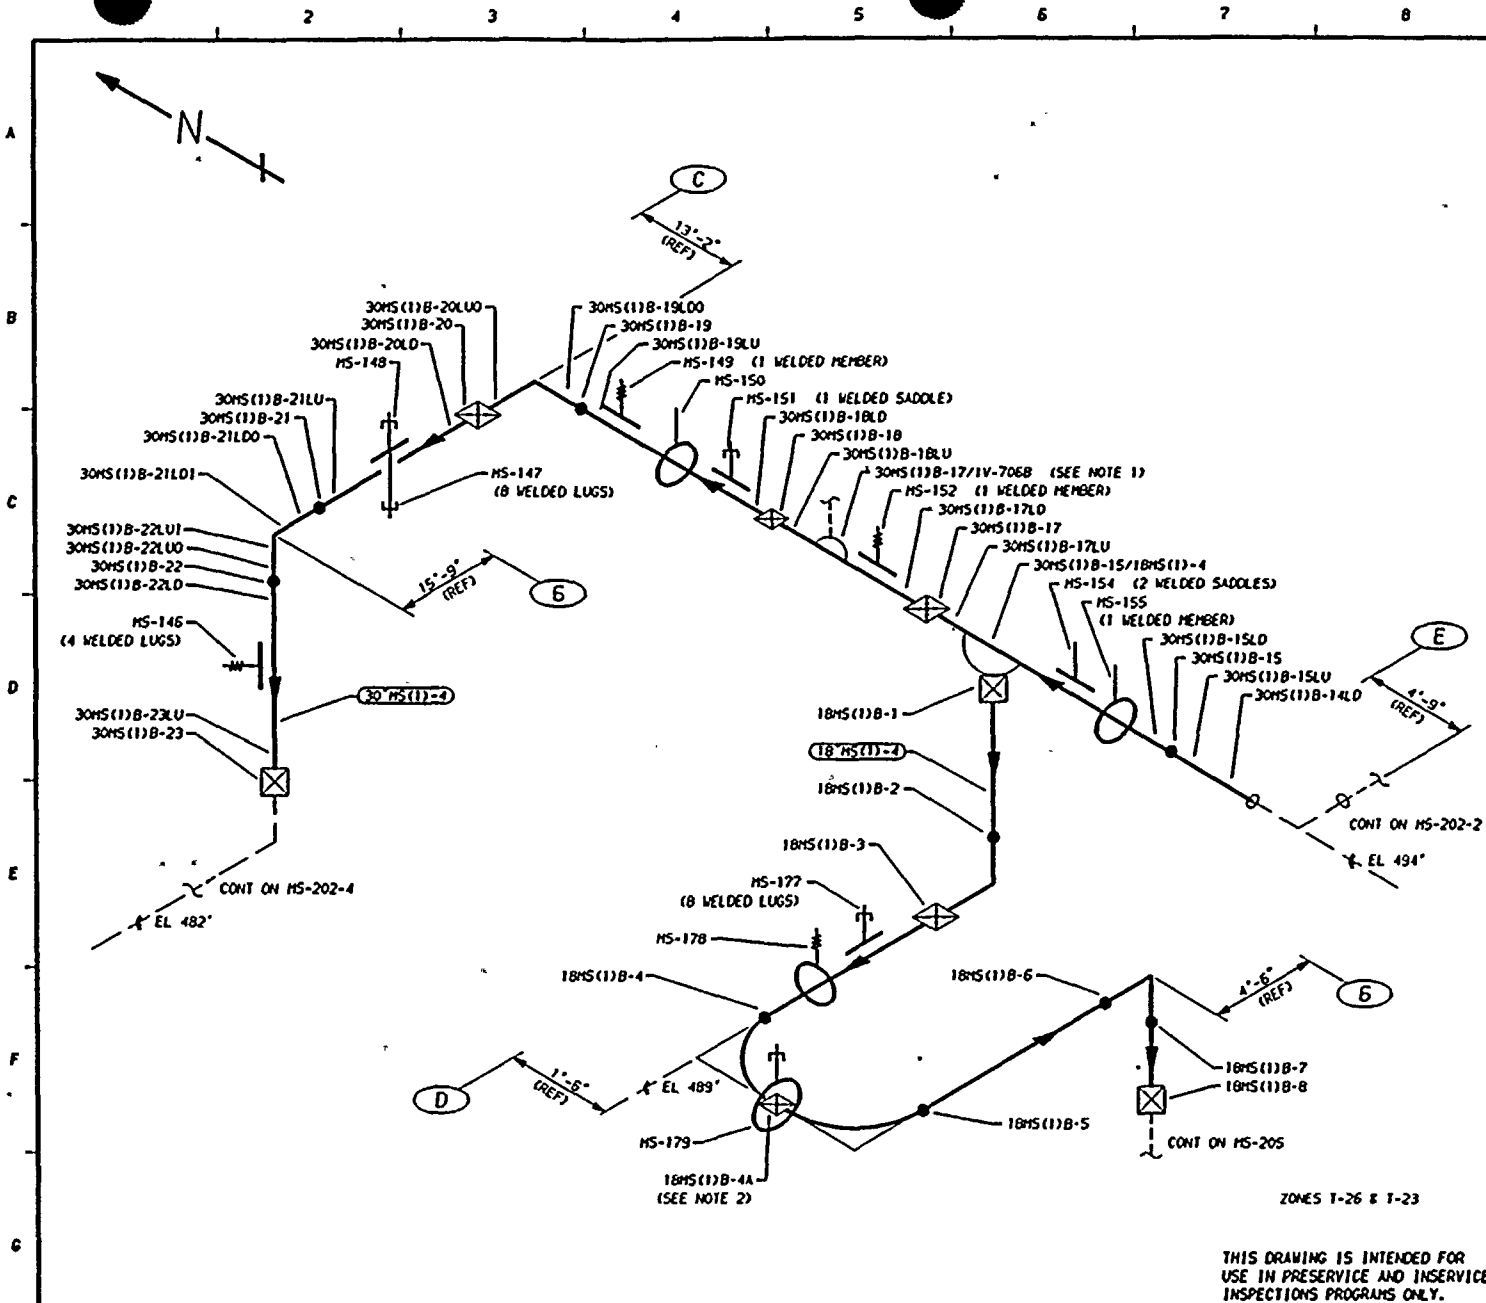

- NOTES**
1. EXTEND LEAKAGE EXAM THROUGH VALVE MS-V-706B TO MAIN STEAM PRESSURER AVERAGING MANIFOLD.
 2. WELD 18MS(11)B-4A IS FITTING TO FITTING. MS-179 IS 1 1/2" FROM WELD 18MS(11)B-4A CENTERLINE.

REFERENCES:
 BOYEE AND CRAIL ISOMETRIC
 MS-529-B.11 REV 7

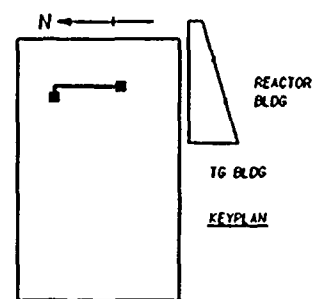

QUALITY CLASS, 1 ASME CODE CLASS, 2.
 ENGR, D TIMMINS | DRAWN, K-McA | DATE, 2-3-78

WASHINGTON PUBLIC POWER
 SUPPLY SYSTEM
 RICHLAND, WASHINGTON 99352

WNP-2
 WELD & COMPONENT
 IDENTIFICATION DIAGRAM

TITLE:
 MAIN STEAM LINE B


DWG NO, MS-202-3 REV 4

THIS DRAWING IS INTENDED FOR
 USE IN PRESERVICE AND INSERVICE
 INSPECTIONS PROGRAMS ONLY.

ZONES T-26 & T-23


NO	DATE	REVISION	BY	CHKD	APVD
4	12-2-83	REVISED HANGERS REDRAWN	K-McA	DPR	TFH
3	12-2-81	REVISED AS NOTED	K-McA	TFH	DWP
2	11-5-80	ADDED FIELD WELD 18MS(11)B-4A & AS NOTED	K-McA	TFH	DWP
1	7-17-79	DEL TEE & CORRESPONDING WELDS, ADDED VOL 24 D-5 & REF 24 G-6	K-McA	TFH	DWP
0	1-9-79	ISSUED FOR USE	K-McA	TFH	DWP
A	4-20-78	ISSUED FOR INFORMATION ONLY	K-McA	TFH	DWP

PIPING SYSTEM	NOM DIA (IN)	SCH	NOM WALL THK	MATERIAL SPECIFICATION	MATL TYPE	CAL BLOCK NO
30"MS(11)-4	30	XXX	1.25	SA 155 CL 1 KCF 70	CS	UT-1
18"MS(11)-4	18	80	0.938	SA 106 GR B	CS	UT-12

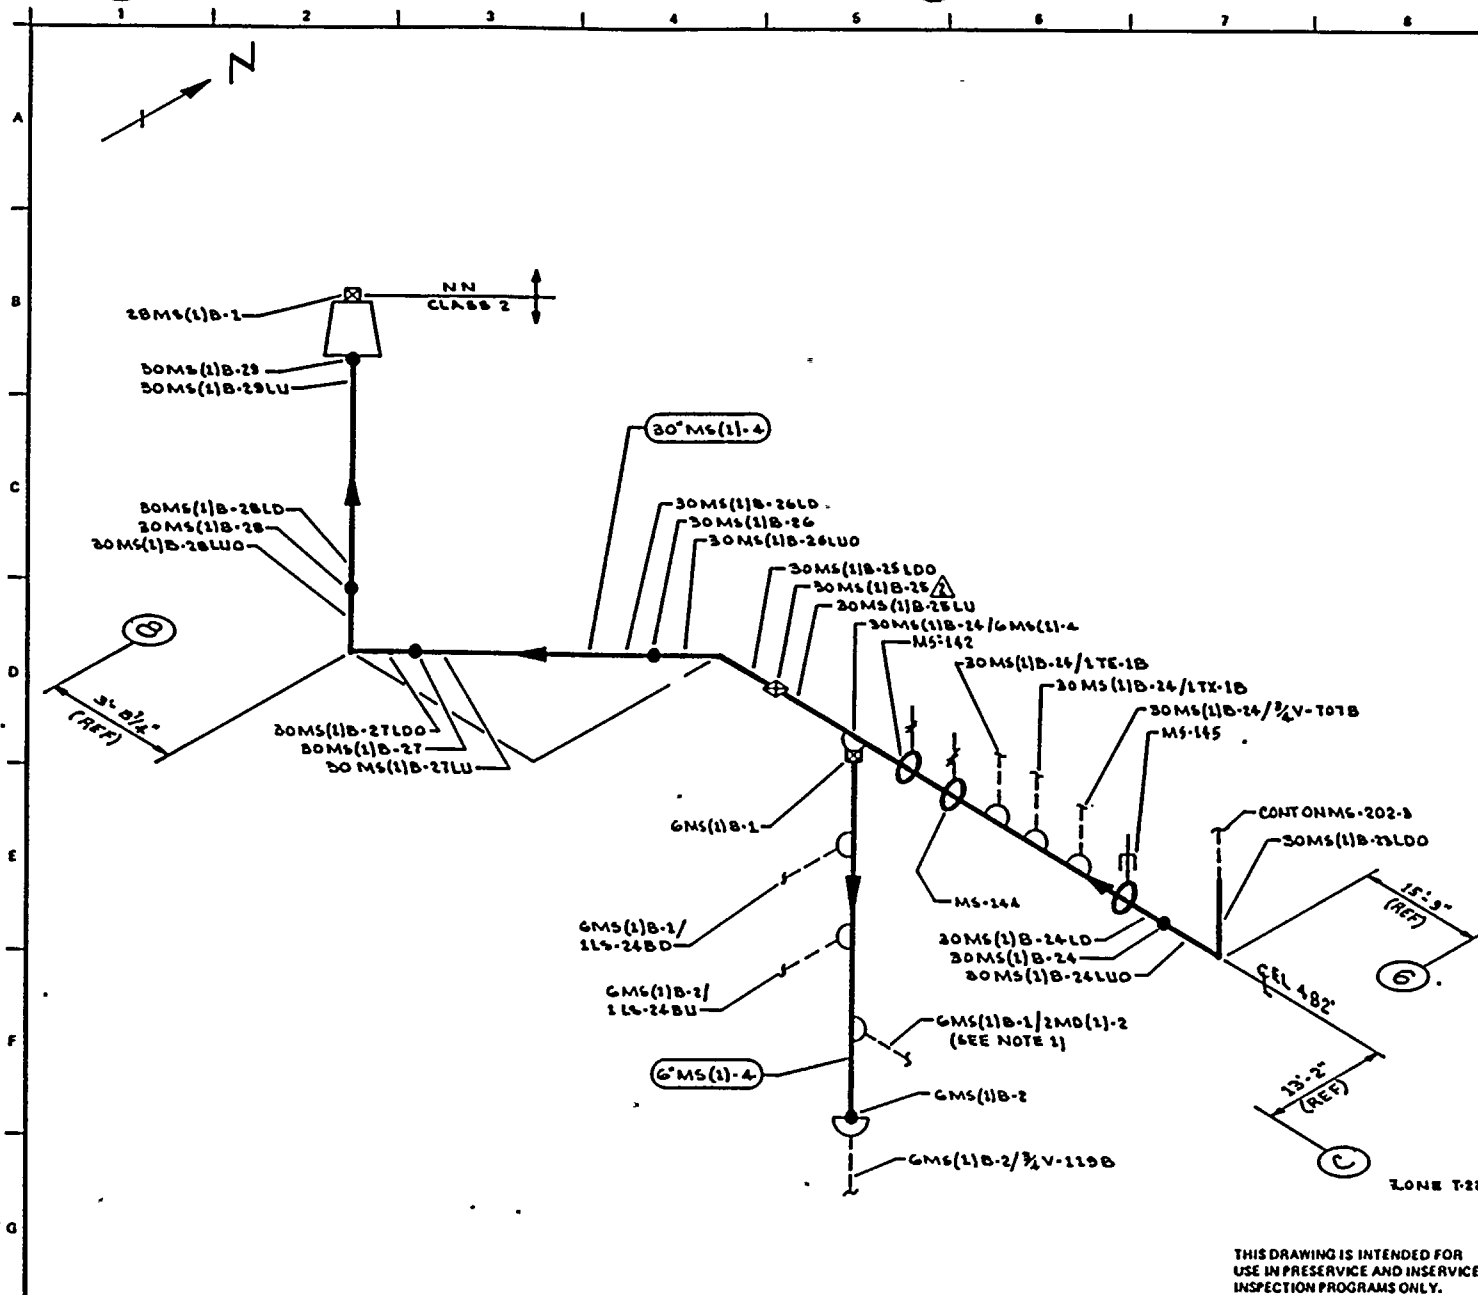

- NOTES:
- EXTEND LEAKAGE EXAM THROUGH VALVES MD-V-120B & MD-V-117B.
 - SCAFFOLDING IS REQUIRED.

- REFERENCES:
- BOVEE & CRAIG ISOMETRICS
 MS-828-12 REV 6
 MS-829-13 REV 1

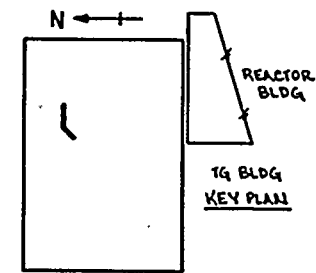

QUALITY CLASS: 1 ASME CODE CLASS: 2
 ENGR: D TIMMINS DRAWN: K-M-C-A DATE: 1-30-78

WASHINGTON PUBLIC POWER SUPPLY SYSTEM
 RICHLAND, WASHINGTON 98362

THIS DRAWING IS INTENDED FOR USE IN PRESERVICE AND INSERVICE INSPECTION PROGRAMS ONLY.


WNP-2 WELD & COMPONENT IDENTIFICATION DIAGRAM

TITLE: MAIN STEAM LINE B

DWG NO: MS-202-4 REV 2

NO	DATE	REVISION	BY	CHKD	APPVD
2	9-26-78	REVISED AS NOTED	KNA	EPF	THB
1	11-5-77	DELETED WELDS 23LDI, 24LUI, 25LDI, 26LUI, 27LDI (28LUI)	KNA	EPF	THB
0	1-9-77	ISSUED FOR USE	KNA	EPF	THB
A	4-20-78	ISSUED FOR INFORMATION ONLY	KNA	EPF	THB


PIPING SYSTEM	NOM DIA (IN)	SCH	NOM WALL THK	MATERIAL SPECIFICATION	MATL TYPE	CAL BLOCK NO
30" MS(1)-4	30	XXX	1.25	SA 155 CLI KCF 70	CS	UT-1
6" MS(1)-4	6	80	0.432	SA 106 GRB	CS	NA
28" MS(1)-4	28	XXX	1.420	SA 155 CLI KCF 70	CS	UT-2

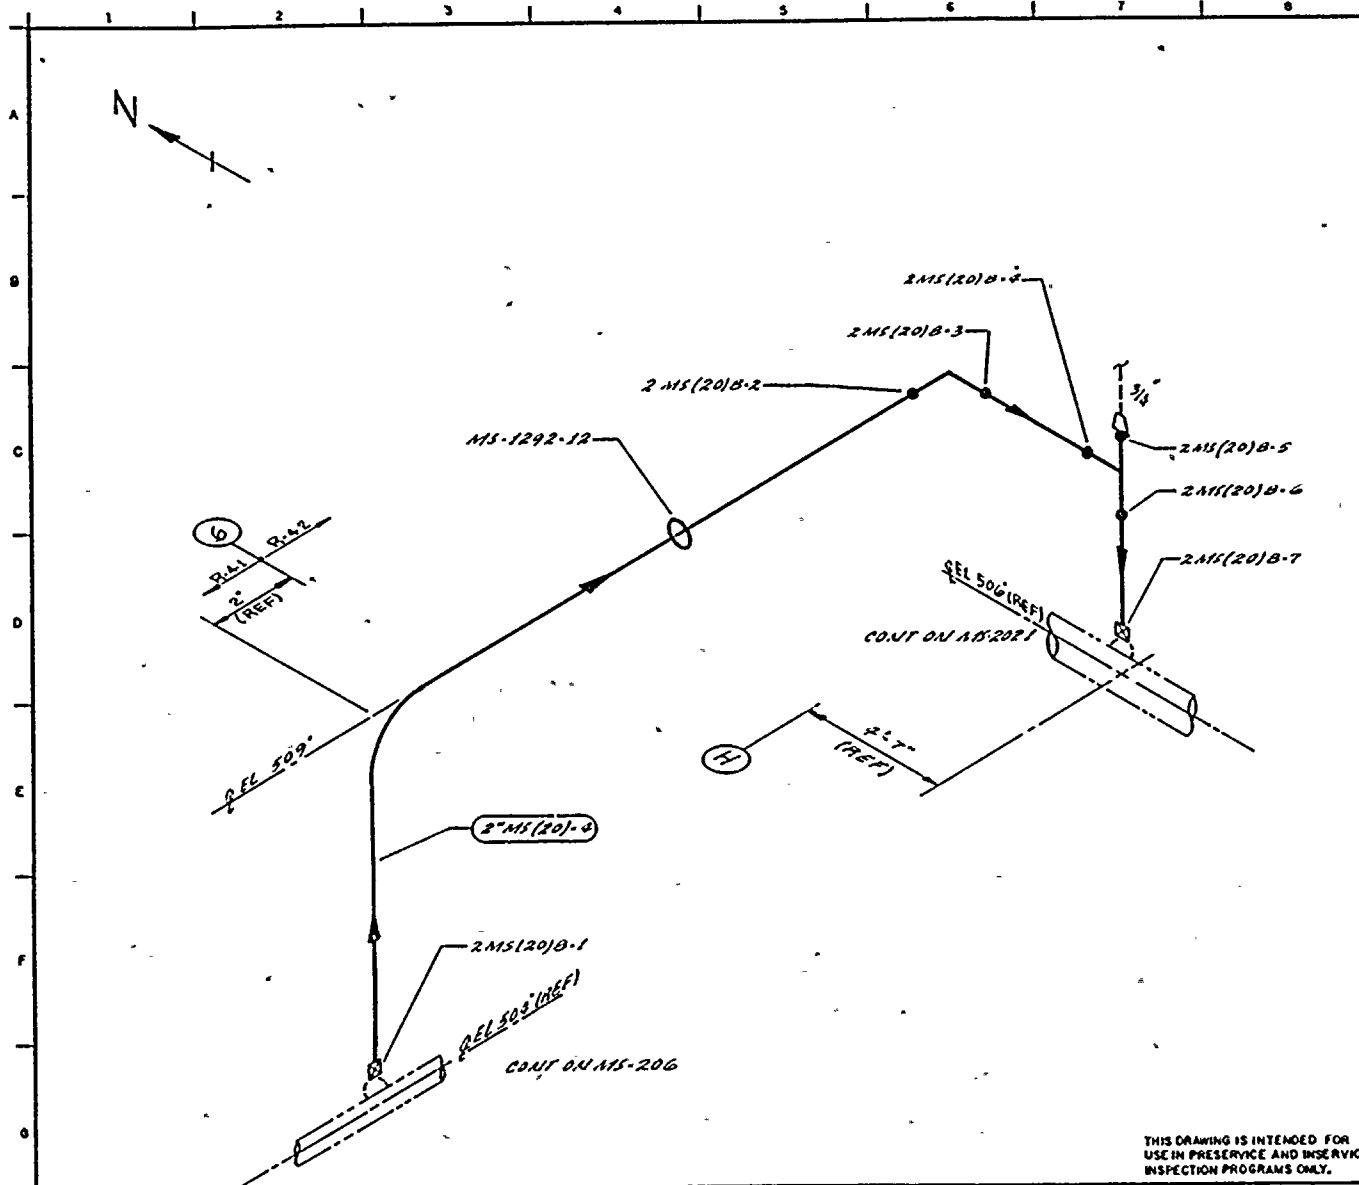

- NOTE:**
1. For branch piping, 1" or less (conn. shown in dashed lines), extend visual leakage exam through the outermost normally closed nuclear class valve, or until transition to instrument tubing, unless otherwise noted.
 2. THIS DIVG. IDENTIFIES PIPING WELDS THAT REQUIRE AUGMENTED ISI.

REFERENCE:
 BONE CRAIL ISOMETRIC
 MS-1292-1 REV 5

QUALITY CLASS: 1 ASME CODE CLASS: 2
 ENGR: *[Signature]* DRAWN: *[Signature]* DATE: 12-4-81

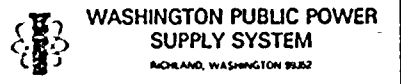

THIS DRAWING IS INTENDED FOR
 USE IN PRESERVICE AND INSERVICE
 INSPECTION PROGRAMS ONLY.

PIPING SYSTEM	NOM DIA (IN)	SCH	NOM WALL THK	MATERIAL SPECIFICATION	MATL TYPE	CAL BLOCK NO
2MS(20)-4	2	160	0.344	SA 106 GR B	CS	NA

WNP-2
 WELD COMPONENT
 IDENTIFICATION DIAGRAM

TITLE:
 MAIN STEAM
 PRESSURE STABILIZATION LINE

DWG NO: MS-202-5 REV 0

NO	DATE	REVISION	BY	CHKD	APPVD
0	12/4/81	ISSUED FOR USE			

WMP-02
 INTERVAL: PSI
 PEPICD: NA
 OUTAGE:
 DRAWING NO. MS-202

WASHINGTON PUBLIC POWER SUPPLY SYSTEM
 PROGRAM PLAN AND SCHEDULE
 SYSTEM OR COMPONENT: MS(1)-4
 DESCRIPTION: MAIN STEAM LINE B

PAGE 001
 DATE 12/14/84

IDENT. NO.	DESCRIPTION	SECT. XI EXAM EYAM.	EXAM MTH.	PROCEDURE	CAL. BLOCK	INSERVICE		NOTES
						REQ.	SCHEDULED OUTAGE	
26MS(1)B-19	VALVE TO PIPE	C-F	VOL	UTP-10	UT-3			AUGHT
			SUR	PTP-1				AUGHT
26MS(1)B-19LD	PIPE LONG SEAM	C-F	VOL	UTP-10	UT-3			
			SUR	PTP-1				
26MS(1)B-19/3/4CAP	CAPPED CONN	N/A	VT-2	N/A				IWC-2510, SEE NOTES #6 & #7.
26MS(1)B-19/3/4V-43	TFST CONN	N/A	VT-2	N/A				IWC-2510, SEE NOTES #6 & #7.
26MS(1)B-19/1-1/2CAP	CAPPED CONN	N/A	VT-2	N/A				IWC-2510, SEE NOTES #6 & #7.
26MS(1)B-19ALU	PIPE LONG SEAM	C-F	VOL	UTP-10	UT-3			
			SUR	PTP-1				
MS-176	SPRING	C-E-2	VT-3	303/8.2.17				
			VT-4	303/8.2.17				
26MS(1)B-19A	PIPE TO PIPE	C-F	VOL	UTP-10	UT-3			AUGHT
			SUR	PTP-1				AUGHT
26MS(1)B-19ALD	PIPE LONG SEAM	C-F	VOL	UTP-10	UT-3			
			SUR	PTP-1				
26MS(1)B-20LU	PIPE LONG SEAM	C-F	VOL	UTP-10	UT-3			

WNP-02
 INTERVAL: PSI
 PERIOD: NA
 OUTAGE:
 DRAWING NO. NS-202

WASHINGTON PUBLIC POWER SUPPLY SYSTEM
 PROGRAM PLAN AND SCHEDULE
 SYSTEM OR COMPONENT: MS(1)-4
 DESCRIPTION: MAIN STEAM LINE B

PAGE 002
 DATE 12/14/84

IDENT. NO.	DESCRIPTION	SECT. XI EXAM.	EXAM MTH.	PROCEDURE	CAL. BLOCK	INSERVICE		NOTES
						REQ.	SCHEDULED OUTAGE	
26MS(1)B-20			SUR	PTP-1				
	PIPE TO PIPE	C-F	VOL	UTP-10	UT-3			AUGMT
26MS(1)B-20LD			SUR	PTP-1				AUGMT
	PIPE LONG SEAM	C-F	VOL	UTP-10	UT-3			
26MS(1)B-20/3V-20			SUR	PTP-1				
	DRAIN CONN	N/A	SUR	PTP-1				IWC-2510, AUGMT.
26MS(1)B-20/3/4V-744B								
	INSTR CONN	N/A	VT-2	N/A				IWC-2510, SEE NOTES #6 & #7.
NS-174								
	PSA-35 SNURRER	C-E-2	VT-3	303/8.2.17				S/N 8688
			VT-4	303/8.2.17				S/N 8688
FWS-315-2								
	PIPE WHIP	N/A	N/A	N/A				SEE NOTE #1
26MS(1)B-21LU								
	PIPE LONG SEAM	C-F	VOL	UTP-10	UT-3			
26MS(1)B-21			SUR	PTP-1				
	PIPE TO EL	C-F	VOL	UTP-10	UT-3			
26MS(1)B-21LDI			SUR	PTP-1				
	EL SEAM	C-F	VOL	UTP-10	UT-3			
26MS(1)B-21LDO			SUR	PTP-1				
	EL SEAM	C-F	VOL	UTP-10	UT-3			

WNP-02
 INTERVAL: PSI
 PERIOD: NA
 OUTAGE:
 DRAWING NO. MS-202

WASHINGTON PUBLIC POWER SUPPLY SYSTEM
 PROGRAM PLAN AND SCHEDULE
 SYSTEM OR COMPONENT: MS(1)-4
 DESCRIPTION: MAIN STEAM LINE B

PAGE 003
 DATE 12/14/84

IDENT. NO.	DESCRIPTION	SECT. XI EXAM.	EXAM MTH.	PROCEDURE	CAL. BLOCK	INSERVICE		NOTES
						REQ.	SCHEDULED OUTAGE	
26MS(1)B-22LUI	EL SEAM	C-F	VOL	UTP-10	UT-3			
26MS(1)B-22LU0	EL SEAM	C-F	VOL	UTP-10	UT-3			
26MS(1)B-22	EL TO PIPE	C-F	VOL	UTP-10	UT-3			
26MS(1)B-22LD	PIPE LONG SEAM	C-F	VOL	UTP-10	UT-3			
MS-173(W)	2 WELDED LUGS	C-E-1	SUR	MTP-1				
MS-173	SPRING	C-E-2	VT-3	303/R.2.17				
26MS(1)B-23LU	PIPE LONG SEAM	C-F	VOL	UTP-10	UT-3			
26MS(1)B-23	PIPE TO REDUCER	C-F	VOL	UTP-10	UT-3			
30MS(1)B-1	REDUCER TO PIPE	C-F	VOL	UTP-10	UT-1			

WNP-02
 INTERVAL: PSI
 PERIOD: NA
 OUTAGE:
 DRAWING NO. MS-202

WASHINGTON PUBLIC POWER SUPPLY SYSTEM
 PROGRAM PLAN AND SCHEDULE
 SYSTEM OR COMPONENT: MS(1)-4
 DESCRIPTION: MAIN STEAM LINE B

PAGE 004
 DATE 12/14/84

IDENT. NO.	DESCRIPTION	SECT. XI EXAM.	EYAM MTH.	PROCEDURE	CAL. BLOCK	INSERVICE		NOTES
						REQ.	SCHEDULED OUTAGE	
30MS(1)B-1LD	PIPE LONG SEAM	C-F	VOL	UTP-10	UT-1			
			SUR	PTP-1				
PWS-315-6	PIPE WHIP	N/A	N/A	N/A				
30MS(1)B-2LU	PIPE LONG SEAM	C-F	VOL	UTP-10	UT-1			
			SUR	PTP-1				
30MS(1)B-2	PIPE TO EL	C-F	VOL	UTP-10	UT-1			
			SUR	PTP-1				
30MS(1)B-2LDD	EL SEAM	C-F	VOL	UTP-10	UT-1			
			SUR	PTP-1				
30MS(1)B-3LU0	EL SEAM	C-F	VOL	UTP-10	UT-1			
			SUR	PTP-1				
30MS(1)B-3	EL TO PIPE	C-F	VOL	UTP-10	UT-1			
			SUR	PTP-1				
30MS(1)B-3LD	PIPE LONG SEAM	C-F	VOL	UTP-10	UT-1			
			SUR	PTP-1				
30MS(1)B-3/3MD(16)-4	DRAIN CONN	N/A	VT-2	N/A				
MS-171	SPRING	C-E-2	VT-3	303/8.2.17				

INC-2510, SEE NOTES
 #6 & #7.

WNP-02
 INTERVAL: PSI
 PERIOD: NA
 OUTAGE:
 DRAWING NO. MS-202

WASHINGTON PUBLIC POWER SUPPLY SYSTEM
 PROGRAM PLAN AND SCHEDULE
 SYSTEM OR COMPONENT: MS(1)-4
 DESCRIPTION: MAIN STEAM LINE B

PAGE 005
 DATE 12/14/84

<u>IDENT. NO.</u>	<u>DESCRIPTION</u>	<u>SECT.</u> <u>XI</u> <u>EXAM.</u>	<u>EXAM</u> <u>MTH.</u>	<u>PROCEDURE</u>	<u>CAL.</u> <u>BLOCK</u>	<u>INSERVICE</u>		<u>NOTES</u>
						<u>REQ.</u>	<u>SCHEDULED</u> <u>OUTAGE</u>	
MS-997N			VT-4	303/8.2.17				
	PSA-10 SN(2)	C-E-2	VT-3	303/8.2.17				S/N 1456/1468
			VT-4	303/8.2.17				S/N 1456/1468
MS-998N(W)	8 WELDED LUGS	C-E-1	SUR	MTP-1				
MS-998N								
	PSA-10 SN(2)	C-E-2	VT-3	303/8.2.17				S/N 710/718
			VT-4	303/8.2.17				S/N 710/718
30MS(1)B-4LU	PIPE LONG SEAM	C-F	VOL	UTP-10	UT-1			
			SUR	PTP-1				
30MS(1)B-4	PIPE TO PIPE	C-F	VOL	UTP-10	UT-1			
			SUR	PTP-1				
30MS(1)B-4LD	PIPE LONG SEAM	C-F	VOL	UTP-10	UT-1			
			SUR	PTP-1				
MS-170	SPRING (2)	C-E-2	VT-3	303/8.2.17				
			VT-4	303/8.2.17				
30MS(1)B-5LU	PIPE LONG SEAM	C-F	VOL	UTP-10	UT-1			
			SUR	PTP-1				
30MS(1)B-5	PIPE TO EL	C-F	VOL	UTP-10	UT-1			
			SUR	PTP-1				

WNP-02
 INTERVAL: PSI
 PERIOD: NA
 OUTAGE:
 DRAWING NO. MS-202

WASHINGTON PUBLIC POWER SUPPLY SYSTEM
 PROGRAM PLAN AND SCHEDULE
 SYSTEM OR COMPONENT: MS(1)-A
 DESCRIPTION: MAIN STEAM LINE B

PAGE 006
 DATE 12/14/84

<u>IDENT. NO.</u>	<u>DESCRIPTION</u>	<u>SECT.</u> <u>XI</u> <u>EXAM.</u>	<u>EXAM</u> <u>MTH.</u>	<u>PROCEDURE</u>	<u>CAL.</u> <u>BLOCK</u>	<u>INSERVICE</u> <u>SCHEDULED</u>		<u>NOTES</u>
						<u>REQ.</u>	<u>OUTAGE</u>	
30MS(1)B-5LDO	EL SEAM	C-F	VOL	UTP-10	UT-1			
			SUR	PTP-1				
30MS(1)B-6LUO	EL SEAM	C-F	VOL	UTP-10	UT-1			
			SUR	PTP-1				
30MS(1)B-6	EL TO PIPE	C-F	VOL	UTP-10	UT-1			
			SUR	PTP-1				
30MS(1)B-6LD	PIPE LONG SEAM	C-F	VOL	UTP-10	UT-1			
			SUR	PTP-1				
30MS(1)B-7LU	PIPE LONG SEAM	C-F	VOL	UTP-10	UT-1			
			SUR	PTP-1				
30MS(1)B-7	PIPE TO PIPE	C-F	VOL	UTP-10	UT-1			
			SUR	PTP-1				
30MS(1)B-7LD	PIPE LONG SEAM	C-F	VOL	UTP-10	UT-1			
			SUR	PTP-1				
MS-168	STRUT	C-E-2	VT-3	303/R.2.17				
30MS(1)B-8LU	PIPE LONG SEAM	C-F	VOL	UTP-10	UT-1			
			SUR	PTP-1				
30MS(1)B-8	PIPE TO PIPE	C-F	VOL	UTP-10	UT-1			

WNP-02
 INTERVAL: PSI
 PERIOD: NA
 OUTAGE:
 DRAWING NO. MS-202

WASHINGTON PUBLIC POWER SUPPLY SYSTEM
 PROGRAM PLAN AND SCHEDULE
 SYSTEM OR COMPONENT: MS(1)-4
 DESCRIPTION: MAIN STEAM LINE B

PAGE 007
 DATE 12/14/84

IDENT. NO.	DESCRIPTION	SECT. XI EXAM.	EXAM MTH.	PROCEDURE	CAL. BLOCK	IN SERVICE		NOTES
						REQ.	SCHEDULED OUTAGE	
30MS(1)B-8LD	PIPE LONG SEAM	C-F	VOL	UTP-10	UT-1			
MS-167	PSA-10 SN(2)	C-E-2	VT-3	303/8.2.17				S/N 9950/9895
MS-996N	PSA-10 SN(2)	C-E-2	VT-4	303/8.2.17				S/N 9950/9895
30MS(1)B-9LU	PIPE LONG SEAM	C-F	VOL	UTP-10	UT-1			S/N 9961/9955
30MS(1)B-9	PIPE TO PIPE	C-F	VOL	UTP-10	UT-1			
30MS(1)B-9LD	PIPE LONG SEAM	C-F	VOL	UTP-10	UT-1			
MS-163	SPRING (2)	C-E-2	VT-3	303/8.2.17				
30MS(1)B-10LU	PIPE LONG SEAM	C-F	VOL	UTP-10	UT-1			
30MS(1)B-10	PIPE TO EL	C-F	VOL	UTP-10	UT-1			

WNP-32
 INTERVAL: PSI
 PERIOD: NA
 OUTAGE:
 DRAWING NO. MS-202

WASHINGTON PUBLIC POWER SUPPLY SYSTEM
 PROGRAM PLAN AND SCHEDULE
 SYSTEM OR COMPONENT: MS(1)-4
 DESCRIPTION: MAIN STEAM LINE B

PAGE 008
 DATE 12/14/84

IDENT. NO.	DESCRIPTION	SCT. XI EXAM.	EXAM MTH.	PROCEDURE	CAL. BLOCK	INSERVICE		NOTES
						REQ.	SCHEDULED OUTAGE	
			SUR	PTP-1				
30MS(1)B-10LDO	EL SEAM	C-F	VOL	UTP-10	UT-1			
			SUR	PTP-1				
30MS(1)B-11LUO	EL SEAM	C-F	VOL	UTP-10	UT-1			
			SUR	PTP-1				
30MS(1)B-11	EL TO PIPE	C-F	VOL	UTP-10	UT-1			
			SUR	PTP-1				
30MS(1)B-11LD	PIPE LONG SEAM	C-F	VOL	UTP-10	UT-1			
			SUR	PTP-1				
MS-160	STRUT	C-E-2	VT-3	303/8.2.17				
MS-162	PSA-13 SN(2)	C-E-2	VT-3	303/8.2.17				S/N 315/325
			VT-4	303/8.2.17				S/N 315/325
30MS(1)B-12LU	PIPE LONG SEAM	C-F	VOL	UTP-10	UT-1			
			SUR	PTP-1				
30MS(1)B-12	PIPE TO PIPE	C-F	VOL	UTP-10	UT-1			
			SUR	PTP-1				
30MS(1)B-12LD	PIPE LONG SEAM	C-F	VOL	UTP-10	UT-1			
			SUR	PTP-1				

WNP-02
 INTERVAL: PSI
 PERIOD: NA
 OUTAGE:
 DRAWING NO. HS-202

WASHINGTON PUBLIC POWER SUPPLY SYSTEM
 PROGRAM PLAN AND SCHEDULE
 SYSTEM OR COMPONENT: HS(1)-4
 DESCRIPTION: MAIN STEAM LINE B

PAGE 009
 DATE 12/14/84

<u>IDENT. NO.</u>	<u>DESCRIPTION</u>	SECT. <u>XI</u> <u>EXAM.</u>	<u>EXAM</u> <u>MTH.</u>	<u>PROCEDURE</u>	<u>CAL.</u> <u>BLOCK</u>	<u>INSERVICE</u>		<u>NOTES</u>
						<u>REQ.</u>	<u>SCHEDULED</u> <u>OUTAGE</u>	
MS-157								
30MS(1)B-13LU	STRUT	C-E-2	VT-3	303/8.2.17				
	PIPE LONG SEAM	C-F	VCL	UTP-10	UT-1			
			SUR	PTP-1				
30MS(1)B-13	PIPE TO EL	C-F	VOL	UTP-10	UT-1			
			SUR	PTP-1				
30MS(1)B-13LDO	EL SEAM	C-F	VOL	UTP-10	UT-1			
			SUR	PTP-1				
30MS(1)B-14LUO	EL SEAM	C-F	VOL	UTP-10	UT-1			
			SUR	PTP-1				
30MS(1)B-14	EL TO PIPE	C-F	VOL	UTP-10	UT-1			
			SUR	PTP-1				
30MS(1)B-14LD	PIPE LONG SEAM	C-F	VOL	UTP-10	UT-1			
			SUR	PTP-1				
30MS(1)B-15LU	PIPE LONG SEAM	C-F	VOL	UTP-10	UT-1			
			SUR	PTP-1				
30MS(1)B-15	PIPE TO PIPE	C-F	VOL	UTP-10	UT-1			
			SUR	PTP-1				
30MS(1)B-15LD	PIPE LONG SEAM	C-F	VOL	UTP-10	UT-1			

WNP-02
 INTERVAL: PSI
 PERIOD: NA
 OUTAGE:
 DRAWING NO. MS-202

WASHINGTON PUBLIC POWER SUPPLY SYSTEM
 PROGRAM PLAN AND SCHEDULE
 SYSTEM OR COMPONENT: MS(1)-4
 DESCRIPTION: MAIN STEAM LINE B

PAGE 010
 DATE 12/14/84

IDENT. NO.	DESCRIPTION	SECT. VI EXAM.	EXAM MTH.	PROCEDURE	CAL. BLOCK	INSERVICE		NOTES
						REQ.	SCHEDULED OUTAGE	
			SUR	PTP-1				
MS-155	STRUT	C-E-2	VT-3	303/8.2.17				
MS-154	RIGID	C-E-2	VT-3	303/8.2.17				
30MS(1)B-15/18MS(1)-4	PIPE TO WOL	C-F	SUR	PTP-1				
18MS(1)B-1	WOL TO PIPE	C-F	VOL	UTP-10	UT-12			
			SUR	PTP-1				
18MS(1)B-2	PIPE TO EL	C-F	VOL	UTP-10	UT-12			
			SUR	PTP-1				
18MS(1)B-3	EL TO PIPE	C-F	VOL	UTP-10	UT-12			
			SUR	PTP-1				
MS-177	PSA-35 SN(2)	C-E-2	VT-3	303/8.2.17				S/N 299/1071
			VT-4	303/8.2.17				S/N 299/1071
MS-178	SPRING	C-E-2	VT-3	303/8.2.17				
			VT-4	303/8.2.17				
18MS(1)B-4	PIPE TO EL	C-F	VOL	UTP-10	UT-12			
			SUR	PTP-1				
18MS(1)B-4A	EL TO EL	C-F	VOL	UTP-10	UT-12			
			SUR	PTP-1				

WMP-02
 INTERVAL: PSI
 PERIOD: NA
 CUTAGE:
 DRAWING NO. MS-202

WASHINGTON PUBLIC POWER SUPPLY SYSTEM
 PROGRAM PLAN AND SCHEDULE
 SYSTEM OR COMPONENT: MS(1)-4
 DESCRIPTION: MAIN STEAM LINE B

PAGE 011
 DATE 12/14/84

IDENT. NO.	DESCRIPTION	SFCT. XI EXAM.	EXAM MTH.	PROCEDURE	CAL. BLOCK	INSERVICE		NOTES
						REQ.	CUTAGE	
MS-179	PSA-1 SN(2)	C-E-2	VT-3	303/8.2.17				S/N 336/340
			VT-4	303/8.2.17				S/N 336/340
18MS(1)B-5	EL TO PIPE	C-F	VOL	UTP-10	UT-12			
			SUR	PTP-1				
18MS(1)B-6	PIPE TO EL	C-F	VOL	UTP-10	UT-12			
			SUR	PTP-1				
18MS(1)B-7	EL TO PIPE	C-F	VOL	UTP-10	UT-12			
			SUR	PTP-1				
18MS(1)B-8	PIPE TO VOL	C-F	VOL	UTP-10	UT-12			
			SUR	PTP-1				
30MS(1)B-17LU	PIPE SEAM	C-F	VOL	UTP-10	UT-1			
			SUR	PTP-1				
30MS(1)B-17	PIPE TO PIPE	C-F	VOL	UTP-10	UT-1			
			SUR	PTP-1				
30MS(1)B-17LD	PIPE LONG SEAM	C-F	VOL	UTP-10	UT-1			
			SUR	PTP-1				
MS-152	SPRING (2)	C-E-2	VT-3	303/8.2.17				
			VT-4	303/8.2.17				

WNP-02
 INTERVAL: PSI
 PERIOD: NA
 OUTAGE:
 DRAWING NO. MS-202

WASHINGTON PUBLIC POWER SUPPLY SYSTEM
 PROGRAM PLAN AND SCHEDULE
 SYSTEM OR COMPONENT: MS(1)-4
 DESCRIPTION: MAIN STEAM LINE B

PAGE 012
 DATE 12/14/84

IDENT. NO.	DESCRIPTION	SECT. XI EXAM.	EXAM MTH.	PROCEDURE	CAL. BLOCK	INSERVICE		NOTES
						REQ.	SCHEDULED OUTAGE	
30MS(1)B-17/1V-706B	INSTR CONN	N/A	VT-2	N/A				SEE NOTES #6 & #7.
30MS(1)R-18LU	PIPE LONG SEAM	C-F	VOL	UTP-10	UT-1			
			SUR	PTP-1				
30MS(1)B-18	PIPE TO PIPE	C-F	VOL	UTP-10	UT-1			
			SUR	PTP-1				
30MS(1)B-18LD	PIPE LONG SEAM	C-F	VOL	UTP-10	UT-1			
			SUR	PTP-1				
MS-151	PSA-3 SN(2)	C-E-2	VT-3	303/R.2.17				S/N 221/2567
			VT-4	303/R.2.17				S/N 221/2567
MS-150	STRUT	C-E-2	VT-3	303/R.2.17				
MS-149	SPRING (2)	C-E-2	VT-3	303/R.2.17				
			VT-4	303/P.2.17				
30MS(1)B-19LU	PIPE LONG SEAM	C-F	VOL	UTP-10	UT-1			
			SUR	PTP-1				
30MS(1)B-19	PIPE TO EL	C-F	VOL	UTP-10	UT-1			
			SUR	PTP-1				
30MS(1)B-19LDO	EL SEAM	C-F	VOL	UTP-10	UT-1			
			SUR	PTP-1				

WNP-02
 INTERVAL: PSI
 PERIOD: NA
 OUTAGE:
 DRAWING NO. MS-202

WASHINGTON PUBLIC POWER SUPPLY SYSTEM
 PROGRAM PLAN AND SCHEDULE
 SYSTEM OR COMPONENT: MS(1)-4
 DESCRIPTION: MAIN STEAM LINE B

PAGE 013
 DATE 12/14/84

IDENT. NO.	DESCRIPTION	SECT. XI EXAM.	EXAM. MTH.	PROCEDURE	CAL. BLOCK	INSERVICE		NOTES
						REQ.	SCHEDULED OUTAGE	
30MS(1)B-20LU0	EL SEAM	C-F	VOL	UTP-10	UT-1			
			SUR	PTP-1				
30MS(1)B-20	EL TO PIPE	C-F	VOL	UTP-10	UT-1			
			SUR	PTP-1				
30MS(1)B-20LD	PIPE LONG SEAM	C-F	VOL	UTP-10	UT-1			
			SUR	PTP-1				
MS-147(W)	8 WELDED LUGS	C-E-1	SUR	QCI 4-3				
MS-147	PSA-10 SN(2)	C-E-2	VT-3	303/8.2.17				S/N 688/70
			VT-4	303/8.2.17				S/N 688/70
MS-148	PSA-10 SNUBBER	C-E-2	VT-3	303/8.2.17				S/N 318
			VT-4	303/8.2.17				S/N 318
30MS(1)B-21LU	PIPE LONG SEAM	C-F	VOL	UTP-10	UT-1			
			SUR	PTP-1				
30MS(1)B-21	PIPE TO EL	C-F	VOL	UTP-10	UT-1			
			SUR	PTP-1				
30MS(1)B-21LDI	EL SEAM	C-F	VOL	UTP-10	UT-1			
			SUR	PTP-1				
30MS(1)B-21LDO	EL SEAM	C-F	VOL	UTP-10	UT-1			

WNP-02
 INTERVAL: PSI
 PERIOD: NA
 OUTAGE:
 DRAWING NO. HS-202

WASHINGTON PUBLIC POWER SUPPLY SYSTEM
 PROGRAM PLAN AND SCHEDULE
 SYSTEM OR COMPONENT: MS(1)-4
 DESCRIPTION: MAIN STEAM LINE B

PAGE 014
 DATE 12/14/84

IDENT. NO.	DESCRIPTION	SECT. XI EXAM.	EXAM MTH.	PROCEDURE	CAL. BLOCK	INSERVICE		NOTES
						REQ.	SCHEDULED OUTAGE	
30MS(1)B-22LUI	EL SEAM	C-F	VOL	UTP-10	UT-1			
30MS(1)B-22LUO	EL SEAM	C-F	VOL	UTP-10	UT-1			
30MS(1)B-22	EL TO PIPE	C-F	VOL	UTP-10	UT-1			
30MS(1)B-22LD	PIPE LONG SEAM	C-F	VOL	UTP-10	UT-1			
MS-146	SPRING (2)	C-E-2	VT-3	303/8.2.17				
30MS(1)B-23LU	PIPE LONG SEAM	C-F	VOL	UTP-10	UT-1			
30MS(1)B-23	PIPE TO EL	C-F	VOL	UTP-10	UT-1			
30MS(1)B-23LDO	EL SEAM	C-F	VOL	UTP-10	UT-1			
30MS(1)B-24LUO	EL SEAM	C-F	VOL	UTP-10	UT-1			

WNP-02
 INTERVAL: PSI
 PERIOD: NA
 OUTAGE:
 DRAWING NO. MS-202

WASHINGTON PUBLIC POWER SUPPLY SYSTEM
 PROGRAM PLAN AND SCHEDULE
 SYSTEM OR COMPONENT: MS(1)-4
 DESCRIPTION: MAIN STEAM LINE B

PAGE 015
 DATE 12/14/84

IDENT. NO.	DESCRIPTION	SFCT. XI EXAM.	EXAM MTH.	PROCEDURE	CAL. BLOCK	INSERVICE		NOTES
						REQ.	SCHEDULED OUTAGE	
30MS(1)B-24	EL TO PIPE	C-F	VOL	PTP-1 UTP-10	UT-1			
30MS(1)B-24LD	PIPE LONG SEAM	C-F	VOL	PTP-1 UTP-10	UT-1			
MS-145	PSA-10 SNURBER	C-E-2	VT-3	PTP-1 303/8.2.17				S/N 580
			VT-4	303/8.2.17				S/N 580
30MS(1)B-24/3/4V-707B	INSTR CONN	N/A	VT-2	N/A				IWC-2510, SEE NOTES #6 & #7.
30MS(1)B-24/1TX-1B	INSTR CONN	N/A	VT-2	N/A				IWC-2510, SEE NOTES #6 & #7.
30MS(1)B-24/1TE-1B	INSTR CONN	N/A	VT-2	N/A				IWC-2510, SEE NOTES #6 & #7.
MS-144	SPRING	C-E-2	VT-3	PTP-1 303/8.2.17				
			VT-4	303/8.2.17				
MS-142	SPRING	C-E-2	VT-3	PTP-1 303/8.2.17				
			VT-4	303/8.2.17				
30MS(1)B-24/6MS(1)-4	WOL TO PIPE	C-F	SUR	PTP-1				
6MS(1)B-1	PIPE TO WOL	C-F	SUR	PTP-1				

WNP-02
 INTERVAL: PSI
 PERIOD: NA
 OUTAGE:
 DRAWING NO. MS-202

WASHINGTON PUBLIC POWER SUPPLY SYSTEM
 PROGRAM PLAN AND SCHEDULE
 SYSTEM OR COMPONENT: MS(1)-4
 DESCRIPTION: MAIN STEAM LINE B

PAGE 016
 DATE 12/14/84

<u>IDENT. NO.</u>	<u>DESCRIPTION</u>	<u>SECT.</u> <u>XT</u> <u>EXAM.</u>	<u>EXAM</u> <u>MTH.</u>	<u>PROCEDURE</u>	<u>CAL.</u> <u>BLOCK</u>	<u>INSERVICE</u>		<u>NOTES</u>
						<u>REQ.</u>	<u>SCHEDULED</u> <u>OUTAGE</u>	
PS-1016S	PSA-1/4 SNUBBER	C-E-2	VT-3	303/R.2.17				S/N 428, LOCATED ON LS-24B.
			VT-4	303/R.2.17				S/N 428, LOCATED ON LS-24B.
6MS(1)B-1/1LS-24BD	INSTR CONN	N/A	VT-2	N/A				IWC-2510, SEE NOTES #6 & #7.
6MS(1)P-2/1LS-24BU	INSTR CONN	N/A	VT-2	N/A				IWC-2510, SEE NOTES #6 & #7.
6MS(1)B-1/2MD(1)-2	DRAIN CONN	N/A	VT-2	N/A				IWC-2510, SEE NOTES #6 & #7.
6MS(1)B-2	CAP TO PIPE	C-F	SUR	PTP-1				
6MS(1)B-2/3/4V-119B	DRAIN CONN	N/A	VT-2	N/A				IWC-2510, SEE NOTES #6 & #7.
30MS(1)P-25LU	PIPE LONG SEAM	C-F	VOL	UTP-10	UT-1			
			SUR	PTP-1				
30MS(1)B-25	PIPE TO EL	C-F	VOL	UTP-10	UT-1			
			SUR	PTP-1				
30MS(1)B-25LDO	EL SEAM	C-F	VOL	UTP-10	UT-1			
			SUR	PTP-1				
30MS(1)B-26LUO	EL SEAM	C-F	VOL	UTP-10	UT-1			
			SUR	PTP-1				

WNP-02
 INTERVAL: PSI
 PERIOD: NA
 OUTAGE:
 DRAWING NO. HS-202

WASHINGTON PUBLIC POWER SUPPLY SYSTEM
 PROGRAM PLAN AND SCHEDULE
 SYSTEM OR COMPONENT: HS(1)-4
 DESCRIPTION: MAIN STEAM LINE R

PAGE 017
 DATE 12/14/84

IDENT. NO.	DESCRIPTION	SECT. XI EYAM.	EYAM MTH.	PROCEDURE	CAL. BLOCK	INSERVICE		NOTES
						REQ.	SCHEDULED OUTAGE	
30MS(1)B-26	EL TO PIPE	C-F	VOL	UTP-10	UT-1			
			SUR	PTP-1				
30MS(1)B-26LD	PIPE LONG SEAM	C-F	VOL	UTP-10	UT-1			
			SUR	PTP-1				
30MS(1)B-27LU	PIPE LONG SEAM	C-F	VOL	UTP-10	UT-1			
			SUR	PTP-1				
30MS(1)B-27	PIPE TO EL	C-F	VOL	UTP-10	UT-1			
			SUR	PTP-1				
30MS(1)B-27LDC	EL SEAM	C-F	VOL	UTP-10	UT-1			
			SUR	PTP-1				
30MS(1)B-28LU0	EL SEAM	C-F	VOL	UTP-10	UT-1			
			SUR	PTP-1				
30MS(1)B-28	EL TO PIPE	C-F	VOL	UTP-10	UT-1			
			SUR	PTP-1				
30MS(1)B-28LD	PIPE LONG SEAM	C-F	VOL	UTP-10	UT-1			
			SUR	PTP-1				
30MS(1)B-29LU	PIPE LONG SEAM	C-F	VOL	UTP-10	UT-1			
			SUR	PTP-1				

WNP-02
 INTERVAL: PSI
 PERIOD: NA
 OUTAGE:
 DRAWING NO. MS-202

WASHINGTON PUBLIC POWER SUPPLY SYSTEM
 PROGRAM PLAN AND SCHEDULE
 SYSTEM OR COMPONENT: MS(1)-4
 DESCRIPTION: MAIN STEAM LINE B

PAGE 018
 DATE 12/14/84

<u>IDENT. NO.</u>	<u>DESCRIPTION</u>	SECT. <u>XI</u> <u>EYAM.</u>	<u>EYAM.</u> <u>MTM.</u>	<u>PROCEDURE</u>	<u>CAL.</u> <u>BLOCK</u>	<u>INSERVICE</u>		<u>NOTES</u>
						<u>REQ.</u>	<u>SCHEDULED</u> <u>OUTAGE</u>	
30MS(1)B-2P	PIPE TO REDUCER	C-F	VOL	UTP-10	UT-1			
			SUR	PTP-1				
28MS(1)D-1	REDUCER TO PIPE	C-F	VOL	UTP-10	UT-2			
			SUR	PTP-1				
MS-PR-202	MS PRESS BNDRY	N/A	VT-2	N/A				IVC-2510, SEE NOTES #6 & #7.

WNP-02
 INTERVAL: PST
 PERIOD: NA
 OUTAGE:
 DRAWING NO. MS-202

WASHINGTON PUBLIC POWER SUPPLY SYSTEM
 PROGRAM PLAN AND SCHEDULE
 SYSTEM OR COMPONENT: 2MS(20)-4
 DESCRIPTION: MS PRFSS STAB. LINE

PAGE 019
 DATE 12/14/84

<u>IDENT. NO.</u>	<u>DESCRIPTION</u>	<u>SECT.</u> <u>XI</u>	<u>EYAM</u> <u>EXAM.</u>	<u>MTM.</u> <u>PROCEDURE</u>	<u>CAL.</u> <u>BLOCK</u>	<u>INSERVICE</u>		<u>NOTES</u>
						<u>REQ.</u>	<u>SCHEDULED</u> <u>OUTAGE</u>	
2MS(20)B-1	SOL TO PIPE	N/A	SUR	PTP-1				AUGMT
2MS(20)B-2	PIPE TO EL	N/A	SUR	FTP-1				AUGMT
2MS(20)B-3	EL TO PIPE	N/A	SUR	PTP-1				AUGMT
2MS(20)B-4	PIPE TO TEE	N/A	SUR	PTP-1				AUGMT
2MS(20)B-5	TEE TO RED	N/A	SUR	PTP-1				AUGMT
2MS(20)B-6	TEE TO PIPE	N/A	SUR	PTP-1				AUGMT
2MS(20)B-7	PIPE TO SOL	N/A	SUR	PTP-1				AUGMT



WNP-02
 INTERVAL: PSI
 PERIOD: NA
 OUTAGE:
 DRAWING NO. MS-201

WASHINGTON PUBLIC POWER SUPPLY SYSTEM
 PROGRAM PLAN AND SCHEDULE
 SYSTEM OR COMPONENT: MS(1)-4
 DESCRIPTION: MAIN STEAM LINE A

PAGE 001
 DATE 12/14/84

IDENT. NO.	DESCRIPTION	SECT. XI EXAM.	EXAM MTH.	PROCEDURE	CAL. BLOCK	INSERVICE		NOTES
						REQ.	SCHEDULED OUTAGE	
26MS(1)A-18	VALVE TO PIPE	C-F	VOL	UTP-10	UT-3			AUGMT
			SUR	PTP-1				AUGMT
26MS(1)A-18LD	PIPE LONG SEAM	C-F	VOL	UTP-10	UT-3			
			SUR	PTP-1				
26MS(1)A-18/3/4CAP	CAPPED CONN	N/A	VT-2	N/A				IWC-2510, SEE NOTES #6 & #7.
26MS(1)A-18/3/4V-41	TEST CONN	N/A	VT-2	N/A				IWC-2510, SEE NOTES #6 & #7.
26MS(1)A-18/5/4TE-N040	INSTR CONN	N/A	VT-2	N/A				IWC-2510, SEE NOTES #6 & #7.
MS-137	SPRING	C-E-2	VT-3	303/R.2.17				
			VT-4	303/R.2.17				
26MS(1)A-19LU	PIPE LONG SEAM	C-F	VOL	UTP-10	UT-3			
			SUR	PTP-1				
26MS(1)A-19	PIPE TO PIPE	C-F	VOL	UTP-10	UT-3			AUGMT
			SUR	PTP-1				AUGMT
26MS(1)A-19LD	PIPE LONG SEAM	C-F	VOL	UTP-10	UT-3			
			SUR	PTP-1				
26MS(1)A-19/3V-20	DRAIN CONN	N/A	SUR	PTP-1				IWC-2510, AUGMT.

WNP-02
 INTERVAL: PSI
 PERIOD: HA
 OUTAGE:
 DRAWING NO. MS-201

WASHINGTON PUBLIC POWER SUPPLY SYSTEM
 PROGRAM PLAN AND SCHEDULE
 SYSTEM OR COMPONENT: MS(1)-4
 DESCRIPTION: MAIN STEAM LINE A

PAGE 002
 DATE 12/14/84

IDENT. NO.	DESCRIPTION	SECT. XI EXAM.	FYAM MTH.	PROCEDURE	CAL. BLOCK	INSERVICE		NOTES
						REQ.	SCHEDULED OUTAGE	
26MS(1)A-19/3/4V-744A	INSTR CONN	N/A	VT-2	N/A				IWC-2510, SEE NOTES #6 & #7.
MS-135	PSA-35 SNUBBER	C-E-2	VT-3	303/8.2.17				S/N 7033
			VT-4	303/8.2.17				S/N 7033
PWS-315-1	PIPE WHIP	N/A	N/A	N/A				
26MS(1)A-20LU	PIPE LONG SEAM	C-F	VOL	UTP-10	UT-3			
			SUR	PTP-1				
26MS(1)A-20	PIPE TO EL	C-F	VOL	UTP-10	UT-3			
			SUR	PTP-1				
26MS(1)A-20LDI	EL SEAM	C-F	VOL	UTP-10	UT-3			
			SUR	PTP-1				
26MS(1)A-20LDO	EL SEAM	C-F	VOL	UTP-10	UT-3			
			SUR	PTP-1				
26MS(1)A-21LUI	EL SEAM	C-F	VOL	UTP-10	UT-3			
			SUR	PTP-1				
26MS(1)A-21LUO	EL SEAM	C-F	VOL	UTP-10	UT-3			
			SUR	PTP-1				
26MS(1)A-21	EL TO PIPE	C-F	VOL	UTP-10	UT-3			

WNP-02
 INTERVAL: PSI
 PERIOD: NA
 OUTAGE:
 DRAWING NO. MS-201

WASHINGTON PUBLIC POWER SUPPLY SYSTEM
 PROGRAM PLAN AND SCHEDULE
 SYSTEM OR COMPONENT: MS(1)-4
 DESCRIPTION: MAIN STEAM LINE A

PAGE 003
 DATE 12/14/84

IDENT. NO.	DESCRIPTION	SECT. XT EYAM.	EXAM MTH.	PROCEDURE	CAL. BLOCK	INSERVICE		NOTES
						REQ.	SCHEDULED OUTAGE	
26MS(1)A-21LD	PIPE LONG SEAM	C-F	VOL	UTP-10	UT-3			
26MS(1)A-22LU	PIPE LONG SEAM	C-F	VOL	UTP-10	UT-3			
26MS(1)A-22	PIPE TO REDUCER	C-F	VOL	UTP-10	UT-3			
30MS(1)A-1	REDUCER TO PIPE	C-F	VOL	UTP-10	UT-1			
30MS(1)A-1LD	PIPE LONG SEAM	C-F	VOL	UTP-10	UT-1			
PWS-315-5	PIPE WHIP	N/A	N/A	N/A				
30MS(1)A-2LU	PIPE LONG SEAM	C-F	VOL	UTP-10	UT-1			
30MS(1)A-2	PIPE TO EL	C-F	VOL	UTP-10	UT-1			
30MS(1)A-2LDD	EL SEAM	C-F	VOL	UTP-10	UT-1			

WNP-02
 INTERVAL: PSI
 PERIOD: NA
 OUTAGE:
 DRAWING NO. MS-201

WASHINGTON PUBLIC POWER SUPPLY SYSTEM
 PROGRAM PLAN AND SCHEDULE
 SYSTEM OR COMPONENT: MS(1)-4
 DESCRIPTION: MAIN STEAM LINE A

PAGE 004
 DATE 12/14/84

IDENT. NO.	DESCRIPTION	SECT.	EXAM MTH.	PROCEDURE	CAL. BLOCK	INSERVICE		NOTES
		YI EXAM.				REQ.	SCHEDULED OUTAGE	
30MS(1)A-3LUC	EL SEAM	C-F	VOL	UTP-10	UT-1			
			SUR	PTP-1				
30MS(1)A-3	EL TO PIPE	C-F	VOL	UTP-10	UT-1			
			SUR	PTP-1				
30MS(1)A-3LD	PIPE LONG SEAM	C-F	VOL	UTP-10	UT-1			
			SUR	PTP-1				
30MS(1)A-4LU	PIPE LONG SEAM	C-F	VOL	UTP-10	UT-1			
			SUR	PTP-1				
30MS(1)A-4	PIPE TO EL	C-F	VOL	UTP-10	UT-1			
			SUR	PTP-1				
30MS(1)A-4LDD	EL SEAM	C-F	VOL	UTP-10	UT-1			
			SUR	PTP-1				
30MS(1)A-5LUG	EL SEAM	C-F	VOL	UTP-10	UT-1			
			SUR	PTP-1				
30MS(1)A-5	EL TO PIPE	C-F	VOL	UTP-10	UT-1			
			SUR	PTP-1				
30MS(1)A-5LD	PIPE LONG SEAM	C-F	VOL	UTP-10	UT-1			
			SUR	PTP-1				

WNP-02
 INTERVAL: PSI
 PERIOD: NA
 OUTAGE:
 DRAWING NO. HS-201

WASHINGTON PUBLIC POWER SUPPLY SYSTEM
 PROGRAM PLAN AND SCHEDULE
 SYSTEM OR COMPONENT: MS(1)-4
 DESCRIPTION: MAIN STEAM LINE A

PAGE 005
 DATE 12/14/84

IDENT. NO.	DESCRIPTION	SFCT. XI EXAM.	EXAM MTH.	PROCEDURE	CAL. BLOCK	INSERVICE		NOTES
						REQ.	SCHEDULED OUTAGE	
30MS(1)A-5/3MD(16)-4	DRAIN CONN	N/A	VT-2	OCT 7-1				IWC-2510
30MS(1)A-5/3/4V-701	INSTR CONN	N/A	VT-2	N/A				IWC-2510, SEE NOTES #6 & #7.
30MS(1)A-5/3/4V-702	INSTR CONN	N/A	VT-2	N/A				IWC-2510, SEE NOTES #6 & #7.
MS-123	STRUT	C-E-2	VT-3	303/R.2.17				
30MS(1)A-6LU	PIPE LONG SEAM	C-F	VOL	UTP-10	UT-1			
			SUR	PTP-1				
30MS(1)A-6	PIPE TO PIPE	C-F	VOL	UTP-10	UT-1			
			SUR	PTP-1				
30MS(1)A-6LD	PIPE LONG SEAM	C-F	VOL	UTP-10	UT-1			
			SUR	PTP-1				
MS-121	SPRING (2)	C-E-2	VT-3	303/R.2.17				
			VT-4	303/R.2.17				
30MS(1)A-7LU	PIPE LONG SEAM	C-F	VOL	UTP-10	UT-1			
			SUR	PTP-1				
30MS(1)A-7	PIPE TO EL	C-F	VOL	UTP-10	UT-1			
			SUR	PTP-1				
30MS(1)A-7LDI	EL SEAM	C-F	VOL	UTP-10	UT-1			

WNP-02
 INTERVAL: PSI
 PERIOD: NA
 OUTAGE:
 DRAWING NO. MS-201

WASHINGTON PUBLIC POWER SUPPLY SYSTEM
 PROGRAM PLAN AND SCHEDULE
 SYSTEM OR COMPONENT: MS(1)-4
 DESCRIPTION: MAIN STEAM LINE A

PAGE 006
 DATE 12/14/84

IDENT. NO.	DESCRIPTION	SECT. XJ EXAM.	EXAM MTH.	PROCEDURE	CAL. BLOCK	INSERVICE		NOTES
						REQ.	SCHEDULED OUTAGE	
30MS(1)A-7LDC	EL SEAM	C-F	VOL	PTP-1 UTP-10	UT-1			
30MS(1)A-8LUI	EL SEAM	C-F	VOL	PTP-1 UTP-10	UT-1			
30MS(1)A-8LUO	EL SEAM	C-F	VOL	PTP-1 UTP-10	UT-1			
30MS(1)A-8	EL TO PIPE	C-F	VOL	PTP-1 UTP-10	UT-1			
30MS(1)A-8LD	PIPE LONG SEAM	C-F	VOL	PTP-1 UTP-10	UT-1			
MS-993N	PSA-10 SN(2)	C-E-2	VT-3	303/8.2.17				S/N T102/B686
MS-120	SPRING (2)	C-E-2	VT-3	303/8.2.17				S/N T102/B686
30MS(1)A-9LU	PIPE LONG SEAM	C-F	VOL	PTP-1 UTP-10	UT-1			
30MS(1)A-9	PIPE TO PIPE	C-F	VOL	PTP-1 UTP-10	UT-1			

WNP-02
 INTERVAL: PSI
 PERIOD: NA
 OUTAGE:
 DRAWING NO. MS-201

WASHINGTON PUBLIC POWER SUPPLY SYSTEM
 PROGRAM PLAN AND SCHEDULE
 SYSTEM OR COMPONENT: MS(1)-4
 DESCRIPTION: MAIN STEAM LINE A

PAGE 007
 DATE 12/14/84

IDENT. NO.	DESCRIPTION	SECT. XI EXAM.	EXAM MTH.	PROCEDURE	CAL. BLOCK	INSERVICE		NOTES
						REQ.	SCHEDULED OUTAGE	
30MS(1)A-9LD			SUR	PTP-1				
	PIPE LONG SEAM	C-F	VOL	UTP-10	UT-1			
MS-119			SUR	PTP-1				
	STRUT	C-E-2	VT-3	303/8.2.17				
30MS(1)A-10LU								
	PIPE LONG SEAM	C-F	VOL	UTP-10	UT-1			
			SUR	PTP-1				
30MS(1)A-10								
	PIPE TO PIPE	C-F	VOL	UTP-10	UT-1			
			SUR	PTP-1				
30MS(1)A-10LD								
	PIPE LONG SEAM	C-F	VOL	UTP-10	UT-1			
			SUR	PTP-1				
MS-118								
	PSA-10 SN(2)	C-E-2	VT-3	303/8.2.17				S/N 112/129
			VT-4	303/8.2.17				S/N 112/129
MS-117								
	SPRING (2)	C-E-2	VT-3	303/8.2.17				
			VT-4	303/8.2.17				
MS-117(S)								
	1 WELDED SADDLE	C-E-1	SUR	MTP-1				
30MS(1)A-11LU								
	PIPE LONG SEAM	C-F	VOL	UTP-10	UT-1			
			SUR	PTP-1				
30MS(1)A-11								
	PIPE TO PIPE	C-F	VOL	UTP-10	UT-1			

WNP-C2
 INTERVAL: PSI
 PERIOD: NA
 OUTAGE:
 DRAWING NO. MS-201

WASHINGTON PUBLIC POWER SUPPLY SYSTEM
 PROGRAM PLAN AND SCHEDULE
 SYSTEM OR COMPONENT: MS(1)-4
 DESCRIPTION: MAIN STEAM LINE A

PAGE 008
 DATE 12/14/84

IDENT. NO.	DESCRIPTION	SECT.	EXAM	MTH.	PROCEDURE	CAL.	INSERVICE		NOTES
		EXAM.					REQ.	SCHEDULED	
30MS(1)A-11LD	PIPE LONG SEAM	C-F	VOL	UTP-10	UT-1				
			SUR	FTP-1					
MS-115	SPRING (2)	C-E-2	VT-3	303/8.2.17					
			VT-4	303/8.2.17					
30MS(1)A-12LU	PIPE LONG SEAM	C-F	VOL	UTP-10	UT-1				
			SUR	PTP-1					
30MS(1)A-12	PIPE TO EL	C-F	VOL	UTP-10	UT-1				
			SUR	PTP-1					
30MS(1)A-12LDO	EL SEAM	C-F	VOL	UTP-10	UT-1				
			SUR	PTP-1					
30MS(1)A-13LUO	EL SEAM	C-F	VOL	UTP-10	UT-1				
			SUR	PTP-1					
30MS(1)A-13	EL TO PIPE	C-F	VOL	UTP-10	UT-1				
			SUR	PTP-1					
30MS(1)A-13LD	PIPE LONG SEAM	C-F	VOL	UTP-10	UT-1				
			SUR	PTP-1					
MS-114(W)	8 WELDED LUGS	C-E-1	SUR	MTP-1					

WNP-02
 INTERVAL: PSI
 PERIOD: NA
 OUTAGE:
 DRAWING NO. MS-201

WASHINGTON PUBLIC POWER SUPPLY SYSTEM
 PROGRAM PLAN AND SCHEDULE
 SYSTEM OR COMPONENT: MS(1)-4
 DESCRIPTION: MAIN STEAM LINE A

PAGE 009
 DATE 12/14/84

<u>IDENT. NO.</u>	<u>DESCRIPTION</u>	<u>SECT.</u> <u>XI</u>	<u>EXAM</u> <u>EXAM.</u>	<u>MTM.</u>	<u>PROCEDURE</u>	<u>CAL.</u> <u>BLOCK</u>	<u>INSERVICE</u>		<u>NOTES</u>
							<u>REQ.</u>	<u>SCHEDULED</u> <u>OUTAGE</u>	
MS-114	PSA-10 SN(2)	C-E-2	VT-3		303/8.2.17				S/N 275/285
			VT-4		303/8.2.17				S/N 275/285
MS-103	BOX	C-E-2	VT-3		303/8.2.17				
30MS(1)A-14LU	PIPE LONG SEAM	C-F	VOL		UTP-10	UT-1			
			SUR		PTP-1				
30MS(1)A-14	PIPE TO PIPE	C-F	VOL		UTP-10	UT-1			
			SUR		PTP-1				
30MS(1)A-14LD	PIPE LONG SEAM	C-F	VOL		UTP-10	UT-1			
			SUR		PTP-1				
MS-101	SPRING (2)	C-E-2	VT-3		303/8.2.17				
			VT-4		303/8.2.17				
30MS(1)A-15LU	PIPE LONG SEAM	C-F	VOL		UTP-10	UT-1			
			SUR		PTP-1				
30MS(1)A-15	PIPE TO EL	C-F	VOL		UTP-10	UT-1			
			SUR		PTP-1				
30MS(1)A-15L00	EL SEAM	C-F	VOL		UTP-10	UT-1			
			SUR		PTP-1				
30MS(1)A-16LU0	EL SEAM	C-F	VOL		UTP-10	UT-1			

WNP-02,
 INTERVAL: PSI
 PERIOD: NA
 OUTAGE:
 DRAWING NO. MS-201

WASHINGTON PUBLIC POWER SUPPLY SYSTEM
 PROGRAM PLAN AND SCHEDULE
 SYSTEM OR COMPONENT: MS(1)-4
 DESCRIPTION: MAIN STEAM LINE A

PAGE 010
 DATE 12/14/84

IDENT. NO.	DESCRIPTION	SECT. XI EXAM EYAN.	EXAM MTH.	PROCEDURE	CAL. BLOCK	INSERVICE		NOTES
						REQ.	SCHEDULED OUTAGE	
30MS(1)A-16	EL TO PIPE	C-F	VOL	PTP-1 UTP-10	UT-1			
30MS(1)A-16LD	PIPE LONG SEAM	C-F	VOL	PTP-1 UTP-10	UT-1			
MS-100	STRUT	C-E-2	VT-3	PTP-1 303/8.2.17				
MS-992N	BOX	C-E-2	VT-3	PTP-1 303/8.2.17				
30MS(1)A-17LU	PIPE LONG SEAM	C-F	VOL	PTP-1 UTP-10	UT-1			
30MS(1)A-17	PIPE TO PIPE	C-F	VOL	PTP-1 UTP-10	UT-1			
30MS(1)A-17LD	PIPE LONG SEAM	C-F	VOL	PTP-1 UTP-10	UT-1			
MS-98	STRUT	C-E-2	VT-3	PTP-1 303/8.2.17				
MS-97	SPRING (2)	C-E-2	VT-3	PTP-1 303/8.2.17				
30MS(1)A-17/18MS(1)-4	PIPE TO WOL	C-F	VT-4	PTP-1 303/8.2.17				
18MS(1)A-1	WOL TO PIPE	C-F	VOL	PTP-1 UTP-10	UT-12			

WNP-02
 INTERVAL: PSI
 PERIOD: NA
 OUTAGE:
 DRAWING NO. MS-201

WASHINGTON PUBLIC POWER SUPPLY SYSTEM
 PROGRAM PLAN AND SCHEDULE
 SYSTEM OR COMPONENT: MS(1)-4
 DESCRIPTION: MAIN STEAM LINE A

PAGE 011
 DATE 12/14/84

<u>IDENT. NO.</u>	<u>DESCRIPTION</u>	<u>SECT.</u> <u>XI</u> <u>EXAM.</u>	<u>EXAM</u> <u>MTM.</u>	<u>PROCEDURE</u>	<u>CAL.</u> <u>BLOCK</u>	<u>INSERVICE</u>		<u>NOTES</u>
						<u>REQ.</u>	<u>SCHEDULED</u> <u>OUTAGE</u>	
18MS(1)A-2	PIPE TO EL	C-F	SUR VOL	PTP-1 UTP-10	UT-12			
18MS(1)A-3	EL TO PIPE	C-F	SUR VOL	PTP-1 UTP-10	UT-12			
18MS(1)A-4	PIPE TO EL	C-F	SUR VOL	PTP-1 UTP-10	UT-12			
18MS(1)A-5	EL TO PIPE	C-F	SUR VOL	PTP-1 UTP-10	UT-12			
MS-139	SPRING	C-E-2	SUR VT-3	PTP-1 303/8.2.17				
MS-140	PSA-3 SNUBBER	C-E-2	VT-4	303/8.2.17				
18MS(1)A-6	PIPE TO EL	C-F	C-E-2 VT-3	303/8.2.17				S/N 2343
18MS(1)A-7	EL TO PIPE	C-F	VT-4	303/8.2.17				S/N 2343
18MS(1)A-8	PIPE TO EL	C-F	SUR VOL	PTP-1 UTP-10	UT-12			

WNP-02
 INTERVAL: PSI
 PERIOD: NA
 OUTAGE:
 DRAWING NO. MS-201

WASHINGTON PUBLIC POWER SUPPLY SYSTEM
 PROGRAM PLAN AND SCHEDULE
 SYSTEM OR COMPONENT: MS(1)-4
 DESCRIPTION: MAIN STEAM LINE A

PAGE 012
 DATE 12/14/84

<u>IDENT. NO.</u>	<u>DESCRIPTION</u>	SECT. XI <u>EXAM.</u>	EXAM MTH.	PROCEDURE	CAL. BLOCK	<u>INSERVICE</u>		<u>NOTES</u>
						<u>REQ.</u>	<u>OUTAGE</u>	
18MS(1)A-9	EL TO PIPE	C-F	VOL	UTP-10	UT-12			
18MS(1)A-10	PIPE TO WOL	C-F	VOL	UTP-10	UT-12			
30MS(1)A-19LU	PIPE SEAM	C-F	VOL	UTP-10	UT-1			
30MS(1)A-19	PIPE TO PIPE	C-F	VOL	UTP-10	UT-1			
30MS(1)A-19LD	PIPE LONG SEAM	C-F	VOL	UTP-10	UT-1			
MS-94	BOX	C-E-2	VT-3	303/8.2.17				
MS-95	STRUT	C-F-2	VT-3	303/8.2.17				
MS-96	PSA-10 SN(2)	C-E-2	VT-3	303/8.2.17				S/N 772/286
30MS(1)A-20LU	PIPE LONG SEAM	C-F	VOL	UTP-10	UT-1			S/N 772/286
30MS(1)A-20	PIPE TO PIPE	C-F	VOL	UTP-10	UT-1			

WNP-02
 INTERVAL: PSI
 PERIOD: NA
 OUTAGE:
 DRAWING NO. NS-201

WASHINGTON PUBLIC POWER SUPPLY SYSTEM
 PROGRAM PLAN AND SCHEDULE
 SYSTEM OR COMPONENT: MS(1)-4
 DESCRIPTION: MAIN STEAM LINE A

PAGE 013
 DATE 12/14/84

IDENT. NO.	DESCRIPTION	SECT. XI EXAM.	EXAM MTH.	PROCEDURE	CAL. BLOCK	INSERVICE		NOTES
						REQ.	SCHEDULED OUTAGE	
30MS(1)A-20LD	PIPE LONG SEAM	C-F	VOL	UTP-10	UT-1			
30MS(1)A-20/1V-706A	INSTR CONN	N/A	VT-2	N/A				IWC-2510, SEE NOTES #6 & #7.
MS-93	SPRING (2)	C-E-2	VT-3	303/8.2.17				
MS-924N	SPRING	C-E-2	VT-3	303/8.2.17				
MS-91	PSA-3 SN(2)	C-E-2	VT-3	303/8.2.17				S/N 2883/2793
30MS(1)A-21LU	PIPE LONG SEAM	C-F	VOL	UTP-10	UT-1			S/N 2883/2793
30MS(1)A-21	PIPE TO EL	C-F	VOL	UTP-10	UT-1			
30MS(1)A-21LDO	EL SEAM	C-F	VOL	UTP-10	UT-1			
30MS(1)A-22LUO	EL SEAM	C-F	VOL	UTP-10	UT-1			

WNP-02
 INTERVAL: PSI
 PERIOD: NA
 OUTAGE:
 DRAWING NO. MS-201

WASHINGTON PUBLIC POWER SUPPLY SYSTEM
 PROGRAM PLAN AND SCHEDULE
 SYSTEM OR COMPONENT: MS(1)-4
 DESCRIPTION: MAIN STEAM LINE A

PAGE 014
 DATE 12/14/84

<u>IDENT. NO.</u>	<u>DESCRIPTION</u>	SECT. XI <u>EXAM.</u>	FXAM <u>MTM.</u>	PROCEDURE	CAL. <u>BLOCK</u>	<u>INSERVICE</u>		<u>NOTES</u>
						<u>REQ.</u>	<u>SCHEDULED</u> <u>OUTAGE</u>	
30MS(1)A-22	EL TO PIPE	C-F	VOL	PTP-1 UTP-10	SUR UT-1			
30MS(1)A-22LD	PIPE LONG SEAM	C-F	VOL	PTP-1 UTP-10	SUR UT-1			
30MS(1)A-23LU	PIPE LONG SEAM	C-F	VOL	PTP-1 UTP-10	SUR UT-1			
30MS(1)A-23	PIPE TO EL	C-F	VOL	PTP-1 UTP-10	SUR UT-1			
30MS(1)A-23LDI	EL SEAM	C-F	VOL	PTP-1 UTP-10	SUR UT-1			
30MS(1)A-23LD0	EL SEAM	C-F	VOL	PTP-1 UTP-10	SUR UT-1			
30MS(1)A-24LUI	EL SEAM	C-F	VOL	PTP-1 UTP-10	SUR UT-1			
30MS(1)A-24LU0	EL SEAM	C-F	VOL	PTP-1 UTP-10	SUR UT-1			
30MS(1)A-24	EL TO PIPE	C-F	VOL	PTP-1 UTP-10	SUR UT-1			

WNP-02
 INTERVAL: PSI
 PERIOD: NA
 OUTAGE:
 DRAWING NO. MS-201

WASHINGTON PUBLIC POWER SUPPLY SYSTEM
 PROGRAM PLAN AND SCHEDULE
 SYSTEM OR COMPONENT: MS(1)-4
 DESCRIPTION: MAIN STEAM LINE A

PAGE 015
 DATE 12/14/84

IDENT. NO.	DESCRIPTION	SECT. XI EXAM.	EYAM MTH.	PROCEDURE	CAL. BLOCK	INSERVICE		NOTES
						REQ.	SCHEDULED OUTAGE	
			SUR	PTP-1				
30MS(1)A-24LD	PIPE LONG SEAM	C-F	VOL	UTP-10	UT-1			
			SUR	PTP-1				
MS-89(V)	4 WELDED LUGS	C-E-1	SUR	MTP-1				
MS-89	SPRING (2)	C-E-2	VT-3	303/R.2.17				
			VT-4	303/R.2.17				
30MS(1)A-25LU	PIPE LONG SEAM	C-F	VOL	UTP-10	UT-1			
			SUR	PTP-1				
30MS(1)A-25	PIPE TO EL	C-F	VOL	UTP-10	UT-1			
			SUR	PTP-1				
30MS(1)A-25L00	EL SEAM	C-F	VOL	UTP-10	UT-1			
			SUR	PTP-1				
30MS(1)A-26LU0	EL SEAM	C-F	VOL	UTP-10	UT-1			
			SUR	PTP-1				
30MS(1)A-26	EL TO PIPE	C-F	VOL	UTP-10	UT-1			
			SUR	PTP-1				
30MS(1)A-26LD	PIPE LONG SEAM	C-F	VOL	UTP-10	UT-1			
			SUR	PTP-1				

WNP-02
 INTERVAL: PSI
 PERIOD: NA
 OUTAGE:
 DRAWING NO. MS-201

WASHINGTON PUBLIC POWER SUPPLY SYSTEM
 PROGRAM PLAN AND SCHEDULE
 SYSTEM OR COMPONENT: MS(1)-4
 DESCRIPTION: MAIN STEAM LINE A

PAGE 016
 DATE 12/14/84

IDENT. NO.	DESCRIPTION	SECT. XI EXAM.	EXAM MTH.	PROCEDURE	CAL. BLOCK	INSERVICE		NOTES
						REQ.	SCHEDULED OUTAGE	
30MS(1)A-26/3/4V-707A	INSTR CONN	N/A	VT-2	N/A				IWC-2510, SEE NOTES #6 & #7.
30MS(1)A-26/1TX-1A	INSTR CONN	N/A	VT-2	N/A				IWC-2510, SEE NOTES #6 & #7.
30MS(1)A-26/1TE-1A	INSTR CONN	N/A	VT-2	N/A				IWC-2510, SEE NOTES #6 & #7.
HS-88	SPRING	C-E-2	VT-3	303/8.2.17				
			VT-4	303/P.2.17				
30MS(1)A-26/6MS(1)-4	PIPE TO WOL	C-F	SUR	PTP-1				
6MS(1)A-1	WOL TO PIPE	C-F	SUR	PTP-1				
MS-1013S	PSA-1/4 SMURBER	N/A	VT-3	N/A				S/N 304, LOCATED ON LS-24A.
			VT-4	N/A				S/N 304, LOCATED ON LS-24A.
6MS(1)A-1/1LS-24AD	INSTR CONN	N/A	VT-2	N/A				IWC-2510, SEE NOTES #6 & #7.
6MS(1)A-2/1LS-24AU	INSTR CONN	N/A	VT-2	N/A				IWC-2510, SEE NOTES #6 & #7.
6MS(1)A-1/2MD(1)-2	DRAIN CONN	N/A	VT-2	N/A				IWC-2510, SEE NOTES #6 & #7.
6MS(1)A-2	PIPE TO CAP	C-F	SUR	PTP-1				

WNP-02
 INTERVAL: PSI
 PERIOD: NA
 OUTAGE:
 DRAWING NO. NS-201

WASHINGTON PUBLIC POWER SUPPLY SYSTEM
 PROGRAM PLAN AND SCHEDULE
 SYSTEM OR COMPONENT: MS(1)-4
 DESCRIPTION: MAIN STEAM LINE A

PAGE 017
 DATE 12/14/84

IDENT. NO.	DESCRIPTION	SECT.	EXAM MTH.	PROCEDURE	CAL. BLOCK	INSERVICE		NOTES
		XI EXAM.				REQ.	SCHEDULED OUTAGE	
MS-1014S	PSA-1/4 SNUBBER	N/A	VT-3	N/A				S/N 421, LOCATED NEAR MS-V-119A.
			VT-4	N/A				S/N 421, LOCATED NEAR MS-V-119A.
6MS(1)A-2/3/4V-119A	DRAIN CONN	N/A	VT-2	N/A				IWC-2510, SEE NOTES #6 & #7.
30MS(1)A-27LU	PIPE LONG SEAM	C-F	VOL	UTP-10	UT-1			
			SUR	PTP-1				
30MS(1)A-27	PIPE TO EL	C-F	VOL	UTP-10	UT-1			
			SUR	PTP-1				
30MS(1)A-27LDD	EL SEAM	C-F	VOL	UTP-10	UT-1			
			SUR	PTP-1				
30MS(1)A-28LUD	EL SEAM	C-F	VOL	UTP-10	UT-1			
			SUR	PTP-1				
30MS(1)A-28	EL TO PIPE	C-F	VOL	UTP-10	UT-1			
			SUR	PTP-1				
30MS(1)A-28LD	PIPE LONG SEAM	C-F	VOL	UTP-10	UT-1			
			SUR	PTP-1				
30MS(1)A-29LU	PIPE LONG SEAM	C-F	VOL	UTP-10	UT-1			

WNP-02
 INTERVAL: PSI
 PERIOD: NA
 OUTAGE:
 DRAWING NO. MS-201

WASHINGTON PUBLIC POWER SUPPLY SYSTEM
 PROGRAM PLAN AND SCHEDULE
 SYSTEM OR COMPONENT: MS(1)-4
 DESCRIPTION: MAIN STEAM LINE A

PAGE 018
 DATE 12/14/84

<u>IDENT. NO.</u>	<u>DESCRIPTION</u>	<u>SECT.</u> <u>XI</u> <u>EXAM.</u>	<u>EXAM</u> <u>MTH.</u>	<u>PROCEDURE</u>	<u>CAL.</u> <u>PLOCK</u>	<u>INSERVICE</u>		<u>NOTES</u>
						<u>REQ.</u>	<u>SCHEDULED</u> <u>OUTAGE</u>	
30MS(1)A-29	PIPE TO REDUCER	C-F	SUR	PTP-1	UT-1			
28MS(1)A-1	REDUCER TO PIPE	C-F	SUR	PTP-1	UT-2			
MS-PB-201	MS PRES BNDRY	N/A	SUR	PTP-1	VT-2			

TWC-2510, SEE NOTES
 #6 & #7.


WNP-02
 INTERVAL: PSI
 PERIOD: NA
 OUTAGE:
 DRAWING NO. NS-201

WASHINGTON PUBLIC POWER SUPPLY SYSTEM
 PROGRAM PLAN AND SCHEDULE
 SYSTEM OR COMPONENT: 2MS(20)-4
 DESCRIPTION: MS PRESS STAB. LINE

PAGE 019
 DATE 12/14/84


<u>IDENT. NO.</u>	<u>DESCRIPTION</u>	<u>SECT.</u>		<u>PROCEDURE</u>	<u>CAL. BLOCK</u>	<u>INSERVICE SCHEDULED</u>		<u>NOTES</u>
		<u>EXAM.</u>	<u>MTH.</u>			<u>REQ.</u>	<u>OUTAGE</u>	
2MS(20)A-1	SOL TO PIPE	N/A	SUR	PTP-1				AUGHT
2MS(20)A-2	PIPE TO EL	N/A	SUR	PTP-1				AUGHT
2MS(20)A-3	EL TO PIPE	N/A	SUR	PTP-1				AUGHT
2MS(20)A-4	PIPE TO TEE	N/A	SUR	PTP-1				AUGHT
2MS(20)A-5	TEE TO RED	N/A	SUR	PTP-1				AUGHT
2MS(20)A-6	TEE TO PIPE	N/A	SUR	PTP-1				AUGHT
2MS(20)A-7	PIPE TO SOL	N/A	SUR	PTP-1				AUGHT



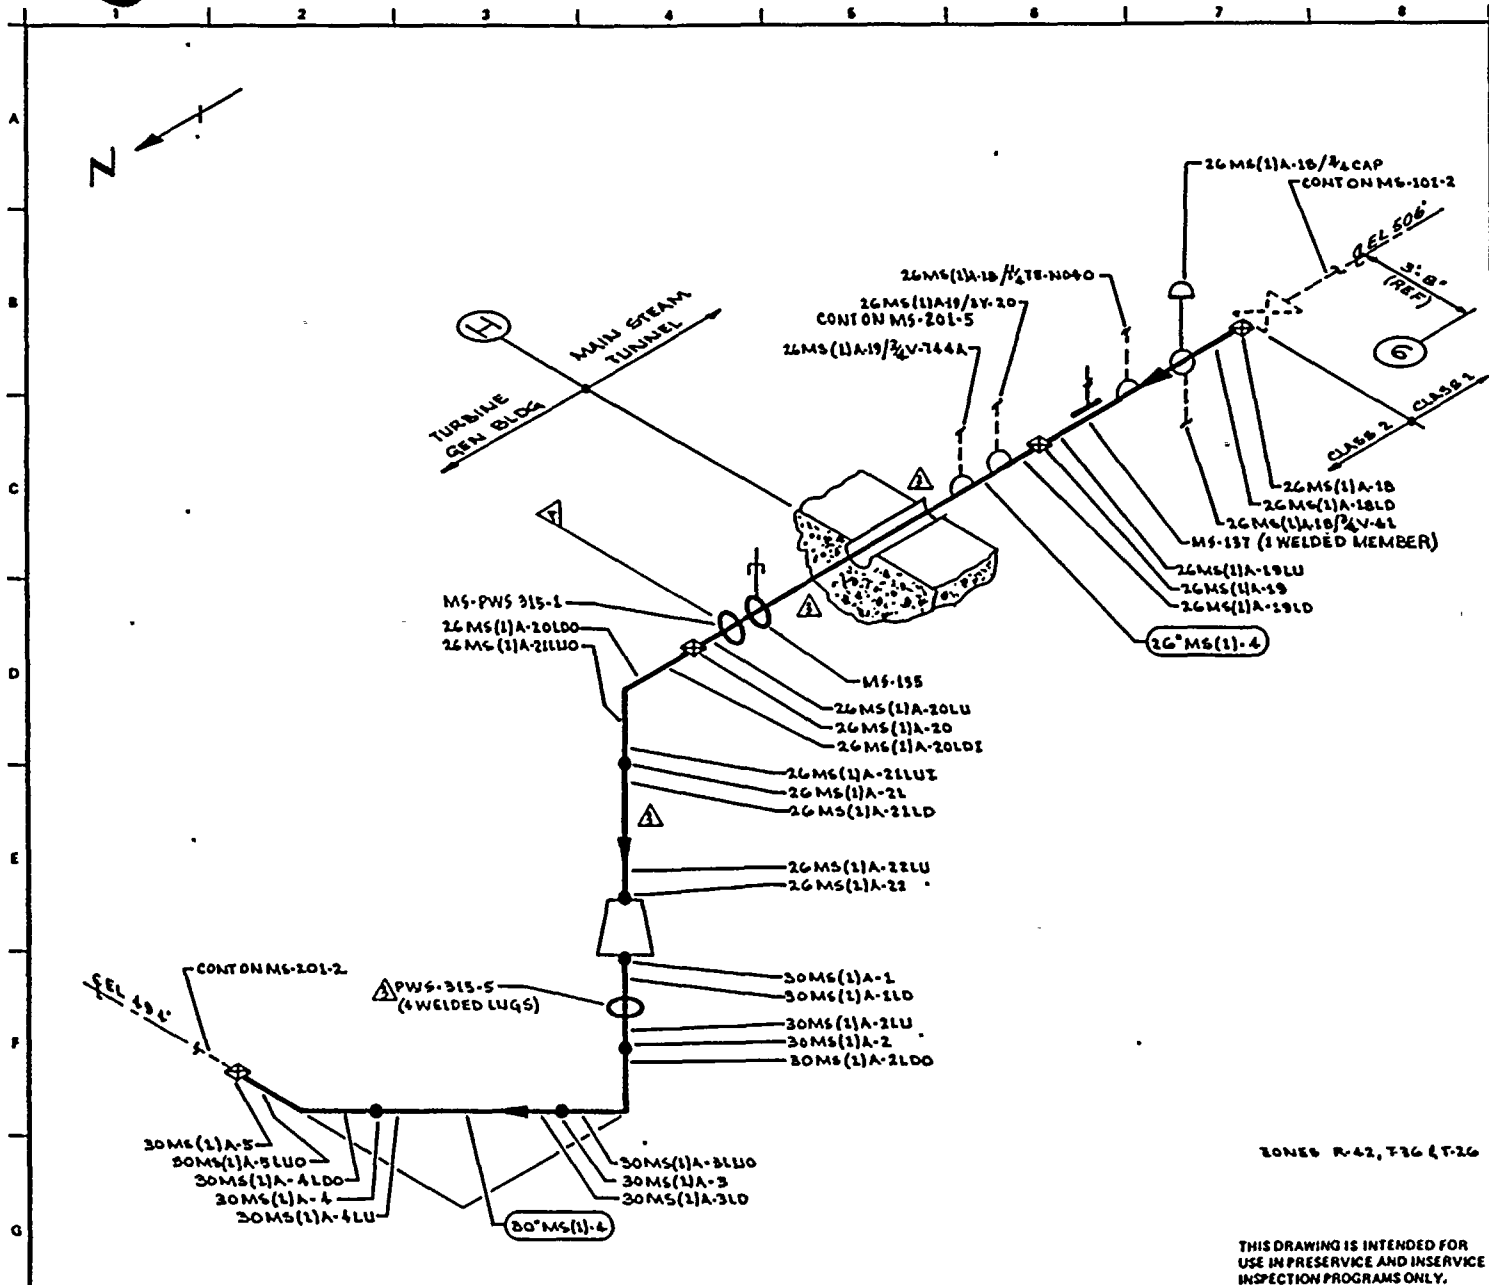

NOTES:
 1. SCAFFOLDING IS REQUIRED.

REFERENCES:
 BOVEE & CRAIL ISOMETRIC
 MS-528-1.3 REV 9

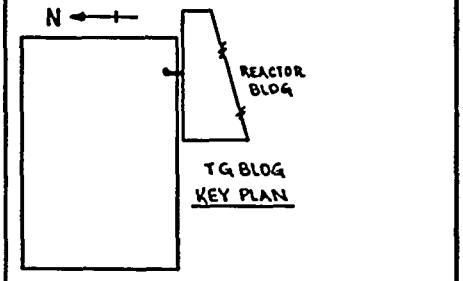


QUALITY CLASS: 1 ASME CODE CLASS: 2
 ENGR: D. TIMMINS DRAWN: K. M. A. DATE: 2-1-78
 WASHINGTON PUBLIC POWER
 SUPPLY SYSTEM
 RICHLAND, WASHINGTON 99302

THIS DRAWING IS INTENDED FOR
 USE IN PRESERVE AND INSERVICE
 INSPECTION PROGRAMS ONLY.

NO	DATE	REVISION	BY	CHKD	APPVD	PIPING SYSTEM	NOM DIA (IN)	SCH	NOM WALL THK	MATERIAL SPECIFICATION	MATL TYPE	CAL BLOCK NO
3	9-21-83	REVISED AS NOTED	K.M.A.	PP	TFH	26MS(1)-4	26	XXX	1.125	SA 153 CLI KCF 70	C6	UT-3
2	12-29-81	REVISED AS NOTED, AUGMENTED ISI ADDED	K.M.A.	PP	TFH	30MS(1)-4	30	XXX	1.25	SA 153 CLI KCF 70	C6	UT-1
1	11-6-80	DELETED WELDS 30MS(1)A-2LD, 3LU, 4LD, 5LU & WELD	K.M.A.	PP	QAP							
0	5-9-79	ISSUED FOR USE	K.M.A.	PP	W/11							
A	2-24-78	ISSUED FOR INFORMATION ONLY	K.M.A.	PP	QAP							
NO	DATE	REVISION	BY	CHKD	APPVD							

WNP-2
 WELD & COMPONENT
 IDENTIFICATION DIAGRAM
 TITLE:
 MAIN STEAM LINE A
 DWG NO: MS-201-1 REV 3

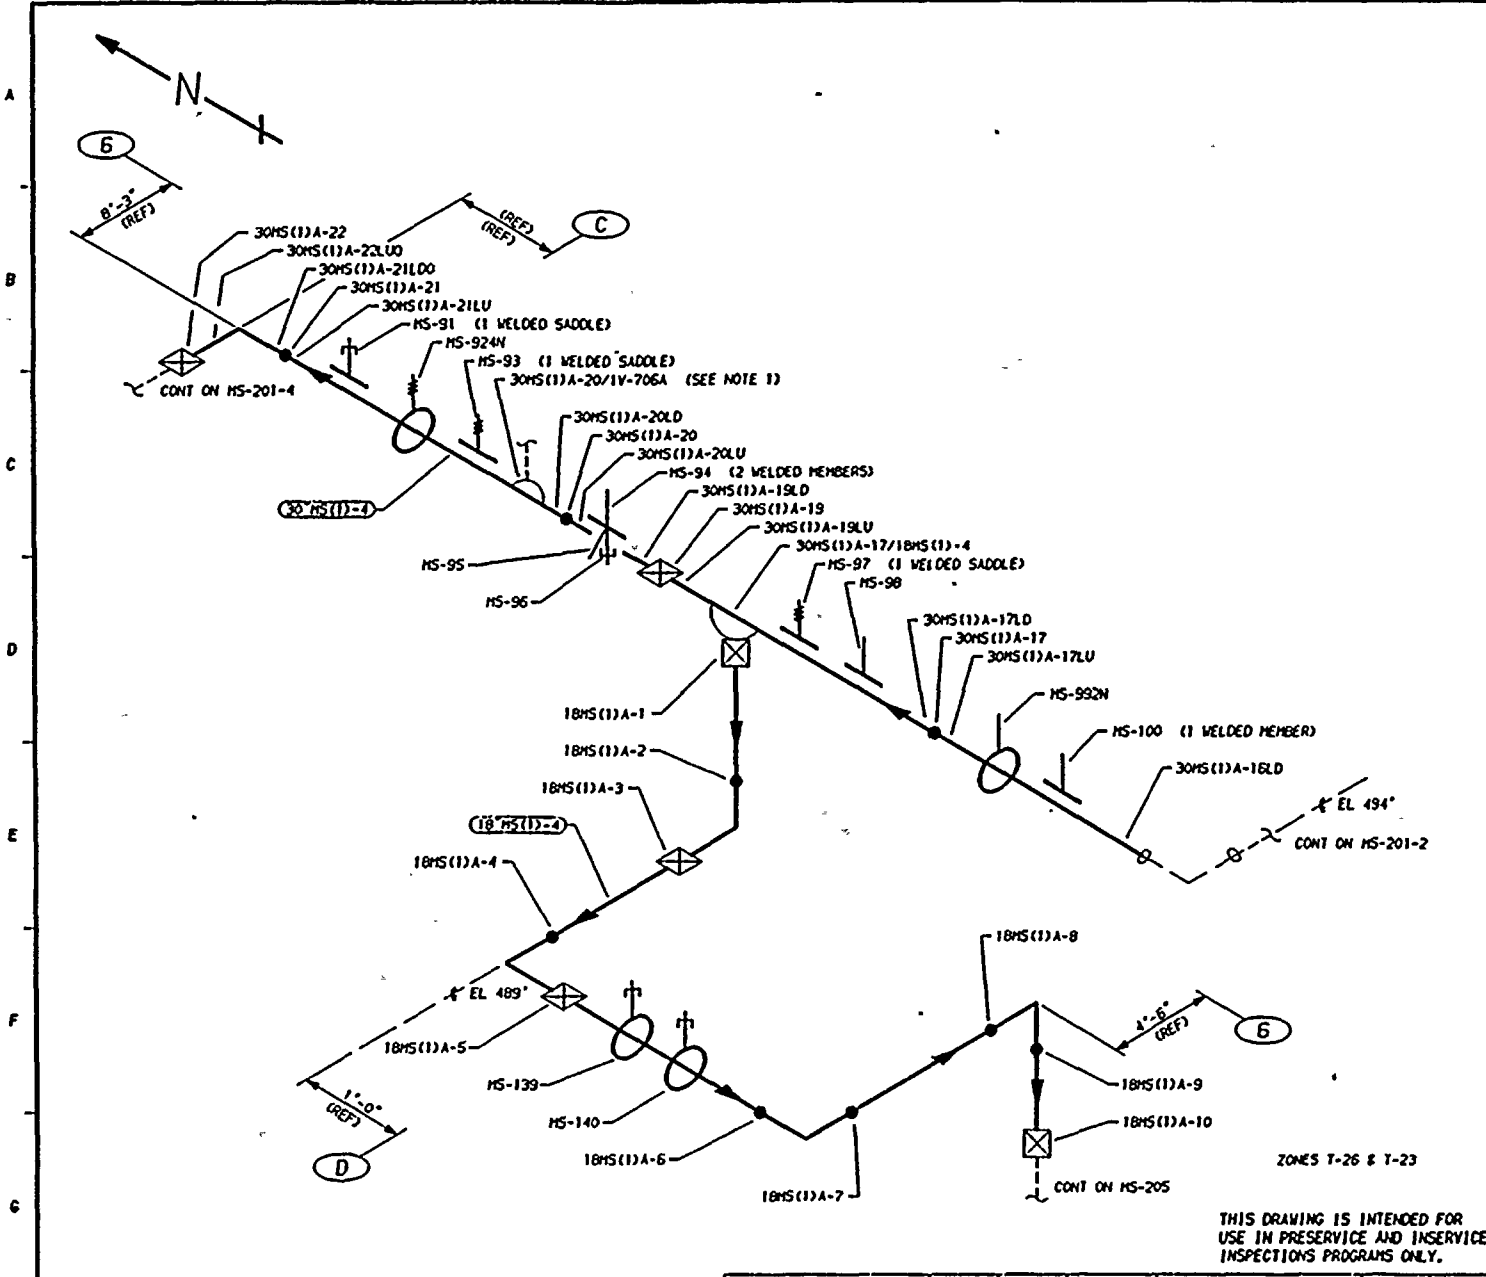


NOTES

1. EXTEND LEAKAGE EXAM THROUGH VALVE HS-V-706A TO MAIN STEAM PRESSURE AVERAGING MANIFOLD.

REFERENCES

BOYEE AND CRAIL ISOMETRIC
MS-528-7.10 REV 6

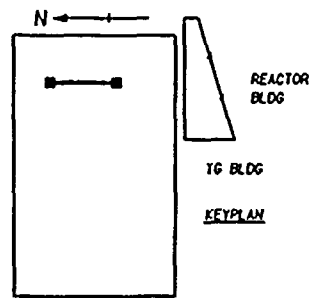

QUALITY CLASS: 1	ASME CODE CLASS: 2
ENGR: D TIMMINS	DRAWN: K-McA DATE: 2-1-78

WASHINGTON PUBLIC POWER
SUPPLY SYSTEM
RICHLAND, WASHINGTON 99352

THIS DRAWING IS INTENDED FOR
USE IN PRESERVICE AND INSERVICE
INSPECTIONS PROGRAMS ONLY.


NO	DATE	REVISION	BY	CHKD	APVD	PIPING SYSTEM	NOM DIA (IN)	SCH	NOM WALL THK	MATERIAL SPECIFICATION	MATL TYPE	CAL BLOCK NO
4	11-5-80	REVISED HANGERS REDRAWN	K-McA	DPR	TFH	30"MS(1)-4	30	XXX	1.25	SA 155 CL 1 KCF 70	CS	UT-1
3	12-2-81	REVISED HANGERS	K-McA	TFH	DWP	18"MS(1)-4	18	80	0.938	SA 106 GR B	CS	UT-12
2	11-5-80	DELETED WELDS 21LD1 & 22LD1, AND AS NOTED	K-McA	TFH	DWP							
1	9-13-79	DELETED TEE & CORRESPONDING WELDS, ADDED WEL IN D-4	K-McA	TFH	DWP							
0	1-9-79	ISSUED FOR USE	K-McA	TFH	DWP							
A	4-20-78	ISSUED FOR INFORMATION ONLY	K-McA	TFH	DWP							

WMP-2
WELD & COMPONENT
IDENTIFICATION DIAGRAM

TITLE: MAIN STEAM LINE A


DWG NO. MS-201-3 REV 4



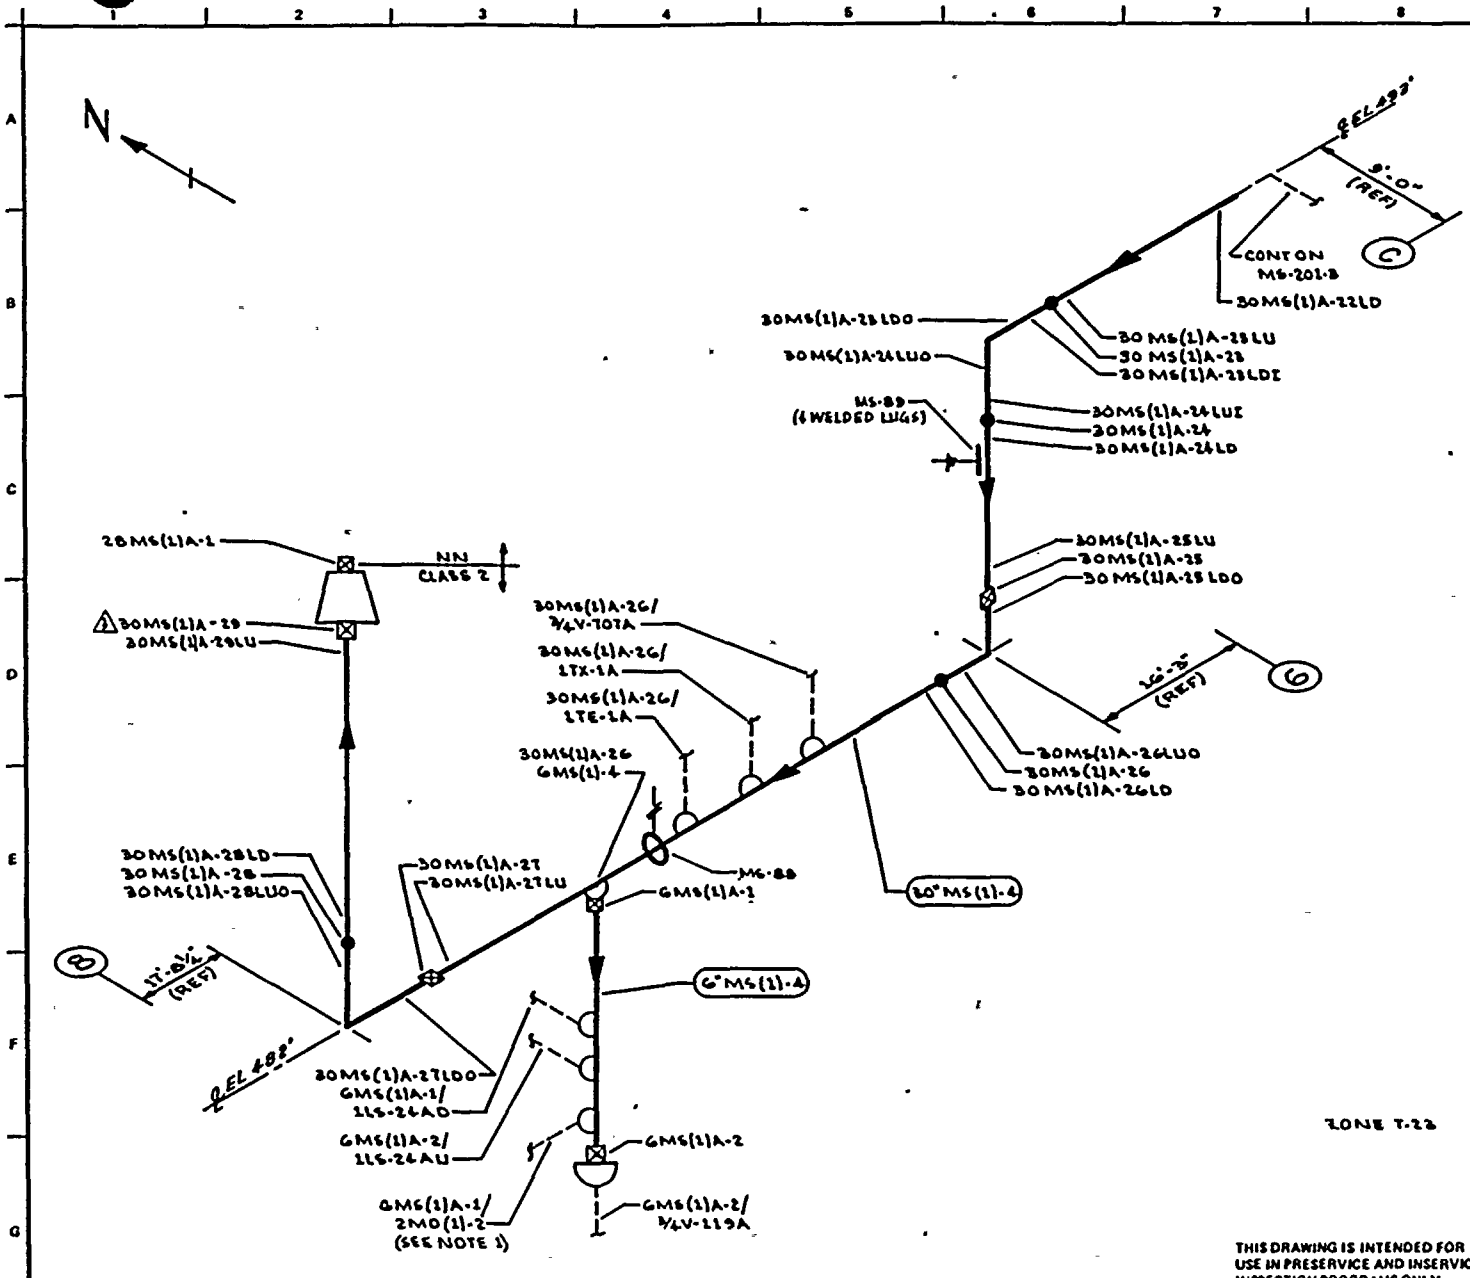

- NOTES:
1. EXTEND LEAKAGE EXAM THROUGH VALVES MD-V-120A & MD-V-117A.
 2. SCAFFOLDING IS REQUIRED.

- REFERENCES:
- DOVE & CRAL ISOMETRICS
- | | |
|--------------|-------|
| MS-52B-7.10 | REV 6 |
| MS-52B-11.12 | REV 5 |
| MS-52B-13 | REV 8 |

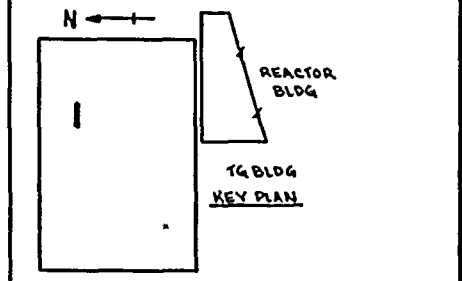

QUALITY CLASS: 1 ASME CODE CLASS: 2
 ENGR: D TIMMINS DRAWN: K.M.L.A. DATE: 1-25-78

WASHINGTON PUBLIC POWER SUPPLY SYSTEM
 RICHLAND, WASHINGTON 98382

THIS DRAWING IS INTENDED FOR USE IN PRESERVICE AND INSERVICE INSPECTION PROGRAMS ONLY.

WNP-2 WELD & COMPONENT IDENTIFICATION DIAGRAM


TITLE: MAIN STEAM LINE A

DWG NO: MS-201-4 REV 3

NO	DATE	REVISION	BY	CHKD	APPVD
3	9-28-83	REVISED AS NOTED	K.M.L.A.	DKR	T.H.P.
2	12-2-81	REVISED AS NOTED	K.M.L.A.	DKR	T.H.P.
1	11-1-80	DELETED WELDS 28LD, 26LU, 27LD & 28LU & NOTED	K.M.L.A.	DKR	T.H.P.
0	1-9-78	ISSUED FOR USE	K.M.L.A.	DKR	T.H.P.
A	4-20-78	ISSUED FOR INFORMATION ONLY	K.M.L.A.	DKR	T.H.P.
NO	DATE	REVISION	BY	CHKD	APPVD

PIPING SYSTEM	NOM DIA (IN)	SCH	NOM WALL THK	MATERIAL SPECIFICATION	MATL TYPE	CAL BLOCK NO
30" MS(1)-4	30	XXX	1.25	SA 155 CL1 KCF T0	C6	UT-1
6" MS(1)-4	6	80	0.432	SA 106 GR B	C5	NA
28" MS(1)-4	28	XXX	1.420	SA 155 CL1 KCF T0	C6	UT-2



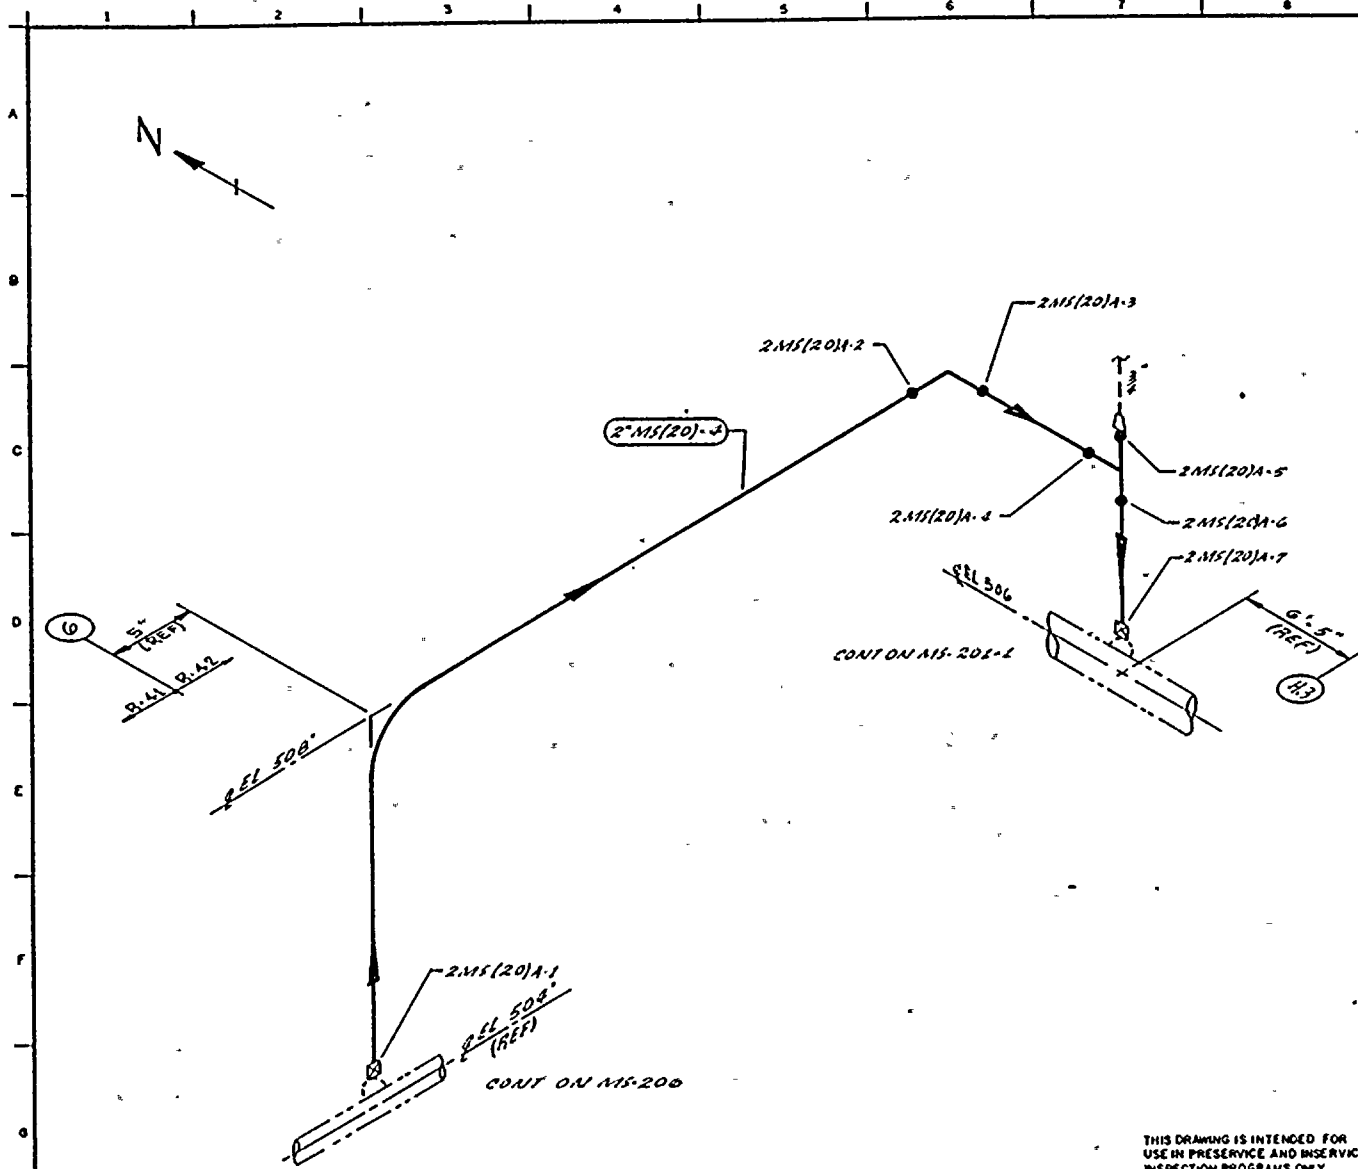

- NOTES:**
1. For branch piping, 1" or less (cons. shown in dashed lines), extend visual leakage exam through the outermost normally closed nuclear class valve, or until transition to instrument tubing, unless otherwise noted.
 2. THIS DWG IDENTIFIES PIPING WELDS THAT REQUIRE AUGMENTED ISI.

REFERENCE:
 BOVE CRAL ISOMETRIC
 MS-1891-1 REV 1

QUALITY CLASS: 1 ASME CODE CLASS: 2
 ENGR *K. H. HUNTER* DRAWN: *K. H. H.* DATE: 12-1-81

WASHINGTON PUBLIC POWER SUPPLY SYSTEM
 PULLMAN, WASHINGTON 99162

THIS DRAWING IS INTENDED FOR USE IN PRESERVICE AND INSERVICE INSPECTION PROGRAMS ONLY.

PIPING SYSTEM	NOM DIA (IN)	SCH	NOM WALL THK	MATERIAL SPECIFICATION	MATL TYPE	CAL BLOCK NO
2"MS(20)-4	2	160	0.364	SA 106 GR B	CS	N/A

WNP-2
 WELD & COMPONENT IDENTIFICATION DIAGRAM

TITLE:
 MAIN STEAM PRESSURE STABILIZATION LINE

DWG NO: MS-201-5 REV 0

NO	DATE	ISSUED FOR USE	REVISION	BY	CHKD	APPVD

SUPPLEMENT TO REGULATIONS OF ASME



WNP-02
 INTERVAL: PSI
 PERIOD: NA
 OUTAGE:
 DRAWING NO. MS-106

WASHINGTON PUBLIC POWER SUPPLY SYSTEM
 PROGRAM PLAN AND SCHEDULE
 SYSTEM OR COMPONENT: MS(12)-4
 DESCRIPTION: MS RX VES HEAD VENT

PAGE 004
 DATE 12/14/84

<u>IDENT. NO.</u>	<u>DESCRIPTION</u>	SECT. XI <u>EXAM.</u>	EXAM <u>MTH.</u>	<u>PROCEDURE</u>	CAL. <u>BLOCK</u>	<u>INSERVICE</u> SCHEDULED		<u>NOTES</u>
						<u>REQ.</u>	<u>OUTAGE</u>	
MS-2619-321			VT-4	303/8.2.17				
	PSA-1/4 SNUBBER	B-K-2	VT-3	303/8.2.17				S/N 19878
			VT-4	303/8.2.17				S/N 19878
MS-2619-322								
	PSA-1/2 SNUBBER	N/A	VT-3	303/8.2.17				S/N 4041
			VT-4	303/8.2.17				S/N 4041
MS-2619-46								
	PSA-1/2 SNUBBER	B-K-2	VT-3	303/8.2.17				S/N 4005
			VT-4	303/8.2.17				S/N 4005
MS-2619-45								
	PSA-1/4 SNUBBER	B-K-2	VT-3	303/8.2.17				S/N 28450
			VT-4	303/8.2.17				S/N 28450
MS-2619-42B								
	PSA-1/2 SNUBBER	B-K-2	VT-3	303/8.2.17				S/N 22363
			VT-4	303/8.2.17				S/N 22363
MS-2619-42A								
	PSA-1/4 SNUBBER	B-K-2	VT-3	303/8.2.17				S/N 28432
			VT-4	303/8.2.17				S/N 28432
MS-2619-42C								
	PSA-1/4 SNUBBER	B-K-2	VT-3	303/8.2.17				S/N
			VT-4	303/8.2.17				S/N
MS-PB-106								
	MS PRES BNDRY	B-P	VT-2	N/A				SEE NOTES #6 & #7.

WNP-02
 INTERVAL: PSI
 PERIOD: NA
 OUTAGE:
 DRAWING NO. MS-106

WASHINGTON PUBLIC POWER SUPPLY SYSTEM
 PROGRAM PLAN AND SCHEDULE
 SYSTEM OR COMPONENT: MS(12)-4
 DESCRIPTION: MS RX VES HEAD VENT

PAGE 003
 DATE 12/14/84

<u>IDENT. NO.</u>	<u>DESCRIPTION</u>	<u>SECT. XI EXAM.</u>	<u>EXAM MTH.</u>	<u>PROCEDURE</u>	<u>CAL. BLOCK</u>	<u>INSERVICE SCHEDULED</u>		<u>NOTES</u>
						<u>REQ.</u>	<u>OUTAGE</u>	
			VT-4	303/8.2.17				S/N 105
MS-2619-312	PSA-1/2 SNUBBER	B-K-2	VT-3	303/8.2.17				S/N 22338
			VT-4	303/8.2.17				S/N 22338
MS-2619-311	PSA-1/2 SNUBBER	B-K-2	VT-3	303/8.2.17				S/N 2524
			VT-4	303/8.2.17				S/N 2524
MS-2619-313	PSA-1/2 SNUBBER	B-K-2	VT-3	303/8.2.17				S/N 2469
			VT-4	303/8.2.17				S/N 2469
MS-2619-314	PSA-1/4 SNUBBER	B-K-2	VT-3	303/8.2.17				S/N 19884
			VT-4	303/8.2.17				S/N 19884
MS-2619-316	PSA-1/4 SNUBBER	B-K-2	VT-3	303/8.2.17				S/N 28428
			VT-4	303/8.2.17				S/N 28428
MS-2619-317	PSA-1/4 SNUBBER	B-K-2	VT-3	303/8.2.17				S/N 19881
			VT-4	303/8.2.17				S/N 19881
MS-2619-319	PSA-1/2 SNUBBER	B-K-2	VT-3	303/8.2.17				S/N 2536
			VT-4	303/8.2.17				S/N 2536
MS-2619-318	PSA-1/4 SNUBBER	B-K-2	VT-3	303/8.2.17				S/N 280
			VT-4	303/8.2.17				S/N 280
MS-2619-320	SPRING	B-K-2	VT-3	303/8.2.17				

WNP-02
 INTERVAL: PSI
 PERIOD: NA
 OUTAGE:
 DRAWING NO. MS-106

WASHINGTON PUBLIC POWER SUPPLY SYSTEM
 PROGRAM PLAN AND SCHEDULE
 SYSTEM OR COMPONENT: MS(12)-4
 DESCRIPTION: MS RX VES HEAD VENT

PAGE 002
 DATE 12/14/84


<u>IDENT. NO.</u>	<u>DESCRIPTION</u>	SECT. <u>XI</u> <u>EXAM.</u>	<u>EXAM</u> <u>MTH.</u>	<u>PROCEDURE</u>	<u>CAL.</u> <u>BLOCK</u>	<u>INSERVICE</u>		<u>NOTES</u>
						<u>REQ.</u>	<u>SCHEDULED</u> <u>OUTAGE</u>	
MS-2619-15			VT-4	303/8.2.17				S/N 362
	PSA-3 SNUBBER	B-K-2	VT-3	303/8.2.17				S/N 635
			VT-4	303/8.2.17				S/N 635
PWS-52-8	PIPE WHIP	N/A	N/A	N/A				SEE NOTE #1
PWS-52-7	PIPE WHIP	N/A	N/A	N/A				SEE NOTE #1
MS-2619-21	PSA-1 SNUBBER	B-K-2	VT-3	303/8.2.17				S/N 22346
			VT-4	303/8.2.17				S/N 22346
MS-2619-23	PSA-3 SNUBBER	B-K-2	VT-3	303/8.2.17				S/N 2597
			VT-4	303/8.2.17				S/N 2597
MS-2619-24	RIGID	B-K-2	VT-3	303/8.2.17				
MS-2619-213	SPRING	B-K-2	VT-3	303/8.2.17				
			VT-4	303/8.2.17				
MS-2619-210	PSA-1 SNUBBER	B-K-2	VT-3	303/8.2.17				S/N 2592
			VT-4	303/8.2.17				S/N 2592
MS-2619-26	PSA-1 SNUBBER	B-K-2	VT-3	303/8.2.17				S/N 22352
			VT-4	303/8.2.17				S/N 22352
MS-2619-310	PSA-1 SNUBBER	B-K-2	VT-3	303/8.2.17				S/N 105

WNP-02
 INTERVAL: PSI
 PERIOD: NA
 OUTAGE:
 DRAWING NO. HS-106

WASHINGTON PUBLIC POWER SUPPLY SYSTEM
 PROGRAM PLAN AND SCHEDULE
 SYSTEM OR COMPONENT: HS(12)-4
 DESCRIPTION: MS_RX_VES_HEAD_VENT

PAGE 001
 DATE 12/14/84

<u>IDENT. NO.</u>	<u>DESCRIPTION</u>	<u>SECT.</u> <u>XI</u> <u>EXAM.</u>	<u>EXAM</u> <u>MTH.</u>	<u>PROCEDURE</u>	<u>CAL.</u> <u>BLOCK</u>	<u>INSERVICE</u> <u>SCHEDULED</u>		<u>NOTES</u>
						<u>REQ.</u>	<u>OUTAGE</u>	
4MS(12)-1	NOZ TO FLANGE	B-J	VOL	UTP-10	UT-108			
			SUR	PTP-1				
4MS(12)-1BD	FLANGE BOLTING	B-G-2	VT-1	OCI 7-1				
4MS(12)-2	FLANGE/REDUCER	B-J	VOL	UTP-10	UT-30			
			SUR	PTP-1				
PWS-52-11	PIPE WHIP	N/A	N/A	N/A				SEE NOTE #1
MS-2619-11	PSA-1/4 SNUBBER	N/A	VT-3	N/A				S/N 398, LOCATED ON CONDENSING CHAMBER.
			VT-4	N/A				S/N 398, LOCATED ON CONDENSING CHAMBER.
MS-2619-12	PSA-1/4 SNUBBER	N/A	VT-3	N/A				S/N 6226
			VT-4	N/A				S/N 6226
MS-2619-14	PSA-1/2 SNUBBER	B-K-2	VT-3	303/8.2.17				S/N 4021
			VT-4	303/8.2.17				S/N 4021
MS-2619-13	PSA-1 SNUBBER	B-K-2	VT-3	303/8.2.17				S/N 625
			VT-4	303/8.2.17				S/N 625
PWS-52-9	PIPE WHIP	N/A	N/A	N/A				SEE NOTE #1
MS-2619-16	PSA-3 SNUBBER	B-K-2	VT-3	303/8.2.17				S/N 362

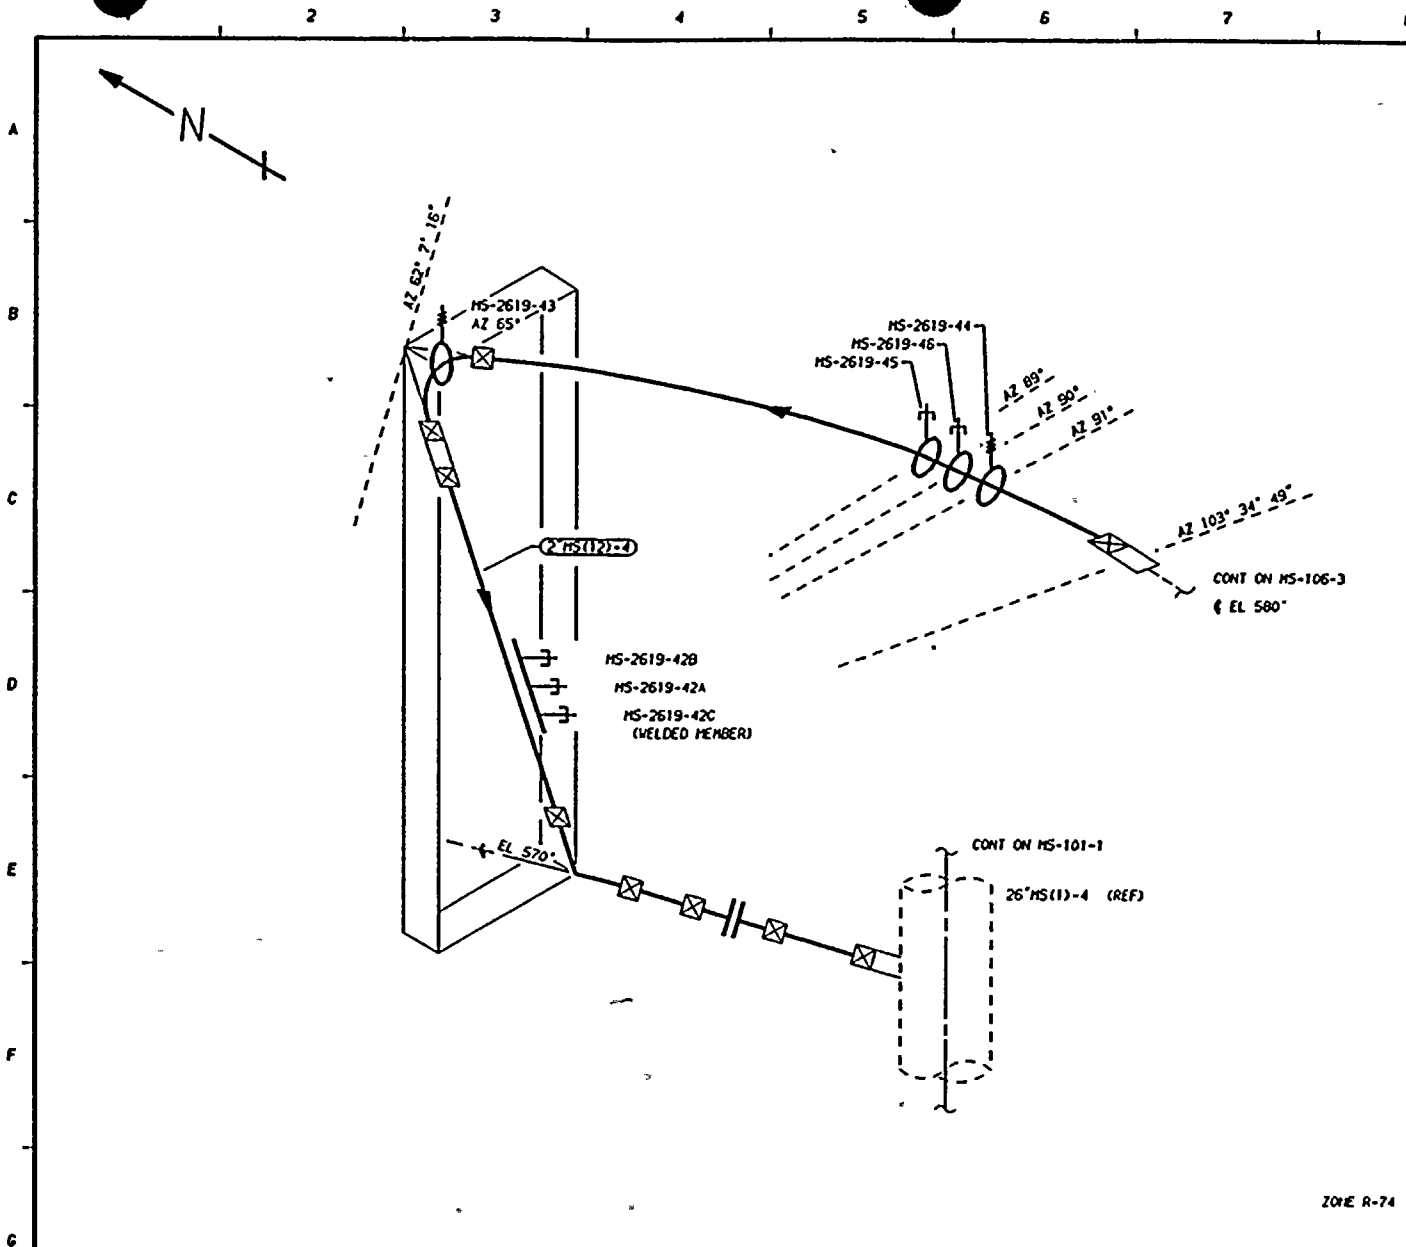


NOTES:

- THIS DRAWING IDENTIFIES PIPING AND COMPONENTS SUBJECT TO A VISUAL EXAM FOR EVIDENCE OF LEAKAGE DURING SYSTEM HYDRO OR OPERABILITY TESTS. TESTS ARE TO BE CONDUCTED PER THE REQUIREMENTS OF ASME SECTION XI, PARAGRAPH 11A-5000.

REFERENCES:

151 - 229
 BURNS & ROE DRAWING
 M200 SH 52 REV 3
 WSH/BOCON/GERI
 MS-2619-4 REV 9
 MS-2619-5 REV 5

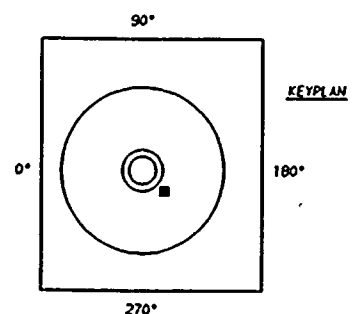

ZONE R-74

THIS DRAWING IS INTENDED FOR USE IN PRESERVICE AND INSERVICE INSPECTIONS PROGRAMS ONLY.

QUALITY CLASS: 1	ASME CODE CLASS: 1
ENGR: D TIMMINS	DRAWN: K-McA DATE: 4-13-78

WASHINGTON PUBLIC POWER
 SUPPLY SYSTEM
 RICHLAND, WASHINGTON 99352


WNP-2
 WELD & COMPONENT
 IDENTIFICATION DIAGRAM

TITLE:
 MAIN STEAM REACTOR VESSEL HEAD VENT

DWG NO. MS-106-4 REV 1


PIPING SYSTEM	NOM DIA (IN)	SCH	NOM WALL THK	MATERIAL SPECIFICATION	MATL TYPE	CAL BLOCK NO
2" MS(12)-4	2	160	0.344	SA 106 GR B	CS	NA

NO	DATE	REVISION	BY	CHKD	APVD
1	12-2-83	GENERAL UPDATE, SPLIT DWG REDRAWN	instad	JRS	TEK
0	12-22-78	ISSUED FOR USE (REDRAWN)	K-McA	LFB	LFB
A	5-18-78	ISSUED FOR INFORMATION ONLY	K-McA	DWP	DWP

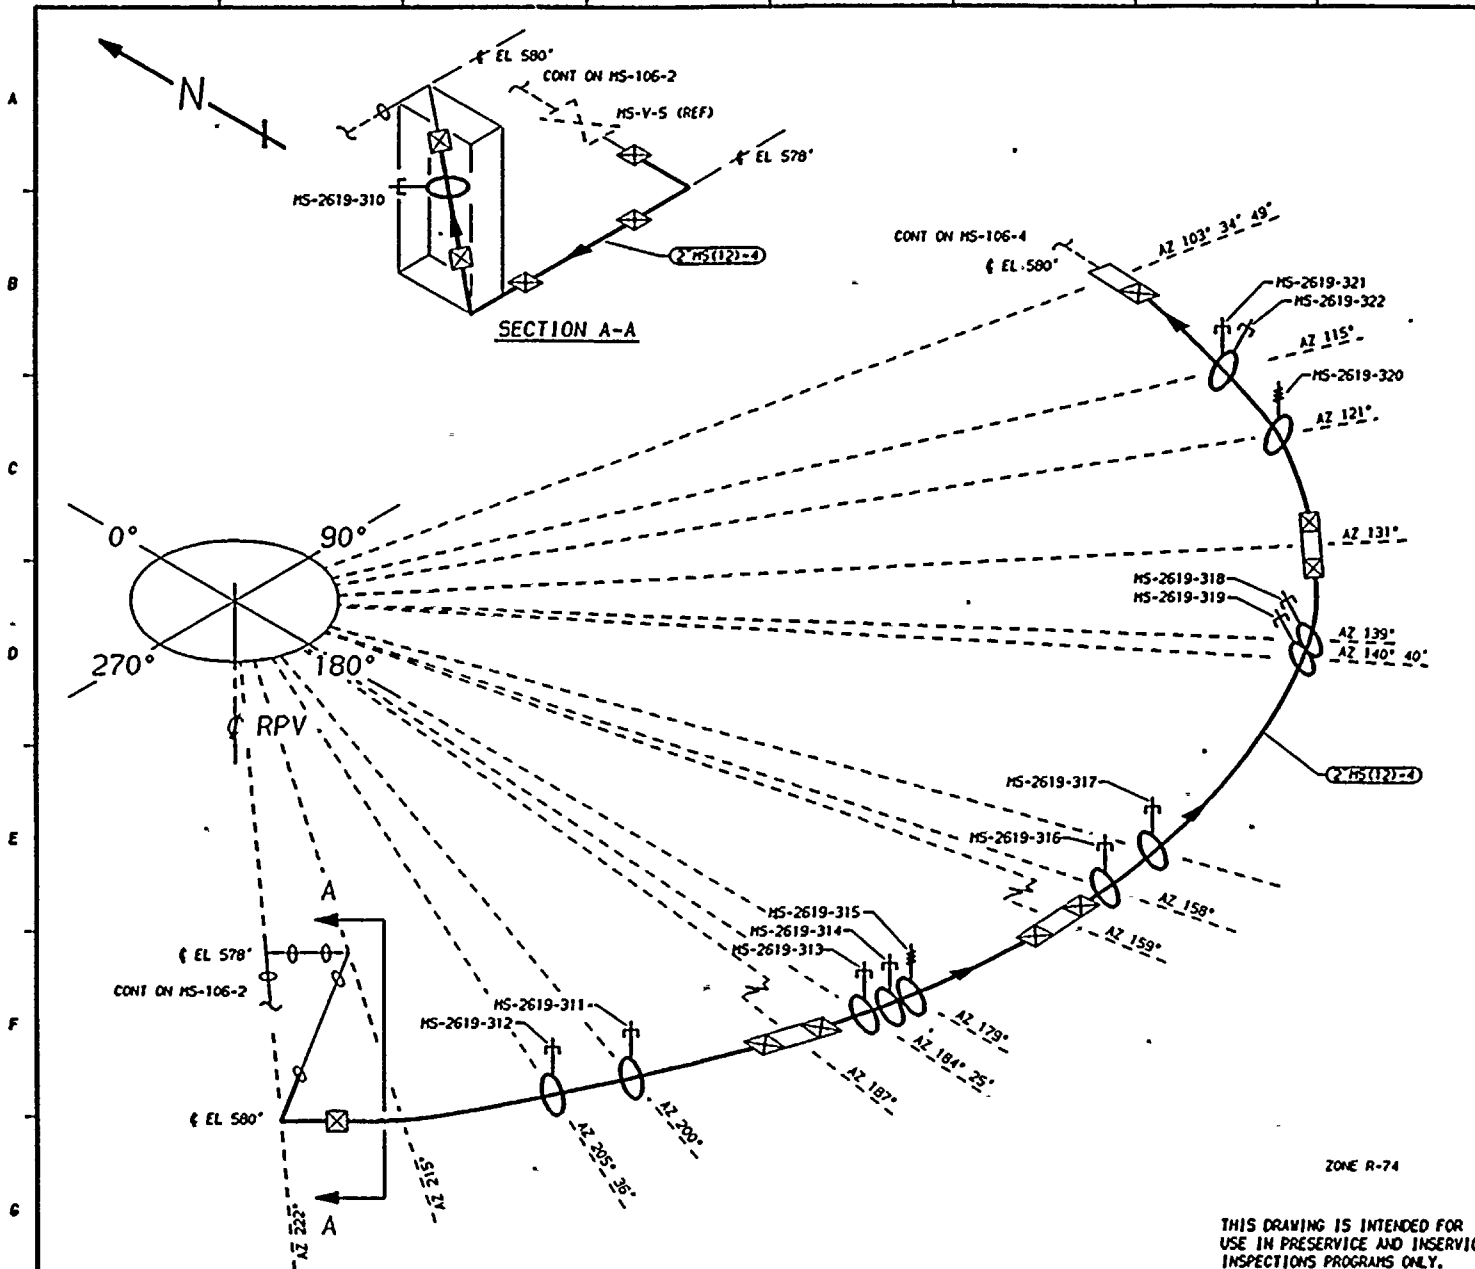

NOTES:
 1. THIS DRAWING IDENTIFIES PIPING AND COMPONENTS SUBJECT TO A VISUAL EXAM FOR EVIDENCE OF LEAKAGE DURING SYSTEM HYDRO OR OPERABILITY TESTS. TESTS ARE TO BE CONDUCTED PER THE REQUIREMENTS OF ASME SECTION XI, PARAGRAPH IWA-5000.

REFERENCES:
 ISI - 229
 BURNS & ROE DRAWING
 M200 SH 52 REV 3
 WSH/BOCON/GERI
 MS-2619-3 REV 9

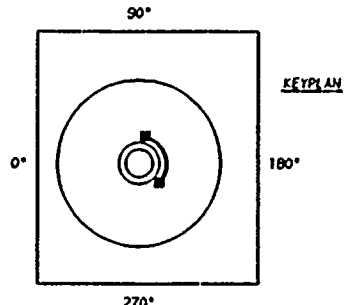

QUALITY CLASS:	1	ASME CODE CLASS:	1
ENGR:	D TIMPINS	DRAWN:	K-McA
DATE:	4-13-78		

WASHINGTON PUBLIC POWER
 SUPPLY SYSTEM
 RICHLAND, WASHINGTON 99352

WNP-2
 WELD & COMPONENT
 IDENTIFICATION DIAGRAM


TITLE:
 MAIN STEAM REACTOR VESSEL HEAD VENT
 DNG NO: MS-106-3 REV 1

THIS DRAWING IS INTENDED FOR USE IN PRESERVICE AND INSERVICE INSPECTIONS PROGRAMS ONLY.

ZONE R-74

PIPING SYSTEM	NOM DIA (IND)	SCH	NOM WALL THK	MATERIAL SPECIFICATION	MATL TYPE	CAL BLOCK NO
2"MS(12)-4	2	160	0.344	SA 106 GR B	CS	NA

NO	DATE	REVISION	BY	CHKD	APVD
1	12-2-73	GENERAL UPDATE, SPLIT DWG REDRAWN	VJB	DPP	LEX
0	12-22-78	ISSUED FOR USE (REDRAWN)	K-McA	DPP	LFB
A	5-18-78	ISSUED FOR INFORMATION ONLY	K-McA	EC	DWP

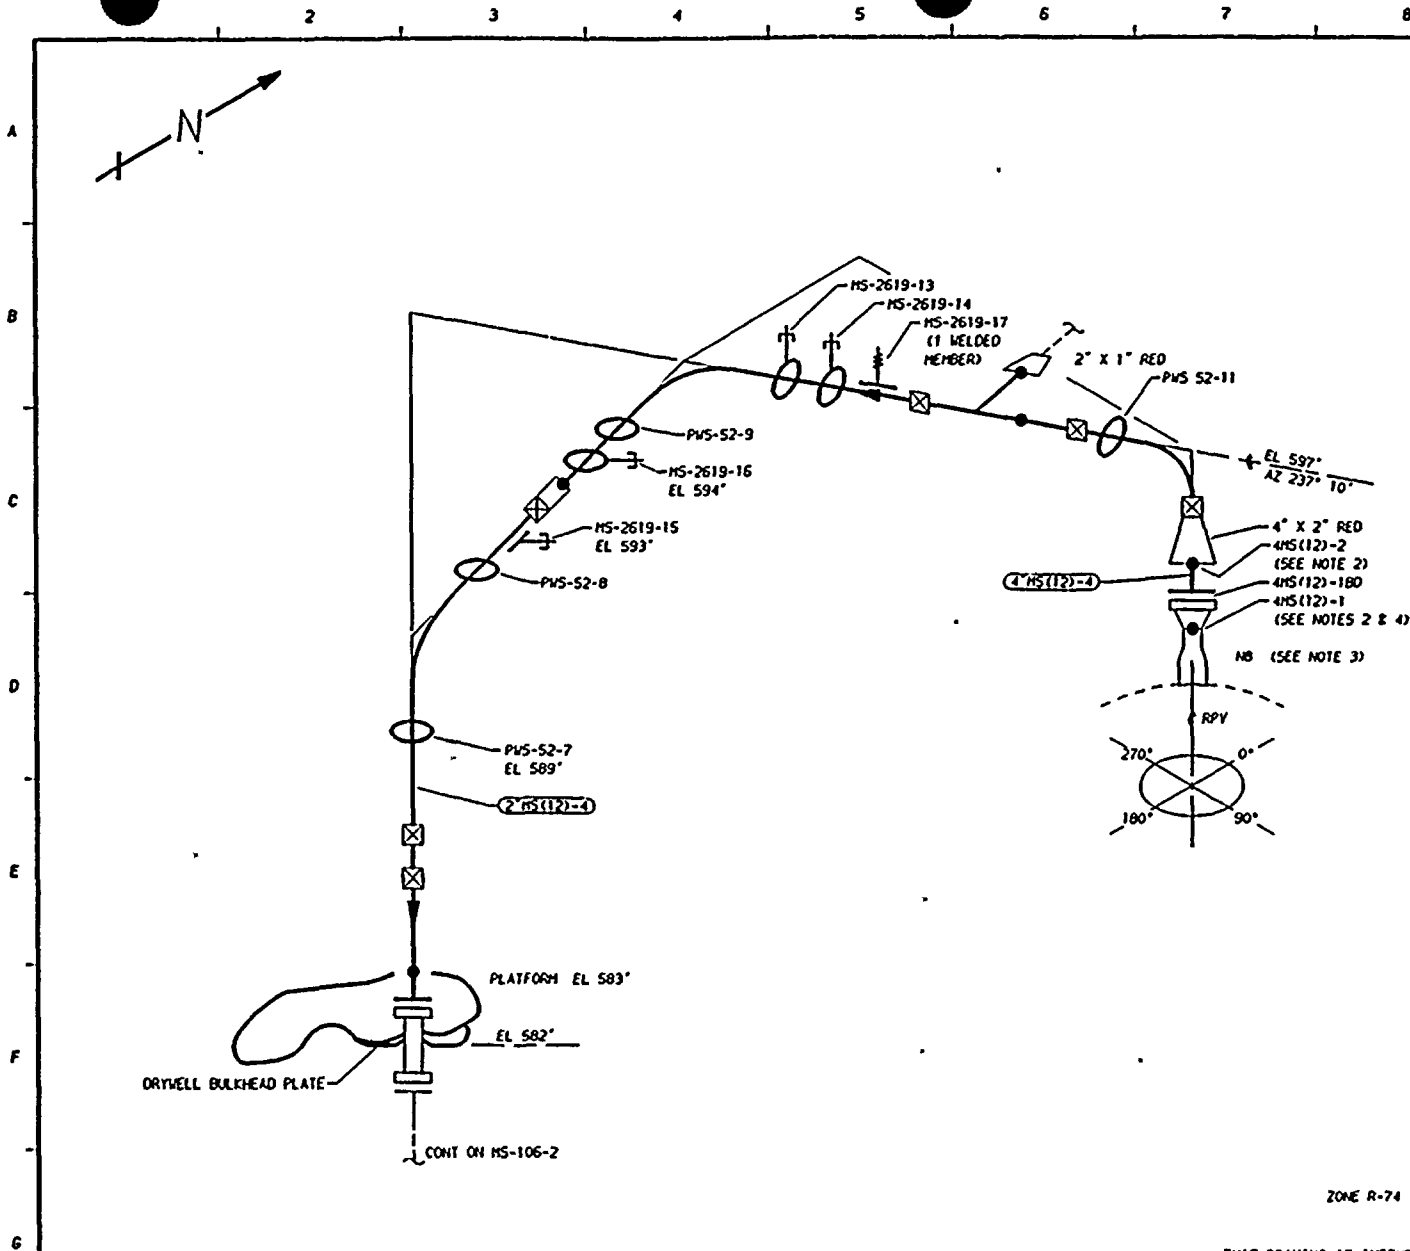


NOTES:

1. THIS DRAWING IDENTIFIES PIPING AND COMPONENTS SUBJECT TO A VISUAL EXAM FOR EVIDENCE OF LEAKAGE DURING SYSTEM HYDRO OR OPERABILITY TESTS. TESTS ARE TO BE CONDUCTED PER THE REQUIREMENTS OF ASME SECTION XI, PARAGRAPH IWA-5000.
2. WELDS 4MS(12)-1 & 4MS(12)-2 ARE FITTING TO FITTING. THEY SHOULD BE GROUND FLUSH AND ULTRASONICALLY EXAMINED WITH SHALL (1/4") TRANSDUCERS.
3. FOR NOZZLE ASSEMBLY DETAILS SEE RPY-112.
4. WELD 4MS(12)-1 UTILIZES CAL BLOCK UT-108.

REFERENCES:

- 151 - 229
- BURNS & ROE DRAWING
M200 SH 52 REV 3
- CBI NUCLEAR CO.
71, REV 9 NB VENT
- WSH/BOCDN/GERT
MS-2619-1 REV B

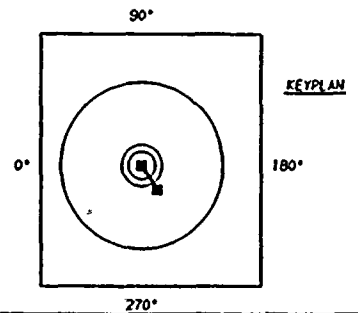

QUALITY CLASS: 1	ASME CODE CLASS: 1
ENGR, D TIMMINS	DRAWN, K-McA DATE, 4-12-78

WASHINGTON PUBLIC POWER
SUPPLY SYSTEM
RICHLAND, WASHINGTON 99352

**WNP-2
WELD & COMPONENT
IDENTIFICATION DIAGRAM**

TITLE:
MAIN STEAM REACTOR VESSEL HEAD VENT

DWG NO: MS-106-1

REV 2


ZONE R-74

THIS DRAWING IS INTENDED FOR
USE IN PRESERVICE AND INSERVICE
INSPECTIONS PROGRAMS ONLY.

PIPING SYSTEM	NOM DIA (IN)	SCH	NOM WALL THK	MATERIAL SPECIFICATION	MATL TYPE	CAL BLOCK NO
2"MS(12)-4	2	160	0.344	SA 106 GR B	CS	NA
4"MS(12)-4	4	80	0.337	SA 106 GR II	CS	UT-30


NO	DATE	REVISION	BY	CHKD	APVD
2	12-2-93	GENERAL UP-DATE REDRAWN	APYD	APYD	APYD
1	11-5-80	ADDED NOTES 3 & 4.	K-McA	APYD	DWP
0	12-22-78	ISSUED FOR USE (REDRAWN)	K-McA	APYD	LFB
A	5-18-78	ISSUED FOR INFORMATION ONLY	K-McA	APYD	LFB

A
B
C
D
E
F
G

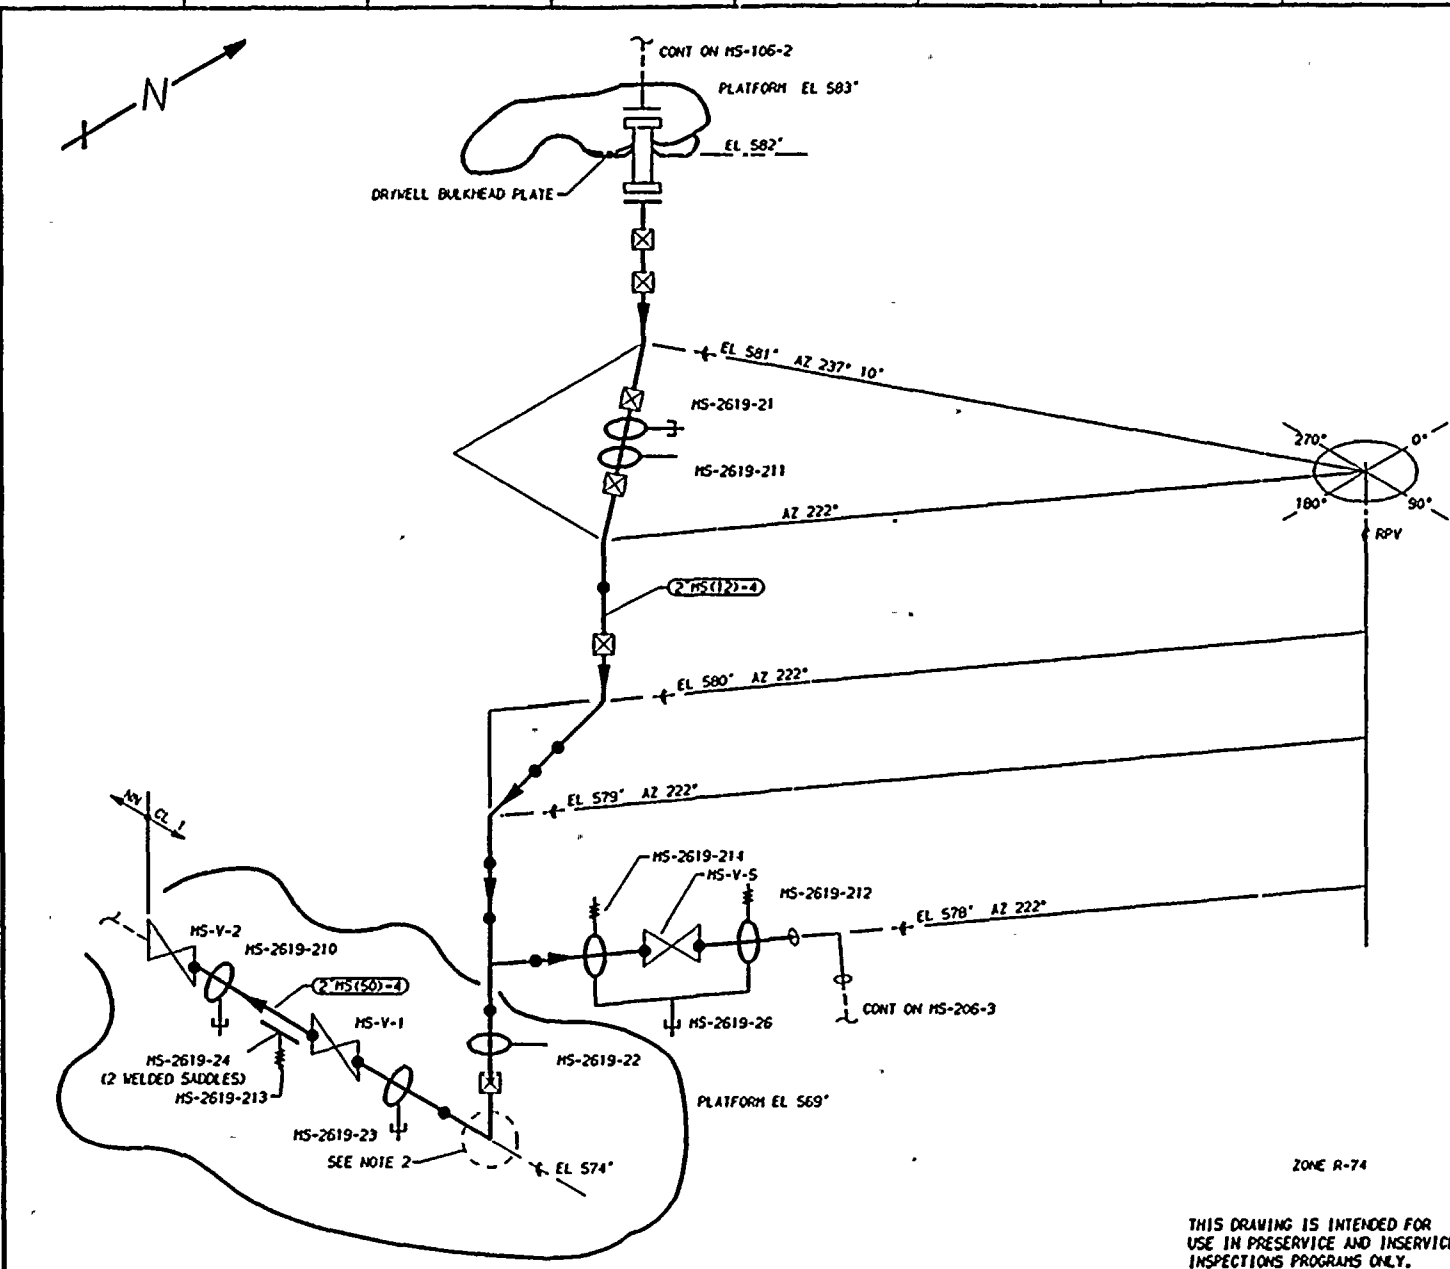

- NOTES:**
1. THIS DRAWING IDENTIFIES PIPING AND COMPONENTS SUBJECT TO A VISUAL EXAM FOR EVIDENCE OF LEAKAGE DURING SYSTEM HYDRO OR OPERABILITY TESTS. TESTS ARE TO BE CONDUCTED PER THE REQUIREMENTS OF ASME SECTION XI, PARAGRAPH IMA-5000.
 2. LEG AT EL 574' HAS BEEN ROTATED FOR CLARITY.

- REFERENCES:**
- ISI - 229
 - BURNS & ROE DRAWING
M200 SH 52 REV 3
 - WSH/BOCON/GERI
MS-2619-1 REV B

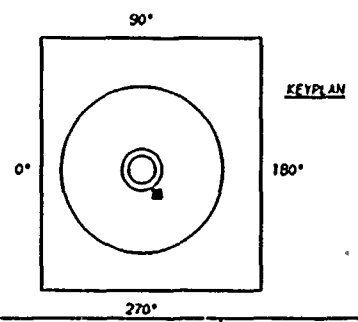

QUALITY CLASS, 1	ASME CODE CLASS, 1
ENGR, D TIMMINS	DRAWN, K-McA DATE, 4-13-78

WASHINGTON PUBLIC POWER
SUPPLY SYSTEM
RICHLAND, WASHINGTON 99352

WNP-2
WELD & COMPONENT
IDENTIFICATION DIAGRAM

TITLE:
MAIN STEAM REACTOR VESSEL HEAD VENT

DWG NO, MS-106-2 REV 1

THIS DRAWING IS INTENDED FOR
USE IN PRESERVICE AND INSERVICE
INSPECTIONS PROGRAMS ONLY.

PIPING SYSTEM	NOM DIA (IN)	SCH	NOM WALL THK	MATERIAL SPECIFICATION	MATL TYPE	CAL BLOCK NO
2"MS(12)-4	2	160	0.344	SA 106 GR B	CS	NA
2"MS(50)-4	2	160	0.344	SA 106 GR B	CS	NA

NO	DATE	REVISION	BY	CHKD	APVD	DWG	APP	DATE
1	12-83	GENERAL UP-DATE REDRAWN						
0	12-22-78	ISSUED FOR USE (REDRAWN)						
A	5-18-78	ISSUED FOR INFORMATION ONLY						

WNP-02
 INTERVAL: PSI
 PERIOD: NA
 OUTAGE:
 DRAWING NO. MS-105

WASHINGTON PUBLIC POWER SUPPLY SYSTEM
 PROGRAM PLAN AND SCHEDULE
 SYSTEM OR COMPONENT: MS(9)-4
 DESCRIPTION: MS VALVE DRAINS

PAGE 002
 DATE 12/14/84


<u>IDENT. NO.</u>	<u>DESCRIPTION</u>	SECT. XI <u>EXAM.</u>	EYAM <u>MTH.</u>	<u>PROCEDURE</u>	CAL. <u>BLOCK</u>	<u>INSERVICE</u>		<u>NOTES</u>
						<u>REQ.</u>	<u>SCHEDULED OUTAGE</u>	
MS-1369-13	PSA-1/2 SNUBBER	B-K-2	VT-3	303/8.2.17				S/N 2582
			VT-4	303/8.2.17				S/N 2582
MS-1369-12	PSA-1/2 SNUBBER	B-K-2	VT-3	303/8.2.17				S/N 2154
			VT-4	303/8.2.17				S/N 2154
PWS-53-13	PIPE WHIP	N/A	N/A	N/A				SEE NOTE #1
PWS-53-3	PIPE WHIP	N/A	N/A	N/A				SEE NOTE #1
PWS-53-2	PIPE WHIP	N/A	N/A	N/A				SEE NOTE #1
PWS-53-1	PIPE WHIP	N/A	N/A	N/A				SEE NOTE #1
MS-PB-105	MS PRES BNDRY	B-P	VT-2	N/A				SEE NOTES #6 & #7.

WNP-02
 INTERVAL: PSI
 PERIOD: NA
 OUTAGE:
 DRAWING NO. MS-105

WASHINGTON PUBLIC POWER SUPPLY SYSTEM
 PROGRAM PLAN AND SCHEDULE
 SYSTEM OR COMPONENT: MS(9)-4
 DESCRIPTION: MS VALVE DRAINS

PAGE 001
 DATE 12/14/84

<u>IDENT. NO.</u>	<u>DESCRIPTION</u>	<u>SECT.</u> <u>XI</u> <u>EXAM.</u>	<u>EXAM</u> <u>MTH.</u>	<u>PROCEDURE</u>	<u>CAL.</u> <u>BLOCK</u>	<u>INSERVICE</u> <u>SCHEDULED</u>		<u>NOTES</u>
						<u>REQ.</u>	<u>OUTAGE</u>	
PWS-53-18	PIPE WHIP	N/A	N/A	N/A				SEE NOTE #1
PWS-53-19	PIPE WHIP	N/A	N/A	N/A				SEE NOTE #1
MS-53-15	PIPE WHIP	N/A	N/A	N/A				SEE NOTE #1
PWS-53-8	PIPE WHIP	N/A	N/A	N/A				SEE NOTE #1
PWS-53-9	PIPE WHIP	N/A	N/A	N/A				SEE NOTE #1
PWS-53-17	PIPE WHIP	N/A	N/A	N/A				SEE NOTE #1
MS-1368-13	PSA-1/2 SNUBBER	B-K-2	VT-3	303/8.2.17				S/N 2145
			VT-4	303/8.2.17				S/N 2145
MS-1368-12	PSA-1/2 SNUBBER	B-K-2	VT-3	303/8.2.17				S/N 2537
			VT-4	303/8.2.17				S/N 2537
PWS-53-16	PIPE WHIP	N/A	N/A	N/A				SEE NOTE #1
PWS-53-12	PIPE WHIP	N/A	N/A	N/A				SEE NOTE #1
PWS-53-11	PIPE WHIP	N/A	N/A	N/A				SEE NOTE #1
PWS-53-10	PIPE WHIP	N/A	N/A	N/A				SEE NOTE #1
PWS-53-5	PIPE WHIP	N/A	N/A	N/A				SEE NOTE #1
PWS-53-6	PIPE WHIP	N/A	N/A	N/A				SEE NOTE #1
PWS-53-14	PIPE WHIP	N/A	N/A	N/A				SEE NOTE #1

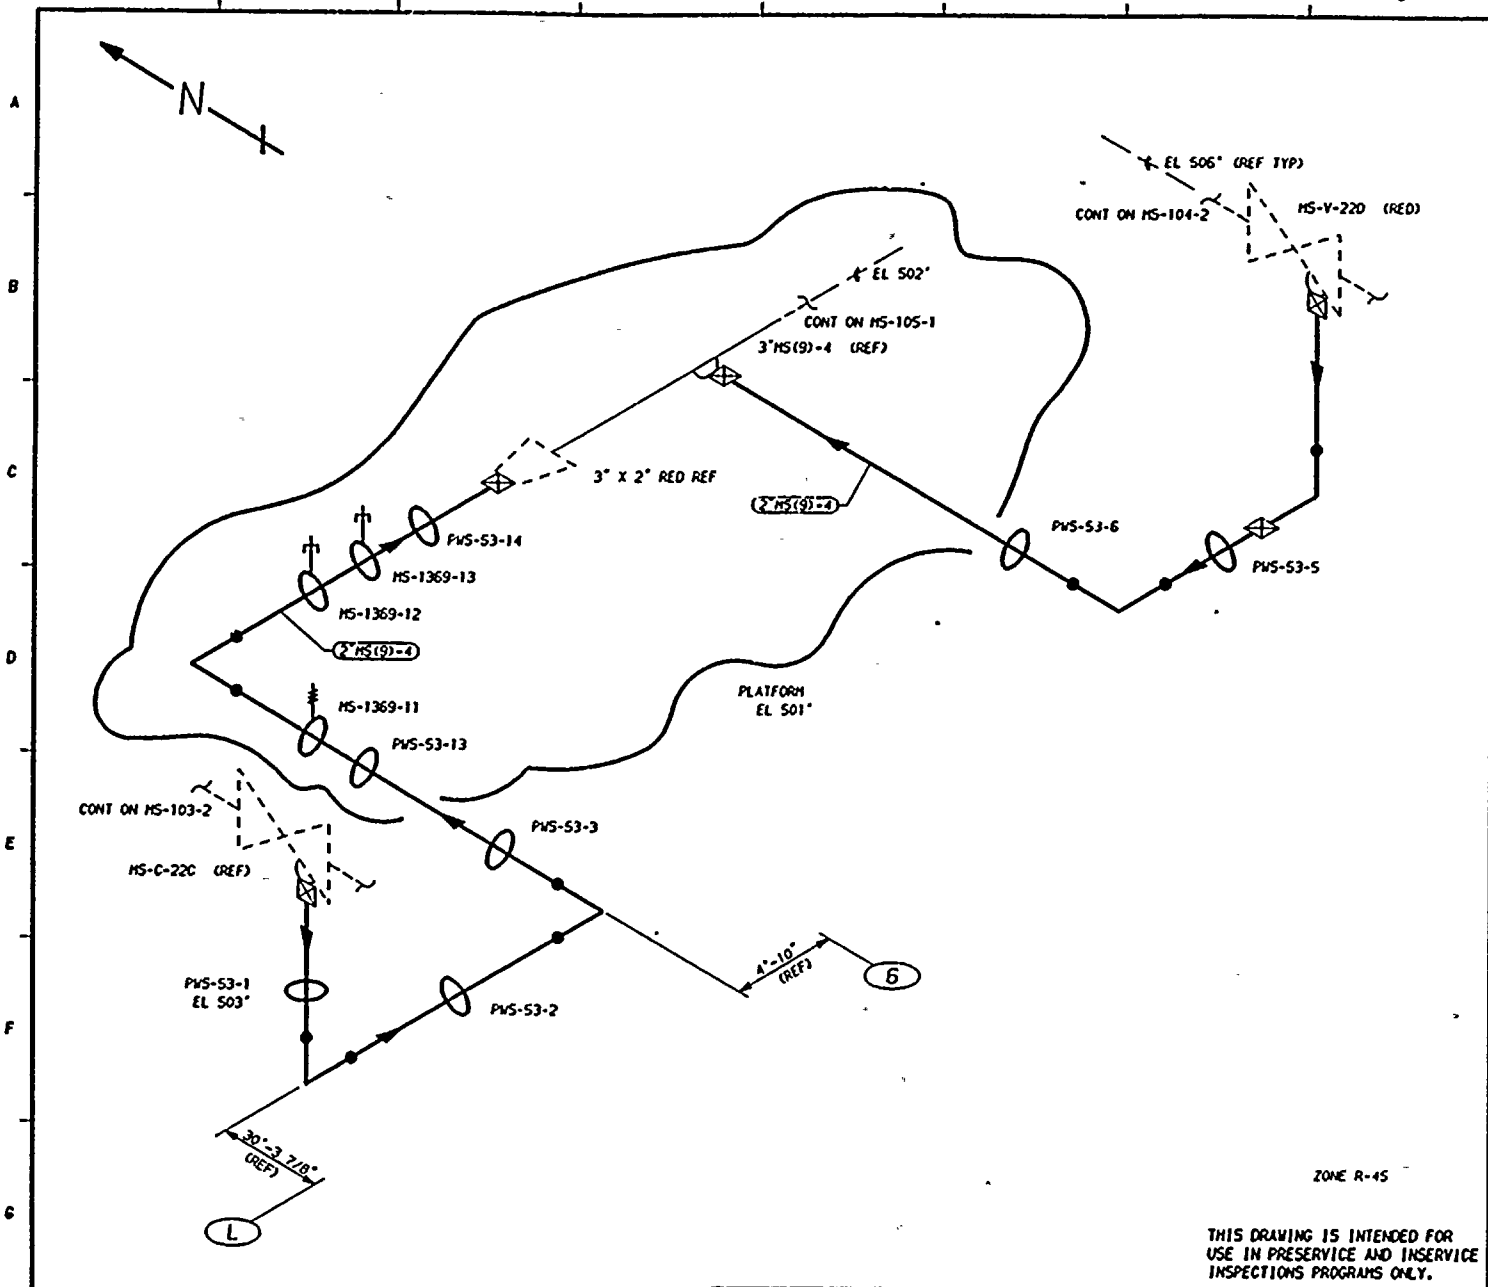


NOTES:

1. THIS DRAWING IDENTIFIES PIPING AND COMPONENTS SUBJECT TO A VISUAL EXAM FOR EVIDENCE OF LEAKAGE DURING SYSTEM HYDRO OR OPERABILITY TESTS. TESTS ARE TO BE CONDUCTED PER THE REQUIREMENTS OF ASME SECTION XI, PARAGRAPH IWA-5000.

REFERENCES:

151 - 229
 BOVEE & CRAIG ISOMETRICS
 MS-1369-1 REV 7
 MS-1370-1 REV 7

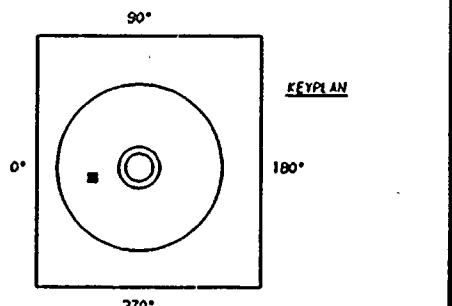

QUALITY CLASS: 1	ASME CODE CLASS: 1
ENGR: D TIMMINS	DATE: 4-11-78

WASHINGTON PUBLIC POWER
 SUPPLY SYSTEM
 RICHLAND, WASHINGTON 99352

WNP-2
 WELD & COMPONENT
 IDENTIFICATION DIAGRAM

TITLE:
 MAIN STEAM VALVE DRAINS


DWG NO. MS-105-3 REV 2

THIS DRAWING IS INTENDED FOR USE IN PRESERVICE AND INSERVICE INSPECTIONS PROGRAMS ONLY.

ZONE R-45

PIPING SYSTEM	NOM DIA (IN)	SCH	NOM WALL THK	MATERIAL SPECIFICATION	MATL TYPE	CAL BLOCK NO
2" MS(9)-4	2	160	0.344	SA 106 GR B	CS	NA

NO	DATE	REVISION	BY	CHKD	APVD
1	12-2-81	GENERAL UP-DATE REDRAWN	K-McA	DPR	TFH
1	12-2-81	REVISED AS NOTED	K-McA	DPR	TFH
0	12-22-78	ISSUED FOR USE (REDRAWN)	K-McA	TFH	LFB
A	5-18-78	ISSUED FOR INFORMATION ONLY	K-McA	DPR	LFB

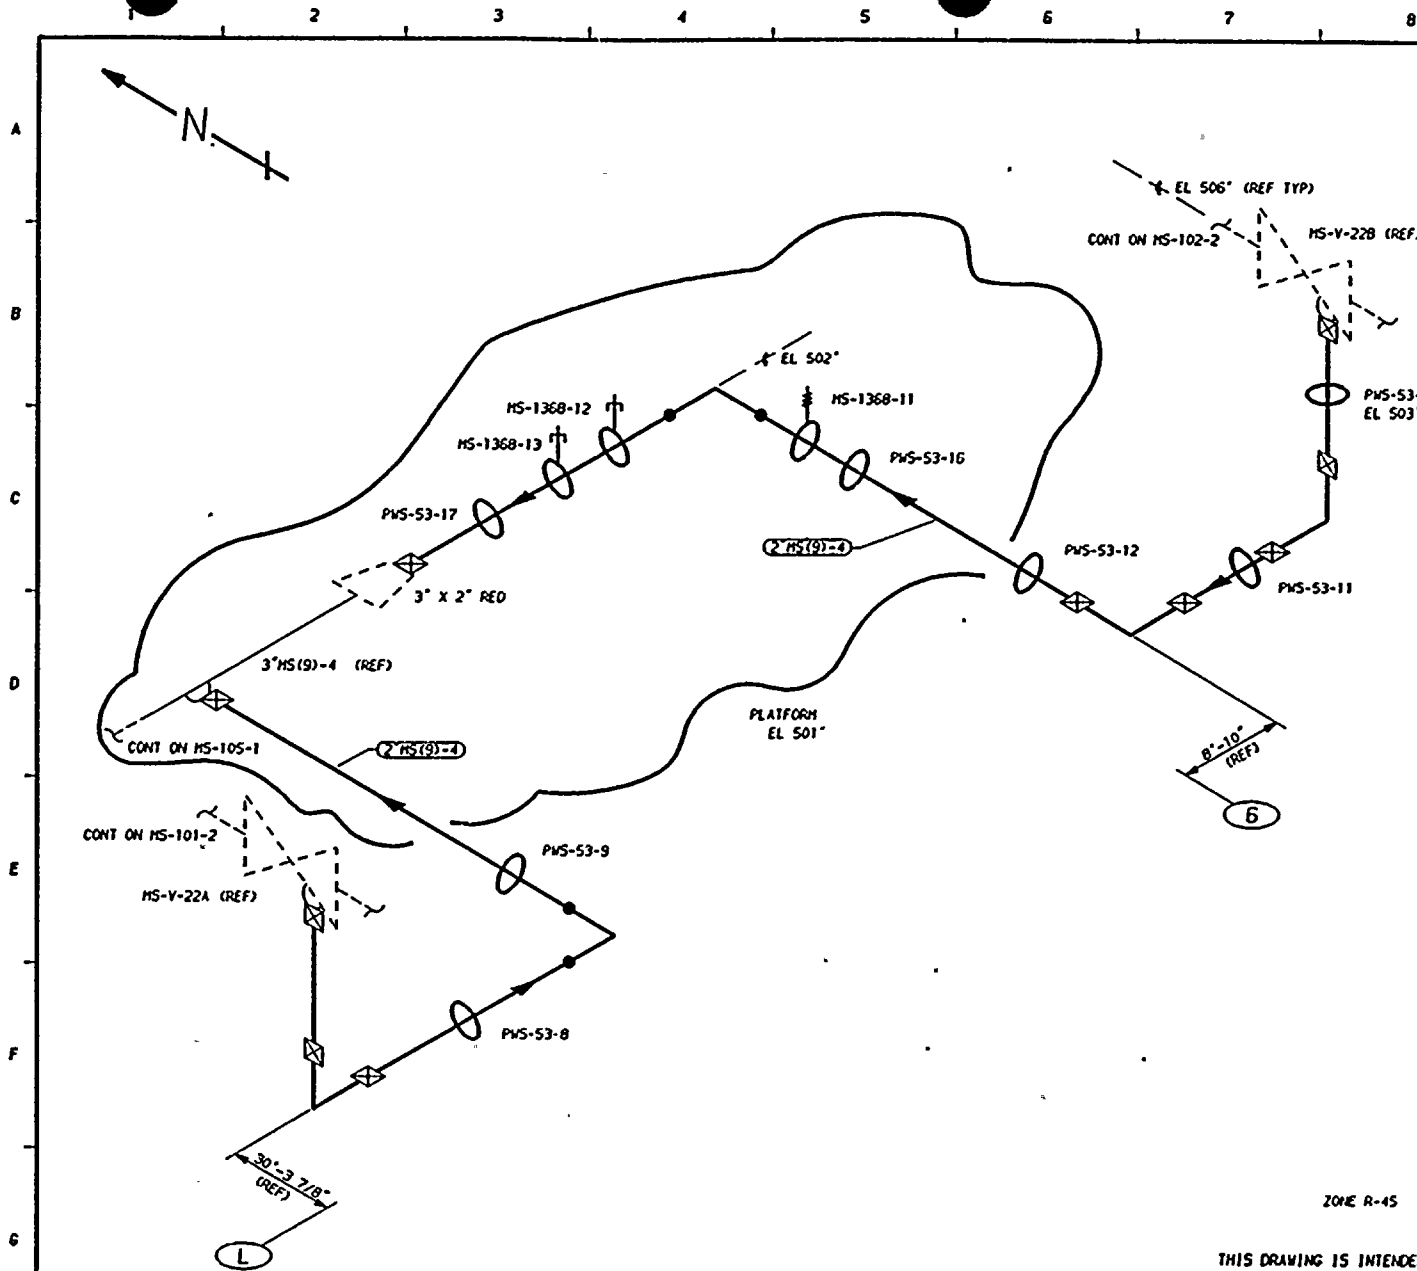


NOTES:

1. THIS DRAWING IDENTIFIES PIPING AND COMPONENTS SUBJECT TO A VISUAL EXAM FOR EVIDENCE OF LEAKAGE DURING SYSTEM HYDRO OR OPERABILITY TESTS. TESTS ARE TO BE CONDUCTED PER THE REQUIREMENTS OF ASME SECTION XI, PARAGRAPH IWA-5000.

REFERENCES:

151 - 229
 BOYEE & CRAIG ISOMETRICS
 MS-1367-1 REV 9
 MS-1368-1 REV 7

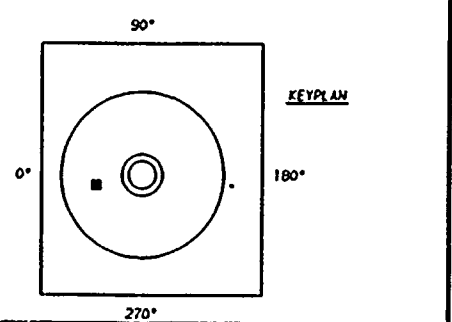

QUALITY CLASS, 1	ASME CODE CLASS, 1
ENGR, D TIMMINS	DATE, 4-11-78

WASHINGTON PUBLIC POWER
 SUPPLY SYSTEM
 RICHLAND, WASHINGTON 99352

WNP-2
 WELD & COMPONENT
 IDENTIFICATION DIAGRAM

TITLE:
 MAIN STEAM VALVE DRAINS

DWG NO, MS-105-2 REV 2


THIS DRAWING IS INTENDED FOR USE IN PRESERVICE AND INSERVICE INSPECTIONS PROGRAMS ONLY.

ZONE R-45

PIPING SYSTEM	NOM DIA (INO)	SCH	NOM WALL THK	MATERIAL SPECIFICATION	MATL TYPE	CAL BLOCK NO
2"MS(9)-4	2	160	0.344	SA 106 GR B	CS	NA


NO	DATE	REVISION	BY	CHKD	APVD
1	11-2-83	GENERAL UP-DATE REDRAWN	K-MCA	DPR	TFH
1	12-2-81	REVISED AS NOTED	K-MCA	DPR	TFH
0	12-22-78	ISSUED FOR USE (REDRAWN)	K-MCA	TFH	LFB
A	5-18-78	ISSUED FOR INFORMATION ONLY	K-MCA	TFH	LFB



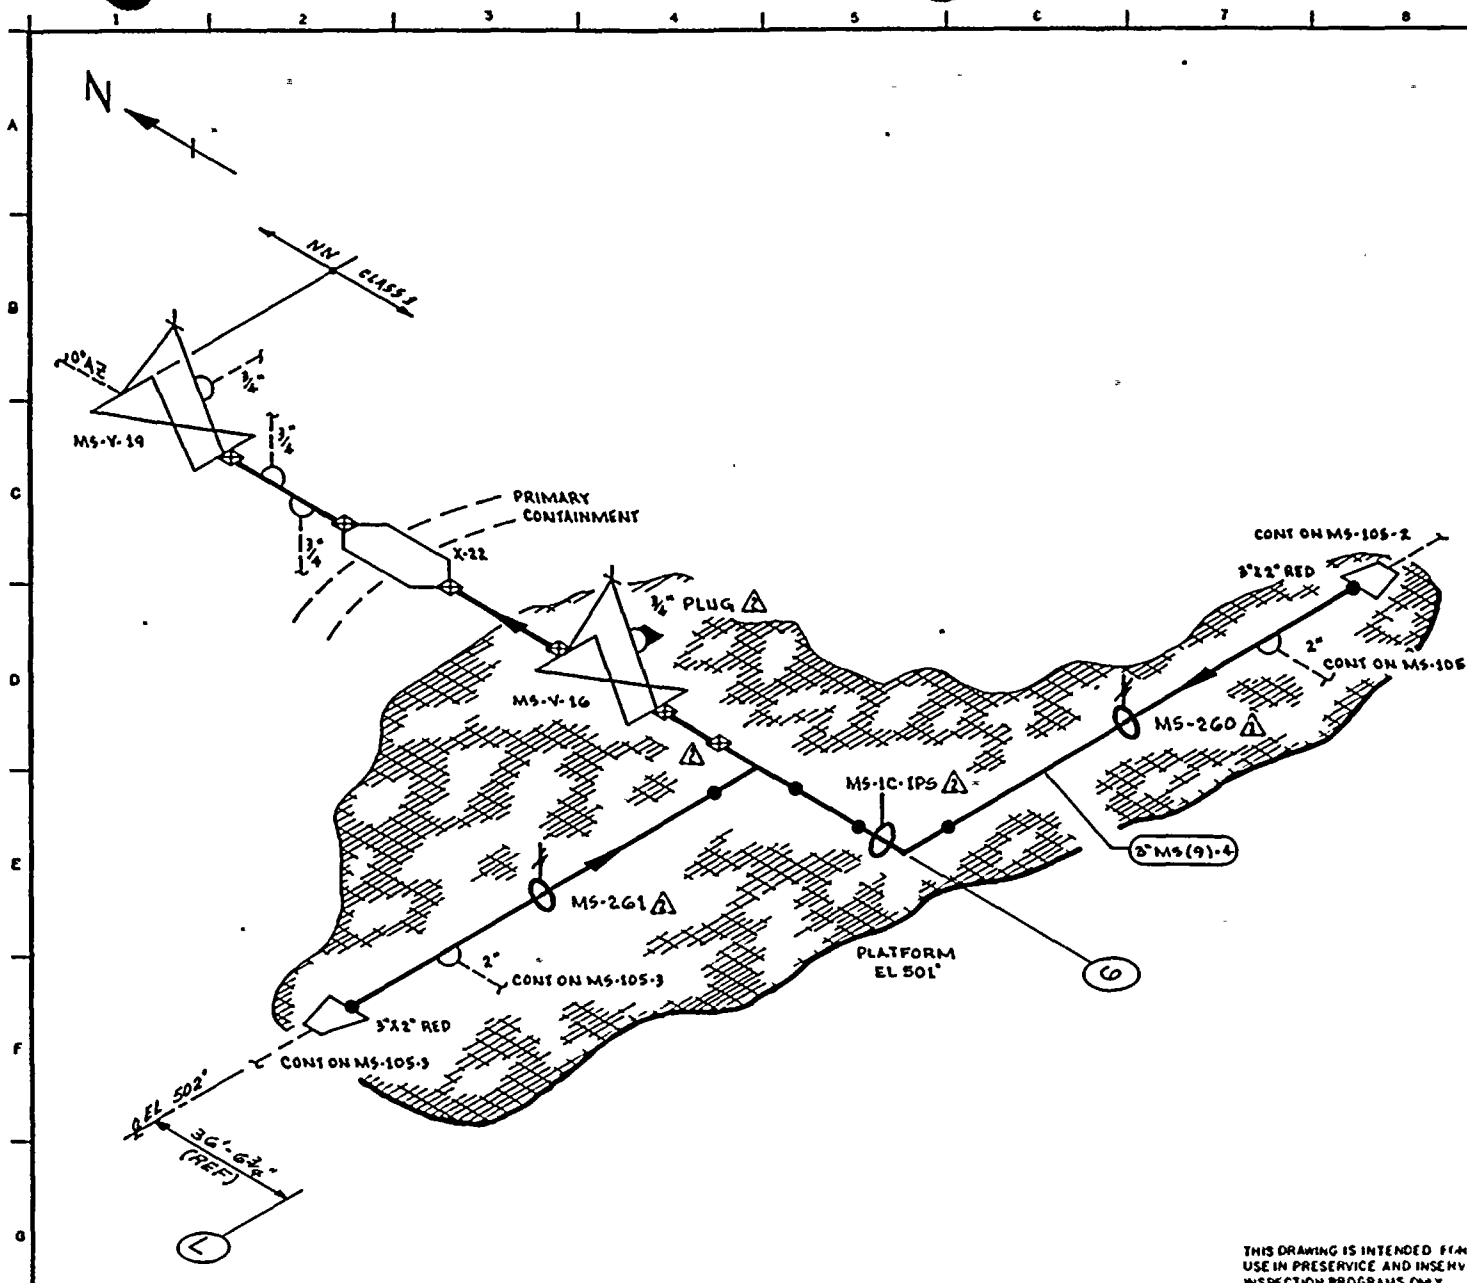

- NOTES:
1. THIS DRAWING IDENTIFIES PIPING & COMPONENTS SUBJECT TO A VISUAL EXAM FOR EVIDENCE OF LEAKAGE DURING SYSTEM HYDRO OR OPERABILITY TESTS. TESTS ARE TO BE CONDUCTED PER THE REQUIREMENTS OF ASME SECTION XI, PARAGRAPH IWA-5000.
 2. FOR BRANCH PIPING (CONN SHOWN IN DASHED LINES) EXTEND VISUAL LEAKAGE EXAM THROUGH THE OUTERMOST NORMALLY CLOSED NUCLEAR CLASS VALVE OR UNTIL TRANSITION TO INSTRUMENT TUBING, UNLESS OTHERWISE NOTED.
 3. AT LOCATIONS WHERE LEAKAGE IS NORMALLY EXPECTED (E.G. VALVE STEM & PUMP SEAL LEAKOFF CONNECTIONS) VERIFY LEAKAGE COLLECTION SYSTEM OPERABILITY ONLY. NO HYDRO TEST OF COLLECTION SYSTEM IS REQUIRED.

REFERENCES:
 BOVEE & CRAIG ISOMETRICS
 MS-582-12 REV 7
 MS-582-24 REV 11

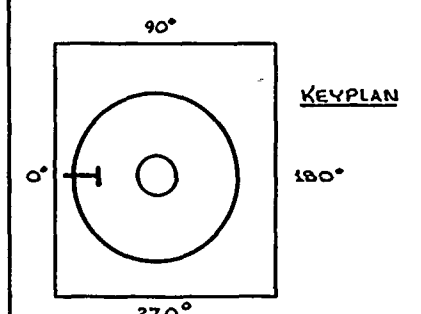

QUALITY CLASS: 1 ASME CODE CLASS: 1
 ENGR D TILAMINS DRAWN: V.M.C.A. DATE: 4-10-78

WASHINGTON PUBLIC POWER SUPPLY SYSTEM
 RICHMOND WASHINGTON 98352

THIS DRAWING IS INTENDED FOR USE IN PRESERVICE AND INSERVICE INSPECTION PROGRAMS ONLY.


PIPING SYSTEM	NOM DIA (IN)	SCH	NOM WALL THK	MATERIAL SPECIFICATION	MATL TYPE	CAL BLOCK NO
3" MS(91-4)	3	160	0.438	SA 106 GR B	CS	NA

NO	DATE	REVISION	BY	CHKD	APPVD
2	12-2-83	REVISED AS NOTED ADDED KEYPLAN	V.M.C.A.	WZ	T.P.H.
1	12-1-81	REVISED AS NOTED	V.M.C.A.	WZ	T.P.H.
0	11-18-78	ISSUED FOR USE (REDRAWN)	V.M.C.A.	WZ	T.P.H.
A	5-18-78	ISSUED FOR INFORMATION ONLY	V.M.C.A.	WZ	T.P.H.

WNP-2
 WELD 8 COMPONENT
 IDENTIFICATION DIAGRAM


TITLE:
MAIN STEAM VALVE DRAINS

DWG NO: MS-105-1 REV 2

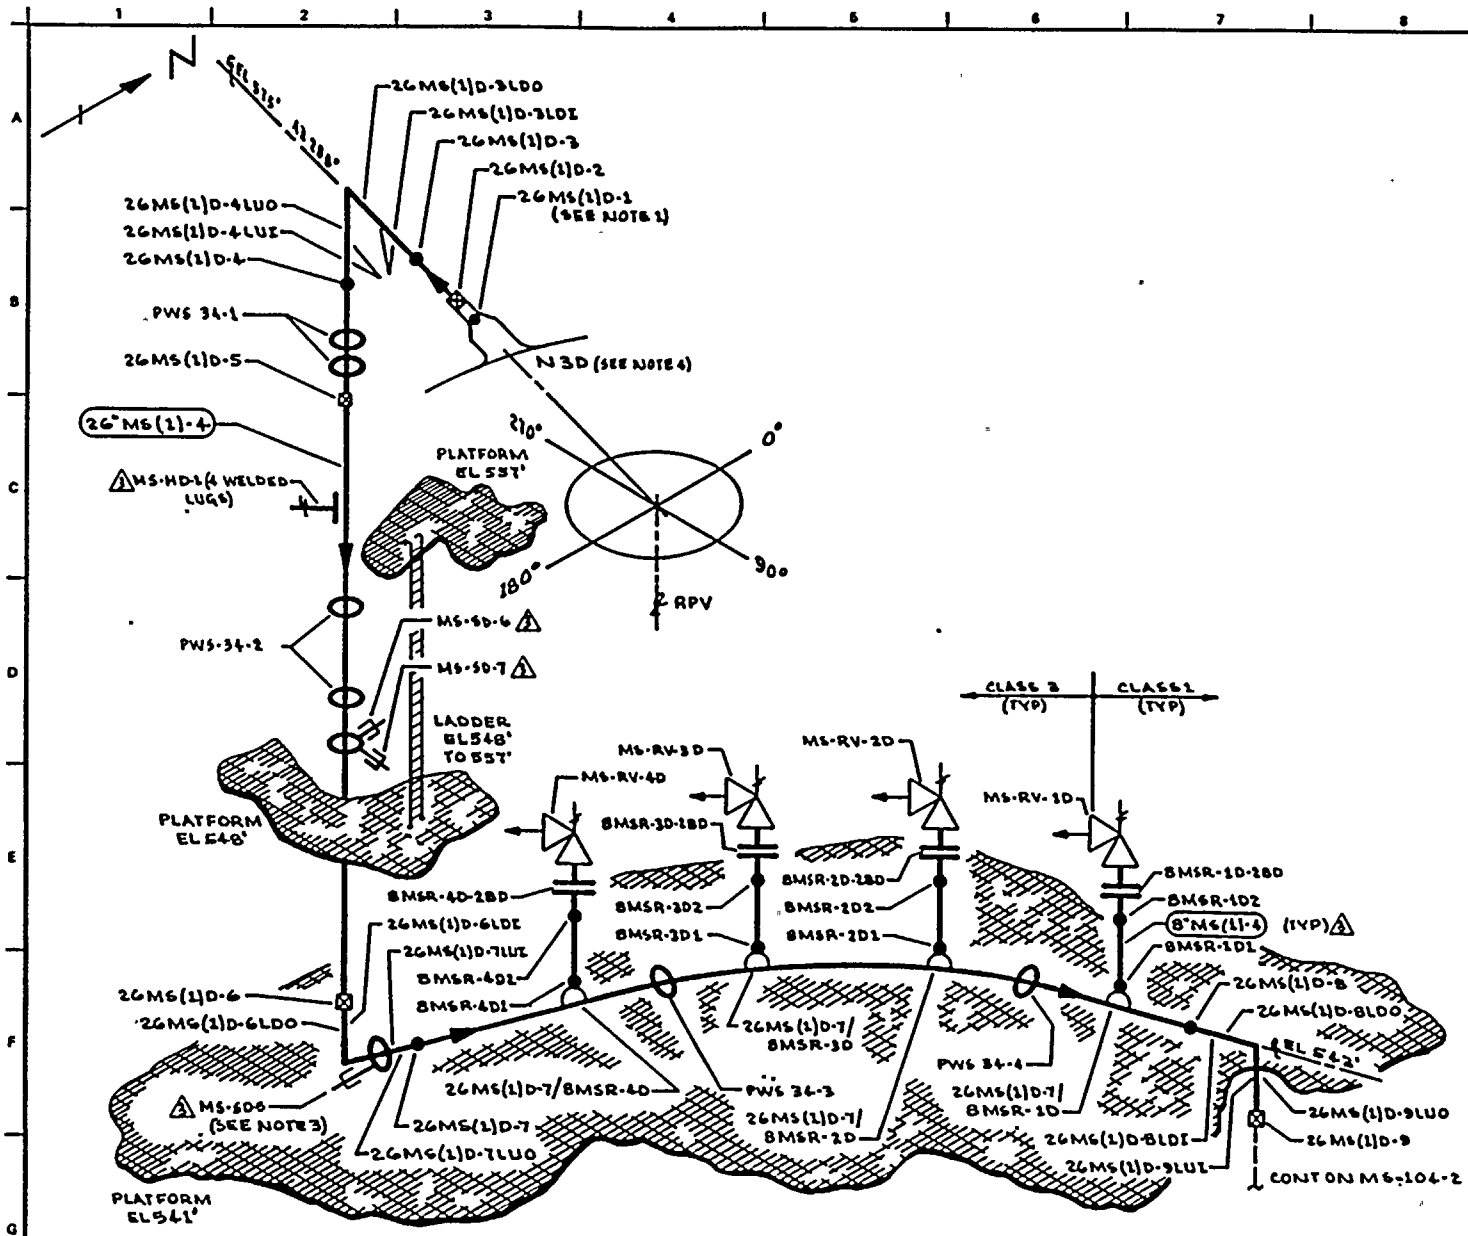

- NOTES:**
1. WELD 26MS(1)D-1 UTILIZES CAL BLOCK UT-104.
 2. ACCESS TO WELDS 26MS(1)D-1 THRU 26MS(1)D-5 REQUIRES TEMPORARY SCAFFOLDING.
 3. ACCESS TO WELD 26MS(1)D-7 REQUIRES REMOVAL OF 26MS(1)D-6PR.
 4. FOR NOZZLE ASSEMBLY DETAILS SEE RPV-107.

- REFERENCES:**
- GENERAL ELECTRIC DRAWINGS
- | | |
|------------|------------|
| 761 E 992 | 131 C 8048 |
| 131 C 7734 | 131 C 8030 |
| 131 C 8403 | 131 C 8031 |
| 131 C 8501 | |
- CEI NUCLEAR CO
 85, REV B, N3-NOZZLE
 BOVEE CRAIG/GERT
 BC/G-214 REV G

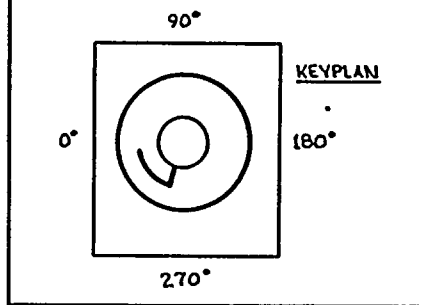

QUALITY CLASS: 1 ASME CODE CLASS: 1
 ENGR'D TIMMINE DRAWN: WJA/A DATE: 1-19-78

WASHINGTON PUBLIC POWER SUPPLY SYSTEM
 RICHLAND, WASHINGTON 98842

THIS DRAWING IS INTENDED FOR USE IN PRESERVE AND INSERVICE INSPECTION PROGRAMS ONLY.


NO	DATE	REVISION	BY	CHKD	APPVD	PIPING SYSTEM	NOM DIA (IN)	SCH	NOM WALL THK	MATERIAL SPECIFICATION	MATL TYPE	CAL BLOCK NO
3	9-26-78	ADDED UT-4G, LUGS & AS NOTED	WJA	EPK	TRV	26MS(1)-4	26	XXX	1.125	SA 106 GR B	CS	UT-4
2	11-5-80	ADDED NOTE 4. REVISED AS NOTED	WJA	TRV	TRV	8" MS(1)-4	8	160	0.306	SA 106 GR B	CS	UT-24
1	1-10-78	CAL BLOCK REFERENCE CHANGED (FOR 8" PIPING)	WJA	TRV	TRV	LUGS	NA	NA	NA	SA 515 GR 70	CS	UT-4G
0	11-27-78	ISSUED FOR USE	WJA	TRV	TRV							
A	4-21-78	ISSUED FOR INFORMATION ONLY	WJA	TRV	TRV							
NO	DATE	REVISION	BY	CHKD	APPVD							

WNP-2
 WELD & COMPONENT
 IDENTIFICATION DIAGRAM

TITLE:
 MAIN STREAM LINE D

DWG NO: MS-104-1 REV B




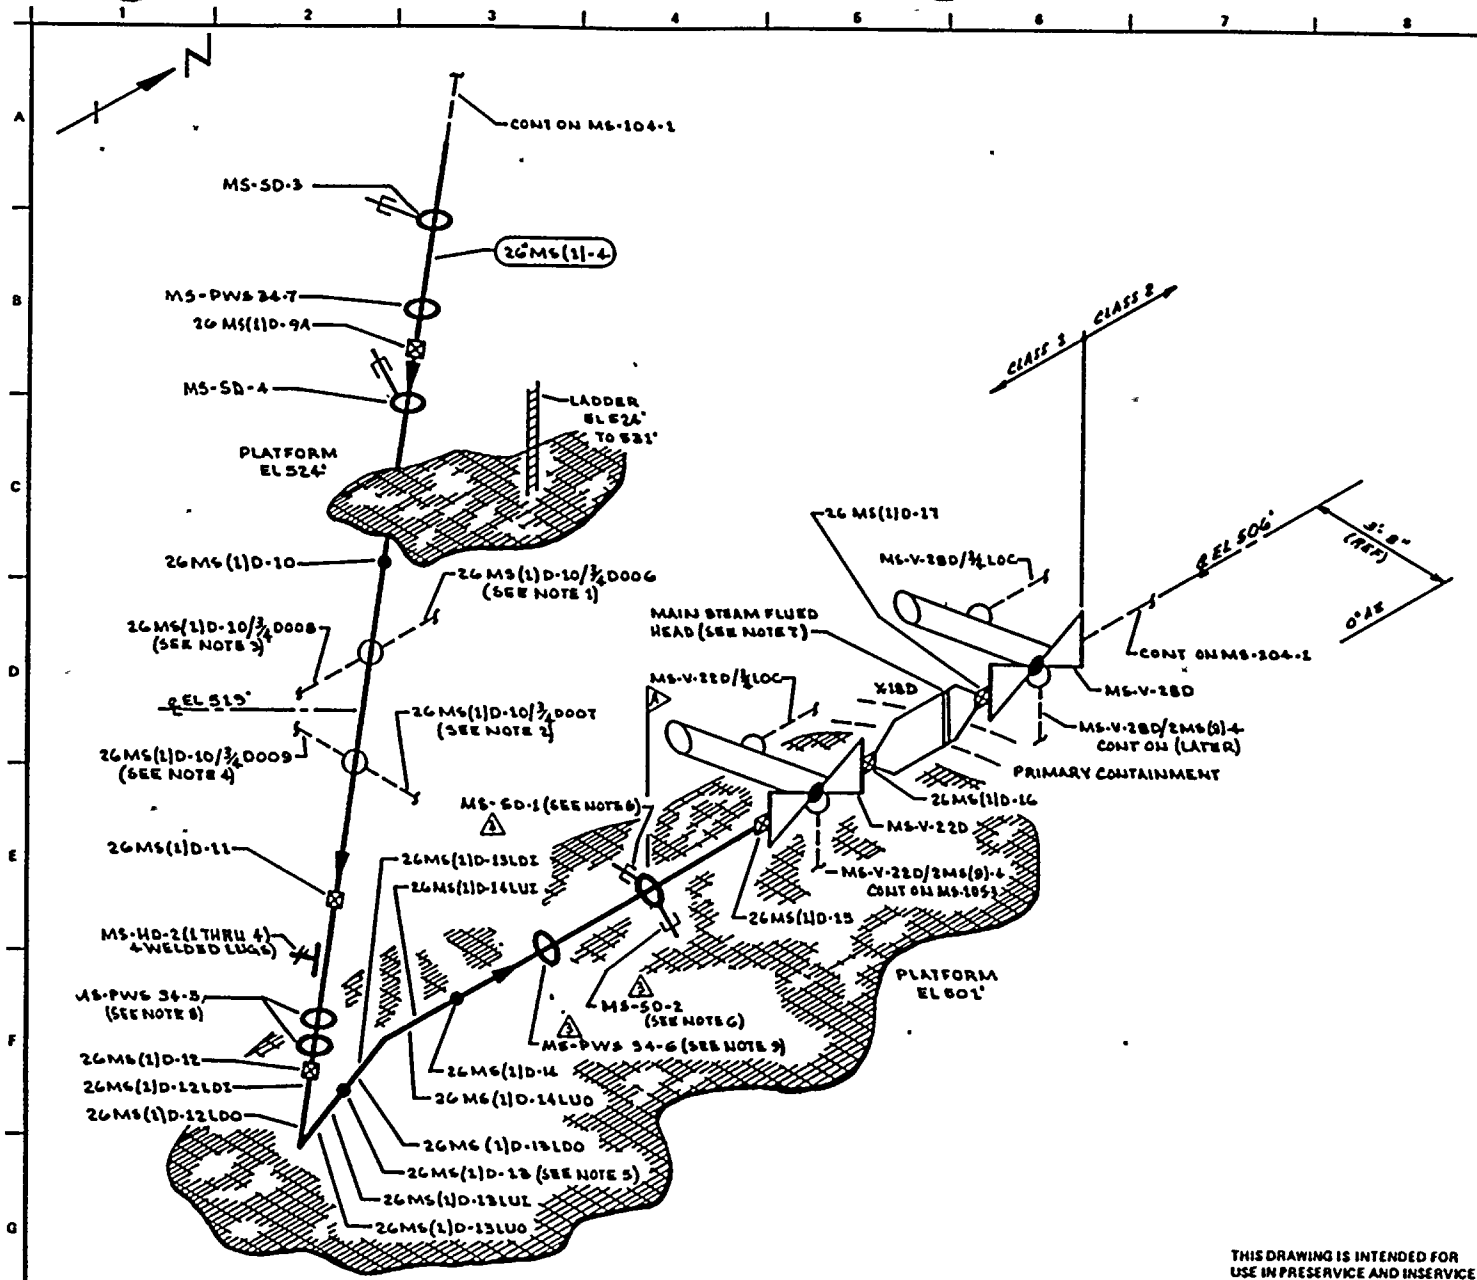

- NOTES:
1. EXTEND LEAKAGE EXAM THROUGH CONTAINMENT (X-41a) THROUGH EXCESS FLOW CHECK VALVE TO INSTRUMENT TUBING CONNECTION.
 2. EXTEND LEAKAGE EXAM THROUGH CONTAINMENT (X-41b) THROUGH EXCESS FLOW CHECK VALVE TO INSTRUMENT TUBING CONNECTION.
 3. EXTEND LEAKAGE EXAM THROUGH CONTAINMENT (X-70c) THROUGH EXCESS FLOW CHECK VALVE TO INSTRUMENT TUBING CONNECTION.
 4. EXTEND LEAKAGE EXAM THROUGH CONTAINMENT (X-70a) THROUGH EXCESS FLOW CHECK VALVE TO INSTRUMENT TUBING CONNECTION.
 5. WELD 26MS(1)D-13 IS FITTING TO FITTING.
 6. ACCESS TO WELD 26MS(1)D-15 REQUIRED REMOVAL OF MS-SD1 & MS-SD2.
 7. FOR EXAM OF MAIN STEAM FLUED HEAD SEE DWG MS-101-3.
 8. ACCESS TO WELD 26MS(1)D-12 IS RESTRICTED BY PWS 24-5.

- REFERENCES:
- GENERAL ELECTRIC DRAWINGS
- | | |
|------------|------------|
| 761 E 992 | 131 C 8048 |
| 131 C 7734 | 131 C 8030 |
| 131 C 8403 | 131 C 8031 |
| 131 C 8501 | |

BOVEE CRAIL/GERI
BC/G-214 REV 6

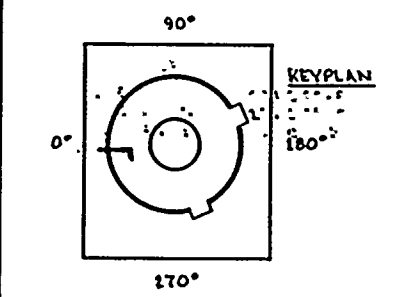

THIS DRAWING IS INTENDED FOR USE IN PRESERVE AND INSERVICE INSPECTION PROGRAMS ONLY.

QUALITY CLASS: 1 ASME CODE CLASS: 1
ENGR: D THIMMING DRAWN: V MCLA DATE: 1-23-76

WASHINGTON PUBLIC POWER SUPPLY SYSTEM
RICHLAND, WASHINGTON 99322

NO	DATE	REVISION	BY	CHKD	APPVD	PIPING SYSTEM	NOM DIA (IN)	SCH	NOM WALL THK	MATERIAL SPECIFICATION	MATL TYPE	CAL BLOCK NO
3	9-26-77	REVISED AS NOTED ADDED KEYPLAN	KML	EPF	JKH	26MS(1)-4	26	XXX	1.125	SA 106 GR B	CS	UT-4
2	12-28-71	REVISED AS NOTED, AUGMENTED IS1 ADDED	KML	2PF	JKH	LUGS	NA	NA	NA	SA 515 GR 70	C6	UT-4G
1	8-30-77	ADDED FIELD WELD 26MS(1)D-9A IN B-2	KML	EPF	JKH							
0	11-27-78	ISSUED FOR USE	KML	EPF	JKH							
A	1-11-78	ISSUED FOR INFORMATION ONLY	KML	DCJ	JKH							
NO	DATE	REVISION	BY	CHKD	APPVD							

WNP-2
WELD & COMPONENT IDENTIFICATION DIAGRAM

TITLE:
MAIN STEAM LINE D

DWG NO: MS-104-2 REV 3

WNP-02
 INTERVAL: PSI
 PERIOD: NA
 OUTAGE:
 DRAWING NO. NS-104

WASHINGTON PUBLIC POWER SUPPLY SYSTEM
 PROGRAM PLAN AND SCHEDULE
 SYSTEM OR COMPONENT: MS(1)-4
 DESCRIPTION: MAIN STEAM LINE D

PAGE 001
 DATE 12/14/84

<u>IDENT. NO.</u>	<u>DESCRIPTION</u>	<u>SECT.</u> <u>XI</u> <u>EXAM</u>	<u>EXAM</u> <u>MTH.</u>	<u>PROCEDURE</u>	<u>CAL.</u> <u>BLOCK</u>	<u>INSERVICE</u> <u>SCHEDULED</u>		<u>NOTES</u>
						<u>REQ.</u>	<u>OUTAGE</u>	
26MS(1)D-1	NZ / TRANSITION	B-J	VOL	UTP-10	UT-104			
			SUR	PTP-1				
26MS(1)D-2	TRANSITION/PIPE	B-J	VOL	UTP-10	UT-4			
			SUR	PTP-1				
26MS(1)D-3	PIPE TO EL	B-J	VOL	UTP-10	UT-4			
			SUR	PTP-1				
26MS(1)D-3LDI	EL SEAM	B-J	VOL	UTP-10	UT-4			
			SUR	PTP-1				
26MS(1)D-3LDO	EL SEAM	B-J	VOL	UTP-10	UT-4			
			SUR	PTP-1				
26MS(1)D-4LUI	EL SEAM	B-J	VOL	UTP-10	UT-4			
			SUR	PTP-1				
26MS(1)D-4LUO	EL SEAM	B-J	VOL	UTP-10	UT-4			
			SUR	PTP-1				
26MS(1)D-4	EL SEAM	B-J	VOL	UTP-10	UT-4			
			SUR	PTP-1				
PWS-34-1	PIPE WHIP	N/A	N/A	N/A				SEE NOTE #1
26MS(1)D-5	PIPE TO SEAM	B-J	VOL	UTP-10	UT-4			

WNP-02
 INTERVAL: PSI
 PERIOD: NA
 OUTAGE:
 DRAWING NO. MS-104

WASHINGTON PUBLIC POWER SUPPLY SYSTEM
 PROGRAM PLAN AND SCHEDULE
 SYSTEM OR COMPONENT: MS(1)-4
 DESCRIPTION: MAIN STEAM LINE D

PAGE 002
 DATE 12/14/84

<u>IDENT. NO.</u>	<u>DESCRIPTION</u>	<u>SECT.</u> <u>XI</u>	<u>EXAM</u> <u>MTH.</u>	<u>PROCEDURE</u>	<u>CAL.</u> <u>BLOCK</u>	<u>INSERVICE</u>		<u>NOTES</u>
						<u>REQ.</u>	<u>SCHEDULED</u> <u>OUTAGE</u>	
			SUR	PTP-1				
MS-HD-1(W)	4 WELDED LUGS	B-K-1	VOL	UTP-26	UT-4			
MS-HD-1	SPRING	B-K-2	VT-3	303/8.2.17				
			VT-4	303/8.2.17				
PWS-34-2	PIPE WHIP	N/A	N/A	N/A				SEE NOTE #1
MS-SD-6	PSA-35 SNUBBER	B-K-2	VT-3	303/8.2.17				S/N 4208
			VT-4	303/8.2.17				S/N 4208
MS-SD-7	PSA-35 SNUBBER	B-K-2	VT-3	303/8.2.17				S/N 4212
			VT-4	303/8.2.17				S/N 4212
26MS(1)D-6	PIPE TO EL	B-J	VOL	UTP-10	UT-4			
			SUR	PTP-1				
26MS(1)D-6LDI	EL SEAM	B-J	VOL	UTP-10	UT-4			
			SUR	PTP-1				
26MS(1)D-6LDO	EL SEAM	B-J	VOL	UTP-10	UT-4			
			SUR	PTP-1				
26MS(1)D-7LUI	EL SEAM	B-J	VOL	UTP-10	UT-4			
			SUR	PTP-1				
26MS(1)D-7LU0	EL SEAM	B-J	VOL	UTP-10	UT-4			

WMP-02
 INTERVAL: PSI
 PERIOD: NA
 OUTAGE:
 DRAWING NO. MS-104

WASHINGTON PUBLIC POWER SUPPLY SYSTEM
 PROGRAM PLAN AND SCHEDULE
 SYSTEM OR COMPONENT: MS(1)-4
 DESCRIPTION: MAIN STEAM LINE D

PAGE 003
 DATE 12/14/84

IDENT. NO.	DESCRIPTION	SECT. XI. EXAM.	EXAM MTH.	PROCEDURE	CAL. BLOCK	INSERVICE		NOTES
						REQ.	SCHEDULED OUTAGE	
MS-SD-5	PSA-35 SNURBER	B-K-2	VT-3	303/8.2.17				S/N 4140
			VT-4	303/8.2.17				S/N 4140
26MS(1)D-7	EL TO PIPE	B-J	VOL	UTP-10	UT-4			
			SUR	PTP-1				
26MS(1)D-7/8MSR-4D	PIPE TO SWL	B-J	VOL	UTP-10	UT-4			
			SUR	PTP-1				
8MSR-4D1	SWL TO PIPE	B-J	VOL	UTP-10	UT-24			
			SUR	PTP-1				
8MSR-4D2	PIPE TO FLANGE	B-J	VOL	UTP-10	UT-24			
			SUR	PTP-1				
8MSR-4D-2BD	FLANGE BOLTING	B-G-2	VT-1	OCI 7-1				
MS-RV-4D-BLT	VALVE BOLTING	B-G-2	VT-1	OCI 7-1				
MS-RV-4D-BDY	VALVE BODY	B-M-2	VT-1	OCI 7-1				
FWS-34-3	PIPE WHIP	N/A	N/A	N/A				SEE NOTE #1
26MS(1)D-7/8MSR-3D	PIPE TO SWL	B-J	VOL	UTP-10	UT-4			
			SUR	PTP-1				
8MSR-3D1	SWL TO PIPE	B-J	VOL	UTP-10	UT-24			

WNP-02
 INTERVAL: PSI
 PERIOD: NA
 OUTAGE:
 DRAWING NO. MS-104

WASHINGTON PUBLIC POWER SUPPLY SYSTEM
 PROGRAM PLAN AND SCHEDULE
 SYSTEM OR COMPONENT: MS(1)-4
 DESCRIPTION: MAIN STEAM LINE D

PAGE 004
 DATE 12/14/84

IDENT. NO.	DESCRIPTION	SECT. XI EXAM.	EXAM. MTH.	PROCEDURE	CAL. BLOCK	INSERVICE		NOTES
						REQ.	SCHEDULED OUTAGE	
8MSR-3D2			SUR	PTP-1				
	SWL TO PIPE	B-J	VOL	UTP-10	UT-24			
8MSR-3D-2BD			SUR	PTP-1				
	FLANGE BOLTING	B-G-2	VT-1	QCI 7-1				
MS-RV-3D-BLT								
	VALVE BOLTING	B-G-2	VT-1	QCI 7-1				
MS-RV-3D-BDY								
	VALVE BODY	B-M-2	VT-1	QCI 7-1				
MS-SD-9								
	PSA-35 SNUBBER	B-K-2	VT-3	303/8.2.17				S/N 4142
			VT-4	303/8.2.17				S/N 4142
MS-SD-10								
	PSA-35 SNUBBER	B-K-2	VT-3	303/8.2.17				S/N 4144
			VT-4	303/8.2.17				S/N 4144
26MS(1)D-7/8MSR-2D								
	PIPE TO SWL	B-J	VOL	UTP-10	UT-4			
			SUR	PTP-1				
8MSR-201								
	SWL TO PIPE	B-J	VOL	UTP-10	UT-24			
			SUR	PTP-1				
8MSR-202								
	PIPE TO FLANGE	B-J	VOL	UTP-10	UT-24			
			SUR	PTP-1				
8MSR-2D-2BD								
	FLANGE BOLTING	B-G-2	VT-1	QCI 7-1				
MS-RV-2D-BLT								
	VALVE BOLTING	B-G-2	VT-1	QCI 7-1				

WNP-02
 INTERVAL: PSI
 PERIOD: NA
 OUTAGE:
 DRAWING NO. MS-104

WASHINGTON PUBLIC POWER SUPPLY SYSTEM
 PROGRAM PLAN AND SCHEDULE
 SYSTEM OR COMPONENT: MS(1)-4
 DESCRIPTION: MAIN STEAM LINE D

PAGE 005
 DATE 12/14/84

IDENT. NO.	DESCRIPTION	SECT. XI EXAM.	EXAM MTH.	PROCEDURE	CAL. BLOCK	INSERVICE		NOTES
						REQ.	SCHEDULED OUTAGE	
MS-RV-2D-BDY	VALVE BODY	B-M-2	VT-1	QCI 7-1				
PWS-34-4	PIPE WHIP	N/A	N/A	N/A				SEE NOTE #1
26MS(1)D-7/8MSR-1D	PIPE TO SWL	B-J	VOL	UTP-10	UT-4			
8MSR-1D1			SUR	PTP-1				
	SWL TO PIPE	B-J	VOL	UTP-10	UT-24			
8MSR-1D2			SUR	PTP-1				
	PIPE TO FLANGE	B-J	VOL	UTP-10	UT-24			
8MSR-1D-2RD			SUR	PTP-1				
	FLANGE BOLTING	B-G-2	VT-1	QCI 7-1				
MS-RV-1D-BLT	VALVE BOLTING	B-G-2	VT-1	QCI 7-1				
MS-RV-1D-BDY	VALVE BODY	B-M-2	VT-1	QCI 7-1				
26MS(1)D-8	PIPE TO EL	B-J	VOL	UTP-10	UT-4			
			SUR	PTP-1				
26MS(1)D-8LDI	EL SEAM	B-J	VOL	UTP-10	UT-4			
			SUR	PTP-1				
26MS(1)D-8LD0	EL SEAM	B-J	VOL	UTP-10	UT-4			
			SUR	PTP-1				
26MS(1)D-9LUI	EL SEAM	B-J	VOL	UTP-10	UT-4			

WNP-02
 INTERVAL: PSI
 PERIOD: NA
 OUTAGE:
 DRAWING NO. MS-104

WASHINGTON PUBLIC POWER SUPPLY SYSTEM
 PROGRAM PLAN AND SCHEDULE
 SYSTEM OR COMPONENT: MS(1)-4
 DESCRIPTION: MAIN STEAM LINE D

PAGE 006
 DATE 12/14/84

IDENT. NO.	DESCRIPTION	SECT. XI EXAM.	EXAM MTH.	PROCEDURE	CAL. PLOCK	INSERVICE		NOTES
						REQ.	SCHEDULED OUTAGE	
26MS(1)D-9LU0	EL SEAM	B-J	VOL	UTP-10	UT-4			
26MS(1)D-9	EL TO PIPE	B-J	VOL	UTP-10	UT-4			
MS-SD-3	PSA-35 SNUBBER	B-K-2	VT-3	303/8.2.17				S/N 4146
PWS-34-7	PIPE WHIP	N/A	N/A	N/A				S/N 4146
26MS(1)D-9A	PIPE TO PIPE	B-J	VOL	UTP-10	UT-4			SEE NOTE #1
MS-SD-4	PSA-35 SNUBBER	B-K-2	VT-3	303/8.2.17				S/N 4148
26MS(1)D-10	PIPE TO PIPE	B-J	VOL	UTP-10	UT-4			S/N 4148
26MS(1)D-10/3/4D006	INSTR CONN	B-P	VT-2	N/A				SEE NOTES #6 & #7.
26MS(1)D-10/3/4D008	INSTR CONN	B-P	VT-2	N/A				SEE NOTES #6 & #7.
26MS(1)D-10/3/4D007	INSTR CONN	B-P	VT-2	N/A				SEE NOTES #6 & #7.

WNP-02
 INTERVAL: PSI
 PERIOD: NA
 OUTAGE:
 DRAWING NO. MS-104

WASHINGTON PUBLIC POWER SUPPLY SYSTEM
 PROGRAM PLAN AND SCHEDULE
 SYSTEM OR COMPONENT: MS(1)-4
 DESCRIPTION: MAIN STEAM LINE D

PAGE 007
 DATE 12/14/84

<u>IDENT. NO.</u>	<u>DESCRIPTION</u>	<u>SECT.</u> <u>XI</u> <u>EXAM.</u>	<u>EXAM</u> <u>MTH.</u>	<u>PROCEDURE</u>	<u>CAL.</u> <u>BLOCK</u>	<u>INSERVICE</u>		<u>NOTES</u>
						<u>REQ.</u>	<u>SCHEDULED</u> <u>OUTAGE</u>	
26MS(1)D-10/3/40009	INSTR CONN	B-P	VT-2	N/A				SEE NOTES #6 & #7.
26MS(1)D-11	PIPE TO PIPE	B-J	VOL	UTR-10	UT-4			
			SUR	PTP-1				
MS-HD-2(Y)	4 WELDED LUGS	B-K-1	VOL	UTP-26	UT-4			
MS-HD-2	SPRING (2)	B-K-2	VT-3	303/R.2.17				
			VT-4	303/R.2.17				
PWS-34-5	PIPE WHIP	N/A	N/A	N/A				SEE NOTE #1
26MS(1)D-12	PIPE TO EL	B-J	VOL	UTP-10	UT-4			
			SUR	PTP-1				
26MS(1)D-12LDI	EL SEAM	B-J	VOL	UTP-10	UT-4			
			SUR	PTP-1				
26MS(1)D-12LDO	EL SEAM	B-J	VOL	UTP-10	UT-4			
			SUR	PTP-1				
26MS(1)D-13LUI	EL SEAM	B-J	VOL	UTP-10	UT-4			
			SUR	PTP-1				
26MS(1)D-13LUO	EL SEAM	B-J	VOL	UTP-10	UT-4			
			SUR	PTP-1				
26MS(1)D-13	EL TO EL	B-J	VOL	UTP-10	UT-4			

WNP-02
 INTERVAL: PSI
 PERIOD: NA
 OUTAGE:
 DRAWING NO. MS-104

WASHINGTON PUBLIC POWER SUPPLY SYSTEM
 PROGRAM PLAN AND SCHEDULE
 SYSTEM OR COMPONENT: MS(1)-4
 DESCRIPTION: MAIN STEAM LINE D

PAGE 008
 DATE 12/14/84

IDENT. NO.	DESCRIPTION	SECT. YI EXAM.	EXAM MTH.	PROCEDURE	CAL. BLOCK	INSERVICE		NOTES
						REQ.	SCHEDULED OUTAGE	
26MS(1)D-13LDI	EL SEAM	B-J	SUR	PTP-1	UT-4			
26MS(1)D-13LDO	EL SEAM	B-J	SUR	PTP-1	UT-4			
26MS(1)D-14LUI	EL SEAM	B-J	SUR	PTP-1	UT-4			
26MS(1)D-14LUO	EL SEAM	B-J	SUR	PTP-1	UT-4			
26MS(1)D-14	EL TO PIPE	B-J	SUR	PTP-1	UT-4			
PWS-34-6	PIPE WHIP	N/A	N/A	N/A				SEE NOTE #1
MS-SD-1	PSA-100 SNUBBER	B-K-2	VT-3	303/8.2.17				S/N 609
MS-SD-2	PSA-100 SNUBBER	B-K-2	VT-4	303/8.2.17				S/N 609
26MS(1)D-15	PIPE TO VALVE	B-J	VT-3	303/8.2.17				S/N 611
			VT-4	303/8.2.17				S/N 611
			SUR	PTP-1	UT-4			AUGMT

WNP-02
 INTERVAL: PSI
 PERIOD: NA
 OUTAGE:
 DRAWING NO. MS-104

WASHINGTON PUBLIC POWER SUPPLY SYSTEM
 PROGRAM PLAN AND SCHEDULE
 SYSTEM OR COMPONENT: MS(1)-4
 DESCRIPTION: MAIN STEAM LINE D

PAGE 009
 DATE 12/14/84

IDENT. NO.	DESCRIPTION	SFCT. XI EXAM. EXAM.	EXAM MTH.	PROCEDURE	CAL. BLOCK	INSERVICE		NOTES
						REQ.	SCHEDULED OUTAGE	
MS-V-22D/2MS(9)-4			SUR	PTP-1				AUGMT
MS-V-22D-BLT	DRAIN CONN	B-J	SUR	PTP-1				
MS-V-22D-BDY	VALVE BOLTING	B-G-2	VT-1	CCI 7-1				
MS-V-22D/3/4CAP	VALVE BODY	B-M-2	VT-1	CCI 7-1				
26MS(1)D-16	LEAKOFF CAPPED	B-P	VT-2	N/A				
	VALVE TO PENE	B-J	VOL	UTP-10	UT-4			AUGMT
			SUR	PTP-1				AUGMT
MS FLUED HEAD D	FLUED HEAD WELD	B-K-1	VOL	UTP-10	UT-40			SEE DWG. #MS-101-3, AUGMT.
			SUR	MTP-1				SEE DWG. #MS-101-3, AUGMT.
26MS(1)D-17	PENE TO PIPE	B-J	VOL	UTP-10	UT-4			AUGMT
			SUR	PTP-1				AUGMT
MS-V-28D/2MS(9)-4	DRAIN CONN	B-J	SUR	PTP-1				AUGMT
MS-V-28D-BLT	VALVE BOLTING	B-G-2	VT-1	CCI 7-1				
MS-V-28D-BDY	VALVE BODY	B-M-2	VT-1	CCI 7-1				
MS-V-28D/3/4CAP	LEAKOFF CAPPED	B-P	VT-2	N/A				
MS-PB-104	MS PRESS BNDRY	B-P	VT-2	N/A				

WNP-02
 INTERVAL: PSI
 PERIOD: NA
 OUTAGE:
 DRAWING NO. MS-103

WASHINGTON PUBLIC POWER SUPPLY SYSTEM
 PROGRAM PLAN AND SCHEDULE
 SYSTEM OR COMPONENT: MS(1)-4
 DESCRIPTION: MAIN STEAM LINE C

PAGE 010
 DATE 12/14/84

IDENT. NO.	DESCRIPTION	SECT. VI EXAM	EXAM MTH.	PROCEDURE	CAL. BLOCK	INSERVICE		NOTES
						REQ.	SCHEDULED OUTAGE	
MS-V-22C-BDY	VALVE BODY	B-M-2	VT-1	GCI 7-1				
MS-V-22C/3/4CAP	LEAKOFF CAPPED	B-P	VT-2	N/A				
26MS(1)C-17	VALVE TO PENE	B-J	VOL	UTP-10	UT-4			AUGMT
MS FLUED HEAD C			SUR	PTP-1				AUGMT
	FLUED HEAD WELD	B-K-1	VOL	UTP-10	UT-40			SEE DWG. #MS-101-3, AUGMT.
26MS(1)C-18			SUR	HTP-1				SEE DWG. #MS-101-3, AUGMT.
	PENE TO VALVE	B-J	VOL	UTP-10	UT-4			AUGMT
MS-V-28C/2MS(9)-4			SUR	PTP-1				AUGMT
	DRAIN CONN	B-J	SUR	PTF-1				AUGMT
MS-V-28C-BLT	VALVE BOLTING	B-G-2	VT-1	GCI 7-1				
MS-V-28C-BDY	VALVE BODY	B-M-2	VT-1	GCI 7-1				
MS-V-28C/3/4CAP	LEAKOFF CAPPED	B-P	VT-2	N/A				
MS-PB-103	MS PRESS BMDRY	B-P	VT-2	N/A				SEE NOTES #6 & #7.

WNP-02
 INTERVAL: PSI
 PERIOD: NA
 OUTAGE:
 DRAWING NO. MS-103

WASHINGTON PUBLIC POWER SUPPLY SYSTEM
 PROGRAM PLAN AND SCHEDULE
 SYSTEM OR COMPONENT: MS(1)-4
 DESCRIPTION: MAIN STEAM LINE C

PAGE 009
 DATE 12/14/84

IDENT. NO.	DESCRIPTION	SECT. XI EXAM.	EXAM MTH.	PROCEDURE	CAL. BLOCK	INSERVICE		NOTES
						REQ.	SCHEDULED OUTAGE	
26MS(1)C-14LD0	EL SEAM	B-J	VOL	UTP-10	UT-4			
26MS(1)C-15LUI	EL SEAM	B-J	VOL	UTP-10	UT-4			
26MS(1)C-15LU0	EL SEAM	B-J	VOL	UTP-10	UT-4			
26MS(1)C-15	EL TO PIPE	B-J	VOL	UTP-10	UT-4			
MS-SC-1	PSA-100 SNUBBER	B-K-2	VT-3	303/8.2.17				S/N 605
MS-SC-2	PSA-100 SNUBBER	B-K-2	VT-3	303/8.2.17				S/N 605
PWS-33-6	PIPE WHIP	N/A	N/A	N/A				SEE NOTE #1
26MS(1)C-16	PIPE TO VALVE	B-J	VOL	UTP-10	UT-4			AUGMT
MS-V-22C/2MS(9)-4	DRAIN CONN	B-J	SUR	PTP-1				AUGMT
MS-V-22C-BLT	VALVE BOLTING	B-G-2	VT-1	QCI 7-1				

WNP-02
 INTERVAL: PSI
 PERIOD: NA
 OUTAGE:
 DRAWING NO. MS-103

WASHINGTON PUBLIC POWER SUPPLY SYSTEM
 PROGRAM PLAN AND SCHEDULE
 SYSTEM OR COMPONENT: MS(1)-4
 DESCRIPTION: MAIN STEAM LINE C

PAGE 008
 DATE 12/14/84

<u>IDENT. NO.</u>	<u>DESCRIPTION</u>	<u>SECT.</u> <u>XI</u> <u>EXAM.</u>	<u>EXAM</u> <u>MTH.</u>	<u>PROCEDURE</u>	<u>CAL.</u> <u>BLOCK</u>	<u>INSERVICE</u>		<u>NOTES</u>
						<u>REQ.</u>	<u>SCHEDULED</u> <u>OUTAGE</u>	
PWS-33-7								
MS-SC-4	PIPE WHIP	N/A	N/A	N/A				SEE NOTE #1
	PSA-35 SNUBBER	B-K-2	VT-3	303/8.2.17				S/N 4154
			VT-4	303/8.2.17				S/N 4154
26MS(1)C-12	PIPE TO PIPE	B-J	VOL	UTP-10	UT-4			
			SUR	PTP-1				
26MS(1)C-12/3/4-D006	INSTR CONN	B-P	VT-2	N/A				SEE NOTES #6 & #7.
26MS(1)C-12/3/4-D008	INSTR CONN	B-P	VT-2	N/A				SEE NOTES #6 & #7.
26MS(1)C-12/3/4-D007	INSTR CONN	B-P	VT-2	N/A				SEE NOTES #6 & #7.
26MS(1)C-12/3/4-D009	INSTR CONN	B-P	VT-2	N/A				SEE NOTES #6 & #7.
26MS(1)C-13	PIPE TO PIPE	B-J	VOL	UTP-10	UT-4			
			SUR	PTP-1				
MS-HC-3(W)	4 WELDED LUGS	B-K-1	VOL	UTP-26	UT-4			
MS-HC-3	SPRING (2)	B-K-2	VT-3	303/8.2.17				
			VT-4	303/8.2.17				
PWS-33-5	PIPE WHIP	N/A	N/A	N/A				SEE NOTE #1
26MS(1)C-14	PIPE TO EL	B-J	VOL	UTP-10	UT-4			
			SUR	PTP-1				
26MS(1)C-14LDI	EL SEAM	B-J	VOL	UTP-10	UT-4			

WMP-02
 INTERVAL: PSI
 PERIOD: NA
 OUTAGE:
 DRAWING NO. MS-103

WASHINGTON PUBLIC POWER SUPPLY SYSTEM
 PROGRAM PLAN AND SCHEDULE
 SYSTEM OR COMPONENT: MS(1)-4
 DESCRIPTION: MAIN STEAM LINE C

PAGE 007
 DATE 12/14/84

<u>IDENT. NO.</u>	<u>DESCRIPTION</u>	SECT. <u>XI</u>	<u>EXAM</u>	<u>PROCEDURE</u>	<u>CAL.</u>	<u>INSERVICE</u>		<u>NOTES</u>
						<u>EXAM.</u>	<u>MTH.</u>	
MS-SC-9	PSA-35 SNUBBER	B-K-2	VT-3	303/8.2.17				S/N 4204
			VT-4	303/8.2.17				S/N 4204
PWS-33-4	PIPE WHIP	N/A	N/A	N/A				SEE NOTE #1
26MS(1)C-10	PIPE TO EL	B-J	VOL	UTP-10	UT-4			
			SUR	PTP-1				
26MS(1)C-10LDI	EL SEAM	B-J	VOL	UTP-10	UT-4			
			SUR	PTP-1				
26MS(1)C-10LDO	EL SEAM	B-J	VOL	UTP-10	UT-4			
			SUR	PTP-1				
26MS(1)C-11LUI	EL SEAM	B-J	VOL	UTP-10	UT-4			
			SUR	PTP-1				
26MS(1)C-11LUO	EL SEAM	B-J	VOL	UTP-10	UT-4			
			SUR	PTP-1				
26MS(1)C-11	EL TO PIPE	B-J	VOL	UTP-10	UT-4			
			SUR	PTP-1				
MS-SC-3	PSA-35 SNUBBER	B-K-2	VT-3	303/8.2.17				S/N 4156
			VT-4	303/8.2.17				S/N 4156

WNP-02
 INTERVAL: PSI
 PERIOD: NA
 OUTAGE:
 DRAWING NO. MS-103

WASHINGTON PUBLIC POWER SUPPLY SYSTEM
 PROGRAM PLAN AND SCHEDULE
 SYSTEM OR COMPONENT: MS(1)-4
 DESCRIPTION: MAIN STEAM LINE C

PAGE 006
 DATE 12/14/84

IDENT. NO.	DESCRIPTION	SECT. XI EXAM.	EXAM MTH.	PROCEDURE	CAL. BLOCK	INSERVICE		NOTES
						REQ.	SCHEDULED OUTAGE	
8MSR-2C1	SWL TO PIPE	B-J	VOL	PTP-1 UTP-10	UT-24			
8MSR-2C2	PIPE TO FLANGE	B-J	VOL	PTP-1 UTP-10	UT-23			
8MSR-2C-2BD	FLANGE, BOLTING	B-G-2	VT-1	PTP-1 OCI 7-1				
MS-RV-2C-BLT	VALVE BOLTING	B-G-2	VT-1	OCI 7-1				
MS-RV-2C-BDY	VALVE BODY	B-M-2	VT-1	OCI 7-1				
26MS(1)C-9/8MSR-1C	PIPE TO SWL	B-J	VOL	PTP-1 UTP-10	UT-4			
8MSR-1C1	SWL TO PIPE	B-J	VOL	PTP-1 UTP-10	UT-4			
8MSR-1C2	PIPE TO FLANGE	B-J	VOL	PTP-1 UTP-10	UT-24			
8MSR-1C-2BD	FLANGE BOLTING	B-G-2	VT-1	PTP-1 OCI 7-1				
MS-RV-1C-BLT	VALVE BOLTING	B-G-2	VT-1	OCI 7-1				
MS-RV-1C-BDY	VALVE BODY	B-M-2	VT-1	OCI 7-1				

WNP-02
 INTERVAL: PSI
 PERIOD: NA
 OUTAGE:
 DRAWING NO. MS-103

WASHINGTON PUBLIC POWER SUPPLY SYSTEM
 PROGRAM PLAN AND SCHEDULE
 SYSTEM OR COMPONENT: MS(1)-4
 DESCRIPTION: MAIN STEAM LINE C

PAGE 905
 DATE 12/14/84

IDENT. NO.	DESCRIPTION	SECT. XI EXAM. EXAM.	EXAM MTH.	PROCEDURE	CAL. BLOCK	INSERVICE		NOTES
						REQ.	SCHEDULED OUTAGE	
			SUR	PTP-1				
8MSR-4C-2BD	FLANGE BOLTING	B-G-2	VT-1	OCI 7-1				
MS-RV-4C-BLT	VALVE BOLTING	B-G-2	VT-1	OCI 7-1				
MS-RV-4C-BDY	VALVE BODY	B-M-2	VT-1	OCI 7-1				
26MS(1)C-9/8MSR-3C	PIPE TO SWL	B-J	VOL	UTP-10	UT-4			
			SUR	PTP-1				
8MSR-3C1	SWL TO PIPE	B-J	VOL	UTP-10	UT-24			
			SUR	PTP-1				
8MSR-3C2	PIPE TO FLANGE	B-J	VOL	UTP-10	UT-24			
			SUR	PTP-1				
8MSR-3C-2BD	FLANGE BOLTING	B-G-2	VT-1	OCI 7-1				
MS-RV-3C-BLT	VALVE BOLTING	B-G-2	VT-1	OCI 7-1				
MS-RV-3C-BDY	VALVE BODY	B-H-2	VT-1	OCI 7-1				
MS-HC-2	SPRING	B-K-2	VT-3	303/8.2.17				
			VT-4	303/8.2.17				
MS-SC-10	PSA-35 SNUBBER	B-K-2	VT-3	303/8.2.17				S/N 4202
			VT-4	303/8.2.17				S/N 4202
26MS(1)C-9/8MSR-2C	PIPE TO SWL	B-J	VOL	UTP-10	UT-4			

WNP-02
 INTERVAL: PSI
 PERIOD: NA
 OUTAGE:
 DRAWING NO. MS-103

WASHINGTON PUBLIC POWER SUPPLY SYSTEM
 PROGRAM PLAN AND SCHEDULE
 SYSTEM OR COMPONENT: MS(1)-4
 DESCRIPTION: MAIN STEAM LINE C

PAGE 004
 DATE 12/14/84

IDENT. NO.	DESCRIPTION	SECT. XI EXAM EXAM.	EXAM MTH.	PROCEDURE	CAL. BLOCK	INSERVICE		NOTES
						REQ.	SCHEDULED OUTAGE	
MS-SC-5	PSA-35 SNUBBER	B-K-2	VT-3	303/P.2.17				S/N 4150
			VT-4	303/P.2.17				S/N 4150
MS-SC-8	PSA-35 SNUBBER	B-K-2	VT-3	303/P.2.17				S/N 4151
			VT-4	303/P.2.17				S/N 4151
26MS(1)C-9/8MSR-5C	PIPE TO SWL	B-J	VOL	UTP-10	UT-4			
			SUR	PTP-1				
8MSR-5C1	SWL TO PIPE	B-J	VOL	UTP-10	UT-24			
			SUR	PTP-1				
8MSR-5C2	PIPE TO FLANGE	B-J	VOL	UTP-10	UT-24			
			SUR	PTP-1				
8MSR-5C-280	FLANGE BOLTING	B-G-2	VT-1	QCI 7-1				
MS-RV-5C-BLT	VALVE BOLTING	B-G-2	VT-1	QCI 7-1				
MS-RV-5C-BDY	VALVE BODY	B-M-2	VT-1	QCI 7-1				
26MS(1)C-9/8MSR-4C	PIPE TO SWL	B-J	VOL	UTP-10	UT-4			
			SUR	PTP-1				
8MSR-4C1	SWL TO PIPE	B-J	VOL	UTP-10	UT-24			
			SUR	PTP-1				
8MSR-4C2	PIPE TO FLANGE	B-J	VOL	UTP-10	UT-24			

WNP-02
 INTERVAL: PSI
 PERIOD: NA
 OUTAGE:
 DRAWING NO. MS-103

WASHINGTON PUBLIC POWER SUPPLY SYSTEM
 PROGRAM PLAN AND SCHEDULE
 SYSTEM OR COMPONENT: MS(1)-4
 DESCRIPTION: MAIN STEAM LINE C

PAGE 063
 DATE 12/14/84

<u>IDENT. NO.</u>	<u>DESCRIPTION</u>	<u>SECT.</u> <u>XI</u>	<u>EXAM</u> <u>EXAM.</u>	<u>PROCEDURE</u>	<u>CAL.</u> <u>BLOCK</u>	<u>INSERVICE</u>		<u>NOTES</u>
						<u>REQ.</u>	<u>SCHEDULED</u> <u>OUTAGE</u>	
26MS(1)C-7LU0	EL SEAM	B-J	VOL	UTP-10	UT-4			
			SUR	PTP-1				
26MS(1)C-7	EL TO PIPE	B-J	VOL	UTP-10	UT-4			
			SUR	PTP-1				
26MS(1)C-8	PIPE TO EL	B-J	VOL	UTP-10	UT-4			
			SUR	PTP-1				
26MS(1)C-8LDI	EL SEAM	B-J	VOL	UTP-10	UT-4			
			SUR	PTP-1				
26MS(1)C-8LDO	EL SEAM	B-J	VOL	UTP-10	UT-4			
			SUR	PTP-1				
26MS(1)C-9LUT	EL SEAM	B-J	VOL	UTP-10	UT-4			
			SUR	PTP-1				
26MS(1)C-9LU0	EL SEAM	B-J	VOL	UTP-10	UT-4			
			SUR	PTP-1				
26MS(1)C-9	EL TO PIPE	B-J	VOL	UTP-10	UT-4			
			SUR	PTP-1				
FWS-33-3	PIPE WHIP	N/A	N/A	N/A				

SEE NOTE #1

WNP-02
 INTERVAL: PSI
 PERIOD: NA
 OUTAGE:
 DRAWING NO. MS-103

WASHINGTON PUBLIC POWER SUPPLY SYSTEM
 PROGRAM PLAN AND SCHEDULE
 SYSTEM OR COMPONENT: MS(1)-4
 DESCRIPTION: MAIN STEAM LINE C

PAGE 002
 DATE 12/14/84


IDENT. NO.	DESCRIPTION	SECT. XI EYAM	EXAM MTH.	PROCEDURE	CAL. BLOCK	INSERVICE		NOTES
						REQ.	SCHEDULED OUTAGE	
			SUR	PTP-1				
MS-HC-1(W)	4 WELDED LUGS	B-K-1	VOL	UTP-26	UT-4			2 1/2"W x 2 1/4"H x 2 1/2"L.
MS-HC-1	SPRING (2)	B-K-2	VT-3	303/8.2.17				
			VT-4	303/8.2.17				
MS-SC-6	PSA-35 SNUBBER	B-K-2	VT-3	303/8.2.17				S/N 4207
			VT-4	303/8.2.17				S/N 4207
MS-SC-7	PSA-35 SNUBBER	B-K-2	VT-3	303/8.2.17				S/N 4211
			VT-4	303/8.2.17				S/N 4211
PWS-33-2	PIPE WHIP	N/A	N/A	N/A				SEE NOTE #1
26MS(1)C-6	PIPE TO EL	B-J	VOL	UTP-10	UT-4			
			SUR	PTP-1				
26MS(1)C-6LDI	EL SEAM	B-J	VOL	UTP-10	UT-4			
			SUR	PTP-1				
26MS(1)C-6LDO	EL SEAM	B-J	VOL	UTP-10	UT-4			
			SUR	PTP-1				
26MS(1)C-7LUI	EL SEAM	B-J	VOL	UTP-10	UT-4			
			SUR	PTP-1				

WNP-02
 INTERVAL: PSI
 PERIOD: NA
 OUTAGE:
 DRAWING NO. MS-103

WASHINGTON PUBLIC POWER SUPPLY SYSTEM
 PROGRAM PLAN AND SCHEDULE
 SYSTEM OR COMPONENT: MS(1)-4
 DESCRIPTION: MAIN STEAM LINE C

PAGE 001
 DATE 12/14/84


IDENT. NO.	DESCRIPTION	SECT. XI EXAM.	EXAM MTH.	PROCEDURE	CAL. BLOCK	INSERVICE		NOTES
						REQ.	SCHEDULED OUTAGE	
26MS(1)C-1	NZ / TRANSITION	B-J	VOL	UTP-10	UT-104			
			SUR	PTP-1				
26MS(1)C-2	TRANSITION/PIPE	B-J	VOL	UTP-10	UT-4			
			SUR	PTP-1				
26MS(1)C-3	PIPE TO EL	B-J	VOL	UTP-10	UT-4			
			SUR	PTP-1				
26MS(1)C-3LDI	EL SEAM	B-J	VOL	UTP-10	UT-4			
			SUR	PTP-1				
26MS(1)C-3LDO	EL SEAM	B-J	VOL	UTP-10	UT-4			
			SUR	PTP-1				
26MS(1)C-4LUI	EL SEAM	B-J	VOL	UTP-10	UT-4			
			SUR	PTP-1				
26MS(1)C-4LUC	EL SEAM	B-J	VOL	UTP-10	UT-4			
			SUR	PTP-1				
26MS(1)C-4	EL TO PIPE	B-J	VOL	UTP-10	UT-4			
			SUR	PTP-1				
PWS-33-1	PIPE WHIP	N/A	N/A	N/A				SEE NOTE #1
26MS(1)C-5	PIPE TO PIPE	B-J	VOL	UTP-10	UT-4			

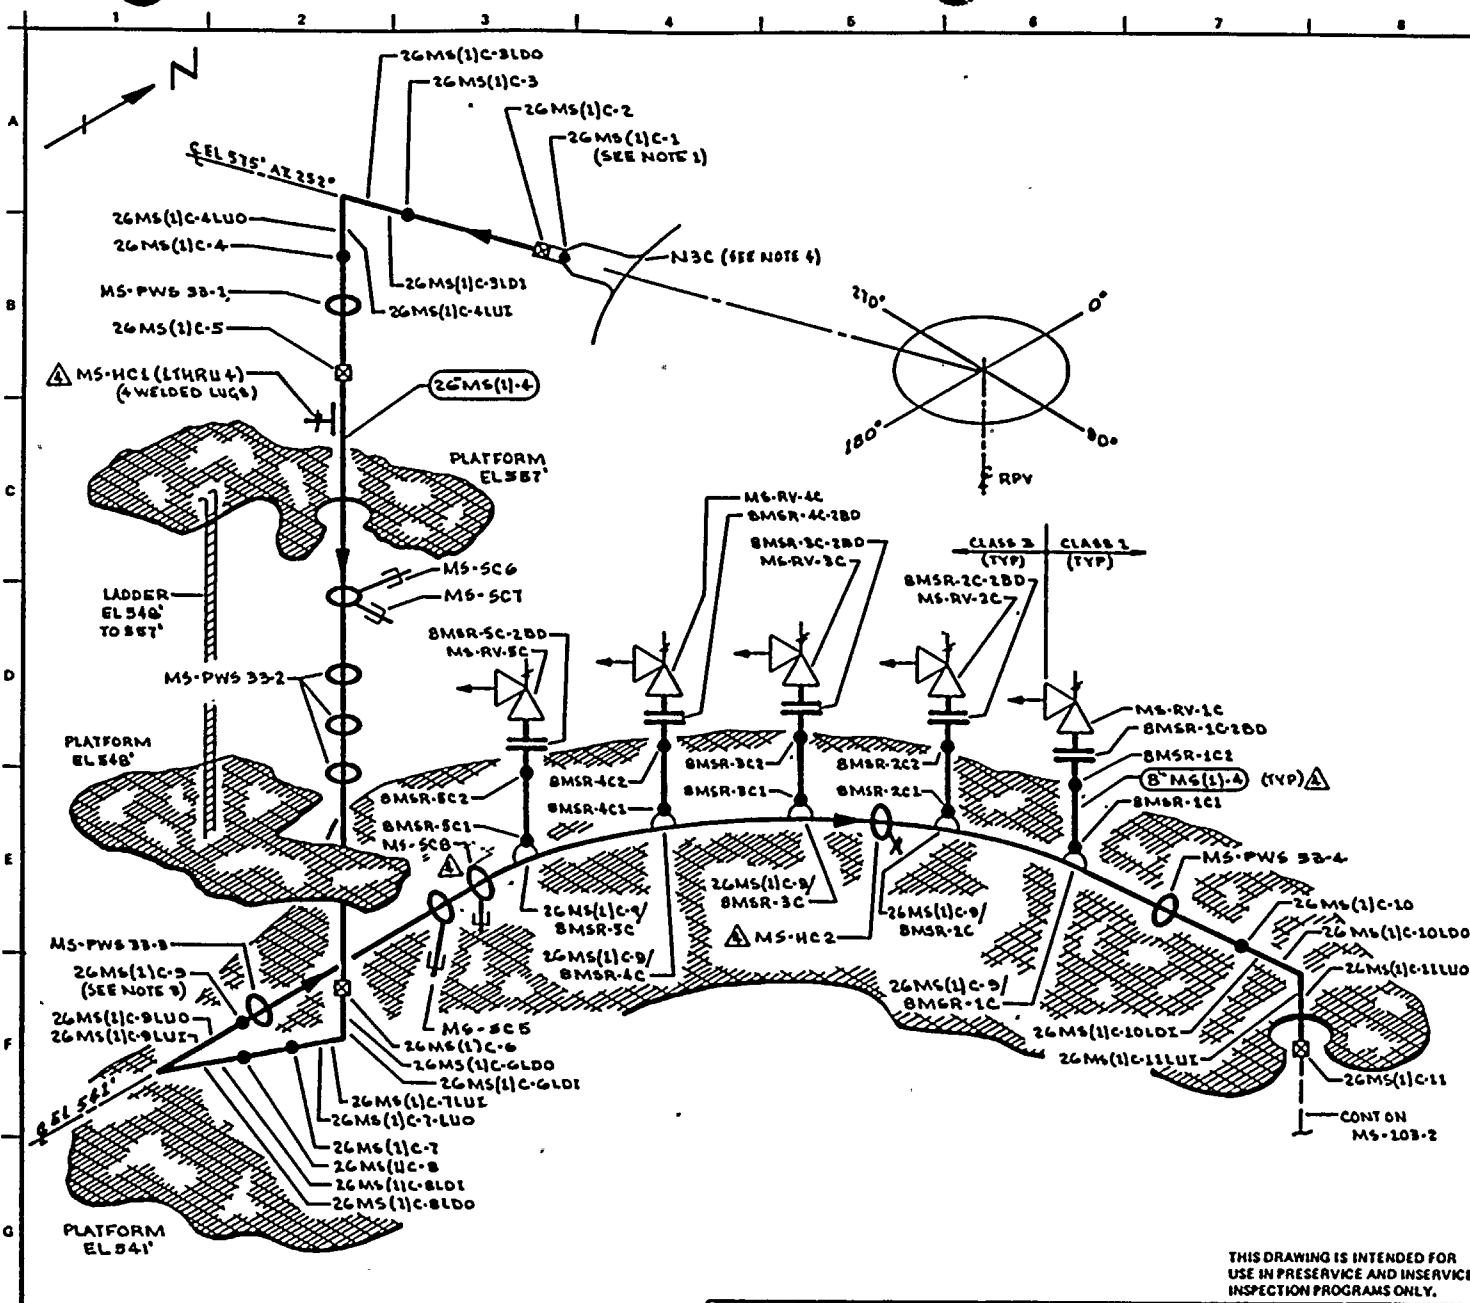

- NOTES:
1. WELD 26MS(1)C-1 UTILIZES CAL BLOCK UT-104.
 2. ACCESS TO WELDS 26MS(1)C-1 THRU 26MS(1)C-5 REQUIRES TEMPORARY SCAFFOLDING.
 3. ACCESS TO WELD 26MS(1)C-9 REQUIRES REMOVAL OF MS-PWS 33-3.
 4. FOR NOZZLE ASSEMBLY DETAILS SEE RPV-107.

- REFERENCES:
- GENERAL ELECTRIC DRAWINGS:
- | | |
|------------|------------|
| 761 E 592 | 131 C 8403 |
| 131 C 7733 | 131 C 8018 |
| 131 C 8047 | 131 C 8019 |
| 131 C 8501 | 131 C 8030 |

CBI NUCLEAR CO.
 85, REV 3, NB NOZZLE
 BOVEE CRAWL / GERS
 BC/Q-213 REV 7

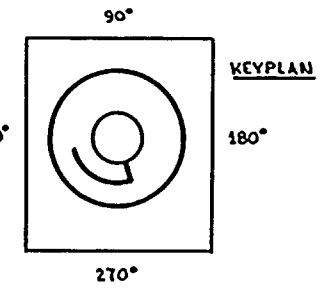

THIS DRAWING IS INTENDED FOR USE IN PRESERVE AND INSERVICE INSPECTION PROGRAMS ONLY.

QUALITY CLASS: 1 ASME CODE CLASS: 1
 ENGR: D TIMMING DRAWN: K MCLA DATE: 1-16-78

WASHINGTON PUBLIC POWER SUPPLY SYSTEM
 RICHMOND, WASHINGTON 98342

NO	DATE	REVISION	BY	CHKD	APPVD
4	9-26-83	REVISED AS NOTED, ADDED KEYPLAN & LUGS	KLA	JWR	TFA
3	11-28-81	REVISED AS NOTED	KLA	JWR	TFA
2	8-30-79	ADDED NOTE 4	KLA	JWR	TFA
1	1-10-78	CAL BLOCK REFERENCE CHANGED (FOR 8" PIPING)	KLA	JWR	TFA
0	11-27-78	ISSUED FOR USE	KLA	JWR	TFA
A	1-11-78	ISSUED FOR INFORMATION ONLY	KLA	JWR	TFA


PIPING SYSTEM	NOM DIA (IN)	SCH	NOM WALL THK	MATERIAL SPECIFICATION	MATL TYPE	CAL BLOCK NO
26MS(1)-4	26	XXX	1.125	SA 106 GR B	CS	UT-4
8"MS(1)-4	8	160	0.306	SA 106 GR B	CS	UT-24
LUGS	NA	NA	NA	SA 516 GR 70	CS	UT-46

WNP-2
 WELD & COMPONENT IDENTIFICATION DIAGRAM

TITLE:
 MAIN STEAM LINE C


DWG NO: MS-102-1 REV 4



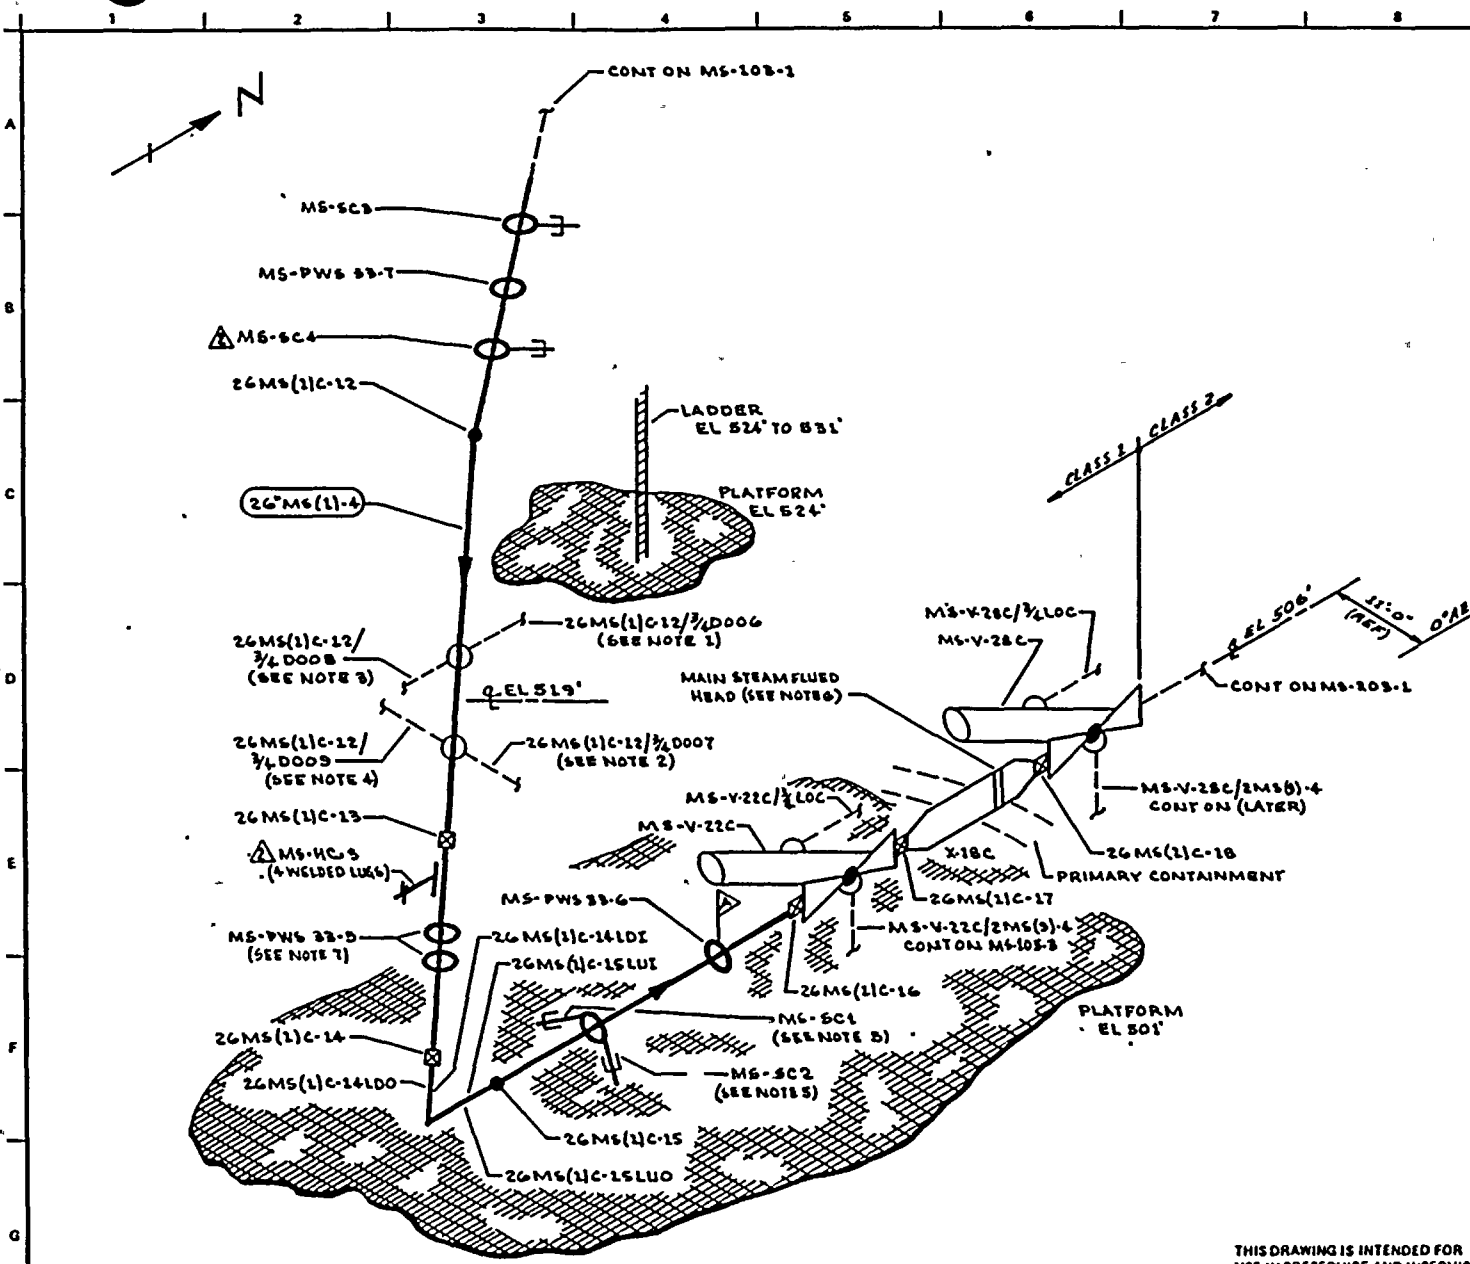

- NOTES:
1. EXTEND LEAKAGE EXAM THROUGH CONTAINMENT (X-71a) THROUGH EXCESS FLOW CHECK VALVE TO INSTRUMENT TUBING CONNECTION.
 2. EXTEND LEAKAGE EXAM THROUGH CONTAINMENT (X-71b) THROUGH EXCESS FLOW CHECK VALVE TO INSTRUMENT TUBING CONNECTION.
 3. EXTEND LEAKAGE EXAM THROUGH CONTAINMENT (X-70a) THROUGH EXCESS FLOW CHECK VALVE TO INSTRUMENT TUBING CONNECTION.
 4. EXTEND LEAKAGE EXAM THROUGH CONTAINMENT (X-70b) THROUGH EXCESS FLOW CHECK VALVE TO INSTRUMENT TUBING CONNECTION.
 5. ACCESS TO WELD 26MS(1)C-12 REQUIRES REMOVAL OF MS-SC1 & MS-SC2.
 6. FOREXAM OF MAIN STEAM FLUED HEAD SEE DWG MS-101-B.
 7. ACCESS TO WELD 26MS(1)C-14 IS RESTRICTED BY PWS 33-D.

- REFERENCES:
- GENERAL ELECTRIC DRAWINGS
- | | |
|------------|------------|
| 761 E 992 | 131 C 8403 |
| 131 C 7733 | 131 C 8028 |
| 131 C 8047 | 131 C 8029 |
| 131 C 8501 | 131 C 8030 |
- BOVEE CRAIL/GERI
BC/G-213 REV 7

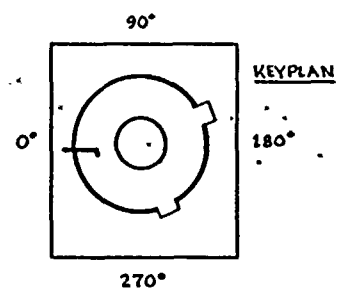

THIS DRAWING IS INTENDED FOR USE IN PRESERVE AND INSERVICE INSPECTION PROGRAMS ONLY.

QUALITY CLASS: 1	ASME CODE CLASS: 1
ENGR: D TIMMINS	DRAWN: MCA DATE: 1-19-75

WASHINGTON PUBLIC POWER SUPPLY SYSTEM
RICHLAND, WASHINGTON 98822


WNP-2
WELD & COMPONENT IDENTIFICATION DIAGRAM

TITLE:
MAIN STEAM LINE C


DWG NO: MS-103-2 REV 2

PIPING SYSTEM	NOM DIA (IN)	SCH	NOM WALL THK	MATERIAL SPECIFICATION	MATL TYPE	CAL BLOCK NO
26MS(1)-4	26	XX	1.125	SA 106 GR B	CS	UT-4
LUGS	NA	NA	NA	SA 516 GR 70	CS	UT-46


NO	DATE	REVISION	BY	CHKD	APPVD
2	9-26-85	REVISED AS NOTED ADDED KEYPLAN & LUGS	K/A	WR	TRP
1	12-2-81	REVISED AS NOTED, AUGMENTED ISI ADDED	K/A	WR	TRP
0	11-27-75	ISSUED FOR USE	K/A	WR	TRP
A	4-11-76	ISSUED FOR INFORMATION ONLY	K/A	DCJ	WRP

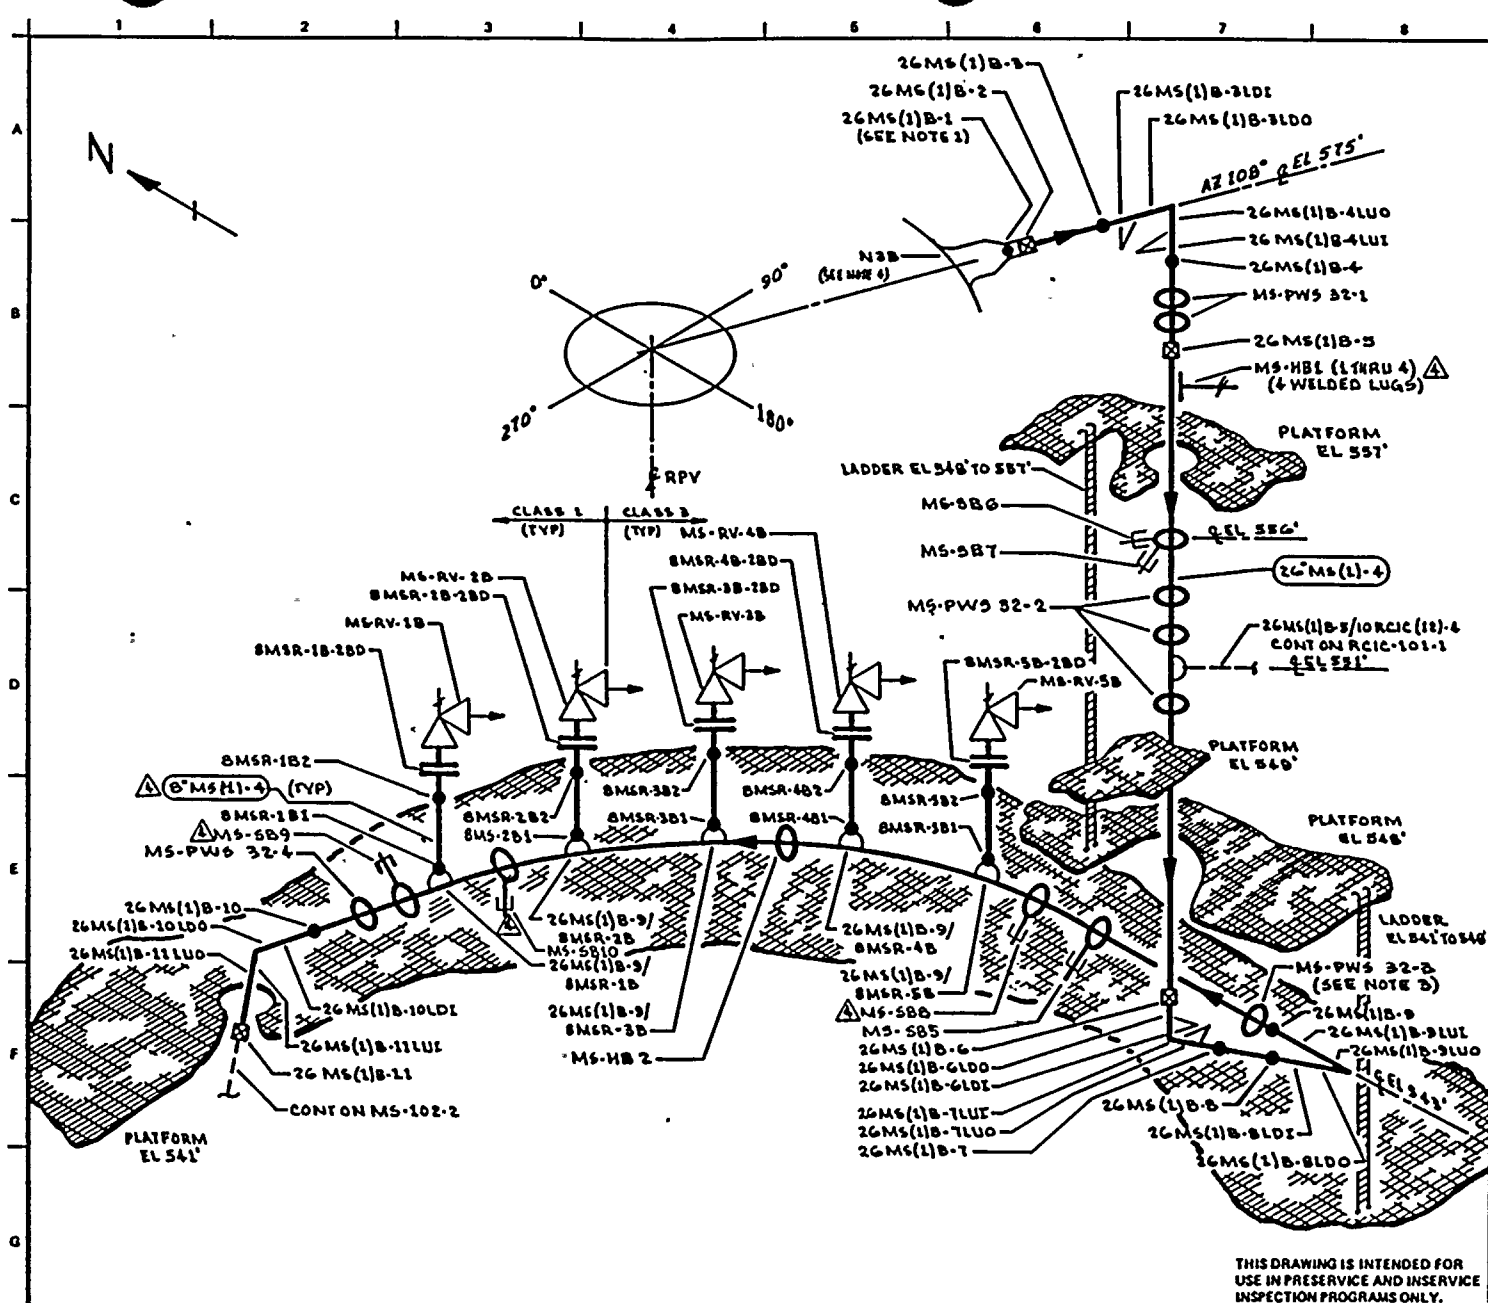

- REFERENCES:
- GENERAL ELECTRIC DRAWINGS:
- | | |
|------------|------------|
| 761 E 992 | 131 C 8028 |
| 131 C 7732 | 131C 8029 |
| 131 C 8403 | 131C 8030 |
| 131 C 8501 | 131 C 8047 |
- CBI NUCLEAR CO.
53, REV 3, N3 NOZZLE
- BOVEE CRAIL/GERI
BC/G-212 REV 6

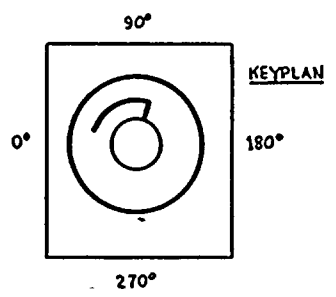

THIS DRAWING IS INTENDED FOR USE IN PRESERVICE AND INSERVICE INSPECTION PROGRAMS ONLY.

QUALITY CLASS: 1	ASME CODE CLASS: 1
ENGR: B TIMMINS	DATE: 1-16-78
 WASHINGTON PUBLIC POWER SUPPLY SYSTEM RICHLAND, WASHINGTON 99352	

NO	DATE	REVISION	BY	CHKD	APPVD
4	9-27-83	ADDED UT-46 LUGS AS NOTED. ADDED KEYPLAN	KMA	DR	TJK
3	12-81	REVISED AS NOTED	KMA	DR	TJK
2	8-30-79	ADDED NOTE 4.	KMA	DR	TJK
1	1-18-78	CAL BLOCK REFERENCE CHANGED (FOR 0° PIPING)	KMA	DR	TJK
0	11-27-78	ISSUED FOR USE	KMA	DR	TJK
A	4-21-78	ISSUED FOR INFORMATION ONLY	KMA	DR	TJK
ISSUED FOR INFORMATION ONLY					
NO	DATE	REVISION	BY	CHKD	APPVD


PIPING SYSTEM	NOM DIA (IN)	SCH	NOM WALL THK	MATERIAL SPECIFICATION	MATL TYPE	CAL BLOCK NO
26MS(1)-4	26	XXX	1.125	SA 106 GR B	C6	UT-4
8"MS(1)-4	8	160	0.906	SA 106 GR B	C6	UT-24
LUGS	N/A	N/A	N/A	SA 515 GR 70	C5	UT-46

WNP-2
WELD & COMPONENT
IDENTIFICATION DIAGRAM

TITLE:
MAIN STEAM LINE B

DWG NO: MS-102-1

REV 4

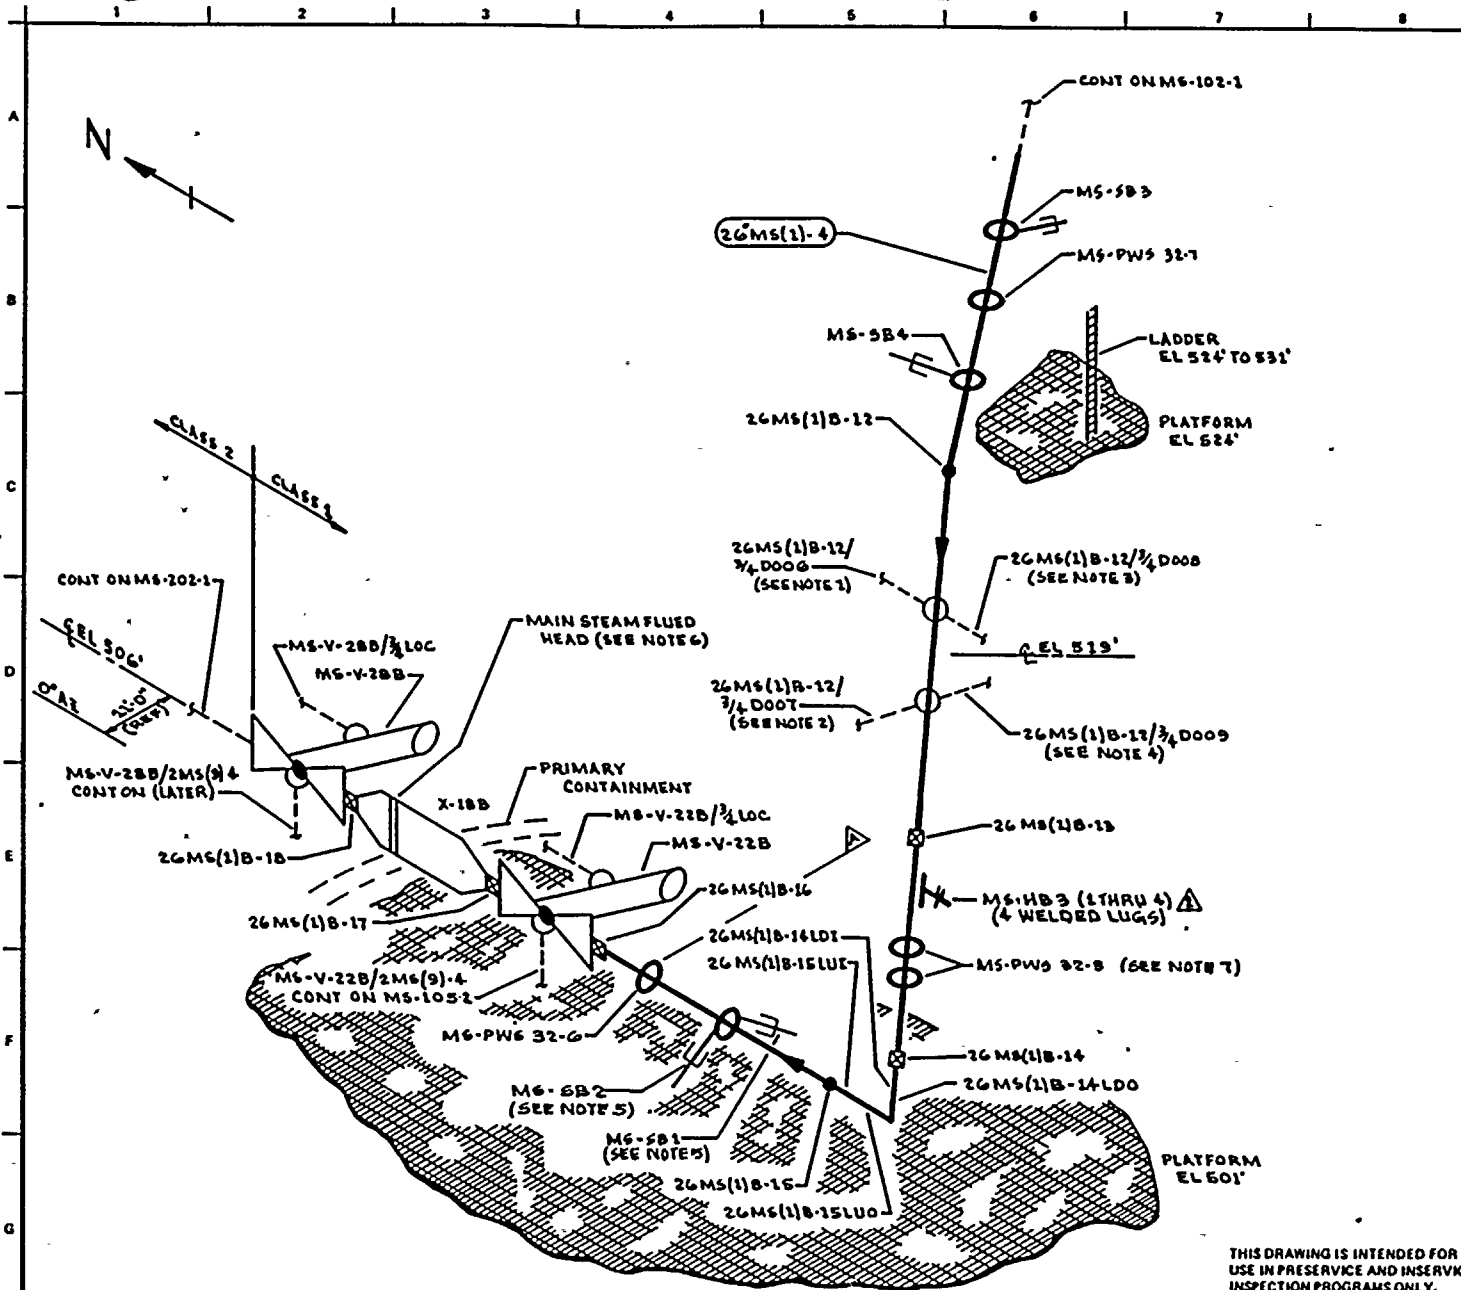


- NOTES:
1. EXTEND LEAKAGE EXAM THROUGH CONTAINMENT (X-29a) THROUGH EXCESS FLOW CHECK VALVE TO INSTRUMENT TUBING CONNECTION.
 2. EXTEND LEAKAGE EXAM THROUGH CONTAINMENT (X-29b) THROUGH EXCESS FLOW CHECK VALVE TO INSTRUMENT TUBING CONNECTION.
 3. EXTEND LEAKAGE EXAM THROUGH CONTAINMENT (88a) THROUGH EXCESS FLOW CHECK VALVE TO INSTRUMENT TUBING CONNECTION.
 4. EXTEND LEAKAGE EXAM THROUGH CONTAINMENT (X-38b) THROUGH EXCESS FLOW CHECK VALVE TO INSTRUMENT TUBING CONNECTION.
 5. ACCESS TO WELD 26MS(1)B-15 REQUIRES REMOVAL OF COLLAR FOR MS-SB1 & MS-SB2.
 6. FOR EXAM OF MAIN STEAM FLUED HEAD SEE DWG MS-101-2.
 7. ACCESS TO WELD 26MS(1)B-14 IS RESTRICTED BY PWS 32-5.

REFERENCES:

GENERAL ELECTRIC DRAWINGS

161 E 992	131 C 8403
131 C 7752	131 C 8028
131 C 8047	131 C 8029
131 C 8501	131 C 8030

BOVEE CRAIL/CERI
BC/G-212 REV 6

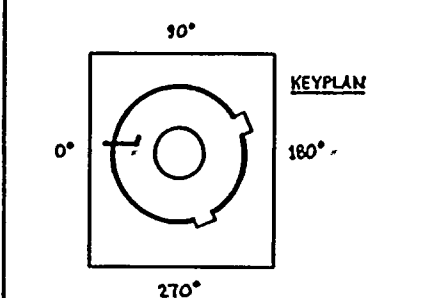

THIS DRAWING IS INTENDED FOR USE IN PRESERVE AND INSERVICE INSPECTION PROGRAMS ONLY.

QUALITY CLASS: 1 ASME CODE CLASS: 1
ENGR: D TIMMING DRAWN: X M/A DATE: 1-17-78

WASHINGTON PUBLIC POWER SUPPLY SYSTEM
RICH AND, WASHINGTON 98362

NO	DATE	REVISION	BY	CHKD	APPVD
2	9-21-77	ADDED UT-4G, LUGS & AS NOTED, & KEYPLAN	K.M.A.	D.C.S.	T.P.H.
1	11-22-77	REVISED AS NOTED, AUGMENTED ISL ADDED	K.M.A.	D.C.S.	T.P.H.
0	11-22-78	ISSUED FOR USE	K.M.A.	D.C.S.	T.P.H.
A	4-11-78	ISSUED FOR INFORMATION ONLY	K.M.A.	D.C.S.	T.P.H.

PIPING SYSTEM	NOM DIA (IN)	SCH	NOM WALL THK	MATERIAL SPECIFICATION	MATL TYPE	CAL BLOCK NO
26MS(1)-4	26	XXX	1.125	SA 106 GR B	CS	UT-4
LUGS	NA	NA	NA	SA 515 GR 70	CS	UT-4G

WNP-2
WELD & COMPONENT IDENTIFICATION DIAGRAM

TITLE:
MAIN STEAM LINE B

DWG NO: MS-102-2 REV 2



WNF-02
 INTERVAL: PSI
 PERIOD: NA
 OUTAGE:
 DRAWING NO: MS-102

WASHINGTON PUBLIC POWER SUPPLY SYSTEM
 PROGRAM PLAN AND SCHEDULE
 SYSTEM OR COMPONENT: MS(1)-4
 DESCRIPTION: MAIN STEAM LINE B

PAGE 001
 DATE 12/14/84

<u>IDENT. NO.</u>	<u>DESCRIPTION</u>	<u>SECT.</u> <u>VI</u> <u>EXAM.</u>	<u>EXAM</u> <u>MTM.</u>	<u>PROCEDURE</u>	<u>CAL.</u> <u>BLOCK</u>	<u>INSERVICE</u> <u>SCHEDULED</u>		<u>NOTES</u>
						<u>REQ.</u>	<u>OUTAGE</u>	
26MS(1)B-1	NZ/TRANSITION	B-J	VOL	UTP-10	UT-104			
			SUR	PTP-1				
26MS(1)B-2	TRANSITION/PIPE	B-J	VOL	UTP-10	UT-4			
			SUR	PTP-1				
26MS(1)B-3	PIPE TO EL	B-J	VOL	UTP-10	UT-4			
			SUR	PTP-1				
26MS(1)B-3LDT	EL SEAM	B-J	VOL	UTP-10	UT-4			
			SUR	PTP-1				
26MS(1)B-3LDG	EL SEAM	B-J	VOL	UTP-10	UT-4			
			SUR	PTP-1				
26MS(1)B-4LDT	EL SEAM	B-J	VOL	UTP-10	UT-4			
			SUR	PTP-1				
26MS(1)B-4LU0	EL SEAM	B-J	VOL	UTP-10	UT-4			
			SUR	PTP-1				
26MS(1)B-4	EL TO PIPE	B-J	VOL	UTP-10	UT-4			
			SUR	PTP-1				
PWS-32-1	PIPE WHIP	N/A	N/A	N/A				
26MS(1)B-5	PIPE TO PIPE	B-J	VOL	UTP-10	UT-4			SEE NOTE #1

WNP-02
 INTERVAL: PSI
 PERIOD: NA
 OUTAGE:
 DRAWING NO. MS-102

WASHINGTON PUBLIC POWER SUPPLY SYSTEM
 PROGRAM PLAN AND SCHEDULE
 SYSTEM OR COMPONENT: MS(1)-4
 DESCRIPTION: MAIN STEAM LINE B

PAGE 002
 DATE 12/14/84

IDENT. NO.	DESCRIPTION	SECT. XI EXAM.	EXAM MTH.	PROCEDURE	CAL. BLOCK	INSERVICE		NOTES
						REQ.	SCHEDULED OUTAGE	
			SUR	PTP-1				
MS-HB-1(W)	4 WELDED LUGS	B-K-1	VOL	UTP-26	UT-4			
MS-HB-1	SPRING (2)	B-K-2	VT-3	303/8.2.17				
			VT-4	303/8.2.17				
MS-SB-6	PSA-35 SNUBBER	B-K-2	VT-3	303/8.2.17				S/N 4206
			VT-4	303/8.2.17				S/N 4206
MS-SB-7	PSA-35 SNUBBER	B-K-2	VT-3	303/8.2.17				S/N 4210
			VT-4	303/8.2.17				S/N 4210
PWS-32-2	PIPE WHIP	N/A	N/A	N/A				SEE NOTE #1
26MS(1)B-5/1GRCIC(12)-4	PIPE TO SWL	B-J	VOL	UTP-10	UT-4			
			SUR	PTP-1				
26MS(1)B-6	PIPE TO EL	B-J	VOL	UTP-10	UT-4			
			SUR	PTP-1				
26MS(1)B-6LDI	EL SEAM	B-J	VOL	UTP-10	UT-4			
			SUR	PTP-1				
26MS(1)B-6LDO	EL SEAM	B-J	VOL	UTP-10	UT-4			
			SUR	PTP-1				
26MS(1)B-7LUI	EL SEAM	B-J	VOL	UTP-10	UT-4			

WNP-02
 INTERVAL: PSI
 PERIOD: NA
 OUTAGE:
 DRAWING NO. MS-102

WASHINGTON PUBLIC POWER SUPPLY SYSTEM
 PROGRAM PLAN AND SCHEDULE
 SYSTEM OR COMPONENT: MS(1)-4
 DESCRIPTION: MAIN STEAM LINE B

PAGE 003
 DATE 12/14/84

<u>IDENT. NO.</u>	<u>DESCRIPTION</u>	SECT. XI <u>EXAM.</u>	EXAM MTH.	PROCEDURE	CAL. BLOCK	<u>INSERVICE</u>		<u>NOTES</u>
						REQ.	SCHEDULED OUTAGE	
26MS(1)B-7LU0	EL SEAM	B-J	SUR VOL	PTP-1 UTP-10	UT-4			
26MS(1)B-7	EL TO PIPE	B-J	SUR VOL	PTP-1 UTP-10	UT-4			
26MS(1)B-8	PIPE TO EL	B-J	SUR VOL	PTP-1 UTP-10	UT-4			
26MS(1)E-8LDI	EL SEAM	B-J	SUR VOL	PTP-1 UTP-10	UT-4			
26MS(1)B-8LD0	EL SEAM	B-J	SUR VOL	PTP-1 UTP-10	UT-4			
26MS(1)B-9LUI	EL SEAM	B-J	SUR VOL	PTP-1 UTP-10	UT-4			
26MS(1)B-9LU0	EL SEAM	B-J	SUR VOL	PTP-1 UTP-10	UT-4			
26MS(1)B-9	EL TO PIPE	B-J	SUR VOL	PTP-1 UTP-10	UT-4			
			SUR	PTP-1				

WNP-02
 INTERVAL: PSI
 PERIOD: NA
 OUTAGE:
 DRAWING NO. MS-102

WASHINGTON PUBLIC POWER SUPPLY SYSTEM
 PROGRAM PLAN AND SCHEDULE
 SYSTEM OR COMPONENT: MS(1)-4
 DESCRIPTION: MAIN STEAM LINE B

PAGE 004
 DATE 12/14/84

<u>IDENT. NO.</u>	<u>DESCRIPTION</u>	<u>SECT. XI EXAM. EXAM. MIN.</u>	<u>PROCEDURE</u>	<u>CAL. BLOCK</u>	<u>INSERVICE SCHEDULED</u>		<u>NOTES</u>
					<u>REQ.</u>	<u>OUTAGE</u>	
PWS-32-3	PIPE WHIP	N/A	N/A	N/A			SEE NOTE #1
MS-SB-5	PSA-35 SNUBBER	B-K-2	VT-3	303/8.2.17			S/N 4149
			VT-4	303/8.2.17			S/N 4149
MS-SB-8	PSA-35 SNUBBER	B-K-2	VT-3	303/8.2.17			S/N 4152
			VT-4	303/8.2.17			S/N 4152
26MS(1)B-9/8MSR-5B	PIPE TO SWL	B-J	VOL	UTP-10	UT-4		
			SUR	PTP-1			
8MSR-5B1	SWL TO PIPE	B-J	VOL	UTP-10	UT-4		
			SUR	PTP-1			
8MSR-5B2	PIPE TO FLANGE	B-J	VOL	UTP-10	UT-4		
			SUR	PTP-1			
8MSR-5B-2BD	FLANGE BOLTING	B-G-2	VT-1	QCI 7-1			
MS-RV-5P-BLT	VALVE BOLTING	B-G-2	VT-1	QCI 7-1			
MS-RV-5B-BDY	VALVE BODY	B-M-2	VT-1	QCI 7-1			
26MS(1)B-9/8MSR-4B	PIPE TO SWL	B-J	VOL	UTP-10	UT-4		
			SUR	PTP-1			
8MSR-4B1	SWL TO PIPE	B-J	VOL	UTP-10	UT-24		
			SUR	PTP-1			

WNP-02
 INTERVAL: PSI
 PERIOD: NA
 OUTAGE:
 DRAWING NO. MS-102

WASHINGTON PUBLIC POWER SUPPLY SYSTEM
 PROGRAM PLAN AND SCHEDULE
 SYSTEM OR COMPONENT: MS(1)-4
 DESCRIPTION: MAIN STEAM LINE D

PAGE 005
 DATE 12/14/84

IDENT. NO.	DESCRIPTION	SECT. XI EXAM.	EXAM MTH.	PROCEDURE	CAL. BLOCK	INSERVICE		NOTES
						REQ.	SCHEDULED OUTAGE	
BMSR-4B2	SWL TO PIPE	B-J	VOL	UTP-10	UT-24			
			SUR	PTP-1				
BMSR-4B-2BD	FLANGE BOLTING	B-G-2	VT-1	OCT 7-1				
MS-RV-4B-BLT	VALVE BOLTING	B-G-2	VT-1	OCT 7-1				
MS-RV-4B-BDY	VALVE BODY	B-M-2	VT-1	OCT 7-1				
MS-HB-2	SPRING	B-K-2	VT-3	303/R.2.17				
			VT-4	303/R.2.17				
26MS(1)B-9/BMSR-3B	PIPE TO SWL	B-J	VOL	UTP-10	UT-4			
			SUR	PTP-1				
BMSR-3B1	SWL TO PIPE	B-J	VOL	UTP-10	UT-24			
			SUR	PTP-1				
BMSR-3B2	PIPE TO FLANGE	B-J	VOL	UTP-10	UT-24			
			SUR	PTP-1				
BMSR-3B-2BD	FLANGE BOLTING	B-G-2	VT-1	OCT 7-1				
MS-RV-3B-BLT	VALVE BOLTING	B-G-2	VT-1	OCT 7-1				
MS-RV-3B-BDY	VALVE BODY	B-M-2	VT-1	OCT 7-1				
26MS(1)B-9/BMSR-2B	PIPE TO SWL	B-J	VOL	UTP-10	UT-4			
			SUR	PTP-1				

WNP-02
 INTERVAL: PSI
 PERIOD: NA
 OUTAGE:
 DRAWING NO. MS-102

WASHINGTON PUBLIC POWER SUPPLY SYSTEM
 PROGRAM PLAN AND SCHEDULE
 SYSTEM OR COMPONENT: MS(1)-4
 DESCRIPTION: MAIN STEAM LINE B

PAGE 006
 DATE 12/14/84

IDENT. NO.	DESCRIPTION	SECT. XI EXAM.	EXAM MTH.	PROCEDURE	CAL. BLOCK	INSERVICE		NOTES
						REQ.	SCHEDULED OUTAGE	
8MSR-2B1	SWL TO PIPE	B-J	VOL	UTP-10	UT-24			
			SUR	PTP-1				
8MSR-2B2	PIPE TO FLANGE	B-J	VCL	UTP-10	UT-24			
			SUR	PTP-1				
8MSR-2B-2BD	FLANGE BOLTING	B-G-2	VT-1	OCI 7-1				
MS-RV-2B-BLT	VALVE BOLTING	B-G-2	VT-1	OCI 7-1				
MS-RV-2B-BDY	VALVE BODY	B-M-2	VT-1	OCI 7-1				
MS-SB-1G	PSA-35 SMUBRER	B-K-2	VT-3	303/8.2.17				S/N 4201
			VT-4	303/8.2.17				S/N 4201
26MS(1)B-9/8MSR-1B	PIPE TO SWL	B-J	VOL	UTP-10	UT-4			
			SUR	PTP-1				
8MSR-1F1	SWL TO PIPE	B-J	VOL	UTP-10	UT-24			
			SUR	PTP-1				
8MSR-1B2	PIPE TO FLANGE	B-J	VCL	UTP-10	UT-24			
			SUR	PTP-1				
8MSR-1F-2BD	FLANGE BOLTING	B-G-2	VT-1	OCI 7-1				
MS-RV-1F-BLT	VALVE BOLTING	B-G-2	VT-1	OCI 7-1				
MS-RV-1B-BDY	VALVE BODY	B-M-2	VT-1	OCI 7-1				

WNP-02
 INTERVAL: PSI
 PERIOD: NA
 OUTAGE:
 DRAWING NO. MS-102

WASHINGTON PUBLIC POWER SUPPLY SYSTEM.
 PROGRAM PLAN AND SCHEDULE
 SYSTEM OR COMPONENT: MS(1)-4
 DESCRIPTION: MAIN STEAM LINE B

PAGE 007
 DATE 12/14/84

<u>IDENT. NO.</u>	<u>DESCRIPTION</u>	<u>SECT.</u> <u>XI</u>	<u>EXAM</u> <u>MTH.</u>	<u>PROCEDURE</u>	<u>CAL.</u> <u>BLOCK</u>	<u>INSERVICE</u>		<u>NOTES</u>
						<u>REQ.</u>	<u>SCHEDULED</u> <u>OUTAGE</u>	
MS-SB-9	PSA-35 SNUBBER	B-K-2	VT-3	303/8.2.17				S/N 4203
			VT-4	303/8.2.17				S/N 4203
PWS-32-4	PIPE WHIP	N/A	N/A	N/A				SEE NOTE #1
26MS(1)B-10	PIPE TO EL	B-J	VOL	UTP-10	UT-4			
			SUR	PTP-1				
26MS(1)B-10LDI	EL SEAM	B-J	VOL	UTP-10	UT-4			
			SUR	PTP-1				
26MS(1)B-10LDO	EL SEAM	B-J	VOL	UTP-10	UT-4			
			SUR	PTP-1				
26MS(1)B-11LUI	EL SEAM	B-J	VOL	UTP-10	UT-4			
			SUR	PTP-1				
26MS(1)B-11LUO	EL SEAM	B-J	VOL	UTP-10	UT-4			
			SUR	PTP-1				
26MS(1)B-11	EL TO PIPE	B-J	VOL	UTP-10	UT-4			
			SUR	PTP-1				
MS-SB-3	PSA-35 SNUBBER	B-K-2	VT-3	303/8.2.17				S/N 4155
			VT-4	303/8.2.17				S/N 4155

WNP-02
 INTERVAL: PSI
 PERIOD: NA
 OUTAGE:
 DRAWING NO. MS-102

WASHINGTON PUBLIC POWER SUPPLY SYSTEM
 PROGRAM PLAN AND SCHEDULE
 SYSTEM OR COMPONENT: MS(1)-4
 DESCRIPTION: MAIN STEAM LINE B

PAGE 008
 DATE 12/14/84

IDENT. NO.	DESCRIPTION	SECT. XT EXAM. EXAM.	EXAM MTH.	PROCEDURE	CAL. BLOCK	INSERVICE		NOTES
						REQ.	SCHEDULED OUTAGE	
PWS-32-7	PIPE WHIP	N/A	N/A	N/A				SEE NOTE #1
MS-SB-4	PSA-35 SNURBER	B-K-2	VT-3	303/8.2.17				S/N 4153
			VT-4	303/8.2.17				S/N 4153
26MS(1)B-12	PIPE TO PIPE	B-J	VOL	UTP-10	UT-4			
			SUR	PTP-1				
26MS(1)B-12/3/4-D006	INSTR CONN	B-P	VT-2	N/A				SEE NOTES #6 & #7.
26MS(1)B-12/3/4-D008	INSTR CONN	B-P	VT-2	N/A				SEE NOTES #6 & #7.
26MS(1)B-12/3/4-DC07	INSTR CONN	B-P	VT-2	N/A				SEE NOTES #6 & #7.
26MS(1)B-12/3/4-D009	INSTR CONN	B-P	VT-2	N/A				SEE NOTES #6 & #7.
26MS(1)B-13	PIPE TO PIPE	B-J	VOL	UTP-10	UT-4			
			SUR	PTP-1				
MS-HB-3(V)	4 WELDED LUGS	B-K-1	VOL	UTP-26	UT-4			
MS-HB-3	SPRING (2)	B-K-2	VT-3	303/8.2.17				
			VT-4	303/8.2.17				
PWS-32-5	PIPE WHIP	N/A	N/A	N/A				SEE NOTE #1
26MS(1)B-14	PIPE TO EL	B-J	VOL	UTP-10	UT-4			
			SUR	PTP-1				
26MS(1)B-14LOI	EL SEAM	B-J	VOL	UTP-10	UT-4			

WNP-02
 INTERVAL: PSI
 PERIOD: NA
 OUTAGE:
 DRAWING NO. MS-102

WASHINGTON PUBLIC POWER SUPPLY SYSTEM
 PROGRAM PLAN AND SCHEDULE
 SYSTEM OR COMPONENT: MS(1)-4
 DESCRIPTION: MAIN STEAM LINE B

PAGE 009
 DATE 12/14/84


IDENT. NO.	DESCRIPTION	SECT. XI EXAM.	EYAM MTH.	PROCEDURE	CAL. BLOCK	INSERVICE		NOTES
						REQ.	SCHEDULED OUTAGE	
26MS(1)B-14LD0	EL SEAM	B-J	VOL	UTP-10	UT-4			
26MS(1)B-15LUI	EL SEAM	B-J	VOL	UTP-10	UT-4			
26MS(1)B-15LU0	EL SEAM	B-J	VOL	UTP-10	UT-4			
26MS(1)B-15	EL TO PIPE	B-J	VOL	UTP-10	UT-4			
MS-SB-1	PSA-100 SNUBBER	B-K-2	VT-3	303/8.2.17				S/N 604
MS-SB-2	PSA-100 SNUBBER	B-K-2	VT-3	303/8.2.17				S/N 604
FWS-32-6	PIPE WHIP	N/A	N/A	N/A				SEE NOTE #1
26MS(1)B-16	PIPE TO VALVE	B-J	VOL	UTP-10	UT-4			AUGHT
MS-V-22B/2MS(9)-4	DRAIN CONN	B-J	SUR	PTP-1				AUGHT
MS-V-22R-BLT	VALVE BOLTING	B-G-2	VT-1	OCI 7-1				

WNP-02
 INTERVAL: PSI
 PERIOD: NA
 OUTAGE:
 DRAWING NO. MS-102

WASHINGTON PUBLIC POWER SUPPLY SYSTEM
 PROGRAM PLAN AND SCHEDULE
 SYSTEM OR COMPONENT: MS(1)-4
 DESCRIPTION: MAIN STEAM LINE B


PAGE 010
 DATE 12/14/84

IDENT. NO.	DESCRIPTION	SECT. XI EXAM.	EXAM MTH.	PROCEDURE	CAL. BLOCK	INSERVICE		NOTES
						REQ.	SCHEDULED OUTAGE	
MS-V-22B-BDY	VALVE BODY	B-M-2	VT-1	QCI 7-1				
MS-V-22B/3/4CAP	LEAKOFF CAPPED	B-P	VT-2	N/A				
26MS(1)B-17	VALVE TO PENE	B-J	VOL	UTP-10	UT-4			AUGMT
MS FLUED HEAD B	FLUED HEAD WELD	B-K-1	SUR	PTP-1				AUGMT
			VOL	UTP-10	UT-40			SEE DWG. #MS-101-3, AUGMT.
26MS(1)B-18	PENE TO VALVE	B-J	SUR	MTP-1				SEE DWG. #MS-101-3, AUGMT.
			VOL	UTP-10	UT-4			AUGMT
MS-V-28B/2MS(9)-4	DRAIN CONN	B-J	SUR	PTP-1				AUGMT
MS-V-28R-BLT	VALVE BOLTING	B-G-2	VT-1	QCI 7-1				
MS-V-28G-BDY	VALVE BODY	B-M-2	VT-1	QCI 7-1				
MS-V-28R/3/4CAP	LEAKOFF CAPPED	B-P	VT-2	N/A				
MS-PB-102	MS PRESS BNDRY	B-P	VT-2	N/A				SEE NOTES #6 & #7.

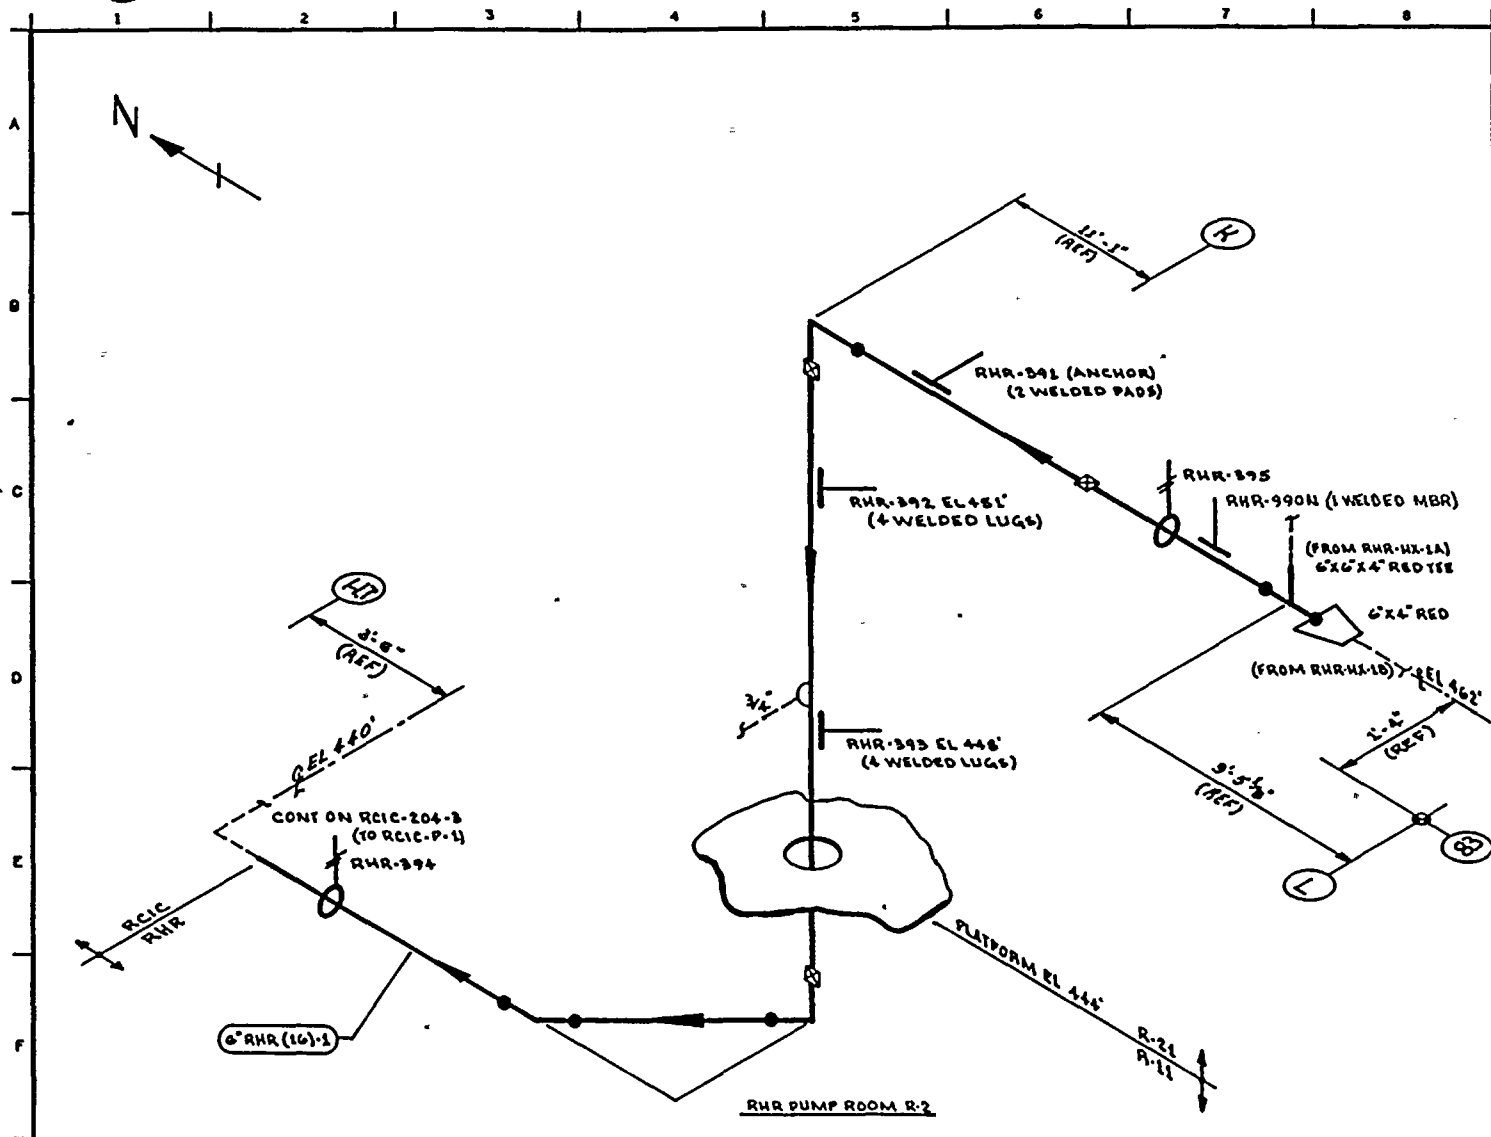

- NOTES:
1. THIS DRAWING IDENTIFIES PIPING & COMPONENTS SUBJECT TO A VISUAL EXAM FOR EVIDENCE OF LEAKAGE DURING SYSTEM HYDRO OR OPERABILITY TESTS. TESTS ARE TO BE CONDUCTED PER THE REQUIREMENTS OF ASME SECTION XI, PARAGRAPH IWA-5000.
 2. FOR BRANCH PIPING 4" DIA OR LESS (CONN SHOWN IN DASHED LINES) EXTEND VISUAL LEAKAGE EXAM THROUGH THE OUTER-MOST NORMALLY CLOSED NUCLEAR VALVE OR UNTIL TRANSITION TO INSTRUMENT TUBING, UNLESS OTHERWISE NOTED.

- REFERENCES:
- DOVE & CRALL ISOMETRICS
 - RHR-667-16.19 REV 11
 - RHR-667-20.21 REV 5

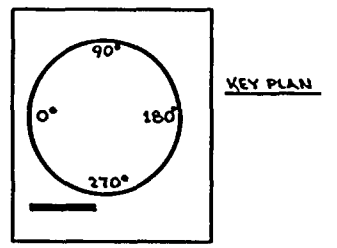

QUALITY CLASS: 1 ASME CODE CLASS: 2
 ENGR: G.A. KUGLER DRAWN: KMcA DATE: 7-21-78

WASHINGTON PUBLIC POWER SUPPLY SYSTEM
 RICHLAND, WASHINGTON 98352

THIS DRAWING IS INTENDED FOR USE IN PRESERVICE AND INSERVICE INSPECTION PROGRAMS ONLY.

PIPING SYSTEM	NOM DIA (IN)	SCH	NOM WALL THK	MATERIAL SPECIFICATION	MATL TYPE	CAL BLOCK NO
6" RHR (16)-1	6	40	0.280	SA 106 GR B	CS	NA

WNP-2
 WELD & COMPONENT IDENTIFICATION DIAGRAM

TITLE: RHR CONDENSING MODE SUPPLY TO RCIC-P-1

DWG NO: RHR-212 REV 1

NO	DATE	REVISION	BY	CHKD	APPVD
1	12-14-83	ADDED RHR-990N	KMcA	DM	JPK
0	10-22-78	ISSUED FOR USE	KMcA	#	
1	10-3-78	ISSUED FOR INFORMATION ONLY	KMcA		



WNP-02
 INTERVAL: PSI
 PERIOD: NA
 OUTAGE:
 DRAWING NO. RHR-212

WASHINGTON PUBLIC POWER SUPPLY SYSTEM
 PROGRAM PLAN AND SCHEDULE
 SYSTEM OR COMPONENT: RHR(16)-1
 DESCRIPTION: COND MODE SUPPLY

PAGE 001
 DATE 12/14/84

<u>IDENT. NO.</u>	<u>DESCRIPTION</u>	<u>SECT.</u> XI	<u>EXAM</u> EXAM.	<u>PROCEDURE</u>	<u>CAL.</u> BLOCK	<u>INSERVICE</u>		<u>NOTES</u>
						<u>REQ.</u>	<u>SCHEDULED</u> OUTAGE	
RHR-990N								
RHR-395	BOX	C-E-2	VT-3	303/8.2.17				
	SPRING	C-E-2	VT-3	303/8.2.17				
			VT-4	303/8.2.17				
RHR-391	ANCHOR	C-E-2	VT-3	303/8.2.17				
RHR-392	BOX	C-E-2	VT-3	303/8.2.17				
RHR-393	BOX	C-E-2	VT-3	303/8.2.17				
RHR-394	SPRING	C-E-2	VT-3	303/8.2.17				
			VT-4	303/8.2.17				
RHR-PB-212	RHR PRES BNDRY	N/A	VT-2	N/A				

WNP-02
INTERVAL: PSI
PERIOD: NA
OUTAGE:
DRAWING NO. RHR-211

WASHINGTON PUBLIC POWER SUPPLY SYSTEM
PROGRAM PLAN AND SCHEDULE
SYSTEM OR COMPONENT: RHR(3)-1
DESCRIPTION: RHR-P-2C SUCTION

PAGE 002
DATE 12/14/84


<u>IDENT. NO.</u>	<u>DESCRIPTION</u>	<u>SECT.</u> <u>XI</u> <u>EXAM.</u>	<u>EXAM</u> <u>MTH.</u>	<u>PROCEDURE</u>	<u>CAL.</u> <u>BLOCK</u>	<u>INSERVICE</u>		<u>NOTES</u>
						<u>REQ.</u>	<u>SCHEDULED</u> <u>OUTAGE</u>	
RHR-50	PSA-3 SN(2)	C-E-2	VT-3	303/8.2.17				S/N 511/479
			VT-4	303/8.2.17				S/N 511/479
RHR-42	PSA-3 SNUBBER	C-E-2	VT-3	303/8.2.17				S/N 3911
			VT-4	303/8.2.17				S/N 3911
RHR-43	SPRING	C-E-2	VT-3	303/8.2.17				
			VT-4	303/8.2.17				
RHR-PB-211	RHR-PB-211	N/A	VT-2	N/A				SEE NOTES #6 & #7.

WNP-02
 INTERVAL: PSI
 PERIOD: NA
 OUTAGE:
 DRAWING NO. RHR-211

WASHINGTON PUBLIC POWER SUPPLY SYSTEM
 PROGRAM PLAN AND SCHEDULE
 SYSTEM OR COMPONENT: RHR(3)-1
 DESCRIPTION: RHR-P-2C SUCTION


PAGE 001
 DATE 12/14/84

<u>IDENT. NO.</u>	<u>DESCRIPTION</u>	<u>SECT.</u> <u>XI</u>	<u>EXAM</u>	<u>PROCEDURE</u>	<u>CAL.</u> <u>BLOCK</u>	<u>INSERVICE</u>		<u>NOTES</u>
						<u>REQ.</u>	<u>SCHEDULED</u> <u>OUTAGE</u>	
RHR-905N	STRUT	C-E-2	VT-3	303/8.2.17				
RHR-900N	STRUT	C-E-2	VT-3	303/8.2.17				
RHR-47	STRUT	C-E-2	VT-3	303/8.2.17				
RHR-46	BOX	C-E-2	VT-3	303/8.2.17				
RHR-966N	ANCHOR	C-E-2	VT-3	303/8.2.17				
RHR-41	BOX	C-E-2	VT-3	303/8.2.17				
RHR-139	SPRING	C-E-2	VT-3	303/8.2.17				
RHR-40			VT-4	303/8.2.17				
RHR-39	STRUT	C-E-2	VT-3	303/8.2.17				
	PSA-1 SN(2)	C-E-2	VT-3	303/8.2.17				S/N 2348
			VT-4	303/8.2.17				S/N 2348
RHR-35	SPRING	C-E-2	VT-3	303/8.2.17				
			VT-4	303/8.2.17				
RHR-37	BOX	C-E-2	VT-3	303/8.2.17				
RHR-140	SPRING	C-E-2	VT-3	303/8.2.17				
			VT-4	303/8.2.17				
RHR-49	STRUT	C-E-2	VT-3	303/8.2.17				
RHR-51	STRUT	C-E-2	VT-3	303/8.2.17				

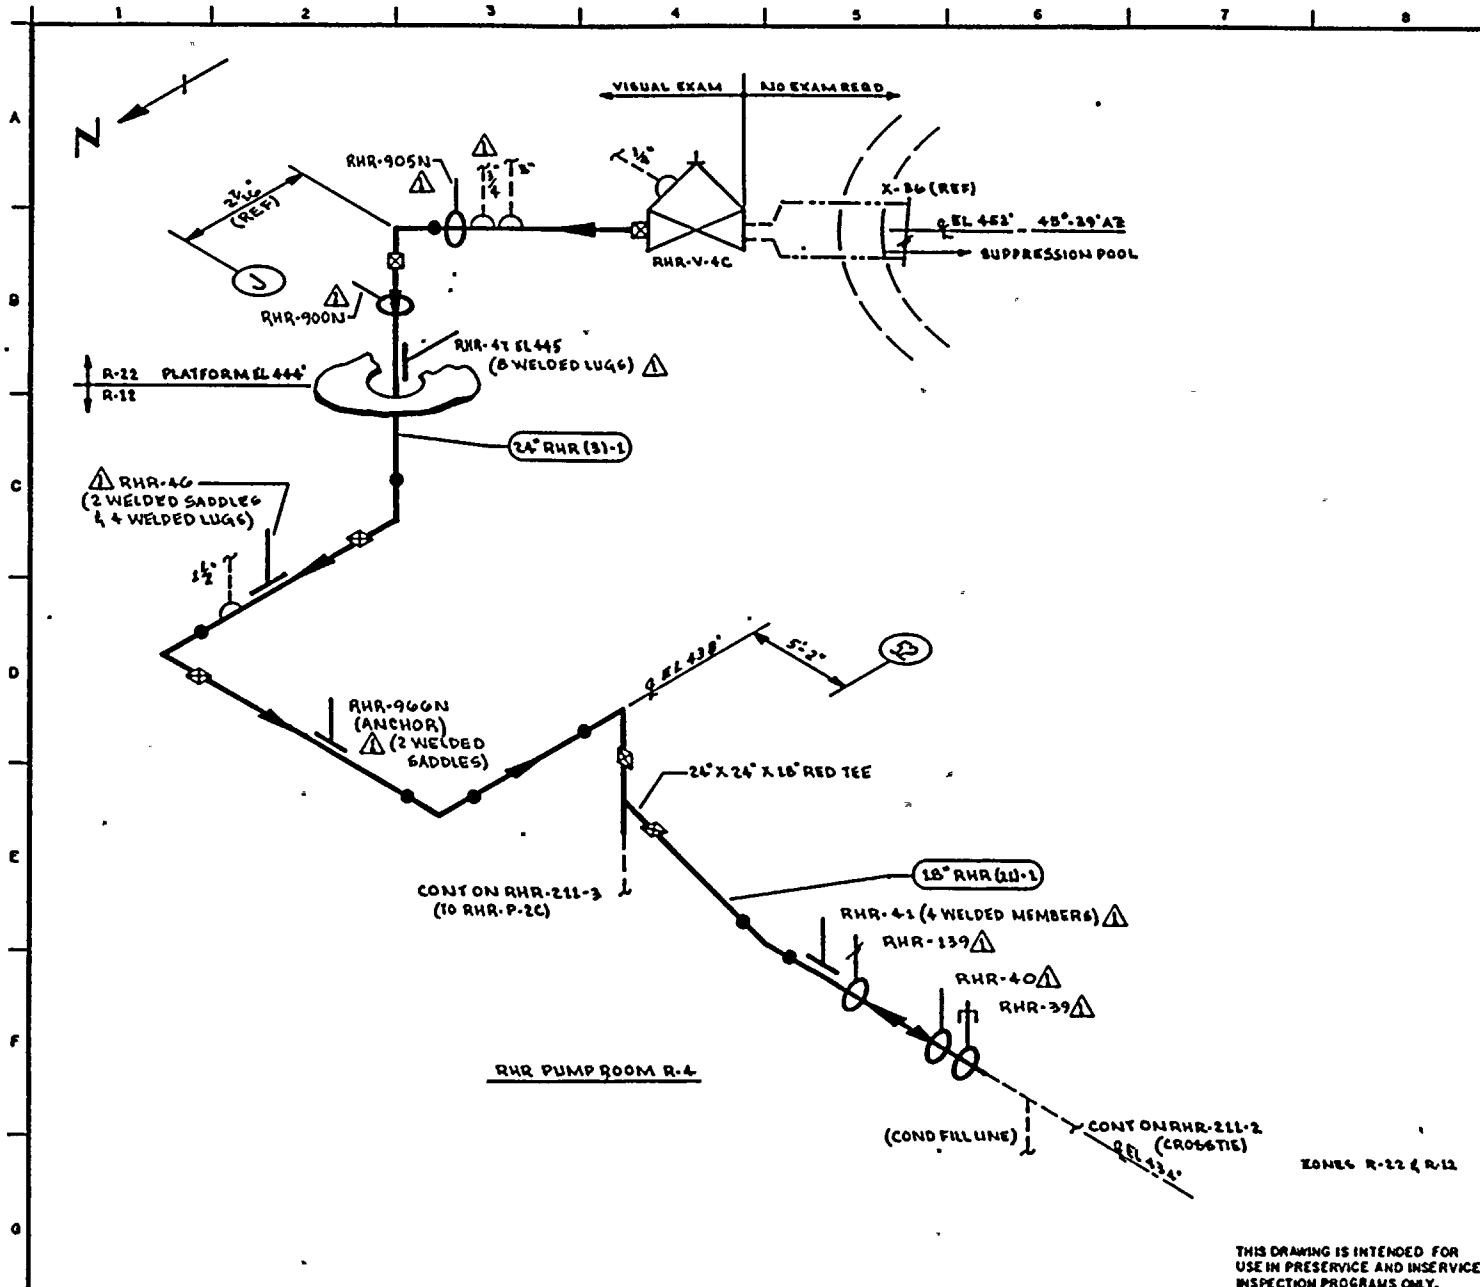

- NOTES:**
1. THIS DRAWING IDENTIFIES PIPING & COMPONENTS SUBJECT TO A VISUAL EXAM FOR EVIDENCE OF LEAKAGE DURING SYSTEM HYDRO OR OPERABILITY TESTS. TESTS ARE TO BE CONDUCTED PER THE REQUIREMENTS OF ASME SECTION XI, PARAGRAPH IWA-5000.
 2. FOR BRANCH PIPING 4" DIA OR LESS (CONN SHOWN IN DASHED LINES) EXTEND VISUAL LEAKAGE EXAM THROUGH THE OUTERMOST NORMALLY CLOSED NUCLEAR CLASS VALVE OR UNTIL TRANSITION TO INSTRUMENT TUBING, UNLESS OTHERWISE NOTED.
 3. AT LOCATIONS WHERE LEAKAGE IS NORMALLY EXPECTED (EQ. VALVE STEM & PUMP SEAL LEAKOFF CONN) VERIFY LEAKAGE COLLECTION SYSTEM OPERABILITY ONLY. NO HYDRO TEST OF COLLECTION SYSTEM IS REQUIRED.

- REFERENCES:**
- BOYER & CRAIG ISOMETRICS
 - RHR-882-1.4 REV B
 - RHR-880-1.6 REV G

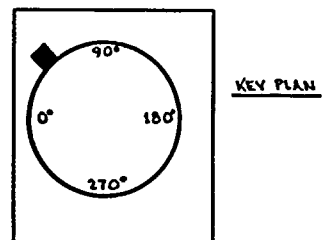

THIS DRAWING IS INTENDED FOR USE IN PRESERVICE AND INSERVICE INSPECTION PROGRAMS ONLY.

QUALITY CLASS: 1 ASME CODE CLASS: 2
 ENGR: GA KUGLER DRAWN: KMcA DATE: 6-20-78



PIPING SYSTEM	NOM DIA (IN)	SCH	NOM WALL THK	MATERIAL SPECIFICATION	MATL TYPE	CAL BLOCK NO
24" RHR(3)-1	24	STD	0.375	SA 106 GR B	CS	NA
18" RHR(2)-1	18	STD	0.375	SA 106 GR B	CS	NA


NO	DATE	REVISION	BY	CHKD	APPVD
1	9-21-78	REVISED AS NOTED	KMcA	DKR	TKK
0	11-22-78	ISSUED FOR USE	KMcA	DKR	TKK
1	9-11-78	ISSUED FOR INFORMATION ONLY	KMcA	DKR	TKK

WNP-2
 WELD 8 COMPONENT
 IDENTIFICATION DIAGRAM

TITLE:
 RHR LOOP C
 SUPPRESSION POOL SUCTION & CROSBTIE


DWG NO: RHR-211-1 REV 1



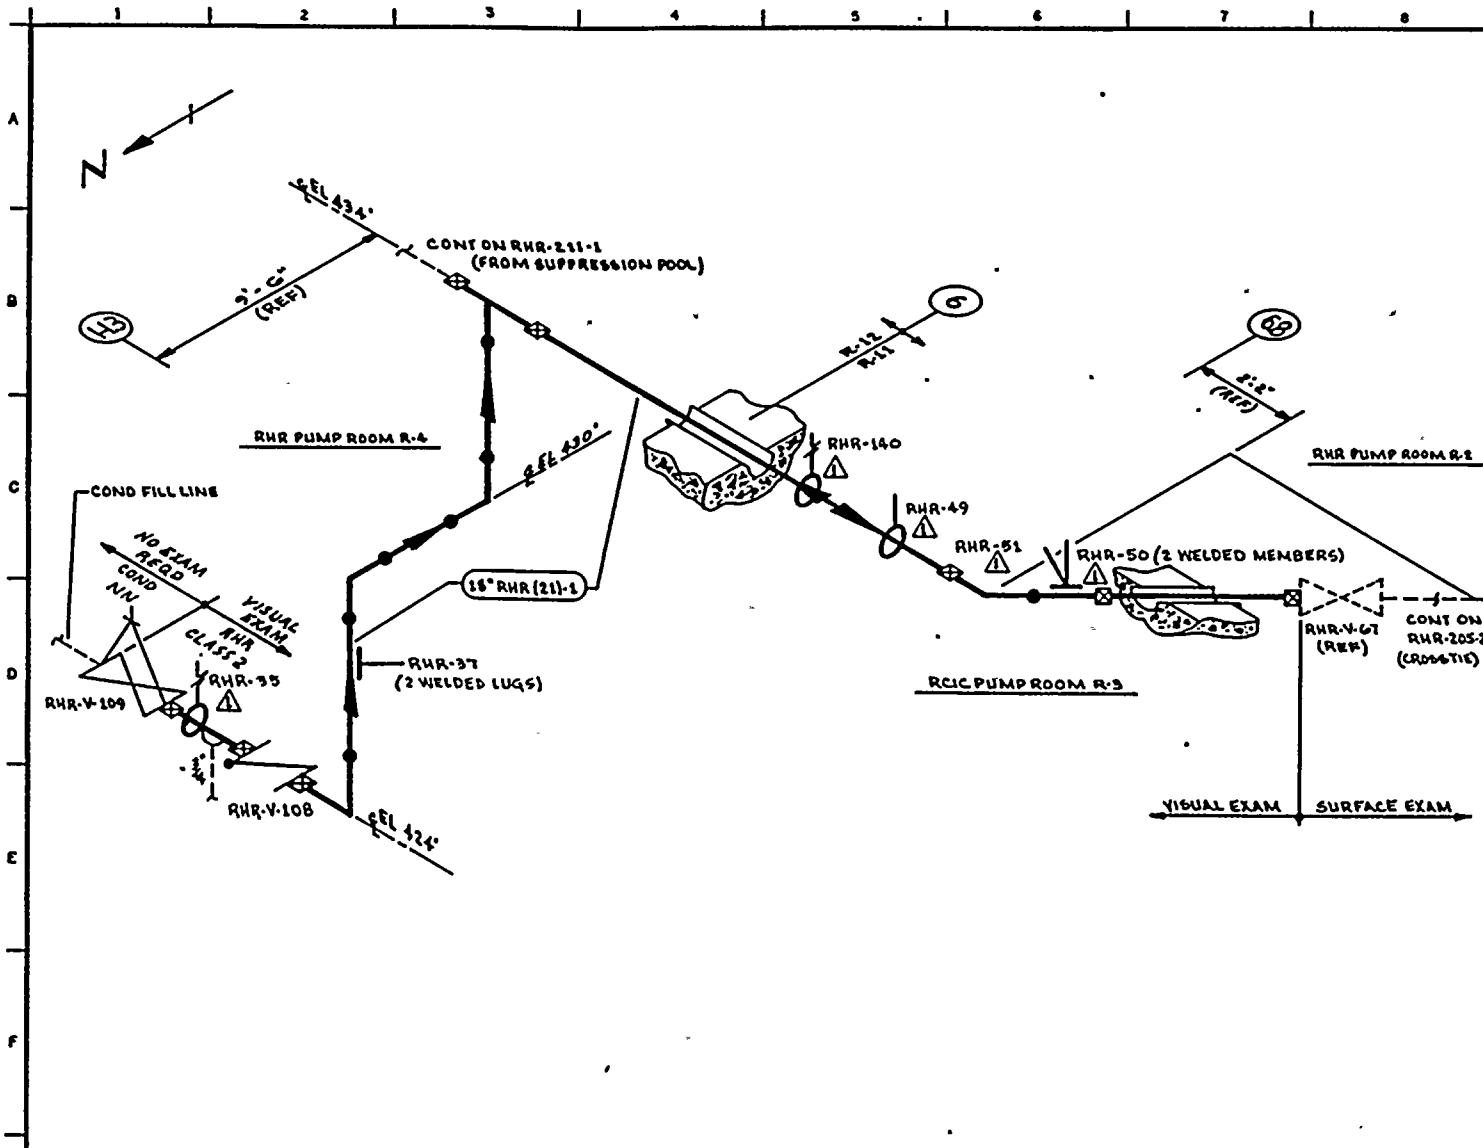

- NOTES:**
1. THIS DRAWING IDENTIFIES PIPING & COMPONENTS SUBJECT TO A VISUAL EXAM FOR EVIDENCE OF LEAKAGE DURING SYSTEM HYDRO DR OPERABILITY TESTS. TESTS ARE TO BE CONDUCTED PER THE REQUIREMENTS OF ASME SECTION XI, PARAGRAPH IWA-5000.
 2. FOR BRANCH PIPING 4" DIA OR LESS (CONN SHOWN IN DASHED LINES) EXTEND VISUAL LEAKAGE EXAM THROUGH THE OUTERMOST NORMALLY CLOSED NUCLEAR CLASS VALVE OR UNTIL TRANSITION TO INSTRUMENT TUBING, UNLESS OTHERWISE NOTED.

REFERENCES
 DOWE & CRAIG ISOMETRIC
 RHR-880-L6 REV 6

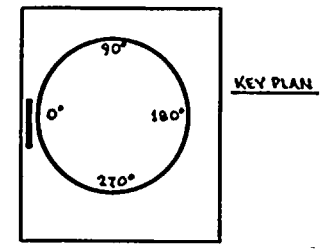

ZONES R-11 & R-12

THIS DRAWING IS INTENDED FOR USE IN PRESERVICE AND INSERVICE INSPECTION PROGRAMS ONLY.

QUALITY CLASS: 1 | ASME CODE CLASS: 2
 ENGR: GA. KLIGLER | DRAWN: K.M.C.A. | DATE: 6-21-78


 **WASHINGTON PUBLIC POWER SUPPLY SYSTEM**
 RICHLAND, WASHINGTON 98342

PIPING SYSTEM	NOM DIA (IN)	SCH	NOM WALL THK	MATERIAL SPECIFICATION	MATL TYPE	CAL BLOCK NO
18" RHR (21)-1	18	STD	0.375	SA 106 GR B	CS	NA

WNP-2
 WELD & COMPONENT IDENTIFICATION DIAGRAM

NO	DATE	REVISION	BY	CHKD	APPVD
1	9-26-83	REVISED AS NOTED	K.M.C.A.	J.P.K.	T.H.
0	11-18-78	ISSUED FOR USE	K.M.C.A.	J.P.K.	T.H.
A	7-12-78	ISSUED FOR INFORMATION ONLY	K.M.C.A.	J.P.K.	T.H.

TITLE: RHR LOOP C
 CROSBIE & COND FILL LINE
 DWG NO: RHR-211-2 | REV 1

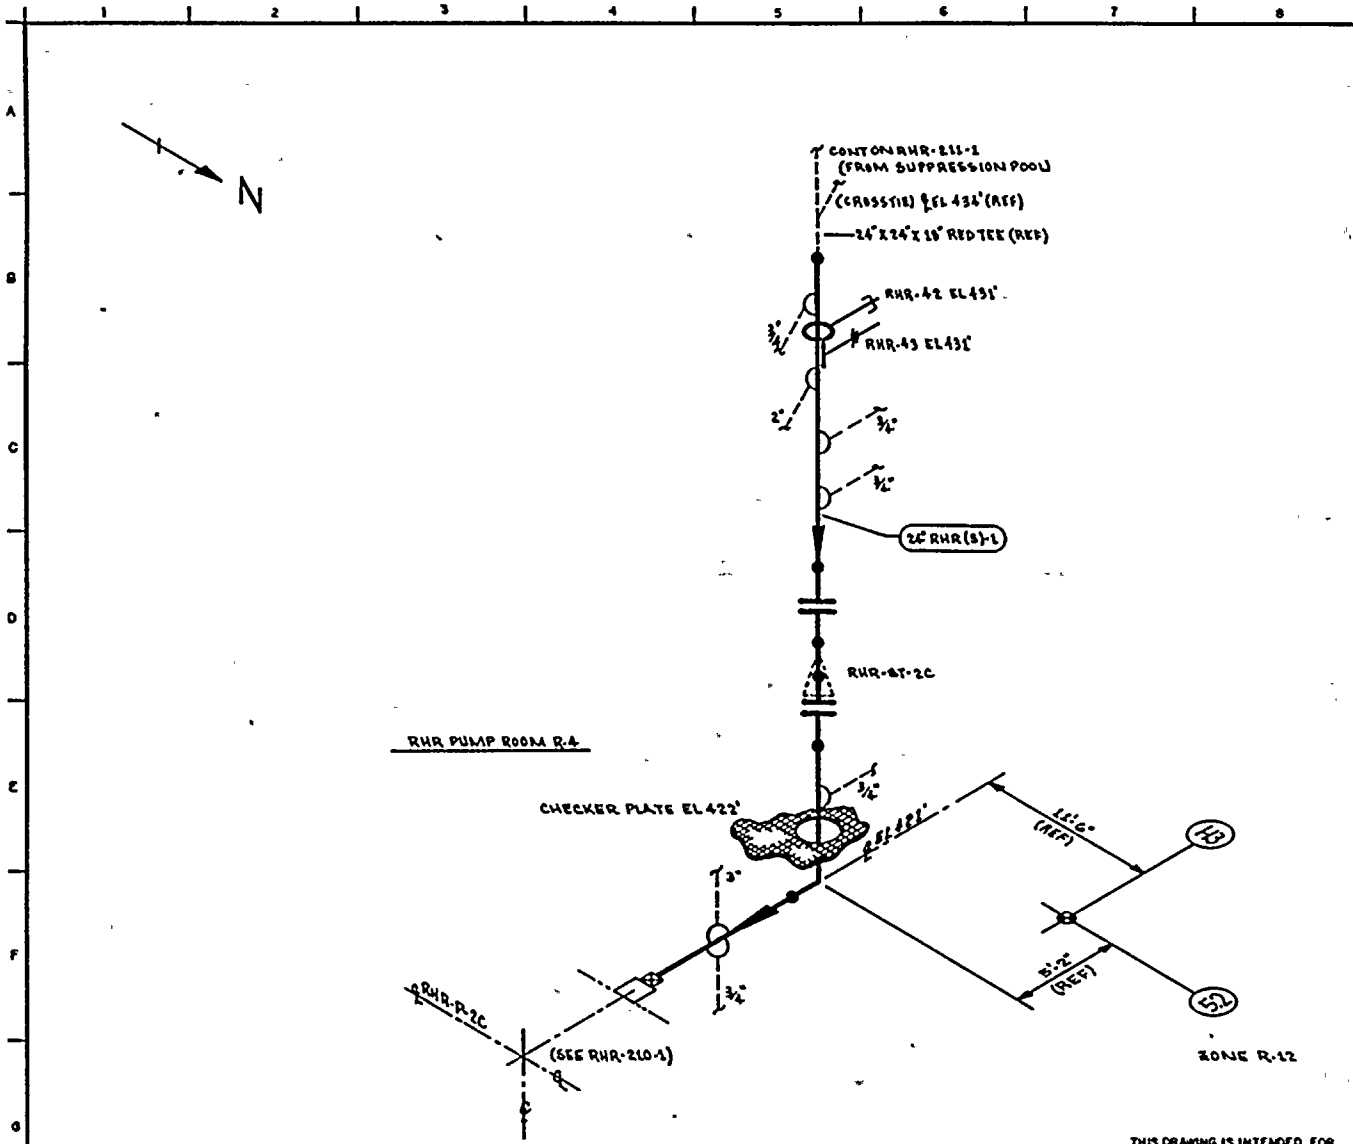


NOTES:

1. THIS DRAWING IDENTIFIES PIPING & COMPONENTS SUBJECT TO A VISUAL EXAM FOR EVIDENCE OF LEAKAGE DURING SYSTEM HYDRO OR OPERABILITY TESTS. TESTS ARE TO BE CONDUCTED PER THE REQUIREMENTS OF ASME SECTION XI, PARAGRAPH IWA-5000.
2. FOR BRANCH PIPING 4" DIA OR LESS (CONN SHOWN IN DASHED LINES) EXTEND VISUAL LEAKAGE EXAM THROUGH THE OUTERMOST NORMALLY CLOSED NUCLEAR CLASS VALVE OR UNTIL TRANSITION TO INSTRUMENT TUBING, UNLESS OTHERWISE NOTED.


REFERENCES:

BOYER & CRAIL ISOMETRICS

RHR-882-5 REV 2
 RHR-882-6-T REV 1
 RHR-882-5H REV 1
 RHR-882-6TH REV 0

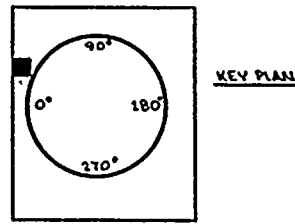

QUALITY CLASS: 1 ASME CODE CLASS: 2
 ENGR: CA KUGLER DRAWN: V. N. A. DATE: 6-21-78

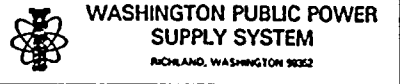

THIS DRAWING IS INTENDED FOR USE IN PRESERVICE AND INSERVICE INSPECTION PROGRAMS ONLY.


PIPING SYSTEM	NOM DIA (IN)	SCH	NOM WALL THK	MATERIAL SPECIFICATION	MATL TYPE	CAL BLOCK NO
24" RHR (S)-1	24	STD	0.215	SA 106 GR B	CS	NA

WNP-2
 WELD & COMPONENT IDENTIFICATION DIAGRAM

TITLE:
 RHR LOOP C
 RHR-PUMP-2C SUCTION

DWG NO: RHR-211-B REV 0

NO	DATE	REVISION	BY	CHKD	APPVD
0	11/11/78	ISSUED FOR USE	K.M.A.	J.P.S.	J.P.S.
1	9/12/78	ISSUED FOR INFORMATION ONLY	K.M.A.	J.P.S.	J.P.S.

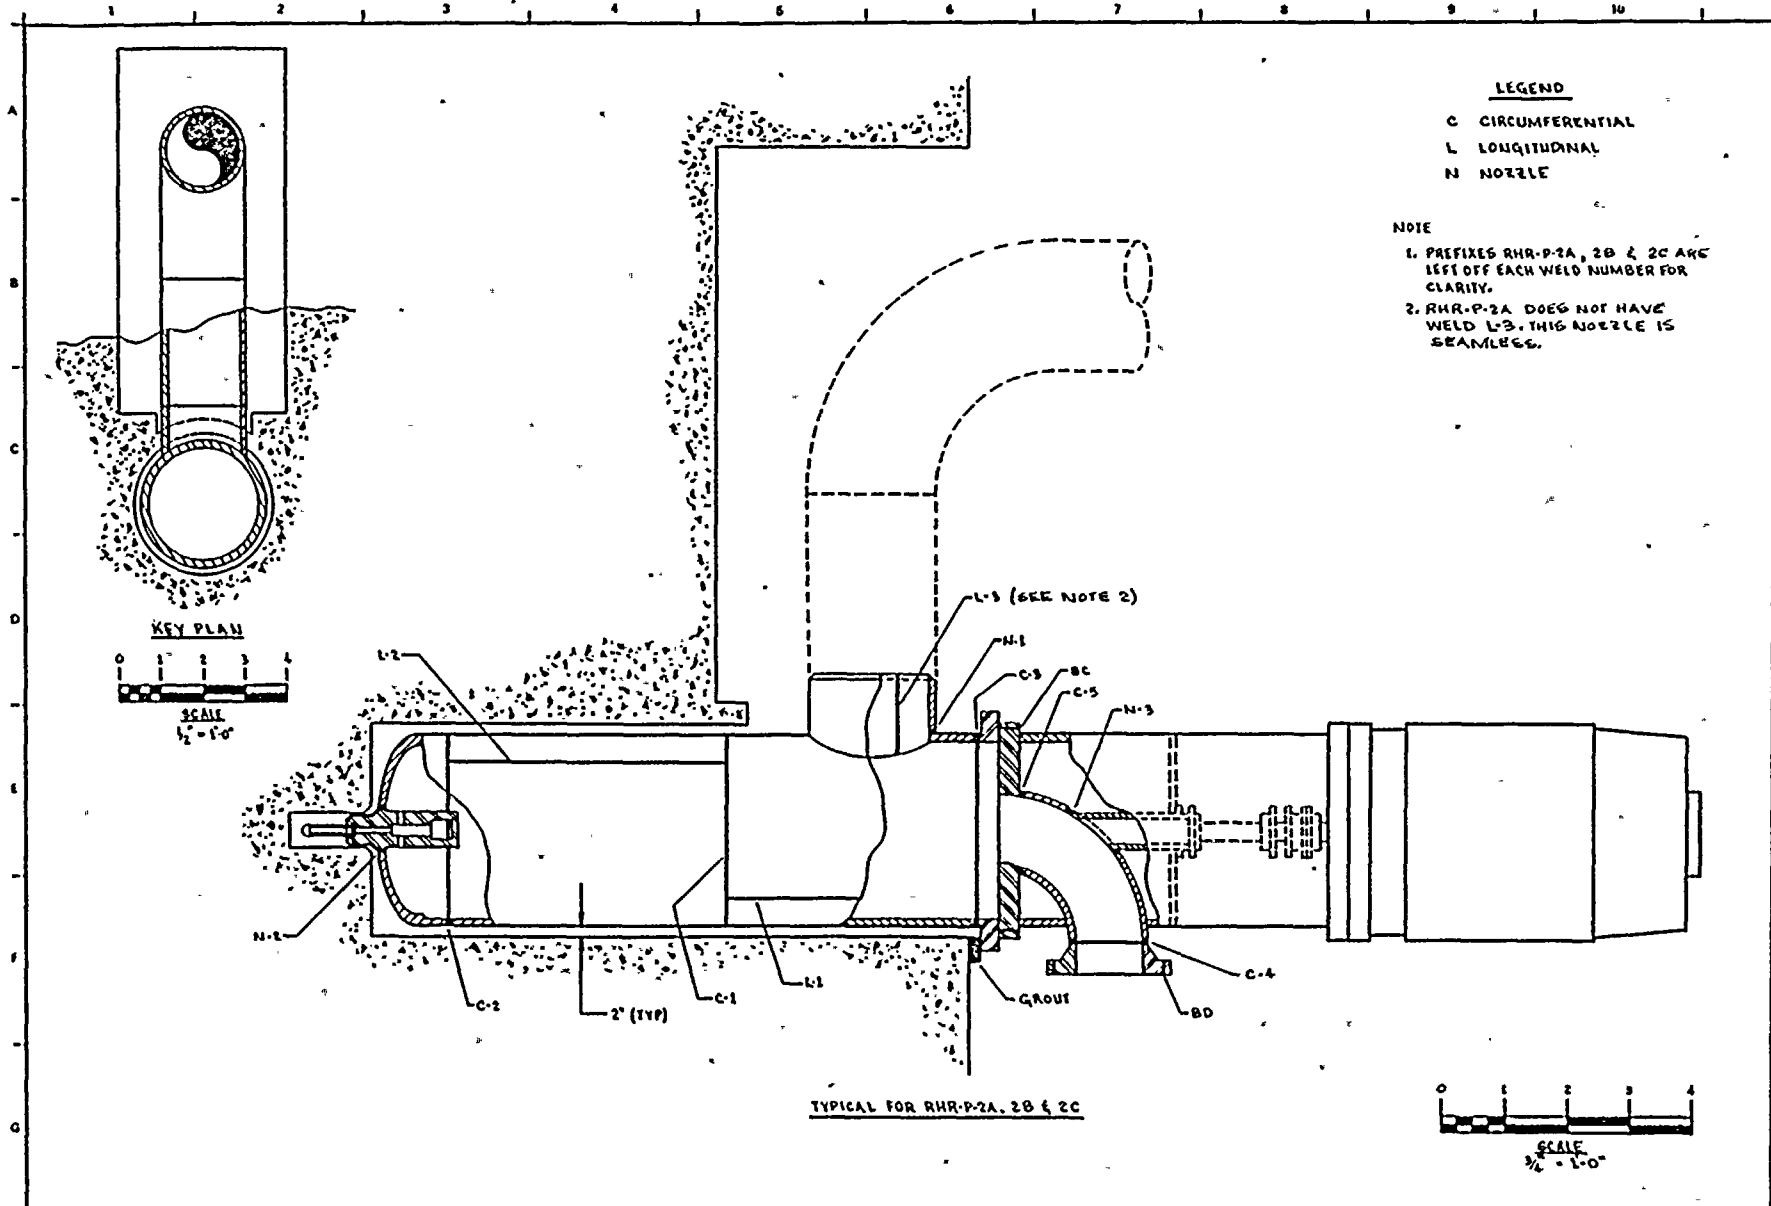

LEGEND
 C CIRCUMFERENTIAL
 L LONGITUDINAL
 N NOZZLE

NOTE
 1. PREFIXES RHR-P-2A, 2B & 2C ARE LEFT OFF EACH WELD NUMBER FOR CLARITY.
 2. RHR-P-2A DOES NOT HAVE WELD L-3. THIS NOZZLE IS SEAMLESS.

TYPICAL FOR RHR-P-2A, 2B & 2C

THIS DRAWING IS INTENDED FOR USE IN PRESERVICE AND INSERVICE INSPECTION PROGRAMS ONLY

WASHINGTON PUBLIC POWER SUPPLY SYSTEM
 RICHLAND, WASHINGTON 99222

2	11-27-81	REVISED TO INCLUDE RHR-P-2C (NOTE 2)	K-4-A	JMM	JFH
1	11-11-81	REDRAWN	K-4-A	APD	JFH
0	11-27-80	ISSUED FOR USE	K-4-A	BDP	JFH

ENGINEER J. NOYLE
 DRAWN K. ANDREW

WPP-2
 WELD & COMPONENT IDENTIFICATION DIAGRAM
 RHR-P-2A, 2B & 2C WGL06
 DWG NO RHR-213
 REV 2

NO	DATE	REVISION	BY	CHKD	APPVD	NO	DATE	REVISION	BY	CHKD	APPVD	DATE 10-24-88	DWG NO RHR-213	REV 2
----	------	----------	----	------	-------	----	------	----------	----	------	-------	---------------	----------------	-------

WNP-02
 INTERVAL: PSI
 PERIOD: NA
 OUTAGE:
 DRAWING NO. RHR-213

WASHINGTON PUBLIC POWER SUPPLY SYSTEM
 PROGRAM PLAN AND SCHEDULE
 SYSTEM OR COMPONENT: RHR-P-2A
 DESCRIPTION: RHR PUMP 2A, 2B, 2C

PAGE 001
 DATE 12/14/84

<u>IDENT. NO.</u>	<u>DESCRIPTION</u>	<u>SECT.</u> XI	<u>EXAM</u> EXAM.	<u>PROCEDURE</u> MTH.	<u>CAL.</u> BLOCK	<u>INSERVICE</u>		<u>NOTES</u>
						<u>REQ.</u>	<u>SCHEDULED</u> OUTAGE	
RHR-P-2AC-1	PMP CAS/CIR WLD	C-F	SUR	MTP-1				SEE NOTE 4.
RHR-P-2AC-2	PMP CAS/CTR WLD	C-F	SUR	MTP-1				SEE NOTE 4.
RHR-P-2AC-3	PMP CAS/CIR WLD	C-F	SUR	MTP-1				SEE NOTE 4.
RHR-P-2AC-4	PMP CAS/CIR WLD	C-F	SUR	MTP-1				SEE NOTE 4.
RHR-P-2AC-5	PMP CAS/CIR WLD	C-F	SUR	MTP-1				SEE NOTE 4.
RHR-P-2AN-1	PMP NOZZLE WELD	C-F	SUR	MTP-1				SEE NOTE 4.
RHR-P-2AN-2	PHP NOZZLE WELD	C-F	SUR	MTP-1				SEE NOTE 4.
RHR-P-2AN-3	PMP NOZZLE WELD	C-F	SUR	MTP-1				SEE NOTE 4.
RHR-P-2AL-1	PMPCAS/LONG.WLD	C-F	SUR	MTP-1				SEE NOTE 4.
RHR-P-2AL-2	PMPCAS/LONG.WLD	C-F	SUR	MTP-1				SEE NOTE 4.
RHR-P-2AL-3	PMPCAS/LONG.WLD	C-F	SUR	MTP-1				SEE NOTE 4.
RHR-P-2BC-1	PMP CAS/CIR WLD	C-F	SUR	MTP-1				SEE NOTE 4.
RHR-P-2BC-2	PMP CAS/CIR WLD	C-F	SUR	MTP-1				SEE NOTE 4.
RHR-P-2BC-3	PMP CAS/CIR WLD	C-F	SUR	MTP-1				SEE NOTE 4.
RHR-P-2BC-4	PMP CAS/CIR WLD	C-F	SUR	MTP-1				SEE NOTE 4.
RHR-P-2BC-5	PMP CAS/CIR WLD	C-F	SUR	MTP-1				SEE NOTE 4.
RHR-P-2BN-1	PMP NOZZLE WELD	C-F	SUR	MTP-1				SEE NOTE 4.

WMP-02
 INTERVAL: PSI
 PERIOD: NA
 OUTAGE:
 DRAWING NO. RHR-213

WASHINGTON PUBLIC POWER SUPPLY SYSTEM
 PROGRAM PLAN AND SCHEDULE
 SYSTEM OR COMPONENT: RHR-P-2B
 DESCRIPTION: RHR PUMP 2A, 2B, 2C


PAGE 002
 DATE 12/14/84

<u>IDENT. NO.</u>	<u>DESCRIPTION</u>	<u>SECT.</u>		<u>EXAM</u>	<u>PROCEDURE</u>	<u>CAL.</u>	<u>INSERVICE</u>		<u>NOTES</u>
		<u>XI</u>	<u>EXAM</u>				<u>SCHEDULED</u>	<u>OUTAGE</u>	
		<u>EXAM.</u>	<u>MTH.</u>			<u>BLOCK</u>	<u>REQ.</u>		
RHR-P-2BN-2	PMP NOZZLE WELD	C-F		SUR	MTP-1				SEE NOTE 4.
RHR-P-2BN-3	PMP NOZZLE WELD	C-F		SUR	MTP-1				SEE NOTE 4.
RHR-P-2BL-1	PMPCAS/LONG.WLD	C-F		SUR	MTP-1				SEE NOTE 4.
RHR-P-2BL-2	PMPCAS/LONG.WLD	C-F		SUR	MTP-1				SEE NOTE 4.
RHR-P-2BL-3	PMPCAS/LONG.WLD	C-F		SUR	MTP-1				SEE NOTE 4.
RHR-PB-213	RHR PRESS BNDRY	N/A		VT-2	N/A				IWC-2510, SEE NOTES #6 & #7.






POOR ORIGINAL

NOTES:


1. WELDS C-1, C-3, L-1, L-2 (L-3 ARE NOT CROSS STRUCTURAL DISCONTINUITIES & DO NOT REQUIRE EXAMINATION)
2. WELD S-2 DOES NOT REQUIRE SURFACE EXAM. IT IS NOT A COMPONENT SUP. PORT DURING NORMAL OPERATION.

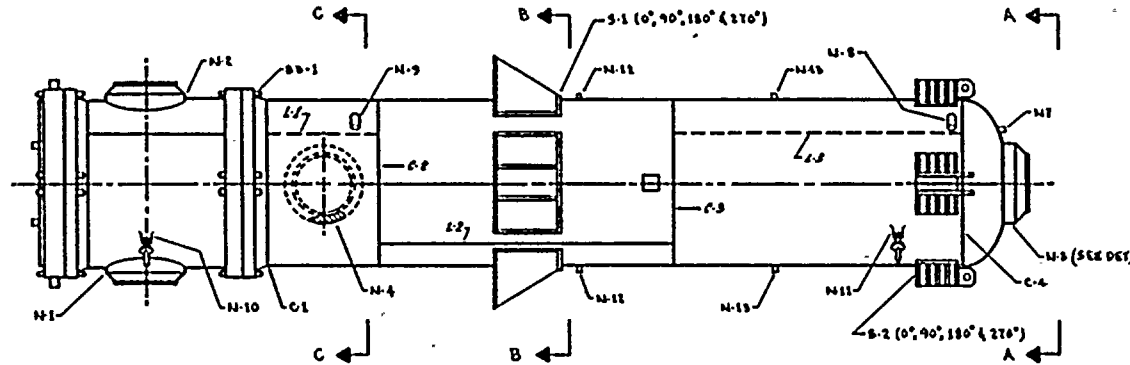

LEGEND
 C CIRCUMFERENTIAL
 L LONGITUDINAL
 S INTERGALLY WELDED SUPPORT
 BD BOLTING

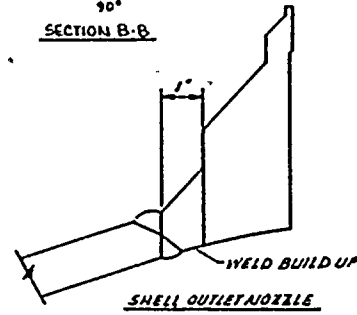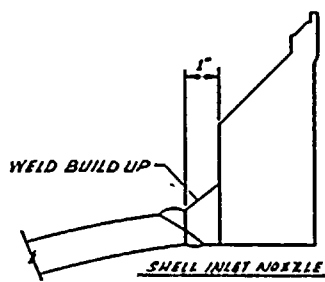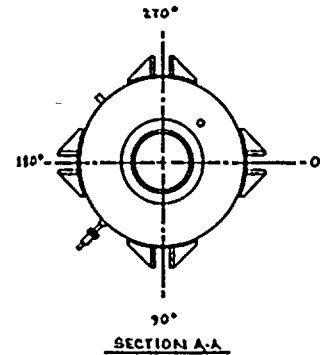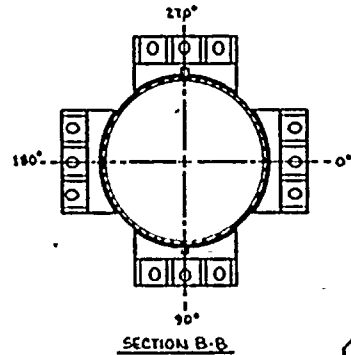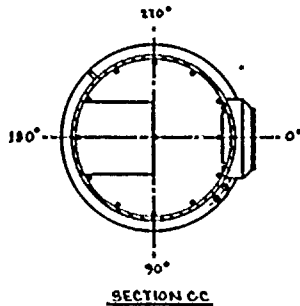

	NOM DIA	NOM WALL THK	MATERIAL SPECIFICATION	CAL BLOCK NO
SHELL	56"	1.0	SA 516 GR70	UT-42
NOZZLE	20"	3.75	SA 105 GR II	UT-42

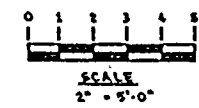

THIS DRAWING IS INTENDED FOR USE IN PRESERVICE AND INSERVICE INSPECTION PROGRAMS ONLY

WASHINGTON PUBLIC POWER SUPPLY SYSTEM
 WPPSS
 NICHOLAND, WASHINGTON 98522

NO	DATE	REVISION	BY	CHKD	APPVD
1	1/2/79	ADDED SHELL INLET (OUTLET) NOZZLE DETAIL	KMP	WJ	WJ
0	1/2/79	ISSUED FOR USE	KMP	WJ	WJ

ENGINEER	T WYLE
DRAWN	K. Mc ANDREW
DATE	1-8-79

WELD & COMPONENT IDENTIFICATION DIAGRAM	RHR HEAT EXCHANGER
DWG NO	RHR-214
REV	3

NO	DATE	REVISION	BY	CHKD	APPVD


BOOK 2147

WNP-02
 INTERVAL: PSI
 PERIOD: NA
 OUTAGE:
 DRAWING NO. RHR-214

WASHINGTON PUBLIC POWER SUPPLY SYSTEM
 PROGRAM PLAN AND SCHEDULE
 SYSTEM OR COMPONENT: RHR-HX-1A
 DESCRIPTION: RHR HEAT EXCHANGE 1A


PAGE 001
 DATE 12/14/84

IDENT. NO.	DESCRIPTION	SECT. XI EXAM.	EXAM MTH.	PROCEDURE	CAL. BLOCK	INSERVICE		NOTES
						REQ.	SCHEDULED OUTAGE	
AC-1	FLG/SHEL CIRWLD	C-A	VOL	UTP-17	UT-42			
AC-4	SHEL/HD CIR WLD	C-A	VOL	UTP-17	UT-42			
AN-3	INLET NZ/SHELWD	C-B	VOL	UTP-17	UT-43			
AN-4	OUT NZ/SHEL WLD	C-B	VOL	UTP-17	UT-43			
AS-1	HEATXCHG SUP WD	C-C	SUR	MTP-1				4 WELDED SUPPORTS 0,90,180,270 DEG.
BC-1	FLG/SHEL CIR WD	C-A	VOL	UTP-17	UT-42			
BC-4	SHEL/HD CIR WLD	C-A	VOL	UTP-17	UT-42			
BN-3	INLT NZ/SHEL WD	C-B	VOL	UTP-17	UT-43			
BN-4	OUT NZ/SHEL WLD	C-B	VOL	UTP-17	UT-43			
BS-1	HEATXCHG SUP WD	C-C	SUR	MTP-1				4 WELDED SUPPORTS, 0,90,180,270 DEG.
RHR-PB-214	RHR PRESS BNDRY	N/A	VT-2	N/A				IWC-2510, SEE NOTES #6 & #7.

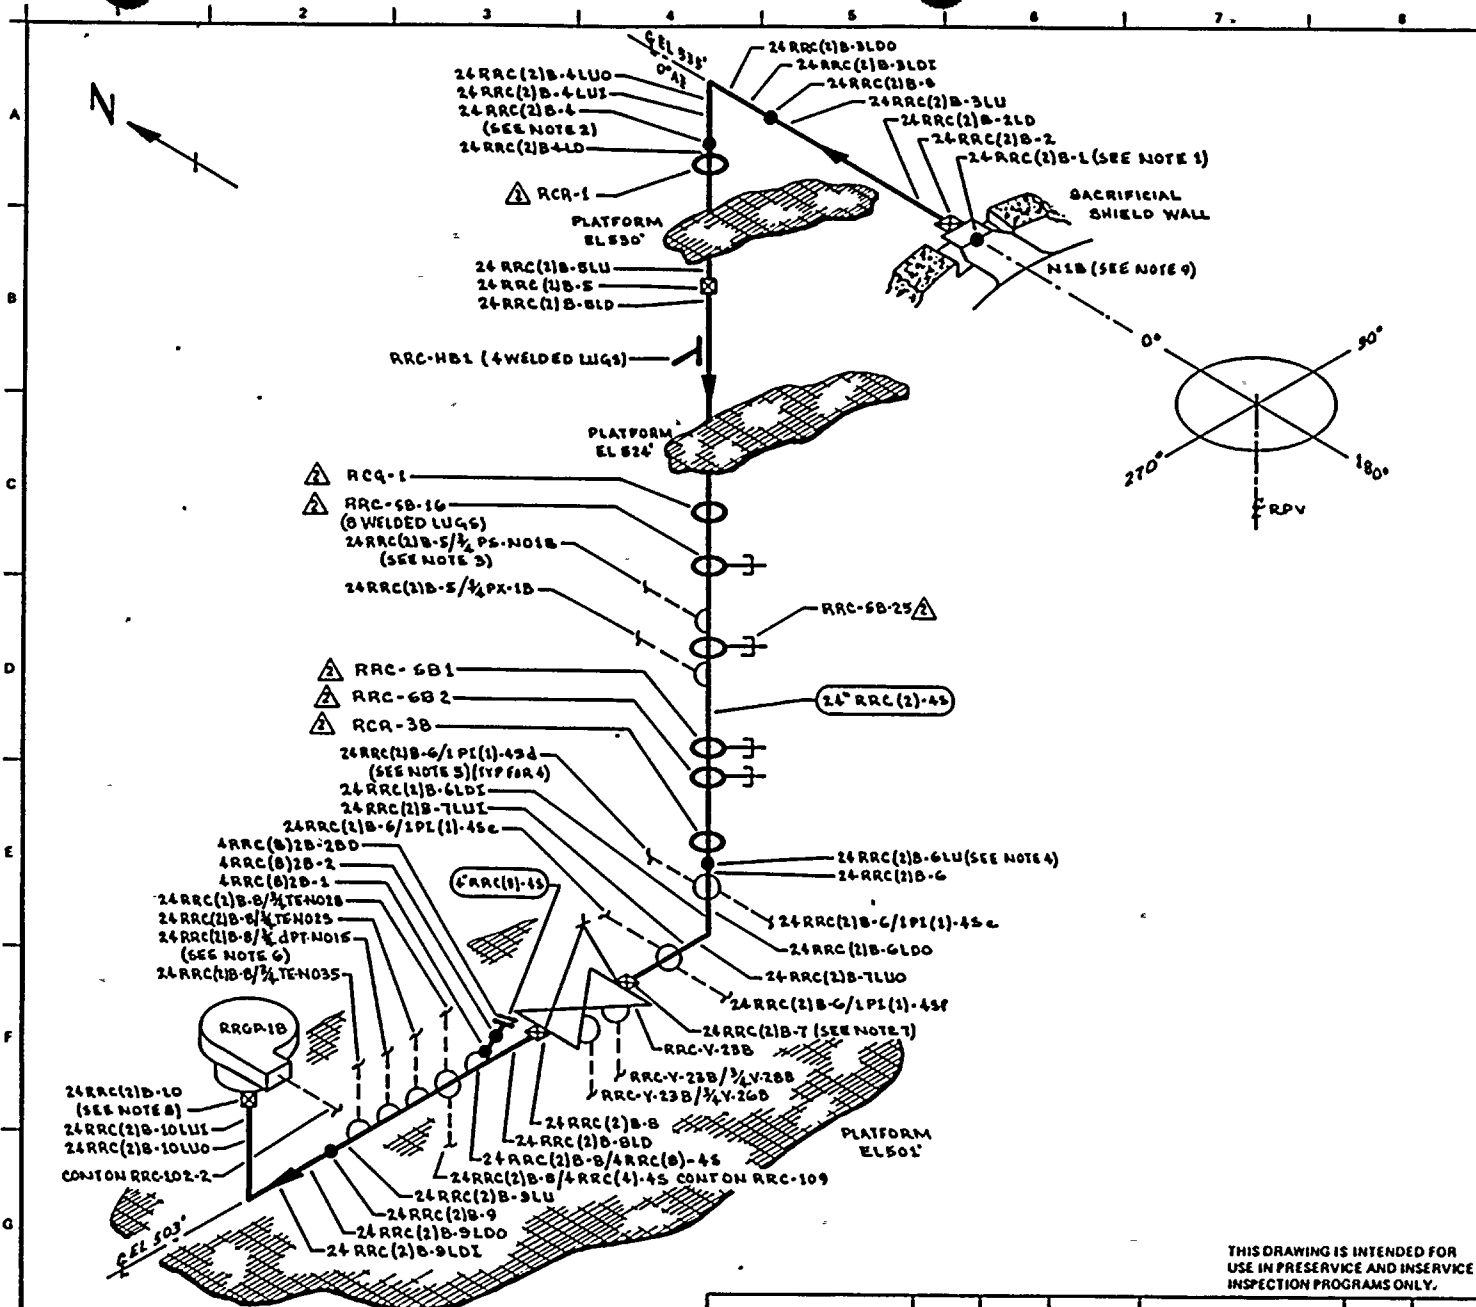

- NOTES:**
- WELD 24RRC(2)B-1 UTILIZES CAL BLOCK UT-101
 - ACCESS TO WELD 24RRC(2)B-4 REQUIRES REMOVAL OF RCR-1.
 - EXTEND LEAKAGE EXAM THROUGH PENETRATION (X-624) THROUGH EXCESS FLOW CHECK VALVE TO INSTRUMENT TUBING CONNECTION.
 - ACCESS TO WELD 24RRC(2)B-6 REQUIRES REMOVAL OF RRC-3B.
 - EXTEND LEAKAGE EXAM THROUGH CONTAINMENT PENETRATION (X-76C, X-76D, X-76E (X-76F) THROUGH EXCESS FLOW CHECK VALVES TO INSTRUMENT TUBING CONNECTIONS.
 - EXTEND LEAKAGE EXAM THROUGH CONTAINMENT PENETRATION (X-414) THROUGH EXCESS FLOW CHECK VALVE TO INSTRUMENT TUBING CONNECTION.
 - WELD 24RRC(2)B-7 IS FITTING TO FITTING.
 - WELD 24RRC(2)B-10 IS FITTING TO FITTING.
 - FOR NOZZLE ASSY. DET. SEE RPV-105.
 - PIPING PURCHASED TO MIN. WALL SPEC - 0.910

- REFERENCES:**
- GENERAL ELECTRIC DRAWINGS
- | | |
|----------------|-------|
| 761 E 424 | REV 2 |
| 762 E 538 SH 1 | REV 3 |
| 762 E 538 SH 2 | REV 3 |
| 761 E 78E | REV 6 |
| 131 C 758G | REV 4 |
| 131 C 758T | REV 3 |
- CB&I NUCLEAR CO.
4B, REV 4 N1 NOZZLE ASSEMBLY
DOVEE CRAIG/GERT
BC/G-217 REV 7

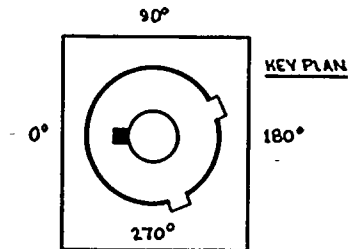

THIS DRAWING IS INTENDED FOR USE IN PRESERVICE AND INSERVICE INSPECTION PROGRAMS ONLY.

QUALITY CLASS: 1 ASME CODE CLASS: 1
ENGR: D THAMMIS DRAWN: V Mc L DATE: 8-29-78



WASHINGTON PUBLIC POWER SUPPLY SYSTEM
PACIFIC WASHINGTON POWER

NO	DATE	REVISION	BY	CHKD	APPVD
2	11/11/81	REVISED AS NOTED ADDED KEYPLAN & LUGS	KMA	SP	TIN
1	11-5-80	ADDED NOTE 9	KMA	SP	TIN
0	11-27-78	ISSUED FOR USE	KMA	SP	TIN
A	5-17-78	ISSUED FOR INFORMATION ONLY	KMA	SP	TIN


PIPING SYSTEM	NOM DIA (IN)	SCH	NOM WALL THK	MATERIAL SPECIFICATION	MATL TYPE	CAL BLOCK NO
24" RRC(2)-45	24	XXX	SEE NOTE 10	SA 358 QR304 CL I	88	UT-7
4" RRC(8)-45	4	80	0.237	SA 376 TP 304	85	UT-31
LUGS	NA	NA	NA	SA 240 TP 304	86	UT-47

WNP-2
WELD & COMPONENT
IDENTIFICATION DIAGRAM

TITLE:
REACTOR RECIRCULATION LOOP B

DWG NO: RRC-102-1 REV 2




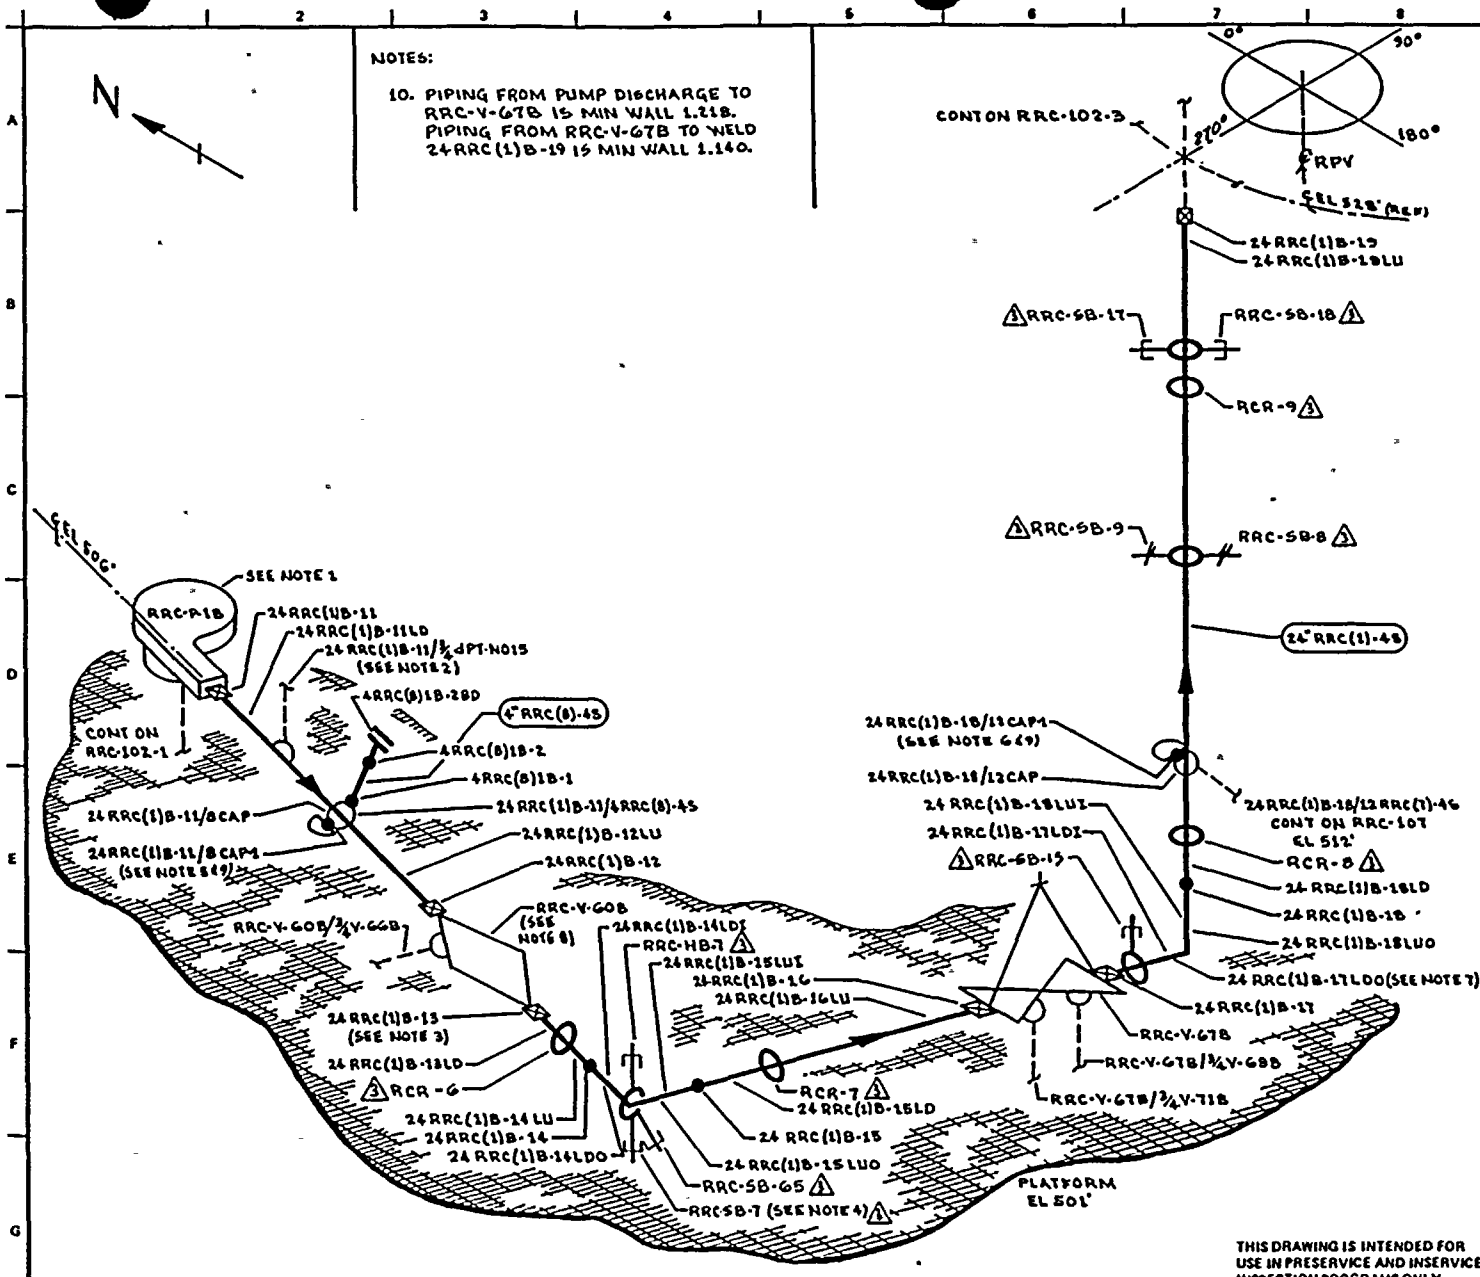

NOTES:
 10. PIPING FROM PUMP DISCHARGE TO RRC-V-67B 15 MIN WALL 1.218.
 PIPING FROM RRC-V-67B TO WELD 24 RRC(1)B-19 15 MIN WALL 1.140.

NOTES:
 1. SEE RRC-P-18 DETAIL DWG RRC-108 FOR PUMP SUPPORT DETAILS.
 2. EXTEND LEAKAGE EXAM THROUGH CONTAINMENT PENETRATION (X-41 d) THROUGH EXCESS FLOW CHECK VALVE TO INSTRUMENT TUBING CONNECTION.
 2. ACCESS TO WELD 24 RRC(1)B-13 REQUIRES REMOVAL OF RCR-6.
 4. SPECIAL CLAMP WITH HB7 & SB7 ATTACHMENTS.
 5. WELD 24 RRC(1)B-11/SCAP1 IS FITTING TO FITTING.
 6. WELD 24 RRC(1)B-18/LOCAP1 IS FITTING TO FITTING.
 7. WELD 24 RRC(1)B-17 IS FITTING TO FITTING.
 8. RRC-V-60B HAS TWELVE (12) 2 1/2 X 15" BODY TO BONNET STUDS.
 9. CAP 10 NOZZLE WELDS ARE CLAD ON THE ID IN THE WELD AREA. SEE REF DWG 131 C 7588 & 131 C 7589.

REFERENCES:
 GENERAL ELECTRIC DRAWINGS
 761 E 424 REV 2
 762 B 530 541 REV 3
 762 E 530 542 REV 5
 761 E 735 REV 6
 131 C 7588 REV 3
 131 C 7589 REV 5
 131 C 7592 REV 3
 BOVEE CRAIG/GERI
 BC/Q-218 REV 7

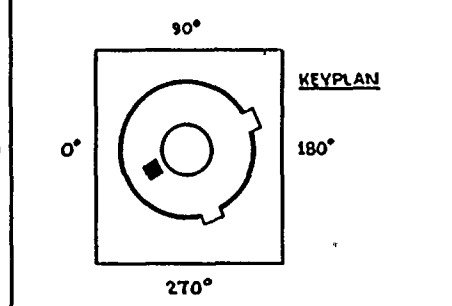



QUALITY CLASS: 1 ASME CODE CLASS: 1
 ENGR: D TIMMING DRAWN: K M L DATE: 3-30-78
 WASHINGTON PUBLIC POWER SUPPLY SYSTEM
 RICHLAND, WASHINGTON 99352

THIS DRAWING IS INTENDED FOR USE IN PRESERVE AND INSERVICE INSPECTION PROGRAMS ONLY.


				PIPING SYSTEM	NOM DIA (IN)	SCH	NOM WALL THK	MATERIAL SPECIFICATION	MATL TYPE	CAL BLOCK NO	
3	11-18-83	REVISED AS NOTED ADDED KEYPLAN	K.M.L. J.P.R.	24 RRC(1)B-15	24	XXX	SEE NOTE 10	SA 338 GR 304 CL 1	56	UT-7	
2	11-5-80	REVISED AS NOTED	K.M.L. J.P.R.	4" RRC(8)B-45	4	40	0.237	SA 376 TP 304	55	UT-21	
1	7-17-79	RELOCATED AT ANGLE ORIENTATION FOR CLARITY, IN A-7	K.M.L. J.P.R.	△ CAP	12	80	0.688	SA 408 GR WP 304	55	UT-19	
0	11-7-78	ISSUED FOR USE	K.M.L. J.P.R.	△ CAP	8	"	0.500	- - - - -	55	UT-20	
A	5-19-78	ISSUED FOR INFORMATION ONLY	K.M.L. J.P.R.								
NO	DATE	REVISION	BY	CHKD	APPVD						

WNP-2
 WELD & COMPONENT
 IDENTIFICATION DIAGRAM
 TITLE: REACTOR RECIRCULATION LOOP B
 DWG NO: RRC-102-2
 REV B



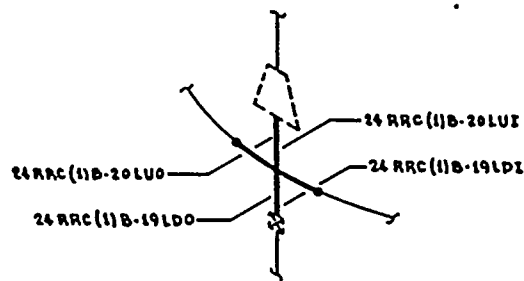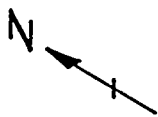


DETAIL 1
(SEE NOTE 3)

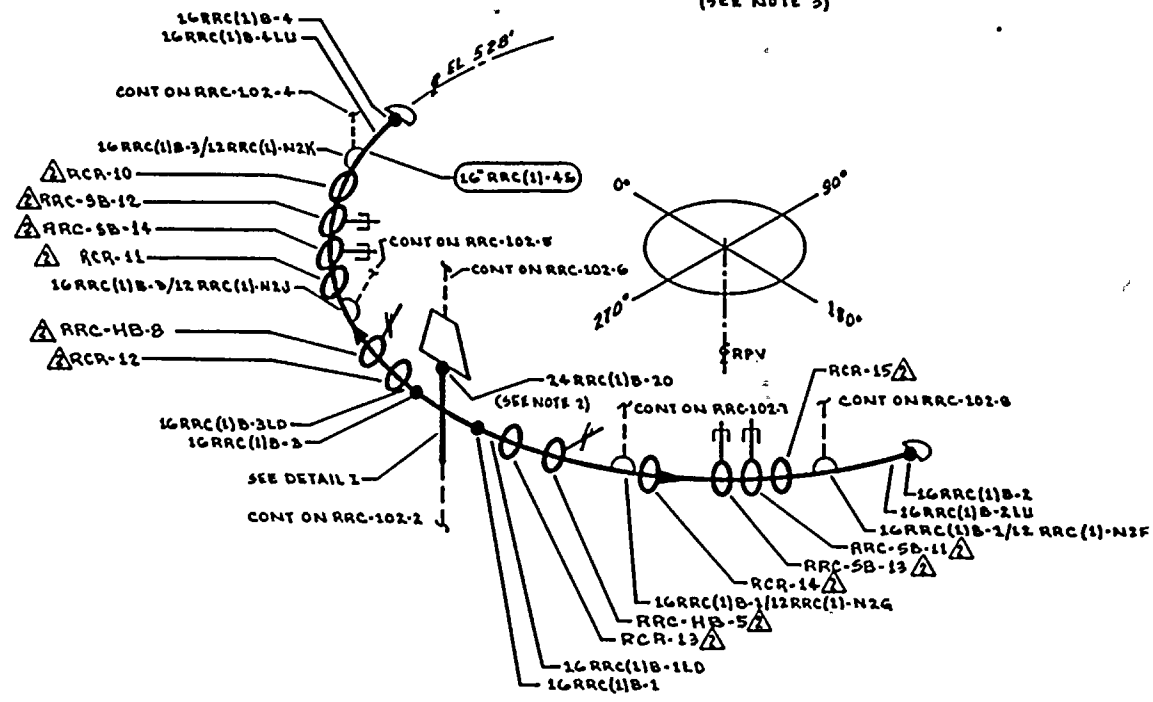

- NOTES:**
1. ACCESS TO WELDS 16 RRC(1)B-1 THRU 4 & 24 RRC(1)B-20 REQUIRES TEMPORARY SCAFFOLDING.
 2. WELD 24 RRC(1)B-20 IS FITTING TO FITTING.
 3. LONGITUDINAL WELDS ON CROSS LOCATED INBOARD & OUTBOARD, IN RESPECT TO THE RPV, ARE 90° FROM HEADER CONNECTIONS.

- REFERENCES:**
- GENERAL ELECTRIC DRAWINGS
- 761 E 424 REV 2
 - 762 E 538 SH 1 REV 3
 - 762 E 538 SH 2 REV 3
 - 761 E 738 REV 6
 - 131 C 7550 REV 1
- BOVES CRAL/GERI
BC/A-21B REV B

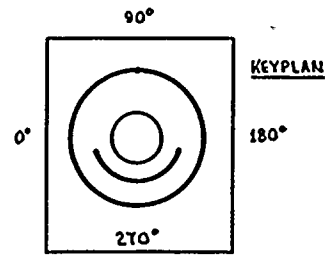

QUALITY CLASS: 1 | ASME CODE CLASS: 1
ENGR: D TIMMINS | DRAWN: K.M.C.A. | DATE: 8-30-78



THIS DRAWING IS INTENDED FOR USE IN PRESERVICE AND INSERVICE INSPECTION PROGRAMS ONLY.

PIPING SYSTEM	NOM DIA (IN)	SCH	NOM WALL THK	MATERIAL SPECIFICATION	MATL TYPE	CAL BLOCK NO
24" RRC(1) 45	24	XXX	1.140	SA 358 QR 304 CLT	SS	UT-7
16" RRC(1) 45	16	XXX	0.758	SA 358 GR 304 CLT	SS	UT-13


NO	DATE	REVISION	BY	CHKD	APPVD
2	9-16-78	REVISED AS NOTED ADDED KEYPLAN	K.M.A.	J.S.C.	J.F.H.
1	7-17-78	REVISED REVISION LETTERING TO REFLECT AS BUILT. REVISED CROSS REFERENCE TO 102-3. ADDED DETAIL FOR CLASITY. REVISED CROSS REFERENCE TO 102-3.	K.M.A.	J.F.H.	J.F.H.
0	11-27-78	ISSUED FOR USE	K.M.A.	D.W.	J.F.H.
A	5-14-78	ISSUED FOR INFORMATION ONLY	K.M.A.	D.W.	J.F.H.

WHP-2
WELD & COMPONENT IDENTIFICATION DIAGRAM

TITLE:
REACTOR RECIRCULATION LOOP B

DWG NO: RRC-102-3 | REV 2




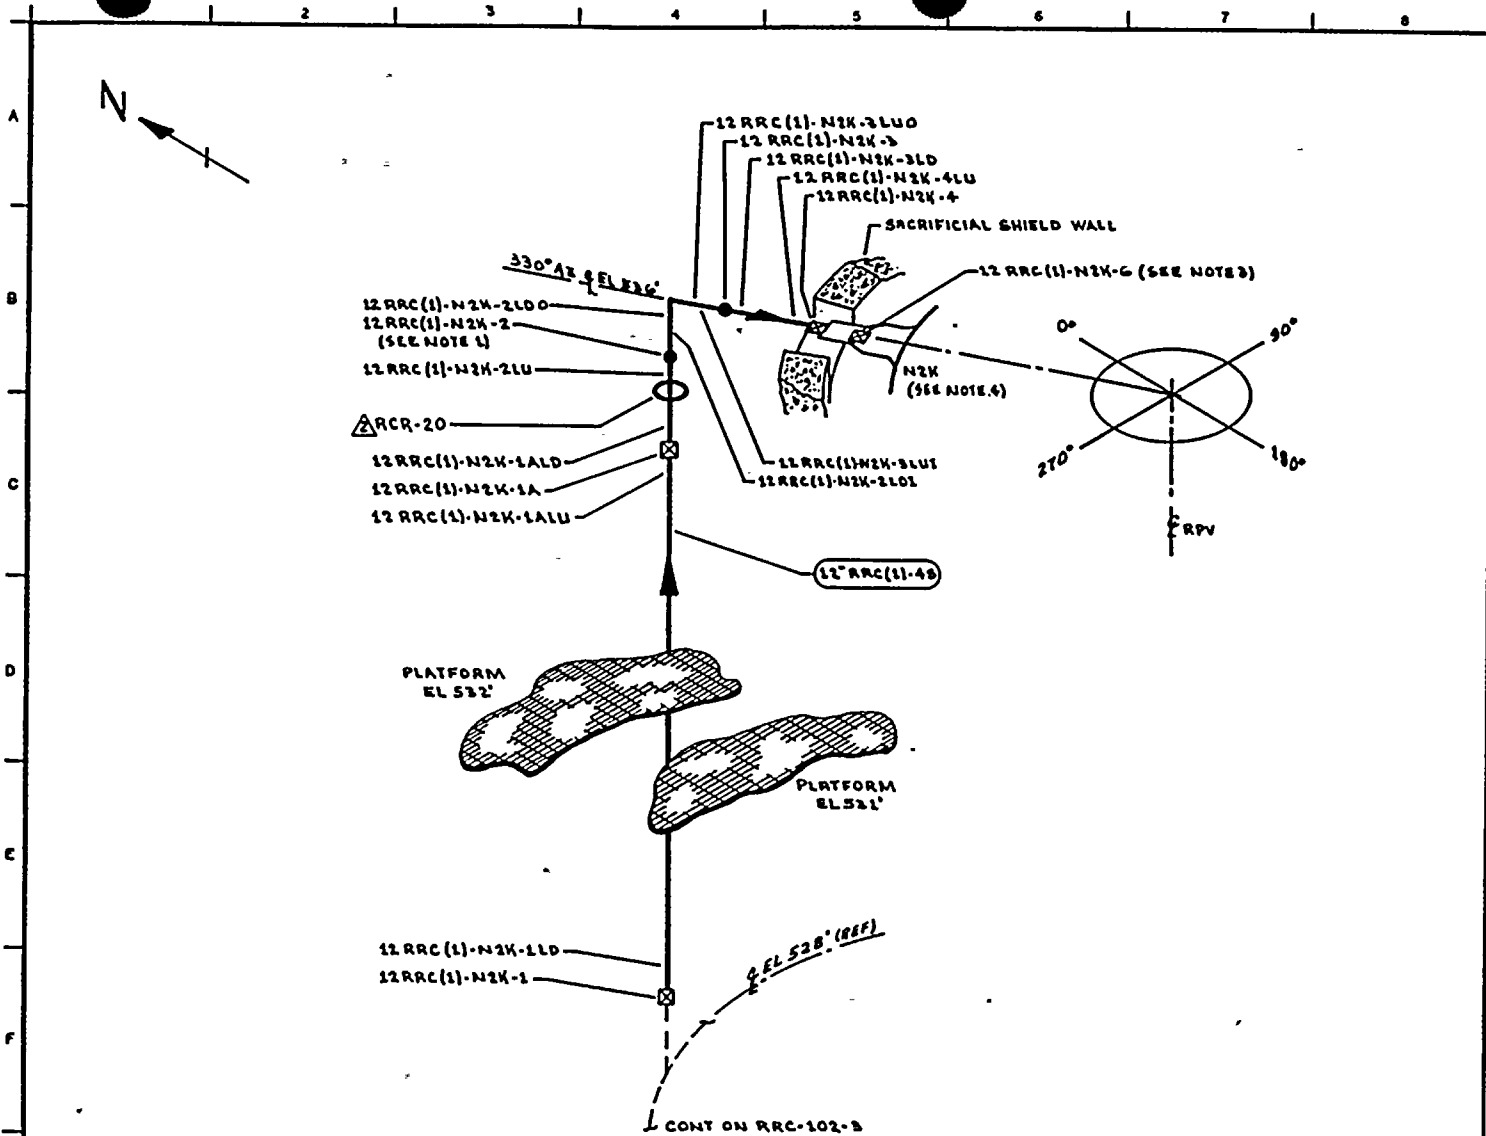

CONT ON RRC-102-3

- NOTES:
1. ACCESS TO WELD 12 RRC(1)-N2K-2 REQUIRES REMOVAL OF RCR-20.
 2. DELETED
 3. WELD 12 RRC(1)-N2K-6 UTILIZES CAL BLOCK UT-311.
 4. FOR NOZZLE ASSEMBLY DETAILS SEE RPV-106.
 5. PIPING PURCHASED TO MIN WALL SPECIFICATION. MIN WALL 0.604".

- REFERENCES:
- GENERAL ELECTRIC DRAWINGS
- 761 E 424 REV 2
 - 761 E 538 SH 1 REV 3
 - 761 E 538 SH 2 REV 3
 - 761 E 735 REV 6
- CBT NUCLEAR CO.
- B2, REV 10, N2 NOZZLE ASSEMBLY
- BOVEE CRAWL/GERI
- BC/G-218 REV 7

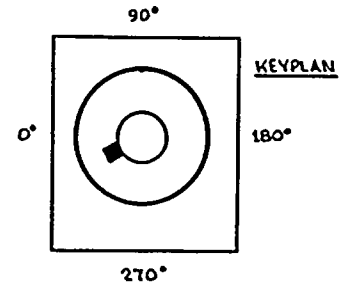

THIS DRAWING IS INTENDED FOR USE IN PRESERVICE AND INSERVICE INSPECTION PROGRAMS ONLY.

QUALITY CLASS: 1 ASME CODE CLASS: 1
 ENGR: D TIMMINS DRAWN: V M C A DATE: 3-31-76

WASHINGTON PUBLIC POWER SUPPLY SYSTEM
 RICHLAND, WASHINGTON 99352

PIPING SYSTEM	NOM DIA (DN)	SCH	NOM WALL THK	MATERIAL SPECIFICATION	MATL TYPE	CAL BLOCK NO
12" RRC(1)-49	12	XXX	SEE NOTE 5	SA 358 QR 304 CL1	SS	UT-19



NO	DATE	REVISION	BY	CHKD	APPVD
2	10-13-78	REVISED AS NOTED ADDED KEYPLAN	KMA	ZPC	TJH
1	7-17-79	REVISED WITH LETTERING FROM FLOW, DELETED NOTE #2 & WELD #2, ADDED FV 3A WELDS 1ALU & 1AID PER AS BUILT.	KMA	POB	WLB
0	11-27-78	ISSUED FOR USE	KMA	SC	WLB
A	5-14-76	ISSUED FOR INFORMATION ONLY	KMA	SC	WLB

WNP-2
 WELD & COMPONENT
 IDENTIFICATION DIAGRAM

TITLE:
 REACTOR RECIRCULATION LOOP B

DWG NO: RRC-102-4 REV 2



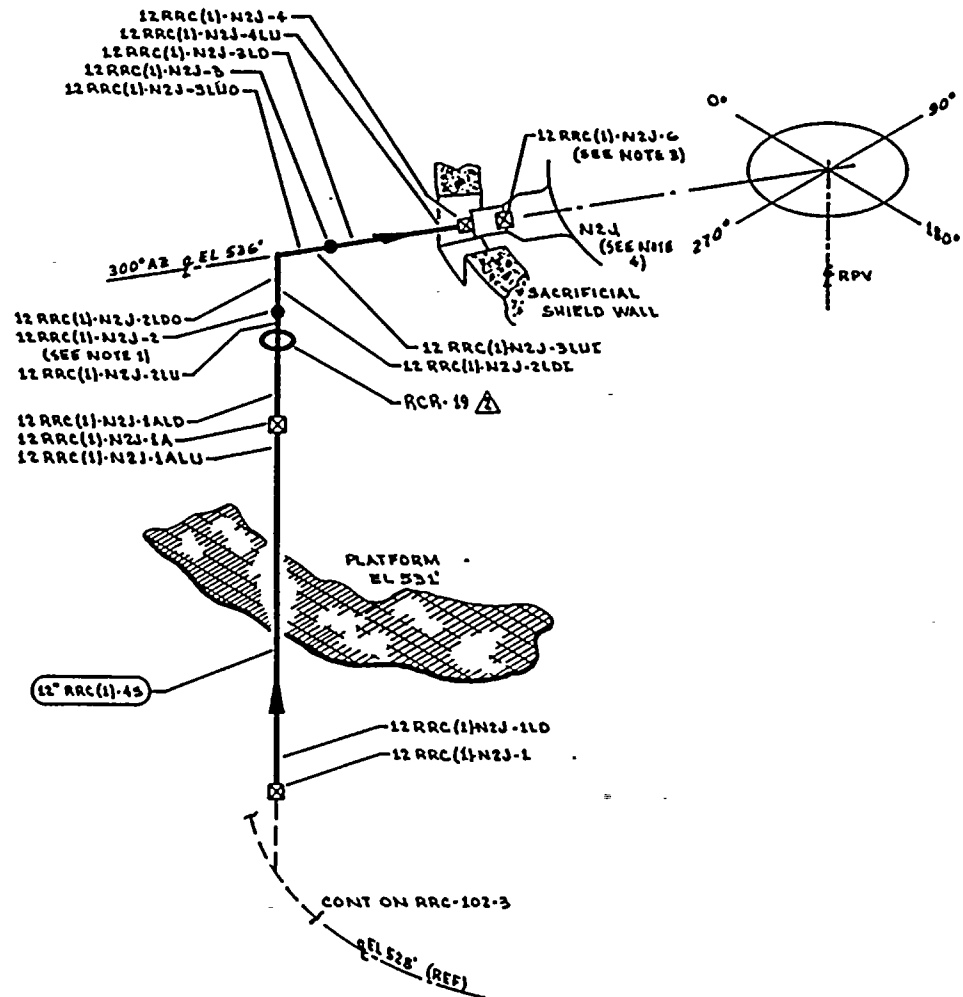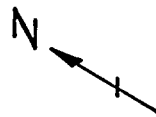


NOTES:

1. ACCESS TO WELD 12 RRC (1)-N2J -2
 ▲ REQUIRES REMOVAL OF RCR-19.
2. DELETED
3. WELD 12 RRC (1)-N2J-6 UTILIZES CAL BLOCK UT-111.
4. FOR NOZZLE ASSEMBLY DETAILS SEE RPV-106.
5. PIPING PURCHASED TO MIN WALL SPECIFICATION, MIN WALL 0.604".

REFERENCES:

- GENERAL ELECTRIC DRAWINGS**
- 761 E 424 REV 2
 - 762 E 538 SH 1 REV 3
 - 762 E 538 SH 2 REV 3
 - 761 E 795 REV 6
- CBI NUCLEAR CO.**
- 52, REV 10, N2 NOZZLE ASSEMBLY
- BOVEE CRAIL / GERL**
- BC/G-218 REV 7

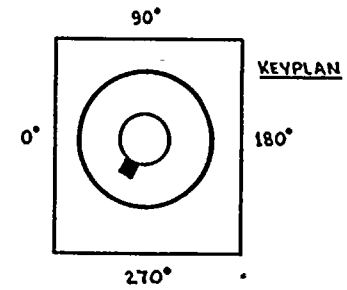

THIS DRAWING IS INTENDED FOR USE IN PRESERVICE AND INSERVICE INSPECTION PROGRAMS ONLY.

QUALITY CLASS: 1	ASME CODE CLASS: 1
ENGR: D TIMMINS	DRAWN: K MCA
	DATE: 3-31-78


WASHINGTON PUBLIC POWER SUPPLY SYSTEM
 RICHLAND, WASHINGTON 99052

PIPING SYSTEM	NOM DIA (IN)	SCH	NOM WALL THK	MATERIAL SPECIFICATION	MATL TYPE	CAL BLOCK NO
12" RRC (1)-45	12	XXX	SEE NOTE 5	SA 358 GR 304 CL 1	SS	UT-19



NO	DATE	REVISION	BY	CHKD	APPVD
2	4-26-78	REVISED AS NOTED ADDED KEYPLAN	KMA	DKR	TFH
1	1-17-78	REVISED AS NOTED DELETED NOTE # 2	KMA	DKR	TFH
0	11-21-77	ISSUED FOR USE	KMA	NR	TFH
A	5-19-78	ISSUED FOR INFORMATION ONLY	KMA	DKR	TFH

WNP-2
WELD B COMPONENT
IDENTIFICATION DIAGRAM

TITLE:
REACTOR RECIRCULATION LOOP B


DWG NO: RRC-102-5 REV 2



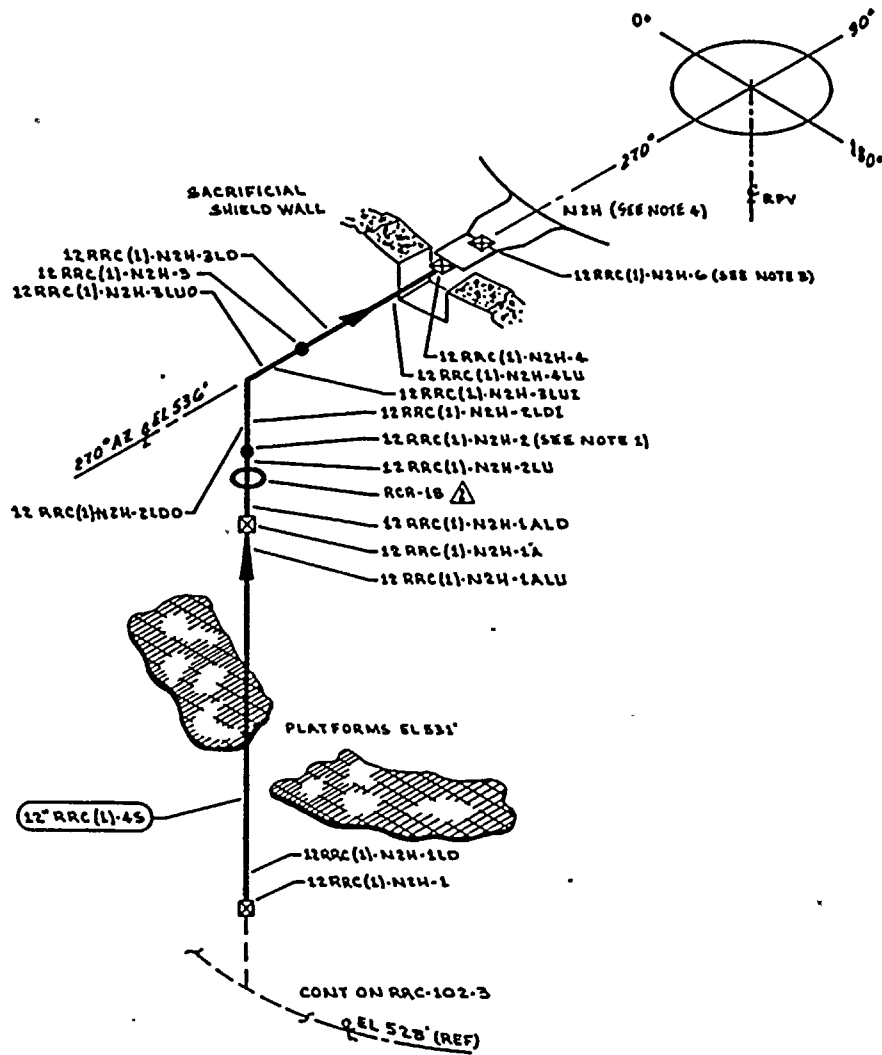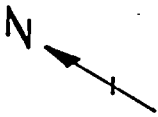

- NOTES:
1. ACCESS TO WELD 12RRC(1)-N2H-2 REQUIRES REMOVAL OF RCR-1B.
 2. DELETED
 3. WELD 12RRC(1)-N2H-6 UTILIZES CAL BLOCK UT-111.
 4. FOR NOZZLE ASSEMBLY DETAILS SEE RPV-106.
 5. PIPING PURCHASED TO MIN WALL SPECIFICATION. MIN WALL 0.604".

- REFERENCES:
- GENERAL ELECTRIC DRAWINGS
- 761 E 424 REV 2
 - 762 E 538 SH 1 REV 3
 - 762 E 538 SH 2 REV 3
 - 761 E 735 REV 6
- CBI NUCLEAR CO.
- 52, REV 10, N2 NOZZLE ASSEMBLY
- BOVER CRAL/GERI
- BC/G-218 REV 7

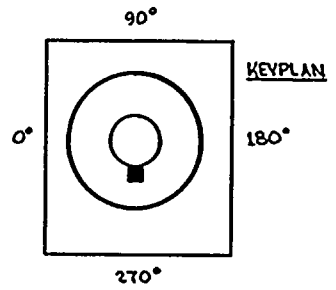

THIS DRAWING IS INTENDED FOR USE IN PRESERVICE AND INSERVICE INSPECTION PROGRAMS ONLY.

QUALITY CLASS: 1	ASME CODE CLASS: 1
ENGR: D TIMMINS	DATE: 3-31-76

WASHINGTON PUBLIC POWER SUPPLY SYSTEM
RICHMOND, WASHINGTON 98352

WNP-2
WELD 8 COMPONENT
IDENTIFICATION DIAGRAM


NO	DATE	REVISION	BY	CHKD	APPVD	PIPING SYSTEM	NOM DIA (IN)	SCH	NOM WALL THK	MATERIAL SPECIFICATION	MATL TYPE	CAL BLOCK NO
2	9-26-71	REVISED AS NOTED ADDED KEYPLAN	KJA	EPR	TFW	12" RRC (1)-45	12	XXX	SEE NOTES	SA 358 GR 904 CL1	SS	UT-19
1	7-17-70	REVISED NOTE #2 & WELD #3. ADDED TW #1A & WELD #1A & 1A. PER AS QUOTED IN NOTE #1.	KJA	EPR	TFW							
0	11-27-70	ISSUED FOR USE	KJA	EPR	TFW							
A	5-19-78	ISSUED FOR INFORMATION ONLY	KJA	EPR	TFW							

TITLE:
REACTOR RECIRCULATION LOOP B

DWG NO: RRC-102-6


REV 2



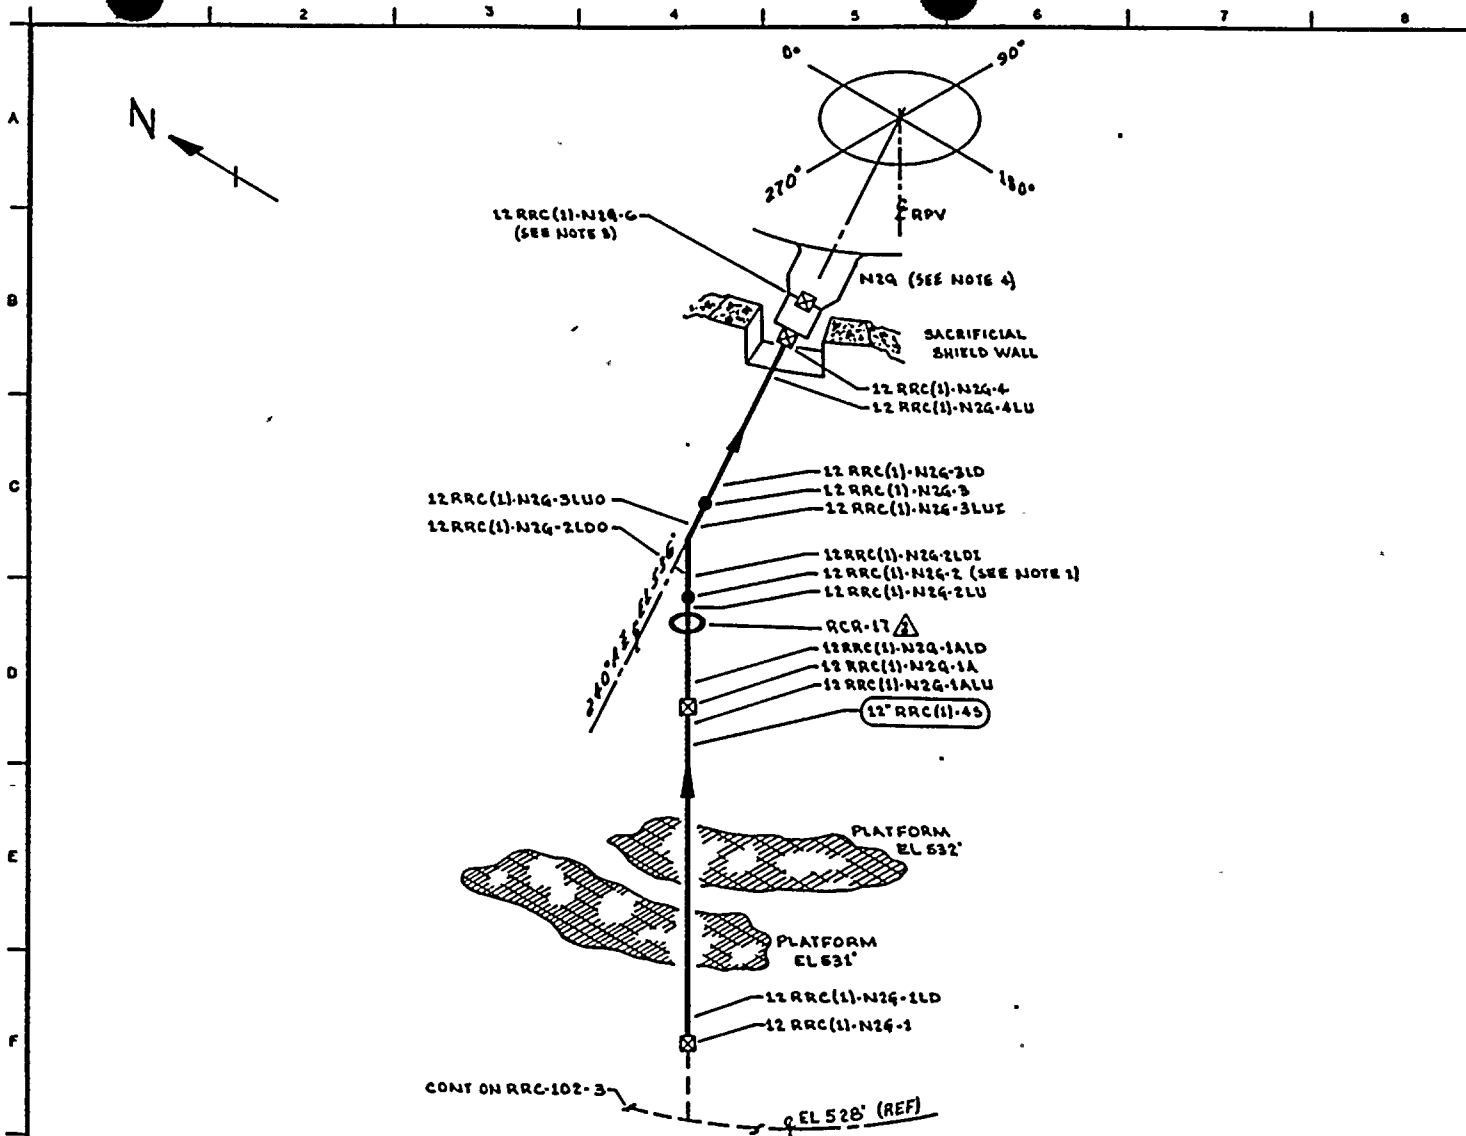

- NOTES:**
1. ACCESS TO WELD 12RRC(1)-N2Q-2 REQUIRES REMOVAL OF RCR-17.
 2. DELETED
 3. WELD 12RRC(1)-N2Q-6 UTILIZES CAL BLOCK UT-111.
 4. FOR NOZZLE ASSEMBLY DETAILS SEE RPV-106.
 5. PIPING PURCHASED TO MIN WALL SPECIFICATION. MIN WALL 0.604".

- REFERENCES:**
- GENERAL ELECTRIC DRAWINGS
- 761 E 424 REV 2
 - 762 E 538 SH 1 REV 3
 - 762 E 538 SH 2 REV 3
 - 761 E 786 REV 6
- CBI NUCLEAR CO.
62, REV 10, N2 NOZZLE ASSEMBLY
- BOVEK CRAIL/GERE
BC/Q-218 REV 7

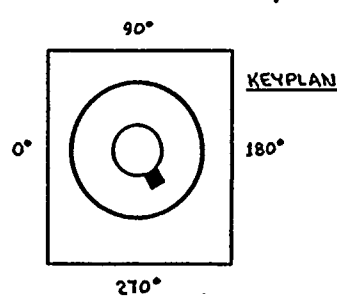

QUALITY CLASS: 1 | ASME CODE CLASS: 1
ENGR: D TIMMINS | DRAWN: K.M.C.L. | DATE: 3-31-76



THIS DRAWING IS INTENDED FOR USE IN PRESERVICE AND INSERVICE INSPECTION PROGRAMS ONLY.

WNP-2
WELD B COMPONENT
IDENTIFICATION DIAGRAM


TITLE:
REACTOR RECIRCULATION LOOP B

OWG NO: RRC-102-T | REV 2

PIPING SYSTEM	NOM DIA (IN)	SCH	NOM WALL THK	MATERIAL SPECIFICATION	MATL TYPE	CAL BLOCK NO
12" RRC(1)-48	12	XXX	SEE NOTES	SA 358 GR 304 CL 1	SS	UT-19


NO	DATE	REVISION	BY	CHKD	APPVD
2	9-22-73	REVISED AS NOTED ADDED KEYPLAN	K/KA	CR	TFH
1	7-17-79	REVISED RISER LETTERING FROM J194. OBELETED WELD P.S. NOTE 12. ADDED PW 31A & WELDS 1A1U & 1A1U WELD FOR ASSEMBLY.	K/KA	CR	TFH
0	11-21-76	ISSUED FOR USE	K/KA	CR	TFH
A	5-19-76	ISSUED FOR INFORMATION ONLY	K/KA	CR	TFH
NO					



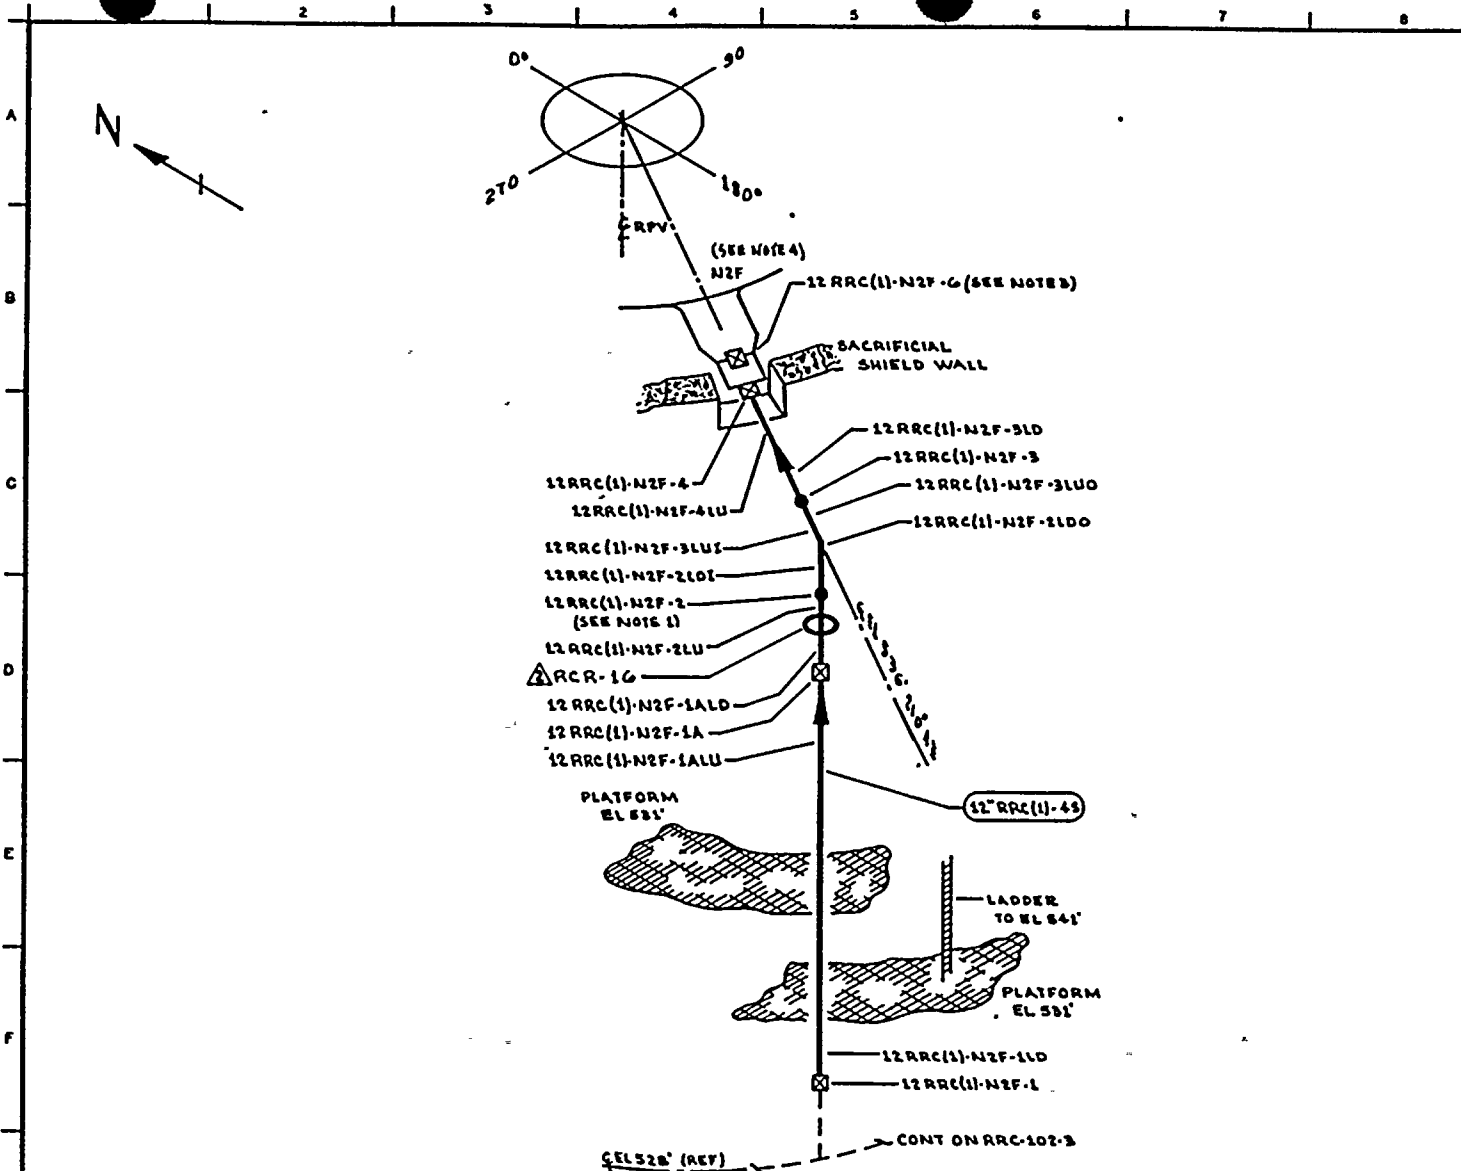

- NOTES:**
1. ACCESS TO WELD 12RRC(1)-N2F-2 REQUIRES REMOVAL OF RCR-16.
 2. DELETED
 3. WELD 12RRC(1)-N2F-6 UTILIZES CAL BLOCK UT-111.
 4. FOR NOZZLE ASSEMBLY DETAILS SEE RPY-106.
 5. PIPING PURCHASED TO MIN WALL SPECIFICATION. MIN WALL 0.604".

- REFERENCES:**
- GENERAL ELECTRIC DRAWINGS
- 761 E 424 REV 2
 - 762 E 538 SH 1 REV 3
 - 762 E 538 SH 2 REV 3
 - 761 E 735 REV 6
- CBI NUCLEAR CO.
- 52, REV 10, N2 NOZZLE ASSEMBLY
- BOVEE CRAIL/GERE
- BC/G-218 REV 7

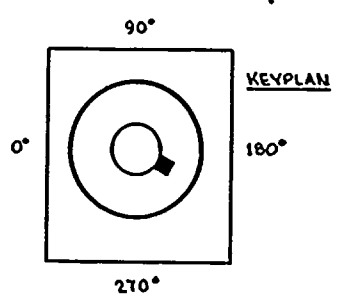

THIS DRAWING IS INTENDED FOR USE IN PRESERVICE AND INSERVICE INSPECTION PROGRAMS ONLY.

QUALITY CLASS: 1 ASME CODE CLASS: 1
 ENGR: D TIMMANS DRAWN: X, MCA DATE: 4-3-78



WNP-2
 WELD B COMPONENT
 IDENTIFICATION DIAGRAM

NO	DATE	REVISION	BY	CHKD	APPVD
2	2-16-82	REVISED AS NOTED ADDED KEYPLAN	K/A	DK	TFH
1	1-17-78	REVISED RCR LETTERING FROM K TO F, DELETED WELD # 5 (NOTE 1) ADDED RPY-106, CALIBER 1ALU & 1ALD PER AS BUILT.	K/A	DK	TFH
0	11-27-78	ISSUED FOR USE	K/A	DK	TFH
A	5-19-78	ISSUED FOR INFORMATION ONLY	K/A	DK	TFH

PIPING SYSTEM	NOM DIA (IN)	SCH	NOM WALL THK	MATERIAL SPECIFICATION	MATL TYPE	CAL BLOCK NO
12" RRC(1)-45	12	XXI	SEE NOTE 5	SA 358 GR 504 CL1	CS	UT-19

TITLE:
 REACTOR RECIRCULATION LOOP B

DWG NO: RRC-102-B REV 2



WNP-02
 INTERVAL: PSI
 PERIOD: NA
 OUTAGE:
 DRAWING NO. RRC-102

WASHINGTON PUBLIC POWER SUPPLY SYSTEM
 PROGRAM PLAN AND SCHEDULE
 SYSTEM OR COMPONENT: RRC(2)-4S
 DESCRIPTION: REACTOR RECIR LOOP B

PAGE 001
 DATE 12/14/84

<u>IDENT. NO.</u>	<u>DESCRIPTION</u>	<u>SECT.</u> <u>XI</u> <u>EXAM.</u>	<u>EXAM</u> <u>MTM.</u>	<u>PROCEDURE</u>	<u>CAL.</u> <u>BLOCK</u>	<u>INSERVICE</u>		<u>NOTES</u>
						<u>REQ.</u>	<u>SCHEDULED</u> <u>OUTAGE</u>	
24RRC(2)B-1	NOZ TO SE	B-F	VOL	UTP-10	UT-101			
			SUR	PTP-1				
24RRC(2)B-2	SE TO PIPE	B-J	VOL	UTP-10	UT-7			
			SUR	PTP-1				
24RRC(2)B-2LD	PIPE SEAM	B-J	VOL	UTP-10	UT-7			
			SUR	PTP-1				
24RRC(2)B-3LU	PIPE SEAM	B-J	VOL	UTP-10	UT-7			
			SUR	PTP-1				
24RRC(2)B-3	PIPE TO EL	B-J	VOL	UTP-10	UT-7			
			SUR	PTP-1				
24RRC(2)B-3LDD	EL SEAM	B-J	VOL	UTP-10	UT-7			
			SUR	PTP-1				
24RRC(2)B-3LDI	EL SEAM	B-J	VOL	UTP-10	UT-7			
			SUR	PTP-1				
24RRC(2)B-4LUI	EL SEAM	B-J	VOL	UTP-10	UT-7			
			SUR	PTP-1				
24RRC(2)B-4LUO	EL SEAM	B-J	VOL	UTP-10	UT-7			
			SUR	PTP-1				

WNP-02
 INTERVAL: PSI
 PERIOD: NA
 OUTAGE:
 DRAWING NO. RRC-102

WASHINGTON PUBLIC POWER SUPPLY SYSTEM
 PROGRAM PLAN AND SCHEDULE
 SYSTEM OR COMPONENT: RRC(2)-4S
 DESCRIPTION: REACTOR RECIR LOOP-B

PAGE 002
 DATE 12/14/84

<u>IDENT. NO.</u>	<u>DESCRIPTION</u>	<u>SECT.</u> <u>XI</u>	<u>EXAM</u> <u>MTH.</u>	<u>PROCEDURE</u>	<u>CAL.</u> <u>BLOCK</u>	<u>INSERVICE</u>		<u>NOTES</u>
						<u>REQ.</u>	<u>SCHEDULED</u> <u>OUTAGE</u>	
24RRC(2)B-4	EL TO PIPE	B-J	VOL	UTP-10	UT-7			
			SUR	PTP-1				
24RRC(2)B-4LD	PIPE SEAM	B-J	VOL	UTP-10	UT-7			
			SUR	PTP-1				
RRC-1B	PIPE WHIP	N/A	N/A	N/A				SEE NOTE #1
24RRC(2)B-5LU	PIPE SEAM	B-J	VOL	UTP-10	UT-7			
			SUR	PTP-1				
24RRC(2)B-5	PIPE TO PIPE	B-J	VOL	UTP-10	UT-7			
			SUR	PTP-1				
24RRC(2)B-5LD	PIPE SEAM	B-J	VOL	UTP-10	UT-7			
			SUR	PTP-1				
RRC-HB-1(W)	4 WELDED LUGS	B-K-1	VOL	UTP-26	UT-7			
RRC-HB-1	SPRING (2)	B-K-2	VT-3	303/R.2.17				
			VT-4	303/R.2.17				
RCG-1	PIPE WHIP	N/A	N/A	N/A				SEE NOTE #1
RRC-SB-16(W)	8 WELDED LUGS	B-K-1	VOL	UTP-26	UT-7			
RRC-SB-16	PSA-35 SN(2)	B-K-2	VT-3	303/R.2.17				S/N E4222/W422

WNP-02
 INTERVAL: PSI
 PERIOD: NA
 OUTAGE:
 DRAWING NO. RRC-102

WASHINGTON PUBLIC POWER SUPPLY SYSTEM
 PROGRAM PLAN AND SCHEDULE
 SYSTEM OR COMPONENT: RRC(2)-4S
 DESCRIPTION: REACTOR RECIR LOOP B

PAGE 003
 DATE 12/14/84

<u>IDENT. NO.</u>	<u>DESCRIPTION</u>	<u>SECT.</u> XI	<u>EXAM</u> EXAM.	<u>PROCEDURE</u> MTH.	<u>CAL.</u> BLOCK	<u>INSERVICE</u>		<u>NOTES</u>
						<u>REQ.</u>	<u>SCHEDULED</u> OUTAGE	
24RRC(2)B-5/3/4PS-M018	INSTR CGNN	B-P	VT-2	N/A				S/N E4222/W422 SEE NOTES #6 & #7.
RRC-SB-25	PSA-35 SNUBBER	B-K-2	VT-3	303/8.2.17				S/N 4158
24RRC(2)B-5/3/4PX-1B	INSTR CONN	B-P	VT-2	N/A				S/N 4158 SEE NOTES #6 & #7.
RRC-SB-1	PSA-35 SNUBBER	B-K-2	VT-3	303/8.2.17				S/N 4161
RRC-SB-2	PSA-35 SNUBBER	B-K-2	VT-3	303/8.2.17				S/N 4161 S/N 4162
RRC-3B	PIPE WHIP	N/A	N/A	N/A				S/N 4162 SEE NOTE #1
24RRC(2)B-6LU	PIPE SEAM	B-J	VOL	UTP-10	UT-7			
24RRC(2)B-6	PIPE TO PIPE	B-J	VOL	UTP-10	UT-7			
24RRC(2)B-6LDD	EL SFAM	B-J	VOL	UTP-10	UT-7			
24RRC(2)B-6LDI	EL SEAM	B-J	VOL	UTP-10	UT-7			
			SUR	PTP-1				

WNP-02
 INTERVAL: PSI
 PERIOD: NA
 OUTAGE:
 DRAWING NO. RRC-102

WASHINGTON PUBLIC POWER SUPPLY SYSTEM
 PROGRAM PLAN AND SCHEDULE
 SYSTEM OR COMPONENT: RPC(2)-4S
 DESCRIPTION: REACTOR RECIR LOOP B

PAGE 004
 DATE 12/14/84

IDENT. NO.	DESCRIPTION	SECT. XI EXAM.	EXAM MTH.	PROCEDURE	CAL. BLOCK	INSERVICE		NOTES
						REQ.	SCHEDULED OUTAGE	
24RRC(2)B-6/1PI(1)-4SC	INSTR CONN	B-P	VT-2	N/A				SEE NOTES #6 & #7.
24RRC(2)B-6/1PI(1)-4SD	INSTR CONN	B-P	VT-2	N/A				SEE NOTES #6 & #7.
24RRC(2)B-6/1PI(1)-4SE	INSTR CONN	B-P	VT-2	N/A				SEE NOTES #6 & #7.
24RRC(2)B-6/1PI(1)-4SF	INSTR CONN	B-P	VT-2	N/A				SEE NOTES #6 & #7.
24RRC(2)B-7LU0	EL SEAM	B-J	VOL	UTP-10	UT-7			
			SUR	PTP-1				
24RRC(2)B-7LUI	EL SEAM	B-J	VOL	UTP-10	UT-7			
			SUR	PTP-1				
24RRC(2)B-7	EL TO VALVE	B-J	VOL	UTP-10	UT-7			
			SUR	PTP-1				
RRC-V-23B/3/4V-28B	VALVE DRAIN	B-P	VT-2	N/A				SEE NOTES #6 & #7.
RRC-V-23B/3/4V-26B	VALVE DRAIN	B-P	VT-2	N/A				SEE NOTES #6 & #7.
RRC-V-23B-BDY	VALVE BODY	B-M-2	VT-1	OCI 7-1				
RRC-V-23B-BLT	VALVE BOLTING	B-G-2	VT-1	OCI 7-1				
24RRC(2)B-8	VALVE TO PIPE	B-J	VOL	UTP-10	UT-7			
			SUR	PTP-1				
24RRC(2)B-8LD	PIPE SEAM	B-J	VOL	UTP-10	UT-7			
			SUR	PTP-1				

WNP-02
 INTERVAL: PSI
 PERIOD: NA
 OUTAGE:
 DRAWING NO. RRC-102

WASHINGTON PUBLIC POWER SUPPLY SYSTEM
 PROGRAM PLAN AND SCHEDULE
 SYSTEM OR COMPONENT: RRC(2)-4S
 DESCRIPTION: REACTOR RECIR LOOP B

PAGE 005
 DATE 12/14/84

IDENT. NO.	DESCRIPTION	SECT. XI EXAM.	EXAM MTH.	PROCEDURE	CAL. BLOCK	INSERVICE		NOTES
						REQ.	SCHEDULED OUTAGE	
24RRC(2)B-8/4RRC(8)-4S	PIPE TO SWL	B-J	SUR	PTP-1				
4RRC(8)2B-1	SWL TO PIPE	B-J	VOL	UTP-10	UT-31			
			SUR	PTP-1				
4RRC(8)2B-2	PIPE TO FLANGE	B-J	VOL	UTP-10	UT-31			
			SUR	PTP-1				
4RRC(8)2B-2B0	FLANGE BOLTING	B-G-2	VT-1	OCI 7-1				
24RRC(2)B-8/3/4TE-N028	INSTR CONN	B-P	VT-2	N/A				SEE NOTES #6 & #7.
24RRC(2)B-8/4RRC(4)-4S	PIPE TO SWL	B-J	SUR	PTP-1				
24RRC(2)B-8/3/4TE-N023	INSTR CONN	B-P	VT-2	N/A				SEE NOTES #6 & #7.
24RRC(2)B-8/3/4DPT-N015	INSTR CONN	B-P	VT-2	N/A				SEE NOTES #6 & #7.
24RRC(2)B-8/3/4TE-N035	INSTR CONN	B-P	VT-2	OCI 7-1				SEE NOTES #6 & #7.
24RRC(2)B-9LU	PIPE SEAM	B-J	VOL	UTP-10	UT-7			
			SUR	PTP-1				
24RRC(2)B-9	PIPE TO EL	B-J	VOL	UTP-10	UT-7			
			SUR	PTP-1				
24RRC(2)B-9LDO	EL SEAM	B-J	VOL	UTP-10	UT-7			
			SUR	PTP-1				
24RRC(2)B-9LDI	EL SFAM	B-J	VOL	UTP-10	UT-7			

WNP-02
 INTERVAL: PSI
 PERIOD: NA
 OUTAGE:
 DRAWING NO. RRC-102

WASHINGTON PUBLIC POWER SUPPLY SYSTEM
 PROGRAM PLAN AND SCHEDULE
 SYSTEM OR COMPONENT: RRC(2)-4S
 DESCRIPTION: REACTOR RECTR LOOP R

PAGE 006
 DATE 12/14/84

IDENT. NO.	DESCRIPTION	SECT. XI EXAM.	EXAM MTH.	PROCEDURE	CAL. BLOCK	INSERVICE		NOTES
						REQ.	SCHEDULED OUTAGE	
24RRC(2)B-10LUO	EL SEAM	B-J	VOL	UTP-10	UT-7			
24RRC(2)B-10LUI	EL SEAM	B-J	VOL	UTP-10	UT-7			
24RRC(2)B-10	EL TO PUMP	B-J	VOL	UTP-10	UT-7			
24RRC(1)B-11	PUMP TO PIPE	B-J	VOL	UTP-10	UT-7			
24RRC(1)B-11LD	PIPE SEAM	B-J	VOL	UTP-10	UT-7			
24RRC(1)B-11/3/4DPT-M015	INSTR CONN	B-P	VT-2	N/A				SEE NOTES #6 & #7.
24RRC(1)B-11/8CAP	PIPE TO SWL	B-J	VOL	UTP-10	UT-7			
24RRC(1)P-11/8CAP-1	SWL TO CAP	B-J	VOL	UTP-10	UT-26			FITTING TO FITTING
24RRC(1)B-11/4REC(8)-4S	PIPE TO SWL	B-J	SUR	PTP-1				FITTING TO FITTING
4RRC(8)B-1	SWL TO PIPE	B-J	VOL	UTP-10	UT-31			

WNP-02
 INTERVAL: PSI
 PERIOD: NA
 OUTAGE:
 DRAWING NO. RRC-102

WASHINGTON PUBLIC POWER SUPPLY SYSTEM
 PROGRAM PLAN AND SCHEDULE
 SYSTEM OR COMPONENT: RRC(21)-AS
 DESCRIPTION: REACTOR RECIR LOOP B

PAGE 007
 DATE 12/14/84

IDENT. NO.	DESCRIPTION	SECT. XI EXAM.	EXAM. MTH.	PROCEDURE	CAL. BLOCK	INSERVICE		NOTES
						REQ.	SCHEDULED OUTAGE	
4RRC(8)1B-2	PIPE TO FLANGE	B-J	VOL	UTP-10	UT-31			
4RRC(8)1B-2BD	FLANGE BOLTING	B-G-2	VT-1	QCI 7-1				
RRC-SB-66	PSA-35 SNUBBER	B-K-2	VT-3	303/R.2.17				S/N 4168
24RRC(1)R-12LU	PIPE SEAM	B-J	VOL	UTP-10	UT-7			S/N 4168
24RRC(1)B-12	PIPE TO VALVE	B-J	VOL	UTP-10	UT-7			
RRC-V-60B-BDY	VALVE BODY	B-M-2	VT-1	QCI 7-1				
RRC-V-60B-BLT	VALVE BOLTING	B-G-1	VOL	UTP-34	UT-43			STUDS: UT WHEN IN PLACE. PT & UT WHEN REMOVED.
			SUR	PTP-1				STUDS: UT WHEN IN PLACE. PT & UT WHEN REMOVED
			VT-1	QCI 7-1				STUDS: UT WHEN IN PLACE. PT & UT WHEN REMOVED

WNP-02
 INTERVAL: PSI
 PERIOD: NA
 OUTAGE:
 DRAWING NO. RRC-102

WASHINGTON PUBLIC POWER SUPPLY SYSTEM
 PROGRAM PLAN AND SCHEDULE
 SYSTEM OR COMPONENT: RRC(2)-4S
 DESCRIPTION: REACTOR RECIR LOOP B

PAGE 008
 DATE 12/14/84

<u>IDENT. NO.</u>	<u>DESCRIPTION</u>	<u>SECT.</u> <u>XI</u> <u>EXAM.</u>	<u>EXAM</u> <u>MTH.</u>	<u>PROCEDURE</u>	<u>CAL.</u> <u>BLOCK</u>	<u>INSERVICE</u>		<u>NOTES</u>
						<u>REQ.</u>	<u>SCHEDULED</u> <u>OUTAGE</u>	
RRC-V-60B/3/4LOC	STEM LEAKOFF	B-P	VT-2	QCI 7-1				SEE NOTES #5 & #6.
24RRC(1)B-13	VALVE TO PIPE	B-J	VOL	UTP-10	UT-7			
24RRC(1)B-13LD	PIPE SEAM	B-J	VOL	UTP-10	UT-7			
RCR-6B	PIPE WHIP	N/A	N/A	N/A				SEE NOTE #1
24RRC(1)B-14LU	PIPE SEAM	B-J	VOL	UTP-10	UT-7			
24RRC(1)B-14	PIPE TO EL	B-J	VOL	UTP-10	UT-7			
24RRC(1)B-14LD9	EL SEAM	B-J	VOL	UTP-10	UT-7			
24RRC(1)B-14LDI	EL SEAM	B-J	VOL	UTP-10	UT-7			
RRC-HB-7	SPRING	B-K-2	VT-3	303/8.2.17				
RRC-SB-7	PSA-35 SNUBBER	B-K-2	VT-3	303/8.2.17				S/N 4191

WNP-02
 INTERVAL: PSI
 PERIOD: NA
 OUTAGE:
 DRAWING NO. RRC-102

WASHINGTON PUBLIC POWER SUPPLY SYSTEM
 PROGRAM PLAN AND SCHEDULE
 SYSTEM OR COMPONENT: RRC(2)-4S
 DESCRIPTION: REACTOR RECIP LOOP B

PAGE 009
 DATE 12/14/84

IDENT. NO.	DESCRIPTION	SECT. YI EXAM.	EXAM MTH.	PROCEDURE	CAL. BLOCK	INSERVICE		NOTES
						REQ.	SCHEDULED OUTAGE	
RRC-SB-65			VT-4	303/8.2.17				S/N 4191
	PSA-35 SNUDDER	B-K-2	VT-3	303/8.2.17				S/N 4160
			VT-4	303/8.2.17				S/N 4160
24RRC(1)B-15LU0	EL SEAM	R-J	VOL	UTP-10	UT-7			
			SUR	PTP-1				
24RRC(1)B-15LUI	EL SEAM	B-J	VOL	UTP-10	UT-7			
			SUR	PTP-1				
24RRC(1)B-15	EL TO PIPE	R-J	VOL	UTP-10	UT-7			
			SUR	PTP-1				
24RRC(1)B-15LD	PIPE SEAM	B-J	VOL	UTP-10	UT-7			
			SUR	PTP-1				
RCR-7B	PIPE WHIP	N/A	N/A	N/A				SEE NOTE #1
24RRC(1)B-16LU	PIPE SEAM	B-J	VOL	UTP-10	UT-7			
			SUR	PTP-1				
24RRC(1)B-16	PIPE TO VALVE	B-J	VOL	UTP-10	UT-7			
			SUR	PTP-1				
RRC-V-67B/3/4V-71B	VALVE DRAIN	B-P	VT-2	N/A				SEE NOTES #6 & #7.
RRC-V-67B-BDY	VALVE BODY	B-M-2	VT-1	GCI 7-1				

WNP-02
 INTERVAL: PSI
 PERIOD: NA
 OUTAGE:
 DRAWING NO. RRC-102

WASHINGTON PUBLIC POWER SUPPLY SYSTEM
 PROGRAM PLAN AND SCHEDULE
 SYSTEM OR COMPONENT: RRC(2)-4S
 DESCRIPTION: REACTOR RECIR LOOP B

PAGE 010
 DATE 12/14/84

IDENT. NO.	DESCRIPTION	SECT. XI	EXAM EXAM.	PROCEDURE	CAL. BLOCK	INSERVICE		NOTES
						REQ.	SCHEDULED OUTAGE	
RRC-V-67D-BLT	VALVE BOLTING	B-G-2	VT-1	CCI 7-1				
RRC-V-67B/3/4V-6 ⁹ B	VALVE VENT	B-P	VT-2	N/A				SEE NOTES #6 & #7.
24RRC(1)B-17	VALVE TO EL	B-J	VOL	UTP-10	UT-7			FITTING TO FITTING
			SUR	PTP-1				FITTING TO FITTING
24RRC(1)B-17LDD	EL SEAM	B-J	VOL	UTP-10	UT-7			
			SUR	PTP-1				
24RRC(1)B-17LDI	EL SEAM	B-J	VOL	UTP-10	UT-7			
			SUR	PTP-1				
RRC-SB-15	PSA-35 SNUDBER	B-K-2	VT-3	303/8.2.17				S/N 4170
			VT-4	303/8.2.17				S/N 4170
24RRC(1)B-18LUO	EL SEAM	B-J	VOL	UTP-10	UT-7			
			SUR	PTP-1				
24RRC(1)B-18LUI	EL SEAM	B-J	VOL	UTP-10	UT-7			
			SUR	PTP-1				
24RRC(1)B-18	EL SEAM	B-J	VOL	UTP-10	UT-7			
			SUR	PTP-1				
24RRC(1)B-18LD	PIPE SEAM	B-J	VOL	UTP-10	UT-7			
			SUR	PTP-1				

WNP-02
 INTERVAL: PSI
 PERIOD: NA
 OUTAGE:
 DRAWING NO. RRC-102

WASHINGTON PUBLIC POWER SUPPLY SYSTEM
 PROGRAM PLAN AND SCHEDULE
 SYSTEM OR COMPONENT: RRC(2)-4S
 DESCRIPTION: REACTOR RECIP LOOP B

PAGE 011
 DATE 12/14/84

IDENT. NO.	DESCRIPTION	SECT. XI EXAM.	EXAM MTH.	PROCEDURE	CAL. BLOCK	INSERVICE		NOTES
						REQ.	SCHEDULED OUTAGE	
FCR-8B								
24RRC(1)B-18/12RRC(7)-4S	PIPE WHIP	N/A	N/A	N/A				SEE NOTE #1
	PIPE TO SWL	B-J	VOL	UTP-10	UT-7			
			SUR	PTP-1				
24RRC(1)B-18/12CAP	PIPE TO SWL	B-J	VOL	UTP-10	UT-7			
			SUR	PTP-1				
24RRC(1)B-18/12CAP-1	SWL TO PIPE	B-J	VOL	UTP-10	UT-19			FITTING TO FITTING
			SUR	PTP-1				FITTING TO FITTING
RRC-SB-8	PSA-35 SNUBBER	B-K-2	VT-3	303/8.2.17				S/N 4164
			VT-4	303/8.2.17				S/N 4164
RRC-SB-9	PSA-35 SNUBBER	B-K-2	VT-3	303/8.2.17				S/N 4166
			VT-4	303/8.2.17				S/N 4166
RCR-9B	PIPE WHIP	N/A	N/A	N/A				SEE NOTE #1
PRC-SB-17	PSA-35 SNUBBER	B-K-2	VT-3	303/8.2.17				S/N 4218
			VT-4	303/8.2.17				S/N 4218
RRC-SB-18	PSA-35 SNUBBER	B-K-2	VT-3	303/8.2.17				S/N 4220
			VT-4	303/8.2.17				S/N 4220
24RRC(1)B-19LU	PIPE SEAM	B-J	VOL	UTP-10	UT-7			
			SUR	PTP-1				

WNP-02
 INTERVAL: PSI
 PERIOD: NA
 OUTAGE:
 DRAWING NO. RRC-102

WASHINGTON PUBLIC POWER SUPPLY SYSTEM
 PROGRAM PLAN AND SCHEDULE
 SYSTEM OR COMPONENT: RRC(2)-4S
 DESCRIPTION: REACTOR RECIR LOOP B

PAGE 012
 DATE 12/14/84

IDENT. NO.	DESCRIPTION	SECT. XI EXAM. EXAM.	EXAM MTH.	PROCEDURE	CAL. BLOCK	INSERVICE		NOTES
						REQ.	SCHEDULED OUTAGE	
24RRC(1)B-19	PIPE TO CROSS	R-J	VOL	UTP-10	UT-7			
			SUR	PTP-1				
24RRC(1)B-19LDI	CROSS SEAM	B-J	VOL	UTP-10	UT-7			
			SUR	PTP-1				
24RRC(1)B-19LDO	CROSS SEAM	B-J	VOL	UTP-10	UT-7			
			SUR	PTP-1				
24RRC(1)B-20LUI	CROSS SFAM	B-J	VOL	UTP-10	UT-7			
			SUR	PTP-1				
24RRC(1)B-20LUO	CROSS SEAM	B-J	VOL	UTP-10	UT-7			
			SUR	PTP-1				
24RRC(1)B-20	CROSS-REDUCER	B-J	VOL	UTP-10	UT-7			FITTING TO FITTING
			SUR	PTP-1				FITTING TO FITTING
16RRC(1)B-1	CROSS TO PIPE	B-J	VOL	UTP-10	UT-13			
			SUR	PTP-1				
16RRC(1)B-1LD	PIPE SEAM	B-J	VOL	UTP-10	UT-13			
			SUR	PTP-1				
RRC-13B	PIPE WHIP	N/A	N/A	N/A				SEE NOTE #1
RRC-HB-9	SPRING	B-K-2	VT-3	303/8.2.17				

WNP-02
 INTERVAL: PSI
 PERIOD: NA
 OUTAGE:
 DRAWING NO. RRC-102

WASHINGTON PUBLIC POWER SUPPLY SYSTEM
 PROGRAM PLAN AND SCHEDULE
 * SYSTEM OR COMPONENT: RRC(2)-4S
 DESCRIPTION: REACTOR RECIR LOOP B

PAGE 013
 DATE 12/14/84

IDENT. NO.	DESCRIPTION	SECT. XI EXAM.	EXAM MTH.	PROCEDURE	CAL. BLOCK	INSERVICE		NOTES
						REQ.	SCHEDULED OUTAGE	
			VT-4	303/8.2.17				
16RRC(1)B-1/12RRC(1)-N2G	PIPE TO SWL	B-J	VOL	UTP-10	UT-13			
			SUR	PTP-1				
RRC-14B	PIPE WHIP	N/A	N/A	N/A				SEE NOTE #1
RRC-SB-13	PSA-35 SNUBBER	B-K-2	VT-3	303/8.2.17				S/N 4194
			VT-4	303/8.2.17				S/N 4194
RRC-SB-11	PSA-35 SNUBBER	B-K-2	VT-3	303/8.2.17				S/N 4199
			VT-4	303/8.2.17				S/N 4199
RRC-15B	PIPE WHIP	N/A	N/A	N/A				SEE NOTE #1
16RRC(1)B-1/12RRC(1)-N2F	PIPE TO SWL	B-J	VOL	UTP-10	UT-13			
			SUR	PTP-1				
16RRC(1)B-2LU	PIPE SEAM	B-J	VOL	UTP-10	UT-13			
			SUR	PTP-1				
16RRC(1)B-2	PIPE TO CAP	B-J	VOL	UTP-10	UT-13			
			SUR	PTP-1				
16RRC(1)B-3	CROSS TO PIPE	B-J	VOL	UTP-10	UT-13			
			SUR	PTP-1				
16RRC(1)B-3LD	PIPE SEAM	B-J	VOL	UTP-10	UT-13			

WNP-02
 INTERVAL: PSI
 PERIOD: NA
 OUTAGE:
 DRAWING NO. RRC-102

WASHINGTON PUBLIC POWER SUPPLY SYSTEM
 PROGRAM PLAN AND SCHEDULE
 SYSTEM OR COMPONENT: RRC(2)-4S
 DESCRIPTION: REACTOR RECIR LOOP B

PAGE 014
 DATE 12/14/84

IDENT. NO.	DESCRIPTION	SECT. VI EXAM.	EXAM MTH.	PROCEDURE	CAL. BLOCK	INSERVICE		NOTES
						REQ.	SCHEDULED OUTAGE	
			SUR	PTP-1				
RCR-12B	PIPE WHIP	N/A	N/A	N/A				SEE NOTE #1
RRC-HB-R	SPRING	B-K-2	VT-3	303/8.2.17				
			VT-4	303/8.2.17				
16RRC(1)B-3/12RRC(1)-N2J	PIPE TO SWL	B-J	VOL	UTP-10	UT-13			
			SUR	PTP-1				
RCR-11B	PIPE WHIP	N/A	N/A	N/A				SEE NOTE #1
RRC-SB-14	PSA-35 SNUBBER	B-K-2	VT-3	303/8.2.17				S/N 4196
			VT-4	303/8.2.17				S/N 4196
RRC-SB-12	PSA-35 SNUBBER	B-K-2	VT-3	303/8.2.17				S/N 4221
			VT-4	303/8.2.17				S/N 4221
RCR-10B	PIPE WHIP	N/A	N/A	N/A				SEE NOTE #1
16RRC(1)B-3/12RRC(1)-N2K	PIPE TO SWL	B-J	VOL	UTP-10	UT-13			
			SUR	PTP-1				
16RRC(1)B-4LU	PIPE SEAM	B-J	VOL	UTP-10	UT-13			
			SUR	PTP-1				
16RRC(1)B-4	PIPE TO CAP	B-J	VOL	UTP-10	UT-13			
			SUR	PTP-1				

WNP-02
 INTERVAL: PSI
 PERIOD: NA
 OUTAGE:
 DRAWING NO. RRC-102

WASHINGTON PUBLIC POWER SUPPLY SYSTEM
 PROGRAM PLAN AND SCHEDULE
 SYSTEM OR COMPONENT: RRC(2)-4S
 DESCRIPTION: REACTOR RECIR LOOP R

PAGE 015
 DATE 12/14/84

IDENT. NO.	DESCRIPTION	SECT. XI EXAM.	EXAM MTH.	PROCEDURE	CAL. BLOCK	INSERVICE		NOTES
						REQ.	SCHEDULED OUTAGE	
12RRC(1)-N2F-1	SWL TO PIPE	B-J	VOL	UTP-10	UT-19			
			SUR	PTP-1				
12RRC(1)-N2F-1LD	PIPE SEAM	B-J	VOL	UTP-10	UT-19			
			SUR	PTP-1				
12RRC(1)-N2F-1ALU	PIPE SEAM	B-J	VOL	UTP-10	UT-19			
			SUR	PTP-1				
12RRC(1)-N2F-1A	PIPE TO PIPE	B-J	VOL	UTP-10	UT-19			
			SUR	PTP-1				
12RRC(1)-N2F-1ALD	PIPE SEAM	B-J	VOL	UTP-10	UT-19			
			SUR	PTP-1				
RCR-168	PIPE WHIP	N/A	N/A	N/A				SEE NOTE #1
12RRC(1)-N2F-2LU	PIPE SEAM	B-J	VOL	UTP-10	UT-19			
			SUR	PTP-1				
12RRC(1)-N2F-2	PIPE TO EL	B-J	VOL	UTP-10	UT-19			
			SUR	PTP-1				
12RRC(1)-N2F-2LD0	EL SEAM	B-J	VOL	UTP-10	UT-19			
			SUR	PTP-1				
12RRC(1)-N2F-2LDI	EL SEAM	B-J	VOL	UTP-10	UT-19			

WNP-02
 INTERVAL: PSI
 PERIOD: NA
 OUTAGE:
 DRAWING NO. RRC-102

WASHINGTON PUBLIC POWER SUPPLY SYSTEM
 PROGRAM PLAN AND SCHEDULE
 SYSTEM OR COMPONENT: RRC(2)-4S
 DESCRIPTION: REACTOR RECIR LOOP B

PAGE 016
 DATE 12/14/84

IDENT. NO.	DESCRIPTION	SECT. XI EXAM.	EXAM MTH.	PROCEDURE	CAL. BLOCK	INSERVICE		NOTES
						REQ.	SCHEDULED OUTAGE	
			SUR	PTP-1				
12RRC(1)-N2F-3LU0	EL SEAM	B-J	VOL	UTP-10	UT-19			
			SUR	PTP-1				
12RRC(1)-N2F-3LUI	EL SEAM	B-J	VOL	UTP-10	UT-19			
			SUR	PTP-1				
12RRC(1)-N2F-3	EL TO PIPE	B-J	VOL	UTP-10	UT-19			
			SUR	PTP-1				
12RRC(1)-N2F-3LD	PIPE SEAM	B-J	VOL	UTP-10	UT-19			
			SUR	PTP-1				
12RRC(1)-N2F-4LU	PIPE SEAM	B-J	VOL	UTP-10	UT-19			
			SUR	PTP-1				
12RRC(1)-N2F-4	PIPE TO SE EXT	B-J	VOL	UTP-10	UT-19			
			SUR	PTP-1				
12RRC(1)-N2F-6	SE TO NOZ	B-F	VOL	UTP-10	UT-111			
			SUR	PTP-1				
12RRC(1)-N2G-1	SWL TO PIPE	B-J	VOL	UTP-10	UT-19			
			SUR	PTP-1				
12RRC(1)-N2G-1LD	PIPE SEAM	B-J	VOL	UTP-10	UT-19			

WNP-02
 INTERVAL: PSI
 PERIOD: NA
 OUTAGE:
 DRAWING NO. RRC-102

WASHINGTON PUBLIC POWER SUPPLY SYSTEM
 PROGRAM PLAN AND SCHEDULE
 SYSTEM OR COMPONENT: RRC(2)-4S
 DESCRIPTION: REACTOR RECIR LOOP B

PAGE 017
 DATE 12/14/84

<u>IDENT. NO.</u>	<u>DESCRIPTION</u>	<u>SECT.</u> <u>XI</u>	<u>EXAM.</u> <u>EXAM.</u>	<u>PROCEDURE</u>	<u>CAL.</u> <u>BLOCK</u>	<u>INSERVICE</u>		<u>NOTES</u>
						<u>REQ.</u>	<u>SCHEDULED</u> <u>OUTAGE</u>	
12RRC(1)-N2G-1ALU	PIPE SEAM	B-J	VOL	PTP-1 UTP-10	UT-19			
12RRC(1)-N2G-1A	PIPE TO PIPE	B-J	VOL	PTP-1 UTP-10	UT-19			
12RRC(1)-N2G-1ALD	PIPE SEAM	B-J	VOL	PTP-1 UTP-10	UT-19			
RCR-17B	PIPE WHIP	N/A	N/A	N/A				SEE NOTE #1
12RRC(1)-N2G-2LU	PIPE SEAM	B-J	VOL	PTP-1 UTP-10	UT-19			
12RRC(1)-N2G-2	PIPE TO EL	B-J	VOL	PTP-1 UTP-10	UT-19			
12RRC(1)-N2G-2LD0	EL SEAM	B-J	VOL	PTP-1 UTP-10	UT-19			
12RRC(1)-N2G-2LDI	EL SEAM	B-J	VOL	PTP-1 UTP-10	UT-19			
12RRC(1)-N2G-3LU0	EL SEAM	B-J	VOL	PTP-1 UTP-10	UT-19			
				SUR PTP-1				

WNP-02
 INTERVAL: PSI
 PERIOD: NA
 OUTAGE:
 DRAWING NO. RRC-102

WASHINGTON PUBLIC POWER SUPPLY SYSTEM
 PROGRAM PLAN AND SCHEDULE
 SYSTEM OR COMPONENT: RRC(2)-4S
 DESCRIPTION: REACTOR RECIR LOOP B

PAGE 018
 DATE 12/14/84

IDENT. NO.	DESCRIPTION	SECT. XI EXAM. EXAM.	MTH.	PROCEDURE	CAL. BLOCK	INSERVICE		NOTES
						REQ.	SCHEDULED OUTAGE	
12RRC(1)-N2G-3LUI	EL SEAM	B-J	VOL	UTP-10	UT-19			
			SUR	PTP-1				
12RRC(1)-N2G-3	EL TO PIPE	B-J	VOL	UTP-10	UT-19			
			SUR	PTP-1				
12RRC(1)-N2G-3LD	PIPE SEAM	B-J	VOL	UTP-10	UT-19			
			SUR	PTP-1				
12RRC(1)-N2G-4LU	PIPE SEAM	B-J	VOL	UTP-10	UT-19			
			SUR	PTP-1				
12RRC(1)-N2G-4	PIPE TO SE EXT	B-J	VOL	UTP-10	UT-19			
			SUR	PTP-1				
12RRC(1)-N2G-6	SE TO NOZ	B-F	VOL	UTP-10	UT-111			
			SUR	PTP-1				
12RRC(1)-N2H-1	REDUCER TO PIPE	B-J	VOL	UTP-10	UT-19			
			SUR	PTP-1				
12RRC(1)-N2H-1LD	PIPE SEAM	B-J	VOL	UTP-10	UT-19			
			SUR	PTP-1				
12RRC(1)-N2H-1ALU	PIPE SEAM	B-J	VOL	UTP-10	UT-19			
			SUR	PTP-1				

WNP-02
 INTERVAL: PSI
 PERIOD: NA
 OUTAGE:
 DRAWING NO. RRC-102

WASHINGTON PUBLIC POWER SUPPLY SYSTEM
 PROGRAM PLAN AND SCHEDULE
 SYSTEM OR COMPONENT: RRC(2)-4S
 DESCRIPTION: REACTOR RECIR LOOP B

PAGE 019
 DATE 12/14/84

<u>IDENT. NO.</u>	<u>DESCRIPTION</u>	<u>SECT.</u> <u>XI</u> <u>EXAM.</u>	<u>EXAM</u> <u>MTH.</u>	<u>PROCEDURE</u>	<u>CAL.</u> <u>BLOCK</u>	<u>INSERVICE</u>		<u>NOTES</u>
						<u>REQ.</u>	<u>SCHEDULED</u> <u>OUTAGE</u>	
12RRC(1)-N2H-1A	PIPE TO PIPE	B-J	VOL	UTP-10	UT-19			
			SUR	PTP-1				
12RRC(1)-N2H-1ALD	PIPE SEAM	B-J	VOL	UTP-10	UT-19			
			SUR	PTP-1				
RCR-188	PIPE WHIP	N/A	N/A	N/A				SEE NOTE #1
12RRC(1)-N2H-2LU	PIPE SEAM	B-J	VOL	UTP-10	UT-19			
			SUR	PTP-1				
12RRC(1)-N2H-2	PIPE TO EL	B-J	VOL	UTP-10	UT-19			
			SUR	PTP-1				
12RRC(1)-N2H-2LD0	EL SEAM	B-J	VOL	UTP-10	UT-19			
			SUR	PTP-1				
12RRC(1)-N2H-2LDI	EL SEAM	B-J	VOL	UTP-10	UT-19			
			SUR	PTP-1				
12RRC(1)-N2H-3LU0	EL SEAM	B-J	VOL	UTP-10	UT-19			
			SUR	PTP-1				
12RRC(1)-N2H-3LUI	EL SEAM	B-J	VOL	UTP-10	UT-19			
			SUR	PTP-1				
12RRC(1)-N2H-3	EL SEAM	B-J	VOL	UTP-10	UT-19			

WNP-02
 INTERVAL: PSI
 PERIOD: NA
 OUTAGE:
 DRAWING NO. RRC-102

WASHINGTON PUBLIC POWER SUPPLY SYSTEM
 PROGRAM PLAN AND SCHEDULE
 SYSTEM OR COMPONENT: RRC(2)-4S
 DESCRIPTION: REACTOR RECIR LOOP B

PAGE 020
 DATE 12/14/84

IDENT. NO.	DESCRIPTION	SECT. XI EXAM.	EXAM MTH.	PROCEDURE	CAL. BLOCK	INSERVICE		NOTES
						REQ.	SCHEDULED OUTAGE	
			SUR	PTP-1				
12RRC(1)-N2H-3LD	PIPE SEAM	B-J	VOL	UTP-10	UT-19			
			SUR	PTP-1				
12RRC(1)-N2H-4LU	PIPE SEAM	B-J	VOL	UTP-10	UT-19			
			SUR	PTP-1				
12RRC(1)-N2H-4	PIPE TO SE	B-J	VOL	UTP-10	UT-19			
			SUR	PTP-1				
12RRC(1)-N2H-6	SE TO NO7	B-F	VOL	UTP-10	UT-111			
			SUR	PTP-1				
12RRC(1)-N2J-1	SWL TO PIPE	B-J	VOL	UTP-10	UT-19			
			SUR	PTP-1				
12RRC(1)-N2J-1LD	PIPE SEAM	B-J	VOL	UTP-10	UT-19			
			SUR	PTP-1				
12RRC(1)-N2J-1ALU	PIPE SEAM	B-J	VOL	UTP-10	UT-19			
			SUR	PTP-1				
12RRC(1)-N2J-1A	PIPE TO PIPE	B-J	VOL	UTP-10	UT-19			
			SUR	PTP-1				
12RRC(1)-N2J-1ALD	PIPE SEAM	B-J	VOL	UTP-10	UT-19			

WNP-02
 INTERVAL: PSI
 PERIOD: NA
 OUTAGE:
 DRAWING NO. RRC-102

WASHINGTON PUBLIC POWER SUPPLY SYSTEM
 PROGRAM PLAN AND SCHEDULE
 SYSTEM OR COMPONENT: RRC(2)-4S
 DESCRIPTION: REACTOR RECIR LOOP B

PAGE 021
 DATE 12/14/84

<u>IDENT. NO.</u>	<u>DESCRIPTION</u>	<u>SECT.</u> <u>XI</u>	<u>EXAM</u> <u>EXAM.</u>	<u>EXAM</u> <u>MTH.</u>	<u>PROCEDURE</u>	<u>CAL.</u> <u>BLOCK</u>	<u>INSERVICE</u>		<u>NOTES</u>
							<u>REQ.</u>	<u>SCHEDULED</u> <u>OUTAGE</u>	
				SUR	PTP-1				
RRC-198	PIPE WHIP	N/A	N/A	N/A					SEE NOTE #1
12RRC(1)-N2J-2LU	PIPE SEAM	B-J	VOL	UTP-10		UT-19			
				SUR	PTP-1				
12RRC(1)-N2J-2	PIPE TO EL	B-J	VOL	UTP-10		UT-19			
				SUR	PTP-1				
12RRC(1)-N2J-2LDI	EL SEAM	B-J	VOL	UTP-10		UT-19			
				SUR	PTP-1				
12RRC(1)-N2J-2LDG	EL SEAM	B-J	VOL	UTP-10		UT-19			
				SUR	PTP-1				
12RRC(1)-N2J-3LU0	EL SEAM	B-J	VOL	UTP-10		UT-19			
				SUR	PTP-1				
12RRC(1)-N2J-3LUI	EL SEAM	B-J	VOL	UTP-10		UT-19			
				SUR	PTP-1				
12RRC(1)-N2J-3	EL TO PIPE	B-J	VOL	UTP-10		UT-19			
				SUR	PTP-1				
12RRC(1)-N2J-3LD	PIPE SEAM	B-J	VOL	UTP-10		UT-19			
				SUR	PTP-1				

WNP-02
 INTERVAL: PSI
 PERIOD: NA
 OUTAGE:
 DRAWING NO. RRC-102

WASHINGTON PUBLIC POWER SUPPLY SYSTEM
 PROGRAM PLAN AND SCHEDULE
 SYSTEM OR COMPONENT: RRC(2)-4S
 DESCRIPTION: REACTOR RECIR LOOP B

PAGE 022
 DATE 12/14/84

IDENT. NO.	DESCRIPTION	SECT. XI EXAM.	EXAM MTH.	PROCEDURE	CAL. BLOCK	INSERVICE		NOTES
						REQ.	SCHEDULED OUTAGE	
12RRC(1)-N2J-4LU	PIPE SEAM	B-J	VOL	UTP-10	UT-19			
			SUR	PTP-1				
12RRC(1)-N2J-4	PIPE TO SE EXT	B-J	VOL	UTP-10	UT-19			
			SUR	PTP-1				
12RRC(1)-N2J-6	SE TO NOZ	B-F	VOL	UTP-10	UT-111			
			SUR	PTP-1				
12RRC(1)-N2K-1	SWL TO PIPE	B-J	VOL	UTP-10	UT-19			
			SUR	PTP-1				
12RRC(1)-N2K-1LD	PIPE SEAM	B-J	VOL	UTP-10	UT-19			
			SUR	PTP-1				
12RRC(1)-N2K-1ALU	PIPE SEAM	B-J	VOL	UTP-10	UT-19			
			SUR	PTP-1				
12RRC(1)-N2K-1A	PIPE TO PIPE	B-J	VOL	UTP-10	UT-19			
			SUR	PTP-1				
12RRC(1)-N2K-1ALD	PIPE SEAM	B-J	VOL	UTP-10	UT-19			
			SUR	PTP-1				
RCR-20B	PIPE WHIP	N/A	N/A	N/A				SEE NOTE #1
12RRC(1)-N2K-2LU	PIPE SEAM	B-J	VOL	UTP-10	UT-19			

WNP-02
 INTERVAL: PSI
 PERIOD: NA
 OUTAGE:
 DRAWING NO. RRC-102

WASHINGTON PUBLIC POWER SUPPLY SYSTEM
 PROGRAM PLAN AND SCHEDULE
 SYSTEM OR COMPONENT: RRC(2)-4S
 DESCRIPTION: REACTOR RECIR LOOP R


PAGE 023
 DATE 12/14/84

<u>IDENT. NO.</u>	<u>DESCRIPTION</u>	<u>SECT.</u> <u>XI</u> <u>EXAM.</u>	<u>EXAM</u> <u>MTN.</u>	<u>PROCEDURE</u>	<u>CAL.</u> <u>BLOCK</u>	<u>INSERVICE</u>		<u>NOTES</u>
						<u>REQ.</u>	<u>SCHEDULED</u> <u>OUTAGE</u>	
12RRC(1)-N2K-2	PIPE TO EL	B-J	VOL	UTP-10	UT-19			
12RRC(1)-N2K-2LDD	EL SEAM	B-J	VOL	UTP-10	UT-19			
12RRC(1)-N2K-2LDI	EL SEAM	B-J	VOL	UTP-10	UT-19			
12RRC(1)-N2K-3LU0	EL SEAM	B-J	VOL	UTP-10	UT-19			
12RRC(1)-N2K-3LUI	EL SEAM	B-J	VOL	UTP-10	UT-19			
12RRC(1)-N2K-3	EL TO PIPE	B-J	VOL	UTP-10	UT-19			
12RRC(1)-N2K-3LD	PIPE SEAM	B-J	VOL	UTP-10	UT-19			
12RRC(1)-N2K-4LU	PIPE SEAM	B-J	VOL	UTP-10	UT-19			
12RRC(1)-N2K-4	PIPE TO SE	B-J	VOL	UTP-10	UT-19			

WNP-02
 INTERVAL: PSI
 PERIOD: NA
 OUTAGE:
 DRAWING NO. RRC-102

WASHINGTON PUBLIC POWER SUPPLY SYSTEM
 PROGRAM PLAN AND SCHEDULE
 SYSTEM OR COMPONENT: RRC(2)-4S
 DESCRIPTION: REACTOR RECIR LOOP R

<u>IDENT. NO.</u>	<u>DESCRIPTION</u>	<u>SECT.</u>		<u>PROCEDURE</u>	<u>CAL. BLOCK</u>	<u>INSERVICE SCHEDULED</u>		<u>NOTES</u>
		<u>XI EXAM.</u>	<u>EXAM. MTH.</u>			<u>REQ.</u>	<u>OUTAGE</u>	
12RRC(1)-N2K-6	SE TO NO7	B-F	VOL	PTP-1 UTP-10	UT-111			
RRC-PB-102	RRC PRES BNDRY	R-P	VT-2	PTP-1 N/A				SEE NOTE #6 & #7.

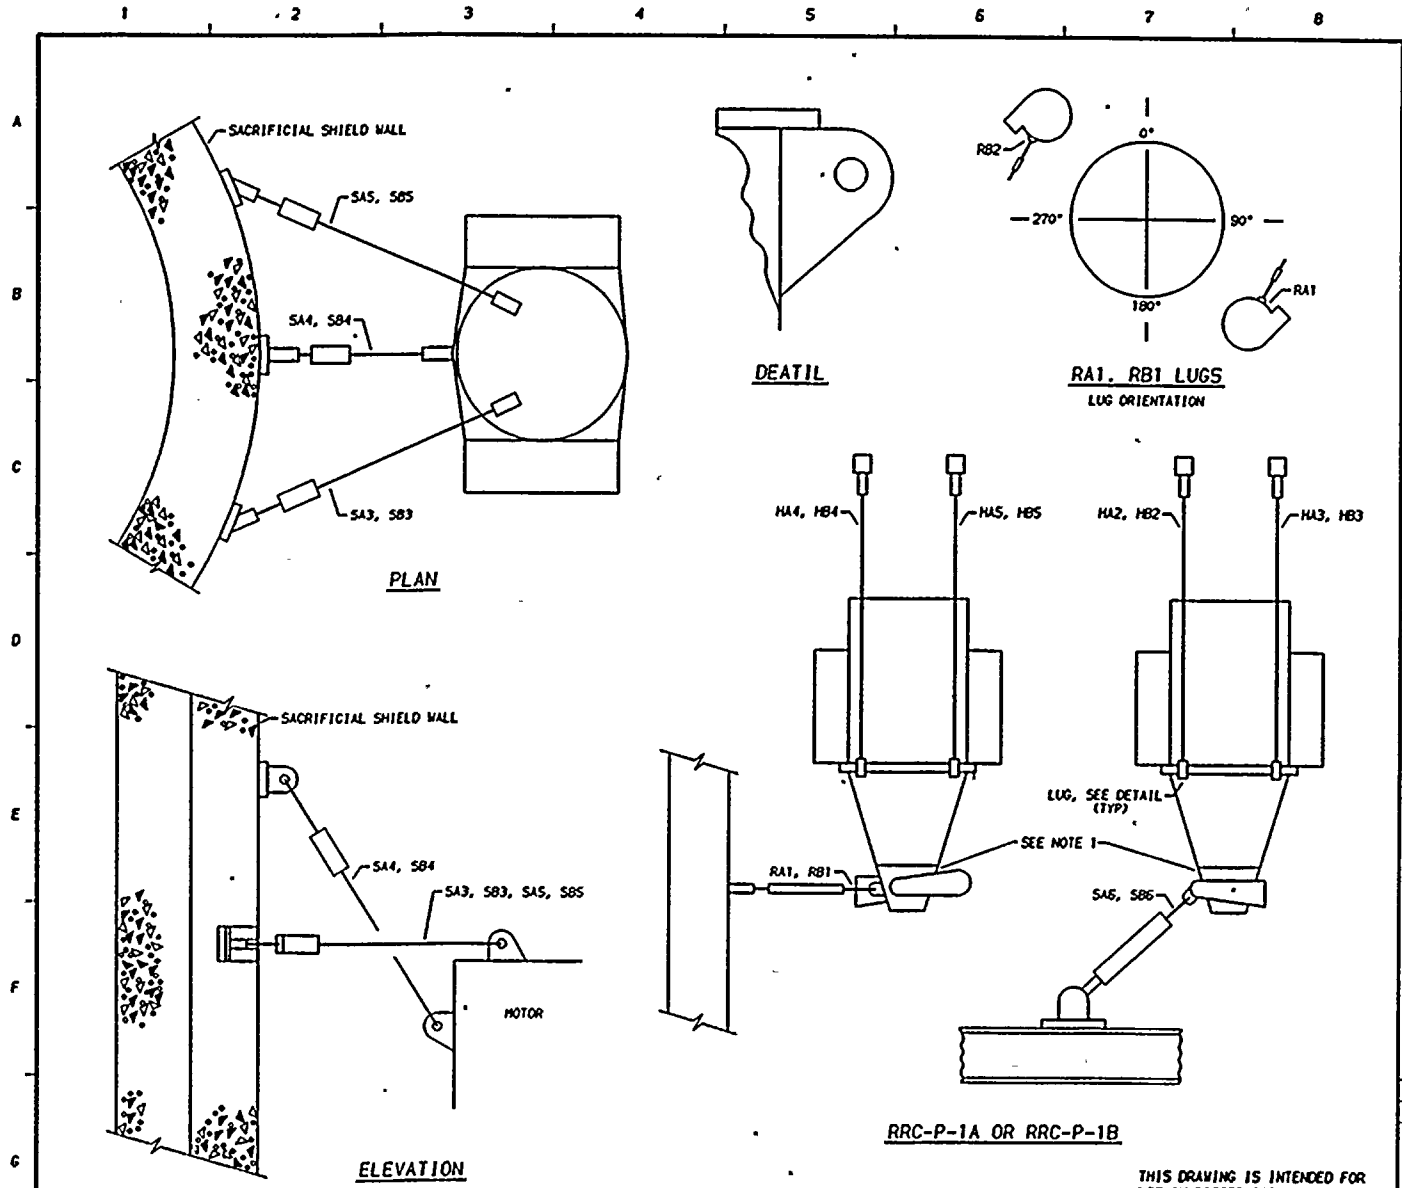

NOTES

- 1 EACH PUMP HAS SIXTEEN (16) 3 1/4" X 23 5/8" BOLTS CONNECTING THE CASING TO SEAL AREAS.
- 2 OBSERVE RRC PUMP SEAL SUPPLY LINES DURING HYDRO.

REFERENCES:
 GENERAL ELECTRIC DRAWINGS
 731 E 724
 731 E 724F
 762 E 538

QUALITY CLASS: 1	ASME CODE CLASS: 1
ENGR: D TIMMINS	DRAWN: K-MCA DATE: 7-13--78

WASHINGTON PUBLIC POWER
 SUPPLY SYSTEM
 RICHLAND, WASHINGTON 99352

WNP-2
 WELD & COMPONENT
 IDENTIFICATION DIAGRAM

TITLE:
 RRC-P-1A & RRC-P-1B SUPPORTS

DWG NO. RRC-103 REV 1

THIS DRAWING IS INTENDED FOR
 USE IN PRESERVICE AND INSERVICE
 INSPECTIONS PROGRAMS ONLY.

PIPING SYSTEM	NOM DIA (IN)	SCH	NOM WALL THK	MATERIAL SPECIFICATION	MATL TYPE	CAL BLOCK NO
RRC PUMPS	3 1/4	-	-	SA 193 GR B-7	CS	UT-41

NO	DATE	REVISION	BY	CHKD	APVD
1	1-24-85	ADDED LUG ORIENTATION DETAIL	K-MCA	158	TEV
0	11-27-78	ISSUED FOR USE	K-MCA	DWP	LFB
A	9-12-78	ISSUED FOR INFORMATION ONLY	K-MCA	DI	DWP



WNP-02
 INTERVAL: PSI
 PERIOD: NA
 OUTAGE:
 DRAWING NO. RRC-103

WASHINGTON PUBLIC POWER SUPPLY SYSTEM
 PROGRAM PLAN AND SCHEDULE
 SYSTEM OR COMPONENT: RRC-P-1A
 DESCRIPTION: RRC LOOP A PUMP

PAGE 001
 DATE 12/14/84

<u>IDENT. NO.</u>	<u>DESCRIPTION</u>	SECT. XI <u>EXAM.</u>	<u>EXAM.</u>	<u>MITH.</u>	<u>PROCEDURE</u>	CAL. <u>BLOCK</u>	<u>INSERVICE</u>		<u>NOTES</u>
							<u>REQ.</u>	<u>SCHEDULED</u> <u>OUTAGE</u>	
RRC-HA-2	SPRING	B-K-2	VT-3		303/8.2.17				
			VT-4		303/8.2.17				
RRC-HA-3	SPRING	B-K-2	VT-3		303/8.2.17				
			VT-4		303/8.2.17				
RRC-HA-4	SPRING	B-K-2	VT-3		303/8.2.17				
			VT-4		303/8.2.17				
RRC-HA-5	SPRING	B-K-2	VT-3		303/8.2.17				
			VT-4		303/8.2.17				
RRC-SA-3	PSA-100 SNUBBER	B-K-2	VT-3		303/8.2.17				S/N 614
			VT-4		303/8.2.17				S/N 614
RRC-SA-4	PSA-100 SNUBBER	B-K-2	VT-3		303/8.2.17				S/N 618
			VT-4		303/8.2.17				S/N 618
RRC-SA-5	PSA-100 SNUBBER	B-K-2	VT-3		303/8.2.17				S/N 615
			VT-4		303/8.2.17				S/N 615
RRC-900N	STRUT	B-K-2	VT-3		303/8.2.17				
RRC-SA-6	PSA-100 SNUBBER	B-K-2	VT-3		303/8.2.17				S/N 620
			VT-4		303/8.2.17				S/N 620
RRC-RA-1(W)	1 WELDED LUG	B-K-1	SUR		PTP-1				

WNP-02
 INTERVAL: PSI
 PERIOD: NA
 OUTAGE:
 DRAWING NO. RRC-103

WASHINGTON PUBLIC POWER SUPPLY SYSTEM
 PROGRAM PLAN AND SCHEDULE
 SYSTEM OR COMPONENT: RRC-P-1A
 DESCRIPTION: RRC LOOP A PUMP

PAGE 002
 DATE 12/14/84

<u>IDENT. NO.</u>	<u>DESCRIPTION</u>	<u>SECT.</u> XI <u>EXAM.</u>	<u>EXAM</u> MTH.	<u>PROCEDURE</u>	<u>CAL.</u> BLOCK	<u>INSERVICE</u> SCHEDULED		<u>NOTES</u>
						<u>REQ.</u>	<u>OUTAGE</u>	
RRC-RA-1								
RRC-P-1A-BLT	STRUT	B-K-2	VT-3	303/8.2.17				
	PUMP BOLTING	B-G-1	VOL	UTP-34	UT-41			STUDS: UT WHEN IN PLACE. UT & PT WHEN REMOVED.
			SUR	PTP-1				STUDS: UT WHEN IN PLACE. UT & PT WHEN REMOVED
			VT-1	QCI 7-1				STUDS: UT WHEN IN PLACE. UT & PT WHEN REMOVED
RRC-P-1A-BDY	PUMP BODY	B-M-2	VT-1	QCI 7-1				
RRC-HB-2	SPRING	B-K-2	VT-3	303/8.2.17				
			VT-4	303/8.2.17				
RRC-HB-3	SPRING	B-K-2	VT-3	303/8.2.17				
			VT-4	303/8.2.17				
RRC-HB-4	SPRING	B-K-2	VT-3	303/8.2.17				
			VT-4	303/8.2.17				
RRC-HB-5	SPRING	B-K-2	VT-3	303/8.2.17				
			VT-4	303/8.2.17				
RRC-SB-3	PSA-100 SNUBBER	B-K-2	VT-3	303/8.2.17				S/N 617

WNP-02
 INTERVAL: PSI
 PERIOD: NA
 OUTAGE:
 DRAWING NO. RRC-103

WASHINGTON PUBLIC POWER SUPPLY SYSTEM
 PROGRAM PLAN AND SCHEDULE
 SYSTEM OR COMPONENT: RRC-P-1A
 DESCRIPTION: RRC LOOP A PUMP

PAGE 003
 DATE 12/14/84

<u>IDENT. NO.</u>	<u>DESCRIPTION</u>	<u>SECT.</u> <u>XI</u> <u>EXAM.</u>	<u>EXAM</u> <u>MTH.</u>	<u>PROCEDURE</u>	<u>CAL.</u> <u>BLOCK</u>	<u>INSERVICE</u>		<u>NOTES</u>
						<u>REQ.</u>	<u>SCHEDULED</u> <u>OUTAGE</u>	
RRC-SB-4			VT-4	303/8.2.17				S/N 617
	PSA-100 SNUBBER	B-K-2	VT-3	303/8.2.17				S/N 619
			VT-4	303/8.2.17				S/N 619
RRC-SB-5			VT-3	303/8.2.17				S/N 616
	PSA-100 SNUBBER	B-K-2	VT-3	303/8.2.17				S/N 616
			VT-4	303/8.2.17				S/N 616
RRC-SB-6			VT-3	303/8.2.17				S/N 621
	PSA-100 SNUBBER	B-K-2	VT-3	303/8.2.17				S/N 621
			VT-4	303/8.2.17				S/N 621
RRC-RB-1(W)			SUP	PTP-1				
	1 WELDED LUG	B-K-1	SUP	PTP-1				
RRC-RB-1			VT-3	303/8.2.17				
	STRUT	B-K-2	VT-3	303/8.2.17				
RRC-901N			VT-3	303/8.2.17				
	STRUT	B-K-2	VT-3	303/8.2.17				
RRC-P-1B-BLT			VOL	UTP-34	UT-41			STUDS: UT WHEN IN PLACE. UT & PT WHEN REMOVED.
			SUR	PTP-1				STUDS: UT WHEN IN PLACE. UT & PT WHEN REMOVED
			VT-1	OCI 7-1				STUDS: UT WHEN IN PLACE. UT & PT WHEN REMOVED
RRC-P-1B-BDY			VT-1	OCI 7-1				
	PUMP BODY	B-M-2	VT-1	OCI 7-1				

WNP-02
INTERVAL: PSI
PERIOD: NA
OUTAGE:
DRAWING NO. RRC-103

WASHINGTON PUBLIC POWER SUPPLY SYSTEM
PROGRAM PLAN AND SCHEDULE
SYSTEM OR COMPONENT: RRC-P-1A
DESCRIPTION: RRC LOOP A PUMP

PAGE 004
DATE 12/14/84

<u>IDENT. NO.</u>	<u>DESCRIPTION</u>	SECT. XI	EXAM EXAM.	MTH.	PROCEDURE	CAL. BLOCK	<u>INSERVICE</u>		<u>NOTES</u>
							REQ.	SCHEDULED OUTAGE	
RRC-PB-103	RRC PRES BNDRY	B-P	VT-2	N/A					SEE NOTES #6 & #7.

WNP-02
 INTERVAL: PSI
 PERIOD: NA
 OUTAGE:
 DRAWING NO. RRC-104

WASHINGTON PUBLIC POWER SUPPLY SYSTEM
 PROGRAM PLAN AND SCHEDULE
 SYSTEM OR COMPONENT: RRC(51)-4
 DESCRIPTION: RPV DRAIN

PAGE 001
 DATE 12/14/84

IDENT. NO.	DESCRIPTION	SECT. XI EXAM.	EXAM. NIH.	PROCEDURE	CAL. BLOCK	INSERVICE		NOTES
						REQ.	SCHEDULED OUTAGE	
2RRC(51)-1	NOZ TO FORG.	B-J	SUR	N/A				INACCESSABLE DUE TO CRD HOUSINGS.
2RRC(51)-2	FORG. TO PIPE	R-J	SUR	N/A				INACCESSABLE DUE TO CRD HOUSINGS.
2RRC(51)-3	PIPE TO REDUCER	B-J	SUR	PTP-1				
3RRC(51)-1	REDUCER TO EL	B-J	SUR	PTP-1				
3RRC(51)-2	EL TO PIPE	B-J	SUR	PTP-1				
3RRC(51)-2/1-1/4TE-N021	PIPE TO SOL	B-J	SUR	PTP-1				
RRC-1C-4	PSA-1/2 SN(2)	B-K-2	VT-3	303/8.2.17				S/N N2099/S212
			VT-4	303/8.2.17				S/N N2099/S212
3RRC(51)-3	PIPE TO EL	B-J	SUR	PTP-1				
3RRC(51)-4	EL TO PIPE	B-J	SUR	PTP-1				
RRC-1C-3	PSA-1 SNUBBER	B-K-2	VT-3	303/8.2.17				S/N 135
			VT-4	303/8.2.17				S/N 135
3RRC(51)-5	PIPE TO REDUCER	B-J	SUR	PTP-1				
4RRC(51)-1	REDUCER TO PIPE	B-J	VOL	UTP-10	UT-30			
			SUR	PTP-1				
4RRC(51)-2	PIPE TO EL	B-J	VOL	UTP-10	UT-30			
			SUR	PTP-1				

WNP-02
 INTERVAL: PSI
 PERIOD: NA
 OUTAGE:
 DRAWING NO. RRC-104

WASHINGTON PUBLIC POWER SUPPLY SYSTEM
 PROGRAM PLAN AND SCHEDULE
 SYSTEM OR COMPONENT: RRC(51)-4
 DESCRIPTION: RPV DRAIN

PAGE 002
 DATE 12/14/84


IDENT. NO.	DESCRIPTION	SECT. - XI EXAM.	EXAM MTH.	PROCEDURE	CAL. BLOCK	INSERVICE		NOTES
						REQ.	SCHEDULED OUTAGE	
4RRC(51)-3	EL TO PIPE	B-J	VOL	UTP-10	UT-30			
			SUR	PTP-1				
RRC-12	SPRING	B-K-2	VT-3	303/8.2.17				
			VT-4	303/8.2.17				
RRC-1C-2	PSA-1 SNUBBER	B-K-2	VT-3	303/8.2.17				S/N 22357
			VT-4	303/8.2.17				S/N 22357
4RRC(51)-4	PIPE TO EL	B-J	VOL	UTP-10	UT-30			
			SUR	PTP-1				
4RRC(51)-5	EL TO PIPE	B-J	VOL	UTP-10	UT-30			
			SUR	PTP-1				
RRC-1C-1(W)	8 WELDED LUGS	B-K-1	VOL	UTP-26	UT-30			
RRC-1C-1	PSA-1 SN(2)	B-K-2	VT-3	303/8.2.17				S/N 348/353
			VT-4	303/8.2.17				S/N 348/353
4RRC(51)-5/1PI(1)-4S	INSTR CONN	B-P	VT-2	N/A				SEE NOTES #6 & #7.
PWS-51-1	PIPE WHIP	N/A	N/A	N/A				SEE NOTE #1
4RRC(51)-5/2RRC(51)-4A	PIPE TO WOL	B-J	SUR	PTP-1				
2RRC(51)-4	WOL TO PIPE	B-J	SUR	PTP-1				
2RRC(51)-7	PIPE TO VALVE	B-J	SUR	PTP-1				

WNP-02
 INTERVAL: PSI
 PERIOD: NA
 OUTAGE:
 DRAWING NO. RRC-104

WASHINGTON PUBLIC POWER SUPPLY SYSTEM
 PROGRAM PLAN AND SCHEDULE
 SYSTEM OR COMPONENT: RRC(51)-4
 DESCRIPTION: RPV DRAIN


PAGE 003
 DATE 12/14/84

<u>IDENT. NO.</u>	<u>DESCRIPTION</u>	<u>SECT.</u>		<u>PROCEDURE</u>	<u>CAL. BLOCK</u>	<u>INSERVICE SCHEDULED</u>		<u>NOTES</u>
		<u>EXAM.</u>	<u>INTH.</u>			<u>REQ.</u>	<u>OUTAGE</u>	
4RRC(51)-5/2RRC(51)-4B	PIPE TO SOL	B-J	SUR	PTP-1				
4RRC(51)-6	PIPE TO VALVE	B-J	SUR	PTP-1				
RRC-1C-900N	PSA-1 SN(2)	B-K-2	VT-3	303/8.2.17				S/N 583/617
			VT-4	303/8.2.17				S/N 583/617
2RRC(51)-8	SOL TO PIPE	B-J	SUR	PTP-1				
2RRC(51)-8A	PIPE TO PIPE	B-J	SUR	PTP-1				
2RRC(51)-8B	PIPE TO PIPE	B-J	SUR	PTP-1				
2RRC(51)-9	PIPE TO VALVE	B-J	SUR	PTP-1				
2RRC(51)-10	VALVE TO PIPE	B-J	SUR	PTP-1				
2RRC(51)-11	PIPE TO VALVE	B-J	SUR	PTP-1				
RRC-PB-104	RRC PRES BNDRY	B-P	VT-2	N/A				SEE NOTES #6 & #7.

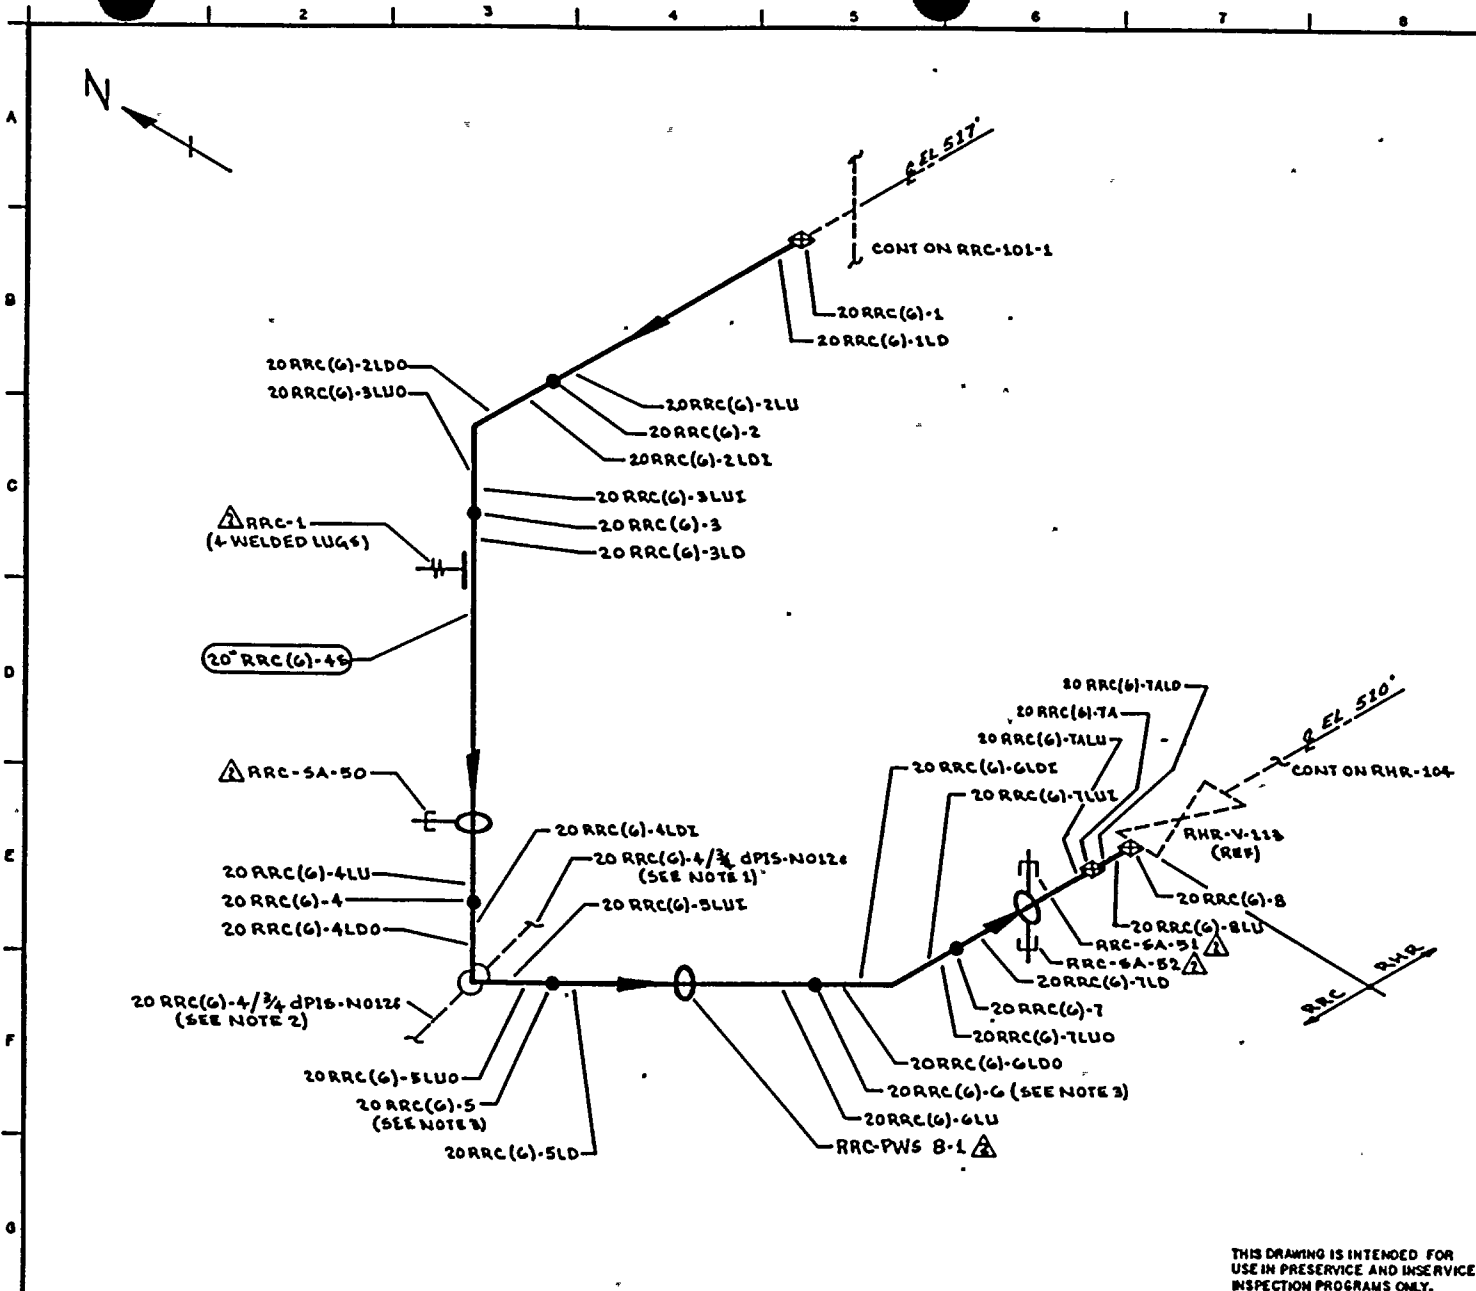

- NOTES:
1. EXTEND LEAKAGE EXAM THROUGH CONTAINMENT PENETRATION (X-74c) THROUGH EXCESS FLOW CHECK VALVE TO INSTRUMENT TUBING CONNECTION.
 2. EXTEND LEAKAGE EXAM THROUGH CONTAINMENT PENETRATION (X-74c) THROUGH EXCESS FLOW CHECK VALVE TO INSTRUMENT TUBING CONNECTION.
 3. ACCESS TO WELDS 20 RRC(6)-8 & 20 RRC(6)-6 REQUIRES REMOVAL OF RRC-PWS B-1

REFERENCES:
BOVEE & CRAL ISOMETRIC
RRC-565-1 REV E2

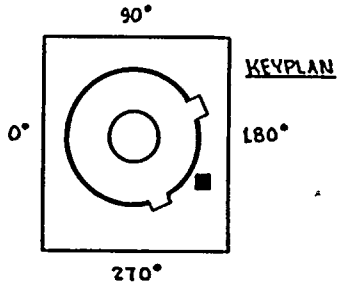

THIS DRAWING IS INTENDED FOR USE IN PRESERVICE AND INSERVICE INSPECTION PROGRAMS ONLY.

QUALITY CLASS: 1 ASME CODE CLASS: 1
ENGR: D TIMMING DRAWN: V McA DATE: 7-14-78

WASHINGTON PUBLIC POWER SUPPLY SYSTEM
RICHLAND, WASHINGTON 99352

WHP-2
WELD & COMPONENT IDENTIFICATION DIAGRAM

TITLE:
RHR SHUTDOWN COOLING SUCTION INTERTIE WITH RRC LOOP A

DWG NO: RRC-105 REV 2

NO	DATE	REVISION	BY	CHKD	APPVD
2	10-17-83	REVISED AS NOTED ADDED KEYPLAN	KMcA	ZFR	TJK
1	7-17-78	ADDED FIELD WELD 20 RRC(6)7A, PER AS BUILT, LN 87	KMcA	JFA	JAS
0	11-27-78	ISSUED FOR USE	KMcA	DJR	JAS
A	9-12-78	ISSUED FOR INFORMATION ONLY	KMcA	DJR	RUP

PIPING SYSTEM	NOM DIA (IN)	SCH	NOM WALL THK	MATERIAL SPECIFICATION	MATL TYPE	CAL BLOCK NO
20" RRC(6)-48	20	80	1.031	SA 358 GR 304	SS	9



WNP-02
 INTERVAL: PSI
 PERIOD: NA
 OUTAGE:
 DRAWING NO. RRC-105

WASHINGTON PUBLIC POWER SUPPLY SYSTEM
 PROGRAM PLAN AND SCHEDULE
 SYSTEM OR COMPONENT: RRC(6)-4S
 DESCRIPTION: RHR SHUTDN COOL SUCT

PAGE 001
 DATE 12/14/84

<u>IDENT. NO.</u>	<u>DESCRIPTION</u>	<u>SECT.</u> <u>XI</u>	<u>EXAM</u> <u>EXAM.</u>	<u>EXAM</u> <u>MTN.</u>	<u>PROCEDURE</u>	<u>CAL.</u> <u>BLOCK</u>	<u>INSERVICE</u>		<u>NOTES</u>
							<u>REQ.</u>	<u>SCHEDULED</u> <u>OUTAGE</u>	
20RRC(6)-1	PIPE/REDUCE TEE	B-J	VOL	UTP-10	UT-9				
			SUR	PTP-1					
20RRC(6)-1LD	PIPE SEAM	B-J	VOL	UTP-10	UT-9				
			SUR	PTP-1					
20RRC(6)-2LU	PIPE SEAM	B-J	VOL	UTP-10	UT-9				
			SUR	PTP-1					
20RRC(6)-2	PIPE TO EL	B-J	VOL	UTP-10	UT-9				
			SUR	PTP-1					
20RRC(6)-2LDI	EL SEAM	B-J	VOL	UTP-10	UT-9				
			SUR	PTP-1					
20RRC(6)-2LDQ	EL SEAM	B-J	VOL	UTP-10	UT-9				
			SUR	PTP-1					
20RRC(6)-3LUI	EL SEAM	B-J	VOL	UTP-10	UT-9				
			SUR	PTP-1					
20RRC(6)-3LUQ	EL SEAM	B-J	VOL	UTP-10	UT-9				
			SUR	PTP-1					
20RRC(6)-3	EL TO PIPE	B-J	VOL	UTP-10	UT-9				
			SUR	PTP-1					

WNP-02
 INTERVAL: PSI
 PERIOD: NA
 OUTAGE:
 DRAWING NO. RRC-105

WASHINGTON PUBLIC POWER SUPPLY SYSTEM
 PROGRAM PLAN AND SCHEDULE
 SYSTEM OR COMPONENT: RRC(6)-4S
 DESCRIPTION: RHR SHUTDN COOL SUCT

PAGE 002
 DATE 12/14/84

<u>IDENT. NO.</u>	<u>DESCRIPTION</u>	SECT. XI <u>EXAM.</u>	EXAM <u>MTM.</u>	PROCEDURE	CAL. <u>BLOCK</u>	<u>INSERVICE</u>		<u>NOTES</u>
						<u>REQ.</u>	<u>OUTAGE</u>	
20RRC(6)-3LD	PIPE SEAM	B-J	VOL	UTP-10	UT-9			
			SUR	PTP-1				
RRC-1	SPRING	B-K-2	VT-3	303/8.2.17				
			VT-4	303/8.2.17				
RRC-SA-50	PSA-35 SNUBBER	B-K-2	VT-3	303/8.2.17				S/N 6093
			VT-4	303/8.2.17				S/N 6093
20RRC(6)-4LU	PIPE SEAM	B-J	VOL	UTP-10	UT-9			
			SUR	PTP-1				
20RRC(6)-4	PIPE SFAM	B-J	VOL	UTP-10	UT-9			
			SUR	PTP-1				
20RRC(6)-4LDI	EL SEAM	B-J	VOL	UTP-10	UT-9			
			SUR	PTP-1				
20RRC(6)-4LDO	EL SEAM	B-J	VOL	UTP-10	UT-9			
			SUR	PTP-1				
20RRC(6)-4/3/4DPIS-N012E	INSTR CONN	B-P	VT-2	N/A				SEE NOTES #5 & #7.
20RRC(6)-4/3/4DPIS-N012F	INSTR CONN	B-P	VT-2	N/A				SEE NOTES #6 & #7.
20RRC(6)-5LUI	EL SEAM	B-J	VOL	UTP-10	UT-9			
			SUR	PTP-1				

WNP-02
 INTERVAL: PSI
 PERIOD: NA
 OUTAGE:
 DRAWING NO. RRC-105

WASHINGTON PUBLIC POWER SUPPLY SYSTEM
 PROGRAM PLAN AND SCHEDULE
 SYSTEM OR COMPONENT: RRC(6)-4S
 DESCRIPTION: RHR SHUTDN COOL SUCT

PAGE 003
 DATE 12/14/84

<u>IDENT. NO.</u>	<u>DESCRIPTION</u>	<u>SECT.</u> <u>XI</u>	<u>EXAM</u> <u>EXAM.</u>	<u>MTM.</u>	<u>PROCEDURE</u>	<u>CAL.</u> <u>BLOCK</u>	<u>INSERVICE</u>		<u>NOTES</u>
							<u>REQ.</u>	<u>SCHEDULED</u> <u>OUTAGE</u>	
20RRC(6)-5LU0	EL SEAM	B-J	VOL	UTP-10	UT-9				
			SUR	PTP-1					
20RRC(6)-5	EL TO PIPE	B-J	VOL	UTP-10	UT-9				
			SUR	PTP-1					
20RRC(6)-5LD	PIPE SEAM	B-J	VOL	UTP-10	UT-9				
			SUR	PTP-1					
PWS-8-1	PIPE WHIP	N/A	N/A	N/A					SEE NOTE #1
20RRC(6)-6LU	PIPE SEAM	B-J	VOL	UTP-10	UT-9				
			SUR	PTP-1					
20RRC(6)-6	PIPE TO EL	B-J	VOL	UTP-10	UT-9				
			SUR	PTP-1					
20RRC(6)-6LDI	EL SEAM	B-J	VOL	UTP-10	UT-9				
			SUR	PTP-1					
20RRC(6)-6LDO	EL SEAM	B-J	VOL	UTP-10	UT-9				
			SUR	PTP-1					
20RRC(6)-7LUI	EL SEAM	B-J	VOL	UTP-10	UT-9				
			SUR	PTP-1					
20RRC(6)-7LU0	EL SEAM	B-J	VOL	UTP-10	UT-9				

WNP-02
 INTERVAL: PSI
 PERIOD: NA
 OUTAGE:
 DRAWING NO. RRC-105

WASHINGTON PUBLIC POWER SUPPLY SYSTEM
 PROGRAM PLAN AND SCHEDULE
 SYSTEM OR COMPONENT: RRC(6)-4S
 DESCRIPTION: RHR SHUTDN COOL SUCT

PAGE 004
 DATE 12/14/84

IDENT. NO.	DESCRIPTION	SECT. XI EXAM.	EXAM MTH.	PROCEDURE	CAL. BLOCK	INSERVICE		NOTES
						REQ.	SCHEDULED OUTAGE	
20RRC(6)-7	EL TO PIPE	B-J	VOL	PTP-1 UTP-10	UT-9			
20RRC(6)-7LD	PIPE SEAM	B-J	VOL	PTP-1 UTP-10	UT-9			
RRC-SA-51	PSA-35 SNUBBER	B-K-2	VT-3	PTP-1 303/8.2.17				S/N 6162
RRC-SA-52	PSA-10 SNUBBER	B-K-2	VT-4	PTP-1 303/8.2.17				S/N 6162
20RRC(6)-7ALU	PIPE SEAM	B-K-2	VT-3	PTP-1 303/8.2.17				S/N 11801
20RRC(6)-7A	PIPE TO PIPE	B-K-2	VT-4	PTP-1 303/8.2.17				S/N 11801
20RRC(6)-7ALD	PIPE SEAM	B-J	VOL	PTP-1 UTP-10	UT-9			
20RRC(6)-8LU	PIPE SEAM	B-J	VOL	PTP-1 UTP-10	UT-9			
20RRC(6)-8	PIPE TO VALVE	B-J	VOL	PTP-1 UTP-10	UT-9			

WNP-02
INTERVAL: PSI
PERIOD: NA
OUTAGE:
DRAWING NO. RRC-105

WASHINGTON PUBLIC POWER SUPPLY SYSTEM
PROGRAM PLAN AND SCHEDULE
SYSTEM OR COMPONENT: RRC(6)-4S
DESCRIPTION: RHR SHUTDN COOL SUCT

PAGE 005
DATE 12/14/84

<u>IDENT. NO.</u>	<u>DESCRIPTION</u>	SECT. XI <u>EXAM.</u>	EXAM <u>MTH.</u>	PROCEDURE	CAL. <u>BLOCK</u>	<u>INSERVICE</u>		<u>NOTES</u>
						<u>REQ.</u>	<u>SCHEDULED</u> <u>OUTAGE</u>	
RRC-PB-105	RRC PRES BNDRY	B-P	SUR VT-2	PTP-1 N/A				SEE NOTES #6 & #7.



WNP-02
 INTERVAL: PSI
 PERIOD: NA
 OUTAGE:
 DRAWING NO. RRC-106

WASHINGTON PUBLIC POWER SUPPLY SYSTEM
 PROGRAM PLAN AND SCHEDULE
 SYSTEM OR COMPONENT: RRC(7)-4S
 DESCRIPTION: SHUTDN COOL RETURN A

PAGE 001
 DATE 12/14/84

<u>IDENT. NO.</u>	<u>DESCRIPTION</u>	SECT. <u>XI</u> <u>EXAM.</u>	<u>EXAM.</u>	<u>MTM.</u>	<u>PROCEDURE</u>	<u>CAL.</u> <u>BLOCK</u>	<u>INSERVICE</u>		<u>NOTES</u>
							<u>REQ.</u>	<u>SCHEDULED</u> <u>OUTAGE</u>	
12RRC(7)A-1	VALVE TO PIPE	B-J	VOL	UTP-10	UT-19				
			SUR	PTP-1					
RHR-SA-30	PSA-10 SN(2)	B-K-2	VT-3	303/8.2.17					S/N 576/1447
			VT-4	303/8.2.17					S/N 576/1447
RHR-SA-31	PSA-10 SNUBBER	B-K-2	VT-3	303/8.2.17					S/N 9938
			VT-4	303/8.2.17					S/N 9938
12RRC(7)A-1LD	PIPE SEAM	B-J	VOL	UTP-10	UT-19				
			SUR	PTP-1					
RRC-9	SPRING	B-K-2	VT-3	303/8.2.17					
			VT-4	303/8.2.17					
12RRC(7)A-2LU	PIPE SEAM	B-J	VOL	UTP-10	UT-19				
			SUR	PTP-1					
12RRC(7)A-2	PIPE TO EL	B-J	VOL	UTP-10	UT-19				
			SUR	PTP-1					
12RRC(7)A-2LDI	EL SEAM	B-J	VOL	UTP-10	UT-19				
			SUR	PTP-1					
12RRC(7)A-2LDO	EL SEAM	B-J	VOL	UTP-10	UT-19				
			SUR	PTP-1					

WNP-02
 INTERVAL: PSI
 PERIOD: NA
 OUTAGE:
 DRAWING NO. RRC-106

WASHINGTON PUBLIC POWER SUPPLY SYSTEM
 PROGRAM PLAN AND SCHEDULE
 SYSTEM OR COMPONENT: RRC(7)-4S
 DESCRIPTION: SHUTDN COOL RETURN A

PAGE 002
 DATE 12/14/84

<u>IDENT. NO.</u>	<u>DESCRIPTION</u>	SECT. XI <u>EXAM.</u>	<u>EXAM.</u> MTH.	<u>PROCEDURE</u>	<u>CAL.</u> BLOCK	<u>INSERVICE</u> SCHEDULED		<u>NOTES</u>
						<u>REQ.</u>	<u>OUTAGE</u>	
12RRC(7)A-3LUI	EL SEAM	B-J	VOL	UTP-10	UT-19			
			SUR	PTP-1				
12RRC(7)A-3LUO	EL SEAM	B-J	VOL	UTP-10	UT-19			
			SUR	PTP-1				
12RRC(7)A-3	EL TO PIPE	B-J	VOL	UTP-10	UT-19			
			SUR	PTP-1				
12RRC(7)A-3LD	PIPE SEAM	B-J	VOL	UTP-10	UT-19			
			SUR	PTP-1				
12RRC(7)A-4LU	PIPE SEAM	B-J	VOL	UTP-10	UT-19			
			SUR	PTP-1				
12RRC(7)A-4	PIPE TO EL	B-J	VOL	UTP-10	UT-19			
			SUR	PTP-1				
12RRC(7)A-4LOI	EL SEAM	B-J	VOL	UTP-10	UT-19			
			SUR	PTP-1				
12RRC(7)A-4LDO	EL SEAM	B-J	VOL	UTP-10	UT-19			
			SUR	PTP-1				
12RRC(7)A-5LUI	EL SEAM	B-J	VOL	UTP-10	UT-19			
			SUR	PTP-1				


WNP-02
 INTERVAL: PSI
 PERIOD: NA
 OUTAGE:
 DRAWING NO. RRC-106


WASHINGTON PUBLIC POWER SUPPLY SYSTEM
 PROGRAM PLAN AND SCHEDULE
 SYSTEM OR COMPONENT: RRC(7)-4S
 DESCRIPTION: SHUTDN COOL RETURN A

PAGE 003
 DATE 12/14/84

<u>IDENT. NO.</u>	<u>DESCRIPTION</u>	<u>SECT.</u> <u>XI</u> <u>EXAM.</u>	<u>EXAM</u> <u>MTH.</u>	<u>PROCEDURE</u>	<u>CAL.</u> <u>BLOCK</u>	<u>INSERVICE</u>		<u>NOTES</u>
						<u>REQ.</u>	<u>SCHEDULED</u> <u>OUTAGE</u>	
12RRC(7)A-5LU0	EL SEAM	B-J	VOL	UTP-10	UT-19			
			SUR	PTP-1				
12RRC(7)A-5	EL TO PIPE	B-J	VOL	UTP-10	UT-19			
			SUR	PTP-1				
12RRC(7)A-5LD	PIPE SEAM	B-J	VOL	UTP-10	UT-19			
			SUR	PTP-1				
12RRC(7)A-6LU	PIPE SEAM	B-J	VOL	UTP-10	UT-19			
			SUR	PTP-1				
12RRC(7)A-6	PIPE TO SWL	B-J	VOL	UTP-10	UT-19			
			SUR	PTP-1				
RRC-PB-106	RRC PRES BNDRY	B-P	VT-2	N/A				


SEE NOTES #6 & #7.

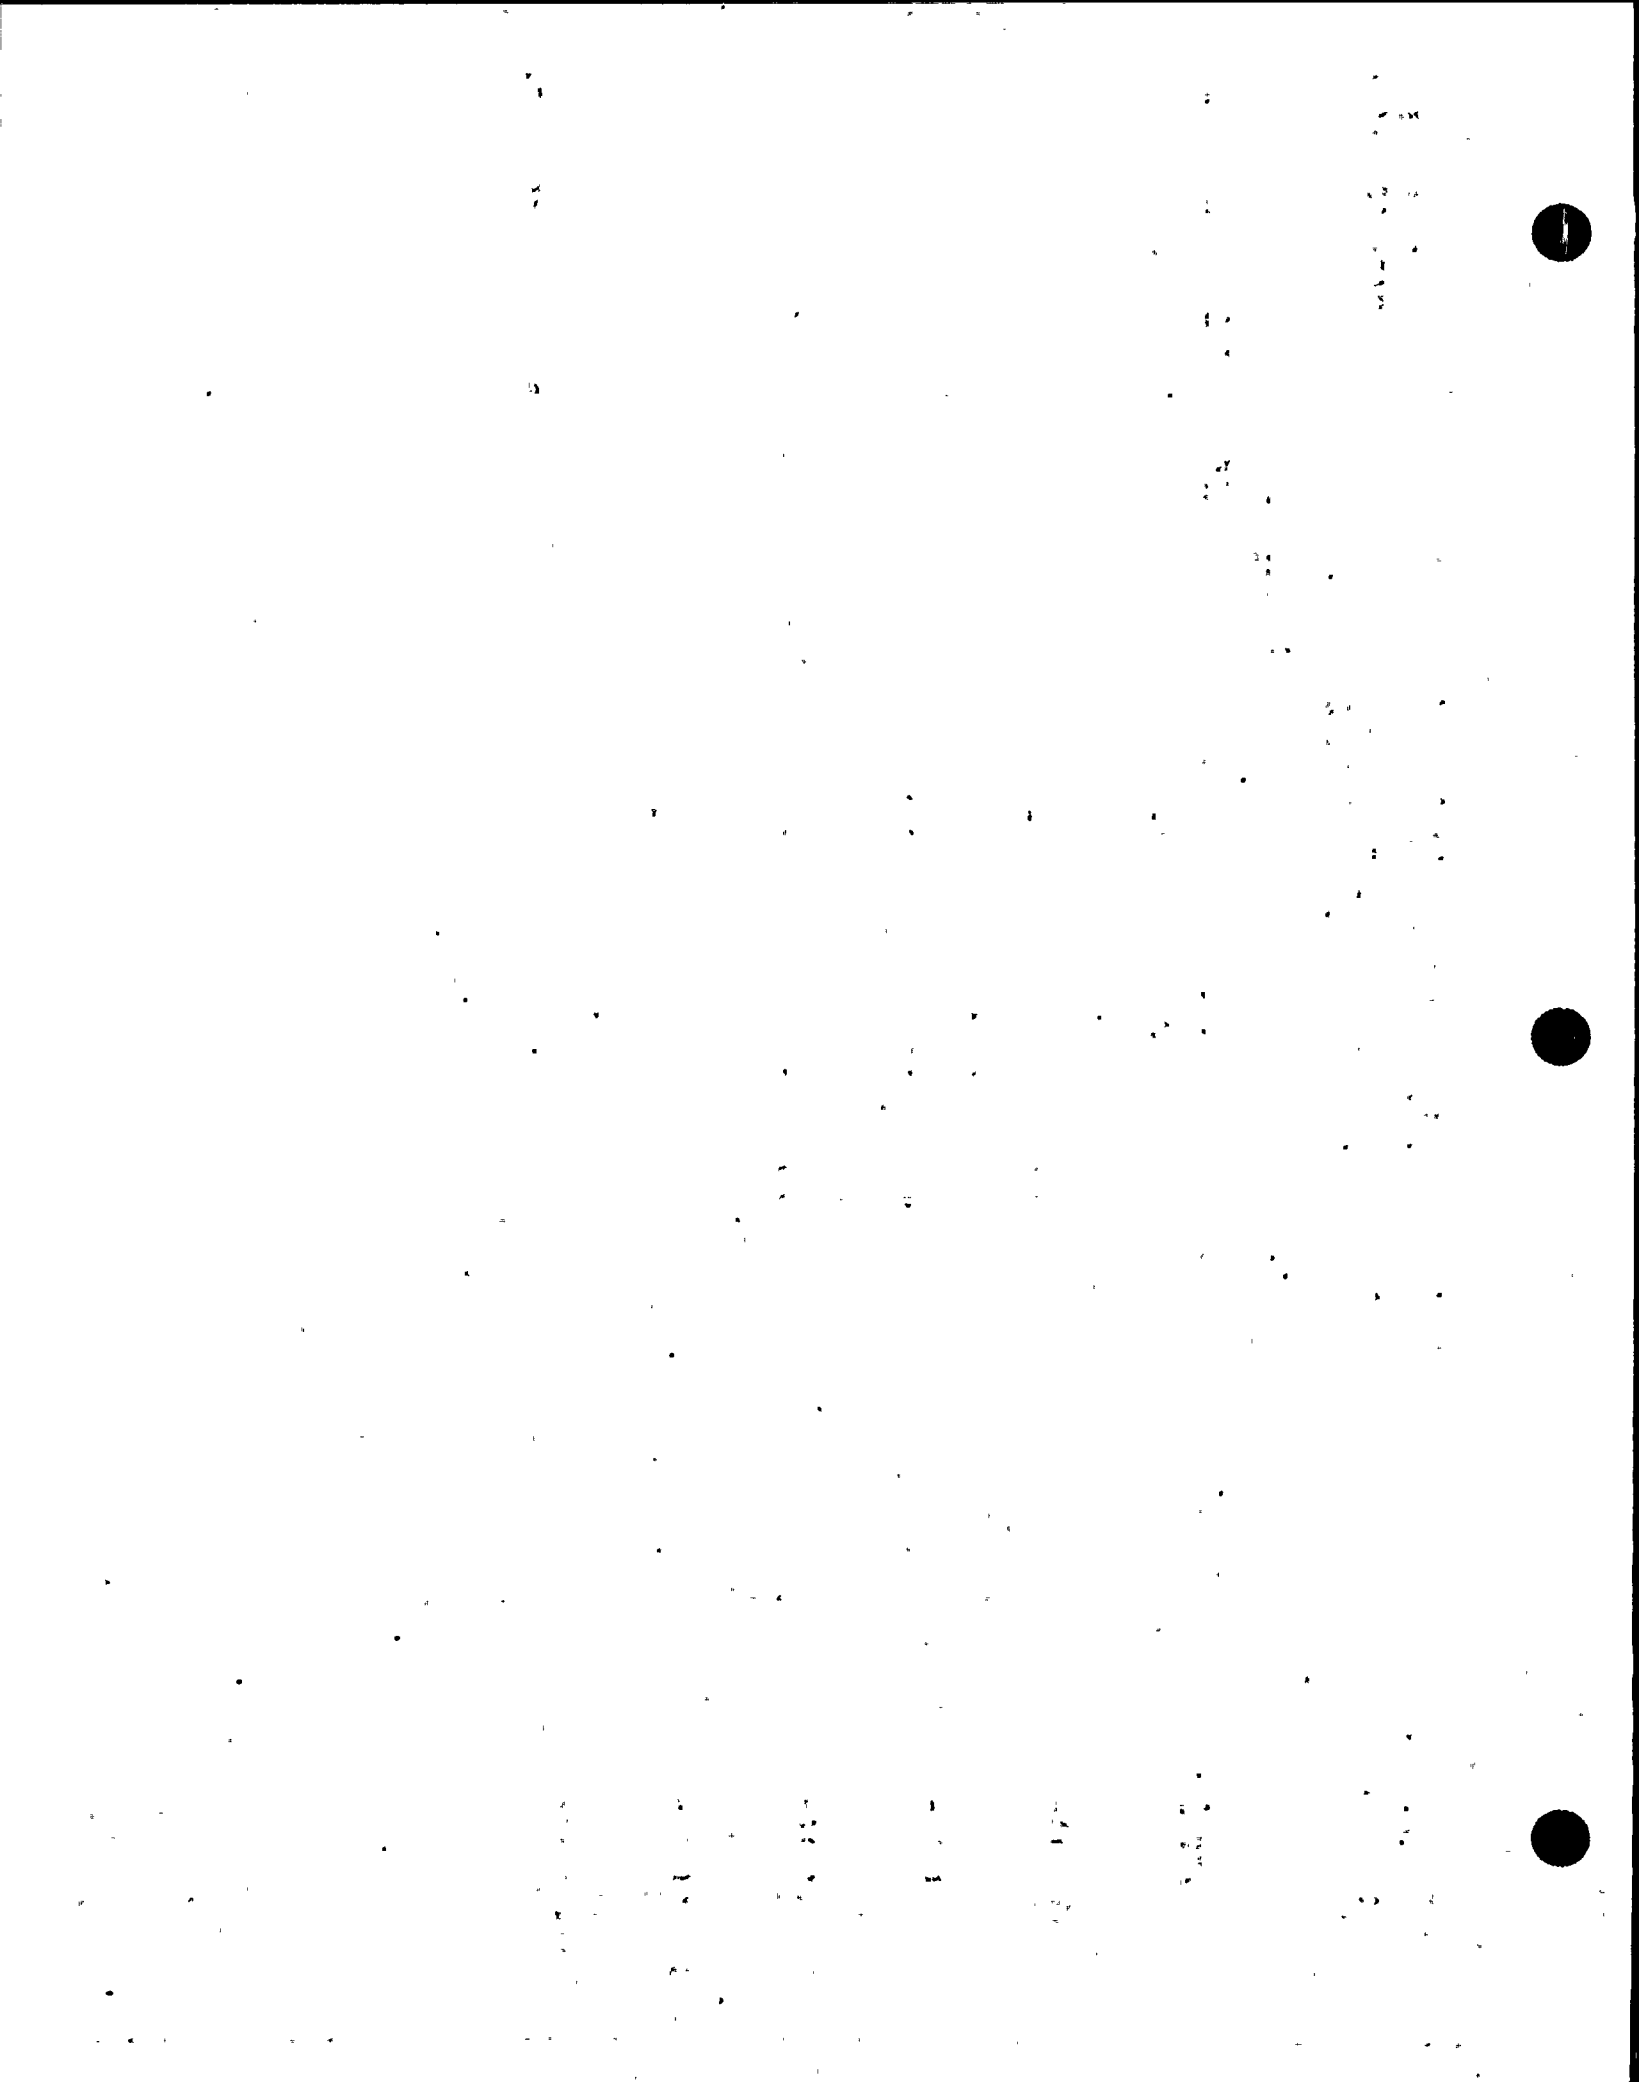

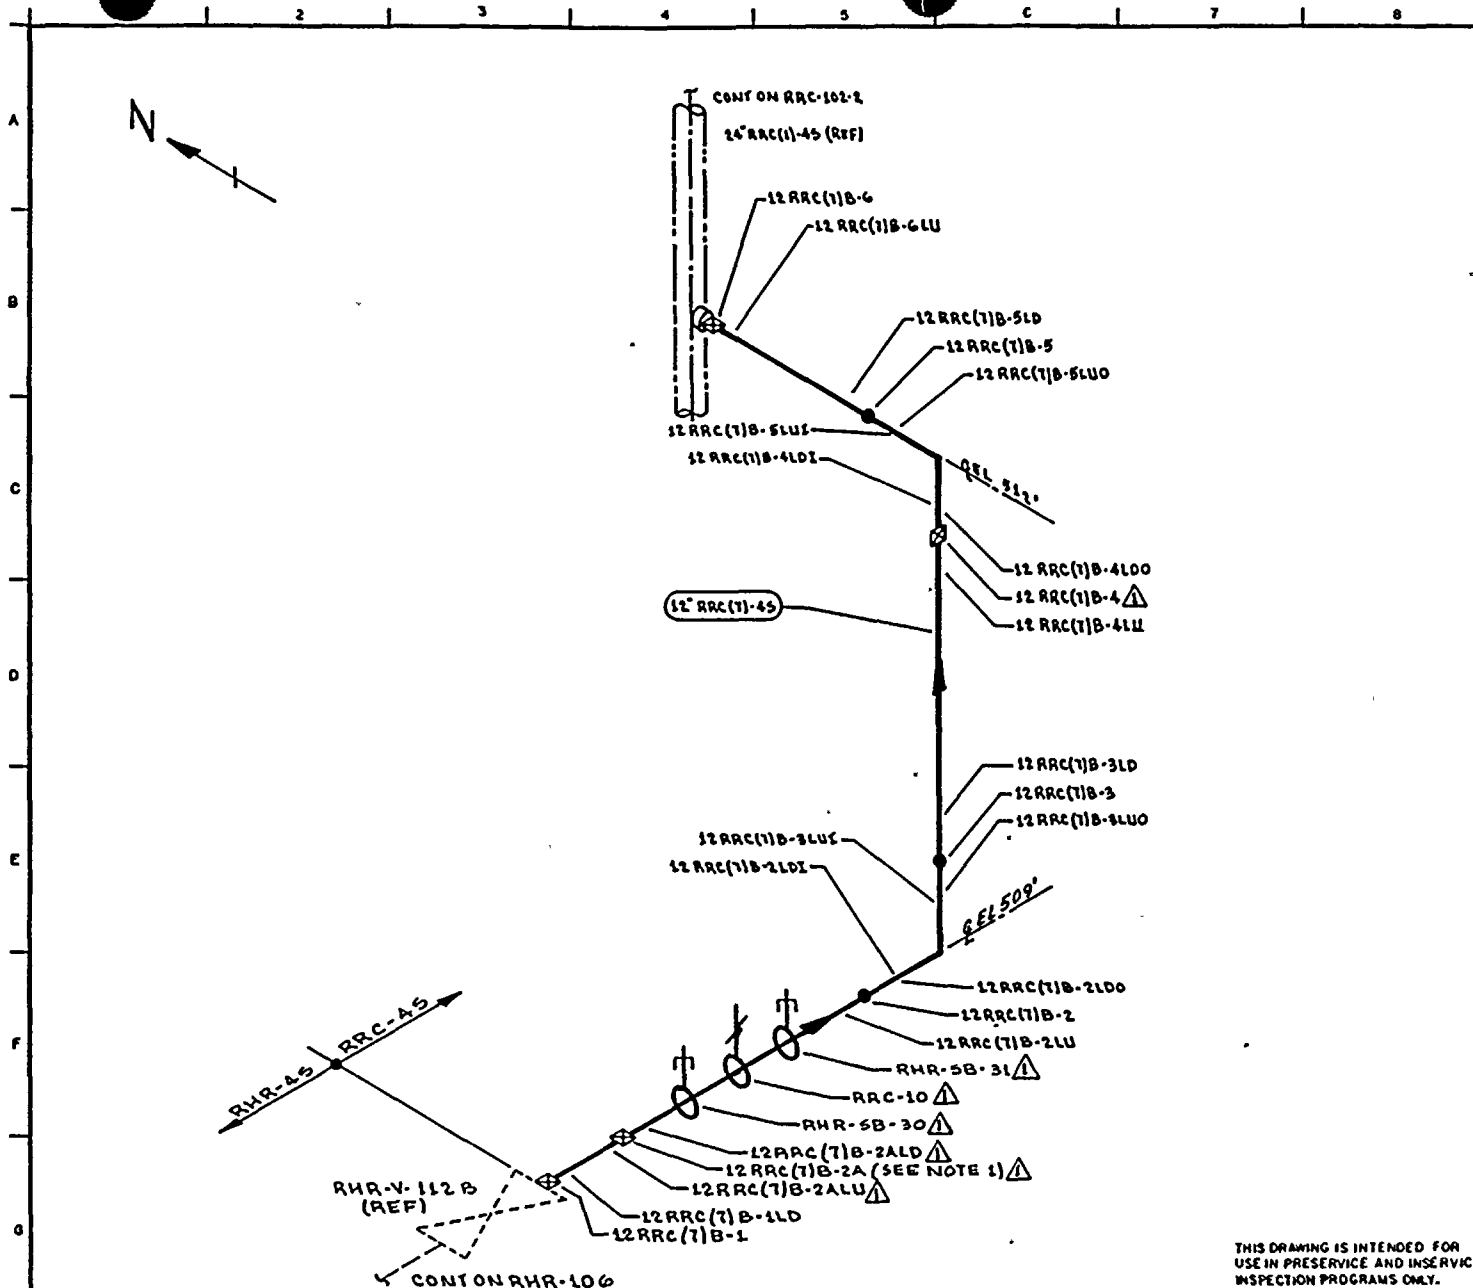

NOTES:
 1. ACCESS TO WELD 12RRC(1)B-2A REQUIRES REMOVAL OF RHR-5B-30.

REFERENCES:
 BOYEE & CRAIL ISOMETRIC
 RRC-568-1 REV 9

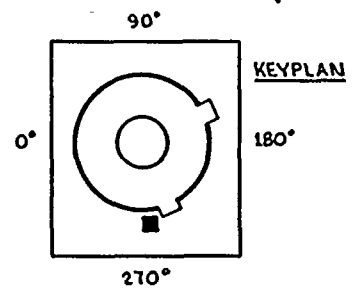

THIS DRAWING IS INTENDED FOR USE IN PRESERVICE AND INSERVICE INSPECTION PROGRAMS ONLY.

QUALITY CLASS: 1 ASME CODE CLASS 1
 ENGR D. FRANKING DRAWN: V. Mc L DATE: 9-15-78

WASHINGTON PUBLIC POWER SUPPLY SYSTEM
 RICHMOND WASHINGTON 99102

PIPING SYSTEM	NOM DIA (IN)	SCH	NOM WALL THK	MATERIAL SPECIFICATION	MATL TYPE	CAL BLOCK NO
12 RRC(1)B-45	12	80	0.687	SA 358 GR 304	SS	UT-19

NO	DATE	REVISION	BY	CHKD	APPRV
5	10-19-78	REVISED AS NOTED ADDED KEYPLAN	KWA	DKR	DPH
0	11-16-78	ISSUED FOR USE	KWA	DKR	DPH
1	10-24-78	ISSUED FOR INFORMATION ONLY	KWA	DKR	DPH

WNP-2
 WELD COMPONENT IDENTIFICATION DIAGRAM

TITLE:
 RHR SHUTDOWN COOLING RETURN TO RRC LOOP B

DWG NO: RRC-107 REV 1

WNP-02
 INTERVAL: PSI
 PERIOD: NA
 OUTAGE:
 DRAWING NO. RRC-107

WASHINGTON PUBLIC POWER SUPPLY SYSTEM
 PROGRAM PLAN AND SCHEDULE
 SYSTEM OR COMPONENT: RRC(7)-4S
 DESCRIPTION: SHUTDN COGL RETURN B

PAGE 001
 DATE 12/14/84

IDENT. NO.	DESCRIPTION	SECT. XI EXAM.	EXAM MTH.	PROCEDURE	CAL. BLOCK	INSERVICE		NOTES
						REQ.	SCHEDULED OUTAGE	
12RRC(7)B-1	VALVE TO PIPE	B-J	VOL	UTP-10	UT-19			
			SUR	PTP-1				
12RRC(7)B-1LD	PIPE SEAM	B-J	VOL	UTP-10	UT-19			
			SUR	PTP-1				
12RRC(7)B-2ALU	PIPE SEAM	B-J	VOL	QCI 6-13	UT-19			
			SUR	QCI 3-3				
12RRC(7)B-2A	PIPE TO PIPE	B-J	VOL	GCI 6-13	UT-19			
			SUR	QCI 3-3				
12RRC(7)B-2ALD	PIPE SEAM	B-J	VOL	UTP-10	UT-19			
			SUR	PTP-1				
RHR-SB-30	PSA-10 SNUBBER	B-K-2	VT-3	303/8.2.17				S/N 9936
			VT-4	303/8.2.17				S/N 9936
FRC-10	SPRING	B-K-2	VT-3	303/8.2.17				
			VT-4	303/8.2.17				
RHR-SB-31	PSA-10 SNUBBER	B-K-2	VT-3	303/8.2.17				S/N 9916
			VT-4	303/8.2.17				S/N 9916
12RRC(7)B-2LU	PIPE SEAM	B-J	VOL	UTP-10	UT-19			
			SUR	PTP-1				

WNP-02
 INTERVAL: PSI
 PERIOD: NA
 OUTAGE:
 DRAWING NO. RRC-107

WASHINGTON PUBLIC POWER SUPPLY SYSTEM
 PROGRAM PLAN AND SCHEDULE
 SYSTEM OR COMPONENT: RRC(7)-4S
 DESCRIPTION: SHUTDN COOL RETURN B

PAGE 002
 DATE 12/14/84

<u>IDENT. NO.</u>	<u>DESCRIPTION</u>	SECT. XI <u>EXAM.</u>	EXAM <u>MTH.</u>	<u>PROCEDURE</u>	CAL. <u>BLOCK</u>	<u>INSERVICE</u>		<u>NOTES</u>
						<u>REQ.</u>	<u>SCHEDULED OUTAGE</u>	
12RRC(7)B-2	PIPE TO EL	B-J	VOL	UTP-10	UT-19			
			SUR	OCI 3-3				
12RRC(7)B-2LDI	EL SEAM	B-J	VOL	UTP-10	UT-19			
			SUR	PTP-1				
12RRC(7)B-2LDO	EL SEAM	B-J	VOL	UTP-10	UT-19			
			SUR	PTP-1				
12RRC(7)B-3LUI	EL SEAM	B-J	VOL	UTP-10	UT-19			
			SUR	PTP-1				
12RRC(7)B-3LUO	EL SEAM	B-J	VOL	UTP-10	UT-19			
			SUR	PTP-1				
12RRC(7)B-3	EL TO PIPE	B-J	VOL	UTP-10	UT-19			
			SUR	OCI 3-3				
12RRC(7)B-3LD	PIPE SEAM	B-J	VOL	UTP-10	UT-19			
			SUR	PTP-1				
12RRC(7)B-4LU	PIPE SEAM	B-J	VOL	UTP-10	UT-19			
			SUR	PTP-1				
12RRC(7)B-4	PIPE TO EL	B-J	VOL	UTP-10	UT-19			
			SUR	PTP-1				


WNP-02
 INTERVAL: PSI
 PERIOD: NA
 OUTAGE:
 DRAWING NO. RRC-107

WASHINGTON PUBLIC POWER SUPPLY SYSTEM
 PROGRAM PLAN AND SCHEDULE
 SYSTEM OR COMPONENT: RRC(7)-4S
 DESCRIPTION: SHUTDN COOL RETURN B

PAGE 003
 DATE 12/14/84


IDENT. NO.	DESCRIPTION	SECT. XI EXAM.	EXAM MTH.	PROCEDURE	CAL. BLOCK	INSERVICE		NOTES
						REQ.	SCHEDULED OUTAGE	
12RRC(7)B-4LOI	EL SEAM	B-J	VOL	UTP-10	UT-19			
			SUR	PTP-1				
12RRC(7)B-4LDO	EL SEAM	B-J	VOL	UTP-10	UT-19			
			SUR	PTP-1				
12RRC(7)B-5LUI	EL SEAM	B-J	VOL	UTP-10	UT-19			
			SUR	PTP-1				
12RRC(7)B-5LUO	EL SEAM	B-J	VOL	UTP-10	UT-19			
			SUR	PTP-1				
12RRC(7)B-5	EL TO PIPE	B-J	VOL	UTP-10	UT-19			
			SUR	PTP-1				
12RRC(7)B-5LD	PIPE SEAM	B-J	VOL	UTP-10	UT-19			
			SUR	PTP-1				
12RRC(7)B-6LU	PIPE SEAM	B-J	VOL	UTP-10	UT-19			
			SUR	PTP-1				
12RRC(7)B-6	PIPE TO SWL	B-J	VOL	UTP-10	UT-19			
			SUR	PTP-1				
RRC-PB-107	RRC PRES BNDRY	B-P	VT-2	N/A				

SEE NOTES #6 & #7.

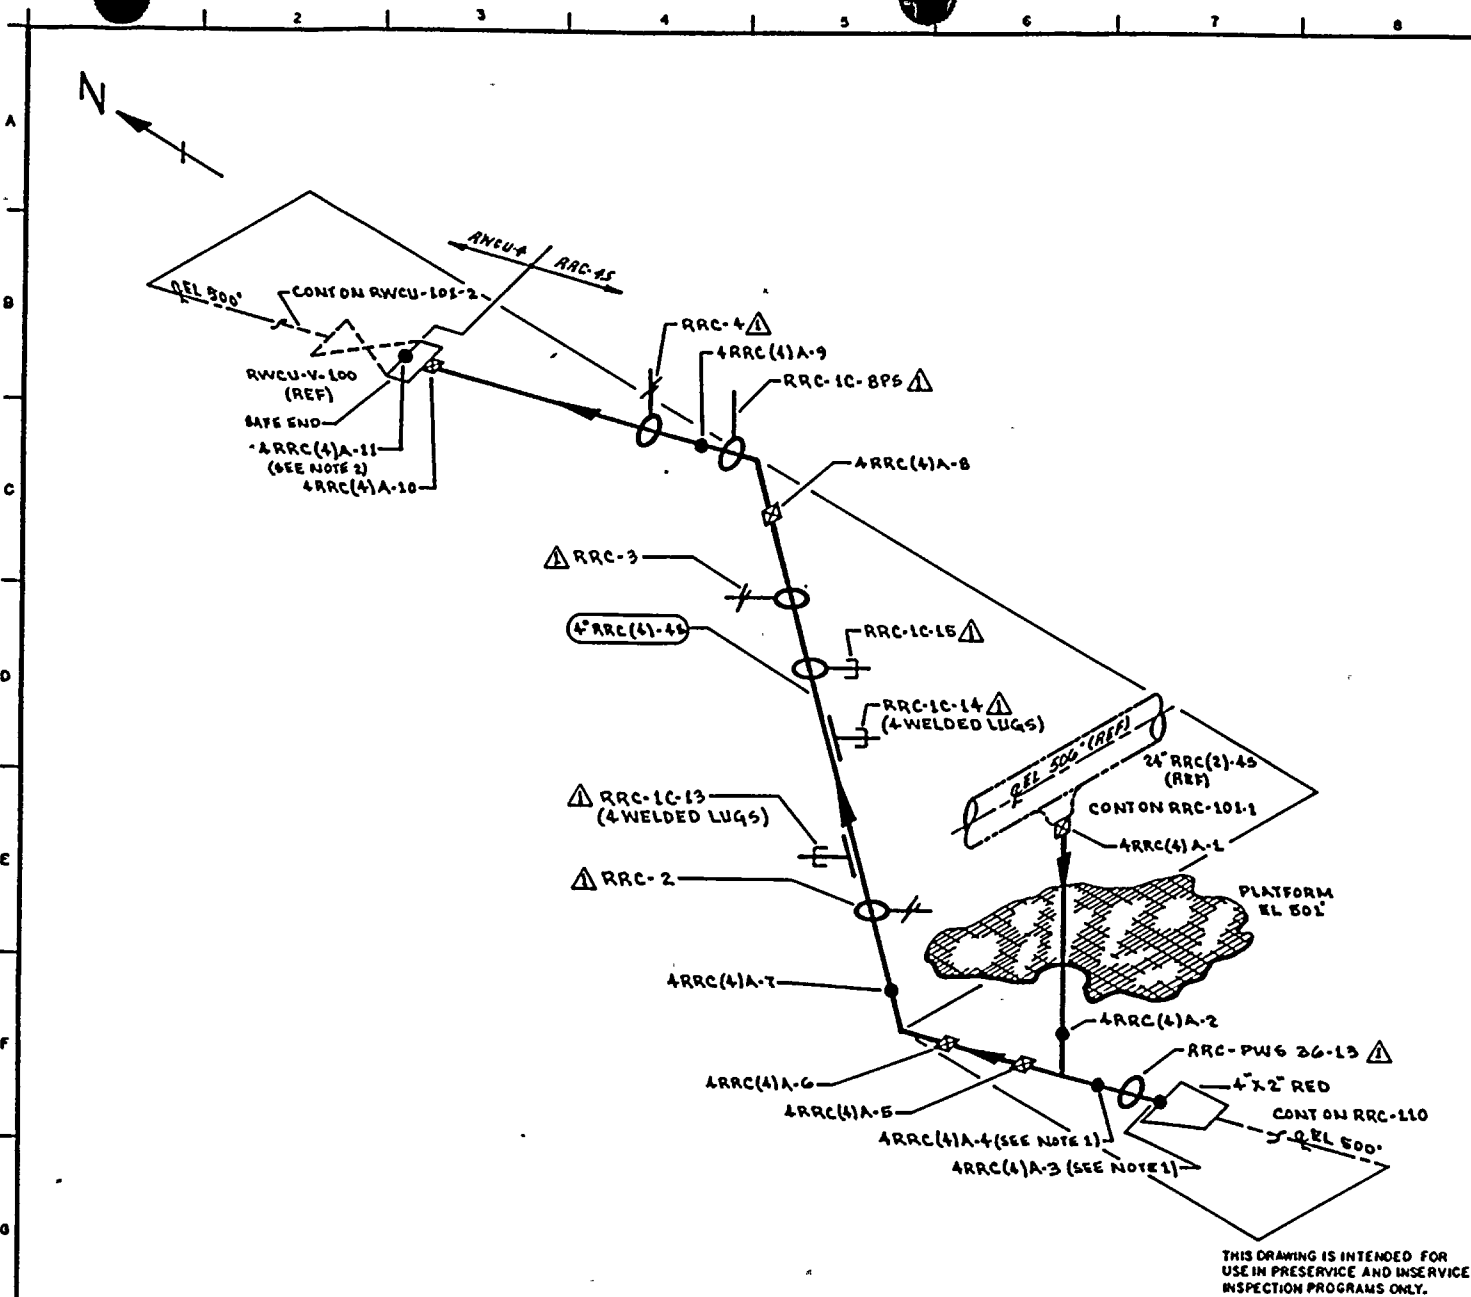

- NOTES:**
1. ACCESS TO WELDS 4RRC(4)A-3 & 4RRC(4)A-4 REQUIRES REMOVAL OF RRC-PW6 36-13
 2. DISSIMILAR METAL WELD, CS TO SS, USE CAL BLOCK UT-29.

REFERENCES:
BOVEE & CRAIG ISOMETRIC
RRC-500-1 REV B

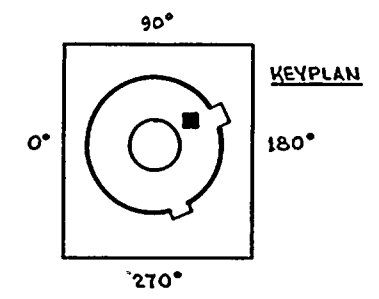

THIS DRAWING IS INTENDED FOR USE IN PRESERVICE AND INSERVICE INSPECTION PROGRAMS ONLY.

QUALITY CLASS: 1 ASME CODE CLASS: 1
ENGR: D TIMMINS | DRAWN: K MCA | DATE: 7-5-78



WASHINGTON PUBLIC POWER SUPPLY SYSTEM
RICHLAND, WASHINGTON 99352

PIPING SYSTEM	NOM DIA (IN)	SCH	NOM WALL THK	MATERIAL SPECIFICATION	MATL TYPE	CAL BLOCK NO
4" RRC(4)-45	4	805	0.337	SA 312 TP 304	SS	UT-29
LUGS	NA	NA	NA	SA 240 TP 304	SS	UT-17

NO	DATE	REVISION	BY	CHKD	APPVD
1	12-13-83	REVISED AS NOTED ADDED LUGS & KEYPLAN	KMCA	JTR	TTH
0	11-11-78	ISSUED FOR USE	KMCA	WLB	JLW
A	7-12-78	ISSUED FOR INFORMATION ONLY	KMCA	DJ	DJP

WNP-2
WELD & COMPONENT IDENTIFICATION DIAGRAM

TITLE:
RWCU INTERTIE TO RRC LOOP A

DWG NO: RRC-10B

REV 1



WNP-02-
 INTERVAL: PSI
 PERIOD: NA
 OUTAGE:
 DRAWING NO. RRC-108

WASHINGTON PUBLIC POWER SUPPLY SYSTEM
 PROGRAM PLAN AND SCHEDULE
 SYSTEM OR COMPONENT: RRC(4)-4S
 DESCRIPTION: RWCU INTERTIE RRC A

PAGE 001
 DATE 12/14/84

<u>IDENT. NO.</u>	<u>DESCRIPTION</u>	SECT. XI <u>EXAM.</u>	EXAM <u>MTM.</u>	<u>PROCEDURE</u>	CAL. <u>BLOCK</u>	<u>INSERVICE</u>		<u>NOTES</u>
						<u>REQ.</u>	<u>SCHEDULED</u> <u>OUTAGE</u>	
4RRC(4)A-1	SOL TO PIPE	B-J	VOL	UTP-10	UT-29			
			SUR	PTP-1				
4RRG(4)A-2	PIPE TO TEE	B-J	VOL	UTP-10	UT-29			
			SUR	PTP-1				
4RRC(4)A-3	PIPE TO REDUCER	B-J	VOL	UTP-10	UT-29			
			SUR	PTP-1				
PWS-36-13	PIPE WHIP	N/A	N/A	N/A				SEE NOTE #1
4RRC(4)A-4	PIPE TO TEE	B-J	VOL	UTP-10	UT-29			
			SUR	PTP-1				
4RRC(4)A-5	TEE TO PIPE	B-J	VOL	UTP-10	UT-29			
			SUR	PTP-1				
4RRC(4)A-6	PIPE TO EL	B-J	VOL	UTP-10	UT-29			
			SUR	PTP-1				
4RRC(4)A-7	EL TO PIPE	B-J	VOL	UTP-10	UT-29			
			SUR	PTP-1				
PWS-36-12	PIPE WHIP	N/A	N/A	N/A				
RRC-2	SPRING	B-K-2	VT-3	303/8.2.17				
			VT-4	303/8.2.17				

WNP-02
 INTERVAL: PSI
 PERIOD: NA
 OUTAGE:
 DRAWING NO. RRC-108

WASHINGTON PUBLIC POWER SUPPLY SYSTEM
 PROGRAM PLAN AND SCHEDULE
 SYSTEM OR COMPONENT: RRC(4)-4S
 DESCRIPTION: RVCU INTERFIF RRC A

PAGE 002
 DATE 12/14/84

<u>IDENT. NO.</u>	<u>DESCRIPTION</u>	<u>SECT.</u> <u>XI</u> <u>EXAM.</u>	<u>EXAM</u> <u>MT#.</u>	<u>PROCEDURE</u>	<u>CAL.</u> <u>BLOCK</u>	<u>INSERVICE</u>		<u>NOTES</u>
						<u>REQ.</u>	<u>SCHEDULED</u> <u>OUTAGE</u>	
RRC-1C-13(W)	4 WELDED LUGS	B-K-1	VOL	UTP-26	UT-29			
RRC-1C-13	PSA-1 SNUBBER	B-K-2	VT-3	303/8.2.17				S/N 357
			VT-4	303/8.2.17				S/N 357
RRC-1C-14(W)	4 WELDED LUGS	B-K-1	VOL	UTP-26	UT-29			
RRC-1C-14	PSA-1 SN(2)	B-K-2	VT-3	303/8.2.17				S/N 646/112
			VT-4	303/8.2.17				S/N 646/112
RRC-1C-15	PSA-1 SNUBBER	B-K-2	VT-3	303/8.2.17				S/N 333
			VT-4	303/8.2.17				S/N 333
RRC-3	SPRING	B-K-2	VT-3	303/8.2.17				
			VT-4	303/8.2.17				
PWS-36-11	PIPE WHIP	N/A	N/A	N/A				
4RRC(4)A-8	PIPE TO EL	B-J	VOL	UTP-10	UT-29			
			SUR	PTP-1				
PWS-36-10	PIPE WHIP	N/A	N/A	N/A				
RRC-1C-8PS	STRUT	B-K-2	VT-3	303/8.2.17				
4RRC(4)A-9	EL TO PIPE	B-J	VOL	UTP-10	UT-29			
			SUR	PTP-1				
RRC-4	SPRING	B-K-2	VT-3	303/8.2.17				



WNP-02
 INTERVAL: PSI
 PERIOD: NA
 OUTAGE:
 DRAWING NO. RRC-108

WASHINGTON PUBLIC POWER SUPPLY SYSTEM
 PROGRAM PLAN AND SCHEDULE
 SYSTEM OR COMPONENT: RRC(4)-4S
 DESCRIPTION: RVCU INTERTIF RRC A

PAGE 003
 DATE 12/14/84

<u>IDENT. NO.</u>	<u>DESCRIPTION</u>	SECT. XI <u>EXAM.</u>	<u>EXAM</u> MTH.	<u>PROCEDURE</u>	CAL. <u>BLOCK</u>	<u>INSERVICE</u>		<u>NOTES</u>
						<u>REQ.</u>	<u>SCHEDULED</u> <u>OUTAGE</u>	
4RRC(4)A-10	PIPE - VALVE SE	B-J	VT-4	303/8.2.17	UT-29			
4RRC(4)A-11	SE TO VALVE	B-F	SUR	PTP-1	UT-29			DISSIMILAR METAL (SS-CS)
RRC-PB-108	RRC PRES BNDRY	B-P	SUR	PTP-1				DISSIMILAR METAL (SS-CS)
			VT-2	II/A				SEE NOTES #6 & #7.




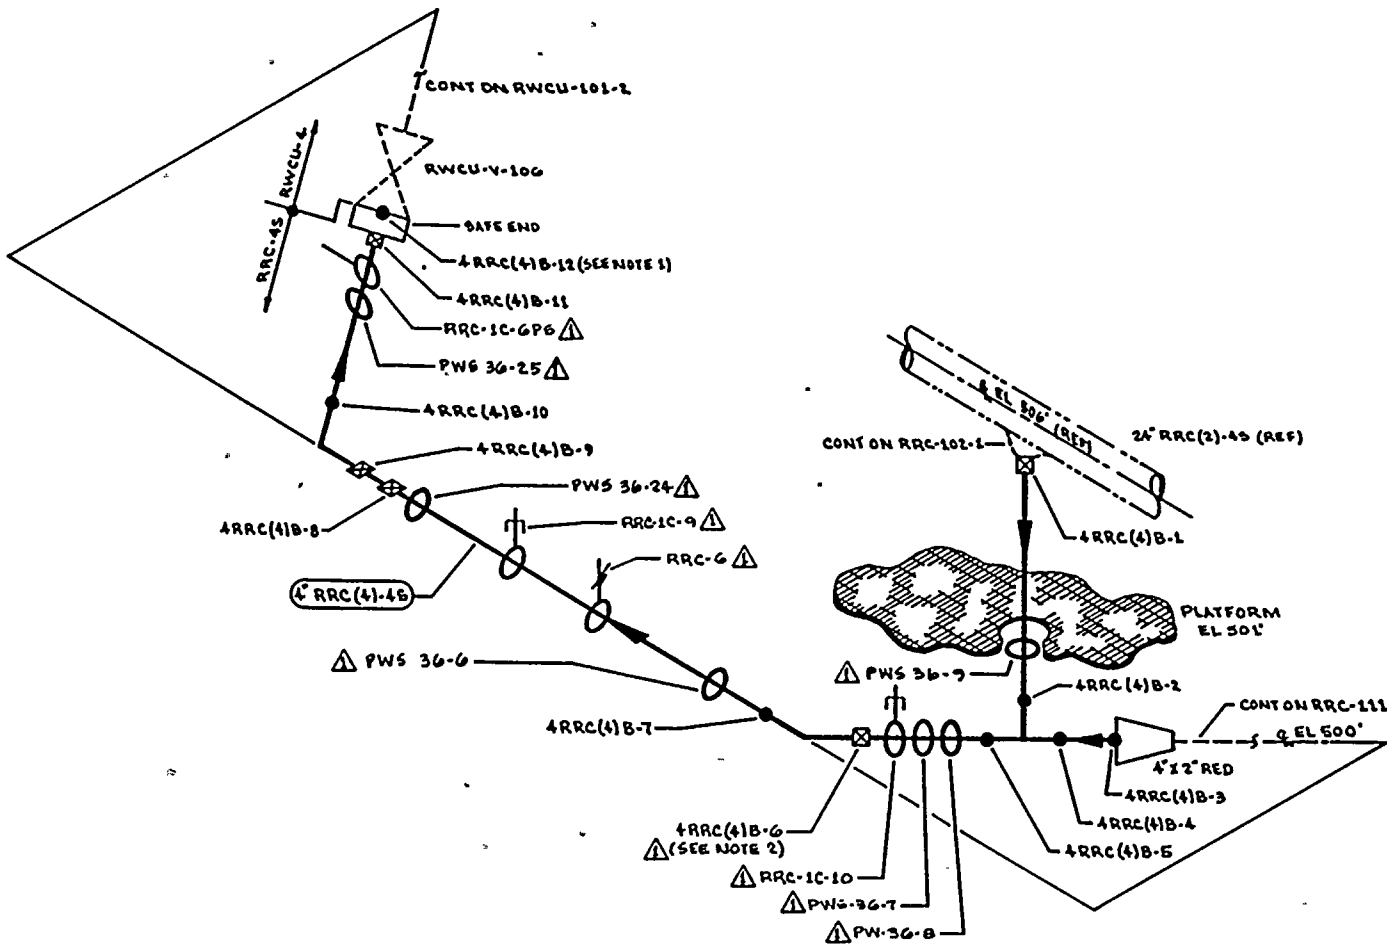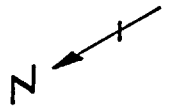

THIS DRAWING IS INTENDED FOR USE IN PRESERVICE AND INSERVICE INSPECTION PROGRAMS ONLY.

- NOTES:**
- DISSIMILAR METAL WELD, CS TO SS, USE CAL BLOCK UT-29.
 - ACCESS TO WELD 4RRC(4)B-6 REQUIRES REMOVAL OF RRC-1C-10.

REFERENCES:
BOVEE & CRAIG ISOMETRIC
RRC-569-1.2 REV B

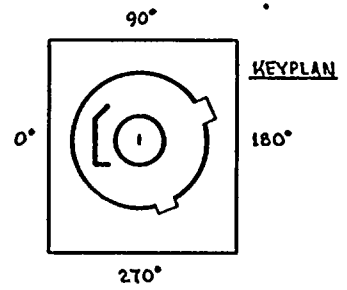

QUALITY CLASS: 1 ASME CODE CLASS 1
ENGR: D TIMMINS DRAWN: K M C A DATE 7-31-78



WASHINGTON PUBLIC POWER SUPPLY SYSTEM
RICHMOND WASHINGTON 99502

PIPING SYSTEM	NOM DIA (DN)	SCH	NOM WALL THK	MATERIAL SPECIFICATION	MATL TYPE	CAL BLOCK NO
4" RRC(4)-45	4	805	0.337	SA 312 TP 304	SS	UT-29

NO	DATE	REVISION	BY	CHKD	APPVD
1	10-13-81	REVISED AS NOTED ADDED KEYPLAN	KML	BPR	JFH
0	11-11-78	ISSUED FOR USE	KML	AKL	JFH
A	8-12-78	ISSUED FOR INFORMATION ONLY	KML	JT	QWP

WNP-2
WELD B COMPONENT
IDENTIFICATION DIAGRAM

TITLE:
RWCU INTERTIE TO RRC LOOP B

DWG NO: RRC-109 REV 1

WNP-02
 INTERVAL: PSI
 PERIOD: NA
 OUTAGE:
 DRAWING NO. RRC-109

WASHINGTON PUBLIC POWER SUPPLY SYSTEM
 PROGRAM PLAN AND SCHEDULE
 SYSTEM OR COMPONENT: RRC(4)-4S
 DESCRIPTION: RVCU INTERTIE RRC B

PAGE 001
 DATE 12/14/84

<u>IDENT. NO.</u>	<u>DESCRIPTION</u>	SECT. XI <u>EXAM.</u>	EXAM <u>MIH.</u>	<u>PROCEDURE</u>	CAL. <u>BLOCK</u>	<u>INSERVICE</u>		<u>NOTES</u>
						<u>REQ.</u>	<u>SCHEDULED</u> <u>OUTAGE</u>	
4RRC(4)B-1	SWL TO PIPE	B-J	VOL	UTP-10	UT-29			
			SUR	PTP-1				
PWS-36-9	PIPE WHIP	N/A	N/A	N/A				SEE NOTE #1
4RRC(4)B-2	PIPE TO TEE	B-J	VOL	UTP-10	UT-29			
			SUR	PTP-1				
4RRC(4)B-3	PIPE TO REDUCER	B-J	VOL	UTP-10	UT-29			
			SUR	PTP-1				
4RRC(4)B-4	PIPE TO TEE	B-J	VOL	UTP-10	UT-29			
			SUR	PTP-1				
4RRC(4)B-5	TEE TO PIPE	B-J	VOL	UTP-10	UT-29			
			SUR	PTP-1				
PWS-36-8	PIPE WHIP	N/A	N/A	N/A				SEE NOTE #1
PWS-36-7	PIPE WHIP	N/A	N/A	N/A				SEE NOTE #1
RRC-1C-10	PSA-1 SNUBBER	B-K-2	VT-3	303/8.2.17				S/N 22372
			VT-4	303/8.2.17				S/N 22372
4RRC(4)B-6	PIPE TO EL	B-J	VOL	UTP-10	UT-29			
			SUR	PTP-1				
4RRC(4)B-7	EL TO PIPE	B-J	VOL	UTP-10	UT-29			

WNP-02
 INTERVAL: PSI
 PERIOD: NA
 OUTAGE:
 DRAWING NO. RRC-109

WASHINGTON PUBLIC POWER SUPPLY SYSTEM
 PROGRAM PLAN AND SCHEDULE
 SYSTEM OR COMPONENT: RRC(4)-4S
 DESCRIPTION: RVCU INTERTIE RRC B

PAGE 002
 DATE 12/14/84


<u>IDENT. NO.</u>	<u>DESCRIPTION</u>	<u>SECT.</u> XI <u>EXAM.</u>	<u>EYAN</u> MTH.	<u>PROCEDURE</u>	<u>CAL.</u> BLOCK	<u>INSERVICE</u>		<u>NOTES</u>
						<u>REQ.</u>	<u>SCHEDULED</u> OUTAGE	
PWS-36-6	PIPE WHIP	N/A	N/A	N/A				SEE NOTE #1
RRC-6	SPRING	B-K-2	VT-3	303/8.2.17				
			VT-4	303/8.2.17				
RRC-1C-9	PSA-1 SNUBBER	B-K-2	VT-3	303/8.2.17				S/N 612
			VT-4	303/8.2.17				S/N 612
PWS-36-24	PIPE WHIP	N/A	N/A	N/A				SEE NOTE #1
4RRC(4)B-8	PIPE TO PIPE	B-J	VOL	UTP-10	UT-29			
			SUR	PTP-1				
4RRC(4)B-9	PIPE TO EL	B-J	VOL	UTP-10	UT-29			
			SUR	PTP-1				
4RRC(4)B-10	EL TO PIPE	B-J	VOL	UTP-10	UT-29			
			SUR	PTP-1				
PWS-36-25	PIPE WHIP	N/A	N/A	N/A				SEE NOTE #1
RRC-1C-6PS	STRUT	B-K-2	VT-3	303/8.2.17				
4RRC(4)B-11	PIPE - VALVE SE	B-J	VOL	UTP-10	UT-29			
			SUR	PTP-1				


WNP-02
 INTERVAL: PSI
 PERIOD: NA
 OUTAGE:
 DRAWING NO. RRC-109

WASHINGTON PUBLIC POWER SUPPLY SYSTEM
 PROGRAM PLAN AND SCHEDULE
 SYSTEM OR COMPONENT: RRC(4)-4S
 DESCRIPTION: RVCU INTERTIE RRC B


PAGE 003
 DATE 12/14/84

<u>IDENT. NO.</u>	<u>DESCRIPTION</u>	SECT. <u>XI</u> <u>EXAM.</u>	<u>EXAM</u> <u>MTH.</u>	<u>PROCEDURE</u>	<u>CAL.</u> <u>BLOCK</u>	<u>INSERVICE</u>		<u>NOTES</u>
						<u>REQ.</u>	<u>SCHEDULED</u> <u>OUTAGE</u>	
4RRC(4)E-12	SE TO VALVE	B-J	VOL	UTP-10	UT-29			DISSIMILAR METAL (SS-CS)
			SUR	FTP-1				DISSIMILAR METAL (SS-CS)
RRC-PB-109	RRC PRES BNDRY	B-P	VT-2	N/A				SEE NOTES #6 & #7.

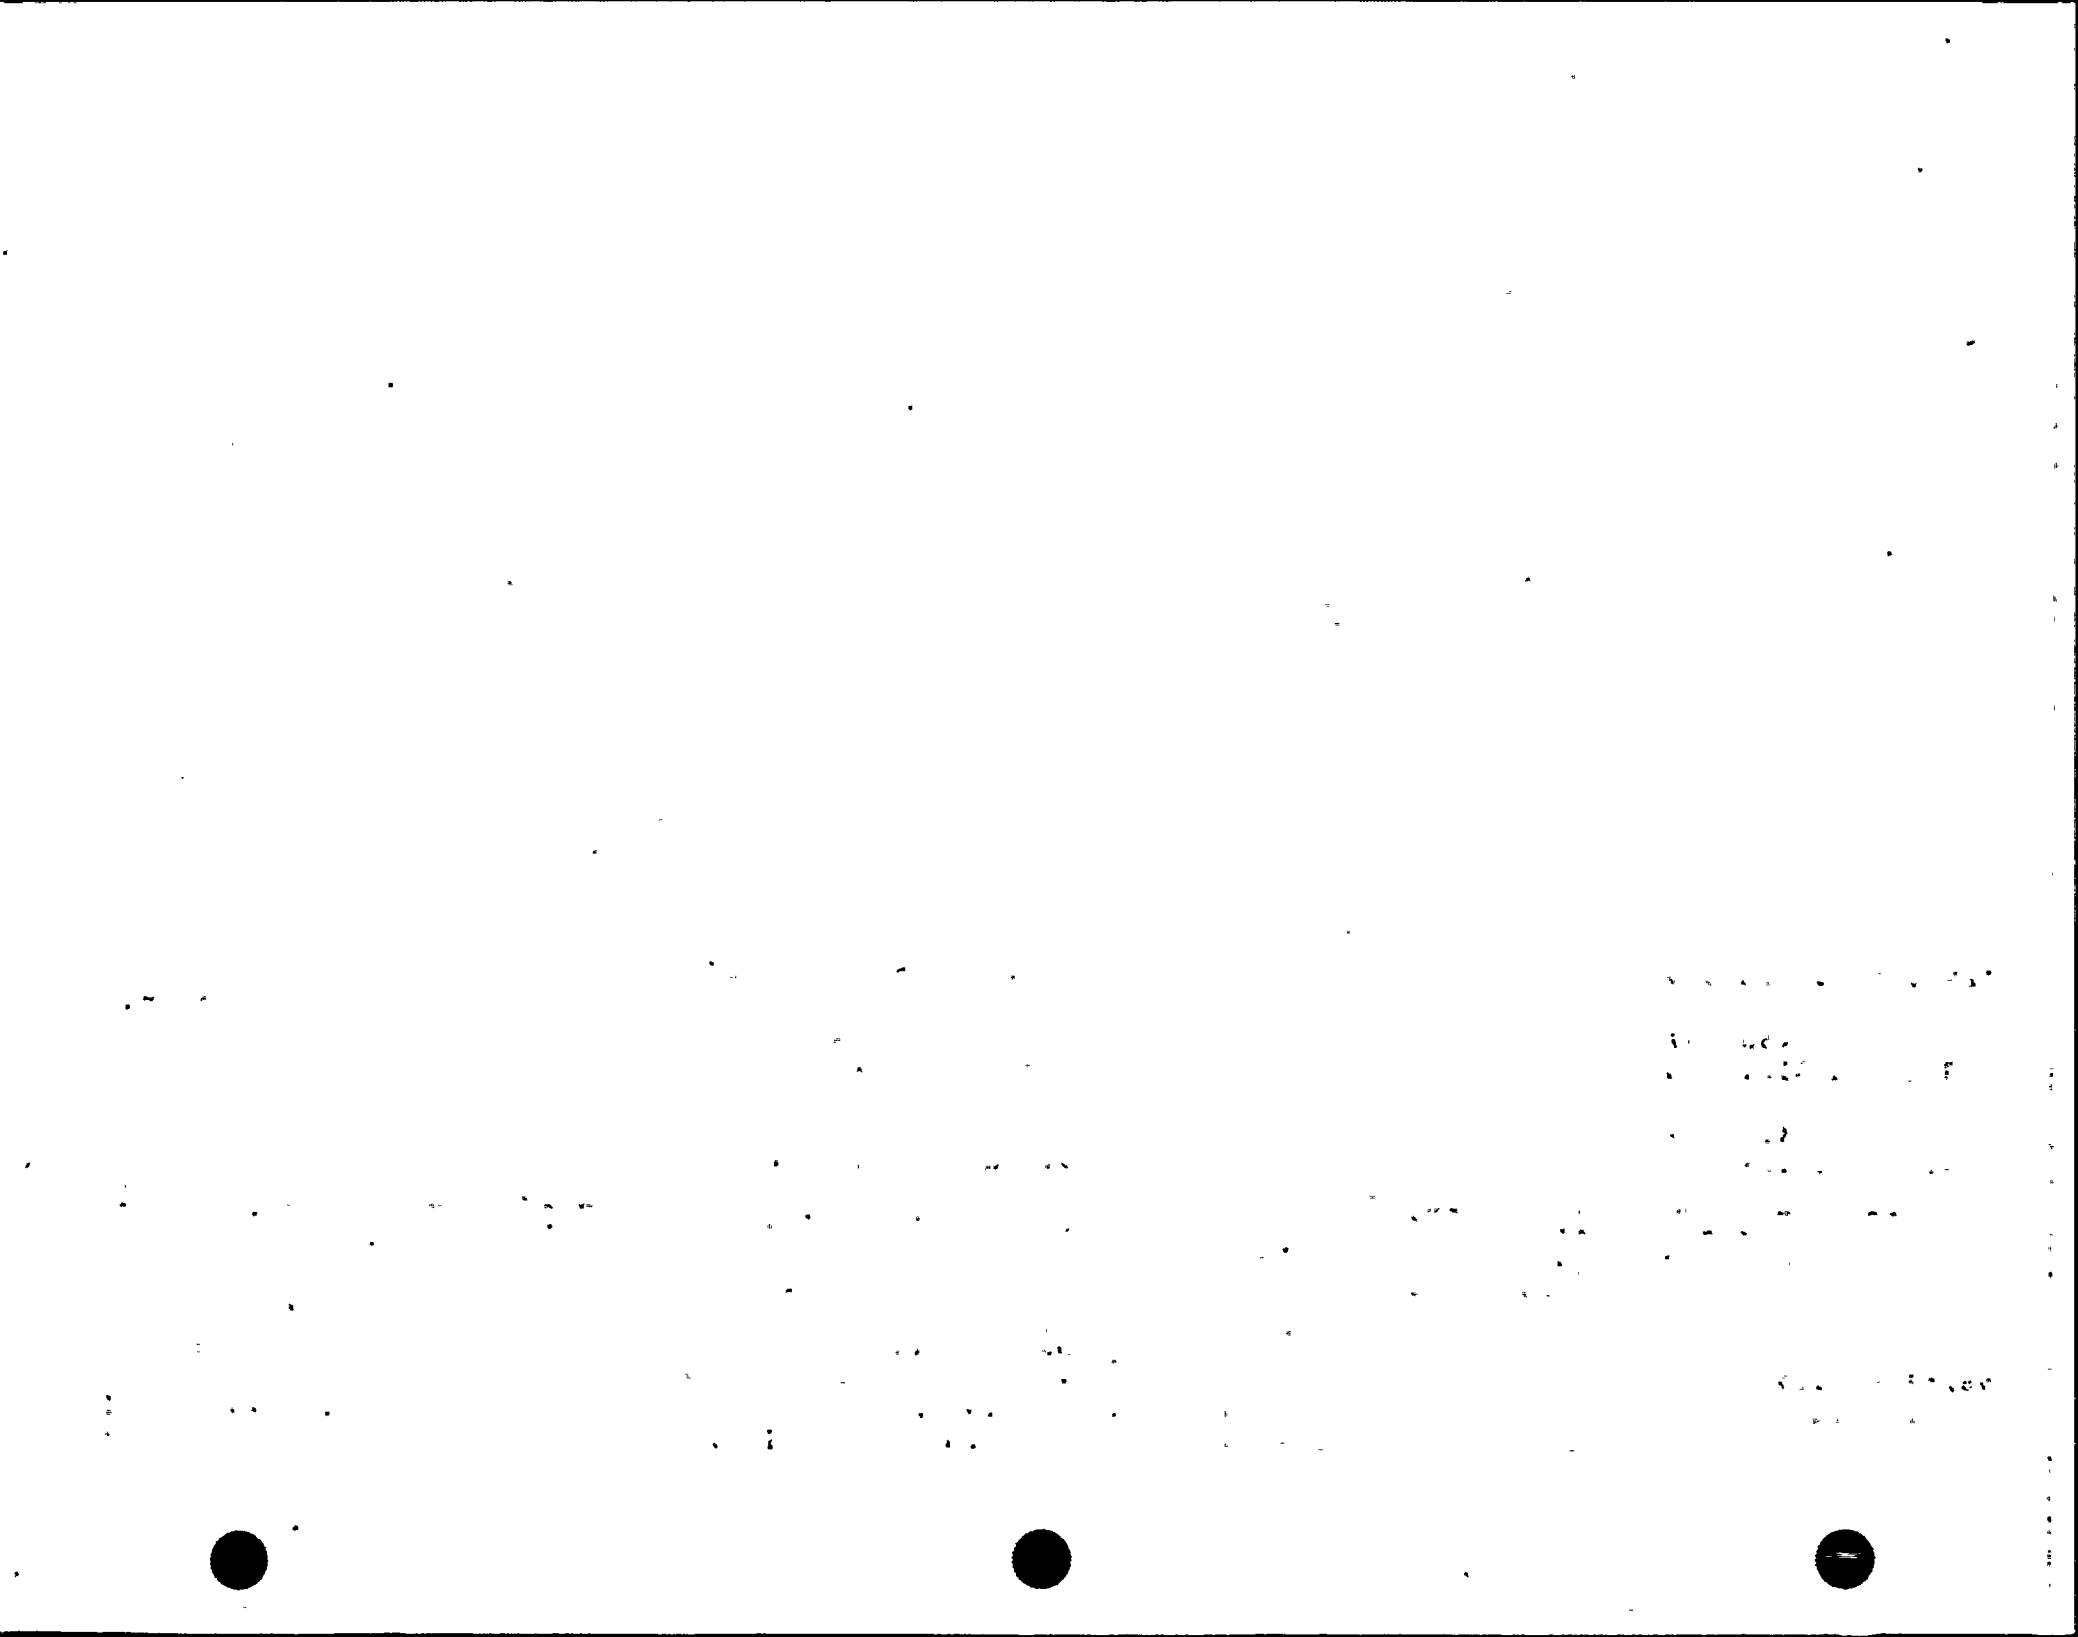

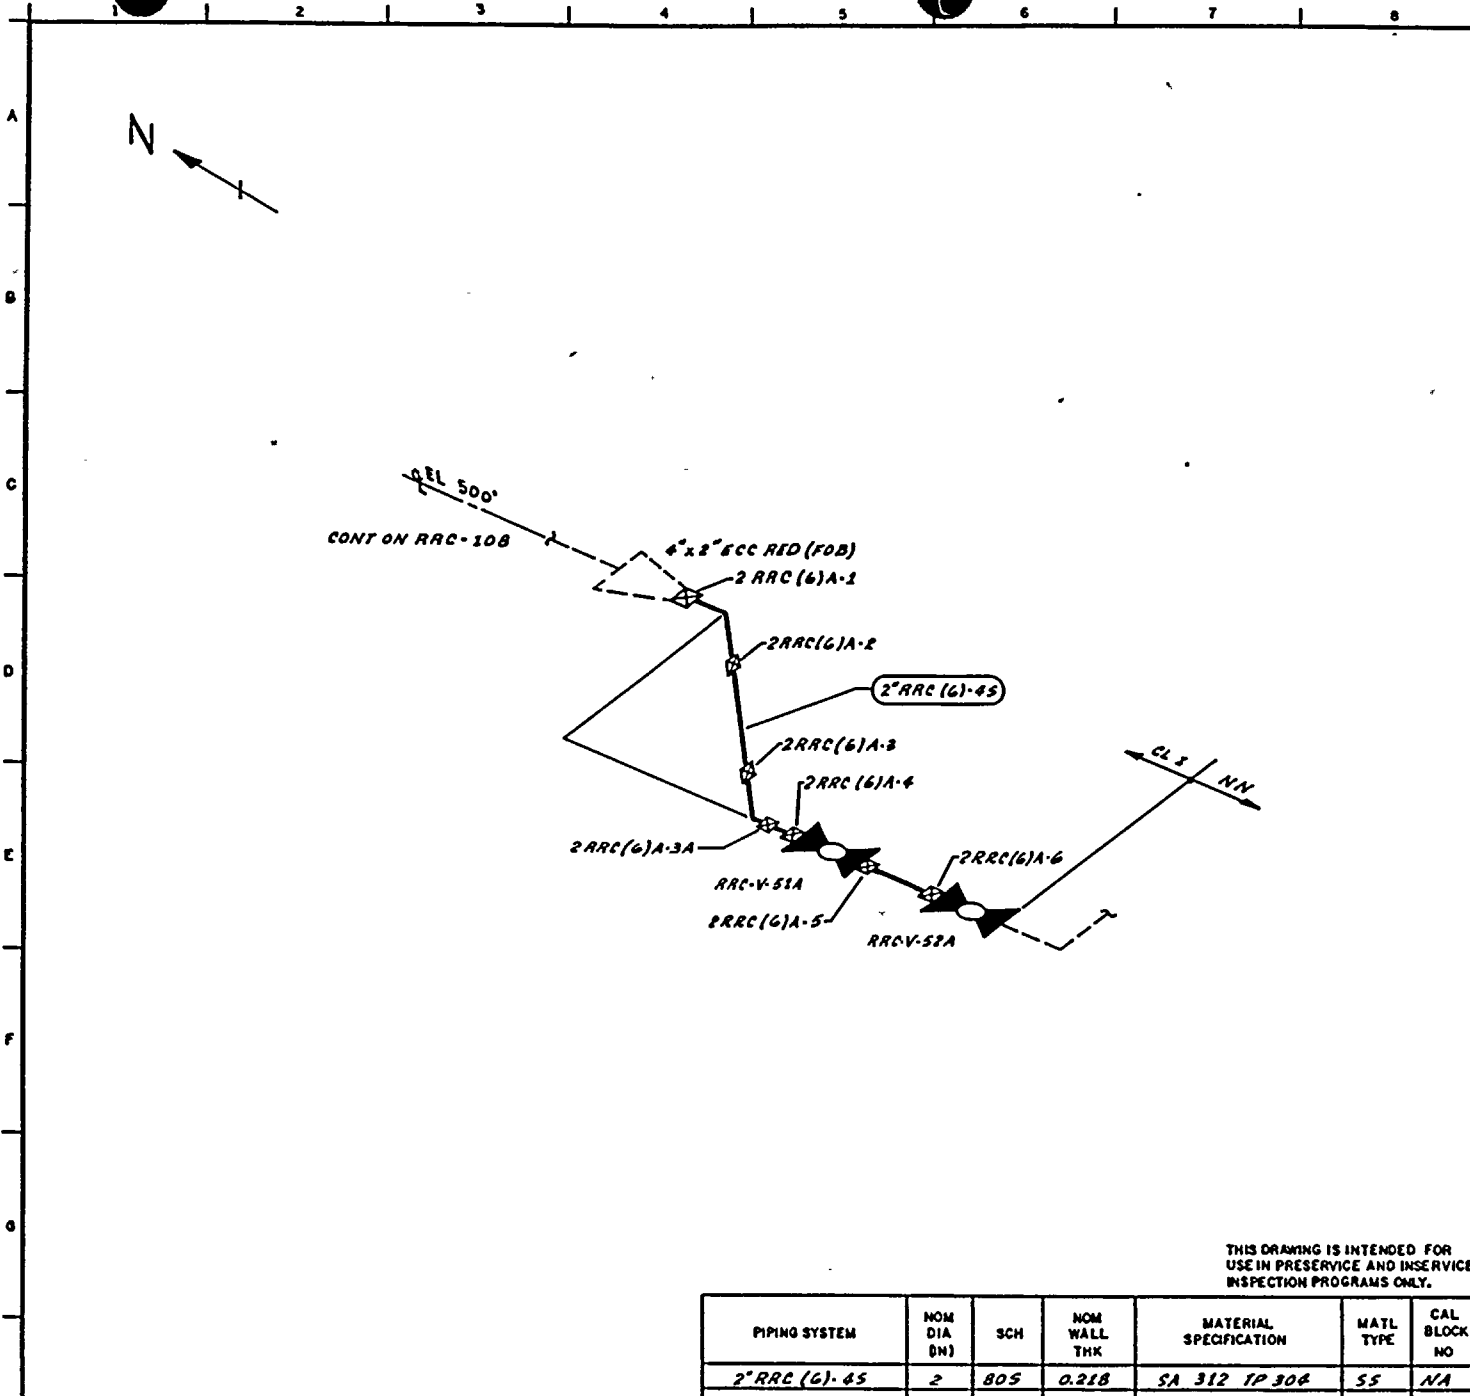

REFERENCES:
 WSH/BOCON/QR1 ISOMETRIC
 RRC-1966-1 REV 7

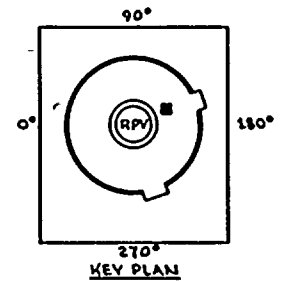

QUALITY CLASS: 1 ASME CODE CLASS: 1
 ENGR: D. JIMMINS DRAWN: A. McCA DATE: 8.27.79

WASHINGTON PUBLIC POWER SUPPLY SYSTEM
 RICHLAND, WASHINGTON 99352

THIS DRAWING IS INTENDED FOR USE IN PRESERVICE AND INSERVICE INSPECTION PROGRAMS ONLY.

PIPING SYSTEM	NOM DIA (IN)	SCH	NOM WALL THK	MATERIAL SPECIFICATION	MATL TYPE	CAL BLOCK NO
2" RRC (G)-45	2	805	0.218	SA 312 TP 306	SS	NA

WNP-2
 WELD & COMPONENT IDENTIFICATION DIAGRAM

TITLE:
RRC LOOP A DRAIN

DWG NO: RRC-110 REV 2

NO	DATE	REVISION	BY	CHKD	APPVD
2	11.17.79	DELETED HANGER	K. J. J.	D. J.	D. J.
1	11.15.79	ADDED FW 2" RRC (G) A-3A	K. J. J.	D. J.	D. J.
0	7.31.79	ISSUED FOR USE	K. J. J.	D. J.	D. J.

WNP-02
 INTERVAL: PSI
 PERIOD: NA
 OUTAGE:
 DRAWING NO. RRC-110



WASHINGTON PUBLIC POWER SUPPLY SYSTEM
 PROGRAM PLAN AND SCHEDULE
 SYSTEM OR COMPONENT: RRC(6)-4S
 DESCRIPTION: RRC LGOP A DRAIN

PAGE 001
 DATE 12/14/84


<u>IDENT. NO.</u>	<u>DESCRIPTION</u>	<u>SECT.</u> <u>XI</u> <u>EXAM.</u>	<u>EXAM</u> <u>MTH.</u>	<u>PROCEDURE</u>	<u>CAL.</u> <u>BLOCK</u>	<u>INSERVICE</u>		<u>NOTES</u>
						<u>REQ.</u>	<u>SCHEDULED</u> <u>OUTAGE</u>	
2RRC(6)A-1	REDUCER TO EL	B-J	SUR	PTP-1				
2RRC(6)A-2	EL TO PIPE	B-J	SUR	PTP-1				
2RRC(6)A-3	PIPE TO EL	B-J	SUR	PTP-1				
2RRC(6)A-3A	EL TO PIPE	B-J	SUR	PTP-1				
2RRC(6)A-4	PIPE TO EL	B-J	SUR	PTP-1				
2RRC(6)A-5	VALVE TO PIPE	B-J	SUR	PTP-1				
2RRC(6)A-6	PIPE TO VALVE	B-J	SUR	PTP-1				
RRC-PB-110	RRC PRES BNDRY	B-P	VT-2	N/A				

SEE NOTES #6 & #7.



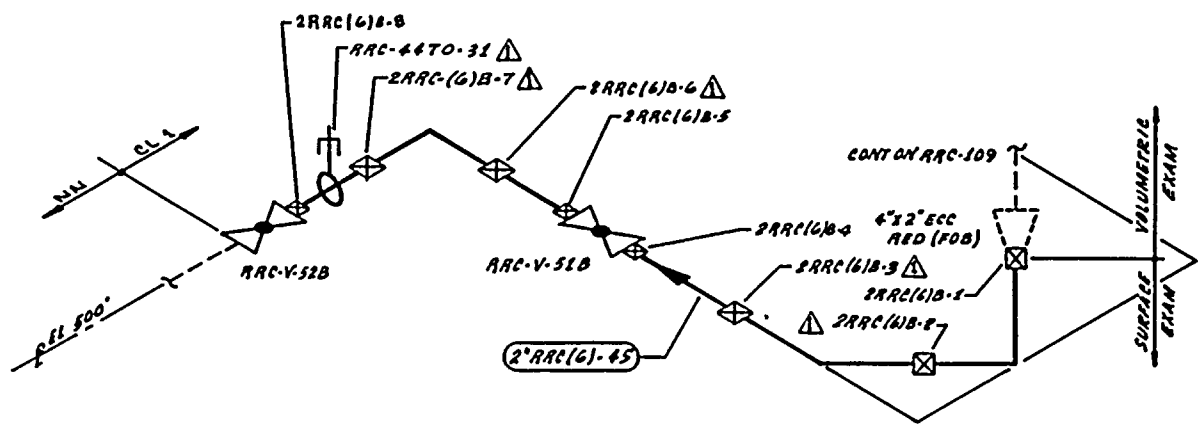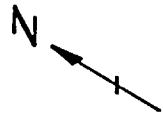

REFERENCES:
 WSH/BOCON/GERI ISOMETRIC
 RRC-4470-3 REV 6

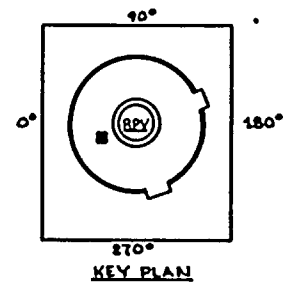

QUALITY CLASS: <i>CL 1</i>	ASME CODE CLASS: <i>CL 1</i>
ENGR: <i>D THAMMUS</i>	DATE: <i>5-27-79</i>
DRAWN: <i>K.H.C.A.</i>	

WASHINGTON PUBLIC POWER SUPPLY SYSTEM
 RICHLAND, WASHINGTON 99352

THIS DRAWING IS INTENDED FOR USE IN PRESERVICE AND INSERVICE INSPECTION PROGRAMS ONLY.

PIPING SYSTEM	NOM DIA (IN)	SCH	NOM WALL THK	MATERIAL SPECIFICATION	MATL TYPE	CAL BLOCK NO
2"RRC(6)B-5	2	80S	0.218	SA 312 TP 306	53	NA

WNP-2
 WELD & COMPONENT IDENTIFICATION DIAGRAM

TITLE:
RRC LOOP B DRAIN

DWG NO: *RRC-111* REV *1*


<i>1</i>	<i>10/1/79</i>	<i>REVISED AS NOTED</i>	<i>K.H.C.A.</i>	<i>DKR</i>	<i>JAY</i>
<i>0</i>	<i>7/31/79</i>	<i>ISSUED FOR USE</i>	<i>K.H.C.A.</i>	<i>DKR</i>	<i>JAY</i>
NO	DATE	REVISION	BY	CHKD	APPVD

WNP-02
 INTERVAL: PSI
 PERIOD: NA
 OUTAGE:
 DRAWING NO. RRC-111

WASHINGTON PUBLIC POWER SUPPLY SYSTEM
 PROGRAM PLAN AND SCHEDULE
 SYSTEM OR COMPONENT: RRC(6)-4S
 DESCRIPTION: RRC LOOP B DRAIN


PAGE 001
 DATE 12/14/84

<u>IDENT. NO.</u>	<u>DESCRIPTION</u>	<u>SECT.</u> <u>XI</u>	<u>EXAM</u> <u>MTH.</u>	<u>PROCEDURE</u>	<u>CAL.</u> <u>BLOCK</u>	<u>INSERVICE</u>		<u>NOTES</u>
						<u>REQ.</u>	<u>SCHEDULED</u> <u>OUTAGE</u>	
2RRC(6)B-1	REDUCER TO EL	B-J	SUR	PTP-1				
2RRC(6)B-2	EL TO EL	B-J	SUR	PTP-1				
2RRC(6)B-3	EL TO PIPE	B-J	SUR	PTP-1				
2RRC(6)B-4	PIPE TO VALVE	B-J	SUR	PTP-1				
2RRC(6)B-5	VALVE TO PIPE	B-J	SUR	PTP-1				
2RRC(6)B-6	PIPE TO EL	B-J	SUR	PTP-1				
2RRC(6)B-7	EL TO PIPE	B-J	SUR	PTP-1				
RRC-4470-31	PSA-1 SNUBBER	B-K-2	VT-3	303/8.2.17				S/N 356
			VT-4	303/8.2.17				S/N 356
2RRC(6)B-8	PIPE TO VALVE	B-J	SUR	PTP-1				
RRC-PB-111	RRC PRES BNDRY	B-P	VT-2	N/A				SEE NOTES #6 & #7.

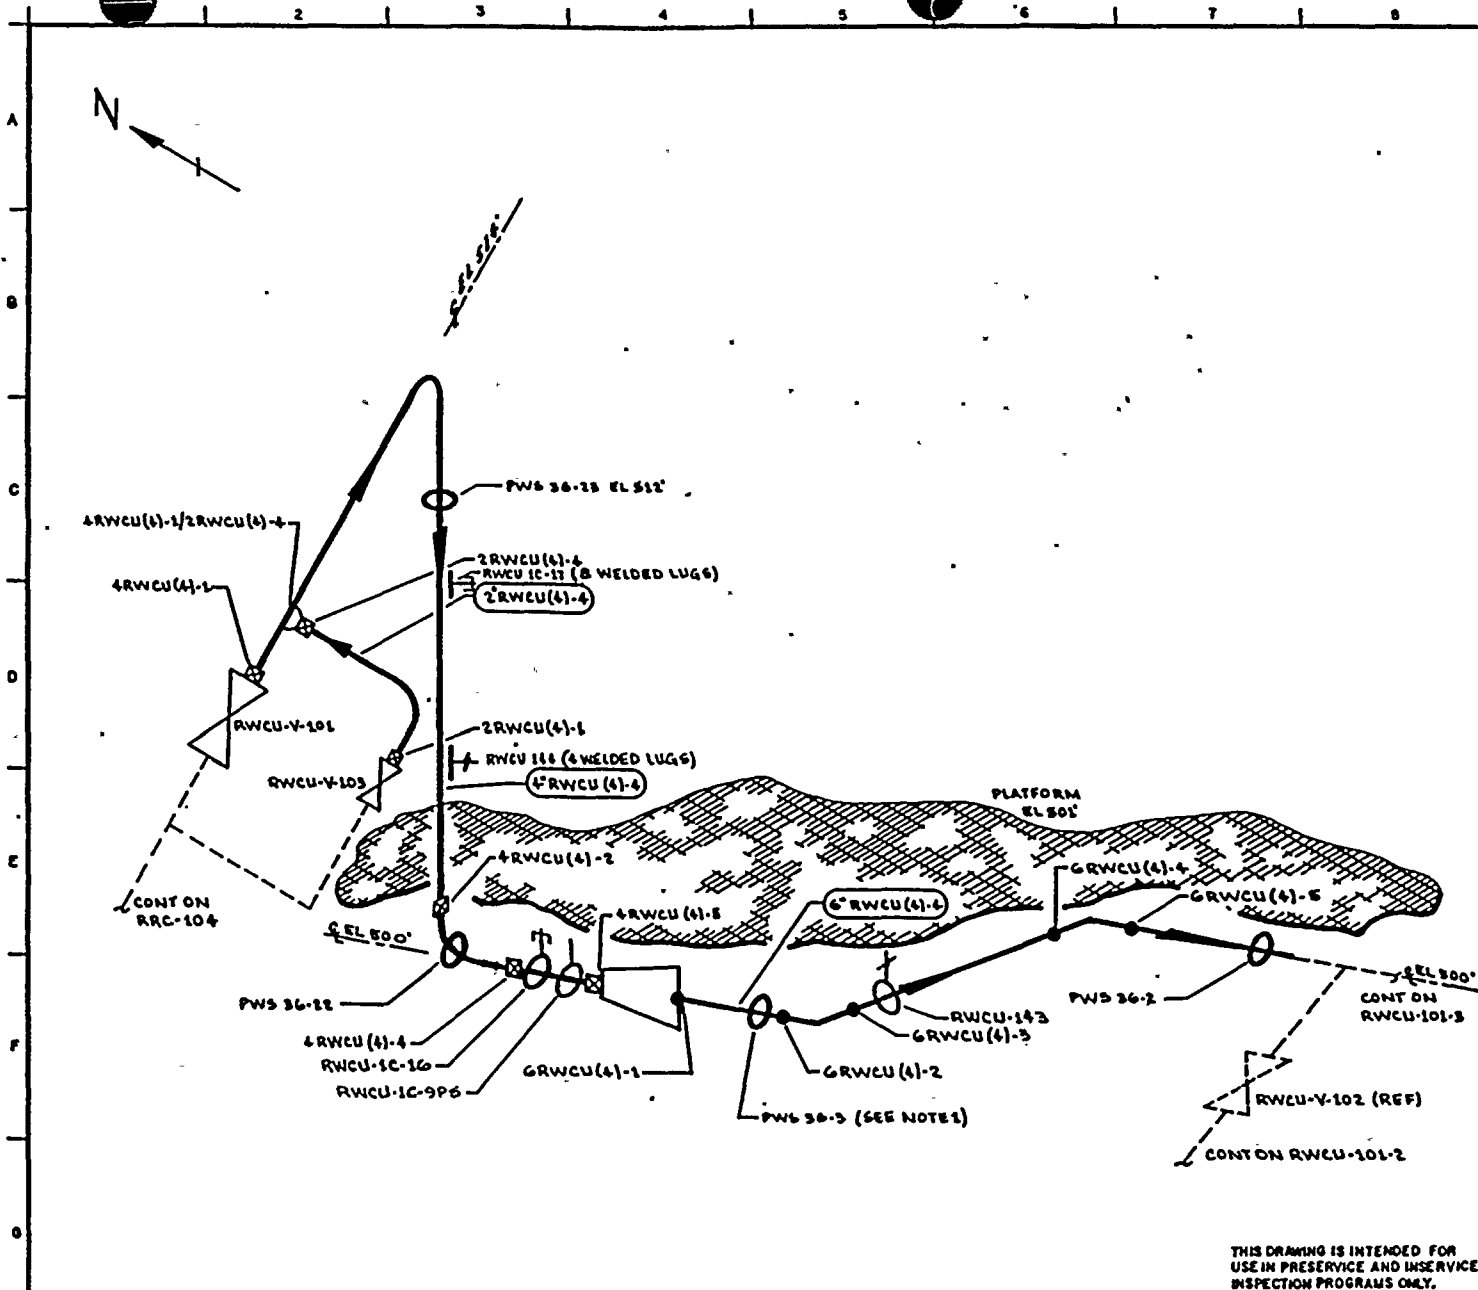

NOTES:
 1. ACCESS TO WELD 6RWCU(4)-2 REQUIRES REMOVAL OF 6RWCU(4)-1 PR.

REFERENCES
 BOVES & CRAIG ISOMETRIC
 RWCU-811-1,2 REV 6

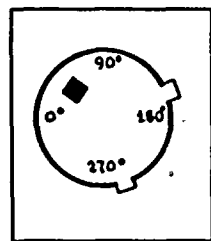

KEY PLAN

THIS DRAWING IS INTENDED FOR USE IN PRESERVICE AND INSERVICE INSPECTION PROGRAMS ONLY.

QUALITY CLASS: 1 ASME CODE CLASS: 1
 ENGR: D TIMMINS DRAWN: V.M.A. DATE: 6-25-78


WASHINGTON PUBLIC POWER SUPPLY SYSTEM
 PUEBLA, WASHINGTON 99032

WNP-2
 WELD & COMPONENT IDENTIFICATION DIAGRAM

TITLE:
 RPV DRAIN TO RWCU


DWG NO: RWCU-101-1 REV B

NO	DATE	REVISION	BY	CHKD	APPVD	PIPING SYSTEM	NOM DIA (IN)	SCH	NOM WALL THK	MATERIAL SPECIFICATION	MATL TYPE	CAL BLOCK NO
3	11-13-83	ADDED RWCU-105, 106, 996 & LUGS. CHANGED RWCU 104-10 & 17. DELETED WELDS 2RWCU(4)-2 & 3.	K.M.A.	D.J.	J.F.H.	4" RWCU(4)-4	4	80	0.337	SA 106 GR B	CS	UT-30
2	11-5-80	DELETED PW 3 (REVISED AS NOTED)	K.M.A.	T.P.	B.D.P.	6" RWCU(4)-4	6	80	0.432	SA 106 GR B	CS	UT-28
1	7-17-79	REVISED CAL BLOCK REF TO UT-28, 30	K.M.A.	K.W.	J.B.	2" RWCU(4)-4	2	160	0.343	SA 106 GR B	CS	NA
0	11-12-78	ISSUED FOR USE	K.M.A.	K.W.	J.B.	LUGS	NA	NA	NA	SA 515 GR 70	CS	UT-46
A	9-12-78	ISSUED FOR INFORMATION ONLY	K.M.A.	D.J.	D.P.							
NO	DATE	REVISION	BY	CHKD	APPVD							

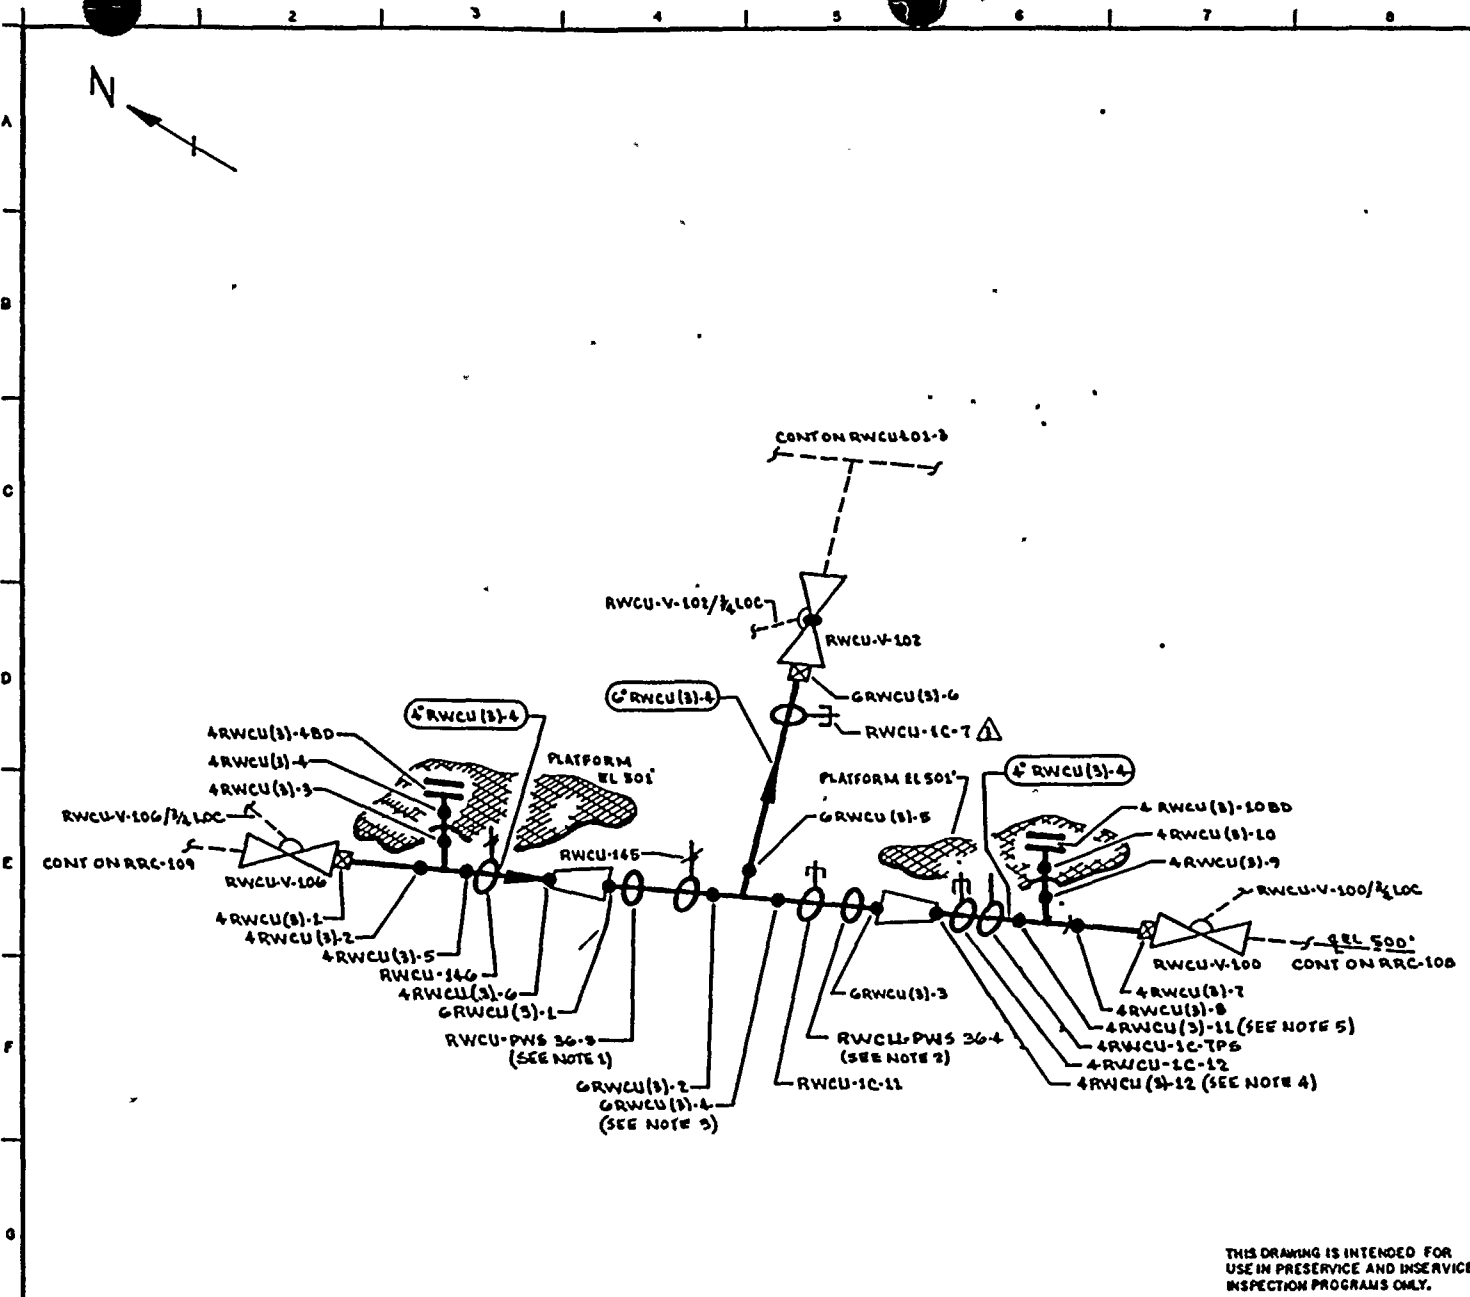

- NOTES:
1. ACCESS TO WELD 6RWCU(3)-1 REQUIRES REMOVAL OF RWCU-PWS 36-5.
 2. ACCESS TO WELD 6RWCU(3)-3 REQUIRES REMOVAL OF RWCU-PWS 36-4.
 3. ACCESS TO WELD 6RWCU(3)-4 REQUIRES REMOVAL OF RWCU-1C-11.
 4. ACCESS TO WELD 4RWCU(3)-12 REQUIRES REMOVAL OF RWCU-1C-12.
 5. ACCESS TO WELD 4RWCU(3)-11 REQUIRES REMOVAL OF RWCU-1C-TP6.

REFERENCES:
BOVEE & CRAIG ISOMETRIC
RWCU-812-1 REV B

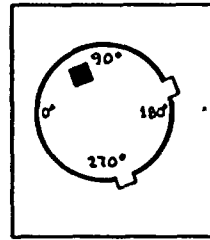

KEY PLAN

QUALITY CLASS: 1 ASME CODE CLASS: 1
ENGR: GA WUGLER DRAWN: K-McA DATE: 6-23-78



WASHINGTON PUBLIC POWER
SUPPLY SYSTEM
NICHLAND, WASHINGTON 98522


THIS DRAWING IS INTENDED FOR
USE IN PRESERVICE AND INSERVICE
INSPECTION PROGRAMS ONLY.

3	9-26-77	ADDED RWCU-1C-11, 12, TP6, RWCU-115, 116. NOTES 3-5	KWA	JF	TFH	6RWCU(3)-4	4	80	0.337	SA 106 GR B	CS	UT-28
2	12-2-68	REVISED AS NOTED	KWA	JR	TFH	6RWCU(3)-4	6	80	0.432	SA 106 GR B	CS	UT-28
1	7-11-77	REVISED CAL BLOCK REF TO UT-28.30	KWA	JF	TFH							
0	11-22-77	ISSUED FOR USE	KWA	JF	TFH							
1	9-23-78	ISSUED FOR INFORMATION ONLY	KWA	JF	TFH							
NO	DATE	REVISION	BY	CHKD	APPVD							

WHP-2
WELD 8 COMPONENT
IDENTIFICATION DIAGRAM


TITLE:
RRC LOOP SUPPLIES TO RWCU

DWG NO: RWCU-101-2 REV 3

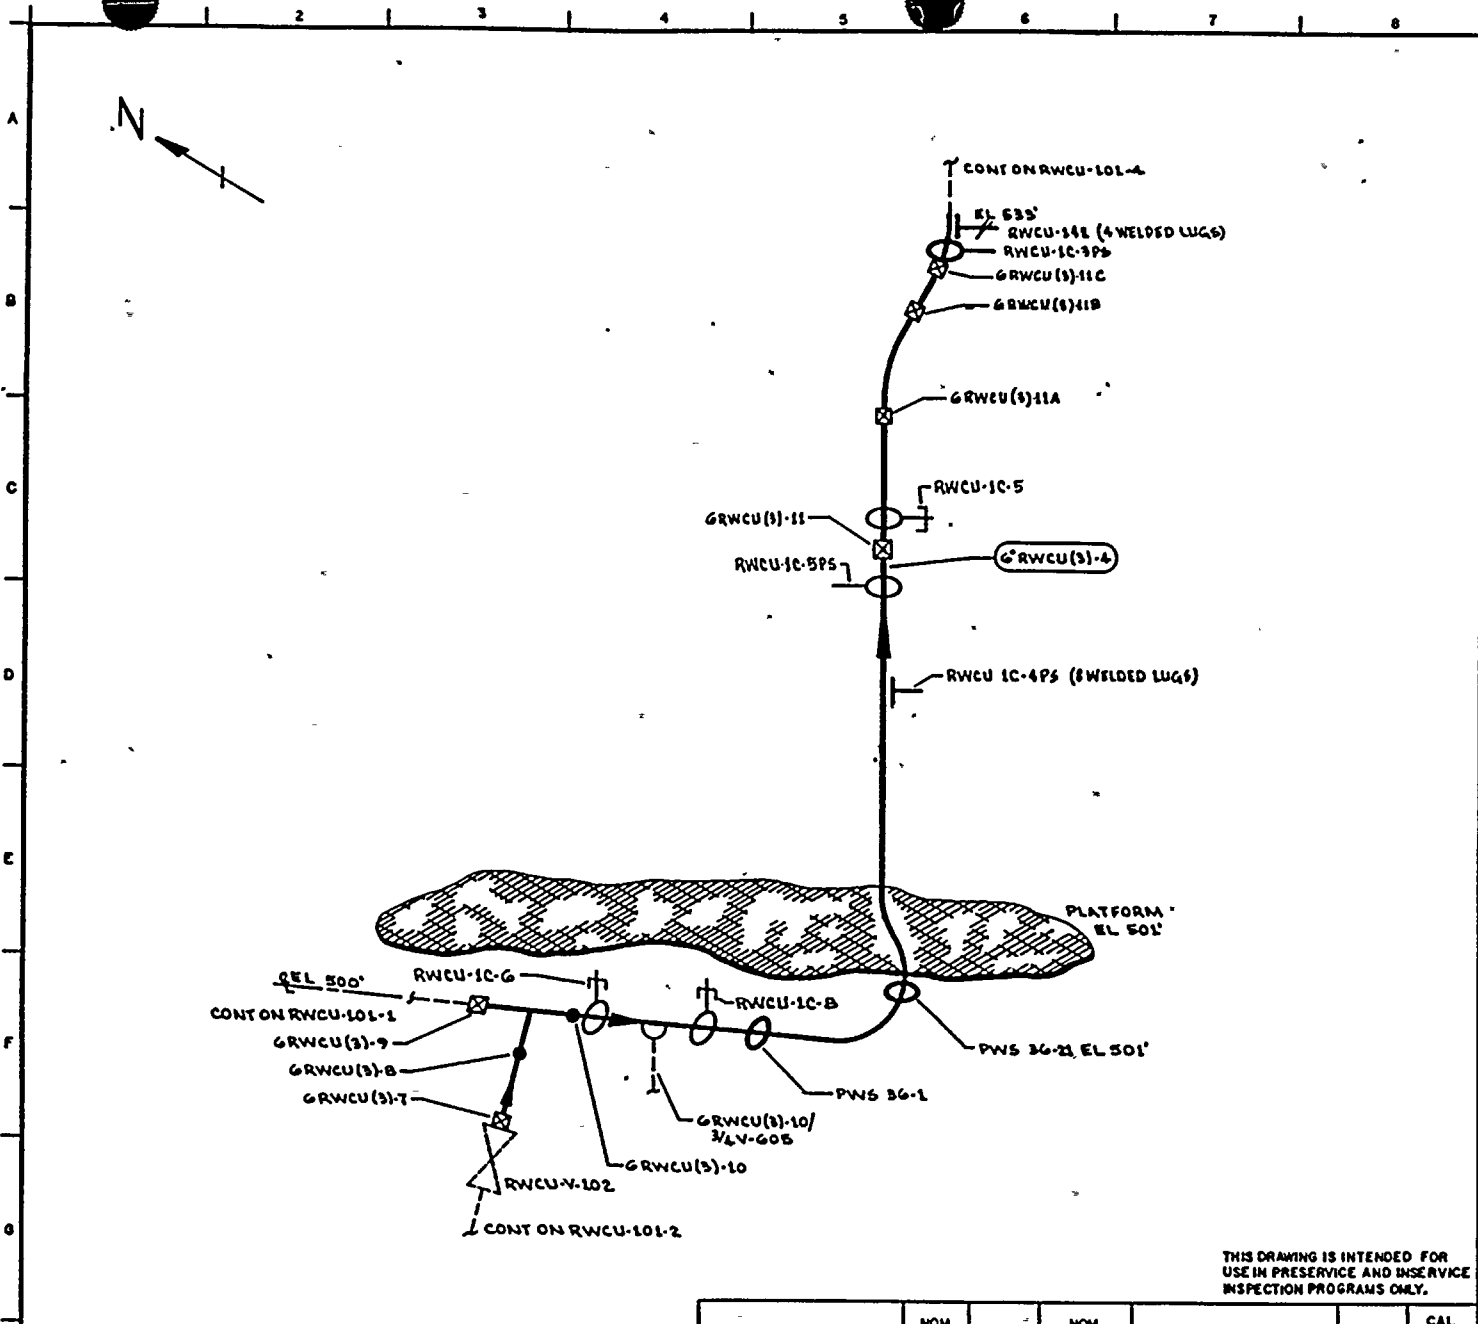

NOTES:

REFERENCES:
BOYER & CRAIG ISOMETRIC
RWCU-812-2 REV B

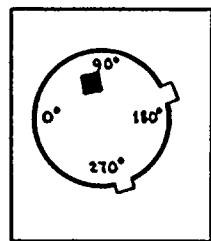

KEY PLAN

QUALITY CLASS: 1 ASME CODE CLASS: 1
ENGR: D TIMMINS DRAWN: V. Mc A DATE: 6-23-78



WASHINGTON PUBLIC POWER
SUPPLY SYSTEM
RICHLAND, WASHINGTON 99082

THIS DRAWING IS INTENDED FOR
USE IN PRESERVICE AND INSERVICE
INSPECTION PROGRAMS ONLY.


NO	DATE	REVISION	BY	CHKD	APPVD	PIPING SYSTEM	NOM DIA (IN)	SCH	NOM WALL THK	MATERIAL SPECIFICATION	MATL TYPE	CAL BLOCK NO
3	10-11-82	ADDED RWCU-1C-6, 8, 5, 5PS, 3PS & RWCU-142	KHL	DP	TFH	6" RWCU(3)-4	6	80	0.432	SA 106 GR B	C5	UT-28
2	8-5-80	REVISED AS NOTED	KHL	TF	DP							
1	7-17-79	REVISED CAL BLOCK REF TO UT-28	KHL	DP	TF							
0	12-27-78	ISSUED FOR USE	KHL	DP	TF							
A	9-22-78	ISSUED FOR INFORMATION ONLY	KHL	DJ	DP							

WNP-2
WELD & COMPONENT
IDENTIFICATION DIAGRAM

TITLE:
RWCU MAIN HEADER FROM RRC


DWG NO: RWCU-101-3 REV B



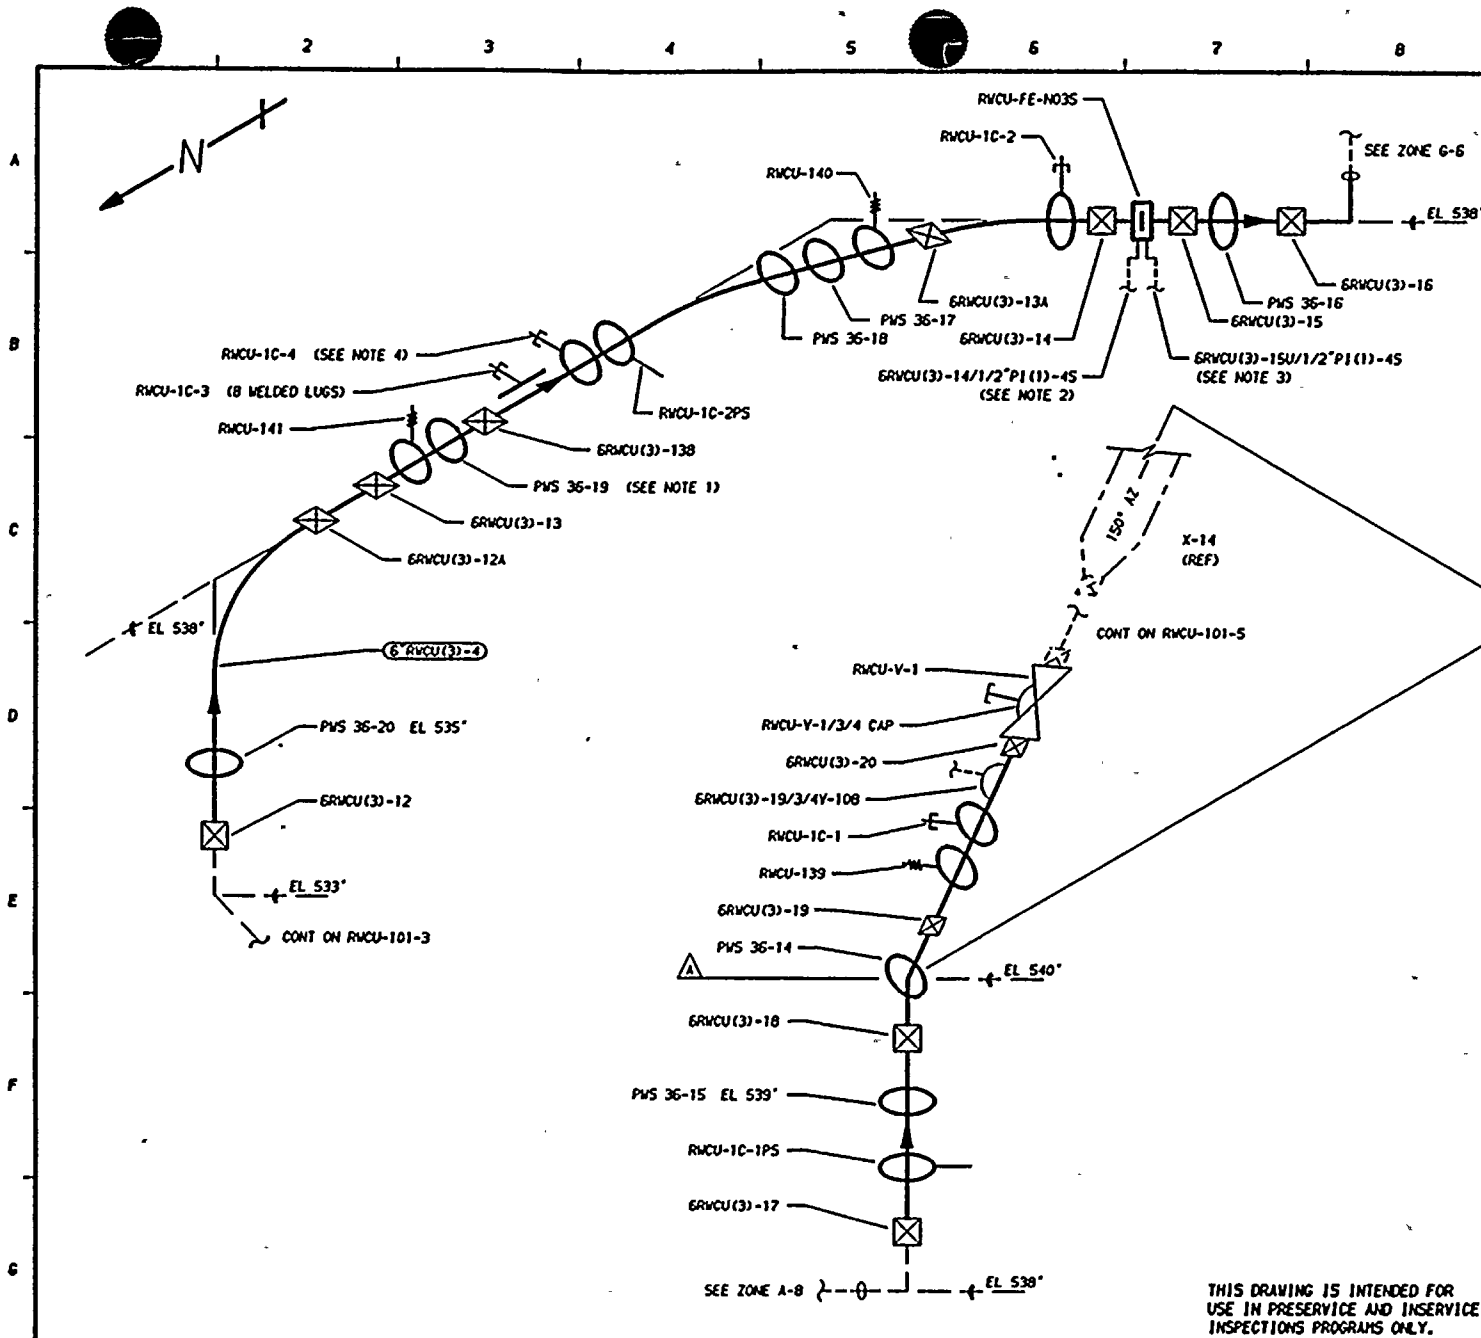

- NOTES**
1. ACCESS TO WELD GRVCU(3)-13 REQUIRES REMOVAL OF GRVCU(3)-13PR1.
 2. EXTEND LEAKAGE EXAM THROUGH CONTAINMENT PENETRATION (X-796) THROUGH EXCESS FLOW CHECK VALVE TO INSTRUMENT TUBING CONNECTION.
 3. EXTEND LEAKAGE EXAM THROUGH CONTAINMENT PENETRATION (X-796) THROUGH EXCESS FLOW CHECK VALVE TO INSTRUMENT TUBING CONNECTION.
 4. FOUR LUGS WERE LEFT NEAR RVCU-10-4. TWO WERE GROUND 1/8" FROM PIPE AND TWO WERE LEFT AS IS. NO EXAMINATION IS REQUIRED.
 5. ACCESS TO WELD GRVCU(3)-13 REQUIRES REMOVAL OF PVS-36-15.

REFERENCES:
 151 - 223
 BOYEE & CRAIL ISOMETRIC
 RVCU-812-3.6 REV 6

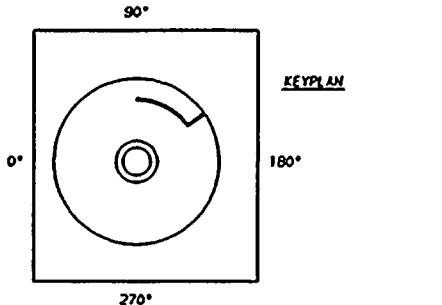

QUALITY CLASS, 1 ASME CODE CLASS, 1
 ENGR. D TIMMINS DRAWN: K-MCA DATE: 6-26-78


WASHINGTON PUBLIC POWER
 SUPPLY SYSTEM
 RICHLAND, WASHINGTON 99352

WNP-2
 WELD & COMPONENT
 IDENTIFICATION DIAGRAM
 TITLE: RVCU MAIN HEADER FROM RRC
 DWG NO: RVCU-101-4 REV 4

NO	DATE	REVISION	BY	CHKD	APVD
4	12-2-83	ADDED SUPPORTS, CHANGED 17-NO-35 TO NON-WELDED, DELETED GRVCU(3)-140D, ADDED NOTES 4 AND 5. (OPERATING)	K-MCA	DPR	TFH
3	12-2-81	AUGMENTED 151 ADDED	K-MCA	DPR	TFH
2	11-5-80	ADDED FIELD WELD 13B AND AS NOTED	K-MCA	DPR	DWP
1	7-17-79	CHANGED TAG "BOLT FROM DT-27 TO DT-26, WELDS 16, 17, 18 & 19 TO FIELD WELDS. ADDED FIELD WELDS 121 & 131.	K-MCA	DPR	LFB
0	12-22-78	ISSUED FOR USE	K-MCA	DPR	LFB
A	9-12-78	ISSUED FOR INFORMATION ONLY	K-MCA	DT	DWP


PIPING SYSTEM	NOM DIA (IN)	SCH	NOM WALL THK	MATERIAL SPECIFICATION	MATL TYPE	CAL BLOCK NO
6" RVCU(3)-4	6	80	0.432	SA 106 GR B	CS	UT-28

THIS DRAWING IS INTENDED FOR USE IN PRESERVICE AND INSERVICE INSPECTIONS PROGRAMS ONLY.

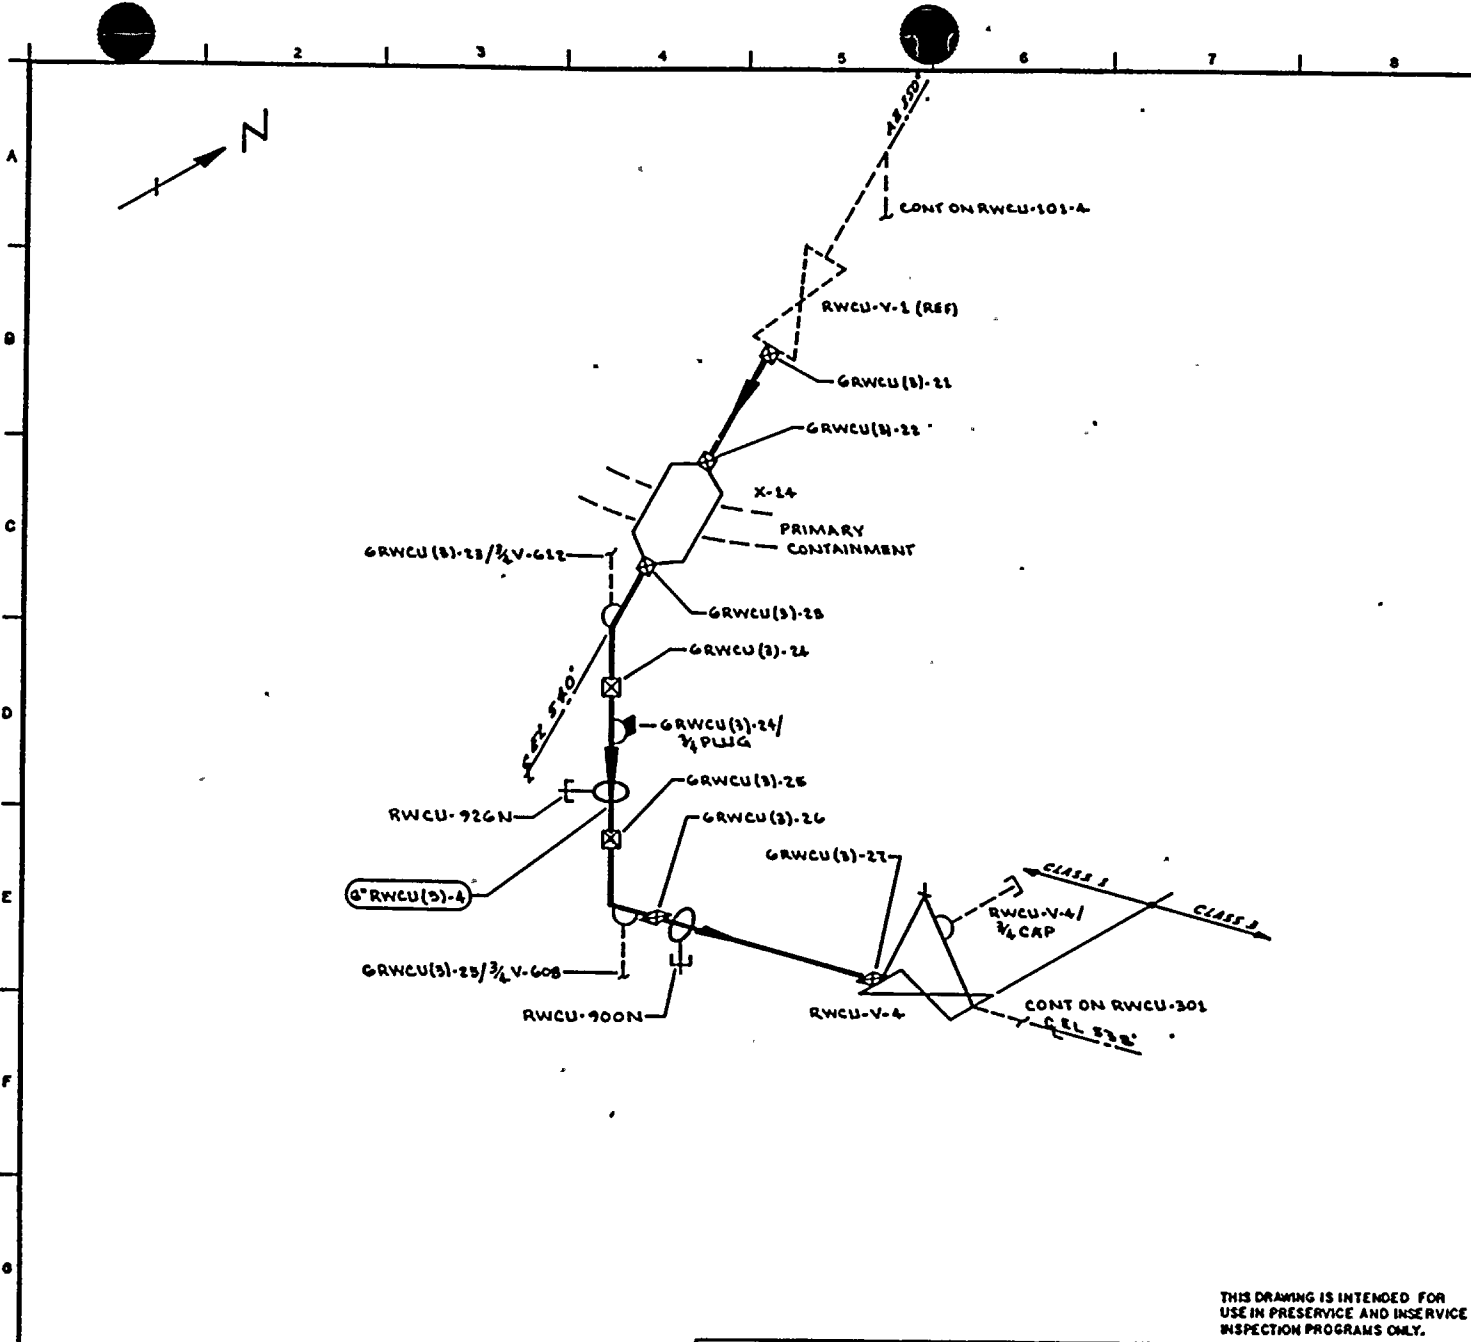

- NOTES:
1. ALL CIRCUMFERENTIAL BUTT WELDS GREATER THAN 1 INCH REQUIRE AUGMENTED ISI.
 2. AUGMENTED ISI CONTINUES ON RWCU-301.
 3. ACCESS TO WELD GRWCU(3)-26 REQUIRES REMOVAL OF RWCU-900N.
 4. ACCESS TO WELDS GRWCU(3)-24 & GRWCU(3)-25 REQUIRES REMOVAL OF RWCU-926N.

REFERENCES:
 BOYEE & CRAIL ISOMETRIC
 RWCU-812-B.13 REV G

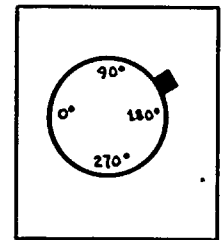

THIS DRAWING IS INTENDED FOR USE IN PRESERVE AND INSERVICE INSPECTION PROGRAMS ONLY.

QUALITY CLASS: 1 ASME CODE CLASS: 1
 ENGR: D THIMMING DRAWN: K. M. A. DATE: 6-26-78



WASHINGTON PUBLIC POWER SUPPLY SYSTEM
 RICHLAND, WASHINGTON 99352

NO	DATE	REVISION	BY	CHKD	APPVD	PIPING SYSTEM	NOM DIA (IN)	SCH	NOM WALL THK	MATERIAL SPECIFICATION	MATL TYPE	CAL BLOCK NO
3	9-26-78	ADDED RWCU-900N, 926N, 3/4 PLUG & NOTES 3 & 4	K.M.A.	D.P.	T.P.H.	GRWCU(3)-4	6	80	0.432	SA 106 GR B	CS	UT-26
2	12-2-81	ADDED NOTES & CONT. CHG IN F-6	K.M.A.	D.P.	T.P.H.							
1	7-17-79	REVISED CAL BLOCK REF TO UT-26	K.M.A.	D.P.	T.P.H.							
0	01-12-77	ISSUED FOR USE	K.M.A.	D.P.	T.P.H.							
A	9-12-78	ISSUED FOR INFORMATION ONLY	K.M.A.	D.P.	T.P.H.							

WNP-2
 WELD 8 COMPONENT
 IDENTIFICATION DIAGRAM

TITLE:
 RWCU MAIN HEADER FROM RRC

DWG NO: RWCU-101-5 REV 3

WNP-02
 INTERVAL: PSI
 PERIOD: NA
 OUTAGE:
 DRAWING NO. RWCU-101

WASHINGTON PUBLIC POWER SUPPLY SYSTEM
 PROGRAM PLAN AND SCHEDULE
 SYSTEM OR COMPONENT: RWCU(4)-4
 DESCRIPTION: RPV DRAIN TO RWCU

PAGE 001
 DATE 12/14/84

IDENT. NO.	DESCRIPTION	SECT. XI EXAM.	EXAM MTH.	PROCEDURE	CAL. BLCK	INSERVICE		NOTES
						REQ.	SCHEDULED OUTAGE	
RWCU-V-101-BLT	VALVE BOLTING	R-G-2	VT-1	OCI 7-1				
4RWCU(4)-1	VALVE TO PIPE	B-J	VOL	UTP-10	UT-30			
4RWCU(4)-1/2RWCU(4)-4			SUR	PTP-1				
2RWCU(4)-1	PIPE TO WOL	B-J	SUR	PTP-1				
2RWCU(4)-4	VALVE TO PIPE	B-J	SUR	OCI 3-3				
FWS-36-23	PIPE TO WOL	B-J	SUR	OCI 3-3				
RWCU-1C-17(W)	PIPE WHIP	N/A	N/A	N/A				SEE NOTE #1
RWCU-1C-17	8 WELDED LUGS	B-K-1	VOL	UTP-26	UT-28			3/4"W x 1 1/8"H x 1"L.
RWCU-144	PSA-1 SN(2)	B-K-2	VT-3	303/R.2.17				S/N 590/592
			VT-4	303/R.2.17				S/N 590/592
	SPRING	B-K-2	VT-3	303/R.2.17				4 WELDED LUGS, 1/2"W x 1 1/8"H x 1L.
			VT-4	303/R.2.17				4 WELDED LUGS, 1/2"W x 1 1/8"H x 1L.
4RWCU(4)-2	PIPE TO PIPE	B-J	VOL	UTP-10	UT-30			
FWS-36-22			SUR	PTP-1				
4RWCU(4)-4	PIPE WHIP	N/A	N/A	N/A				SEE NOTE #1
	PIPE TO PIPE	B-J	VOL	UTP-10	UT-30			

WNP-02
 INTERVAL: PSI
 PERIOD: NA
 OUTAGE:
 DRAWING NO. RWCU-101

WASHINGTON PUBLIC POWER SUPPLY SYSTEM
 PROGRAM PLAN AND SCHEDULE
 SYSTEM OR COMPONENT: RWCU(4)-4
 DESCRIPTION: RPV DRAIN TO RWCU

PAGE 002
 DATE 12/14/84

<u>IDENT. NO.</u>	<u>DESCRIPTION</u>	<u>SECT.</u> <u>XI</u> <u>EXAM.</u>	<u>EXAM</u> <u>MTH.</u>	<u>PROCEDURE</u>	<u>CAL.</u> <u>BLOCK</u>	<u>INSERVICE</u> <u>SCHEDULED</u>		<u>NOTES</u>
						<u>REQ.</u>	<u>OUTAGE</u>	
			SUR	PTP-1				
RWCU-1C-16	PSA-1 SNUBBER	B-K-2	VT-3	303/8.2.17				S/N 22344
			VT-4	303/8.2.17				S/N 22344
RWCU-1C-9PS	STRUT	B-K-2	VT-3	303/8.2.17				
4RWCU(4)-5	PIPE TO REDUCER	B-J	VOL	UTP-10	UT-30			
			SUR	PTP-1				
6RWCU(4)-1	REDUCER TO PIPE	B-J	VOL	UTP-10	UT-28			
			SUR	PTP-1				
PWS-36-3	PIPE WHIP	N/A	N/A	N/A				SEE NOTE #1
6RWCU(4)-2	PIPE TO EL	B-J	VOL	UTP-10	UT-28			
			SUR	PTP-1				
6RWCU(4)-3	EL TO PIPE	B-J	VOL	UTP-10	UT-28			
			SUR	PTP-1				
RWCU-143	SPRING	B-K-2	VT-3	303/8.2.17				
			VT-4	303/8.2.17				
6RWCU(4)-4	PIPE TO EL	B-J	VOL	UTP-10	UT-28			
			SUR	PTP-1				
6RWCU(4)-5	EL TO PIPE	B-J	VOL	UTP-10	UT-28			

WNP-02
 INTERVAL: PSI
 PERIOD: NA
 OUTAGE:
 DRAWING NO. RWCU-101

WASHINGTON PUBLIC POWER SUPPLY SYSTEM
 PROGRAM PLAN AND SCHEDULE
 SYSTEM OR COMPONENT: RWCU(4)-4
 DESCRIPTION: RPV DRAIN TO RWCU

PAGE 003
 DATE 12/14/84

IDENT. NO.	DESCRIPTION	SECT. XI EXAM. EXAM.	EXAM MTH.	PROCEDURE	CAL. BLOCK	INSERVICE		NOTES
						REQ.	SCHEDULED OUTAGE	
PWS-36-2.			SUR	PTP-1				
RWCU-V-106-BLT	PIPE WHIP	N/A	N/A	N/A				SEE NOTE #1
RWCU-V-106/3/4CAP	VALVE BOLTING	B-G-2	VT-1	OCI 7-1				
4RWCU(3)-1	LEAKOFF CAPPED	B-P	VT-2	N/A				SEE NOTES #6 & #7.
	VALVE TO PIPE	B-J	VOL	UTP-10	UT-30			
4RWCU(3)-2			SUR	PTP-1				
	PIPE TO TEE	B-J	VOL	UTP-10	UT-30			
4RWCU(3)-3			SUR	PTP-1				
	TEE TO PIPE	B-J	VOL	UTP-10	UT-30			
4RWCU(3)-4			SUR	PTP-1				
	PIPE TO FLANGF	B-J	VOL	UTP-10	UT-30			
4RWCU(3)-4RD			SUR	PTP-1				
	FLANGE BOLTING	B-G-2	VT-1	OCI 7-1				
4RWCU(3)-5								
	TEE TO PIPE	B-J	VOL	UTP-10	UT-30			
RWCU-146			SUR	PTP-1				
	SPRING	B-K-2	VT-3	303/R.2.17				
4RWCU(3)-6			VT-4	303/R.2.17				
	PIPE TO REDUCER	B-J	VOL	UTP-10	UT-30			

WNP-02
 INTERVAL: PSI
 PERIOD: NA
 OUTAGE:
 DRAWING NO. RWCU-101

WASHINGTON PUBLIC POWER SUPPLY SYSTEM
 PROGRAM PLAN AND SCHEDULE
 SYSTEM OR COMPONENT: RWCU(4)-4.
 DESCRIPTION: RPV DRAIN TO RWCU

PAGE 004
 DATE 12/14/84

IDENT. NO.	DESCRIPTION	SECT. XI EXAM.	EXAM MTH.	PROCEDURE	CAL. BLOCK	INSERVICE		NOTES
						REQ.	SCHEDULED OUTAGE	
			SUR	PTP-1				
RWCU-V-100-BLT	VALVE BOLTING	B-G-2	VT-1	OCT 7-1				
RWCU-V-100/3/4CAP	LEAKOFF CAPPED	B-P	VT-2	N/A				SEE NOTES #6 & #7.
4RWCU(3)-7	VALVE TO PIPE	B-J	VOL	UTP-10	UT-30			
			SUR	PTP-1				
4RWCU(3)-8	PIPE TO TEE	B-J	VOL	UTP-10	UT-30			
			SUR	PTP-1				
4RWCU(3)-9	TEE TO PIPE	B-J	VOL	UTP-10	UT-30			
			SUR	PTP-1				
4RWCU(3)-10	PIPE TO FLANGE	B-J	VOL	UTP-10	UT-30			
			SUR	PTP-1				
4RWCU(3)-10BD	FLANGE BOLTING	B-G-2	VT-1	OCT 7-1				
4RWCU(3)-11	TEE TO PIPE	B-J	VOL	UTP-10	UT-30			
			SUR	PTP-1				
RWCU-1C-7PS	STRUT	B-K-2	VT-3	303/8.2.17				
RWCU-1C-12	PSA-3 SNUBBER	B-K-2	VT-3	303/8.2.17				S/N 2372
			VT-4	303/8.2.17				S/N 2372
4RWCU(3)-12	PIPE TO REDUCER	B-J	VOL	UTP-10	UT-30			

WNP-02
 INTERVAL: PSI
 PERIOD: NA
 OUTAGE:
 DRAWING NO. RWCU-101

WASHINGTON PUBLIC POWER SUPPLY SYSTEM
 PROGRAM PLAN AND SCHEDULE
 SYSTEM OR COMPONENT: RWCU(4)-4
 DESCRIPTION: RPV DRAIN TO RWCU

PAGE 005
 DATE 12/14/84

IDENT. NO.	DESCRIPTION	SECT. XI EXAM.	EXAM MTH.	PROCEDURE	CAL. BLOCK	INSERVICE		NOTES
						REQ.	SCHEDULED OUTAGE	
6RWCU(3)-1	REDUCER TO PIPE	B-J	VOL	UTP-10	UT-28			
			SUR	PTP-1				
FWS-36-5	PIPE WHIP	N/A	N/A	N/A				SEE NOTE #1
RWCU-145	SPRING	B-K-2	VT-3	303/R.2.17				
			VT-4	303/R.2.17				
6RWCU(3)-2	PIPE TO TEE	B-J	VOL	UTP-10	UT-28			
			SUR	PTP-1				
6RWCU(3)-3	REDUCER TO PIPE	B-J	VOL	UTP-10	UT-28			
			SUR	PTP-1				
FWS-36-4	PIPE WHIP	N/A	N/A	N/A				SEE NOTE #1
RWCU-1C-11	PSA-3 SNUBBER	B-K-2	VT-3	303/R.2.17				S/N 2359
			VT-4	303/R.2.17				S/N 2359
6RWCU(3)-4	PIPE TO TEE	B-J	VOL	UTP-10	UT-28			
			SUR	PTP-1				
6RWCU(3)-5	TEE TO PIPE	B-J	VOL	UTP-10	UT-28			
			SUR	PTP-1				

WNP-02
 INTERVAL: PSI
 PERIOD: NA
 OUTAGE:
 DRAWING NO. RWCU-101

WASHINGTON PUBLIC POWER SUPPLY SYSTEM
 PROGRAM PLAN AND SCHEDULE
 SYSTEM OR COMPONENT: RWCU(4)-4
 DESCRIPTION: RPV DRAIN TO RWCU

PAGE 006
 DATE 12/14/84

IDENT. NO.	DESCRIPTION	SECT. XI EXAM. EXAM.	EXAM MTH.	PROCEDURE	CAL. BLOCK	INSERVICE		NOTES
						REQ.	SCHEDULED OUTAGE	
RWCU-1C-7	PSA-3 SNUBBER	B-K-2	VT-3	303/8.2.17				S/N 2595
			VT-4	303/8.2.17				S/N 2595
6RWCU(3)-6	PIPE TO VALVE	B-J	VOL	UTP-10	UT-28			
			SUR	PTP-1				
RWCU-V-102-BOY	VALVE BODY	B-M-2	VT-1	QCI 7-1				
RWCU-V-102/3/4CAP	LEAKOFF CAPPED	B-P	VT-2	N/A				SEE NOTES #6 & #7.
6RWCU(3)-7	VALVE TO PIPE	B-J	VOL	UTP-10	UT-28			
			SUR	PTP-1				
6RWCU(3)-8	PIPE TO TEE	B-J	VOL	UTP-10	UT-28			
			SUR	PTP-1				
6RWCU(3)-9	PIPE TO TEE	B-J	VOL	UTP-10	UT-28			
			SUR	PTP-1				
6RWCU(3)-10	TEE TO PIPE	B-J	VOL	UTP-10	UT-28			
			SUR	PTP-1				
RWCU-1C-6	PSA-3 SNUBBER	B-K-2	VT-3	303/8.2.17				S/N 2569
			VT-4	303/8.2.17				S/N 2569
6RWCU(3)-10/3/4V-605	DRAIN CONN	B-P	VT-2	N/A				SEE NOTES #6 & #7.

WNP-02
 INTERVAL: PSI
 PERIOD: NA
 OUTAGE:
 DRAWING NO. RWCU-101

WASHINGTON PUBLIC POWER SUPPLY SYSTEM
 PROGRAM PLAN AND SCHEDULE
 SYSTEM OR COMPONENT: RWCU(4)-4
 DESCRIPTION: RPV DRAIN TO RWCU

PAGE 007
 DATE 12/14/84

IDENT. NO.	DESCRIPTION	SECT. XI EXAM.	EXAM. MTH.	PROCEDURE	CAL. BLOCK	INSERVICE		NOTES
						REQ.	SCHEDULED OUTAGE	
RWCU-1C-8	PSA-3 SNUBBER	B-K-2	VT-3	303/8.2.17				S/N 2587
			VT-4	303/8.2.17				S/N 2587
PWS-36-1	PIPE WHIP	N/A	N/A	N/A				SEE NOTE #1
PWS-36-21	PIPE WHIP	N/A	N/A	N/A				SEE NOTE #1
RWCU-1C-4PS(W)	8 WELDED LUGS	B-K-1	VOL	OCT 6-15	UT-28			3/4"W x 1 3/8"H x 3"L.
RWCU-1C-4PS	STRUT	B-K-2	VT-3	303/8.2.17				
RWCU-1C-5PS	STRUT	B-K-2	VT-3	303/8.2.17				
ERWCU(3)-11	PIPE TO PIPE	B-J	VOL	UTP-10	UT-28			
			SUR	PTP-1				
RWCU-1C-5	PSA-3 SNUBBER	B-K-2	VT-3	303/8.2.17				S/N 4439
			VT-4	303/8.2.17				S/N 4439
ERWCU(3)-11A	PIPE TO PIPE	B-J	VOL	UTP-10	UT-28			
			SUR	PTP-1				
6RWCU(3)-11B	PIPE TO PIPE	B-J	VOL	UTP-10	UT-28			
			SUR	PTP-1				
ERWCU(3)-11C	PIPE TO PIPE	B-J	VOL	UTP-10	UT-28			
			SUR	PTP-1				

WNP-02
 INTERVAL: PSI
 PERIOD: NA
 OUTAGE:
 DRAWING NO. RWCU-101

WASHINGTON PUBLIC POWER SUPPLY SYSTEM
 PROGRAM PLAN AND SCHEDULE
 SYSTEM OR COMPONENT: RWCU(4)-4
 DESCRIPTION: RPV DRAIN TO RWCU

PAGE 008
 DATE 12/14/84

IDENT. NO.	DESCRIPTION	SECT. XI EXAM.	EXAM MTH.	PROCEDURE	CAL. BLOCK	INSERVICE		NOTES
						REQ.	SCHEDULED OUTAGE	
RWCU-1C-3PS	STRUT	B-K-2	VT-3	303/8.2.17				
RWCU-142	SPRING	B-K-2	VT-3	303/8.2.17				4 WELDED LUGS, 1/2"W x 1 1/2"H x 2 1/2"L.
			VT-4	303/8.2.17				4 WELDED LUGS, 1/2"W x 1 1/2"H x 2 1/2"L.
6RWCU(3)-12	PIPE TO PIPE	B-J	VGL	UTP-10	UT-28			
			SUR	PTP-1				
FWS-36-20	PIPE WHIP	N/A	N/A	N/A				SEE NOTE #1
6RWCU(3)-12A	PIPE TO PIPE	B-J	VOL	UTP-10	UT-28			
			SUR	PTP-1				
6RWCU(3)-13	PIPE TO PIPE	B-J	VGL	UTP-10	UT-28			
			SUR	PTP-1				
RWCU-141	SPRING	B-K-2	VT-3	303/8.2.17				
			VT-4	303/8.2.17				
FWS-36-19	PIPE WHIP	N/A	N/A	N/A				SEE NOTE #1
6RWCU(3)-13B	PIPE TO PIPE	B-J	VOL	UTP-10	UT-28			
			SUR	PTP-1				
RWCU-1C-3(W)	8 WELDED LUGS	B-K-1	VOL	CCI 6-15	UT-28			3/4"W x 1"H x 2 7/8"L.

WNP-02
 INTERVAL: PSI
 PERIOD: NA
 OUTAGE:
 DRAWING NO. RWCU-101

WASHINGTON PUBLIC POWER SUPPLY SYSTEM
 PROGRAM PLAN AND SCHEDULE
 SYSTEM OR COMPONENT: RWCU(4)-4
 DESCRIPTION: RPV DRAIN TO RWCU

PAGE 009
 DATE 12/14/84

IDENT. NO.	DESCRIPTION	SECT. XI EXAM.	EXAM MTH.	PROCEDURE	CAL. BLOCK	INSERVICE		NOTES
						REQ.	SCHEDULED OUTAGE	
RWCU-1C-3	PSA-3 SN(2)	B-K-2	VT-3	303/8.2.17				S/N 3946/3938
			VT-4	303/8.2.17				S/N 3946/3938
RWCU-1C-4	PSA-3 SNUBBER	B-K-2	VT-3	303/8.2.17				S/N 314
			VT-4	303/8.2.17				S/N 314
RWCU-1C-2PS	STRUT	B-K-2	VT-3	303/8.2.17				
PWS-36-18	PIPE WHIP	N/A	N/A	N/A				SEE NOTE #1
RWCU-140	SPRINGS	B-K-2	VT-3	303/8.2.17				
			VT-4	303/8.2.17				
PWS-36-17	PIPE WHIP	N/A	N/A	N/A				SEE NOTE #1
6RWCU(3)-13A	PIPE TO PIPE	B-J	VOL	UTP-10	UT-28			
			SUR	PTP-1				
RWCU-1C-2	PSA-1 SNUBBER	B-K-2	VT-3	303/8.2.17				S/N 387
			VT-4	303/8.2.17				S/N 387
6RWCU(3)-14	PIPE TO FLANGE	B-J	VOL	OCI 6-13	UT-28			
			SUR	OCI 3-3				
6RWCU(3)-14/1/2PI(1)-4S	PRESSURE TAP	B-P	VT-2	N/A				SEE NOTES #6 & #7.
6RWCU(3)-15/1/2PI(1)-4S	PRESSURE TAP	B-P	VT-2	N/A				SEE NOTES #6 & #7.
6RWCU(3)-15	FLANGE TO PIPE	B-J	VOL	OCI 6-13	UT-28			

WMP-02
 INTERVAL: .PSI
 PERIOD: NA
 OUTAGE:
 DRAWING NO. RUCU-101

WASHINGTON PUBLIC POWER SUPPLY SYSTEM
 PROGRAM PLAN AND SCHEDULE
 SYSTEM OR COMPONENT: RUCU(4)-4
 DESCRIPTION: RPV DRAIN TO RUCU

PAGE 010
 DATE 12/14/84

IDENT. NO.	DESCRIPTION	SECT. XI EXAM.	EXAM MTH.	PROCEDURE	CAL. BLOCK	INSERVICE		NOTES
						REQ.	SCHEDULED OUTAGE	
PWS-36-16			SUR	QCI 3-3				
6RUCU(3)-16	PIPE WHIP	N/A	N/A	N/A				SEE NOTE #1
	PIPE TO EL	B-J	VOL	UTF-10	UT-28			
6RUCU(3)-17			SUR	PTP-1				
	EL TO PIPE	B-J	VOL	UTF-10	UT-28			
RUCU-1C-1PS			SUR	PTP-1				
PWS-36-15	PIPE STOP	B-K-2	VT-3	303/8.2.17				
6RUCU(3)-18	PIPE WHIP	N/A	N/A	N/A				SEE NOTE #1
	PIPE TO EL	B-J	VOL	UTF-10	UT-28			
PWS-36-14			SUR	PTP-1				
6RUCU(3)-19	PIPE WHIP	N/A	N/A	N/A				SEE NOTE #1
	EL TO PIPE	B-J	VOL	UTF-10	UT-28			
RUCU-139			SUR	PTP-1				
	SPRING	B-K-2	VT-3	303/8.2.17				
RUCU-1C-1			VT-4	303/8.2.17				
	PSA-3 SNUBBER	B-K-2	VT-3	303/8.2.17				S/N 4445
			VT-4	303/8.2.17				S/N 4445

WNP-02
 INTERVAL: PSI
 PERIOD: NA
 OUTAGE:
 DRAWING NO. RVCU-101

WASHINGTON PUBLIC POWER SUPPLY SYSTEM
 PROGRAM PLAN AND SCHEDULE
 SYSTEM OR COMPONENT: RVCU(4)-4
 DESCRIPTION: RPV DRAIN TO RVCU

PAGE 011
 DATE 12/14/84



IDENT. NO.	DESCRIPTION	SECT. XI EXAM.	EXAM MTH.	PROCEDURE	CAL. BLOCK	INSERVICE		NOTES
						REQ.	SCHEDULED OUTAGE	
6RVCU(3)-19/3/4V-108	TEST CONN	R-P	VT-2	N/A				SEE NOTES #6 & #7.
6RVCU(3)-20	PIPE TO VALVE	R-J	VOL	UTP-10	UT-28			AUGHT
			SUR	PTP-1				AUGHT
RVCU-V-1-BDY	VALVE BODY	B-M-2	VT-1	GCT 7-1				
RVCU-V-1-BLT	VALVE BOLTING	B-G-2	VT-1	GCT 7-1				
RVCU-V-1/3/4CAP	LEAKOFF CAPPED	B-P	VT-2	N/A				SEE NOTES #6 & #7.
6RVCU(3)-21	VALVE TO PIPE	B-J	VOL	UTP-10	UT-28			AUGHT
			SUR	PTP-1				AUGHT
6RVCU(3)-22	PIPE TO PENE	B-J	VOL	UTP-10	UT-28			AUGHT
			SUR	PTP-1				AUGHT
6RVCU(3)-23	PENE TO EL	B-J	VOL	UTP-10	UT-28			AUGHT
			SUR	PTP-1				AUGHT
6RVCU(3)-23/3/4V-612	VENT CONN	B-P	VT-2	N/A				SEE NOTES #6 & #7.
6RVCU(3)-24	EL TO PIPE	B-J	VOL	UTP-10	UT-28			AUGHT
			SUR	PTP-1				AUGHT
6RVCU(3)-24/3/4PLUG	PLUG TEST CONN	B-P	VT-2	N/A				SEE NOTES #6 & #7.
RVCU-926H	PSA-35 SNUBBER	B-K-2	VT-3	303/8.2.17				S/N 7505

WMP-02
 INTERVAL: PSI
 PERIOD: NA
 OUTAGE:
 DRAWING NO. RWCU-101

WASHINGTON PUBLIC POWER SUPPLY SYSTEM
 PROGRAM PLAN AND SCHEDULE
 SYSTEM OR COMPONENT: RWCU(4)-4
 DESCRIPTION: RPV DRAIN TO RUCU

PAGE 012
 DATE 12/14/84

IDENT. NO.	DESCRIPTION	SECT. XI EXAM. EXAM.	VT#	PROCEDURE	CAL. BLOCK	INSERVICE		NOTES
						REQ.	SCHEDULED OUTAGE	
6RWCU(3)-25			VT-4	303/R.2.17				S/N 7505
	PIPE TO EL	B-J	VOL	UTP-10	UT-28			AUGHT
			SUR	PTP-1				AUGHT
6RWCU(3)-25/3/4V-608	DRAIN CONN	B-P	VT-2	N/A				SEE NOTES #6 & #7.
6RWCU(3)-26	EL TO PIPE	B-J	VOL	UTP-10	UT-28			AUGHT
			SUR	PTP-1				AUGHT
RWCU-900N	PSA-3 SN(2)	B-K-2	VT-3	303/R.2.17				S/N 3943/3878
			VT-4	303/R.2.17				S/N 3943/3878
6RWCU(3)-27	PIPE TO VALVE	B-J	VOL	UTP-10	UT-28			AUGHT
			SUR	PTP-1				AUGHT
RWCU-V-4-BDY	VALVE BODY	B-M-2	VT-1	QCI 7-1				
RWCU-V-4-BLT	VALVE BOLTING	B-G-2	VT-1	QCI 7-1				
RWCU-V-4/3/4CAP	LEAKOFF CAPPED	B-P	VT-2	N/A				SEE NOTE #6 & #7.
RWCU-P8-101	RWCU PRES BNDRY	B-P	VT-2	N/A				SEE NOTES #6 & #7.

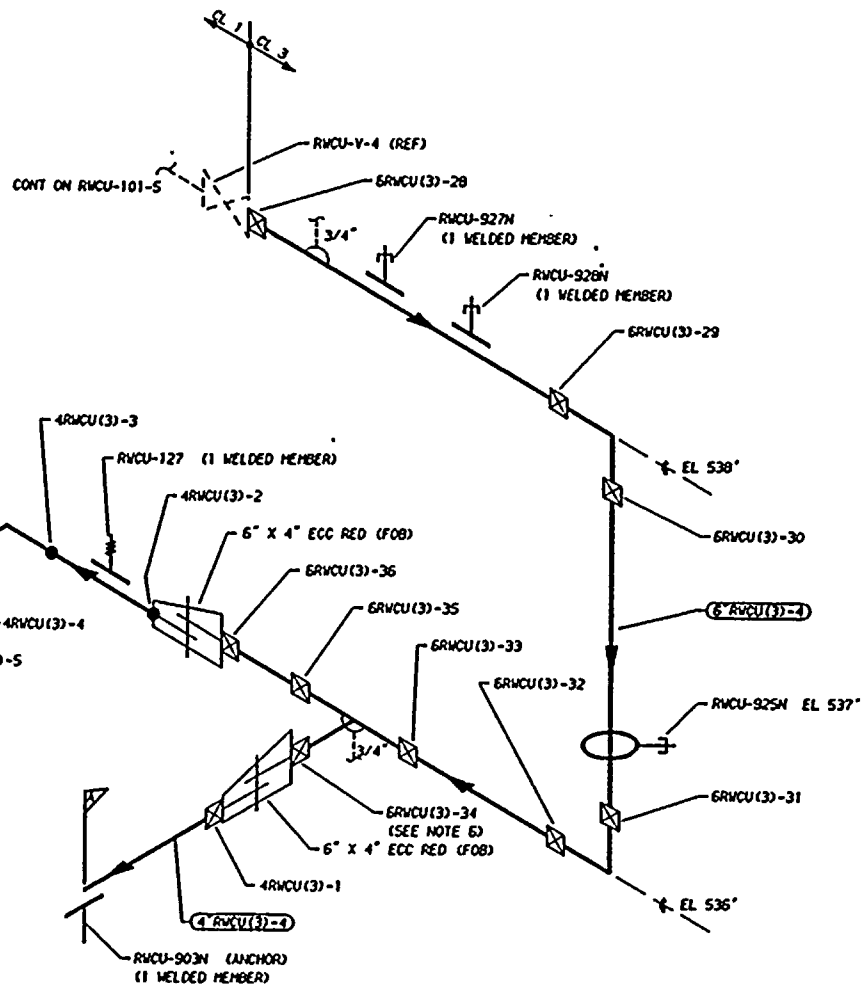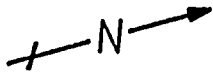

ZONE R-53

THIS DRAWING IS INTENDED FOR
USE IN PRESERVICE AND INSERVICE
INSPECTIONS PROGRAMS ONLY.

PIPING SYSTEM	NOM DIA (IN)	SCH	NOM WALL THK	MATERIAL SPECIFICATION	MATL TYPE	CAL BLOCK NO
6" RVCU(3)-4	6	80	0.432	SA 106 GR B	CS	UT-28
4" RVCU(3)-4	4	80	0.337	SA 106 GR B	CS	UT-30


NO	DATE	REVISION	BY	CHKD	APYD
1	12-28-83	GENERAL UP-DATE REDRAWN	K-McA	DRP	TFH
0	12-8-81	ISSUED FOR USE	K-McA	DRP	TFH

NOTES

1. DELETED
2. DELETED
3. DELETED
4. THIS DRAWING IDENTIFIES PIPING AND COMPONENTS SUBJECT ONLY TO A VISUAL EXAM FOR (1) EVIDENCE OF LEAKAGE DURING SYSTEM PRESSURE OR OPERABILITY TESTS, (2) PRESSURE DECAY TESTS OF BURIED PIPING, AND (3) LOSS OF SUPPORT CAPABILITY OR INADEQUATE RESTRAINT FOR SUPPORTS AND HANGERS ON PIPING EXCEEDING 4" NOM. TESTS SHALL BE CONDUCTED PER ASME SECTION XI, ARTICLES 1WA-5000 AND 1WD-2000.
5. ALL CIRCUMFERENTIAL BUTT WELDS GREATER THAN 1 INCH REQUIRE AUGMENTED ISI.
6. WELD 6RVCU(3)-34 IS FITTING TO FITTING.

REFERENCES:

- ISI - 223
- BOYEE & CRAIL ISOMETRICS
RVCU-812-8.13 REV 10

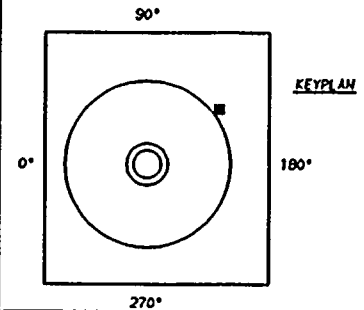

QUALITY CLASS: 1	ASME CODE CLASS: 3
ENGR: K-McANDREW	DATE: 5-7-79

WASHINGTON PUBLIC POWER
SUPPLY SYSTEM
RICHLAND, WASHINGTON 99352

HNP-2
WELD & COMPONENT
IDENTIFICATION DIAGRAM

TITLE:	RVCU-P-1A & 1B SUCTION
DWG NO: RVCU-301	REV 1

WNP-02
 INTERVAL: PSI
 PERIOD: NA
 OUTAGE:
 DRAWING NO. RWCU-301

WASHINGTON PUBLIC POWER SUPPLY SYSTEM
 PROGRAM PLAN AND SCHEDULE
 SYSTEM OR COMPONENT: RWCU(3)-4
 DESCRIPTION: RWCU PUMP SUCTION

PAGE 001
 DATE 12/14/84


<u>IDENT. NO.</u>	<u>DESCRIPTION</u>	<u>SECT.</u>		<u>PROCEDURE</u>	<u>CAL. BLOCK</u>	<u>INSERVICE SCHEDULED</u>		<u>NOTES</u>
		<u>XI EXAM</u>	<u>EXAM</u>			<u>REQ.</u>	<u>OUTAGE</u>	
6RWCU(3)-28	VLV TO PIPE	AUGMT	VOL	QCI 6-13	UT-28			
RWCU-927N	PSA-35 SNUBBER	N/A	VT-3	303/8.2.17				S/N 7038
			VT-4	303/8.2.17				S/N 7038
RWCU-928N	PSA-10 SNUBBER	N/A	VT-3	303/8.2.17				S/N 134
			VT-4	303/8.2.17				S/N 134
6RWCU(3)-29	PIPE TO ELL	AUGMT	VOL	QCI 6-13	UT-28			
6RWCU(3)-30	ELL TO PIPE	AUGMT	VOL	QCI 6-13	UT-28			
RWCU-925N	PSA-1/4 SNUBBER	N/A	VT-3	303/8.2.17				S/N 624
			VT-4	303/8.2.17				S/N 624
6RWCU(3)-31	PIPE TO ELL	AUGMT	VOL	QCI 6-13	UT-28			
6RWCU(3)-32	ELL TO PIPE	AUGMT	VOL	QCI 6-13	UT-28			
6RWCU(3)-33	PIPE TO TEE	AUGMT	VOL	QCI 6-13	UT-28			
6RWCU(3)-34	TEE TO REDUCER	AUGMT	VOL	QCI 6-13	UT-28			
4RWCU(3)-1A	REDUCER TO PIPE	AUGMT	VOL	QCI 6-13	UT-30			FITTING TO FITTING
6RWCU(3)-35	TEE TO PIPE	AUGMT	VOL	QCI 6-13	UT-28			
6RWCU(3)-36	PIPE TO REDUCER	AUGMT	VOL	QCI 6-13	UT-28			
4RWCU(3)-2A	REDUCER TO PIPE	AUGMT	VOL	QCI 6-13	UT-30			
4RWCU(3)-3A	PIPE TO ELL	AUGMT	VOL	QCI 6-13	UT-30			

WNP-02
 INTERVAL: PSI
 PERIOD: NA
 OUTAGE:
 DRAWING NO. RWCU-301

WASHINGTON PUBLIC POWER SUPPLY SYSTEM
 PROGRAM PLAN AND SCHEDULE
 SYSTEM OR COMPONENT: RWCU(3)-4
 DESCRIPTION: RWCU PUMP SUCTION


PAGE 002
 DATE 12/14/84

<u>IDENT. NO.</u>	<u>DESCRIPTION</u>	<u>SECT.</u> XI <u>EXAM.</u>	<u>EXAM</u> MTH.	<u>PROCEDURE</u>	<u>CAL.</u> BLOCK	<u>INSERVICE</u>		<u>NOTES</u>
						<u>REQ.</u>	<u>SCHEDULED</u> OUTAGE	
4RWCU(3)-4A	ELL TO PIPE	AUGMT	VOL	QCI 6-13	UT-30			
4RWCU(3)-5A	PIPE TO PIPE	AUGMT	VOL	QCI 6-13	UT-30			
RWCU-PB-301	RWCU PRES BNDRY	N/A	VT-2	N/A				SEE NOTES #6 & #7.

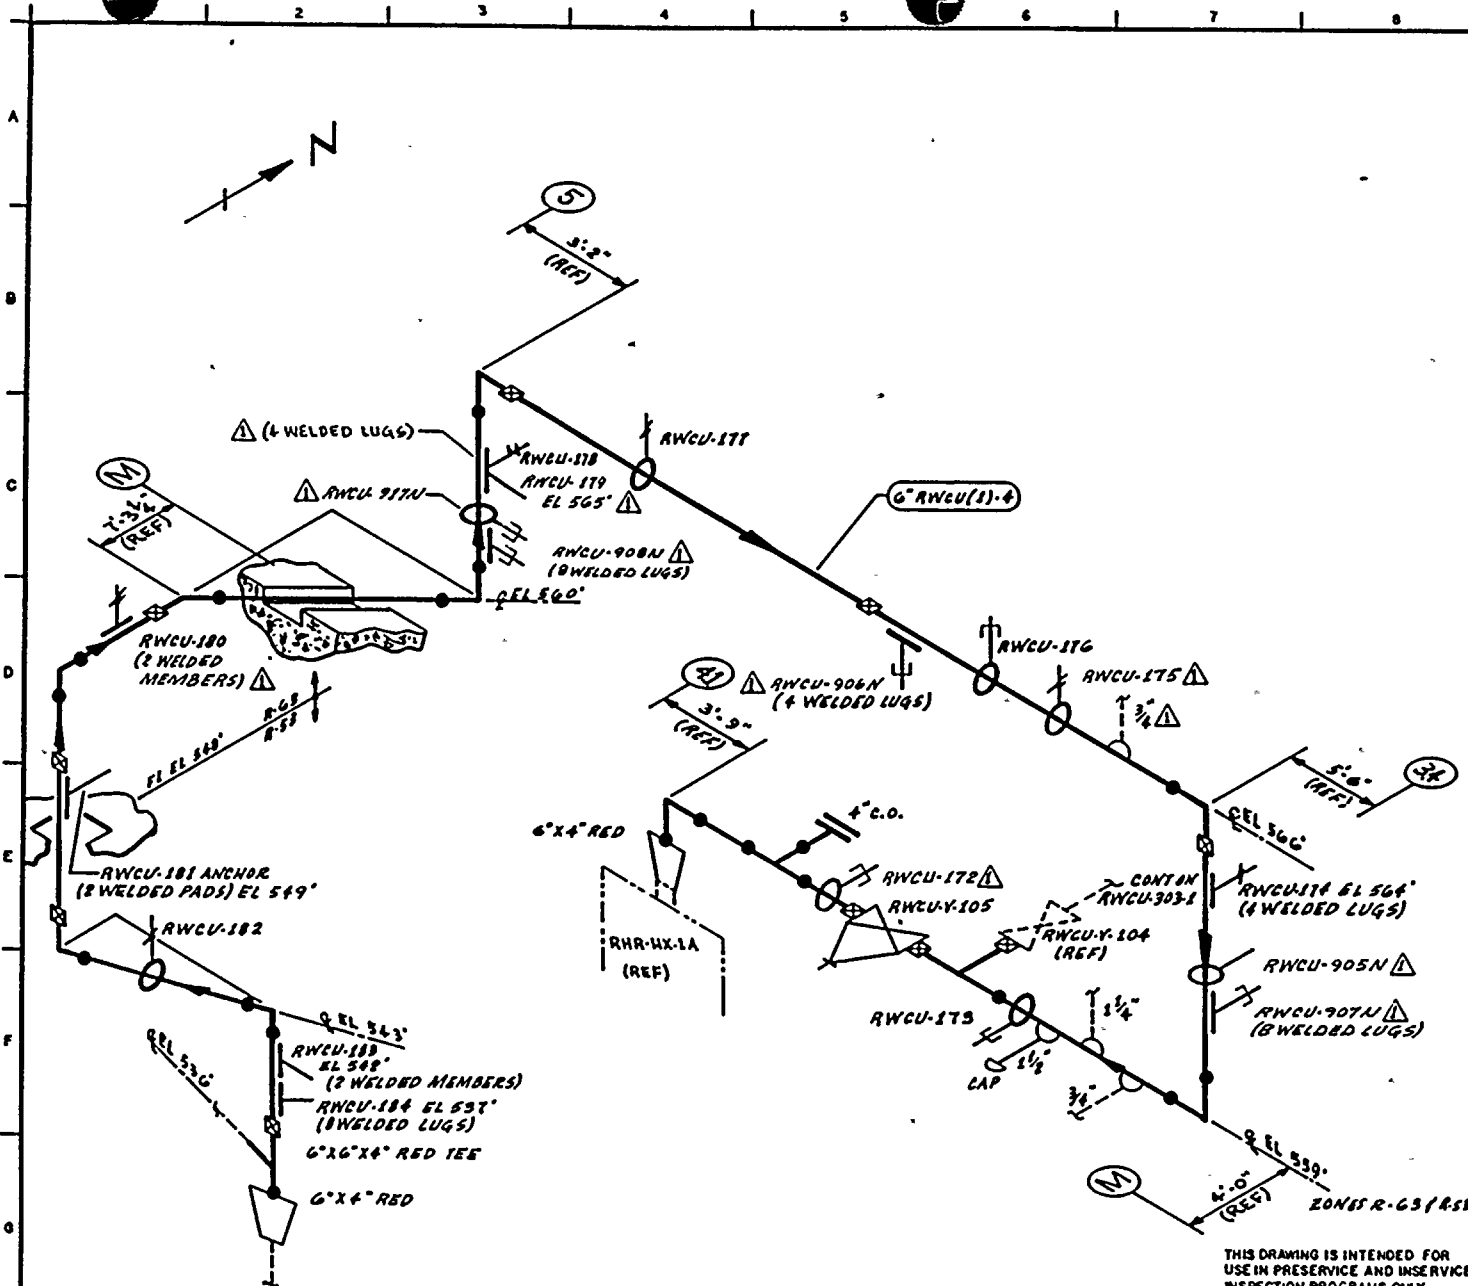

NOTES:

1. THIS DRAWING IDENTIFIES PIPING & COMPONENTS SUBJECT ONLY TO A VISUAL EXAM FOR (1) EVIDENCE OF LEAKAGE DURING SYSTEM PRESSURE OR OPERABILITY TESTS; (2) PRESSURE DECAY TESTS FOR BURIED PIPING; & (3) LOSS OF SUPPORT CAPABILITY OR INADEQUATE RESTRAINT FOR SUPPORTS & HANGERS ON PIPING EXCEEDING 4" NOM. TESTS SHALL BE CONDUCTED PER ASME SECTION XI, ARTICLES IWA-5000 & IWD-2000.
2. FOR BRANCH PIPING 6" DIA OR LESS (CONN SHOWN IN DASHED LINES) EXTEND VISUAL LEAKAGE EXAM THROUGH THE OUTERMOST NORMALLY CLOSED NUCLEAR CLASS VALVE OR UNTIL TRANSITION TO INSTRUMENT TUBING, UNLESS OTHERWISE NOTED.

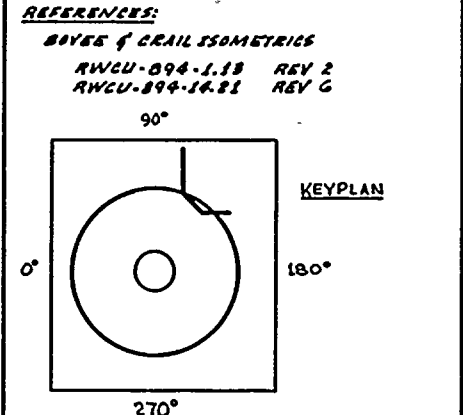

QUALITY CLASS: 2 ASME CODE CLASS: 3
 ENGR: J. J. J. DRAWN: J. M. A. DATE: 5-7-79

WASHINGTON PUBLIC POWER SUPPLY SYSTEM
 RICHLAND, WASHINGTON 99352

THIS DRAWING IS INTENDED FOR USE IN PRESERVICE AND INSERVICE INSPECTION PROGRAMS ONLY.

PIPING SYSTEM	NOM DIA (IN)	SCH	NOM WALL THK	MATERIAL SPECIFICATION	MATL TYPE	CAL BLOCK NO
6" RWCU(1)-4	6	80	0.432	SA 106 GR B	CS	NA

NO	DATE	REVISION	BY	CHKD	APPVD
1	12-2-91	REVISED AS NOTED ADDED KEYPLAN	J. J. J.	J. M. A.	J. J. J.
0	12-2-91	ISSUED FOR USE	J. J. J.	J. M. A.	J. J. J.

WNP- 2
 WELD & COMPONENT
 IDENTIFICATION DIAGRAM

TITLE:
 RWCU-302 & 18 DISCHARGE TO RHR-HX-1A


DWG NO: RWCU-302 REV 1

WNP-02
 INTERVAL: PSI
 PERIOD: NA
 OUTAGE:
 DRAWING NO. RWCU-302

WASHINGTON PUBLIC POWER SUPPLY SYSTEM
 PROGRAM PLAN AND SCHEDULE
 SYSTEM OR COMPONENT: RWCU(1)-4
 DESCRIPTION: RWCU PUMP DISCHARGE


PAGE 001
 DATE 12/14/84

IDENT. NO.	DESCRIPTION	SECT. XI EXAM.	EXAM MTH.	PROCEDURE	CAL. BLOCK	INSERVICE		NOTES
						REQ.	SCHEDULED OUTAGE	
RWCU-908N	PSA-1/4 SN(2)	N/A	VT-3	303/8.2.17				S/N N2531/S256
			VT-4	303/8.2.17				S/N N2531/S256
RWCU-917N	PSA-3 SNUBBER	N/A	VT-3	303/8.2.17				S/N 2392
			VT-4	303/8.2.17				S/N 2392
RWCU-906N	PSA-1/4 SNUBBER	N/A	VT-3	303/8.2.17				S/N 2468
			VT-4	303/8.2.17				S/N 2468
RWCU-907N	PSA-1/4 SN(2)	N/A	VT-3	303/8.2.17				S/N N2089/S214
			VT-4	303/8.2.17				S/N N2089/S214
RWCU-173	PSA-1 SNUBBER	N/A	VT-3	303/8.2.17				S/N 382
			VT-4	303/8.2.17				S/N 382
RWCU-PB-302	RWCU PRES BNDRY	N/A	VT-2	N/A				SEE NOTES #6 & #7.

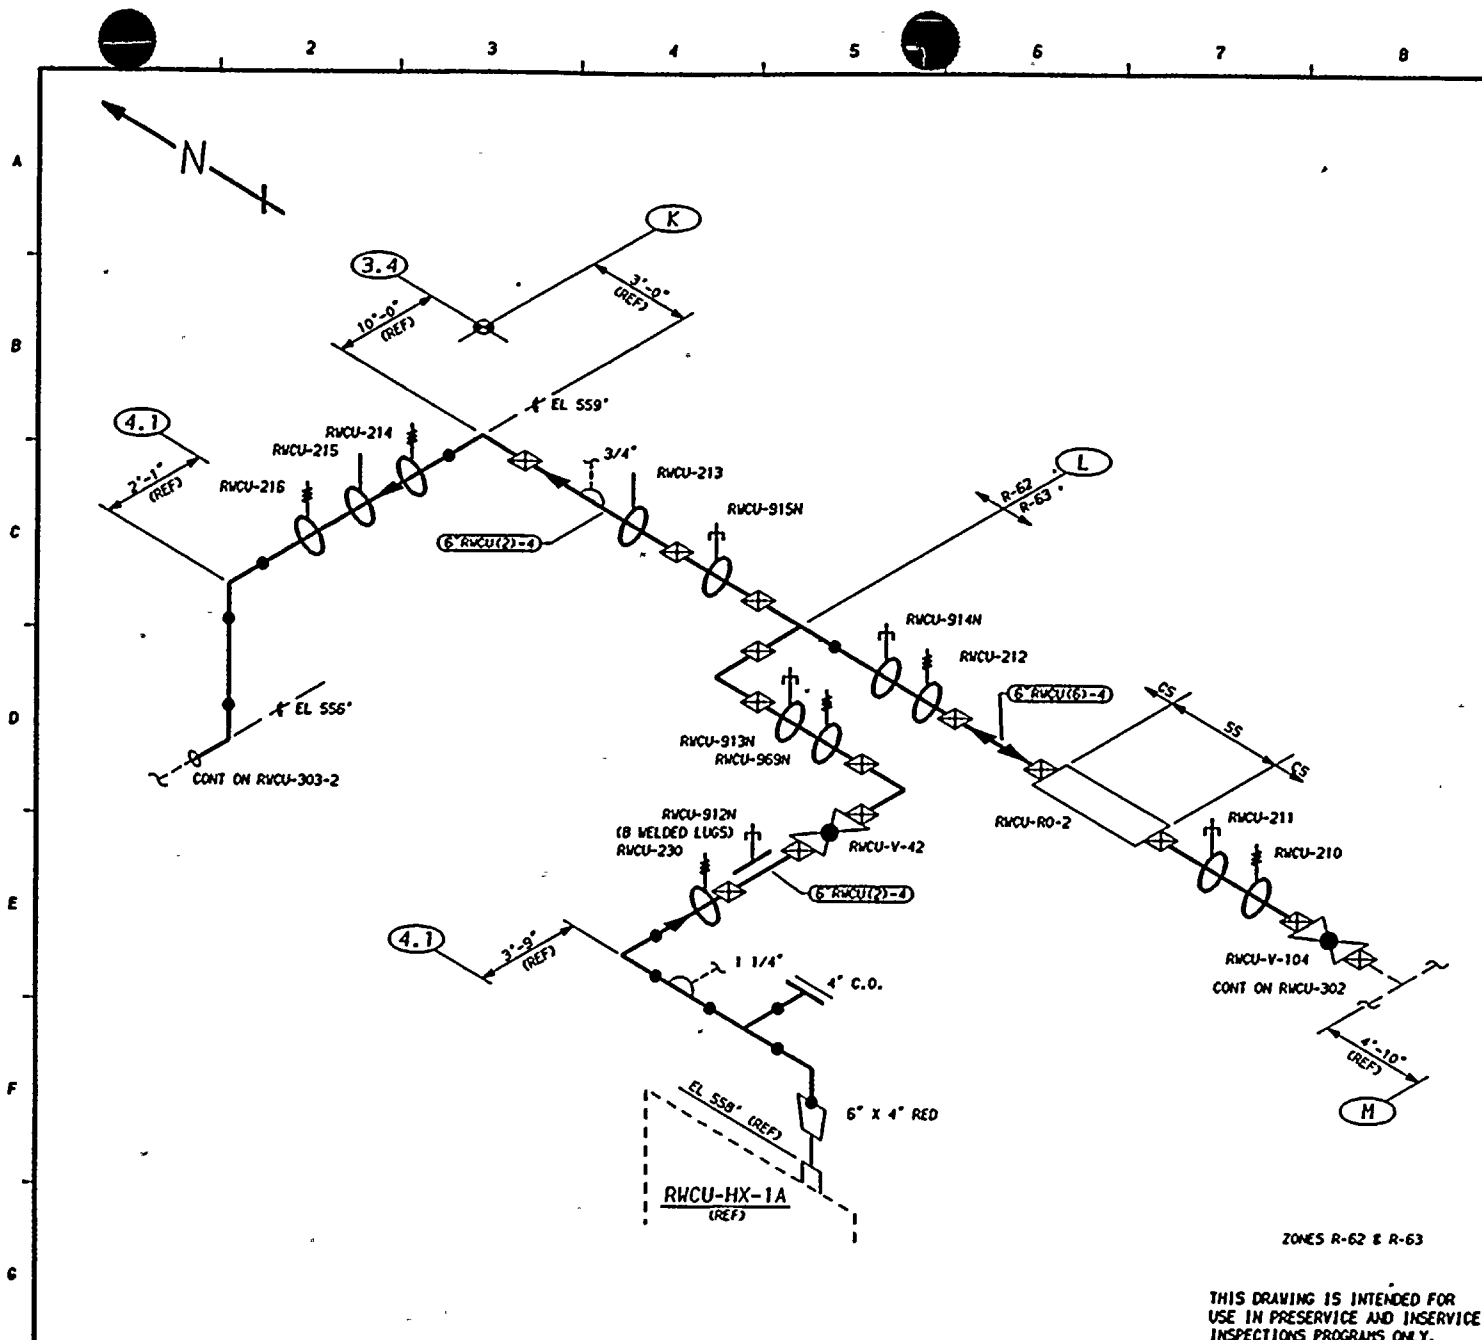

- NOTES:**
1. THIS DRAWING IDENTIFIES PIPING AND COMPONENTS SUBJECT ONLY TO A VISUAL EXAM FOR (1) EVIDENCE OF LEAKAGE DURING SYSTEM PRESSURE OR OPERABILITY TESTS; (2) PRESSURE DECAY TESTS OF BURIED PIPING; AND (3) LOSS OF SUPPORT CAPABILITY OR INADEQUATE RESTRAINT FOR SUPPORTS AND HANGERS ON PIPING EXCEEDING 4" NOM. TESTS SHALL BE CONDUCTED PER ASME SECTION XI, ARTICLES 1WA-5000 AND 1MO-2000.
 2. FOR BRANCH PIPING 4" NOM. OR LESS (CONNECTION SHOWN IN DASHED LINES) EXTEND VISUAL LEAKAGE EXAM THROUGH THE OUTERMOST NORMALLY CLOSED NUCLEAR CLASS VALVE, OR UNTIL TRANSITION TO INSTRUMENT TUBING, UNLESS OTHERWISE NOTED.

- REFERENCES:**
- 151 - 229
 - BOYEE & GRILL ISOMETRIC RVCU-895-1.7 REV 6

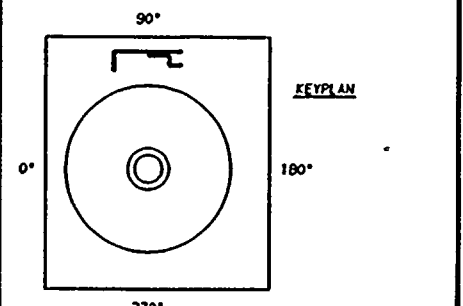

QUALITY CLASS, 2	ASME CODE CLASS, 3
ENGR, K-McANDREW	DRAWN, K-McA DATE, 6-25-79

WASHINGTON PUBLIC POWER
SUPPLY SYSTEM
 RICHLAND, WASHINGTON 99352

WNP-2
 WELD & COMPONENT
IDENTIFICATION DIAGRAM


TITLE:
 RVCU-HX-1A RETURN TO RFV

DWG NO, RVCU-303-1 REV 1

THIS DRAWING IS INTENDED FOR USE IN PRESERVICE AND INSERVICE INSPECTIONS PROGRAMS ONLY.


PIPING SYSTEM	NOM DIA (IN)	SCH	NOM WALL THK	MATERIAL SPECIFICATION	MATL TYPE	CAL BLOCK NO
6" RVCU(6)-4	6	80	0.432	SA 106 GR B	CS	NA
6" RVCU(2)-4	6	80	0.432	SA 106 GR B	CS	NA

NO	DATE	REVISION	BY	CHKD	APVD
1	12-2-81	GENERAL UPDATE REDRAW	K-McA	DPF	TFH
0	12-2-81	ISSUED FOR USE	K-McA	DPF	TFH

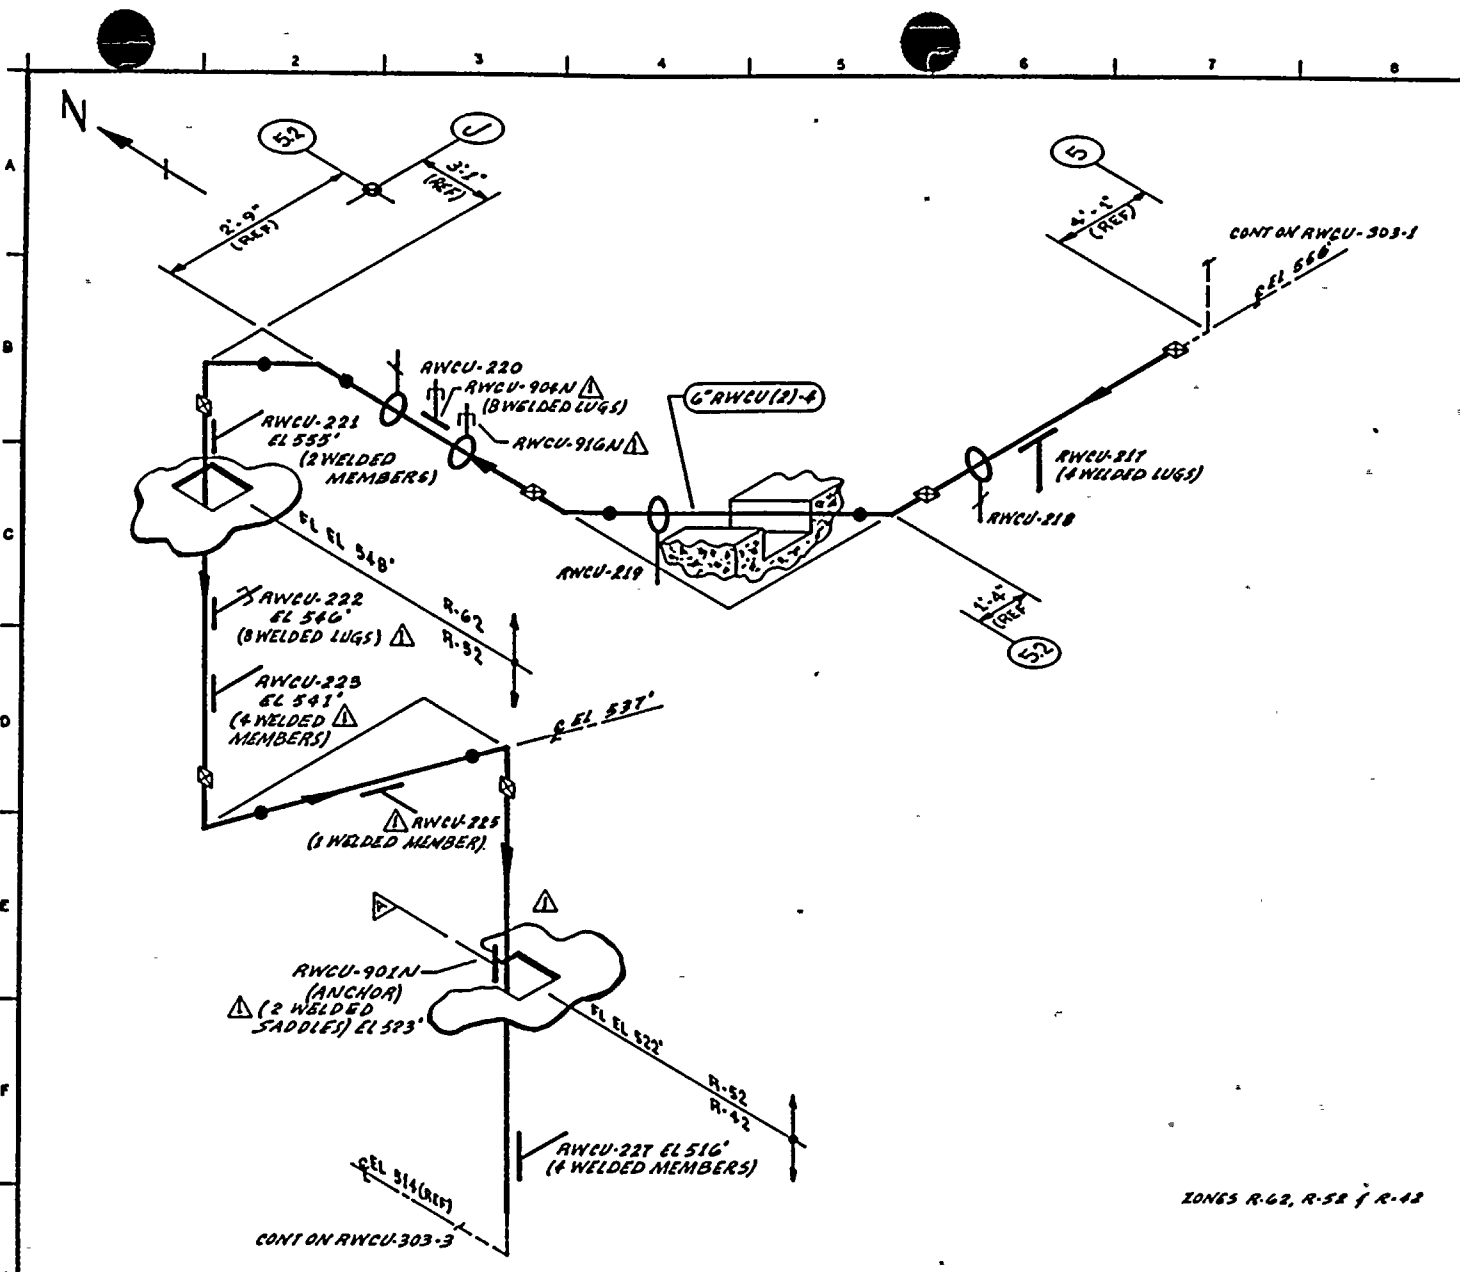

NOTES:
 1. THIS DRAWING IDENTIFIES PIPING & COMPONENTS SUBJECT ONLY TO A VISUAL EXAM FOR (1) EVIDENCE OF LEAKAGE DURING SYSTEM PRESSURE OR OPERABILITY TESTS; (2) PRESSURE DECAY TESTS OF BURIED PIPING; & (3) LOSS OF SUPPORT CAPABILITY OR INADEQUATE RESTRAINT FOR SUPPORTS & HANGERS ON PIPING EXCEEDING 4" NOM. TESTS SHALL BE CONDUCTED PER ASME SECTION XI, ARTICLES IWA-5000 & IWD-2000.

REFERENCES:
 BOVEE & CRAIL ISOMETRICS
 RWCU-895-1.7 REV 6
 RWCU-895-8.12 REV 9

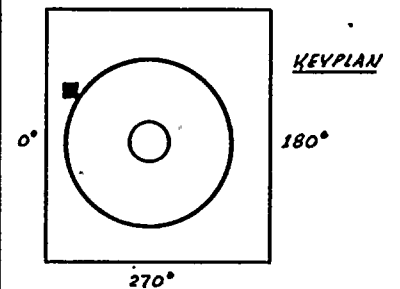

ZONES R-62, R-52 & R-42

THIS DRAWING IS INTENDED FOR USE IN PRESERVICE AND INSERVICE INSPECTION PROGRAMS ONLY.


QUALITY CLASS: 2	ASME CODE CLASS: 3
ENGR: M. ANDRIN	DRAWN: M. & A.
DATE: 6-28-78	

WASHINGTON PUBLIC POWER SUPPLY SYSTEM
 RICHLAND, WASHINGTON 99352

PIPING SYSTEM	NOM DIA (IN)	SCH	NOM WALL THK	MATERIAL SPECIFICATION	MATL TYPE	CAL BLOCK NO
6" RWCU(2)-4	6	80	0.172	SA 106 GR B	CS	NA

WNP-2
 WELD B COMPONENT
 IDENTIFICATION DIAGRAM
 TITLE:
 RWCU-HX-1A RETURN TO RW
 DWG NO: RWCU-303-2
 REV 1

NO	DATE	REVISION	BY	CHKD	APPVD
1	12-84	REVISED AS NOTED ADDED KEYPLAN	KMA	LR	TW
0	12-81	ISSUED FOR USE	KMA	LR	TFW

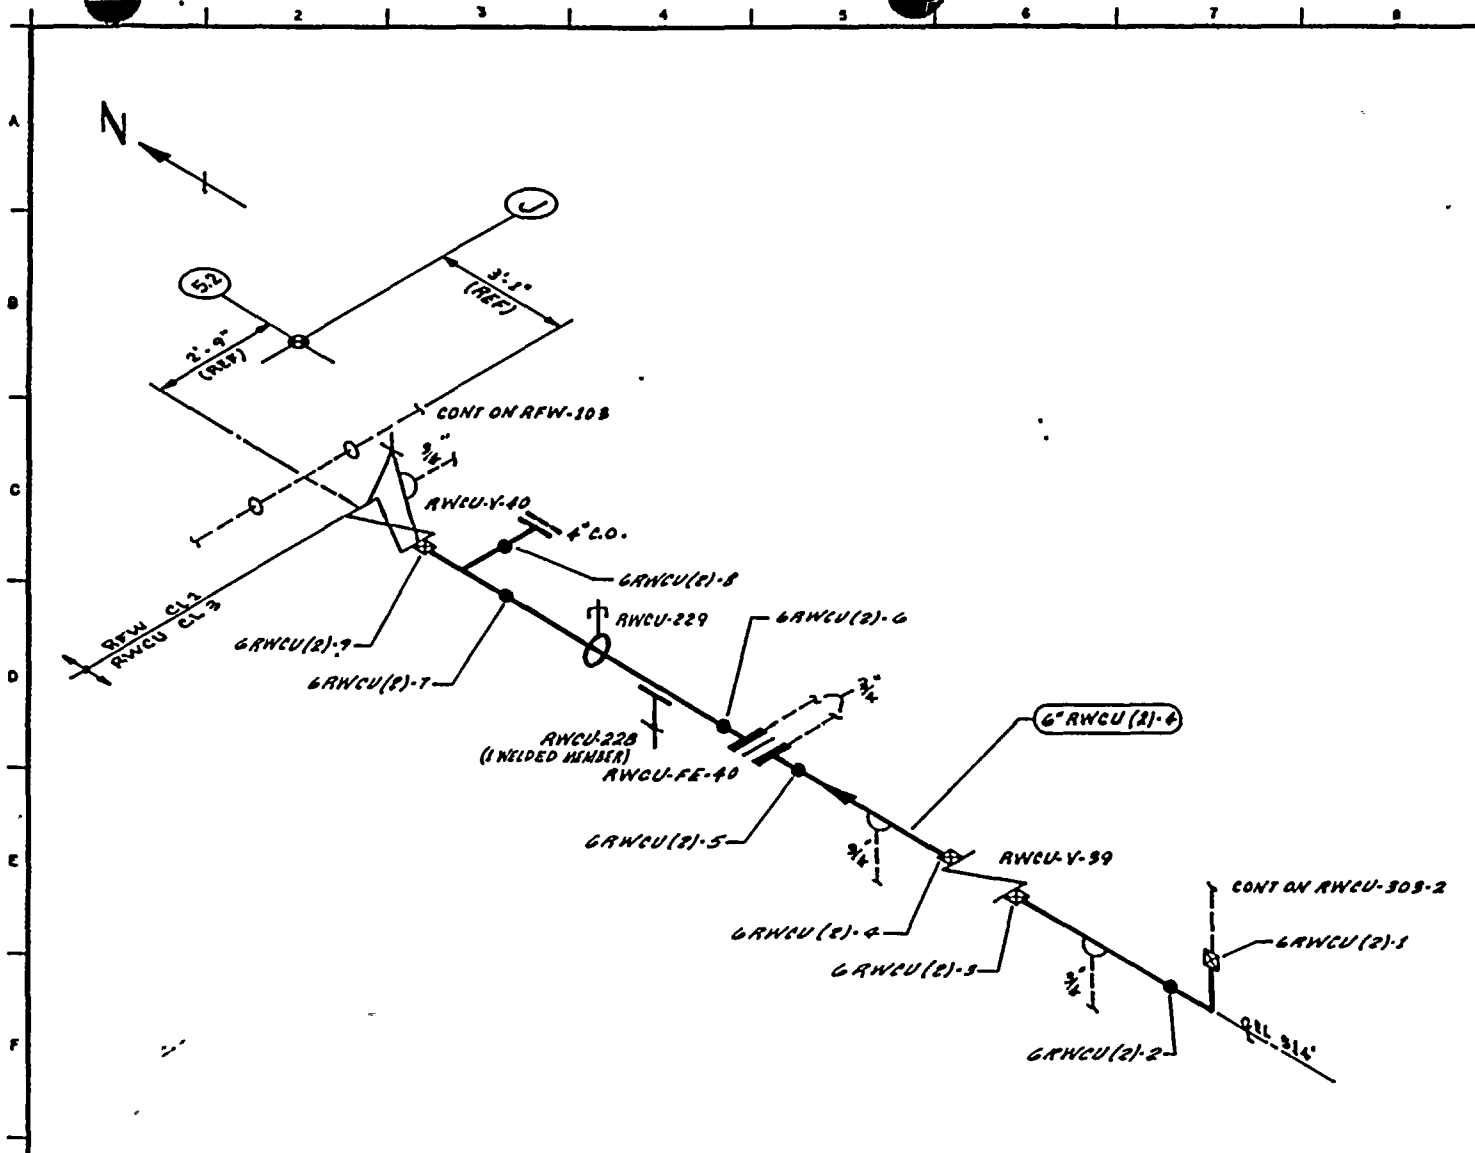

ZONE R-42


THIS DRAWING IS INTENDED FOR USE IN PRESERVICE AND INSERVICE INSPECTION PROGRAMS ONLY.

NOTES:

1. WELDS 6RWCU(2)-8 & 6RWCU(2)-9 ARE FITTING TO FITTING.
2. ALL CIRCUMFERENTIAL BUTT WELDS GREATER THAN 1 INCH REQUIRE AUGMENTED ISI.
3. FOR BRANCH PIPING 4" NOM OR LESS (CONN SHOWN IN DASHED LINES) EXTEND VISUAL LEAKAGE EXAM THROUGH THE OUTERMOST NORMALLY CLOSED NUCLEAR CLASS VALVE, OR UNTIL TRANSITION TO INSTRUMENT TUBING, UNLESS OTHERWISE NOTED.
4. AT LOCATIONS WHERE LEAKAGE IS NORMALLY EXPECTED, (E.G., VALVE STEM OR PUMP SEAL LEAKOFF CONN) VERIFY LEAKAGE COLLECTION SYSTEM OPERABILITY ONLY. NO HYDRO TEST OF COLLECTION SYSTEM IS REQUIRED.

REFERENCES:

BOYER & CRAIG ISOMETRICS
RWCU-895-B.12 RBY 9

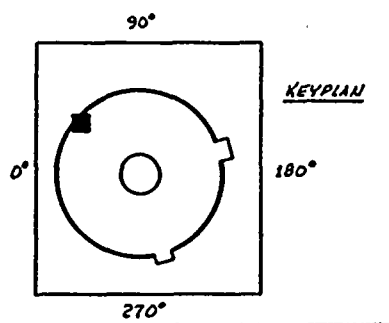

QUALITY CLASS: 2	ASME CODE CLASS: 3
ENGR: AM/ADR/DM	DRAWN: J.McA DATE: 6-28-79

WASHINGTON PUBLIC POWER SUPPLY SYSTEM
RICHLAND, WASHINGTON 99342

PIPING SYSTEM	NOM DIA (IN)	SCH	NOM WALL THK	MATERIAL SPECIFICATION	MATL TYPE	CAL BLOCK NO
6"RWCU(2)-4	6	80	0.632	SA 106 GR B	CS	UI-28

WNP-2
WELD & COMPONENT IDENTIFICATION DIAGRAM
TITLE:
RWCU-HX-1A RETURN TO RFW
DWG NO: RWCU-303-3
REV 1

NO	DATE	REVISION	BY	CHKD	APPVD
1	1/29/81	REVISED RWCU-228 ADDED RWCU-229 & KEYPLAN	MLL	DMR	TFK
0	1/19/81	ISSUED FOR USE	MLL	DMR	TFK



WNP-02
 INTERVAL: PSI
 PERIOD: NA
 OUTAGE:
 DRAWING NO. RWCU-303

WASHINGTON PUBLIC POWER SUPPLY SYSTEM
 PROGRAM PLAN AND SCHEDULE
 SYSTEM OR COMPONENT: RWCU(2)-4
 DESCRIPTION: RWCU HX RTN TO RFW

PAGE 001
 DATE 12/14/84


<u>IDENT. NO.</u>	<u>DESCRIPTION</u>	SECT. XI <u>EXAM.</u>	EXAM <u>MTG.</u>	<u>PROCEDURE</u>	CAL. <u>BLOCK</u>	<u>INSERVICE</u>		<u>NOTES</u>
						<u>REQ.</u>	<u>SCHEDULED OUTAGE</u>	
RWCU-211	PSA-1/2 SNUBBER	N/A	VT-3	303/8.2.17				S/N 377
			VT-4	303/8.2.17				S/N 377
RWCU-914N	PSA-1 SNUBBER	N/A	VT-3	303/8.2.17				S/N 22336
			VT-4	303/8.2.17				S/N 22336
RWCU-912N	PSA-1/4 SN(3)	N/A	VT-3	303/8.2.17				S/N N2583/W246
			VT-4	303/8.2.17				S/N N2583/W246
RWCU-913N	PSA-1 SNUBBER	N/A	VT-3	303/8.2.17				S/N 108
			VT-4	303/8.2.17				S/N 108
RWCU-915N	PSA-1/2 SNUBBER	N/A	VT-3	303/8.2.17				S/N 2157
			VT-4	303/8.2.17				S/N 2157
RWCU-916N	PSA-1/2 SN(2)	N/A	VT-3	303/8.2.17				S/N T2567/B247
			VT-4	303/8.2.17				S/N T2567/B247
RWCU-904N	PSA-1/2 SN(2)	N/A	VT-3	303/8.2.17				S/N T2525/B257
			VT-4	303/8.2.17				S/N T2525/B257
RWCU-222	PSA-1/4 SN(2)	N/A	VT-3	303/8.2.17				S/N W435/E2093
			VT-4	303/8.2.17				S/N W435/E2093
6RWCU(2)-1	PIPE TO ELL	AUGMT	VOL	QCI 6-13	UT-28			
6RWCU(2)-2	ELL TO PIPE	AUGMT	VOL	QCI 6-13	UT-28			

WNP-02
 INTERVAL: PSI
 PERIOD: NA
 OUTAGE:
 DRAWING NO. RWCU-303

WASHINGTON PUBLIC POWER SUPPLY SYSTEM
 PROGRAM PLAN AND SCHEDULE
 SYSTEM OR COMPONENT: RWCU(2)-4
 DESCRIPTION: RWCU HX RTN TO RFW


PAGE 002
 DATE 12/14/84

<u>IDENT. NO.</u>	<u>DESCRIPTION</u>	<u>SECT.</u>		<u>PROCEDURE</u>	<u>CAL. BLOCK</u>	<u>INSERVICE SCHEDULED</u>		<u>NOTES</u>
		<u>XI EXAM.</u>	<u>EXAM. MTH.</u>			<u>REQ.</u>	<u>OUTAGE</u>	
6RWCU(2)-3	PIPE TO VLV	AUGMT	VOL	OCI 6-13	UT-28			
6RWCU(2)-4	VLV TO PIPE	AUGMT	VOL	OCI 6-13	UT-28			
6RWCU(2)-5	PIPE TO FE	AUGMT	VOL	OCI 6-13	UT-28			
6RWCU(2)-6	FE TO PIPE	AUGMT	VOL	OCI 6-13	UT-28			
RWCU-229	PSA-3 SNUBBER	N/A	VT-3	303/8.2.17				S/N 2374
			VT-4	303/8.2.17				S/N 2374
6RWCU(2)-7	PIPE TO TEE	AUGMT	VOL	OCI 6-13	UT-28			
4RWCU(2)-8	RED TEE TO FLG	AUGMT	SUR	OCI 3-3				UT NOT POSSIBLE.
6RWCU(2)-9	TEE TO VLV	AUGMT	VOL	OCI 6-13	UT-28			FITTING TO FITTING
RWCU-PB-303	RWCU PRES BNDRY	N/A	VT-2	N/A				SEE NOTES #6 & #7.

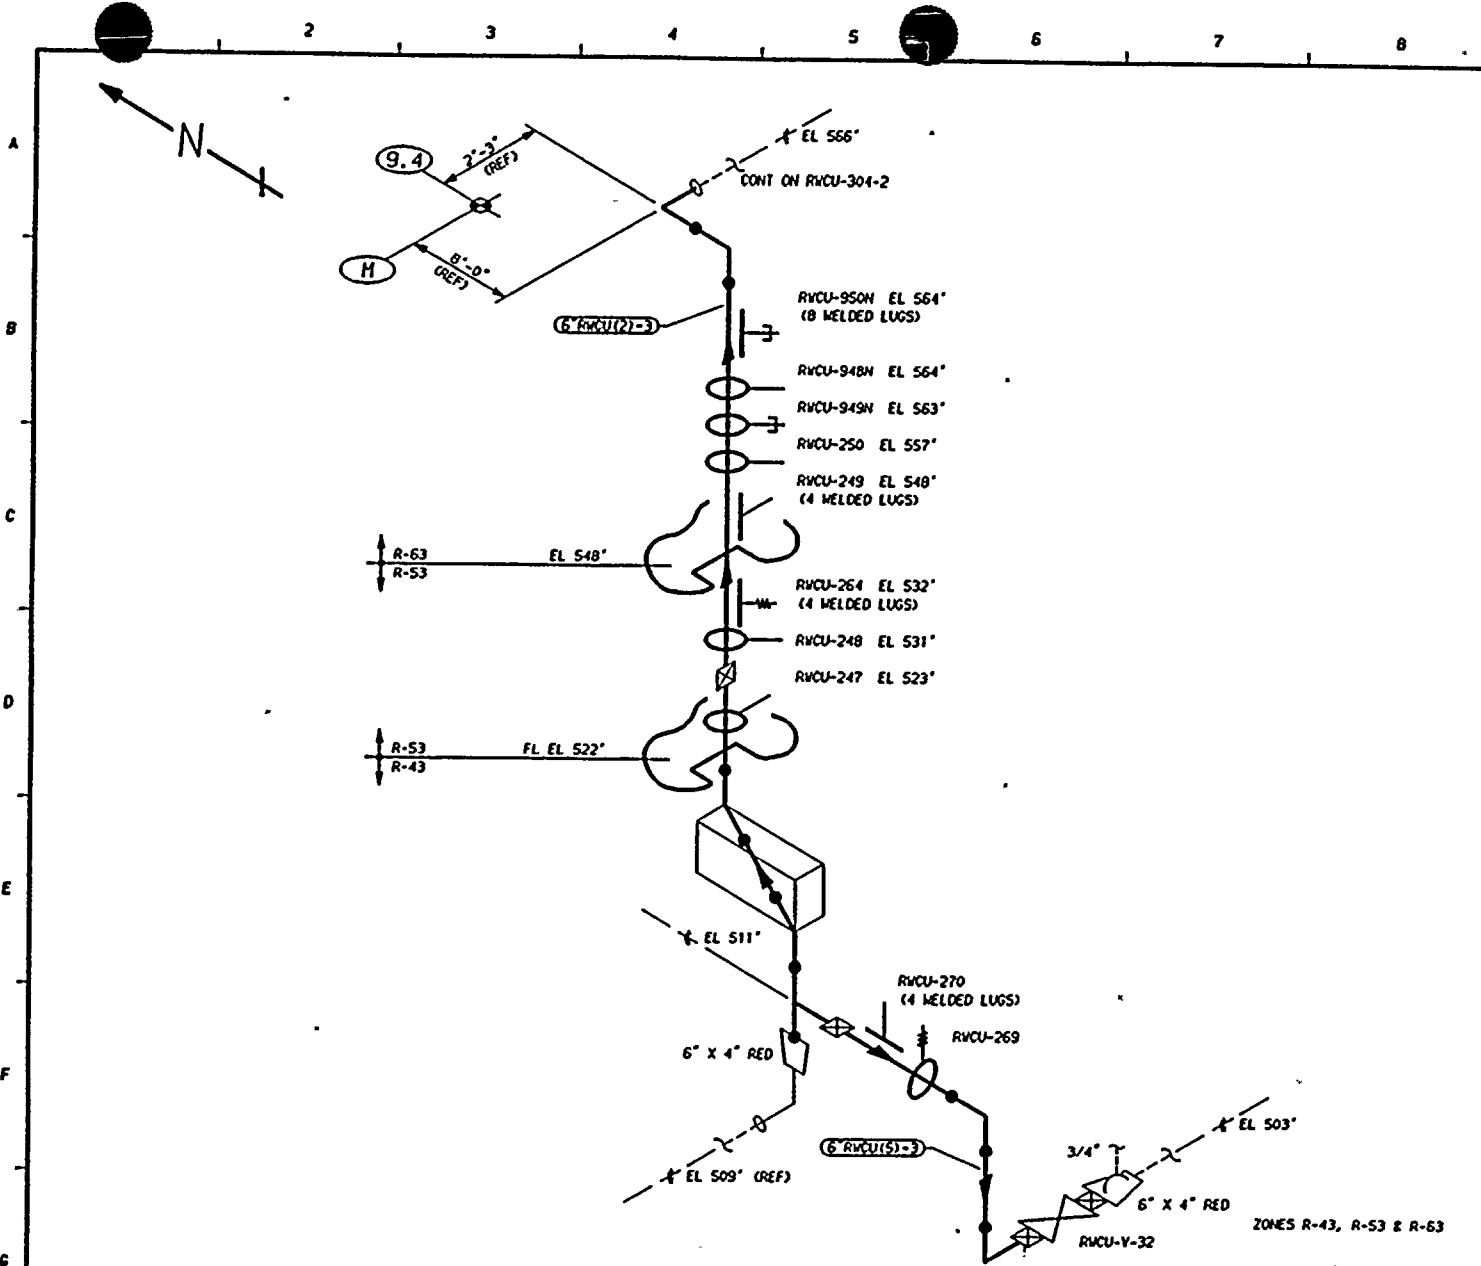

- NOTES:**
1. THIS DRAWING IDENTIFIES PIPING AND COMPONENTS SUBJECT ONLY TO A VISUAL EXAM FOR (1) EVIDENCE OF LEAKAGE DURING SYSTEM PRESSURE OR OPERABILITY TESTS; (2) PRESSURE DECAY TESTS OF BURIED PIPING; AND (3) LOSS OF SUPPORT CAPABILITY OR INADEQUATE RESTRAINT FOR SUPPORTS AND HANGERS ON PIPING EXCEEDING 4" NOM. TESTS SHALL BE CONDUCTED PER ASME SECTION XI, ARTICLES IMA-5000 AND IWD-2000.
 2. FOR BRANCH PIPING 4" NOM. OR LESS (CONNECTION SHOWN IN DASHED LINES) EXTEND VISUAL LEAKAGE EXAM THROUGH THE OUTERMOST NORMALLY CLOSED NUCLEAR CLASS VALVE, OR UNTIL TRANSITION TO INSTRUMENT TUBING, UNLESS OTHERWISE NOTED.

- REFERENCES:**
- ISI - 229
 - BOYEE & CRAIL ISOMETRICS
 - RVCU-699- 1.4 REV 6
 - RVCU-278-22.24 REV 6

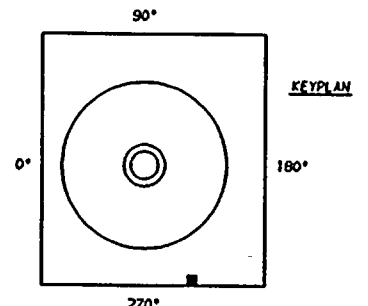

QUALITY CLASS: 2	ASME CODE CLASS: 3
ENGR: K-McANDREW	DATE: 6-28-79

WASHINGTON PUBLIC POWER
SUPPLY SYSTEM
RICHLAND, WASHINGTON 99352

WNP-2
WELD & COMPONENT
IDENTIFICATION DIAGRAM


TITLE:	RVCU DISCHARGE FROM RVCU-DH-1A & 1B
DWG NO. RVCU-304-1	REV 1

THIS DRAWING IS INTENDED FOR USE IN PRESERVICE AND INSERVICE INSPECTIONS PROGRAMS ONLY.

PIPING SYSTEM	NOM DIA (IN)	SCH	NOM WALL THK	MATERIAL SPECIFICATION	MATL TYPE	CAL BLOCK NO
6" RVCU(5)-3	6	80	0.432	SA 106 GR B	CS	NA
6" RVCU(2)-3	6	80	0.432	SA 106 GR B	CS	NA

NO	DATE	REVISION	BY	CHKD	APVD
1	12-2-81	GENERAL UPDATE REDRAWN	KMcA	DPR	TFH
0	12-2-81	ISSUED FOR USE	KMcA	DPR	TFH



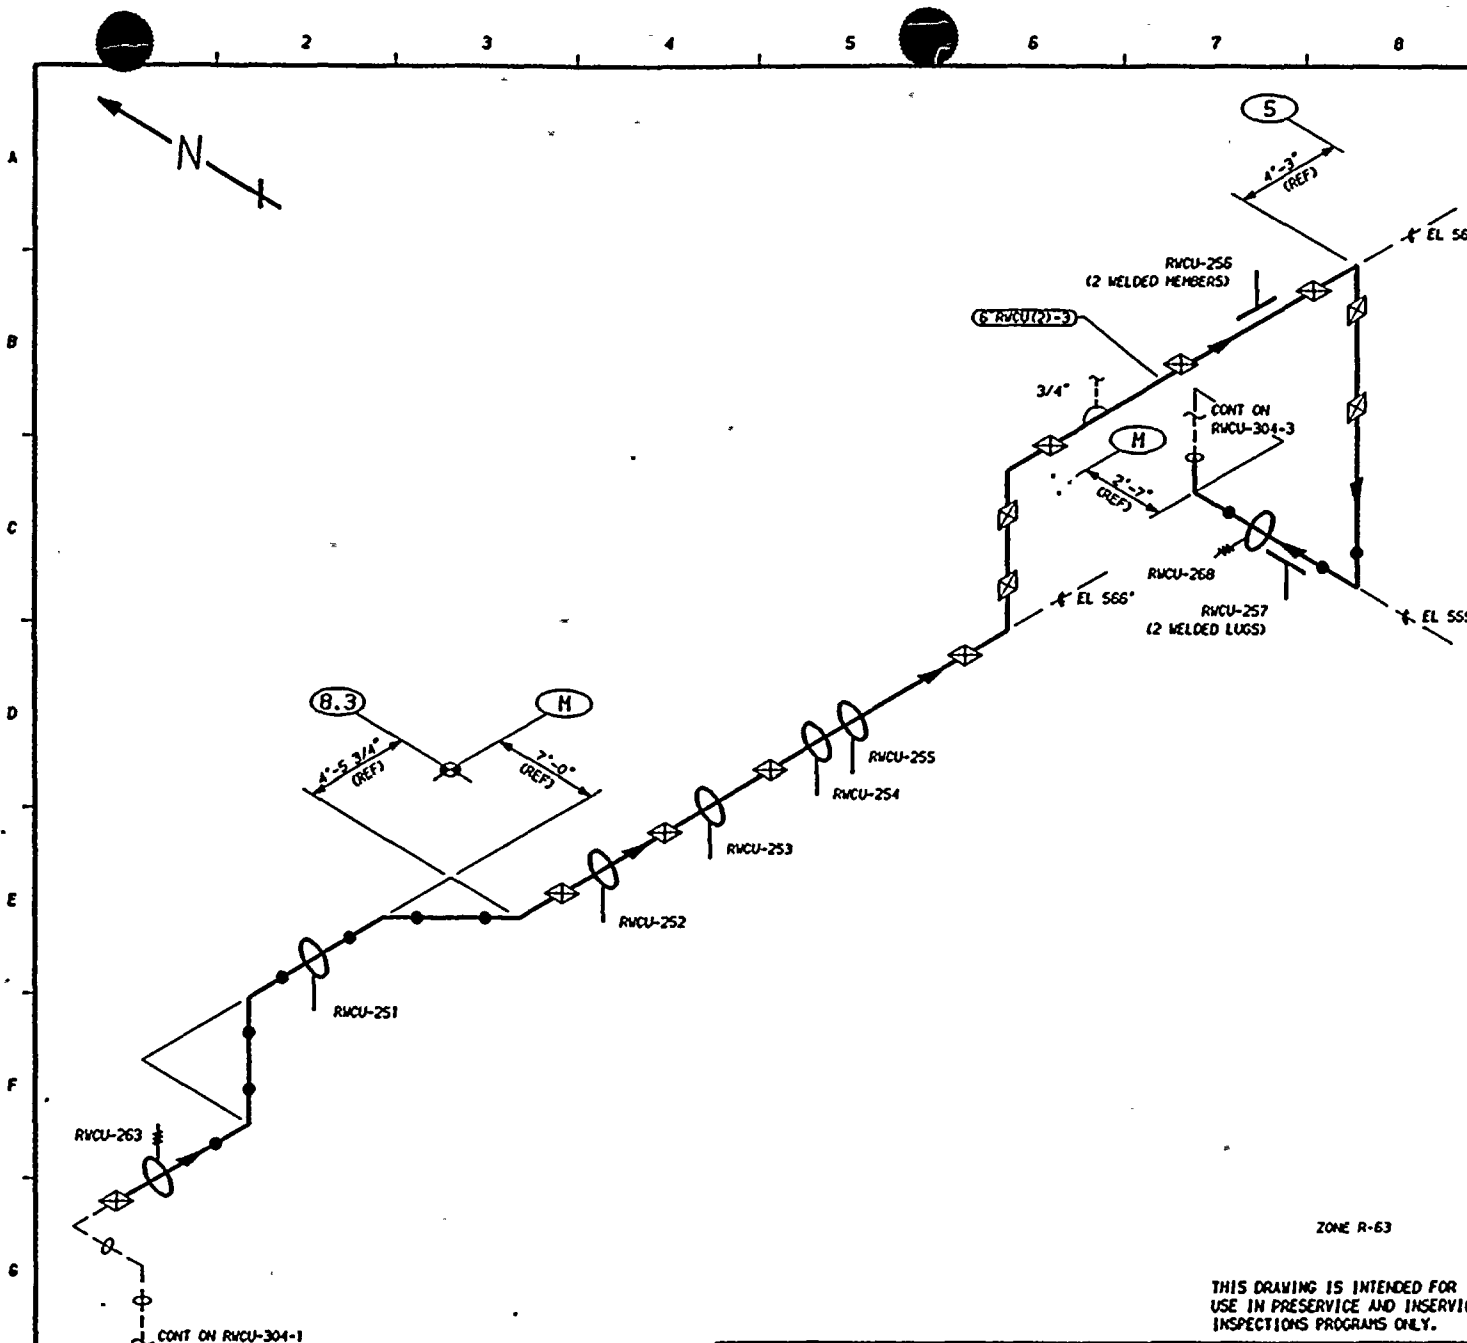


NOTES:

1. THIS DRAWING IDENTIFIES PIPING AND COMPONENTS SUBJECT ONLY TO A VISUAL EXAM FOR (1) EVIDENCE OF LEAKAGE DURING SYSTEM PRESSURE OR OPERABILITY TESTS; (2) PRESSURE DECAY TESTS OF BURIED PIPING; AND (3) LOSS OF SUPPORT CAPABILITY OR INADEQUATE RESTRAINT FOR SUPPORTS AND HANGERS ON PIPING EXCEEDING 4" NOM. TESTS SHALL BE CONDUCTED PER ASME SECTION XI, ARTICLES 1WA-5000 AND 1WD-2000.
2. FOR BRANCH PIPING 4" NOM. OR LESS (CONNECTION SHOWN IN DASHED LINES) EXTEND VISUAL LEAKAGE EXAM THROUGH THE OUTERMOST NORMALLY CLOSED NUCLEAR CLASS VALVE, OR UNTIL TRANSITION TO INSTRUMENT TUBING, UNLESS OTHERWISE NOTED.

REFERENCES:

- 151 - 229
 BOYCE & CRAIL ISOMETRICS
 RVCU-278-25.29 REV 6
 RVCU-278-30.35 REV 6

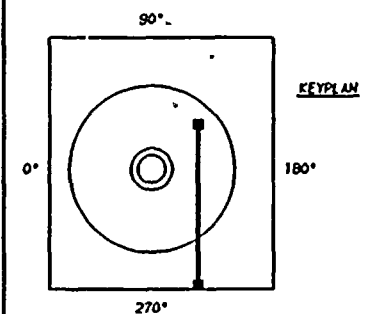

QUALITY CLASS, 2	ASME CODE CLASS, 3
ENGR, K-McANDREW	DRAWN, K-McA DATE, 6-28-79

WASHINGTON PUBLIC POWER
 SUPPLY SYSTEM
 RICHLAND, WASHINGTON 99352

WNP-2
 WELD & COMPONENT
 IDENTIFICATION DIAGRAM


TITLE:	RVCU-DH-1A & B TO RVCU-HX-1C
DWG NO, RVCU-304-2	REV 1

PIPING SYSTEM	NOM DIA (110)	SCH	NOM WALL THK	MATERIAL SPECIFICATION	MATL TYPE	CAL BLOCK NO
6"RVCU(2)-3	6	80	0.432	SA 106 GR B	CS	NA

1	1-26-80	GENERAL UPDATE REDRAWN		DKK	TFH
0	12-2-81	ISSUED FOR USE	K-McA	DPR	TFH
NO	DATE	REVISION	BY	CHKD	APVD


THIS DRAWING IS INTENDED FOR USE IN PRESERVICE AND INSERVICE INSPECTIONS PROGRAMS ONLY.

ZONE R-63

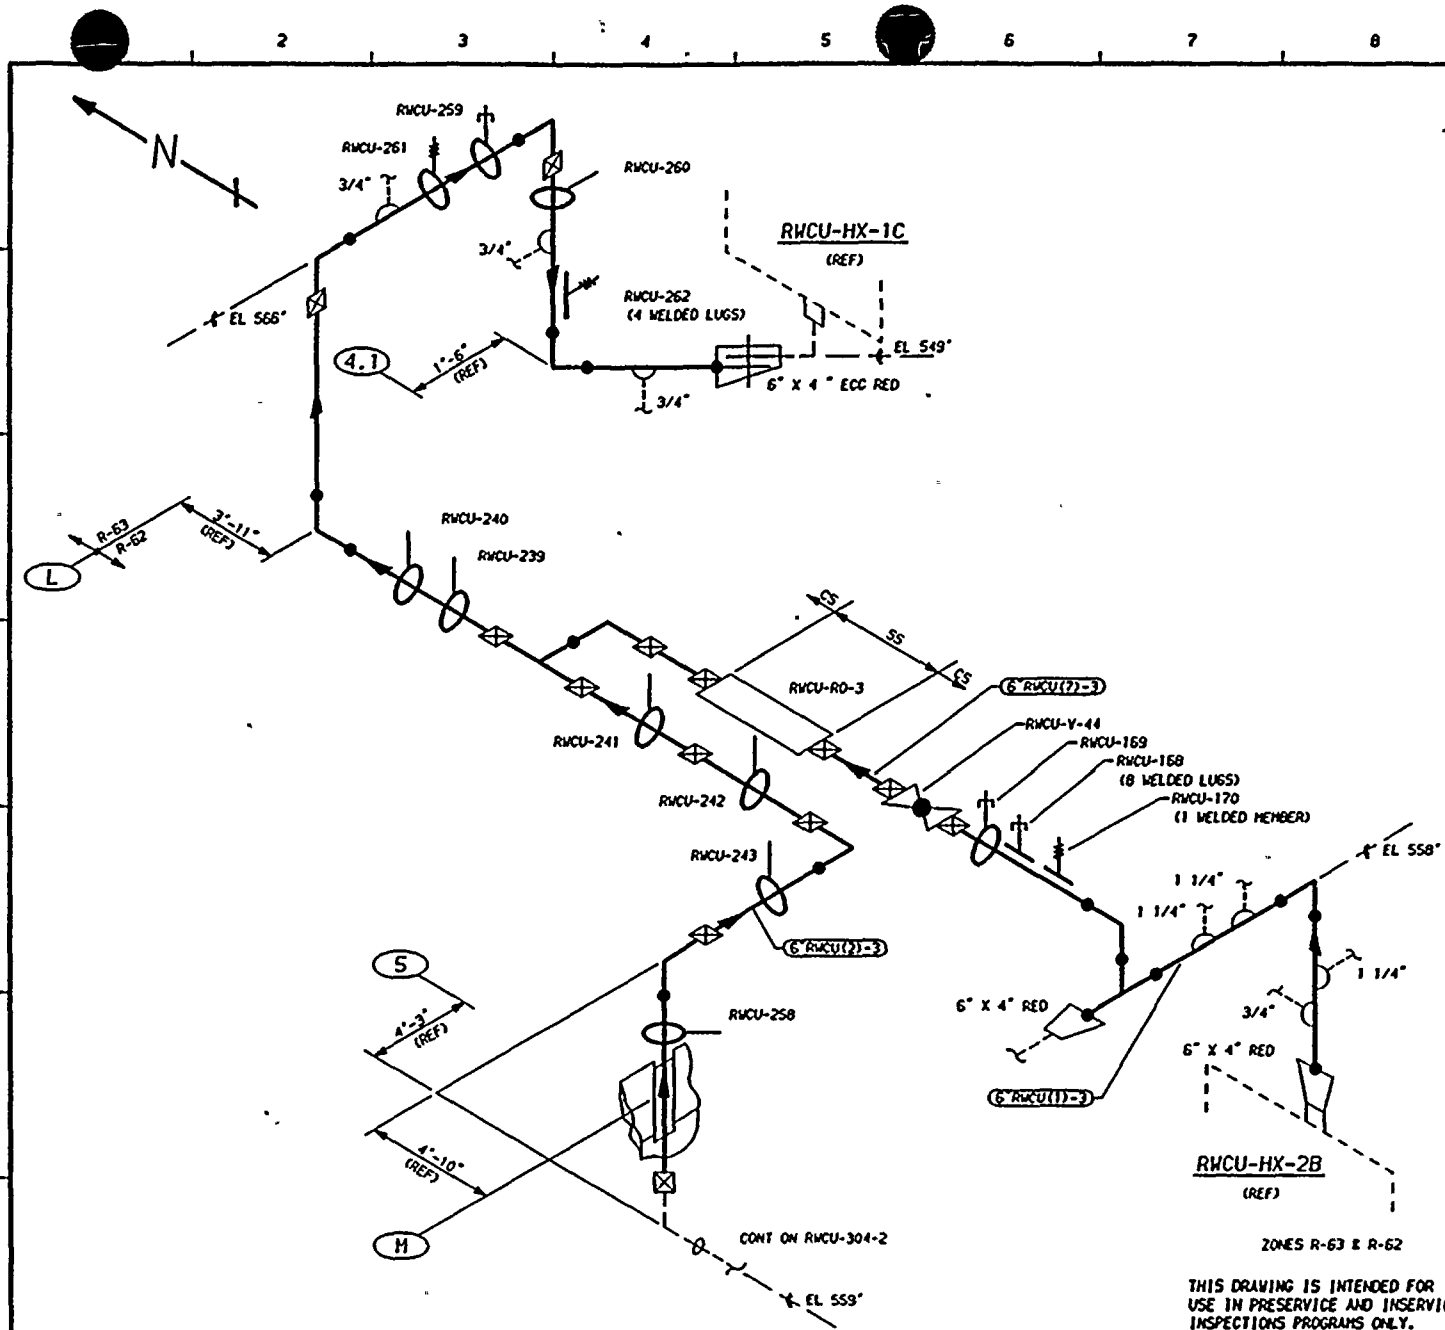

- NOTES:**
- THIS DRAWING IDENTIFIES PIPING AND COMPONENTS SUBJECT ONLY TO A VISUAL EXAM FOR (1) EVIDENCE OF LEAKAGE DURING SYSTEM PRESSURE OR OPERABILITY TESTS, (2) PRESSURE DECAY TESTS OF BURIED PIPING, AND (3) LOSS OF SUPPORT CAPABILITY OR INADEQUATE RESTRAINT FOR SUPPORTS AND HANGERS ON PIPING EXCEEDING 4" NOM. TESTS SHALL BE CONDUCTED PER ASME SECTION XI, ARTICLES 1WA-5000 AND 1WD-2000.
 - FOR BRANCH PIPING 4" NOM. OR LESS (CONNECTION SHOWN IN DASHED LINES) EXTEND VISUAL LEAKAGE EXAM THROUGH THE OUTERMOST NORMALLY CLOSED NUCLEAR CLASS VALVE, OR UNTIL TRANSITION TO INSTRUMENT TUBING, UNLESS OTHERWISE NOTED.

- REFERENCES:**
- 151 - 229
 - BOYCE & CRAIL ISOMETRICS
 - RVCU-278-30.35 REV 6
 - RVCU-278- 1.3 REV 5

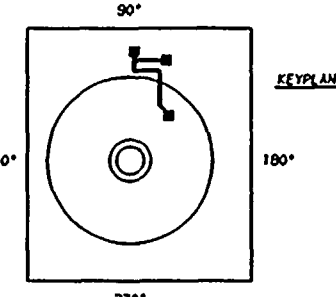

QUALITY CLASS: 2 | ASME CODE CLASS: 3
 ENGR: K-McANDREW | DRAWN: K-McA | DATE: 7-2-79

WASHINGTON PUBLIC POWER
 SUPPLY SYSTEM
 RICHLAND, WASHINGTON 99352

PIPING SYSTEM	NOM DIA (1NO)	SCH	NOM WALL THK	MATERIAL SPECIFICATION	MATL TYPE	CAL BLOCK NO
6" RVCU(2)-3	6	80	0.432	SA 106 GR B	CS	NA
6" RVCU(7)-3	6	80	0.432	SA 106 GR B	CS	NA
6" RVCU(1)-3	6	80	0.432	SA 106 GR B	CS	NA

THIS DRAWING IS INTENDED FOR USE IN PRESERVICE AND INSERVICE INSPECTIONS PROGRAMS ONLY.

NO	DATE	REVISION	BY	CHKD	APYD
1	1-87-86	GENERAL UPDATE REDRAWN	K-McA	DPR	TFH
0	12-2-81	ISSUED FOR USE	K-McA	DPR	TFH

WNP-2
 WELD & COMPONENT
 IDENTIFICATION DIAGRAM

TITLE: RVCU-DH-1A & B AND RVCU-HX-2B TO RVCU-HX-1C

DWG NO. RVCU-304-3 | REV 1





WNP-02
 INTERVAL: PSI
 PERIOD: NA
 OUTAGE:
 DRAWING NO. RWCU-304

WASHINGTON PUBLIC POWER SUPPLY SYSTEM
 PROGRAM PLAN AND SCHEDULE
 SYSTEM OR COMPONENT: RWCU(2)-3
 DESCRIPTION: DISCHARGE FROM DM-1A

PAGE 001
 DATE 12/14/84

<u>IDENT. NO.</u>	<u>DESCRIPTION</u>	<u>SECT.</u> <u>YI</u> <u>EXAM.</u>	<u>EXAM</u> <u>MTH.</u>	<u>PROCEDURE</u>	<u>CAL.</u> <u>BLOCK</u>	<u>INSERVICE</u>		<u>NOTES</u>
						<u>REQ.</u>	<u>SCHEDULED</u> <u>OUTAGE</u>	
RWCU-168	PSA-1/4 SN(2)	N/A	VT-3	303/8.2.17				S/N
			VT-4	303/8.2.17				S/N
RWCU-169	PSA-1/2 SNUBBER	N/A	VT-3	303/8.2.17				S/N
			VT-4	303/8.2.17				S/N
RWCU-259	PSA-1/2 SNUBBER	N/A	VT-3	303/8.2.17				S/N
			VT-4	303/8.2.17				S/N
RWCU-PB-304	RWCU PRES BNDRY	N/A	VT-2	N/A				SEE NOTES #6 & #7.



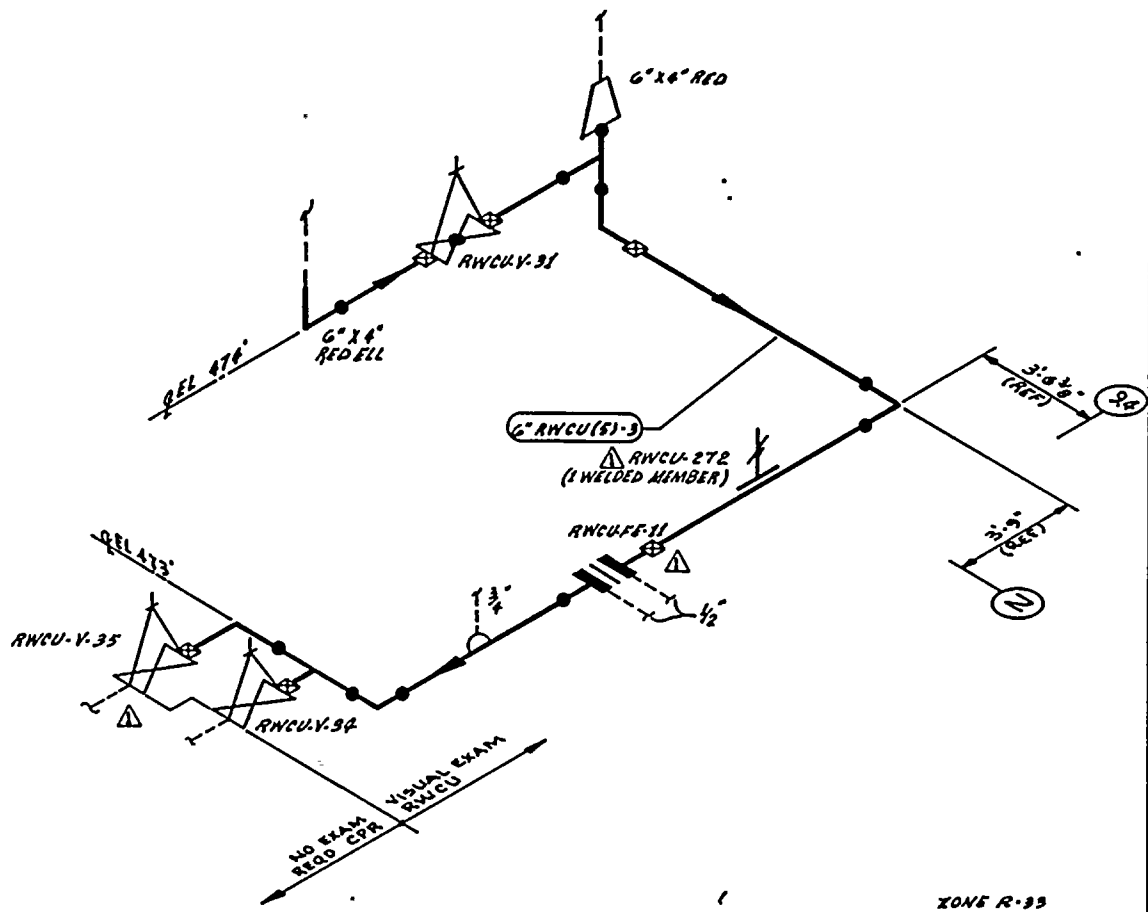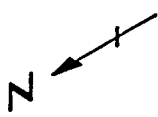


ZONE R-33

THIS DRAWING IS INTENDED FOR USE IN PRESERVICE AND INSERVICE INSPECTION PROGRAMS ONLY.

- NOTES:**
1. THIS DRAWING IDENTIFIES PIPING & COMPONENTS SUBJECT ONLY TO A VISUAL EXAM FOR (1) EVIDENCE OF LEAKAGE DURING SYSTEM PRESSURE OR OPERABILITY TESTS; (2) PRESSURE DECAY TESTS OF BURIED PIPING; & (3) LOSS OF SUPPORT CAPABILITY OR INADEQUATE RESTRAINT FOR SUPPORTS & HANGERS ON PIPING EXCEEDING 4" NOM. TESTS SHALL BE CONDUCTED PER ASME SECTION XI, ARTICLES IWA-5000 & IWD-2000.
 2. FOR BRANCH PIPING 4" NOM OR LESS (CONN SHOWN IN DASHED LINES) EXTEND VISUAL LEAKAGE EXAM THROUGH THE OUTERMOST NORMALLY CLOSED NUCLEAR CLASS VALVE, OR UNTIL TRANSITION TO INSTRUMENT TUBING, UNLESS OTHERWISE NOTED.

- REFERENCES:**
- BOVES & CRAL ISOMETRICS
 - RWCU-699-5.7 REV B

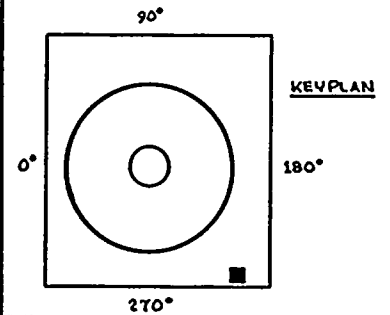

QUALITY CLASS: 2	ASME CODE CLASS: 3
ENGR: J. McARDLEW	DRAWN: J. McARDLEW
DATE: 7-8-79	

WASHINGTON PUBLIC POWER SUPPLY SYSTEM
 RICHLAND, WASHINGTON 99352

PIPING SYSTEM	NOM DIA (IN)	SCH	NOM WALL THK	MATERIAL SPECIFICATION	MATL TYPE	CAL BLOCK NO
6" RWCU(5)-3	6	80	0.432	SA 106 GR B	CS	NA

WNP-2
 WELD COMPONENT
 IDENTIFICATION DIAGRAM

TITLE:
RWCU DISCHARGE TO RADWASTE

DWG NO: RWCU-305 REV 1

NO	DATE	REVISION	BY	CHKD	APPVD
1	1/1/82	REVISED AS NOTED ADDED KEYPLAN	AGL	WFS	TFW
0	1/1/81	ISSUED FOR USE	WFA	WFS	TFW



WNP-02
INTERVAL: PSI
PERIOD: NA
OUTAGE:
DRAWING NO. RWCU-305

WASHINGTON PUBLIC POWER SUPPLY SYSTEM
PROGRAM PLAN AND SCHEDULE
SYSTEM OR COMPONENT: RWCU(5)-3
DESCRIPTION: DISCHARGE - RADWASTE

PAGE 001
DATE 12/14/84

<u>IDENT. NO.</u>	<u>DESCRIPTION</u>	<u>SECT.</u> <u>XI</u>	<u>EXAM</u> <u>EXAM.</u>	<u>EXAM</u> <u>MTH.</u>	<u>PROCEDURE</u>	<u>CAL.</u> <u>BLOCK</u>	<u>INSERVICE</u> <u>SCHEDULED</u> <u>REQ.</u>	<u>OUTAGE</u>	<u>NOTES</u>
RWCU-PB-305	RWCU PRES BNDRY	N/A		VT-2	N/A				SEE NOTES #6 & #7.



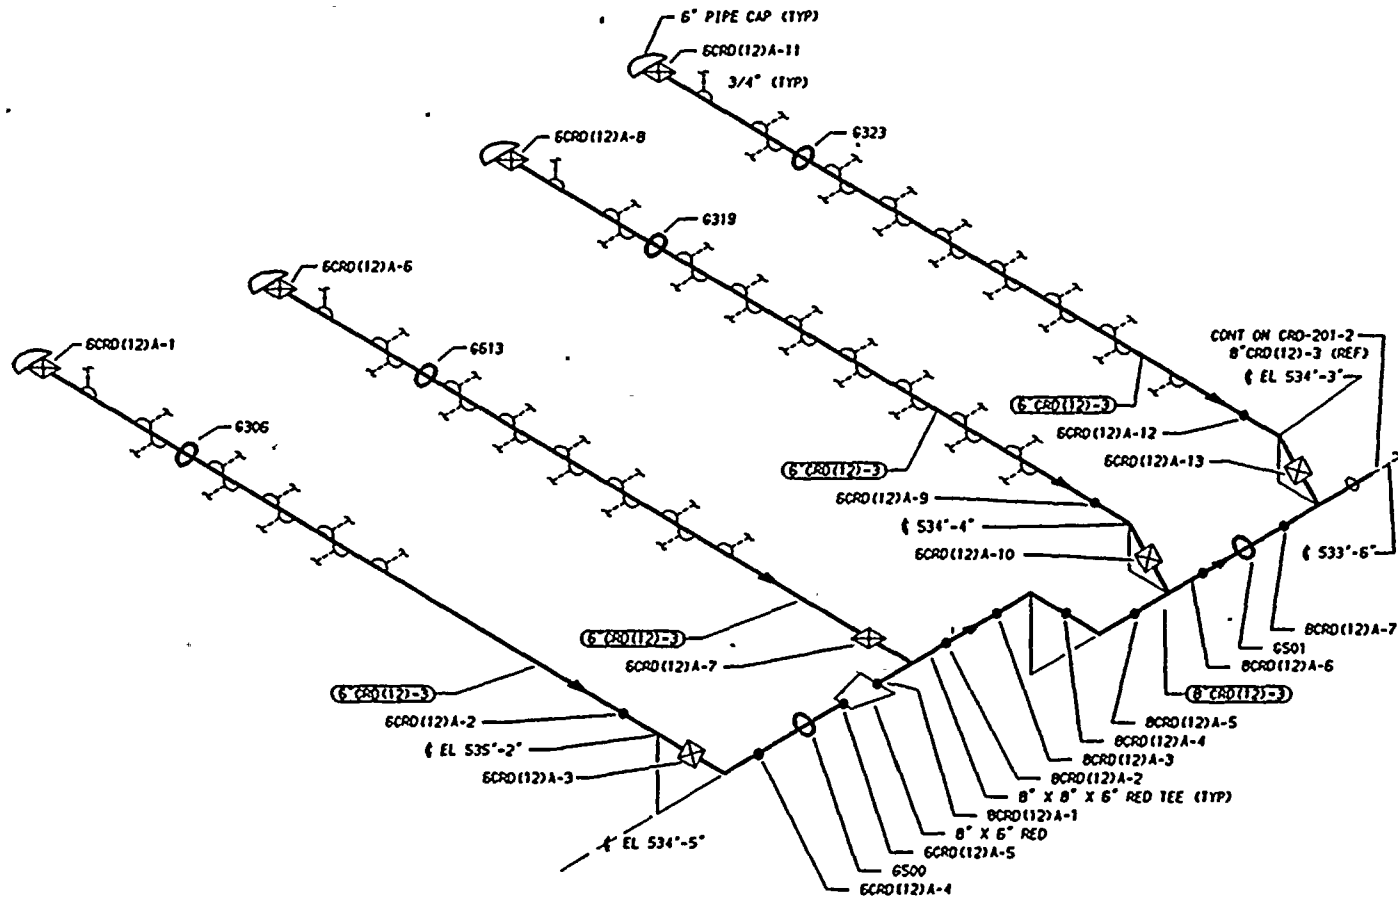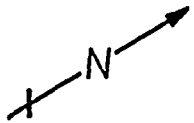

NOTES:

1. THIS DRAWING IDENTIFIES PIPING AND COMPONENTS SUBJECT TO A VISUAL EXAM FOR EVIDENCE OF LEAKAGE DURING SYSTEM HYDRO OR OPERABILITY TESTS. TESTS ARE TO BE CONDUCTED PER THE REQUIREMENTS OF ASME SECTION XI, PARAGRAPH IWA-5000.
2. FOR BRANCH PIPING 4" NOM. OR LESS (CONNECTION SHOWN IN DASHED LINES) EXTEND VISUAL LEAKAGE EXAM THROUGH THE OUTERMOST NORMALLY CLOSED NUCLEAR CLASS VALVE, OR UNTIL TRANSITION TO INSTRUMENT TUBING, UNLESS OTHERWISE NOTED.

REFERENCES:

- 151 - 228
 GENERAL ELECTRIC DWGS
 SK-X01-75C-02 SH 22 REV 0
 SK-X01-75C-02 SH 29 REV 0
 SK-X01-75C-02 SH 30 REV 0
 SK-X01-75C-02 SH 31 REV 0
 SK-X01-75C-02 SH 32 REV 0

QUALITY CLASS: 1	ASME CODE CLASS: 2
ENGR: K-McANDREW	DRAWN: K-McA DATE: 12-23-62

WASHINGTON PUBLIC POWER
 SUPPLY SYSTEM
 RICHLAND, WASHINGTON 99352

THIS DRAWING IS INTENDED FOR
 USE IN PRESERVICE AND INSERVICE
 INSPECTIONS PROGRAMS ONLY.


PIPING SYSTEM	NOM DIA (IN)	SCH	NOM WALL THK	MATERIAL SPECIFICATION	MATL TYPE	CAL BLOCK NO
8"CRD(12)-3	8	80	0.500	SA 106 GR B	CS	XXXX
6"CRD(12)-3	6	80	0.432	SA 106 GR B	CS	XXXX

WNP-2
 WELD & COMPONENT
 IDENTIFICATION DRAWING

TITLE:
 CONTROL ROD DRIVE SYSTEM
 SCRAM DISCHARGE HEADER A

0	1/2/63	ISSUED FOR USE			
NO	DATE	REVISION	BY	CHKD	APVD

DWG NO. CRD-201-1 REV 0

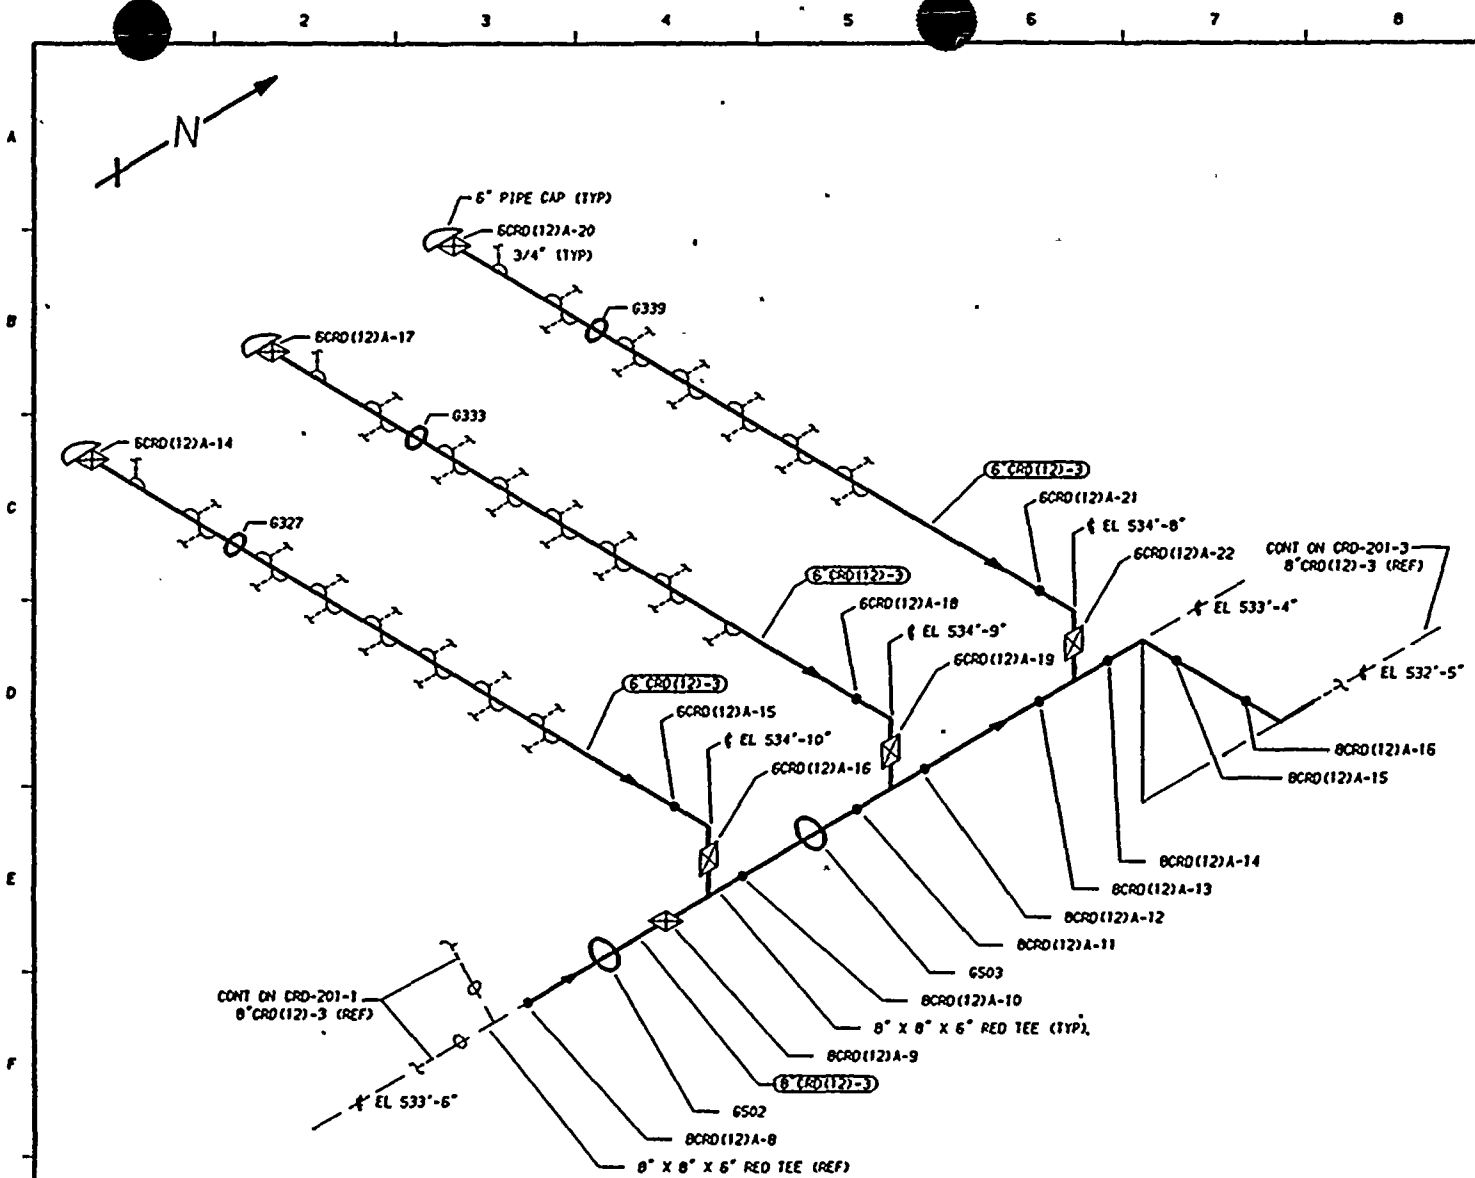

- NOTES:**
1. THIS DRAWING IDENTIFIES PIPING AND COMPONENTS SUBJECT TO A VISUAL EXAM FOR EVIDENCE OF LEAKAGE DURING SYSTEM HYDRO OR OPERABILITY TESTS. TESTS ARE TO BE CONDUCTED PER THE REQUIREMENTS OF ASME SECTION XI, PARAGRAPH IWA-5000.
 2. FOR BRANCH PIPING 4" NOM. OR LESS (CONNECTION SHOWN IN DASHED LINES) EXTEND VISUAL LEAKAGE EXAM THROUGH THE OUTERMOST NORMALLY CLOSED NUCLEAR CLASS VALVE, OR UNTIL TRANSITION TO INSTRUMENT TUBING, UNLESS OTHERWISE NOTED.

- REFERENCES:**
- 151 - 220
 - GENERAL ELECTRIC DWGS
 - SK-X01-75C-02 SH 22 REV 0
 - SK-X01-75C-02 SH 23 REV 0
 - SK-X01-75C-02 SH 33 REV 0
 - SK-X01-75C-02 SH 34 REV 0
 - SK-X01-75C-02 SH 35 REV 0

QUALITY CLASS: 1 ASME CODE CLASS: 2
 ENGR, K-McANDREW | DRAWN, K-McA | DATE, 12-29-82

WASHINGTON PUBLIC POWER
 SUPPLY SYSTEM
 RICHLAND, WASHINGTON 99352

WNP-2
 WELD & COMPONENT
 IDENTIFICATION DRAWING


TITLE:
 CONTROL ROD DRIVE SYSTEM
 SCRAM DISCHARGE HEADER A

THIS DRAWING IS INTENDED FOR
 USE IN PRESERVICE AND INSERVICE
 INSPECTIONS PROGRAMS ONLY.

PIPING SYSTEM	NOM DIA (INO)	SCH	NOM WALL THK	MATERIAL SPECIFICATION	MATL TYPE	CAL BLOCK NO
8" CRD(12)-3	8	80	0.500	SA 106 GR B	CS	XXXX
6" CRD(12)-3	6	80	0.432	SA 106 GR B	CS	XXXX

NO	DATE	REVISION	BY	CHKD	APYD
0	1-27-83	ISSUED FOR USE	KMcA	TK	TK

DWG NO, CRD-201-2 REV 0

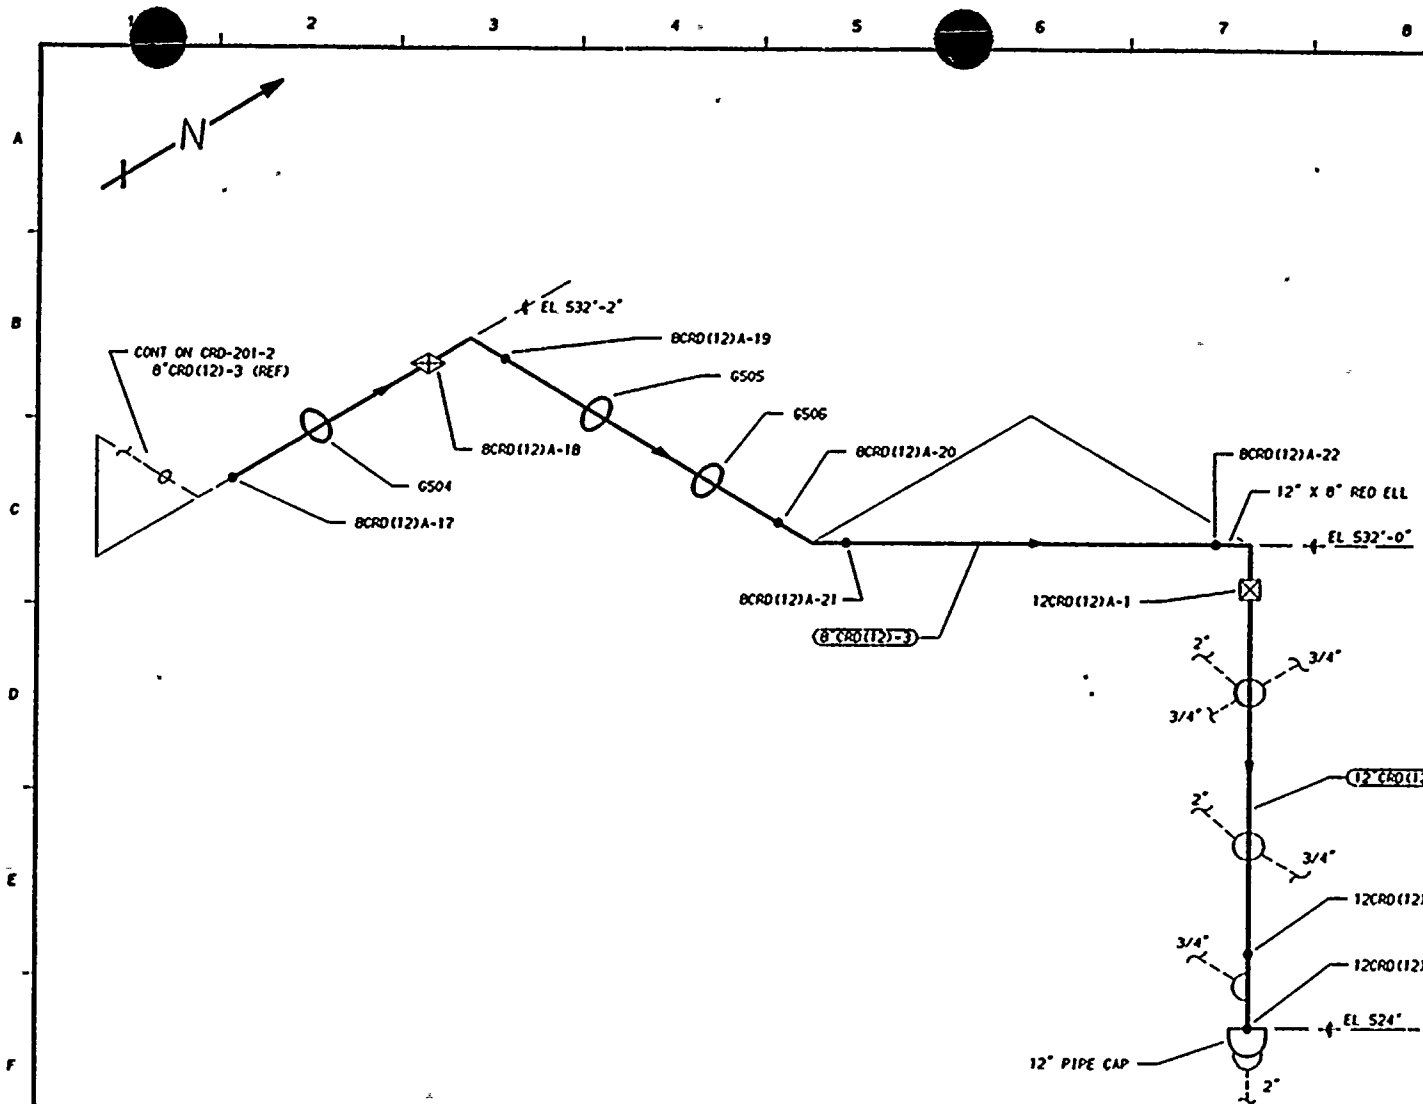

NOTES:

1. THIS DRAWING IDENTIFIES PIPING AND COMPONENTS SUBJECT TO A VISUAL EXAM FOR EVIDENCE OF LEAKAGE DURING SYSTEM HYDRO OR OPERABILITY TESTS. TESTS ARE TO BE CONDUCTED PER THE REQUIREMENTS OF ASME SECTION XI, PARAGRAPH IWA-5000.
2. FOR BRANCH PIPING 4" NOM. OR LESS (CONNECTION SHOWN IN DASHED LINES) EXTEND VISUAL LEAKAGE EXAM THROUGH THE OUTERMOST NORMALLY CLOSED NUCLEAR CLASS VALVE, OR UNTIL TRANSITION TO INSTRUMENT TUBING, UNLESS OTHERWISE NOTED.

REFERENCES:

- ISI - 228
- GENERAL ELECTRIC DWGS
 - SK-X01-75C-02 SH 23 REV 0
 - SK-X01-75C-02 SH 24 REV 0
- BURNS AND ROE DWGS
 - CRD-1000-1 REV 0
 - CRD-1002-1 REV 0

QUALITY CLASS:	1	ASME CODE CLASS:	2
ENGR:	K-McANDREW	DRAWN:	K-McA
DATE:	12-26-82		

WASHINGTON PUBLIC POWER
SUPPLY SYSTEM
RICHLAND, WASHINGTON 99352

WNP-2
WELD & COMPONENT
IDENTIFICATION DRAWING

TITLE:
CONTROL ROD DRIVE SYSTEM
SCRAM DISCHARGE HEADER A

DWG NO. CRD-201-3 REV 0

THIS DRAWING IS INTENDED FOR
USE IN PRESERVICE AND INSERVICE
INSPECTIONS PROGRAMS ONLY.

PIPING SYSTEM	NOM DIA (IN)	SCH	NOM WALL THK	MATERIAL SPECIFICATION	MATL TYPE	CAL BLOCK NO
8" CRD(12)-3	8	80	0.500	SA 106 CR B	(S)	NA
12" CRD(12)-3	12	80	0.689	SA 333 CR 6	(S)	1A


0	ISSUED FOR USE	BY	CHKD	APVD
NO	DATE	REVISION		

WNP-02
 INTERVAL: PSI
 PERIOD: NA
 GUTAGE:
 DRAWING NO. CRD-201

WASHINGTON PUBLIC POWER SUPPLY SYSTEM
 PROGRAM PLAN AND SCHEDULE
 SYSTEM OR COMPONENT: CRD(12)-3
 DESCRIPTION: CRD SCRAM DISCHARGE

PAGE 001
 DATE 12/14/84

IDENT. NO.	DESCRIPTION	SECT. XI EXAM.	EXAM MTH.	PROCEDURE	CAL. BLOCK	INSERVICE		NOTES
						REQ.	SCHEDULED OUTAGE	
6CRD(12)A-3	PIPE TO ELL	N/A	VOL	QCI 6-13	UT-36			SCRAM DISCHARGE VOLUME - 10% SAMPLE.
6CRD(12)A-4	ELL TO PIPE	N/A	VOL	QCI 6-13	UT-36			SCRAM DISCHARGE VOLUME - 10% SAMPLE.
6CRD(12)A-7	PIPE TO TEE	N/A	VOL	QCI 6-13	UT-36			SCRAM DISCHARGE VOLUME - 10% SAMPLE.
6CRD(12)A-12	PIPE TO ELL	N/A	VOL	QCI 6-13	UT-36			SCRAM DISCHARGE VOLUME - 10% SAMPLE.
6CRD(12)A-18	PIPE TO ELL	N/A	VOL	QCI 6-13	UT-36			SCRAM DISCHARGE VOLUME - 10% SAMPLE.
8CRD(12)A-3	ELL TO ELL	N/A	VOL	QCI 6-13	UT-35			SCRAM DISCHARGE VOLUME - 10% SAMPLE.
8CRD(12)A-13	PIPE TO TEE	N/A	VOL	QCI 6-13	UT-35			SCRAM DISCHARGE VOLUME - 10% SAMPLE.
8CRD(12)A-15	ELL TO PIPE	N/A	VOL	QCI 6-13	UT-35			SCRAM DISCHARGE VOLUME - 10% SAMPLE.
8CRD(12)A-19	ELL TO PIPE	N/A	VOL	QCI 6-13	UT-35			SCRAM DISCHARGE VOLUME - 10% SAMPLE.
12CRD(12)A-3	PIPE TO CAP	N/A	VOL	QCI 6-13	UT-34			SCRAM DISCHARGE VOLUME - 10% SAMPLE.
CRD-PB-201	CRD PRES BNDRY	N/A	VT-2	N/A				SEE NOTES #6 & #7.

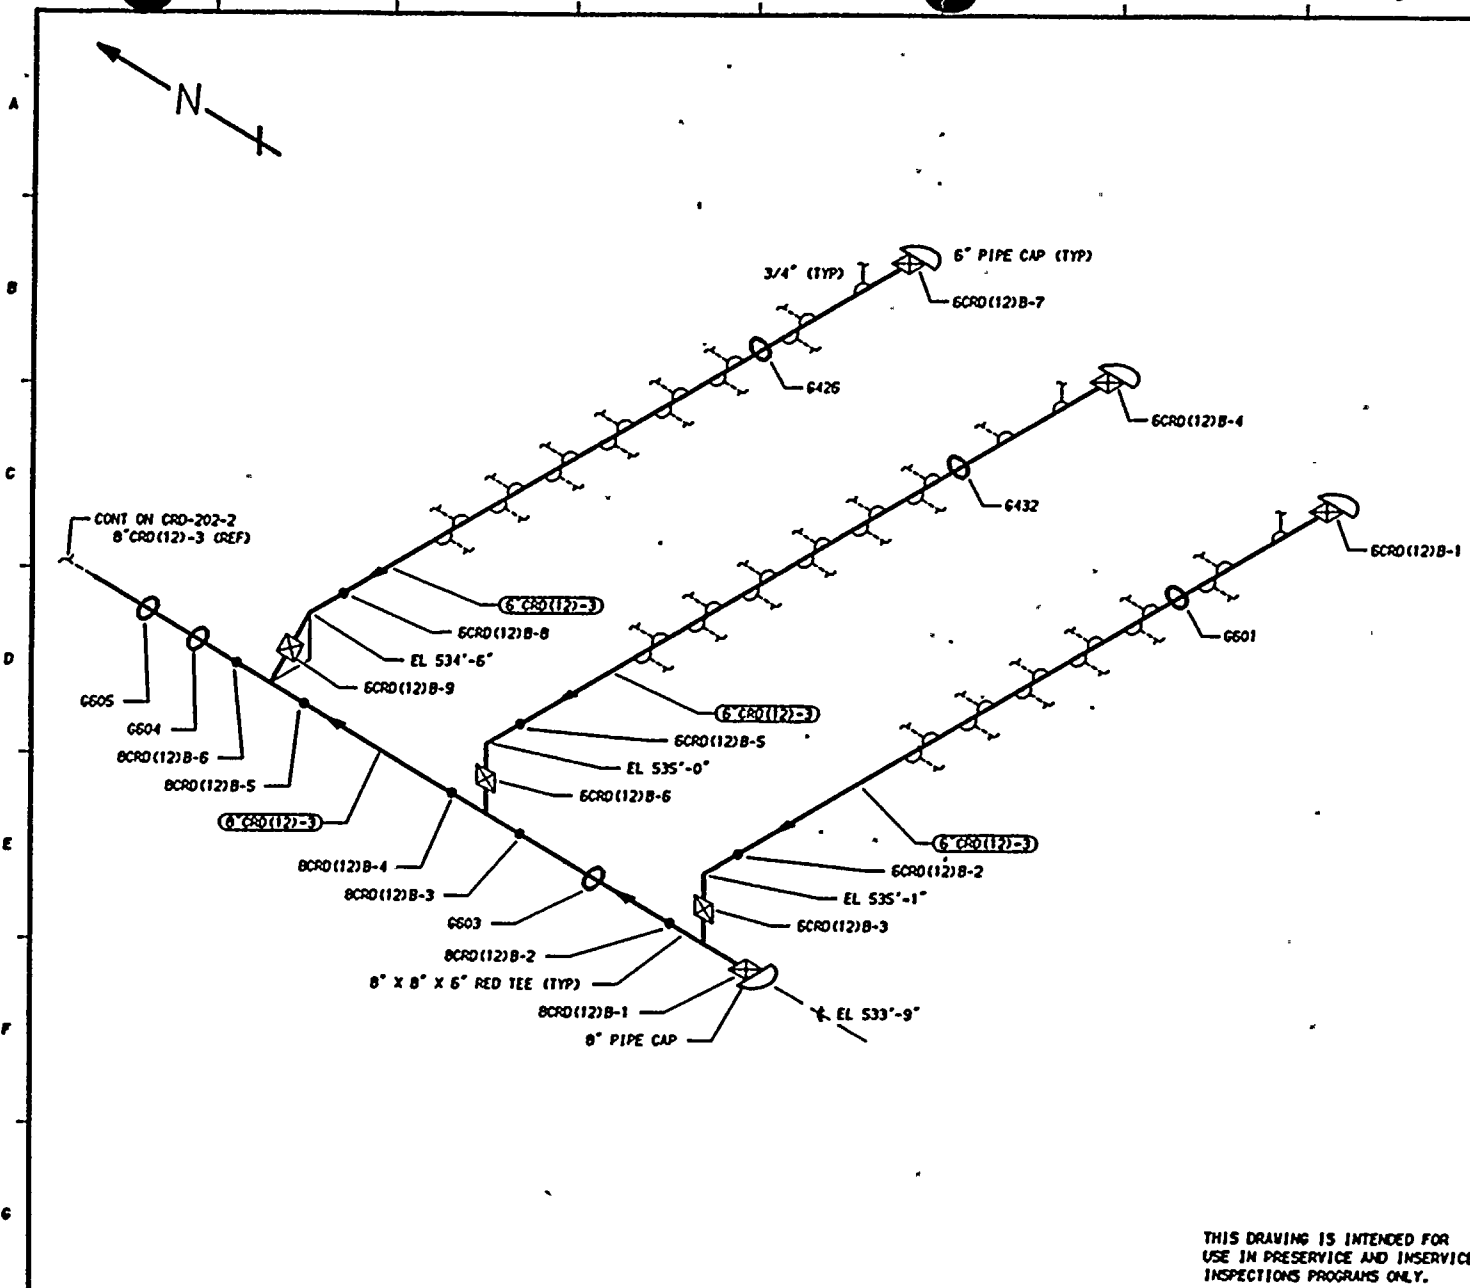

- NOTES:**
1. THIS DRAWING IDENTIFIES PIPING AND COMPONENTS SUBJECT TO A VISUAL EXAM FOR EVIDENCE OF LEAKAGE DURING SYSTEM HYDRO OR OPERABILITY TESTS. TESTS ARE TO BE CONDUCTED PER THE REQUIREMENTS OF ASME SECTION XI, PARAGRAPH IWA-5000.
 2. FOR BRANCH PIPING 4" NOM. OR LESS (CONNECTION SHOWN IN DASHED LINES) EXTEND VISUAL LEAKAGE EXAM THROUGH THE OUTERMOST NORMALLY CLOSED NUCLEAR CLASS VALVE, OR UNTIL TRANSITION TO INSTRUMENT TUBING, UNLESS OTHERWISE NOTED.

- REFERENCES:**
- 151 - 228
- GENERAL ELECTRIC DWGS
- SK-X01-75C-02 SH 28 REV 0
 - SK-X01-75C-02 SH 42 REV 0
 - SK-X01-75C-02 SH 41 REV 0
 - SK-X01-75C-02 SH 40 REV 0

QUALITY CLASS: 1	ASME CODE CLASS: 2
ENGR: K-McANDREW	DRAWN: K-McA DATE: 12-26-82

WASHINGTON PUBLIC POWER
 SUPPLY SYSTEM
 RICHLAND, WASHINGTON 99352


THIS DRAWING IS INTENDED FOR
 USE IN PRESERVICE AND INSERVICE
 INSPECTIONS PROGRAMS ONLY.

PIPING SYSTEM	NOM DIA (IN)	SCH	NOM WALL THK	MATERIAL SPECIFICATION	MATL TYPE	CAL BLOCK NO
8"CRD(12)-3	8	80	0.500	SA 106 GR B	CS	XXXX
6"CRD(12)-3	6	80	0.432	SA 106 GR B	CS	XXXX

WNP-2
 WELD & COMPONENT
 IDENTIFICATION DRAWING

TITLE:	CONTROL ROD DRIVE SYSTEM SCRAM DISCHARGE HEADER B
DWG NO:	CRD-202-1
REV	0

0	1/2/83	ISSUED FOR USE			
NO	DATE	REVISION	BY	CHKD	APVD

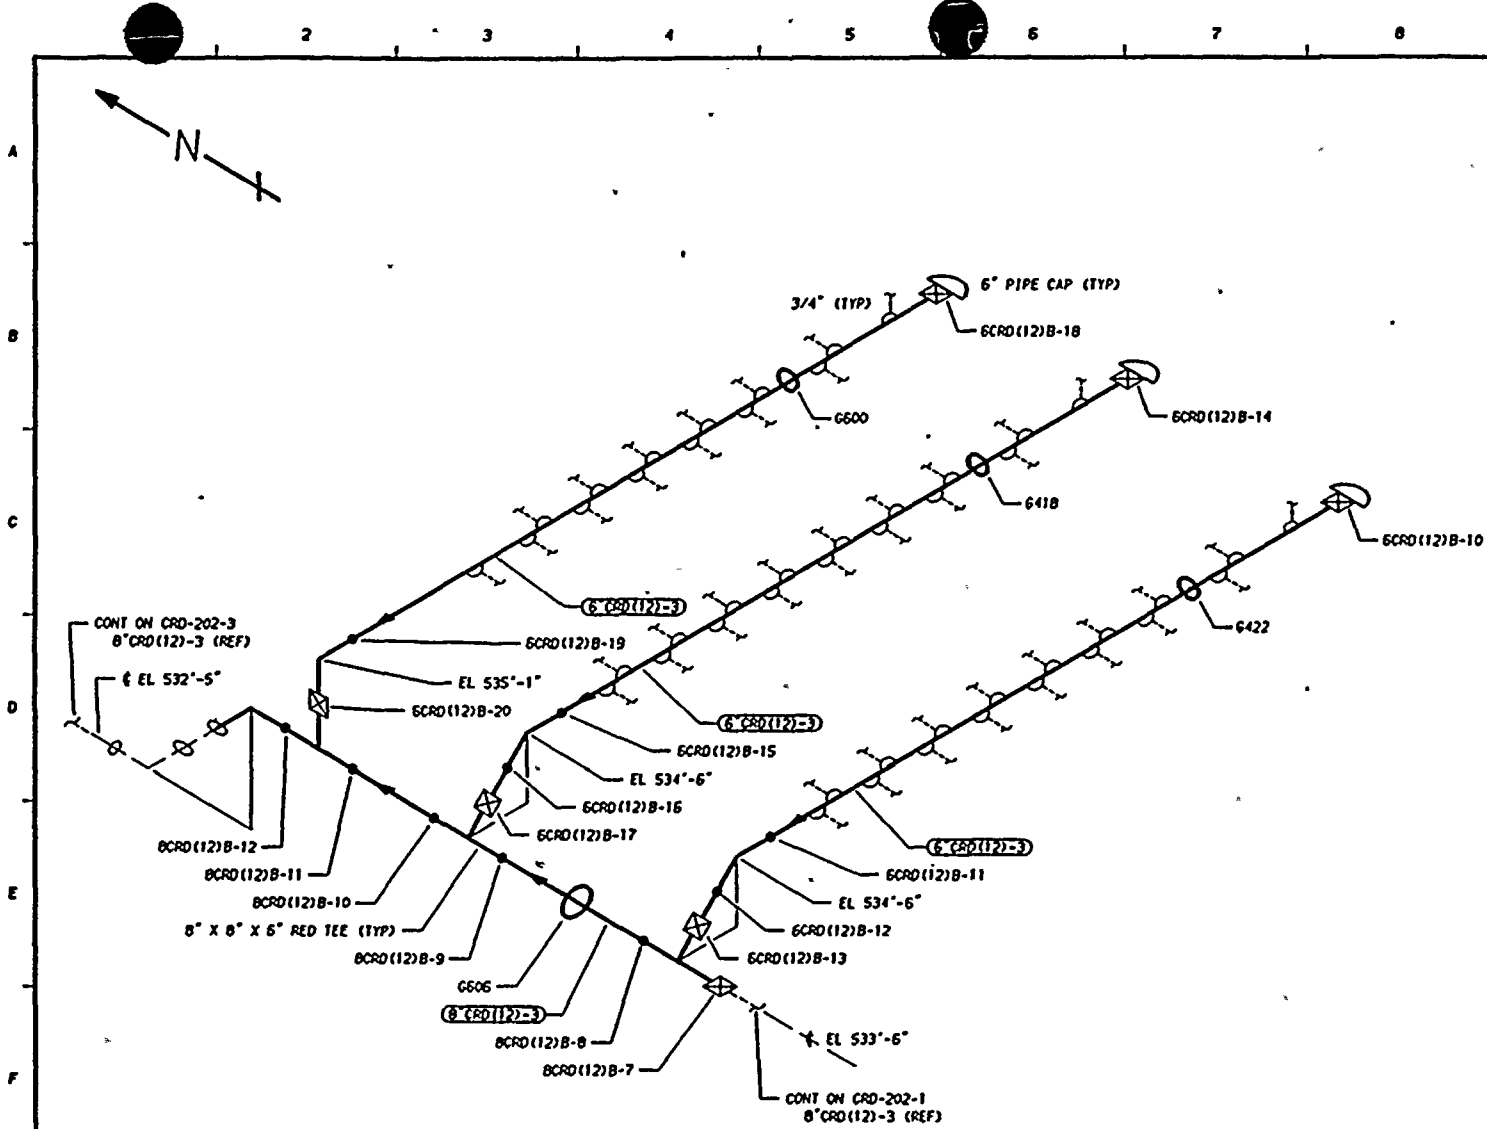

- NOTES:**
1. THIS DRAWING IDENTIFIES PIPING AND COMPONENTS SUBJECT TO A VISUAL EXAM FOR EVIDENCE OF LEAKAGE DURING SYSTEM HYDRO OR OPERABILITY TESTS. TESTS ARE TO BE CONDUCTED PER THE REQUIREMENTS OF ASME SECTION XI, PARAGRAPH 1WA-5000.
 2. FOR BRANCH PIPING 4" NOM. OR LESS (CONNECTION SHOWN IN DASHED LINES) EXTEND VISUAL LEAKAGE EXAM THROUGH THE OUTERMOST NORMALLY CLOSED NUCLEAR CLASS VALVE, OR UNTIL TRANSITION TO INSTRUMENT TUBING, UNLESS OTHERWISE NOTED.

- REFERENCES:**
- 151 - 228
- GENERAL ELECTRIC DWGS
- SK-X01-75C-02 SH 27 REV 0
 - SK-X01-75C-02 SH 39 REV 0
 - SK-X01-75C-02 SH 38 REV 0
 - SK-X01-75C-02 SH 37 REV 0

QUALITY CLASS, 1 ASME CODE CLASS, 2
 ENGR, K-McANDREW | DRAWN, K-McA | DATE, 12-26-82

WASHINGTON PUBLIC POWER
 SUPPLY SYSTEM
 RICHLAND, WASHINGTON 99352

WNP-2
 WELD & COMPONENT
 IDENTIFICATION DRAWING


TITLE:
 CONTROL ROD DRIVE SYSTEM
 SCRAM DISCHARGE HEADER B

DWG NO., CRD-202-2 REV 0

THIS DRAWING IS INTENDED FOR
 USE IN PRESERVICE AND INSERVICE
 INSPECTIONS PROGRAMS ONLY.

PIPING SYSTEM	NOM DIA (IN)	SCH	NOM WALL THK	MATERIAL SPECIFICATION	MATL TYPE	CAL BLOCK NO
8"CRD(12)-3	8	80	0.500	SA 106 GR B	CS	XXXX
6"CRD(12)-3	6	80	0.432	SA 106 GR B	CS	XXXX

NO	DATE	REVISION	BY	CHKD	APVD
0	1-2-83	ISSUED FOR USE			

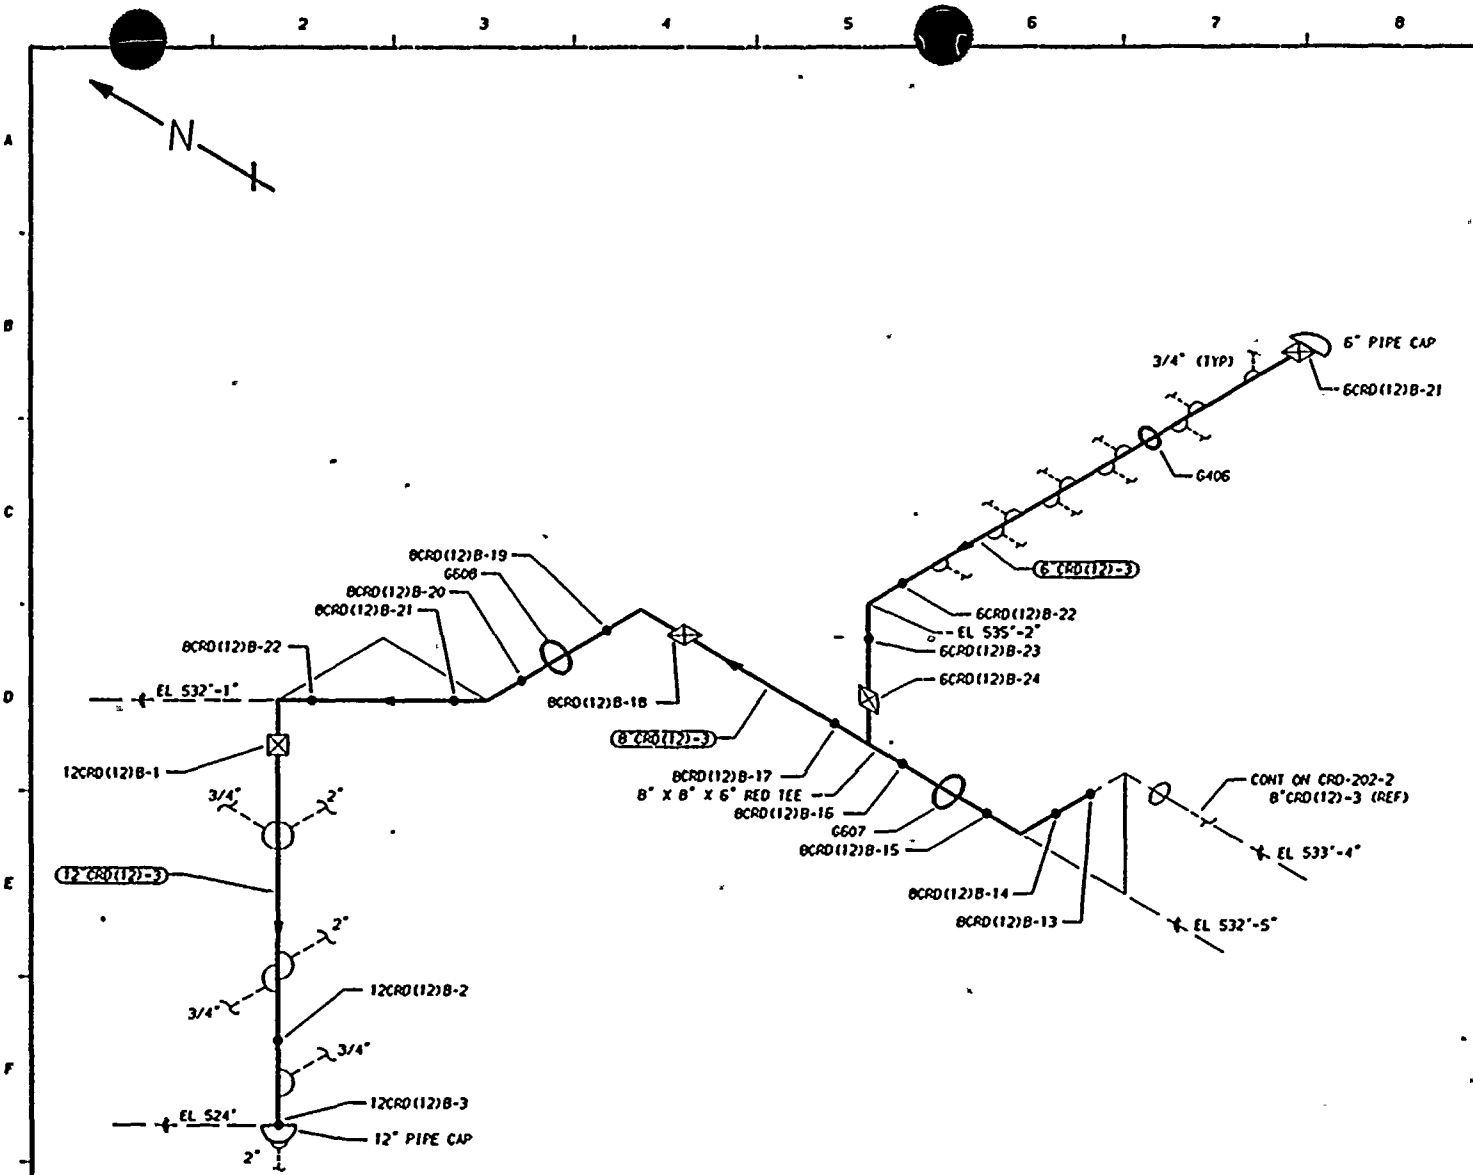

NOTES:

1. THIS DRAWING IDENTIFIES PIPING AND COMPONENTS SUBJECT TO A VISUAL EXAM FOR EVIDENCE OF LEAKAGE DURING SYSTEM HYDRO OR OPERABILITY TESTS. TESTS ARE TO BE CONDUCTED PER THE REQUIREMENTS OF ASME SECTION XI, PARAGRAPH IWA-5000.
2. FOR BRANCH PIPING 4" NOM. OR LESS (CONNECTION SHOWN IN DASHED LINES) EXTEND VISUAL LEAKAGE EXAM THROUGH THE OUTERMOST NORMALLY CLOSED NUCLEAR CLASS VALVE, OR UNTIL TRANSITION TO INSTRUMENT TUBING, UNLESS OTHERWISE NOTED.

REFERENCES:

- 151 - 228⁺
- GENERAL ELECTRIC DWGS
 SK-X01-75C-02 SH 27 REV 0
 SK-X01-75C-02 SH 36 REV 0
 SK-X01-75C-02 SH 26 REV 0
 SK-X01-75C-02 SH 25 REV 0
- BURNS AND ROE DWGS
 CRD-1001-1 REV 0
 CRD-1002-1 REV 0

QUALITY CLASS, 1	ASME CODE CLASS, 2
ENGR, K-McANDREW	DRAWN, K-McA DATE, 12-26-82

WASHINGTON PUBLIC POWER
 SUPPLY SYSTEM
 RICHLAND, WASHINGTON 99352

THIS DRAWING IS INTENDED FOR
 USE IN PRESERVICE AND INSERVICE
 INSPECTIONS PROGRAMS ONLY.

PIPING SYSTEM	NOM DIA (IND)	SCH	NOM WALL THK	MATERIAL SPECIFICATION	MATL TYPE	CAL BLOCK NO
8"CRD(12)-3	8	80	0.500	SA 106 GR B	CS	NA
6"CRD(12)-3	6	80	0.432	SA 106 GR B	CS	NA
12"CRD(12)-3	12	80	0.668	SA 333 GR 6	CS	NA

WNP-2
 WELD & COMPONENT
 IDENTIFICATION DRAWING

TITLE:
 CONTROL ROD DRIVE SYSTEM
 SCRAM DISCHARGE HEADER B

0	1-26-83	ISSUED FOR USE				
NO	DATE	REVISION	BY	CHKD	APVD	


DWG NO, CRD-202-3	REV 0
-------------------	-------

WNP-02
INTERVAL: PSI
PERIOD: NA
OUTAGE:
DRAWING NO. CRD-202


WASHINGTON PUBLIC POWER SUPPLY SYSTEM
PROGRAM PLAN AND SCHEDULE
SYSTEM OR COMPONENT: CRD(12)-3
DESCRIPTION: CRD SCRAM DISCHARGE

PAGE 001
DATE 12/14/84

<u>IDENT. NO.</u>	<u>DESCRIPTION</u>	<u>SECT.</u> XI	<u>EXAM</u> EXAM.	<u>EXAM</u> MIH.	<u>PROCEDURE</u>	<u>CAL.</u> BLOCK	<u>INSERVICE</u>		<u>NOTES</u>
							<u>REQ.</u>	<u>SCHEDULED</u> OUTAGE	
CRD-PB-202	CRD PRES BNDRY	N/A		VT-2	N/A				SEE NOTES #6 & #7.

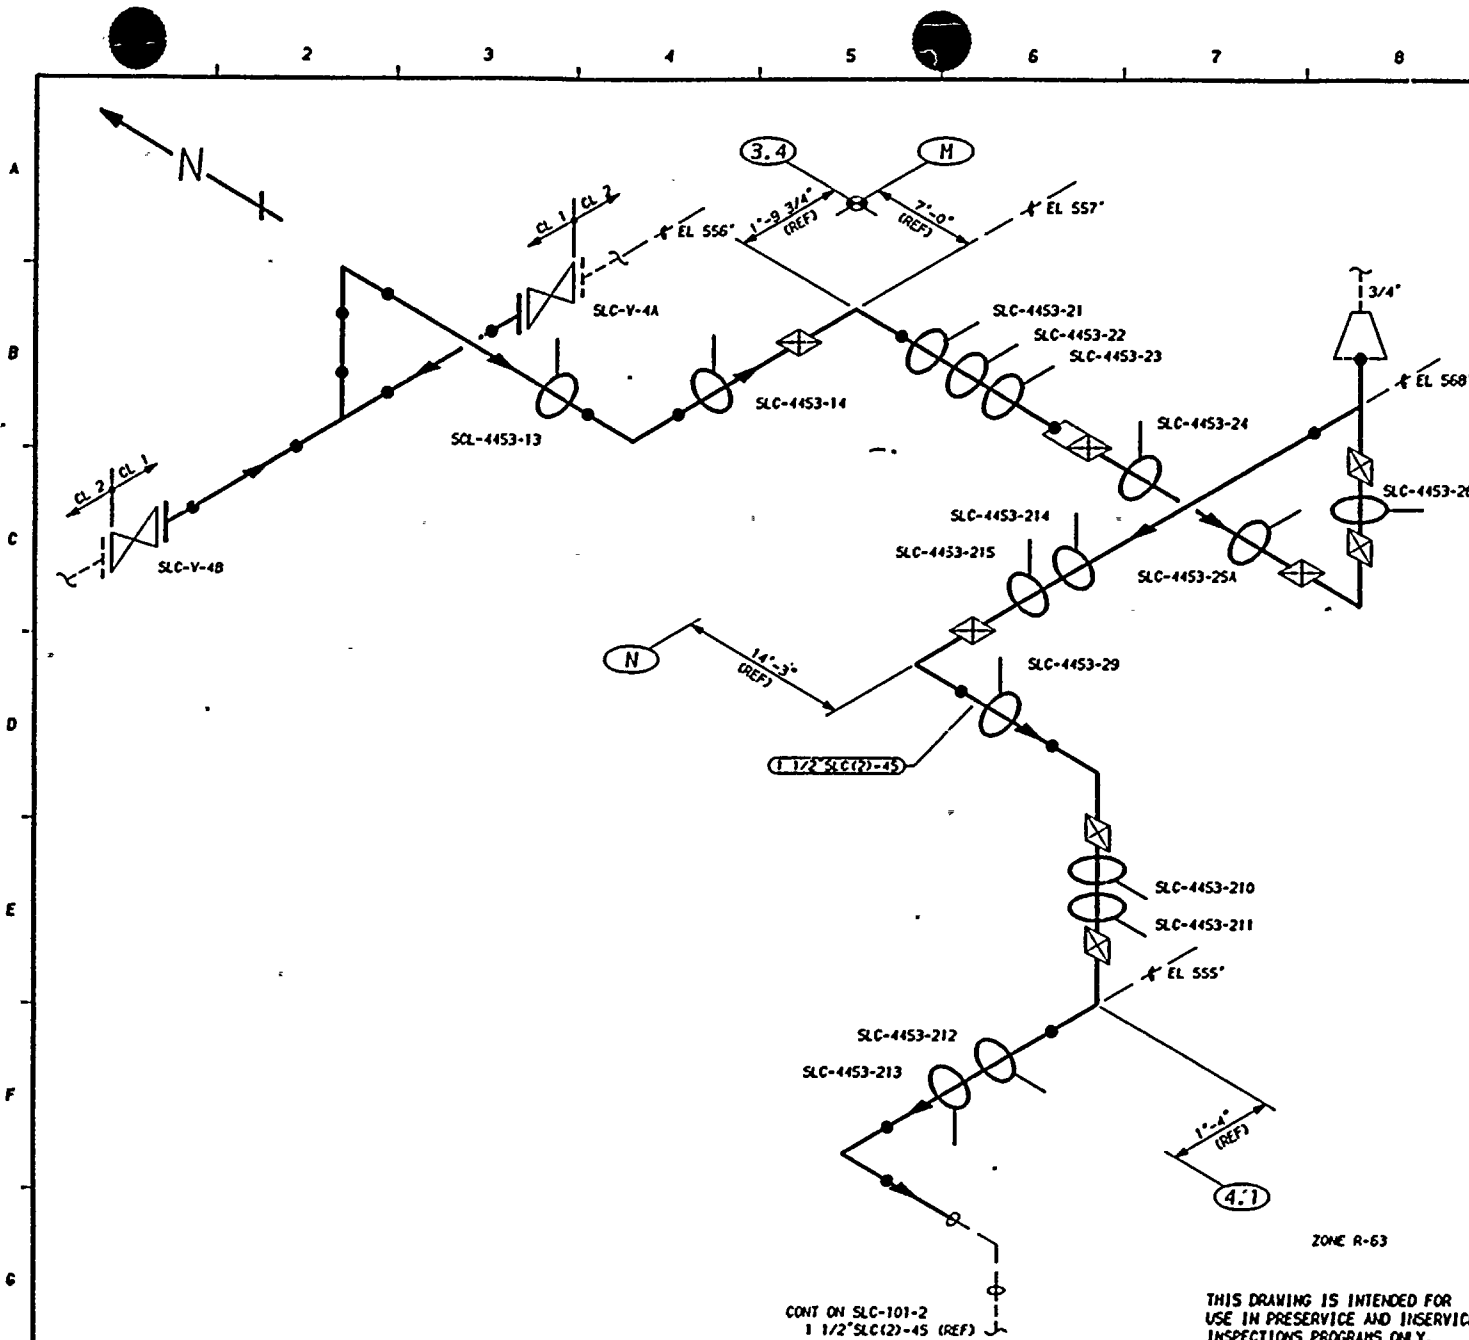

- REFERENCES:**
 151 - 222
 WSH/BOCON/GERI DWG
 SLC-4453-1 REV 6
 SLC-4453-2 REV 8

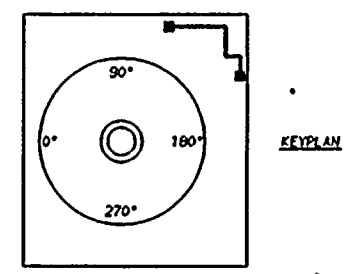

QUALITY CLASS:	1	ASME CODE CLASS:	1
ENGR:	K-McANDREW	DRAWN:	K-McA
DATE:	8-11-83		

WASHINGTON PUBLIC POWER
 SUPPLY SYSTEM
 RICHLAND, WASHINGTON 99352

WNP-2
 WELD & COMPONENT
 IDENTIFICATION DIAGRAM

TITLE:
 SCL-PUMP-1A & 1B DISCHARGE
 THROUGH PENETRATION 13 TO RPV N11
 DWG NO. SLC-101-1 REV 0


PIPING SYSTEM	NOM DIA (IND)	SCH	NOM WALL THK	MATERIAL SPECIFICATION	MATL TYPE	CAL BLOCK NO
1 1/2" SLC(2)-45	1 1/2	805	0.200	SA 312 TP 304	SS	NA


0	ISSUED FOR USE	BY	CHKD	APVD
NO	DATE	REVISION	BY	CHKD

CONT ON SLC-101-2
 1 1/2" SLC(2)-45 (REF)


THIS DRAWING IS INTENDED FOR
 USE IN PRESERVICE AND INSERVICE
 INSPECTIONS PROGRAMS ONLY.

ZONE R-63

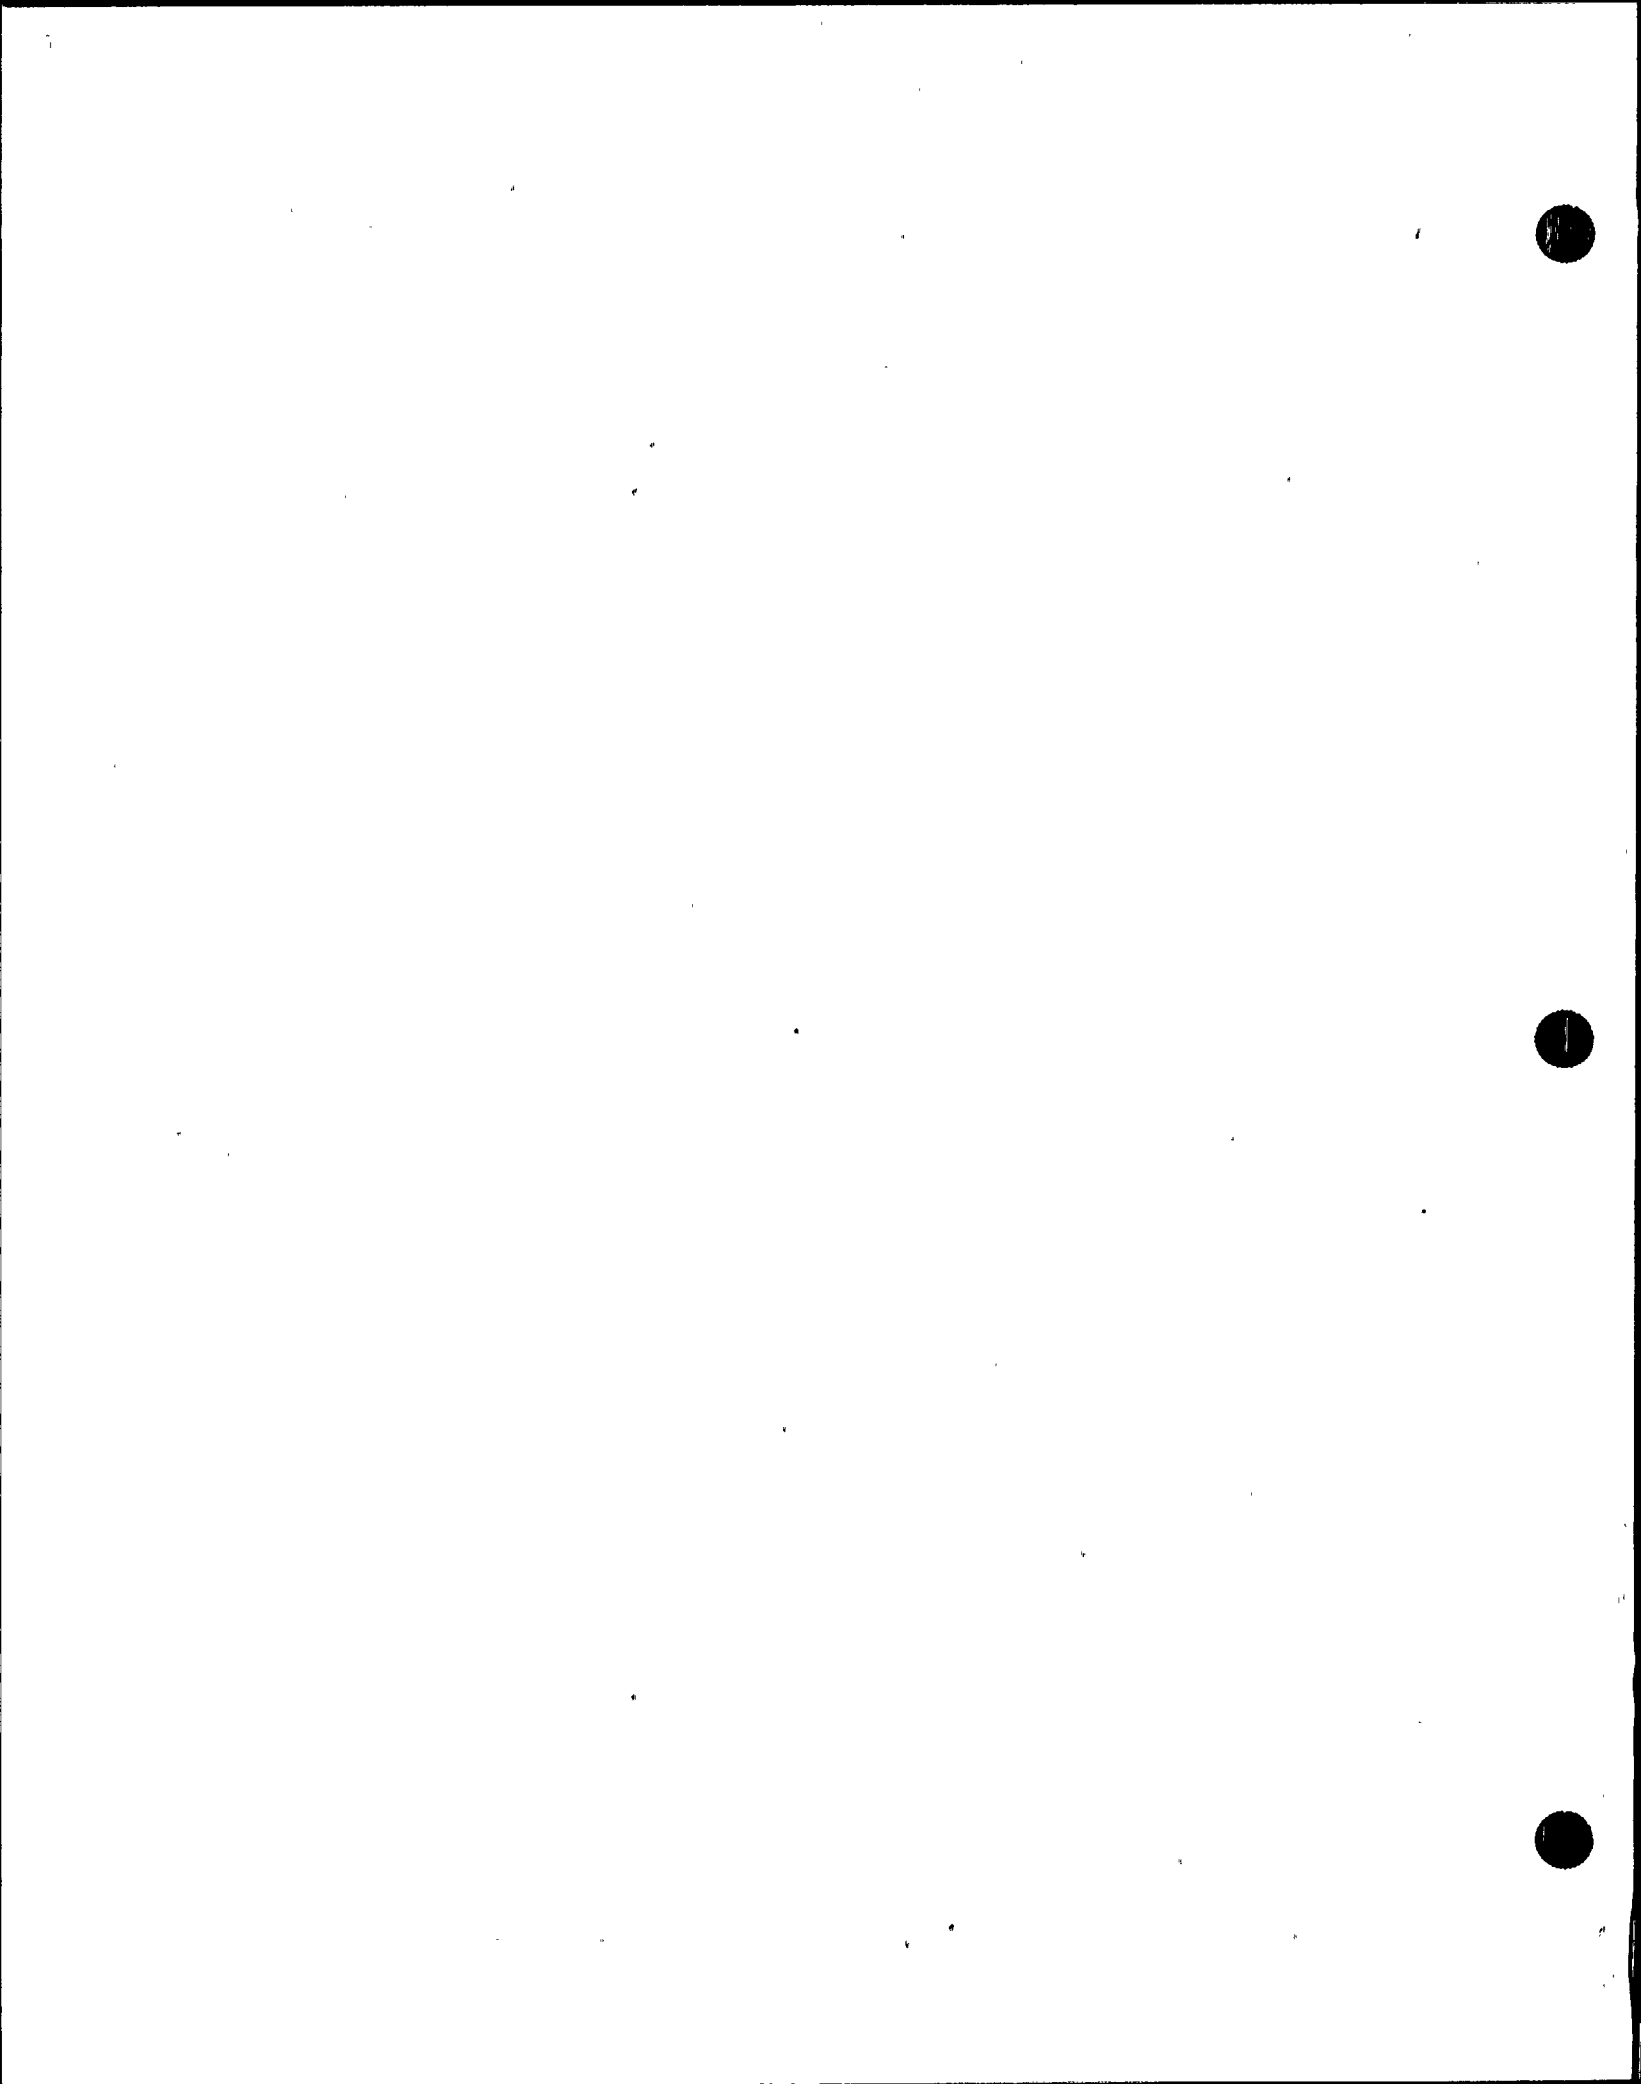

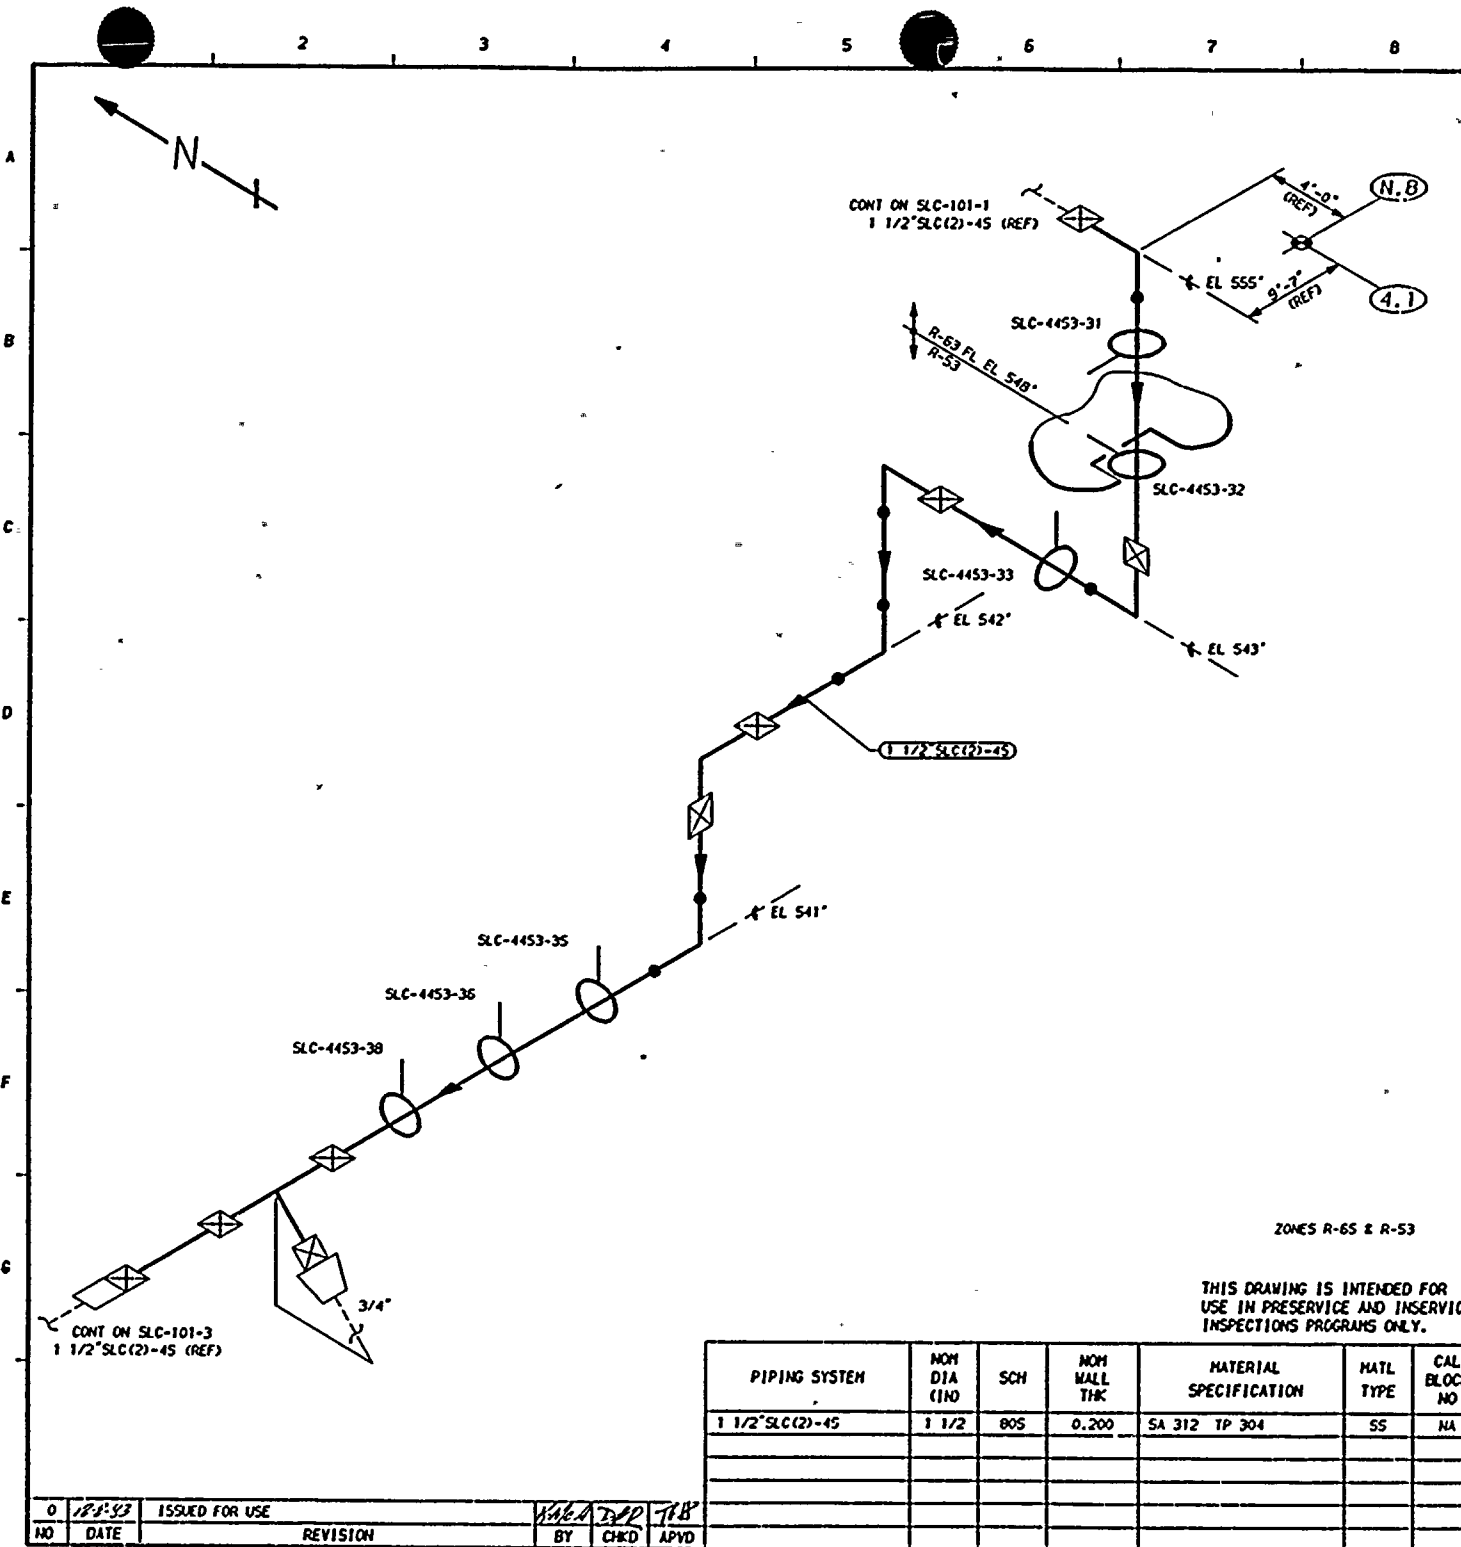

REFERENCES:
 151 - 222
 WSH/BOCON/GERI DWG
 SLC-4453-3 REV 9

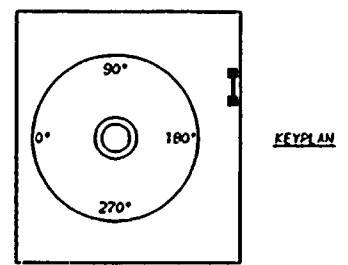

QUALITY CLASS: 1 ASME CODE CLASS: 1
 ENGR: K-McANDREW DRAWN: K-McA DATE: 8-12-83

WASHINGTON PUBLIC POWER
 SUPPLY SYSTEM
 RICHLAND, WASHINGTON 99352

WNP-2
 WELD & COMPONENT
 IDENTIFICATION DIAGRAM

TITLE:
 SCL-PUMP-1A & 1B DISCHARGE
 THROUGH PENETRATION 13 TO RPV N11


DWG NO: SLC-101-2 REV 0

ZONES R-65 & R-53


THIS DRAWING IS INTENDED FOR
 USE IN PRESERVICE AND INSERVICE
 INSPECTIONS PROGRAMS ONLY.

PIPING SYSTEM	NOM DIA (IND)	SCH	NOM WALL THK	MATERIAL SPECIFICATION	MATL TYPE	CAL BLOCK NO
1 1/2" SLC(2)-45	1 1/2	805	0.200	SA 312 TP 304	SS	NA

NO	DATE	ISSUED FOR USE	REVISION	BY	CHKD	APVD
0	8/23/83	ISSUED FOR USE		K-McA	WSP	TJB

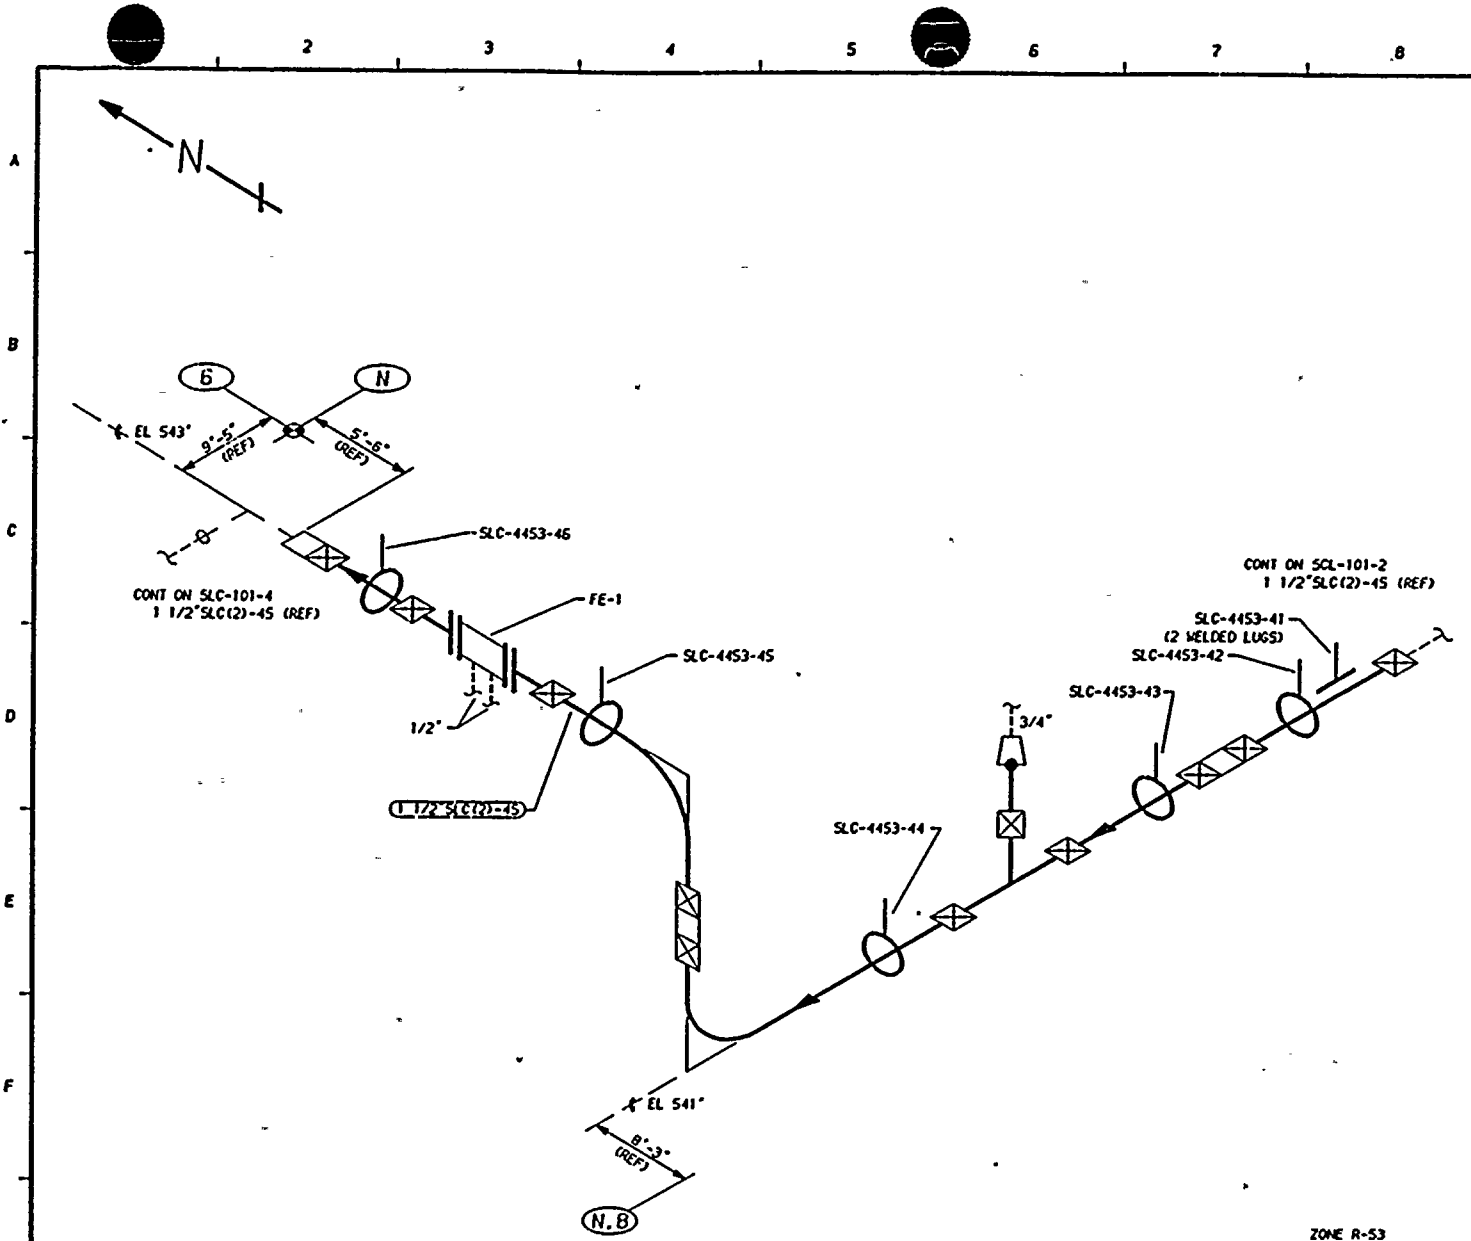

REFERENCES:
 151 - 222
 WSH/BOCON/GERI DWG
 SLC-4453-4 REV 9

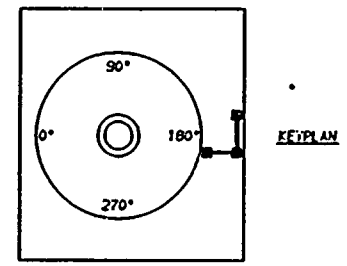

QUALITY CLASS, 1 ASME CODE CLASS, 1
 ENGR, K-McANDREW DRAWN, K-McA DATE, 8-15-83

WASHINGTON PUBLIC POWER
 SUPPLY SYSTEM
 RICHLAND, WASHINGTON 99352

WNP-2
 WELD & COMPONENT
 IDENTIFICATION DIAGRAM

TITLE:
 SCL-PUMP-1A & 1B DISCHARGE
 THROUGH PENETRATION 13 TO RPV N11
 DWG NO, SLC-101-3 REV 0


THIS DRAWING IS INTENDED FOR
 USE IN PRESERVICE AND INSERVICE
 INSPECTIONS PROGRAMS ONLY.

ZONE R-53


PIPING SYSTEM	NOM DIA (IN)	SCH	NOM WALL THK	MATERIAL SPECIFICATION	MATL TYPE	CAL BLOCK NO
1 1/2" SLC(2)-45	1 1/2	80S	0.200	SA 312 TP 304	SS	NA

NO	DATE	ISSUED FOR USE	BY	CHKD	APVD
0	12-1-83	ISSUED FOR USE	K-McA	EDS	TPH



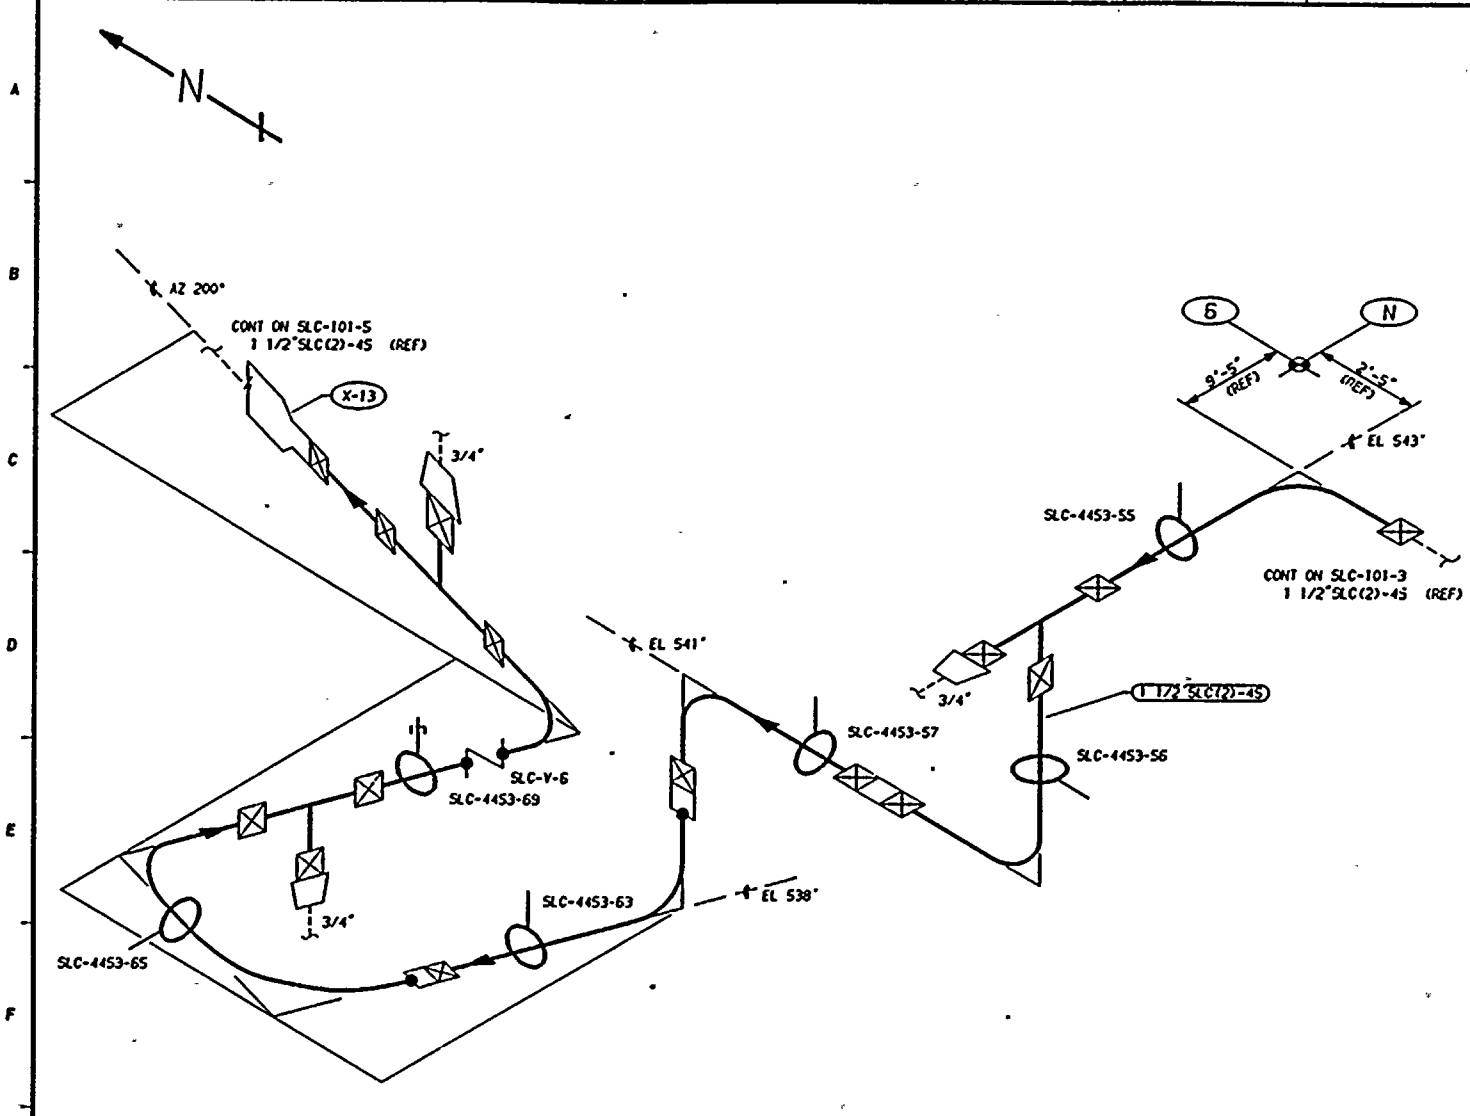

- REFERENCES:**
- 151 - 222
 - WSH/BOCON/CERT DWG
 - SLC-4453-5 REV 7
 - SLC-4453-6 REV 8

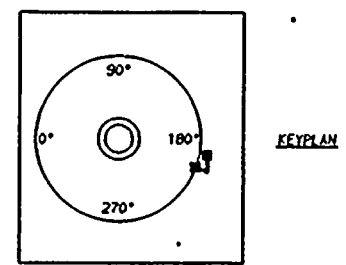

ZONE R-53

THIS DRAWING IS INTENDED FOR USE IN PRESERVICE AND INSERVICE INSPECTIONS PROGRAMS ONLY.

QUALITY CLASS, 1	ASME CODE CLASS, 1
ENGR, K-McANDREW	DATE, 8-15-83


WASHINGTON PUBLIC POWER
SUPPLY SYSTEM
RICHLAND, WASHINGTON 99352

WNP-2
WELD & COMPONENT
IDENTIFICATION DIAGRAM

TITLE:	SLC-PUMP-1A & 1B DISCHARGE THROUGH PENETRATION 13 TO RPV N11
DWG NO., SLC-101-4	REV 0

PIPING SYSTEM	NOM DIA (INO)	SCH	NOM WALL THK	MATERIAL SPECIFICATION	MATL TYPE	CAL BLOCK NO
1 1/2" SLC(2)-45	1 1/2	805	0.200	SA 312 TP 304	SS	1A

0	12/83	ISSUED FOR USE			
NO	DATE	REVISION	BY	CHKD	APVD

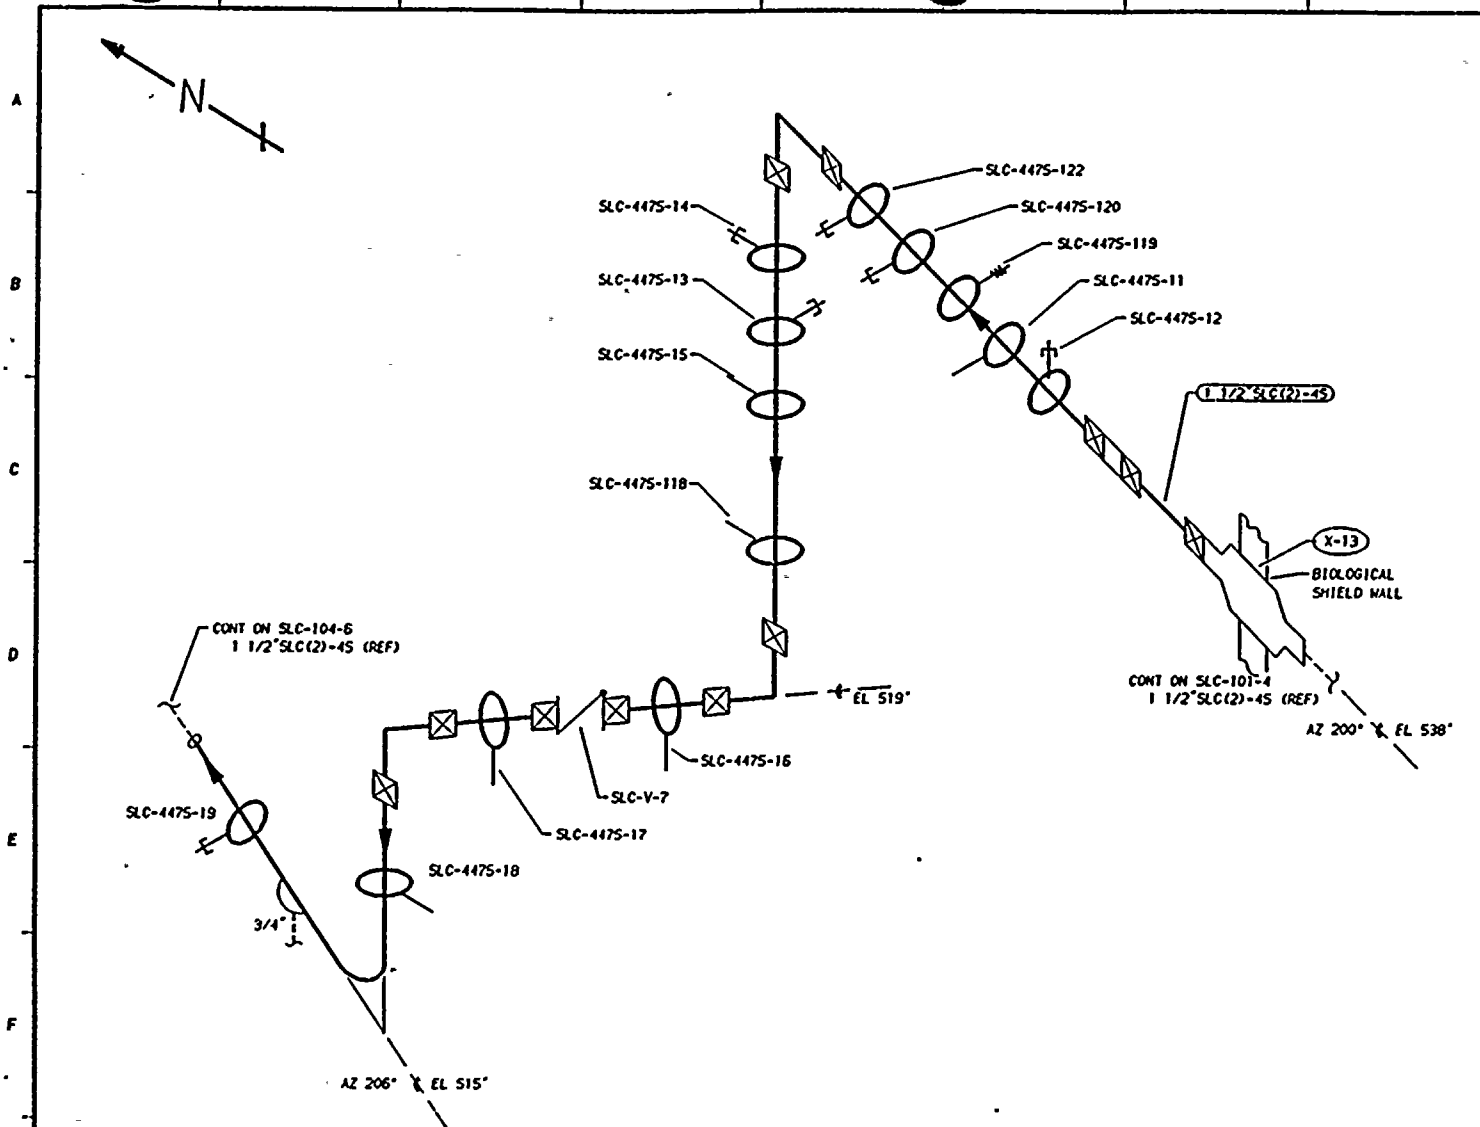

REFERENCES:
 151 - 222
 WSH/BOCON/GERI DWG
 SLC-4475-1 REV 13

KEYPLAN

QUALITY CLASS: 1	ASME CODE CLASS: 1
ENGR: K-McANDREW	DATE: 8-16-83

WASHINGTON PUBLIC POWER
 SUPPLY SYSTEM
 RICHLAND, WASHINGTON 99352


TITLE:
 SCL-PUMP-1A & 1B DISCHARGE
 THROUGH PENETRATION 13 TO RPV N11

DWG NO: SLC-101-5 REV 0


THIS DRAWING IS INTENDED FOR
 USE IN PRESERVICE AND INSERVICE
 INSPECTIONS PROGRAMS ONLY.

PIPING SYSTEM	NOM DIA (IND)	SCH	NOM WALL THK	MATERIAL SPECIFICATION	MATL TYPE	CAL BLOCK NO
1 1/2" SLC(2)-45	1 1/2	805	0.200	SA 312 TP 304	SS	NA

0	12/83	ISSUED FOR USE			
NO	DATE	REVISION	BY	CHKD	APVD

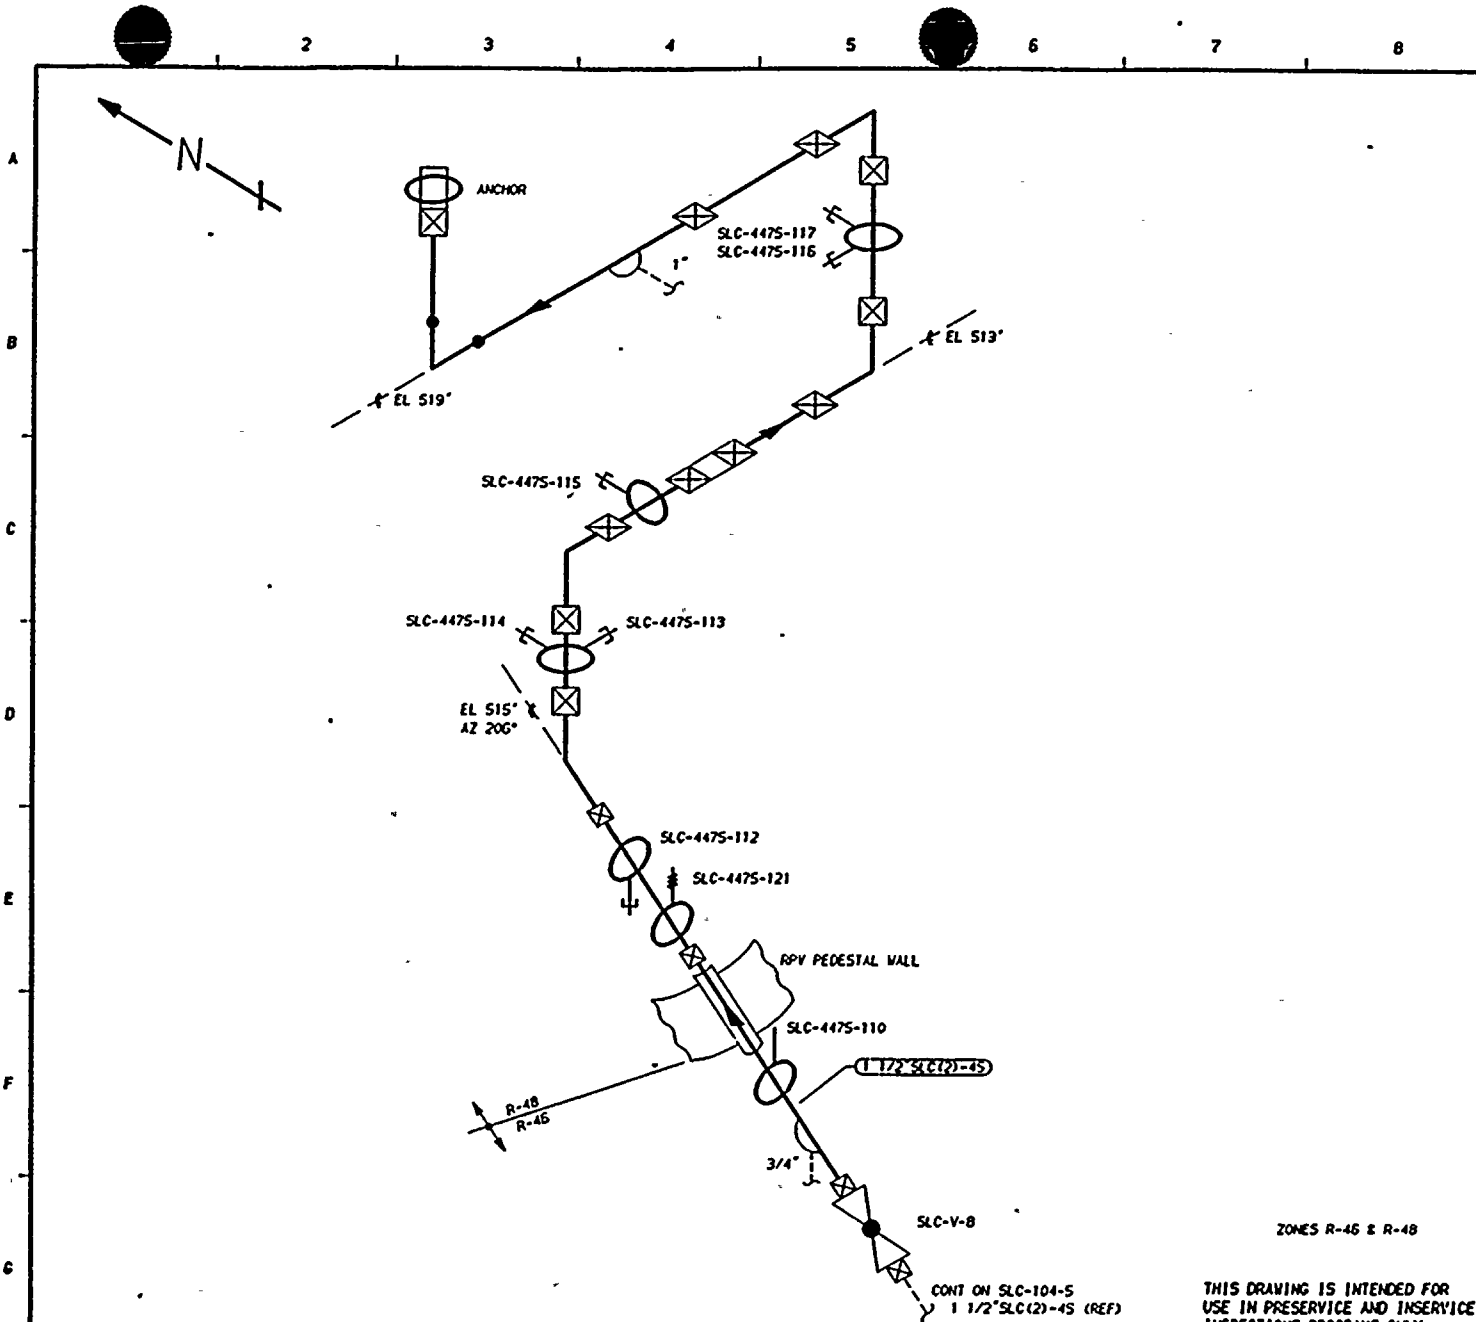

REFERENCES:
 ISI - 222
 WSH/BOCON/GERI DMG
 SLC-4475-1 REV 13

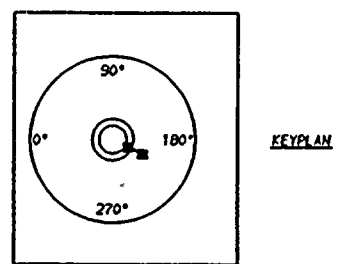

QUALITY CLASS, 1 ASME CODE CLASS, 1
 ENGR, K-McANDREW DRAWN, K-McA DATE, 8-16-83

WASHINGTON PUBLIC POWER
 SUPPLY SYSTEM
 RICHLAND, WASHINGTON 99352

WNP-2
 WELD & COMPONENT
 IDENTIFICATION DIAGRAM



TITLE:
 SCL-PUMP-1A & 1B DISCHARGE
 THROUGH PENETRATION 13 TO RPV N11

DMG NO, SLC-101-6 REV 0

THIS DRAWING IS INTENDED FOR
 USE IN PRESERVICE AND INSERVICE
 INSPECTIONS PROGRAMS ONLY.

PIPING SYSTEM	NOM DIA (IN)	SCH	NOM WALL THK	MATERIAL SPECIFICATION	MATL TYPE	CAL BLOCK NO
1 1/2" SLC(2)-45	1 1/2	80S	0.200	SA 312 TP 304	SS	NA

0	12-83	ISSUED FOR USE	K-McA	DOR	JTB
NO	DATE	REVISION	BY	CHKD	APVD

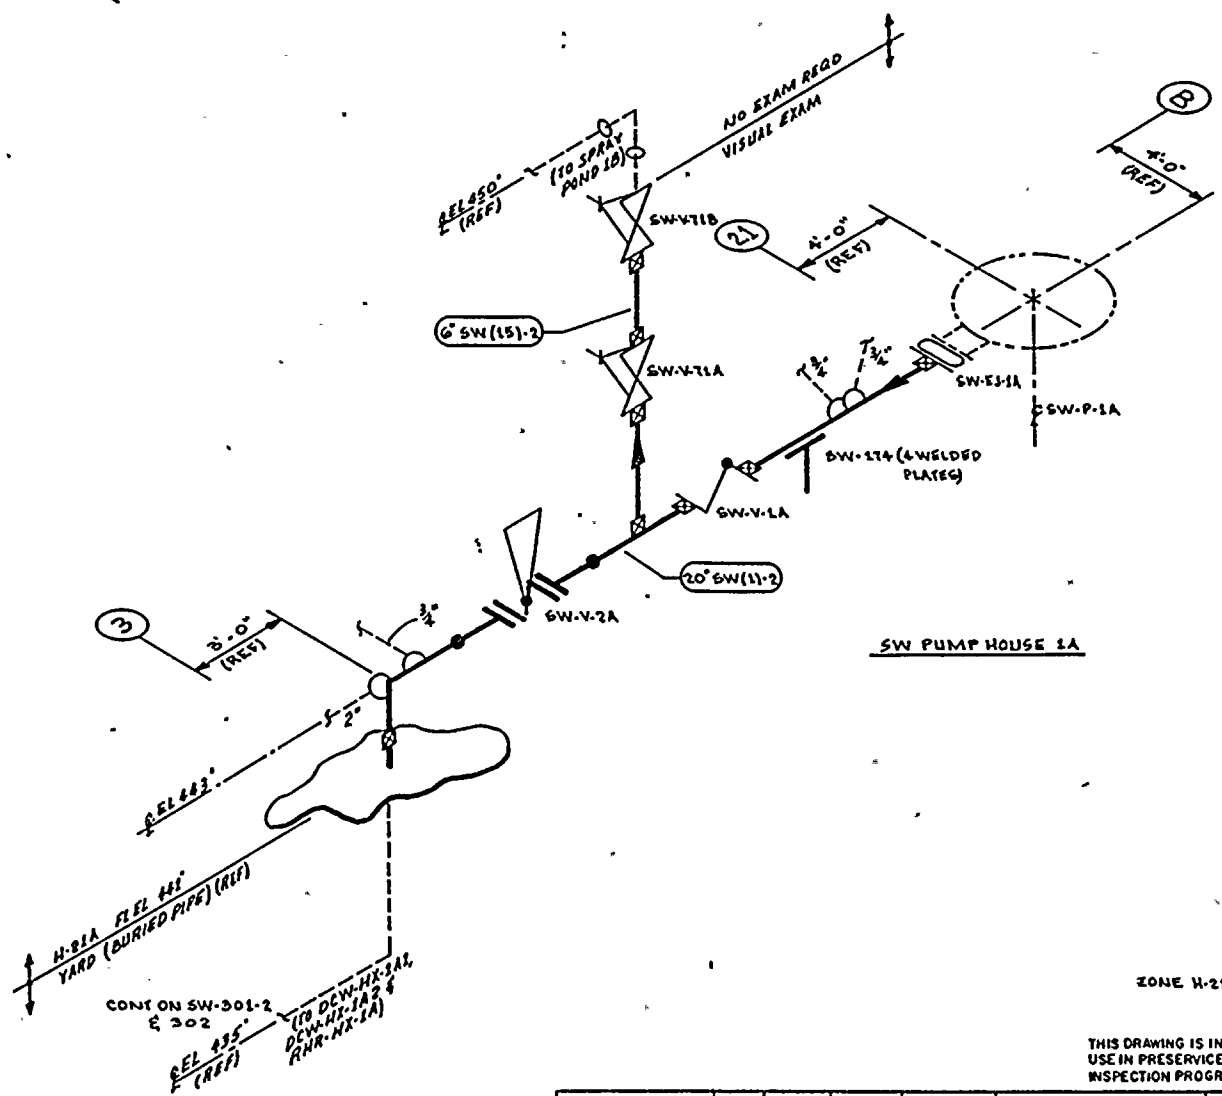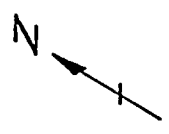

NOTES:

1. THIS DRAWING IDENTIFIES PIPING & COMPONENTS SUBJECT ONLY TO A VISUAL EXAM FOR (1) EVIDENCE OF LEAKAGE DURING SYSTEM PRESSURE OR OPERABILITY TESTS; (2) PRESSURE DECAY TESTS OF BURIED PIPING; & (3) LOSS OF SUPPORT CAPABILITY OR INADEQUATE RESTRAINT FOR SUPPORTS & HANGERS ON PIPING EXCEEDING 4" NOM. TESTS SHALL BE CONDUCTED PER ASME SECTION XI, ARTICLES IWA-5000 & IWA-7000.
2. FOR BRANCH PIPING 4" NOM OR LESS (CALC SHOWN IN DASHED LINES) EXTEND VISUAL LEAKAGE EXAM THROUGH THE OUTERMOST NORMALLY CLOSED NUCLEAR CLASS VALVE, OR UNTIL TRANSITION TO INSTRUMENT TUBING, UNLESS OTHERWISE NOTED.

REFERENCES:

- BOVEE & CRAIG ISOMETRICS-**
- SW-250-1.3 REV 6
 - SW-291-1.6 REV 2
 - SW-250-1.3H REV 0
 - SW-291-1.6H REV 0

QUALITY CLASS: 1	ASME CODE CLASS: B
ENGR: G.A. KUGLER	DATE: 10-20-78



WASHINGTON PUBLIC POWER SUPPLY SYSTEM
 RICHMOND WASHINGTON 99152

THIS DRAWING IS INTENDED FOR USE IN PRESERVICE AND INSERVICE INSPECTION PROGRAMS ONLY.


PIPING SYSTEM	NOM DIA (IN)	SCH	NOM WALL THK	MATERIAL SPECIFICATION	MATL TYPE	CAL BLOCK NO
20" SW(1)-2	20	STD	0.375	SA 106 GR B	CS	NA
6" SW(15)-2	6	STD	0.280	SA 106 GR B	CS	NA
6" SW(15)-2	6	160	0.119	SA 106 GR B	CS	NA

WNP-2
 WELD 8 COMPONENT IDENTIFICATION DIAGRAM

TITLE: SW LOOP A SUPPLY
 SW-P-1A DISCHARGE TO RHR-HX-1A

0	11-5-80	ISSUED FOR USE			
NO	DATE	REVISION	BY	CHKD	APPVD

DWG NO: SW-301-L REV 0

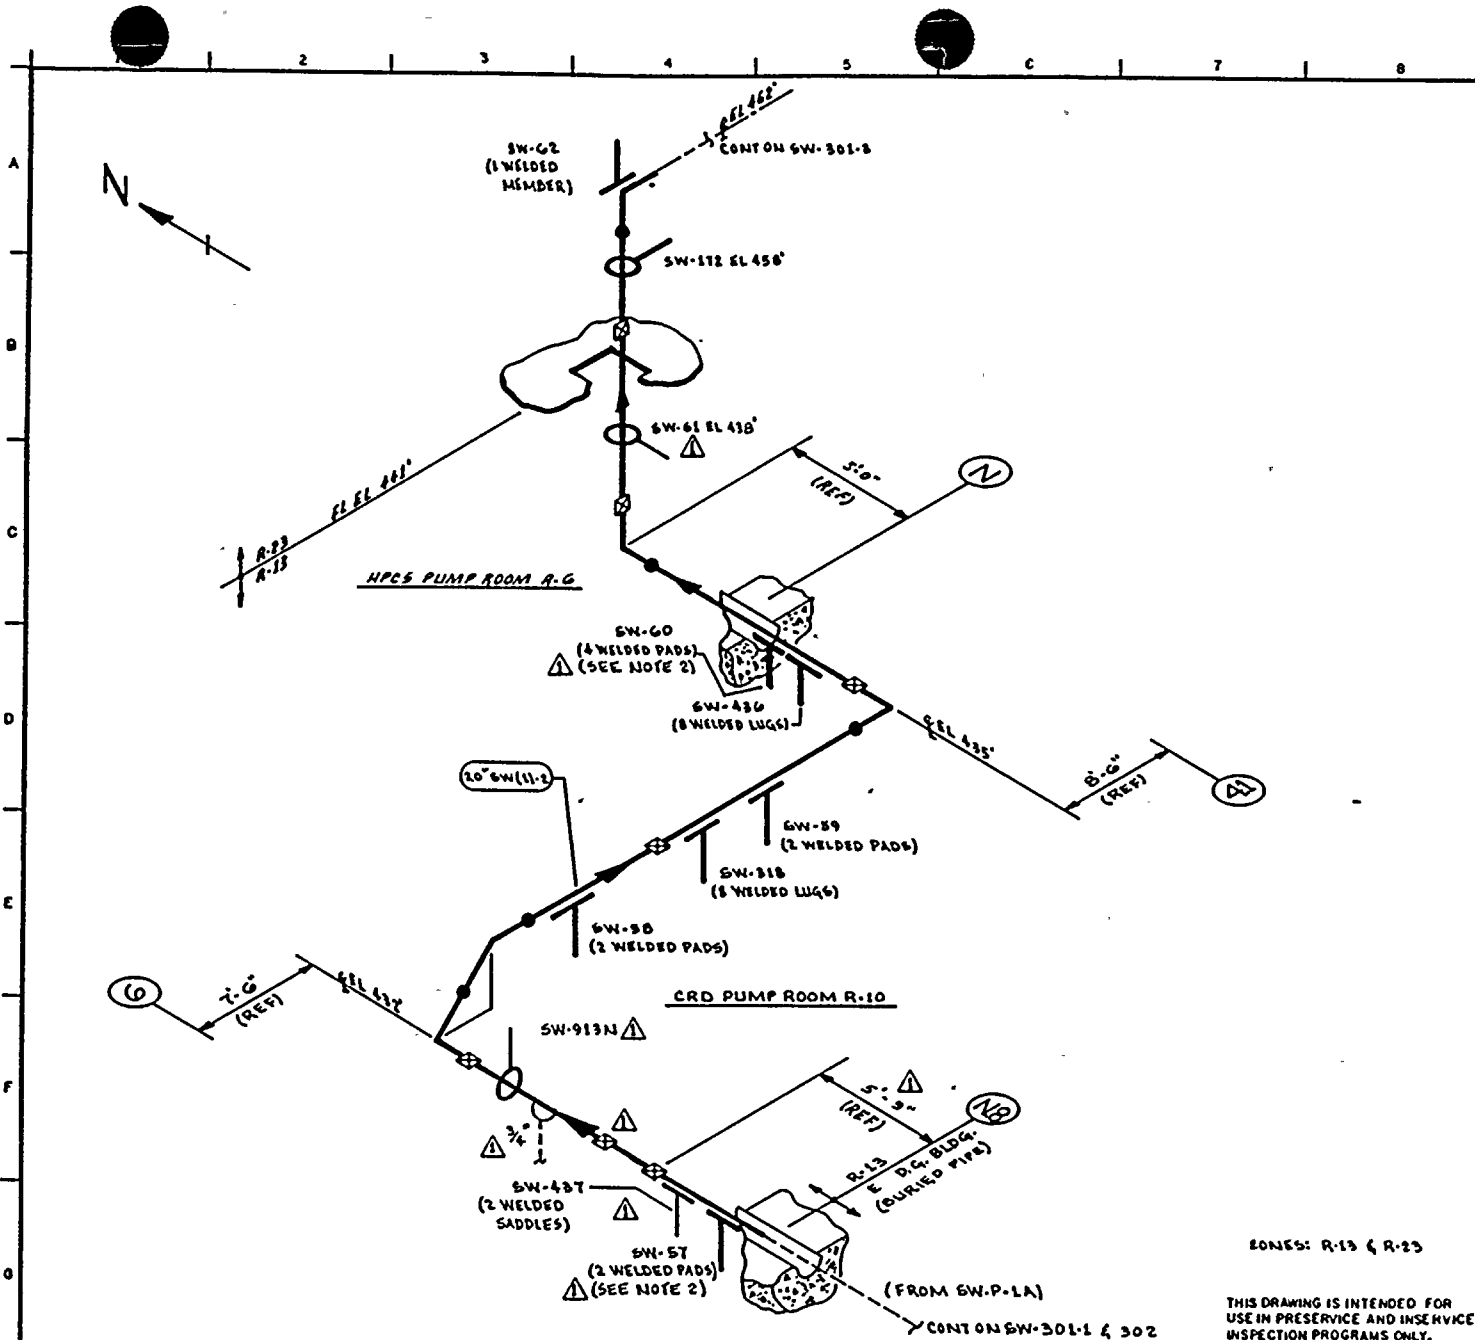


NOTES:

1. THIS DRAWING IDENTIFIES PIPING & COMPONENTS SUBJECT ONLY TO A VISUAL EXAM FOR (1) EVIDENCE OF LEAKAGE DURING SYSTEM PRESSURE OR OPERABILITY TESTS; (2) PRESSURE DECAY TESTS OF BURIED PIPING; & (3) LOSS OF SUPPORT CAPABILITY OR INADEQUATE RESTRAINT FOR SUPPORTS & HANGERS ON PIPING EXCEEDING 4" NOM. TESTS SHALL BE CONDUCTED PER ASME SECTION XI, ARTICLE 6 IWA-5000 & IWD-2000.
2. COMPONENT SUPPORT IS INACCESSIBLE DUE TO FOAM FILLED WATER TIGHT BOOT.

REFERENCES:

DOVE & CRAIL ISOMETRICS
 SW-250-25.30 REV 7
 SW-250-21.24 REV 9

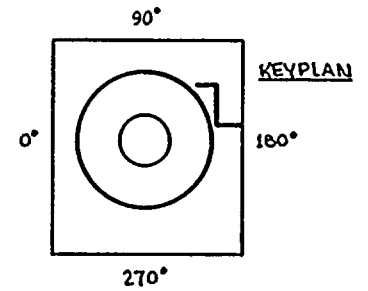

ZONES: R-13 & R-23

THIS DRAWING IS INTENDED FOR USE IN PRESERVICE AND INSERVICE INSPECTION PROGRAMS ONLY.

QUALITY CLASS: 1 ASME CODE CLASS: 3
 ENGR GA WUGLER DRAWN WMLA DATE: 10-24-78

WASHINGTON PUBLIC POWER SUPPLY SYSTEM
 RICHARD WASHINGTON 9932


PIPING SYSTEM	NOM DIA (IN)	SCH	NOM WALL THK	MATERIAL SPECIFICATION	MATL TYPE	CAL BLOCK NO
20" SW(11)-2	20	610	0.315	SA 106 GR B	CS	NA

NO	DATE	REVISION	BY	CHKD	APPVD
1	1-27-84	REVISED AS NOTED ADDED KEYPLAN	KWA	WPR	TFH
0	11-5-80	ISSUED FOR USE	KWA	XAK	PDP

WNP-2
 WELD & COMPONENT
 IDENTIFICATION DIAGRAM


TITLE:
 SW LOOP A SUPPLY TO RHR-WX-1A

DWG NO: SW-301-2 REV 1

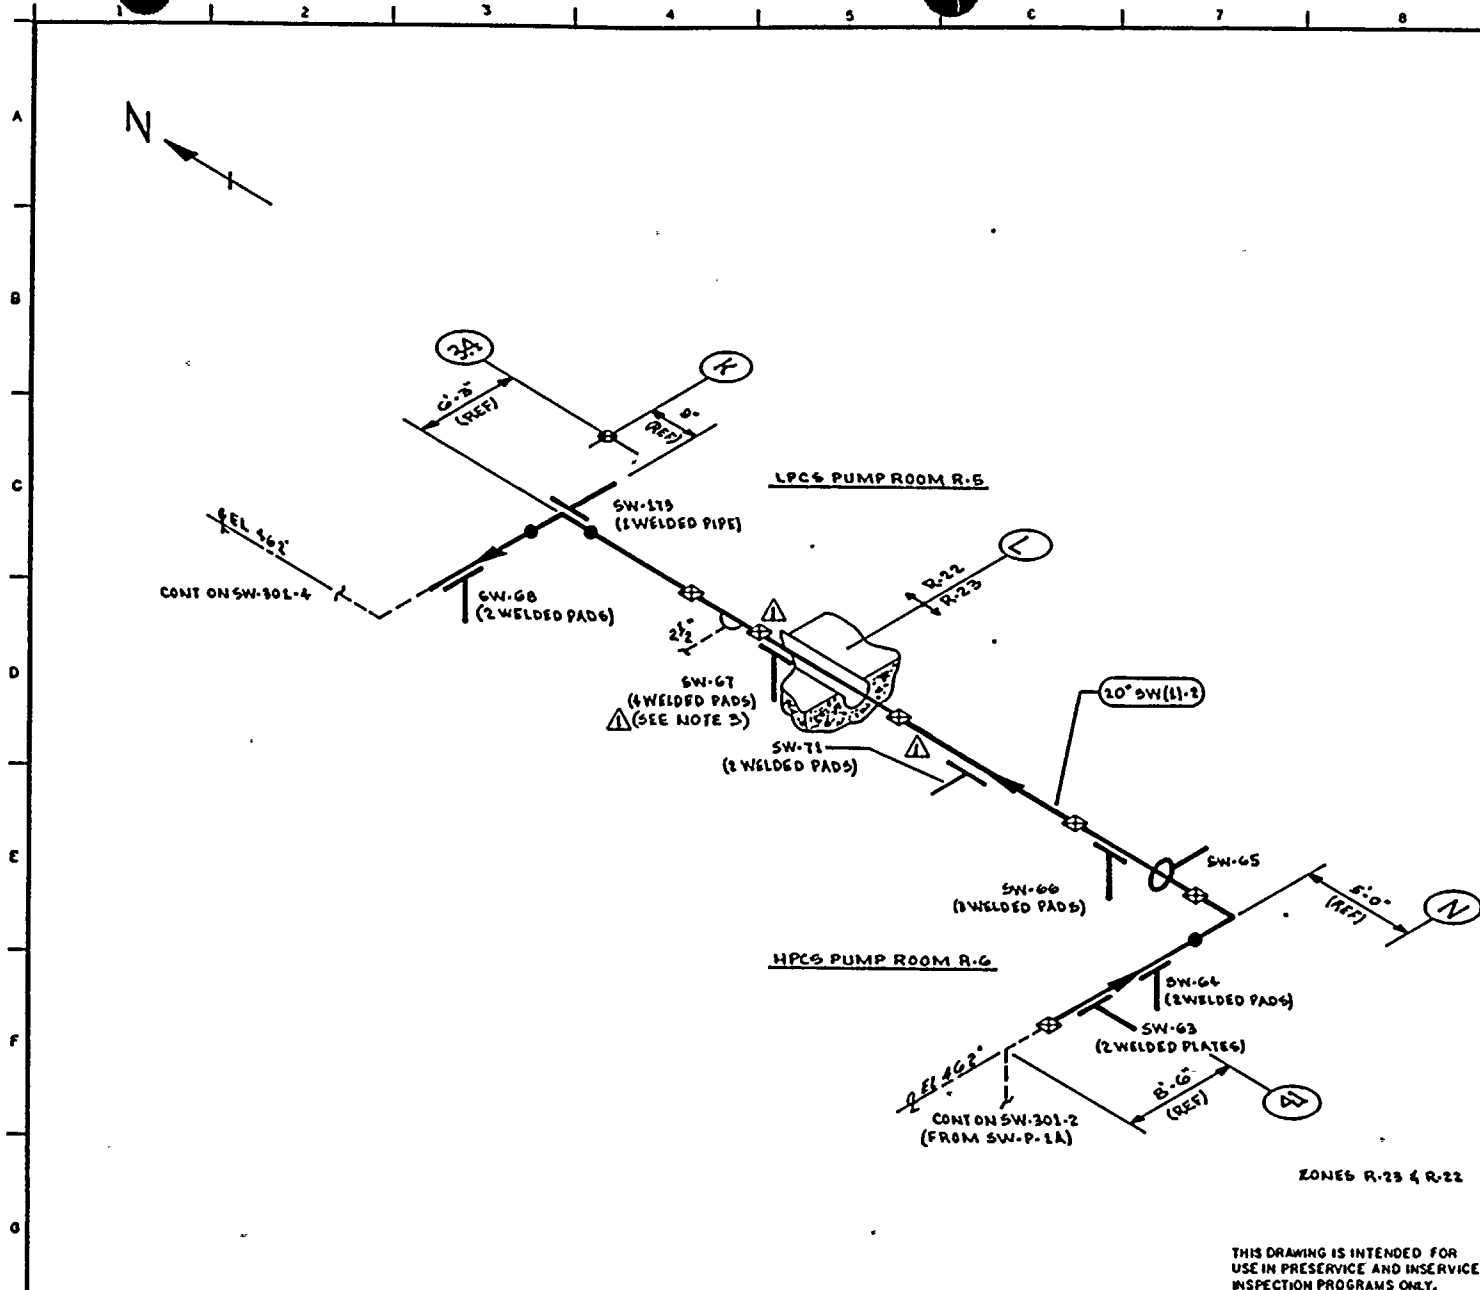

- NOTES:
- THIS DRAWING IDENTIFIES PIPING & COMPONENTS SUBJECT ONLY TO A VISUAL EXAM FOR (1) EVIDENCE OF LEAKAGE DURING SYSTEM PRESSURE OR OPERABILITY TESTS; (2) PRESSURE DECAY TESTS OF BURIED PIPING; & (3) LOSS OF SUPPORT CAPABILITY OR INADEQUATE RESTRAINT FOR SUPPORTS & HANGERS ON PIPING EXCEEDING 4" NOM. TESTS SHALL BE CONDUCTED PER ASME SECTION XI, ARTICLES IWA-5000 & IWD-2000.
 - FOR BRANCH PIPING 4" NOM OR LESS (CONN SHOWN IN DASHED LINES) EXTEND VISUAL LEAKAGE EXAM THROUGH THE OUTERMOST NORMALLY CLOSED NUCLEAR CLASS VALVE, OR UNTIL TRANSITION TO INSTRUMENT TUBING, UNLESS OTHERWISE NOTED.
 - COMPONENT SUPPORT IS INACCESSIBLE DUE TO FOAM FILLED WATER TIGHT BOOT.

REFERENCES:
 BOVEE & CRAIG ISOMETRICS
 SW-250-31.40 REV 10

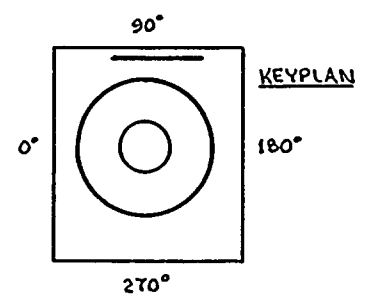

THIS DRAWING IS INTENDED FOR USE IN PRESERVICE AND INSERVICE INSPECTION PROGRAMS ONLY.

QUALITY CLASS: 1	ASME CODE CLASS: 3
ENGR: GA KUGLER	DATE: 10-27-76

WASHINGTON PUBLIC POWER SUPPLY SYSTEM
 MCNARD WASHINGTON 9252


PIPING SYSTEM	NOM DIA (IN)	SCH	NOM WALL THK	MATERIAL SPECIFICATION	MATL TYPE	CAL BLOCK NO
20" SW(1)-3	20	STD	0.375	SA 106 GR B	CS	NA

NO	DATE	REVISION	BY	CHKD	APPVD
1	1-27-84	REVISED AS NOTED ADDED KEYPLAN	KJA	ME	TGW
0	11-5-80	ISSUED FOR USE	KJA	BAK	KDOL

WNP-2
 WELD COMPONENT IDENTIFICATION DIAGRAM


TITLE:
 SW LOOP A SUPPLY TO RHR-WX-1A

OWG NO: SW-301-3 REV 1

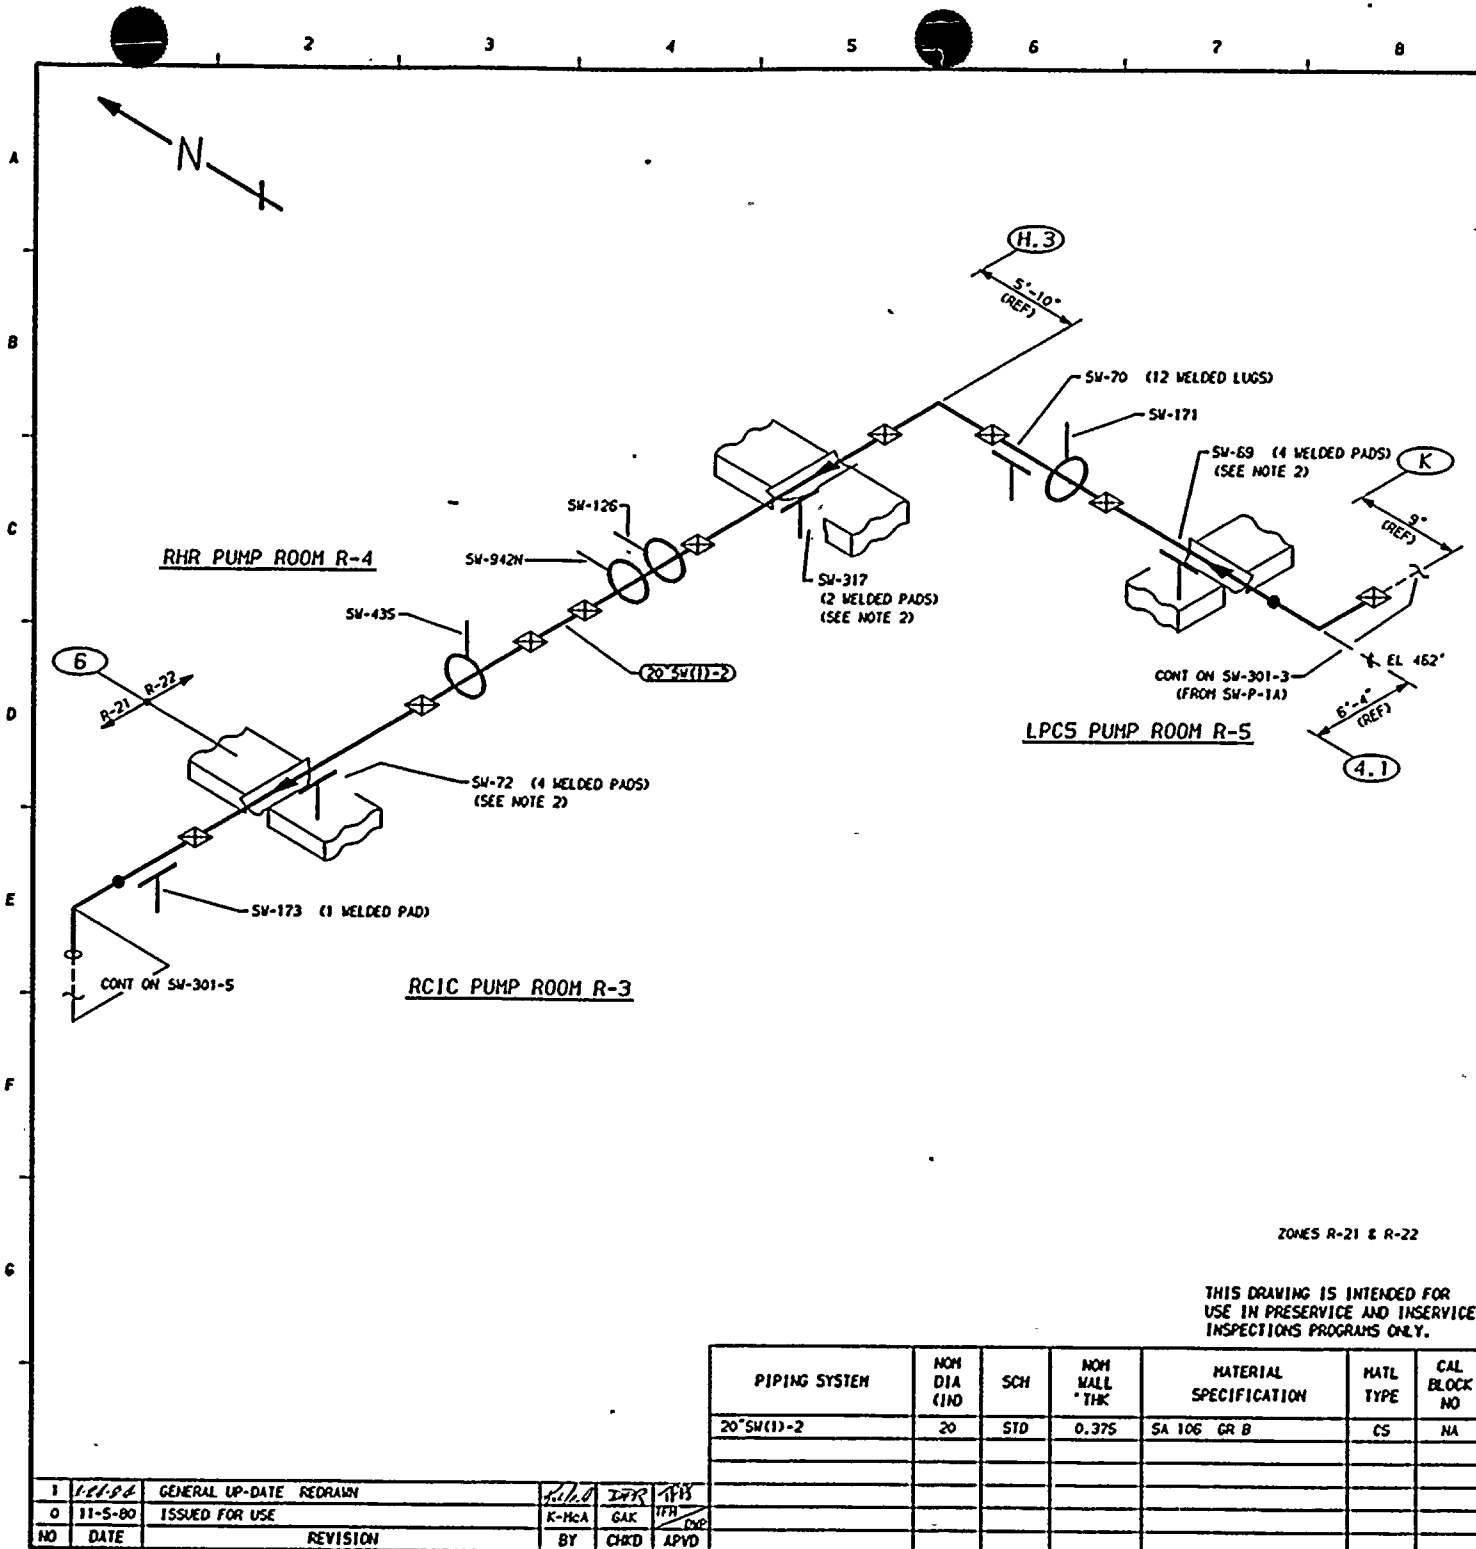

- NOTES:**
1. THIS DRAWING IDENTIFIES PIPING AND COMPONENTS SUBJECT ONLY TO A VISUAL EXAM FOR (1) EVIDENCE OF LEAKAGE DURING SYSTEM PRESSURE OR OPERABILITY TESTS; (2) PRESSURE DECAY TESTS OF BURIED PIPING; AND (3) LOSS OF SUPPORT CAPABILITY OR INADEQUATE RESTRAINT FOR SUPPORTS AND HANGERS ON PIPING EXCEEDING 4" NOM. TESTS SHALL BE CONDUCTED PER ASME SECTION XI, ARTICLES 1WA-5000 AND 1WD-2000.
 2. COMPONENT SUPPORT IS UNACCESSIBLE DUE TO FOAM FILLED WATER TIGHT BOOT.

- REFERENCES:**
- 151 - 224
 - BOYEE & CRAIL ISOMETRICS
 - SW-250-31.40 REV 10
 - SW-250-41.50 REV 9

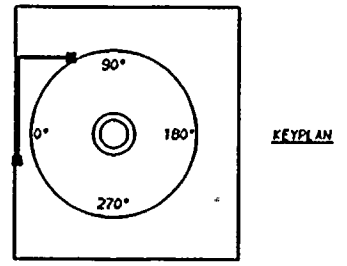


ZONES R-21 & R-22

THIS DRAWING IS INTENDED FOR USE IN PRESERVICE AND INSERVICE INSPECTIONS PROGRAMS ONLY.

PIPING SYSTEM	NOM DIA (IN)	SCH	NOM WALL THK	MATERIAL SPECIFICATION	MATL TYPE	CAL BLOCK NO
20" SW(1)-2	20	STD	0.375	SA 106 GR B	CS	NA


NO	DATE	REVISION	BY	CHKD	APVD
1	1-18-80	GENERAL UP-DATE REDRAWN	K-HCA	GAK	1/18/80
0	11-5-80	ISSUED FOR USE	K-HCA	GAK	1/18/80

QUALITY CLASS: 1	ASME CODE CLASS: 3
ENGR: GA KUGLER	DRAWN: K-HCA DATE: 10-30-78
WASHINGTON PUBLIC POWER SUPPLY SYSTEM RICHLAND, WASHINGTON 99352	
WNP-2 WELD & COMPONENT IDENTIFICATION DIAGRAM	
TITLE: SW LOOP A SUPPLY TO RHR-HX-1A	
DWG NO. SW-301-4	REV 1

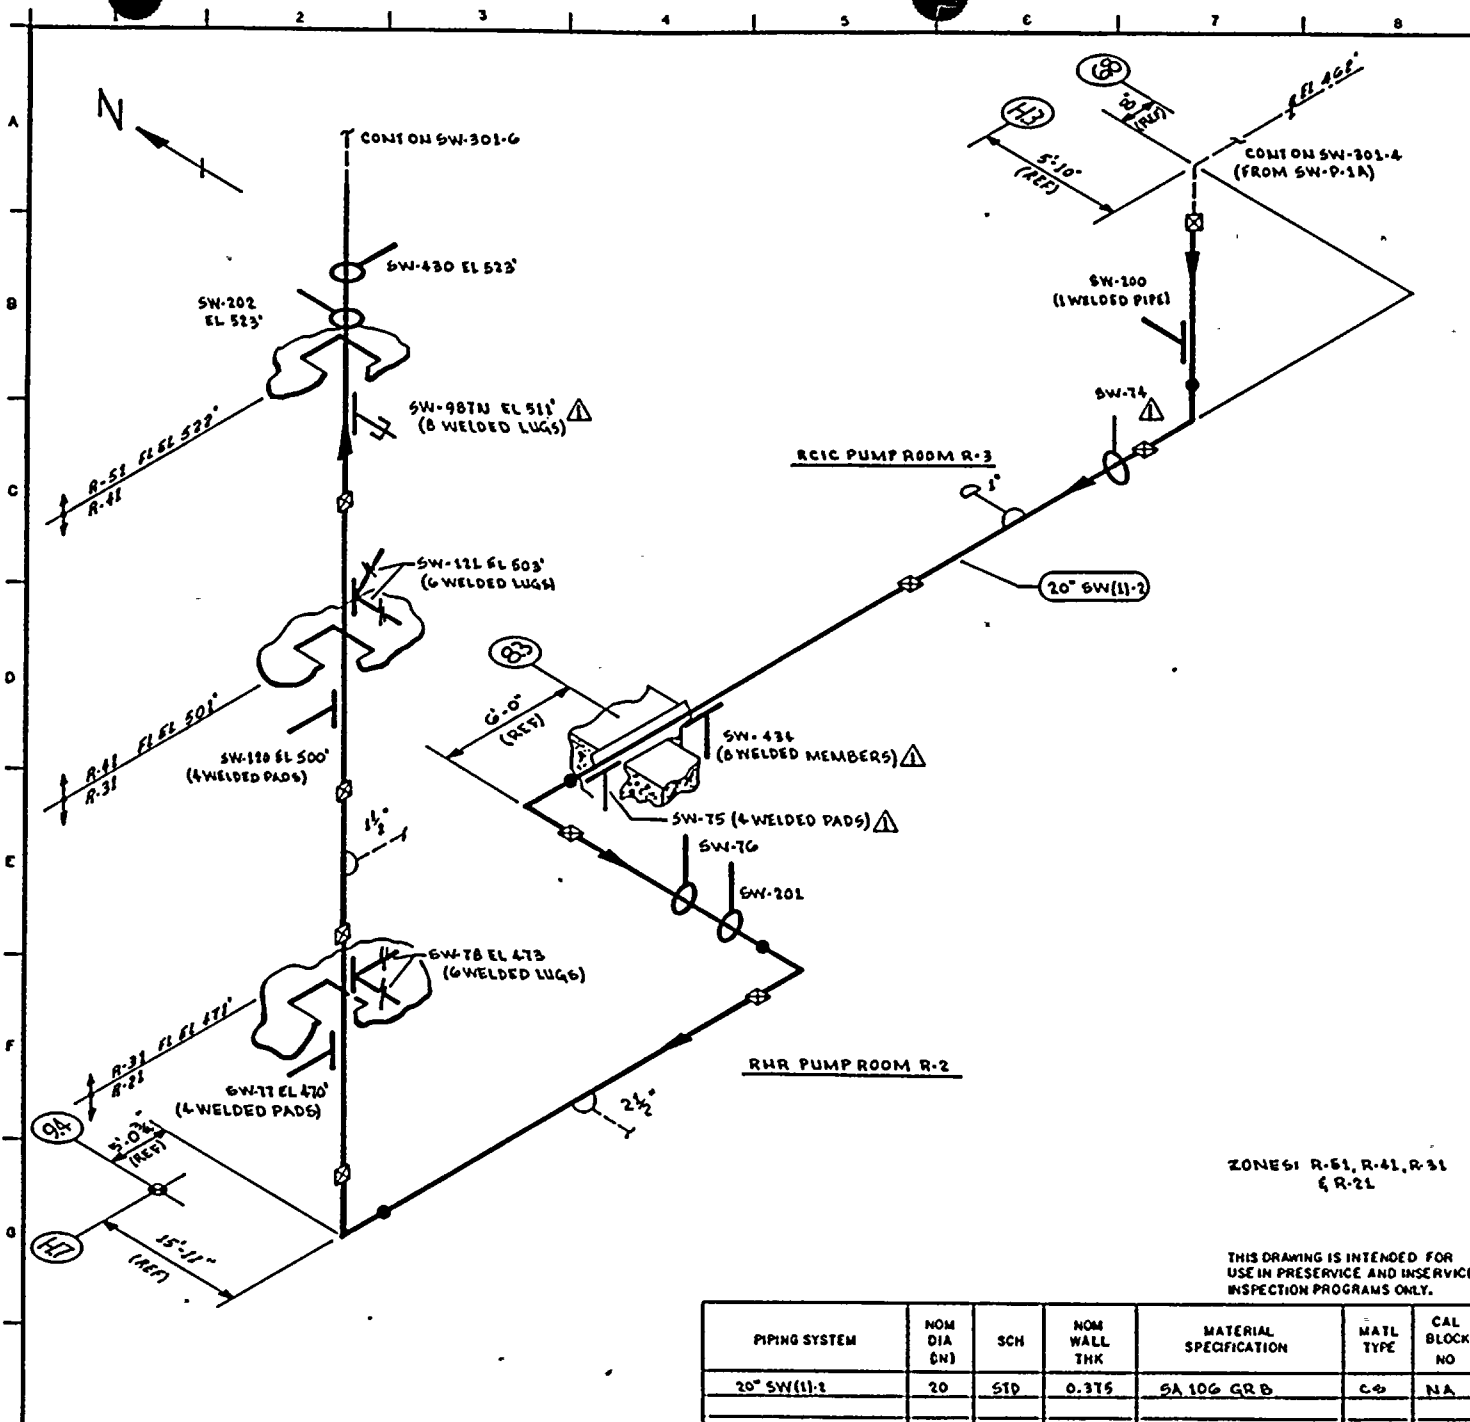

- NOTES:**
- THIS DRAWING IDENTIFIES PIPING & COMPONENTS SUBJECT TO A VISUAL EXAM FOR (1) EVIDENCE OF LEAKAGE DURING SYSTEM PRESSURE OR OPERABILITY TESTS; (2) PRESSURE DECAY TESTS OF BURIED PIPING; & (3) LOSS OF SUPPORT CAPABILITY OR INADEQUATE RESTRAINT FOR SUPPORTS & HANGERS ON PIPING EXCEEDING 4" NOM. TESTS SHALL BE CONDUCTED PER ASME SECTION XI, ARTICLES IWA-5000 & IWD-2000.
 - FOR BRANCH PIPING 4" NOM OR LESS (CONN SHOWN IN DASHED LINES) EXTEND VISUAL LEAKAGE EXAM THROUGH THE OUTERMOST NORMALLY CLOSED NUCLEAR CLASS VALVE, OR UNTIL TRANSITION TO INSTRUMENT TUBING, UNLESS OTHERWISE NOTED.

REFERENCES:
 BOVEE & CRAIG ISOMETRICS
 SW-250-41.50 REV 9

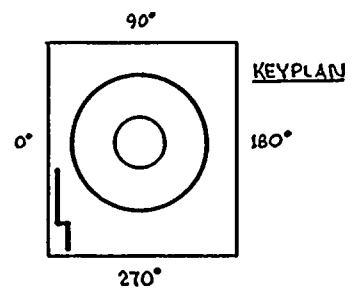

ZONES: R-51, R-41, R-31 & R-21

THIS DRAWING IS INTENDED FOR USE IN PRESERVICE AND INSERVICE INSPECTION PROGRAMS ONLY.


QUALITY CLASS: 1	ASME CODE CLASS: B
ENGR GA KUHLER	DRAWN: K.M.L. DATE: 11-2-78


WASHINGTON PUBLIC POWER SUPPLY SYSTEM
 RICHMOND WASHINGTON 9332

PIPING SYSTEM	NOM DIA (N)	SCH	NOM WALL THK	MATERIAL SPECIFICATION	MATL TYPE	CAL BLOCK NO
20" SW(1)-2	20	STD	0.375	SA 106 GR B	C-2	NA

NO	DATE	REVISION	BY	CHKD	APPVD
1	12-7-83	REVISED AS NOTED ADDED KEYPLAN	K.M.L.		J.P.A.
0	11-5-80	ISSUED FOR USE	K.M.L.		J.P.A.


WNP-2
 WELD COMPONENT
 IDENTIFICATION DIAGRAM
 TITLE:
 SW LOOP A SUPPLY TO RHR-HX-1A
 DWG NO: SW-301-5 REV 1

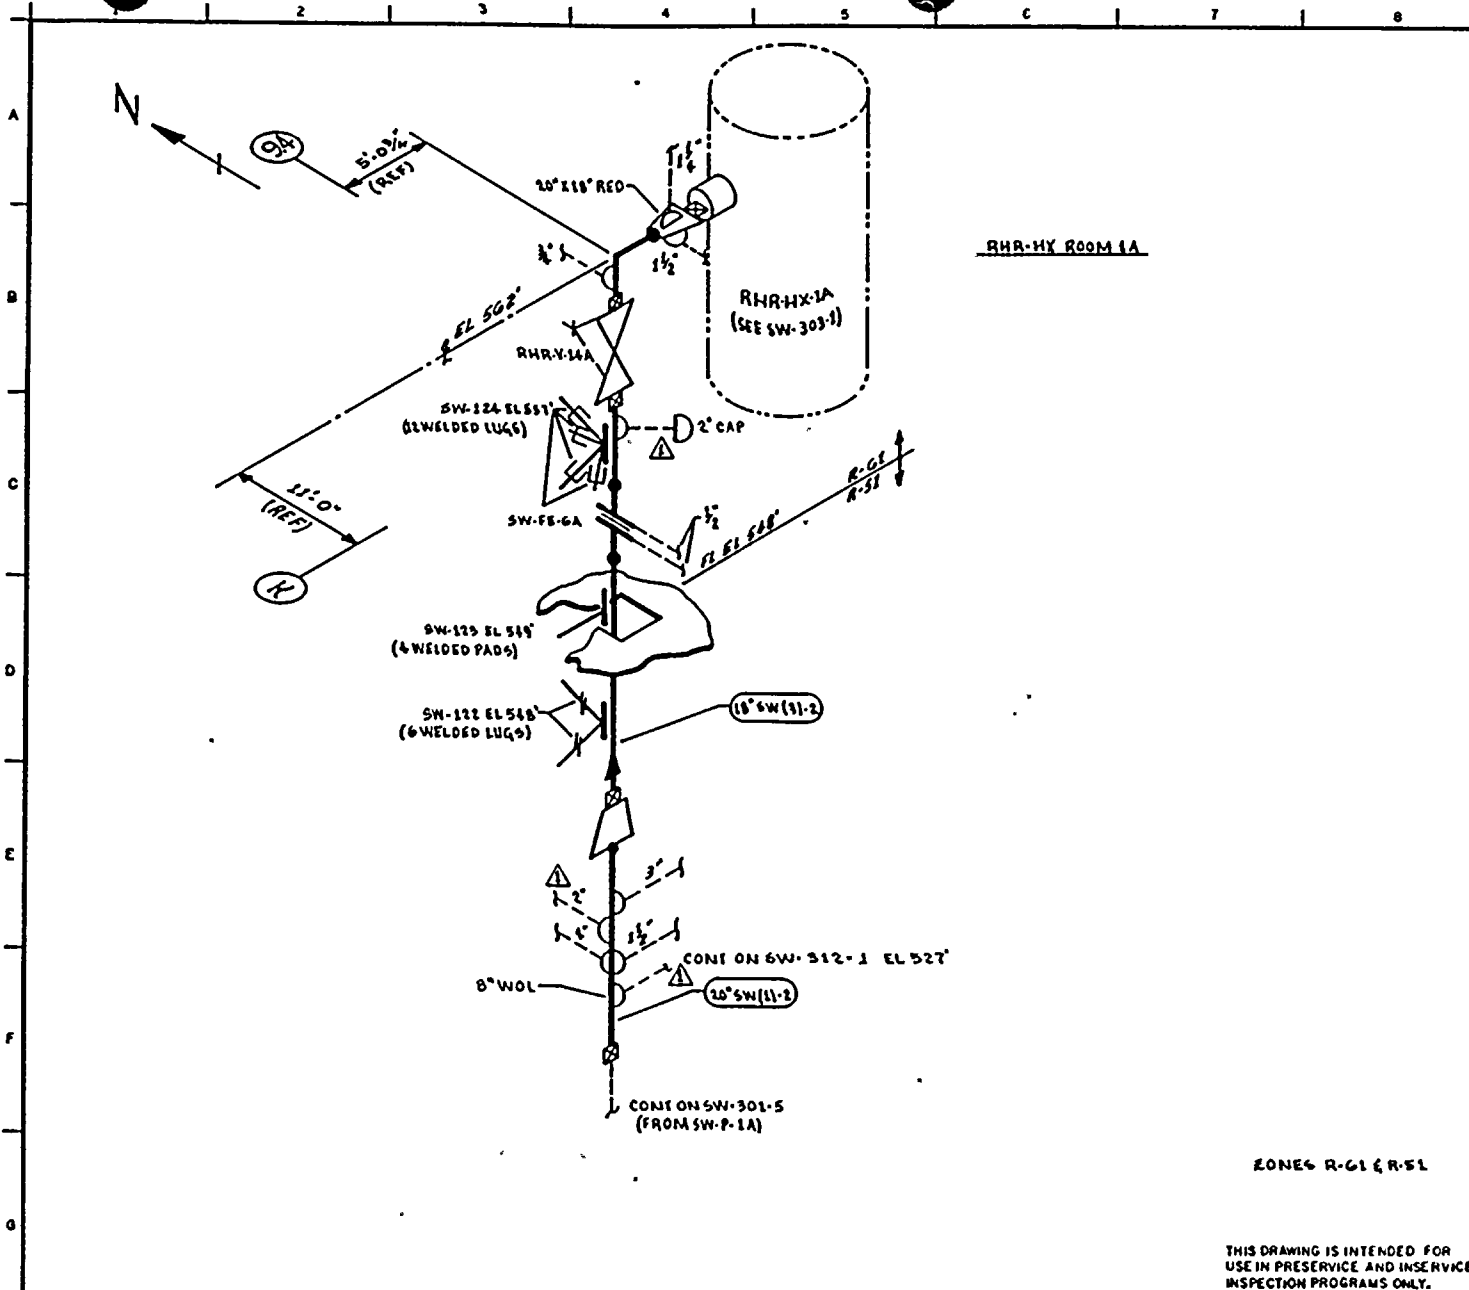

RHR-HX ROOM 1A

- NOTES:
1. THIS DRAWING IDENTIFIES PIPING & COMPONENTS SUBJECT ONLY TO A VISUAL EXAM FOR (1) EVIDENCE OF LEAKAGE DURING SYSTEM PRESSURE OR OPERABILITY TESTS; (2) PRESSURE DECAY TESTS OF BURIED PIPING; & (3) LOSS OF SUPPORT CAPABILITY OR INADEQUATE RESTRAINT FOR SUPPORTS & HANGERS ON PIPING EXCEEDING 4" NOM. TESTS SHALL BE CONDUCTED PER ASME SECTION XI, ARTICLES IWA-5000 & IWD-2000.
 2. FOR BRANCH PIPING 4" NOM OR LESS (CONN SHOWN W/ DASHED LINES) EXTEND VISUAL LEAKAGE EXAM THROUGH THE OUTERMOST NORMALLY CLOSED NUCLEAR CLASS VALVE, OR UNTIL TRANSITION TO INSTRUMENT TUBING, UNLESS OTHERWISE NOTED.

- REFERENCES:
- BOYCE & CRAIL ISOMETRICS
 SW-250-B1 REV 9
 SW-250-52.54 REV B

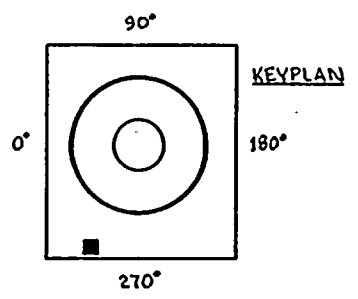

EONES R-61 & R-51

THIS DRAWING IS INTENDED FOR USE IN PRESERVICE AND INSERVICE INSPECTION PROGRAMS ONLY.

QUALITY CLASS: 1	ASME CODE CLASS: B
ENGR GA WUGLER	DATE: 11-3-78

WASHINGTON PUBLIC POWER SUPPLY SYSTEM
 RICHMOND WASHINGTON 99502

PIPING SYSTEM	NOM DIA (DN)	SCH	NOM WALL THK	MATERIAL SPECIFICATION	MATL TYPE	CAL BLOCK NO
20" SW(11)-2	20	STD	0.375	SA 106 GR B	CS	NA
18" SW(3)-2	18	STD	0.375	SA 106 GR B	CS	NA

WHP-2
 WELD & COMPONENT IDENTIFICATION DIAGRAM

TITLE:
 SW LOOP A SUPPLY TO RHR-HX-1A

OWG NO: SW-301-G REV 1

NO	DATE	REVISION	BY	CHKD	APPVD
1	12-84	REVISED AS NOTED ADDED KEYPLAN	YLN	WDR	TFC
0	11-5-80	ISSUED FOR USE	KMA	WAK	APD

WNP-02
 INTERVAL: PSI
 PERIOD: NA
 OUTAGE:
 DRAWING NO. SW-301

WASHINGTON PUBLIC POWER SUPPLY SYSTEM
 PROGRAM PLAN AND SCHEDULE
 SYSTEM OR COMPONENT: SW(1)-2
 DESCRIPTION: SW LOOP A SUPPLY

PAGE 001
 DATE 12/14/84

<u>IDENT. NO.</u>	<u>DESCRIPTION</u>	<u>SECT.</u> <u>XI</u> <u>EXAM.</u>	<u>EXAM</u> <u>MTM.</u>	<u>PROCEDURE</u>	<u>CAL.</u> <u>BLOCK</u>	<u>INSERVICE</u>		<u>NOTES</u>
						<u>REQ.</u>	<u>SCHEDULED</u> <u>OUTAGE</u>	
SW-174	BOX	N/A	VT-3	303/8.2.17				
SW-57	RIGID	N/A	VT-3	303/8.2.17				
SW-437	STRUT	N/A	VT-3	303/8.2.17				
SW-913N	STRUT	N/A	VT-3	303/8.2.17				
SW-58	BOX	N/A	VT-3	303/8.2.17				
SW-318	STRUT	N/A	VT-3	303/8.2.17				
SW-59	BOX	N/A	VT-3	303/8.2.17				
SW-436	STRUT	N/A	VT-3	303/8.2.17				
SW-60	RIGID	N/A	VT-3	303/8.2.17				
SW-61	STRUT	N/A	VT-3	303/8.2.17				
SW-172	STRUT	N/A	VT-3	303/8.2.17				
SW-62	STRUT	N/A	VT-3	303/8.2.17				
SW-63	BOX	N/A	VT-3	303/8.2.17				
SW-64	BOX	N/A	VT-3	303/8.2.17				
SW-65	STRUT	N/A	VT-3	303/8.2.17				
SW-66	BOX	N/A	VT-3	303/8.2.17				
SW-71	STRUT	N/A	VT-3	303/8.2.17				
SW-67	RIGID	N/A	VT-3	303/8.2.17				

WNP-02
INTERVAL: PSI
PERIOD: NA
OUTAGE:
DRAWING NO. SW-301

WASHINGTON PUBLIC POWER SUPPLY SYSTEM
PROGRAM PLAN AND SCHEDULE
SYSTEM OR COMPONENT: SW(1)-2
DESCRIPTION: SW LOOP A SUPPLY

PAGE 002
DATE 12/14/84

<u>IDENT. NO.</u>	<u>DESCRIPTION</u>	<u>SECT.</u> XI	<u>EXAM</u> MTH.	<u>PROCEDURE</u>	<u>CAL.</u> BLOCK	<u>INSERVICE</u>		<u>NOTES</u>
						<u>REQ.</u>	<u>SCHEDULED</u> OUTAGE	
SW-173	STRUT	N/A	VT-3	303/8.2.17				
SW-68	BOX	N/A	VT-3	303/8.2.17				
SW-69	RIGID	N/A	VT-3	303/8.2.17				
SW-171	STRUT	N/A	VT-3	303/8.2.17				
SW-70	STRUT	N/A	VT-3	303/8.2.17				
SW-317	RIGID	N/A	VT-3	303/8.2.17				
SW-126	STRUT	N/A	VT-3	303/8.2.17				
SW-942N	STRUT	N/A	VT-3	303/8.2.17				
SW-435	BOX	N/A	VT-3	303/8.2.17				
SW-72	RIGID	N/A	VT-3	303/8.2.17				
SW-73	STRUT	N/A	VT-3	303/8.2.17				
SW-200	STRUT	N/A	VT-3	303/8.2.17				
SW-74	STRUT	N/A	VT-3	303/8.2.17				
SW-434	BOX	N/A	VT-3	303/8.2.17				
SW-75	RIGID	N/A	VT-3	303/8.2.17				
SW-76	STRUT	N/A	VT-3	303/8.2.17				
SW-201	STRUT	N/A	VT-3	303/8.2.17				
SW-77	BOX	N/A	VT-3	303/8.2.17				


WNP-02
 INTERVAL: PSI
 PERIOD: NA
 OUTAGE:
 DRAWING NO. SW-301

WASHINGTON PUBLIC POWER SUPPLY SYSTEM
 PROGRAM PLAN AND SCHEDULE
 SYSTEM OR COMPONENT: SW(1)-2
 DESCRIPTION: SW LOOP A SUPPLY

PAGE 003
 DATE 12/14/84


<u>IDENT. NO.</u>	<u>DESCRIPTION</u>	<u>SECT.</u> <u>XI</u> <u>EXAM.</u>	<u>EXAM</u> <u>MTG.</u>	<u>PROCEDURE</u>	<u>CAL.</u> <u>BLOCK</u>	<u>INSERVICE</u>		<u>NOTES</u>
						<u>REQ.</u>	<u>SCHEDULED</u> <u>OUTAGE</u>	
SW-78	SPRING (2)	N/A	VT-3	303/8.2.17				
			VT-4	303/8.2.17				
SW-120	BOX	N/A	VT-3	303/8.2.17				
SW-121	SPRING (2)	N/A	VT-3	303/8.2.17				
			VT-4	303/8.2.17				
SW-987N	PSA-3 SN(2)	N/A	VT-3	303/8.2.17				
			VT-4	303/8.2.17				
SW-202	STRUT	N/A	VT-3	303/8.2.17				
SW-430	STRUT	N/A	VT-3	303/8.2.17				
SW-122	SPRING (2)	N/A	VT-3	303/8.2.17				
			VT-4	303/8.2.17				
SW-123	RIGID	N/A	VT-3	303/8.2.17				
SW-124	PSA-35 SN(4)	N/A	VT-3	303/8.2.17				S/N
			VT-4	303/8.2.17				S/N
SW-PB-301	SW PRES BNDRY	N/A	VT-2	N/A				SEE NOTES #6 & #7.



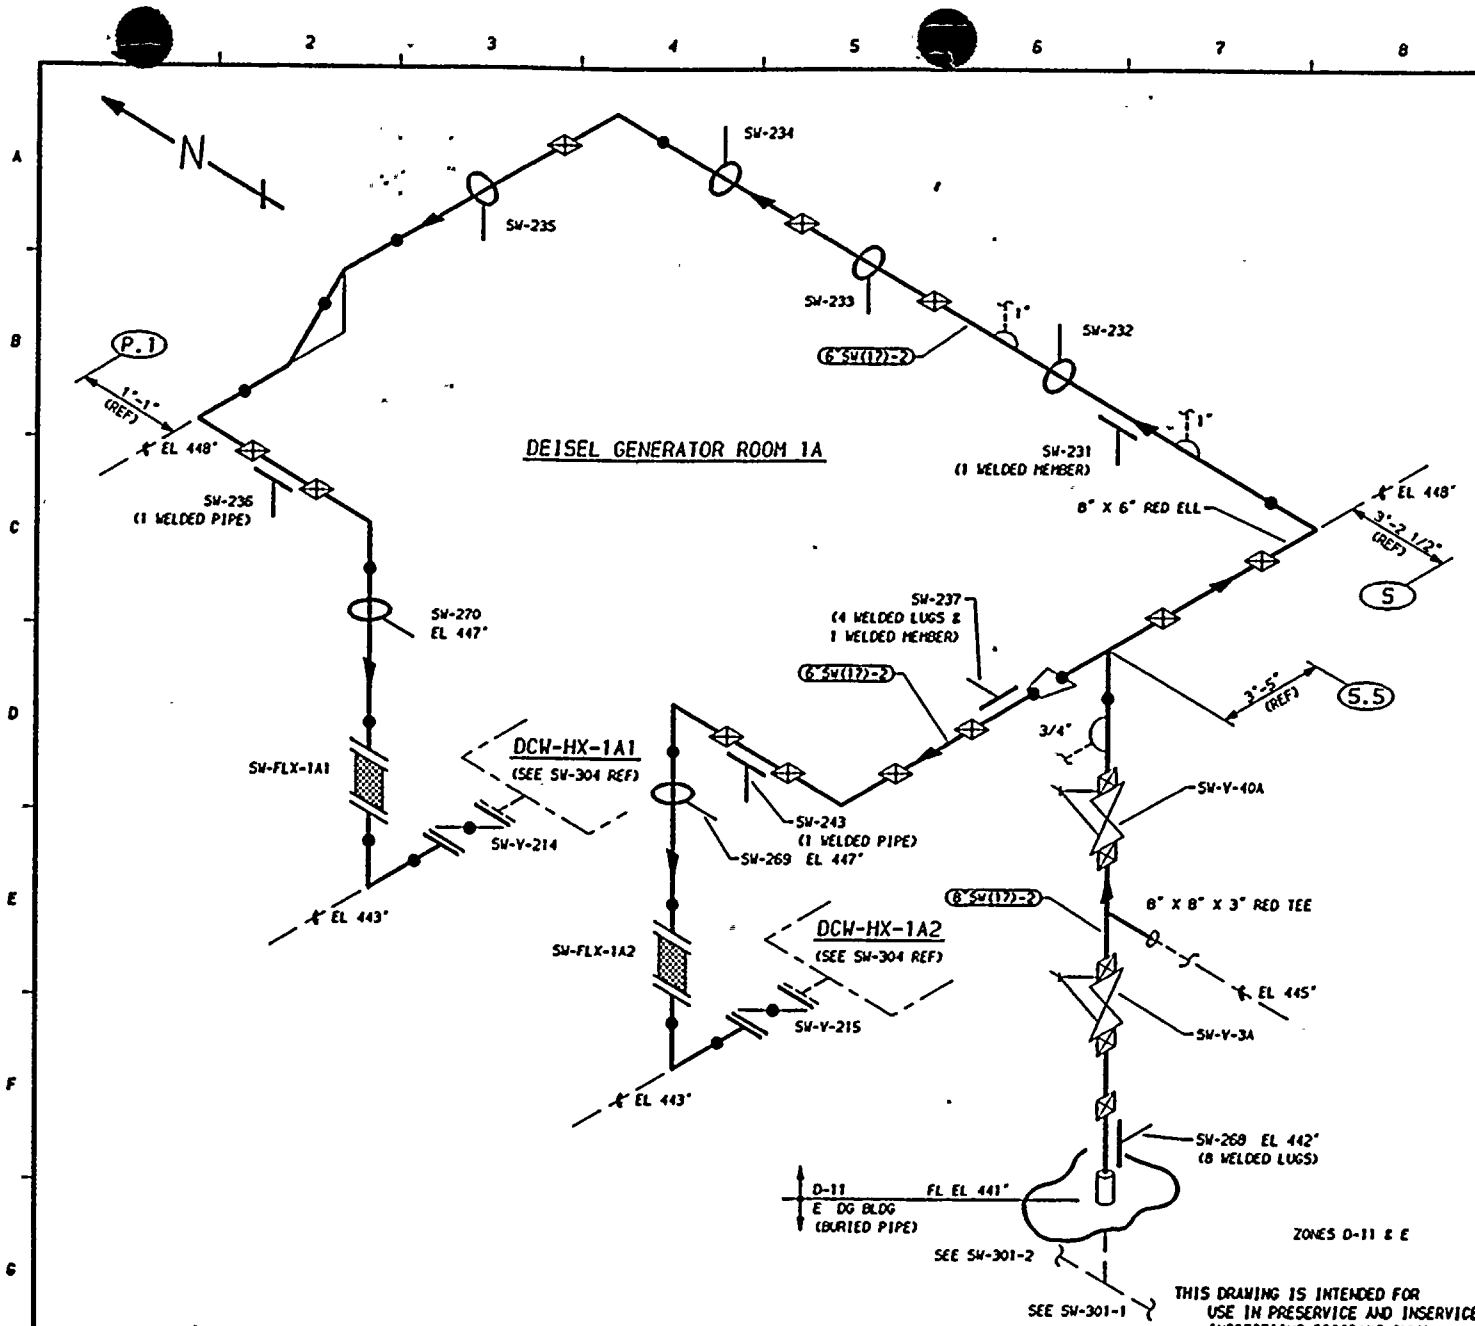

- NOTES:**
1. THIS DRAWING IDENTIFIES PIPING AND COMPONENTS SUBJECT ONLY TO A VISUAL EXAM FOR (1) EVIDENCE OF LEAKAGE DURING SYSTEM PRESSURE OR OPERABILITY TESTS; (2) PRESSURE DECAY TESTS OF BURIED PIPING; AND (3) LOSS OF SUPPORT CAPABILITY OR INADEQUATE RESTRAINT FOR SUPPORTS AND HANGERS ON PIPING EXCEEDING 4" NOM. TESTS SHALL BE CONDUCTED PER ASME SECTION XI, ARTICLES IWA-5000 AND IWD-2000.
 2. FOR BRANCH PIPING 4" NOM. OR LESS (CONNECTION SHOWN IN DASHED LINES) EXTEND VISUAL LEAKAGE EXAM THROUGH THE OUTERMOST NORMALLY CLOSED NUCLEAR CLASS VALVE, OR UNTIL TRANSITION TO INSTRUMENT TUBING, UNLESS OTHERWISE NOTED.

- REFERENCES:**
- 151 - 224
 - BOYEE & CRAIL ISOMETRICS
 - SW-250-21.24 REV 9
 - SW-300-1.3 REV 6
 - SW-300-4.9 REV 9

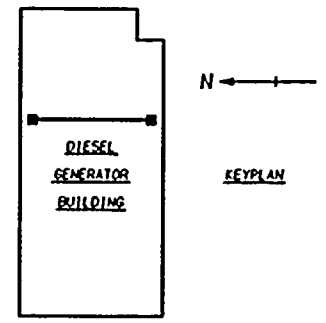

QUALITY CLASS, 1	ASME CODE CLASS, 3
ENGR, GA KUCLER	DRAWN, K-McA DATE, 11-9-78

WASHINGTON PUBLIC POWER
SUPPLY SYSTEM
RICHLAND, WASHINGTON 99352


WNP-2
WELD & COMPONENT
IDENTIFICATION DIAGRAM

TITLE, SW LOOP A SUPPLY TO DCW-HX-1A1 & 1A2	DWG NO, SW-302	REV 1
--	----------------	-------

PIPING SYSTEM	NOM DIA (IN)	SCH	NOM WALL THK	MATERIAL SPECIFICATION	MATL TYPE	CAL BLOCK NO
8" SW(17)-2	8	STD	0.322	SA 106 GR B	CS	NA
6" SW(17)-2	6	STD	0.280	SA 106 GR B	CS	NA

1	1-27-84	GENERAL UP-DATE REDRAWN	K-McA	DPR	JFK
0	11-5-80	ISSUED FOR USE	K-McA	GAK	W/H
NO	DATE	REVISION	BY	CHKD	APVD

 THIS DRAWING IS INTENDED FOR USE IN PRESERVICE AND INSERVICE INSPECTIONS PROGRAMS ONLY.




WNP-02
 INTERVAL: PSI
 PERIOD: NA
 OUTAGE:
 DRAWING NO. SW-302

WASHINGTON PUBLIC POWER SUPPLY SYSTEM
 PROGRAM PLAN AND SCHEDULE
 SYSTEM OR COMPONENT: SW(17)-2
 DESCRIPTION: SW LOOP A SUPPLY

PAGE 001
 DATE 12/14/84

<u>IDENT. NO.</u>	<u>DESCRIPTION</u>	<u>SECT.</u> <u>XI</u> <u>EXAM.</u>	<u>EXAM</u> <u>MTN.</u>	<u>PROCEDURE</u>	<u>CAL.</u> <u>BLOCK</u>	<u>INSERVICE</u>		<u>NOTES</u>
						<u>REQ.</u>	<u>SCHEDULED</u> <u>OUTAGE</u>	
SW-268	BOX	N/A	VT-3	303/8.2.17				
SW-231	BOX	N/A	VT-3	303/8.2.17				
SW-232	BOX	N/A	VT-3	303/8.2.17				
SW-233	BOX	N/A	VT-3	303/8.2.17				
SW-234	BOX	N/A	VT-3	303/8.2.17				
SW-235	BOX	N/A	VT-3	303/8.2.17				
SW-236	BOX	N/A	VT-3	303/8.2.17				
SW-270	BOX	N/A	VT-3	303/8.2.17				
SW-237	BOX	N/A	VT-3	303/8.2.17				
SW-243	BOX	N/A	VT-3	303/8.2.17				
SW-269	RIGID	N/A	VT-3	303/8.2.17				
SW-PB-302	BOX	N/A	VT-3	303/8.2.17				
	SW PRES BNDRY	N/A	VT-2	N/A				

SEE NOTES #6 & #7.

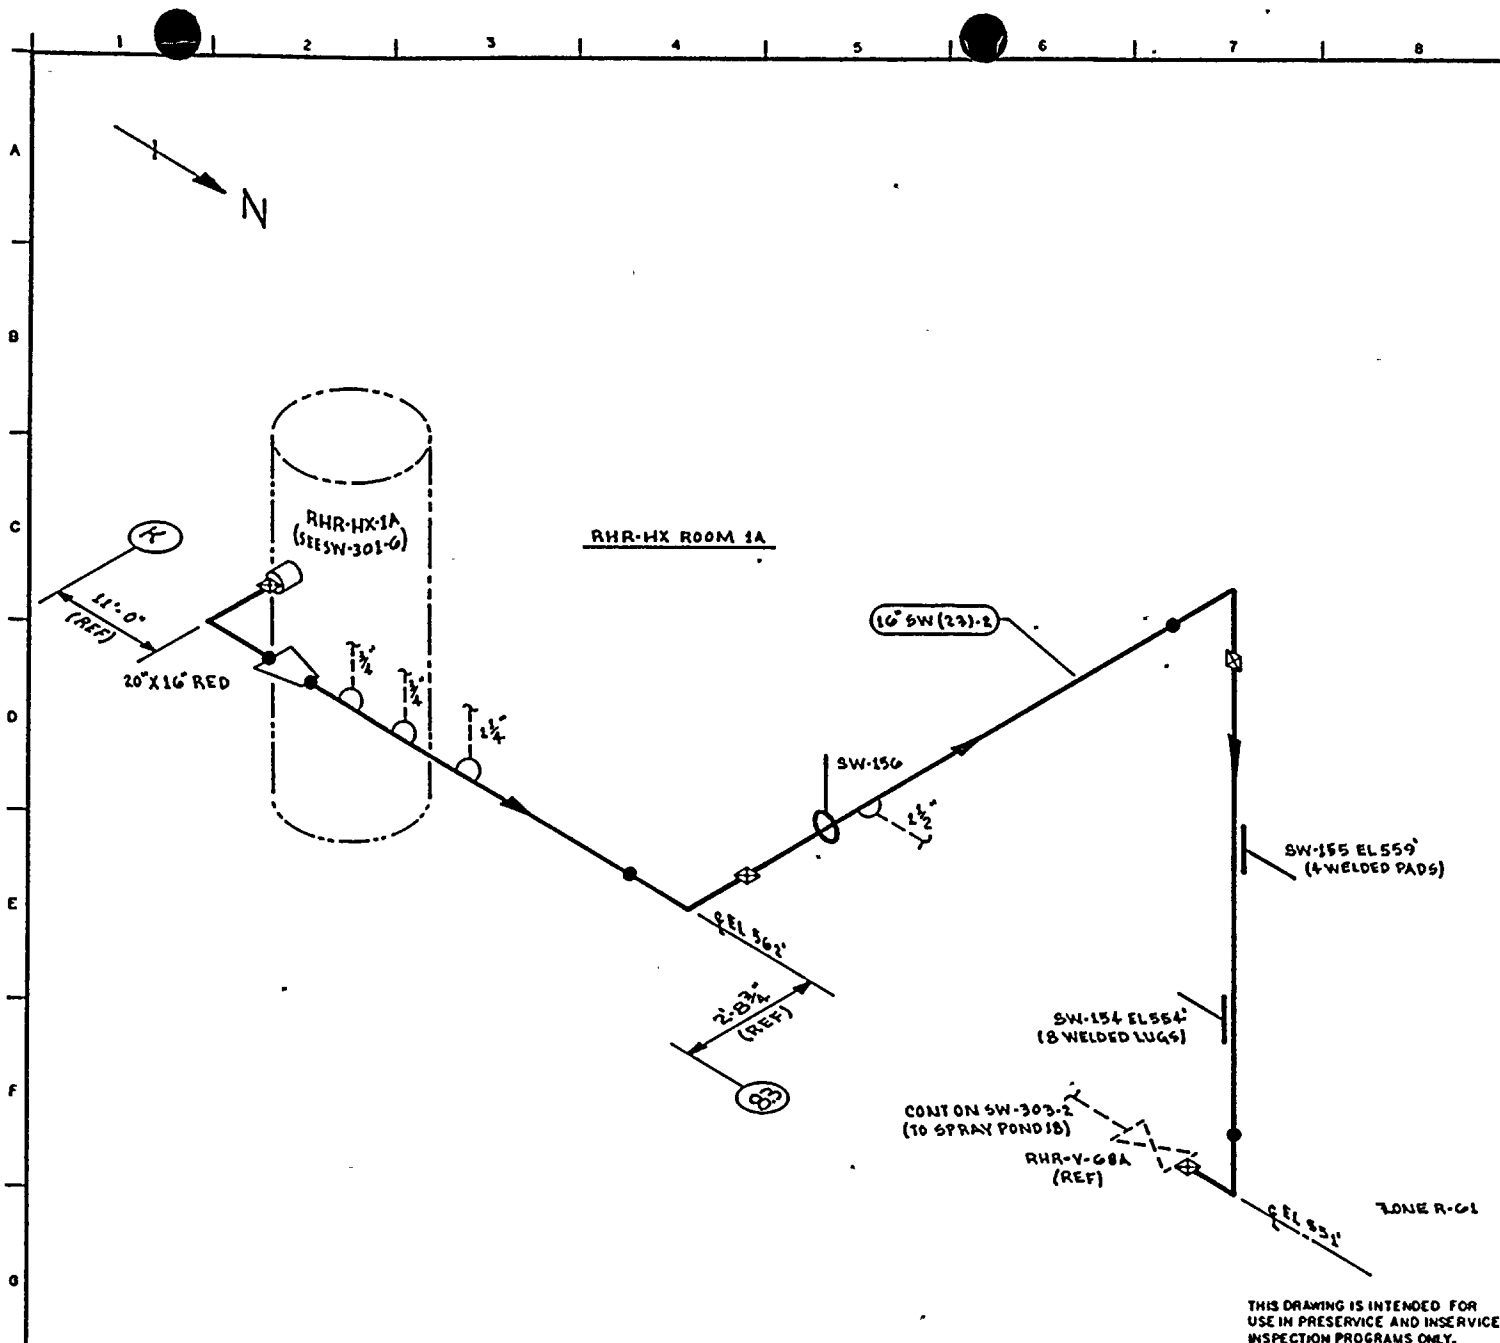

NOTES:

1. THIS DRAWING IDENTIFIES PIPING & COMPONENTS SUBJECT ONLY TO A VISUAL EXAM FOR (1) EVIDENCE OF LEAKAGE DURING SYSTEM PRESSURE OR OPERABILITY TESTS; (2) PRESSURE DECAY TESTS OF BURIED PIPING; & (3) LOSS OF SUPPORT CAPABILITY OR INADEQUATE RESTRAINT FOR SUPPORTS & HANGERS ON PIPING EXCEEDING 4" NOM. TESTS SHALL BE CONDUCTED PER ASME SECTION XI, ARTICLES SWA-5000 & IWD-2000.
2. FOR BRANCH PIPING 4" NOM OR LESS (CONN SHOWN IN DASHED LINES) EXTEND VISUAL LEAKAGE EXAM THROUGH THE OUTERMOST NORMALLY CLOSED NUCLEAR CLASS VALVE, OR UNTIL TRANSITION TO INSTRUMENT TUBING, UNLESS OTHERWISE NOTED.

REFERENCES:

- BOYCE & CRAIL ISOMETRICS
- SW-296-1.5 REV 4
- SW-296-1.5H REV 0

QUALITY CLASS: 1	ASME CODE CLASS: 3
ENGR: GA KUGLER	DATE: 11-8-78


WASHINGTON PUBLIC POWER SUPPLY SYSTEM
 RICHMOND, WASHINGTON 99052

THIS DRAWING IS INTENDED FOR USE IN PRESERVICE AND INSERVICE INSPECTION PROGRAMS ONLY.


PIPING SYSTEM	NOM DIA (IN)	SCH	NOM WALL THK	MATERIAL SPECIFICATION	MATL TYPE	CAL BLOCK NO
16" SW (23)-2	16	STD	0.375	SA 106 GR B	CS	NA

WNP-2
 WELD & COMPONENT
 IDENTIFICATION DIAGRAM

TITLE:
 SW LOOP A RETURN RHR-HX-1A DISCHARGE


DWG NO: SW-303-1 REV 0

0	11-5-80	ISSUED FOR USE	GA	GA	GA
NO	DATE	REVISION	BY	CHKD	APPVD

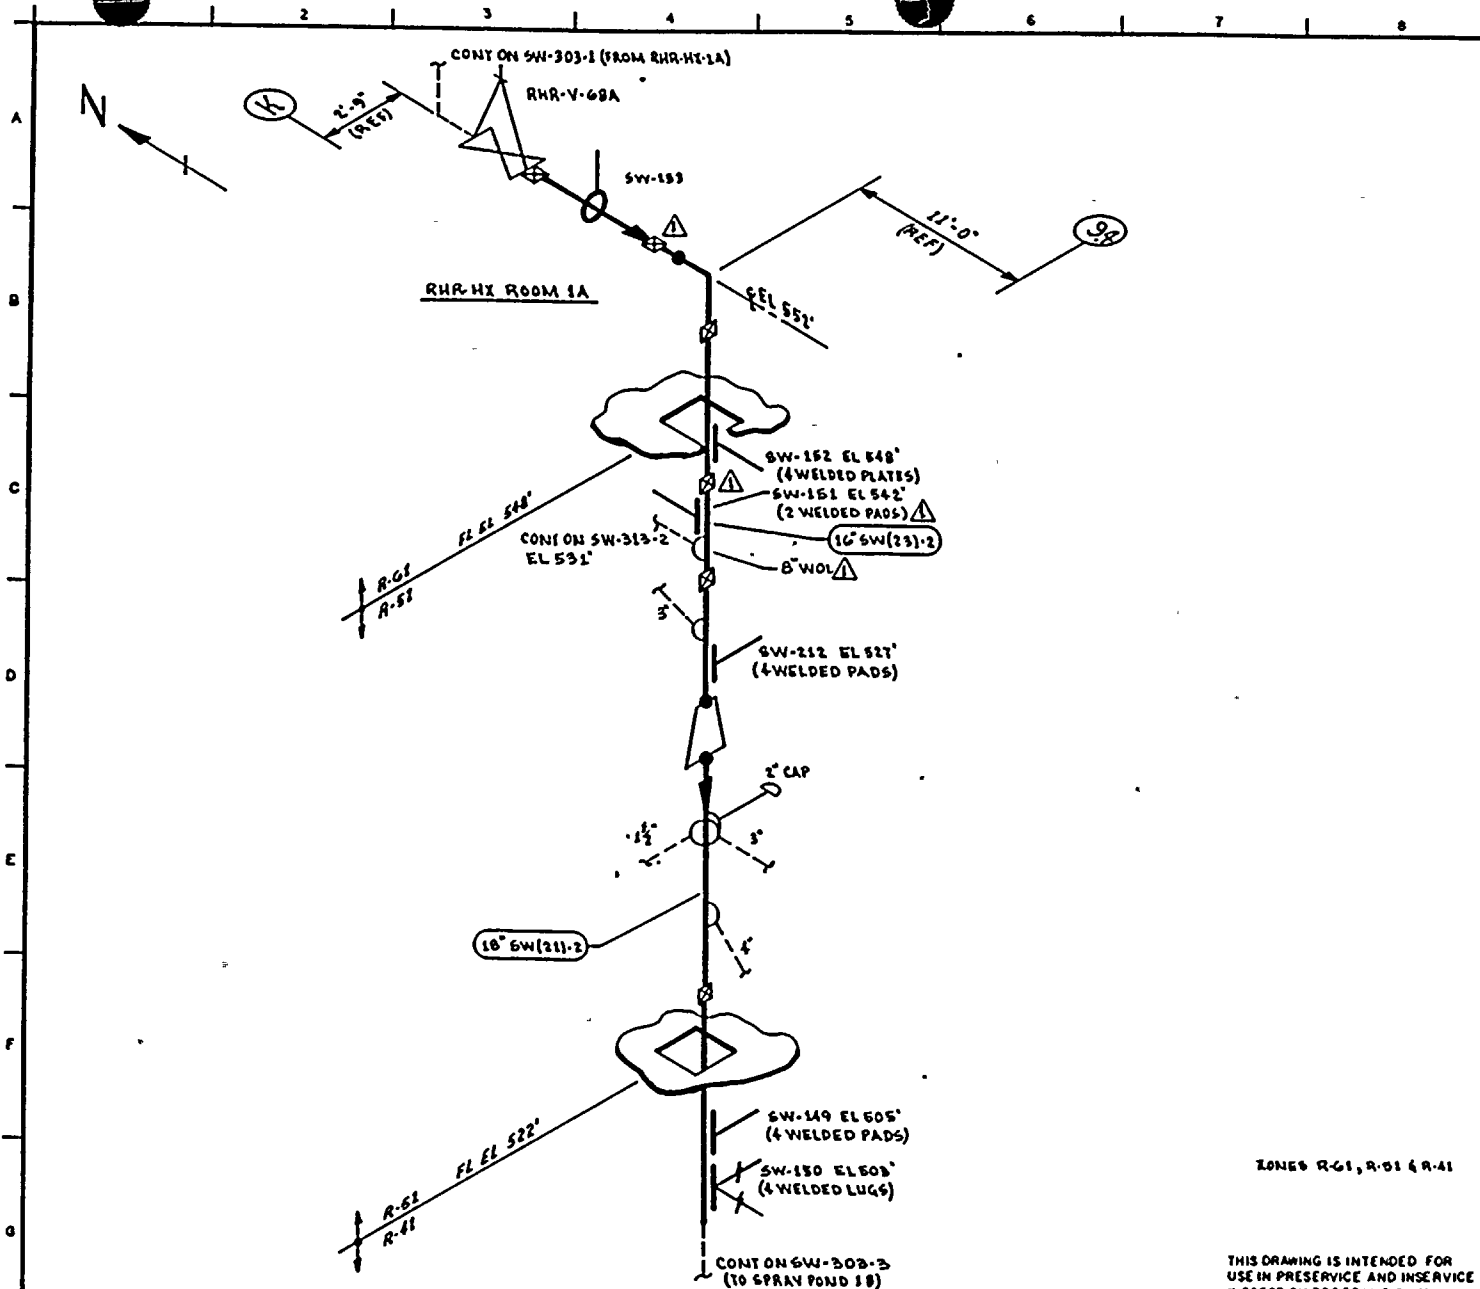

- NOTES:
1. THIS DRAWING IDENTIFIES PIPING & COMPONENTS SUBJECT ONLY TO A VISUAL EXAM FOR (1) EVIDENCE OF LEAKAGE DURING SYSTEM PRESSURE OR OPERABILITY TESTS; (2) PRESSURE DECAY TESTS OF BURIED PIPING; & (3) LOSS OF SUPPORT CAPABILITY OR INADEQUATE RESTRAINT FOR SUPPORTS & HANGERS ON PIPING EXCEEDING 4" NOM. TESTS SHALL BE CONDUCTED PER ASME SECTION XI, ARTICLES IWA-5000 & IWD-2000.
 2. FOR BRANCH PIPING 4" NOM OR LESS (EVEN SHOWN IN DASHED LINES) EXTEND VISUAL LEAKAGE EXAM THROUGH OUTERMOST NORMALLY CLOSED NUCLEAR CLASS VALVE, OR UNTIL TRANSITION TO SUSSTAINMENT TUBING, UNLESS OTHERWISE NOTED.

- REFERENCES:
- DOVEE & CRAIG ISOMETRICS
- SW-296-1.5 REV 12
 SW-296-6 REV 18
 SW-296-7.16 REV 9

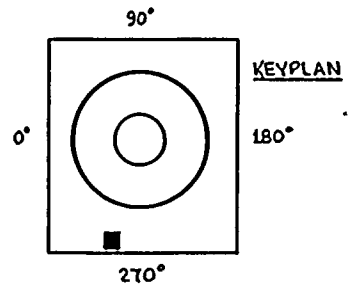

ZONES R-01, R-01 & R-41

THIS DRAWING IS INTENDED FOR USE IN PRESERVICE AND INSERVICE INSPECTION PROGRAMS ONLY.

QUALITY CLASS: 1	ASME CODE CLASS: 3
ENGR: GA KUGLER	DATE: 11-10-78

WASHINGTON PUBLIC POWER SUPPLY SYSTEM
 RICHMOND WASHINGTON 98042

PIPING SYSTEM	NOM DIA (IN)	SCH	NOM WALL THK	MATERIAL SPECIFICATION	MATL TYPE	CAL BLOCK NO
16" SW(23)-2	16	STD	0.375	SA 106 GR B	CG	N/A
18" SW(21)-2	18	STD	0.375	SA 106 GR B	CG	N/A


WNP-2
 WELD & COMPONENT IDENTIFICATION DIAGRAM

TITLE:
 SW LOOP A RETURN TO SPRAY POND 1B

DWG NO: SW-303-2 REV 1


1	1-21-84	REVISED AS NOTED ADDED KEYPLAN	GA	DK	TFW
0	11-5-80	ISSUED FOR USE	GA	DK	TFW
NO	DATE	REVISION	BY	CHKD	APPVD



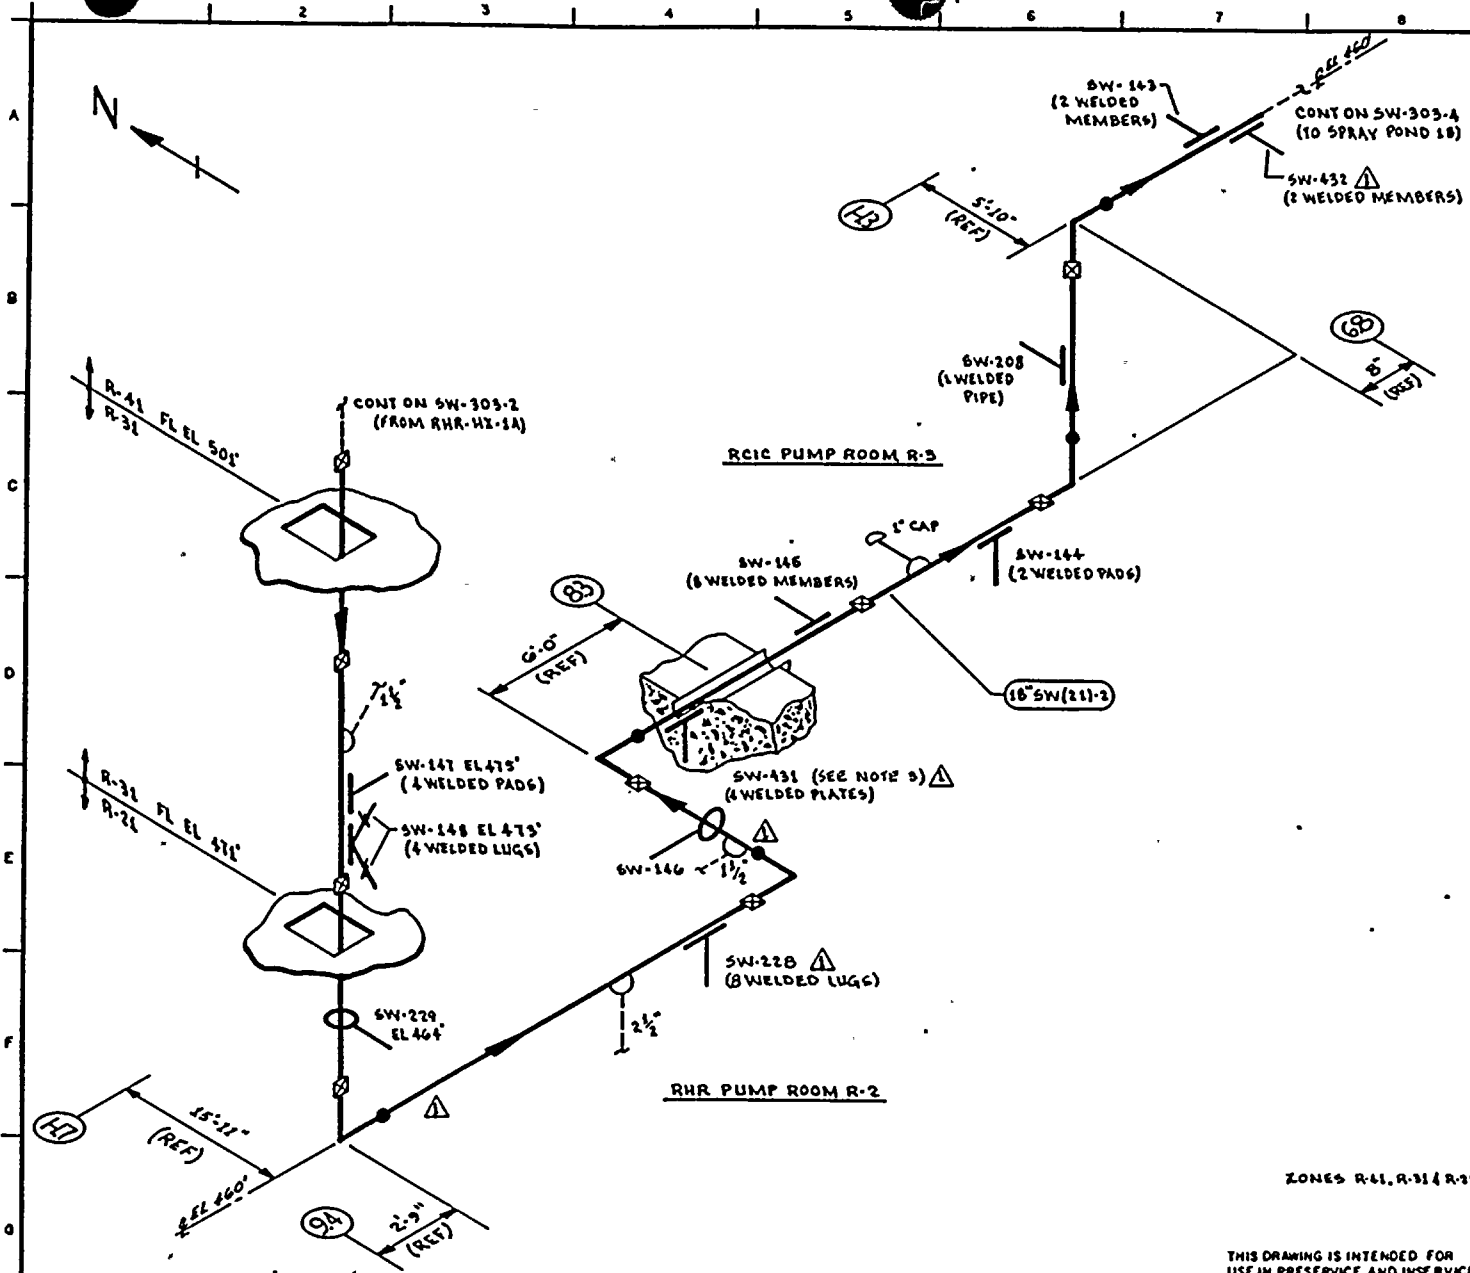

- NOTES:
1. THIS DRAWING IDENTIFIES PIPING & COMPONENTS SUBJECT ONLY TO A VISUAL EXAM FOR (1) EVIDENCE OF LEAKAGE DURING SYSTEM PRESSURE OR OPERABILITY TESTS; (2) PRESSURE DECAY TESTS OF BURIED PIPING; & (3) LOSS OF SUPPORT CAPABILITY OR INADEQUATE RESTRAINT FOR SUPPORTS & HANGERS ON PIPING EXCEEDING 4" NOM. TESTS SHALL BE CONDUCTED PER ASME SECTION XI, ARTICLES IWA-5000 & IWD-2000.
 2. FOR BRANCH PIPING 4" NOM. OR LESS (CONN SHOWN IN DASHED LINES) EXTEND VISUAL LEAKAGE EXAM THROUGH THE OUTERMOST NORMALLY CLOSED NUCLEAR CLASS VALVE, OR UNTIL TRANSITION TO INSTRUMENT TUBING, UNLESS OTHERWISE NOTED.
 3. COMPONENT SUPPORT IS INACCESSIBLE DUE TO FOAM FILLED WATER TIGHT BOOT.

REFERENCES:
BOVEE & CRAIG ISOMETRIC
SW-296-7.16 REV 9

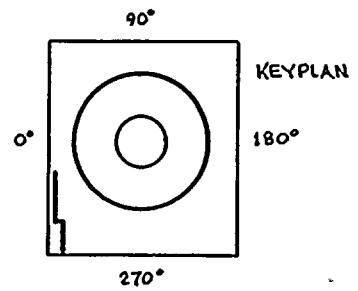

ZONES R-41, R-31 & R-21

THIS DRAWING IS INTENDED FOR USE IN PRESERVICE AND INSERVICE INSPECTION PROGRAMS ONLY.

QUALITY CLASS: 1 ASME CODE CLASS: 3
ENGR: GA WUGLER DRAWN: K-MEA DATE: 11-15-78



WASHINGTON PUBLIC POWER SUPPLY SYSTEM
RICHLAND WASHINGTON 98342

PIPING SYSTEM	NOM DIA (IN)	SCH	NOM WALL THK	MATERIAL SPECIFICATION	MATL TYPE	CAL BLOCK NO
18" SW(211)-2	18	STD	0.375	SA 106 GR B	CS	NA


WNP-2
WELD COMPONENT
IDENTIFICATION DIAGRAM

TITLE:
SW LOOP A RETURN TO SPRAY POND 1B

DWG NO: SW-303-3 REV 1


NO	DATE	REVISION	BY	CHKD	APPVD
L	12-8-84	REVISED AS NOTED ADDED KEYPLAN	K-MEA	EM	TFM
D	11-5-80	ISSUED FOR USE	K-MEA	NI	CSW



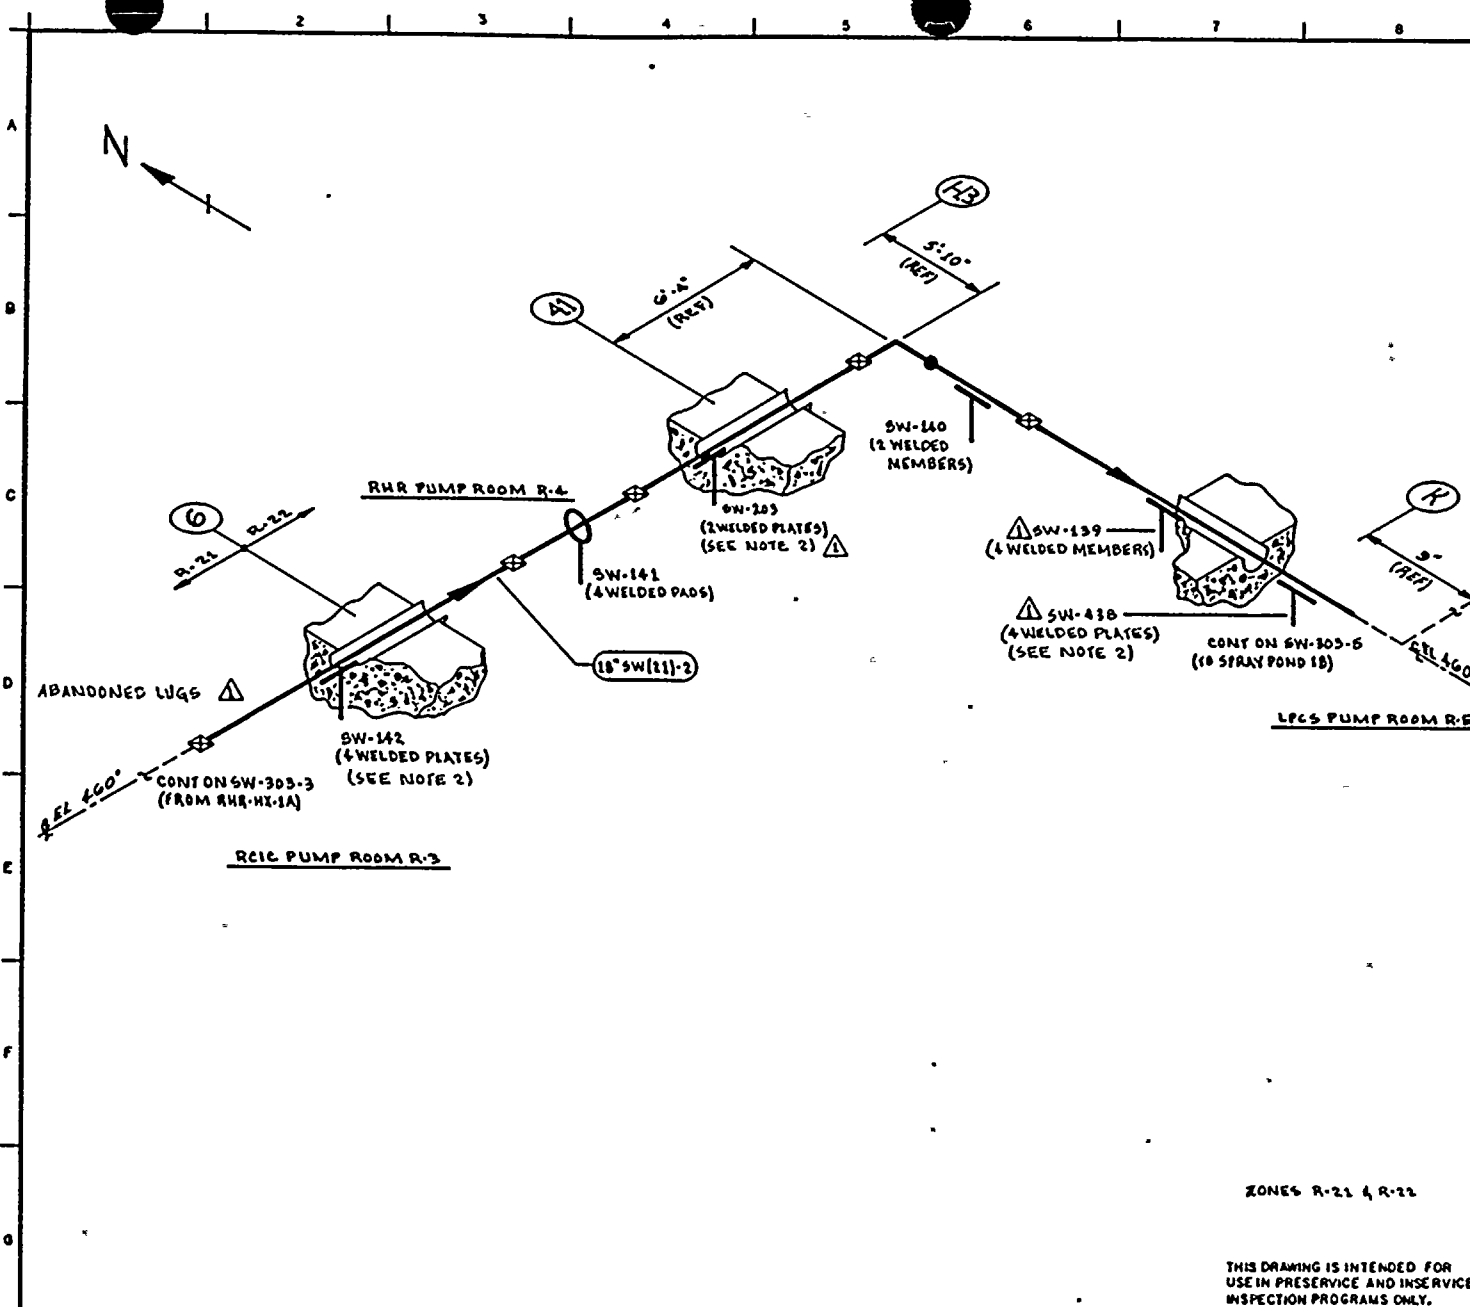

- NOTES:**
1. THIS DRAWING IDENTIFIES PIPING & COMPONENTS SUBJECT ONLY TO A VISUAL EXAM FOR (1) EVIDENCE OF LEAKAGE DURING SYSTEM PRESSURE OR OPERABILITY TESTS; (2) PRESSURE DECA TESTS OF BURIED PIPING; & (3) LOSS OF SUPPORT CAPABILITY OR INADEQUATE RESTRAINT FOR SUPPORTS & HANGERS ON PIPING EXCEEDING 4" NOM. TESTS SHALL BE CONDUCTED PER ASME SECTION XI, ARTICLES SVA-5000 & SVA-2000.
 2. COMPONENT SUPPORT IS INACCESSIBLE DUE TO FOAM FILLED WATER TIGHT BOOT.

REFERENCES:
BOYCE & CRAIG ISOMETRIC
SW-296-17-26 REV 3

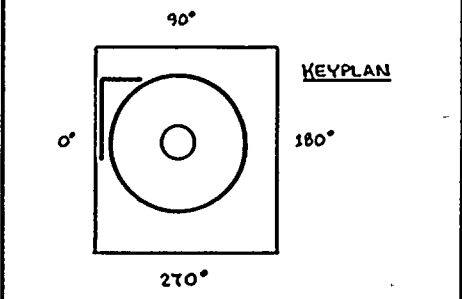

ZONES R-21 & R-22

THIS DRAWING IS INTENDED FOR USE IN PRESERVICE AND INSERVICE INSPECTION PROGRAMS ONLY.

QUALITY CLASS: 1	ASME CODE CLASS: 2
ENGR: GA KUGLER	DRAWN: K.M.C.A. DATE: 11-20-78

WASHINGTON PUBLIC POWER SUPPLY SYSTEM
RICHLAND, WASHINGTON 99352


PIPING SYSTEM	NOM DIA (IN)	SCH	NOM WALL THK	MATERIAL SPECIFICATION	MATL TYPE	CAL BLOCK NO
18" SW(21)-2	18	STD	0.375	SA 106 GR B	CS	NA

WNP-2
WELD & COMPONENT
IDENTIFICATION DIAGRAM

TITLE:
SW LOOP A RETURN TO SPRAY POND 1B


DWG NO: SW-303-4 REV 1

NO	DATE	REVISION	BY	CHKD	APPVD
1	11-27-81	REVISED AS NOTED ADDED KEYPLAN	K.M.C.A.	J.M.	T.F.H.
0	11-5-80	ISSUED FOR USE	K.M.C.A.	B.M.	A.M.P.

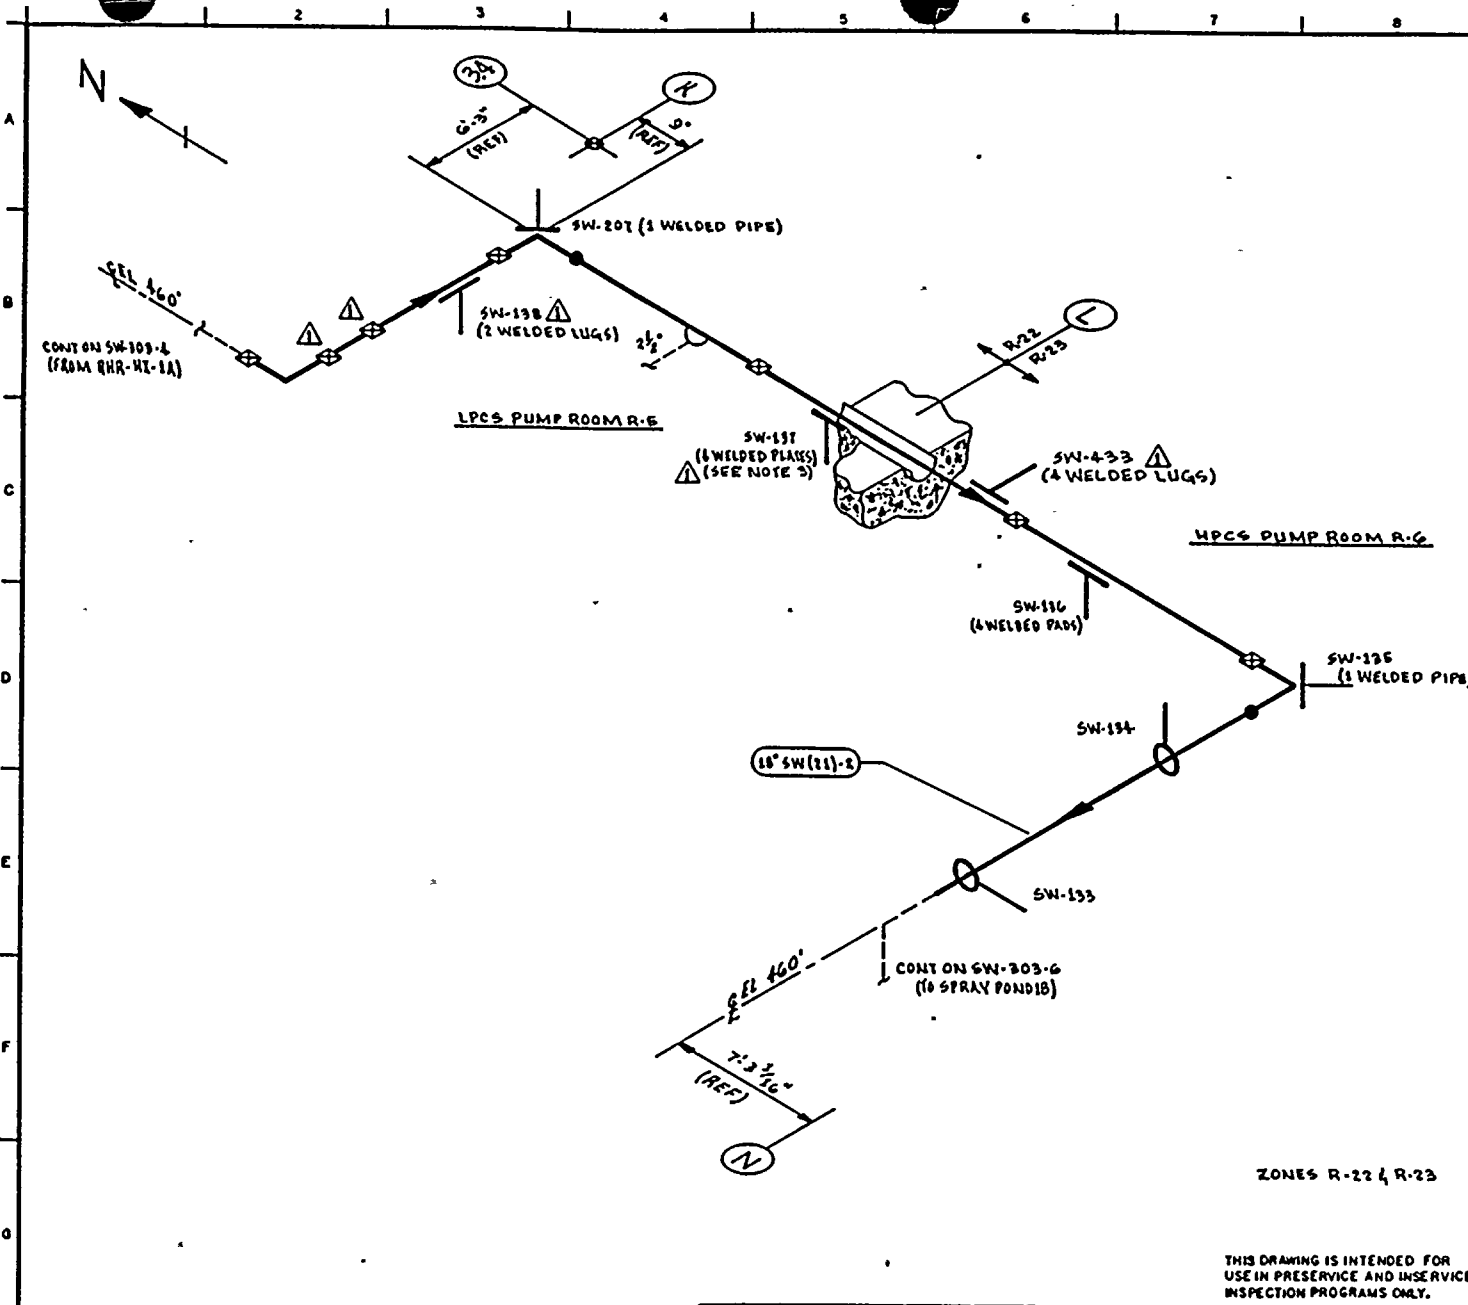

- NOTES:
1. THIS DRAWING IDENTIFIES PIPING & COMPONENTS SUBJECT ONLY TO A VISUAL EXAM FOR (1) EVIDENCE OF LEAKAGE DURING SYSTEM PRESSURE OR OPERABILITY TESTS; (2) PRESSURE DECAY TESTS OF BURIED PIPING; & (3) LOSS OF SUPPORT CAPABILITY OR INADEQUATE RESTRAINTS FOR SUPPORTS & HANGERS ON PIPING EXCEEDING 4" NOM. TESTS SHALL BE CONDUCTED PER ASME SECTION XI, ARTICLES SVA-5000 & SWD-2000.
 2. FOR BRANCH PIPING 4" NOM OR LESS (CONN SHOWN IN DASHED LINES) EXTEND VISUAL LEAKAGE EXAM THROUGH THE OUTERMOST NORMALLY CLOSED NON-CLEAR CLASS VALVE, OR UNTIL TRANSITION TO INSTRUMENT TUBING, UNLESS OTHERWISE NOTED.
 3. COMPONENT SUPPORT IS INACCESSIBLE DUE TO FOAM FILLED WATER TIGHT BOOF.

REFERENCES:
 BOVEE & CRAL ISOMETRICS
 SW-296-17-26 REV 3

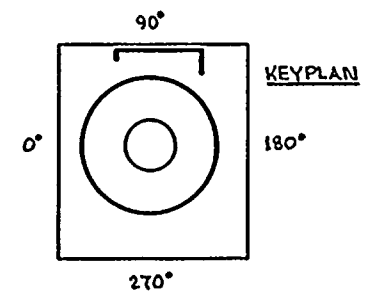

THIS DRAWING IS INTENDED FOR USE IN PRESERVE AND INSERVICE INSPECTION PROGRAMS ONLY.

QUALITY CLASS: 1	ASME CODE CLASS: 3
ENGR: GA KUQLER	DRAWN: K.M.C.A. DATE: 11-20-78

WASHINGTON PUBLIC POWER SUPPLY SYSTEM
 RICHLAND, WASHINGTON 99352

PIPING SYSTEM	NOM DIA (IN)	SCH	NOM WALL THK	MATERIAL SPECIFICATION	MATL TYPE	CAL BLOCK NO
18" SW(21)-2	18	STD	0.315	SA 106 GR B	CS	N/A


NO	DATE	REVISION	BY	CHKD	APPROV
1	1-27-84	REVISED AS NOTED ADDED KEYPLAN	K.A.A.	Z.W.	J.F.H.
0	11-5-80	ISSUED FOR USE	K.A.A.	C.A.N.	A.S.D.V.

WHP- 2
 WELD & COMPONENT IDENTIFICATION DIAGRAM

TITLE:
 SW LOOP A RETURN TO SPRAY POND 1B

DWG NO: SW-303-5
 REV 1



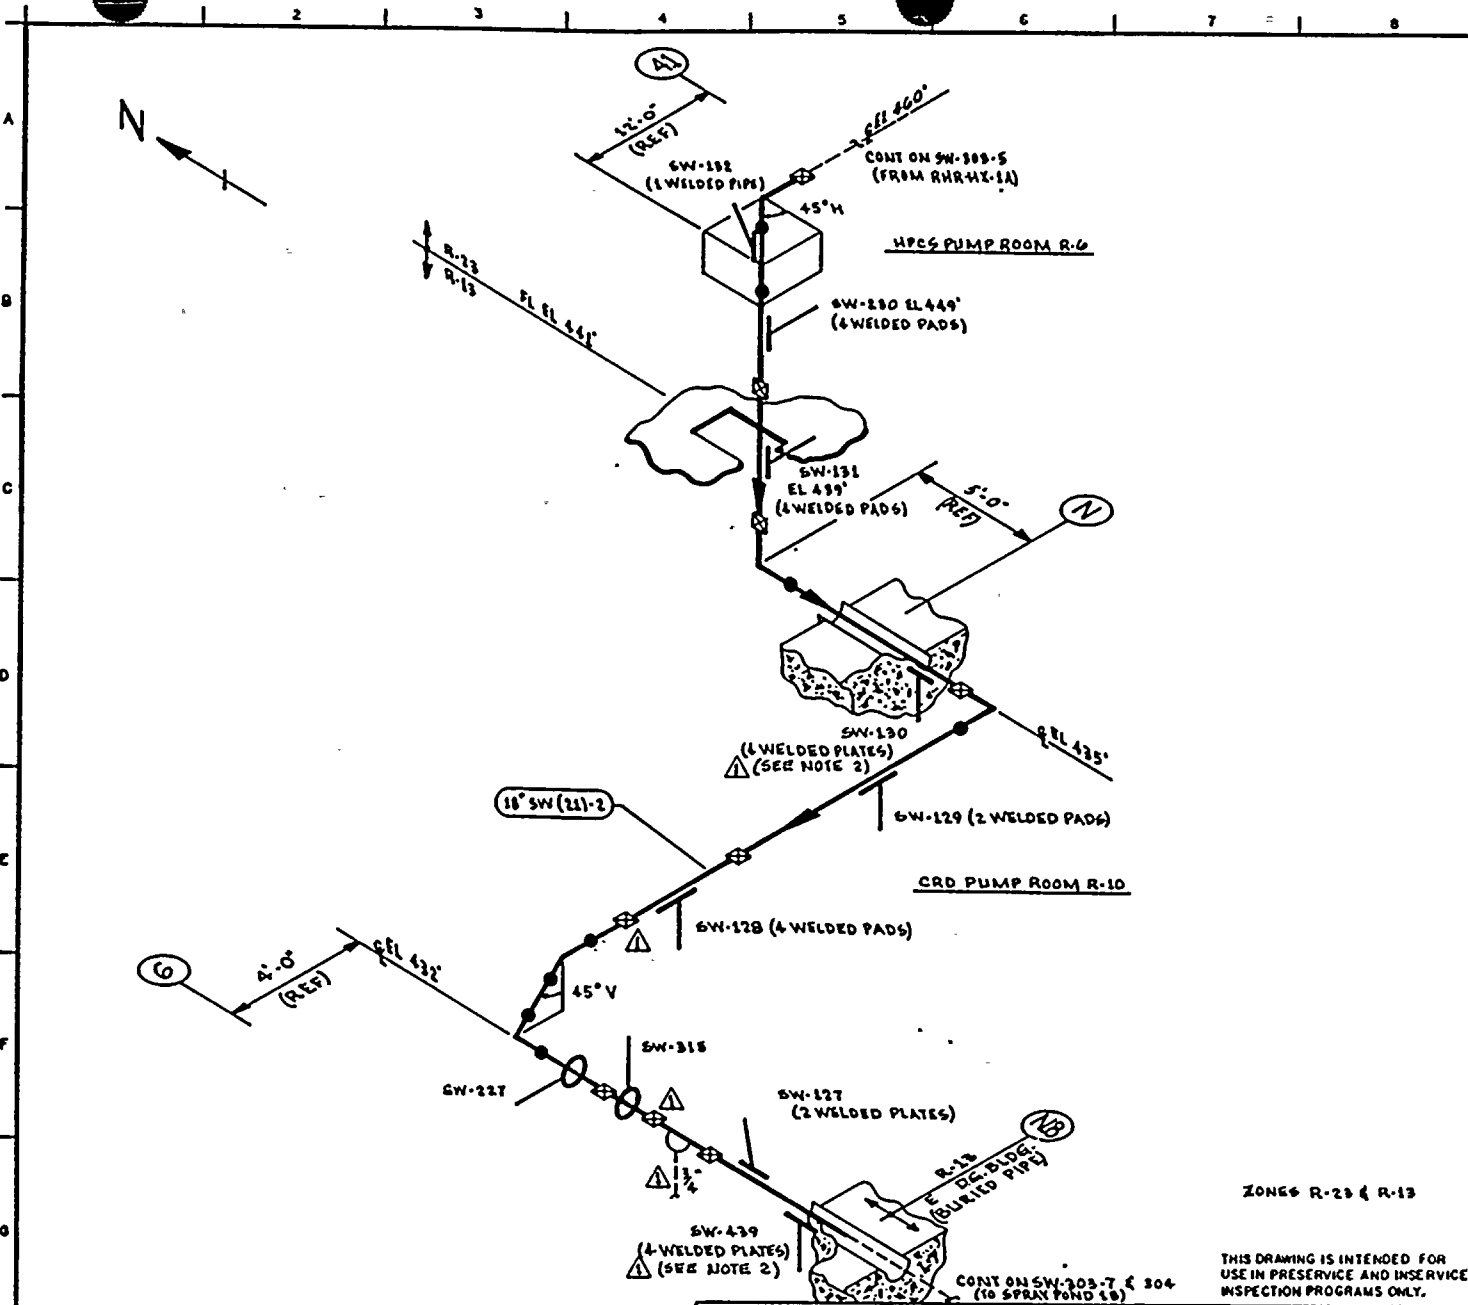


NOTES:

- THIS DRAWING IDENTIFIES PIPING & COMPONENTS SUBJECT ONLY TO A VISUAL EXAM FOR (1) EVIDENCE OF LEAKAGE DURING SYSTEM PRESSURE OR OPERABILITY TESTS; (2) PRESSURE DECAY TESTS OF BURIED PIPING; & (3) LOSS OF SUPPORT CAPABILITY OR INADEQUATE RESTRAINT FOR SUPPORTS & HANGERS ON PIPING EXCEEDING 4" NOM. TESTS SHALL BE CONDUCTED PER ASME SECTION XI, ARTICLES IWA-5000 & IWD-2000.
- COMPONENT SUPPORT IS UNACCESSIBLE DUE TO FOAM FILLED WATERTIGHT BOOT.

REFERENCES:

BOVEE & CRAIG ISOMETRICS
 SW-296-27.32 REV 10
 SW-296-33.36 REV 6

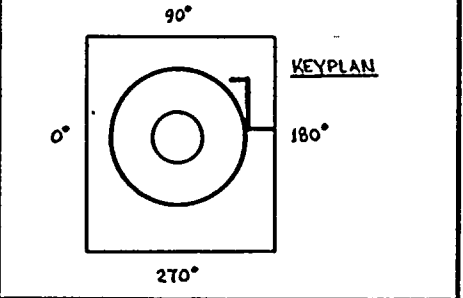

QUALITY CLASS: 1 ASME CODE CLASS: 3
 ENGR GA WUGLER DRAWN: K-MCA DATE: 11-27-78

WASHINGTON PUBLIC POWER SUPPLY SYSTEM
 RICHMOND, WASHINGTON 99252

WNP- 2
 WELD & COMPONENT IDENTIFICATION DIAGRAM


TITLE:
 SW LOOP A RETURN TO SPRAY POND 1B

DWG NO: SW-303-6 REV 1

THIS DRAWING IS INTENDED FOR USE IN PRESERVICE AND INSERVICE INSPECTION PROGRAMS ONLY.


PIPING SYSTEM	NOM DIA (IN)	SCH	NOM WALL THK	MATERIAL SPECIFICATION	MATL TYPE	CAL BLOCK NO
18" SW(21)-2	18	STD	0.375	SA 106 GRB	C6	NA

NO	DATE	REVISION	BY	CHKD	APPVD
1	1-21-84	REVISED AS NOTED ADDED KEYPLAN	KWJ	ENC	JFH
0	11-5-80	ISSUED FOR USE	KWJ	ENC	JFH

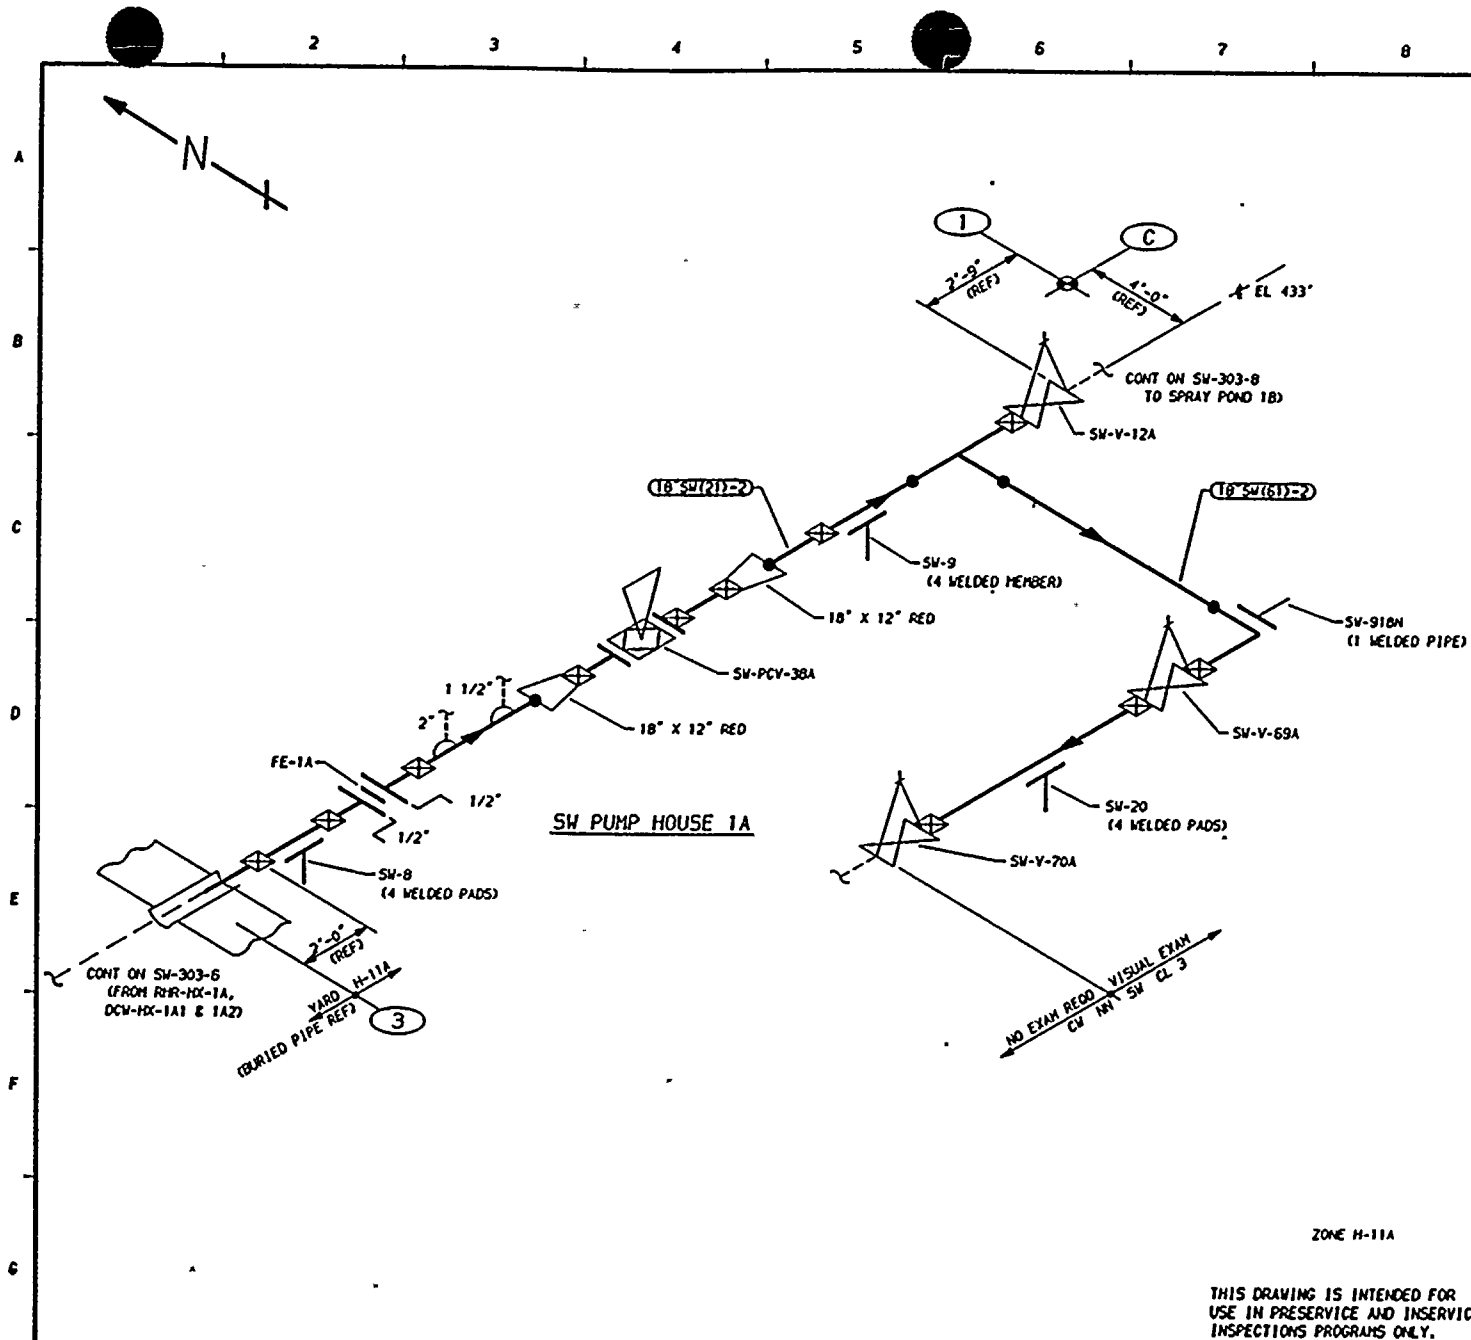

- NOTES:**
1. THIS DRAWING IDENTIFIES PIPING AND COMPONENTS SUBJECT ONLY TO A VISUAL EXAM FOR (1) EVIDENCE OF LEAKAGE DURING SYSTEM PRESSURE OR OPERABILITY TESTS, (2) PRESSURE DECAY TESTS OF BURIED PIPING, AND (3) LOSS OF SUPPORT CAPABILITY OR INADEQUATE RESTRAINT FOR SUPPORTS AND HANGERS ON PIPING EXCEEDING 4" NOM. TESTS SHALL BE CONDUCTED PER ASME SECTION XI, ARTICLES 1WA-5000 AND 1WD-2000.
 2. FOR BRANCH PIPING 4" NOM. OR LESS (CONNECTION SHOWN IN DASHED LINES) EXTEND VISUAL LEAKAGE EXAM THROUGH THE OUTERMOST NORMALLY CLOSED NUCLEAR CLASS VALVE, OR UNTIL TRANSITION TO INSTRUMENT TUBING, UNLESS OTHERWISE NOTED.

- REFERENCES:**
- 151 - 224
 - BOYCE & CRAIL ISOMETRICS
 - SW-296-47.53 REV 7
 - SW-296-54.57 REV 14

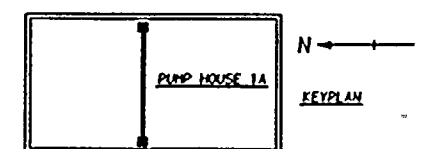

QUALITY CLASS:	1	ASME CODE CLASS:	3
ENGR:	GA KUGLER	DRAWN:	K-McA
DATE:	11-29-78		

WASHINGTON PUBLIC POWER
SUPPLY SYSTEM
 RICHLAND, WASHINGTON 99352

**WNP-2
 WELD & COMPONENT
 IDENTIFICATION DIAGRAM**

TITLE:
 SW LOOP A RETURN TO SPRAY POND 1B


DWG NO: SW-303-7 REV 1

THIS DRAWING IS INTENDED FOR
 USE IN PRESERVICE AND INSERVICE
 INSPECTIONS PROGRAMS ONLY.

PIPING SYSTEM	NOM DIA (IN)	SCH	NOM WALL THK	MATERIAL SPECIFICATION	MATL TYPE	CAL BLOCK NO
18"SW(21)-2	18	STD	0.375	SA 106 GR B	CS	NA
18"SW(61)-2	18	STD	0.375	SA 106 GR B	CS	NA

NO	DATE	REVISION	BY	CHKD	APVD
1	1-27-81	GENERAL UP-DATE REDRAW	K-McA	DJK	TFH
0	11-5-80	ISSUED FOR USE	K-McA	GAK	TFH



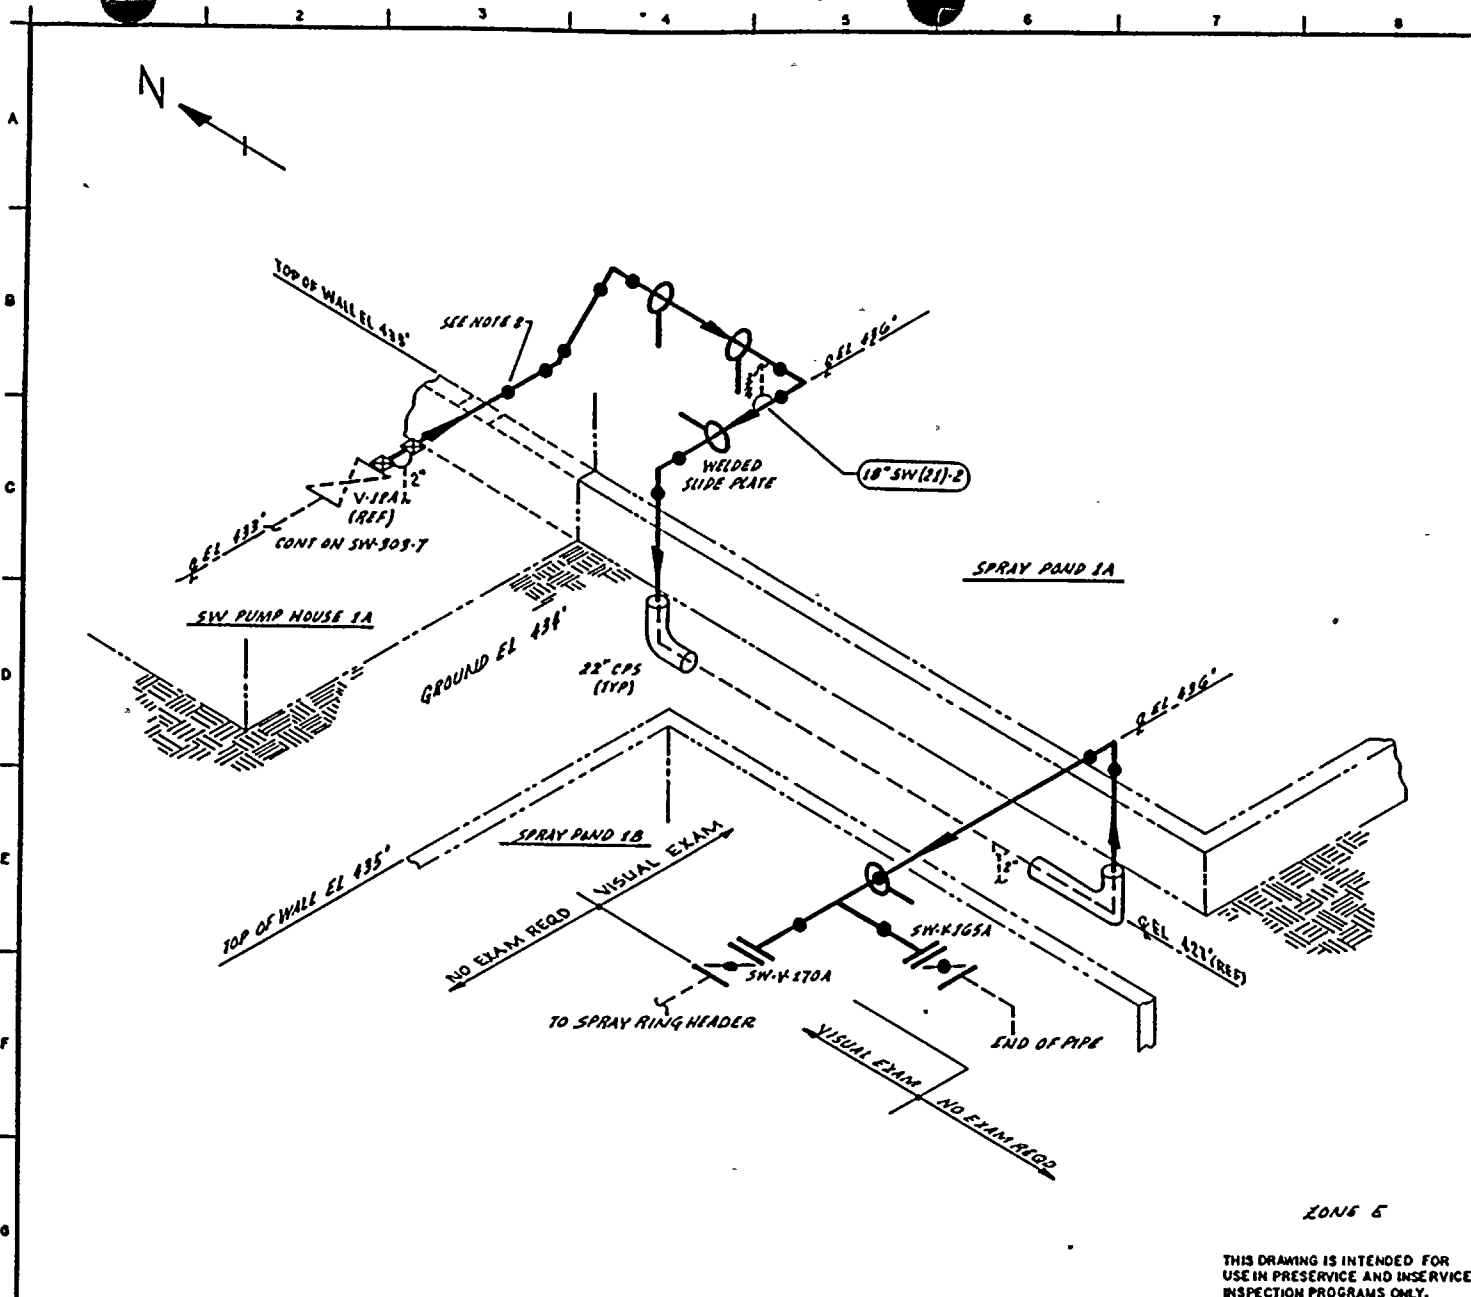

NOTES:

1. THIS DRAWING IDENTIFIES PIPING & COMPONENTS SUBJECT ONLY TO A VISUAL EXAM FOR (1) EVIDENCE OF LEAKAGE DURING SYSTEM PRESSURE OR OPERABILITY TESTS; (2) PRESSURE DECAY TESTS OF BURIED PIPING; & (3) LOSS OF SUPPORT CAPABILITY OR INADEQUATE RESTRAINT FOR SUPPORTS & HANGERS ON PIPING EXCEEDING 4" NOM. TESTS SHALL BE CONDUCTED PER ASME SECTION XI, ARTICLES IWA-5000 & IWD-2000.
2. NO ATTEMPT HAS BEEN MADE TO DIFFERENTIATE BETWEEN SHOP & FIELD WELDS SINCE REF. DWGS. GAVE NO WELD TYPE INDICATION.

REFERENCES:

BURNS & ROE DWGS.

M584 SH2 REV 41
 M782 REV 4
 S533 REV A
 S534 REV A
 S535 REV A
 M200-708 REV 0
 SW-296-5457 REV 14

QUALITY CLASS: 1 ASME CODE CLASS: 3
 ENGR: QA KUGLER DRAWN: J.M.L. DATE: 11-7-79

WASHINGTON PUBLIC POWER SUPPLY SYSTEM
 RICHLAND, WASHINGTON 98352

THIS DRAWING IS INTENDED FOR USE IN PRESERVICE AND INSERVICE INSPECTION PROGRAMS ONLY.

PIPING SYSTEM	NOM DIA (IN)	SCH	NOM WALL THK	MATERIAL SPECIFICATION	MATL TYPE	CAL BLOCK NO
18" SW(21)-2	18	STD	0.315	SA 106 GR B	CS	NA

WNP-2
 WELD & COMPONENT
 IDENTIFICATION DIAGRAM

TITLE:
 SW LOOP A RETURN TO SPRAY POND 1B

DWG NO: SW-303-B REV 1

NO	DATE	REVISION	BY	CHKD	APPVD
1	12/83	ADDED 2" CONN IN C-2	FLA	WR	JFK
0	12/81	ISSUED FOR USE	FLA	J	JFK



WNP-02-
 INTERVAL: PSI
 PERIOD: NA
 OUTAGE:
 DRAWING NO. SW-303

WASHINGTON PUBLIC POWER SUPPLY SYSTEM
 PROGRAM PLAN AND SCHEDULE
 SYSTEM OR COMPONENT: SW(23)-2
 DESCRIPTION: RETURN RHR-HX-1A

PAGE 001
 DATE 12/14/84

IDENT. NO.	DESCRIPTION	SECT.	EXAM	PROCEDURE	CAL. BLOCK	INSERVICE		NOTES
		EXAM.	MTM.			REQ.	SCHEDULED OUTAGE	
SW-156	STRUT	N/A	VT-3	303/8.2.17				
SW-155	BOX	N/A	VT-3	303/8.2.17				
SW-154	STRUT	N/A	VT-3	303/8.2.17				
SW-153	BOX	N/A	VT-3	303/8.2.17				
SW-152	RIGID	N/A	VT-3	303/8.2.17				
SW-151	STRUT	N/A	VT-3	303/8.2.17				
SW-212	BOX	N/A	VT-3	303/8.2.17				
SW-149	BOX	N/A	VT-3	303/8.2.17				
SW-150	BOX	N/A	VT-3	303/8.2.17				
	SPRING (2)	N/A	VT-3	303/8.2.17				
			VT-4	303/8.2.17				
SW-147	BOX	N/A	VT-3	303/8.2.17				
SW-148	SPRING (2)	N/A	VT-3	303/8.2.17				
			VT-4	303/8.2.17				
SW-229	STRUT	N/A	VT-3	303/8.2.17				
SW-228	STRUT	N/A	VT-3	303/8.2.17				
SW-146	STRUT	N/A	VT-3	303/8.2.17				
SW-431	STRUT	N/A	VT-3	303/8.2.17				
SW-145	RIGID	N/A	VT-3	303/8.2.17				
	BOX	N/A	VT-3	303/8.2.17				

WNP-02
 INTERVAL: PSI
 PERIOD: NA
 OUTAGE:
 DRAWING NO. SW-303

WASHINGTON PUBLIC POWER SUPPLY SYSTEM
 PROGRAM PLAN AND SCHEDULE
 SYSTEM OR COMPONENT: SW(23)-2
 DESCRIPTION: RETURN RHR-HX-1A

PAGE 002
 DATE 12/14/84

<u>IDENT. NO.</u>	<u>DESCRIPTION</u>	<u>SECT. XI EXAM.</u>	<u>EXAM MTH.</u>	<u>PROCEDURE</u>	<u>CAL. BLOCK</u>	<u>INSERVICE</u>		<u>NOTES</u>
						<u>REQ.</u>	<u>SCHEDULED OUTAGE</u>	
SW-144	BOX	N/A	VT-3	303/8.2.17				
SW-208	STRUT	N/A	VT-3	303/8.2.17				
SW-143	STRUT	N/A	VT-3	303/8.2.17				
SW-432	STRUT	N/A	VT-3	303/8.2.17				
SW-142	RIGID	N/A	VT-3	303/8.2.17				
SW-141	STRUT	N/A	VT-3	303/8.2.17				
SW-203	RIGID	N/A	VT-3	303/8.2.17				
SW-140	BOX	N/A	VT-3	303/8.2.17				
SW-139	STRUT	N/A	VT-3	303/8.2.17				
SW-438	RIGID	N/A	VT-3	303/8.2.17				
SW-138	BOX	N/A	VT-3	303/8.2.17				
SW-207	STRUT	N/A	VT-3	303/8.2.17				
SW-137	RIGID	N/A	VT-3	303/8.2.17				
SW-433	BOX	N/A	VT-3	303/8.2.17				
SW-136	BOX	N/A	VT-3	303/8.2.17				
SW-135	STRUT	N/A	VT-3	303/8.2.17				
SW-134	STRUT	N/A	VT-3	303/8.2.17				
SW-133	STRUT	N/A	VT-3	303/8.2.17				

WNP-02
 INTERVAL: PSI
 PEPIOD: NA
 OUTAGE:
 DRAWING NO. SW-303


WASHINGTON PUBLIC POWER SUPPLY SYSTEM
 PROGRAM PLAN AND SCHEDULE
 SYSTEM OR COMPONENT: SW(23)-2
 DESCRIPTION: RETURN RHR-HY-1A

PAGE 003
 DATE 12/14/84

<u>IDENT. NO.</u>	<u>DESCRIPTION</u>	<u>SECT.</u> <u>XI</u> <u>EXAM.</u>	<u>EXAM</u> <u>MTH.</u>	<u>PROCEDURE</u>	<u>CAL.</u> <u>BLOCK</u>	<u>INSERVICE</u>		<u>NOTES</u>
						<u>REQ.</u>	<u>SCHEDULED</u> <u>OUTAGE</u>	
SW-132	STRUT	N/A	VT-3	303/8.2.17				
SW-230	BOX	N/A	VT-3	303/8.2.17				
SW-131	BOX	N/A	VT-3	303/8.2.17				
SW-130	RIGID	N/A	VT-3	303/8.2.17				
SW-129	BOX	N/A	VT-3	303/8.2.17				
SW-128	BOX	N/A	VT-3	303/8.2.17				
SW-227	STRUT	N/A	VT-3	303/8.2.17				
SW-315	STRUT	N/A	VT-3	303/8.2.17				
SW-127	STRUT	N/A	VT-3	303/8.2.17				
SW-439	RIGID	N/A	VT-3	303/8.2.17				
SW-8	BOX	N/A	VT-3	303/8.2.17				
SW-9	BOX	N/A	VT-3	303/8.2.17				
SW-918N	BOX	N/A	VT-3	303/8.2.17				
SW-20	STRUT	N/A	VT-3	303/8.2.17				
SW-PB-303	BOX	N/A	VT-3	303/8.2.17				
	SW PRES BNDRY	N/A	VT-2	N/A				


SEE NOTES #6 & #7.



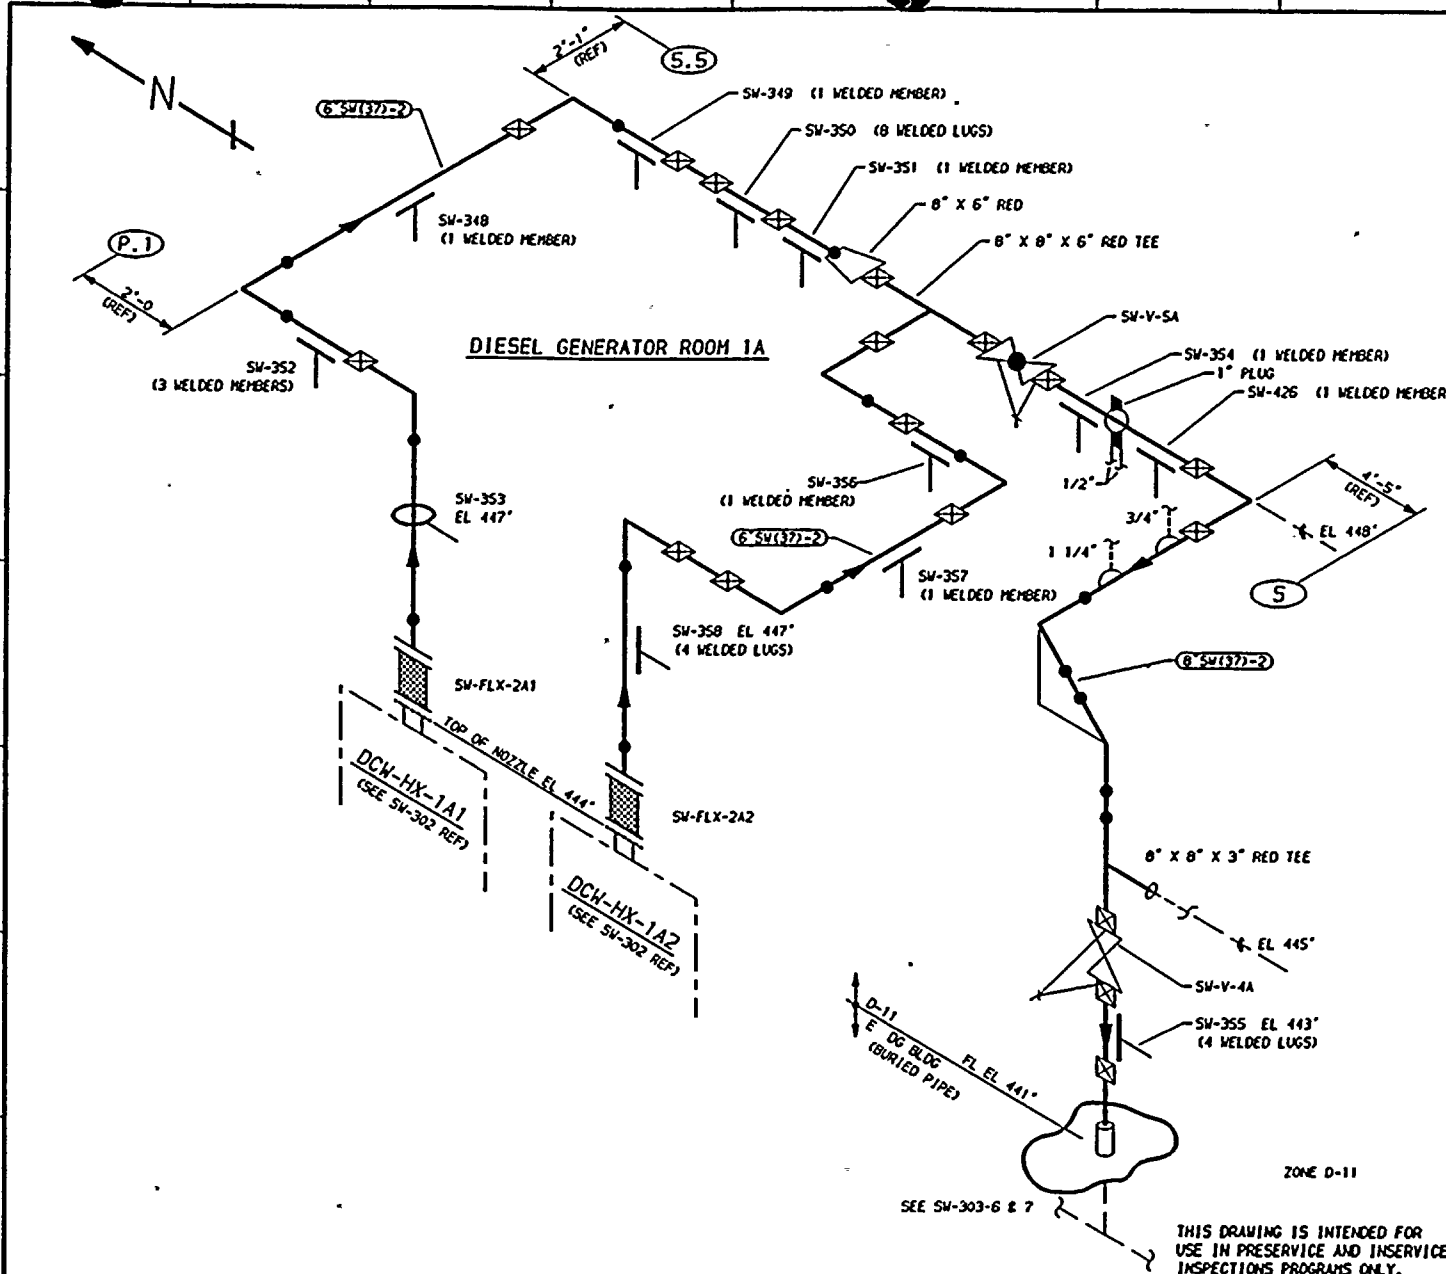

- NOTES:**
1. THIS DRAWING IDENTIFIES PIPING AND COMPONENTS SUBJECT ONLY TO A VISUAL EXAM FOR (1) EVIDENCE OF LEAKAGE DURING SYSTEM PRESSURE OR OPERABILITY TESTS, (2) PRESSURE DECAY TESTS OF BURIED PIPING, AND (3) LOSS OF SUPPORT CAPABILITY OR INADEQUATE RESTRAINT FOR SUPPORTS AND HANGERS ON PIPING EXCEEDING 4" NOM. TESTS SHALL BE CONDUCTED PER ASME SECTION XI, ARTICLES IMA-5000 AND 110-2000.
 2. FOR BRANCH PIPING 4" NOM. OR LESS (CONNECTION SHOWN IN DASHED LINES) EXTEND VISUAL LEAKAGE EXAM THROUGH THE OUTERMOST NORMALLY CLOSED NUCLEAR CLASS VALVE, OR UNTIL TRANSITION TO INSTRUMENT TUBING, UNLESS OTHERWISE NOTED.

- REFERENCES:**
- ISI - 224
 - BOYCE & CRILL ISOMETRICS
 - SW-296-33.36 REV 6
 - SW-304-1,5 REV 9
 - SW-304-6 REV 5

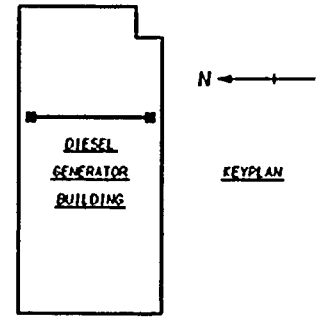

QUALITY CLASS, 1	ASME CODE CLASS, 3
ENGR, GA KUGLER	DRAWN, K-McA DATE, 11-30-78

WASHINGTON PUBLIC POWER
SUPPLY SYSTEM
RICHLAND, WASHINGTON 99352

WNP-2
WELD & COMPONENT
IDENTIFICATION DIAGRAM

TITLE:
SW LOOP A RETURN FROM DCW-HX-1A1 & 1A2

DWG NO, SW-304 REV 1

PIPING SYSTEM	NOM DIA (IND)	SCH	NOM WALL THK	MATERIAL SPECIFICATION	MATL TYPE	CAL BLOCK NO
6"SW(37)-2	6	STD	0.280	SA 106 GR B	CS	NA
8"SW(37)-2	8	STD	0.322	SA 106 GR B	CS	NA

1	11-27-80	GENERAL UP-DATE REDRAWN	K-McA	DPG	TFK
0	11-5-80	ISSUED FOR USE	K-McA	GAK	TFK
NO	DATE	REVISION	BY	CHKD	APVD

THIS DRAWING IS INTENDED FOR USE IN PRESERVICE AND INSERVICE INSPECTIONS PROGRAMS ONLY.

SEE SW-303-6 & 7

ZONE D-11

D-11
E DG PLOG (BURIED PIPE)
FL EL 441"

DCW-HX-1A1
(SEE SW-302 REF)
TOP OF NOZZLE EL 444"
DCW-HX-1A2
(SEE SW-302 REF)

DIESEL GENERATOR ROOM 1A

SW-352
(3 WELDED MEMBERS)

SW-353
EL 447"

SW-FLX-2A1

SW-356
(1 WELDED MEMBER)

SW-358 EL 447"
(4 WELDED LUGS)

SW-FLX-2A2

SW-357
(1 WELDED MEMBER)

8"SW(37)-2

8" X 8" X 3" RED TEE

SW-V-4A

SW-355 EL 443"
(4 WELDED LUGS)

SW-349 (1 WELDED MEMBER)

SW-350 (8 WELDED LUGS)

SW-351 (1 WELDED MEMBER)

8" X 6" RED

8" X 8" X 6" RED TEE

SW-V-5A

SW-354 (1 WELDED MEMBER)

1" PLUG

SW-426 (1 WELDED MEMBER)

1/2"

3/4"

1 1/4"

5

4'-5" (REF)

EL 448"

EL 445"

N

N

KEYPLAN

2 3 4 5 6 7 8

A
B
C
D
E
F
G

WNP-02
 INTERVAL: PSI
 PERIOD: NA
 OUTAGE:
 DRAWING NO. SW-304


WASHINGTON PUBLIC POWER SUPPLY SYSTEM
 PROGRAM PLAN AND SCHEDULE
 SYSTEM OR COMPONENT: SW(37)-2
 DESCRIPTION: RETURN DCW-HX-1A1&A2

PAGE 001
 DATE 12/14/84

<u>IDENT. NO.</u>	<u>DESCRIPTION</u>	<u>SECT.</u> <u>XI</u> <u>EXAM.</u>	<u>EXAM</u> <u>MTM.</u>	<u>PROCEDURE</u>	<u>CAL.</u> <u>BLOCK</u>	<u>INSERVICE</u>		<u>NOTES</u>
						<u>REQ.</u>	<u>SCHEDULED</u> <u>OUTAGE</u>	
SW-353	BOX	N/A	VT-3	303/8.2.17				
SW-352	BOX	N/A	VT-3	303/8.2.17				
SW-348	BOX	N/A	VT-3	303/8.2.17				
SW-349	BOX	N/A	VT-3	303/8.2.17				
SW-350	BOX	N/A	VT-3	303/8.2.17				
SW-351	BOX	N/A	VT-3	303/8.2.17				
SW-358	BOX	N/A	VT-3	303/8.2.17				
SW-357	BOX	N/A	VT-3	303/8.2.17				
SW-356	BOX	N/A	VT-3	303/8.2.17				
SW-354	BOX	N/A	VT-3	303/8.2.17				
SW-426	BOX	N/A	VT-3	303/8.2.17				
SW-355	BOX	N/A	VT-3	303/8.2.17				
SW-PB-304	SW PRES BNDRY	N/A	VT-2	N/A				


SEE NOTES #6 & #7.



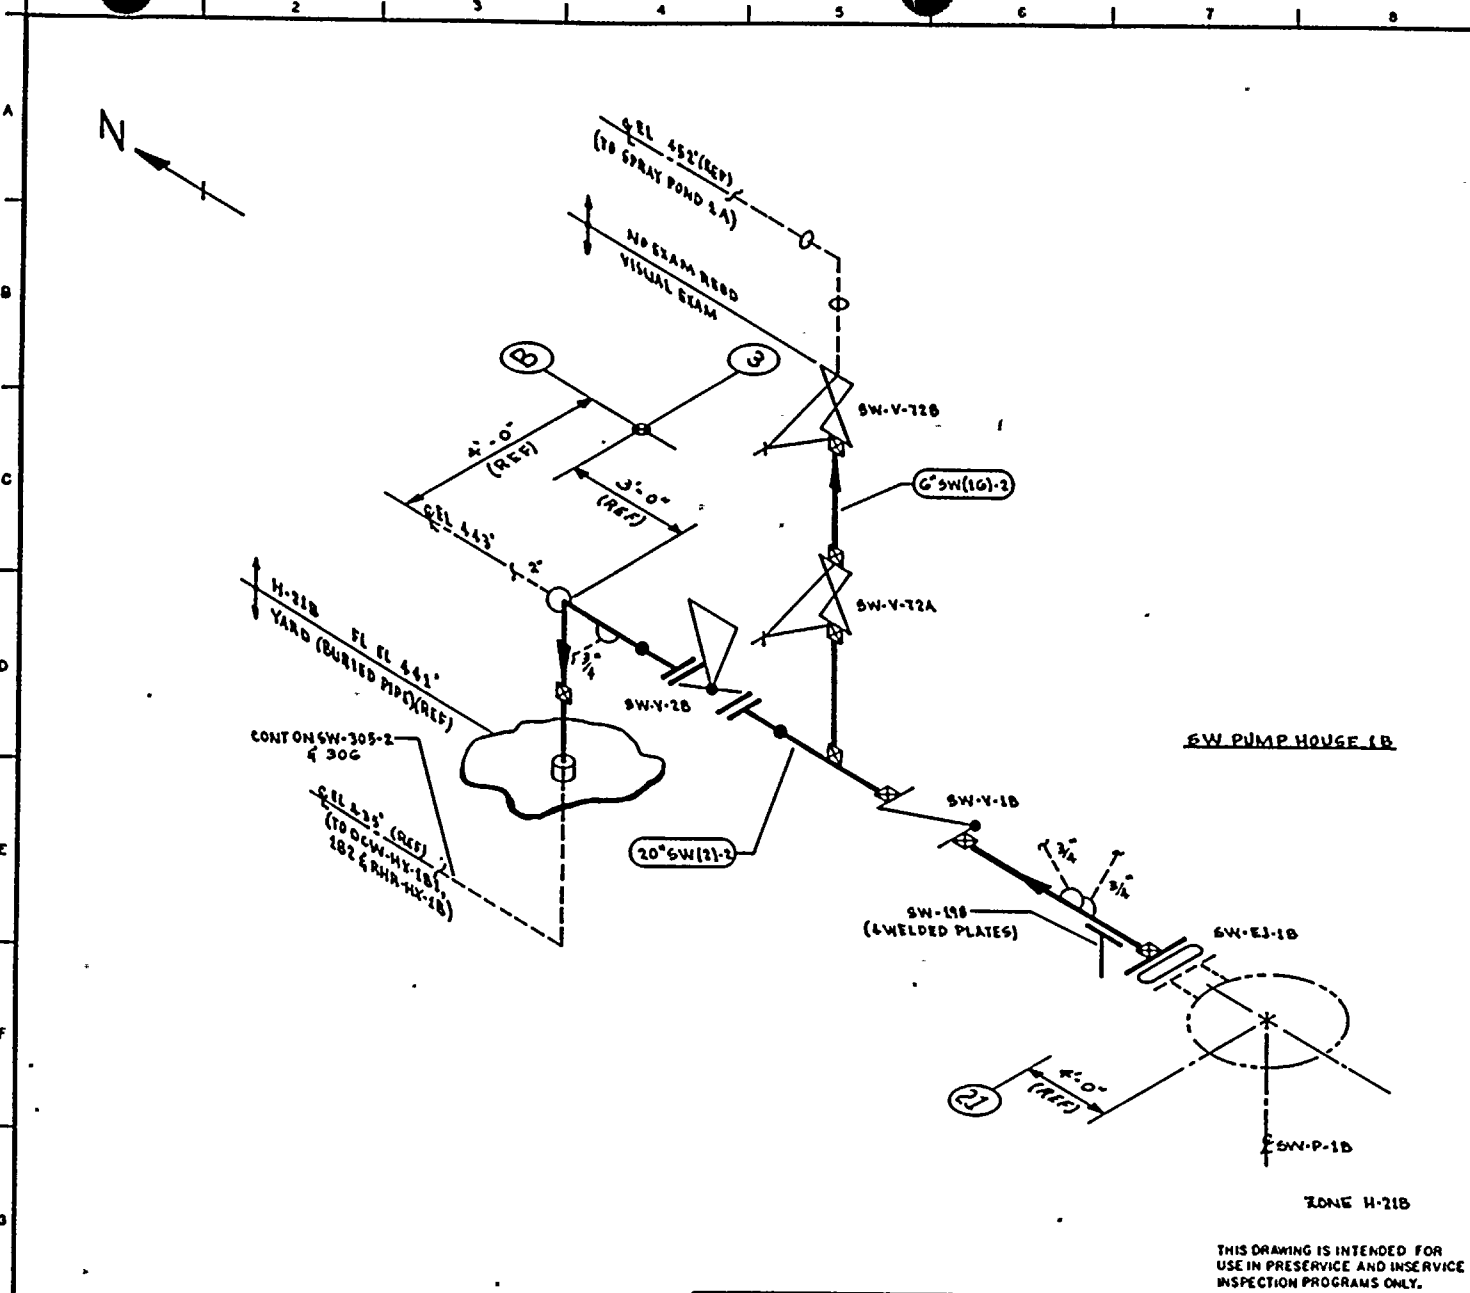

- NOTES:
1. THIS DRAWING IDENTIFIES PIPING & COMPONENTS SUBJECT ONLY TO A VISUAL EXAM FOR (1) EVIDENCE OF LEAKAGE DURING SYSTEM PRESSURE OR OPERABILITY TESTS; (2) PRESSURE DECAY TESTS OF BURIED PIPING & (3) LOSS OF SUPPORT CAPABILITY OR INADEQUATE RESTRAINT FOR SUPPORTS & HANGERS ON PIPING EXCEEDING 4" NOM. TESTS SHALL BE CONDUCTED PER ASME SECTION XI, ARTICLES IWA-5000 & IWD-2000.
 2. FOR BRANCH PIPING 4" NOM OR LESS (CONN SHOWN IN DASHED) EXTEND VISUAL LEAKAGE EXAM THROUGH THE OUTER MOST NORMALLY CLOSED NUCLEAR CLASS VALVE, OR UNTIL TRANSITION TO INSTRUMENT TUBING, UNLESS OTHERWISE NOTED.

- REFERENCES:
- BOVEE & CRAIL ISOMETRICS
 - SW-281-1.3 REV II
 - SW-292-1.5 REV B

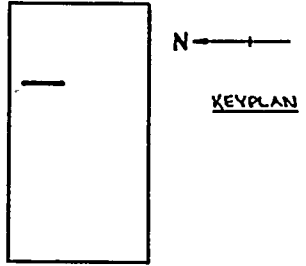

QUALITY CLASS: 1 ASME CODE CLASS: 3
 ENGR: G.A. KUGLER DRAWN: K.McA DATE: 12-5-78

WASHINGTON PUBLIC POWER SUPPLY SYSTEM
 RICHMOND WASHINGTON 9332

THIS DRAWING IS INTENDED FOR USE IN PRESERVICE AND INSERVICE INSPECTION PROGRAMS ONLY.


PIPING SYSTEM	NOM DIA (IN)	SCH	NOM WALL THK	MATERIAL SPECIFICATION	MATL TYPE	CAL BLOCK NO
20° SW(21)-2	20	STD	0.375	SA 106 GR B	CS	NA
6" SW(16)-2	6	STD	0.280	SA 106 GR B	CS	NA
6" SW(16)-2	6	100	0.719	SA 106 GR B	CS	NA

NO	DATE	REVISION	BY	CHKD	APPVD
1	12-84	RELOCATED SW-17B ADDED KEYPLAN	KMcA	cmc	TFH
0	11-5-80	ISSUED FOR USE	KMcA	SNK	PDH

WNP-2
 WELD B COMPONENT
 IDENTIFICATION DIAGRAM


TITLE:
 SW LOOP B SUPPLY SW-P-1B DISCHARGE

DWG NO: SW-305-1 REV 1

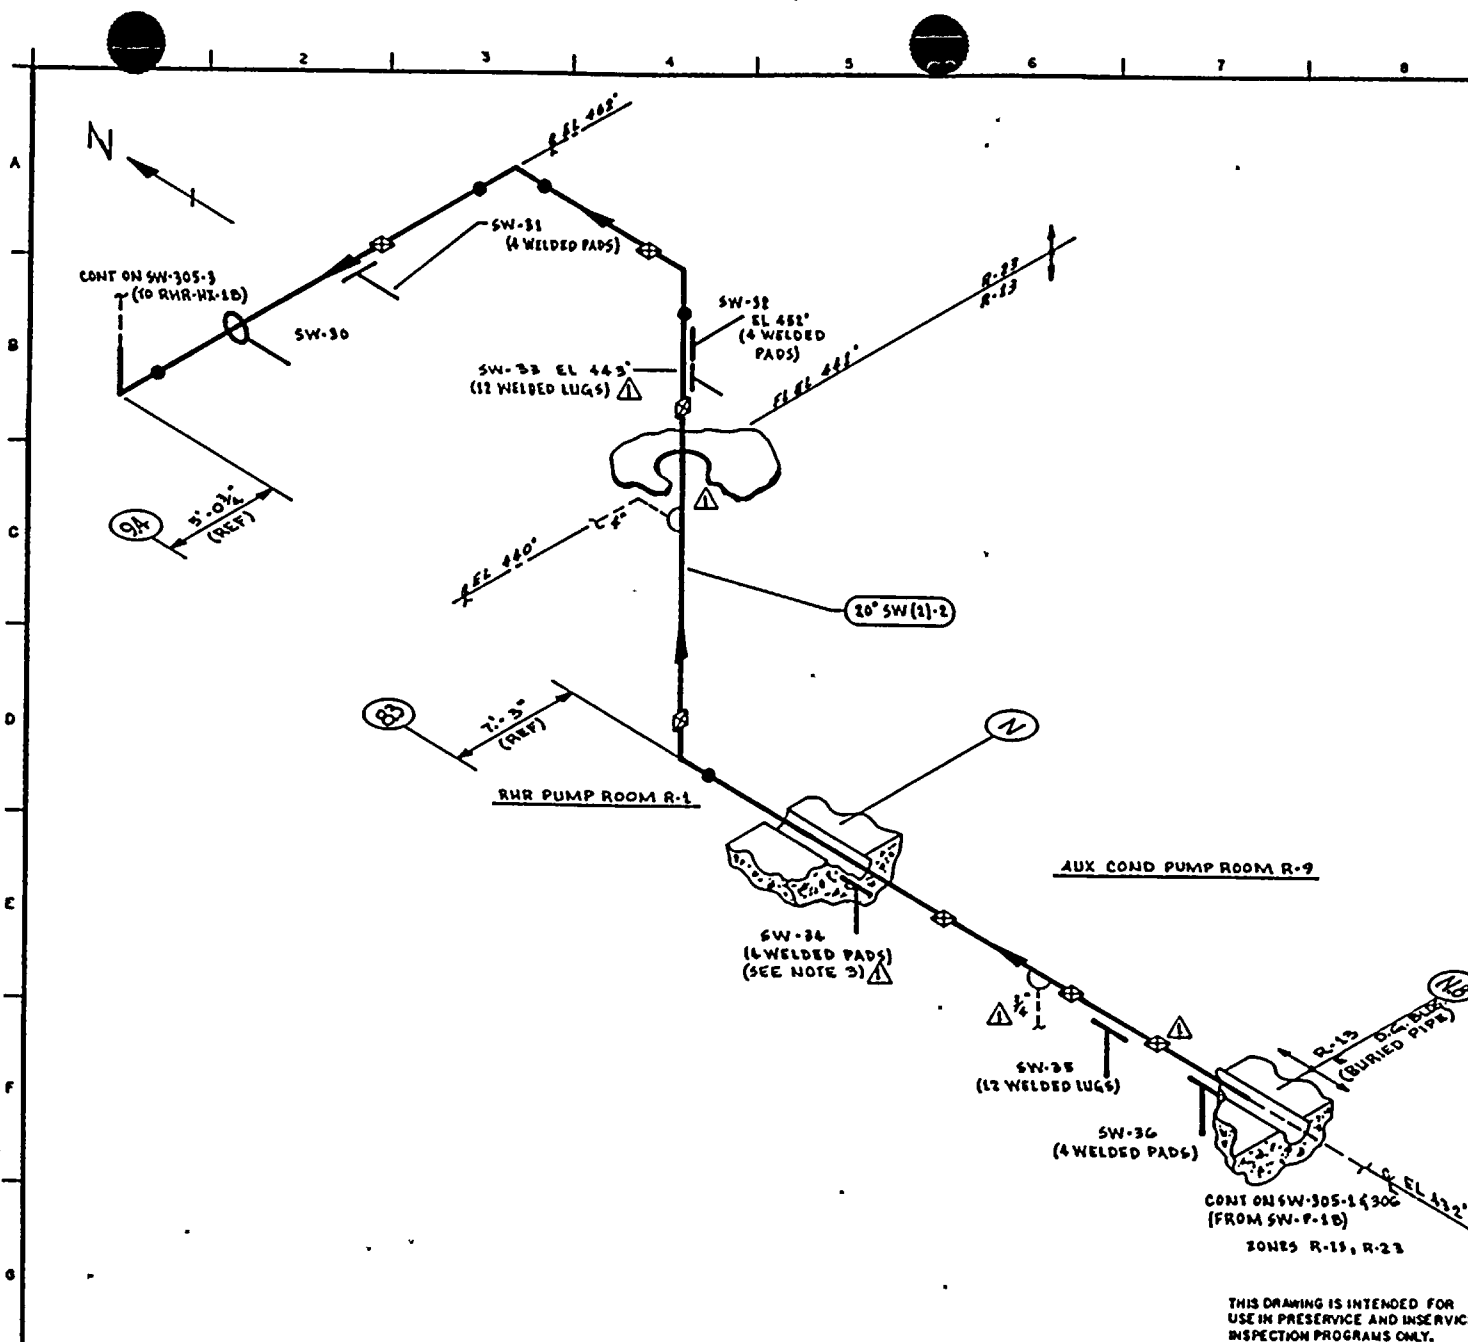

- NOTES:
1. THIS DRAWING IDENTIFIES PIPING & COMPONENTS SUBJECT ONLY TO A VISUAL EXAM FOR (1) EVIDENCE OF LEAKAGE DURING SYSTEM PRESSURE OR OPERABILITY TESTS; (2) PRESSURE DECAY TESTS OF BURIED PIPING; & (3) LOSS OF SUPPORT CAPABILITY OR INADEQUATE RESTRAINT FOR SUPPORTS & HANGERS ON PIPING EXCEEDING 4" NOM. TESTS SHALL BE CONDUCTED PER ASME SECTION XI, ARTICLES SNA-5000 & SNA-2000.
 2. FOR BRANCH PIPING 4" NOM & LESS (CONN SHOWN IN DASHED LINES) EXTEND VISUAL LEAKAGE EXAM THROUGH THE OUTERMOST NORMALLY CLOSED NUCLEAR CLASS VALVE OR UNTIL TRANSITION TO INSTRUMENT TUBING, UNLESS OTHERWISE NOTED.
 3. COMPONENT SUPPORT IS INACCESSIBLE DUE TO FOAM FILLED WATER TIGHT BOOT.

- REFERENCES:
- BOYES & CRALL ISOMETRICS
- SW-251-19.22 REV B
 SW-251-23.29 REV 10
 SW-251-30.33 REV B

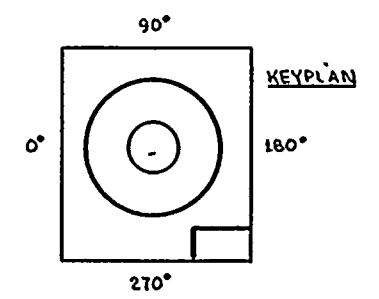

QUALITY CLASS: 1	ASME CODE CLASS: 3
ENGR: GA KUGLER	DRAWN: K-M-C-A DATE: 1-11-79

WASHINGTON PUBLIC POWER SUPPLY SYSTEM
 RICHLAND, WASHINGTON 98342

THIS DRAWING IS INTENDED FOR USE IN PRESERVICE AND INSERVICE INSPECTION PROGRAMS ONLY.


PIPING SYSTEM	NOM DIA (IN)	SCH	NOM WALL THK	MATERIAL SPECIFICATION	MATL TYPE	CAL BLOCK NO
20" SW(2)-2	20	STD	0.375	SA 106 GR B	CS	NA

WNP- 2
 WELD & COMPONENT IDENTIFICATION DIAGRAM

TITLE:
 SW LOOP B SUPPLY TO RHR-WX-1B


DWG NO: SW-305-2

NO	DATE	REVISION	BY	CHKD	APPVD
1	1-22-81	REVISED AS NOTED ADDED KEYPLAN	KMG	MC	TFH
0	11-5-80	ISSUED FOR USE	KMG	MC	TFH

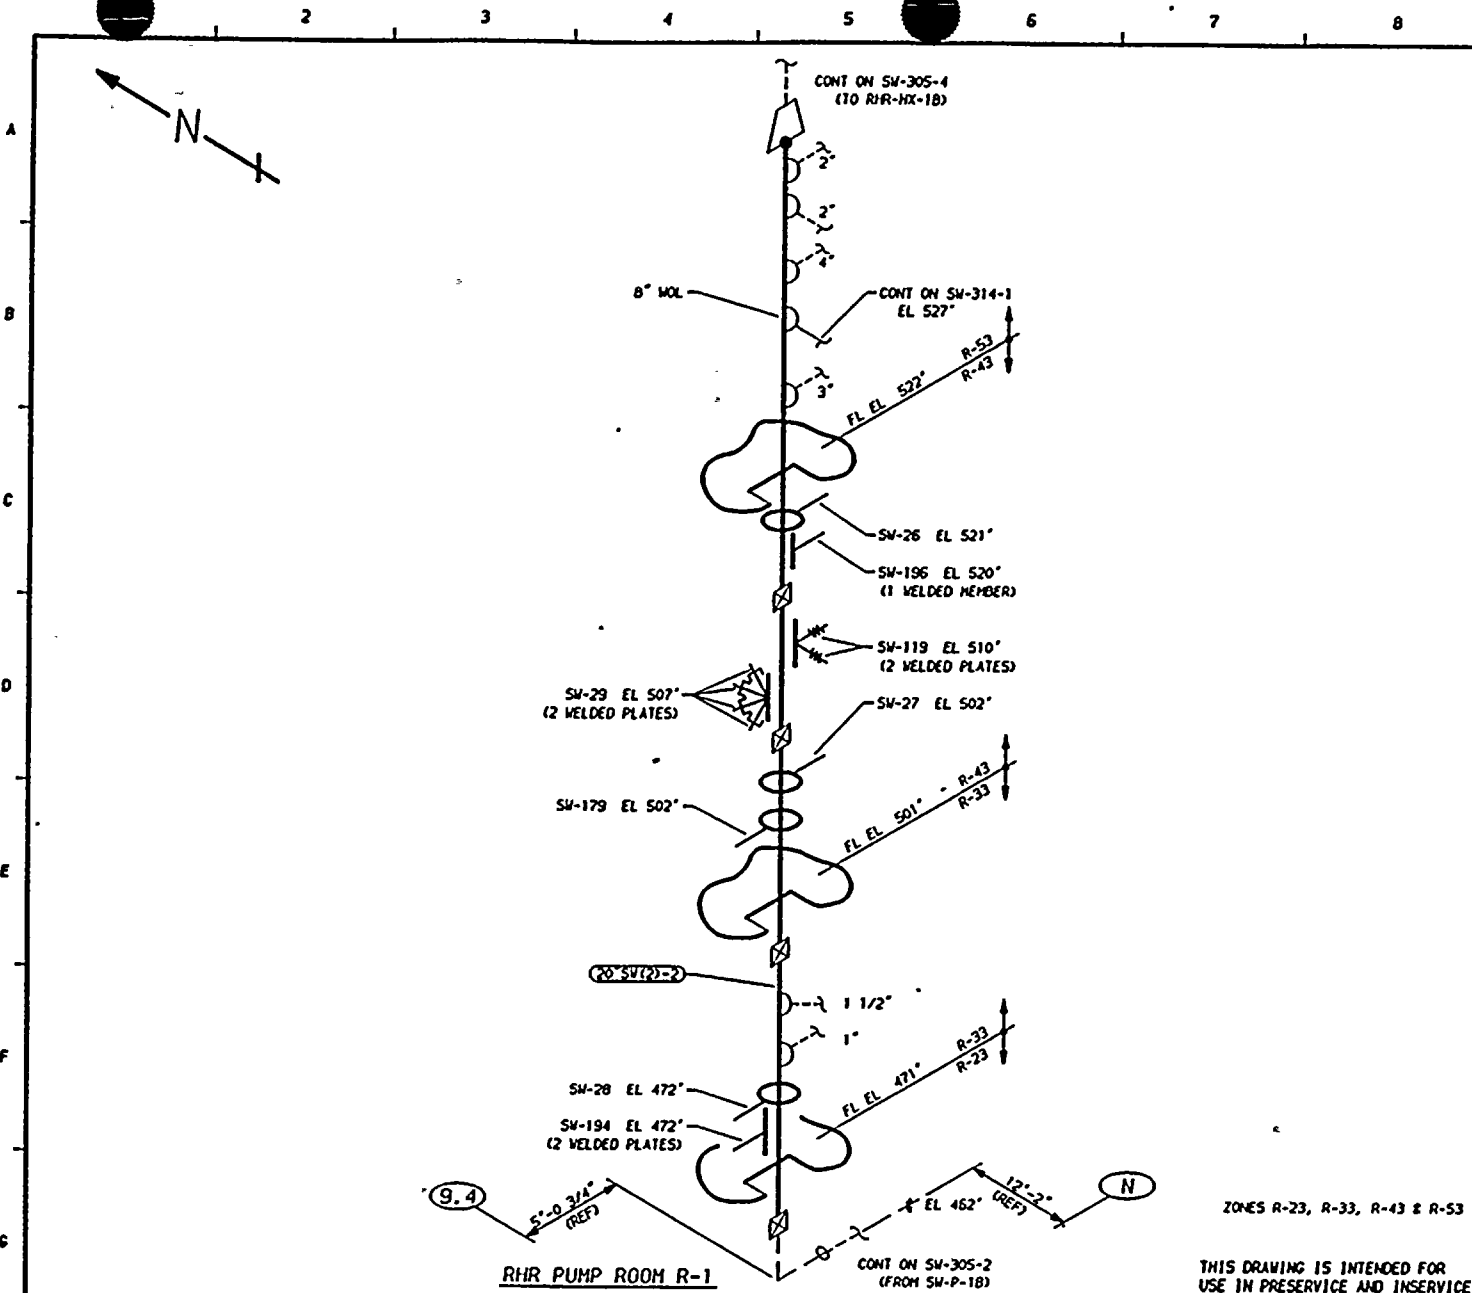

- NOTES:**
1. THIS DRAWING IDENTIFIES PIPING AND COMPONENTS SUBJECT ONLY TO A VISUAL EXAM FOR (1) EVIDENCE OF LEAKAGE DURING SYSTEM PRESSURE OR OPERABILITY TESTS, (2) PRESSURE DECAY TESTS OF BURIED PIPING, AND (3) LOSS OF SUPPORT CAPABILITY OR INADEQUATE RESTRAINT FOR SUPPORTS AND HANGERS ON PIPING EXCEEDING 4" NOM. TESTS SHALL BE CONDUCTED PER ASME SECTION XI, ARTICLES IWA-5000 AND IWD-2000.
 2. FOR BRANCH PIPING 4" NOM. OR LESS (CONNECTION SHOWN IN DASHED LINES) EXTEND VISUAL LEAKAGE EXAM THROUGH THE OUTERMOST NORMALLY CLOSED NUCLEAR CLASS VALVE, OR UNTIL TRANSITION TO INSTRUMENT TUBING, UNLESS OTHERWISE NOTED.

- REFERENCES:**
- 151 - 224
 - BOVEE & CRAIG ISOMETRICS
 - SW-251-30.33 REV 8
 - SW-251-34.35 REV 11

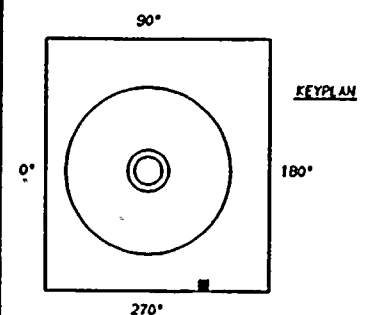

QUALITY CLASS, 1	ASME CODE CLASS, 3
ENGR, GA KUGLER	DRAWN, K-MCA DATE, 2-28-79

WASHINGTON PUBLIC POWER
SUPPLY SYSTEM
RICHLAND, WASHINGTON 99352


WNP-2
WELD & COMPONENT
IDENTIFICATION DIAGRAM

TITLE:
SW LOOP B SUPPLY TO RHR-HX-1B

DWG NO, SW-305-3 REV 1

PIPING SYSTEM	NOM DIA (IN)	SCH	NOM WALL THK	MATERIAL SPECIFICATION	MATL TYPE	CAL BLOCK NO
20"SW(2)-2	20	STD	0.375	SA 106 GR B	CS	NA

NO	DATE	REVISION	BY	CHKD	APVD
1	11-5-80	GENERAL UP-DATE REDRAWN	K-MCA	GAK	APVD
0	11-5-80	ISSUED FOR USE	K-MCA	GAK	APVD

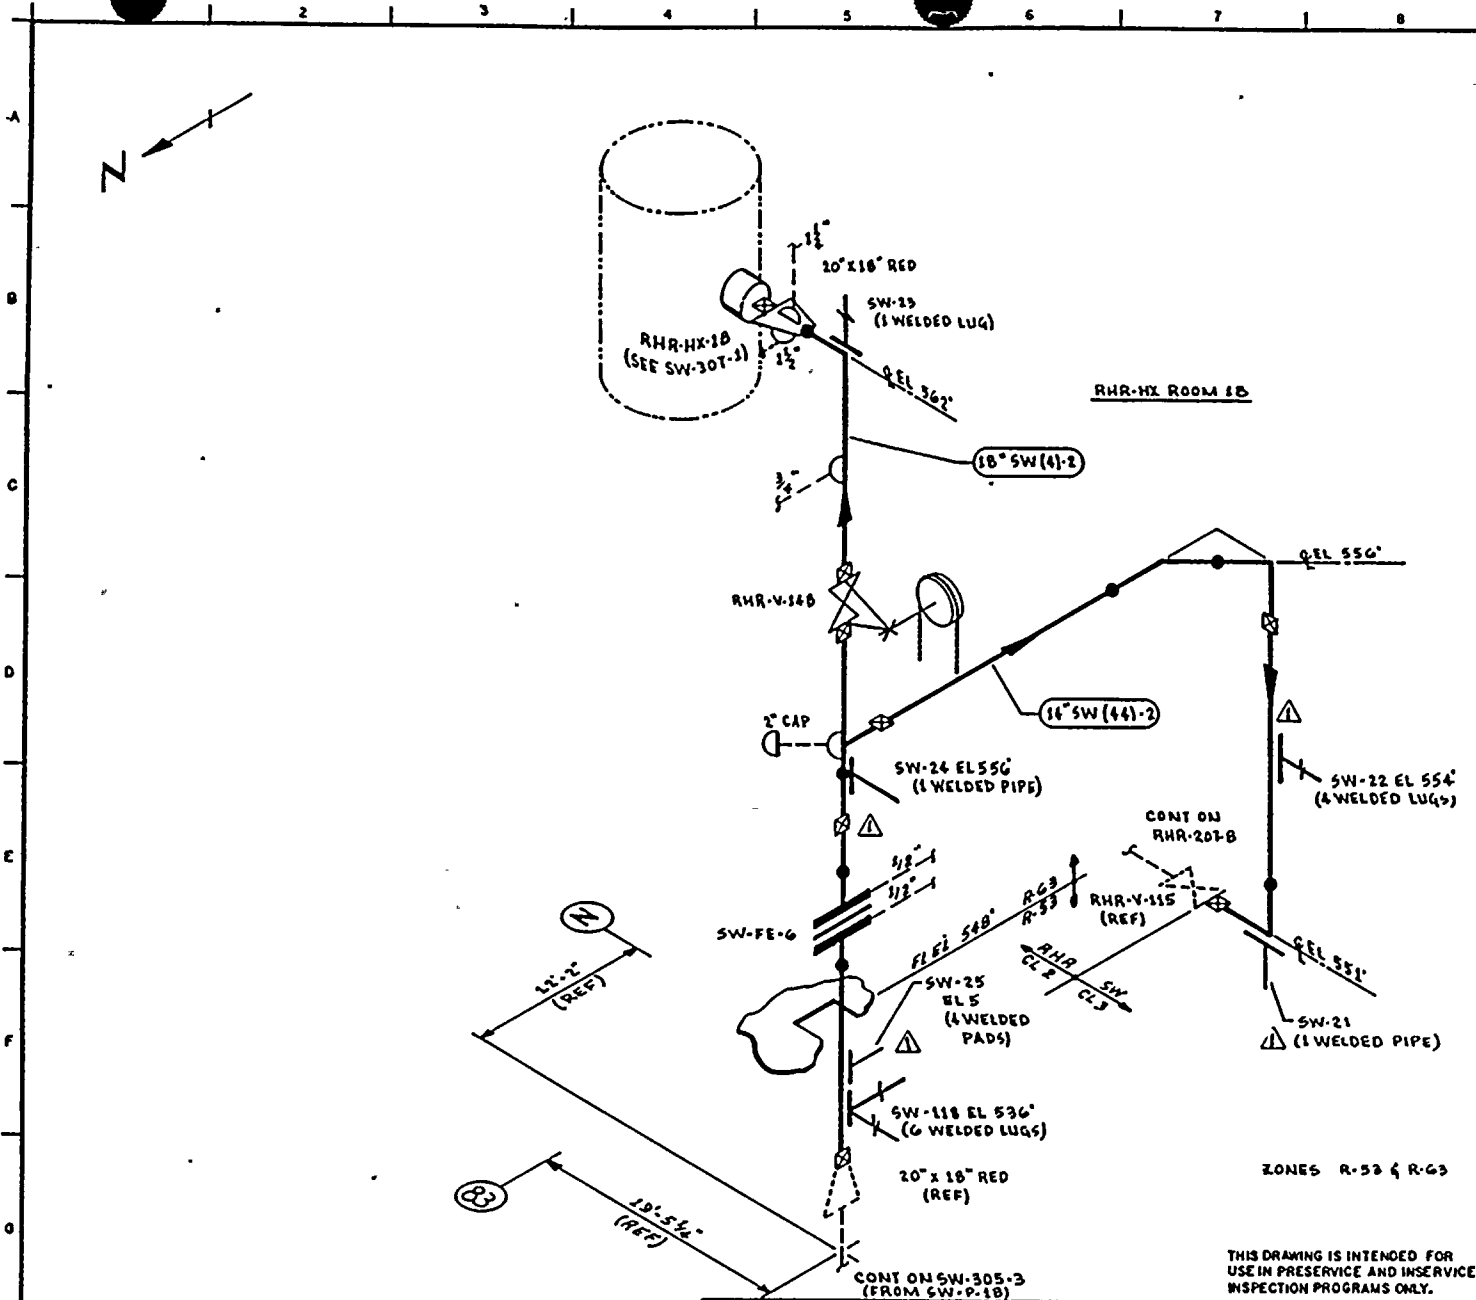


NOTES:

1. THIS DRAWING IDENTIFIES PIPING & COMPONENTS SUBJECT ONLY TO A VISUAL EXAM FOR (1) EVIDENCE OF LEAKAGE DURING SYSTEM PRESSURE OR OPERABILITY TESTS; (2) PRESSURE DECAY TESTS OF BURIED PIPING; & (3) LOSS OF SUPPORT CAPABILITY OR INADEQUATE RESTRAINT FOR SUPPORTS & HANGERS ON PIPING EXCEEDING 4" NOM. TESTS SHALL BE CONDUCTED PER ASME SECTION XI, ARTICLES SWA-5000 & SWD-2000.
2. FOR BRANCH PIPING 4" NOM. OR LESS (CONN SHOWN IN DASHED LINES) EXTEND VISUAL LEAKAGE EXAM THROUGH THE OUTER-MOST NORMALLY CLOSED NUCLEAR CLASS VALVE, OR UNTIL TRANSITION TO INSTRUMENT TUBING, UNLESS OTHERWISE NOTED.

REFERENCES:

BOVEE & CRAIG ISOMETRICS

SW-251-34.35 REV 11
 SW-251-36.3T REV 8
 SW-322-1.2 REV 6

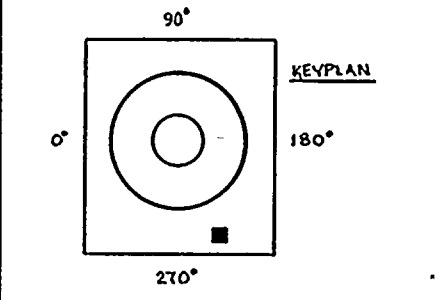

QUALITY CLASS: 1 ASME CODE CLASS: 3
 ENGR: GA KUGLER DRAWN: K. Mc L DATE: 3-2-79

WASHINGTON PUBLIC POWER SUPPLY SYSTEM
 RICHLAND, WASHINGTON 99302

WNP-2
 WELD & COMPONENT
 IDENTIFICATION DIAGRAM

TITLE:
 SW LOOP B SUPPLY TO RHR-HX-1B
 DWG NO: SW-305-4 REV 1

THIS DRAWING IS INTENDED FOR USE IN PRESERVE AND INSERVICE INSPECTION PROGRAMS ONLY.

PIPING SYSTEM	NOM DIA (IN)	SCH	NOM WALL THK	MATERIAL SPECIFICATION	MATL TYPE	CAL BLOCK NO
18" SW (4)-2	18	STD	0.375	SA 106 GR B	CS	NA
14" SW (44)-2	14	STD	0.375	SA 106 GR B	CS	NA

NO	DATE	REVISION	BY	CHKD	APPVD
1	12/84	REVISED AS NOTED ADDED KEYPLAN	KMcL
0	11-6-80	ISSUED FOR UGE	KMcL

WNP-02
 INTERVAL: PSI
 PERIOD: NA
 OUTAGE:
 DRAWING NO. SW-305

WASHINGTON PUBLIC POWER SUPPLY SYSTEM
 PROGRAM PLAN AND SCHEDULE
 SYSTEM OR COMPONENT: SW(2)-2
 DESCRIPTION: SW LOOP R SUPPLY

PAGE 001
 DATE 12/14/94

<u>IDENT. NO.</u>	<u>DESCRIPTION</u>	SECT. XI <u>EXAM.</u>	EXAM <u>MTM.</u>	<u>PROCEDURE</u>	CAL. <u>BLOCK</u>	<u>INSERVICE</u>		<u>NOTES</u>
						<u>REQ.</u>	<u>SCHEDULED OUTAGE</u>	
SW-198	BOX	N/A	VT-3	303/8.2.17				
SW-36	RIGID	N/A	VT-3	303/8.2.17				
SW-35	STRUT	N/A	VT-3	303/8.2.17				
SW-34	RIGID	N/A	VT-3	303/8.2.17				
SW-33	BOX	N/A	VT-3	303/8.2.17				
SW-32	BOX	N/A	VT-3	303/8.2.17				
SW-31	BOX	N/A	VT-3	303/8.2.17				
SW-30	STRUT	N/A	VT-3	303/8.2.17				
SW-194	STRUT	N/A	VT-3	303/8.2.17				
SW-28	STRUT	N/A	VT-3	303/8.2.17				
SW-179	STRUT	N/A	VT-3	303/8.2.17				
SW-27	STRUT	N/A	VT-3	303/8.2.17				
SW-29	PSA-10 SN(4)	N/A	VT-3	303/8.2.17				S/N
SW-119			VT-4	303/8.2.17				S/N
SW-196	SPRING (2)	N/A	VT-3	303/8.2.17				
SW-26	STRUT	N/A	VT-3	303/8.2.17				
SW-118	BOX	N/A	VT-3	303/8.2.17				
	SPRING	N/A	VT-3	303/8.2.17				


WNP-02
 INTERVAL: PSI
 PERIOD: NA
 OUTAGE:
 DRAWING NO. SW-305

WASHINGTON PUBLIC POWER SUPPLY SYSTEM
 PROGRAM PLAN AND SCHEDULE
 SYSTEM OR COMPONENT: SW(2)-2
 DESCRIPTION: SW LOOP B SUPPLY

PAGE 002
 DATE 12/14/84


IDENT. NO.	DESCRIPTION	SECT. XI EXAM.	EXAM MTH.	PROCEDURE	CAL. BLOCK	INSERVICE		NOTES
						REQ.	SCHEDULED OUTAGE	
			VT-4	303/8.2.17				
SW-25	RIGID	N/A	VT-3	303/8.2.17				
SW-24	RIGID	N/A	VT-3	303/8.2.17				
SW-23	SPRING	N/A	VT-3	303/8.2.17				
			VT-4	303/8.2.17				
SW-22	SPRING	N/A	VT-3	303/8.2.17				
			VT-4	303/8.2.17				
SW-21	PSA-3 SNUBBER	N/A	VT-3	303/8.2.17				
			VT-4	303/8.2.17				
SW-PB-305	SW PRES BNDRY	N/A	VT-2	N/A				

SEE NOTES #6 & #7.

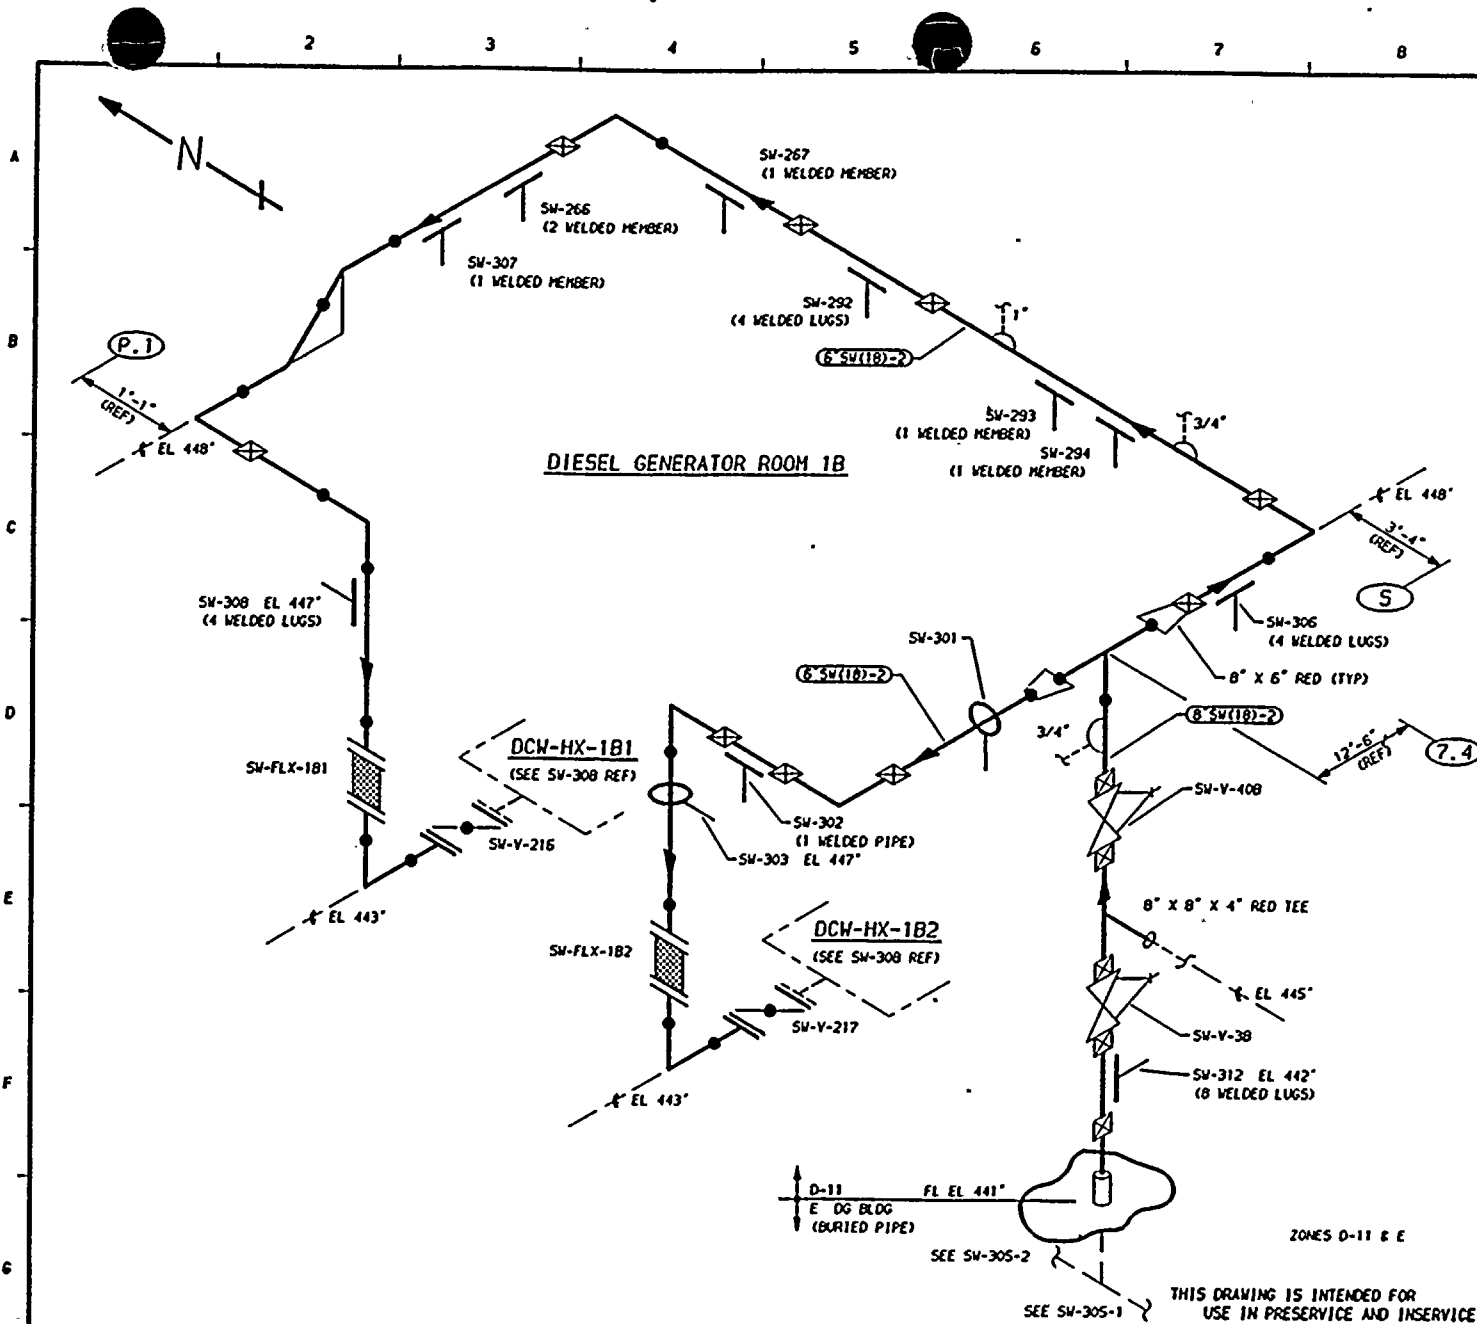

- NOTES:**
1. THIS DRAWING IDENTIFIES PIPING AND COMPONENTS SUBJECT ONLY TO A VISUAL EXAM FOR (1) EVIDENCE OF LEAKAGE DURING SYSTEM PRESSURE OR OPERABILITY TESTS; (2) PRESSURE DECAY TESTS OF BURIED PIPING; AND (3) LOSS OF SUPPORT CAPABILITY OR INADEQUATE RESTRAINT FOR SUPPORTS AND HANGERS ON PIPING EXCEEDING 4" NOM. TESTS SHALL BE CONDUCTED PER ASME SECTION XI, ARTICLES 1WA-5000 AND 1W0-2000.
 2. FOR BRANCH PIPING 4" NOM. OR LESS (CONNECTION SHOWN IN DASHED LINES) EXTEND VISUAL LEAKAGE EXAM THROUGH THE OUTERMOST NORMALLY CLOSED NUCLEAR CLASS VALVE, OR UNTIL TRANSITION TO INSTRUMENT TUBING, UNLESS OTHERWISE NOTED.

- REFERENCES:**
- 151 - 224
 - BOYEE & CRAIL ISOMETRICS
 - SW-251-19-22 REV 8
 - SW-293-1.2 REV 6
 - SW-293-3.8 REV 8

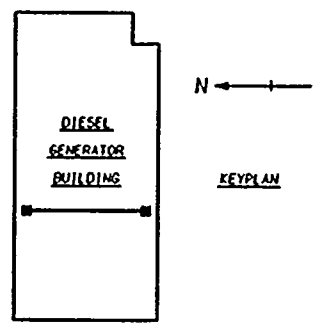

QUALITY CLASS: 1	ASME CODE CLASS: 3
ENGR, GA KUGLER	DATE, 3-9-79

WASHINGTON PUBLIC POWER
SUPPLY SYSTEM
RICHLAND, WASHINGTON 99352

WNP-2
WELD & COMPONENT
IDENTIFICATION DIAGRAM

TITLE:
SW LOOP B SUPPLY TO DCW-HX-1B1 & 1B2

DWG NO: SW-306 REV 1

PIPING SYSTEM	NOM DIA (IN)	SCH	NOM WALL THK	MATERIAL SPECIFICATION	MATL TYPE	CAL BLOCK NO
8" SW(18)-2	8	STD	0.322	SA 106 GR B	CS	NA
6" SW(18)-2	6	STD	0.280	SA 106 GR B	CS	NA

1	1-29-86	GENERAL UP-DATE REDRAWN	K/A	JHR	TEV
0	11-5-80	ISSUED FOR USE	K-MCA	GAK	TPA
NO	DATE	REVISION	BY	CHKD	APVD

THIS DRAWING IS INTENDED FOR USE IN PRESERVICE AND INSERVICE INSPECTIONS PROGRAMS ONLY.

D-11
E DG BLDG
FL EL 441'
(BURIED PIPE)

ZONES D-11 & E


WNP-02
 INTERVAL: PSI
 PERIOD: NA
 OUTAGE:
 DRAWING NO. SW-306

WASHINGTON PUBLIC POWER SUPPLY SYSTEM
 PROGRAM PLAN AND SCHEDULE
 SYSTEM OR COMPONENT: SW(18)-2
 DESCRIPTION: SW LOOP B SUPPLY

PAGE 001
 DATE 12/14/84


<u>IDENT. NO.</u>	<u>DESCRIPTION</u>	<u>SECT.</u> <u>XI</u> <u>EYAM.</u>	<u>EYAM</u> <u>MTM.</u>	<u>PROCEDURE</u>	<u>CAL.</u> <u>BLOCK</u>	<u>INSERVICE</u>		<u>NOTES</u>
						<u>REQ.</u>	<u>SCHEDULED</u> <u>OUTAGE</u>	
SW-308	BOX	N/A	VT-3	303/8.2.17				
SW-307	BOX	N/A	VT-3	303/8.2.17				
SW-266	BOX	N/A	VT-3	303/8.2.17				
SW-267	BOX	N/A	VT-3	303/8.2.17				
SW-292	BOX	N/A	VT-3	303/8.2.17				
SW-293	BOX	N/A	VT-3	303/8.2.17				
SW-294	BOX	N/A	VT-3	303/8.2.17				
SW-306	BOX	N/A	VT-3	303/8.2.17				
SW-303	BOX	N/A	VT-3	303/8.2.17				
SW-302	BOX	N/A	VT-3	303/8.2.17				
SW-301	BOX	N/A	VT-3	303/8.2.17				
SW-312	BOX	N/A	VT-3	303/8.2.17				
SW-PB-306	SW PRES BNDRY	N/A	VT-2	N/A				

SEE NOTES #6 & #7.

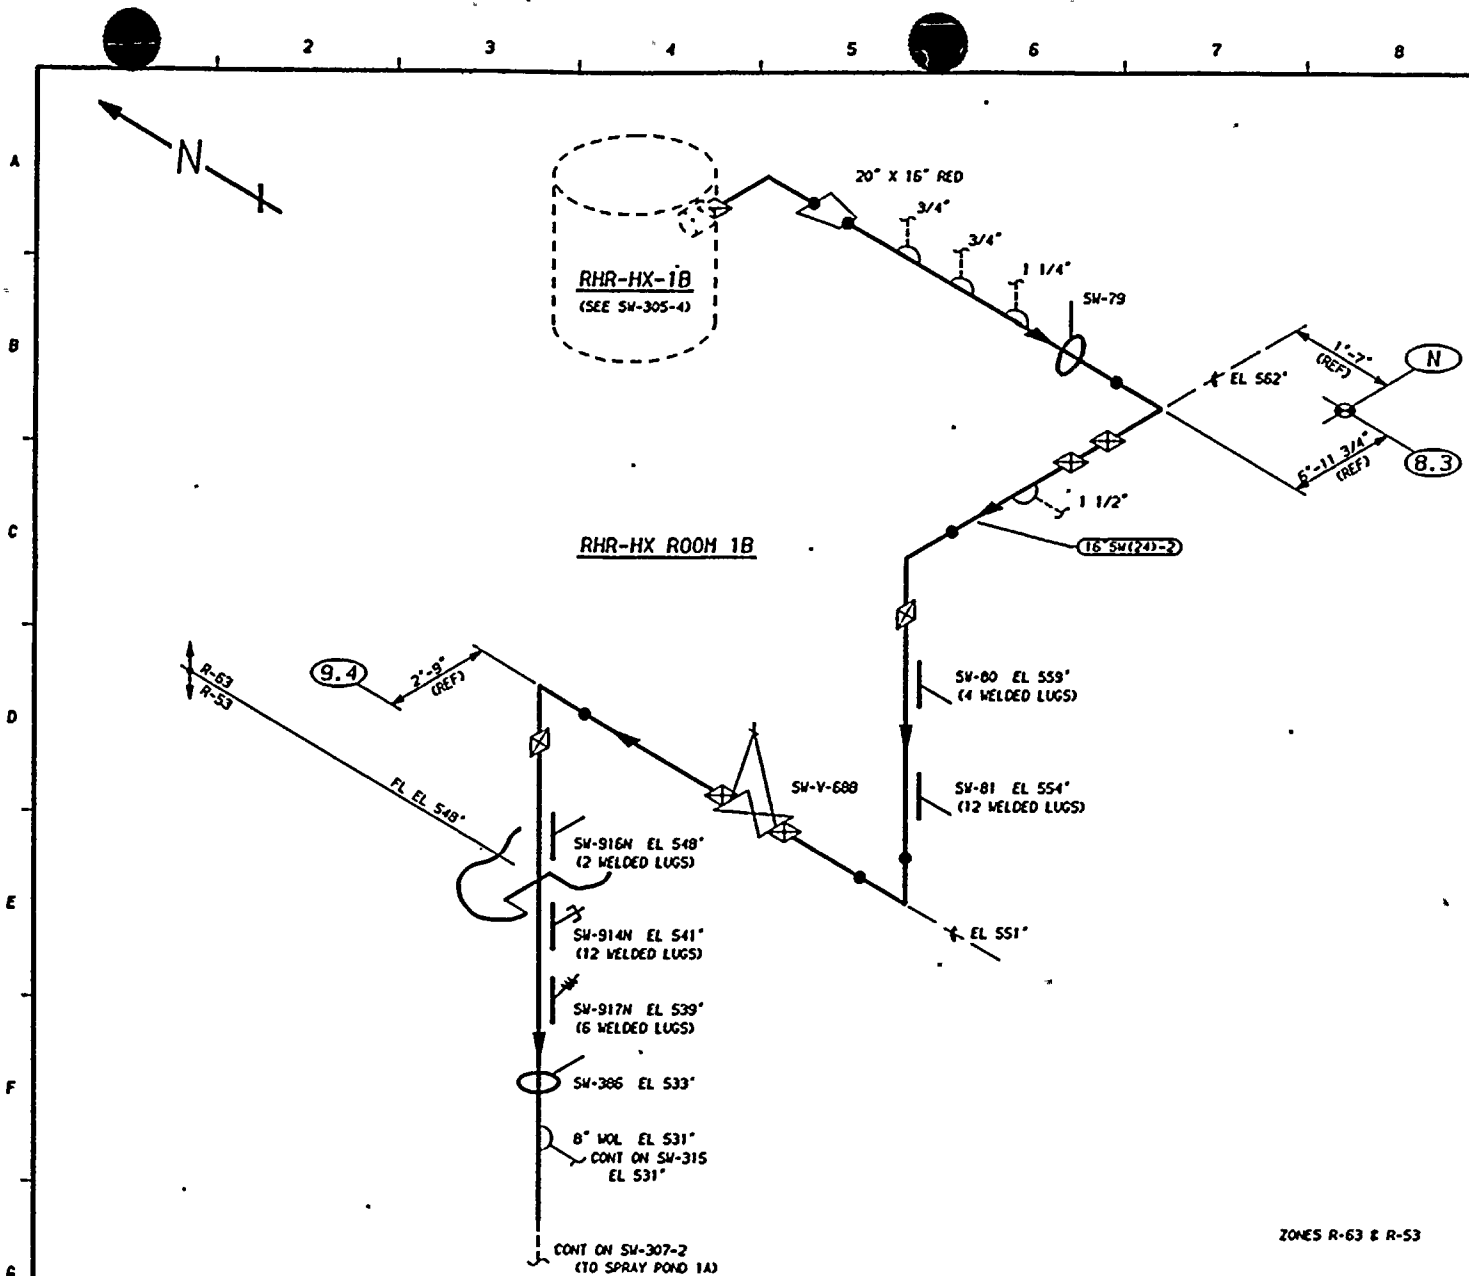

- NOTES:**
1. THIS DRAWING IDENTIFIES PIPING AND COMPONENTS SUBJECT ONLY TO A VISUAL EXAM FOR (1) EVIDENCE OF LEAKAGE DURING SYSTEM PRESSURE OR OPERABILITY TESTS; (2) PRESSURE DECAY TESTS OF BURIED PIPING; AND (3) LOSS OF SUPPORT CAPABILITY OR INADEQUATE RESTRAINT FOR SUPPORTS AND HANGERS ON PIPING EXCEEDING 4" NOM. TESTS SHALL BE CONDUCTED PER ASME SECTION XI, ARTICLES 1WA-5000 AND 1WD-2000.
 2. FOR BRANCH PIPING 4" NOM. OR LESS (CONNECTION SHOWN IN DASHED LINES) EXTEND VISUAL LEAKAGE EXAM THROUGH THE OUTERMOST NORMALLY CLOSED NUCLEAR CLASS VALVE, OR UNTIL TRANSITION TO INSTRUMENT TUBING, UNLESS OTHERWISE NOTED.

- REFERENCES:**
- 151 - 224
 - BOYEE & CRAIL ISOMETRICS
 - SW-295-1.3 REV 10
 - SW-295-4.6 REV 13

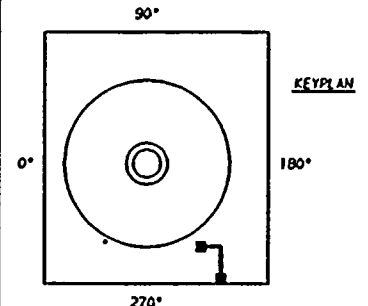

ZONES R-63 & R-53

THIS DRAWING IS INTENDED FOR USE IN PRESERVICE AND INSERVICE INSPECTIONS PROGRAMS ONLY.

QUALITY CLASS:	1	ASME CODE CLASS:	3
ENGR:	GA KUGLER	DRAWN:	K-MCA
DATE:	3-7-79		

WASHINGTON PUBLIC POWER
SUPPLY SYSTEM
RICHLAND, WASHINGTON 99352


WNP-2
WELD & COMPONENT
IDENTIFICATION DIAGRAM

TITLE:
SW LOOP A SUPPLY TO RHR-HX-1A

DWG NO: SW-307-1 REV 1


PIPING SYSTEM	NOM DIA (IN)	SCH	NOM WALL THK	MATERIAL SPECIFICATION	MATL TYPE	CAL BLOCK NO
16"SV(24)-2	16	STD	0.375	SA 106 GR B	CS	NA

NO	DATE	REVISION	BY	CHKD	APVD
1	1/21/96	GENERAL UP-DATE REDRAWN	[Signature]	[Signature]	[Signature]
0	11-5-80	ISSUED FOR USE	K-MCA	GAK	[Signature]

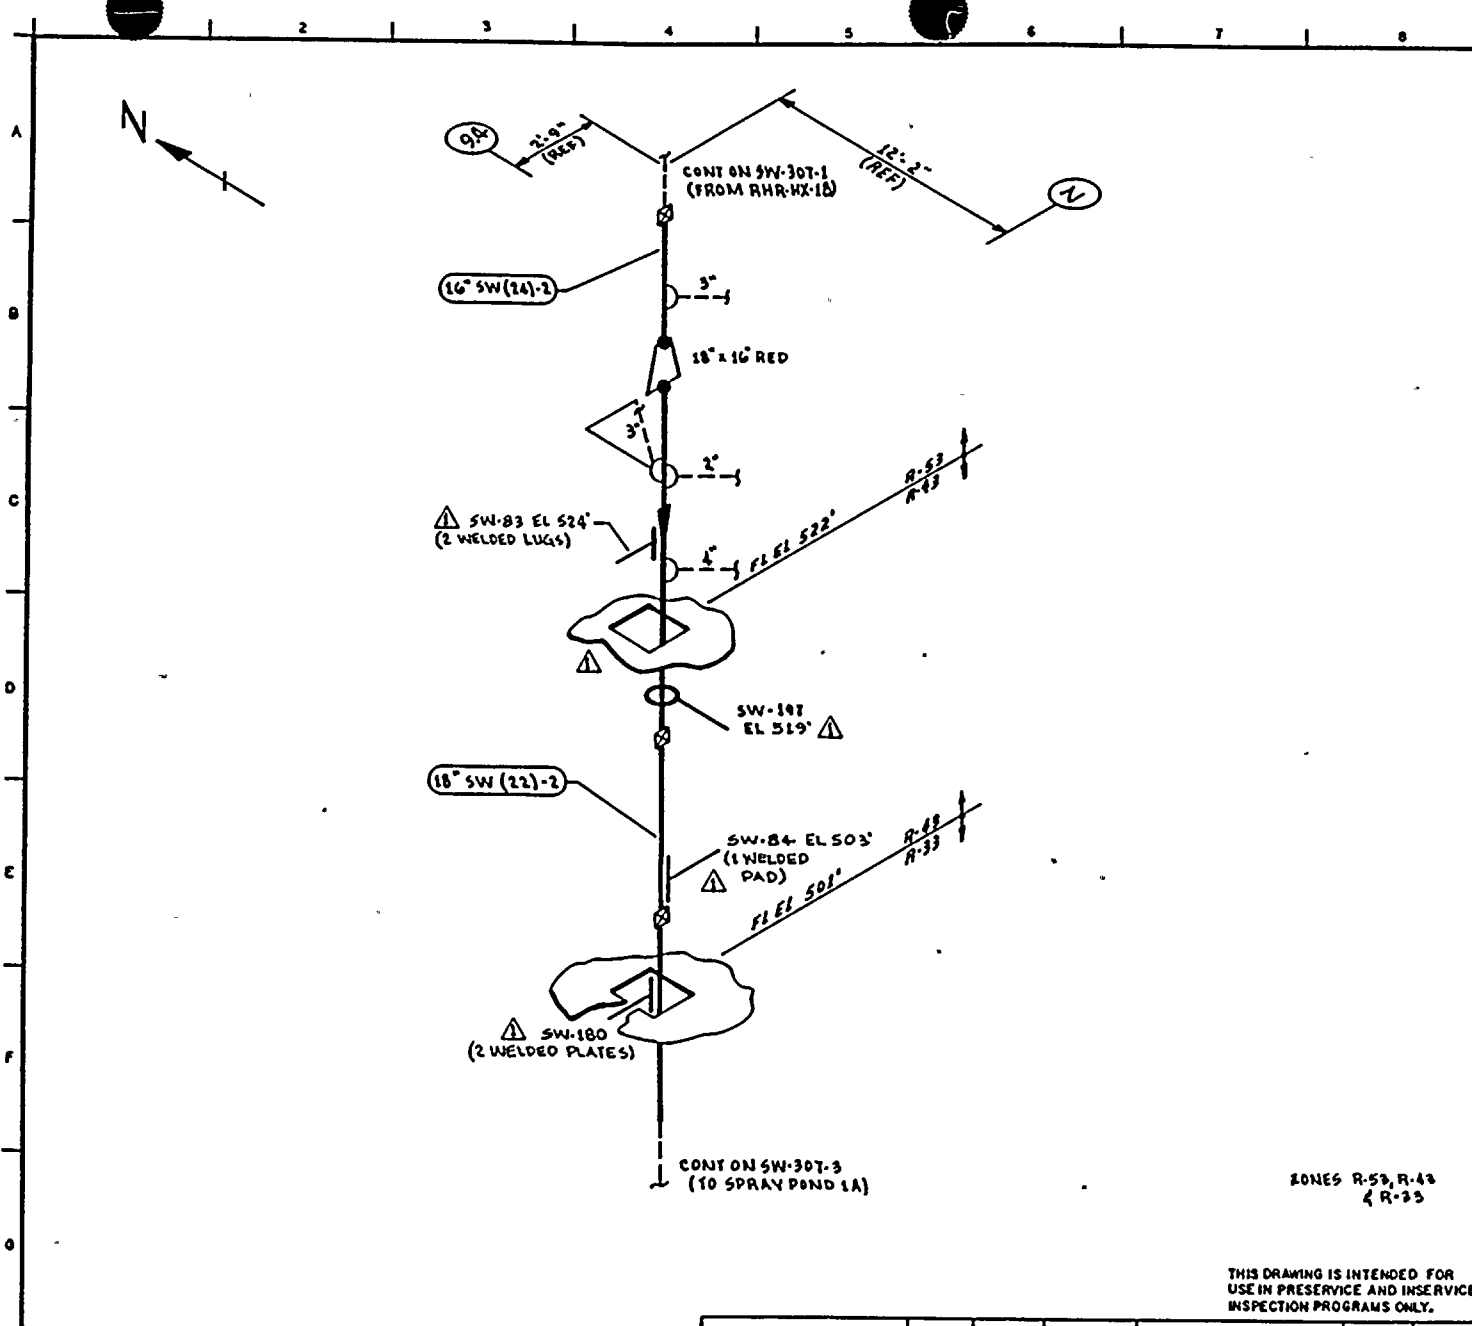

- NOTES:**
1. THIS DRAWING IDENTIFIES PIPING & COMPONENTS SUBJECT ONLY TO A VISUAL EXAM FOR (1) EVIDENCE OF LEAKAGE DURING SYSTEM PRESSURE OR OPERABILITY TESTS; (2) PRESSURE DECAY TESTS OF BURIED PIPING; & (3) LOSS OF SUPPORT CAPABILITY OR INADEQUATE RESTRAINT FOR SUPPORTS & HANGERS ON PIPING EXCEEDING 4" NOM. TESTS SHALL BE CONDUCTED PER ASME SECTION XI, ARTICLES SNA-5000 & SWD-2000.
 2. FOR BRANCH PIPING 4" NOM OR LESS (CONN SHOWN IN DASHED LINES) EXTEND VISUAL LEAKAGE EXAM THROUGH THE OUTERMOST NORMALLY CLOSED NUCLEAR CLASS VALVE, OR UNIL TRANSITION TO INSTRUMENT TUBING, UNLESS OTHERWISE NOTED.

- REFERENCES:**
- BOYCE & CRAIL ISOMETRICS
 - SW-295-4.6 REV 13
 - SW-295-7.11 REV 10

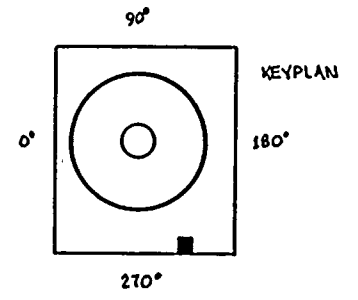

ZONES R-53, R-43 & R-33

THIS DRAWING IS INTENDED FOR USE IN PRESERVICE AND INSERVICE INSPECTION PROGRAMS ONLY.

QUALITY CLASS: 1	ASME CODE CLASS: 3
ENGR: QA KUGLER	DATE: 3-8-79
DRAWN: V-McA	

WASHINGTON PUBLIC POWER SUPPLY SYSTEM
 RICHLAND, WASHINGTON 99352


PIPING SYSTEM	NOM DIA (IN)	SCH	NOM WALL THK	MATERIAL SPECIFICATION	MATL TYPE	CAL BLOCK NO
16" SW(24)-2	16"	STD	0.375	SA 106	CG	NA
18" SW(22)-2	18"	STD	0.375	SA 106	CG	NA

WNP-2
 WELD & COMPONENT IDENTIFICATION DIAGRAM

TITLE:
 SW LOOP RETURN TO SPRAY POND 1A

DWG NO: SW-307-2 REV 1

NO	DATE	REVISION	BY	CHKD	APPVD
1	1-27-81	REVISED AS NOTED ADDED KEYPLAN	KUGLER	WPK	TFB
0	11-5-80	ISSUED FOR USE	KMcA	DMR	[Signature]

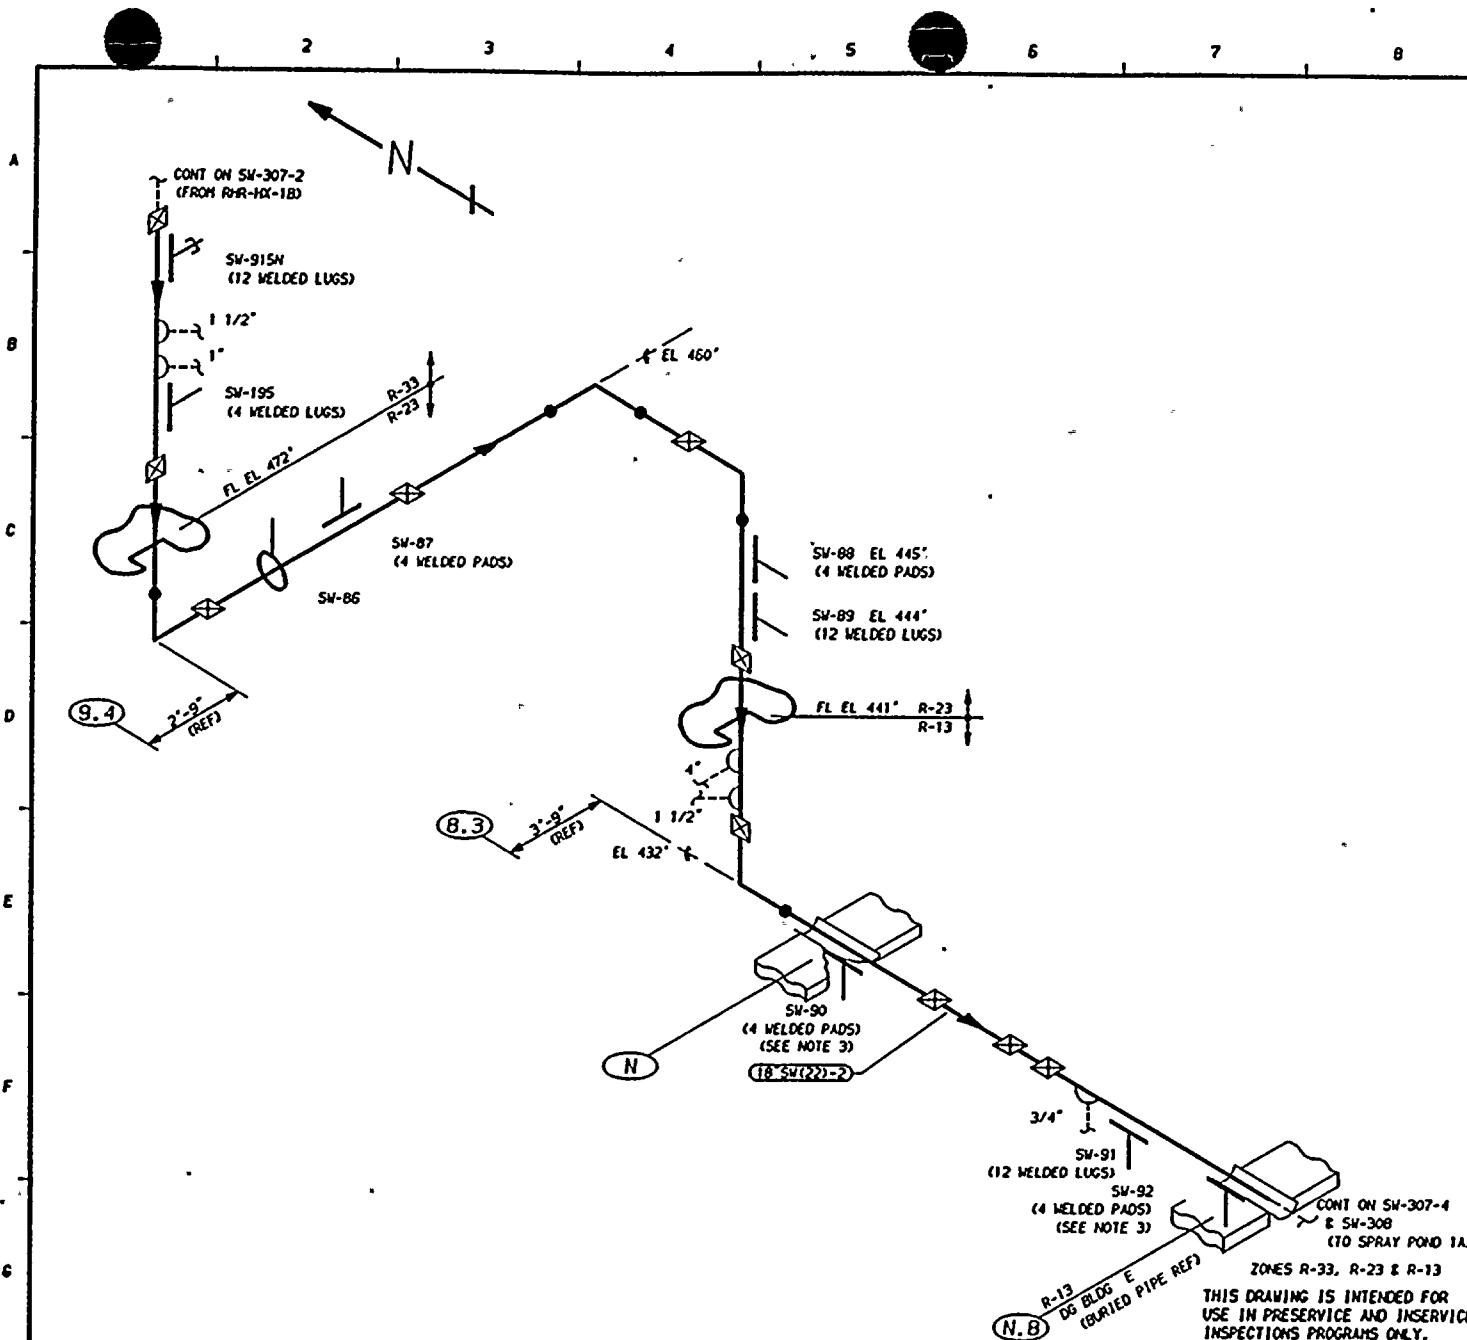


NOTES:

1. THIS DRAWING IDENTIFIES PIPING AND COMPONENTS SUBJECT ONLY TO A VISUAL EXAM FOR (1) EVIDENCE OF LEAKAGE DURING SYSTEM PRESSURE OR OPERABILITY TESTS; (2) PRESSURE DECAY TESTS OF BURIED PIPING; AND (3) LOSS OF SUPPORT CAPABILITY OR INADEQUATE RESTRAINT FOR SUPPORTS AND HANGERS ON PIPING EXCEEDING 4" NOM. TESTS SHALL BE CONDUCTED PER ASME SECTION XI, ARTICLES 1WA-5000 AND 1WD-2000.
2. FOR BRANCH PIPING 4" NOM. OR LESS (CONNECTION SHOWN IN DASHED LINES) EXTEND VISUAL LEAKAGE EXAM THROUGH THE OUTERMOST NORMALLY CLOSED NUCLEAR CLASS VALVE, OR UNTIL TRANSITION TO INSTRUMENT TUBING, UNLESS OTHERWISE NOTED.
3. COMPONENT SUPPORT IS UNACCESSIBLE DUE TO FOAM FILLED WATER TIGHT BOOT.

REFERENCES:

- 151 - 224
- BOYEE & CRAIL ISOMETRICS
 - SW-295-7.11 REV 10
 - SW-295-12.18 REV 11
 - SW-295-19.22 REV 9

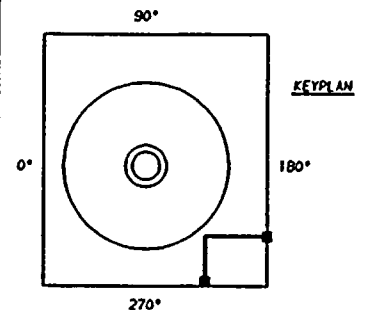

QUALITY CLASS:	1	ASME CODE CLASS:	3
ENGR:	GA KUGLER	DRAWN:	K-MCA
DATE:	3-8-79		

WASHINGTON PUBLIC POWER
SUPPLY SYSTEM
RICHLAND, WASHINGTON 99352

WNP-2
WELD & COMPONENT
IDENTIFICATION DIAGRAM

TITLE:
SW LOOP B RETURN TO SPRAY POND 1A


DWG NO: SW-307-3

REV 1

PIPING SYSTEM	NOM DIA (INO)	SCH	NOM WALL THK	MATERIAL SPECIFICATION	MATL TYPE	CAL BLOCK NO
18"SW(22)-2	18	STD	0.375	SA 106 GR B	CS	NA


THIS DRAWING IS INTENDED FOR USE IN PRESERVICE AND INSERVICE INSPECTIONS PROGRAMS ONLY.

1	12/2/80	GENERAL UP-DATE REDRAWN	K-MCA	DWR	TKK
0	11-5-80	ISSUED FOR USE	K-MCA	GAK	TKK
NO	DATE	REVISION	BY	CHKD	APVD

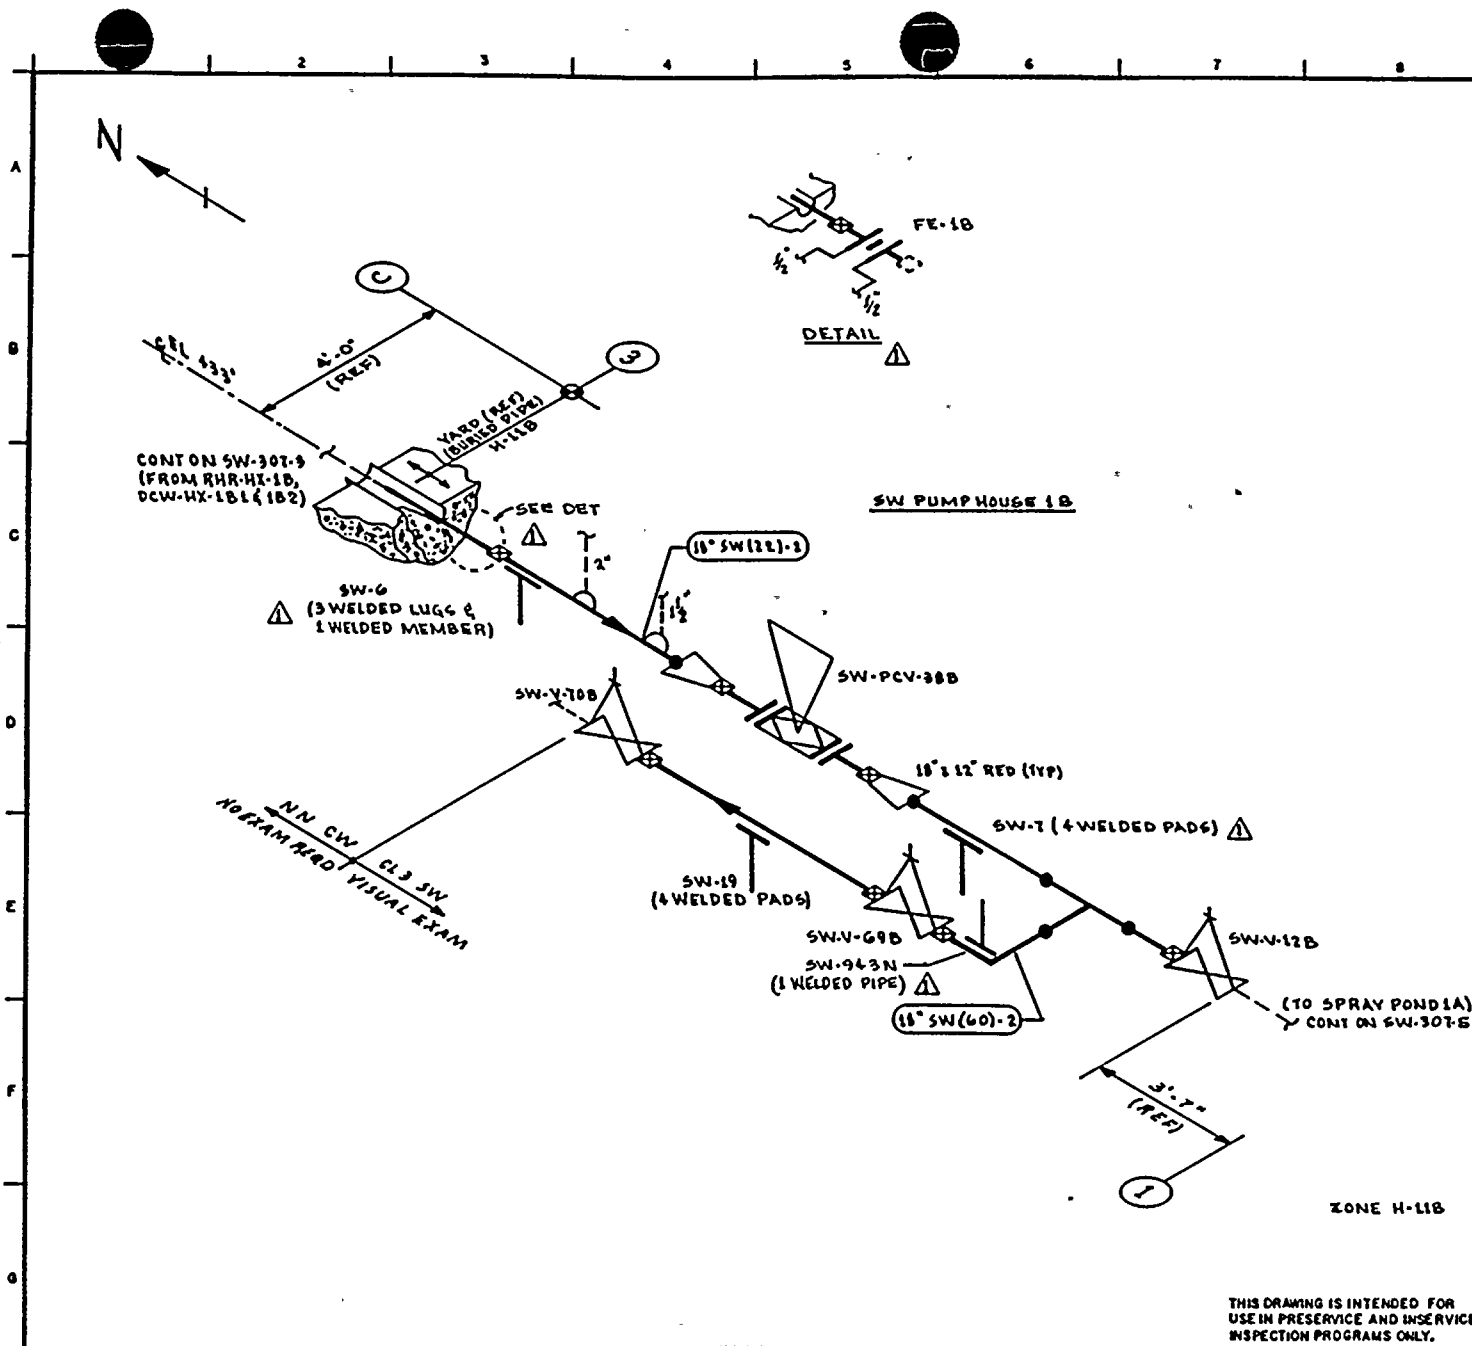

- NOTES:**
1. THIS DRAWING IDENTIFIES PIPING & COMPONENTS SUBJECT ONLY TO A VISUAL EXAM FOR (1) EVIDENCE OF LEAKAGE DURING SYSTEM PRESSURE OR OPERABILITY TESTS; (2) PRESSURE DECAY TESTS OF BURIED PIPING; & (3) LOSS OF SUPPORT CAPABILITY OR INADEQUATE RESTRAINT FOR SUPPORTS & HANGERS ON PIPING 4" NOM. TESTS SHALL BE CONDUCTED PER ASME SECTION XI, ARTICLES IWA-3000 & IWD 2000.
 2. FOR BRANCH PIPING 4" NOM OR LESS (CONN SHOWN IN DASHED LINES) EXTEND VISUAL LEAKAGE EXAM THROUGH THE OUTERMOST NORMALLY CLOSED NUCLEAR CLASS VALVE, OR UNTIL TRANSITION TO INSTRUMENT TUBING, UNLESS OTHERWISE NOTED.

- REFERENCES:**
- BOVEE & CRAL ISOMETRICS
 - SW-295-33.38 REV 12
 - SW-295-29.42 REV 13

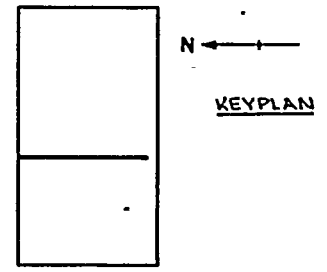

THIS DRAWING IS INTENDED FOR USE IN PRESERVICE AND INSERVICE INSPECTION PROGRAMS ONLY.

QUALITY CLASS: 1	ASME CODE CLASS: 3
ENGR: G.A. KUGLER	DRAWN: K.M.L.A. DATE: 3-9-79

WASHINGTON PUBLIC POWER SUPPLY SYSTEM
 RICHLAND, WASHINGTON 99352


PIPING SYSTEM	NOM DIA (IN)	SCH	NOM WALL THK	MATERIAL SPECIFICATION	MATL TYPE	CAL BLOCK NO
18" SW (22)-2	18"	STD	0.375	SA 106 GR B	C5	NA
18" SW (40)-2	18"	STD	0.375	SA 106 GR B	C5	NA

NO	DATE	REVISION	BY	CHKD	APPVD
1	1-21-81	REVISED AS NOTED ADDED KEYPLAN	K.M.L.A.	---	---
0	11-5-80	ISSUED FOR USE	K.M.L.A.	---	---

WNP- 2
 WELD & COMPONENT IDENTIFICATION DIAGRAM

TITLE:
 SW LOOP B RETURN TO SPRAY POND 1A

DWG NO: SW-307-4 REV 1

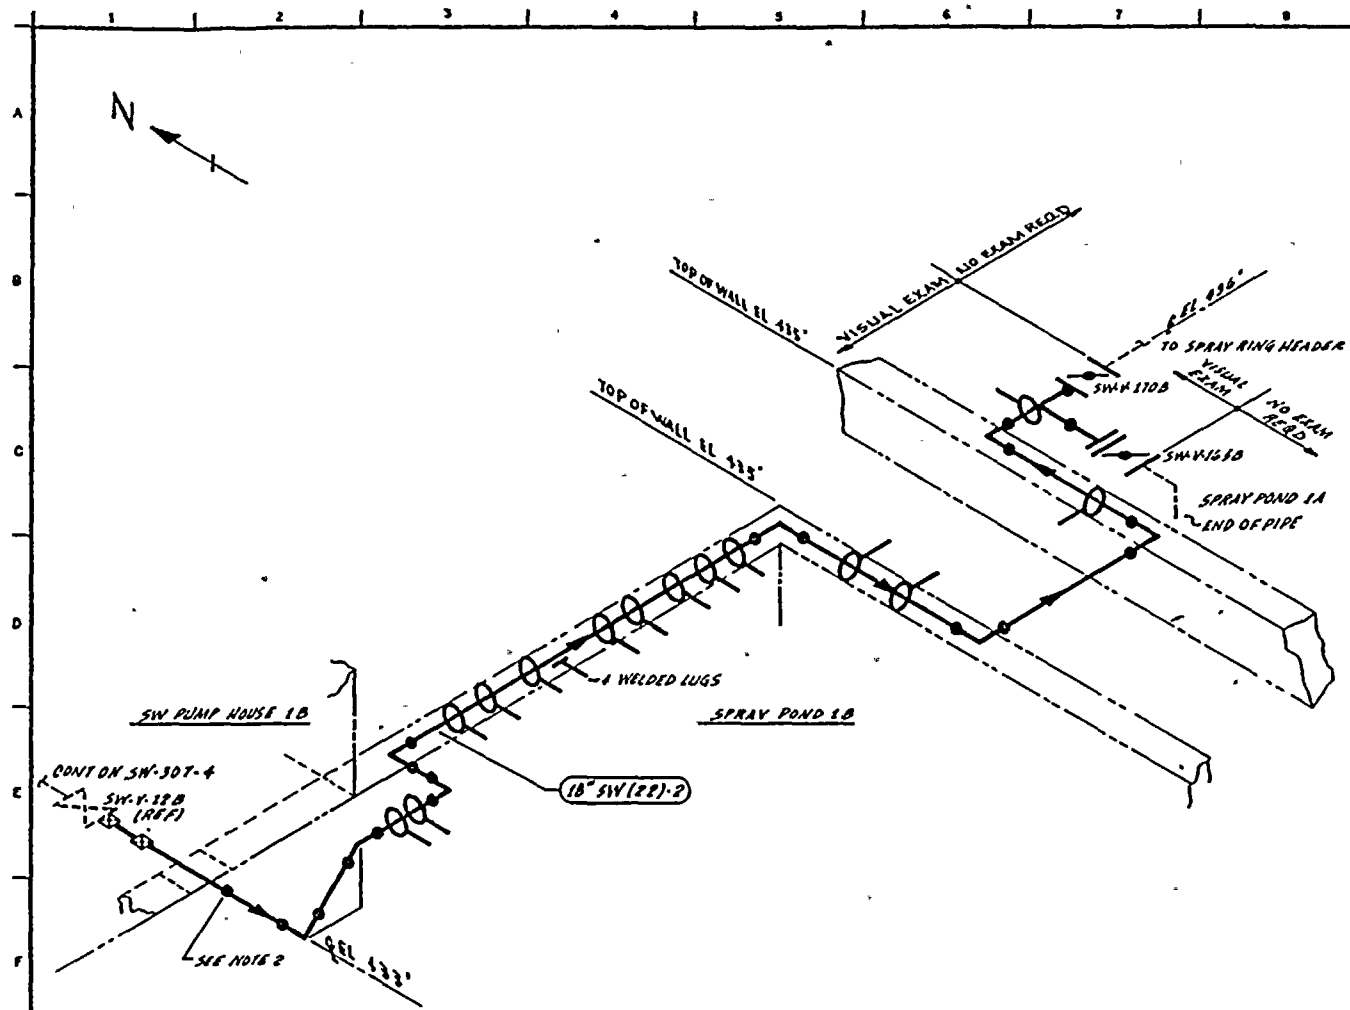

- NOTES:**
1. THIS DRAWING IDENTIFIES PIPING & COMPONENTS SUBJECT ONLY TO A VISUAL EXAM FOR (1) EVIDENCE OF LEAKAGE DURING SYSTEM PRESSURE OR OPERABILITY TESTS; (2) PRESSURE DECAY TESTS OF BURIED PIPING & (3) LOSS OF SUPPORT CAPABILITY OR INADEQUATE RESTRAINT FOR SUPPORTS & HANGERS ON PIPING EXCEEDING 4" NOM. TESTS SHALL BE CONDUCTED PER ASME SECTION XI, ARTICLES IWA-5000 & IWD-2000.
 2. NO ATTEMPT HAS BEEN MADE TO DIFFERENTIATE BETWEEN SHOP & FIELD WELDS SINCE REF. DWGS. GAVE NO WELD TYPE INDICATION.

- REFERENCES:**
- BURNS & ROE DWGS.
 M566 REV 12
 M782 REV 4
 S534 REV A
 S535 REV A
 M200-207 REV 0

QUALITY CLASS: 1 ASME CODE CLASS: 3
 ENGR: QA KUGLER DRAWN: KMA DATE: 11.7.79

WASHINGTON PUBLIC POWER SUPPLY SYSTEM
 RICHLAND, WASHINGTON 99122

THIS DRAWING IS INTENDED FOR USE IN PRESERVICE AND INSERVICE INSPECTION PROGRAMS ONLY.

PIPING SYSTEM	NOM DIA (IN)	SCH	NOM WALL THK	MATERIAL SPECIFICATION	WATL TYPE	CAL BLOCK NO
18" SW (??)-2	18	STD	0.375	SA 106 GR B	CS	NA

WNP-2
 WELD & COMPONENT
 IDENTIFICATION DIAGRAM

TITLE:
 SW LOOP B RETURN TO SPRAY POND 1A

DWG NO: SW-307-B REV 0

NO	DATE	REVISION	BY	CHKD	APPVD
0	11/7/79	ISSUED FOR USE	KMA	SM	QSP



WNP-02
 INTERVAL: PSI
 PERIOD: NA
 OUTAGE:
 DRAWING NO. SW-307

WASHINGTON PUBLIC POWER SUPPLY SYSTEM
 PROGRAM PLAN AND SCHEDULE
 SYSTEM OR COMPONENT: SW(24)-2
 DESCRIPTION: SW LOOP B RETURN

PAGE 001
 DATE 12/14/84

<u>IDENT. NO.</u>	<u>DESCRIPTION</u>	SECT. XI <u>EXAM.</u>	EXAM <u>MTH.</u>	<u>PROCEDURE</u>	CAL. <u>BLOCK</u>	<u>INSERVICE</u>		<u>NOTES</u>
						<u>REQ.</u>	<u>SCHEDULED</u> <u>OUTAGE</u>	
SW-79	STRUT	N/A	VT-3	303/8.2.17				
SW-80	BOX	N/A	VT-3	303/8.2.17				
SW-81	BOX	N/A	VT-3	303/8.2.17				
SW-916N	RIGID	N/A	VT-3	303/8.2.17				
SW-914N	PSA-10 SN(2)	N/A	VT-3	303/8.2.17				S/N
			VT-4	303/8.2.17				S/N
SW-917N	SPRING	N/A	VT-3	303/8.2.17				
			VT-4	303/8.2.17				
SW-386	STRUT	N/A	VT-3	303/8.2.17				
SW-83	STRUT	N/A	VT-3	303/8.2.17				
SW-197	BOX	N/A	VT-3	303/8.2.17				
SW-84	STRUT	N/A	VT-3	303/8.2.17				
SW-180	STRUT	N/A	VT-3	303/8.2.17				
SW-915N	PSA-10 SN(2)	N/A	VT-3	303/8.2.17				S/N
			VT-4	303/8.2.17				S/N
SW-195	BOX	N/A	VT-3	303/8.2.17				
SW-86	STRUT	N/A	VT-3	303/8.2.17				
SW-87	BOX	N/A	VT-3	303/8.2.17				


WNP-02
 INTERVAL: PSI
 PERIOD: NA
 OUTAGE:
 DRAWING NO. SW-307

WASHINGTON PUBLIC POWER SUPPLY SYSTEM
 PROGRAM PLAN AND SCHEDULE
 SYSTEM OR COMPONENT: SW(24)-2
 DESCRIPTION: SW LOOP E RETURN

PAGE 002
 DATE 12/14/84


<u>IDENT. NO.</u>	<u>DESCRIPTION</u>	<u>SECT.</u>		<u>PROCEDURE</u>	<u>CAL. BLOCK</u>	<u>INSERVICE</u>		<u>NOTES</u>
		<u>XI EXAM</u>	<u>EXAM</u>			<u>REQ.</u>	<u>SCHEDULED OUTAGE</u>	
SW-88	BOX	N/A	VT-3	303/8.2.17				
SW-89	BOX	N/A	VT-3	303/8.2.17				
SW-90	RIGID	N/A	VT-3	303/8.2.17				
SW-91	STRUT	N/A	VT-3	303/8.2.17				
SW-92	RIGID	N/A	VT-3	303/8.2.17				
SW-6	BOX	N/A	VT-3	303/8.2.17				
SW-7	BOX	N/A	VT-3	303/8.2.17				
SW-943N	STRUT	N/A	VT-3	303/8.2.17				
SW-19	BOX	N/A	VT-3	303/8.2.17				
SW-PP-307	SW PRES BNDRY	N/A	VT-2	N/A				

SEE NOTES #6 & #7.

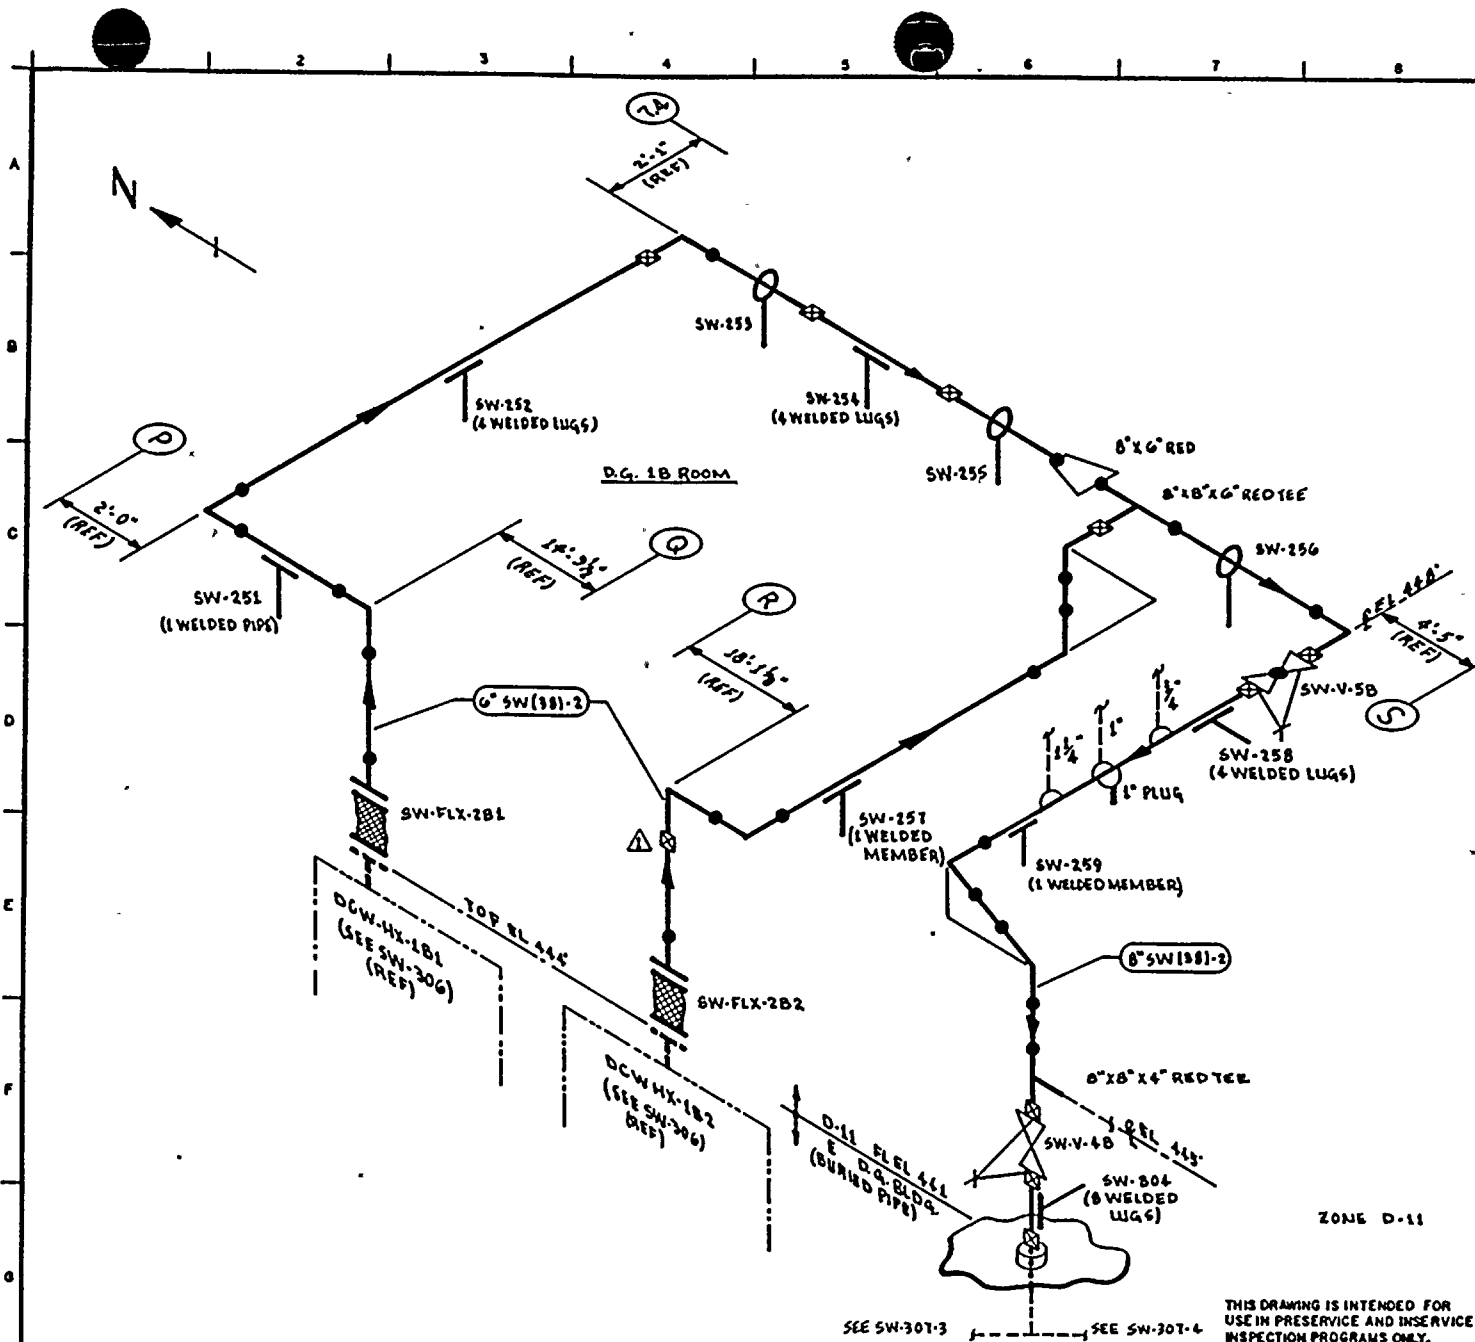

- NOTES:
1. THIS DRAWING IDENTIFIES PIPING & COMPONENTS SUBJECT ONLY TO A VISUAL EXAM FOR (1) EVIDENCE OF LEAKAGE DURING SYSTEM PRESSURE OR OPERABILITY TESTS; (2) PRESSURE DECAY TESTS OF BURIED PIPING; & (3) LOSS OF SUPPORT CAPABILITY OR INADEQUATE RESTRAINT FOR SUPPORTS & HANGERS ON PIPING EXCEEDING 4" NOM. TESTS SHALL BE CONDUCTED PER ASME SECTION XI, ARTICLES IWA-5000 & IWD-2000.
 2. FOR BRANCH PIPING 4" NOM OR LESS (CONJ. SHOWN IN DASHED LINES) EXTEND VISUAL LEAKAGE EXAM THROUGH THE OUTERMOST NORMALLY CLOSED NUCLEAR CLASS VALVE, OR UNTIL TRANSITION TO INSTRUMENT TUBING, UNLESS OTHERWISE NOTED.

- REFERENCES:
- BOYCE & CHAIL ISOMETRICS
- SW-295-19.22 REV 9
 - SW-283-1.5 REV 6
 - SW-283-6 REV 7

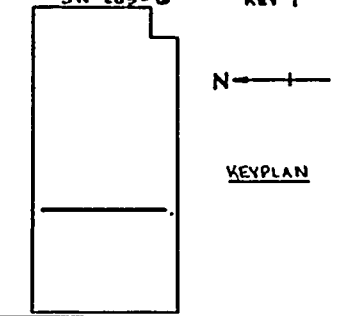

QUALITY CLASS: 1 ASME CODE CLASS: 3
 ENGR: G.A. KUGLER DRAWN: K.M.L. DATE: 5-9-79

WASHINGTON PUBLIC POWER SUPPLY SYSTEM
 RICHLAND, WASHINGTON 99302

WNP-2
 WELD B COMPONENT
 IDENTIFICATION DIAGRAM

TITLE:
 SW LOOP B RETURN FROM DCW-HX-1B1 & 1B2

DWG NO: SW-30B REV 1

THIS DRAWING IS INTENDED FOR USE IN PRESERVICE AND INSERVICE INSPECTION PROGRAMS ONLY.

PIPING SYSTEM	NOM DIA (IN)	SCH	NOM WALL THK	MATERIAL SPECIFICATION	MATL TYPE	CAL BLOCK NO
6" SW(38)-2	6	STD	0.280	SA 106 GRB	CS	NA
8" SW(38)-2	8	STD	0.322	SA 106 GRB	CS	NA

1	12-84	ADDED FW ZN G-6 ADDED KEYPLAN	KARA	TFH
0	11-5-80	ISSUED FOR USE	KARA	BAK
	NO DATE	REVISION	BY	CHKD APPVD


WNP-02
 INTERVAL: PSI
 PERIOD: NA
 OUTAGE:
 DRAWING NO. SW-308

WASHINGTON PUBLIC POWER SUPPLY SYSTEM
 PROGRAM PLAN AND SCHEDULE
 SYSTEM OR COMPONENT: SW(38)-2
 DESCRIPTION: SW LOOP B RETURN

PAGE 001
 DATE 12/14/84


<u>IDENT. NO.</u>	<u>DESCRIPTION</u>	<u>SECT.</u>		<u>PROCEDURE</u>	<u>CAL. BLOCK</u>	<u>INSERVICE SCHEDULED</u>		<u>NOTES</u>
		<u>XI EXAM.</u>	<u>EXAM. MTH.</u>			<u>REQ.</u>	<u>OUTAGE</u>	
SW-251	BOX	N/A	VT-3	303/8.2.17				
SW-252	BOX	N/A	VT-3	303/8.2.17				
SW-253	BOX	N/A	VT-3	303/8.2.17				
SW-254	BOX	N/A	VT-3	303/8.2.17				
SW-255	BOX	N/A	VT-3	303/8.2.17				
SW-256	BOX	N/A	VT-3	303/8.2.17				
SW-257	BOX	N/A	VT-3	303/8.2.17				
SW-258	BOX	N/A	VT-3	303/8.2.17				
SW-259	BOX	N/A	VT-3	303/8.2.17				
SW-304	BOX	N/A	VT-3	303/8.2.17				
SW-PB-308	SW PRES BNDRY	N/A	VT-2	N/A				

SEE NOTES #6 & #7.

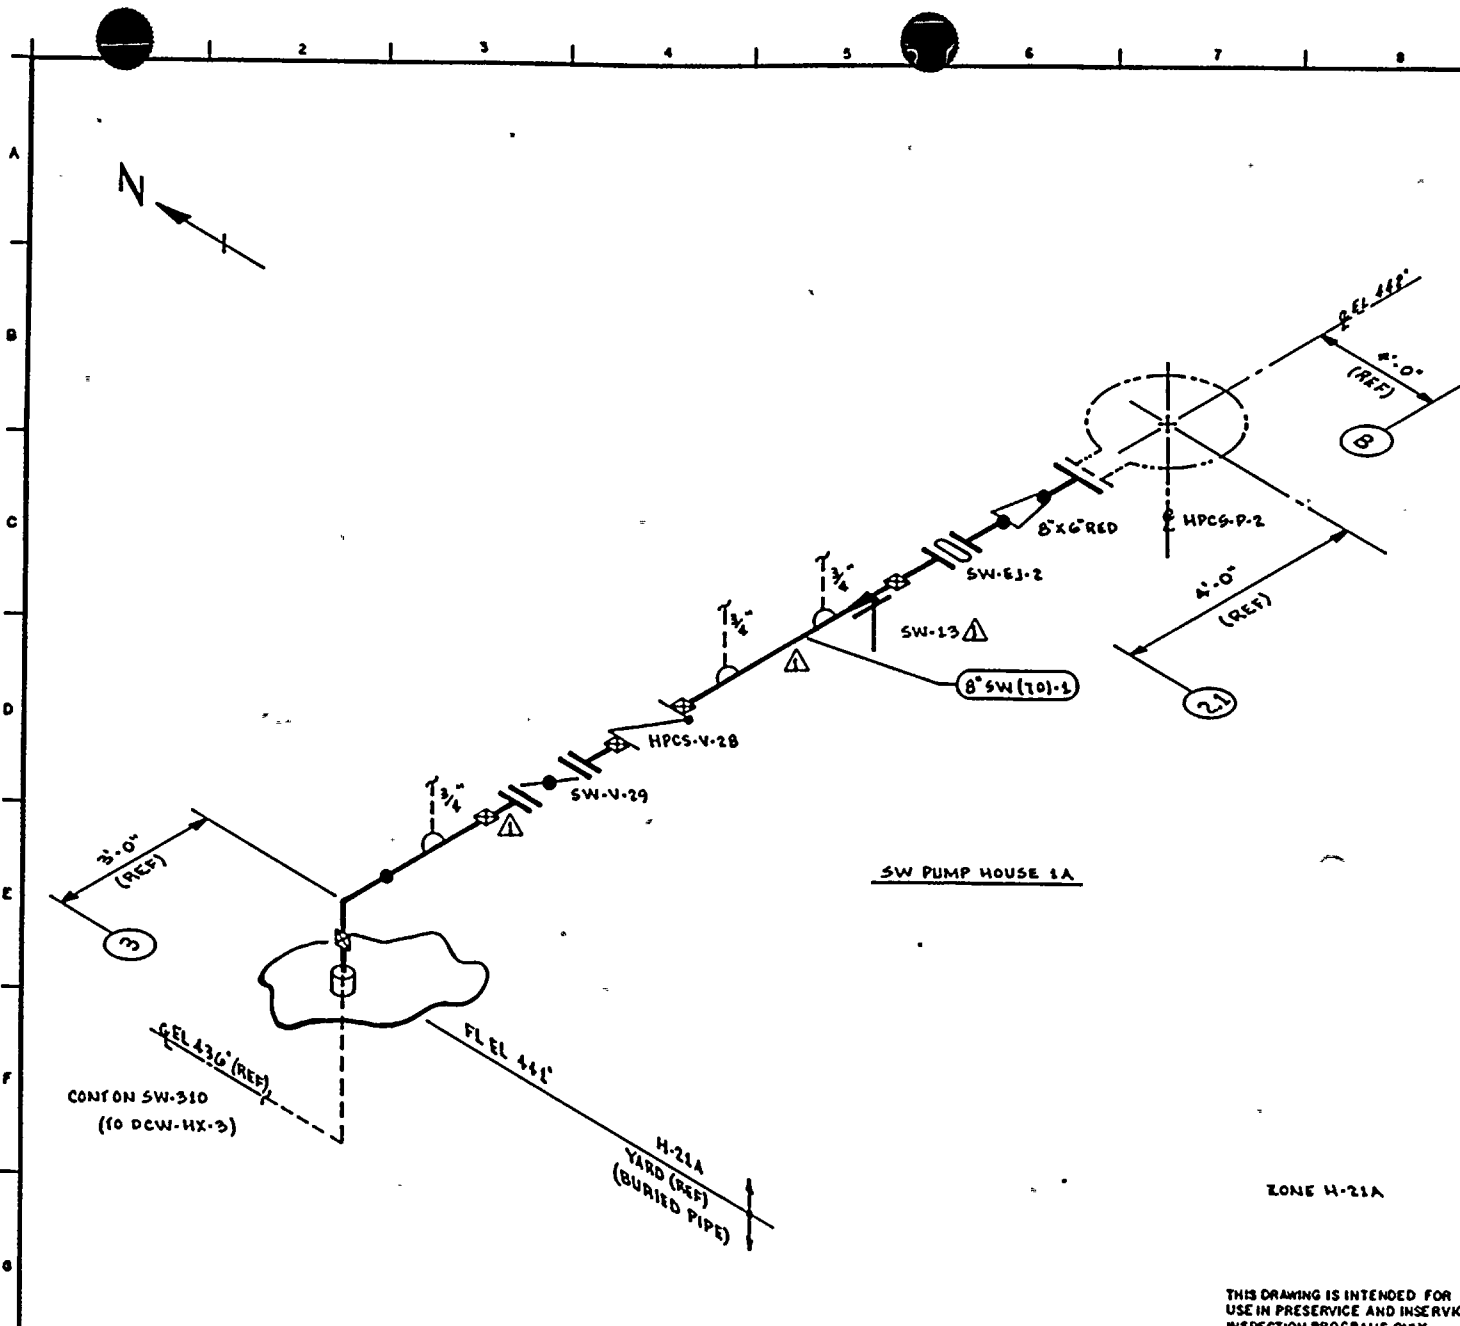

- NOTES:**
1. THIS DRAWING IDENTIFIES PIPING & COMPONENTS SUBJECT ONLY TO A VISUAL EXAM FOR (1) EVIDENCE OF LEAKAGE DURING SYSTEM PRESSURE OR OPERABILITY TESTS; (2) PRESSURE DECAY TESTS OF BURIED PIPING; & (3) LOSS OF SUPPORT CAPABILITY OR INADEQUATE RESTRAINT FOR SUPPORTS & HANGERS ON PIPING EXCEEDING 4" NOM. TESTS SHALL BE CONDUCTED PER ASME SECTION XI, ARTICLES IWA-5000 & IWD-2000.
 2. FOR BRANCH PIPING 4" NOM OR LESS (CONN SHOWN IN DASHED LINES) EXTEND VISUAL LEAKAGE EXAM THROUGH THE OUTERMOST NORMALLY CLOSED NUCLEAR CLASS VALVE, OR UNTIL TRANSITION TO INSTRUMENT TUBING, UNLESS OTHERWISE NOTED.

REFERENCES:
 BOVEE & CRAIL ISOMETRICS
 SW-290-1.3 REV 11

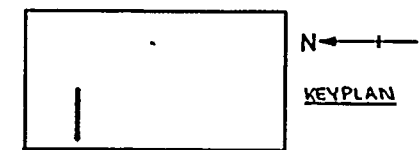

THIS DRAWING IS INTENDED FOR USE IN PRESERVICE AND INSERVICE INSPECTION PROGRAMS ONLY.

QUALITY CLASS: 1 ASME CODE CLASS: 3
 ENGR: GA KUGLER DRAWN: K-MCA DATE: 3-12-79

WASHINGTON PUBLIC POWER SUPPLY SYSTEM
 RICHLAND, WASHINGTON 98352

PIPING SYSTEM	NOM DIA (IN)	SCH	NOM WALL THK	MATERIAL SPECIFICATION	MATL TYPE	CAL BLOCK NO
8" SW (10)-1	8	STD	0.322	SA 106 GR B	CB	NA

NO	DATE	REVISION	BY	CHKD	APPVD
1	1-24-84	REVISED AS NOTED ADDED KEYPLAN	KMA		TGI
0	11-5-80	ISSUED FOR USE	KMA		PDP

WHP-2
 WELD & COMPONENT IDENTIFICATION DIAGRAM

TITLE:
 SW SUPPLY HPCS LOOP

DWG NO: SW-309 REV 1




WNP-02
INTERVAL: PSI
PERIOD: NA
OUTAGE:
DRAWING NO: SW-309

WASHINGTON PUBLIC POWER SUPPLY SYSTEM
PROGRAM PLAN AND SCHEDULE
SYSTEM OR COMPONENT: SV(70)-1
DESCRIPTION: SW SUPPLY HPCS LOOP

PAGE 001
DATE 12/14/84


<u>IDENT. NO.</u>	<u>DESCRIPTION</u>	<u>SECT.</u> XI	<u>EXAM</u> EXAM	<u>PROCEDURE</u>	<u>CAL.</u> CAL.	<u>INSERVICE</u> SCHEDULED	<u>NOTES</u>
		<u>EXAM.</u>	<u>MTM.</u>		<u>BLOCK</u>	<u>REQ.</u> <u>OUTAGE</u>	
SW-13	BOX	N/A	VT-3	303/8.2.17			
SW-PB-309	SW PRES BNDRY	N/A	VT-2	N/A			SEE NOTES #6 & #7.



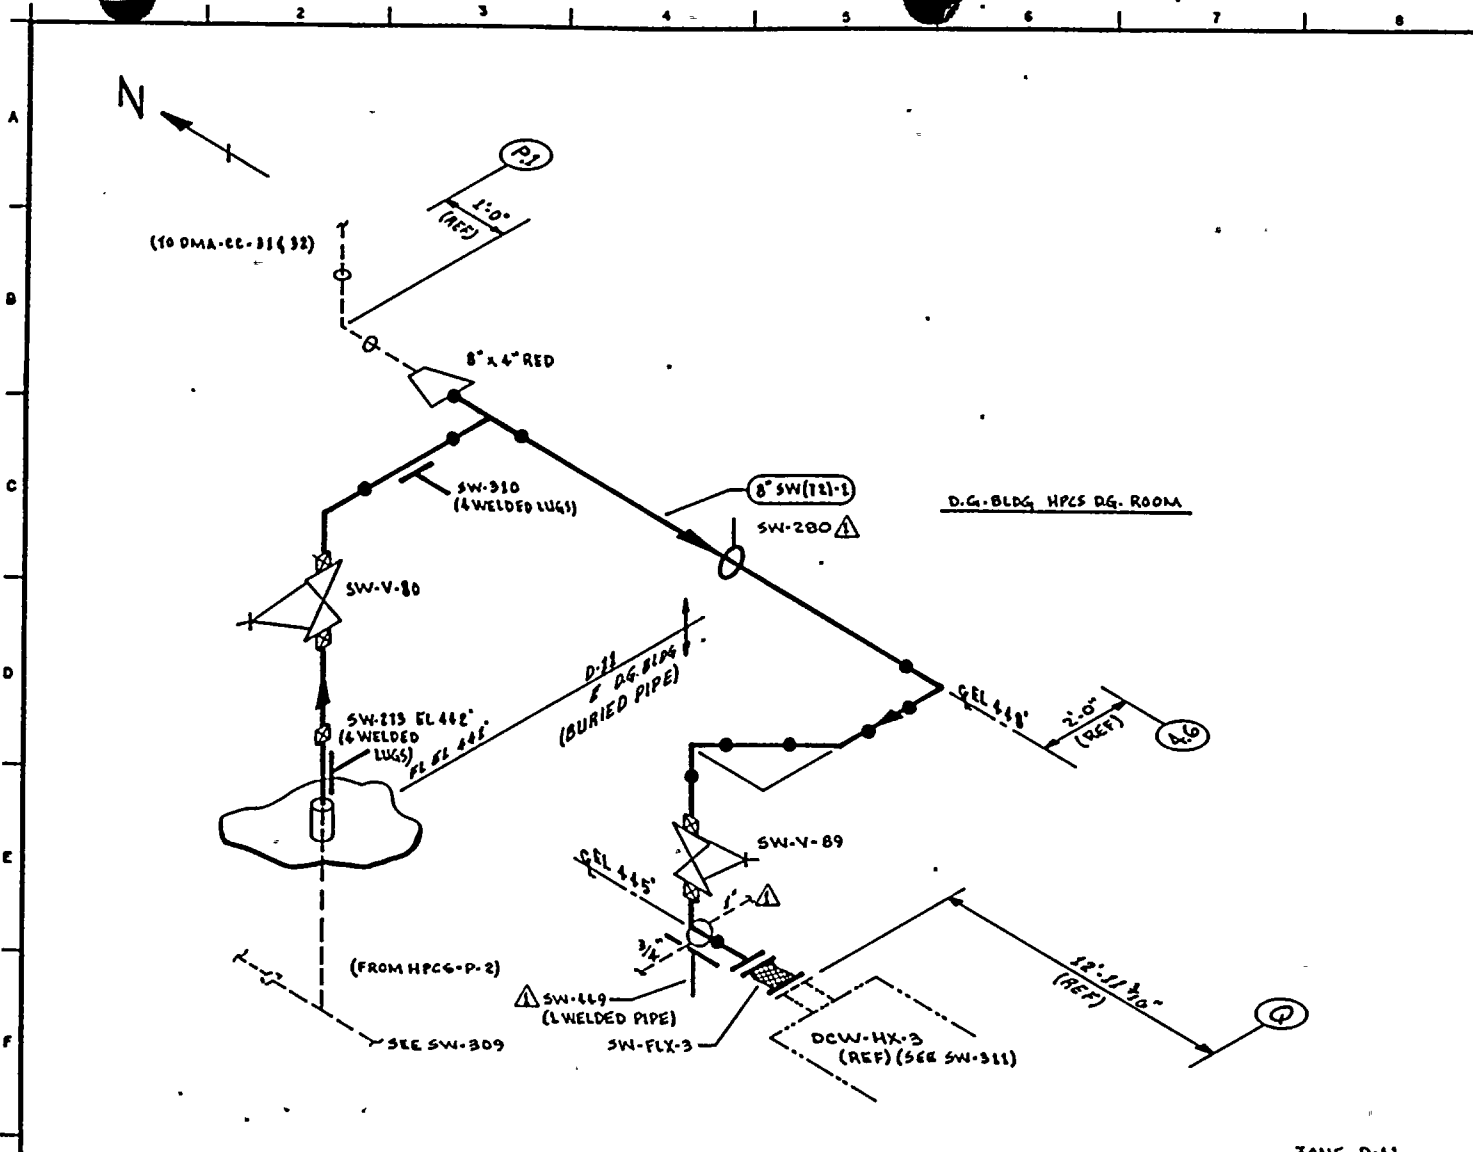

- NOTES:**
1. THIS DRAWING IDENTIFIES PIPING & COMPONENTS SUBJECT ONLY TO A VISUAL EXAM FOR (1) EVIDENCE OF LEAKAGE DURING SYSTEM PRESSURE OR OPERABILITY TESTS; (2) PRESSURE DECAY TESTS OF BURIED PIPING; & (3) LOSS OF SUPPORT CAPABILITY OR INADEQUATE RESTRAINT FOR SUPPORTS & HANGERS ON PIPING EXCEEDING 4" NOM. TESTS SHALL BE CONDUCTED PER ASME SECTION XI, ARTICLES SWA-5000 & SWD-2000.
 2. FOR BRANCH PIPING 4" NOM OR LESS (CONNS SHOWN IN DASHED LINES) EXTEND VISUAL LEAKAGE EXAM THROUGH THE OUTERMOST NORMALLY CLOSED NUCLEAR CLASS VALVE, OR UNTIL TRANSITION TO INSTRUMENT TUBING, UNLESS OTHERWISE NOTED.

- REFERENCES:**
- BOVEE & CRAIL ISOMETRICS
 SW-290-21.23 REV G
 SW-290-24.29 REV 10

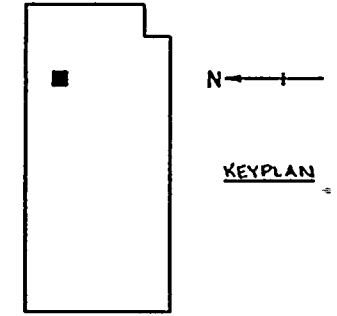

ZONE D-11

THIS DRAWING IS INTENDED FOR USE IN PRESERVICE AND INSERVICE INSPECTION PROGRAMS ONLY.

QUALITY CLASS: 1 ASME CODE CLASS: 3
 ENGR: GA WUGLER DRAWN: K-McA DATE: 3-12-79

WASHINGTON PUBLIC POWER SUPPLY SYSTEM
 RICHMOND, WASHINGTON 98352

PIPING SYSTEM	NOM DIA (IN)	SCH	NOM WALL THK	MATERIAL SPECIFICATION	MATL TYPE	CAL BLOCK NO
8" SW(121)1	8	STD	0.322	SA 106 GR B	CG	NA

NO	DATE	REVISION	BY	CHKD	APPVD
1	1-24-84	REVISED AS NOTED ADDED KEYPLAN	KMcA	GR	TFH
0	11-8-80	ISSUED FOR USE	KMcA	TFH	A'DW

WNP-2
 WELD COMPONENT IDENTIFICATION DIAGRAM

TITLE:
 SW HPC6 LOOP SUPPLY TO DCW-HX-3

DWG NO: SW-310 REV 1


WNP-02
 INTERVAL: PSI
 PERIOD: NA
 OUTAGE:
 DRAWING NO. SW-310

WASHINGTON PUBLIC POWER SUPPLY SYSTEM
 PROGRAM PLAN AND SCHEDULE
 SYSTEM OR COMPONENT: SW(72)-1
 DESCRIPTION: SW HPCS LOOP SUPPLY

PAGE 001
 DATE 12/14/84

<u>IDENT. NO.</u>	<u>DESCRIPTION</u>	<u>SECT.</u> XI <u>EXAM.</u>	<u>EXAM</u> MTH.	<u>PROCEDURE</u>	<u>CAL.</u> BLOCK	<u>INSERVICE</u>		<u>NOTES</u>
						<u>REQ.</u>	<u>SCHEDULED</u> OUTAGE	
SW-273	BOX	N/A	VT-3	303/8.2.17				
SW-310	BOX	N/A	VT-3	303/8.2.17				
SW-280	STRUT	N/A	VT-3	303/8.2.17				
SW-449	RIGID	N/A	VT-3	303/8.2.17				
SW-PB-310	SW PRES BNDRY	N/A	VT-2	N/A				

SEE NOTES #6 & #7.

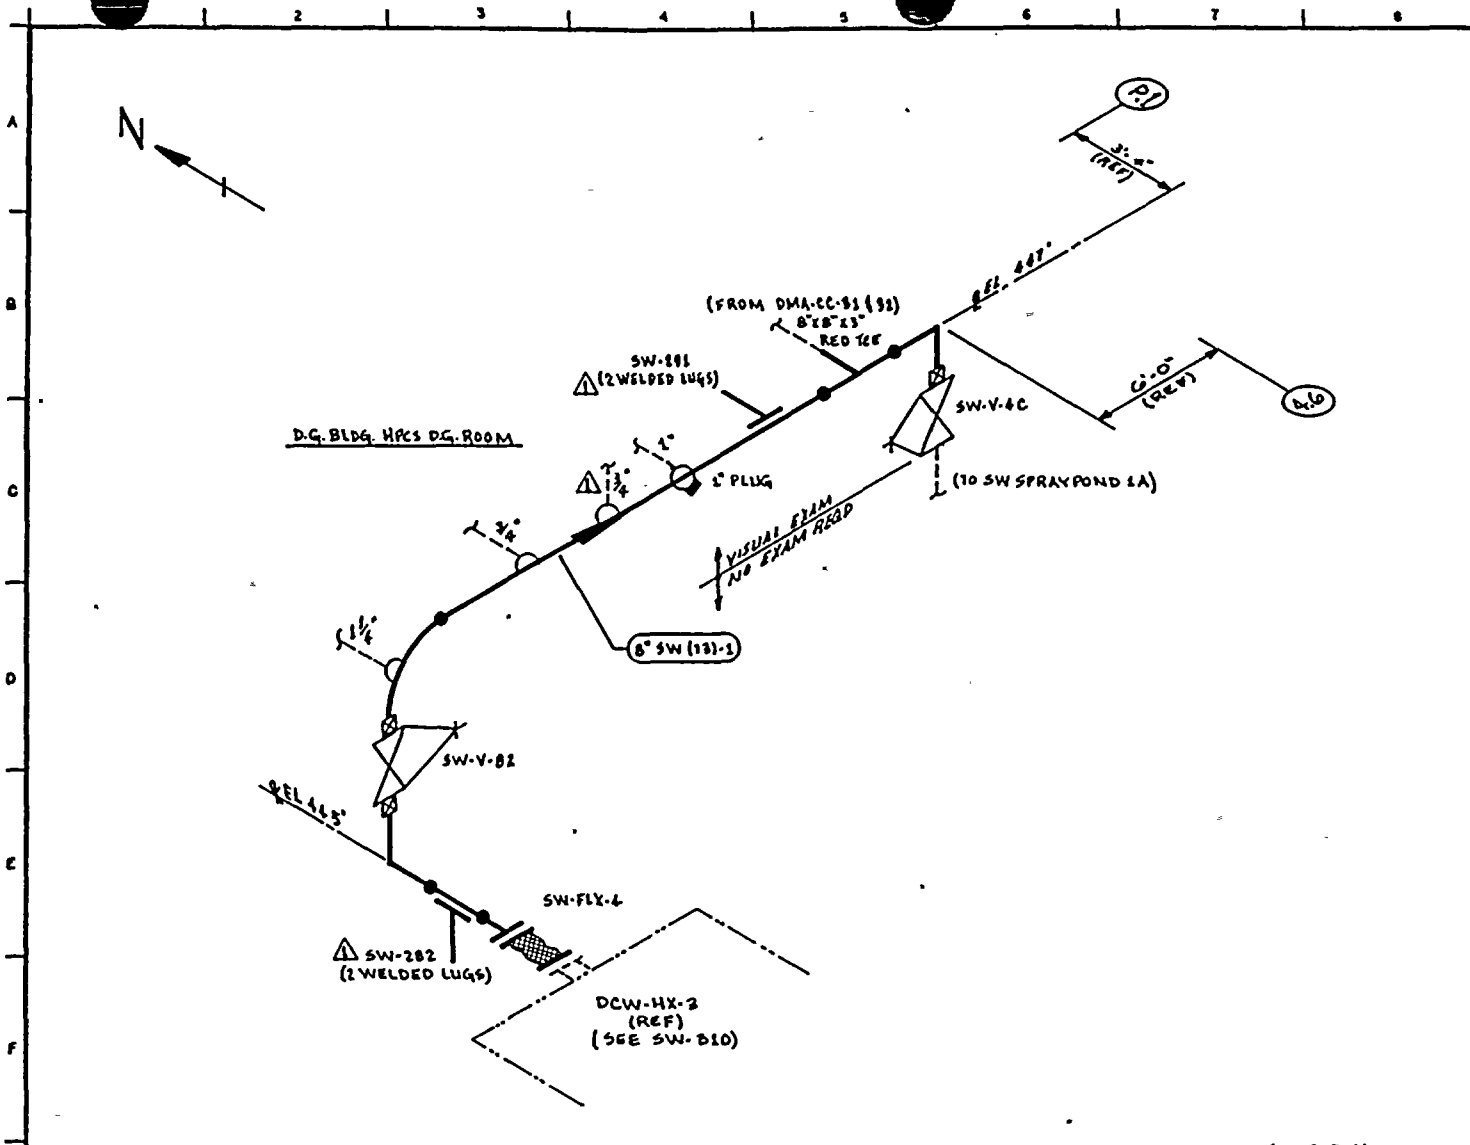

- NOTES:**
1. THIS DRAWING IDENTIFIES PIPING & COMPONENTS SUBJECT ONLY TO A VISUAL EXAM FOR (1) EVIDENCE OF LEAKAGE DURING SYSTEM PRESSURE OR OPERABILITY TESTS; (2) PRESSURE DECAY OF BURIED PIPING; & (3) LOSS OF SUPPORT CAPABILITY OR INADEQUATE RESTRAINT FOR SUPPORTS & HANGERS ON PIPING EXCEEDING 4" NDM. TESTS SHALL BE CONDUCTED PER ASME SECTION II, ARTICLES SWA-5000 & SWD-2000.
 2. FOR BRANCH PIPING 4" NDM OR LESS (EVEN SHOWN IN DASHED LINES) EXTEND VISUAL LEAKAGE EXAM THROUGH THE OUTERMOST NORMALLY CLOSED NUCLEAR CLASS VALVE, OR UNTIL TRANSITION TO INSTRUMENT TUBING, UNLESS OTHERWISE NOTED.

REFERENCES:
 BOVEE & CRAIG ISOMETRICS
 SW-112-7.9 REV 9

QUALITY CLASS: 1 ASME CODE CLASS: 3
 ENGR: GA KUGLER DRAWN: K.M.A DATE: 8-15-79

WASHINGTON PUBLIC POWER SUPPLY SYSTEM
 RICHLAND, WASHINGTON 98302

WNP-2 WELD & COMPONENT IDENTIFICATION DIAGRAM

TITLE:
 SW HPCS LOOP RETURN FROM DCW-HX-3

DWG NO: SW-311 REV 1

THIS DRAWING IS INTENDED FOR USE IN PRESERVICE AND INSERVICE INSPECTION PROGRAMS ONLY.

PIPING SYSTEM	NOM DIA (DN)	SCH	NOM WALL THK	MATERIAL SPECIFICATION	MATL TYPE	CAL BLOCK NO
8" SW (13)-1	8	STD	0.322	SA 106 GR B	CS	N/A


NO	DATE	REVISION	BY	CHKD	APPVD
1	1-21-84	REVISED AS NOTED	K.M.A	Z.M.Z	T.F.H
0	11-5-80	ISSUED FOR USE	K.M.A		S.D.W

WNP-02
INTERVAL: PSI
PERIOD: NA
OUTAGE:
DRAWING NO. SW-311

WASHINGTON PUBLIC POWER SUPPLY SYSTEM
PROGRAM PLAN AND SCHEDULE
SYSTEM OR COMPONENT: SW(73)-1
DESCRIPTION: SW_HPCS_LOOP_RETURN


PAGE 001
DATE 12/14/84

<u>IDENT. NO.</u>	<u>DESCRIPTION</u>	SECT. XI <u>EXAM.</u>	EXAM <u>MTM.</u>	<u>PROCEDURE</u>	CAL. <u>BLOCK</u>	<u>INSERVICE</u> SCHEDULED <u>REQ.</u>	<u>OUTAGE</u>	<u>NOTES</u>
SW-282	BOX	N/A	VT-3	303/8.2.17				
SW-291	BOX	N/A	VT-3	303/8.2.17				
SW-PB-311	SW PRES BNDRY	N/A	VT-2	N/A				SEE NOTES #6 & #7.

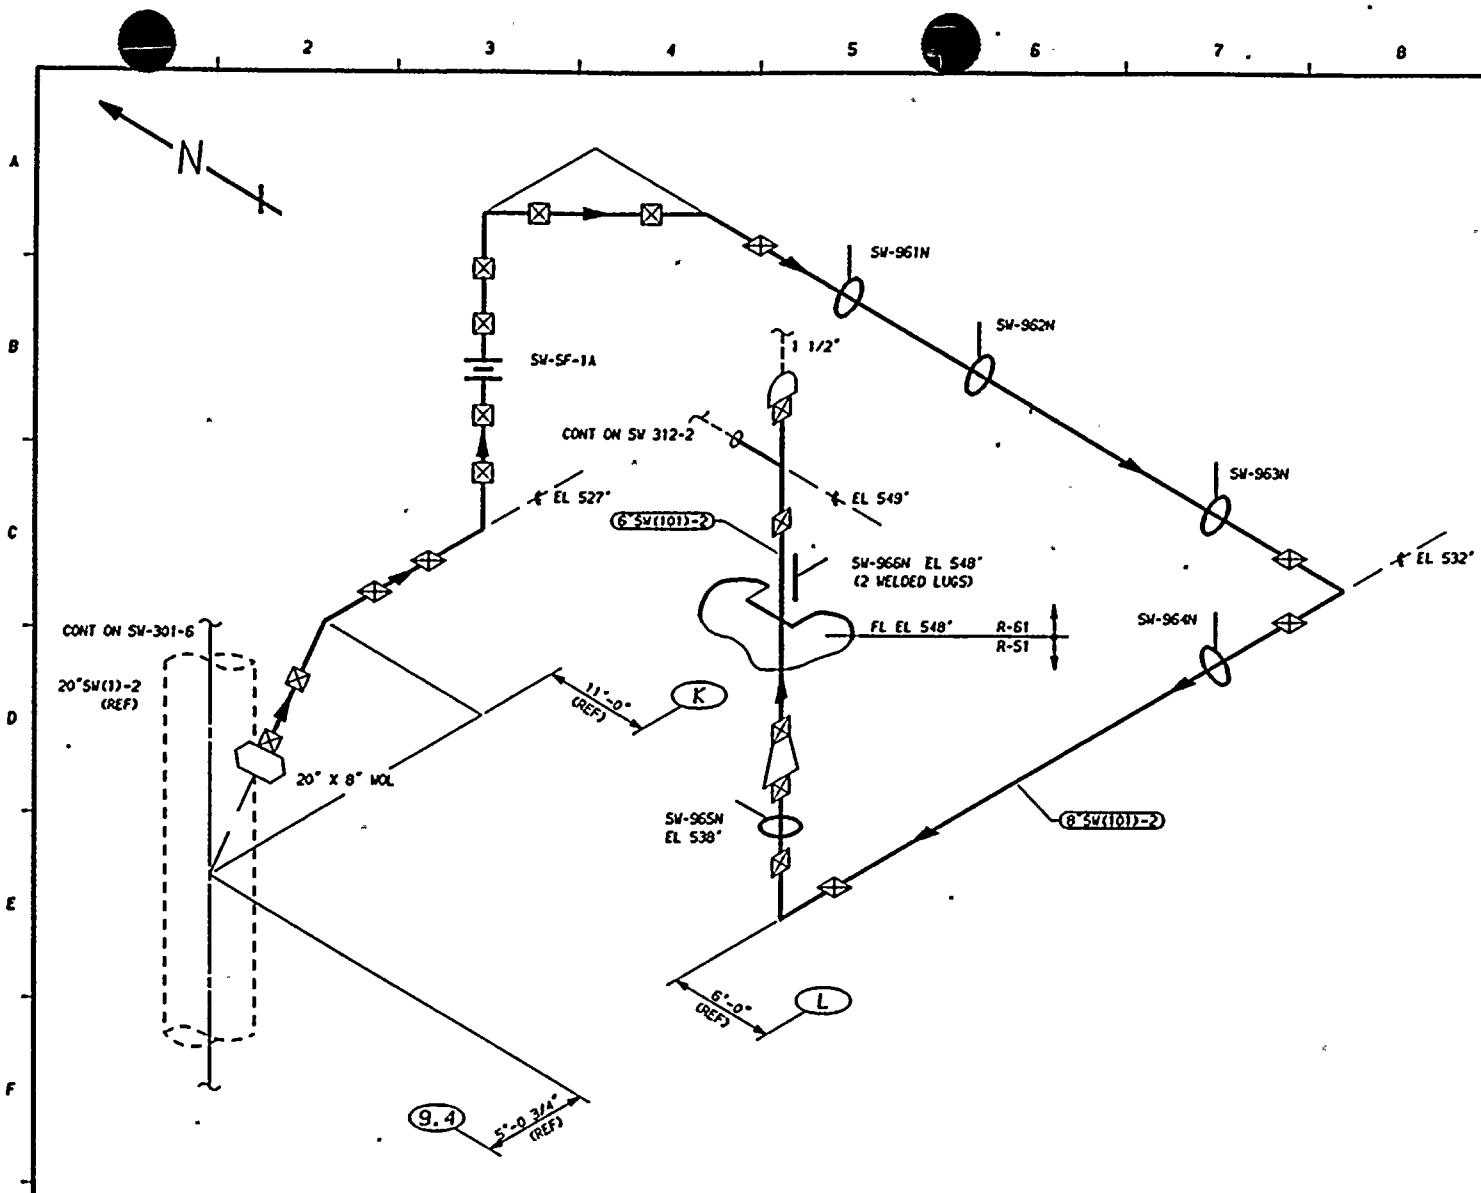

- NOTES:**
1. THIS DRAWING IDENTIFIES PIPING AND COMPONENTS SUBJECT ONLY TO A VISUAL EXAM FOR (1) EVIDENCE OF LEAKAGE DURING SYSTEM PRESSURE OR OPERABILITY TESTS, (2) PRESSURE DECAY TESTS OF BURIED PIPING, AND (3) LOSS OF SUPPORT CAPABILITY OR INADEQUATE RESTRAINT FOR SUPPORTS AND HANGERS ON PIPING EXCEEDING 4" NOM. TESTS SHALL BE CONDUCTED PER ASME SECTION XI, ARTICLES IMA-5000 AND IMA-2000.
 2. FOR BRANCH PIPING 4" NOM. OR LESS (CONNECTION SHOWN IN DASHED LINES) EXTEND VISUAL LEAKAGE EXAM THROUGH THE OUTERMOST NORMALLY CLOSED NUCLEAR CLASS VALVE, OR UNTIL TRANSITION TO INSTRUMENT TUBING, UNLESS OTHERWISE NOTED.

REFERENCES:
 ISI - 224
 BOYEE & CRAIL ISOMETRIC
 SV-250-55.75 REV 7

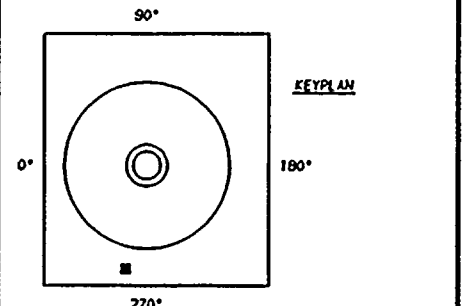

ZONES R-51 & R-61

THIS DRAWING IS INTENDED FOR USE IN PRESERVICE AND INSERVICE INSPECTIONS PROGRAMS ONLY.

PIPING SYSTEM	NOM DIA (IND)	SCH	NOM WALL THK	MATERIAL SPECIFICATION	MATL TYPE	CAL BLOCK NO
8"SW(101)-2	8	STD	0.322	SA 106 GR B	CS	NA
6"SW(101)-2	6	STD	0.280	SA 106 GR B	CS	NA

QUALITY CLASS, 1	ASME CODE CLASS, 3
ENGR, K-McANDREW	DRAWN, K-McA DATE, 11-15-83

WASHINGTON PUBLIC POWER
 SUPPLY SYSTEM
 RICHLAND, WASHINGTON 99352


WNP-2
 WELD & COMPONENT
 IDENTIFICATION DIAGRAM

TITLE:
 SW LOOP A SUPPLY TO FPC-HX-1A

DWG NO, SW-312-1 | REV 0

0	11-15-83	ISSUED FOR USE			
NO	DATE	REVISION	BY	CHKD	APVD



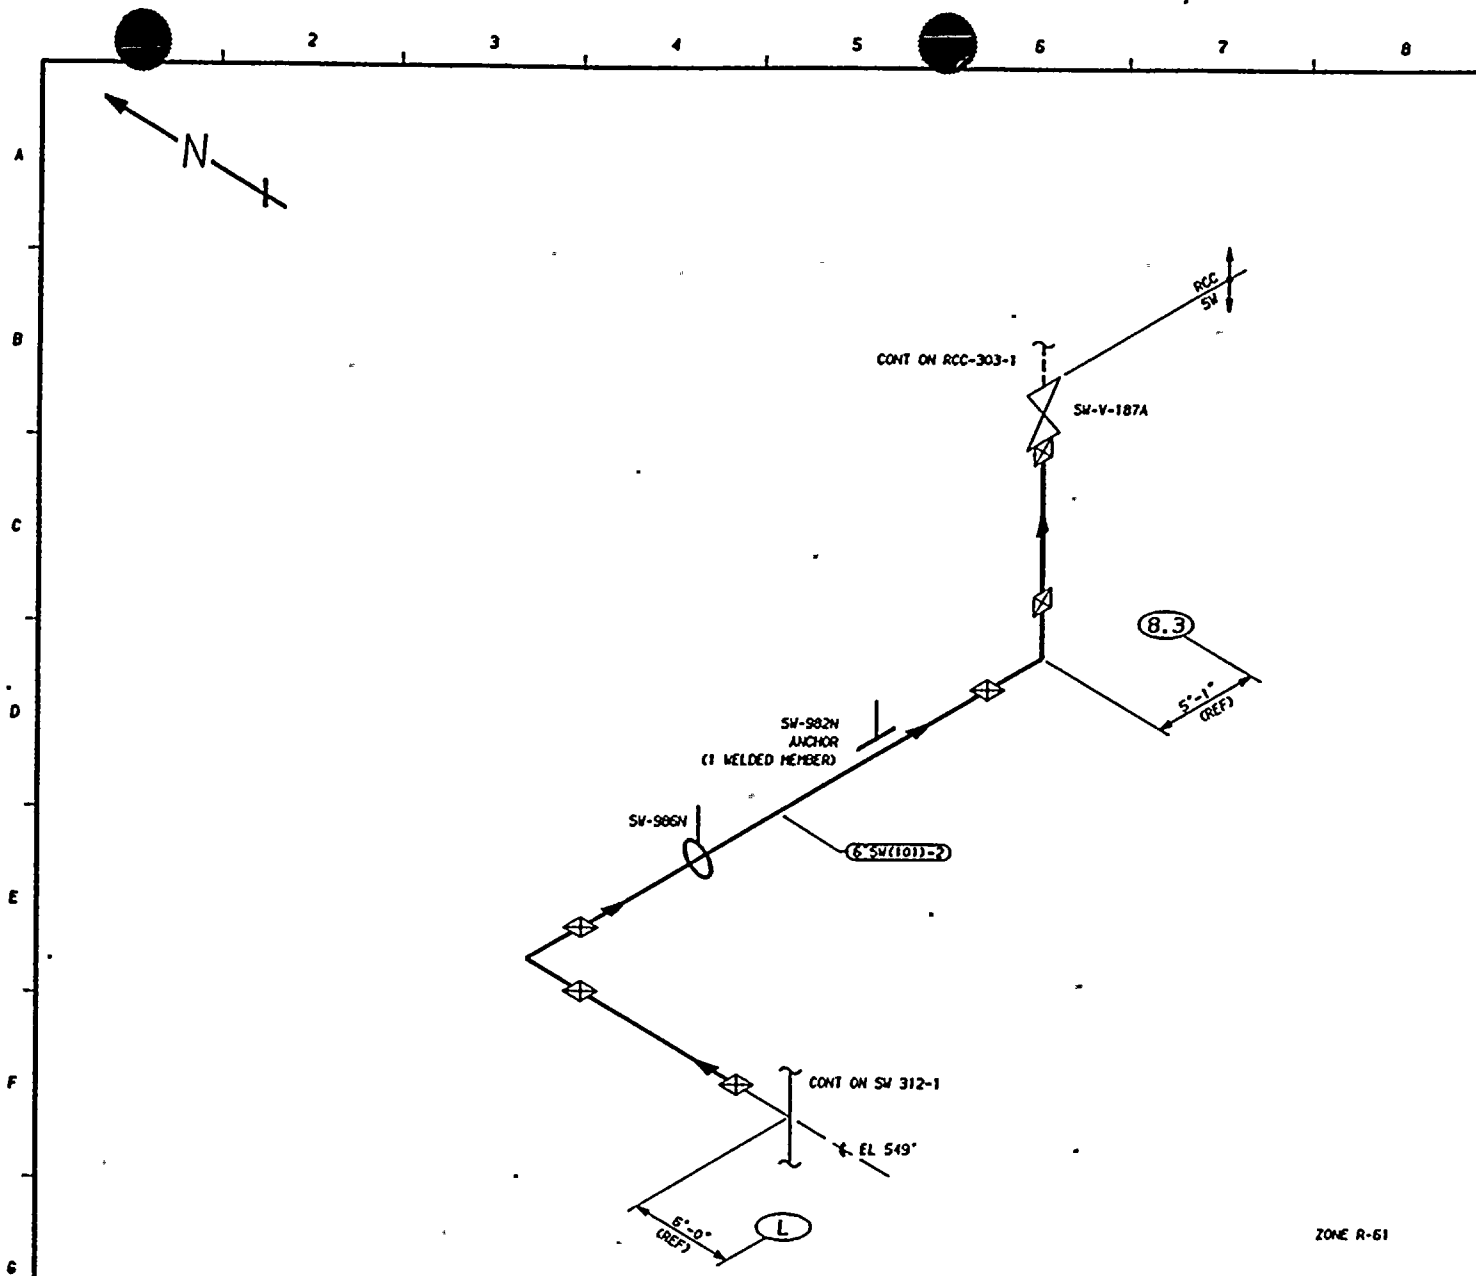


NOTES:

1. THIS DRAWING IDENTIFIES PIPING AND COMPONENTS SUBJECT ONLY TO A VISUAL EXAM FOR (1) EVIDENCE OF LEAKAGE DURING SYSTEM PRESSURE OR OPERABILITY TESTS; (2) PRESSURE DECAY TESTS OF BURIED PIPING; AND (3) LOSS OF SUPPORT CAPABILITY OR INADEQUATE RESTRAINT FOR SUPPORTS AND HANGERS ON PIPING EXCEEDING 4" NOM. TESTS SHALL BE CONDUCTED PER ASME SECTION XI, ARTICLES IWA-5000 AND IWD-2000.

REFERENCES:

ISI - 224
 BOYEE & CRAIL ISOMETRIC
 SW-500-1.5 REV 3

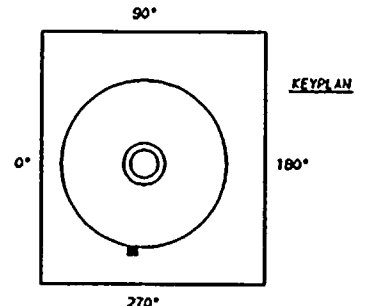

QUALITY CLASS: 1	ASME CODE CLASS: 3
ENGR, K-McANDREW	DRAWN, K-McA DATE, 11-15-83

WASHINGTON PUBLIC POWER
 SUPPLY SYSTEM
 RICHLAND, WASHINGTON 99352

WNP-2
 WELD & COMPONENT
 IDENTIFICATION DIAGRAM

TITLE:
 SW LOOP A SUPPLY TO FPR-1X-1A

THIS DRAWING IS INTENDED FOR
 USE IN PRESERVICE AND INSERVICE
 INSPECTIONS PROGRAMS ONLY.

ZONE R-61

PIPING SYSTEM	NOM DIA (IN)	SCH	NOM WALL THK	MATERIAL SPECIFICATION	MATL TYPE	CAL BLOCK NO
6"SW(101)-2	6	STD	0.280	SA 106 GR B	CS	NA

0	1.28.84	ISSUED FOR USE			
NO	DATE	REVISION	BY	CHKD	APVD




WNP-02
 INTERVAL: PSI
 PERIOD: NA
 OUTAGE:
 DRAWING NO. SW-312

WASHINGTON PUBLIC POWER SUPPLY SYSTEM
 PROGRAM PLAN AND SCHEDULE
 SYSTEM OR COMPONENT: SW(10)-2
 DESCRIPTION: SUPPLY TO FPC-HX-1A

PAGE 001
 DATE 12/14/84


<u>IDENT. NO.</u>	<u>DESCRIPTION</u>	<u>SECT.</u> <u>XI</u> <u>EXAM.</u>	<u>EXAM</u> <u>MTH.</u>	<u>PROCEDURE</u>	<u>CAL.</u> <u>BLOCK</u>	<u>INSERVICE</u>		<u>NOTES</u>
						<u>REQ.</u>	<u>SCHEDULED</u> <u>OUTAGE</u>	
SW-961N	RIGID	N/A	VT-3	303/8.2.17				
SW-962N	RIGID	N/A	VT-3	303/8.2.17				
SW-963N	RIGID	N/A	VT-3	303/8.2.17				
SW-964N	RIGID	N/A	VT-3	303/8.2.17				
SW-965N	RIGID	N/A	VT-3	303/8.2.17				
SW-966N	RIGID	N/A	VT-3	303/8.2.17				
SW-986N	RIGID	N/A	VT-3	303/8.2.17				
SW-982N	RIGID	N/A	VT-3	303/8.2.17				
SW-PB-312	ANCHOR	N/A	VT-3	303/8.2.17				
	SW PRES BNDRY	N/A	VT-2	N/A				

SEE NOTES #6 & #7.

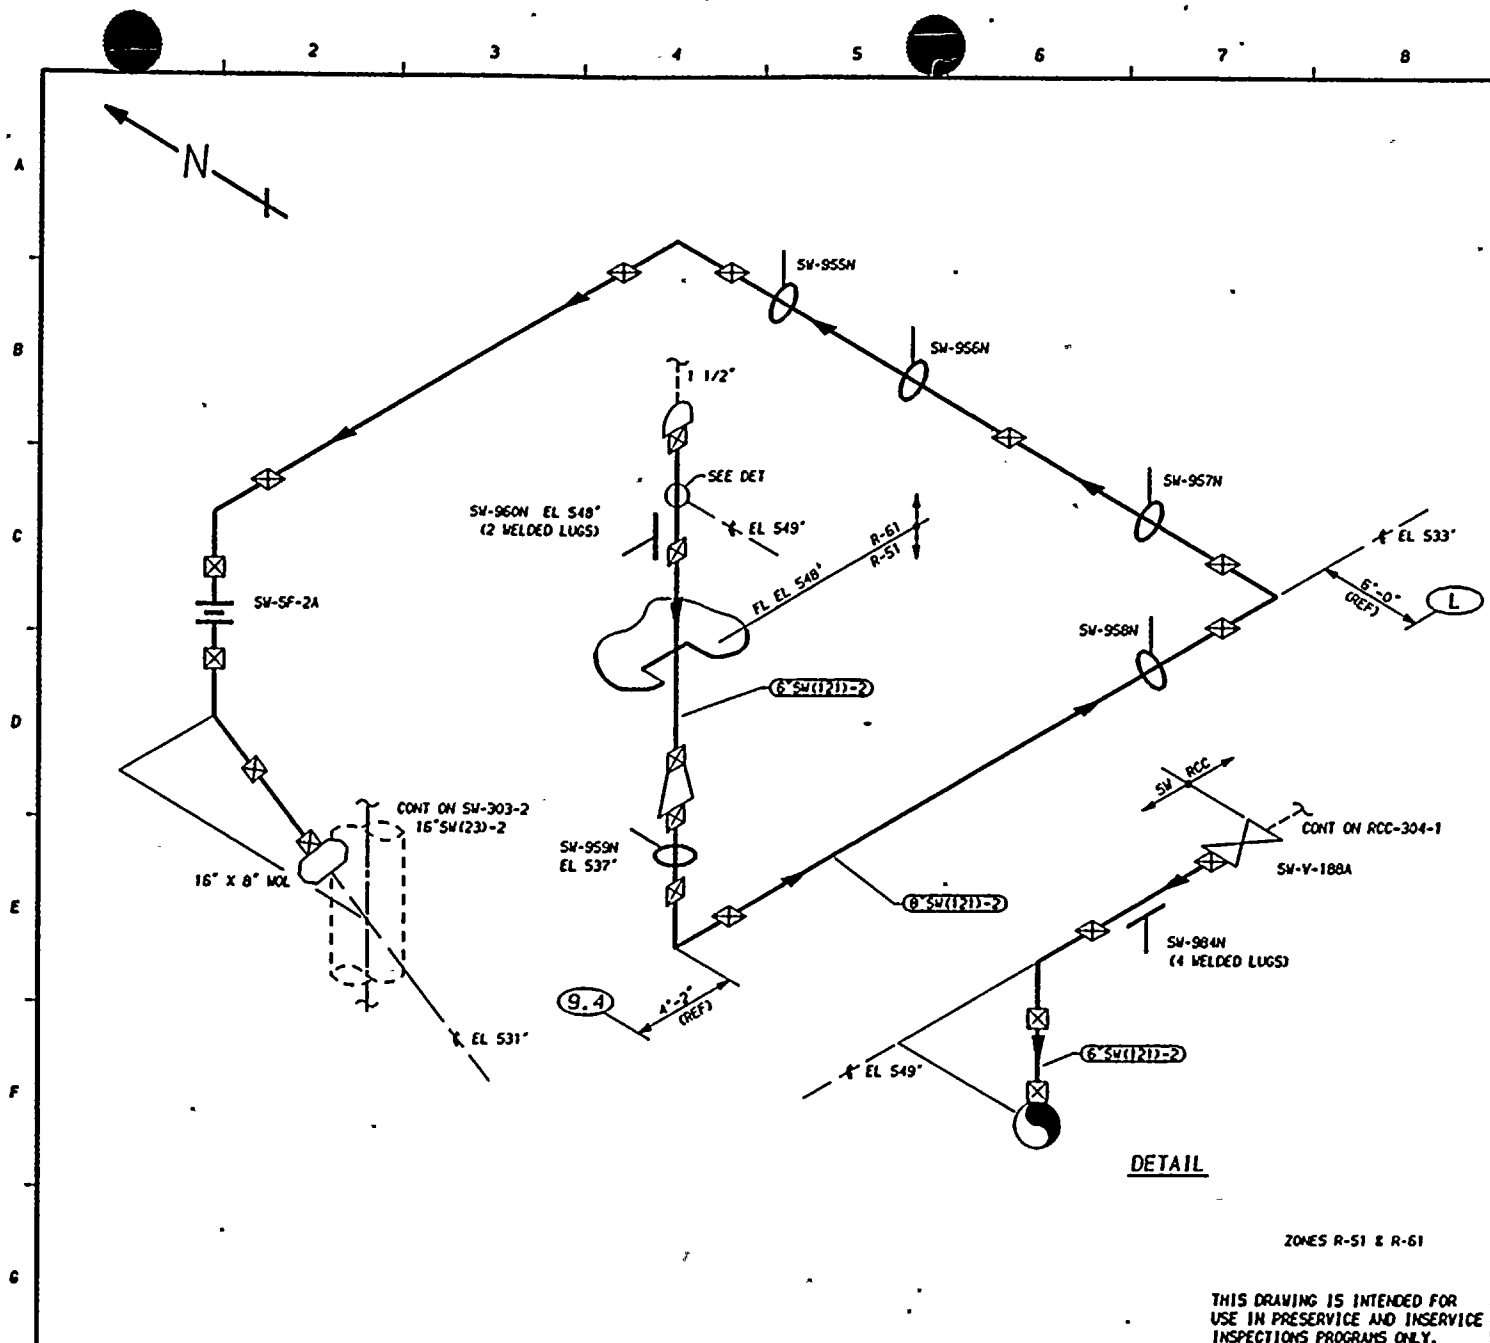

- NOTES:**
1. THIS DRAWING IDENTIFIES PIPING AND COMPONENTS SUBJECT ONLY TO A VISUAL EXAM FOR (1) EVIDENCE OF LEAKAGE DURING SYSTEM PRESSURE OR OPERABILITY TESTS, (2) PRESSURE DECAY TESTS OF BURIED PIPING, AND (3) LOSS OF SUPPORT CAPABILITY OR INADEQUATE RESTRAINT FOR SUPPORTS AND HANGERS ON PIPING EXCEEDING 4" NOM. TESTS SHALL BE CONDUCTED PER ASME SECTION XI, ARTICLES 1WA-5000 AND 1WD-2000.
 2. FOR BRANCH PIPING 4" NOM. OR LESS (CONNECTION SHOWN IN DASHED LINES) EXTEND VISUAL LEAKAGE EXAM THROUGH THE OUTERMOST NORMALLY CLOSED NUCLEAR CLASS VALVE, OR UNTIL TRANSITION TO INSTRUMENT TUBING, UNLESS OTHERWISE NOTED.

- REFERENCES:**
- ISI - 224
 - BOYEE & CRAIL ISOMETRICS
 - SW-502-1.3 REV 1
 - SW-296-58.77 REV 9

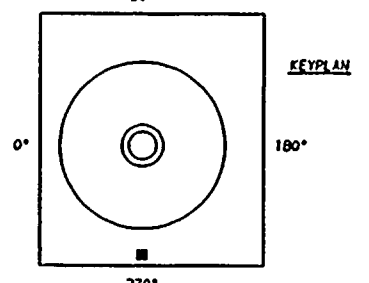

QUALITY CLASS: 1	ASME CODE CLASS: 3
ENGR: K-McANDREW	DRAWN: K-McA DATE: 11-15-83

WASHINGTON PUBLIC POWER
SUPPLY SYSTEM
 RICHLAND, WASHINGTON 99352

WNP-2.
 WELD & COMPONENT
IDENTIFICATION DIAGRAM

TITLE:
 SW LOOP A RETURN TO RHR-HX-1A

DWG NO: SW-313 | REV 0

ZONES R-51 & R-61

THIS DRAWING IS INTENDED FOR
 USE IN PRESERVICE AND INSERVICE
 INSPECTIONS PROGRAMS ONLY.

PIPING SYSTEM	NOM DIA (INO)	SCH	NOM WALL THK	MATERIAL SPECIFICATION	MATL TYPE	CAL BLOCK NO
8"SW(121)-2	8	STD	0.322	SA 106 GR B	*CS	NA
6"SW(121)-2	6	STD	0.280	SA 106 GR B	CS	NA

0	1/21/84	ISSUED FOR USE				
NO	DATE	REVISION	BY	CHKD	APVD	




WNP-02
 INTERVAL: PSI
 PERIOD: NA
 OUTAGE:
 DRAWING NO. SW-313

WASHINGTON PUBLIC POWER SUPPLY SYSTEM
 PROGRAM PLAN AND SCHEDULE
 SYSTEM OR COMPONENT: SW(12)-2
 DESCRIPTION: RETURN TO RHR-HX-1A

PAGE 001
 DATE 12/14/84

<u>IDENT. NO.</u>	<u>DESCRIPTION</u>	<u>SECT.</u> <u>XI</u> <u>EXAM.</u>	<u>EXAM</u> <u>MTH.</u>	<u>PROCEDURE</u>	<u>CAL.</u> <u>BLOCK</u>	<u>INSERVICE</u>		<u>NOTES</u>
						<u>REQ.</u>	<u>SCHEDULED</u> <u>OUTAGE</u>	
SW-960N	RIGID	N/A	VT-3	303/8.2.17				
SW-959N	RIGID	N/A	VT-3	303/8.2.17				
SW-958N	RIGID	N/A	VT-3	303/8.2.17				
SW-957N	RIGID	N/A	VT-3	303/8.2.17				
SW-956N	RIGID	N/A	VT-3	303/8.2.17				
SW-955N	RIGID	N/A	VT-3	303/8.2.17				
SW-984N	RIGID	N/A	VT-3	303/8.2.17				
SW-PC-313	SW PRES BNDRY	N/A	VT-2	N/A				

SEE NOTES #6 & #7.

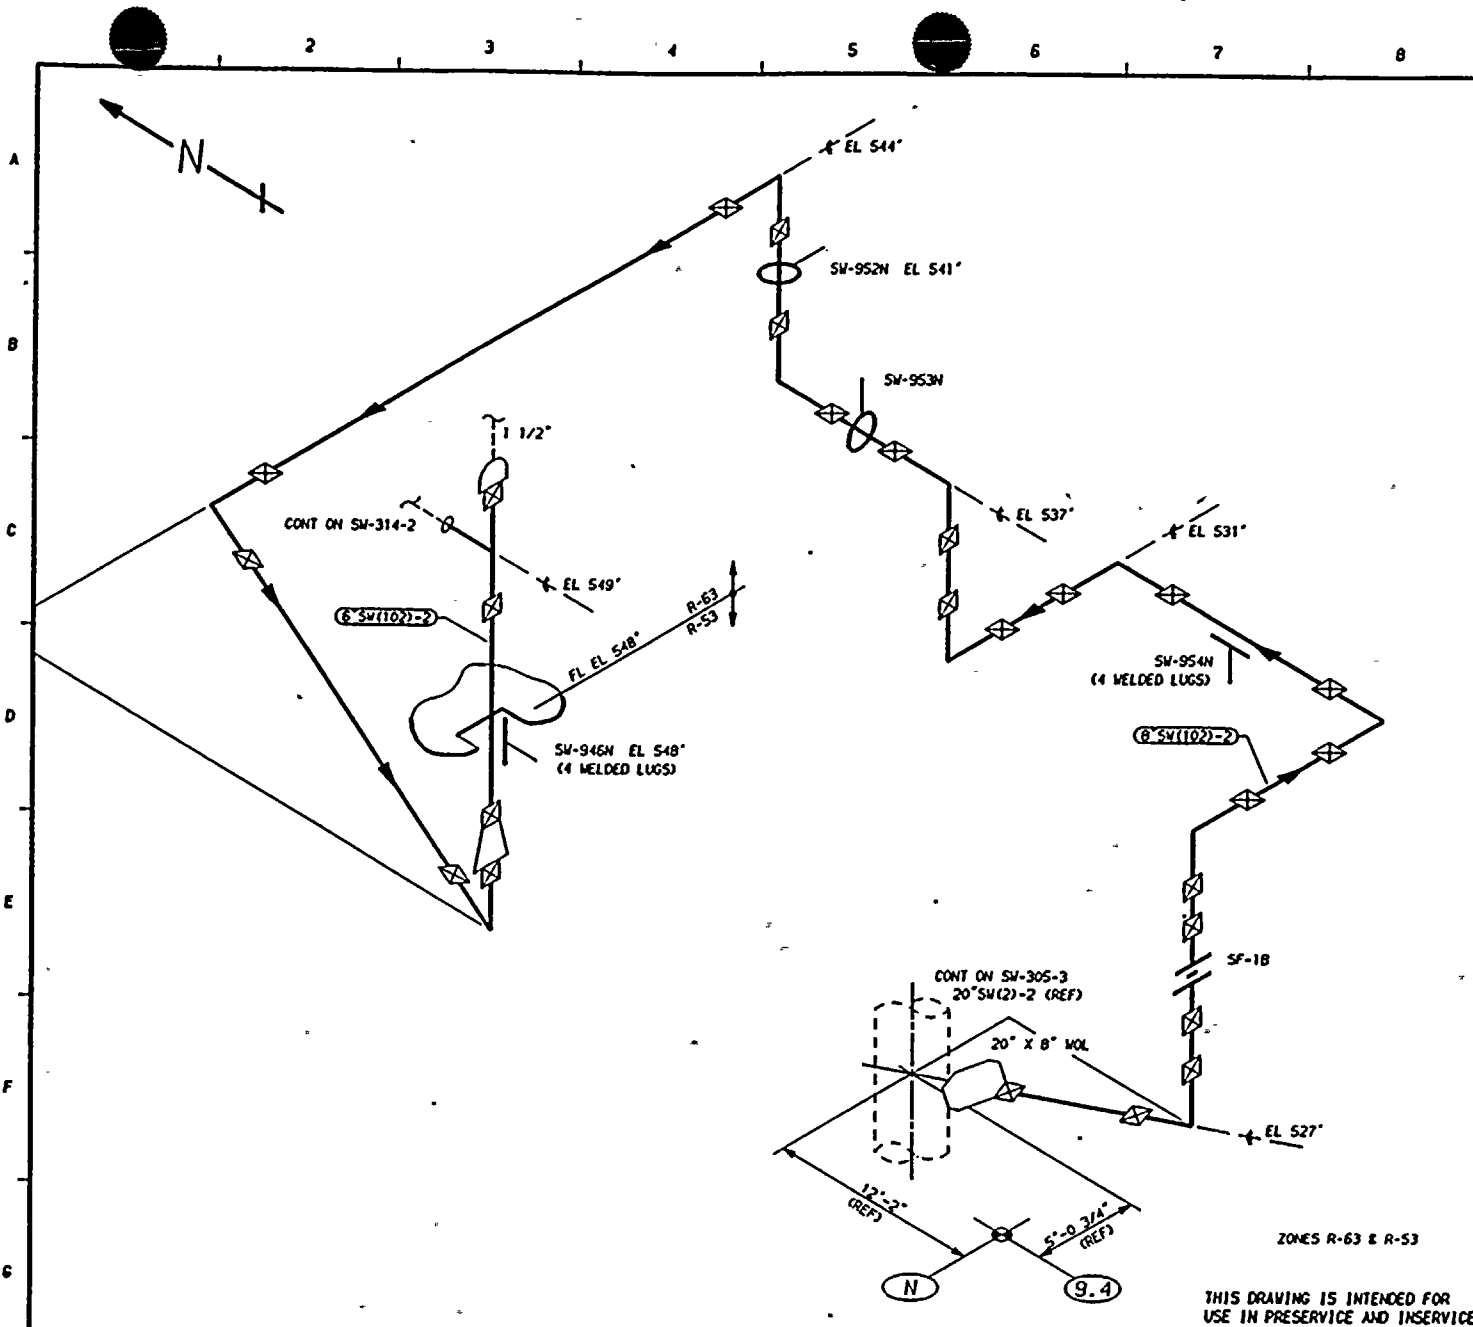


NOTES:

1. THIS DRAWING IDENTIFIES PIPING AND COMPONENTS SUBJECT ONLY TO A VISUAL EXAM FOR (1) EVIDENCE OF LEAKAGE DURING SYSTEM PRESSURE OR OPERABILITY TESTS; (2) PRESSURE DECAY TESTS OF BURIED PIPING; AND (3) LOSS OF SUPPORT CAPABILITY OR INADEQUATE RESTRAINT FOR SUPPORTS AND HANGERS ON PIPING EXCEEDING 4" NOM. TESTS SHALL BE CONDUCTED PER ASME SECTION XI, ARTICLES IWA-5000 AND IWD-2000.
2. FOR BRANCH PIPING 4" NOM. OR LESS (CONNECTION SHOWN IN DASHED LINES) EXTEND VISUAL LEAKAGE EXAM THROUGH THE OUTERMOST NORMALLY CLOSED NUCLEAR CLASS VALVE, OR UNTIL TRANSITION TO INSTRUMENT TUBING, UNLESS OTHERWISE NOTED.

REFERENCES:

- 151 - 224
- BOVEE & CRAIG ISOMETRICS
SW-251-30.64 REV 9

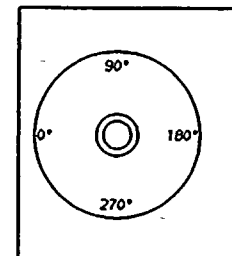

KEYPLAN

ZONES R-63 & R-53

THIS DRAWING IS INTENDED FOR USE IN PRESERVICE AND INSERVICE INSPECTIONS PROGRAMS ONLY.

PIPING SYSTEM	NOM DIA (IN)	SCH	NOM WALL THK	MATERIAL SPECIFICATION	MATL TYPE	CAL BLOCK NO
8" SW(102)-2	8	STD	0.322	SA 106 GR B	CS	NA
6" SW(102)-2	6	STD	0.280	SA 106 GR B	CS	NA

QUALITY CLASS: 1	ASME CODE CLASS: 3
ENGR: K-McANDREW	DRAWN: K-McA DATE: 11-2-83


WASHINGTON PUBLIC POWER
SUPPLY SYSTEM
RICHLAND, WASHINGTON 99352

WNP-2
WELD & COMPONENT
IDENTIFICATION DIAGRAM

TITLE:
SW LOOP B SUPPLY TO FPC-HX-1B

DWG NO. SW-314-1 REV 0

0	11-2-83	ISSUED FOR USE			
NO	DATE	REVISION	BY	CHKD	APVD

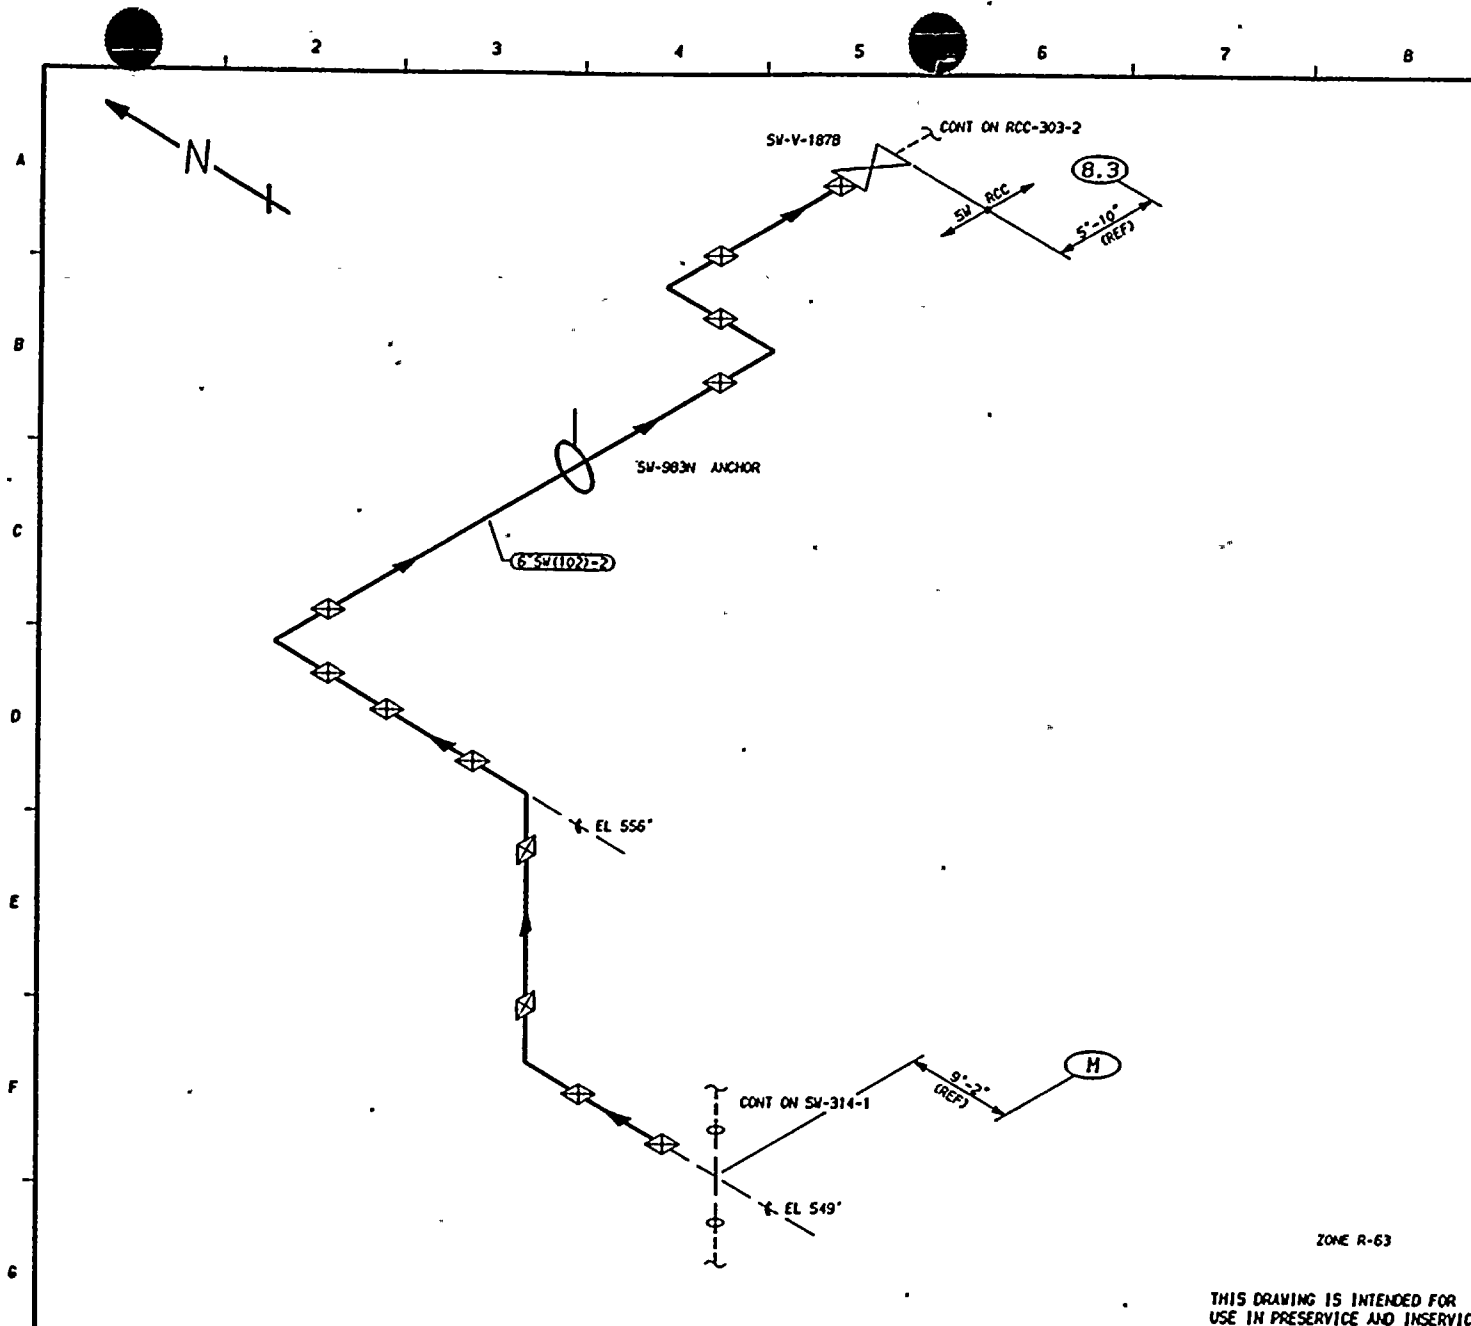


NOTES:

1. THIS DRAWING IDENTIFIES PIPING AND COMPONENTS SUBJECT ONLY TO A VISUAL EXAM FOR (1) EVIDENCE OF LEAKAGE DURING SYSTEM PRESSURE OR OPERABILITY TESTS, (2) PRESSURE DECAY TESTS OF BURIED PIPING, AND (3) LOSS OF SUPPORT CAPABILITY OR INADEQUATE RESTRAINT FOR SUPPORTS AND HANGERS ON PIPING EXCEEDING 4" NOM. TESTS SHALL BE CONDUCTED PER ASME SECTION XI, ARTICLES 1VA-5000 AND 1V-2000.

REFERENCES:

151 - 224
 BOYEE & CRAIL ISOMETRICS
 SW-501-1.10 REV 2

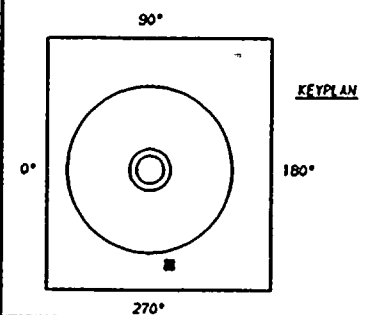

QUALITY CLASS, 1	ASME CODE CLASS, 3
ENGR, K-McANDREW	DRAWN, K-McA DATE, 11-2-83

WASHINGTON PUBLIC POWER
 SUPPLY SYSTEM
 RICHLAND, WASHINGTON 99352

WNP-2
 WELD & COMPONENT
 IDENTIFICATION DIAGRAM

TITLE:
 SW LOOP B SUPPLY TO FPC-HX-1B.

THIS DRAWING IS INTENDED FOR
 USE IN PRESERVICE AND INSERVICE
 INSPECTIONS PROGRAMS ONLY.

ZONE R-63

PIPING SYSTEM	NOM DIA (IN)	SCH	NOM WALL THK	MATERIAL SPECIFICATION	MATL TYPE	CAL BLOCK NO
6"SW(102)-2	6	STD	0.280	SA 106 CR B	CS	NA

0	12/1/82	ISSUED FOR USE	K-McA	DR	JFH
NO	DATE	REVISION	BY	CHKD	APVD


DWG NO, SW-314-2 | REV 0

WNP-02
 INTERVAL: PSI
 PERIOD: NA
 OUTAGE:
 DRAWING NO. SW-314

WASHINGTON PUBLIC POWER SUPPLY SYSTEM
 PROGRAM PLAN AND SCHEDULE
 SYSTEM OR COMPONENT: SW(102)-2
 DESCRIPTION: SUPPLY TO FPC-HX-1B


PAGE 001
 DATE 12/14/84

<u>IDENT. NO.</u>	<u>DESCRIPTION</u>	<u>SECT.</u>		<u>EXAM.</u>	<u>PROCEDURE</u>	<u>CAL.</u>	<u>INSERVICE</u>		<u>NOTES</u>
		<u>XI</u>	<u>EXAM</u>				<u>SCHEDULED</u>	<u>OUTAGE</u>	
		<u>EXAM.</u>	<u>MIH.</u>			<u>BLOCK</u>	<u>REQ.</u>		
SW-954N	RIGID	N/A	VT-3		303/8.2.17				
SW-953N	RIGID	N/A	VT-3		303/8.2.17				
SW-946N	RIGID	N/A	VT-3		303/8.2.17				
SW-PB-314	SW PRES BNDRY	N/A	VT-2		N/A				SEE NOTES #6 & #7.

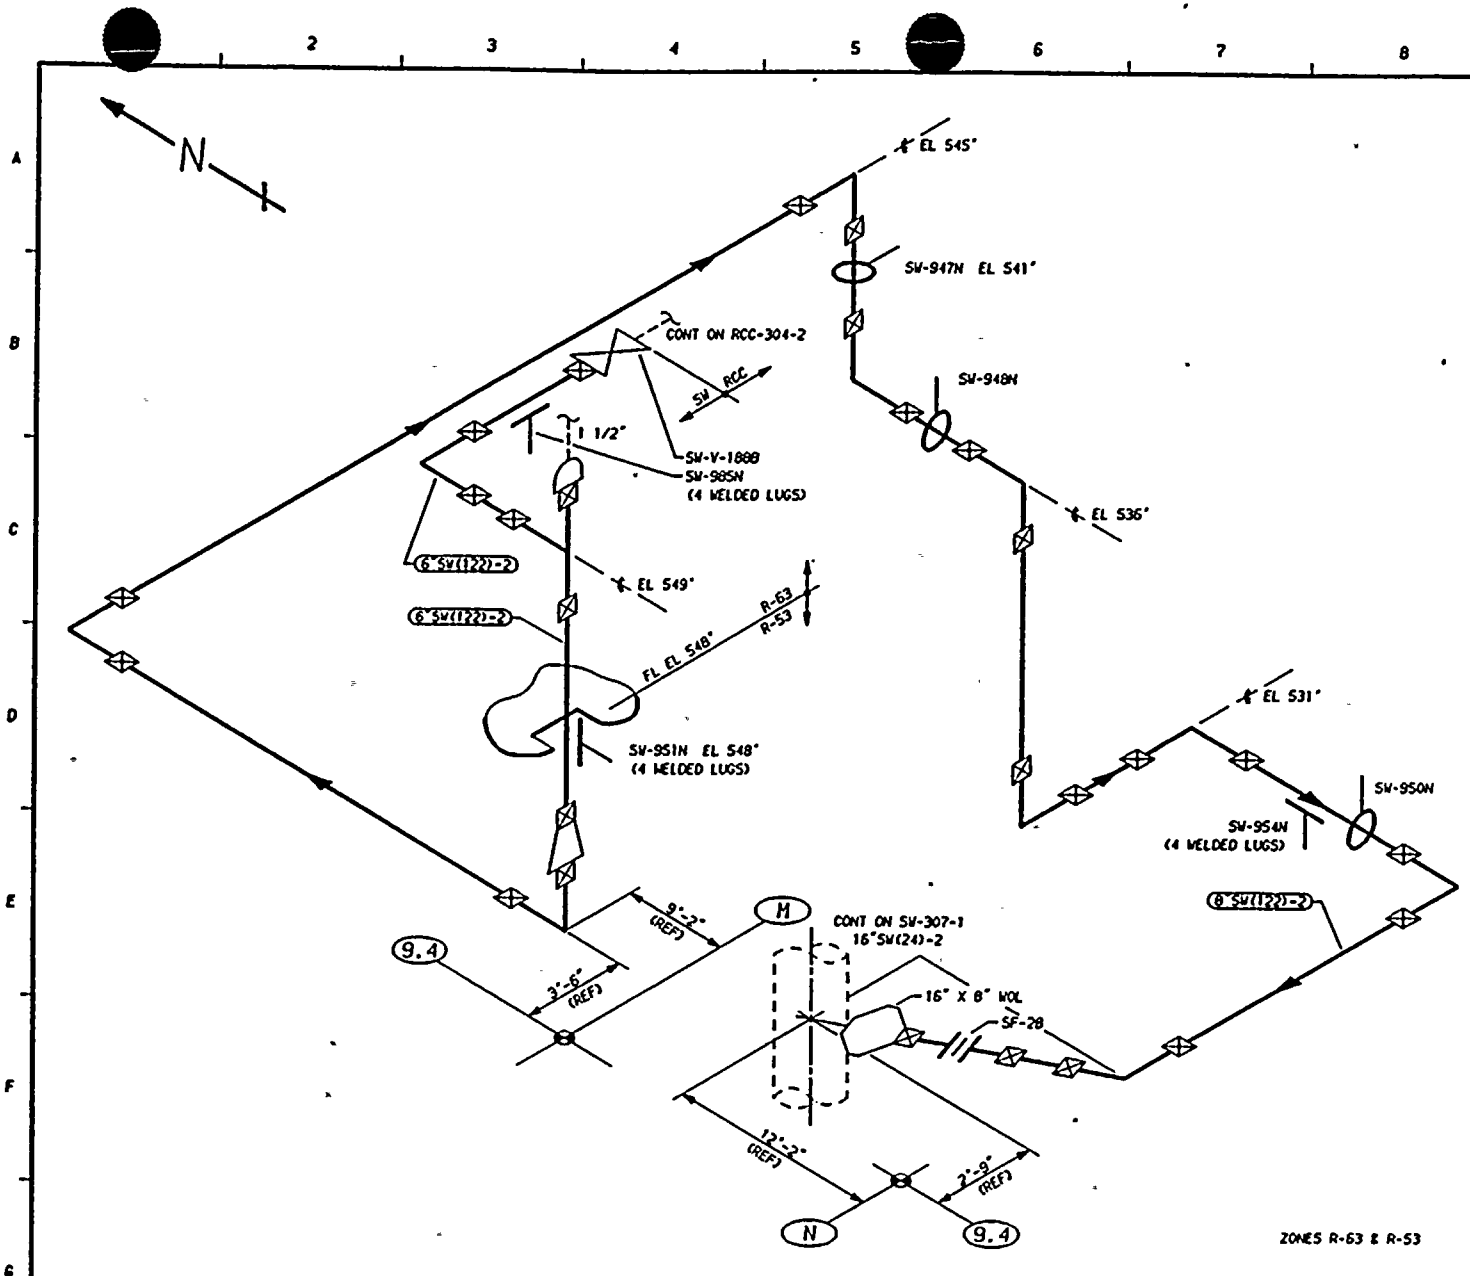

- NOTES:**
1. THIS DRAWING IDENTIFIES PIPING AND COMPONENTS SUBJECT ONLY TO A VISUAL EXAM FOR (1) EVIDENCE OF LEAKAGE DURING SYSTEM PRESSURE OR OPERABILITY TESTS; (2) PRESSURE DECAY TESTS OF BURIED PIPING; AND (3) LOSS OF SUPPORT CAPABILITY OR INADEQUATE RESTRAINT FOR SUPPORTS AND HANGERS ON PIPING EXCEEDING 4" NOM. TESTS SHALL BE CONDUCTED PER ASME SECTION XI, ARTICLES IWA-5000 AND IWD-2000.
 2. FOR BRANCH PIPING 4" NOM. OR LESS (CONNECTION SHOWN IN DASHED LINES) EXTEND VISUAL LEAKAGE EXAM THROUGH THE OUTERMOST NORMALLY CLOSED NUCLEAR CLASS VALVE, OR UNTIL TRANSITION TO INSTRUMENT TUBING, UNLESS OTHERWISE NOTED.

- REFERENCES:**
- 151 - 224
 - BOYEE & CRAIL ISOMETRICS
 - SV-295-43.68 REV 9
 - SV-503- 1.3 REV 2

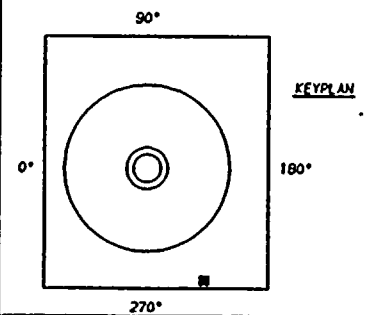

QUALITY CLASS: 1	ASME CODE CLASS: 3
ENGR, K-McANDREW	DRAWN, K-McA DATE, 11-2-83

WASHINGTON PUBLIC POWER
SUPPLY SYSTEM
RICHLAND, WASHINGTON 99352

WNP-2
WELD & COMPONENT
IDENTIFICATION DIAGRAM

TITLE:
SW LOOP RETURN FROM FPC-HX-1B

DWG NO, SW-315 REV 0

THIS DRAWING IS INTENDED FOR
USE IN PRESERVICE AND INSERVICE
INSPECTIONS PROGRAMS ONLY.

PIPING SYSTEM	NOM DIA (INO)	SCH	NOM WALL THK	MATERIAL SPECIFICATION	MATL TYPE	CAL BLOCK NO
8"SW(122)-2	8	STD	0.322	SA 106 GR B	CS	NA
6"SW(122)-2	6	STD	0.280	SA 106 GR B	CS	NA

0	12/84	ISSUED FOR USE			
NO	DATE	REVISION	BY	CHKD	APVD

WNP-02
 INTERVAL: PSI
 PERIOD: NA
 OUTAGE:
 DRAWING NO. SW-315

WASHINGTON PUBLIC POWER SUPPLY SYSTEM
 PROGRAM PLAN AND SCHEDULE
 SYSTEM OR COMPONENT: SW(122)-2
 DESCRIPTION: RET FROM FPC-HY-1R

PAGE 001
 DATE 12/14/84.

<u>IDENT. NO.</u>	<u>DESCRIPTION</u>	<u>SECT.</u> <u>XI</u> <u>EXAM.</u>	<u>EXAM</u> <u>MTM.</u>	<u>PROCEDURE</u>	<u>CAL.</u> <u>BLOCK</u>	<u>INSERVICE</u>		<u>NOTES</u>
						<u>REQ.</u>	<u>SCHEDULED</u> <u>OUTAGE</u>	
SW-951N	RIGID	N/A	VT-3	303/8.2.17				
SW-947N	RIGID	N/A	VT-3	303/8.2.17				
SW-948N	RIGID	N/A	VT-3	303/8.2.17				
SW-950N	RIGID	N/A	VT-3	303/8.2.17				
SW-985N	RIGID	N/A	VT-3	303/8.2.17				
SW-PB-315	SW PRES BNDRY	N/A	VT-2	N/A				SEE NOTES #6 & #7.

WNP-02
 INTERVAL: PSI
 PERIOD: NA
 OUTAGE:
 DRAWING NO. FPC-201



WASHINGTON PUBLIC POWER SUPPLY SYSTEM
 PROGRAM PLAN AND SCHEDULE
 SYSTEM OR COMPONENT: FPC(7)-1
 DESCRIPTION: RET TO SUPPR POOL

PAGE 001
 DATE 12/14/84

<u>IDENT. NO.</u>	<u>DESCRIPTION</u>	<u>SECT.</u> <u>XI</u> <u>EXAM.</u>	<u>EXAM</u> <u>MTH.</u>	<u>PROCEDURE</u>	<u>CAL.</u> <u>BLOCK</u>	<u>INSERVICE</u> <u>SCHEDULED</u>		<u>NOTES</u>
						<u>REQ.</u>	<u>OUTAGE</u>	
FPC-903N	ANCHOR	C-E-2	VT-3	303/8.2.17				
FPC-170	BOX	C-E-2	VT-3	303/8.2.17				
FPC-172	BOX	C-E-2	VT-3	303/8.2.17				
FPC-237	BOX	C-E-2	VT-3	303/8.2.17				
FPC-238	BOX	C-E-2	VT-3	303/8.2.17				
FPC-239	BOX	C-E-2	VT-3	303/8.2.17				
FPC-PB-201	FPC PRESS BNDRY	N/A	VT-2	N/A				


SEE NOTES #6 & #7.



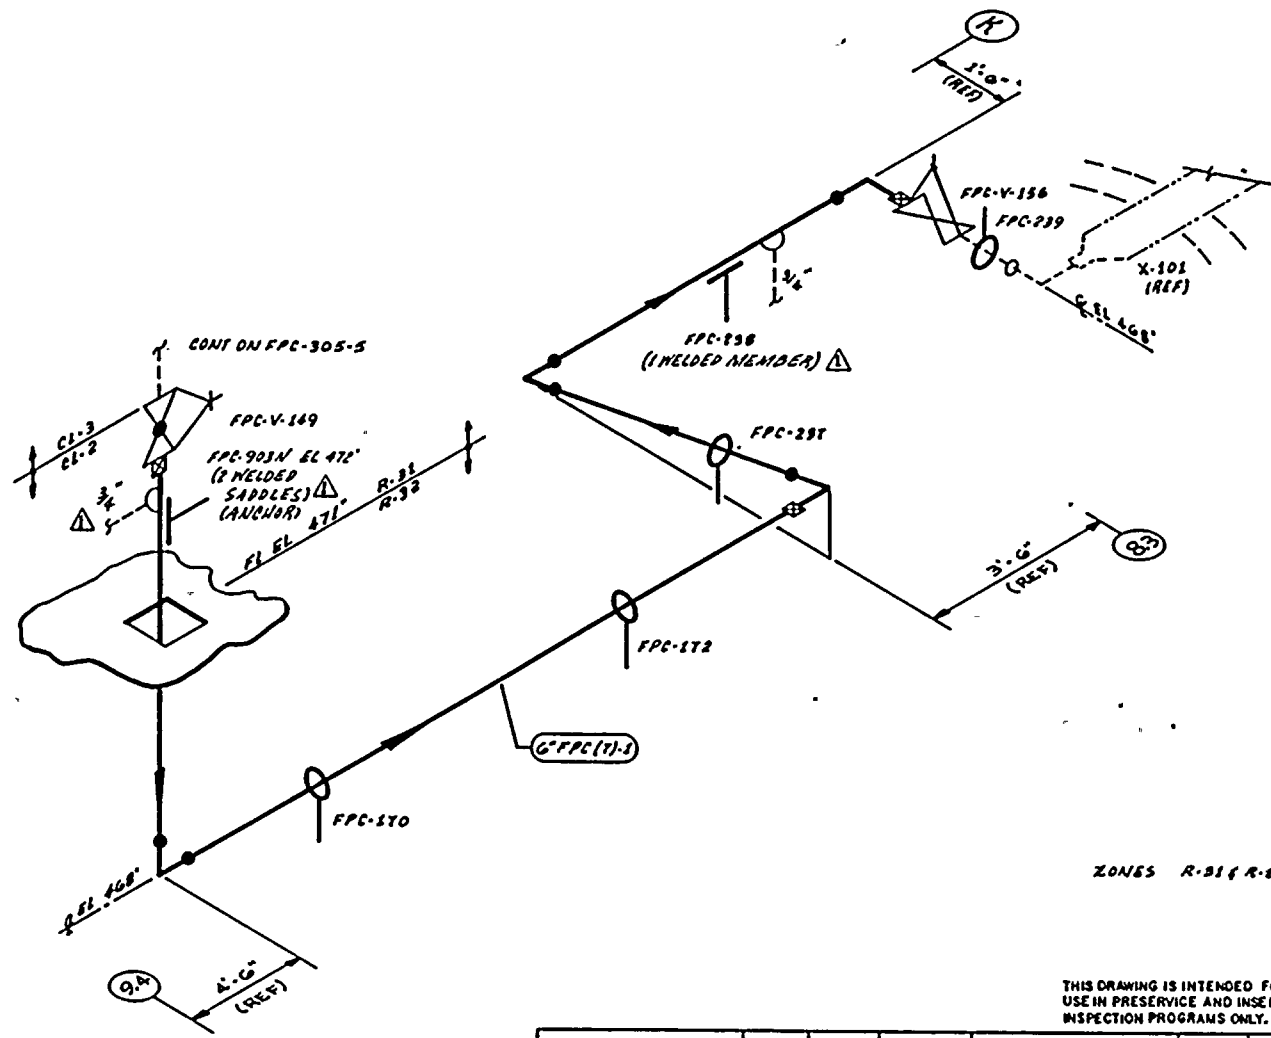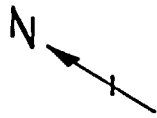

- NOTES:**
1. THIS DRAWING IDENTIFIES PIPING & COMPONENTS SUBJECT TO A VISUAL EXAM FOR EVIDENCE OF LEAKAGE DURING SYSTEM HYDRO OR OPERABILITY TESTS. TESTS ARE TO BE CONDUCTED PER THE REQUIREMENTS OF ASME SECTION XI, PARAGRAPH EWA-5000.
 2. FOR BRANCH PIPING 4" DIA OR LESS (CONN SHOWN IN DASHED LINES) EXTEND VISUAL LEAKAGE EXAM THROUGH THE OUTERMOST NORMALLY CLOSED NUCLEAR CLASS VALVE OR UNTIL TRANSITION TO INSTRUMENT TUBING, UNLESS OTHERWISE NOTED.

REFERENCES:
BOYER & CRAIG ISOMETRICS
FPC-610-10.12 REV 9

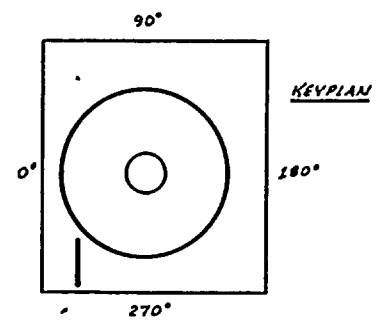

QUALITY CLASS: 1 ASME CODE CLASS: 2
ENGR: A. McAndrew DRAWN: A. McAndrew DATE: 8-25-79

WASHINGTON PUBLIC POWER SUPPLY SYSTEM
RICHLAND, WASHINGTON 99352

THIS DRAWING IS INTENDED FOR USE IN PRESERVICE AND INSERVICE INSPECTION PROGRAMS ONLY.

PIPING SYSTEM	NOM DIA (IN)	SCH	NOM WALL THK	MATERIAL SPECIFICATION	MATL TYPE	CAL BLOCK NO
6" FPC (71-1)	6	STD	0.280	SA 106 GR B	CS	NA


WNP- 2
WELD & COMPONENT
IDENTIFICATION DIAGRAM

TITLE:
FPC RETURN TO SUPPRESSION POOL

DWG NO: FPC-201 REV 1

NO	DATE	REVISION	BY	CHKD	APPVD
1	12-88	REVISED AS NOTED ADDED KEYPLAN	KSL	EM	TW
0	12-88	ISSUED FOR USE	KSL	EM	TW



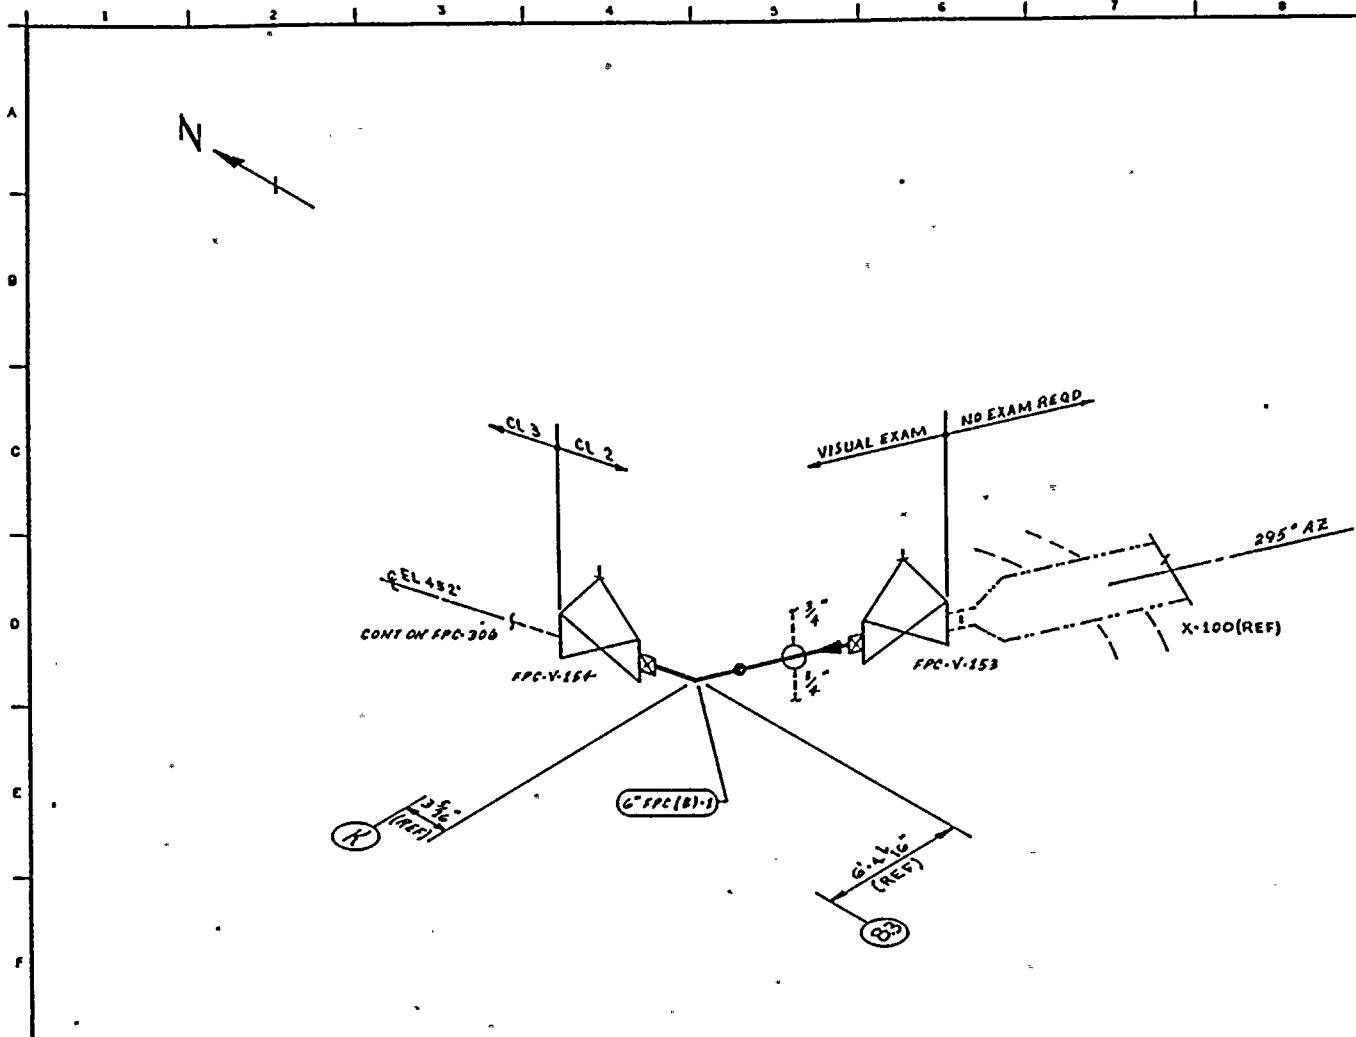

- NOTES:**
1. THIS DRAWING IDENTIFIES PIPING & COMPONENTS SUBJECT TO A VISUAL EXAM FOR EVIDENCE OF LEAKAGE DURING SYSTEM HYDRO OR OPERABILITY TESTS. TESTS ARE TO BE CONDUCTED PER THE REQUIREMENTS OF ASME SECTION XI, PARAGRAPH IWA-5000.
 2. FOR BRANCH PIPING 4" DIA OR LESS (CANN SHOWN IN DASHED LINES) EXTEND VISUAL LEAKAGE EXAM THROUGH THE OUTER-MOST NORMALLY CLOSED NUCLEAR CLASS VALVE, OR UNTIL TRANSITION TO INSTRUMENT TUBING, UNLESS OTHERWISE NOTED.

- REFERENCES:**
- BOYCE & CRAIG ISOMETRICS
 - FPC-369-1.2 REV 2
 - FPC-369-1.2H REV 0

ZONE R-11

THIS DRAWING IS INTENDED FOR USE IN PRESERVICE AND INSERVICE INSPECTION PROGRAMS ONLY.

QUALITY CLASS: 1	ASME CODE CLASS: 2
ENGR: <i>K. McAdams</i>	DRAWN: <i>K. McAd</i> DATE: 4-27-79


WASHINGTON PUBLIC POWER SUPPLY SYSTEM
 RICHLAND, WASHINGTON 99352

PIPING SYSTEM	NOM DIA (IN)	SCH	NOM WALL THK	MATERIAL SPECIFICATION	MATL TYPE	CAL BLOCK NO
6" FPC (B)-1	6	STD	0.280	SA 106 GR B	CS	NA

WNP-2 WELD & COMPONENT IDENTIFICATION DIAGRAM
TITLE: SUPPRESSION POOL TO FPC-P-3 SUCTION
DWG NO: FPC-20R
REV 0

0	12-2-79	ISSUED FOR USE	<i>W. J. R.</i>	<i>W. J. R.</i>	<i>T. E. S.</i>
NO	DATE	REVISION	BY	CHKD	APPVD



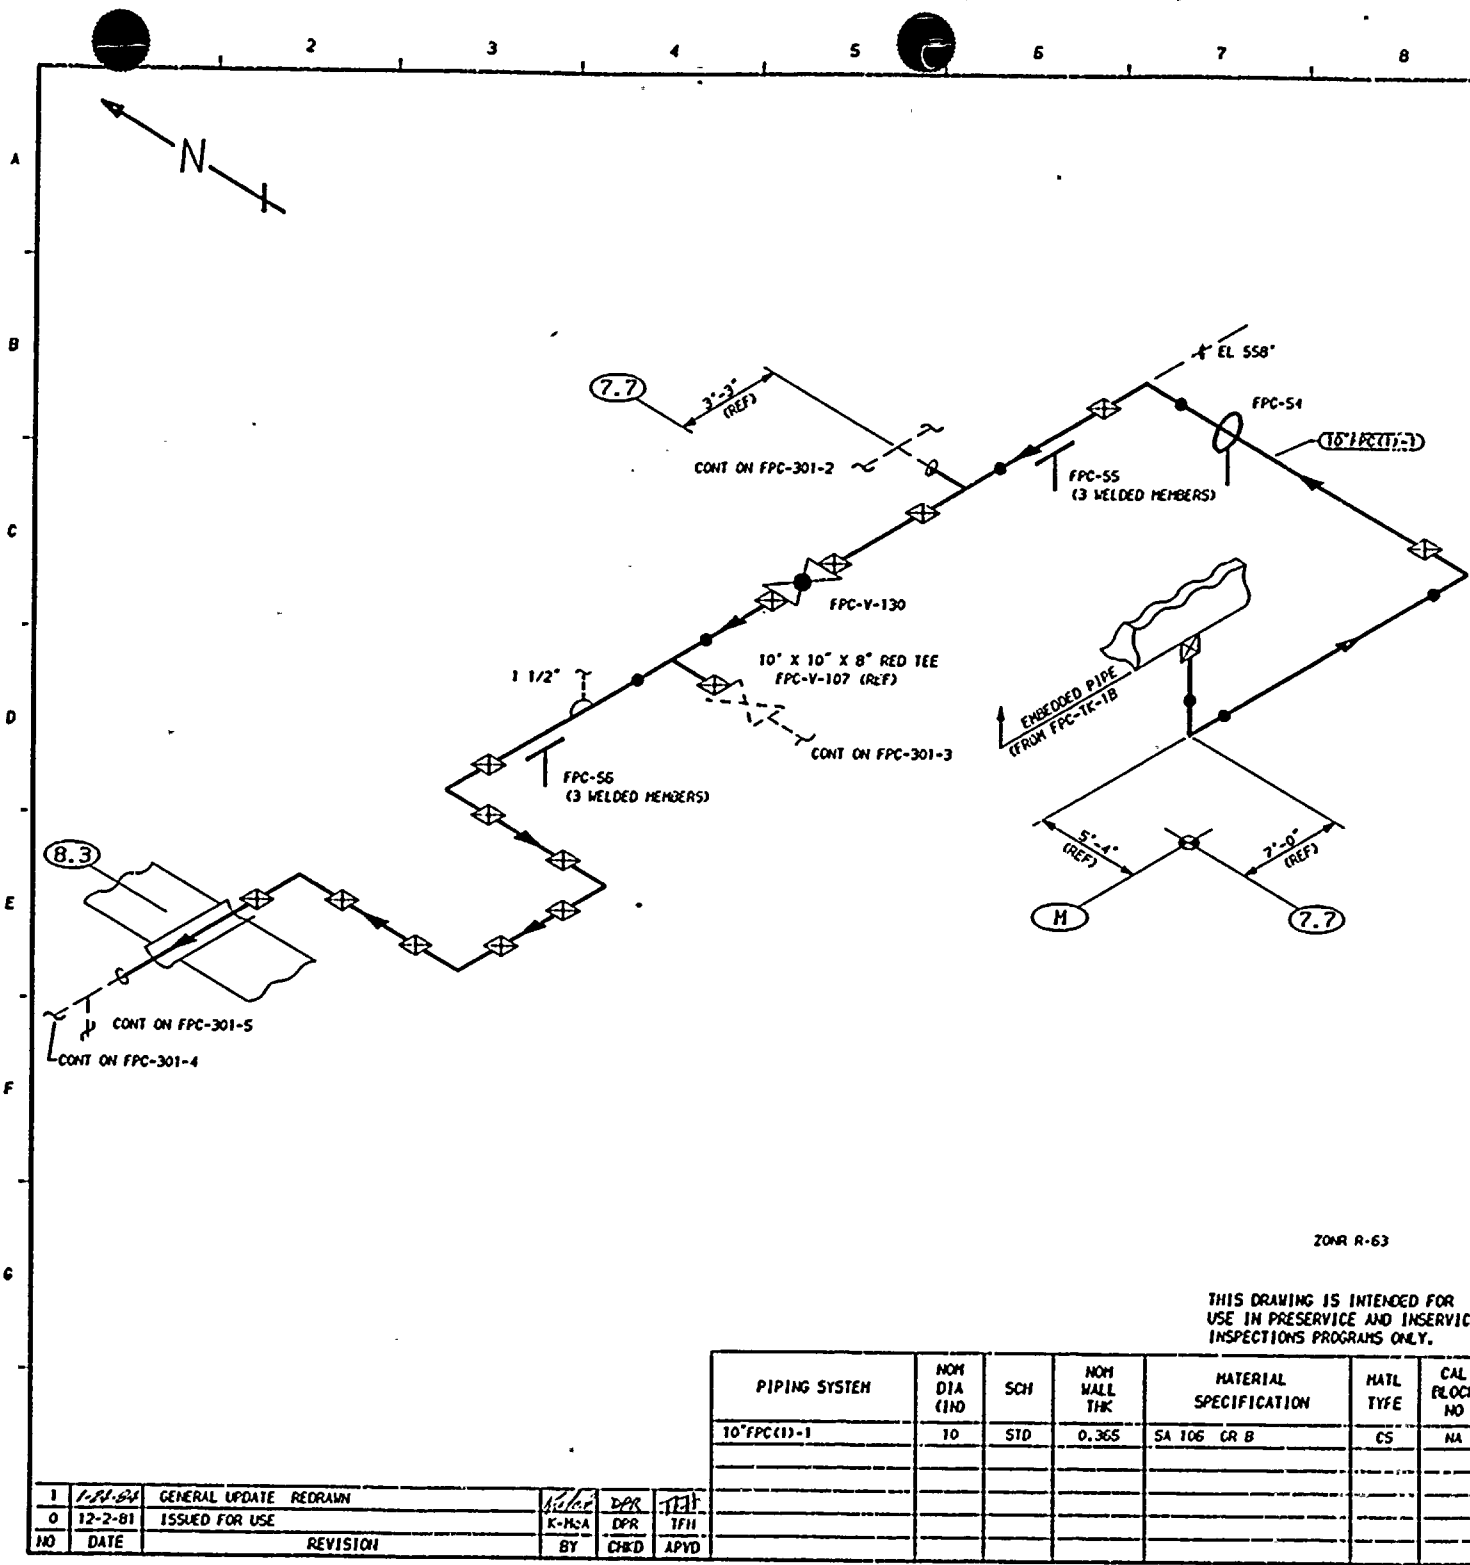


NOTES:

1. THIS DRAWING IDENTIFIES PIPING AND COMPONENTS SUBJECT ONLY TO A VISUAL EXAM FOR (1) EVIDENCE OF LEAKAGE DURING SYSTEM PRESSURE OR OPERABILITY TESTS; (2) PRESSURE DECAY TESTS OF BURIED PIPING; AND (3) LOSS OF SUPPORT CAPABILITY OR INADEQUATE RESTRAINT FOR SUPPORTS AND HANGERS ON PIPING EXCEEDING 4" NOM. TESTS SHALL BE CONDUCTED PER ASME SECTION XI, ARTICLES 1WA-5000 AND 1WD-2000.

REFERENCES:

151 - 226
 RAYE & CRILL ISOMETRIC
 FPC-604-4.6 REV 6

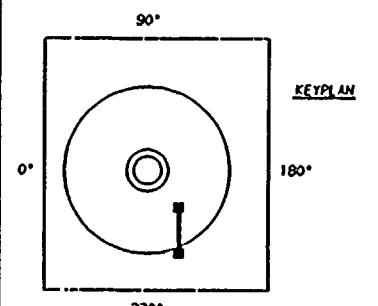

QUALITY CLASS, 2 ASME CODE CLASS, 3
 ENGR, K-McANDREW | DRAWN, K-McA | DATE, 3-21-79

WASHINGTON PUBLIC POWER
 SUPPLY SYSTEM
 RICHLAND, WASHINGTON 99352

WNP-2
 WELD & COMPONENT
 IDENTIFICATION DIAGRAM

TITLE:
 FUEL POOL CIRCULATION FROM FPC-TK-1B


DWG NO, FPC-301-1 REV 1

ZONR R-63

THIS DRAWING IS INTENDED FOR
 USE IN PRESERVICE AND INSERVICE
 INSPECTIONS PROGRAMS ONLY.

PIPING SYSTEM	NOM DIA (IN)	SCH	NOM WALL THK	MATERIAL SPECIFICATION	MATL TYPE	CAL BLOCK NO
10" FPC(1)-1	10	STD	0.365	SA 106 GR B	CS	NA


NO	DATE	REVISION	BY	CHKD	APVD
1	1-21-81	GENERAL UPDATE REDRAW	K-McA	DPR	TFH
0	12-2-81	ISSUED FOR USE	K-McA	DPR	TFH

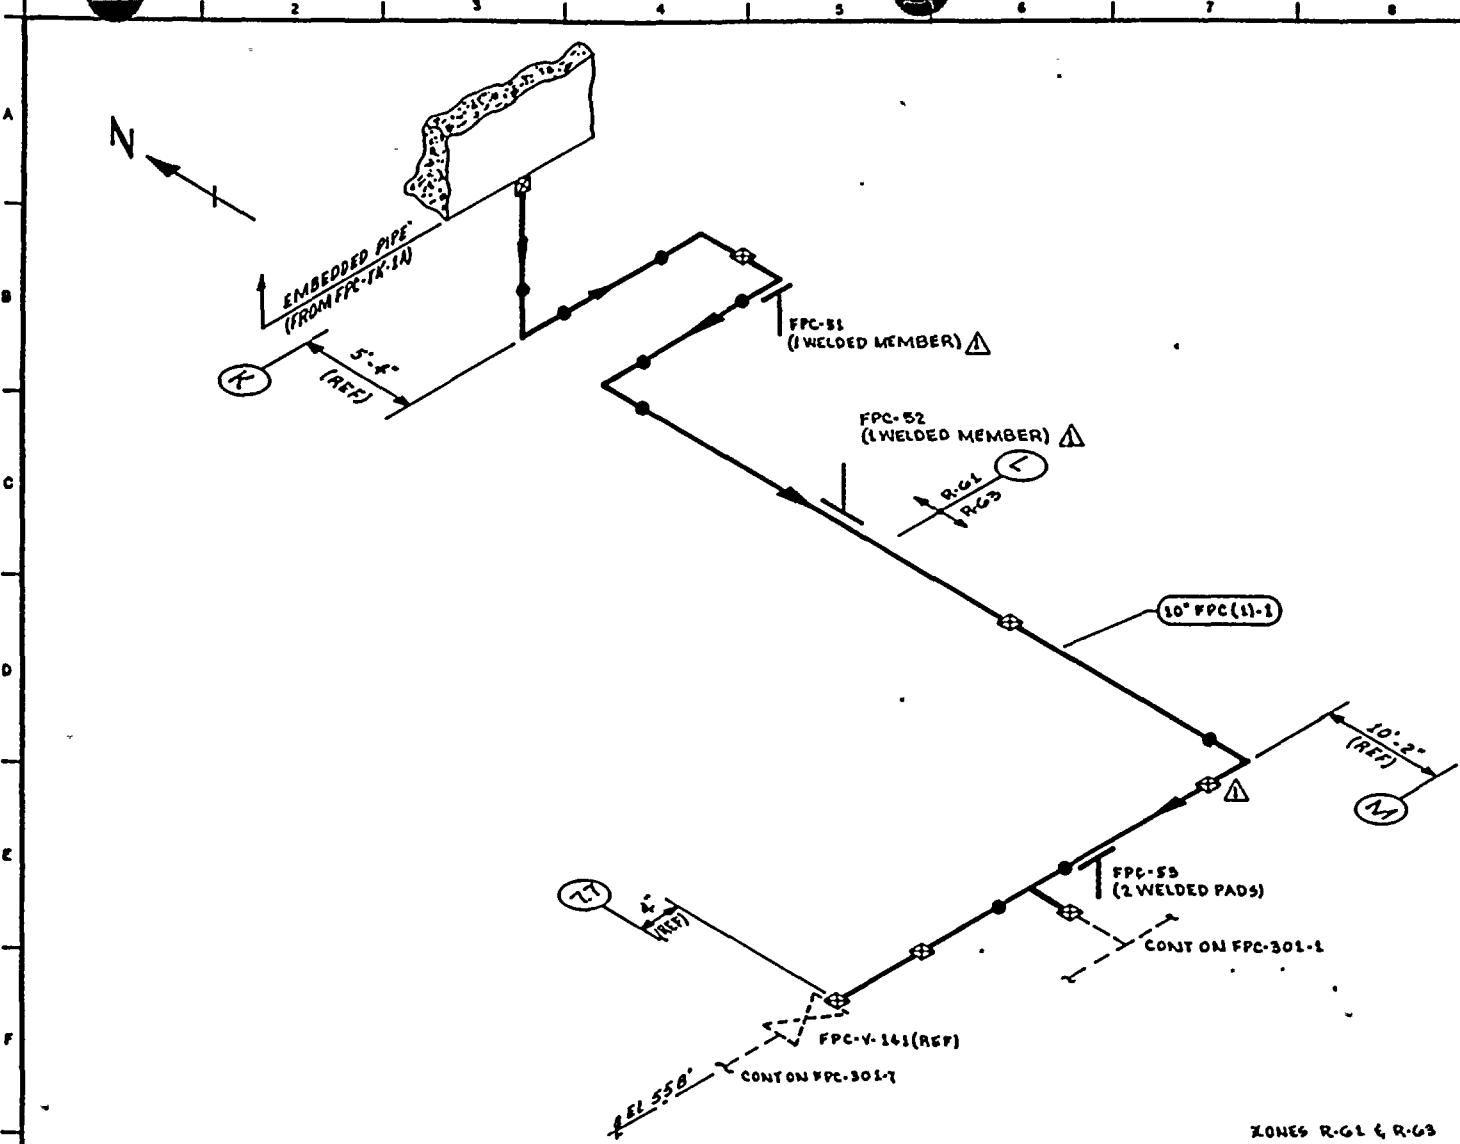

NOTES:

1. THIS DRAWING IDENTIFIES PIPING & COMPONENTS SUBJECT ONLY TO A VISUAL EXAM FOR (1) EVIDENCE OF LEAKAGE DURING SYSTEM PRESSURE OR OPERABILITY TESTS; (2) PRESSURE DECAY TESTS OF BURIED PIPING; & (3) LOSS OF SUPPORT CAPABILITY OR INADEQUATE RESTRAINT FOR SUPPORTS & HANGERS ON PIPING EXCEEDING 4\"/>

REFERENCES:
BOVEE & CRAIG ISOMETRICS
FPC-604-1.3 REV 5

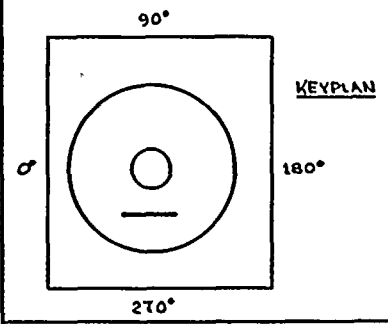

QUALITY CLASS: 2 ASME CODE CLASS: 3
ENGR: M. ANDREWS DRAWN: K. M. & L. DATE: 3-22-79

WASHINGTON PUBLIC POWER SUPPLY SYSTEM
RICHLAND, WASHINGTON 99352

THIS DRAWING IS INTENDED FOR USE IN PRESERVICE AND INSERVICE INSPECTION PROGRAMS ONLY.


PIPING SYSTEM	NOM DIA (DN)	SCH	NOM WALL THK	MATERIAL SPECIFICATION	MATL TYPE	CAL BLOCK NO
10" FPC (11-1)	10	STD	0.365	SA 106 GR B	CS	NA


NO	DATE	REVISION	BY	CHKD	APPVD
1	1/28/81	REVISED AS NOTED ADDED KEYPLAN	KJH	WJR	TFW
0	1/28/81	ISSUED FOR USE	KJH	DM	TFW

WHP- 2
WELD & COMPONENT IDENTIFICATION DIAGRAM

TITLE:
FUEL POOL CIRCULATION FROM FPC-TK-1A

 
DWG NO: FPC-301-2 REV 1



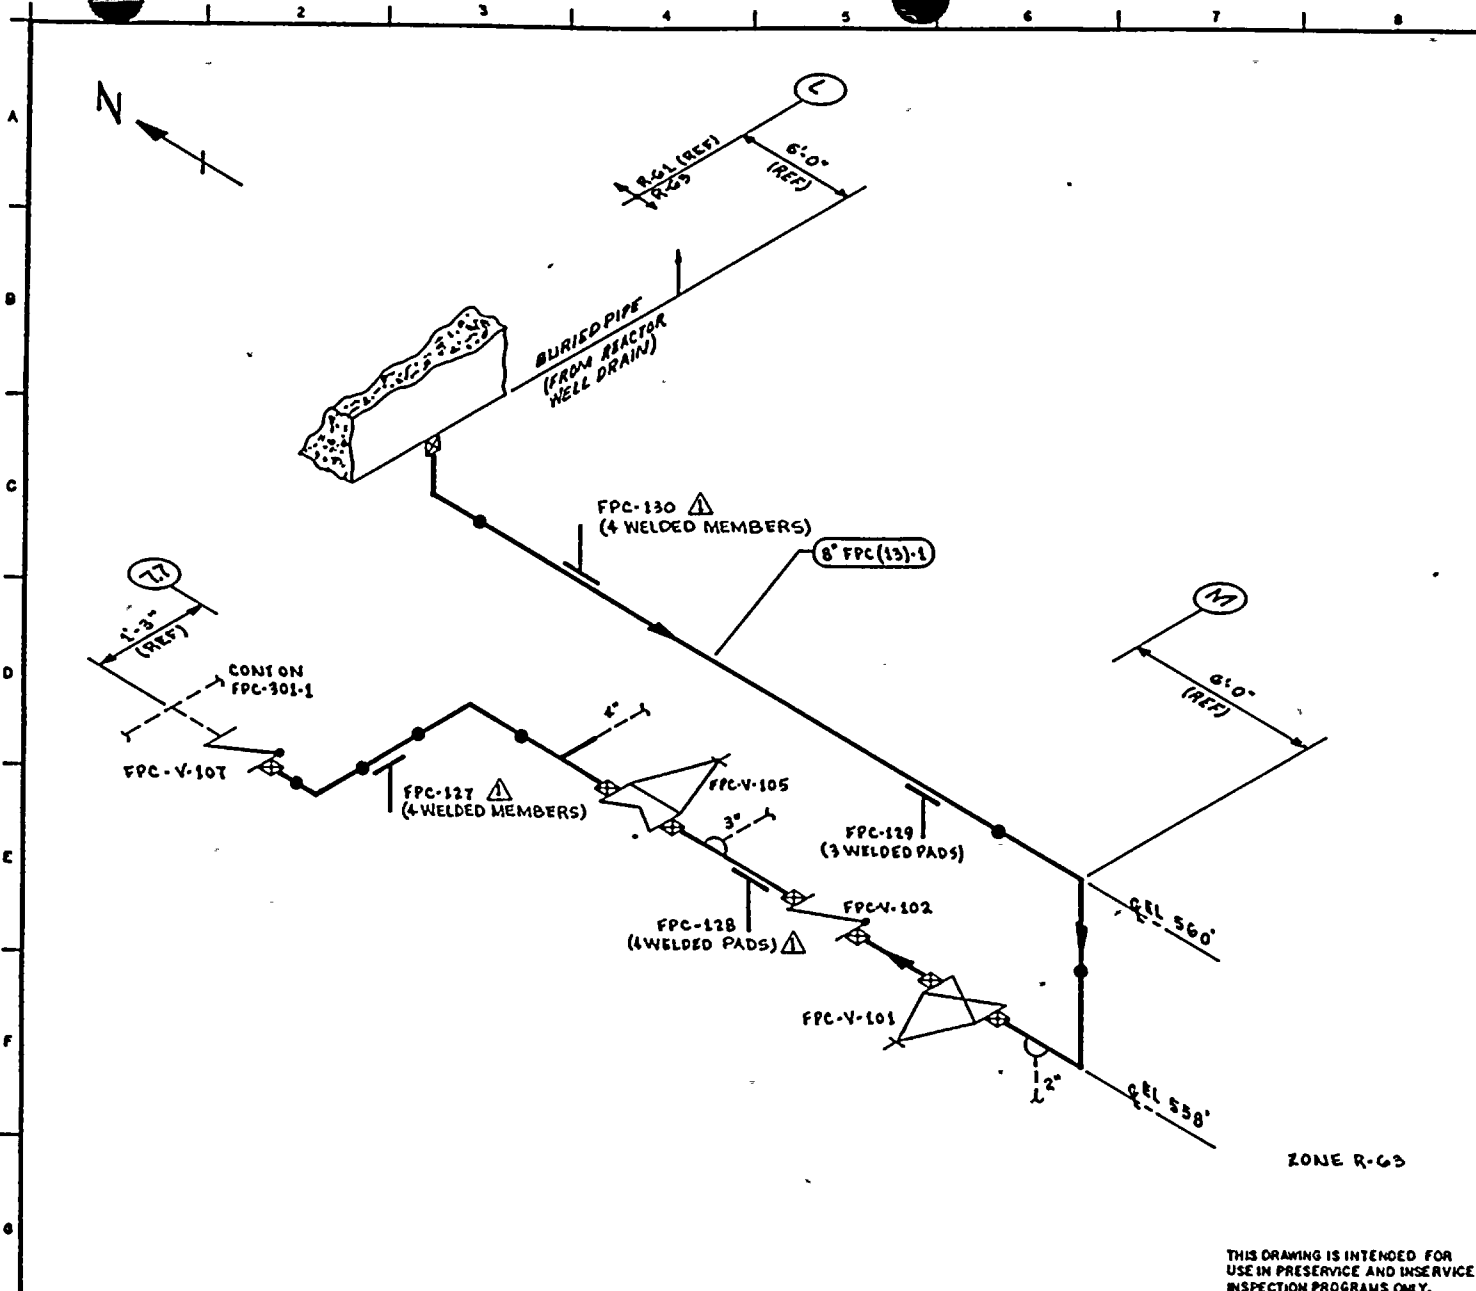

- NOTES:**
1. THIS DRAWING IDENTIFIES PIPING & COMPONENTS SUBJECT ONLY TO A VISUAL EXAM FOR (1) EVIDENCE OF LEAKAGE DURING SYSTEM PRESSURE OR OPERABILITY TESTS; (2) PRESSURE DECAY TESTS OF BURIED PIPING; & (3) LOSS OF SUPPORT CAPABILITY OR INADEQUATE RESTRAINT FOR SUPPORTS & HANGERS ON PIPING EXCEEDING 4" NOM. TESTS SHALL BE CONDUCTED PER ASME SECTION XI, ARTICLES IWA-5000 & IWD-2000.
 2. FOR BRANCH PIPING 4" NOM OR LESS (CONN SHOWN IN DASHED LINES) EXTEND VISUAL LEAKAGE EXAM THROUGH THE OUTER MOST NORMALLY CLOSED NUCLEAR CLASS VALVE OR UNTIL TRANSITION TO INSTRUMENT TUBING, UNLESS OTHERWISE NOTED.

REFERENCES:
BOVEE & CRAIG ISOMETRIC
FPC-608-1.4 REV 5

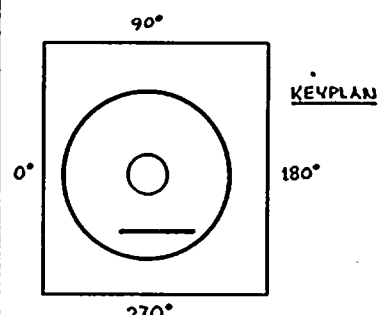

ZONE R-63

THIS DRAWING IS INTENDED FOR USE IN PRESERVICE AND INSERVICE INSPECTION PROGRAMS ONLY.

QUALITY CLASS: 2	ASME CODE CLASS: 3
ENGR: W. McLENDREW	DRAWN: W. McLENDREW
DATE: 3-22-79	

WASHINGTON PUBLIC POWER SUPPLY SYSTEM
RICHLAND, WASHINGTON 99352

PIPING SYSTEM	NOM DIA (IN)	SCH	NOM WALL THK	MATERIAL SPECIFICATION	MATL TYPE	CAL BLOCK NO
8" FPC (13)-L	8	STD	0.322	SA 106 GR B	CS	N/A

WNP-2
WELD & COMPONENT
IDENTIFICATION DIAGRAM


TITLE:
FUEL POOL CIRCULATION FROM REACTOR WELL DRAIN

DWG NO: FPC-301-3

REV 1


NO	DATE	REVISION	BY	CHKD	APPVD
1	3/28/79	REVISED AS NOTED ADDED KEYPLAN	WMA	BR	TFR
0	3/22/79	ISSUED FOR USE	WMA	BR	TFR



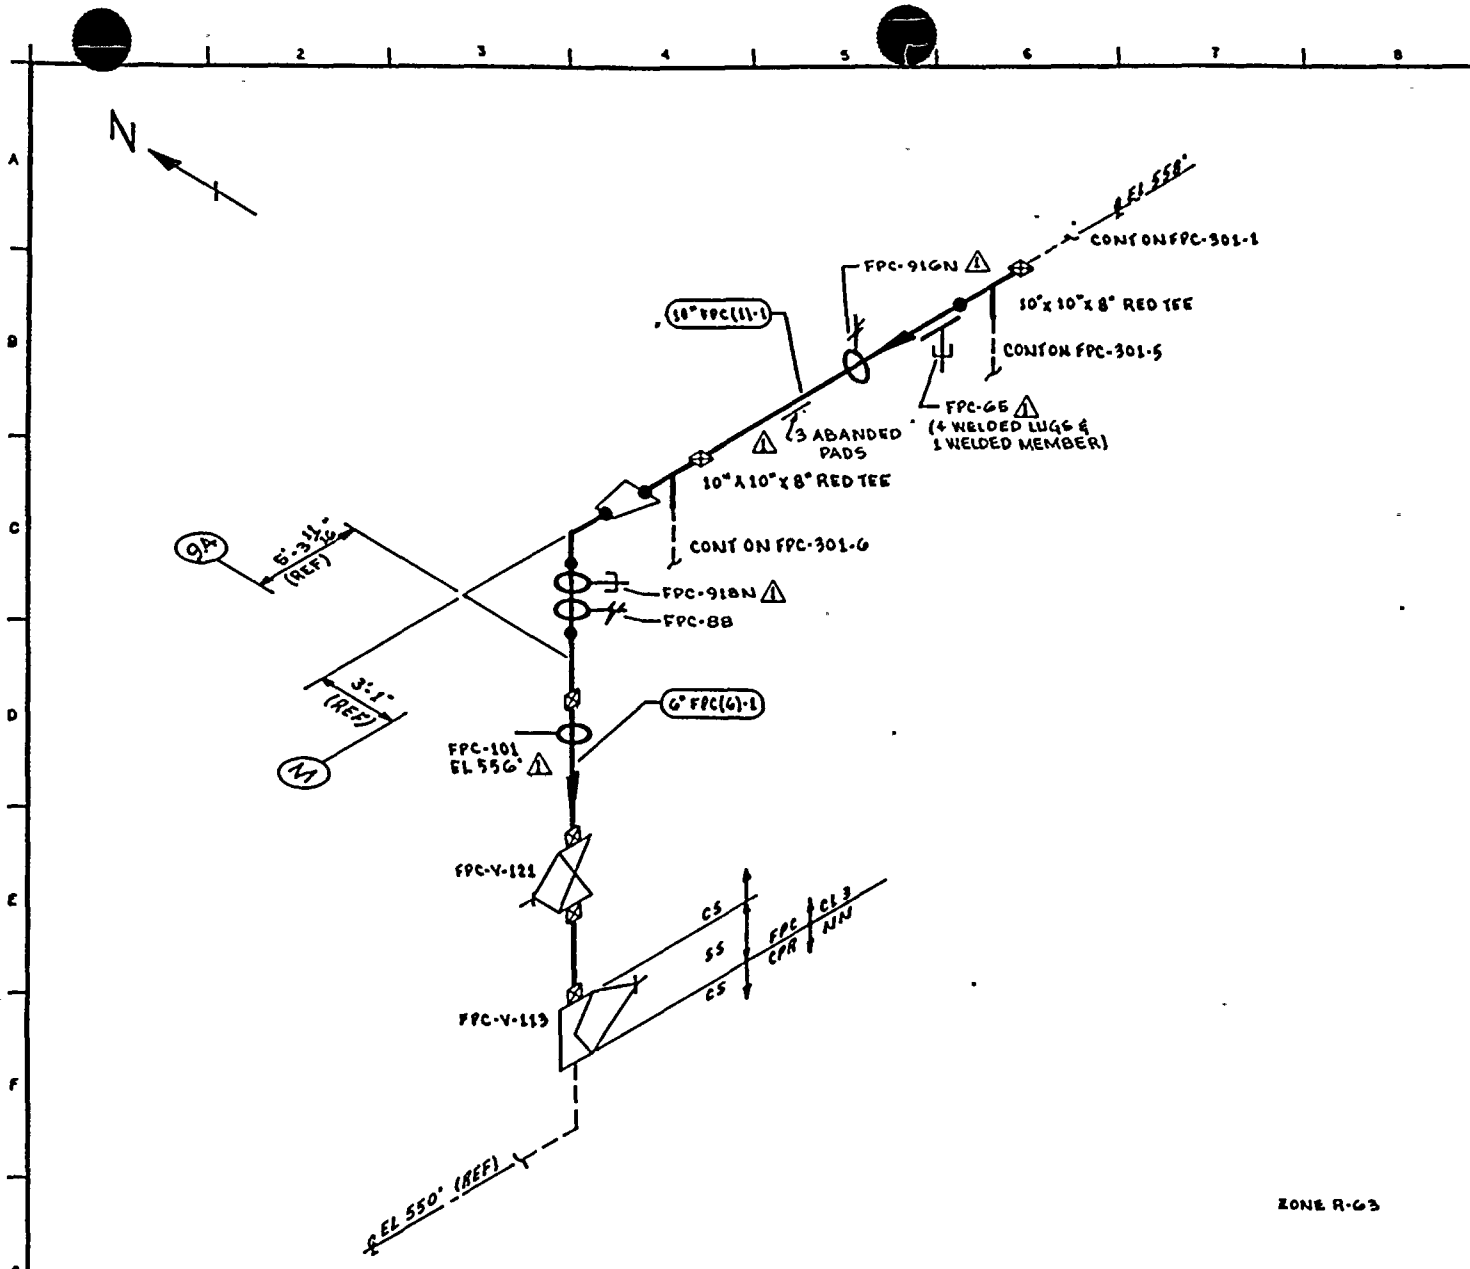

NOTES:
 1. THIS DRAWING IDENTIFIES PIPING & COMPONENTS SUBJECT ONLY TO A VISUAL EXAM FOR (1) EVIDENCE OF LEAKAGE DURING SYSTEM PRESSURE OR OPERABILITY TESTS; (2) PRESSURE DECAY TESTS OF BURIED PIPING; & (3) LOSS OF SUPPORT CAPABILITY OR INADEQUATE RESTRAINT FOR SUPPORTS & HANGERS ON PIPING EXCEEDING 4" NOM. TESTS SHALL BE CONDUCTED PER ASEM SECTION XI, ARTICLES IWA-5000 & IWD-2000.

REFERENCES:
 BOVEE & CRAIG ISOMETRICS
 FPC-604-T-9 REV 7

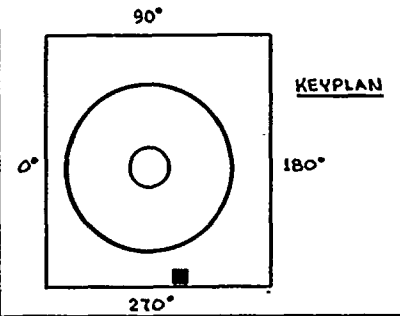

ZONE R-63

THIS DRAWING IS INTENDED FOR USE IN PRESERVICE AND INSERVICE INSPECTION PROGRAMS ONLY.

QUALITY CLASS: 2 ASME CODE CLASS: B
 ENGR: K. Mc ANDREWS DRAWN: K. Mc A. DATE: 9-22-79




WASHINGTON PUBLIC POWER SUPPLY SYSTEM
 RICHLAND, WASHINGTON 99352

PIPING SYSTEM	NOM DIA (DN)	SCH	NOM WALL THK	MATERIAL SPECIFICATION	MATL TYPE	CAL BLOCK NO
10" FPC (1)-L	10	S10	0.365	SA 106 GR B	CS	NA
6" FPC (6)-L	6	S10	0.280	SA 106 GR B	CS	NA


WHP-2
 WELD & COMPONENT IDENTIFICATION DIAGRAM
 TITLE:
 FUEL POOL CIRCULATION TO FPC-P-1A & 1B
 DWG NO: FPC-301-4 REV 1

NO	DATE	REVISION	BY	CHKD	APPVD
1	1/28/81	REVISED AS NOTED ADDED KEYPLAN	K. Mc A.	ZMR	TJK
0	1/28/81	ISSUED FOR USE	K. Mc A.	ZMR	TJK

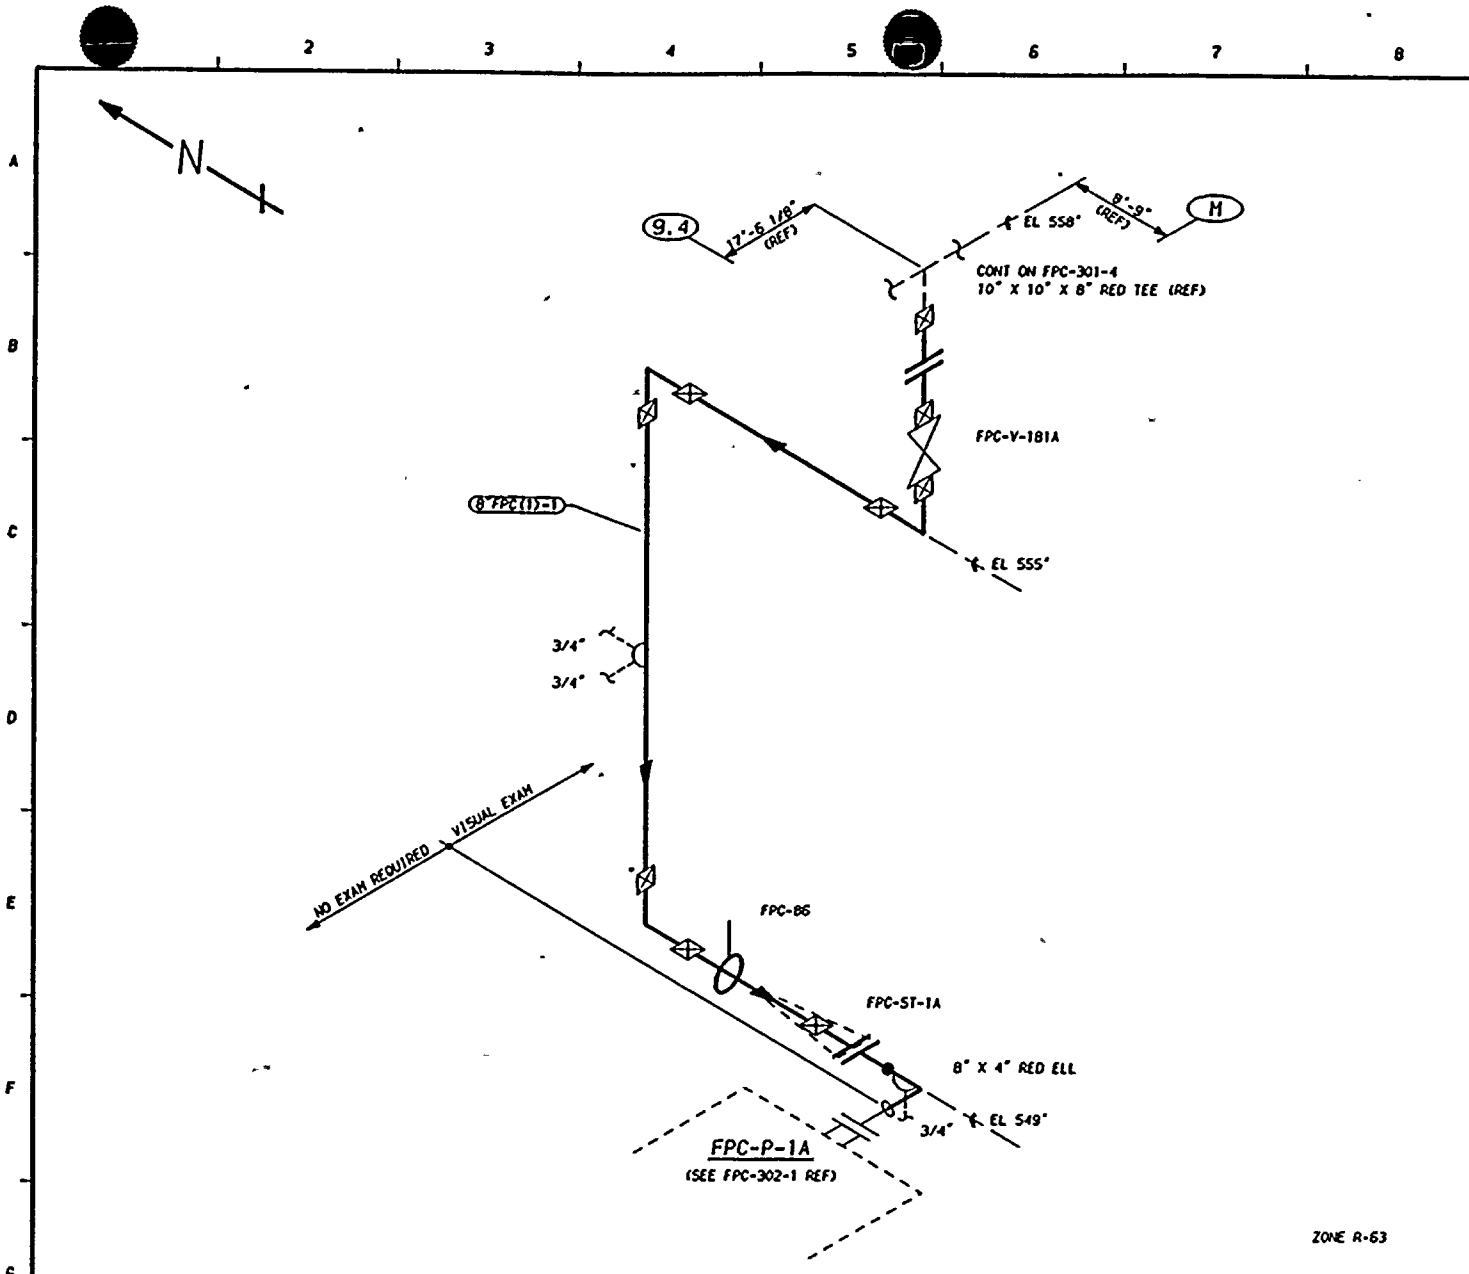

- NOTES:**
1. THIS DRAWING IDENTIFIES PIPING AND COMPONENTS SUBJECT ONLY TO A VISUAL EXAM FOR (1) EVIDENCE OF LEAKAGE DURING SYSTEM PRESSURE OR OPERABILITY TESTS; (2) PRESSURE DECAY TESTS OF BURIED PIPING; AND (3) LOSS OF SUPPORT CAPABILITY OR INADEQUATE RESTRAINT FOR SUPPORTS AND HANGERS ON PIPING EXCEEDING 4" NOM. TESTS SHALL BE CONDUCTED PER ASME SECTION XI, ARTICLES IMA-5000 AND IMD-2000.
 2. FOR BRANCH PIPING 4" NOM. OR LESS (CONNECTION SHOWN IN DASHED LINES) EXTEND VISUAL LEAKAGE EXAM THROUGH THE OUTERMOST NORMALLY CLOSED NUCLEAR CLASS VALVE, OR UNTIL TRANSITION TO INSTRUMENT TUBING, UNLESS OTHERWISE NOTED.
 3. EXTEND VISUAL LEAKAGE EXAM THROUGH FPC-P-1A DRAIN PIPING TO FPC-V-150A.

REFERENCES:
 151 - 226
 BOYEE & CRAIL ISOMETRIC
 FPC-604-10.12 REV 9

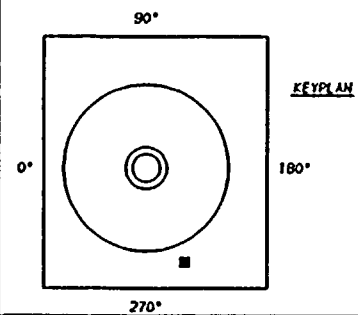

QUALITY CLASS, 2 | ASME CODE CLASS, 3
 ENGR, K-McANDREW | DRAWN, K-McA | DATE, 3-23-79

WASHINGTON PUBLIC POWER
 SUPPLY SYSTEM
 RICHLAND, WASHINGTON 99352

WNP-2
 WELD & COMPONENT
 IDENTIFICATION DIAGRAM

TITLE:
 FPC-P-1A SUCTION
 FROM FPC-TK-1A & 1B, REACTOR WELL DRAIN
 DWG NO, FPC-301-5 | REV 1



THIS DRAWING IS INTENDED FOR
 USE IN PRESERVICE AND INSERVICE
 INSPECTIONS PROGRAMS ONLY.

ZONE R-63

PIPING SYSTEM	NOM DIA (IN)	SCH	NOM WALL THK	MATERIAL SPECIFICATION	MATL TYPE	CAL BLOCK NO
8" FPC(1)-1	8	STD	0.322	SA 106 GR B	CS	NA

NO	DATE	REVISION	BY	CHKD	APVD
1	12-2-81	GENERAL UPDATE REDRAWN	K-McA	DPR	TFH
0	12-2-81	ISSUED FOR USE	K-McA	DPR	TFH

A
B
C
D
E
F
G

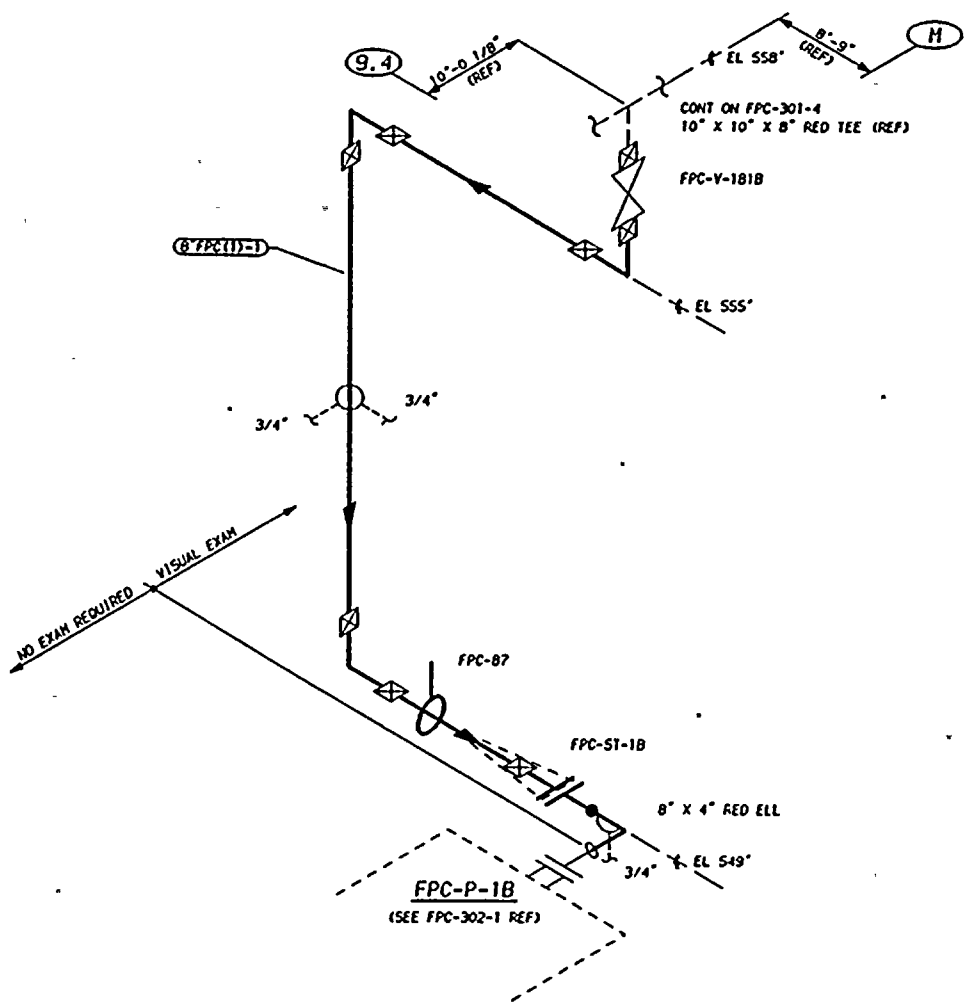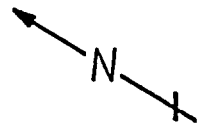

NO EXAM REQUIRED VISUAL EXAM

ZONE R-63


THIS DRAWING IS INTENDED FOR USE IN PRESERVICE AND INSERVICE INSPECTIONS PROGRAMS ONLY.

PIPING SYSTEM	NOM DIA (IN)	SCH	NOM WALL THK	MATERIAL SPECIFICATION	MATL TYPE	CAL BLOCK NO
8" FPC(1)-1	8	STD	0.322	SA 106 GR B	CS	NA

NO	DATE	REVISION	BY	CHK'D	APVD
1	12-2-81	GENERAL UPDATE REDRAWN	K-MCA	DPR	TFH
0	12-2-81	ISSUED FOR USE	K-MCA	DPR	TFH

- NOTES:**
1. THIS DRAWING IDENTIFIES PIPING AND COMPONENTS SUBJECT ONLY TO A VISUAL EXAM FOR (1) EVIDENCE OF LEAKAGE DURING SYSTEM PRESSURE OR OPERABILITY TESTS, (2) PRESSURE DECAY TESTS OF BURIED PIPING, AND (3) LOSS OF SUPPORT CAPABILITY OR INADEQUATE RESTRAINT FOR SUPPORTS AND HANGERS ON PIPING EXCEEDING 4" NOM. TESTS SHALL BE CONDUCTED PER ASME SECTION XI, ARTICLES IWA-5000 AND IWD-2000.
 2. FOR BRANCH PIPING 4" NOM. OR LESS (CONNECTION SHOWN IN DASHED LINES) EXTEND VISUAL LEAKAGE EXAM THROUGH THE OUTERMOST NORMALLY CLOSED NUCLEAR CLASS VALVE, OR UNTIL TRANSITION TO INSTRUMENT TUBING, UNLESS OTHERWISE NOTED.
 3. EXTEND VISUAL LEAKAGE EXAM THROUGH FPC-P-1B DRAIN PIPING TO FPC-V-150B.

- REFERENCES:**
- 151 - 226
 - BOYEE & CRAIL ISOMETRIC FPC-604-14.17 REV 11

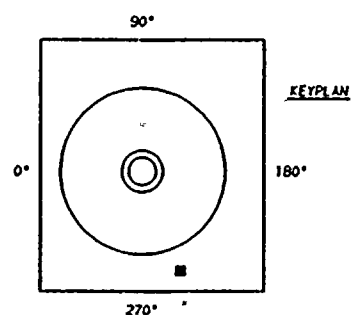


QUALITY CLASS: 2	ASME CODE CLASS: 3
ENGR, K-McANDREW	DRAWN, K-MCA DATE, 3-23-79

WASHINGTON PUBLIC POWER SUPPLY SYSTEM
RICHLAND, WASHINGTON 99352

WNP-2
WELD & COMPONENT
IDENTIFICATION DIAGRAM

TITLE: FPC-P-1B SUCTION FROM FPC-TK-1A & 1B, REACTOR WELL DRAIN
DWG NO: FPC-301-6 REV 1

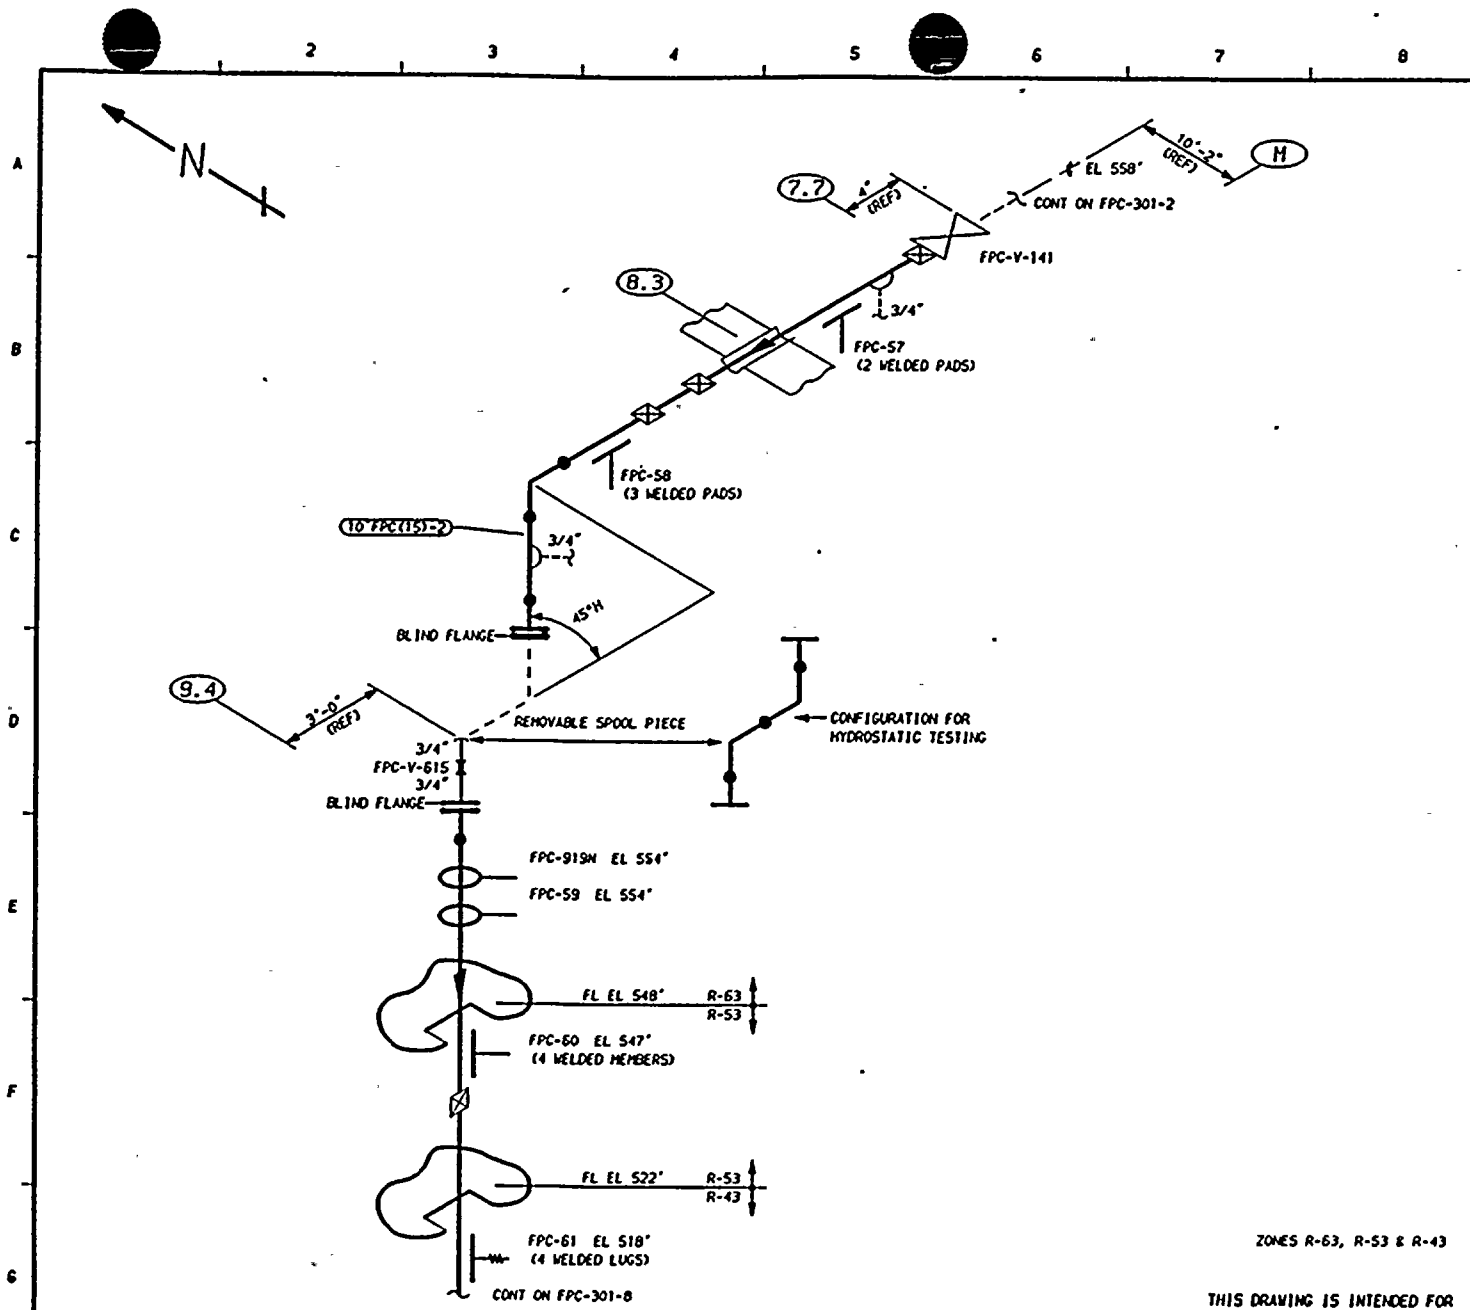


NOTES:

1. THIS DRAWING IDENTIFIES PIPING AND COMPONENTS SUBJECT ONLY TO A VISUAL EXAM FOR (1) EVIDENCE OF LEAKAGE DURING SYSTEM PRESSURE OR OPERABILITY TESTS; (2) PRESSURE DECAY TESTS OF BURIED PIPING; AND (3) LOSS OF SUPPORT CAPABILITY OR INADEQUATE RESTRAINT FOR SUPPORTS AND HANGERS ON PIPING EXCEEDING 4" NOM. TESTS SHALL BE CONDUCTED PER ASME SECTION XI, ARTICLES 1VA-5000 AND 1VD-2000.

REFERENCES:

151 - 226
 BOYEE & CRAIL ISOMETRICS
 FPC-605-1.4 REV 7
 FPC-605-5.9 REV 5

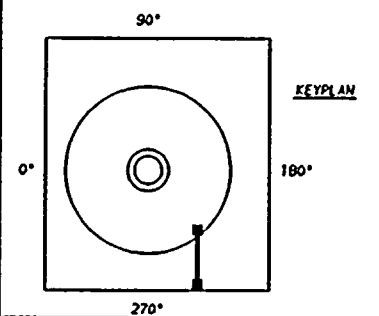

ZONES R-63, R-53 & R-43

THIS DRAWING IS INTENDED FOR USE IN PRESERVICE AND INSERVICE INSPECTIONS PROGRAMS ONLY.

QUALITY CLASS, 2	ASME CODE CLASS, 3
ENGR, K-McANDREW	DATE, 4-5-79

WASHINGTON PUBLIC POWER
 SUPPLY SYSTEM
 RICHLAND, WASHINGTON 99352


WNP-2
 WELD & COMPONENT
 IDENTIFICATION DIAGRAM

TITLE:
 FPC INTERTIE R/R-P-2A SUCTION

DWG NO, FPC-301-7 REV 1

PIPING SYSTEM	NOM DIA (INO)	SCH	NOM WALL THK	MATERIAL SPECIFICATION	MATL TYPE	CAL BLOCK NO
10" FPC(15)-2	10	STD	0.365	SA 106 GR B	CS	NA

NO	DATE	REVISION	BY	CHKD	APVD
1	12-2-81	GENERAL UPDATE REDRAWN	K-McA	DPR	TFH
0	12-2-81	ISSUED FOR USE	K-McA	DPR	TFH

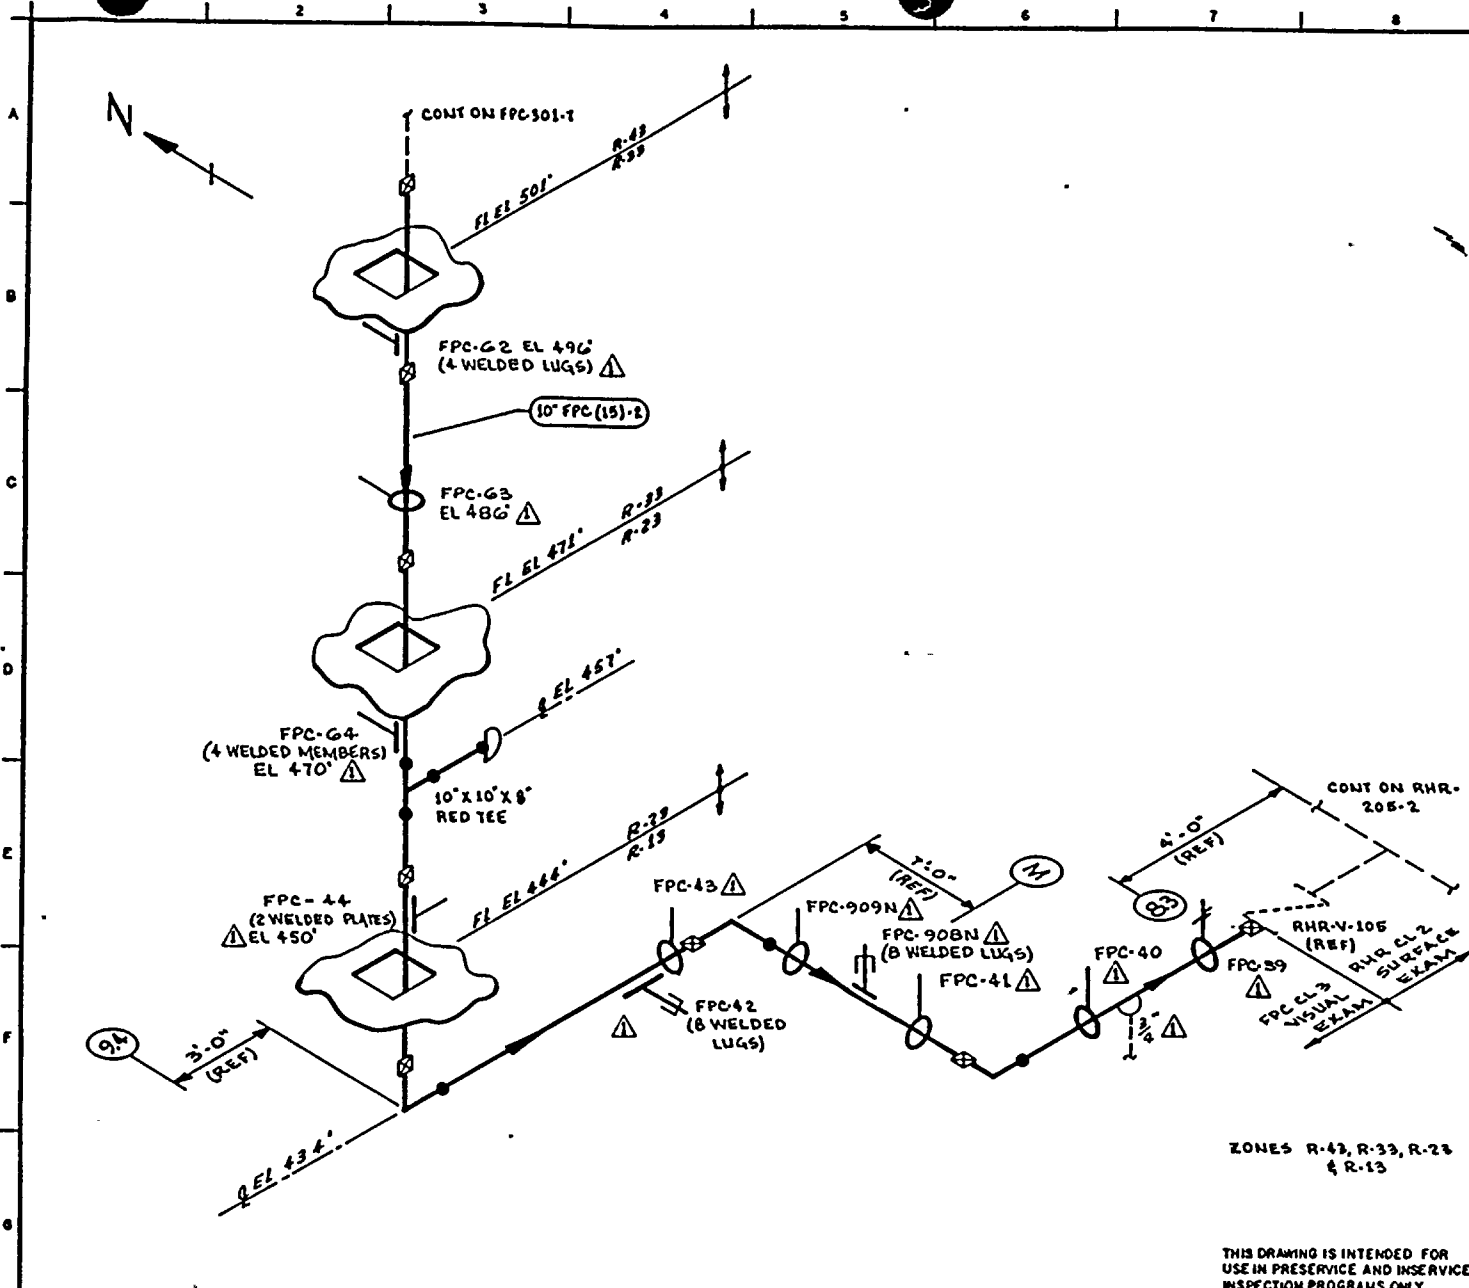


NOTES:

- THIS DRAWING IDENTIFIES PIPING & COMPONENTS SUBJECT ONLY TO A VISUAL EXAM FOR (1) EVIDENCE OF LEAKAGE DURING SYSTEM PRESSURE OR OPERABILITY TESTS; (2) PRESSURE DECAY TESTS OF BURIED PIPING; & (3) LOGS OF SUPPORT CAPABILITY OR INADEQUATE RESTRAINT FOR SUPPORTS & HANGERS ON PIPING EXCEEDING 4" NOM. TESTS SHALL BE CONDUCTED PER AGME SECTION XI, ARTICLES IWA-5000 & IWD-2000.

REFERENCES:

BOVEE & CRAIG ISOMETRICS
 FPC-G05-5.9 REV 5
 FPC-G05-10.12 REV 6

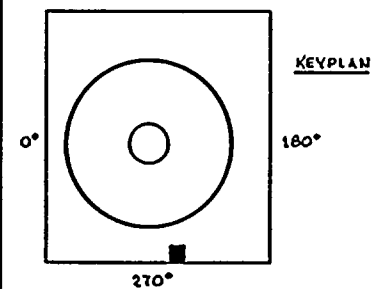

ZONES R-43, R-33, R-23 & R-13

THIS DRAWING IS INTENDED FOR USE IN PRESERVICE AND INSERVICE INSPECTION PROGRAMS ONLY.

QUALITY CLASS: 2 ASME CODE CLASS: B
 ENGR: K.M.C. ANDREW DRAWN: K.M.C.A. DATE: 4-6-79

WASHINGTON PUBLIC POWER SUPPLY SYSTEM
 RICHLAND, WASHINGTON 98352

PIPING SYSTEM	NOM DIA (IN)	SCH	NOM WALL THK	MATERIAL SPECIFICATION	MATL TYPE	CAL BLOCK NO
10" FPC(15)-2	10	STD	0.365	SA 106 GR B	CS	NA

NO	DATE	REVISION	BY	CHKD	APPVD
1	12/2/81	REVISED AS NOTED ADDED KEYPLAN	K.M.C.A.	K.M.C.A.	T.F.H.
0	12/2/81	ISSUED FOR USE	K.M.C.A.	K.M.C.A.	T.F.H.

WNP-2
 WELD & COMPONENT
 IDENTIFICATION DIAGRAM

TITLE:
FPC INTERTIE RHR-P-2A SUCTION

DWG NO: FPC-201-B REV 1

WNP-02
 INTERVAL: PSI
 PERIOD: NA
 OUTAGE:
 DRAWING NO. FPC-301

WASHINGTON PUBLIC POWER SUPPLY SYSTEM
 PROGRAM PLAN AND SCHEDULE
 SYSTEM OR COMPONENT: FPC(1)-1
 DESCRIPTION: FUEL POOL CIRC/TK-1B

PAGE 001
 DATE 12/14/84

<u>IDENT. NO.</u>	<u>DESCRIPTION</u>	<u>SECT.</u> <u>XI</u> <u>EXAM.</u>	<u>EXAM</u> <u>MTH.</u>	<u>PROCEDURE</u>	<u>CAL.</u> <u>BLOCK</u>	<u>INSERVICE</u>		<u>NOTES</u>
						<u>REQ.</u>	<u>SCHEDULED</u> <u>OUTAGE</u>	
FPC-54	BOX	N/A	VT-3	303/8.2.17				
FPC-55	BOX	N/A	VT-3	303/8.2.17				
FPC-56	BOX	N/A	VT-3	303/8.2.17				
FPC-51	BOX	N/A	VT-3	303/8.2.17				
FPC-52	BOX	N/A	VT-3	303/8.2.17				
FPC-53	BOX	N/A	VT-3	303/8.2.17				
FPC-130	BOX	N/A	VT-3	303/8.2.17				
FPC-129	BOX	N/A	VT-3	303/8.2.17				
FPC-128	BOX	N/A	VT-3	303/8.2.17				
FPC-127	BOX	N/A	VT-3	303/8.2.17				
FPC-65	BOX	N/A	VT-3	303/8.2.17				
	PSA-1 SNUBBER	N/A	VT-3	303/8.2.17				
			VT-4	303/8.2.17				
FPC-916N	SPRING	N/A	VT-3	303/8.2.17				
			VT-4	303/8.2.17				
FPC-916N	PSA-1/2 SNUBBER	N/A	VT-3	303/8.2.17				
			VT-4	303/8.2.17				
FPC-88	SPRING	N/A	VT-3	303/8.2.17				
			VT-4	303/8.2.17				

WNP-02
 INTERVAL: PSI
 PERIOD: NA
 OUTAGE:
 DRAWING NO. FPC-301

WASHINGTON PUBLIC POWER SUPPLY SYSTEM
 PROGRAM PLAN AND SCHEDULE
 SYSTEM OR COMPONENT: FPC(1)-1
 DESCRIPTION: FUEL POOL CIRC/TK-1R

PAGE 002
 DATE 12/14/84


<u>IDENT. NO.</u>	<u>DESCRIPTION</u>	<u>SECT.</u> <u>XI</u>	<u>EXAM</u> <u>EXAM.</u>	<u>PROCEDURE</u>	<u>CAL.</u> <u>BLOCK</u>	<u>INSERVICE</u>		<u>NOTES</u>
						<u>REQ.</u>	<u>SCHEDULED</u> <u>OUTAGE</u>	
FPC-101								
FPC-86	RIGID	N/A	VT-3	303/8.2.17				
	SPRING	N/A	VT-3	303/8.2.17				
			VT-4	303/8.2.17				
FPC-87	SPRING	N/A	VT-3	303/8.2.17				
			VT-4	303/8.2.17				
FPC-57	BOX	N/A	VT-3	303/8.2.17				
FPC-58	BOX	N/A	VT-3	303/8.2.17				
FPC-919N	BOX	N/A	VT-3	303/8.2.17				
FPC-59	RIGID	N/A	VT-3	303/8.2.17				
FPC-60	BOX	N/A	VT-3	303/8.2.17				
FPC-61	BOX	N/A	VT-3	303/8.2.17				
	SPRING	N/A	VT-3	303/8.2.17				
			VT-4	303/8.2.17				
FPC-62	BOX	N/A	VT-3	303/8.2.17				
FPC-63	BOX	N/A	VT-3	303/8.2.17				
FPC-64	BOX	N/A	VT-3	303/8.2.17				
FPC-44	BOX	N/A	VT-3	303/8.2.17				
FPC-42	ANCHOR	N/A	VT-3	303/8.2.17				
	STRUT	N/A	VT-3	303/8.2.17				

WNP-02
 INTERVAL: PSI
 PERIOD: NA
 OUTAGE:
 DRAWING NO. FPC-301

WASHINGTON PUBLIC POWER SUPPLY SYSTEM
 PROGRAM PLAN AND SCHEDULE
 SYSTEM OR COMPONENT: FPC(1)-1
 DESCRIPTION: FUEL POOL CIRC/TK-1B


PAGE 003
 DATE 12/14/84

<u>IDENT. NO.</u>	<u>DESCRIPTION</u>	<u>SECT.</u> <u>XI</u> <u>EXAM.</u>	<u>EXAM</u> <u>MTH.</u>	<u>PROCEDURE</u>	<u>CAL.</u> <u>BLOCK</u>	<u>INSERVICE</u>		<u>NOTES</u>
						<u>REQ.</u>	<u>SCHEDULED</u> <u>OUTAGE</u>	
FPC-43	PSA-1 SNUBBER	N/A	VT-3	303/8.2.17				S/N
			VT-4	303/8.2.17				S/N
FPC-909N	RIGID.	N/A	VT-3	303/8.2.17				
FPC-908N	PSA-1 SN(2)	N/A	VT-3	303/8.2.17				S/N
			VT-4	303/8.2.17				S/N
FPC-41	SPRING	N/A	VT-3	303/8.2.17				
			VT-4	303/8.2.17				
FPC-40	STRUT	N/A	VT-3	303/8.2.17				
FPC-39	SPRING	N/A	VT-3	303/8.2.17				
			VT-4	303/8.2.17				
FPC-PB-301	FPC PRESS BNDRY	N/A	VT-2	N/A				SEE NOTES #6 & #7.

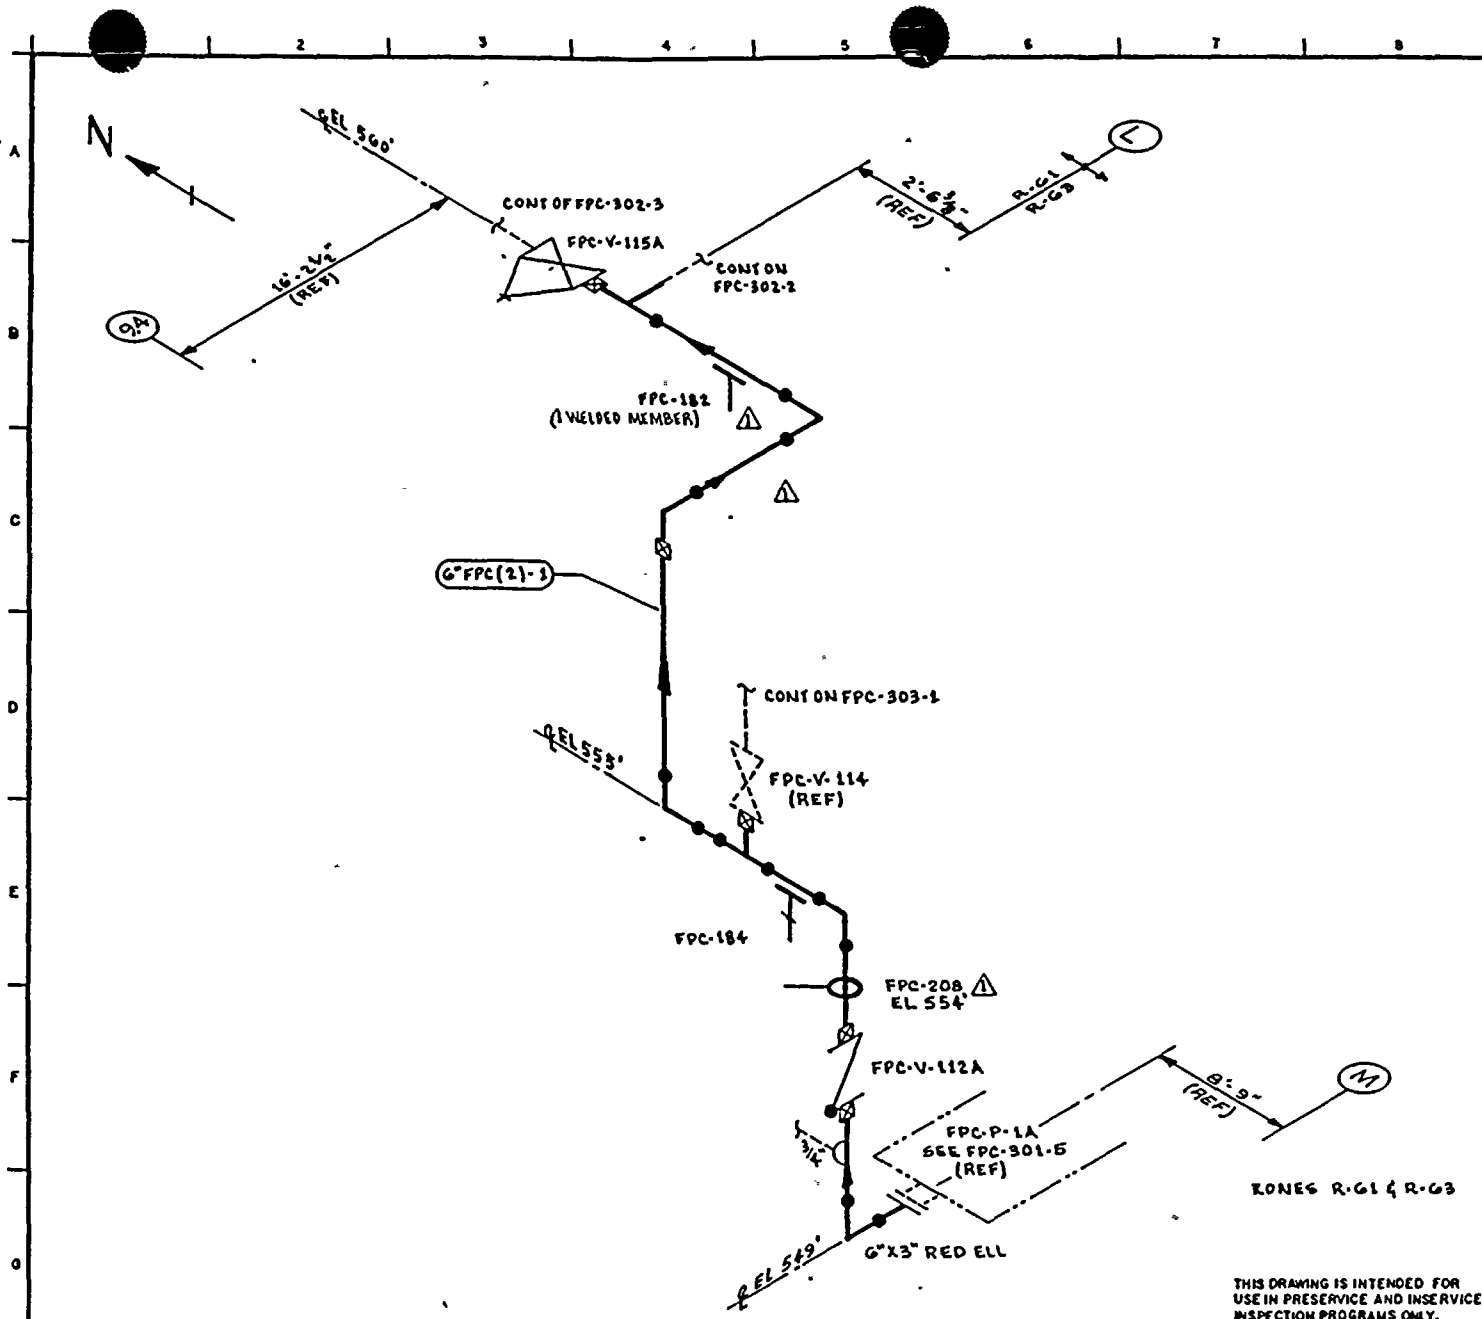

- NOTES:**
1. THIS DRAWING IDENTIFIES PIPING & COMPONENTS SUBJECT ONLY TO A VISUAL EXAM FOR (1) EVIDENCE OF LEAKAGE DURING SYSTEM PRESSURE OR OPERABILITY TESTS; (2) PRESSURE DECAY TESTS OF BURIED PIPING; (3) LOSS OF SUPPORT CAPABILITY OR INADEQUATE RESTRAINT FOR SUPPORTS & HANGERS ON PIPING EXCEEDING 4" NOM. TESTS SHALL BE CONDUCTED PER ASME SECTION XI, ARTICLES IWA-3000 & IWD-2000.
 2. FOR BRANCH PIPING 4" NOM OR LESS (CONN SHOWN IN DASHED LINES) EXTEND VISUAL LEAKAGE EXAM THROUGH THE OUTERMOST NORMALLY CLOSED NUCLEAR CLASS VALVE, OR UNTIL TRANSITION TO INSTRUMENT TUBING, UNLESS OTHERWISE NOTED.

REFERENCES:
 BOVEE & CRAIG ISOMETRICS
 FPC-636-1.3 REV 7

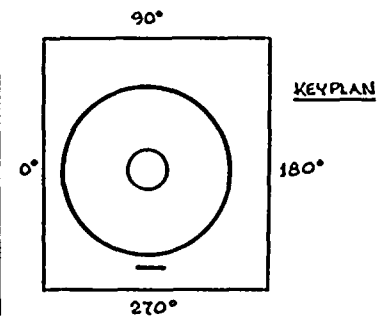

ZONES R-G1 & R-G3
 THIS DRAWING IS INTENDED FOR USE IN PRESERVICE AND INSERVICE INSPECTION PROGRAMS ONLY.

QUALITY CLASS: 2	ASME CODE CLASS: 3
ENGR: <i>[Signature]</i>	DRAWN: <i>[Signature]</i>
DATE: 4-6-79	

WASHINGTON PUBLIC POWER SUPPLY SYSTEM
 RICHLAND, WASHINGTON 99352


PIPING SYSTEM	NOM DIA (IN)	SCH	NOM WALL THK	MATERIAL SPECIFICATION	MATL TYPE	CAL BLOCK NO
6" FPC(2)-1	6	STD	0.280	SA 106 GR B	CS	NA


NO	DATE	REVISION	BY	CHKD	APPVD
1	12-21-81	REVISED AS NOTED ADDED KEYPLAN	<i>[Signature]</i>	<i>[Signature]</i>	<i>[Signature]</i>
0	12-2-81	ISSUED FOR USE	<i>[Signature]</i>	<i>[Signature]</i>	<i>[Signature]</i>

WNP-2
 WELD & COMPONENT IDENTIFICATION DIAGRAM

TITLE:
 FPC-P-1A TO FPC-DM-1A & 1B

 DWG NO: FPC-302-1 REV 1



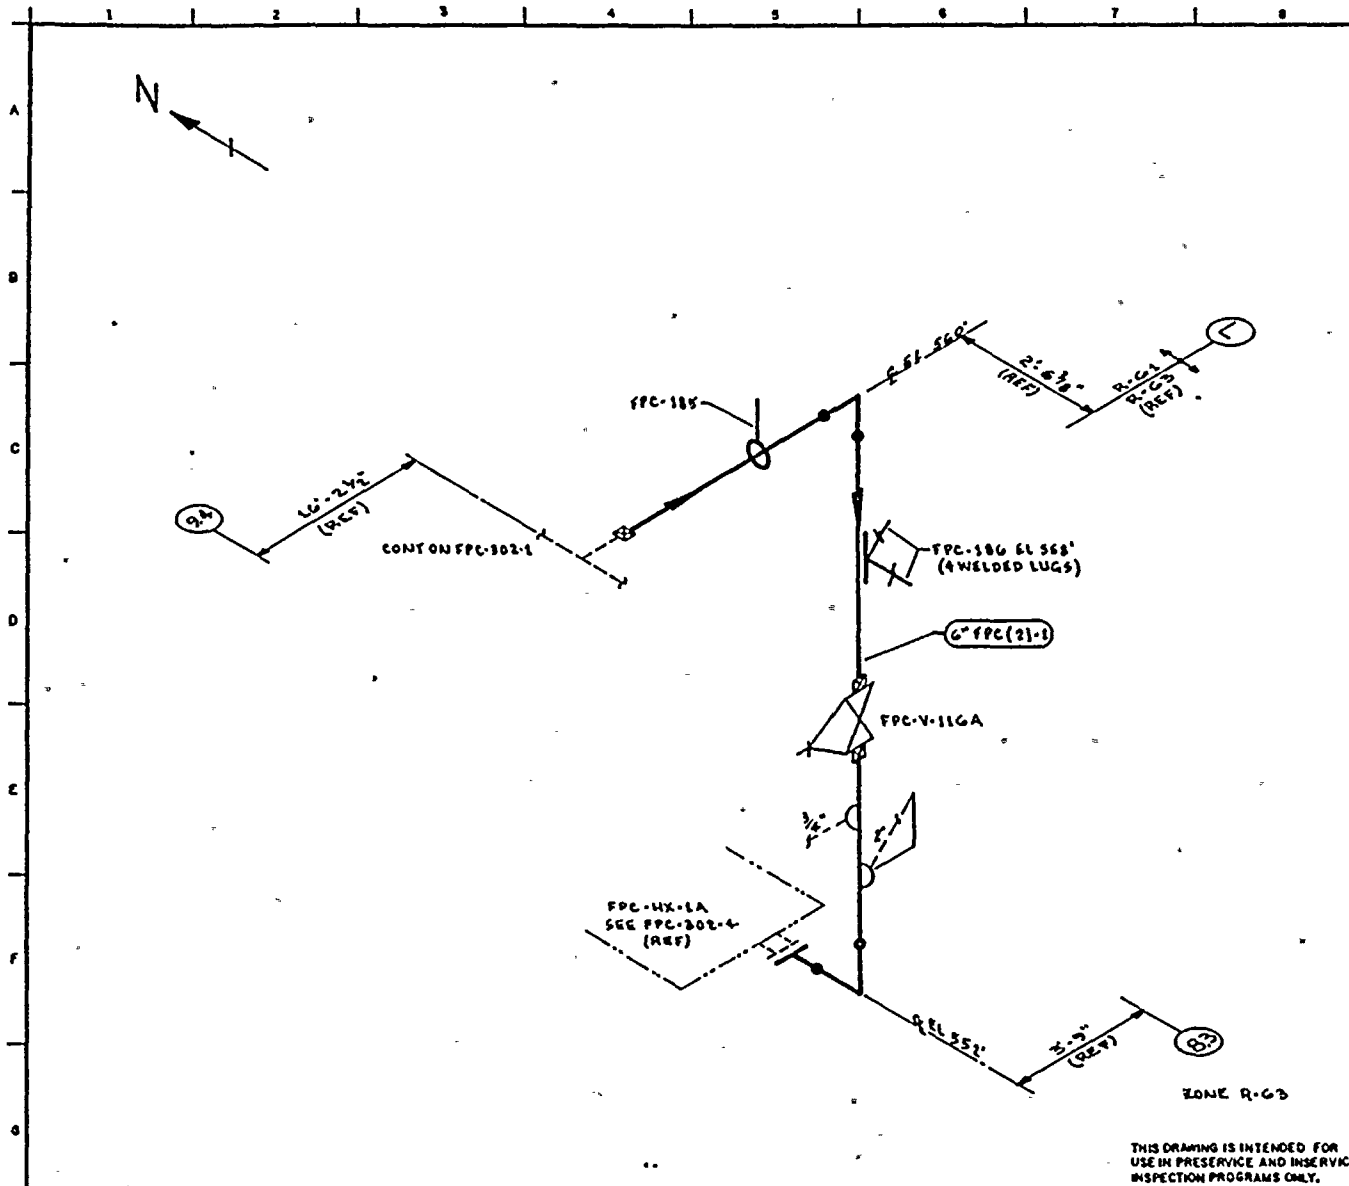

NOTES:

1. THIS DRAWING IDENTIFIES PIPING & COMPONENTS SUBJECT ONLY TO A VISUAL EXAM FOR (1) EVIDENCE OF LEAKAGE DURING SYSTEM PRESSURE OR OPERABILITY TESTS; (2) PRESSURE DECAY TESTS OF BURIED PIPING; & (3) LOSS OF SUPPORT CAPABILITY OR INADEQUATE RESTRAINT FOR SUPPORTS & HANGERS ON PIPING EXCEEDING 4" NOM. TESTS SHALL BE CONDUCTED PER ASME SECTION XI, ARTICLES IWA-5000 & IWD-2000.
2. FOR BRANCH PIPING 4" NOM OR LESS (CONN SHOWN IN DASHED LINES) EXTEND VISUAL EXAM THROUGH THE OUTERMOST NORMAL CLOSED NUCLEAR CLASS VALVE OR UNTIL TRANSITION TO INSTRUMENT TUBING, UNLESS OTHERWISE NOTED.

REFERENCES:

- BOVEE & CRALL ISOMETRICS:
 FPC-636-6.7
 FPC-636-6.7H

QUALITY CLASS: 2 ASME CODE CLASS: 3
 ENGR. K. W. ANDREW DRAWN: K. Mc. A. DATE: 4-9-79



WASHINGTON PUBLIC POWER SUPPLY SYSTEM
 RICHLAND, WASHINGTON 99352

THIS DRAWING IS INTENDED FOR USE IN PRESERVICE AND INSERVICE INSPECTION PROGRAMS ONLY.


PIPING SYSTEM	NOM DIA (IN)	SCH	NOM WALL THK	MATERIAL SPECIFICATION	MATL TYPE	CAL BLOCK NO
6" FPC(21-L)	6	STD	0.280	SA 106 GR B	CS	N/A


WNP- 2
 WELD & COMPONENT IDENTIFICATION DIAGRAM

TITLE:
FPC-P-1A DISCHARGE TO FPC-HX-1A

DWG NO: FPC-3D2-2 REV 0


0	10/28/1	ISSUED FOR USE	KMLA	DR	JFK
NO	DATE	REVISION	BY	CHKD	APPVD

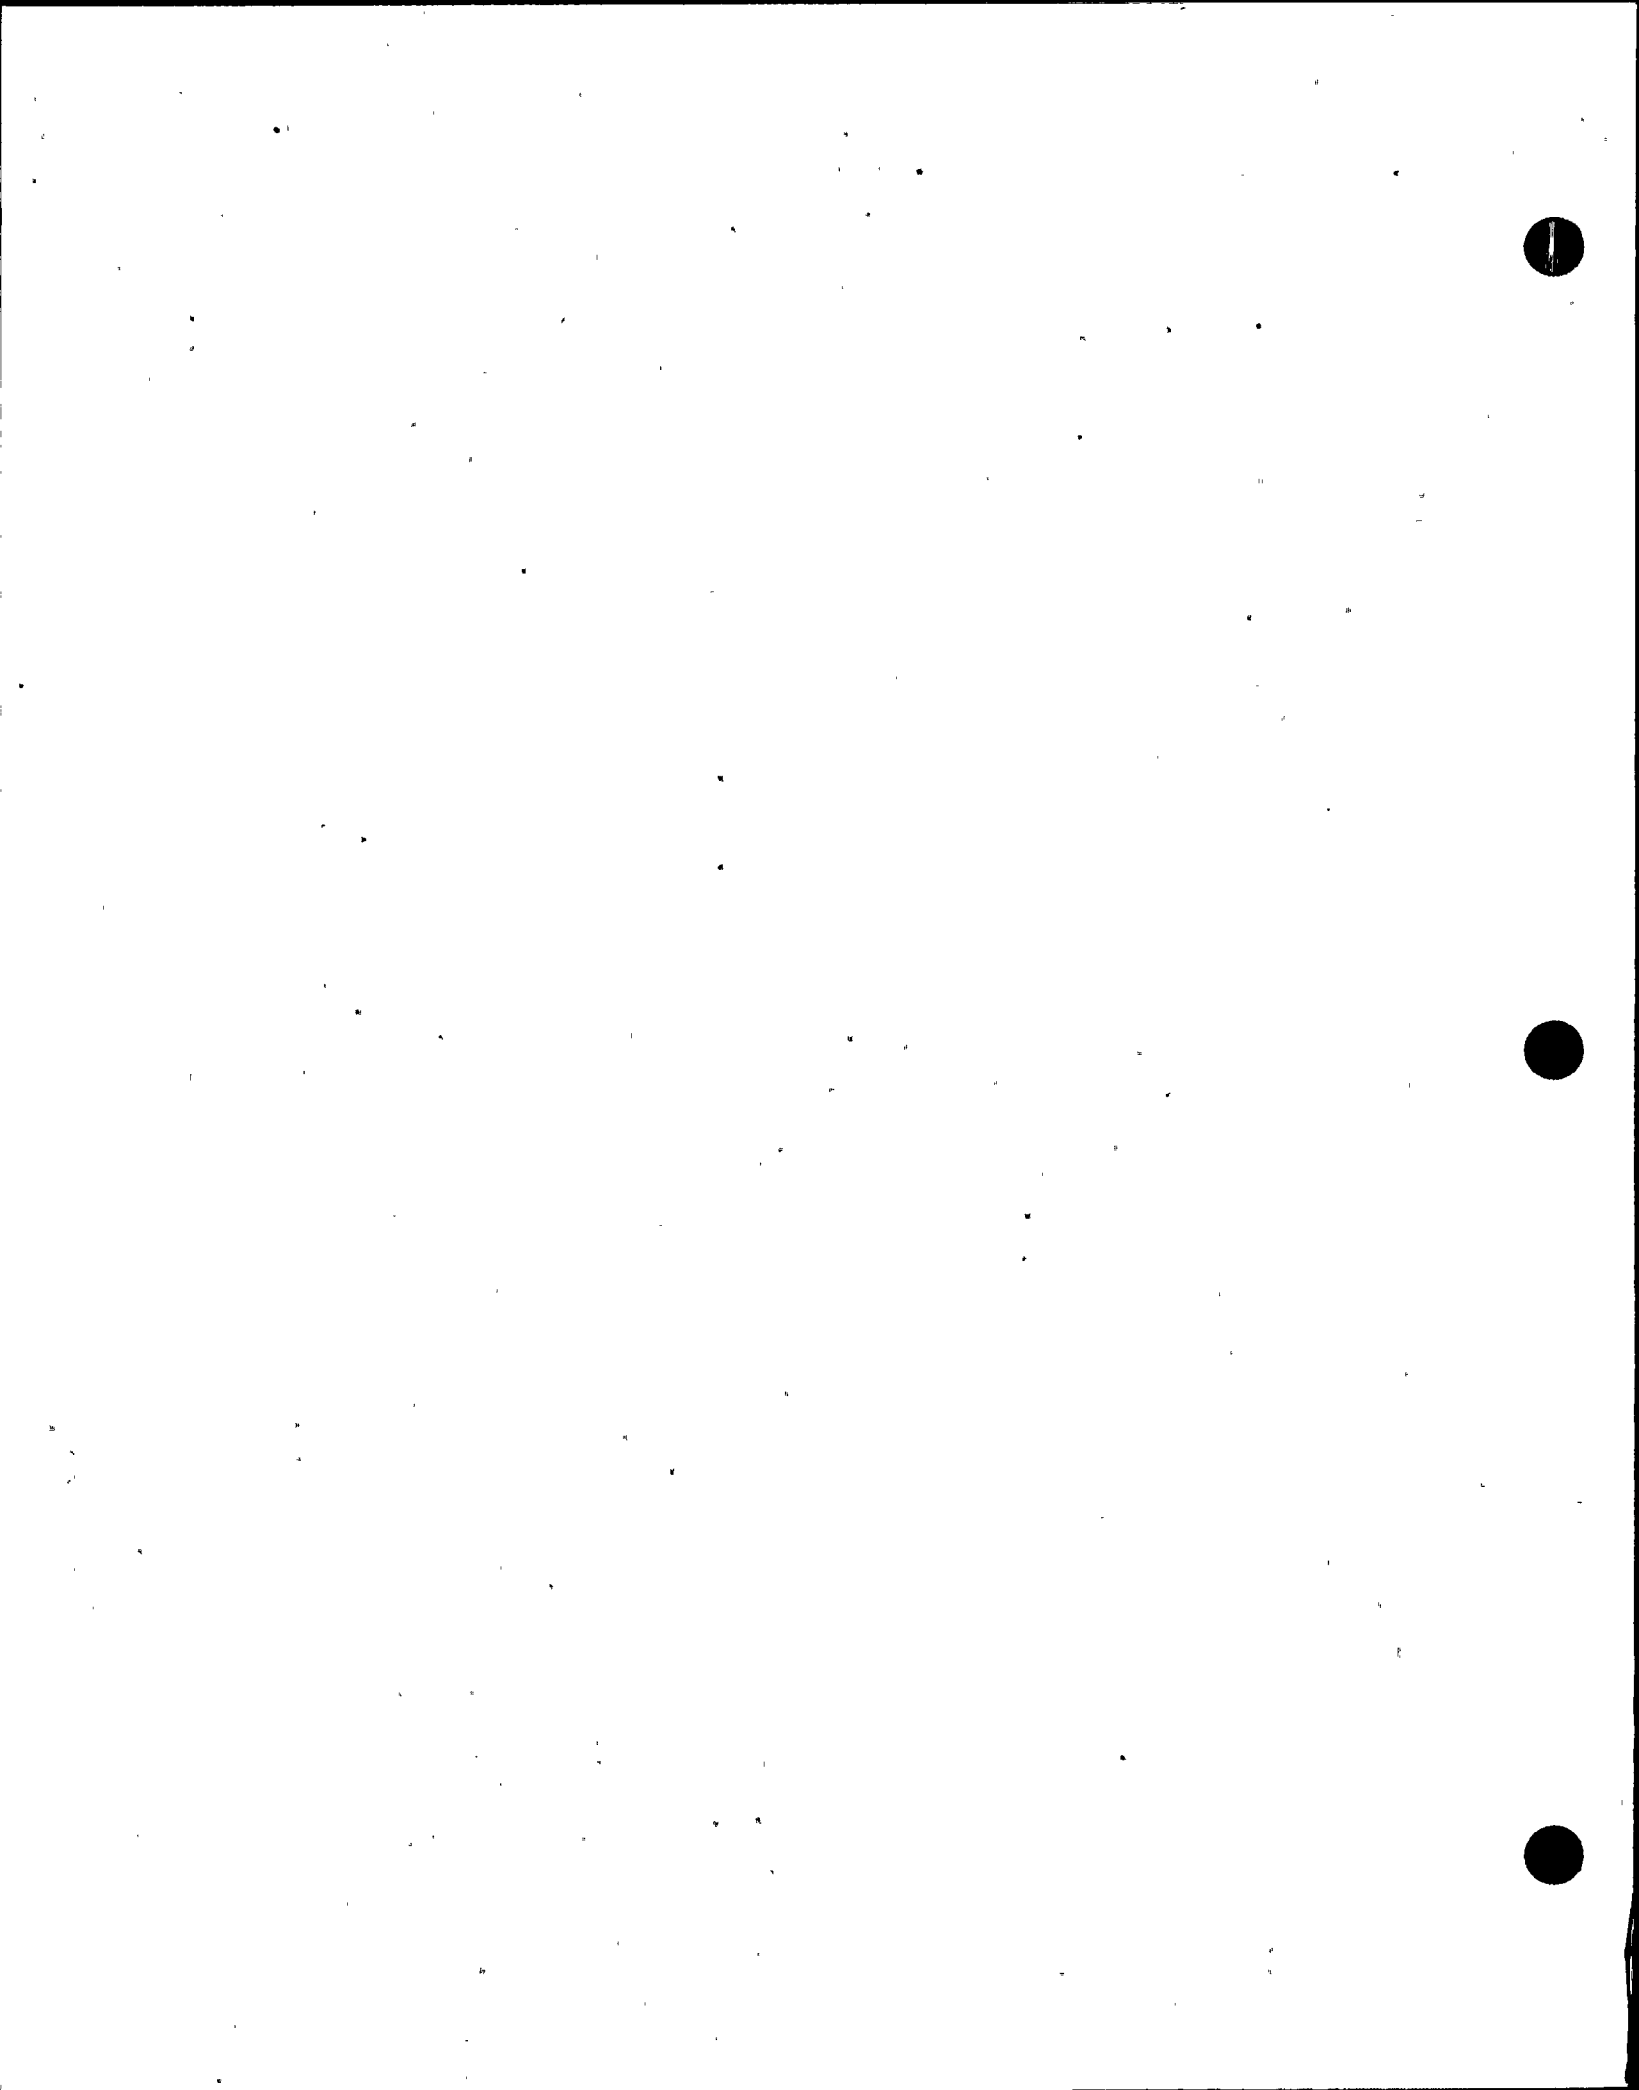

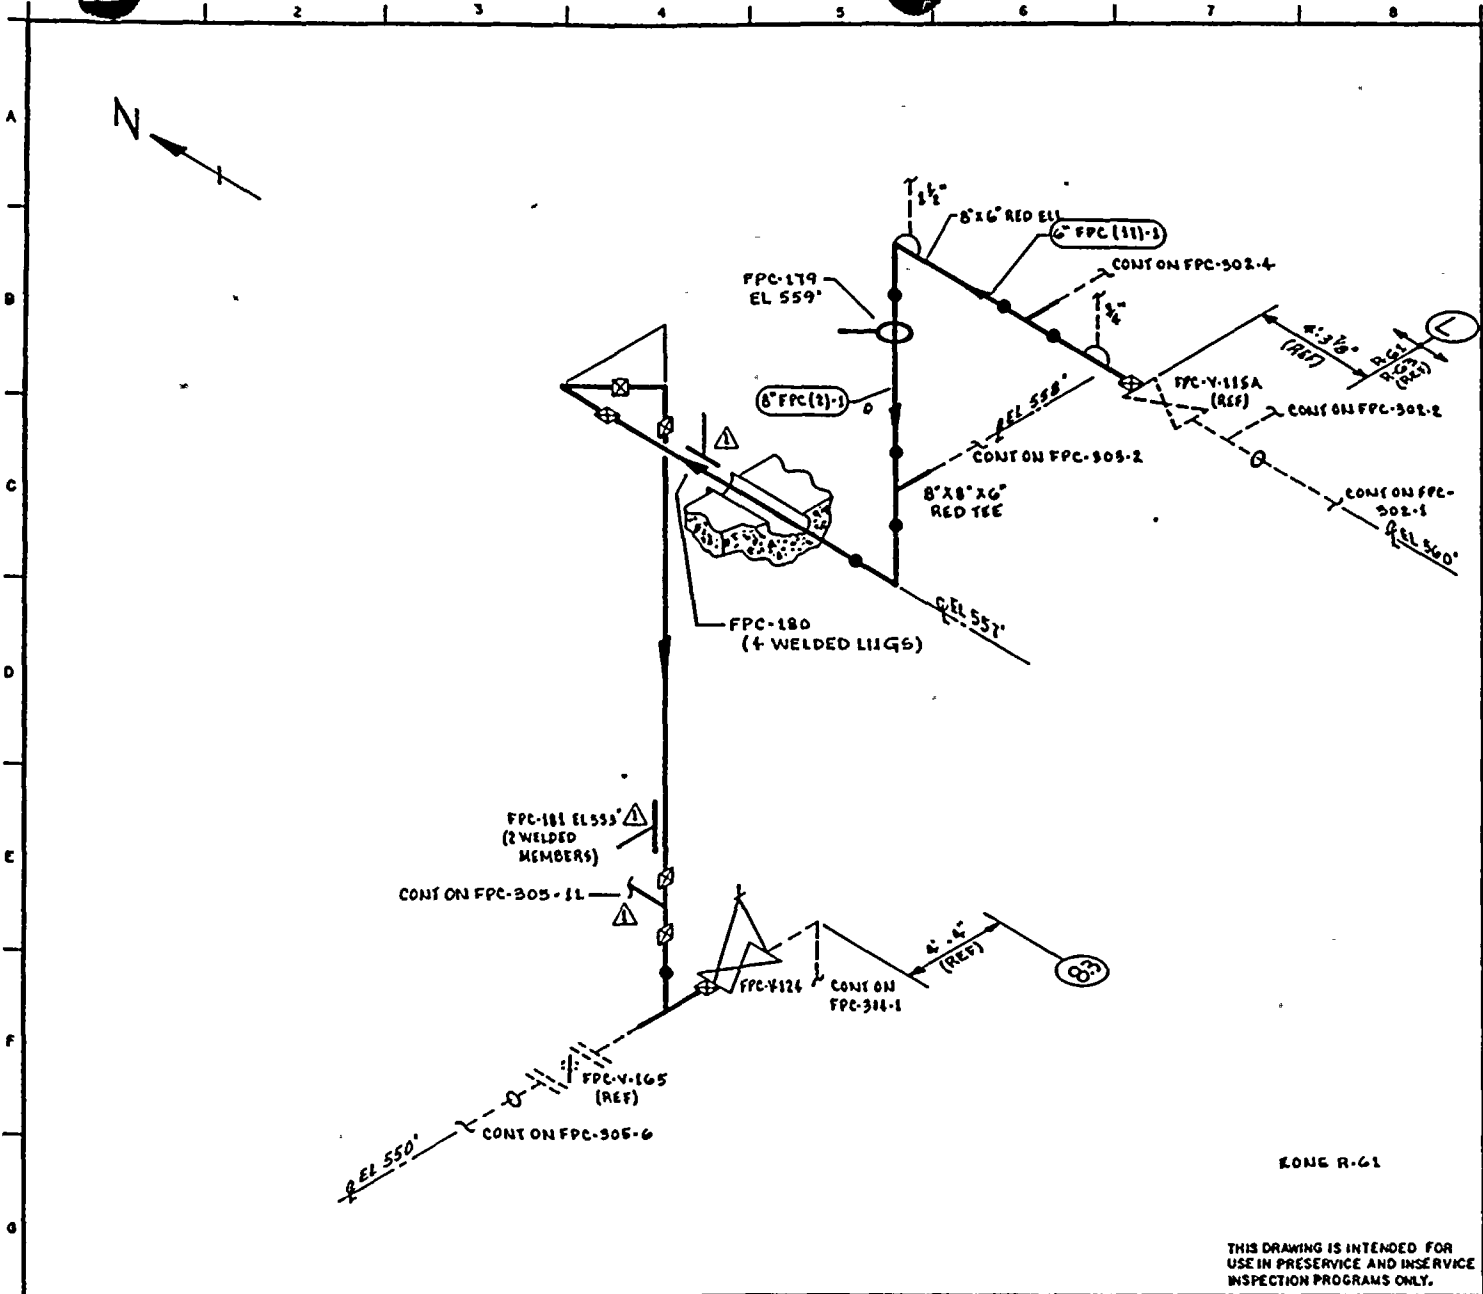

- NOTES:**
- THIS DRAWING IDENTIFIES PIPING & COMPONENTS SUBJECT ONLY TO A VISUAL EXAM FOR (1) EVIDENCE OF LEAKAGE DURING SYSTEM PRESSURE OR OPERABILITY TESTS; (2) PRESSURE DELAY TESTS OF BURIED PIPING; & (3) LOSS OF SUPPORT CAPABILITY & INADEQUATE RESTRAINT FOR SUPPORTS & HANGERS ON PIPING EXCEEDING 4" NOM. TESTS SHALL BE CONDUCTED PER ASME SECTION XI, ARTICLES SVA-5000 & SWD-2000.
 - FOR BRANCH PIPING 4" NOM OR LESS (CONJ) SHOWN IN DASHED LINES) EXTEND VISUAL LEAKAGE EXAM THROUGH THE OUTERMOST NORMALLY CLOSED NUCLEAR CLASS VALVE, OR UNTIL TRANSITION TO INSTRUMENT TUBING, UNLESS OTHERWISE NOTED.

REFERENCES:
 BOVEE & CRAIG ISOMETRICS
 FPC-636-4.5 REV T

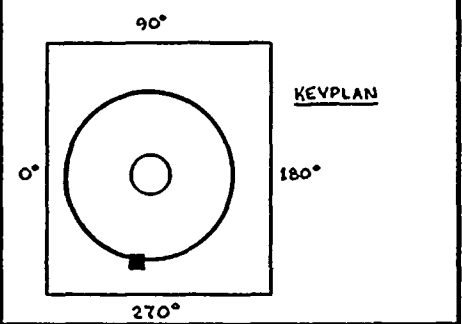

KONG R-61

THIS DRAWING IS INTENDED FOR USE IN PRESERVICE AND INSERVICE INSPECTION PROGRAMS ONLY.

QUALITY CLASS: 2 ASME CODE CLASS: 3
 ENGR: K.M. ANDREW DRAWN: K.H.L.A. DATE: 6-11-77

WASHINGTON PUBLIC POWER SUPPLY SYSTEM
 RICHLAND, WASHINGTON 98922


PIPING SYSTEM	NOM DIA (IN)	SCH	NOM WALL THK	MATERIAL SPECIFICATION	MATL TYPE	CAL BLOCK NO
6" FPC (17)-1	6	STD	0.280	SA 106 GR B	CS	NA
8" FPC (2)-2	8	STD	0.312	SA 106 GR B	CS	NA

NO	DATE	REVISION	BY	CHKD	APPVD
1	1/28/77	REVISED AS NOTED ADDED KEYPLAN	J.S.L.	J.P.R.	T.H.H.
0	12-2-81	ISSUED FOR USE	H.A.L.A.	J.M.	K.B.

WNP-2
 WELD & COMPONENT IDENTIFICATION DIAGRAM

TITLE:
 FPC-DM-1A & 1B

DWG NO: FPC-302-3 REV 1

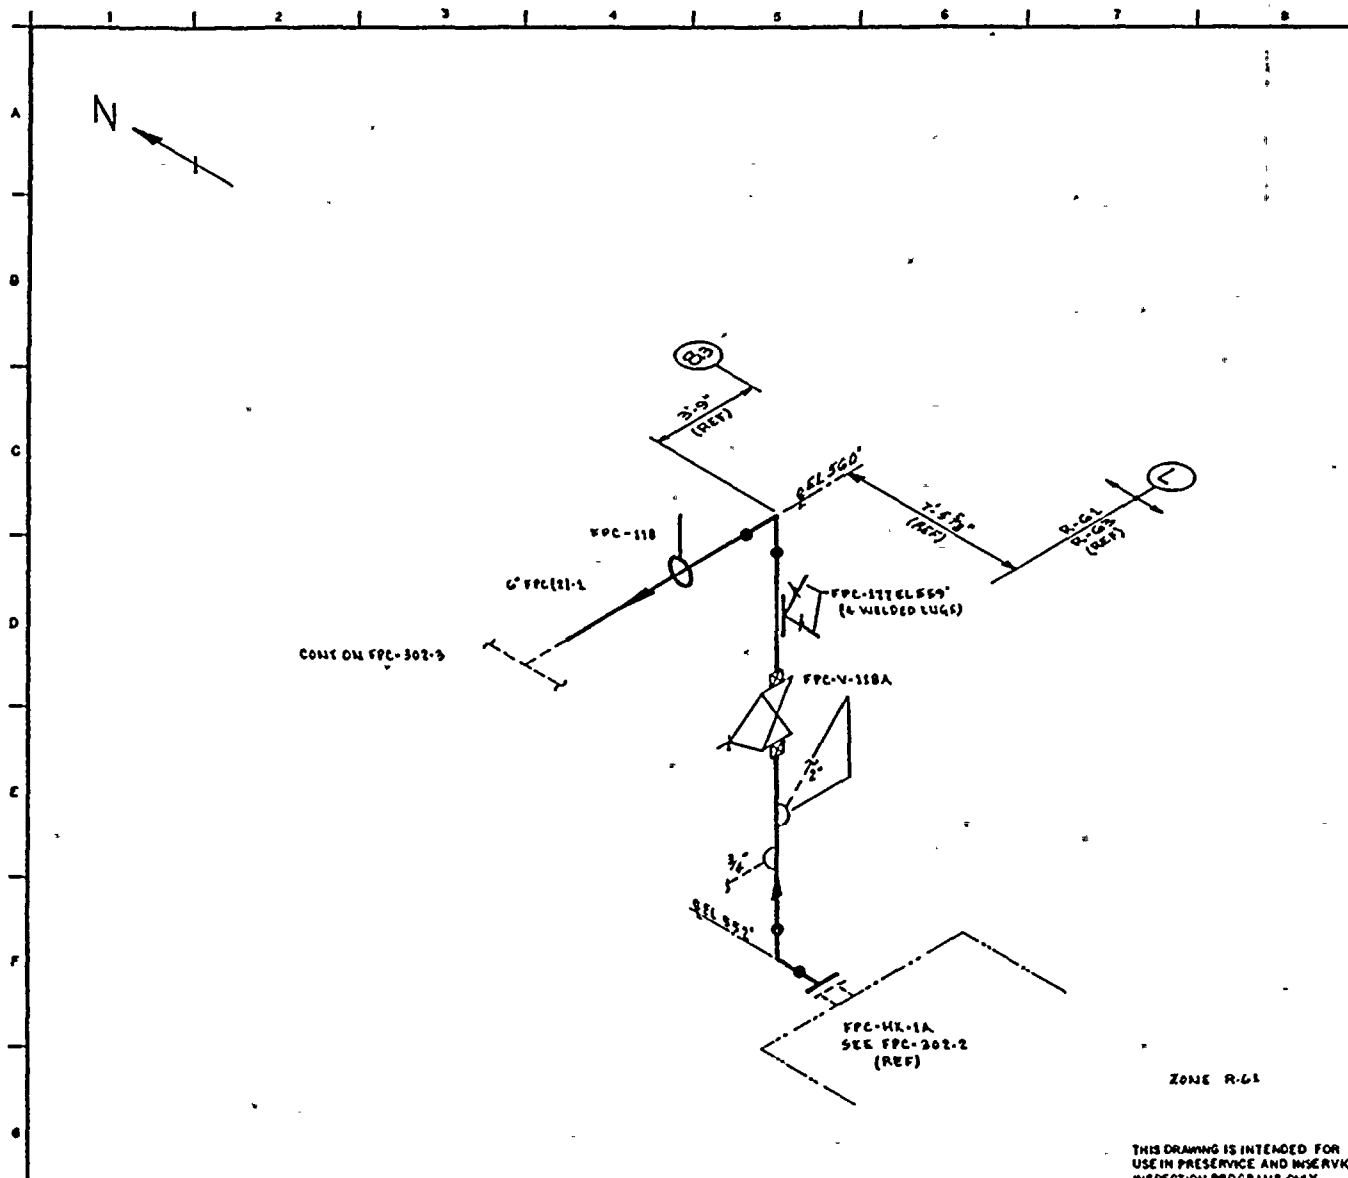

- NOTES:**
1. THIS DRAWING IDENTIFIES PIPING & COMPONENTS SUBJECT ONLY TO A VISUAL EXAM FOR (1) EVIDENCE OF LEAKAGE DURING SYSTEM PRESSURE OR OPERABILITY TESTS; (2) PRESSURE DECAY TESTS OF BURIED PIPING; (3) LOSS OF SUPPORT CAPABILITY OR INADEQUATE RESTRAINT FOR SUPPORTS & HANGERS ON PIPING EXCEEDING 6" NOM. TESTS SHALL BE CONDUCTED PER ASME SECTION XI, ARTICLES IWA-5000 & IWD-8000.
 2. FOR BRANCH PIPING 6" NOM. OR LESS (CONN. SHOWN IN DASHED LINES) EXTEND VISUAL LEAKAGE EXAM THROUGH THE DOWNMOST NORMALLY CLOSED NUCLEAR CLASS VALVE, OR UNTIL TRANSITION TO INSTRUMENT TUBING, UNLESS OTHERWISE NOTED.

- REFERENCES:**
- BOYCE & ORRILL ISOMETRICS
 - FPC-636-8.9 REV 2
 - FPC-636-8.9H REV 0

QUALITY CLASS: 2 ASME CODE CLASS: 3
 ENGR: K. M. ANDREWS DRAWN: R. H. A. DATE: 6-21-79

WASHINGTON PUBLIC POWER SUPPLY SYSTEM
 RICHLAND, WASHINGTON 99352

THIS DRAWING IS INTENDED FOR USE IN PRESERVICE AND INSERVICE INSPECTION PROGRAMS ONLY.

PIPING SYSTEM	NOM DIA (IN)	SCH	NOM WALL THK	MATERIAL SPECIFICATION	MATL TYPE	CAL BLOCK NO
6" FPC(8)-1	6	STD	0.280	SA 106 GR B	CS	N/A


WNP-2
 WELD & COMPONENT IDENTIFICATION DIAGRAM

TITLE:
 FPC-HX-1A TO FPC-DM-11 & 1B

OWG NO: FPC-302-4 REV 0

0 2781	ISSUED FOR USE	4/4	20	1/1	
NO	DATE	REVISION	BY	CHKD	APPVD

SCALE: AS SHOWN

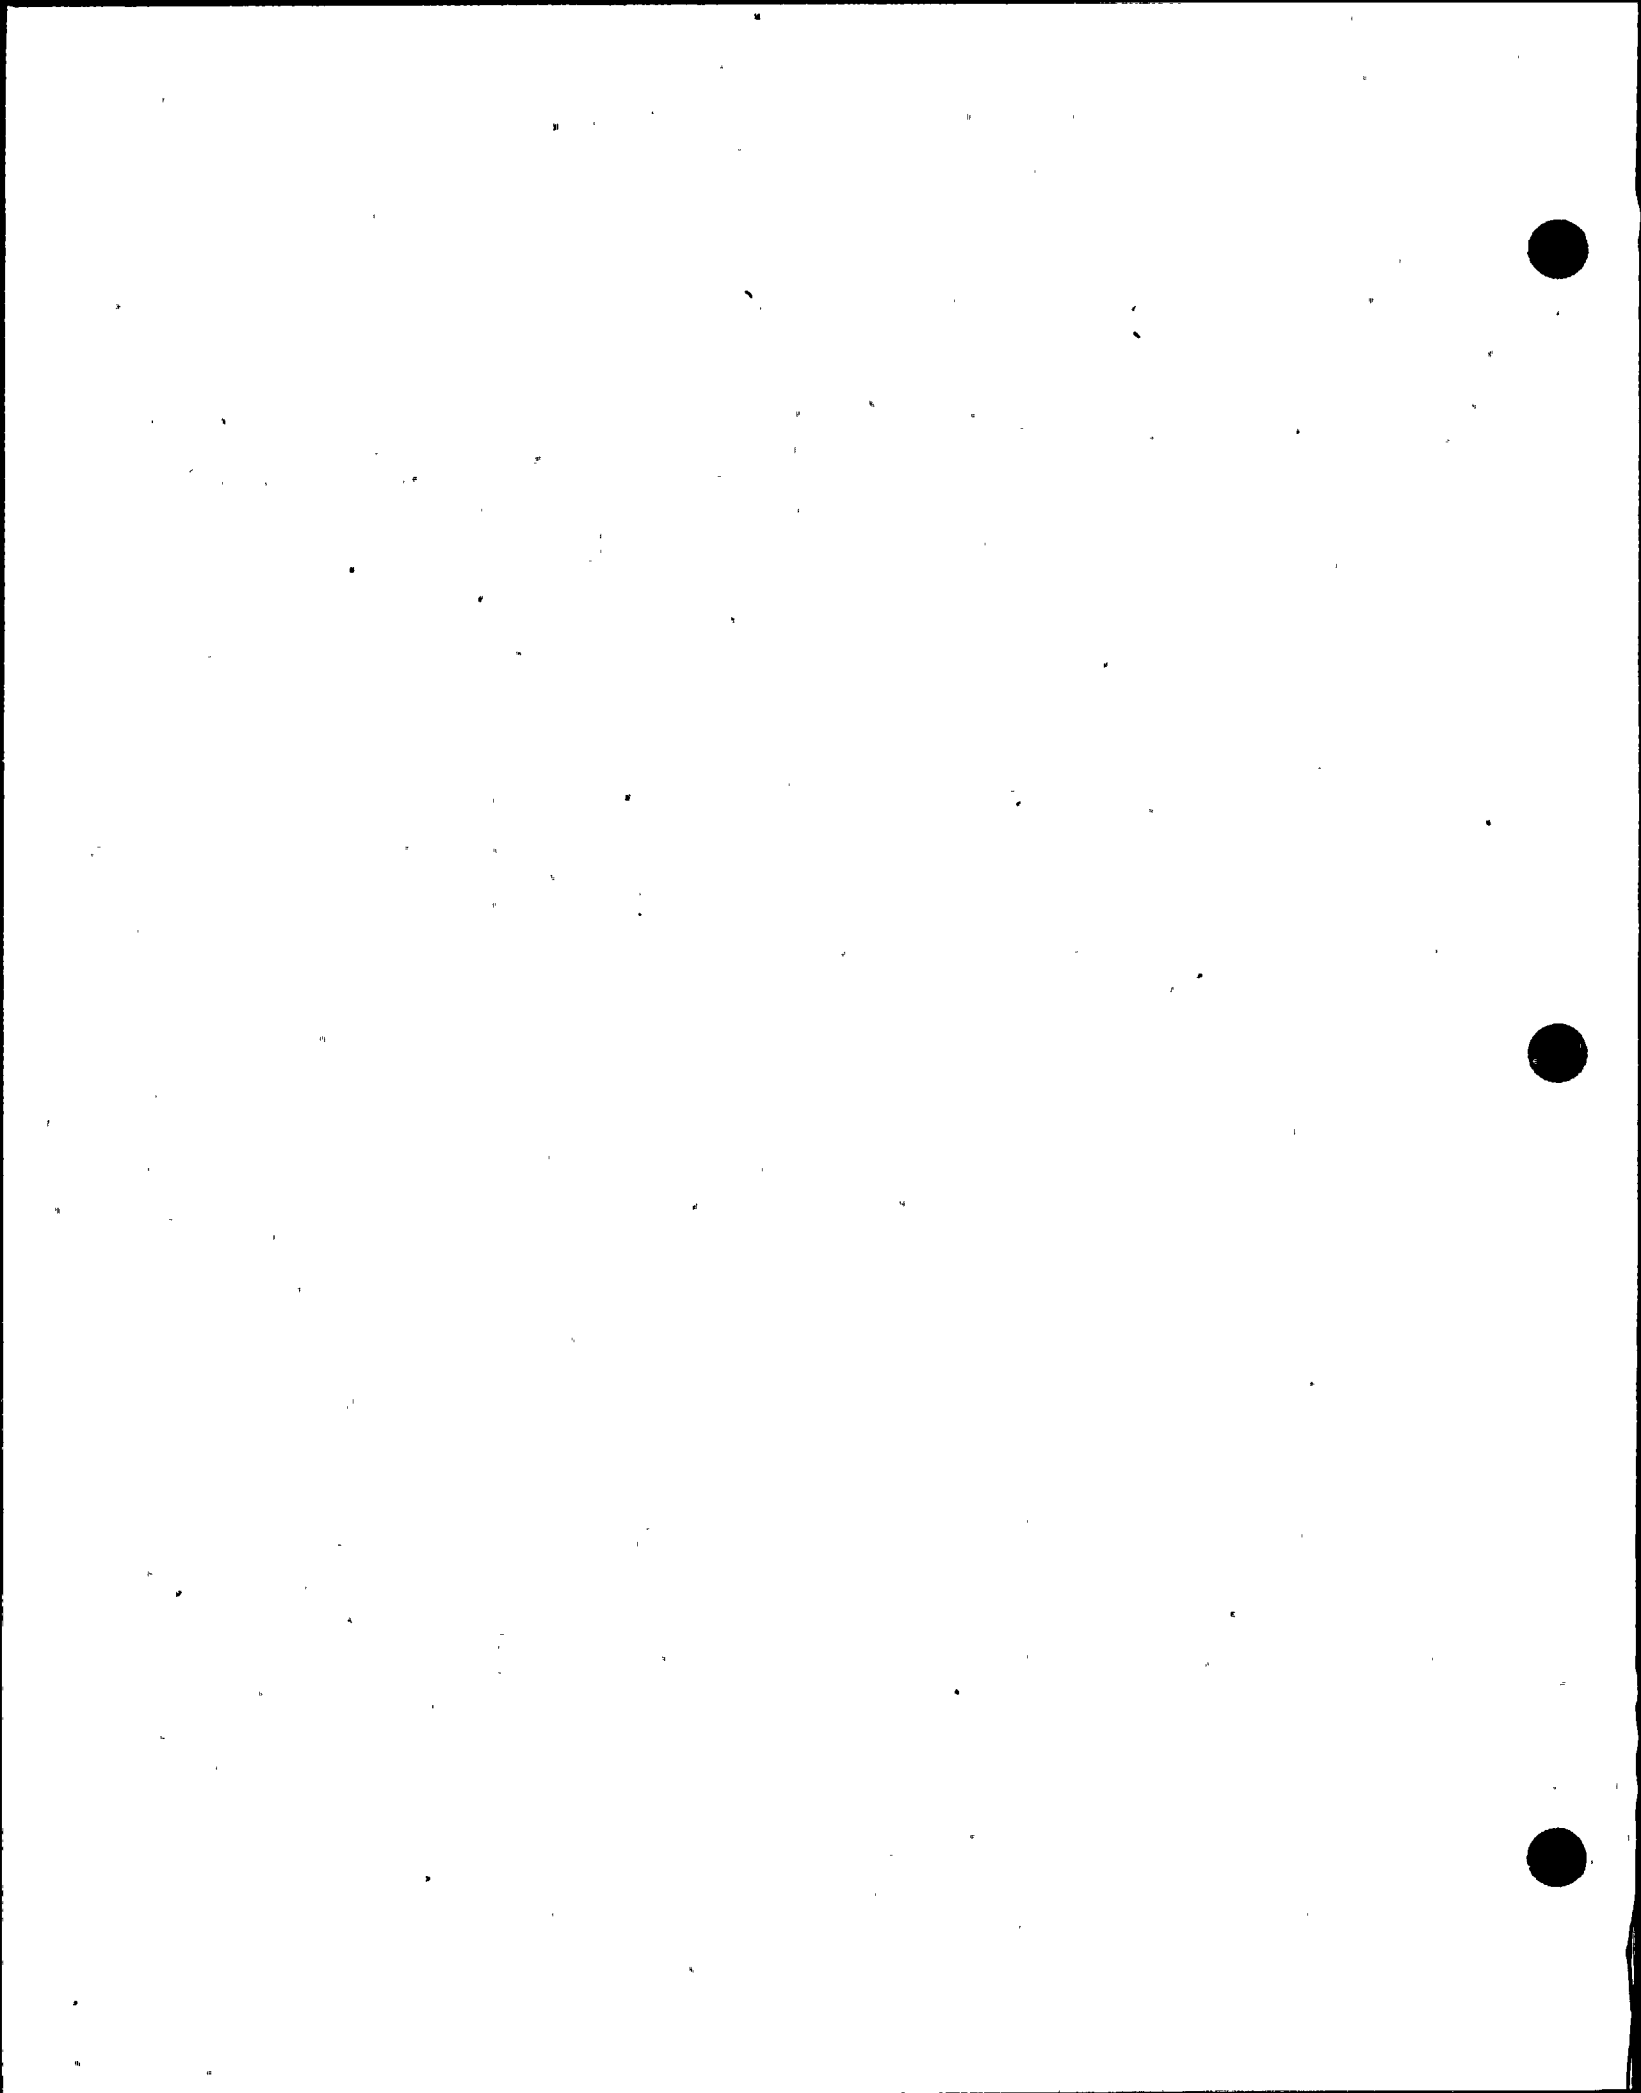


WNP-02
 INTERVAL: PSI
 PERIOD: NA
 OUTAGE:
 DRAWING NO. FPC-302

WASHINGTON PUBLIC POWER SUPPLY SYSTEM
 PROGRAM PLAN AND SCHEDULE
 SYSTEM OR COMPONENT: FPC(2)-1
 DESCRIPTION: FPC-P-1A TO DM-1A&1B

PAGE 001
 DATE 12/14/84


<u>IDENT. NO.</u>	<u>DESCRIPTION</u>	<u>SECT.</u> <u>XI</u> <u>EXAM.</u>	<u>EXAM</u> <u>MTH.</u>	<u>PROCEDURE</u>	<u>CAL.</u> <u>BLOCK</u>	<u>INSERVICE</u>		<u>NOTES</u>
						<u>REQ.</u>	<u>SCHEDULED</u> <u>OUTAGE</u>	
FPC-208								
FPC-184	BOX	N/A	VT-3	303/8.2.17				
	SPRING	N/A	VT-3	303/8.2.17				
			VT-4	303/8.2.17				
FPC-182	BOX	N/A	VT-3	303/8.2.17				
FPC-185	BOX	N/A	VT-3	303/8.2.17				
FPC-186	SPRING	N/A	VT-3	303/8.2.17				
			VT-4	303/8.2.17				
FPC-179	BOX	N/A	VT-3	303/8.2.17				
FPC-180	BOX	N/A	VT-3	303/8.2.17				
FPC-181	BOX	N/A	VT-3	303/8.2.17				
FPC-177	SPRING	N/A	VT-3	303/8.2.17				
			VT-4	303/8.2.17				
FPC-178	BOX	N/A	VT-3	303/8.2.17				
FPC-PB-302	FPC PRESS BNDRY	N/A	VT-2	N/A				

SEE NOTES #6 & #7.

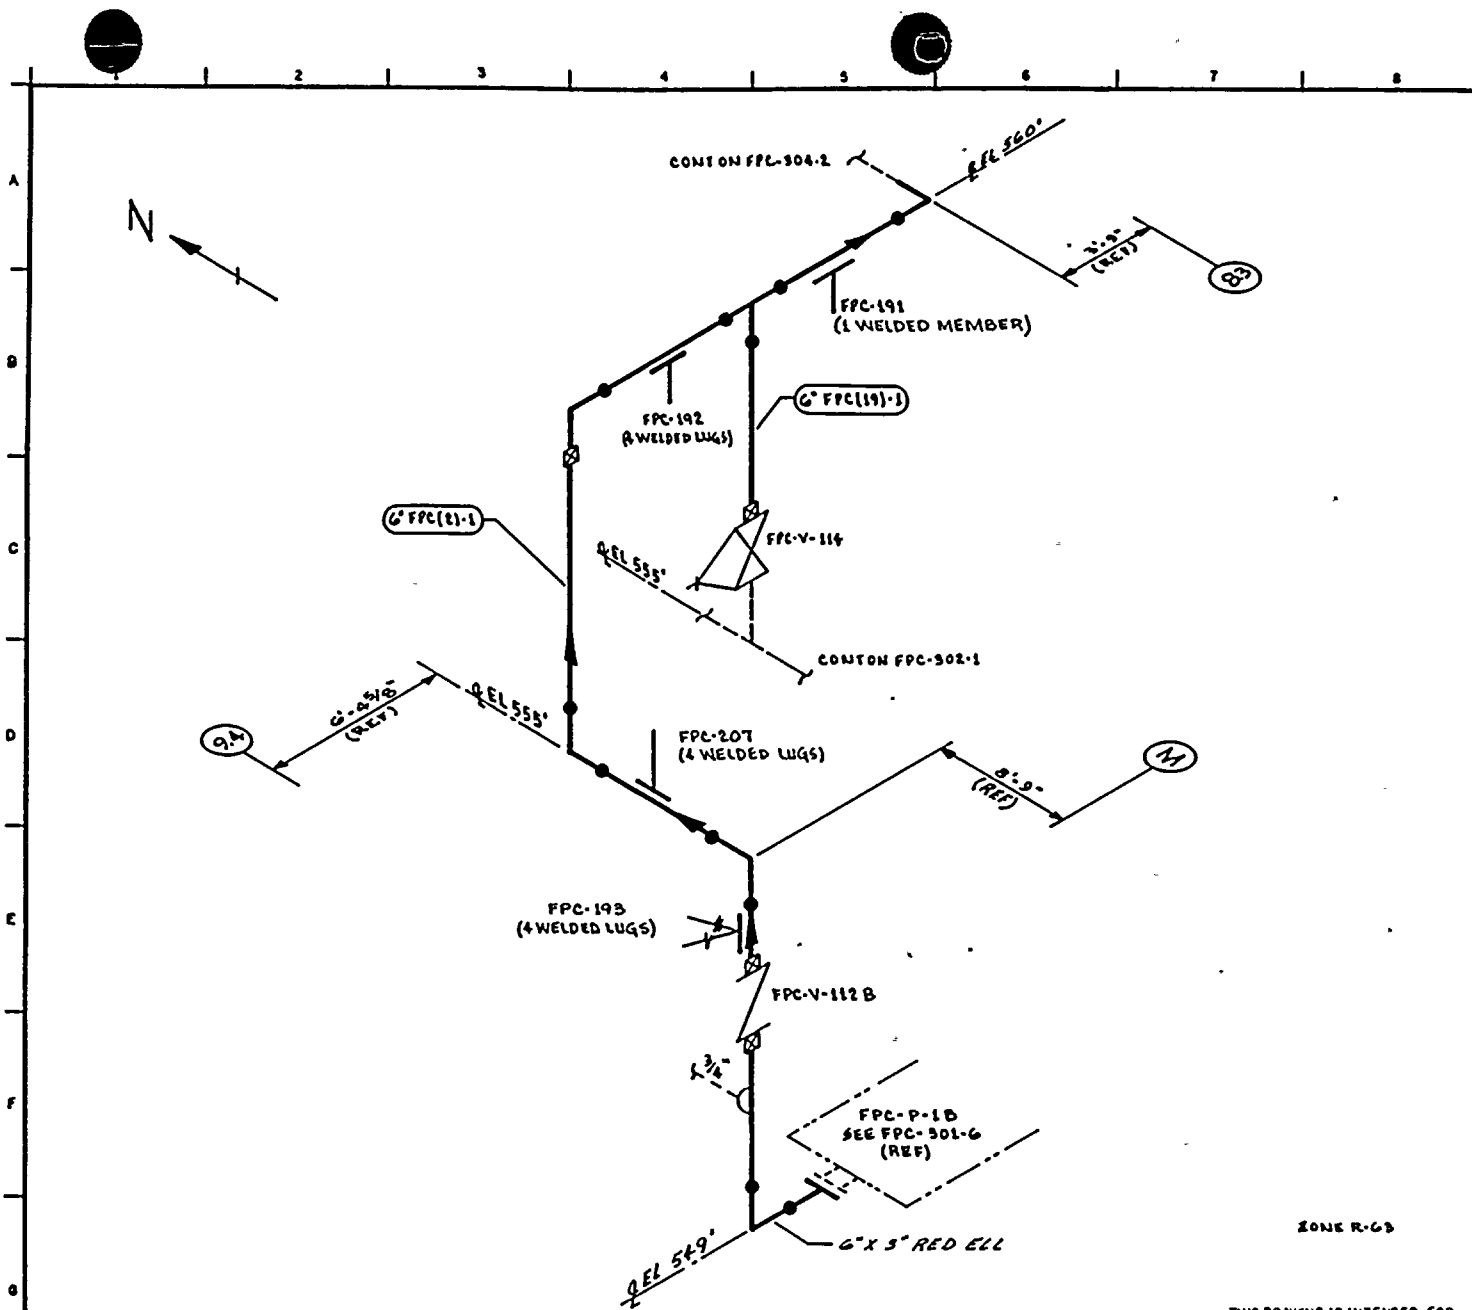

NOTES:
 1. THIS DRAWING IDENTIFIES PIPING & COMPONENTS SUBJECT ONLY TO A VISUAL EXAM FOR (1) EVIDENCE OF LEAKAGE DURING SYSTEM PRESSURE OR OPERABILITY TESTS; (2) PRESSURE DECAY TESTS OF BURIED PIPING; & (3) LOSS OF SUPPORT CAPABILITY OR INADEQUATE RESTRAINT FOR SUPPORTS & HANGERS ON PIPING EXCEEDING 4" NOM. TESTS SHALL BE CONDUCTED PER ASME SECTION XI, ARTICLES IWA-8000 & IWD-2000.
 2. FOR BRANCH PIPING 4" NOM OR LESS (CONN SHOWN IN DASHED LINES) EXTEND VISUAL LEAKAGE EXAM THROUGH THE OUTERMOST NORMALLY CLOSED NUCLEAR CLASS VALVE, OR UNTILL TRANSITION TO INSTRUMENT TUBING, UNLESS OTHERWISE NOTED.

REFERENCES:
 BOVEE & CRAIG ISOMETRICS
 FPC-637-1.4 REV 4

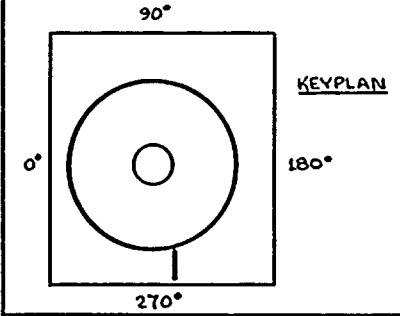

QUALITY CLASS: 2 | ASME CODE CLASS: 3
 ENGR: K.M. ANDREW | DRAWN: W.M.E.A. | DATE: 4-6-79



THIS DRAWING IS INTENDED FOR USE IN PRESERVICE AND INSERVICE INSPECTION PROGRAMS ONLY.


PIPING SYSTEM	NOM DIA (IN)	SCH	NOM WALL THK	MATERIAL SPECIFICATION	MATL TYPE	CAL BLOCK NO
6" FPC (2)-1	6	STD	0.280	SA 106 GR B	CS	NA
6" FPC (19)-1	6	STD	0.280	SA 106 GR B	CS	NA

WNP-2
 WELD & COMPONENT IDENTIFICATION DIAGRAM
 TITLE:
 FPC-P-1B TO FPC-DM-1A & 1B
 DWG NO: FPC-303-1 | REV 1

NO	DATE	REVISION	BY	CHKD	APPVD
1	1-27-79	CHGD FPC-191 & 207 TO WELDED ADDED KEYPLAN	W.M.E.A.	W.M.E.A.	W.M.E.A.
0	12-28-78	ISSUED FOR USE	W.M.E.A.	W.M.E.A.	W.M.E.A.

SEE PIPING REPROGRAMS TO 17




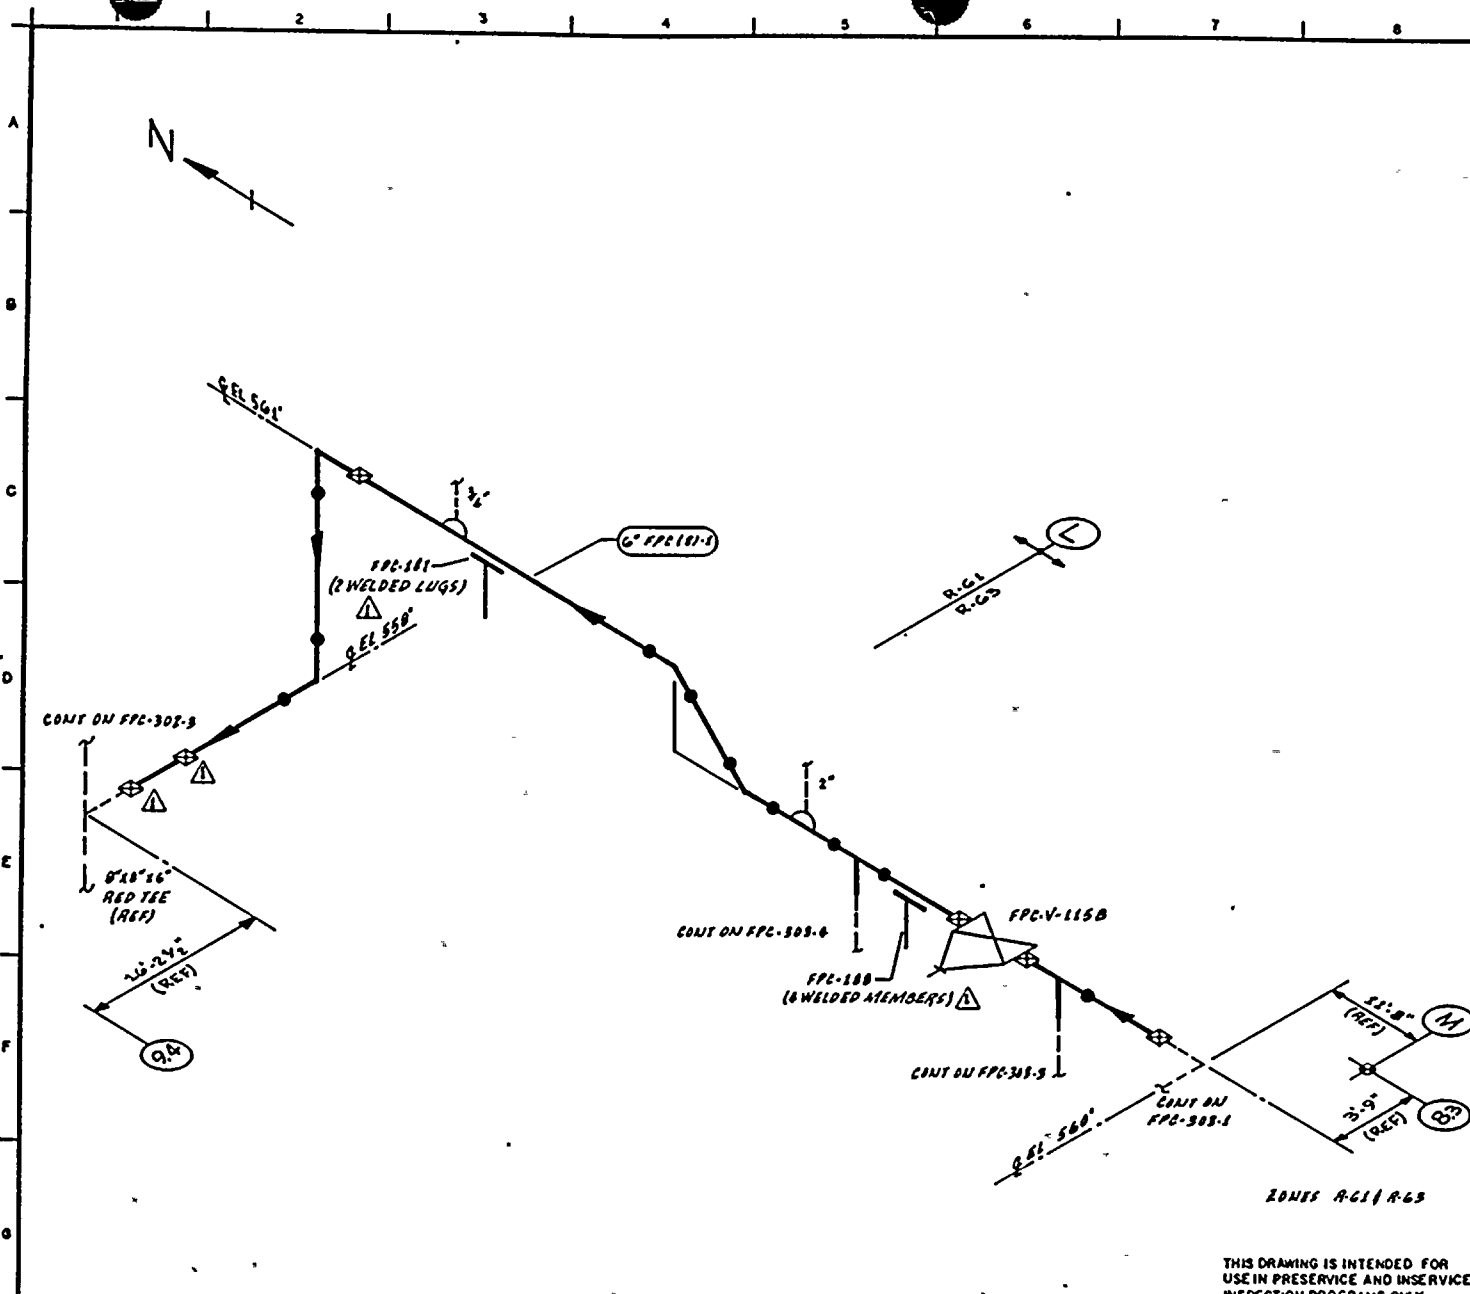

NOTES:

1. THIS DRAWING IDENTIFIES PIPING & COMPONENTS SUBJECT ONLY TO A VISUAL EXAM FOR (1) EVIDENCE OF LEAKAGE DURING SYSTEM PRESSURE OR OPERABILITY TESTS; (2) PRESSURE DECAY TESTS OF BURIED PIPING; & (3) LOSS OF SUPPORT CAPABILITY OR INADEQUATE RESTRAINT FOR SUPPORTS & HANGERS ON PIPING EXCEEDING 6" NOM. TESTS SHALL BE CONDUCTED PER ASME SECTION XI, ARTICLES XMA-5000 & XWD-2000.
2. FOR BRANCH PIPING 6" NOM OR LESS (CANAL SHOWN IN DASHED LINES) EXTEND VISUAL LEAKAGE CLAM THROUGH THE OUTERMOST NORMALLY CLOSED NUCLEAR CLASS VALVE, OR UNTIL TRANSITION TO INSTRUMENT TUBING, UNLESS OTHERWISE NOTED.

REFERENCES:
 BOVES & ORAL ISOMETRICS
 FPC-637-5.7 REV 5

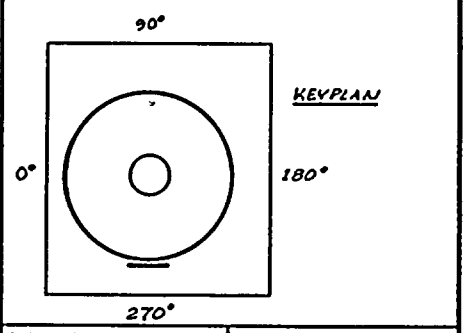

QUALITY CLASS: 2 ASME CODE CLASS: B
 ENGR: KMcANDREW DRAWN: KMcA DATE: 4-11-79

WASHINGTON PUBLIC POWER SUPPLY SYSTEM
 RICHLAND, WASHINGTON 99352

THIS DRAWING IS INTENDED FOR USE IN PRESERVE AND INSERVICE INSPECTION PROGRAMS ONLY.


PIPING SYSTEM	NOM DIA (IN)	SCH	NOM WALL THK	MATERIAL SPECIFICATION	MATL TYPE	CAL BLOCK NO
6" FPC 121-1	6	STD	0.280	SA 106 GR B		

NO	DATE	REVISION	BY	CHKD	APPVD
1	1/14/84	REVISED AS NOTED ADDED KEYPLAN	KMcA	DKR	JFA
0	12/2/81	ISSUED FOR USE	KMcA	DKR	JFA

WHP-2
 WELD & COMPONENT IDENTIFICATION DIAGRAM

TITLE:
 FPC-P-1B DISCHARGE TO FPC-DM-1A & 1B

DWG NO: FPC-303-2 REV 1

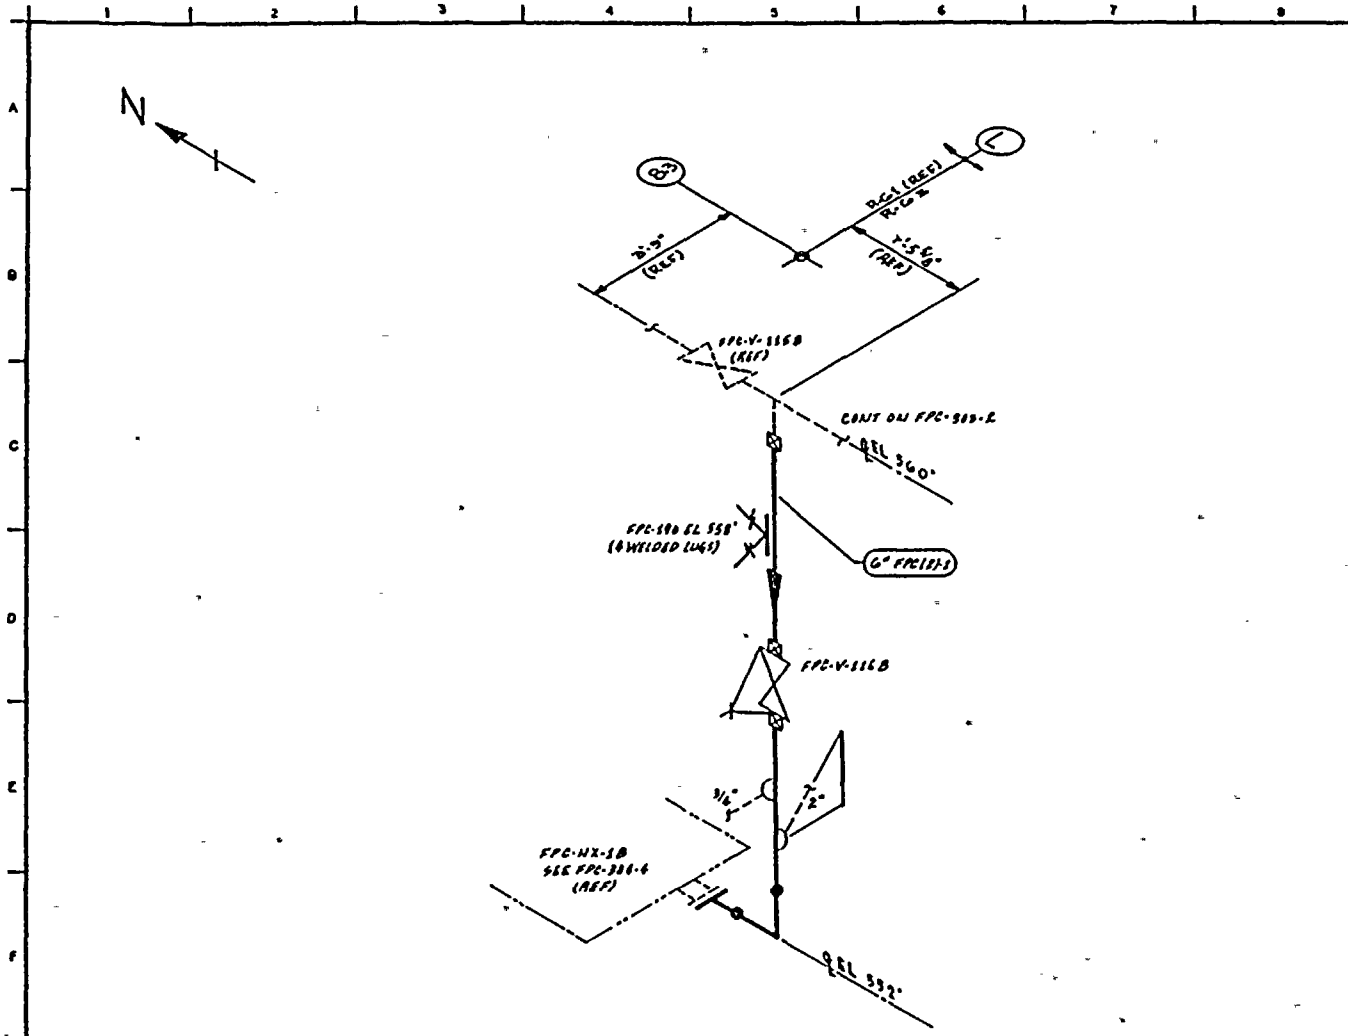

ZONE A-61

THIS DRAWING IS INTENDED FOR USE IN PRESERVICE AND INSERVICE INSPECTION PROGRAMS ONLY.

NOTES:

1. THIS DRAWING IDENTIFIES PIPING & COMPONENTS SUBJECT ONLY TO A VISUAL EXAM FOR (1) EVIDENCE OF LEAKAGE DURING SYSTEM PRESSURE OR OPERABILITY TESTS; (2) PRESSURE DECAY TESTS OF BURIED PIPING; & (3) LOSS OF SUPPORT CAPABILITY OR INADEQUATE RESTRAINT FOR SUPPORTS & HANGERS ON PIPING EXCEEDING 4" NOM. TESTS SHALL BE CONDUCTED FOR ASME SECTION XI, ARTICLES IWA-5000 & IWD-2000.
2. FOR BRANCH PIPING 6" NOM. OR LESS (MAIN SHOWN IN DASHED LINES) EXTEND VISUAL LEAKAGE EXAM THROUGH THE OUTERMOST NORMALLY CLOSED NUCLEAR CLASS VALVE, OR UNTIL TRANSITION TO INSTRUMENT TUBING, UNLESS OTHERWISE NOTED.

REFERENCES:

BOVES & ORAIL ISOMETRICS
 FPC-637-B.9 REV 2
 FPC-637-B.9H REV 0

QUALITY CLASS: 2 ASME CODE CLASS: 3
 ENGR: *John Auderby* DRAWN: *J. M. A.* DATE: 6-22-79



WASHINGTON PUBLIC POWER SUPPLY SYSTEM
 RICHLAND WASHINGTON 99352

PIPING SYSTEM	NOM DIA (IN)	SCH	NOM WALL THK	MATERIAL SPECIFICATION	MATL TYPE	CAL BLOCK NO
6" FPC (21)-1	6	STD	0.280	SA 106 GR B	CS	NA


WNP-2
 WELD & COMPONENT IDENTIFICATION DIAGRAM


TITLE:
 FPC-HX-1B TO FPC-DM-1A & 1B

DWG NO: FPC-303-3 REV 0

NO	DATE	REVISION	BY	CHKD	APPVD
0	1281	ISSUED FOR USE	<i>K. A.</i>	<i>J. M. A.</i>	<i>J. M. A.</i>

© COPYRIGHT BY THE ENGINEERING SOCIETY OF AMERICA

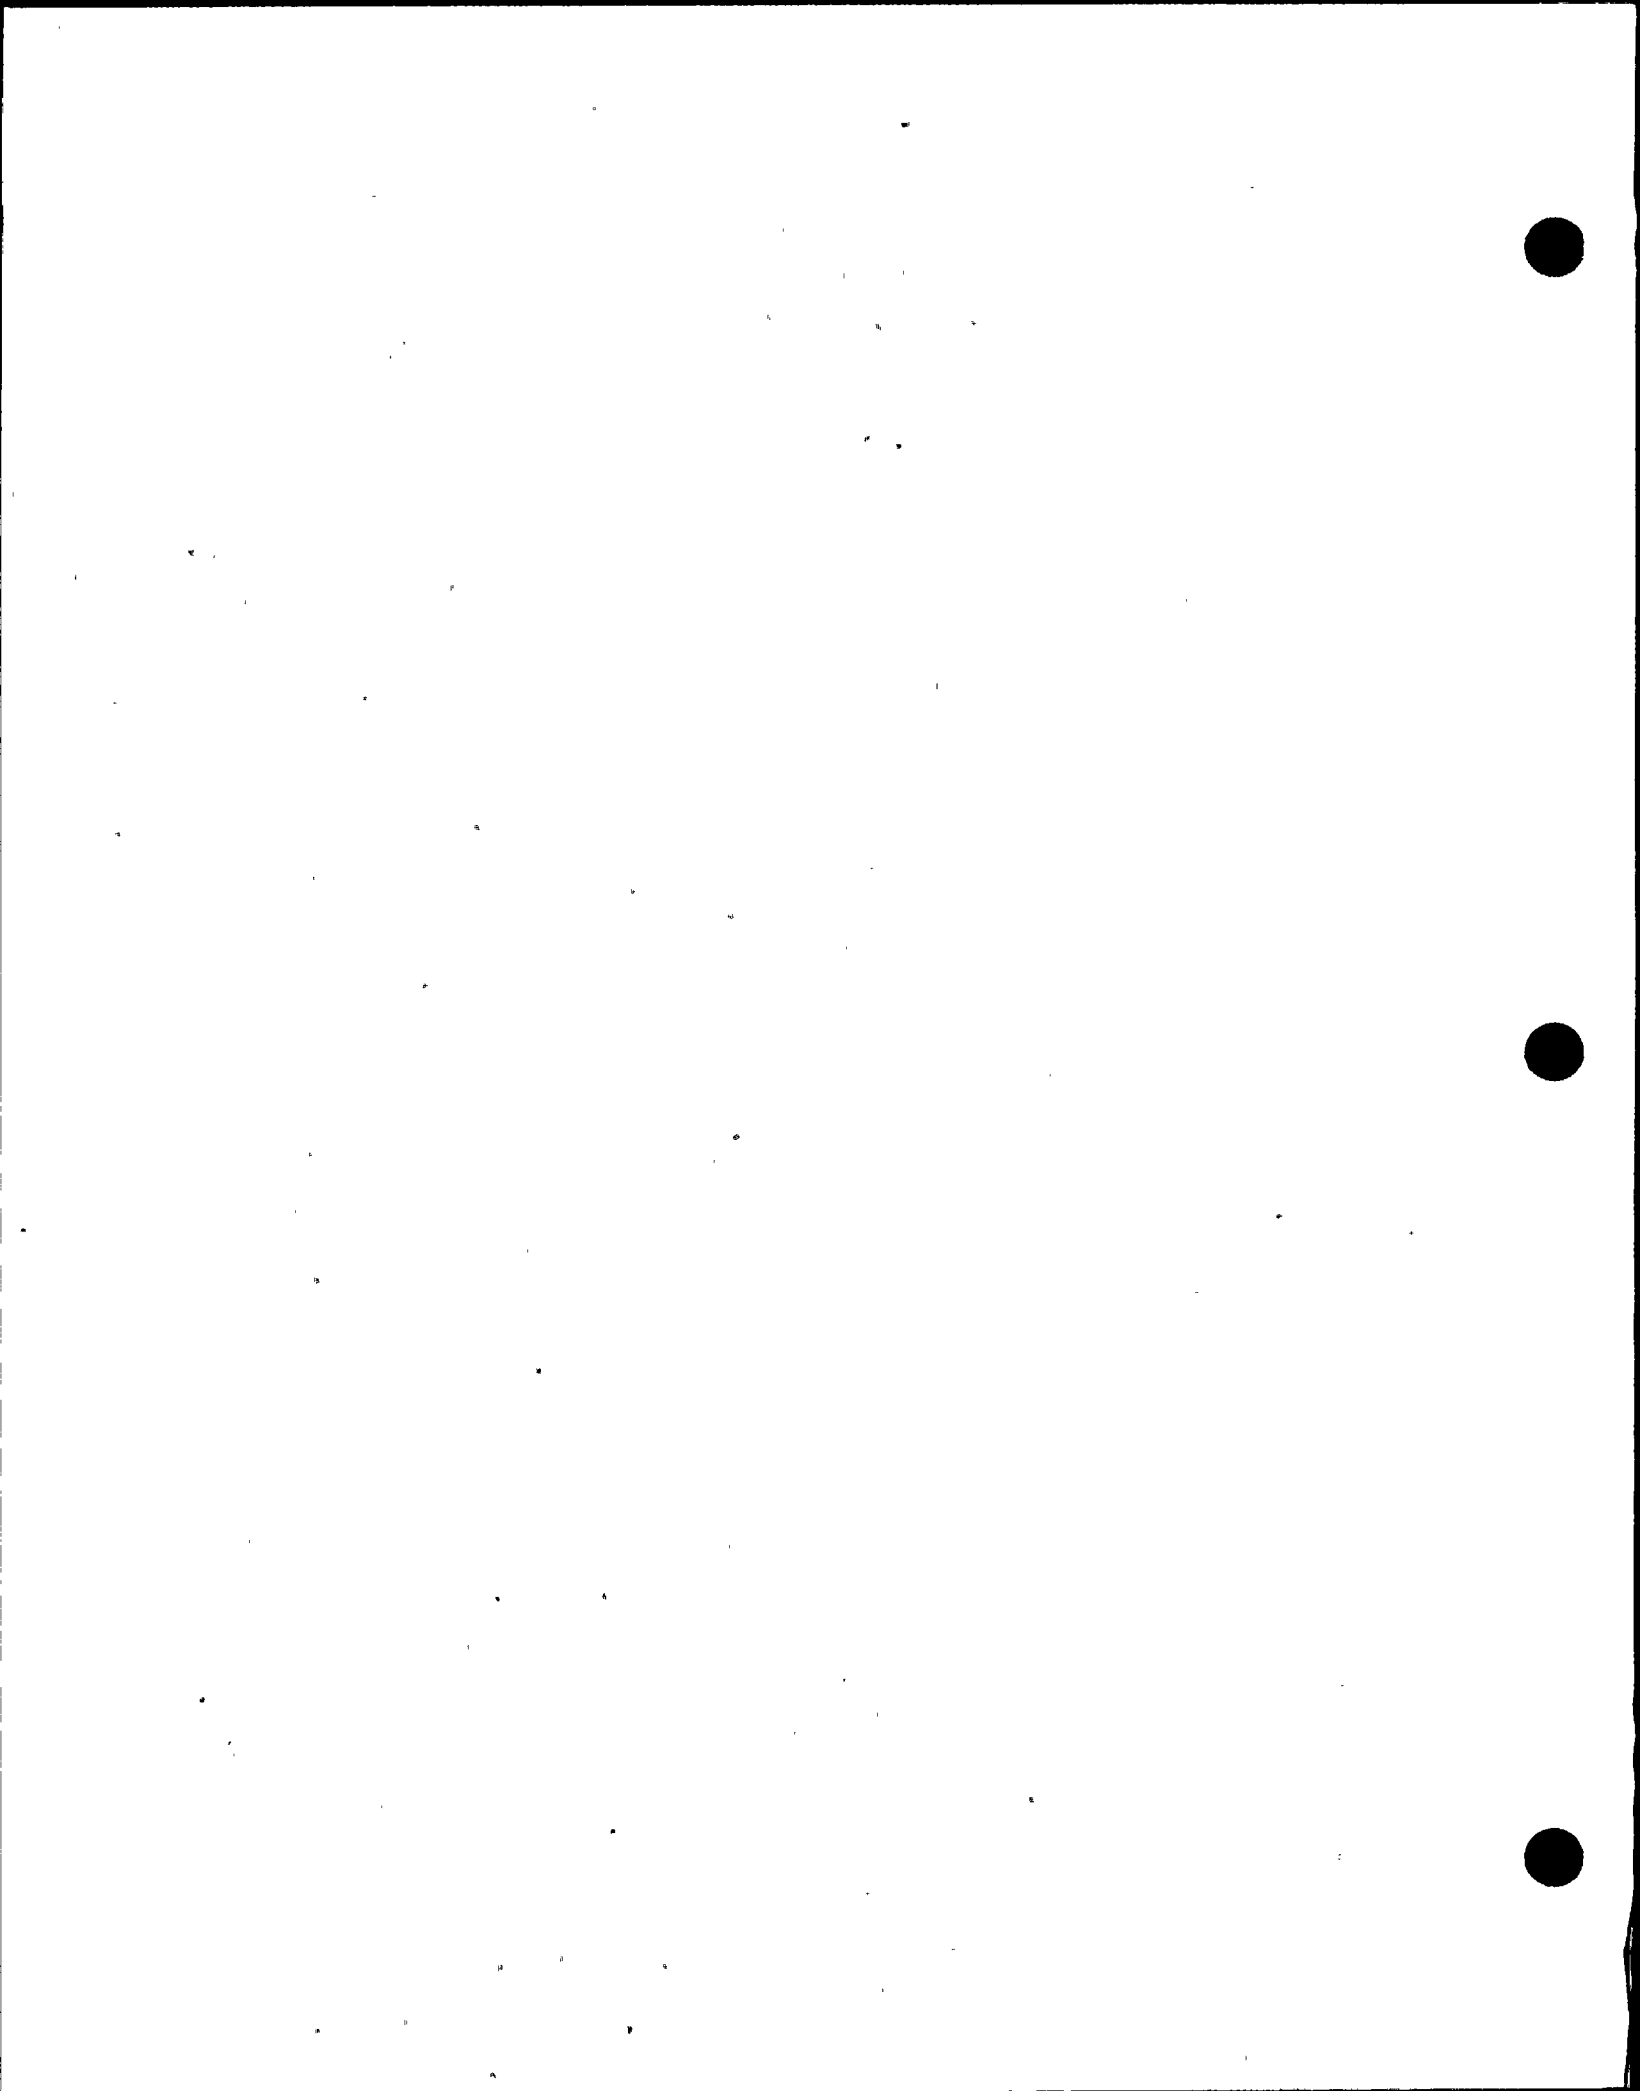


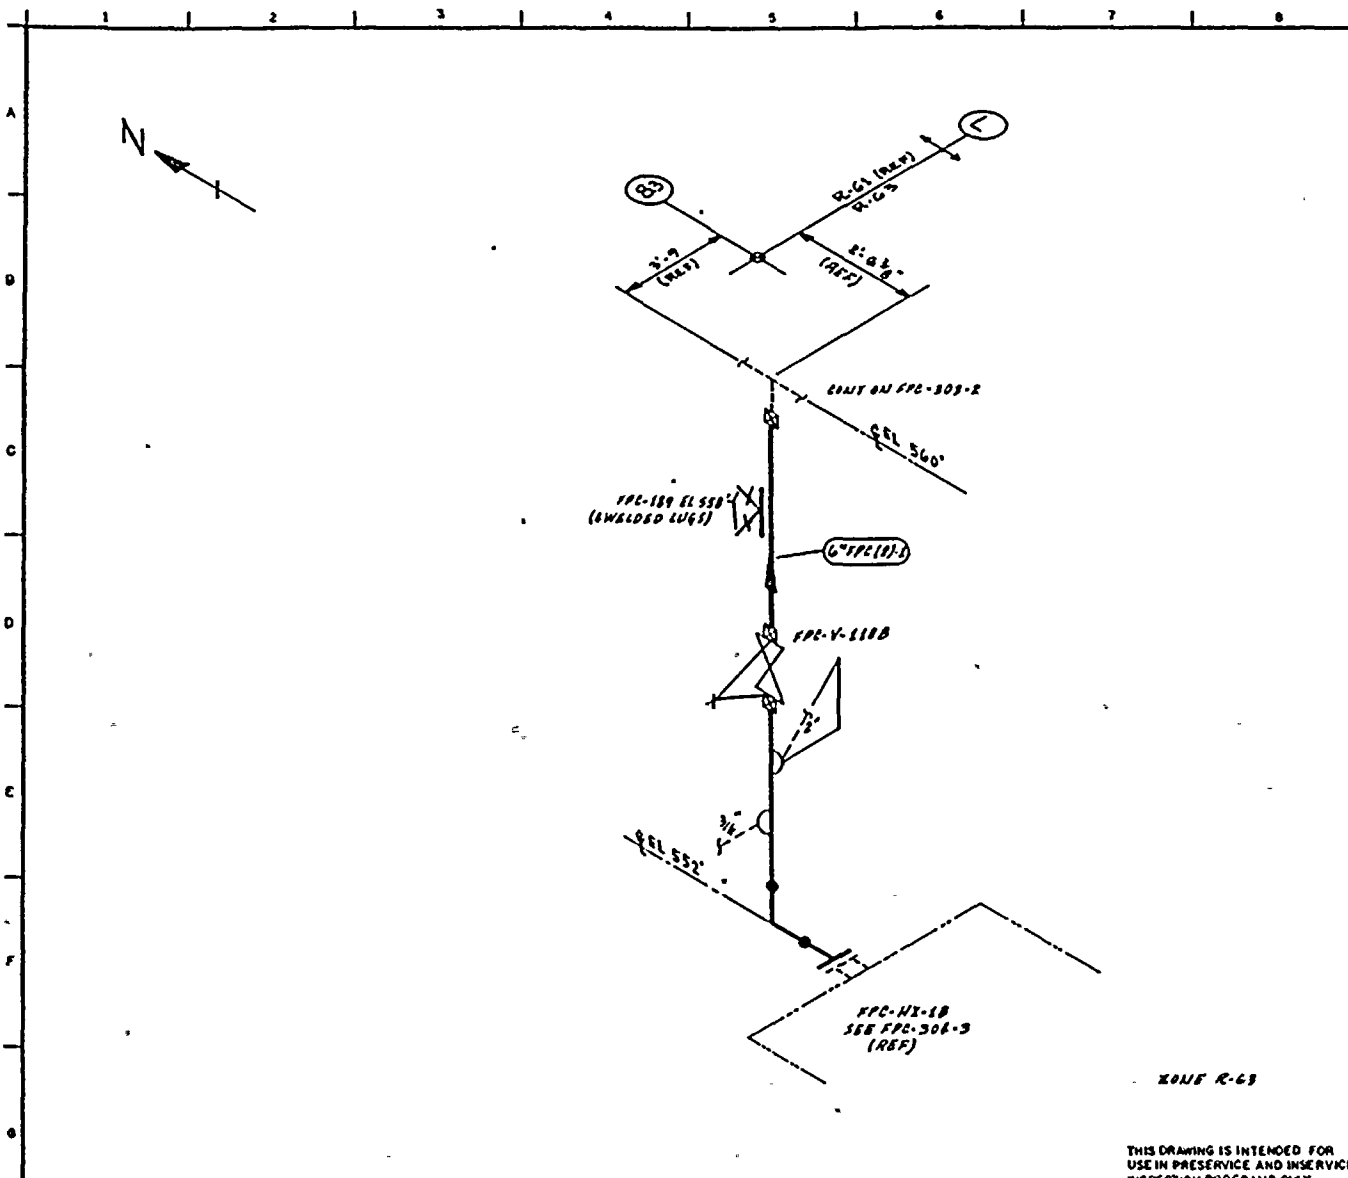

- NOTES:**
1. THIS DRAWING IDENTIFIES PIPING & COMPONENTS SUBJECT ONLY TO A VISUAL EXAM FOR (1) EVIDENCE OF LEAKAGE DURING SYSTEM PRESSURE OR OPERABILITY TESTS; (2) PRESSURE DECAY TESTS OF BURIED PIPING; & (3) LOSS OF SUPPORT CAPABILITY OR INADEQUATE RESTRAINT FOR SUPPORTS & HANGERS ON PIPING EXCEEDING 8" DIA. TESTS SHALL BE CONDUCTED PER ASME SECTION XI, ARTICLES IWA-5000 & IWD-2000.
 2. FOR BRANCH PIPING 4" DIA OR LESS (CONJ. SHOWN IN DASHED LINES) EXTEND VISUAL LEAKAGE EXAM THROUGH THE OUTERMOST NORMALLY CLOSED NUCLEAR CLASS VALVE, OR UNTIL TRANSITION TO INSTRUMENT TUBING, UNLESS OTHERWISE NOTED.

- REFERENCES:**
- DNV & CRAIL ISOMETRICS
 - FPC-637-10.11 REV 2
 - FPC-637-10.11H REV 0

QUALITY CLASS: **B** ASME CODE CLASS: **B**
 ENGR: *Matthew* DRAWN: *M.H.L.* DATE: **8-11-79**

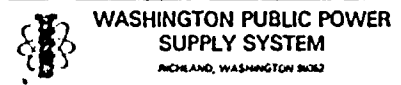

WNP-2
 WELD & COMPONENT
 IDENTIFICATION DIAGRAM

TITLE:
FPC-NX-18 TO FPC-DM-1A & 1B

DWG NO: **FPC-303-4** REV **0**

THIS DRAWING IS INTENDED FOR USE IN PRESERVICE AND INSERVICE INSPECTION PROGRAMS ONLY.

PIPING SYSTEM	NOM DIA (IN)	SCH	NOM WALL THK	MATERIAL SPECIFICATION	MATL TYPE	CAL BLOCK NO
6" FPC (21-E)	6	STD	0.280	SA 106 GR B	CS	NA

0	12-1-81	ISSUED FOR USE	<162	200	THH
NO.	DATE	REVISION	BY	CHKD	APPVD




WNP-02
 INTERVAL: PSI
 PERIOD: NA
 OUTAGE:
 DRAWING NO. FPC-303

WASHINGTON PUBLIC POWER SUPPLY SYSTEM
 PROGRAM PLAN AND SCHEDULE
 SYSTEM OR COMPONENT: FPC(2)-1
 DESCRIPTION: FPC-P-1B TO DM-1A&1B

PAGE 001
 DATE 12/14/84


<u>IDENT. NO.</u>	<u>DESCRIPTION</u>	SECT. <u>XI</u> <u>EXAM.</u>	<u>EXAM</u> <u>MTM.</u>	<u>PROCEDURE</u>	<u>CAL.</u> <u>BLOCK</u>	<u>INSERVICE</u>		<u>NOTES</u>
						<u>REQ.</u>	<u>SCHEDULED</u> <u>OUTAGE</u>	
FPC-193	SPRING	N/A	VT-3	303/8.2.17				
			VT-4	303/8.2.17				
FPC-207	BOX	N/A	VT-3	303/8.2.17				
FPC-192	BOX	N/A	VT-3	303/8.2.17				
FPC-191	BOX	N/A	VT-3	303/8.2.17				
FPC-188	BOX	N/A	VT-3	303/8.2.17				
FPC-187	BOX	N/A	VT-3	303/8.2.17				
FPC-190	SPRING	N/A	VT-3	303/8.2.17				
			VT-4	303/8.2.17				
FPC-189	SPRING	N/A	VT-3	303/8.2.17				
			VT-4	303/8.2.17				
FPC-PB-303	FPC PRESS BNDRY	N/A	VT-2	N/A				

SEE NOTES #6 & #7.

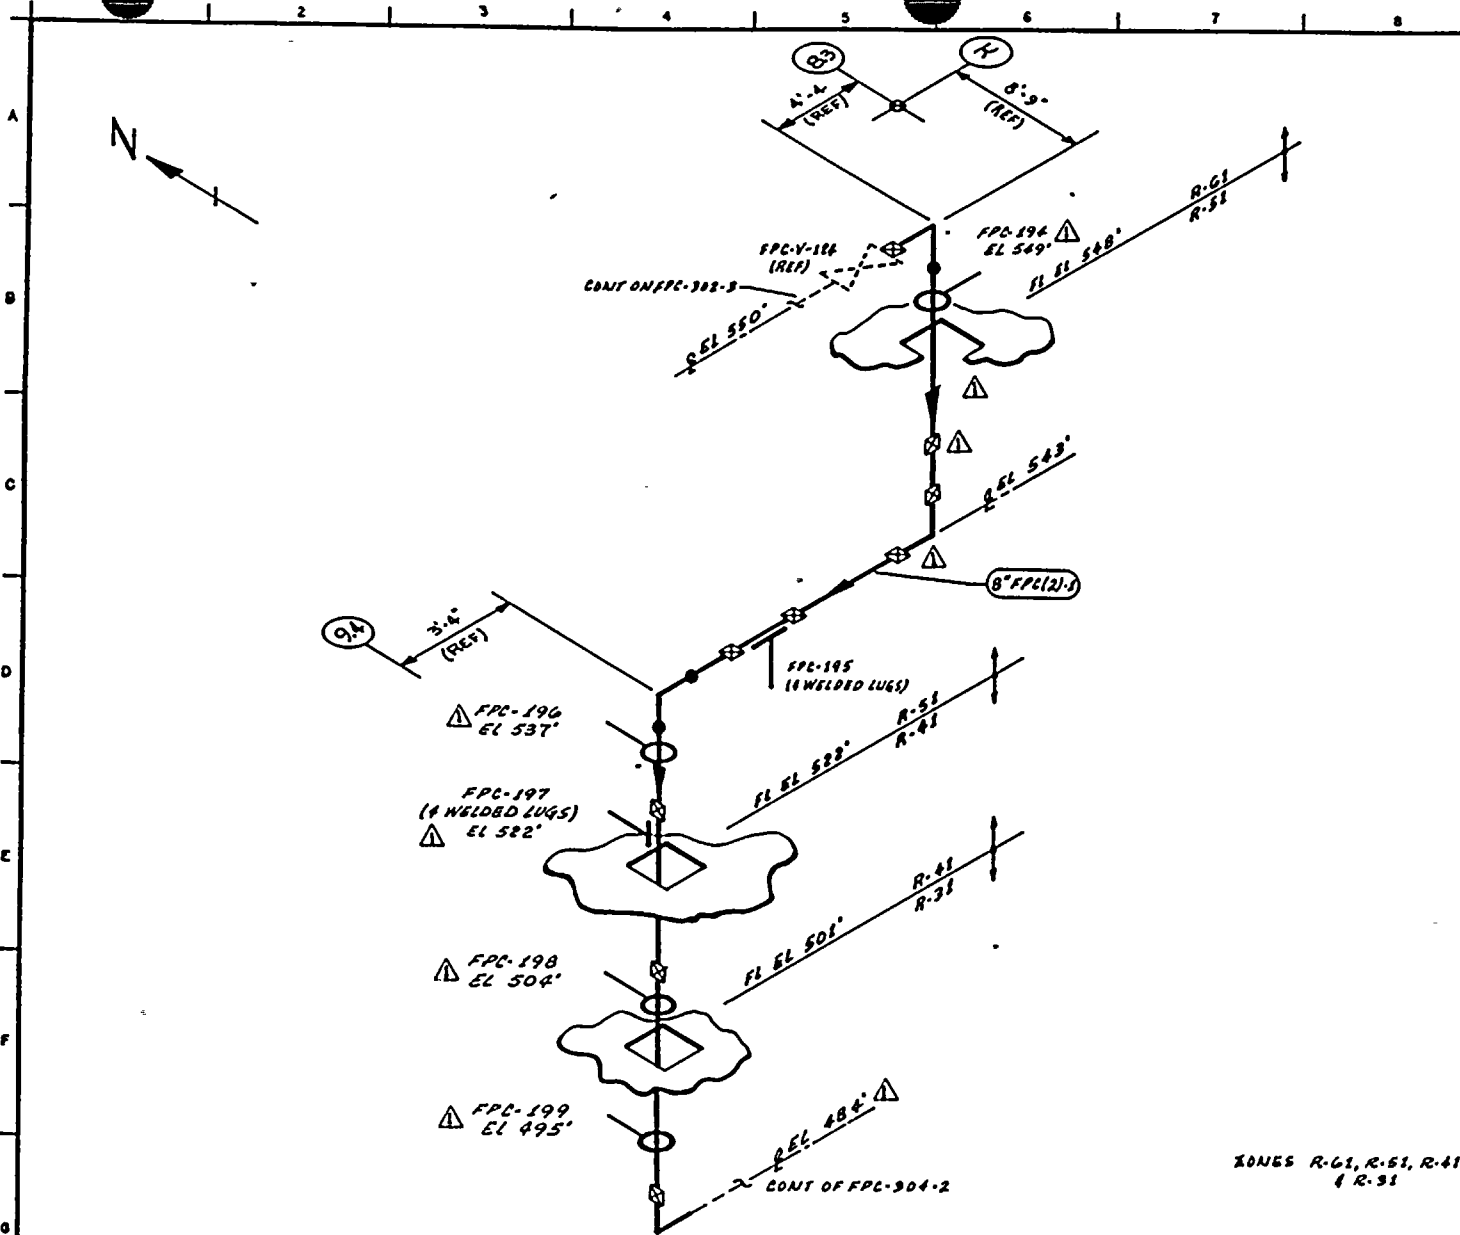

NOTES:
 1. THIS DRAWING IDENTIFIES PIPING & COMPONENTS SUBJECT ONLY TO A VISUAL EXAM FOR (1) EVIDENCE OF LEAKAGE DURING SYSTEM PRESSURE OR OPERABILITY TESTS; (2) PRESSURE DECAY TESTS OF BURIED PIPING; (3) LOSS OF SUPPORT CAPABILITY OR INADEQUATE RESIDUAL FOR SUPPORTS & HANGERS ON PIPING EXCEEDING 4" N.A.M. TESTS SHALL BE CONDUCTED PER ASME SECTION XI, ARTICLES IWA-5000 & IWD-2000.

REFERENCES:
 BOYER & CRAIG ISOMETRICS
 FPC-636-10.15 REV T

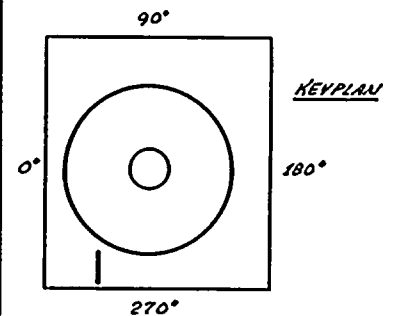

ZONES R-61, R-51, R-41 & R-31

THIS DRAWING IS INTENDED FOR USE IN PRESERVICE AND INSERVICE INSPECTION PROGRAMS ONLY.

QUALITY CLASS: 2	ASME CODE CLASS: 9
ENGR: <i>[Signature]</i>	DRAWN: <i>[Signature]</i> DATE: 8.12.79

WASHINGTON PUBLIC POWER SUPPLY SYSTEM
 RICHLAND, WASHINGTON 99352


PIPING SYSTEM	NOM DIA (IN)	SCH	NOM WALL THK	MATERIAL SPECIFICATION	MATL TYPE	CAL BLOCK NO
8" FPC (2)-1	8	STD	0.322	SA 106 GR B	CS	NA

WNP-2
 WELD B COMPONENT
 IDENTIFICATION DIAGRAM

TITLE:
 FPC-P-1A & 1B DISCHARGE TO FPC-DM-1A & 1B


DWG NO: FPC-304-1 REV 1

1	12/1/84	REVISED AS NOTED ADDED KEYPLAN	<i>[Signature]</i>	WHR	ITR
0	12-2-81	ISSUED FOR USE	<i>[Signature]</i>	DR	ITW
NO	DATE	REVISION	BY	CHKD	APPVD

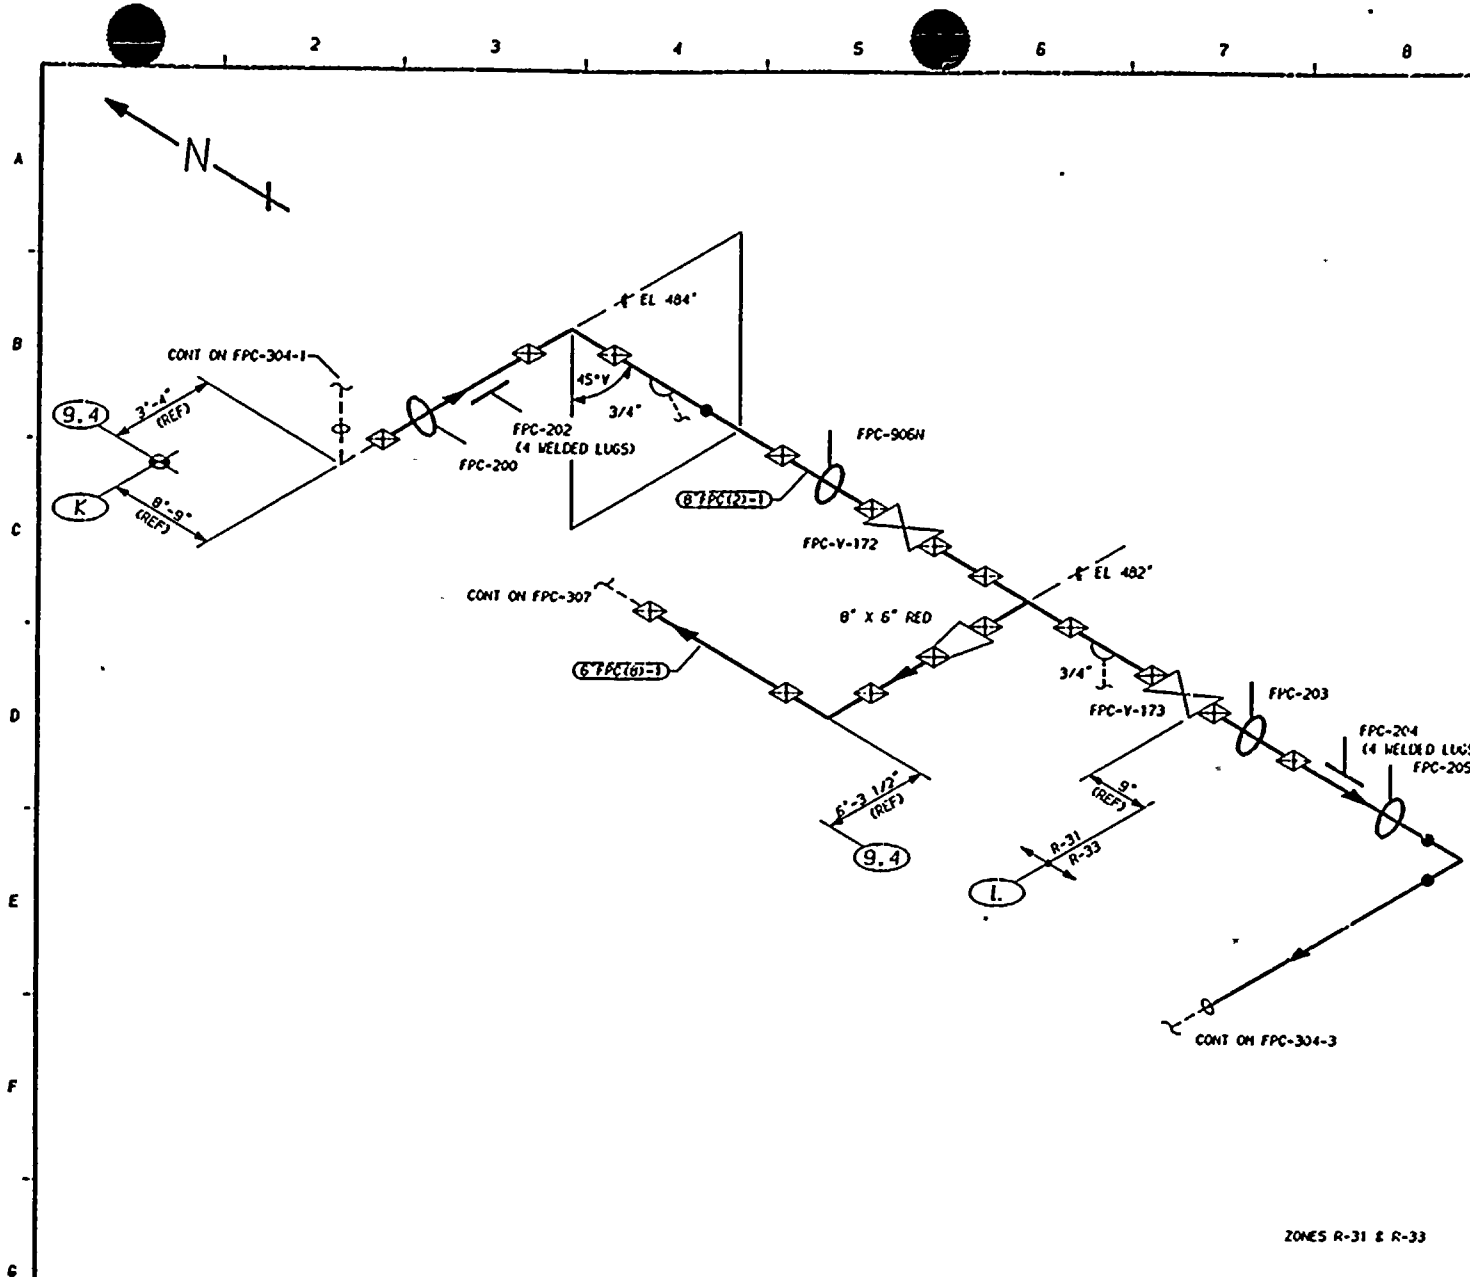

- NOTES:**
1. THIS DRAWING IDENTIFIES PIPING AND COMPONENTS SUBJECT ONLY TO A VISUAL EXAM FOR (1) EVIDENCE OF LEAKAGE DURING SYSTEM PRESSURE OR OPERABILITY TESTS, (2) PRESSURE DECAY TESTS OF BURIED PIPING, AND (3) LOSS OF SUPPORT CAPABILITY OR INADEQUATE RESTRAINT FOR SUPPORTS AND HANGERS ON PIPING EXCEEDING 4" NOM. TESTS SHALL BE CONDUCTED PER ASME SECTION XI, ARTICLES 19A-5000 AND 19J-2000.
 2. FOR BRANCH PIPING 4" NOM. OR LESS (CONNECTION SHOWN IN DASHED LINES) EXTEND VISUAL LEAKAGE EXAM THROUGH THE OUTER, ST NORMALLY CLOSED NUCLEAR CLASS VALVE, OR UNTIL TRANSITION TO INSTRUMENT TUBING, UNLESS OTHERWISE NOTED.

REFERENCES:
 ISI - 226
 DOYEE & CRAIG ISOMETRIC
 FPC-636-14.15 REV 11

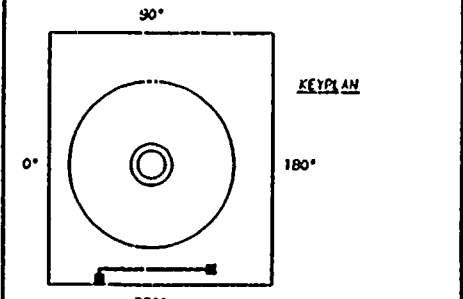

ZONES R-31 & R-33

THIS DRAWING IS INTENDED FOR USE IN PRESERVICE AND INSERVICE INSPECTIONS PROGRAMS ONLY.

PIPING SYSTEM	NOM DIA (IN)	SCH	NOM WALL THK	MATERIAL SPECIFICATION	MATL TYPE	CAL BLOCK NO
6" FPC(8)-1	6	STD	0.260	SA 106 GR B	CS	NA
8" FPC(2)-1	8	STD	0.322	SA 106 GR B	CS	NA

NO	DATE	REVISION	BY	CHKD	APVD
1	12-2-81	GENERAL UPDATE REDRAWN	K-McA	DPR	TFH
0	12-2-81	ISSUED FOR USE			


QUALITY CLASS, 2	ASME CODE CLASS, 3
ENGR, K-McANDREW	DRAWN, K-McA DATE, 4-12-79

WASHINGTON PUBLIC POWER
 SUPPLY SYSTEM
 RICHLAND, WASHINGTON 99352

WNP-2
 WELD & COMPONENT
 IDENTIFICATION DIAGRAM


TITLE:
 FPC-P-1A & 1B DISCHARGE
 TO FPC-DN-1A & 1B

DWG NO, FPC-304-2 REV 1

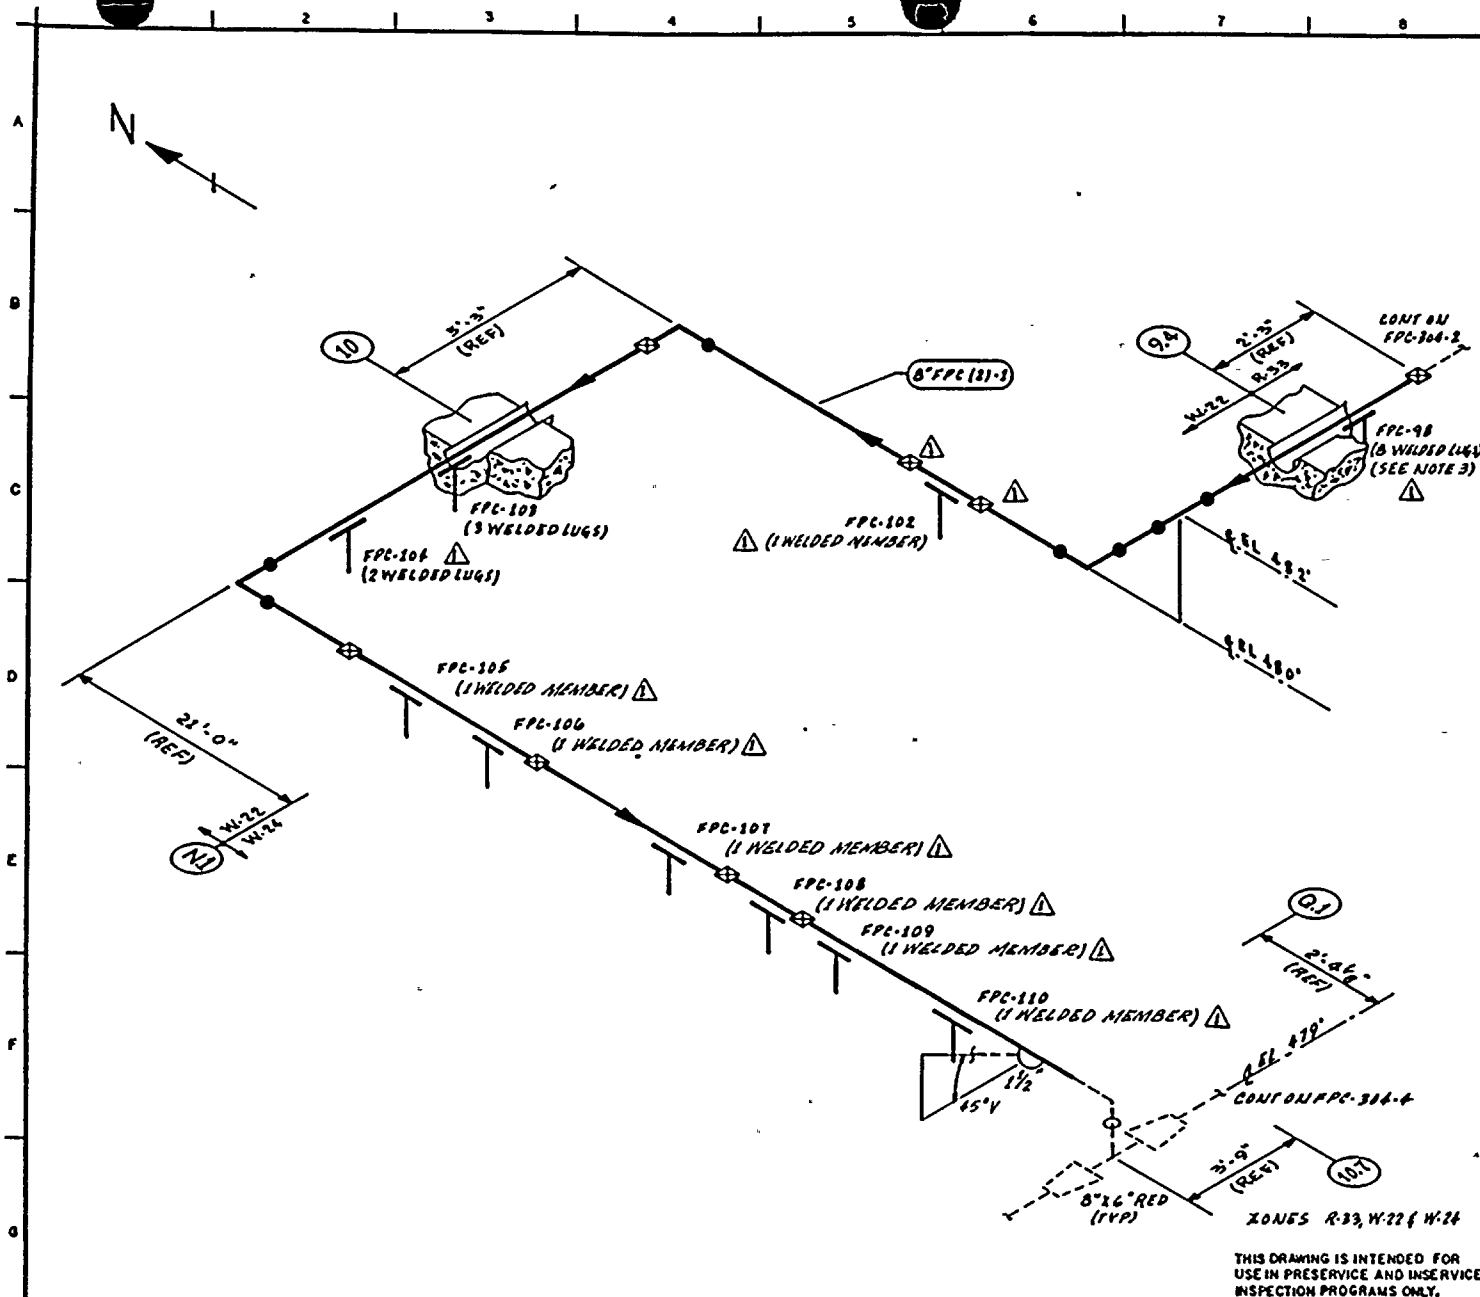

- NOTES:**
- THIS DRAWING IDENTIFIES PIPING & COMPONENTS SUBJECT ONLY TO A VISUAL EXAM FOR (1) EVIDENCE OF LEAKAGE DURING SYSTEM PRESSURE OR OPERABILITY TESTS; (2) PRESSURE DECAY TESTS OF BURIED PIPING; & (3) LOSS OF SUPPORT CAPABILITY OR INADEQUATE RESTRAINT FOR SUPPORTS & HANGERS ON PIPING EXCEEDING 4" NOM. TESTS SHALL BE CONDUCTED PER ASME SECTION XI, ARTICLES IWA-5000 & IWD-2000.
 - FOR BRANCH PIPING 4" NOM. OR LESS (DASH SHOWN IN DASHED LINES) EXTEND VISUAL LEAKAGE EXAM THROUGH THE OUTERMOST NORMALLY CLOSED NUCLEAR CLASS VALVE, OR UNTIL TRANSITION TO INSTRUMENT TUBING, UNLESS OTHERWISE NOTED.
 - COMPONENT SUPPORT IS INACCESSIBLE DUE TO FOAM FILLED WATER TIGHT BOOT.

REFERENCES:
BOVEE & CRAIL ISOMETRICS
FPC-636-16.21 REV 6

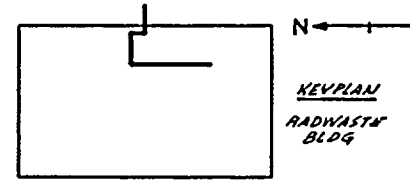

QUALITY CLASS: 2 ASME CODE CLASS: 3
ENGR: *[Signature]* DRAWN: *[Signature]* DATE: 6-12-79

WASHINGTON PUBLIC POWER SUPPLY SYSTEM
RICHLAND, WASHINGTON 99352

THIS DRAWING IS INTENDED FOR USE IN PRESERVICE AND INSERVICE INSPECTION PROGRAMS ONLY.

PIPING SYSTEM	NOM DIA (DN)	SCH	NOM WALL THK	MATERIAL SPECIFICATION	MATL TYPE	CAL BLOCK NO
8" FPC (21-1)	B	SCH	0.312	SA 106 GR B	CS	N/A


NO	DATE	REVISION	BY	CHKD	APPVD
1	12/81	REVISED AS NOTED ADDED KEYPLAN	SAK	SR	JFH
0	12/81	ISSUED FOR USE	SAK	SR	JFH

WNP-2
WELD 8 COMPONENT
IDENTIFICATION DIAGRAM

TITLE:
FPC-P-1A & 1B DISCHARGE TO FPC-DN-1A & 1B

DWG NO: FPC-304-3 REV 1



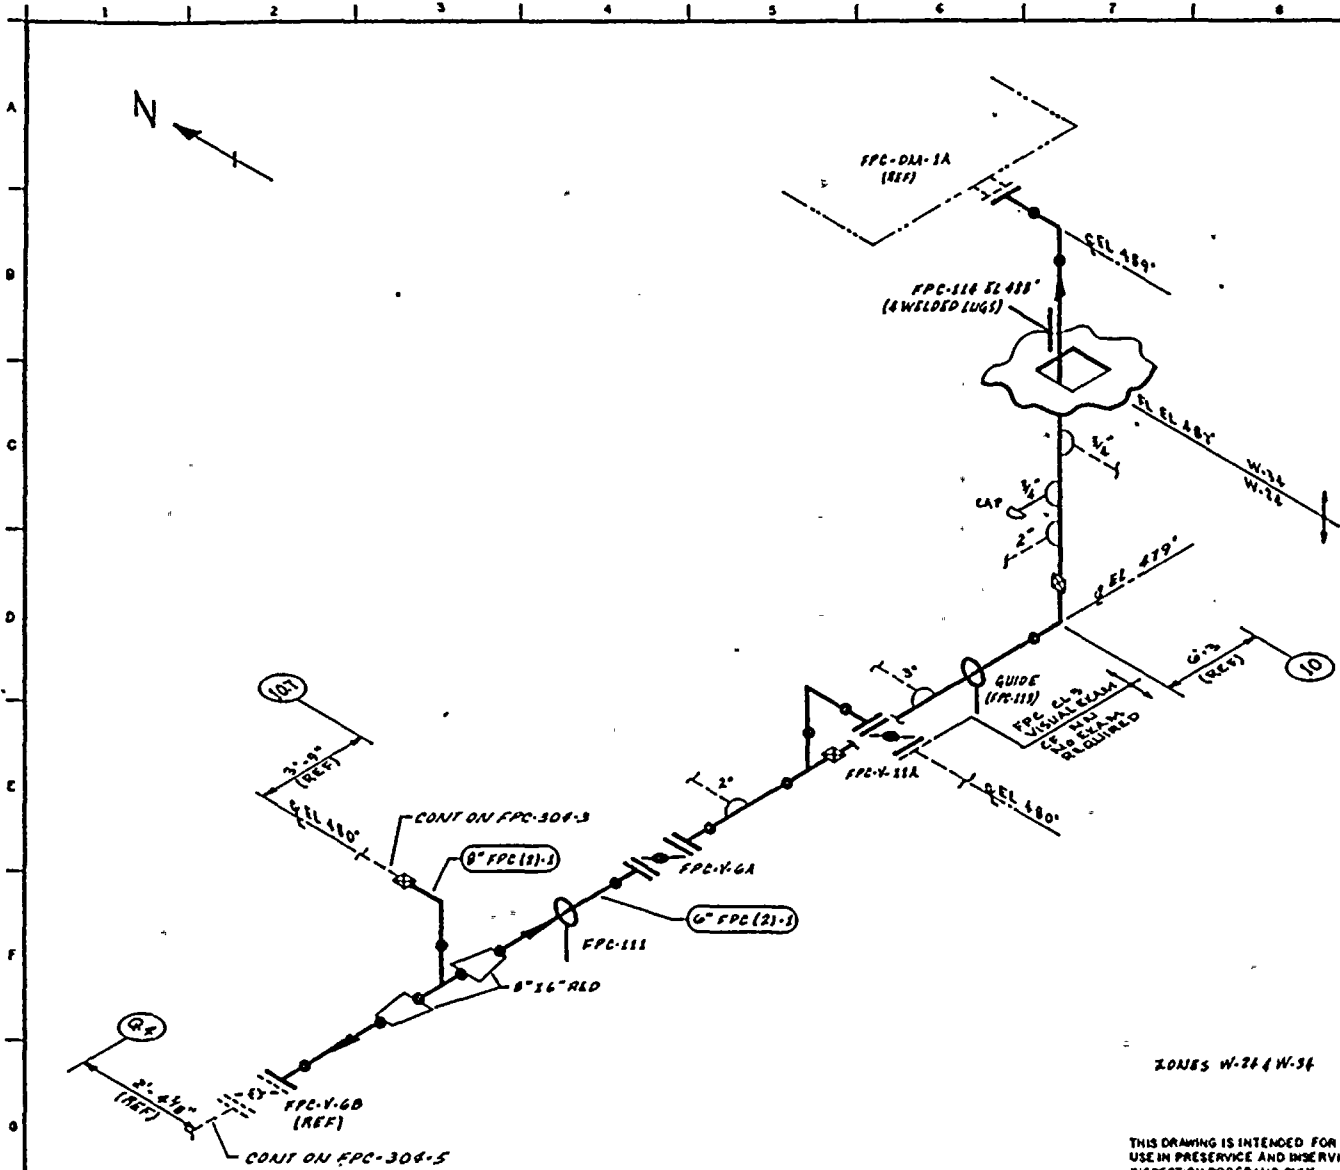

- NOTES:**
1. THIS DRAWING IDENTIFIES PIPING & COMPONENTS SUBJECT ONLY TO VISUAL EXAM FOR (1) EVIDENCE OF LEAKAGE DURING SYSTEM PRESSURE OR OPERABILITY TESTS; (2) PRESSURE DECAY TESTS OF BURIED PIPING; & (3) LOSS OF SUPPORT CAPABILITY OR INADEQUATE RESTRAINT FOR SUPPORTS & HANGERS ON PIPING EXCEEDING 6" NOM. TESTS SHALL BE CONDUCTED FOR ASME SECTION XI, ARTICLES IWA-5000 & IWD-2800.
 2. FOR BRANCH PIPING 4" NOM OR LESS (CAN SHOW IN DASHED LINES) EXTEND VISUAL LEAKAGE EXAM THROUGH THE OUTERMOST NORMALLY CLOSED NUCLEAR CLASS VALVE, OR UNTIL TRANSITION TO INSTRUMENT TUBING, UNLESS OTHERWISE NOTED.

- REFERENCES:**
- BOOKS & CRAL ISOMETRICS
 FPC-636-22.24 REV 0
 FPC-636-26.16 REV 0
 FPC-636-22.26H REV 1
 FPC-636-25.26H REV 0

QUALITY CLASS: 2 ASME CODE CLASS: B
 ENGR: J. Anderson DRAWN: J. McI. DATE: 8-18-79

WASHINGTON PUBLIC POWER SUPPLY SYSTEM
 RICHLAND, WASHINGTON 99352


WNP-2
 WELD & COMPONENT IDENTIFICATION DIAGRAM

TITLE:
 FPC-P-1A & 1B DISCHARGE TO FPC-DM-1A & 1B

DWG NO: FPC-306-4 REV 0

PIPING SYSTEM	NOM DIA (IN)	SCH	NOM WALL THK	MATERIAL SPECIFICATION	MATL TYPE	CAL BLOCK NO
8" FPC(2)-1	8"	STD	0.322	SA 116 GR B	CS	NA
6" FPC(2)-1	6"	STD	0.280	SA 106 GR B	CS	NA

0	12-1-81	ISSUED FOR USE			
NO	DATE	REVISION	BY	CHKD	APPVD

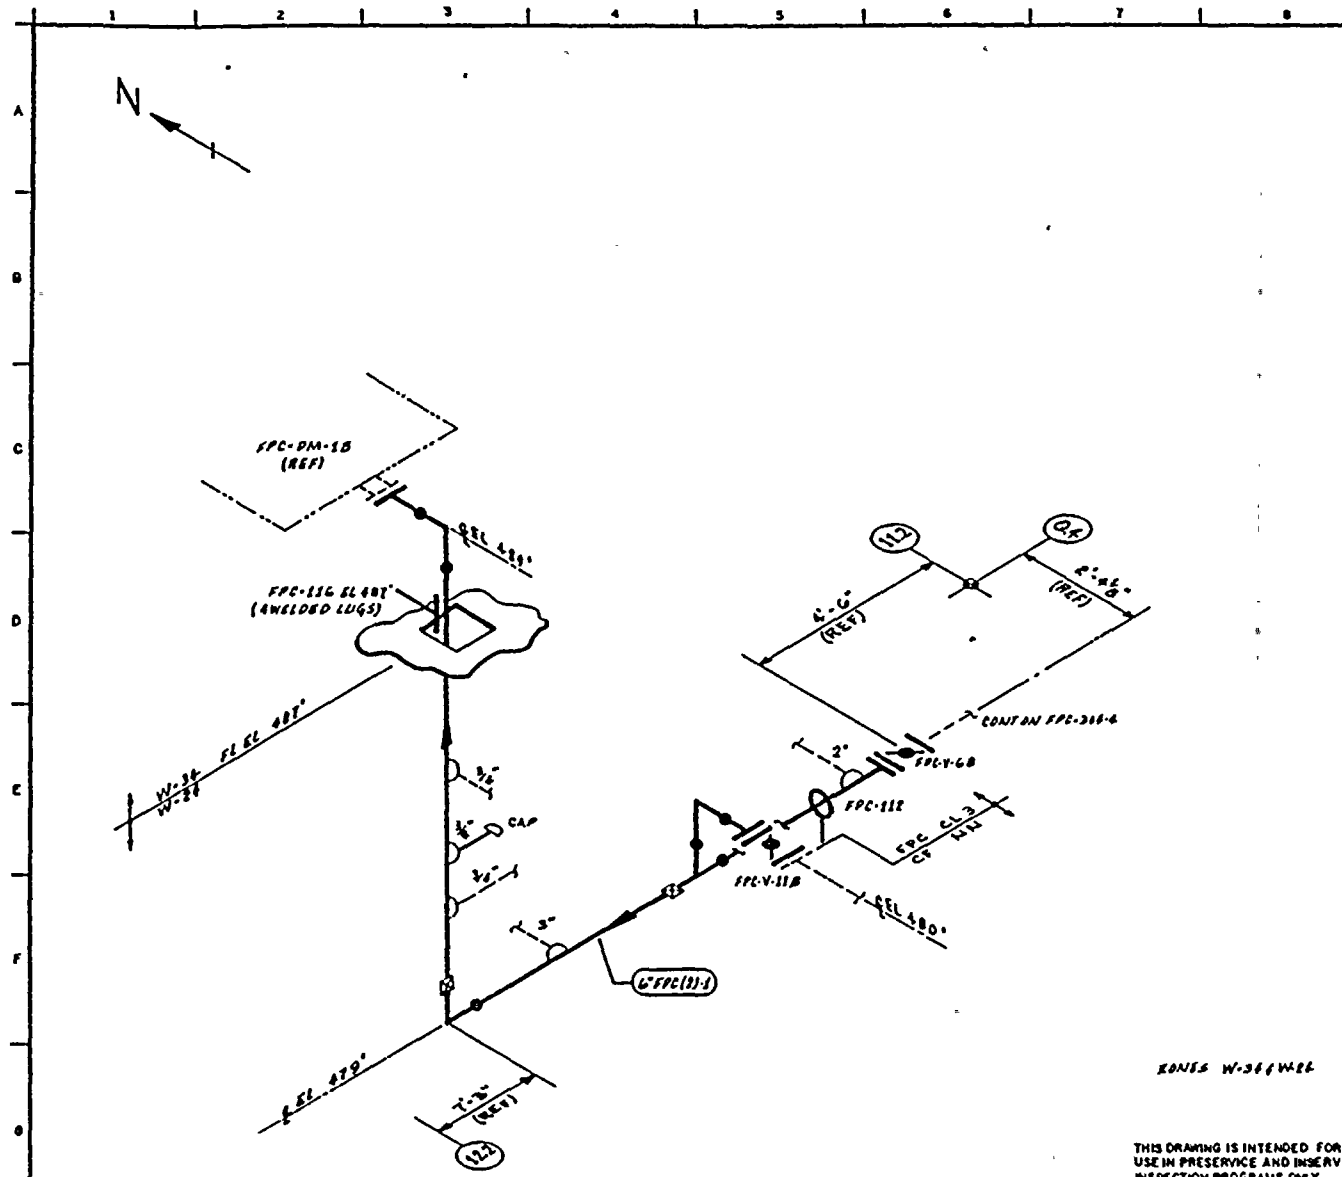

NOTES:

1. THIS DRAWING IDENTIFIES PIPING & COMPONENTS SUBJECT ONLY TO A VISUAL EXAM FOR (1) EVIDENCE OF LEAKAGE DURING SYSTEM PRESSURE OR OPERABILITY TESTS; (2) PRESSURE DECAY TESTS OF BURIED PIPING; & (3) LOSS OF SUPPORT CAPABILITY OR INADEQUATE RESTRAINT FOR SUPPORTS & HANGERS ON PIPING EXCEEDING 4" NOM. TESTS SHALL BE CONDUCTED PER ASME SECTION XI, ARTICLES IWA-5000 & IWD-2000.
2. FOR BRANCH PIPING 4" NOM. OR LESS (CONJ. SHOWN IN DASHED LINES) EXTEND VISUAL LEAKAGE EXAM THROUGH THE OUTERMOST NORMALLY CLOSED NUCLEAR CLASS VALVE OR UNTIL TRANSITION TO INSTRUMENT TUBING, UNLESS OTHERWISE NOTED.

REFERENCES:

- BOVES & ORAIL ISOMETRICS**
- FPC-696-22.24 REV 0
 - FPC-696-27.28 REV 0
 - FPC-696-28.24N REV 1
 - FPC-696-27.28N REV 0

KONES W-361422

THIS DRAWING IS INTENDED FOR USE IN PRESERVICE AND INSERVICE INSPECTION PROGRAMS ONLY.

QUALITY CLASS: 2	ASME CODE CLASS: 3
ENGR: <i>[Signature]</i>	DATE: 6-17-79



WASHINGTON PUBLIC POWER SUPPLY SYSTEM
 RICHLAND, WASHINGTON 98921

WNP-2
 WELD & COMPONENT IDENTIFICATION DIAGRAM


TITLE:
 FPC-P-1A & 1B TO FPC-DM-1B

OWG NO: FPC-304-5 REV 0

PIPING SYSTEM	NOM DIA (IN)	SCH	NOM WALL THK	MATERIAL SPECIFICATION	MATL TYPE	CAL BLOCK NO
6" FPC (2)-1	6	STD	0.280	SA 106 GR B	CS	AJA

0	1-1-81	ISSUED FOR USE	WAL	DK	TR
NO	DATE	REVISION	BY	CHKD	APPVD

SEE REFERENCE TO SHEET

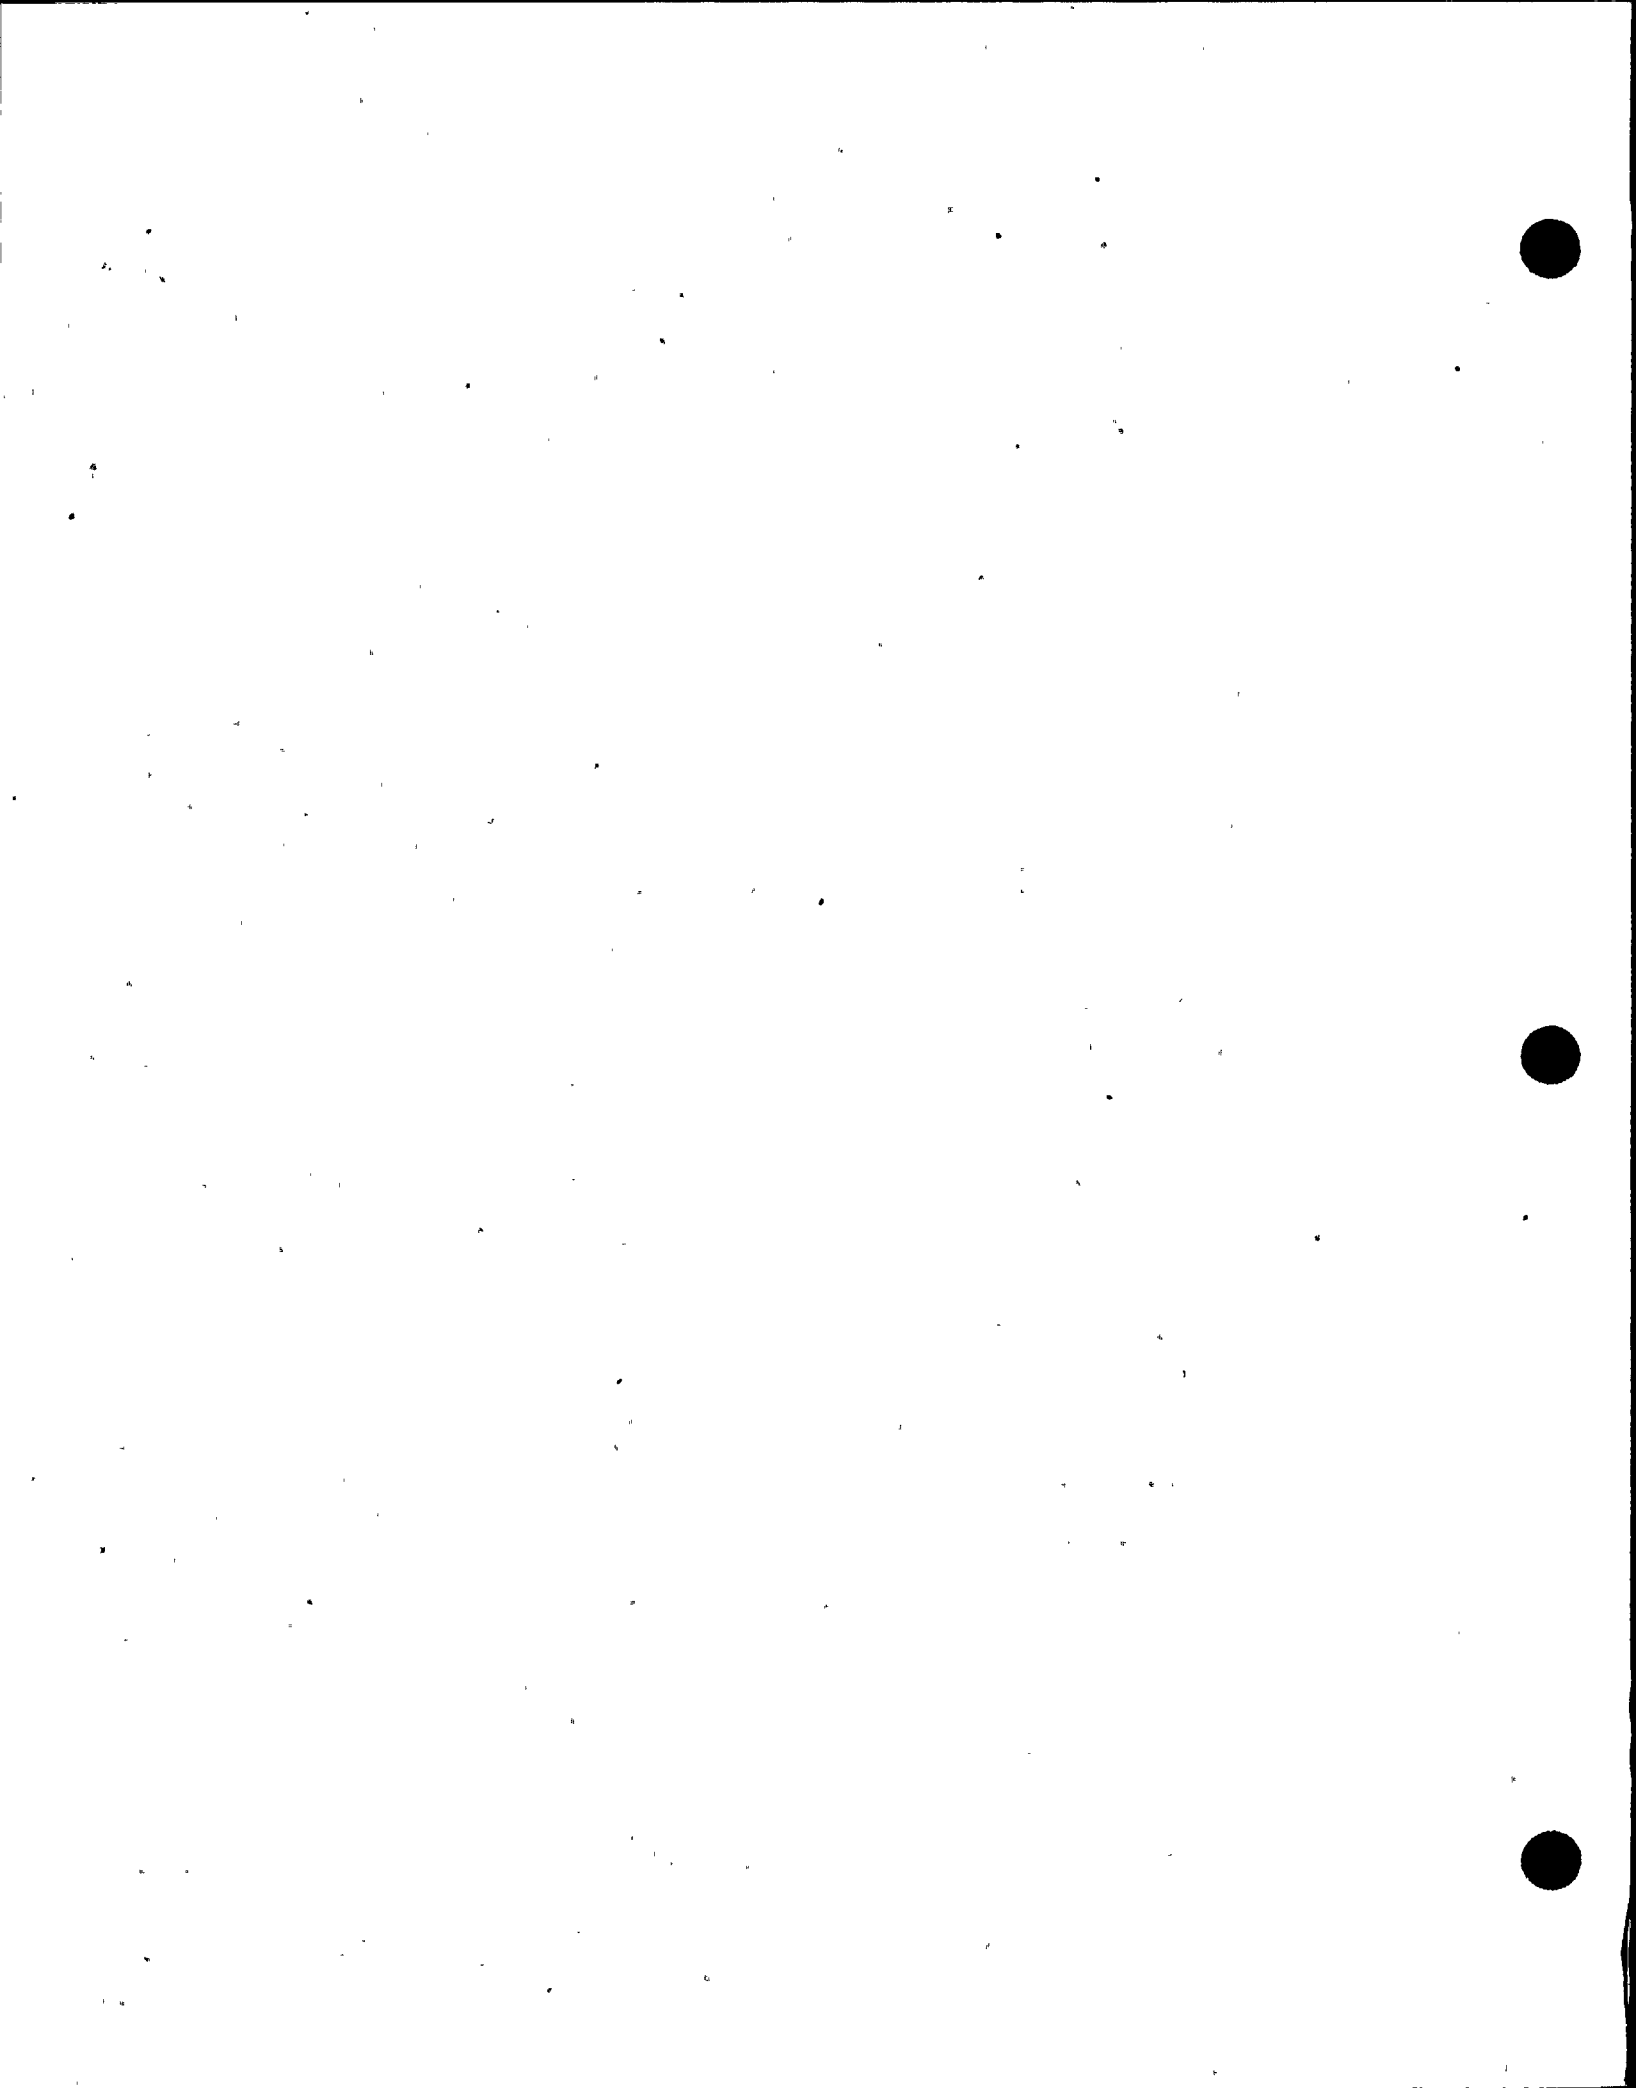

WNP-02
 INTERVAL: PSI
 PERIOD: NA
 OUTAGE:
 DRAWING NO. FPC-304

WASHINGTON PUBLIC POWER SUPPLY SYSTEM
 PROGRAM PLAN AND SCHEDULE
 SYSTEM OR COMPONENT: FPC(2)-1
 DESCRIPTION: FPC-1A&1B DISCHARGE

PAGE 001
 DATE 12/14/84


<u>IDENT. NO.</u>	<u>DESCRIPTION</u>	<u>SECT.</u> <u>XI</u> <u>EXAM.</u>	<u>EXAM</u> <u>MTM.</u>	<u>PROCEDURE</u>	<u>CAL.</u> <u>BLOCK</u>	<u>INSERVICE</u>		<u>NOTES</u>
						<u>REQ.</u>	<u>SCHEDULED</u> <u>OUTAGE</u>	
FPC-194	BOX	N/A	VT-3	303/8.2.17				
FPC-195	BOX	N/A	VT-3	303/8.2.17				
FPC-196	BOX	N/A	VT-3	303/8.2.17				
FPC-197	BOX	N/A	VT-3	303/8.2.17				
FPC-198	BOX	N/A	VT-3	303/8.2.17				
FPC-199	BOX	N/A	VT-3	303/8.2.17				
FPC-200	BOX	N/A	VT-3	303/8.2.17				
FPC-202	BOX	N/A	VT-3	303/8.2.17				
FPC-203	BOX	N/A	VT-3	303/8.2.17				
FPC-204	BOX	N/A	VT-3	303/8.2.17				
FPC-205	BOX	N/A	VT-3	303/8.2.17				
FPC-98	RIGID	N/A	VT-3	303/8.2.17				
FPC-102	RIGID	N/A	VT-3	303/8.2.17				
FPC-103	RIGID	N/A	VT-3	303/8.2.17				
FPC-104	RIGID	N/A	VT-3	303/8.2.17				
FPC-105	RIGID	N/A	VT-3	303/8.2.17				
FPC-106	RIGID	N/A	VT-3	303/8.2.17				

WNP-02
 INTERVAL: PSI
 PERIOD: NA
 OUTAGE:
 DRAWING NO. FPC-304

WASHINGTON PUBLIC POWER SUPPLY SYSTEM
 PROGRAM PLAN AND SCHEDULE
 SYSTEM OR COMPONENT: FPC(2)-1
 DESCRIPTION: FPC-1A&1B DISCHARGE


PAGE 002
 DATE 12/14/84

<u>IDENT. NO.</u>	<u>DESCRIPTION</u>	<u>SECT.</u>		<u>PROCEDURE</u>	<u>CAL. BLOCK</u>	<u>INSERVICE SCHEDULED</u>		<u>NOTES</u>
		<u>XI EXAM.</u>	<u>EXAM MTH.</u>			<u>REQ.</u>	<u>OUTAGE</u>	
FPC-107	RIGID	N/A	VT-3	303/8.2.17				
FPC-108	RIGID	N/A	VT-3	303/8.2.17				
FPC-109	RIGID	N/A	VT-3	303/8.2.17				
FPC-110	RIGID	N/A	VT-3	303/8.2.17				
FPC-111	BOX	N/A	VT-3	303/8.2.17				
FPC-113	BOX	N/A	VT-3	303/8.2.17				
FPC-114	RIGID	N/A	VT-3	303/8.2.17				
FPC-112	STRUT	N/A	VT-3	303/8.2.17				
FPC-116	RIGID	N/A	VT-3	303/8.2.17				
FPC-PB-304	FPC PRESS BNDRY	N/A	VT-2	N/A				

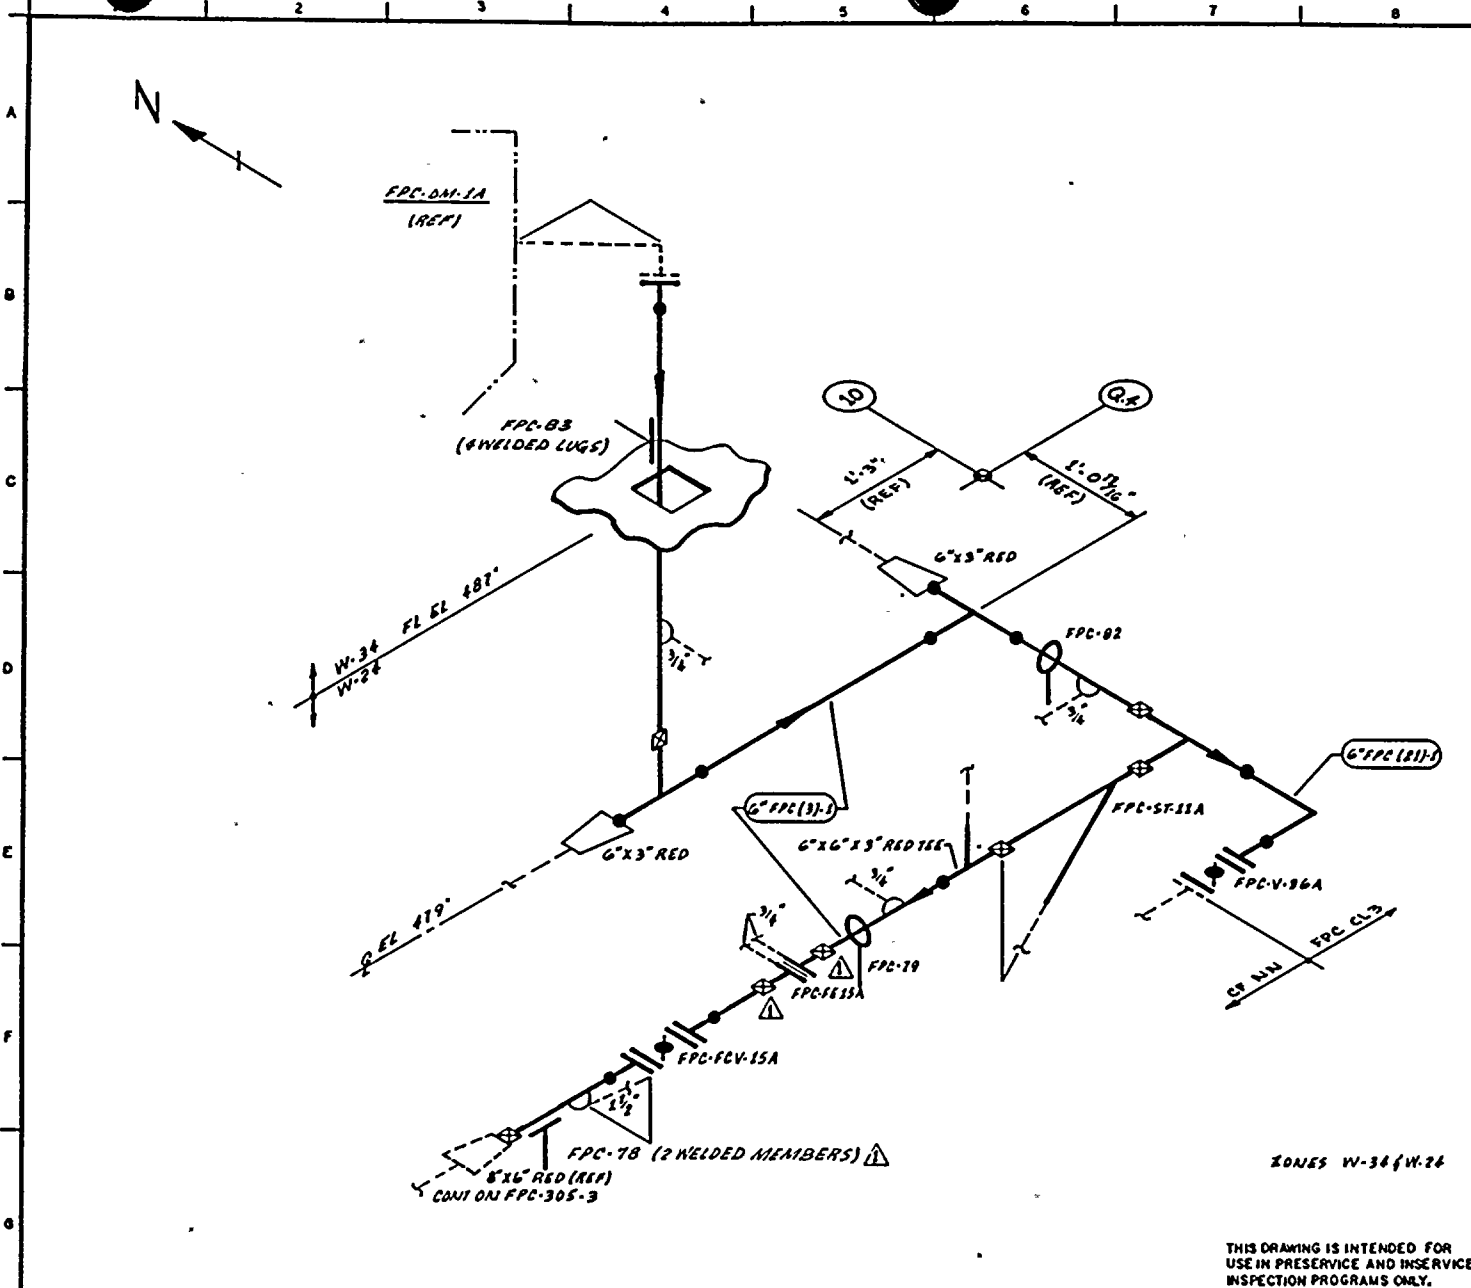

- NOTES:**
1. THIS DRAWING IDENTIFIES PIPING & COMPONENTS SUBJECT ONLY TO A VISUAL EXAM FOR (1) EVIDENCE OF LEAKAGE DURING SYSTEM PRESSURE OR OPERABILITY TESTS; (2) PRESSURE DECAY TESTS OF BURIED PIPING; & (3) LOSS OF SUPPORT CAPABILITY OR INADEQUATE RESTRAINT FOR SUPPORTS & HANGERS ON PIPING EXCEEDING 4" NOM. TESTS SHALL BE CONDUCTED PER ASME SECTION XI, ARTICLES IWA-5000 & IWD-2000.
 2. FOR BRANCH PIPING 4" NOM OR LESS (CAN BE SHOWN IN DASHED LINES) EXTEND VISUAL LEAKAGE EXAM THROUGH THE OUTERMOST NORMALLY CLOSED NUCLEAR CLASS VALVE, OR UNTIL TRANSITION TO INSTRUMENT TUBING, UNLESS OTHERWISE NOTED.

- REFERENCES:**
- DOVE & CRAL ISOMETRICS
 - FPC-640-26.25 REV 2
 - FPC-640-20.29 REV 5

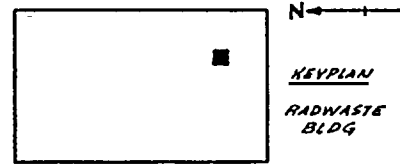

QUALITY CLASS: 2 ASME CODE CLASS: 3
 ENGR: *[Signature]* DRAWN: *[Signature]* DATE: 4-17-79

WASHINGTON PUBLIC POWER SUPPLY SYSTEM
 RICHLAND, WASHINGTON 99352

THIS DRAWING IS INTENDED FOR USE IN PRESERVICE AND INSERVICE INSPECTION PROGRAMS ONLY.


PIPING SYSTEM	NOM DIA (IN)	SCH	NOM WALL THK	MATERIAL SPECIFICATION	MATL TYPE	CAL BLOCK NO
6" FPC (79)-1	6	STD	0.280	SA 106 GR B	CS	N/A
6" FPC (21)-1	6	STD	0.280	SA 106 GR B	CS	N/A

NO	DATE	REVISION	BY	CHKD	APPVD
1	1/22/85	REVISED AS NOTED ADDED KEYPLAN	<i>[Signature]</i>	UPR	TEW
0	12/2/81	ISSUED FOR USE	<i>[Signature]</i>	UPR	TEW

WNP-2
 WELD & COMPONENT IDENTIFICATION DIAGRAM

TITLE:
FPC-DM-1A RETURN

OWG NO: FPC-305-1 REV 1

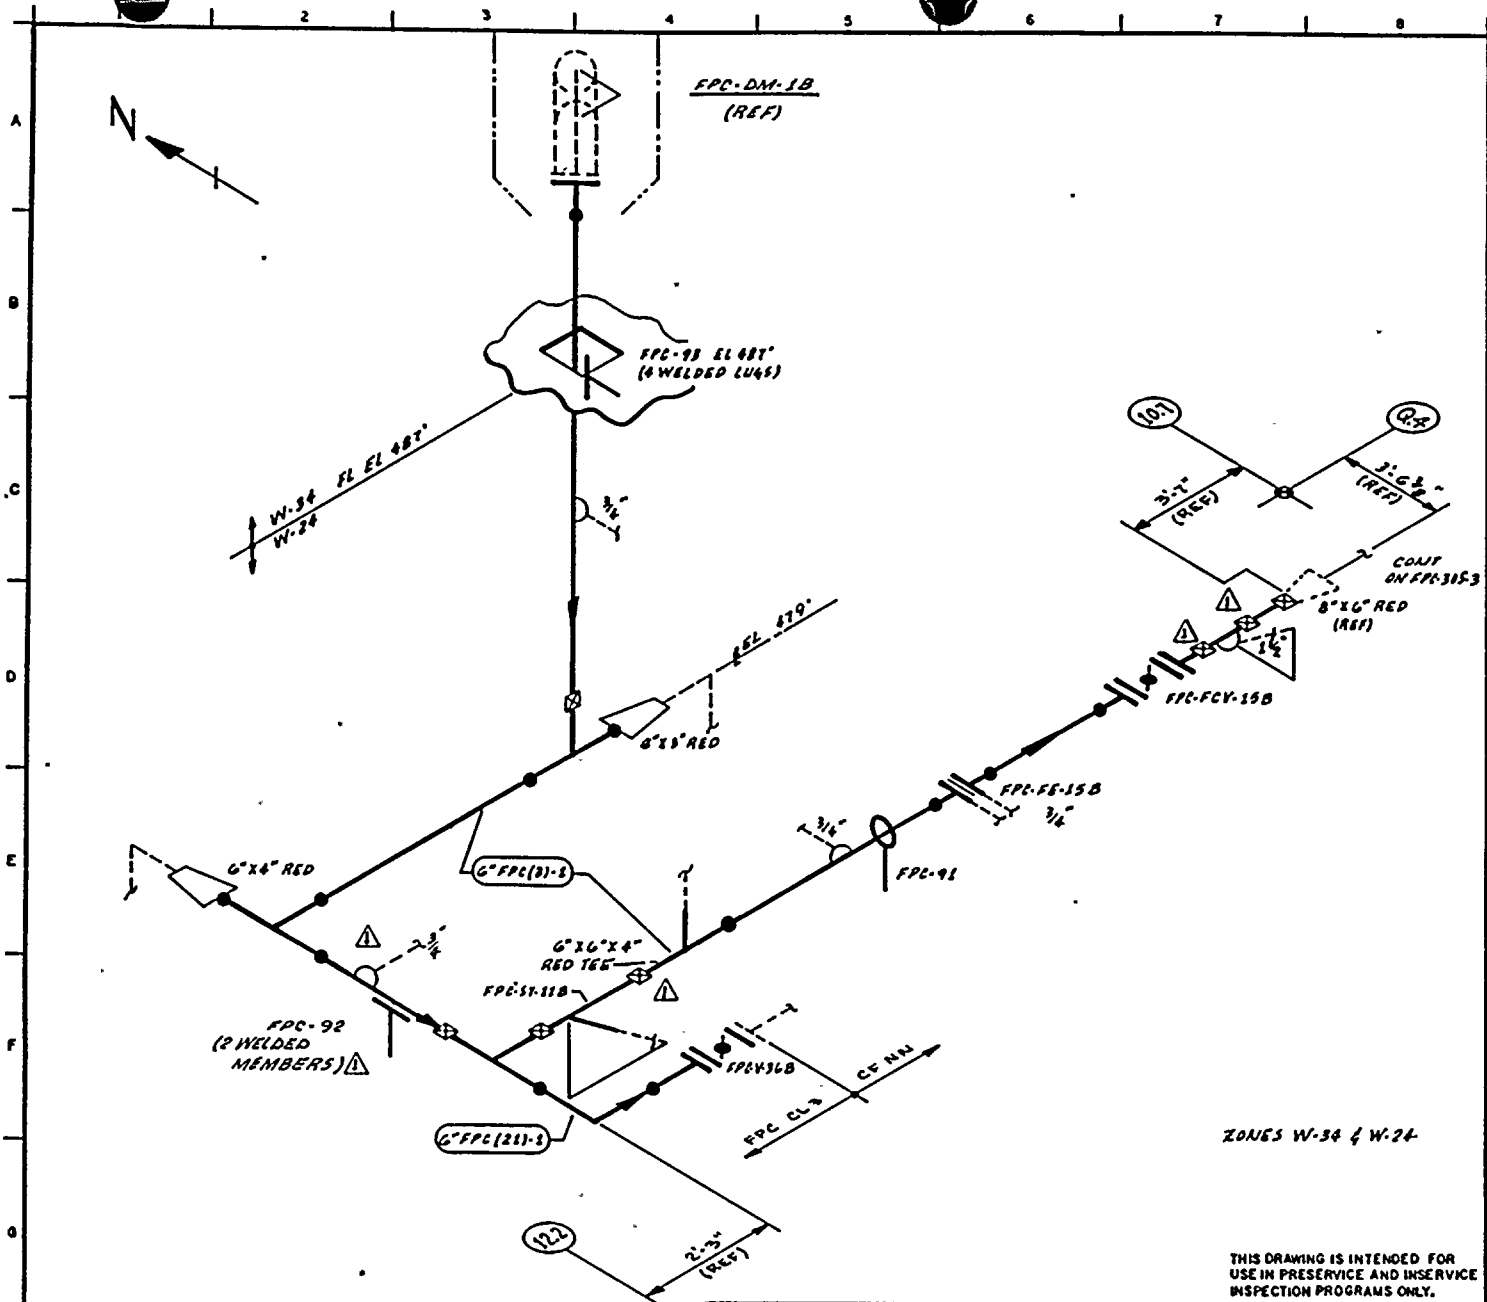


NOTES:

- THIS DRAWING IDENTIFIES PIPING & COMPONENTS SUBJECT ONLY TO A VISUAL EXAM FOR (1) EVIDENCE OF LEAKAGE DURING SYSTEM PRESSURE OR OPERABILITY TESTS; (2) PRESSURE DECAY TESTS OF BURIED PIPING; & (3) LOSS OF SUPPORT CAPABILITY OR INADEQUATE RESTRAINT FOR SUPPORTS & HANGERS ON PIPING EXCEEDING 4" NOM. TESTS SHALL BE CONDUCTED PER ASME SECTION XI, ARTICLES IWA-5000 & IWD-2000.
- FOR BRANCH PIPING 4" NOM OR LESS (CANV SHOWN IN DASHED LINES) EXTEND VISUAL LEAKAGE EXAM THROUGH THE OUTERMOST NORMALLY CLOSED NUCLEAR CLASS VALVE, OR UNTIL TRANSITION TO INSTRUMENT TUBING, UNLESS OTHERWISE NOTED.

REFERENCES:

BOVEE & CRAIG ISOMETRICS
 FPC-640-29.30 REV 3
 FPC-640-26.28 REV G

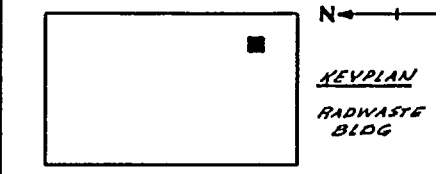

QUALITY CLASS: 2 ASME CODE CLASS: 3
 ENGR: *Schubert* DRAWN: *R.M.A.* DATE: 4-18-79

WASHINGTON PUBLIC POWER SUPPLY SYSTEM
 RICHMOND, WASHINGTON 98052

THIS DRAWING IS INTENDED FOR USE IN PRESERVICE AND INSERVICE INSPECTION PROGRAMS ONLY.

PIPING SYSTEM	NOM DIA (IN)	SCH	NOM WALL THK	MATERIAL SPECIFICATION	MATL TYPE	CAL BLOCK NO
6" FPC(3)-1	6	STD	0.280	SA 106 GRB	CS	NA
6" FPC(21)-1	6	STD	0.280	SA 106 GRB	CS	NA


NO	DATE	REVISION	BY	CHKD	APPVD
1	1/27/81	REVISED AS NOTED ADDED KEYPLAN	SRA	ZPK	TGH
0	12/2/81	ISSUED FOR USE	SKH	ZPK	TGH

WNP-2
 WELD B COMPONENT
 IDENTIFICATION DIAGRAM

TITLE:
FPC-DM-1B RETURN


DWG NO: FPC-305-2 REV 1



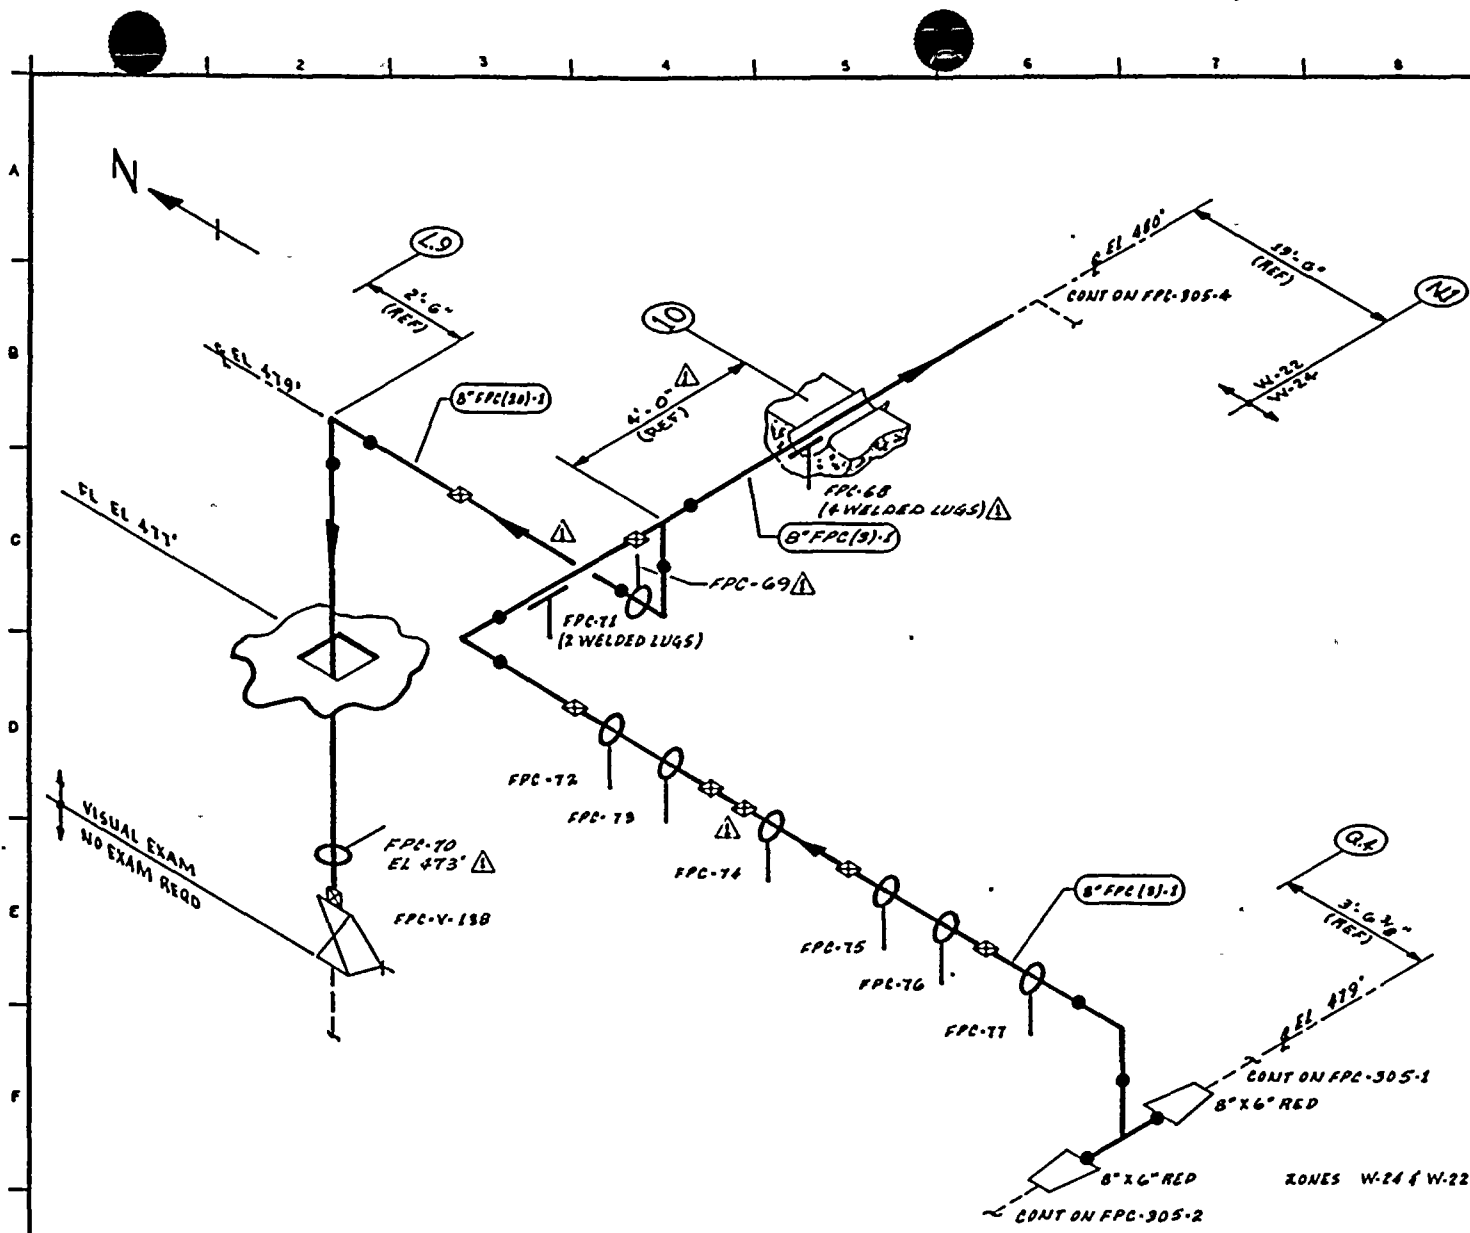

- NOTES:**
1. THIS DRAWING IDENTIFIES PIPING & COMPONENTS SUBJECT ONLY TO A VISUAL EXAM FOR (1) EVIDENCE OF LEAKAGE DURING SYSTEM PRESSURE OR OPERABILITY TESTS; (2) PRESSURE DECAY TESTS OF BURIED PIPING & (3) LOSS OF SUPPORT CAPABILITY OR IN ADEQUATE RESTRAINT FOR SUPPORTS & HANGERS ON PIPING EXCEEDING 4" NOM. TESTS SHALL BE CONDUCTED PER ASME SECTION XI, ARTICLES IWA-5000 & IWD-2000.
 2. FOR BRANCH PIPING 4" NOM OR LESS (CANN SHOWN IN DASHED LINES) EXTEND VISUAL LEAKAGE EXAM THROUGH THE OUTERMOST NORMALLY CLOSED NUCLEAR CLASS VALVE, OR UNTIL TRANSITION TO INSTRUMENT TUBING, UNLESS OTHERWISE NOTED.

- REFERENCES:**
- BOYCE & CRAIG ISOMETRICS
 - FPC-640-17.19 REV 7
 - FPC-640-13.16 REV 9

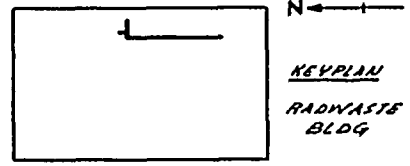

QUALITY CLASS: 2 ASME CODE CLASS: 3
 ENGR: *K. McLean* DRAWN: *K. McLean* DATE: 4-18-79


WASHINGTON PUBLIC POWER SUPPLY SYSTEM
 RICHLAND, WASHINGTON 99302

THIS DRAWING IS INTENDED FOR USE IN PRESERVICE AND INSERVICE INSPECTION PROGRAMS ONLY.

PIPING SYSTEM	NOM DIA (IN)	SCH	NOM WALL THK	MATERIAL SPECIFICATION	MATL TYPE	CAL BLOCK NO
8" FPC (20)-1	8	STD	0.322	SA 106 GR B	CS	NA
8" FPC (9)-1	8	STD	0.322	SA 106 GR B	CS	NA

NO	DATE	REVISION	BY	CHKD	APPVD
1	12/28/84	REVISED AS NOTED ADDED KEYPLAN	<i>K. McLean</i>	<i>ZOR</i>	<i>JFH</i>
0	12/2/84	ISSUED FOR USE	<i>K. McLean</i>	<i>ZOR</i>	<i>JFH</i>

WNP-2
 WELD & COMPONENT IDENTIFICATION DIAGRAM
 TITLE:
FPC-DM-1A & 1B RETURN
 DWG NO: FPC-305-3 REV 1

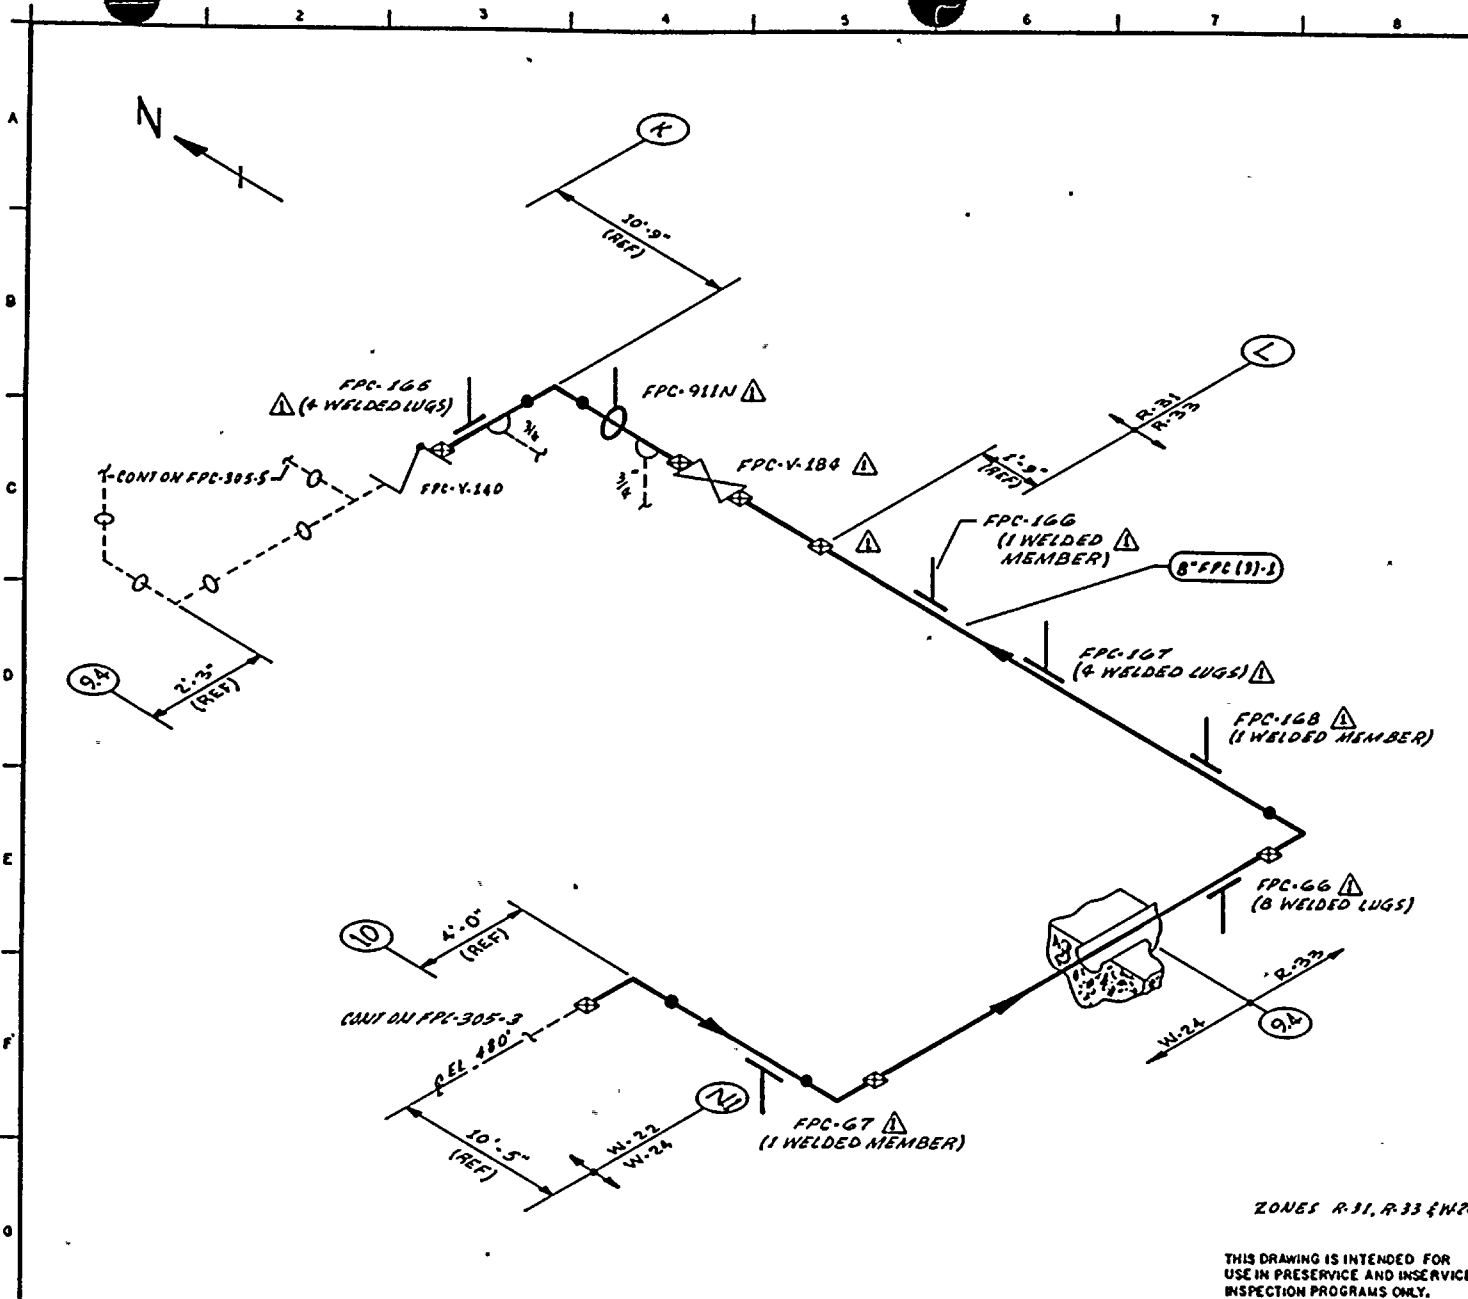


NOTES:

1. THIS DRAWING IDENTIFIES PIPING & COMPONENTS SUBJECT ONLY TO A VISUAL EXAM FOR (1) EVIDENCE OF LEAKAGE DURING SYSTEM PRESSURE OR OPERABILITY TESTS; (2) PRESSURE DECAY TESTS OF BURIED PIPING; & (3) LOSS OF SUPPORT CAPABILITY OR INADEQUATE RESTRAINT FOR SUPPORTS & HANGERS ON PIPING EXCEEDING 4" NOM. TESTS SHALL BE CONDUCTED PER ASME SECTION XI, ARTICLES IWA-5000 & IWD-2000.
2. FOR BRANCH PIPING 4" NOM. OR LESS (CONN SHOWN IN DASHED LINES) EXTEND VISUAL LEAKAGE EXAM THROUGH THE OUTERMOST NORMALLY CLOSED NUCLEAR CLASS VALVE OR UNTIL TRANSITION TO INSTRUMENT TUBING UNLESS OTHERWISE NOTED.

REFERENCES:

- BOYCE & CRAIG ISOMETRICS
 FPC-640-19.16 REV 9
 FPC-640-7.9 REV 12

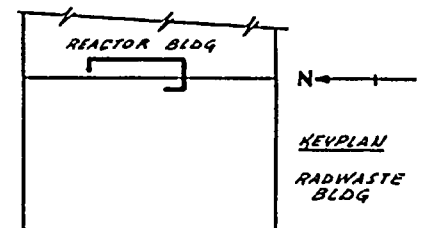

QUALITY CLASS: 2	ASME CODE CLASS: 3
ENGR: K. M. Hudson	DRAWN: K. M. A. DATE: 4-19-79


WASHINGTON PUBLIC POWER SUPPLY SYSTEM
 RICHLAND, WASHINGTON 99352


ZONES R-31, R-33 & W-24
 THIS DRAWING IS INTENDED FOR USE IN PRESERVICE AND INSERVICE INSPECTION PROGRAMS ONLY.

PIPING SYSTEM	NOM DIA (IN)	SCH	NOM WALL THK	MATERIAL SPECIFICATION	MATL TYPE	CAL BLOCK NO
8" FPC (3)-1	8	STD	0.322	3A 10G GR B	CS	N/A

NO	DATE	REVISION	BY	CHKD	APPVD
1	8-29-80	REVISED AS NOTED ADDED KEYPLAN	KMA	SK	TSN
0	12-29-79	ISSUED FOR USE	KMA	SK	TSN


WNP-2
 WELD & COMPONENT IDENTIFICATION DIAGRAM
 TITLE:
 FPC-DM-1A & 1B RETURN
 DWG NO: FPC-305-4
 REV 1

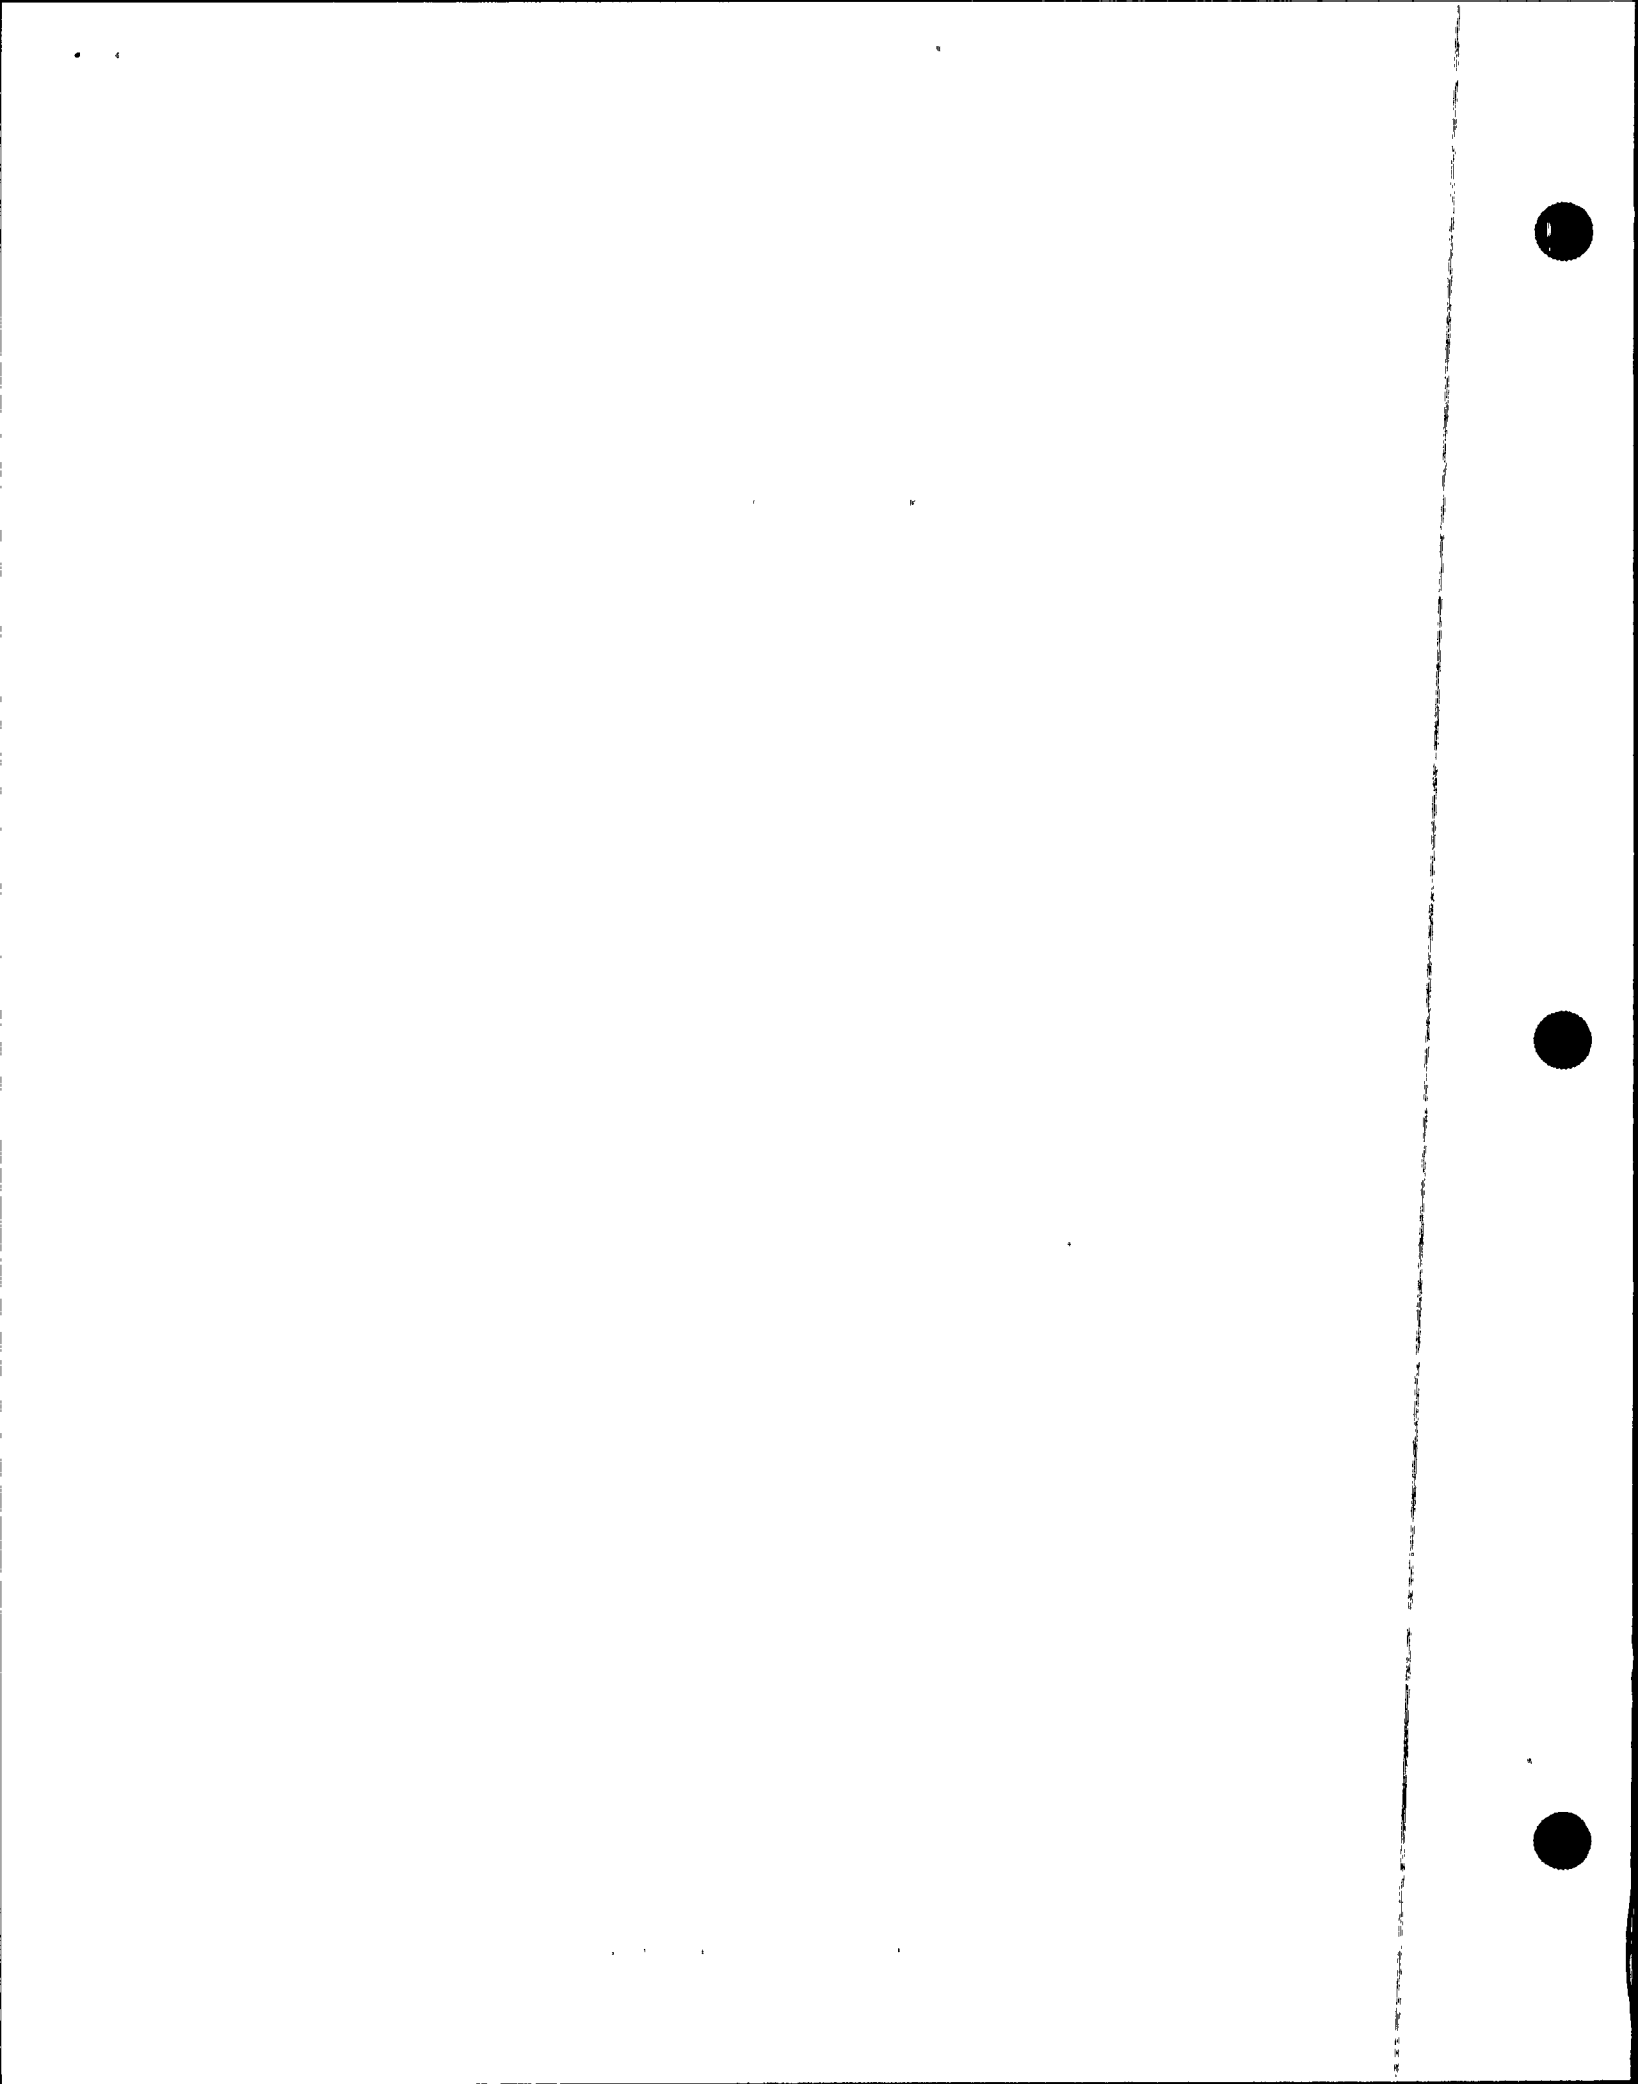

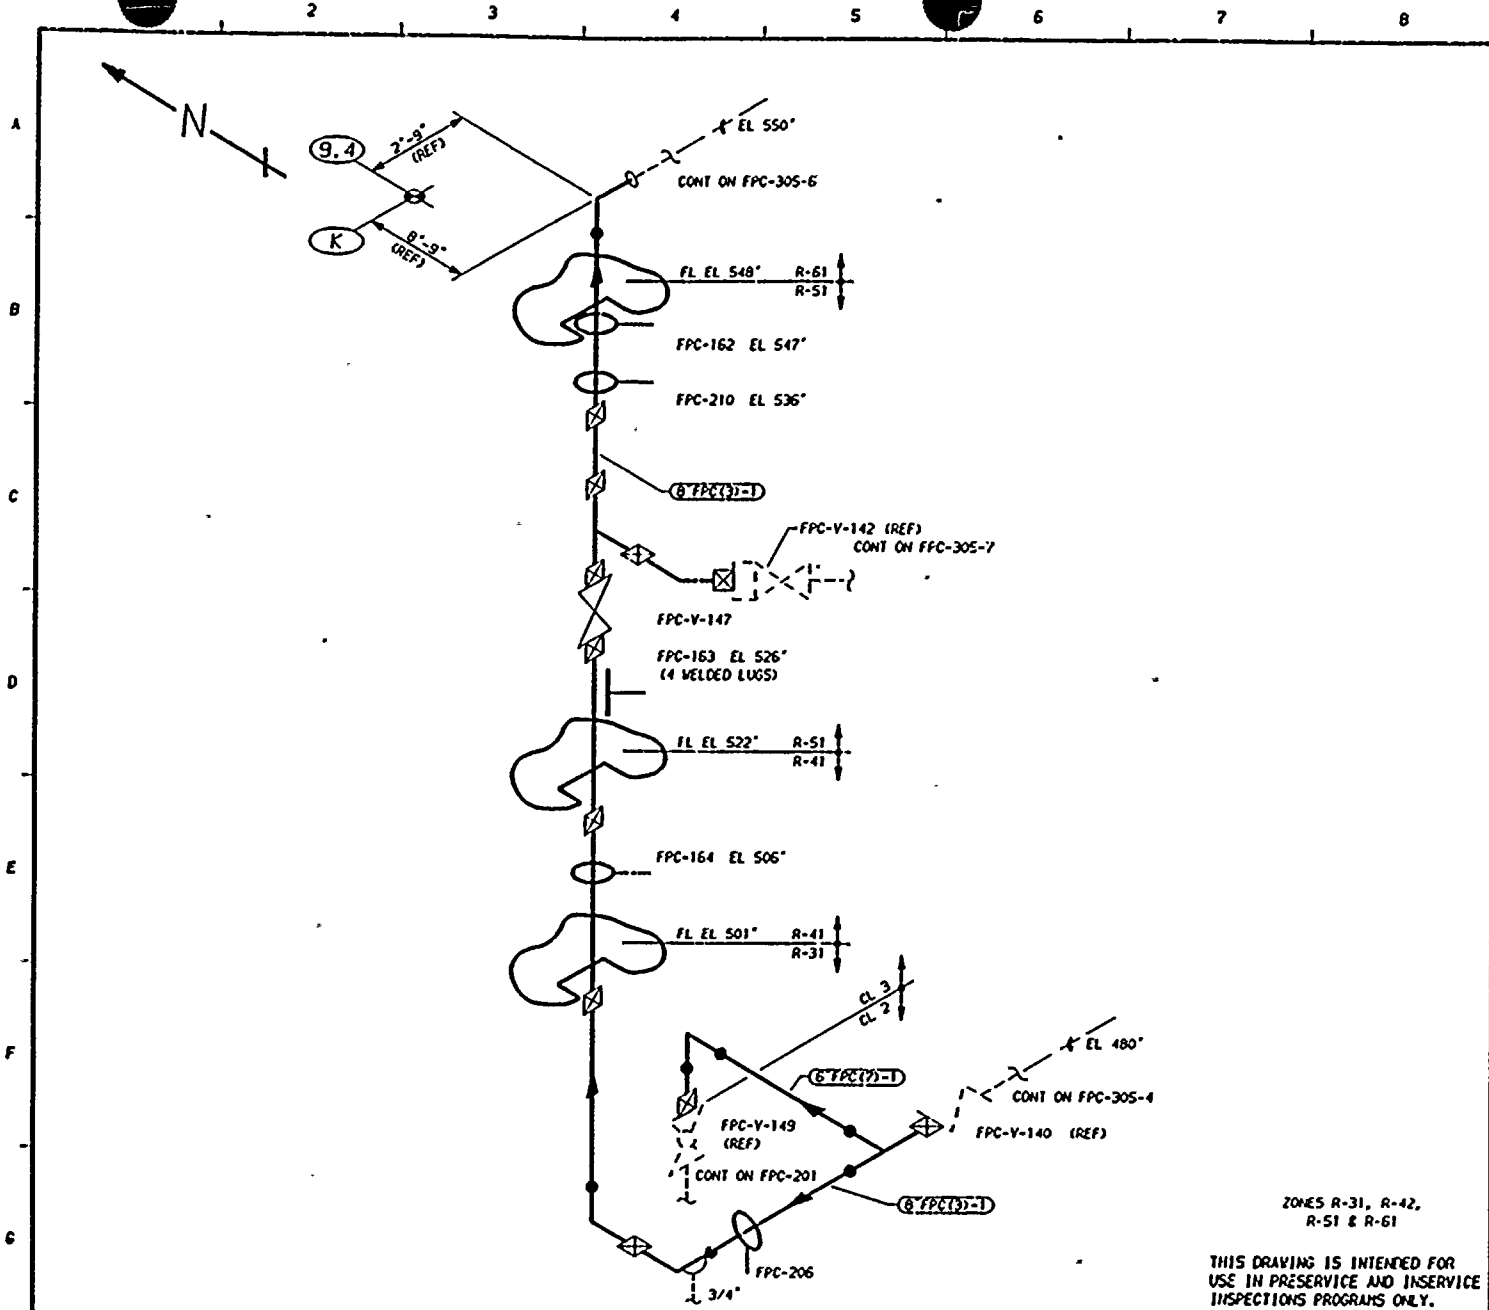

- NOTES:**
1. THIS DRAWING IDENTIFIES PIPING AND COMPONENTS SUBJECT ONLY TO A VISUAL EXAM FOR (1) EVIDENCE OF LEAKAGE DURING SYSTEM PRESSURE OR OPERABILITY TESTS, (2) PRESSURE DECAY TESTS OF BURIED PIPING, AND (3) LOSS OF SUPPORT CAPABILITY OR INADEQUATE RESTRAINT FOR SUPPORTS AND HANGERS ON PIPING EXCEEDING 4" NOM. TESTS SHALL BE CONDUCTED PER ASME SECTION XI, ARTICLES 1WA-5000 AND 1WD-2000.
 2. FOR BRANCH PIPING 4" NOM. OR LESS (CONNECTION SHOWN IN DASHED LINES) EXTEND VISUAL LEAKAGE EXAM THROUGH THE OUTERMOST NORMALLY CLOSED NUCLEAR CLASS VALVE, OR UNTIL TRANSITION TO INSTRUMENT TUBING, UNLESS OTHERWISE NOTED.

- REFERENCES:**
- 151 - 226
 - BOYEE & GRILL ISOMETRICS
 - FPC-640-1.6 REV 8
 - FPC-640-7.9 REV 12

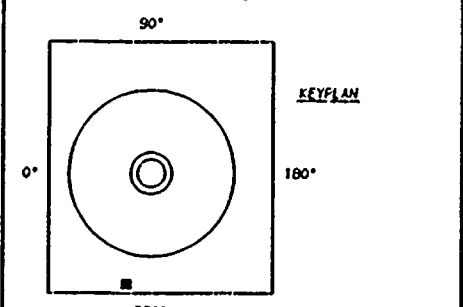

ZONES R-31, R-42,
R-51 & R-61

THIS DRAWING IS INTENDED FOR
USE IN PRESERVICE AND INSERVICE
INSPECTIONS PROGRAMS ONLY.

PIPING SYSTEM	NOM DIA (IN)	SCH	NOM WALL THK	MATERIAL SPECIFICATION	MATL TYPE	CAL BLOCK NO
8" FPC(3)-1	8	STD	0.322	SA 106 GR B	CS	NA
6" FPC(7)-1	6	STD	0.260	SA 106 GR B	CS	NA

QUALITY CLASS: 2	ASME CODE CLASS: 3
ENGR: K-McANDREW	DRAWN: K-McA DATE: 4-19-79

WASHINGTON PUBLIC POWER
SUPPLY SYSTEM
RICHLAND, WASHINGTON 99352



WNP-2
WELD & COMPONENT
IDENTIFICATION DIAGRAM

TITLE:	FPC-DH-1A & 1B RETURN
DWG NO: FPC-305-5	REV 1

NO	DATE	REVISION	BY	CHKD	APVD
1	12-2-81	GENERAL UPDATE REDRAWN	K-McA	DPR	TFH
0	12-2-81	ISSUED FOR USE	K-McA	DPR	TFH

Vertical line of text or markings along the right edge of the page.



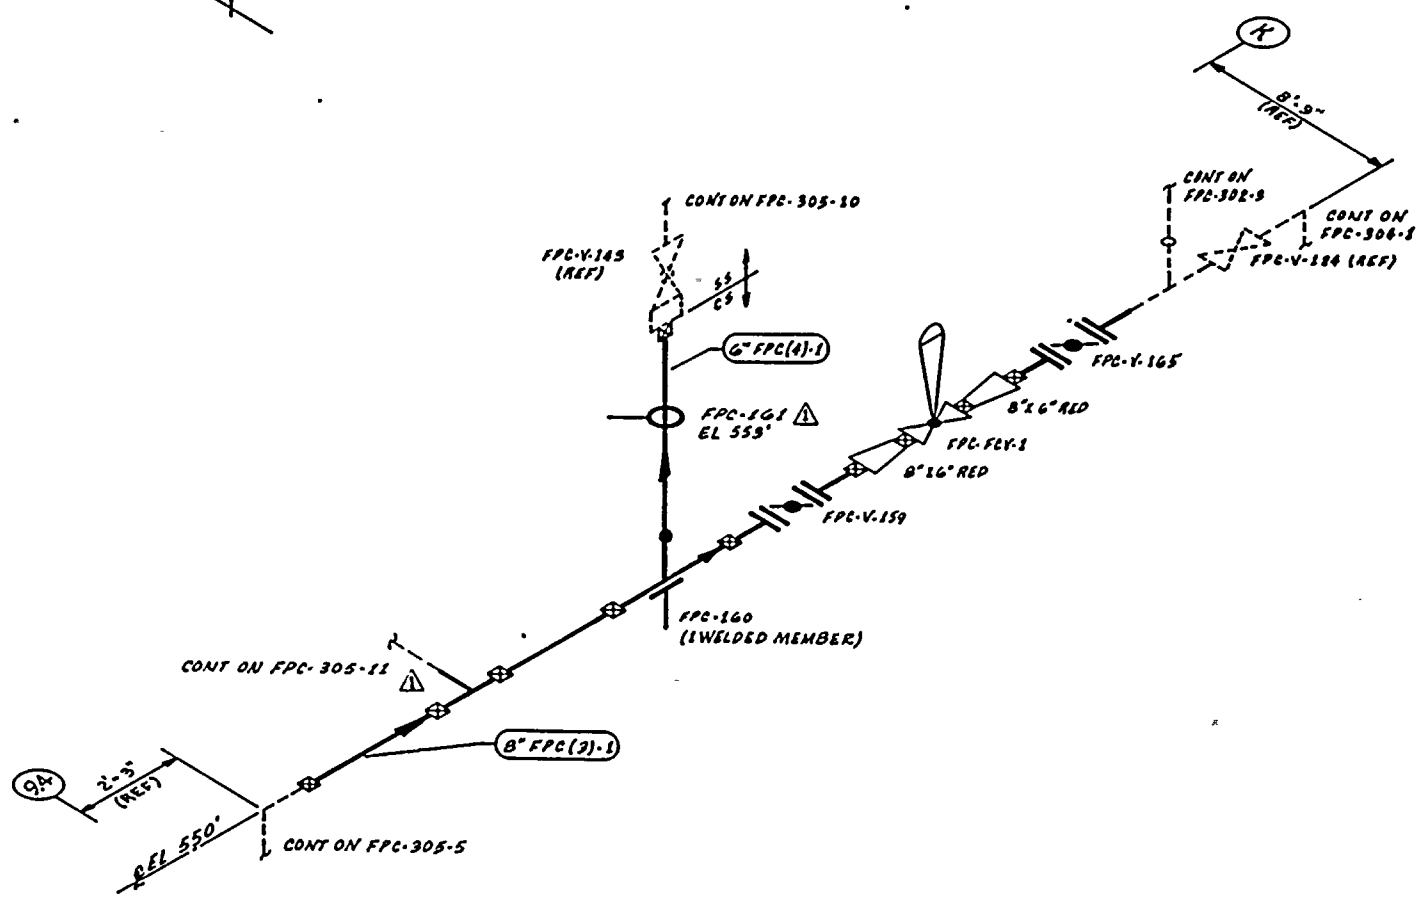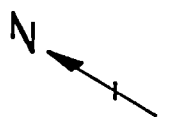


ZONE R-61

THIS DRAWING IS INTENDED FOR USE IN PRESERVE AND INSERVICE INSPECTION PROGRAMS ONLY.

- NOTES:**
- THIS DRAWING IDENTIFIES PIPING & COMPONENTS SUBJECT ONLY TO A VISUAL EXAM FOR (1) EVIDENCE OF LEAKAGE DURING SYSTEM PRESSURE OR OPERABILITY TESTS; (2) PRESSURE DECAY TESTS OF BURIED PIPING; & (3) LOSS OF SUPPORT CAPABILITY OR INADEQUATE RESTRAINT FOR SUPPORTS & HANGERS ON PIPING EXCEEDING 4" NOM. TESTS SHALL BE CONDUCTED PER ASME SECTION XI, ARTICLES IWA-6000 & IWD-2000.
 - FOR BRANCH PIPING 4" NOM OR LESS (CONN SHOWN IN DASHED LINES) EXTEND VISUAL LEAKAGE EXAM THROUGH THE OUTERMOST NORMALLY CLOSED NUCLEAR CLASS VALVE, OR UNTIL TRANSITION TO INSTRUMENT TUBING, UNLESS OTHERWISE NOTED.

REFERENCES:
 BOVEE & CRAIL ISOMETRICS
 FPC-640-1.6 REV B

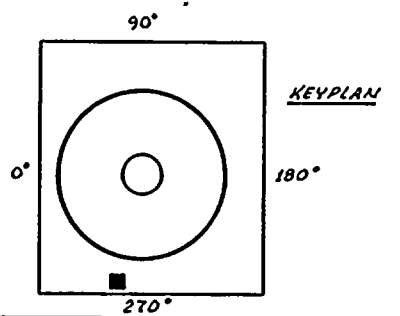

QUALITY CLASS: 2 ASME CODE CLASS: 3
 ENGR: *[Signature]* DRAWN: *[Signature]* DATE: 4-23-79

WASHINGTON PUBLIC POWER SUPPLY SYSTEM
 RICHMOND, WASHINGTON 98352

WNP-2
 WELD & COMPONENT
 IDENTIFICATION DIAGRAM


TITLE:
FPC-DM-1A & 1B RETURN


DWG NO: FPC-305-6 REV 1

PIPING SYSTEM	NOM DIA (IN)	SCH	NOM WALL THK	MATERIAL SPECIFICATION	MATL TYPE	CAL BLOCK NO
8" FPC (3)-1	8	STD	0.322	SA 106 GR B	CS	NA
6" FPC (4)-1	6	STD	0.280	SA 106 GR B	CS	NA

NO	DATE	REVISION	BY	CHKD	APPVD
1	1-24-82	REVISED AS NOTED ADDED KEYPLAN	<i>[Signature]</i>	SPC	TFH
0	12-28-81	ISSUED FOR USE	<i>[Signature]</i>	DKR	IFW

WPPSS PIPING IDENTIFICATION SYSTEM 5-10-87

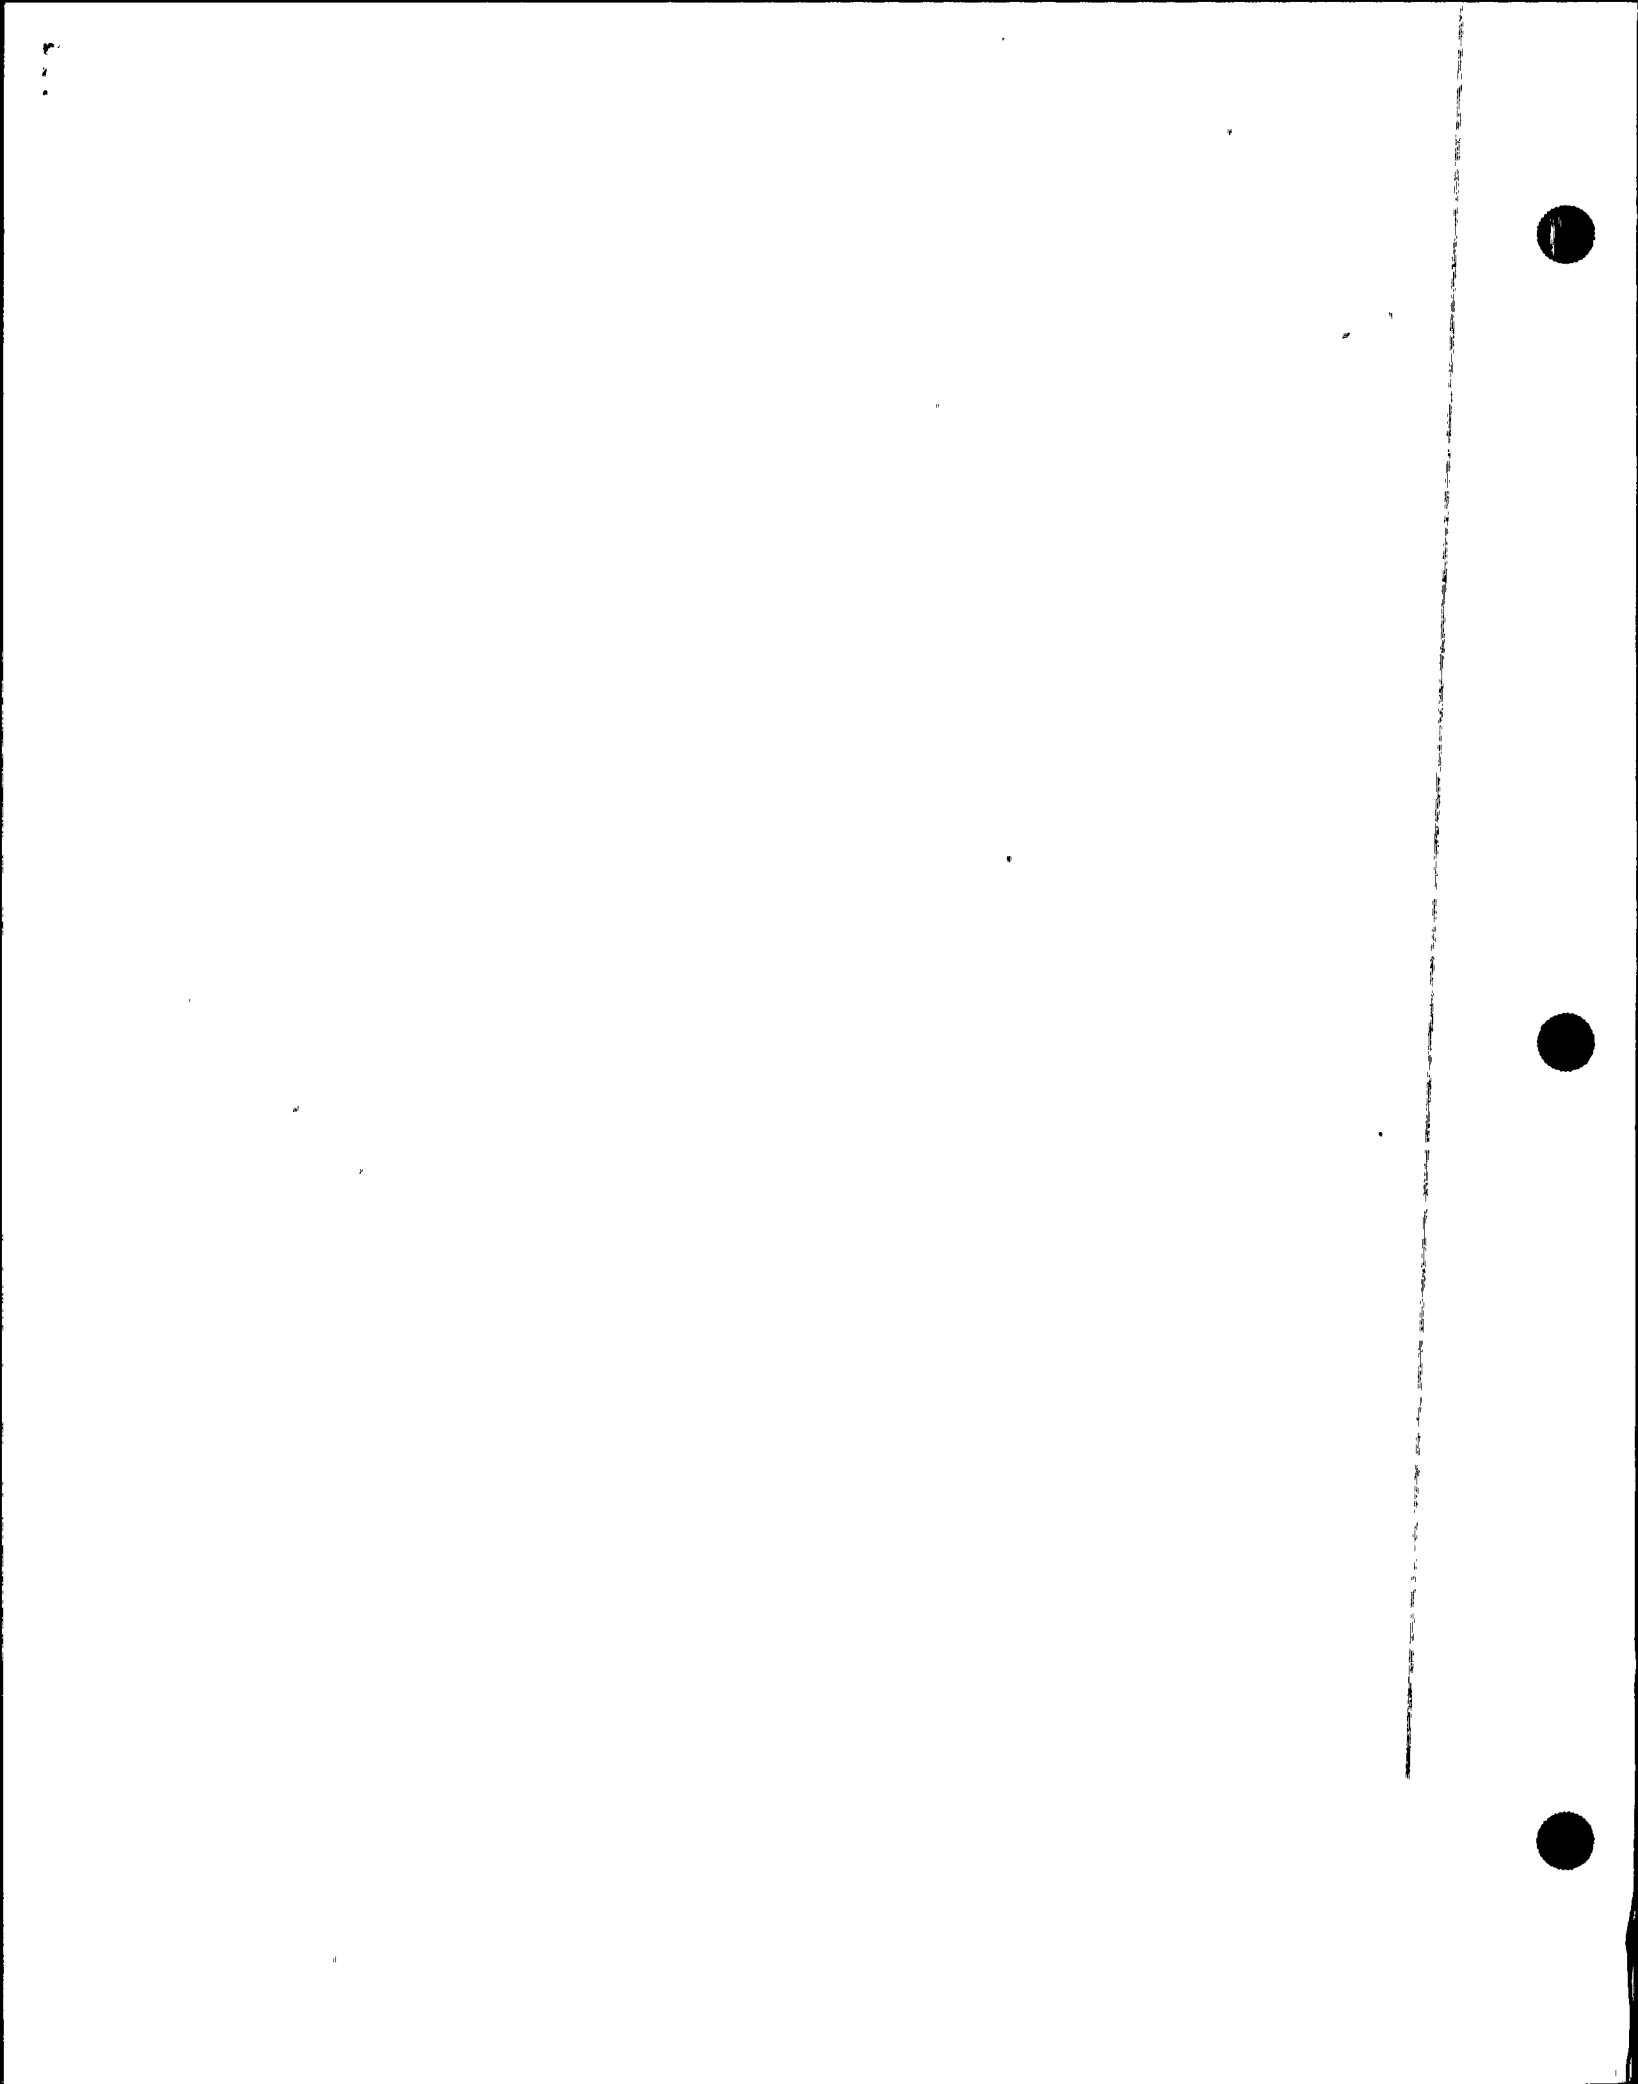

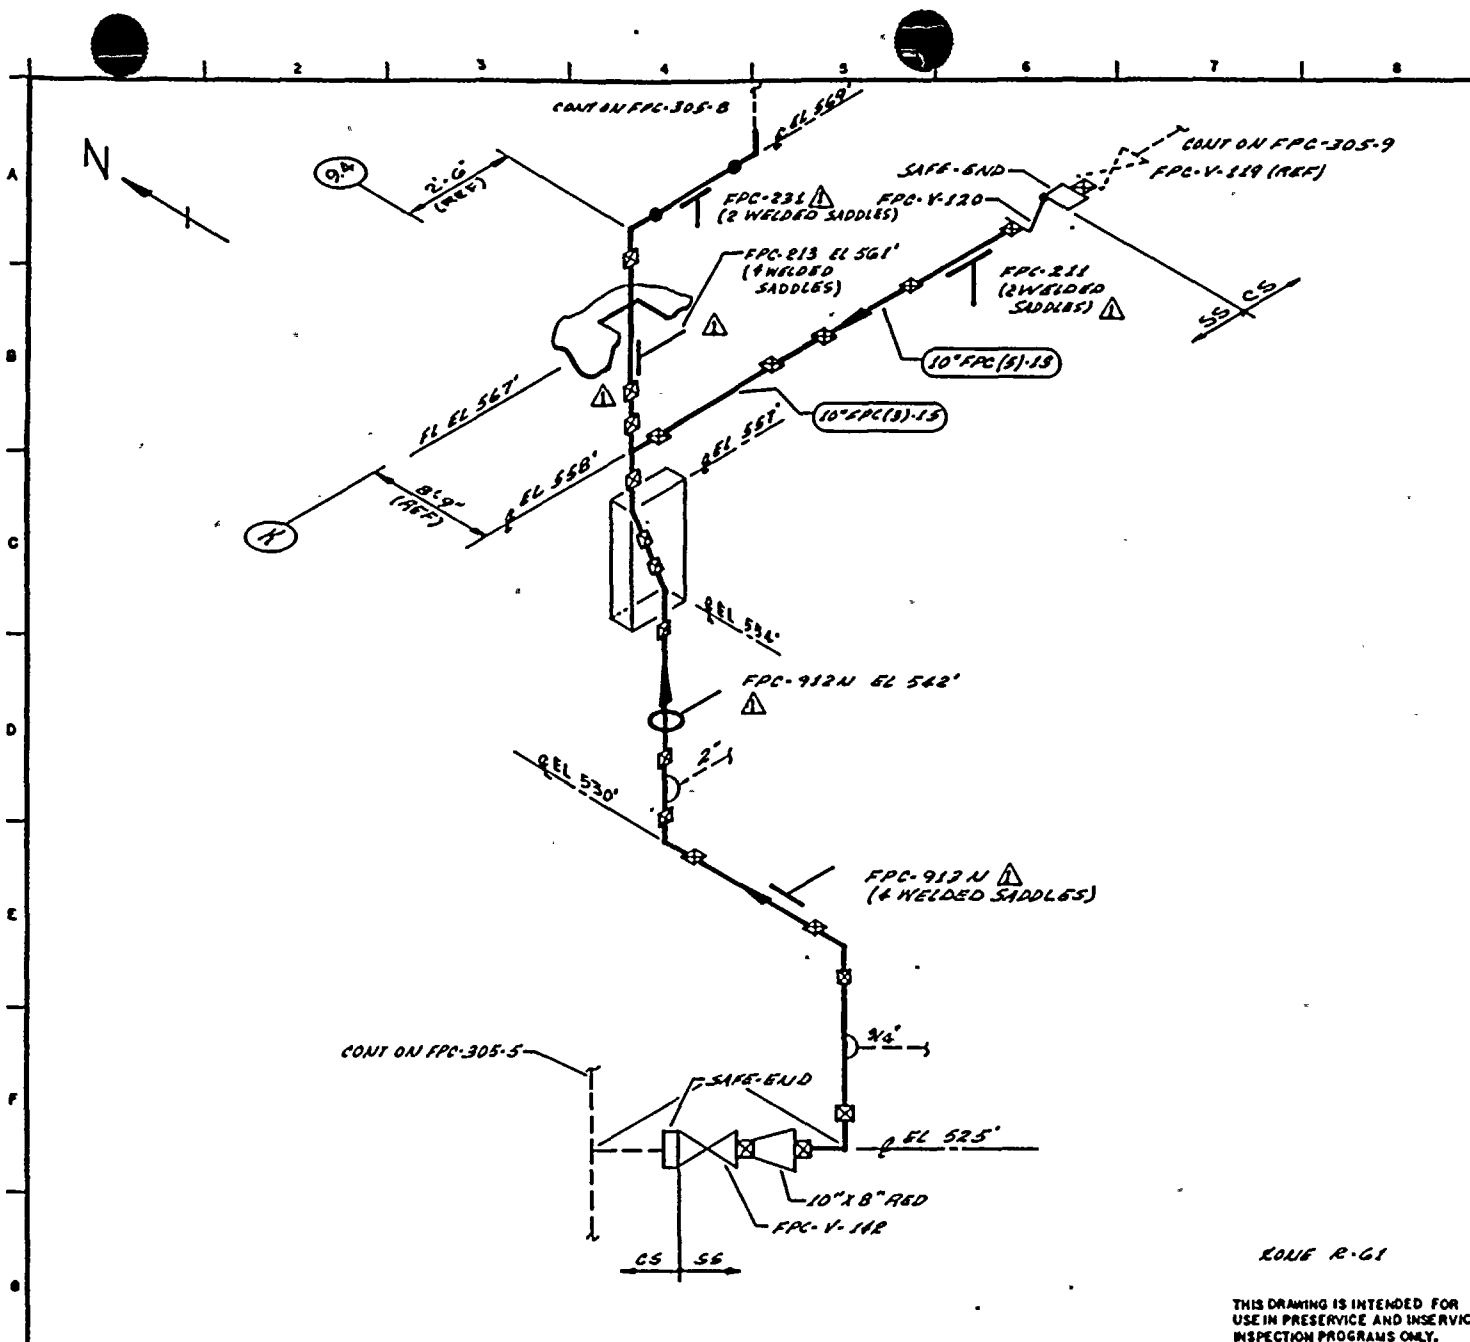


NOTES:

1. THIS DRAWING IDENTIFIES PIPING & COMPONENTS SUBJECT ONLY TO A VISUAL EXAM FOR (1) EVIDENCE OF LEAKAGE DURING SYSTEM PRESSURE OR OPERABILITY TESTS; (2) PRESSURE DEGRY TESTS OF BURIED PIPING & (3) LOSS OF SUPPORT CAPABILITY OR INADEQUATE RESTRAINT FOR SUPPORTS & HANGERS ON PIPING EXCEEDING 4" NOM. TESTS SHALL BE CONDUCTED PER ASME SECTION XI, ARTICLES IWA-5000 & IWD-3000.
2. FOR BRANCH PIPING 4" NOM OR LESS (CONN SHOWN IN DASHED LINES) EXTEND VISUAL LEAKAGE EXAM THROUGH THE OUTERMOST NORMALLY CLOSED NUCLEAR CLASS VALVE, OR WITH TRANSITION TO INSTRUMENT TUBING, UNLESS OTHERWISE NOTED.

REFERENCES:

BOVEE & CRAIG ISOMETRICS
 FPC-670-1.2 REV 10
 FPC-049-1.13 REV 7

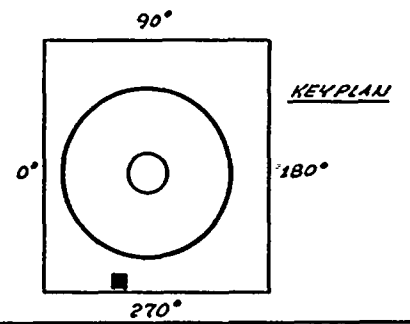

QUALITY CLASS: 2 ASME CODE CLASS: 5
 ENGR: *[Signature]* DRAWN: *[Signature]* DATE: 7-24-81

WASHINGTON PUBLIC POWER SUPPLY SYSTEM
 RICHLAND, WASHINGTON 98342

ZONE R-61
 THIS DRAWING IS INTENDED FOR USE IN PRESERVICE AND INSERVICE INSPECTION PROGRAMS ONLY.


PIPING SYSTEM	NOM DIA (IN)	SCH	NOM WALL THK	MATERIAL SPECIFICATION	MATL TYPE	CAL BLOCK NO
10" FPC (S)-15	10	10S	0.165	SA 312 TP 308	SS	NA
10" FPC (S)-15	"	"	"	" " " "	"	"

NO	DATE	REVISION	BY	CHKD	APPVD
1	1-28-81	REVISED AS NOTED ADDED KEYPLAN	<i>[Signature]</i>	<i>[Signature]</i>	<i>[Signature]</i>
0	1-28-81	ISSUED FOR USE	<i>[Signature]</i>	<i>[Signature]</i>	<i>[Signature]</i>

WNP-2
 WELD & COMPONENT IDENTIFICATION DIAGRAM


TITLE: FPC-DN-1A & 1B RETURN 5" RHE STEAM INLET

DWG NO: FPC-305-7 REV 1

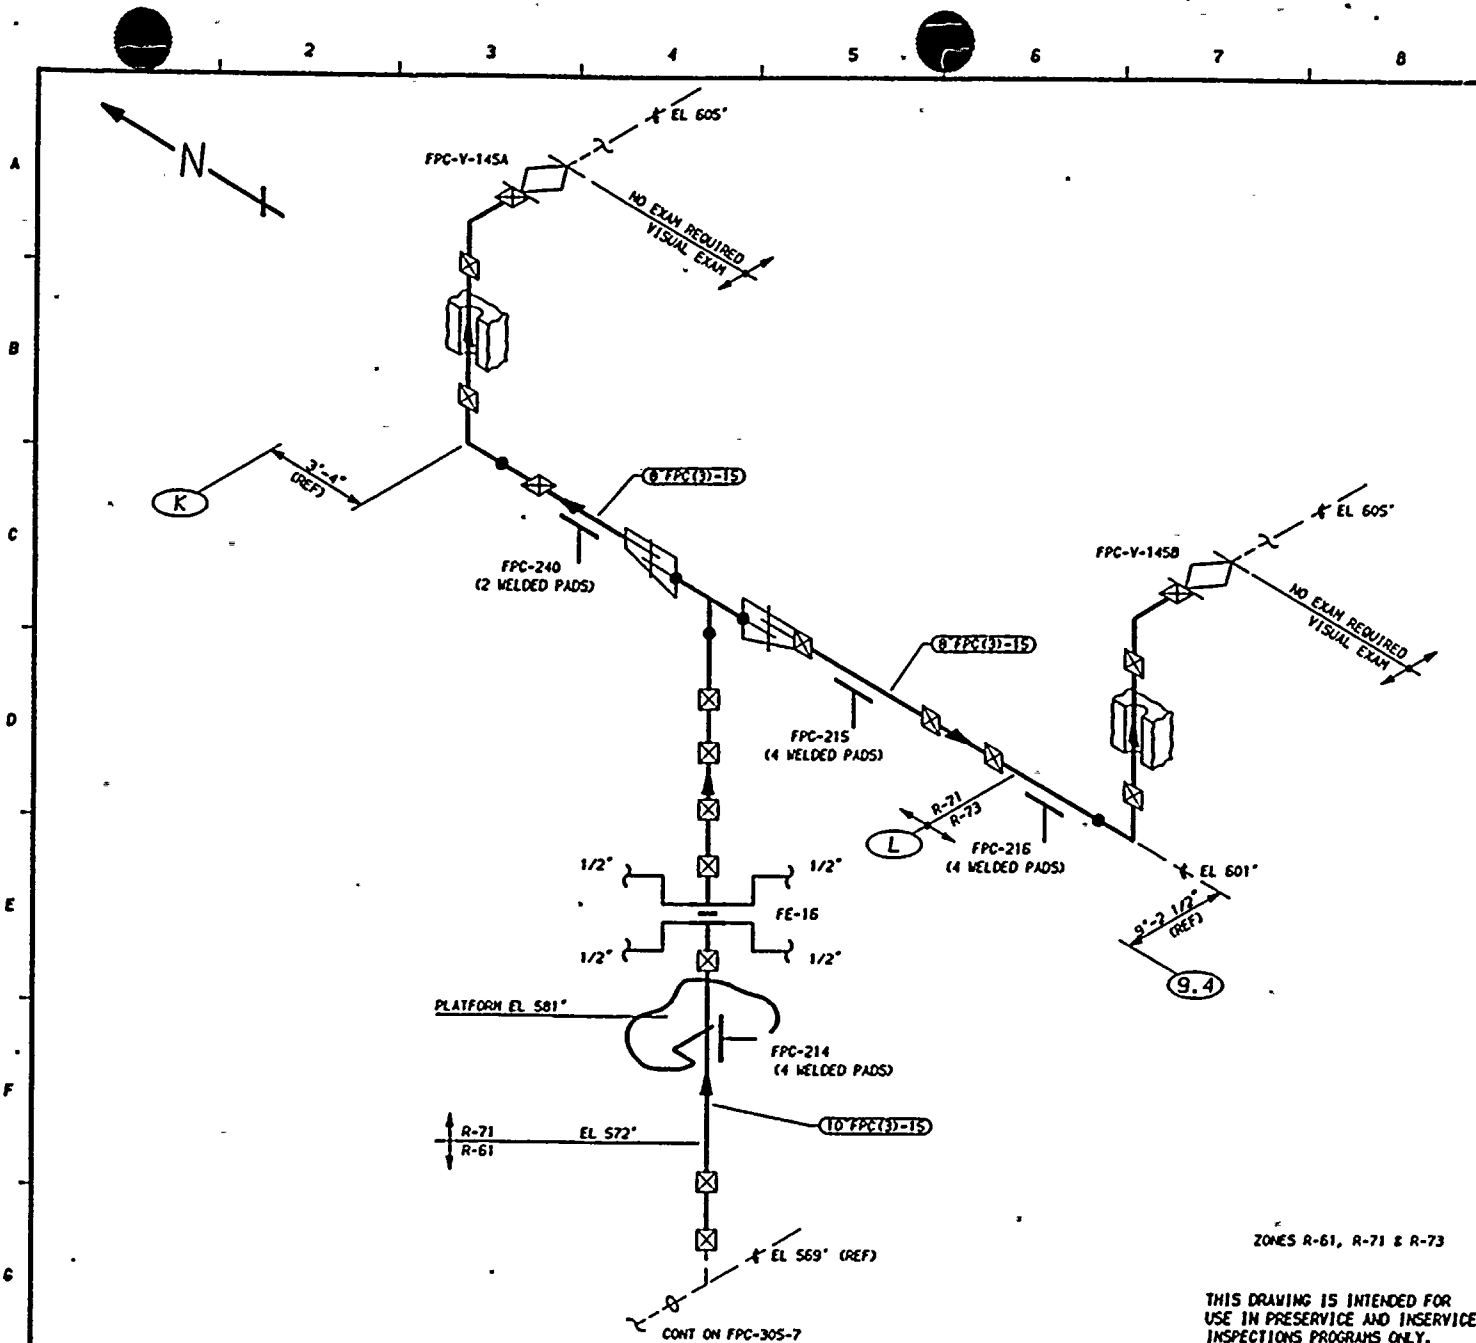

- NOTES:**
1. THIS DRAWING IDENTIFIES PIPING AND COMPONENTS SUBJECT ONLY TO A VISUAL EXAM FOR (1) EVIDENCE OF LEAKAGE DURING SYSTEM PRESSURE OR OPERABILITY TESTS; (2) PRESSURE DECAY TESTS OF BURIED PIPING; AND (3) LOSS OF SUPPORT CAPABILITY OR INADEQUATE RESTRAINT FOR SUPPORTS AND HANGERS ON PIPING EXCEEDING 4" NOM. TESTS SHALL BE CONDUCTED PER ASME SECTION XI, ARTICLES 1WA-5000 AND 1W-2000.
 2. FOR BRANCH PIPING 4" NOM. OR LESS (CONNECTION SHOWN IN DASHED LINES) EXTEND VISUAL LEAKAGE EXAM THROUGH THE OUTERMOST NORMALLY CLOSED NUCLEAR CLASS VALVE, OR UNTIL TRANSITION TO INSTRUMENT TUBING, UNLESS OTHERWISE NOTED.

- REFERENCES:**
- 151 - 226
 - BOYEE & CRAIL ISOMETRICS
 - FPC-670- 3.6 REV 8
 - FPC-670- 7-11 REV 9
 - FPC-670-12.16 REV 7

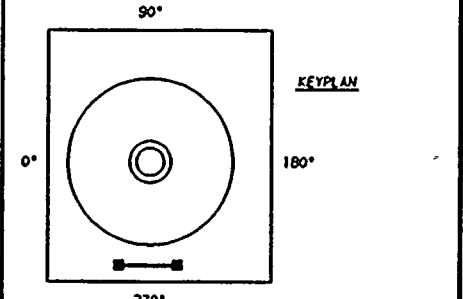

QUALITY CLASS: 2	ASME CODE CLASS: 3
ENGR: K-McANDREW	DATE: 4-24-79

WASHINGTON PUBLIC POWER
SUPPLY SYSTEM
 RICHLAND, WASHINGTON 99352

WNP-2
 WELD & COMPONENT
IDENTIFICATION DIAGRAM

TITLE:
 FPC-DN-1A & 1B TO DIFFUSERS


DWG NO. FPC-305-B REV 1

THIS DRAWING IS INTENDED FOR USE IN PRESERVICE AND INSERVICE INSPECTIONS PROGRAMS ONLY.

ZONES R-61, R-71 & R-73

PIPING SYSTEM	NOM DIA (IN)	SCH	NOM WALL THK	MATERIAL SPECIFICATION	MATL TYPE	CAL BLOCK NO
10" FPC(3)-15	10	STD	0.365	SA 106 GR B	CS	NA
8" FPC(3)-15	8	STD	0.322	SA 106 GR B	CS	NA


NO	DATE	REVISION	BY	CHKD	APVD
1	4-24-84	GENERAL UPDATE REDRAWN	K-McA	DPR	TJH
0	12-2-81	ISSUED FOR USE	K-McA	DPR	TJH

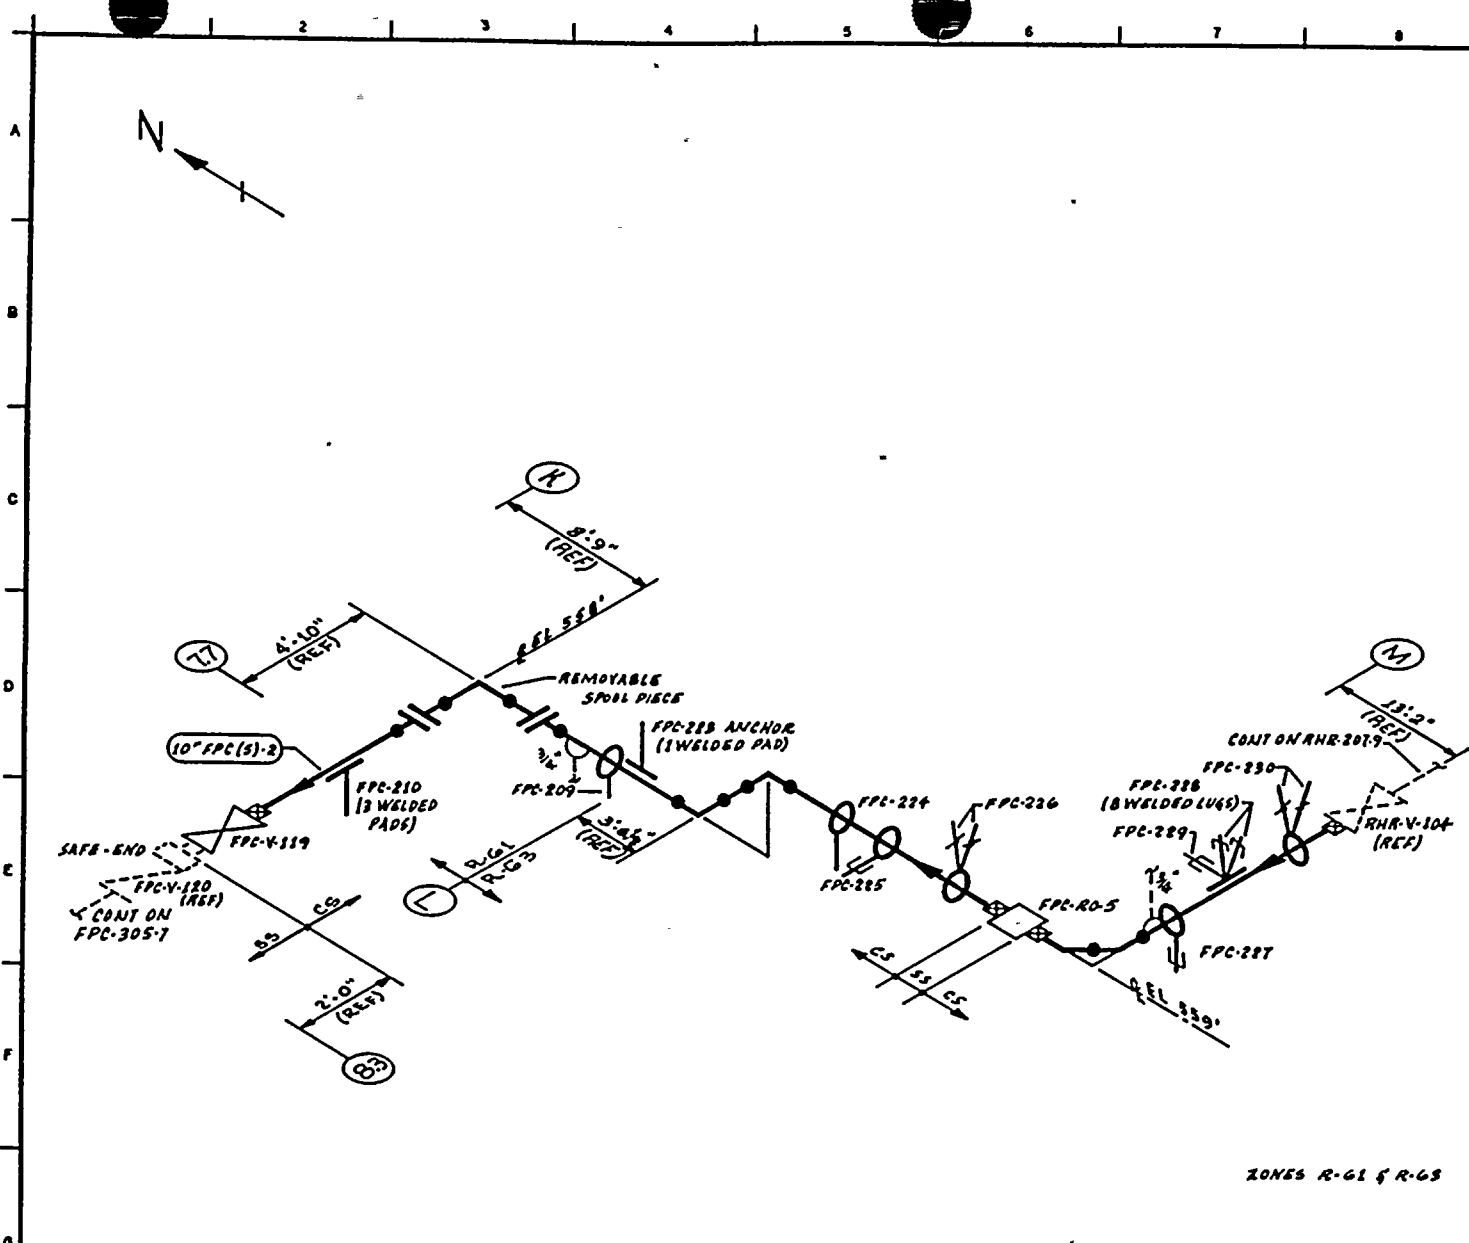

NOTES:

- THIS DRAWING IDENTIFIES PIPING & COMPONENTS SUBJECT ONLY TO VISUAL EXAM FOR (1) EVIDENCE OF LEAKAGE DURING SYSTEM PRESSURE OR OPERABILITY TESTS; (2) PRESSURE DECAY TESTS OF BURIED PIPING; & (3) LOSS OF SUPPORT CAPABILITY OR INADEQUATE RESTRAINT FOR SUPPORTS & HANGERS ON PIPING EXCEEDING 4" NOM. TESTS SHALL BE CONDUCTED PER ASME SECTION XI, ARTICLES IWA-5000 & IWD-2000.

REFERENCES:
BOYCE & GRAY ISOMETRICS
FPC-GTI-1.4 REV II

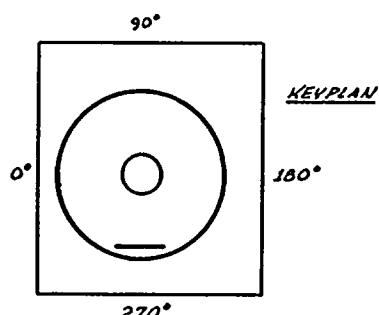

ZONES R-61 & R-63

THIS DRAWING IS INTENDED FOR USE IN PRESERVICE AND INSERVICE INSPECTION PROGRAMS ONLY.

QUALITY CLASS: 2	ASME CODE CLASS: 3
ENGR: <i>K.M. ANDERSON</i>	DRAWN: <i>K.M.A.</i> DATE: 6-26-79

WASHINGTON PUBLIC POWER SUPPLY SYSTEM
RICHLAND, WASHINGTON 98342

PIPING SYSTEM	NOM DIA (IN)	SCH	NOM WALL THK	MATERIAL SPECIFICATION	MATL TYPE	CAL BLOCK NO
10" FPC(S)-2	10	STD	0.365	SA 106 GR B	CS	NA

WNP- 2
WELD & COMPONENT
IDENTIFICATION DIAGRAM



TITLE:
FPC - RHR INTERTIE INLET

DWG NO: FPC-305-9 REV 1

NO	DATE	REVISION	BY	CHKD	APPVD
1	FR88	ADDED 3/4" CONN EN D-F	<i>F.M.A.</i>	<i>W.K.</i>	<i>T.H.H.</i>
0	1/23/79	ISSUED FOR USE	<i>K.M.A.</i>	<i>W.K.</i>	<i>T.H.H.</i>

7



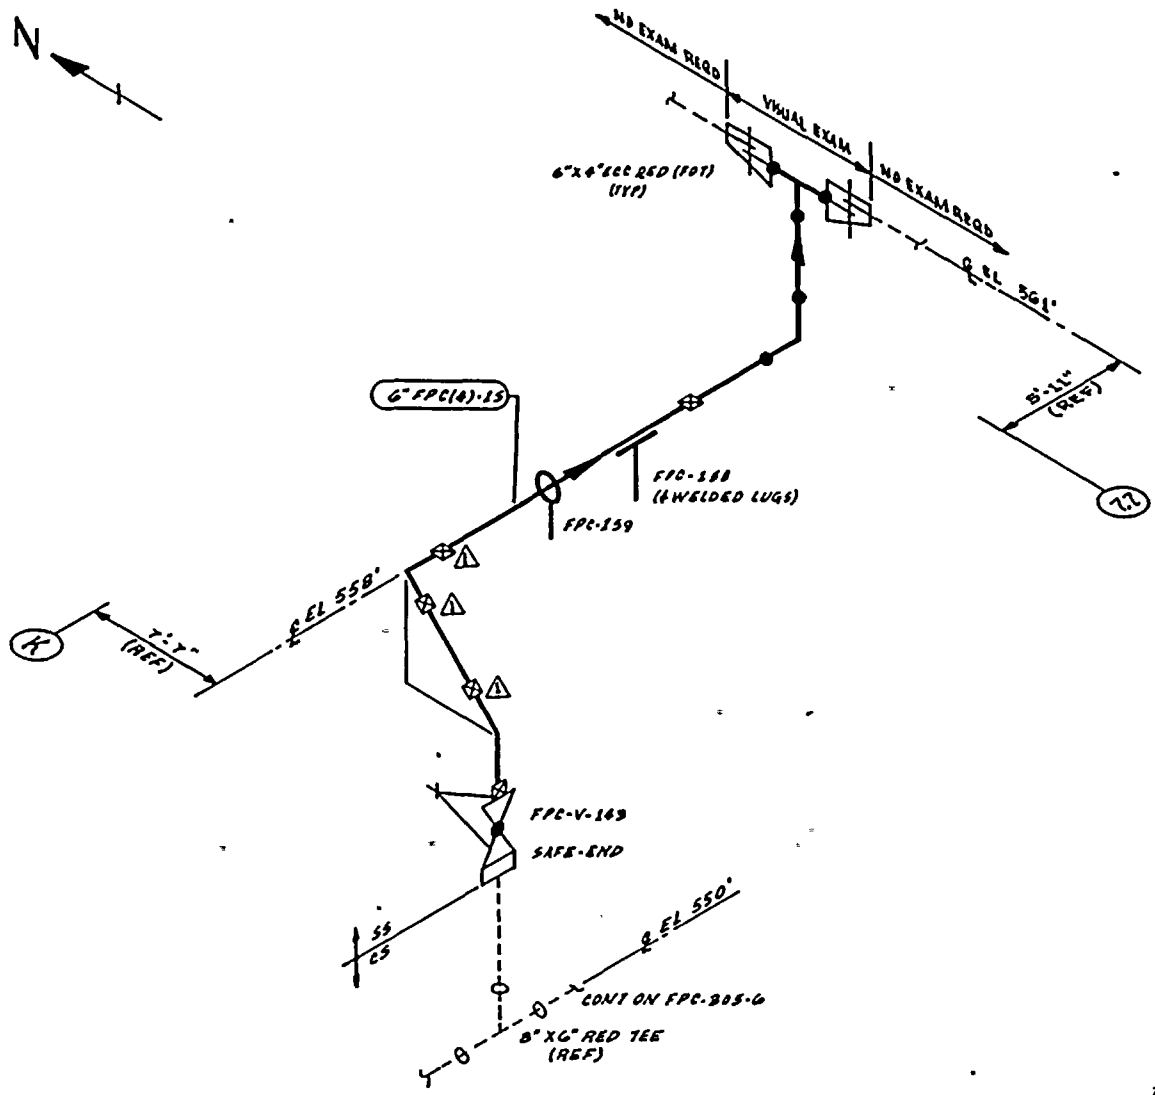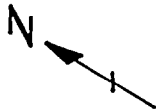


ZONE R-61

THIS DRAWING IS INTENDED FOR USE IN PRESERVICE AND INSERVICE INSPECTION PROGRAMS ONLY.

NOTES:
 1. THIS DRAWING IDENTIFIES PIPING & COMPONENTS SUBJECT ONLY TO A VISUAL EXAM FOR (1) EVIDENCE OF LEAKAGE DURING SYSTEM PRESSURE OR OPERABILITY TESTS; (2) PRESSURE DECAY TESTS OF BURIED PIPING; & (3) LOSS OF SUPPORT CAPABILITY OR INADEQUATE RESTRAINT FOR SUPPORTS & HANGERS ON PIPING EXCEEDING 4" NOM. TESTS SHALL BE CONDUCTED PER ASME SECTION XI, ARTICLES IWA-5000 & IWD-2000.

REFERENCES:
 BOVES & CRAL ISOMETRICS
 FPC-669-1.7, REV 5

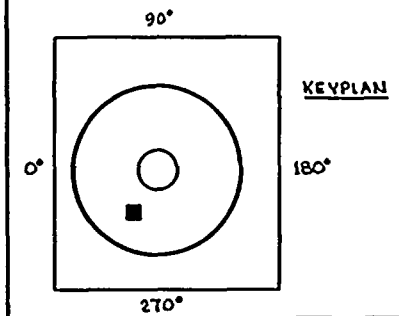

QUALITY CLASS: 2 ASME CODE CLASS: 3
 ENGR: *[Signature]* DRAWN: *[Signature]* DATE: 4-25-79

WASHINGTON PUBLIC POWER SUPPLY SYSTEM
 RICHLAND, WASHINGTON 98352



PIPING SYSTEM	NOM DIA (IN)	SCH	NOM WALL THK	MATERIAL SPECIFICATION	MATL TYPE	CAL BLOCK NO
6" FPC(4)-1B	6	10S	0.134	SA 312 TP 304	SS	NA

WNP-2
 WELD & COMPONENT IDENTIFICATION DIAGRAM
 TITLE:
 FPC-DM-1A & 1B TO DIFFUSERS
 DWG NO: FPC-305-10 REV 1

NO	DATE	REVISION	BY	CHKD	APPVD
1	11-2-93	REVISED AS NOTED ADDED KEYPLAN	<i>[Signature]</i>	<i>[Signature]</i>	<i>[Signature]</i>
0	12-2-79	ISSUED FOR USE	<i>[Signature]</i>	<i>[Signature]</i>	<i>[Signature]</i>

2 3 4 5 6 7 8

A
B
C
D
E
F
G

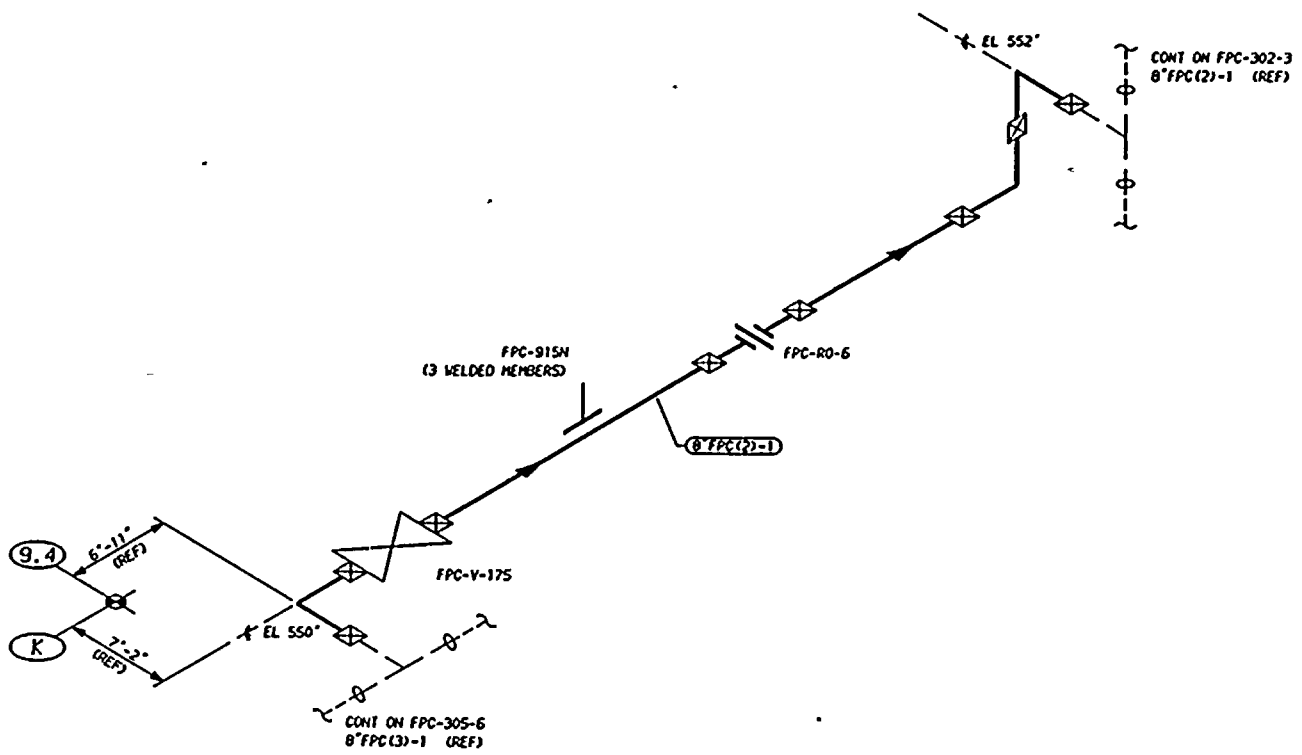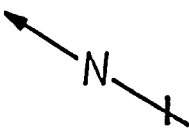


NOTES:

1. THIS DRAWING IDENTIFIES PIPING AND COMPONENTS SUBJECT ONLY TO A VISUAL EXAM FOR (1) EVIDENCE OF LEAKAGE DURING SYSTEM PRESSURE OR OPERABILITY TESTS, (2) PRESSURE DECAY TESTS OF BURIED PIPING, AND (3) LOSS OF SUPPORT CAPABILITY OR INADEQUATE RESTRAINT FOR SUPPORTS AND HANGERS ON PIPING EXCEEDING 4" NOM. TESTS SHALL BE CONDUCTED PER ASME SECTION XI, ARTICLES 1WA-5000 AND 1WD-2000.

REFERENCES:

151 - 226
BOYEE & CRAIL ISOMETRIC
FPC-640-31.40 REV 5

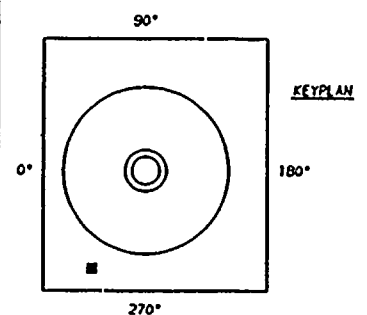

R-61

THIS DRAWING IS INTENDED FOR USE IN PRESERVICE AND INSERVICE INSPECTIONS PROGRAMS ONLY.

QUALITY CLASS, 2	ASME CODE CLASS, 3
ENGR: K-MANDREW	DATE: 1-5-84

WASHINGTON PUBLIC POWER
SUPPLY SYSTEM
RICHLAND, WASHINGTON 99352

WNP-2
WELD & COMPONENT
IDENTIFICATION DIAGRAM

TITLE:
BY-PASS BETWEEN INFULENT & EFFLUENT TO REACTOR

DWG NO, FPC-305-11 REV 0

PIPING SYSTEM	NOM DIA (IN)	SCH	NOM WALL THK	MATERIAL SPECIFICATION	MATL TYPE	CAL BLOCK NO
8" FPC(2)-1	8	STD	0.322	SA 106 GR B	CS	NA

0	1-1-84	ISSUED FOR USE			
NO	DATE	REVISION	BY	CHKD	APVD



WNP-02
 INTERVAL: PSI
 PERIOD: NA
 OUTAGE:
 DRAWING NO. FPC-305

WASHINGTON PUBLIC POWER SUPPLY SYSTEM
 PROGRAM PLAN AND SCHEDULE
 SYSTEM OR COMPONENT: FPC(3)-1
 DESCRIPTION: FPC-DM-1A RETURN

PAGE 001
 DATE 12/14/84

<u>IDENT. NO.</u>	<u>DESCRIPTION</u>	<u>SECT.</u> <u>XI</u>	<u>EXAM</u>	<u>PROCEDURE</u>	<u>CAL.</u> <u>BLOCK</u>	<u>INSERVICE</u>		<u>NOTES</u>
						<u>EXAM.</u>	<u>MTG.</u>	
FPC-83	RIGID	N/A	VT-3	303/8.2.17				
FPC-82	RIGID	N/A	VT-3	303/8.2.17				
FPC-79	RIGID	N/A	VT-3	303/8.2.17				
FPC-78	RIGID	N/A	VT-3	303/8.2.17				
FPC-93	BOX	N/A	VT-3	303/8.2.17				
FPC-92	RIGID	N/A	VT-3	303/8.2.17				
FPC-91	RIGID	N/A	VT-3	303/8.2.17				
FPC-77	STRUT	N/A	VT-3	303/8.2.17				
FPC-76	RIGID	N/A	VT-3	303/8.2.17				
FPC-75	BOX	N/A	VT-3	303/8.2.17				
FPC-74	RIGID	N/A	VT-3	303/8.2.17				
FPC-73	RIGID	N/A	VT-3	303/8.2.17				
FPC-72	BOX	N/A	VT-3	303/8.2.17				
FPC-71	RIGID	N/A	VT-3	303/8.2.17				
FPC-68	BOX	N/A	VT-3	303/8.2.17				
FPC-69	RIGID	N/A	VT-3	303/8.2.17				
FPC-70	RIGID	N/A	VT-3	303/8.2.17				
FPC-67	RIGID	N/A	VT-3	303/8.2.17				

WNP-02
 INTERVAL: PSI
 PERIOD: NA
 OUTAGE:
 DRAWING NO. FPC-305

WASHINGTON PUBLIC POWER SUPPLY SYSTEM
 PROGRAM PLAN AND SCHEDULE
 SYSTEM OR COMPONENT: FPC(3)-1
 DESCRIPTION: FPC-DM-1A RETURN

PAGE 002
 DATE 12/14/84

<u>IDENT. NO.</u>	<u>DESCRIPTION</u>	<u>SECT.</u> <u>XI</u>	<u>EXAM</u> <u>MTH.</u>	<u>PROCEDURE</u>	<u>CAL.</u> <u>BLOCK</u>	<u>INSERVICE</u> <u>SCHEDULED</u>		<u>NOTES</u>
						<u>REQ.</u>	<u>OUTAGE</u>	
FPC-66								
	RIGID	N/A	VT-3	303/8.2.17				
FPC-168								
	BOX	N/A	VT-3	303/8.2.17				
FPC-167								
	BOX	N/A	VT-3	303/8.2.17				
FPC-166								
	BOX	N/A	VT-3	303/8.2.17				
FPC-911N								
	BOX	N/A	VT-3	303/8.2.17				
FPC-165								
	BOX	N/A	VT-3	303/8.2.17				
FPC-206								
	BOX	N/A	VT-3	303/8.2.17				
FPC-164								
	BOX	N/A	VT-3	303/8.2.17				
FPC-163								
	BOX	N/A	VT-3	303/8.2.17				
FPC-201								
	BOX	N/A	VT-3	303/8.2.17				
FPC-201	RIGID	N/A	VT-3	303/8.2.17				
FPC-162								
	BOX	N/A	VT-3	303/8.2.17				
FPC-160								
	RIGID	N/A	VT-3	303/8.2.17				
FPC-161								
	BOX	N/A	VT-3	303/8.2.17				
FPC-913N								
	BOX	N/A	VT-3	303/8.2.17				
FPC-912N								
	BOX	N/A	VT-3	303/8.2.17				
FPC-211								
	STRUT	N/A	VT-3	303/8.2.17				
FPC-213								
	BOX	N/A	VT-3	303/8.2.17				
FPC-231								
	BOX	N/A	VT-3	303/8.2.17				

WNP-02
 INTERVAL: PSI
 PERIOD: NA
 OUTAGE:
 DRAWING NO. FPC-305

WASHINGTON PUBLIC POWER SUPPLY SYSTEM
 PROGRAM PLAN AND SCHEDULE
 SYSTEM OR COMPONENT: FPC(3)-1
 DESCRIPTION: FPC-DH-1A RETURN

PAGE 003
 DATE 12/14/84



<u>IDENT. NO.</u>	<u>DESCRIPTION</u>	SECT. <u>XI</u> <u>EXAM.</u>	<u>EXAM</u> <u>MTM.</u>	<u>PROCEDURE</u>	<u>CAL.</u> <u>BLOCK</u>	<u>INSERVICE</u>		<u>NOTES</u>
						<u>REQ.</u>	<u>SCHEDULED</u> <u>OUTAGE</u>	
FPC-214	BOX	N/A	VT-3	303/8.2.17				
FPC-215	BOX	N/A	VT-3	303/8.2.17				
FPC-216	BOX	N/A	VT-3	303/8.2.17				
FPC-240	BOX	N/A	VT-3	303/8.2.17				
FPC-230	SPRING	N/A	VT-3	303/8.2.17				
			VT-4	303/8.2.17				
FPC-229	PSA-3 SNUBBER	N/A	VT-3	303/8.2.17				S/N
			VT-4	303/8.2.17				S/N
FPC-228	PSA-1/2 SN(2)	N/A	VT-3	303/8.2.17				S/N
			VT-4	303/8.2.17				S/N
FPC-227	PSA-1 SNUBBER	N/A	VT-3	303/8.2.17				S/N
			VT-4	303/8.2.17				S/N
FPC-226	SPRING	N/A	VT-3	303/8.2.17				
			VT-4	303/8.2.17				
FPC-225	PSA-1 SNUBBER	N/A	VT-3	303/8.2.17				S/N
			VT-4	303/8.2.17				S/N
FPC-224	BOX	N/A	VT-3	303/8.2.17				
FPC-223	ANCHOR	N/A	VT-3	303/8.2.17				

WNP-02
 INTERVAL: PSI
 PERIOD: NA
 OUTAGE:
 DRAWING NO. FPC-305

WASHINGTON PUBLIC POWER SUPPLY SYSTEM
 PROGRAM PLAN AND SCHEDULE
 SYSTEM OR COMPONENT: FPC(3)-1
 • DESCRIPTION: FPC-DM-1A RFTURN


PAGE 004
 DATE 12/14/84

<u>IDENT. NO.</u>	<u>DESCRIPTION</u>	<u>SECT.</u> XI <u>EXAM.</u>	<u>EXAM</u> <u>MTM.</u>	<u>PROCEDURE</u>	<u>CAL.</u> <u>BLOCK</u>	<u>INSERVICE</u>		<u>NOTES</u>
						<u>REQ.</u>	<u>SCHEDULED</u> <u>OUTAGE</u>	
FPC-209	BOX	N/A	VT-3	303/8.2.17				
FPC-210	BOX	N/A	VT-3	303/8.2.17				
FPC-159	BOX	N/A	VT-3	303/8.2.17				
FPC-158	BOX	N/A	VT-3	303/8.2.17				
FPC-PB-305	FPC PRES BNDRY	N/A	VT-2	N/A				SEE NOTES #6 & #7.

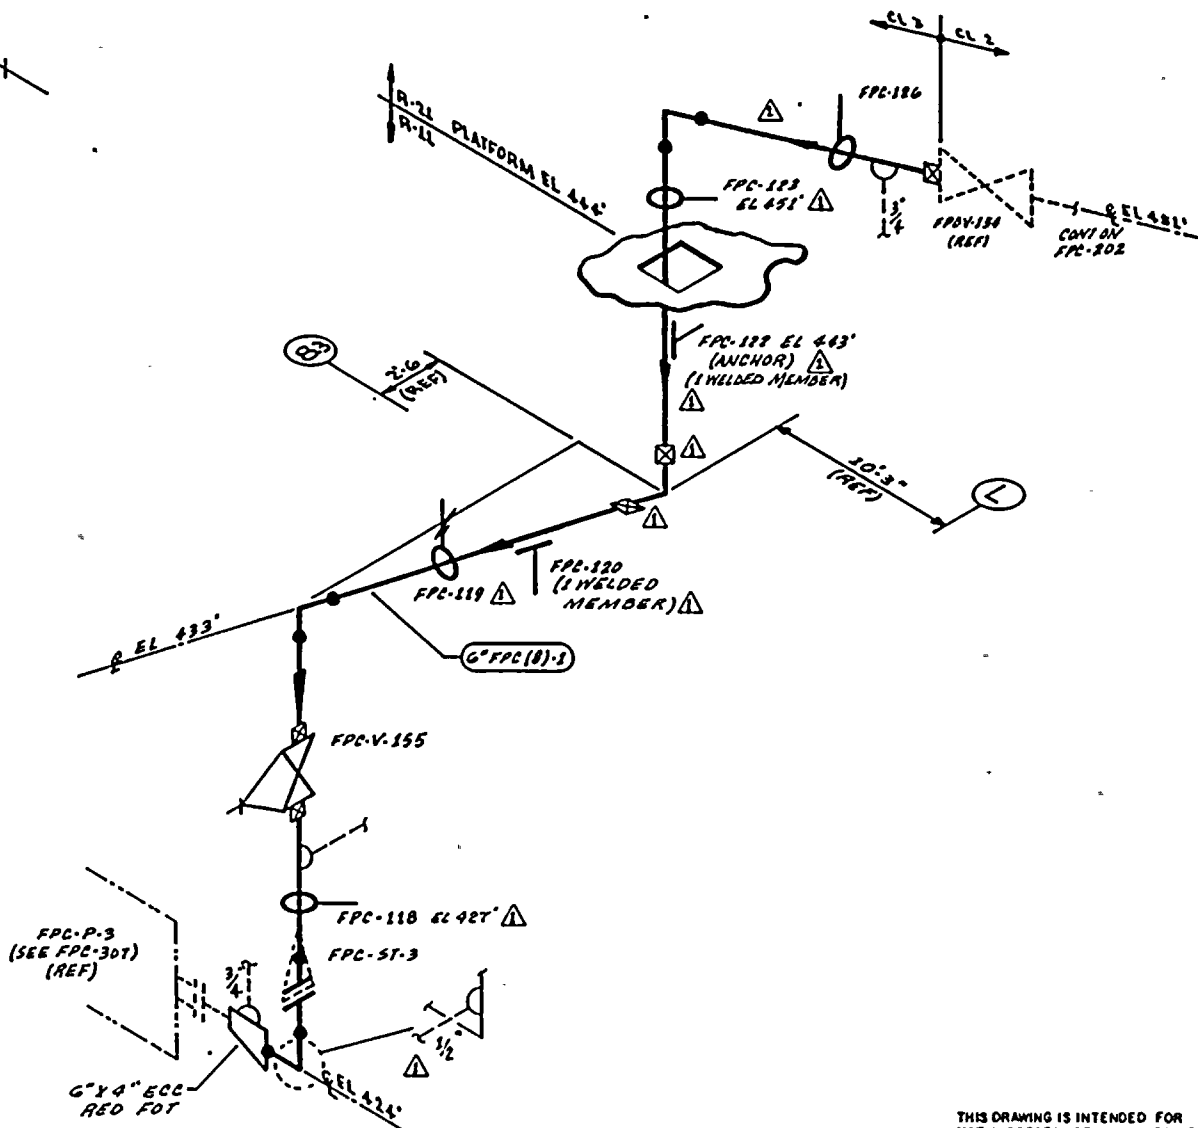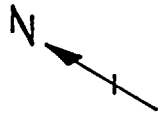

- NOTES**
1. THIS DRAWING IDENTIFIES PIPING & COMPONENTS SUBJECT ONLY TO A VISUAL EXAM FOR (1) EVIDENCE OF LEAKAGE DURING SYSTEM PRESSURE OR OPERABILITY TESTS; (2) PRESSURE DECAY TESTS OF BURIED PIPING; & (3) LOSS OF SUPPORT CAPABILITY OR INADEQUATE RESTRAINT FOR SUPPORTS & HANGERS ON PIPING EXCEEDING 4" NOM. TESTS SHALL BE CONDUCTED PER ASME SECTION XI, ARTICLES IMA-5000 & IWD-2000.
 2. FOR BRANCH PIPING 4" NOM. OR LESS (UNLESS SHOWN IN DASHED LINES) EXTEND VISUAL LEAKAGE EXAM THROUGH THE OUTERMOST NORMALLY CLOSED NUCLEAR CLASS VALVE, OR UNTIL TRANSITION TO INSTRUMENT TUBING, UNLESS OTHERWISE NOTED.

- REFERENCES:**
- BOYCE & CRAIL ISOMETRICS
 - FPC-G39-1.2 REV 10
 - FPC-G39-3.5 REV 9

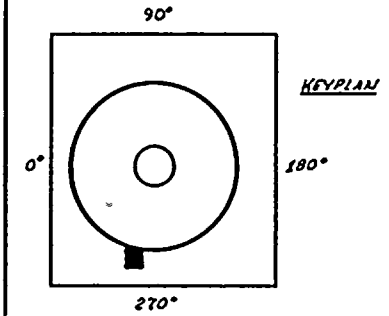

THIS DRAWING IS INTENDED FOR USE IN PRESERVICE AND INSERVICE INSPECTION PROGRAMS ONLY.

QUALITY CLASS: 2	ASME CODE CLASS: 3
ENGR: <i>A. Anderson</i>	DRAWN: <i>A. M. A.</i> DATE: 4-27-79

WASHINGTON PUBLIC POWER SUPPLY SYSTEM
 RICHMOND, WASHINGTON 98362

PIPING SYSTEM	NOM DIA (IN)	SCH	NOM WALL THK	MATERIAL SPECIFICATION	MATL TYPE	CAL BLOCK NO
6" FPC (B)-1	6	STD	0.280	SA 106 GR B	CS	NA

WNP-2
 WELD & COMPONENT
 IDENTIFICATION DIAGRAM

TITLE:
SUPPRESSION POOL TO FPC-P-3 SUCTION

DWG NO: FPC-306 REV 1

NO	DATE	REVISION	BY	CHKD	APPVD
1	1/27/84	REVISED AS NOTED ADDED KEYPLAN	<i>J. M. A.</i>	<i>M. R.</i>	<i>T. H.</i>
0	12/21/77	ISSUED FOR USE	<i>J. M. A.</i>	<i>D. W.</i>	<i>T. H.</i>


SUPPLEMENTARY REFERENCES TO 200

WNP-02
 INTERVAL: PSI
 PERIOD: NA
 OUTAGE:
 DRAWING NO. FPC-306

WASHINGTON PUBLIC POWER SUPPLY SYSTEM
 PROGRAM PLAN AND SCHEDULE
 SYSTEM OR COMPONENT: FPC(8)-1
 DESCRIPTION: SUPPR POOL TO SUCT


PAGE 001
 DATE 12/14/84

<u>IDENT. NO.</u>	<u>DESCRIPTION</u>	SECT. XI <u>EXAM.</u>	EXAM <u>MTG.</u>	<u>PROCEDURE</u>	CAL. <u>BLOCK</u>	<u>INSERVICE</u>		<u>NOTES</u>
						<u>REQ.</u>	<u>SCHEDULED OUTAGE</u>	
FPC-126	STRUT	N/A	VT-3	303/8.2.17				
FPC-123	BOX	N/A	VT-3	303/8.2.17				
FPC-122	ANCHOR	N/A	VT-3	303/8.2.17				
FPC-120	BOX	N/A	VT-3	303/8.2.17				
FPC-119	SPRING	N/A	VT-3	303/8.2.17				
FPC-118	RIGID	N/A	VT-4	303/8.2.17				
FPC-PB-306	FPC PRES BNDRY	N/A	VT-3	303/8.2.17				
		N/A	VT-2	N/A				SEE NOTES #6 & #7.

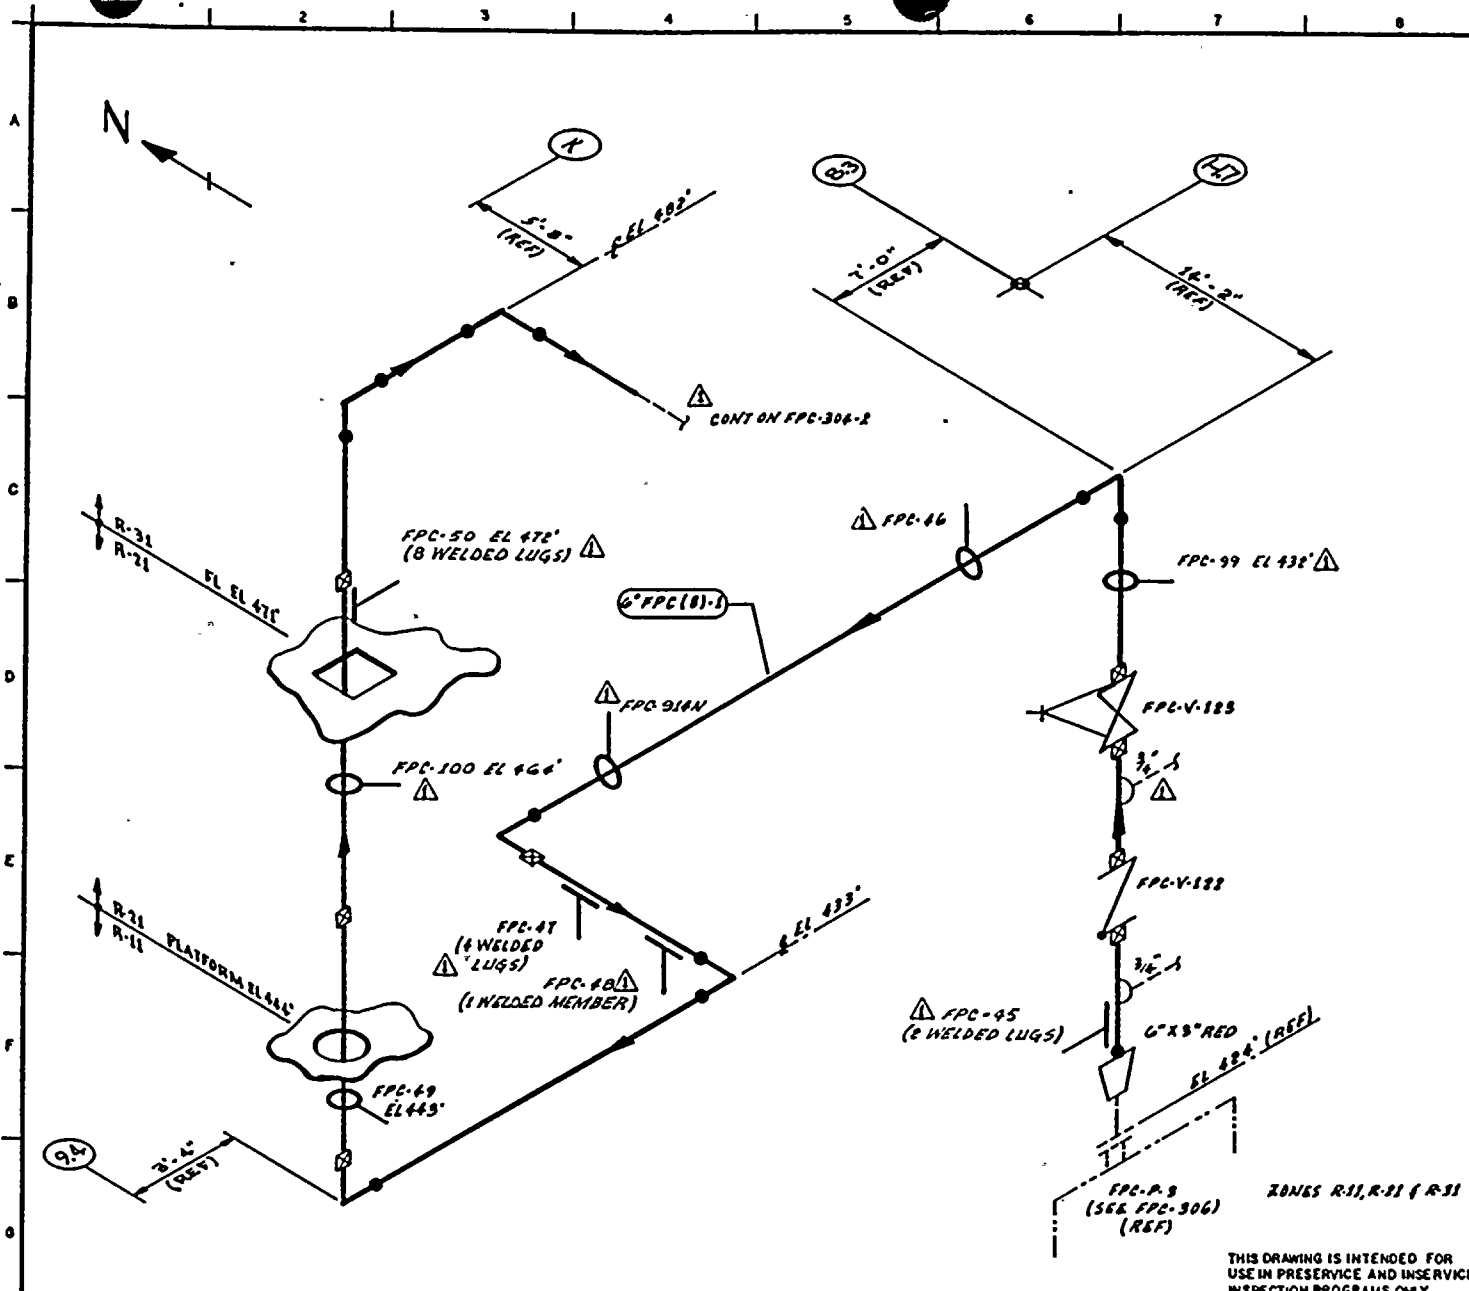

- NOTES:**
1. THIS DRAWING IDENTIFIES PIPING & COMPONENTS SUBJECT ONLY TO A VISUAL EXAM FOR (1) EVIDENCE OF LEAKAGE DURING SYSTEM PRESSURE OR OPERABILITY TESTS; (2) PRESSURE DECAY TESTS OF BURIED PIPING; & (3) LOSS OF SUPPORT CAPABILITY OR INADEQUATE RESTRAINT FOR SUPPORTS & HANGERS ON PIPING EXCEEDING 4" NOM. TESTS SHALL BE CONDUCTED PER ASME SECTION XI, ARTICLES IWA-5000 & IWD-2000.
 2. FOR BRANCH PIPING 4" NOM OR LESS (CONN SHOWN IN DASHED LINES) EXTEND VISUAL LEAKAGE EXAM THROUGH THE OUTERMOST NORMALLY CLOSED NUCLEAR CLASS VALVE, OR UNTIL TRANSITION TO INSTRUMENT TUBING, UNLESS OTHERWISE NOTED.

- REFERENCES:**
- BOYCE & GRAY ISOMETRICS
 - FPC-638-1.3 REV B
 - FPC-638-4.7 REV 7

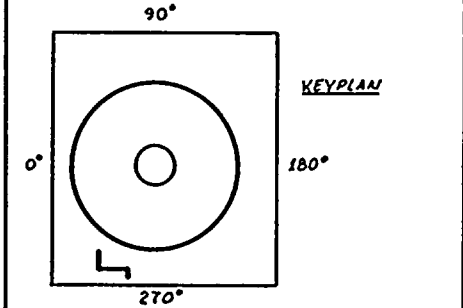

QUALITY CLASS: 2 ASME CODE CLASS: 3
 ENGR: J.M. LUDMAN DRAWN: J.M. LUDMAN DATE: 4-30-79

WASHINGTON PUBLIC POWER SUPPLY SYSTEM
 RICHLAND, WASHINGTON 99352

PIPING SYSTEM	NOM DIA (IN)	SCH	NOM WALL THK	MATERIAL SPECIFICATION	MATL TYPE	CAL BLOCK NO
6" FPC (81)-1	6	STD	0.280	SA 106 GR B	CS	NA

NO	DATE	REVISION	BY	CHKD	APPVD
1	12/83	REVISED AS NOTED ADDED KEYPLAN	JML	JML	JML
0	12/81	ISSUED FOR USE	JML	JML	JML

THIS DRAWING IS INTENDED FOR USE IN PRESERVICE AND INSERVICE INSPECTION PROGRAMS ONLY.

WNP-2
 WELD & COMPONENT IDENTIFICATION DIAGRAM

TITLE:
FPC-P-3 DISCHARGE

DWG NO: FPC-307 REV 1




WNP-02
 INTERVAL: PSI
 PERIOD: NA
 OUTAGE:
 DRAWING NO. FPC-307

WASHINGTON PUBLIC POWER SUPPLY SYSTEM
 PROGRAM PLAN AND SCHEDULE
 SYSTEM OR COMPONENT: FPC(8)-1
 DESCRIPTION: FPC-P-3 DISCHARGE

PAGE 001
 DATE 12/14/84


<u>IDENT. NO.</u>	<u>DESCRIPTION</u>	<u>SECT.</u>		<u>PROCEDURE</u>	<u>CAL. BLOCK</u>	<u>INSERVICE SCHEDULED</u>		<u>NOTES</u>
		<u>XI EXAM</u>	<u>EXAM</u>			<u>REQ.</u>	<u>OUTAGE</u>	
FPC-45	BOX	N/A	VT-3	303/8.2.17				
FPC-99	BOX	N/A	VT-3	303/8.2.17				
FPC-47	BOX	N/A	VT-3	303/8.2.17				
FPC-48	BOX	N/A	VT-3	303/8.2.17				
FPC-49	BOX	N/A	VT-3	303/8.2.17				
FPC-100	BOX	N/A	VT-3	303/8.2.17				
FPC-50	BOX	N/A	VT-3	303/8.2.17				
FPC-PB-307	BOX	N/A	VT-3	303/8.2.17				
	FPC PRES BNDRY	N/A	VT-2	N/A				SEE NOTES #6 & #7.



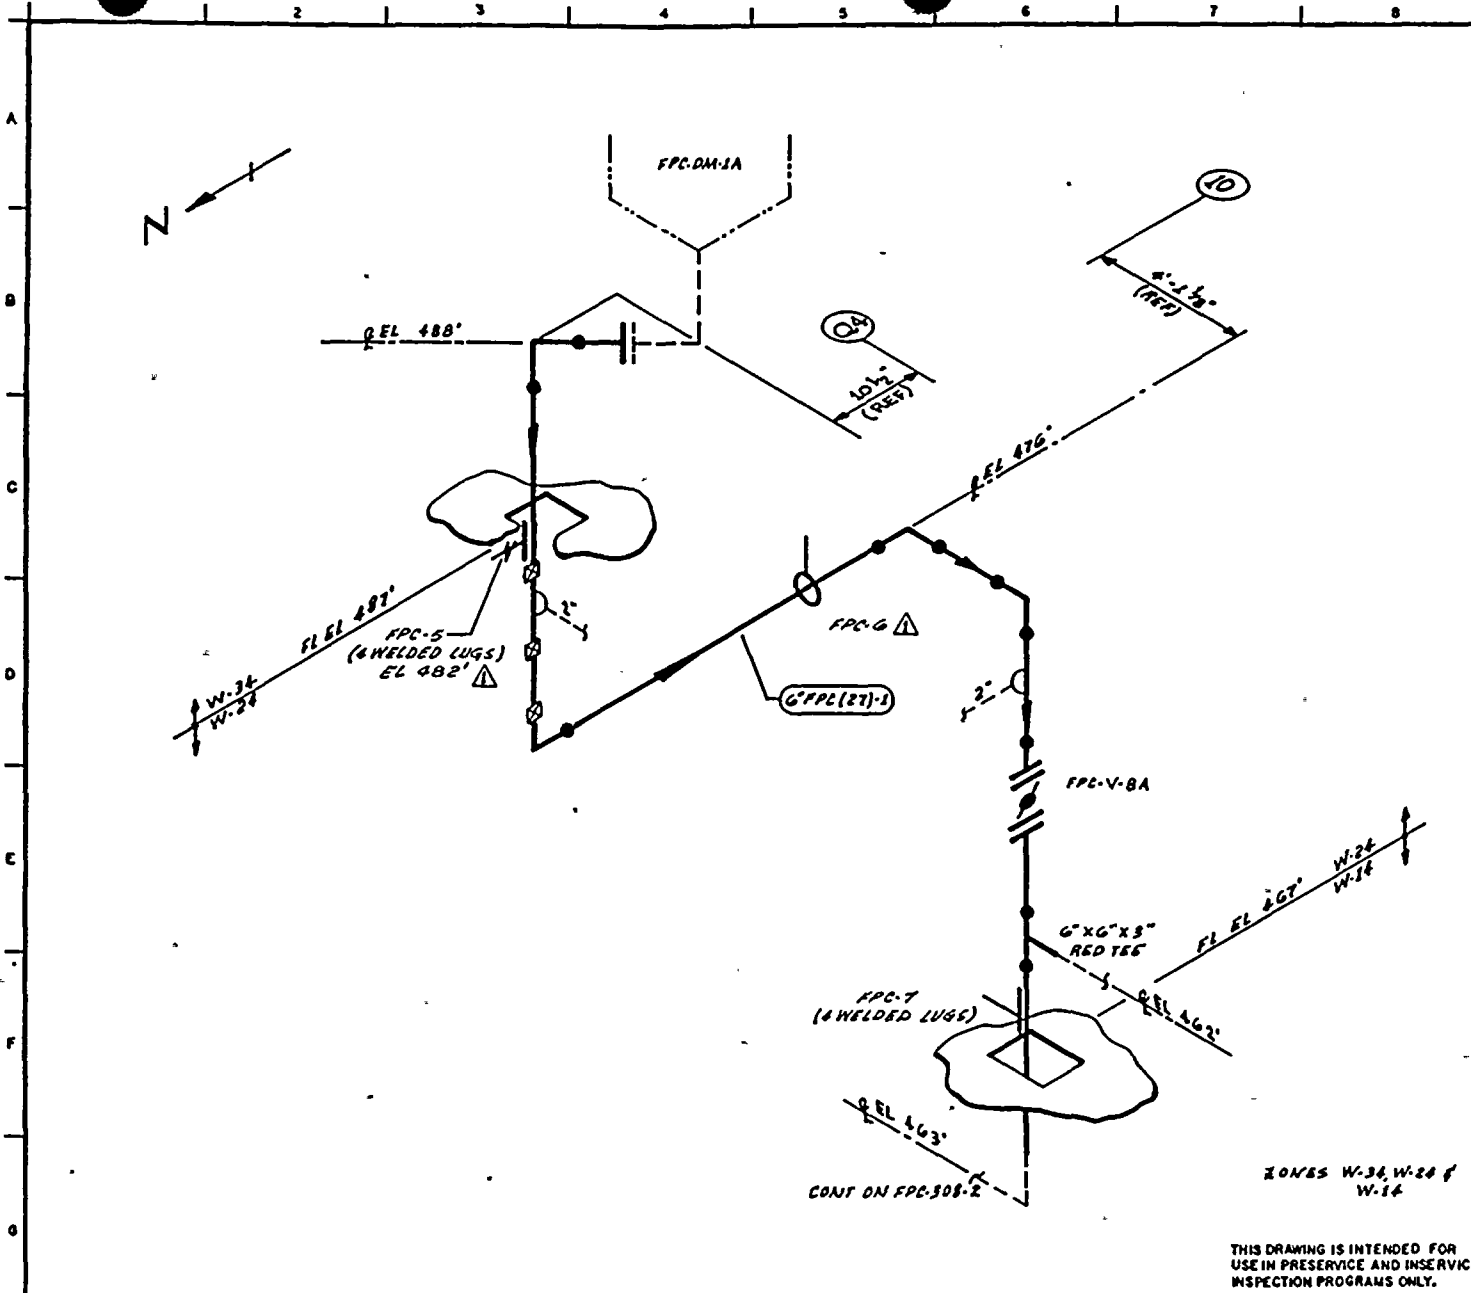

- NOTES:**
1. THIS DRAWING IDENTIFIES PIPING & COMPONENTS SUBJECT ONLY TO A VISUAL EXAM FOR (1) EVIDENCE OF LEAKAGE DURING SYSTEM PRESSURE OR OPERABILITY TESTS; (2) PRESSURE DECAY TESTS OF BURIED PIPING; & (3) LOSS OF SUPPORT CAPABILITY OR INADEQUATE RESTRAINT FOR SUPPORTS & HANGERS ON PIPING EXCEEDING 4" NOM. TESTS SHALL BE CONDUCTED PER ASME SECTION XI, ARTICLES IWA-5000 & IWD-2000.
 2. FOR BRANCH PIPING 4" NOM OR LESS (CONN SHOWN IN DASHED LINES) EXTEND VISUAL LEAKAGE EXAM THROUGH THE OUTERMOST NORMALLY CLOSED NUCLEAR CLASS VALVE, OR UNTIL TRANSITION TO INSTRUMENT TUBING, UNLESS OTHERWISE NOTED.

REFERENCES:
BOVGE & CRAIG ISOMETRIC
FPC-778-1.3 REV 2

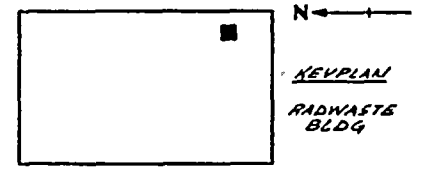

QUALITY CLASS: 2 ASME CODE CLASS: 3
ENGR: *A. H. Anderson* DRAWN: *R. H. L.* DATE: 4-30-79

WASHINGTON PUBLIC POWER SUPPLY SYSTEM
RICHLAND, WASHINGTON 99352

THIS DRAWING IS INTENDED FOR USE IN PRESERVICE AND INSERVICE INSPECTION PROGRAMS ONLY.


PIPING SYSTEM	NOM DIA (IN)	SCH	NOM WALL THK	MATERIAL SPECIFICATION	MATL TYPE	CAL BLOCK NO
G\"/>						

WNP-2
WELD & COMPONENT
IDENTIFICATION DIAGRAM

TITLE:
FPC-DM-1A TO FDR-TK-22

DWG NO: FPC-308-1 REV 1

NO	DATE	REVISION	BY	CHKD	APPVD
1	1/28/86	REVISED AS NOTED ADDED KEYPLAN	<i>J. H. A.</i>	<i>Z. R.</i>	<i>J. H. W.</i>
0	12/28/79	ISSUED FOR USE	<i>A. H. A.</i>	<i>Z. R.</i>	<i>J. H. W.</i>

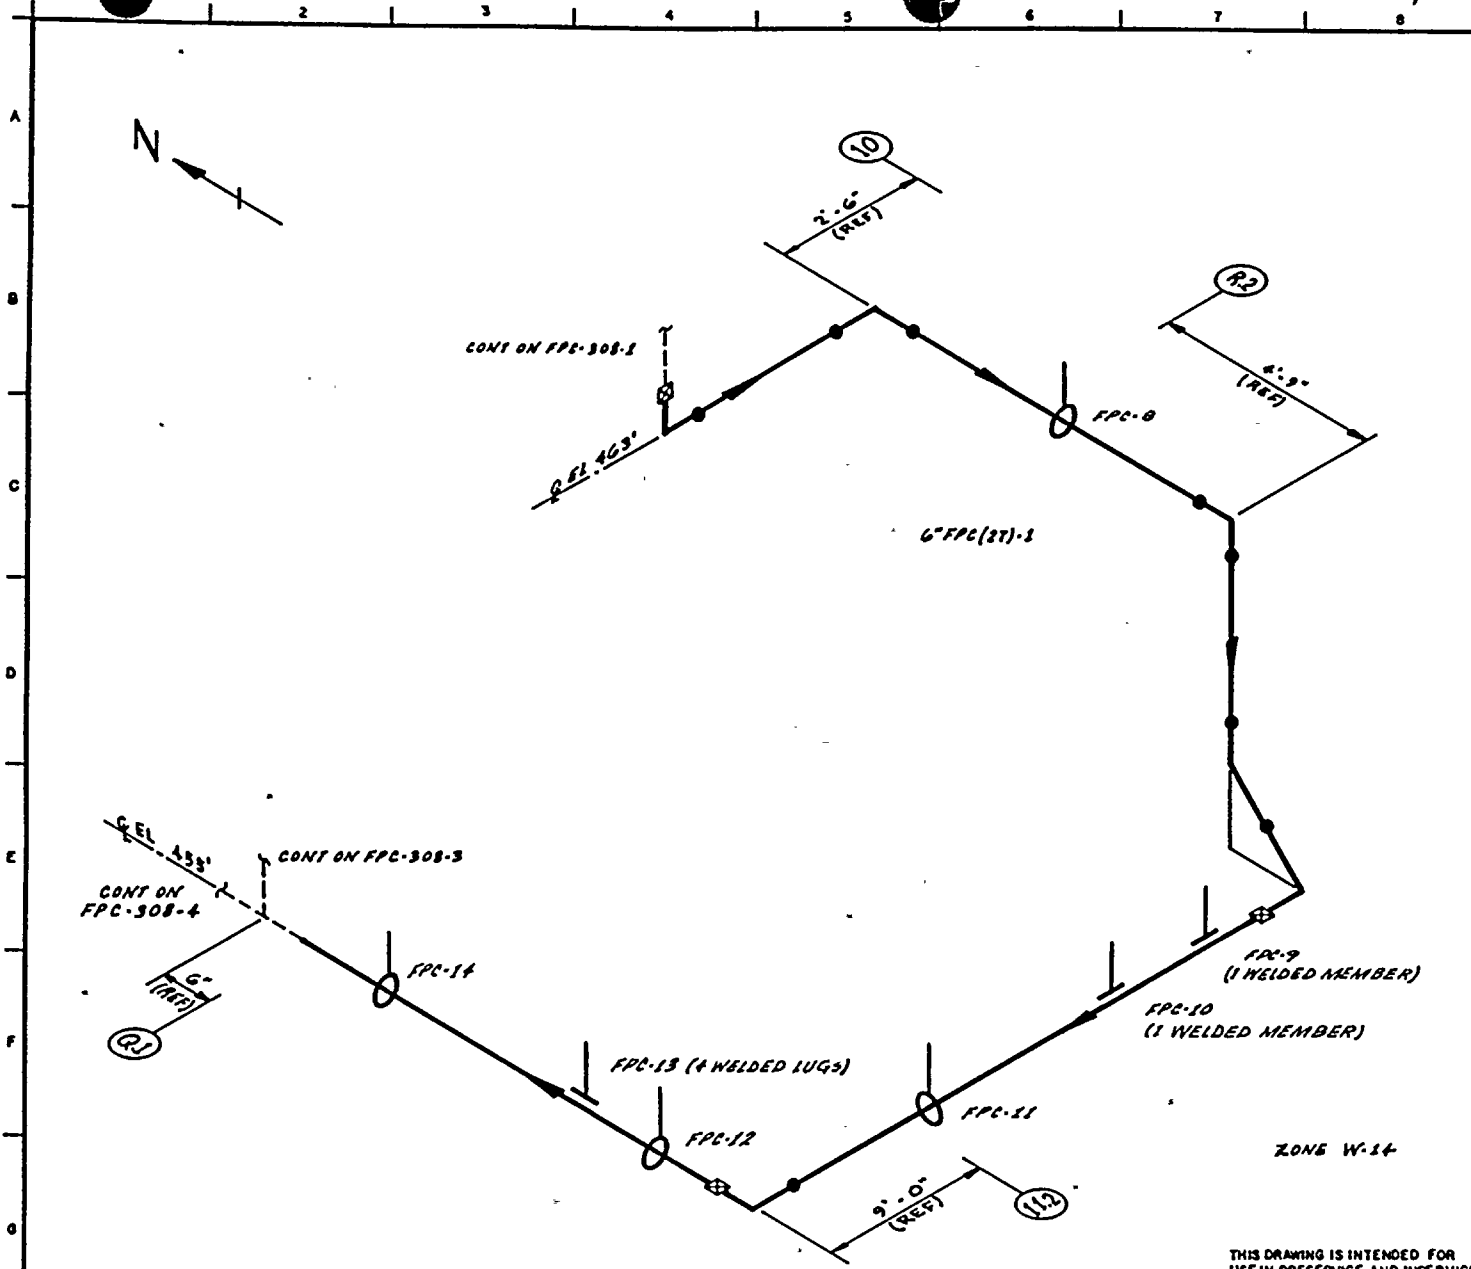


NOTES:

1. THIS DRAWING IDENTIFIES PIPING & COMPONENTS SUBJECT ONLY TO A VISUAL EXAM FOR (1) EVIDENCE OF LEAKAGE DURING SYSTEM PRESSURE OR OPERABILITY TESTS; (2) PRESSURE DECAY TESTS OF BURIED PIPING; & (3) LOSS OF SUPPORT CAPABILITY OR INADEQUATE RESTRAINT FOR SUPPORTS & HANGERS ON PIPING EXCEEDING 4" NOM. TESTS SHALL BE CONDUCTED PER ASME SECTION XI, ARTICLES IWA-5000 & IWD-2000.

REFERENCES:

BOYCE & GRILL ISOMETRIC
FPC-778-4.6 REV 4

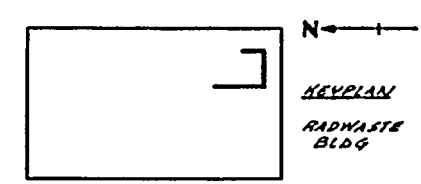

QUALITY CLASS: 2 ASME CODE CLASS: 3
ENGR: *[Signature]* DRAWN: *[Signature]* DATE: 5-1-79

WASHINGTON PUBLIC POWER SUPPLY SYSTEM
RICHLAND, WASHINGTON 98822

THIS DRAWING IS INTENDED FOR USE IN PRESERVICE AND INSERVICE INSPECTION PROGRAMS ONLY.


PIPING SYSTEM	NOM DIA (IN)	SCH	NOM WALL THK	MATERIAL SPECIFICATION	MATL TYPE	CAL BLOCK NO
6" FPC(27)-1	6	STD	0.280	SA 106 GR B	CS	NA


WNP- 2
WELD & COMPONENT IDENTIFICATION DIAGRAM

TITLE:
FPC-DM-1A TO FDR-TK-22

DWG NO: FPC-308-2 REV 1


NO	DATE	REVISION	BY	CHKD	APPVD
1	1/2/80	REVISED ALL HANGERS ADDED KEYPLAN	Y4CA	ZMR	TRW
0	12/78	ISSUED FOR USE	Y4CA	ZMR	TRW

 

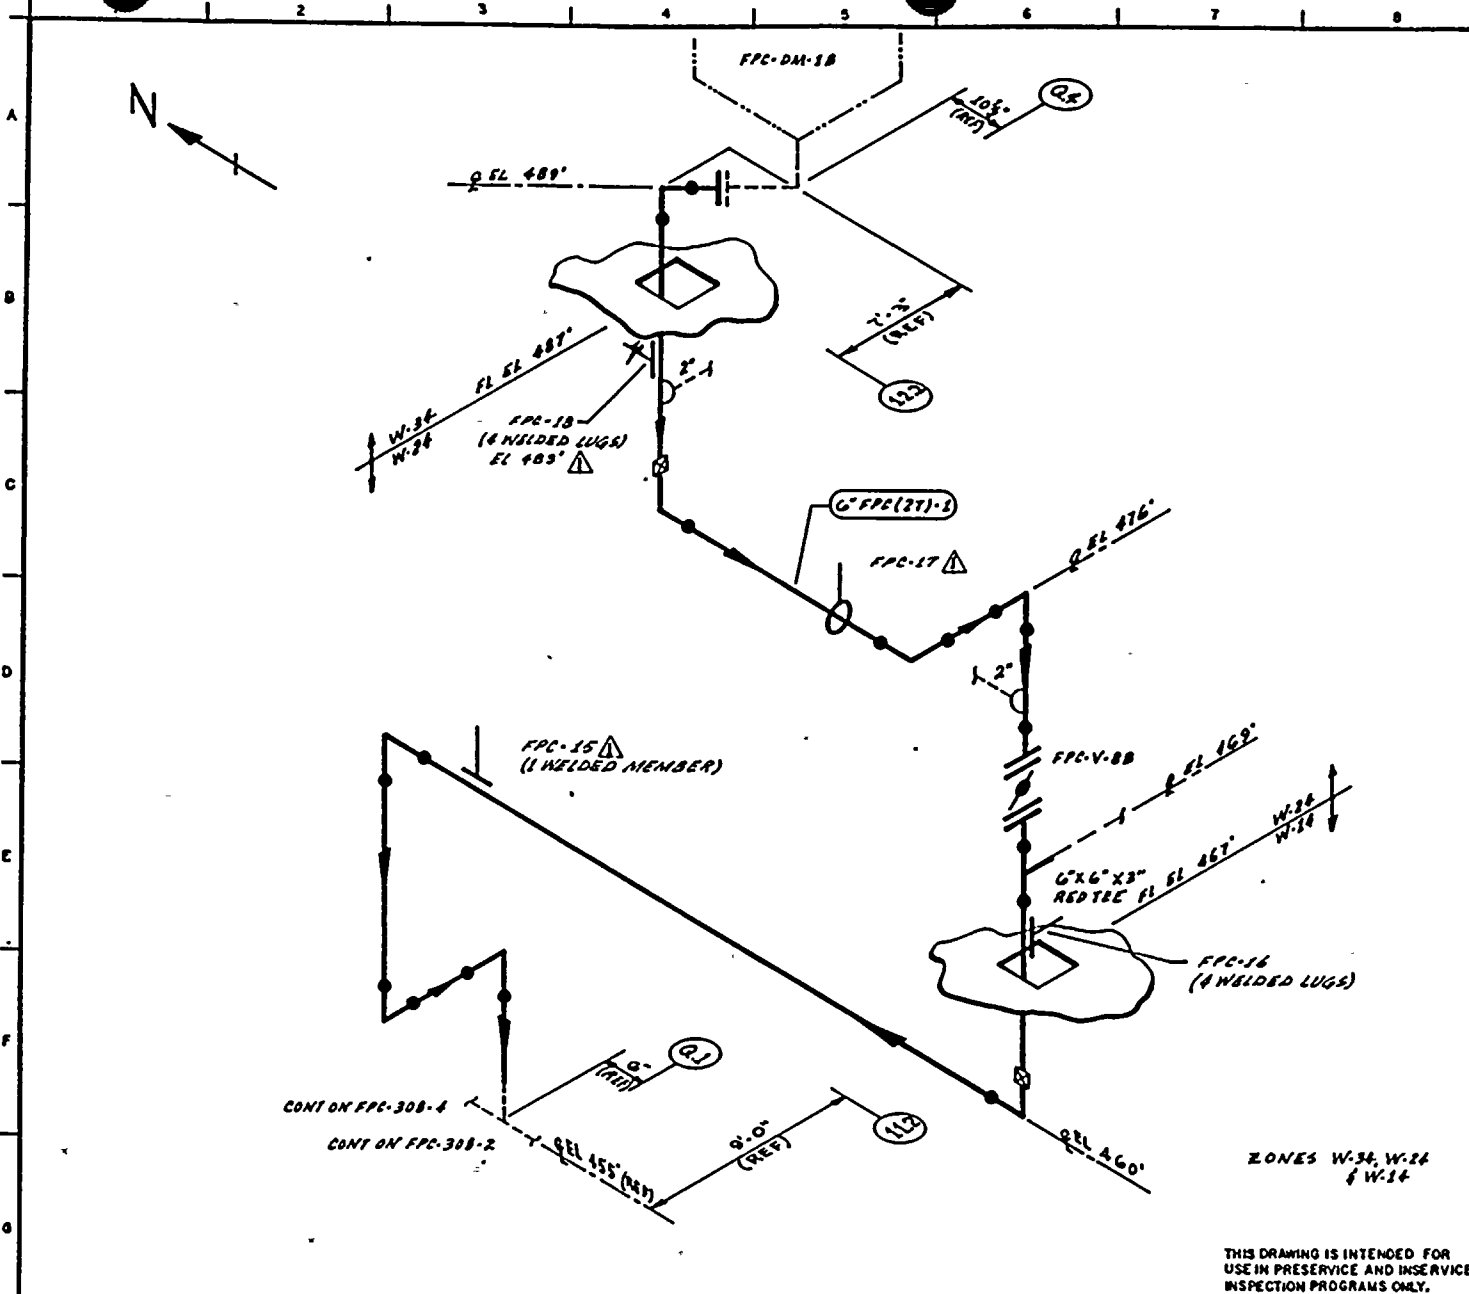

- NOTES:**
1. THIS DRAWING IDENTIFIES PIPING & COMPONENTS SUBJECT ONLY TO A VISUAL EXAM FOR (1) EVIDENCE OF LEAKAGE DURING SYSTEM PRESSURE OR OPERABILITY TESTS; (2) PRESSURE DECAY TESTS OF BURIED PIPING; & (3) LOSS OF SUPPORT CAPABILITY OR INADEQUATE RESTRAINT FOR SUPPORTS & HANGERS ON PIPING EXCEEDING 4" NOM. TESTS SHALL BE CONDUCTED PER ASME SECTION XI, ARTICLES IWA-5000 & IWD-2000.
 2. FOR BRANCH PIPING 4" NOM OR LESS (CONN SHOWN IN DASHED LINES) EXTEND VISUAL LEAKAGE EXAM THROUGH THE OUTER-MOST NORMALLY CLOSED NUCLEAR CLASS VALVE, OR UNTIL TRANSITION TO INSTRUMENT TUBING, UNLESS OTHERWISE NOTED.

REFERENCES:
 BOYCE & CRAIG ISOMETRIC
 FPC-778-10-13 REV 1

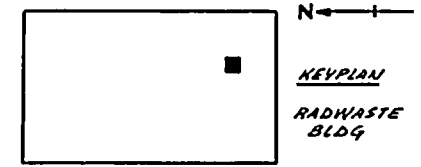

QUALITY CLASS: 2 ASME CODE CLASS: 3
 ENGR: J. H. HARRIS DRAWN: K. M. L. DATE: 5-1-79

WASHINGTON PUBLIC POWER SUPPLY SYSTEM
 RICHLAND, WASHINGTON 99352

THIS DRAWING IS INTENDED FOR USE IN PRESERVICE AND INSERVICE INSPECTION PROGRAMS ONLY.


PIPING SYSTEM	NOM DIA (IN)	SCH	NOM WALL THK	MATERIAL SPECIFICATION	MATL TYPE	CAL BLOCK NO
6" FPC(27)-1	6	STD	0.280	SA 106 GR B	CN	NA

WNP-2
 WELD & COMPONENT IDENTIFICATION DIAGRAM

TITLE:
 FPC-DM-1B TO FDR-TX-22

OWG NO: FPC-308-3 REV 1


NO	DATE	REVISION	BY	CHKD	APPVD
1	12-18-84	REVISED AS NOTED ADDED KEYPLAN	K. M. L.	EPR	TFW
0	12-21-81	ISSUED FOR USE	K. M. L.	WT	TFW

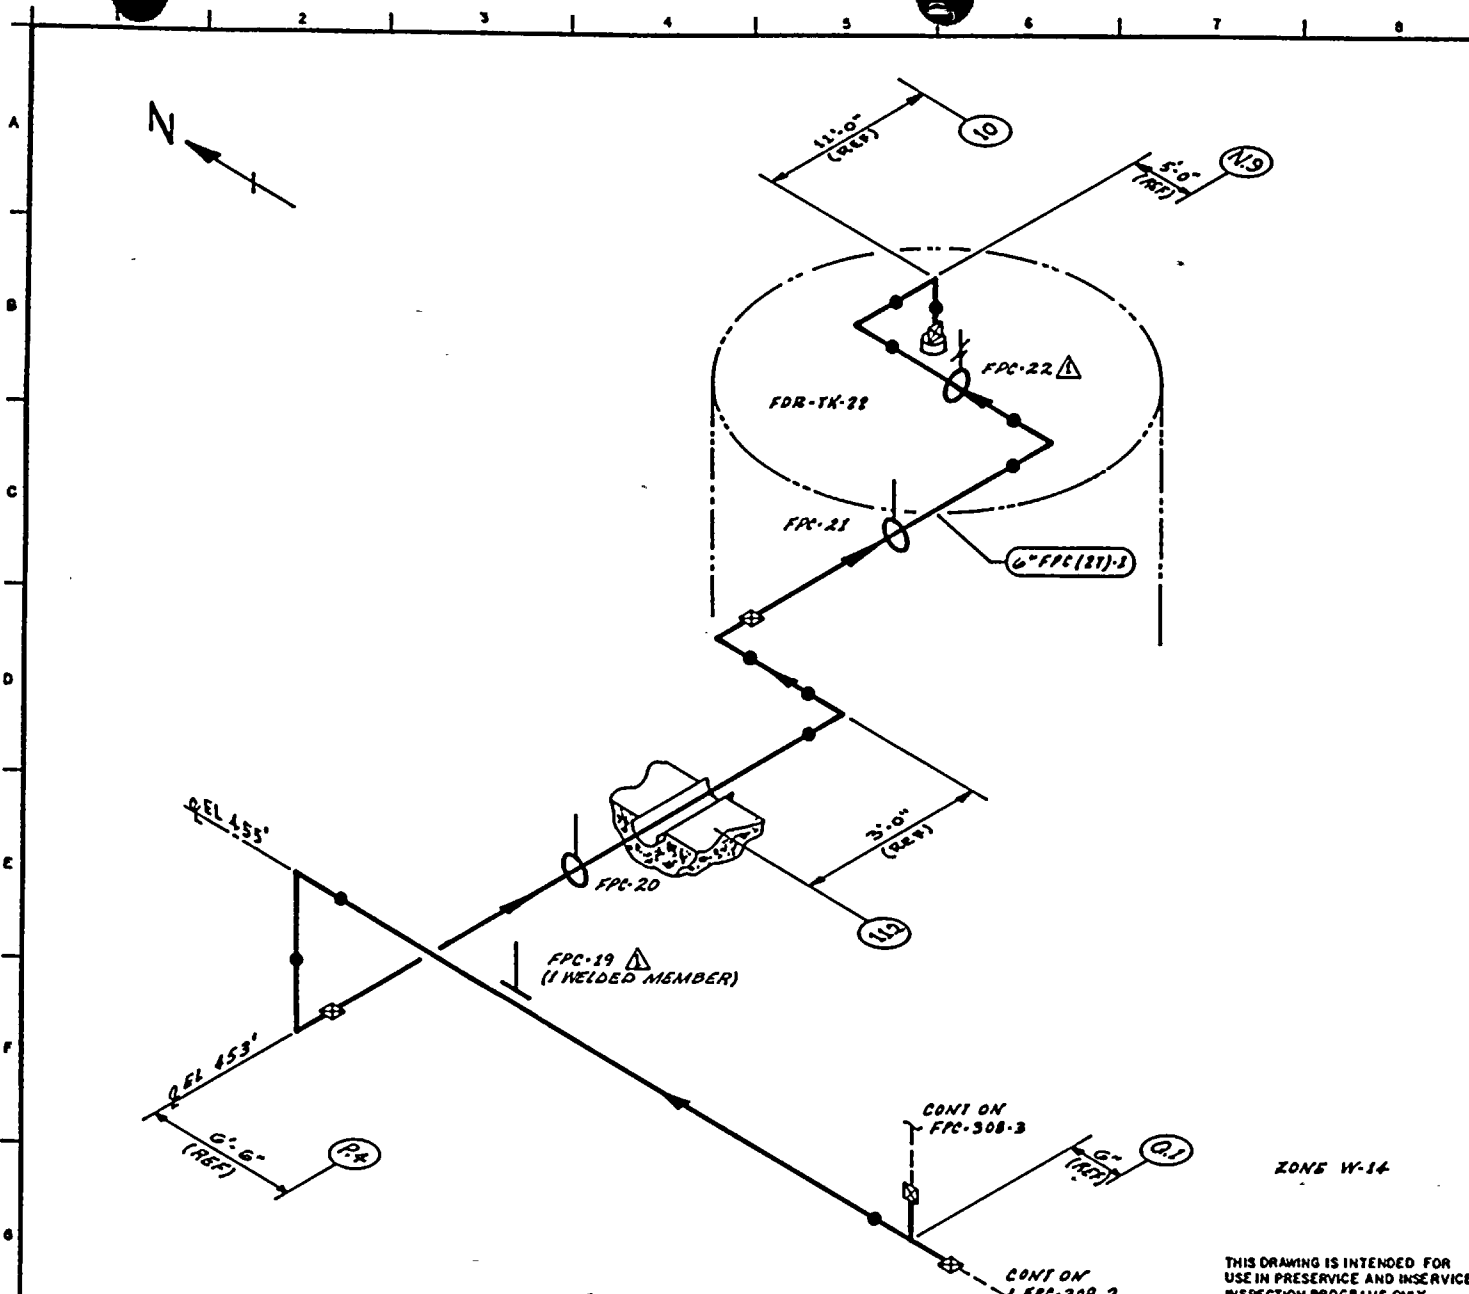

NOTES:

- THIS DRAWING IDENTIFIES PIPING & COMPONENTS SUBJECT ONLY TO A VISUAL EXAM FOR (1) EVIDENCE OF LEAKAGE DURING SYSTEM PRESSURE OR OPERABILITY TESTS; (2) PRESSURE DECAY TESTS OF BURIED PIPING; & (3) LOSS OF SUPPORT CAPABILITY OR INADEQUATE RESTRAINT FOR SUPPORTS & HANGERS ON PIPING EXCEEDING 4" NOM. TESTS SHALL BE CONDUCTED PER ASME SECTION XI, ARTICLES IWA-5000 & IWD-2000.

REFERENCES:
 BAYSE & CRAIG ISOMETRIC
 FPC-778-7.9 REV 3

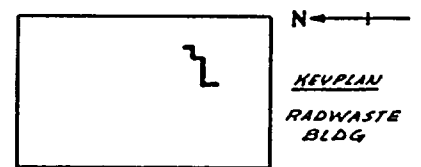

QUALITY CLASS: 2 ASME CODE CLASS: B
 ENGR: *[Signature]* DRAWN: *K.McA* DATE: 5-1-79

WASHINGTON PUBLIC POWER SUPPLY SYSTEM
 RICHLAND, WASHINGTON 98352

THIS DRAWING IS INTENDED FOR USE IN PRESERVICE AND INSERVICE INSPECTION PROGRAMS ONLY.

PIPING SYSTEM	NOM DIA (IN)	SCH	NOM WALL THK	MATERIAL SPECIFICATION	MATL TYPE	CAL BLOCK NO
6" FPC (37)-1	6	STD	0.280	SA 106 GR B	CS	NA

WHP-2
 WELD & COMPONENT IDENTIFICATION DIAGRAM

TITLE:
FPC-DM-1A & 1B TO FDR-TK-22

DWG NO: FPC-308-4 REV 1

NO	DATE	REVISION	BY	CHKD	APPVD
1	5/1/79	REVISED AS NOTED ADDED KEY PLAN	<i>[Signature]</i>	DKR	TFH
0	1/1/79	ISSUED FOR USE	<i>[Signature]</i>	JHM	TFH



WNP-02
 INTERVAL: PSI
 PERIOD: NA
 OUTAGE:
 DRAWING NO. FPC-308

WASHINGTON PUBLIC POWER SUPPLY SYSTEM
 PROGRAM PLAN AND SCHEDULE
 SYSTEM OR COMPONENT: FPC(27)-1
 DESCRIPTION: FPC-DH-1A/R TO TK-22

PAGE 001
 DATE 12/14/84


<u>IDENT. NO.</u>	<u>DESCRIPTION</u>	<u>SECT.</u> <u>XI</u>	<u>EYAM</u> <u>HTH.</u>	<u>PROCEDURE</u>	<u>CAL.</u> <u>BLOCK</u>	<u>INSERVICE</u>		<u>NOTES</u>
						<u>REQ.</u>	<u>SCHEDULED</u> <u>OUTAGE</u>	
FPC-5	SPRING	N/A	VT-3	303/8.2.17				
			VT-4	303/8.2.17				
FPC-6	STRUT	N/A	VT-3	303/8.2.17				
FPC-7	RIGID	N/A	VT-3	303/8.2.17				
FPC-8	STRUT	N/A	VT-3	303/8.2.17				
FPC-9	BOX	N/A	VT-3	303/8.2.17				
FPC-10	BOX	N/A	VT-3	303/8.2.17				
FPC-11	BOX	N/A	VT-3	303/8.2.17				
FPC-12	STRUT	N/A	VT-3	303/8.2.17				
FPC-13	BOX	N/A	VT-3	303/8.2.17				
FPC-14	STRUT	N/A	VT-3	303/8.2.17				
FPC-15	RIGID	N/A	VT-3	303/8.2.17				
FPC-16	RIGID	N/A	VT-3	303/8.2.17				
FPC-17	STRUT	N/A	VT-3	303/8.2.17				
FPC-18	SPRING	N/A	VT-3	303/8.2.17				
			VT-4	303/8.2.17				
FPC-19	BOX	N/A	VT-3	303/8.2.17				
FPC-20	STRUT	N/A	VT-3	303/8.2.17				

WNP-02
INTERVAL: PSI
PERIOD: NA
OUTAGE:
DRAWING NO. FPC-308

WASHINGTON PUBLIC POWER SUPPLY SYSTEM
PROGRAM PLAN AND SCHEDULE
SYSTEM OR COMPONENT: FPC(27)-1
DESCRIPTION: FPC-DM-1A/B TO IK-22

PAGE 002
DATE 12/14/84

<u>IDENT. NO.</u>	<u>DESCRIPTION</u>	<u>SECT.</u> <u>XI</u>	<u>EXAM</u> <u>EXAM.</u>	<u>PROCEDURE</u>	<u>CAL.</u> <u>BLOCK</u>	<u>INSERVICE</u>		<u>NOTES</u>
						<u>REQ.</u>	<u>SCHEDULED</u> <u>OUTAGE</u>	
FPC-21	STRUT	N/A	VT-3	303/8.2.17				
FPC-22	SPRING	N/A	VT-3	303/8.2.17				
			VT-4	303/8.2.17				
FPC-PB-308	FPC PRES BNDRY	N/A	VT-2	N/A				SEE NOTES #6 & #7.

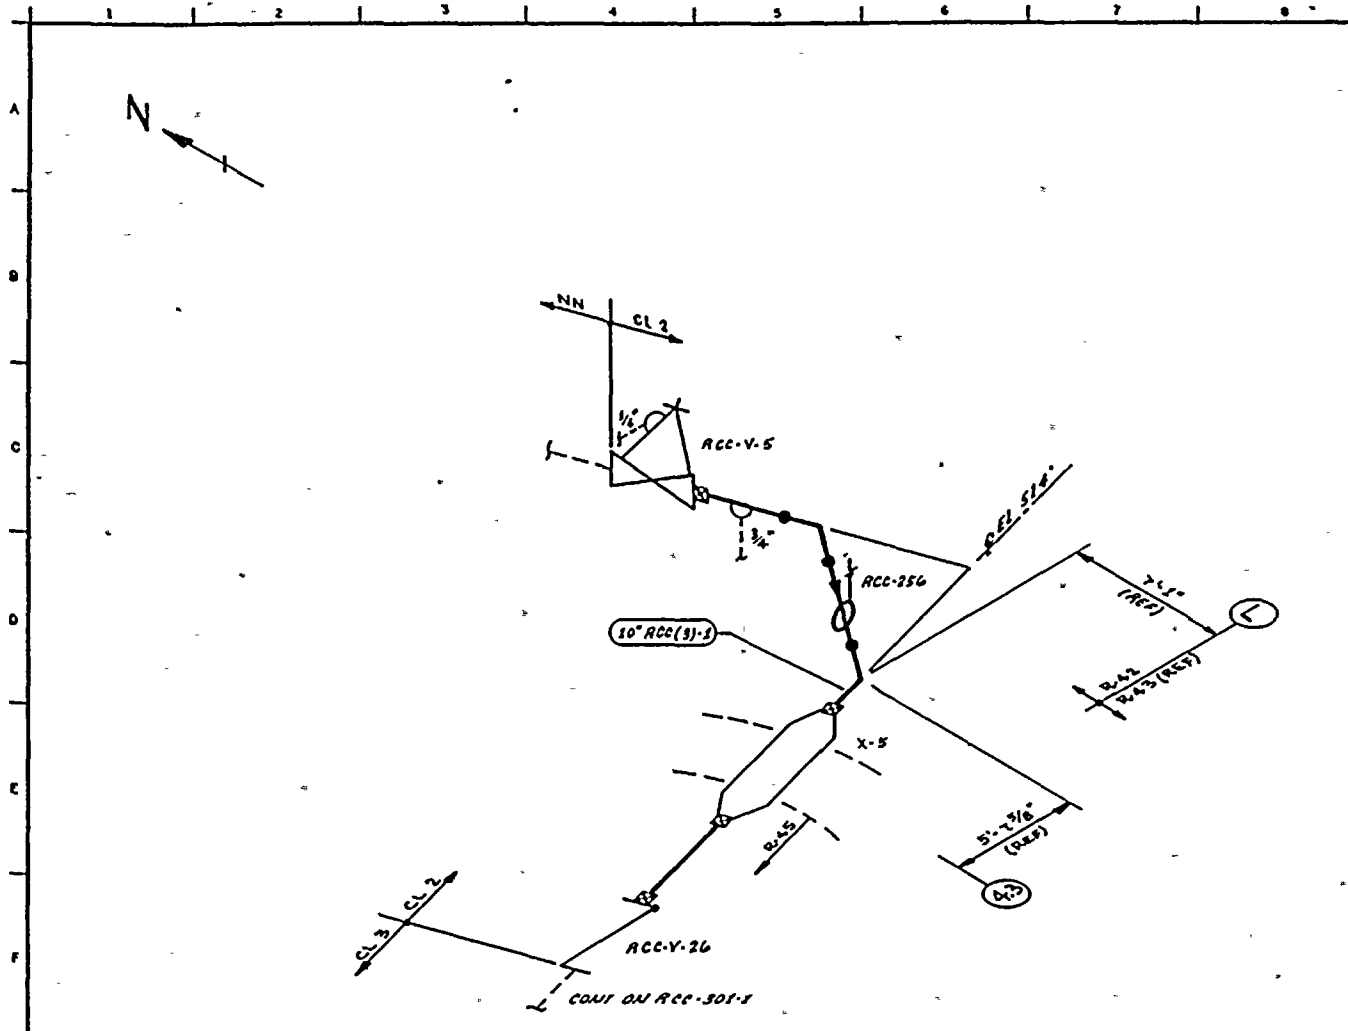

- NOTES:**
1. THIS DRAWING IDENTIFIES PIPING & COMPONENTS SUBJECT TO A VISUAL EXAM FOR EVIDENCE OF LEAKAGE DURING SYSTEM HYDRO OR OPERABILITY TESTS. TESTS SHALL BE CONDUCTED PER THE REQUIREMENTS OF ASME SECTION XI, PARAGRAPH IWA-5000.
 2. FOR BRANCH PIPING 4" DIA OR LESS (CONN SHOWN IN DASHED LINES) EXTEND VISUAL EXAM THROUGH THE OUTERMOST NORMALLY CLOSED NUCLEAR CLASS VALVE, OR UNTIL TRANSITION TO INSTRUMENT TUBING, UNLESS OTHERWISE NOTED.
 3. AT LOCATIONS WHERE LEAKAGE IS NORMALLY EXPECTED (E.G. VALVE STEM & PUMP SEAL LEAKOFF CONNECTIONS) VERIFY LEAKAGE COLLECTION SYSTEM OPERABILITY ONLY. NO HYDRO TEST OF COLLECTION SYSTEM IS REQUIRED.

- REFERENCES:**
- BOVES & CRAIG ISOMETRICS
- RCC-949-10-12 REV 4
 - RCC-831-1.2 REV 3
 - RCC-949-10-12H REV 3
 - RCC-831-1.2H REV 0

ZONE R-42 & R-45

THIS DRAWING IS INTENDED FOR USE IN PRESERVE AND INSERVICE INSPECTION PROGRAMS ONLY.

QUALITY CLASS: 1	ASME CODE CLASS: 2
ENGR: <i>[Signature]</i>	DRAWN: <i>[Signature]</i> DATE: 5.2.79

WASHINGTON PUBLIC POWER SUPPLY SYSTEM
 RICHLAND, WASHINGTON 99352

PIPING SYSTEM	NOM DIA (IN)	SCH	NOM WALL THK	MATERIAL SPECIFICATION	MATL TYPE	CAL BLOCK NO
10" RCC(3)-1	10	STD	0.365	SA 106 GR B	CS	NA

WNP-2
 WELD & COMPONENT IDENTIFICATION DIAGRAM

TITLE:

DWG NO: **RCC-201** REV 0

0	12/28	ISSUED FOR USE			
NO	DATE	REVISION	BY	CHKD	APPVD




WNP-02
INTERVAL: PSI
PERIOD: NA
OUTAGE:
DRAWING NO. RCC-201

WASHINGTON PUBLIC POWER SUPPLY SYSTEM
PROGRAM PLAN AND SCHEDULE
SYSTEM OR COMPONENT: RCC(3)-1
DESCRIPTION: RCC SUPPLY


PAGE 001
DATE 12/14/84

<u>IDENT. NO.</u>	<u>DESCRIPTION</u>	<u>SECT.</u>		<u>PROCEDURE</u>	<u>CAL. BLOCK</u>	<u>INSERVICE</u>		<u>NOTES</u>
		<u>XI</u>	<u>EXAM</u>			<u>REQ.</u>	<u>SCHEDULED</u>	
		<u>EXAM.</u>	<u>MTH.</u>			<u>OUTAGE</u>		
RCC-256	SPRING	N/A	VT-3	303/8.2.17				
			VT-4	303/8.2.17				
RCC-PB-201	RCC PRES BNDRY	N/A	VT-2	N/A				SEE NOTES #6 & #7.

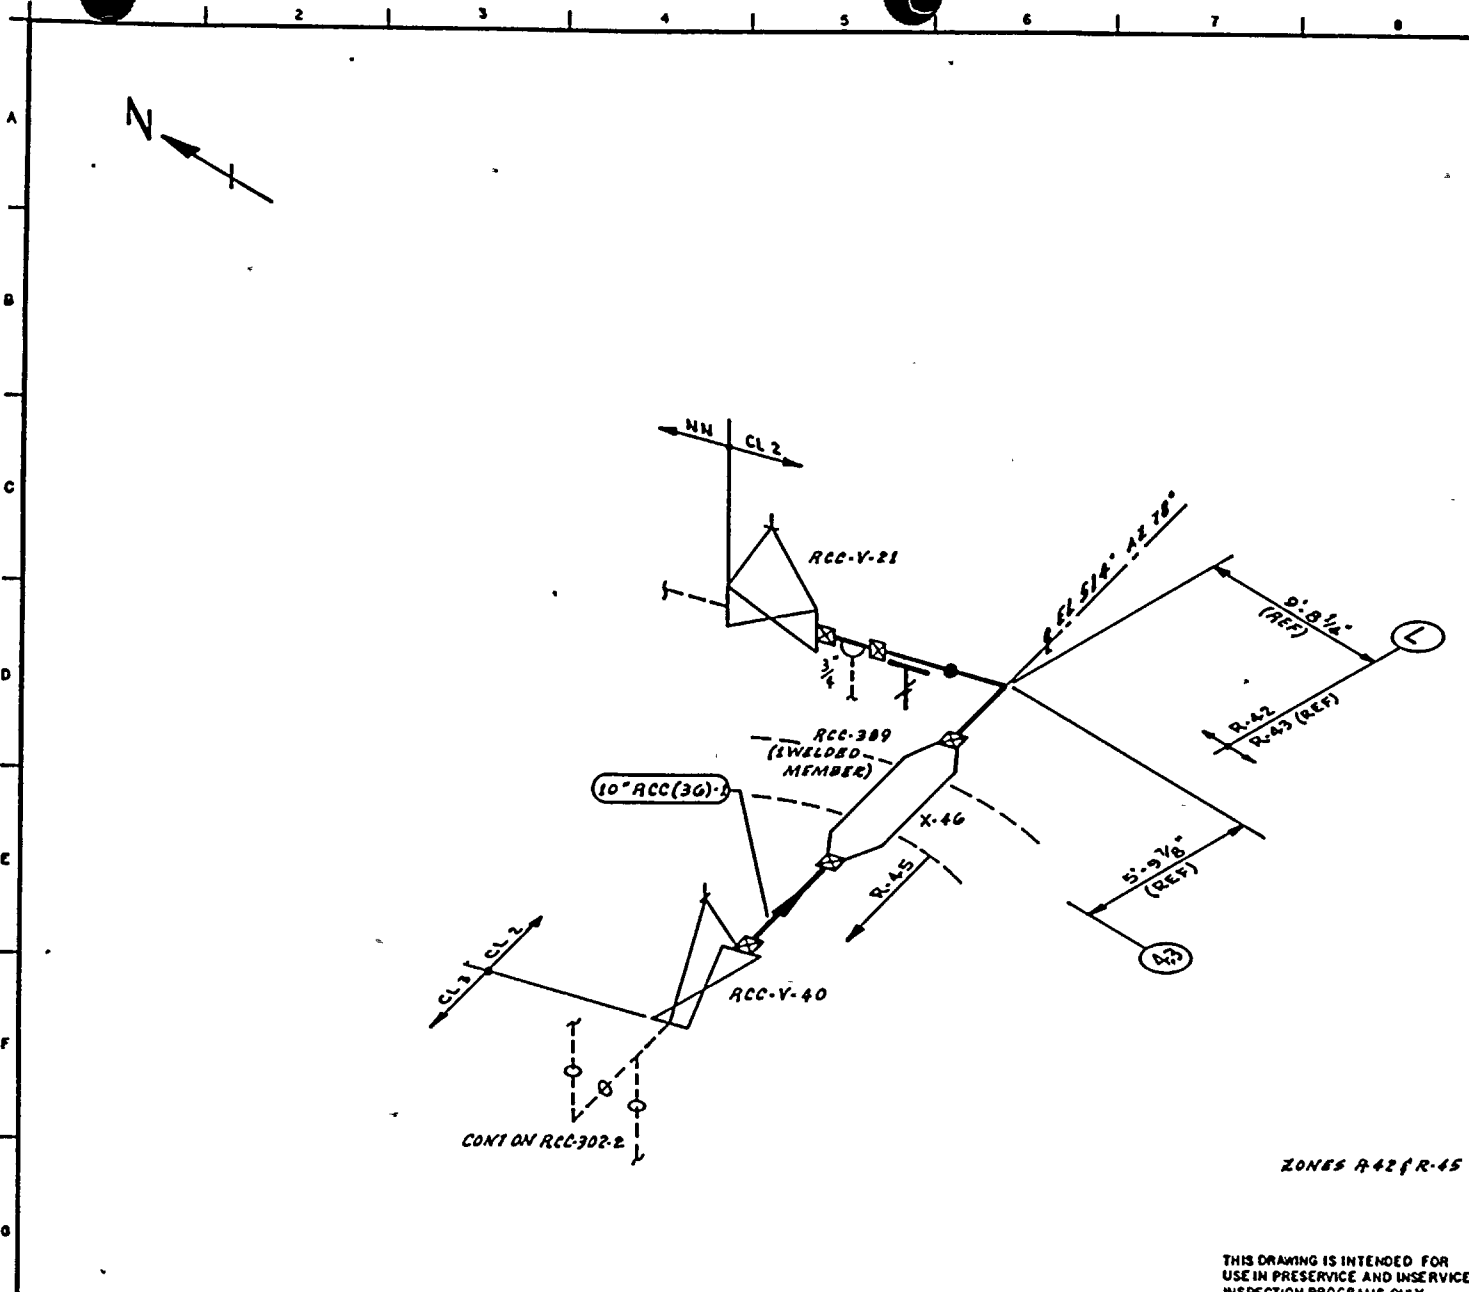

- NOTES:**
1. THIS DRAWING IDENTIFIES PIPING & COMPONENTS SUBJECT TO A VISUAL EXAM FOR EVIDENCE OF LEAKAGE DURING SYSTEM HYDRO OR OPERABILITY TESTS. TESTS ARE TO BE CONDUCTED PER THE REQUIREMENTS OF ASME SECTION XI, PARAGRAPH IWA-5000.
 2. FOR BRANCH PIPING 4" DIA OR LESS (CONN SHOWN IN DASHED LINES) EXTEND VISUAL LEAKAGE EXAM THROUGH THE OUTERMOST NORMALLY CLOSED NUCLEAR CLASS VALVE, OR UNTIL TRANSITION TO INSTRUMENT, TUBING, UNLESS OTHERWISE NOTED.

- REFERENCES:**
- BOVEE & CRAIG ISOMETRICS
 RCC-820-30.32 REV 11
 RCC-948-1.3 REV 10

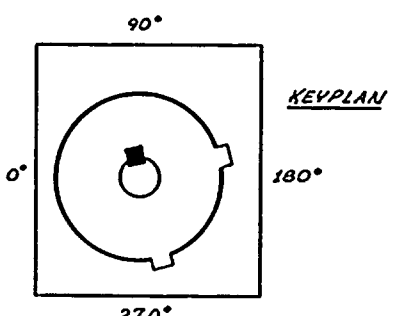

ZONES R42 & R-45

THIS DRAWING IS INTENDED FOR USE IN PRESERVICE AND INSERVICE INSPECTION PROGRAMS ONLY.

QUALITY CLASS: 1 ASME CODE CLASS: 2
 ENGR: *[Signature]* DRAWN: *[Signature]* DATE: 5-2-79



PIPING SYSTEM	NOM DIA (IN)	SCH	NOM WALL THK	MATERIAL SPECIFICATION	MATL TYPE	CAL BLOCK NO
10" RCC (3G)-1	10	STD	0.366	SA 106 GR B	CS	NA

WNP-2
 WELD & COMPONENT
 IDENTIFICATION DIAGRAM

TITLE:
 RCC RETURN

DWG NO: RCC-202 REV 1


NO	DATE	REVISION	BY	CHKD	APPVD
1	1-28-80	REVISED AS NOTED ADDED KEYPLAN	<i>[Signature]</i>	DVR	TFH
0	12-2-79	ISSUED FOR USE	<i>[Signature]</i>	EVZ	TFH

WNP-02
 INTERVAL: PSI
 PERIOD: NA
 OUTAGE:
 DRAWING NO. RCC-202

WASHINGTON PUBLIC POWER SUPPLY SYSTEM
 PROGRAM PLAN AND SCHEDULE
 SYSTEM OR COMPONENT: RCC(36)-1
 DESCRIPTION: RCC RETURN


PAGE 001
 DATE 12/14/84

<u>IDENT. NO.</u>	<u>DESCRIPTION</u>	<u>SECT.</u> XI <u>EXAM.</u>	<u>EXAM</u> <u>MTH.</u>	<u>PROCEDURE</u>	<u>CAL.</u> <u>BLOCK</u>	<u>INSERVICE</u> <u>SCHEDULED</u>		<u>NOTES</u>
						<u>REQ.</u>	<u>OUTAGE</u>	
RCC-389	SPRING	N/A	VT-3	303/8.2.17				
			VT-4	303/8.2.17				
RCC-PB-202	RCC PRES BNDRY	N/A	VT-2	N/A				SEE NOTES #6 & #7.

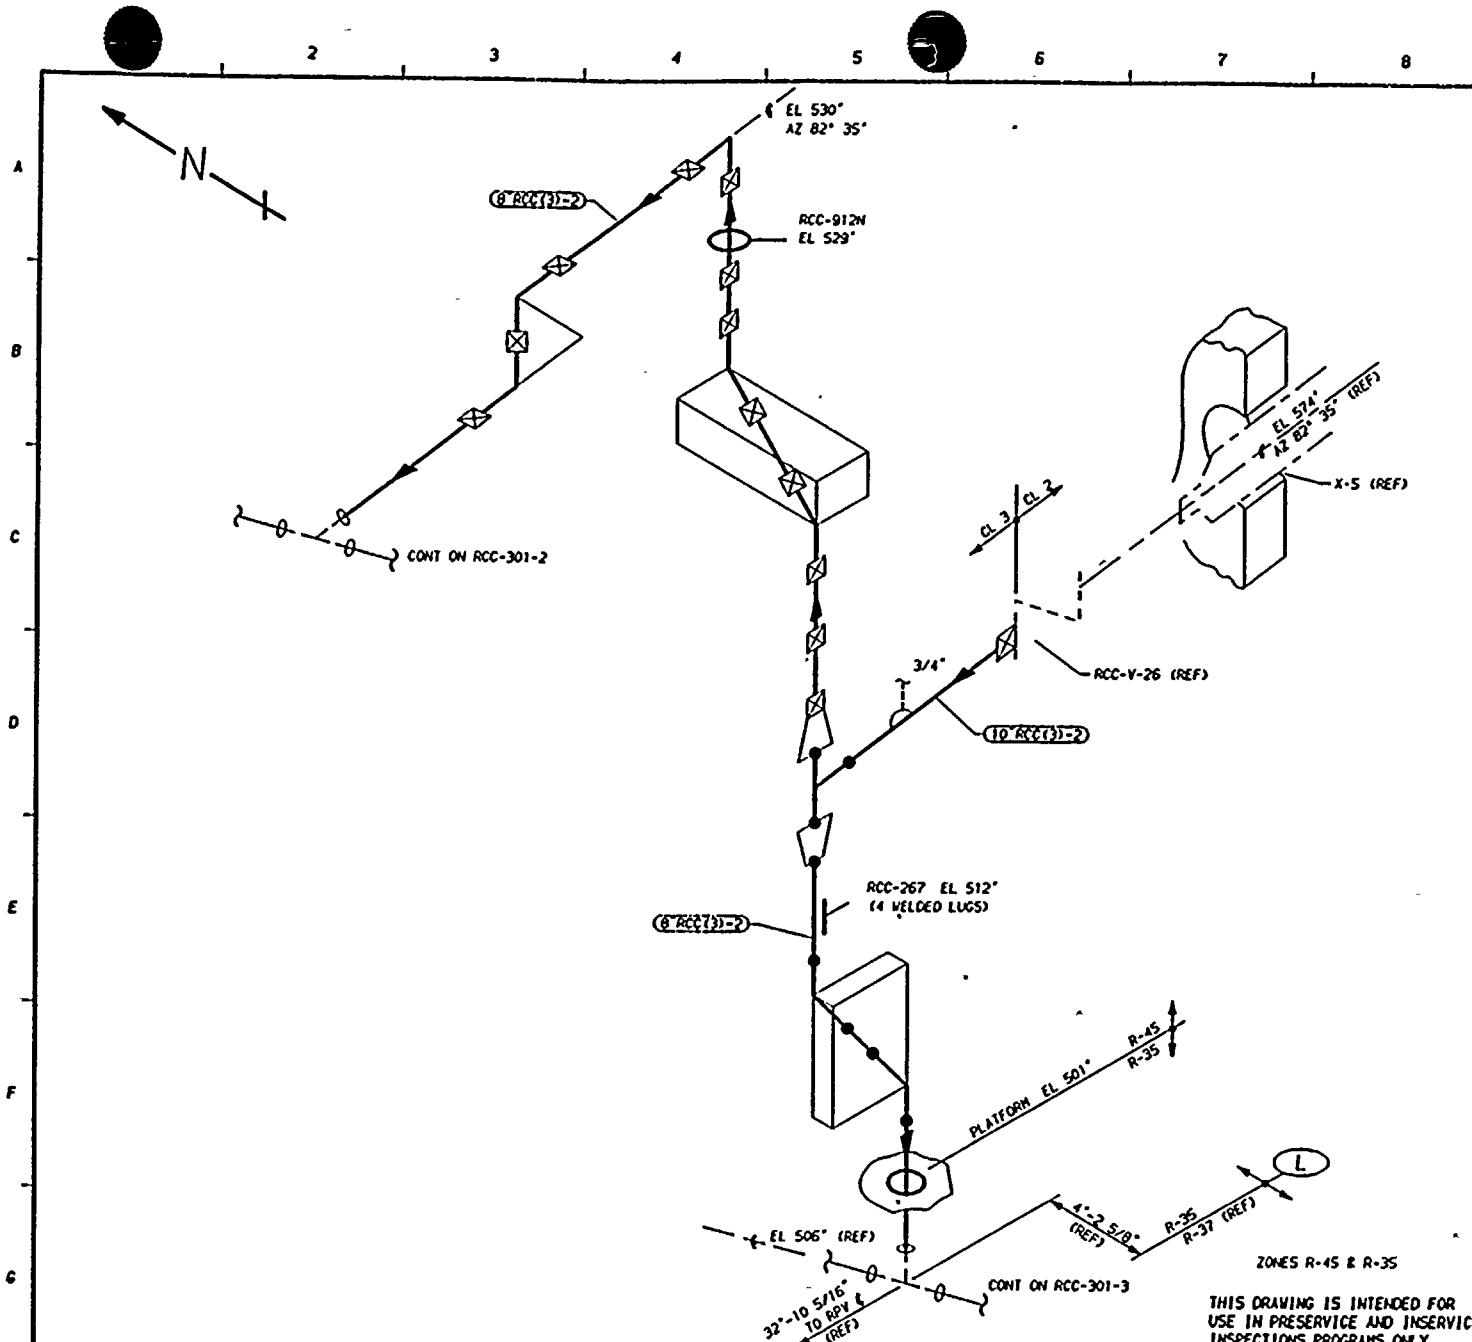

- NOTES:**
1. THIS DRAWING IDENTIFIES PIPING AND COMPONENTS SUBJECT ONLY TO A VISUAL EXAM FOR (1) EVIDENCE OF LEAKAGE DURING SYSTEM PRESSURE OR OPERABILITY TESTS; (2) PRESSURE DECAY TESTS OF BURIED PIPING; AND (3) LOSS OF SUPPORT CAPABILITY OR INADEQUATE RESTRAINT FOR SUPPORTS AND HANGERS ON PIPING EXCEEDING 4" NOM. TESTS SHALL BE CONDUCTED PER ASME SECTION XI, ARTICLES 1WA-5000 AND 1W-2000.
 2. FOR BRANCH PIPING 4" NOM. OR LESS (CONNECTION SHOWN IN DASHED LINES) EXTEND VISUAL LEAKAGE EXAM THROUGH THE OUTERMOST NORMALLY CLOSED NUCLEAR CLASS VALVE, OR UNTIL TRANSITION TO INSTRUMENT TUBING, UNLESS OTHERWISE NOTED.

- REFERENCES:**
- 151 - 225
 - BOVEE & CRAIL ISOMETRICS
 - RCC-831- 1.2 REV 9
 - RCC-831-23.26 REV 8

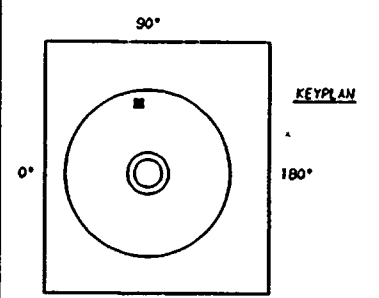

QUALITY CLASS, 1	ASME CODE CLASS, 3
ENGR, K-McANDREW	DATE, 5-2-79

WASHINGTON PUBLIC POWER
 SUPPLY SYSTEM
 RICHLAND, WASHINGTON 99352

WNP-2
 WELD & COMPONENT
 IDENTIFICATION DIAGRAM


TITLE:	RCC SUPPLY TO RCC-P-1A
DWG NO, RCC-301-1	REV 1

THIS DRAWING IS INTENDED FOR USE IN PRESERVICE AND INSERVICE INSPECTIONS PROGRAMS ONLY.

PIPING SYSTEM	NOM DIA (IN)	SCH	NOM WALL THK	MATERIAL SPECIFICATION	MATL TYPE	CAL BLOCK NO
10" RCC(3)-2	10	STD	0.365	SA 106 GR B	CS	NA
8" RCC(3)-2	8	STD	0.322	SA 106 GR B	CS	NA


1	12-14-81	GENERAL UPDATE REDRAW	BY	CHKD	APVD
0	12-2-81	ISSUED FOR USE	K-McA	DPR	TFH
NO	DATE	REVISION	BY	CHKD	APVD



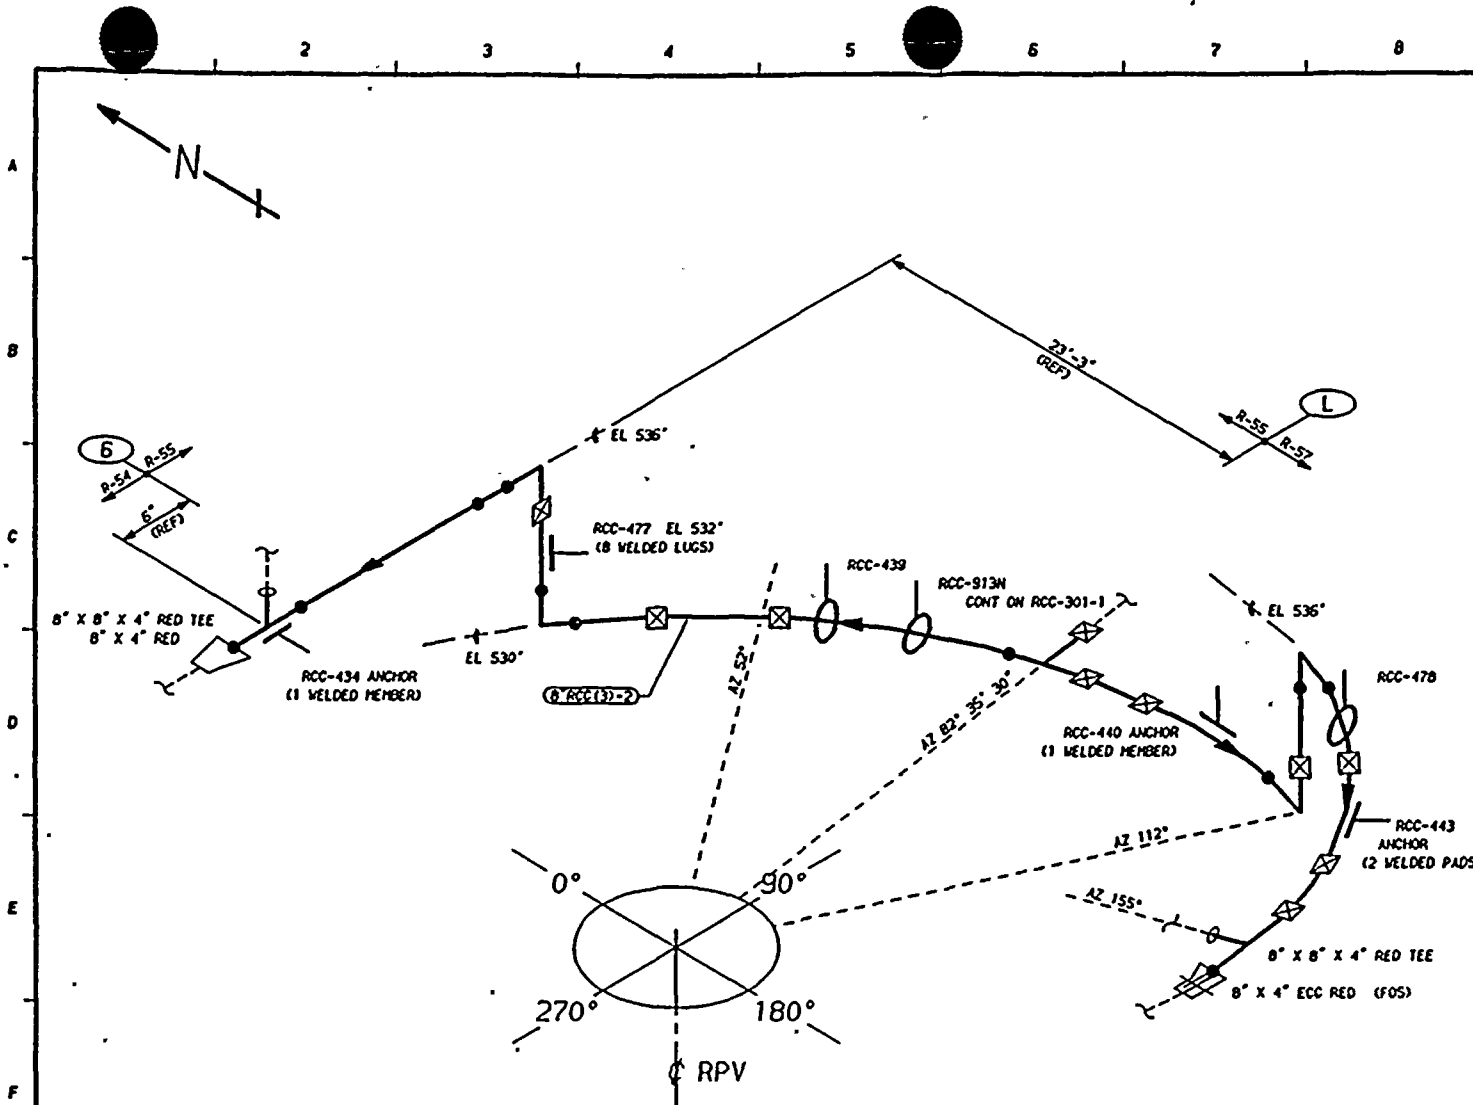

- NOTES:**
1. THIS DRAWING IDENTIFIES PIPING AND COMPONENTS SUBJECT ONLY TO A VISUAL EXAM FOR (1) EVIDENCE OF LEAKAGE DURING SYSTEM PRESSURE OR OPERABILITY TESTS; (2) PRESSURE DECAY TESTS OF BURIED PIPING; AND (3) LOSS OF SUPPORT CAPABILITY OR INADEQUATE RESTRAINT FOR SUPPORTS AND HANGERS ON PIPING EXCEEDING 4" NOM. TESTS SHALL BE CONDUCTED PER ASME SECTION XI, ARTICLES IMA-5000 AND IMA-2000.
 2. FOR BRANCH PIPING 4" NOM. OR LESS (CONNECTION SHOWN IN DASHED LINES) EXTEND VISUAL LEAKAGE EXAM THROUGH THE OUTERMOST NORMALLY CLOSED NUCLEAR CLASS VALVE, OR UNTIL TRANSITION TO INSTRUMENT TUBING, UNLESS OTHERWISE NOTED.

- REFERENCES:**
- 151 - 225
 - BOYEE & CRAIL ISOMETRICS
 - RCC-831-23.26 REV B
 - RCC-831-38.40 REV G

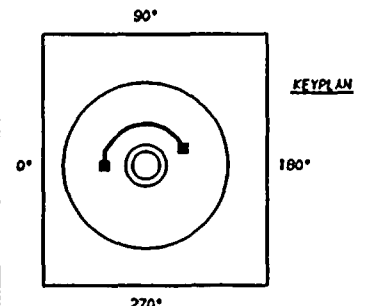

QUALITY CLASS: 1	ASME CODE CLASS: 3
ENGR: K-McANDREW	DRAWN: K-McA DATE: 5-3-79

WASHINGTON PUBLIC POWER
SUPPLY SYSTEM
RICHLAND, WASHINGTON 99352

**WNP-2
WELD & COMPONENT
IDENTIFICATION DIAGRAM**

TITLE:	RCC SUPPLY TO RCC-P-1B
DWG NO: RCC-301-2	REV 1



ZONES R-54, R-55 & R-57
THIS DRAWING IS INTENDED FOR
USE IN PRESERVICE AND INSERVICE
INSPECTIONS PROGRAMS ONLY.

PIPING SYSTEM	NOM DIA (INO)	SCH	NOM WALL THK	MATERIAL SPECIFICATION	MATL TYPE	CAL BLOCK NO
8" RCC(3)-2	8	STD	0.322	SA 106 GR B	CS	NA

NO	DATE	REVISION	BY	CHKD	APVD
1	1-21-86	GENERAL UPDATE REDRAWN	K-McA	DPR	TFH
0	12-2-81	ISSUED FOR USE	K-McA	DPR	TFH

2 3 4 5 6 7 8

A
B
C
D
E
F
G

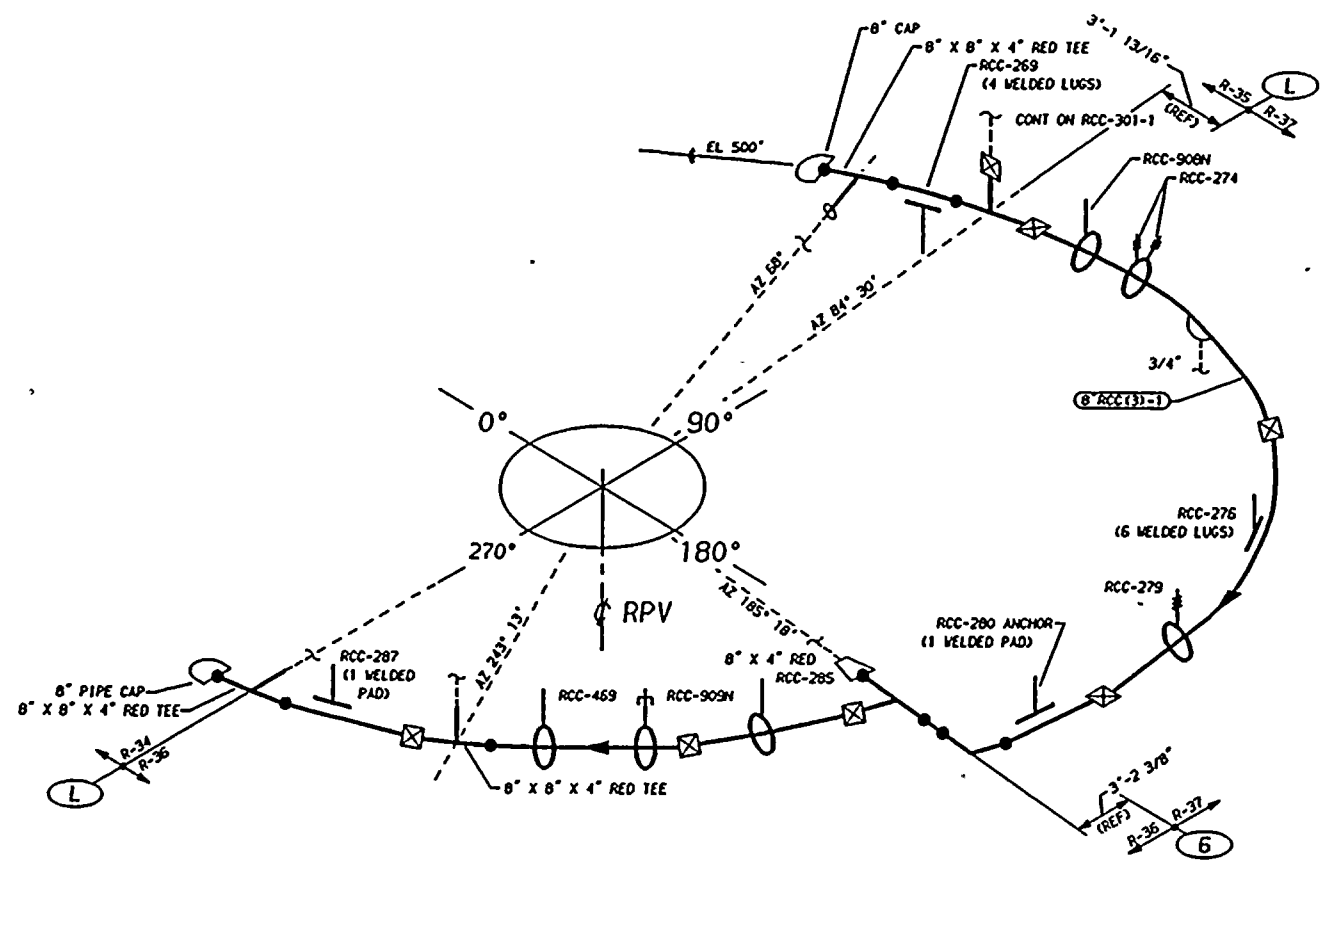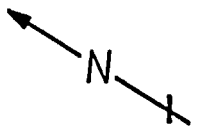


ZONES R-34, R-35,
R-36 & R-37

THIS DRAWING IS INTENDED FOR
USE IN PRESERVICE AND INSERVICE
INSPECTIONS PROGRAMS ONLY.

- NOTES:**
1. THIS DRAWING IDENTIFIES PIPING AND COMPONENTS SUBJECT ONLY TO A VISUAL EXAM FOR (1) EVIDENCE OF LEAKAGE DURING SYSTEM PRESSURE OR OPERABILITY TESTS, (2) PRESSURE DECAY TESTS OF BURIED PIPING, AND (3) LOSS OF SUPPORT CAPABILITY OR INADEQUATE RESTRAINT FOR SUPPORTS AND HANGERS ON PIPING EXCEEDING 4" NOM. TESTS SHALL BE CONDUCTED PER ASME SECTION XI, ARTICLES 1VA-5000 AND 1VD-2000.
 2. FOR BRANCH PIPING 4" NOM. OR LESS (CONNECTION SHOWN IN DASHED LINES) EXTEND VISUAL LEAKAGE EXAM THROUGH THE OUTERMOST NORMALLY CLOSED NUCLEAR CLASS VALVE, OR UNTIL TRANSITION TO INSTRUMENT TUBING, UNLESS OTHERWISE NOTED.

- REFERENCES:**
- 151 - 225
 - BOYCE & CRAIL ISOMETRICS
 - RCC-831- 3.5 REV 7
 - RCC-831- 6.10 REV 7
 - RCC-831-11.15 REV 6

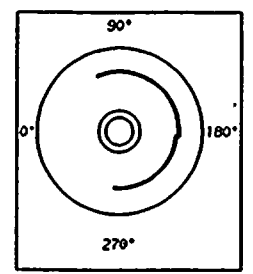

QUALITY CLASS:	1	ASME CODE CLASS:	3
ENGR:	K-McANDREW	DRAWN:	K-McA
DATE:	5-3-79		

WASHINGTON PUBLIC POWER
SUPPLY SYSTEM
RICHLAND, WASHINGTON 99352

WNP-2
WELD & COMPONENT
IDENTIFICATION DIAGRAM

TITLE:
RCC SUPPLY INSIDE CONTAINMENT

DWG NO: RCC-301-3 REV 1

PIPING SYSTEM	NOM DIA (IND)	SCH	NOM WALL THK	MATERIAL SPECIFICATION	MATL TYPE	CAL BLOCK NO
8"RCC(3)-1	8	STD	0.322	SA 106 GR B	CS	NA

NO	DATE	REVISION	BY	CHKD	APVD
1	1-21-81	GENERAL UP-DATE REDRAWN	K-McA	DPR	TFH
0	12-2-81	ISSUED FOR USE	K-McA	DPR	TFH

WNP-02
 INTERVAL: PSI
 PERIOD: NA
 OUTAGE:
 DRAWING NO. RCC-301

WASHINGTON PUBLIC POWER SUPPLY SYSTEM
 PROGRAM PLAN AND SCHEDULE
 SYSTEM OR COMPONENT: RCC(3)-2
 DESCRIPTION: RCC SUPPLY TO P-1A/B

PAGE 001
 DATE 12/14/84

<u>IDENT. NO.</u>	<u>DESCRIPTION</u>	SECT.	<u>EXAM</u>	<u>PROCEDURE</u>	<u>CAL.</u>	<u>INSERVICE</u>		<u>NOTES</u>
		<u>XI</u>				<u>REQ.</u>	<u>SCHEDULED</u>	
		<u>EXAM.</u>	<u>MTG.</u>		<u>BLOCK</u>		<u>OUTAGE</u>	
RCC-912N								
RCC-267	STRUT	N/A	VT-3	303/8.2.17				
	SPRING	N/A	VT-3	303/8.2.17				
			VT-4	303/8.2.17				
RCC-913N								
RCC-439	STRUT	N/A	VT-3	303/8.2.17				
	STRUT	N/A	VT-3	303/8.2.17				
RCC-477								
	STRUT	N/A	VT-3	303/8.2.17				
RCC-434								
	ANCHOR	N/A	VT-3	303/8.2.17				
RCC-440								
	ANCHOR	N/A	VT-3	303/8.2.17				
RCC-478								
	STRUT	N/A	VT-3	303/8.2.17				
RCC-443								
	ANCHOR	N/A	VT-3	303/8.2.17				
RCC-269								
	BOX	N/A	VT-3	303/8.2.17				
RCC-908N								
	BOX	N/A	VT-3	303/8.2.17				
RCC-274								
	SPRING	N/A	VT-3	303/8.2.17				
			VT-4	303/8.2.17				
RCC-276								
	BOX	N/A	VT-3	303/8.2.17				
RCC-279								
	SPRING	N/A	VT-3	303/8.2.17				
			VT-4	303/8.2.17				
RCC-280								
	ANCHOR	N/A	VT-3	303/8.2.17				

WNP-02
 INTERVAL: PSI
 PERIOD: NA
 OUTAGE:
 DRAWING NO. RCC-301

WASHINGTON PUBLIC POWER SUPPLY SYSTEM
 PROGRAM PLAN AND SCHEDULE
 SYSTEM OR COMPONENT: RCC(3)-2
 DESCRIPTION: RCC SUPPLY TO P-1A/B

PAGE 002
 DATE 12/14/84

<u>IDENT. NO.</u>	<u>DESCRIPTION</u>	SECT. <u>XI</u>	<u>EXAM</u>	<u>PROCEDURE</u>	<u>CAL.</u>	<u>INSERVICE</u>		<u>NOTES</u>
						<u>EXAM.</u>	<u>MIH.</u>	
RCC-285	STRUT	N/A	VT-3	303/8.2.17				
RCC-909N	PSA-3 SNUBBER	N/A	VT-3	303/8.2.17				S/N
			VT-4	303/8.2.17				S/N
RCC-469	STRUT	N/A	VT-3	303/8.2.17				
RCC-287	ANCHOR	N/A	VT-3	303/8.2.17				
			VT-4	303/8.2.17				

WNP-02
 INTERVAL: PSI
 PERIOD: NA
 OUTAGE:
 DRAWING NO. RCC-301

WASHINGTON PUBLIC POWER SUPPLY SYSTEM
 PROGRAM PLAN AND SCHEDULE
 SYSTEM OR COMPONENT: +9C I SN
 DESCRIPTION: MISC SNUBBERS

PAGE 003
 DATE 12/14/84



<u>IDENT. NO.</u>	<u>DESCRIPTION</u>	<u>SECT.</u> <u>XI</u>	<u>EXAM</u> <u>EXAM.</u>	<u>EXAM</u> <u>MTM.</u>	<u>PROCEDURE</u>	<u>CAL.</u> <u>BLOCK</u>	<u>INSERVICE</u>		<u>NOTES</u>
							<u>REQ.</u>	<u>SCHEDULED</u> <u>OUTAGE</u>	
RCC-911N	PSA-1 SNUBBER	N/A		VT-3	303/8.2.17				S/N 22369
				VT-4	303/8.2.17				S/N 22369

WNP-02
INTERVAL: PSI
PERIOD: NA
OUTAGE:
DRAWING NO. RCC-301

WASHINGTON PUBLIC POWER SUPPLY SYSTEM
PROGRAM PLAN AND SCHEDULE
SYSTEM OR COMPONENT: RCC(3)-2
DESCRIPTION: RCC SUPPLY TO P-1A/B


PAGE 004
DATE 12/14/84

<u>IDENT. NO.</u>	<u>DESCRIPTION</u>	<u>SECT.</u> XI	<u>EXAM</u> EXAM.	<u>MTW.</u> MTW.	<u>PROCEDURE</u>	<u>CAL.</u> BLOCK	<u>INSERVICE</u>		<u>NOTES</u>
							<u>REQ.</u>	<u>SCHEDULED</u> OUTAGE	
RCC-PB-301	RCC PRES BNDRY	N/A	VT-2	N/A					SEE NOTES #6 & #7.

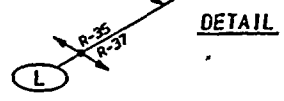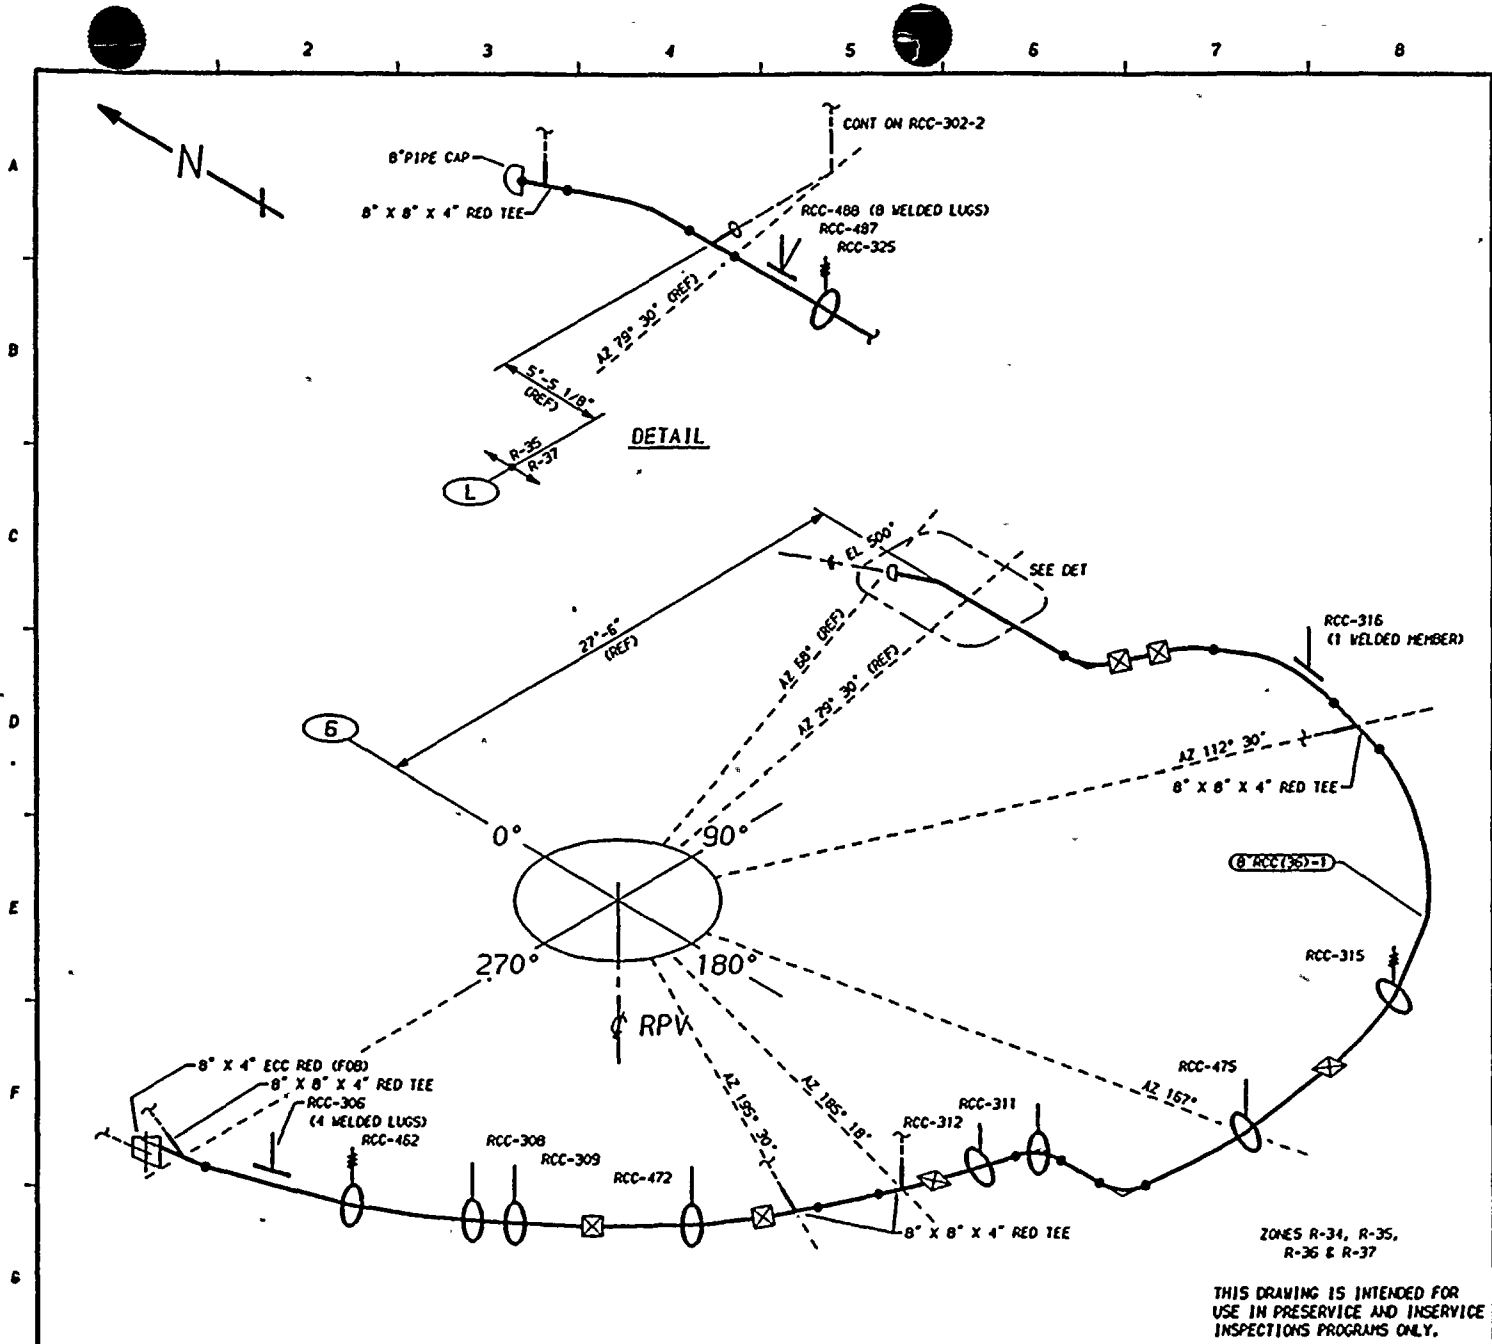

- NOTES:**
1. THIS DRAWING IDENTIFIES PIPING AND COMPONENTS SUBJECT ONLY TO A VISUAL EXAM FOR (1) EVIDENCE OF LEAKAGE DURING SYSTEM PRESSURE OR OPERABILITY TESTS; (2) PRESSURE DECAY TESTS OF BURIED PIPING; AND (3) LOSS OF SUPPORT CAPABILITY OR INADEQUATE RESTRAINT FOR SUPPORTS AND HANGERS ON PIPING EXCEEDING 4" NOM. TESTS SHALL BE CONDUCTED PER ASME SECTION XI, ARTICLES 1WA-5000 AND 1MD-2000.
 2. FOR BRANCH PIPING 4" NOM. OR LESS (CONNECTION SHOWN IN DASHED LINES) EXTEND VISUAL LEAKAGE EXAM THROUGH THE OUTERMOST NORMALLY CLOSED NUCLEAR CLASS VALVE, OR UNTIL TRANSITION TO INSTRUMENT TUBING, UNLESS OTHERWISE NOTED.

- REFERENCES:**
- 151 - 225
 - BOVEE & CRAIL ISOMETRICS
 - RCC-830-12.13 REV 5
 - RCC-830-20.21 REV 7

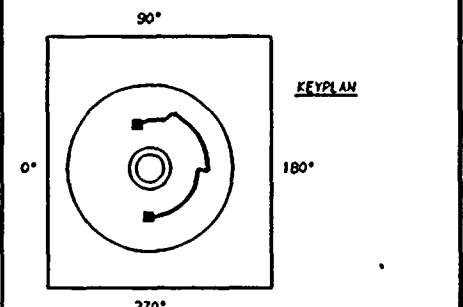

QUALITY CLASS:	2	ASME CODE CLASS:	3
ENGR:	K-McANDREW	DRAWN:	K-McA
DATE:	5-4-79		

WASHINGTON PUBLIC POWER
SUPPLY SYSTEM
 RICHLAND, WASHINGTON 99352

**HWP-2
 WELD & COMPONENT
 IDENTIFICATION DIAGRAM**

TITLE:
 RCC RETURN HEADER INSIDE CONTAINMENT


DWG NO. RCC-302-1 REV 1

PIPING SYSTEM	NOM DIA (INO)	SCH	NOM WALL THK	MATERIAL SPECIFICATION	MATL TYPE	CAL BLOCK NO
B'RCC(36)-1	8	STD	0.322	SA 106 GR B	CS	NA

NO	DATE	REVISION	BY	CHKD	APVD
1	6-21-82	GENERAL UPDATE REDRAWN	K-McA	ISR	TFB
0	12-2-81	ISSUED FOR USE	K-McA	DPR	TFH


THIS DRAWING IS INTENDED FOR USE IN PRESERVICE AND INSERVICE INSPECTIONS PROGRAMS ONLY.

ZONES R-34, R-35, R-36 & R-37

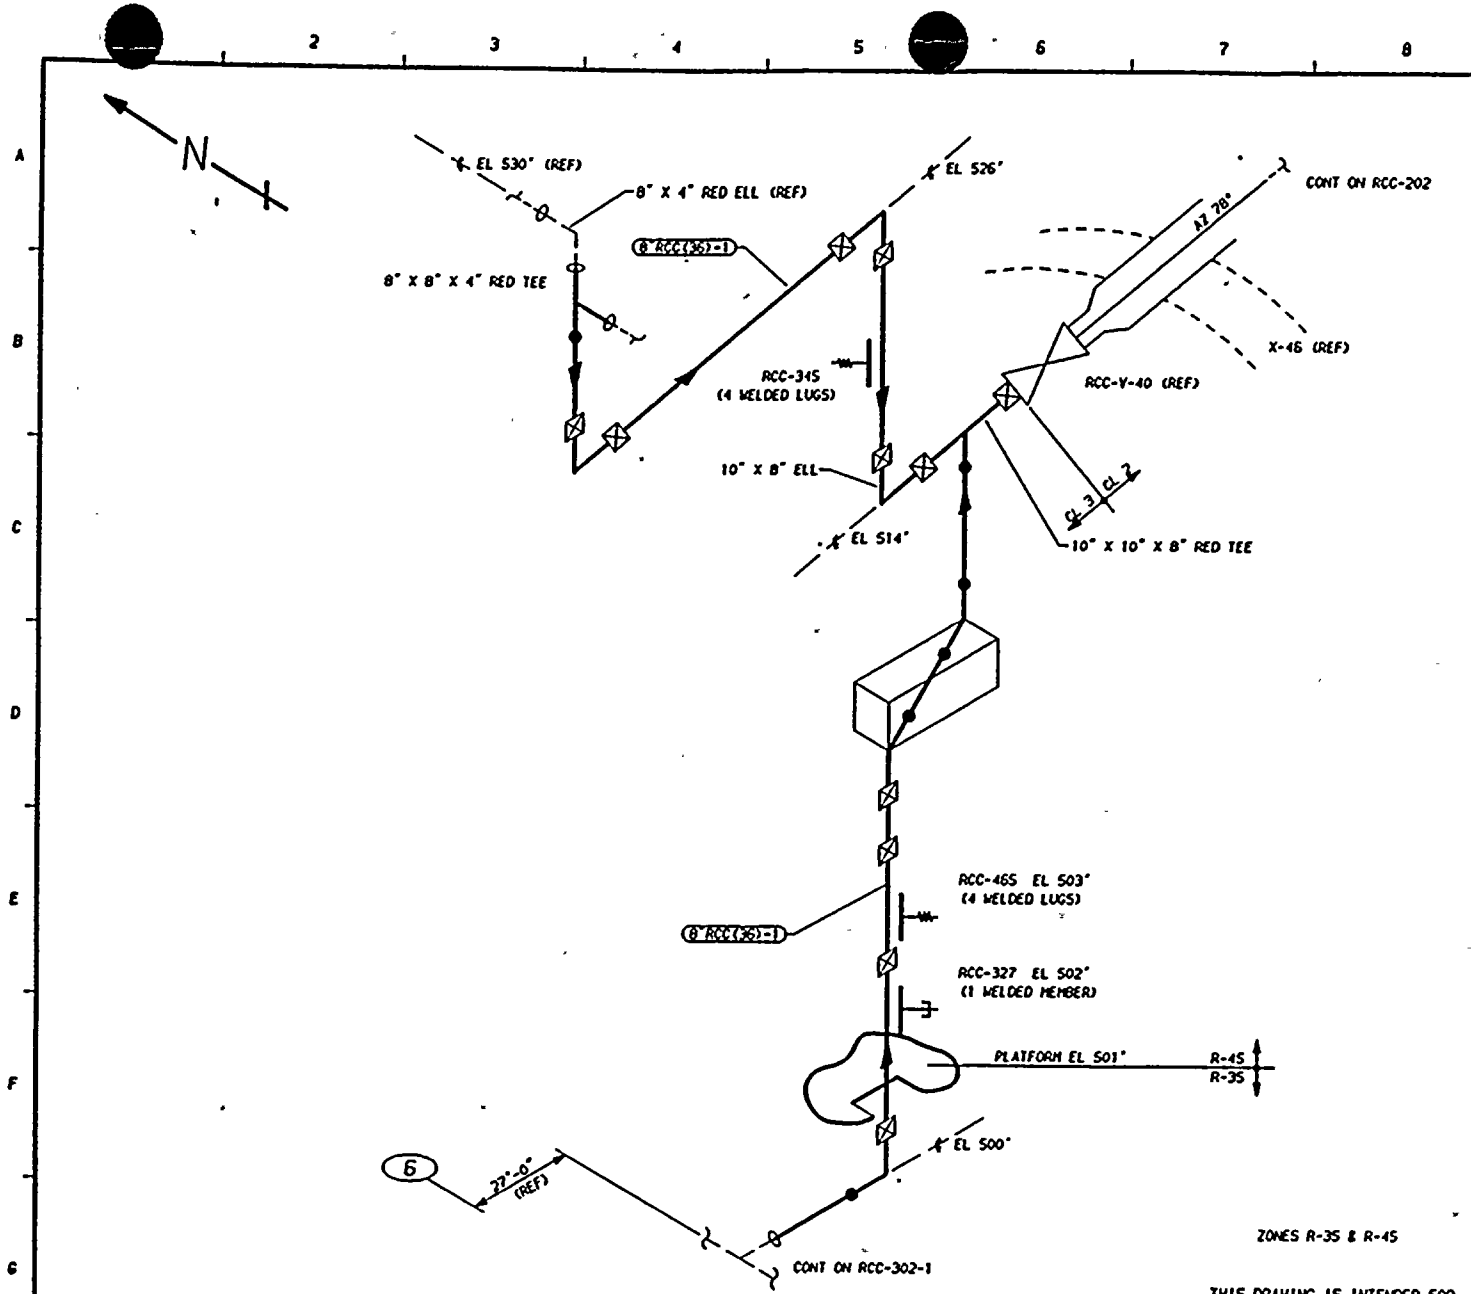

- NOTES:**
1. THIS DRAWING IDENTIFIES PIPING AND COMPONENTS SUBJECT ONLY TO A VISUAL EXAM FOR (1) EVIDENCE OF LEAKAGE DURING SYSTEM PRESSURE OR OPERABILITY TESTS, (2) PRESSURE DECAY TESTS OF BURIED PIPING, AND (3) LOSS OF SUPPORT CAPABILITY OR INADEQUATE RESTRAINT FOR SUPPORTS AND HANGERS ON PIPING EXCEEDING 4" NOM. TESTS SHALL BE CONDUCTED PER ASME SECTION XI, ARTICLES 1VA-5000 AND 1VD-2000.
 2. FOR BRANCH PIPING 4" NOM. OR LESS (CONNECTION SHOWN IN DASHED LINES) EXTEND VISUAL LEAKAGE EXAM THROUGH THE OUTERMOST NORMALLY CLOSED NUCLEAR CLASS VALVE, OR UNTIL TRANSITION TO INSTRUMENT TUBING, UNLESS OTHERWISE NOTED.

- REFERENCES:**
- 151 - 225
 - BOYEE & CRAIL ISOMETRICS
 - RCC-830-30.32 REV 11
 - RCC-830-37.39 REV 9

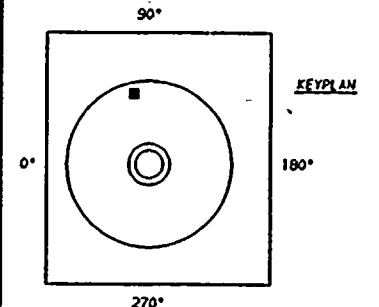

QUALITY CLASS:	2	ASME CODE CLASS:	3
ENGR:	K-McANDREW	DRAWN:	K-McA
DATE:	5-4-79		

WASHINGTON PUBLIC POWER
SUPPLY SYSTEM
RICHLAND, WASHINGTON 99352

WNP-2
WELD & COMPONENT
IDENTIFICATION DIAGRAM

TITLE:	
RCC RETURN INSIDE CONTAINMENT	
DWG NO:	RCC-302-2
REV	1

THIS DRAWING IS INTENDED FOR
USE IN PRESERVICE AND INSERVICE
INSPECTIONS PROGRAMS ONLY.

PIPING SYSTEM	NOM DIA (IN)	SCH	NOM WALL THK	MATERIAL SPECIFICATION	MATL TYPE	CAL BLOCK NO
8"RCC(36)-1	8	STD	0.322	SA 106 GR B	CS	NA

NO	DATE	REVISION	BY	CHKD	APVD
1	1-27-84	GENERAL UPDATE REDRAWN	K-McA	DPR	TFH
0	12-2-81	ISSUED FOR USE	K-McA	DPR	TFH

WNP-02
 INTERVAL: PSI
 PERIOD: NA
 OUTAGE:
 DRAWING NO. RCC-302

WASHINGTON PUBLIC POWER SUPPLY SYSTEM
 PROGRAM PLAN AND SCHEDULE
 SYSTEM OR COMPONENT: RCC(36)-1
 DESCRIPTION: RCC RETURN HEADER

PAGE 001
 DATE 12/14/84


<u>IDENT. NO.</u>	<u>DESCRIPTION</u>	<u>SECT.</u> <u>XI</u> <u>EXAM.</u>	<u>EXAM</u> <u>MTH.</u>	<u>PROCEDURE</u>	<u>CAL.</u> <u>BLOCK</u>	<u>INSERVICE</u>		<u>NOTES</u>
						<u>REQ.</u>	<u>SCHEDULED</u> <u>OUTAGE</u>	
RCC-306								
RCC-462	BOX	N/A	VT-3	303/8.2.17				
	SPRING	N/A	VT-3	303/8.2.17				
			VT-4	303/8.2.17				
RCC-308	STRUT	N/A	VT-3	303/8.2.17				
RCC-309	STRUT	N/A	VT-3	303/8.2.17				
RCC-472	STRUT	N/A	VT-3	303/8.2.17				
RCC-312	STRUT	N/A	VT-3	303/8.2.17				
RCC-311	STRUT	N/A	VT-3	303/8.2.17				
RCC-475	STRUT	N/A	VT-3	303/8.2.17				
RCC-315	STRUT	N/A	VT-3	303/8.2.17				
	SPRING	N/A	VT-3	303/8.2.17				
			VT-4	303/8.2.17				
RCC-316	ANCHOR	N/A	VT-3	303/8.2.17				
RCC-325	SPRING	N/A	VT-3	303/8.2.17				
			VT-4	303/8.2.17				
RCC-487	STRUT	N/A	VT-3	303/8.2.17				
RCC-488	BOX	N/A	VT-3	303/8.2.17				
RCC-345	SPRING	N/A	VT-3	303/8.2.17				
			VT-4	303/8.2.17				

WNP-02
 INTERVAL: PSI
 PERIOD: NA
 OUTAGE:
 DRAWING NO. RCC-302

WASHINGTON PUBLIC POWER SUPPLY SYSTEM
 PROGRAM PLAN AND SCHEDULE
 SYSTEM OR COMPONENT: RCC(36)-1
 DESCRIPTION: RCC RETURN HEADER


PAGE 002
 DATE 12/14/84

<u>IDENT. NO.</u>	<u>DESCRIPTION</u>	<u>SECT.</u> <u>XI</u> <u>EXAM.</u>	<u>EXAM</u> <u>MTH.</u>	<u>PROCEDURE</u>	<u>CAL.</u> <u>BLOCK</u>	<u>INSERVICE</u>		<u>NOTES</u>
						<u>REQ.</u>	<u>SCHEDULED</u> <u>OUTAGE</u>	
RCC-465	SPRING	N/A	VT-3	303/P.2.17				
			VT-4	303/8.2.17				
RCC-327	SPRING	N/A	VT-3	303/8.2.17				
			VT-4	303/8.2.17				
RCC-PB-302	RCC PRES BNDRY	N/A	VT-2	N/A				SEE NOTES #6 & #7.

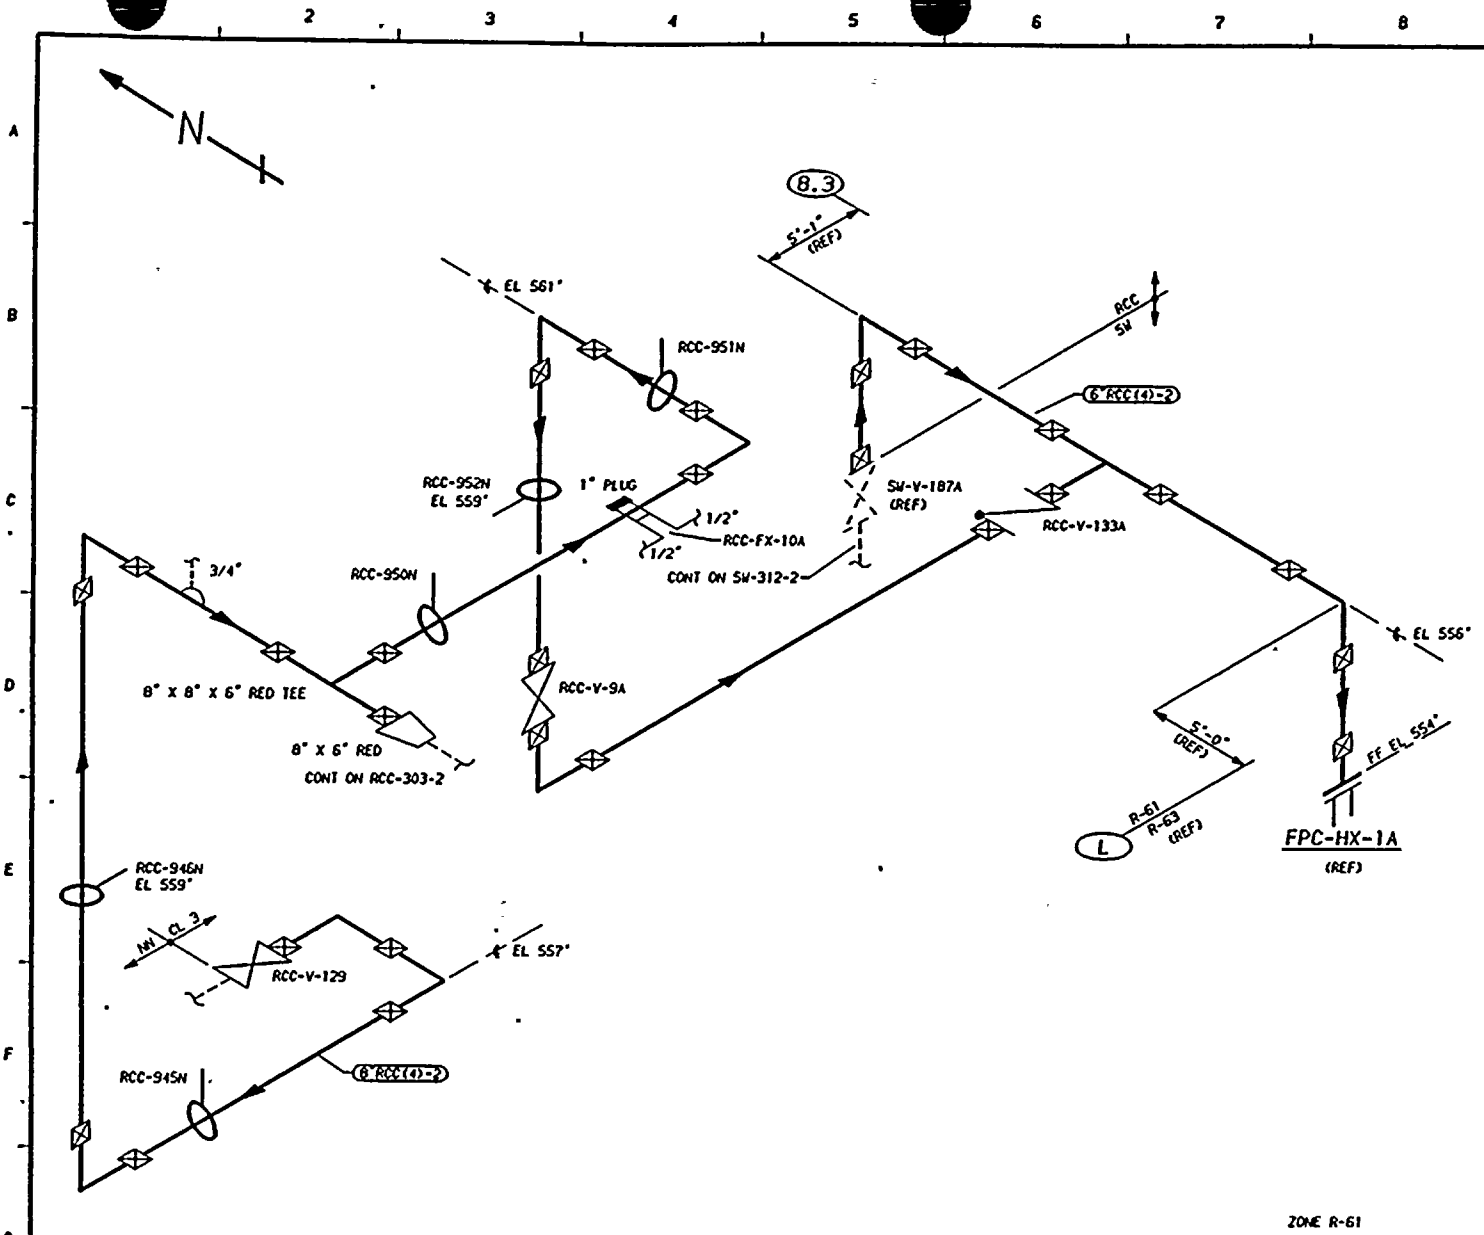

- NOTES:**
1. THIS DRAWING IDENTIFIES PIPING AND COMPONENTS SUBJECT ONLY TO A VISUAL EXAM FOR (1) EVIDENCE OF LEAKAGE DURING SYSTEM PRESSURE OR OPERABILITY TESTS; (2) PRESSURE DECAY TESTS OF BURIED PIPING; AND (3) LOSS OF SUPPORT CAPABILITY OR INADEQUATE RESTRAINT FOR SUPPORTS AND HANGERS ON PIPING EXCEEDING 4" NOM. TESTS SHALL BE CONDUCTED PER ASME SECTION XI, ARTICLES IWA-5000 AND IWD-2000.
 2. FOR BRANCH PIPING 4" NOM. OR LESS (CONNECTION SHOWN IN DASHED LINES) EXTEND VISUAL LEAKAGE EXAM THROUGH THE OUTERMOST NORMALLY CLOSED NUCLEAR CLASS VALVE, OR UNTIL TRANSITION TO INSTRUMENT TUBING, UNLESS OTHERWISE NOTED.

REFERENCES:
 151 - 225
 BOYEE & CRAIG ISOMETRIC
 RCC-950-8.10 REV 14

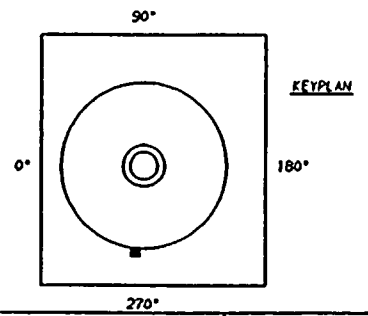

QUALITY CLASS, 1	ASME CODE CLASS, 3
ENGR, K-McANDREW	DRAWN, K-McA DATE, 11-18-83

WASHINGTON PUBLIC POWER
 SUPPLY SYSTEM
 RICHLAND, WASHINGTON 99352

WNP-2
 WELD & COMPONENT
 IDENTIFICATION DIAGRAM

TITLE:
 RCC SUPPLY TO FPC-HX-1A

ZONE R-61
 THIS DRAWING IS INTENDED FOR
 USE IN PRESERVICE AND INSERVICE
 INSPECTIONS PROGRAMS ONLY.


PIPING SYSTEM	NOM DIA (110)	SCH	NOM WALL THK	MATERIAL SPECIFICATION	MATL TYPE	CAL BLOCK NO
6" RCC(4)-2	6	STD	0.280	SA 106 GR B	CS	NA
8" RCC(4)-2	8	STD	0.322	SA 106 GR B	CS	NA

0	8/16/83	ISSUED FOR USE			
NO	DATE	REVISION	BY	CHKD	APVD

DWG NO: RCC-303-1 REV 0

7



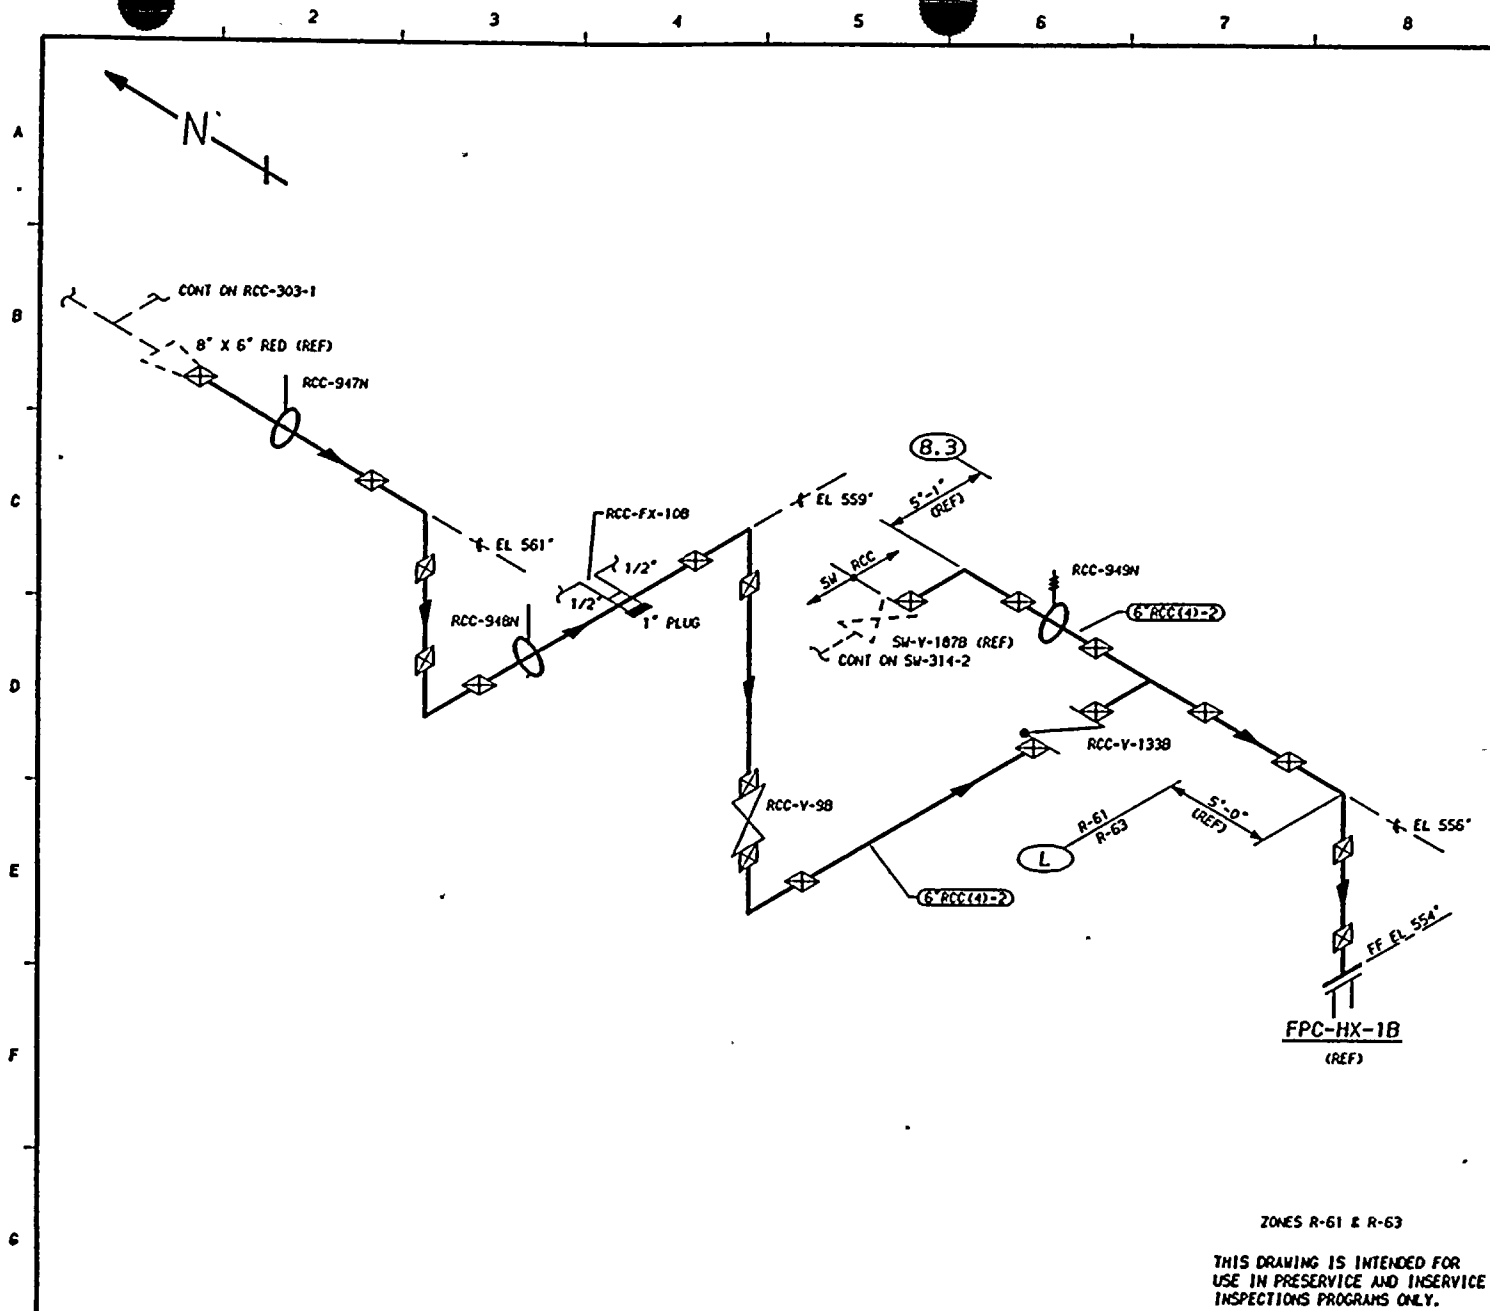


NOTES:

1. THIS DRAWING IDENTIFIES PIPING AND COMPONENTS SUBJECT ONLY TO A VISUAL EXAM FOR (1) EVIDENCE OF LEAKAGE DURING SYSTEM PRESSURE OR OPERABILITY TESTS; (2) PRESSURE DECAY TESTS OF BURIED PIPING; AND (3) LOSS OF SUPPORT CAPABILITY OR INADEQUATE RESTRAINT FOR SUPPORTS AND HANGERS ON PIPING EXCEEDING 4" NOM. TESTS SHALL BE CONDUCTED PER ASME SECTION XI, ARTICLES IMA-5000 AND IMA-2000.
2. FOR BRANCH PIPING 4" NOM. OR LESS (CONNECTION SHOWN IN DASHED LINES) EXTEND VISUAL LEAKAGE EXAM THROUGH THE OUTERMOST NORMALLY CLOSED NUCLEAR CLASS VALVE, OR UNTIL TRANSITION TO INSTRUMENT TUBING, UNLESS OTHERWISE NOTED.

REFERENCES:

151 - 225
 BOYEE & CRAIL ISOMETRIC
 RCC-950-8.10 REV 14

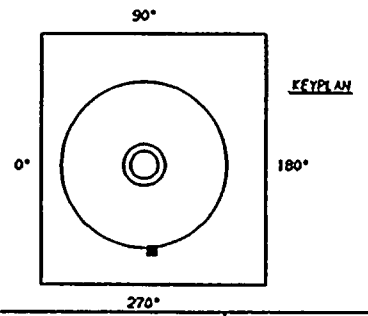

ZONES R-61 & R-63

THIS DRAWING IS INTENDED FOR USE IN PRESERVICE AND INSERVICE INSPECTIONS PROGRAMS ONLY.

PIPING SYSTEM	NOM DIA (IND)	SCH	NOM WALL THK	MATERIAL SPECIFICATION	MATL TYPE	CAL BLOCK NO
6" RCC(4)-2	6	STD	0.280	SA 106 GR B	CS	NA

QUALITY CLASS: 1	ASME CODE CLASS: 3
ENGR: K-McANDREW	DRAWN: K-McA DATE: 11-18-83

WASHINGTON PUBLIC POWER
 SUPPLY SYSTEM
 RICHLAND, WASHINGTON 99352

WNP-2
 WELD & COMPONENT
 IDENTIFICATION DIAGRAM

TITLE:
 RCC SUPPLY TO FPC-HX-1B

0	12/1/83	ISSUED FOR USE			
NO	DATE	REVISION	BY	CHKD	APVD

DWG NO: RCC-303-2 REV 0

WNP-02
 INTERVAL: PSI
 PERIOD: NA
 OUTAGE:
 DRAWING NO. RCC-303

WASHINGTON PUBLIC POWER SUPPLY SYSTEM
 PROGRAM PLAN AND SCHEDULE
 SYSTEM OR COMPONENT: RCC(4)-2
 DESCRIPTION: RCC SUPPLY-FPC-HX-1A

PAGE 001
 DATE 12/14/84

<u>IDENT. NO.</u>	<u>DESCRIPTION</u>	<u>SECT.</u> XI	<u>EXAM</u> MTH.	<u>PROCEDURE</u>	<u>CAL.</u> BLOCK	<u>INSERVICE</u>		<u>NOTES</u>
						<u>REQ.</u>	<u>SCHEDULED</u> OUTAGE	
RCC-945N	RIGID	N/A	VT-3	303/8.2.17				
RCC-946N	RIGID	N/A	VT-3	303/8.2.17				
RCC-950N	RIGID	N/A	VT-3	303/8.2.17				
RCC-951N	RIGID	N/A	VT-3	303/8.2.17				
RCC-952N	RIGID	N/A	VT-3	303/8.2.17				
RCC-947N	RIGID	N/A	VT-3	303/8.2.17				
RCC-948N	RIGID	N/A	VT-3	303/8.2.17				
RCC-949N	RIGID	N/A	VT-3	303/8.2.17				
	SPRING	N/A	VT-3	303/8.2.17				
			VT-4	303/8.2.17				
RCC-PB-303	RCC PRES BNDRY	N/A	VT-2	N/A				

SEE NOTES #6 & #7.



WNP-02
INTERVAL: PSI
PERIOD: NA
OUTAGE:
DRAWING NO. RCC-304

WASHINGTON PUBLIC POWER SUPPLY SYSTEM
PROGRAM PLAN AND SCHEDULE
SYSTEM OR COMPONENT: RRC(4)-2
DESCRIPTION: RCC RTN FROM HX-1A

PAGE 001
DATE 12/14/84

<u>IDENT. NO.</u>	<u>DESCRIPTION</u>	<u>SECT.</u> XI	<u>EXAM</u> EXAM.	<u>EXAM</u> MTH.	<u>PROCEDURE</u>	<u>CAL.</u> BLOCK	<u>INSERVICE</u>		<u>NOTES</u>
							<u>REQ.</u>	<u>SCHEDULED</u> OUTAGE	
RCC-941N	RIGID	N/A	VT-3	303/8.2.17					
RCC-PB-304	RCC PRES BNDRY	N/A	VT-2	N/A					SEE NOTES #6 & #7.

A
B
C
D
E
F
G

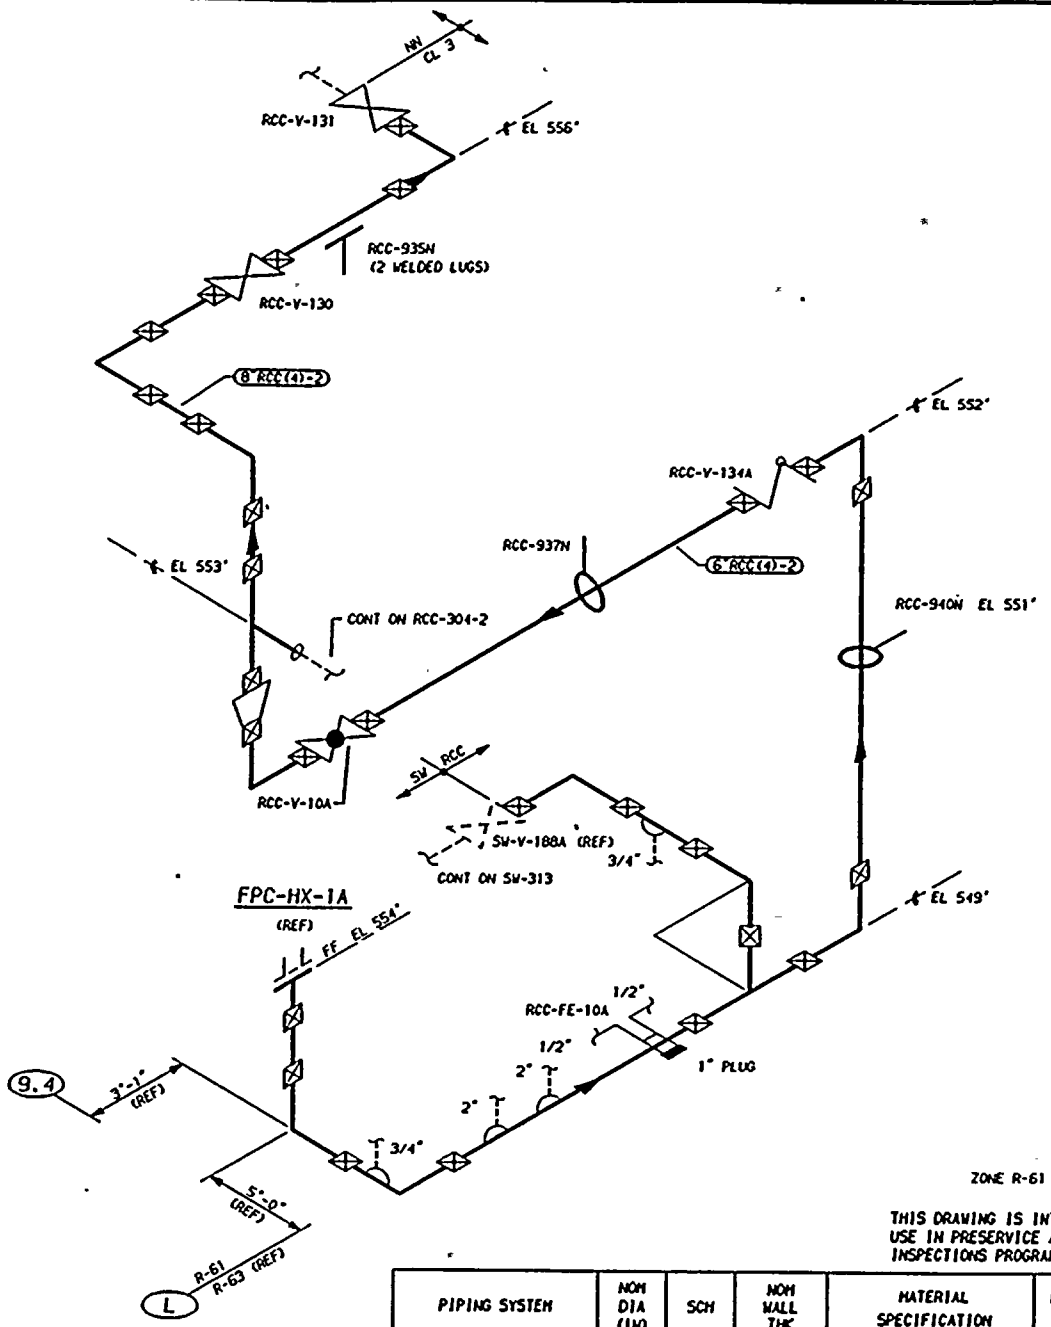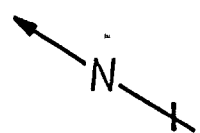

ZONE R-61


THIS DRAWING IS INTENDED FOR USE IN PRESERVICE AND INSERVICE INSPECTIONS PROGRAMS ONLY.

NOTES:

1. THIS DRAWING IDENTIFIES PIPING AND COMPONENTS SUBJECT ONLY TO A VISUAL EXAM FOR (1) EVIDENCE OF LEAKAGE DURING SYSTEM PRESSURE OR OPERABILITY TESTS; (2) PRESSURE DECAY TESTS OF BURIED PIPING; AND (3) LOSS OF SUPPORT CAPABILITY OR INADEQUATE RESTRAINT FOR SUPPORTS AND HANGERS ON PIPING EXCEEDING 4" NOM. TESTS SHALL BE CONDUCTED PER ASME SECTION XI, ARTICLES IWA-5000 AND IWD-2000.
2. FOR BRANCH PIPING 4" NOM. OR LESS (CONNECTION SHOWN IN DASHED LINES) EXTEND VISUAL LEAKAGE EXAM THROUGH THE OUTERMOST NORMALLY CLOSED NUCLEAR CLASS VALVE, OR UNTIL TRANSITION TO INSTRUMENT TUBING, UNLESS OTHERWISE NOTED.

REFERENCES:

- 151 - 225
- BOYCE & CRAIL ISOMETRIC
- RCC-825-19.21 REV 13

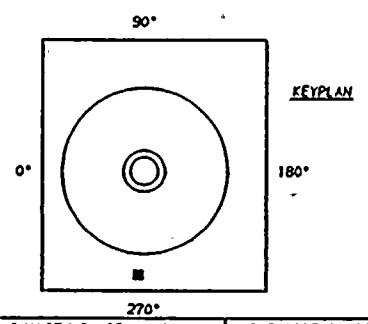

QUALITY CLASS, 1	ASME CODE CLASS, 3
ENGR, K-McANDREW	DATE, 11-18-83

WASHINGTON PUBLIC POWER
SUPPLY SYSTEM
RICHLAND, WASHINGTON 99352

WNP-2
WELD & COMPONENT
IDENTIFICATION DIAGRAM


TITLE:
RCC RETURN FROM FPC-HX-1A

DWG NO, RCC-304-1 REV 0

PIPING SYSTEM	NOM DIA (IN)	SCH	NOM WALL THK	MATERIAL SPECIFICATION	MATL TYPE	CAL BLOCK NO
6" RCC(4)-2	6	STD	0.280	SA 106 GR B	-CS	NA
8" RCC(4)-2	8	STD	0.322	SA 106 GR B	CS	NA

0	12/18/83	ISSUED FOR USE			
NO	DATE	REVISION	BY	CHKD	APPV

1

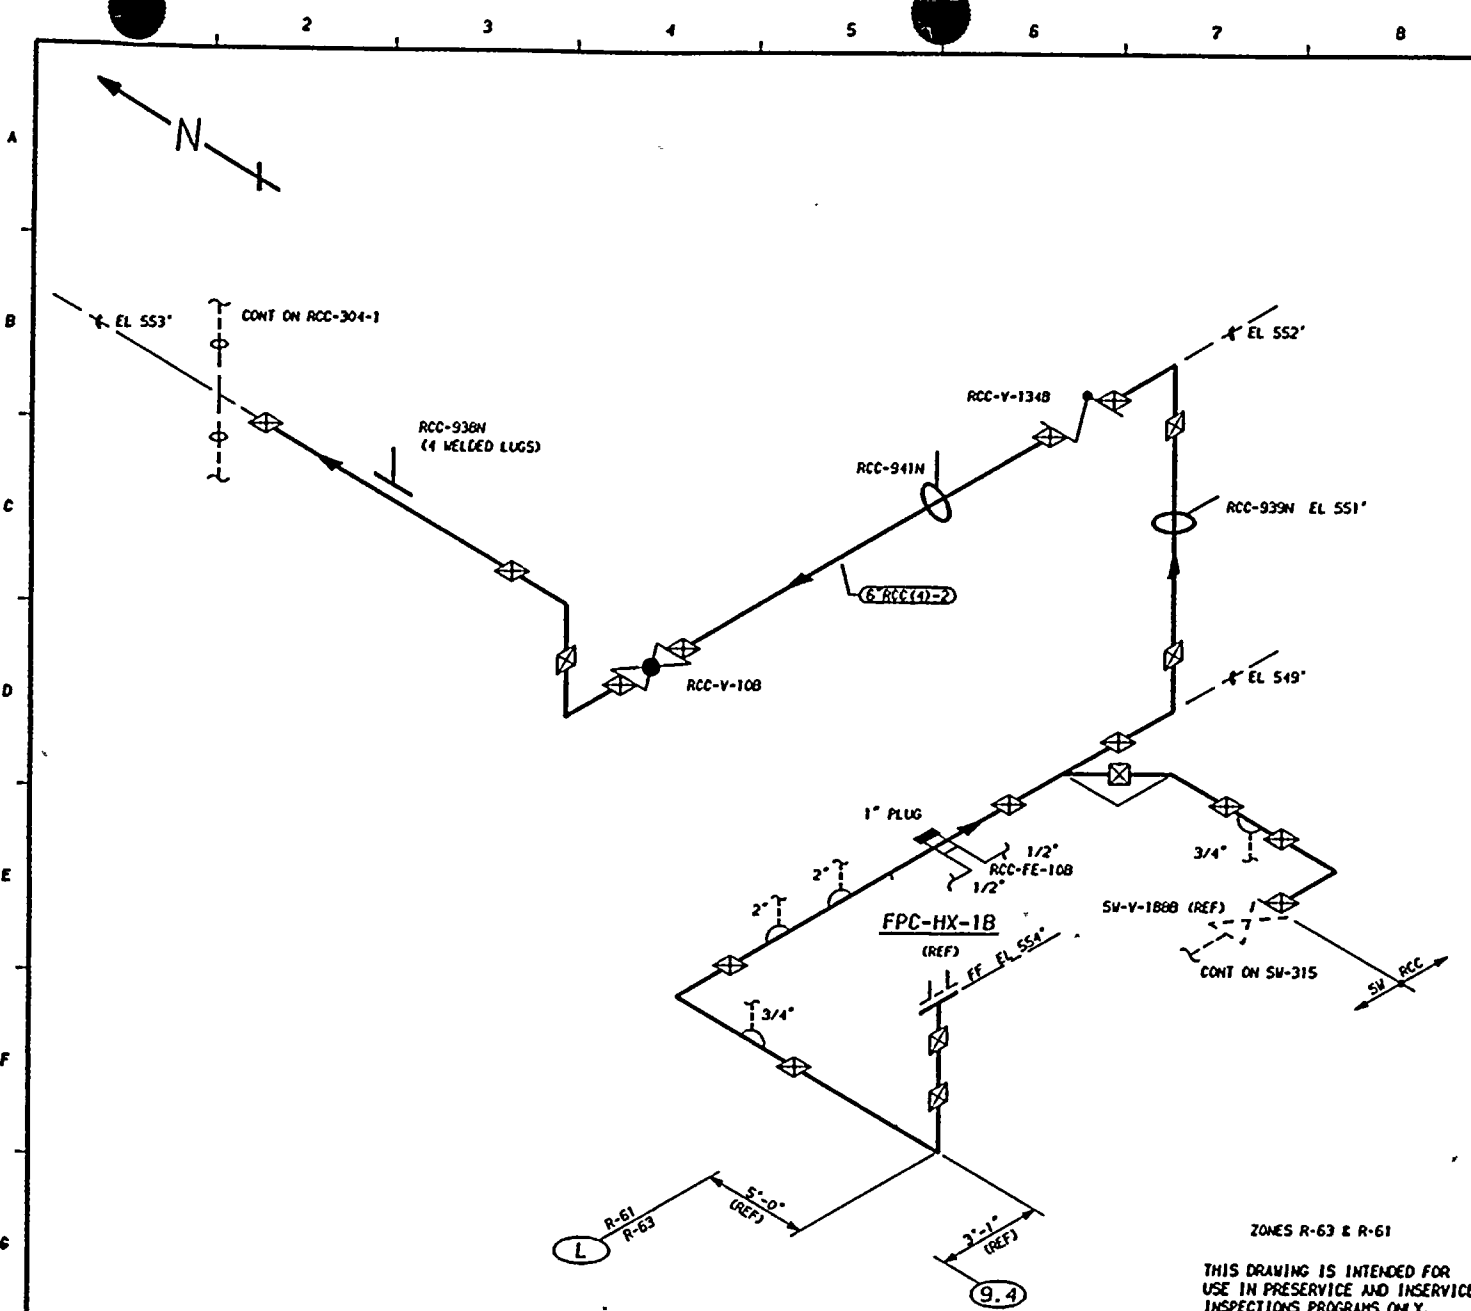


NOTES:

1. THIS DRAWING IDENTIFIES PIPING AND COMPONENTS SUBJECT ONLY TO A VISUAL EXAM FOR (1) EVIDENCE OF LEAKAGE DURING SYSTEM PRESSURE OR OPERABILITY TESTS; (2) PRESSURE DECAY TESTS OF BURIED PIPING; AND (3) LOSS OF SUPPORT CAPABILITY OR INADEQUATE RESTRAINT FOR SUPPORTS AND HANGERS ON PIPING EXCEEDING 4" NOM. TESTS SHALL BE CONDUCTED PER ASME SECTION XI, ARTICLES 1WA-5000 AND 1WD-2000.
2. FOR BRANCH PIPING 4" NOM. OR LESS (CONNECTION SHOWN IN DASHED LINES) EXTEND VISUAL LEAKAGE EXAM THROUGH THE OUTERMOST NORMALLY CLOSED NUCLEAR CLASS VALVE, OR UNTIL TRANSITION TO INSTRUMENT TUBING, UNLESS OTHERWISE NOTED.

REFERENCES:

- 151 - 225
- BOYEE & CRAIL ISOMETRIC
- RCC-825-19.21 REV 13

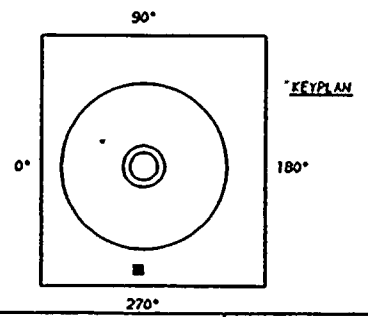

QUALITY CLASS: 1	ASME CODE CLASS: 3
ENGR: K-McANDREW	DATE: 11-29-83

WASHINGTON PUBLIC POWER
SUPPLY SYSTEM
RICHLAND, WASHINGTON 99352

**WNP-2
WELD & COMPONENT
IDENTIFICATION DIAGRAM**

TITLE:
RCC RETURN FROM FPC-HX-1B

DWG NO. RCC-304-2 REV 0

ZONES R-63 & R-61
THIS DRAWING IS INTENDED FOR
USE IN PRESERVICE AND INSERVICE
INSPECTIONS PROGRAMS ONLY.

PIPING SYSTEM	NOM DIA (IN)	SCH	NOM WALL THK	MATERIAL SPECIFICATION	MATL TYPE	CAL BLOCK NO
6" RCC(1)-2	6	STD	0.280	SA 106 GR B	CS	NA

0	12/1/83	ISSUED FOR USE				
NO	DATE	REVISION	BY	CHKD	APVD	

Date 1/8/79

Revision 0

 
WNP-2 PSI PROGRAM PLAN



WELD AND COMPONENT
IDENTIFICATION DIAGRAM

DEMINERALIZED WATER (DW)

L A T E R


NOTE: This system is subject only to a visual examination for evidence of leakage. Isometric drawings will be provided at a later date. See Section 7.0 for ISI Boundary Diagram for this system.



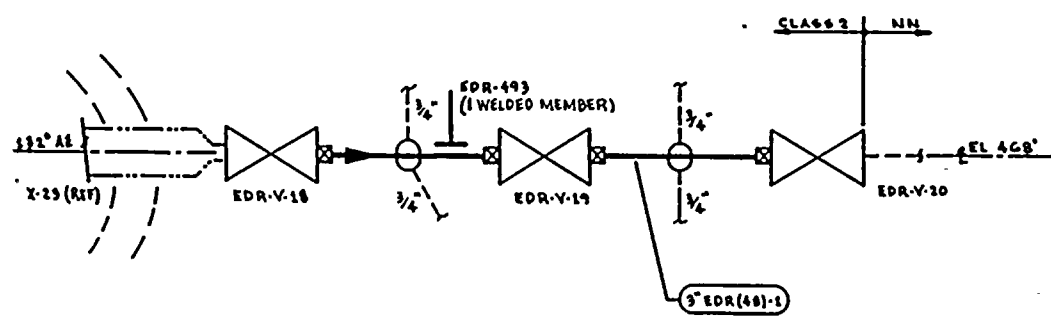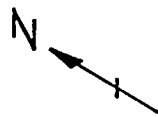

- NOTES:**
1. THIS DRAWING IDENTIFIES PIPING & COMPONENTS SUBJECT TO VISUAL EXAM FOR EVIDENCE OF LEAKAGE DURING SYSTEM HYDRO OR OPERABILITY TESTS. TESTS ARE TO BE CONDUCTED PER THE REQUIREMENTS OF ASME SECTION XI, PARAGRAPH 5WA-5000.
 2. FOR BRANCH PIPING 4" DIA OR LESS (CONN SHOWN IN DASHED LINES) EXTEND VISUAL LEAKAGE EXAM THROUGH THE OUTERMOST NORMALLY CLOSED NUCLEAR CLASS VALVE OR UNTIL TRANSITION TO INSTRUMENT TUBING, UNLESS OTHERWISE NOTED.

REFERENCES:
BOVRE & CRAIL ISOMETRICS
EDR-526-T-9 REV 9

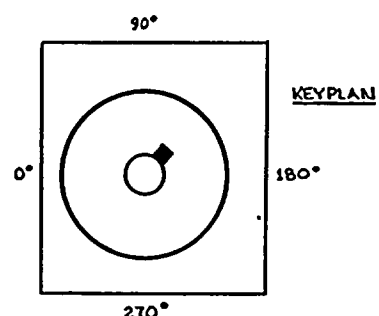

ZONE R-28

THIS DRAWING IS INTENDED FOR USE IN PRESERVICE AND INSERVICE INSPECTION PROGRAMS ONLY.

QUALITY CLASS: 1	ASME CODE CLASS: 2
ENGR: D'AMMINS	DRAWN: K.McA DATE: 3-13-19



WASHINGTON PUBLIC POWER SUPPLY SYSTEM
RICHLAND WASHINGTON 99282

PIPING SYSTEM	NOM DIA (IN)	SCH	NOM WALL THK	MATERIAL SPECIFICATION	MATL TYPE	CAL BLOCK NO
3" EDR (48)-1	3	40	0.216	SA 106 GR B	CS	NA

WNP-2
WELD & COMPONENT
IDENTIFICATION DIAGRAM

TITLE:
DRYWELL TO EQUIPMENT DRAIN SUMP

DWG NO: EDR-201 REV 1

NO	DATE	REVISION	BY	CHKD	APPVD
1	1/21/86	CHG EDR-493 TO WELDED ADDED KEYPLAN	KMcA	DK	TFW
0	1/13/79	ISSUED FOR USE	KMcA	DK	TFW

Date 1/8/79

Revision 0

WNP-2 PSI PROGRAM PLAN

WELD AND COMPONENT
IDENTIFICATION DIAGRAM

MAIN STEAM LEAKAGE CONTROL (MSLC)

L A T E R

WNP-02
 INTERVAL: PSI
 PERIOD: NA
 OUTAGE:
 DRAWING NO. MS-301

WASHINGTON PUBLIC POWER SUPPLY SYSTEM
 PROGRAM PLAN AND SCHEDULE
 SYSTEM OR COMPONENT: MS(18)-2-1
 DESCRIPTION: MS-RV-1A DISCHARGE

PAGE 001
 DATE 12/14/84

<u>IDENT. NO.</u>	<u>DESCRIPTION</u>	<u>SECT.</u> <u>XI</u>	<u>EXAM</u> <u>EXAM.</u>	<u>PROCEDURE</u> <u>MTH.</u>	<u>CAL.</u> <u>BLOCK</u>	<u>INSERVICE</u>		<u>NOTES</u>
						<u>REQ.</u>	<u>SCHEDULED</u> <u>OUTAGE</u>	
MSRV-1A-1	PSA-10 SNUBBER	N/A	VT-3	303/8.2.17				S/N 9902
			VT-4	303/8.2.17				S/N 9902
MSRV-1A-3	PSA-10 SNUBBER	N/A	VT-3	303/8.2.17				S/N 11857
			VT-4	303/8.2.17				S/N 11857
MSRV-1A-4	PSA-10 SNUBBER	N/A	VT-3	303/8.2.17				S/N 9925
			VT-4	303/8.2.17				S/N 9925
MSRV-1A-2	PSA-10 SNUBBER	N/A	VT-3	303/8.2.17				S/N 9901
			VT-4	303/8.2.17				S/N 9901
MSRV-1A-5	PSA-10 SNUBBER	N/A	VT-3	303/8.2.17				S/N 682
			VT-4	303/8.2.17				S/N 682
MSRV-1A-6	PSA-10 SNUBBER	N/A	VT-3	303/8.2.17				S/N 302
			VT-4	303/8.2.17				S/N 302

WNP-02
 INTERVAL: PSI
 PERIOD: NA
 OUTAGE:
 DRAWING NO. MS-302

WASHINGTON PUBLIC POWER SUPPLY SYSTEM
 PROGRAM PLAN AND SCHEDULE
 SYSTEM OR COMPONENT: MS(18)-2-2
 DESCRIPTION: MS-RV-2A DISCHARGE

PAGE 001
 DATE 12/14/84


<u>IDENT. NO.</u>	<u>DESCRIPTION</u>	SECT. XI <u>EXAM.</u>	EXAM <u>MTG.</u>	<u>PROCEDURE</u>	CAL. <u>BLOCK</u>	<u>INSERVICE</u>		<u>NOTES</u>
						<u>REQ.</u>	<u>SCHEDULED</u> <u>OUTAGE</u>	
KSRV-2A-2	PSA-10 SNUBBER	N/A	VT-3	303/8.2.17				S/N 702
			VT-4	303/8.2.17				S/N 702
MSRV-2A-3	PSA-35 SNUBBER	N/A	VT-3	303/8.2.17				S/N 10585
			VT-4	303/8.2.17				S/N 10585
MSRV-2A-1	PSA-10 SNUBBER	N/A	VT-3	303/8.2.17				S/N 317
			VT-4	303/8.2.17				S/N 317
MSRV-2A-5	PSA-10 SNUBBER	N/A	VT-3	303/8.2.17				S/N 11846
			VT-4	303/8.2.17				S/N 11846
MSRV-2A-4	PSA-10 SNUBBER	N/A	VT-3	303/8.2.17				S/N 11853
			VT-4	303/8.2.17				S/N 11853

WNP-02
 INTERVAL: PSI
 PERIOD: NA
 OUTAGE:
 DRAWING NO. 4S-303

WASHINGTON PUBLIC POWER SUPPLY SYSTEM
 PROGRAM PLAN AND SCHEDULE
 SYSTEM OR COMPONENT: MS(18)-2-3
 DESCRIPTION: MS-RV-7A DISCHARGE

PAGE 001
 DATE 12/14/84

<u>IDENT. NO.</u>	<u>DESCRIPTION</u>	SECT. XI <u>EXAM.</u>	EXAM <u>MTW.</u>	<u>PROCEDURE</u>	CAL. <u>BLOCK</u>	<u>INSERVICE</u>		<u>NOTES</u>
						<u>REQ.</u>	<u>SCHEDULED OUTAGE</u>	
MSRV-3A-2	PSA-10 SNUBBER	N/A	VT-3	303/8.2.17				S/N 703
			VT-4	303/8.2.17				S/N 703
MSRV-3A-3	PSA-10 SNUBBER	N/A	VT-3	303/8.2.17				S/N 13041
			VT-4	303/8.2.17				S/N 13041
MSRV-3A-1	PSA-10 SNUBBER	N/A	VT-3	303/8.2.17				S/N 11852
			VT-4	303/8.2.17				S/N 11852
MSRV-3A-4	PSA-10 SNUBBER	N/A	VT-3	303/8.2.17				S/N 4858
			VT-4	303/8.2.17				S/N 4858
MSRV-3A-5	PSA-10 SNUBBER	N/A	VT-3	303/8.2.17				S/N 701
			VT-4	303/8.2.17				S/N 701
MSRV-3A-6	PSA-10 SNUBBER	N/A	VT-3	303/8.2.17				S/N 321
			VT-4	303/8.2.17				S/N 321

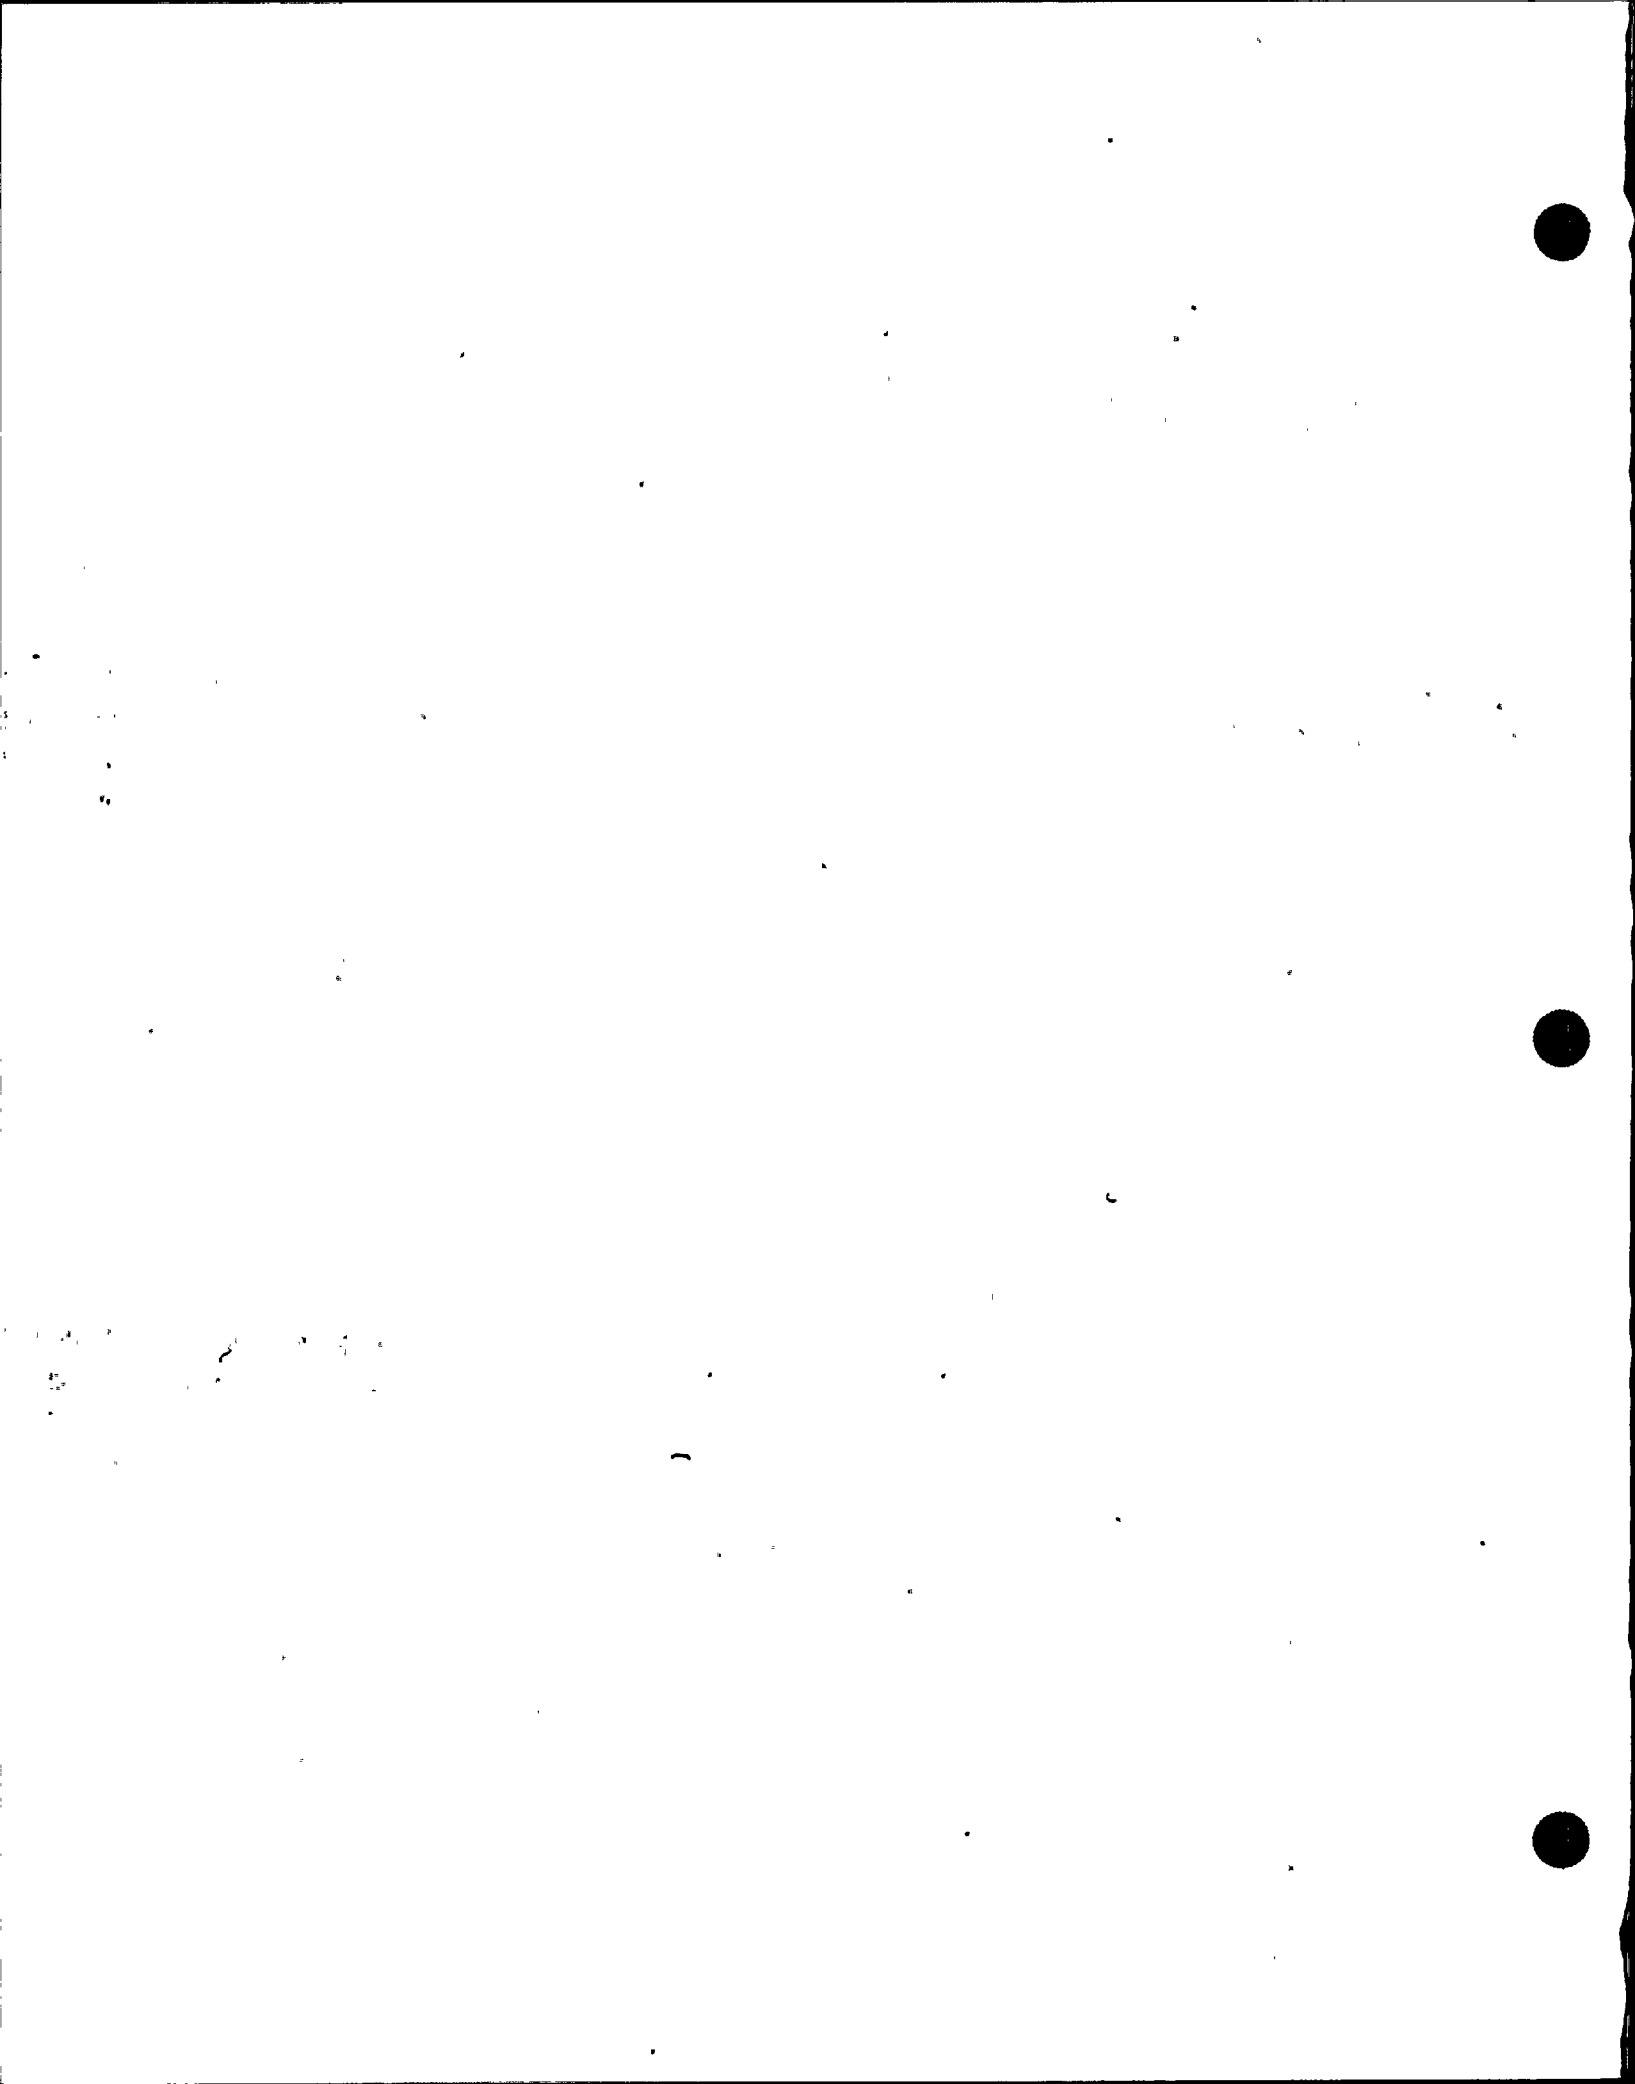

WNF-02
 INTERVAL: PSI
 PERIOD: NA
 OUTAGE:
 DRAWING NO. MS-304

WASHINGTON PUBLIC POWER SUPPLY SYSTEM
 PROGRAM PLAN AND SCHEDULE
 SYSTEM OR COMPONENT: MS(18)-2-4
 DESCRIPTION: MS-RV-4A DISCHARGE

PAGE 001
 DATE 12/14/84

<u>IDENT. NO.</u>	<u>DESCRIPTION</u>	<u>SECT.</u> <u>XI</u> <u>EXAM.</u>	<u>EXAM</u> <u>HTH.</u>	<u>PROCEDURE</u>	<u>CAL.</u> <u>BLOCK</u>	<u>INSERVICE</u> <u>SCHEDULED</u>		<u>NOTES</u>
						<u>REQ.</u>	<u>OUTAGE</u>	
MSRV-4A-2	PSA-10 SNUBBER	N/A	VT-3	303/8.2.17				S/N 694
			VT-4	303/8.2.17				S/N 694
MSRV-4A-3	PSA-10 SNUBBER	N/A	VT-3	303/8.2.17				S/N 13049
			VT-4	303/8.2.17				S/N 13049
MSRV-4A-1	PSA-10 SNUBBER	N/A	VT-3	303/8.2.17				S/N 1457
			VT-4	303/8.2.17				S/N 1457
MSRV-4A-4	PSA-10 SNUBBER	N/A	VT-3	303/8.2.17				S/N 13039
			VT-4	303/8.2.17				S/N 13039
MSRV-4A-5	PSA-10 SNUBBER	N/A	VT-3	303/8.2.17				S/N 13042
			VT-4	303/8.2.17				S/N 13042
MSRV-4A-8	PSA-10 SNUBBER	N/A	VT-3	303/8.2.17				S/N 3064
			VT-4	303/8.2.17				S/N 3064
MSRV-4A-10	PSA-10 SNUBBER	N/A	VT-3	303/8.2.17				S/N 13038
			VT-4	303/8.2.17				S/N 13038
MSRV-4A-9	PSA-10 SNUBBER	N/A	VT-3	303/8.2.17				S/N 13055
			VT-4	303/8.2.17				S/N 13055
MSRV-4A-6	PSA-10 SNUBBER	N/A	VT-3	303/8.2.17				S/N 11865

WNP-02
 INTERVAL: PSI
 PERIOD: NA
 OUTAGE:
 DRAWING NO. MS-304

WASHINGTON PUBLIC POWER SUPPLY SYSTEM
 PROGRAM PLAN AND SCHEDULE
 SYSTEM OR COMPONENT: MS(18)-2-4
 DESCRIPTION: MS-RV-4A DISCHARGE

PAGE 002
 DATE 12/14/84

<u>IDENT. NO.</u>	<u>DESCRIPTION</u>	<u>SECT.</u> <u>XI</u>	<u>EXAM</u> <u>EXAM.</u>	<u>INH.</u>	<u>PROCEDURE</u>	<u>CAL.</u> <u>BLOCK</u>	<u>INSERVICE</u>		<u>NOTES</u>
							<u>REQ.</u>	<u>SCHEDULED</u> <u>OUTAGE</u>	
MSRV-4A-7	PSA-10 SNUBBER	N/A		VT-4	303/8.2.17				S/N 11865
				VT-3	303/8.2.17				S/N 1461
				VT-4	303/8.2.17				S/N 1461

WNP-02
 INTERVAL: PSI
 PERIOD: NA
 OUTAGE:
 DRAWING NO. MS-305

WASHINGTON PUBLIC POWER SUPPLY SYSTEM
 PROGRAM PLAN AND SCHEDULE
 SYSTEM OR COMPONENT: MS(10)2-10
 DESCRIPTION: MS-RV-1E DISCHARGE

PAGE 001
 DATE 12/14/84


<u>IDENT. NO.</u>	<u>DESCRIPTION</u>	<u>SECT.</u> <u>XI</u>	<u>EXAM</u> <u>ETH.</u>	<u>PROCEDURE</u>	<u>CAL.</u> <u>BLOCK</u>	<u>INSERVICE</u>		<u>NOTES</u>
						<u>REQ.</u>	<u>SCHEDULED</u> <u>OUTAGE</u>	
MSRV-1B-2	PSA-10 SNUBBER	N/A	VT-3	303/8.2.17				S/N 13035
			VT-4	303/8.2.17				S/N 13035
MSRV-1B-3	PSA-10 SNUBBER	N/A	VT-3	303/8.2.17				S/N 4864
			VT-4	303/8.2.17				S/N 4864
MSRV-1B-1	PSA-10 SNUBBER	N/A	VT-3	303/8.2.17				S/N 13681
			VT-4	303/8.2.17				S/N 13681
MSRV-1B-5	PSA-10 SNUBBER	N/A	VT-3	303/8.2.17				S/N 295
			VT-4	303/8.2.17				S/N 295
MSRV-1B-4	PSA-10 SNUBBER	N/A	VT-3	303/8.2.17				S/N 690
			VT-4	303/8.2.17				S/N 690

WNP-02
 INTERVAL: PSI
 PERIOD: NA
 OUTAGE:
 DRAWING NO. MS-306

WASHINGTON PUBLIC POWER SUPPLY SYSTEM
 PROGRAM PLAN AND SCHEDULE
 SYSTEM OR COMPONENT: MS(1R)2-11
 DESCRIPTION: MS-RV-2R DISCHARGE

PAGE 001
 DATE 12/14/84

<u>IDENT. NO.</u>	<u>DESCRIPTION</u>	<u>SECT.</u>		<u>PROCEDURE</u>	<u>CAL. BLOCK</u>	<u>INSERVICE SCHEDULED</u>		<u>NOTES</u>
		<u>XI EXAM.</u>	<u>EXAM. MTH.</u>			<u>REQ.</u>	<u>OUTAGE</u>	
MSRV-2B-3	PSA-10 SNUBBER	N/A	VT-3	303/8.2.17				S/N 10729
			VT-4	303/8.2.17				S/N 10729
MSRV-2B-1	PSA-10 SNUBBER	N/A	VT-3	303/8.2.17				S/N 13063
			VT-4	303/8.2.17				S/N 13063
MSRV-2B-4	PSA-10 SNUBBER	N/A	VT-3	303/8.2.17				S/N 13037
			VT-4	303/8.2.17				S/N 13037
MSRV-2B-2	PSA-10 SNUBBER	N/A	VT-3	303/8.2.17				S/N 13047
			VT-4	303/8.2.17				S/N 13047
MSRV-2B-6	PSA-10 SNUBBER	N/A	VT-3	303/8.2.17				S/N 9910
			VT-4	303/8.2.17				S/N 9910
MSRV-2B-5	PSA-10 SNUBBER	N/A	VT-3	303/8.2.17				S/N 271
			VT-4	303/8.2.17				S/N 271
MSRV-2B-7	PSA-10 SNUBBER	N/A	VT-3	303/8.2.17				S/N 13040
			VT-4	303/8.2.17				S/N 13040
MSRV-2B-8	PSA-10 SNUBBER	N/A	VT-3	303/8.2.17				S/N 13045
			VT-4	303/8.2.17				S/N 13045

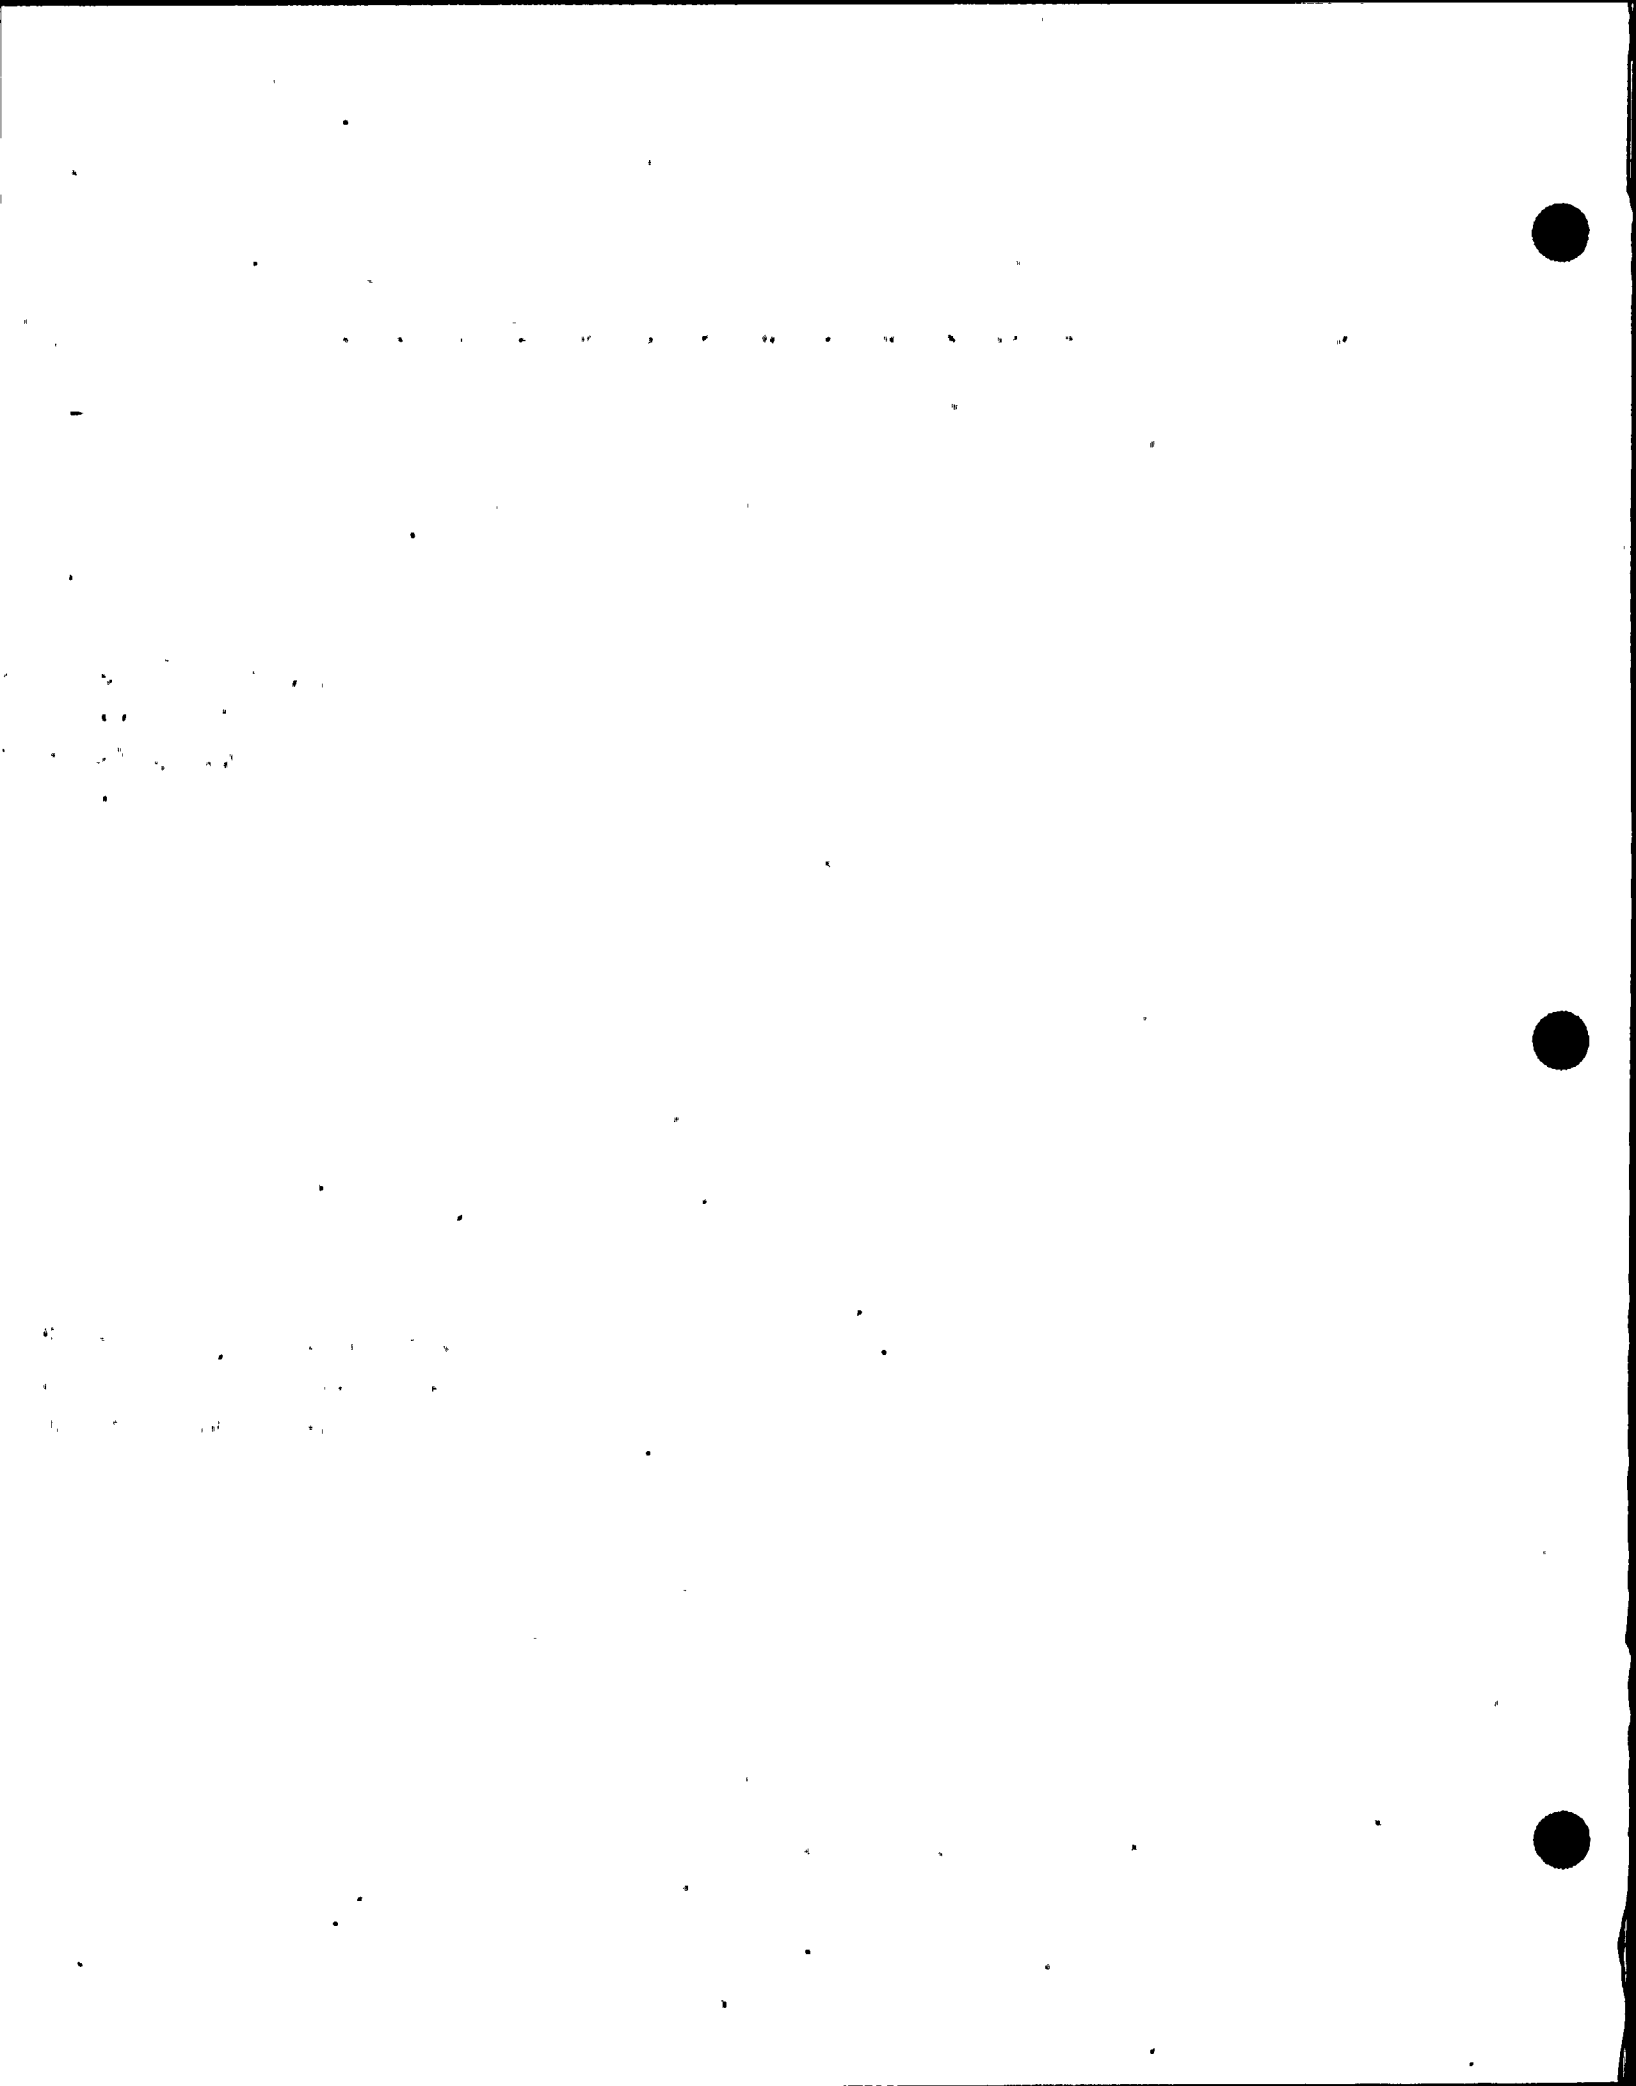

WNP-02
 INTERVAL: PSI
 PERIOD: NA
 OUTAGE:
 DRAWING NO. MS-307

WASHINGTON PUBLIC POWER SUPPLY SYSTEM
 PROGRAM PLAN AND SCHEDULE
 SYSTEM OF COMPONENT: MS(18)2-12
 DESCRIPTION: MS-RV-3B DISCHARGE

PAGE 001
 DATE 12/14/84

<u>IDENT. NO.</u>	<u>DESCRIPTION</u>	<u>SECT.</u> <u>XI</u> <u>EXAM.</u>	<u>EXAM</u> <u>MTN.</u>	<u>PROCEDURE</u>	<u>CAL.</u> <u>BLOCK</u>	<u>INSERVICE</u>		<u>NOTES</u>
						<u>REQ.</u>	<u>SCHEDULED</u> <u>OUTAGE</u>	
MSRV-3B-2	PSA-10 SNUBBER	N/A	VT-3	303/8.2.17				S/N 316
			VT-4	303/8.2.17				S/N 316
MSRV-3B-3	PSA-10 SNUBBER	N/A	VT-3	303/8.2.17				S/N 13050
			VT-4	303/8.2.17				S/N 13050
MSRV-3B-1	PSA-10 SNUBBER	N/A	VT-3	303/8.2.17				S/N 13048
			VT-4	303/8.2.17				S/N 13048
MSRV-3B-5	PSA-10 SNUBBER	N/A	VT-3	303/8.2.17				S/N 4862
			VT-4	303/8.2.17				S/N 4862
MSRV-3B-4	PSA-10 SNUBBER	N/A	VT-3	303/8.2.17				S/N 274
			VT-4	303/8.2.17				S/N 274
MSRV-3B-6	PSA-10 SNUBBER	N/A	VT-3	303/8.2.17				S/N 13056
			VT-4	303/8.2.17				S/N 13056
MSRV-3B-7	PSA-10 SNUBBER	N/A	VT-3	303/8.2.17				S/N 13062
			VT-4	303/8.2.17				S/N 13062

WNP-02
 INTERVAL: PSI
 PERIOD: NA
 OUTAGE:
 DRAWING NO. MS-308

WASHINGTON PUBLIC POWER SUPPLY SYSTEM
 PROGRAM PLAN AND SCHEDULE
 SYSTEM OR COMPONENT: MS(18)2-13
 DESCRIPTION: MS-RV-4B DISCHARGE

PAGE 001
 DATE 12/14/84

<u>IDENT. NO.</u>	<u>DESCRIPTION</u>	SECT. VI <u>EXAM.</u>	EXAM NTH.	<u>PROCEDURE</u>	CAL. <u>BLOCK</u>	<u>INSERVICE</u> SCHEDULED		<u>NOTES</u>
						<u>REQ.</u>	<u>OUTAGE</u>	
MSRV-4B-3	PSA-10 SNUBBER	N/A	VT-3	303/8.2.17				S/N 11863
			VT-4	303/8.2.17				S/N 11863
MSRV-4B-4	PSA-10 SNUBBER	N/A	VT-3	303/8.2.17				S/N 13027
			VT-4	303/8.2.17				S/N 13027
MSRV-4B-2	PSA-10 SNUBBER	N/A	VT-3	303/8.2.17				S/N 9953
			VT-4	303/8.2.17				S/N 9953
MSRV-4B-5	PSA-10 SNUBBER	N/A	VT-3	303/8.2.17				S/N 6202
			VT-4	303/8.2.17				S/N 6202
MSRV-4B-6	PSA-10 SNUBBER	N/A	VT-3	303/8.2.17				S/N 13032
			VT-4	303/8.2.17				S/N 13032
MSRV-4B-7	PSA-10 SNUBBER	N/A	VT-3	303/8.2.17				S/N 106
			VT-4	303/8.2.17				S/N 106
MSRV-4B-10	PSA-10 SNUBBER	N/A	VT-3	303/8.2.17				S/N 6119
			VT-4	303/8.2.17				S/N 6119
MSRV-4B-8	PSA-10 SNUBBER	N/A	VT-3	303/8.2.17				S/N 294
			VT-4	303/8.2.17				S/N 294
MSRV-4B-9	PSA-10 SNUBBER	N/A	VT-3	303/8.2.17				S/N 13052

WNP-02
INTERVAL: PSI
PERIOD: NA
OUTAGE:
DRAWING NO. MS-308

WASHINGTON PUBLIC POWER SUPPLY SYSTEM
PROGRAM PLAN AND SCHEDULE
SYSTEM OR COMPONENT: MS(18)2-13
DESCRIPTION: MS-RV-4R DISCHARGE

PAGE 002
DATE 12/14/84

<u>IDENT. NO.</u>	<u>DESCRIPTION</u>	SECT. XI	EXAM MTH.	PROCEDURE	CAL. BLOCK	INSERVICE		NOTES
						REQ.	SCHEDULED OUTAGE	
			VT-4	303/8.2.17				S/N 13052

WNP-02
 INTERVAL: PSI
 PERIOD: NA
 OUTAGE:
 DRAWING NO. MS-309

WASHINGTON PUBLIC POWER SUPPLY SYSTEM
 PROGRAM PLAN AND SCHEDULE
 SYSTEM OR COMPONENT: MS(18)2-14
 DESCRIPTION: MS-RV-5B DISCHARGE

PAGE 001
 DATE 12/14/84

<u>IDENT. NO.</u>	<u>DESCRIPTION</u>	SECT. • XI <u>EXAM.</u>	EXAM <u>MTG.</u>	<u>PROCEDURE</u>	CAL. <u>BLOCK</u>	<u>INSERVICE</u>		<u>NOTES</u>
						<u>REQ.</u>	<u>SCHEDULED OUTAGE</u>	
MSRV-5B-2	PSA-10 SNUBBER	N/A	VT-3	303/8.2.17				S/N 6205
			VT-4	303/8.2.17				S/N 6205
MSRV-5B-1	PSA-10 SN(2)	N/A	VT-3	303/8.2.17				S/N 3904/3948
			VT-4	303/8.2.17				S/N 3904/3948
MSRV-5B-3	PSA-10 SNUBBER	N/A	VT-3	303/8.2.17				S/N 291
			VT-4	303/8.2.17				S/N 291
MSRV-5B-5	PSA-10 SNUBBER	N/A	VT-3	303/8.2.17				S/N 684
			VT-4	303/8.2.17				S/N 684
MSRV-5B-4	PSA-10 SNUBBER	N/A	VT-3	303/8.2.17				S/N 13054
			VT-4	303/8.2.17				S/N 13054
MSRV-5B-6	PSA-10 SNUBBER	N/A	VT-3	303/8.2.17				S/N 11866
			VT-4	303/8.2.17				S/N 11866
MSRV-5B-7	PSA-10 SNUBBER	N/A	VT-3	303/8.2.17				S/N 13051
			VT-4	303/8.2.17				S/N 13051
MSRV-5B-8	PSA-10 SNUBBER	N/A	VT-3	303/8.2.17				S/N 578
			VT-4	303/8.2.17				S/N 578
MSRV-5B-9	PSA-10 SNUBBER	N/A	VT-3	303/8.2.17				S/N 11854

WNP-02
INTERVAL: PSI
PERIOD: NA
OUTAGE:
DRAWING NO. MS-309

WASHINGTON PUBLIC POWER SUPPLY SYSTEM
PROGRAM PLAN AND SCHEDULE
SYSTEM OR COMPONENT: MS(18)2-14
DESCRIPTION: MS-RV-5B DISCHARGE

PAGE 02
DATE 12/14/84

<u>IDENT. NO.</u>	<u>DESCRIPTION</u>	SECT. XI	EXAM EXAM.	EXAM MTH.	PROCEDURE	CAL. BLOCK	<u>INSERVICE</u>		<u>NOTES</u>
							REQ.	<u>SCHEDULED</u> OUTAGE	
				VT-4	303/8.2.17				S/N 11854

WNP-02
 INTERVAL: PSI
 PERIOD: NA
 OUTAGE:
 DRAWING NO. MS-310

WASHINGTON PUBLIC POWER SUPPLY SYSTEM
 PROGRAM PLAN AND SCHEDULE
 SYSTEM OR COMPONENT: MS(18)-2-9
 DESCRIPTION: MS-RV-1C DISCHARGE

PAGE 001
 DATE 12/14/84

<u>IDENT. NO.</u>	<u>DESCRIPTION</u>	<u>SECT.</u> <u>XI</u>	<u>EXAM</u> <u>MTH.</u>	<u>PROCEDURE</u>	<u>CAL.</u> <u>BLOCK</u>	<u>INSERVICE</u>		<u>NOTES</u>
						<u>REQ.</u>	<u>SCHEDULED</u> <u>OUTAGE</u>	
MSRV-1C-2	PSA-10 SNUBBER	N/A	VT-3	303/8.2.17				S/N 10566
			VT-4	303/8.2.17				S/N 10566
MSRV-1C-3	PSA-10 SNUBBER	N/A	VT-3	303/8.2.17				S/N 10731
			VT-4	303/8.2.17				S/N 10731
MSRV-1C-1	PSA-10 SNUBBER	N/A	VT-3	303/8.2.17				S/N 4870
			VT-4	303/8.2.17				S/N 4870
MSRV-1C-7	PSA-10 SNUBBER	N/A	VT-3	303/8.2.17				S/N 681
			VT-4	303/8.2.17				S/N 681
MSRV-1C-4	PSA-10 SNUBBER	N/A	VT-3	303/8.2.17				S/N 9943
			VT-4	303/8.2.17				S/N 9943
MSRV-1C-5	PSA-10 SNUBBER	N/A	VT-3	303/8.2.17				S/N 9908
			VT-4	303/8.2.17				S/N 9908

WNP-02
 INTERVAL: PSI
 PERIOD: NA
 OUTAGE:
 DRAWING NO. MS-311

WASHINGTON PUBLIC POWER SUPPLY SYSTEM
 PROGRAM PLAN AND SCHEDULE
 SYSTEM OR COMPONENT: MS(18)-2-8
 DESCRIPTION: MS-RV-2C DISCHARGE

PAGE 001
 DATE 12/14/84

<u>IDENT. NO.</u>	<u>DESCRIPTION</u>	<u>SECT.</u> <u>XI</u> <u>EYAM.</u>	<u>EYAM</u> <u>MTM.</u>	<u>PROCEDURE</u>	<u>CAL.</u> <u>BLOCK</u>	<u>INSERVICE</u> <u>SCHEDULED</u>		<u>NOTES</u>
						<u>REQ.</u>	<u>OUTAGE</u>	
MSRV-2C-2	PSA-10 SNUBBER	N/A	VT-3	303/8.2.17				S/N 4867
			VT-4	303/8.2.17				S/N 4867
MSRV-2C-1	PSA-10 SNUBBER	N/A	VT-3	303/8.2.17				S/N 685
			VT-4	303/8.2.17				S/N 685
MSRV-2C-3	PSA-10 SNUBBER	N/A	VT-3	303/8.2.17				S/N 4871
			VT-4	303/8.2.17				S/N 4871
MSRV-2C-8	PSA-10 SNUBBER	N/A	VT-3	303/8.2.17				S/N 9905
			VT-4	303/8.2.17				S/N 9905
MSRV-2C-9	PSA-10 SNUBBER	N/A	VT-3	303/8.2.17				S/N 9954
			VT-4	303/8.2.17				S/N 9954
MSRV-2C-5	PSA-10 SNUBBER	N/A	VT-3	303/8.2.17				S/N 9921
			VT-4	303/8.2.17				S/N 9921
MSRV-2C-4	PSA-10 SNUBBER	N/A	VT-3	303/8.2.17				S/N 9917
			VT-4	303/8.2.17				S/N 9917
MSRV-2C-6	PSA-10 SNUBBER	N/A	VT-3	303/8.2.17				S/N 9947
			VT-4	303/8.2.17				S/N 9947
MSRV-2C-7	PSA-10 SNUBBER	N/A	VT-3	303/8.2.17				S/N 9926

WNP-02
INTERVAL: PSI
PERIOD: NA
OUTAGE:
DRAWING NO. MS-311

WASHINGTON PUBLIC POWER SUPPLY SYSTEM
PROGRAM PLAN AND SCHEDULE
SYSTEM OR COMPONENT: MS(18)-2-8
DESCRIPTION: MS-RV-2C DISCHARGE

PAGE 002
DATE 12/14/84

<u>IDENT. NO.</u>	<u>DESCRIPTION</u>	<u>SECT.</u> <u>XT</u>	<u>EXAM</u> <u>EXAM.</u>	<u>PROCEDURE</u>	<u>CAL.</u> <u>BLOCK</u>	<u>INSERVICE</u>		<u>NOTES</u>
						<u>REQ.</u>	<u>SCHEDULED</u> <u>OUTAGE</u>	
			VT-4	303/8.2.17				S/N 9926

WNP-02
 INTERVAL: PSI
 PERIOD: NA
 OUTAGE:
 DRAWING NO. MS-312

WASHINGTON PUBLIC POWER SUPPLY SYSTEM
 PROGRAM PLAN AND SCHEDULE
 SYSTEM OR COMPONENT: MS(18)-2-7
 DESCRIPTION: MS-RV-3C DISCHARGE

PAGE 001
 DATE 12/14/84

<u>IDENT. NO.</u>	<u>DESCRIPTION</u>	<u>SECT.</u> <u>XI</u> <u>EXAN.</u>	<u>EYAM</u> <u>MIN.</u>	<u>PROCEDURE</u>	<u>CAL.</u> <u>BLOCK</u>	<u>INSERVICE</u> <u>SCHEDULED</u>		<u>NOTES</u>
						<u>REQ.</u>	<u>OUTAGE</u>	
MSRV-3C-2	PSA-10 SNUBBER	N/A	VT-3	303/8.2.17				S/N 4865
MSRV-3C-1	PSA-10 SNUBBER	N/A	VT-4	303/8.2.17				S/N 4865
			VT-3	303/8.2.17				S/N 9262
MSRV-3C-3	PSA-10 SNUBBER	N/A	VT-4	303/8.2.17				S/N 9262
			VT-3	303/8.2.17				S/N 4866
MSRV-3C-8	PSA-10 SNUBBER	N/A	VT-4	303/8.2.17				S/N 4866
			VT-3	303/8.2.17				S/N 14554
MSRV-3C-4	PSA-10 SNUBBER	N/A	VT-4	303/8.2.17				S/N 14554
			VT-3	303/8.2.17				S/N 4874
MSRV-3C-6	PSA-10 SNUBBER	N/A	VT-4	303/8.2.17				S/N 4874
			VT-3	303/8.2.17				S/N 319
MSRV-3C-5	PSA-10 SNUBBER	N/A	VT-4	303/8.2.17				S/N 319
			VT-3	303/8.2.17				S/N 313
MSRV-3C-7	PSA-10 SNUBBER	N/A	VT-4	303/8.2.17				S/N 313
			VT-3	303/8.2.17				S/N 9897
MSRV-3C-10	PSA-3 SN(2)	N/A	VT-4	303/8.2.17				S/N 9897
			VT-3	303/8.2.17				S/N E9912/W991

WNP-02
INTERVAL: PSI
PERIOD: NA
OUTAGE:
DRAWING NO. MS-312

WASHINGTON PUBLIC POWER SUPPLY SYSTEM
PROGRAM PLAN AND SCHEDULE
SYSTEM OR COMPONENT: MS(18)-2-7
DESCRIPTION: MS-RV-3C DISCHARGE

PAGE 002
DATE 12/14/84

<u>IDENT. NO.</u>	<u>DESCRIPTION</u>	<u>SECT.</u> XI	<u>EXAM</u> EXAM.	<u>EXAM</u> MTH.	<u>PROCEDURE</u>	<u>CAL.</u> BLOCK	<u>INSERVICE</u>		<u>NOTES</u>
							<u>REQ.</u>	<u>SCHEDULED</u> OUTAGE	
				VT-4	303/8.2.17				S/N E9912/W991

WNP-02
 INTERVAL: PSI
 PERIOD: NA
 OUTAGE:
 DRAWING NO. MS-313

WASHINGTON PUBLIC POWER SUPPLY SYSTEM
 PROGRAM PLAN AND SCHEDULE
 SYSTEM OR COMPONENT: MS(18)-2-6
 DESCRIPTION: MS-RV-4C DISCHARGE

PAGE 001
 DATE 12/14/84

IDENT. NO.	DESCRIPTION	SECT. XI EXAM.	EXAM MTH.	PROCEDURE	CAL. CLOCK	INSERVICE		NOTES
						REQ.	SCHEDULED OUTAGE	
MSRV-4C-2	PSA-10 SNUBBER	N/A	VT-3	303/8.2.17				S/N 282
MSRV-4C-3	PSA-10 SNUBBER	N/A	VT-4	303/8.2.17				S/N 282
			VT-3	303/8.2.17				S/N 9932
MSRV-4C-1	PSA-10 SNUBBER	N/A	VT-4	303/8.2.17				S/N 9932
			VT-3	303/8.2.17				S/N 712
MSRV-4C-5	PSA-10 SNUBBER	N/A	VT-4	303/8.2.17				S/N 712
			VT-3	303/8.2.17				S/N 9946
MSRV-4C-6	PSA-10 SNUBBER	N/A	VT-4	303/8.2.17				S/N 9946
			VT-3	303/8.2.17				S/N 116
MSRV-4C-4	PSA-10 SNUBBER	N/A	VT-4	303/8.2.17				S/N 116
			VT-3	303/8.2.17				S/N 9911
MSRV-4C-8	PSA-10 SNUBBER	N/A	VT-4	303/8.2.17				S/N 9911
			VT-3	303/8.2.17				S/N 10736
MSRV-4C-7	PSA-10 SNUBBER	N/A	VT-4	303/8.2.17				S/N 10736
			VT-3	303/8.2.17				S/N 277
MSRV-4C-9	PSA-10 SN(2)	N/A	VT-4	303/8.2.17				S/N 277
			VT-3	303/8.2.17				S/N E4502/W446

WNP-02
INTERVAL: PSI
PERIOD: NA
OUTAGE:
DRAWING NO. MS-313

WASHINGTON PUBLIC POWER SUPPLY SYSTEM
PROGRAM PLAN AND SCHEDULE
SYSTEM OR COMPONENT: MS(18)-2-6
DESCRIPTION: MS-RV-4C DISCHARGE

PAGE 002
DATE 12/14/84

<u>IDENT. NO.</u>	<u>DESCRIPTION</u>	<u>SECT.</u>		<u>PROCEDURE</u>	<u>CAL.</u> <u>BLOCK</u>	<u>INSERVICE</u>		<u>NOTES</u>
		<u>XI</u> <u>FYAM.</u>	<u>FYAM</u> <u>MTH.</u>			<u>SCHEDULED</u>	<u>OUTAGE</u>	
			VT-4	303/8.2.17				S/N E4502/W446

WNP-02
 INTERVAL: PSI
 PERIOD: NA
 OUTAGE:
 DRAWING NO. MS-314

WASHINGTON PUBLIC POWER SUPPLY SYSTEM
 PROGRAM PLAN AND SCHEDULE
 SYSTEM OR COMPONENT: MS(18)-2-5
 DESCRIPTION: MS-RV-5C DISCHARGE

PAGE 001
 DATE 12/14/84

IDENT. NO.	DESCRIPTION	SECT. XI EXAM.	EXAM NTH.	PROCEDURE	CAL. BLOCK	INSERVICE		NOTES
						REQ.	SCHEDULED OUTAGE	
MSRV-5C-3	PSA-10 SNUBBER	N/A	VT-3	303/8.2.17				S/N 9263
			VT-4	303/8.2.17				S/N 9263
MSRV-5C-2	PSA-10 SNUBBER	N/A	VT-3	303/8.2.17				S/N 4872
			VT-4	303/8.2.17				S/N 4872
MSRV-5C-1	PSA-10 SNUBBER	N/A	VT-3	303/8.2.17				S/N 13058
			VT-4	303/8.2.17				S/N 13058
MSRV-5C-6	PSA-10 SNUBBER	N/A	VT-3	303/8.2.17				S/N 11858
			VT-4	303/8.2.17				S/N 11858
MSRV-5C-4	PSA-10 SNUBBER	N/A	VT-3	303/8.2.17				S/N 10737
			VT-4	303/8.2.17				S/N 10737
MSRV-5C-5	PSA-10 SNUBBER	N/A	VT-3	303/8.2.17				S/N 9903
			VT-4	303/8.2.17				S/N 9903
MSRV-5C-7	PSA-10 SNUBBER	N/A	VT-3	303/8.2.17				S/N 273
			VT-4	303/8.2.17				S/N 273
MSRV-5C-8	PSA-35 SNUBBER	N/A	VT-3	303/8.2.17				S/N 10740
			VT-4	303/8.2.17				S/N 10740
MSRV-5C-9	PSA-10 SNUBBER	N/A	VT-3	303/8.2.17				S/N 9963

WNP-02
INTERVAL: PSI
PERIOD: NA
OUTAGE:
DRAWING NO. MS-314

WASHINGTON PUBLIC POWER SUPPLY SYSTEM
PROGRAM PLAN AND SCHEDULE
SYSTEM OR COMPONENT: MS(18)-2-5
DESCRIPTION: MS-RV-5C DISCHARGE

PAGE 002
DATE 12/14/84


<u>IDENT. NO.</u>	<u>DESCRIPTION</u>	SECT.			<u>INSERVICE</u>		<u>NOTES</u>	
		<u>EXAM.</u>	<u>MTH.</u>	<u>PROCEDURE</u>	<u>BLOCK</u>	<u>REQ.</u>		<u>SCHEDULED</u> <u>OUTAGE</u>
		XI	EXAM		CAL.			
		VT-4	303/8.2.17					S/N 9963

WNP-02
 INTERVAL: PSI
 PERIOD: NA
 OUTAGE:
 DRAWING NO., MS-315

WASHINGTON PUBLIC POWER SUPPLY SYSTEM
 PROGRAM PLAN AND SCHEDULE
 SYSTEM OR COMPONENT: MS(10)2-10
 DESCRIPTION: MS-RV-10 DISCHARGE

PAGE 001
 DATE 12/14/84

<u>IDENT. NO.</u>	<u>DESCRIPTION</u>	<u>SECT.</u> <u>XI</u> <u>EXAM.</u>	<u>EXAM</u> <u>MTG.</u>	<u>PROCEDURE</u>	<u>CAL.</u> <u>BLOCK</u>	<u>INSERVICE</u>		<u>NOTES</u>
						<u>REQ.</u>	<u>SCHEDULED</u> <u>OUTAGE</u>	
MSRV-10-1	PSA-10 SNUBBER	N/A	VT-3	303/8.2.17				S/N 9914
			VT-4	303/8.2.17				S/N 9914
MSRV-10-3	PSA-10 SNUBBER	N/A	VT-3	303/8.2.17				S/N 9930
			VT-4	303/8.2.17				S/N 9930
MSRV-10-4	PSA-10 SNUBBER	N/A	VT-3	303/8.2.17				S/N 9904
			VT-4	303/8.2.17				S/N 9904
MSRV-10-2	PSA-10 SNUBBER	N/A	VT-3	303/8.2.17				S/N 9928
			VT-4	303/8.2.17				S/N 9928
MSRV-10-6	PSA-10 SNUBBER	N/A	VT-3	303/8.2.17				S/N 9962
			VT-4	303/8.2.17				S/N 9962
MSRV-10-5	PSA-10 SNUBBER	N/A	VT-3	303/8.2.17				S/N 9956
			VT-4	303/8.2.17				S/N 9956
MSRV-10-7	PSA-10 SN(2)	N/A	VT-3	303/8.2.17				S/N E9927/W996
			VT-4	303/8.2.17				S/N E9927/W996

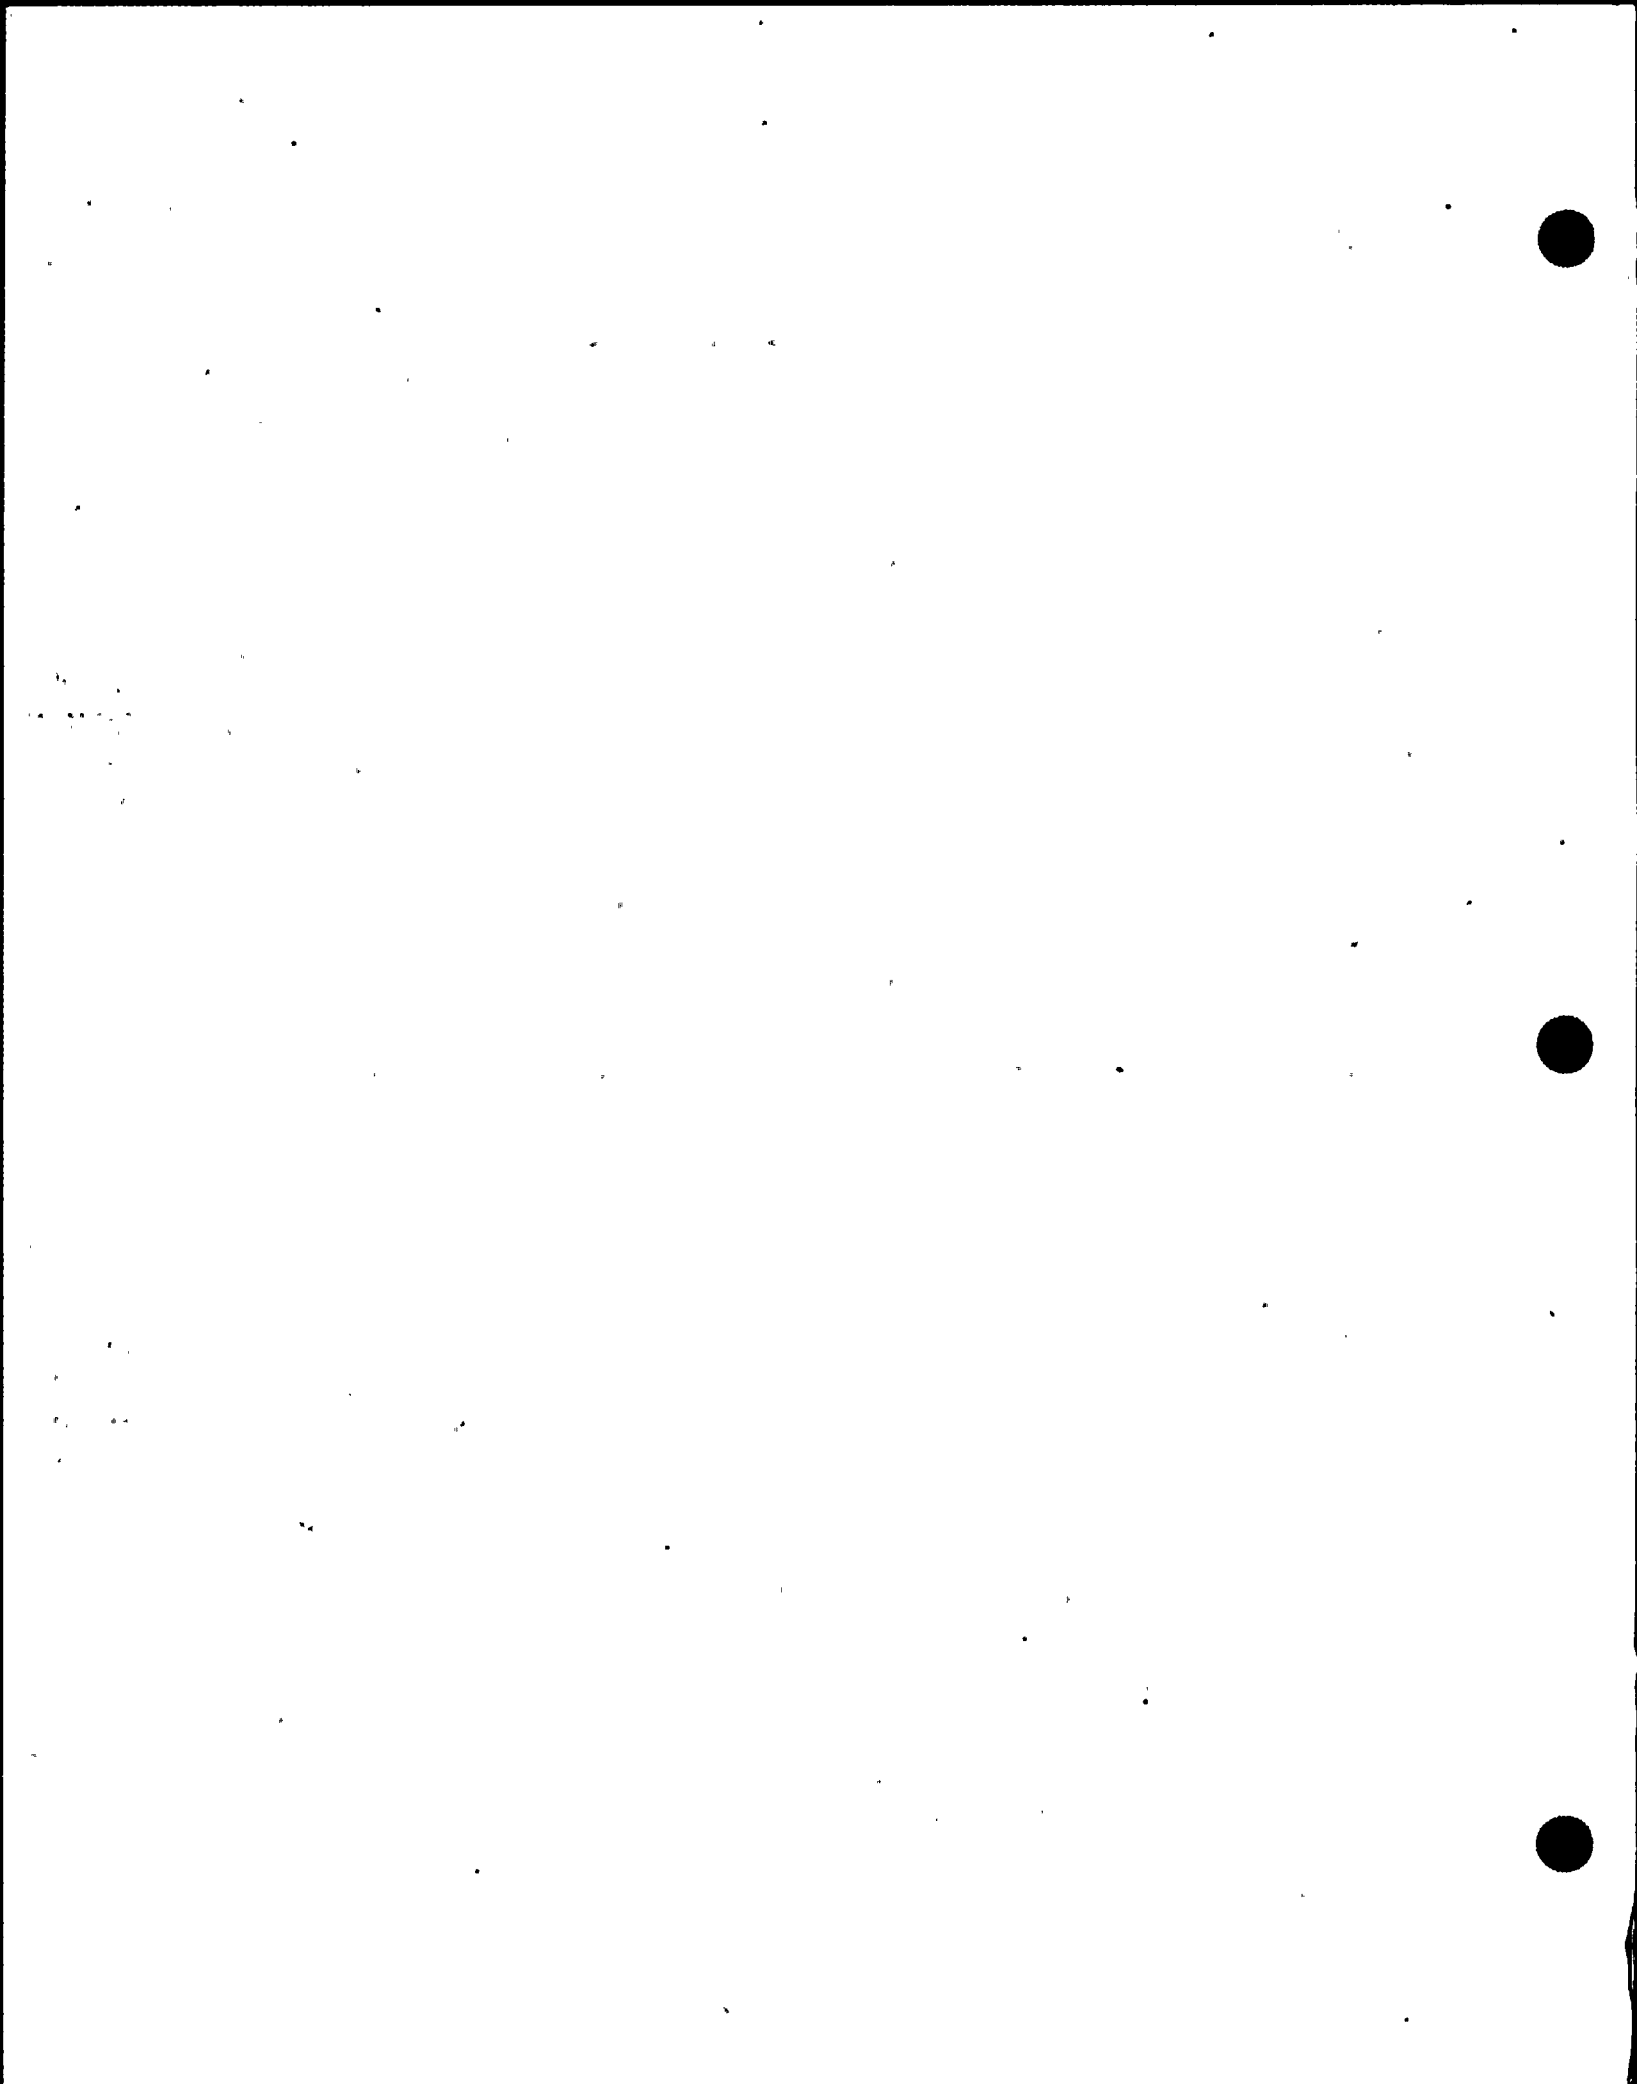


WNP-02
 INTERVAL: PSI
 PERIOD: NA
 OUTAGE:
 DRAWING NO. MS-316

WASHINGTON PUBLIC POWER SUPPLY SYSTEM
 PROGRAM PLAN AND SCHEDULE
 SYSTEM OR COMPONENT: MS(18)2-17
 DESCRIPTION: MS-RV-2D DISCHARGE

PAGE 001
 DATE 12/14/84

IDENT. NO.	DESCRIPTION	SECT. XI EXAM.	EXAM MTH.	PROCEDURE	CAL. BLOCK	INSERVICE		NOTES
						REQ.	SCHEDULED OUTAGE	
MSRV-2D-2	PSA-10 SNUBBER	N/A	VT-3	303/8.2.17				S/N 326
			VT-4	303/8.2.17				S/N 326
MSRV-2D-3	PSA-10 SNUBBER	N/A	VT-3	303/8.2.17				S/N 9957
			VT-4	303/8.2.17				S/N 9957
MSRV-2D-1	PSA-10 SNUBBER	N/A	VT-3	303/8.2.17				S/N 287
			VT-4	303/8.2.17				S/N 287
MSRV-2D-5	PSA-10 SNUBBER	N/A	VT-3	303/8.2.17				S/N 9898
			VT-4	303/8.2.17				S/N 9898
MSRV-2D-4	PSA-10 SNUBBER	N/A	VT-3	303/8.2.17				S/N 9909
			VT-4	303/8.2.17				S/N 9909

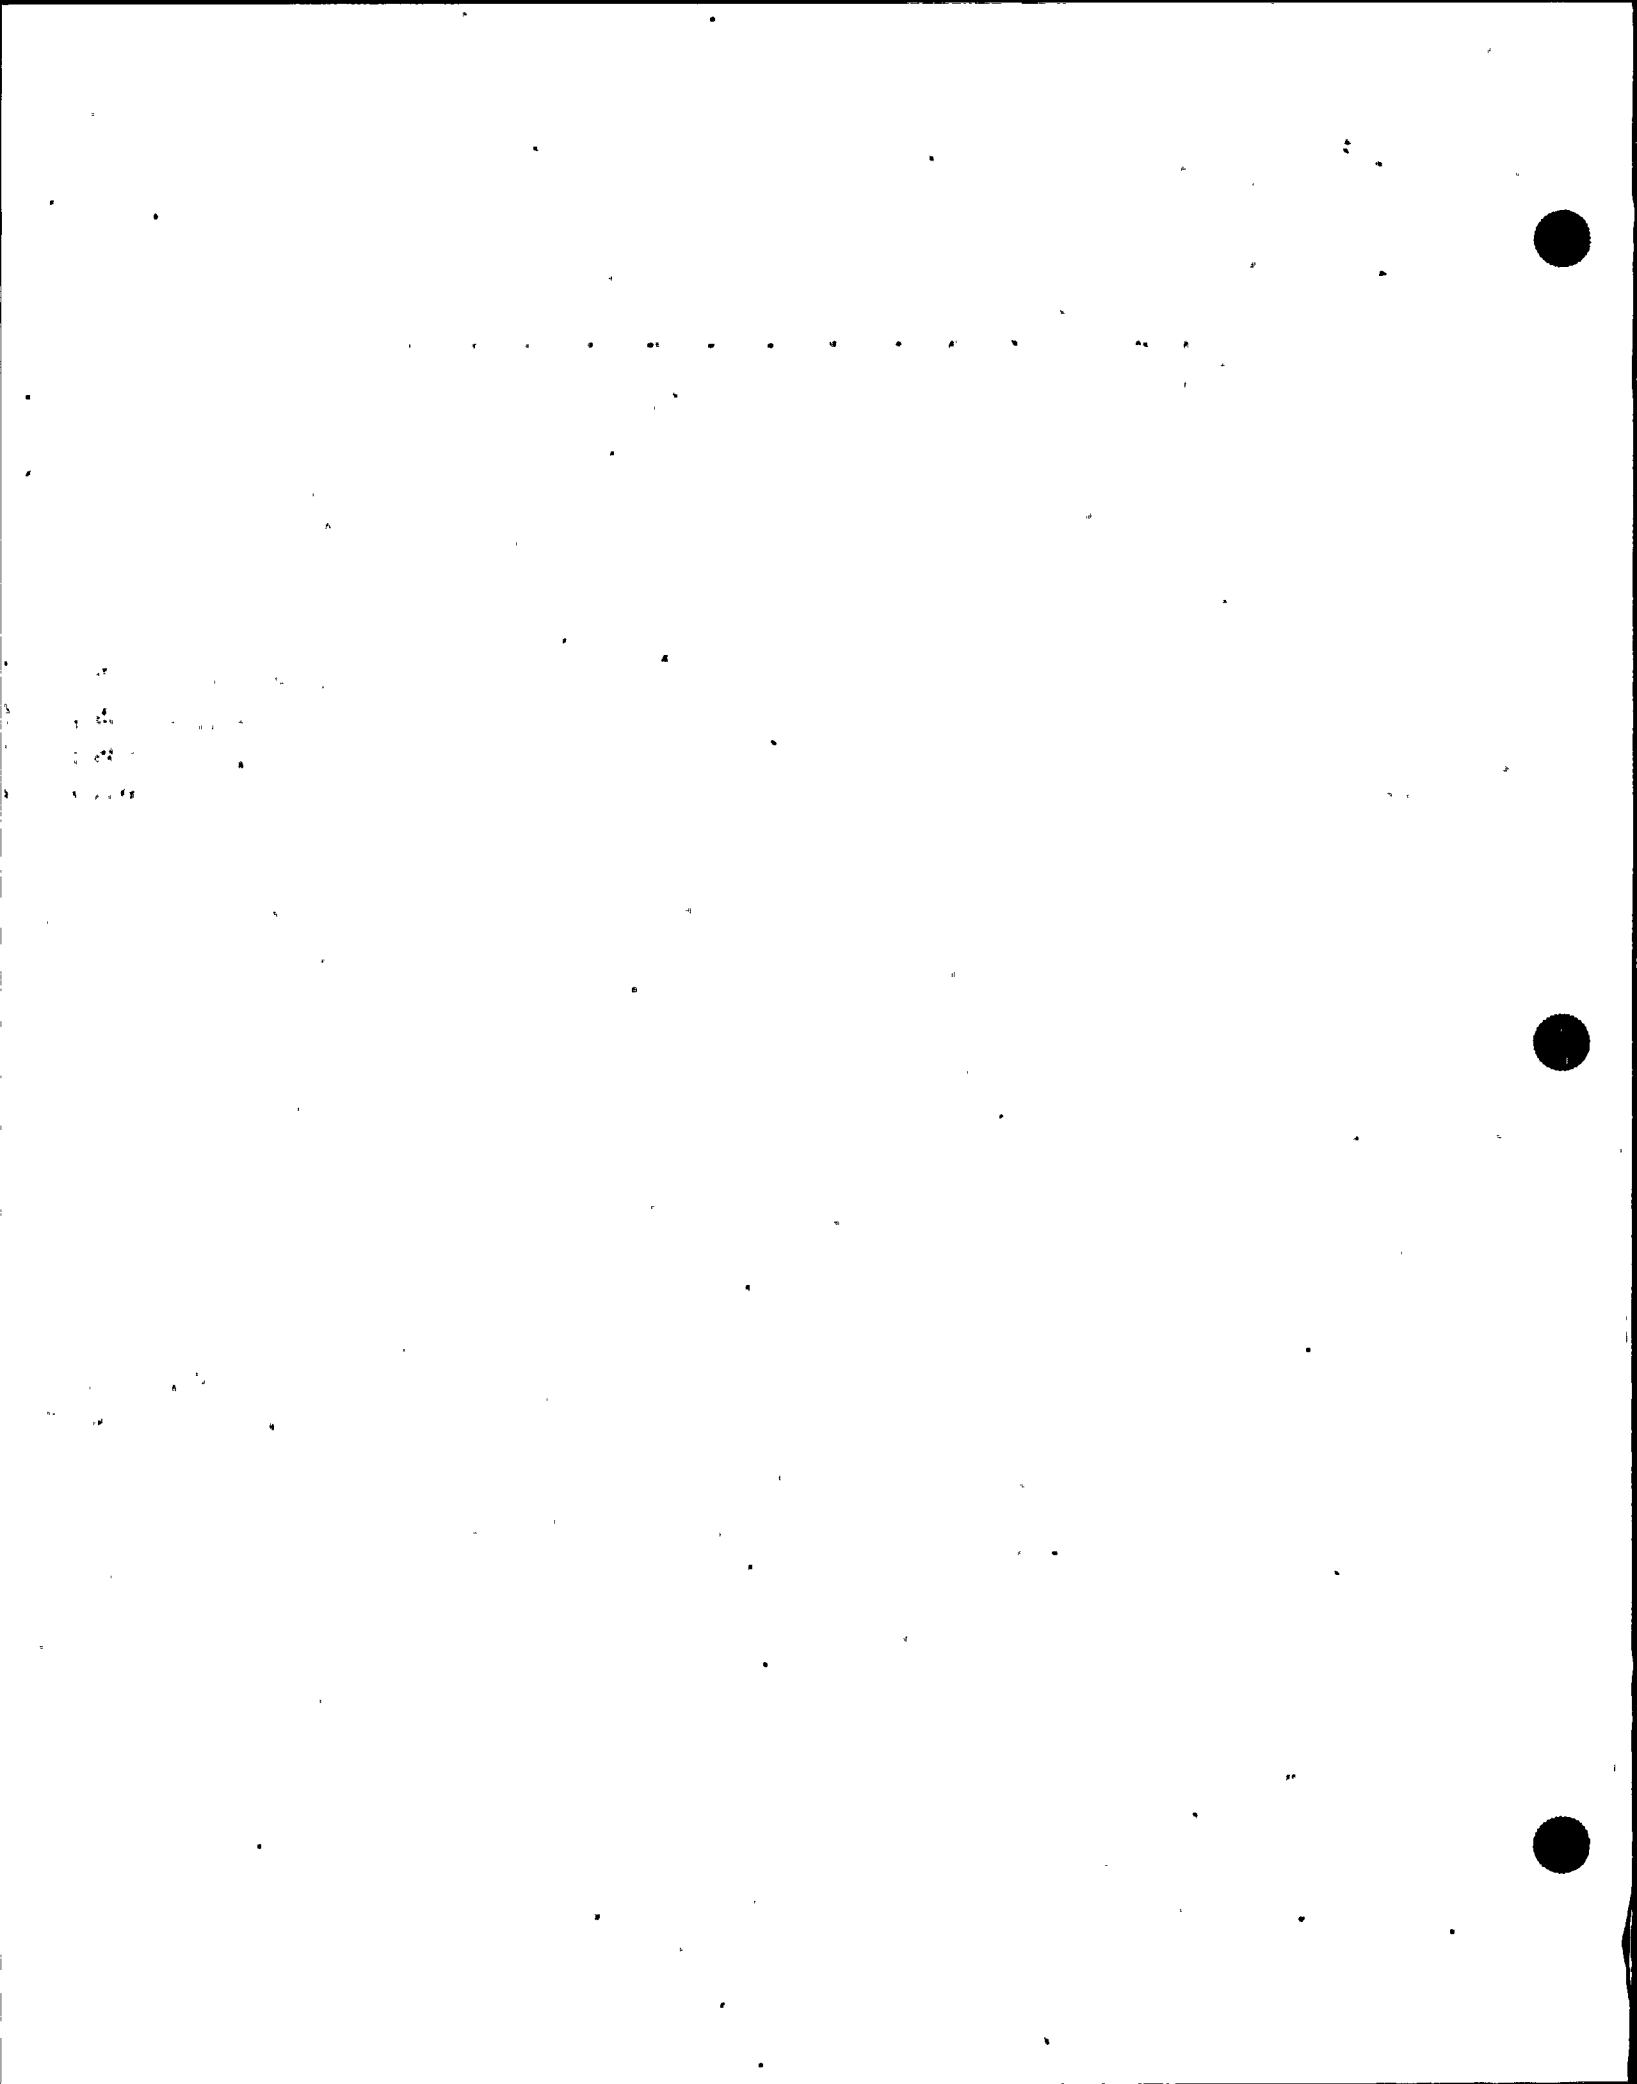

WNP-02
 INTERVAL: PSI
 PERIOD: NA
 OUTAGE:
 DRAWING NO. MS-317

WASHINGTON PUBLIC POWER SUPPLY SYSTEM
 PROGRAM PLAN AND SCHEDULE
 SYSTEM OR COMPONENT: MS(18)2-16
 DESCRIPTION: MS-RV-3D DISCHARGE

PAGE 001
 DATE 12/14/84


IDENT. NO.	DESCRIPTION	SECT. XI EXAM. EXAM.	EXAM MTH.	PROCEDURE	CAL. BLOCK	INSERVICE		NOTES
						REQ.	SCHEDULED OUTAGE	
PSRV-3D-4	PSA-10 SNUBBER	N/A	VT-3	303/8.2.17				S/N 9929
			VT-4	303/8.2.17				S/N 9929
MSRV-3D-2	PSA-10 SNUBBER	N/A	VT-3	303/8.2.17				S/N 9923
			VT-4	303/8.2.17				S/N 9923
MSRV-3D-1	PSA-10 SNUBBER	N/A	VT-3	303/8.2.17				S/N 9948
			VT-4	303/8.2.17				S/N 9948
MSRV-3D-5	PSA-10 SNUBBER	N/A	VT-3	303/8.2.17				S/N 1472
			VT-4	303/8.2.17				S/N 1472
MSRV-3D-3	PSA-10 SNUBBER	N/A	VT-3	303/8.2.17				S/N 9919
			VT-4	303/8.2.17				S/N 9919
MSRV-3D-7	PSA-10 SNUBBER	N/A	VT-3	303/8.2.17				S/N 9945
			VT-4	303/8.2.17				S/N 9945
MSRV-3D-6	PSA-10 SNUBBER	N/A	VT-3	303/8.2.17				S/N 323
			VT-4	303/8.2.17				S/N 323

WNP-02
 INTERVAL: PSI
 PERIOD: NA
 OUTAGE:
 DRAWING NO. MS-318

WASHINGTON PUBLIC POWER SUPPLY SYSTEM
 PROGRAM PLAN AND SCHEDULE
 SYSTEM OR COMPONENT: MS(18)2-15
 DESCRIPTION: MS-RV-4D DISCHARGE

PAGE 001
 DATE 12/14/84

<u>IDENT. NO.</u>	<u>DESCRIPTION</u>	<u>SECT.</u> <u>XI</u>	<u>EXAM</u> <u>EXAM.</u>	<u>EXAM</u> <u>MTM.</u>	<u>PROCEDURE</u>	<u>CAL.</u> <u>BLOCK</u>	<u>INSERVICE</u>		<u>NOTES</u>
							<u>REQ.</u>	<u>SCHEDULED</u> <u>OUTAGE</u>	
MSRV-4D-2	PSA-10 SNUBBER	N/A	VT-3	303/8.2.17					S/N 9933
			VT-4	303/8.2.17					S/N 9933
MSRV-4D-3	PSA-10 SNUBBER	N/A	VT-3	303/8.2.17					S/N 697
			VT-4	303/8.2.17					S/N 697
MSRV-4D-1	PSA-10 SNUBBER	N/A	VT-3	303/8.2.17					S/N 9952
			VT-4	303/8.2.17					S/N 9952
MSRV-4D-6	PSA-10 SNUBBER	N/A	VT-3	303/8.2.17					S/N 9940
			VT-4	303/8.2.17					S/N 9940
MSRV-4D-4	PSA-10 SNUBBER	N/A	VT-3	303/8.2.17					S/N 9941
			VT-4	303/8.2.17					S/N 9941
MSRV-4D-5	PSA-10 SNUBBER	N/A	VT-3	303/8.2.17					S/N 9920
			VT-4	303/8.2.17					S/N 9920

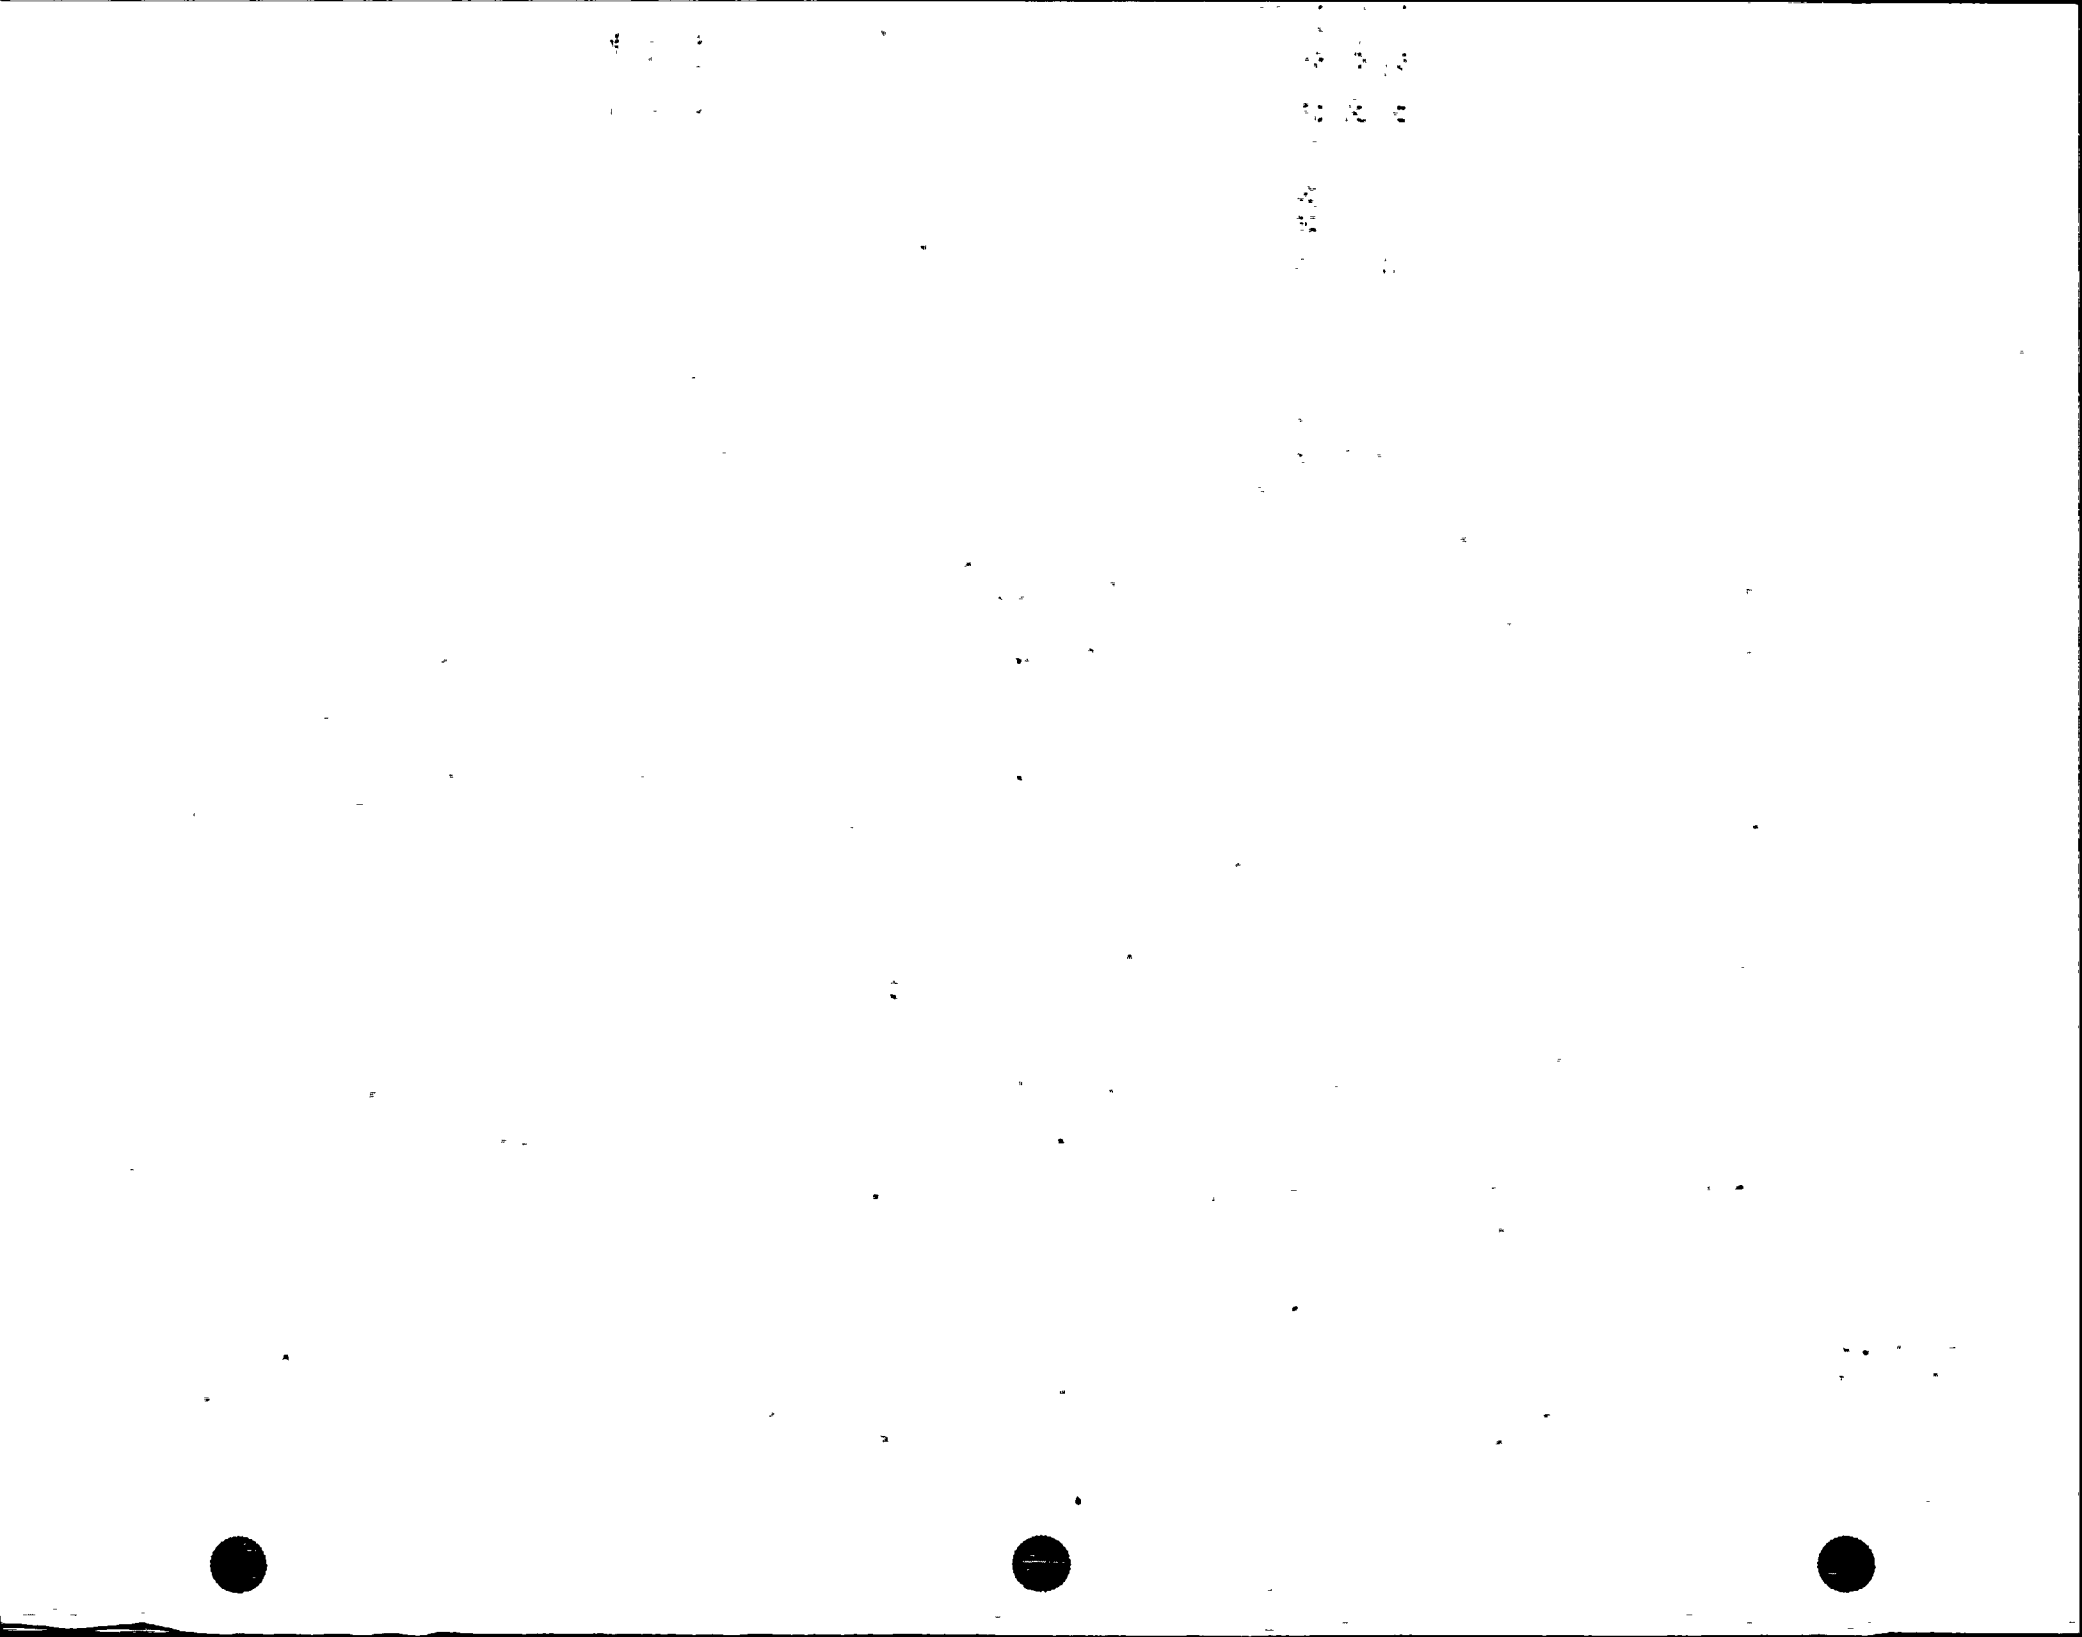

WNP-02
 INTERVAL: PSI
 PERIOD: NA
 OUTAGE:
 DRAWING NO. +QC I SN.

WASHINGTON PUBLIC POWER SUPPLY SYSTEM
 PROGRAM PLAN AND SCHEDULE
 SYSTEM OR COMPONENT: +QC I SN
 DESCRIPTION: MISC SNUBBER S

PAGE 001
 DATE 12/14/84

<u>IDENT. NO.</u>	<u>DESCRIPTION</u>	<u>SECT.</u> XI <u>EXAM.</u>	<u>EXAM</u> MTH.	<u>PROCEDURE</u>	<u>CAL.</u> BLOCK	<u>INSERVICE</u>		<u>NOTES</u>
						<u>REQ.</u>	<u>SCHEDULED</u> OUTAGE	
AS-129	PSA-3 SNUBBER	N/A	VT-3	303/8.2.17				
			VT-4	303/8.2.17				
AS-131	PSA-1/2 SNUBBER	N/A	VT-3	303/8.2.17				
			VT-4	303/8.2.17				
AS-139	PSA-1/2 SN(2)	N/A	VT-3	303/8.2.17				S/N 122 S/N 389
			VT-4	303/8.2.17				S/N 122 S/N 389
AS-157	PSA-1 SNUBBER	N/A	VT-3	303/8.2.17				S/N 368
			VT-4	303/8.2.17				S/N 368
AS-180	PSA-1/2 SNUBBER	N/A	VT-3	303/8.2.17				S/N 399
			VT-4	303/8.2.17				S/N 399

WMP-02
 INTERVAL: PSI
 PERIOD: NA
 OUTAGE:
 DRAWING NO. +OC I SN

WASHINGTON PUBLIC POWER SUPPLY SYSTEM
 PROGRAM PLAN AND SCHEDULE
 SYSTEM OR COMPONENT: +OC I SN
 DESCRIPTION: MISC. SNUBBERS

PAGE 002
 DATE 12/14/84

<u>IDENT. NO.</u>	<u>DESCRIPTION</u>	<u>SECT. XI EXAM.</u>	<u>EXAM. MTH.</u>	<u>PROCEDURE</u>	<u>CAL. BLOCK</u>	<u>INSERVICE SCHEDULED</u>		<u>NOTES</u>
						<u>REQ.</u>	<u>OUTAGE</u>	
CEP-905S	PSA-1/2 SNUBBER	N/A	VT-3	303/8.2.17				S/N
			VT-4	303/8.2.17				S/N
CEP-908N	PSA-3 SNUBBER	N/A	VT-3	303/8.2.17				S/N
			VT-4	303/8.2.17				S/N
COND-862	PSA-1/2 SN(2)	N/A	VT-3	303/8.2.17				S/N 418 S/N 114
			VT-4	303/8.2.17				S/N 418 S/N 114
COND-863	PSA-1 SNUBBER	N/A	VT-3	303/8.2.17				S/N 613
			VT-4	303/8.2.17				S/N 613
COND-880	PSA-3 SN(2)	N/A	VT-3	303/8.2.17				S/N 847 S/N 358
			VT-4	303/8.2.17				S/N 847 S/N 358
COND-957N	PSA-1 SNUBBER	N/A	VT-3	303/8.2.17				S/N 367
			VT-4	303/8.2.17				S/N 367

WNP-C2
 INTERVAL: PSI
 PERIOD: NA
 OUTAGE:
 DRAWING NO. +QC I SN

WASHINGTON PUBLIC POWER SUPPLY SYSTEM
 PROGRAM PLAN AND SCHEDULE
 SYSTEM OR COMPONENT: +QC I SN
 DESCRIPTION: MISC SNUBBERS

PAGE 003
 DATE 12/14/84

IDENT. NO.	DESCRIPTION	SECT. XI EXAM.	EXAM MTH.	PROCEDURE	CAL. BLOCK	INSERVICE		NOTES
						REQ.	SCHEDULED OUTAGE	
DE-2	PSA-3 SNUBBER	N/A	VT-3	303/8.2.17				S/N 3934
			VT-4	303/8.2.17				S/N 3934
DE-3	PSA-3 SN(2)	N/A	VT-3	303/8.2.17				S/N 3929/
			VT-4	303/8.2.17				S/N 3929/
DE-23	PSA-3 SNUBBER	N/A	VT-3	303/8.2.17				S/N 2381
			VT-4	303/8.2.17				S/N 2381
DE-49	PSA-3 SNUBBER	N/A	VT-3	303/8.2.17				S/N 2354
			VT-4	303/8.2.17				S/N 2354
DE-57	PSA-3 SNUBBER	N/A	VT-3	303/8.2.17				S/N 2355
			VT-4	303/8.2.17				S/N 2355
DE-59	PSA-3 SNUBBER	N/A	VT-3	303/8.2.17				S/N 2380
			VT-4	303/8.2.17				S/N 2380
DE-902N	PSA-1 SN(2)	N/A	VT-3	303/8.2.17				S/N 614/
			VT-4	303/8.2.17				S/N 614/
DE-2836-15	PSA-1/2 SNUBBER	N/A	VT-3	303/8.2.17				S/N
			VT-4	303/8.2.17				S/N
DE-2837-17	PSA-1/4 SNUBBER	N/A	VT-3	303/8.2.17				S/N 6214

WNP-02
 INTERVAL: PSI
 PERIOD: NA
 OUTAGE:
 DRAWING NO. +QC I SN

WASHINGTON PUBLIC POWER SUPPLY SYSTEM
 PROGRAM PLAN AND SCHEDULE
 SYSTEM OR COMPONENT: +QC I SN
 DESCRIPTION: MISC SNUBBERS

PAGE 004
 DATE 12/14/84

IDENT. NO.	DESCRIPTION	SECT. XI EXAM.	EXAM MTH.	PROCEDURE	CAL. BLOCK	INSERVICE		NOTES
						REQ.	SCHEDULED OUTAGE	
DE-2832-18			VT-4	303/8.2.17				S/N 6214
	PSA-1/4 SNUBBER	N/A	VT-3	303/8.2.17				S/N 434
			VT-4	303/8.2.17				S/N 434
DE-2839-14B			VT-3	303/8.2.17				S/N 399
	PSA-1/4 SNUBBER	N/A	VT-3	303/8.2.17				S/N 399
			VT-4	303/8.2.17				S/N 399
EDR-903N			VT-3	303/8.2.17				S/N
	PSA-1/4 SNUBBER	N/A	VT-3	303/8.2.17				S/N
			VT-4	303/8.2.17				S/N
EDR-904N			VT-3	303/8.2.17				S/N
	PSA-1/4 SNUBBER	N/A	VT-3	303/8.2.17				S/N
			VT-4	303/8.2.17				S/N
EDR-905N			VT-3	303/8.2.17				S/N
	PSA-1/4 SNUBBER	N/A	VT-3	303/8.2.17				S/N
			VT-4	303/8.2.17				S/N
EDR-906N			VT-3	303/8.2.17				S/N
	PSA-1/4 SNUBBER	N/A	VT-3	303/8.2.17				S/N
			VT-4	303/8.2.17				S/N
FDR-900N			VT-3	303/8.2.17				S/N
	PSA-1 SNUBBER	N/A	VT-3	303/8.2.17				S/N
			VT-4	303/8.2.17				S/N
FDR-901N			VT-3	303/8.2.17				S/N
	PSA-1/4 SNUBBER	N/A	VT-3	303/8.2.17				S/N
			VT-4	303/8.2.17				S/N

WNP-02
 INTERVAL: PSI
 PERIOD: NA
 OUTAGE:
 DRAWING NO. +OC I SN

WASHINGTON PUBLIC POWER SUPPLY SYSTEM
 PROGRAM PLAN AND SCHEDULE
 SYSTEM OR COMPONENT: +OC I SN
 DESCRIPTION: MISC SNUBBERS

PAGE 005
 DATE 12/14/84

IDENT. NO.	DESCRIPTION	SECT. XI EXAM.	EXAM MTH.	PROCEDURE	CAL. BLOCK	INSERVICE		NOTES
						REQ.	SCHEDULED OUTAGE	
FDR-902N	PSA-1 SNUBBER	N/A	VT-3	303/8.2.17				S/N
			VT-4	303/8.2.17				S/N
FDR-903N	PSA-3 SN(2)	N/A	VT-3	303/8.2.17				S/N 4429/4489
			VT-4	303/8.2.17				S/N 4429/4489
HY-4235-110	PSA-1/4 SNUBBER	N/A	VT-3	303/8.2.17				S/N 28429
			VT-4	303/8.2.17				S/N 28429
HY-4236-110	PSA-1/4 SNUBBER	N/A	VT-3	303/8.2.17				S/N 28430
			VT-4	303/8.2.17				S/N 28430
HY-4237-110	PSA-1/4 SNUBBER	N/A	VT-3	303/8.2.17				S/N 28434
			VT-4	303/8.2.17				S/N 28434
MD-74	PSA-1/2 SNUBBER	N/A	VT-3	303/8.2.17				S/N
			VT-4	303/8.2.17				S/N
MD-1285-11B	PSA-1/4 SNUBBER	N/A	VT-3	303/8.2.17				S/N
			VT-4	303/8.2.17				S/N
MD-1285-14A	PSA-1/4 SNUBBER	N/A	VT-3	303/8.2.17				S/N
			VT-4	303/8.2.17				S/N
MD-1285-14D	PSA-1/2 SNUBBER	N/A	VT-3	303/8.2.17				S/N

WNP-02
 INTERVAL: PSI
 PERIOD: NA
 OUTAGE:
 DRAWING NO. +OC I SN

WASHINGTON PUBLIC POWER SUPPLY SYSTEM
 PROGRAM PLAN AND SCHEDULE
 SYSTEM OR COMPONENT: +OC I SN
 DESCRIPTION: MISC SNUBBERS

PAGE 006
 DATE 12/14/84

IDENT. NO.	DESCRIPTION	SECT. XI EXAM.	EYAM MTH.	PROCEDURE	CAL. BLOCK	INSERVICE		NOTES
						REQ.	SCHEDULED OUTAGE	
MD-1285-14C			VT-4	303/8.2.17				S/N
	PSA-1/4 SNUBBER	N/A	VT-3	303/8.2.17				S/N
			VT-4	303/8.2.17				S/N
MD-1287-11			VT-3	303/8.2.17				S/N
	PSA-1/4 SNUBBER	N/A	VT-3	303/8.2.17				S/N
			VT-4	303/8.2.17				S/N
MD-1287-15			VT-3	303/8.2.17				S/N
	PSA-1 SNUBBER	N/A	VT-3	303/8.2.17				S/N
			VT-4	303/8.2.17				S/N
MD-1288-17			VT-3	303/8.2.17				S/N
	PSA-1/2 SNUBBER	N/A	VT-3	303/8.2.17				S/N
			VT-4	303/8.2.17				S/N
MD-1290-11B			VT-3	303/8.2.17				S/N
	PSA-1/4 SNUBBER	N/A	VT-3	303/8.2.17				S/N
			VT-4	303/8.2.17				S/N
MS-249			VT-3	303/8.2.17				S/N 341
	PSA-1 SNUBBER	N/A	VT-3	303/8.2.17				S/N 341
			VT-4	303/8.2.17				S/N 341
MS-255			VT-3	303/8.2.17				S/N 363
	PSA-1 SNUBBER	N/A	VT-3	303/8.2.17				S/N 363
			VT-4	303/8.2.17				S/N 363
MS-256			VT-3	303/8.2.17				S/N 4444/
	PSA-3 SN(2)	N/A	VT-3	303/8.2.17				S/N 4444/
			VT-4	303/8.2.17				S/N 4444/

WNP-02
 INTERVAL: PSI
 PERIOD: NA
 OUTAGE:
 DRAWING NO. +QC I SN

WASHINGTON PUBLIC POWER SUPPLY SYSTEM
 PROGRAM PLAN AND SCHEDULE
 SYSTEM OR COMPONENT: +QC I SN
 DESCRIPTION: MISC SNUBBERS

PAGE 007
 DATE 12/14/84

IDENT. NO.	DESCRIPTION	SECT. XI EXAM.	EXAM MTH.	PROCEDURE	CAL. BLOCK	INSERVICE		NOTES
						REG.	SCHEDULED OUTAGE	
MS-953N	PSA-3 SNUBBER	N/A	VT-3	303/8.2.17				S/N 2568
			VT-4	303/8.2.17				S/N 2568
MS-954N	PSA-3 SNUBBER	N/A	VT-3	303/8.2.17				S/N 2366
			VT-4	303/8.2.17				S/N 2366
MS-2618-12A	PSA-1/4 SNUBBER	N/A	VT-3	303/8.2.17				S/N 19879
			VT-4	303/8.2.17				S/N 19879
MS-2618-12B	PSA-1/2 SNUBBER	N/A	VT-3	303/8.2.17				S/N 2554
			VT-4	303/8.2.17				S/N 2554
MS-2618-13A	PSA-1/4 SNUBBER	N/A	VT-3	303/8.2.17				S/N 315
			VT-4	303/8.2.17				S/N 315
MS-2618-13B	PSA-1/4 SNUBBER	N/A	VT-3	303/8.2.17				S/N 28462
			VT-4	303/8.2.17				S/N 28462
MS-2618-11	PSA-1/2 SNUBBER	N/A	VT-3	303/8.2.17				S/N 2094
			VT-4	303/8.2.17				S/N 2094
MS-4448-12	PSA-1/4 SNUBBER	N/A	VT-3	303/8.2.17				S/N 291
			VT-4	303/8.2.17				S/N 291
MS-4448-46	PSA-1/4 SNUBBER	N/A	VT-3	303/8.2.17				S/N 433

WNP-02
 INTERVAL: PSI
 PERIOD: NA
 OUTAGE:
 DRAWING NO. +OC I SN

WASHINGTON PUBLIC POWER SUPPLY SYSTEM
 PROGRAM PLAN AND SCHEDULE
 SYSTEM OR COMPONENT: +OC I SN
 DESCRIPTION: MISC SNUBBERS

PAGE 008
 DATE 12/14/84

IDENT. NO.	DESCRIPTION	SECT. XI EXAN. EXAN.	EXAM MTH.	PROCEDURE	CAL. BLOCK	INSERVICE		NOTES
						REQ.	SCHEDULED OUTAGE	
MS-4448-411	PSA-1/4 SNUBBER	N/A	VT-4	303/8.2.17				S/N 433
			VT-3	303/8.2.17				S/N
MS-4448-413	PSA-1/4 SNUBBER	N/A	VT-4	303/8.2.17				S/N
			VT-3	303/8.2.17				S/N 318
MS-4448-64	PSA-1/4 SNUBBER	N/A	VT-4	303/8.2.17				S/N 318
			VT-3	303/8.2.17				S/N 316
MS-4448-66	PSA-1/4 SNUBBER	N/A	VT-4	303/8.2.17				S/N 316
			VT-3	303/8.2.17				S/N 309
MS-4448-68	PSA-1/4 SNUBBER	N/A	VT-4	303/8.2.17				S/N 309
			VT-3	303/8.2.17				S/N 295
MS-4448-72	PSA-1/4 SNUBBER	N/A	VT-4	303/8.2.17				S/N 295
			VT-3	303/8.2.17				S/N 422
MS-4448-75	PSA-1/4 SNUBBER	N/A	VT-4	303/8.2.17				S/N 422
			VT-3	303/8.2.17				S/N 19882
MSLC-2821-12	PSA-1/2 SN (2)	N/A	VT-4	303/8.2.17				S/N 19882
			VT-3	303/8.2.17				S/N
			VT-4	303/8.2.17				S/N

WNP-02
 INTERVAL: PSI
 PERIOD: NA
 OUTAGE:
 DRAWING NO. +QC I SN

WASHINGTON PUBLIC POWER SUPPLY SYSTEM
 PROGRAM PLAN AND SCHEDULE
 SYSTEM OR COMPONENT: +QC I SN
 DESCRIPTION: MISC SNUBBERS

PAGE 009
 DATE 12/14/84

<u>IDENT. NO.</u>	<u>DESCRIPTION</u>	SECT. XI <u>EXAM.</u>	EXAM <u>MTG.</u>	<u>PROCEDURE</u>	CAL. <u>BLOCK</u>	<u>INSERVICE</u>		<u>NOTES</u>
						<u>REQ.</u>	<u>SCHEDULED OUTAGE</u>	
MSLC-2821-22	PSA-1 SNUBBER	N/A	VT-3	303/8.2.17				S/N 581
			VT-4	303/8.2.17				S/N 581
MSLC-2822-12	PSA-1/2 SNUBBER	N/A	VT-3	303/8.2.17				S/N
			VT-4	303/8.2.17				S/N
MSLC-2822-31	PSA-1/4 SNUBBER	N/A	VT-3	303/8.2.17				S/N
			VT-4	303/8.2.17				S/N
RCC-146	PSA-1 SN (2)	N/A	VT-3	303/8.2.17				S/N 369 S/N 370
			VT-4	303/8.2.17				S/N 369S/N 370
RCC-148	PSA-3 SNUBBER	N/A	VT-3	303/8.2.17				S/N 4494
			VT-4	303/8.2.17				S/N 4494
RCC-150	PSA-1/2 SN	N/A	VT-3	303/8.2.17				S/N 2110
			VT-4	303/8.2.17				S/N 2110
RCC-151	PSA-1/2 SN (2)	N/A	VT-3	303/8.2.17				S/N 2110
			VT-4	303/8.2.17				S/N 2110
RCC-161	PSA-1/2 SNUBBER	N/A	VT-3	303/8.2.17				S/N 2153
			VT-4	303/8.2.17				S/N 2153
RCC-163	PSA-1/4 SNUBBER	N/A	VT-3	303/8.2.17				S/N 6228

WNP-02
 INTERVAL: PSI
 PERIOD: NA
 OUTAGE:
 DRAWING NO. +QC I SN

WASHINGTON PUBLIC POWER SUPPLY SYSTEM
 PROGRAM PLAN AND SCHEDULE
 SYSTEM OR COMPONENT: +QC I SN
 DESCRIPTION: MISC SNUBBERS

PAGE 010
 DATE 12/14/84

IDENT. NO.	DESCRIPTION	SECT. XI EXAM.	EXAM MTH.	PROCEDURE	CAL. BLOCK	INSERVICE		NOTES
						REQ.	SCHEDULED OUTAGE	
RCC-165			VT-4	303/8.2.17				S/N 6228
	PSA-1 SNUBBER	N/A	VT-3	303/8.2.17				S/N 584
RCC-166			VT-4	303/8.2.17				S/N 584
	PSA-1 SNUBBER	N/A	VT-3	303/8.2.17				S/N 351
RCC-167			VT-4	303/8.2.17				S/N 351
	PSA-1/4 SN (2)	N/A	VT-3	303/8.2.17				S/N 301S/N 313
RCC-177			VT-4	303/8.2.17				S/N 301S/N 313
	PSA-3 SNUBBER	N/A	VT-3	303/8.2.17				S/N 472
			VT-3	303/8.2.17				S/N 472
RCC-334			VT-4	303/8.2.17				S/N 472
	PSA-1/2 SN (2)	N/A	VT-3	303/8.2.17				S/N 1479S/N 2466
RCC-337			VT-4	303/8.2.17				S/N 1479S/N 2466
	PSA-3 SNUBBER	N/A	VT-3	303/8.2.17				S/N 2356
RCC-341			VT-4	303/8.2.17				S/N 2356
	PSA-1/2 SNUBBER	N/A	VT-3	303/8.2.17				S/N 2485
RCC-344			VT-4	303/8.2.17				S/N 2485
	PSA-1/4 SN (2)	N/A	VT-3	303/8.2.17				S/N 6213S/N 6220

WNP-02
 INTERVAL: PSI
 PERIOD: NA
 OUTAGE:
 DRAWING NO. +QC I SN

WASHINGTON PUBLIC POWER SUPPLY SYSTEM
 PROGRAM PLAN AND SCHEDULE
 SYSTEM OR COMPONENT: +QC I SN
 DESCRIPTION: MISC SNUBBER

PAGE 011
 DATE 12/14/84

IDENT. NO.	DESCRIPTION	SECT. XI EYAN.	EYAN MTH.	PROCEDURE	CAL. BLOCK	INSERVICE		NOTES
						REQ.	SCHEDULED OUTAGE	
RCC-371			VT-4	303/8.2.17				S/N 6213S/N 6220
	PSA-1/2 SNUBBER	N/A	VT-3	303/8.2.17				S/N 2569
			VT-4	303/8.2.17				S/N 2569
RCC-375			VT-3	303/8.2.17				S/N 350
	PSA-1 SNUBBER	N/A	VT-3	303/8.2.17				S/N 350
			VT-4	303/8.2.17				S/N 350
RCC-376			VT-3	303/8.2.17				S/N 4002
	PSA-1/2 SNUBBER	N/A	VT-3	303/8.2.17				S/N 4002
			VT-4	303/8.2.17				S/N 4002
FCC-379			VT-3	303/8.2.17				S/N 128
	PSA-1 SNUBBER	N/A	VT-3	303/8.2.17				S/N 128
			VT-4	303/8.2.17				S/N 128
RCC-430			VT-3	303/8.2.17				S/N 19887 S/N 19883
	PSA-1/4 SN (2)	N/A	VT-3	303/8.2.17				S/N 19887 S/N 19883
			VT-4	303/8.2.17				S/N 19887 S/N 19883
RCC-474			VT-3	303/8.2.17				S/N 19880 S/N 19885
	PSA-1/4 SN (2)	N/A	VT-3	303/8.2.17				S/N 19880 S/N 19885
			VT-4	303/8.2.17				S/N 19980 S/N 19885
RCC-481			VT-3	303/8.2.17				S/N 22341
	PSA-1 SNUBBER	N/A	VT-3	303/8.2.17				S/N 22341
			VT-4	303/8.2.17				S/N 22341

WNP-02
 INTERVAL: PSI
 PERIOD: NA
 OUTAGE:
 DRAWING NO. +QC I SN

WASHINGTON PUBLIC POWER SUPPLY SYSTEM
 PROGRAM PLAN AND SCHEDULE
 SYSTEM OR COMPONENT: +QC I SN
 DESCRIPTION: MISC SNUBBERS

PAGE 012
 DATE 12/14/84

IDENT. NO.	DESCRIPTION	SECT. XI EXAM.	EXAM MTH.	PROCEDURE	CAL. BLOCK	INSERVICE		NOTES
						REQ.	SCHEDULED OUTAGE	
RCC-482	PSA-1 SNUBBER	N/A	VT-3	303/8.2.17				S/N 386
			VT-4	303/8.2.17				S/N 386
RCC-484	PSA-1/4 SNUBBER	N/A	VT-3	303/8.2.17				S/N 2106
			VT-4	303/8.2.17				S/N 2106
RCC-485	PSA-1/4 SNUBBER	N/A	VT-3	303/8.2.17				S/N 310
			VT-4	303/8.2.17				S/N 310
RCC-902N	PSA-1/4 SNUBBER	N/A	VT-3	303/8.2.17				S/N 19891
			VT-4	303/8.2.17				S/N 19891
RCC-904N	PSA-1 SNUBBER	N/A	VT-3	303/8.2.17				S/N 343
			VT-4	303/8.2.17				S/N 343
RCC-905N	PSA-1 SN (2)	N/A	VT-3	303/8.2.17				S/N 22354 S/N 22343
			VT-4	303/8.2.17				S/N 22354 S/N 22343
RCC-907N	PSA-1/4 SNUBBER	N/A	VT-3	303/8.2.17				S/N 306
			VT-4	303/8.2.17				S/N 306
RCC-915N	PSA-1 SNUBBER	N/A	VT-3	303/8.2.17				S/N 588
			VT-4	303/8.2.17				S/N 588

WNP-02
 INTERVAL: PSI
 PERIOD: NA
 OUTAGE:
 DRAWING NO. +QC I SN

WASHINGTON PUBLIC POWER SUPPLY SYSTEM
 PROGRAM PLAN AND SCHEDULE
 SYSTEM OR COMPONENT: +QC I SN
 DESCRIPTION: MISC. SNUBBERS

PAGE 013
 DATE 12/14/84

IDENT. NO.	DESCRIPTION	SECT. XI EXAM.	EXAM MTH.	PROCEDURE	CAL. BLOCK	INSERVICE		NOTES
						REQ.	SCHEDULED OUTAGE	
RCC-926N	PSA-1/2 SNUBBER	N/A	VT-3	303/8.2.17				S/N 4042
			VT-4	303/8.2.17				S/N 4042
FCC-927N	PSA-3 SNUBBER	N/A	VT-3	303/8.2.17				S/N 1067
			VT-4	303/8.2.17				S/N 1067
RCC-954N	PSA-1/2 SNUBBER	N/A	VT-3	303/8.2.17				S/N 2557
			VT-4	303/8.2.17				S/N 2557
RCC-963N	PSA-1 SNUBBER	N/A	VT-3	303/8.2.17				S/N 226
			VT-4	303/8.2.17				S/N 226
RCC-2035-11	PSA-1/4 SNUBBER	N/A	VT-3	303/8.2.17				S/N 28445
			VT-4	303/8.2.17				S/N 28445
RCC-2035-14	PSA-1/4 SNUBBER	N/A	VT-3	303/8.2.17				S/N 28446
			VT-4	303/8.2.17				S/N 28446
RCC-2035-15	PSA-1/2 SNUBBER	N/A	VT-3	303/8.2.17				S/N 2123
			VT-4	303/8.2.17				S/N 2123
RCC-2035-16	PSA-1/2 SNUBBER	N/A	VT-3	303/8.2.17				S/N 4044
			VT-4	303/8.2.17				S/N 4044
RCIC-1490-13	PSA-1/2 SNUBBER	N/A	VT-3	303/8.2.17				S/N

WNP-02
 INTERVAL: PSI
 PERIOD: NA
 OUTAGE:
 DRAWING NO. +OC I SN

WASHINGTON PUBLIC POWER SUPPLY SYSTEM
 PROGRAM PLAN AND SCHEDULE
 SYSTEM OR COMPONENT: +OC I SN
 DESCRIPTION: MISC SNUBBERS

PAGE 014
 DATE 12/14/84

IDENT. NO.	DESCRIPTION	SECT. XI EXAM.	EXAM MTH.	PROCEDURE	CAL. BLOCK	INSERVICE		NOTES
						REQ.	OUTAGE SCHEDULED	
RHR-9			VT-4	303/8.2.17				S/N
	PSA-1/2 SNUBBER	N/A	VT-3	303/8.2.17				S/N
			VT-4	303/8.2.17				S/N
RHR-20			VT-4	303/8.2.17				S/N
	PSA-1/2 SNUBBER	N/A	VT-3	303/8.2.17				S/N
			VT-4	303/8.2.17				S/N
RHR-23			VT-4	303/8.2.17				S/N
	PSA-1/4 SN(2)	N/A	VT-3	303/8.2.17				S/N
			VT-4	303/8.2.17				S/N
RHR-183			VT-4	303/8.2.17				S/N
	PSA-10 SN(2)	N/A	VT-3	303/8.2.17				S/N 122/281
			VT-4	303/8.2.17				S/N 122/281
RHR-200			VT-4	303/8.2.17				S/N
	PSA-1/2 SNUBBER	N/A	VT-3	303/8.2.17				S/N
			VT-4	303/8.2.17				S/N
RHR-206			VT-4	303/8.2.17				S/N
	PSA-1/2 SNUBBER	N/A	VT-3	303/8.2.17				S/N 610
			VT-4	303/8.2.17				S/N 610
RHR-210			VT-4	303/8.2.17				S/N
	PSA-1/2 SNUBBER	N/A	VT-3	303/8.2.17				S/N 111
			VT-4	303/8.2.17				S/N 111
RHR-214			VT-4	303/8.2.17				S/N
	PSA-1/2 SNUBBER	N/A	VT-3	303/8.2.17				S/N 2104
			VT-4	303/8.2.17				S/N 2104

WNP-02
 INTERVAL: PSI
 PERIOD: NA
 OUTAGE:
 DRAWING NO. +QC I SN

WASHINGTON PUBLIC POWER SUPPLY SYSTEM
 PROGRAM PLAN AND SCHEDULE
 SYSTEM OR COMPONENT: +QC I SN
 DESCRIPTION: MISC SNUBBERS

PAGE 015
 DATE 12/14/84

IDENT. NO.	DESCRIPTION	SECT. XI EXAM.	EXAM MTH.	PROCEDURE	CAL. BLOCK	INSERVICE		NOTES
						REQ.	SCHEDULED OUTAGE	
RHR-325	PSA-1/2 SNUBBER	N/A	VT-3	303/8.2.17				S/N
			VT-4	303/8.2.17				S/N
RHR-326	PSA-1/4 SN(2)	N/A	VT-3	303/8.2.17				S/N
			VT-4	303/8.2.17				S/N
RHR-332	PSA-1 SNUBBER	N/A	VT-3	303/8.2.17				S/N
			VT-4	303/8.2.17				S/N
RHR-333	PSA-1 SNUBBER	N/A	VT-3	303/8.2.17				S/N
			VT-4	303/8.2.17				S/N
RHR-334	PSA-1/4 SNUBBER	N/A	VT-3	303/8.2.17				S/N
			VT-4	303/8.2.17				S/N
RHR-290	PSA-1/2 SNUBBER	N/A	VT-3	303/8.2.17				S/N
			VT-4	303/8.2.17				S/N
RHR-373	PSA-1 SNUBBER	N/A	VT-3	303/8.2.17				S/N
			VT-4	303/8.2.17				S/N
RHR-400	PSA-1/2 SNUBBER	N/A	VT-3	303/8.2.17				S/N
			VT-4	303/8.2.17				S/N
RHR-401	PSA-1/2 SNUBBER	N/A	VT-3	303/8.2.17				S/N

WNP-02
INTERVAL: PSI
PERIOD: NA
OUTAGE:

WASHINGTON PUBLIC POWER SUPPLY SYSTEM
PROGRAM PLAN AND SCHEDULE
SYSTEM OR COMPONENT: +OC I SN
DESCRIPTION: MISC SNUBBERS

PAGE 016
DATE 12/14/84

DRAWING NO. +OC I SN

IDENT. NO.	DESCRIPTION	SECT.	EXAM MTH.	PROCEDURE	CAL. BLOCK	INSERVICE		NOTES
		XI EXAM.				REQ.	SCHEDULED OUTAGE	
RHR-403	PSA-1 SNUBBER	N/A	VT-4	303/8.2.17				S/N
			VT-3	303/8.2.17				S/N
			VT-4	303/8.2.17				S/N
RHR-441	PSA-1/2 SNUBBER	N/A	VT-3	303/8.2.17				S/N
			VT-4	303/8.2.17				S/N
RHR-442	PSA-1/2 SNUBBER	N/A	VT-3	303/8.2.17				S/N
			VT-4	303/8.2.17				S/N
RHR-443	PSA-1/2 SNUBBER	N/A	VT-3	303/8.2.17				S/N
			VT-4	303/8.2.17				S/N
RHR-448	PSA-1/2 SNUBBER	N/A	VT-3	303/8.2.17				S/N
			VT-4	303/8.2.17				S/N
RHR-449	PSA-1/4 SN(2)	N/A	VT-3	303/8.2.17				S/N
			VT-4	303/8.2.17				S/N
RHR-453	PSA-1/4 SNUBBER	N/A	VT-3	303/8.2.17				S/N
			VT-4	303/8.2.17				S/N
RHR-454	PSA-1/2 SNUBBER	N/A	VT-3	303/8.2.17				S/N
			VT-4	303/8.2.17				S/N

WNP-02
 INTERVAL: PSI
 PERIOD: NA
 OUTAGE:
 DRAWING NO. +QC I SN

WASHINGTON PUBLIC POWER SUPPLY SYSTEM
 PROGRAM PLAN AND SCHEDULE
 SYSTEM OR COMPONENT: +QC I SN
 DESCRIPTION: MISC SNUBBERS

PAGE 017
 DATE 12/14/84

IDENT. NO.	DESCRIPTION	SECT. XI EXAM.	EXAM MTH.	PROCEDURE	CAL. BLOCK	INSERVICE		NOTES
						REQ.	SCHEDULED OUTAGE	
RHR-903N	PSA-3 SNUBBER	N/A	VT-3	303/8.2.17				S/N 3926
			VT-4	303/8.2.17				S/N 3926
RHR-906N	PSA-3 SN(2)	N/A	VT-3	303/8.2.17				S/N
			VT-4	303/8.2.17				S/N
RHR-913N	PSA-3 SNUBBER	N/A	VT-3	303/8.2.17				S/N 4430
			VT-4	303/8.2.17				S/N 4430
RHR-914N	PSA-10 SNUBBER	N/A	VT-3	303/8.2.17				S/N
			VT-4	303/8.2.17				S/N
RHR-940N	PSA-1 SN(2)	N/A	VT-3	303/8.2.17				S/N
			VT-4	303/8.2.17				S/N
RHR-946N	PSA-3 SNUBBER	N/A	VT-3	303/8.2.17				S/N 4438
			VT-4	303/8.2.17				S/N 4438
RHR-952N	PSA-3 SNUBBER	N/A	VT-3	303/8.2.17				S/N 657 STM SUPP MODE DEACT
			VT-4	303/8.2.17				S/N 657 STM SUPP MODE DEACT
RHR-954N	PSA-1 SN (2)	N/A	VT-3	303/8.2.17				S/N 125 S/N 126 STM SUPP MODE DEACT

WNP-02
 INTERVAL: PSI
 PERIOD: NA
 OUTAGE:
 DRAWING NO. +OC I SN

WASHINGTON PUBLIC POWER SUPPLY SYSTEM
 PROGRAM PLAN AND SCHEDULE
 SYSTEM OR COMPONENT: +OC I SN
 DESCRIPTION: MISC SNUBBERS

PAGE 018
 DATE 12/14/84

IDENT. NO.	DESCRIPTION	SECT. XI EXAM.	EXAM MTH.	PROCEDURE	CAL. BLOCK	INSERVICE		NOTES
						REQ.	SCHEDULED OUTAGE	
			VT-4	303/8.2.17				S/N 125 S/N 126 STM SUPP MODE DEACT
RHR-959N	PSA-1 SN(2)	N/A	VT-3	303/8.2.17				S/N
			VT-4	303/8.2.17				S/N
RHR-962N	PSA-3 SNUBBER	N/A	VT-3	303/8.2.17				S/N
			VT-4	303/8.2.17				S/N
RHR-974N	PSA-3 SNUBBER	N/A	VT-3	303/8.2.17				S/N 4457
			VT-4	303/8.2.17				S/N 4457
RHR-977N	PSA-3 SN (2)	N/A	VT-3	303/8.2.17				S/N 250 S/N 264
			VT-4	303/8.2.17				S/N 250 S/N 264
RHR-986N	PSA-1 SNUBBER	N/A	VT-3	303/8.2.17				S/N 122 STM SUPP MODE DEACT
			VT-4	303/8.2.17				S/N 122 STM SUPP MODE DEACT
RHR-993N	PSA-1 SNUBBER	N/A	VT-3	303/8.2.17				S/N
			VT-4	303/8.2.17				S/N
RHR-2264-11	PSA-1/4 SNUBBER	N/A	VT-3	303/8.2.17				S/N 28454

WNP-02
 INTERVAL: PSI
 PERIOD: NA
 OUTAGE:
 DRAWING NO. +OC I SN

WASHINGTON PUBLIC POWER SUPPLY SYSTEM
 PROGRAM PLAN AND SCHEDULE
 SYSTEM OR COMPONENT: +OC I SN
 DESCRIPTION: MISC SNUBBERS

PAGE 019
 DATE 12/14/84

IDENT. NO.	DESCRIPTION	SECT. XI EXAM.	EXAM MTH.	PROCEDURE	CAL. BLOCK	INSERVICE		NOTES
						REQ.	SCHEDULED OUTAGE	
RHR-2264-21			VT-4	303/8.2.17				S/N 28454
	PSA-1/4 SNUBBER	N/A	VT-3	303/8.2.17				S/N 19887
RHR-2264-22			VT-4	303/8.2.17				S/N 19887
	PSA-1 SNUBBER	N/A	VT-3	303/8.2.17				S/N 352
RHR-4605-41A			VT-4	303/8.2.17				S/N 352
	PSA-1/4 SNUBBER	N/A	VT-3	303/8.2.17				S/N 419
RHR-983N			VT-4	303/8.2.17				S/N 419
	PSA-1/4 SNUBBER	N/A	VT-3	303/8.2.17				S/N
RRC-1549-62			VT-4	303/8.2.17				S/N
	PSA-1/4 SNUBBER	N/A	VT-3	303/8.2.17				S/N
RRC-1552-12			VT-4	303/8.2.17				S/N
	PSA-1/4 SNUBBER	N/A	VT-3	303/8.2.17				S/N
RRC-1946-2A1			VT-4	303/8.2.17				S/N
	PSA-1/2 SNUBBER	N/A	VT-3	303/8.2.17				S/N 4018
RRC-1946-2A3			VT-4	303/8.2.17				S/N 4018
	PSA-1/4 SNUBBER	N/A	VT-3	303/8.2.17				S/N 28426
			VT-4	303/8.2.17				S/N 28426

WNP-02
 INTERVAL: PSI
 PERIOD: NA
 OUTAGE:
 DRAWING NO. +CC I SN

WASHINGTON PUBLIC POWER SUPPLY SYSTEM
 PROGRAM PLAN AND SCHEDULE
 SYSTEM OR COMPONENT: +CC I SN
 DESCRIPTION: MISC SNUBBERS

PAGE 020
 DATE 12/14/84

IDENT. NO.	DESCRIPTION	SECT. XI EXAM.	EVAL MTH.	PROCEDURE	CAL. BLOCK	INSERVICE		NOTES
						REQ.	SCHEDULED OUTAGE	
RRC-1946-2A5	PSA-1/4 SNUBBER	N/A	VT-3	303/8.2.17				S/N 33296
			VT-4	303/8.2.17				S/N 33296
RRC-1946-2A8	PSA-1/4 SNUBBER	N/A	VT-3	303/8.2.17				S/N 6215
			VT-4	303/8.2.17				S/N 6215
RRC-1946-2A9	PSA-1/2 SNUBBER*	N/A	VT-3	303/9.2.17				S/N 4016
			VT-4	303/8.2.17				S/N 4016
RRC-4470-2A1	PSA-1/4 SNUBBER	N/A	VT-3	303/8.2.17				S/N 28421
			VT-4	303/8.2.17				S/N 28421
RRC-4470-2A2	PSA-1/4 SNUBBER	N/A	VT-3	303/8.2.17				S/N 28445
			VT-4	303/8.2.17				S/N 28445
RRC-4470-2A3	PSA-1/4 SNUBBER	N/A	VT-3	303/8.2.17				S/N 28424
								S/N 28443
			VT-4	303/8.2.17				S/N 28424
								S/N 28443
RRC-4470-2A4	PSA-1/4 SNUBBER	N/A	VT-3	303/8.2.17				S/N 2568
			VT-4	303/8.2.17				S/N 2568
RRC-4470-2B1	PSA-1/4 SNUBBER	N/A	VT-3	303/8.2.17				S/N 28464
			VT-4	303/8.2.17				S/N 28464

WNP-02
 INTERVAL: PSI
 PERIOD: NA
 OUTAGE:
 DRAWING NO. +QC I SN

WASHINGTON PUBLIC POWER SUPPLY SYSTEM
 PROGRAM PLAN AND SCHEDULE
 SYSTEM OR COMPONENT: +QC I SN
 DESCRIPTION: MISC SNUBBERS

PAGE 021
 DATE 12/14/84

IDENT. NO.	DESCRIPTION	SECT. YI EXAM.	EXAM MTH.	PROCEDURE	CAL. BLOCK	INSERVICE		NOTES
						REQ.	SCHEDULED OUTAGE	
RRC-1946-31	PSA-1/4 SNUBBER	N/A	VT-3	303/8.2.17				S/N 623
			VT-4	303/8.2.17				S/N 623
RRC-1946-32	PSA-1/4 SNUBBER	N/A	VT-3	303/8.2.17				S/N
			VT-4	303/8.2.17				S/N
RWCU-166	PSA-3 SN (2)	N/A	VT-3	303/8.2.17				S/N 3955 S/N 2582
			VT-4	303/8.2.17				S/N 3955 S/N 2582
RWCU-185	PSA-1/2 SN (2)	N/A	VT-3	303/8.2.17				S/N 2539 S/N 2516
			VT-4	303/8.2.17				S/N 2539 S/N 2516
RWCU-186	PSA-1/2 SNUBBER	N/A	VT-3	303/8.2.17				S/N 108
			VT-4	303/8.2.17				S/N 108
RWCU-188	PSA-1/2 SNUBBER	N/A	VT-3	303/8.2.17				S/N 2522
			VT-4	303/8.2.17				S/N 2522
RWCU-189	PSA-1 SNUBBER	N/A	VT-3	303/8.2.17				S/N 634
			VT-4	303/8.2.17				S/N 634
RWCU-191	PSA-1/2 SNUBBER	N/A	VT-3	303/8.2.17				S/N 112

WNP-02
 INTERVAL: PSI
 PERIOD: NA
 OUTAGE:
 DRAWING NO. +QC I SN

WASHINGTON PUBLIC POWER SUPPLY SYSTEM
 PROGRAM PLAN AND SCHEDULE
 SYSTEM OR COMPONENT: +QC I SN
 DESCRIPTION: MISC SNUBBERS

PAGE 022
 DATE 12/14/84

IDENT. NO.	DESCRIPTION	SECT. XI EXAM.	EXAM MTH.	PROCEDURE	CAL. BLOCK	INSERVICE		NOTES
						REQ.	SCHEDULED OUTAGE	
RWCU-198			VT-4	303/8.2.17				S/N 112
	PSA-1/2 SNUBBER	N/A	VT-3	303/8.2.17				S/N 110
			VT-4	303/8.2.17				S/N 110
RWCU-206			VT-3	303/8.2.17				S/N 380
	PSA-1/2 SNUBBER	N/A	VT-3	303/8.2.17				S/N 380
			VT-4	303/8.2.17				S/N 380
RWCU-208			VT-3	303/8.2.17				S/N 101
	PSA-1/2 SN (2)	N/A	VT-3	303/8.2.17				S/N 101
			VT-4	303/8.2.17				S/N 101
RWCU-236			VT-3	303/8.2.17				S/N 2345
	PSA-3 SNUBBER	N/A	VT-3	303/8.2.17				S/N 2345
			VT-4	303/8.2.17				S/N 2345
RWCU-909N			VT-3	303/8.2.17				S/N 4023
	PSA-1/2 SNUBBER	N/A	VT-3	303/8.2.17				S/N 4023
			VT-4	303/8.2.17				S/N 4023
RWCU-910N			VT-3	303/8.2.17				S/N 2580
	PSA-1/2 SNUBBER	N/A	VT-3	303/8.2.17				S/N 2580
			VT-4	303/8.2.17				S/N 2580
RWCU-911N			VT-3	303/8.2.17				S/N 2142
	PSA-1/4 SNUBBER	N/A	VT-3	303/8.2.17				S/N 2142
			VT-4	303/8.2.17				S/N 2142
RWCU-932N			VT-3	303/8.2.17				S/N 367
	PSA-35 SNUBBER	N/A	VT-3	303/8.2.17				S/N 367
			VT-4	303/8.2.17				S/N 367

WNP-02
 INTERVAL: PSI
 PERIOD: NA
 OUTAGE:
 DRAWING NO. +QC I SN

WASHINGTON PUBLIC POWER SUPPLY SYSTEM
 PROGRAM PLAN AND SCHEDULE
 SYSTEM OR COMPONENT: +QC I SN
 DESCRIPTION: MISC SNUBBERS

PAGE 023
 DATE 12/14/84

IDENT. NO.	DESCRIPTION	SECT. XI EXAM.	EXAM MTH.	PROCEDURE	CAL. BLOCK	INSERVICE		NOTES
						REQ.	SCHEDULED OUTAGE	
RWCU-933N	PSA-1/4 SNUBBER	N/A	VT-3	303/8.2.17				S/N 2517
			VT-4	303/8.2.17				S/N 2517
RWCU-934N	PSA-1/4 SNUBBER	N/A	VT-3	303/8.2.17				S/N 934
			VT-4	303/8.2.17				S/N 934
RWCU-935N	PSA-3 SNUBBER	N/A	VT-3	303/8.2.17				S/N 3923
			VT-4	303/8.2.17				S/N 3923
RWCU-936N	PSA-1/4 SNUBBER	N/A	VT-3	303/8.2.17				S/N 2559
			VT-4	303/8.2.17				S/N 2559
RWCU-937N	PSA-1 SNURRER	N/A	VT-3	303/8.2.17				S/N 388
			VT-4	303/8.2.17				S/N 388
RWCU-949N	PSA-1 SN (2)	N/A	VT-3	303/8.2.17				S/N 213 S/N 212
			VT-4	303/8.2.17				S/N 213 S/N 212
RWCU-950N	PSA-1 SN (2)	N/A	VT-3	303/8.2.17				S/N 593 S/N 574
			VT-4	303/8.2.17				S/N 593 S/N 574
SGT-11	PSA-10 SN(2)	N/A	VT-3	303/8.2.17				S/N T324/B778

WNP-02
 INTERVAL: PSI
 PERIOD: NA
 OUTAGE:
 DRAWING NO. +QC I SN

WASHINGTON PUBLIC POWER SUPPLY SYSTEM
 PROGRAM PLAN AND SCHEDULE
 SYSTEM OR COMPONENT: +QC I SN
 DESCRIPTION: MISC SNUBBERS

PAGE 024
 DATE 12/14/84

IDENT. NO.	DESCRIPTION	SECT. XI EXAM. EXAM.	EXAM HTH.	PROCEDURE	CAL. BLOCK	INSERVICE		NOTES
						REQ.	SCHEDULED OUTAGE	
SGT-19	PSA-3 SNUBBER	N/A	VT-4	303/8.2.17				S/N T324/B778
			VT-3	303/8.2.17				
			VT-4	303/8.2.17				
SGT-23	PSA-3 SN(2)	N/A	VT-3	303/8.2.17				S/N T4487/B44
			VT-4	303/8.2.17				S/N T4487/B44
VR-3	PSA-1/2 SN(2)	N/A	VT-3	303/8.2.17				S/N
			VT-4	303/8.2.17				S/N
VR-6	PSA-1 SNUBBER	N/A	VT-3	303/8.2.17				S/N
			VT-4	303/8.2.17				S/N
VR-8	PSA-1 SNUBBER	N/A	VT-3	303/8.2.17				S/N
			VT-4	303/8.2.17				S/N
VR-900M	PSA-1/2 SNUBBER	N/A	VT-3	303/8.2.17				S/N
			VT-4	303/8.2.17				S/N
VR-901M	PSA-1/2 SNUBBER	N/A	VT-3	303/8.2.17				S/N
			VT-4	303/8.2.17				S/N
VR-902N	PSA-1/2 SNUBBER	N/A	VT-3	303/8.2.17				S/N
			VT-4	303/8.2.17				S/N

WNP-02
 INTERVAL: PSI
 PERIOD: NA
 OUTAGE:
 DRAWING NO. +QC I SN

WASHINGTON PUBLIC POWER SUPPLY SYSTEM
 PROGRAM PLAN AND SCHEDULE
 SYSTEM OR COMPONENT: +QC I SN
 DESCRIPTION: MISC SNUBBERS

PAGE 025
 DATE 12/14/84

IDENT. NO.	DESCRIPTION	SECT. XI EXAM.	EXAM MTH.	PROCEDURE	CAL. BLOCK	INSERVICE		NOTES
						REQ.	SCHEDULED OUTAGE	
SLC-4453-68	PSA-1/4 SNUBBER	N/A	VT-3	303/8.2.17				S/N 6209
			VT-4	303/8.2.17				S/N 6209
SLC-4453-69	PSA-1/4 SNUBBER	N/A	VT-3	303/8.2.17				S/N 294
			VT-4	303/8.2.17				S/N 294
SLC-4475-12	PSA-1/4 SNUBBER	N/A	VT-3	303/8.2.17				S/N 311
			VT-4	303/8.2.17				S/N 311
SLC-4475-13	PSA-1/2 SNUBBER	N/A	VT-3	303/8.2.17				S/N 2155
			VT-4	303/8.2.17				S/N 2155
SLC-4475-14	PSA-1/2 SNUBBER	N/A	VT-3	303/8.2.17				S/N 2138
			VT-4	303/8.2.17				S/N 2138
SLC-4475-19	PSA-1/2 SNUBBER	N/A	VT-3	303/8.2.17				S/N 2480
			VT-4	303/8.2.17				S/N 2480
SLC-4475-112	PSA-1/4 SNUBBER	N/A	VT-3	303/8.2.17				S/N 6224
			VT-4	303/8.2.17				S/N 6224
SLC-4475-113	PSA-1/2 SNUBBER	N/A	VT-3	303/8.2.17				S/N 4056
			VT-4	303/8.2.17				S/N 4056
SLC-4475-114	PSA-1/4 SNUBBER	N/A	VT-3	303/8.2.17				S/N 384

WNP-02
 INTERVAL: PSI
 PERIOD: NA
 OUTAGE:
 DRAWING NO. +QC I SN

WASHINGTON PUBLIC POWER SUPPLY SYSTEM
 PROGRAM PLAN AND SCHEDULE
 SYSTEM OR COMPONENT: +QC I SN
 DESCRIPTION: MISC SNUBBERS

PAGE 026
 DATE 12/14/84

<u>IDENT. NO.</u>	<u>DESCRIPTION</u>	<u>SECT.</u> XI <u>EXAM.</u>	<u>EXAM</u> MTH.	<u>PROCEDURE</u>	<u>CAL.</u> BLOCK	<u>INSERVICE</u>		<u>NOTES</u>
						<u>REQ.</u>	<u>SCHEDULED</u> OUTAGE	
SLC-4475-116	PSA-1 SNUBBER	N/A	VT-4	303/8.2.17				S/N 384
			VT-3	303/8.2.17				S/N 366
SLC-4475-117	PSA-1/2 SNUBBER	N/A	VT-4	303/8.2.17				S/N 366
			VT-3	303/8.2.17				S/N 2100
SLC-4475-120	PSA-1 SNUBBER	N/A	VT-4	303/8.2.17				S/N 2100
			VT-3	303/8.2.17				S/N 334
SLC-4475-122	PSA-1/4 SNUBBER	N/A	VT-4	303/8.2.17				S/N 334
			VT-3	303/8.2.17				S/N 424
			VT-4	303/8.2.17				S/N 424

9.0 VISUAL EXAMINATION PROGRAM9.1 Introduction

The Supply System is committed to ensuring that the requirements for preservice visual examinations of ASME Section III, Class 1, 2, and 3 components found in ASME Section XI are satisfied. The Preservice Visual Examination Program addressed in this section will be implemented separately from the volumetric and surface nondestructive examination activities being conducted by the NDE contractor, Lambert-McGill-Thomas, Inc. To the extent practical, these preservice visual examination activities will be combined with and/or directly utilize the records of related examinations performed to the requirements of ASME Section III. In any case, personnel and procedures utilized to perform those examinations will satisfy the pertinent ASME Section XI requirements. Records documenting the results of those examinations will be suitable for reference during subsequent inservice inspections.

9.2 Visual Examination Categories

The four visual examination categories describe in ASME Section XI, 1977 Edition and defined below will be used in the visual program:

Method VT-1--Visual examination for component mechanical and surface condition to document the presence, if any, of cracks, wear, corrosion, erosion or physical damage. This examination is performed on bolting and pump and valve body interiors.

Method VT-2--Visual examination for evidence of leakage from pressure retaining components during pressure or functional tests. This examination is performed on both exempt and non-exempt pressure retaining components.

Method VT-3--Visual examination to locate mechanical and structural misalignment, loss of integrity of welded or bolted connections, wear or erosion, corrosion, or any visual evidence that indicates equipment degradation. Examinations may include the use of dimensional measuring instruments or torquing devices to confirm visual observations. This examination is performed on essentially all types of component supports and restraints.

Method VT-4--Visual examination to confirm functional adequacy, verification of settings or freedom of motion for components or devices such as mechanical and hydraulic snubbers and spring loaded and constant weight hangers.

9.3 Program Description

The Preservice Visual Examination Program is divided into three major divisions as described below:

1) Visual Examination of Pump and Valve Interiors (VT-1):

These examinations will be performed by WPPSS personnel qualified to VT-1 examination criteria in accordance with the WPPSS visual examination qualification program. Essentially all accessible surfaces on the interior of Class 1 pumps, and Class 1 valves greater than 4 inch nominal pipe size, will be examined. Procedure QCS&I-002, found in Section 10, Tab 23, will be used. The scope of items subject to the VT-1 examination is defined in the Program Plan and Schedule Tables found in Section 8.0.

2) Visual Examination for evidence of leakage during System Hydrostatic Test (VT-2):

It is the Supply System's intent to reference the hydrostatic test report required by Section III of the ASME Code to document the VT-2 preservice examination performance. This is allowed by Paragraph IWA-5210(b) of ASME Section XI. In addition, the Supply System will reconfirm pressure boundary integrity for components whose pressure boundary is disassembled following the Section III hydrostatic test (e.g., RPV head removal, valve rework, etc.). This is required by the normal plant startup and operating procedures. The above satisfies the preservice visual examination requirements for evidence of leakage of ASME Section XI, Sections IWA-, IWB-, IWC-, and IWD-5000. Details regarding the Inservice Inspection program for the VT-2 leakage tests will be provided in the WNP-2 Inservice Inspection Program Plan.

3) Visual Examination of component supports (VT-3 and VT-4):

The Supply System is cognizant of the content of subsection IWF of ASME Section XI which was introduced in the Winter 1978 Addenda. Recognizing that Inservice Inspections of component supports will be subject to the requirements of this subsection, every effort will be made to comply with those requirements. IWF-2200, entitled "PRESERVICE EXAMINATION", requires that all component support visual examinations be performed once prior to service. It also requires that all preservice examinations be performed following the initiation of hot functional tests. It is our understanding that the intent of performing the examinations following initiation of hot functional tests is to ensure that the supports have performed successfully having been subjected to normal loads and displacements to which they will be subject inservice. The Supply System will perform

Date 1/18/85

Revision 3

component support examinations as described in the following paragraphs, in a manner which meets the intent of the Code. However, strict compliance is not possible in that the startup program at WNP-2 does not include hot functional tests per se. A copy of the Preservice Component Support Program Plan is included at the end of this section.

a) Pre-Heatup Examinations

All IWF supports will be examined following installation but prior to system heatup. The VT-3 and VT-4 examinations will be performed in conjunction with the Test and Startup program for verification of proper installation and adjustment of component supports per procedure SLT-S303.0, Section 10.0, Tab 40. That procedure includes requirements to look for signs of abnormal corrosion, strain, galling, or anomalies that might inhibit operability, proper clearances and cold settings per hanger detail drawings, and so on. The Test and Startup personnel performing these examinations will be qualified to VT-3 and VT-4 requirements as stated above. Any anomalies or discrepancies with the hanger detail drawings noted during these examinations will be entered on the data sheet form found at the end of the procedure cited above and corrected as part of the regular Test and Startup Program. For purposes of the Preservice Inspection Report, the data file containing those data sheets and corrective action records, which will be filed by Component Support Tag number, will be referenced as documentation of the "pre-heatup" phase of the Preservice Component Support Visual Examination Program.


b). Post-Heatup Examinations

Following heatup, plant operations personnel, also qualified to VT-3 and VT-4 requirements, will once again examine the IWF component supports. Examiners will use procedure SLT 17 and 33 "Piping System Expansion and Vibration Test" found in Section 10.0, Tab 41. Hot settings and clearances will be verified, and any signs of loss of integrity, structural distress, or loss of operability will be identified on the data sheet found at the end of that procedure. Abnormalities will be corrected per the routine Plant Operations and Maintenance procedures. These records will, in conjunction with the "pre-heatup" records described above, satisfy the Section XI, subsection IWF-2200 requirements for preservice inspection of component supports.

The scope of IWF component supports subject to VT-3 and VT-4 examinations is defined by Tag number on Weld and Component Identification Diagrams and Program Plan and Schedule Tables found in Section 8.0 for non-exempt Class 1 and 2 piping systems. Exempt Class 2 and all Class 3 component supports subject to preservice inspection are identified by Tag number on Weld and Component Identification Diagrams, also in Section 8.0.

4) Visual Examination of Reactor Pressure Vessel (RPV) Internals (VT-1 and VT-3)

These examinations will be performed by Supply System personnel qualified to VT-1 and VT-3 examination criteria in accordance with the Supply System visual examination qualification program. These examinations satisfy ASME Section XI Code categories B-I-1, B-N-1 and B-N-2. The following table lists the components that will be examined during the RPV internal visual examination.

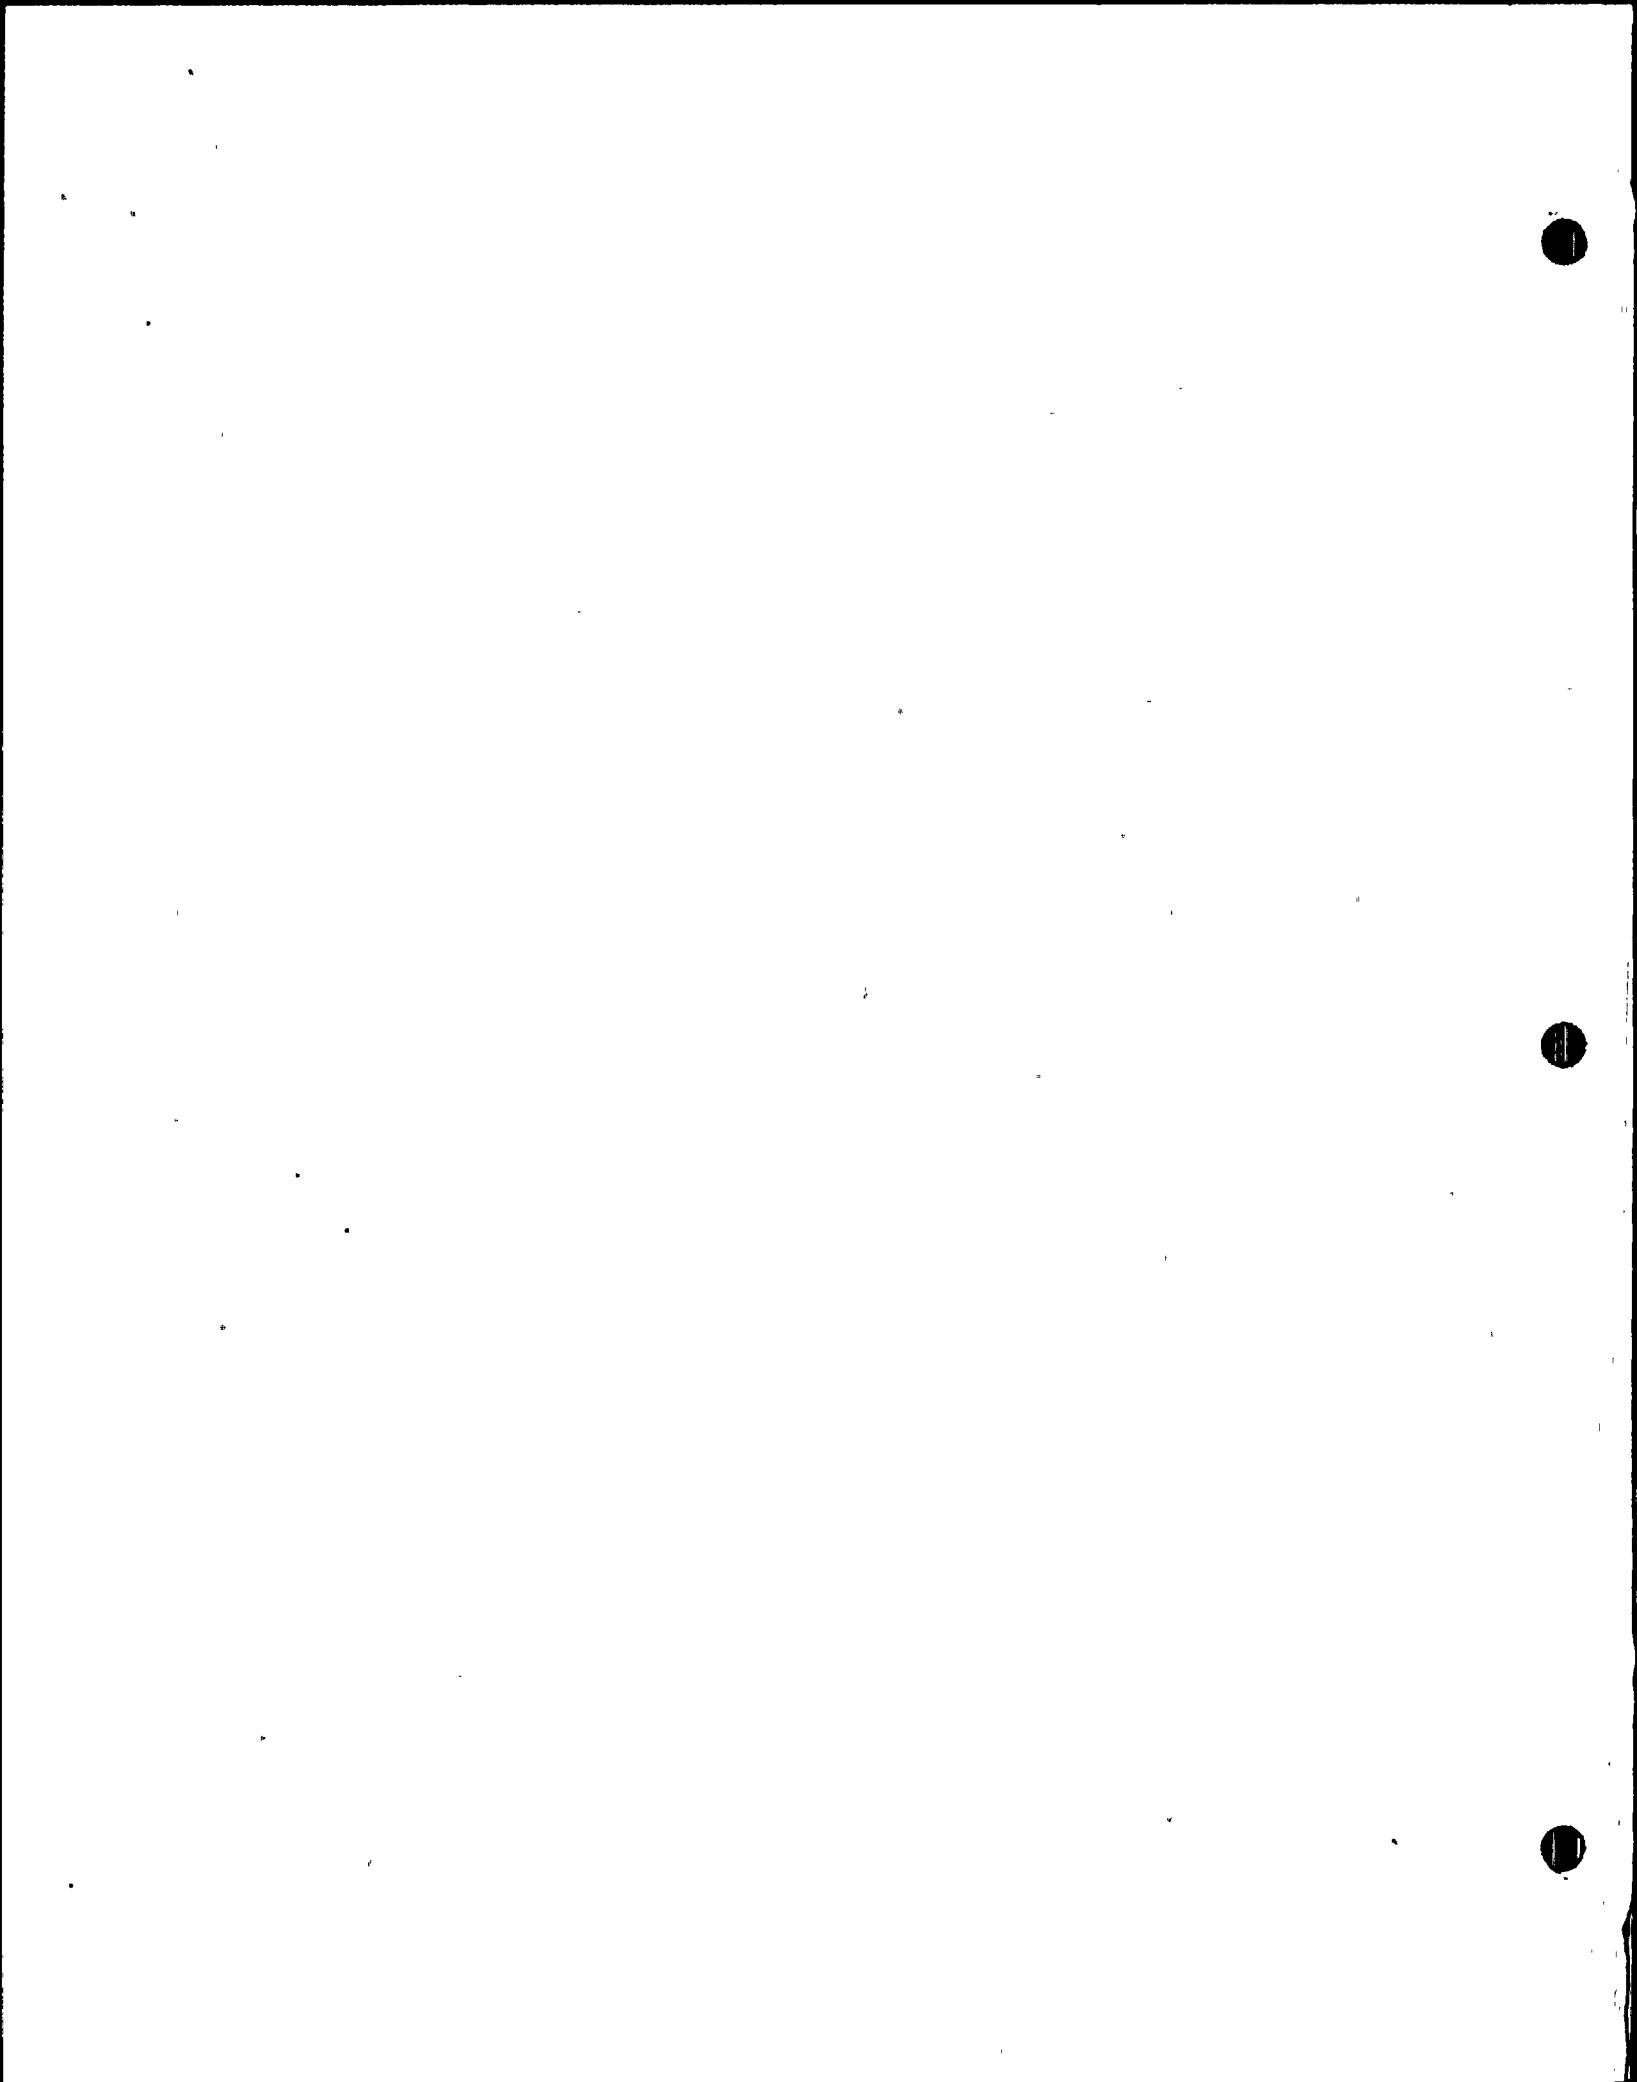

Date 1/18/85

Revision 0

TABLE 9-1

RPV INTERNALS
FOR VISUAL EXAMINATIONS

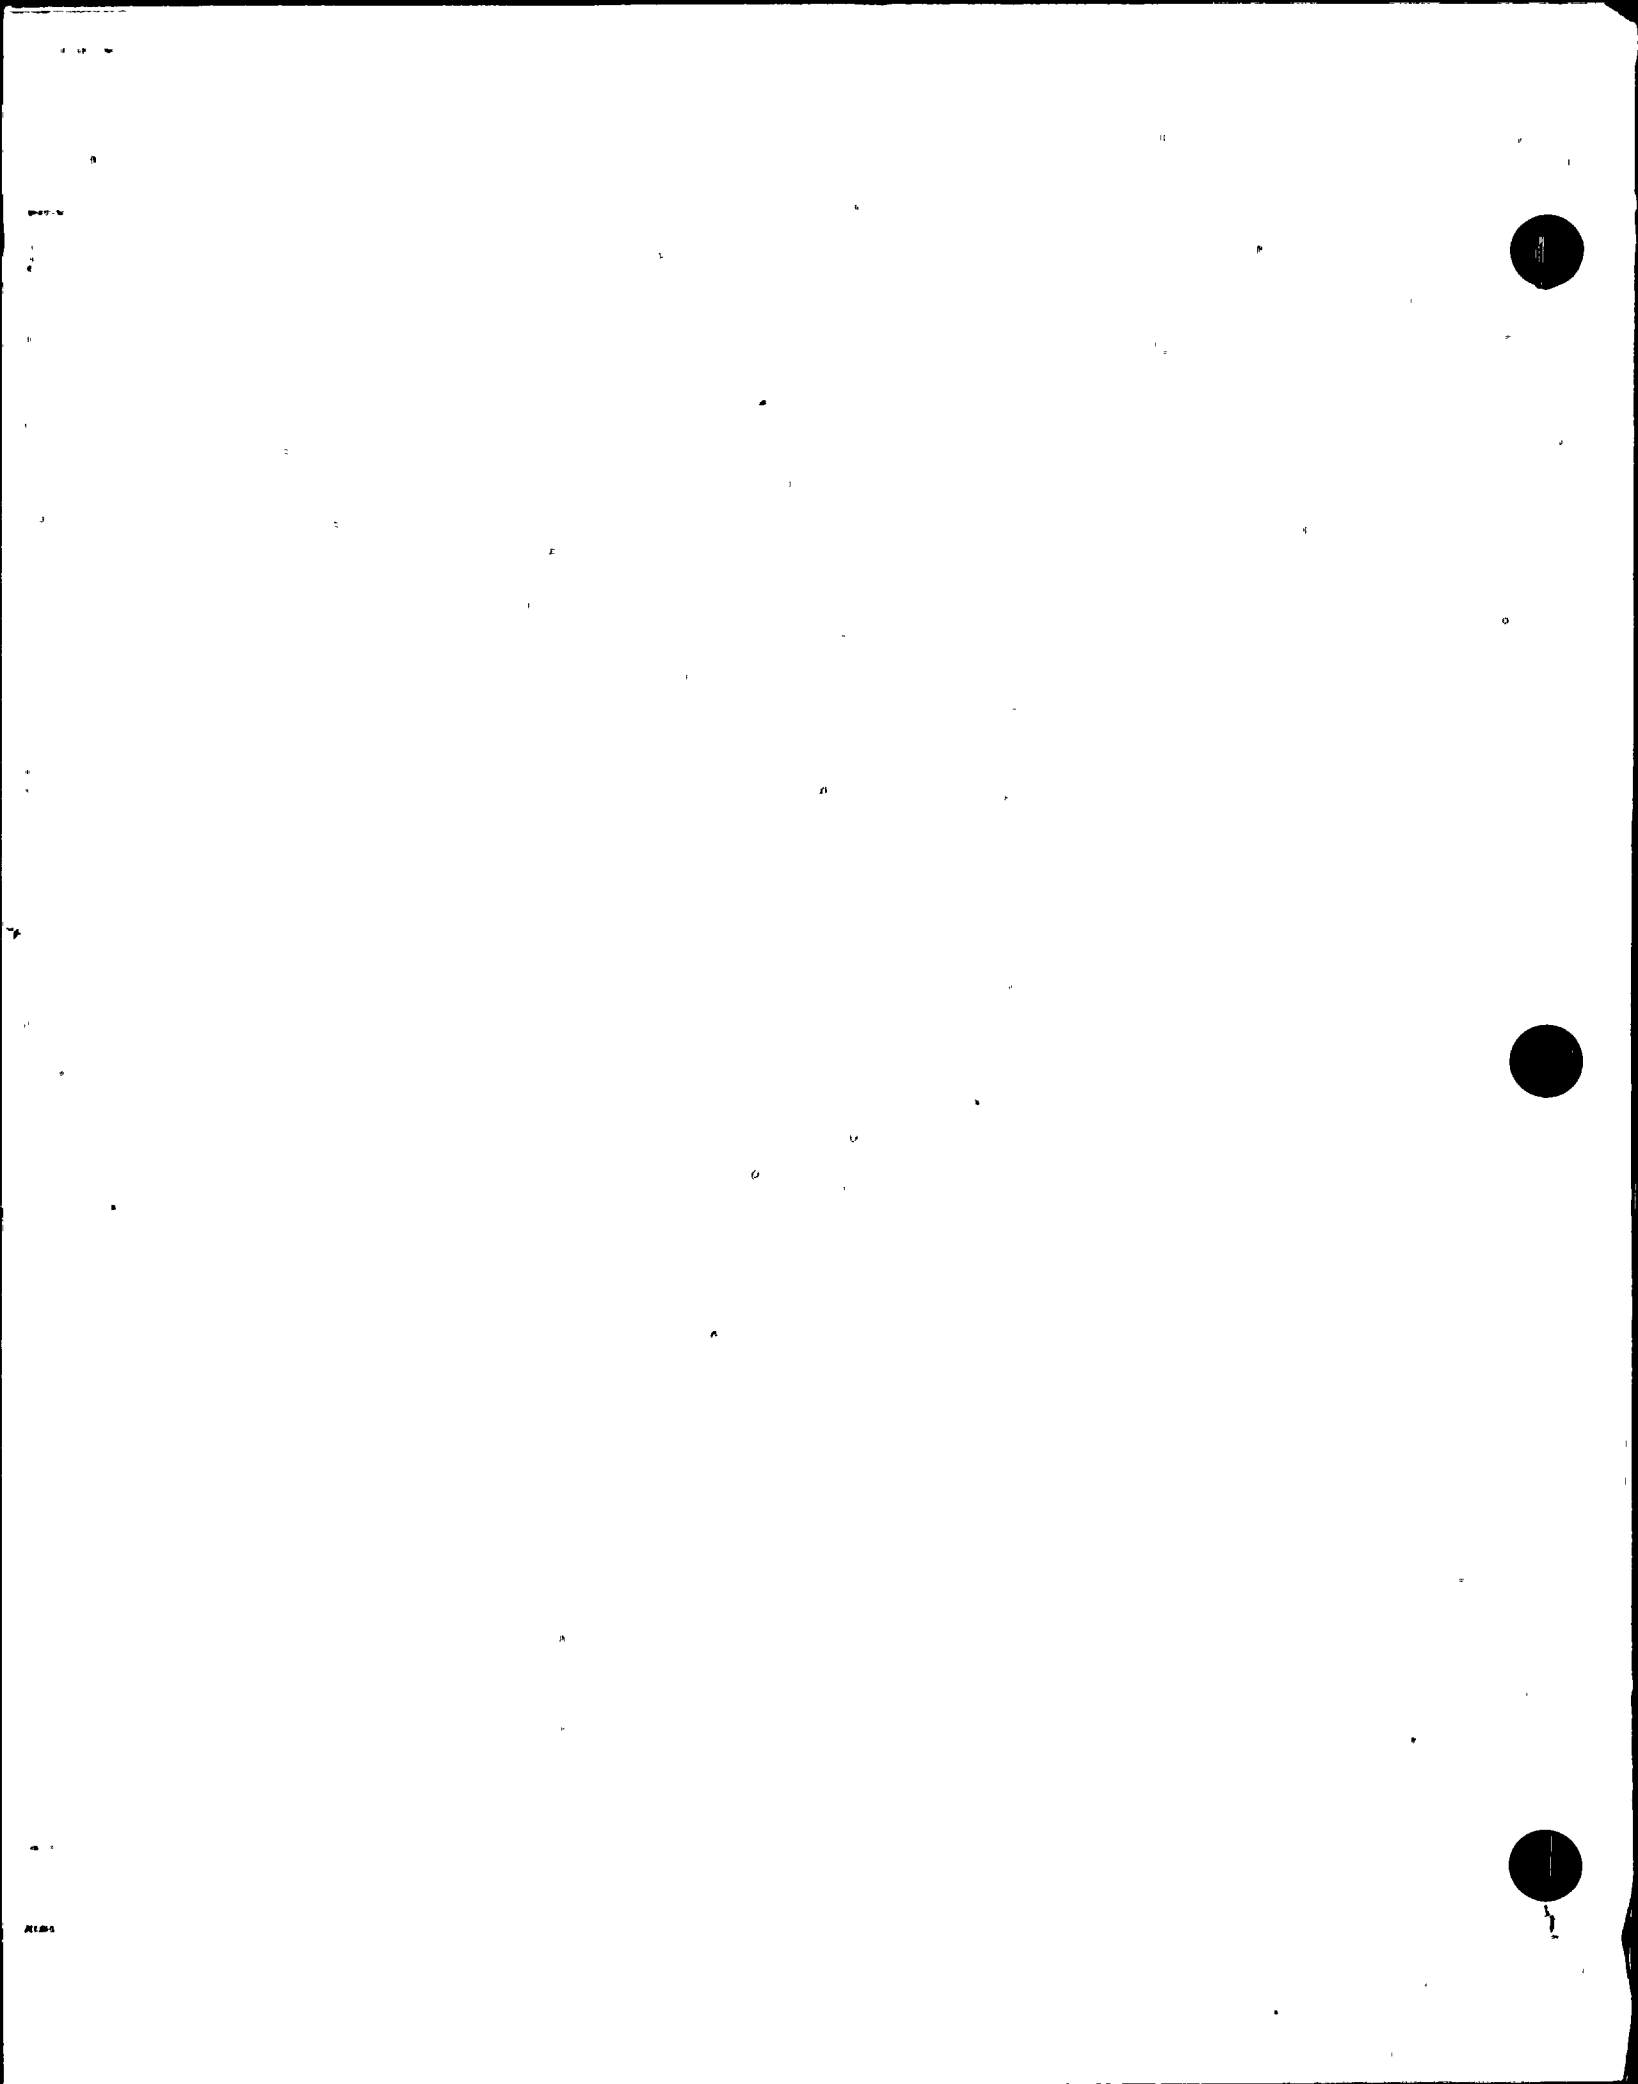


TABLE 9-1
RPV INTERNALS
FOR VISUAL EXAMINATIONS

Date 1/18/85

Revision 0

Page 1 of 20

ITEM NO.	DESCRIPTION	LOCATION		ASME Category	METHOD
		Azimuth	Elevation		
	<u>HPCS Sparger - (A), 89° to 271°</u>				
1	HPCS Sparger to Cap Weld	271°	355"	B-N-1	VT-3
2	HPCS Sparger Support Brackets	275°	367"	*	VT-3
3	HPCS Sparger Support Brackets	313°	367"	*	VT-3
4	HPCS Tee to Sparger Circ. Weld	350°	355"	B-N-1	VT-3
5	HPCS Sparger Tee Cover Weld	352°	355"	B-N-1	VT-3
6	HPCS Tee to Sparger Circ Weld	354°	355"	B-N-1	VT-3
7	HPCS Sparger Support Brackets	47°	367"	*	VT-3
8	HPCS Sparger Support Brackets	85°	367"	*	VT-3
9	HPCS Sparger to Cap Weld	89°	355"	B-N-1	VT-3
10	HPCS Sparger (A)	89°- 271°	367"	B-N-1	VT-3
11	HPCS Sparger (A) Nozzles	89°- 271°	367"	B-N-1	VT-3

TABLE 9-1
RPV INTERNALS
FOR VISUAL EXAMINATIONS

DATE 1/18/85

Revision 0

Page 2 of 20

ITEM NO.	DESCRIPTION	LOCATION		ASME Category	METHOD
		Azimuth	Elevation		
	<u>HPCS Sparger, (C), 91° to 269°</u>				
12	HPCS Sparger to Cap Weld	91°	355"	B-N-1	VT-3
13	HPCS Sparger Support Brackets	95°	367"	*	VT-3
14	HPCS Sparger Support Brackets	133°	367"	*	VT-3
15	HPCS Tee to Sparger Circ Weld	186°	355"	B-N-1	VT-3
16	HPCS Sparger Tee Cover Weld	188°	355"	B-N-1	VT-3
17	HPCS Tee to Sparger Circ. Weld	190°	355"	B-N-1	VT-3
18	HPCS Sparger Support Brackets	227°	367"	*	VT-3
19	HPCS Sparger Support Brackets	265°	367"	*	VT-3
20	HPCS Sparger to Cap Weld	269°	355"	B-N-1	VT-3
21	HPCS Sparger (c)	91° 269°	367"	B-N-1	VT-3
22	HPCS Sparger (C) Nozzles	91° 269°	367"	B-N-1	VT-3

TABLE 9-1
RPV INTERNALS
FOR VISUAL EXAMINATIONS

Date 1/18/85

Revision 0

Page 3 of 20

ITEM NO.	DESCRIPTION	LOCATION		ASME Category	METHOD
		Azimuth	Elevation		
	<u>HPCS Core Spray Piping (A Loop)</u>				
23	HPCS Elbow Shroud Weld	352 ⁰	355"	B-N-1	VT-3
24	HPCS Riser to Elbow Weld	352 ⁰	346"	B-N-1*	VT-3
25	HPCS Riser Sleeves (3 Circ. Welds)	352 ⁰	341"	B-N-1*	VT-3
26	HPCS Elbow to Riser Weld	352 ⁰	267"	B-N-1*	VT-3
27	HPCS Header to Elbow Weld	348 ⁰	255"	B-N-1*	VT-3
28	HPCS Header Clamp	345 ⁰	256"	B-N-1*	VT-3
29	HPCS Header Clamp Attachment Weld (Lower)	345 ⁰	263"	B-N-2*	VT-1
30	HPCS Header Clamp Bolt/Tack Weld (Lower)	345 ⁰	263"	B-N-1*	VT-3
31	HPCS Header Clamp Attachment Weld (Upper)	345 ⁰	267"	B-N-2*	VT-1
33	HPCS Header Clamp Bolt/Tack Weld (Upper)	345 ⁰	267"	B-N-2*	VT-3
34	HPCS Header Bracket, Seismic, Horizontal	292 ⁰	270"	B-N-1*	VT-3
35	HPCS Header Bracket Attachment Weld	292 ⁰	270"	B-N-2*	VT-1
36	HPCS Bracket Bolt/Tack Weld	291 ⁰	270"	B-N-1*	VT-3
37	HPCS Bracket Bolt/Tack Weld	293 ⁰	270"	B-N-1*	VT-3
38	HPCS Bracket Positioning Stud/Tack Weld	291 ⁰	271"	B-N-1*	VT-3
39	HPCS Bracket Positioning Stud/Tack Weld	293 ⁰	271"	B-N-1*	VT-3

TABLE 9-1
RPV INTERNALS
FOR VISUAL EXAMINATIONS

Date 1/18/85

Revision 0

Page 4 of 20

ITEM NO.	DESCRIPTION	LOCATION		ASME Category	METHOD
		Azimuth	Elevation		
40	HPCS Bracket Bolt/Tack Weld	291 ⁰	272"	B-N-1*	VT-3
41	HPCS Bracket Bolt/Tack Weld	293 ⁰	272"	B-N-1*	VT-3
42	HPCS Header Bracket, Seismic, Vertical	265 ⁰	270"	B-N-1*	VT-3
43	HPCS Header Bracket Attachment Weld	265 ⁰	270"	B-N-2*	VT-1
44	HPCS Bracket Bolt/Tack Weld	265 ⁰	270"	B-N-1*	VT-3
45	HPCS Bracket Bolt/Tack Weld	266 ⁰	270"	B-N-1*	VT-3
46	HPCS Bracket Positioning Stud/Tack Weld	264 ⁰	271"	B-N-1*	VT-3
47	HPCS Bracket Positioning Stud/Tack Weld	266 ⁰	271"	B-N-1*	VT-3
48	HPCS Bracket Bolt/Tack Weld	264 ⁰	272"	B-N-1*	VT-3
49	HPCS Bracket Bolt/Tack Weld	266 ⁰	272"	B-N-1*	VT-3
50	HPCS Header and Riser Pipe (A Loop)	353 ⁰ 267 ⁰	355" 265"	B-N-1*	VT-3

TABLE 9-1
RPV INTERNALS
FOR VISUAL EXAMINATIONS

Date 1/18/85

Revision 0

Page 5 of 20

ITEM NO.	DESCRIPTION	LOCATION		ASME Category	METHOD
		Azimuth	Elevation		
	<u>HPCS Core Spray Piping (C Loop)</u>				
51	HPCS Elbow to Shroud Weld	188 ⁰	355"	B-N-1*	VT-3
52	HPCS Riser to Elbow Weld	188 ⁰	346"	B-N-1*	VT-3
53	HPCS Riser Sleeves (3 Circ. Welds)	188 ⁰	341"	B-N-1*	VT-3
54	HPCS Elbow to Riser Weld	188 ⁰	267"	B-N-1*	VT-3
55	HPCS Header to Elbow Weld	192 ⁰	265"	B-N-1*	VT-3
56	HPCS Header Clamp	195 ⁰	265"	B-N-1*	VT-3
57	HPCS Header Clamp Attachment Weld (Lower)	195 ⁰	265"	B-N-2*	VT-1
58	HPCS Header Clamp Bolt/Tack Weld (Lower)	195 ⁰	265"	B-N-1*	VT-3
59	HPCS Header Clamp Attachment Weld (Upper)	195 ⁰	265"	B-N-1*	VT-3
60	HPCS Header Clamp Bolt/Tack Weld (Upper)	195 ⁰	265"	B-N-1*	VT-3
61	HPCS Header and Riser Pipe (C Loop)	187 ⁰ 268 ⁰	355" 265"	B-N-1	VT-3
62	HPCS Cover Plate to Tee Weld	240 ⁰	265"	B-N-1*	VT-3
63	HPCS Tee to Header Weld	242 ⁰	265"	B-N-1*	VT-3
64	HPCS Tee to Header Weld	238 ⁰	265"	B-N-1*	VT-3
65	HPCS Tee to Nozzle Thermal Sleeve Weld (Limited Exam)	240 ⁰	265"	B-N-1*	VT-3

TABLE 9-1
 RPV INTERNALS
 FOR VISUAL EXAMINATIONS

Date 1/18/85
 Revision 0
 Page 6 of 20

ITEM NO.	DESCRIPTION	LOCATION		ASME Category	METHOD
		Azimuth	Elevation		
	<u>LPCS Sparger (B) 271⁰ to 89⁰</u>				
66	LPCS Sparger to Cap Weld	271 ⁰	367"	B-N-1	VT-3
67	LPCS Sparger Support Brackets	275 ⁰	367"		VT-3
68	LPCS Sparger Support Brackets	313 ⁰	367"		VT-3
69	LPCS Tee to Sparger Circ. Weld	6 ⁰	367"	B-N-1	VT-3
70	LPCS Sparger Tee Cover Weld	8 ⁰	367"	B-N-1	VT-3
71	LPCS Tee to Sparger Circ. Weld	10 ⁰	367"	B-N-1	VT-3
72	LPCS Sparger Support Brackets	47 ⁰	367"		VT-3
73	LPCS Sparger Support Brackets	85 ⁰	367"		VT-3
74	LPCS Sparger to Cap Weld	89 ⁰	367"	B-N-1	VT-3
75	LPCS Sparger (B)	271 ⁰ 89 ⁰	367"	B-N-1	VT-3
76	LPCS Sparger Nozzles (B)	271 ⁰ 89 ⁰	367"	B-N-1	VT-3

TABLE 9-1
RPV INTERNALS
FOR VISUAL EXAMINATIONS

Date 1/18/85

Revision 0

Page 7 of 20

ITEM NO.	DESCRIPTION	LOCATION		ASME Category	METHOD
		Azimuth	Elevation		
	<u>LPCS Sparger (D), 91° to 269°</u>				
77	LPCS Sparger to Cap Weld	91°	367"	B-N-1	VT-3
78	LPCS Sparger Support Brackets	95°	367"	*	VT-3
79	LPCS Sparger Support Brackets	133°	367"	*	VT-3
80	LPCS Sparger Tee Cover Weld	172°	367"	B-N-1	VT-3
81	LPCS Tee to Sparger Circ. Weld	174°	367"	B-N-1	VT-3
82	LPCS Tee to Sparger Circ. Weld	176°	367"	B-N-1	VT-3
83	LPCS Sparger Support Brackets	227°	367"	*	VT-3
84	LPCS Sparger Support Brackets	265°	367"	*	VT-3
85	LPCS Sparger to Cap Weld	269°	367"	B-N-1	VT-3
86	LPCS Sparger (D)	91° 269°	367"	B-N-1	VT-3
87	LPCS Nozzles (D)	91° 269°	367"	B-N-1	VT-3

TABLE 9-1
RPV INTERNALS
FOR VISUAL EXAMINATIONS

Date 1/18/85

Revision 0

Page 8 of 20

ITEM NO.	DESCRIPTION	LOCATION		ASME Category	METHOD
		Azimuth	Elevation		
	<u>LPCS Core Spray Piping, (B) Loop</u>				
88	LPCS Elbow to Shroud Weld	8 ⁰	367"	B-N-1*	VT-3
89	LPCS Riser to Elbow Weld	8 ⁰	367"	B-N-1*	VT-3
90	LPCS Riser Sleeves (3 Circ. Welds)	8 ⁰	341"	B-N-1*	VT-3
91	LPCS Elbow to Riser Weld	8 ⁰	267"	B-N-1*	VT-3
92	LPCS Header to Elbow Weld	12 ⁰	265"	B-N-1*	VT-3
93	LPCS Header Clamp	15 ⁰	265"	B-N-1*	VT-3
94	LPCS Header Clamp Attachment Weld (Lower)	15 ⁰	263"	B-N-2*	VT-1
95	LPCS Header Clamp Bolt/Tack Weld (Lower)	15 ⁰	263"	B-N-1*	VT-1
96	LPCS Header Clamp Attachment Weld (Upper)	15 ⁰	263"	B-N-2*	VT-1
97	LPCS Header Clam Bolt/Tack Weld (Upper)	15 ⁰	263"	B-N-1*	VT-3
98	LPCS Header Bracket, Seismic, Horizontal	67 ⁰	270"	B-N-1*	VT-3
99	LPCS Header Bracket Attachment Weld	67 ⁰	270"	B-N-2	VT-1
100	LPCS Bracket Bolt/with Tack weld	66 ⁰	270"	B-N-1*	VT-3
101	LPCS Bracket Positioning Stud/with Tack Weld	66 ⁰	271"	B-N-1*	VT-3
102	LPCS Bracket Bolt/with Tack Weld	66 ⁰	272"	B-N-1*	VT-3
103	LPCS Bracket Bolt/with Tack Weld	68 ⁰	270"	B-N-1*	VT-3
104	LPCS Bracket Positioning Stud/with Tack Weld	68 ⁰	271"	B-N-1*	VT-3
105	LPCS Bracket Bolt/with Tack Weld	68 ⁰	272"	B-N-1*	VT-3
106	LPCS Header Bracket, Seismic, Vertical	94 ⁰	270"	B-N-1*	VT-3
107	LPCS Header Bracket Attachment Weld	94 ⁰	270"	B-N-2*	VT-1
	LPCS Bracket Bolt/with Tack Weld	93 ⁰	270"	B-N-1*	VT-3

TABLE 9-1
 RPV INTERNALS
 FOR VISUAL EXAMINATIONS

Date 1/18/85

Revision 0

Page 9 of 20

ITEM NO.	DESCRIPTION	LOCATION		ASME Category	METHOD
		Azimuth	Elevation		
109	LPCS Bracket Positioning Stud/with Tack Weld	93 ⁰	271"	B-N-1*	VT-3
110	LPCS Bracket Bolt/with Tack Weld	93 ⁰	272"	B-N-1*	VT-3
111	LPCS Bracket Bolt/with Tack Weld	95 ⁰	270"	B-N-1*	VT-3
112	LPCS Bracket Positioning Stud/with Tack Weld	95 ⁰	271"	B-N-1*	VT-3
113	LPCS Bracket Bolt/with Tack Weld	95 ⁰	272"	B-N-1*	VT-3
114	LPCS Header and Riser Pipe	80- 118 ⁰	367"- 265"	B-N-1*	VT-3

TABLE 9-1
RPV INTERNALS
FOR VISUAL EXAMINATIONS

Date 1/18/85

Revision 0

Page 10 of 20

ITEM NO.	DESCRIPTION	LOCATION		ASME Category	METHOD
		Azimuth	Elevation		
	<u>LPCS Core Spray Piping (D Loop)</u>				
115	LPCS Elbow to Shroud Weld	172 ⁰	367"	B-N-1*	VT-3
116	LPCS Riser to Elbow Weld	172 ⁰	361"	B-N-1*	VT-3
117	LPCS Riser Sleeves (3 Circ. Welds)	172 ⁰	341"	B-N-1*	VT-3
118	LPCS Elbow to Riser Weld	172 ⁰	263"	B-N-1*	VT-3
119	LPCS Header to Elbow Weld	168 ⁰	263"	B-N-1*	VT-3
120	LPCS Header Clamp	165 ⁰	263"	B-N-2*	VT-3
121	LPCS Header Clamp Attachment Weld (Lower)	165 ⁰	263"	B-N-2*	VT-1
122	LPCS Header Clamp Bolt/Tack Weld (Lower)	165 ⁰	263"	B-N-2*	VT-3
123	LPCS Header Clamp Attachment Weld (Upper)	165 ⁰	263"	B-N-2*	VT-1
124	LPCS Header Clamp Bolt/Tack Weld (Upper)	165 ⁰	263"	B-N-1*	VT-3
125	LPCS Header and Riser Pipe	172 ⁰ 122 ⁰	367"	B-N-1*	VT-3
126	LPCS Tee to Nozzle Thermal Sleeve Weld (Limited Exam)	120 ⁰	265"	B-N-1*	VT-3
127	LPCS Cover Plate to Tee Weld	120 ⁰	263"	B-N-1*	VT-3
128	LPCS Tee to Header Weld	122 ⁰	265"	B-N-1*	VT-3
129	LPCS Tee to Header Weld	118 ⁰	265"	B-N-1*	VT-3

TABLE 9-1
RPV INTERNALS,
FOR VISUAL EXAMINATIONS

Date 1/18/85

Revision 0

Page 11 of 20

ITEM NO.	DESCRIPTION	LOCATION		ASME Category	METHOD
		Azimuth	Elevation		
	<u>Feedwater Sparger, No. 1, 5° to 55°</u>				
1	Feedwater Sparger Bracket	5°	252"	B-N-1	VT-3
2	Feedwater Sparger Bracket Attachment Welds	5°	252"	B-N-2	VT-1
3	Feedwater Sparger Bracket Pin	5°	252"	B-N-1	VT-3
4	Feedwater Sparger Bracket to Sparger Flange bolt/Tack Weld	9°	256"	B-N-1	VT-3
5	Feedwater Sparger Bracket to Sparger Flange bolt/Tack Weld	9°	248"	B-N-1	VT-3
6	Feedwater Sparger Flange to Pipe Circ. Weld	9°	252"	B-N-1	VT-3
7	Feedwater Sparger Pipe to Tee Circ. Weld	28°			
8	Feedwater Sparger Tee Long Seam	28°-32°	252"	B-N-1	VT-3
9	Feedwater Sparger Tee to Sparger Pipe Circ. Weld	32°	252"	B-N-1	VT-3
10	Feedwater Sparger Tee to Thermal Sleeve Circ. Weld	30°	252"	B-N-1	VT-3
11	Feedwater Sparger Pipe to Flange Circ. Weld	51°	252"	B-N-1	VT-3
12	Feedwater Sparger Bracket to Sparger Flange bolt/Tack Weld	51°	256"	B-N-1	VT-3
13	Feedwater Sparger Bracket to Sparger Flange bolt/Tack Weld	51°	248"	B-N-1	VT-3
14	Feedwater Sparger Bracket Pin	55°	252"	B-N-1	VT-3
15	Feedwater Sparger Bracket Attachment Welds	55°	252"	B-N-2	VT-1
16	Feedwater Sparger Bracket	55°	252"	B-N-1	VT-3
17	Feedwater Sparger (No. 1)	90°-51°	252"	B-N-1	VT-3

TABLE 9-1
RPV INTERNALS
FOR VISUAL EXAMINATIONS

Date 1/18/85

Revision 0

Page 12 of 20

ITEM NO.	DESCRIPTION	LOCATION		ASME Category	METHOD
		Azimuth	Elevation		
	<u>Feedwater Sparger, No. 2, 65° to 125°</u>				
18	Feedwater Sparger Bracket	65°	252"	B-N-1	VT-3
19	Feedwater Sparger Bracket Attachment Welds	65°	252"	B-N-2	VT-1
20	Feedwater Sparger Bracket Pin	65°	252"	B-N-1	VT-3
21	Feedwater Sparger Bracket to Sparger Flange bolt/Tack Weld	69°	256"	B-N-1	VT-3
22	Feedwater Sparger Bracket to Sparger Flange bolt/Tack Weld	69°	248"	B-N-1	VT-3
23	Feedwater Sparger Flange to Pipe Circ. Weld	69°	252"	B-N-1	VT-3
24	Feedwater Sparger Pipe to Tee Circ. Weld	88°	252"	B-N-1	VT-3
25	Feedwater Sparger Tee Long Seam	88°- 92°	252"	B-N-1	VT-3
26	Feedwater Sparger Tee to Sparger Pipe Circ. Weld	92°	252"	B-N-1	VT-3
27	Feedwater Sparger Tee to Thermal Sleeve Circ. Weld	90°	252"	B-N-1	VT-3
28	Feedwater Sparger Pipe to Flange Circ. Weld	111°	252"	B-N-1	VT-3
29	Feedwater Sparger Bracket to Sparger Flange bolt/Tack Weld	111°	256"	B-N-1	VT-3
30	Feedwater Sparger Bracket to Sparger Flange bolt/Tack Weld	111°	248"	B-N-1	VT-3
31	Feedwater Sparger Bracket Pin	115°	252"	B-N-1	VT-3
32	Feedwater Sparger Bracket Attachment Welds	115°	252"	B-N-2	VT-1
33	Feedwater Sparger Bracket	115°	252"	B-N-1	VT-3
34	Feedwater Sparger	69°- 111°	252"	B-N-1	VT-3

TABLE 9-1
RPV INTERNALS
FOR VISUAL EXAMINATIONS

Date 1/18/85

Revision 0

Page 13 of 20

ITEM NO.	DESCRIPTION	LOCATION		ASME Category	METHOD
		Azimuth	Elevation		
	<u>Feedwater Sparger, No. 3, 125⁰ to 175⁰</u>				
35	Feedwater Sparger Bracket	125 ⁰	252"	B-N-1	VT-3
36	Feedwater Sparger Bracket Attachment Welds	125 ⁰	252"	B-N-2	VT-1
37	Feedwater Sparger Bracket Pin	125 ⁰	252"	B-N-1	VT-3
38	Feedwater Sparger Bracket to Sparger Flange bolt/Tack Weld	129 ⁰	256"	B-N-1	VT-3
39	Feedwater Sparger Bracket to Sparger Flange bolt/Tack Weld	129 ⁰	248"	B-N-1	VT-3
40	Feedwater Sparger Flange to Pipe Circ. Weld	129 ⁰	252"	B-N-1	VT-3
41	Feedwater Sparger Pipe to Tee Circ. Weld	148 ⁰	252"	B-N-1	VT-3
42	Feedwater Sparger Tee Long Seam.	148 ⁰ 150 ⁰	252"	B-N-1	VT-3
43	Feedwater Sparger Tee to Sparger Pipe Circ. Weld	152 ⁰	252"	B-N-1	VT-3
44	Feedwater Sparger Tee to Thermal Sleeve Circ. Weld	150 ⁰	252"	B-N-1	VT-3
45	Feedwater Sparger Pipe to Flange Circ. Weld	171 ⁰	252"	B-N-1	VT-3
46	Feedwater Sparger Bracket to Sparger Flange bolt/Tack Weld	171 ⁰	256"	B-N-1	VT-3
47	Feedwater Sparger Bracket to Sparger Flange bolt/Tack Weld	171 ⁰	248"	B-N-1	VT-3
48	Feedwater Sparger Bracket Pin	175 ⁰	252"	B-N-1	VT-3
49	Feedwater Sparger Bracket Attachment Welds	175 ⁰	252"	B-N-2	VT-1
50	Feedwater Sparger Bracket	175 ⁰	252"	B-N-1	VT-3
51	Feedwater Sparger	129 ⁰ 171 ⁰	252"	B-N-1	VT-3

TABLE 9-1
RPV INTERNALS
FOR VISUAL EXAMINATIONS

Date 1/18/85

Revision 0

Page 14 of 20

ITEM NO.	DESCRIPTION	LOCATION		ASME Category	METHOD
		Azimuth	Elevation		
	<u>Feedwater Sparger, No. 4, 185° to 235°</u>				
52	Feedwater Sparger Bracket	185°	252"	B-N-1	VT-3
53	Feedwater Sparger Bracket Attachment Welds	185°	252"	B-N-2	VT-1
54	Feedwater Sparger Bracket Pin	185°	252"	B-N-1	VT-3
55	Feedwater Sparger Bracket to Sparger Flange bolt/Tack Weld	189°	256"	B-N-1	VT-3
56	Feedwater Sparger Bracket to Sparger Flange bolt/Tack Weld	189°	248"	B-N-1	VT-3
57	Feedwater Sparger Flange to Pipe Circ. Weld	189°	252"	B-N-1	VT-3
58	Feedwater Sparger Pipe to Tee Circ. Weld	208°	252"	B-N-1	VT-3
59	Feedwater Sparger Tee Long Seam	208° 212°	252"	B-N-1	VT-3
60	Feedwater Sparger Tee to Sparger Pipe Circ.	212°	252"	B-N-1	VT-3
61	Feedwater Sparger Tee to Thermal Sleeve Circ. Weld	210°	252"	B-N-1	VT-3
62	Feedwater Sparger Pipe to Flange Circ. Weld	231°	252"	B-N-1	VT-3
63	Feedwater Sparger Bracket to Sparger Flange bolt/Tack Weld	231°	256"	B-N-1	VT-3
64	Feedwater Sparger Bracket to Sparger Flange bolt/Tack Weld	231°	248"	B-N-1	VT-3
65	Feedwater Sparger Bracket Pin	235°	252"	B-N-1	VT-3
66	Feedwater Sparger Bracket Attachment Welds	235°	252"	B-N-2	VT-1
67	Feedwater Sparger Bracket	235°	252"	B-N-1	VT-3
68	Feedwater Sparger	189° 231°	252"	B-N-1	VT-3

TABLE 9-1
RPV INTERNALS
FOR VISUAL EXAMINATIONS

Date 1/18/85

Revision _____

Page 15 of 20

ITEM NO.	DESCRIPTION	LOCATION		ASME Category	METHOD
		Azimuth	Elevation		
	<u>Feedwater Sparger, No. 5, 245⁰ to 295⁰</u>				
69	Feedwater Sparger Bracket	245 ⁰	252"	B-N-1	VT-3
70	Feedwater Sparger Bracket Attachment Welds	245 ⁰	252"	B-N-2	VT-1
71	Feedwater Sparger Bracket Pin	245 ⁰	252"	B-N-1	VT-3
72	Feedwater Sparger Bracket to Sparger Flange bolt/Tack Weld	249 ⁰	256"	B-N-1	VT-3
73	Feedwater Sparger Bracket to Sparger Flange bolt/Tack Weld	249 ⁰	248"	B-N-1	VT-3
74	Feedwater Sparger Flange to Pipe Circ. Weld	249 ⁰	252"	B-N-1	VT-3
75	Feedwater Sparger Pipe to Tee Circ. Weld	268 ⁰	252"	B-N-1	VT-3
76	Feedwater Sparger Tee Long Seam	268 ⁰ 272 ⁰	252"	B-N-1	VT-3
77	Feedwater Sparger Tee to Sparger Pipe Circ. Weld	272 ⁰	252"	B-N-1	VT-3
78	Feedwater Sparger Tee to Thermal Sleeve Circ. Weld	270 ⁰	252"	B-N-1	VT-3
79	Feedwater Sparger Pipe to Flange Circ. Weld	291 ⁰	252"	B-N-1	VT-3
80	Feedwater Sparger Bracket to Sparger Flange bolt/Tack Weld	291 ⁰	256"	B-N-1	VT-3
81	Feedwater Sparger Bracket to Sparger Flange bolt/Tack Weld	291 ⁰	248"	B-N-1	VT-3
82	Feedwater Sparger Bracket Pin	295 ⁰	252"	B-N-1	VT-3
83	Feedwater Sparger Bracket Attachment Welds	295 ⁰	252"	B-N-2	VT-1
84	Feedwater Sparger Bracket	295 ⁰	252"	B-N-1	VT-3
85	Feedwater Sparger	249 ⁰ 291 ⁰	252"	B-N-1	VT-3

TABLE 9-1
RPV INTERNALS
FOR VISUAL EXAMINATIONS

Date 1/18/85

Revision 0

Page 16 of 10

ITEM NO.	DESCRIPTION	LOCATION		ASME Category	METHOD
		Azimuth	Elevation		
	<u>Feedwater Sparger, No. 6, 305° to 355°</u>				
86	Feedwater Sparger Bracket	305°	252"	B-N-1	VT-3
87	Feedwater Sparger Bracket Attachment Welds	305°	252"	B-N-2	VT-1
88	Feedwater Sparger Bracket Pin	305°	252"	B-N-1	VT-3
89	Feedwater Sparger Bracket to Sparger Flange bolt/Tack Weld	309°	256"	B-N-1	VT-3
90	Feedwater Sparger Bracket to Sparger Flange bolt/Tack Weld	309°	248"	B-N-1	VT-3
91	Feedwater Sparger Flange to Pipe Circ. Weld	309°	252"	B-N-1	VT-3
92	Feedwater Sparger Pipe to Tee Circ. Weld	328°	252"	B-N-1	VT-3
93	Feedwater Sparger Tee Long Seam	328° 332°	252"	B-N-1	VT-3
94	Feedwater Sparger Tee to Sparger Pipe Circ. Weld	332°	252"	B-N-1	VT-3
95	Feedwater Sparger Tee to Thermal Sleeve Circ. Weld	330°	252"	B-N-1	VT-3
96	Feedwater Sparger Pipe to Flange Circ. Weld	351°	252"	B-N-1	VT-3
97	Feedwater Sparger Bracket to Sparger Flange bolt/Tack Weld	351°	256"	B-N-1	VT-3
98	Feedwater Sparger Bracket to Sparger Flange bolt/Tack Weld	351°	248"	B-N-1	VT-3
99	Feedwater Sparger Bracket Pin	355°	252"	B-N-1	VT-3
100	Feedwater Sparger Bracket Attachment Weld	355°	252"	B-N-2	VT-1
101	Feedwater Sparger Bracket	355°	252"	B-N-1	VT-3
102	Feedwater Sparger	309° 351°	252"	B-N-1	VT-3

TABLE 9-1
RPV INTERNALS
FOR VISUAL EXAMINATIONS

Date 1/18/85

Revision 0

Page 17 of 20

ITEM NO.	DESCRIPTION	LOCATION		ASME Category	METHOD
		Azimuth	Elevation		
1	Riser Support Pad for Jet Pump No. 1 and 2	30 ⁰	443"	B-N-2	VT-3
2	Hold Down Beam, Jet Pump No. 1	28 ⁰	467"	B-N-1	VT-1
3	Hold Down Beam, Nut Spot Weld, Jet Pump No. 1	28 ⁰	467"	B-N-1	VT-3
4	Hold Down Beam, Head Bolt Keeper Tack Welds (4 Ea), Jet Pump No. 1	28 ⁰	467"	B-N-1	VT-3
5	Hold Down Beam, Jet Pump No. 2	32 ⁰	467"	B-N-1	VT-1
6	Hold Down Beam, Nut Spot Weld, Jet Pump No. 2	32 ⁰	467"	B-N-1	VT-3
7	Hold Down Beam, Head Bolt Keeper Tack Welds (4 ea) Jet Pump No. 1	32 ⁰	467"	B-N-1	VT-3
8	Riser Support Pad for Jet Pump No. 3 and 4	60 ⁰	443"	B-N-2	VT-3
9	Hold Down Beam, Jet Pump No. 3	58 ⁰	467"	B-N-1	VT-1
10	Hold Down Beam, Nut Spot Weld, Jet Pump No. 3	58 ⁰	467"	B-N-1	VT-3
11	Hold Down Beam, Head Bolt Keeper Tack Welds (4 ea.) Jet Pump No. 3	58 ⁰	467"	B-N-1	VT-3
12	Hold Down Beam, Jet Pump No. 4	62 ⁰	467"	B-N-1	VT-1
13	Hold Down Beam, Nut Spot Weld, Jet Pump No. 4	62 ⁰	467"	B-N-1	VT-3
14	Hold Down Beam, Head Bolt Keeper Tack Welds (4 ea.) Jet Pump No. 4	62 ⁰	467"	B-N-1	VT-3
15	Riser Support Pad for Jet Pump No. 5 and 6	90 ⁰	443"	B-N-2	VT-3
16	Hold Down Beam, Jet Pump No. 5	88 ⁰	467"	B-N-1	VT-1
17	Hold Down Beam, Nut Spot Weld, Jet Pump No. 5	88 ⁰	467"	B-N-1	VT-3

TABLE 9-1
RPV INTERNALS
FOR VISUAL EXAMINATIONS

Date 1/18/85

Revision _____

Page 18 of 20

ITEM NO.	DESCRIPTION	LOCATION		ASME Category	METHOD
		Azimuth	Elevation		
18	Hold Down Beam, Head Bolt Keeper Tackwelds (4 ea.) Jet Pump No. 5	88 ⁰	476"	B-N-1	VT-3
19	Hold Down Beam, Jet Pump No. 6	92 ⁰	476"	B-N-1	VT-1
20	Hold Down Beam, Nut Spot Weld, Jet Pump No. 6	92 ⁰	467"	B-N-1	VT-3
21	Hold Down Beam, Head Bolt Keeper Tack Welds (4 ea.) Jet Pump No. 6	92 ⁰	467"	B-N-1	VT-3
22	Riser Support Pad for Jet Pump No. 7 and 8	120 ⁰	443"	B-N-1	VT-1
23	Hold Down Beam, Jet Pump No. 7	118 ⁰	476"	B-N-1	VT-1
24	Hold Down Beam, Nut Spot Weld, Jet Pump No. 7	118 ⁰	467"	B-N-1	VT-3
25	Hold Down Beam, Head Bolt Keeper Tackwelds (4 ea.) Jet Pump No. 7	118 ⁰	467"	B-N-1	VT-3
26	Hold Down Beam, Jet Pump No. 8	122 ⁰	467"	B-N-1	VT-1
27	Hold Down Beam, Nut Spot Weld, Jet Pump No. 8	122 ⁰	467"	B-N-1	VT-3
28	Hold Down Beam, Head Bolt Keeper Tackwelds (4 ea.) Jet Pump No. 8	122 ⁰	467"	B-N-1	VT-3
29	Riser Support Pad for Jet Pump No. 9 and 10	150 ⁰	443"	B-N-2	VT-3
30	Hold Down Beam, Jet Pump No. 9	148 ⁰	467"	B-N-1	VT-1
31	Hold Down Beam, Nut Spot Weld, Jet Pump No. 9	148 ⁰	467"	B-N-1	VT-3
32	Hold Down Beam, Head Bolt Keeper Tack Welds (4 ea.) Jet Pump No. 9	148 ⁰	467"	B-N-1	VT-3
33	Hold Down Beam, Jet Pump No. 10	152 ⁰	467"	B-N-1	VT-1
34	Hold Down Beam, Nut Spot Weld, Jet Pump No. 10	152 ⁰	467"	B-N-1	VT-3
35	Hold Down Beam, Head Bolt Keeper Tackwelds (4 ea.) Jet Pump No. 10	152 ⁰	467"	B-N-1	VT-3
36	Riser Support Pad for Jet Pump No. 11 and 12	210 ⁰	443"	B-N-2	VT-3
37	Hold Down Beam, Jet Pump No. 11	208 ⁰	467"	B-N-1	VT-1
38	Hold Down Beam, Nut Spot Weld, Jet Pump No. 11	208 ⁰	467"	B-N-1	VT-3

TABLE 9-1
RPV INTERNALS
FOR VISUAL EXAMINATIONS

Date 1/18/85

Revision 0

Page 19 of 20

ITEM NO.	DESCRIPTION	LOCATION		ASME Category	METHOD
		Azimuth	Elevation		
39	Hold Down Beam, Head Bolt Keeper Tackwelds (4 ea.) Jet Pump No. 11	208 ⁰	467"	B-N-1	VT-3
40	Hold Down Beam, Jet Pump No. 12	212 ⁰	467"	B-N-1	VT-1
41	Hold Down Beam, Nut Spot Weld, Jet Pump No. 12	212 ⁰	467"	B-N-1	VT-3
42	Hold Down Beam, Head Bolt Keeper Tack Welds	212 ⁰	467"	B-N-1	VT-3
43	Riser Support Pad for Jet Pump No. 13 and 14	240 ⁰	443"	B-N-2	VT-3
44	Hold Down Beam, Jet Pump No. 13	238 ⁰	467"	B-N-1	VT-1
45	Hold Down Beam, Nut Spot Weld, Jet Pump No. 13	238 ⁰	467"	B-N-1	VT-3
46	Hold Down Beam, Head Bolt Keeper Tack Welds (4 ea.) Jet Pump No. 13	238 ⁰	467"	B-N-1	VT-3
47	Hold Down Beam Jet Pump No. 14	242 ⁰	467"	B-N-1	VT-1
48	Hold Down Beam, Nut Sport Weld, Jet Pump No. 14	242 ⁰	467"	B-N-1	VT-3
49	Hold Down Beam, Head Bolt Keeper Tack Welds	242 ⁰	467"	B-N-1	VT-3
50	Riser Support Pad for Jet Pump No. 15 and 16	270 ⁰	443"	B-N-2	VT-3
51	Hold Down Beam, Jet Pump No. 15	268 ⁰	467"	B-N-1	VT-1
52	Hold Down Beam, Nut Spot Weld, Jet Pump No. 15	268 ⁰	467"	B-N-1	VT-3
53	Hold Down Beam, Head Bolt Keeper Tack Welds (4 ea.) Jet Pump No. 15	268 ⁰	467"	B-N-1	VT-3
54	Hold Down Beam Jet Pump No. 16	272 ⁰	467"	B-N-1	VT-1
55	Hold Down Beam, Nut Spot Weld, Jet Pump No. 16	272 ⁰	467"	B-N-1	VT-3
56	Hold Down Beam, Head Bolt Keeper Tack Welds	272 ⁰	467"	B-N-1	VT-3
57	Riser Support Pad for Jet Pump No. 17 and 18	300 ⁰	443"	B-N-2	VT-3
58	Hold Down Beam, Jet Pump No. 17	298 ⁰	467"	B-N-1	VT-1
59	Hold Down Beam, Nut Spot Weld, Jet Pump No. 17	298 ⁰	467"	B-N-1	VT-3

TABLE 9-1.
RPV INTERNALS
FOR VISUAL EXAMINATIONS

Date 1/18/85

Revision 0

Page 20 of 20

ITEM NO.	DESCRIPTION	LOCATION		ASME Category	METHOD
		Azimuth	Elevation		
60	Hold Down Beam, Head Bolt Keeper Tack Welds (4 ea.) Jet Pump No. 17	298 ⁰	467"	B-N-1	VT-3
61	Hold Down Beam, Jet Pump No. 18	302 ⁰	467"	B-N-1	VT-1
62	Hold Down Beam, Nut Spot Weld, Jet Pump No. 18	302 ⁰	467"	B-N-1	VT-3
63	Hold Down Beam, Head Bolt Keeper Tack Welds	302 ⁰	467"	B-N-1	VT-3
64	Riser Support Pad for Jet Pump No. 19 and 20	330 ⁰	443"	B-N-2	VT-3
65	Hold Down Beam, Jet Pump No. 19	328 ⁰	467"	B-N-1	VT-1
66	Hold Down Beam, Nut Spot Weld, Jet Pump No. 19	328 ⁰	467"	B-N-1	VT-3
67	Hold Down Beam, Head Bolt Keeper Tack Welds (4 ea.) Jet Pump No. 19	328 ⁰	467"	B-N-1	VT-3
68	Hold Down Beam, Jet Pump No. 20	332 ⁰	467"	B-N-1	VT-1
69	Hold Down Beam, Nut Spot Weld, Jet Pump No. 20	332 ⁰	467"	B-N-1	VT-3
70	Hold Down Beam, Head Bolt Keeper Tack Welds	332 ⁰	467"	B-N-1	VT-3

Date 1/18/85

Revision 0

WNP-2
PRESERVICE COMPONENT
SUPPORT
PROGRAM PLAN



WPPSS
NUCLEAR PROJECT
NO. 2

PRESERVICE COMPONENT SUPPORT PROGRAM PLAN.

Washington Public Power
Supply System

Date March 14, 1983
Rev. 0

COMPONENT-SUPPORT INSPECTION AND TEST PROGRAM PLAN
FOR THE
SUPPLY SYSTEM NUCLEAR PROJECT NO. 2

Prepared by: Larry Hill 14 MARCH 1983
Code Programs Date

Plan Approvals: Thomas J. Angle 3/14/83
Supervisor, Code Programs Date

Rhoney B. ... 3/28/83
WNP-2 Test and Startup Manager Date

Industrial ... m. neid 5/9/83
WNP-2 Plant Technical Manager Date

D. W. ... 5-9/83
Manager, Systems Design Date

... 5/9/83
Assistant Director System Engineering Date

Concurrences: D. A. Walker 3-31-83
Licensing and Assurance Date

... 5/26/83
Authorized Nuclear Inspector
(for ASME Section XI portions) Date

TABLE OF CONTENTS

- 1.0 Introduction
- 2.0 Scope
- 3.0 Program Examination and Testing Requirements
- 4.0 Program Implementation
 - 4.1 Organizations Involved
 - 4.2 Pre-fuel Load Examinations
 - 4.3 Post-fuel Load Examinations
 - 4.4 Manpower Requirements
 - 4.5 Documentation Requirements
 - 4.6 Program Outline
 - 4.7 Schedule
- 5.0 References
- 6.0 Attachments
 - 6.1 Figure 1 - WNP-2 Plant Component Support Inspection and Test Program Outline
 - 6.2 Figure 2 - WNP-2 Component Support Inspection and Test Program Schedule
 - 6.3 Appendix A - Basis for WNP-2 Component Support Inspection and Test Program
 - 6.4 WNP-2 Response to I.E. Bulletin 79-14 "Seismic Analysis for the As-Built Safety-Related Piping Systems"
 - 6.5 Table 1 - List of Component Supports Within PSI Boundaries
 - 6.6 Table 2 - List of Safety Related Snubbers Outside PSI Boundaries

1.0 INTRODUCTION

WNP-2 piping system supports were designed, fabricated, installed and certified by numerous different contractors. In addition to the construction quality assurance program certification of proper component support installation, there are several component support examinations and tests required by State and Federal law and plant licensing commitments. It is the purpose of this program to integrate these additional examinations and tests into one overall program under the direction of a Program Manager. This program addresses in detail the various examination and testing requirements for component supports prior to commercial operation and describes where credit is taken for construction activities in meeting these requirements. This program addresses organizations, personnel, schedules, procedures, and documentation required for implementation of these requirements.

Most of the examination requirements and documentation result from WNP-2 Preservice Inspection requirements. Therefore, the Component Support and Test Program is incorporated and will be implemented as part of the WNP-2 PSI Program Plan.

2.0 SCOPE

This program addresses component support related activities prior to commercial operation of WNP-2. This program satisfies the requirements of the ASME Boiler and Pressure Vessel Code Section XI (reference a,) as outlined in Section 9 of the WNP-2 Preservice Inspection Plan and requirements made by licensing commitments as specified in the WNP-2 FSAR and other correspondence (references b through g). Appendix A addresses the basis for this program in detail and shows specifically how each requirement is satisfied.

I.E. Bulletin 79-14, "Seismic Analysis for As-Built Safety-Related Piping Systems", dated July 2, 1979, which required a field walkdown verification of pipe hanger as-built configuration is not included in the scope of this program. See Attachment 6.4 for the WNP-2 response to this Bulletin.

Component support examination and testing following commercial operation will be addressed separately in the WNP-2 Inservice Inspection (ISI) Program which will be developed in accordance with requirements contained in Subsection IWF.

3.0 PROGRAM EXAMINATION AND TESTING REQUIREMENTS

The consolidated requirements of the Component Support Inspection and Testing Program are those specifically required or committed to in the reference documents. These requirements, summarily stated, are as follows:

- 1) Perform pre-heatup system visual examination of safety-related snubbers (within the six months prior to system heatup) to check for snubber damage.

- 2) Perform preservice visual examination of all accessible ASME Section III NF component supports (including snubbers) on systems where normal operating temperature is greater than 250°F during hot system testing. This examination involves at least three separate walkdowns, one at intermediate system temperature, one at operating temperature and one at cold conditions following thermal transients.
- 3) All safety-related snubbers must be stroked following installation.
- 4) All safety-related snubbers must be checked to verify as-built conditions following installation.

Additionally, all examiners performing visual examinations on component supports need to be qualified to VT-3 and VT-4 per ASME Section XI. This requires completing a QA approved training program with written and practical examinations.

This program has been developed in accordance with the preservice inspection requirements of the 1977 Edition of ASME Section XI through and including the Winter 1978 Addenda in order to provide a smooth transition from Preservice Inspection (PSI) to Inservice Inspection (ISI). In so doing, this program meets all the preservice visual examination and testing requirements of the 1974 Edition of ASME Section XI through the Summer 1975 Addenda.

Specific examination requirements and tests are outlined by Figure 1, "WNP-2 Plant Component Support Inspection Program", for each portion of the program. See Section 4.6 for a detailed explanation of Figure 1.

4.0 PROGRAM IMPLEMENTATION

The component support program is a large effort and one which involves many organizations. The program interfaces with construction hanger installation and as-building, the Test and Startup Program concerning system balancing, schedule and manpower, the Power Ascension Test Program concerning schedule, containment access and piping system expansion tests and with plant Technical Specification submittal. Since hangers and snubbers are usually among the last items to be completed on a system, the success of this program depends on adequate scheduling and coordination between the organizations and programs involved.

The appointed Program Manager is responsible for the overall scheduling, budgeting and implementing of this program. The Test and Startup Manager is the Program Manager for the pre-fuel load portion of the program and Plant Technical Manager is Program Manager for the post-fuel portion of the program.

4.1 Organizations Involved

The organizations involved and a breakdown of their responsibilities is as follows:

Test and Startup shall be responsible for:

- o organizing, scheduling, controlling and administering program component support examinations and tests in conjunction with the Test and Startup Program for piping support system balancing,
- o development of examination procedures for the initial cold exams and procedures for snubber stroking (if required),
- o for ensuring sufficient numbers of level I, II or III examiners are trained and certified for VT-3 (H) and VT-4(H) examinations,
- o dispositioning discrepancies found during the initial examination,
- o establishing the working document files.

The Plant Technical organization shall be responsible for:

- o organizing, scheduling, controlling and administering the component support examinations in conjunction with the Power Ascension Test Program and piping system expansion tests,
- o development of examination procedures for the hot examination and post-shakedown cold examinations,
- o dispositioning discrepancies found during these examinations,
- o providing examiners as required.

The Code Programs group shall be responsible for:

- o developing, revising, and coordinating implementation of the component support program,
- o reviewing examination procedures,
- o providing examiners as required,
- o coordinating the filing and retention of the component support examination documentation,
- o assist in dispositioning discrepancies as required,
- o assist in preparation of Section XI Repair Program which may be needed to disposition discrepancies.

The NDE&I organization shall be responsible for:

- o providing examiners as required,
- o assisting in training and certifying examiners as required.

The Supply System QA organization shall be responsible for:

- o reviewing and approving the VT-3, VT-4 training course,
- o certifying the visual examiners.

4.2 Pre-Fuel Load Examinations

Pre-fuel load component support-related activities are governed by Test and Startup procedures SLT-S303.0, "Visual Examination of Component Supports", and SLT-S305.0, "Adjustment and Balancing of Component Supports". The activities covered by these procedures may be conducted concurrently. SLT-S303.0 verifies that safety-related snubbers stroke properly either by stroking the snubber or by reviewing construction records which provide evidence of acceptable snubber stroking. SLT-S303.0 also directs and documents the initial cold condition VT-3 and VT-4 examination of ASME Code Class 1, 2 and 3 piping system hangers. Supports to be examined are listed in Tables 1 and 2. VT-4 examinations will be performed after the piping system supports are balanced. The hanger examinations will be conducted in accordance with SLT-S303.0 which incorporates the specific examination requirements outlined by Figure 1, "WNP-2 Plant Component Support Inspection Program". Cold load setting of snubbers and spring type hangers will be recorded. SLT-S303.0 data serves as a baseline information for subsequent examinations at elevated temperatures and for Inservice Inspection Programs. Discrepancies noted during the pre-fuel load exams will be dispositioned as part of the Test and Startup Program.

4.3 Post-Fuel Load Examinations

Post-fuel load component support examinations are governed by WNP-2 Plant Procedure, "Piping Systems Expansion and Vibration Tests", PPM 8.2.17. This procedure provides for hot and post-shakedown cold component support visual examinations in addition to recording and evaluating piping thermal movement and vibration. Visual component support exams are performed at an intermediate temperature (200-300°F), at normal operating temperature (~545°F) and at cold conditions after at least three full thermal cycles. The performance of these examinations requires personnel access to the drywell during portions of the Power Ascension Test Program. To minimize time required for the exams the examiners will be familiar with their assigned system(s). If the examiner has not performed the SLT-S303.0 exam on his assigned system(s), he/she will walk down the assigned system(s) in the cold condition prior to establishing primary containment integrity for initial reactor startup.

PPM 8.2.17 incorporates the specific examination requirements outlined by Figure 1. Since pipe whip restraints are checked at the same time that the support examinations are performed, PPM 8.2.17 also contains the visual inspection acceptance criteria for pipe whip restraints. Supports examined as part of SLT S303.0 that are on systems whose operating temperature is $\geq 250^{\circ}\text{F}$ and are accessible during reactor operation will be examined in accordance with PPM 8.2.17 in the hot and after shakedown cold condition. All supports listed in Tables 1 and 2 will be examined during the post shakedown cold examination to provide assurance that hangers remain operational following cyclic loading and are adequate for continued plant operation. Abnormalities found during these exams will be corrected per the routine Plant Operations and Maintenance procedures. The data collected during these exams provides baseline information for Inservice Inspection Programs.

4.4 Manpower Requirements

Manpower requirements for this program are significant in that numerous examiners are needed (approximately 30) and the examinations are performed during the tightly scheduled Test and Startup Program and Power Ascension Programs. It is beneficial to have as much Supply System personnel involvement performing these exams as possible since these are the people who will be involved in developing and performing the subsequent ISI examinations over the life of the plant. The examiners will be supplied from Test and Startup, Plant Technical, NDE&I and Code Programs. It is the responsibility of Test and Startup to ensure the examiners are trained and certified VT-3 and VT-4. It is intended that the same examiners will be used, to the extent possible, for performance of the pre-fuel load and the post-fuel load exams. A copy of each examiner's certification shall be kept with the program files.

The Program Manager (T/SU or Plant Technical as applicable) is responsible for ensuring that there are adequate numbers of examiners available when the examinations are scheduled to be performed.

4.5 Documentation Requirements

A Component Support Inspection working document file is to be initially established and maintained by the Test and Startup organization. When the SLT-S303.0 initial examinations are complete the working file will be transferred to Code Programs (ISI Engineering) who will maintain the file through completion of the program. The working file shall not be used to store completed original quality documents. Originals of quality documents when completed will be stored in appropriately controlled files in the Operations vault. A microfilm will be permanently kept in the Operations vault as the official record copy.

A summary of documents that comprise the Component Support Program is as follows:

<u>Document</u>	<u>When Document Becomes a Quality Affecting Record</u>
a. Copy of Snubber installation checklist	Filing of PSI Final Report with NRC.
b. Data Sheet SLT S303.0	Filing of PSI Final Report with NRC
c. Data Sheet PPM 8.2.17	Filing of PSI Final Report with NRC
d. Additional calculation and deficiency sheets	Filing of PSI Final Report with NRC
e. Copy of Personnel Qualification sheets	Filing of PSI Final Report with NRC

NOTE: Supply System ANI(I) review is required for the data sheets within SLT-S303.0, PPM 8.2.17 and also for ASME Code related deficiency resolution records.

4.6 Program Outline

Figure (1) is a flowchart representation of the WNP-2 Component Support Inspection and Testing Program. The following explanation describes the installation, testing and examination requirements:

SNUBBER INSTALLATION (Block 1)

The stroking of snubbers installed on safety-related systems (QC-I snubbers) satisfies the requirement of reference (e) to ensure the snubbers are not seized, frozen or jammed. The intent of the requirement is for stroking to be performed within a short time frame (6 months) prior to fuel load. The WNP-2 startup schedule currently supports this. The snubber stroking is documented by the Bechtel Snubber Installation Checklist, a copy of which becomes part of the program documentation. A snubber may also be stroked as part of the visual preservice cold exam (block 3) when the snubber appears to be damaged.

HANGER AS-BUILDING (Block 2)

The construction as-building of QC-1 snubber installations meets requirements of reference (e) to check that snubber location, orientation, position setting and configuration are according to design drawings and specifications, and to ensure structural connections such as pins, fasteners and other connecting hardware are installed correctly. These as-built drawings become part of the program documentation.

VISUAL PRE-SERVICE (COLD) EXAMS (Block 3)

Preheatup visual exams are conducted by personnel qualified to VT-3 and VT-4, level II or level III. Specific items to be emphasized during these exams are denoted on Figure (1). Additionally, for snubbers, the requirements of reference (e) to visually check for "no visible damage" and "adequate swing clearance" are met. Recording cold settings of snubbers and spring hangers and checking these settings against design drawings satisfies the commitment of reference (b) to ensure Reactor Coolant Pressure Boundary (RCPB) and connected systems hanger elements are correctly adjusted to cold setting and is one step in meeting the requirements of reference (a) to verify support settings of constant and variable type spring hangers and snubbers.

INTERMEDIATE TEMPERATURE (30 PSI) VISUAL EXAMS (Block 4)

Since a BWR has no hot pre-operational test program, visual exams of snubbers during initial system heatup provide one datum point of three in meeting the requirements of reference (e) to verify (1) expected snubber thermal movement and (2) snubber swing clearance at "specified temperature intervals" during the initial system heatup part of the pre-operational test program.

Additionally, this intermediate temperature data for selected component supports provides one datum point in meeting the requirement of reference (c) to verify that piping systems are free and unrestrained in regard to thermal expansion.

HOT (1000 PSI) VISUAL EXAMS (Block 5)

Visual exams of selected component supports at operating temperature provide a second datum point in meeting requirements of references (e) and (c) as previously described. Additionally, recording and evaluating hot snubber and spring hanger settings is a second step in meeting the requirement of reference (a) to verify support settings of constant and variable type spring hangers and snubbers.

For systems that do not reach operating temperature (none are identified at this time) snubber movement must be verified by calculation and/or visual observation as a check that snubber has satisfactory swing clearance and stroke to accommodate expected thermal movement.

The documentation for the intermediate and hot examinations are the PPM data sheets. Additional sheets documenting hanger problems and their resolution and to document calculation/observations to verify snubber accommodation for systems inaccessible at operating temperature will be resolved in PPM 8.2.17.

COLD SHUTDOWN VISUAL EXAM FOLLOWING PLANT SHUTDOWN (Block 6)

The visual exam following plant shutdown ensures the continued integrity of the piping system supports. This exam provides the final datum point and data whose evaluation fulfills the requirements of (1) reference (a) to verify spring hanger and snubber settings, (2) reference (c) to verify piping systems free and unrestrained in regards to thermal expansion and suspension components are functioning in the specified manner, and (3) reference (f) for verifying snubber expected thermal movement and snubber swing clearances. The criteria for evaluating the performance of the selected component supports against these requirements will be contained within PPM 8.2.17.

4.7 Program Schedule


The schedule for component support examinations and testing is dependent on plant startup schedule and fuel load date. Key issues in the program schedule are 1) all initial cold exams should be complete by fuel load and 2) intermediate and operating temperature hot exams are required to be performed during initial plant heatup. The specific implementing schedule for this program is the responsibility of the Program Manager. Figure 2 is a rough schedule for specific program issues keyed on fuel load date for WNP-2.

5.0 REFERENCES

- a) ASME Section XI (1974 Edition through Summer 1975 Addenda).
- b) WNP-2 FSAR Section 5.4.14.4 (Amend. 0).
- c) WNP-2 FSAR Section 14.2.12.3.17 (Amend. 25).
- d) WNP-2 SCN-80-155 Response dated November 9, 1982.
- e) Letter, R. L. Tedesco (NRC) to R. L. Ferguson, dated March 6, 1982.
- f) Letter, J. W. Shannon (WPPSS) to R. L. Tedesco, dated September 24, 1982.

6.0 ATTACHMENTS

- 6.1 Figure 1 - WNP-2 Component Support Inspection and Test Program Outline.
- 6.2 Figure 2 - WNP-2 Component Support Inspection and Test Program Schedule.
- 6.3 Appendix A - Basis for WNP-2 Component Support Inspection and Test Program.
- 6.4 WNP-2 Response to I. E. Bulletin 79-14 "Seismic Analysis for As-Built Safety-Related Piping Systems"
- 6.5 Table 1 - List of Component Supports Within PSI Boundaries.
- 6.6 Table 2 - List of Safety Related Snubbers Outside PSI Boundaries.

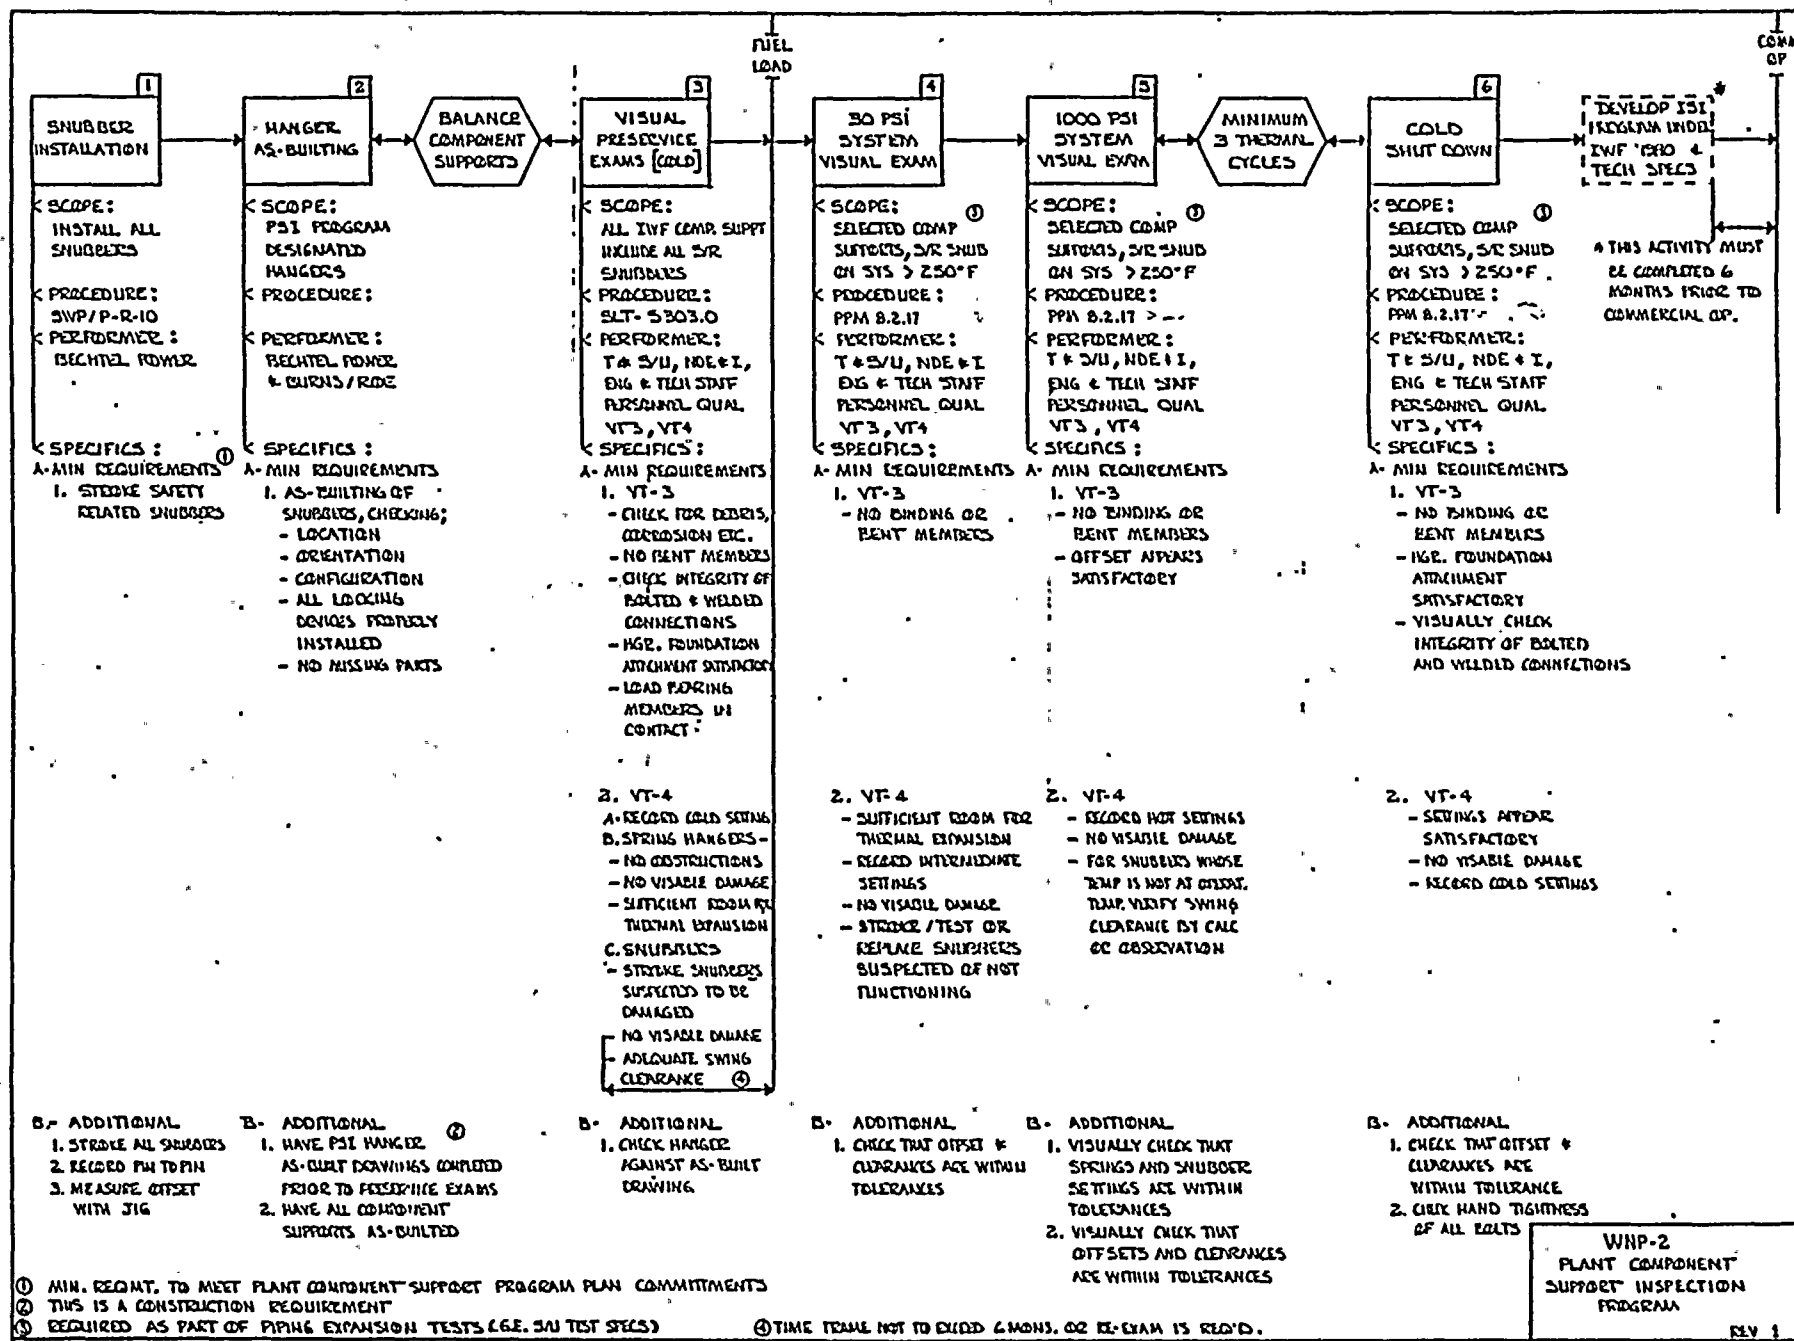

1
SNUBBER
INSTALLATION

SCOPE:
INSTALL ALL
SNUBBERS
PROCEDURE:
SWP/P-R-10
PERFORMER:
BECHTEL POWER

SPECIFICS:
A- MIN REQUIREMENTS
1. STRIKE SAFETY
RELATED SNUBBERS

B- ADDITIONAL
1. STRIKE ALL SNUBBERS
2. RECORD PIV TO PIN
3. MEASURE OFFSET
WITH JIG

2
HANGER
AS-BUILDING

SCOPE:
PSI PROGRAM
DESIGNATED
HANGERS
PROCEDURE:
PERFORMER:
BECHTEL POWER
& CURNS/RDE

SPECIFICS:
A- MIN REQUIREMENTS
1. AS-BUILDING OF
SNUBBERS, CHECKING;
- LOCATION
- ORIENTATION
- CONFIGURATION
- ALL LOCKING
DEVICES PROPERLY
INSTALLED
- NO MISSING PARTS

B- ADDITIONAL
1. HAVE PSI HANGER
AS-BUILT DRAWINGS COMPLETED
PRIOR TO PERSERVICE EXAMS
2. HAVE ALL COMPONENT
SUPPORTS AS-BUILT

BALANCE
COMPONENT
SUPPORTS

3
VISUAL
PRESERVICE
EXAMS (COLD)

SCOPE:
ALL IWF COMP SUPPT
INCLUDE ALL SVR
SNUBBERS
PROCEDURE:
SLT- 5303.0
PERFORMER:
T & S/U, NDE & I,
ENG & TECH STAFF
PERSONNEL QUAL
VT3, VT4

SPECIFICS:
A- MIN REQUIREMENTS
1. VT-3
- CHECK FOR DEBRIS,
CORROSION ETC.
- NO BENT MEMBERS
- CHECK INTEGRITY OF
BOLTED & WELDED
CONNECTIONS
- HGR. FOUNDATION
ATTACHMENT SATISFACTORY
- LOAD FLOORING
MEMBERS IN
CONTACT

2. VT-4
A- RECORDED COLD SETTINGS
B. SPRING HANGERS -
- NO OBSTRUCTIONS
- NO VISIBLE DAMAGE
- SUFFICIENT ROOM FOR
THERMAL EXPANSION
C. SNUBBERS
- STRIKE SNUBBERS
SUSPECTED TO BE
DAMAGED
- NO VISIBLE DAMAGE
- ADEQUATE SWING
CLEARANCE ④

B- ADDITIONAL
1. CHECK HANGER
AGAINST AS-BUILT
DRAWING

FUEL
LOAD

4
30 PSI
SYSTEM
VISUAL EXAM

SCOPE:
SELECTED COMP
SUPPORTS, SVR SHUD
ON SYS > 250°F
PROCEDURE:
PPM 8.2.17
PERFORMER:
T & S/U, NDE & I,
ENG & TECH STAFF
PERSONNEL QUAL
VT3, VT4

SPECIFICS:
A- MIN REQUIREMENTS
1. VT-3
- NO BENDING OR
BENT MEMBERS

2. VT-4
- SUFFICIENT ROOM FOR
THERMAL EXPANSION
- RECORDED INTERMEDIATE
SETTINGS
- NO VISIBLE DAMAGE
- STRIKE /TEST OR
REPLACE SNUBBERS
SUSPECTED OF NOT
FUNCTIONING

B- ADDITIONAL
1. CHECK THAT OFFSET &
CLEARANCES ARE WITHIN
TOLERANCES

5
1000 PSI
SYSTEM
VISUAL EXAM

SCOPE:
SELECTED COMP
SUPPORTS, SVR SHUD
ON SYS > 250°F
PROCEDURE:
PPM 8.2.17
PERFORMER:
T & S/U, NDE & I,
ENG & TECH STAFF
PERSONNEL QUAL
VT3, VT4

SPECIFICS:
A- MIN REQUIREMENTS
1. VT-3
- NO BENDING OR
BENT MEMBERS
- OFFSET APPEARS
SATISFACTORY

2. VT-4
- RECORDED HOT SETTINGS
- NO VISIBLE DAMAGE
- FOR SNUBBERS WHOSE
TEMP IS NOT AT DESIGN
TEMP, VERIFY SWING
CLEARANCE BY CALL
OR OBSERVATION

B- ADDITIONAL
1. VISUALLY CHECK THAT
SPRINGS AND SNUBBER
SETTINGS ARE WITHIN
TOLERANCES
2. VISUALLY CHECK THAT
OFFSETS AND CLEARANCES
ARE WITHIN TOLERANCES

MINIMUM
3 THERMAL
CYCLES

6
COLD
SHUT DOWN

SCOPE:
SELECTED COMP
SUPPORTS, SVR SHUD
ON SYS > 250°F
PROCEDURE:
PPM 8.2.17
PERFORMER:
T & S/U, NDE & I,
ENG & TECH STAFF
PERSONNEL QUAL
VT3, VT4

SPECIFICS:
A- MIN REQUIREMENTS
1. VT-3
- NO BENDING OR
BENT MEMBERS
- HGR. FOUNDATION
ATTACHMENT
SATISFACTORY
- VISUALLY CHECK
INTEGRITY OF BOLTED
AND WELDED CONNECTIONS

2. VT-4
- SETTINGS APPEAR
SATISFACTORY
- NO VISIBLE DAMAGE
- RECORDED COLD SETTINGS

B- ADDITIONAL
1. CHECK THAT OFFSET &
CLEARANCES ARE
WITHIN TOLERANCE
2. CHECK HAND TIGHTNESS
OF ALL BOLTS

DEVELOP ISI
PROGRAM UNDER
IWF INFO &
TECH SPECS

THIS ACTIVITY MUST
BE COMPLETED 6
MONTHS PRIOR TO
COMMERCIAL OP.

WNP-2
PLANT COMPONENT
SUPPORT INSPECTION
PROGRAM

REV 1

① MIN. REQMT. TO MEET PLANT COMPONENT SUPPORT PROGRAM PLAN COMMITMENTS
② THIS IS A CONSTRUCTION REQUIREMENT
③ REQUIRED AS PART OF PIPING EXPANSION TESTS (E.G. SAU TEST SPECS)

④ TIME FRAME NOT TO EXCEED 6MONS. OR RE-EXAM IS REQ'D.

WNP-2 COMPONENT SUPPORT INSPECTION AND TEST PROGRAM SCHEDULE

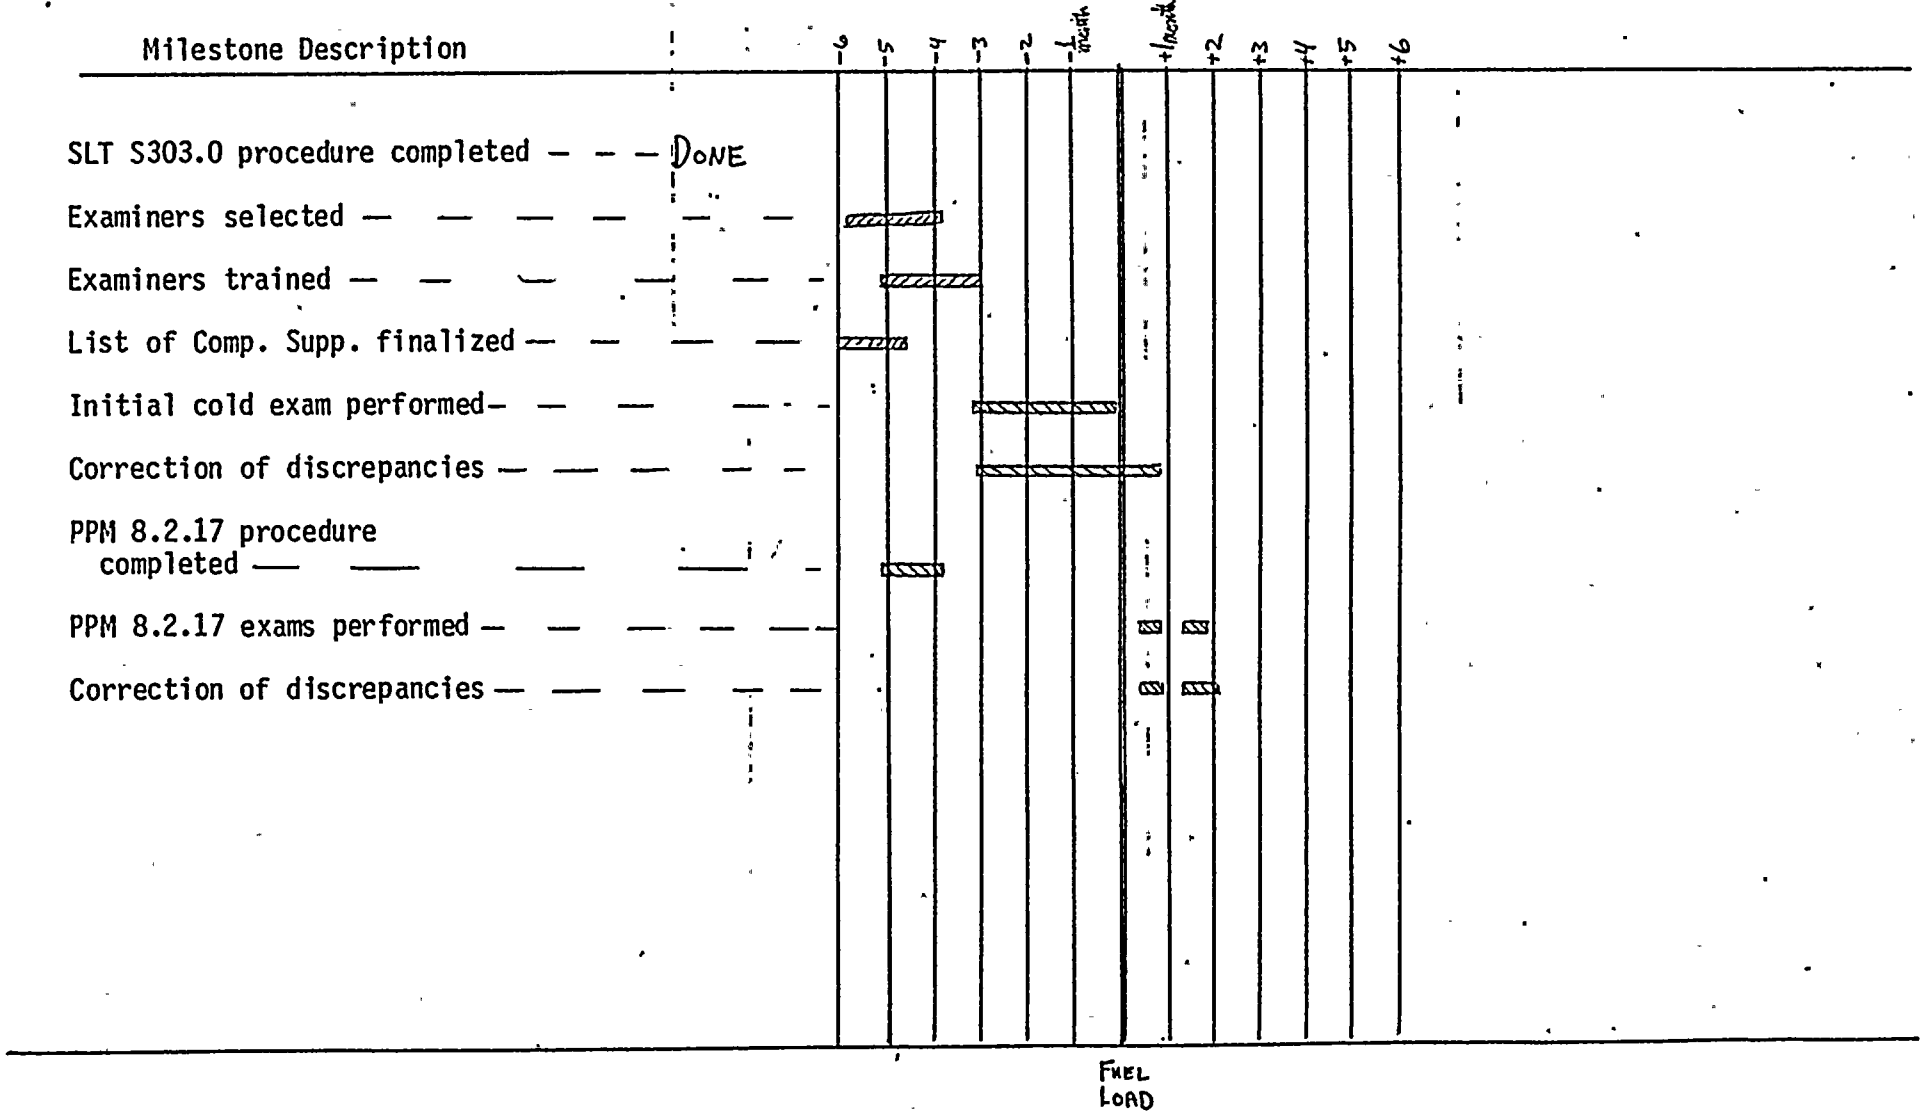


Figure 2
Attachment 6.2

Appendix A

Basis for WNP-2 Component Support Inspection and Test Program

A1.0 Background

Component support examination and testing requirements come from several different sources. In an attempt to satisfy all of these requirements with minimum impact on plant Startup and the Power Ascension Test Program, all of the pre-commercial operation examination and testing requirements have been brought together to form this appendix. Each specific requirement of each reference source is stated and given a commitment number. In several cases separate references contain the same commitment, these situations have been annotated in Table 1 which shows which implementing procedure satisfies a particular requirement.

There are four primary sources that make up the basis for this Program. They are:

- 1) ASME Section XI (1974 Edition through Summer 1975 Addenda) gives preservice examination requirements for component supports, additionally subsection IWF (Winter 1978) provides guidance which can be used for more detailed interpretations of how the visual exams are performed, i.e., component support examination boundaries.
- 2) The WNP-2 Preservice Inspection Program Plan states applicable ASME Section XI Edition and Addenda and defines the Visual Examinations (VT) used for the examination of Component Supports. The WNP-2 PSI Program Plan clarifies and implements the requirement of ASME Section XI (see 1) above).
- 3) The WNP-2 FSAR contains specific commitments on component support inspections.
- 4) Additional WNP-2 licensing commitments have been made in response to the Tedesco (NRC) letter (reference (g)) and to NRC licensing questions. These commitments are primarily concerned with snubbers.

A2.0 COMPONENT SUPPORT INSPECTION PROGRAM SPECIFIC COMMITMENTS

A2.1 ASME Section XI (1974 Edition through Summer 1975)

IWB-2100 requires all exams of Table IWB-2500 to be done as a Pre-service exam requirement, prior to Plant Startup.

Commitment
Number

- 2.1-1 B-K-2 requires all component supports to be examined,
- 2.1-2 B-K-2 requires settings of spring hangers and snubbers to be verified.

IWC-2100 Table IWC-2500--C-E-2 same requirements as IWB.

"Prior to Plant Startup" infers that system hot functional testing will be performed allowing the verification of hot system component support settings prior to Plant Start-up. Since this is not the case with WNP-2 (being a BWR) the verification of hot settings of component supports must be performed during initial plant heatup.

"All component supports" is interpreted to be all component supports in piping systems requiring PSI within the PSI boundaries. Vessel, pump, heat exchanger and valve supports as well as piping supports are included.

NOTE: IWB-1220, IWC-1220, and IWD-2600 specifically exclude from examination some component supports which receive preservice visual exams. These supports will not be examined.

A2.2 WNP-2 PSI PROGRAM COMMITMENTS

Commitment
Number

- 2.2-1 Perform pre-heat up VT-3 and VT-4 visual examinations of all IWF supports.
- 2.2-2 Perform post-heat up VT-3 and VT-4 visual examinations of all IWF supports.
- 2.2-3 Hot settings will be verified.
- 2.2-4 Examiners qualified to Supply System written practices for VT-3 and VT-4.

A2.3 FSAR COMMITMENTS

A2.3.1 FSAR Section 5.4.14.4 (RCPB and Connected Systems) commits to:

Commitment
Number

- 2.3-1 Following installation visually inspect all hanger elements to ensure correctly adjusted to cold setting.
- 2.3-2 Upon system heat up observe thermal growth to ensure spring hangers properly function between hot and cold settings.

A2.3.2 FSAR Section 14.2.12.3.17 (System Expansion Test) commits to:

Commitment
Number

- 2.3-3 Hanger position of major equipment and piping in the nuclear steam supply system and auxiliary systems will be recorded during initial thermal cycle and after shakedown has taken place.
- 2.3-4 During initial plant heat up conduct visual exams of component supports at intermediate and rated plant temperature.
- 2.3-5 For all snubbers on safety related system 250°F operating temperature, verify thermal movement and swing clearance at specified temperature intervals during initial system heatup and cold after system shakedown.
- 2.3-6 Visual examiners will be qualified to ASME Section XI VT-3 and VT-4, level II or level III (same requirement as 2.2-4).
- 2.3-7 For systems which are inaccessible at normal operating temperature, verify snubbers can accommodate thermal expansion by alternate method.

A2.4 TEDESCO (NRC) LETTER (e) AND RESPONSE (f)

Commits to all requirements outlined in Tedesco letter

Commitment
Number

Preservice Exam:

- 2.4-1 - to be performed on all snubbers in Tech Spec Table, following installation

Attachment 6.3
Page 3 of 4

Commitment
Number

- 2.4-2 *- Visual exam--no damage
 - 2.4-3 - Installed in accordance with design drawings
 - 2.4-4 - Not seized or frozen (stroke snubber)
 - 2.4-5 *- Adequate swing clearance
 - 2.4-6 - Pins, washers, etc. properly installed
- * Reinspect if not performed within 6 months prior to initial system pre-operational tests.

Preoperational Testing:

- 2.4-7 - To be performed on all snubbers on safety-related systems whose operating temperature is 250°F or greater.
- 2.4-8 - Inspect during initial system heatup and cooldown at specified temperature to verify expected snubber thermal movement and snubber swing clearance.
- 2.4-9 - For systems that do not attain operating temperature verify above by observation and/or calculation. This requirement is interpreted to mean in the case of WNP-2 that safety-related snubbers that are not accessible for visual inspection at normal operating temperature, snubber swing clearance will be verified by an alternate method.

Additionally, our response commits to detailing snubber pre-operational testing requirements in Chapter 14 of the FSAR and this was accomplished by SCN 80-155.

Table 1 Listing of Implementing Procedures That Satisfy Specific Commitments

Commitment Number	SLT-S303.0	PPM-8:2.17	Bechtel As-Building Program	SWP/P-R-10	Appropriate Block of Flow Diagram (Figure 1)
2.1-1	X				Block 3 - Scope 3.A.2.A, 5.A.2 and 6.A.2
2.1-2	1/3	2/3, 3/3			
2.2-1	X				3.A.1 and 3.A.2 Block 6 5.A.2 Blocks 3, 4, 5, 6
2.2-2		X			
2.2-3		X			
2.2-4	X	X			
2.3-1	X				3.A.2A 4.A.2 plus 5.A.2 4.A.2, 5.H.2 plus 6.A.2
2.3-2		X			
2.3-3		X			
2.3-4		X			4.A.1, 4.A.2, 5.A.1, 5.A.2 4.A.2, 5.A.2, 6.A.2 5.A.2
2.3-5		X			
2.3-6	Same as 2.2-4				
2.3-7		X			
2.4-1	X				
2.4-2	X				Block 3 - Scope 3.A.2.C 2.A.1
2.4-3			X		
2.4-4				X	1.A 3.A.2.C 2.A.1
2.4-5	X				
2.4-6			X		
2.4-7		X			Block 4 - Scope
2.4-8	Same as 2.3-5				
2.4-9	Same as 2.3-7				

X = requirement completely satisfied by referenced procedure.
1/3 = step part 1 of 3 met by referenced procedure.

Appendix A Table 1

WNP-2 Response to I.E. Bulletin 79-14
"Seismic Analysis for As-Built Safety-Related Piping Systems"

WNP-2 response to this Bulletin is contained in letters G02-79-156, D. L. Renberger to R. H. Engelken, dated September 7, 1979 and G02-82-858, R. G. Matlock to R. H. Engelken, dated October 20, 1982. These letters briefly outline WNP-2 as-builting and component support calculation reconciliation process. Component Support as-builting is performed by Bechtel field engineers and this as-built data is then provided to the designers (BRI, GE, JCI and Teledyne) and the component support design calculations are reconciled with the as-built data.

Additionally in the WNP-2 Reverification Program Supply System Engineering Mechanics engineers are verifying the above process for a random sampling of component supports.

Attachment 6.4

NOTES TO TABLES 1 AND 2

<u>EXAM</u>	<u>EXPLANATION OF EXAM AND NOTES</u>
1	Initial Cold Preservice Examination
4	Initial Cold Preservice Examination, Intermediate Temperature Examination, Full Temperature Hot Examination and Final Cold (Shakedown) Examination.
1.4.M	<p>Initial Cold Preservice Examination and Final Cold Examinations only.</p> <p>This is an exception used on a case by case basis as follows:</p> <ol style="list-style-type: none">(1) Main Steam Relief Valve Discharge lines in the drywell. An intermediate temperature exam is not applicable since these lines do not heat up slowly. A hot exam will not be done since MSR/V piping is only heated up during valve actuation which represents a potential personnel hazard.(2) Lines in which there is no flow and are not expected to heat up to the same temperature as the main line. This exam is applied to the portion of the branch line connected directly to and within 5 pipe diameters of the main line.(3) Reactor Feedwater lines in the steam tunnel. These lines do not reach operating temperature until high power levels are achieved at which time these lines are inaccessible due to high radiation levels. These lines are directly adjacent to the main steam lines.
N1	Initial Cold Preservice Examination only. This note applies to the RCIC/RHR Steam Condensing mode of RHR which is installed but which has been deactivated at WNP-2 and will not be used.
N2	Reactor Feedwater System inside the drywell. This system will be checked when the <u>reactor</u> vessel is at intermediate and at rated conditions to <u>ensure</u> this piping follows vessel growth. This <u>system</u> cannot be checked at intermediate and hot conditions since the drywell is inaccessible during power operation. The feedwater drywell piping is instrumented with lanyard potentiometers and this piping will be evaluated at 25% and 100% reactor power.
N3	There will be no intermediate temperature examinations on the diesel generator exhaust system safety related snubbers. An intermediate temperature exam is not applicable since these lines do not heat up slowly.

N4

Not used.

N5

There will be no intermediate temperature exams on the RHR piping outside the drywell. When the RHR system is put into service, it comes up to temperature very quickly and then cools depending on plant cooling capacity requirements. There is not a controllable time frame available to walk down the piping for an intermediate temperature examination. Additionally, the concept of an intermediate inspection was adopted for Class I systems in the drywell due to the relatively large differential temperature and component support interference potential. These concerns are not valid for this portion of the RHR system.

N6

Hangers Annotated with N6 have a design temperature 250°F but are not expected to exceed 250°F during power ascension testing or operation. A cold PSI exam has been done on all hangers so annotated. Some examples are:

- o RHR connection to SW
- o Standby Gas Treatment
- o RHR to FPC intertie
- o Class I LPCS and RHR/LPCI between the drywell and the Class 1/2 interface valve. (outside containment)
- o Class II RHR Full Flow Test Line to the suppression pool
- o Class I RCIC (injection) outside containment
- o RHR Pump minflow line

N7

An intermediate temperature examination is not performed on RWCU piping outside the drywell. The system does not have provisions for controlling heatup or cooldown such that a time frame exists for a system walkdown. The shakedown examination will adequately verify support system performance. It should also be noted that most of this system is non-safety related.

A

Component Support examinations can be included in Primary System heatup.

B

Component Support examinations must be done when individual system is heated up.

TABLE 1 -- COMPONENT SUPPORTS WITHIN PSI BOUNDARIES -- 21 JAN 1985

EQUIP PIECE NO	DESCRIPTION	ISOMETRIC DWG NO	ISO DWG NO	EXAMS
*****	*****	*****	*****	*****
FPC-10	BOX	FPC 778-4.6	308	1
FPC-100	BOX	FPC 638-4.7	307	1
FPC-101	RIGID	FPC 604-7.9	301	1
FPC-102	RIGID	FPC 636-16.21	304	1
FPC-103	RIGID	FPC 636-16.21	304	1
FPC-104	RIGID	FPC 636-16.21	304	1
FPC-105	RIGID	FPC 636-16.21	304	1
FPC-106	RIGID	FPC 636-16.21	304	1
FPC-107	RIGID	FPC 636-16.21	304	1
FPC-108	RIGID	FPC 636-16.21	304	1
FPC-109	RIGID	FPC 636-16.21	304	1
FPC-11	BOX	FPC 778-4.6	308	1
FPC-111	BOX	FPC 636-22.24	304	1
FPC-112	U-BOLT	FPC 636-22.24	304	1
FPC-113	BOX	FPC 636-25.26	304	1
FPC-114	OTHER	FPC 636-25.26	304	1
FPC-116	OTHER	FPC 636-27.28	304	1
FPC-118	RIGID	FPC 639-3.5	306	1
FPC-119	SPRING	FPC 639-3.5	306	1
FPC-12	ROD	FPC 778-4.6	308	1
FPC-120	BOX	FPC 639-3.5	306	1
FPC-122	ANCHOR	FPC 639-1.2	306	1
FPC-123	BOX	FPC 639-1.2	306	1
FPC-126	STRUT	FPC 639-1.2	306	1
FPC-127	BOX	FPC 608-1.4	301	1
FPC-128	BOX	FPC 608-1.4	301	1
FPC-129	BOX	FPC 608-1.4	301	1
FPC-13	BOX	FPC 778-4.6	308	1
FPC-130	BOX	FPC 608-1.4	301	1
FPC-14	ROD	FPC 778-4.6	308	1
FPC-15	OTHER	FPC 778-10.13	308	1
FPC-158	BOX	FPC 669-1.7	305	1
FPC-159	BOX	FPC 669-1.7	305	1
FPC-16	OTHER	FPC 778-10.13	308	1
FPC-160	OTHER	FPC 640-1.6	305	1
FPC-161	BOX	FPC 640-1.6	305	1
FPC-162	BOX	FPC 640-1.6	305	1
FPC-163	BOX	FPC 640-1.6	305	1
FPC-164	BOX	FPC 640-1.6	305	1
FPC-165	BOX	FPC 640-7.9	305	1
FPC-166	BOX	FPC 640-7.9	305	1
FPC-167	BOX	FPC 640-7.9	305	1
FPC-168	BOX	FPC 640-7.9	305	1
FPC-17	ROD	FPC 778-10.13	308	1
FPC-170	BOX	FPC 640-10.12	201	1
FPC-172	BOX	FPC 640-10.12	201	1
FPC-177	SPRING	FPC 636-8.9	302	1
FPC-178	BOX	FPC 636-8.9	302	1
FPC-179	BOX	FPC 636-4.5	302	1

TABLE 1 -- COMPONENT SUPPORTS WITHIN PSI BOUNDARIES -- 21 JAN 1985

EQUIP PIECE NO	DESCRIPTION	ISOMETRIC DWG NO	ISO DWG NO	EXAMS
*****	*****	*****	*****	*****
FPC-18	SPRING	FPC 778-10.13	308	1
FPC-180	BOX	FPC 636-4.5	302	1
FPC-181	BOX	FPC 636-4.5	302	1
FPC-182	BOX	FPC 636-1.3	302	1
FPC-184	SPRING	FPC 636-1.3	302	1
FPC-185	BOX	FPC 636-6.7	302	1
FPC-186	SPRING	FPC 636-6.7	302	1
FPC-187	BOX	FPC 637-5.7	303	1
FPC-188	BOX	FPC 637-5.7	303	1
FPC-189	SPRING	FPC 637-10.11	303	1
FPC-19	BOX	FPC 778-7.9	308	1
FPC-190	SPRING	FPC 637-8.9	302	1
FPC-191	BOX	FPC 637-1.4	303	1
FPC-192	BOX	FPC 637-1.4	303	1
FPC-193	SPRING	FPC 637-1.4	303	1
FPC-194	BOX	FPC 636-10.13	304	1
FPC-195	BOX	FPC 636-10.13	304	1
FPC-196	BOX	FPC 636-10.13	304	1
FPC-197	BOX	FPC 636-10.13	304	1
FPC-198	BOX	FPC 636-10.13	304	1
FPC-199	BOX	FPC 636-10.13	304	1
FPC-20	ROD	FPC 778-7.9	308	1
FPC-200	BOX	FPC 636-14.15	304	1
FPC-201	BOX	FPC 640-1.6	305	1
FPC-202	BOX	FPC 636-14.15	304	1
FPC-203	BOX	FPC 636-14.15	304	1
FPC-204	BOX	FPC 636-14.15	304	1
FPC-205	RIGID	FPC 636-14.15	304	1
FPC-206	BOX	FPC 640-7.9	305	1
FPC-207	BOX	FPC 637-1.4	303	1
FPC-208	BOX	FPC 636-1.3	302	1
FPC-209	BOX	FPC 671-1.4	305	1
FPC-21	ROD	FPC 778-7.9	308	1
FPC-210	BOX	FPC 671-1.4	305	1
FPC-211	STRUT	FPC 670-1.2	305	1
FPC-213	BOX	FPC 670-1.2	305	1
FPC-214	BOX	FPC 670-3.6	305	1
FPC-215	BOX	FPC 670-3.6	305	1
FPC-216	BOX	FPC 670-3.6	305	1
FPC-22	SPRING	FPC 778-7.9	308	1
FPC-223	ANCHOR	FPC 671-1.4	305	1
FPC-224	BOX	FPC 671-1.4	305	1
FPC-225	PSA-1 SN	FPC 671-1.4	305	1
FPC-226	SPRING	FPC 671-1.4	305	1
FPC-227	PSA-1 SN	FPC 671-1.4	305	1
FPC-228	PSA-1/2 SN(2)	FPC 671-1.4	305	1
FPC-229	PSA-3 SN	FPC 671-1.4	305	1
FPC-230	SPRING	FPC 671-1.4	305	1
FPC-231	BOX	FPC 670-1.2	305	1

TABLE 1 -- COMPONENT SUPPORTS WITHIN PSI BOUNDARIES -- 21 JAN 1985

EQUIP-PIECE NO	DESCRIPTION	ISOMETRIC DWG NO	ISO DWG NO	EXAMS
*****	*****	*****	*****	*****
FPC-237	BOX	FPC 640-10.12	201	1
FPC-238	BOX	FPC 640-10.12	201	1
FPC-239	BOX	FPC 640-10.12	201	1
FPC-240	BOX	FPC 670-3.6	305	1
FPC-243	BOX	FPC 670-12.16	305	1
FPC-244	BOX	FPC 670-12.16	305	1
FPC-245	BOX	FPC 670-12.16	305	1
FPC-246	OTHER	FPC 670-7.11	305	1
FPC-247	BOX	FPC 670-7.11	305	1
FPC-248	OTHER	FPC 670-7.11	305	1
FPC-39	SPRING	FPC 605-10.12	301	1
FPC-40	STRUT	FPC 605-10.12	301	1
FPC-41	SPRING	FPC 605-10.12	301	1
FPC-42	STRUT	FPC 605-10.12	301	1
FPC-43	PSA-1 SN	FPC 605-10.12	301	1
FPC-44	ANCHOR	FPC 605-5.9	301	1
FPC-45	BOX	FPC 638-1.3	307	1
FPC-47	BOX	FPC 638-4.7	307	1
FPC-48	BOX	FPC 638-4.7	307	1
FPC-49	BOX	FPC 638-4.7	307	1
FPC-5	SPRING	FPC 778-1.3	308	1
FPC-50	BOX	FPC 638-4.7	307	1
FPC-51	BOX	FPC 604-1.3	301	1
FPC-52	BOX	FPC 604-1.3	301	1
FPC-53	BOX	FPC 604-1.3	301	1
FPC-54	BOX	FPC 604-4.6	301	1
FPC-55	BOX	FPC 604-4.6	301	1
FPC-56	BOX	FPC 604-4.6	301	1
FPC-57	BOX	FPC 605-1.4	301	1
FPC-58	BOX	FPC 605-1.4	301	1
FPC-59	BOX	FPC 605-1.4	301	1
FPC-6	ROD	FPC 778-1.3	308	1
FPC-60	BOX	FPC 605-1.4	301	1
FPC-61	SPRING	FPC 605-5.9	301	1
FPC-62	BOX	FPC 605-5.9	301	1
FPC-63	BOX	FPC 605-5.9	301	1
FPC-64	BOX	FPC 605-5.9	301	1
FPC-65	PSA-1 SN	FPC 604-7.9	301	1
FPC-66	OTHER	FPC 640-13.16	305	1
FPC-67	RIGID	FPC 640-17.19	305	1
FPC-68	RIGID	FPC 640-17.19	305	1
FPC-69	RIGID	FPC 640-17.19	305	1
FPC-7	OTHER	FPC 778-1.3	308	1
FPC-70	RIGID	FPC 640-17.19	305	1
FPC-71	BOX	FPC 640-17.19	305	1
FPC-72	OTHER	FPC 640-17.19	305	1
FPC-73	BOX	FPC 640-17.19	305	1
FPC-74	OTHER	FPC 640-17.19	305	1
FPC-75	OTHER	FPC 640-17.19	305	1

TABLE 1 -- COMPONENT SUPPORTS WITHIN PSI BOUNDARIES -- 21 JAN 1985

EQUIP PIECE NO	DESCRIPTION	ISOMETRIC DWG NO	ISO DWG NO	EXAMS
*****	*****	*****	*****	*****
FPC-76	BOX	FPC 640-17.19	305	1
FPC-77	OTHER	FPC 640-17.19	305	1
FPC-78	BOX	FPC 640-20.23	305	1
FPC-79	OTHER	FPC 640-20.23	305	1
FPC-8	ROD	FPC 778-4.6	308	1
FPC-82	OTHER	FPC 640-24.25	305	1
FPC-83	OTHER	FPC 640-24.25	305	1
FPC-86	SPRING	FPC 604-10.12	301	1
FPC-87	SPRING	FPC 604-14.17	301	1
FPC-88	STRUT	FPC 604-7.9	301	1
FPC-9	BOX	FPC 778-4.6	308	1
FPC-903N	ANCHOR	FPC 640-10.12	201	1
FPC-906N	BOX	FPC 636-14.15	304	1
FPC-907N	BOX	FPC 636-14.15	304	1
FPC-908N	PSA-1 SN(2)	FPC 605-10.12	301	1
FPC-909N	RIGID	FPC 605-10.12	301	1
FPC-91	U-BOLT	FPC 640-26.28	305	1
FPC-911N	BOX	FPC 640-7.9	305	1
FPC-912N	BOX	FPC 049-1.13	305	1
FPC-913N	BOX	FPC 049-1.13	305	1
FPC-915N			305	1
FPC-916N	SPRING	FPC 604-7.9	301	1
FPC-918N	PSA-1	FPC 604-7.9	301	1
FPC-919N	RIGID	FPC 605-1.4	301	1
FPC-92	OTHER	FPC 640-29.30	305	1
FPC-93	OTHER	FPC 640-26.28	305	1
FPC-98	OTHER	FPC 636-16.21	304	1
FPC-99	BOX	FPC 638-1.3	307	1
HPCS-1	SPRING	HPCS 630-1.4	202	1
HPCS-12	BOX	HPCS 632-1.3	202	1
HPCS-13	ANCHOR	HPCS 630-11.12	202	1
HPCS-15	ANCHOR	HPCS 630-11.12	202	1
HPCS-16	STRUT	HPCS 633-1.2	202	1
HPCS-17	STRUT	HPCS 633-1.2	202	1
HPCS-18	STRUT	HPCS 633-1.2	202	1
HPCS-20	ANCHOR	HPCS 630-7.10	202	1
HPCS-21	STRUT	HPCS 630-7.10	202	1
HPCS-23	SPRING	HPCS 630-7.10	202	1
HPCS-24	STRUT	HPCS 630-7.10	202	1
HPCS-25	SPRING	HPCS 630-13.19	202	1
HPCS-26	STRUT	HPCS 630-13.19	202	1
HPCS-27	STRUT	HPCS 630-13.19	202	1
HPCS-28	BOX	HPCS 630-13.19	202	1
HPCS-31	STRUT	HPCS 630-20.23	202	1
HPCS-32	SPRING	HPCS 630-20.23	202	1
HPCS-33	BOX	HPCS 630-20.23	202	1
HPCS-34	SPRING	HPCS 630-20.23	202	1
HPCS-35	SPRING	HPCS 630-20.23	202	1
HPCS-37	ANCHOR	HPCS 630-20.23	202	1

TABLE 1 -- COMPONENT SUPPORTS WITHIN PSI BOUNDARIES -- 21 JAN 1985

EQUIP PIECE NO	DESCRIPTION	ISOMETRIC DWG NO	ISO DWG NO	EXAMS
*****	*****	*****	*****	*****
HPCS-38	SPRING	HPCS 630-20.23	202	1
HPCS-40	STRUT	HPCS 630-24.25	202	1
HPCS-42	SPRING	HPCS 630-26.28	101.1	1
HPCS-44	SPRING	HPCS 633-1.2	202	1
HPCS-45	SPRING	HPCS 629-5.7	201	1
HPCS-46	SPRING	HPCS 629-5.7	201	1
HPCS-47	PSA-3 SN(2)	HPCS 629-5.7	201	1
HPCS-48	STRUT	HPCS 629-5.7	201	1
HPCS-49	STRUT	HPCS 629-5.7	201	1
HPCS-52	ANCHOR	HPCS 629-1.4	201	1
HPCS-63	PSA-10 SN(2)	HPCS 630-29.30	101.1	4
HPCS-64	BOX	HPCS 630-29.30	101.1	4
HPCS-66	C SPRING	HPCS 630-29.30	101.1	4
HPCS-7	ANCHOR	HPCS 632-1.3	202	1
HPCS-900N	STRUT	HPCS 629-1.4	201	1
HPCS-901N	BOX	HPCS 629-1.4	201	1
HPCS-903N	STRUT	HPCS 630-13.19	202	1
HPCS-904N	SPRING (2)	HPCS 630-29.30	101.1	4
HPCS-905N	PSA-10 SN	HPCS 630-24.25	202	1
HPCS-906N	SPRING	HPCS 630-29.30	101.1	4
HPCS-907N	STRUT	HPCS 630-26.28	101.1	4
HPCS-908N	STRUT	HPCS 630-26.28	101.1	4
HPCS-909N	STRUT	HPCS 630-13.19	202	1
HPCS-910N	PSA-3 SN(2)	HPCS 630-26.28	101.1	4
HPCS-911N	PSA-10 SN	HPCS 630-26.28	101.1	4
HPCS-912N	PSA-3 SN	HPCS 630-29.30	101.1	4
HPCS-915N	STRUT	HPCS 630-13.19	202	1
HPCS-916N	BOX	HPCS 630-20.23	202	1
HPCS-917N	STRUT	HPCS 630-13.19	202	1
HPCS-918N	PSA-10 SN	HPCS 630-31.33	101.1	4
HPCS-919N	PSA-10 SN	HPCS 630-31.33	101.1	4
HPCS-921N	STRUT	HPCS 632-1.3	202	1
HPCS-922N	STRUT	HPCS 632-1.3	202	1
HPCS-924N	PSA-3 SN(2)	HPCS 630-24.25	202	1
HPCS-925N	PSA-3 SN	HPCS 630-24.25	202	1
LPCS-1	OTHER	LPCS 758-3.5	201	1
LPCS-11	SPRING	LPCS 756-1.4	202	1
LPCS-12	BOX	LPCS 756-8.10	202	1
LPCS-13	SPRING	LPCS 756-19.21	101.1	N6
LPCS-14	ANCHOR	LPCS 756-8.10	202	1
LPCS-17	BOX	LPCS 756-8.10	202	1
LPCS-18	SPRING	LPCS 756-11.15	202	1
LPCS-19	ANCHOR	LPCS 756-11.15	202	1
LPCS-2	OTHER	LPCS 758-3.5	201	1
LPCS-20	STRUT	LPCS 756-11.15	202	1
LPCS-21	BOX	LPCS 756-11.15	202	1
LPCS-22	STRUT	LPCS 756-11.15	202	1
LPCS-23	SPRING	LPCS 756-11.15	202	1
LPCS-24	BOX	LPCS 756-11.15	202	1

TABLE 1 -- COMPONENT SUPPORTS WITHIN PSI BOUNDARIES -- 21 JAN 1985

EQUIP PIECE NO	DESCRIPTION	ISOMETRIC DWG NO	ISO DWG NO	EXAMS
*****	*****	*****	*****	*****
LPCS-25	SPRING	LPCS 756-11.15	202	1
LPCS-28	PSA-3 SN	LPCS 756-19.21	101.1	NE
LPCS-3	ANCHOR	LPCS 758-1.2	201	1
LPCS-31	BOX	LPCS 756-5.7	202	1
LPCS-38	BOX	LPCS 756-1.4	202	1
LPCS-39	BOX	LPCS 756-1.4	202	1
LPCS-41	STRUT	LPCS 756-11.15	202	1
LPCS-42	BOX	LPCS 756-11.15	202	1
LPCS-46	BOX	LPCS 756-5.7	202	1
LPCS-57	BOX	LPCS 756-22.24	101.0	4
LPCS-61	PSA-10 SN(2)	LPCS 756-22.24	101.0	4
LPCS-63	C SPRING (2)	LPCS 756-22.24	101.0	4
LPCS-64	SPRING	LPCS 756-22.24	101.0	4
LPCS-9	SPRING	LPCS 756-1.4	202	1
LPCS-900N	BOX	LPCS 758-1.2	201	1
LPCS-901N	ANCHOR	LPCS 759-1	202	1
LPCS-902N	SPRING	LPCS 758-3.5	201	1
LPCS-903N	ANCHOR	LPCS 756-11.15	202	1
LPCS-904N	STRUT	LPCS 756-19.21	101.0	4
LPCS-905N	PSA-3 SN	LPCS 756-22.24	101.0	4
LPCS-906N	SPRING	LPCS 756-22.24	101.0	4
LPCS-907N	STRUT	LPCS 756-19.21	101.0	4
LPCS-908N	PSA-10 SN	LPCS 756-19.21	101.0	4
LPCS-909N	PSA-3 SN(2)	LPCS 756-19.21	101.0	4
MS-100	STRUT	MS 528-7.10	201	4
MS-1000N	BOX	MS 530-4.6	203	4
MS-1001N	PSA-X SN	MS 530-4.6	203	4
MS-1002N	PSA-10 SN(2)	MS 530-4.6	203	4
MS-1003N	PSA-10 SN(2)	MS 530-1.3	203	4
MS-1005N	PSA-35 SN	MS 531-4.6	204	4
MS-1006N	PSA-3 SN(2)	MS 531-4.6	204	4
MS-1007N	PSA-10 SN(2)	MS 531-4.6	204	4
MS-1009N	RIGID	MS 531-4.6	204	4
MS-101	SPRING (2)	MS 528-4.6	201	4
MS-1010N	PSA-10 SN(2)	MS 531-4.6	204	4
MS-103	BOX	MS 528-4.6	201	4
MS-114	PSA-10 SN(2)	MS 528-4.6	201	4
MS-115	SPRING (2)	MS 528-4.6	201	4
MS-117	SPRING (2)	MS 528-4.6	201	4
MS-118	PSA-10 SN(2)	MS 528-4.6	201	4
MS-119	STRUT	MS 528-4.6	201	4
MS-120	SPRING (2)	MS 528-4.6	201	4
MS-121	SPRING (2)	MS 528-4.6	201	4
MS-123	STRUT	MS 528-4.6	201	4
MS-135	PSA-35 SN	MS 528-1.3	201	4
MS-1368-11	V SPRING	MS 1368-1	105.2	4, A
MS-1368-12	PSA-1/2 SN	MS 1368-1	106	4, A
MS-1368-13	PSA-1/2 SN	MS 1368-1	106	4, A
MS-1369-11	V SPRING	MS 1369-1	105.3	4, A

TABLE 1 -- COMPONENT SUPPORTS WITHIN PSI BOUNDARIES -- 21 JAN 1985

EQUIP PIECE NO	DESCRIPTION	ISOMETRIC DWG NO	ISO DWG NO	EXAMS
*****	*****	*****	*****	*****
MS-1369-12	PSA-1/2 SN	MS 1369-1	106	4, A
MS-1369-13	PSA-1/2 SN	MS 1369-1	106	4, A
MS-137	SPRING	MS 528-1.3	201	4
MS-139	SPRING	MS 528-7.10	201	4
MS-140	PSA-3 SN	MS 528-7.10	201	4
MS-141	SPRING	MS 530-11	203	4
MS-142	SPRING	MS 529-12	202	4
MS-144	SPRING	MS 529-12	202	4
MS-145	PSA-10 SN	MS 529-12	202	4
MS-146	SPRING (2)	MS 529-8.11	202	4
MS-147	PSA-10 SN(2)	MS 529-8.11	202	4
MS-148	PSA-10 SN	MS 529-8.11	202	4
MS-149	SPRING (2)	MS 529-8.11	202	4
MS-150	STRUT	MS 529-8.11	202	4
MS-151	PSA-3 SN(2)	MS 529-8.11	202	4
MS-152	SPRING (2)	MS 529-8.11	202	4
MS-154	RIGID	MS 529-8.11	202	4
MS-155	STRUT	MS 529-8.11	202	4
MS-157	STRUT	MS 529-4.7	202	4
MS-160	STRUT	MS 529-4.7	202	4
MS-162	PSA-10 SN(2)	MS 529-4.7	202	4
MS-163	SPRING (2)	MS 529-4.7	202	4
MS-167	PSA-10 SN(2)	MS 529-4.7	202	4
MS-168	STRUT	MS 529-4.7	202	4
MS-170	SPRING (2)	MS 529-4.7	202	4
MS-171	SPRING (2)	MS 529-4.7	202	4
MS-173	SPRING	MS 529-1.3	202	4
MS-174	PSA-35 SN	MS 529-1.3	202	4
MS-176	SPRING	MS 529-1.3	202	4
MS-177	PSA-35 SN(2)	MS 529-8.11	202	4
MS-178	SPRING	MS 529-8.11	202	4
MS-179	PSA-1 SN(2)	MS 529-8.11	202	4
MS-180	ROD	MS 534-1	205	4
MS-181	ROD	MS 534-1	205	4
MS-182	ROD	MS 534-1	205	4
MS-1C-1PS	STRUT	MS 582-1.2	105.2	4, A
MS-24	SPRING	MS 530-11	203	4
MS-26	STRUT	MS 530-7.10	203	4
MS-260	V SPRING	MS 582-1.2	105.1	4, A
MS-261	V SPRING	MS 582-1.2	105.1	4, A
MS-2619-13	PSA-1 SNQ1	MS 2619-1	106.1	4
MS-2619-14	PSA-1/2 SNQ1	MS 2619-1	106.1	4
MS-2619-15	PSA-3 SNQ1	MS 2619-1	106.1	4
MS-2619-16	PSA-3 SNQ1	MS 2619-1	106.1	4
MS-2619-17	V SPRING	MS 2619-1	106.1	4
MS-2619-21	PSA-1 SNQ1	MS 2619-2	106.2	4
MS-2619-210	PSA-1 SNQ1	MS 2619-2	106.2	4
MS-2619-211	V SPRING	MS 2619-2	106.2	4
MS-2619-212	V SPRING	MS 2619-2	106.3	4

TABLE 1 -- COMPONENT SUPPORTS WITHIN PSI BOUNDARIES -- 21 JAN 1985

EQUIP PIECE NO	DESCRIPTION	ISOMETRIC DWG NO	ISO DWG NO	EXAMS
*****	*****	*****	*****	*****
MS-2619-213	V SPRING	MS 2619-2	106.2	4
MS-2619-214	SPRING	MS 2619-2	106.2	4
MS-2619-22	RIGID	MS 2619-2	106.2	4
MS-2619-23	PSA-3 SNQ1	MS 2619-2	106.2	4
MS-2619-24	RIGID	MS 2619-2	106.2	4
MS-2619-26	PSA-1 SNQ1	MS 2619-2	106.2	4
MS-2619-310	PSA-1 SNQ1	MS 2619-3	106.3	4
MS-2619-311	PSA-1/2 SNQ1	MS 2619-3	106.3	4
MS-2619-312	PSA-1/2 SNQ1	MS 2619-3	106.3	4
MS-2619-313	PSA-1/2 SNQ1	MS 2619-3	106.3	4
MS-2619-314	PSA-1/4 SNQ1	MS 2619-3	106.3	4
MS-2619-315	V SPRING	MS 2619-2	106.3	4
MS-2619-316	PSA-1/4 SNQ1	MS 2619-3	106.3	4
MS-2619-317	PSA-1/4 SN	MS 2619-3	106.3	4
MS-2619-318	PSA-1/4 SNQ1	MS 2619-3	106.3	4
MS-2619-319	PSA-1/2 SNQ1	MS 2619-3	106.3	4
MS-2619-320	SPRING	MS 2619-2	106.3	4
MS-2619-321	PSA-1/4 SNQ1	MS 2619-3	106.3	4
MS-2619-322	PSA-1/2 SNQ1	MS 2619-3	106.3	4
MS-2619-42A	PSA-1/4 SNQ1	MS 2619-4	106.4	4
MS-2619-42B	PSA-1/2 SNQ1	MS 2619-4	106.4	4
MS-2619-42C	PSA-1/4 SNQ1	MS 2619-4	106.4	4
MS-2619-43	V SPRING	MS 2619-2	106.4	4
MS-2619-44	V SPRING	MS 2619-2	106.4	4
MS-2619-45	PSA-1/4 SNQ1	MS 2619-4	106.4	4
MS-2619-46	PSA-1/2 SNQ1	MS 2619-4	106.4	4
MS-266	SPRING	MS 547-1	301	1,4,M
MS-267	SPRING	MS 547-2	301	1,4,M
MS-268	SPRING	MS 547-3	301	1,4,M
MS-269	SPRING	MS 548-1.2	302	1,4,M
MS-27	PSA-10 SN(2)	MS 530-7.10	203	4
MS-270	C SPRING	MS 548-3.4	302	1,4,M
MS-271	SPRING	MS 548-5	302	1,4,M
MS-272	SPRING	MS 549-1	303	1,4,M
MS-273	SPRING	MS 549-2.3	303	1,4,M
MS-274	C SPRING	MS 549-4.5	303	1,4,M
MS-275	SPRING	MS 549-4.5	303	1,4,M
MS-276	SPRING	MS 550-1.2	304	1,4,M
MS-277	SPRING	MS 550-3.4	304	1,4,M
MS-278	SPRING	MS 550-3.4	304	1,4,M
MS-279	SPRING (2)	MS 550-5.6	304	1,4,M
MS-28	SPRING	MS 530-7.10	203	4
MS-280	SPRING	MS 538-1	305	1,4,M
MS-281	C SPRING (2)	MS 538-2.3	305	1,4,M
MS-282	SPRING	MS 538-4	305	1,4,M
MS-283	SPRING	MS 540-1	307	1,4,M
MS-284	SPRING	MS 540-2.4	307	1,4,M
MS-285	V SPRING	MS 540-2.4	307	1,4,M
MS-286	SPRING	MS 540-5.6	307	1,4,M

TABLE 1 -- COMPONENT SUPPRTS WITHIN PSI BOUNDARIES -- 21 JAN 1985

EQUIP PIECE NO	DESCRIPTION	ISOMETRIC DWG NO	ISO DWG NO	EXAMS
*****	*****	*****	*****	*****
MS-287	SPRING	MS 541-1.2	308	1,4,M
MS-288	SPRING	MS 541-1.2	308	1,4,M
MS-289	V SPRING (2)	MS 541-3.4	308	1,4,M
MS-290	SPRING	MS 541-3.4	308	1,4,M
MS-291	SPRING	MS 541-6	308	1,4,M
MS-292	SPRING	MS 541-6	308	1,4,M
MS-293	SPRING	MS 555-1	310	1,4,M
MS-294	SPRING	MS 555-3	310	1,4,M
MS-295	SPRING (2)	MS 555-4	310	1,4,M
MS-296	SPRING	MS 554-1	311	1,4,M
MS-297	V SPRING	MS 554-3	311	1,4,M
MS-298	SPRING	MS 554-3	311	1,4,M
MS-299	SPRING (2)	MS 554-4	311	1,4,M
MS-30	SPRING (2)	MS 530-7.10	203	4
MS-300	SPRING	MS 553-1	312	1,4,M
MS-301	SPRING	MS 553-2	312	1,4,M
MS-302	SPRING	MS 553-3.4	312	1,4,M
MS-303	SPRING	MS 553-5.6	312	1,4,M
MS-304	SPRING	MS 552-1.2	313	1,4,M
MS-305	SPRING	MS 552-3.4	313	1,4,M
MS-306	SPRING	MS 552-3.4	313	1,4,M
MS-307	SPRING	MS 552-5.6	313	1,4,M
MS-308	SPRING	MS 546-1	315	1,4,M
MS-309	SPRING	MS 546-3	315	1,4,M
MS-31	PSA-3 SN(2)	MS 530-7.10	203	4
MS-310	SPRING	MS 546-4	315	1,4,M
MS-311	SPRING	MS 545-1	316	1,4,M
MS-312	SPRING	MS 545-3	316	1,4,M
MS-313	SPRING	MS 545-5	316	1,4,M
MS-314	SPRING	MS 544-1	317	1,4,M
MS-315	SPRING	MS 544-3	317	1,4,M
MS-316	SPRING (2)	MS 544-4.5	317	1,4,M
MS-317	SPRING	MS 543-1	318	1,4,M
MS-318	SPRING	MS 543-3	318	1,4,M
MS-319	SPRING	MS 543-3	318	1,4,M
MS-320	SPRING	MS 539-1	306	1,4,M
MS-321	SPRING	MS 539-2	306	1,4,M
MS-322	SPRING	MS 539-2	306	1,4,M
MS-323	SPRING	MS 539-4.5	306	1,4,M
MS-324	SPRING	MS 551-1	314	1,4,M
MS-325	SPRING (2)	MS 551-1	314	1,4,M
MS-326	SPRING	MS 551-2	314	1,4,M
MS-327	SPRING (2)	MS 551-4.5	314	1,4,M
MS-328	SPRING	MS 542-1.2	309	1,4,M
MS-329	V SPRING (2)	MS 542-3.4	309	1,4,M
MS-33	SPRING (2)	MS 530-4.6	203	4
MS-330	SPRING	MS 542-6	309	1,4,M
MS-332	SPRING	MS 548-5	302	1,4,M
MS-333	SPRING	MS 550-5.6	304	1,4,M

TABLE 1 -- COMPONENT SUPPORTS WITHIN PSI BOUNDARIES -- 21 JAN 1985

EQUIP PIECE NO	DESCRIPTION	ISOMETRIC DWG NO	ISO DWG NO	EXAMS
*****	*****	*****	*****	*****
MS-334	SPRING	MS 538-4	305	1,4,M
MS-335	SPRING	MS 540-5.6	307	1,4,M
MS-336	SPRING	MS 555-4	310	1,4,M
MS-337	SPRING	MS 554-4	311	1,4,M
MS-338	SPRING	MS 553-5.6	312	1,4,M
MS-339	SPRING	MS 552-5.6	313	1,4,M
MS-34	STRUT	MS 530-4.6	203	4
MS-340	SPRING	MS 546-4	315	1,4,M
MS-341	SPRING	MS 545-5	316	1,4,M
MS-342	SPRING	MS 544-4.5	317	1,4,M
MS-344	SPRING	MS 539-4.5	306	1,4,M
MS-345	SPRING	MS 542-6	309	1,4,M
MS-346	SPRING	MS 551-4.5	314	1,4,M
MS-36	STRUT	MS 530-4.6	203	4
MS-37	SPRING (2)	MS 530-4.6	203	4
MS-38	PSA-10 SN(2)	MS 530-4.6	203	4
MS-39	STRUT	MS 530-4.6	203	4
MS-40	STRUT	MS 530-4.6	203	4
MS-42	SPRING (2)	MS 530-4.6	203	4
MS-44	SPRING	MS 530-1.3	203	4
MS-45	PSA-35 SN	MS 530-1.3	203	4
MS-47	SPRING	MS 530-1.3	203	4
MS-48	PSA-3 SN	MS 530-7.10	203	4
MS-49	SPRING	MS 530-7.10	203	4
MS-50	SPRING	MS 531-11	204	4
MS-51	SPRING (2)	MS 531-7.10	204	4
MS-53	PSA-35 SN(2)	MS 531-7.10	204	4
MS-54	PSA-10 SN	MS 531-7.10	204	4
MS-55	SPRING (2)	MS 531-7.10	204	4
MS-56	PSA-10 SN(2)	MS 531-7.10	204	4
MS-57	PSA-3 SN(2)	MS 531-7.10	204	4
MS-58	SPRING (2)	MS 531-7.10	204	4
MS-59	STRUT	MS 531-4.6	204	4
MS-61	STRUT	MS 531-4.6	204	4
MS-62	SPRING (2)	MS 531-4.6	204	4
MS-63	SPRING (2)	MS 531-4.6	204	4
MS-65	STRUT	MS 531-4.6	204	4
MS-66	SPRING (2)	MS 531-4.6	204	4
MS-68	STRUT	MS 531-4.6	204	4
MS-69	SPRING	MS 531-4.6	204	4
MS-71	SPRING	MS 531-1.3	204	4
MS-72	PSA-35 SN	MS 531-1.3	204	4
MS-74	SPRING	MS 531-1.3	204	4
MS-86	PSA-3 SN	MS 531-7.10	204	4
MS-87	SPRING	MS 531-7.10	204	4
MS-88	SPRING	MS 528-11.12	201	4
MS-89	SPRING (2)	MS 528-7.10	201	4
MS-906N	PSA-3 SN(2)	MS 531-4.6	204	4
MS-908N	PSA-35 SN(2)	MS 531-4.6	204	4

TABLE 1 -- COMPONENT SUPPORTS WITHIN PSI BOUNDARIES -- 21 JAN 1985

EQUIP PIECE NO	DESCRIPTION	ISOMETRIC DWG NO	ISO DWG NO	EXAMS
*****	*****	*****	*****	*****
MS-91	PSA-3 SN(2)	MS 528-7.10	201	4
MS-921N	STRUT	MS 530-4.6	203	4
MS-924N	SPRING	MS 528-7.10	201	4
MS-93	SPRING (2)	MS 528-7.10	201	4
MS-94	BOX	MS 528-7.10	201	4
MS-95	STRUT	MS 528-7.10	201	4
MS-96	PSA-10 SN(2)	MS 528-7.10	201	4
MS-97	SPRING (2)	MS 528-7.10	201	4
MS-98	STRUT	MS 528-7.10	201	4
MS-992N	BOX	MS 528-7.10	201	4
MS-993N	PSA-10 SN(2)	MS 528-4.6	201	4
MS-994N	BOX	MS 530-7.10	203	4
MS-996N	PSA-10 SN(2)	MS 529-4.7	202	4
MS-997N	PSA-10 SN(2)	MS 529-4.7	202	4
MS-998N	PSA-10 SN(2)	MS 529-4.7	202	4
MS-999N	PSA-10 SN	MS 530-7.10	203	4
MS-HA-1	SPRING (2)	BC/G 211	101.1	4
MS-HA-2	SPRING (2)	BC/G 211	101.2	4
MS-HB-1	SPRING (2)	BC/G 212	102.1	4
MS-HB-2	SPRING	BC/G 212	102.1	4
MS-HB-3	SPRING (2)	BC/G 212	102.2	4
MS-HC-1	SPRING (2)	BC/G 213	103.1	4
MS-HC-2	SPRING	BC/G 213	103.1	4
MS-HC-3	SPRING (2)	BC/G 213	103.2	4
MS-HD-1	V SPRING (2)	BC/G 214	104.1	4
MS-HD-2	SPRING (2)	BC/G 214	104.2	4
MS-SA-1	PSA-100 SN	BC/G 211	101.2	4
MS-SA-10	PSA-35 SN	BC/G 211	101.1	4
MS-SA-2	PSA-100 SN	BC/G 211	101.2	4
MS-SA-3	PSA-35 SN	BC/G 211	101.2	4
MS-SA-4	PSA-35 SN	BC/G 211	101.2	4
MS-SA-5	PSA-35 SN	BC/G 211	101.1	4
MS-SA-6	PSA-35 SN	BC/G 211	101.1	4
MS-SA-7	PSA-35 SN	BC/G 211	101.1	4
MS-SA-9	PSA-35 SN	BC/G 211	101.1	4
MS-SB-1	PSA-100 SN	BC/G 212	102.2	4
MS-SB-10	PSA-35 SN	BC/G 212	102.1	4
MS-SB-2	PSA-100 SN	BC/G 212	102.2	4
MS-SB-3	PSA-35 SN	BC/G 212	102.2	4
MS-SB-4	PSA-35 SN	BC/G 212	102.2	4
MS-SB-5	PSA-35 SN	BC/G 212	102.1	4
MS-SB-6	PSA-35 SN	BC/G 212	102.1	4
MS-SB-7	PSA-35 SN	BC/G 212	102.1	4
MS-SB-8	PSA-35 SN	BC/G 212	102.1	4
MS-SB-9	PSA-35 SN	BC/G 212	102.1	4
MS-SC-1	PSA-100 SN	BC/G 213	103.2	4
MS-SC-10	PSA-35 SN	BC/G 213	103.1	4
MS-SC-2	PSA-100 SN	BC/G 213	103.2	4
MS-SC-3	PSA-35 SN	BC/G 213	103.2	4

TABLE 1 -- COMPONENT SUPPORTS WITHIN PSI BOUNDARIES -- 21 JAN 1985

EQUIP PIECE NO	DESCRIPTION	ISOMETRIC DWG NO	ISO DWG NO	EXAMS
*****	*****	*****	*****	*****
MS-SC-4	PSA-35 SN	BC/G 213	103.2	4
MS-SC-5	PSA-35 SN	BC/G 213	103.1	4
MS-SC-6	PSA-35 SN	BC/G 213	103.1	4
MS-SC-7	PSA-35 SN	BC/G 213	103.1	4
MS-SC-8	PSA-35 SN	BC/G 213	103.1	4
MS-SC-9	PSA-35 SN	BC/G 213	103.1	4
MS-SD-1	PSA-100 SN	BC/G 214	104.2	4
MS-SD-10	PSA-35 SN	BC/G 214	104.1	4
MS-SD-2	PSA-100 SN	BC/G 214	104.2	4
MS-SD-3	PSA-35 SN	BC/G 214	104.2	4
MS-SD-4	PSA-35 SN	BC/G 214	104.2	4
MS-SD-5	PSA-35 SN	BC/G 214	104.1	4
MS-SD-6	PSA-35 SN	BC/G 214	104.1	4
MS-SD-7	PSA-35 SN	BC/G 214	104.1	4
MS-SD-9	PSA-35 SN	BC/G 214	104.1	4
MSRV-1A-1	PSA-10 SN	MS 547-1	301	1,4,M
MSRV-1A-2	PSA-10 SN	MS 547-1	301	1,4,M
MSRV-1A-3	PSA-10 SN	MS 547-1	301	1,4,M
MSRV-1A-4	PSA-10 SN	MS 547-1	301	1,4,M
MSRV-1A-5	PSA-10 SN	MS 547-2	301	1,4,M
MSRV-1A-6	PSA-10 SN	MS 547-2	301	1,4,M
MSRV-1A-7PS	RIGID	MS 547-3	301	1,4,M
MSRV-1B-1	PSA-10 SN	MS 538-1	305	1,4,M
MSRV-1B-2	PSA-10 SN	MS 538-1	305	1,4,M
MSRV-1B-3	PSA-10 SN	MS 538-1	305	1,4,M
MSRV-1B-4	PSA-10 SN	MS 538-2.3	305	1,4,M
MSRV-1B-5	PSA-10 SN	MS 538-2.3	305	1,4,M
MSRV-1B-6PS	RIGID	MS 538-4	305	1,4,M
MSRV-1C-1	PSA-10 SN	MS 555-2	310	1,4,M
MSRV-1C-1PS				1,4,M
MSRV-1C-2	PSA-10 SN	MS 555-1	310	1,4,M
MSRV-1C-3	PSA-10 SN	MS 555-2	310	1,4,M
MSRV-1C-4	PSA-10 SN	MS 555-3	310	1,4,M
MSRV-1C-5	PSA-10 SN	MS 555-3	310	1,4,M
MSRV-1C-6PS	RIGID	MS 555-4	310	1,4,M
MSRV-1C-7	PSA-10 SN	MS 555-3	310	1,4,M
MSRV-1D-1	PSA-10 SN	MS 546-1	315	1,4,M
MSRV-1D-2	PSA-10 SN	MS 546-2	315	1,4,M
MSRV-1D-3	PSA-10 SN	MS 546-2	315	1,4,M
MSRV-1D-4	PSA-10 SN	MS 546-2	315	1,4,M
MSRV-1D-5	PSA-10 SN	MS 546-4	315	1,4,M
MSRV-1D-6	PSA-10 SN	MS 546-4	315	1,4,M
MSRV-1D-7	PSA-10 SN(2)	MS 546-4	315	1,4,M
MSRV-1D-7PS	RIGID	MS 546-4	315	1,4,M
MSRV-2A-1	PSA-10 SN	MS 548-1.2	302	1,4,M
MSRV-2A-2	PSA-10 SN	MS 548-1.2	302	1,4,M
MSRV-2A-3	PSA-35 SN	MS 548-1.2	302	1,4,M
MSRV-2A-4	PSA-10 SN	MS 548-3.4	302	1,4,M
MSRV-2A-5	PSA-10 SN	MS 548-3.4	302	1,4,M

TABLE 1 -- COMPONENT SUPPORTS WITHIN PSI BOUNDARIES -- 21 JAN 1985

EQUIP PIECE NO	DESCRIPTION	ISOMETRIC DWG NO	ISO. DWG. NO.	EXAMS
MSRV-2A-5PS	RIGID	MS 548-5	302	1,4,M
MSRV-2B-1	PSA-10 SN	MS 539-1	306	1,4,M
MSRV-2B-2	PSA-10 SN	MS 539-1	306	1,4,M
MSRV-2B-3	PSA-10 SN	MS 539-1	306	1,4,M
MSRV-2B-4	PSA-10 SN	MS 539-1	306	1,4,M
MSRV-2B-5	PSA-10 SN	MS 539-3	306	1,4,M
MSRV-2B-6	PSA-10 SN	MS 539-3	306	1,4,M
MSRV-2B-7	PSA-10 SN	MS 539-3	306	1,4,M
MSRV-2B-8	PSA-10 SN	MS 539-3	306	1,4,M
MSRV-2B-9PS	RIGID	MS 539-4.5	306	1,4,M
MSRV-2C-1	PSA-10 SN	MS 554-4	311	1,4,M
MSRV-2C-10PS	RIGID	MS 554-2	311	1,4,M
MSRV-2C-2	PSA-10 SN	MS 554-1	311	1,4,M
MSRV-2C-3	PSA-10 SN	MS 554-1	311	1,4,M
MSRV-2C-4	PSA-10 SN	MS 554-3	311	1,4,M
MSRV-2C-5	PSA-10 SN	MS 554-3	311	1,4,M
MSRV-2C-6	PSA-10 SN	MS 554-3	311	1,4,M
MSRV-2C-7	PSA-10 SN	MS 554-3	311	1,4,M
MSRV-2C-8	PSA-10 SN	MS 554-2	311	1,4,M
MSRV-2C-9	PSA-10 SN	MS 554-2	311	1,4,M
MSRV-2D-1	PSA-10 SN	MS 545-2	316	1,4,M
MSRV-2D-2	PSA-10 SN	MS 545-1	316	1,4,M
MSRV-2D-3	PSA-10 SN	MS 545-2	316	1,4,M
MSRV-2D-4	PSA-10 SN	MS 545-3	316	1,4,M
MSRV-2D-5	PSA-10 SN	MS 545-3	316	1,4,M
MSRV-3C-6	PSA-10 SN	MS 553-3.4	312	1,4,M
MSRV-3C-7	PSA-10 SN	MS 553-3.4	312	1,4,M
MSRV-3C-8	PSA-10 SN	MS 553-3.4	312	1,4,M

TABLE 1 -- COMPONENT SUPPORTS WITHIN PSI BOUNDARIES -- 21 JAN 1985

EQUIP PIECE NO	DESCRIPTION	ISOMETRIC DWG NO	ISO DWG NO	EXAMS
*****	*****	*****	*****	*****
MSRV-3D-1	PSA-10 SN	MS 544-1	317	1,4,M
MSRV-3D-2	PSA-10 SN	MS 544-1	317	1,4,M
MSRV-3D-3	PSA-10 SN	MS 554-2	317	1,4,M
MSRV-3D-4	PSA-10 SN	MS 544-1	317	1,4,M
MSRV-3D-5	PSA-10 SN	MS 544-2	317	1,4,M
MSRV-3D-6	PSA-10 SN	MS 544-4.5	317	1,4,M
MSRV-3D-7	PSA-10 SN	MS 544-4.5	317	1,4,M
MSRV-3D-8PS	RIGID	MS 544-4.5	317	1,4,M
MSRV-4A-1	PSA-10 SN	MS 550-1.2	304	1,4,M
MSRV-4A-10	PSA-10 SN	MS 550-3.4	304	1,4,M
MSRV-4A-2	PSA-10 SN	MS 550-1.2	304	1,4,M
MSRV-4A-3	PSA-10 SN	MS 550-1.2	304	1,4,M
MSRV-4A-4	PSA-10 SN	MS 550-3.4	304	1,4,M
MSRV-4A-5	PSA-10 SN	MS 550-3.4	304	1,4,M
MSRV-4A-6	PSA-10 SN	MS 550-5.6	304	1,4,M
MSRV-4A-7	PSA-10 SN	MS 550-5.6	304	1,4,M
MSRV-4A-8	PSA-10 SN	MS 550-3.4	304	1,4,M
MSRV-4A-8PS	RIGID	MS 541-3.4	308	1,4,M
MSRV-4A-9	PSA-10 SN	MS 550-3.4	304	1,4,M
MSRV-4B-10	PSA-10 SN	MS 541-3.4	308	1,4,M
MSRV-4B-2	PSA-10 SN	MS 541-1.2	308	1,4,M
MSRV-4B-3	PSA-10 SN	MS 541-1.2	308	1,4,M
MSRV-4B-4	PSA-10 SN	MS 541-1.2	308	1,4,M
MSRV-4B-5	PSA-10 SN	MS 541-3.4	308	1,4,M
MSRV-4B-6	PSA-10 SN	MS 541-3.4	308	1,4,M
MSRV-4B-7	PSA-10 SN	MS 541-3.4	308	1,4,M
MSRV-4B-8	PSA-10 SN	MS 541-5	308	1,4,M
MSRV-4B-9	PSA-10 SN	MS 541-5	308	1,4,M
MSRV-4B-9PS	RIGID	MS 541-6	308	1,4,M
MSRV-4C-1	PSA-10 SN	MS 552-1.2	313	1,4,M
MSRV-4C-2	PSA-10 SN	MS 552-1.2	313	1,4,M
MSRV-4C-3	PSA-10 SN	MS 552-1.2	313	1,4,M
MSRV-4C-4	PSA-10 SN	MS 552-3.4	313	1,4,M
MSRV-4C-5	PSA-10 SN	MS 552-3.4	313	1,4,M
MSRV-4C-6	PSA-10 SN	MS 552-3.4	313	1,4,M
MSRV-4C-7	PSA-10 SN	MS 552-3.4	313	1,4,M
MSRV-4C-8	PSA-10 SN	MS 552-3.4	313	1,4,M
MSRV-4C-9	PSA-10 SN(2)	MS 552-5.6	313	1,4,M
MSRV-4D-1	PSA-10 SN	MS 543-1	318	1,4,M
MSRV-4D-2	PSA-10 SN	MS 543-1	318	1,4,M
MSRV-4D-3	PSA-10 SN	MS 543-1	318	1,4,M
MSRV-4D-4	PSA-10 SN	MS 543-3	318	1,4,M
MSRV-4D-5	PSA-10 SN	MS 543-3	318	1,4,M
MSRV-4D-6	PSA-10 SN	MS 543-2	318	1,4,M
MSRV-4D-7PS	RIGID	MS 543-2	318	1,4,M
MSRV-5B-1	PSA-10 SN(2)	MS 542-1.2	309	1,4,M
MSRV-5B-10PS	RIGID	MS 542-6	309	1,4,M
MSRV-5B-2	PSA-10 SN	MS 542-1.2	309	1,4,M
MSRV-5B-3	PSA-10 SN	MS 542-1.2	309	1,4,M

TABLE 1 -- COMPONENT SUPPORTS WITHIN PSI BOUNDARIES -- 21 JAN 1985

EQUIP PIECE NO	DESCRIPTION	ISOMETRIC DWG NO	ISO DWG NO	EXAMS
*****	*****	*****	*****	*****
MSRV-5B-4	PSA-10 SN	MS 542-1.2	309	1,4,M
MSRV-5B-5	PSA-10 SN	MS 542-1.2	309	1,4,M
MSRV-5B-6	PSA-10 SN	MS 542-3.4	309	1,4,M
MSRV-5B-7	PSA-10 SN	MS 542-5	309	1,4,M
MSRV-5B-8	PSA-10 SN	MS 542-5	309	1,4,M
MSRV-5B-9	PSA-10 SN	MS 542-6	309	1,4,M
MSRV-5C-1	PSA-10 SN	MS 551-1	314	1,4,M
MSRV-5C-2	PSA-10 SN	MS 551-1	314	1,4,M
MSRV-5C-3	PSA-10 SN	MS 551-1	314	1,4,M
MSRV-5C-4	PSA-10 SN	MS 551-2	314	1,4,M
MSRV-5C-5	PSA-10 SN	MS 551-3	314	1,4,M
MSRV-5C-6	PSA-10 SN	MS 551-2	314	1,4,M
MSRV-5C-7	PSA-10 SN	MS 551-3	314	1,4,M
MSRV-5C-8	PSA-35 SN	MS 551-3	314	1,4,M
MSRV-5C-9	PSA-10 SN	MS 551-4.5	314	1,4,M
RCC-255	BOX	RCC 949-10.12	201	1
RCC-256	SPRING	RCC 949-10.12	201	1
RCC-267	SPRING	RCC 831-1.2	301	1
RCC-269	BOX	RCC 831-3.5	301	1
RCC-274	SPRING	RCC 831-6.10	301	1
RCC-276	BOX	RCC 831-6.10	301	1
RCC-279	SPRING	RCC 831-6.10	301	1
RCC-280	ANCHOR	RCC 831-6.10	301	1
RCC-285	STRUT	RCC 831-11.15	301	1
RCC-287	ANCHOR	RCC 831-11.15	301	1
RCC-306	BOX	RCC 830-12.13	302	1
RCC-308	STRUT	RCC 830-12.13	302	1
RCC-309	STRUT	RCC 830-12.13	302	1
RCC-311	STRUT	RCC 830-20.21	302	1
RCC-312	STRUT	RCC 830-20.21	302	1
RCC-315	SPRING	RCC 830-20.21	302	1
RCC-316	ANCHOR	RCC 830-20.21	302	1
RCC-325	SPRING	RCC 830-20.21	302	1
RCC-327	PSA-3 SN	RCC 830-30.32	302	1
RCC-345	SPRING	RCC 830-37.39	302	1
RCC-389	SPRING	RCC 948-1.3	202	1
RCC-434	ANCHOR	RCC 831-38.40	301	1
RCC-439	STRUT	RCC 831-23.26	301	1
RCC-440	ANCHOR	RCC 831-23.26	301	1
RCC-443	ANCHOR	RCC 831-23.26	301	1
RCC-462	SPRING	RCC 830-12.13	302	1
RCC-465	SPRING	RCC 830-30.32	302	1
RCC-469	STRUT	RCC 831-11.15	301	1
RCC-472	STRUT	RCC 830-12.13	302	1
RCC-475	STRUT	RCC 830-20.21	302	1
RCC-477	STRUT	RCC 831-38.40	301	1
RCC-478	STRUT	RCC 831-23.26	301	1
RCC-487	STRUT	RCC 830-20.21	302	1
RCC-488	BOX	RCC 830-20.21	302	1

TABLE 1 -- COMPONENT SUPPORTS WITHIN PSI BOUNDARIES -- 21 JAN 1985

EQUIP. PIECE NO	DESCRIPTION	ISOMETRIC DWG NO	ISO DWG NO	EXAMS
*****	*****	*****	*****	*****
RCC-908N	BOX	RCC 831-3.5	301	1
RCC-909N	PSA-3 SN	RCC 830-11.15	301	1
RCC-912N	STRUT	RCC 831-1.2	301	1
RCC-913N	STRUT	RCC 831-23.26	301	1
RCC-937N	RIGID	RCC 825-19.21	304	1
RCC-938N	RIGID	RCC 825-19.21	304	1
RCC-939N	RIGID	RCC 825-19.21	304	1
RCC-940N	RIGID	RCC 825-19.21	304	1
RCC-941N	RIGID	RCC 825-19.21	304	1
RCC-945N	RIGID	RCC 950-8.10	303	1
RCC-946N	RIGID	RCC 950-8.10	303	1
RCC-947N	RIGID	RCC 950-8.10	303	1
RCC-948N	RIGID	RCC 950-8.10	303	1
RCC-949N	SPRING	RCC 950-8.10	303	1
RCC-950N	RIGID	RCC 950-8.10	303	1
RCC-951N	RIGID	RCC 950-8.10	303	1
RCC-952N	RIGID	RCC 950-8.10	303	1
RCIC-1	PSA-1 SN	RCIC 660-1	203	4,8
RCIC-10	STRUT	RCIC 659-3.6	205	1
RCIC-100	PSA-1 SN	RCIC 659-22.23	102	1
RCIC-102	STRUT	RCIC 659-24	102	NE
RCIC-103	STRUT	RCIC 659-24	102	NE
RCIC-104	SPRING	RCIC 659-24	102	NE
RCIC-106	BOX	RCIC 664-1.7	202	N1
RCIC-107	BOX	RCIC 664-8.10	202	N1
RCIC-108	PSA-172 SN	RCIC 664-8.10	202	N1
RCIC-109	PSA-3 SN	RCIC 664-8.10	202	N1
RCIC-11	BOX	RCIC 659-3.6	205	1
RCIC-111	BOX	RCIC 664-8.10	202	N1
RCIC-113	SPRING	RCIC 664-1.7	202	N1
RCIC-114	SPRING	RCIC 664-8.10	202	N1
RCIC-116	STRUT	RCIC 665-4.9	202	N1
RCIC-117	STRUT	RCIC 665-4.9	202	N1
RCIC-119	SPRING	RCIC 665-4.9	202	N1
RCIC-12	BOX	RCIC 659-3.6	205	1
RCIC-121	SPRING	RCIC 665-4.9	202	N1
RCIC-123	SPRING	RCIC 665-4.9	202	N1
RCIC-126	PSA-1 SN(2)	RCIC 659-26	102.2	4
RCIC-127	SPRING	RCIC 659-27.28	102.3	4
RCIC-128	PSA-3 SN	RCIC 659-27.28	102.3	4
RCIC-129	SPRING	RCIC 659-27.28	102.3	4
RCIC-13	BOX	RCIC 659-1.2	205	1
RCIC-14	BOX	RCIC 659-7.10	205	1
RCIC-15	BOX	RCIC 659-7.10	205	1
RCIC-16	BOX	RCIC 659-7.10	205	1
RCIC-17	BOX	RCIC 659-7.10	205	1
RCIC-18	OTHER	RCIC 659-7.10	205	1
RCIC-19	BOX	RCIC 659-7.10	205	1
RCIC-1C-1	PSA-1 SN	RCIC 662-2.4	101.3	4,A,B

TABLE 1 -- COMPONENT SUPPORTS WITHIN PSI BOUNDARIES -- 21 JAN 1985

EQUIP PIECE NO	DESCRIPTION	ISOMETRIC DWG NO	ISO DWG NO	EXAMS
*****	*****	*****	*****	*****
RCIC-1C-10	PSA-3 SN	RCIC 663-1.2	101.1	4, A, B
RCIC-1C-12	PSA-3 SN	RCIC 662-1	101.2	4, A, B
RCIC-1C-13	PSA-3 SN(2)	RCIC 662-2.4	101.2	4, A, B
RCIC-1C-14	PSA-1 SN	RCIC 662-2.4	101.3	4, A, B
RCIC-1C-15	PSA-3 SN(2)	RCIC 662-1	101.2	4, A, B
RCIC-1C-16	PSA-3 SN	RCIC 662-2.4	101.2	4, A, B
RCIC-1C-2	PSA-3 SN(2)	RCIC 662-2.4	101.3	4, A, B
RCIC-1C-3	PSA-1 SN	RCIC 662-2.4	101.3	4, A, B
RCIC-1C-4	PSA-1 SN	RCIC 662-2.4	101.2	4, A, B
RCIC-1C-5	PSA-10 SN	RCIC 662-2.4	101.2	4, A, B
RCIC-1C-6	PSA-3 SN(2)	RCIC 662-2.4	101.2	4, A, B
RCIC-1C-7	PSA-3 SN	RCIC 662-2.4	101.2	4, A, B
RCIC-1C-8	PSA-3 SN	RCIC 662-2.4	101.2	4, A, B
RCIC-1C-9	PSA-10 SN	RCIC 663-1.2	101.1	4, A, B
RCIC-2	PSA-1 SN	RCIC 660-1	203	4, B
RCIC-20	BOX	RCIC 659-7.10	205	1
RCIC-21	STRUT	RCIC 659-7.10	205	1
RCIC-22	BOX	RCIC 649-11.17	205	1
RCIC-23	STRUT	RCIC 660-2.4	203	4, B
RCIC-24	STRUT	RCIC 660-2.4	203	4, B
RCIC-25	STRUT	RCIC 660-2.4	203	4, B
RCIC-26	PSA-3 SN	RCIC 660-5	203	4, B
RCIC-27	SPRING	RCIC 660-5	203	4, B
RCIC-28	BOX	RCIC 661-1.2	203	4, B
RCIC-29	ANCHOR	RCIC 659-11.17	205	1
RCIC-3	V. SPRING (2)	RCIC 660-1	203	4, B
RCIC-30	SPRING (2)	RCIC 661-1.2	203	4, B
RCIC-31	SPRING	RCIC 659-1.2	205	1
RCIC-32	BOX	RCIC 662-11.15	201.1	4, B
RCIC-33	ANCHOR	RCIC 662-11.15	201.1	4, B
RCIC-34	PSA-1/2 SNO1	RCIC 662-11.15	201	4, B
RCIC-35	BOX	RCIC 662-11.15	201.1	4, B
RCIC-36	SPRING	RCIC 662-11.15	201.1	4, B
RCIC-38	BOX	RCIC 662-6	201.1	4, B
RCIC-4	BOX	RCIC 660-2.4	203	4, B
RCIC-40	SPRING	RCIC 662-7.10	201.1	4, B
RCIC-41	BOX	RCIC 662-7.10	201.1	4, B
RCIC-42	BOX	RCIC 662-7.10	201.1	4, B
RCIC-43	SPRING	RCIC 662-7.10	201.1	4, B
RCIC-44	PSA-1/A SNO1	RCIC 662-7.10	201	4, B
RCIC-45	ANCHOR	RCIC 662-7.10	201.1	4, B
RCIC-47	BOX	RCIC 656-1.3	204	1
RCIC-5	PSA-1/2 SN(2)	RCIC 660-2.4	203	4, B
RCIC-52	ANCHOR	RCIC 658-1.2	204	1
RCIC-53	SPRING	RCIC 558-1.2	204	1
RCIC-54	SPRING	RCIC 642-1.5	205	1
RCIC-56	SPRING	RCIC 656-1.3	204	1
RCIC-59	SPRING (2)	RCIC 662-2.4	101.3	4, A, B
RCIC-6	SPRING	RCIC 660-2.4	203	4, B

TABLE 1 -- COMPONENT SUPPORTS WITHIN PSI BOUNDARIES -- 21 JAN 1985

EQUIP. PIECE NO	DESCRIPTION	ISOMETRIC DWG NO	ISO DWG NO	EXAMS
*****	*****	*****	*****	*****
RCIC-61	SPRING	RCIC 662-2.4	101.2	4, A, B
RCIC-66	SPRING	RCIC 662-2.4	101.2	4, A, B
RCIC-67	SPRING	RCIC 662-2.4	101.2	4, A, B
RCIC-68	SPRING	RCIC 662-2.4	101.2	4, A, B
RCIC-7	ANCHOR	RCIC 660-2.4	203	4, B
RCIC-72	SPRING	RCIC 662-1	101.2	4, A, B
RCIC-74	SPRING	RCIC 663-1.2	101.1	4, A, B
RCIC-75	SPRING	RCIC 663-1.2	101.1	4, A, B
RCIC-79	BOX	RCIC 659-11.17	205	1
RCIC-8	PSA-1 SN (2)	RCIC 642-1.5	205	1
RCIC-80	U-BOLT	RCIC 659-11.17	205	1
RCIC-82	BOX	RCIC 659-11.17	205	1
RCIC-83	SPRING	RCIC 659-18.21	205	1
RCIC-86	SPRING	RCIC 659-18.21	205	1
RCIC-88	BOX	RCIC 659-18.21	205	1
RCIC-9	BOX	RCIC 642-1.5	205	1
RCIC-90	BOX	RCIC 659-18.21	205	1
RCIC-900N	PSA-3 SN	RCIC 664-1.7	202	N1
RCIC-901N	STRUT	RCIC 665-5.8	204	1
RCIC-902N	SPRING	RCIC 656-1.3	204	1
RCIC-903N	STRUT	RCIC 657-1.2	204	1
RCIC-904N	BOX	RCIC 657-1.2	204	1
RCIC-905N	PSA-10 SN	RCIC 665-1.3	202	N1
RCIC-906N	STRUT	RCIC 665-1.3	202	N1
RCIC-907N	STRUT	RCIC 665-1.3	202	N1
RCIC-908N	PSA-3 SN	RCIC 665-1.3	202	N1
RCIC-909N	PSA-3 SN	RCIC 665-1.3	202	N1
RCIC-91	ANCHOR	RCIC 659-18.21	205	1
RCIC-910N	STRUT	RCIC 665-1.3	202	N1
RCIC-911N	STRUT	RCIC 665-4.9	202	N1
RCIC-912N	ANCHOR	RCIC 665-4.9	202	N1
RCIC-913N	ANCHOR	RCIC 664-1.7	202	N1
RCIC-914N	PSA-3 SN Q2	RCIC 664-1.7	202	N1
RCIC-916N	STRUT	RCIC 657-1.2	204	1
RCIC-917N	PSA-3 SN	RCIC 663-3.5	101	N1
RCIC-918N	PSA-3 SN	RCIC 664-1.7	202	N1
RCIC-919N	SPRING	RCIC 663-3.5	101	N1
RCIC-920N	SPRING	RCIC 663-3.5	101	N1
RCIC-921N	STRUT	RCIC 664-1.7	202	N1
RCIC-922N	SPRING	RCIC 664-1.7	202	N1
RCIC-923N	STRUT	RCIC 664-1.7	202	N1
RCIC-924N	STRUT	RCIC 664-1.7	202	N1
RCIC-925N	PSA-3 SN	RCIC 663-3.5	191	N1
RCIC-926N	SPRING	RCIC 664-1.7	202	N1
RCIC-927N	ANCHOR	RCIC 656-1.3	204	1
RCIC-928N	STRUT	RCIC 664-1.7	202	N1
RCIC-929N	STRUT	RCIC 665-4.9	202	N1
RCIC-93	BOX	RCIC 659-18.21	205	1
RCIC-931N	PSA-3 SN	RCIC 659-27.28	102.3	4

TABLE 1 -- COMPONENT SUPPORTS WITHIN PSI BOUNDARIES -- 21 JAN 1985

EQUIP PIECE NO	DESCRIPTION	ISOMETRIC DWG NO	ISO DWG NO	EXAMS
*****	*****	*****	*****	*****
RCIC-932N	PSA-1 SN(2)	RCIC 659-27.28	102.3	4
RCIC-933N	PSA-1 SN	RCIC 659-27.28	102.3	4
RCIC-934N	PSA-1 SN	RCIC 659-27.28	102.3	4
RCIC-935N	PSA-1 SN	RCIC 659-27.28	102.3	4
RCIC-936N	PSA-1 SN(2)	RCIC 659-27.28	102.3	4
RCIC-937N	PSA-3 SN	RCIC 659-26	102.2	4
RCIC-938N	PSA-3 SN	RCIC 659-26	102.2	4
RCIC-939N	PSA-3 SN	RCIC 659-26	102.2	4
RCIC-940N	SPRING	RCIC 659-27.28	102.3	4
RCIC-941N	SPRING	RCIC 659-27.28	102.3	4
RCIC-942N	SPRING	RCIC 659-26	102.2	4
RCIC-943N	PSA-10 SNG1	RCIC 662-6	201	4,B
RCIC-944N	PSA-3 SN(2)Q1	RCIC 662-6	201	4,B
RCIC-945N	PSA-10 SNG1	RCIC 662-6	201	4,B
RCIC-946N	STRUT	RCIC 662-6	201.1	4,B
RCIC-948N	PSA-1 SN(2)	RCIC 659-24	102	N6
RCIC-949N	PSA-10 SN	RCIC 662-7.10	201.1	4,B
RCIC-95	BOX	RCIC 659-18.21	205	1
RCIC-951N	SPRING	RCIC 665-4.9	202	N1
RCIC-952N	BOX	RCIC 659-11.17	205	1
RCIC-954N	BOX	RCIC 659-11.17	205	1
RCIC-955N	BOX	RCIC 659-11.17	205	1
RCIC-956N	STRUT	RCIC 659-7.10	205	1
RCIC-961N	PSA-1 1/4 SN	RCIC 662-11.15	201.1	4,B
RCIC-962N	PSA-1 1/2 SN	RCIC 662-11.15	201.1	4,B
RCIC-966N	BOX	RCIC 658-1.2	204	1
RCIC-967N	PSA-1 1/4 SN	RCIC 658-1.2	204	1
RCIC-968S	PSA-1 SN	RCIC 663-1.2	101.1	4,B
RCIC-969S	PSA-1 1/2 SN	RCIC 663-1.2	101.1	4,B
RCIC-97	SPRING	RCIC 659-22.23	205	1
RCIC-970S	PSA-1 1/2 SN	RCIC 663-1.2	101.1	4,B
RCIC-971N	PSA-1 SN	RCIC 660-2.4	203	4
RCIC-973N	STRUT	RCIC 659-3.6	205	1
RCIC-974S	PSA-1 SN	RCIC 663-1.2	101.1	4,B
RCIC-975S	PSA-1 1/4 SN	RCIC 663-1.2	101.1	4,B
RCIC-976S	SPRING	RCIC 663-1.2	101.1	1
RCIC-98	STRUT	RCIC 659-22.23	205	1
RCIC-99	STRUT	RCIC 659-22.23	205	1
RFW-146	PSA-10 SN(2)	RFW 418-4	101.1	4,A,N
RFW-147	PSA-100 SN	RFW 418-4	101.1	4,A,N
RFW-148	PSA-35 SN	RFW 418-4	101.1	4,A,N
RFW-150	PSA-10 SN(2)	RFW 418-7.8	101.2	4,A,N
RFW-151	PSA-10 SN	RFW 418-7.8	101.3	4,A,N
RFW-152	SPRING	RFW 418-7.8	101.3	4,A,N
RFW-153	PSA-10 SN	RFW 418-7.8	101.3	4,A,N
RFW-154	PSA-10 SN(2)	RFW 418-7.8	101.2	4,A,N
RFW-155	PSA-10 SN(2)	RFW 418-7.8	101.2	4,A,N
RFW-156	SPRING	RFW 418-9.10	101.5	4,A,N
RFW-157	C SPRING (2)	RFW 418-9.10	101.5	4,A,N

TABLE 1 -- COMPONENT SUPPORTS WITHIN PSI BOUNDARIES -- 21 JAN 1985

EQUIP PIECE NO	DESCRIPTION	ISOMETRIC DWG NO	ISO DWG NO	EXAMS
RFW-158	C SPRING	RFW 418-11.12	101.4	4, A, N
RFW-159	SPRING	RFW 418-13	101.3	4, A, N
RFW-160	PSA-10 SN(2)	RFW 418-7.8	101.2	4, A, N
RFW-162	PSA-10 SN(2)	RFW 419-4	102.1	4, A, N
RFW-163	PSA-100 SN	RFW 419-4	102.1	4, A, N
RFW-164	PSA-35 SN	RFW 419-4	102.1	4, A, N
RFW-166	PSA-10 SN(2)	RFW 419-5.7	102.2	4, A, N
RFW-167	PSA-10 SN(2)	RFW 419-5.7	102.2	4, A, N
RFW-168	PSA-10 SN(2)	RFW 419-5.7	102.2	4, A, N
RFW-170	PSA-10 SN(2)	RFW 419-5.7	102.2	4, A, N
RFW-171	PSA-10 SN	RFW 419-8.9	102.3	4, A, N
RFW-172	PSA-35 SN	RFW 419-8.9	102.3	4, A, N
RFW-173	SPRING	RFW 419-8.9	102.3	4, A, N
RFW-175	SPRING	RFW 419-12.13	102.5	4, A, N
RFW-177	V SPRING	RFW 438-1.2	103	1, 4, M
RFW-178	BOX	RFW 438-1.2	103	1, 4, M
RFW-179	RIGID	RFW 438-1.2	103	1, 4, M
RFW-180	PSA-1 SN	RFW 438-3	103	1, 4, M
RFW-181	SPRING	RFW 438-3	103	1, 4, M
RFW-182	SPRING	RFW 419-4	102.1	4, A, N
RFW-183	C SPRING (2)	RFW 419-8.5	102.3	4, A, N
RFW-185	SPRING (2)	RFW 419-12.13	102.5	4, A, N
RFW-186	SPRING	RFW 418-4	101.1	4, A, N
RFW-903N	SPRING	RFW 438-3	103	1, 4, M
RFW-915N	PSA-10 SN	RFW 419-8.9	102.3	4, A, N
RFW-929N	PSA-10 SN	RFW 418-7.8	101.3	4, A, N
RFW-942N	SPRING	RFW 438-1.2	103	1, 4, M
RHR-1000N	PSA-3 SN	RHR 867-13.15	201.1	4, B, N
RHR-1001N	PSA-1 SN(2)	RHR 867-13.15	201.1	4, B, N
RHR-1002N	PSA-1 SN(2)	RHR 898-9.14	207.1	4, B, N
RHR-1003N	STRUT	RHR 898-21.29	208	N1
RHR-1004N	STRUT	RHR 851-3.9	201.6	4, B, N
RHR-1017N	SPRING	RHR 897-19	103	N6
RHR-1019N	---	RHR 851-18.19	201	N6
RHR-1020N	---	RHR 898-36.38	207	1
RHR-1021N	PSA-3 SN(2)	RHR 897-1.2	210	1
RHR-1022N	PSA-35 SN(2)	RHR 851-13	201.6	4, B, N
RHR-117	SPRING	RHR 879-1.3	209	1
RHR-118	SPRING	RHR 875-9.12	209	4, B, N
RHR-119	STRUT	RHR 875-13.16	205	4, B, N
RHR-120	STRUT	RHR 875-13.16	205	4, B, N
RHR-121	PSA-10 SN(2)	RHR 881-4.7	206	1
RHR-122	STRUT	RHR 881-4.7	206	1
RHR-123	BOX	RHR 881-4.7	206	1
RHR-124	STRUT	RHR 881-4.7	206	1
RHR-125	STRUT	RHR 881-8.13	206	1
RHR-126	STRUT	RHR 881-8.13	206	1
RHR-127	BOX	RHR 881-8.13	206	1
RHR-128	BOX	RHR 881-8.13	206	1

TABLE 1 -- COMPONENT SUPPORTS WITHIN PSI BOUNDARIES -- 21 JAN 1985

EQUIP PIECE NO	DESCRIPTION	ISOMETRIC DWG NO	ISO DWG NO	EXAMS
*****	*****	*****	*****	*****
RHR-129	STRUT	RHR 881-8.13	206	1
RHR-130	BOX	RHR 881-8.13	206	1
RHR-131	STRUT	RHR 881-8.13	206	1
RHR-132	ANCHOR	RHR 881-8.13	206	1
RHR-135	STRUT	RHR 881-1.3	205	1
RHR-136	STRUT	RHR 881-1.3	205	1
RHR-137	PSA-3 SN(2)	RHR 881-1.3	205	1
RHR-138	SPRING	RHR 881-1.3	205	1
RHR-139	SPRING	RHR 880-1.6	211	1
RHR-140	SPRING	RHR 880-1.6	211	1
RHR-142	PSA-1 SN(2)	RHR 867-20.22	201	1
RHR-144	SPRING	RHR 867-16.19	201	1
RHR-145	PSA-1 SN	RHR 867-16.19	201	1
RHR-146	SPRING	RHR 867-16.19	201	1
RHR-147	PSA-1 SN(2)	RHR 867-16.19	201	1
RHR-148	BOX	RHR 867-16.19	201	1
RHR-149	STRUT	RHR 867-16.19	201	1
RHR-150	SPRING	RHR 854-12.16	203	1
RHR-157	SPRING (2)	RHR 867-1.4	201.1	A, B, N
RHR-158	PSA-3 SN	RHR 867-1.4	201.1	A, B, N
RHR-159	STRUT	RHR 867-1.4	201.1	A, B, N
RHR-160	PSA-3 SN	RHR 867-1.4	201.1	A, B, N
RHR-161	SPRING	RHR 867-1.4	201.1	A, B, N
RHR-162	STRUT	RHR 867-1.4	201.1	A, B, N
RHR-163	STRUT	RHR 867-1.4	201.1	A, B, N
RHR-164	STRUT	RHR 867-5.7	201.1	A, B, N
RHR-165	STRUT	RHR 867-5.7	201.1	A, B, N
RHR-166	SPRING	RHR 875-6.8	205	A, B, N
RHR-167	SPRING	RHR 875-9.12	209	A, B, N
RHR-174	BOX	RHR 867-8.12	201.1	A, B, N
RHR-176	RIGID	RHR 875-13.16	205	A, B, N
RHR-181	SPRING	RHR 976-5.6	207	1
RHR-183	PSA-10 SN	RHR 976-5.6	207	1
RHR-184	STRUT	RHR 976-1.4	207	N6
RHR-185	SPRING	RHR 976-1.4	207	1, 4, M
RHR-187	SPRING	RHR 867-16.19	201	N6
RHR-188	SPRING	RHR 867-5.7	201.1	A, B, N
RHR-218	PSA-3 SN(2)	RHR 976-1.4	207	N6
RHR-228	ANCHOR	RHR 745-1.2	207.11	N6
RHR-230	BOX	RHR 745-1.2	207.11	N6
RHR-231	SPRING	RHR 851-20	101	N6
RHR-232	RIGID	RHR 851-20	101	N6
RHR-234	BOX	RHR 851-3.9	201.6	A, B, N
RHR-235	PSA-10 SN	RHR 851-3.9	201.6	A, B, N
RHR-237	STRUT	RHR 851-3.9	201.6	A, B, N
RHR-238	ANCHOR	RHR 851-3.9	201.6	A, B, N
RHR-240	BOX	RHR 851-10.12	201.6	A, B, N
RHR-243	SPRING (2)	RHR 851-13	201.6	A, B, N
RHR-244	PSA-35 SN	RHR 851-13	201.6	A, B, N

TABLE 1 -- COMPONENT SUPPORTS WITHIN PSI BOUNDARIES -- 21 JAN 1985

EQUIP	PIECE NO	DESCRIPTION	ISOMETRIC DWG NO	ISO DWG NO	EXAMS
RHR-245		BOX	RHR 855-1.3	201	N6
RHR-247		SPRING	RHR 855-1.3	201	1
RHR-248		SPRING	RHR 853-1.4	202	N6
RHR-249		BOX	RHR 853-1.4	201	N6
RHR-251		PSA-3 SN	RHR 853-1.4	202	N6
RHR-252		SPRING	RHR 853-1.4	202	N6
RHR-256		PSA-35 SN	RHR 853-5.6	202	1
RHR-260		PSA-3 SN	RHR 851-13	201.6	4,B,N
RHR-261		SPRING	RHR 851-13	201.6	4,B,N
RHR-262		SPRING	RHR 854-1.5	203	1,4,M
RHR-263		C SPRING	RHR 851-3.9	201.6	4,B,N
RHR-264		PSA-3 SN(2)	RHR 851-3.9	201.6	4,B,N
RHR-265		SPRING	RHR 854-1.5	203	N6
RHR-266		BOX	RHR 851-3.9	201.6	4,B,N
RHR-267		BOX	RHR 851-3.9	201.6	4,B,N
RHR-268		BOX	RHR 851-3.9	201.6	4,B,N
RHR-269		PSA-3 SN	RHR 851-3.9	201.6	4,B,N
RHR-270		PSA-3 SN	RHR 851-3.9	201.6	4,B,N
RHR-271		PSA-3 SN(2)	RHR 851-3.9	201.6	4,B,N
RHR-272		PSA-3 SN	RHR 854-1.5	203	N6
RHR-273		PSA-3 SN	RHR 854-1.5	203	N6
RHR-274		PSA-3 SNQ1	RHR 854-1.5	203	N6
RHR-275		PSA-3 SN	RHR 854-1.5	203	N6
RHR-276		PSA-1 SN(2)	RHR 854-1.5	203	N6
RHR-277		PSA-3 SN	RHR 854-1.5	203	N6
RHR-278		BOX	RHR 854-1.5	203	N6
RHR-279		SPRING	RHR 854-1.5	203	N6
RHR-280		C SPRING	RHR 851-3.9	201.6	4,B,N
RHR-281		PSA-10 SN	RHR 897-20.24	103	4,A
RHR-282		PSA-35	RHR 897-20.24	103	4,A
RHR-286		PSA-10 SN(2)	RHR 897-20.24	103	4,A
RHR-287		PSA-35 SN	RHR 897-20.24	103	4,A
RHR-295		BOX	RHR 897-10.14	210	1
RHR-298		BOX	RHR 897-3.5	210	1
RHR-301		PSA-3 SN	RHR 897-3.5	210	1
RHR-302		STRUT	RHR 897-3.5	210	1
RHR-303		SPRING	RHR 897-3.5	210	1
RHR-304		PSA-1.0 SN	RHR 897-3.5	210	1
RHR-311		PSA-1 SN(2)	RHR 897-3.5	210	1
RHR-316		SPRING	RHR 897-6.9	210	1
RHR-321		SPRING	RHR 897-1.2	210	1
RHR-322		BOX	RHR 897-1.2	210	1
RHR-323		SPRING	RHR 897-1.2	210	1
RHR-324		STRUT	RHR 897-25.30	210	1
RHR-337		STRUT	RHR 897-25.30	210	1
RHR-338		SPRING	RHR 897-25.30	210	1
RHR-345		PSA-1/4 SN(2)	RHR 897-25.30	210	1
RHR-346		STRUT	RHR 897-25.30	210	1
RHR-347		BOX	RHR 897-25.30	210	1

TABLE 1 -- COMPONENT SUPPORTS WITHIN PSI BOUNDARIES -- 21 JAN 1985

EQUI PCE NO	DESCRIPTION	ISOMETRIC DWG NO	ISO DWG NO	EXAMS
RHR-348	SPRING	RHR 897-25.30	210	201-881
RHR-349	SPRING	RHR 897-25.30	210	201-881
RHR-35	SPRING	RHR 880-1.6	211	201-881
RHR-350	SPRING	RHR 851-18.19	201	201-881 N6
RHR-351	C SPRING	RHR 851-3.9	201.6	201-881 4, B, N
RHR-352	STRUT	RHR 851-3.9	201.6	201-881 4, B, N
RHR-353	STRUT	RHR 851-3.9	201.6	201-881 4, B, N
RHR-354	SPRING (2)	RHR 852-1.4	201.1	201-881 4, B, N
RHR-355	PSA-3 SN	RHR 852-1.4	201.1	201-881 4, B, N
RHR-356	PSA-3 SN	RHR 852-1.4	201.1	201-881 4, B, N
RHR-357	PSA-3 SN	RHR 852-1.4	201.1	201-881 4, B, N
RHR-358	BOX	RHR 852-1.4	201.1	201-881 4, B, N
RHR-359	PSA-3 SN	RHR 852-1.4	201.1	201-881 4, B, N
RHR-360	SPRING	RHR 852-1.4	201.1	201-881 4, B, N
RHR-361	PSA-3 SN	RHR 852-1.4	201.1	201-881 4, B, N
RHR-362	PSA-3 SN (2)	RHR 852-1.4	201.1	201-881 4, B, N
RHR-363	SPRING	RHR 852-1.4	201.1	201-881 4, B, N
RHR-365	STRUT	RHR 851-1.2	201.6	201-881 4, B, N
RHR-366	STRUT	RHR 851-1.2	201.6	201-881 4, B, N
RHR-367	SPRING (2)	RHR 851-1.2	201.6	201-881 4, B, N
RHR-368	STRUT	RHR 851-1.2	201.6	201-881 4, B, N
RHR-369	PSA-3 SN	RHR 854-1.5	203	201-881 N6
RHR-37	BOX	RHR 880-1.6	211	201-881
RHR-380	PSA-10 SN	RHR 851-21.24	101	201-881 4, A
RHR-381	PSA-10 SN (2)	RHR 851-21.24	101	201-881 4, A
RHR-382	PSA-35 SN	RHR 851-21.24	101	201-881 4, A
RHR-383	PSA-35 SN	RHR 851-21.24	101	201-881 4, A
RHR-387	PSA-10 SN	RHR 899-39.44	102	201-881 4, A
RHR-388	PSA-10 SN (2)	RHR 899-39.44	102	201-881 4, A
RHR-389	PSA-35 SN	RHR 899-39.44	102	201-881 4, A
RHR-39	PSA-1 SN (2)	RHR 880-1.6	211	201-881
RHR-390	PSA-35 SN	RHR 899-39.44	102	201-881 4, A
RHR-391	ANCHOR	RHR 667-16.19	212	201-881 N1
RHR-392	BOX	RHR 667-20.21	212	201-881 N1
RHR-393	BOX	RHR 667-20.21	212	201-881 N1
RHR-394	SPRING	RHR 667-20.21	212	201-881 N1
RHR-395	SPRING	RHR 667-16.19	212	201-881 N1
RHR-40	STRUT	RHR 880-1.6	211	201-881 N6
RHR-405	PSA-3 SN	RHR 854-1.5	203	201-881 N6
RHR-406	PSA-3 SN	RHR 854-1.5	203	201-881 N6
RHR-407	SPRING	RHR 854-1.5	203	201-881 N6
RHR-408	STRUT	RHR 854-6.11	203	201-881 N6
RHR-409	BOX	RHR 854-6.11	203	201-881 N6
RHR-41	BOX	RHR 880-1.6	211	201-881 N6
RHR-410	ANCHOR	RHR 854-6.11	203	201-881 N6
RHR-411	BOX	RHR 854-6.11	203	201-881 N6
RHR-412	STRUT	RHR 854-6.11	203	201-881 N6
RHR-414	PSA-3 SN (2)	RHR 854-6.11	203	201-881 N6
RHR-415	STRUT	RHR 854-6.11	203	201-881 N6

TABLE 1 -- COMPONENT SUPPORTS WITHIN PSI BOUNDARIES -- 21 JAN 1985

EQUIP PIECE NO.	DESCRIPTION	ISOMETRIC DWG NO.	ISO DWG NO	EXAMS
RHR-416	PSA-10 SN(2)	RHR 854-6.11	203	N6
RHR-417	STRUT	RHR 854-12.16	203	N6
RHR-419	PSA-3 SN(2) Q1	RHR 854-12.16	203	N6
RHR-42	PSA-3 SN	RHR 882-5	211	1
RHR-420	SPRING	RHR 854-12.16	203	N6
RHR-423	SPRING	RHR 881-8.13	206	N6
RHR-425	SPRING	RHR 874-1.3	104	4, A, B
RHR-428	SPRING (2)	RHR 874-1.3	104	4, A, B
RHR-43	SPRING	RHR 882-5	211	1
RHR-431	SPRING	RHR 874-1.3	104	4, A, B
RHR-432	SPRING	RHR 881-8.13	206	1
RHR-433	V SPRING (2)	RHR 899-1.4	207.7	4, B, N
RHR-434	BOX	RHR 899-1.4	207.7	4, B, N
RHR-435	STRUT	RHR 899-1.4	207.7	4, B, N
RHR-436	BOX	RHR 899-1.4	207.7	4, B, N
RHR-437	PSA-3 SN(2)	RHR 899-1.4	207.7	4, B, N
RHR-438	STRUT	RHR 899-1.4	207.7	4, B, N
RHR-459	PSA-10 SN	RHR 978-1.4	207	N6
RHR-46	BOX	RHR 882-1.4	211	1
RHR-461	SPRING	RHR 900-1.5	207.1	4, B, N
RHR-462	SPRING	RHR 899-1.4	207.7	4, B, N
RHR-463	PSA-3 SN	RHR 899-5.7	207.7	4, B, N
RHR-464	BOX	RHR 899-5.7	207.7	4, B, N
RHR-465	PSA-3 SN(2)	RHR 899-5.7	207.7	4, B, N
RHR-466	PSA-3 SN	RHR 899-5.7	207.7	4, B, N
RHR-467	STRUT	RHR 899-5.7	207.7	4, B, N
RHR-468	C SPRING	RHR 899-5.7	207.7	4, B, N
RHR-469	SPRING	RHR 899-5.7	207.7	4, B, N
RHR-47	STRUT	RHR 882-1.4	211	1
RHR-470	STRUT	RHR 899-36.37	207	N6
RHR-471	V SPRING	RHR 875-6.8	205	4, B, N
RHR-472	PSA-1 SN	RHR 899-36.37	207	N6
RHR-473	SPRING	RHR 899-36.37	207	N6
RHR-475	ANCHOR	RHR 899-8.11	207.7	4, B, N
RHR-476	BOX	RHR 745-1.2	207.11	N6
RHR-478	SPRING	RHR 899-8.11	207.7	4, B, N
RHR-479	PSA-3 SN(2)	RHR 899-8.11	207.7	4, B, N
RHR-480	STRUT	RHR 899-8.11	207.7	4, B, N
RHR-481	PSA-35 SN	RHR 899-8.11	207.7	4, B, N
RHR-482	STRUT	RHR 899-38	102	N6
RHR-483	SPRING	RHR 899-38	102	N6
RHR-485	PSA-10 SN	RHR 899-12.17	207.7	4, B, N
RHR-486	C SPRING	RHR 899-8.11	207.7	4, B, N
RHR-488	ANCHOR	RHR 899-12.17	207.7	4, B, N
RHR-49	STRUT	RHR 880-1.5	211	1
RHR-491	SPRING	RHR 899-12.17	207.7	4, B, N
RHR-492	PSA-3 SN(2)	RHR 899-12.17	207.7	4, B, N
RHR-493	C SPRING	RHR 899-18.19	207.7	4, B, N
RHR-494	PSA-3 SN	RHR 899-18.19	207.7	4, B, N

TABLE 1 -- COMPONENT SUPPORTS WITHIN PSI BOUNDARIES 21 JAN 1985

EQUIP PIECE NO	DESCRIPTION	ISOMETRIC DWG NO	ISO DWG NO	EXAMS
RHR-495	PSA-3 SN(2)	RHR 899-18.19	207.7	4,B,N
RHR-496	PSA-3 SN	RHR 899-18.19	207.7	4,B,N
RHR-497	C SPRING	RHR 899-18.19	207.7	4,B,N
RHR-498	SPRING	RHR 899-20.22	207	NG
RHR-50	STRUT	RHR 880-1.6	211	1
RHR-500	PSA-3 SN	RHR 899-18.19	207	4,M
RHR-501	SPRING	RHR 899-20.22	207	1
RHR-502	PSA-3 SN	RHR 899-20.22	207	1
RHR-503	PSA-10 SN	RHR 899-20.22	207	1
RHR-504	SPRING	RHR 851-15.16	105	4,A,B
RHR-506	SPRING	RHR 851-15.16	105	4,A,B
RHR-51	STRUT	RHR 880-1.6	211	1
RHR-510	SPRING	RHR 851-17	105	4,A,B
RHR-512	SPRING	RHR 899-46.47	106	4,A,B
RHR-514	SPRING	RHR 899-46.47	106	4,A,B
RHR-518	SPRING	RHR 899-48	106	4,A,B
RHR-52	PSA-3 SN	RHR 978-1.4	207	NG
RHR-520	V SPRING	RHR 748-1	102(RCIC)	NG
RHR-521	C SPRING	RHR 899-39.44	102	4,A
RHR-522	C SPRING	RHR 899-39.44	102	4,A
RHR-523	SPRING	RHR 899-39.44	102	4,A
RHR-524	C SPRING	RHR 897-20.24	103	4,A
RHR-525	C SPRING	RHR 897-20.24	103	4,A
RHR-526	SPRING	RHR 897-20.24	103	4,A
RHR-527	SPRING	RHR 851-21.24	101	4,A
RHR-528	C SPRING	RHR 851-21.24	101	4,A
RHR-529	C SPRING	RHR 851-21.24	101	4,A
RHR-53	SPRING	RHR 978-1.4	207	NG
RHR-539	STRUT	RHR 898-9.14	207.1	4,B,N
RHR-54	SPRING	RHR 978-1.4	207	NG
RHR-540	STRUT	RHR 898-9.14	207.1	4,B,N
RHR-548	PSA-1 SN(2)	RHR 898-9.14	207.1	4,B,N
RHR-55	BOX	RHR 881-8.13	206	1
RHR-551	PSA-3 SN(2)	RHR 898-9.14	207.1	4,B,N
RHR-552	STRUT	RHR 898-9.14	207.1	4,B,N
RHR-553	STRUT	RHR 898-9.14	207.1	4,B,N
RHR-554	STRUT	RHR 898-9.14	207.1	4,B,N
RHR-555	SPRING (2)	RHR 898-9.14	207.1	4,B,N
RHR-556	PSA-3 SN	RHR 898-9.14	207.1	4,B,N
RHR-557	PSA-3 SN(2)	RHR 900-1.5	207.1	4,B,N
RHR-558	PSA-3 SN	RHR 900-1.5	207.1	4,B,N
RHR-559	C SPRING	RHR 900-1.5	207.1	4,B,N
RHR-56	SPRING	RHR 875-6.8	205	1
RHR-560	SPRING (2)	RHR 900-1.5	207.1	4,B,N
RHR-561	STRUT	RHR 900-1.5	207.1	4,B,N
RHR-562	PSA-3 SN	RHR 900-1.5	207.1	4,B,N
RHR-563	PSA-1 SN(2)	RHR 900-1.5	207.1	4,B,N
RHR-564	PSA-3 SN	RHR 900-1.5	207.1	4,B,N
RHR-565	PSA-3 SN	RHR 900-1.5	207.1	4,B,N

TABLE 1 -- COMPONENT SUPPORTS WITHIN, PSI BOUNDARIES -- 21 JAN 1985

EQUIP	PIECE NO	DESCRIPTION	ISOMETRIC DWG NO	ISO DWG NO	EXAMS
RHR-566		STRUT	RHR 898-21.29	208	N1
RHR-567		STRUT	RHR 898-21.29	208	N1
RHR-568		SPRING	RHR 898-21.29	208	N1
RHR-569		PSA-3 SN	RHR 898-21.29	208	N1
RHR-570		PSA-3 SN	RHR 898-21.29	208	N1
RHR-571		SPRING	RHR 898-16.17	208	N1
RHR-572		SPRING	RHR 898-15.	208	N1
RHR-573		PSA-3 SN	RHR 898-15.	208	N1
RHR-574		PSA-3 SN	RHR 898-15.	208	N1
RHR-575		PSA-3 SN	RHR 898-16.17	208	N1
RHR-576		STRUT	RHR 898-16.17	208	N1
RHR-577		SPRING	RHR 898-18.20	208	N1
RHR-578		PSA-3 SN	RHR 898-18.20	208	N1
RHR-58		ANCHOR	RHR 875-6.8	205	4,B,N
RHR-580		SPRING	RHR 898-15.	208	N1
RHR-581		STRUT	RHR 898-18.20	208	N1
RHR-582		STRUT	RHR 867-31.37	204	N1
RHR-583		STRUT	RHR 867-31.37	204	N1
RHR-584		SPRING	RHR 867-31.37	204	N1
RHR-585		PSA-3 SN	RHR 867-31.37	204	N1
RHR-586		PSA-3 SN	RHR 867-31.37	204	N1
RHR-587		SPRING	RHR 867-24.25	204	N1
RHR-588		PSA-3 SN (2)	RHR 867-24.25	204	N1
RHR-589		PSA-3 SN	RHR 867-24.25	204	N1
RHR-59		PSA-10 SN	RHR 875-6.8	205	4,B,N
RHR-590		SPRING	RHR 867-24.25	204	N1
RHR-591		SPRING	RHR 867-28.30	204	N1
RHR-592		PSA-1/2 SN	RHR 867-28.30	204	N1
RHR-593		STRUT	RHR 867-28.30	204	N1
RHR-594		STRUT	RHR 867-28.30	204	N1
RHR-595		PSA-1 SN	RHR 867-28.30	204	N1
RHR-596		SPRING	RHR 867-28.30	204	N1
RHR-597		STRUT	RHR 867-28.30	204	N6
RHR-598		SPRING	RHR 867-13.15	201.1	4,B,N
RHR-599		PSA-3 SN	RHR 867-13.15	201.1	4,B,N
RHR-60		PSA-3 SN	RHR 875-6.8	205	4,B,N
RHR-600		STRUT	RHR 867-13.15	201.1	4,B,N
RHR-601		STRUT	RHR 867-13.15	201.1	4,B,N
RHR-603		PSA-3 SN (2)	RHR 867-8.12	201.1	4,B,N
RHR-604		SPRING (2)	RHR 867-8.12	201.1	4,B,N
RHR-605		STRUT	RHR 867-8.12	201.1	4,B,N
RHR-606		STRUT	RHR 867-8.12	201.1	4,B,N
RHR-607		SPRING	RHR 898-16.17	208	N1
RHR-608		SPRING	RHR 898-18.20	208	N1
RHR-609		SPRING	RHR 900-1.5	207.1	4,B
RHR-61		PSA-10 SN	RHR 875-6.8	205	4,B
RHR-611		SPRING	RHR 867-24.25	204	N1
RHR-612		SPRING	RHR 867-24.25	204	N1
RHR-62		SPRING	RHR 875-6.8	205	4,B,N

TABLE 1 -- COMPONENT SUPPORTS WITHIN PSI BOUNDARIES -- 21 JAN 1985

EQUIP PIECE NO	DESCRIPTION	ISOMETRIC DWG NO	ISO DWG NO	EXAMS
RHR-66	V-SPRING	RHR 875-1.5	205	4,B,N
RHR-67	PSA-3 SN	RHR 875-1.5	205	4,B,N
RHR-68	STRUT	RHR 875-1.5	205	4,B,N
RHR-69	STRUT	RHR 875-1.5	205	4,B,N
RHR-70	STRUT	RHR 875-1.5	205	4,B,N
RHR-71	ANCHOR	RHR 875-1.5	205	4,B,N
RHR-76	SPRING	RHR 875-1.5	205	4,B,N
RHR-77	SPRING (2)	RHR 875-1.5	205	4,B,N
RHR-78	SPRING	RHR 874-6	205	4,B,N
RHR-79	SPRING	RHR 875-9.12	209	4,B,N
RHR-80	STRUT	RHR 875-9.12	209	4,B,N
RHR-81	RIGID	RHR 875-9.12	209	4,B,N
RHR-84	ANCHOR	RHR 879-1.3	209	1
RHR-87	PSA-10 SN	RHR 897-19	210	N6
RHR-90	BOX	RHR 897-15.18	210	1
RHR-900N	STRUT	RHR 882-1.4	211	1
RHR-901N	PSA-3 SN (2)	RHR 976-1.4	207	N6
RHR-902N	PSA-3 SN	RHR 976-1.4	207	N6
RHR-903N	PSA-3 SN	RHR 976-7.8	207	1
RHR-904N	STRUT	RHR 879-1.3	209	1
RHR-905N	STRUT	RHR 882-1.4	211	1
RHR-907N	PSA-35 SN	RHR 899-38	102	N6
RHR-908N	PSA-3 SN (2)	RHR 899-12.17	207.7	4,B,N
RHR-909N	STRUT	RHR 881-1.3	205	1
RHR-91	STRUT	RHR 897-15.18	210	1
RHR-910N	STRUT	RHR 899-45	207.7	4,B,N
RHR-911N	PSA-10 SN	RHR 899-45	207.7	4,B,N
RHR-912N	PSA-3 SN	RHR 976-1.4	207	N6
RHR-913N	PSA-3 SN	RHR 976-1.4	207	1
RHR-915N	PSA-3 SN	RHR 976-1.4	207	N6
RHR-916N	OTHER	RHR 881-8.13	206	1
RHR-917N	SPRING (2)	RHR 875-13.16	205	4,B,N
RHR-918N	BOX	RHR 898-1.4	207.1	4,B,N
RHR-919N	BOX	RHR 898-1.4	207.1	4,B,N
RHR-920N	BOX	RHR 898-5.8	207.1	4,B,N
RHR-921N	BOX	RHR 898-5.8	207.1	4,B,N
RHR-922N	PSA-1 SN	RHR 898-36.38	207	1
RHR-923N	SPRING (2)	RHR 898-1.4	207.1	4,B,N
RHR-924N	SPRING (2)	RHR 898-5.8	207.1	4,B,N
RHR-925N	SPRING	RHR 898-36.38	207	1
RHR-926N	SPRING	RHR 898-1.4	207.1	4,B,N
RHR-927N	SPRING	RHR 898-36.38	207	1
RHR-928N	SPRING	RHR 898-36.38	207	N6
RHR-929N	SPRING	RHR 898-1.4	207.1	4,B,N
RHR-930N	STRUT	RHR 898-21.29	208	N1
RHR-933N	SPRING	RHR 898-30.32	208	N1
RHR-935N	SPRING	RHR 898-21.29	208	N1
RHR-936N	SPRING	RHR 898-21.29	208	N1
RHR-938N	PSA-1 SN (2)	RHR 898-21.29	208	N1

TABLE 1. -- COMPONENT SUPPORTS WITHIN PSI BOUNDARIES -- 21 JAN 1985

EQUIP. PIECE NO	DESCRIPTION	ISOMETRIC DWG NO	ISO DWG NO	EXAMS
*****	*****	*****	*****	*****
RHR-939N	PSA-3 SN	RHR 898-21.29	208	N1
RHR-94	STRUT	RHR 897-10.14	210	1
RHR-941N	PSA-3 SN	RHR 851-20.33	101	N6
RHR-942N	PSA-1 SN(2)	RHR 898-36.38	207	1
RHR-943N	PSA-3 SN	RHR 898-1.44	207.1	4,B
RHR-944N	PSA-3 SN	RHR 898-1.44	207.1	4,B
RHR-945N	PSA-1 SN(2)	RHR 898-36.38	207	1
RHR-946N	PSA-3 SNQ1	RHR 867-20.22	201	N6
RHR-947N	PSA-3 SN(2)	RHR 854-12.16	203	1
RHR-948N	PSA-3 SN(2)	RHR 854-12.16	203	1
RHR-949N	BOX	RHR 867-31.37	204	N1
RHR-95	SPRING	RHR 897-10.14	210	1
RHR-950N	BOX	RHR 867-31.37	204	N1
RHR-951N	BOX	RHR 867-38.39	204	N1
RHR-952N	PSA-3 SN	RHR 867-40.44	204	N1
RHR-953N	PSA-3 SN	RHR 867-38.39	204	N1
RHR-954N	PSA-1 SN(2)	RHR 867-40.44	204	N1
RHR-955N	BOX	RHR 867-40.44	204	N1
RHR-956N	BOX	RHR 899-5.7	207.7	4,B,N
RHR-957N	PSA-3 SN	RHR 898-21.29	208	N1
RHR-958N	ANCHOR	RHR 853-1.4	202	N6
RHR-96	BOX	RHR 897-10.14	210	1
RHR-960N	PSA-1 SN	RHR 898-21.29	208	N1
RHR-961N	PSA-3 SN	RHR 898-21.29	208	N1
RHR-963N	BOX	RHR 855-1.3	201	N6
RHR-964N	ANCHOR	RHR 851-10.12	201.6	4,B,N
RHR-965N	ANCHOR	RHR 851-18.19	201	N6
RHR-966N	ANCHOR	RHR 882-1.4	211	1
RHR-967N	ANCHOR	RHR 898-36.38	207	1
RHR-968N	ANCHOR	RHR 898-5.8	207.1	4,B,N
RHR-969N	ANCHOR	RHR 898-21.29	208	N1
RHR-97	BOX	RHR 897-10.14	210	1
RHR-970N	ANCHOR	RHR 867-8.12	201.1	4,B,N
RHR-971N	ANCHOR	RHR 867-16.19	201	1
RHR-972N	BOX	RHR 897-25.30	210	1
RHR-973N	ANCHOR	RHR 897-25.30	210	1
RHR-974N	PSA-3 SN	RHR 867-20.22	201	N6
RHR-975N	ANCHOR	RHR 867-31.37	204	N1
RHR-976N	STRUT	RHR 899-12.17	207.7	4,B,N
RHR-977N	PSA-1 SN(2)	RHR 867-40.44	204	N1
RHR-979N	STRUT	RHR 748-1.3	102(RCIC)	N6
RHR-98	STRUT	RHR 897-10.14	210	1
RHR-980N	PSA-3 SN	RHR 898-9.14	207.1	4,B,N
RHR-984N	SPRING	RHR 867-28.30	204	N1
RHR-985N	STRUT	RHR 898-18.20	208	N1
RHR-986N	PSA-1 SN	RHR 667-16.19	212	N1
RHR-987N	STRUT	RHR 667-16.19	212	N1
RHR-99	ANCHOR	RHR 897-10.14	210	1
RHR-990N	BOX	RHR 667-16.19	212	N1

TABLE 1 -- COMPONENT SUPPORTS WITHIN PSI BOUNDARIES 2- 21 JAN 1985

EQUIP PIECE NO	DESCRIPTION	ISOMETRIC DWG NO	ISO DWG NO	EXAMS
*****	*****	*****	*****	*****
RHR-996N	ANCHOR	RHR 897-15.18	210	1
RHR-997N	ANCHOR	RHR 897-6.9	210	1
RHR-998N	PSA-3 SN	RHR 978-1.4	207	N6
RHR-999N	STRUT	RHR 897-6.9	210	1
RHR-SA-32	PSA-10 SN(2)	RHR 851-17	105	4, A, B
RHR-SA-33	PSA-10 SN	RHR 851-17	105	4, A, B
RHR-SA-34	PSA-35 SN	RHR 851-17	105	4, A, B
RHR-SA-35	PSA-10	RHR 851-15.16	105	4, A, B
RHR-SA-36	PSA-10	RHR 851-15.16	105	4, A, B
RHR-SA-37	PSA-10	RHR 851-15.16	105	4, A, B
RHR-SA-38	PSA-10	RHR 851-15.16	105	4, A, B
RHR-SA-39	PSA-10 SN(2)	RHR 851-15.16	105	4, A, B
RHR-SA-40	PSA-10	RHR 851-15.16	105	4, A, B
RHR-SA-53	PSA-10 SN	RHR 874-1.3	104	4, A, B
RHR-SA-54	PSA-35 SN	RHR 874-1.3	104	4, A, B
RHR-SA-55	PSA-100 SN	RHR 874-1.3	104	4, A, B
RHR-SA-56	PSA-10 SN	RHR 874-1.3	104	4, A, B
RHR-SA-57	PSA-35 SN	RHR 874-1.3	104	4, A, B
RHR-SA-58	PSA-35 SN(2)	RHR 874-1.3	104	4, A, B
RHR-SA-59	PSA-35 SN	RHR 874-1.3	104	4, A, B
RHR-SB-32	PSA-10 SN	RHR 899-46.47	106	4, A, B
RHR-SB-33	PSA-10 SN	RHR 899-46.47	106	4, A, B
RHR-SB-34	PSA-10 SN(2)	RHR 899-46.47	106	4, A, B
RHR-SB-35	PSA-10 SN	RHR 899-46.47	106	4, A, B
RHR-SB-36	PSA-10 SN	RHR 899-46.47	106	4, A, B
RHR-SB-37	PSA-10 SN	RHR 899-46.47	106	4, A, B
RHR-SB-38	PSA-10 SN	RHR 899-46.47	106	4, A, B
RHR-SB-39	PSA-10 SN(2)	RHR 899-46.47	106	4, A, B
RHR-SB-40	PSA-10 SN	RHR 899-46.47	106	4, A, B
RRC-1	SPRING	RRC 565-1	105	4, A
RRC-10	SPRING (RRC)	RRC 568-1	106	4, A
RRC-11	SPRING	RHR 874-1.3	104 (RHR)	4, A, B
RRC-1C-1	PSA-1 SN(2)	RRC 564-1.3	104	4, A
RRC-1C-10	PSA-1 SN	RRC 569-1.2	109	4, A
RRC-1C-12	SPRING	RRC 564-1.3	104	4, A
RRC-1C-13	PSA-1 SN	RRC 566-1	108	4, A
RRC-1C-14	PSA-1 SN(2)	RRC 566-1	108	4, A
RRC-1C-15	PSA-1 SN	RRC 566-1	108	4, A
RRC-1C-2	PSA-1 SN	RRC 564-1.3	104	4, A
RRC-1C-3	PSA-1 SN	RRC 564-1.3	104	4, A
RRC-1C-4	PSA-1 1/2 SN(2)	RRC 564-1.3	104	4, A
RRC-1C-6PS	STRUT	RRC 569-1.2	109	4, A
RRC-1C-8PS	STRUT	RRC 566-1	108	4, A
RRC-1C-9	PSA-1 SN	RRC 569-1.2	109	4, A
RRC-1C-900N	PSA-1 SN(2)	RRC 564-1.3	104	4, A
RRC-2	C SPRING	RRC 566-1	108	4, A
RRC-3	SPRING	RRC 566-1	108	4, A
RRC-4	SPRING	RRC 566-1	108	4, A
RRC-6	C SPRING	RRC 569-1.2	109	4, A

TABLE 1 -- COMPONENTS SUPPORTS WITHIN PSI BOUNDARIES -- 21 JAN 1985

EQUIP	PIECE NO	DESCRIPTION	ISOMETRIC DWG NO	ISO DWG NO	EXAMS
	RRC-9	SPRING (RRC)	RRC 567-12	105	1,4,A
	RRC-900N	STRUT	BC/G 216-12	101.1	4,A
	RRC-901N	STRUT	BC/G 218-12	102.1	4,A
	RRC-HA-1	V SPRING (2)	BC/G 215-12	101.1	4,A
	RRC-HA-2	C SPRING	BC/G 216-12	101.1	4,A
	RRC-HA-3	C SPRING	BC/G 216-12	101.1	4,A
	RRC-HA-4	C SPRING	BC/G 216-12	101.1	4,A
	RRC-HA-5	C SPRING	BC/G 216-12	101.1	4,A
	RRC-HA-7	C SPRING	BC/G 216-12	101.1	4,A
	RRC-HA-8	SPRING	BC/G 216-12	101.1	4,A
	RRC-HA-9	SPRING	BC/G 216-12	101.1	4,A
	RRC-HB-1	V SPRING (2)	BC/G 217-12	102.1	4,A
	RRC-HB-2	C SPRING	BC/G 218-12	102.1	4,A
	RRC-HB-3	C SPRING	BC/G 218-12	102.1	4,A
	RRC-HB-4	C SPRING	BC/G 218-12	102.1	4,A
	RRC-HB-5	C SPRING	BC/G 218-12	102.3	4,A
	RRC-HB-7	C SPRING	BC/G 218-12	102.2	4,A
	RRC-HB-8	V SPRING	BC/G 218-12	102.3	4,A
	RRC-HB-9	V SPRING	BC/G 218-12	102.1	4,A
	RRC-RA-1	STRUT	BC/G 216-12	101.1	4,A
	RRC-RB-1	STRUT	BC/G 218-12	102.1	4,A
	RRC-SA-1	PSA-35 SN	BC/G 219-12	101.1	4,A
	RRC-SA-11	PSA-35 SN	BC/G 216-12	101.1	4,A
	RRC-SA-12	PSA-35 SN	BC/G 216-12	101.1	4,A
	RRC-SA-13	PSA-35 SN	BC/G 216-12	101.1	4,A
	RRC-SA-14	PSA-35 SN	BC/G 216-12	101.1	4,A
	RRC-SA-15	PSA-35 SN	BC/G 216-12	101.1	4,A
	RRC-SA-16	PSA-35 SN	BC/G 215-12	101.1	4,A
	RRC-SA-17	PSA-35 SN	BC/G 216-12	101.1	4,A
	RRC-SA-18	PSA-35 SN	BC/G 216-12	101.1	4,A
	RRC-SA-19	PSA-35 SN	BC/G 215-12	101.1	4,A
	RRC-SA-2	PSA-35 SN	BC/G 215-12	101.1	4,A
	RRC-SA-20	PSA-35 SN	BC/G 215-12	101.1	4,A
	RRC-SA-25	PSA-35 SN	BC/G 215-12	101.1	4,A
	RRC-SA-3	PSA-100 SN	BC/G 216-12	101.1	4,A
	RRC-SA-30	SN	RRC 567-12	106	4,A
	RRC-SA-31	SN	RRC 567-12	106	4,A
	RRC-SA-4	PSA-100 SN	BC/G 216-12	101.1	4,A
	RRC-SA-5	PSA-100 SN	BC/G 216-12	101.1	4,A
	RRC-SA-50	PSA-35 SN	RRC 565-12	304	4,A
	RRC-SA-51	PSA-35 SN	RRC 565-12	304	4,A
	RRC-SA-52	PSA-10 SN	RRC 565-12	304	4,A
	RRC-SA-6	PSA-100 SN	BC/G 216-12	101.1	4,A
	RRC-SA-65	PSA-35 SN	BC/G 216-12	101.1	4,A
	RRC-SA-66	PSA-35 SN	BC/G 216-12	101.1	4,A
	RRC-SA-7	PSA-35 SN	BC/G 216-12	101.1	4,A
	RRC-SA-8	PSA-35 SN	BC/G 216-12	101.1	4,A
	RRC-SA-9	PSA-35 SN	BC/G 216-12	101.1	4,A
	RRC-SB-1	PSA-35 SN	BC/G 217-12	102.1	4,A

TABLE 1 -- COMPONENT SUPPORTS WITHIN PSE BOUNDARIES -- 21 JAN 1985

EQUIP	PIECE NO	DESCRIPTION	ISOMETRIC DWG NO.	ISO DWG NO.	EXAMS
RRC-SB-11		PSA-35 SN 329	BC/G 218-422	102.3	4,A
RRC-SB-12		PSA-35 SN 329	BC/G 218-422	102.3	4,A
RRC-SB-13		PSA-35 SN 329	BC/G 218-422	102.3	4,A
RRC-SB-14		PSA-35 SN 329	BC/G 218-422	102.3	4,A
RRC-SB-15		PSA-35 SN 329	BC/G 218-422	102.2	4,A
RRC-SB-16		PSA-35 SN (2) 329	BC/G 217-422	102.1	4,A
RRC-SB-17		PSA-35 SN 329	BC/G 218-422	102.2	4,A
RRC-SB-18		PSA-35 SN 329	BC/G 218-422	102.2	4,A
RRC-SB-2		PSA-35 SN 329	BC/G 217-422	102.1	4,A
RRC-SB-25		PSA-35 SN 329	BC/G 217-422	102.1	4,A
RRC-SB-3		PSA-100 SN 329	BC/G 218-422	102.1	4,A
RRC-SB-30		SN 329	RRC 568-11	107.1	4,A
RRC-SB-31		SN 329	RRC 568-11	107.1	4,A
RRC-SB-4		PSA-100 SN 329	BC/G 218-422	102.1	4,A
RRC-SB-5		PSA-100 SN 329	BC/G 218-422	102.1	4,A
RRC-SB-6		PSA-100 SN 329	BC/G 217-422	102.1	4,A
RRC-SB-65		PSA-35 SN 329	BC/G 218-422	102.2	4,A
RRC-SB-66		PSA-35 SN 329	BC/G 218-422	102.1	4,A
RRC-SB-7		PSA-35 SN 329	BC/G 218-422	102.2	4,A
RRC-SB-8		PSA-35 SN 329	BC/G 218-422	102.2	4,A
RRC-SB-9		PSA-35 SN 329	BC/G 218-422	102.2	4,A
RWCU-139		SPRING 329	RWCU 812-3.7	101.4	4,B
RWCU-140		SPRING 329	RWCU 812-3.7	101.4	4,B
RWCU-141		SPRING 329	RWCU 812-3.7	101.4	4,B
RWCU-142		SPRING (2) 329	RWCU 812-2	101.3	4,B
RWCU-143		SPRING 329	RWCU 811-1.2	101.1	4,B
RWCU-144		SPRING 329	RWCU 811-1.2	101.1	4,B
RWCU-145		SPRING 329	RWCU 812-1.3	101.2	4,B
RWCU-146		C SPRING 329	RWCU 812-1	101.2	4,B
RWCU-168		PSA-174 SN (2)	RWCU 277-1.3	304.1	1
RWCU-169		PSA-172 SN 329	RWCU 277-1.3	304.1	1
RWCU-170		SPRING 329	RWCU 277-1.3	304.1	1
RWCU-172		SPRING 329	RWCU 894-14.21	302.2	4,B,N
RWCU-173		PSA-11 SN 329	RWCU 894-14.21	302.2	4,B,N
RWCU-174		SPRING 329	RWCU 894-14.21	302.2	4,B,N
RWCU-175		SPRING 329	RWCU 894-14.21	302.2	4,B,N
RWCU-176		BOX 329	RWCU 894-14.21	302.2	4,B,N
RWCU-177		C SPRING 329	RWCU 894-14.21	302.2	4,B,N
RWCU-178		C SPRING 329	RWCU 894-14.21	302.2	4,B,N
RWCU-179		STRUT 329	RWCU 894-14.21	302.2	4,B,N
RWCU-180		SPRING 329	RWCU 894-14.21	302.2	4,B,N
RWCU-181		ANCHOR 329	RWCU 894-14.21	302.2	4,B,N
RWCU-182		SPRING 329	RWCU 894-14.21	302.2	4,B,N
RWCU-183		BOX 329	RWCU 894-14.21	302.2	4,B,N
RWCU-184		STRUT 329	RWCU 894-14.21	302.2	4,B,N
RWCU-1C-1		PSA-35 SN 329	RWCU 812-3.7	101.4	4,B
RWCU-1C-11		PSA-35 SN 329	RWCU 812-1	101.2	4,B
RWCU-1C-12		PSA-35 SN 329	RWCU 812-1	101.2	4,B
RWCU-1C-16		PSA-11 SN 329	RWCU 811-1.2	101.1	4,B

TABLE 1 -- COMPONENT SUPPORTS WITHIN PSI BOUNDARIES -- 21 JAN 1985

EQUIP. PIECE NO	DESCRIPTION	ISOMETRIC DWG NO	ISO DWG NO	EXAMS
RWCU-1C-17	PSA-1 SN(2)	RWCU 811-1.2	101.1	4,B
RWCU-1C-1PS	ANCHOR PIPE WH	RWCU 812-3.7	101.4	4,B
RWCU-1C-2	PSA-1 SN	RWCU 812-3.7	101.4	4,B
RWCU-1C-2PS	STRUT	RWCU 812-3.7	101.4	4,B
RWCU-1C-3	PSA-3 SN(2)	RWCU 812-3.7	101.4	4,B
RWCU-1C-3PS	STRUT	RWCU 812-2	101.3	4,B
RWCU-1C-4	PSA-3 SN	RWCU 812-3.7	101.4	4,B
RWCU-1C-4PS	STRUT	RWCU 812-2	101.3	4,B
RWCU-1C-5	PSA-3 SNG1	RWCU 812-2	101.3	4,B
RWCU-1C-5PS	STRUT	RWCU 812-2	101.3	4,B
RWCU-1C-6	PSA-3 SNG1	RWCU 812-2	101.3	4,B
RWCU-1C-7	PSA-3 SN	RWCU 812-1	101.2	4,B
RWCU-1C-7PS	STRUT	RWCU 812-1	101.2	4,B
RWCU-1C-8	PSA-3 SN	RWCU 812-1	101.3	4,B
RWCU-1C-9PS	STRUT	RWCU 811-1.2	101.1	4,B
RWCU-210	SPRING	RWCU 895-1.7	303	4,B,N
RWCU-211	PSA-1/2 SN	RWCU 895-1.7	303	4,B,N
RWCU-212	V-SPRING	RWCU 895-1.7	303	4,B,N
RWCU-213	STRUT	RWCU 895-1.7	303	4,B,N
RWCU-214	V-SPRING	RWCU 895-1.7	303	4,B,N
RWCU-215	BOX	RWCU 895-1.7	303	4,B,N
RWCU-216	V-SPRING	RWCU 895-1.7	303	4,B,N
RWCU-217	BOX	RWCU 895-1.7	303	4,B,N
RWCU-218	V-SPRING	RWCU 895-1.7	303	4,B,N
RWCU-219	BOX	RWCU 895-1.7	303	4,B,N
RWCU-220	SPRING	RWCU 895-1.7	303	4,B,N
RWCU-221	BOX	RWCU 895-8.12	303	4,B,N
RWCU-222	PSA-1/4 SN(2)	RWCU 895-8.12	303	4,B,N
RWCU-223	BOX	RWCU 895-8.12	303	4,B,N
RWCU-225	STRUT	RWCU 895-8.12	303	4,B,N
RWCU-227	BOX	RWCU 895-8.12	303	4,B,N
RWCU-228	SPRING	RWCU 895-8.12	303	4,B,N
RWCU-229	PSA-3 SN	RWCU 895-8.12	303	4,B,N
RWCU-230	V-SPRING	RWCU 895-1.7	303	4,B,N
RWCU-239	OTHER	RWCU 278-30.35	304	1
RWCU-240	STRUT	RWCU 278-30.35	304	1
RWCU-241	STRUT	RWCU 278-30.35	304	1
RWCU-242	BOX	RWCU 278-30.35	304	1
RWCU-243	STRUT	RWCU 278-30.35	304	1
RWCU-247		RWCU	304	1
RWCU-248		RWCU	304	1
RWCU-249		RWCU	304	1
RWCU-250		RWCU	304	1
RWCU-251	BOX	RWCU 278-25.29	304	1
RWCU-252	BOX	RWCU 278-25.29	304	1
RWCU-253	BOX	RWCU 278-25.29	304	1
RWCU-254	BOX	RWCU 278-25.29	304	1
RWCU-255	BOX	RWCU 278-25.29	304	1
RWCU-256	ANCHOR	RWCU 278-25.29	304	1

TABLE 1 -- COMPONENT SUPPORTS WITHIN PSI BOUNDARIES -- 21 JAN 1985

EQUIP PIECE NO.	DESCRIPTION	ISOMETRIC DWG NO	ISO DWG NO	EXAMS
RWCU-257	OTHER	RWCU 278-30.35	304	1
RWCU-258	U-BOLT	RWCU 278-30.35	304	1
RWCU-259	PSA-1/2 SN	RWCU 278-30.35	304	1
RWCU-260	BOX	RWCU 278-30.35	304	1
RWCU-261	SPRING	RWCU 278-30.35	304	1
RWCU-262	SPRING	RWCU 278-30.35	304	1
RWCU-263	SPRING	RWCU 278-25.29	304	1
RWCU-264		RWCU	304	1
RWCU-266	SPRING	RWCU 278-25.29	304	1
RWCU-268	SPRING	RWCU 278-30.35	304	1
RWCU-269	SPRING	RWCU 699-1.4	304	1
RWCU-270	BOX	RWCU 699-1.4	304	1
RWCU-272	SPRING	RWCU 699-5.7	305	1
RWCU-900N	PSA-3 SN(2) Q1	RWCU 812-8.13	301	4, B, N
RWCU-901N	ANCHOR	RWCU 895-8.12	303	4, B, N
RWCU-904N	PSA-1/2 SN(2)	RWCU 895-1.7	303	4, B, N
RWCU-905N	STRUT	RWCU 894-14.21	302.2	4, B, N
RWCU-906N	PSA-1/4 SN	RWCU 894-14.21	302.2	4, B, N
RWCU-907N	PSA-1/4 SN(2)	RWCU 894-14.21	302.2	4, B, N
RWCU-908N	PSA-1/4 SN(2)	RWCU 894-14.21	302.2	4, B, N
RWCU-912N	PSA-1/4 SN(3)	RWCU 895-1.7	303	4, B, N
RWCU-913N	PSA-1 SN	RWCU 895-1.7	303	4, B, N
RWCU-914N	PSA-1 SN	RWCU 895-1.7	303	4, B, N
RWCU-915N	PSA-1/2 SN	RWCU 895-1.7	303	4, B, N
RWCU-916N	PSA-1/2 SN(2)	RWCU 895-1.7	303	4, B, N
RWCU-917N	PSA-3 SN	RWCU 894-14.21	302.2	4, B, N
RWCU-925N	PSA-1/4 SN	RWCU 812-8.13	301	4, B, N
RWCU-926N	PSA-35 SN	RWCU 812-8.13	301	4, B, N
RWCU-927N	PSA-35 SN	RWCU 812-8.13	301	4, B, N
RWCU-928N	PSA-10 SMOQ1	RWCU 812-8.13	301	4, B, N
RWCU-949N	PSA-1 SN(2)	RWCU 278-22.24	304	1
RWCU-950N	PSA-1/2 SN	RWCU 278-22.24	304	1
RWCU-969N	V-SPRING	RWCU 895-1.7	303	4, B, N
SW-1	BOX	SW 291-1.6	301	1
SW-10	BOX	SW 292-1.5	----	1
SW-11	BOX	SW 292-1.5	----	1
SW-118	SPRING	SW 251-34.35	305	1
SW-119	SPRING	SW 251-30.33	----	1
SW-12	BOX	SW 292-1.5	----	1
SW-120	BOX	SW 250-41.50	301	1
SW-121	SPRING	SW 250-41.50	301	1
SW-122	SPRING	SW 250-52.54	301	1
SW-123	OTHER	SW 250-52.54	301	1
SW-124	PSA-35 SN(2)	SW 250-52.54	301	1
SW-126	STRUT	SW 250-31.40	301	1
SW-127	STRUT	SW 296-33.36	303	1
SW-128	BOX	SW 296-27.32	303	1
SW-129	BOX	SW 296-27.32	303	1
SW-13	BOX	SW 290-1.3	309	1

TABLE 1 -- COMPONENT SUPPORTS WITHIN PSI BOUNDARIES -- 21 JAN 1985

EQUIP. PIECE NO	DESCRIPTION	ISOMETRIC DWG NO	ISO DWG NO	EXAMS
*****	*****	*****	*****	*****
SW-130	OTHER	SW 296-27.32	303	1
SW-131	BOX	SW 296-27.32	303	1
SW-132	STRUT	SW 296-27.32	303	1
SW-133	STRUT	SW 296-17.26	303	1
SW-134	STRUT	SW 296-17.26	303	1
SW-135	STRUT	SW 296-17.26	303	1
SW-136	BOX	SW 296-17.26	303	1
SW-137	OTHER	SW 296-17.26	303	1
SW-138	BOX	SW 296-17.26	303	1
SW-139	STRUT	SW 296-17.26	303	1
SW-140	BOX	SW 296-17.26	303	1
SW-141	STRUT	SW 296-17.26	303	1
SW-142	OTHER	SW 296-17.26	303	1
SW-143	STRUT	SW 296-7.16	303	1
SW-144	BOX	SW 296-7.16	303	1
SW-145	BOX	SW 296-7.16	303	1
SW-146	STRUT	SW 296-7.16	303	1
SW-147	BOX	SW 296-7.16	303	1
SW-148	SPRING	SW 296-7.16	303	1
SW-149	BOX	SW 296-7.16	303	1
SW-150	SPRING	SW 296-7.16	303	1
SW-151	STRUT	SW 296-1.5	303	1
SW-152	OTHER	SW 296-1.5	303	1
SW-153	BOX	SW 296-1.5	303	1
SW-154	STRUT	SW 296-1.5	303	1
SW-155	BOX	SW 296-1.5	303	1
SW-156	STRUT	SW 296-1.5	303	1
SW-171	STRUT	SW 250-31.40	301	1
SW-172	STRUT	SW 250-25.30	301	1
SW-173	STRUT	SW 250-31.40	301	1
SW-174	BOX	SW 250-1.3	301	1
SW-179	STRUT	SW 251-30.33	----	1
SW-180	STRUT	SW 295-7.11	307	1
SW-19	BOX	SW 295-39.42	307	1
SW-194	STRUT	SW 251-30.33	----	1
SW-195	BOX	SW 295-7.11	307	1
SW-196	STRUT	SW 251-34.35	305	1
SW-197	BOX	SW 295-4.6	307	1
SW-198	BOX	SW 251-1.3	----	1
SW-2	BOX	SW 291-1.6	301	1
SW-20	BOX	SW 296-54.57	303	1
SW-200	STRUT	SW 251-41.50	----	1
SW-201	STRUT	SW 251-41.50	----	1
SW-202	STRUT	SW 251-41.50	----	1
SW-203	OTHER	SW 291-1.6	----	1
SW-205	STRUT	SW 291-1.6	----	1
SW-207	STRUT	SW 296-17.26	303	1
SW-208	STRUT	SW 296-7.16	303	1
SW-21	PSA-3 SN	SW 322-1.2	305	1

TABLE 1 -- COMPONENT SUPPORTS WITHIN PSI BOUNDARIES -- 21 JAN 1985

EQUIP PIECE NO	DESCRIPTION	ISOMETRIC DWG NO	ISO DWG NO	EXAMS
*****	*****	*****	*****	*****
SW-212	BOX	SW 296-6	303	1
SW-22	SPRING	SW 322-1.2	305	1
SW-227	STRUT	SW 296-27.32	303	1
SW-228	STRUT	SW 296-7.16	303	1
SW-229	STRUT	SW 296-7.16	303	1
SW-23	SPRING	SW 251-36.37	305	1
SW-230	BOX	SW 296-27.32	303	1
SW-231	BOX	SW 300-4.9	302	1
SW-232	BOX	SW 300-4.9	302	1
SW-233	BOX	SW 300-4.9	302	1
SW-234	BOX	SW 300-4.9	302	1
SW-235	BOX	SW 300-4.9	302	1
SW-236	BOX	SW 300-4.9	302	1
SW-237	BOX	SW 300-1.3	302	1
SW-24	OTHER	SW 251-36.37	305	1
SW-243	OTHER	SW 300-1.3	302	1
SW-25	OTHER	SW 251-34.35	305	1
SW-251	BOX	SW 283-1.5	308	1
SW-252	BOX	SW 283-1.5	308	1
SW-253	BOX	SW 283-1.5	308	1
SW-254	BOX	SW 283-1.5	308	1
SW-255	BOX	SW 283-1.5	308	1
SW-256	BOX	SW 283-1.5	308	1
SW-257	BOX	SW 283-1.5	308	1
SW-258	BOX	SW 283-6	308	1
SW-259	BOX	SW 283-6	308	1
SW-26	BOX	SW 251-34.35	305	1
SW-266	BOX	SW 293-3.8	306	1
SW-267	BOX	SW 293-3.8	306	1
SW-268	BOX	SW 250-21.24	301	1
SW-269	BOX	SW 300-1.3	302	1
SW-27	STRUT	SW 251-30.33	305	1
SW-270	BOX	SW 300-4.9	302	1
SW-273	BOX	SW 290-21.23	310	1
SW-28	STRUT	SW 251-30.33	305	1
SW-280	STRUT	SW 290-24.29	310	1
SW-282	BOX	SW 112-7.9	311	1
SW-29	PSA-10, SN(4)	SW 251-30.33	305	1
SW-291	BOX	SW 112-7.9	311	1
SW-292	BOX	SW 293-3.8	306	1
SW-293	BOX	SW 293-3.8	306	1
SW-294	BOX	SW 293-3.8	306	1
SW-3	BOX	SW 291-1.6	301	1
SW-30	STRUT	SW 251-30.33	305	1
SW-301	BOX	SW 293-1.2	306	1
SW-302	BOX	SW 293-1.2	306	1
SW-303	BOX	SW 293-1.2	306	1
SW-304	BOX	SW 295-19.22	307	1
SW-306	BOX	SW 293-3.8	306	1

TABLE 14-- COMPONENT SUPPORTS WITHIN PSI BOUNDARIES -- 21 JAN 1985

EQUIP	PIECE NO	DESCRIPTION	ISOMETRIC	DWG NO	ISO DWG NO	EXAMS
SW-307		BOX	SW	293-3.8	306	1
SW-308		BOX	SW	293-3.8	306	1
SW-31		BOX	SW	251-30.33	305	1
SW-310		BOX	SW	290-24.29	310	1
SW-312		BOX	SW	293-12.70	306	1
SW-315		STRUT	SW	296-27.32	303	1
SW-317		RIGID	SW	250-31.40	301	1
SW-318		STRUT	SW	250-25.30	301	1
SW-319		STRUT	SW	250-25.30	301	1
SW-32		BOX	SW	251-23.29	305	1
SW-33		BOX	SW	251-23.29	305	1
SW-34		OTHER	SW	251-23.29	305	1
SW-348		BOX	SW	304-1.5	----	1
SW-349		BOX	SW	304-1.5	----	1
SW-35		STRUT	SW	251-23.29	305	1
SW-350		BOX	SW	304-1.5	----	1
SW-351		BOX	SW	304-1.5	----	1
SW-352		BOX	SW	304-1.5	----	1
SW-353		BOX	SW	304-1.5	----	1
SW-354		BOX	SW	304-6.0	----	1
SW-355		BOX	SW	304-6.0-U	----	1
SW-356		BOX	SW	304-1.5	----	1
SW-357		BOX	SW	304-1.5	----	1
SW-358		BOX	SW	304-1.5	----	1
SW-36		OTHER	SW	251-19.22	306	1
SW-386		STRUT	SW	295-4.6	307	1
SW-4		BOX	SW	291-11.6	301	1
SW-426		BOX	SW	304-6.0	----	1
SW-430		STRUT	SW	250-41.50	301	1
SW-431		OTHER	SW	296-7.16	303	1
SW-432		STRUT	SW	296-17.26	303	1
SW-433		BOX	SW	296-17.26	303	1
SW-434		BOX	SW	250-41.50	301	1
SW-435		BOX	SW	250-31.40	301	1
SW-436		STRUT	SW	250-25.30	301	1
SW-437		STRUT	SW	250-25.30	301	1
SW-438		OTHER	SW	296-17.26	303	1
SW-439		OTHER	SW	296-33.36	303	1
SW-449		OTHER	SW	290-24.29	310	1
SW-57		OTHER	SW	250-21.24	302	1
SW-58		BOX	SW	250-25.30	301	1
SW-59		BOX	SW	250-25.30	301	1
SW-6		BOX	SW	295-39.42	307	1
SW-60		OTHER	SW	250-25.30	301	1
SW-61		STRUT	SW	250-25.30	301	1
SW-62		STRUT	SW	250-25.30	301	1
SW-63		BOX	SW	250-31.40	301	1
SW-64		BOX	SW	250-31.40	301	1
SW-65		STRUT	SW	250-31.40	301	1

TABLE 1 -- COMPONENT SUPPORTS WITHIN PSI BOUNDARIES -- 21 JAN 1985

EQUIP	PIECE NO	DESCRIPTION	ISOMETRIC DWG NO	ISO DWG NO	EXAMS
SW-66		BOX	SW 250-31.40	301	1
SW-67		OTHER	SW 250-31.40	301	1
SW-68		BOX	SW 250-31.40	301	1
SW-69		OTHER	SW 250-31.40	301	1
SW-7		BOX	SW 295-39.42	307	1
SW-70		STRUT	SW 250-31.40	301	1
SW-71		STRUT	SW 250-31.40	301	1
SW-72		OTHER	SW 250-31.40	301	1
SW-73		STRUT	SW 250-41.50	301	1
SW-74		STRUT	SW 250-41.50	301	1
SW-75		OTHER	SW 250-41.50	301	1
SW-76		STRUT	SW 250-41.50	301	1
SW-77		BOX	SW 250-41.50	301	1
SW-78		SPRING	SW 250-41.50	301	1
SW-79		STRUT	SW 295-1.3	307	1
SW-8		BOX	SW 296-49.53	303	1
SW-80		BOX	SW 295-1.3	307	1
SW-81		BOX	SW 295-1.3	307	1
SW-83		U-BOLT	SW 295-4.6	307	1
SW-84		U-BOLT	SW 295-7.11	307	1
SW-86		STRUT	SW 295-7.11	307	1
SW-87		BOX	SW 295-7.11	307	1
SW-88		BOX	SW 295-12.16	307	1
SW-89		BOX	SW 295-12.18	307	1
SW-9		BOX	SW 295-54.57	303	1
SW-90		OTHER	SW 295-12.18	307	1
SW-91		STRUT	SW 295-19.22	307	1
SW-913N		STRUT	SW 250-25.30	301	1
SW-914N		PSA-IG-SN(2)	SW 295-4.6	307	1
SW-915N		PSA-IG-SN(2)	SW 295-7.11	307	1
SW-916N		OTHER	SW 295-4.6	307	1
SW-917N		SPRING	SW 295-4.6	307	1
SW-918N		STRUT	SW 296-54.57	303	1
SW-919N		BOX	M200 707	307	1
SW-92		OTHER	SW 295-19.22	307	1
SW-920N		BOX	M200 707	307	1
SW-921N		BOX	M200 707	307	1
SW-922N		BOX	M200 707	307	1
SW-923N		BOX	M200 707	307	1
SW-924N		BOX	M200 707	307	1
SW-925N		BOX	M200 707	307	1
SW-926N		BOX	M200 707	307	1
SW-927N		BOX	M200 707	307	1
SW-928N		BOX	M200 707	307	1
SW-929N		BOX	M200 707	307	1
SW-930N		BOX	M200 707	307	1
SW-931N		BOX	M200 707	307	1
SW-932N		BOX	M200 707	307	1
SW-933N		BOX	M200 707	307	1

TABLE 1 -- COMPONENT SUPPORTS WITHIN PSI BOUNDARIES -- 21 JAN 1985

EQUIP	PIECE NO	DESCRIPTION	ISOMETRIC DWG NO	ISO DWG NO	EXAMS
SW-934N		SN	M200 707	307	1
SW-935N		BOX	M200 707	307	1
SW-936N		BOX	M200 707	307	1
SW-937N		SN	M200 707	307	1
SW-938N		BOX	M200 707	307	1
SW-939N		BOX	M200 707	307	1
SW-940N		BOX	M200 707	307	1
SW-941N		BOX	M200 707	307	1
SW-942N		STRUT	SW 250-31.40	301	1
SW-943N		STRUT	SW 295-39.42	307	1
SW-946N		RIGID	SW 251-38.64	314	1
SW-948N		RIGID	SW 295-43.63	315	1
SW-949N		RIGID	SW		1
SW-950N		RIGID	SW 295-43.63	315	1
SW-951N		RIGID	SW 251-38.64	314	1
SW-953N		RIGID	SW 251-38.64	314	1
SW-954N		RIGID	SW 251-38.64	314	1
SW-955N		RIGID	SW 296-58.77	313	1
SW-956N		RIGID	SW 296-58.77	313	1
SW-957N		RIGID	SW 296-58.77	313	1
SW-958N		RIGID	SW 296-58.77	313	1
SW-959N		RIGID	SW 296-58.77	313	1
SW-960N		RIGID	SW 296-58.77	313	1
SW-961N		RIGID	SW 250-55.75	312	1
SW-962N		RIGID	SW 250-55.75	312	1
SW-963N		RIGID	SW 250-55.75	312	1
SW-964N		RIGID	SW 250-55.75	312	1
SW-965N		RIGID	SW 250-55.75	312	1
SW-966N		RIGID	SW 250-55.75	312	1
SW-982N		ANCHOR	SW 500-11.5	312	1
SW-983N		ANCHOR	SW 501-11.10	314	1
SW-984N		RIGID	SW 502-11.3	313	1
SW-985N		RIGID	SW 503-11.3	315	1
SW-986N		RIGID	SW 500-11.5	312	1
SW-987N		PSA=3 SN(2)	SW 250-41.50	301	1

TOTAL COUNT = 1848

TABLE 2 -- LIST OF ADDITIONAL SAFETY RELATED SNUBBERS
OUTSIDE PSI BOUNDARIES -- AS OF 21 JAN 1985

EQUIP PIECE NO	DESCRIPTION	ISOMETRIC DWG NO	ISO DWG NO	EXAMS
CEP-905S	PSA-1/2 SN		QC-1-SN	1
CEP-908N	PSA-3 SN	CEP 625-5.8	+ QC-1-SN	1
COND-862	PSA-1/2 SN(2)	COND 364-5.10	+ QC-1-SN	1
COND-863	PSA-1 SN	COND 364-5.10	+ QC-1-SN	1
COND-880	PSA-3 SN(2)	COND 361-7.11	+ QC-1-SN	1
COND-957N	PSA-1 SN	COND 363-1.3	+ QC-1-SN	1
DE-2	PSA-3 SN	DE 797-1.5	+ QC-1-SN	4, B, N
DE-23	PSAS-3 SN	DE 065-1.19	+ QC-1-SN	4, B, N
DE-2836-15	PSA-1/2 SN	DE 2836-1	+ QC-1-SN	4, B, N
DE-2837-17	PSA-1/4 SN	DE 2837-1	+ QC-1-SN	4, B, N
DE-2838-18	PSA-1/4 SN	DE 2838-1	+ QC-1-SN	4, B, N
DE-2839-14	PSA-1/4 SN	DE 2839-1	+ QC-1-SN	4, B, N
DE-3	PSA-3 SN(2)	DE 797-1.5	+ QC-1-SN	4, B, N
DE-49	PSA-3 SN	DE 064-1.19	+ QC-1-SN	4, B, N
DE-57	PSA-3 SN	DE 062-1.19	+ QC-1-SN	4, B, N
DE-59	PSA-3 SN	DE 063-1.19	+ QC-1-SN	4, B, N
DE-902N	PSA-1 SN(2)	DE 797-1.5	+ QC-1-SN	4, B, N
EDR-903N	PSA-1/4 SNQ1	EDE 526-7.9	+ QC-1-SN	1
EDR-904N	PSA-1/4 SNQ1	EDE 526-7.9	+ QC-1-SN	1
EDR-905N	PSA-1/4 SNQ1	EDE 526-7.9	+ QC-1-SN	1
EDR-906N	PSA-1/4 SNQ1	EDE 526-7.9	+ QC-1-SN	1
FDR-900N	PSA-1 SNQ1	FDR 527-7.9	+ QC-1-SN	1
FDR-901N	PSA-1/4 SNQ1	FDR 527-7.9	+ QC-1-SN	1
FDR-902N	PSA-1 SNQ1	FDR 527-7.9	+ QC-1-SN	1
FDR-903N	PSA-3 SN(2)	FDR 527-7.9	+ QC-1-SN	1
HY-4235-11	PSA-1/4 SN	HY 4235-1	+ QC-1-SN	1
HY-4236-11	PSA-1/4 SN	HY 4236-1	+ QC-1-SN	1
HY-4237-11	PSA-1/4 SN	HY 4237-1	+ QC-1-SN	1
MD-1285-11B	PSA-1/4 SN	MD 1285-1	+ QC-1-SN	1
MD-1285-14A	PSA-1/4 SN	MD 1285-1	+ QC-1-SN	1
MD-1285-14C	PSA-1/4 SN	MD 1285-1	+ QC-1-SN	1
MD-1285-14D	PSA-1/2 SN	MD 1285-1	+ QC-1-SN	1
MD-1287-11	PSA-1/4 SN	MD 1287-1	+ QC-1-SN	1
MD-1287-15	PSA-1 SN	MD 1287-1	+ QC-1-SN	1
MD-1288-17	PSA-1/2 SN	MD 1288-1	+ QC-1-SN	1
MD-1290-11B	PSA-1/4 SN	MD 1290-1	+ QC-1-SN	1
MD-74	PSA-1/2 SN	MD 580-1.2	+ QC-1-SN	1
MS-1011S	PSA-1/4 SN	MS 531-12	+ QC-1-SN	4, A
MS-1012S	PSA-1/4 SN	MS 531-12	+ QC-1-SN	4, A
MS-1013S	PSA-1/4 SN	MS 528-13	+ QC-1-SN	4, A
MS-1014S	PSA-1/4 SN	MS 528-13	+ QC-1-SN	4, A
MS-1015S	PSA-1/4 SN	MS 530-12	+ QC-1-SN	4, A
MS-1016S	PSA-1/4 SN	MS 529-13	+ QC-1-SN	4, A
MS-255	PSA-1 SN	MS 582-5	+ QC-1-SN	4, A
MS-256	PSA-3 SN(2)	MS 582-5	+ QC-1-SN	4, A
MS-2619-11	PSA-1/4 SNQ1	MS 2619-1	+ QC-1-SN	4, A
MS-2619-12	PSA-1/4 SNQ1	MS 2619-1	+ QC-1-SN	4, A
MS-4448-12	PSA-1/4 SN	MS 4448-1	+ QC-1-SN	4, A

TABLE 2 -- LIST OF ADDITIONAL SAFETY RELATED SNUBBERS
OUTSIDE PSI BOUNDARIES -- AS OF 21 JAN 1985

EQUIP PIECE NO	DESCRIPTION	ISOMETRIC DWG NO	ISO DWG NO	EXAMS
MS-4448-411	PSA-1/4 SN	MS 4448-4	QC-1-SN	4,A
MS-4448-413	PSA-1/4 SN	MS 4448-4	+ QC-1-SN	4,A
MS-4448-46	PSA-1/4 SN	MS 4448-4	+ QC-1-SN	4,A
MS-954N	PSA-3 SN	MS 582-5	+ QC-1-SN	4,A
MSLC-2821-12	PSA-1/2 SN(2)	MSLC 2821-1	+ QC-1-SN	4,A
MSLC-2821-22	PSA-1 SN	MSLC 2821-2	+ QC-1-SN	4,A
MSLC-2822-12	PSA-1/2 SN	MSLC 2822-1	+ QC-1-SN	4,A
RCC-177	PSA-3 SN	RCC 826-4.5	+ QC-1-SN	1
RCC-4505-13	PSA-1/4 SN	RCC 4505-1	+ QC-1-SN	1
RCC-4505-15	PSA-1/2 SN	RCC 4505-1	+ QC-1-SN	1
RCC-4505-17	PSA-1/2 SN	RCC 4505-1	+ QC-1-SN	1
RCC-915N	PSA-1 SN	RCC 830-7	+ QC-1-SN	1
RCIC-1490-13	PSA-1/2 SN	RCIC 1490-1	+ QC-1-SN	1
RHR-10	PSA-1 SN	RHR 883-34.38	+ QC-1-SN	1
RHR-20	PSA-1/2 SN	RHR 883-34.38	+ QC-1-SN	1
RHR-200	PSA-1/2 SN	RHR 977-1.2	+ QC-1-SN	1
RHR-206	PSA-1/2 SN	RHR 883-16.19	+ QC-1-SN	1
RHR-210	PSA-1/2 SN	RHR 883-16.19	+ QC-1-SN	1
RHR-214	PSA-1/2 SN	RHR 883-16.19	+ QC-1-SN	1
RHR-2264-11	PSA-1/4 SN	RHR 2264-1	+ QC-1-SN	4,B
RHR-2264-21	PSA-1/4 SN	RHR 2264-2	+ QC-1-SN	4,B
RHR-2264-22	PSA-1 SN	RHR 2264-2	+ QC-1-SN	4,B
RHR-23	PSA-1/4 SN(2)	RHR 883-34.38	+ QC-1-SN	1
RHR-290	PSA-1/2 SN	RHR 883-20.22	+ QC-1-SN	1
RHR-325	PSA-1/2 SN	RHR 667-3.7	+ QC-1-SN	1
RHR-326	PSA-1/4 SN(2)	RHR 667-3.7	+ QC-1-SN	1
RHR-332	PSA-1 SN	RHR 667-3.7	+ QC-1-SN	1
RHR-333	PSA-1 SN	RHR 667-3.7	+ QC-1-SN	1
RHR-334	PSA-1/4 SN	RHR 667-3.7	+ QC-1-SN	1
RHR-373	PSA-1 SN	RHR 667-8.12	+ QC-1-SN	1
RHR-400	PSA-1/2 SN	RHR 667-22.23	+ QC-1-SN	1
RHR-401	PSA-1/2 SN	RHR 667-22.23	+ QC-1-SN	1
RHR-403	PSA-1 SN	RHR 899-33.35	+ QC-1-SN	1
RHR-441	PSA-1/2 SN	RHR 899-23.26	+ QC-1-SN	1
RHR-442	PSA-1/2 SN	RHR 899-23.26	+ QC-1-SN	1
RHR-443	PSA-1/2 SN	RHR 899-23.26	+ QC-1-SN	1
RHR-448	PSA-1/2 SN	RHR 899-27.32	+ QC-1-SN	1
RHR-449	PSA-1/4 SN(2)	RHR 899-27.32	+ QC-1-SN	1
RHR-453	PSA-1/4 SN	RHR 899-27.32	+ QC-1-SN	1
RHR-454	PSA-1/2 SN	RHR 899-27.32	+ QC-1-SN	1
RHR-4605-41A	PSA-1/4 SN	RHR 4605-4	+ QC-1-SN	4,B
RHR-9	PSA-1/2 SN	RHR 883-26.29	+ QC-1-SN	1
RHR-906N	PSA-3 SN(2)	RHR 898-33	+ QC-1-SN	N1
RHR-914N	PSA-10 SN	RHR 898-36.38	+ QC-1-SN	1
RHR-940N	PSA-1 SN(2)	RHR 898-34.35	+ QC-1-SN	N1
RHR-959N	PSA-1 SN(2)	RHR 898-34.35	+ QC-1-SN	N1
RHR-962N	PSA-3 SN	RHR 898-33	+ QC-1-SN	N1
RHR-983N	PSA-1/4 SNQ1	RHR 667-8.12	+ QC-1-SN	1

TABLE 2 -- LIST OF ADDITIONAL SAFETY RELATED SNUBBERS
OUTSIDE PSI BOUNDARIES -- AS OF 21 JAN 1985

EQUIP PIECE NO.	DESCRIPTION	ISOMETRIC DWG NO	ISO DWG NO	EXAMS
RHR-993N	PSA-1 SN	RHR 883-16.19	+ QC-1-SN	1
RRC-1549-62	PSA-1/4 SN	RRC 1549-6	+ QC-1-SN	4 A
RRC-1552-12	PSA-1/4 SN	RRC 1552-1	+ QC-1-SN	4 A
RRC-1946-31	PSA-1/4 SN	RRC 1946-3	+ QC-1-SN	4 A
RRC-1946-32	PSA-1/4 SN	RRC 1946-3	+ QC-1-SN	4 A
RRC-4470-31	PSA-1 SN	RRC 4470-3	+ QC-1-SN	4 A
SGT-11	PSA-1/2 SN(2)	SGT 624-6.7	+ QC-1-SN	4 A
SGT-19	PSA-3 SN	SGT 623-4.7	+ QC-1-SN	N6
SGT-23	PSA-3 SN(2)	SGT 624-5	+ QC-1-SN	4 A
SLC-4453-68	PSA-1/4 SN	SLC 4453-6	+ QC-1-SN	1
SLC-4453-69	PSA-1/4 SN	SLC 4453-6	+ QC-1-SN	1
SLC-4475-112	PSA-1/4 SN	SLC 4475-11	+ QC-1-SN	1
SLC-4475-113	PSA-1/2 SN	SLC 4475-11	+ QC-1-SN	1
SLC-4475-114	PSA-1 SN	SLC 4475-11	+ QC-1-SN	1
SLC-4475-116	PSA-1 SN	SLC 4475-11	+ QC-1-SN	1
SLC-4475-117	PSA-1/2 SN	SLC 4475-11	+ QC-1-SN	1
SLC-4475-12	PSA-1/4 SN	SLC 4475-11	+ QC-1-SN	1
SLC-4475-120	PSA-1 SN	SLC 4475-12	+ QC-1-SN	1
SLC-4475-122	PSA-1/4 SN	SLC 4475-12	+ QC-1-SN	1
SLC-4475-13	PSA-1/2 SN	SLC 4475-11	+ QC-1-SN	1
SLC-4475-14	PSA-1/2 SN	SLC 4475-11	+ QC-1-SN	1
SLC-4475-19	PSA-1/2 SN	SLC 4475-11	+ QC-1-SN	1
VR-3	PSA-1/2 SN(2)	VR 666-1.3	+ QC-1-SN	1
VR-6	PSA-1 SN	VR 666-4.5	+ QC-1-SN	1
VR-8	PSA-1 SN	VR 666-4.5	+ QC-1-SN	1
VR-900N	PSA-1/2 SN	VR 666-1.3	+ QC-1-SN	1
VR-901N	PSA-1/2 SN	VR 666-4.5	+ QC-1-SN	1
VR-902N	PSA-1/2 SN	VR 666-4.5	+ QC-1-SN	1
	TOTAL COUNT			124



Faint, illegible text at the top of the page, possibly a header or title.

Main body of faint, illegible text, appearing to be a list or table with multiple columns.

